




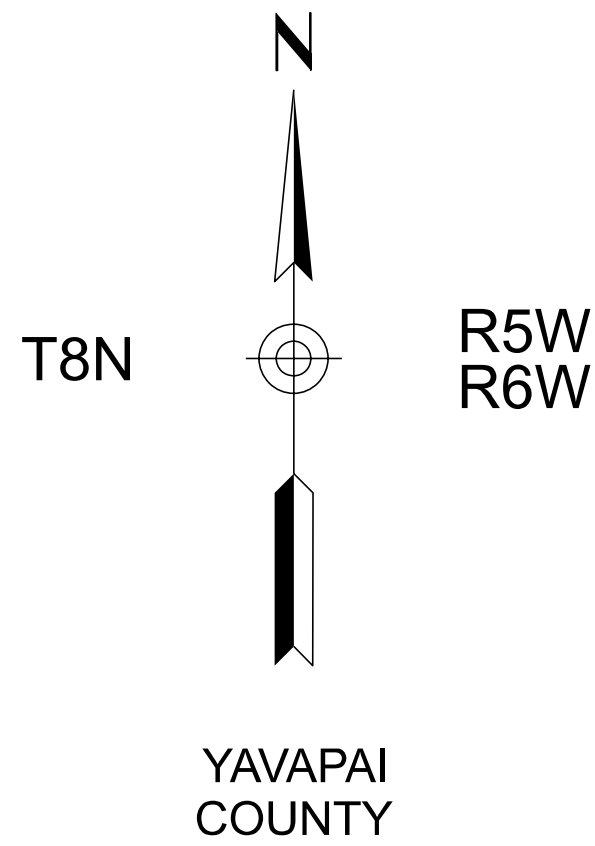

STATE OF ARIZONA
DEPARTMENT OF TRANSPORTATION
PROJECT DELIVERY AND OPERATIONS DIVISION
PROJECT PLANS

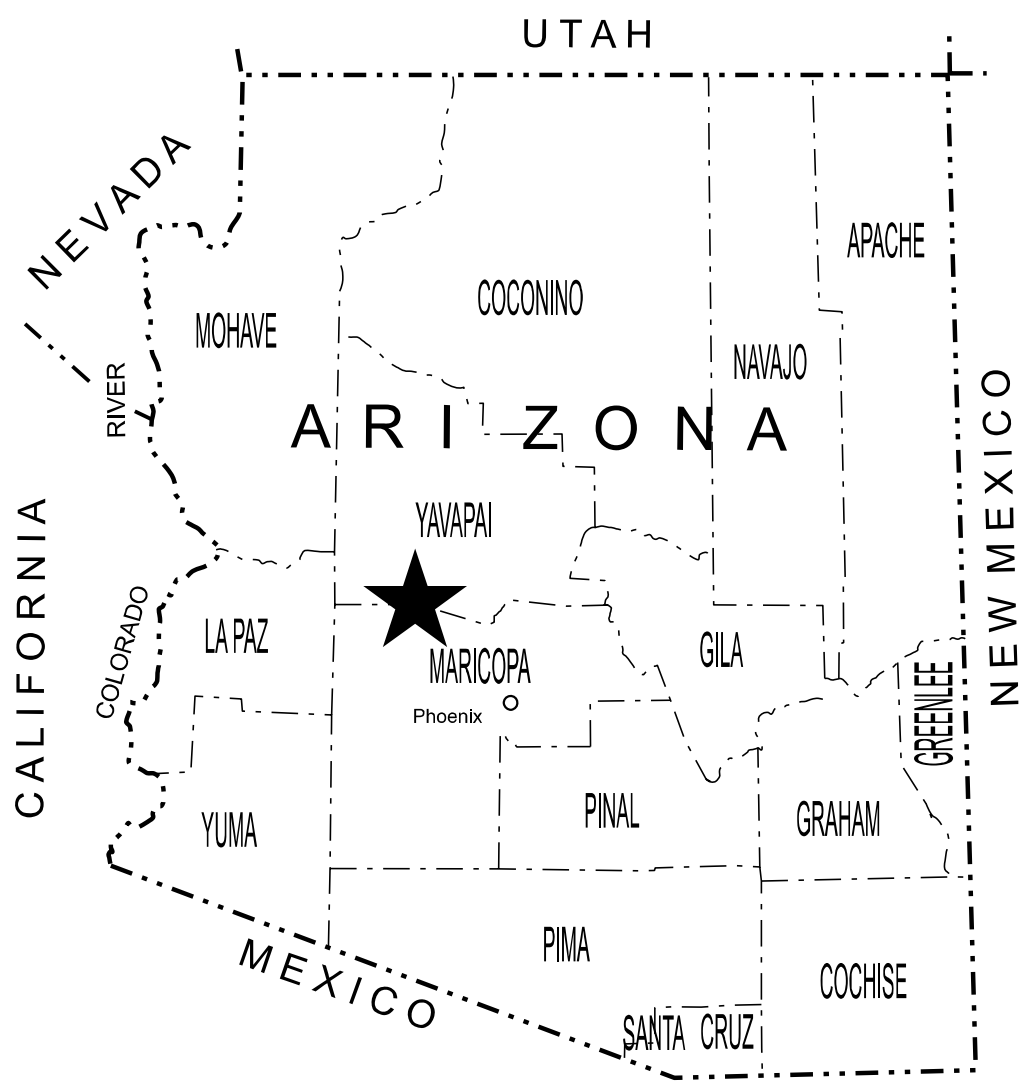

STATE HIGHWAY
KINGMAN-WICKENBURG HIGHWAY
US 93

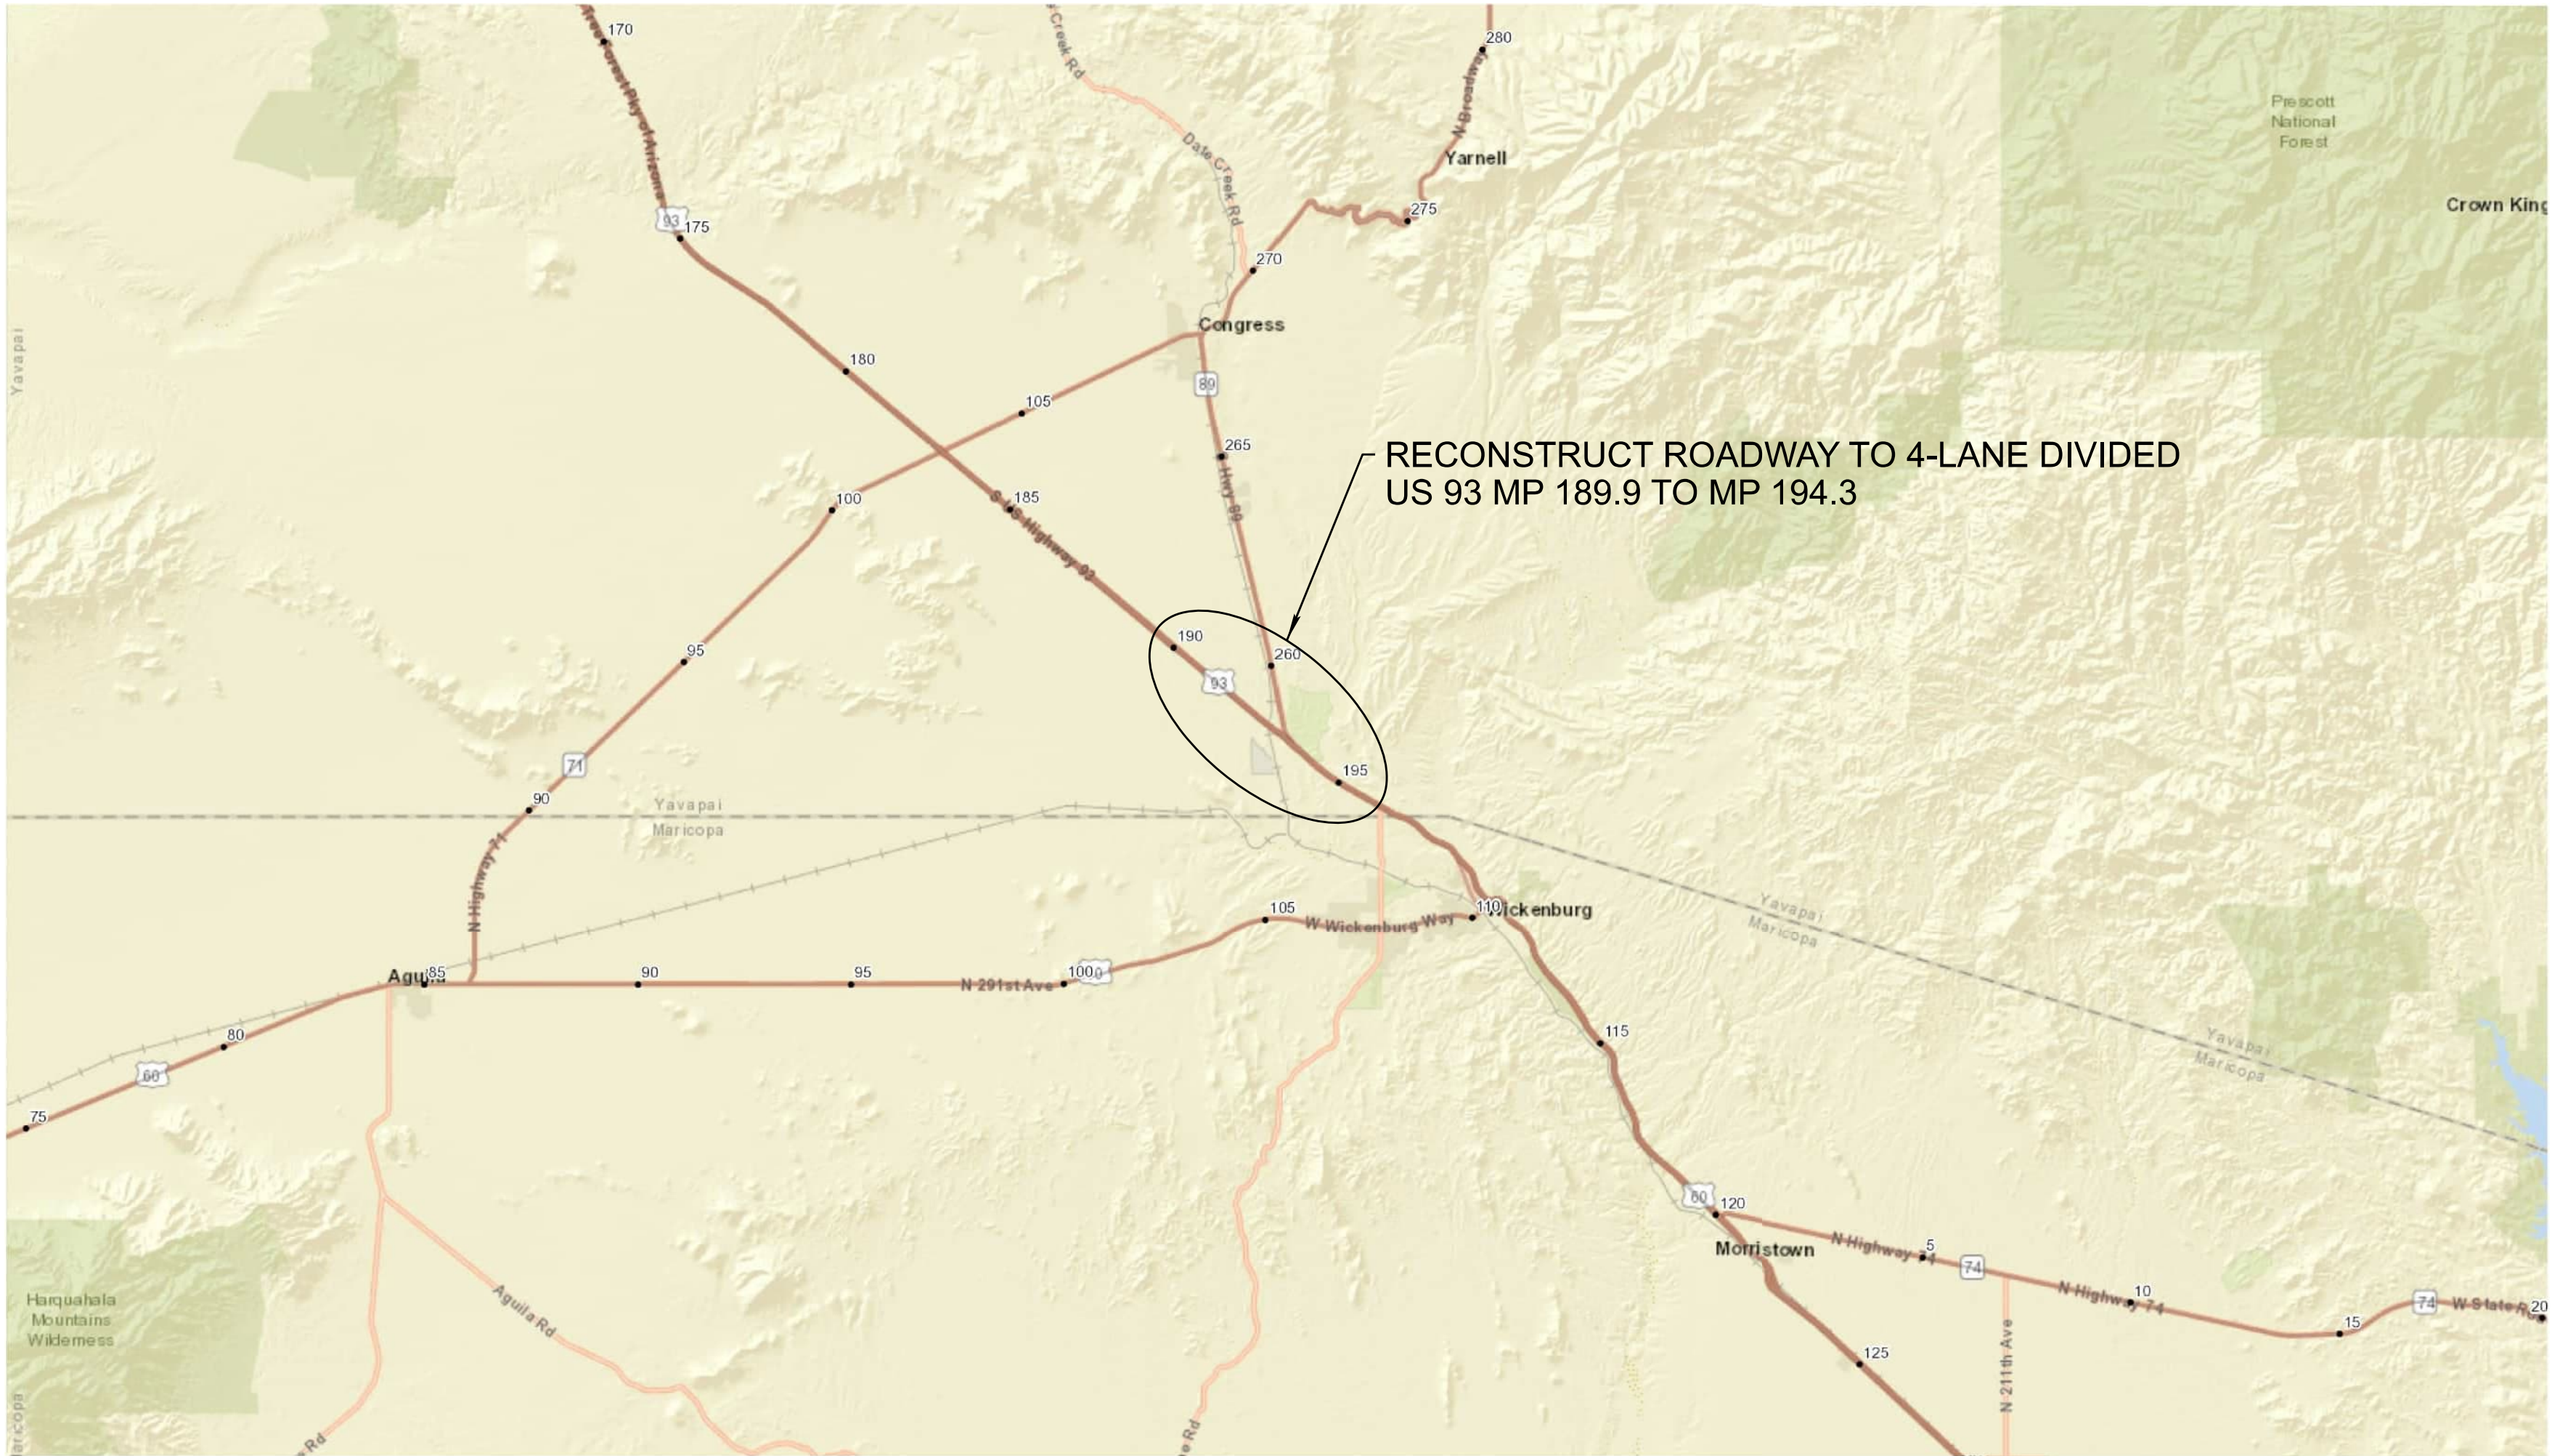

WICKENBURG RANCH WAY TO VISTA ROYALE
PROJECT NO. 093 YV 189 F0738 01C
FEDERAL AID NO. 093-B(230)T

Constructed by:

Construction Company

Completion Date

Red-Lines by:

Construction Administrator Name & Company

Completion Date

Record Drawings by:

Record Drawings Designer Name & Company

Completion Date

ARIZONA DEPARTMENT OF TRANSPORTATION
PROJECT DELIVERY AND OPERATIONS DIVISION
AUDRA MERRICK, P.E., STATE ENGINEER

REC. DWGS. DATA	REC. DWG. DATE	_____ OF _____
--------------------	----------------	----------------

ADOT STANDARD DRAWINGS

CONSTRUCTION STANDARDS
EFFECTIVE MARCH 2025

DATE	STANDARD	SUBJECT TITLE
5/12	C-01.10 SH 1	SYMBOL LEGEND
5/12	C-01.10 SH 2	SYMBOL LEGEND
5/12	C-01.10 SH 3	SYMBOL LEGEND
5/12	C-01.10 SH 4	SYMBOL LEGEND
12/17	C-01.30 SH 1	GENERAL ABBREVIATIONS
5/12	C-01.30 SH 2	GENERAL ABBREVIATIONS
5/12	C-01.30 SH 3	GENERAL ABBREVIATIONS
5/12	C-02.10	SLOPES, RURAL DIVIDED HIGHWAYS
5/12	C-02.20	SLOPES, RURAL UNDIVIDED AND FRINGE-URBAN HIGHWAYS
5/12	C-02.30	SLOPES, MISCELLANEOUS ROADWAYS
5/12	C-03.10 SH 1	DITCHES, CHANNELS, DIKES AND BERMS, DITCHES AND CHANNELS
5/12	C-03.10 SH 2	DITCHES, CHANNELS, DIKES AND BERMS, DIKES
5/12	C-03.10 SH 3	DITCHES, CHANNELS, DIKES AND BERMS, DITCH DIKE
5/12	C-03.10 SH 4	DITCHES, CHANNELS, DIKES AND BERMS, PIPE BERMS
5/12	C-03.10 SH 5	DITCHES, CHANNELS, DIKES AND BERMS, HEADWALL BERMS
12/17	C-04.10 SH 1	SPILLWAY, EMBANKMENT SINGLE INLET
12/17	C-04.10 SH 2	SPILLWAY, EMBANKMENT DOUBLE INLET
12/17	C-04.20 SH 1	DOWNDRAIN, EMBANKMENT SINGLE INLET
12/17	C-04.20 SH 2	DOWNDRAIN, EMBANKMENT DOUBLE INLET
12/17	C-04.30	SPILLWAY LENGTH TABLE
12/17	C-04.40	DOWNDRAIN LENGTH TABLE
5/12	C-04.50	DOWNDRAIN ENERGY DISSIPATOR
5/12	C-05.10	CURB & GUTTER, CURB, GUTTER
5/12	C-05.12 SH 1	CURB & GUTTER TRANSITIONS
5/12	C-05.12 SH 2	CURB & GUTTER TRANSITIONS
5/12	C-05.12 SH 3	CURB AND GUTTER TRANSITIONS
5/12	C-05.20 SH 1	CONCRETE DRIVEWAYS & SIDEWALKS, DRIVEWAYS
5/12	C-05.20 SH 2	CONCRETE DRIVEWAYS & SIDEWALKS, SIDEWALKS
5/12	C-05.30 SH 1	SIDEWALK RAMP, TYPE A
5/12	C-05.30 SH 2	SIDEWALK RAMP, TYPE B
5/12	C-05.30 SH 3	SIDEWALK RAMP, TYPE C
5/12	C-05.30 SH 4	SIDEWALK RAMP, TYPE D
5/12	C-05.30 SH 5	SIDEWALK RAMP, TYPE E
5/12	C-05.30 SH 6	SIDEWALK RAMP, TYPE F
5/12	C-05.30 SH 7	SIDEWALK RAMP, DETECTABLE WARNING STRIP
5/12	C-05.40	MEDIAN PAVING AND NOSE TAPER
5/12	C-05.50	CONCRETE BUS BAY
5/12	C-06.10 SH 1	DRIVEWAY & TURNOUT LAYOUTS
5/12	C-06.10 SH 2	DRIVEWAY & TURNOUT LAYOUTS
5/12	C-07.01 SH 1	PCCP JOINTS
5/12	C-07.01 SH 2	PCCP JOINTS
5/12	C-07.02	LOAD TRANSFER DOWEL ASSEMBLY
5/12	C-07.03 SH 1	PCCP JOINT LOCATIONS, MAINLINE SKEWED JOINTS
5/12	C-07.03 SH 2	PCCP JOINT LOCATIONS, MAINLINE SKEWED JOINTS
5/12	C-07.03 SH 3	PCCP JOINT LOCATIONS, MAINLINE SKEWED JOINTS
5/12	C-07.03 SH 4	PCCP JOINT LOCATIONS, MAINLINE SKEWED JOINTS
5/12	C-07.03 SH 5	PCCP JOINT LOCATIONS, MAINLINE NON-SKEWED JOINTS
5/12	C-07.03 SH 6	PCCP JOINT LOCATIONS, MAINLINE NON-SKEWED JOINTS
5/12	C-07.03 SH 7	PCCP JOINT LOCATIONS, MAINLINE NON-SKEWED JOINTS
5/12	C-07.03 SH 8	PCCP JOINT LOCATIONS, MAINLINE NON-SKEWED JOINTS
5/12	C-07.04 SH 1	PCCP JOINT LOCATIONS, PARALLEL-TYPE ENTRANCE RAMP WITH AUXILIARY LANE
5/12	C-07.04 SH 2	PCCP JOINT LOCATIONS, PARALLEL-TYPE EXIT RAMP WITH AUXILIARY LANE
5/12	C-07.04 SH 3	PCCP JOINT LOCATIONS, TAPER-TYPE ENTRANCE RAMP
5/12	C-07.04 SH 4	PCCP JOINT LOCATIONS, TAPER-TYPE EXIT RAMP
5/12	C-07.04 SH 5	PCCP JOINT LOCATIONS, CROSSROAD AND RAMP TERMINI
8/21	C-07.06	TRENCH BACKFILL AND PAVEMENT REPLACEMENT
5/12	C-08.20	PAVED GORE AREA
12/17	C-10.00	GUARDRAIL MEASUREMENT LIMITS
12/17	C-10.01	GUARDRAIL INSTALLATION
12/17	C-10.03	W-BEAM GUARDRAIL, MGS BLOCKED-OUT TIMBER POST
12/17	C-10.04	W-BEAM GUARDRAIL, MGS BLOCKED-OUT STEEL POST
12/17	C-10.05 SH 1	W-BEAM GUARDRAIL (MODIFIED) WITH FREEWAY CURB AND GUTTER
12/17	C-10.05 SH 2	W-BEAM GUARDRAIL (MODIFIED) WITH FREEWAY CURB AND GUTTER
12/17	C-10.06	W-BEAM GUARDRAIL LONG-SPAN
12/17	C-10.07 SH 1	W-BEAM GUARDRAIL, BOX CULVERT GUARDRAIL POST
12/17	C-10.07 SH 2	W-BEAM GUARDRAIL, BOX CULVERT GUARDRAIL POST
12/17	C-10.08 SH 1	W-BEAM GUARDRAIL, END ANCHOR
12/17	C-10.08 SH 2	W-BEAM GUARDRAIL, END ANCHOR
12/17	C-10.09	GUARDRAIL POST ROCK INSTALLATION
4/19	C-10.20 SH 1	GUARDRAIL END TERMINAL PAD LAYOUT FOR SOFTSTOP
4/19	C-10.20 SH 2	GUARDRAIL END TERMINAL PAD LAYOUT FOR SOFTSTOP
4/19	C-10.21 SH 1	GUARDRAIL END TERMINAL PAD LAYOUT FOR MSKT
4/19	C-10.21 SH 2	GUARDRAIL END TERMINAL PAD LAYOUT FOR MSKT
4/19	C-10.22 SH 1	GUARDRAIL END TERMINAL PAD LAYOUT FOR MAX-TENSION
4/19	C-10.22 SH 2	GUARDRAIL END TERMINAL PAD LAYOUT FOR MAX-TENSION
4/21	C-10.23 SH 1	GUARDRAIL END TERMINAL PAD LAYOUT FOR SGET
4/21	C-10.23 SH 2	GUARDRAIL END TERMINAL PAD LAYOUT FOR SGET
3/25	C-10.24 SH 1	GUARDRAIL END TERMINAL PAD LAYOUT FOR NGT
3/25	C-10.24 SH 2	GUARDRAIL END TERMINAL PAD LAYOUT FOR NGT
11/19	C-10.26 SH 1	GUARDRAIL END TERMINAL PAD LAYOUT FOR MFLEAT
11/19	C-10.26 SH 2	GUARDRAIL END TERMINAL PAD LAYOUT FOR MFLEAT
12/17	C-10.30 SH 1	GUARDRAIL TRANSITION TO CONCRETE BARRIER, TIMBER POST
12/17	C-10.30 SH 2	GUARDRAIL TRANSITION TO CONCRETE BARRIER, TIMBER POST
12/17	C-10.31 SH 1	GUARDRAIL TRANSITION TO CONCRETE BARRIER, STEEL POST
12/17	C-10.31 SH 2	GUARDRAIL TRANSITION TO CONCRETE BARRIER, STEEL POST
12/17	C-10.38 SH 1	GUARDRAIL TAPER G4 TO MGS W-BEAM WITH STAGGERED POST
12/17	C-10.38 SH 2	GUARDRAIL TAPER G4 TO MGS W-BEAM WITH OFFSET RAIL
12/17	C-10.40	CONCRETE MEDIAN BARRIER, 32" TYPE 'F', CAST-IN-PLACE
12/17	C-10.41	CONCRETE MEDIAN BARRIER, 42" TYPE 'F', CAST-IN-PLACE
12/17	C-10.44 SH 1	CONCRETE MEDIAN BARRIER, 42" TYPE 'F'WITH VARIABLE HEIGHT SIDES, H=0"TO 26"
12/17	C-10.44 SH 2	CONCRETE MEDIAN BARRIER, 42" TYPE 'F'WITH VARIABLE HEIGHT SIDES, H=0"TO 26"
12/17	C-10.45 SH 1	CONCRETE MEDIAN BARRIER, 42" TYPE 'F'WITH VARIABLE HEIGHT SIDES, H=26"TO 60"
12/17	C-10.45 SH 2	CONCRETE MEDIAN BARRIER, 42" TYPE 'F'WITH VARIABLE HEIGHT SIDES, H=26"TO 60"
12/17	C-10.50 SH 1	CONCRETE HALF BARRIER, 32" TYPE 'F', CAST-IN-PLACE
12/17	C-10.50 SH 2	CONCRETE HALF BARRIER, 32" TYPE 'F', PRECAST
12/17	C-10.51	CONCRETE HALF BARRIER, 32" TYPE 'F' WITH SIDEWALK

DATE	STANDARD	SUBJECT TITLE
12/17	C-10.52	CONCRETE HALF BARRIER, 32" TYPE 'F' WITH GUTTER
12/17	C-10.53	CONCRETE HALF BARRIER, 42" TYPE 'F' WITH GUTTER
12/17	C-10.54 SH 1	CONCRETE HALF BARRIER, 32" TYPE 'F' AT PIERS, CAST-IN-PLACE
12/17	C-10.54 SH 2	CONCRETE HALF BARRIER, 32" TYPE 'F' AT PIERS, PRECAST
12/17	C-10.54 SH 3	CONCRETE HALF BARRIER, 32" TYPE 'F' AT PIERS, LAYOUT
12/17	C-10.55 SH 1	CONCRETE HALF BARRIER, 42" TYPE 'F' AT PIERS, CAST-IN-PLACE
12/17	C-10.55 SH 2	CONCRETE HALF BARRIER, 42" TYPE 'F' AT PIERS, PRECAST
12/17	C-10.55 SH 3	CONCRETE HALF BARRIER, 42" TYPE 'F' AT PIERS, LAYOUT
12/17	C-10.70 SH 1	CONCRETE HALF-BARRIER TRANSITION TO VERTICAL, 32" TYPE 'F' WITH CAISSONS
12/17	C-10.70 SH 2	CONCRETE HALF-BARRIER TRANSITION TO VERTICAL, 32" TYPE 'F' WITH CAISSONS
12/17	C-10.70 SH 3	CONCRETE HALF-BARRIER TRANSITION TO VERTICAL, 32" TYPE 'F' WITH CAISSONS
12/17	C-10.71 SH 1	CONCRETE HALF-BARRIER TRANSITION TO VERTICAL, 32" TYPE 'F' WITH CURB & GUTTER
12/17	C-10.71 SH 2	CONCRETE HALF-BARRIER TRANSITION TO VERTICAL, 32" TYPE 'F' WITH CURB & GUTTER
12/17	C-10.72 SH 1	CONCRETE HALF-BARRIER TRANSITION TO VERTICAL, 42" TO 32" TYPE 'F' WITH CAISSONS
12/17	C-10.72 SH 2	CONCRETE HALF-BARRIER TRANSITION TO VERTICAL, 42" TO 32" TYPE 'F' WITH CAISSONS
12/17	C-10.72 SH 3	CONCRETE HALF-BARRIER TRANSITION TO VERTICAL, 42" TO 32" TYPE 'F' WITH CAISSONS
12/17	C-10.73 SH 1	CONCRETE HALF-BARRIER TRANSITION TO VERTICAL, 42" TO 32" TYPE 'F' WITH GUTTER
12/17	C-10.73 SH 2	CONCRETE HALF-BARRIER TRANSITION TO VERTICAL, 42" TO 32" TYPE 'F' WITH GUTTER
12/17	C-10.74	CONCRETE HALF-BARRIER TRANSITION, 42" TO 32" TYPE 'F'
12/17	C-10.75 SH 1	CONCRETE HALF-BARRIER TRANSITION, TYPE 'F' TANGENT DEPARTURE TYPE 1
12/17	C-10.75 SH 2	CONCRETE HALF-BARRIER TRANSITION, TYPE 'F' TANGENT DEPARTURE TYPE 2
12/17	C-10.76	CONCRETE HALF-BARRIER TRANSITION, TYPE 'F' AT RADIUS, 32" TO 0"
4/19	C-10.77	CONCRETE BARRIER TRANSITION TO GUARDRAIL END TERMINAL LAYOUT WITH CURB
12/17	C-10.78	CONCRETE HALF-BARRIER TRANSITION, 32" TYPE 'F' LOW SPEED APPROACH
12/17	C-10.79	CONCRETE HALF-BARRIER TRANSITION, 42" TYPE 'F' TANGENT DEPARTURE
5/12	C-11.10 SH 1	ROADWAY CATTLE GUARD
5/12	C-11.10 SH 2	ROADWAY CATTLE GUARD
5/12	C-11.10 SH 3	ROADWAY CATTLE GUARD
5/12	C-11.10 SH 4	ROADWAY CATTLE GUARD
5/12	C-11.20	CATTLE GUARD, DRAINAGE
5/12	C-12.10 SH 1	FENCE, WOVEN WIRE
5/12	C-12.10 SH 2	FENCE, BARBED WIRE
5/12	C-12.10 SH 3	FENCE, TYPE 1 AND 2 GATES, FLOOD GATE
5/12	C-12.10 SH 4	FENCE, FLOOD GATE INSTALLATION
5/12	C-12.10 SH 5	FENCE, MISCELLANEOUS DETAILS
5/12	C-12.20 SH 1	FENCE, CHAIN LINK, TYPE 1
5/12	C-12.20 SH 2	FENCE, CHAIN LINK, TYPE 2
5/12	C-12.20 SH 3	FENCE, CHAIN LINK, GATES
5/12	C-12.30 SH 1	FENCE, CHAIN LINK CABLE BARRIER
5/12	C-12.30 SH 2	FENCE, CHAIN LINK CABLE BARRIER
5/12	C-12.30 SH 3	FENCE, CHAIN LINK CABLE BARRIER
5/12	C-13.10 SH 1	PIPE CULVERT INSTALLATION
5/12	C-13.10 SH 2	PIPE CULVERT INSTALLATION
8/23	C-13.15	TYPICAL PIPE INSTALLATION
5/12	C-13.20	PIPE, REINFORCED CONCRETE END SECTION
5/12	C-13.25	PIPE, CORRUGATED METAL END SECTION
5/12	C-13.30	PIPE AND PIPE ARCH, CORRUGATED METAL, CONCRETE INVERT PAVING
5/12	C-13.55	PIPE, CATTLE-VEHICLE PASS, MITERED END TREATMENT
5/12	C-13.60	SLOTTED DRAIN DETAILS
5/12	C-13.65	SLOTTED DRAIN INSTALLATION DETAILS
5/12	C-13.70	STORM DRAIN CONNECTION DETAILS
5/12	C-13.75	STORM DRAIN OUTLET BARRIER GATE
5/12	C-13.76	STORM DRAIN OUTLET AND STORM DRAIN PLUG
5/12	C-13.80	PIPE COLLAR DETAILS
5/12	C-15.10	CATCH BASIN, TYPE 1
5/12	C-15.20 SH 1	CATCH BASIN, TYPE 3
5/12	C-15.20 SH 2	CATCH BASIN, TYPE 3
5/12	C-15.20 SH 3	CATCH BASIN, ACCESS FRAME AND COVER DETAILS
5/12	C-15.30	CATCH BASIN, TYPE 4
5/12	C-15.40 SH 1	CATCH BASIN, TYPE 5
5/12	C-15.40 SH 2	CATCH BASIN, TYPE 5
5/12	C-15.50	CATCH BASIN, FRAME AND GRATE
5/12	C-15.70 SH 1	CATCH BASIN, MISCELLANEOUS DETAILS
5/12	C-15.70 SH 2	CATCH BASIN, MISCELLANEOUS DETAILS
5/12	C-15.75	CATCH BASIN, DROP INLET
5/12	C-15.80	CATCH BASIN, FLUSH
5/12	C-15.81	CATCH BASIN, SIDE SLOPE
5/12	C-15.90	CATCH BASIN, MEDIAN DIKE, PRECAST
5/12	C-15.91 SH 1	FREEWAY CATCH BASIN DETAILS
5/12	C-15.91 SH 2	FREEWAY CATCH BASIN DETAILS
5/12	C-15.92 SH 1	CATCH BASIN WITH TYPE 'F' CONCRETE HALF BARRIER
5/12	C-15.92 SH 2	CATCH BASIN WITH TYPE 'F' CONCRETE HALF BARRIER
5/12	C-16.40	IRRIGATION SLEEVES
5/12	C-17.10	RAIL BANK PROTECTION FOR DRAINAGEWAYS, TYPES 1, 2 & 3
5/12	C-17.15	RAIL BANK PROTECTION AT ABUTMENTS, TYPES 4, 5 & 6
5/12	C-17.20	RAIL BANK PROTECTION FOR DRAINAGEWAYS, TYPES 7, 8 & 9
5/12	C-18.10 SH 1	MANHOLE, RISER DETAILS
5/12	C-18.10 SH 2	MANHOLE, BASE DETAILS, NORMAL INSTALLATION
5/12	C-18.10 SH 3	MANHOLE, FRAME AND COVER DETAILS
5/12	C-19.10 SH 1	FORD, CONCRETE WALLS
5/12	C-19.10 SH 2	FORD, TYPES 1 AND 2
5/12	C-21.10	SURVEY MONUMENT FRAME AND COVER
5/12	C-21.20	SURVEY MARKER

ADOT STANDARD DRAWINGS			
REVISION DATES and STANDARD NO.'s REVIEW			
		NAME	DATE
CONSTRUCTION STANDARDS		D WIGGINS	09/30/2025
PROJECT NO.		093 YV 189 F0738 01C	1A OF 524
RECORD DRAWING DATA	FEDERAL ID NO. 093-B(230)T		OF
		REC. DWG. DATE	

ADOT STANDARD DRAWINGS

TRAFFIC SIGNING & MARKING STANDARDS

(SHEET 1 OF 2)

EFFECTIVE MAY 2025

REVISION DATE	STANDARD NUMBER	SUBJECT : SIGNING AND MARKING DETAILS
6/14	M-1	CURB MARKINGS FOR RAISED MEDIAN AND ISLANDS
1/20	M-2 SHT 1	INTERSECTION STRIPING
5/15	M-2 SHT 2	INTERSECTION STRIPING (TWO-LANE RURAL)
6/14	M-2 SHT 3	CENTERLINE AND REVERSE CURVE DETAILS
6/14	M-3	STRIPING AND DELINEATION FOR FREEWAY TERMINALS
6/14	M-4	PASSING LANE STRIPING DETAILS
6/14	M-5	RAILROAD PAVEMENT MARKINGS
6/14	M-6	WORD MARKINGS
6/14	M-7	PAVEMENT LETTERS
6/14	M-8	PAVEMENT LETTERS
6/14	M-9	PAVEMENT NUMBERS
6/14	M-10 SHT 1	PAVEMENT MARKING SYMBOLS
6/14	M-10 SHT 2	PAVEMENT MARKING SYMBOLS
5/25	M-10 SHT 3	PAVEMENT MARKING SYMBOLS
6/14	M-11	TURN LANE PAVEMENT MARKINGS
6/14	M-12	WRONG-WAY ARROWS
1/19	M-13	PREFERENTIAL LANE PAVEMENT MARKINGS
6/14	M-14	STRIPING AND DELINEATION FOR TRUCK ESCAPE RAMPS
8/20	M-15 SHT 1	PAVEMENT MARKING FOR FREEWAY ENTRANCE RAMP - TAPERED ACCELERATION LANE
8/20	M-15 SHT 2	PAVEMENT MARKING FOR FREEWAY ENTRANCE RAMP - PARALLEL ACCELERATION LANE
8/20	M-15 SHT 3	PAVEMENT MARKING FOR FREEWAY ENTRANCE RAMP - PARALLEL ACCELERATION LANE WITH HOV BYPASS
6/14	M-15 SHT 4	PAVEMENT MARKING FOR FREEWAY PARALLEL - ACCELERATION LANE
8/20	M-16 SHT 1	PAVEMENT MARKING FOR FREEWAY EXIT RAMPS - TAPERED DECELERATION LANE
8/20	M-16 SHT 2	PAVEMENT MARKING FOR FREEWAY EXIT RAMP - PARALLEL DECELERATION LANE
8/20	M-17	FREEWAY LANE DROP PAVEMENT MARKINGS
11/24	M-19 SHT 1	RAISED PAVEMENT MARKER PLAN LEGEND
6/14	M-19 SHT 2	NON-REFLECTIVE RAISED PAVEMENT MARKER DETAILS
11/24	M-19 SHT 3	RETROREFLECTIVE RAISED PAVEMENT MARKER DETAILS
11/24	M-19 SHT 4	RETROREFLECTIVE RAISED PAVEMENT MARKER DETAILS
5/15	M-19 SHT 5	PAVEMENT MARKING DETAILS FOR UNDIVIDED HIGHWAYS
6/14	M-19 SHT 6	RETROREFLECTIVE RAISED PAVEMENT MARKERS (RPM) FOR UNDIVIDED HIGHWAYS
8/20	M-19 SHT 7	FREEWAY AND DIVIDED HIGHWAY EDGE LINE AND LANE STRIPING
5/15	M-19 SHT 8	LANE DROP MARKING AND RAMP OR INTERSECTION GUIDE STRIPING
8/20	M-19 SHT 9	PAVEMENT MARKING CROSS-SECTION DETAILS FOR HIGHWAYS AND FREEWAYS
6/24	M-19 SHT 10	CONTRAST LANE LINE FOR FREEWAY AND DIVIDED HIGHWAY
10/23	M-19 SHT 11	LEAD-LAG CONTRAST PAVEMENT MARKINGS FOR CONCRETE PAVEMENT

REVISION DATE	STANDARD NUMBER	SUBJECT : SIGNING AND MARKING DETAILS
6/14	M-20 SHT 1	CHIP SEAL MARKER USAGE FOR TEMPORARY MARKERS
6/14	M-20 SHT 2	CHIP SEAL MARKER USAGE FOR TEMPORARY MARKERS
6/14	M-21	TRANSVERSE RUMBLE STRIP DETAILS
9/21	M-22 SHT 1	LONGITUDINAL RUMBLE STRIP GROOVE, PATTERN - AND LOCATION DETAILS
9/21	M-22 SHT 2	LONGITUDINAL RUMBLE STRIP EXCEPTION DETAILS
9/21	M-22 SHT 3	ENTRANCE AND EXIT RAMPS RUMBLE STRIP INSTALLATION DETAILS
3/22	M-22 SHT 4	CENTERLINE RUMBLE STRIP GROOVE, PATTERN - AND LOCATION DETAILS
6/14	M-23	OBJECT MARKER DETAILS
6/14	M-24	OBJECT MARKER PLACEMENT DETAILS
2/21	M-26 SHT 1	DELINEATOR PLACEMENT AND SPACING
2/21	M-26 SHT 2	DELINEATOR PLACEMENT AND SPACING
2/21	M-26 SHT 3	FLEXIBLE DELINEATOR ASSEMBLIES
2/21	M-26 SHT 4	SQUARE STEEL POST DELINEATOR
2/21	M-26 SHT 5	DELINEATOR FOUNDATION DETAILS
2/21	M-27 SHT 1	DELINEATION DETAILS FOR MEDIAN CROSSTOVERS
2/21	M-27 SHT 2	DELINEATION DETAILS FOR MEDIAN CROSSTOVERS
6/14	M-29	OFF- MAINLINE REFERENCE MARKER LOCATION DETAIL
6/14	M-30	OFF- MAINLINE REFERENCE MARKER DETAILS
6/14	M-32	BRIDGE AND BARRIER MARKER DETAILS
6/14	M-33	BRIDGE AND BARRIER MARKER PLACEMENT AND INSTALLATION DETAILS
6/14	M-34	GUARDRAIL END TERMINAL DELINEATION DETAILS
6/14	M-35	OBJECT MARKER FOR SAND BARREL CRASH CUSHION

ADOT STANDARD DRAWINGS REVISION DATES and STANDARD NO.'s REVIEW			
SIGNING & MARKING STANDARDS		NAME	DATE
PROJECT NO.		D WIGGINS	09/30/2025
093 YV 189 F0738 01C		1B-1	OF 524
RECORD DRAWING DATA	FEDERAL ID NO. 093-B(230)T	REC. DWG. DATE	OF

ADOT STANDARD DRAWINGS

TRAFFIC SIGNING & MARKING STANDARDS

(SHEET 2 OF 2)

EFFECTIVE MAY 2025

REVISION DATE	STANDARD NUMBER	SUBJECT : SIGNING AND MARKING DETAILS
4/19	S-1 SHT 1	GENERAL SIGNING NOTES
6/14	S-2 SHT 1	S & W BREAKAWAY POST SELECTION CHART
6/14	S-2 SHT 2	S & W BREAKAWAY POST INSTALLATION DETAILS
6/14	S-3 SHT 1	FLAT SHEET SIGNS SQUARE TUBE POST GENERAL NOTES
6/14	S-3 SHT 2	SINGLE POST FLAT SHEET RECTANGULAR SIGN ASSEMBLY - 12, 18 AND 24 INCH WIDTHS
6/14	S-3 SHT 3	SINGLE POST FLAT SHEET RECTANGULAR SIGN ASSEMBLY - 30, 36, 42 AND 54 INCH WIDTHS
6/14	S-3 SHT 4	TWO POST FLAT SHEET RECTANGULAR SIGN ASSEMBLY - 36, 42 AND 48 INCH WIDTHS
6/14	S-3 SHT 5	TWO POST FLAT SHEET RECTANGULAR SIGN ASSEMBLY - 54, 60 AND 72 INCH WIDTHS
6/14	S-3 SHT 6	TWO POST FLAT SHEET RECTANGULAR SIGN ASSEMBLY - 84 - 144 INCH WIDTHS
6/14	S-3 SHT 7	THREE POST FLAT SHEET RECTANGULAR SIGN ASSEMBLY - 48, 60 AND 72 INCH WIDTHS
6/14	S-3 SHT 8	THREE POST FLAT SHEET RECTANGULAR SIGN ASSEMBLY - 84 - 144 INCH WIDTHS
6/14	S-3 SHT 9	WARNING SIGN ASSEMBLY - SINGLE POST
6/14	S-3 SHT 10	WARNING SIGN ASSEMBLY - TWO POST
6/14	S-3 SHT 11	WARNING SIGN ASSEMBLY - THREE POST
6/14	S-3 SHT 12	MULTIPLE ROUTE MARKER ASSEMBLIES
6/14	S-3 SHT 13	SPECIAL SIGN ASSEMBLIES
6/14	S-3 SHT 14	STRINGER DETAILS FOR SQUARE TUBE POSTS
6/14	S-3 SHT 15	SQUARE TUBE SIGN POST FOUNDATION
6/14	S-3 SHT 16	SQUARE TUBE POST SLIP BASE DETAILS
6/14	S-4	W SHAPE BREAKAWAY POST FUSE PLATE AND HINGE DETAILS
6/22	S-5	W SHAPE BREAKAWAY POST DETAILS
6/22	S-6	S4x7.7 BREAKAWAY POST DETAILS
6/14	S-7 SHT 1	ALUMINUM EXTRUSION SIGN PANEL DETAILS
6/14	S-7 SHT 2	ALUMINUM EXTRUSION AUXILIARY SIGN INSTALLATION DETAILS
5/15	S-7 SHT 3	ALUMINUM EXTRUSION EXIT PANEL INSTALLATION DETAIL
6/14	S-8 SHT 1	FLAT SHEET ALUMINUM PANEL ON BREAKAWAY POSTS INSTALLATION DETAIL
6/14	S-8 SHT 2	ALUMINUM EXTRUSION SIGN TO PERFORATED POSTS INSTALLATION DETAIL
8/22	S-9 SHT 1	SIGN INSTALLATION ON POLE
8/22	S-9 SHT 2	SIGNS (BACK TO BACK) INSTALLATION ON POLE
8/22	S-9 SHT 3	SIGN INSTALLATION ON SIGNAL POLE
8/22	S-9 SHT 4	SIGN INSTALLATION ON POLE BAND-TYPE CLAMP
6/14	S-10	MILEPOST AND REFERENCE LOCATION SIGNS
11/22	S-11 SHT 1	TAPERED TUBE SIGN STRUCTURE SINGLE BEAM
4/19	S-11 SHT 2	TAPERED TUBE SIGN STRUCTURE SINGLE BEAM POST AND BEAM DETAILS

REVISION DATE	STANDARD NUMBER	SUBJECT : SIGNING AND MARKING DETAILS
6/14	S-12 SHT 1	TYPE A, B, AND DOWN ARROWS
6/14	S-12 SHT 2	TYPE C AND D ARROWS
6/14	S-12 SHT 3	C2 ARROW DETAIL
6/14	S-13	SIGN IDENTIFICATION DETAILS
6/14	S-14 SHT 1	ROTATING OPEN/CLOSED SIGN
6/14	S-14 SHT 2	ROTATING OPEN/CLOSED SIGN DETAILS
6/14	S-14 SHT 3	ROTATING OPEN/CLOSED SIGN MOUNTING DETAILS
6/14	S-15 SHT 1	FOLDING RECTANGULAR SIGN ASSEMBLY
6/14	S-15 SHT 2	FOLDING RECTANGULAR SIGN OPERATION
6/14	S-15 SHT 3	FOLDING DIAMOND SIGN ASSEMBLY
4/19	S-16 SHT 1	TEMPORARY WOOD POSTS
4/19	S-16 SHT 2	TEMPORARY WOOD POSTS SELECTION CHART
6/14	S-17	END OF ROAD BARRICADE
7/19	S-18 SHT 1	ALUMINUM GRAFFITI SHIELD EXIT AND GUIDE SIGN ASSEMBLY
7/19	S-18 SHT 2	ALUMINUM GRAFFITI SHIELD RIGHT RIDER SIDE PANEL
7/19	S-18 SHT 3	ALUMINUM GRAFFITI SHIELD LEFT RIDER SIDE PANEL
7/19	S-18 SHT 4	ALUMINUM GRAFFITI SHIELD CORNER
7/19	S-18 SHT 5	ALUMINUM GRAFFITI SHIELD SPLICE PLATE
7/19	S-18 SHT 6	ALUMINUM GRAFFITI SHIELD FIN
7/19	S-18 SHT 7	ALUMINUM GRAFFITI SHIELD TOP PANEL
7/19	S-18 SHT 8	ALUMINUM GRAFFITI SHIELD SIDE PANEL
7/19	S-18 SHT 9	ALUMINUM GRAFFITI SHIELD RIGHT TRANSITION FROM RIDER
7/19	S-18 SHT 10	ALUMINUM GRAFFITI SHIELD LEFT TRANSITION FROM RIDER
7/19	S-18 SHT 11	ALUMINUM GRAFFITI SHIELD SPLICE PLATE FOR FIN
12/18	C-1	SAND BARREL CRASH CUSHION
12/18	C-2	SAND BARREL CRASH CUSHION TYPICAL INSTALLATION
6/14	C-3 SHT 1	PRECAST CONCRETE BARRIER STRUCTURAL DETAILS
6/14	C-3 SHT 2	PRECAST CONCRETE BARRIER PIN AND LOOP ASSEMBLY
6/14	C-4 SHT 1	MEDIAN CROSSOVER
6/14	C-4 SHT 2	TYPICAL END TREATMENTS FOR DETOURS USING TEMPORARY CONCRETE BARRIER (TCB)
6/14	C-5 SHT 1	APPROACH PLATE AND TRANSITION SECTION FOR TEMPORARY CONCRETE BARRIER
6/14	C-5 SHT 2	APPROACH PLATE AND TRANSITION SECTION FOR TEMPORARY CONCRETE BARRIER

ADOT STANDARD DRAWINGS			
REVISION DATES and STANDARD NO.'s REVIEW			
SIGNING & MARKING STANDARDS		NAME	DATE
PROJECT NO.		D WIGGINS	09/30/2025
093 YV 189 F0738 01C		1B-2	OF 524
RECORD DRAWING DATA	FEDERAL ID NO. 093-B(230)T	REC. DWG. DATE	OF

ADOT STANDARD DRAWINGS

TRAFFIC SIGNAL AND LIGHTING STANDARDS
(SHEET 1 OF 2)
EFFECTIVE NOVEMBER 2024

REVISION DATE	STANDARD NUMBER	SUBJECT : TRAFFIC SIGNALS AND LIGHTING DETAILS
	T.S. 0	ABBREVIATIONS, SYMBOLS AND DEFINITIONS
05/15	0-1	STANDARD ABBREVIATIONS
01/12	0-2 SHT 1	PLAN SYMBOLS
01/12	0-2 SHT 2	PLAN SYMBOLS
01/12	0-2 SHT 3	PLAN SYMBOLS
03/10	0-3 SHT 1	STANDARD DEFINITIONS
03/10	0-3 SHT 2	STANDARD DEFINITIONS
11/22	0-4	REFERENCE DOCUMENTS AND GENERAL REQUIREMENTS
	T.S. 1	PULL BOXES
03/15	1-2	HEAVY DUTY NO. 5 AND NO. 7 STRAIGHT BODY WALL PULL BOX DETAILS
09/11	1-3	REPLACEMENT LID SIZING FOR EXISTING NO. 5 AND NO. 7 PULL BOXES
09/11	1-4 SHT 1	TYPICAL PULL BOX INSTALLATION AND WIRING DETAILS
09/11	1-4 SHT 2	TYPICAL PULL BOX INSTALLATION AND WIRING DETAILS
09/11	1-4 SHT 3	TYPICAL PULL BOX INSTALLATION DETAILS
09/11	1-5 SHT 1	ELECTRICAL CONDUIT COVER AND TRENCH REQUIREMENTS
09/11	1-5 SHT 2	CONDUIT EXPANSION COUPLINGS
09/11	1-6	CONDUCTOR REQUIREMENTS
03/10	1-7	TRAFFIC SIGNAL IMSA CABLE COLOR CODES
09/11	1-8 SHT 1	FRONT OF BARRIER JUNCTION BOX
09/11	1-8 SHT 2	BACK OF BARRIER JUNCTION BOX
09/11	1-9	TOP OF BARRIER JUNCTION BOX DETAILS
09/11	1-10	TOP OF BARRIER JUNCTION BOX DETAILS
10/13	1-11 SHT 1	HEAVY DUTY LIGHTING NO. 4 AND NO. 6 PULL BOX
10/13	1-11 SHT 2	HEAVY DUTY LIGHTING NO. 4 AND NO. 6 PULL BOX
03/15	1-11 SHT 3	HEAVY DUTY LIGHTING NO. 4 AND NO. 6 PULL BOX LID
03/15	1-12 SHT 1	PRECAST HEAVY DUTY LIGHTING NO. 4B AND NO. 6B PULL BOX
03/15	1-12 SHT 2	PRECAST HEAVY DUTY LIGHTING NO. 4B AND NO. 6B PULL BOX
	T.S. 2	FOUNDATIONS
03/10	2-1	FOUNDATION FOR TYPE II LOAD CENTER CABINET
03/10	2-2	FOUNDATION FOR TYPE IV LOAD CENTER CABINET
03/10	2-3	FOUNDATION FOR TYPE III CONTROL CABINET
03/10	2-4	FOUNDATION FOR TYPE IV AND V CONTROL CABINETS
03/10	2-5	FOUNDATION FOR TYPE 340 CONTROL CABINET
03/10	2-6	METER PEDESTAL CABINET FOUNDATION AND BASE
03/15	2-7	TRAFFIC SIGNAL UPS CABINET FOUNDATION DETAIL
	T.S. 3	CABINETS
12/12	3-0	NOTES FOR TYPE II AND IV LOAD CENTER CABINETS
03/10	3-1	TYPE II LOAD CENTER CABINET
03/10	3-2	TYPE IV LOAD CENTER CABINET
03/10	3-3	TYPE II OR IV LOAD CENTER CABINET WIRING DETAILS 240/480 3W W/DISCONNECT
03/10	3-4 SHT 1	PHOTO ELECTRIC CELL MOUNTING DETAILS
03/10	3-4 SHT 2	PHOTO ELECTRIC CELL MOUNTING DETAILS
03/10	3-5 SHT 1	TYPE I AND II METER PEDESTAL CABINET
12/12	3-5 SHT 2	METER PEDESTAL CABINET
03/10	3-6	TYPE III CONTROL CABINET
03/10	3-7	POLE MOUNTED TYPE III CONTROL CABINET
03/10	3-8 SHT 1	POLE MOUNT DETAILS FOR TYPE III CONTROL CABINET
03/10	3-8 SHT 2	POLE MOUNT DETAILS FOR TYPE III CONTROL CABINET
03/10	3-9 SHT 1	TYPE IV AND V CONTROL CABINET NOTES
03/10	3-9 SHT 2	TYPE IV CONTROL CABINET
03/10	3-9 SHT 3	TYPE V CONTROL CABINET
03/10	3-10	CABINET EXTENSION OR ELEVATOR BASE
03/10	3-11	CONTROL CABINET MOUNTED SERVICE ENCLOSURE
03/10	3-12 SHT 1	120/240 OR 240/480 VOLT, SINGLE PHASE UTILITY PULL SECTION AND SERVICE DISCONNECT DETAILS
03/10	3-12 SHT 2	120/240 OR 240/480 VOLT, SINGLE PHASE UTILITY PULL SECTION AND SERVICE DISCONNECT DETAILS
03/10	3-13 SHT 1	TRAFFIC SIGNALS AND LIGHTING MODEL 345 CABINET DETAILS
03/10	3-13 SHT 2	TRAFFIC SIGNALS AND LIGHTING MODEL 345 CABINET DETAILS
03/10	3-13 SHT 3	TRAFFIC SIGNALS AND LIGHTING MODEL 345 CABINET CAGE DETAILS

REVISION DATE	STANDARD NUMBER	SUBJECT : TRAFFIC SIGNALS AND LIGHTING DETAILS
	T-SL. 4	POLES AND POSTS
11/22	4.01	TYPE A POLE
11/22	4.02	TYPE S POLE
11/22	4.03	TYPE T POLE
11/22	4.04	TYPE S AND TYPE T STEEL TWIN LUMINAIRE MOUNTING BRACKET AND EXTENSIONS
11/22	4.05	ALUMINUM TYPE S POLE
11/22	4.06	ALUMINUM TYPE T POLE
11/22	4.07	TYPE G POLE
11/22	4.10	ALUMINUM TYPE I POLE
11/22	4.11	GENERAL NOTES FOR TRAFFIC SIGNALS AND LIGHTING POLES WITH MAXIMUM LOADING CASE
04/19	4.12	TYPE J POLES (25-J, 30-J, 35-J, AND 40-J) WITH 25 FT TO 40 FT MAST ARM SPAN LENGTH
04/19	4.13	TYPE Q POLES (25-QL, 30-QL, 35-QL, AND 40-QL) WITH 25 FT TO 40 FT MAST ARM SPAN LENGTH WITH LUMINAIRES
04/19	4.14	TYPE K POLES (45-K, 50-K, AND 55-K) WITH 45 FT TO 55 FT MAST ARM SPAN LENGTH
04/19	4.15	TYPE R POLES (45-RL, 50-RL, AND 55-RL) WITH 45 FT TO 55 FT MAST ARM SPAN LENGTH WITH LUMINAIRES
11/22	4.16	TYPE V POLES (60-V AND 65-V) WITH 60 FT TO 65 FT MAST ARM SPAN LENGTH
11/22	4.17	TYPE W POLES (60-WL AND 65-WL) WITH 60 FT TO 65 FT MAST ARM SPAN LENGTH WITH LUMINAIRES
11/22	4.18	POLE HAND HOLE DETAILS
11/22	4.19	TYPE U POLE (ELLIPTICAL BASE) DETAILS
11/22	4.20	TYPE U POLE (ROUND POLE WITH SQUARE BASE) NOTES
04/19	4.21	TYPE U POLE (ROUND POLE WITH SQUARE BASE) FOUNDATION DETAILS
04/19	4.22	TYPE U POLE (ROUND POLE WITH SQUARE BASE) DEATILS 1
04/19	4.23	TYPE U POLE (ROUND POLE WITH SQUARE BASE) DEATILS 2
04/19	4.24	TYPE U POLE (ROUND POLE WITH SQUARE BASE) PIPE TENON DETAILS
04/19	4.25	TYPE U POLE (ROUND POLE WITH SQUARE BASE) TWIN LUMINAIRE BRACKET DETAILS
04/19	4.26	EQUIPMENT MOUNTING HEIGHT DETAILS
04/19	4.27	PEDESTRIAN PUSH BUTTON POST "TYPE PB POLE"
11/22	4.28	POLE FOUNDATION ANCHOR BOLTS
04/19	4.29	STEEL MAST ARM DETAILS LUMINAIRE AND SIGNAL ARMS TO 20'
04/19	4.30	ALUMINUM TRUSS MAST ARM DETAILS FOR TYPE G, H, AND I POLES
04/19	4.31	SIGNAL MAST ARM TENON DETAIL
04/19	4.32	TYPICAL HIGHWAY LIGHTING OFFSETS IN CUT AND FILL SECTIONS
11/22	4.33	STEEL ADAPTER PLATE FOR 30 FT ALUMINUM TYPE "G" OR TYPE "S" LIGHT POLES
	T.S. 5	POLE BASES - SPECIAL
11/24	5-0	TYPE 2 AND 3 CAST ALUMINUM BREAK-AWAY BASES
04/19	5-1	TYPE 2 CAST ALUMINUM BREAK-AWAY BASE
04/19	5-2	TYPE 3 CAST ALUMINUM BREAK-AWAY BASE
05/21	5-3	INSTALLATION DETAILS FOR POLE FOUNDATIONS WITH TYPE 2 AND 3 BREAK-AWAY BASES
	T.S. 6	HIGHWAY TRAFFIC DATA DETECTORS
03/10	6-1	TYPE C VEHICLE DETECTOR LOOPS FOR TRAFFIC COUNTERS
03/10	6-2 SHT 1	TYPE SA AND SB SPEED/VEHICLE CLASSIFICATION SYSTEMS
03/10	6-2 SHT 2	TYPE SA SPEED/VEHICLE CLASSIFICATION SYSTEMS
03/10	6-2 SHT 3	TYPE SB SPEED/VEHICLE CLASSIFICATION SYSTEMS
12/12	6-3	PIEZOELECTRIC WEIGHT SENSOR AND LOOP LANE LAYOUT
12/12	6-4 SHT 1	DETECTOR LOOPS AND PIEZOELECTRIC SENSOR DETAILS
12/12	6-4 SHT 2	DETECTOR LOOPS AND PIEZOELECTRIC SENSOR DETAILS
03/15	6-4 SHT 3	DETAIL A PIEZOELECTRIC SENSOR DETAILS
12/12	6-4 SHT 4	DETAIL B DETECTOR LOOP DETAILS
12/12	6-4 SHT 5	DETECTOR LOOPS AND PIEZOELECTRIC SENSOR DETAILS
03/10	6-5	MICROLOOPS FOR SPEED/VEHICLE CLASSIFICATION
03/10	6-6	QUARTZ PIEZOELECTRIC WEIGHT SENSOR AND LOOP LANE LAYOUT
03/10	6-7	TRAFFIC DATA COLLECTION CABINET INSTALLATION DETAILS
03/10	6-8	TYPE MPD CABINET POLE, BASE AND FOUNDATION INSTALLATION DETAILS

ADOT STANDARD DRAWINGS REVISION DATES and STANDARD NO.'s REVIEW			
		NAME	DATE
TRAFFIC SIGNAL & LIGHTING STANDARDS		D WIGGINS	09/30/2025
PROJECT NO.		093 YV 189 F0738 01C	1C-1 OF 524
RECORD DRAWING DATA	FEDERAL ID NO. 093-B(230)T		OF
		REC. DWG. DATE	

ADOT STANDARD DRAWINGS

TRAFFIC SIGNAL AND LIGHTING STANDARDS

(SHEET 2 OF 2)

EFFECTIVE NOVEMBER 2024

REVISION DATE	STANDARD NUMBER	SUBJECT : TRAFFIC SIGNALS AND LIGHTING DETAILS
	T.S. 7	TRAFFIC SIGNAL DETECTORS
03/10	7-1 SHT 1	LOOP DETECTOR LOCATION SAWCUT PATTERNS AND INSTALLATION DETAILS
03/10	7-1 SHT 2	SAW CUT AND CORING DETAILS
03/15	7-1 SHT 3	SAW CUT AND CORING DETAILS
03/10	7-1 SHT 4	TYPICAL DETECTOR LOOP LEAD-IN ROAD TO PULL BOX DETAIL
03/10	7-1 SHT 5	LOOP DETECTOR LOCATION AND INSTALLATION DETAILS
03/10	7-2	PRE-FORMED LOOP DETECTORS FOR RAMP METERING AND COUNTING
03/10	7-3	PRE-FORMED LOOP DETECTORS IN BRIDGE DECK
03/10	7-4	PRE-FORMED LOOP DETECTORS IN PCCP
03/10	7-5	TYPICAL PRE-FORMED LOOP DETECTOR STUB-OUT DETAIL
	T.S. 8	SIGNAL ASSEMBLIES
12/23	8-0	TRAFFIC SIGNAL VEHICLE FACE ASSEMBLY REQUIREMENTS AND DETAILS
12/23	8-1	VEHICLE TRAFFIC SIGNAL FACE ASSEMBLY
12/23	8-2	VEHICLE TRAFFIC SIGNAL FACE ASSEMBLY
10/13	8-4 SHT 1	12-INCH VEHICLE TRAFFIC SIGNAL HOUSING/SECTION
01/12	8-4 SHT 2	12-INCH VEHICLE TRAFFIC SIGNAL HOUSING/SECTION NOTES
01/12	8-4 SHT 3	VEHICLE TRAFFIC SIGNAL HOUSING/SECTION DETAILS
03/10	8-4 SHT 4	VISORS FOR 8-INCH AND 12-INCH VEHICLE TRAFFIC SIGNAL FACE ASSEMBLIES
01/12	8-5	FLASHING BEACON SIGNAL FACE ASSEMBLY
01/12	8-6	LED LAMP FOR PROGRAMMED VISIBILITY SIGNAL
01/12	8-7 SHT 1	PEDESTRIAN SIGNAL ASSEMBLY REQUIREMENTS AND DETAILS
01/12	8-7 SHT 2	PEDESTRIAN SIGNAL ASSEMBLY HOUSING
01/12	8-7 SHT 3	PEDESTRIAN SIGNAL ASSEMBLY VISOR
	T.S. 9	MOUNTING ASSEMBLIES - SIGNAL
03/10	9-0 SHT 1	MOUNTING ASSEMBLY GENERAL REQUIREMENTS
03/10	9-0 SHT 2	MOUNTING ASSEMBLY GENERAL REQUIREMENTS
03/10	9-1	TYPE I AND II MOUNTING ASSEMBLIES
03/10	9-2	TYPE III AND IV MOUNTING ASSEMBLIES
10/13	9-3	TYPE V MOUNTING ASSEMBLY
03/10	9-4	TYPE VI MOUNTING ASSEMBLY
03/10	9-5	TYPE VII MOUNTING ASSEMBLY
03/10	9-6	TYPE VIII MOUNTING ASSEMBLY
03/10	9-7	TYPE IX MOUNTING ASSEMBLY
03/10	9-8	TYPE X MOUNTING ASSEMBLY
03/10	9-9	TYPE XI MOUNTING ASSEMBLY
	T.S. 10	MOUNTING CASTINGS - SIGNAL
03/10	10-1	MISCELLANEOUS SIGNAL MOUNTING PARTS
03/10	10-2	MAST ARM SIGNAL MOUNTING PLUMBIZER
03/10	10-3	SIGNAL MOUNTING POLE PLATE DETAILS
03/10	10-4	TERMINAL COMPARTMENT, SIDE MOUNTED AND POLE TOP MOUNTED
	T.S. 11	PEDESTRIAN DETAILS
03/15	11-1	TYPE I PEDESTRIAN PUSH BUTTON HOUSING ASSEMBLY
03/15	11-2	CAN STYLE PEDESTRIAN PUSH BUTTON
	T.S. 12	FLASHERS
03/10	12-1 SHT 1	ADVANCE WARNING FLASHER POLE DETAIL
03/10	12-1 SHT 2	ADVANCE WARNING FLASHER POLE SIGN MOUNTING DETAILS
03/10	12-1 SHT 3	ADVANCE WARNING FLASHER POLE DETAIL
	T.S. 13	ILLUMINATION - SIGNS
03/10	13-1	SIGN LIGHTING DETAIL FOR TUBULAR SIGN STRUCTURES
03/10	13-2	FUSE PANEL DETAILS FOR SIGN LIGHTING
03/15	13-3	PLACEMENT OF LIGHTING FIXTURES FOR OVERHEAD SIGNS
	T.S. 14	ILLUMINATION - SPECIAL
03/10	14-1 SHT 1	HIGH PRESSURE SODIUM (HPS) LAMPS
03/10	14-1 SHT 2	HIGH PRESSURE SODIUM (HPS) LAMPS
03/10	14-1 SHT 3	HIGH PRESSURE SODIUM (HPS) LAMPS
03/10	14-2	PEDESTRIAN BRIDGE LIGHTING DETAILS

REVISION DATE	STANDARD NUMBER	SUBJECT : TRAFFIC SIGNALS AND LIGHTING DETAILS
	T.S 15	SPAN WIRE SIGNALS AND LIGHTING
		GENERAL NOTES
04/19	15-0 SHT 2	GENERAL NOTES
04/19	15-0 SHT 3	GENERAL NOTES
04/19	15-1 SHT 1	STEEL POLE TYPICAL DETAILS
04/19	15-1 SHT 2	STEEL POLE FOUNDATION DETAILS
04/19	15-1 SHT 3	STEEL POLE ATTACHMENT DETAILS
04/19	15-1 SHT 4	WOOD POLE TYPICAL DETAILS
04/19	15-1 SHT 5	WOOD POLE TYPICAL DETAILS
04/19	15-1 SHT 6	TYPICAL DETAILS
01/12	15-2	HANGER AND BALANCE ADJUSTER TYPICAL DETAILS
01/12	15-3 SHT 1	SIGNAL ASSEMBLY DETAILS
01/12	15-3 SHT 2	CONDUCTOR ENTRANCE HEADS TYPE A, B AND C
01/12	15-3 SHT 3	ALUMINUM PIPE EXTENSION AND TYPICAL DETAILS
01/12	15-4 SHT 1	ADJUSTABLE SIGN HANGER TYPICAL DETAILS
01/12	15-4 SHT 2	ADJUSTABLE SIGN HANGER TYPICAL DETAILS
01/12	15-4 SHT 3	ADJUSTABLE SIGN HANGER TYPICAL DETAILS
01/12	15-5	ADJUSTABLE HANGER TOP AND EXTENSION DETAILS
01/12	15-6	SIGNAL TETHER CLAMP TYPICAL DETAILS
01/12	15-7	POLE BAND TYPICAL DETAILS
01/12	15-8	WEATHERHEAD TYPICAL DETAILS

ADOT STANDARD DRAWINGS			
REVISION DATES and STANDARD NO.'s REVIEW			
		NAME	DATE
TRAFFIC SIGNAL AND LIGHTING STANDARDS		D WIGGINS	09/30/2025
PROJECT NO.		093 YV 189 F0738 01C	1C-2 OF 524
RECORD DRAWING DATA	FEDERAL ID NO. 093-B(230)T		OF
		REC. DWG. DATE	

ADOT STANDARD DRAWINGS

STRUCTURE DETAIL DRAWINGS
EFFECTIVE NOVEMBER 2024

DATE	STANDARD	SUBJECT TITLE
RAILINGS		
09/24	SD 1.10 (1 OF 2)	38" SINGLE SLOPE BRIDGE BARRIER AND TRANSITION
09/24	SD 1.10 (2 OF 2)	38" SINGLE SLOPE BRIDGE BARRIER AND TRANSITION
10/24	SD 1.11 (1 OF 1)	42" SINGLE SLOPE BRIDGE BARRIER AND TRANSITION
10/24	SD 1.11 (2 OF 2)	42" SINGLE SLOPE BRIDGE BARRIER AND TRANSITION
06/23	SD 1.12	COMBINATION PEDESTIAN-TRAFFIC BRIDGE RAILING
01/20	SD 1.13	PEDESTRIAN FENCE FOR BRIDGE RAILING SD1.12
01/20	SD 1.20	32' TYPE F ROADWAY BARRIER TRANSITION TO 38' SINGLE SLOPE BARRIER
01/20	SD 1.21	32' TYPE F ROADWAY BARRIER TRANSITION TO 42' SINGLE SLOPE BARRIER
01/20	SD 1.22	42' TYPE F ROADWAY BARRIER TRANSITION TO 42' SINGLE SLOPE BARRIER
01/20	SD 1.30	BARRIER JUNCTION BOX
APPROACHES		
08/23	SD 2.01	APPROACH SLAB DETAILS
08/23	SD 2.02	TYPE 1 ANCHOR SLAB DETAILS
08/23	SD 2.03	TYPE 2 ANCHOR SLAB DETAILS
08/23	SD 2.04	SLOPE PAVING DETAILS
DECK JOINTS		
02/20	SD 3.01	DECK JOINT ASSEMBLY - COMPRESSION SEAL
02/20	SD 3.02	DECK JOINT ASSEMBLY - STRIP SEAL
02/20	SD 3.03 (1 OF 2)	DECK JOINT ASSEMBLY - FLANGELESS STRIP SEAL
02/20	SD 3.03 (2 OF 2)	DECK JOINT ASSEMBLY - FLANGELESS STRIP SEAL
SUBSTRUCTURE		
11/12	SD 5.01	STRUCTURAL EXCAVATION - PAYMENT LIMITS
11/12	SD 5.02	STRUCTURE BACKFILL - PAYMENT LIMITS
DRAINAGE STRUCTURES		
05/15	SD 6.01 (1 OF 5)	REINFORCED CONCRETE BOX CULVERTS - MISCELLANEOUS DETAILS
02/12	SD 6.01 (2 OF 5)	REINFORCED CONCRETE BOX CULVERTS - MISCELLANEOUS DETAILS
02/12	SD 6.01 (3 OF 5)	REINFORCED CONCRETE BOX CULVERTS - EXTENSION DETAILS
02/12	SD 6.01 (4 OF 5)	REINFORCED CONCRETE BOX CULVERTS - STRUCTURAL EXCAVATION & STRUCTURE BACKFILL
05/15	SD 6.01 (5 OF 5)	REINFORCED CONCRETE BOX CULVERTS - SINGLE BARREL (0'-30' FILLS)
05/15	SD 6.02 (1 OF 2)	REINFORCED CONCRETE BOX CULVERTS - DOUBLE BARREL (0'-15' FILLS)
05/15	SD 6.02 (2 OF 2)	REINFORCED CONCRETE BOX CULVERTS - DOUBLE BARREL (15'-30' FILLS)
05/15	SD 6.03 (1 OF 2)	REINFORCED CONCRETE BOX CULVERTS - TRIPLE BARREL (0'-15' FILLS)
05/15	SD 6.03 (2 OF 2)	REINFORCED CONCRETE BOX CULVERTS - TRIPLE BARREL (15'-30' FILLS)
05/15	SD 6.04 (1 OF 2)	REINFORCED CONCRETE BOX CULVERTS - FOUR BARREL (0'-15' FILLS)
05/15	SD 6.04 (2 OF 2)	REINFORCED CONCRETE BOX CULVERTS - FOUR BARREL (15'-30' FILLS)
05/15	SD 6.05 (1 OF 2)	REINFORCED CONCRETE BOX CULVERTS - FIVE BARREL (0'-15' FILLS)
05/15	SD 6.05 (2 OF 2)	REINFORCED CONCRETE BOX CULVERTS - FIVE BARREL (15'-30' FILLS)
05/15	SD 6.06 (1 OF 2)	REINFORCED CONCRETE BOX CULVERTS - SIX BARREL (0'-15' FILLS)
05/15	SD 6.06 (2 OF 2)	REINFORCED CONCRETE BOX CULVERTS - SIX BARREL (15'-30' FILLS)
02/12	SD 6.07	REINFORCED CONCRETE BOX CULVERTS - 16'x 14' EQUIPMENT PASS (0'-20' FILLS)
05/15	SD 6.08 (1 OF 8)	REINFORCED CONCRETE BOX CULVERTS - OUTLET WINGS - SKEW 0°to 20° - CULVERT HEIGHT 3'to 7'
02/12	SD 6.08 (2 OF 8)	REINFORCED CONCRETE BOX CULVERTS - OUTLET WINGS - SKEW 0°to 20° - CULVERT HEIGHT 8'to 12'
05/15	SD 6.08 (3 OF 8)	REINFORCED CONCRETE BOX CULVERTS - INLET WINGS - SKEW 0°to 20° - CULVERT HEIGHT 3'to 7'
02/12	SD 6.08 (4 OF 8)	REINFORCED CONCRETE BOX CULVERTS - INLET WINGS - SKEW 0°to 20° - CULVERT HEIGHT 8'to 12'
05/15	SD 6.08 (5 OF 8)	REINFORCED CONCRETE BOX CULVERTS - OUTLET WINGS - SKEW 25°to 45° - CULVERT HEIGHT 3'to 7'
02/12	SD 6.08 (6 OF 8)	REINFORCED CONCRETE BOX CULVERTS - OUTLET WINGS - SKEW 25°to 45° - CULVERT HEIGHT 8'to 12'
05/15	SD 6.08 (7 OF 8)	REINFORCED CONCRETE BOX CULVERTS - INLET WINGS - SKEW 25°to 45° - CULVERT HEIGHT 3'to 7'
02/12	SD 6.08 (8 OF 8)	REINFORCED CONCRETE BOX CULVERTS - INLET WINGS - SKEW 25°to 45° - CULVERT HEIGHT 8'to 12'
05/15	SD 6.09 (1 OF 3)	REINFORCED CONCRETE BOX CULVERTS - HEADWALL QUANTITIES - 2 :1 SLOPE
05/15	SD 6.09 (2 OF 3)	REINFORCED CONCRETE BOX CULVERTS - HEADWALL QUANTITIES - 4 :1 SLOPE
05/15	SD 6.09 (3 OF 3)	REINFORCED CONCRETE BOX CULVERTS - HEADWALL QUANTITIES - 6 :1 SLOPE
05/15	SD 6.10 (1 OF 2)	REINFORCED CONCRETE BOX CULVERTS - INLET OR OUTLET - LEVEL WINGS - CULVERT HEIGHT 3'to 7'
02/12	SD 6.10 (2 OF 2)	REINFORCED CONCRETE BOX CULVERTS - INLET OR OUTLET - LEVEL WINGS - CULVERT HEIGHT 8'to 12'
02/12	SD 6.11 (1 OF 4)	REINFORCED CONCRETE BOX CULVERTS - OUTLET APRON DETAILS
05/15	SD 6.11 (2 OF 4)	REINFORCED CONCRETE BOX CULVERTS - OUTLET APRON - DIMENSIONS & QUANTITIES (2 :1 SLOPE)
05/15	SD 6.11 (3 OF 4)	REINFORCED CONCRETE BOX CULVERTS - OUTLET APRON - DIMENSIONS & QUANTITIES (4 :1 SLOPE)
05/15	SD 6.11 (4 OF 4)	REINFORCED CONCRETE BOX CULVERTS - OUTLET APRON - DIMENSIONS & QUANTITIES (6 :1 SLOPE)
10/24	SD 6.20 (1 OF 5)	PRECAST REINFORCED CONCRETE BOX CULVERTS - SINGLE BARREL NOTES & DIMENSIONS
10/24	SD 6.20 (2 OF 5)	PRECAST REINFORCED CONCRETE BOX CULVERTS - MISCELLANEOUS DETAILS 1
10/24	SD 6.20 (3 OF 5)	PRECAST REINFORCED CONCRETE BOX CULVERTS - END SECTION & CONNECTION DETAILS
10/24	SD 6.20 (4 OF 5)	PRECAST REINFORCED CONCRETE BOX CULVERTS - MISCELLANEOUS DETAILS 2
10/24	SD 6.20 (5 OF 5)	PRECAST REINFORCED CONCRETE BOX CULVERTS - MISCELLANEOUS DETAILS 3
07/12	SD 6.30 (1 OF 5)	PIPE CULVERT HEADWALLS - MISCELLANEOUS DETAILS
07/12	SD 6.30 (2 OF 5)	PIPE CULVERT HEADWALLS - INLET AND OUTLET - 18" to 42" PIPES
07/12	SD 6.30 (3 OF 5)	PIPE CULVERT HEADWALLS - RIGHT ANGLE INLET AND OUTLET - 48" to 84" PIPES
07/12	SD 6.30 (4 OF 5)	PIPE CULVERT HEADWALLS - SKEWED INLET AND OUTLET - 48" to 84" PIPES
07/12	SD 6.30 (5 OF 5)	PIPE CULVERT HEADWALLS - MULTI-PIPE - 48" to 84" PIPES
07/12	SD 6.31 (1 OF 8)	PIPE CULVERT HEADWALLS - RIGHT ANGLE INLET
07/12	SD 6.31 (2 OF 8)	PIPE CULVERT HEADWALLS - RIGHT ANGLE INLET - 2 :1 SLOPE
07/12	SD 6.31 (3 OF 8)	PIPE CULVERT HEADWALLS - RIGHT ANGLE INLET - 4 :1 SLOPE
07/12	SD 6.31 (4 OF 8)	PIPE CULVERT HEADWALLS - RIGHT ANGLE INLET - 6 :1 SLOPE
07/12	SD 6.31 (5 OF 8)	PIPE CULVERT HEADWALLS - RIGHT ANGLE OUTLET
07/12	SD 6.31 (6 OF 8)	PIPE CULVERT HEADWALLS - RIGHT ANGLE OUTLET - 2 :1 SLOPE
07/12	SD 6.31 (7 OF 8)	PIPE CULVERT HEADWALLS - RIGHT ANGLE OUTLET - 4 :1 SLOPE
07/12	SD 6.31 (8 OF 8)	PIPE CULVERT HEADWALLS - RIGHT ANGLE OUTLET - 6 :1 SLOPE
07/12	SD 6.32 (1 OF 8)	PIPE CULVERT HEADWALLS - 15° SKEW INLET
07/12	SD 6.32 (2 OF 8)	PIPE CULVERT HEADWALLS - 15° SKEW INLET - 2 :1 SLOPE
07/12	SD 6.32 (3 OF 8)	PIPE CULVERT HEADWALLS - 15° SKEW INLET - 4 :1 SLOPE
07/12	SD 6.32 (4 OF 8)	PIPE CULVERT HEADWALLS - 15° SKEW INLET - 6 :1 SLOPE
07/12	SD 6.32 (5 OF 8)	PIPE CULVERT HEADWALLS - 15° SKEW OUTLET
07/12	SD 6.32 (6 OF 8)	PIPE CULVERT HEADWALLS - 15° SKEW OUTLET - 2 :1 SLOPE
07/12	SD 6.32 (7 OF 8)	PIPE CULVERT HEADWALLS - 15° SKEW OUTLET - 4 :1 SLOPE
07/12	SD 6.32 (8 OF 8)	PIPE CULVERT HEADWALLS - 15° SKEW OUTLET - 6 :1 SLOPE

DATE	STANDARD	SUBJECT TITLE
DRAINAGE STRUCTURES (Continued)		
07/12	SD 6.33 (1 OF 8)	PIPE CULVERT HEADWALLS - 30° SKEW INLET
07/12	SD 6.33 (2 OF 8)	PIPE CULVERT HEADWALLS - 30° SKEW INLET - 2 :1 SLOPE
07/12	SD 6.33 (3 OF 8)	PIPE CULVERT HEADWALLS - 30° SKEW INLET - 4 :1 SLOPE
07/12	SD 6.33 (4 OF 8)	PIPE CULVERT HEADWALLS - 30° SKEW INLET - 6 :1 SLOPE
07/12	SD 6.33 (5 OF 8)	PIPE CULVERT HEADWALLS - 30° SKEW OUTLET
07/12	SD 6.33 (6 OF 8)	PIPE CULVERT HEADWALLS - 30° SKEW OUTLET - 2 :1 SLOPE
07/12	SD 6.33 (7 OF 8)	PIPE CULVERT HEADWALLS - 30° SKEW OUTLET - 4 :1 SLOPE
07/12	SD 6.33 (8 OF 8)	PIPE CULVERT HEADWALLS - 30° SKEW OUTLET - 6 :1 SLOPE
07/12	SD 6.34 (1 OF 8)	PIPE CULVERT HEADWALLS - 45° SKEW INLET
07/12	SD 6.34 (2 OF 8)	PIPE CULVERT HEADWALLS - 45° SKEW INLET - 2 :1 SLOPE
07/12	SD 6.34 (3 OF 8)	PIPE CULVERT HEADWALLS - 45° SKEW INLET - 4 :1 SLOPE
07/12	SD 6.34 (4 OF 8)	PIPE CULVERT HEADWALLS - 45° SKEW INLET - 6 :1 SLOPE
07/12	SD 6.34 (5 OF 8)	PIPE CULVERT HEADWALLS - 45° SKEW OUTLET
07/12	SD 6.34 (6 OF 8)	PIPE CULVERT HEADWALLS - 45° SKEW OUTLET - 2 :1 SLOPE
07/12	SD 6.34 (7 OF 8)	PIPE CULVERT HEADWALLS - 45° SKEW OUTLET - 4 :1 SLOPE
07/12	SD 6.34 (8 OF 8)	PIPE CULVERT HEADWALLS - 45° SKEW OUTLET - 6 :1 SLOPE
07/12	SD 6.35 (1 OF 2)	PIPE CULVERT HEADWALLS - MULTI-PIPE WITHOUT APRON
07/12	SD 6.35 (2 OF 2)	PIPE CULVERT HEADWALLS - MULTI-PIPE WITH OUTLET APRON
07/12	SD 6.36 (1 OF 4)	PIPE CULVERT HEADWALLS - OUTLET APRONS
07/12	SD 6.36 (2 OF 4)	PIPE CULVERT HEADWALLS - OUTLET APRON STEEL LIST - 2 :1 SLOPE
07/12	SD 6.36 (3 OF 4)	PIPE CULVERT HEADWALLS - OUTLET APRON STEEL LIST - 4 :1 SLOPE
07/12	SD 6.36 (4 OF 4)	PIPE CULVERT HEADWALLS - OUTLET APRON STEEL LIST - 6 :1 SLOPE
RETAINING WALLS		
10/24	SD 7.01 (1 OF 5)	RETAINING WALL (REINFORCED CONCRETE CANTILEVER)
12/21	SD 7.01 (2 OF 5)	RETAINING WALL (REINFORCED CONCRETE CANTILEVER)
12/21	SD 7.01 (3 OF 5)	RETAINING WALL (REINFORCED CONCRETE CANTILEVER)
12/21	SD 7.01 (4 OF 5)	RETAINING WALL (REINFORCED CONCRETE CANTILEVER)
12/21	SD 7.01 (5 OF 5)	RETAINING WALL (REINFORCED CONCRETE CANTILEVER)
12/21	SD 7.02 (1 OF 2)	RETAINING WALL (MASONRY CANTILEVER)
12/21	SD 7.02 (2 OF 2)	RETAINING WALL (MASONRY CANTILEVER)
SOUND BARRIER WALLS		
06/22	SD 8.01	SOUND BARRIER WALL (CONCRETE)
06/22	SD 8.02 (1 OF 2)	SOUND BARRIER WALL (MASONRY)
06/22	SD 8.02 (2 OF 2)	SOUND BARRIER WALL (MASONRY)
TRAFFIC STRUCTURES		
04/19	SD 9.01 (1 OF 5)	MEDIAN SIGN STRUCTURE (TWO SIDED) - ELEVATION & NOTES
03/22	SD 9.01 (2 OF 5)	MEDIAN SIGN STRUCTURE (TWO SIDED) - FOUNDATION DETAILS
04/19	SD 9.01 (3 OF 5)	MEDIAN SIGN STRUCTURE (TWO SIDED) - TYPE A SIGN MOUNT ASSEMBLY
04/19	SD 9.01 (4 OF 5)	MEDIAN SIGN STRUCTURE (TWO SIDED) - TYPE B SIGN MOUNT ASSEMBLY
04/19	SD 9.01 (5 OF 5)	MEDIAN SIGN STRUCTURE (TWO SIDED) - LIGHT SUPPORT AND MISC. DETAILS
04/19	SD 9.02 (1 OF 5)	MEDIAN SIGN STRUCTURE (ONE SIDED) - ELEVATION & NOTES
03/22	SD 9.02 (2 OF 5)	MEDIAN SIGN STRUCTURE (ONE SIDED) - FOUNDATION DETAILS
04/19	SD 9.02 (3 OF 5)	MEDIAN SIGN STRUCTURE (ONE SIDED) - TYPE A SIGN MOUNT ASSEMBLY
04/19	SD 9.02 (4 OF 5)	MEDIAN SIGN STRUCTURE (ONE SIDED) - TYPE B SIGN MOUNT ASSEMBLY
04/19	SD 9.02 (5 OF 5)	MEDIAN SIGN STRUCTURE (ONE SIDED) - LIGHT SUPPORT AND MISC. DETAILS
04/19	SD 9.10 (1 OF 5)	TUBULAR SIGN STRUCTURES - TUBULAR CANTILEVER - GENERAL PLAN
09/23	SD 9.10 (2 OF 5)	TUBULAR SIGN STRUCTURES - TUBULAR CANTILEVER - FOUNDATION DETAILS
04/19	SD 9.10 (3 OF 5)	TUBULAR SIGN STRUCTURES - TUBULAR CANTILEVER - POST AND MAST ARM DETAILS
04/19	SD 9.10 (4 OF 5)	TUBULAR SIGN STRUCTURES - TUBULAR CANTILEVER - SIGN SUPPORT DETAILS
09/23	SD 9.10 (5 OF 5)	TUBULAR SIGN STRUCTURES - TUBULAR CANTILEVER - LIGHT SUPPORT DETAILS
04/19	SD 9.20 (1 OF 5)	TUBULAR SIGN STRUCTURES - TUBULAR FRAME - GENERAL PLAN
09/23	SD 9.20 (2 OF 5)	TUBULAR SIGN STRUCTURES - TUBULAR FRAME - FOUNDATION DETAILS
04/19	SD 9.20 (3 OF 5)	TUBULAR SIGN STRUCTURES - TUBULAR FRAME - POST AND MAST ARM DETAILS
04/19	SD 9.20 (4 OF 5)	TUBULAR SIGN STRUCTURES - TUBULAR FRAME - SIGN SUPPORT DETAILS
09/23	SD 9.20 (5 OF 5)	TUBULAR SIGN STRUCTURES - TUBULAR FRAME - LIGHT SUPPORT AND MISC. DETAILS
04/19	SD 9.50 (1 OF 5)	VARIABLE MESSAGE SIGN - TUBULAR FRAME - PLAN & ELEVATION
04/19	SD 9.50 (2 OF 5)	VARIABLE MESSAGE SIGN - TUBULAR FRAME - MOUNTING DETAILS
04/19	SD 9.50 (3 OF 5)	VARIABLE MESSAGE SIGN - TUBULAR FRAME - MOUNTING & SIGN BRACKET DETAILS
04/19	SD 9.50 (4 OF 5)	VARIABLE MESSAGE SIGN - CATWALK - HANDRAIL DETAILS
04/19	SD 9.50 (5 OF 5)	VARIABLE MESSAGE SIGN - CATWALK - MISCELLANEOUS DETAILS
04/19	SD 9.51	DUAL VARIABLE MESSAGE SIGN - TUBULAR FRAME
04/19	SD 9.52 (1 OF 5)	DYNAMIC MESSAGE SIGN - TUBULAR FRAME - PLAN & ELEVATION
04/19	SD 9.52 (2 OF 5)	DYNAMIC MESSAGE SIGN - TUBULAR FRAME - MOUNTING DETAILS
04/19	SD 9.52 (3 OF 5)	DYNAMIC MESSAGE SIGN - TUBULAR FRAME - MOUNTING DETAILS
04/19	SD 9.52 (4 OF 5)	DYNAMIC MESSAGE SIGN - CATWALK - HANDRAIL DETAILS
04/19	SD 9.52 (5 OF 5)	DYNAMIC MESSAGE SIGN - CATWALK - MISCELLANEOUS DETAILS
04/19	SD 9.53 (1 OF 5)	DMS (VARIABLE TILT CABINET) - TUBULAR FRAME - PLAN & ELEVATION
04/19	SD 9.53 (2 OF 5)	DMS (VARIABLE TILT CABINET) - TUBULAR FRAME - MOUNTING DETAILS
04/19	SD 9.53 (3 OF 5)	DMS (VARIABLE TILT CABINET) - TUBULAR FRAME - MOUNTING DETAILS
04/19	SD 9.53 (4 OF 5)	DMS (VARIABLE TILT CABINET) - CATWALK - HANDRAIL DETAILS
04/19	SD 9.53 (5 OF 5)	DMS (VARIABLE TILT CABINET) - CATWALK - MISCELLANEOUS DETAILS
05/22	SD 9.60 (1 OF 7)	DYNAMIC MESSAGE SIGN (BUTTERFLY) - GENERAL PLAN AND ELEVATION
05/22	SD 9.60 (2 OF 7)	DYNAMIC MESSAGE SIGN (BUTTERFLY) - FOUNDATION DETAILS
05/22	SD 9.60 (3 OF 7)	DYNAMIC MESSAGE SIGN (BUTTERFLY) - DMS MONOTUBE ASSEMBLY
05/22	SD 9.60 (4 OF 7)	DYNAMIC MESSAGE SIGN (BUTTERFLY) - DMS MAST ARM DETAILS
05/22	SD 9.60 (5 OF 7)	DYNAMIC MESSAGE SIGN (BUTTERFLY) - MISCELLANEOUS DETAIL
05/22	SD 9.60 (6 OF 7)	DYNAMIC MESSAGE SIGN (BUTTERFLY) - CATWALK ASSEMBLY AND HANDRAIL
05/22	SD 9.60 (7 OF 7)	DYNAMIC MESSAGE SIGN (BUTTERFLY) - CATWALK DETAILS

ADOT STANDARD DRAWINGS REVISION DATES and STANDARD NO.'s REVIEW				
		NAME	DATE	
STRUCTURES STANDARDS		D WIGGINS	09/30/2025	
PROJECT NO.			1D	OF 524
093 YV 189 F0738 01C				
RECORD DRAWING DATA	FEDERAL ID NO. 093-B(230)T	REC. DWG. DATE	OF	

INDEX OF SHEETS

SHEET. NO.	DWG. NO.	SHEET TITLE
GENERAL SHEETS		
1	N/A	Face Sheet
1A, 1B, 1C, 1D, 1F	N/A	ADOT Standard Drawings
2	G-1.01	Index Drawing Only
3	G-1.02	Design Data Sheets
4	G-1.03	Earth Quantity Table
5-6	G-2.01 - G-2.02	Key Map
7-19	G-3.01 - G-3.13	Typical Sections
20-40	G-4.01 - G-4.21	Summary Sheets
41-48	G-5.01 - G-5.08	Detail Sheets
DRAINAGE SHEETS		
49-79	D-1.01 - D-1.31	Drainage Details
80-115	D-2.01 - D-2.36	Culvert Plan & Profile
116-126	D-3.01 - D-3.11	Pipe Profiles Sheets
127-130	D-4.01 - D-4.04	Channel Pan & Profile
ROADWAY SHEETS		
131	C-1.01	Survey Control Sheets
132-140	C-2.01 - C-2.09	Geometric Layout Sheets
141-147	C-2.10 - C-2.16	Geometric Data Sheets
148-192	C-3.01 - C-3.45	Plan & Profile Sheets (US-93)
193-215	C-4.01 - C-4.23	Plan & Profile Sheets (Sideroads)
216-232	C-5.01 - C-5.17	US 93/SR 89 Roundabout Geometric Layout Plan, Data Sheet and Staking Table
233-252	C-6.01 - C-6.20	US 93/Moreton/Nine Irons Roundabout Geometric Layout Plan, Data Sheet and Staking Table
253-275	C-7.01 - C-7.23	Fencing Plans
276-284	C-8.01 - C-8.09	Detour Plans
TRAFFIC SHEETS		
285-288	T-1.01 - T-1.04	Maintenance of Traffic & Construction Activity
289-304	T-1.05 - T-1.20	Advance Warning Signs & Construction Sequence Plans
305-347	T-2.01 - T-2.43	Traffic Control General Notes & Quantities
348-351	T-3.01 - T-3.04	Signing & Pavement Marking Sheets Notes, Quantities, & Details
352-374	T-4.01 - T-4.23	Sign Summary
375-380	T-5.01 - T-5.06	Existing Sign Plans
381-407	T-5.07 - T-5.33	Signing & Pavement Marking Plans
408-410	T-6.01 - T-6.03	Sign Formats
411-412	T-7.01 - T-7.02	Traffic Recorder Plans
413-419	T-8.01 - T-8.07	Lighting Plans
STRUCTURES		
420-443	S-1.01 - S-1.24	SB BNSF OP Bridge Structure Sheets
444-448	S-2.01 - S-2.05	MSE Retaining Wall Sheets
449-454	S-3.01 - S-3.06	NB BNSF OP Bridge Structure Sheets
455-459	SF-1.01 - SF-1.05	SB BNSF Underpass Foundation Data Sheets
ROADSIDE DEVELOPMENT SHEETS		
460	P-1.01	Plant Inventory Summary Sheets
461-474	P-2.01 - P-2.14	Plant Inventory Plan Sheets
475-476	L-1.01 - L-1.02	Plant Revegetation Detail Sheets
477-490	L-2.01 - L-2.14	Plan Revegetation Plan Sheets
EROSION CONTROL		
491	E-1.01	Erosion Control Summary (CMIS)
492	E-1.02	Erosion Control Quantity Summary
493-499	E-2.01 - E-2.07	Erosion Detail
500-524	E-3.01 - E-3.25	Erosion Control Plans

	DESIGN	J GILLIS	06/26	ARIZONA DEPARTMENT OF TRANSPORTATION PROJECT DELIVERY AND OPERATIONS DIVISION ROADWAY DESIGN SERVICES	ROUTE	US 93	F.H.W.A. Arizona Division	STATE	ARIZ.	PROJECT NO.	093 YV 189	FEDERAL ID NO.	093-B(230)T	SHEET NO.	2	TOTAL SHEETS	524	RECORD DRAWING	
	DRAWN	M SAMUELSON	06/26		MILEPOST	189.9		LOCATION	WICKENBURG RANCH WAY TO VISTA ROYALE							DWG No.	G-1.01		
	CHECKED	D WIGGINS	06/26		STRUCTURE NO.			TRACS NO.	F0738 01C							_____ OF _____			
	TRANSPORTATION AECOM TECHNICAL SERVICES, Inc. 7720 N. 18th St., Suite 100 Phoenix, Arizona 85021 T 602.371.1100 AECOM www.aecom.com				DESIGN SHEET														

MIDPOINT OF PROJECT

Central Zone
State Plane Coordinates

X= 423,878
Y= 1,106,640

Mainline	Design Speed
MP 189.9-193.0 SB US 93	= 65 mph
MP 193.0 - 194.3 US 93	= 55 mph
SR 89	= 35 mph
Roundabout	= 25 mph
East Frontage Road	= 30 mph
Crossroads	
Moreton Rd	= 30 mph
Nine Irons Ranch Rd	= 30 mph
Antelope Creek Rd	= 30 mph
Wickenburg Ranch Way	= 35 mph
Matthie Ranch Road	= 35 mph

DESIGN DATA

US 93 2024 ADT	
MP 189.9 -192.1	= 8,326 vpd
MP 192.1-193.6	= 12,307 vpd
MP 193.6-194.3	= 14,264 vpd
US 93 2044 ADT	
MP 189.9 -192.1	= 8,572 vpd
MP 192.1-193.6	= 12,670 vpd
MP 193.6-194.3	= 14,685 vpd
SR 89 2040 ADT	= 11,703 vpd
US 93 2024 ADT	= 2,719 vpd
SR 89 2044	= 3,418 vpd

GENERAL NOTES

The roadway plans have been designed utilizing the Construction Standard Drawings (C-Series) and current revisions. Refer to the 1A sheet for a listing of current revision dates.

The project roadway shall be striped by the contractor in accordance with the current edition of the Signing and Marking Standard Drawings (M&S-Series) and the pavement marking plans.

For R/W and Survey information not shown, see Right-of-Way project No's. 093 YV 198 F0031, 093 YV 194 F0125, 093 YV 179 H48710R, S089-A-702 and 093 YV 190 F0738/093-B(0)T

Bench markers will be furnished by the State and shall be placed by the Contractor: Std C-21.20 at no additional cost to the Department.

Pavement lift thickness is nominal.

Where only the horizontal location of an existing utility is shown, the location is approximate. Where both the horizontal and vertical location of an existing utility is shown, the location has been verified by field survey methods. The contractor shall comply with all current AZ811 laws and Section 107.15 of the Specifications.

Delineators, object markers and mile post markers shall be removed and reset as required at no additional cost to the Department.

The average project elevation is 2495'.

New Right of Way and TCE are required for this project.

Changes in location or length of spillway or downdrain installation may be made by the Engineer to improve drainage conditions.

Slope rounding shall be applied per Std C-02 series unless otherwise noted.

The pavement shoulders shall be treated with a rumble strip: see Traffic sheets.

Project plans have been developed utilizing alignment and survey control from Result of Survey Project No. 093 YV 190 F0738 and 093-B(217)Z (093 YV 194 F0125)

LENGTH OF PROJECT

US 93 Med Cst CL
Sta 2103+35.63 to 2160+00.00 =5,664.37'

US 93 Southbound
Sta 178+45.32 to 196+74.95 = 1,829.63'
Sta 196+74.95 to 200+07.75 = 332.80' BNSF Railroad Overpass
Sta 200+07.75 to 354+10.00 = 15,402.25'

Gross & Net Length = 23,229.05' - 4.4 miles
MP 194.3 to MP 189.9

SR 89
Sta 507+62.57 to 514+45.85 (Median CL) = 683.28'
Sta 115+38.52 to 130+87.63 (Cst CL) = 1,549.11'

Gross & Net Length = 2,232.39' - 0.42 miles
MP 258.3 to 258.7

US 93 Northbound
Sta 178+45.12 to 197+82.23 = 1,937.11'
Sta 197+91.51 to 199+31.39 = 139.88' BNSF Railroad Overpass
Sta 199+31.39 to 341+10.07 = 14,178.68'

Gross & Net Length = 21,920.04' - 4.1 miles
MP 194.3 to MP 190.2

REFERENCES

F-035-1(3)	STP-025-1(17)P
F-FG-035-1(4)	U-093-B-505
093-B(215)S	NH-093-B(200)A
STP-035-1(48)P	HSIP-093-B(210)T
STP-035-1(24)P	093-B-NFA

	DESIGN	J GILLIS	06/26	ARIZONA DEPARTMENT OF TRANSPORTATION PROJECT DELIVERY AND OPERATIONS DIVISION ROADWAY DESIGN SERVICES	ROUTE	US 93	F.H.W.A. Arizona Division	STATE	ARIZ.	PROJECT NO.	093 YV 189	FEDERAL ID NO.	093-B(230)T	SHEET NO.	3	TOTAL SHEETS	524	RECORD DRAWING		
	DRAWN	M SAMUELSON	06/26		MILEPOST	189.9		LOCATION	WICKENBURG RANCH WAY TO VISTA ROYALE										DWG No.	G-1.02
	CHECKED	D WIGGINS	06/26		STRUCTURE NO.			TRACS NO.	F0738 01C		____ OF ____									
	TRANSPORTATION AECOM TECHNICAL SERVICES, Inc. 7720 N. 16th St., Suite 100 Phoenix, Arizona 85020 T 602.371.1100 www.aecom.com				DESIGN SHEET															

	EARTHWORK QUANTITIES (All quantitist shown in cubic yards)																
	Phase 1			Phase 2				Phase 3			Phase 4A		Phase 4B		Phase 5		Totals
	Mainline (US 93/SR 89) Roundabouts	Crossroads	Detours	Mainline	Southbound US 93 Channel	Crossroads	Detours	Mainline Roundabouts	Cross Roads	Detours	Mainline Roundabouts	Detours	Mainline NB US 93	Detours	Mainline NB/SB US 93	Detours	
Roadway Excavation	2,409	92,239	1,770	134,630	0	9,779	592	17,008	65	2	2,730	1,590	300	231	1,081	156	264,582
Shrink (Varies))	-422	-9,224	-310	-28,545	0	-978	-83	-2,975	-7	0	-473	-278	-53	-40	-189	-27	-43,604
Roadway Excavation (Overexcavation)	0	0	0	5,440	0	0	0	0	0	0	0	0	0	0	0	0	5,440
Shrink (Varies))	0	0	0	-544	0	0	0	0	0	0	0	0	0	0	0	0	-544
Structural Excavation	0	0	0	10,099	0	0	0	0	947	0	0	0	0	0	0	0	11,046
Shrink (Varies))	0	0	0	-1,023	0	0	0	0	-95	0	0	0	0	0	0	0	-1,118
Pipe Excavation	0	910	0	2,530	0	0	0	148	0	0	713	0	39	0	0	0	4,340
Shrink (Varies))	0	-91	0	-307	0	0	0	-15	0	0	-110	0	-4	0	0	0	-527
Drainage Excavation	0	22,656	0	4,823	31,191	0	0	492	0	0	238	0	0	0	0	0	59,399
Shrink (Varies))	0	-2,266	0	-534	-3,119	0	0	-86	0	0	-42	0	0	0	0	0	-6,046
Riprap Excavation	0	74	0	26	0	0	0	12	0	0	6	0	0	0	0	0	118
Shrink (Varies))	0	-7	0	-5	0	0	0	-2	0	0	-1	0	0	0	0	0	-15
											0	0					
Total Excavation Available	1,987	104,291	1,460	126,591	28,072	8,801	509	14,581	910	2	3,061	1,312	282	191	892	129	293,071
Haul in (Shrink Applied)				56,608													
			0														
Roadway Embankment	483	44,610	2,392	202,646	0	4,965	1,899	13,801	16	131	789	0	0	0	0	0	271,732
Berm Embankment	0	3,025	0	1,304	0	0	0	0	0	0	0	0	0	0	0	0	4,329
Pipe Trench Backfill	0	0	0	-668	0	0	0	0	0	0	123	0	0	0	0	0	-545
Ground Compaction	0	620	0	1,977	0	515	9	444	7	0	19	0	0	0	0	0	3,591
Total Embankment Required	483	48,255	2,392	205,258	0	5,480	1,908	14,245	23	131	931	0	0	0	0	0	279,107
												0		0			0
Haul Out (Shrink Applied)			-56,608														
Waste							-7,935			-1,094		-3,442		-473		-1,021	-13,964
Pipe Backfill ③	0	800	0	1,525	0	0	0	0	0	0	0	0	0	0	0	0	2,325
Pipe Bedding ③	0	618	0	1,063	0	0	0	0	0	0	0	0	0	0	0	0	1,681
Structure Backfill ③	0	0	0	5,177	0	0	0	0	401	0	0	0	0	0	0	0	5,578

EARTHWORK FACTORS		
Station	Shrink/Swell	Ground Compaction
US 93 Sta 2109+78 to 2125+00	35% Shrink	0.20 Feet
Mathie Ranch Road & Wickenburg Ranch Way	10% Shrink	0.10 Feet
SR 89	17.5% Shrink	0.20 Feet
US 93 Sta 2125+00.00 to 2160+00	17.5% Shrink	0.20 Feet
SB US 93 Sta 178+50.15 to 190+00	17.5% Shrink	0.20 Feet
SB US 93 Sta 190+00 to 354+10	10% Shrink	0.10 Feet

LEGEND:

- 10% Shrink
- 17.5% Shrink
- 35% Shrink

EARTHWORK NOTES

1. Drainage Excavation Quantity Includes only includes excavation to construct drainage channels.
2. The Average AC thickness is assumed to be 8 inches. The cost of AC Removal is not included in Roadway Excavation Item
3. These materials are considered to be imported material, and not included in the embankment quantities.

c:\pwworking\usaz\dms08894\0738_ds02.dgn
6/23/2026 @5:03:45 PM jason.heredia



DESIGN	J GILLIS	06/26
DRAWN	M SAMUELSON	06/26
CHECKED	D WIGGINS	06/26

TRANSPORTATION
AECOM TECHNICAL SERVICES, Inc.
7720 N. 16th St., Suite 100
Phoenix, Arizona 85020
T 602.371.1100

AECOM
www.aecom.com



ARIZONA DEPARTMENT OF TRANSPORTATION
PROJECT DELIVERY AND OPERATIONS DIVISION
ROADWAY DESIGN SERVICES

EARTHWORK QUANTITIES

ROUTE US 93	F.H.W.A. Arizona Division	STATE ARIZ.	PROJECT NO. 093 YV 189	FEDERAL ID NO. 093-B(230)T	SHEET NO. 4	TOTAL SHEETS 524	RECORD DRAWING
MILEPOST 189.9	LOCATION WICKENBURG RANCH WAY TO VISTA ROYALE						DWG No. G-1.03 ____ OF ____
STRUCTURE NO.	TRACS NO. F0738 01C						

F.H.W.A. REGION	STATE	PROJECT NO.	SHEET NO.	TOTAL SHEETS	RECORD DRAWING
9	ARIZ.	093-B(230)T	5	524	



093 YV 189

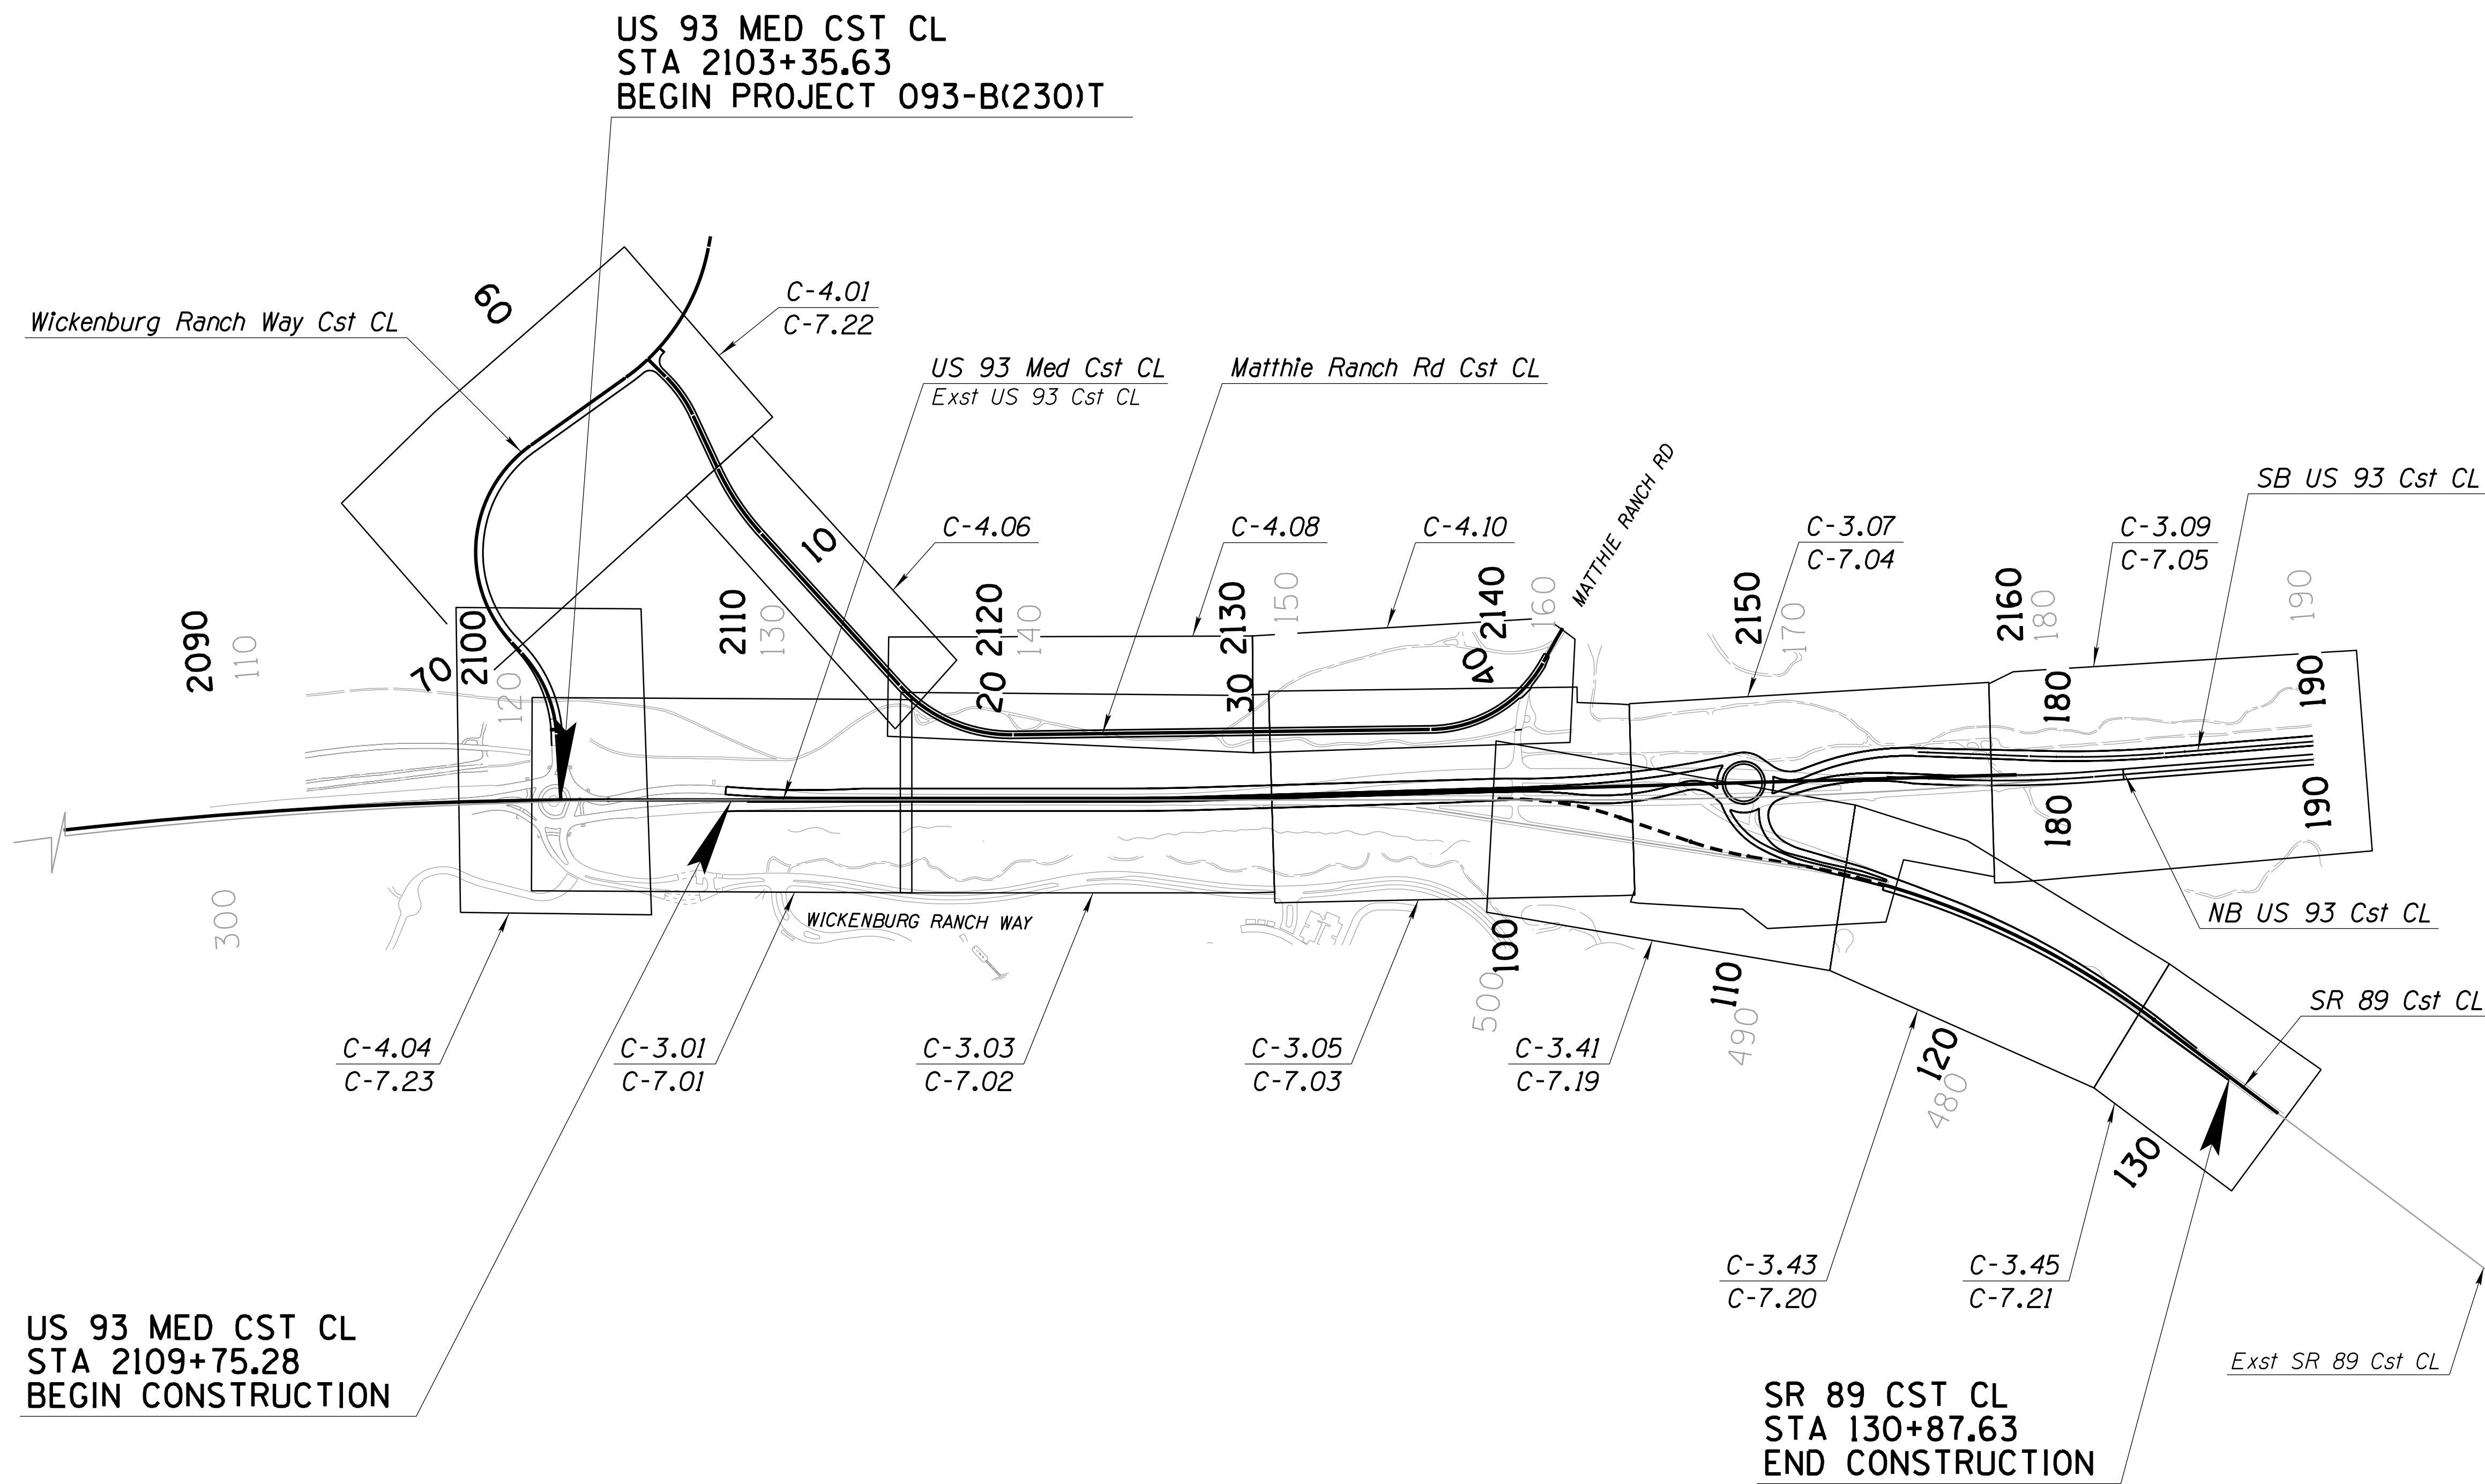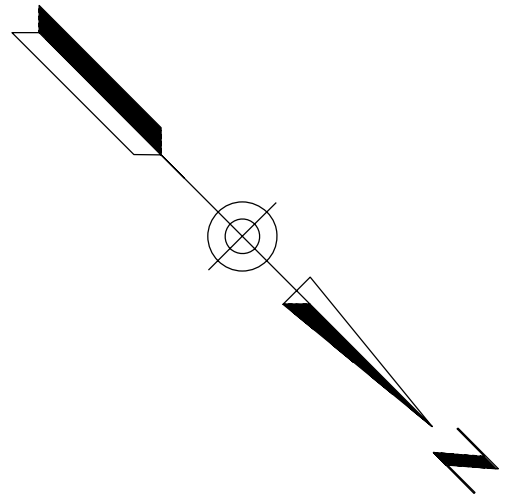


US 93 MED CST CL
STA 2109+75.28
BEGIN CONSTRUCTION

SR 89 CST CL
STA 130+87.63
END CONSTRUCTION


DESIGN		ZSZ	06-26	ARIZONA DEPARTMENT OF TRANSPORTATION PROJECT DELIVERY AND OPERATIONS DIVISION ROADWAY DESIGN SERVICES	
DRAWN		RM	06-26		
CHECKED		DBK	06-26		
ROUTE		LOCATION			KEY MAP STA 89+00 TO STA 190+00
US 93		WICKENBURG RANCH WAY TO VISTA ROYALE			
TRACS NO.		F0738 OIC			DWG NO. G-2.01
		093-B(230)T			OF

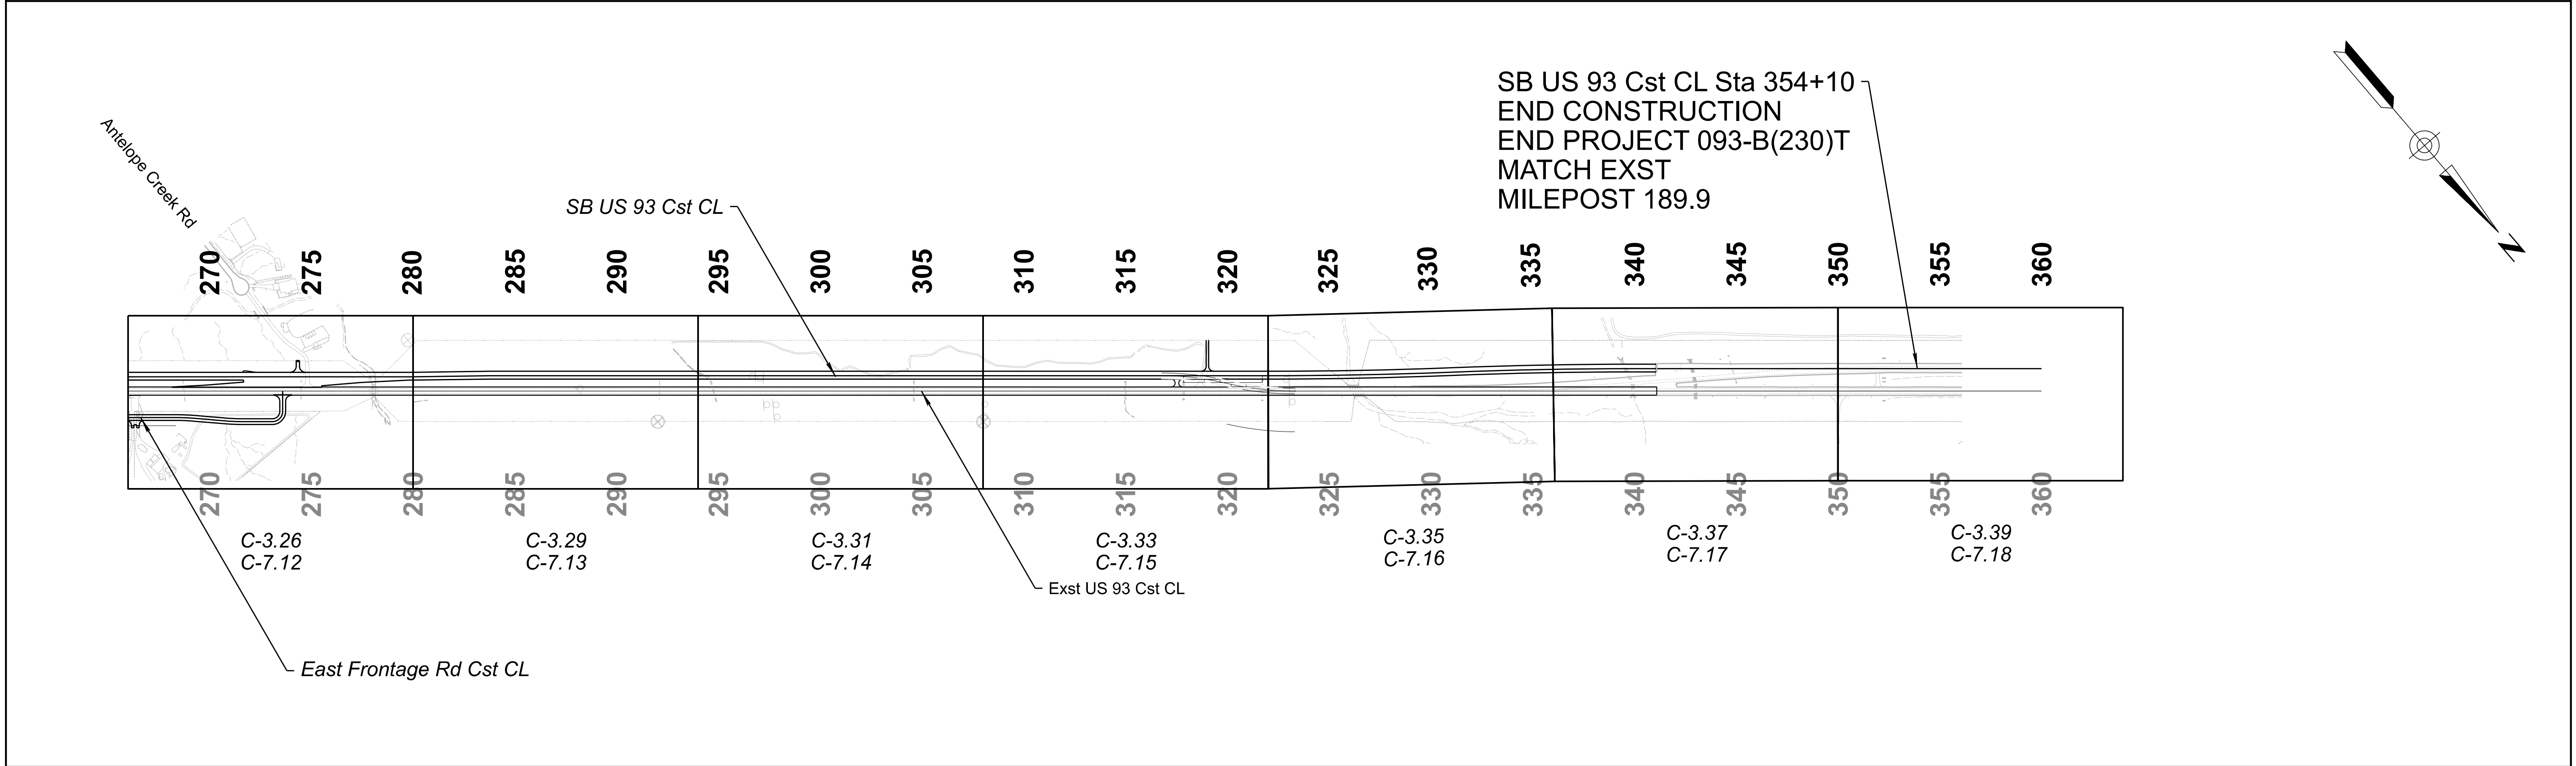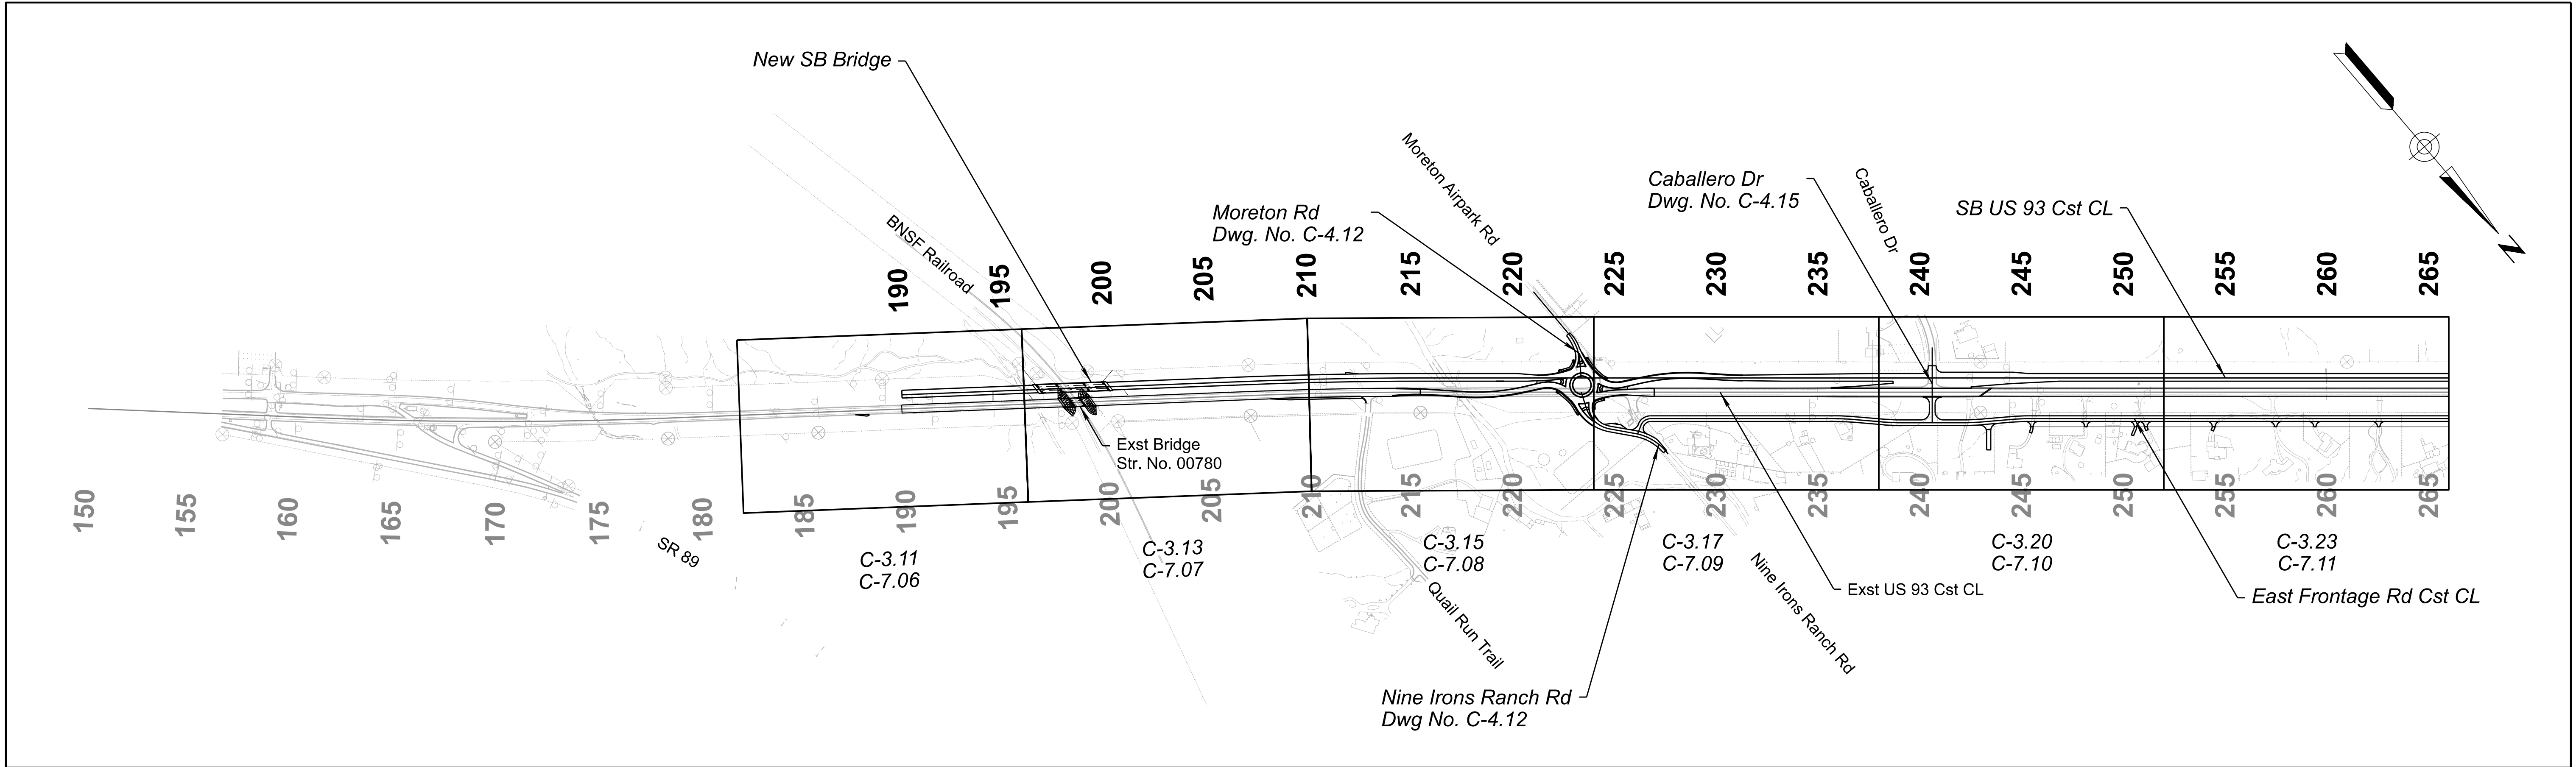


	NAME		DATE	ARIZONA DEPARTMENT OF TRANSPORTATION PROJECT DELIVERY AND OPERATIONS DIVISION ROADWAY DESIGN SERVICES	ROUTE US 93	F.H.W.A. Arizona Division	STATE ARIZ.	PROJECT NO.	FEDERAL ID NO.	SHEET NO.	TOTAL SHEETS	RECORD DRAWING
	DESIGN J GILLIS		06/26					093 YV 189	093-B(230)T	6	524	
	DRAWN M SAMUELSON		06/26					WICKENBURG RANCH WAY TO VISTA ROYALE				DWG No. G-2.02
	CHECKED D WIGGINS		06/26	TRACS NO. F0738 01C		OF						
TRANSPORTATION AECOM TECHNICAL SERVICES, Inc. 7720 N. 169th St., Suite 100 Phoenix, Arizona 85029 T 602.376.1100 www.aecom.com AECOM				KEY MAP Sta 190+00 to Sta 351+10	STRUCTURE NO.							

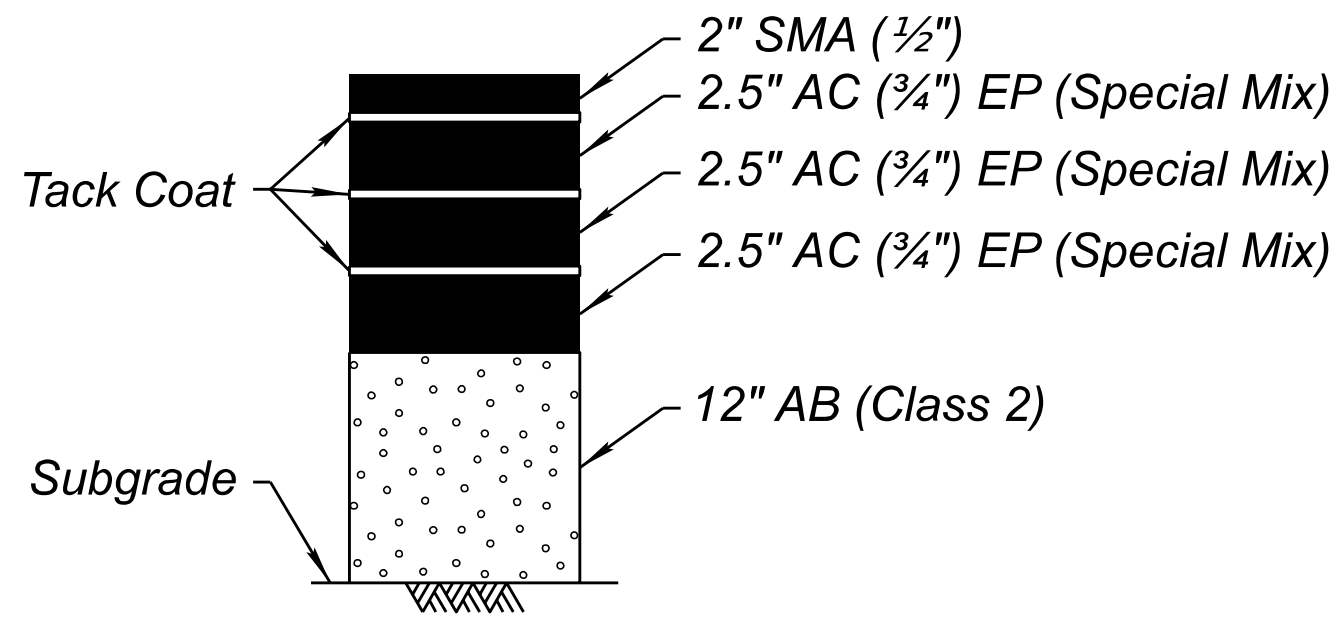


Total Thickness = 21.5"
SECTION NO. 1
US 93 Travel Lanes
US 93 Shoulders

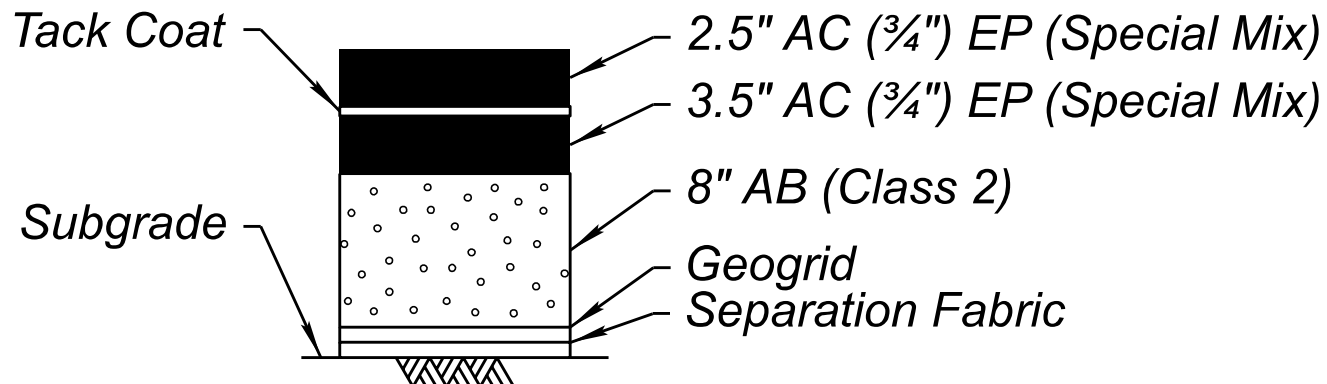


Total Thickness = 14"
SECTION NO. 2
SR 89

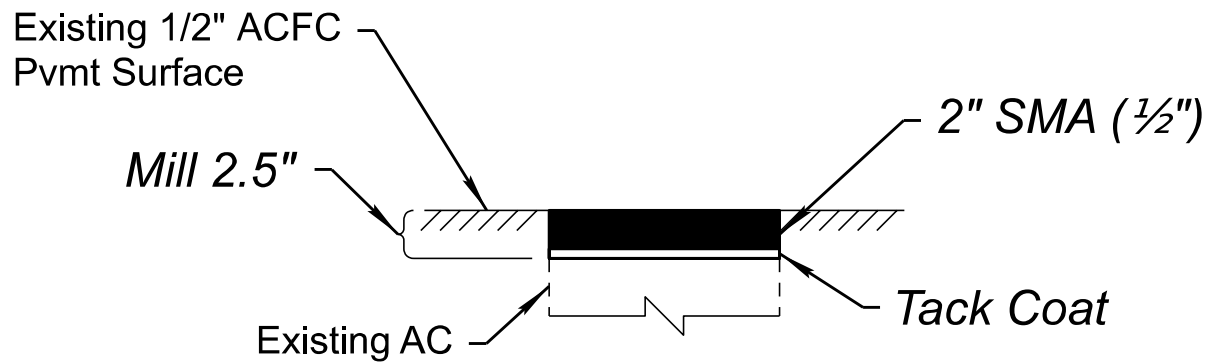


Total Thickness = 2"
SECTION NO. 3
US 93 Exst Pavement Rehab

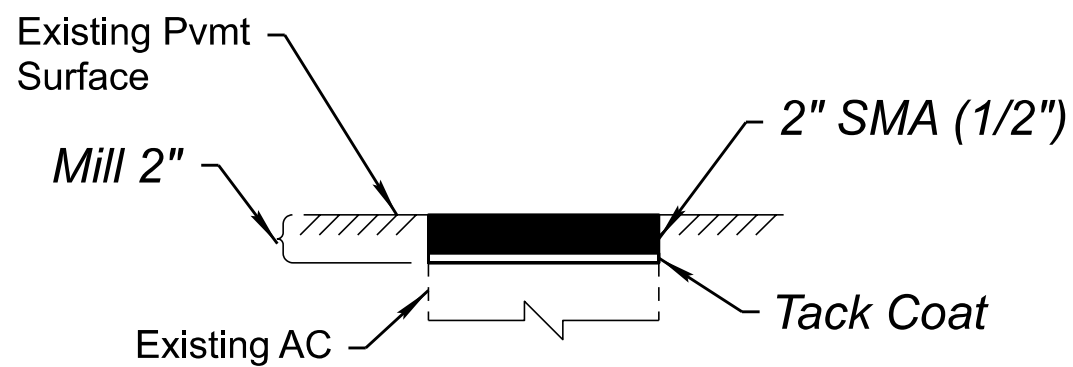


Total Thickness = 2.5"
SECTION NO. 4
US 93 Exst Shoulder Pavement Rehab

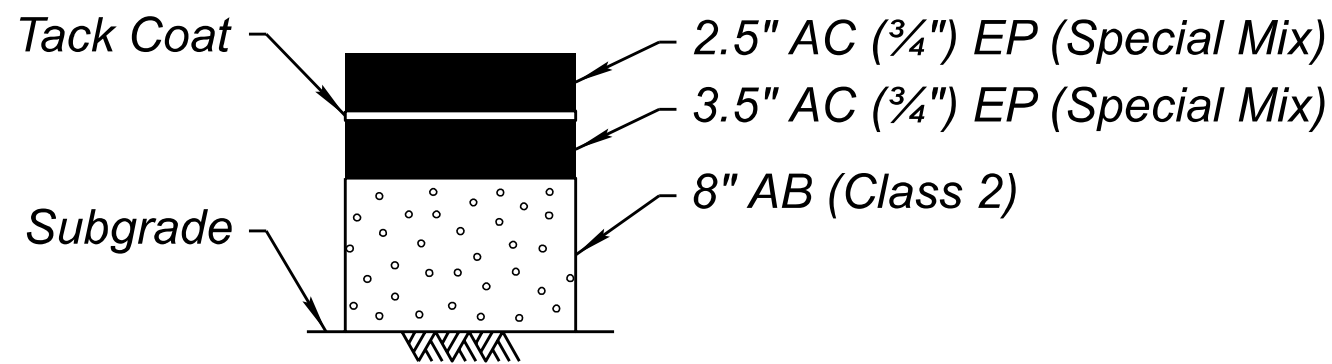


Total Thickness = 14"
SECTION NO. 5
SR 89

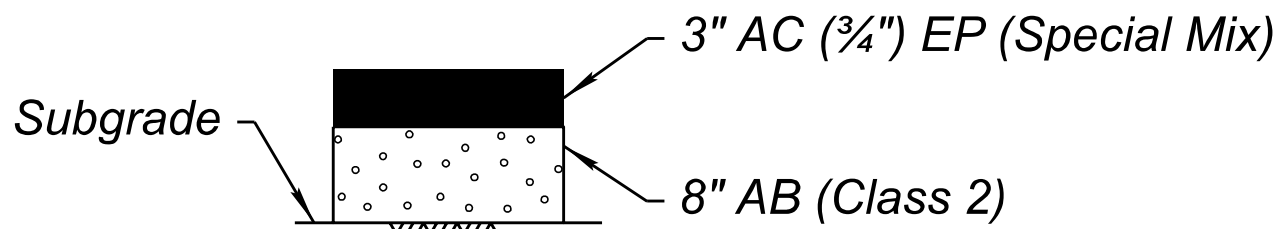


Total Thickness = 8"
SECTION NO. 6
(Outside of ADOT R/W)
Matthie Ranch Rd & Wickenburg Ranch Way

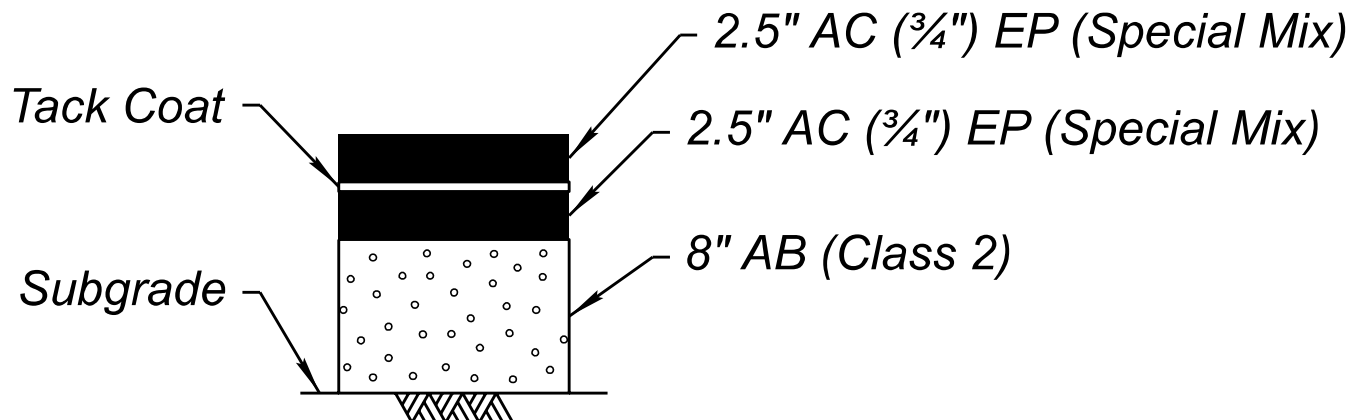


Total Thickness = 13"
SECTION NO. 7
(Inside ADOT R/W)
East Frontage Rd
Moreton Rd
Nine Irons Ranch Rd
Caballero Dr

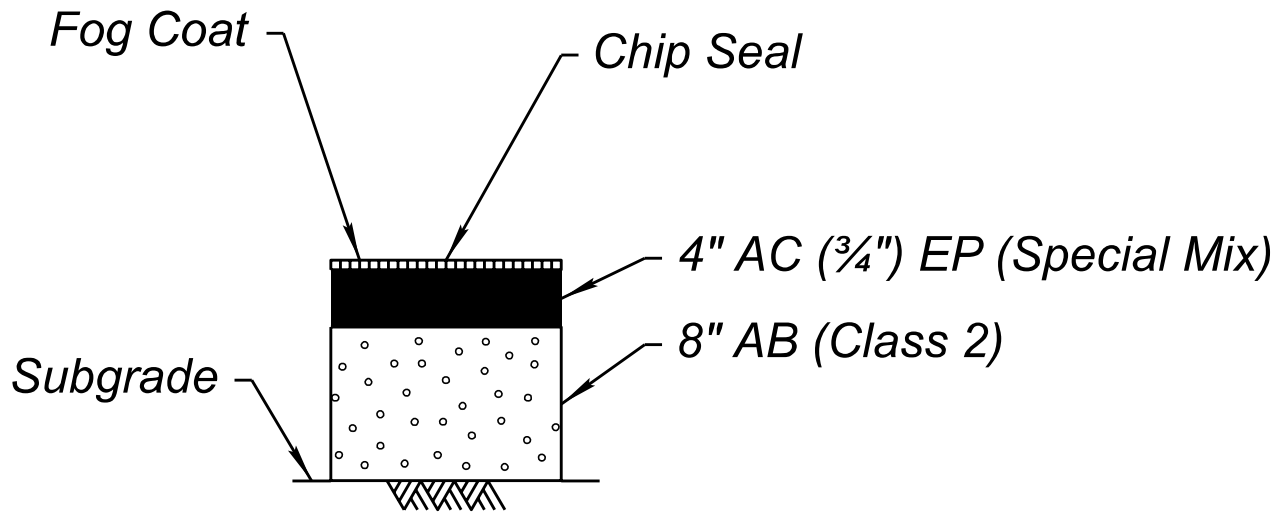


Total Thickness = 12"
SECTION NO. 8
(Outside ADOT R/W)
East Frontage Rd
Moreton Rd
Nine Irons Ranch Rd
Caballero Dr

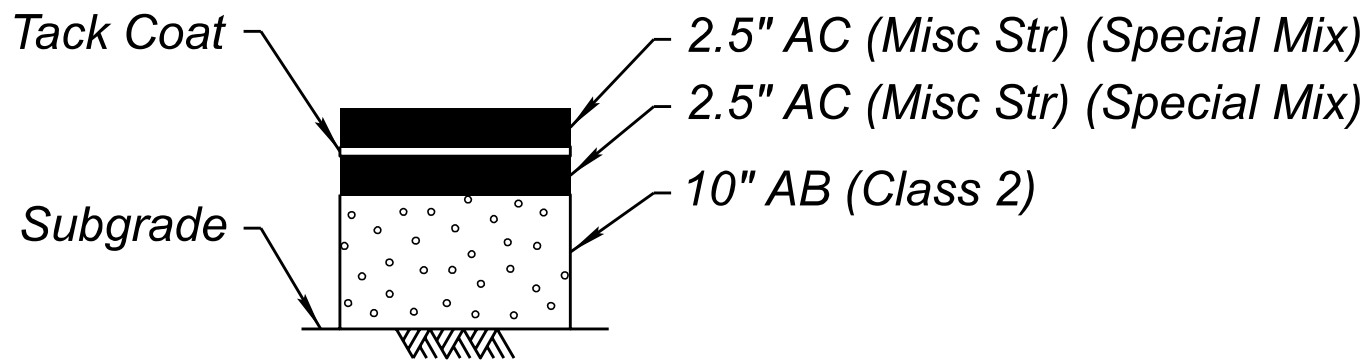


Total Thickness = 15"
SECTION NO. 9
Detours

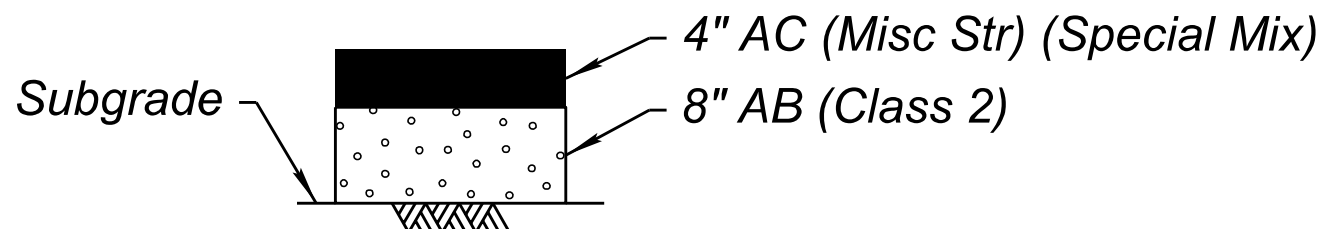


Total Thickness = 12"
SECTION NO. 10
Driveways (Inside R/W)

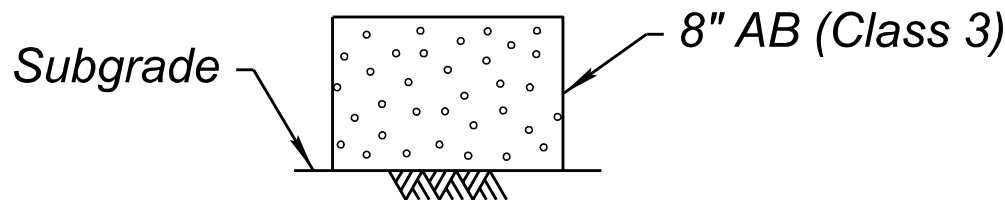


Total Thickness = 8"
SECTION NO. 11
Driveways (Outside R/W)

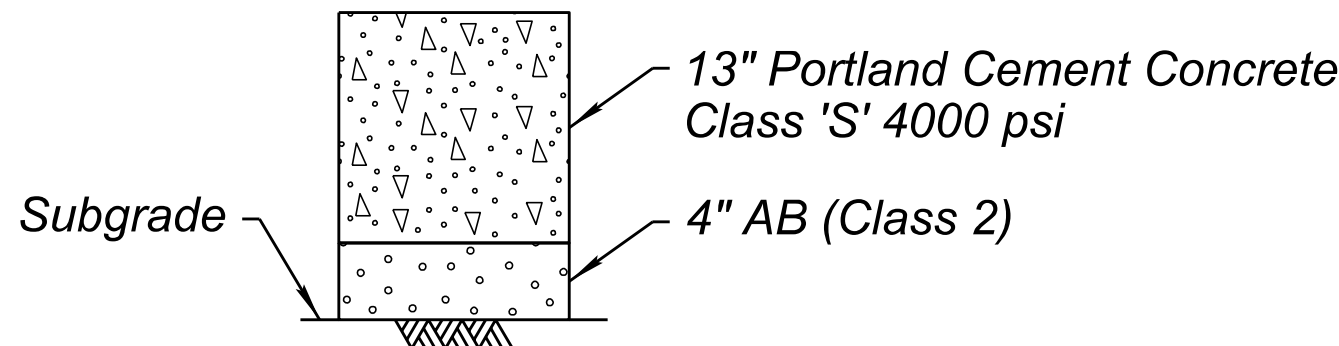


Total Thickness = 17"
SECTION NO. 12
Roundabout Truck Apron

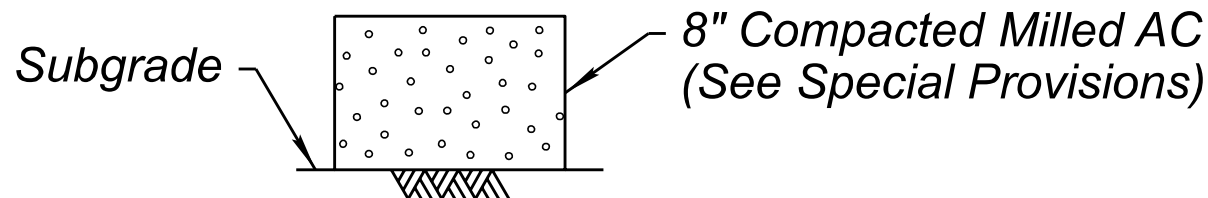

Total Thickness = 8"
SECTION NO. 13
Maintenance & Emergency Vehicles
Median Crossovers

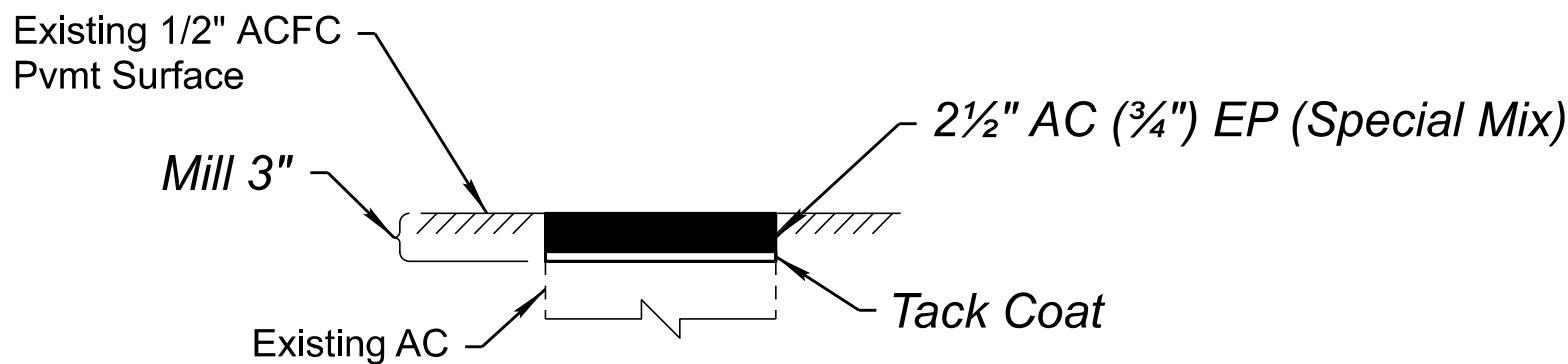


Total Thickness = 2 1/2"
SECTION NO. 14
SR 89 Exst Pavement Rehab

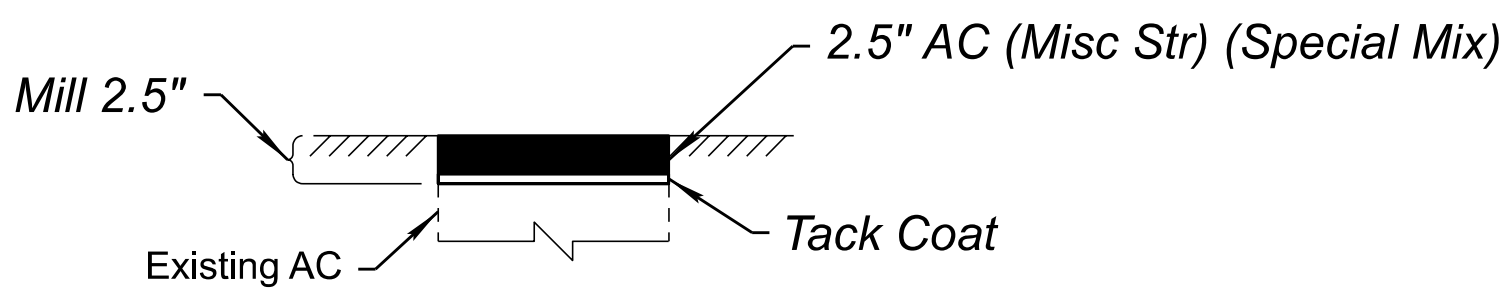

Total Thickness = 2 1/2"
SECTION NO. 15
Detour

New Profile Grade Shall Match Existing
Pavement Under 1/2" ACFC

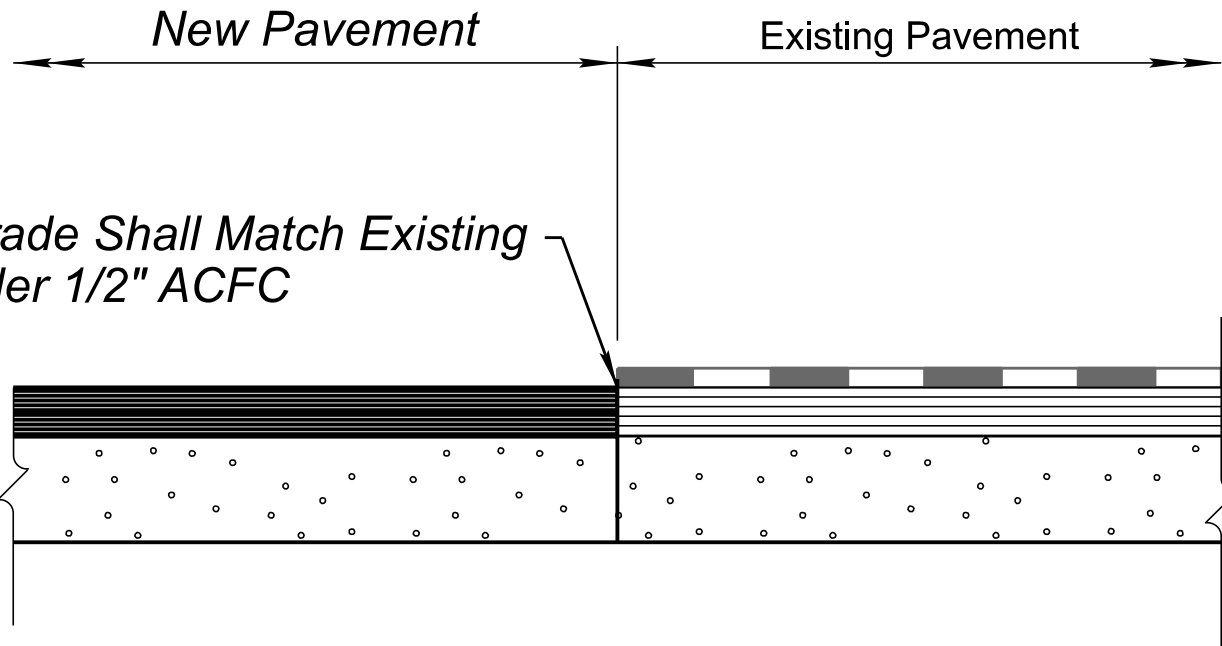

PAVEMENT STRUCTURAL SECTIONS

TREATMENT AT BEGIN/END PROJECT
(SR 89 & US 93)



	NAME	DATE
DESIGN	J GILLIS	06/26
DRAWN	M SAMUELSON	06/26
CHECKED	D WIGGINS	06/26

TRANSPORTATION
AECOM TECHNICAL SERVICES, Inc.
7720 N. 16th St., Suite 100
Phoenix, Arizona 85020
T 602.371.1100
www.aecom.com


AECOM

ARIZONA DEPARTMENT OF TRANSPORTATION PROJECT DELIVERY AND OPERATIONS DIVISION ROADWAY DESIGN SERVICES	ROUTE US 93
DESIGN SHEET	MILEPOST 189.9
	STRUCTURE NO.

STATE	PROJECT NO.	FEDERAL ID NO.	SHEET NO.	TOTAL SHEETS	RECORD DRAWING
F.H.W.A. Arizona Division	093 YV 189	093-B(230)T	7	524	
LOCATION	WICKENBURG RANCH WAY TO VISTA ROYALE				DWG No. G-3.01
TRACS NO.	F0738 01C				OF

F.H.W.A. REGION	STATE	PROJECT NO.	SHEET NO.	TOTAL SHEETS	RECORD DRAWING
9	ARIZ.	093-B(230)T	8	524	

093 YV 189

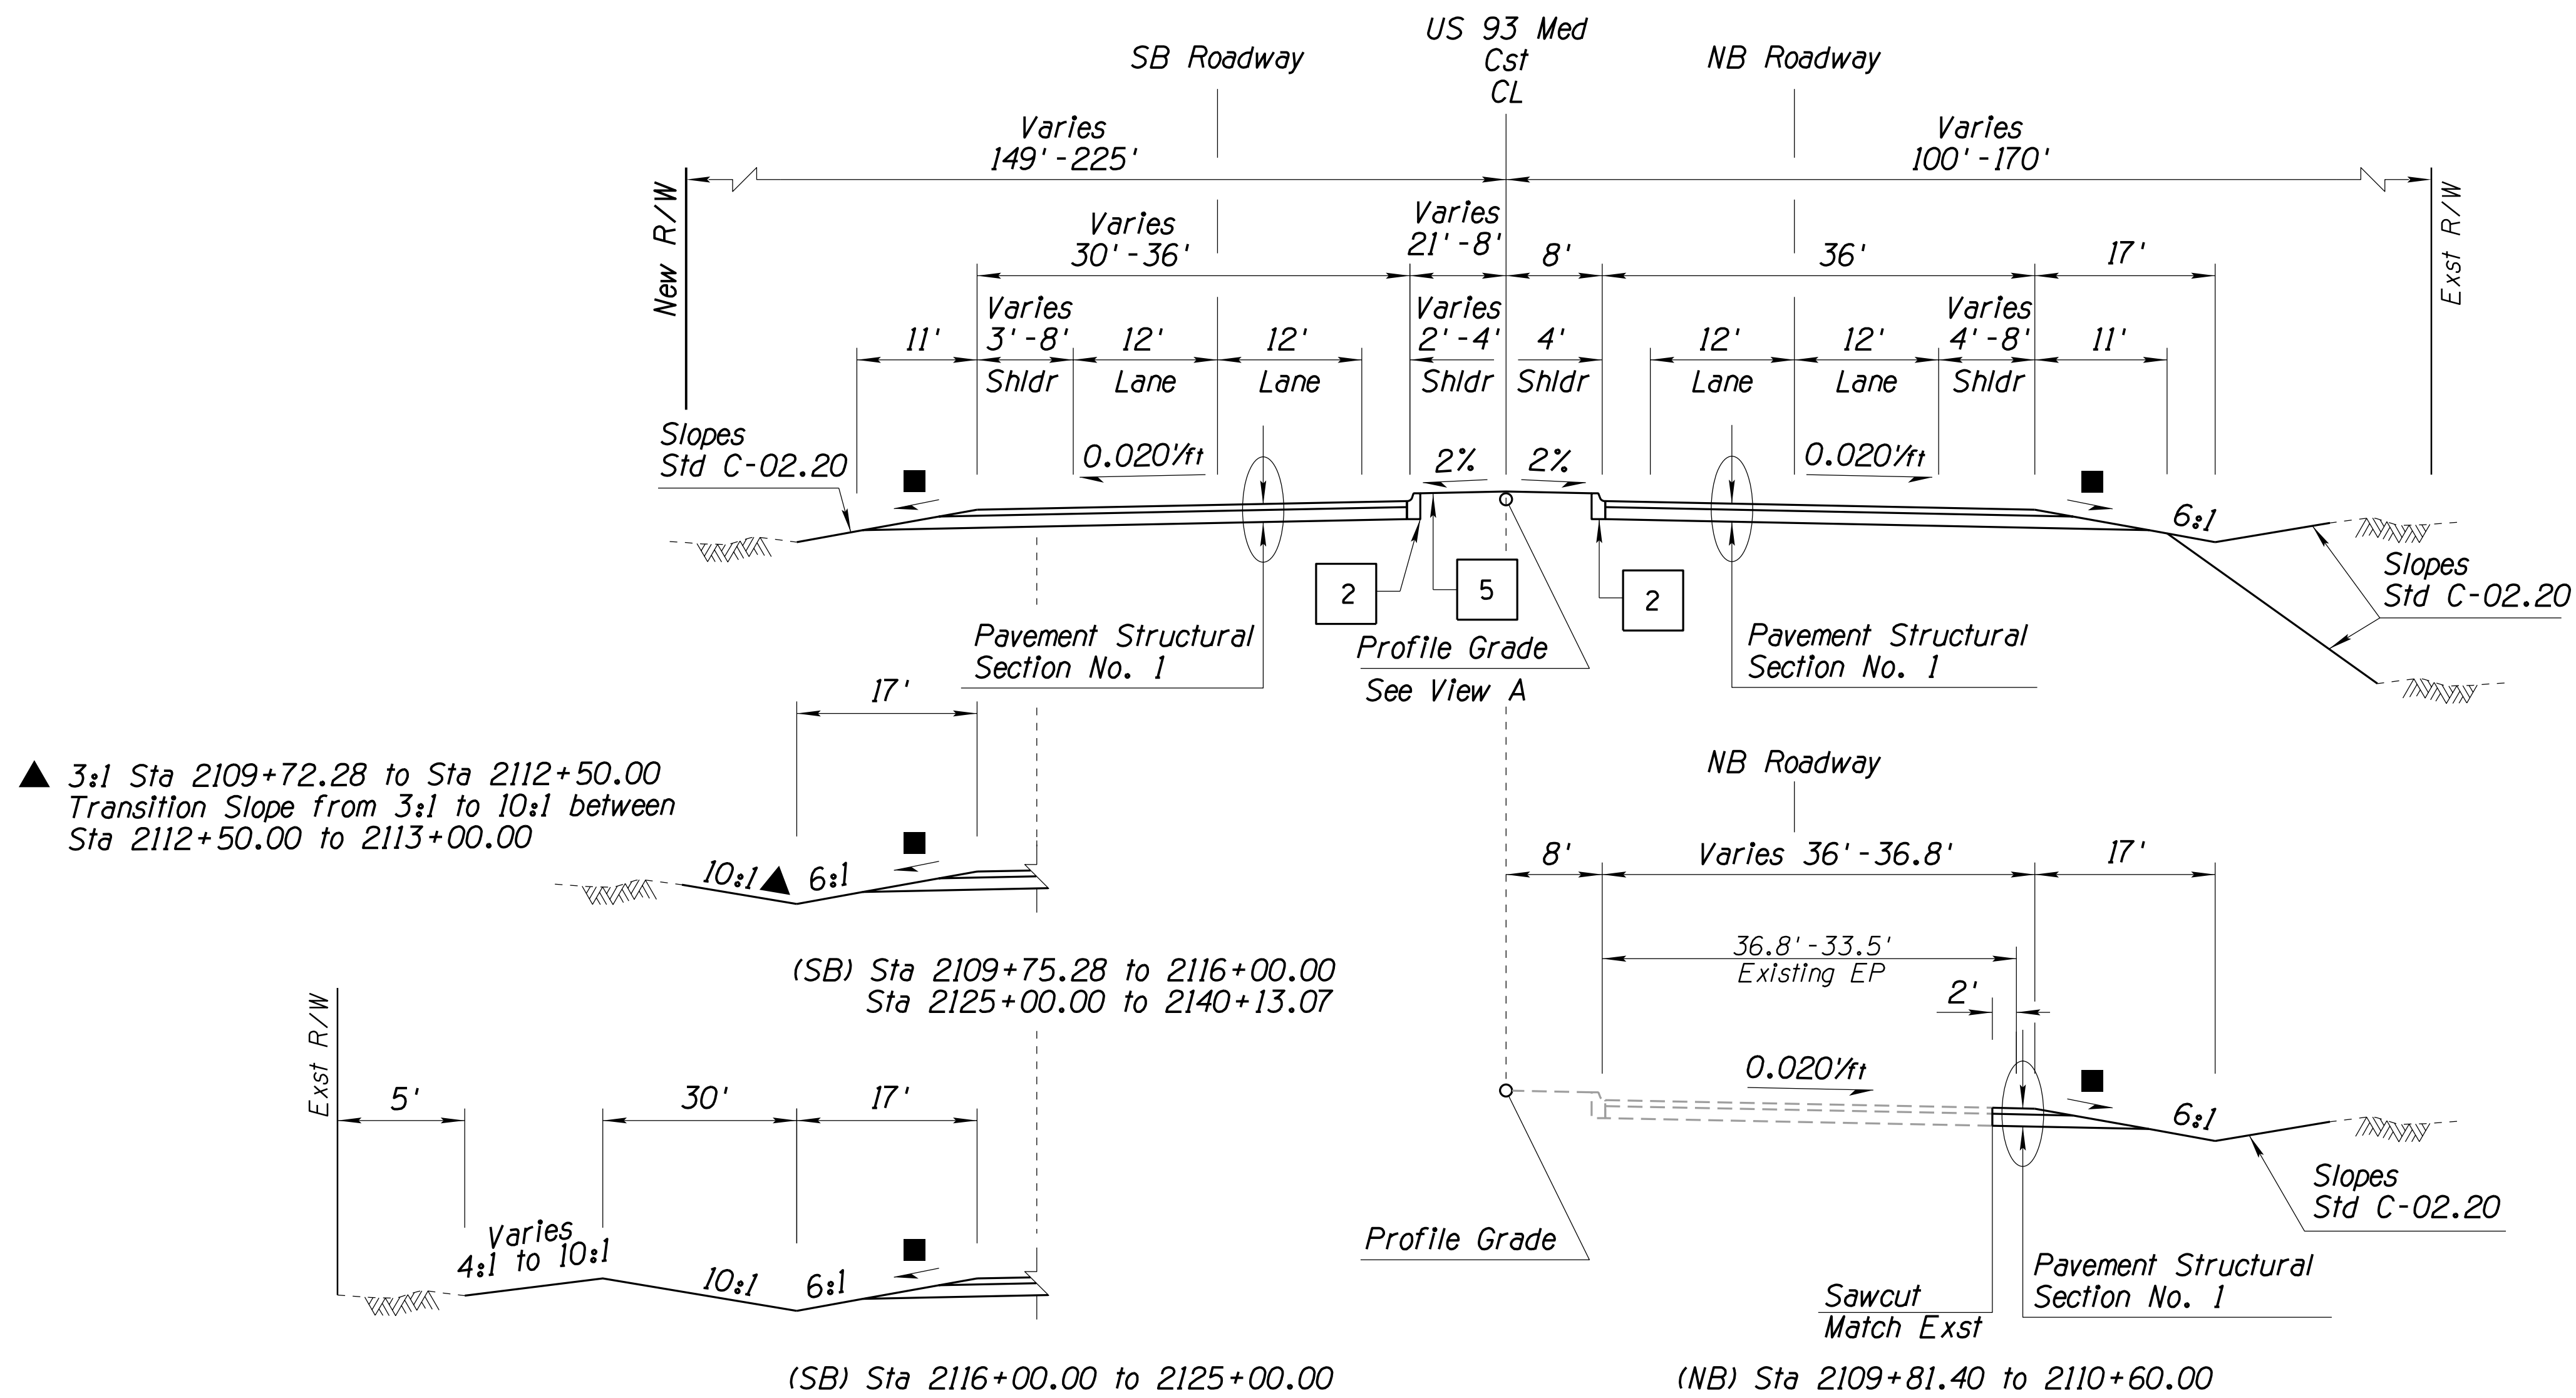


US 93 TYPICAL SECTION

(SB) Sta 2109+75.28 to 2141+06.07

(NB) Sta 2109+81.40 to 2140+37.01

See Staking Plans for Edge of Pavement Location
and Elevation Control Sta 2140+37.01 to 2141+06.07

- 2 Conc Single Curb, Std C-05.10, Type A1, h=6"
- 5 Granite Mulch (Item 8030092)
- Subgrade/Slope Hinge Treatment Detail per Std C-02.20

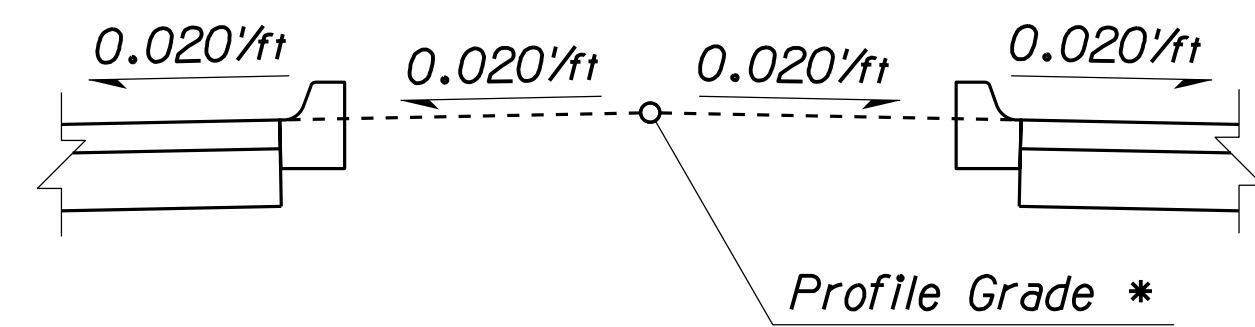


* See Staking Plans for Additional Information.

		NAME	DATE	ARIZONA DEPARTMENT OF TRANSPORTATION PROJECT DELIVERY AND OPERATIONS DIVISION ROADWAY DESIGN SERVICES		
DESIGN	ZSZ	06-26				
DRAWN	RM	06-26				
CHECKED	DBK	06-26		TYPICAL SECTIONS		
 Stanley Consultants inc. 3133 East Camelback Road, Suite 100 Phoenix, Arizona 85016 Phone: (602) 333-2200						
ROUTE		LOCATION		US 93 WICKENBURG RANCH WAY TO VISTA ROYALE		DWG NO. G-3.02
US 93						
TRACS NO.		F0738 OIC		093-B(230)T		___ OF ___

F.H.W.A. REGION	STATE	PROJECT NO.	SHEET NO.	TOTAL SHEETS	RECORD DRAWING
9	ARIZ.	093-B(230)T	9	524	

093 YV 189

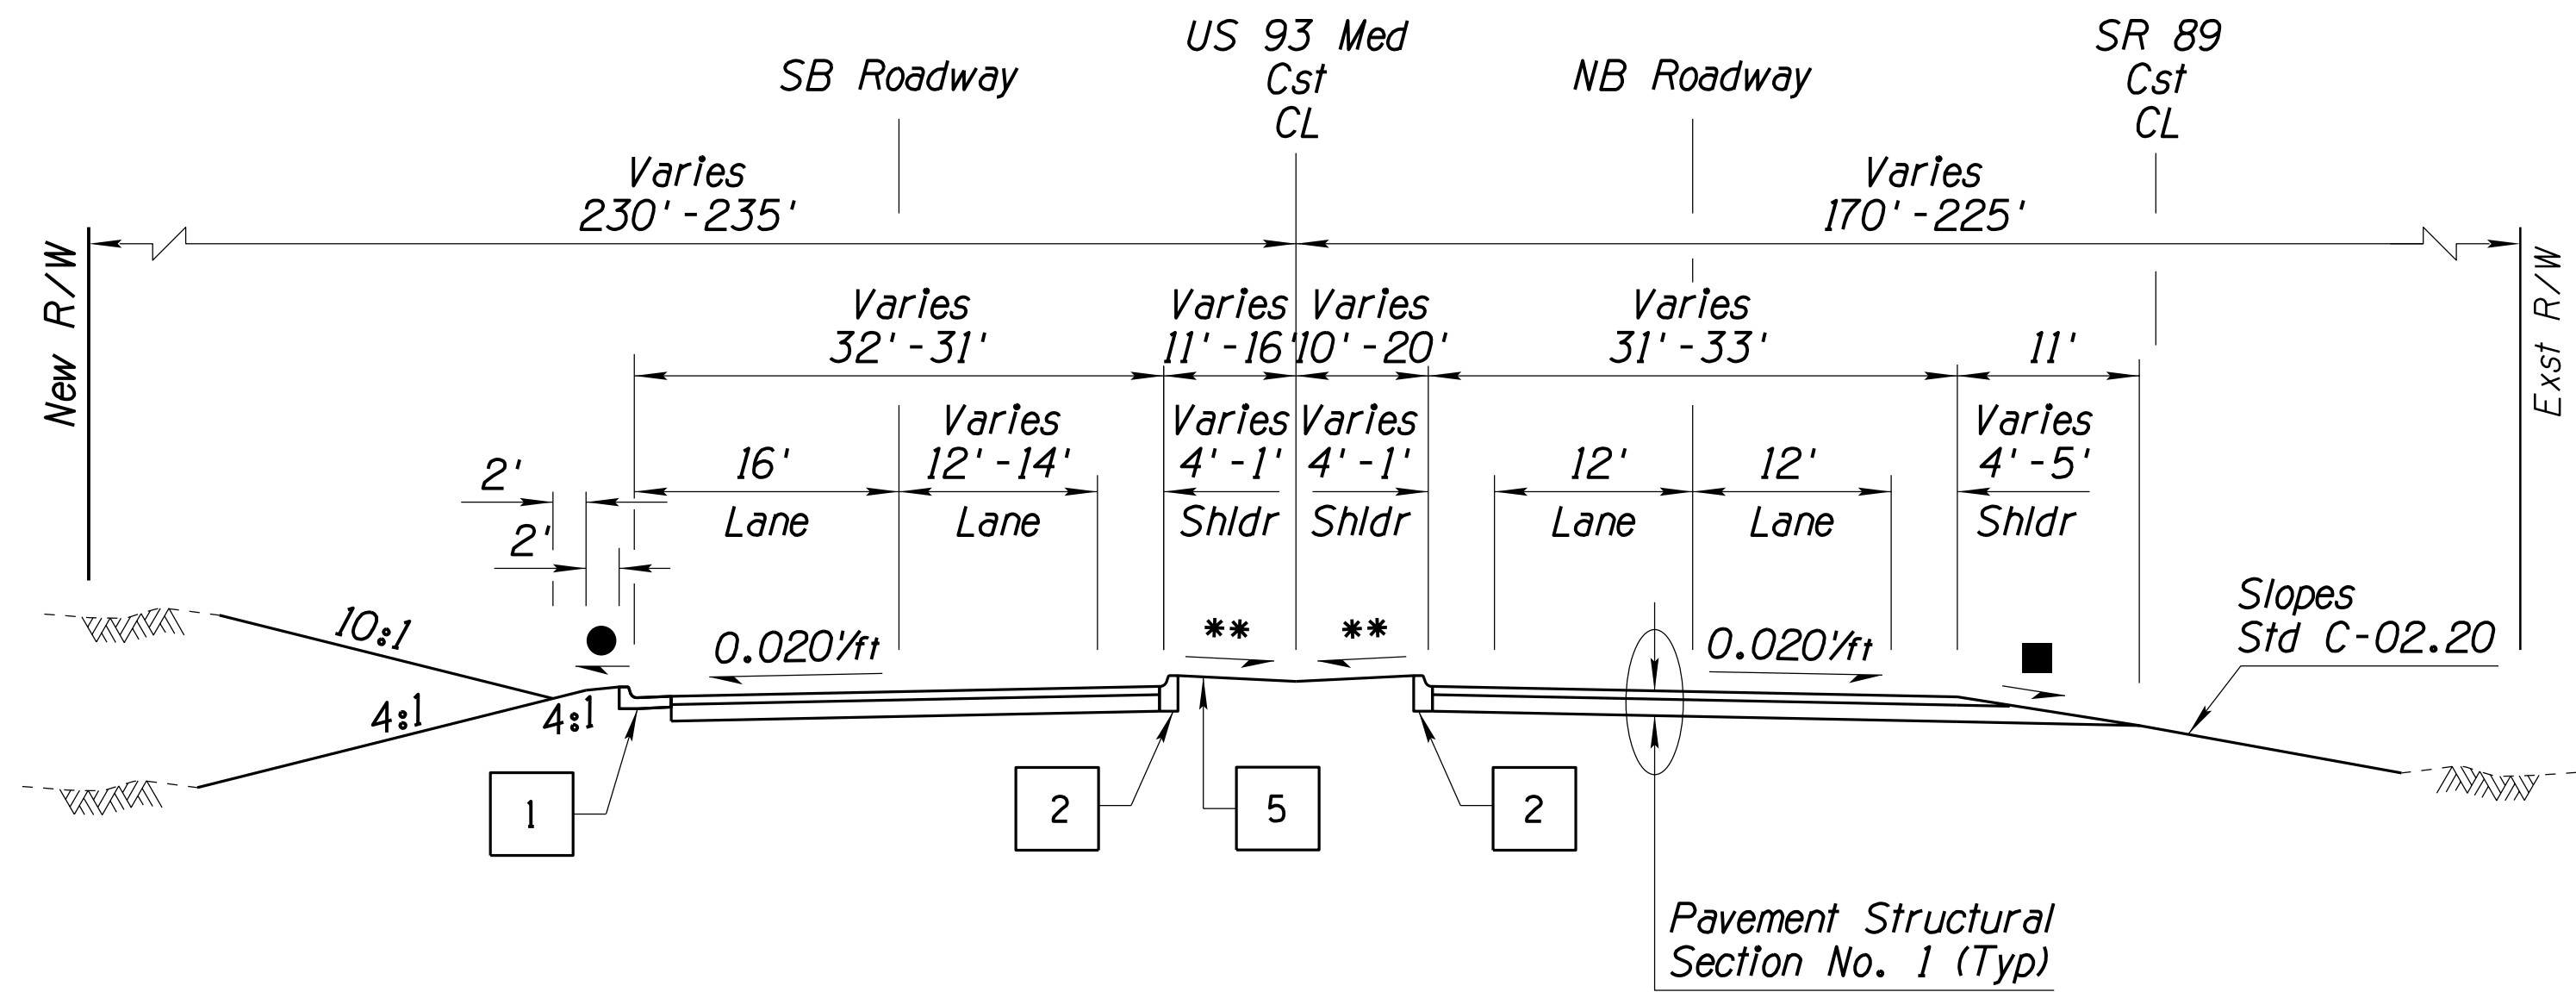


US 93 TYPICAL SECTION

(SB) Sta 2141+06.07 to 2143+44.82

(NB) Sta 2140+37.01 to 2142+67.32

See Staking Plans for Edge of Pavement Location
and Elevation Control

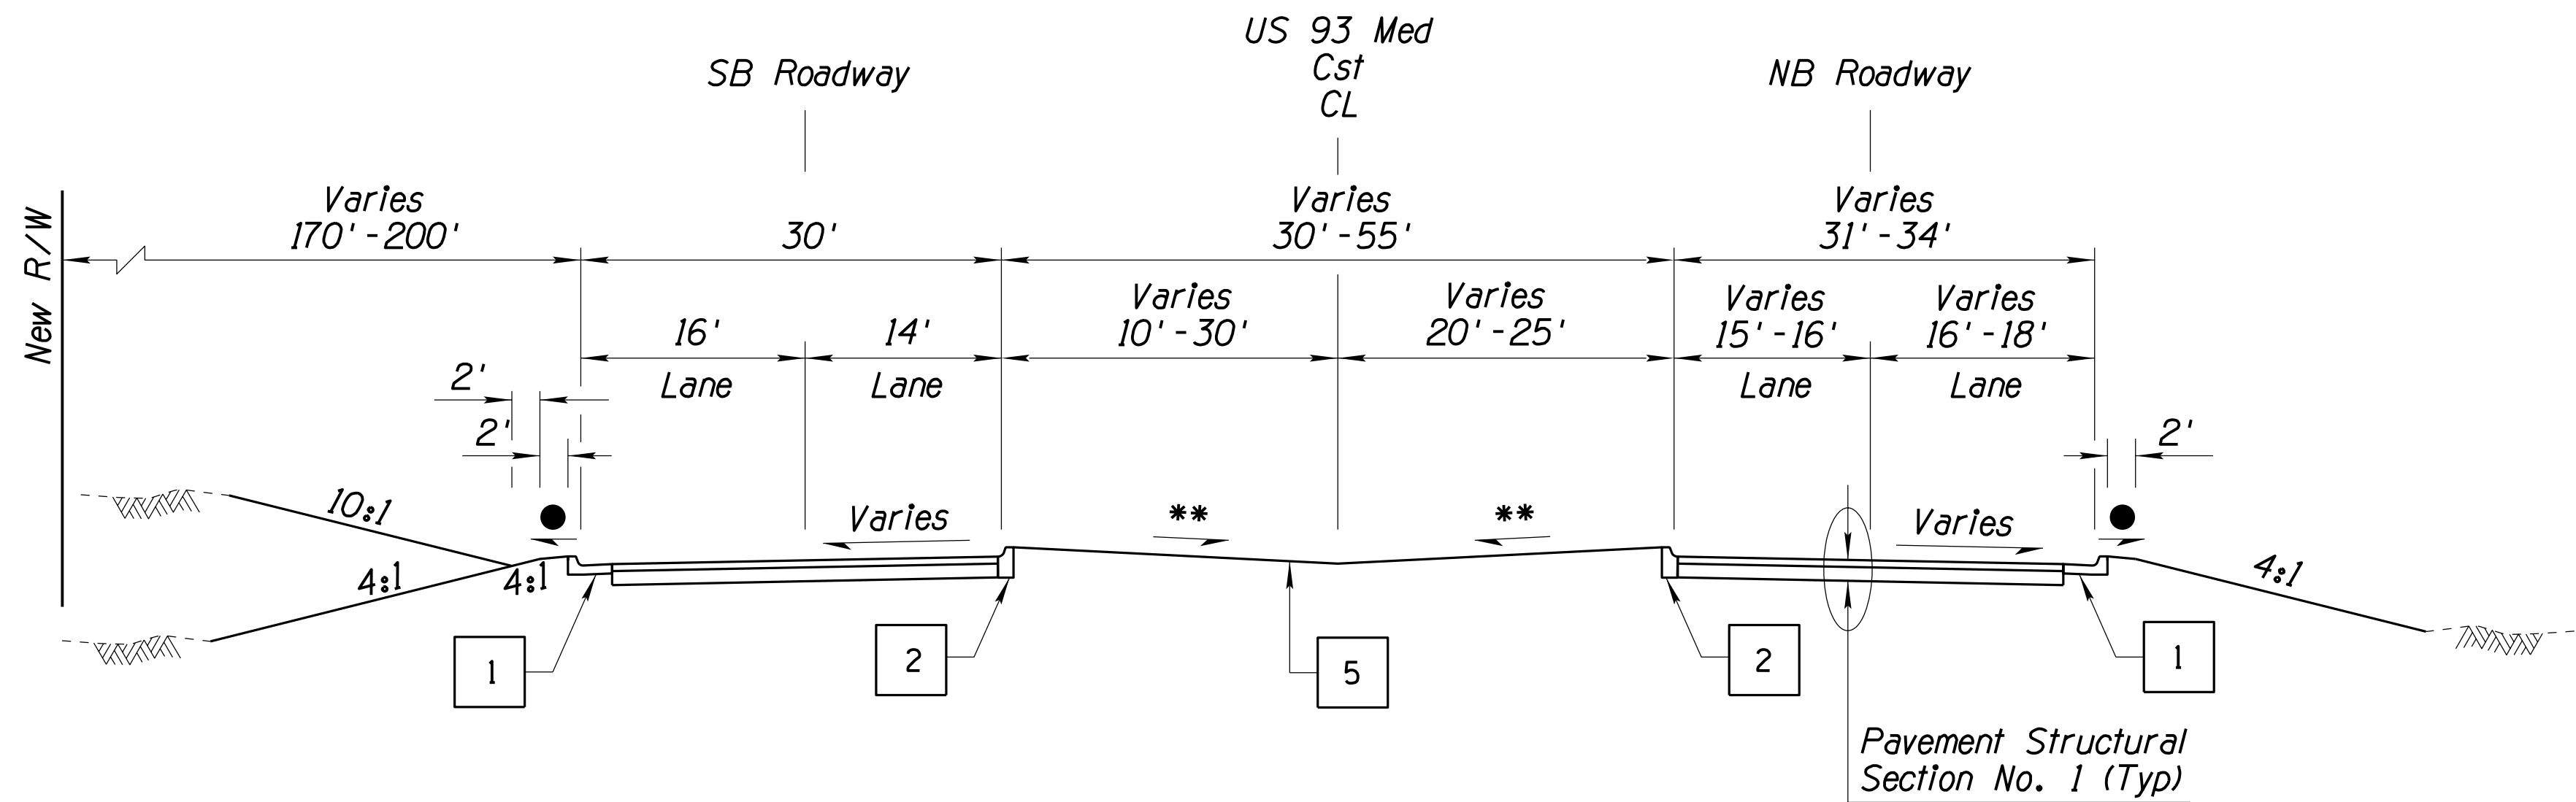

US 93 TYPICAL SECTION

(SB) Sta 2143+44.82 to 2148+32.23

(NB) Sta 2142+67.32 to 2148+32.23


See Staking Plans for Edge of Pavement Location
and Elevation Control

- 1 Conc Curb & Gutter, Std C-05.10, Type D, h=6"
- 2 Conc Single Curb, Std C-05.10, Type A1, h=6"
- 5 Granite Mulch (Item 8030092)
- Subgrade/Slope Hinge Treatment Detail per Std C-02.20
- 10:1
- ** See Plans for Grading Information.

DESIGN	NAME	DATE	ARIZONA DEPARTMENT OF TRANSPORTATION PROJECT DELIVERY AND OPERATIONS DIVISION ROADWAY DESIGN SERVICES	
DRAWN	RM	06-26	TYPICAL SECTIONS	
CHECKED	DBK	06-26	Stanley Consultants Inc. 3133 East Camelback Road, Suite 100 Phoenix, Arizona 85016 Phone: (602) 333-2200	DWG NO. G-3.03
ROUTE	LOCATION		US 93 WICKENBURG RANCH WAY TO VISTA ROYALE	
TRACS NO.	F0738 OIC		093-B(230)T	OF


F.H.W.A. REGION	STATE	PROJECT NO.	SHEET NO.	TOTAL SHEETS	RECORD DRAWING
9	ARIZ.	093-B(230)T	10	524	

093 YV 189

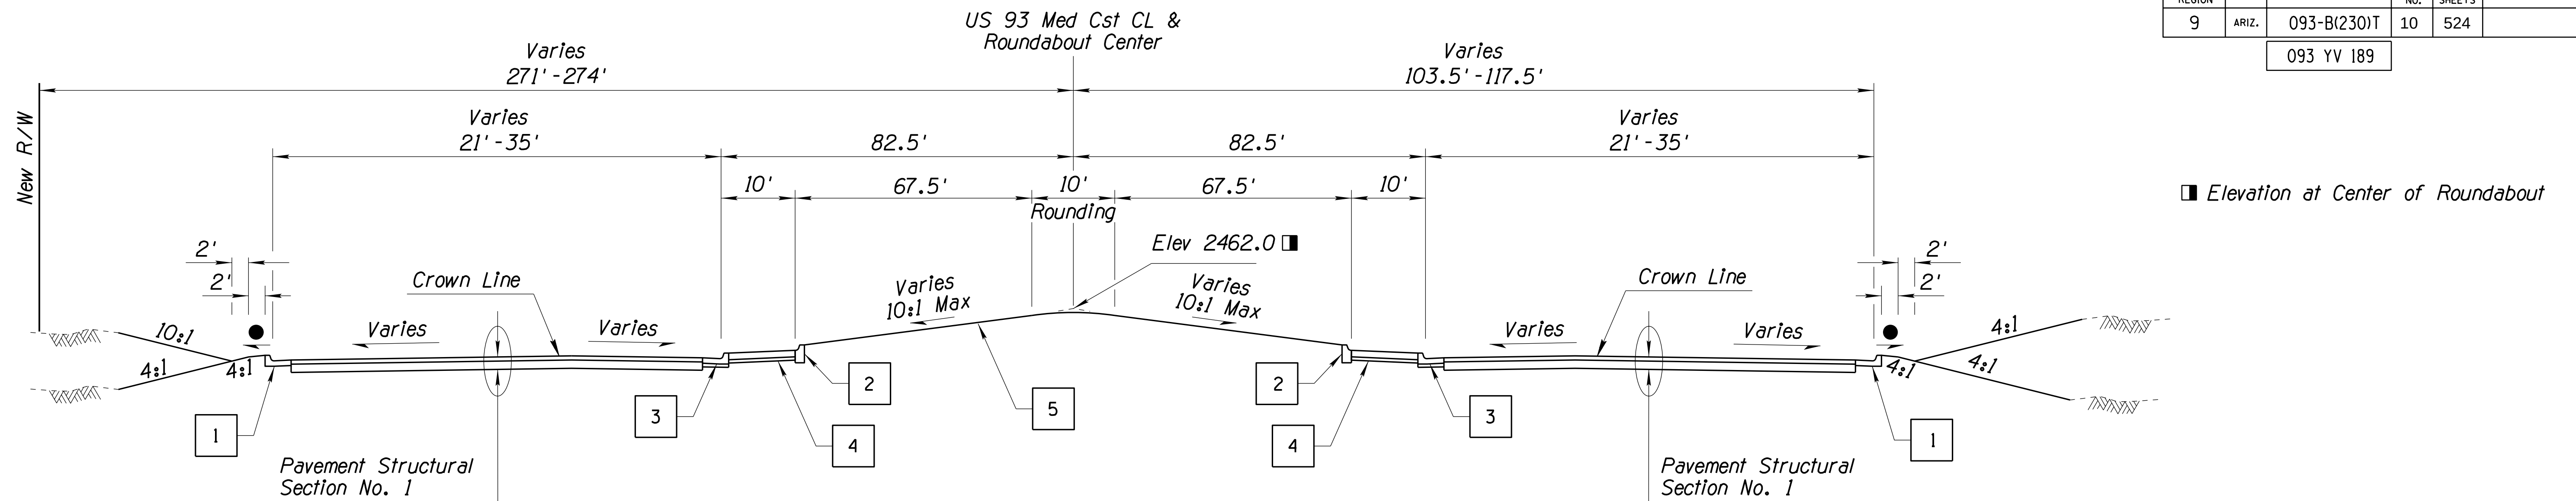

US 93 TYPICAL SECTION

Sta 2148+32.23 to 2150+52.23
See Staking Plans for Edge of Pavement Location
and Elevation Control

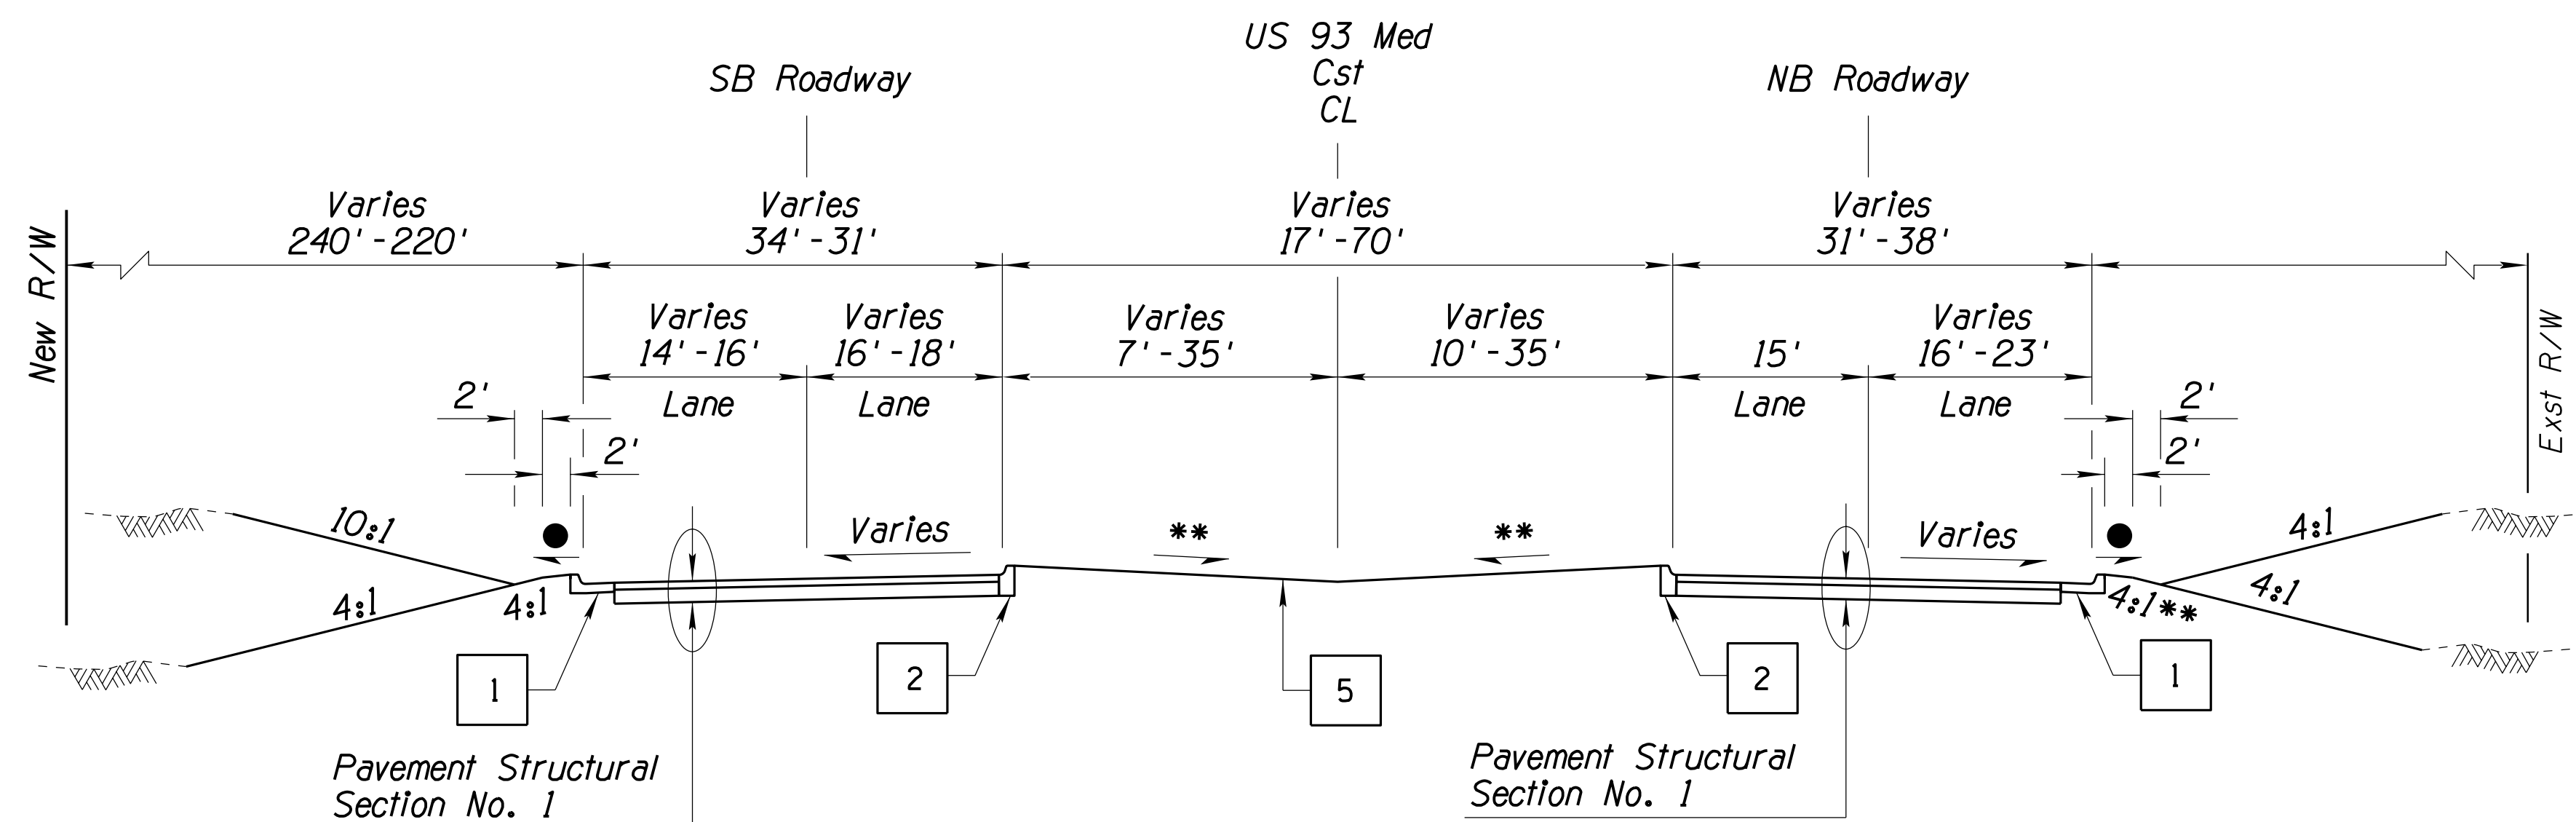

US 93 TYPICAL SECTION

(SB) Sta 2150+52.23 to 2156+13.43 (NB) Sta 2150+52.23 to 2155+97.66
See Staking Plans for Edge of Pavement Location
and Elevation Control

- 1 Conc Curb & Gutter, Std C-05.10, Type D, h=6"
- 2 Conc Single Curb, Std C-05.10, Type A1, h=6"
- 3 Conc Curb & Gutter, Class S Concrete - 4000 psi Std C-05.10, Type G, h=4"
- 4 Truck Apron, Detail A
- 5 Granite Mulch (Item 8030092)


● 10:1

** See Plans for Grading Information.

DESIGN	NAME	DATE	ARIZONA DEPARTMENT OF TRANSPORTATION PROJECT DELIVERY AND OPERATIONS DIVISION ROADWAY DESIGN SERVICES	
DRAWN	RM	06-26	TYPICAL SECTIONS	
CHECKED	DBK	06-26	US 93 WICKENBURG RANCH WAY TO VISTA ROYALE	DWG NO. G-3.04
Stanley Consultants inc. 3133 East Camelback Road, Suite 100 Phoenix, Arizona 85016 Phone: (602) 333-2200			TRACS NO. F0738 OIC	093-B(230)T
				OF

F.H.W.A. REGION	STATE	PROJECT NO.	SHEET NO.	TOTAL SHEETS	RECORD DRAWING
9	ARIZ.	093-B(230)T	11	524	


093 YV 189

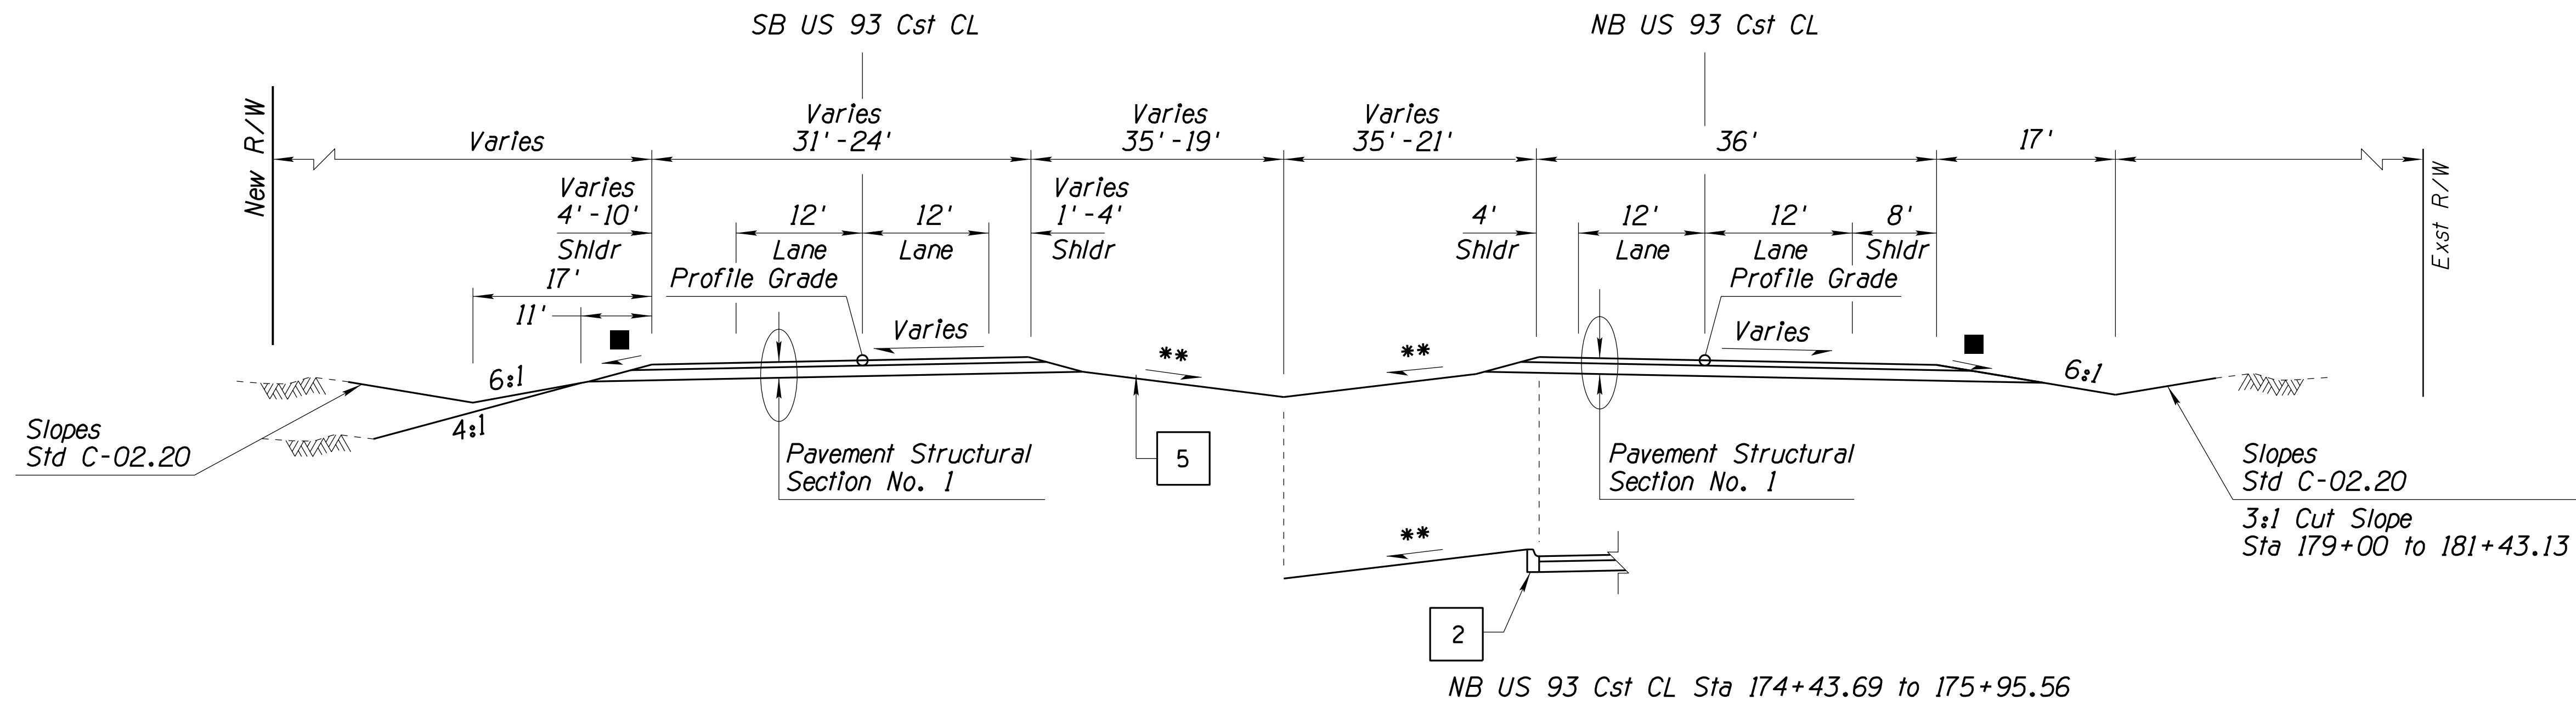

US 93 TYPICAL SECTION

SB US 93 Cst CL Sta 174+57.92 to 183+00.00

NB US 93 Cst CL Sta 174+43.69 to 182+58.00

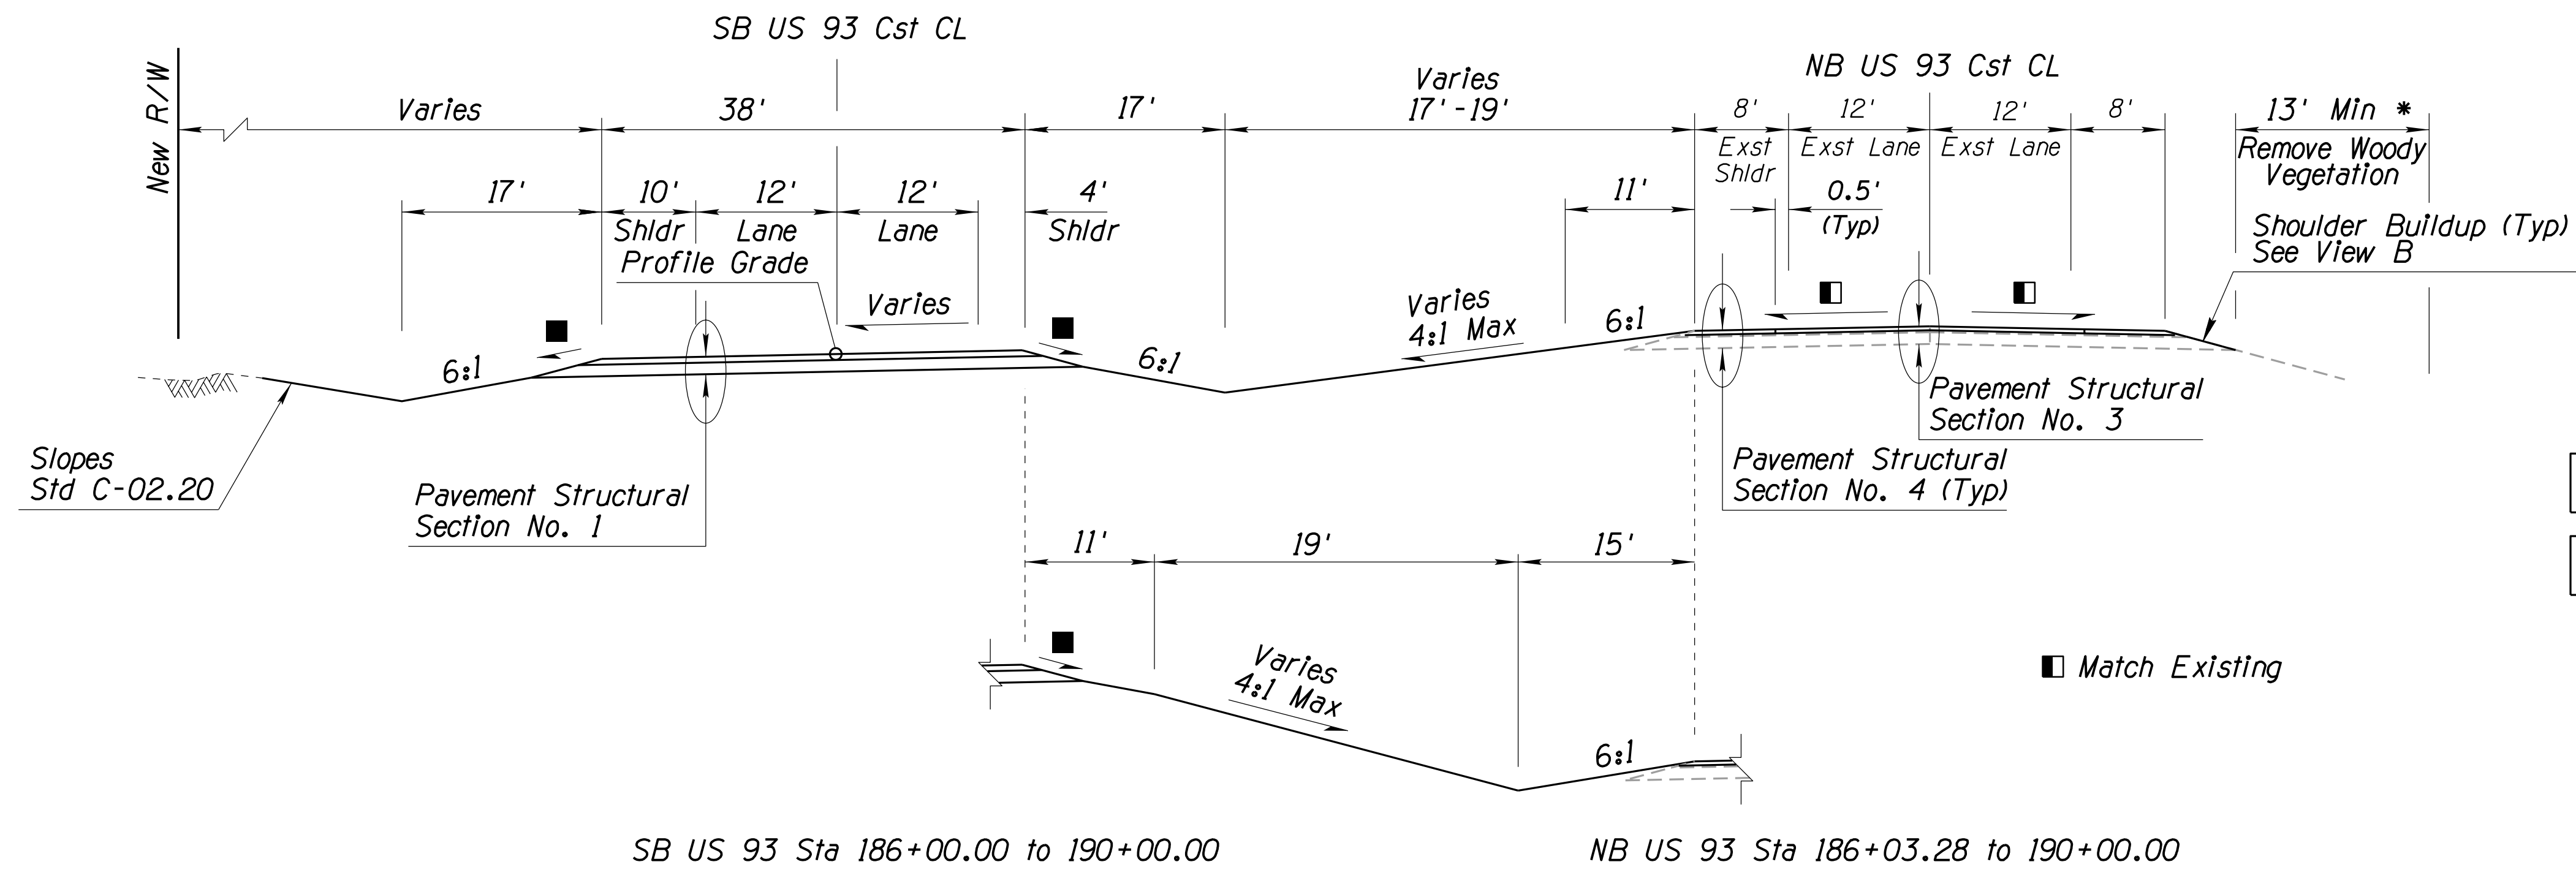


US 93 TYPICAL SECTION

SB US 93 Cst CL Sta 183+00.00 to 190+00.00

NB US 93 Cst CL Sta 182+58.00 to 190+00.00

- 2 Conc Single Curb, Std C-05.10, Type A1, h=6"
- 5 Granite Mulch (Item 8030092)
- Subgrade/Slope Hinge Treatment Detail per Std C-02.20
- * 22' Maximum for Areas Without Shoulder Buildup
- ** See Plans for Grading Information.


NAME	DATE	ARIZONA DEPARTMENT OF TRANSPORTATION PROJECT DELIVERY AND OPERATIONS DIVISION ROADWAY DESIGN SERVICES	
DESIGN	ZSZ 06-26		
DRAWN	RM 06-26		
CHECKED	DBK 06-26		
Stanley Consultants inc.		TYPICAL SECTIONS	
ROUTE	LOCATION		DWG NO. G-3.05
US 93	WICKENBURG RANCH WAY TO VISTA ROYALE		
TRACS NO. F0738 OIC		093-B(230)T	OF

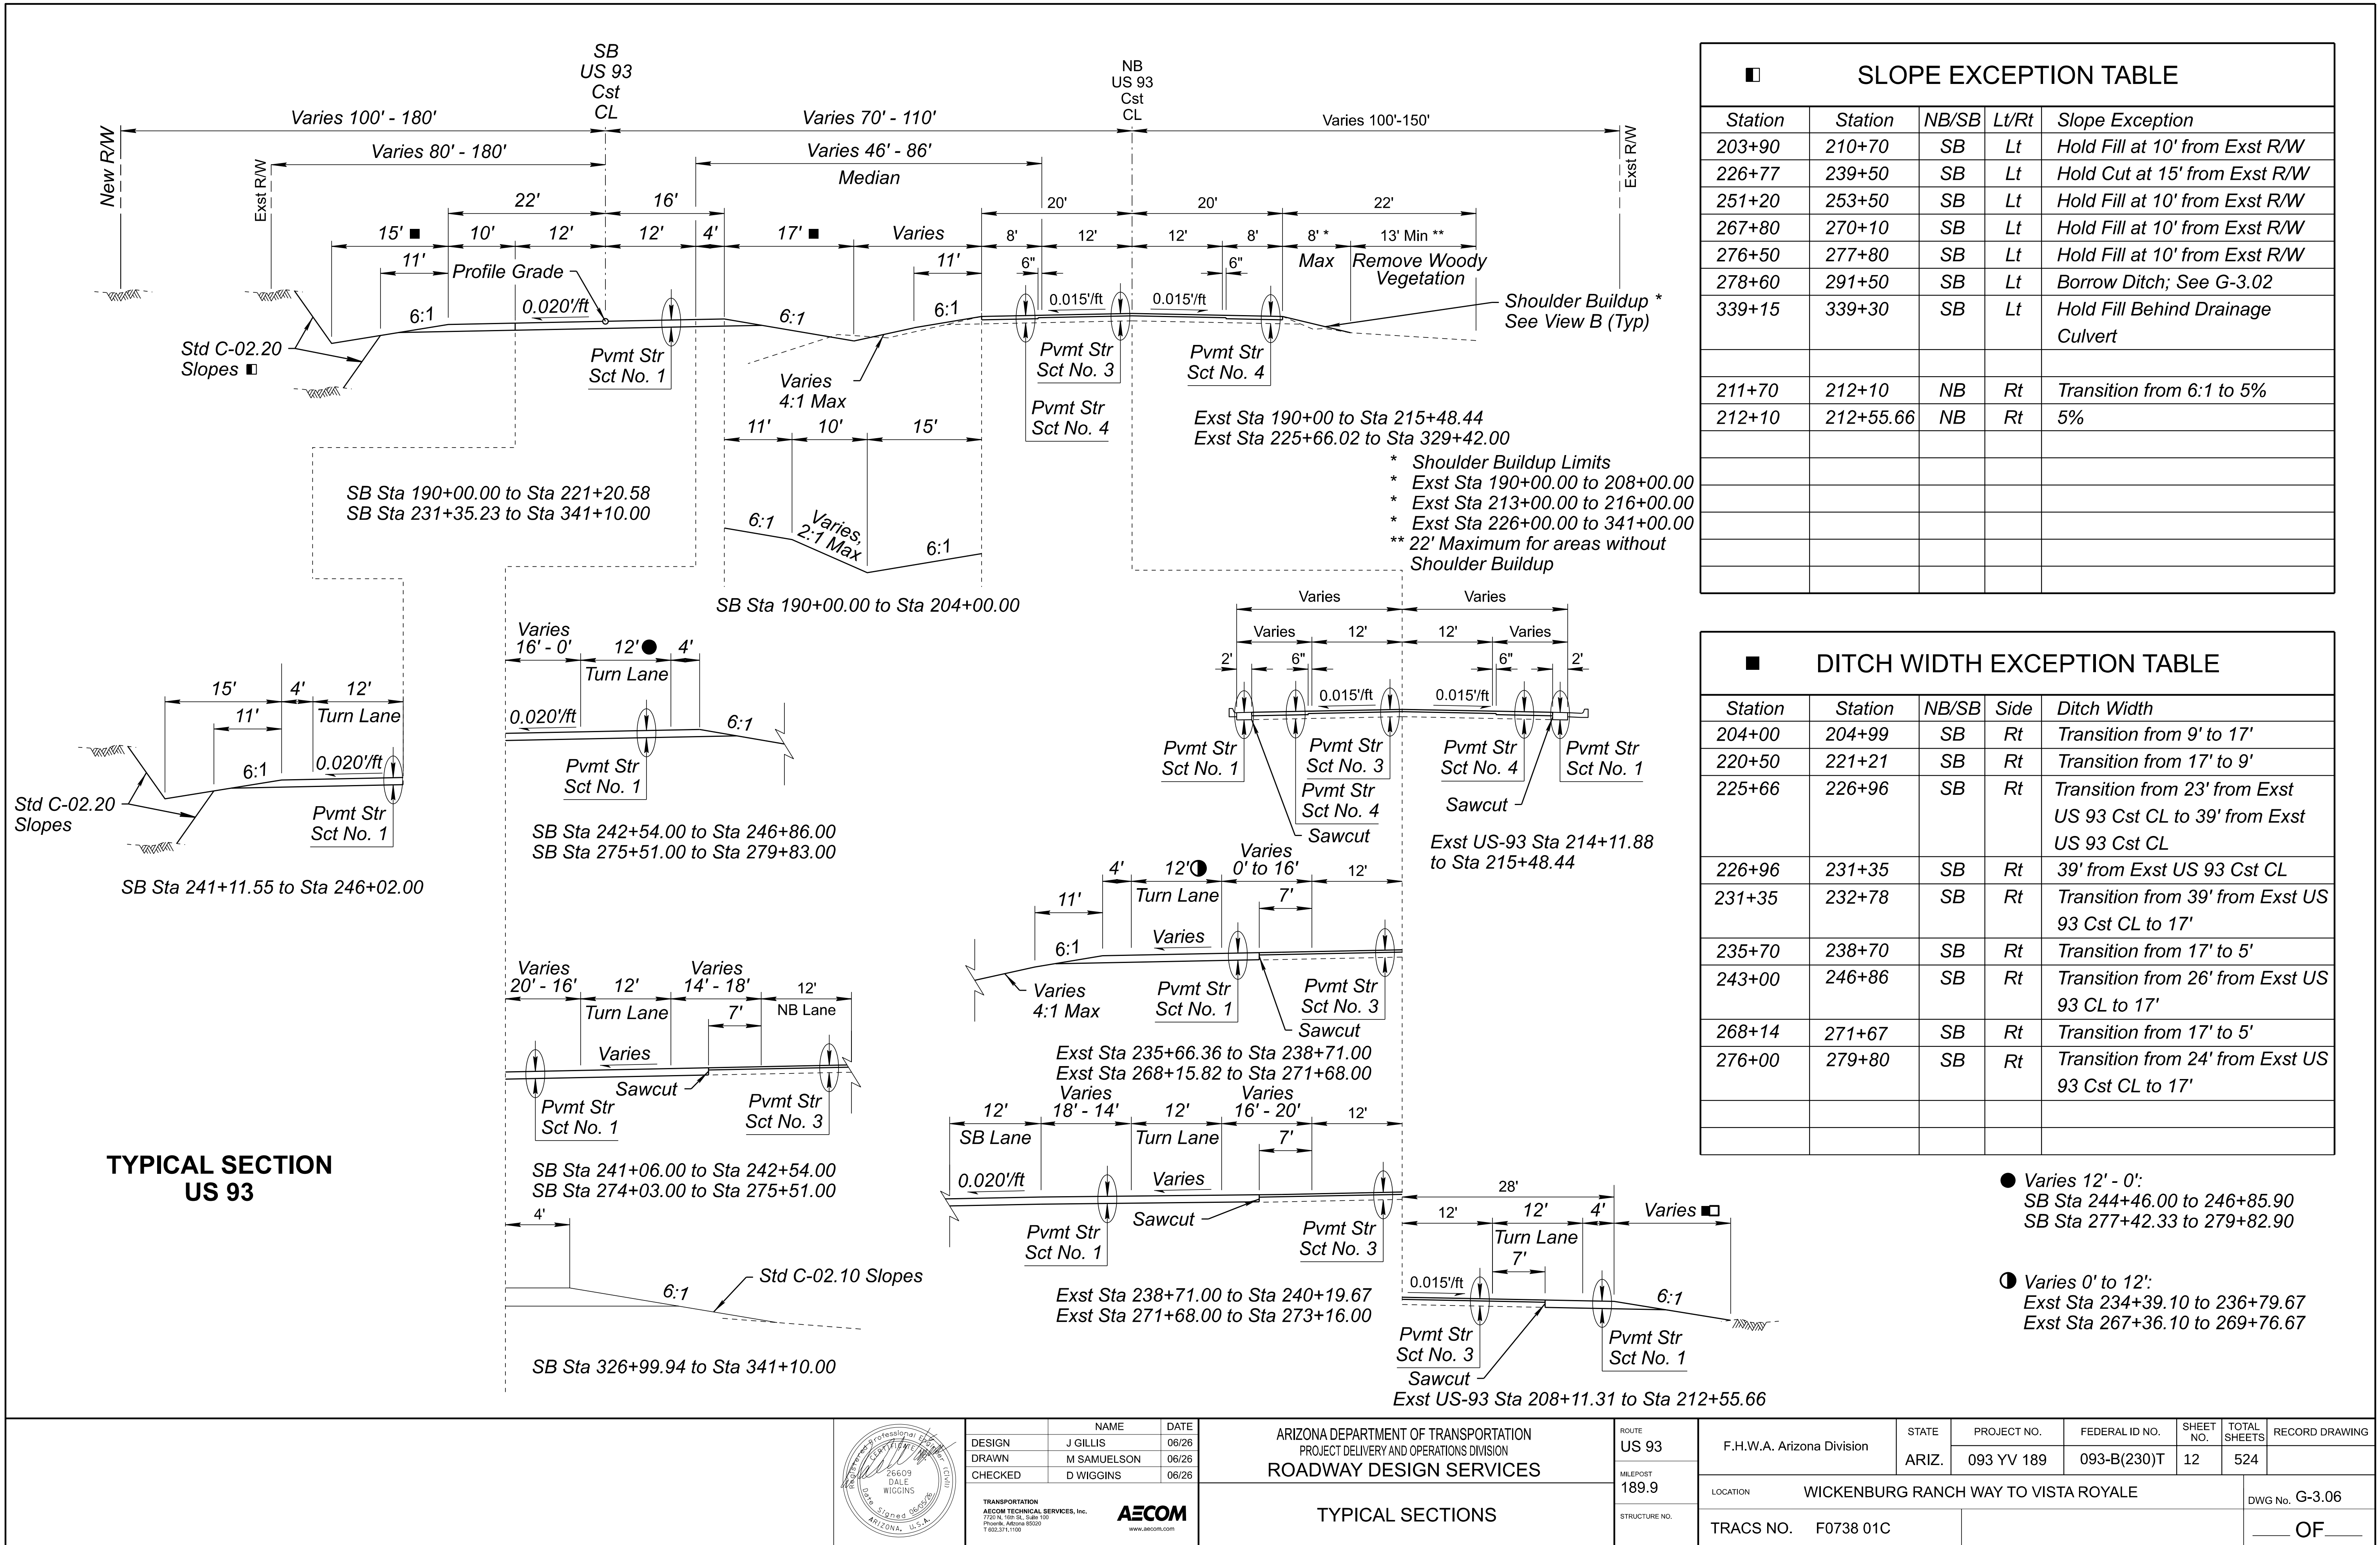


SLOPE EXCEPTION TABLE				
Station	Station	NB/SB	Lt/Rt	Slope Exception
203+90	210+70	SB	Lt	Hold Fill at 10' from Exst R/W
226+77	239+50	SB	Lt	Hold Cut at 15' from Exst R/W
251+20	253+50	SB	Lt	Hold Fill at 10' from Exst R/W
267+80	270+10	SB	Lt	Hold Fill at 10' from Exst R/W
276+50	277+80	SB	Lt	Hold Fill at 10' from Exst R/W
278+60	291+50	SB	Lt	Borrow Ditch; See G-3.02
339+15	339+30	SB	Lt	Hold Fill Behind Drainage Culvert
211+70	212+10	NB	Rt	Transition from 6:1 to 5%
212+10	212+55.66	NB	Rt	5%

DITCH WIDTH EXCEPTION TABLE				
Station	Station	NB/SB	Side	Ditch Width
204+00	204+99	SB	Rt	Transition from 9' to 17'
220+50	221+21	SB	Rt	Transition from 17' to 9'
225+66	226+96	SB	Rt	Transition from 23' from Exst US 93 Cst CL to 39' from Exst US 93 Cst CL
226+96	231+35	SB	Rt	39' from Exst US 93 Cst CL
231+35	232+78	SB	Rt	Transition from 39' from Exst US 93 Cst CL to 17'
235+70	238+70	SB	Rt	Transition from 17' to 5'
243+00	246+86	SB	Rt	Transition from 26' from Exst US 93 CL to 17'
268+14	271+67	SB	Rt	Transition from 17' to 5'
276+00	279+80	SB	Rt	Transition from 24' from Exst US 93 Cst CL to 17'


- **Varies 12' - 0':**
SB Sta 244+46.00 to 246+85.90
SB Sta 277+42.33 to 279+82.90
- **Varies 0' to 12':**
Exst Sta 234+39.10 to 236+79.67
Exst Sta 267+36.10 to 269+76.67

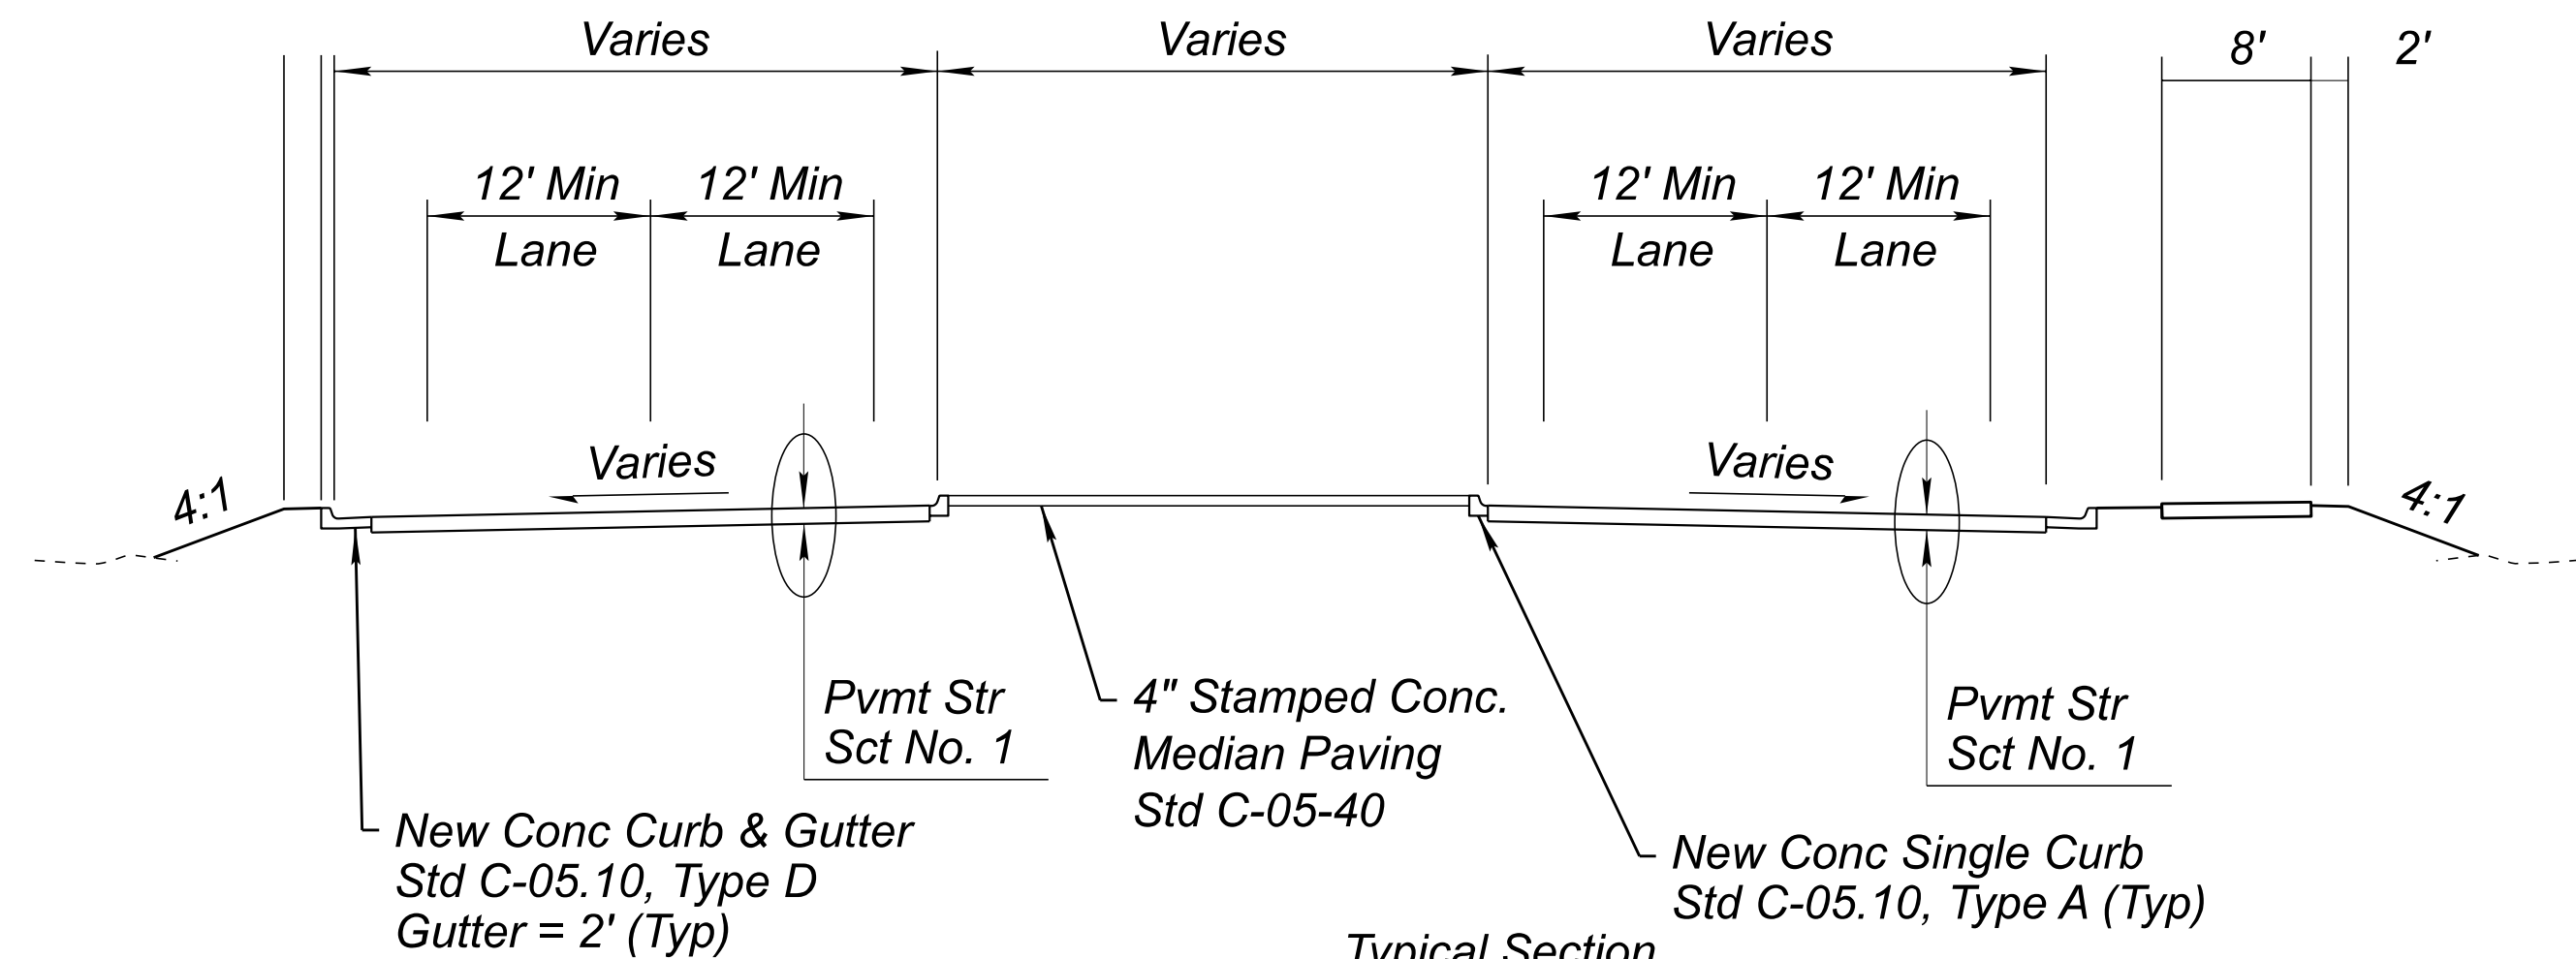


Typical Section
US 93
SB Sta 221+20.58 to 222+68.89
SB Sta 224+20.39 to 231+35.23
NB Sta 215+48.44 to 222+63.56
NB Sta 224+13.97 to 225+66.02
See Staking Plans for Edge of Pavement and Elevation Control

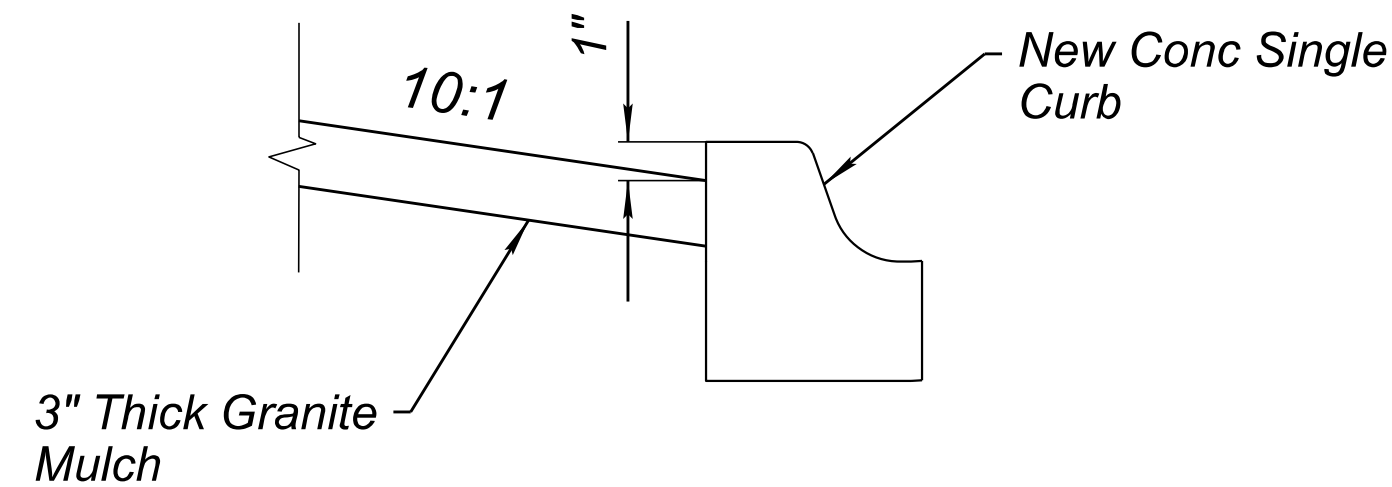


Detail AA

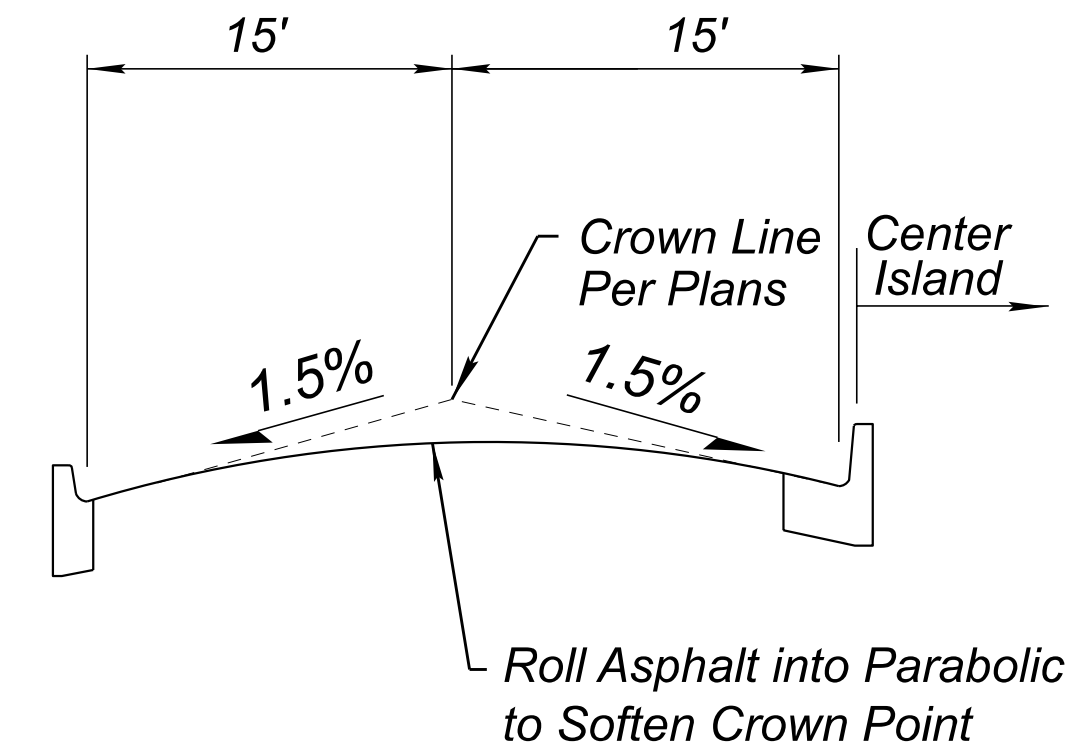


Rounded Crown Within Roundabout

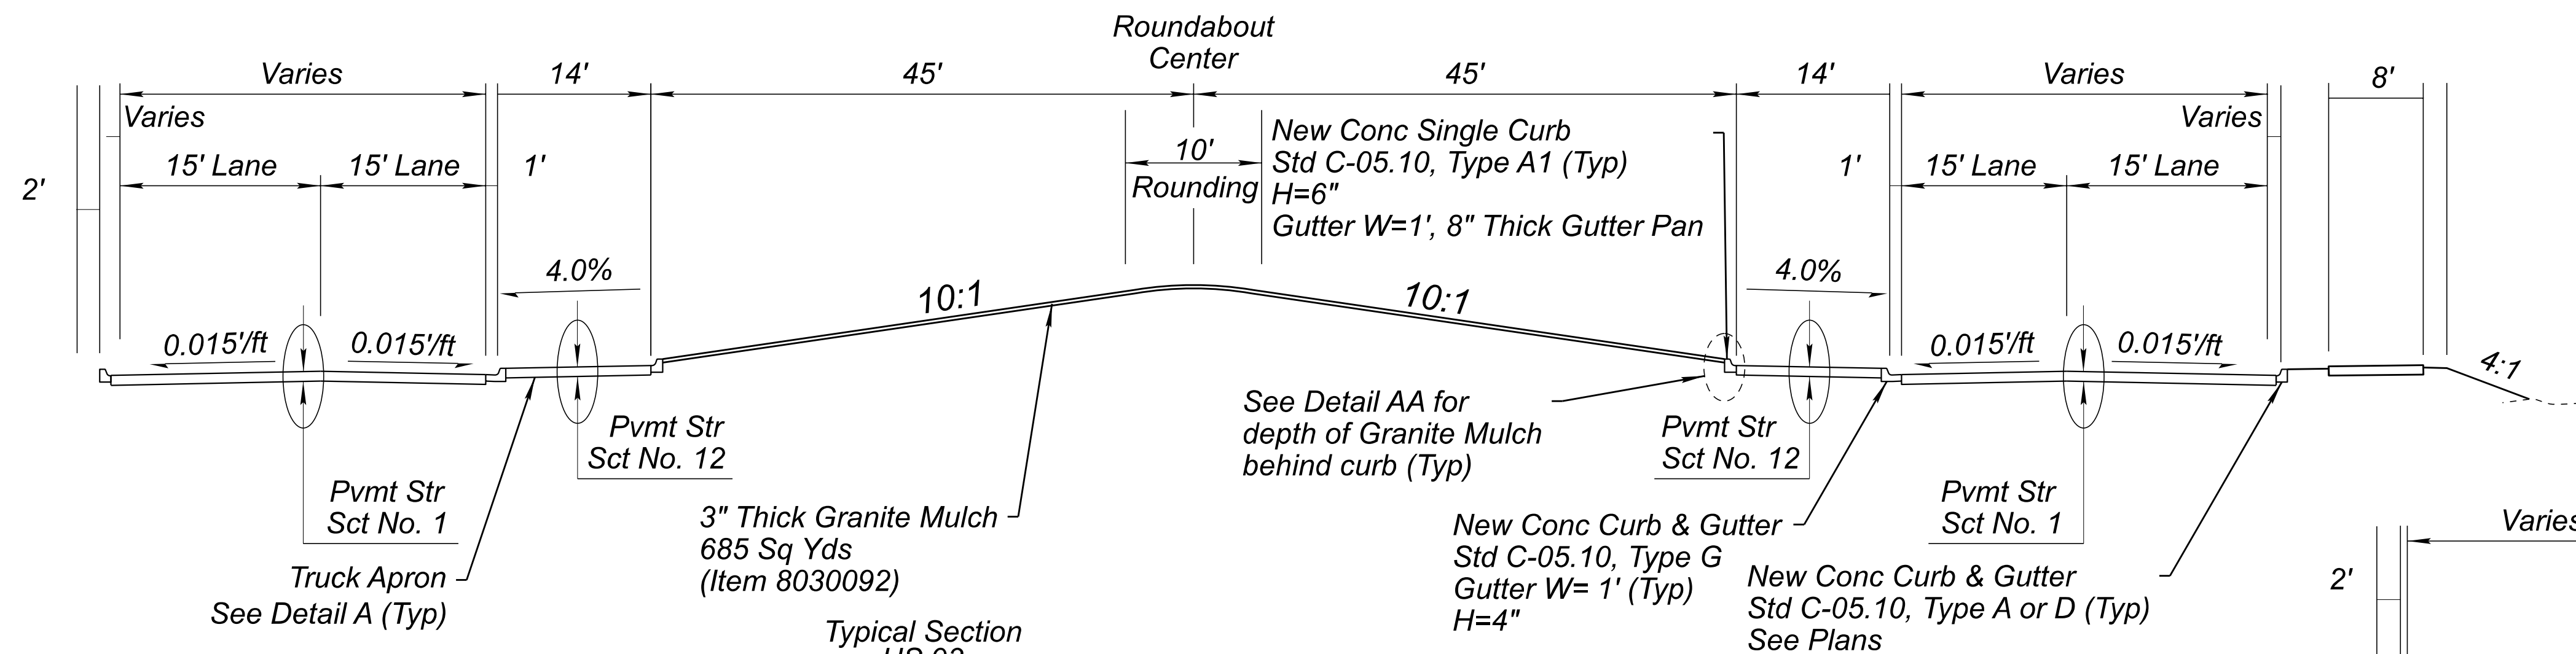


Typical Section
US 93
SB Sta 222+68.89 to 224+20.39
NB Sta 222+63.56 to 224+13.97
See Staking Plans for Edge of Pavement and Elevation Control

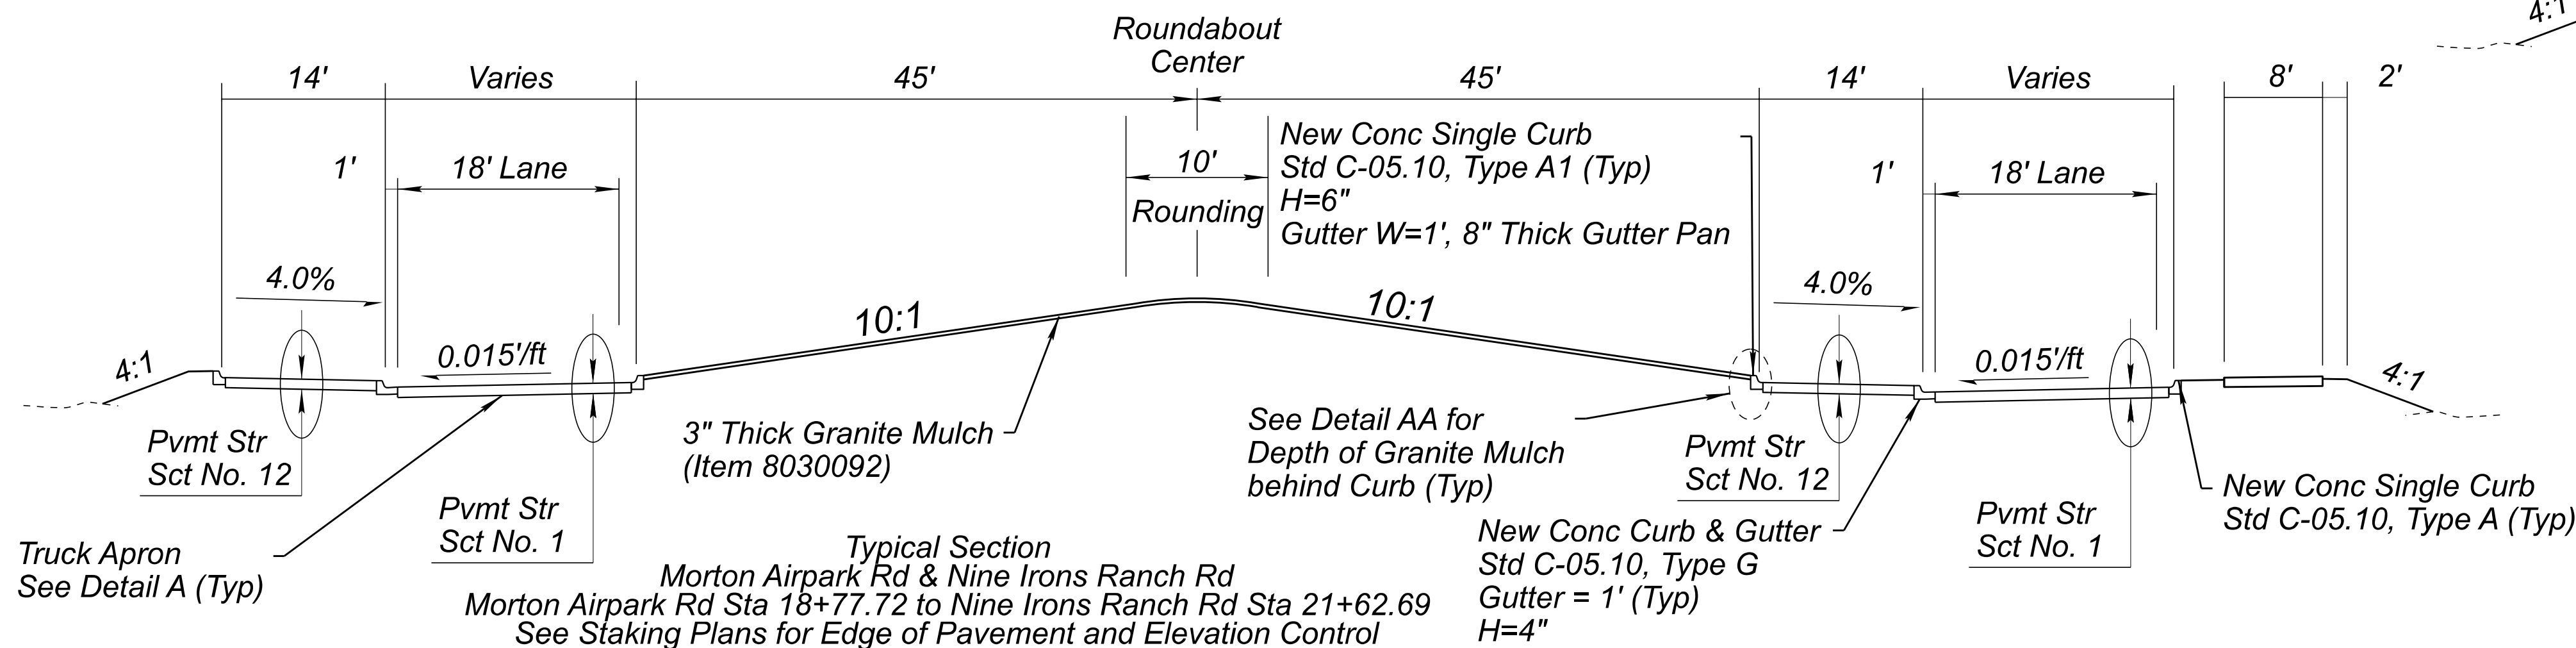

Typical Section
Morton Airpark Rd & Nine Irons Ranch Rd
Morton Airpark Rd Sta 18+77.72 to 20+35.13
Nine Irons Ranch Rd Sta 19+63.12 to 21+62.69
See Staking Plans for Edge of Pavement and Elevation Control

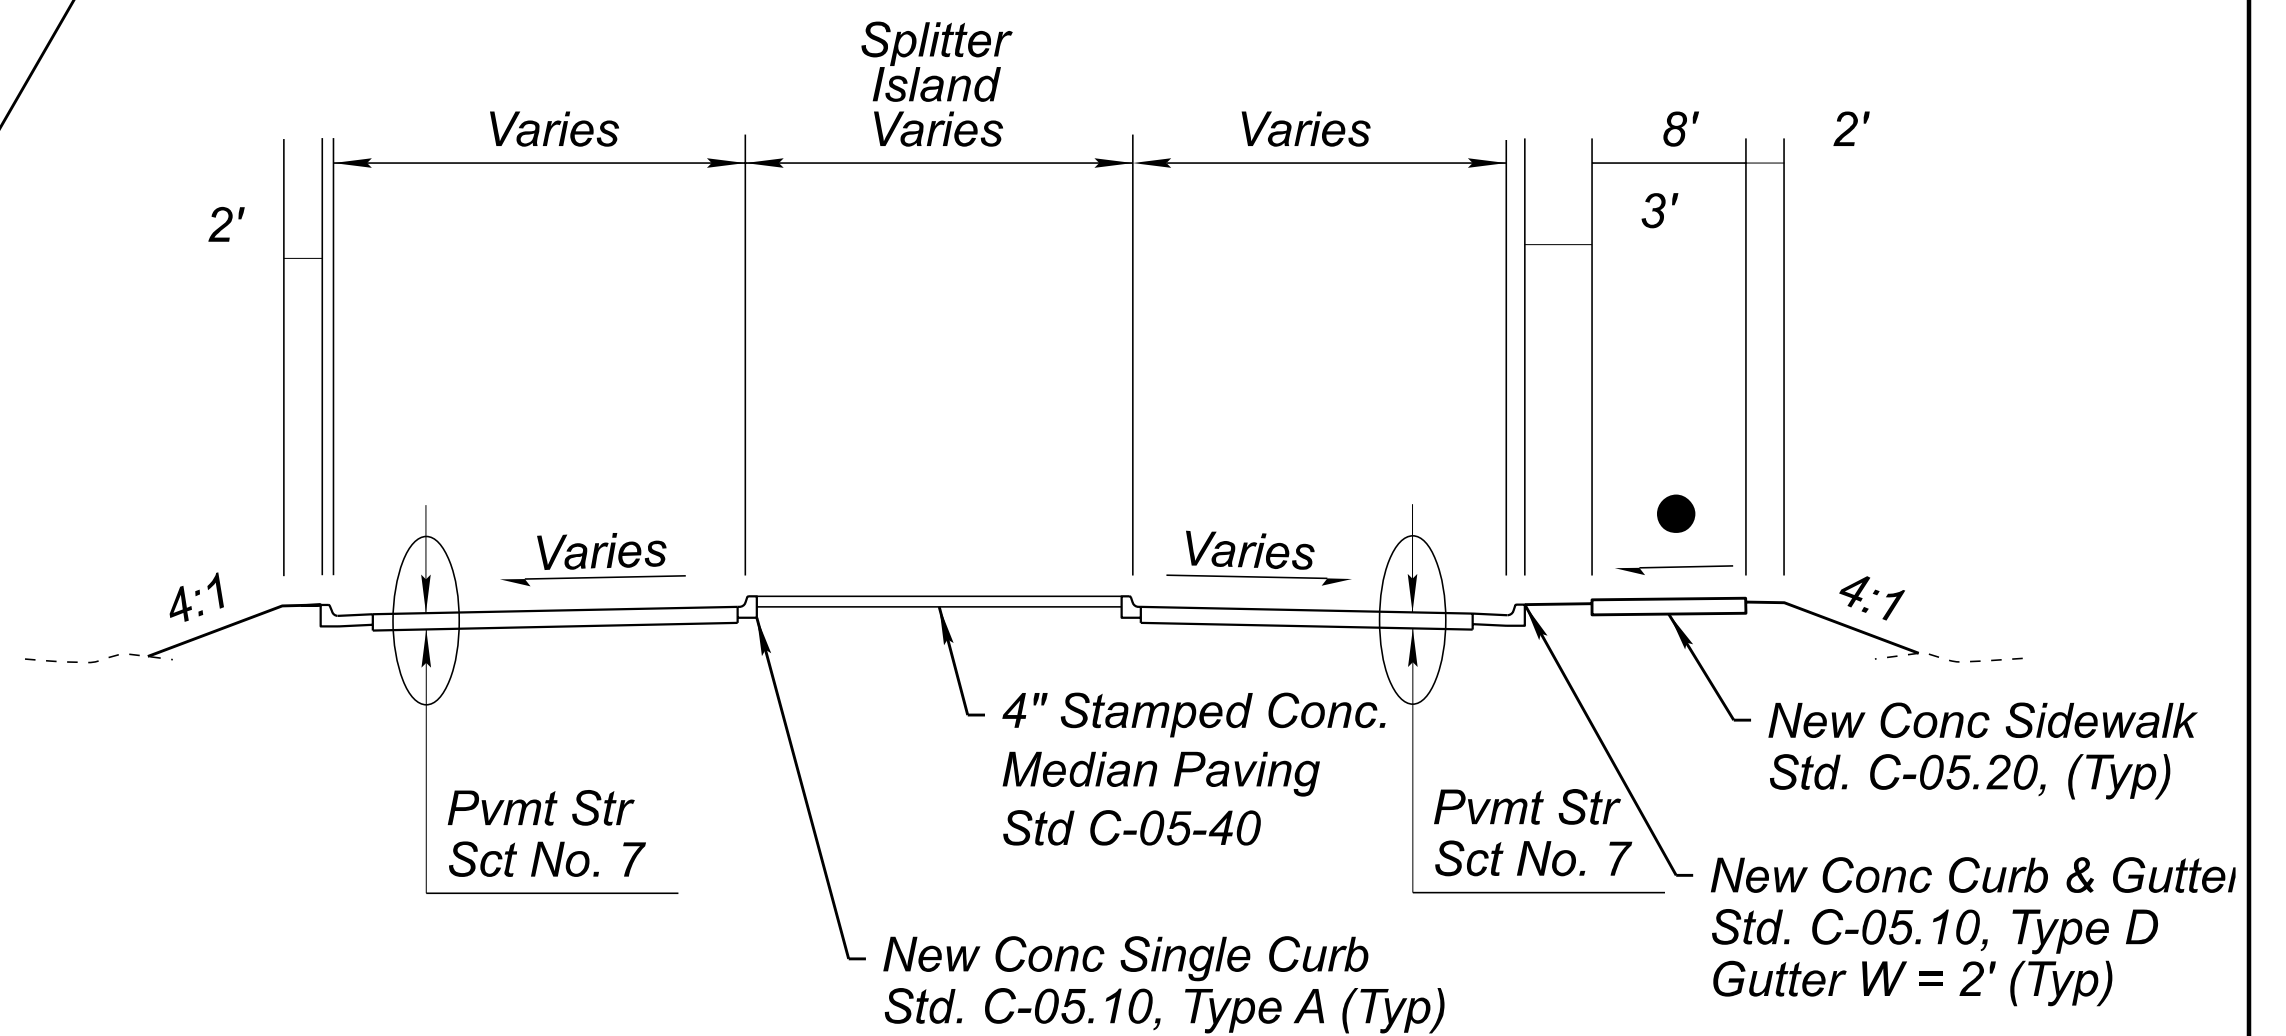

Typical Section
Morton Airpark Rd & Nine Irons Ranch Rd
Morton Airpark Rd Sta 18+77.72 to 20+35.13
Nine Irons Ranch Rd Sta 19+63.12 to 21+62.69
See Staking Plans for Edge of Pavement and Elevation Control

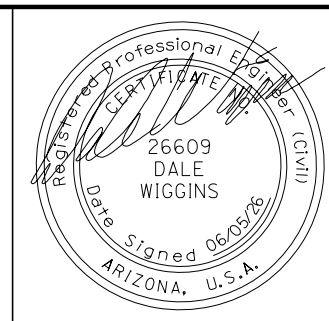


DESIGN	NAME	DATE
J GILLIS	06/26	
DRAWN	M SAMUELSON	06/26
CHECKED	D WIGGINS	06/26

TRANSPORTATION
AECOM TECHNICAL SERVICES, Inc.
7720 N. 16th St., Suite 100
Phoenix, Arizona 85020
T 602.371.1100
www.aecom.com

ARIZONA DEPARTMENT OF TRANSPORTATION
PROJECT DELIVERY AND OPERATIONS DIVISION
ROADWAY DESIGN SERVICES

TYPICAL SECTIONS


ROUTE US 93	F.H.W.A. Arizona Division	STATE ARIZ.	PROJECT NO. 093 YV 189	FEDERAL ID NO. 093-B(230)T	SHEET NO. 13	TOTAL SHEETS 524	RECORD DRAWING
MILEPOST 189.9	LOCATION WICKENBURG RANCH WAY TO VISTA ROYALE	TRACS NO. F0738 01C	DWG No. G-3.07	OF			

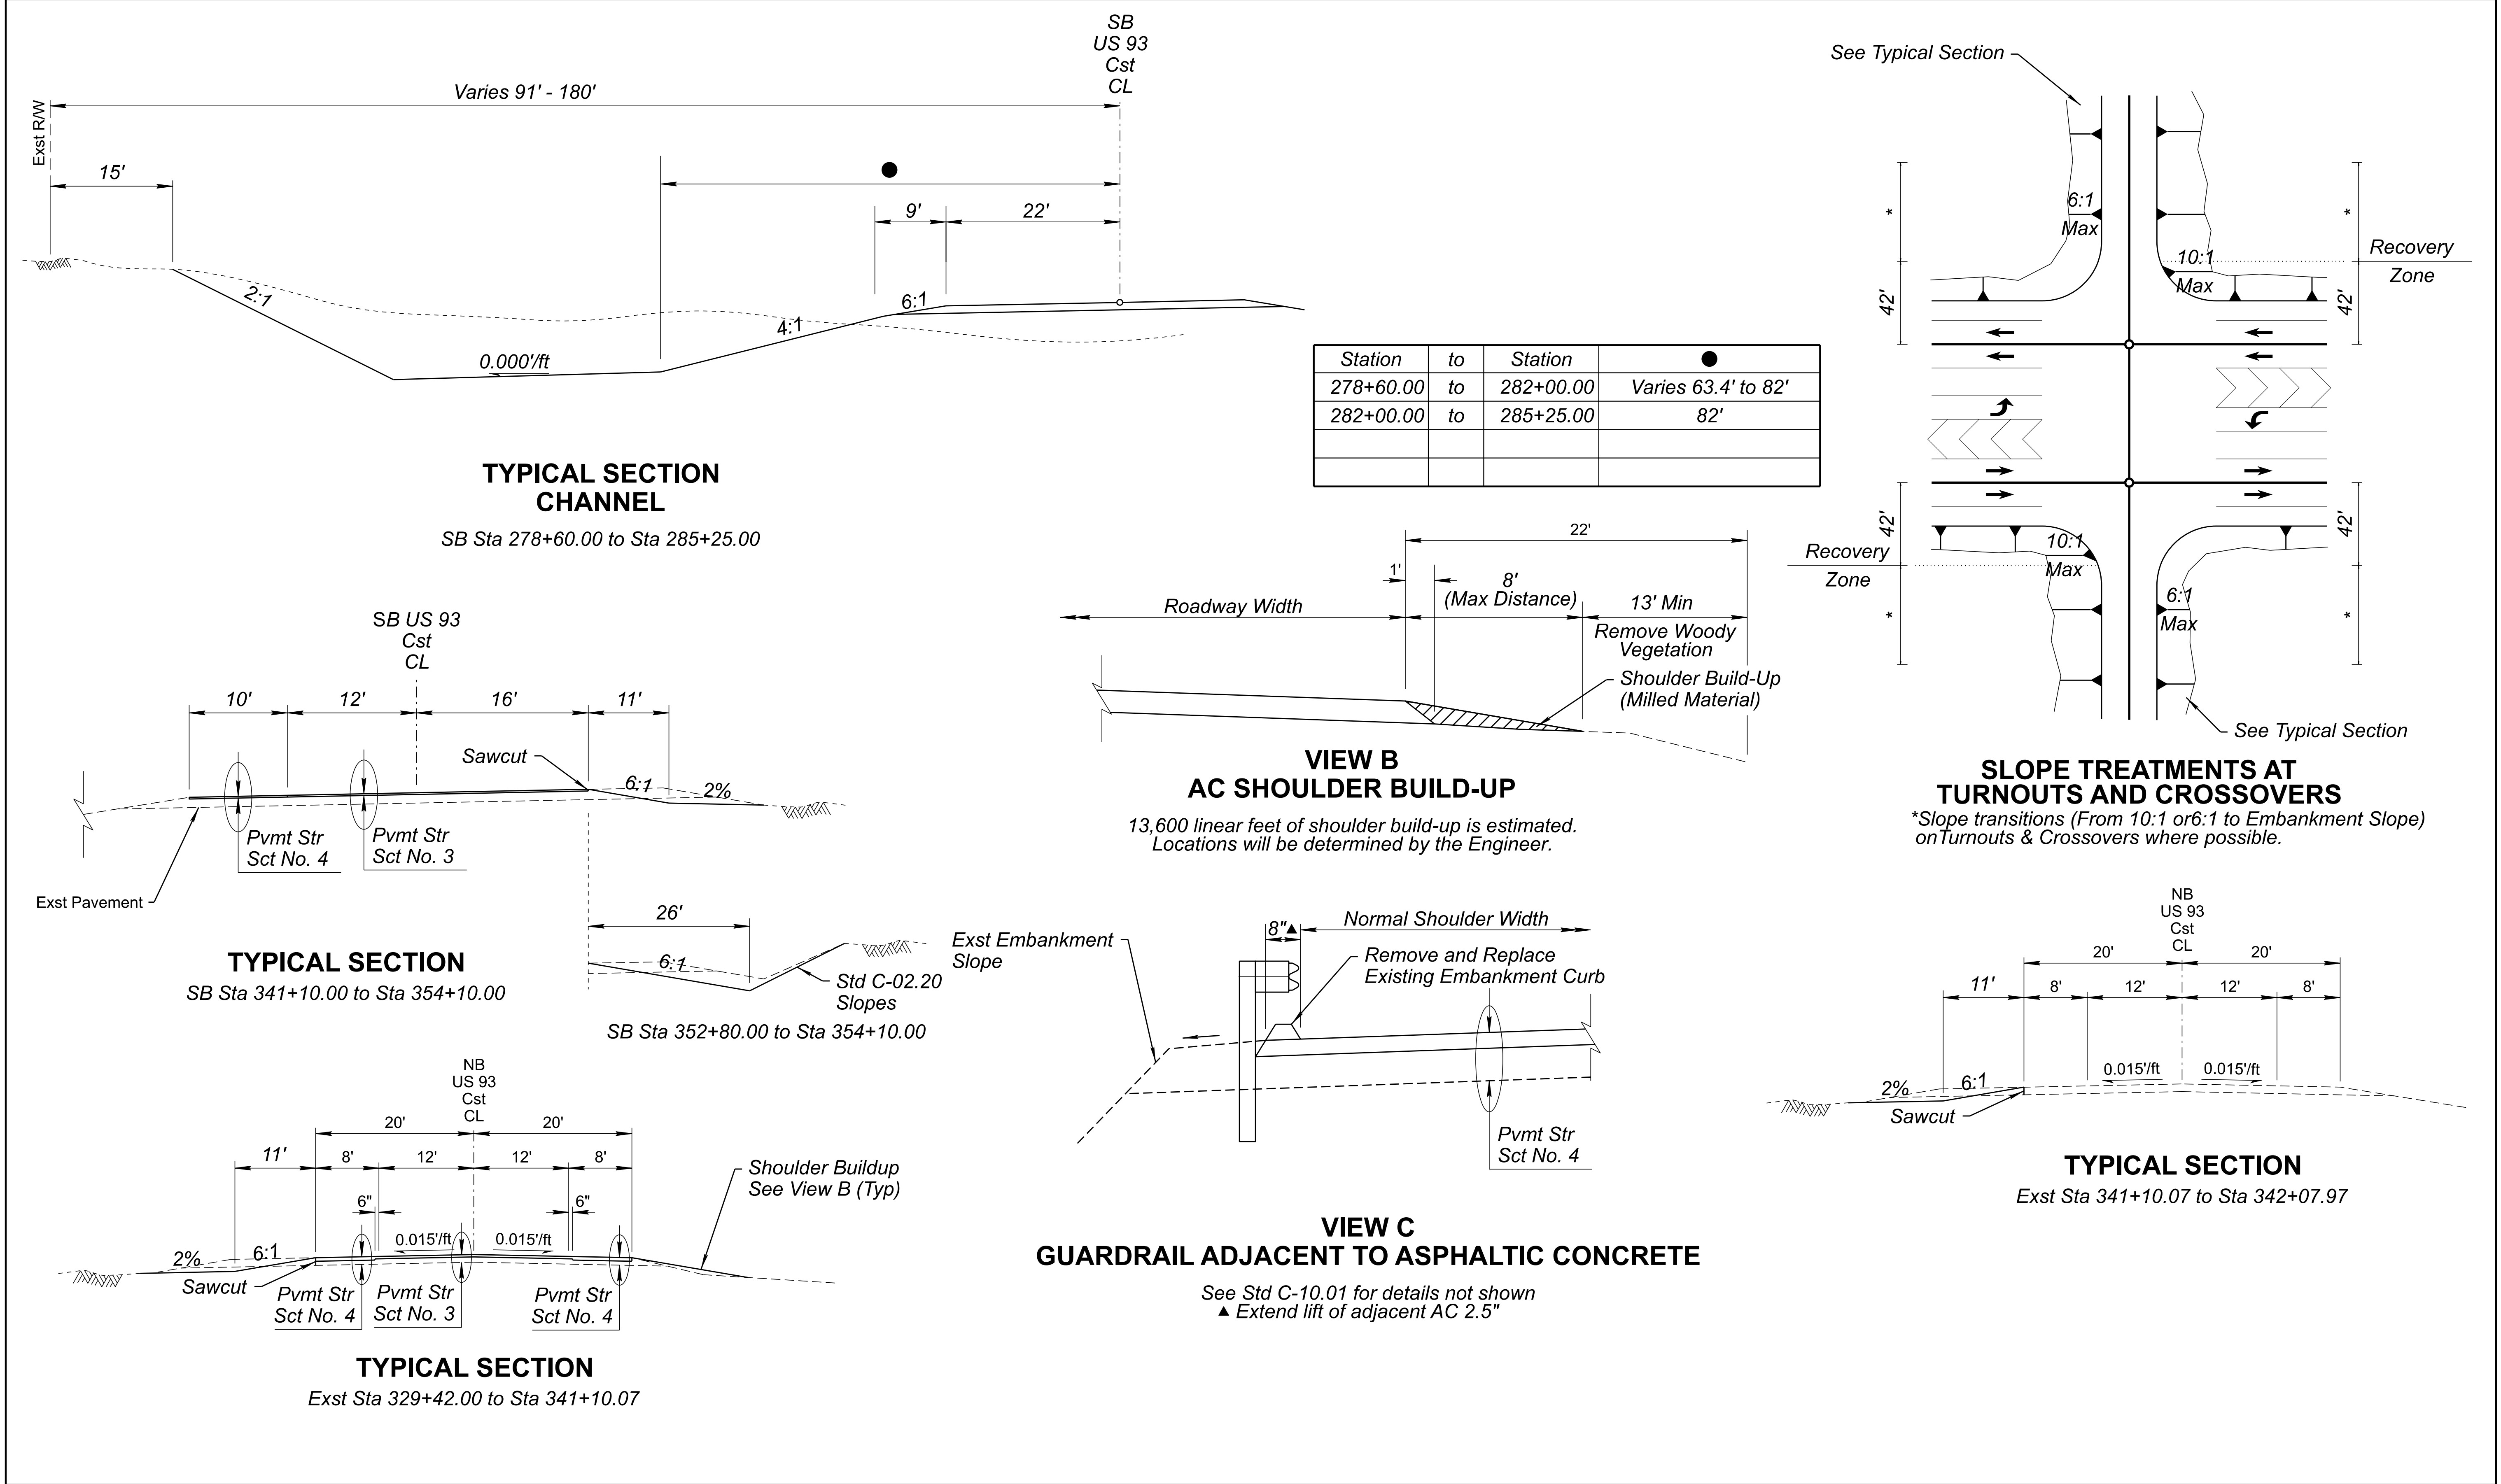

	DESIGN	J GILLIS	06/26	ARIZONA DEPARTMENT OF TRANSPORTATION PROJECT DELIVERY AND OPERATIONS DIVISION ROADWAY DESIGN SERVICES	ROUTE	US 93	F.H.W.A. Arizona Division	STATE	ARIZ.	PROJECT NO.	FEDERAL ID NO.	SHEET NO.	TOTAL SHEETS	RECORD DRAWING
	DRAWN	M SAMUELSON	06/26		093 YV 189	093-B(230)T				14	524			
	CHECKED	D WIGGINS	06/26		MILEPOST	189.9		LOCATION WICKENBURG RANCH WAY TO VISTA ROYALE				DWG No. G-3.08		
	TRANSPORTATION AECOM TECHNICAL SERVICES, Inc. 7720 N. 16th St., Suite 100 Phoenix, Arizona 85020 T 602.371.1100			AECOM www.aecom.com		STRUCTURE NO.		TRACS NO. F0738 01C		OF				
				TYPICAL SECTIONS										

F.H.W.A. REGION	STATE	PROJECT NO.	SHEET NO.	TOTAL SHEETS	RECORD DRAWING
9	ARIZ.	093-B(230)T	15	524	


093 YV 189

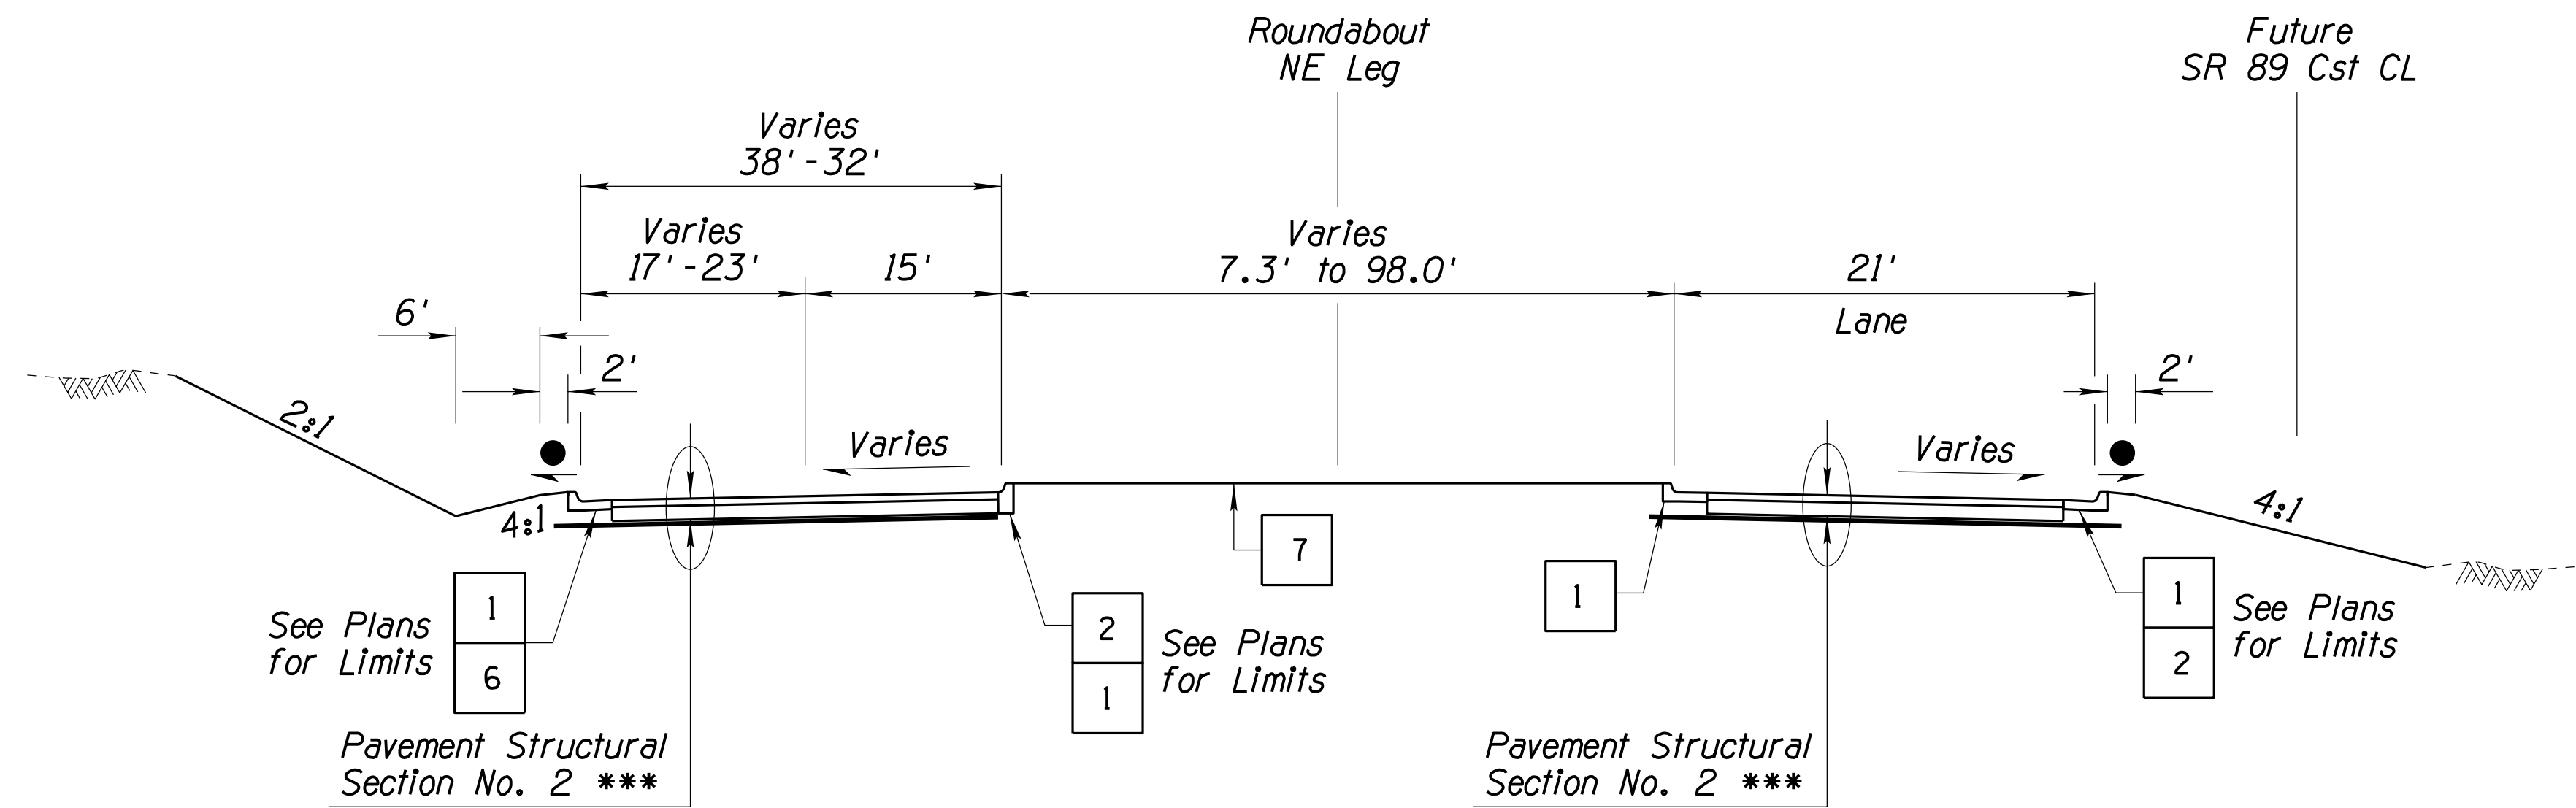

SR 89 TYPICAL SECTION

Sta 108+46.75 to 111+56.84

See Staking Plans for Edge of Pavement Location and Elevation Control

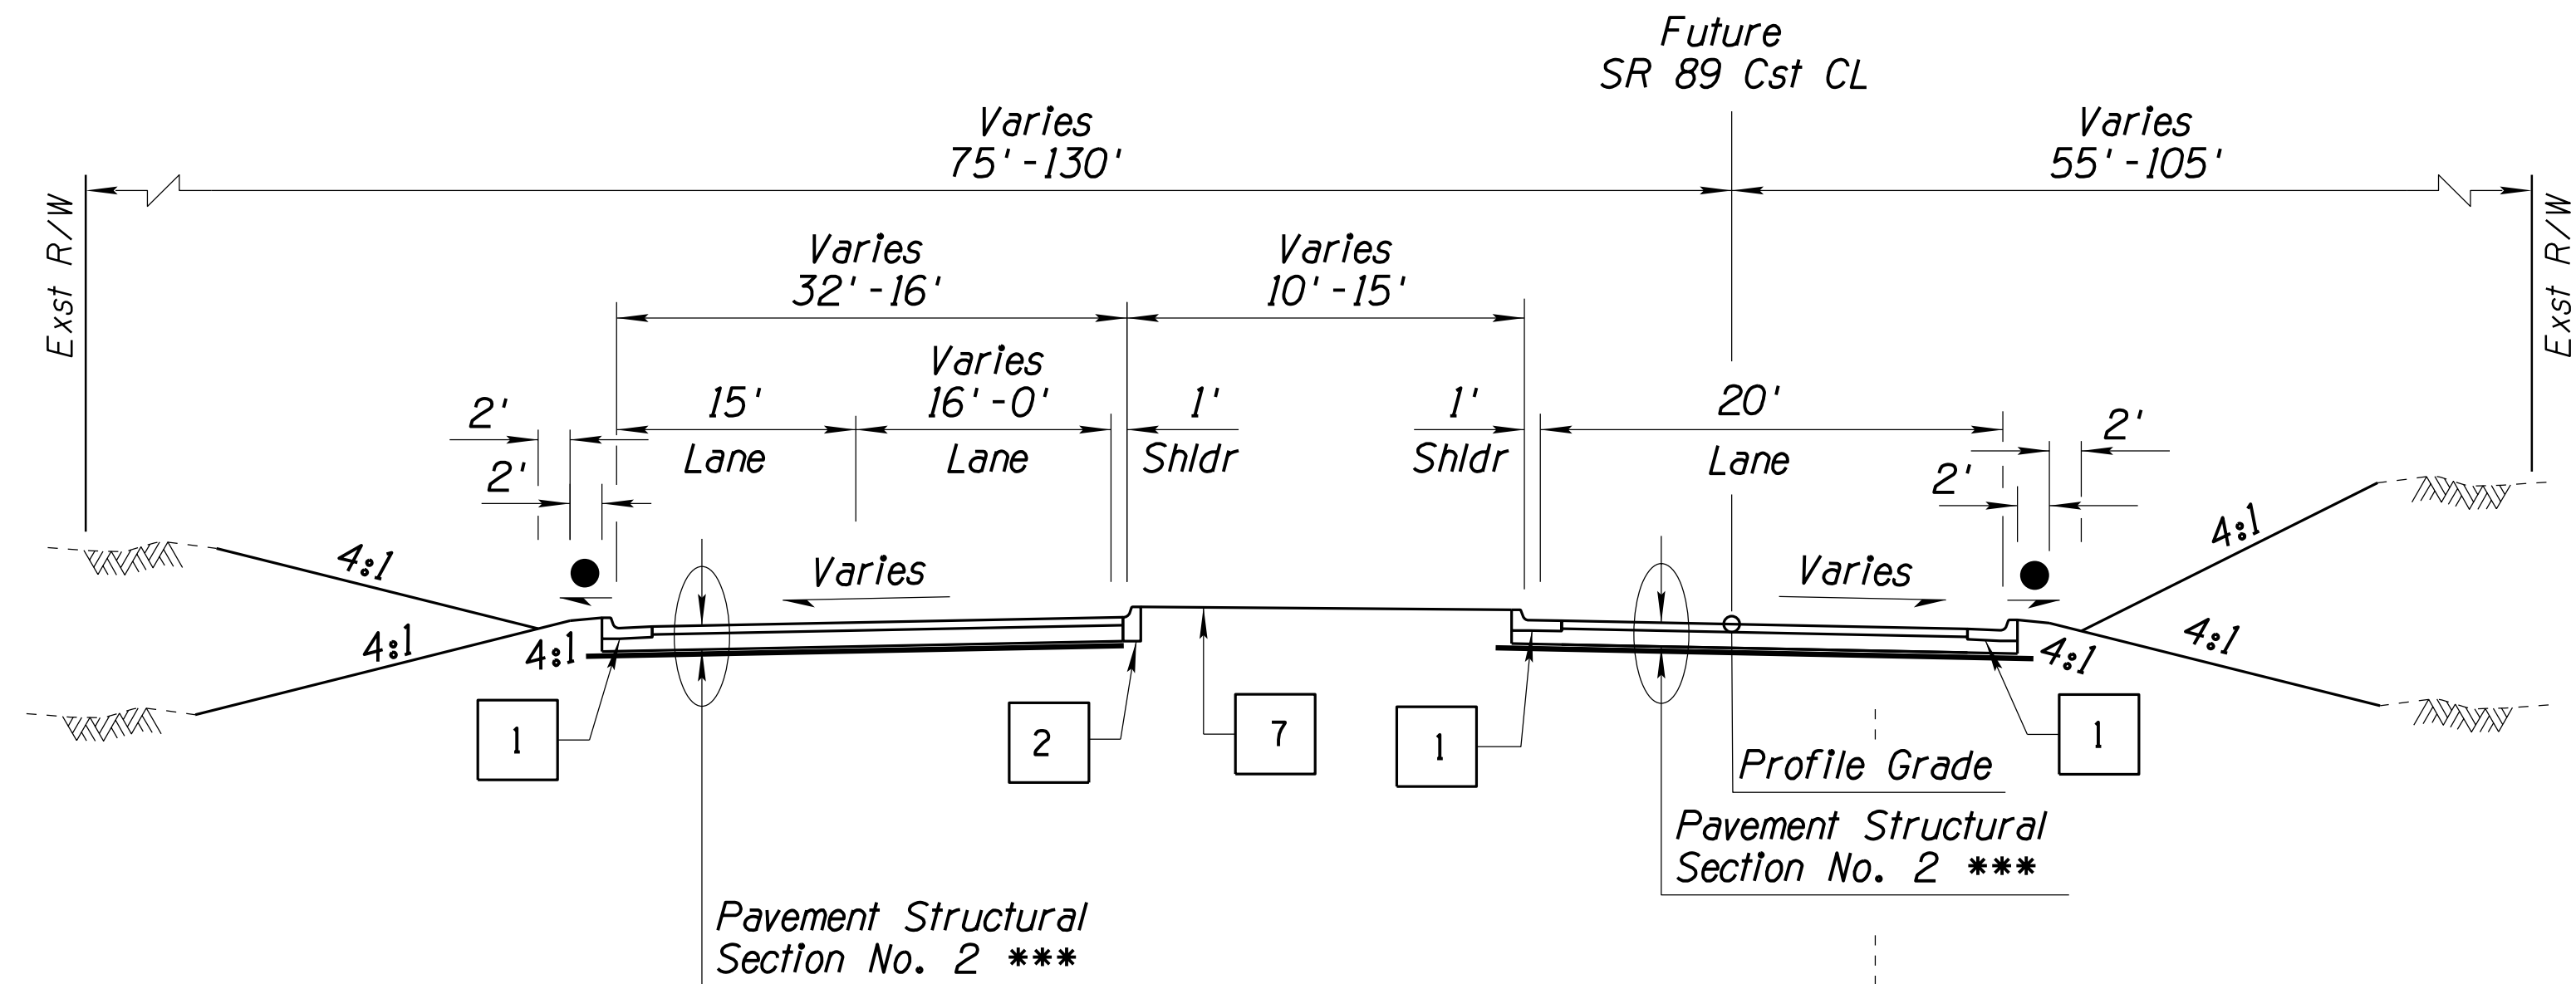

SR 89 TYPICAL SECTION

Sta 111+56.84 to 115+38.52


See Staking Plans for Edge of Pavement Location and Elevation Control

- 1 Conc Curb & Gutter, Std C-05.10, Type D, h=6" with AB Class 2 (Sta 108+46.75 to 115+38.52)
- 2 Conc Single Curb, Std C-05.10, Type A1, h=6"
- 6 Conc Curb & Gutter, Std C-05.10, Type D-3, h=6" with AB Class 2 (Sta 108+46.75 to 115+38.52)
- 7 Concrete Median Paving (Stamped), Std C-05.40
- 10:1
- ** See Plans for Grading Information.
- *** Geogrid and Separation Fabric Placement Detail See Detail B

		NAME	DATE	ARIZONA DEPARTMENT OF TRANSPORTATION PROJECT DELIVERY AND OPERATIONS DIVISION ROADWAY DESIGN SERVICES		
DESIGN	ZSZ	06-26		TYPICAL SECTIONS		
DRAWN	RM	06-26				
CHECKED	DBK	06-26				
 Stanley Consultants INC.		3133 East Camelback Road, Suite 100 Phoenix, Arizona 85016 Phone: (602) 333-2200				
ROUTE		LOCATION				
US 93		WICKENBURG RANCH WAY TO VISTA ROYALE				DWG NO. G-3.09
TRACS NO. F0738 OIC				093-B(230)T		___ OF ___

F.H.W.A. REGION	STATE	PROJECT NO.	SHEET NO.	TOTAL SHEETS	RECORD DRAWING
9	ARIZ.	093-B(230)T	16	524	


093 YV 189

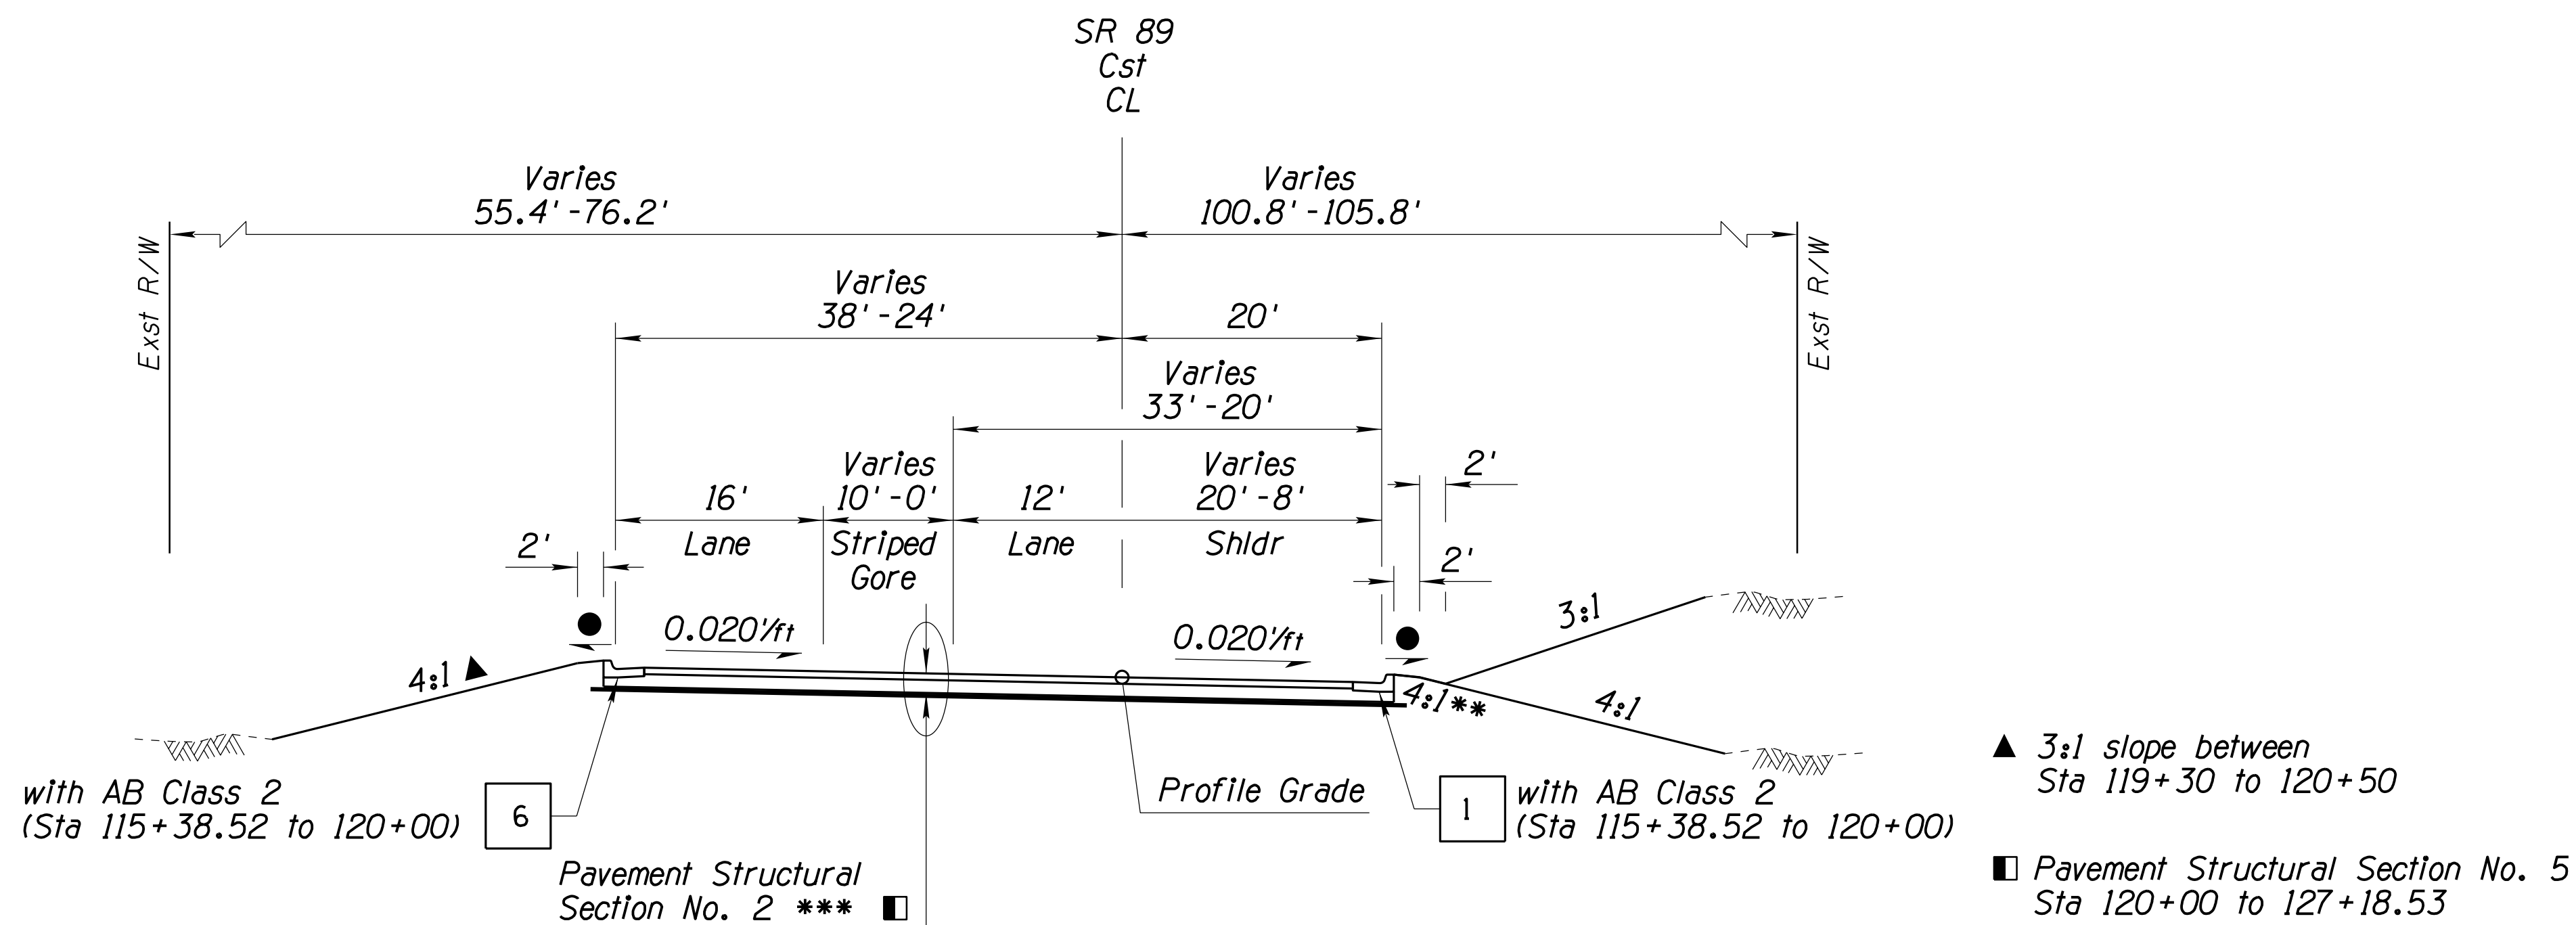

SR 89 TYPICAL SECTION

Sta 115+38.52 to 127+18.53

See Staking Plans for Lt Edge of Pavement Location
and Elevation Control Sta 115+38.52 to 118+16.32

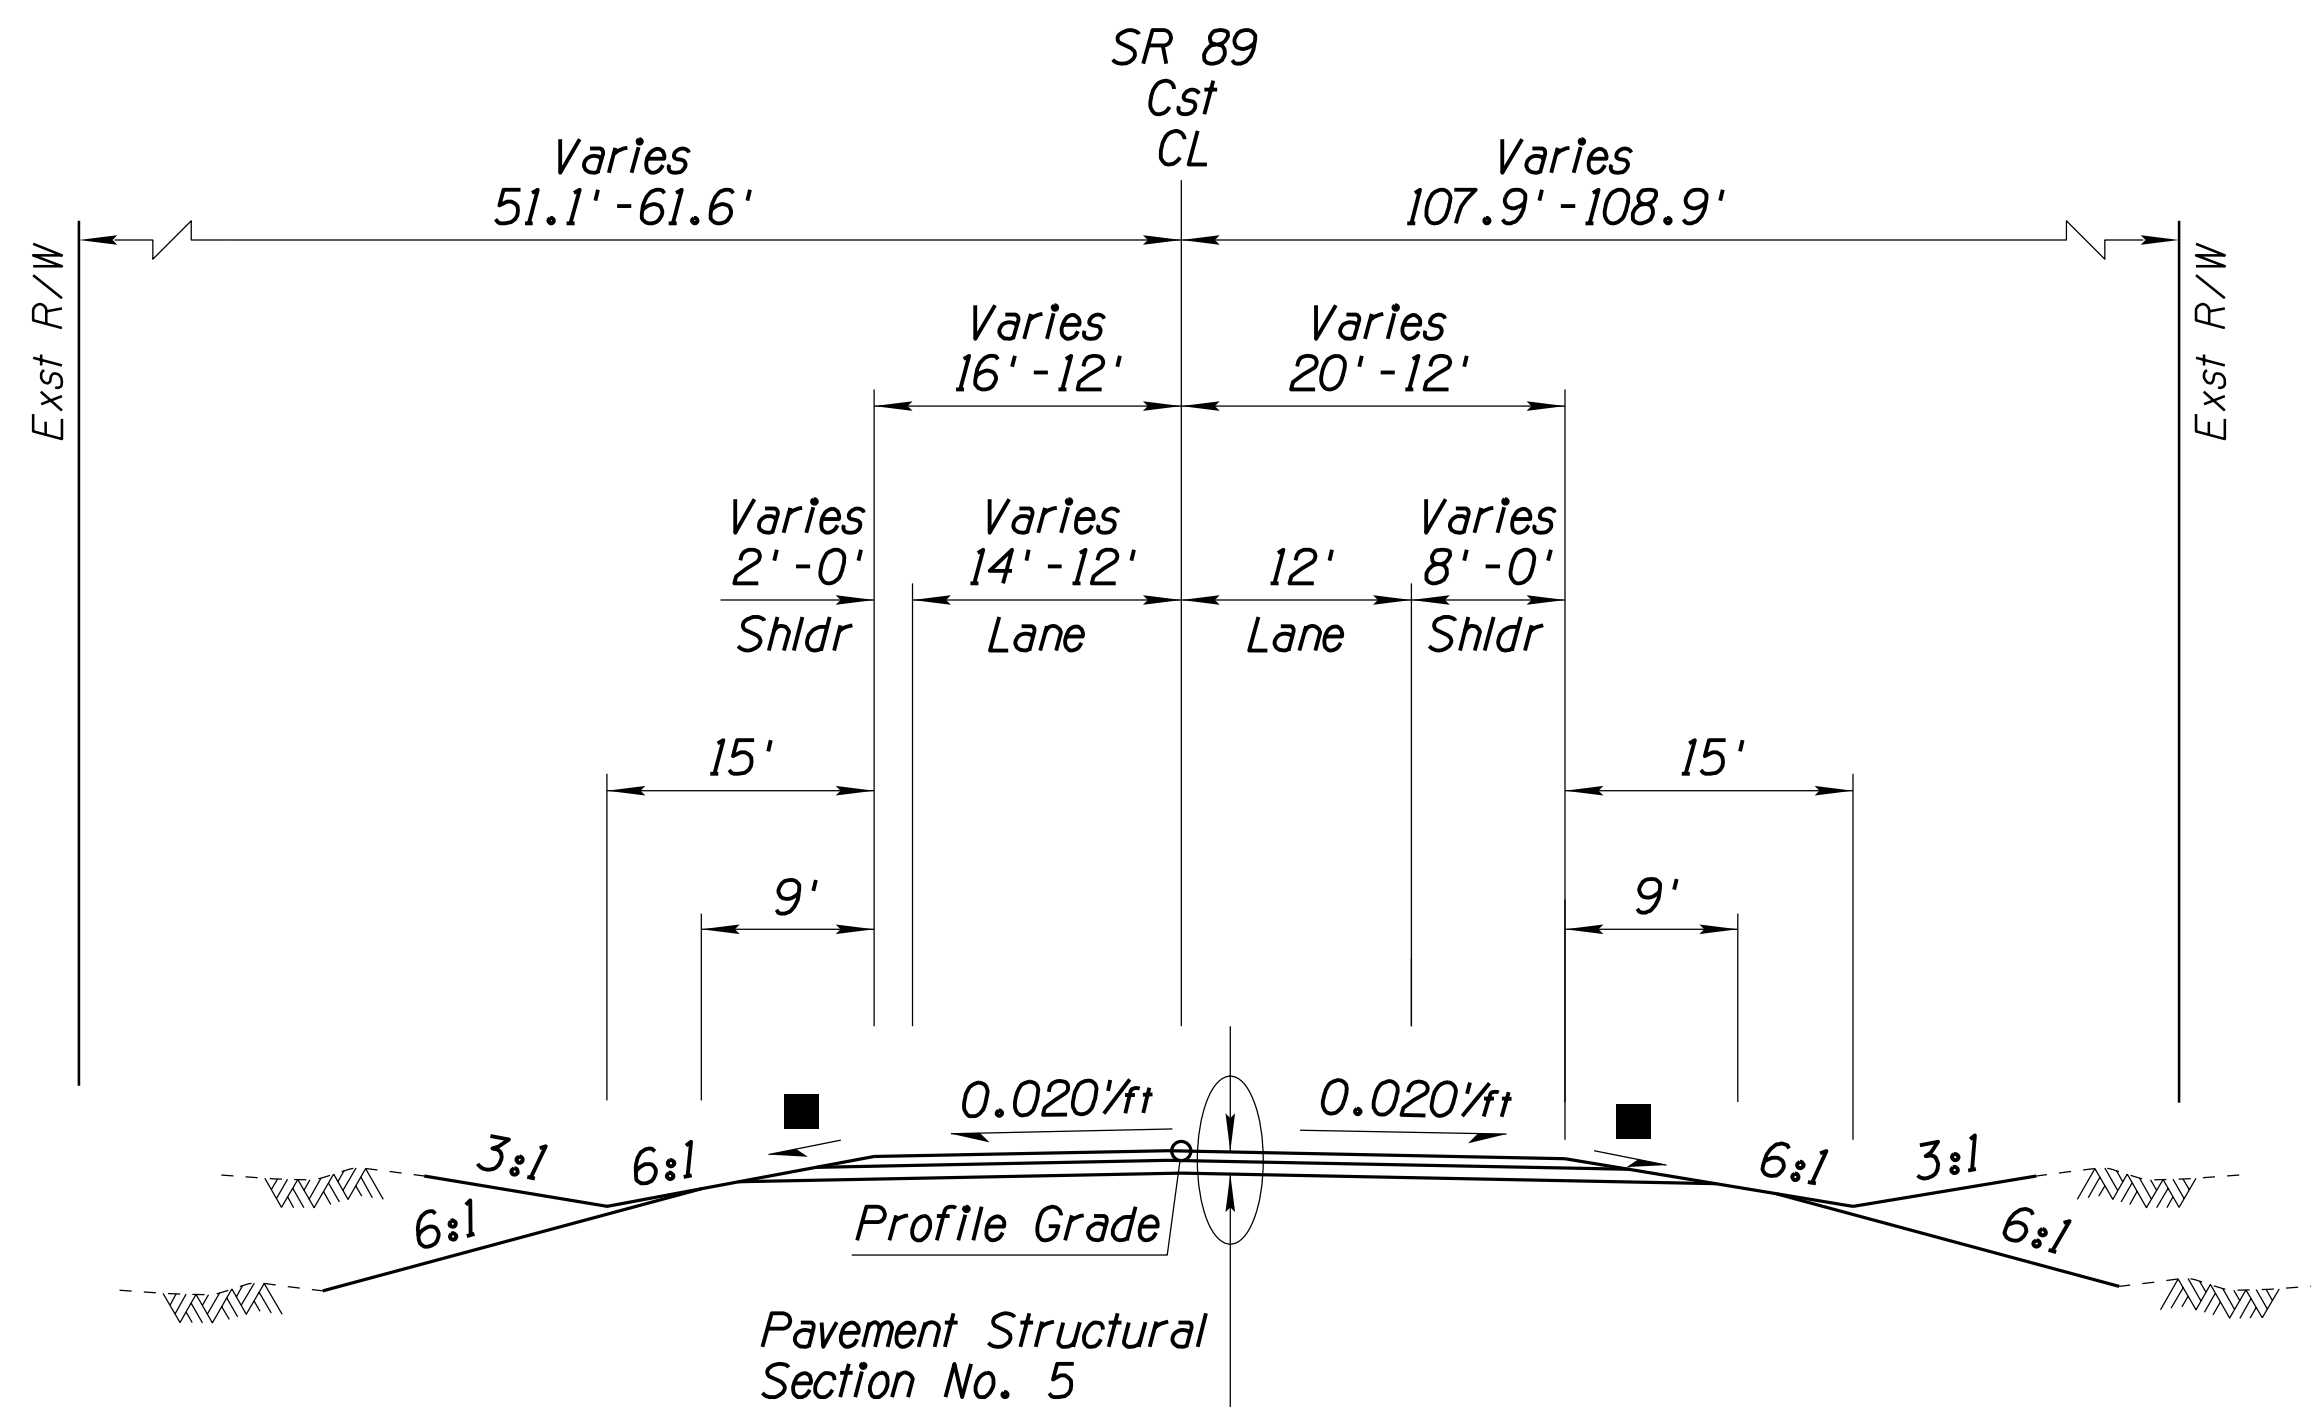

SR 89 TYPICAL SECTION


Sta 127+18.53 to Sta 128+30.94

- 1 Conc Curb & Gutter, Std C-05.10, Type D, h=6"
- 6 Conc Curb & Gutter, Std C-05.10, Type D-3, h=6"
- Subgrade/Slope Hinge Treatment Detail Per Std C-02.20
- 10:1
- ** See Plans for Grading Information.
- *** Geogrid and Separation Fabric Placement Detail See Detail B

DESIGN	ZSZ	DATE	06-26	ARIZONA DEPARTMENT OF TRANSPORTATION PROJECT DELIVERY AND OPERATIONS DIVISION ROADWAY DESIGN SERVICES	
DRAWN	RM	DATE	06-26		
CHECKED	DBK	DATE	06-26		
				TYPICAL SECTIONS	
ROUTE	US 93	LOCATION	WICKENBURG RANCH WAY TO VISTA ROYALE	DWG NO. G-3.10	
TRACS NO.	F0738	OIC		093-B(230)T	

F.H.W.A. REGION	STATE	PROJECT NO.	SHEET NO.	TOTAL SHEETS	RECORD DRAWING
9	ARIZ.	093-B(230)T	17	524	

093 YV 189

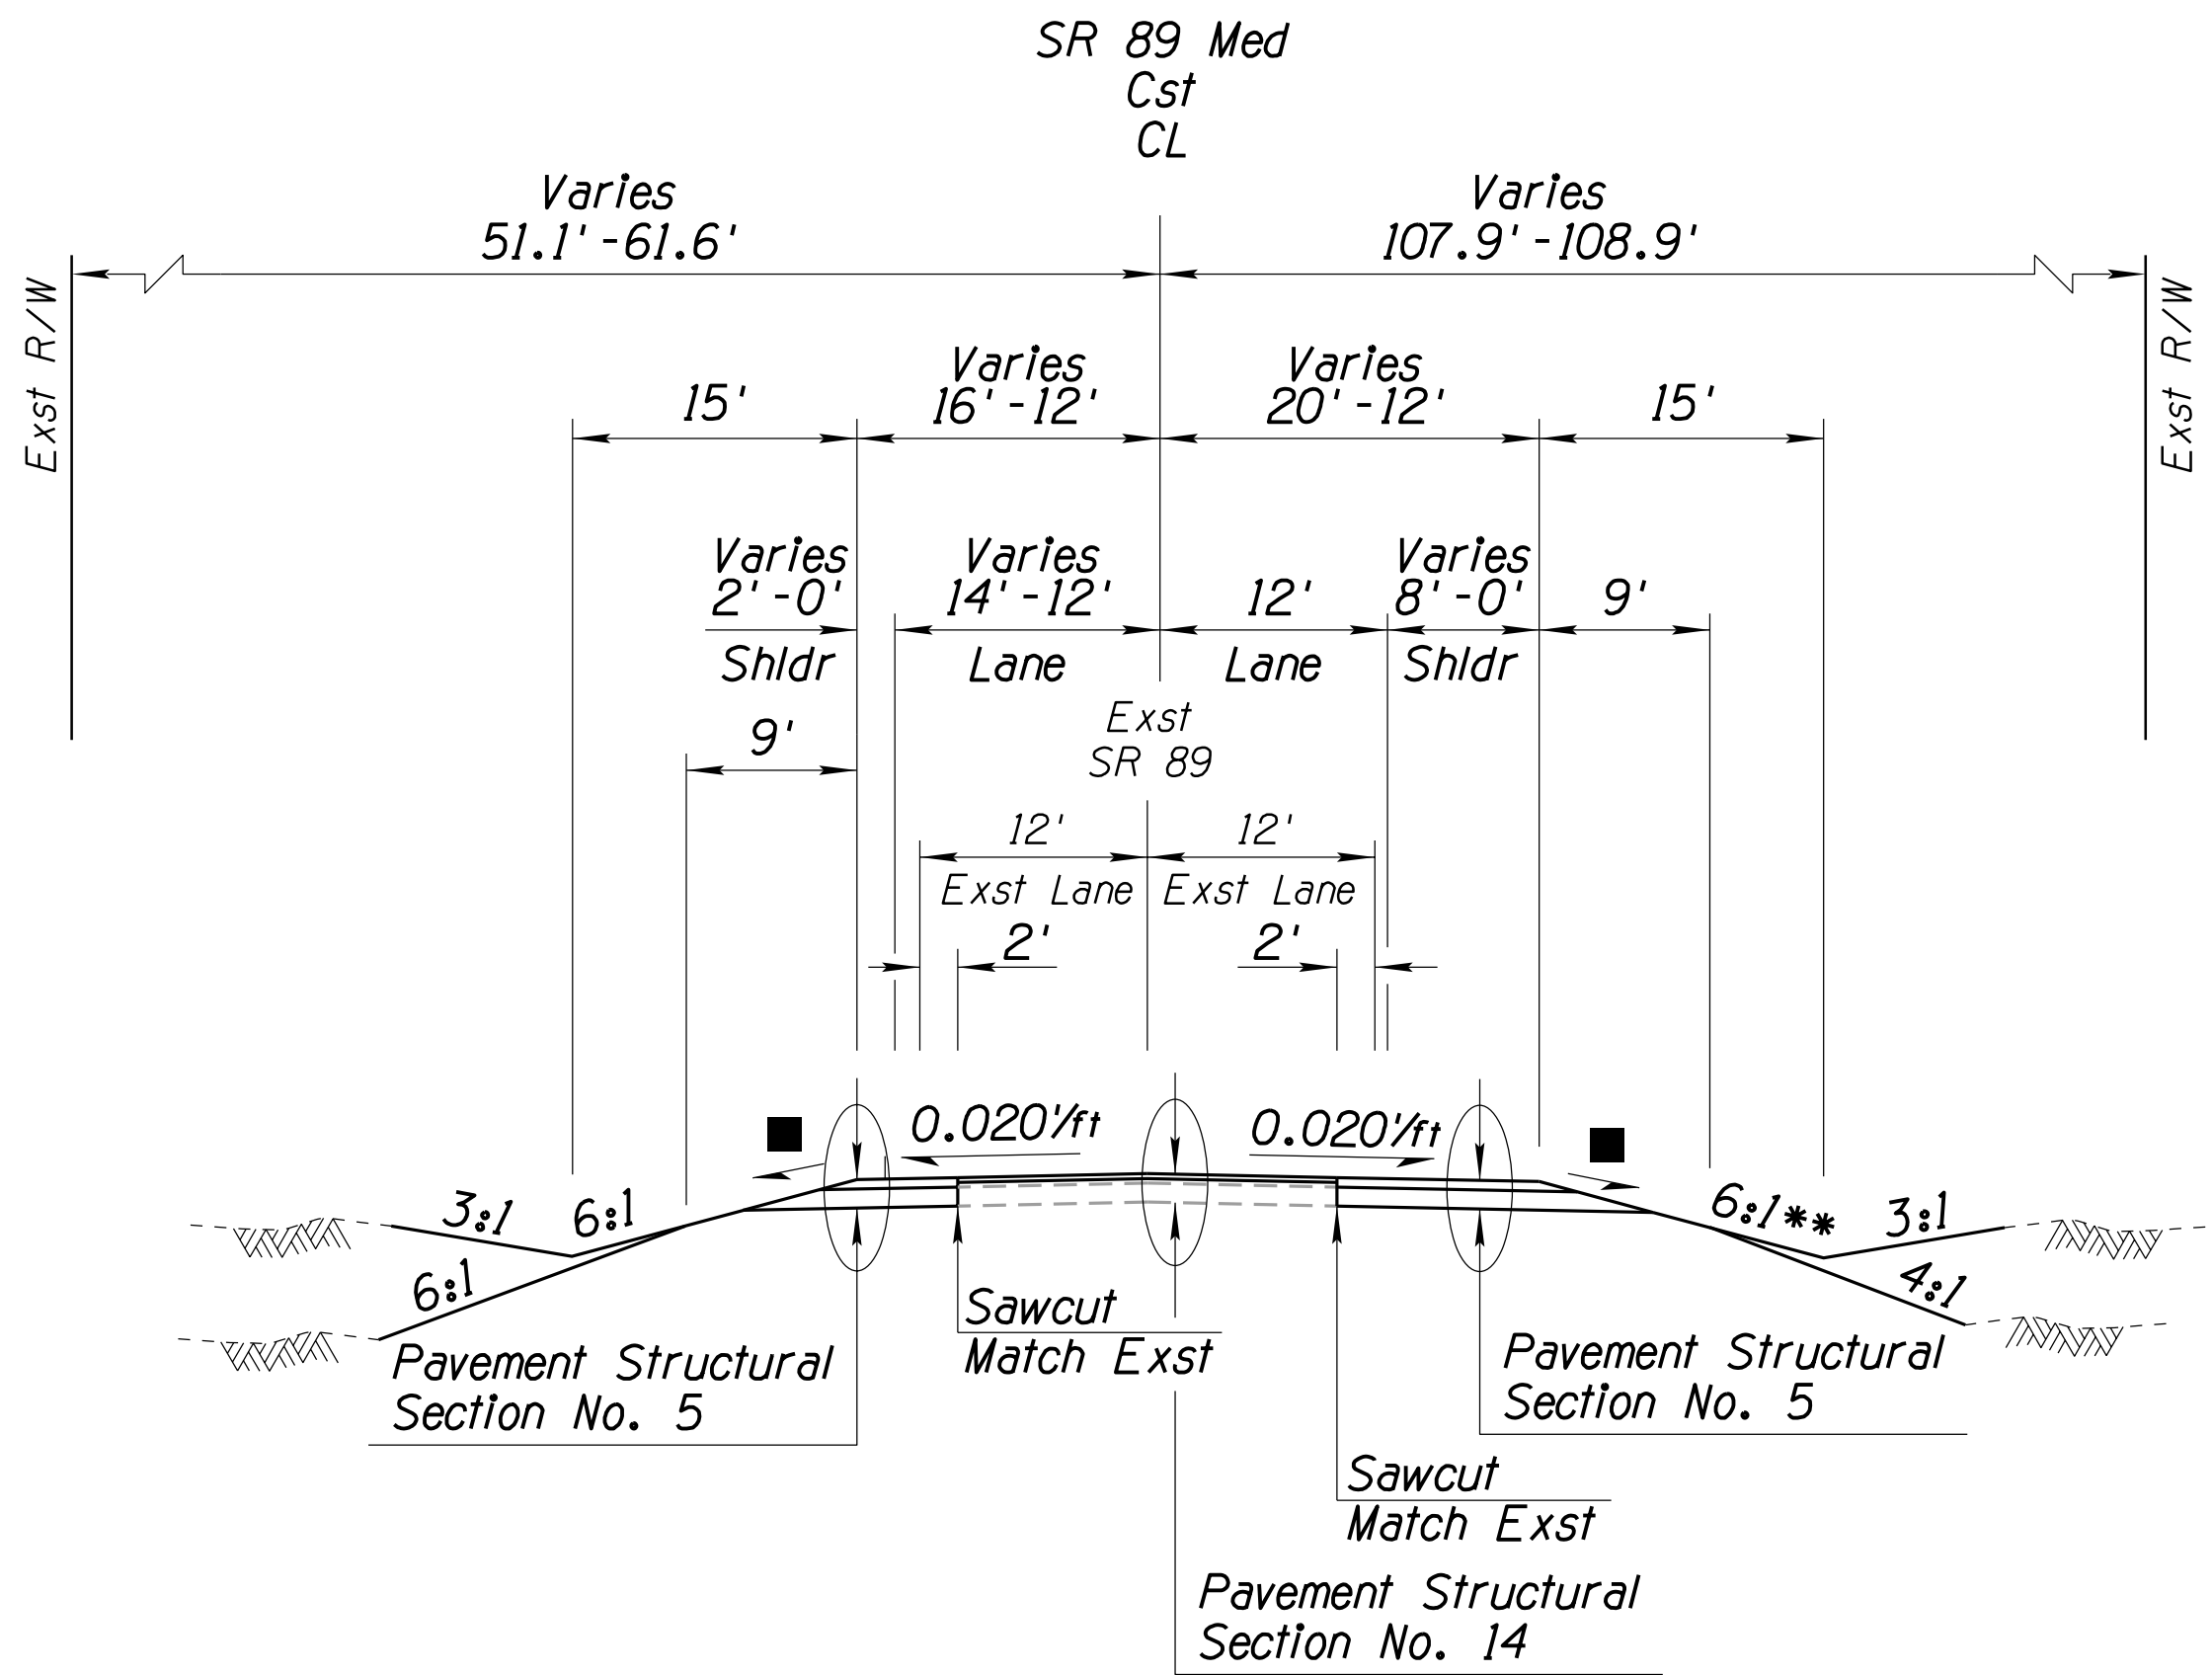

■ Subgrade/Slope Hinge Treatment Detail per Std C-02.20

** See Plans for Grading Information.


SR 89 TYPICAL SECTION

Sta 128+30.94 to 130+87.63

DESIGN	ZSZ	DATE	06-26	ARIZONA DEPARTMENT OF TRANSPORTATION PROJECT DELIVERY AND OPERATIONS DIVISION ROADWAY DESIGN SERVICES	
DRAWN	RM	DATE	06-26		
CHECKED	DBK	DATE	06-26		
 3133 East Camelback Road, Suite 100 Phoenix, Arizona 85016 Phone: (602) 333-2200				TYPICAL SECTIONS	
ROUTE		LOCATION		DWG NO. G-3.11	
US 93		WICKENBURG RANCH WAY TO VISTA ROYALE			
TRACS NO. F0738 OIC			093-B(230)T		
			OF		


F.H.W.A. REGION	STATE	PROJECT NO.	SHEET NO.	TOTAL SHEETS	RECORD DRAWING
9	ARIZ.	093-B(230)T	18	524	

093 YV 189

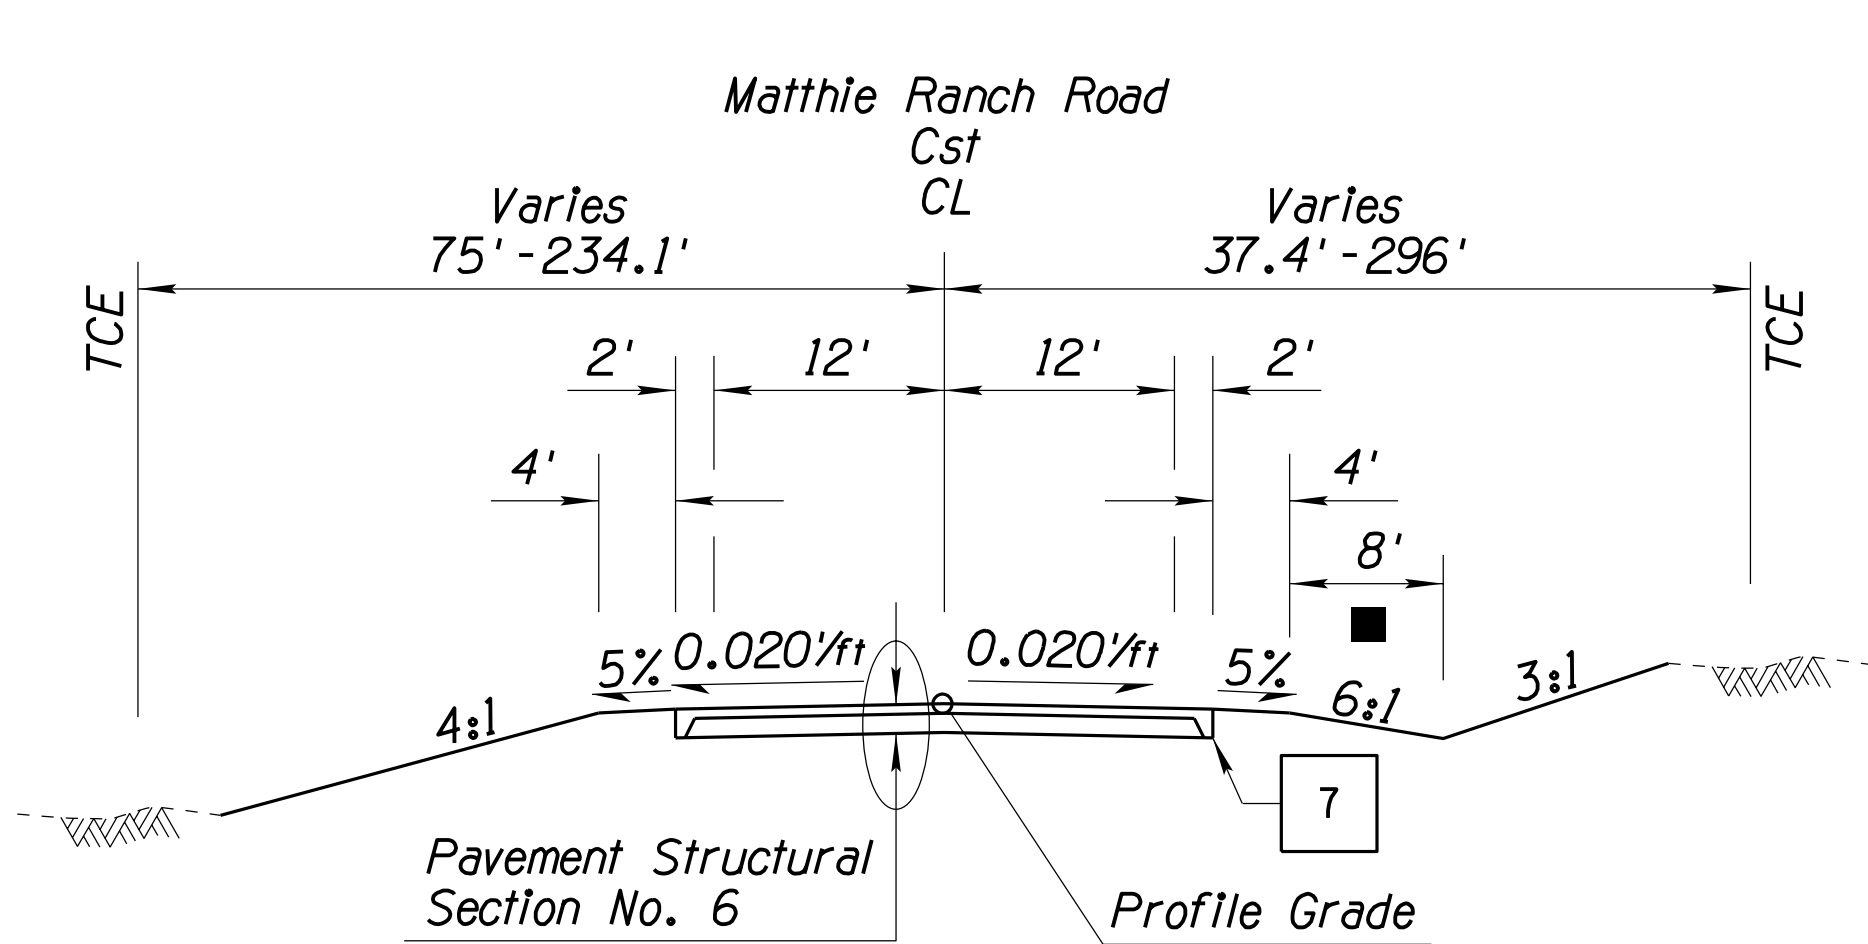

TYPICAL SECTION
MATTHIE RANCH RD

Sta 0+00.00 to 43+00.00

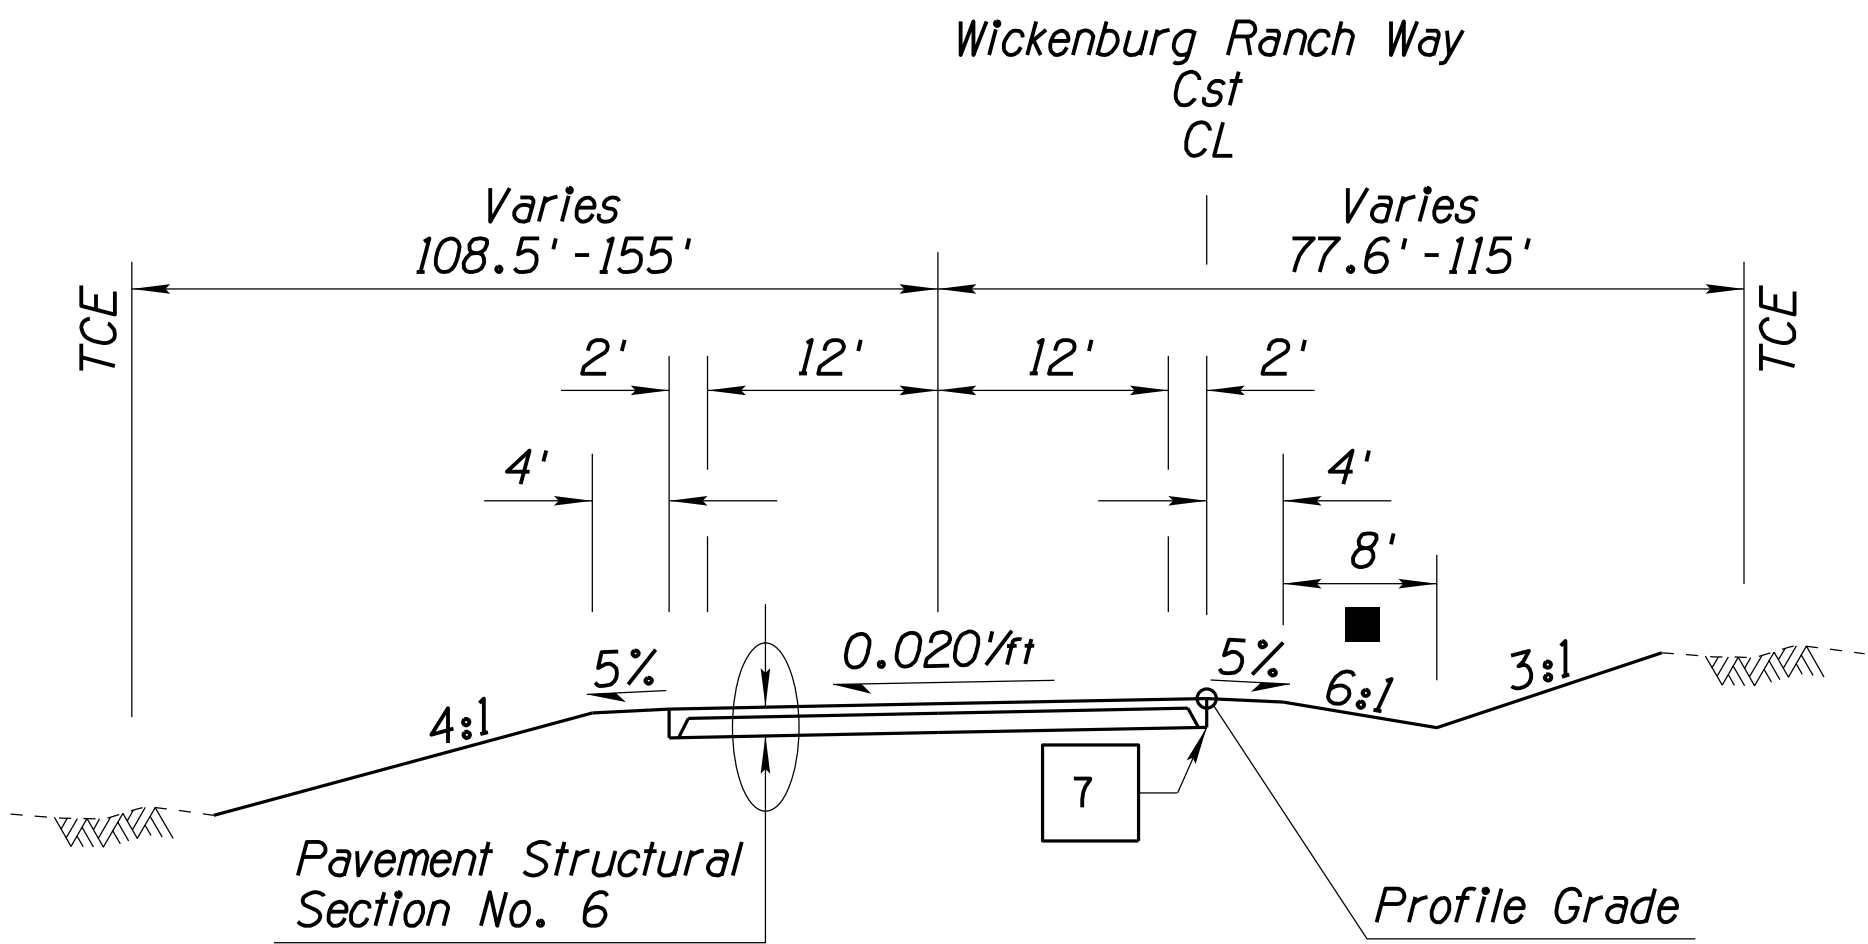


TYPICAL SECTION
WICKENBURG RANCH WAY

Sta 55+75.00 to 75+25.00

DITCH EXCEPTION TABLE ■			
Location	Lt/Rt	Width	Foreslope
Wickenburg Ranch Way Cst CL			
56+68.80 to 73+93.43	Lt	12'	6:1
Matthie Ranch Rd Cst CL			
9+09.80 to 12+56.95	Lt	24'	6:1
12+56.95 to 33+20	Lt	14.4'	4:1
16+00 to 24+20	Rt	21'	6:1

7 Thickened Edge, Type A (Typ)
MAG Dtl 201



		NAME	DATE	ARIZONA DEPARTMENT OF TRANSPORTATION PROJECT DELIVERY AND OPERATIONS DIVISION ROADWAY DESIGN SERVICES		
DESIGN		ZSZ	06-26			
DRAWN		RM	06-26			
CHECKED		DBK	06-26			
		3133 East Camelback Road, Suite 100 Phoenix, Arizona 85016 Phone: (602) 333-2200		TYPICAL SECTIONS		
ROUTE		LOCATION		DWG NO. G-3.12		
US 93		WICKENBURG RANCH WAY TO VISTA ROYALE				
TRACS NO. F0738 OIC			093-B(230)T		___ OF ___	

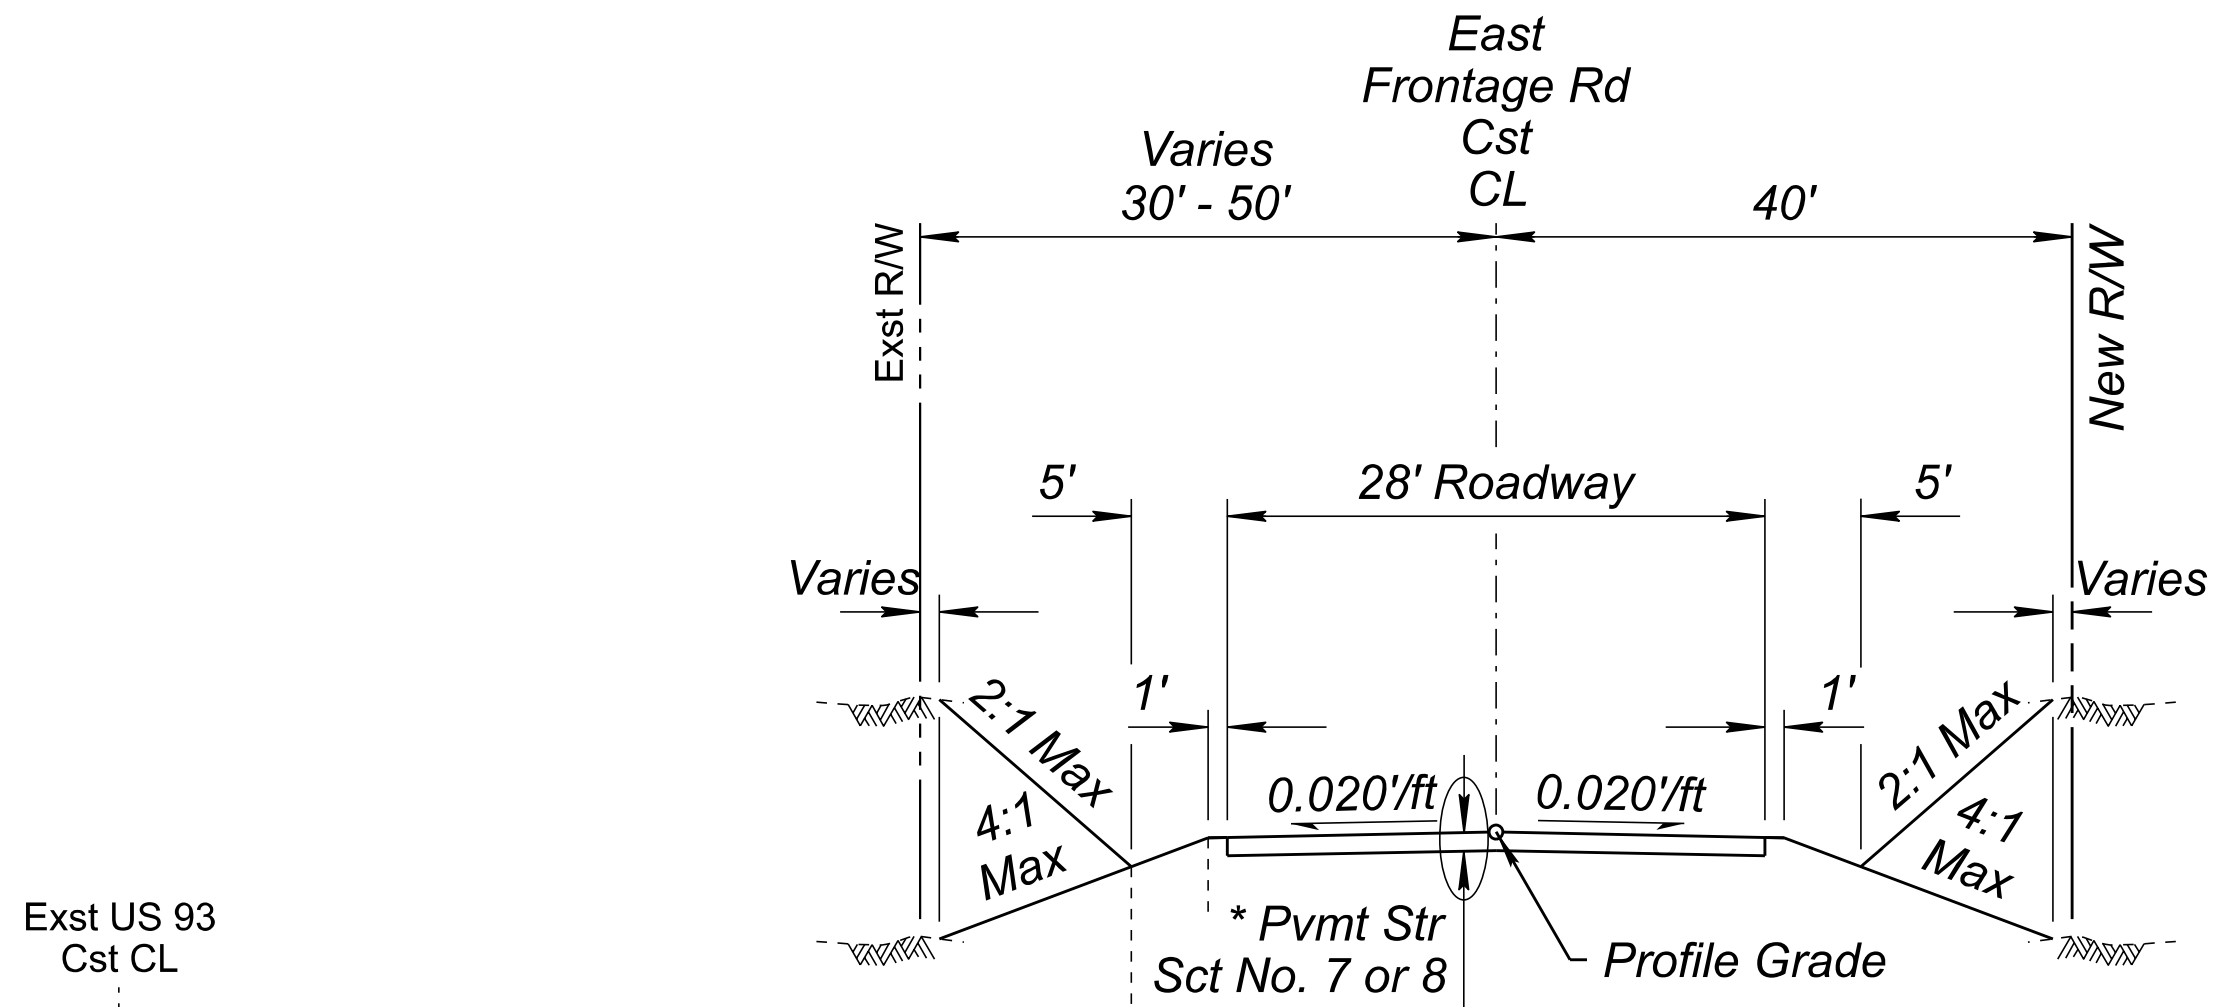

TYPICAL SECTION EAST FRONTAGE RD

Sta 113+62.31 to Sta 162+45.58

* PSS 8 and Application of Chip Seal
Sta 113+62.31 to Sta 161+66.62

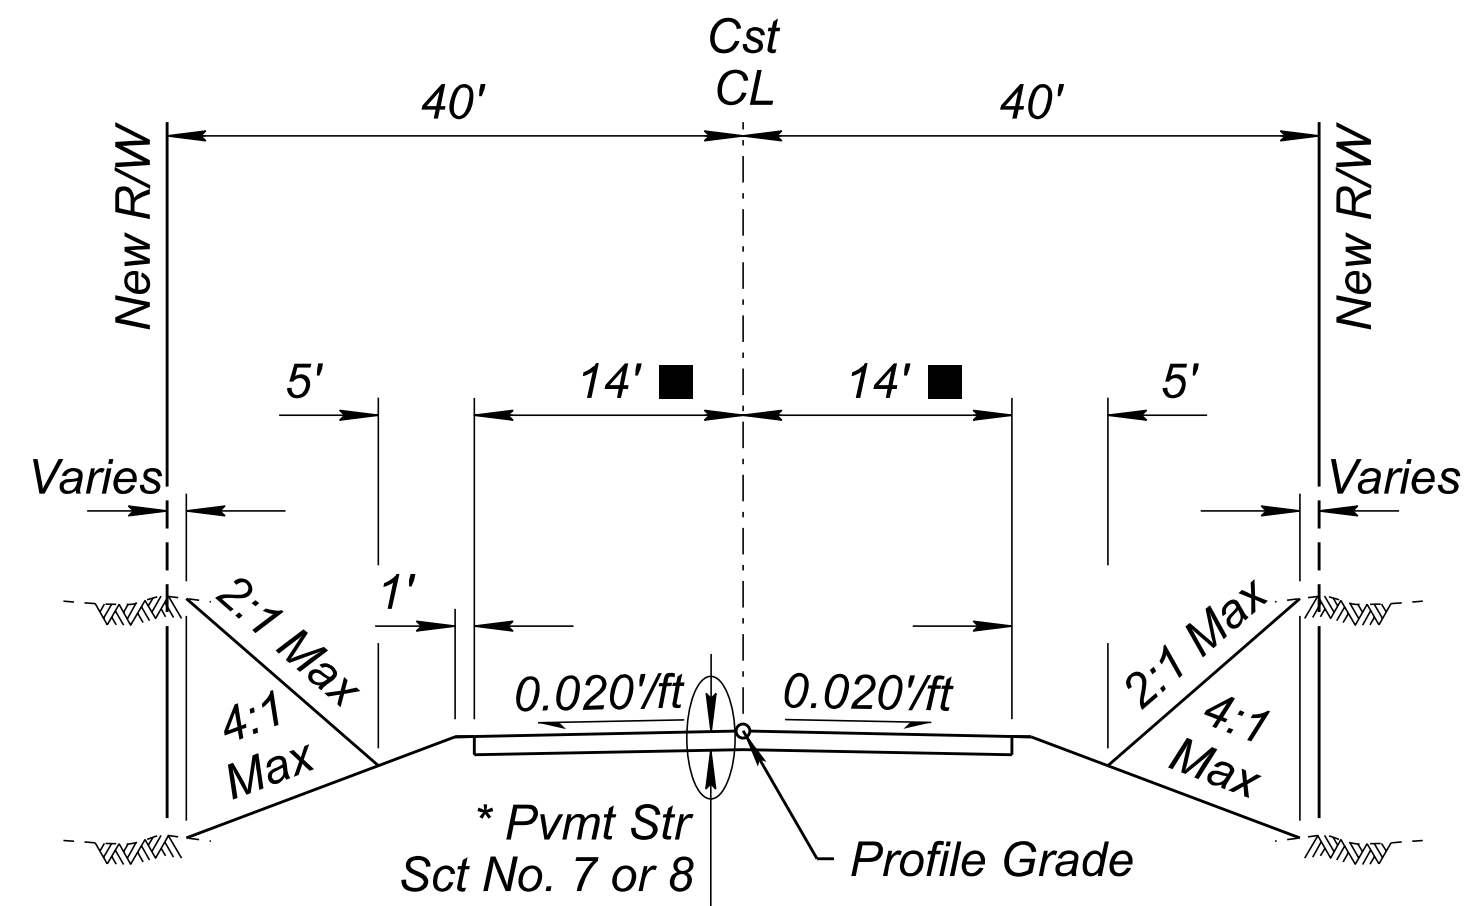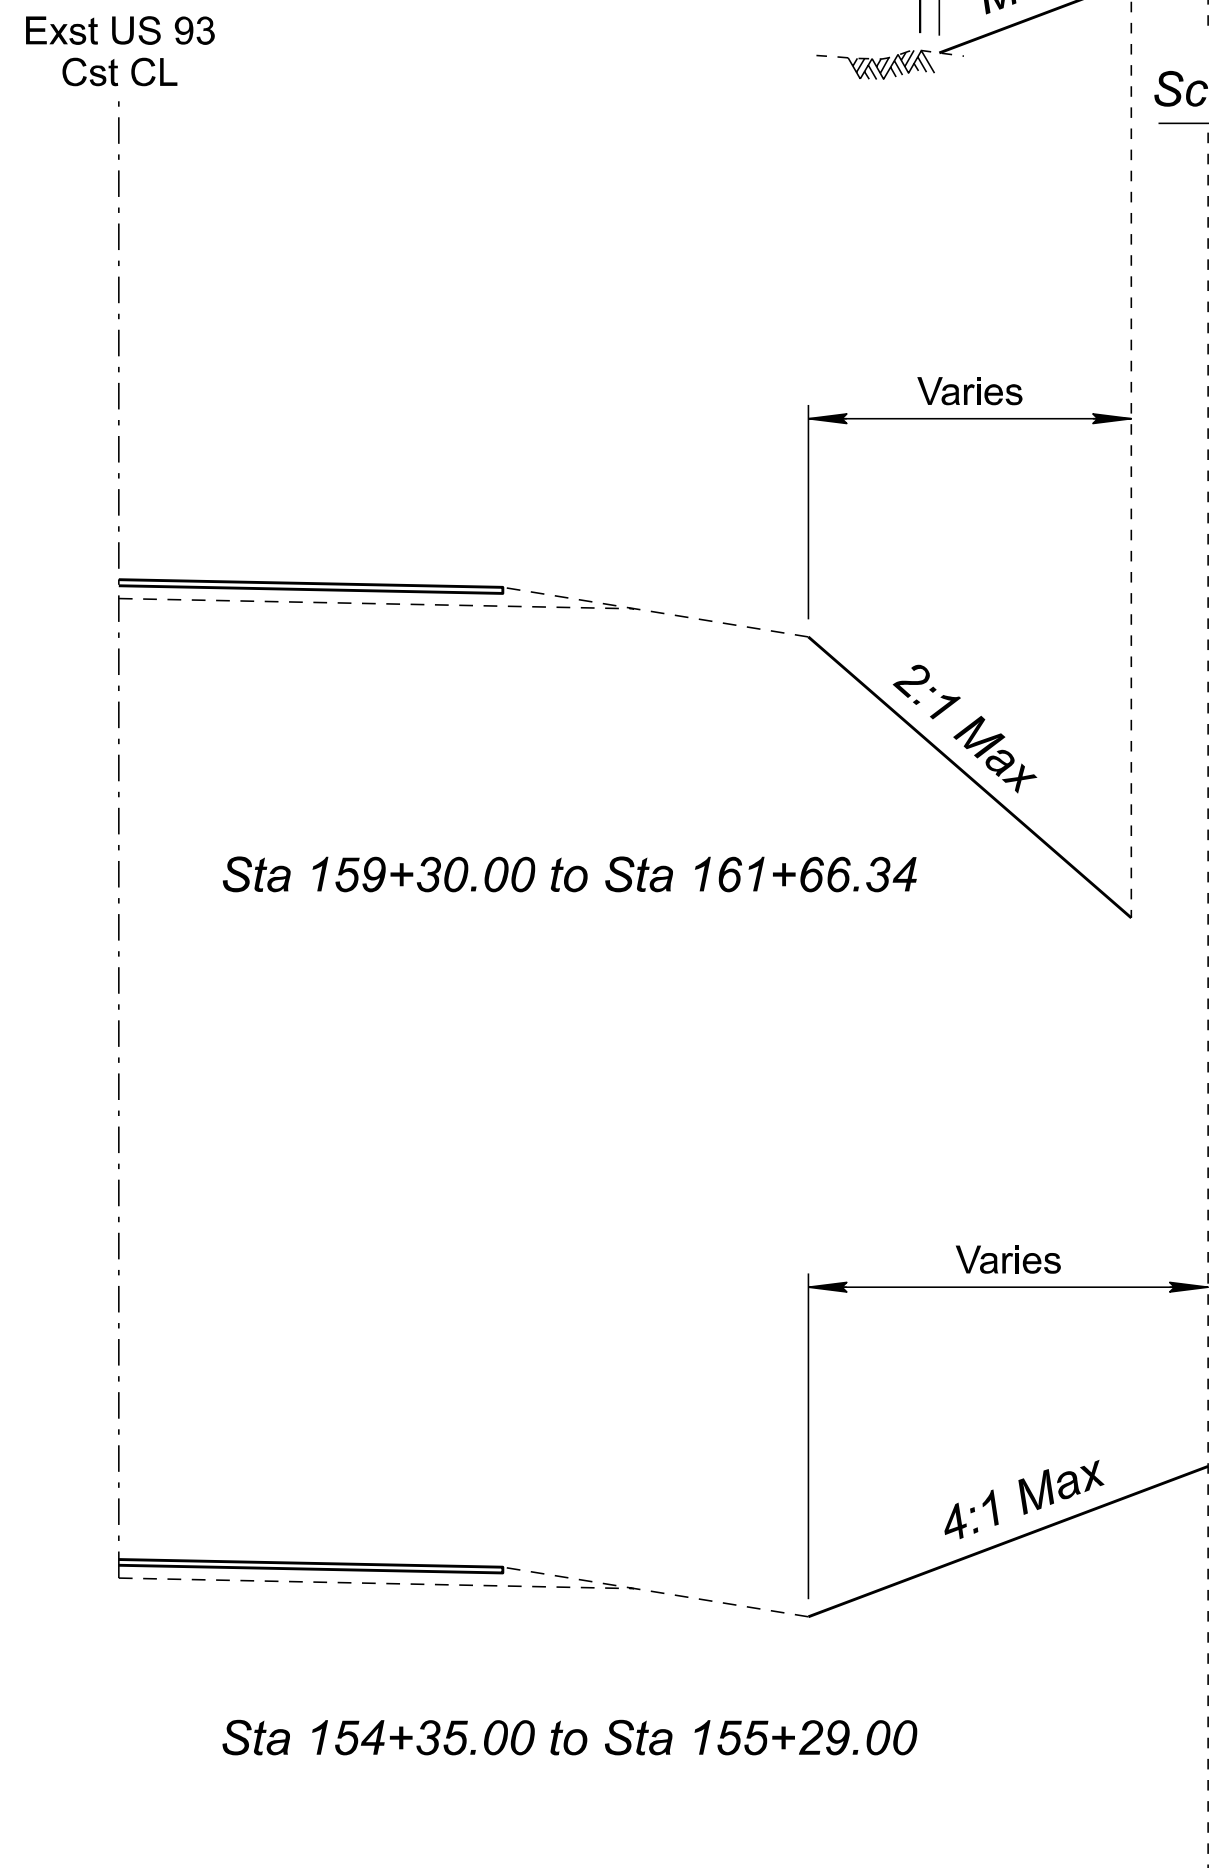


TYPICAL SECTION

Moreton Rd Sta 17+70.00 to Sta 18+77.72
Nine Irons Ranch Rd Sta 21+62.69 to Sta 25+46.59
Caballero Dr Sta 19+40.00 to Sta 19+48.55
Caballero Dr Sta 21+25.43 to Sta 21+66.00

* PSS 8 and Application of Chip Seal
Nine Irons Ranch Rd Sta 22+09.21 to Sta 24+23.10


■ **Varies, Lt & Rt**
Moreton Rd
See Plans

Varies Lt & Rt
Nine Irons Ranch Rd
See Plans

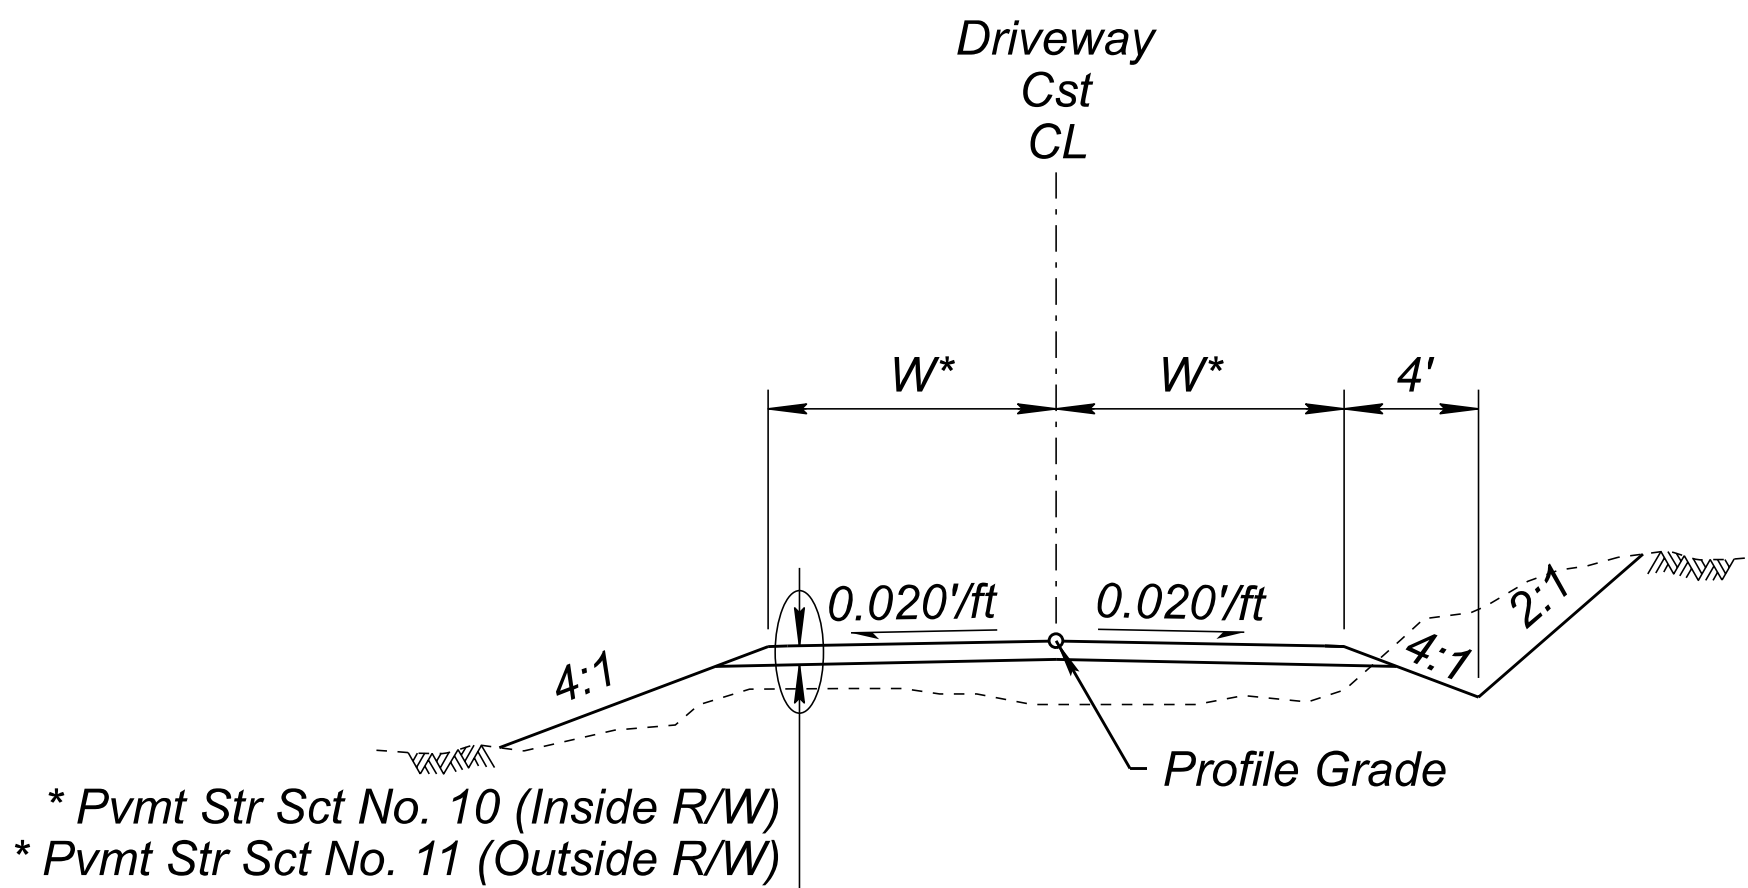

TYPICAL SECTION DRIVEWAYS


* See Driveway Plan & Profile
Sheet for Driveway Widths

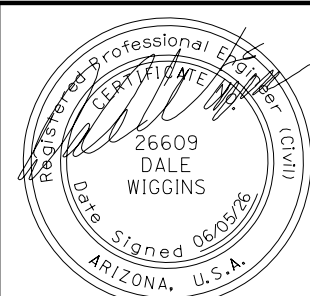

	NAME	DATE
DESIGN	J GILLIS	06/26
DRAWN	M SAMUELSON	06/26
CHECKED	D WIGGINS	06/26




TRANSPORTATION
 AECOM TECHNICAL SERVICES, Inc.
 7720 N. 16th St., Suite 100
 Phoenix, Arizona 85020
 T 602.371.1100
AECOM
 www.aecom.com

ROUTE US 93 MILEPOST 189.9 STRUCTURE NO.	ARIZONA DEPARTMENT OF TRANSPORTATION PROJECT DELIVERY AND OPERATIONS DIVISION ROADWAY DESIGN SERVICES	F.H.W.A. Arizona Division ARIZ.	PROJECT NO. 093 YV 189	FEDERAL ID NO. 093-B(230)T	SHEET NO. 19	TOTAL SHEETS 524	RECORD DRAWING
	TYPICAL SECTIONS	WICKENBURG RANCH WAY TO VISTA ROYALE					DWG No. G-3.13
		TRACS NO. F0738 01C					____ OF ____

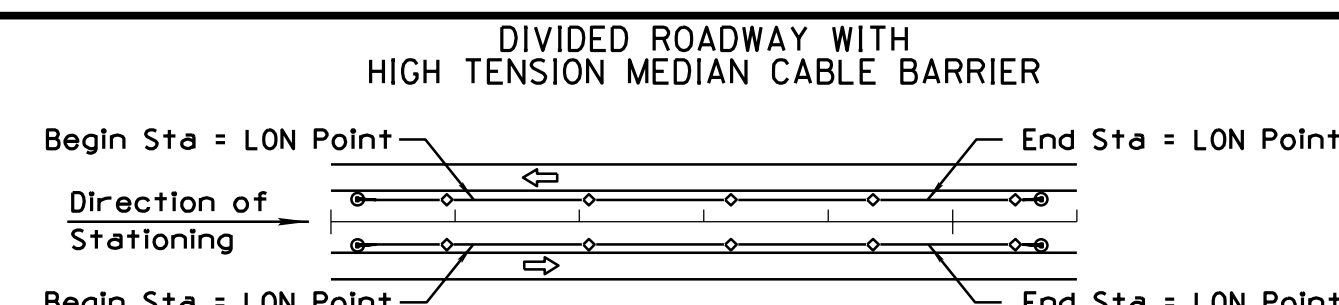093 YV 189

■ ARRAY TYPE AND ANGLE IS NOTED UNDER 'REMARKS'.

 OE

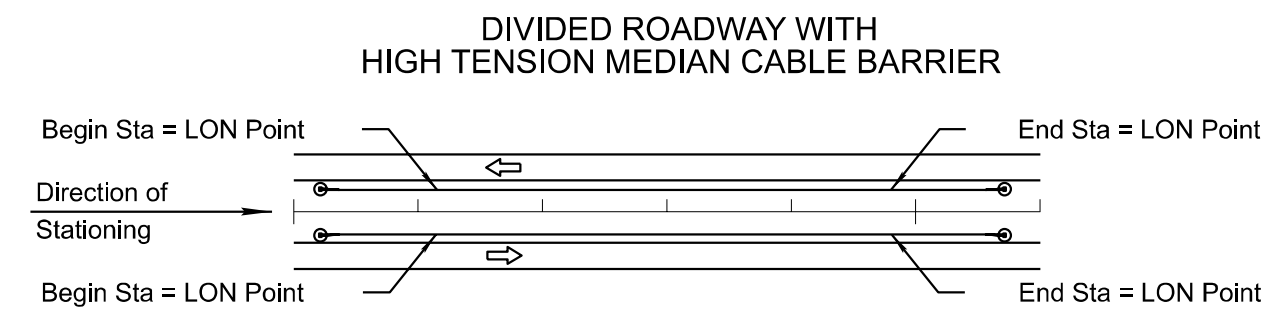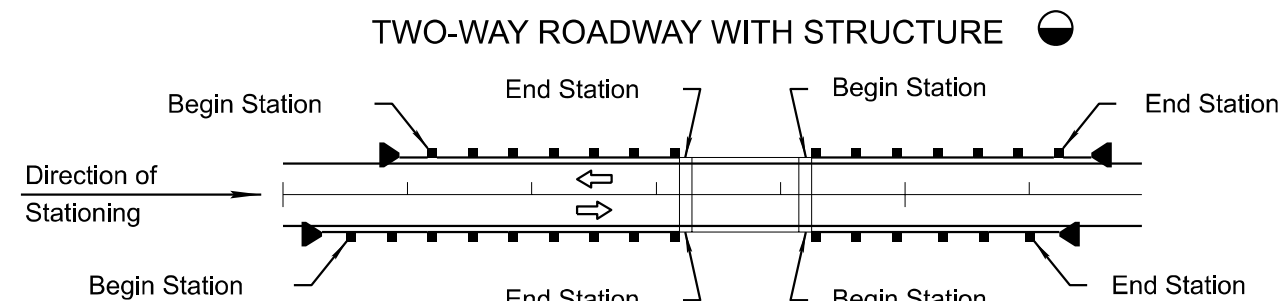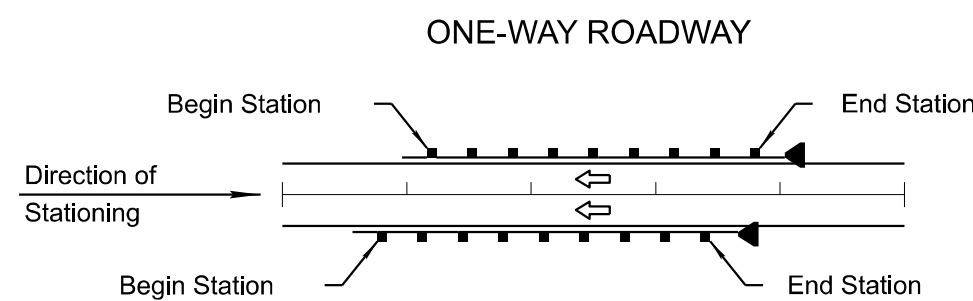[illegible]

THE ZEROS IN PARENTHESES (0.0) INDICATE THE DIMENSIONAL PRECISION FOR THAT COLUMN.

● LENGTH IS FROM LENGTH OF NEED (LON) POINT TO LON POINT. ACTUAL SEGMENT LENGTH VARIES DEPENDING ON TERMINAL TYPE. SEE SPECIAL PROVISIONS.

NOTE: FOR RECORD DRAWING PREPARATION - CIRCLE END TREATMENT INSTALLED.


● SEE BRIDGE SHEETS FOR BRIDGE BARRIER DETAILS AND QUANTITIES.

☒ ALLOWABLE END TREATMENT OPTIONS ARE INDICATED WITH THE NUMBER '1' IN THE SPACE. BLANK SPACES ARE NOT VIABLE ALTERNATIVES.

■ ARRAY TYPE AND ANGLE IS NOTED UNDER 'REMARKS'.

[illegible]

MR = Moreton Road
NIRR = Nine Irons Ranch Road

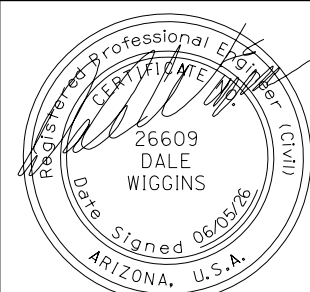

	NAME	DATE
DESIGN	J GILLIS	06/26
DRAWN	M SAMUELSON	06/26
CHECKED	D WIGGINS	06/26

TRANSPORTATION
AECOM TECHNICAL SERVICES, Inc.
 7720 N. 16th St., Suite 100
 Phoenix, Arizona 85020
 T 602.371.1100



ARIZONA DEPARTMENT OF TRANSPORTATION
PROJECT DELIVERY AND OPERATIONS DIVISION
ROADWAY DESIGN SERVICES

CURB & GUTTER SUMMARY SHEET

ROUTE US 93	F.H.W.A. Arizona Division	STATE ARIZ.	PROJECT NO. 093 YV 189	FEDERAL ID NO. 093-B(230)T	SHEET NO. 23	TOTAL SHEETS 524	RECORD DRAWING
MILEPOST 189.9	LOCATION WICKENBURG RANCH WAY TO VISTA ROYALE						DWG No. G-4.04
STRUCTURE NO.	TRACS NO. F0738 01C					OF	

NOTE:
PIPE OPTIONS SELECTED ARE THOSE REQUIRED TO
MEET MINIMUM SERVICE LIFE.
ALLOWABLE PIPE OPTIONS ARE INDICATED WITH THE
LETTER 'X' IN THE SPACE. BLANK SPACES ARE NOT
ALLOWABLE ALTERNATIVES.

CSP - CORRUGATED STEEL PIPE CAP - CORRUGATED ALUMINUM PIPE
RCP - REINFORCED CONCRETE PIPE
NRCP - NON-REINFORCED CONCRETE PIPE
NRCIPCP - NON-REINFORCED CAST-IN-PLACE CONCRETE PIPE
CHDPEP - CORRUGATED HIGH-DENSITY POLYETHYLENE PIPE
CPPP - CORRUGATED POLYPROPYLENE PIPE

093 YV 189

OF

NOTE:
PIPE OPTIONS SELECTED ARE THOSE REQUIRED TO
MEET MINIMUM SERVICE LIFE.
ALLOWABLE PIPE OPTIONS ARE INDICATED WITH THE
LETTER 'X' IN THE SPACE. BLANK SPACES ARE NOT
ALLOWABLE ALTERNATIVES.

CSP - CORRUGATED STEEL PIPE CAP - CORRUGATED ALUMINUM PIPE
RCP - REINFORCED CONCRETE PIPE
NRCP - NON-REINFORCED CONCRETE PIPE
NRCIPCP - NON-REINFORCED CAST-IN-PLACE CONCRETE PIPE
CHDPEP - CORRUGATED HIGH-DENSITY POLYETHYLENE PIPE
CPPP - CORRUGATED POLYPROPYLENE PIPE

093 YV 189

PIPE CORRUGATION			
A	2 ² / ₃ x 1/2	D	6 x 2
B	3 x 1	E	3 x 1 or 9 x 2 1/2
C	9 x 2 1/2		

		NAME		DATE		ARIZONA DEPARTMENT OF TRANSPORTATION PROJECT DELIVERY AND OPERATIONS DIVISION ROADWAY DESIGN SERVICES			
DESIGN		ETW		06-26					
DRAWN		JML		06-26					
CHECKED		JPM		06-26					
 Stanley Consultants INC.		3133 East Camelback Road, Suite 100 Phoenix, Arizona 85016 Phone: (602) 333-2200				NEW PIPE SUMMARY SHEET			
ROUTE		LOCATION							
US 93		WICKENBURG RANCH WAY TO VISTA ROYALE						DWG NO. G-4.06	
TRACS NO. F0738 OLC				093-B(230)T				_____ <i>OF</i> _____	

NOTE:
PIPE OPTIONS SELECTED ARE THOSE REQUIRED TO
MEET MINIMUM SERVICE LIFE.
ALLOWABLE PIPE OPTIONS ARE INDICATED WITH THE
LETTER 'X' IN THE SPACE. BLANK SPACES ARE NOT
ALLOWABLE ALTERNATIVES.

CSP	- CORRUGATED STEEL PIPE	CAP	- CORRUGATED ALUMINUM PIPE
RCP	- REINFORCED CONCRETE PIPE		
NRCP	- NON-REINFORCED CONCRETE PIPE		
NRCIPCP	- NON-REINFORCED CAST-IN-PLACE CONCRETE PIPE		
CHDPEP	- CORRUGATED HIGH-DENSITY POLYETHYLENE PIPE		
CPPP	- CORRUGATED POLYPROPYLENE PIPE		

F.H.W.A. REGION	STATE	PROJECT NO.	SHEET NO.	TOTAL SHEETS	RECORD DRAWING
9	ARIZ.	093-B(230)T	26	524	

093 YV 189

[illegible]

RANGE NO.		1	2	3	4	5	6	7	8	9	10	11	12
FILL	≥	1	3	5	8	11	15	20	25	30	40	55	70
HEIGHT (F ₊)		3	5	8	11	15	20	25	30	40	55	70	90

● SHOULD FILL CONDITIONS VARY FROM THE RANGE INDICATED, CONTACT DESIGN FOR RE-EVALUATION OF PIPE REQUIREMENTS.

☑ PIPE CORRUGATION			
A	2 ² / ₃ x 1/2	D	6 x 2
B	3 x 1	E	3 x 1 or 9 x 2 1/2
C	9 x 2 1/2		

		NAME		DATE		ARIZONA DEPARTMENT OF TRANSPORTATION PROJECT DELIVERY AND OPERATIONS DIVISION ROADWAY DESIGN SERVICES			
DESIGN		ETW		06-26					
DRAWN		JML		06-26					
CHECKED		JPM		06-26					
 Stanley Consultants Inc.		3133 East Camelback Road, Suite 100 Phoenix, Arizona 85016 Phones (602) 333-2200				NEW PIPE SUMMARY SHEET			
ROUTE		LOCATION							
US 93		WICKENBURG RANCH WAY TO VISTA ROYALE						DWG NO. G-4.07	
TRACS NO. F0738 OIC						093-B(230)T		_____ <i>OF</i> _____	

NOTE:
PIPE OPTIONS SELECTED ARE THOSE REQUIRED TO MEET MINIMUM SERVICE LIFE.
ALLOWABLE PIPE OPTIONS ARE INDICATED WITH THE LETTER 'X' IN THE SPACE. BLANK SPACES ARE NOT ALLOWABLE ALTERNATIVES.

CSP	- CORRUGATED STEEL PIPE	CAP	- CORRUGATED ALUMINUM PIPE
RCP	- REINFORCED CONCRETE PIPE		
NRCPP	- NON-REINFORCED CONCRETE PIPE		
NRCPCP	- NON-REINFORCED CAST-IN-PLACE CONCRETE PIPE		
CHDPEP	- CORRUGATED HIGH-DENSITY POLYETHYLENE PIPE		
CPPP	- CORRUGATED POLYPROPYLENE PIPE		

093 YV 189DWG NO. G-4.08

093-B(230)T


 OF

NOTE: THE ZEROS IN PARENTHESES (0, 0.0 & 0.000) INDICATE THE DIMENSIONAL PRECISION FOR THAT COLUMN	NOTE: FOR PIPE CULVERT PLACEMENT SEE STANDARD DRAWINGS C-13.10 AND C-13.15
---	---

NOTE: THE ZEROS IN PARENTHESES (0, 0.0 & 0.000) INDICATE THE DIMENSIONAL PRECISION FOR THAT COLUMN	NOTE: FOR PIPE CULVERT PLACEMENT SEE STANDARD DRAWINGS C-13.10 AND C-13.15
---	---


NOTE: THE ZEROS IN PARENTHESES (0, 0.0 & 0.000) INDICATE THE DIMENSIONAL PRECISION FOR THAT COLUMN	NOTE: FOR PIPE CULVERT PLACEMENT SEE STANDARD DRAWINGS C-13.10 AND C-13.15	NOTE: PIPE OPTIONS SELECTED ARE THOSE REQUIRED TO MEET MINIMUM SERVICE LIFE. ALLOWABLE PIPE OPTIONS ARE INDICATED WITH THE LETTER 'X' IN THE SPACE. BLANK SPACES ARE NOT ALLOWABLE ALTERNATES.
---	---	--

CSP	- CORRUGATED STEEL PIPE	CAP	- CORRUGATED ALUMINUM PIPE
RCP	- REINFORCED CONCRETE PIPE		
NRCP	- NON-REINFORCED CONCRETE PIPE		
NRCCPCP	- NON-REINFORCED CAST-IN-PLACE CONCRETE PIPE		
CHDPEP	- CORRUGATED HIGH-DENSITY POLYETHYLENE PIPE		
CPPP	- CORRUGATED POLYPROPYLENE PIPE		

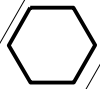Station	DESCRIPTION												CSP			CAP			RCP			C P	C P	E P	I P	END TREATMENT															QUANTITIES																																																																																																																																																																																																																																																																																																																																																																																																																																																																																																				
	Plan Reference Number		Size, Corrugated	Size, Smooth	Length (0)	Skew (0)		Corrugation	Wall Thickness (0.000)	Zinc	Bituminous Coated Zinc	Aluminum		Corrugation	Wall Thickness (0.000)	Uncoated	Bituminous Coated	Class - Non-Trench	Class - Trench	Class	Minimum Wall Thickness (0)					AASHTO M-294 Type S	AASHTO M-330 Type S	C-13-20 & C-13-25	Size, (In) Manhole	Standard or Detail	End Section	Each	Catch Basin, Manhole, Headwall & Junction Structure															Cubic Yard																																																																																																																																																																																																																																																																																																																																																																																																																																																																																													
																																	S-Single / D-Double	Location	H (0.0)	L Wing (0.0)	L 18" Slotted Drain (0)	L 24" Slotted Drain (0)	Type	Elevation (0.00)	Depth	Grate		Inlet Depression C-15.70	Pipe Excavation (0)	Pipe Backfill (0) C-13.15	Drainage Excavation (0)		Berm/Dike Embankment (0)																																																																																																																																																																																																																																																																																																																																																																																																																																																																																												
																																										Ft.	In.							Ft.																																																																																																																																																																																																																																																																																																																																																																																																																																																																																											
																																																			L (0.0)	In.	Ft.																																																																																																																																																																																																																																																																																																																																																																																																																																																																																								
REMARKS																																																																																																																																																																																																																																																																																																																																																																																																																																																																																																																																													
SB US 93 CL 224+78, 18' Lt	224	1	36		75	0	A	.064	X			B	0.060				V	V		X	X						Dtl DG			4.4					2486.59			97	31			CB-224 to MH-225																																																																																																																																																																																																																																																																																																																																																																																																																																																																																																			
NB US 93 CL 224+51, 19'Lt																																																																																																																																																																																																																																																																																																																																																																																																																																																																																																																																													
NB US 93 CL 224+51, 19' Lt	225	2	36		88	37 Rt	A	.064	X			B	0.060				IV	IV		X	X			≤36	C-18.10			8.9					2490.29			104	36					MH-225 to MH-410																																																																																																																																																																																																																																																																																																																																																																																																																																																																																																			
NIRR CL 20+82, 52' Lt																																																																																																																																																																																																																																																																																																																																																																																																																																																																																																																																													
SB US 93 CL 294+64, 33' Rt	294	2	42		122	40 Lt	A	.064	X			B	0.060				III	III		X	X				Dtl DI			6.5					2564.57			69	38					CB-294 to L-Headw all, See Dtl D14																																																																																																																																																																																																																																																																																																																																																																																																																																																																																																			
SB US 93 CL 293+94, 47' Lt			42		122	40 Lt	A	.064	X			B	0.060				III	III		X	X				SD-6.30	D																																																																																																																																																																																																																																																																																																																																																																																																																																																																																																																			
NIRR CL 20+82, 52' Lt	410	2	36		125	12 Rt	A	.064	X			B	0.060				III	III		X	X		≤36	C-18.10			6.9					2487.27			54	52					MH-410 to Headw all, Dtl DH																																																																																																																																																																																																																																																																																																																																																																																																																																																																																																				
NIRR CL 20+91, 67' Rt																																																																																																																																																																																																																																																																																																																																																																																																																																																																																																																																													
NIRR CL 21+23, 44' Lt	415	2	36		115	20 Lt	A	.064	X			B	0.060				III	III		X	X			Dtl DH												29	36					Headw all to Triple Barrel Headw all																																																																																																																																																																																																																																																																																																																																																																																																																																																																																																			
NIRR CL 20+91, 67' Rt			36		115	20 Lt	A	.064	X			B	0.060				III	III		X	X																								See Dtl DH & Dtl D31																																																																																																																																																																																																																																																																																																																																																																																																																																																																																																
Caballero Dr CL 21+27, 27' Lt	425	2	24		55		A	.064	X			B	0.060									1														21	16					End Section to End Section																																																																																																																																																																																																																																																																																																																																																																																																																																																																																																			
Caballero Dr CL 21+27, 28' Rt																						1																																																																																																																																																																																																																																																																																																																																																																																																																																																																																																																							
E Frontage Rd 113+85, 37' Rt	110	1	24		76		A	.064	X			B	0.060				IV	IV		X	X			C-15.80			4.7					2485.02			36	22					CB-110 to Straight Headw all																																																																																																																																																																																																																																																																																																																																																																																																																																																																																																				
E Frontage Rd 113+94, 38' Lt																								SD-06.30																																																																																																																																																																																																																																																																																																																																																																																																																																																																																																																					
Dw y 131+17 CL 10+31, 25' Lt	170	1	18		49		A	.064	X			B	0.060									2														4	14					End Section to End Section																																																																																																																																																																																																																																																																																																																																																																																																																																																																																																			
Dw y 131+17 CL 10+40, 23' Rt																																																																																																																																																																																																																																																																																																																																																																																																																																																																																																																																													
																							0	4	2																																																																																																																																																																																																																																																																																																																																																																																																																																																																																																																				

FILL HEIGHT RANGE TABLE (Ft.)													
RANGE NO.		1	2	3	4	5	6	7	8	9	10	11	12
FILL	>	1	3	5	8	11	15	20	25	30	40	55	70
HEIGHT (Ft.)	≤	3	5	8	11	15	20	25	30	40	55	70	90
● SHOULD FIELD CONDITIONS VARY FROM THE RANGE INDICATED, CONTACT DESIGN FOR RE-EVALUATION OF PIPE DESIGN REQUIREMENTS.													

PIPE CORRUGATION			
A	2 $\frac{2}{3}$ x1 $\frac{1}{2}$	D	6x2
B	3x1	E	3x1 or 9x2 $\frac{1}{2}$
C	9x2 $\frac{1}{2}$		

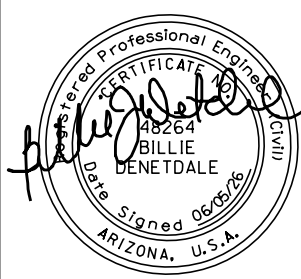

	NAME	DATE
DESIGN	K LEANDER	06/26
DRAWN	B LEANDER	06/26
CHECKED	B DENETDALE	06/26

TRANSPORTATION
AECOM TECHNICAL SERVICES, Inc.
 7720 N. 16th St., Suite 100
 Phoenix, Arizona 85020
 T 602.371.1100

AECOM
www.aecom.com

ARIZONA DEPARTMENT OF TRANSPORTATION
PROJECT DELIVERY AND OPERATIONS DIVISION
ROADWAY DESIGN SERVICES

NEW PIPE SUMMARY SHEET

ROUTE US 93	F.H.W.A. Arizona Division	STATE	PROJECT NO.	FEDERAL ID NO.	SHEET NO.	TOTAL SHEETS	RECORD DRAWING
MILEPOST 189.9		ARIZ.	093 YV 189	093-B(230)T	28	524	
	LOCATION	WICKENBURG RANCH WAY TO VISTA ROYALE					DWG No. G-4.09
STRUCTURE NO.	TRACS NO. F0738 01C						___ OF ___

NOTE:
PIPE OPTIONS SELECTED ARE THOSE REQUIRED TO MEET MINIMUM SERVICE LIFE.
ALLOWABLE PIPE OPTIONS ARE INDICATED WITH THE LETTER 'X' IN THE SPACE. BLANK SPACES ARE NOT ALLOWABLE ALTERNATES.

	N R C P	N R C I P C P	C H D P E P	C P P P
--	---------	---------------	-------------	---------

 PIPE CORRUGATION			
A	2 ² / ₃ x1 ¹ / ₂	D	6x2
B	3x1	E	3x1 or 9x2 ¹ / ₂
C	9x2 ¹ / ₂		

REV. DATE: MAR 2022

CSP	- CORRUGATED STEEL PIPE	CAP	- CORRUGATED ALUMINUM PIPE
RCP	- REINFORCED CONCRETE PIPE		
NRCP	- NON-REINFORCED CONCRETE PIPE		
NRCICP	- NON-REINFORCED CAST-IN-PLACE CONCRETE PIPE		
CHDPEP	- CORRUGATED HIGH-DENSITY POLYETHYLENE PIPE		
CPPP	- CORRUGATED POLYPROPYLENE PIPE		

Station	Plan Reference Number	Controlling Fill Height Range	Size, Corrugated	Size, Smooth	DESCRIPTION								CSP				CAP		RCP		P	C	P	E	P	END TREATMENT												QUANTITIES									
					In.		In.		Ft.	Degree	In.	Coating	In.														Each	Catch Basin, Manhole, Headwall & Junction Structure						Cubic Yard													
					Length (0)	Skew (0)	Corrugation	Wall Thickness (0.000)	Zinc	Bituminous Coated Zinc	Aluminum	Corrugation	Wall Thickness (0.000)	Uncoated	Bituminous Coated	Class - Non-Trench	Class - Trench	Class	Minimum Wall Thickness	AASHTO M-294 Type S						AASHTO M-330 Type S	C-13-20 & C-13-25	Size, (In) Manhole	Standard or Detail	End Section	Ea	S-Single / D-Double	Location	H (0.0)	L Wing (0.0)	L 18" Slotted Drain (0)	L 24" Slotted Drain (0)	Type	Elevation (0.00)	Depth	Grate		Inlet Depression C-15.70	Pipe Excavation (0)	Pipe Backfill (0) C-13, 15	Drainage Excavation (0)	Berm/Dike Embankment (0)
																																									In.	Ft.					
REMARKS																																															
SB US 93 CL 226+51, 35' Rt	514	2	24		81		A	.064	X			B	0.060			III	III		X	X				Dtl DF			4.5					2489.41			38	24			CB-514 to CB-513								
NB US 93 CL, 225+69, 24' Lt																																															
SB US 93 CL 227+34, 31' Rt	515	2	24		81		A	.064	X			B	0.060			III	III		X	X				Dtl DF			4.5					2489.81			83	24			CB-515 to CB-514								
SB US 93 CL 226+51, 35' Rt																																															
NB US 93 CL 243+72, 29' Lt	518	2	18		129		A	.064	X			B	0.060			III	III		X	X				C-15.80			3.5				2521.60			133	38			CB-518 to End Section									
NB US 93 CL 243+65, 43' Rt																					1																										
SB US 93 CL 246+79, 33' Rt	520	3	24		84		A	.064	X			B	0.060			III	III		X	X				C-15.80			3.5				2522.93			40	25			CB-520 to End Section									
SB US 93 CL 246+79, 52' Lt																					1																										
SB US 93 CL 292+21, 33' Rt	522	1	28 x 20		11		A	.064	X			B	0.060						X	X				C-15.90			2.2				2561.01			5	3			CB-522 to MH-292									
SB US 93 CL 292+11, 33' Rt																																															
SB US 93 CL 252+57, 33' Rt	525	2	24		91		A	.064	X			B	0.060			III	III		X	X				C-15.81			5.7				2528.43			70	27			CB-525 to Straight Headw all									
SB US 93 CL 252+49, 57' Lt																							SD-6.30																								
SB US 93 CL 260+06, 33' Rt	526	1	28 x 20		8		A	.064	X			B	0.060											C-15.90			2.2				2533.40			5	2			CB-526 to MH-260									
SB US 93 CL 259+99, 33' Rt																																															
SB US 93 CL 315+14, 33' Rt	527	1	28 x 20		6		A	.064	X			B	0.060											C-15.90			2.2				2582.35			3	2			CB-527 to MH-315, Dtl DJ									
SB US 93 CL 315+04, 33' Rt																																															

PIPE CORRUGATION			
A	2 $\frac{2}{3}$ x1 $\frac{1}{2}$	D	6x2
B	3x1	E	3x1 or 9x2 $\frac{1}{2}$
C	9x2 $\frac{1}{2}$		

	<table><tr><th></th><th>NAME</th><th>DATE</th></tr><tr><td>DESIGN</td><td>K LEANDER</td><td>06/26</td></tr><tr><td>DRAWN</td><td>B LEANDER</td><td>06/26</td></tr><tr><td>CHECKED</td><td>B DENETDALE</td><td>06/26</td></tr></table>			NAME	DATE	DESIGN	K LEANDER	06/26	DRAWN	B LEANDER	06/26	CHECKED	B DENETDALE	06/26	ARIZONA DEPARTMENT OF TRANSPORTATION PROJECT DELIVERY AND OPERATIONS DIVISION ROADWAY DESIGN SERVICES		ROUTE US 93	F.H.W.A. Arizona Division ARIZ.	STATE	PROJECT NO.	FEDERAL ID NO.	SHEET NO.	TOTAL SHEETS	RECORD DRAWING
		NAME	DATE																					
	DESIGN	K LEANDER	06/26																					
	DRAWN	B LEANDER	06/26																					
CHECKED	B DENETDALE	06/26																						
<table><tr><td colspan="3">TRANSPORTATION AECOM TECHNICAL SERVICES, Inc. 7725 N. 110th St., Suite 102 Phoenix, Arizona 85020 T 602.371.1100  www.aecom.com</td></tr></table>		TRANSPORTATION AECOM TECHNICAL SERVICES, Inc. 7725 N. 110th St., Suite 102 Phoenix, Arizona 85020 T 602.371.1100  www.aecom.com			NEW PIPE SUMMARY SHEET		MILEPOST 189.9	LOCATION WICKENBURG RANCH WAY TO VISTA ROYALE DWG No. G-4.11																
TRANSPORTATION AECOM TECHNICAL SERVICES, Inc. 7725 N. 110th St., Suite 102 Phoenix, Arizona 85020 T 602.371.1100  www.aecom.com																								
				STRUCTURE NO.	TRACS NO. F0738 01C		OF																	

REV. DATE: MAR 2022

NOTE:
THE ZEROS IN PARENTHESES (0, 0.0 & 0.000) INDICATE THE DIMENSIONAL PRECISION FOR THAT COLUMN

NOTE:
FOR PIPE CULVERT PLACEMENT SEE STANDARD DRAWINGS C-13.10 AND C-13.15

NOTE:
PIPE OPTIONS SELECTED ARE THOSE REQUIRED TO MEET MINIMUM SERVICE LIFE.
ALLOWABLE PIPE OPTIONS ARE INDICATED WITH THE LETTER 'X' IN THE SPACE. BLANK SPACES ARE NOT ALLOWABLE ALTERNATES.

N
R
C
P

N
R
C
I
P
C
P

C
H
D
P
E
P

C
P
P
P

CSP - CORRUGATED STEEL PIPE
RCP - REINFORCED CONCRETE PIPE
NRCP - NON-REINFORCED CONCRETE PIPE
NRCIPCP - NON-REINFORCED CAST-IN-PLACE CONCRETE PIPE
CHDPEP - CORRUGATED HIGH-DENSITY POLYETHYLENE PIPE
CPPP - CORRUGATED POLYPROPYLENE PIPE

CAP - CORRUGATED ALUMINUM PIPE

DESCRIPTION															CSP		CAP			RCP		END TREATMENT										QUANTITIES												
Station	Plan Reference Number	Controlling Fill Height Range	Size, Corrugated	Size, Smooth	Length (0)	Skew (0)	Corrugation	Wall Thickness (0.000)	Zinc	Bituminous Coated Zinc	Aluminum	Bituminous Coated Aluminum	Corrugation	Wall Thickness (0.000)	Uncoated	Bituminous Coated	Class - Non-Trench	Class - Trench	Class	Minimum Wall Thickness (0)	AASHTO M-294 Type S	AASHTO M-330 Type S	C-13.20 & C-13.25	C-13.25	Size, (In) Manhole	Standard or Detail	Each	Catch Basin, Manhole, Headwall & Junction Structure										Cubic Yard						
																												End Section	Ea	Ft.	Grate	Ft.	Inlet Depression C-15.70	Pipe Excavation (0)	Pipe Backfill (0)	Drainage Excavation (0)	Berm/Dike Embankment (0)	REMARKS						
																																							Type	Elevation (0.00)	Depth	L (0.0)	Ft.	
																																												S-Single / D-Double
SB US 93 CL 318+00, 33' Rt	528	1	28 x 20		10		A	.064	X				B	0.060												C-15.90			3.1					2583.88			6	3			CB-528 to MH-317, Dtl DJ			
SB US 93 CL 317+85, 33' Rt																																												
SB US 93 CL 321+86, 33' Rt	529	1	28 x 20		9		A	.064	X				B	0.060													C-15.90			3.1					2585.90			5	3			CB-529 to MH-321, Dtl DJ		
SB US 93 CL 321+72, 33' Rt																																												
SB US 93 CL 326+77, 33' Rt	530	2	24		42		A	.064	X				B	0.060			III	III		X	X						Dtl DF			5.0					2588.13			40	12			CB-530 to CBC		
SB US 93 CL 326+36, 33' Rt																											Dtl DE																	
SB US 93 CL 276+68, 43' Rt	535	2	24		128		A	.064	X				B	0.060			III	III		X	X						C-15.80			4.9					2540.16			153	38			CB-535 to CBC		
SB US 93 CL 277+96, 33' Rt																											Dtl DE																	
SB US 93 CL 281+83, 33' Rt	540	2	24		107		A	.064	X				B	0.060			III	III		X	X						C-15.80			4.5					2545.01			50	32			CB-540 to End Section		
SB US 93 CL 281+84, 75' Lt																					1																							
NB US 93 CL 222+87, 9' Lt	610	1	24		89		A	.064	X				B	0.060			IV	IV		X	X						C-15.30	S		5.2					2485.70			42	26			CB-610 to End Section		
NB US 93 CL 222+22, 51' Rt																					1																							
NB US 93 CL 223+37, 26' Rt	615	2	18		58		A	.064	X				B	0.060			III	III		X	X						C-15.30	S		5.3					2486.83			37	17			CB-615 to CB-610		
NB US 93 CL 222+87, 9' Lt																																												
SB US 93 CL 224+02, 22' Rt	630	2	24		57		A	.064	X				B	0.060			III	III		X	X						C-15.30	S		6.9					2489.54			61	17			CB-630 to MH-225		
NB US 93 CL 224+51, 19' Lt																																												
																									2	0	0											395	148					

FILL HEIGHT RANGE TABLE (Ft.)

RANGE NO.	1	2	3	4	5	6	7	8	9	10	11	12	
FILL	>	1	3	5	8	11	15	20	25	30	40	55	70
HEIGHT (Ft.)	≤	3	5	8	11	15	20	25	30	40	55	70	90

SHOULD FIELD CONDITIONS VARY FROM THE RANGE INDICATED, CONTACT DESIGN FOR RE-EVALUATION OF PIPE DESIGN REQUIREMENTS.

PIPE CORRUGATION

A	2 7/8x1 1/2	D	6x2
B	3x1	E	3x1 or 9x2 1/2
C	9x2 1/2		

NAME

DESIGN

DRAWN

CHECKED

K LEANDER

B LEANDER

B DENETDALE

06/26

06/26

06/26

TRANSPORTATION

AECOM TECHNICAL SERVICES, Inc.

7720 N. 16th St., Suite 100

Phoenix, Arizona 85020

T 602.371.1100

AECOM

www.aecom.com

ARIZONA DEPARTMENT OF TRANSPORTATION

PROJECT DELIVERY AND OPERATIONS DIVISION

ROADWAY DESIGN SERVICES

NEW PIPE SUMMARY SHEET

ROUTE

US 93

MILEPOST

189.9

STRUCTURE NO.

F.H.W.A. Arizona Division

STATE

ARIZ.

PROJECT NO.

093 YV 189

FEDERAL ID NO.

093-B(230)T

SHEET NO.

31

TOTAL SHEETS

524

RECORD DRAWING

LOCATION

WICKENBURG RANCH WAY TO VISTA ROYALE

TRACS NO.

F0738 01C


DWG No.

G-4.12

OF

BRYCE.SAVAGE25/2026 9:24:15 AM

c:\pwworking\usaz\dms09621\0738_sp04.dgn \ Model Name: 0738_sp04

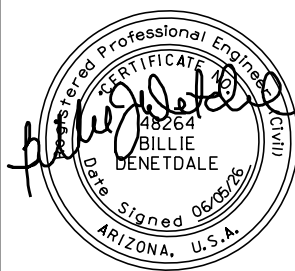CSP - CORRUGATED STEEL PIPE																																																																																																
DESCRIPTION														CSP								END TREATMENT														QUANTITIES																																																												
Station	Plan Reference Number	Controlling Fill Height Range	Size	Length In Place (0.0)	In.	Ft.	Degree	Each	Ft.	Remove Existing Pipe	Corrugation	Wall Thickness (0.000)	Zinc	Aluminum	Bituminous	Reset Salvaged End Section New	Detail	Size, (In.) Manhole	Standard or Detail	S-Single / D-Double	Location	H (0.0)	L Wing (0.0)	L 18" Slotted Drain (0)	L 24" Slotted Drain (0)	Type	Elevation (0.00)	Depth	Grate		Pipe Excavation (0)	Pipe Backfill (0) C-13 15	Drainage Excavation (0)	Berm Embankment (0)	Dike Embankment (0)																																																													
					Extend	In.	End Section C-13.25	Ft.	Inlet Depression C-15.70																																																																																							
								In.	Ft.																																																																																							
					Cubic Yard																																																																																											
REMARKS																																																																																																
SB US 93 CL 199+18, 22' Rt	198	9	24	167	45 LT			25.0		46.0		A	0.064	X																83	14					Dtl D9, See MH260, New End Section Lt																																																												
SB US 93 CL 198+86, 10' Lt																1																				Riprap Basin Lt, Dtl DA																																																												
NB US 93 CL 208+60	209	2	24	84				14.0		100.0	14.0	A	0.064	X				1			C-15.80	S								59	34					Dtl D6, See CB208, New End Sections Lt & Rt																																																												
																1																				Riprap Basin Lt, Dtl DA																																																												
NB US 93 CL 260+00	261	1	24	85				26.0		103.0		A	0.064	X			1	≤36	C-18.10											10	4					Dtl D9, See MH260, New End Section Lt																																																												
																																				Riprap Basin Lt, Dtl DA																																																												
NB US 93 CL 268+75	268	3	42	104				13.0		93.0		A	0.064	X					SD-6.30	S										55	44					Dtl D10, See CB268, New Headw all Lt																																																												
																			Dtl DG																	Riprap Basin Lt, Dtl DA																																																												
NB US 93 CL 274+50	274	2	24	91				31.0		137.0		A	0.064	X			1	≤36	C-18.10											100	41					Dtl D11, See MH274, New End Section Lt																																																												
																																				Riprap Basin Lt, Dtl DA																																																												
NB US 93 CL 292+11	292	1	24	89				8.0		84.0		A	0.064	X			1	≤36	C-18.10											18	25					Dtl D13, See MH292, New End Sections Lt																																																												
																																				Riprap Basin Lt, Dtl DA																																																												
NB US 93 CL 304+61	304	3	36	103				12.0		107.0		A	0.064	X					SD-6.30	D										78	32					Dtl D15, See CB304, New Headw all Lt																																																												
			36	103				12.0		107.0		A	0.064	X					Dtl DI																	Riprap Basin Lt, Dtl DA																																																												
NB US 93 CL 315+00, 55' Rt	316	1	42 x 29	86				27.0		108.0		A	0.064	X					SD-6.30	D										103	34					Dtl D16, See MH 315, New Headw all Lt																																																												
			42 x 29	86				27.0		108.0		A	0.064	X					Dtl DJ																	Riprap Basin Lt, Dtl DA																																																												
SB US 93 CL 317+85, 55' Rt	318	1	49 x 33	91				27.0		98.0		A	0.064	X					SD-6.30	D										101	30					Dtl D17, See MH317, New Headw all Lt																																																												
SB US 93 CL 317+85, 33 'Rt			49 x 33	91				27.0		98.0		A	0.064	X					Dtl DJ																	Riprap Basin Lt, Dtl DB																																																												
					0	0															0	6	0	3															0	0					607	258	0	0	0																																															
FILL HEIGHT RANGE TABLE (Ft.)												☑ PIPE CORRUGATION				NOTE: FOR PIPE CULVERT PLACEMENT SEE STANDARD DRAWINGS C-13.10 AND C-13.15																																																																																
RANGE NO.	1	2	3	4	5	6	7	8	9	10	11	12	A	2½x½	D	6x2																																																																																
FILL	>	1	3	5	8	11	15	20	25	30	40	55	70	B	3x1	E	3x1 or 9x2½																																																																															
HEIGHT (Ft.)	≤	3	5	8	11	15	20	25	30	40	55	70	90	C	9x2½																																																																																	
● SHOULD FIELD CONDITIONS VARY FROM THE RANGE INDICATED, CONTACT DESIGN FOR RE-EVALUATION OF PIPE DESIGN REQUIREMENTS.																																																																																																
																								<table><tr><td>DESIGN</td><td>K LEANDER</td><td>06/26</td></tr><tr><td>DRAWN</td><td>B LEANDER</td><td>06/26</td></tr><tr><td>CHECKED</td><td>B DENETDALE</td><td>06/26</td></tr></table>				DESIGN	K LEANDER	06/26	DRAWN	B LEANDER	06/26	CHECKED	B DENETDALE	06/26	<table><tr><td>TRANSPORTATION</td><td>AECOM TECHNICAL SERVICES, Inc.</td><td>AECOM</td></tr><tr><td colspan="2">1700 N. 100th St., Suite 100</td><td>www.aecom.com</td></tr><tr><td colspan="2">Phoenix, Arizona 85020</td><td></td></tr><tr><td colspan="2">T 602.375.1100</td><td></td></tr></table>				TRANSPORTATION	AECOM TECHNICAL SERVICES, Inc.	AECOM	1700 N. 100th St., Suite 100		www.aecom.com	Phoenix, Arizona 85020			T 602.375.1100			ARIZONA DEPARTMENT OF TRANSPORTATION PROJECT DELIVERY AND OPERATIONS DIVISION ROADWAY DESIGN SERVICES NEW CORRUGATED STEEL PIPE EXTENSIONS SUMMARY SHEET				<table><tr><td>ROUTE</td><td>US 93</td></tr><tr><td>MILEPOST</td><td>189.9</td></tr><tr><td>STRUCTURE NO.</td><td></td></tr></table>		ROUTE	US 93	MILEPOST	189.9	STRUCTURE NO.		<table><tr><td>F.H.W.A. Arizona Division</td><td>STATE</td><td>PROJECT NO.</td><td>FEDERAL ID NO.</td><td>SHEET NO.</td><td>TOTAL SHEETS</td><td>RECORD DRAWING</td></tr><tr><td></td><td>ARIZ.</td><td>093 YV 189</td><td>093-B(230)T</td><td>33</td><td>524</td><td></td></tr></table>		F.H.W.A. Arizona Division	STATE	PROJECT NO.	FEDERAL ID NO.	SHEET NO.	TOTAL SHEETS	RECORD DRAWING		ARIZ.	093 YV 189	093-B(230)T	33	524		<table><tr><td>LOCATION</td><td colspan="4">WICKENBURG RANCH WAY TO VISTA ROYALE</td><td>DWG No. G-4.14</td></tr><tr><td>TRACS NO.</td><td colspan="4">F0738 01C</td><td>___ OF ___</td></tr></table>				LOCATION	WICKENBURG RANCH WAY TO VISTA ROYALE				DWG No. G-4.14	TRACS NO.	F0738 01C				___ OF ___
DESIGN	K LEANDER	06/26																																																																																														
DRAWN	B LEANDER	06/26																																																																																														
CHECKED	B DENETDALE	06/26																																																																																														
TRANSPORTATION	AECOM TECHNICAL SERVICES, Inc.	AECOM																																																																																														
1700 N. 100th St., Suite 100		www.aecom.com																																																																																														
Phoenix, Arizona 85020																																																																																																
T 602.375.1100																																																																																																
ROUTE	US 93																																																																																															
MILEPOST	189.9																																																																																															
STRUCTURE NO.																																																																																																
F.H.W.A. Arizona Division	STATE	PROJECT NO.	FEDERAL ID NO.	SHEET NO.	TOTAL SHEETS	RECORD DRAWING																																																																																										
	ARIZ.	093 YV 189	093-B(230)T	33	524																																																																																											
LOCATION	WICKENBURG RANCH WAY TO VISTA ROYALE				DWG No. G-4.14																																																																																											
TRACS NO.	F0738 01C				___ OF ___																																																																																											

[illegible]

093 YV 189

NOTE:
THE ZEROS IN PARENTHESES (0, 0.0 & 0.00) INDICATE THE DIMENSIONAL PRECISION FOR THAT COLUMN

1 TOTALS SHOWN FOR THE BOX CULVERT INCLUDE THE QUANTITIES FOR HEADWALLS, WINGS, APRONS, CURBS, CUT-OFF WALLS AND LAPS AT CONSTRUCTION JOINTS.

2 BRIDGE GROUP STRUCTURE DETAIL DRAWINGS SD 6.01 TO SD 6.11 TO SD 6.20

3 CONSTRUCTION & LOOKING AHEAD

NOTE:
FOR STRUCTURAL EXCAVATION, STRUCTURE BACKFILL PLACEMENT AND MEASUREMENT, SEE STRUCTURE DETAIL DRAWING SD 6.01 (4 OF 5)

NAME		DATE
DESIGN	ETW	06-26
DRAWN	JML	06-26
CHECKED	JPM	06-26

3133 East Camelback Road, Suite 100
Phoenix, Arizona 85016
Phone: (602) 333-2200

ARIZONA DEPARTMENT OF TRANSPORTATION
PROJECT DELIVERY AND OPERATIONS DIVISION
ROADWAY DESIGN SERVICES

REINFORCED CONC BOX
CULVERT AND BOX CULVERT
EXTENSION SUMMARY SHEET

ROUTE	LOCATION
US 93	WICKENBURG RANCH WAY TO VISTA ROYALE

TRACS NO. F0738 01C		093-B(230)T
---------------------	--	-------------

DWG NO. G-4.16

OF

[illegible]

093 YV 189

SHEET TOTAL	6,314
-------------	-------

See Dwg No. C-7.01 to C-7.05 and C-7.19 to C-7.23 for locations.

Plan Reference No.	LOCATION						FENCING			GATES			NOTES ● Stations and offsets are approximate. Use ROW Projects (Tracs Nos. 093 YV 190 F0738/093-B(0)T) for exact locations.
	From ●			To ●			BW Game Fence Detail F	Type 2 BW Fence Std C-12.10	Flood Gate (LF)	Standard Detail C-12.10			
	Reference	Station	Offset	Reference	Station	Offset				Type 1 Single 14' (Each)	Type 2 Single 14' (Each)	Station / Offset @ Gate Center	
210	SB US 93 Cst CL	190+00	130' Lt	SB US 93 Cst CL	194+04	130' Lt	405'						
211	SB US 93 Cst CL	194+04	130' Lt	SB US 93 Cst CL	194+04	180' Lt	50'						
212	SB US 93 Cst CL	194+04	180' Lt	SB US 93 Cst CL	195+64	180' Lt	160'		131'				FLOOD GATE - STA 194+33 TO 195+64
213	SB US 93 Cst CL	194+64	180' Lt	SB US 93 Cst CL	196+15	130' Lt	72'						
214	SB US 93 Cst CL	196+15	130' Lt	SB US 93 Cst CL	196+13	121' Lt	9'				1	196+12, 117' Lt	
215	SB US 93 Cst CL	196+09	108' Lt	SB US 93 Cst CL	196+05	95' Lt	13'						
216	SB US 93 Cst CL	196+05	95' Lt	SB US 93 Cst CL	195+62	104' Lt	45'						
217	SB US 93 Cst CL	194+82	104' Lt	SB US 93 Cst CL	195+12	96' Lt	31'						
218	SB US 93 Cst CL	194+71	141' Lt	SB US 93 Cst CL	194+82	104' Lt	38'				1	194+67, 147' Lt	
219	SB US 93 Cst CL	194+62	151' Lt	SB US 93 Cst CL	194+33	180' Lt	40'						
220	SB US 93 Cst CL	200+39	80.5' Lt	SB US 93 Cst CL	200+40	89' Lt	9'				1	200+41, 96' Lt	
221	SB US 93 Cst CL	200+42	103' Lt	SB US 93 Cst CL	200+42	108' Lt	5'						
222	SB US 93 Cst CL	198+79	130' Lt	SB US 93 Cst CL	201+00	100' Lt	224'						
223	SB US 93 Cst CL	201+00	100' Lt	SB US 93 Cst CL	215+00	100' Lt	1404'						
224	SB US 93 Cst CL	215+00	100' Lt	SB US 93 Cst CL	215+16	92' Lt	18'				1	215+21, 89' Lt	
225	SB US 93 Cst CL	215+29	86' Lt	SB US 93 Cst CL	215+90	58' Lt	67'						
226	SB US 93 Cst CL	215+00	100' Lt	SB US 93 Cst CL	215+00	165' Lt	65'						
227	SB US 93 Cst CL	215+00	165' Lt	SB US 93 Cst CL	217+00	165' Lt	200'		200'				FLOOD GATE - STA 215+00 TO 217+00
228	SB US 93 Cst CL	217+00	165' Lt	SB US 93 Cst CL	217+00	100' Lt	65'						
229	SB US 93 Cst CL	216+37	90' Lt	SB US 93 Cst CL	217+00	100' Lt	63'						
230	SB US 93 Cst CL	217+00	100' Lt	SB US 93 Cst CL	222+64	100' Lt	564'						
231	SB US 93 Cst CL	222+64	100' Lt	SB US 93 Cst CL	222+82	125' Lt	31'						
232	SB US 93 Cst CL	222+82	125' Lt	SB US 93 Cst CL	222+87	127' Lt	5'			1		18+61, 28' Rt Moreton Rd	
233	SB US 93 Cst CL	223+37	143' Lt	SB US 93 Cst CL	223+54	149' Lt	18'						
234	SB US 93 Cst CL	273+91	79' Lt	SB US 93 Cst CL	274+22	79' Lt	31'			1		274+34, 79' Lt	
235	SB US 93 Cst CL	274+46	79' Lt	SB US 93 Cst CL	274+89	79' Lt	43'						
236	SB US 93 Cst CL	276+59	79' Lt	SB US 93 Cst CL	276+65	79' Lt	7'						
237	SB US 93 Cst CL	276+65	79' Lt	SB US 93 Cst CL	276+86	79' Lt	23'				1	276+93, 67' Lt	
238	SB US 93 Cst CL	276+99	64' Lt	SB US 93 Cst CL	277+18	55' Lt	21'						
242	SB US 93 Cst CL	277+69	56.25' Lt	SB US 93 Cst CL	278+52	79' Lt	86'						
243	SB US 93 Cst CL	278+52	79' Lt	SB US 93 Cst CL	279+71	178' Lt	155'						
244	SB US 93 Cst CL	279+71	178' Lt	SB US 93 Cst CL	280+21	178' Lt	48'						
246	SB US 93 Cst CL	323+30	173' Lt	SB US 93 Cst CL	324+34	118' Lt	117'				1	324+40, 116' Lt	
247	SB US 93 Cst CL	324+47	112' Lt	SB US 93 Cst CL	325+61	55' Lt	128'						
249	SB US 93 Cst CL	327+03	169' Lt	SB US 93 Cst CL	326+20	54' Lt	142'						

REV. DATE: 05/03/2010

F.H.W.A. REGION	STATE	PROJECT NO.	SHEET NO.	TOTAL SHEETS	RECORD DRAWING
9	ARIZ.	093-B(230)T	40	524	

093 YV 189

NOTE:
THE ZEROS IN PARENTHESES (0, 0.0 & 0.000) INDICATE
THE DIMENSIONAL PRECISION FOR THAT COLUMN

NOTE:
FOR PIPE CULVERT PLACEMENT SEE
SEE STANDARD DRAWINGS C-13.10 AND C-13.15

NOTE:
PIPE OPTIONS SELECTED ARE THOSE REQUIRED TO
MEET MINIMUM SERVICE LIFE.
ALLOWABLE PIPE OPTIONS ARE INDICATED WITH THE
LETTER 'X' IN THE SPACE. BLANK SPACES ARE NOT
ALLOWABLE ALTERNATES.

CSP - CORRUGATED STEEL PIPE
CAP - CORRUGATED ALUMINUM PIPE
BSP - BLACK STEEL PIPE
CHDPEP - CORRUGATED HIGH-DENSITY POLYETHYLENE PIPE
CPPP - CORRUGATED POLYPROPYLENE PIPE

NOTE:
PIPE OPTIONS SELECTED ARE THOSE REQUIRED TO
MEET MINIMUM SERVICE LIFE.
ALLOWABLE PIPE OPTIONS ARE INDICATED WITH THE
LETTER 'X' IN THE SPACE. BLANK SPACES ARE NOT
ALLOWABLE ALTERNATES.


DESCRIPTION												CSP				CAP		BSP	
Station	Plan Reference Number	Controlling Fill Height Range	C-Corrugated / S-Smooth	Size	Length (0)	Skew (0)	C-16.40 Irrigation Sleeve Detail J	Corrugation	Wall Thickness (0.000)	Zinc	Bituminous Coated Aluminum	Bituminous Coated Zinc	Corrugation	Wall Thickness (0.000)	Uncoated Bituminous Coated Size (0)	Wall Thickness (0.000)	AASHTO M-294 Type S	AASHTO M-330 Type S	
US 93 MED CST CL 2148+61.37	2	1	C		52		X											X	
US 93 MED CST CL 2149+92.83	3	1	C		49		X											X	
Wickenburg Ranch Way 73+98	4	2	C		80		X										X	X	
Wickenburg Ranch Way 74+03	5	5	C		80		X										X	X	
Wickenburg Ranch Way 74+09	6	2	C		80		X								18	0.375			
Wickenburg Ranch Way 74+20	7	2	C		80		X								24	0.375			
Wickenburg Ranch Way 74+28	8	2	C		80		X								24	0.375			
Matthie Ranch Rd 25+50	9	3	C		68		X								24	0.375			
			C																
			S																
			C																
			S																
Sheet Total					569														

CSP		- CORRUGATED STEEL PIPE		NOTE: PIPE OPTIONS SELECTED ARE THOSE REQUIRED TO MEET MINIMUM SERVICE LIFE. ALLOWABLE PIPE OPTIONS ARE INDICATED WITH THE LETTER 'X' IN THE SPACE. BLANK SPACES ARE NOT ALLOWABLE ALTERNATES.												CAP		BSP	
CAP		- CORRUGATED ALUMINUM PIPE														CSP		CAP	
BSP		- BLACK STEEL PIPE																	
CHDPEP		- CORRUGATED HIGH-DENSITY POLYETHYLENE PIPE																	
CPPP		- CORRUGATED POLYPROPYLENE PIPE																	
DESCRIPTION																			
In.		Ft.		Degree		In.		Coating		In.		In.							
Station		Plan Reference Number		C-Corrugated / S-Smooth		Length (0)		Skew (0)		C-16.40 Irrigation Sleeve Detail		Zinc		Bituminous Coated Aluminum		Bituminous Coated Zinc			
Type S		Controlling Fill Height Range		Size		C-16.40 Irrigation Sleeve		Wall Thickness (0.000)		Corrugation		Uncoated		Bituminous Coated Aluminum		Wall Thickness (0.000)			
Type S		PS		S-Smooth		Wall Thickness (0.000)		Zinc		Bituminous Coated Aluminum		Corrugation		Uncoated		Bituminous Coated			


FILL HEIGHT RANGE TABLE (Ft.)													
RANGE NO.		1	2	3	4	5	6	7	8	9	10	11	12
FILL	>	1	3	5	8	11	15	20	25	30	40	55	70
HEIGHT (Ft.)	≤	3	5	8	11	15	20	25	30	40	55	70	90
● SHOULD FIELD CONDITIONS VARY FROM THE RANGE INDICATED, CONTACT DESIGN FOR RE-EVALUATION OF PIPE DESIGN REQUIREMENTS.													

PIPE CORRUGATION			
A	2 3/4 x 1/2	D	6 x 2
B	3 x 1	E	3 x 1 or 9 x 2 1/2
C	9 x 2 1/2		

DESIGN	ZSZ	NAME	DATE	ARIZONA DEPARTMENT OF TRANSPORTATION PROJECT DELIVERY AND OPERATIONS DIVISION ROADWAY DESIGN SERVICES	
DRAWN	RM		06-26		
CHECKED	DBK		06-26		
 3133 East Camelback Road, Suite 100 Phoenix, Arizona 85016 Phone: (602) 333-2200				NEW PIPE SLEEVE SUMMARY SHEET	
ROUTE		LOCATION		DWG NO. G-4.21	
US 93		WICKENBURG RANCH WAY TO VISTA ROYALE			
TRACS NO. F0738 OIC				093-B(230)T	
				OF	

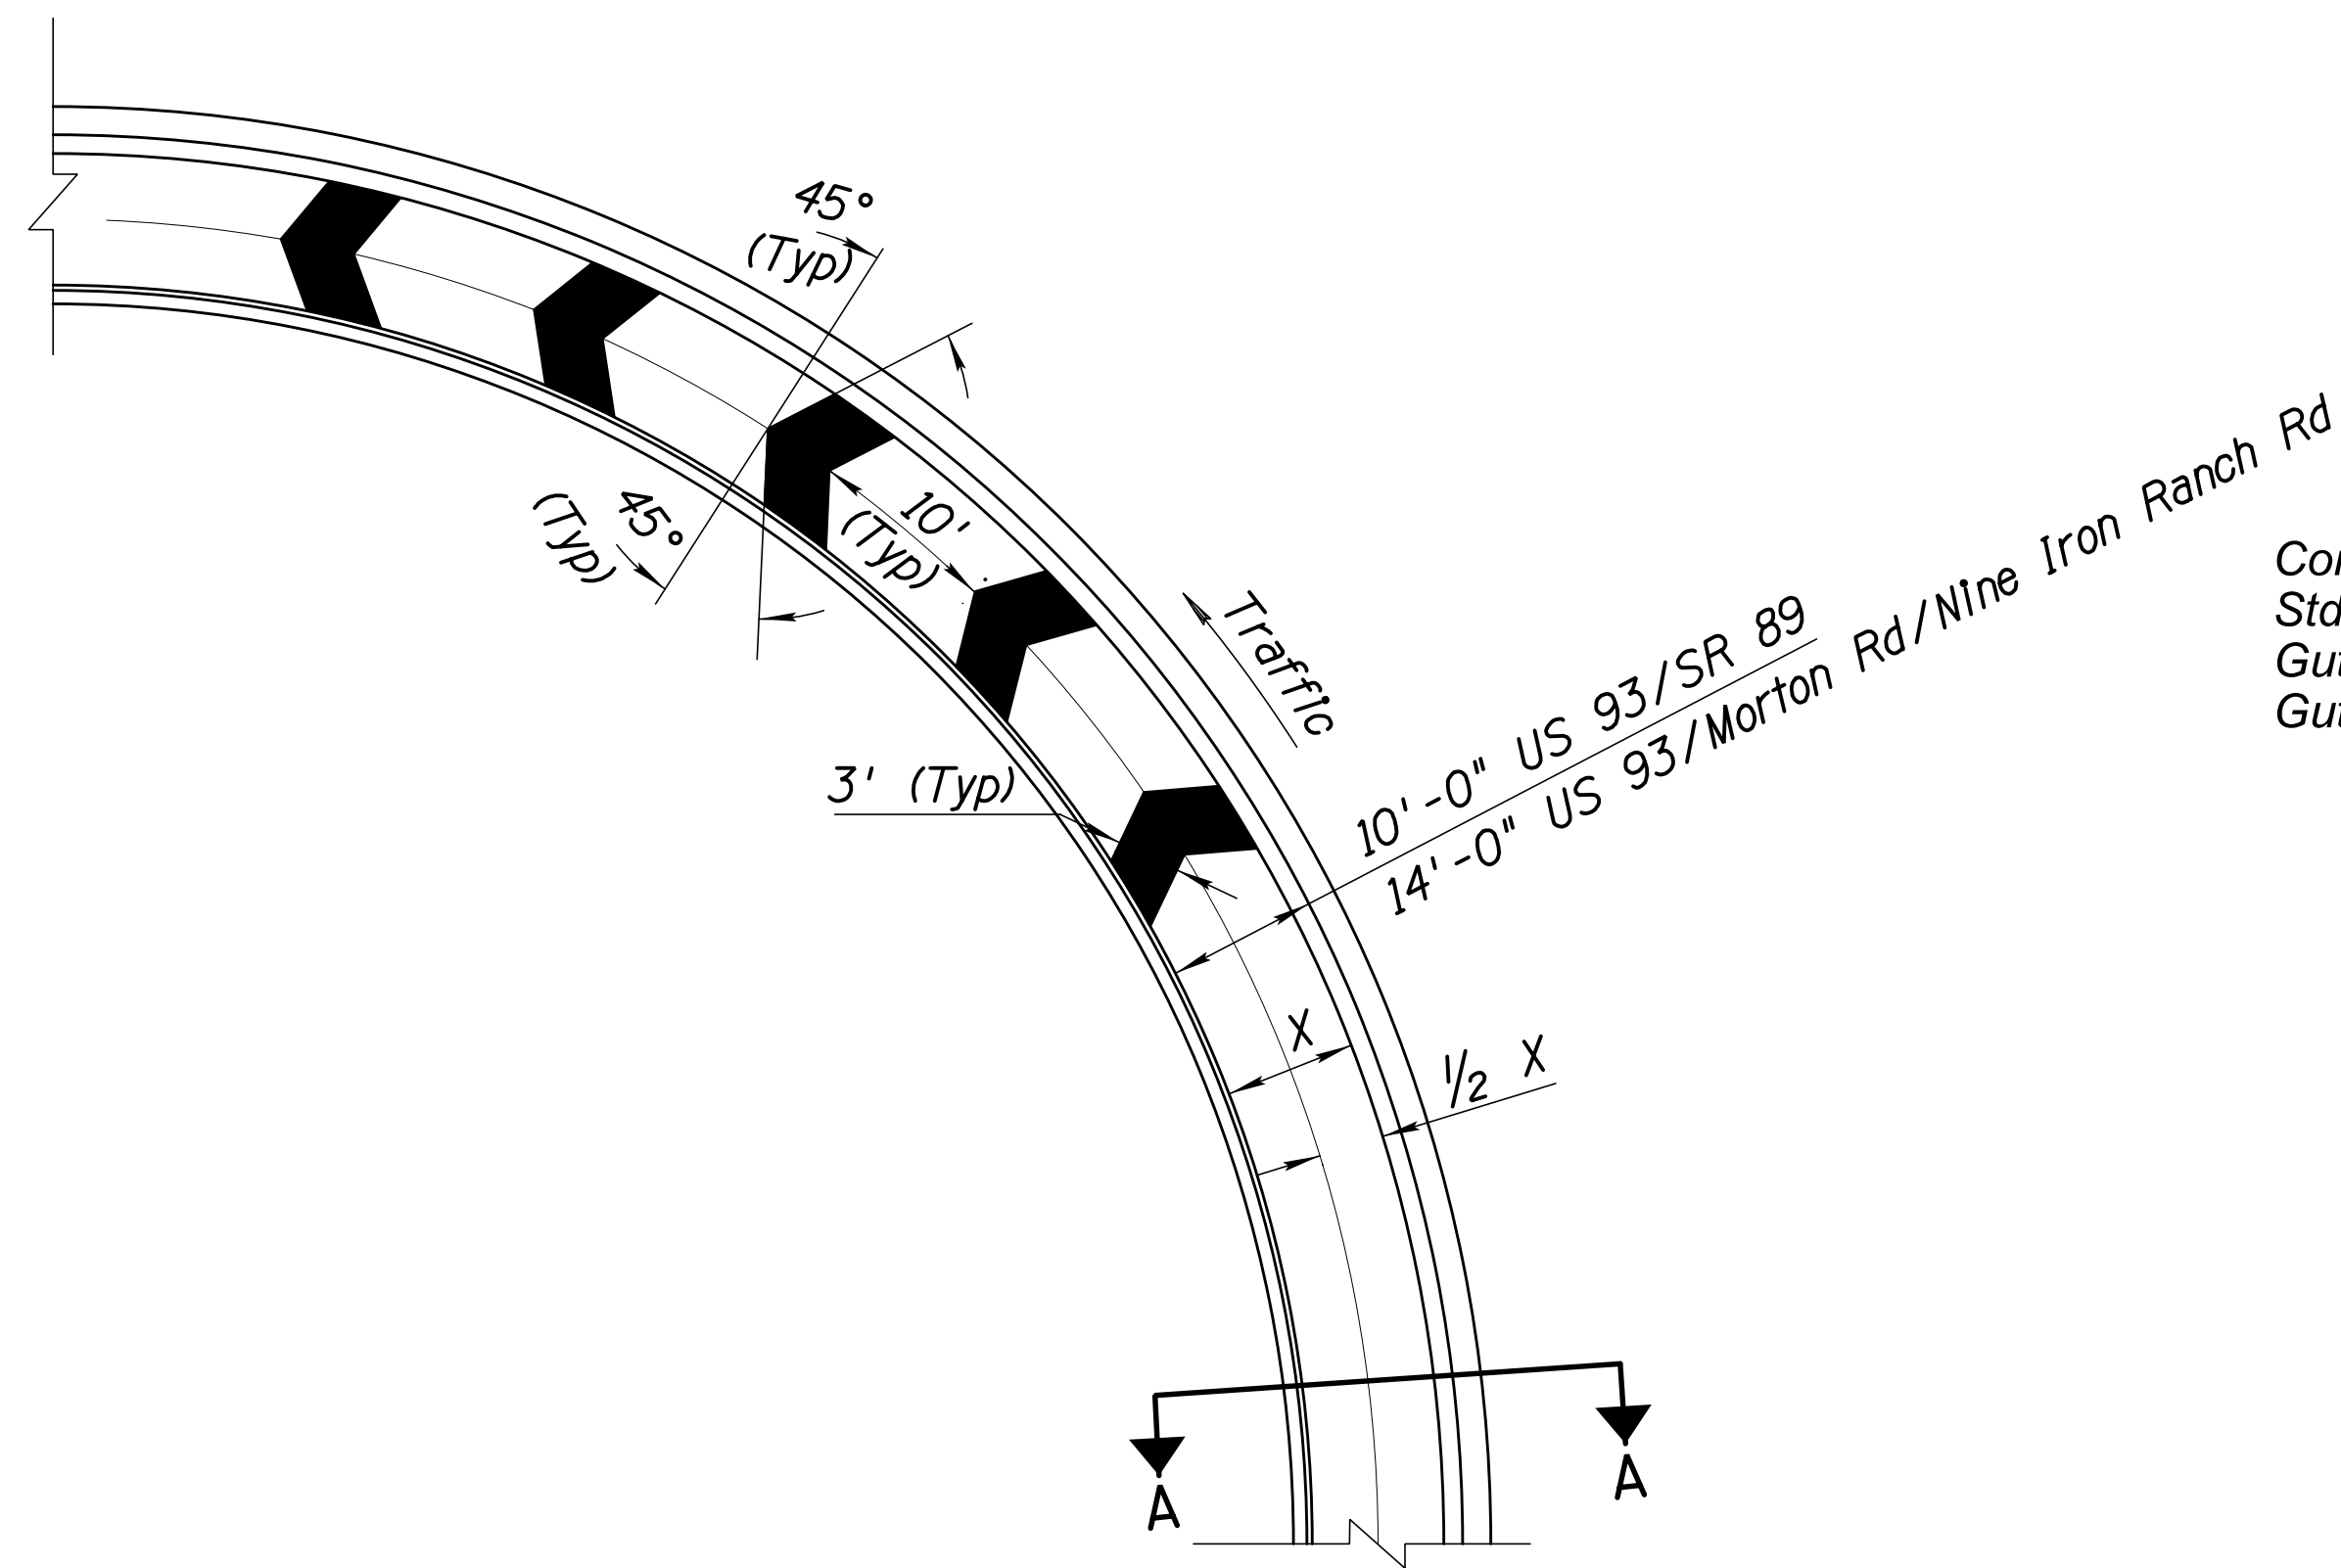

Conc Curb & Gutter,
Std C-05.10, Type G
Gutter=1', h=4"
Gutter W=2', 10" Thick Gutter Pan

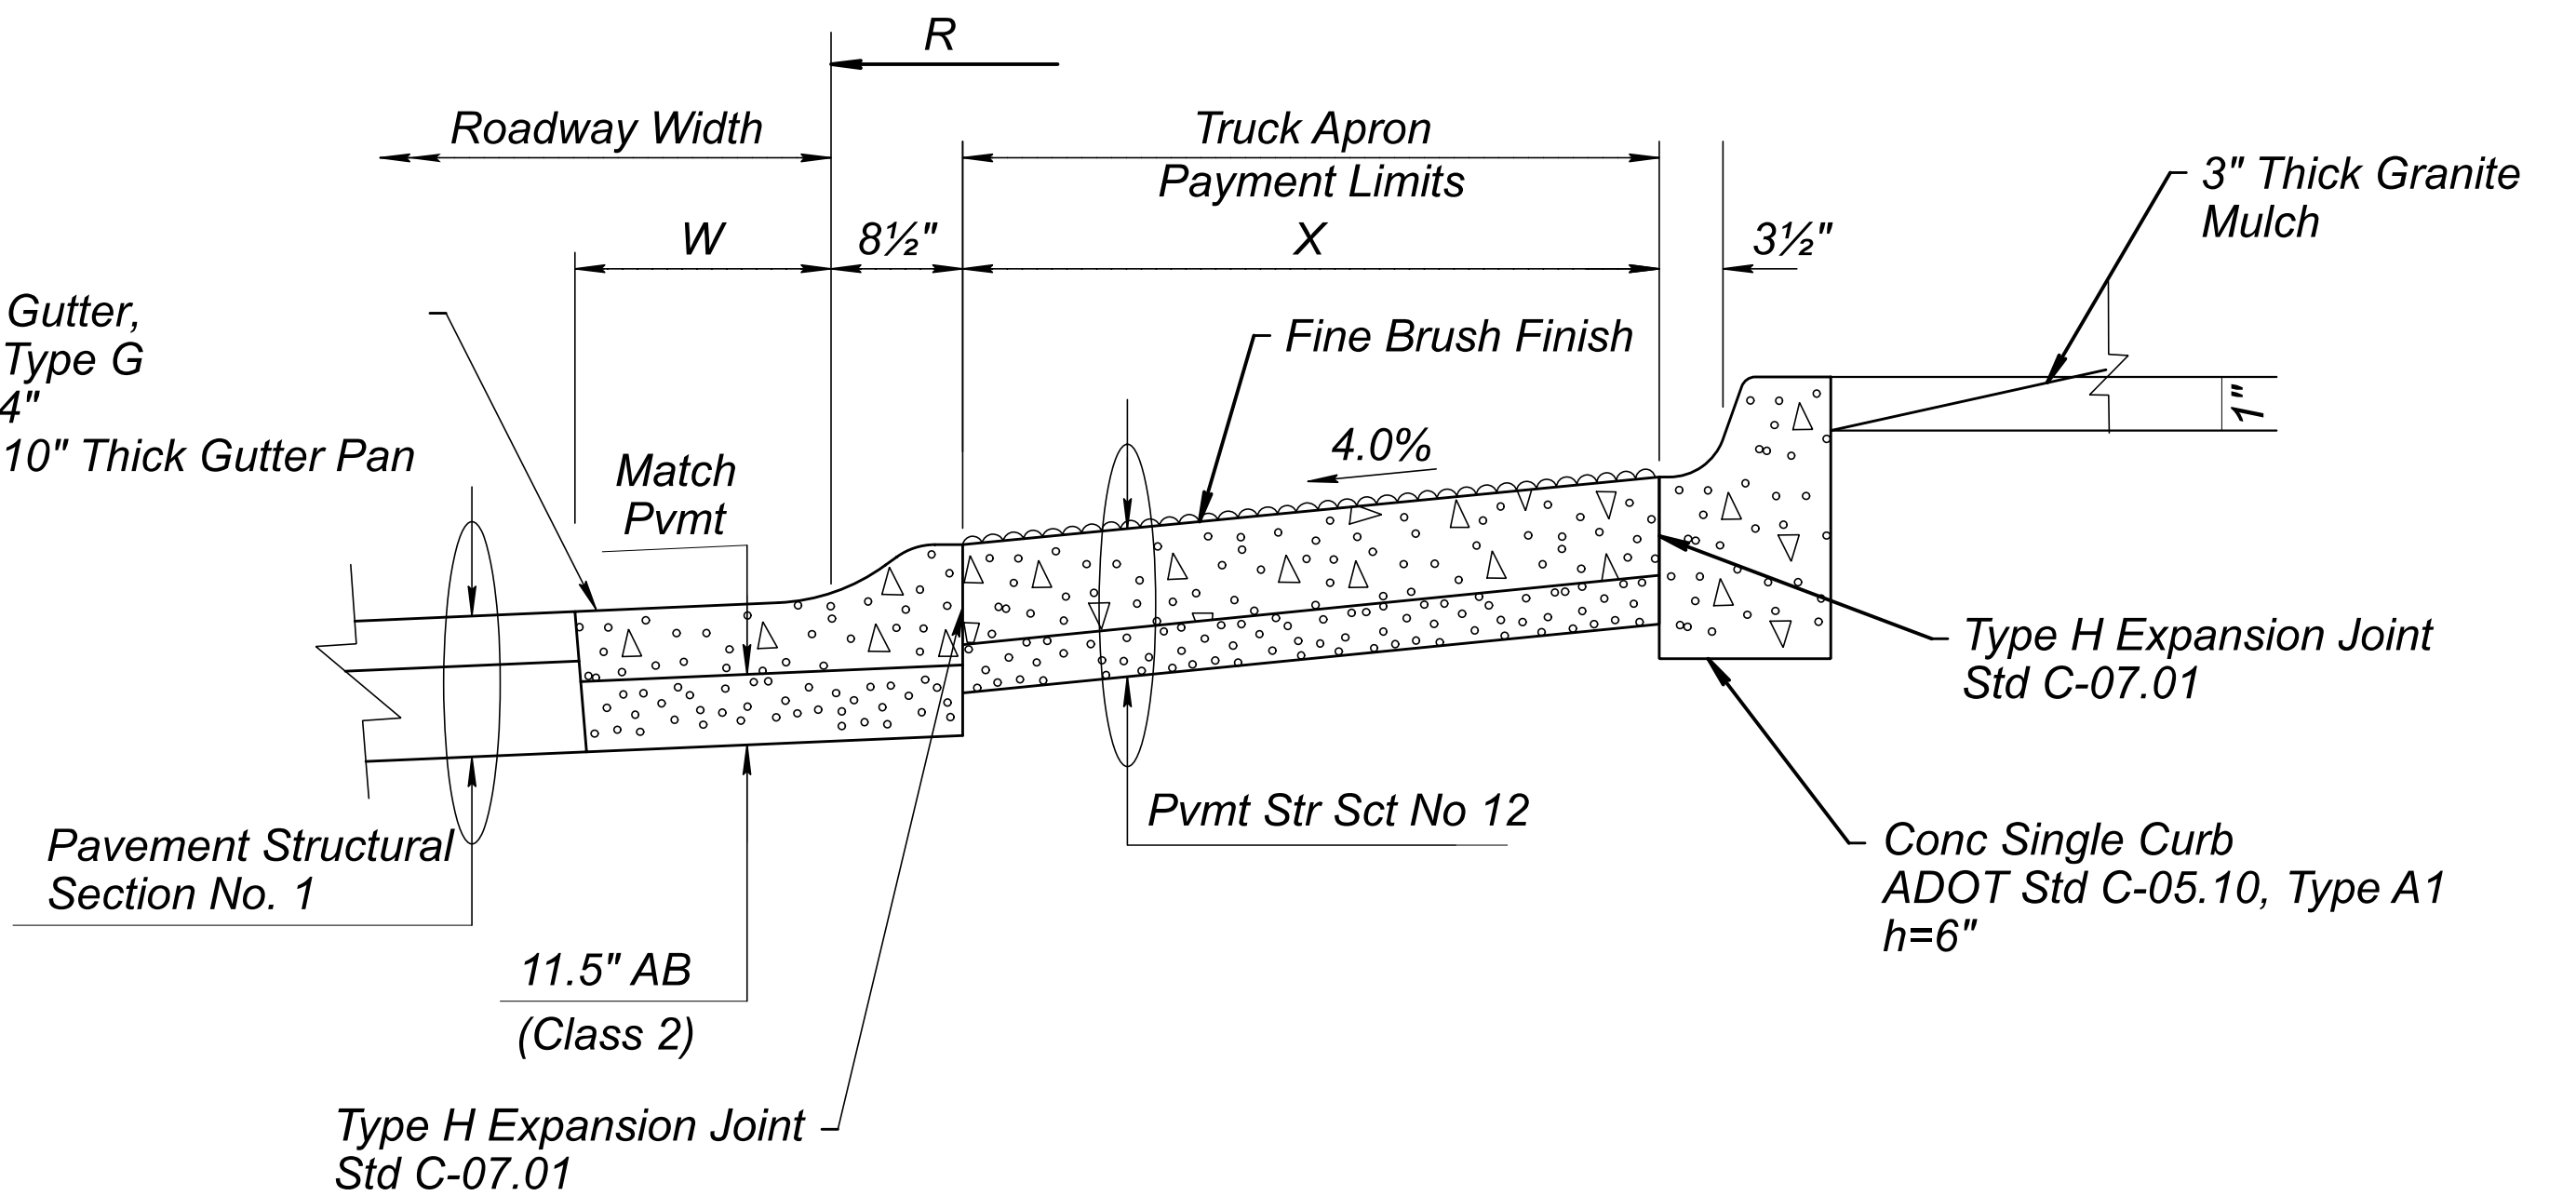

SECTION A-A

Roundabout Location	Truck Apron Width X	Gutter Width W	R
US 93/SR 89	9.29'	2.0'	82.50'
US 93/ Moreton Rd & Nine Irons Ranch Rd	13.0'	1.0'	59.00'


- NOTES:
- See Plans for Limits of Roundabout Truck Aprons and Geometric Control.
 - Concrete Curb & Gutter (C-05.10) (Type G) will be Measured and Paid for under Item No. 9080085 and 9080086.
 - Aggregate Base (Class 2) under curb and gutter and apron will be Measured and Paid for under Item No. 3030022.
 - Chevrons are to be Stained Concrete Per Item No. 9080245. No Measurement or direct Payment will be made for Chevrons, the cost being considered as Included in the cost of the truck apron.
 - Truck apron will be measured and paid for under Item No. 9080245.
 - See Dwg C-6.04 for Joint types and spacing for both roundabouts at US 93/SR 89 and at US 93/Moreton Rd & Nine Irons Ranch Rd.
 - Concrete for Curb and Gutter, Type G, shall be Class S (f'c = 4000 psi)

DETAIL **A**


TRUCK APRON FOR
ROUNABOUT

	DESIGN	J GILLIS	06/26	ARIZONA DEPARTMENT OF TRANSPORTATION PROJECT DELIVERY AND OPERATIONS DIVISION ROADWAY DESIGN SERVICES	ROUTE	F.H.W.A. Arizona Division	STATE ARIZ.	PROJECT NO.	FEDERAL ID NO.	SHEET NO.	TOTAL SHEETS	RECORD DRAWING
	DRAWN	M SAMUELSON	06/26		US 93			093 YV 189	093-B(230)T	41	524	
	CHECKED	D WIGGINS	06/26		MILEPOST 189.9			LOCATION WICKENBURG RANCH WAY TO VISTA ROYALE				
	TRANSPORTATION AECOM TECHNICAL SERVICES, Inc. 7720 N. 18th St., Suite 100 Phoenix, Arizona 85020 T 602.371.1100 www.aecom.com				STRUCTURE NO.	TRACS NO. F0738 01C						
	DETAIL SHEET DETAIL A											


F.H.W.A. REGION	STATE	PROJECT NO.	SHEET NO.	TOTAL SHEETS	RECORD DRAWING
9	ARIZ.	093-B(230)T	42	524	
093 YV 189					

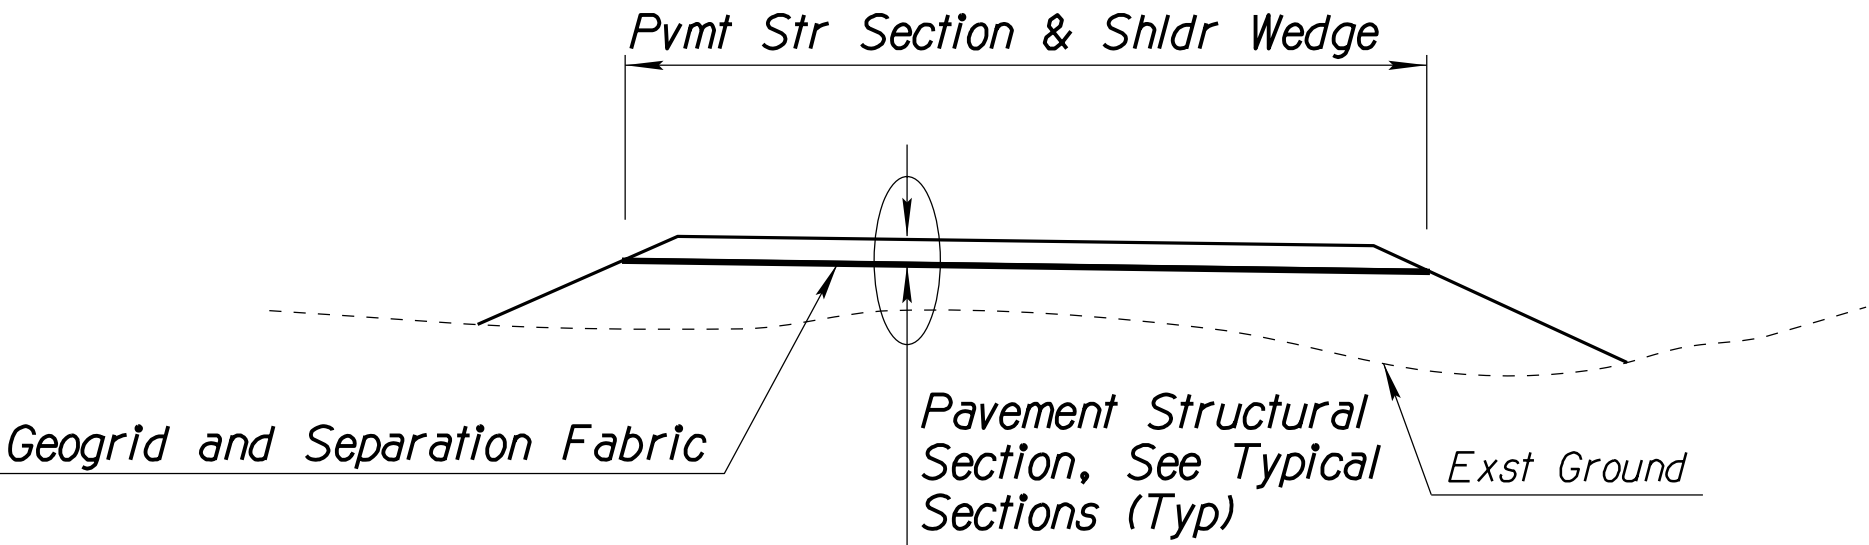

FILL CONDITION

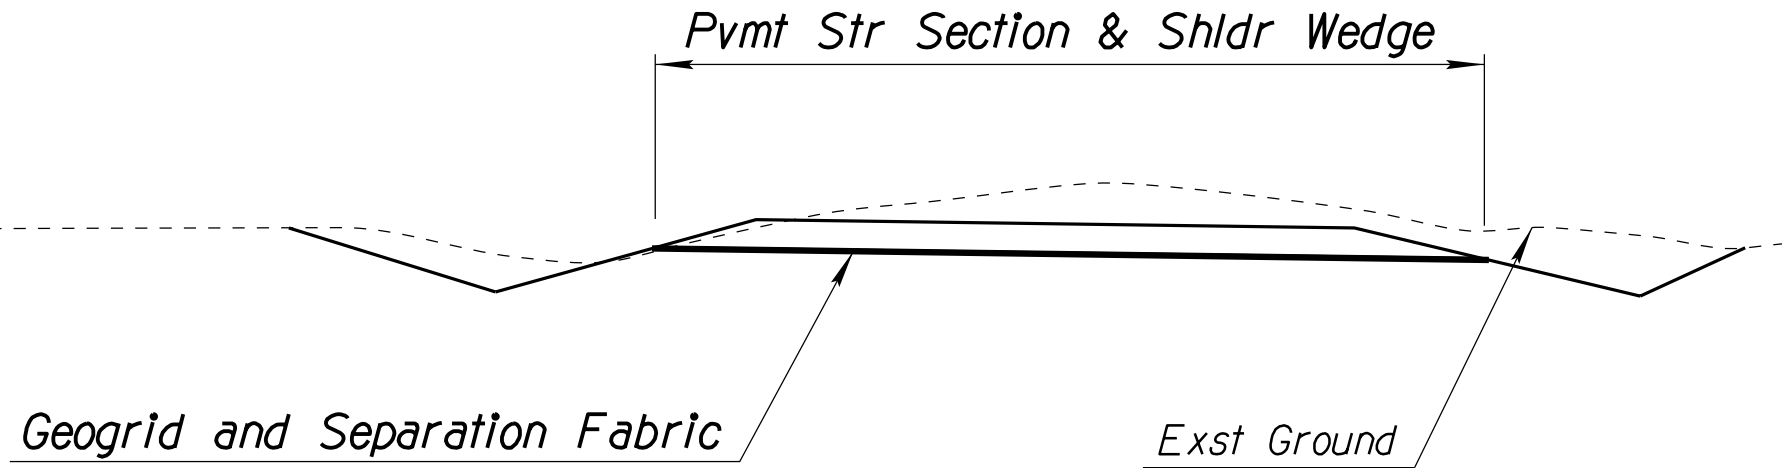

CUT CONDITION

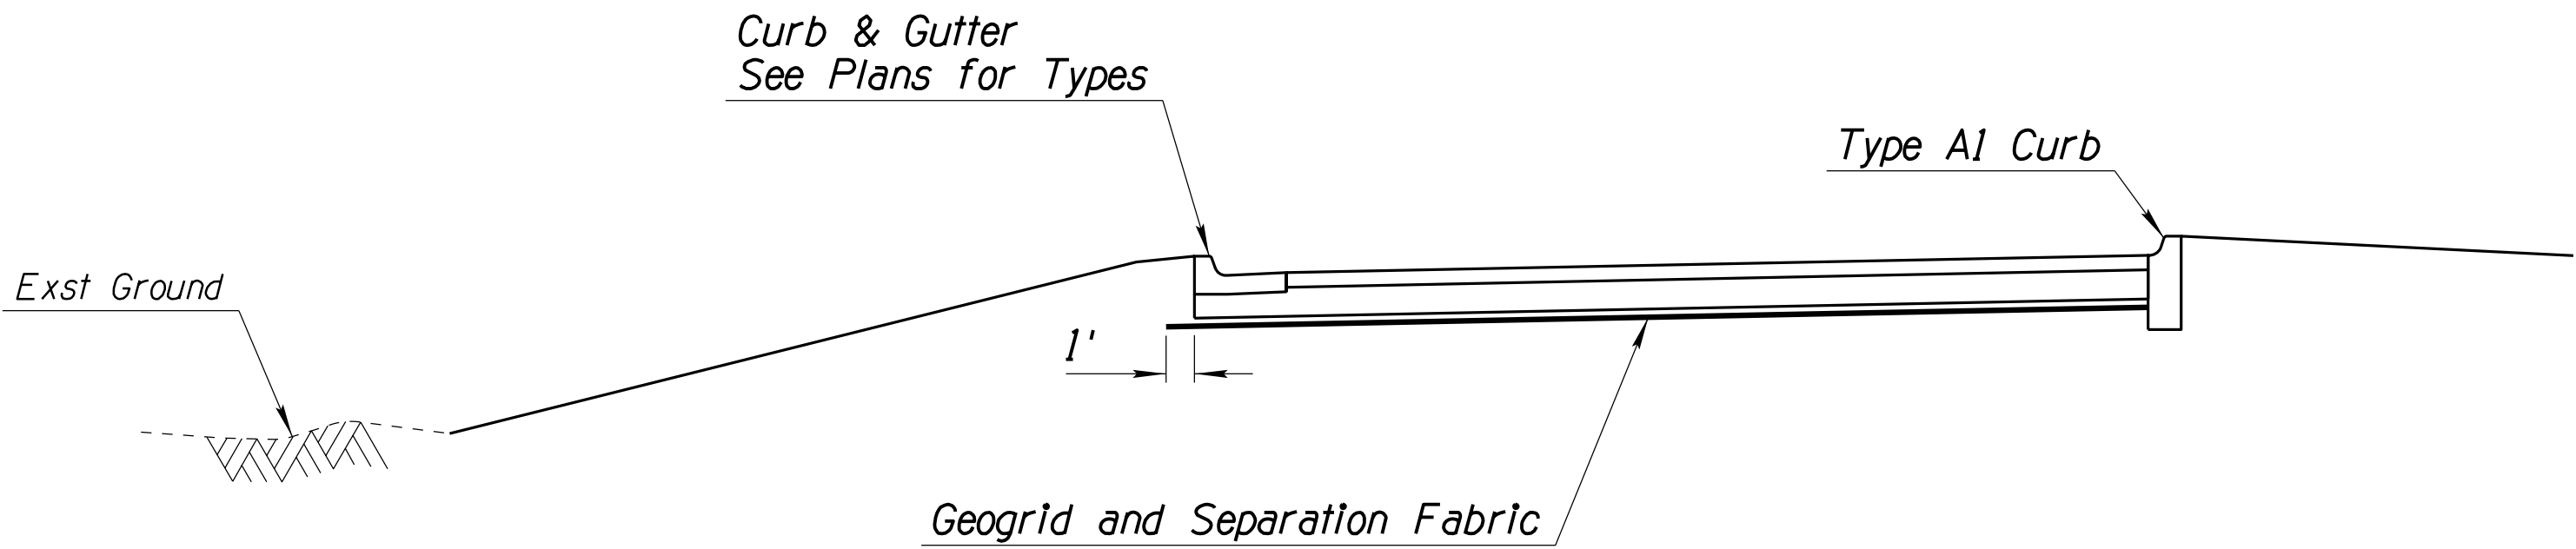

GEOGRID LIMITS
Scale: NTS

GEOGRID LIMITS TABLE	
Roadway Segment	Station Limits
SR 89	108+46.75 - 120+00


NOTE:
Geogrid will be Measured and Paid for under Item No. 3060001.
Separation Fabric will be Measured and Paid for under Item No. 2080001.

DETAIL B

GEOGRID & SEPARATION FABRIC LIMITS

DESIGN	MWD	NAME	DATE	ARIZONA DEPARTMENT OF TRANSPORTATION PROJECT DELIVERY AND OPERATIONS DIVISION ROADWAY DESIGN SERVICES	
DRAWN	RM		06-26	DETAIL SHEET DETAIL B	
CHECKED	DBK		06-26		
ROUTE		LOCATION		DWG NO. G-5.02	
US 93		WICKENBURG RANCH WAY TO VISTA ROYALE			
TRACS NO. F0738 OIC		093-B(230)T			

OVER-EXCAVATION LOCATIONS			
	From Station	To Station	Excavation (CY)
SB US 93 Cst CL	242+75.00	258+75.00	1905
SB US 93 Cst CL	336+45.00	341+10.00	584
	TOTAL:		2489

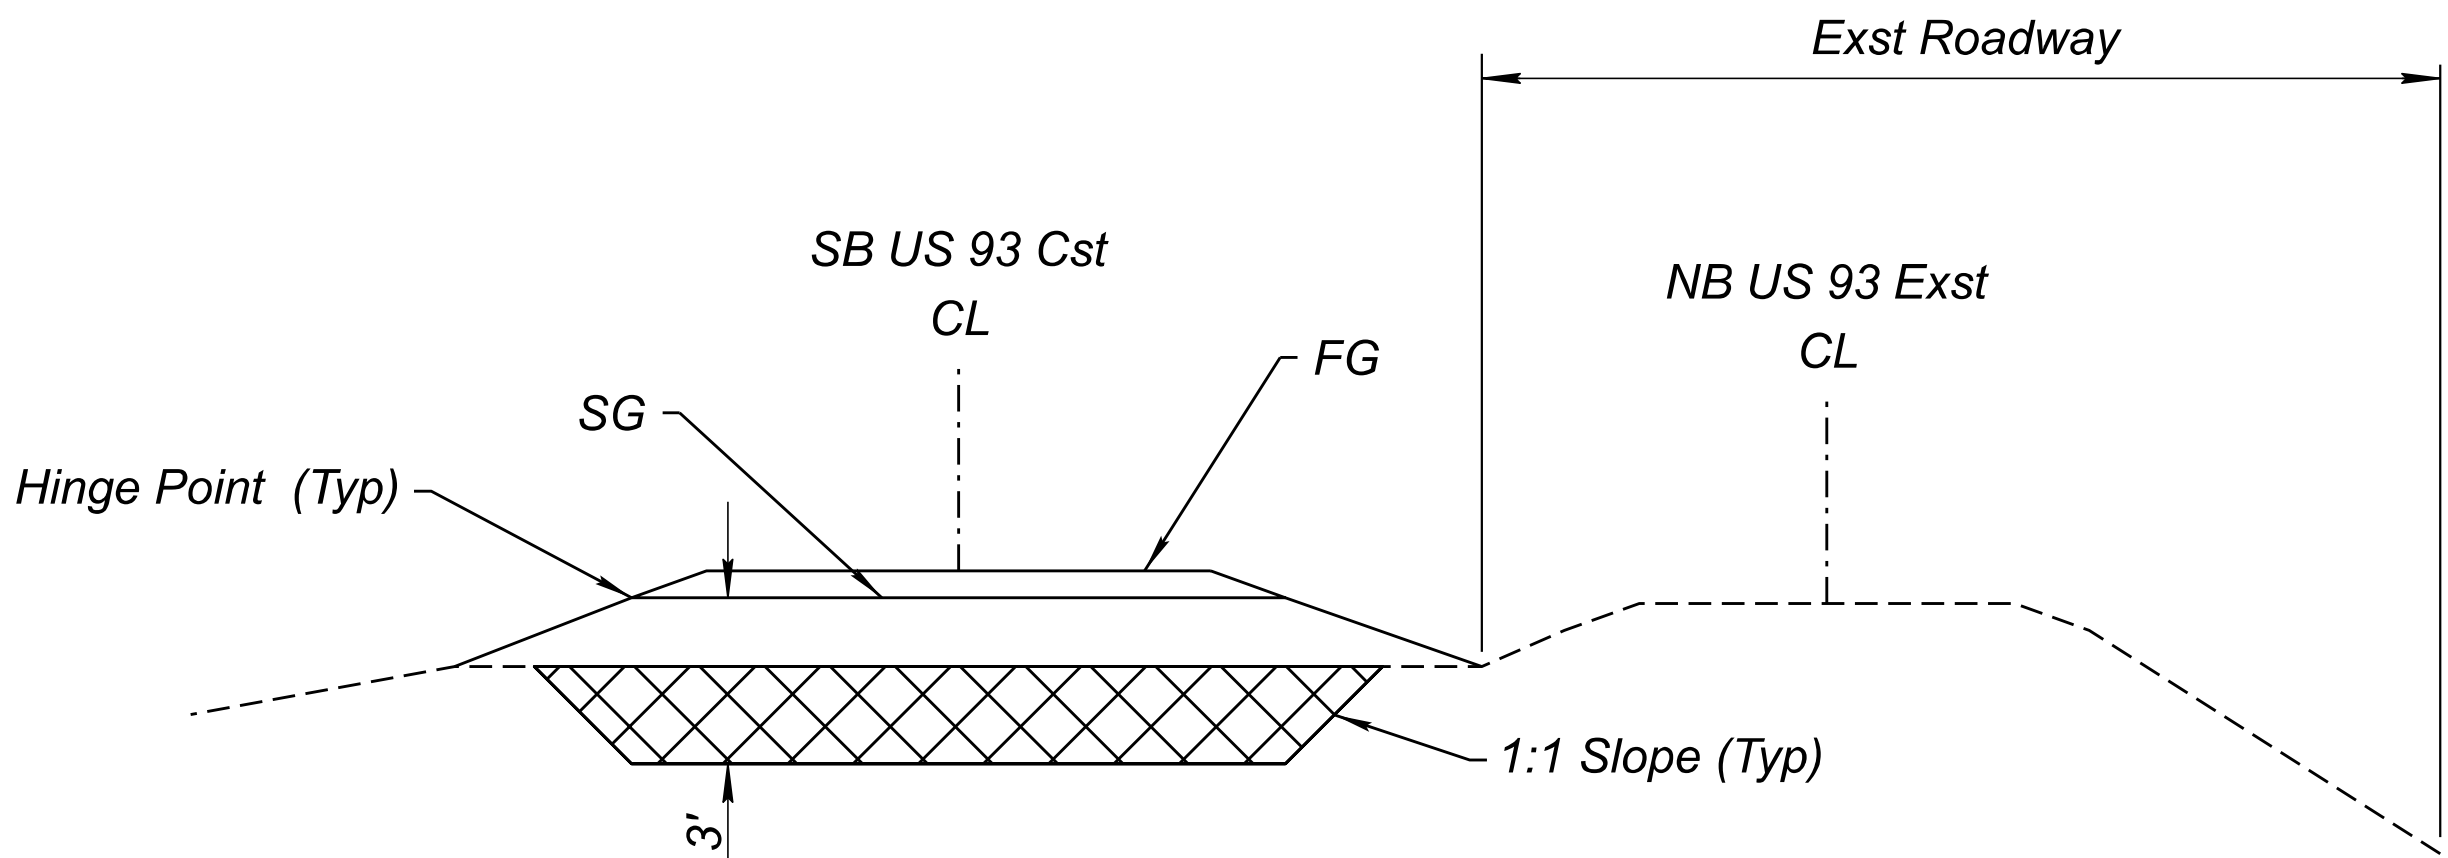


 Pay Limits for Over-Excavation of unsuitable pavement subgrade Included in Roadway Excavation


Notes:

1. Unsuitable pavement subgrade materials may be placed below 3' of finished subgrade in pavement areas, or outside of pavement areas. They do not need to be hauled offsite.

The following locations shall have the existing material removed and recompacted:

OVER EXCAVATION LOCATIONS				
	From Station	To Station	Estimated Max Height 'H' (Ft)	Excavation (CY)
SB US 93 Cst CL	192+70.00	196+50.00	34.84	2829
SB US 93 Cst CL	200+10.00	200+34.00	22.47	122
	TOTAL:			2951

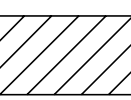 Pay Limits for Over-Excavation of pavement subgrade Included in Roadway Excavation

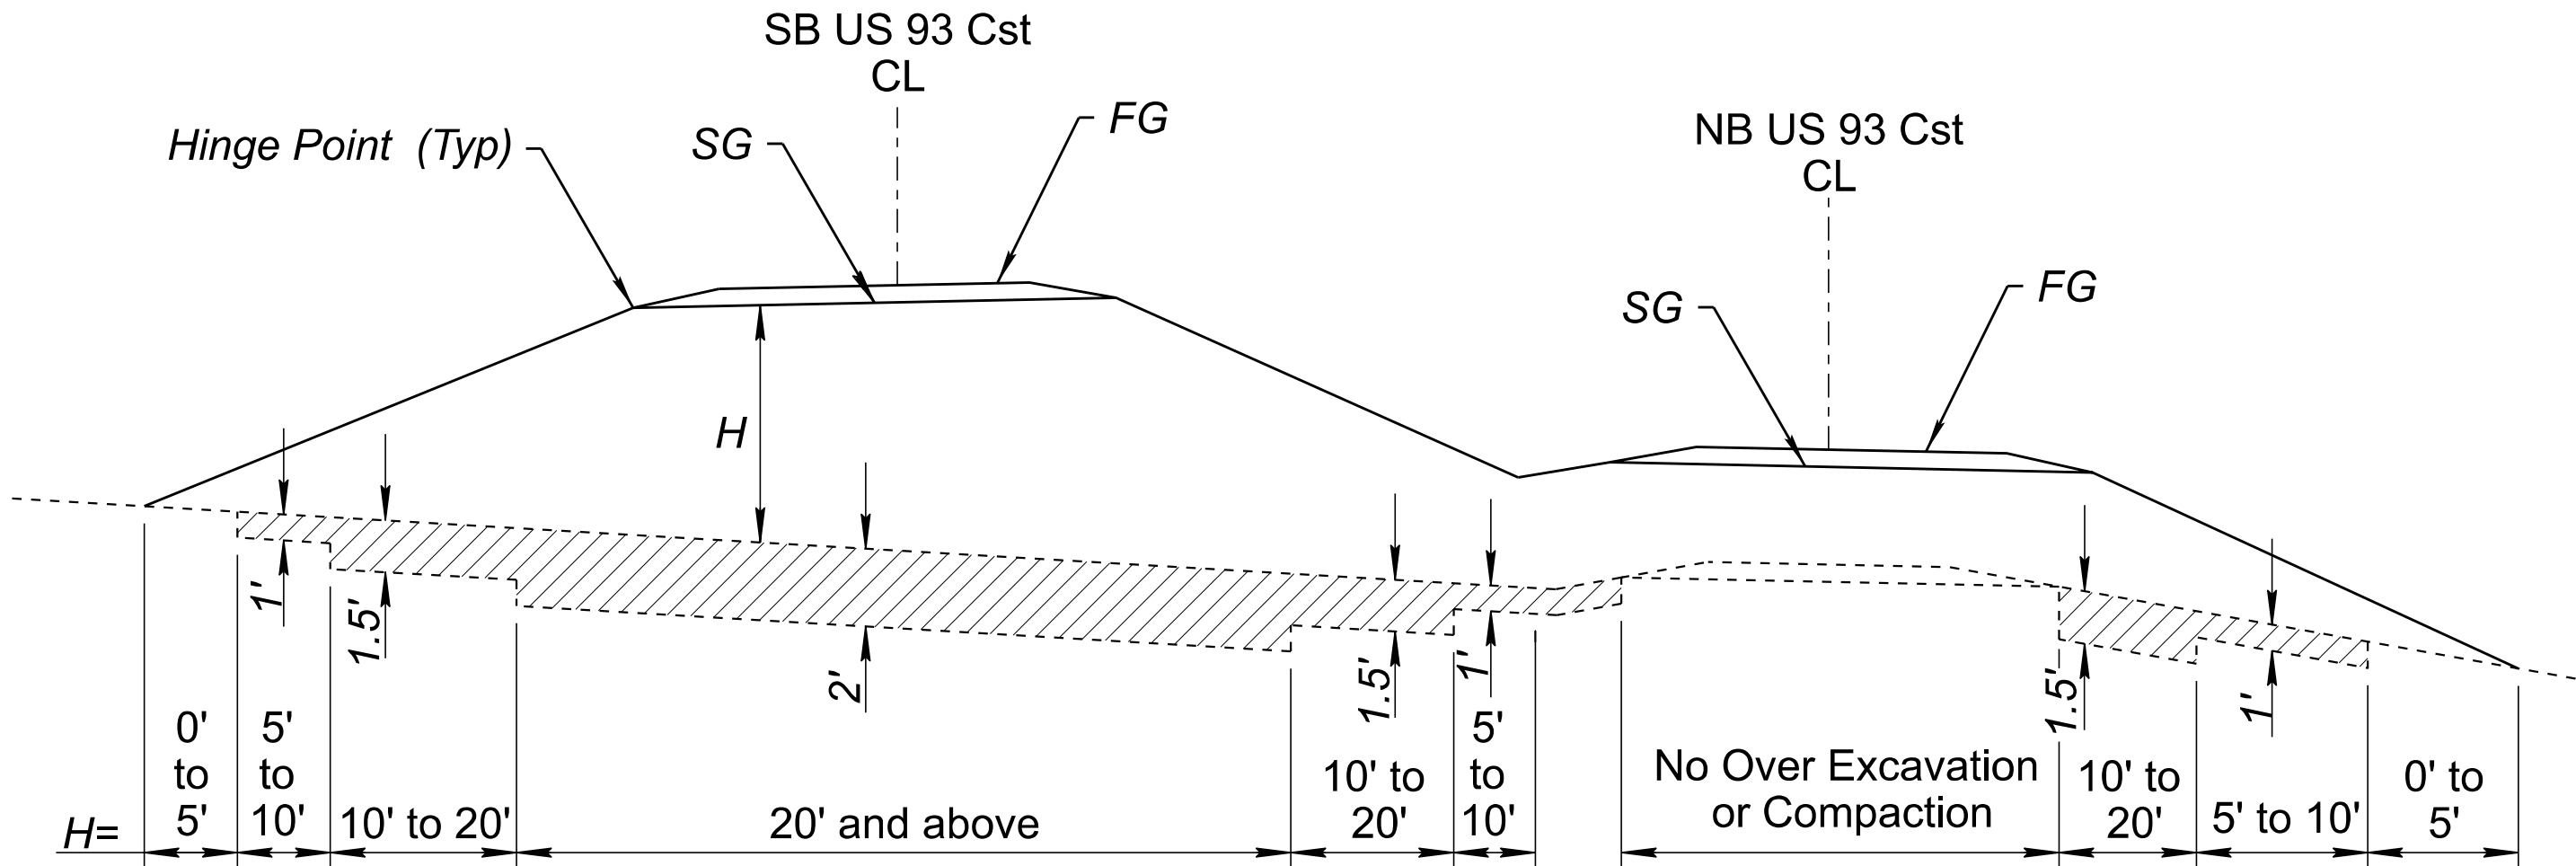

Notes:

1. These materials can be reused as compacted fill.
2. These materials may be used in for subgrade if they meet the design R-value.

DETAIL C

OVER EXCAVATION AREAS





	NAME	DATE
DESIGN	J GILLIS	06/26
DRAWN	M SAMUELSON	06/26
CHECKED	D WIGGINS	06/26

TRANSPORTATION
AECOM TECHNICAL SERVICES, Inc.
7720 N. 16th St., Suite 100
Phoenix, Arizona 85020
T 602.371.1100

AECOM
www.aecom.com

ARIZONA DEPARTMENT OF TRANSPORTATION PROJECT DELIVERY AND OPERATIONS DIVISION ROADWAY DESIGN SERVICES	ROUTE US 93 MILEPOST 189.9 STRUCTURE NO.
DETAIL SHEET DETAIL C	


F.H.W.A. Arizona Division	STATE ARIZ.	PROJECT NO. 093 YV 189	FEDERAL ID NO. 093-B(230)T	SHEET NO. 43	TOTAL SHEETS 524	RECORD DRAWING
WICKENBURG RANCH WAY TO VISTA ROYALE						DWG No. G-5.03
TRACS NO. F0738 01C						___ OF ___

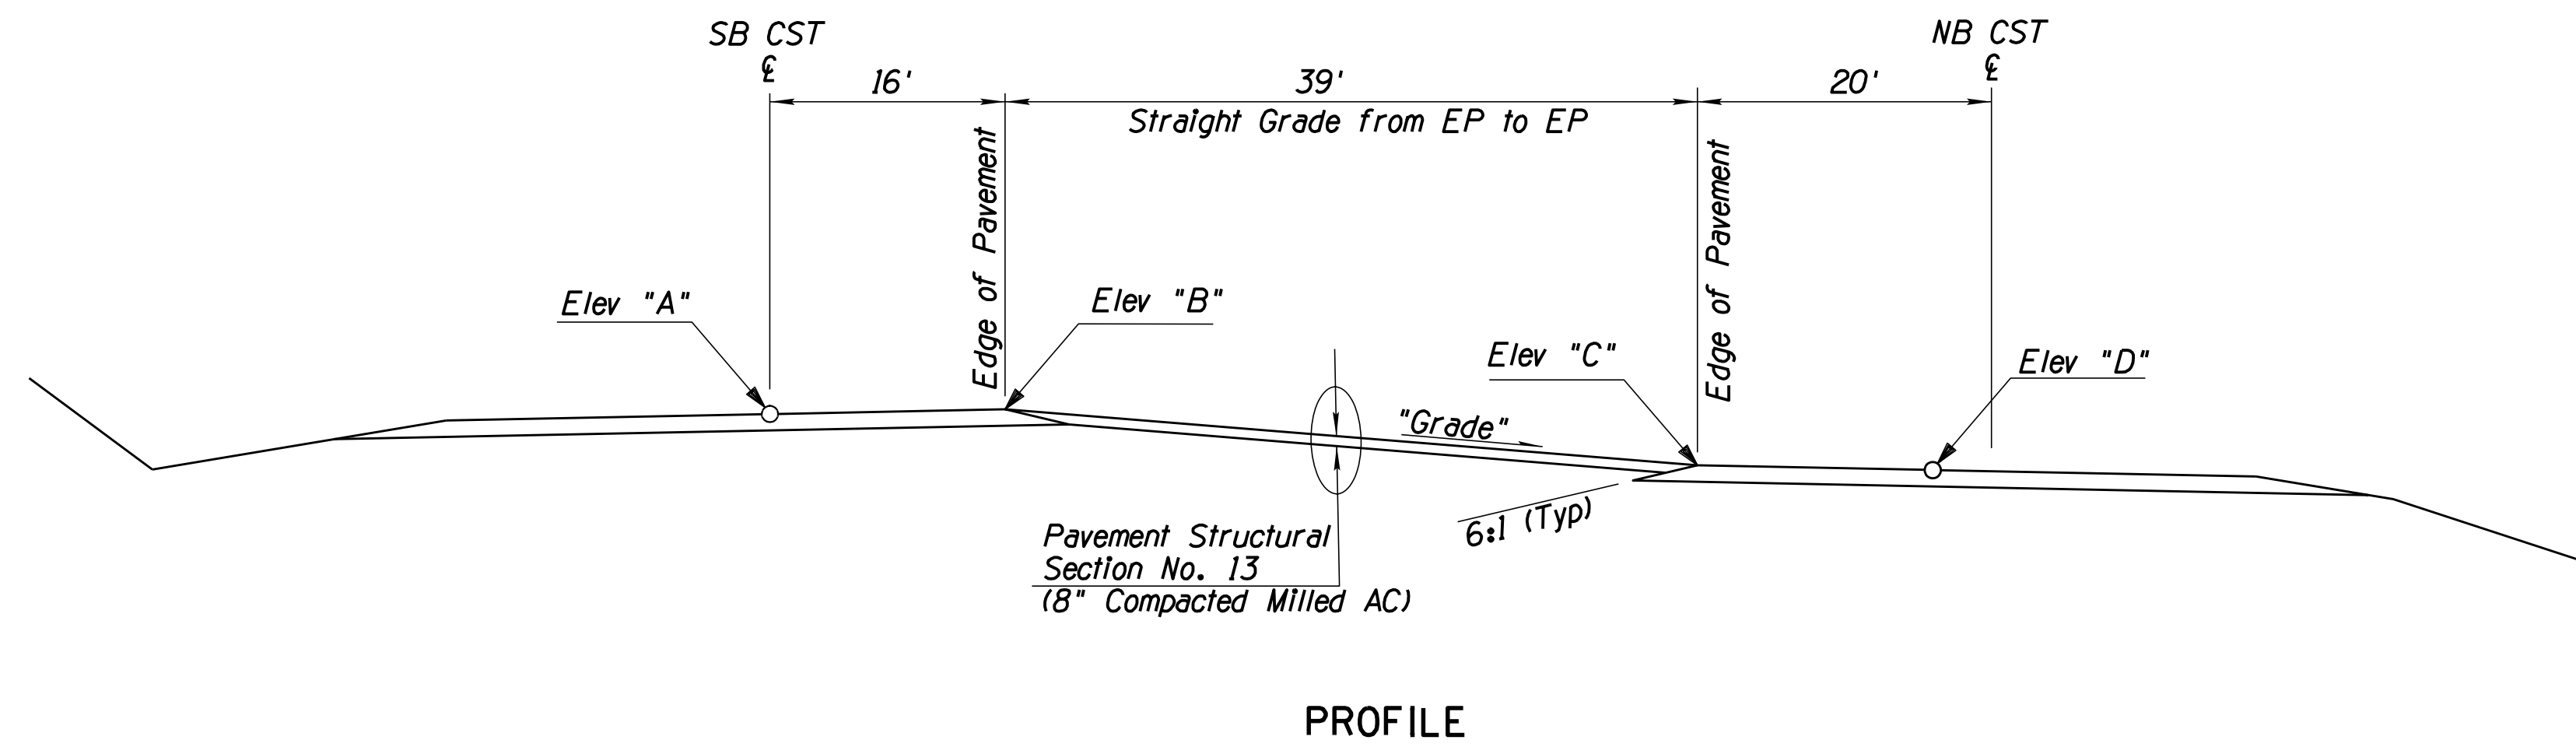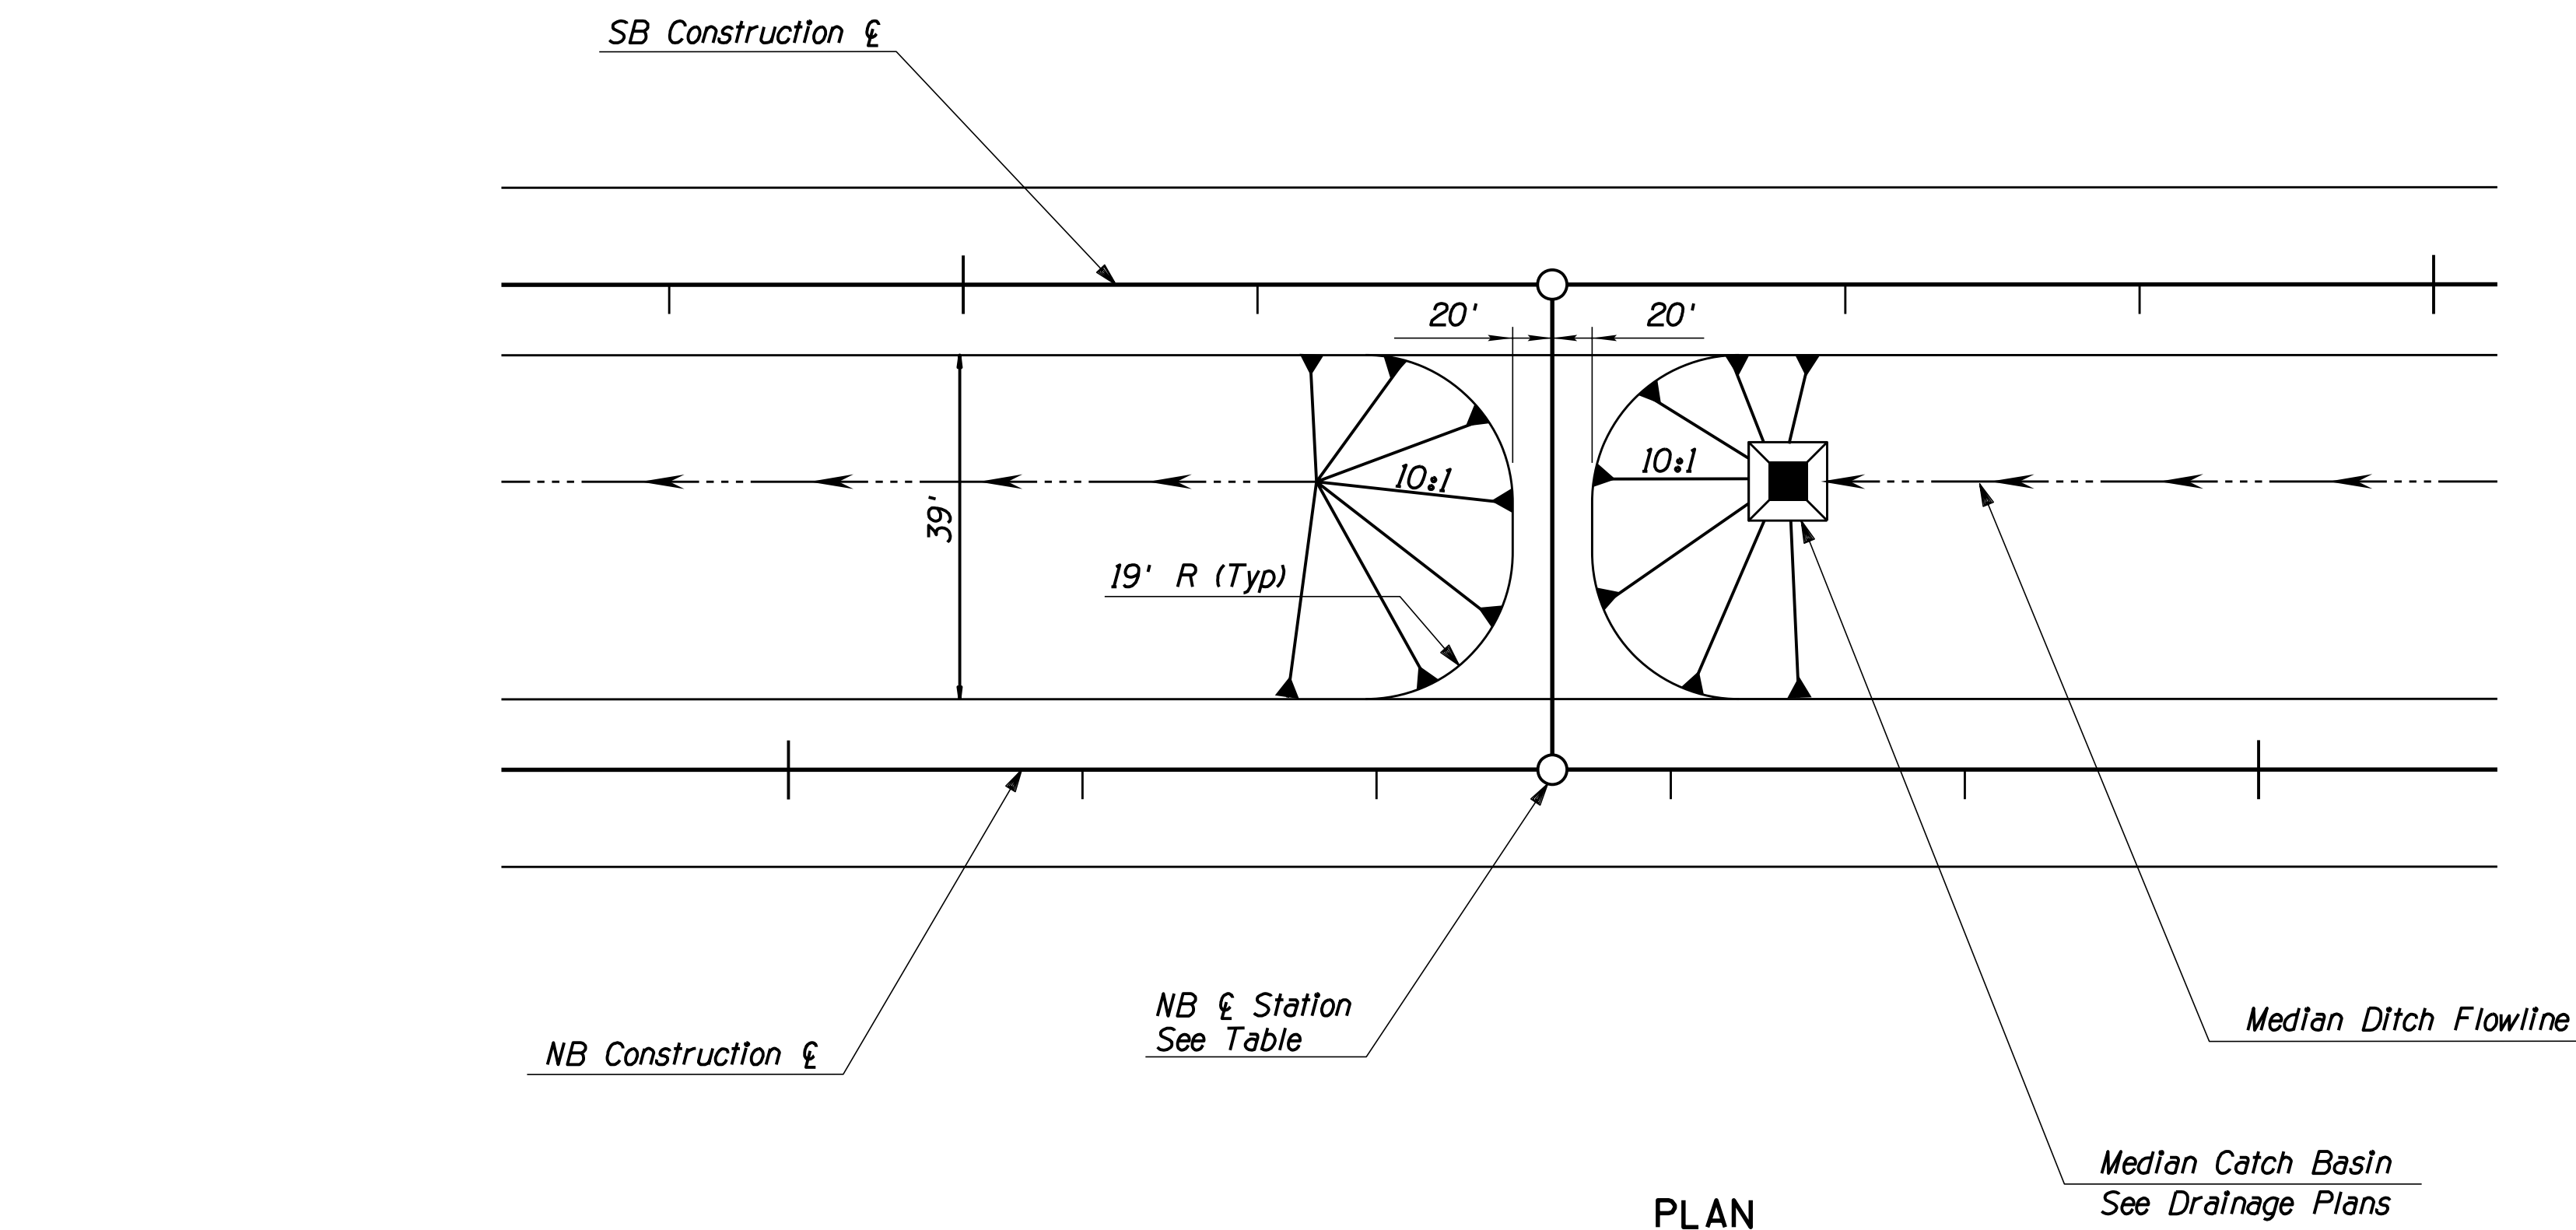


EMERGENCY CROSSOVER GRADE CONTROL						
Station	"Grade"	Elev "A"	Elev "B"	Elev "C"	Elev "D"	8" Compacted Milled AC (SQ YD)
SB 317+52.53	10.9744%	2585.97	2585.54	2581.26	2585.05	113.00

DETAIL D
EMERGENCY CROSSOVER


	DESIGN	J GILLIS	06/26	ARIZONA DEPARTMENT OF TRANSPORTATION PROJECT DELIVERY AND OPERATIONS DIVISION ROADWAY DESIGN SERVICES	ROUTE	US 93	F.H.W.A. Arizona Division	STATE	PROJECT NO.	FEDERAL ID NO.	SHEET NO.	TOTAL SHEETS	RECORD DRAWING
	DRAWN	M SAMUELSON	06/26		MILEPOST	189.9			093 YV 189	093-B(230)T	44	524	
	CHECKED	D WIGGINS	06/26		TRANSPORTATION AECOM TECHNICAL SERVICES, Inc. 7720 N. 18th St., Suite 100 Phoenix, Arizona 85020 T 602.371-1700 AECOM www.aecom.com	STRUCTURE NO.	LOCATION WICKENBURG RANCH WAY TO VISTA ROYALE						
	DETAIL SHEET DETAIL D								DWG No. G-5.04				
									TRACS NO. F0738 01C				___ OF ___

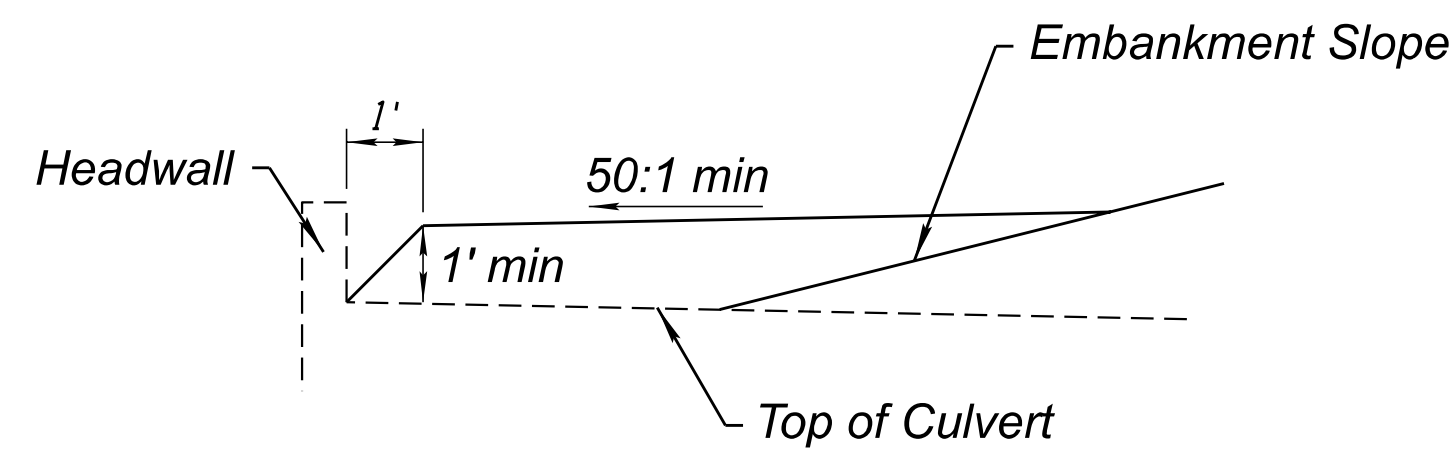

SECTION A-A
(OUTSIDE SLOPES AT BOX CULVERTS)

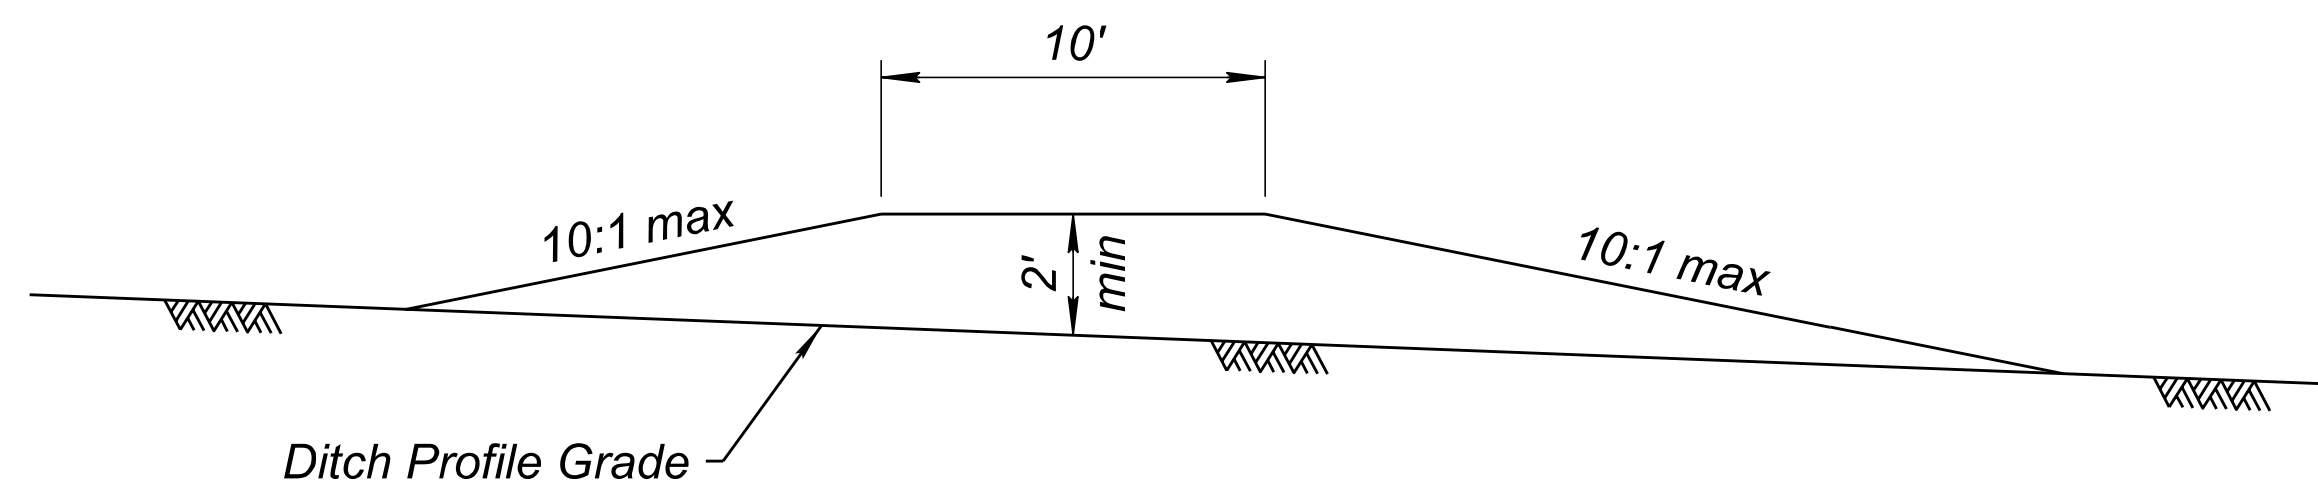


SECTION B-B
(TRANSVERSE DITCH DIKE)

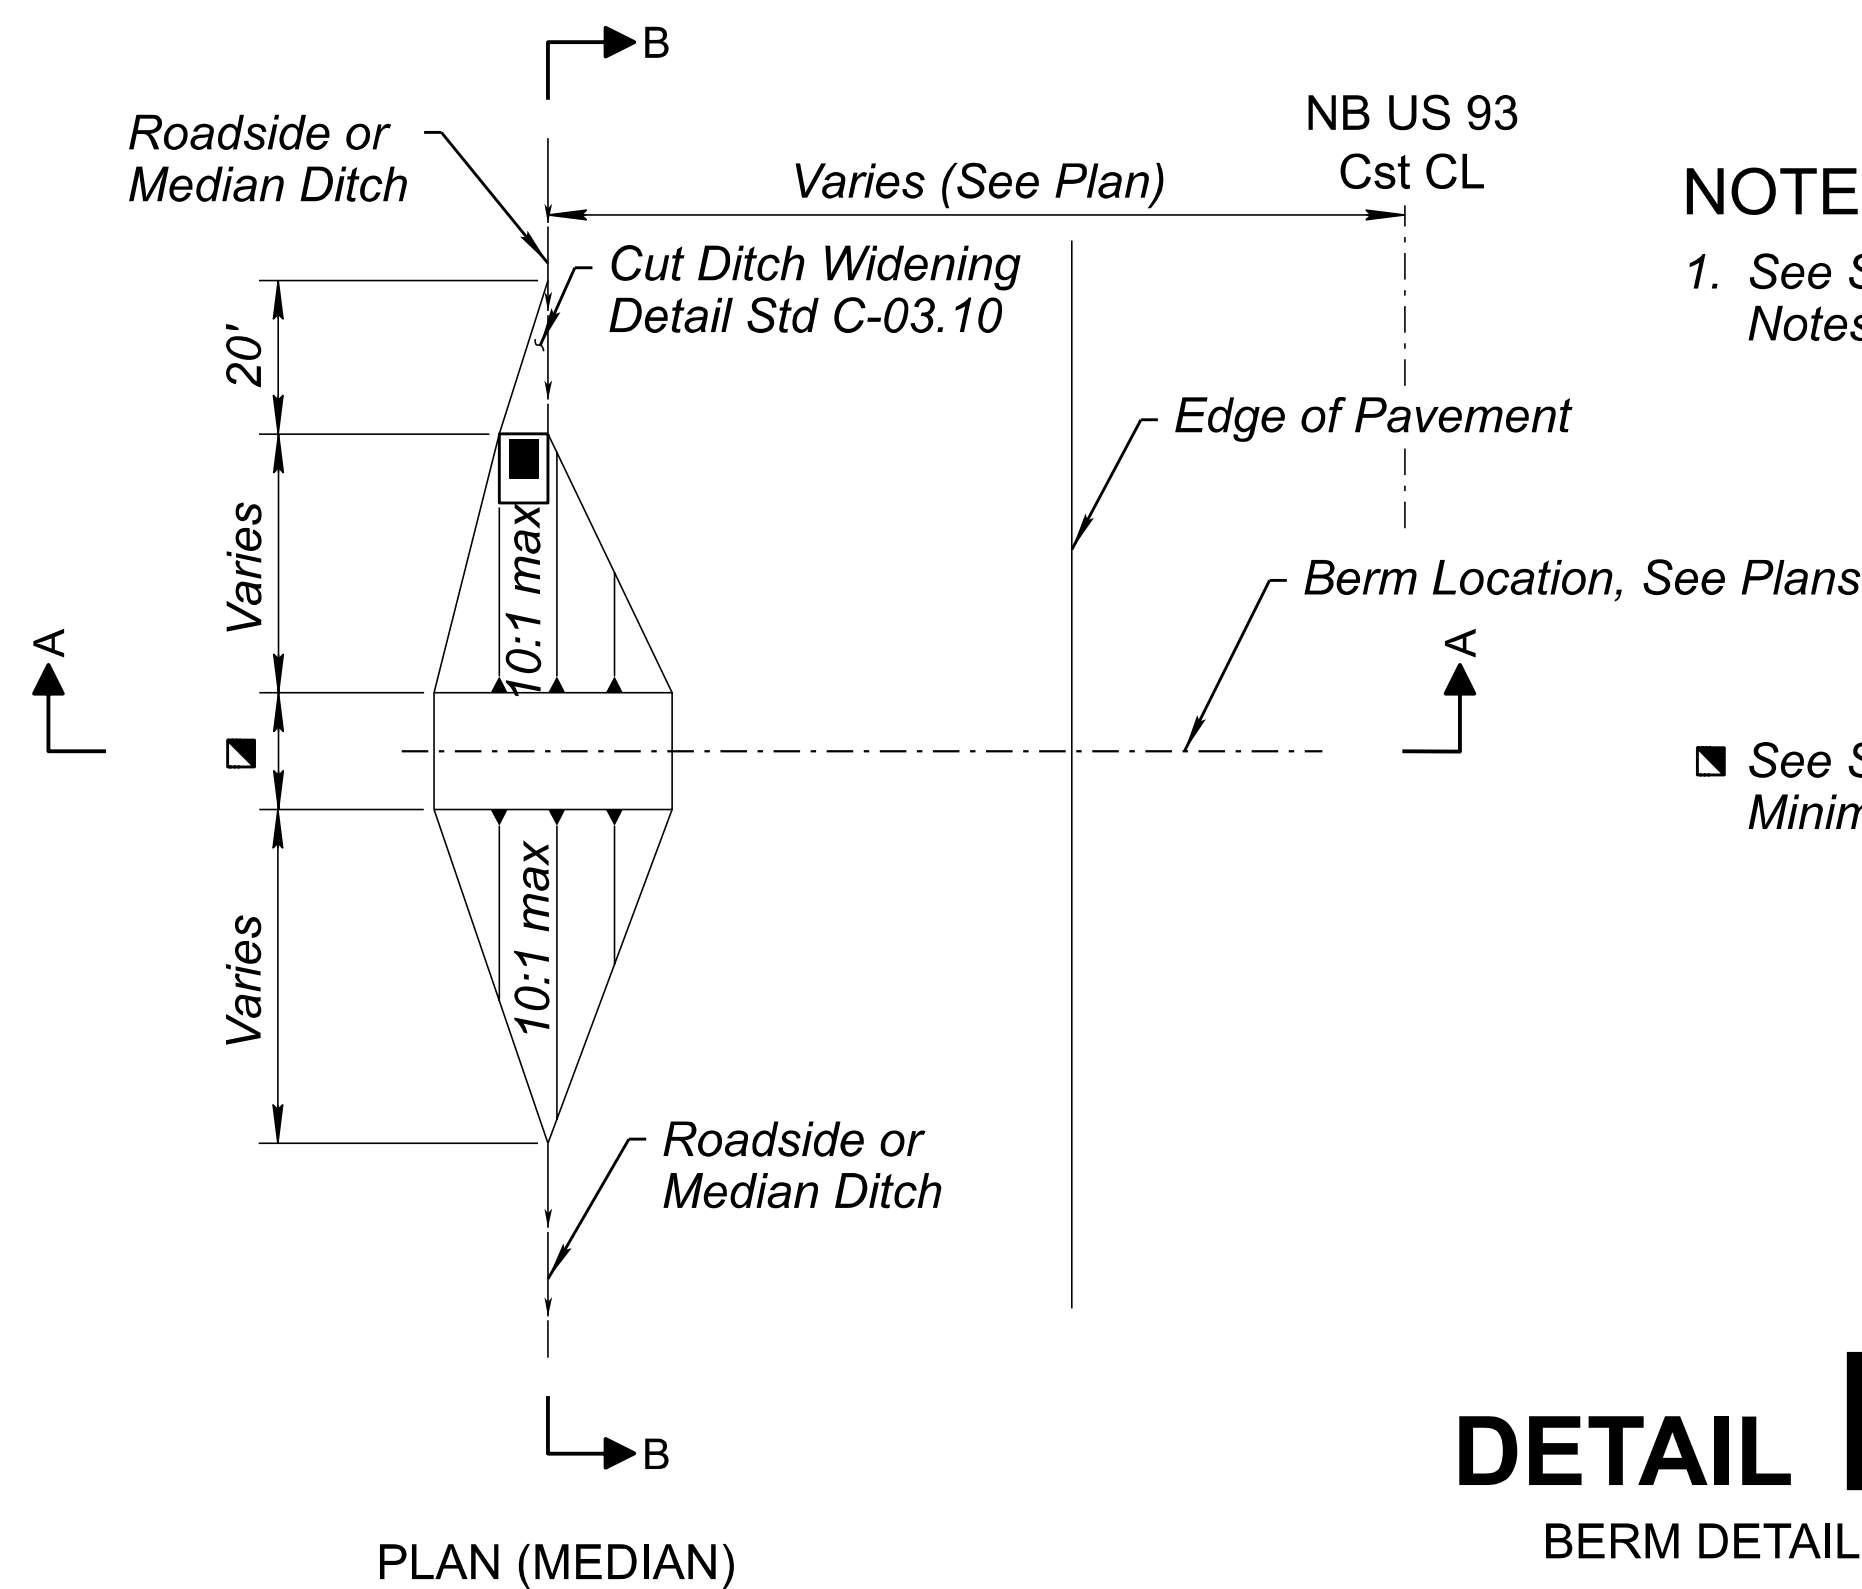

NOTE
1. See Std C-03.10 for Notes and Details Not Shown.

See Std C-03.10 for Minimum Berm Widths

DETAIL E
BERM DETAILS

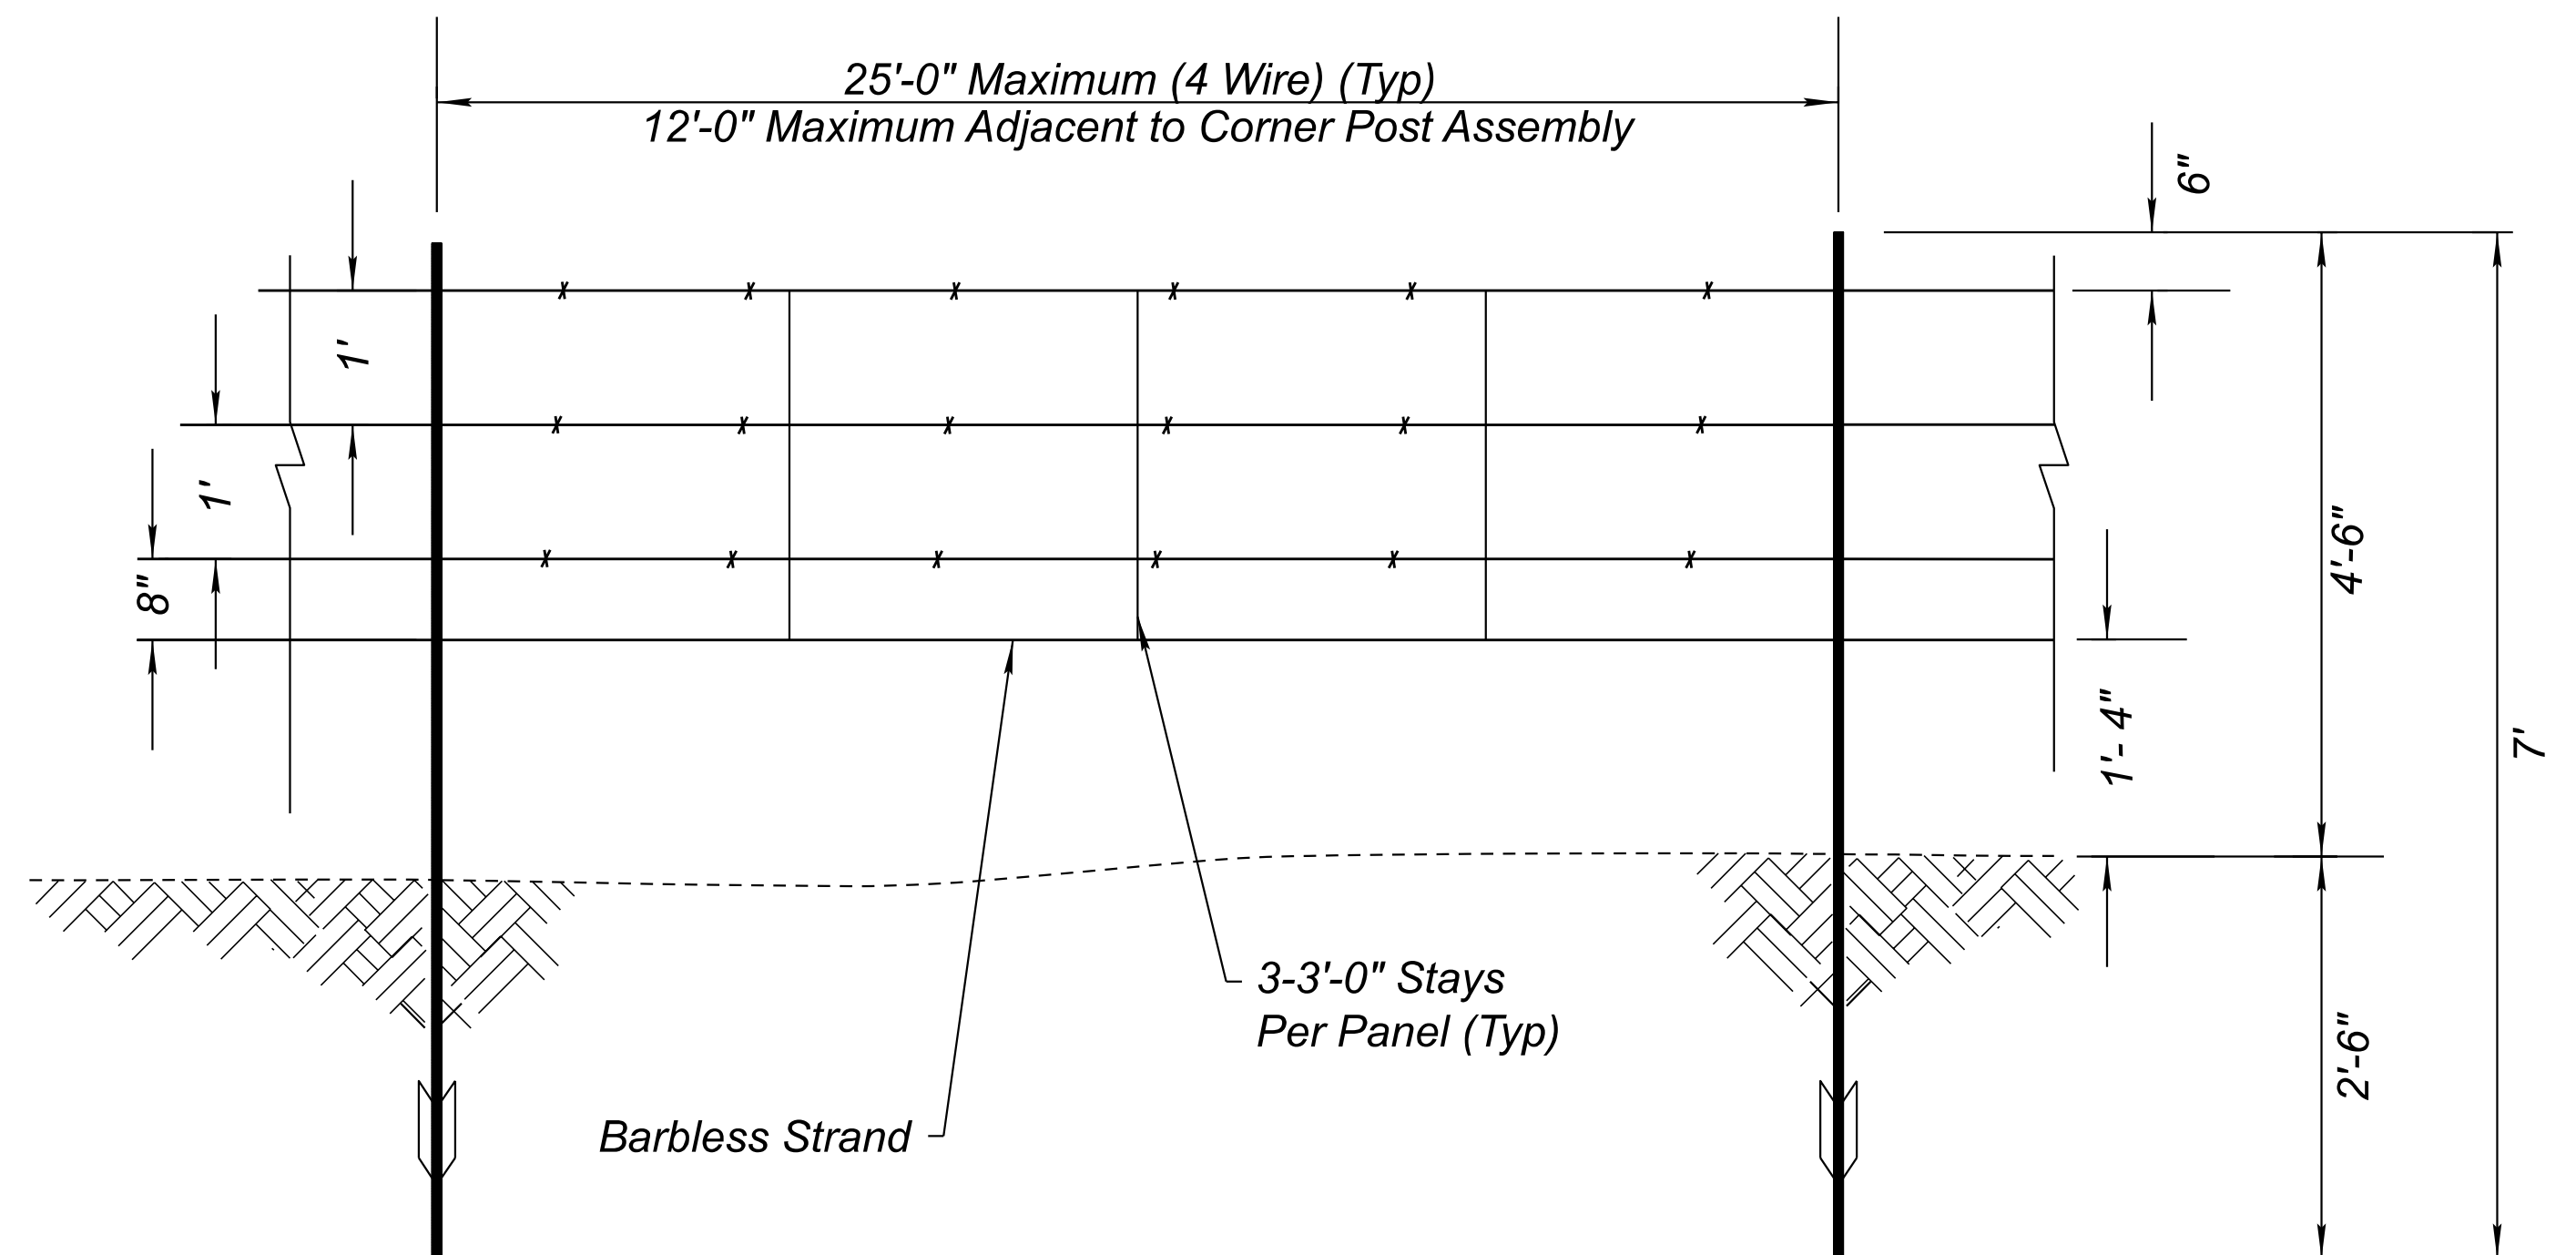


MODIFIED BW GAME FENCE

GENERAL NOTES

- Intermediate Post Assemblies shall be located as show and at Intervals not to exceed 650' , or midway between all braced posts.
- The stays on the fence shall have their ends turned up to prevent injuries to game.
- Fence Wire shall be placed on the side of the line posts away from the main roadway.
- Modified BW Game Fence shall be used at all Flood Gate Fence Crossing.

DETAIL F
MODIFIED BW GAME FENCE

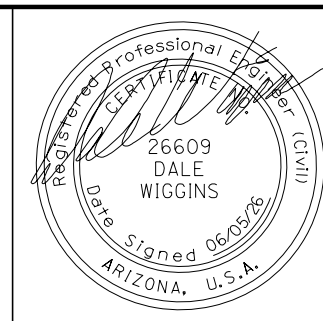

	NAME	DATE
DESIGN	J GILLIS	06/26
DRAWN	M SAMUELSON	06/26
CHECKED	D WIGGINS	06/26


TRANSPORTATION
AECOM TECHNICAL SERVICES, Inc.
7720 N. 16th St., Suite 100
Phoenix, Arizona 85020
T 602.371.1100

AECOM
www.aecom.com


ARIZONA DEPARTMENT OF TRANSPORTATION
PROJECT DELIVERY AND OPERATIONS DIVISION
ROADWAY DESIGN SERVICES

DETAIL SHEET
DETAIL E & F

ROUTE US 93	F.H.W.A. Arizona Division	STATE ARIZ.	PROJECT NO. 093 YV 189	FEDERAL ID NO. 093-B(230)T	SHEET NO. 45	TOTAL SHEETS 524	RECORD DRAWING
MILEPOST 189.9	WICKENBURG RANCH WAY TO VISTA ROYALE					DWG No. G-5.05	
STRUCTURE NO.	TRACS NO. F0738 01C					OF	

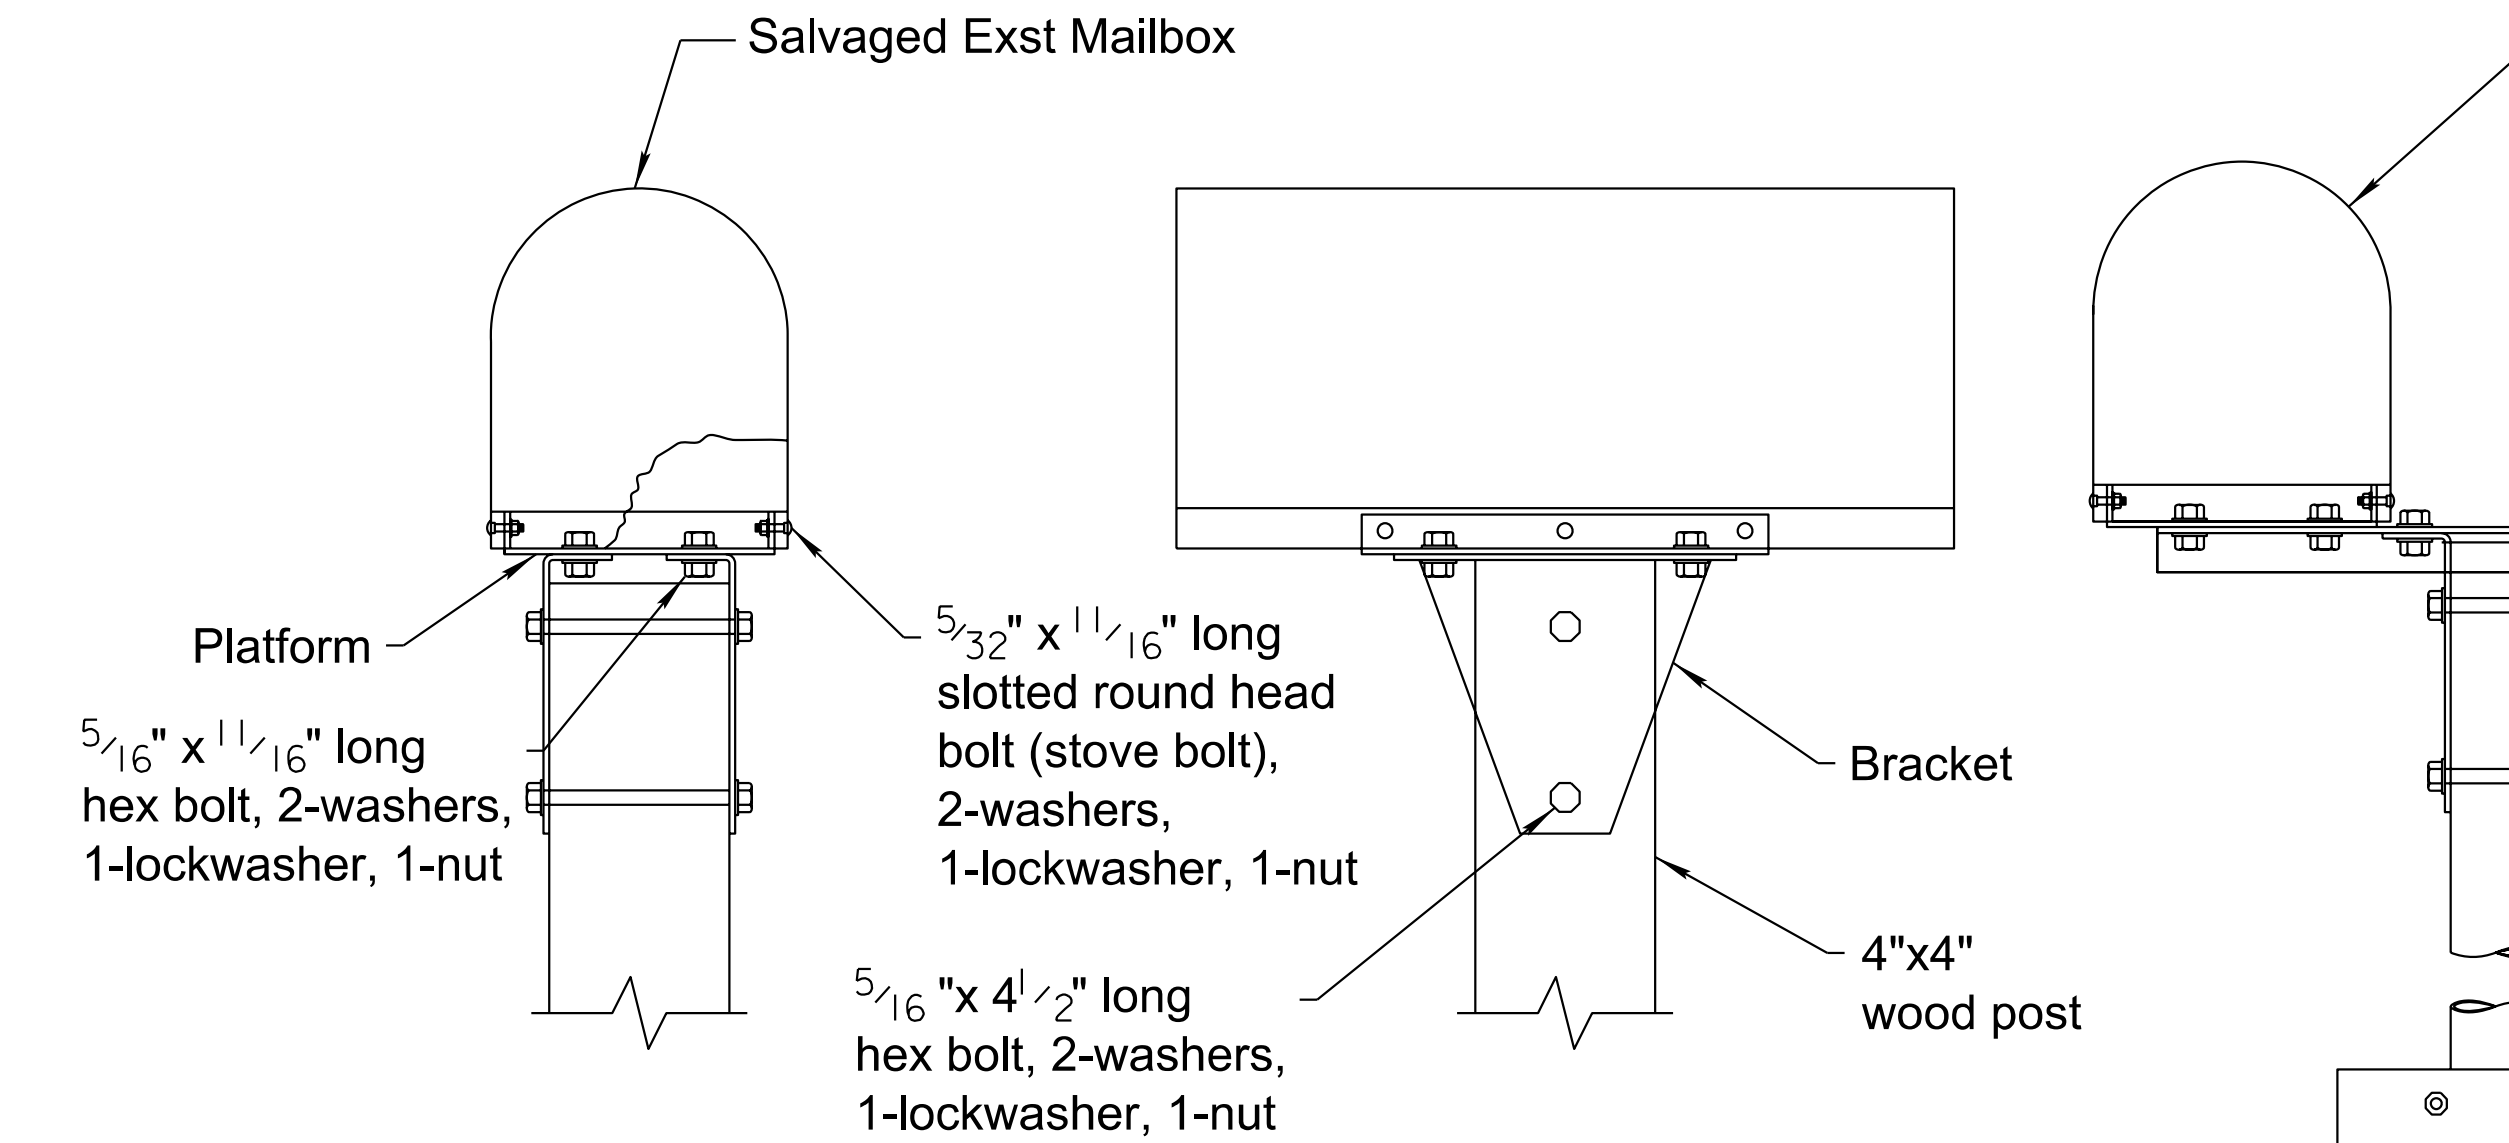

SINGLE MAILBOX INSTALLATION

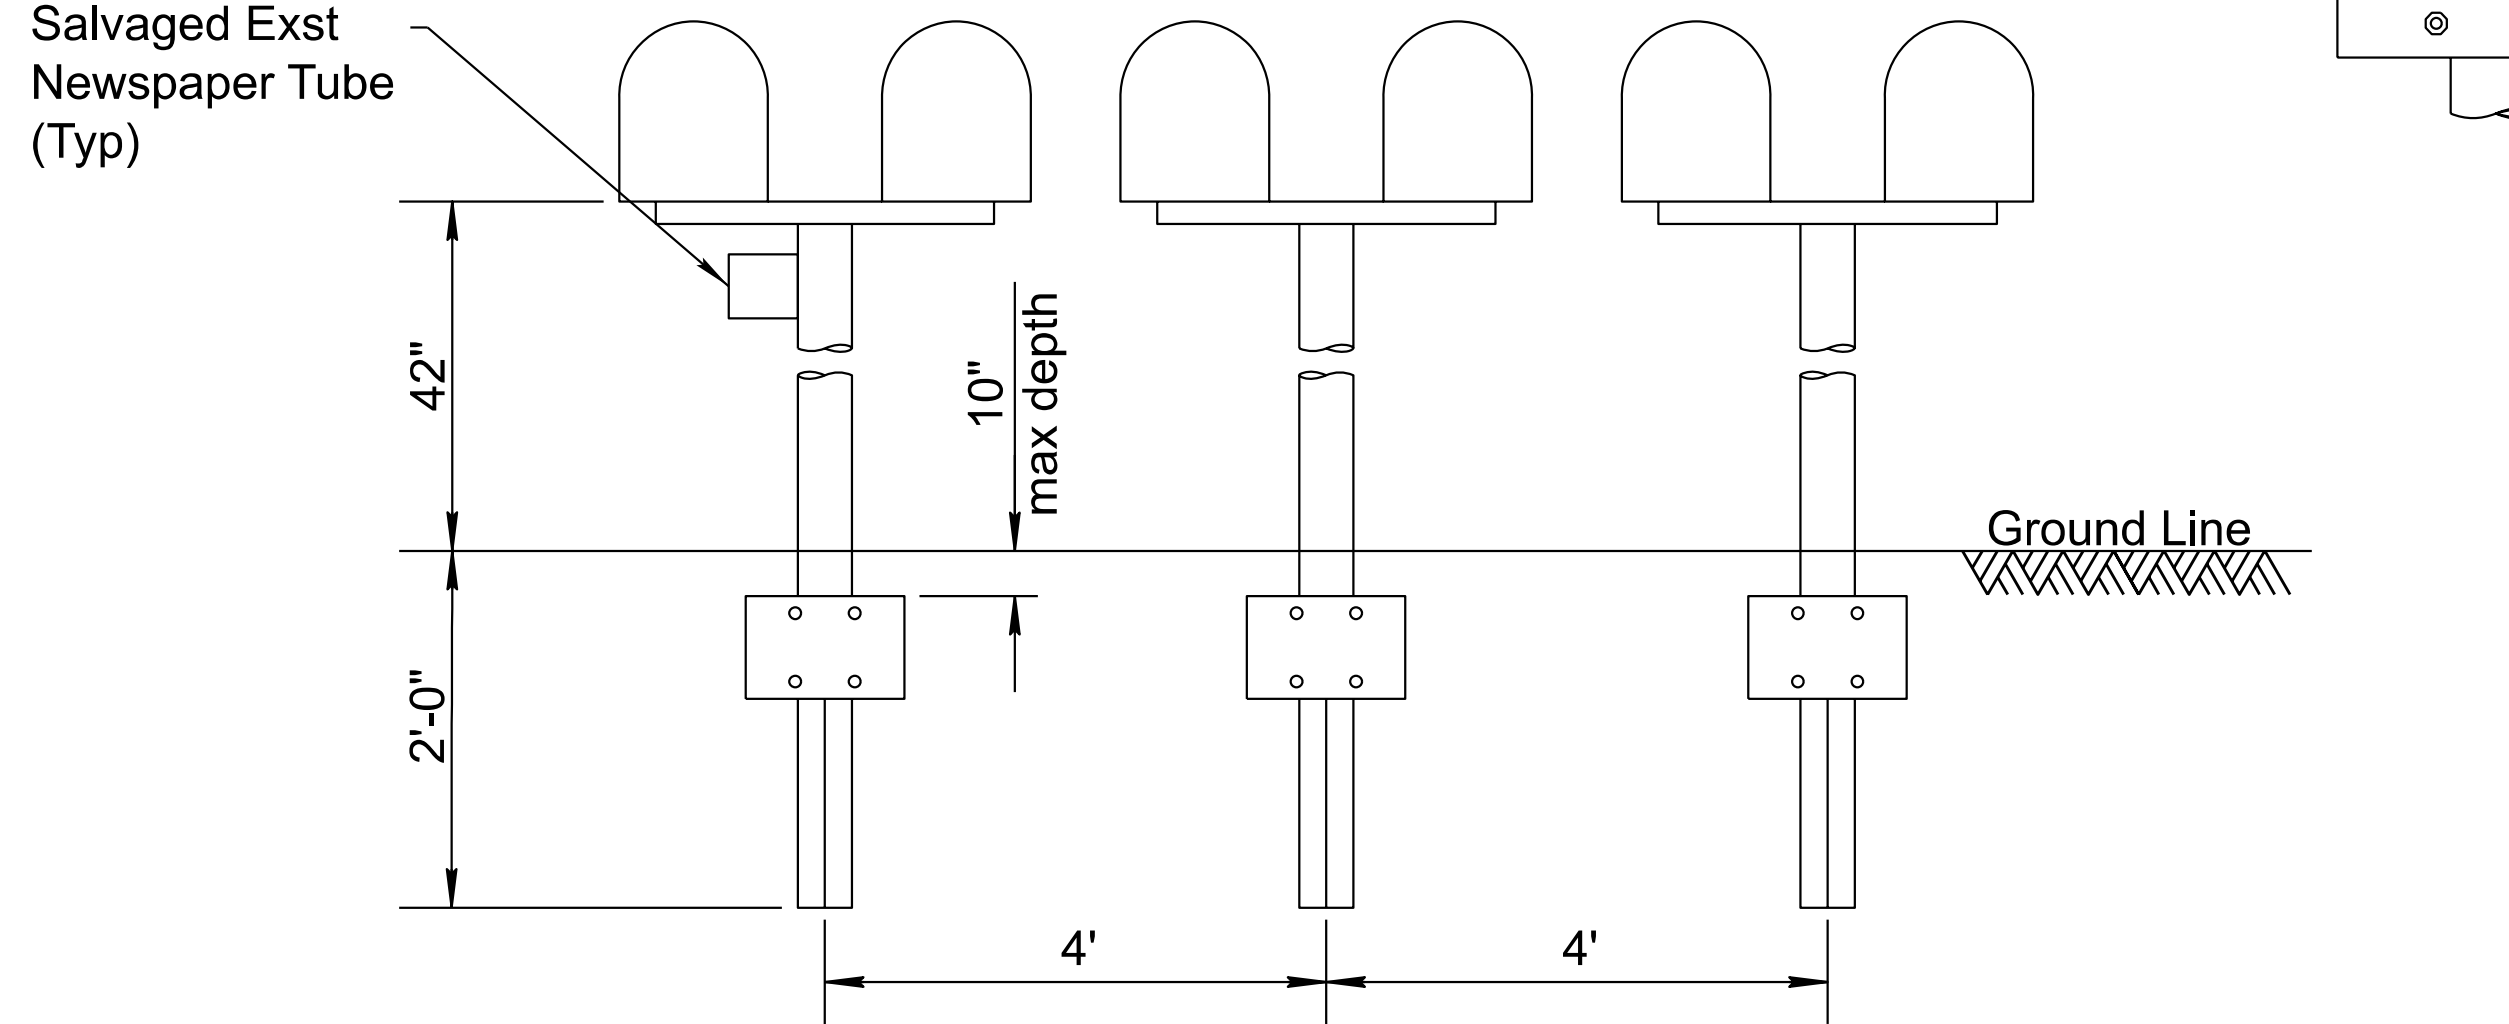

SPACING FOR MULTIPLE POST INSTALLATION

REMOVE AND RELOCATE EXISTING MAILBOXES - 9240122							
EXISTING			PROPOSED		Salvage Existing Steel Post	Single Installation with New Wood Post	Double Installation with New Steel Post
Station	Offset	Salvage Number of Boxes	Frontage Rd Station	Address			
226+14	68' RT	2	24+70, Lt*	35150 34283			X
242+58	60' RT	1	130+25, Rt	35395	X		
245+77	46' RT	1	133+66, Rt	35365		X	
248+04	61' RT	1	136+31, Rt	35325		X	
250+68	48' RT	1	139+27, Rt		X		
257+45	71' RT	4	142+60, Rt	35265		X	
			145+63, Rt	35245		X	
			147+56, Rt	35225			X
266+56	62' RT	1		35119	X		
266+56	60' RT	1		35111	X		

*Nine Iron Ranch




	NAME	DATE
DESIGN	J GILLIS	06/26
DRAWN	M SAMUELSON	06/26
CHECKED	D WIGGINS	06/26

TRANSPORTATION
AECOM TECHNICAL SERVICES, Inc.
7720 N. 16th St., Suite 100
Phoenix, Arizona 85020
T 602.371.1100


AECOM
www.aecom.com

ARIZONA DEPARTMENT OF TRANSPORTATION PROJECT DELIVERY AND OPERATIONS DIVISION ROADWAY DESIGN SERVICES	
DETAIL SHEET DETAIL H	


ROUTE US 93	F.H.W.A. Arizona Division	STATE ARIZ.	PROJECT NO. 093 YV 189	FEDERAL ID NO. 093-B(230)T	SHEET NO. 47	TOTAL SHEETS 524	RECORD DRAWING
MILEPOST 189.9	LOCATION WICKENBURG RANCH WAY TO VISTA ROYALE					DWG No. G-5.07	
STRUCTURE NO.	TRACS NO. F0738 01C					OF	

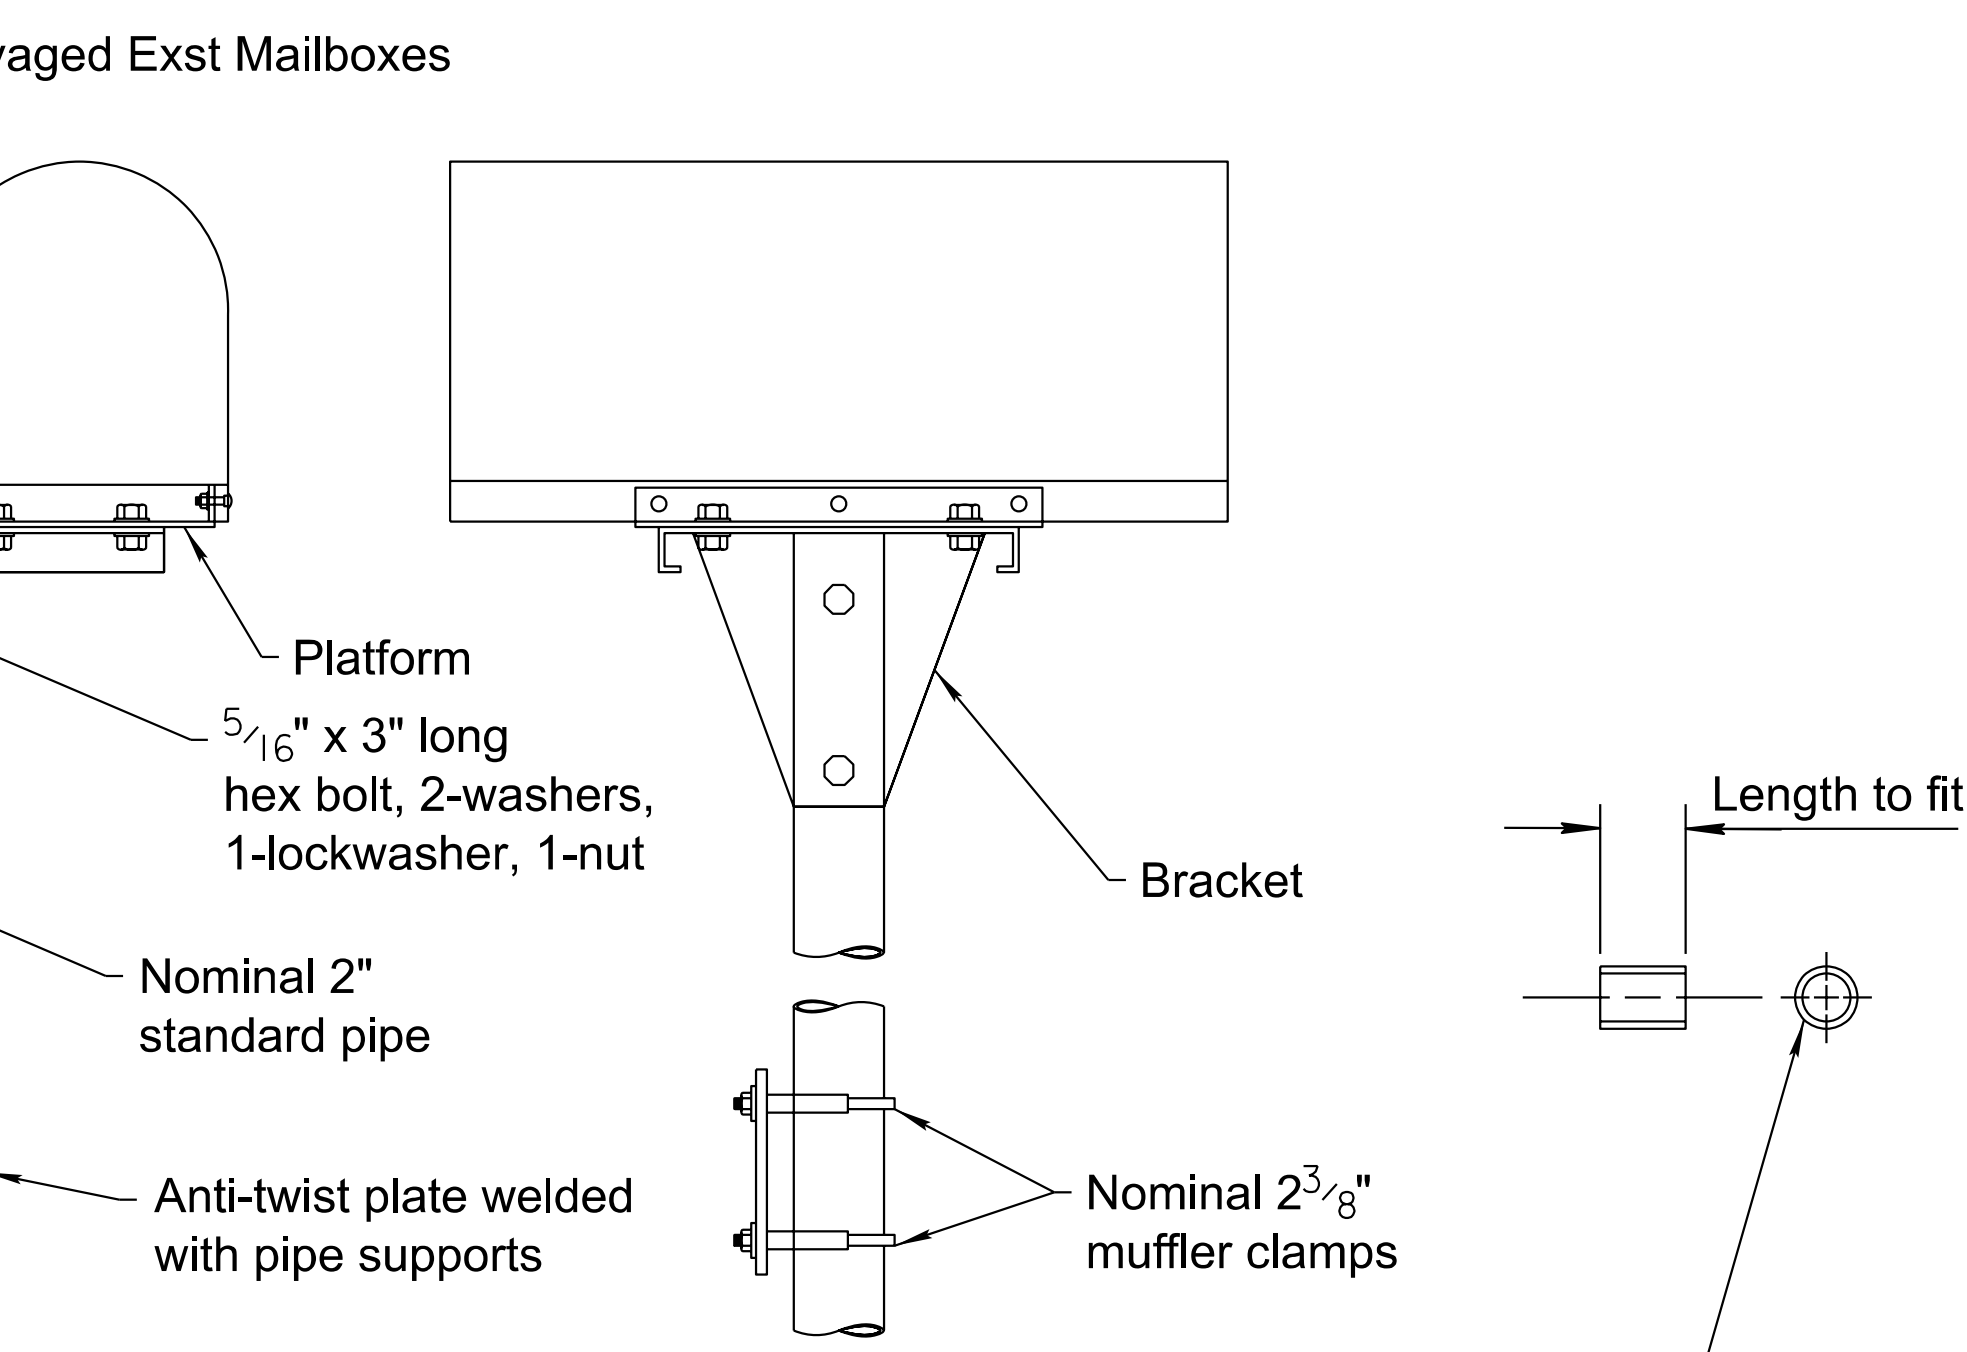

DOUBLE MAILBOX INSTALLATION

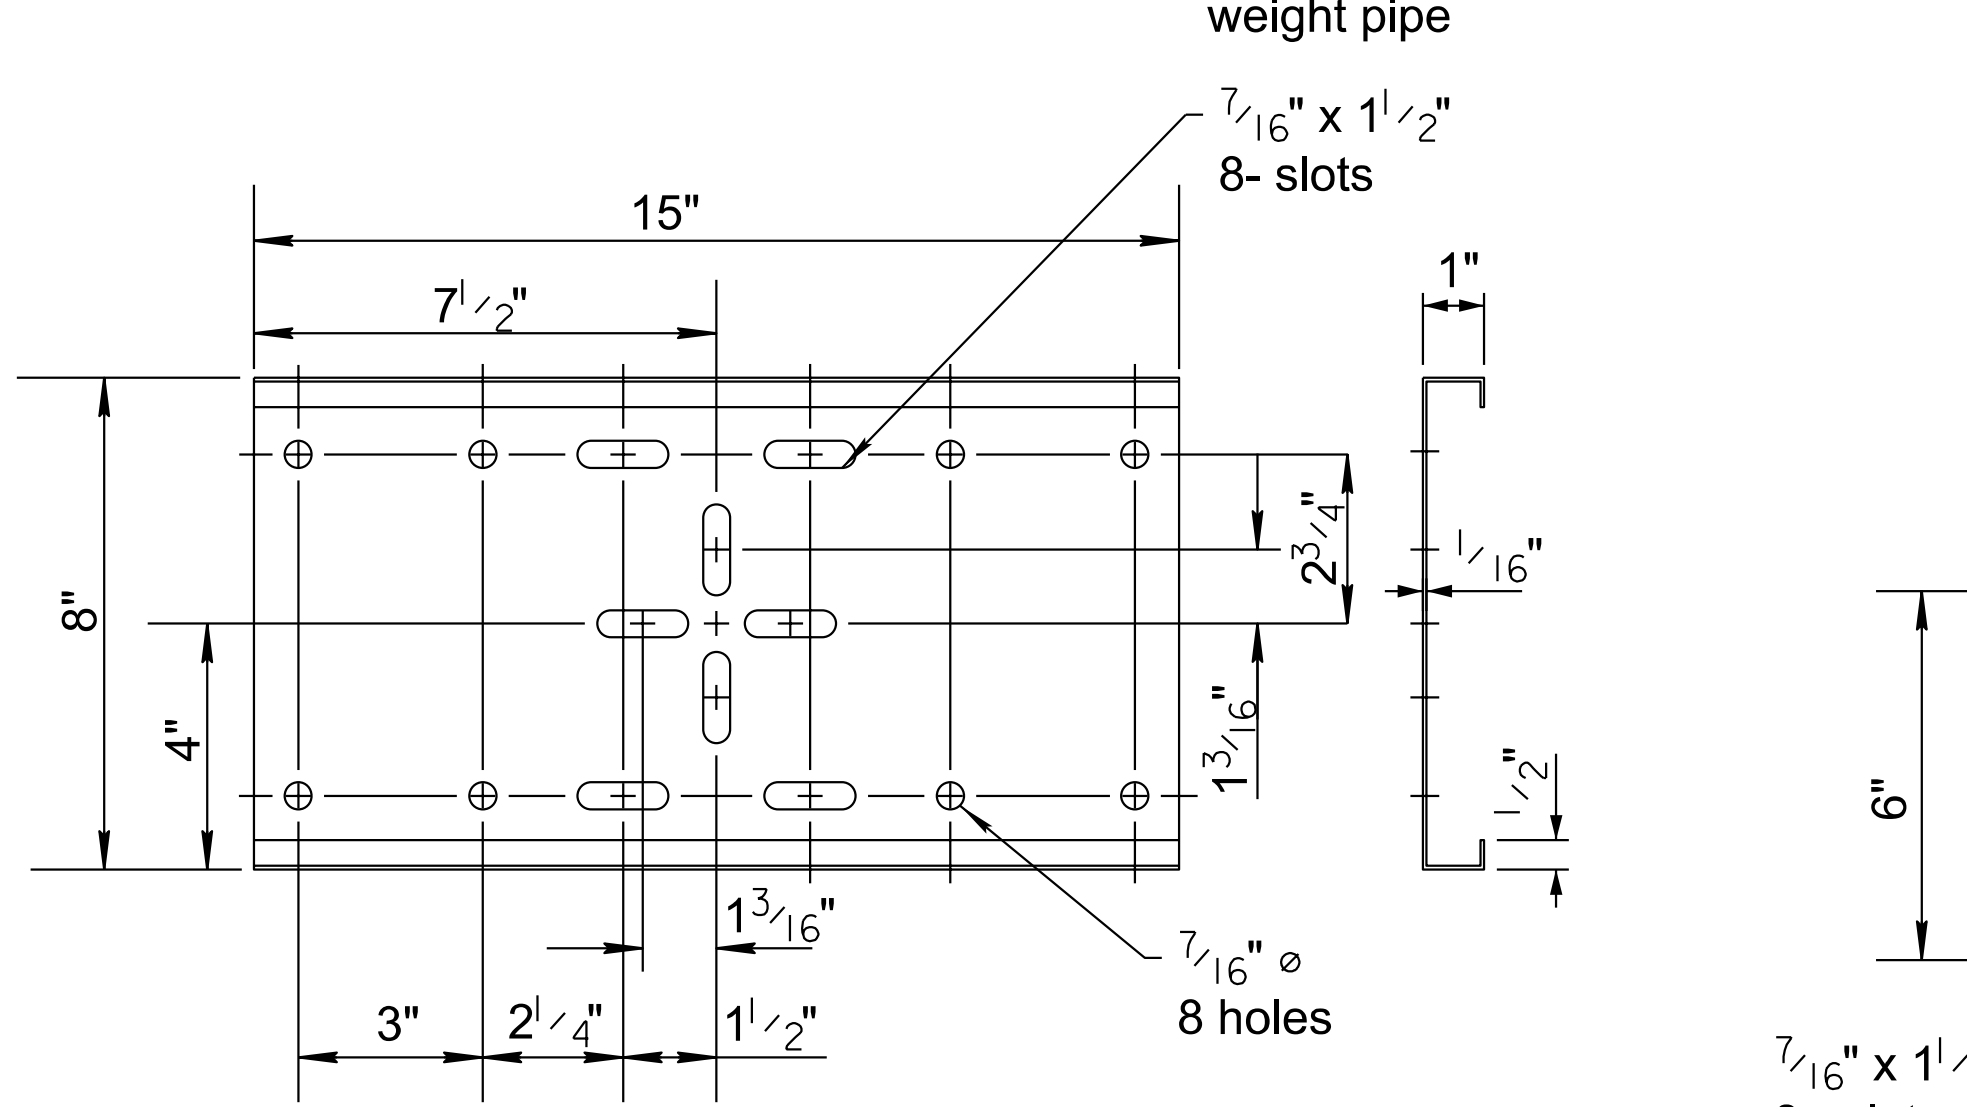


SHELF

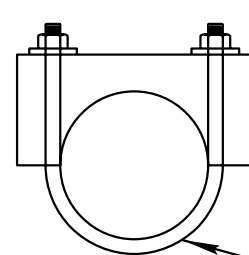


CLAMP

NOTES:


- Salvage existing steel posts. If the existing post is wood, install new 4"x4" S4S redwood post. Cost of the post shall be included in the cost to relocate.
- Locate face of mailbox minimum 0.5 feet from edge of pavement or as directed by the Engineer.
- This work shall be paid for under Item 9240122, Miscellaneous Work (Remove and Relocate Mail Boxes)

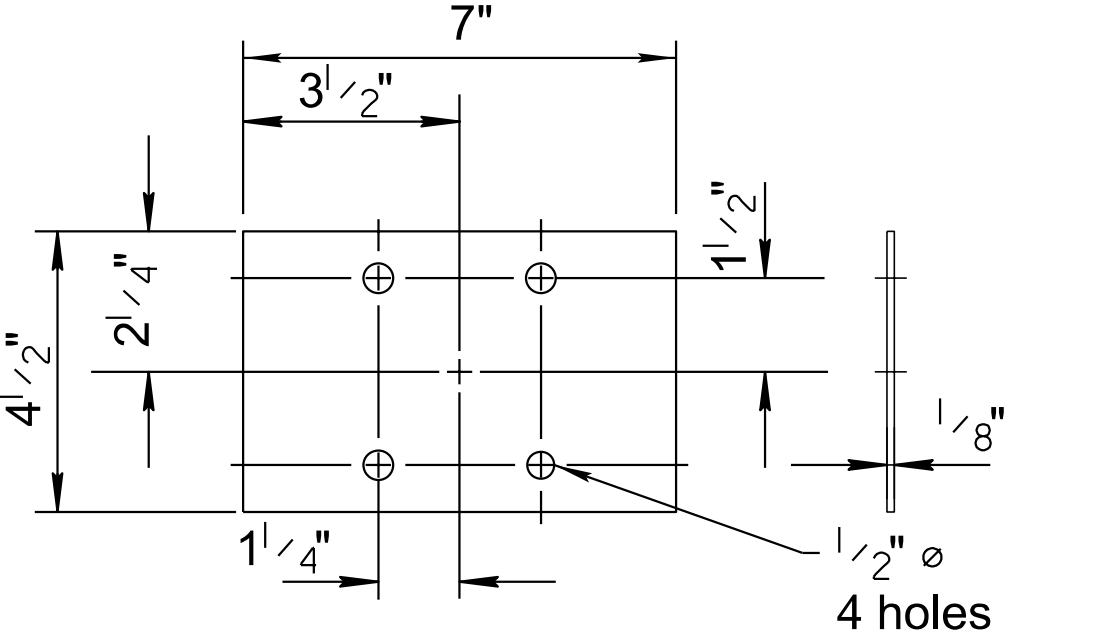

ANTI-TWIST PLATE

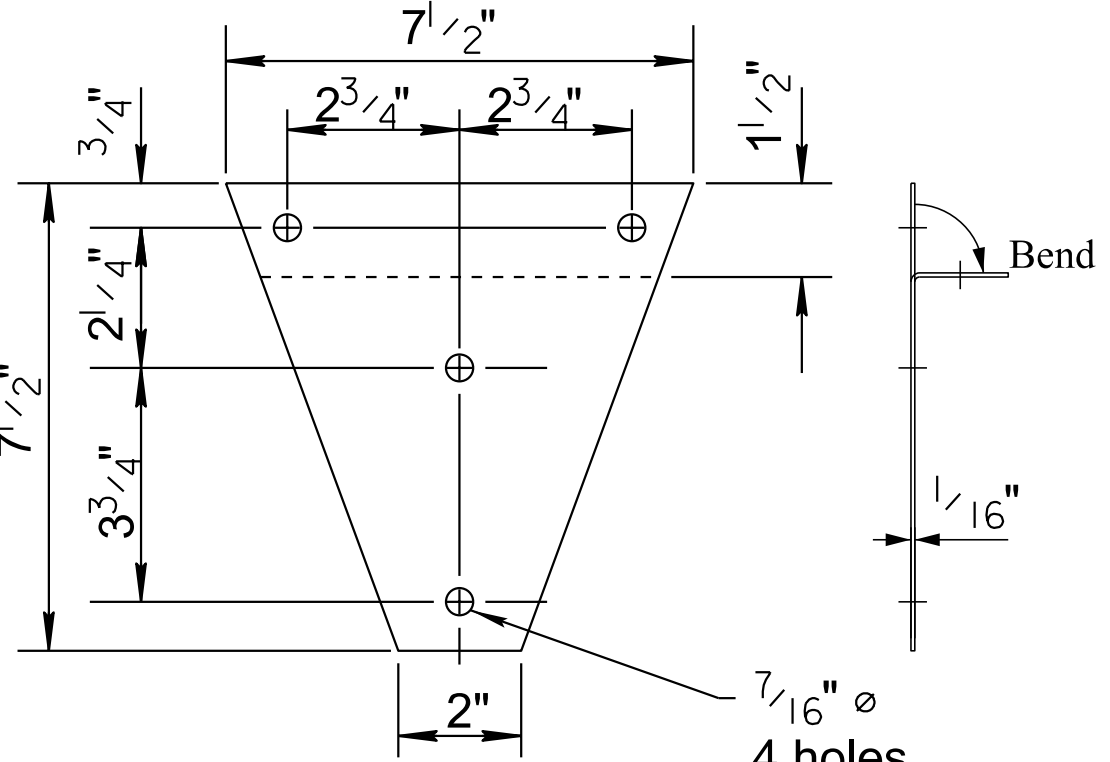


BRACKET

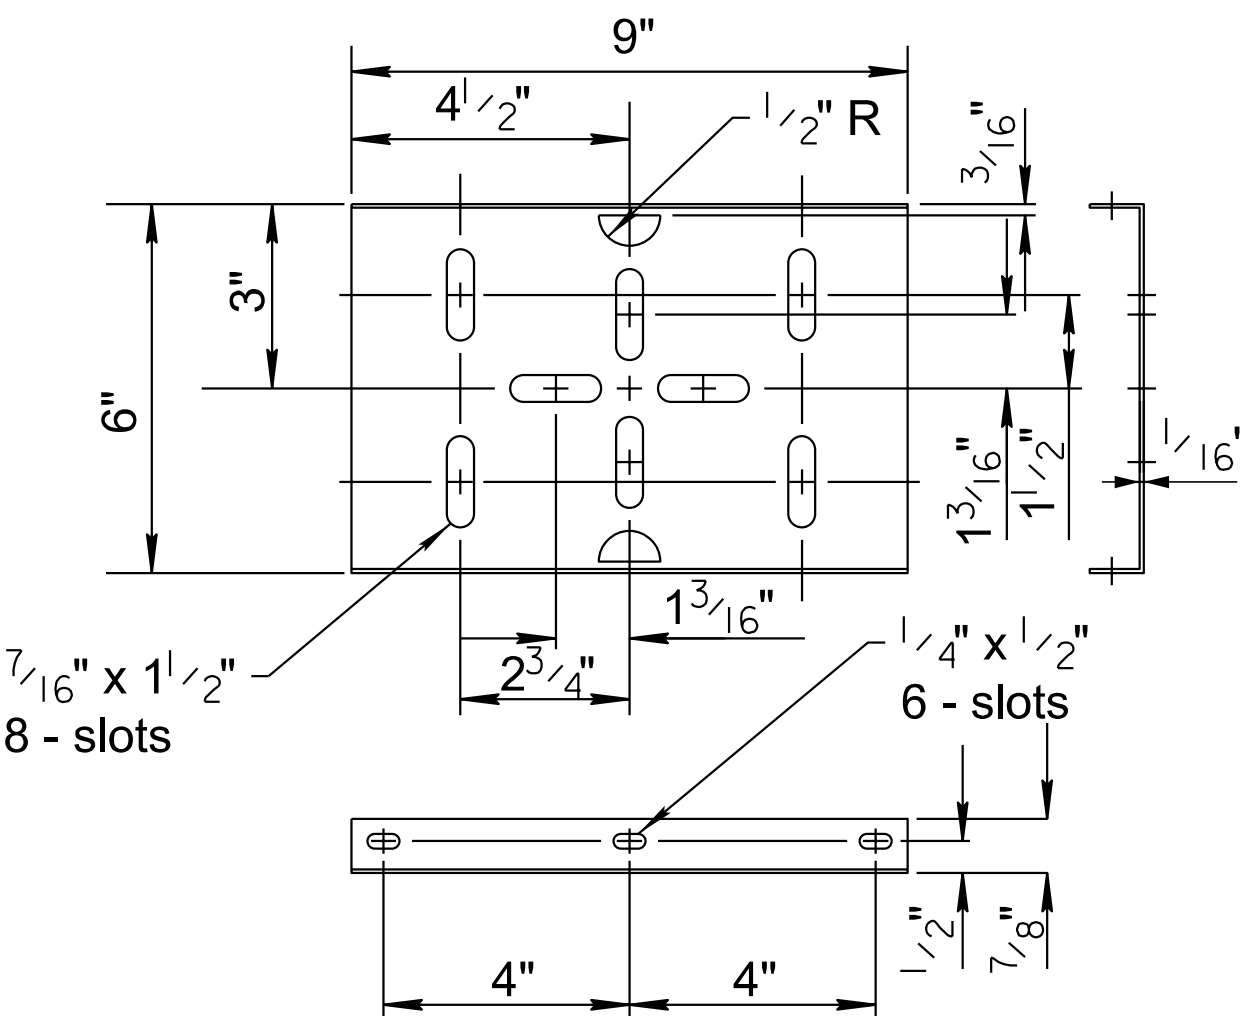

PLATFORM

F.H.W.A. REGION	STATE	PROJECT NO.	SHEET NO.	TOTAL SHEETS	RECORD DRAWING
9	ARIZ.	093-B(230)T			
093 YV 189					

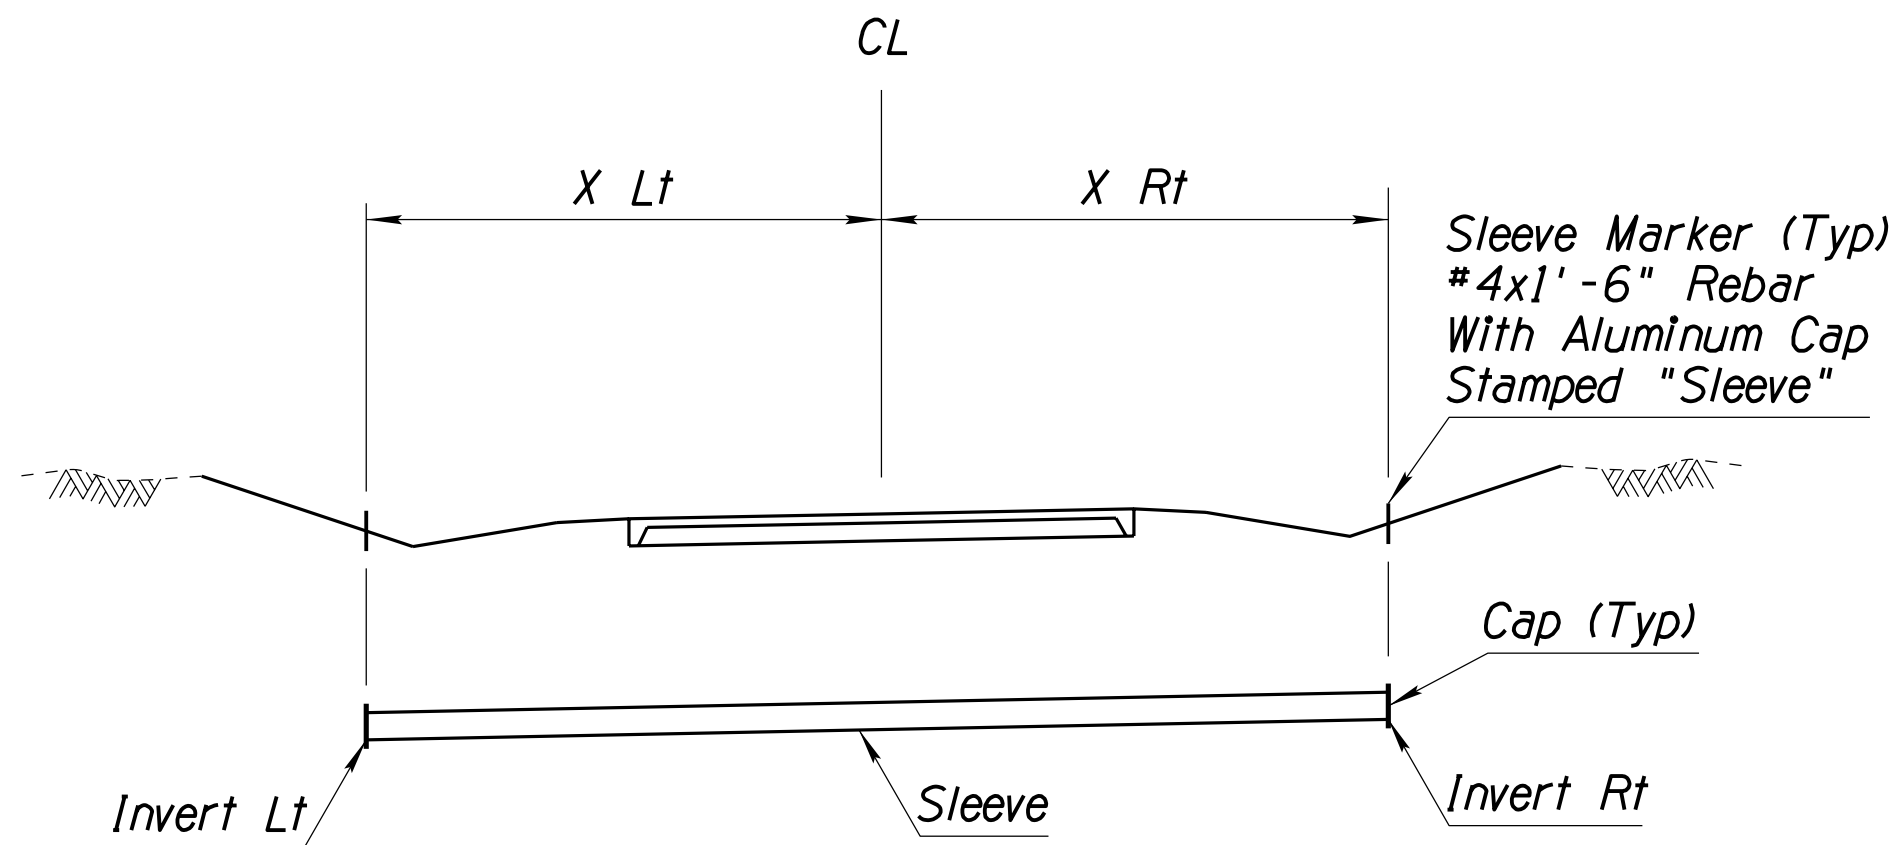


SLEEVE UNDER ROAD

- NOTES:
1. Sleeves shall be installed in a trench condition. See Std C-13.15.
 2. Pipe installation shall conform to Section 501 of Std Specs. See Std C-13.15 for pipe installation information.
 3. Materials used for caps or plugs shall be as recommended by the pipe supplier and approved by the Engineer.
 4. 12" Pipe Sleeve for PS 4 & 5 will be measured and paid for under Item No. 9240167 - MISCELLANEOUS WORK (PIPE SLEEVE)(12"XPLASTIC). 18" Pipe Sleeve for PS 6 will be measured and paid for under Item No. 9240168 - MISCELLANEOUS WORK (PIPE SLEEVE)(18"XSTEEL). 24" Pipe Sleeve for PS 7, 8 & 9 will be measured and paid for under Item No. 9240169 - MISCELLANEOUS WORK (PIPE SLEEVE)(24"XSTEEL).

PIPE SLEEVE INSTALLATION DATA						
Location	Ref. No.	Size (in)	X Lt	X Rt	Invert Lt	Invert Rt
Wickenburg Ranch Way Cst CL Sta 73+98	PS 4	12	40'	40'	2408.0	2407.8
Wickenburg Ranch Way Cst CL Sta 74+03	PS 5	12	40'	40'	2408.0	2407.8
Wickenburg Ranch Way Cst CL Sta 74+09	PS 6	18	40'	40'	2408.0	2407.8
Wickenburg Ranch Way Cst CL Sta 74+20	PS 7	24	40'	40'	2408.0	2407.8
Wickenburg Ranch Way Cst CL Sta 74+28	PS 8	24	40'	40'	2400.0	2400.4
Matthie Ranch Rd Cst CL Sta 25+50	PS 9	24	34'	34'	2398.0	2397.8

DETAIL J
PIPE SLEEVE


		NAME		DATE		ARIZONA DEPARTMENT OF TRANSPORTATION PROJECT DELIVERY AND OPERATIONS DIVISION ROADWAY DESIGN SERVICES	
DESIGN		JML		06-26			
DRAWN		BAP		06-26			
CHECKED		DBK		06-26			
		3133 East Camelback Road, Suite 100 Phoenix, Arizona 85016 Phone: (602) 333-2200				DETAIL SHEET DETAIL J	
Stanley Consultants inc.							
ROUTE		LOCATION					
US 93		WICKENBURG RANCH WAY TO VISTA ROYALE				DWG NO. G-5.08	
TRACS NO. F0738 OIC				093-B(230)T		___ OF ___	

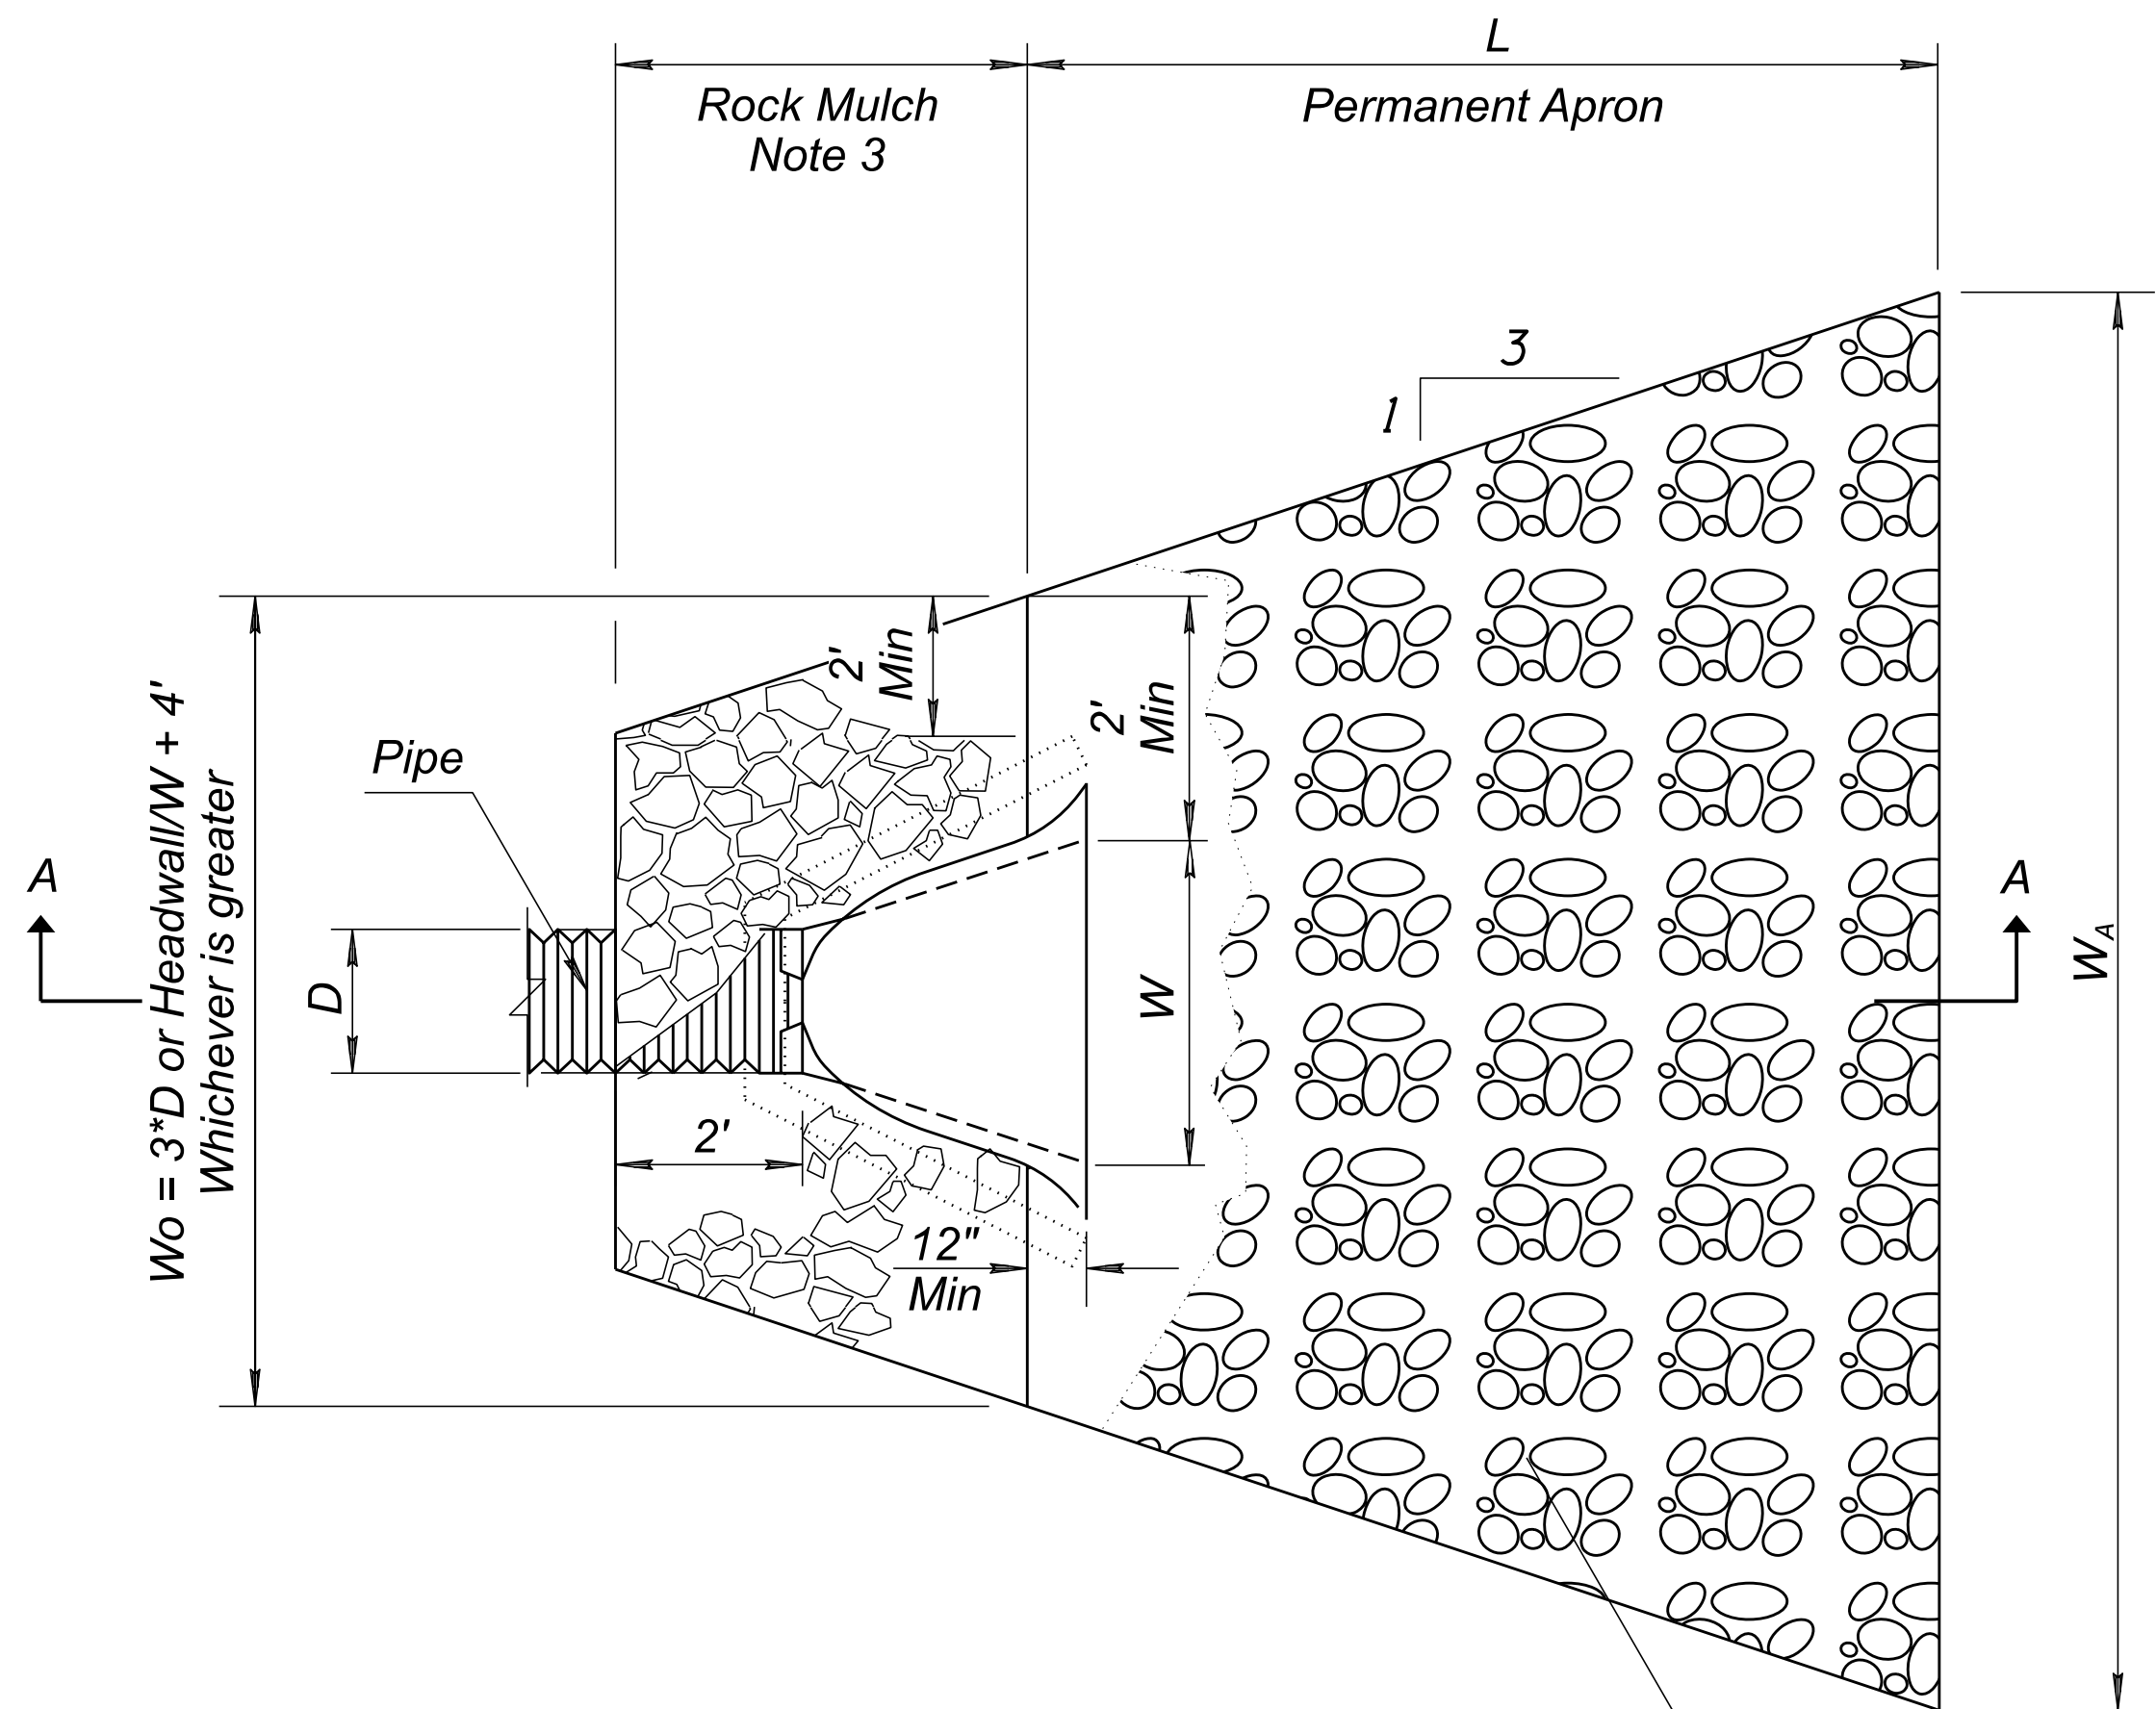

PLAN (FLARED END SECTIONS AND WINGWALLS)


N.T.S.

Dumped Riprap
 $D_{50}=6"$

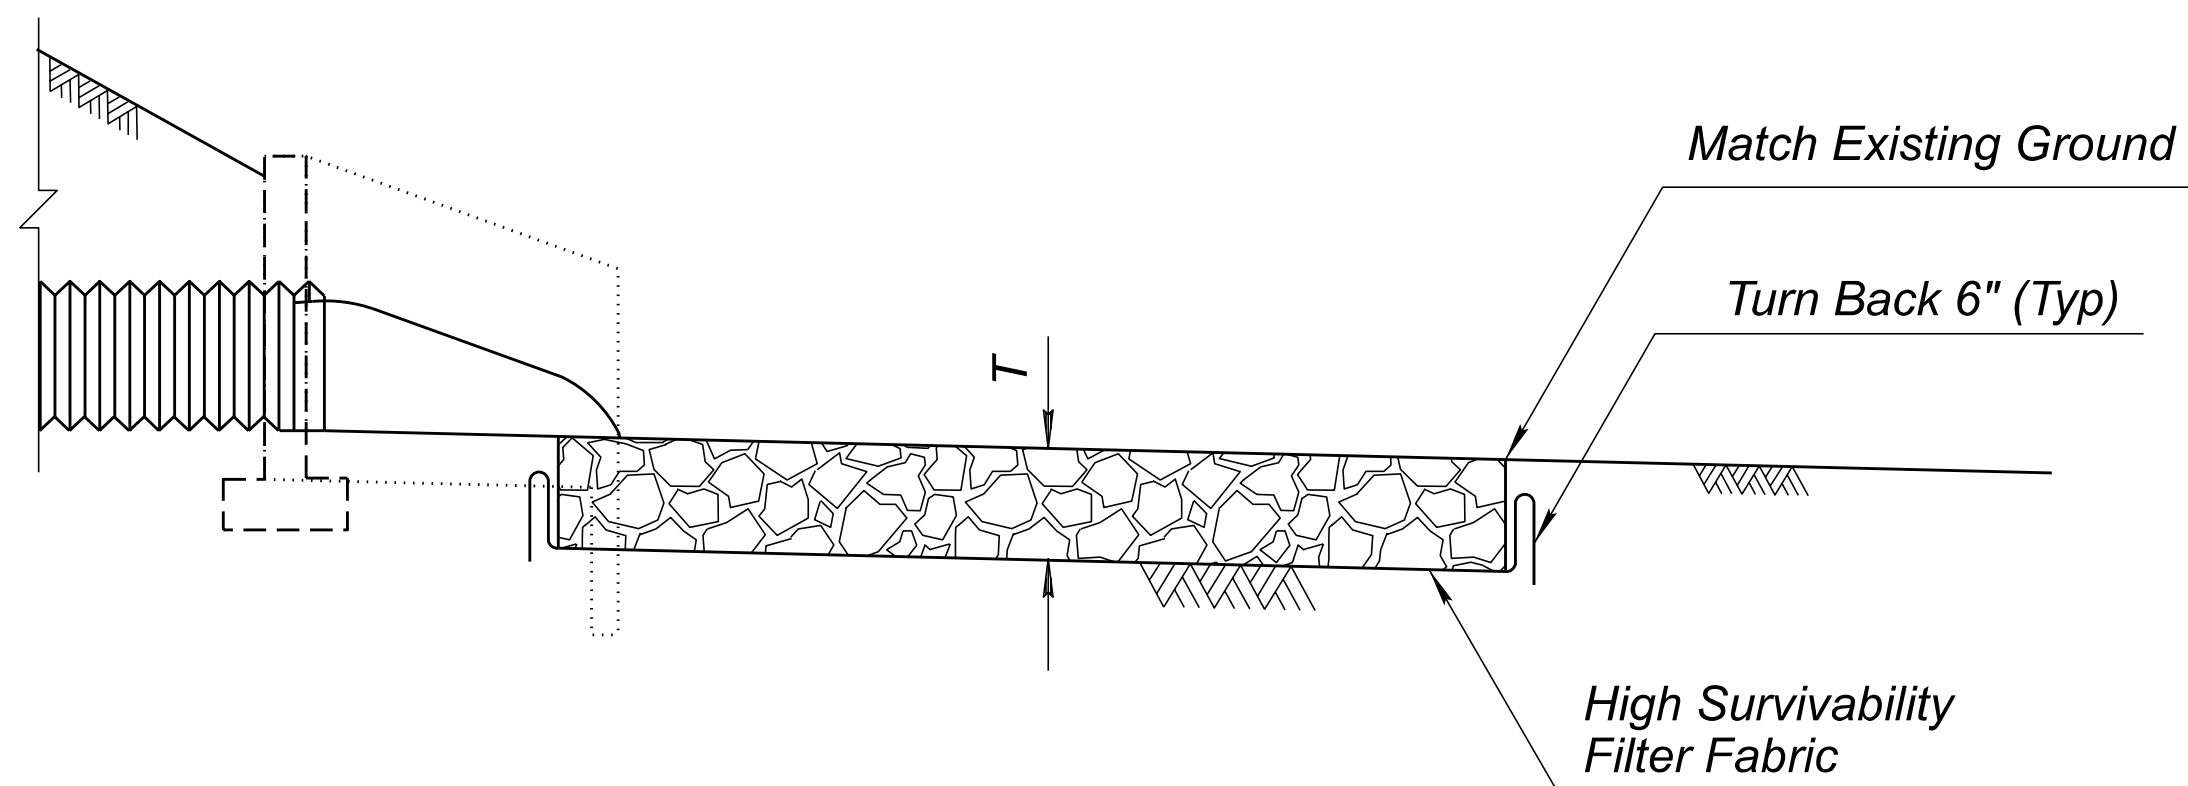

SECTION A-A

N.T.S.

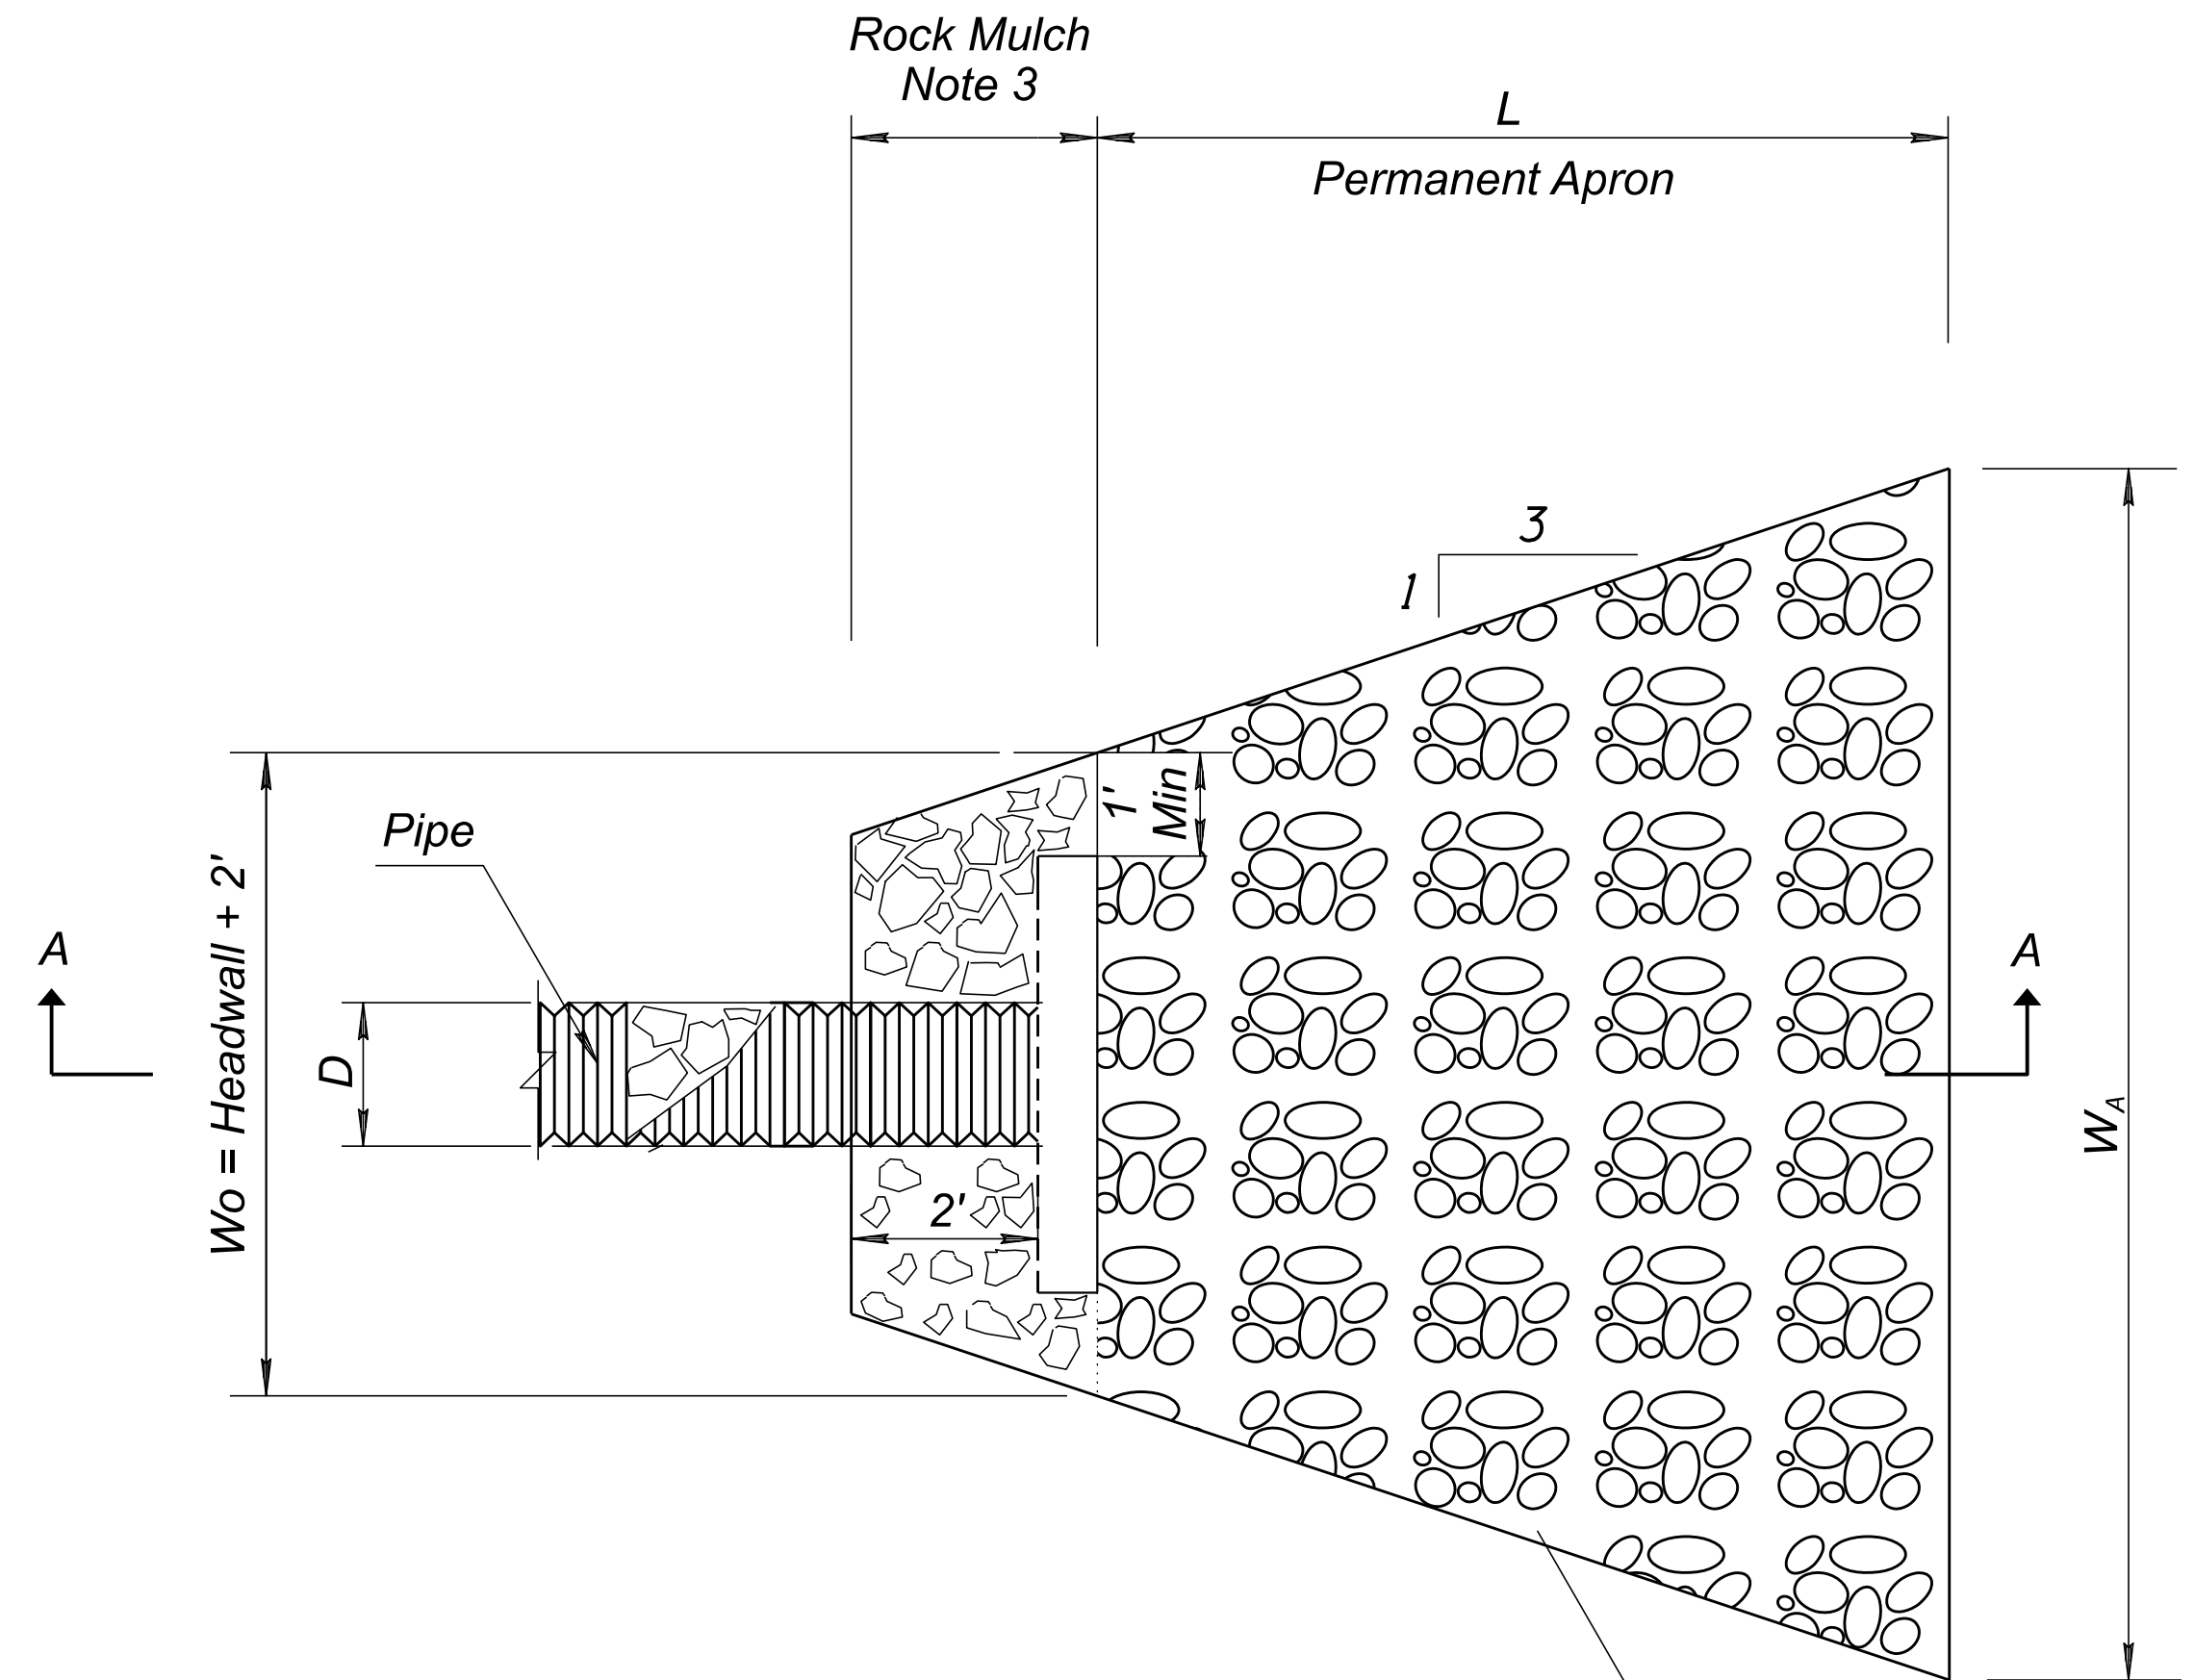

PLAN (STRAIGHT HEADWALLS)

N.T.S.


Dumped Riprap
 $D_{50}=6"$

NOTES

1. The geometric shape of the apron may vary to match the existing site conditions as directed by the Engineer.
2. L is measured (on pipe alignment) from 1-ft back from end of flared end section to edge of apron farthest from the roadway centerline or from front of straight headwall to edge of apron farthest from the roadway centerline.
3. See Erosion Control Plans for rock mulch installation around end sections or headwalls.
4. See ADOT Std C-13.25 for measurements of W based on pipe sizes for flared end sections.
5. See Detail DR for Riprap Gradation

DETAIL DA

RIPRAP APRON
SHEET 1 OF 2

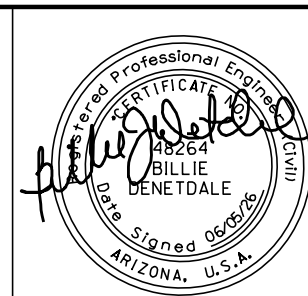

	NAME	DATE
DESIGN	K LEANDER	06/26
DRAWN	B LEANDER	06/26
CHECKED	B DENETDALE	06/26

TRANSPORTATION
AECOM TECHNICAL SERVICES, Inc.
7720 N. 16th St., Suite 100
Phoenix, Arizona 85020
T 602.371.1100

AECOM
www.aecom.com

ARIZONA DEPARTMENT OF TRANSPORTATION
PROJECT DELIVERY AND OPERATIONS DIVISION
ROADWAY DESIGN SERVICES

ROUTE US 93	F.H.W.A. Arizona Division	STATE ARIZ.	PROJECT NO. 093 YV 189	FEDERAL ID NO. 093-B(230)T	SHEET NO. 49	TOTAL SHEETS 524	RECORD DRAWING
MILEPOST 189.9	LOCATION WICKENBURG RANCH WAY TO VISTA ROYALE					DWG No. D-1.01	
STRUCTURE NO.	TRACS NO. F0738 01C					____ OF ____	

Pipe or Culvert ID	Location	D (IN)	# Barrels	W (FT) ^o	L (FT)	W (FT) ^A	T (FT)	D50=6" 9130051 (CY)
100	US 93 Med Cst Cl Sta 2120+74	24	1	4.2	3.5	4.2	1	1.0
104	US 93 Med Cst Cl Sta 2153+15	18	1	7	6	11	1	2.0
111	US 93 Med Cst Cl Sta 2150+25	24	1	8	6	12	1	3.0
116	US 93 Med Cst Cl Sta 2158+86	18	1	3.5	6	7.5	1	2.0
118	SR 89 Cst CL Sta 114+70	18	1	7	6	11	1	2.0
PE1	Future SR 89 Cst CL Sta 114+83	30	1	8	10	14	1	5.0
PE4	SR 89 Cst CL Sta 114+70	24	1	8	6	12	1	3.0
PE5	US 93 Med Cst Cl Sta 2141+01	24	1	8	6	12	1	3.0
105	US 93 Med Cst Cl Sta 2125+56	48	1	19	16	30	1	15.0
	SB US-93 CST CL							
PE 209	208+60	24	1	8	8	12	1	3.0
PE 261	259+99	24	1	8	8	12	1	3.0
PE 268	268+71	42	1	20	15	29	1	13.6
PE 274	274+38	24	1	8	8	12	1	3.0
PE 292	292+12	24	1	8	8	12	1	3.0
294	294+37	42	2	25	12	33	1	12.9
PE 304	304+47	36	2	22	12	30	1	11.6
PE 316	315+10	42x29	2	25	14	36	1	15.8
PE 322	321+72	42	2	25	14	36	1	15.8
505	200+57	24	1	8	6	12	1	2.2
507	213+41	24	1	8	6	12	1	2.2
520	246+79	24	1	8	6	12	1	2.2
525	252+57	24	1	14	6	17	1	3.4
	NB US-93							
610	222+87	24	1	8	6	12	1	2.2
	NINE IRONS RANCH RD							
410/415	20+93	36	3	27	14	36	1	16.3
	E FRONTAGE RD							
150	126+62	28x20	1	8	8	12	1	3.0
160	158+50	28x20	1	8	8	12	1	3.0
Total:								152.2



DETAIL DA
RIPRAP APRON
SHEET 2 OF 2

BRYCE.SAVAGE


2026 10:23:54 AM

c:\pwworking\usaz\dms09621\0738_ddt\01-2.dgn

Model Name: f0738_ddt\01-2

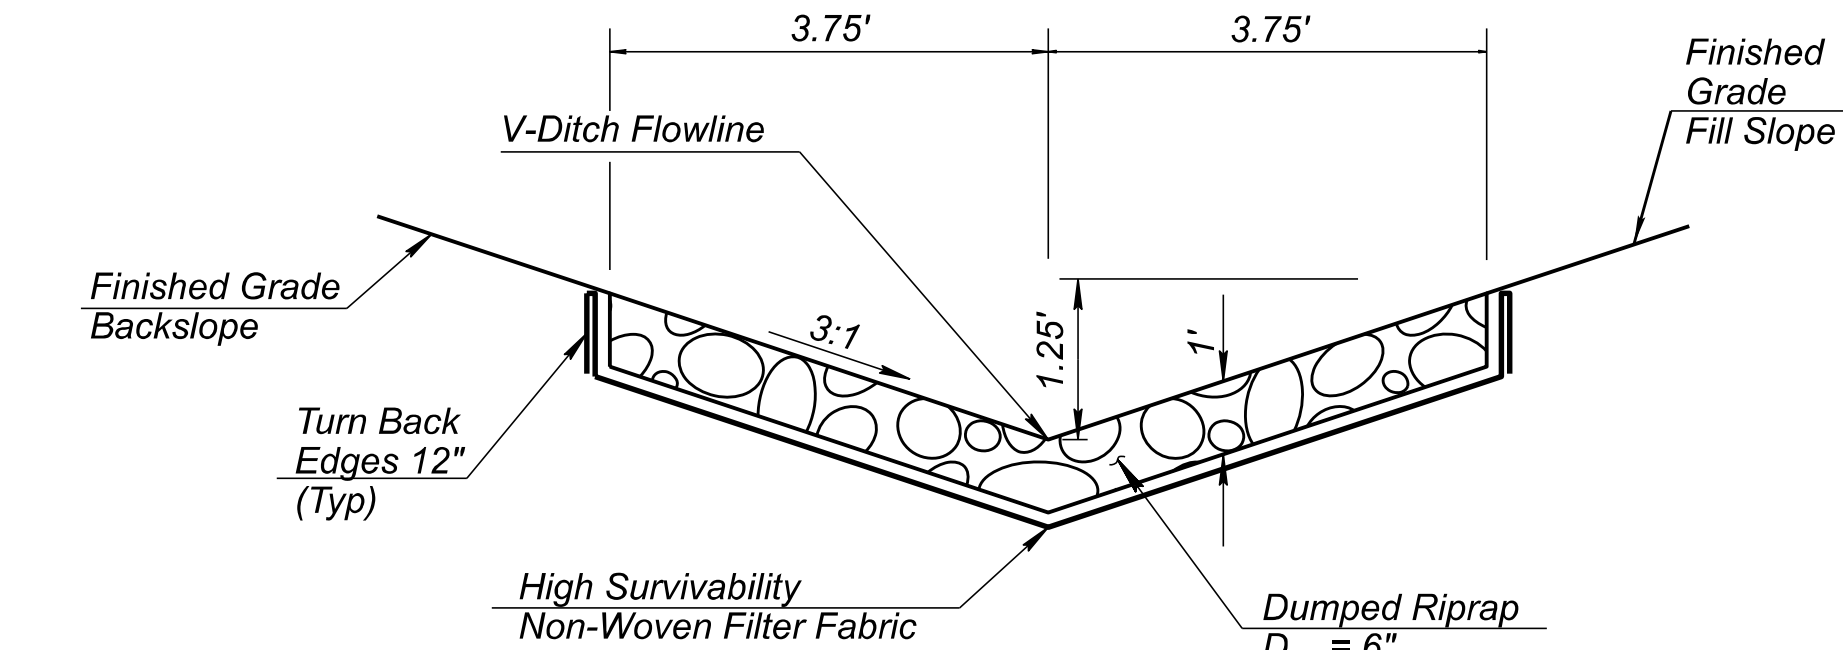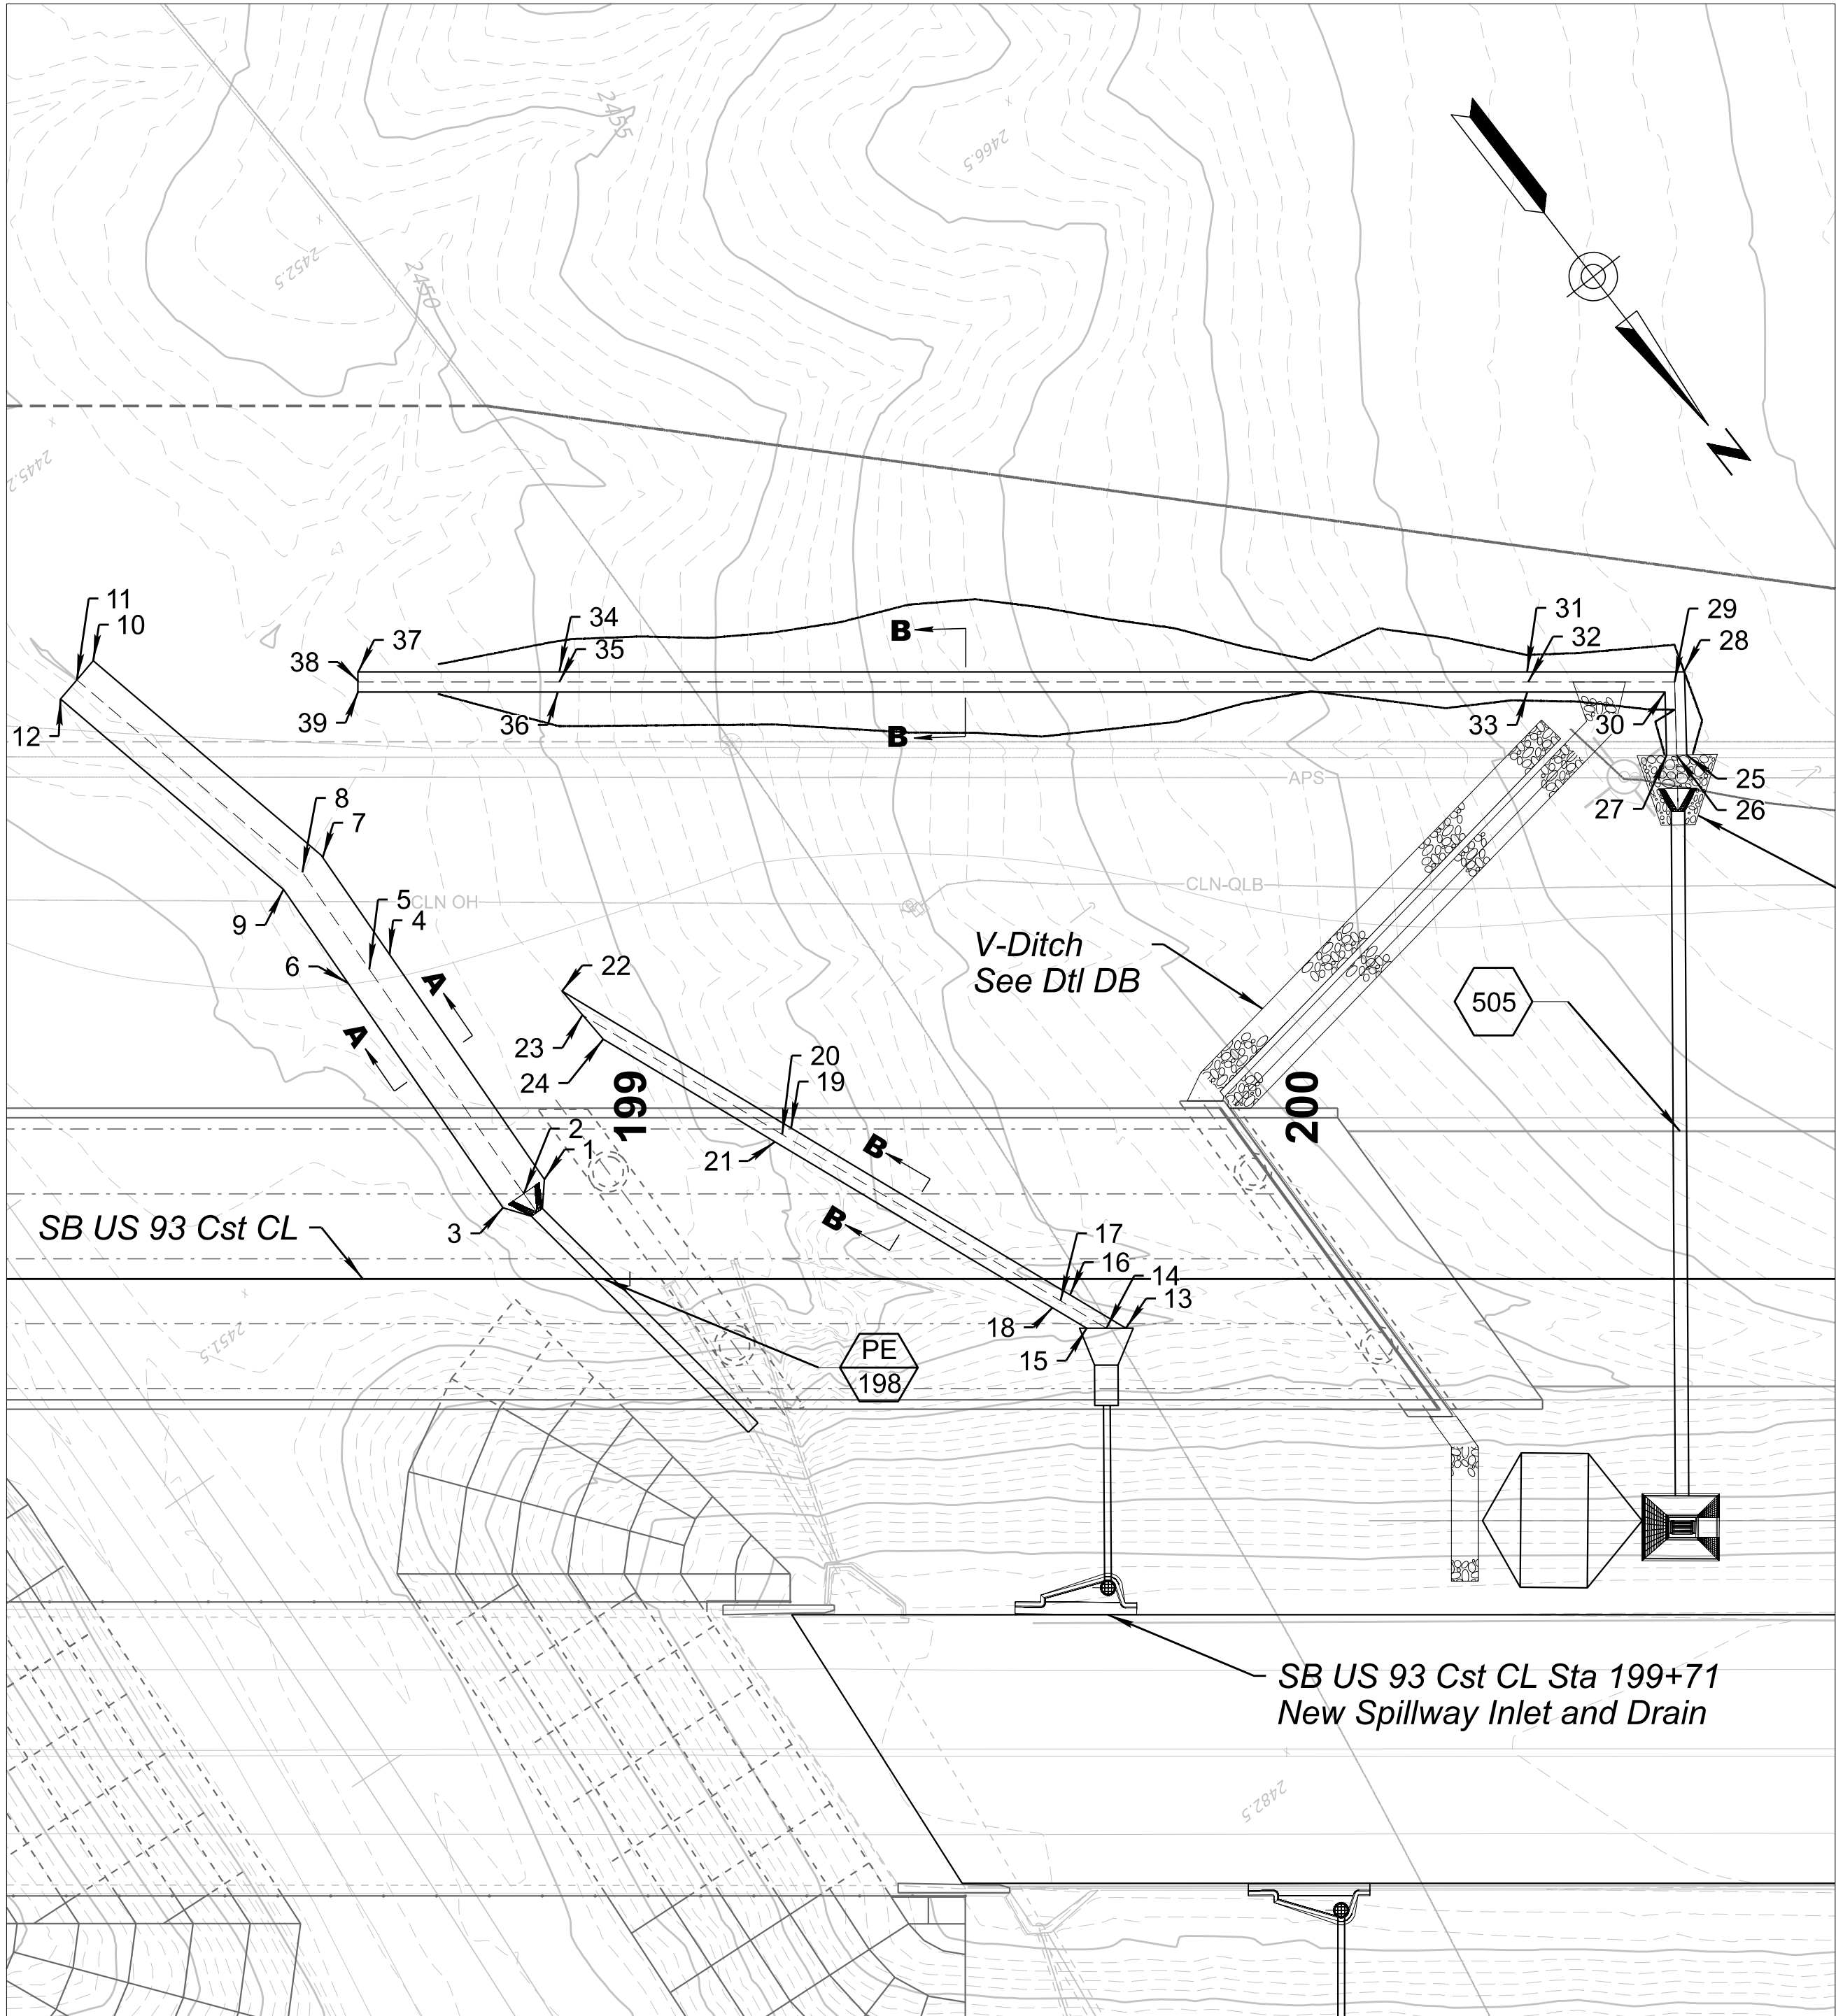

See Detail DA for
Riprap Apron

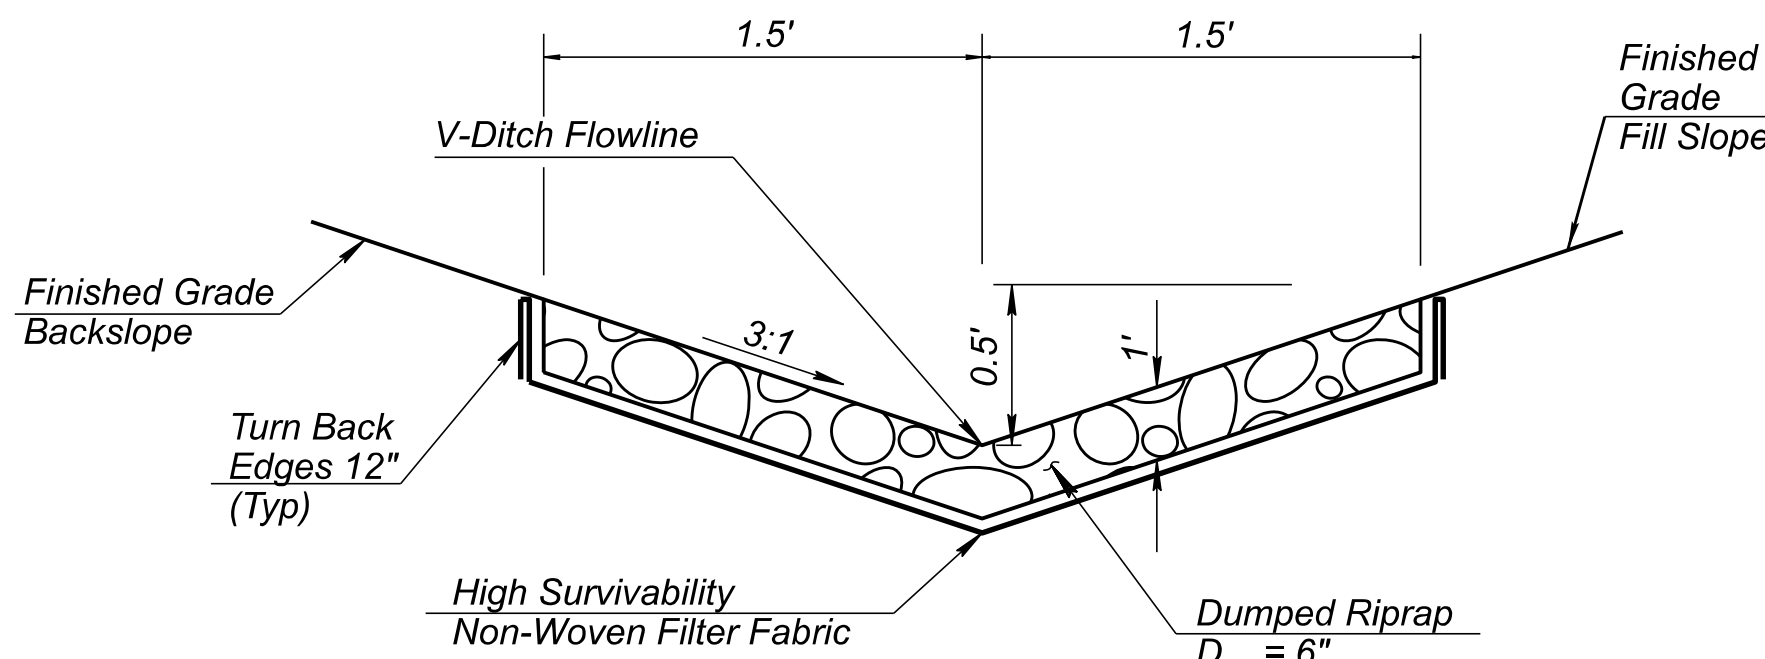

CHANNEL GRADING CONTROL POINTS			
Point No.	SBUS 93 CST CL	Offset Lt	Elev
1	198+87.29	14.83	2447.34
2	198+84.21	12.70	2446.15
3	198+81.12	10.57	2448.09
4	198+64.15	48.40	2446.35
5	198+60.84	46.60	2445.15
6	198+57.80	44.39	2446.70
7	198+54.03	63.07	2446.07
8	198+51.22	60.54	2445.09
9	198+48.42	58.01	2447.00
10	198+20.12	92.05	2445.40
11	198+17.68	89.20	2445.00
12	198+15.25	86.35	2446.84

CHANNEL GRADING CONTROL POINTS				
Point No.	SBUS 93 CST CL	Offset Rt	Offset Lt	Elev
13	199+73.84	7.36		2460.09
14	199+70.93	7.37		2459.71
15	199+68.01	7.37		2459.34
16	199+67.47	3.55		2459.81
17	199+66.63	4.80		2457.83
18	199+65.90	6.11		2458.31
19	199+23.28		22.89	2450.98
20	199+22.39		21.67	2449.47
21	199+21.84		20.26	2450.24
22	198+89.89		42.86	2448.01
23	198+92.97		39.28	2447.86
24	198+96.04		35.69	2447.87

CHANNEL GRADING CONTROL POINTS			
Point No.	SBUS 93 CST CL	Offset Lt	Elev
25	200+57.34	78.03	2477.63
26	200+55.84	78.01	2476.88
27	200+54.34	77.98	2477.48
28	200+56.98	90.40	2477.99
29	200+55.52	88.91	2476.39
30	200+54.08	87.40	2477.68
31	200+33.46	90.40	2476.65
32	200+33.39	88.87	2475.39
33	200+33.54	87.40	2476.27
34	198+89.69	90.40	2450.46
35	198+89.76	88.66	2448.42
36	198+89.69	87.40	2450.45
37	198+59.53	90.40	2446.36
38	198+59.53	88.62	2446.28
39	198+59.53	87.40	2446.19

RIPRAP QUANTITIES 198		
X Sectional Area	7.49	sq ft
Length	102.22	ft
Volume	28.36	cu yd

RIPRAP QUANTITIES 199+71		
X Sectional Area	3.00	sq ft
Length	90.85	ft
Volume	10.09	cu yd

RIPRAP QUANTITIES 505		
X Sectional Area	3.00	sq ft
Length	206.93	ft
Volume*	22.99	cu yd

Note: See Detail DR for Riprap Gradation


* See Detail DA for Riprap Apron Quantity

DETAIL DB


(SHEET 1 OF 4)

DUMPED RIPRAP
OUTLET GRADING PLAN
PIPES 198, 199+71, 505

		NAME	DATE	ARIZONA DEPARTMENT OF TRANSPORTATION PROJECT DELIVERY AND OPERATIONS DIVISION ROADWAY DESIGN SERVICES	ROUTE	F.H.W.A. Arizona Division	STATE	PROJECT NO.	FEDERAL ID NO.	SHEET NO.	TOTAL SHEETS	RECORD DRAWING
	DESIGN	K LEANDER	06/26		US 93		ARIZ.	093 YV 189	093-B(230)T	51	524	
	DRAWN	B LEANDER	06/26		MILEPOST							
	CHECKED	B DENETDALE	06/26	189.9	LOCATION	WICKENBURG RANCH WAY TO VISTA ROYALE					DWG No. D-1.03	
	TRANSPORTATION AECOM TECHNICAL SERVICES, Inc. 7720 N. 18th St., Suite 100 Phoenix, Arizona 85020 T 602.371.1100				STRUCTURE NO.	TRACS NO. F0738 01C					OF	

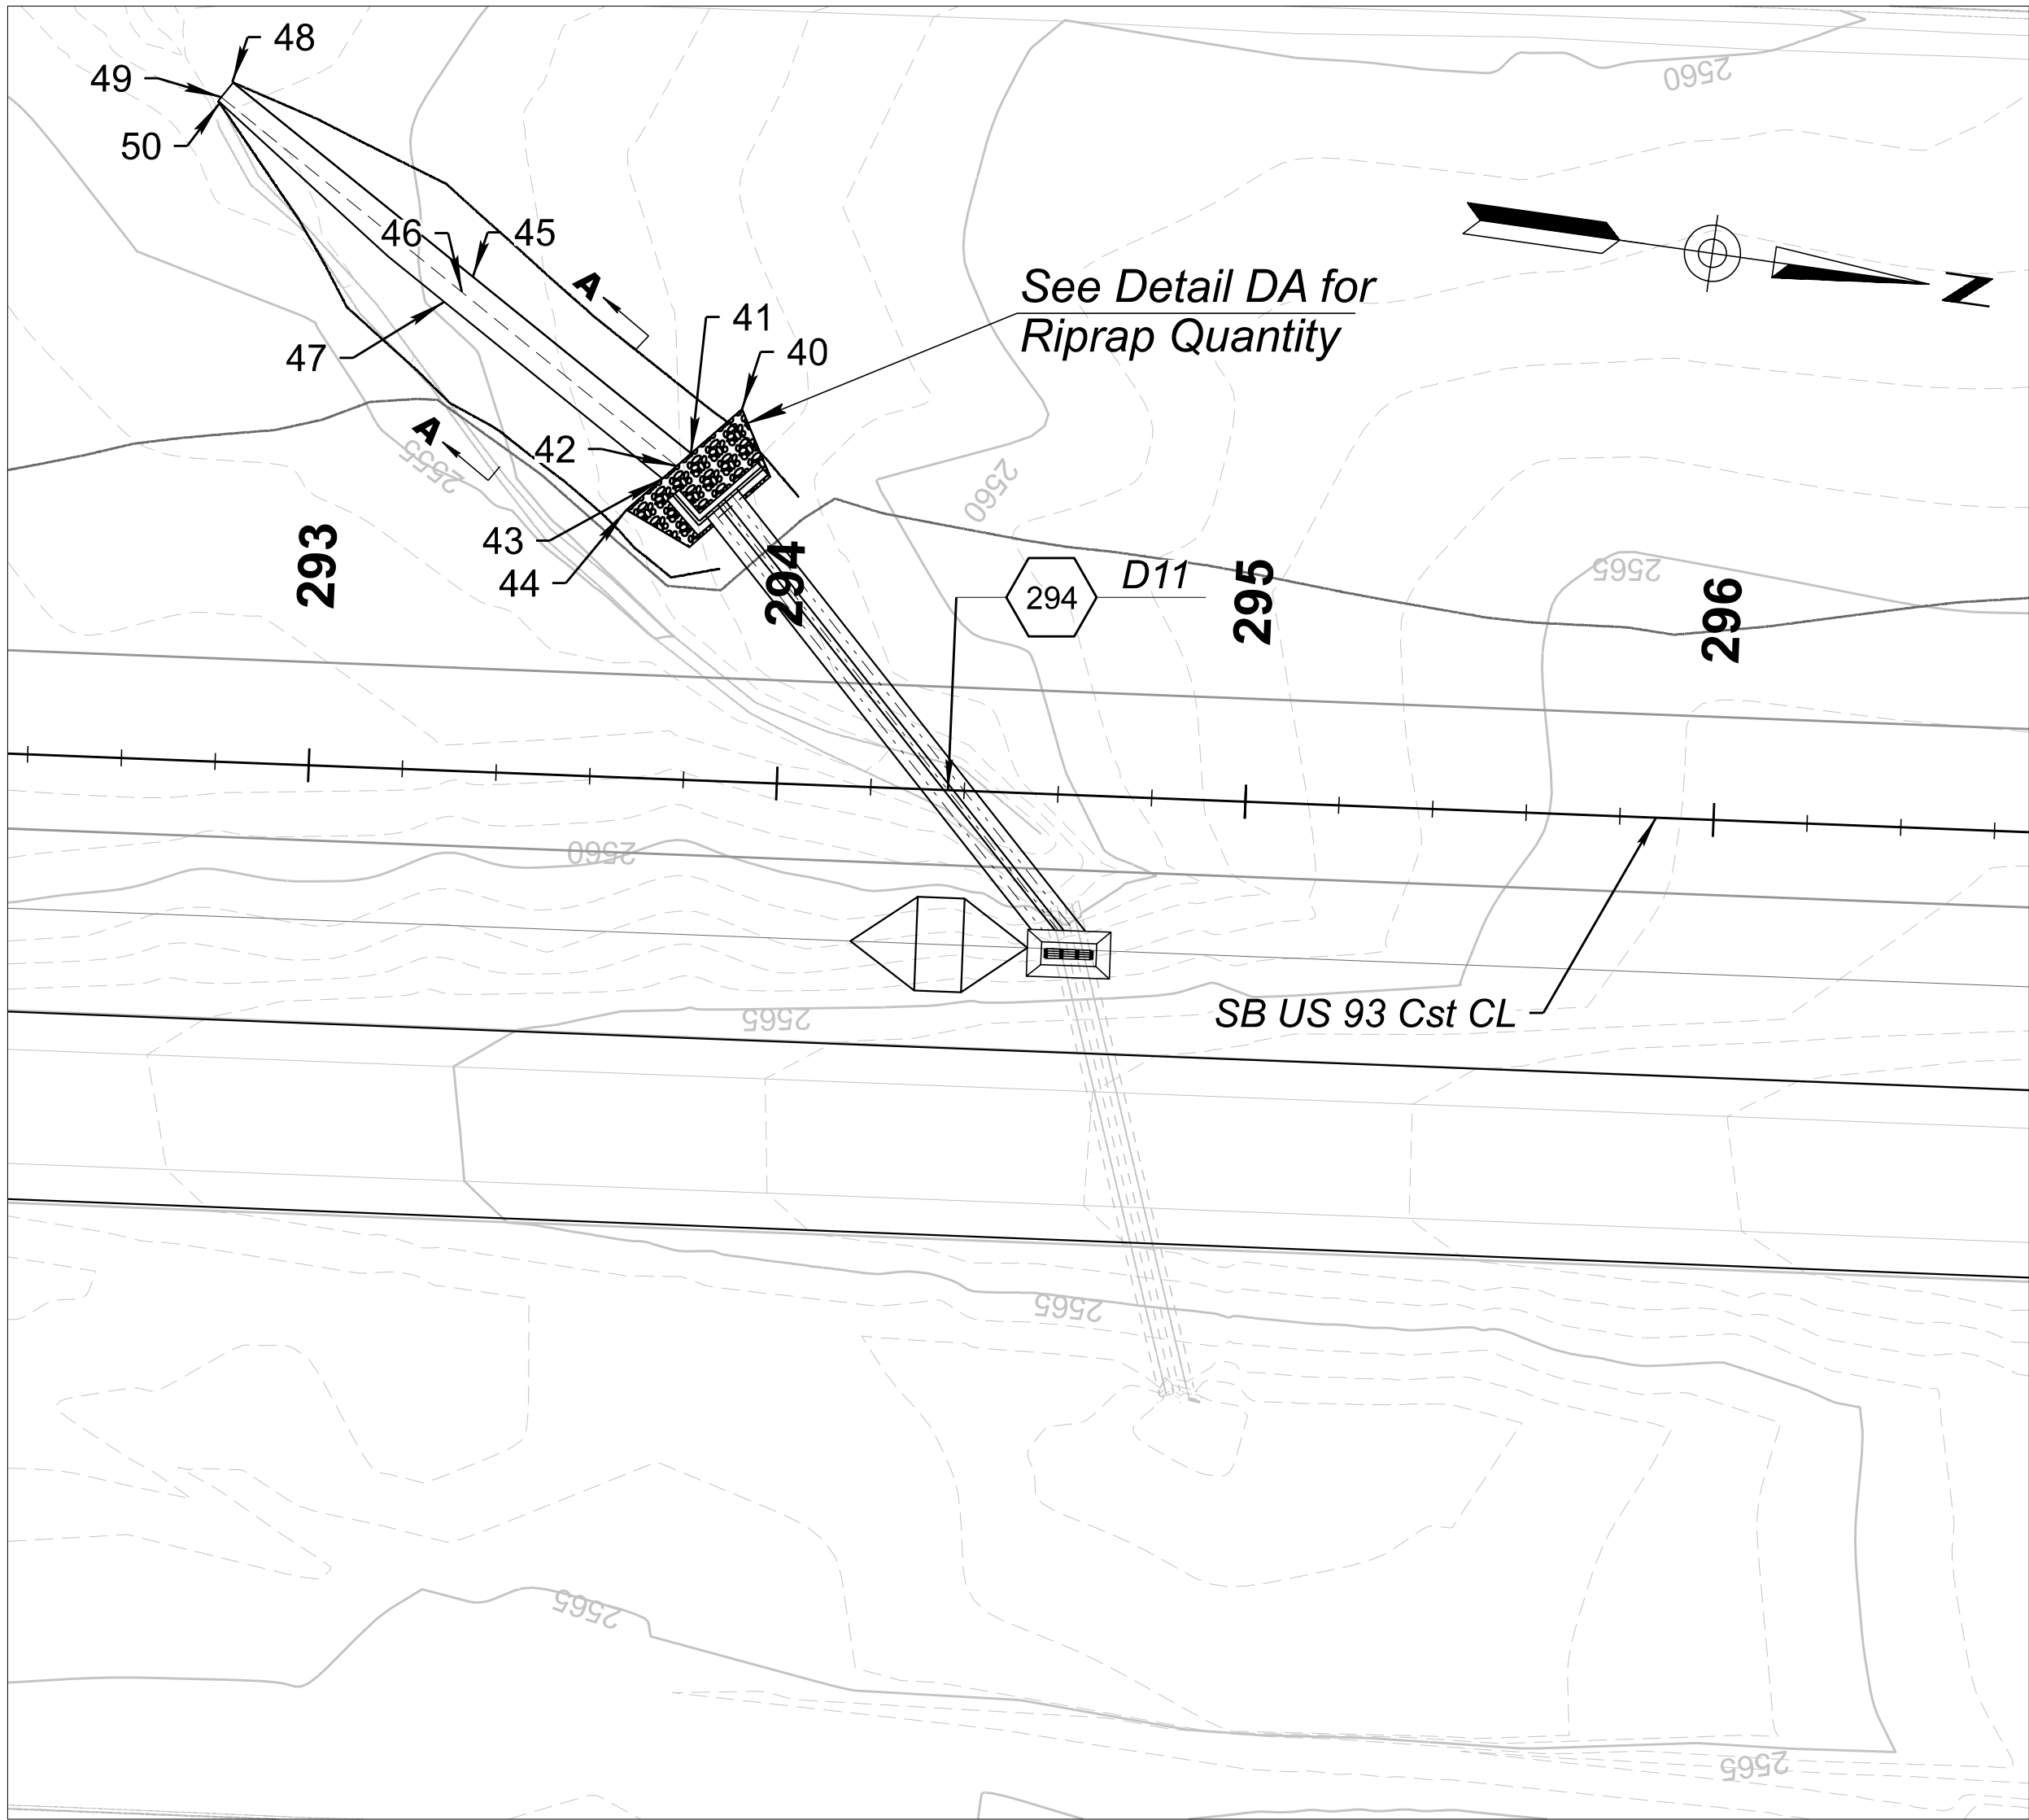


CHANNEL GRADING CONTROL POINTS			
Point No.	SBUS 93 CST CL	Offset Lt	Elev
40	293+89.44	79.52	2557.49
41	293+78.94	69.63	2554.80
42	293+75.98	66.84	2554.64
43	293+73.03	64.06	2554.79
44	293+65.60	57.06	2558.12
45	293+33.40	103.65	2554.01
46	293+31.01	100.44	2553.90
47	293+28.62	97.24	2553.99
48	292+78.04	145.01	2553.02
49	292+75.79	141.70	2553.00
50	292+75.19	140.89	2553.00

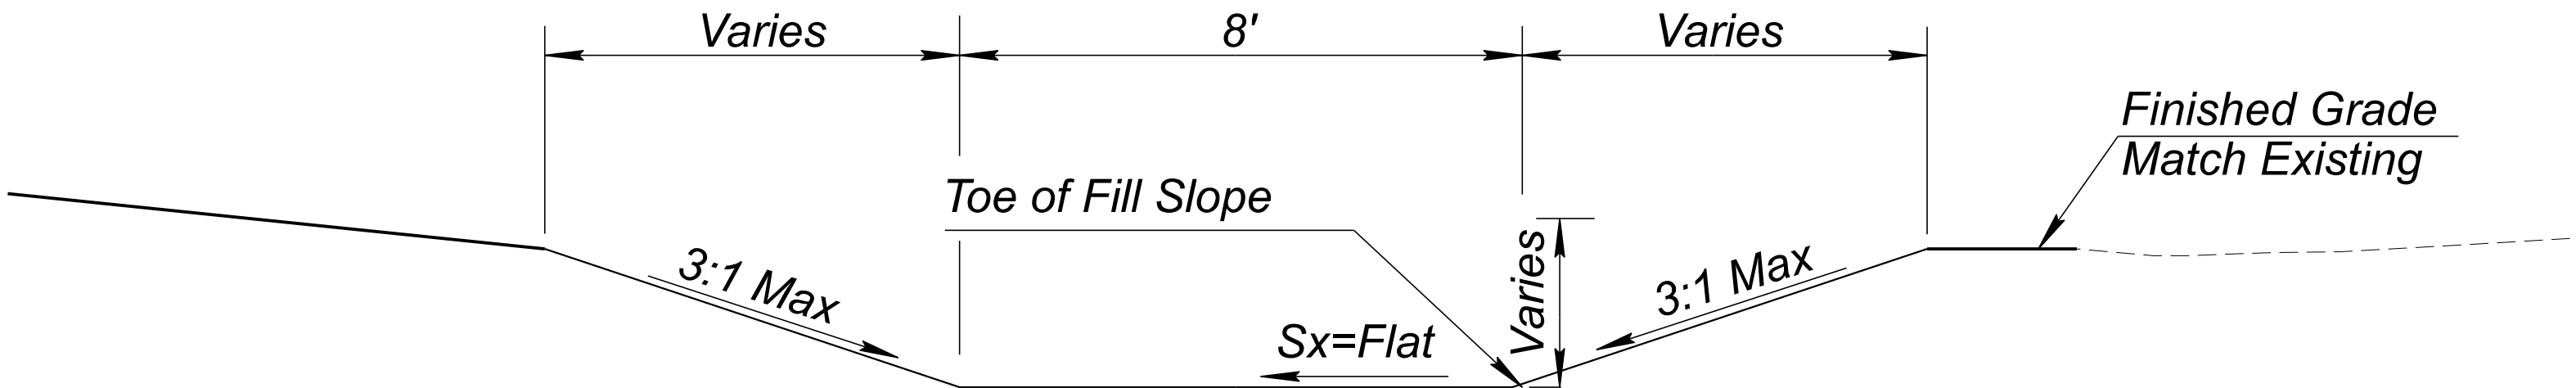

SECTION A-A
N.T.S

DETAIL DB
(SHEET 2 OF 4)

DUMPED RIPRAP
OUTLET GRADING PLAN
PIPE 294

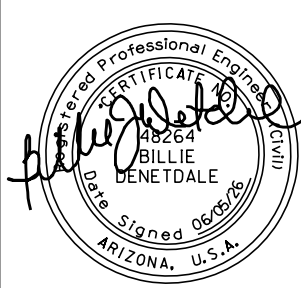


	NAME	DATE
DESIGN	K LEANDER	06/26
DRAWN	B LEANDER	06/26
CHECKED	B DENETDALE	06/26

TRANSPORTATION
AECOM TECHNICAL SERVICES, Inc.
7720 N. 16th St., Suite 100
Phoenix, Arizona 85020
T 602.371.1100

AECOM
www.aecom.com


ARIZONA DEPARTMENT OF TRANSPORTATION PROJECT DELIVERY AND OPERATIONS DIVISION ROADWAY DESIGN SERVICES	
DETAIL DB OUTLET GRADING PLAN FOR PIPE 294	

ROUTE US 93	F.H.W.A. Arizona Division	STATE	PROJECT NO.	FEDERAL ID NO.	SHEET NO.	TOTAL SHEETS	RECORD DRAWING
MILEPOST 189.9		ARIZ.	093 YV 189	093-B(230)T	52	524	
	LOCATION WICKENBURG RANCH WAY TO VISTA ROYALE						DWG No. D-1.04
STRUCTURE NO.	TRACS NO. F0738 01C						____ OF ____

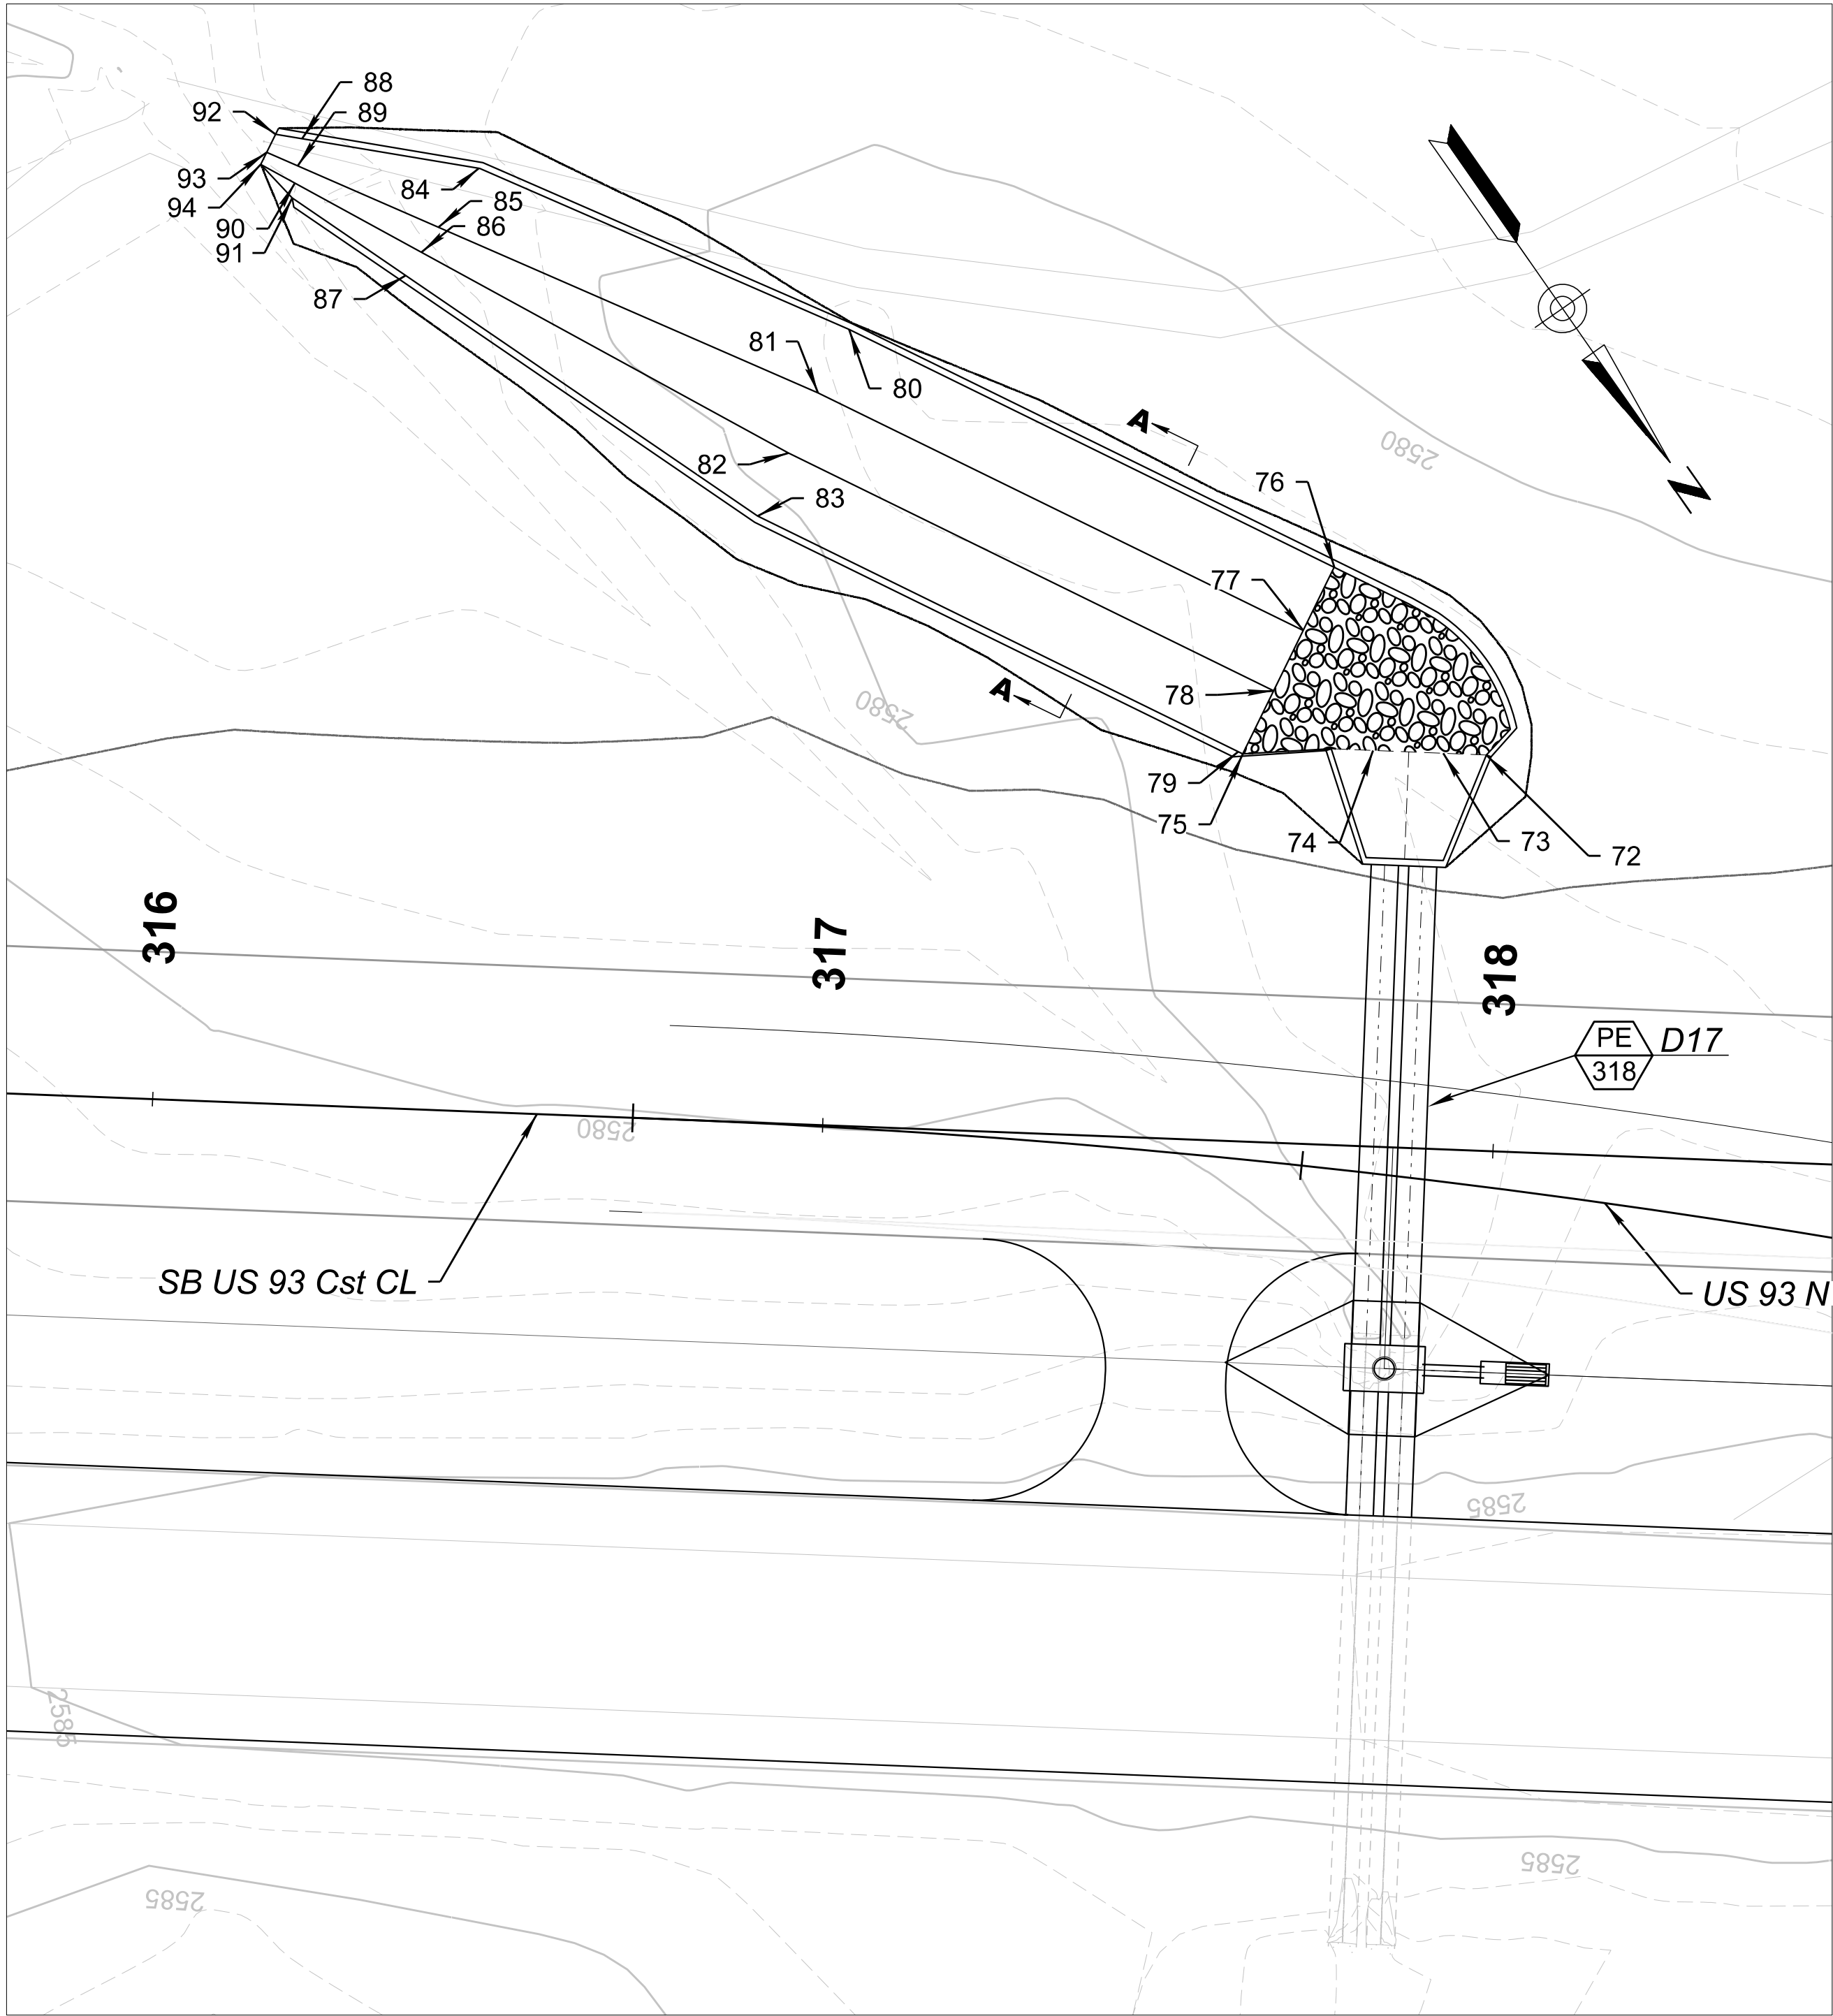

CHANNEL GRADING CONTROL POINTS			
Point No.	SBUS 93 CST CL	Offset Lt	Elev
72	317+96.71	59.04	2580.74
73	317+90.26	59.04	2578.59
74	317+79.83	59.04	2578.53
75	317+73.58	59.04	2579.83
76	317+72.97	86.10	2581.87
77	317+68.72	76.50	2578.37
78	317+64.67	67.36	2578.37
79	317+60.42	57.76	2581.87
80	316+99.29	118.73	2581.23
81	316+95.04	109.12	2577.73
82	316+90.99	99.98	2577.73

CHANNEL GRADING CONTROL POINTS			
Point No.	SBUS 93 CST CL	Offset Lt	Elev
83	316+86.74	90.38	2581.23
84	316+43.19	140.59	2580.75
85	316+37.53	131.58	2577.25
86	316+35.13	127.76	2577.24
87	316+32.90	124.21	2578.63
88	316+16.71	143.97	2578.38
89	316+16.19	139.91	2577.07
90	316+15.86	137.34	2577.07
91	316+15.57	135.09	2577.79
92	316+12.72	144.48	2578.03
93	316+11.50	141.74	2577.03
94	316+10.69	139.91	2577.03

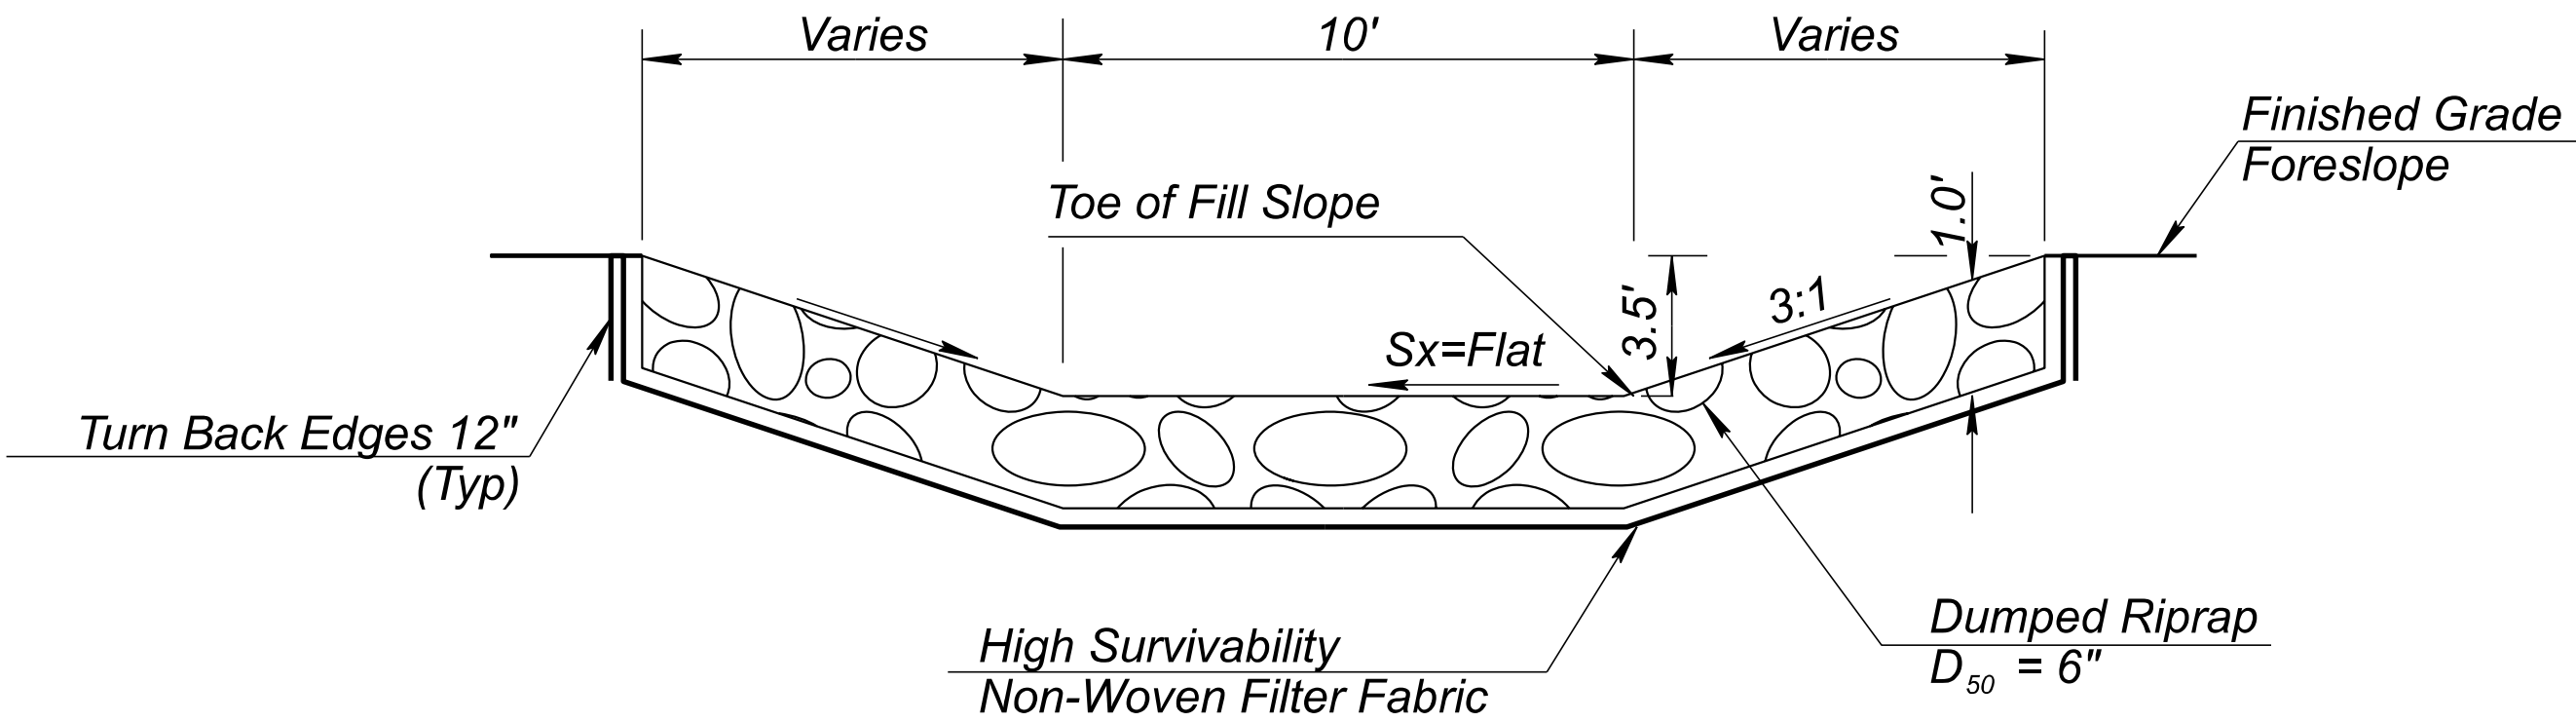

NOTE: RIPRAP ONLY WHERE SHOWN ON PLAN


SECTION A-A
N.T.S

RIPRAP QUANTITIES 317		
Area	696.72	sq ft
Depth	1.00	ft
Volume	25.80	cu yd

Note: See Detail DR for Riprap Gradation

DETAIL DB
(SHEET 3 OF 4)

DUMPED RIPRAP
OUTLET GRADING PLAN
PIPE EXTENSION 318


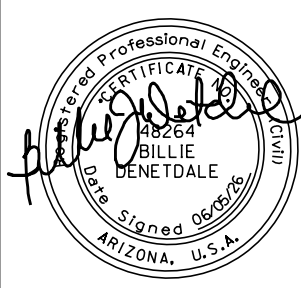


	NAME	DATE
DESIGN	K LEANDER	06/26
DRAWN	B LEANDER	06/26
CHECKED	B DENETDALE	06/26

TRANSPORTATION
AECOM TECHNICAL SERVICES, Inc.
7720 N. 16th St., Suite 100
Phoenix, Arizona 85020
T 602.371.1100
www.aecom.com

ARIZONA DEPARTMENT OF TRANSPORTATION PROJECT DELIVERY AND OPERATIONS DIVISION ROADWAY DESIGN SERVICES	ROUTE US 93 MILEPOST 189.9 STRUCTURE NO.
DETAIL DB OUTLET GRADING PLAN FOR PIPE EXTENSION 318	

F.H.W.A. Arizona Division	STATE ARIZ.	PROJECT NO. 093 YV 189	FEDERAL ID NO. 093-B(230)T	SHEET NO. 53	TOTAL SHEETS 524	RECORD DRAWING
LOCATION WICKENBURG RANCH WAY TO VISTA ROYALE						DWG No. D-1.05
TRACS NO. F0738 01C						OF

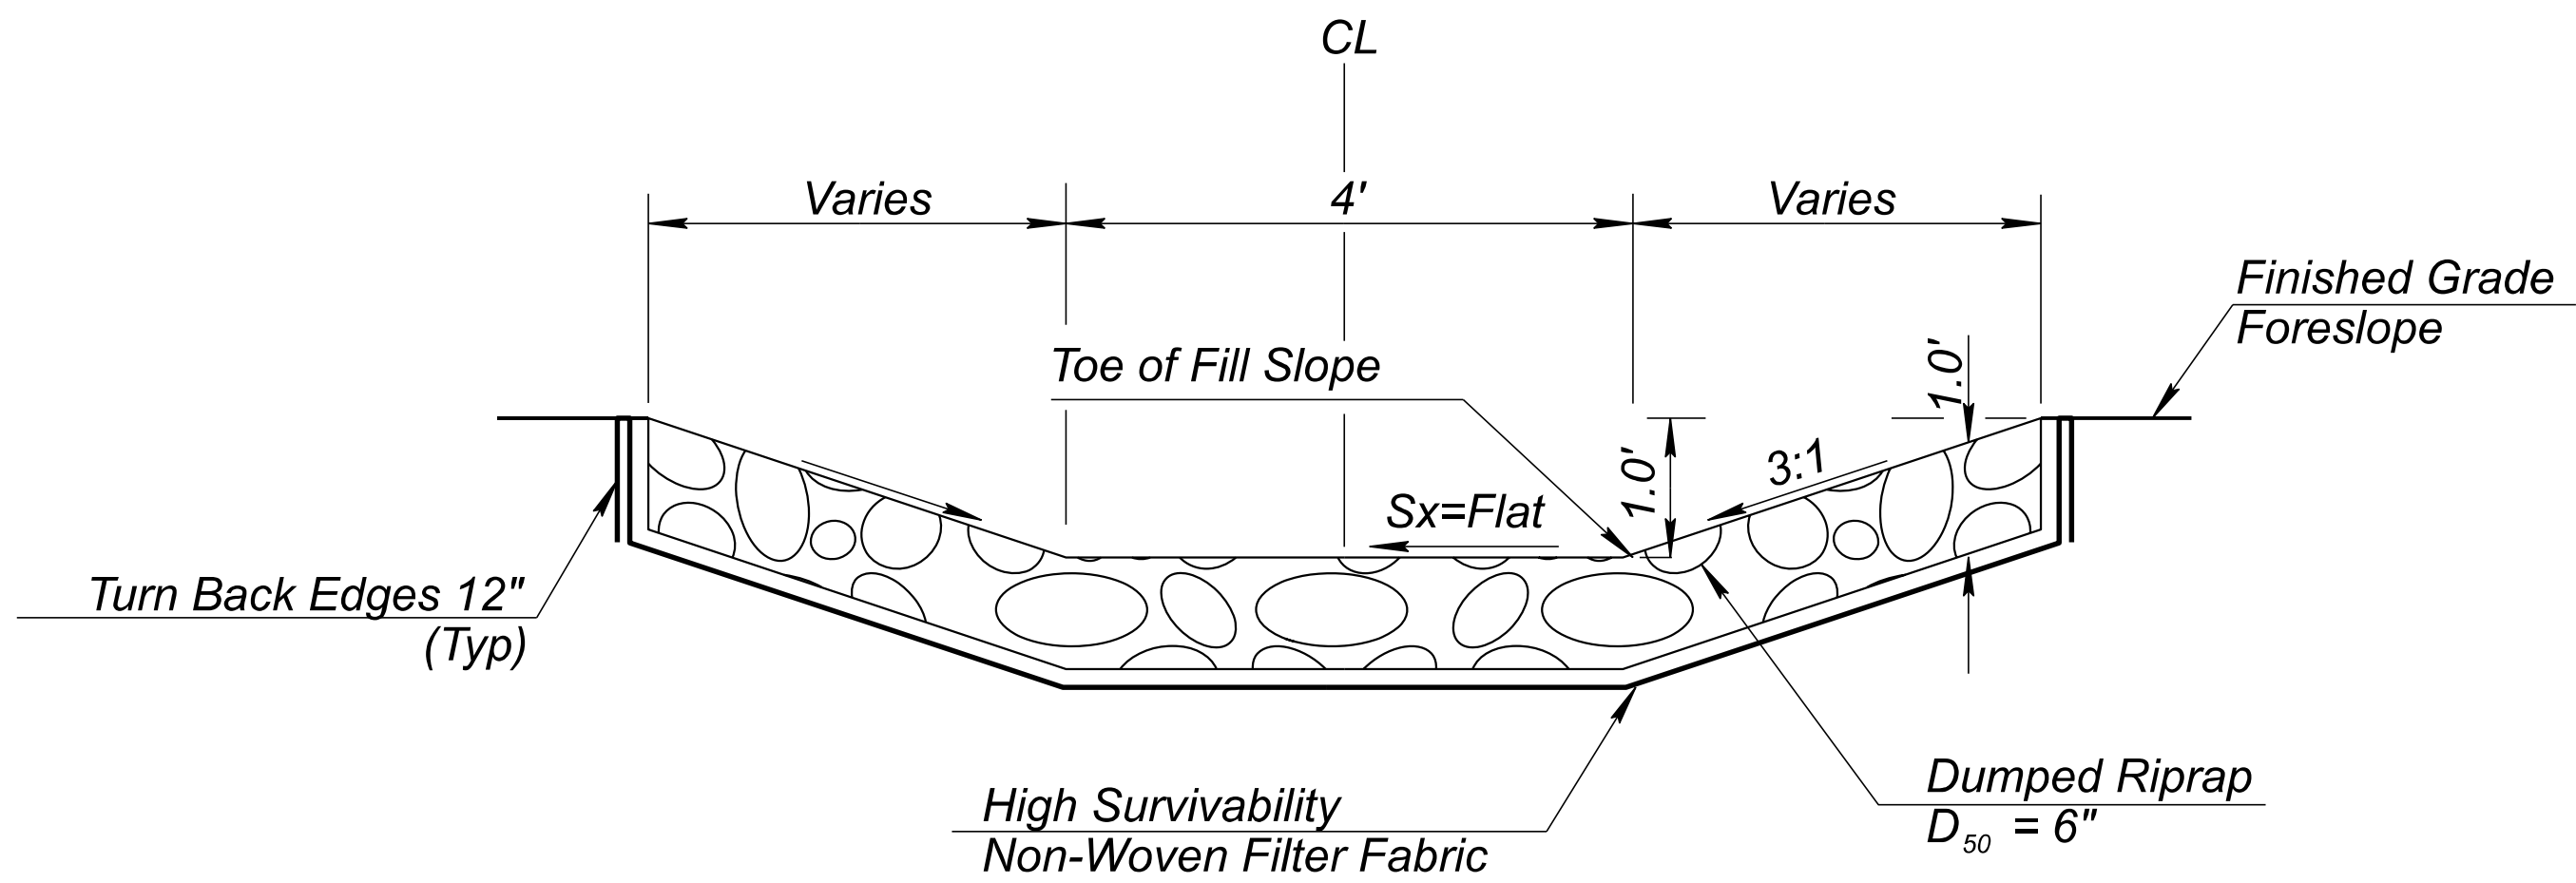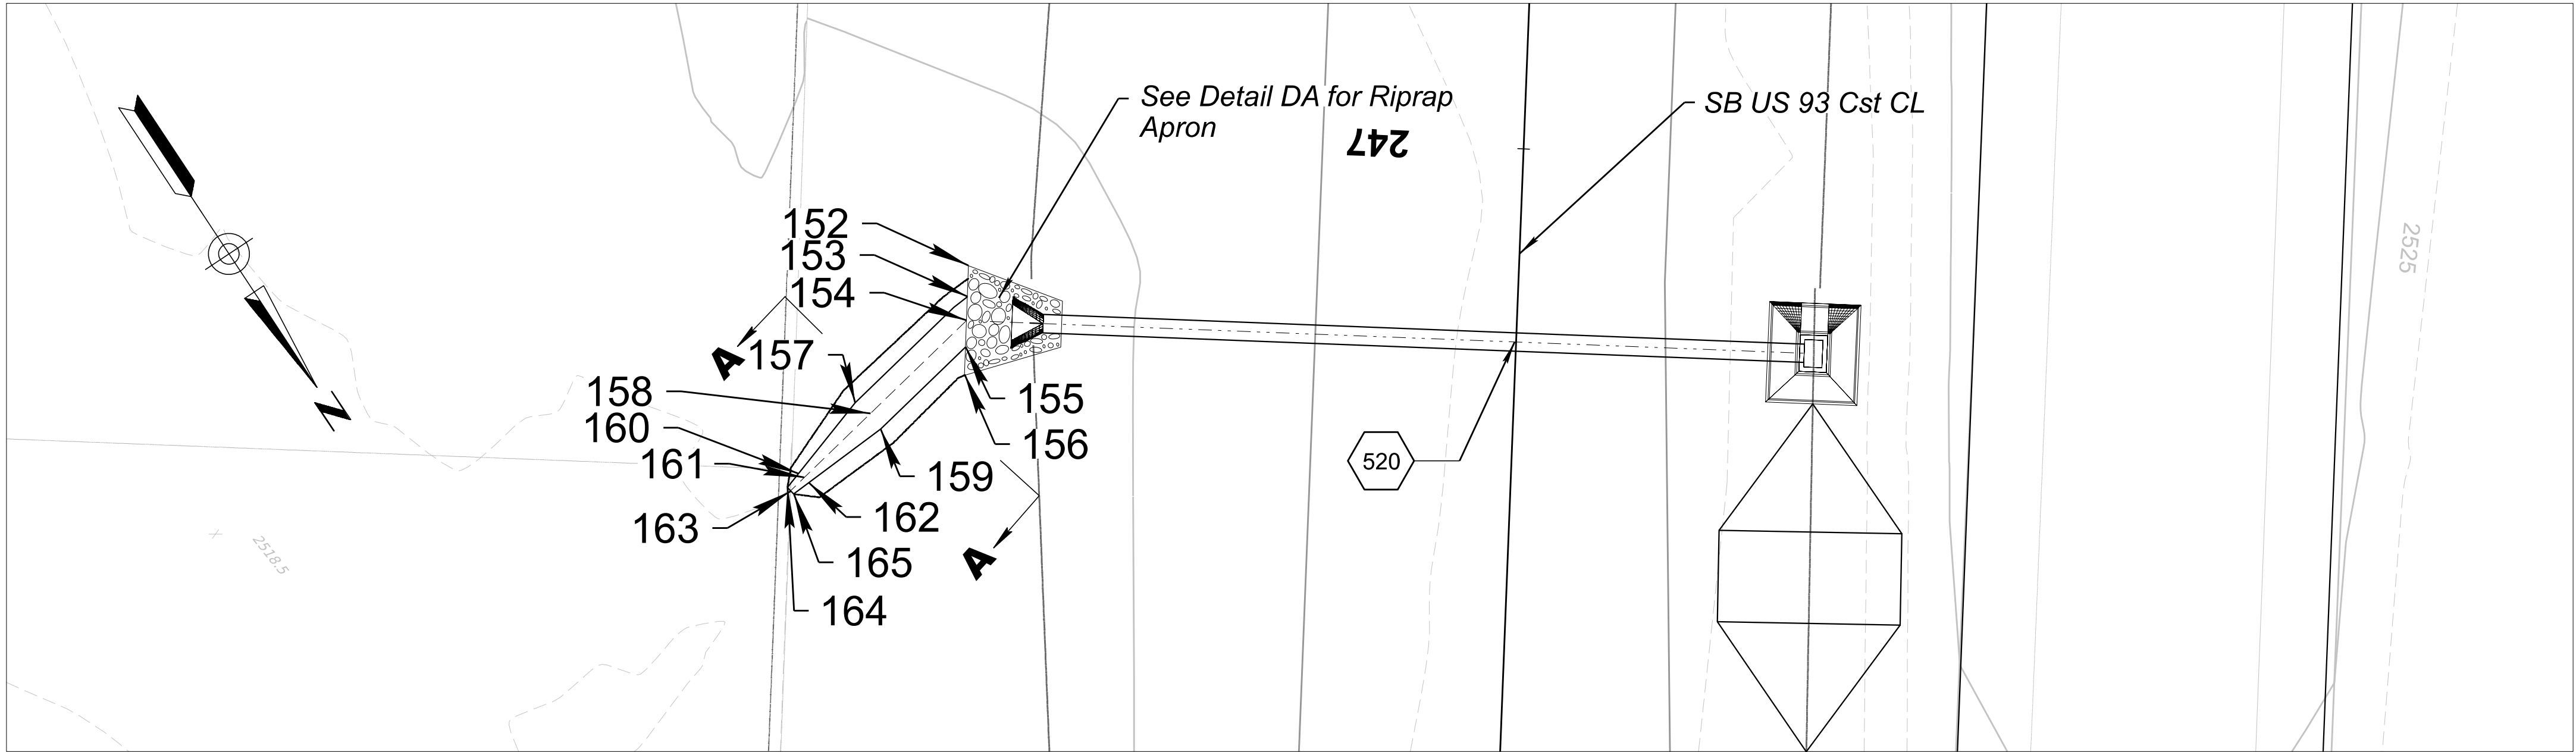


CHANNEL GRADING CONTROL POINTS			
Point No.	SBUS 93 CST CL	Offset Lt	Elev
152	246+84.84	60.20	2519.68
153	246+81.47	60.20	2519.51
154	246+78.85	60.20	2519.07
155	246+75.95	60.20	2519.04
156	246+72.85	60.20	2519.64
157	246+69.37	72.02	2518.87
158	246+67.99	70.57	2518.87
159	246+66.61	69.13	2518.87
160	246+61.27	78.01	2518.74
161	246+60.76	77.48	2518.74
162	246+60.26	76.96	2518.74
163	246+59.83	79.07	2518.72
164	246+59.48	78.70	2518.72
165	246+59.14	78.35	2518.72

RIPRAP QUANTITIES 520		
Area	89.30	sq ft
Depth	1.00	ft
Volume *	3.31	cu yd

Note: See Detail DR for Riprap Gradation
* See Detail DA for Apron Quantity

DETAIL DB
(SHEET 4 OF 4)

DUMPED RIPRAP
OUTLET GRADING PLAN
PIPE 520

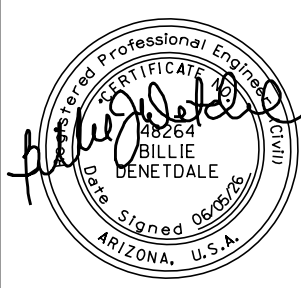


	NAME	DATE
DESIGN	K LEANDER	06/26
DRAWN	B LEANDER	06/26
CHECKED	B DENETDALE	06/26

TRANSPORTATION
AECOM TECHNICAL SERVICES, Inc.
7720 N. 16th St., Suite 100
Phoenix, Arizona 85020
T 602.371.1100

AECOM
www.aecom.com

ARIZONA DEPARTMENT OF TRANSPORTATION PROJECT DELIVERY AND OPERATIONS DIVISION ROADWAY DESIGN SERVICES	ROUTE US 93
DETAIL DB OUTLET GRADING PLAN FOR PIPE 520	MILEPOST 189.9
	STRUCTURE NO.

F.H.W.A. Arizona Division	STATE ARIZ.	PROJECT NO. 093 YV 189	FEDERAL ID NO. 093-B(230)T	SHEET NO. 54	TOTAL SHEETS 524	RECORD DRAWING
LOCATION WICKENBURG RANCH WAY TO VISTA ROYALE						DWG No. D-1.06
TRACS NO. F0738 01C						____ OF ____

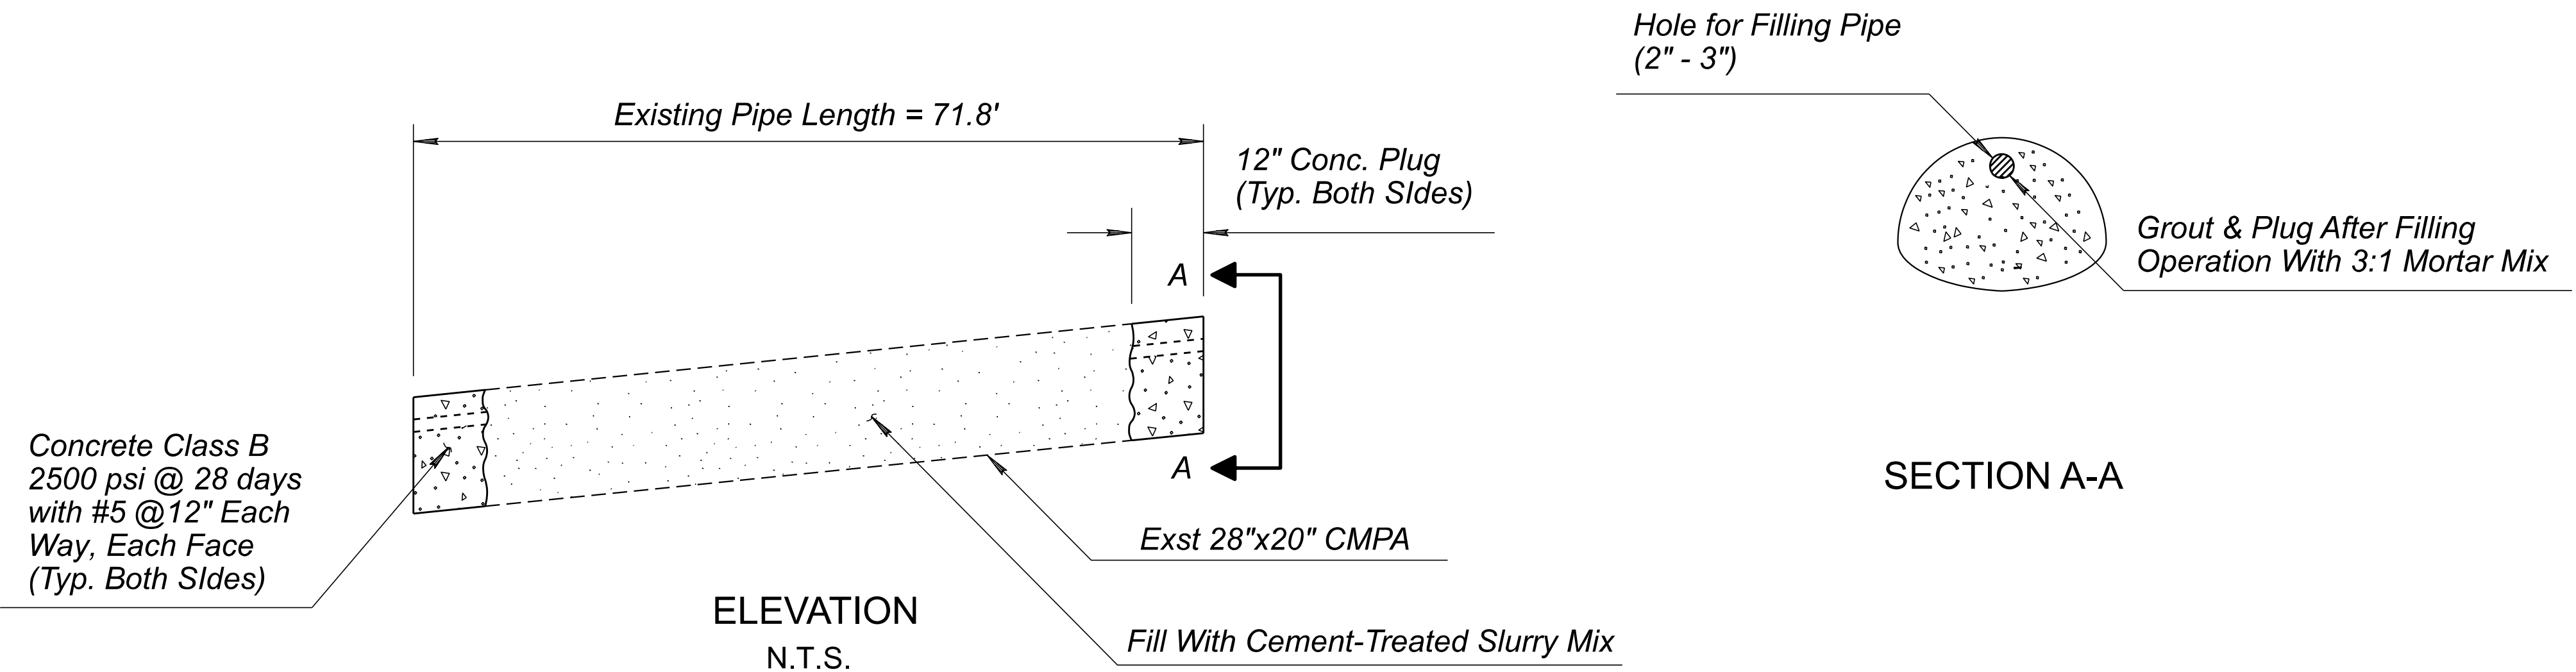



- NOTES
- 1. Verify cover over plug is 1ft minimum.
 - 2. Smooth out any Crushed or Damaged end of pipe prior to mortar placement.

DETAIL DC
PIPE PLUG DETAIL

		NAME	DATE	ARIZONA DEPARTMENT OF TRANSPORTATION PROJECT DELIVERY AND OPERATIONS DIVISION ROADWAY DESIGN SERVICES	ROUTE	F.H.W.A. Arizona Division	STATE	PROJECT NO.	FEDERAL ID NO.	SHEET NO.	TOTAL SHEETS	RECORD DRAWING
	DESIGN	K LEANDER	06/26		US 93			093 YV 189	093-B(230)T	55	524	
	DRAWN	B LEANDER	06/26		MILEPOST	LOCATION WICKENBURG RANCH WAY TO VISTA ROYALE DWG No. D-1.07						
	CHECKED	B DENETDALE	06/26	189.9								
	TRANSPORTATION AECOM TECHNICAL SERVICES, Inc. 7720 N. 16th St., Suite 100 Phoenix, Arizona 85020 T 602.371.1100  www.aecom.com			DETAIL DC - PIPE PLUG DETAIL	STRUCTURE NO.	TRACS NO. F0738 01C		OF				


NOTES

- 1. Intercepted drainage locations shall be verified in the field by the Engineer prior to construction.
- 2. Match embankment fill slope per roadway typical section.
- 3. Refer to Retaining Wall Details for Measurements not Shown.
- 4. See Detail DR for Riprap Gradation

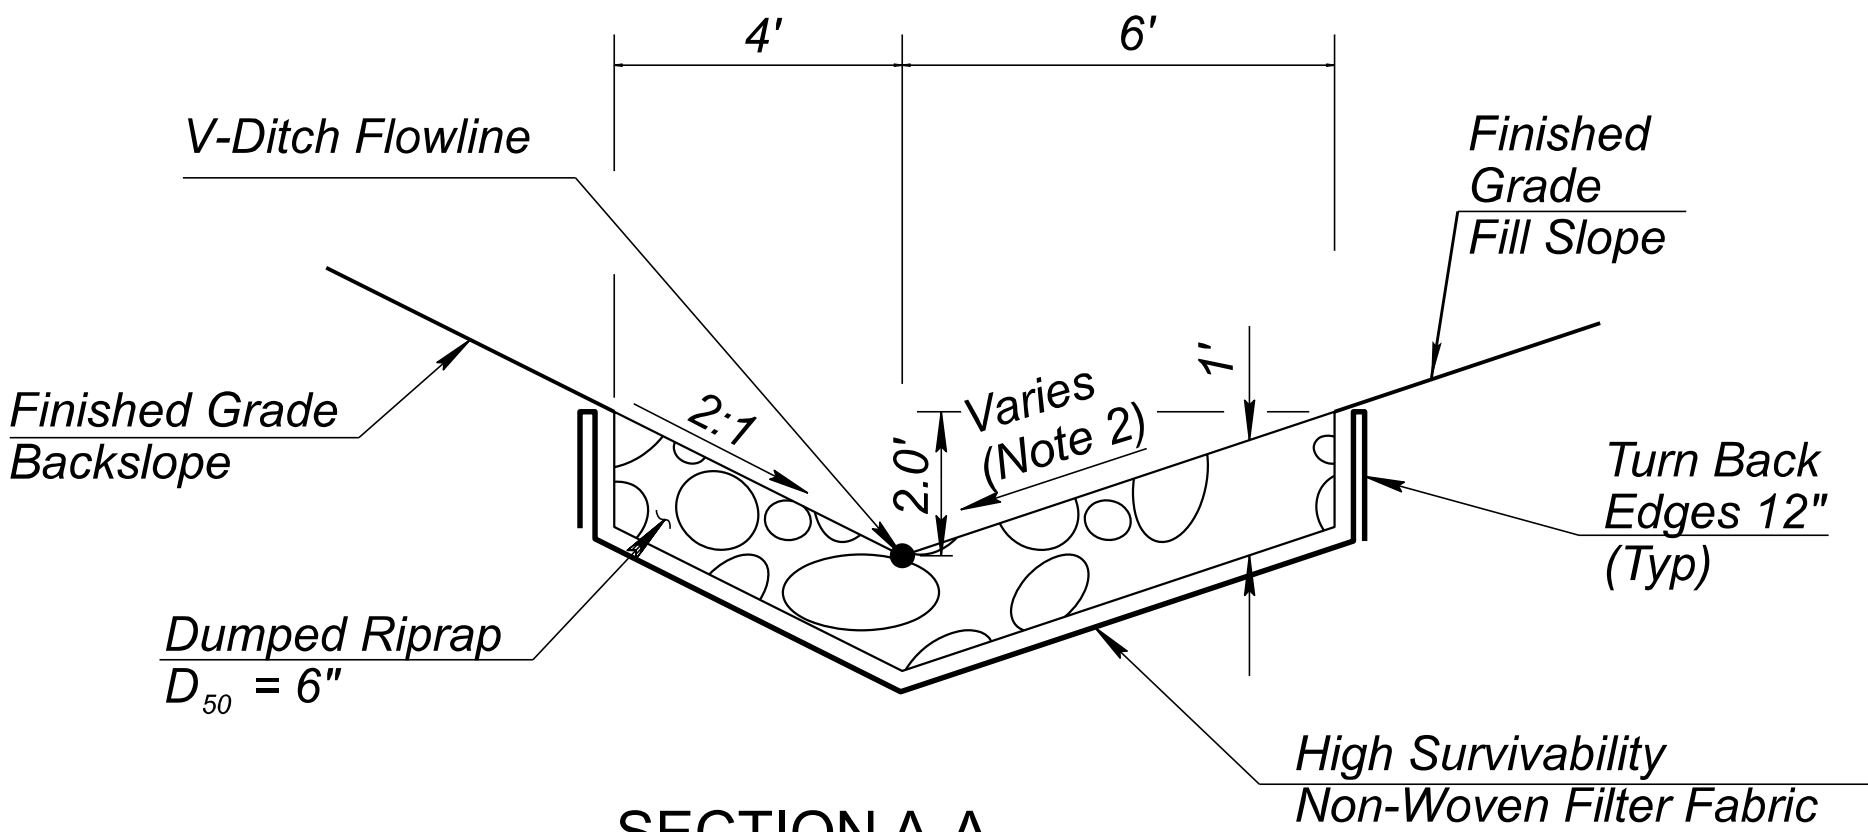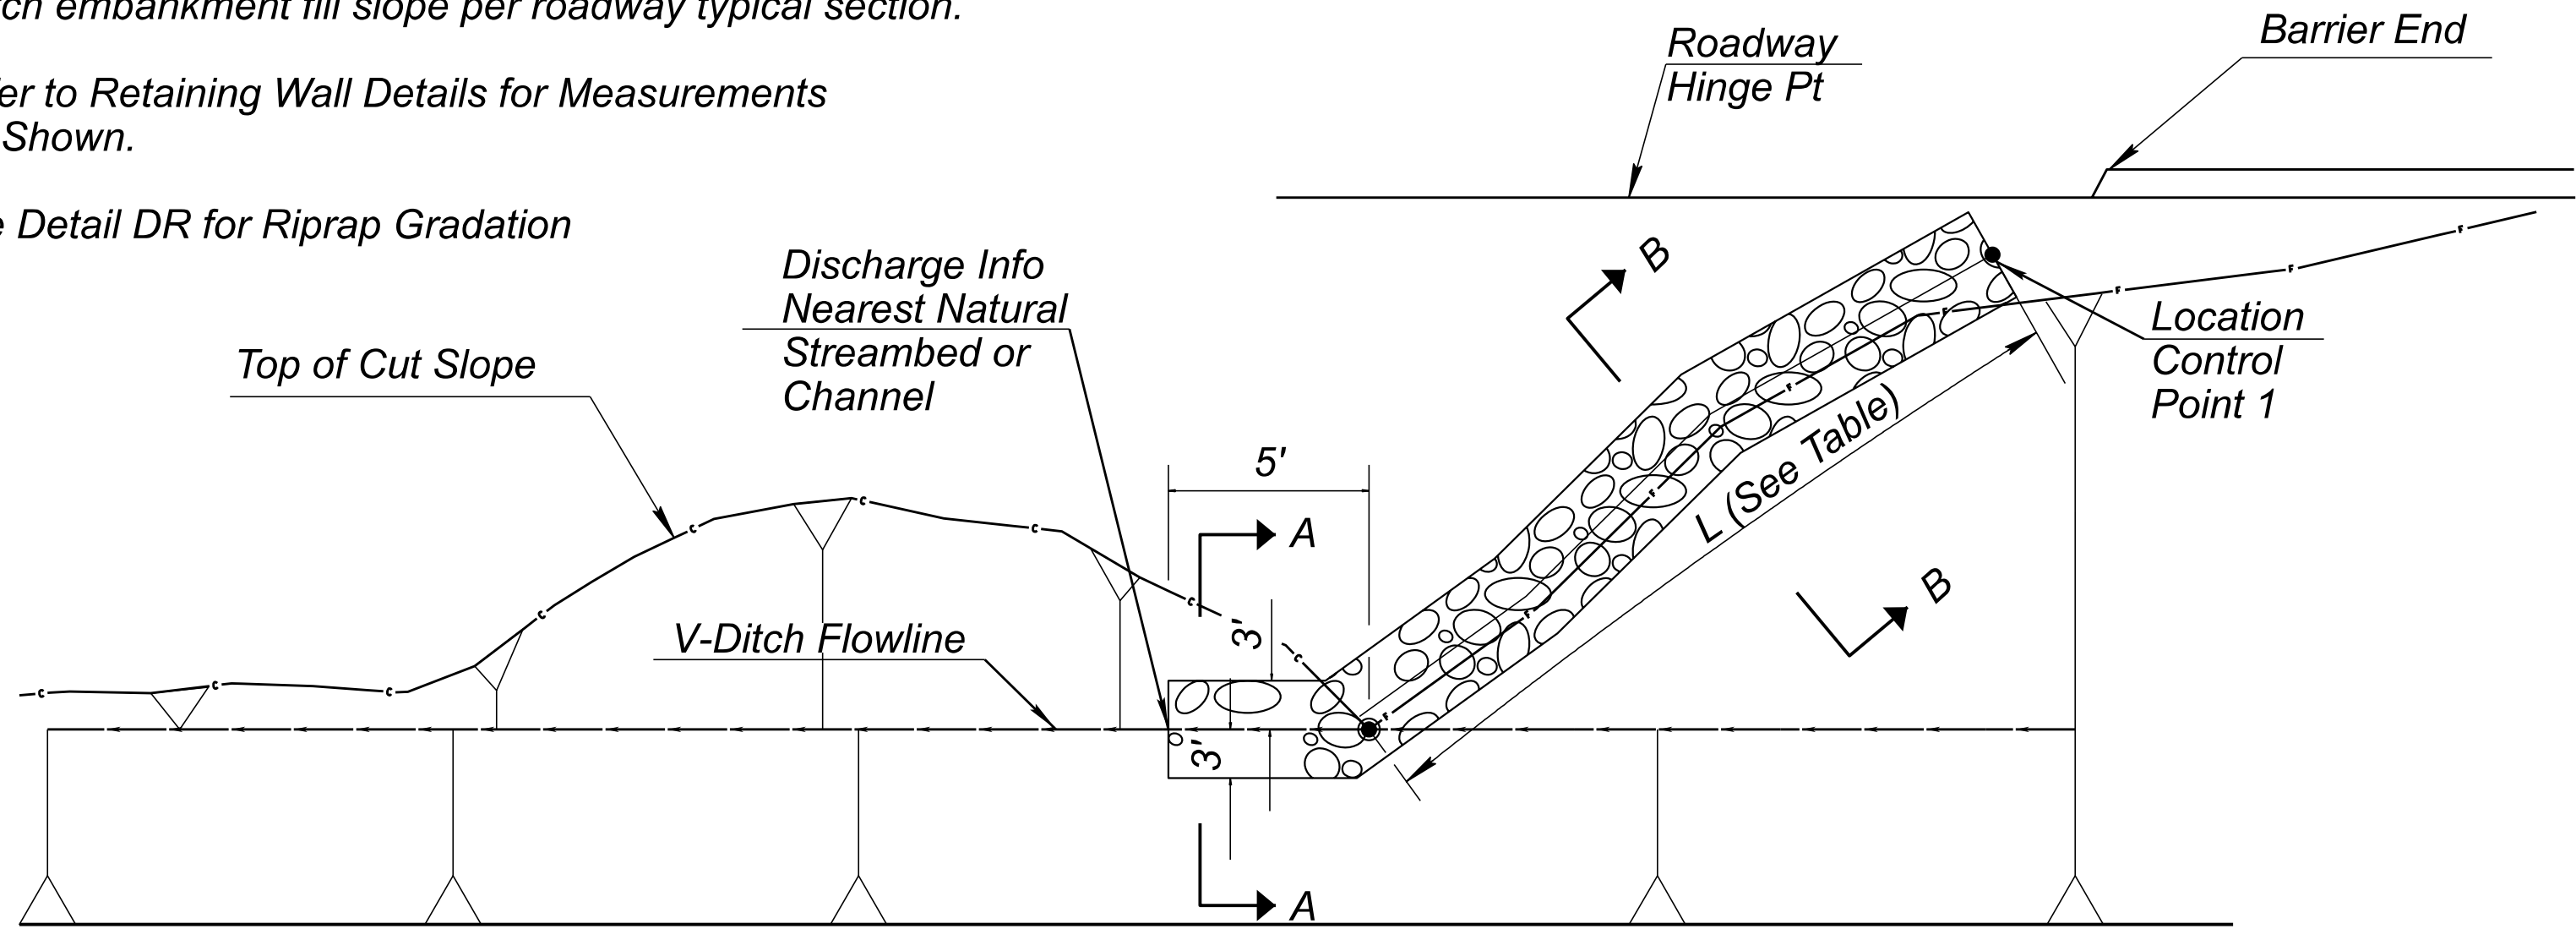


SECTION A-A
TYPE 4 - V-DITCH RIPRAP
N.T.S.


DUMPED RIPRAP DITCHES					
Station	Offset	Side	Volume	L	Type
(SB US-93 Cst CL)	(ft)	(Lt/Rt)	(CY)	(ft)	1/2/3/4
196+52.5	25.0	Lt	14	88.0	1
196+00	97.0	Lt			
196+57.5	26.0	Lt	13	90.0	3
196+03	98.0	Lt			
196+45	36.0	Rt	1	5.0	4
196+50	36.0	Rt			
196+50	36.0	Rt	8	28.5	2
196+71	17.1	Rt			
196+92	45.0	Rt	3	22.0	3
199+84	26.0	Lt			
200+39	81.0	Lt	11	77.0	3
199+90	25.0	Lt			
200+46	81.0	Lt	13	85.0	1
200+46	87.0	Lt			
200+23	20.0	Rt	4	24.0	3
200+25	45.0	Rt			

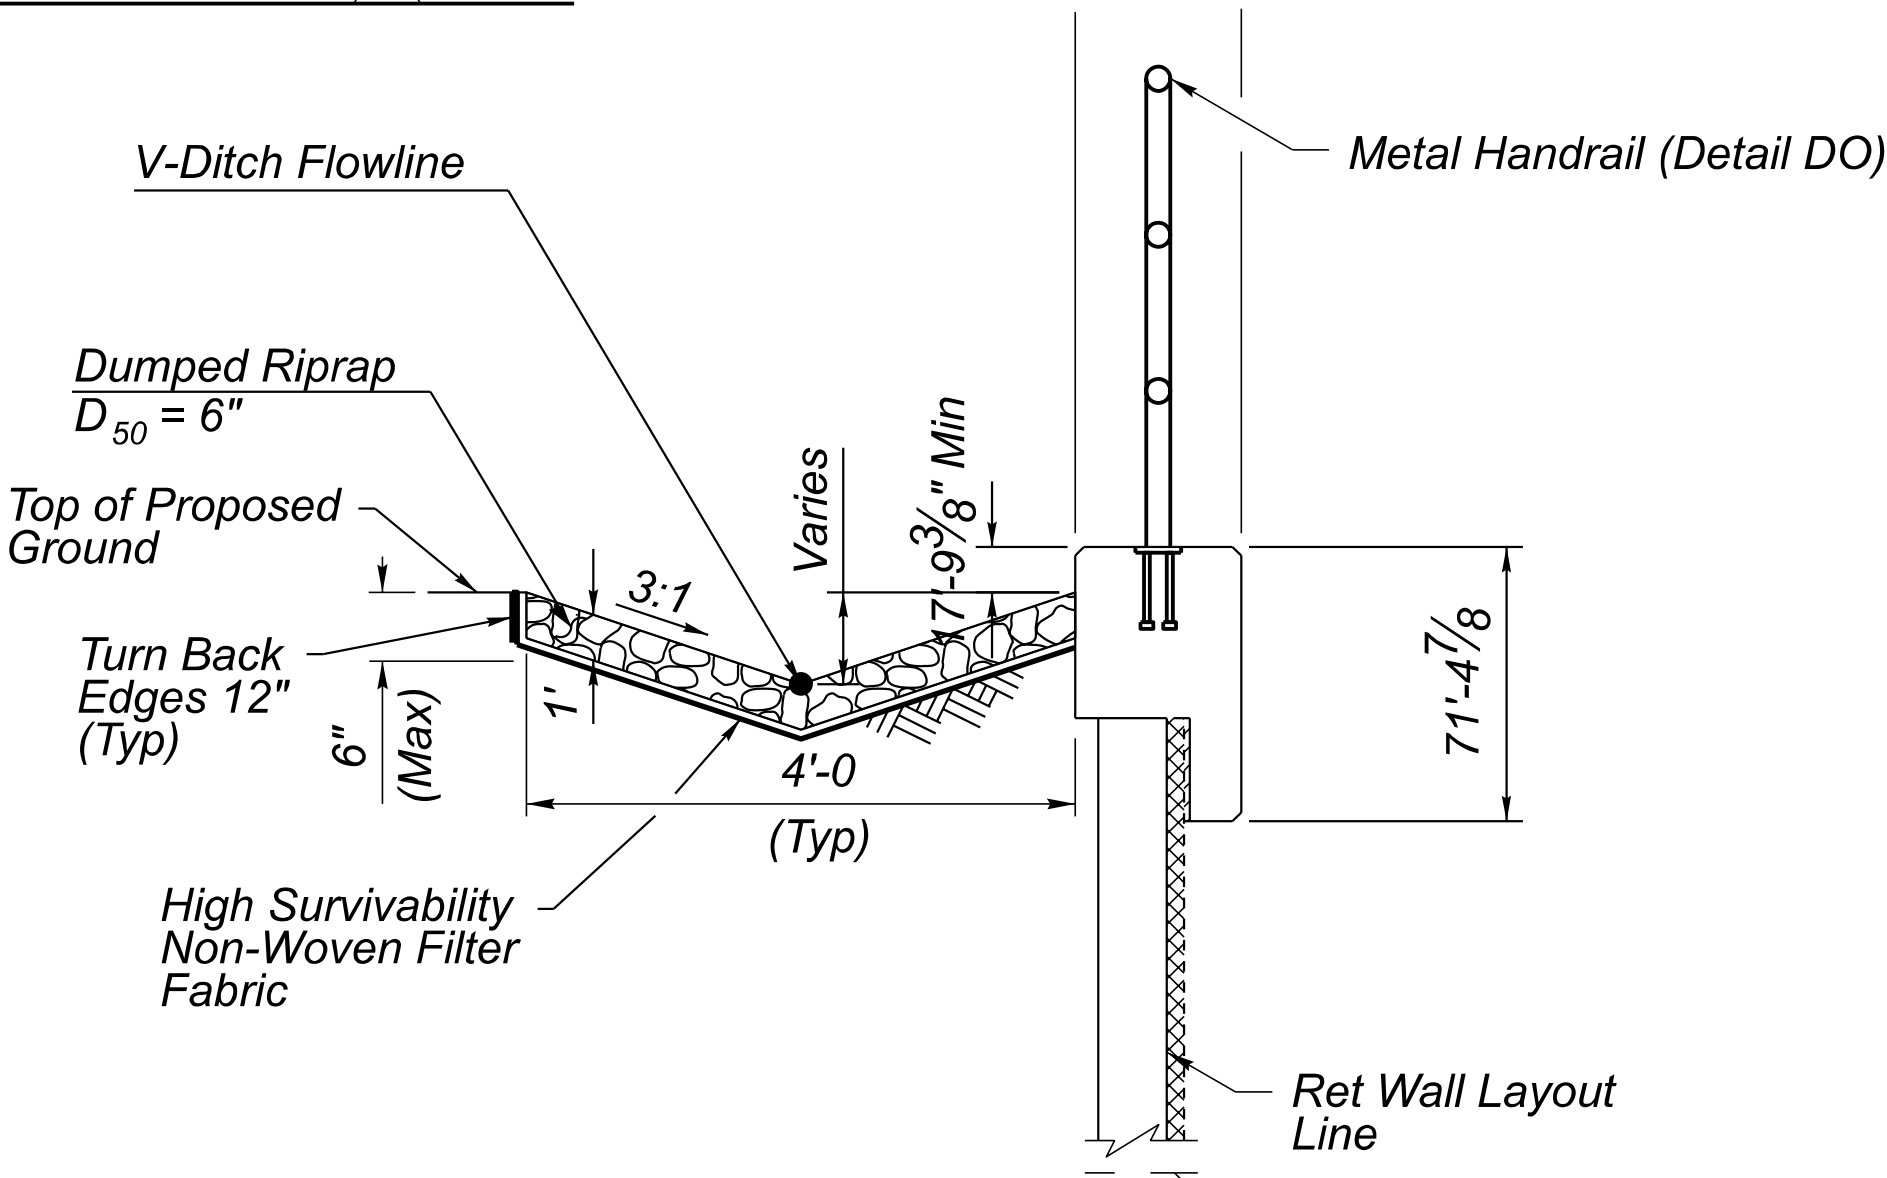

SECTION
TYPE 1 - V-DITCH RIPRAP AGAINST RETAINING WALL
N.T.S.

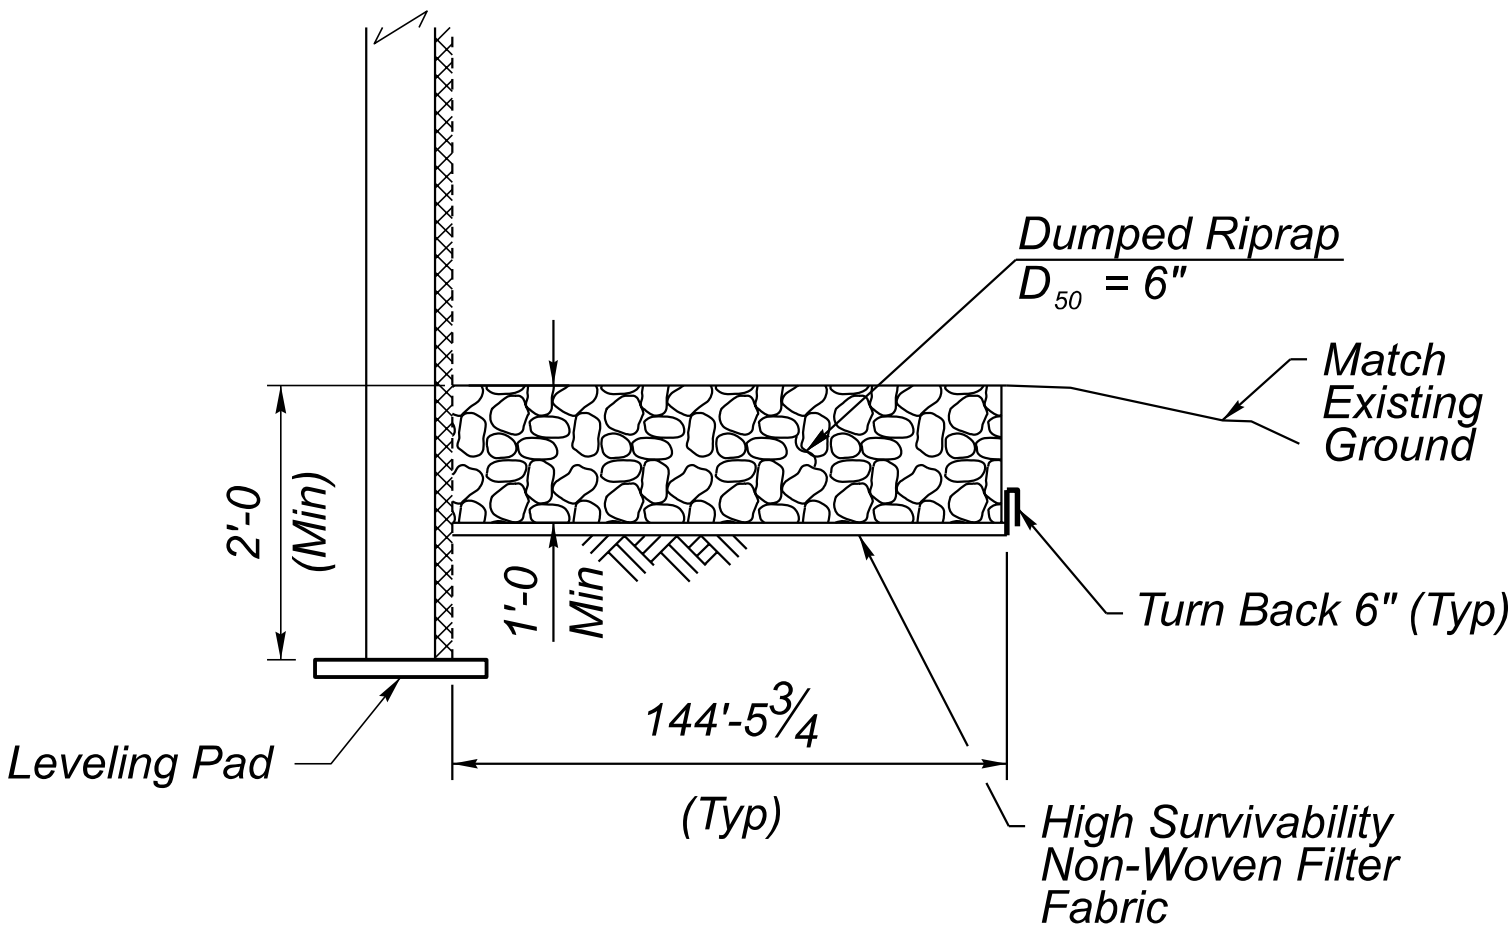

SECTION
TYPE 3 - RIPRAP AGAINST BOTTOM OF RETAINING WALL
N.T.S.

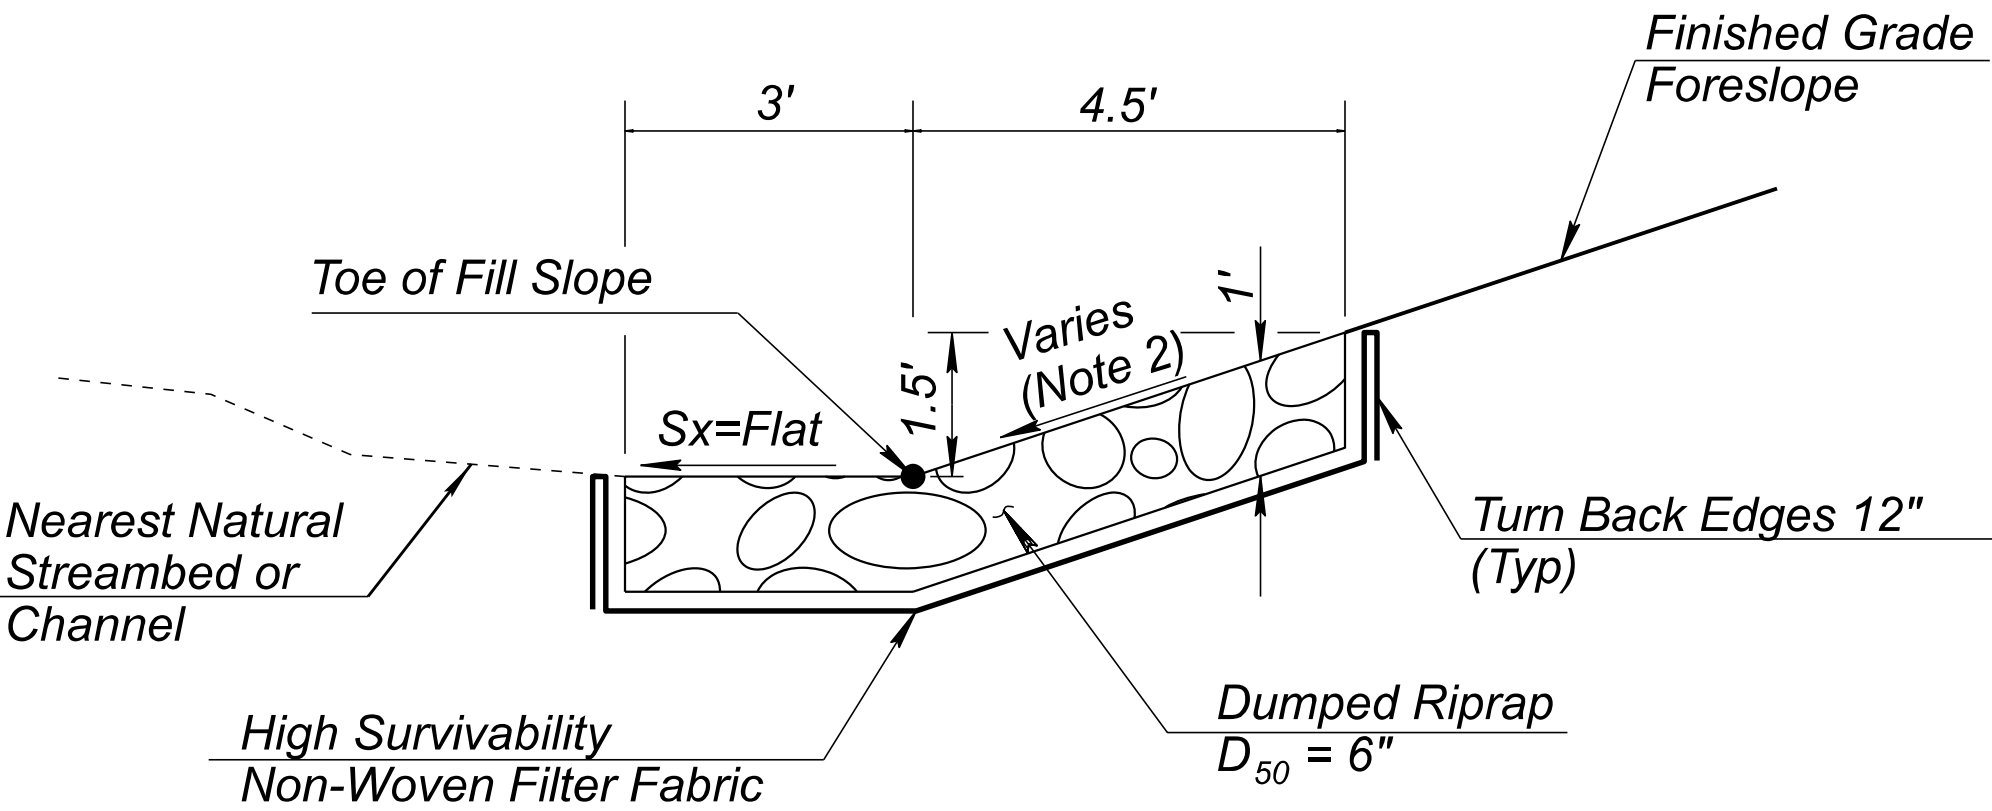

SECTION B-B
TYPE 2 - RIPRAP AGAINST FILL SLOPE
N.T.S.

DETAIL DD

DUMPED RIPRAP CHANNELS & V-DITCHES



	NAME	DATE
DESIGN	K LEANDER	06/26
DRAWN	B LEANDER	06/26
CHECKED	B DENETDALE	06/26

TRANSPORTATION
AECOM TECHNICAL SERVICES, Inc.
7720 N. 16th St., Suite 100
Phoenix, Arizona 85020
T 602.371.1100


AECOM
www.aecom.com

ARIZONA DEPARTMENT OF TRANSPORTATION PROJECT DELIVERY AND OPERATIONS DIVISION ROADWAY DESIGN SERVICES	ROUTE US 93
DETAIL DD - DUMPED RIPRAP CHANNELS & V-DITCHES	MILEPOST 189.9
	STRUCTURE NO.

F.H.W.A. Arizona Division	STATE ARIZ.	PROJECT NO. 093 YV 189	FEDERAL ID NO. 093-B(230)T	SHEET NO. 56	TOTAL SHEETS 524	RECORD DRAWING
LOCATION WICKENBURG RANCH WAY TO VISTA ROYALE						DWG No. D-1.08
TRACS NO. F0738 01C						OF

NOTES

- 1. Reinforcing steel shall conform to the requirements of Section 1003 of the specifications.
- 2. Reinforcing bars shall have 2" clear cover from edge of CBC and around opening unless otherwise noted.
- 3. No separate measurement or payment will be made for constructing the pipe penetration, the cost of this item is considered as included in the box culvert pay items. The cost of this item is considered as included in the junction structure pay items.
- 4. Area of additional bars at each edge of opening in each direction shall match 1/2 of the cross sectional area of the interrupted bars.
- 5. Provide standard ACI hook if straight extension past opening cannot be obtained.
- 6. Place additional reinforcing in the same plane as the reinforcing it is replacing.
- 7. Provide four diagonal bars at opening for each mat of steel. Locate diagnosis as to not affect positioning of mat or minimum clearances required. When typical reinforcing bars are not interrupted by an opening, diagonal bars shall be a minimum requirement if the opening is larger than 4".
- 8. See Drainage Sheets for Pipe Size, Location, and invert Elevations.
- 9. See ADOT Standard Structure Details for Box Culvert details not shown.

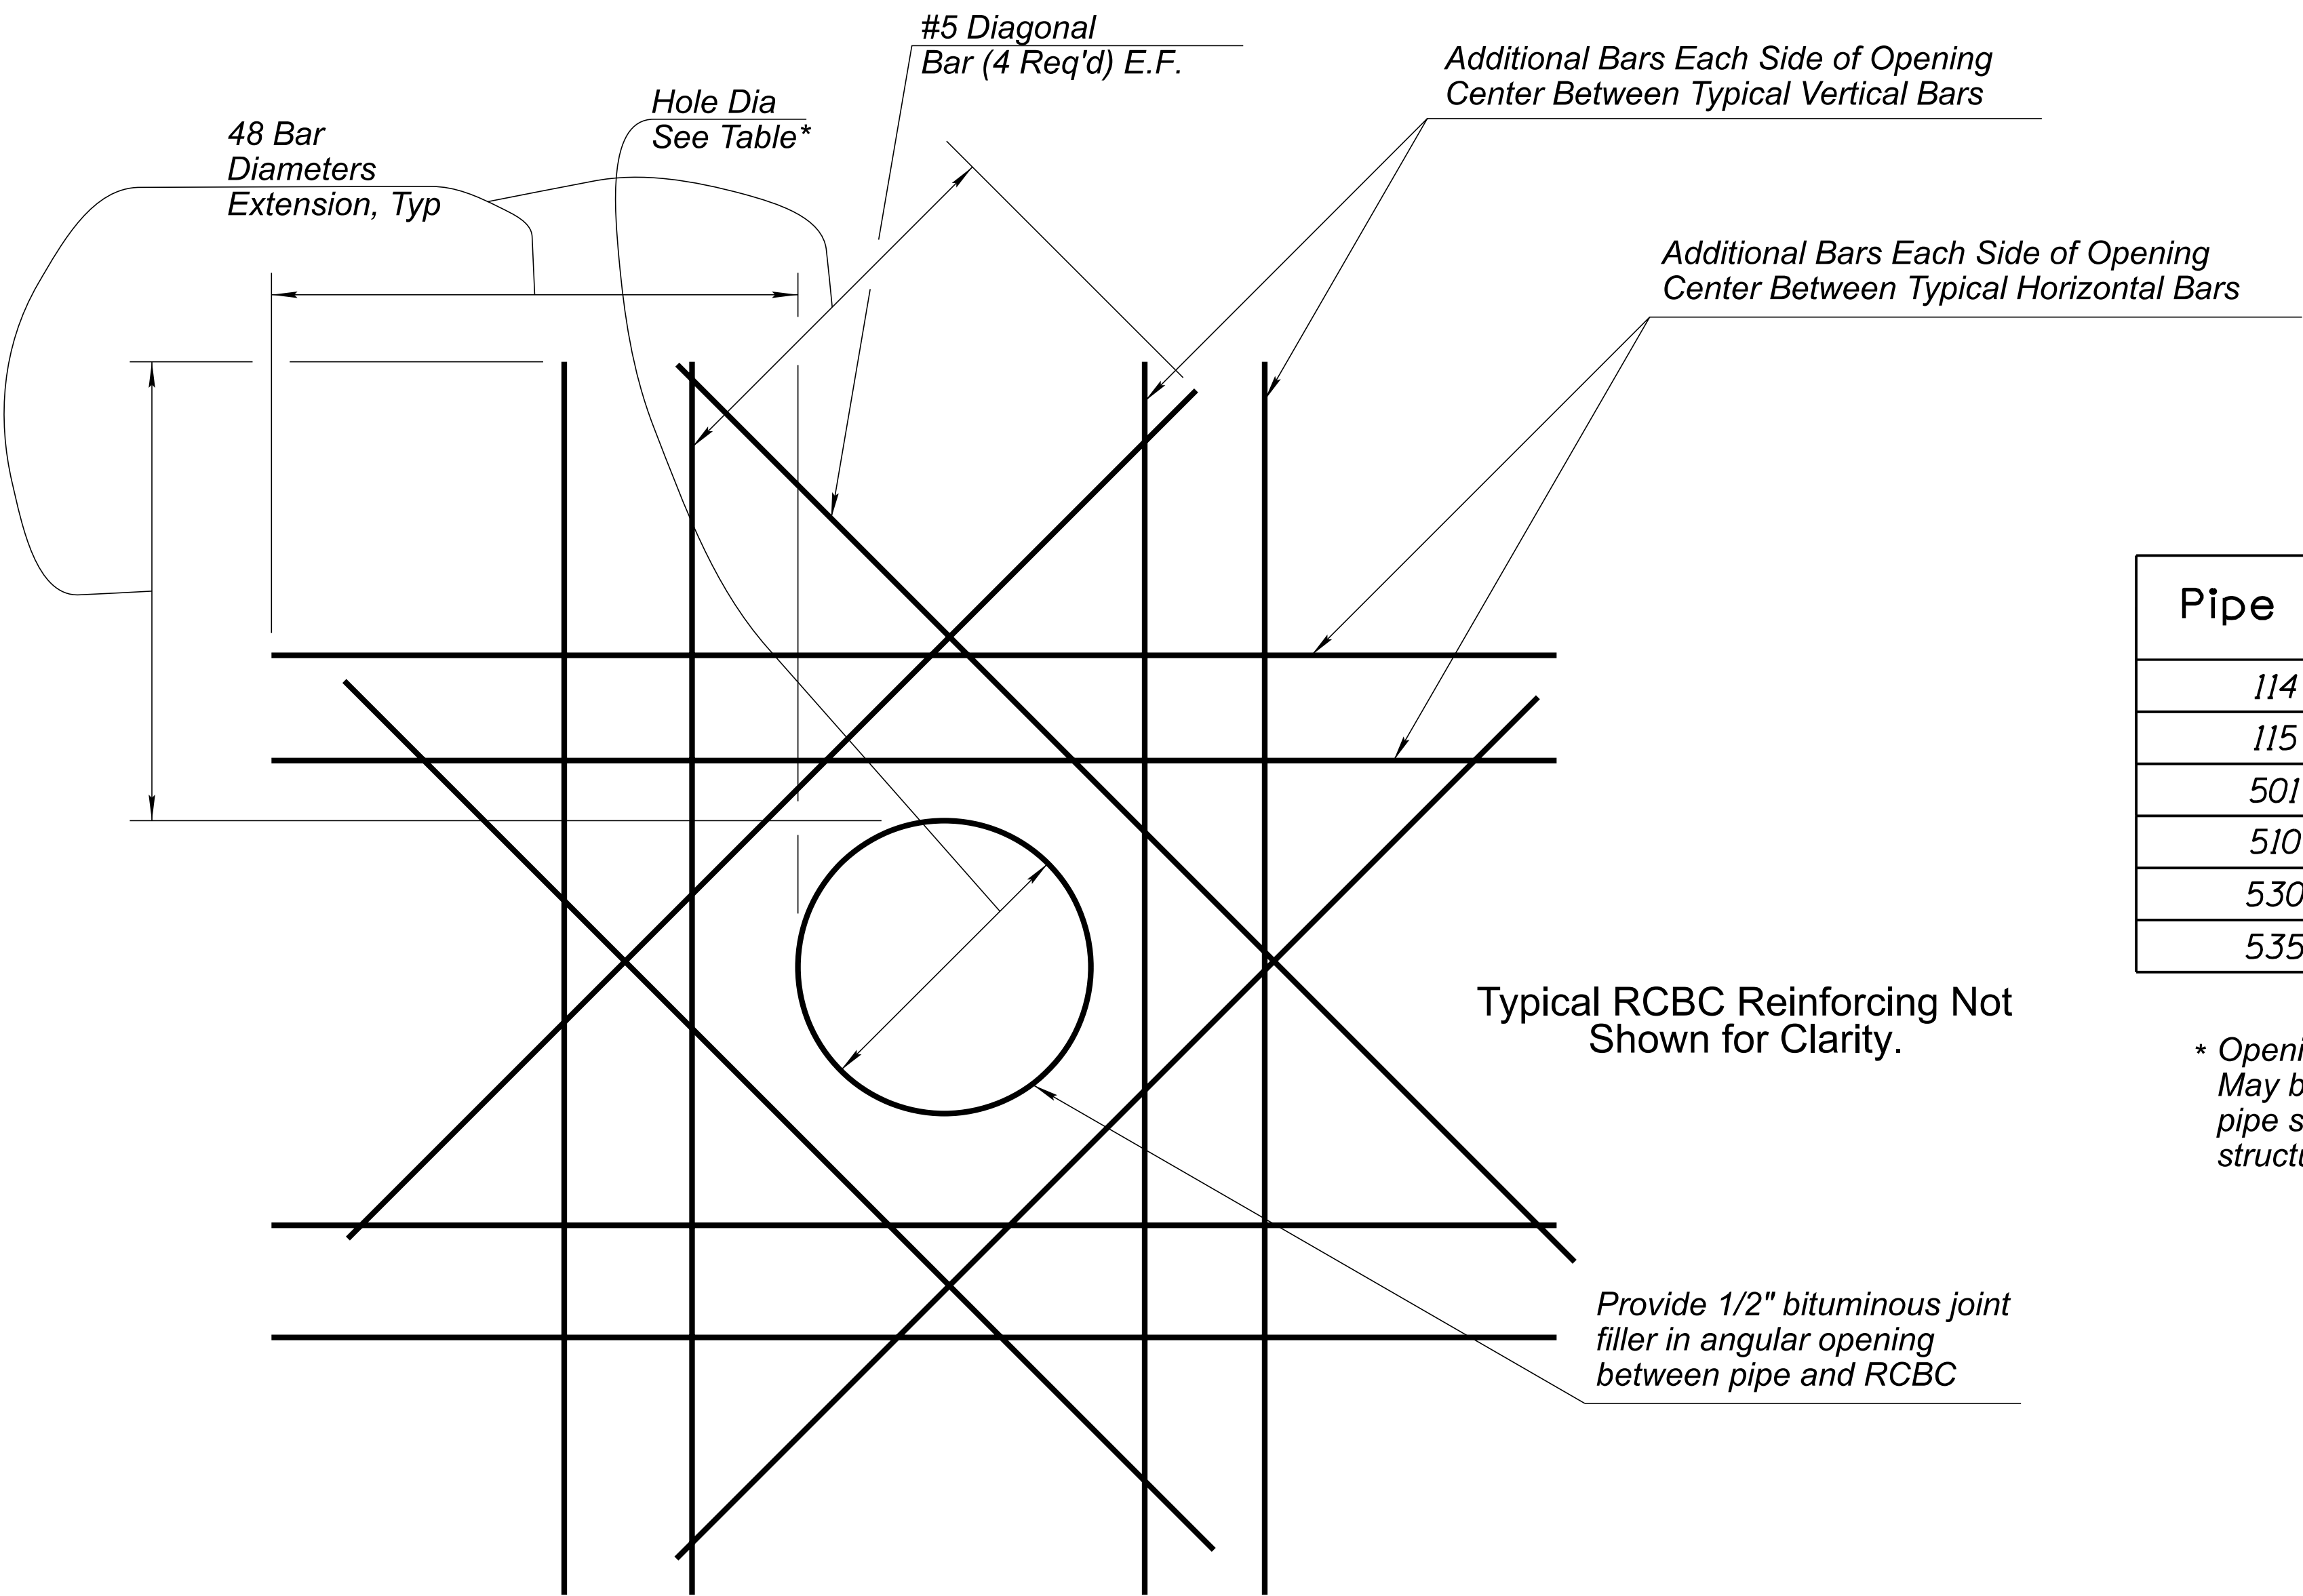

Pipe No.	Pipe Size (IN)*
114	24
115	18
501	24
510	24
530	24
535	24

* Opening May Not Be Circular. May be elliptical to allow for pipe skew angle relative the structure wall.

ADDITIONAL REINF. AT PIPE
OPENING IN NEW RCBC OR WINGWALL

N.T.S.

DETAIL DE
PIPE PENETRATION




	NAME	DATE
DESIGN	K LEANDER	06/26
DRAWN	B LEANDER	06/26
CHECKED	B DENETDALE	06/26

TRANSPORTATION
AECOM TECHNICAL SERVICES, Inc.
7720 N. 16th St., Suite 100
Phoenix, Arizona 85020
T 602.371.1100

AECOM
www.aecom.com


ARIZONA DEPARTMENT OF TRANSPORTATION PROJECT DELIVERY AND OPERATIONS DIVISION ROADWAY DESIGN SERVICES	ROUTE US 93
DETAIL DE - PIPE PENETRATION	MILEPOST 189.9
	STRUCTURE NO.

ROUTE US 93	F.H.W.A. Arizona Division	STATE	PROJECT NO.	FEDERAL ID NO.	SHEET NO.	TOTAL SHEETS	RECORD DRAWING
MILEPOST 189.9		ARIZ.	093 YV 189	093-B(230)T	57	524	
LOCATION WICKENBURG RANCH WAY TO VISTA ROYALE						DWG No. D-1.09	
STRUCTURE NO.	TRACS NO. F0738 01C			OF			

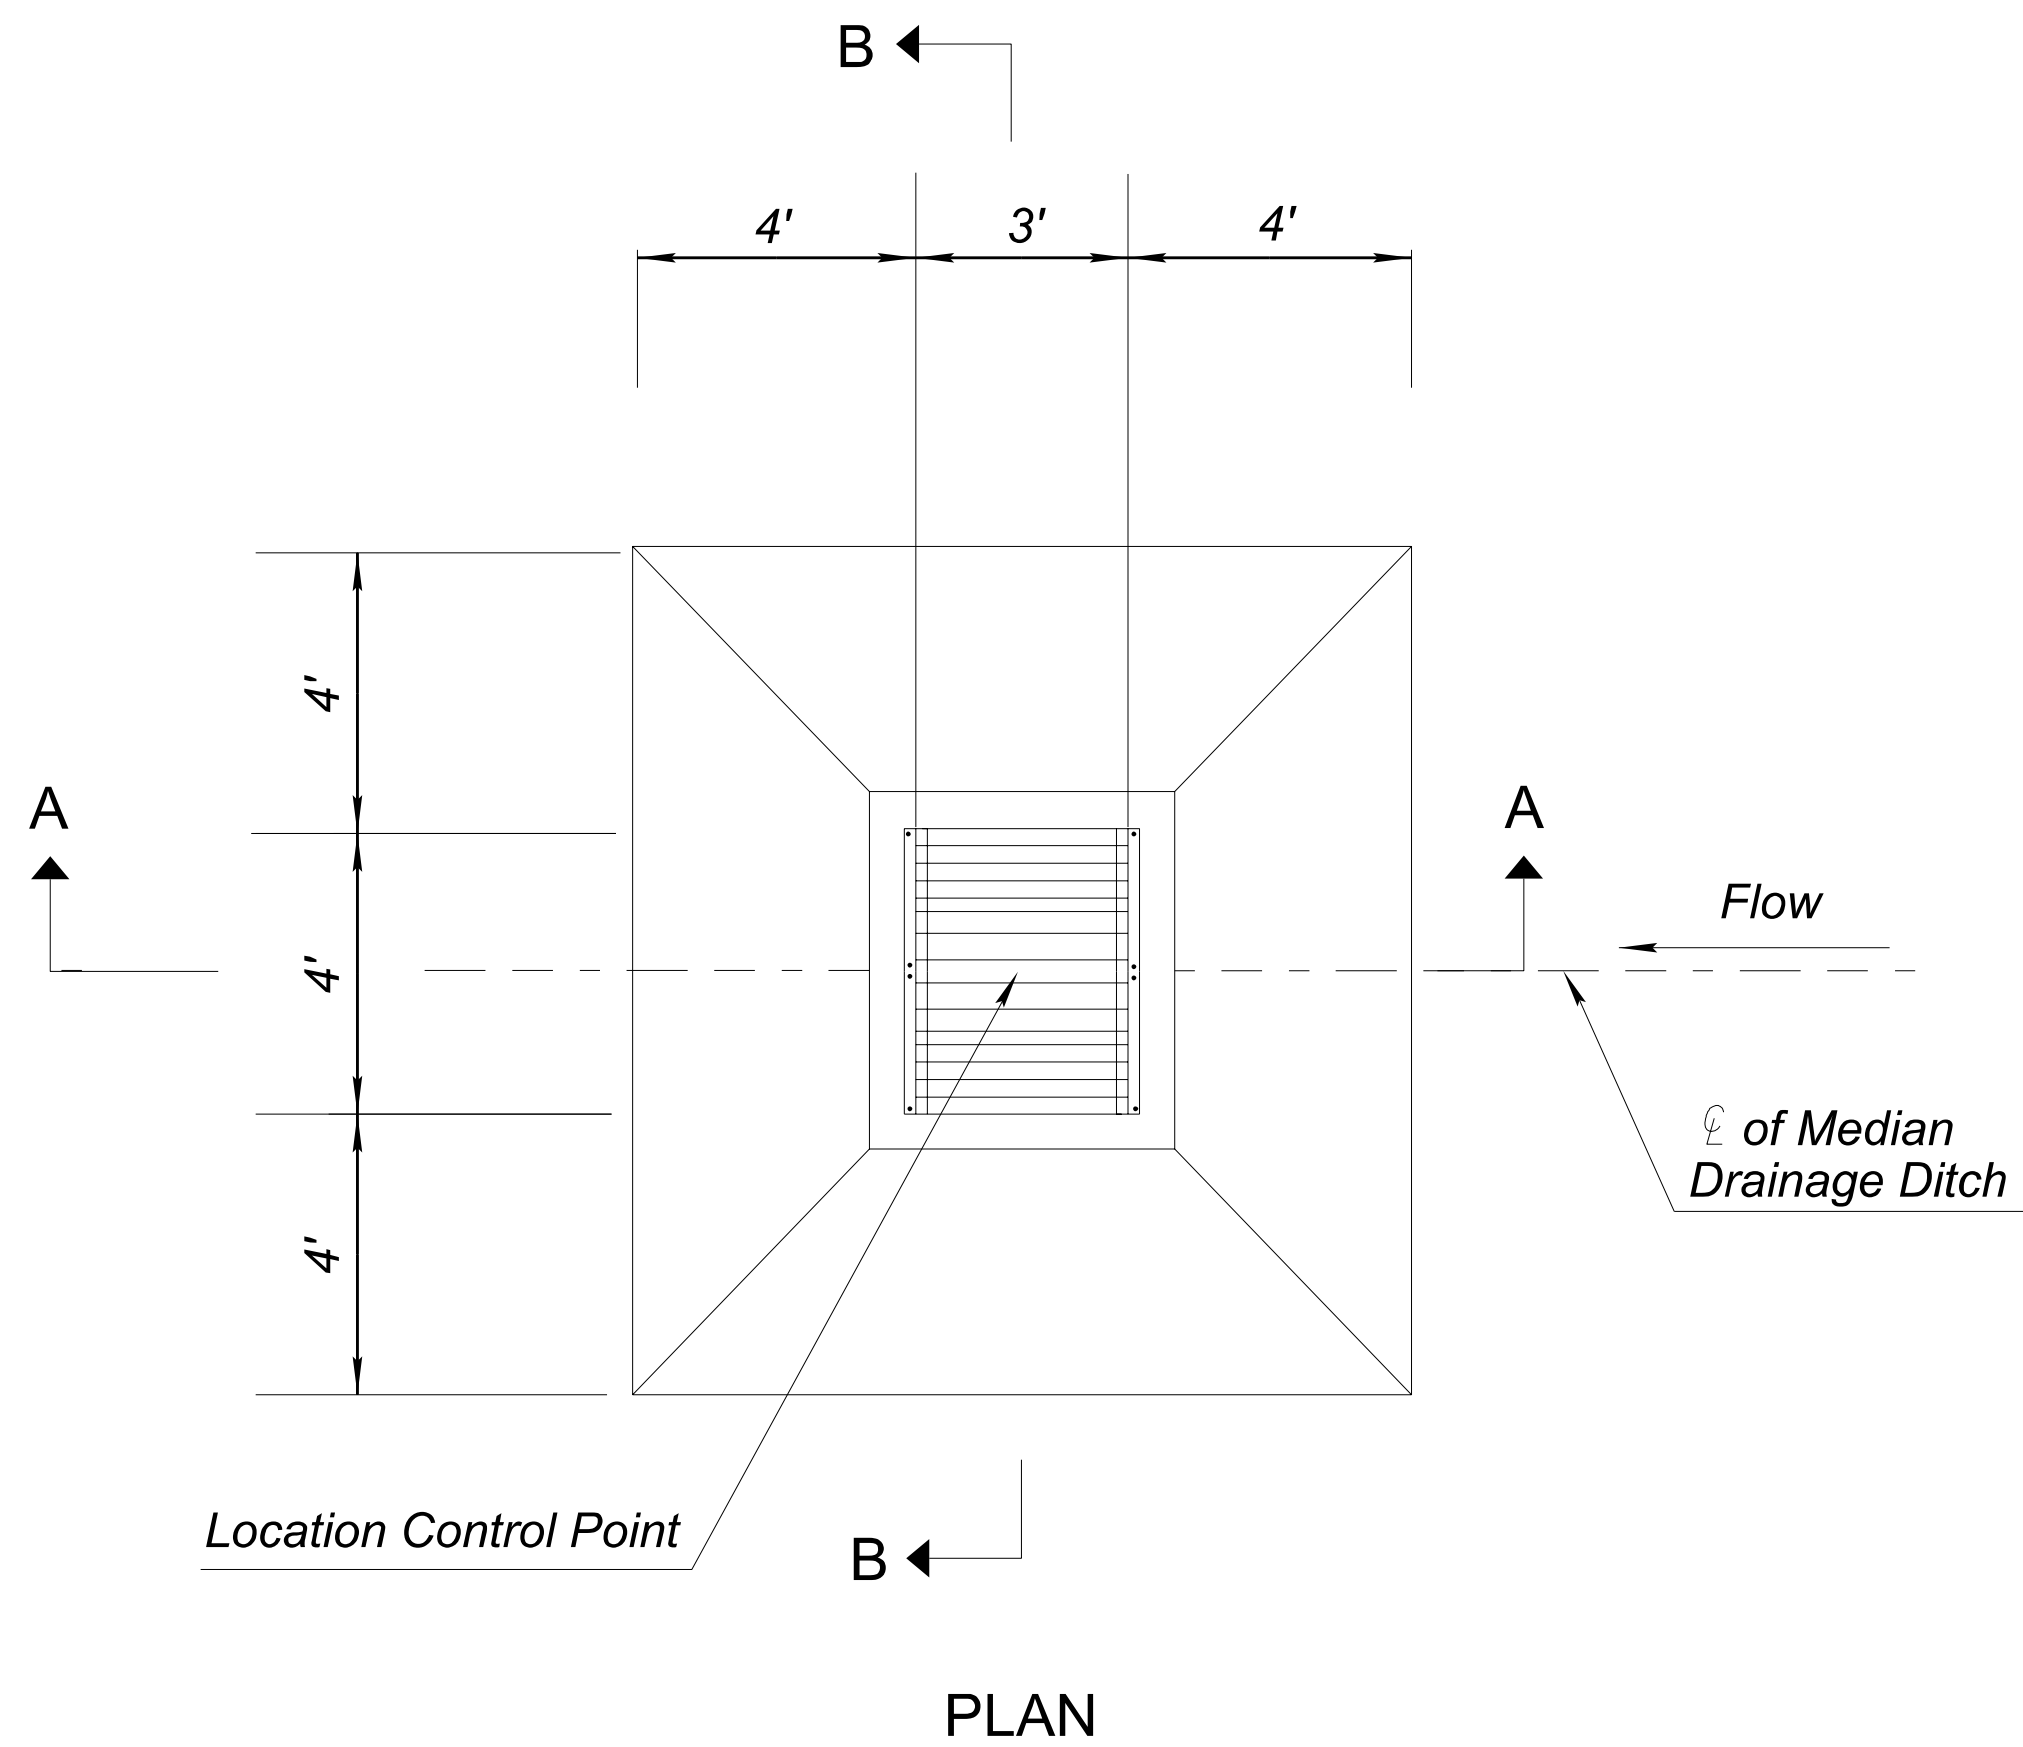


GENERAL NOTES

1. See Details C-15.80 and C-15.81 For Wall Thicknesses, Grating And Other Information Not Shown In This Detail.
2. Apron Slopes shall match the natural flow line of the ditch, no additional depression will be allowed.

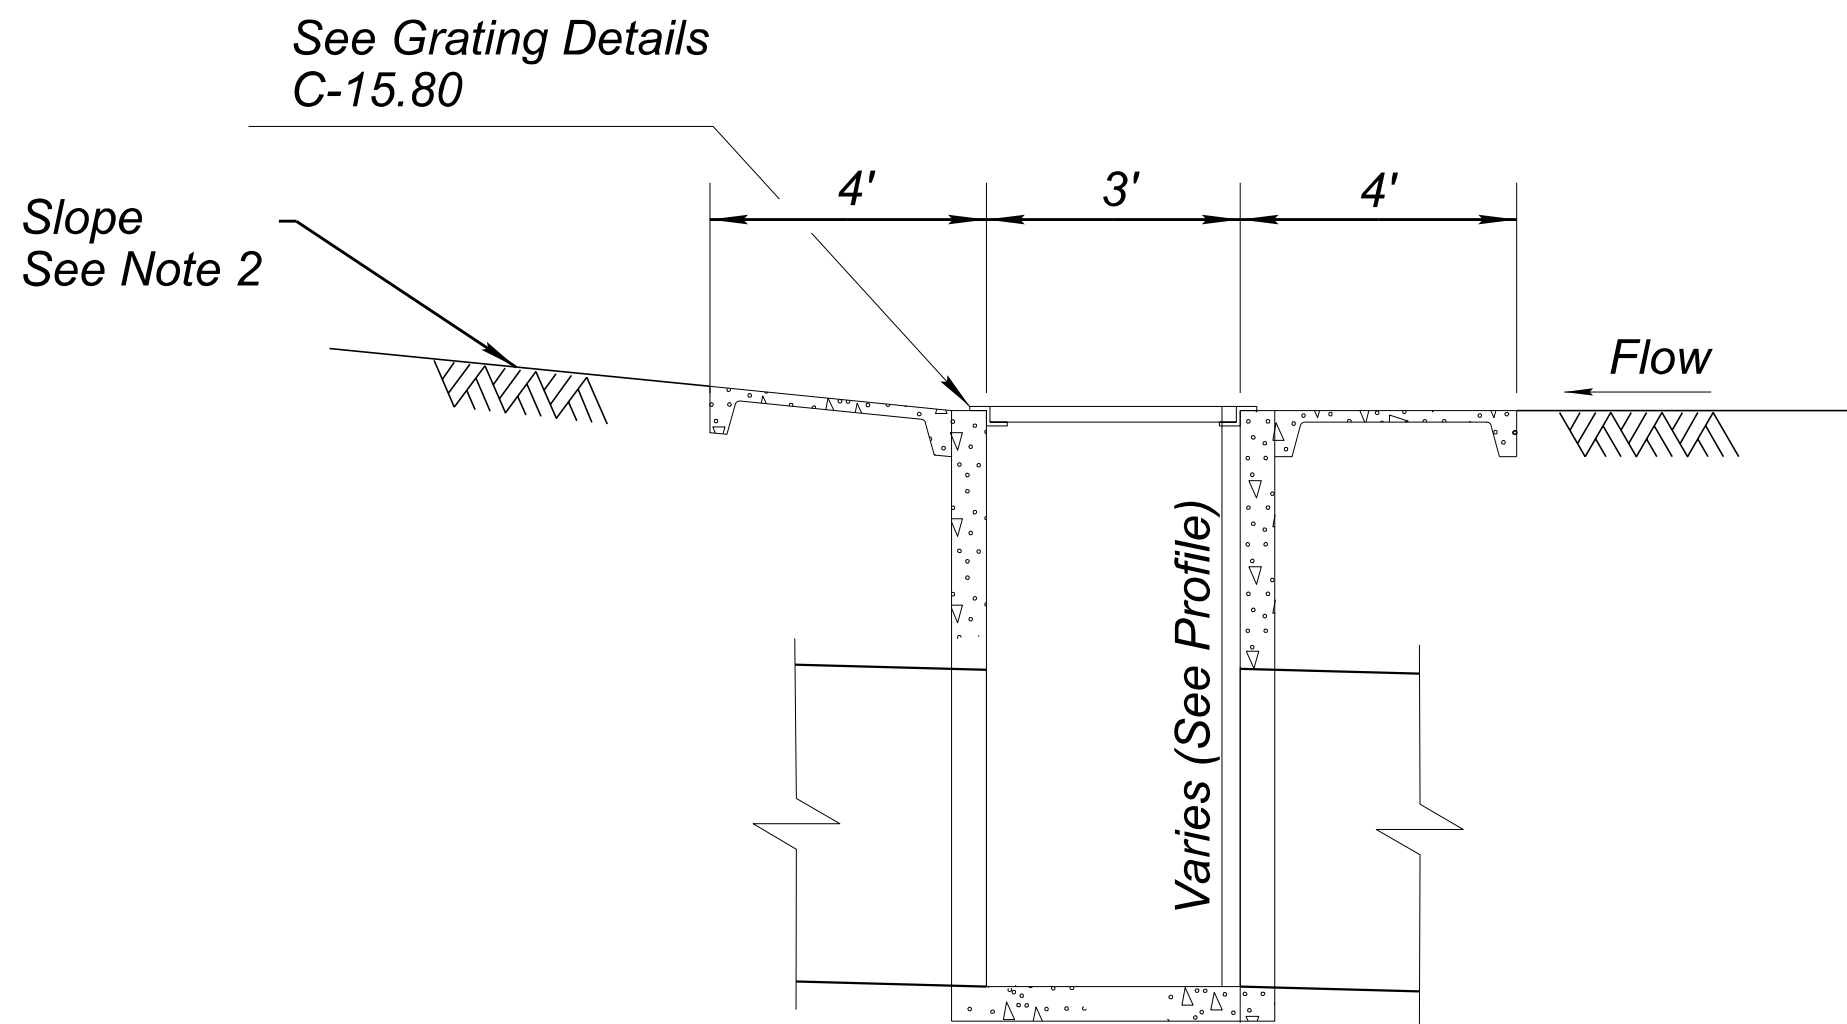


SECTION A-A

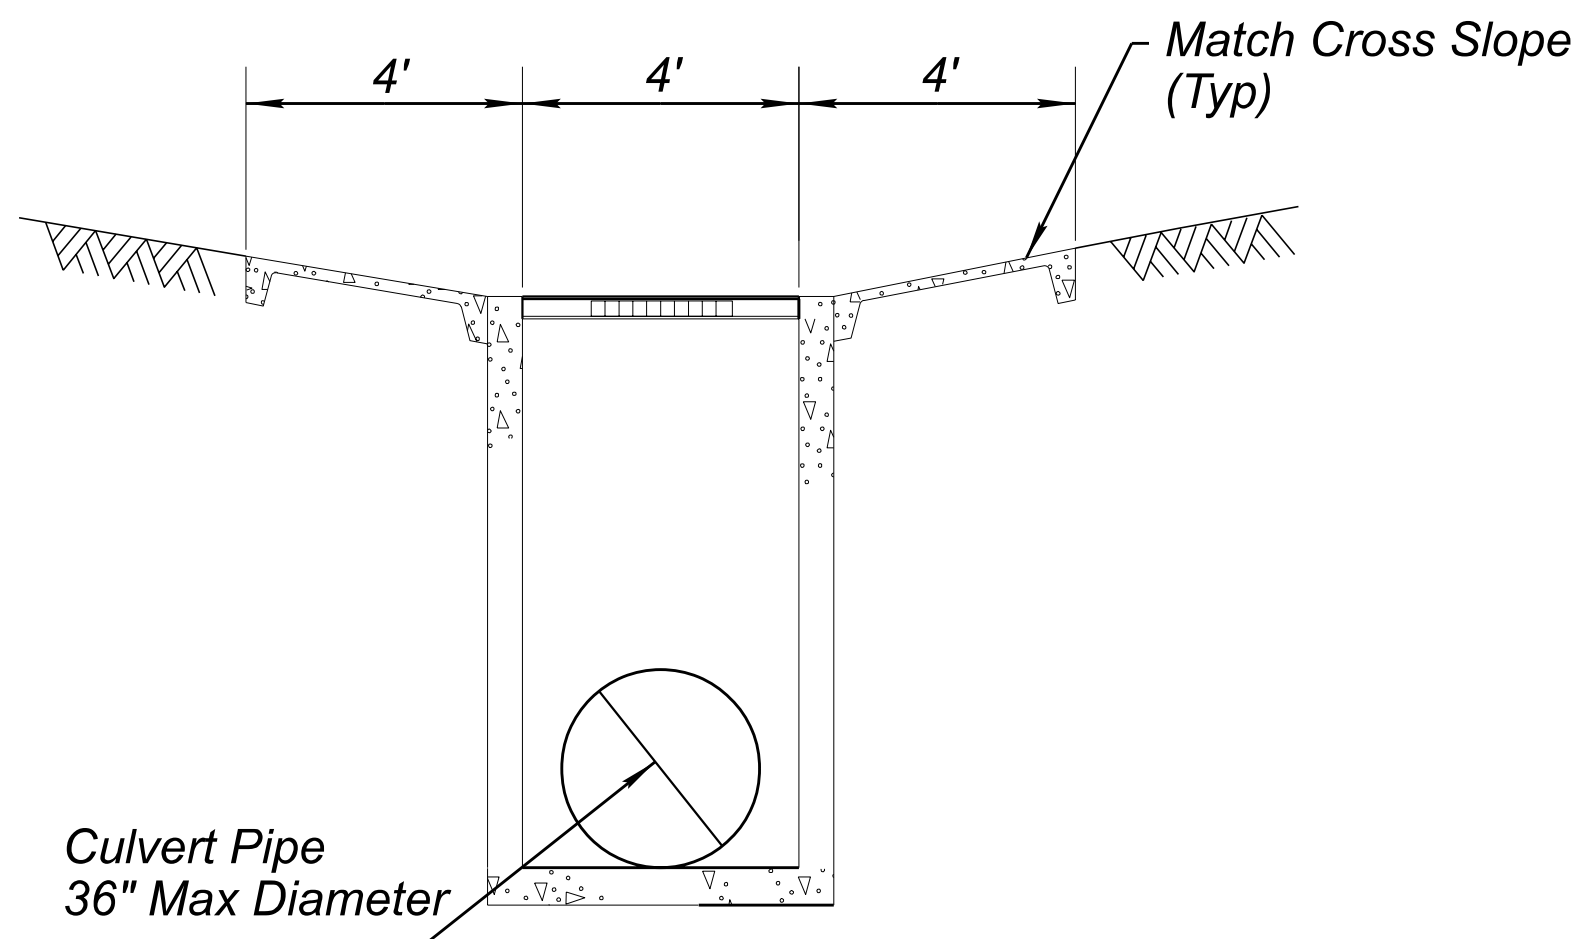

SECTION B-B

MODIFIED C-15.80

DETAIL DF
MODIFIED ADOT MEDIAN
CATCH BASIN DOUBLE

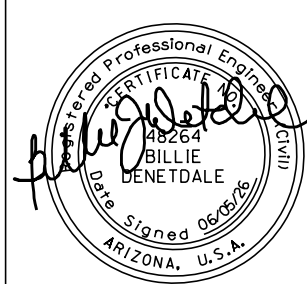


	NAME	DATE
DESIGN	K LEANDER	06/26
DRAWN	B LEANDER	06/26
CHECKED	B DENETDALE	06/26

TRANSPORTATION
AECOM TECHNICAL SERVICES, Inc.
7720 N. 16th St., Suite 100
Phoenix, Arizona 85020
T 602.371.1100
www.aecom.com


ARIZONA DEPARTMENT OF TRANSPORTATION PROJECT DELIVERY AND OPERATIONS DIVISION ROADWAY DESIGN SERVICES
DETAIL DF - MODIFIED ADOT MEDIAN CATCH BASIN DOUBLE

ROUTE US 93	F.H.W.A. Arizona Division	STATE ARIZ.	PROJECT NO. 093 YV 189	FEDERAL ID NO. 093-B(230)T	SHEET NO. 58	TOTAL SHEETS 524	RECORD DRAWING
MILEPOST 189.9		LOCATION WICKENBURG RANCH WAY TO VISTA ROYALE					
STRUCTURE NO.	TRACS NO. F0738 01C						____ OF ____

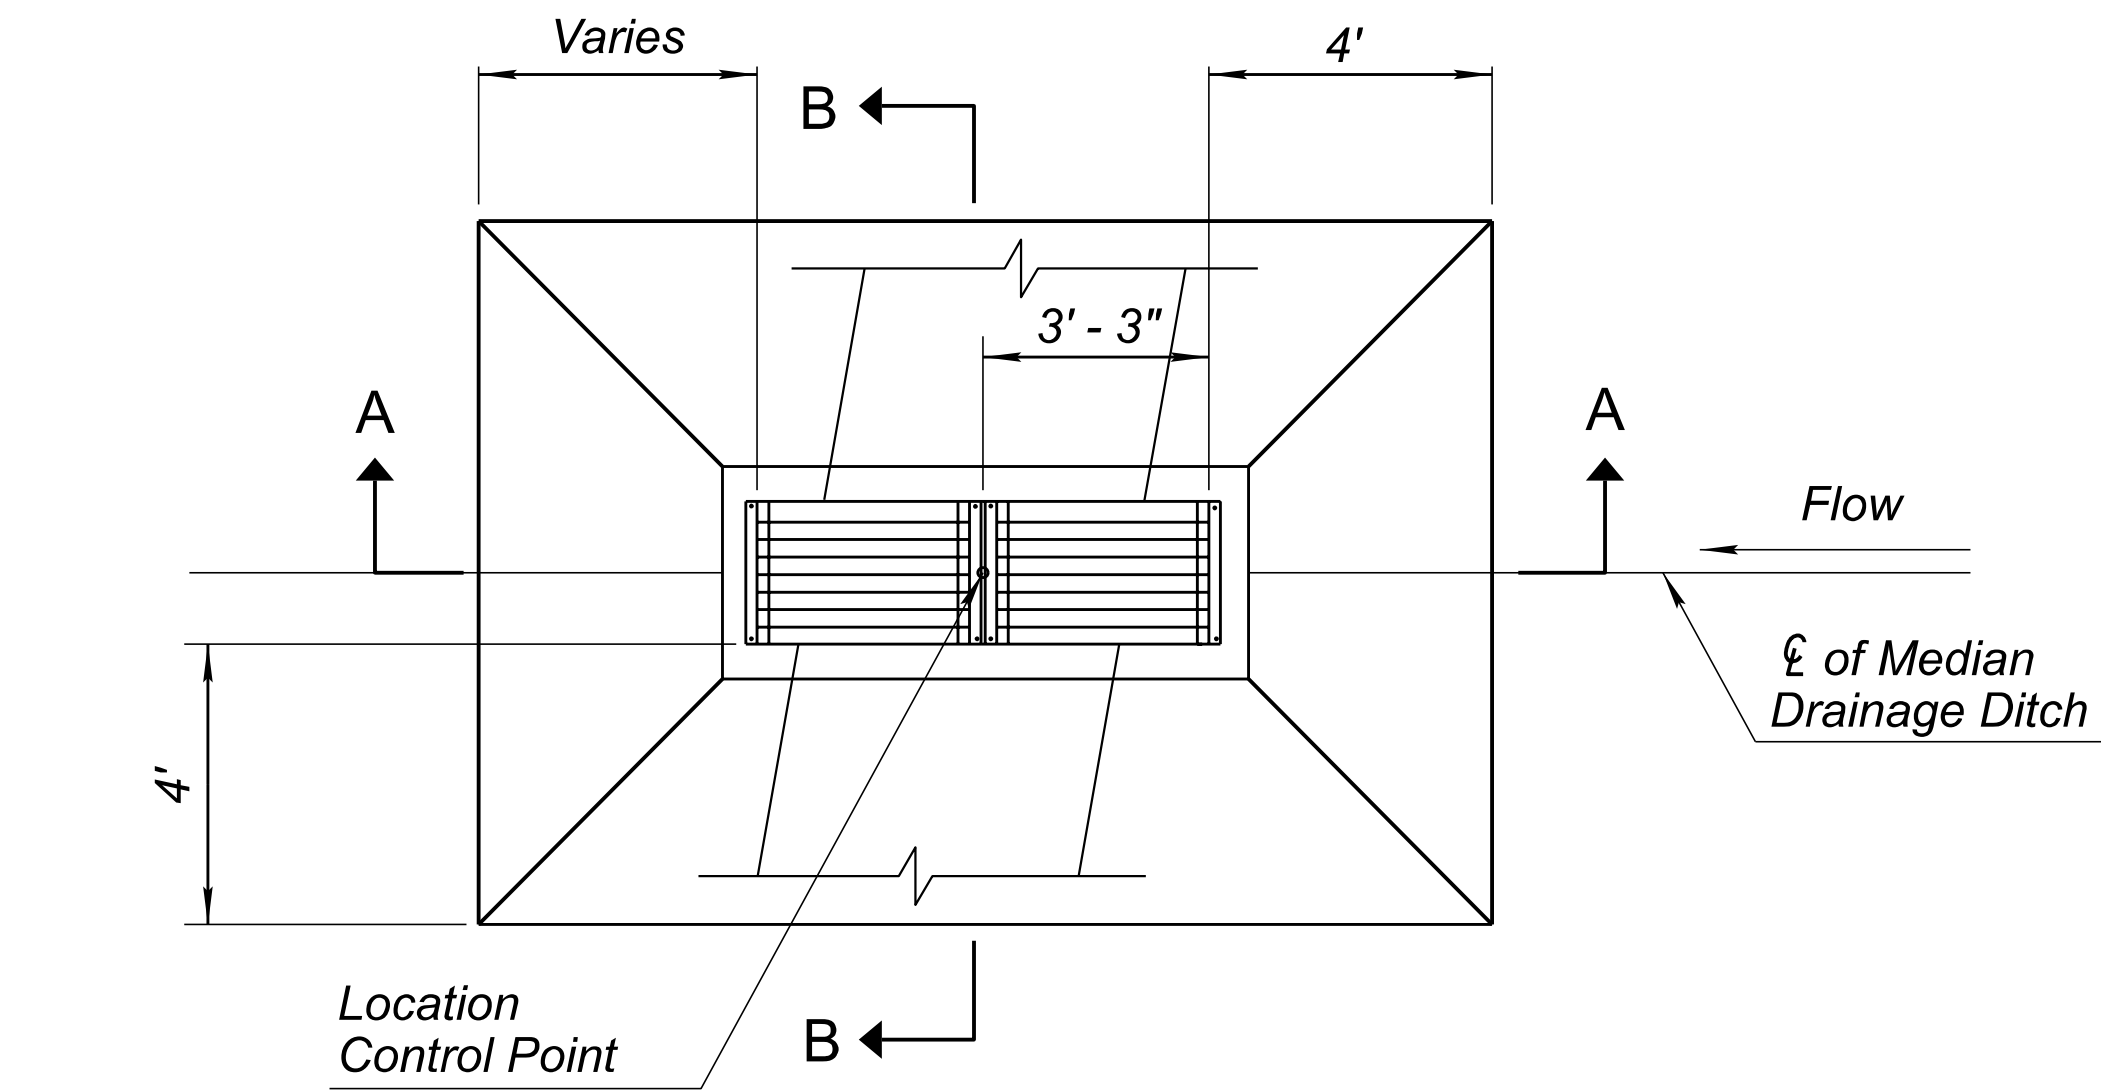


PLAN

See Grating Details
C-15.80

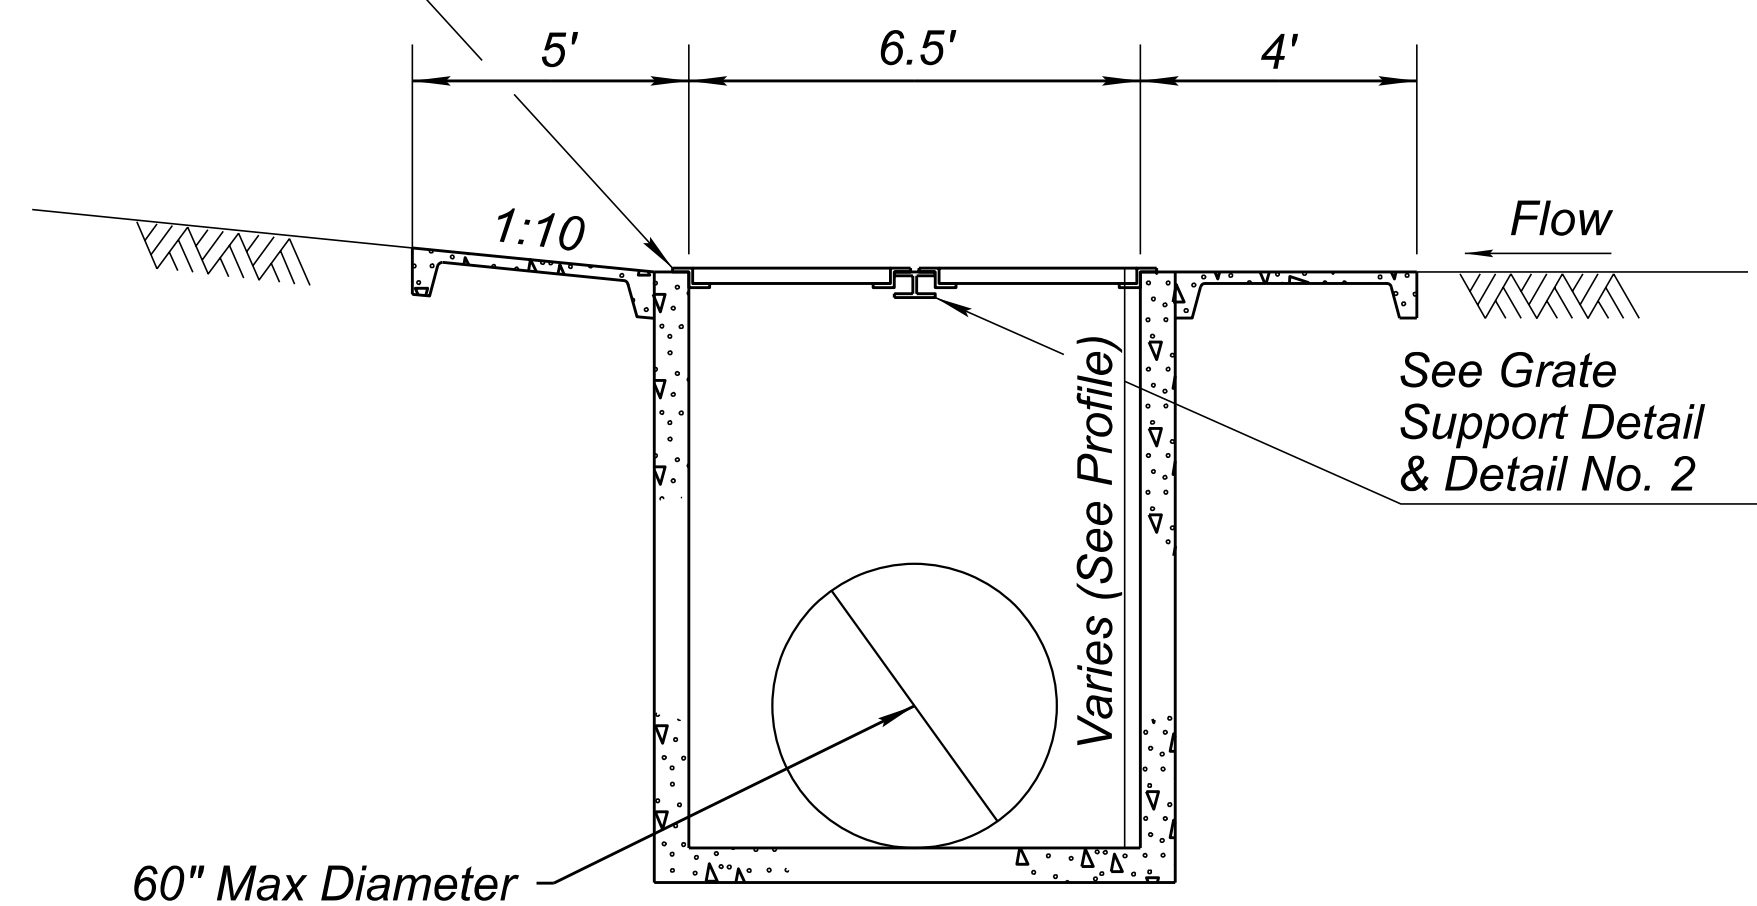


SECTION A-A

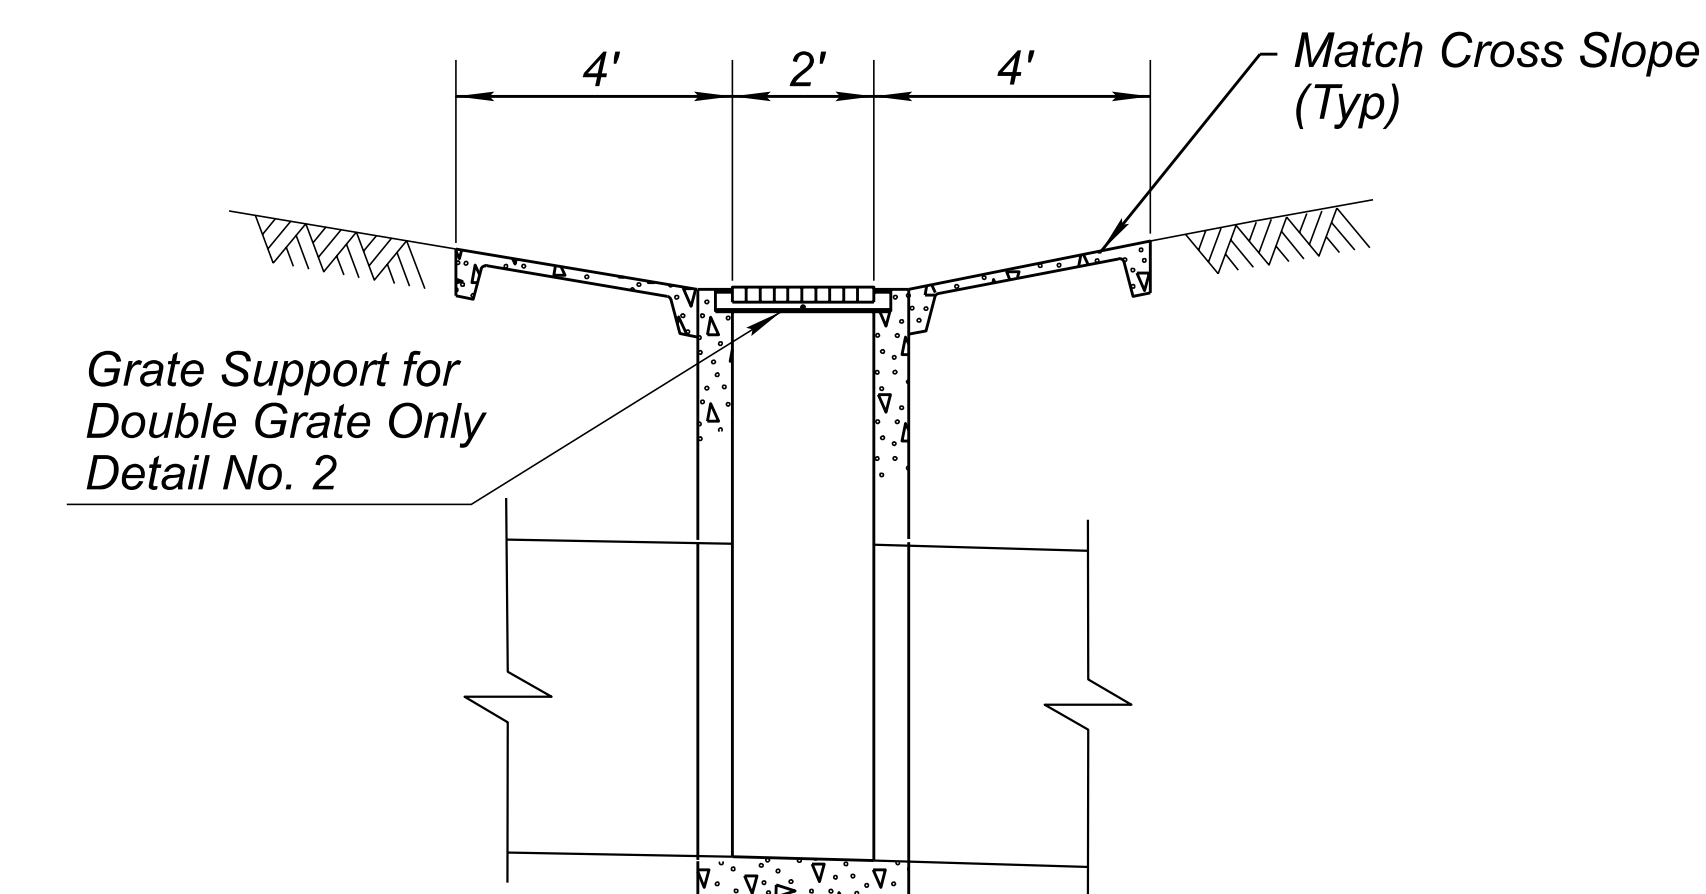


SECTION B-B

MODIFIED C-15.80

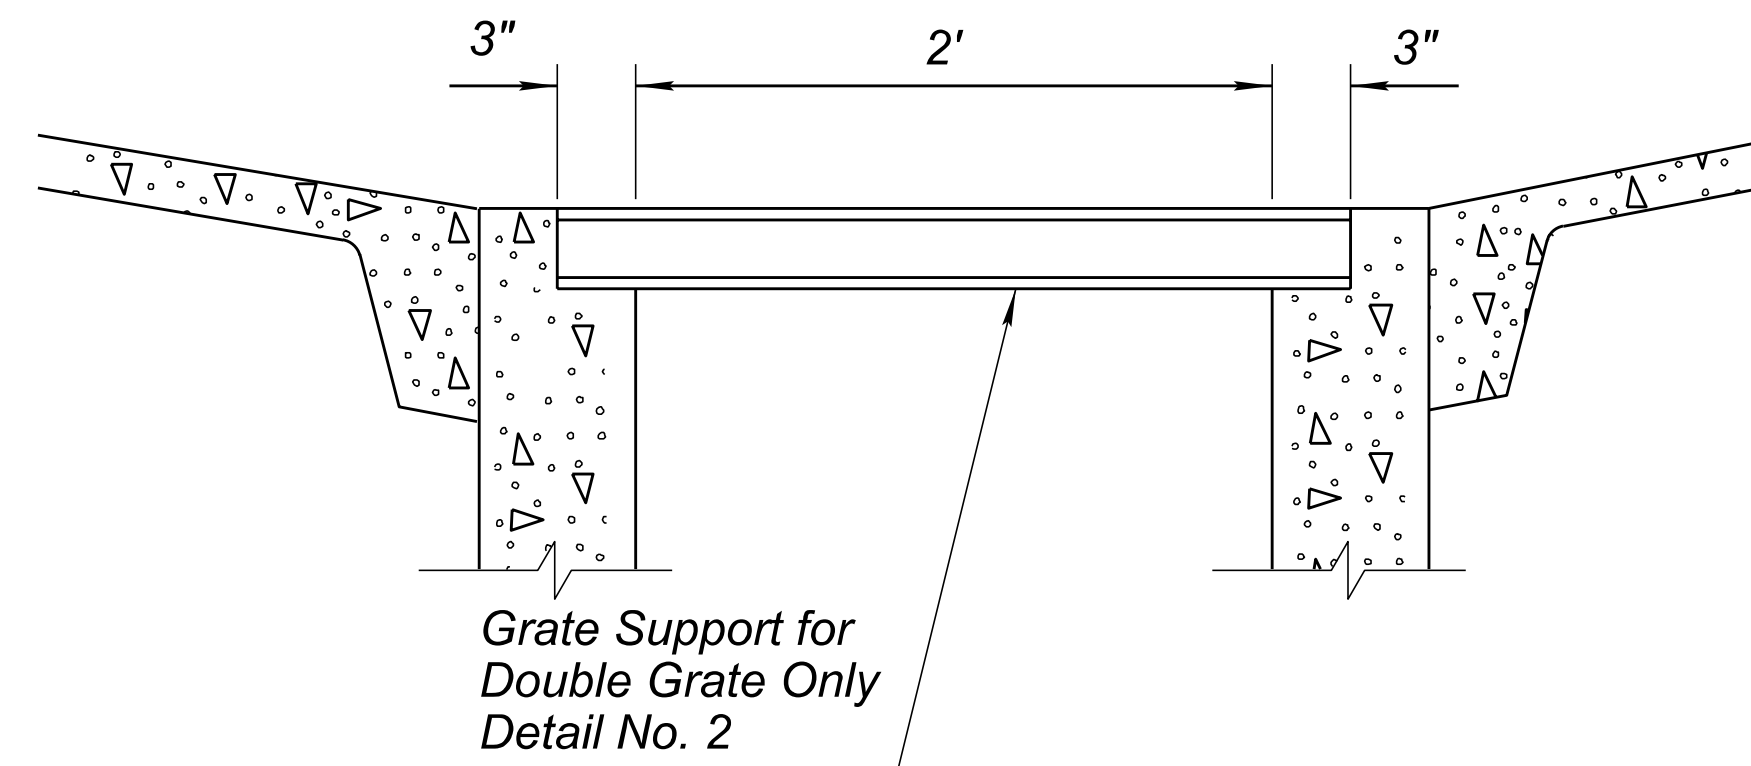

GRATE SUPPORT DETAIL

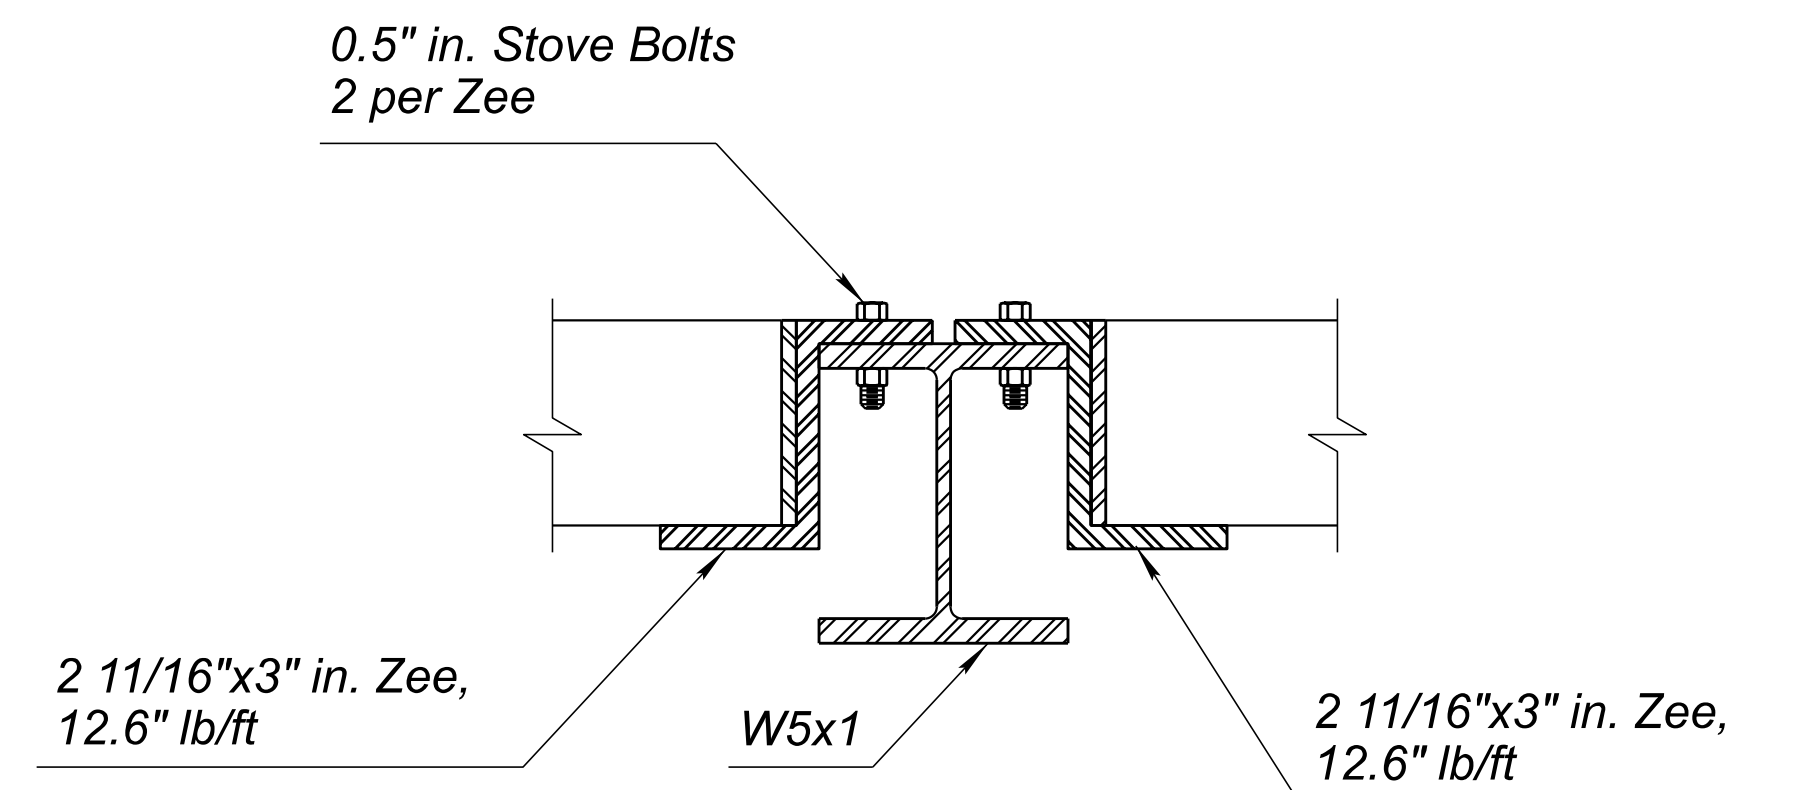


DETAIL NO. 2

GENERAL NOTES

- See Details C-15.80 and C-15.81 For Wall Thicknesses And Other Information Not Shown In This Detail.

DETAIL DG

MODIFIED ADOT MEDIAN CATCH BASIN

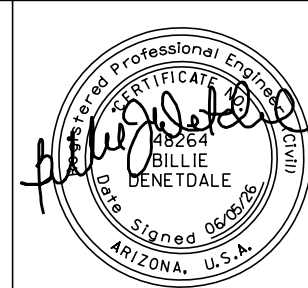


	NAME	DATE
DESIGN	K LEANDER	06/26
DRAWN	B LEANDER	06/26
CHECKED	B DENETDALE	06/26


ARIZONA DEPARTMENT OF TRANSPORTATION
PROJECT DELIVERY AND OPERATIONS DIVISION
ROADWAY DESIGN SERVICES

DETAIL DG - MODIFIED ADOT
MEDIAN CATCH BASIN


ROUTE US 93	F.H.W.A. Arizona Division	STATE ARIZ.	PROJECT NO. 093 YV 189	FEDERAL ID NO. 093-B(230)T	SHEET NO. 59	TOTAL SHEETS 524	RECORD DRAWING
MILEPOST 189.9	LOCATION WICKENBURG RANCH WAY TO VISTA ROYALE					DWG No. D-1.11	
STRUCTURE NO.	TRACS NO. F0738 01C					____ OF ____	

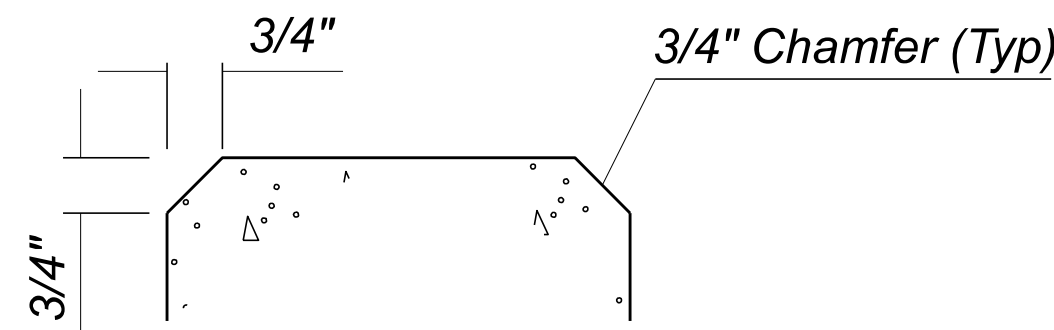


CHAMFER DETAIL

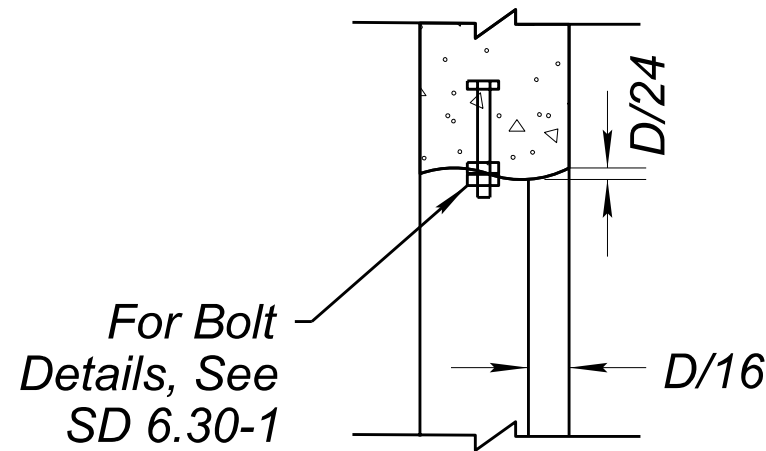

BEVEL DETAIL FOR CMP

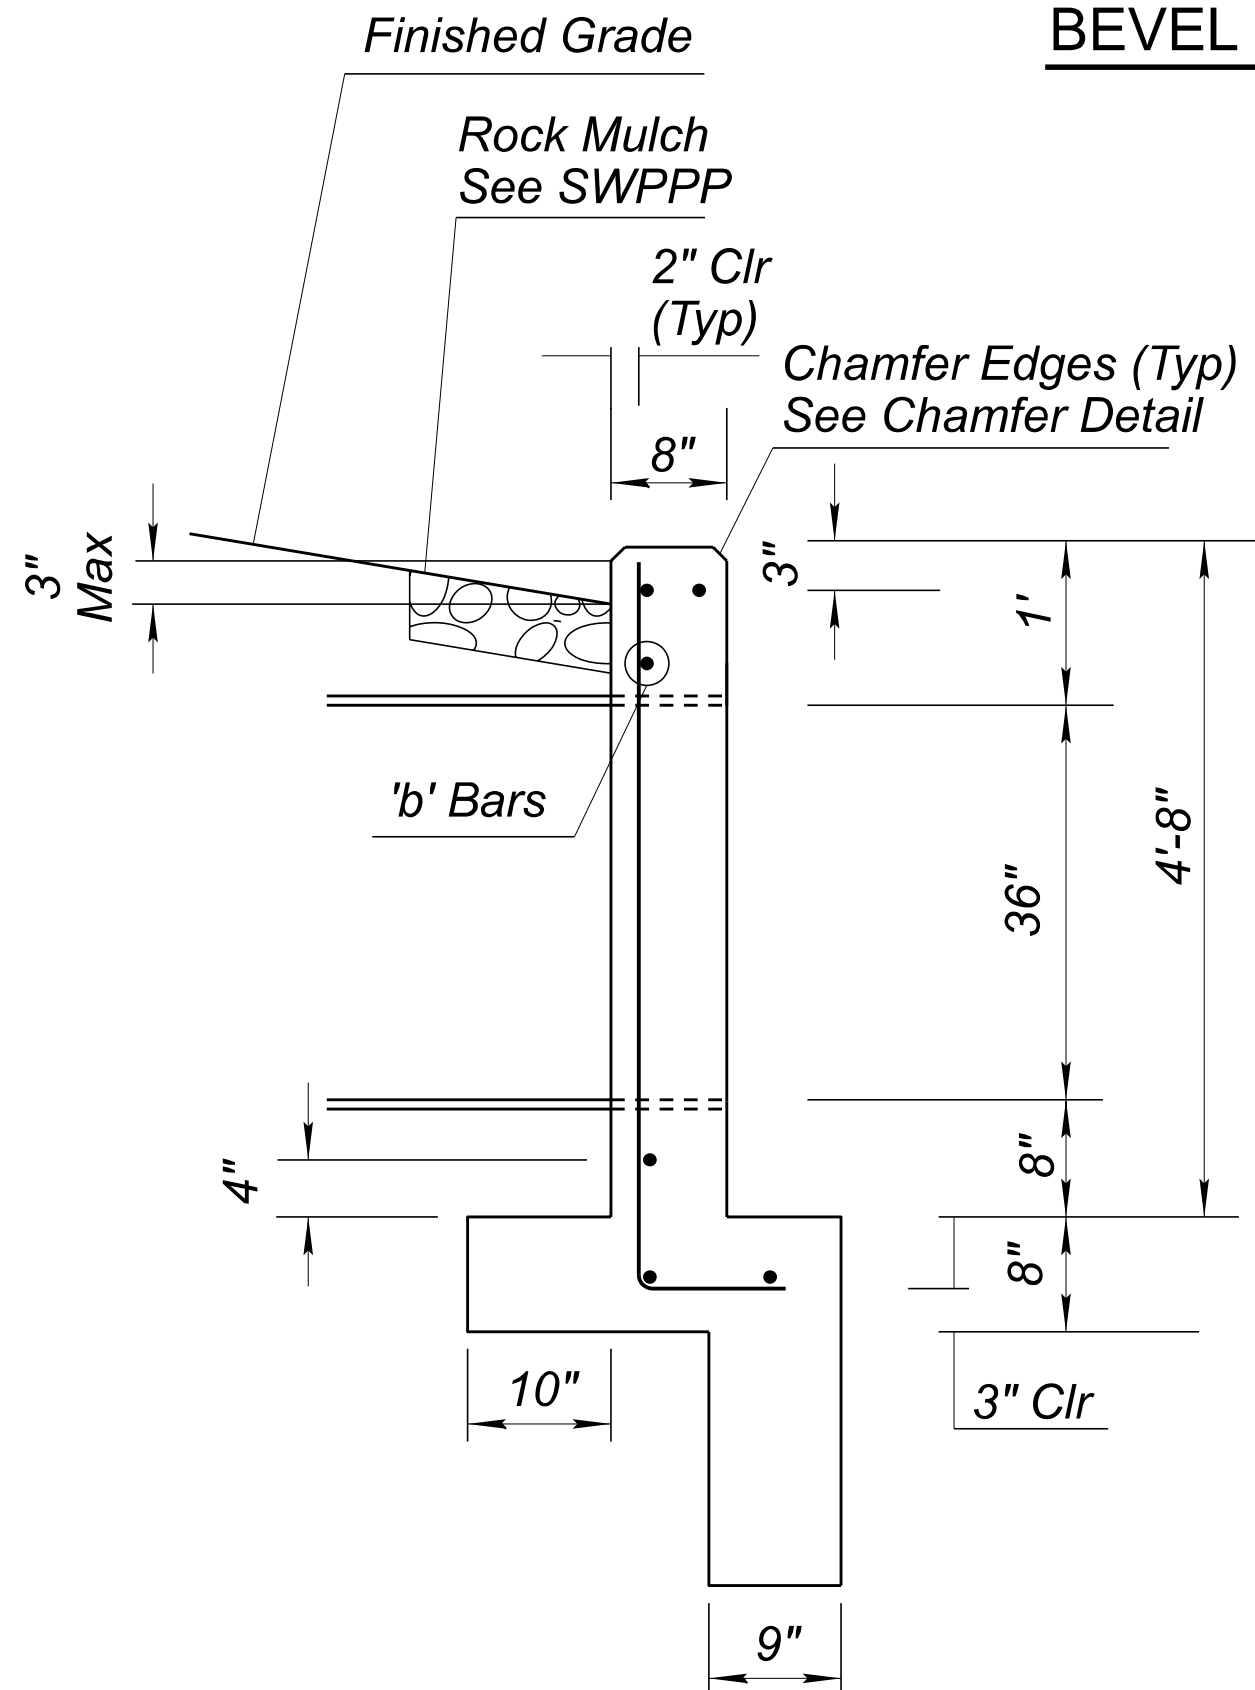


SECTION A-A
N.T.S.

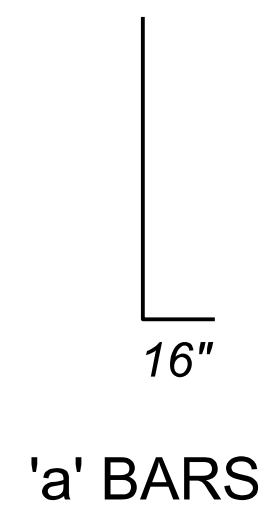


'a' BARS

REINFORCING			
'a' Bars		'b' Bars	
Quantity	Length	Quantity	Length
14	6'-3"	6	24'

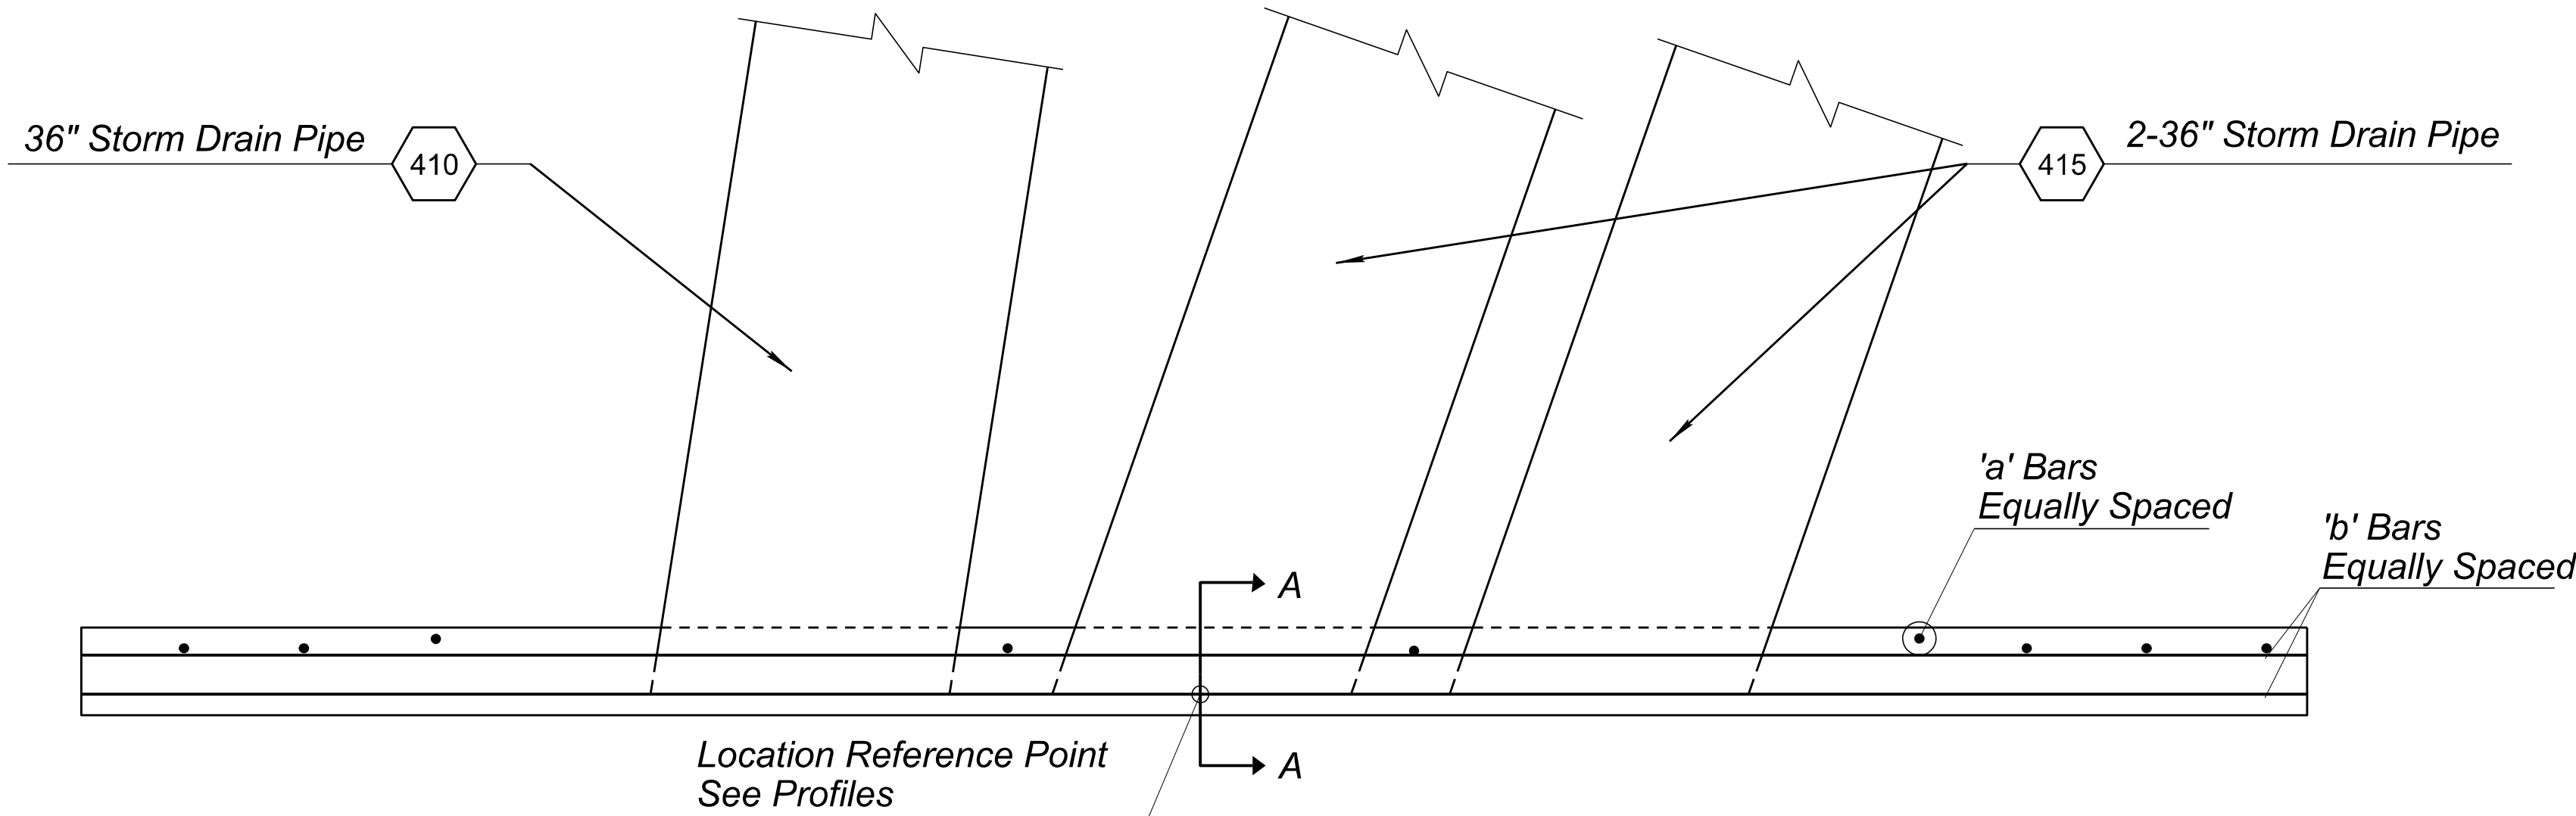

PLAN
N.T.S.

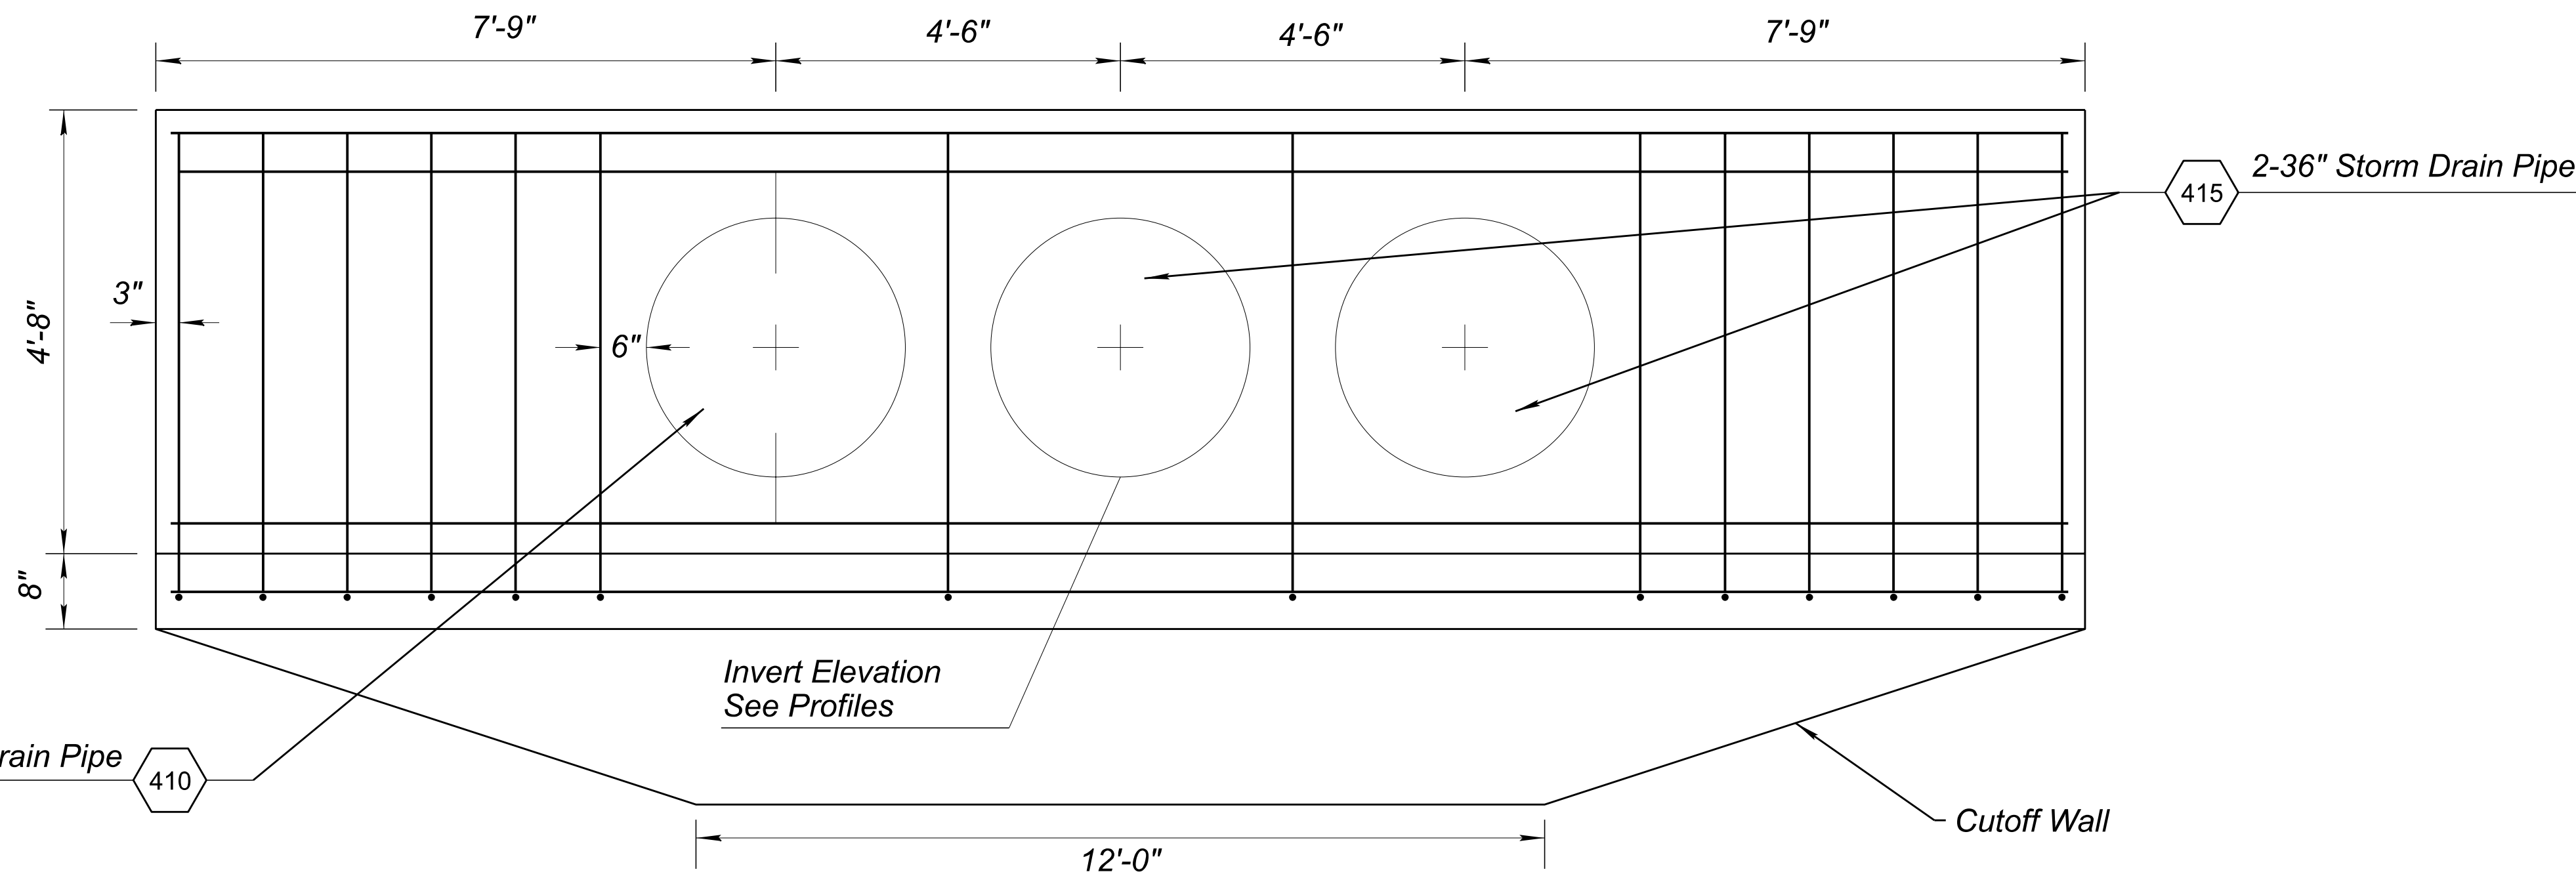

ELEVATION
3-BARREL STRAIGHT HEADWALL
N.T.S.

NOTES

1. All reinforcing bars are #4
2. All concrete shall be Class S, Fc=3000psi
3. See SD-6.30 (1 of 5) for general notes

DETAIL DH
TRIPLE BARREL
STRAIGHT HEADWALL




	NAME	DATE
DESIGN	K LEANDER	06/26
DRAWN	B LEANDER	06/26
CHECKED	B DENETDALE	06/26


TRANSPORTATION
AECOM TECHNICAL SERVICES, Inc.
7720 N. 16th St., Suite 100
Phoenix, Arizona 85020
T 602.371.1100
www.aecom.com

ARIZONA DEPARTMENT OF TRANSPORTATION PROJECT DELIVERY AND OPERATIONS DIVISION ROADWAY DESIGN SERVICES DETAIL DH - TRIPLE BARREL STRAIGHT HEADWALL


ROUTE US 93	F.H.W.A. Arizona Division	STATE ARIZ.	PROJECT NO. 093 YV 189	FEDERAL ID NO. 093-B(230)T	SHEET NO. 60	TOTAL SHEETS 524	RECORD DRAWING
MILEPOST 189.9	LOCATION WICKENBURG RANCH WAY TO VISTA ROYALE					DWG No. D-1.12	
STRUCTURE NO.	TRACS NO. F0738 01C					___ OF ___	

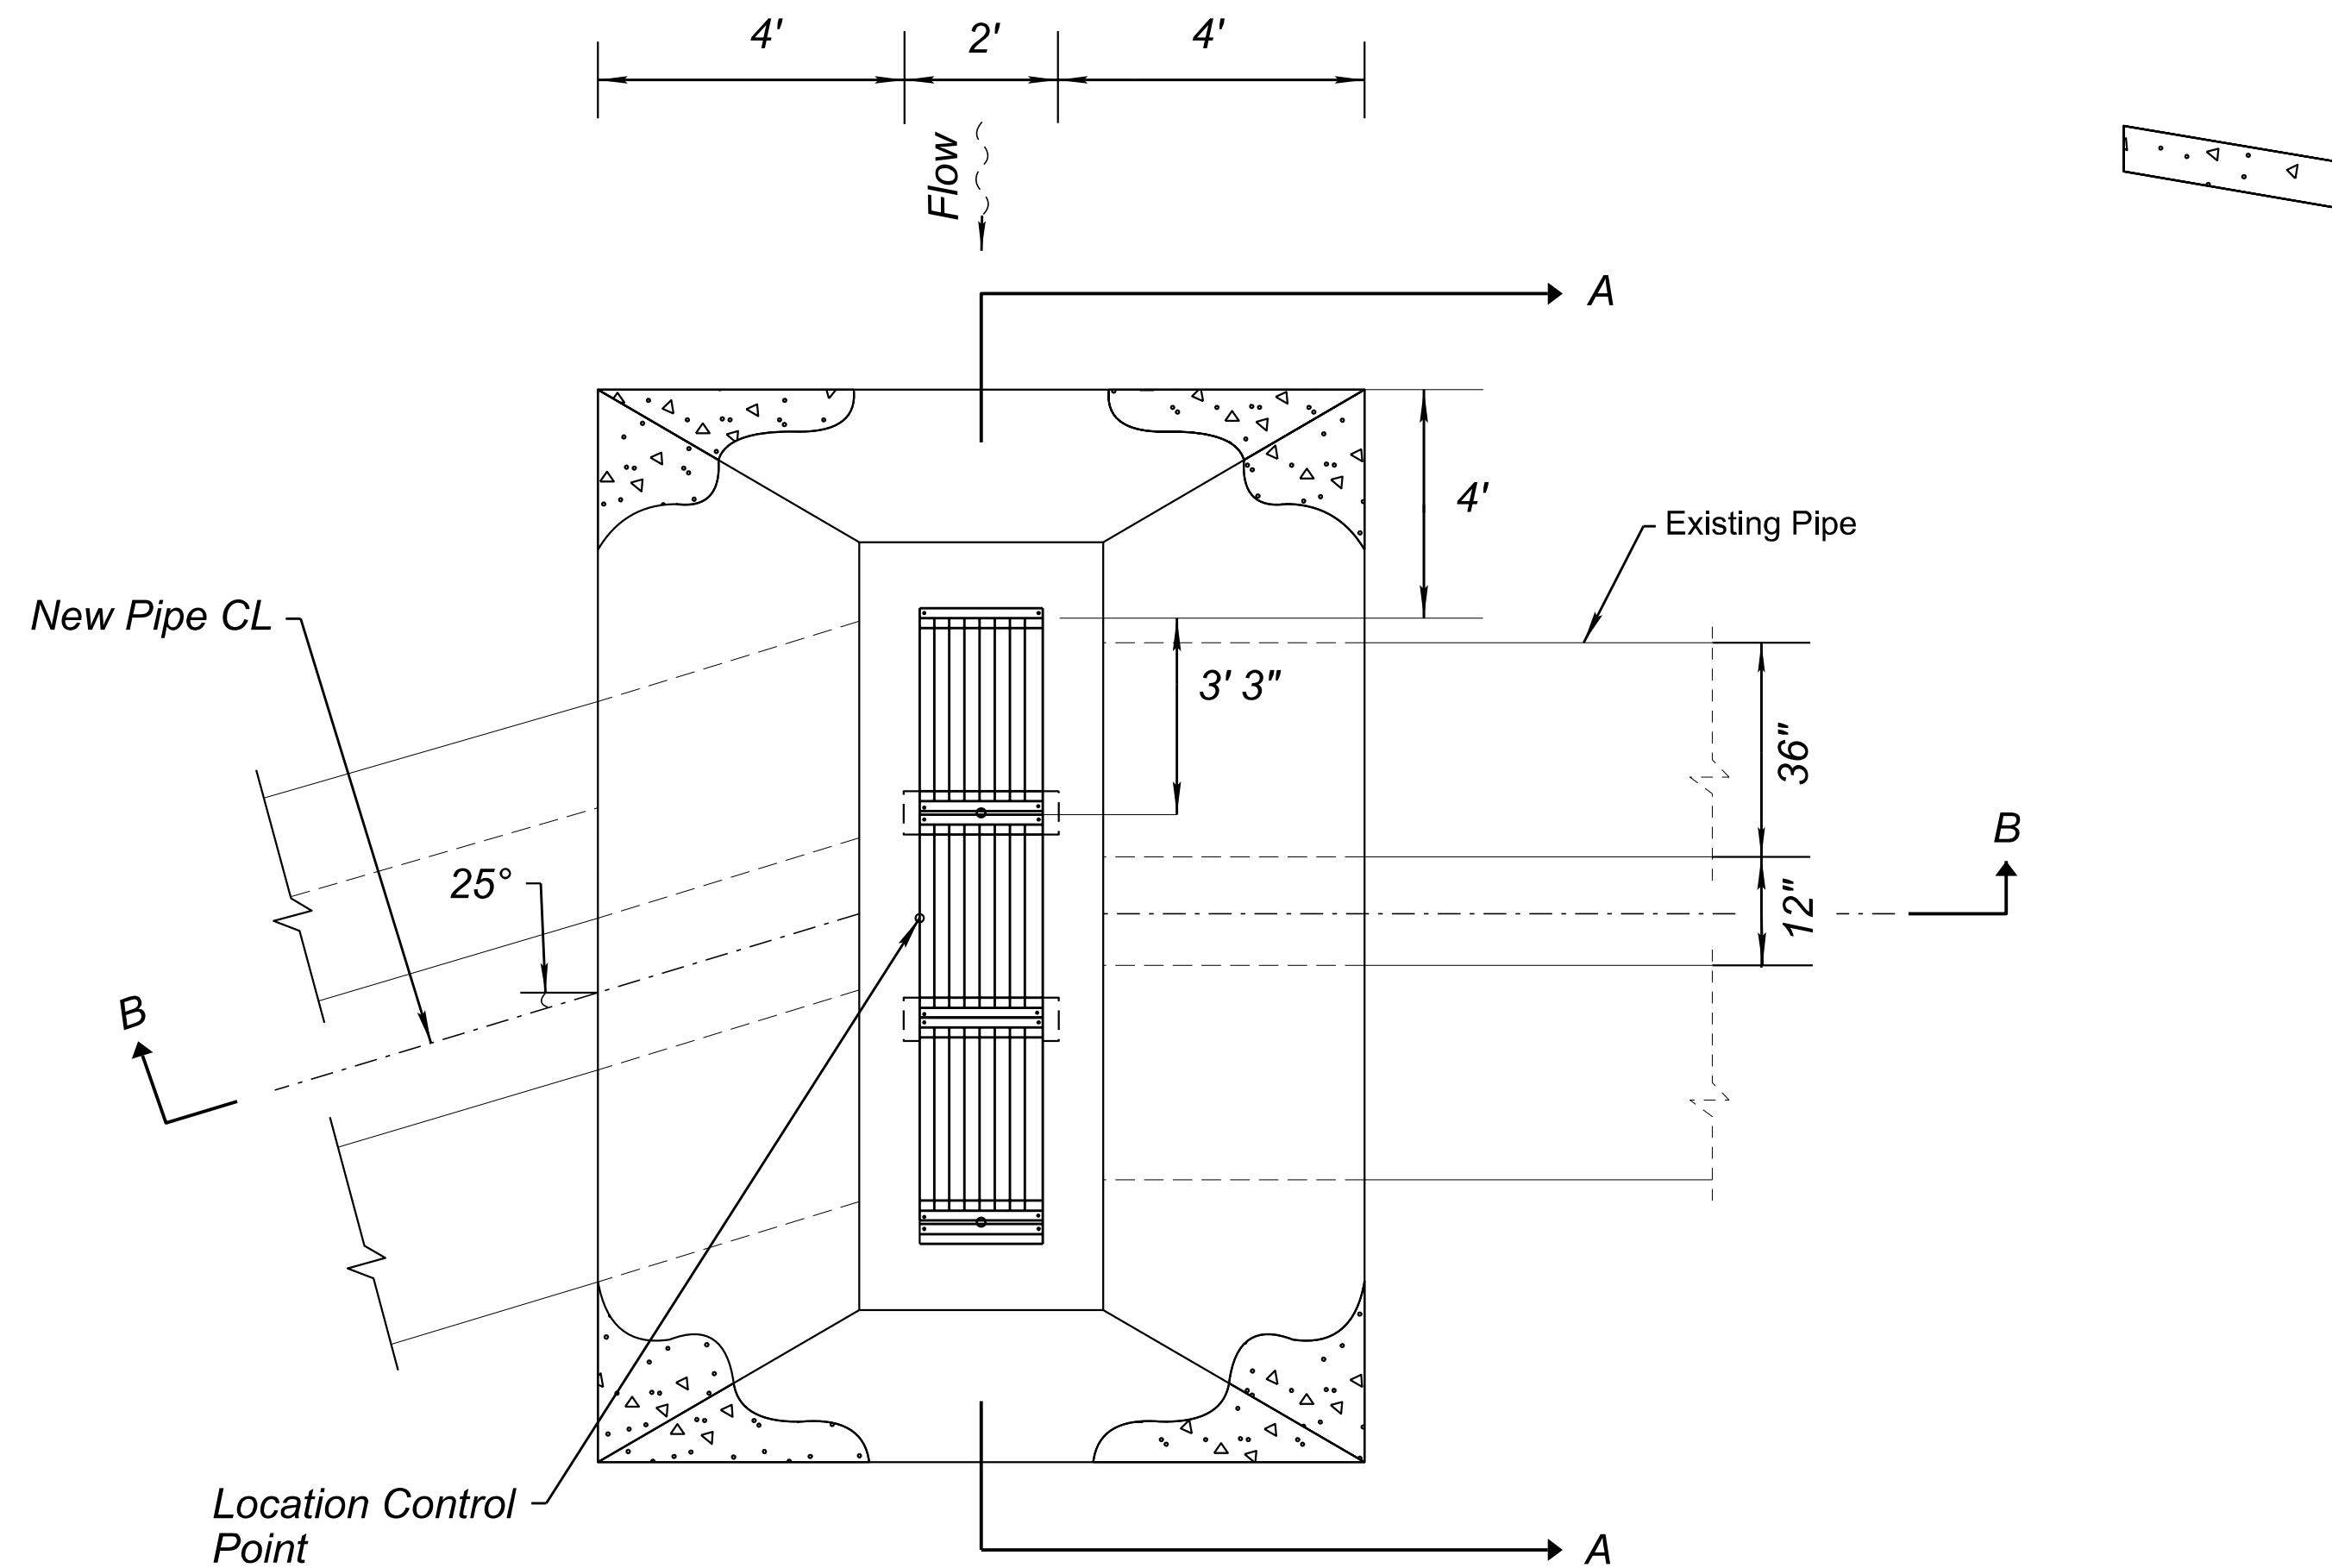


PLAN VIEW
N.T.S.

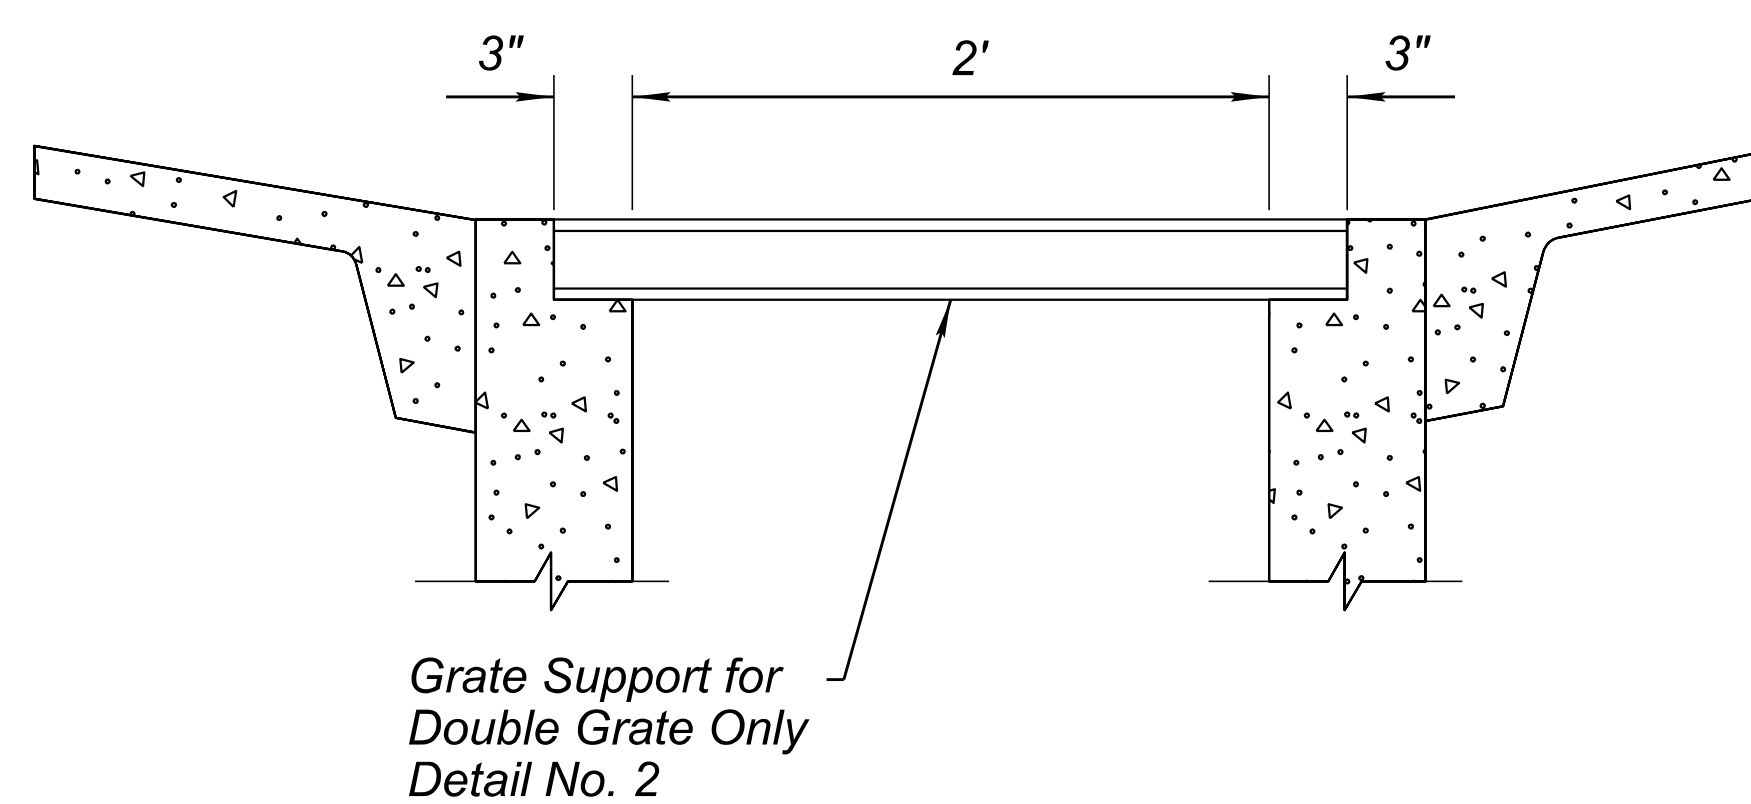

GRATE SUPPORT DETAIL
N.T.S.

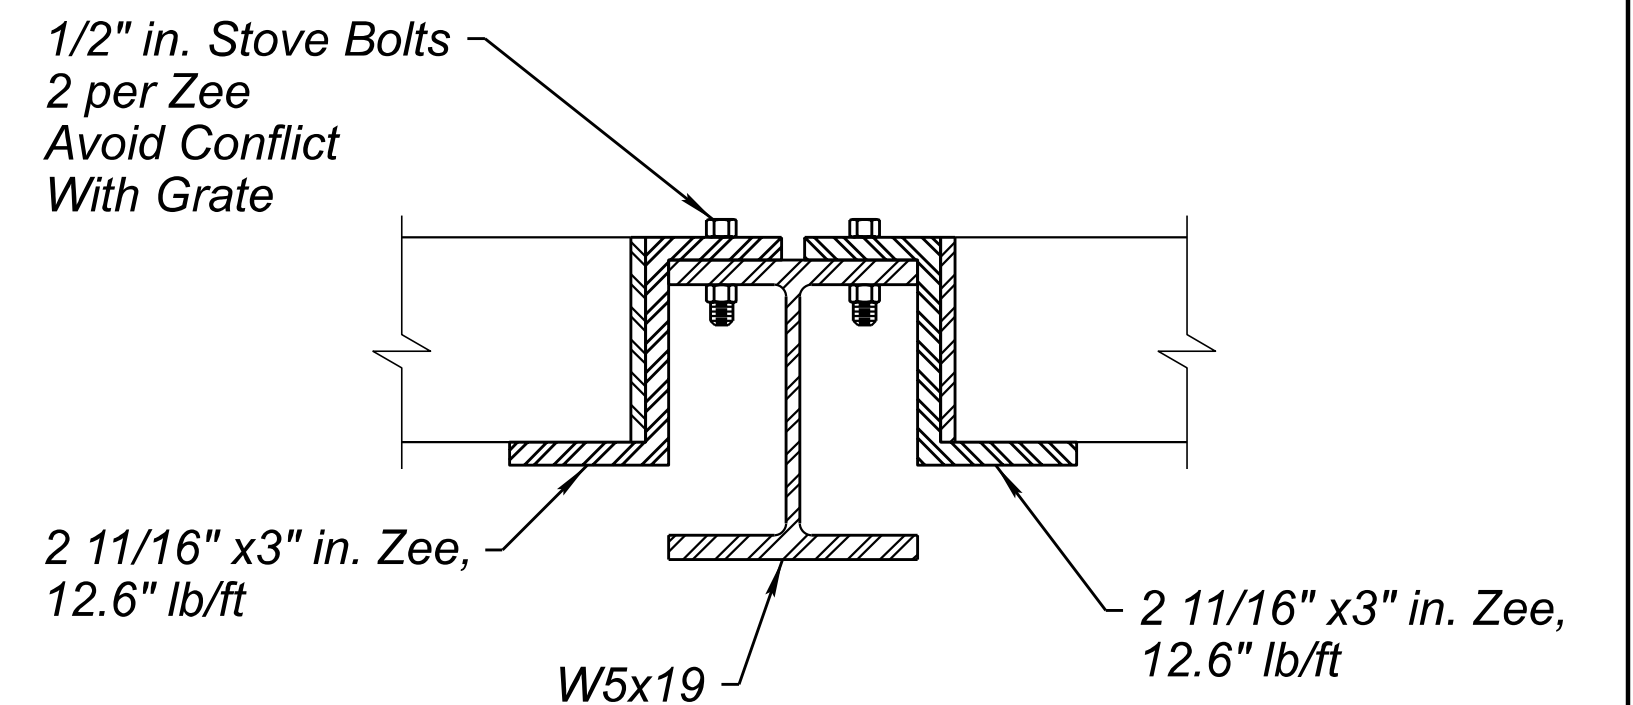


DETAIL NO. 2

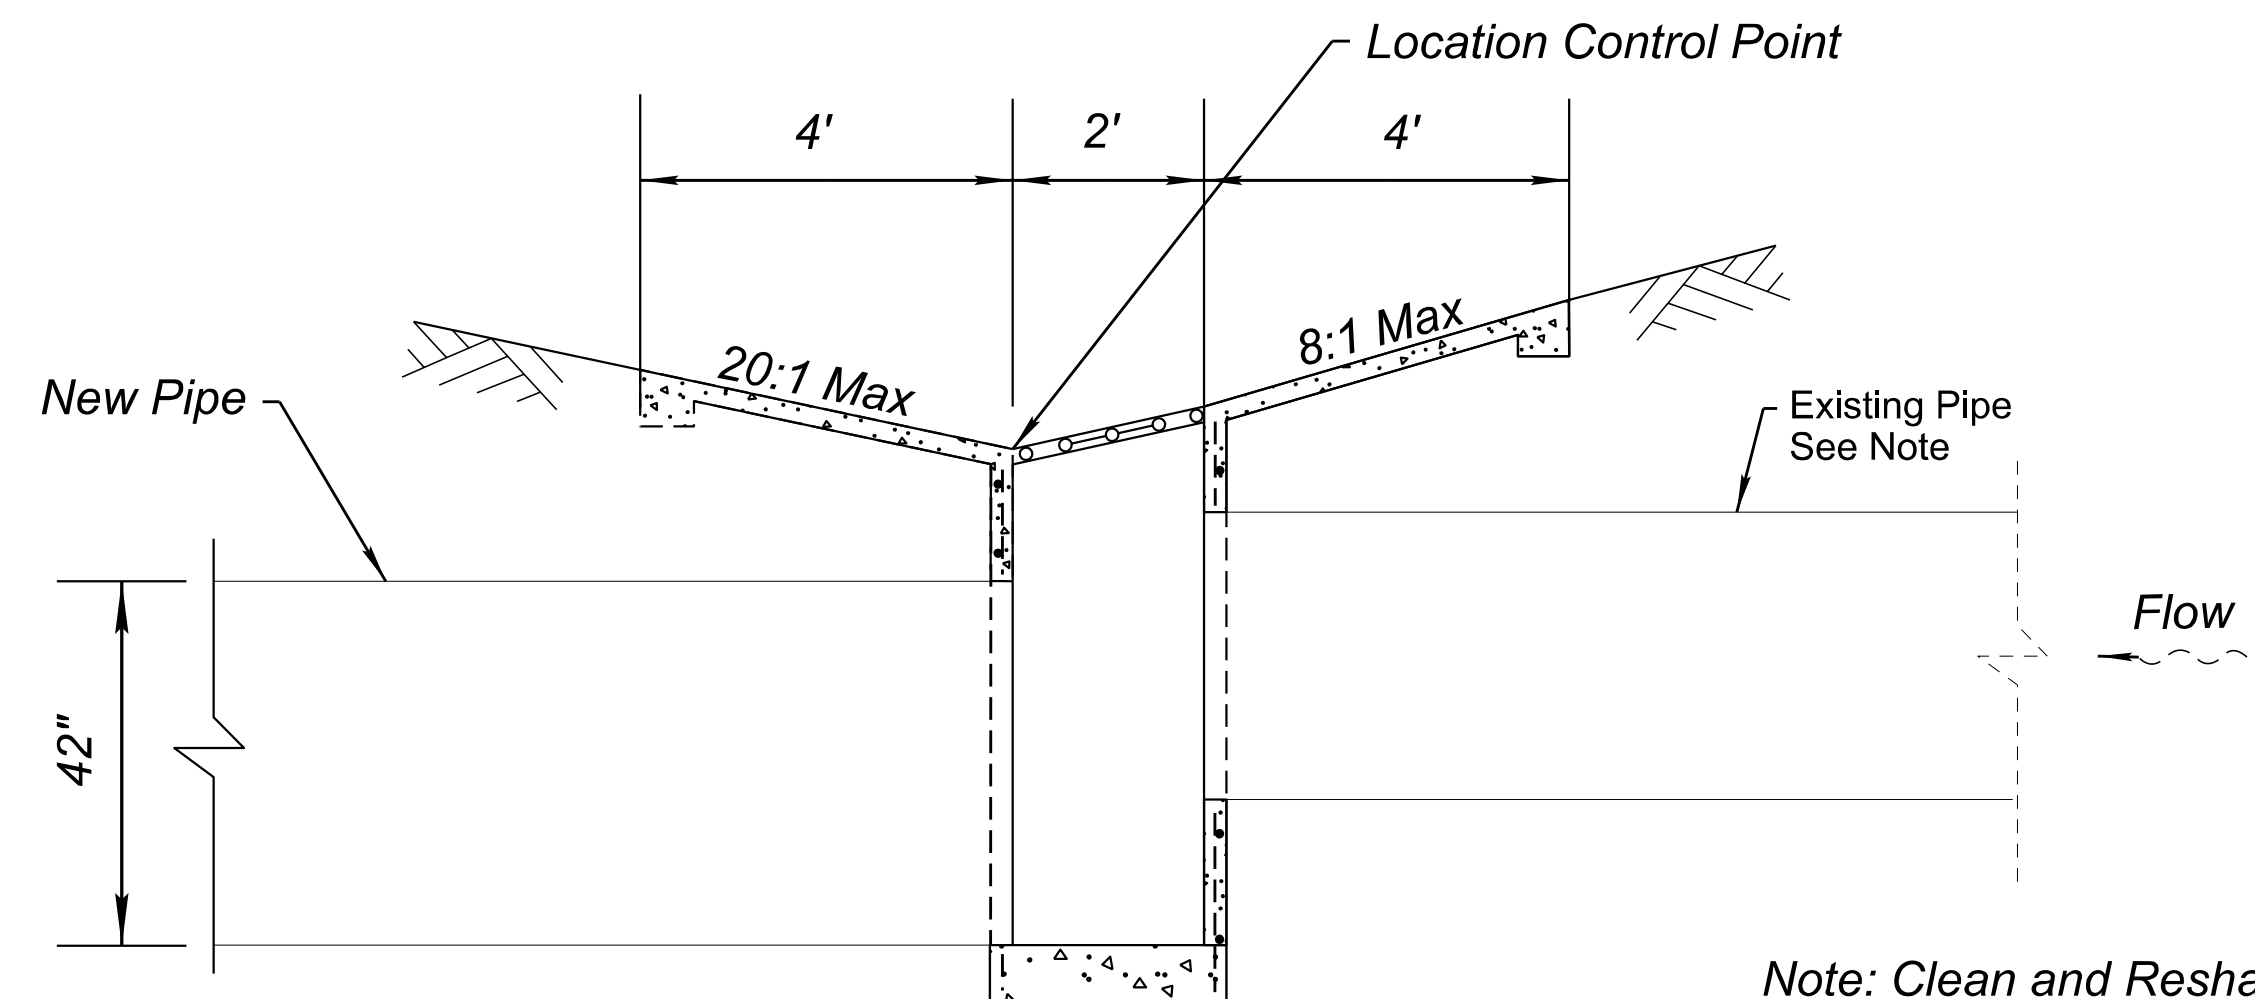


SECTION B-B (CB-294)
N.T.S.

Note: Clean and Reshape existing pipe
prior to connection.

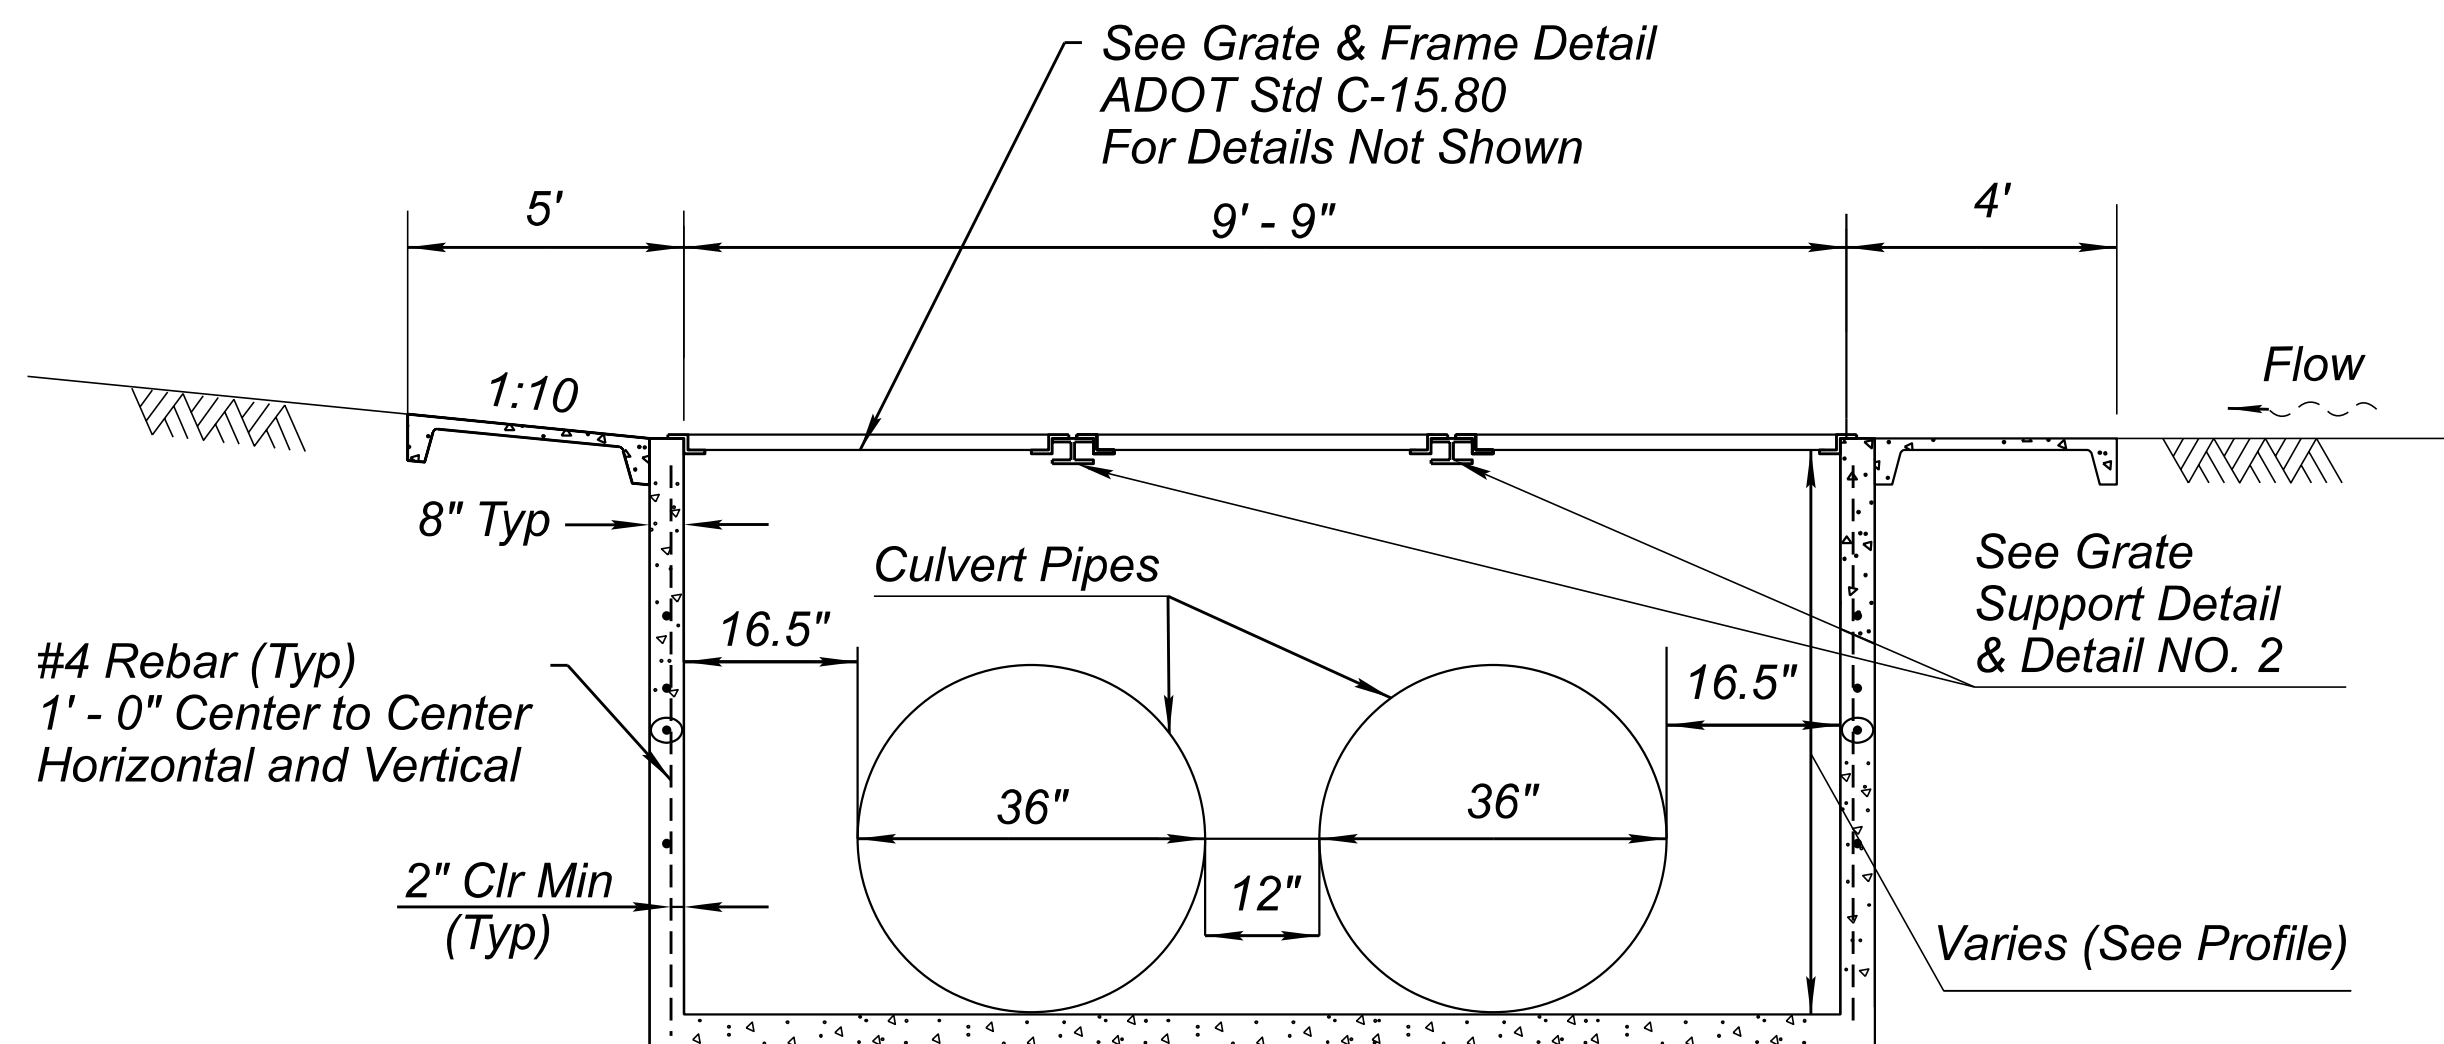


SECTION A-A
N.T.S.

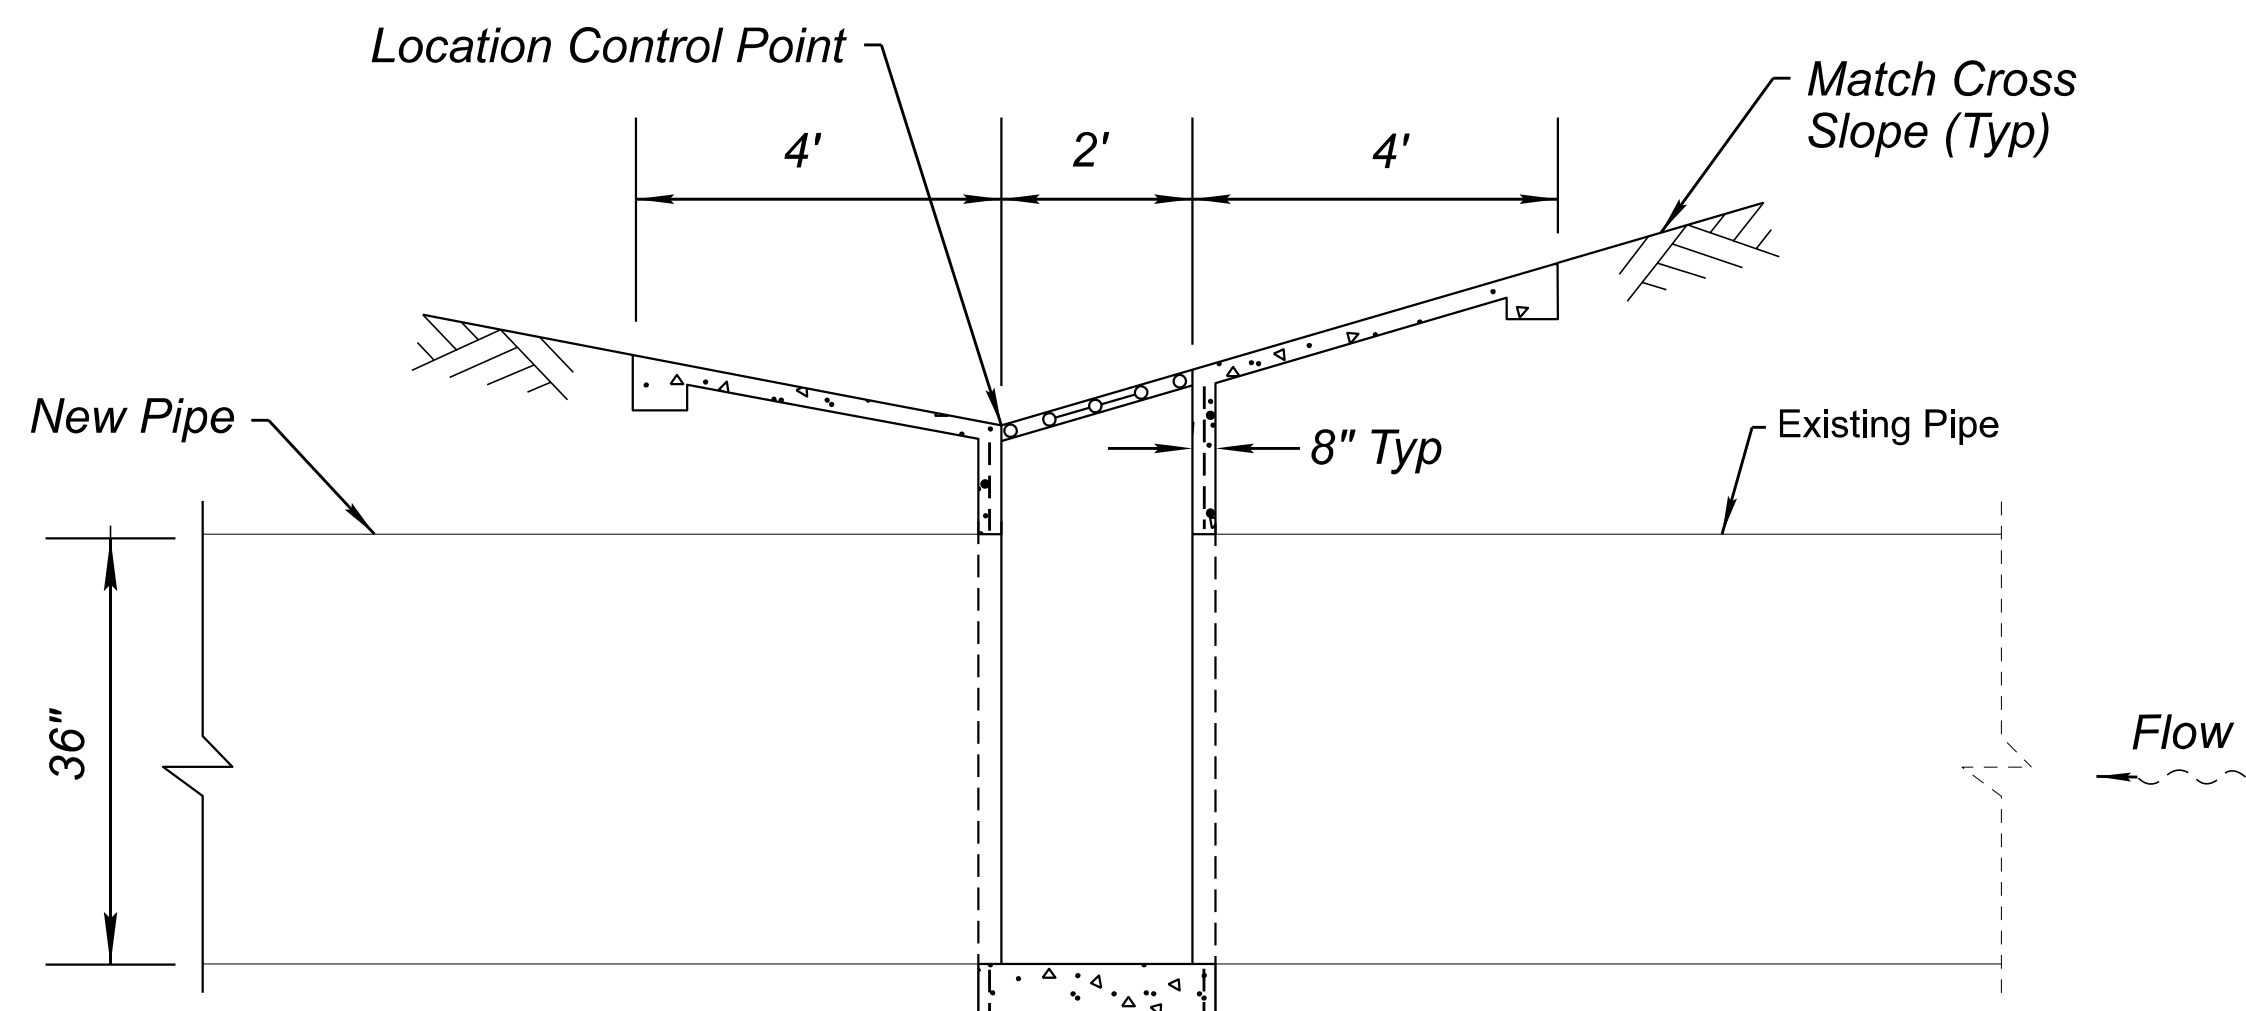

SECTION B-B (CB-304)
N.T.S.

DETAIL DI CONCRETE CATCH BASIN

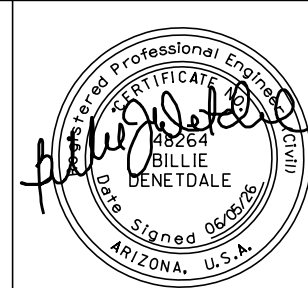


	NAME	DATE
DESIGN	K LEANDER	06/26
DRAWN	B LEANDER	06/26
CHECKED	B DENETDALE	06/26

TRANSPORTATION
AECOM TECHNICAL SERVICES, Inc.
7720 N. 16th St., Suite 100
Phoenix, Arizona 85020
T 602.371.1100


AECOM
www.aecom.com

ARIZONA DEPARTMENT OF TRANSPORTATION PROJECT DELIVERY AND OPERATIONS DIVISION ROADWAY DESIGN SERVICES	ROUTE US 93 MILEPOST 189.9 STRUCTURE NO.
DETAIL DI - CONCRETE CATCH BASIN	


F.H.W.A. Arizona Division	STATE ARIZ.	PROJECT NO. 093 YV 189	FEDERAL ID NO. 093-B(230)T	SHEET NO. 61	TOTAL SHEETS 524	RECORD DRAWING
LOCATION WICKENBURG RANCH WAY TO VISTA ROYALE	TRACS NO. F0738 01C	DWG No. D-1.13	OF			

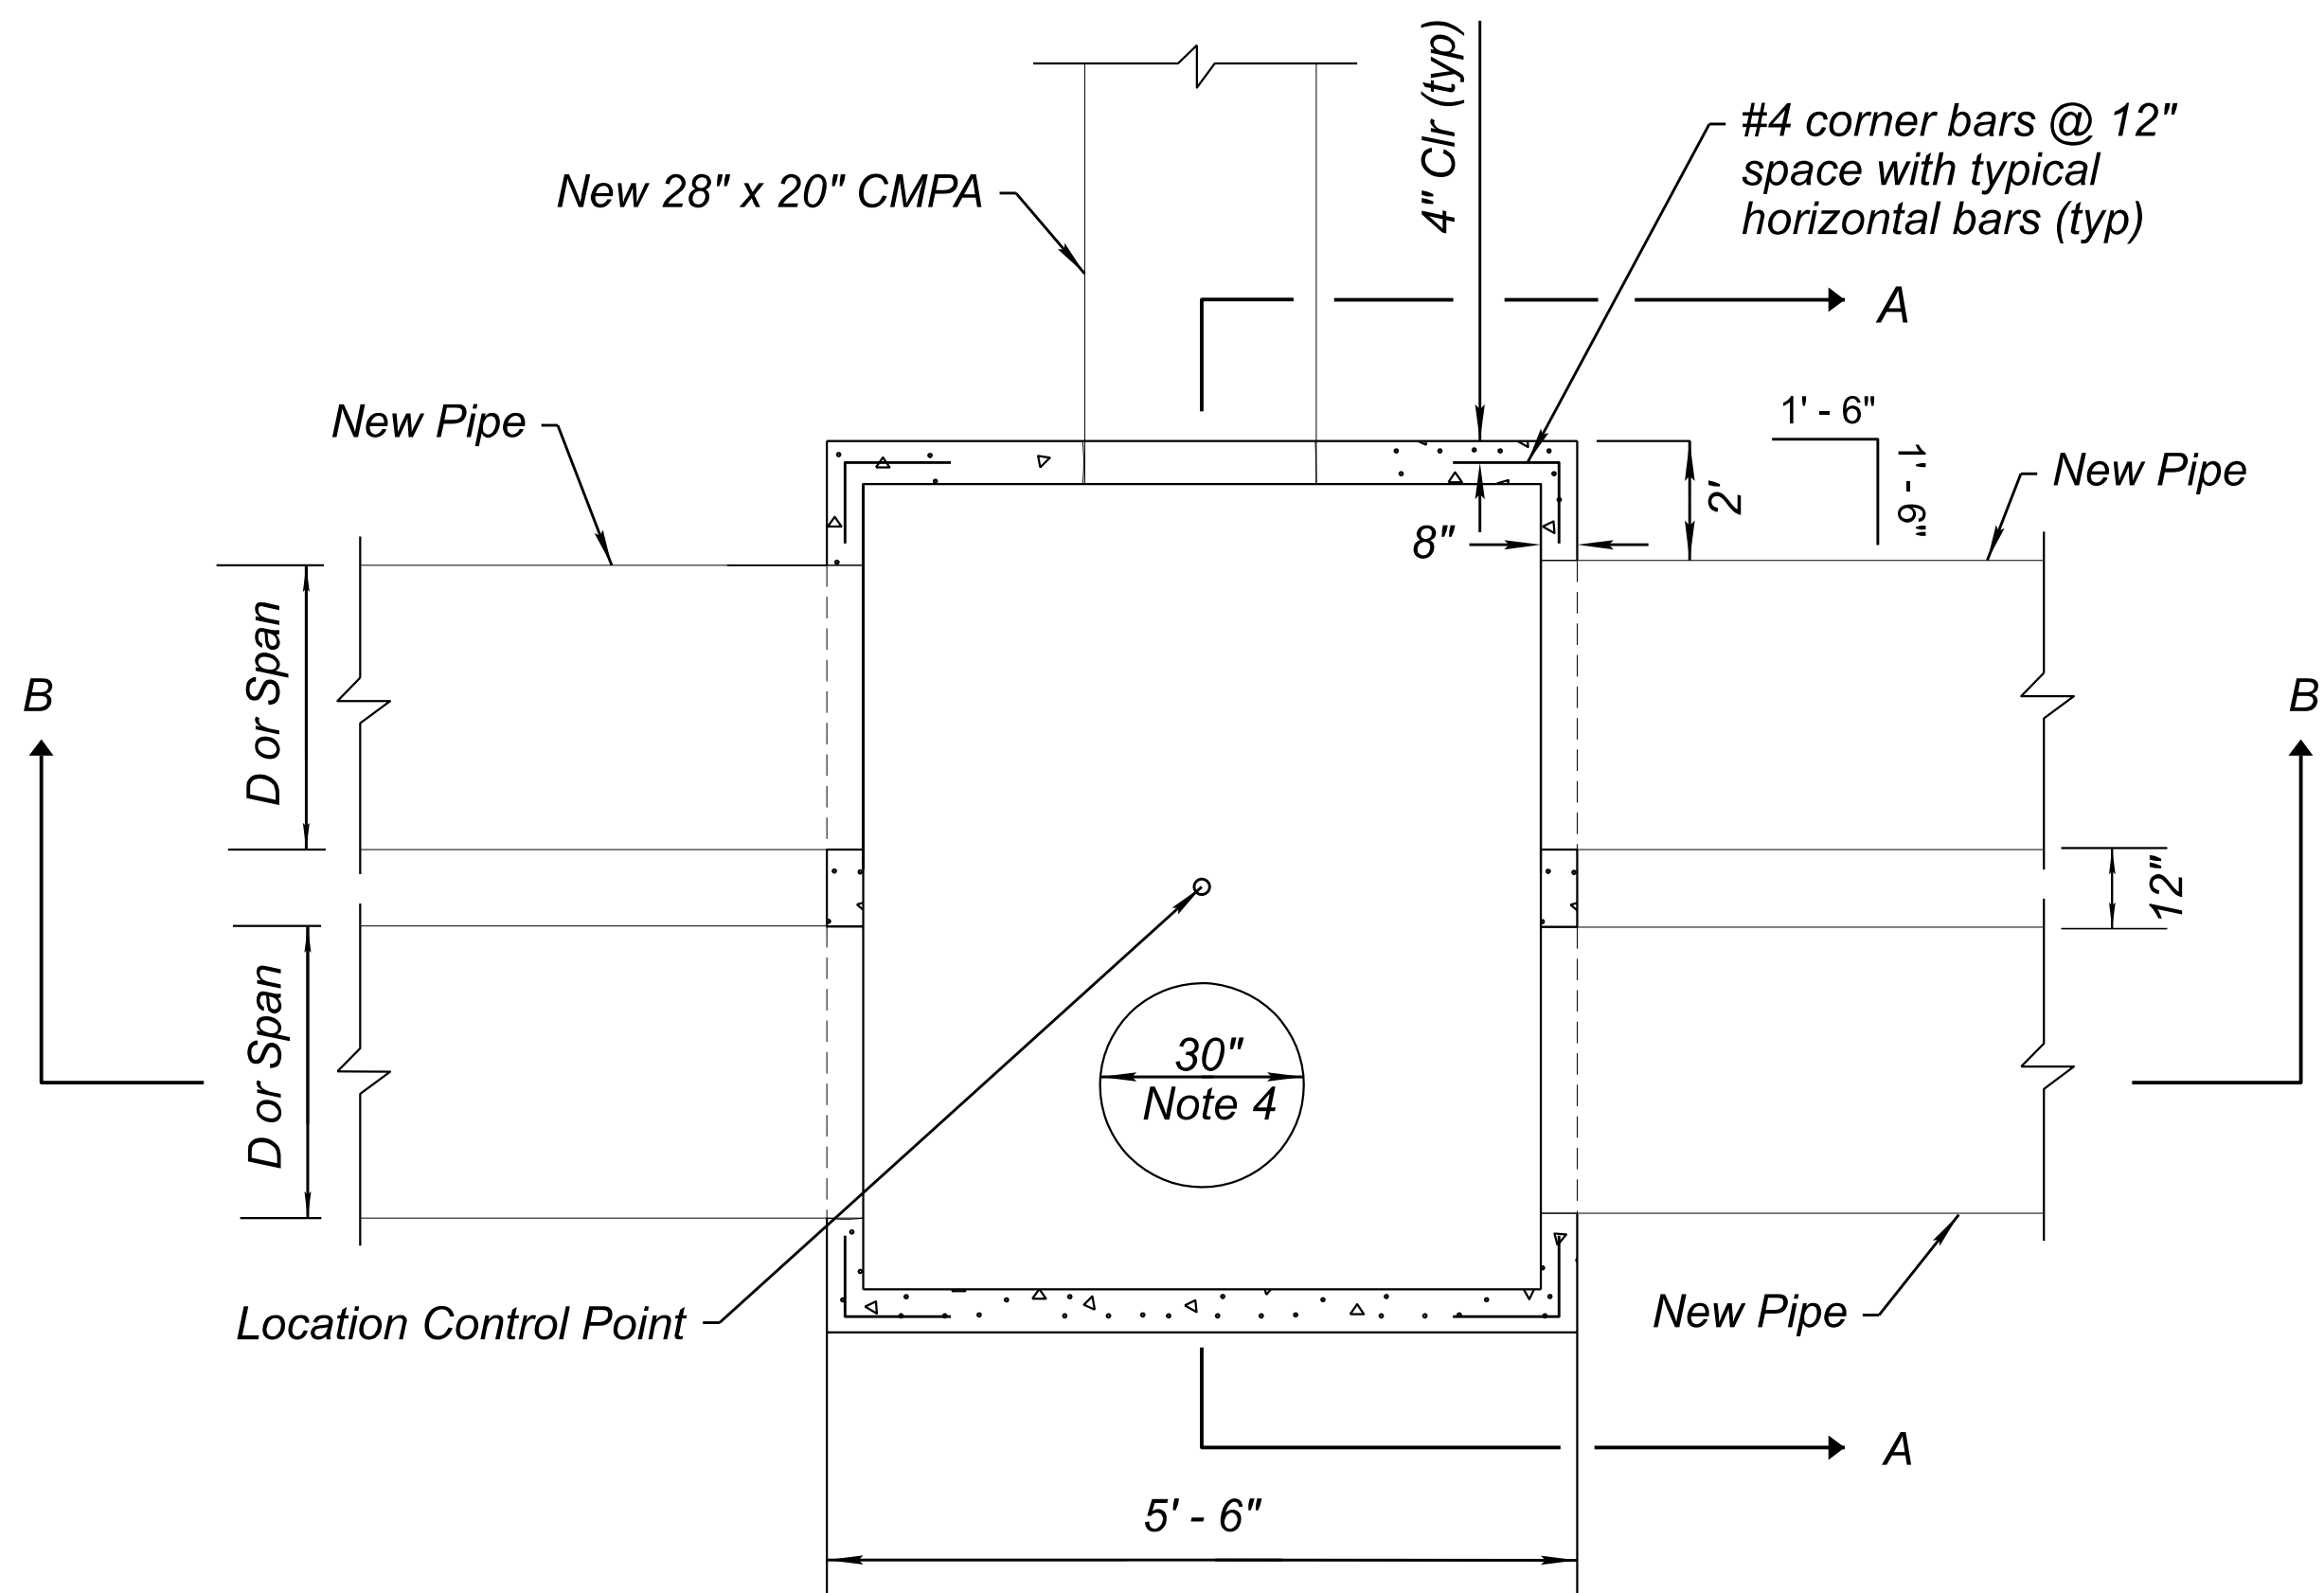

PLAN VIEW
N.T.S.

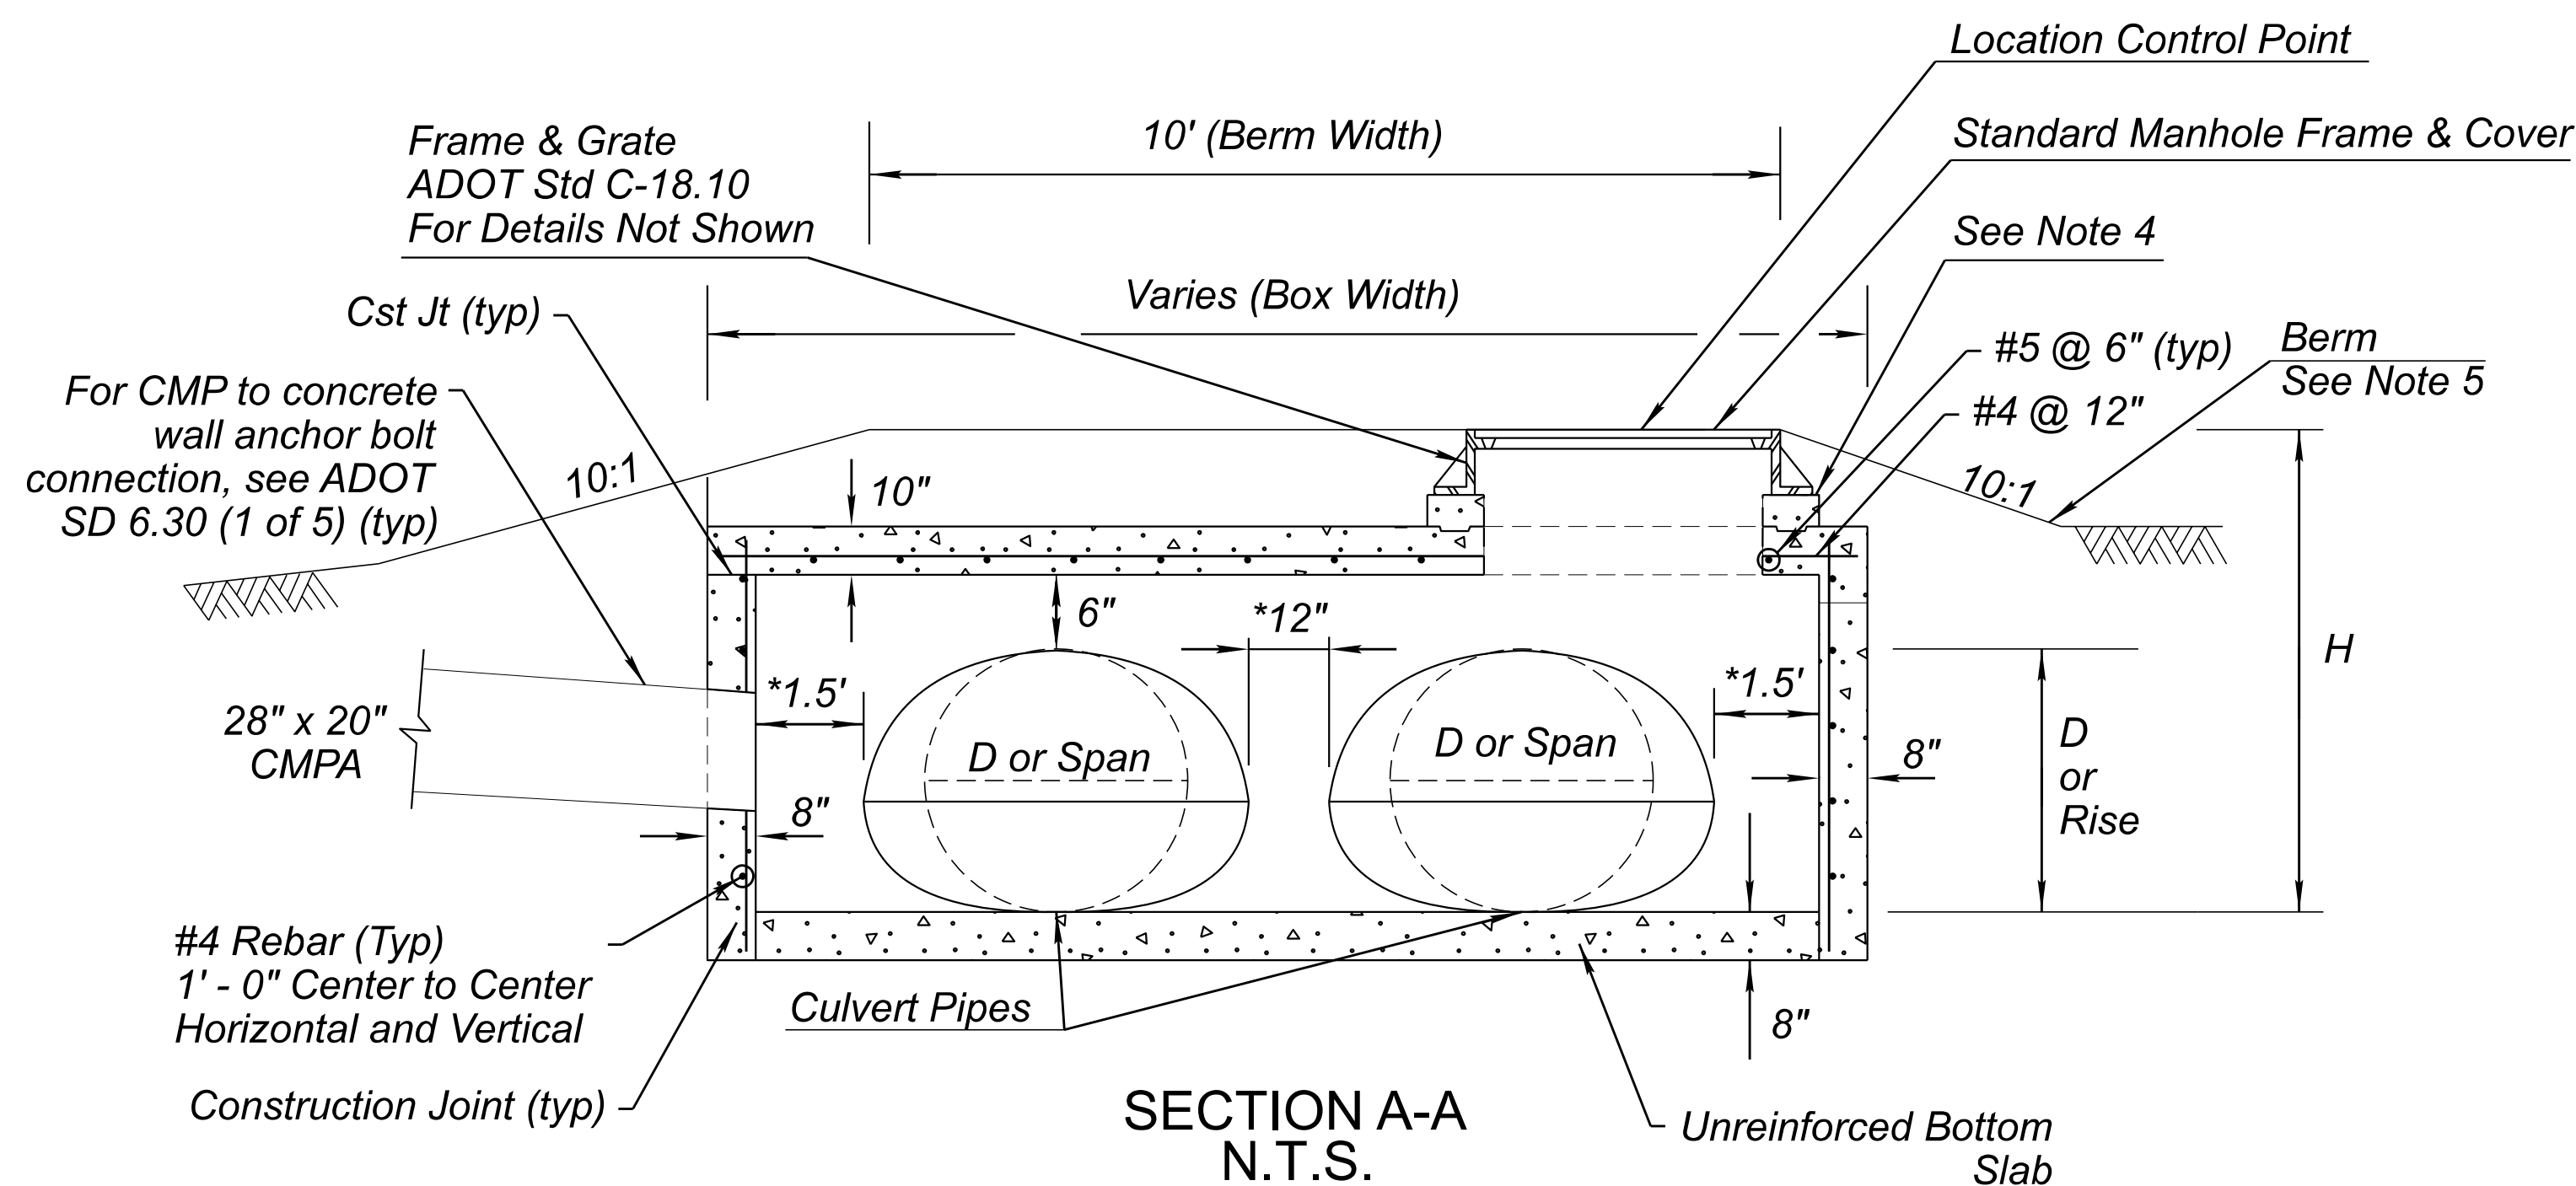

SECTION A-A
N.T.S.

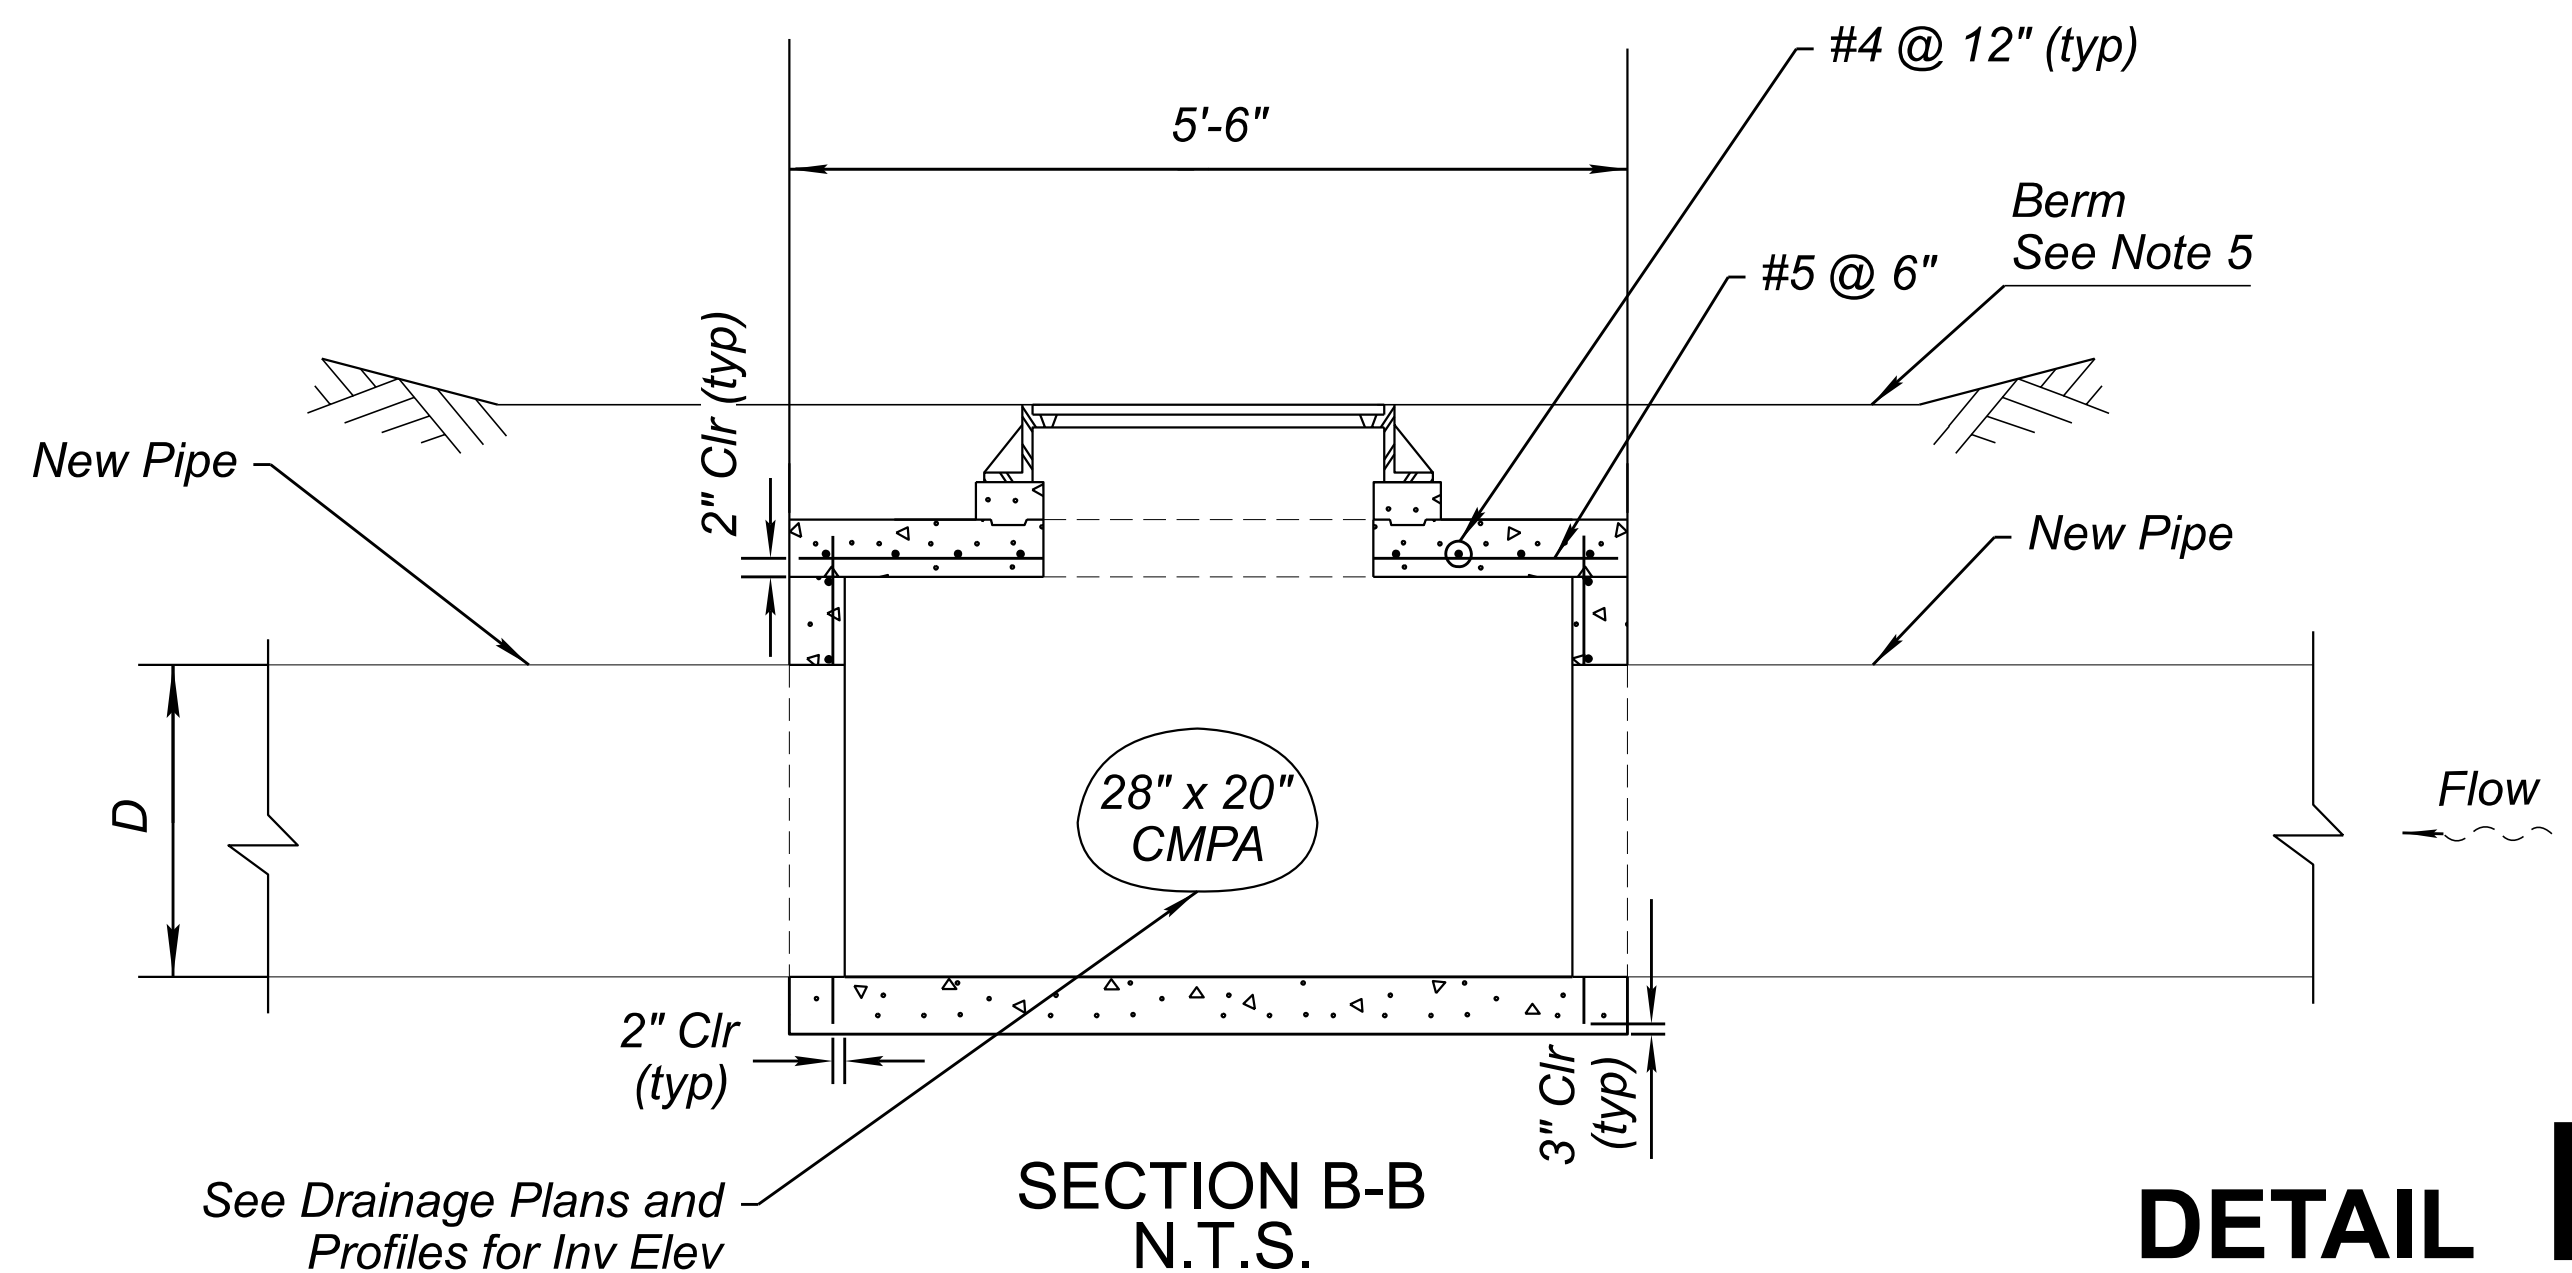


SECTION B-B
N.T.S.

DETAIL DJ
JUNCTION STRUCTURE

NOTES

1. Pipe Sizes & Elevations are shown on Drainage Details.
2. Manhole Rim Elevations are shown on Drainage Details.
3. All concrete shall be Class 'S' ($f'_c = 3000$ psi). Reinforcing steel shall conform to the requirements of Section 1003 of the specifications.
4. 4", 6", 8", or 12" Grade Rings, 30" inside diameter grade rings. See ADOT Std C-18.10 for details not shown.
5. See Detail E for Berm Details not shown.
6. See Detail DE for additional reinforcements at pipe opening.

* Spacing between pipes and from outside of pipes to the inside of the box is the same for Circular Pipes and CMPAs.

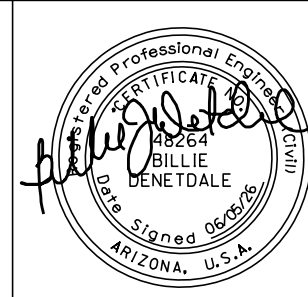


	NAME	DATE
DESIGN	K LEANDER	06/26
DRAWN	B LEANDER	06/26
CHECKED	B DENETDALE	06/26

TRANSPORTATION
AECOM TECHNICAL SERVICES, Inc.
7720 N. 16th St., Suite 100
Phoenix, Arizona 85020
T 602.371.1100


AECOM
www.aecom.com




ARIZONA DEPARTMENT OF TRANSPORTATION PROJECT DELIVERY AND OPERATIONS DIVISION ROADWAY DESIGN SERVICES
DETAIL DJ - JUNCTION STRUCTURE

ROUTE US 93	F.H.W.A. Arizona Division	STATE ARIZ.	PROJECT NO. 093 YV 189	FEDERAL ID NO. 093-B(230)T	SHEET NO. 62	TOTAL SHEETS 524	RECORD DRAWING
MILEPOST 189.9	LOCATION WICKENBURG RANCH WAY TO VISTA ROYALE						DWG No. D-1.14
STRUCTURE NO.	TRACS NO. F0738 01C			OF			

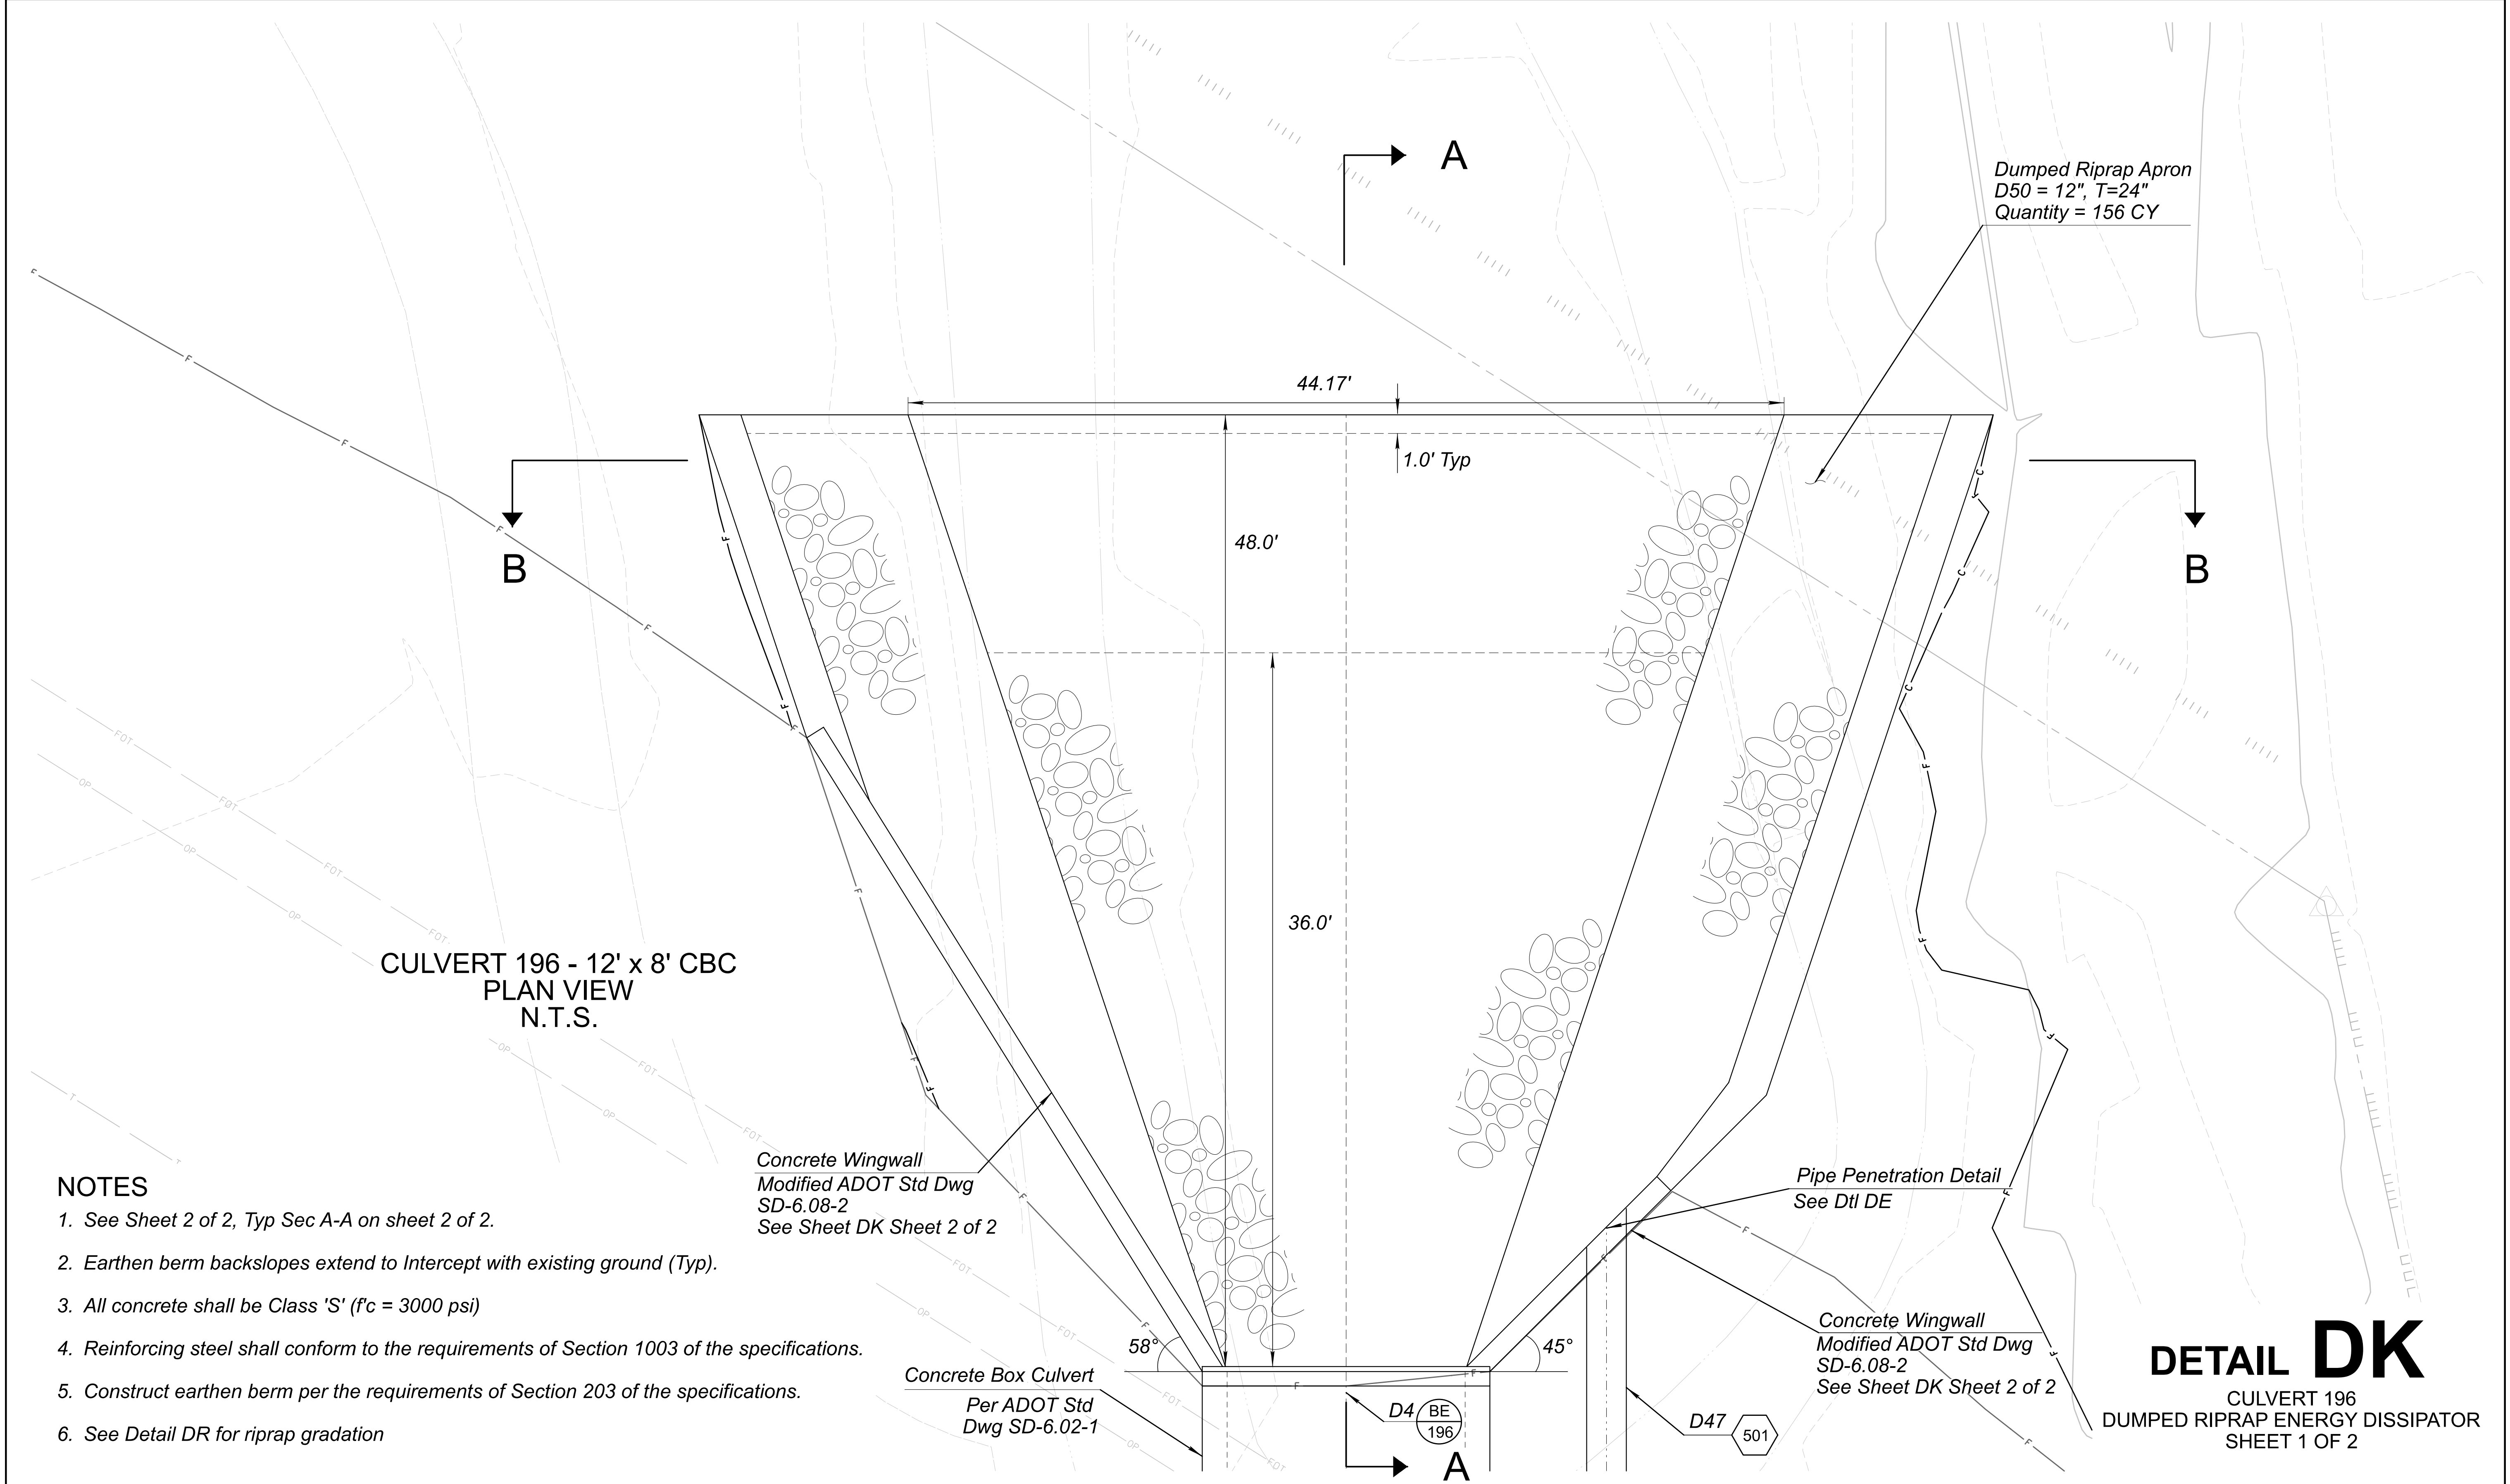

DETAIL DK
CULVERT 196
DUMPED RIPRAP ENERGY DISSIPATOR
SHEET 1 OF 2

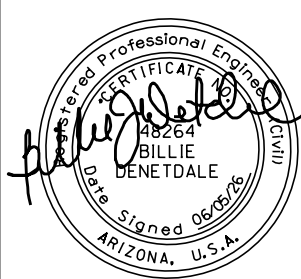
	NAME		DATE	ARIZONA DEPARTMENT OF TRANSPORTATION PROJECT DELIVERY AND OPERATIONS DIVISION ROADWAY DESIGN SERVICES DETAIL DK - CULVERT 196 DUMPED RIPRAP ENERGY DISSIPATOR SHEET 1 OF 2	ROUTE US 93	F.H.W.A. Arizona Division	STATE ARIZ.	PROJECT NO.	FEDERAL ID NO.	SHEET NO.	TOTAL SHEETS	RECORD DRAWING	
	DESIGN K LEANDER		06/26					093 YV 189	093-B(230)T	63	524		
	DRAWN B LEANDER		06/26					LOCATION WICKENBURG RANCH WAY TO VISTA ROYALE					DWG No. D-1.15
	CHECKED B DENETDALE		06/26										
TRANSPORTATION AECOM TECHNICAL SERVICES, Inc. 7720 N. 18th St., Suite 100 Phoenix, Arizona 85020 T 602.371.1100 www.aecom.com					STRUCTURE NO.		TRACS NO. F0738 01C		____ OF ____				

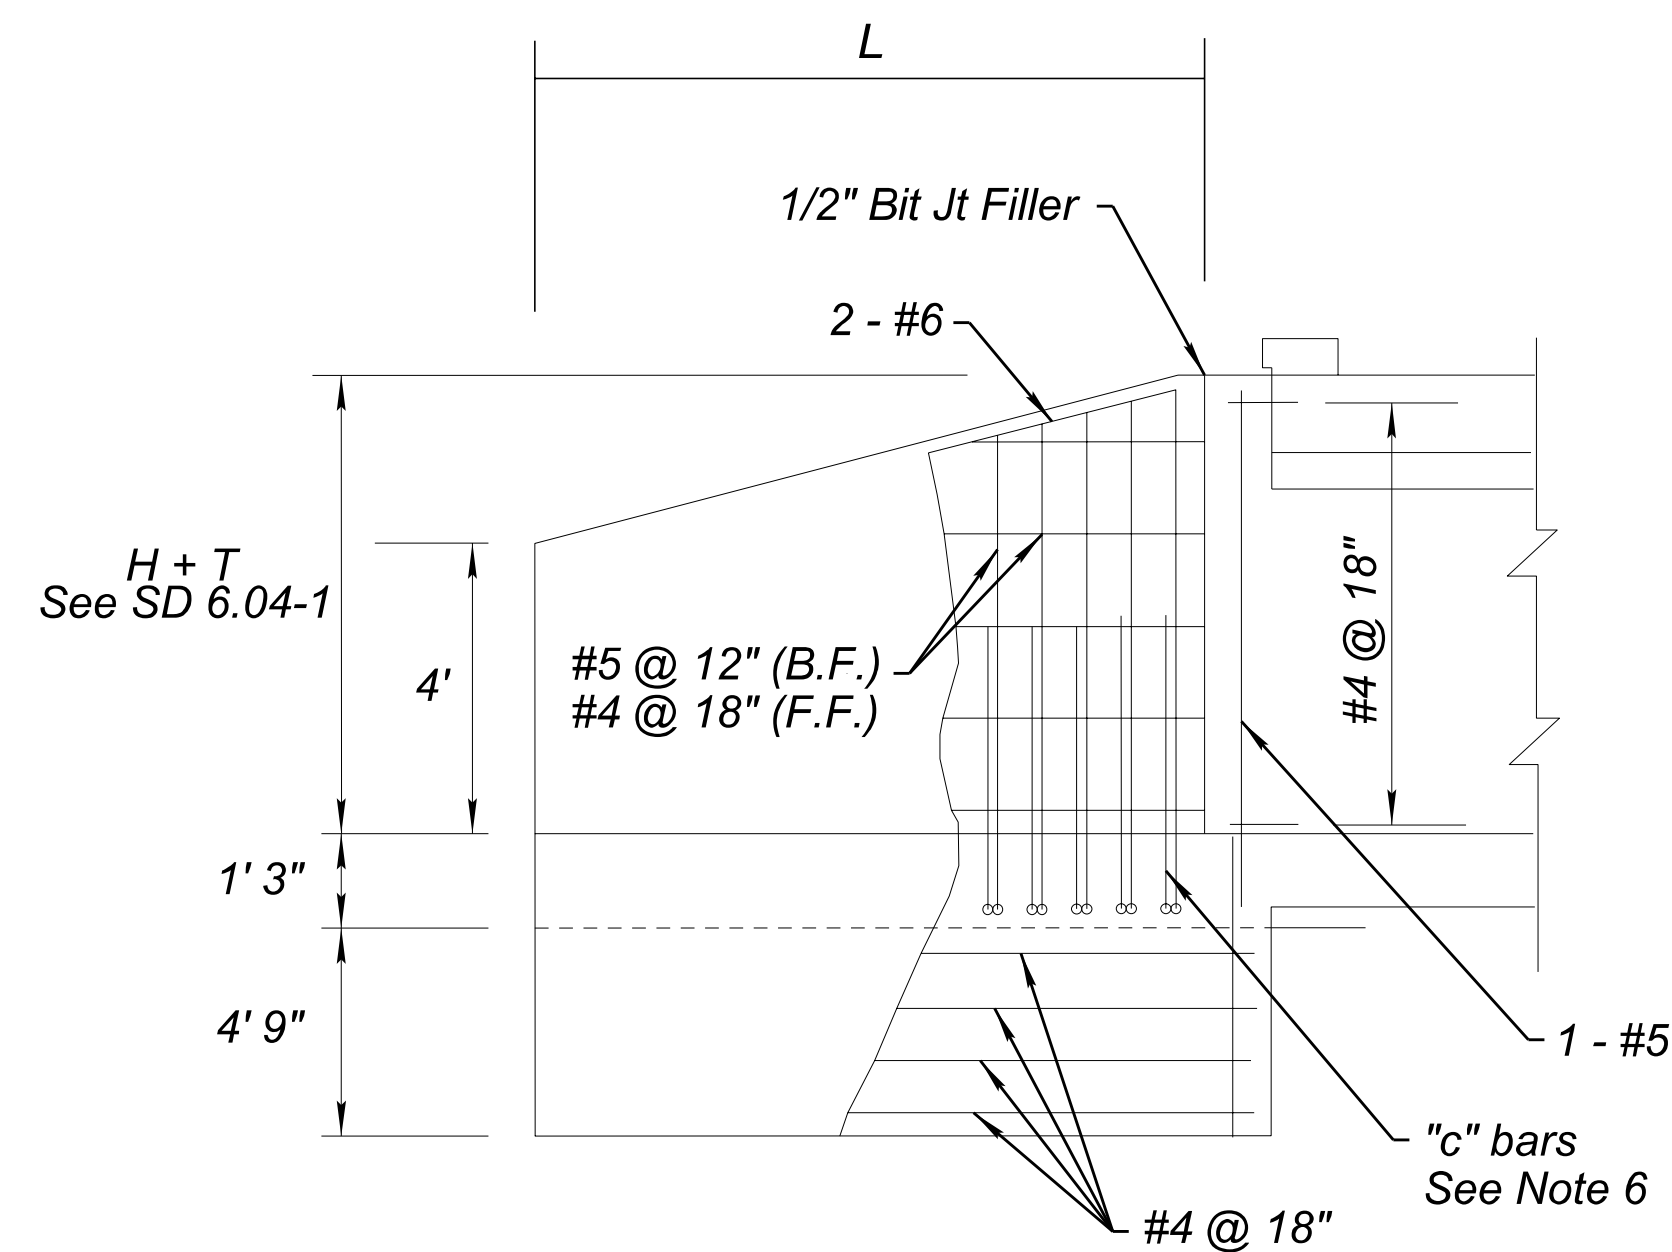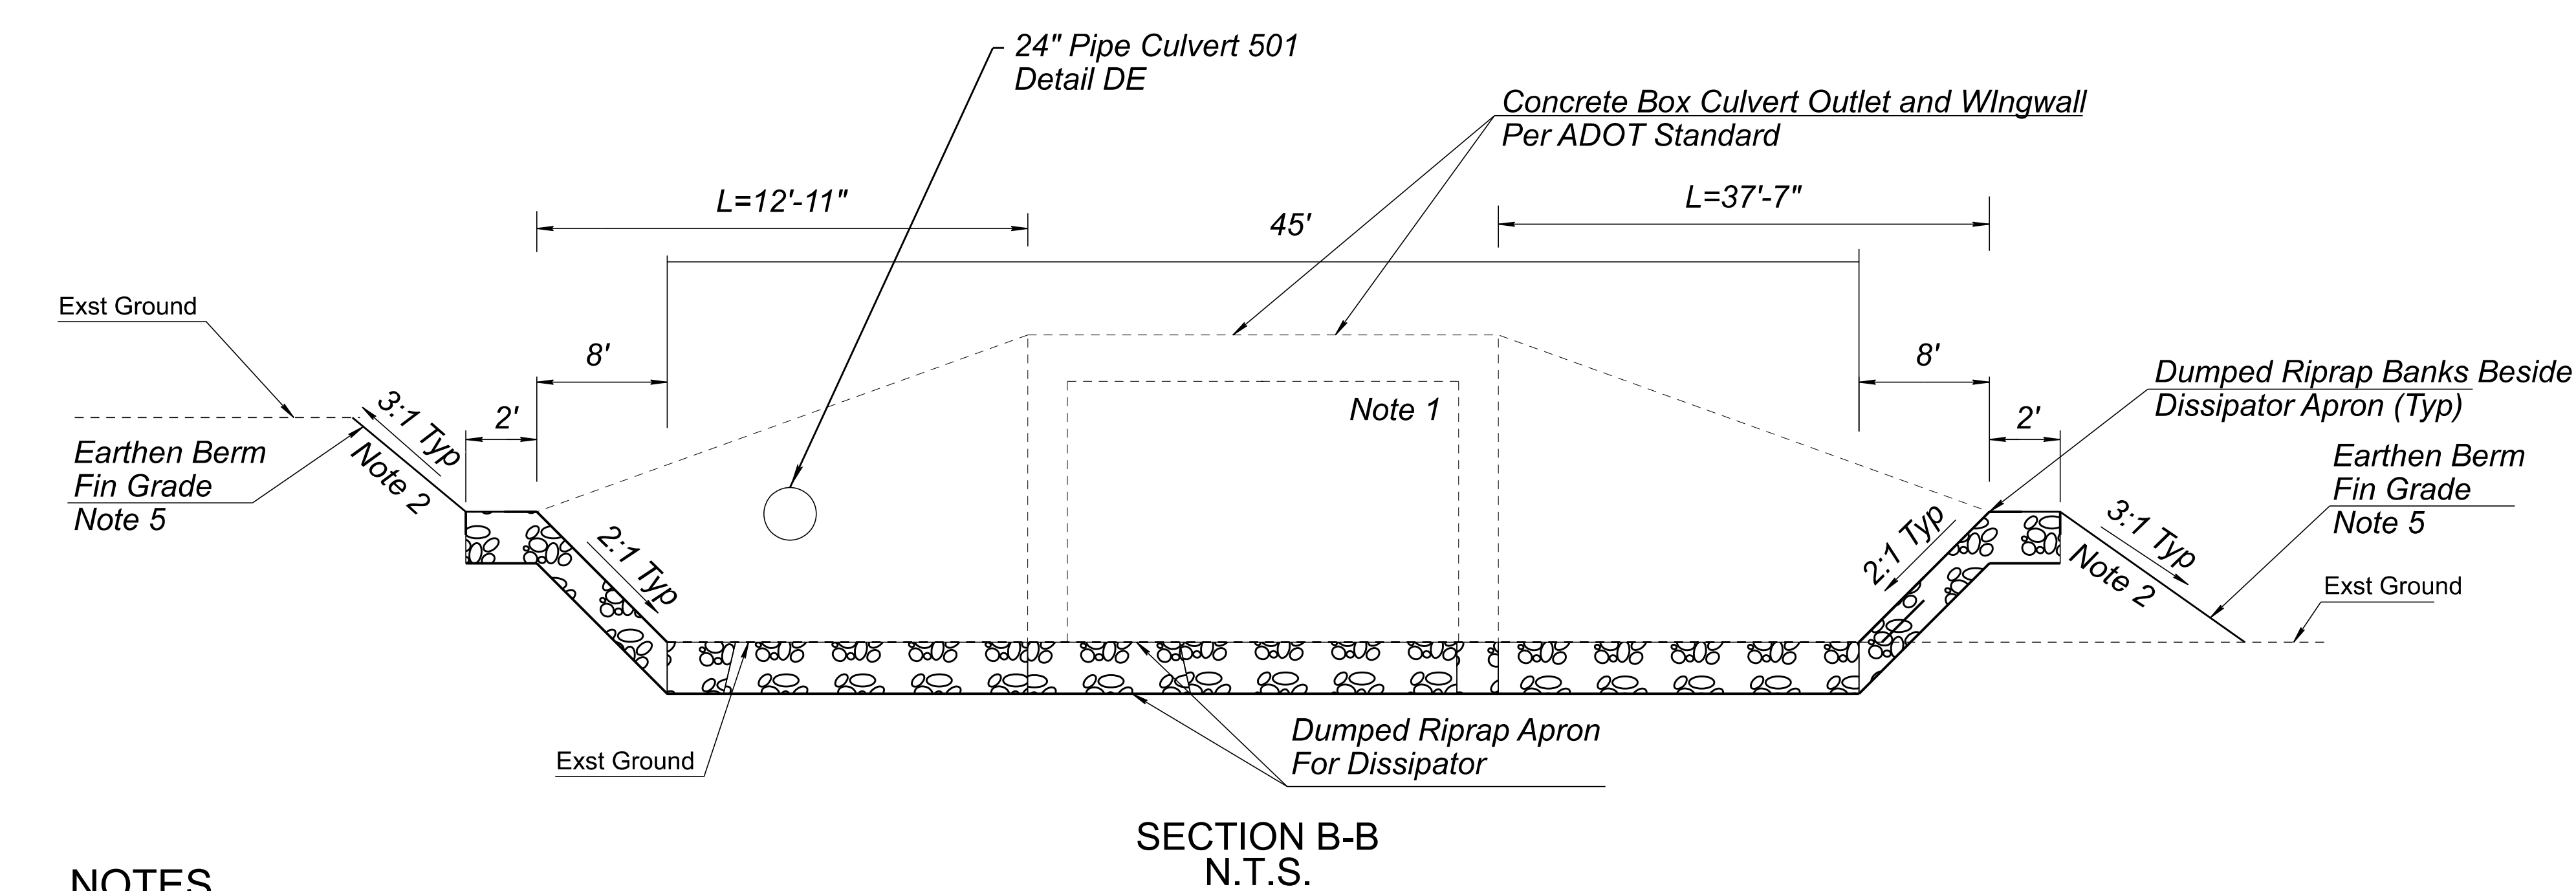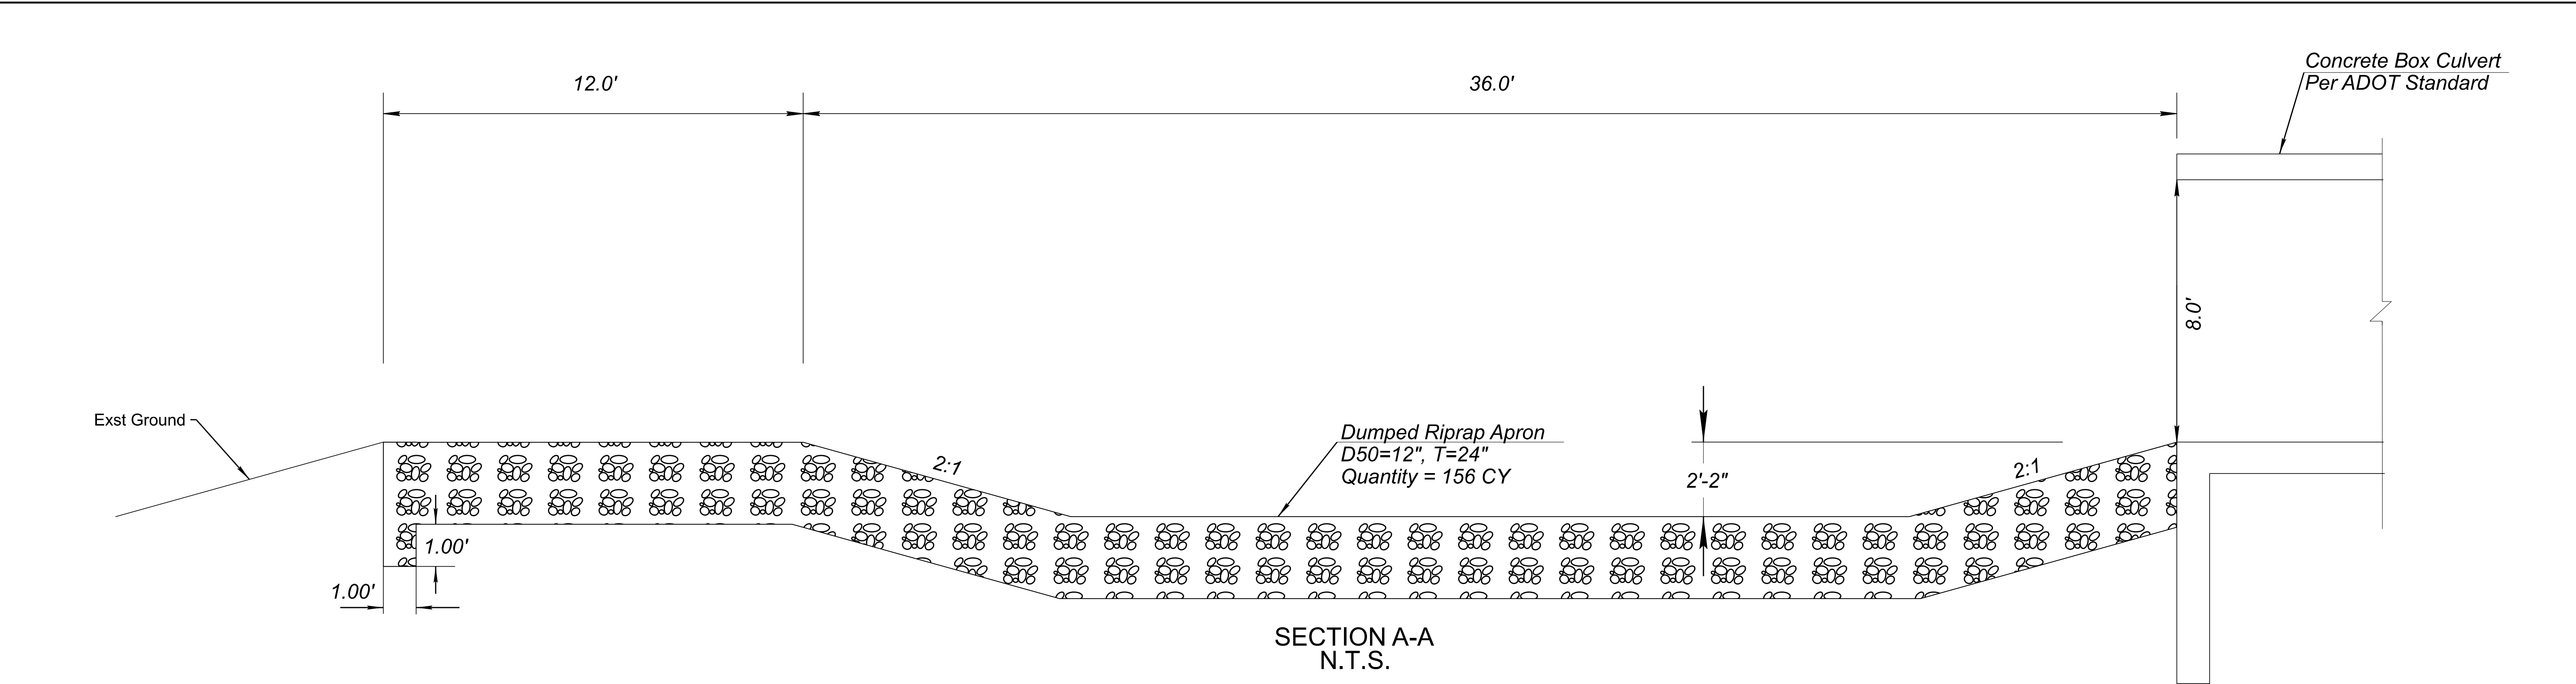

- NOTES**
1. See Sheet 1 of 2 for Plan View. See Typ Sec A-A on this sheet for dumped riprap basin dimensions.
 2. Earthen berm backslopes extend to intercept with existing ground.
 3. All concrete shall be Class 'S' (f'c = 3000 psi)
 4. Reinforcing steel shall conform to ASTM Specification A615. All reinforcing shall be furnished as Grade 60.
 5. Construct earthen berm per ADOT Specification Section 203.
 6. Refer to ADOT SD-6.08-2 for Embankment slope 2:1 and Skew angle 0° for additional information about wingwall and footer dimension and reinforcement.

DETAIL DK
CULVERT 196
DUMPED RIPRAP ENERGY DISSIPATOR
SHEET 2 OF 2

		NAME	DATE	ARIZONA DEPARTMENT OF TRANSPORTATION PROJECT DELIVERY AND OPERATIONS DIVISION ROADWAY DESIGN SERVICES	ROUTE	F.H.W.A. Arizona Division	STATE	PROJECT NO.	FEDERAL ID NO.	SHEET NO.	TOTAL SHEETS	RECORD DRAWING		
	DESIGN	K LEANDER	06/26		US 93		ARIZ.	093 YV 189	093-B(230)T	64	524			
	DRAWN	B LEANDER	06/26		MILEPOST	LOCATION							WICKENBURG RANCH WAY TO VISTA ROYALE	DWG No. D-1.16
	CHECKED	B DENETDALE	06/26		189.9									
	TRANSPORTATION AECOM TECHNICAL SERVICES, Inc. 7720 N. 16th St., Suite 100 Phoenix, Arizona 85020 T 602.371.1100 www.aecom.com			DETAIL DK - CULVERT 196 DUMPED RIPRAP ENERGY DISSIPATOR SHEET 2 OF 2										

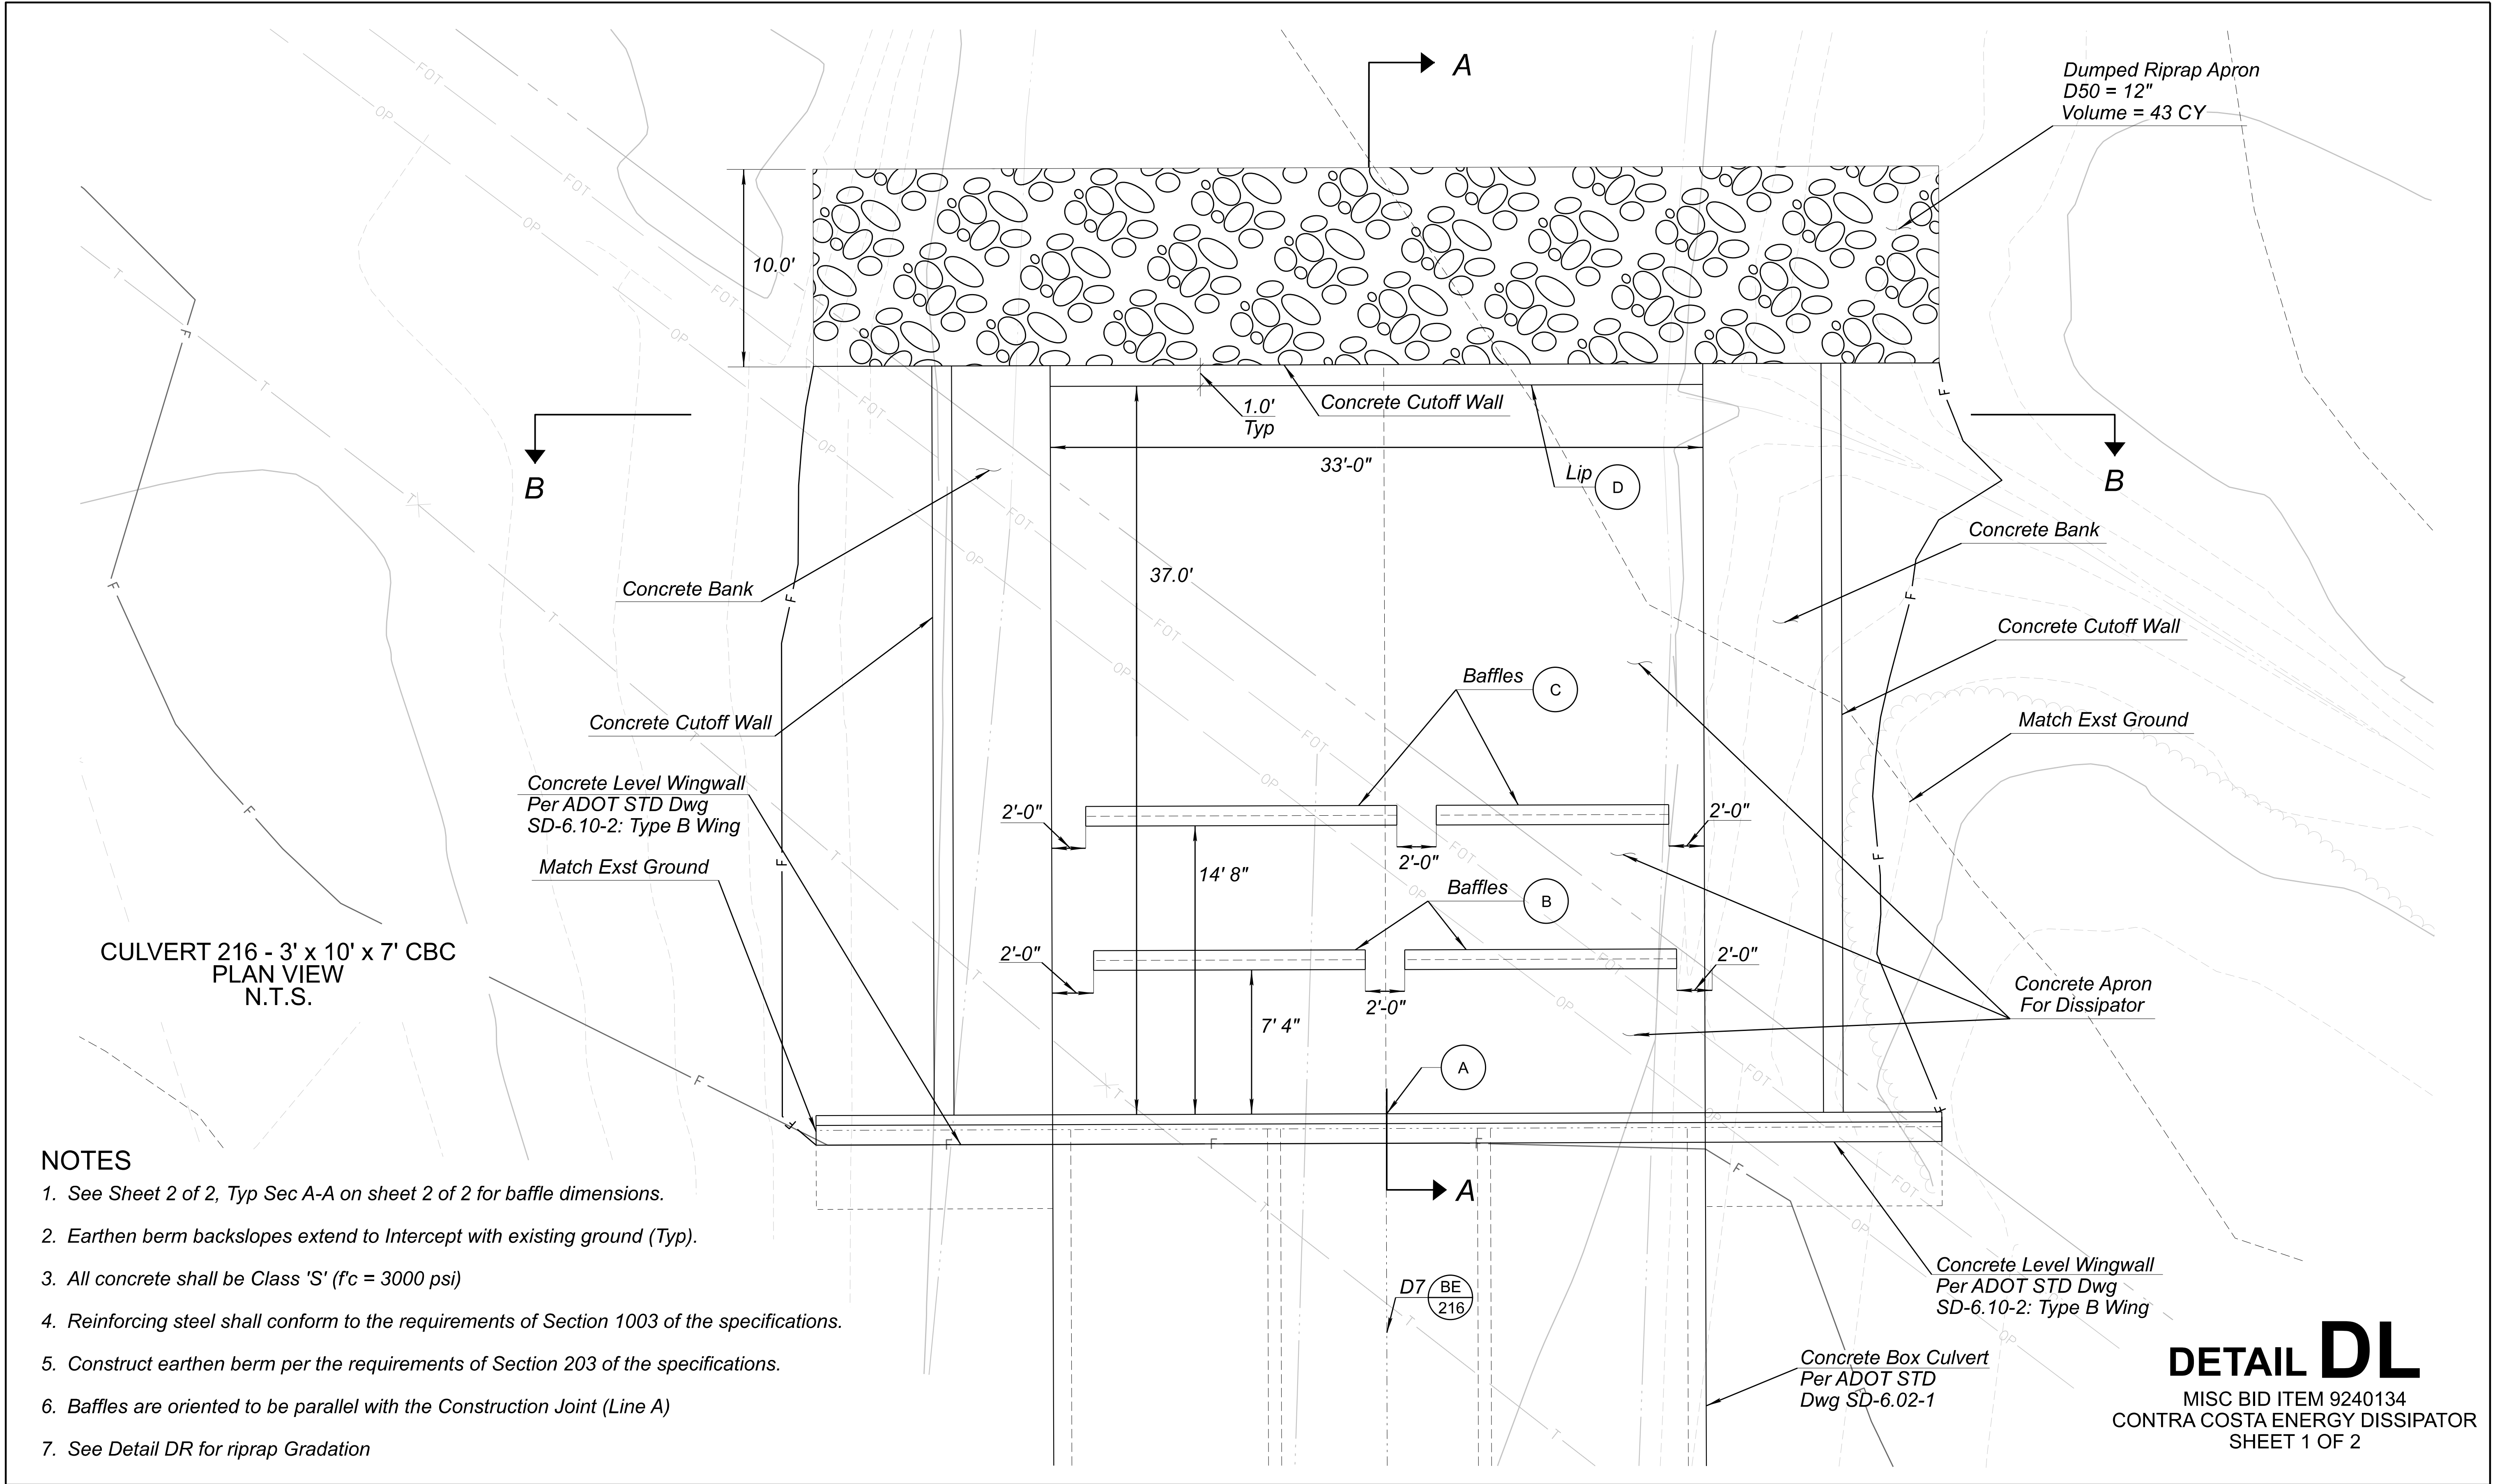






NOTES

1. See Sheet 2 of 2, Typ Sec A-A on sheet 2 of 2 for baffle dimensions.
2. Earthen berm backslopes extend to Intercept with existing ground (Typ).
3. All concrete shall be Class 'S' (f'c = 3000 psi)
4. Reinforcing steel shall conform to the requirements of Section 1003 of the specifications.
5. Construct earthen berm per the requirements of Section 203 of the specifications.
6. Baffles are oriented to be parallel with the Construction Joint (Line A)
7. See Detail DR for riprap Gradation

DETAIL DL

MISC BID ITEM 9240134
CONTRA COSTA ENERGY DISSIPATOR
SHEET 1 OF 2

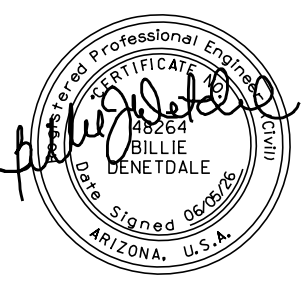	NAME		DATE	ARIZONA DEPARTMENT OF TRANSPORTATION PROJECT DELIVERY AND OPERATIONS DIVISION ROADWAY DESIGN SERVICES DETAIL DL - CULVERT 216 CONTRA COSTA ENERGY DISSIPATOR SHEET 1 OF 2			ROUTE	F.H.W.A. Arizona Division		STATE	PROJECT NO.	FEDERAL ID NO.	SHEET NO.	TOTAL SHEETS	RECORD DRAWING
	DESIGN	K LEANDER	06/26				US 93			ARIZ.	093 YV 189	093-B(230)T	65	524	
	DRAWN	B LEANDER	06/26				MILEPOST	LOCATION			WICKENBURG RANCH WAY TO VISTA ROYALE				
	CHECKED	B DENETDALE	06/26	TRANSPORTATION AECOM TECHNICAL SERVICES, Inc. 7720 N. 16th St., Suite 100 Phoenix, Arizona 85020 T 602.371.1100 www.aecom.com			STRUCTURE NO.	TRACS NO.		F0738 01C				DWG No. D-1.17	

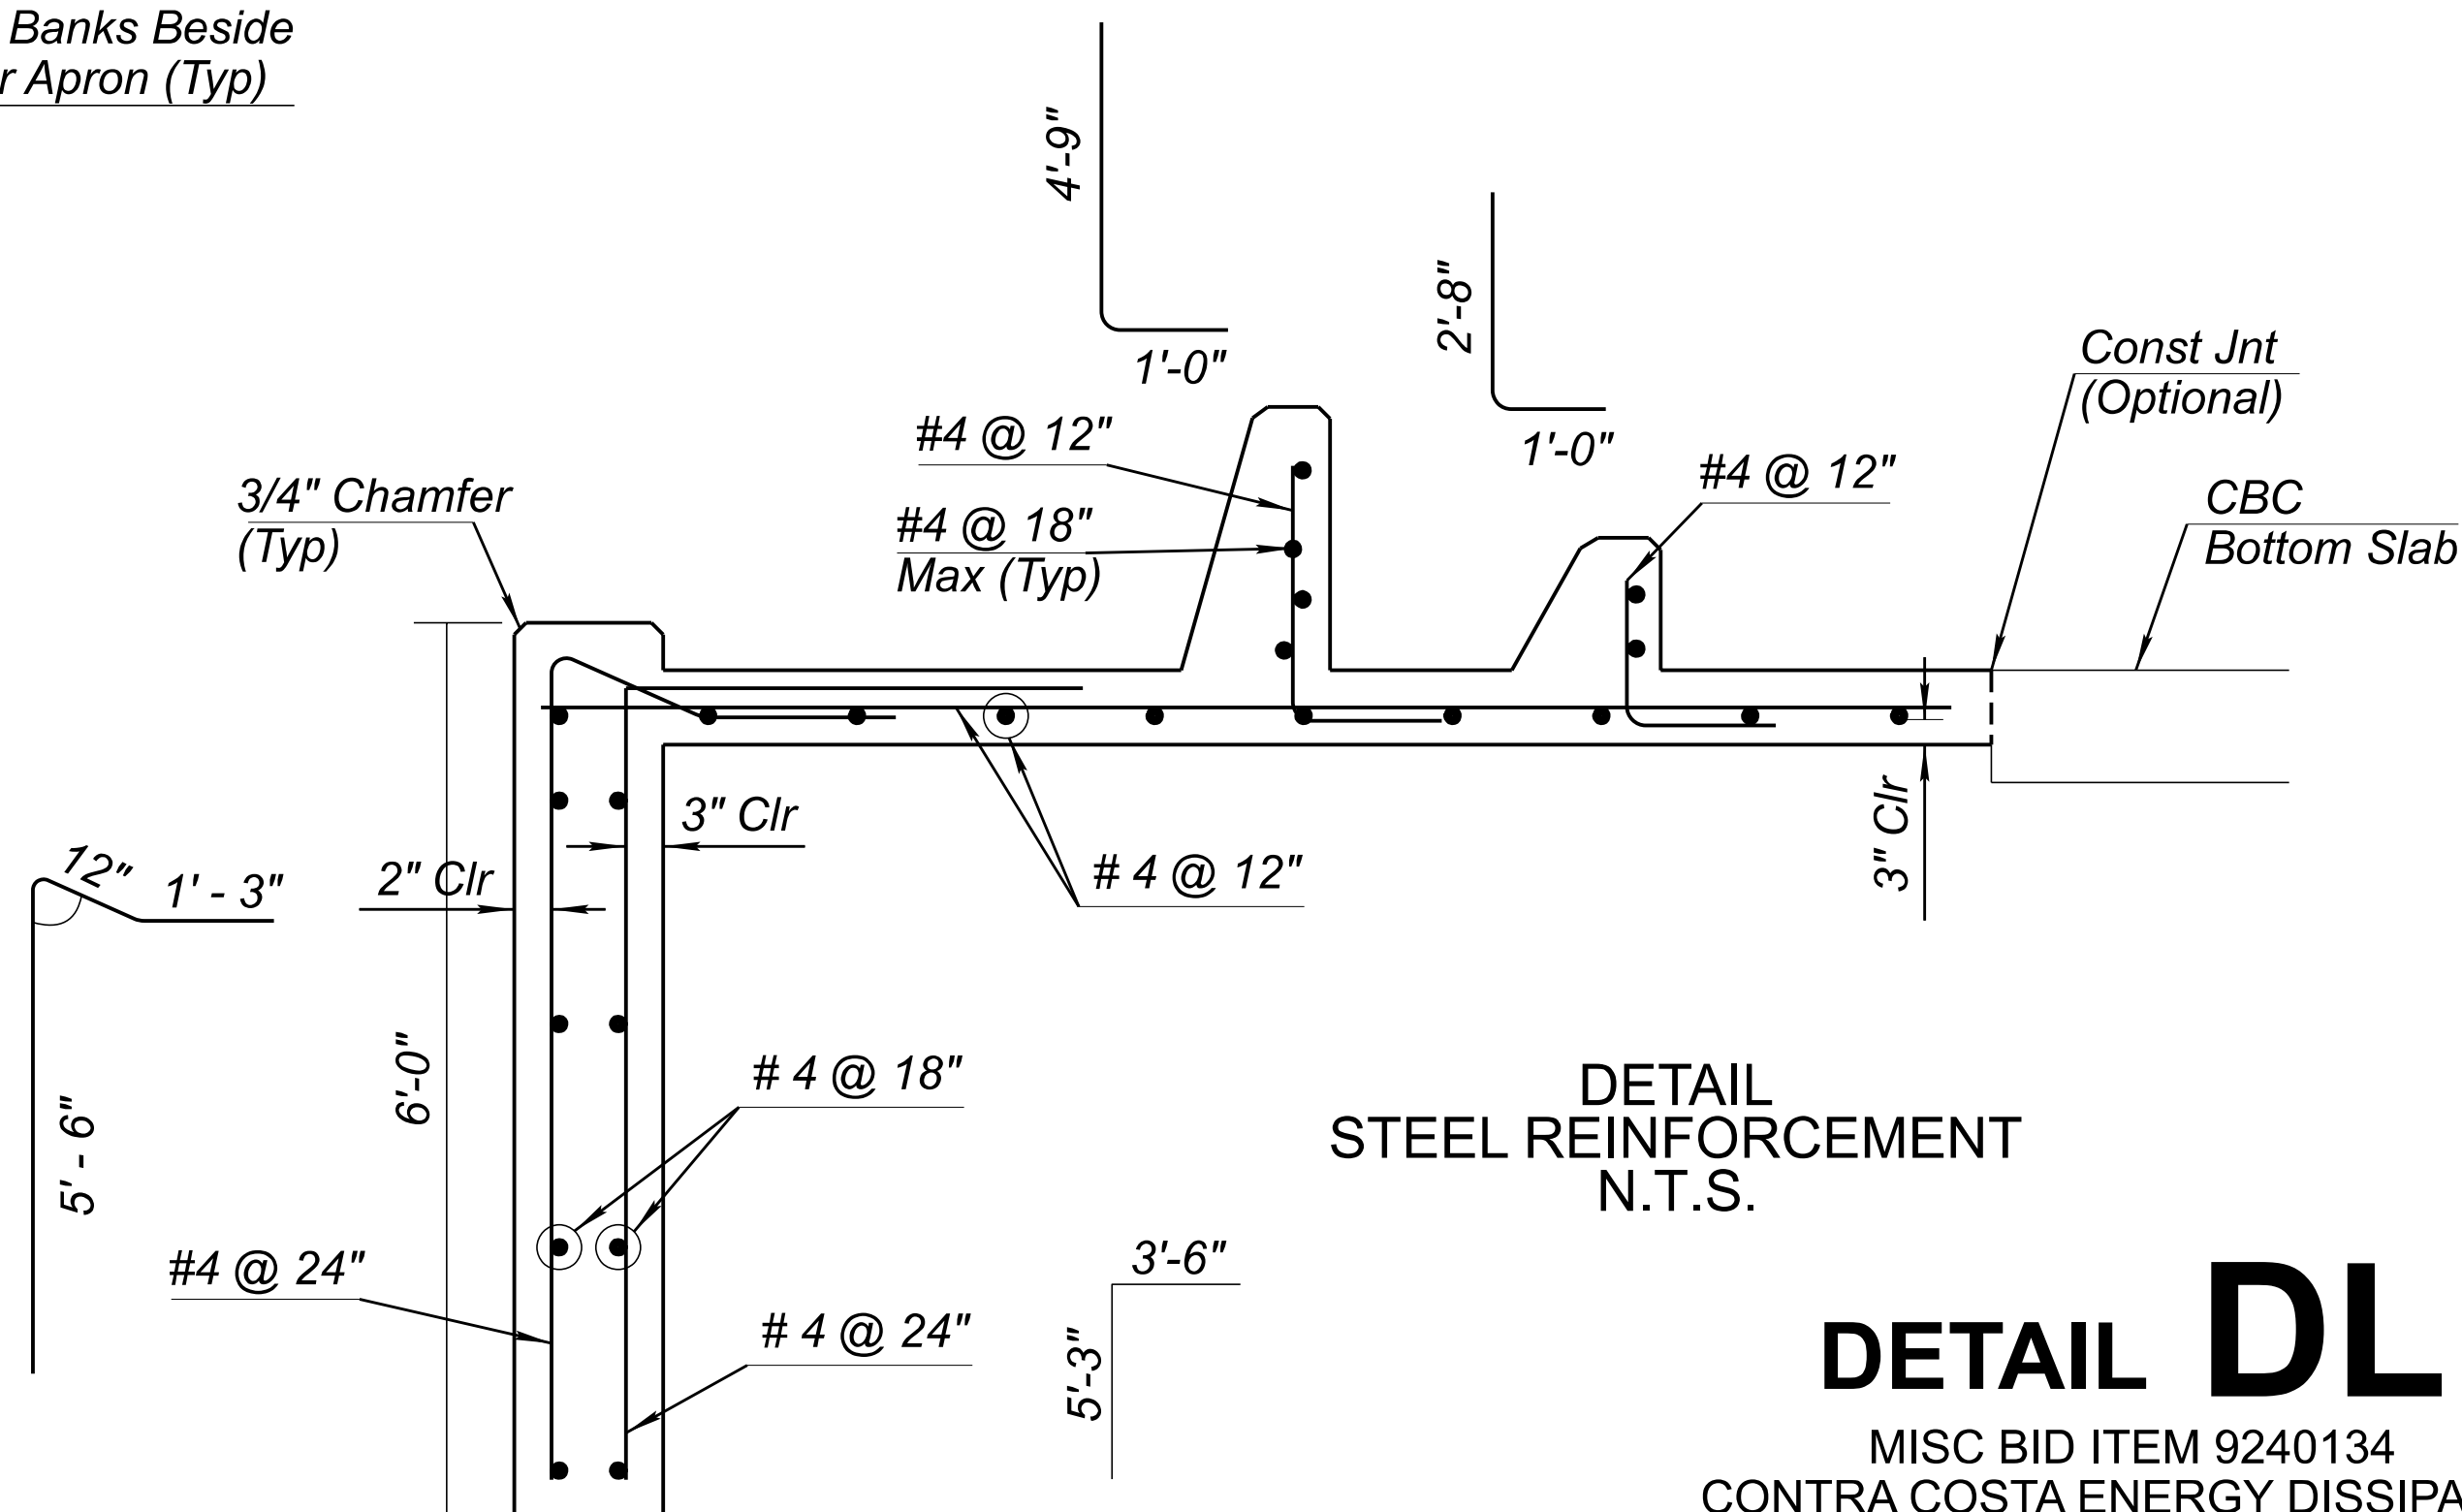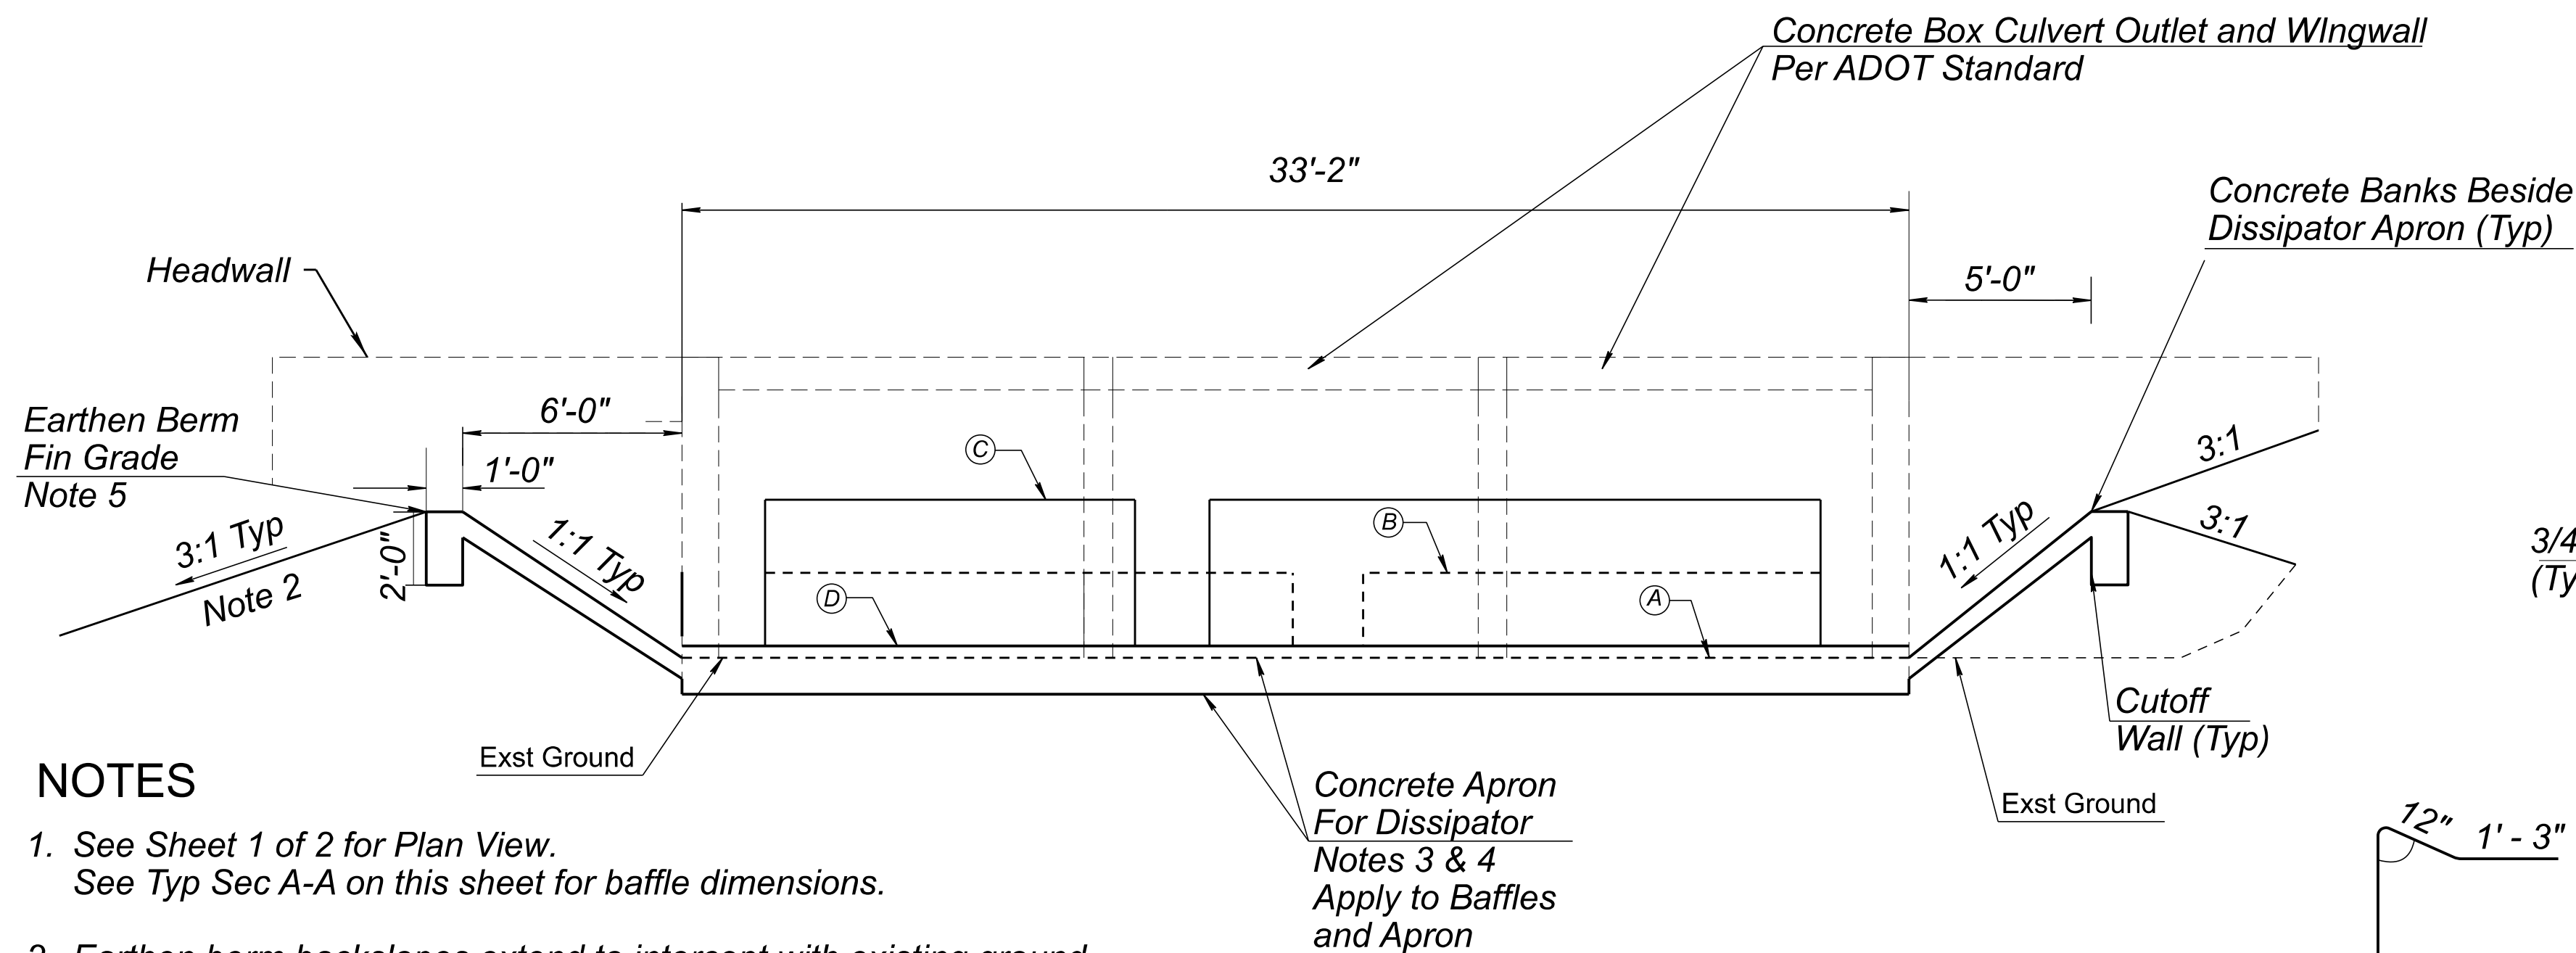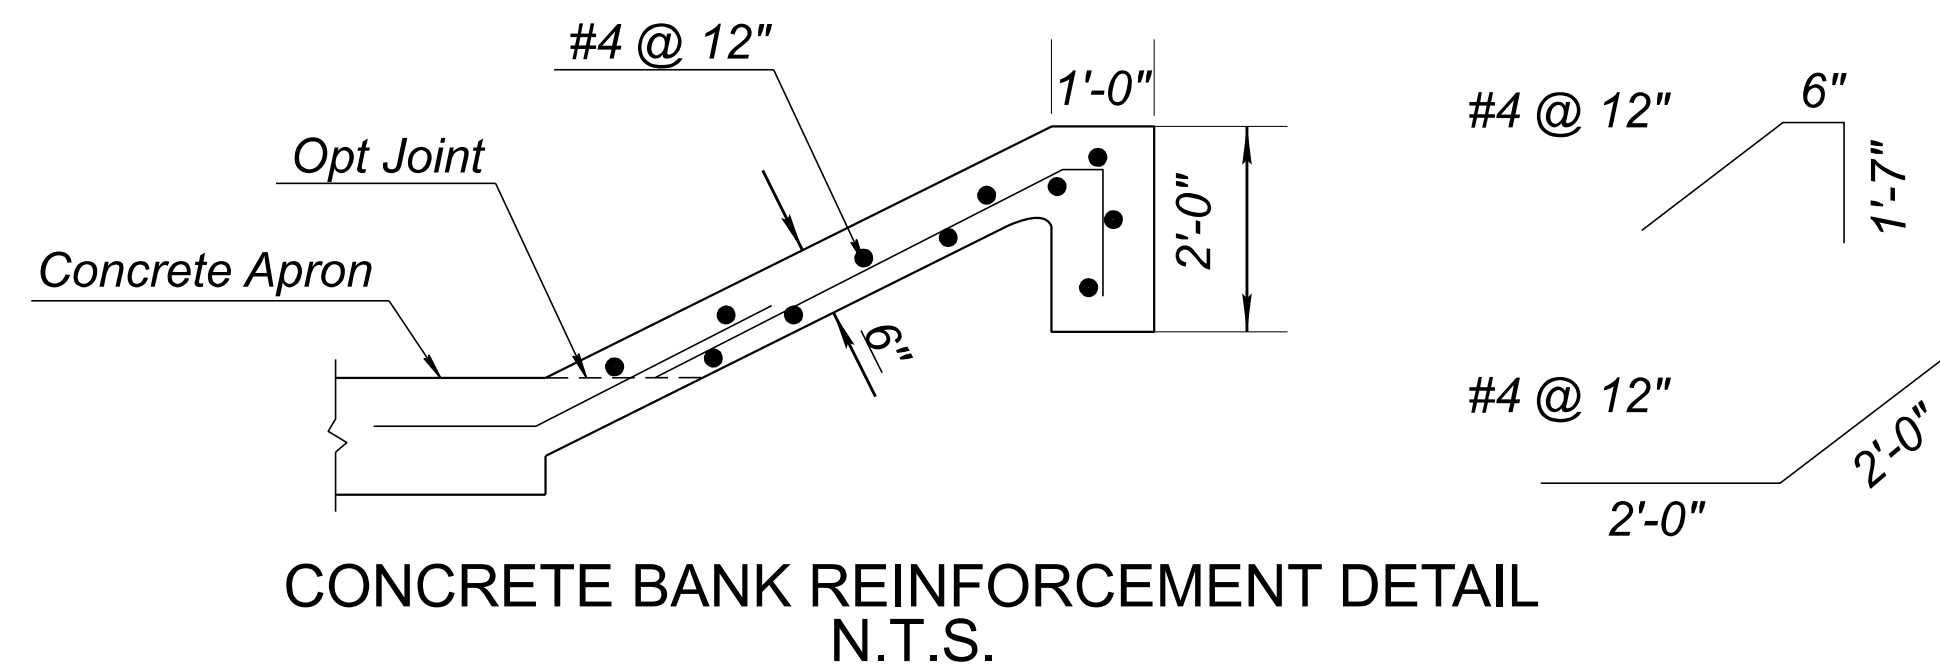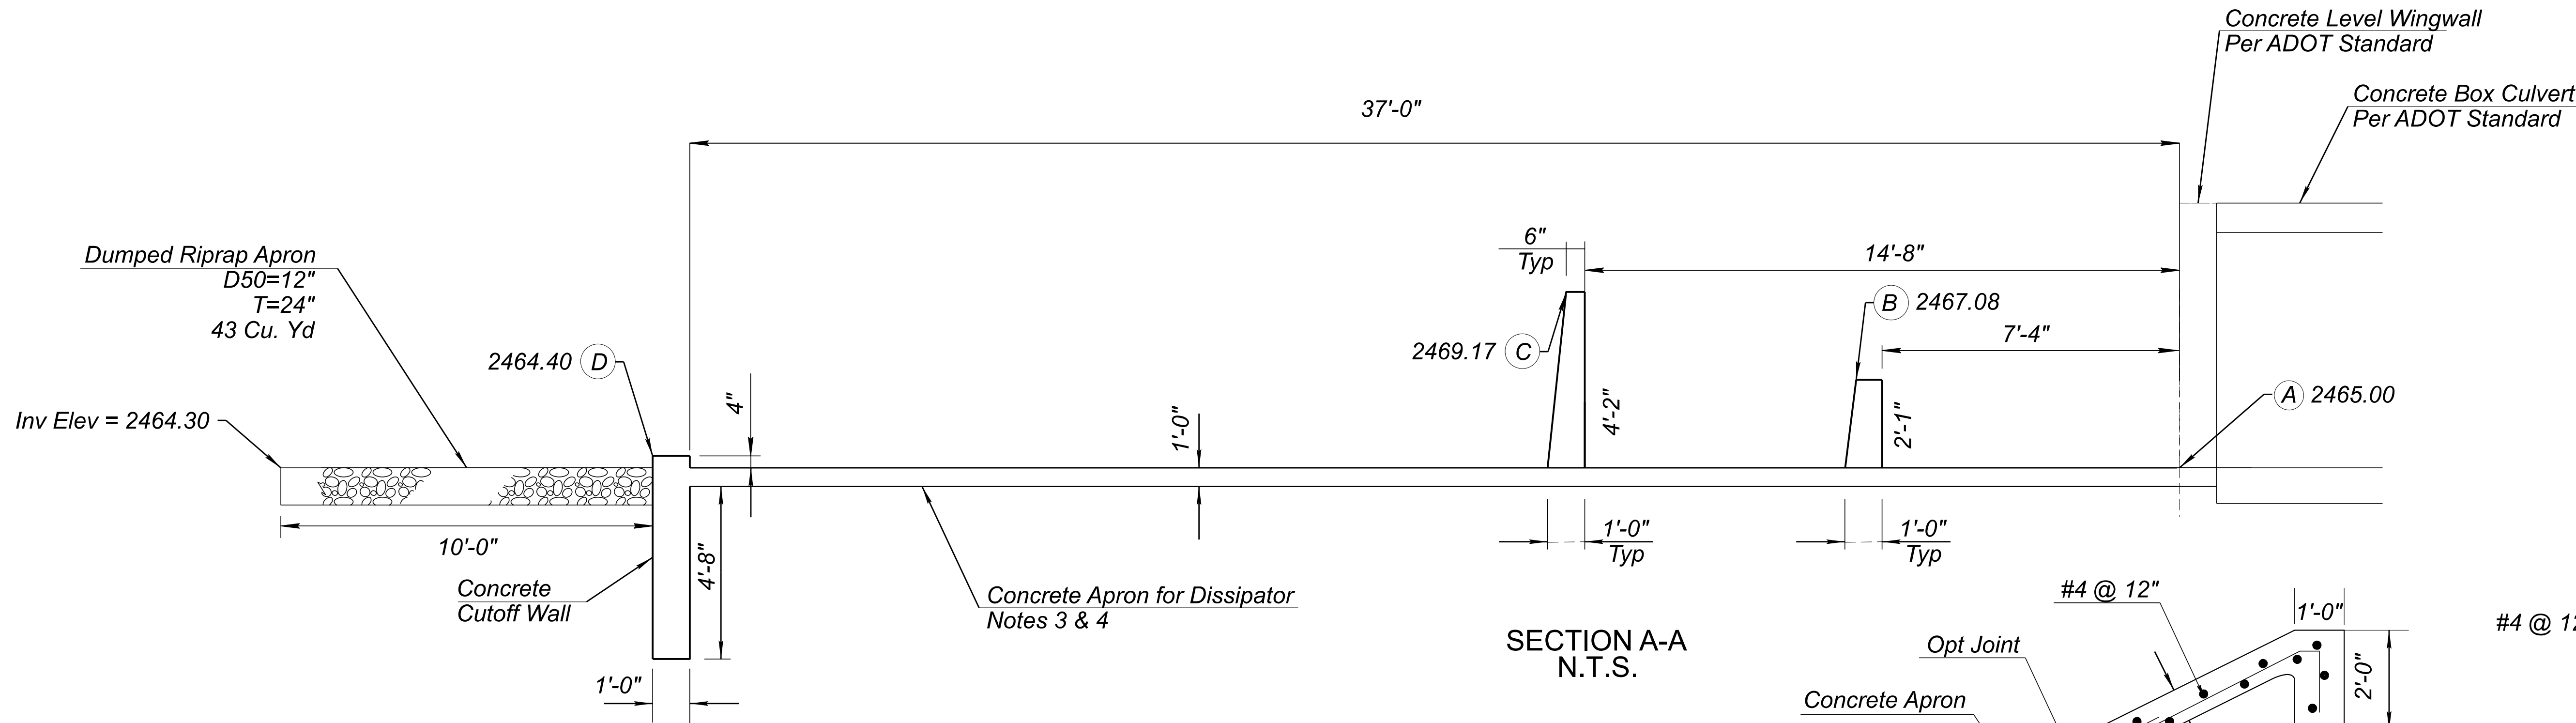

NOTES


- See Sheet 1 of 2 for Plan View.
See Typ Sec A-A on this sheet for baffle dimensions.
- Earthen berm backslopes extend to intercept with existing ground.
- All concrete shall be Class 'S' ($f_c = 3000$ psi)
- Reinforcing steel shall conform to ASTM Specification A615.
All reinforcing shall be furnished as Grade 60.
- Construct earthen berm per ADOT Specification Section 203.
- Dumped Riprap Apron will be paid for separately under pay item 9130053

SECTION B-B N.T.S.

DETAIL STEEL REINFORCEMENT N.T.S.

DETAIL DL

MISC BID ITEM 9240134
CONTRA COSTA ENERGY DISSIPATOR
SHEET 2 OF 2

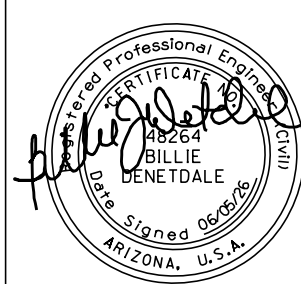




	NAME	DATE
DESIGN	K LEANDER	06/26
DRAWN	B LEANDER	06/26
CHECKED	B DENETDALE	06/26

TRANSPORTATION
AECOM TECHNICAL SERVICES, Inc.
7720 N. 16th St., Suite 100
Phoenix, Arizona 85020
T 602.371.1100

AECOM
www.aecom.com

ARIZONA DEPARTMENT OF TRANSPORTATION
PROJECT DELIVERY AND OPERATIONS DIVISION
ROADWAY DESIGN SERVICES
DETAIL DL - CULVERT 216
CONTRA COSTA ENERGY DISSIPATOR
SHEET 2 OF 2

ROUTE US 93	F.H.W.A. Arizona Division	STATE ARIZ.	PROJECT NO. 093 YV 189	FEDERAL ID NO. 093-B(230)T	SHEET NO. 66	TOTAL SHEETS 524	RECORD DRAWING
MILEPOST 189.9	LOCATION WICKENBURG RANCH WAY TO VISTA ROYALE	TRACS NO. F0738 01C	DWG No. D-1.18	OF			
STRUCTURE NO.							

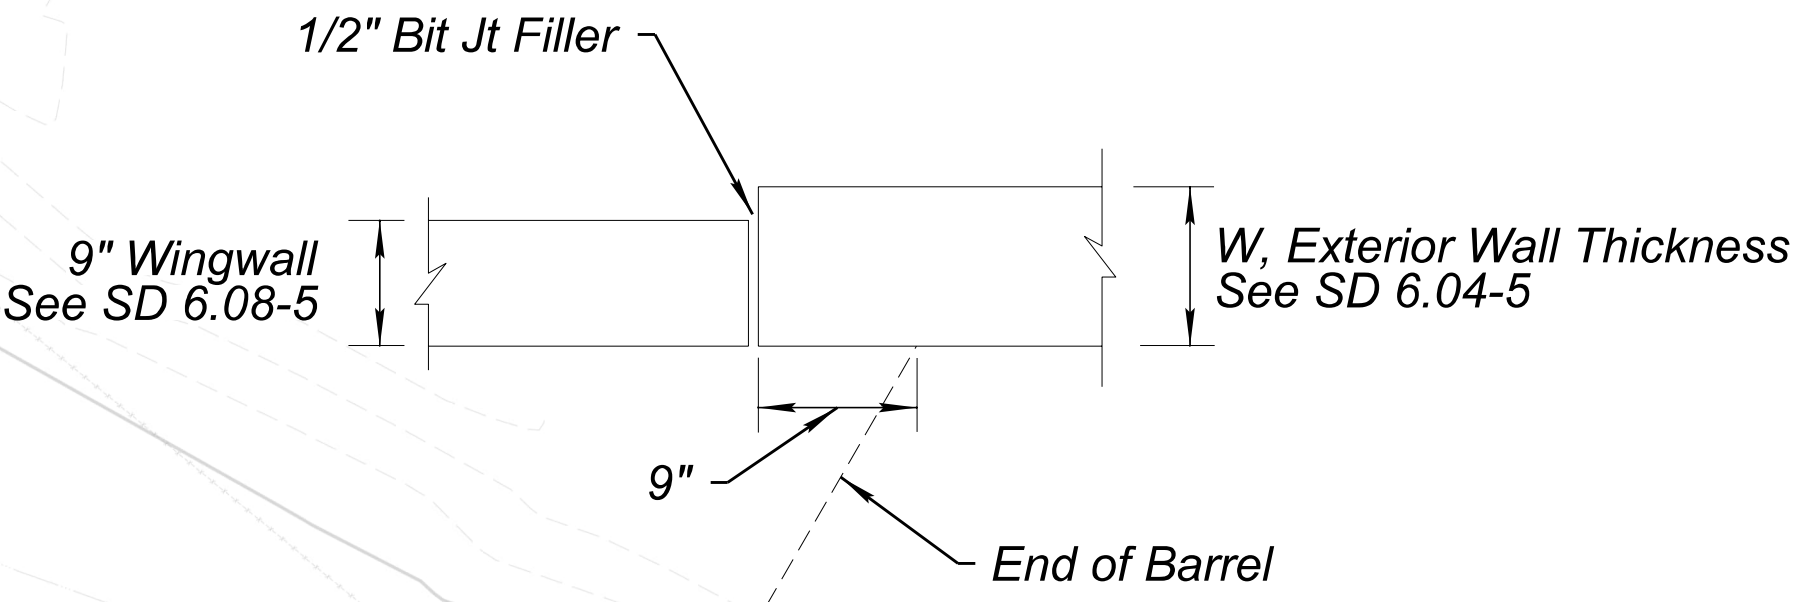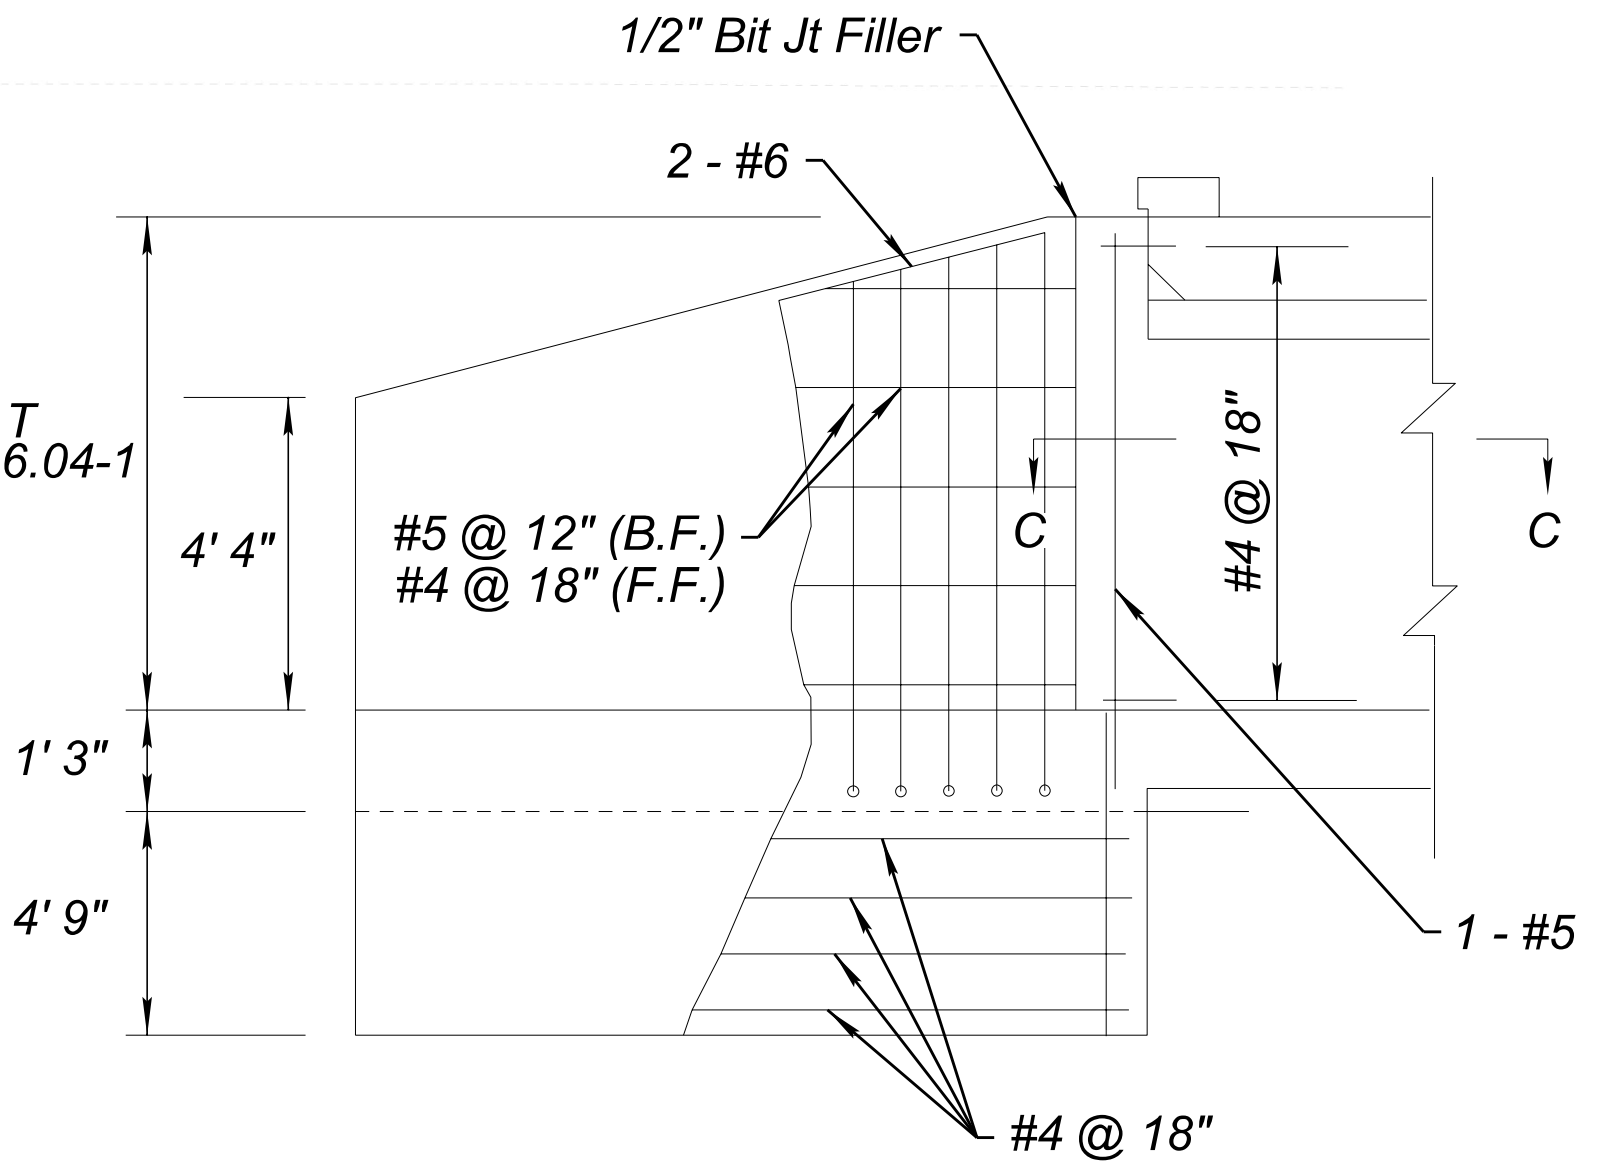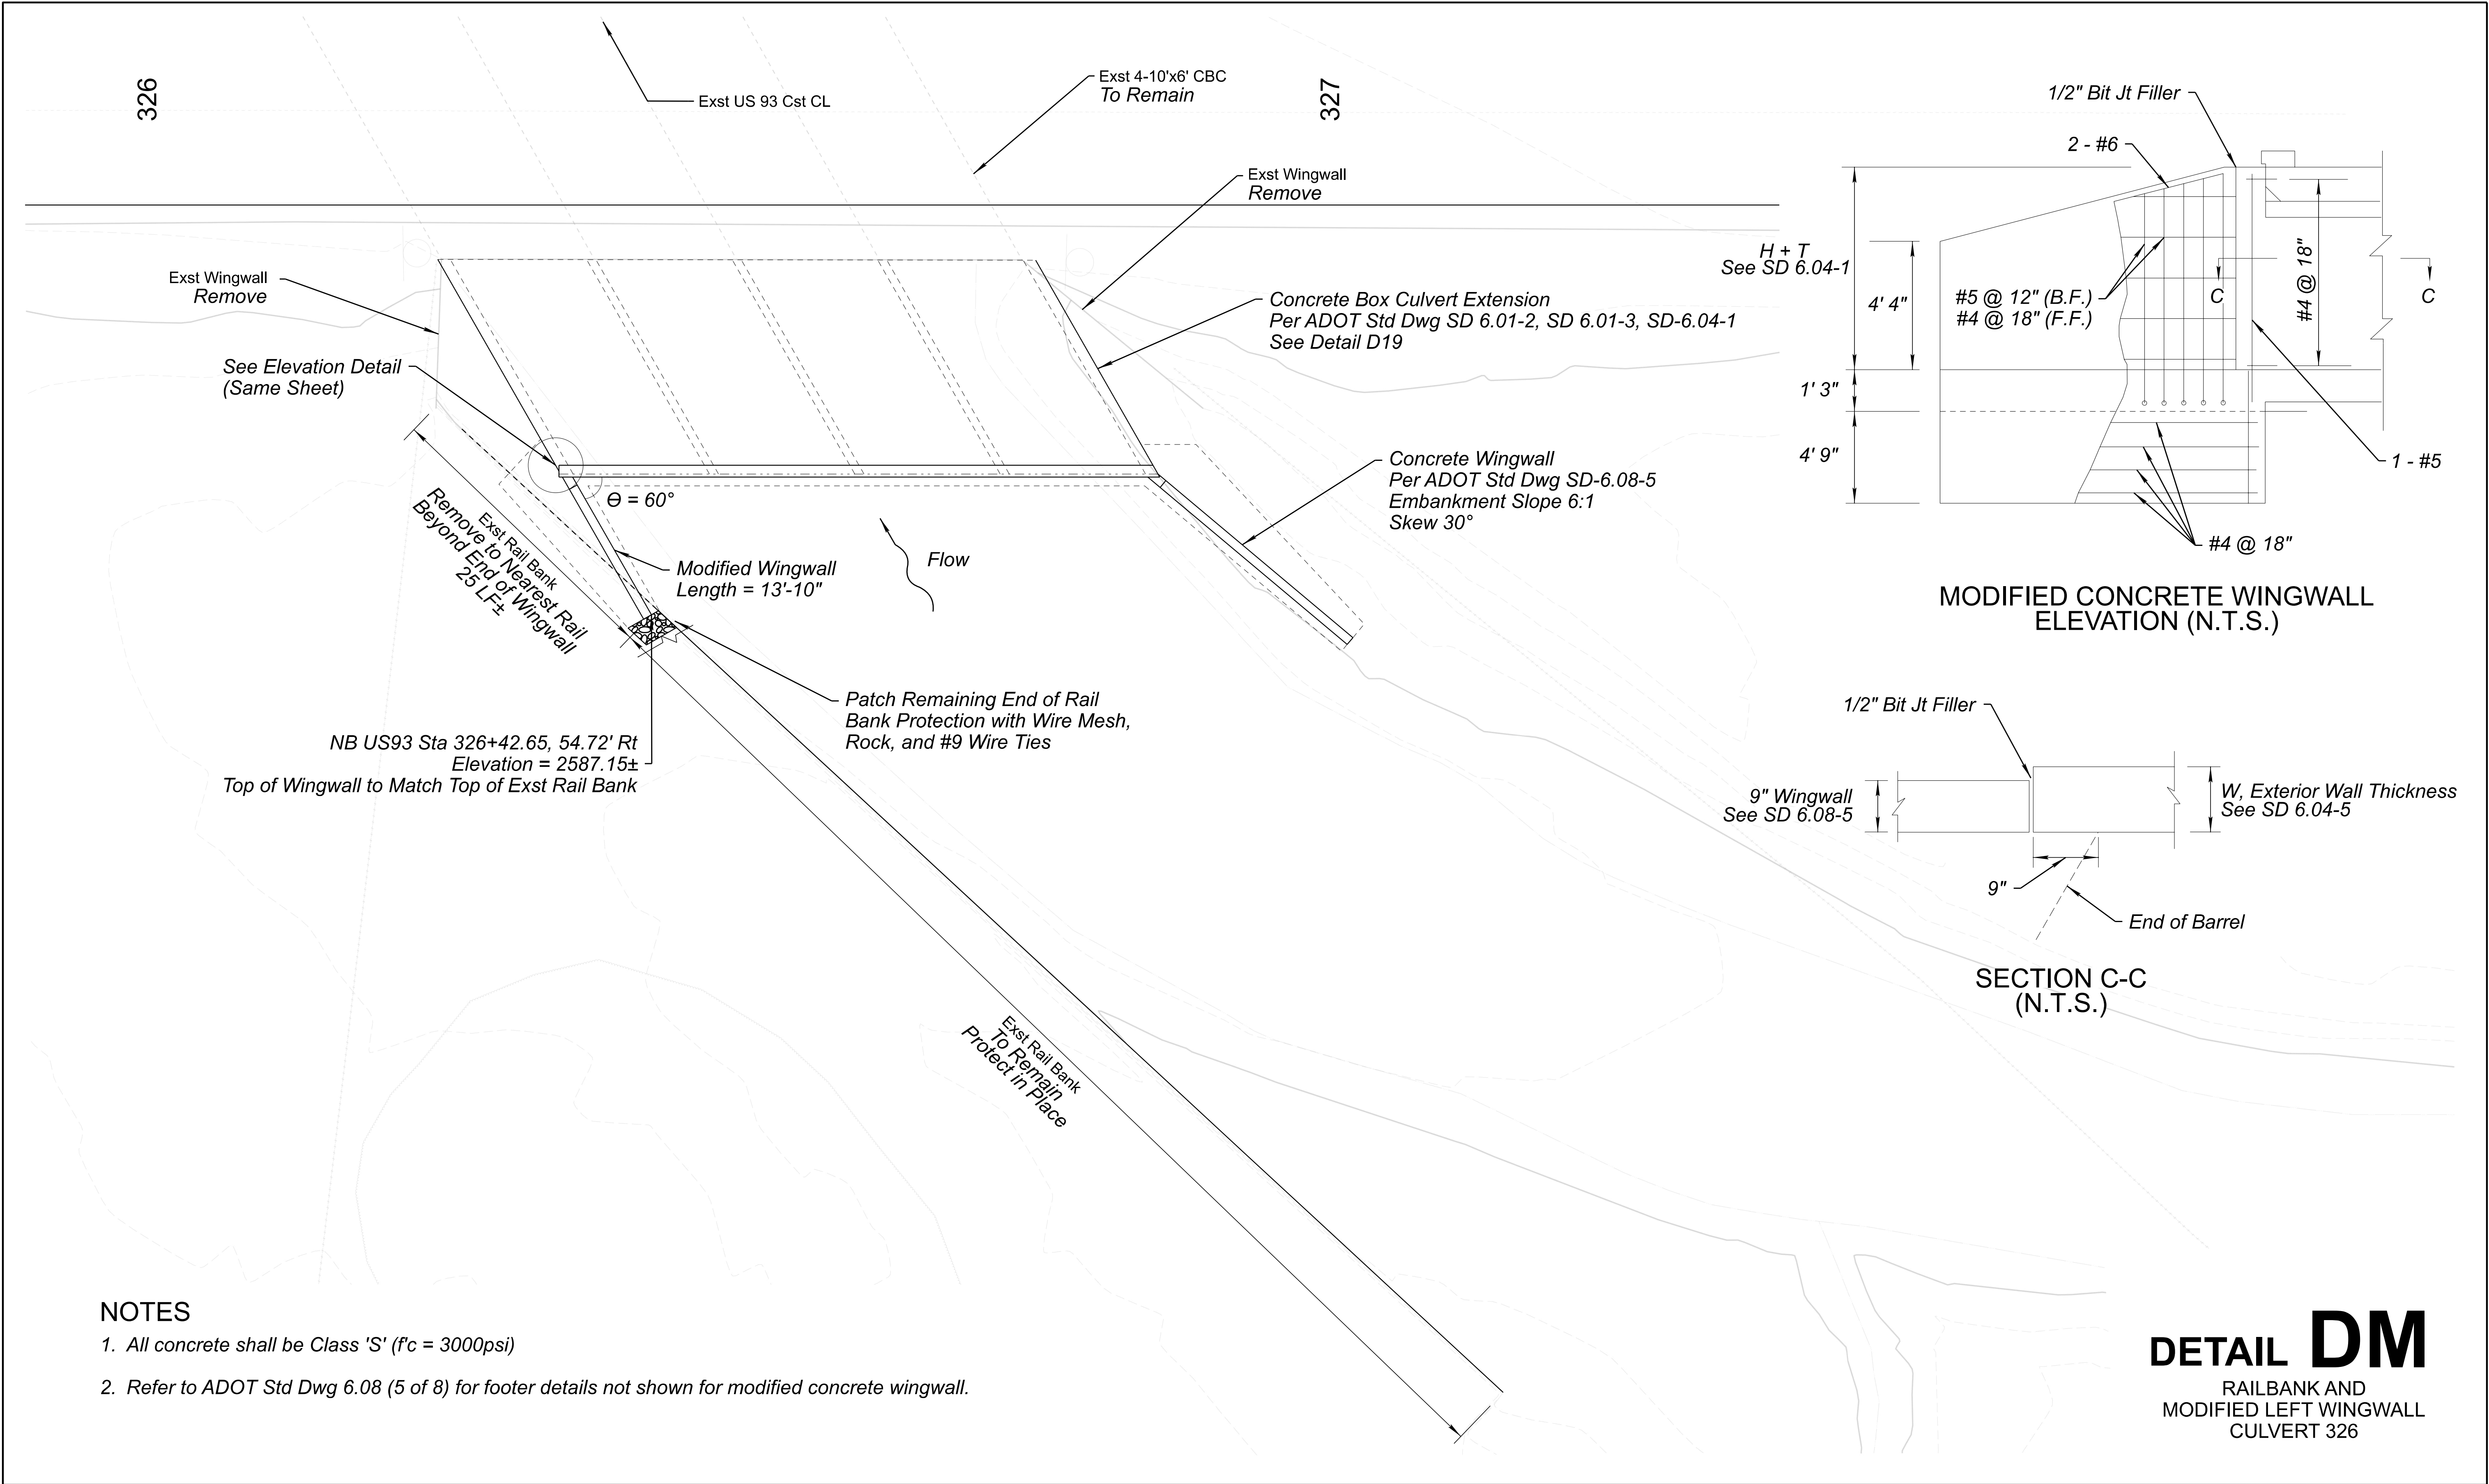


NOTES


1. All concrete shall be Class 'S' ($f'_c = 3000\text{psi}$)
2. Refer to ADOT Std Dwg 6.08 (5 of 8) for footer details not shown for modified concrete wingwall.

DETAIL DM
RAILBANK AND
MODIFIED LEFT WINGWALL
CULVERT 326


	<table><tr><td></td><td>NAME</td><td>DATE</td></tr><tr><td>DESIGN</td><td>K LEANDER</td><td>06/26</td></tr><tr><td>DRAWN</td><td>B LEANDER</td><td>06/26</td></tr><tr><td>CHECKED</td><td>B DENETDALE</td><td>06/26</td></tr></table>			NAME	DATE	DESIGN	K LEANDER	06/26	DRAWN	B LEANDER	06/26	CHECKED	B DENETDALE	06/26	ARIZONA DEPARTMENT OF TRANSPORTATION PROJECT DELIVERY AND OPERATIONS DIVISION ROADWAY DESIGN SERVICES		ROUTE US 93	F.H.W.A. Arizona Division	STATE ARIZ.	PROJECT NO.	FEDERAL ID NO.	SHEET NO.	TOTAL SHEETS	RECORD DRAWING
		NAME	DATE																					
	DESIGN	K LEANDER	06/26																					
	DRAWN	B LEANDER	06/26																					
	CHECKED	B DENETDALE	06/26																					
				MILEPOST 189.9	093 YV 189	093-B(230)T	67	524																
TRANSPORTATION AECOM TECHNICAL SERVICES, Inc. 7720 N. 16th St., Suite 100 Phoenix, Arizona 85020 T 602.371.1100  www.aecom.com		DETAIL DM - RAIL BANK AND MODIFIED LEFT WINGWALL		STRUCTURE NO.	LOCATION WICKENBURG RANCH WAY TO VISTA ROYALE DWG No. D-1.19																			
					TRACS NO. F0738 01C		OF																	

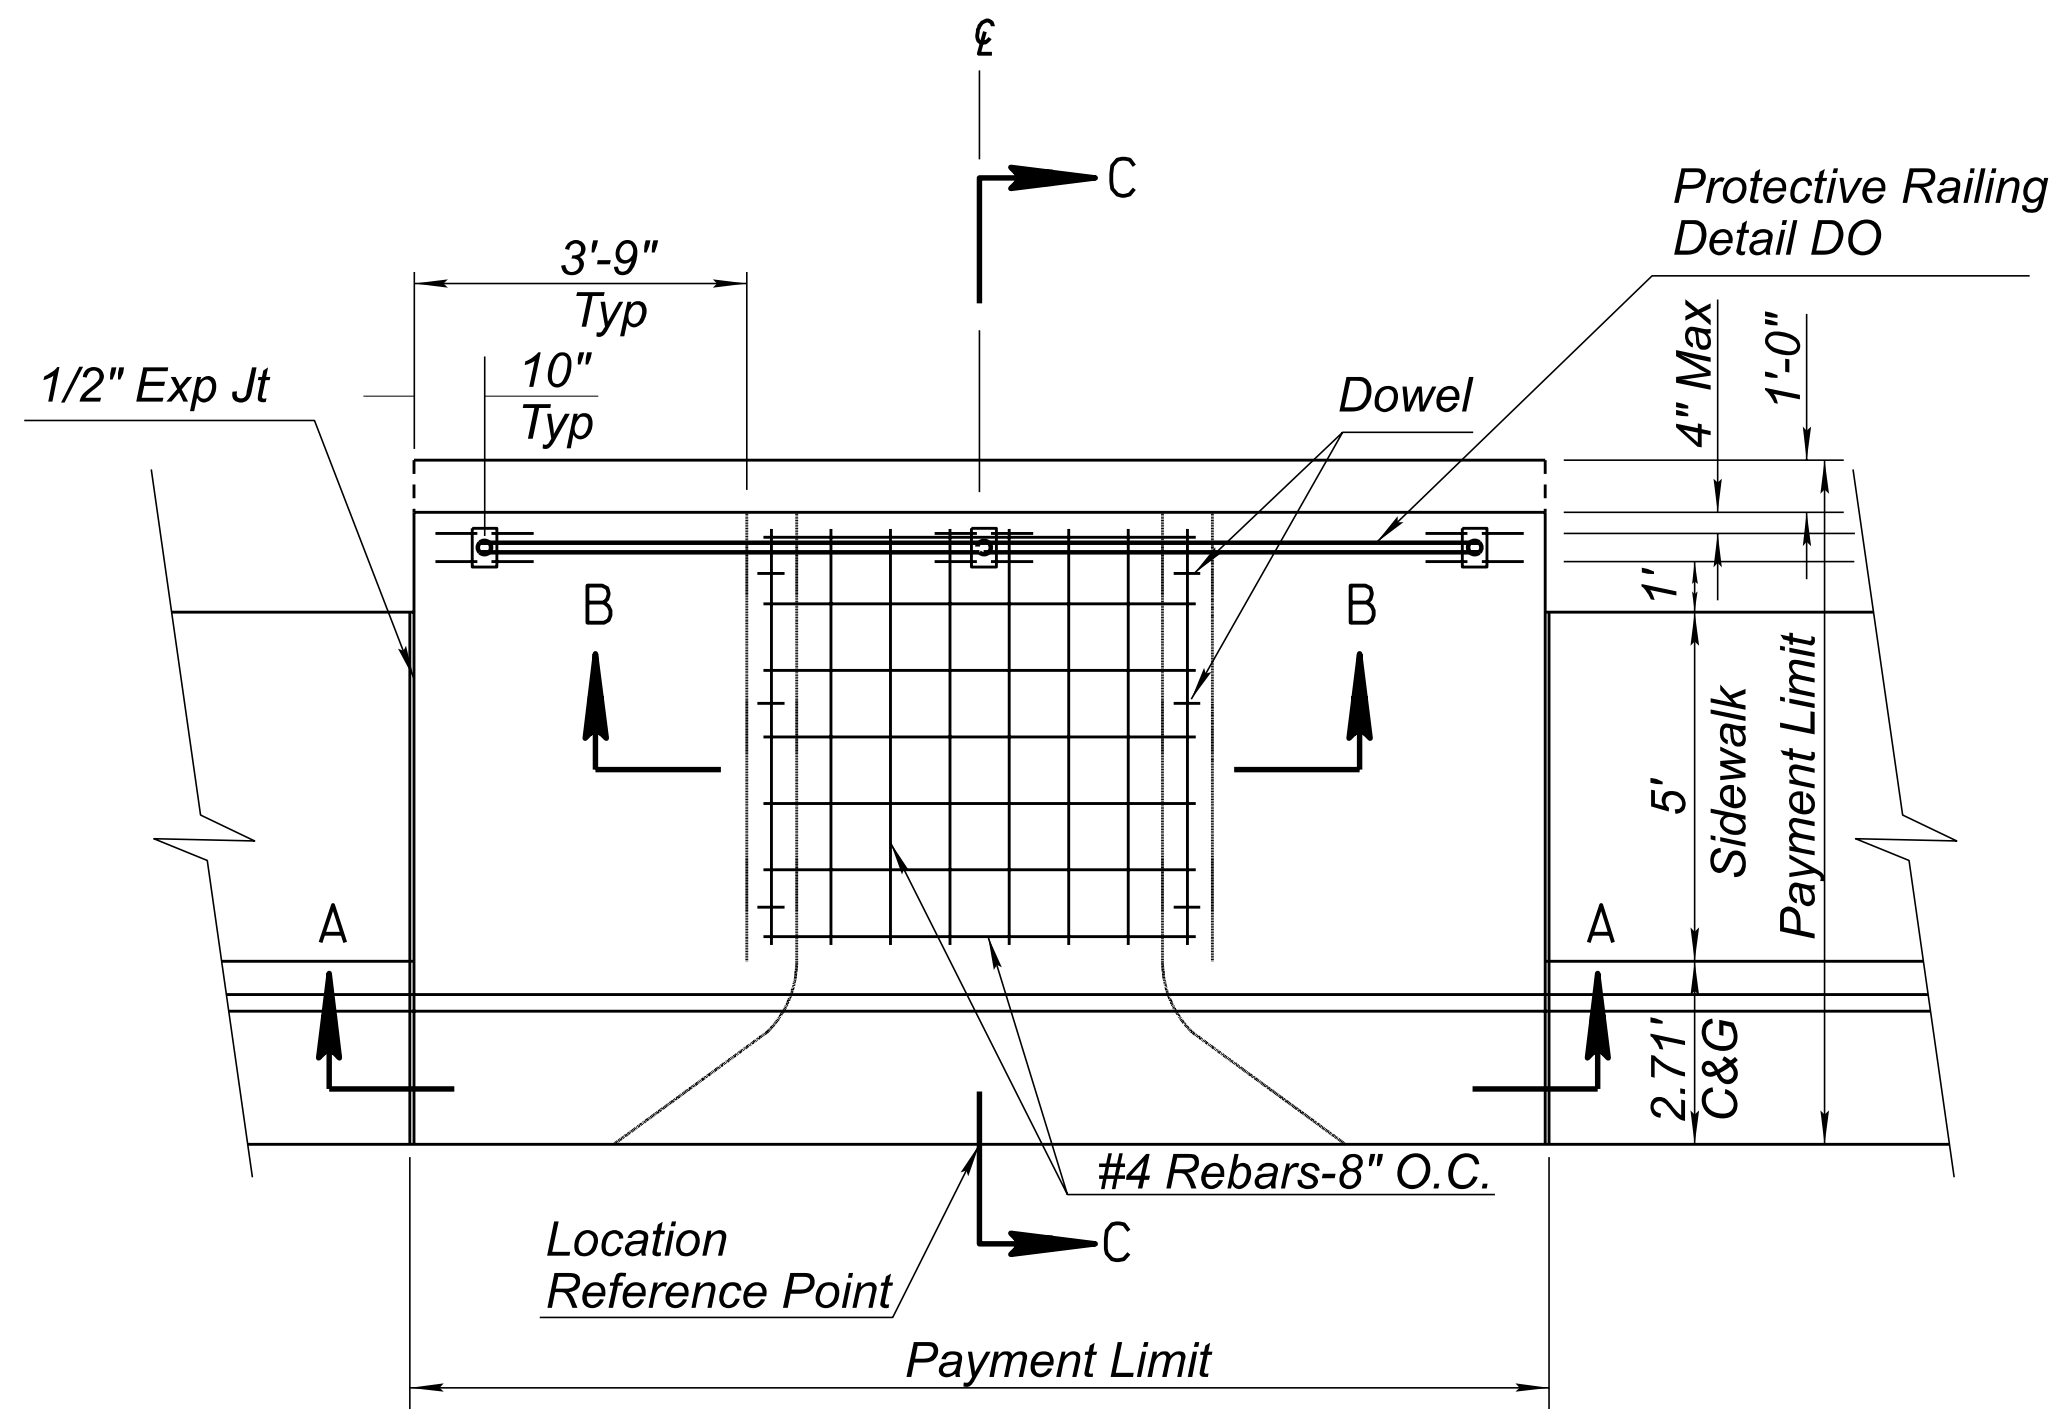


SCUPPER PLAN VIEW
N.T.S.

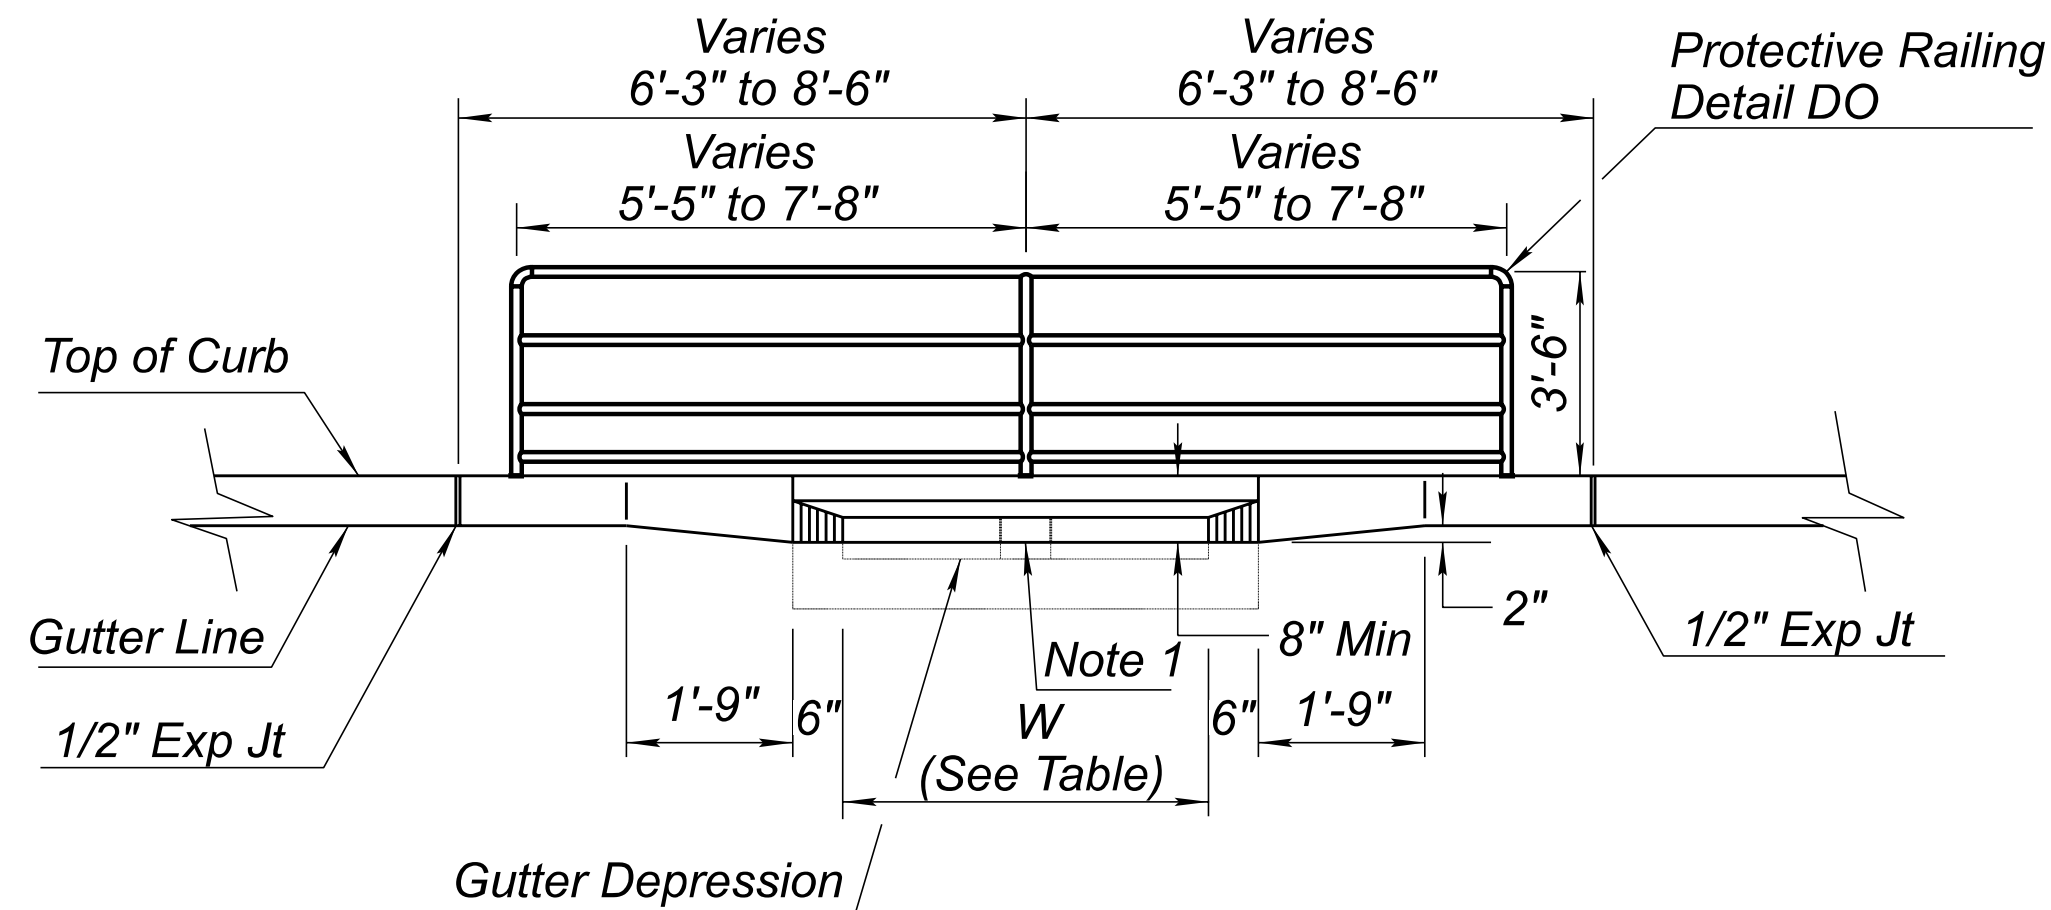


SECTION A-A
N.T.S.

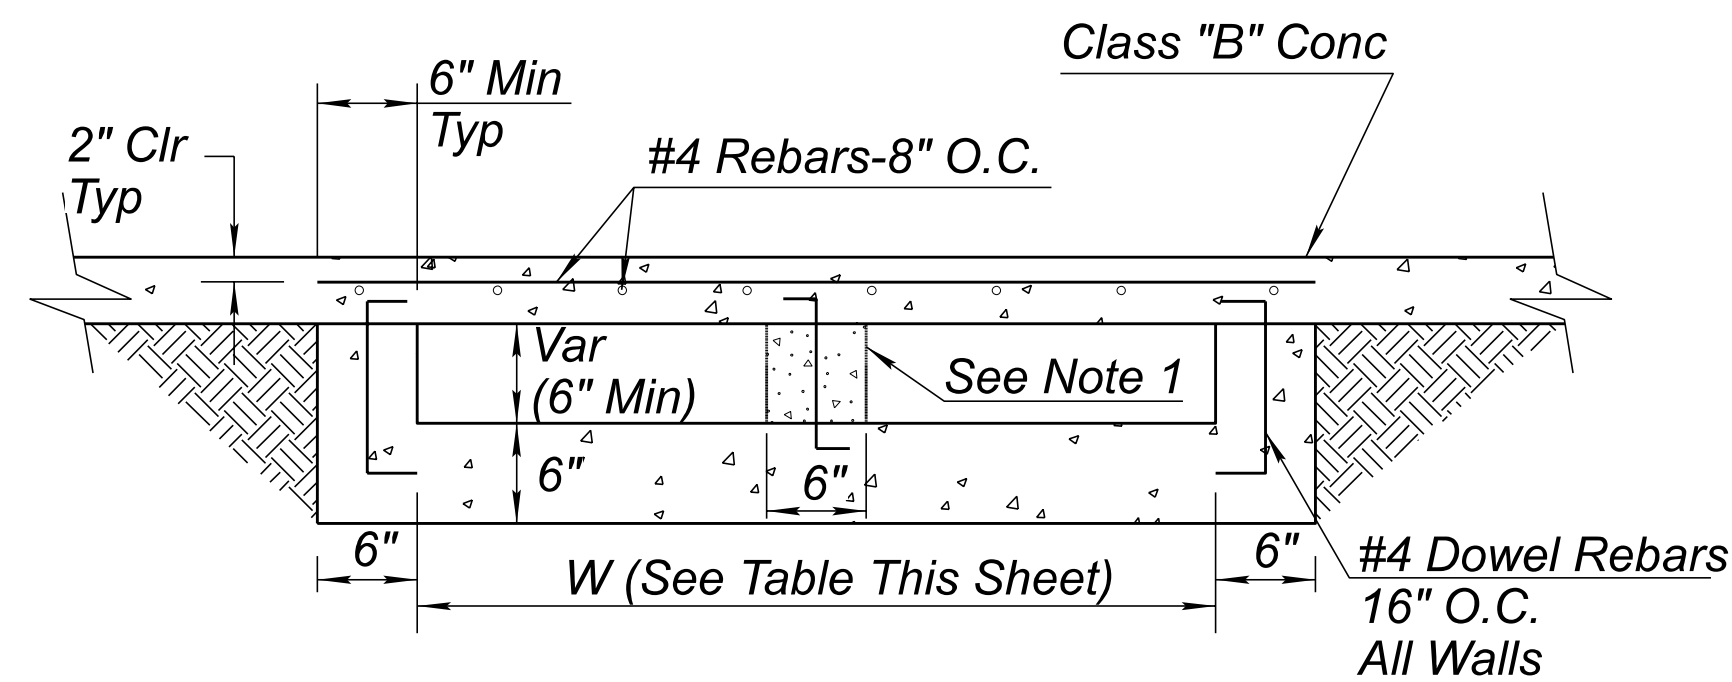

SECTION B-B
N.T.S.

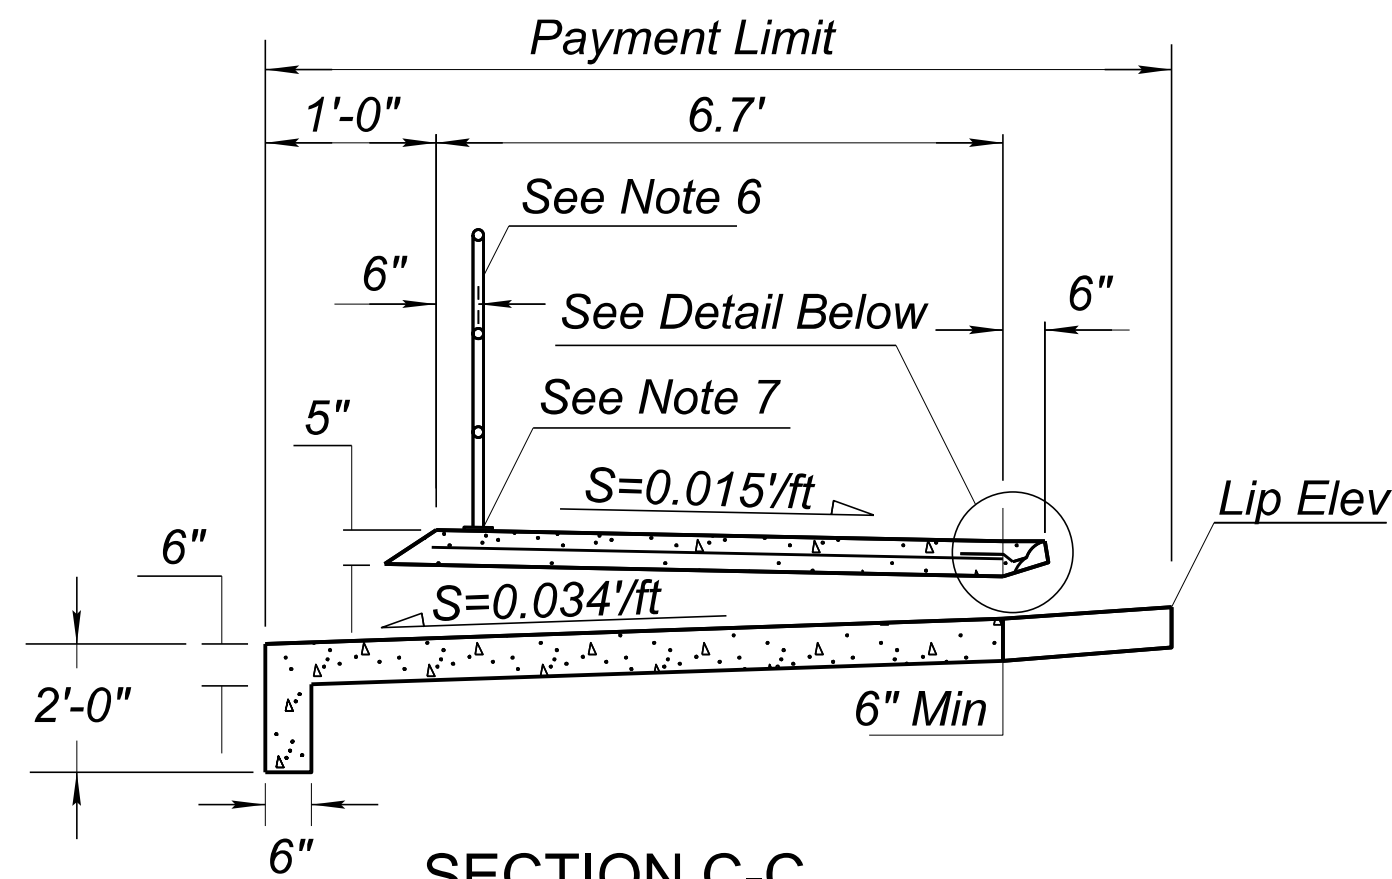

SECTION C-C
N.T.S.

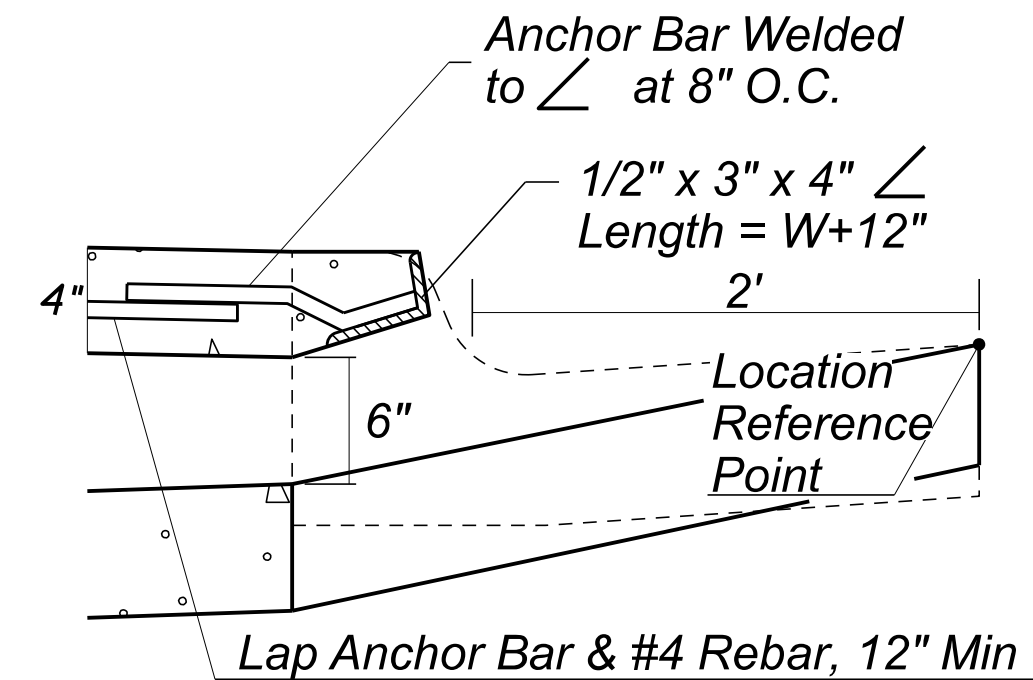


NOTES

- 6" Conc Walls Shall Be Constructed Between Each Barrel of Multi-cell Scuppers.
- Expansion Joint Filler Shall Be 1/2" Bituminous Type Performed Expansion Joint Filler, ASTM D-1751.
- Concrete shall be Class B in accordance with Section 1006 of the Specifications.
- Payment for Protective Railing will be at the Contract Unit Price Per Linear Foot. Item 6110200.
- Protective Rail shall be continuous between the scupper exterior.
- Use welded plates for protective rail anchors located in the 5" thick concrete (see Detail DO).
- Construct spillway with straight flowline slope between scupper flowline and toe of embankment slope.

US 93 Cst CL Station	No. of Barrels*	W (Ft)	Spillway Length	Item 8101016
			Rock Mulch L ₁ (Ft)	Rock Mulch (CY)
221+87.89	1	3	9.57	3
221+84.91	1	3	6.23	3
224+97.00	1	3	20.09	4
224+85.00	1	3	13.14	3

DETAIL DN


CONCRETE SCUPPER
SHEET 1 OF 3

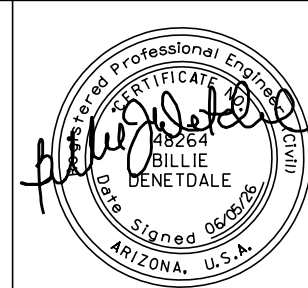

DESIGN	NAME	DATE
DRAWN	K LEANDER	06/26
CHECKED	B DENETDALE	06/26

ARIZONA DEPARTMENT OF TRANSPORTATION PROJECT DELIVERY AND OPERATIONS DIVISION ROADWAY DESIGN SERVICES
DETAIL DN - CONCRETE SCUPPER SHEET 1 OF 3


ROUTE US 93	F.H.W.A. Arizona Division	STATE ARIZ.	PROJECT NO. 093 YV 189	FEDERAL ID NO. 093-B(230)T	SHEET NO. 68	TOTAL SHEETS 524	RECORD DRAWING
MILEPOST 189.9	LOCATION WICKENBURG RANCH WAY TO VISTA ROYALE					DWG No. D-1.20	
STRUCTURE NO.	TRACS NO. F0738 01C					____ OF ____	

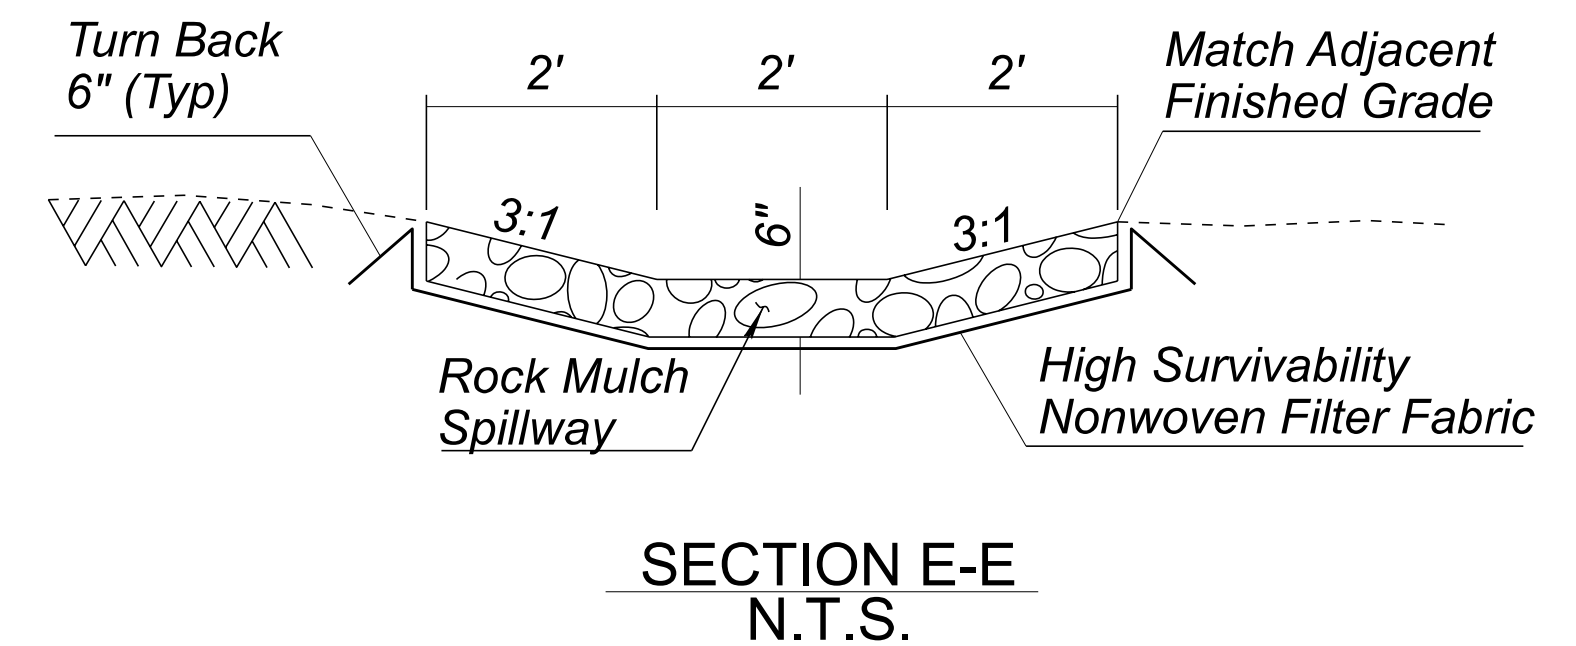


3. *All new concrete shall be Class B, in Accordance with Section 1006 of the Specifications.*
4. *Install Rock Mulch such that top of surface matches adjacent finished grade.*
5. *Rock Mulch shall be in accordance with Section 810-2 of the Specifications, and shall be Gradation C.*

DETAIL DN
CONCRETE SCUPPER
SHEET 2 OF 3

	DESIGN	K LEANDER	06/26	ARIZONA DEPARTMENT OF TRANSPORTATION PROJECT DELIVERY AND OPERATIONS DIVISION ROADWAY DESIGN SERVICES	ROUTE	US 93	F.H.W.A. Arizona Division	STATE	ARIZ.	PROJECT NO.	093 YV 189	FEDERAL ID NO.	093-B(230)T	SHEET NO.	69	TOTAL SHEETS	524	RECORD DRAWING		
	DRAWN	B LEANDER	06/26		MILEPOST	189.9		LOCATION	WICKENBURG RANCH WAY TO VISTA ROYALE										DWG NO.	D-1.21
	CHECKED	B DENETDALE	06/26		STRUCTURE NO.			TRACS NO.	F0738 01C										OF	
	TRANSPORTATION AECOM TECHNICAL SERVICES, Inc. 7720 W. 16th St., Suite 100 Phoenix, Arizona 85020 T 602.371.1100 www.aecom.com			DETAIL DN - CONCRETE SCUPPER SHEET 2 OF 3																

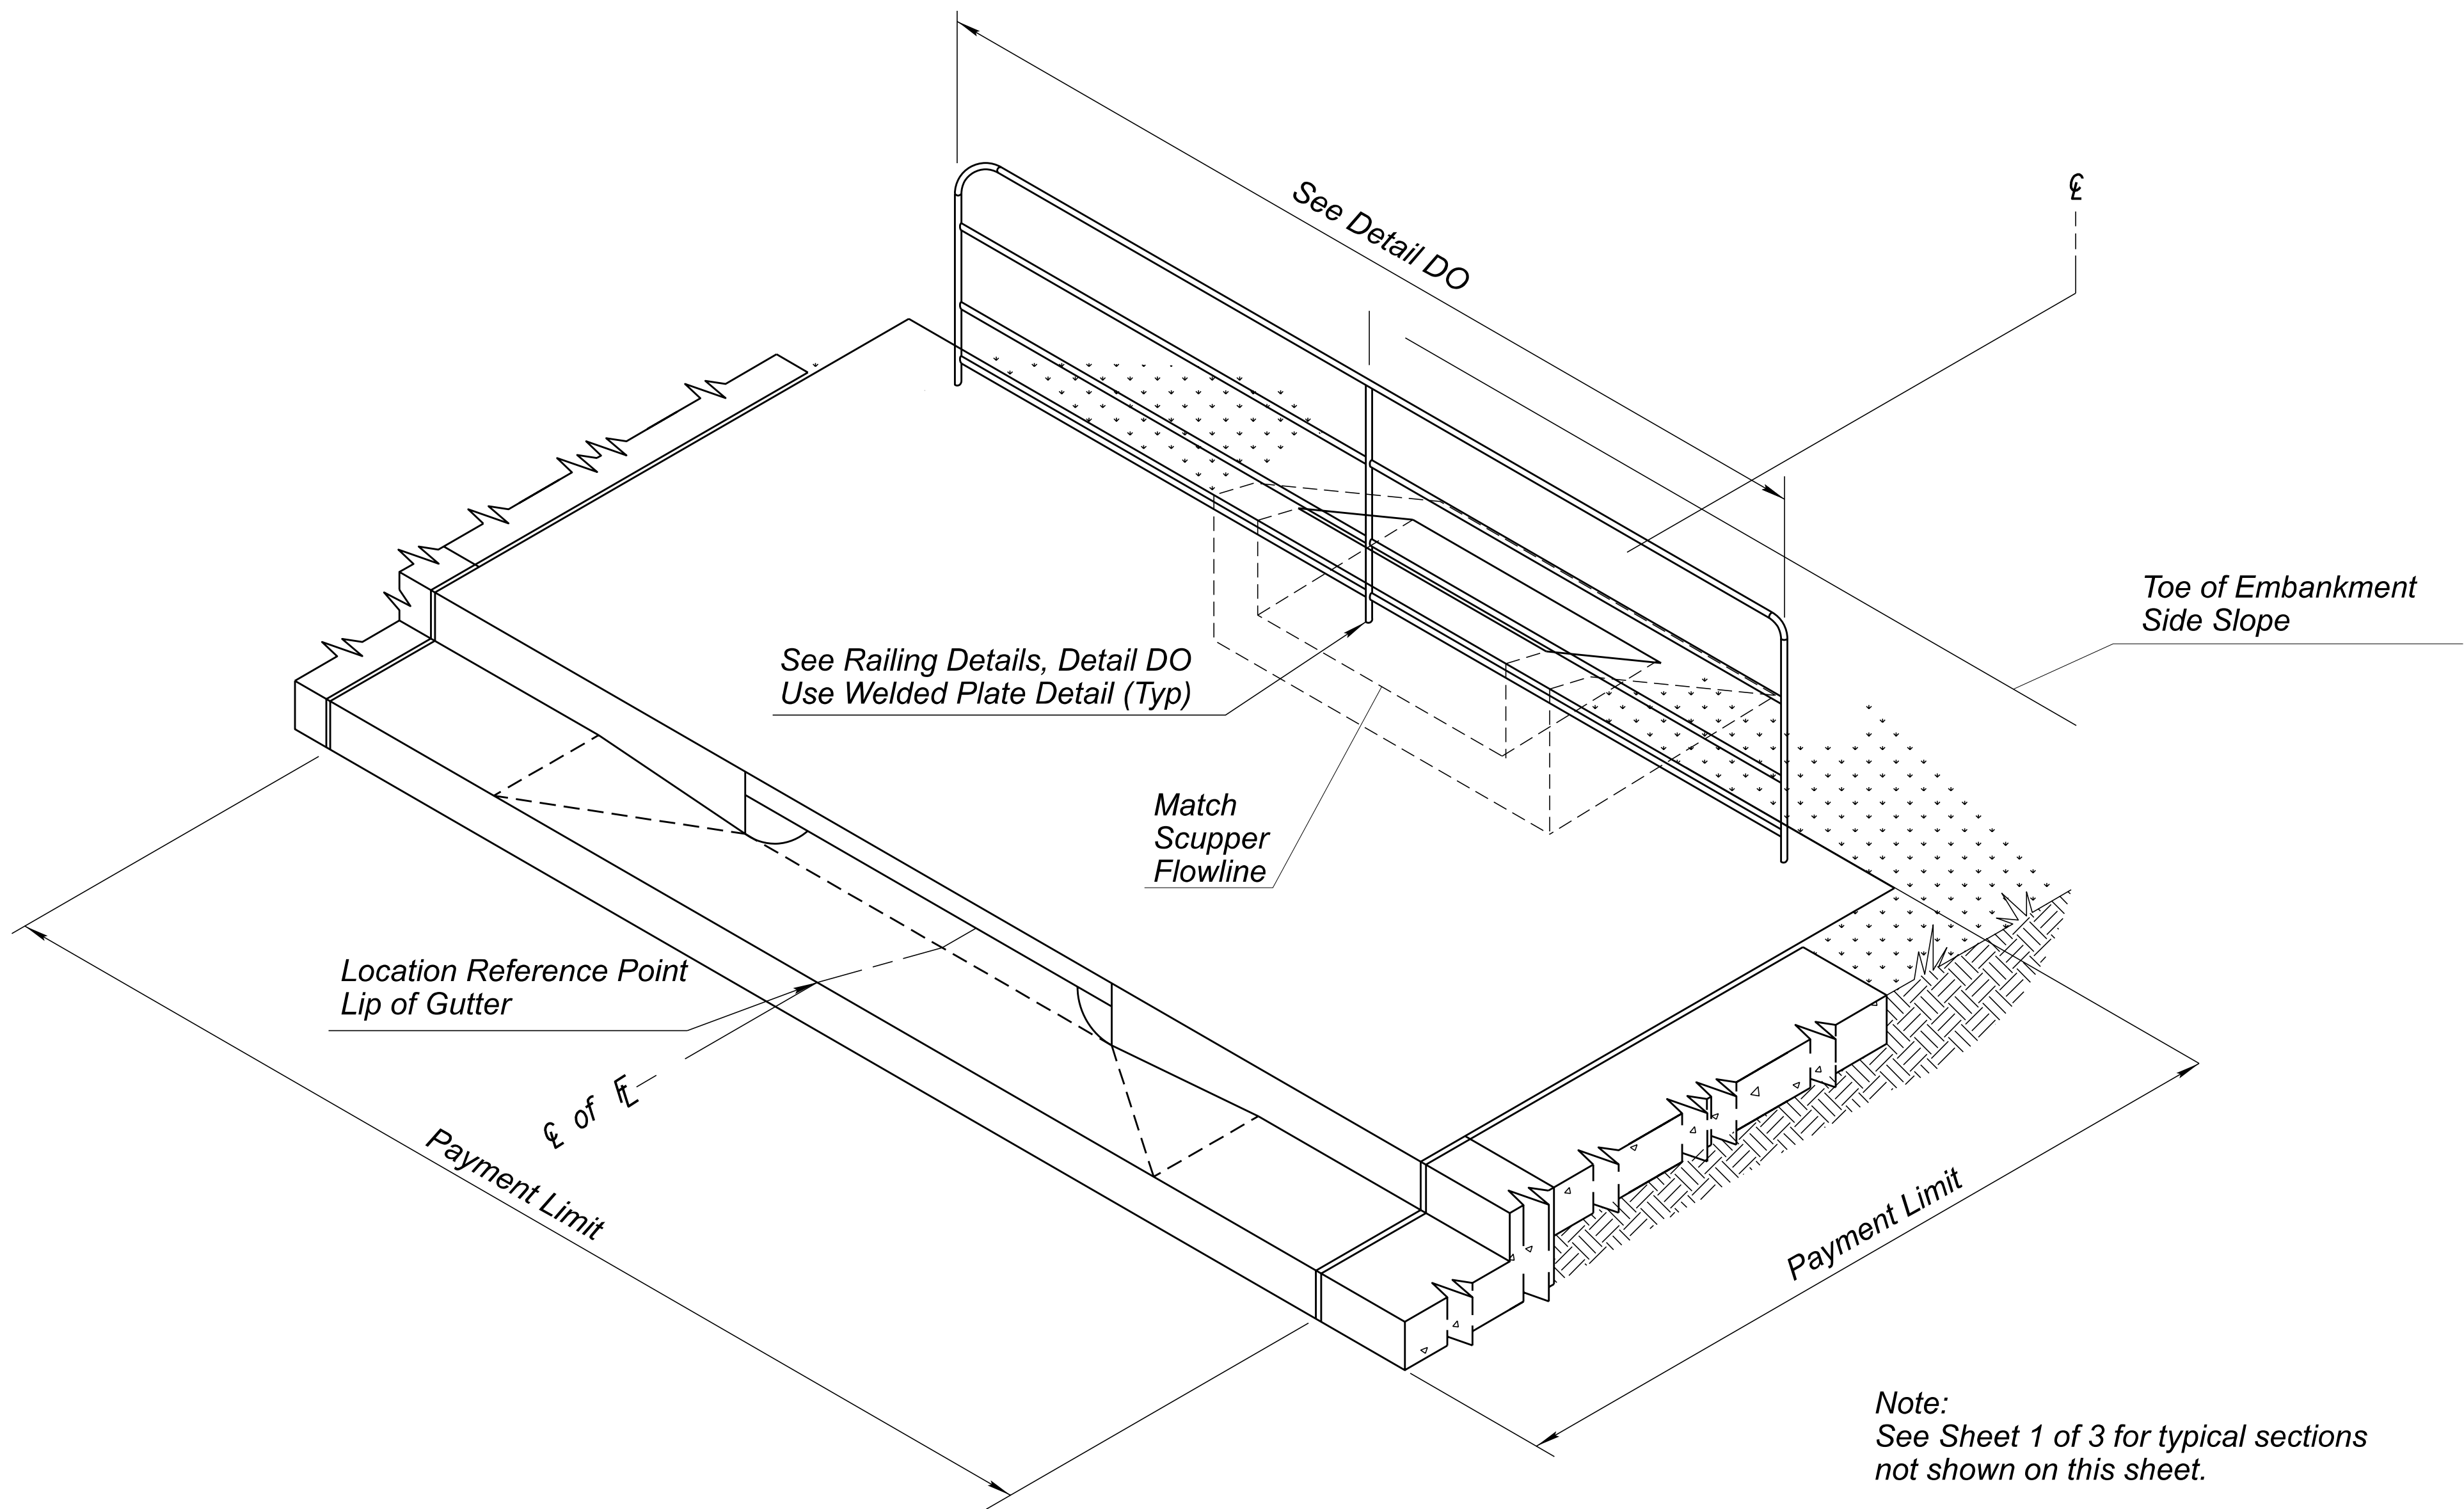

DETAIL **DN**
CONCRETE SCUPPER
SHEET 3 OF 3

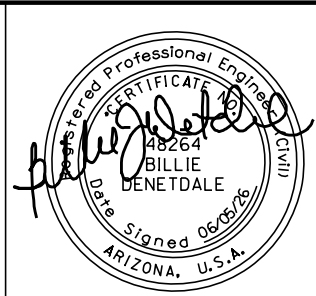

	NAME	DATE
DESIGN	K LEANDER	06/26
DRAWN	B LEANDER	06/26
CHECKED	B DENETDALE	06/26

TRANSPORTATION
AECOM TECHNICAL SERVICES, Inc.
7720 N. 16th St., Suite 100
Phoenix, Arizona 85020
T 602.371.1100

AECOM
www.aecom.com

ARIZONA DEPARTMENT OF TRANSPORTATION PROJECT DELIVERY AND OPERATIONS DIVISION ROADWAY DESIGN SERVICES
DETAIL DN - CONCRETE SCUPPER SHEET 3 OF 3

ROUTE US 93	F.H.W.A. Arizona Division	STATE	PROJECT NO.	FEDERAL ID NO.	SHEET NO.	TOTAL SHEETS	RECORD DRAWING
MILEPOST 189.9		ARIZ.	093 YV 189	093-B(230)T	70	524	
	LOCATION WICKENBURG RANCH WAY TO VISTA ROYALE						DWG No. D-1.22
STRUCTURE NO.	TRACS NO. F0738 01C						OF



Technical drawing of a handrail post showing dimensions and materials. The drawing includes the following labels and dimensions:

- Handrail Post**: Points to the top of the post.
- 1" (Typ)**: Dimension for the top of the post.
- Finish Grade**: Points to the ground level.
- Utility Concrete**: Points to the concrete base.
- 30" Min**: Minimum height of the post above the finish grade.
- 6" Min**: Minimum height of the concrete base below the finish grade.
- 4" Min**: Minimum width of the concrete base on each side.



POST MOUNTING DETAIL
GROUND INSTALLATION DETAIL
NTS

PROTECTIVE RAILING QUANTITIES			
Roadway	Station	Side	Length (LF)
US 93 Cst CL	2125+56	Lt	40'
US 93 Cst CL	2125+56	Rt	29'
Wickenburg Ranch Way	57+51	Lt	41'
Wickenburg Ranch Way	57+51	Rt	50'
Abut 1 Wall	*		
Abut 2 Wall	*		
SB US 93	221+89	Rt	11'
SB US 93	221+86	Lt	11'
SB US 93	224+98	Rt	11'
SB US 93	224+88	Lt	11'

**See Bridge Plans for Retaining Wall Handrail Quantities*



1. *All welding shall be in accordance with Section 604-3.06 of the Specifications.*
2. *Posts shall be installed vertically. Railings shall be installed so that they are parallel to the Sidewalk or top of wall.*
3. *Pipe Shall be in Accordance With the Requirements of ASTM A 53, Type E or S, Grade B (Fy=35ksi).*
4. *Railing Assemblies Shall be Galvanized After Fabrication in Accordance With ASTM A 123.*
5. *Vertical Posts To Be Evenly Spaced.*
6. *Remove All Sharp Edges.*
7. *The Embedment for Anchor Types 1 and 2 Shall Be Located Inside the Wall Reinforcement Cage.*

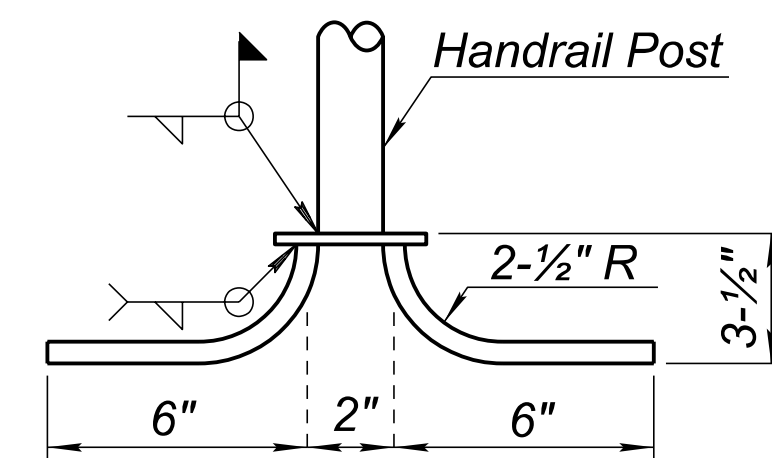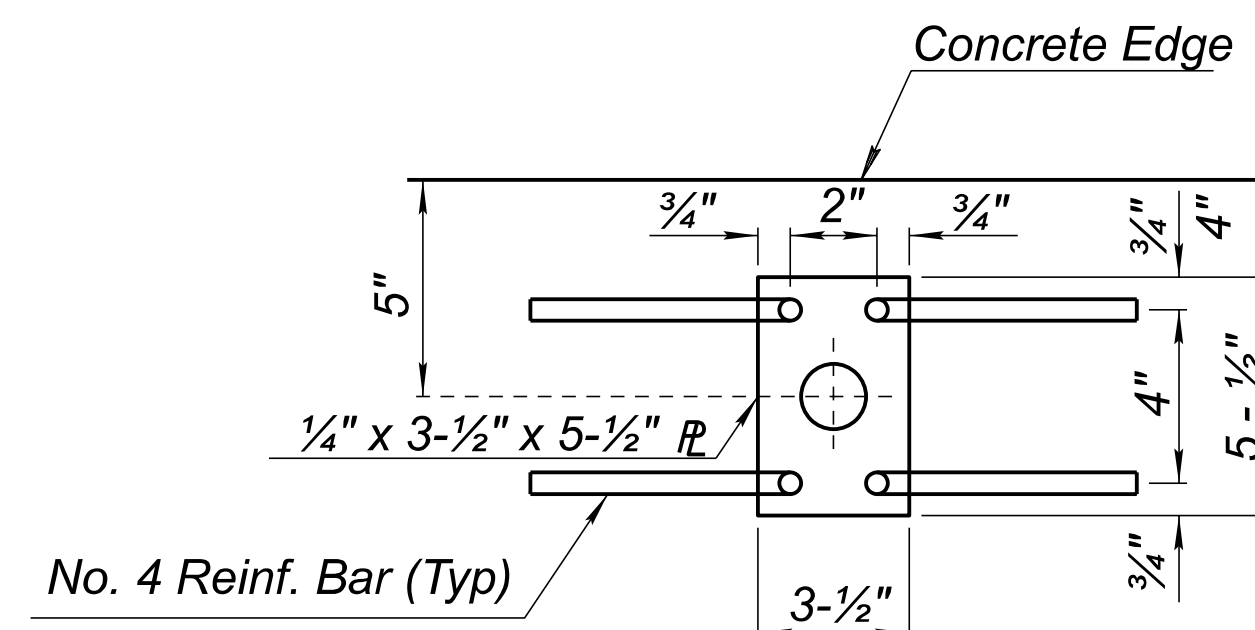


SCUPPER MOUNTING DETAIL
WELDED PLATE DETAIL
NTS

DETAIL DO
METAL HANDRAIL

F.H.W.A. REGION	STATE	PROJECT NO.	SHEET NO.	TOTAL SHEETS	RECORD DRAWING
9	ARIZ.	093-B(230)T	72	524	

093 YV 189

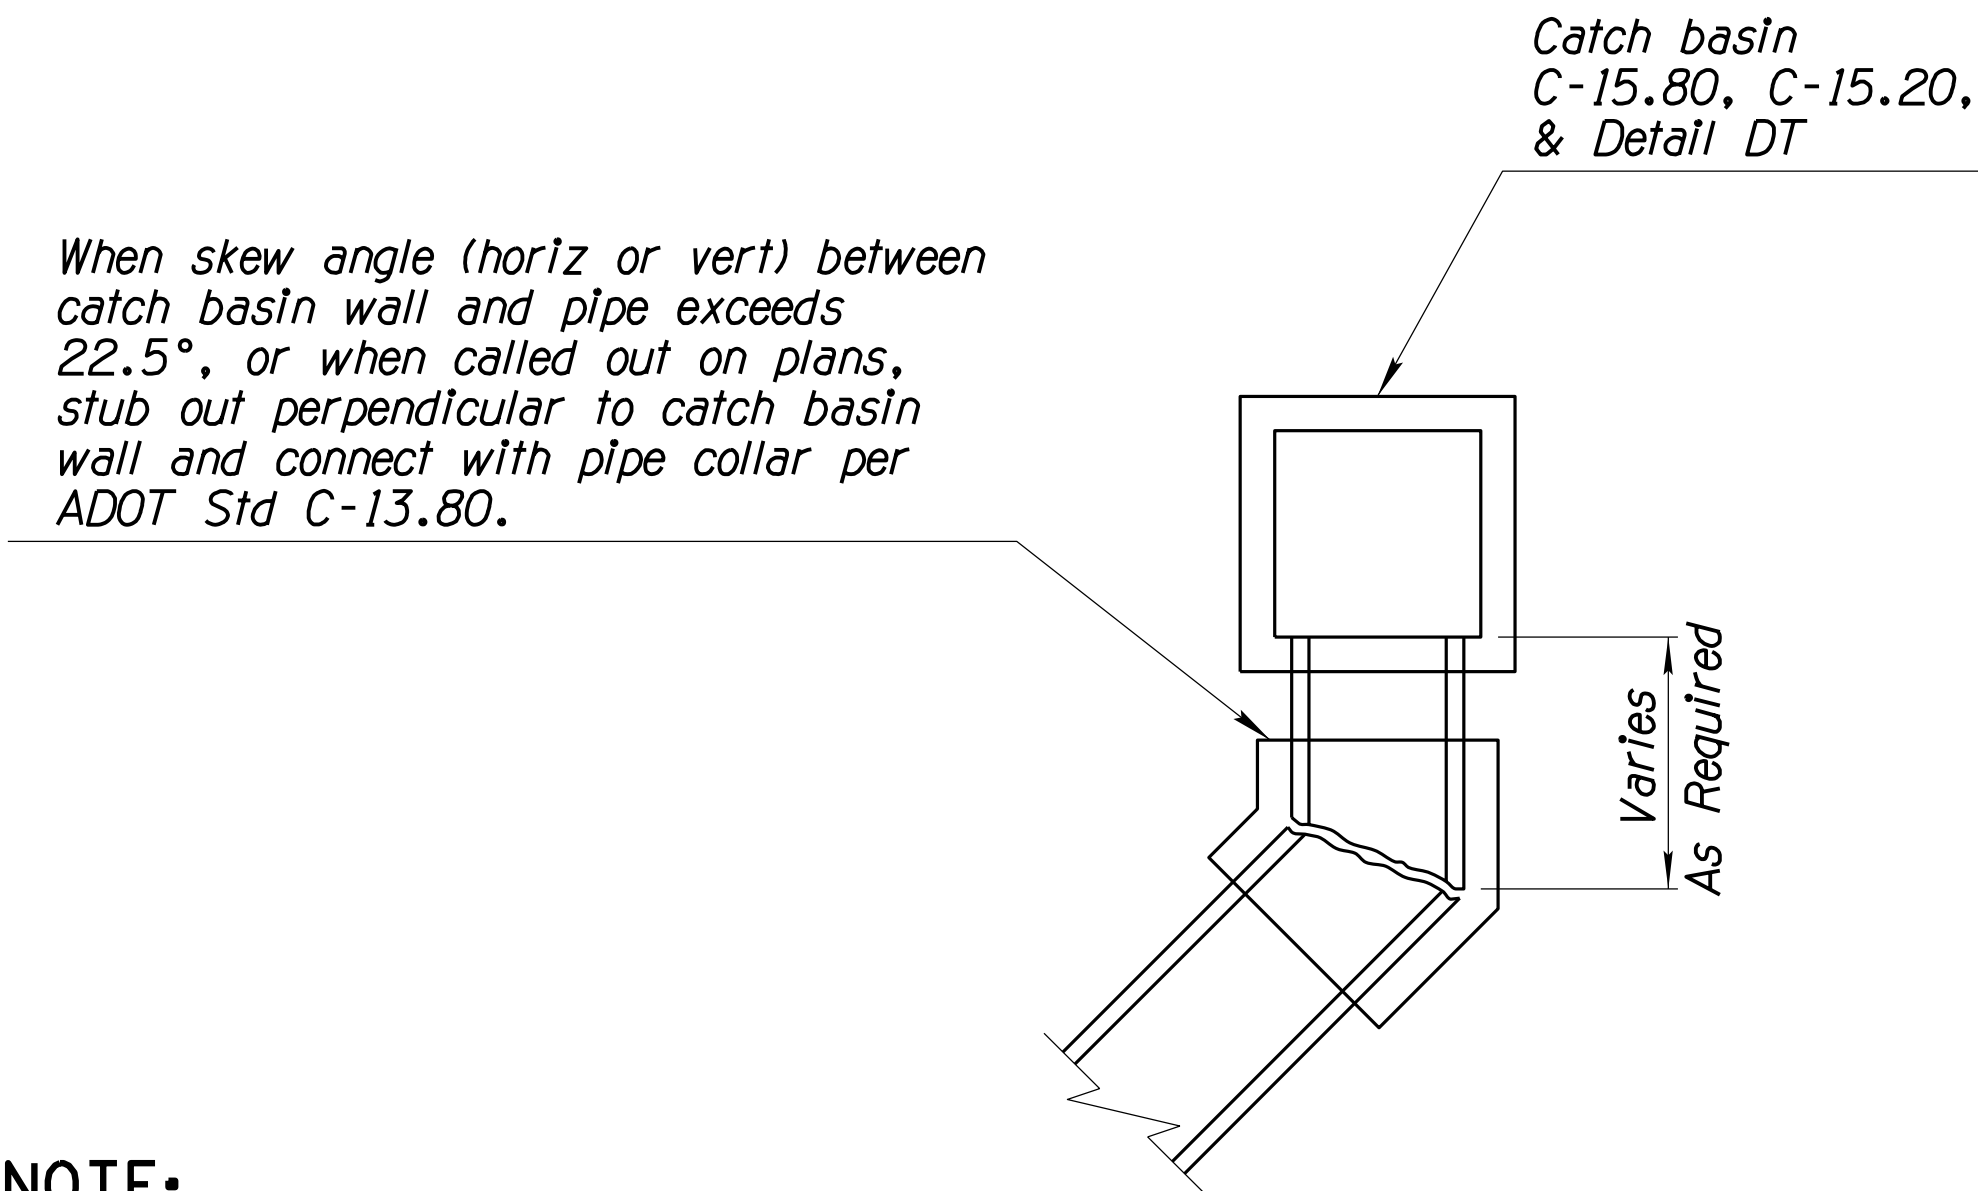


NOTE:
No measurement or direct payment will be made for the pipe connection or pipe collar, the cost being considered as included in the cost of the pipe.


PLAN VIEW
PIPE CONNECTION DETAIL
N.T.S.

DETAIL DP

DESIGN	JML	DATE	06-26	ARIZONA DEPARTMENT OF TRANSPORTATION PROJECT DELIVERY AND OPERATIONS DIVISION ROADWAY DESIGN SERVICES	
DRAWN	EM	DATE	06-26		
CHECKED	DBK	DATE	06-26		
 3133 East Camelback Road, Suite 100 Phoenix, Arizona 85016 Phone: (602) 333-2200				DETAIL DP PIPE CONNECTION DETAILS	
ROUTE		LOCATION		DWG NO. D-1.24	
US 93		WICKENBURG RANCH WAY TO VISTA ROYALE			
TRACS NO. F0738 OIC			093-B(230)T		
			OF		

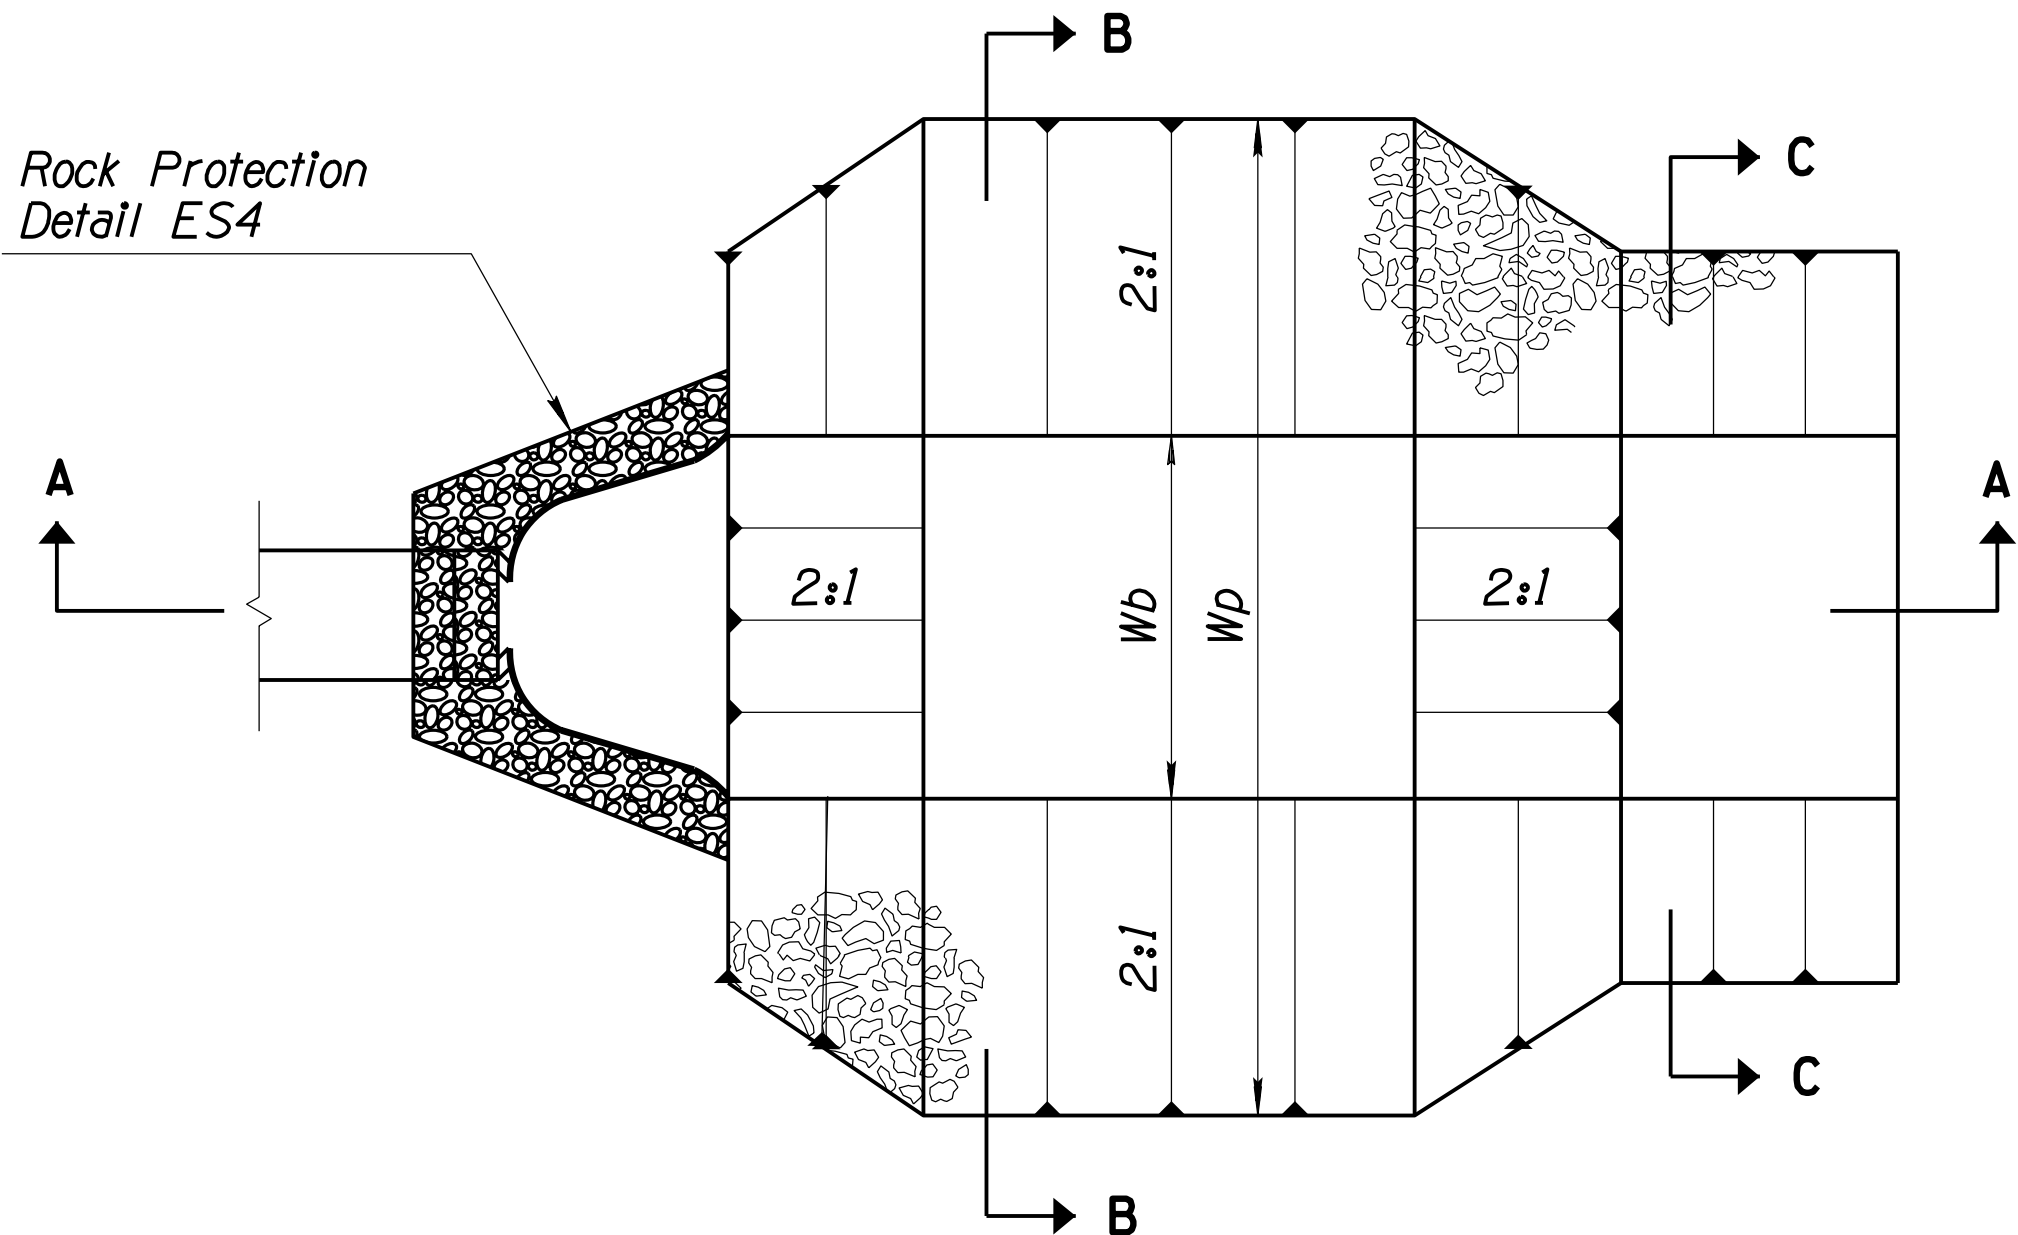

PLAN - FLARED END SECTION

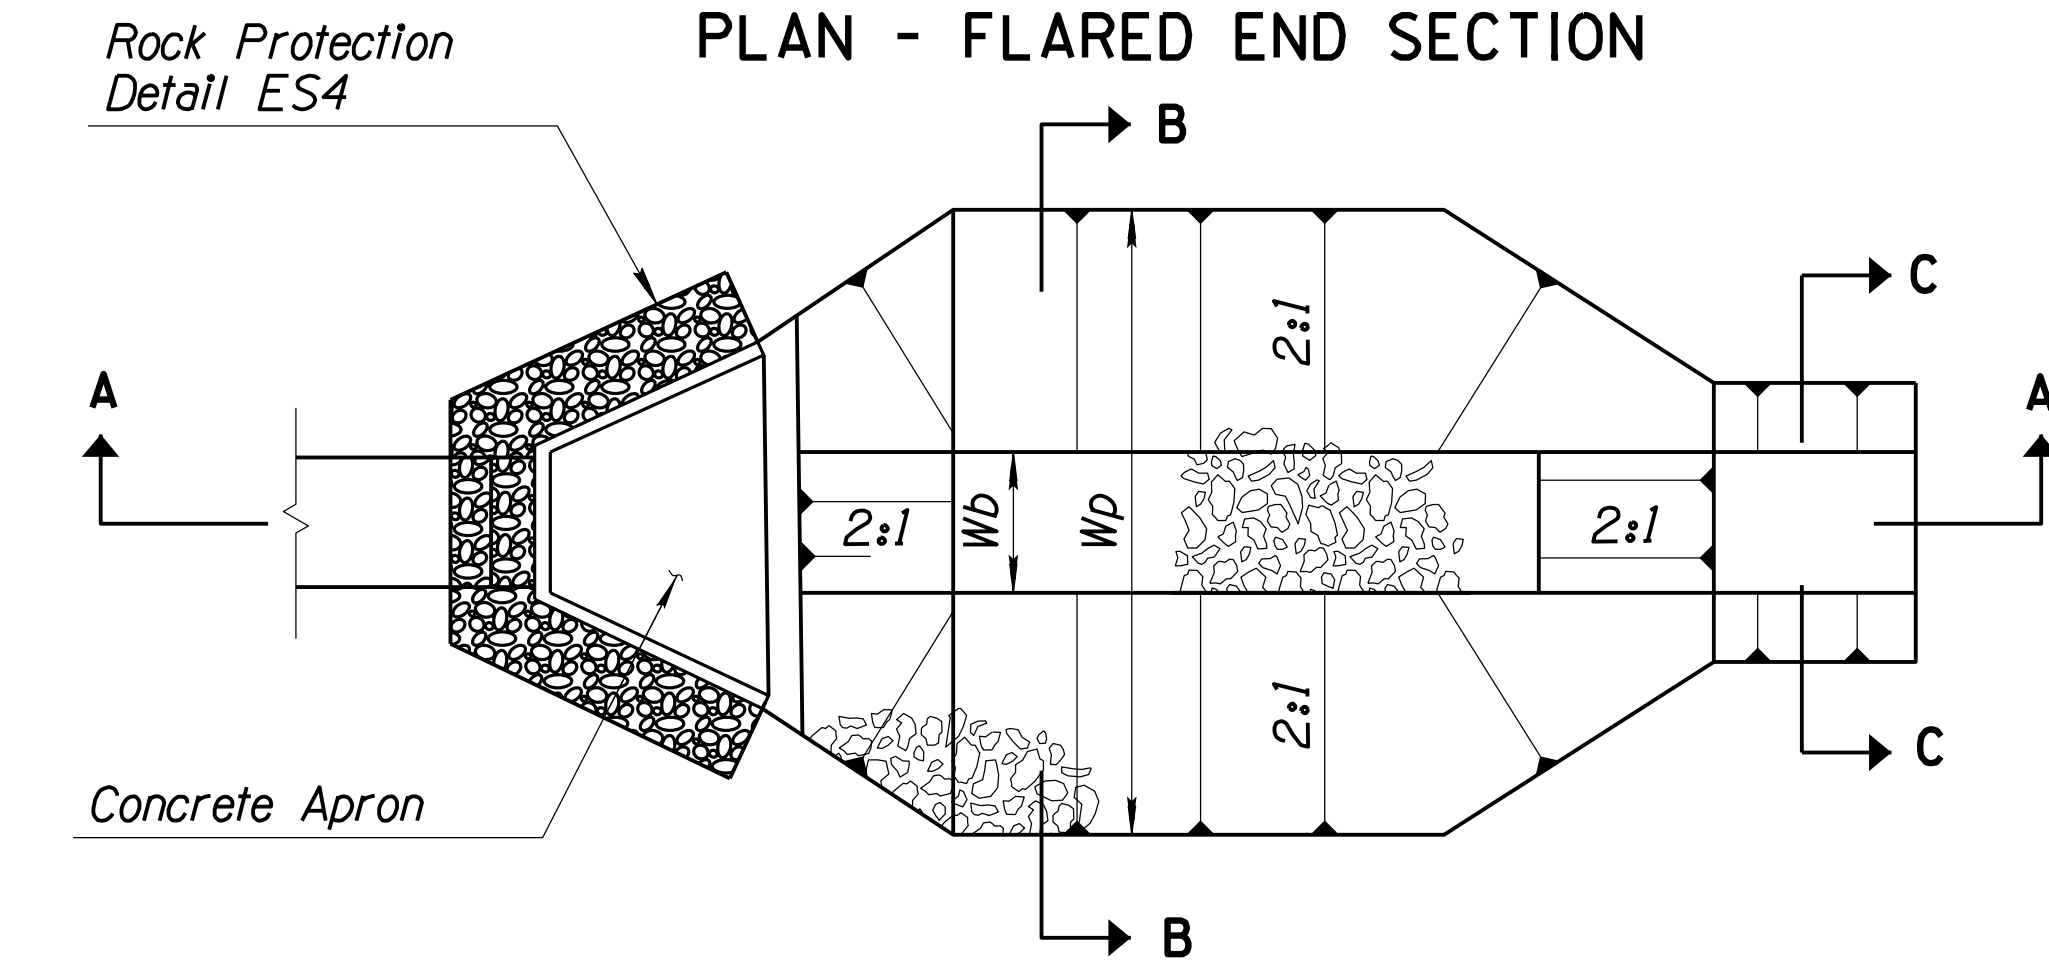


PLAN - HEADWALL

NOTES:


1. Align basin within existing wash so that the culvert discharges into the plunge pool and the downstream edge of the apron is perpendicular to the flow line of the existing channel.
2. Warp basin to conform to natural stream channel. Top of riprap in floor of basin should be at the same elevation or lower than natural channel bottom.

DESIGN GRADATION FOR RIPRAP CLASSIFICATION (D ₅₀)				
Gradation		D ₅₀ (in)	D ₅₀ (in)	D ₅₀ (in)
% Passing	Size	6	9	12
100-90	2.0 D ₅₀	12	18	24
85-70	1.5 D ₅₀	9	12	18
50-30	1.0 D ₅₀	6	9	12
15-5	0.67 D ₅₀	4	6	8
5-0	0.33 D ₅₀	2	3	4

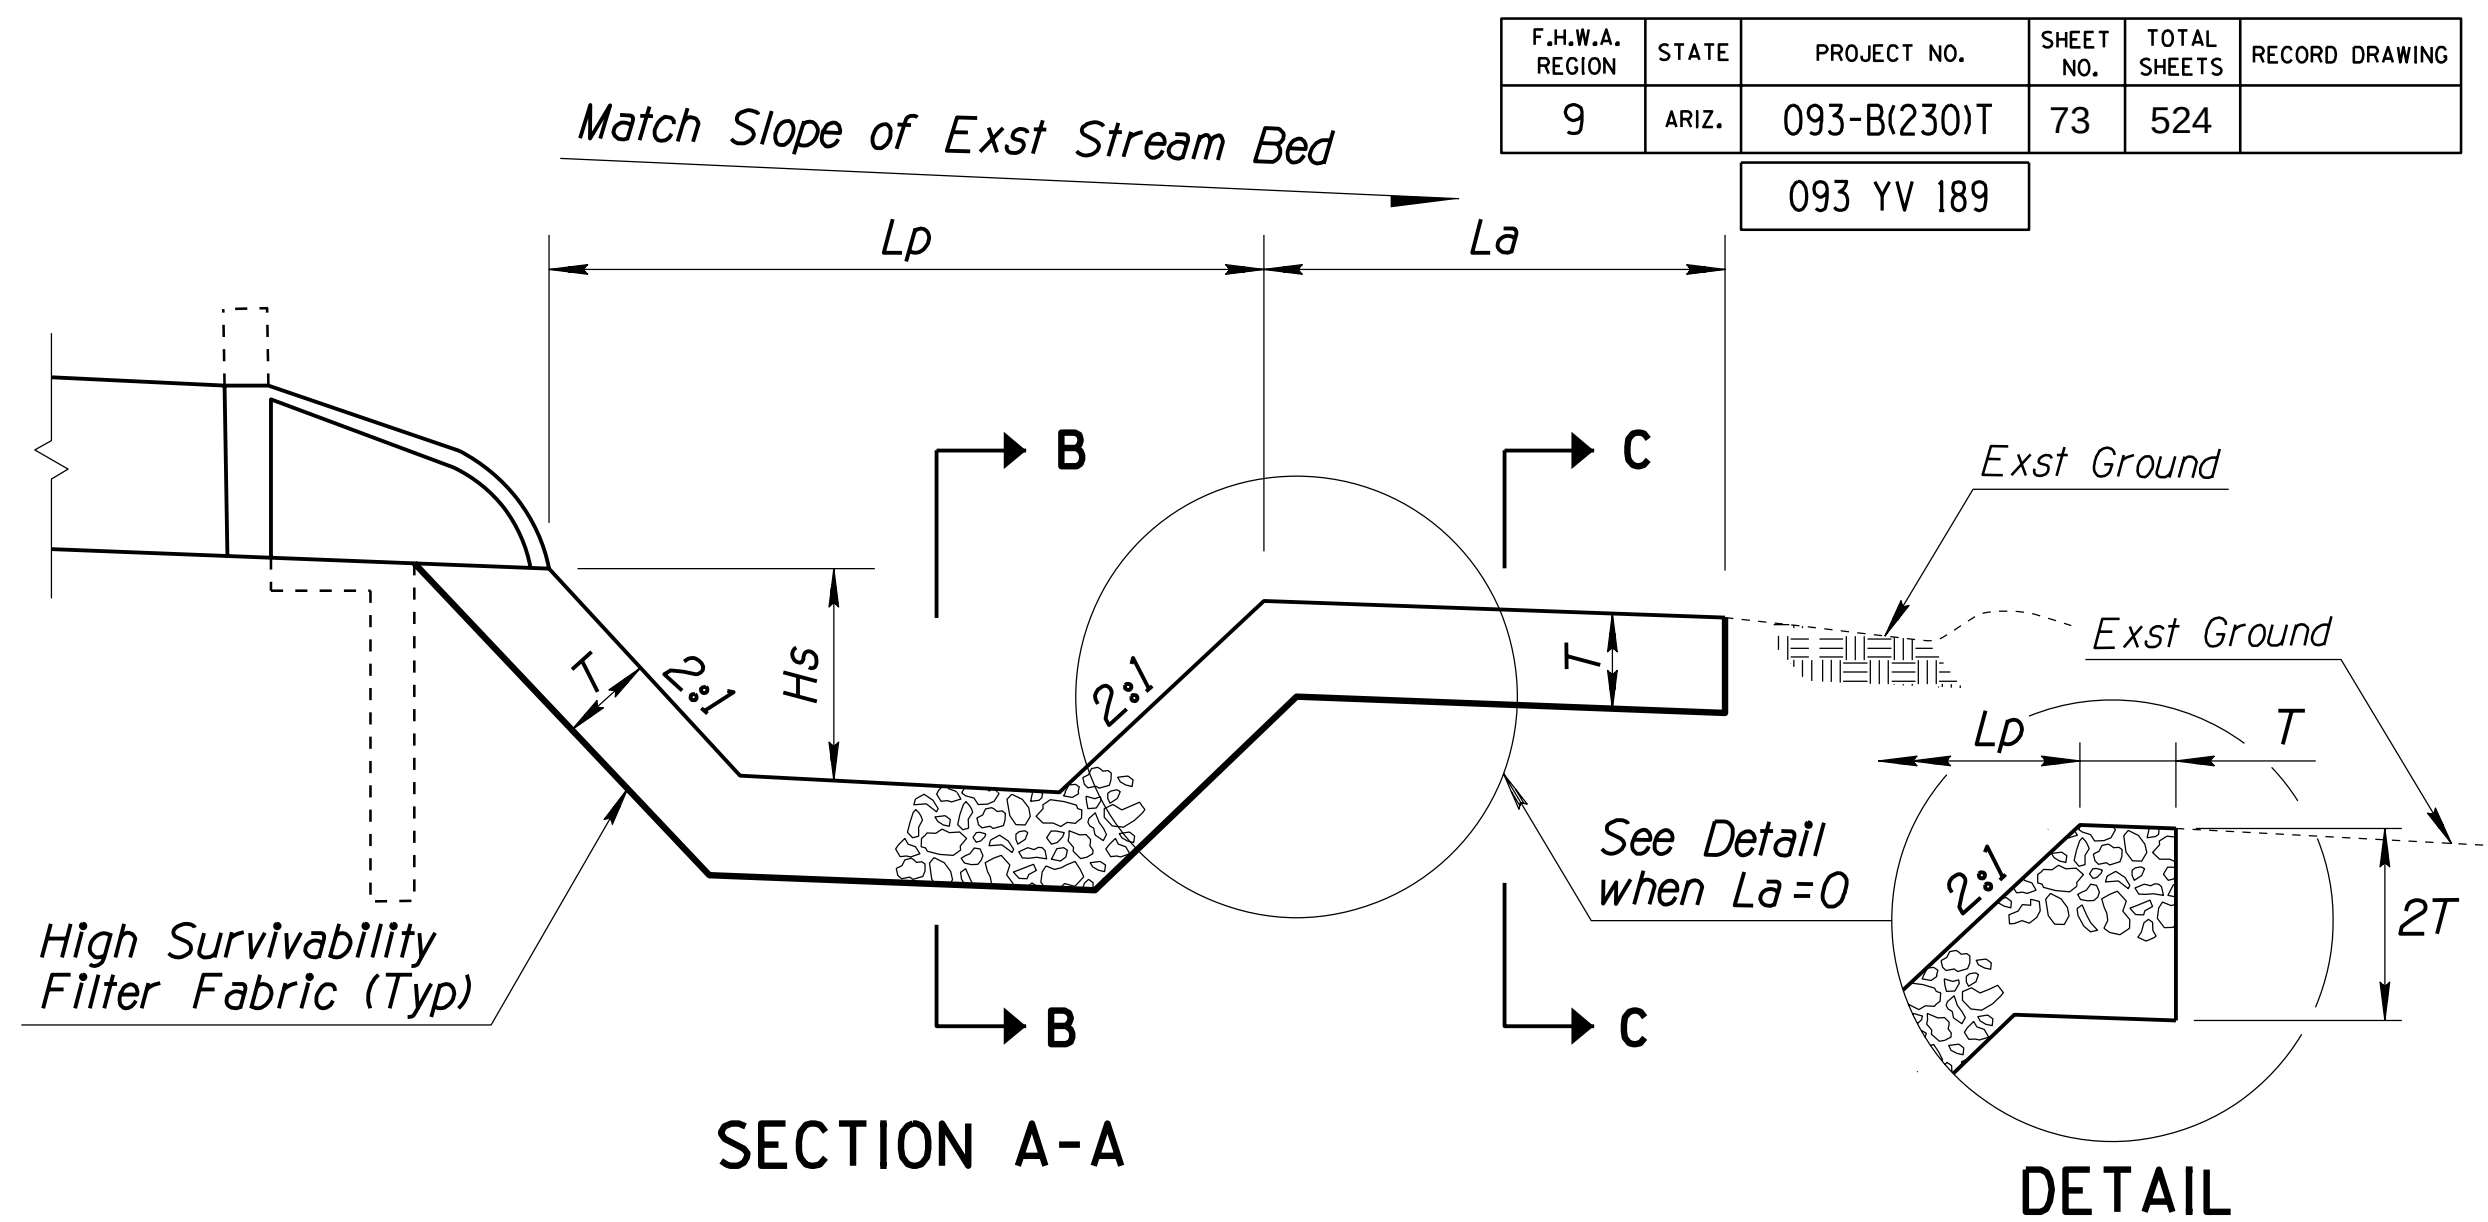


SECTION A-A

DETAIL

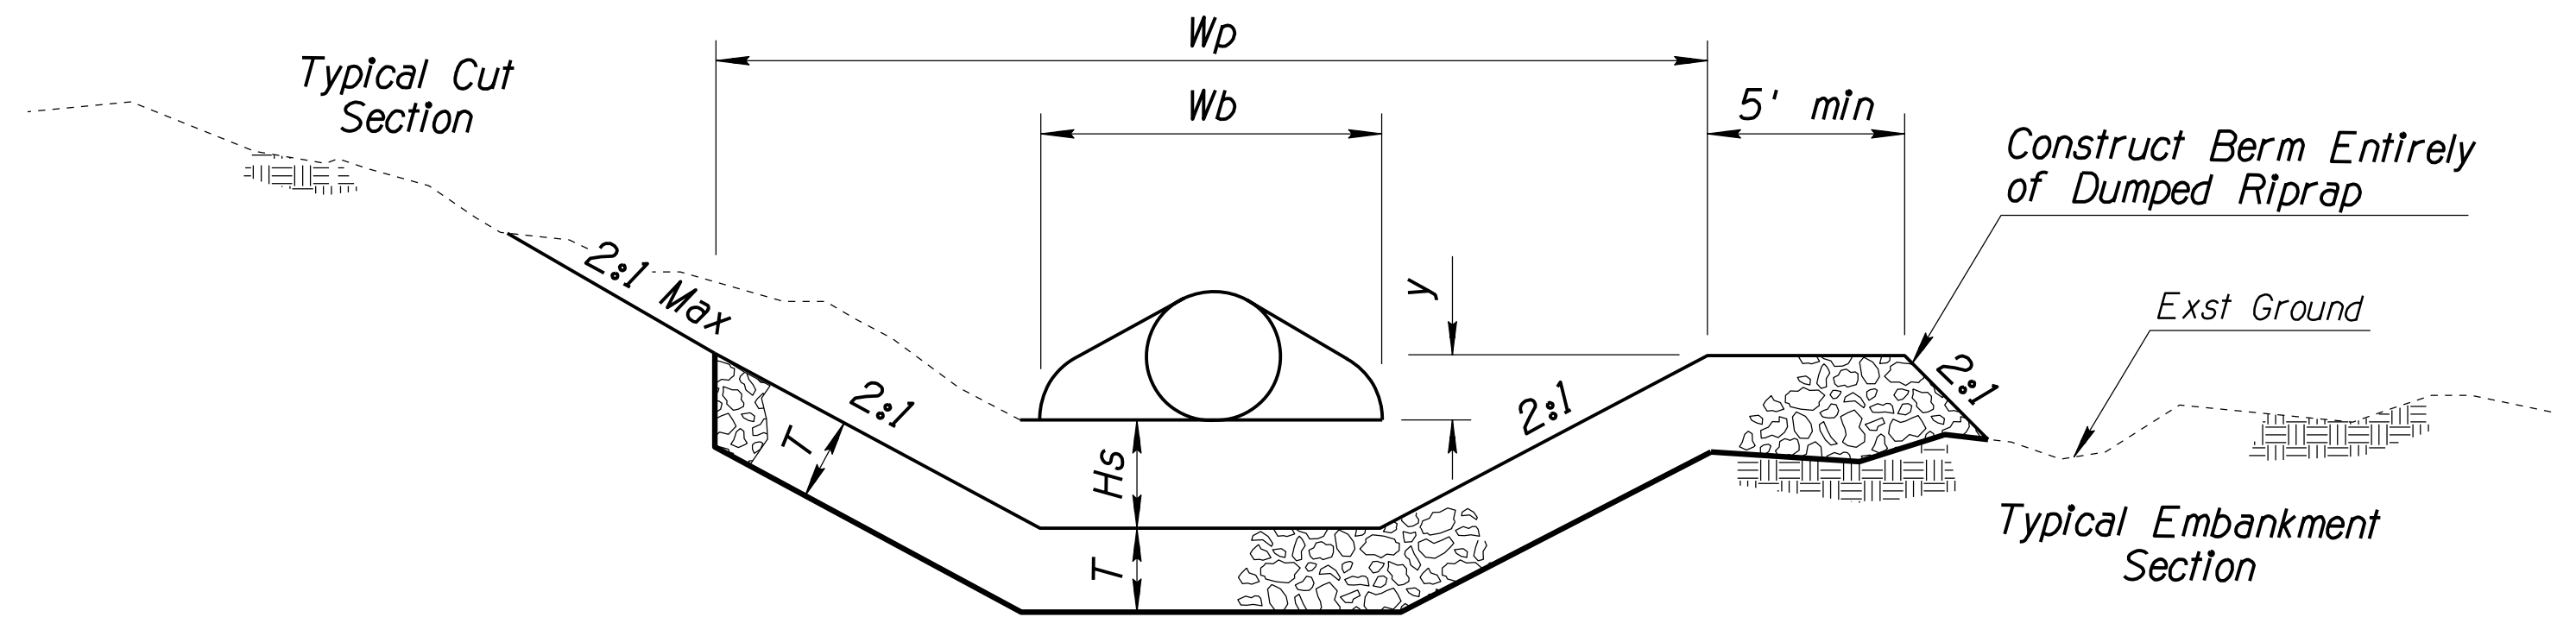

SECTION B-B

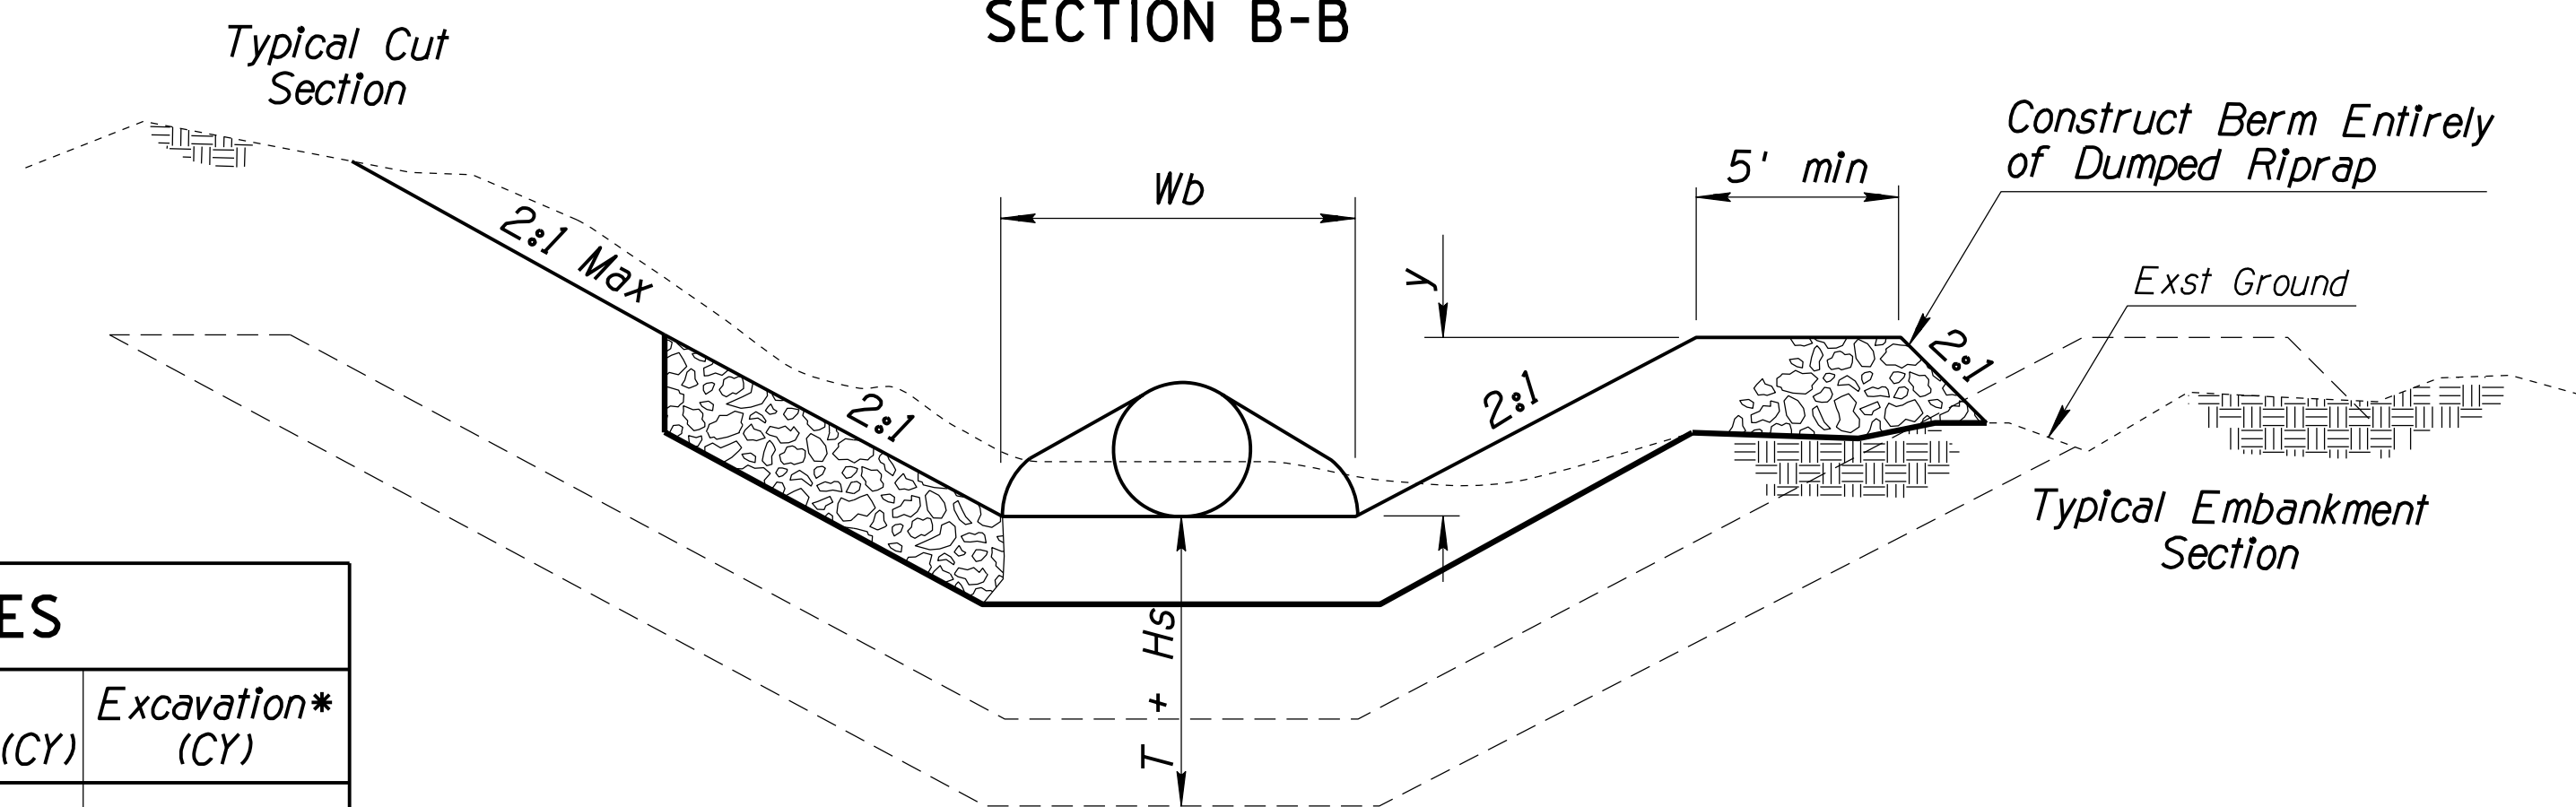


SECTION C-C

DETAIL DR
RIPRAP BASIN

RIPRAP BASIN TABLE											QUANTITIES		
Ref No.	Detail	Location Station	D ₅₀ (in)	T (in)	Hs (ft)	y (ft)	Lp (ft)	La (ft)	Wp (ft)	Wb (ft)	Vol of Riprap (CY)	Drainage Excavation (CY)	Excavation* (CY)
131	D26	57+51	6	12	0.5	1.5	12	4	38	30	16	35	16
132	D27	2+14	12	24	0.5	1.0	9	3	15	9	8	7	8
133	D28	4+39	12	24	0.5	1.0	9	3	15	9	8	7	8
134	D29	8+53	12	24	0.5	1.0	9	3	20	14	12	10	12
135	D30	15+93	12	24	0.5	1.0	9	3	20	14	12	10	12
PE 2	D22	119+77	12	24	0.5	1.0	5	0	11.7	5.7	4	3	4
PE 3	D23	125+23	6	12	0.5	1.0	5	0	11.7	5.7	2	3	2
BE 1	D3	2156+28	6	12	1.8	4.0	18	8.8	32	14	26	85	26
TOTAL:											88	160	88

* Riprap Excavation is for Information Only

DESIGN	JML	DATE	06-26	ARIZONA DEPARTMENT OF TRANSPORTATION PROJECT DELIVERY AND OPERATIONS DIVISION ROADWAY DESIGN SERVICES	
DRAWN	EM	DATE	06-26		
CHECKED	DBK	DATE	06-26		
				DETAIL DR RIPRAP BASIN	
ROUTE		LOCATION		DWG NO. D-1.25	
US 93		WICKENBURG RANCH WAY TO VISTA ROYALE			
TRACS NO. F0738 OIC		093-B(230)T		OF	

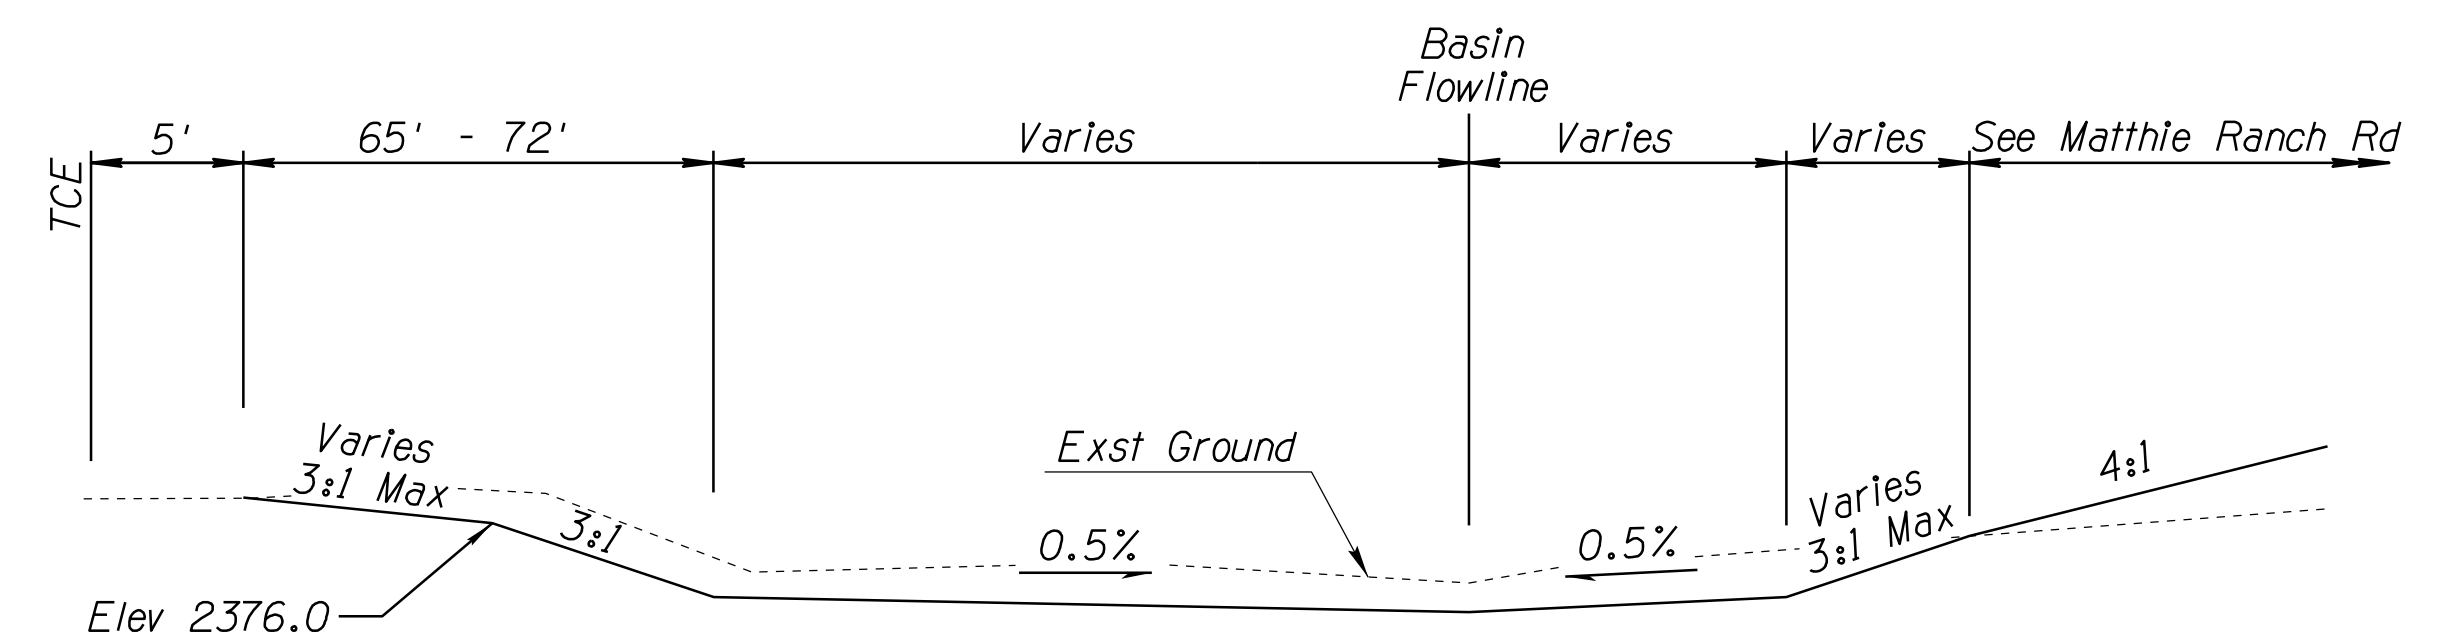093 YV 189

SECTION A-A
Not to Scale

DETAIL DS


		<table><tr><th>NAME</th><th>DATE</th></tr><tr><td>JML</td><td>06-26</td></tr><tr><td>EM</td><td>06-26</td></tr><tr><td>DBK</td><td>06-26</td></tr></table>		NAME	DATE	JML	06-26	EM	06-26	DBK	06-26	ARIZONA DEPARTMENT OF TRANSPORTATION PROJECT DELIVERY AND OPERATIONS DIVISION ROADWAY DESIGN SERVICES		
NAME	DATE													
JML	06-26													
EM	06-26													
DBK	06-26													
<table><tr><td>DESIGN</td><td>JML</td></tr><tr><td>DRAWN</td><td>EM</td></tr><tr><td>CHECKED</td><td>DBK</td></tr></table>		DESIGN	JML	DRAWN	EM	CHECKED	DBK	 5333 East Camelback Road, Suite 100 Phoenix, Arizona 85018 Phone: (602) 333-2200		DETAIL DS BASIN DETAIL				
DESIGN	JML													
DRAWN	EM													
CHECKED	DBK													
ROUTE		LOCATION		DWG NO. D-1.26										
US 93		WICKENBURG RANCH WAY TO VISTA ROYALE												
TRACS NO. F0738 OIC			093-B(230)T											
_____ OF _____														

F.H.W.A. REGION	STATE	PROJECT NO.	SHEET NO.	TOTAL SHEETS	RECORD DRAWING
9	ARIZ.	093-B(230)T	75	524	

093 YV 189

NOTE:

For Catch Basin Grates Reinforcement, Dimensions, and Notes Not Shown See Detail C-15.30.

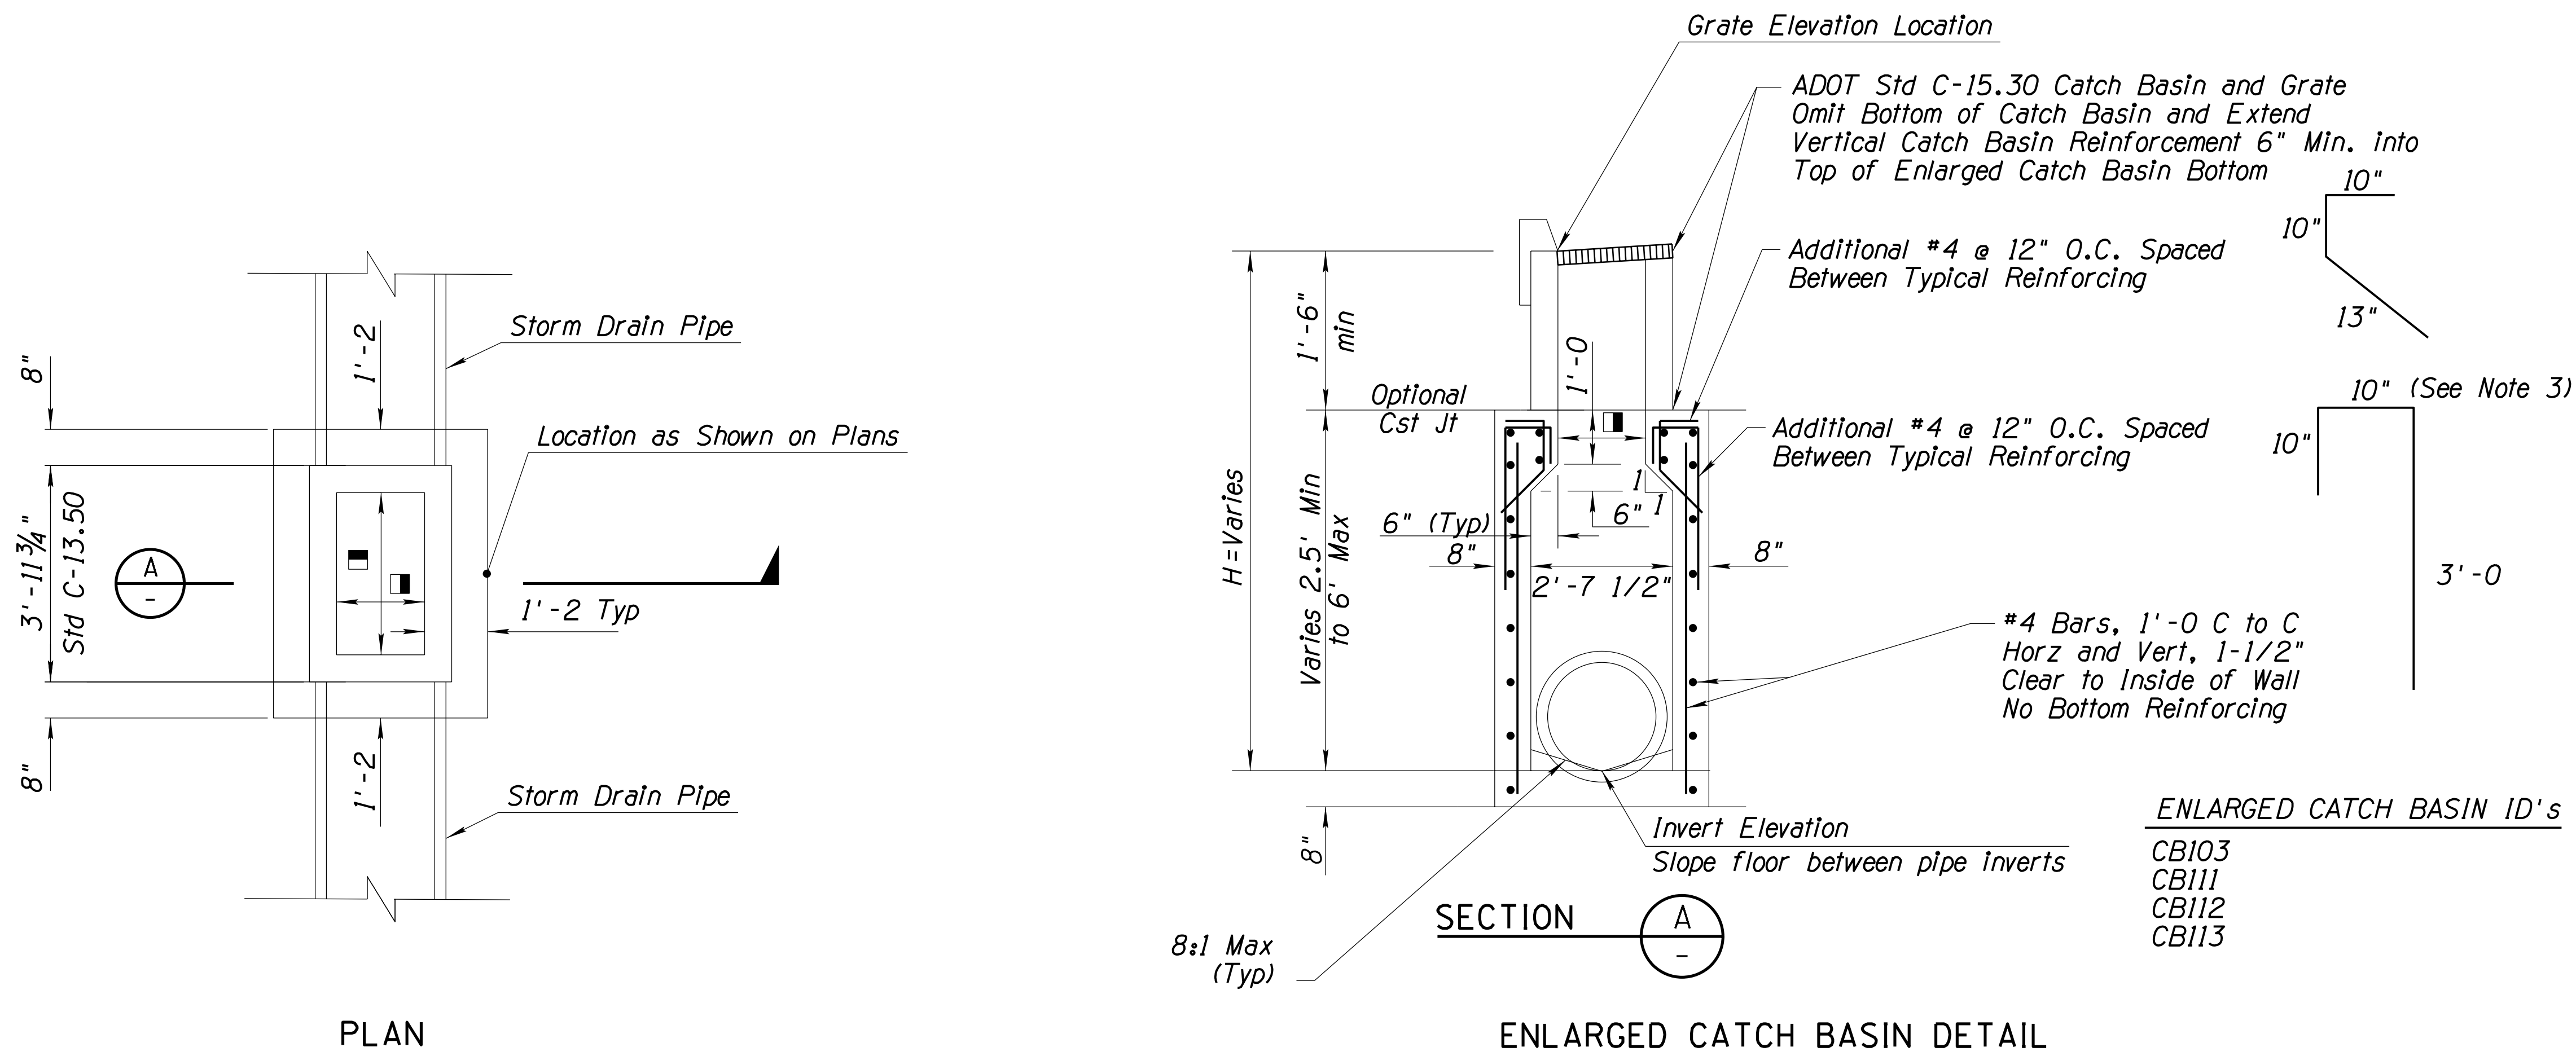

Dimension between inside walls of corbels shall match the inside dimension of catch basin.

NOTES:

- Catch basin materials per ADOT Std C-15.30.
- See C-15.30 for details, dimensions, reinforcing, and items not shown.
- Catch Basin will be measured and paid for under Item 5030606 - Concrete Catch Basin (Detail DT)
- No measurement or direct payment will be made for the doweling (drill & epoxy), the cost being considered as included in the cost of the catch basin.

DOWELING NOTES:

Diamond Core 1 inch diameter hole minimum 8 inches deep for #5 Dowel. Epoxy dowel in hole with an approved epoxy adhesive. Epoxy anchorage shall develop a tensile strength of 18 kips for dowels.



Details of the anchorage system shall be submitted to the Engineer for approval prior to installation.

DETAIL DT



		NAME	DATE	ARIZONA DEPARTMENT OF TRANSPORTATION PROJECT DELIVERY AND OPERATIONS DIVISION ROADWAY DESIGN SERVICES		
DESIGN		JML	06-26			
DRAWN		EM	06-26			
CHECKED		DBK	06-26			
 3133 East Camelback Road, Suite 100 Phoenix, Arizona 85016 Phone: (602) 333-2200				DETAIL DT ENLARGED CATCH BASIN		
ROUTE		LOCATION			DWG NO. D-1.27	
US 93		WICKENBURG RANCH WAY TO VISTA ROYALE				
TRACS NO. F0738 OIC			093-B(230)T			___ OF ___

F.H.W.A. REGION	STATE	PROJECT NO.	SHEET NO.	TOTAL SHEETS	RECORD DRAWING
9	ARIZ.	093-B(230)T	76	524	

093 YV 189

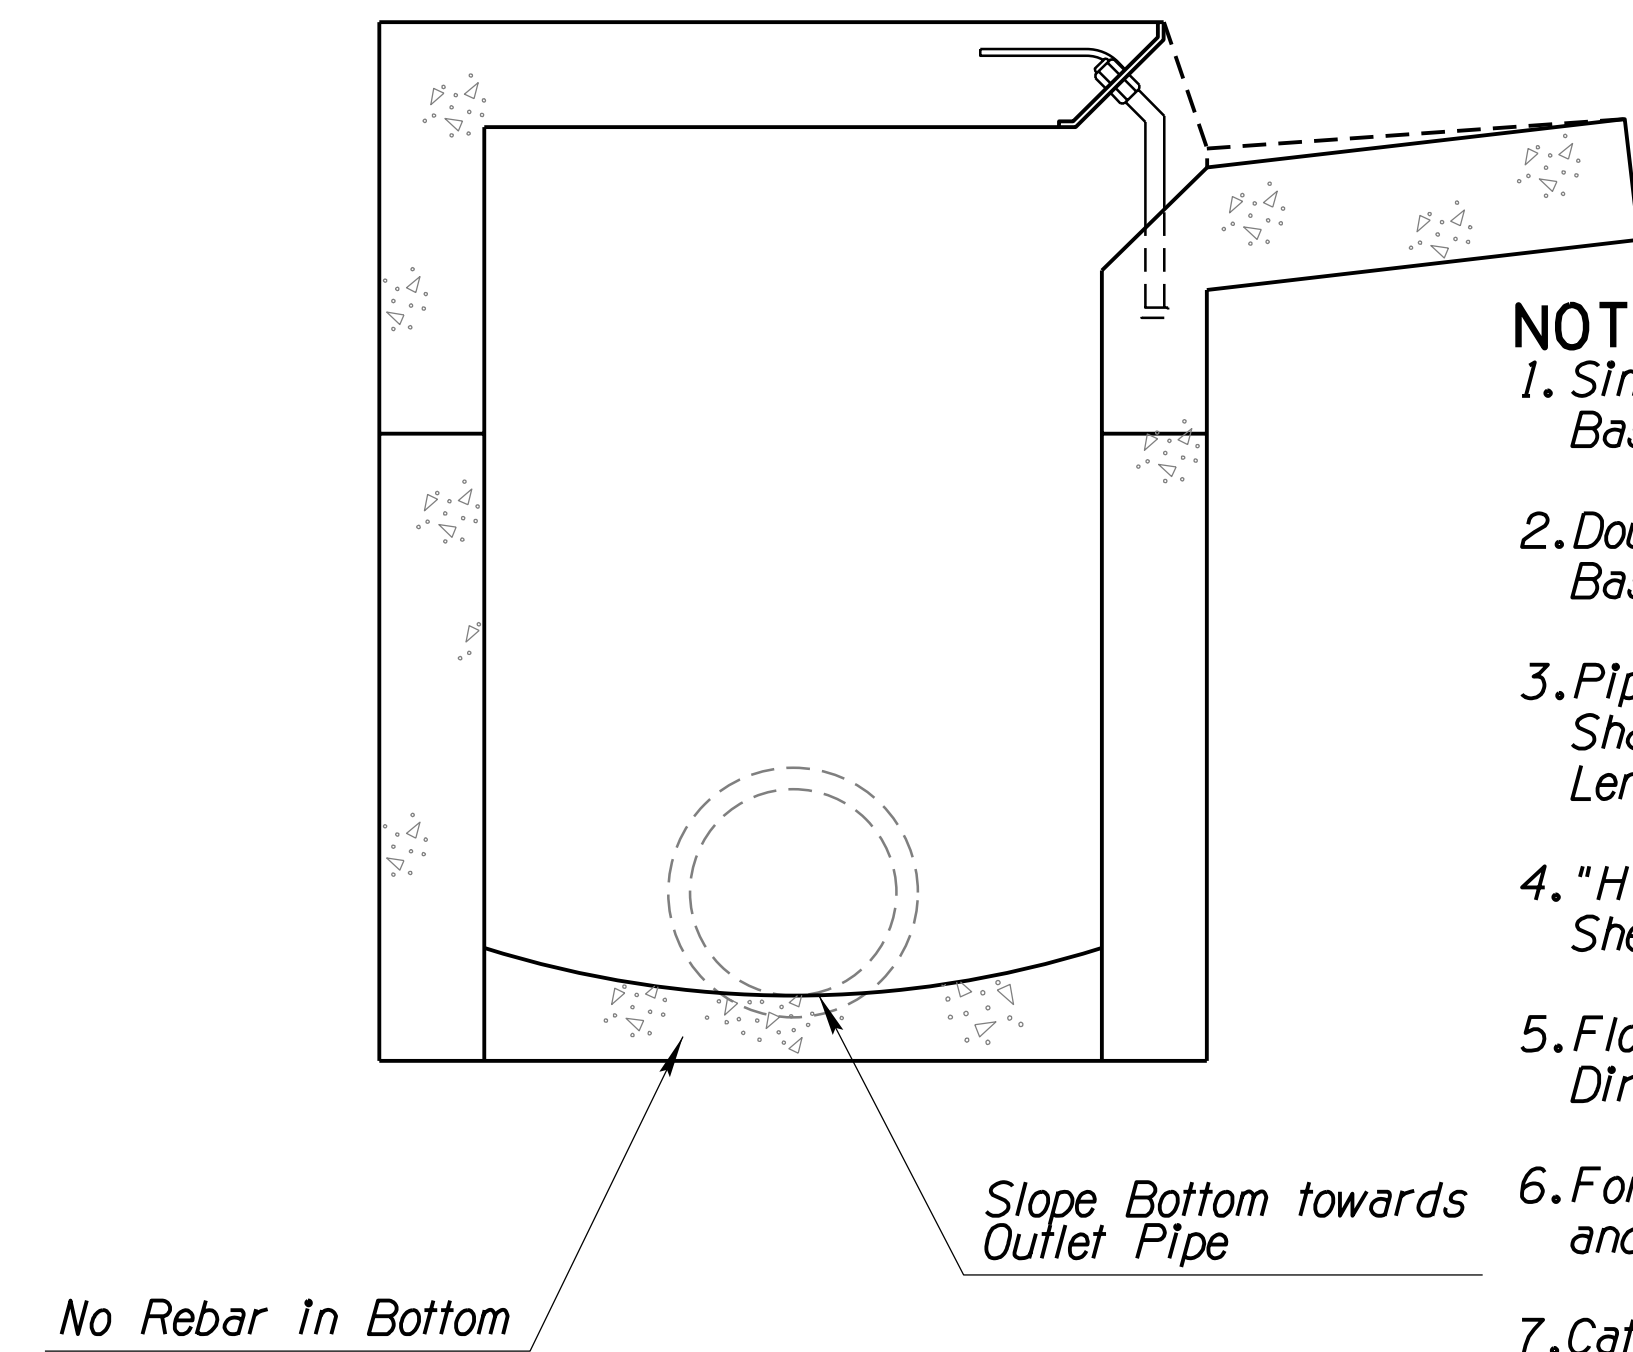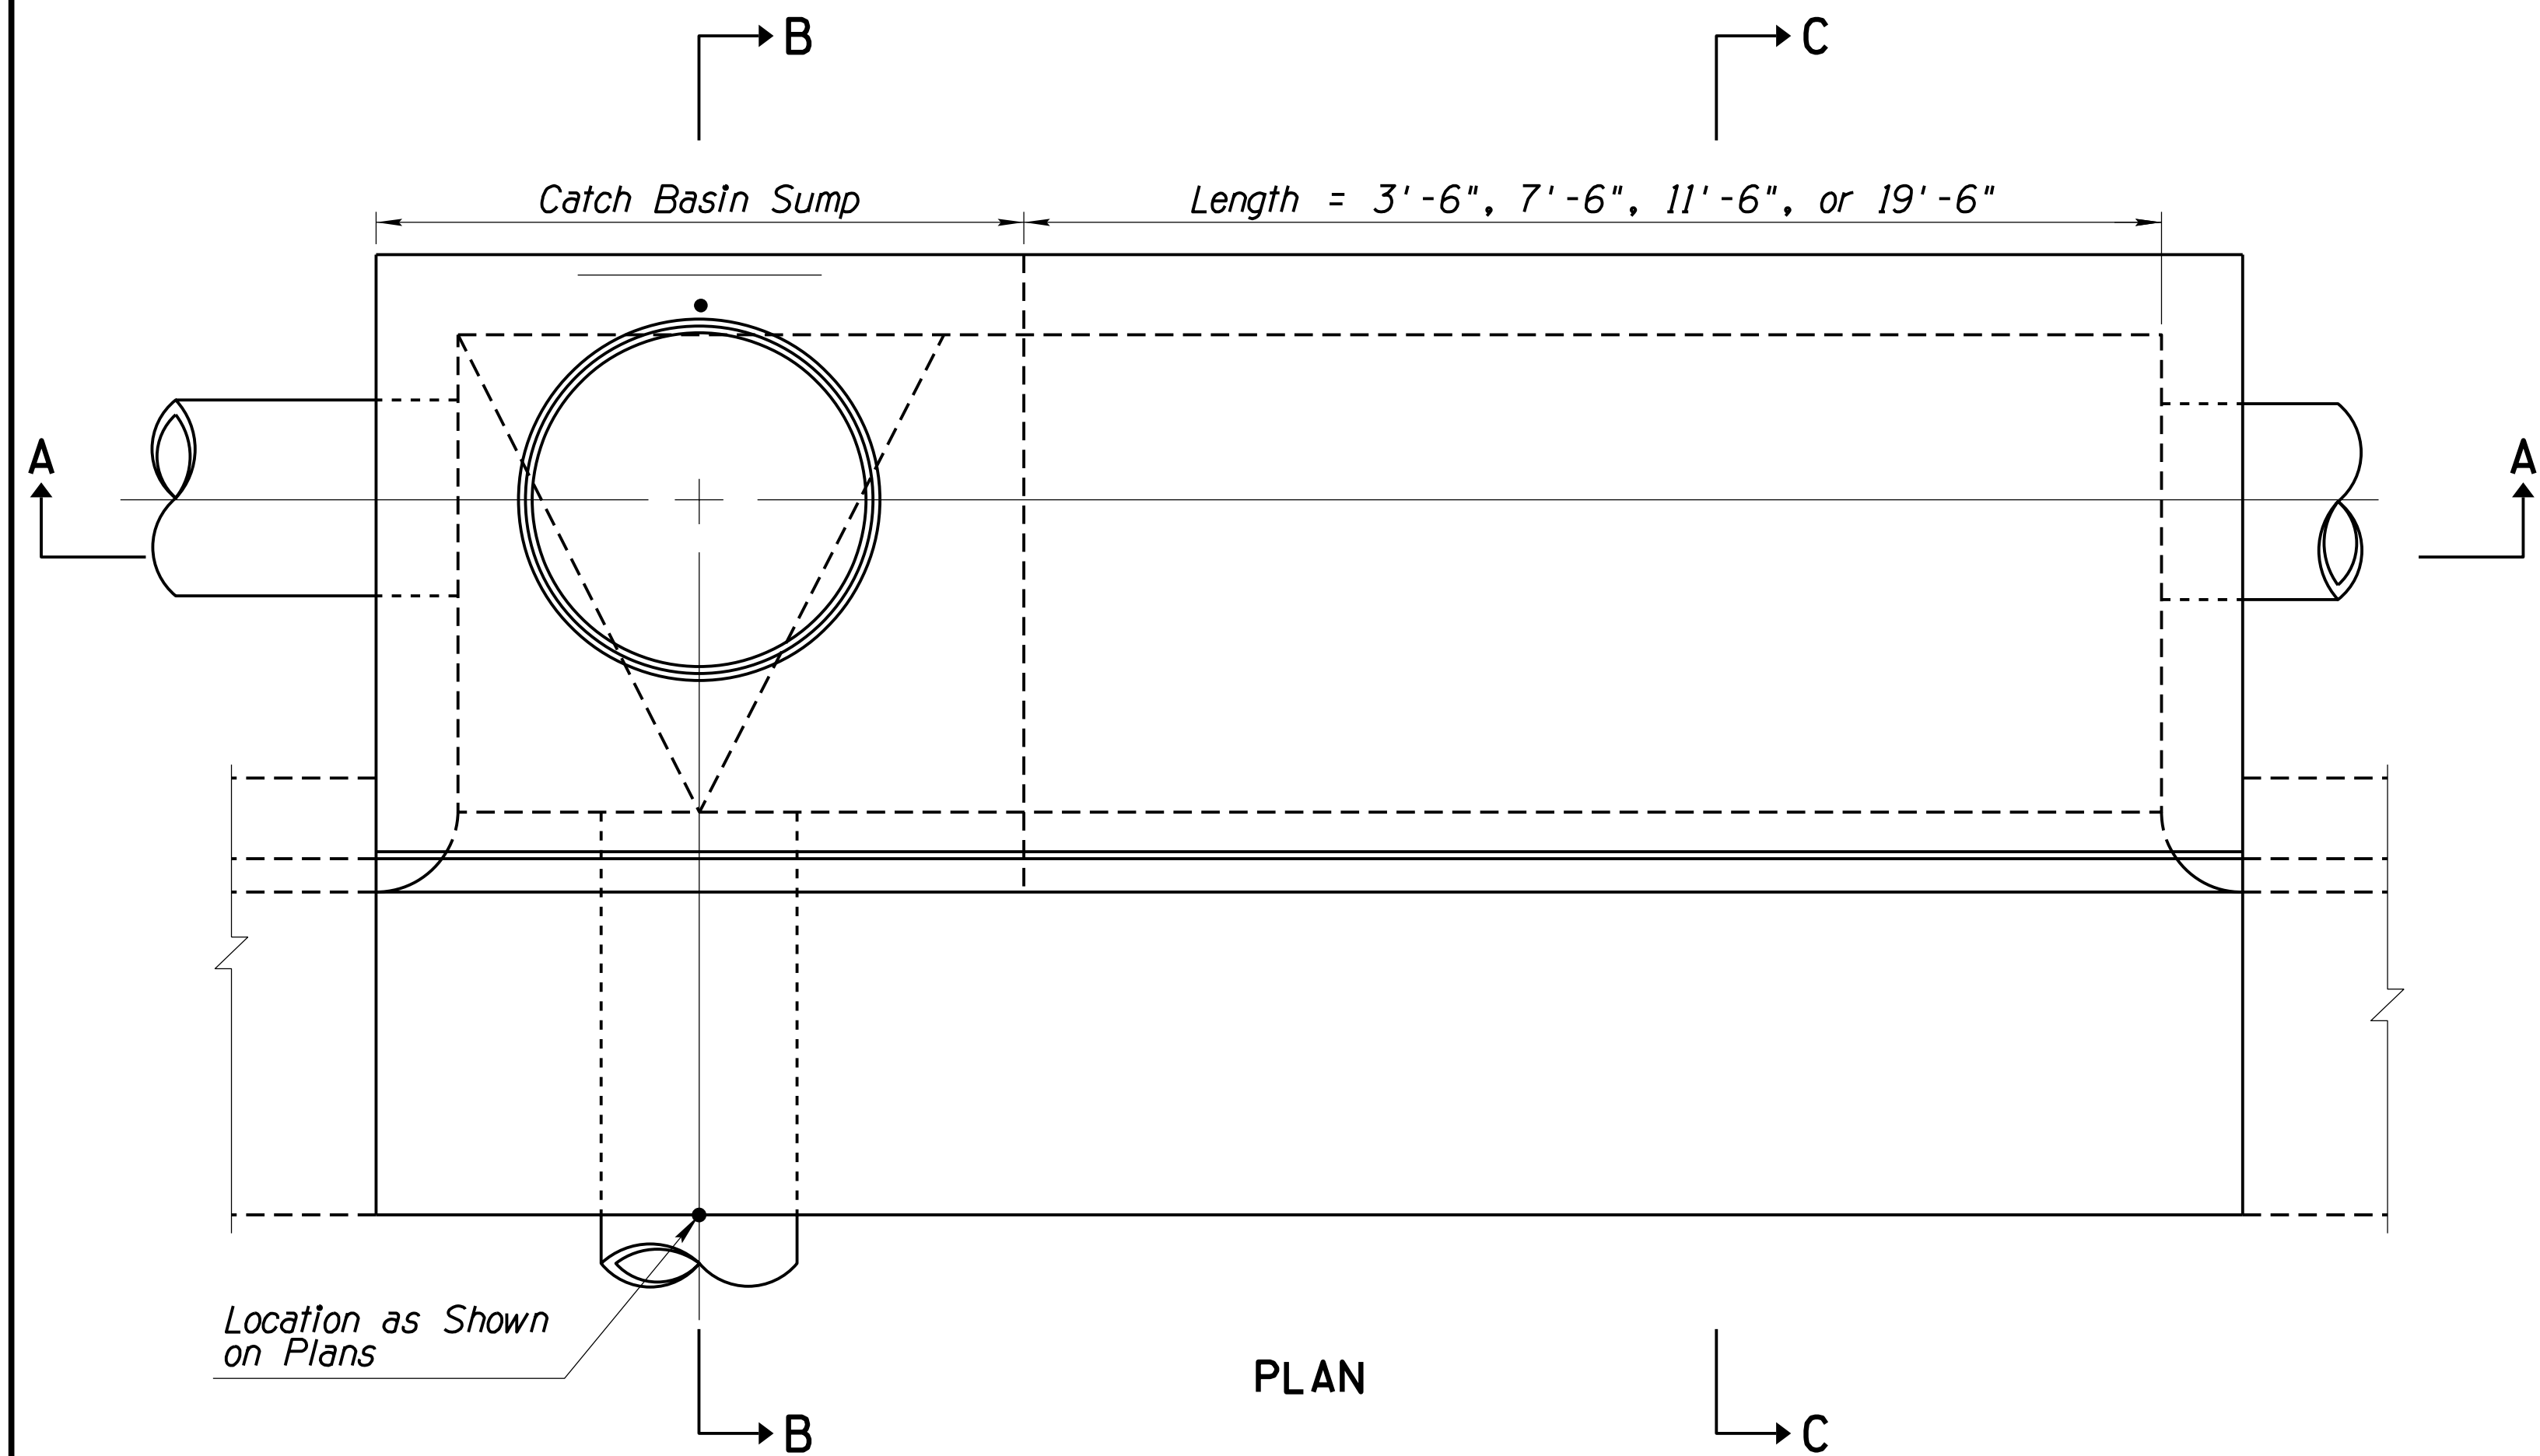

- NOTES:**
1. Single CB (Illustrated), Sump With Wing Basin Upstream.
 2. Double CB Sump With Symmetrical Wing Basins Each Side.
 3. Pipes Can Be Placed In Any Wall. Pipe Shall Be Trimmed To Final Shape And Length Before Concrete Is Placed.
 4. "H" As Indicated on Pipe Summary Sheet.
 5. Floor of Basin Shall Slope from All Directions to the Outlet.
 6. For Dimensions, Reinforcement, Details, and Notes, See Std C-15.20.
 7. Catch Basin will be measured and paid for under Item 5030610 - Concrete Catch Basin (Detail DU).

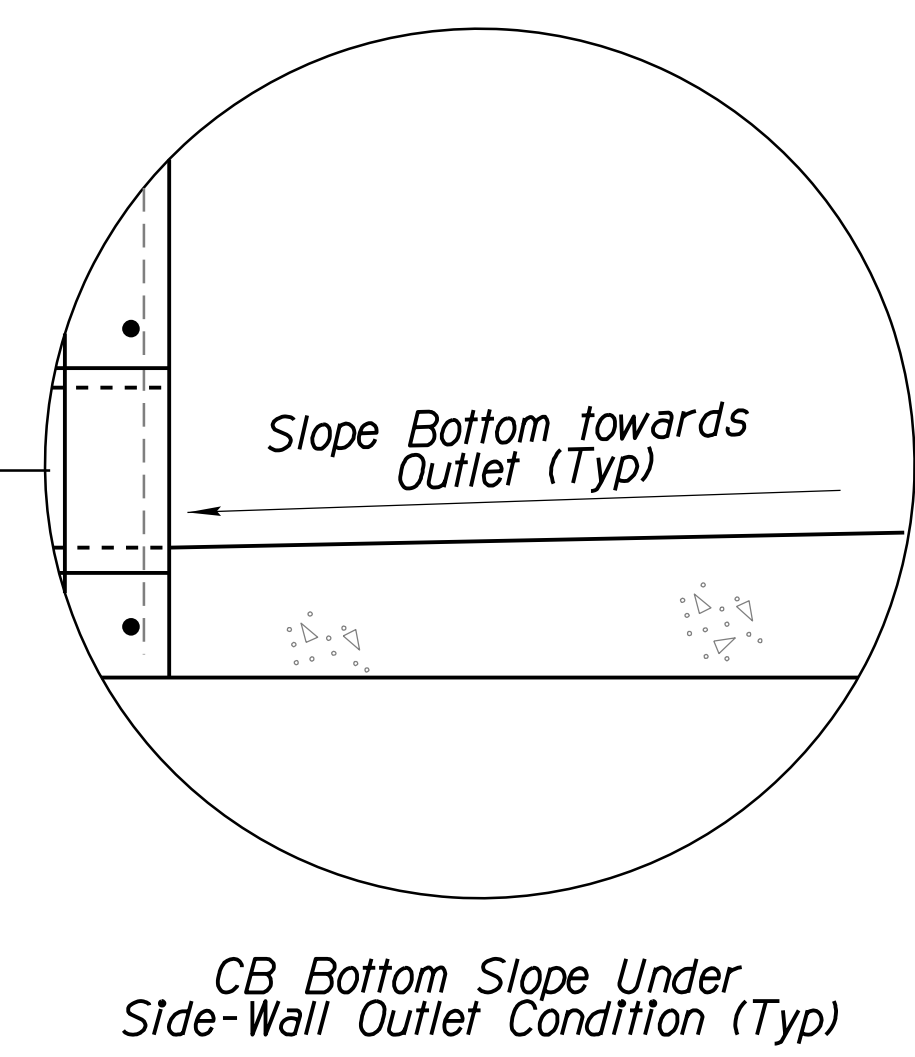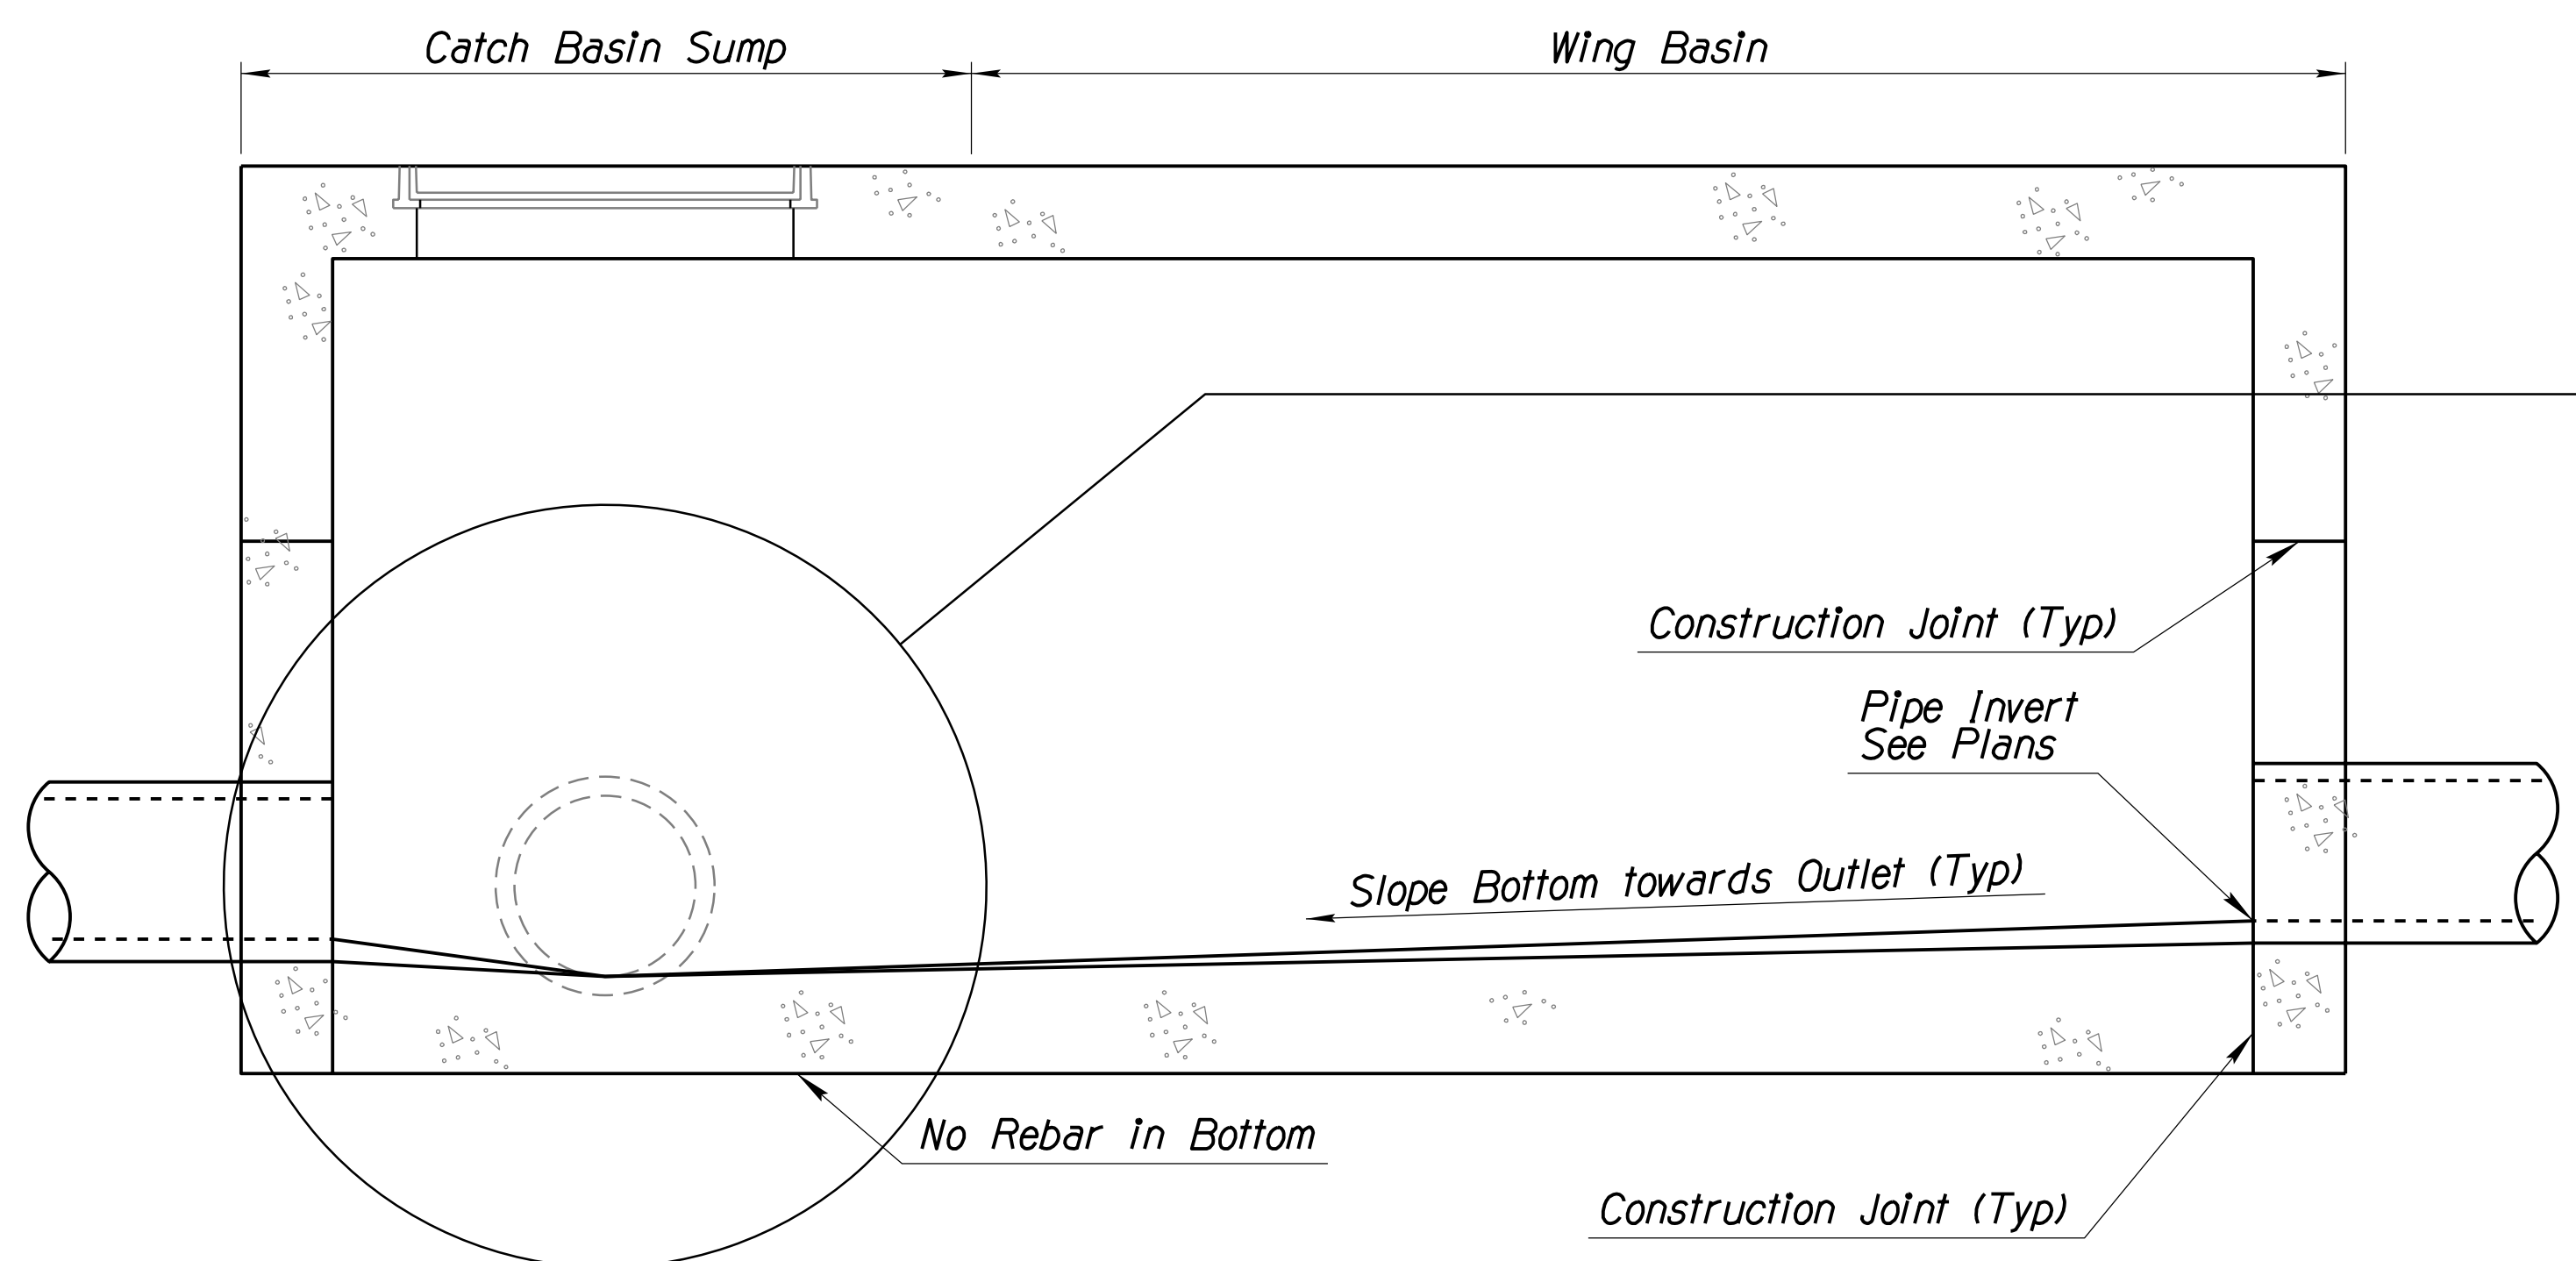


DETAIL DU

DESIGN	JML	DATE	06-26	ARIZONA DEPARTMENT OF TRANSPORTATION PROJECT DELIVERY AND OPERATIONS DIVISION ROADWAY DESIGN SERVICES	
DRAWN	EM	DATE	06-26		
CHECKED	DBK	DATE	06-26		
Stanley Consultants inc.		3133 East Camelback Road, Suite 100 Phoenix, Arizona 85016 Phone: (602) 333-2200		DETEAIL DU MODIFIED CATCH BASIN	
ROUTE	US 93	LOCATION	WICKENBURG RANCH WAY TO VISTA ROYALE		DWG NO. D-1.28
TRACS NO. F0738 OIC			093-B(230)T		OF


F.H.W.A. REGION	STATE	PROJECT NO.	SHEET NO.	TOTAL SHEETS	RECORD DRAWING
9	ARIZ.	093-B(230)T	77	524	

093 YV 189

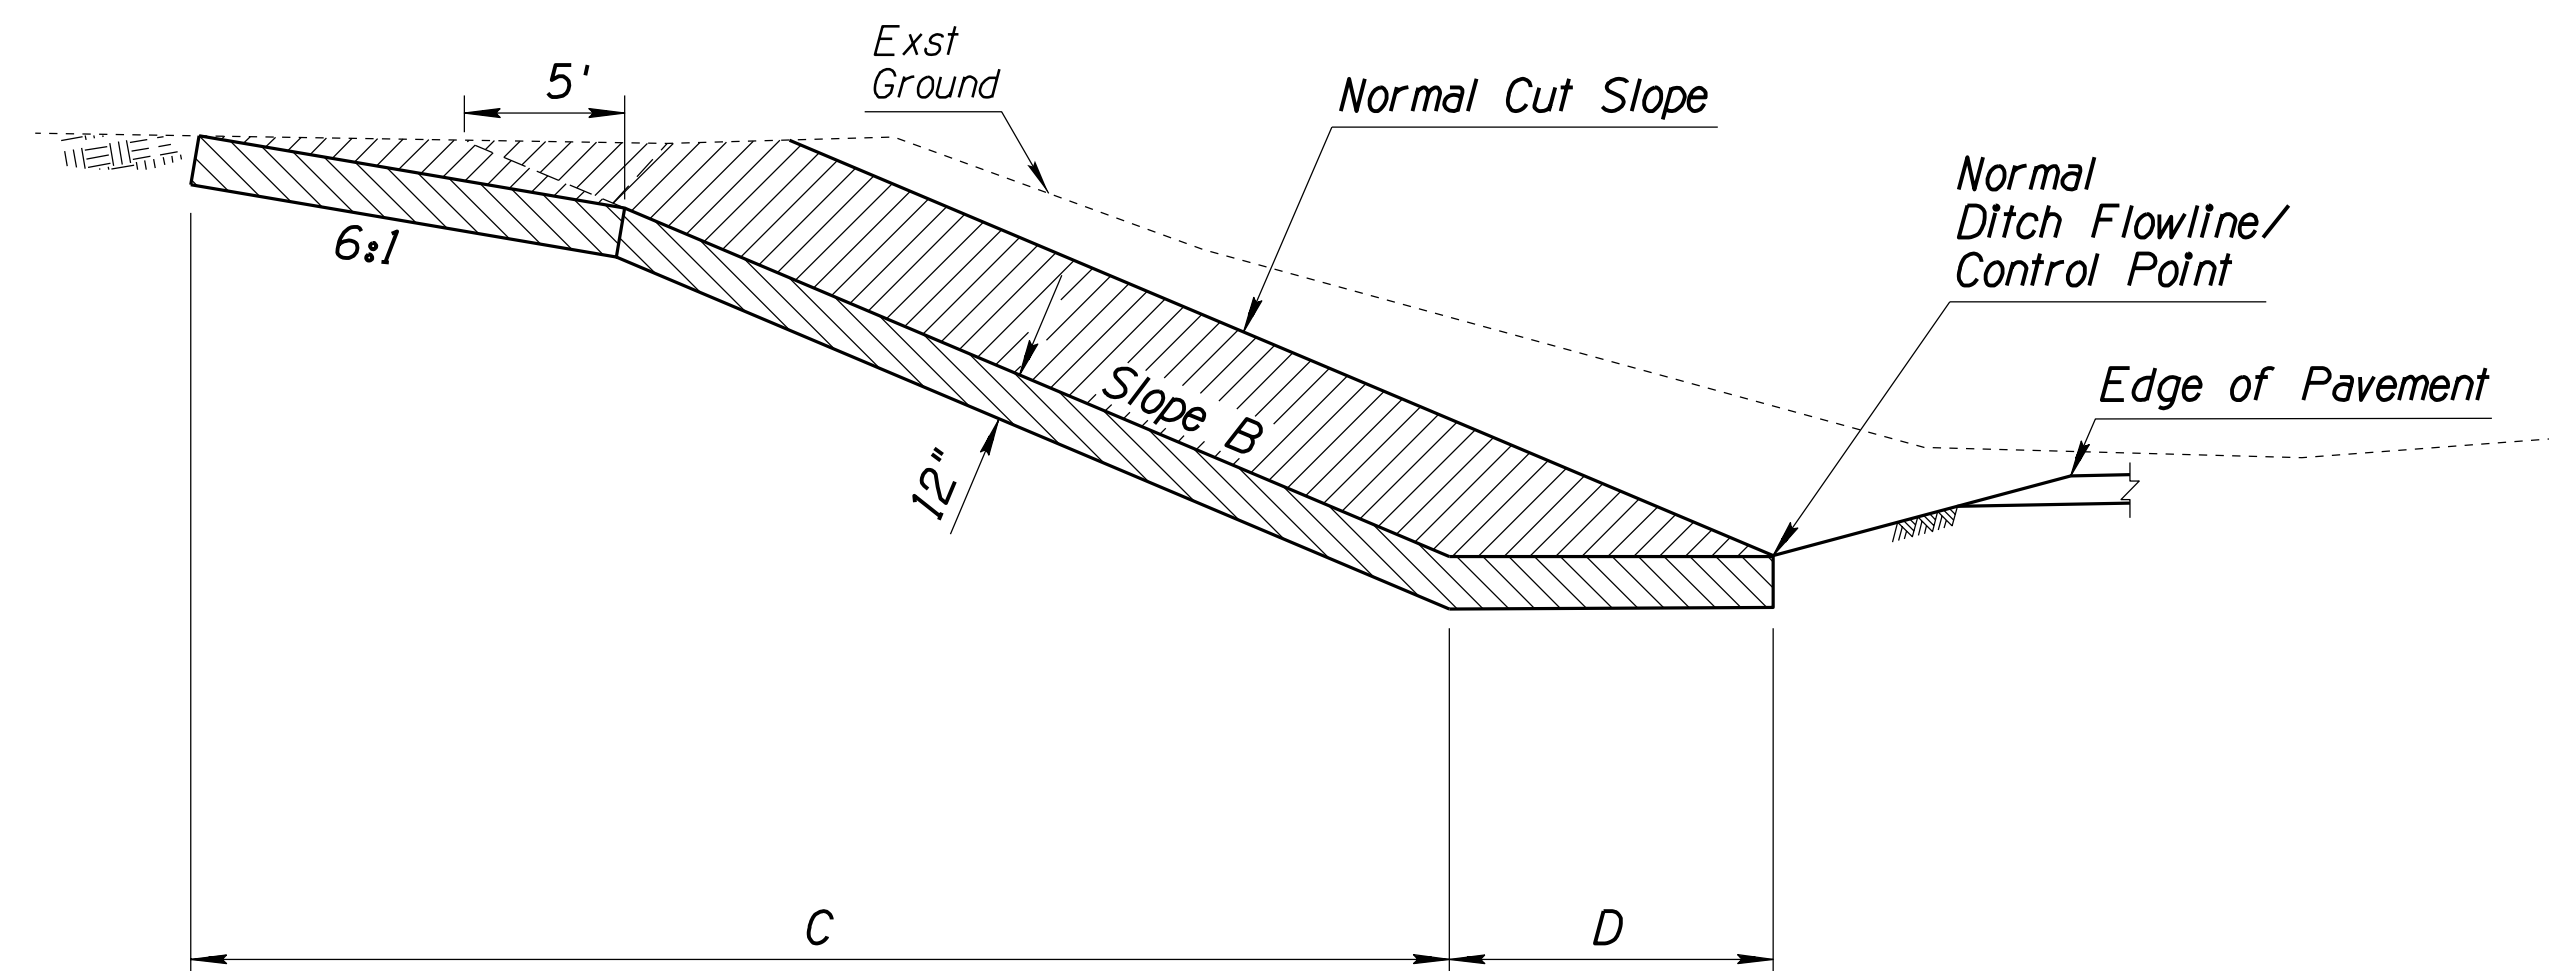


- Drainage Excavation Limits
- Riprap Excavation Limits

SECTION B-B

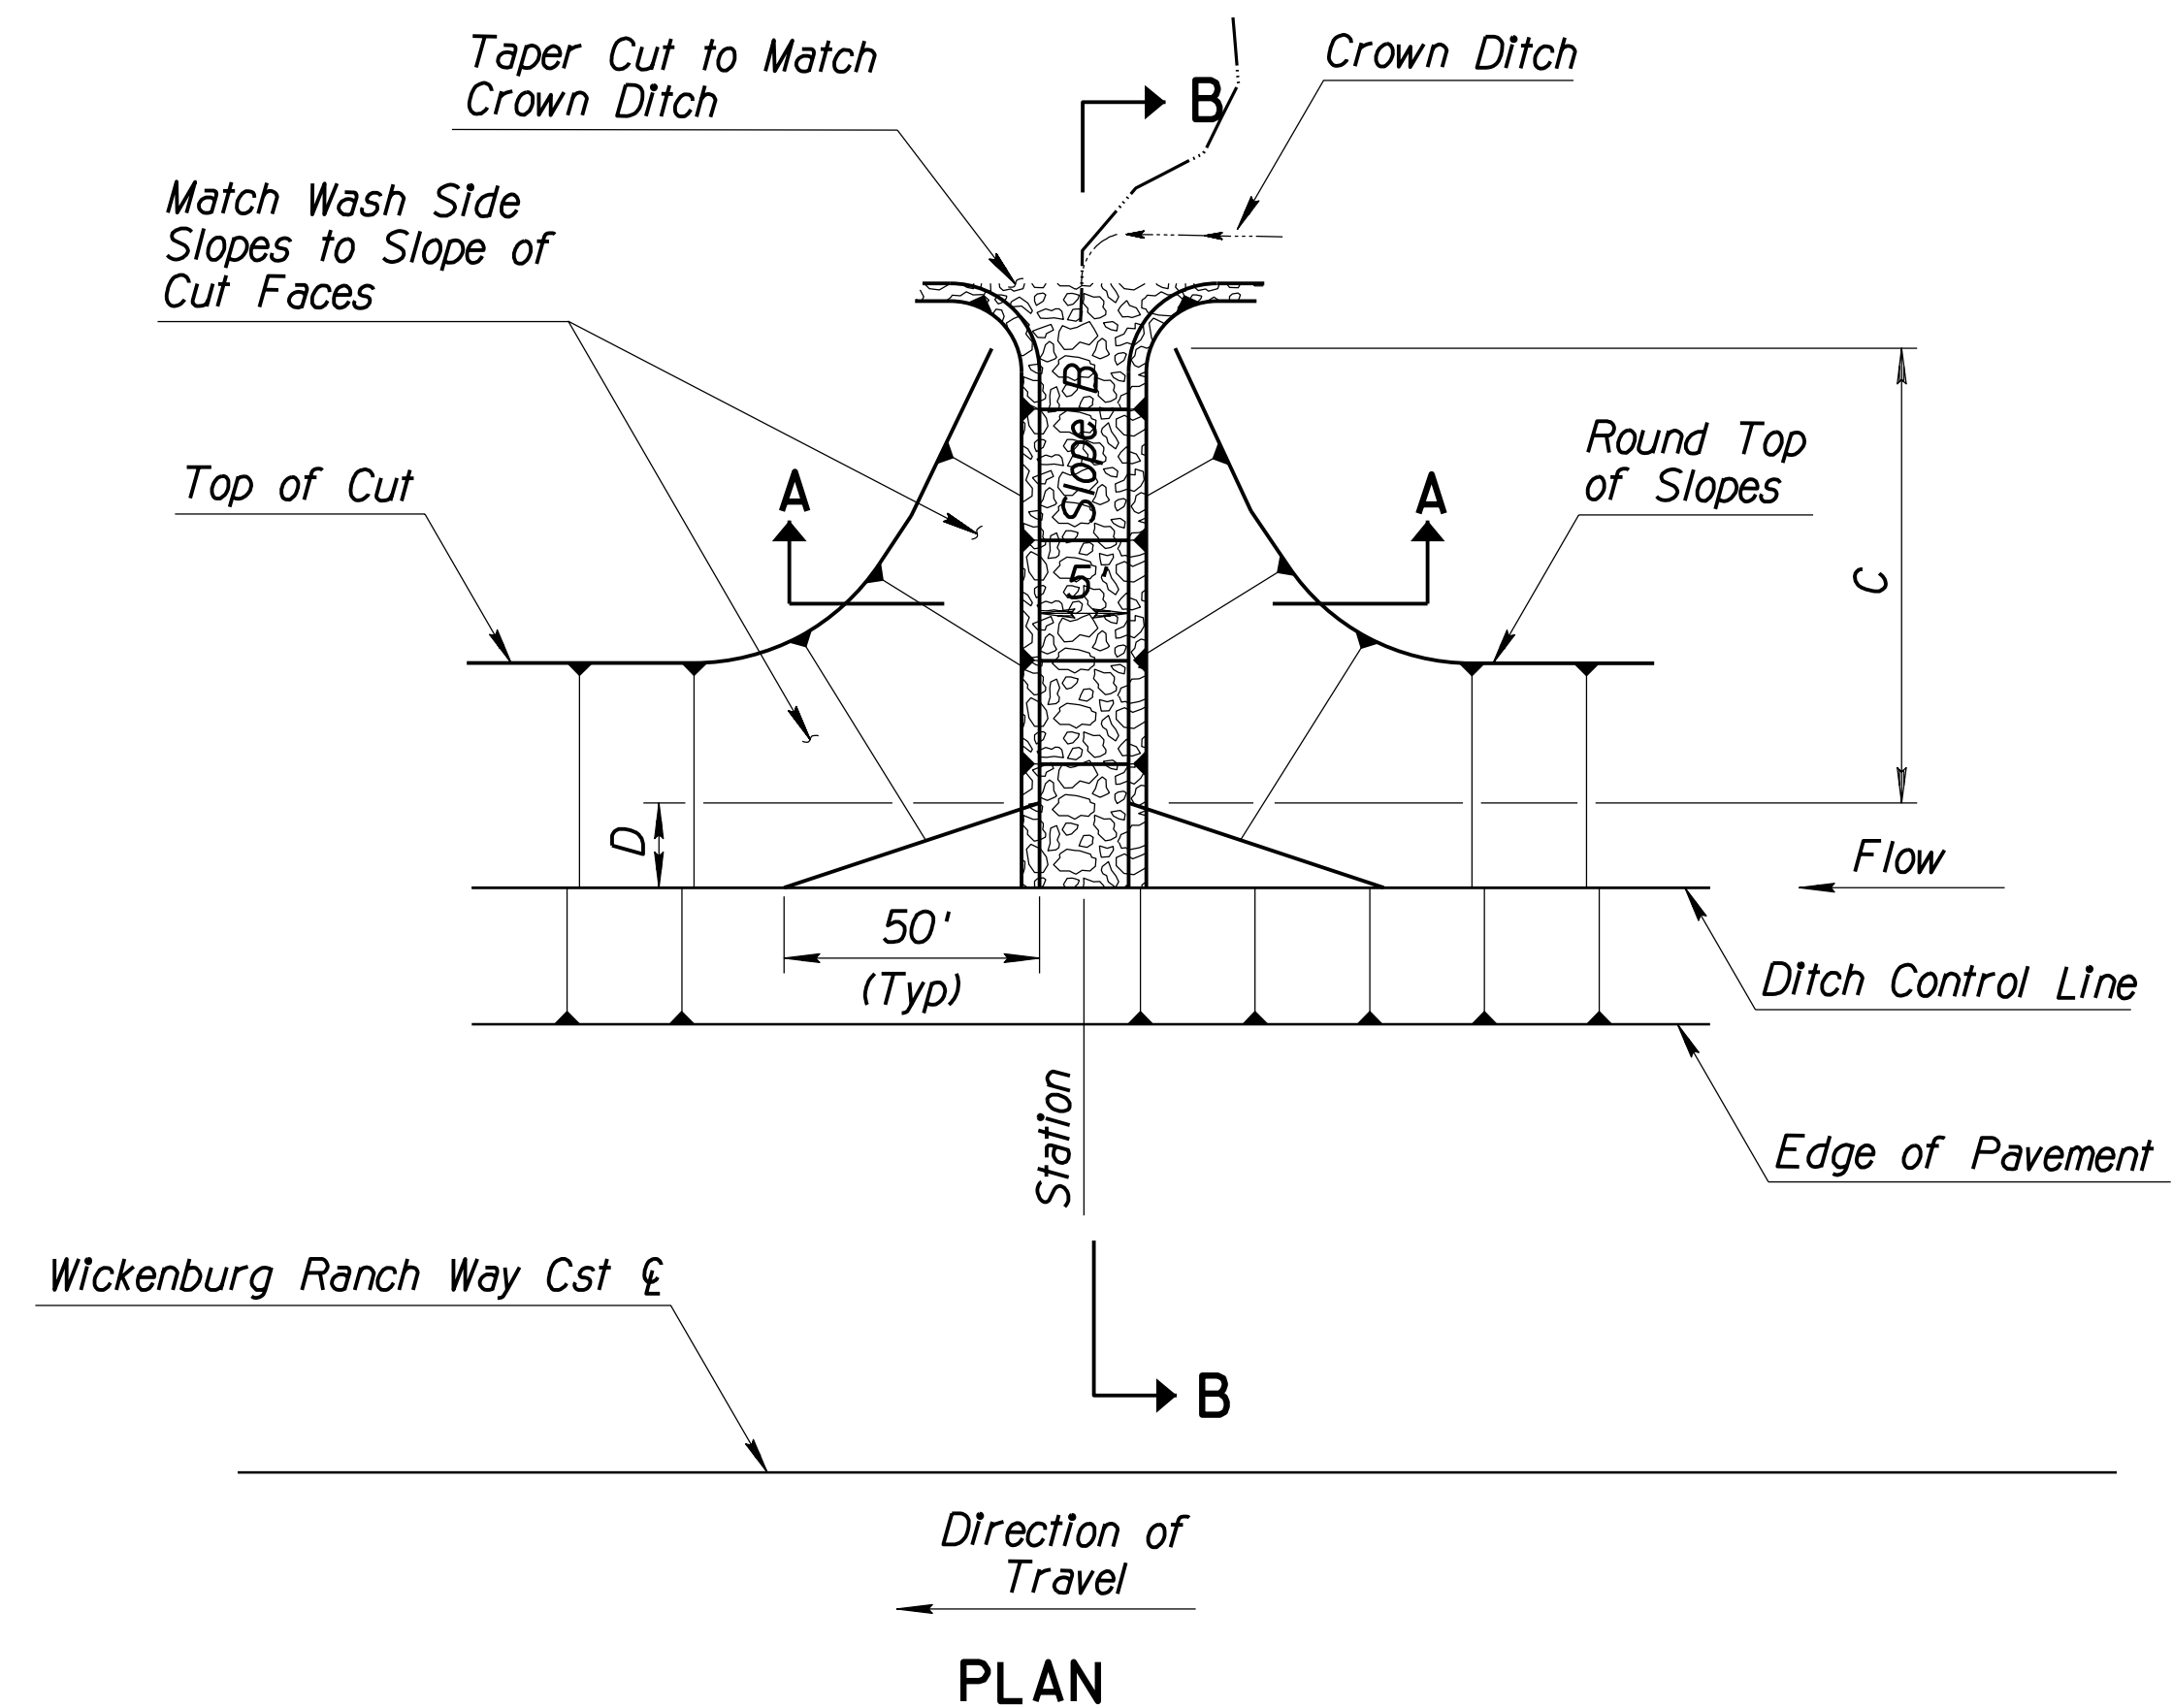


INTERCEPTED DRAINAGE							
Location	Skew (degrees)	B	C (ft)	D (ft)	Riprap Volume (CY) D ₅₀ =6"	Riprap Excavation* (CY)	Drainage Excavation** (CY)
Wickenburg Ranch Way Cst & Sta 68+29	45	6:1	63	6	18	18	15

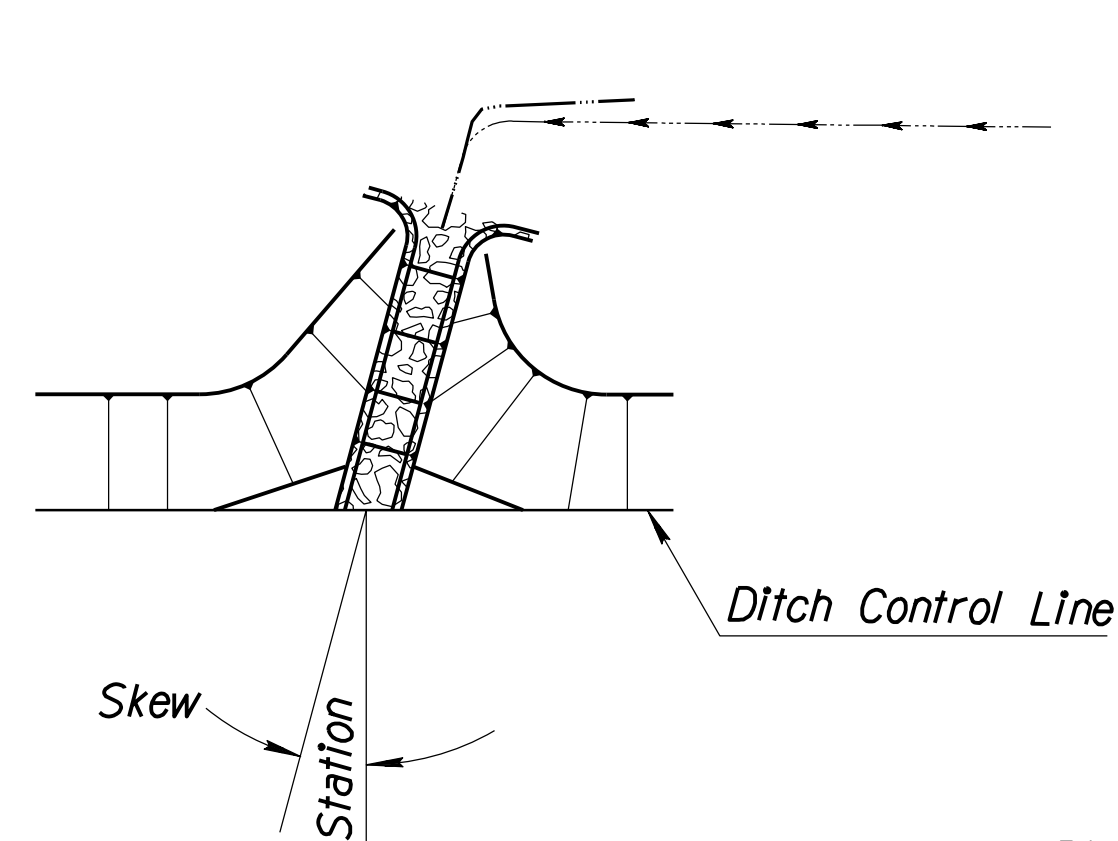

DETAIL SKEW

* Riprap Excavation is for Information Only.

** Drainage Excavation is based on Additional Excavation Beyond the Typical Cut Slope called out in Plans.

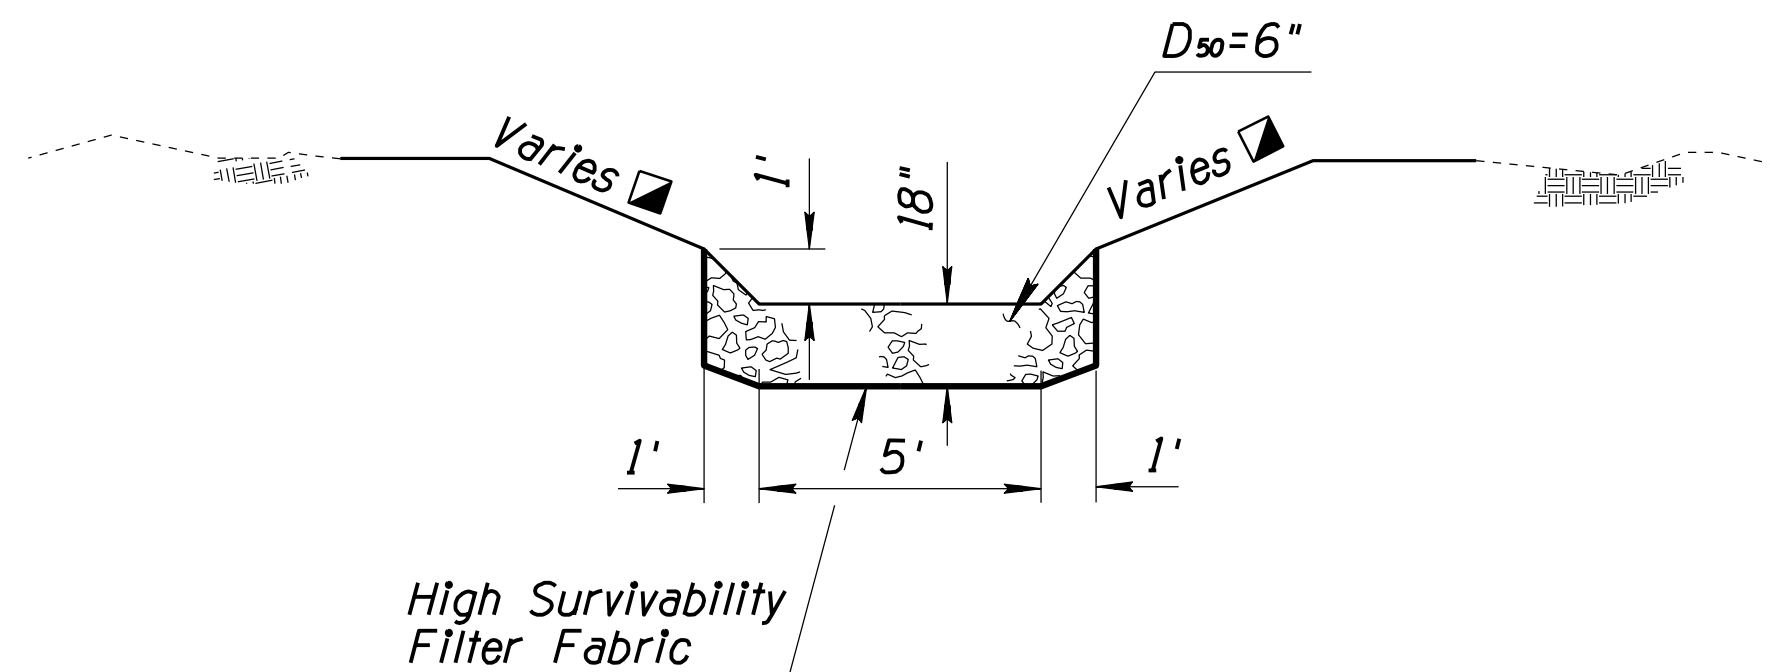

SECTION A-A

▣ Slope Varies from Roadway Cut Slope to 6:1

NOTES:

- Intercepted drainage locations shall be verified in the field by the Engineer prior to construction.
- See Detail DR for Riprap Gradations.


DETAIL DV

		NAME	DATE	ARIZONA DEPARTMENT OF TRANSPORTATION PROJECT DELIVERY AND OPERATIONS DIVISION ROADWAY DESIGN SERVICES	
DESIGN		JML	06-26		
DRAWN		EM	06-26		
CHECKED		DBK	06-26		
 Stanley Consultants inc. 3133 East Camelback Road, Suite 100 Phoenix, Arizona 85016 Phone: (602) 333-2200				DETAIL DV INTERCEPTED DRAINAGE	
ROUTE		LOCATION		DWG NO. D-1.29	
US 93		WICKENBURG RANCH WAY TO VISTA ROYALE			
TRACS NO. F0738 OIC				093-B(230)T	
				OF	





F.H.W.A. REGION	STATE	PROJECT NO.	SHEET NO.	TOTAL SHEETS	RECORD DRAWING
9	ARIZ.	093-B(230)T	78	524	
093 YV 189					

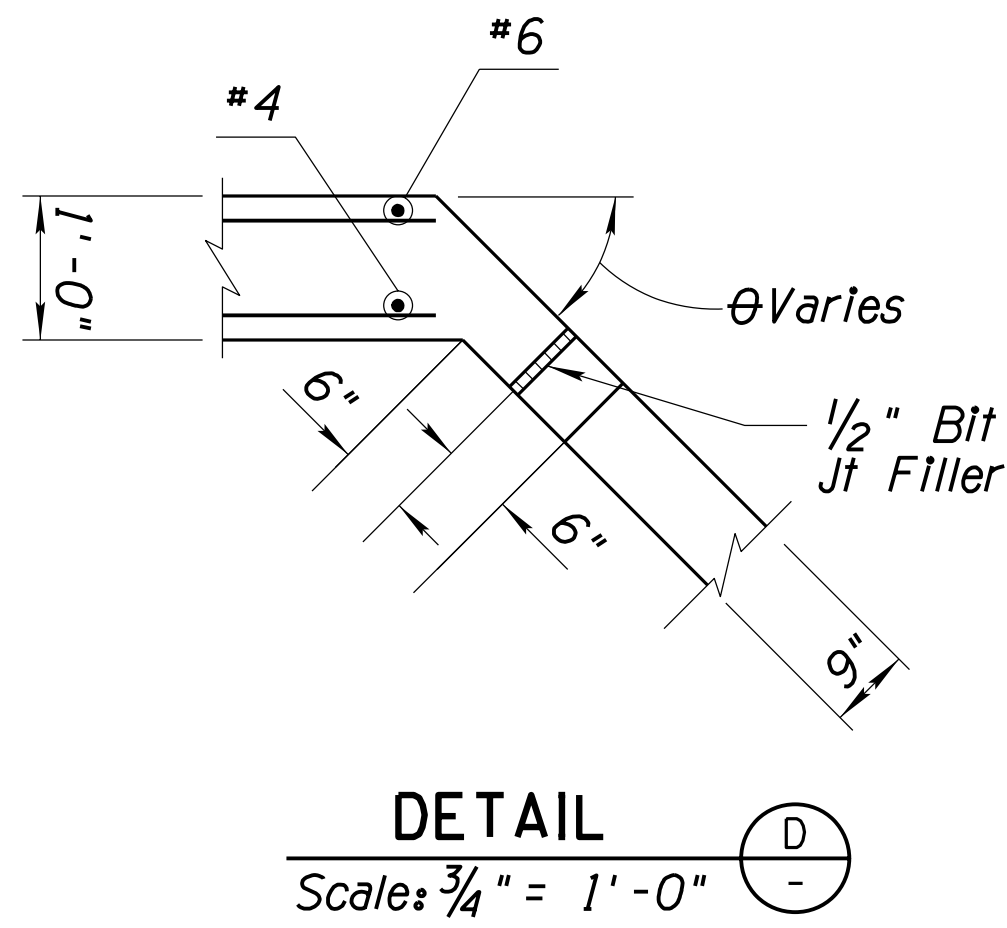


Plan Reference	DIMENSIONS							
	NORTH WINGWALL				SOUTH WINGWALL			
	A	B	θ (Degrees)	C	D	θ (Degrees)	E	F
105	11'-4"	11'-4"	45	10'-10"	2'-10"	45	10'-10"	2'-10"
								5'-3"

GENERAL NOTES:

- Construction Specifications - Arizona Department of Transportation Standard Specifications for Road & Bridge Construction, 2021 Edition.
- Design Specifications - AASHTO Standard Specifications for Highway Bridges, 17th Edition, 2002.
- Dead Load - Weight of backfill = 120 pcf
Angle of internal friction = 33.25°
- All concrete shall be Class 'S' unless noted otherwise.
- Reinforcing steel shall conform to ASTM Specification A615. All reinforcing shall be furnished as Grade 60.
- All bends & hooks shall meet the requirements of AASHTO Article 8.23. All bend dimensions for reinforcing steel shall be out-to-out of bars. All placement dimensions for reinforcing steel shall be to center of bars unless noted otherwise.
- All reinforcing steel shall have 2 inch clear cover unless noted otherwise.
- Stresses:
Class 'S' Concrete..... $f'_c = 3,000$ psi
Grade 60 reinforcement..... $f_s = 24,000$ psi
- Chamfer all exposed corners $\frac{3}{4}"$ unless noted otherwise.
- Dimensions shall not be scaled from drawings.
- Depressed inlet will be measured and paid for under Item No. 6016099 - Headwall (48") (Detail DW).

Plan Reference	ELEVATIONS				
	H	J	K	L	M
105	2406.93	2408.75	2409.75	2412.43	2404.93

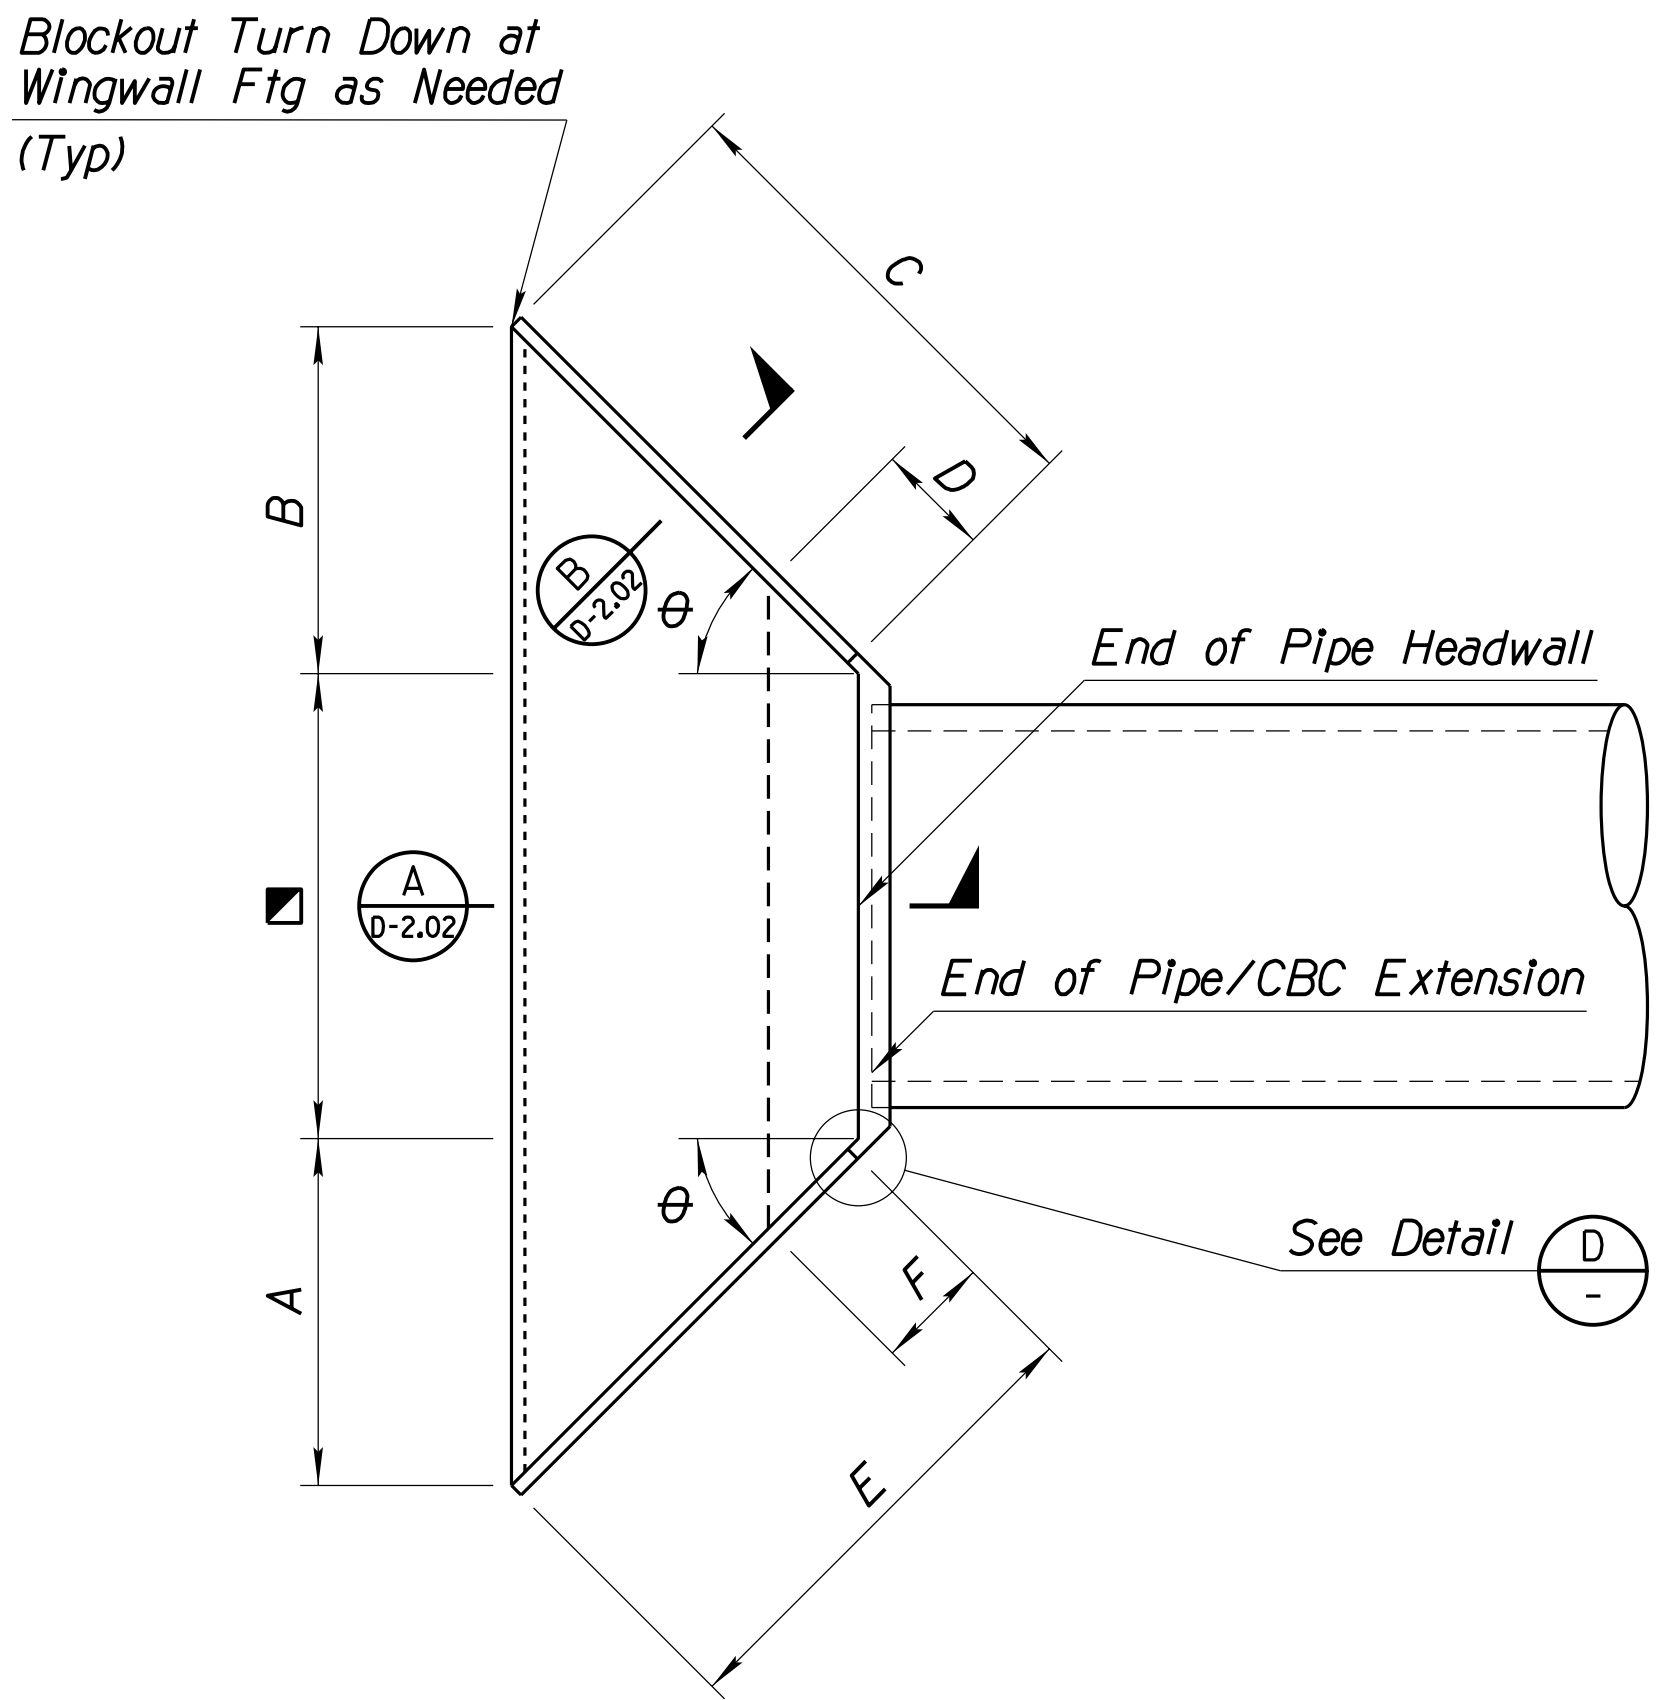


See Std Dwg No. SD 6.30 for Details and Dimensions not shown.

INLET PLAN VIEW
NTS


DETAIL DW
Sheet 1 of 2
HEADWALL

NAME			DATE	ARIZONA DEPARTMENT OF TRANSPORTATION PROJECT DELIVERY AND OPERATIONS DIVISION ROADWAY DESIGN SERVICES	
DESIGN	DK		06-26		
DRAWN	DK		06-26		
CHECKED	MEW		06-26		
Stanley Consultants inc.			3133 East Camelback Road, Suite 100 Phoenix, Arizona 85016 Phone: (602) 333-2200	DETAIL DW HEADWALL	
ROUTE		LOCATION			DWG NO. D-1.30
US 93		WICKENBURG RANCH WAY TO VISTA ROYALE			
TRACS NO. F0738 OIC			093-B(230)T		OF

F.H.W.A. REGION	STATE	PROJECT NO.	SHEET NO.	TOTAL SHEETS	RECORD DRAWING
9	ARIZ.	093-B(230)T	79	524	
		093 YV 189			

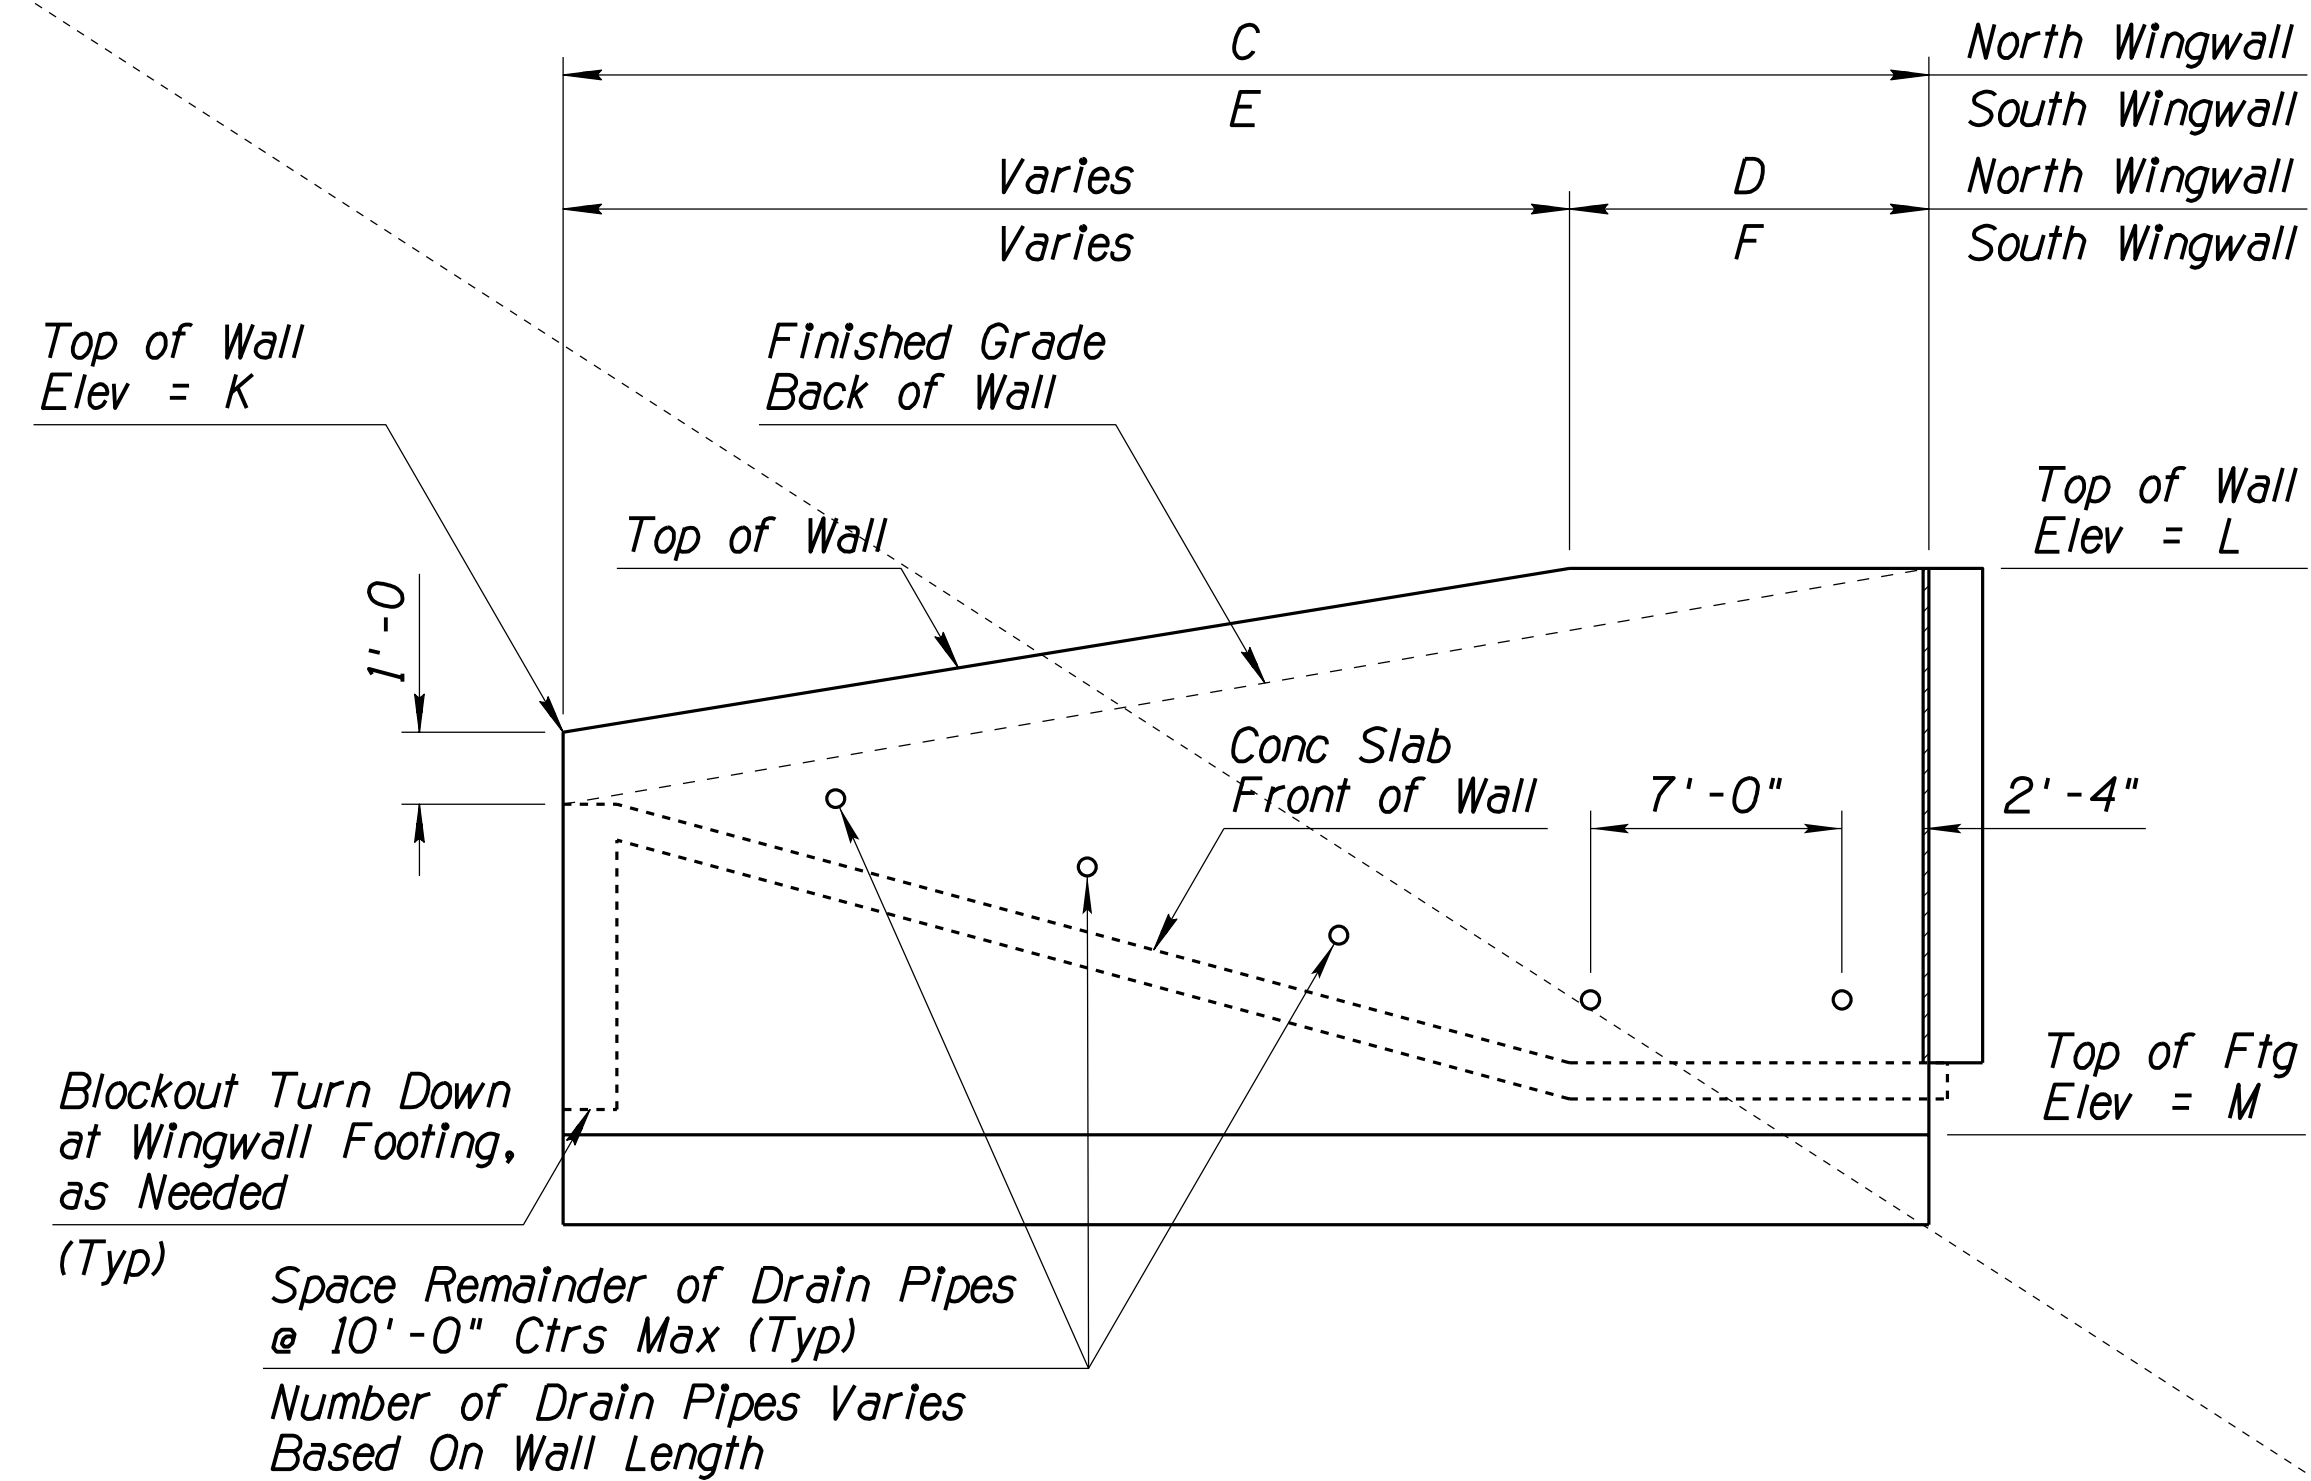


WINGWALL ELEVATION
Scale: $\frac{3}{8}" = 1'-0"$

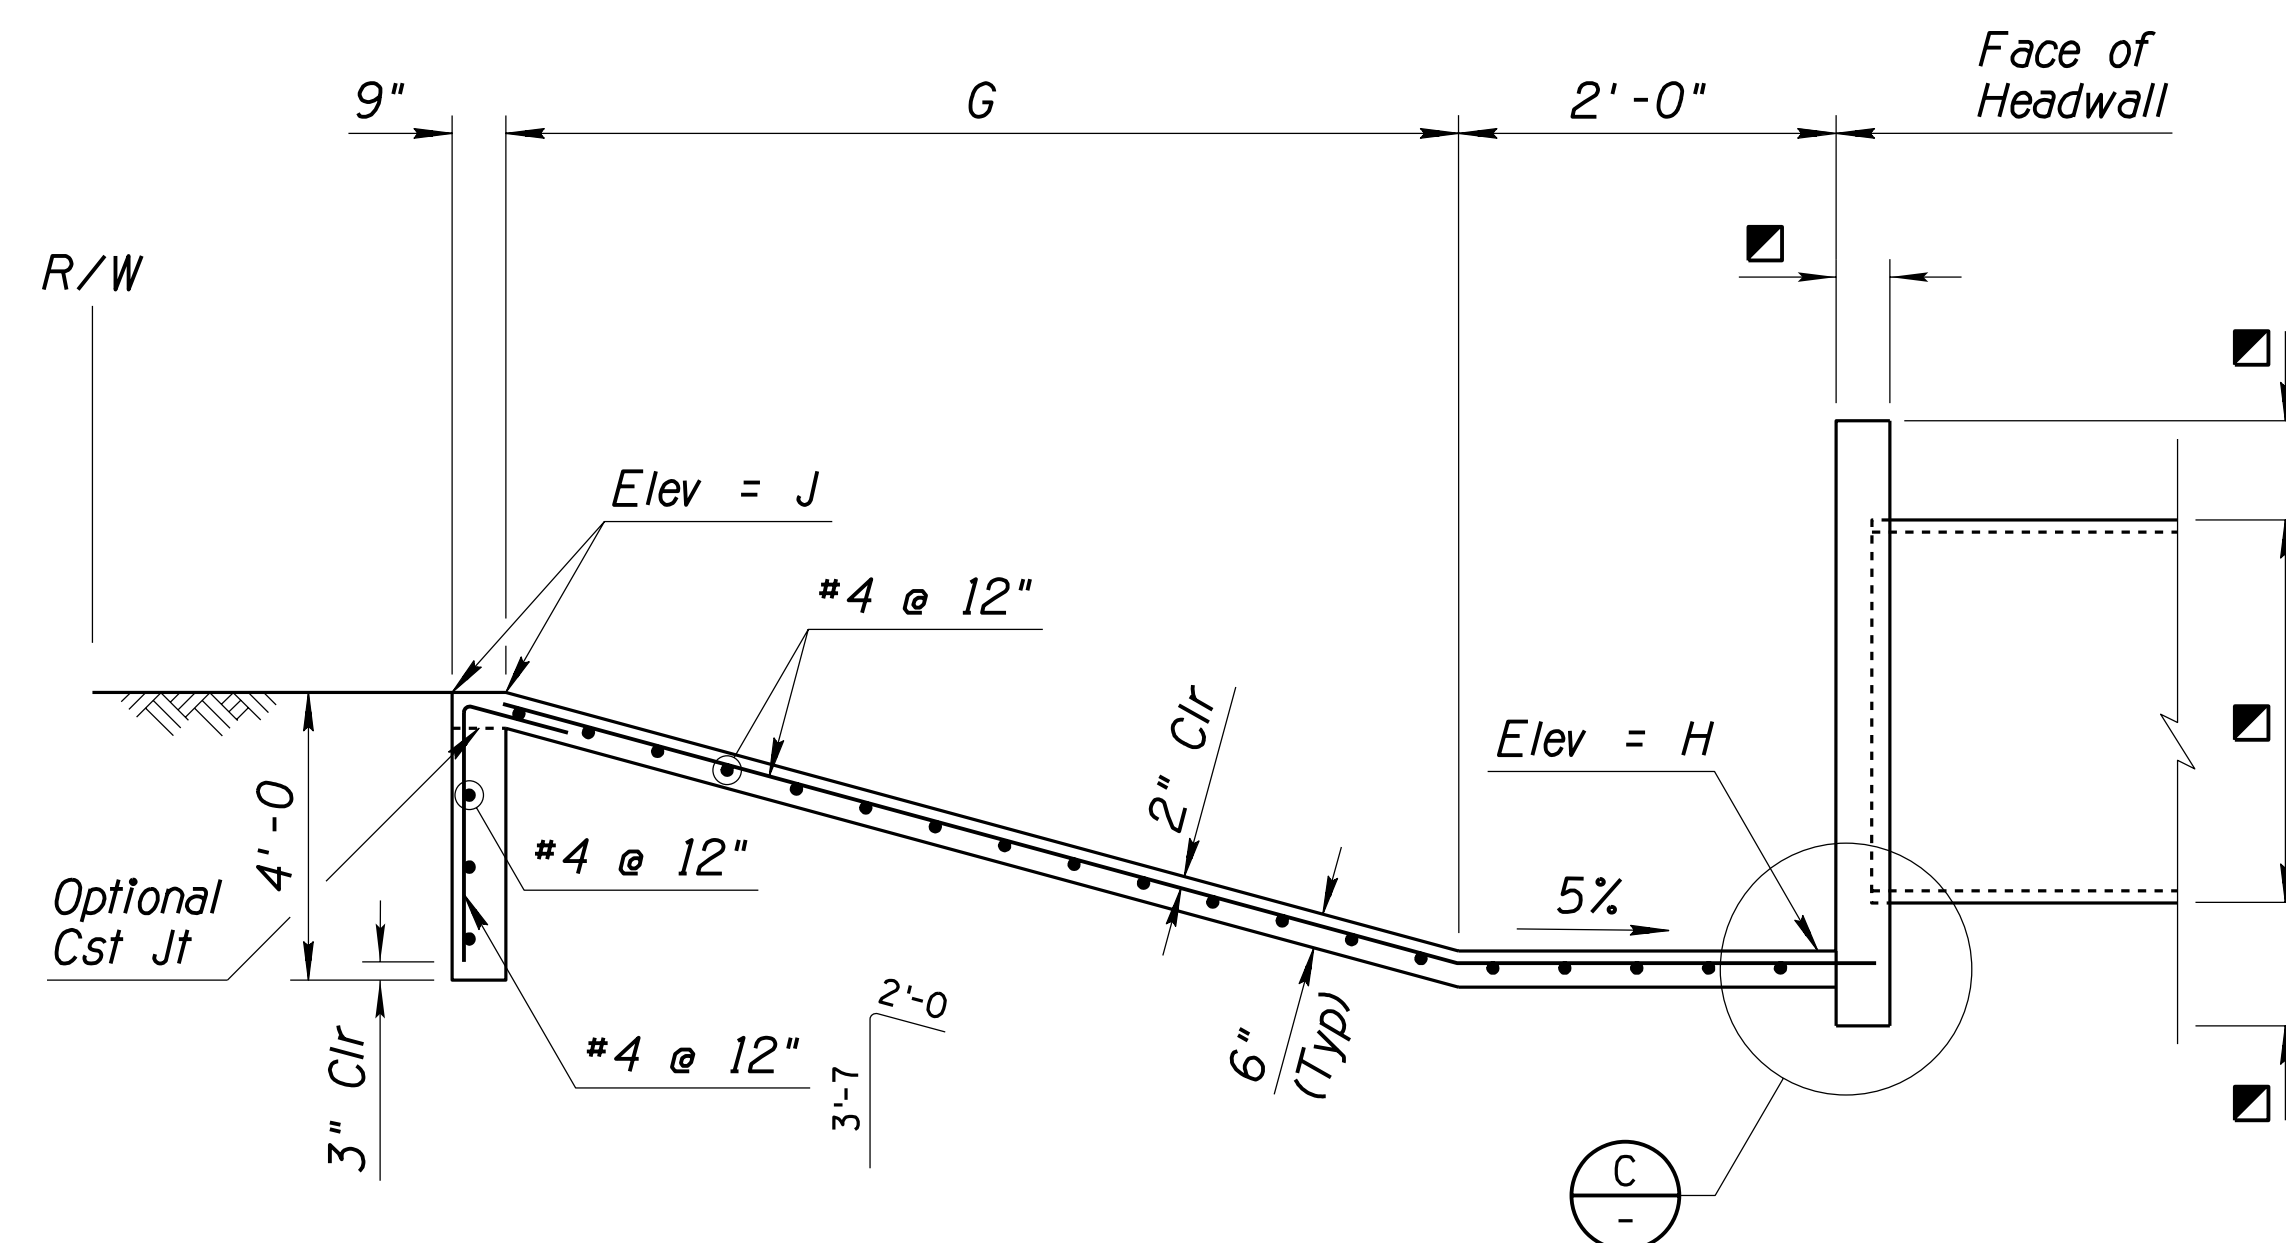

SECTION A
No Scale D-1.31


■ See Std SD 6.30 for details and dimensions not shown.

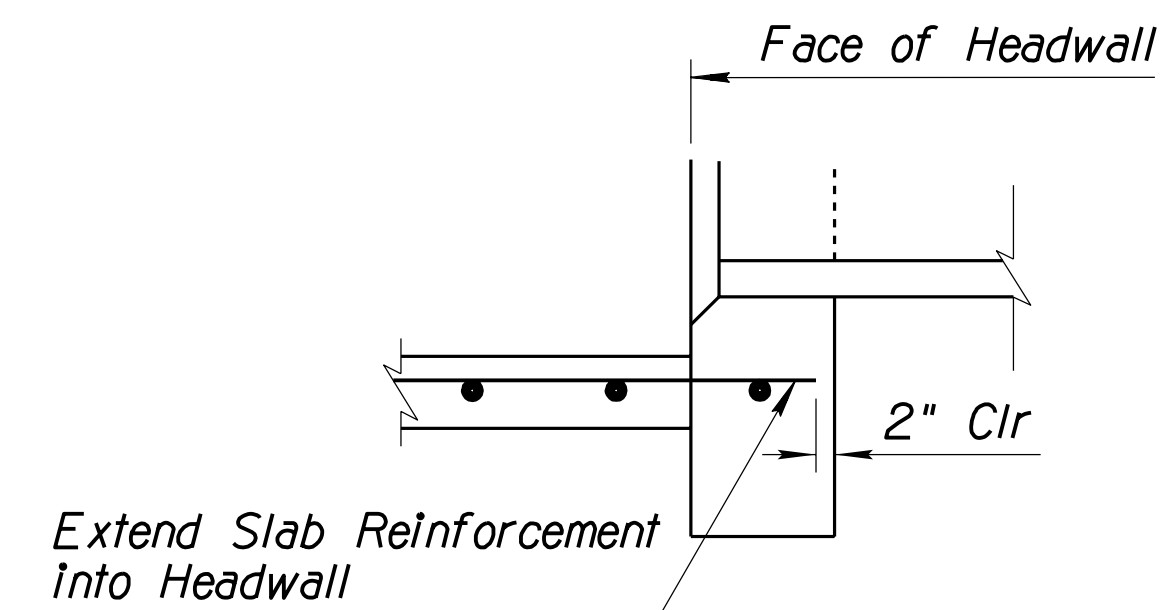

See Std SD 6.30 for additional reinforcement,
dimensions, and details not shown

PIPE DETAIL

DETAIL C
-
NTS

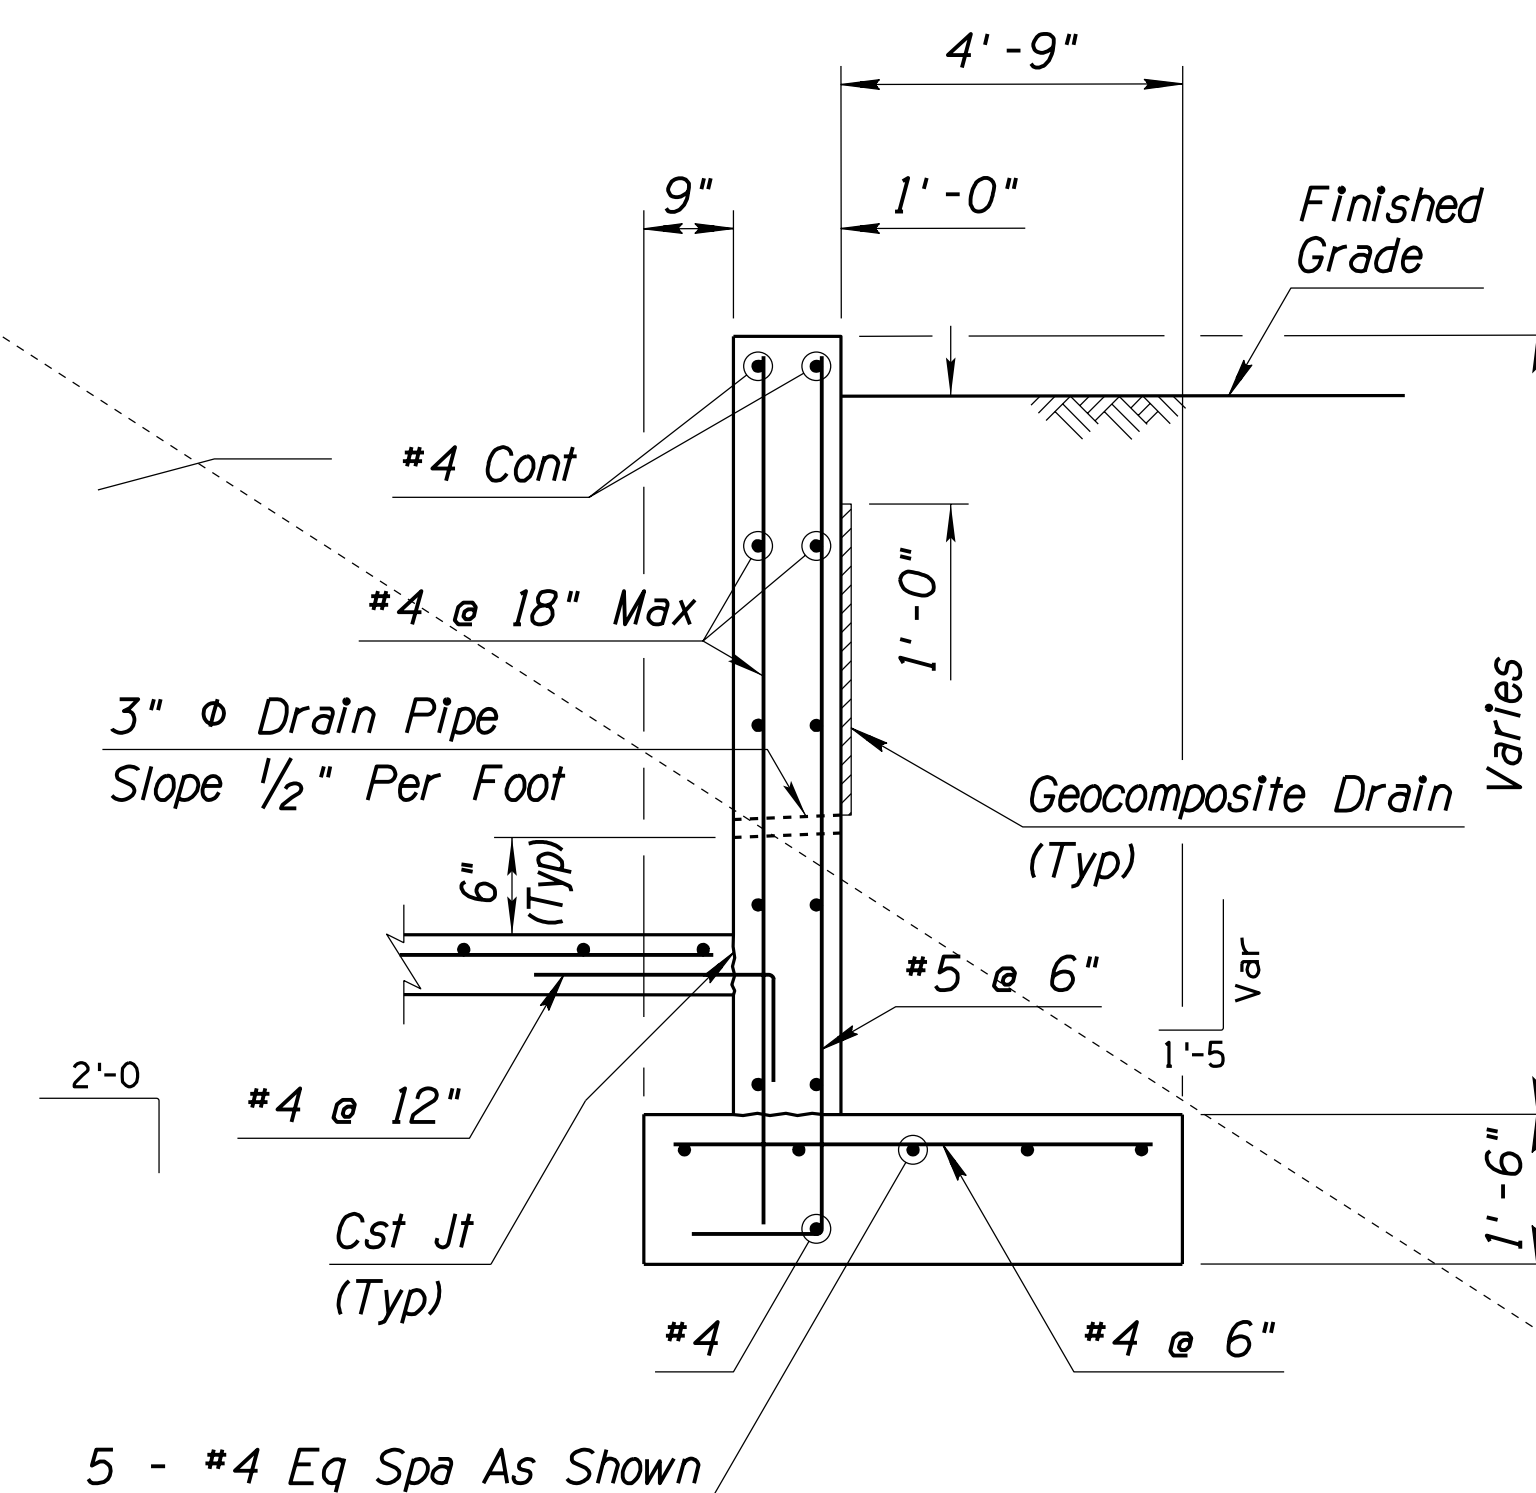

SECTION B
D-1.3

NTS


DETAIL DW

Sheet 2 of 2
HEADWALL


 3133 East Camelback Road, Suite 100 Phoenix, Arizona 85016 Phone: (602) 333-2200		ARIZONA DEPARTMENT OF TRANSPORTATION PROJECT DELIVERY AND OPERATIONS DIVISION ROADWAY DESIGN SERVICES		
ROUTE LOCATION US 93 WICKENBURG RANCH WAY TO VISTA ROYALE		DETAIL DW HEADWALL		
TRACS NO. F0738 OIC		093-B(230)T		DWG NO. D-1.31 OF

F.H.W.A. REGION	STATE	PROJECT NO.	SHEET NO.	TOTAL SHEETS	RECORD DRAWING
9	ARIZ.	093-B(230)T	80	524	

093 YV 189

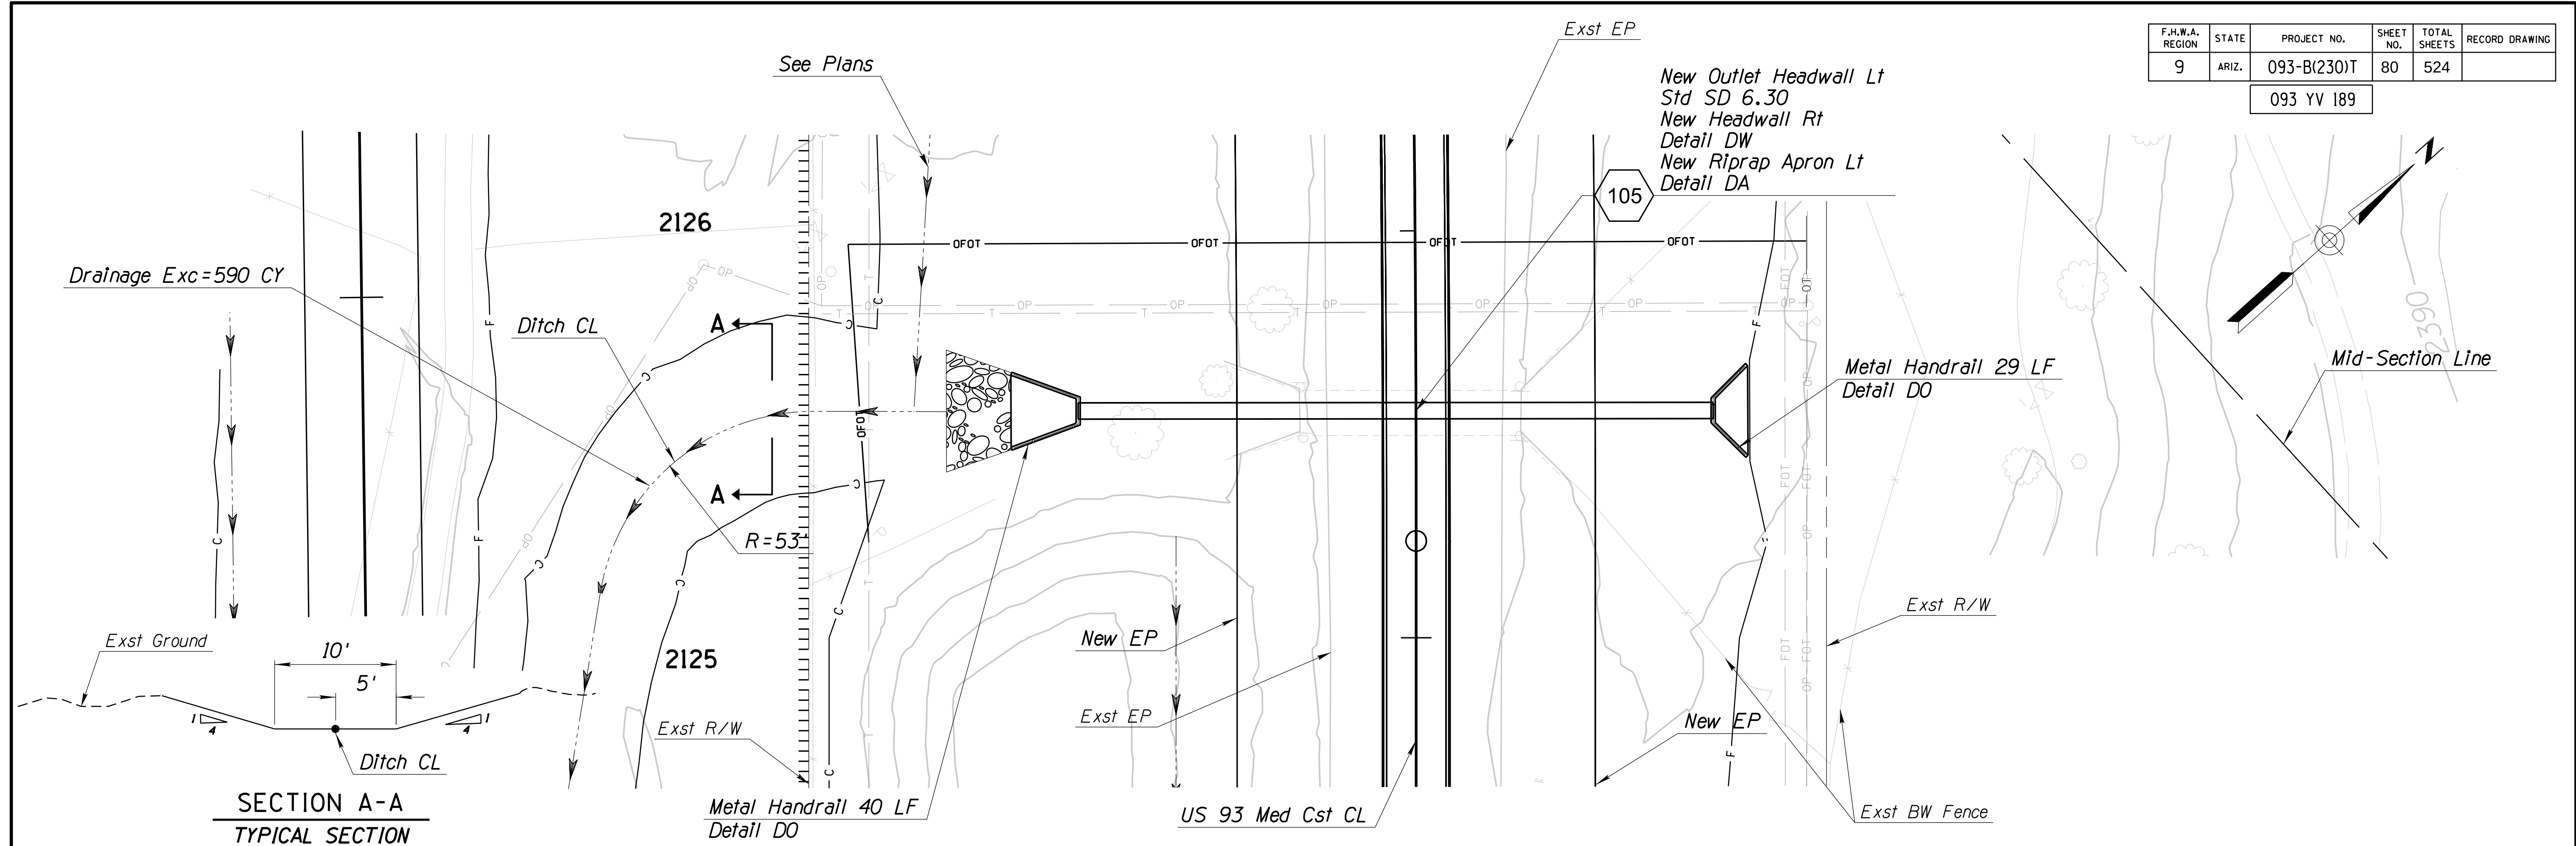



- NOTES:**
1. Outlet Wingwall dimensions shall be based on 0° skew with 6:1 Slopes.
 2. The contractor shall remove the concrete box culvert in its entirety. The box culvert removal will be measured and paid for under Bid Item 2020153-Remove (Reinforced Concrete Box Culvert).

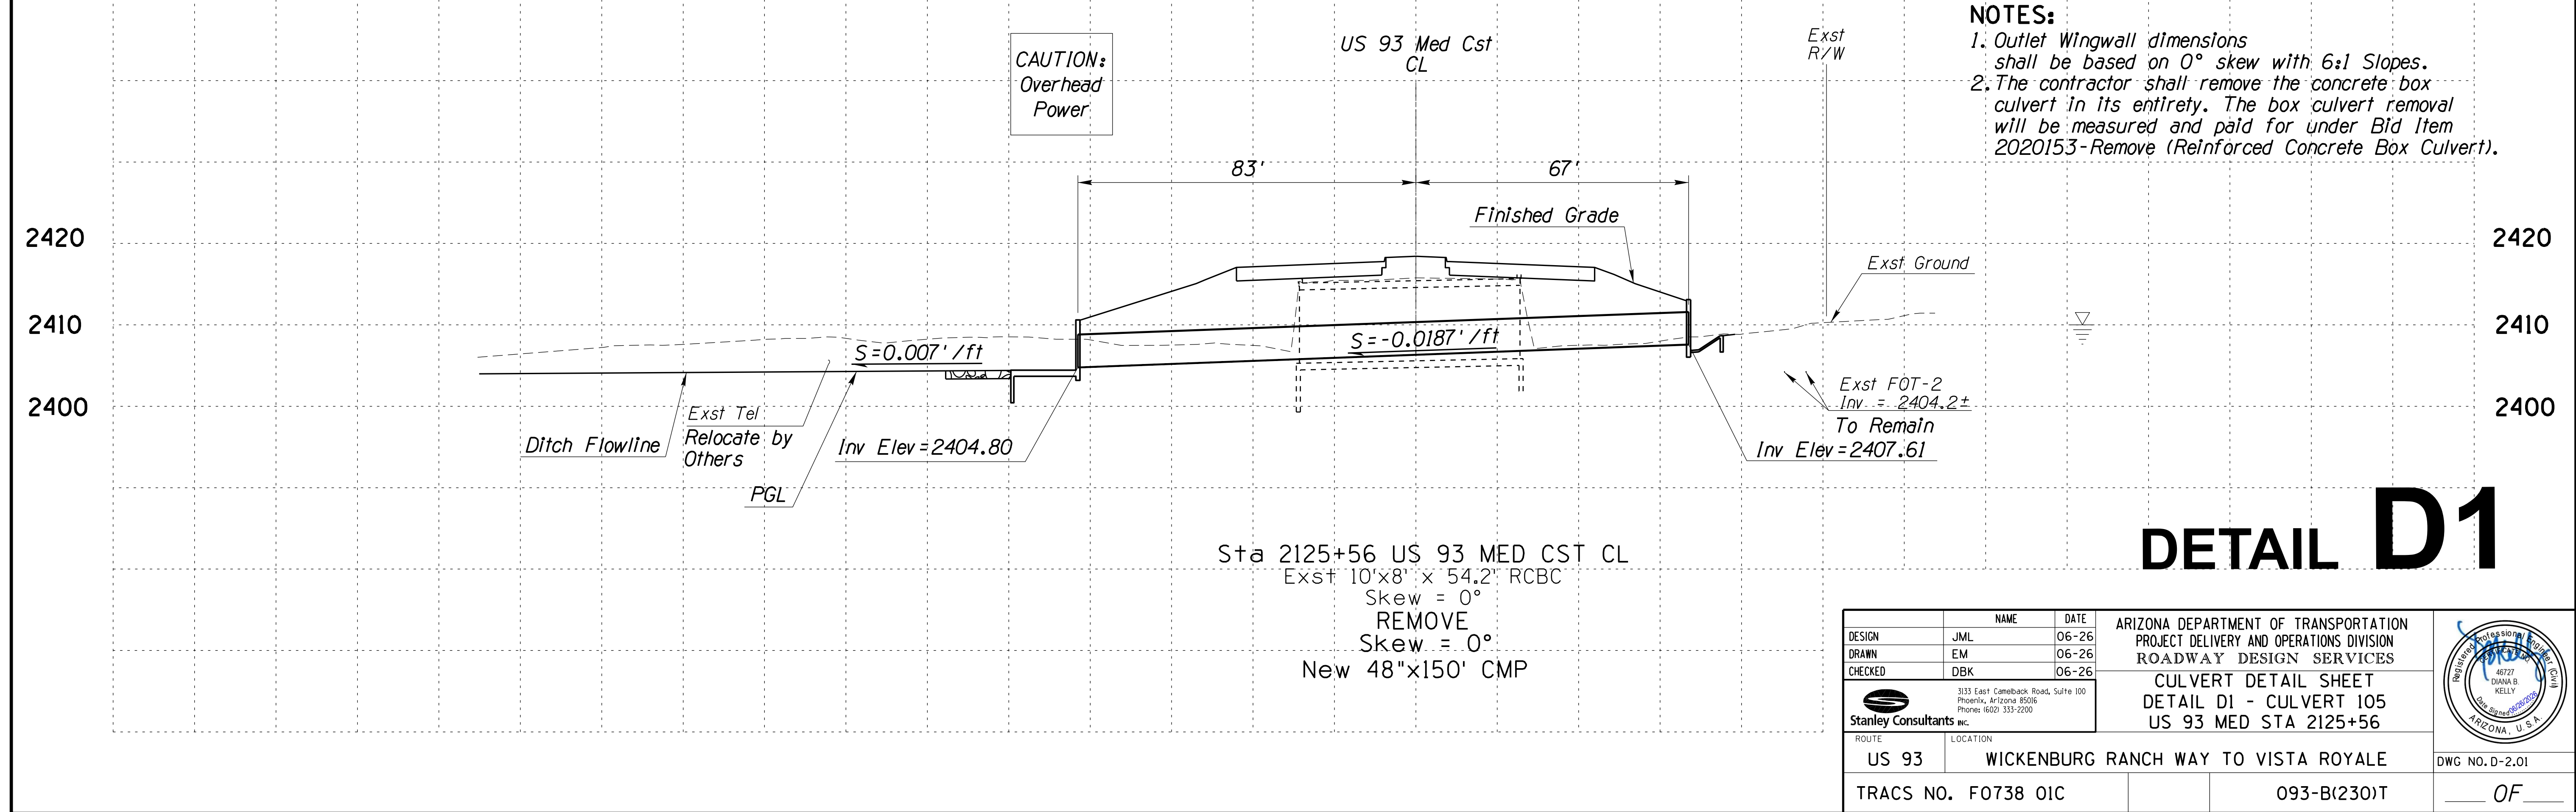

DESIGN	JML	NAME	DATE	ARIZONA DEPARTMENT OF TRANSPORTATION PROJECT DELIVERY AND OPERATIONS DIVISION ROADWAY DESIGN SERVICES	
DRAWN	EM	NAME	DATE	CULVERT DETAIL SHEET DETAIL D1 - CULVERT 105 US 93 MED STA 2125+56	
CHECKED	DBK	NAME	DATE	ROUTE US 93 LOCATION WICKENBURG RANCH WAY TO VISTA ROYALE	DWG NO. D-2.01
TRACS NO. F0738 OIC				093-B(230)T	OF

F.H.W.A. REGION	STATE	PROJECT NO.	SHEET NO.	TOTAL SHEETS	RECORD DRAWING
9	ARIZ.	093-B(230)T	81	524	

093 YV 189

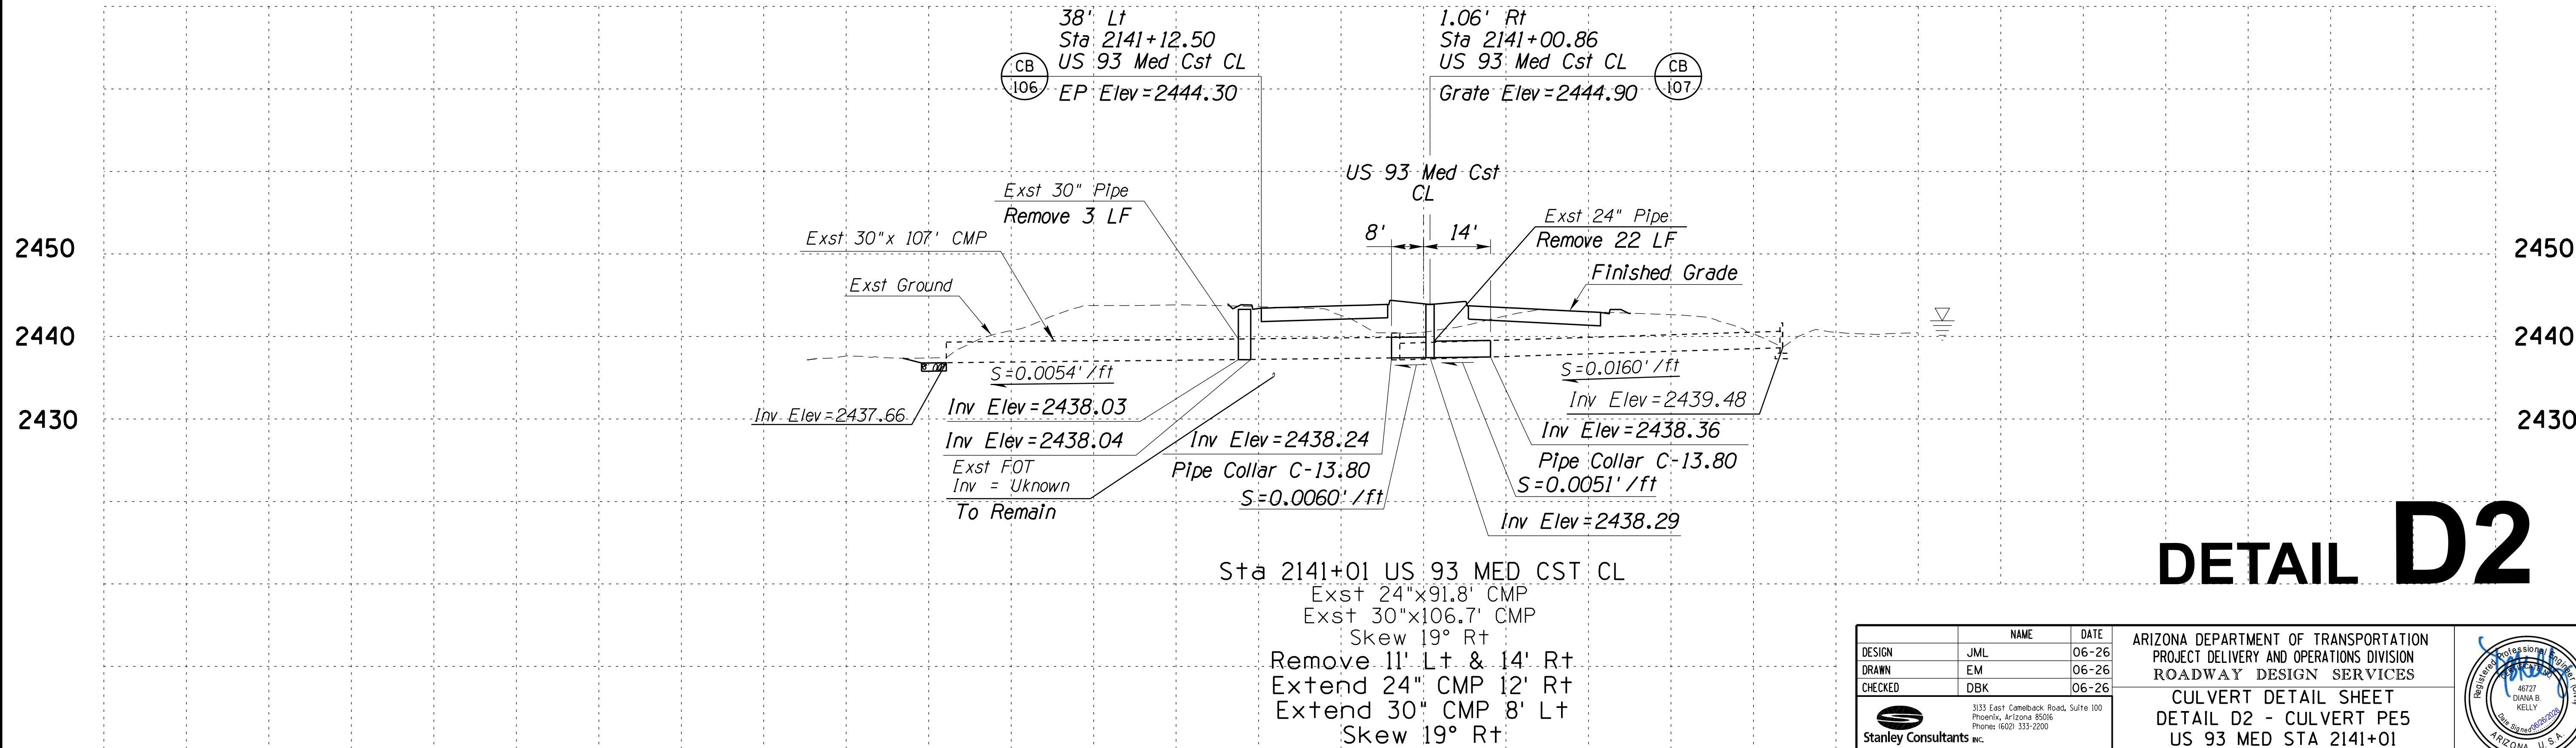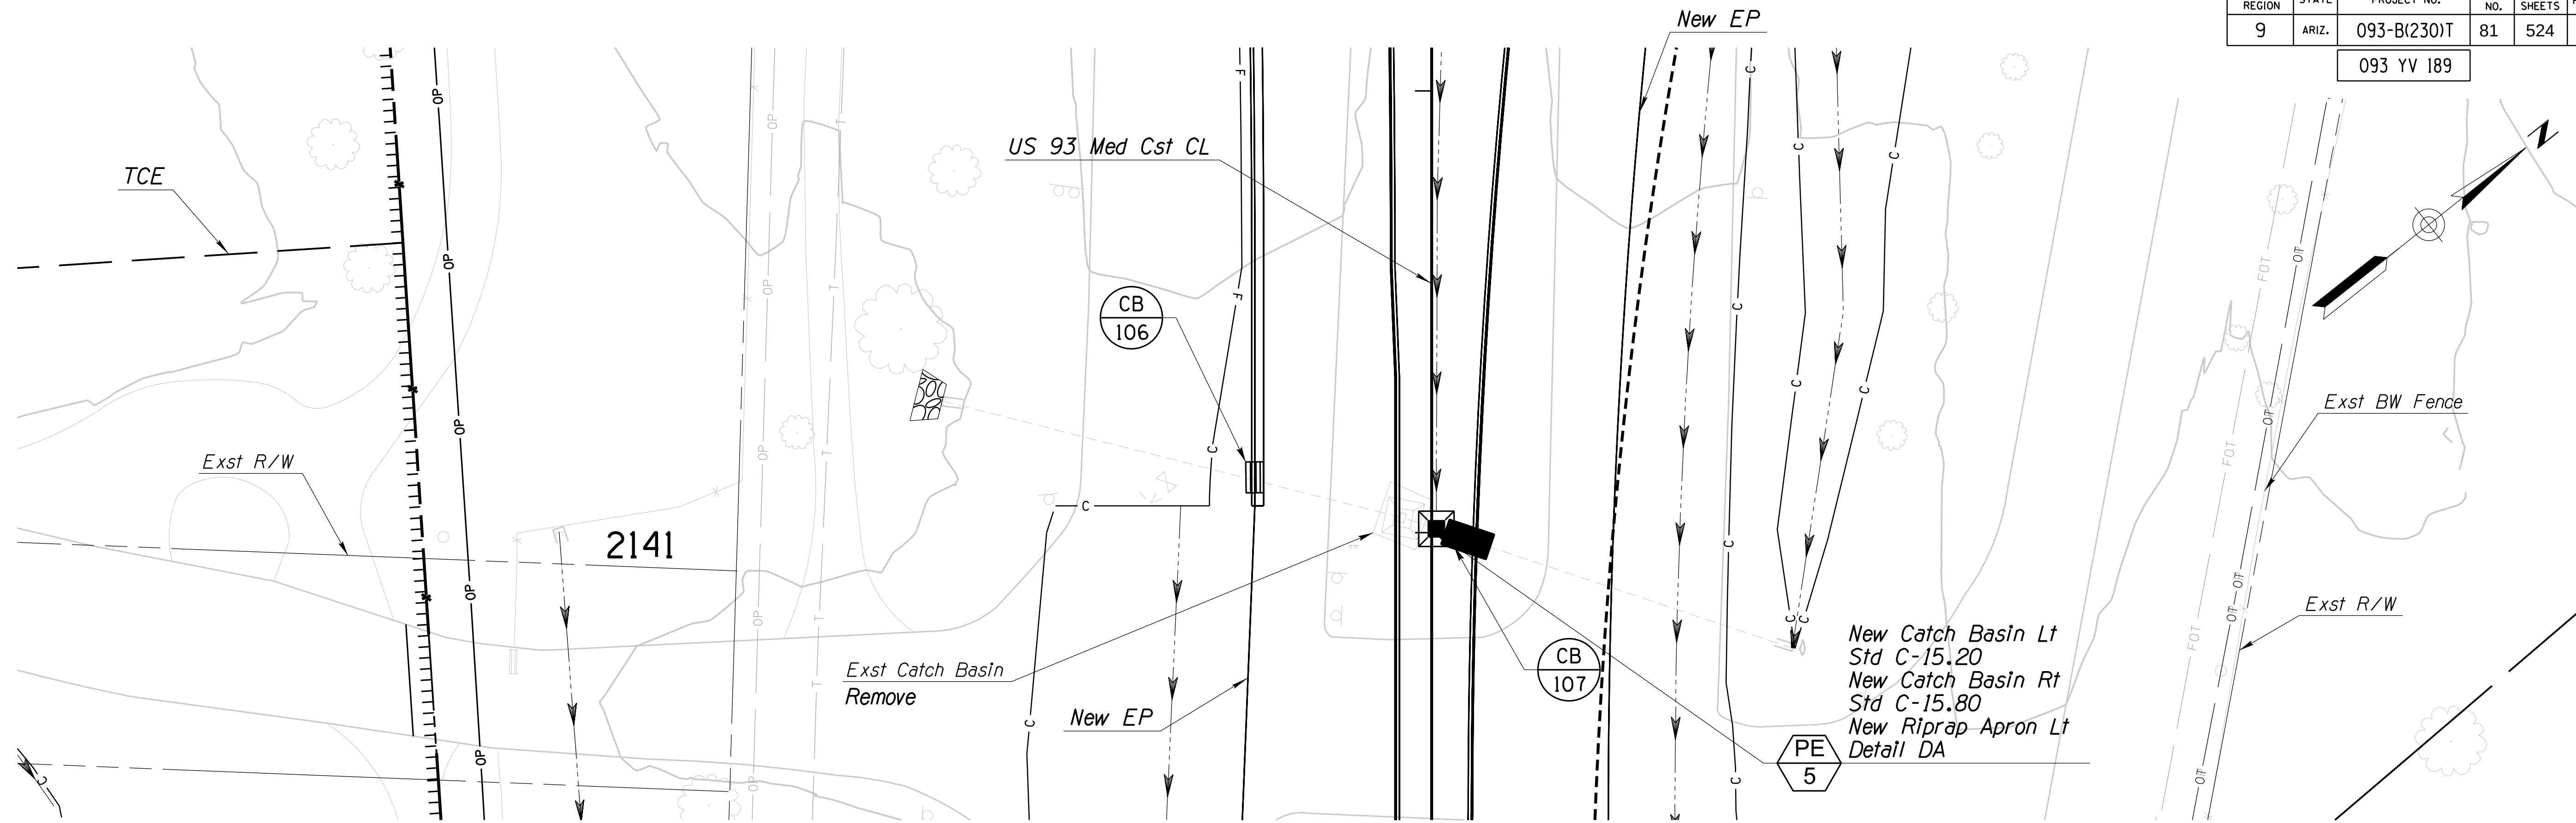


DETAIL D2

DESIGN	NAME	DATE	ARIZONA DEPARTMENT OF TRANSPORTATION PROJECT DELIVERY AND OPERATIONS DIVISION ROADWAY DESIGN SERVICES CULVERT DETAIL SHEET DETAIL D2 - CULVERT PE5 US 93 MED STA 2141+01	
DRAWN	JML	06-26		
CHECKED	DBK	06-26		
Stanley Consultants inc.			3133 East Camelback Road, Suite 100 Phoenix, Arizona 85016 Phone: (602) 333-2200	
ROUTE	LOCATION	US 93 WICKENBURG RANCH WAY TO VISTA ROYALE		DWG NO. D-2.02
TRACS NO. F0738 OIC			093-B(230)T	OF


F.H.W.A. REGION	STATE	PROJECT NO.	SHEET NO.	TOTAL SHEETS	RECORD DRAWING
9	ARIZ.	093-B(230)T	82	524	

093 YV 189

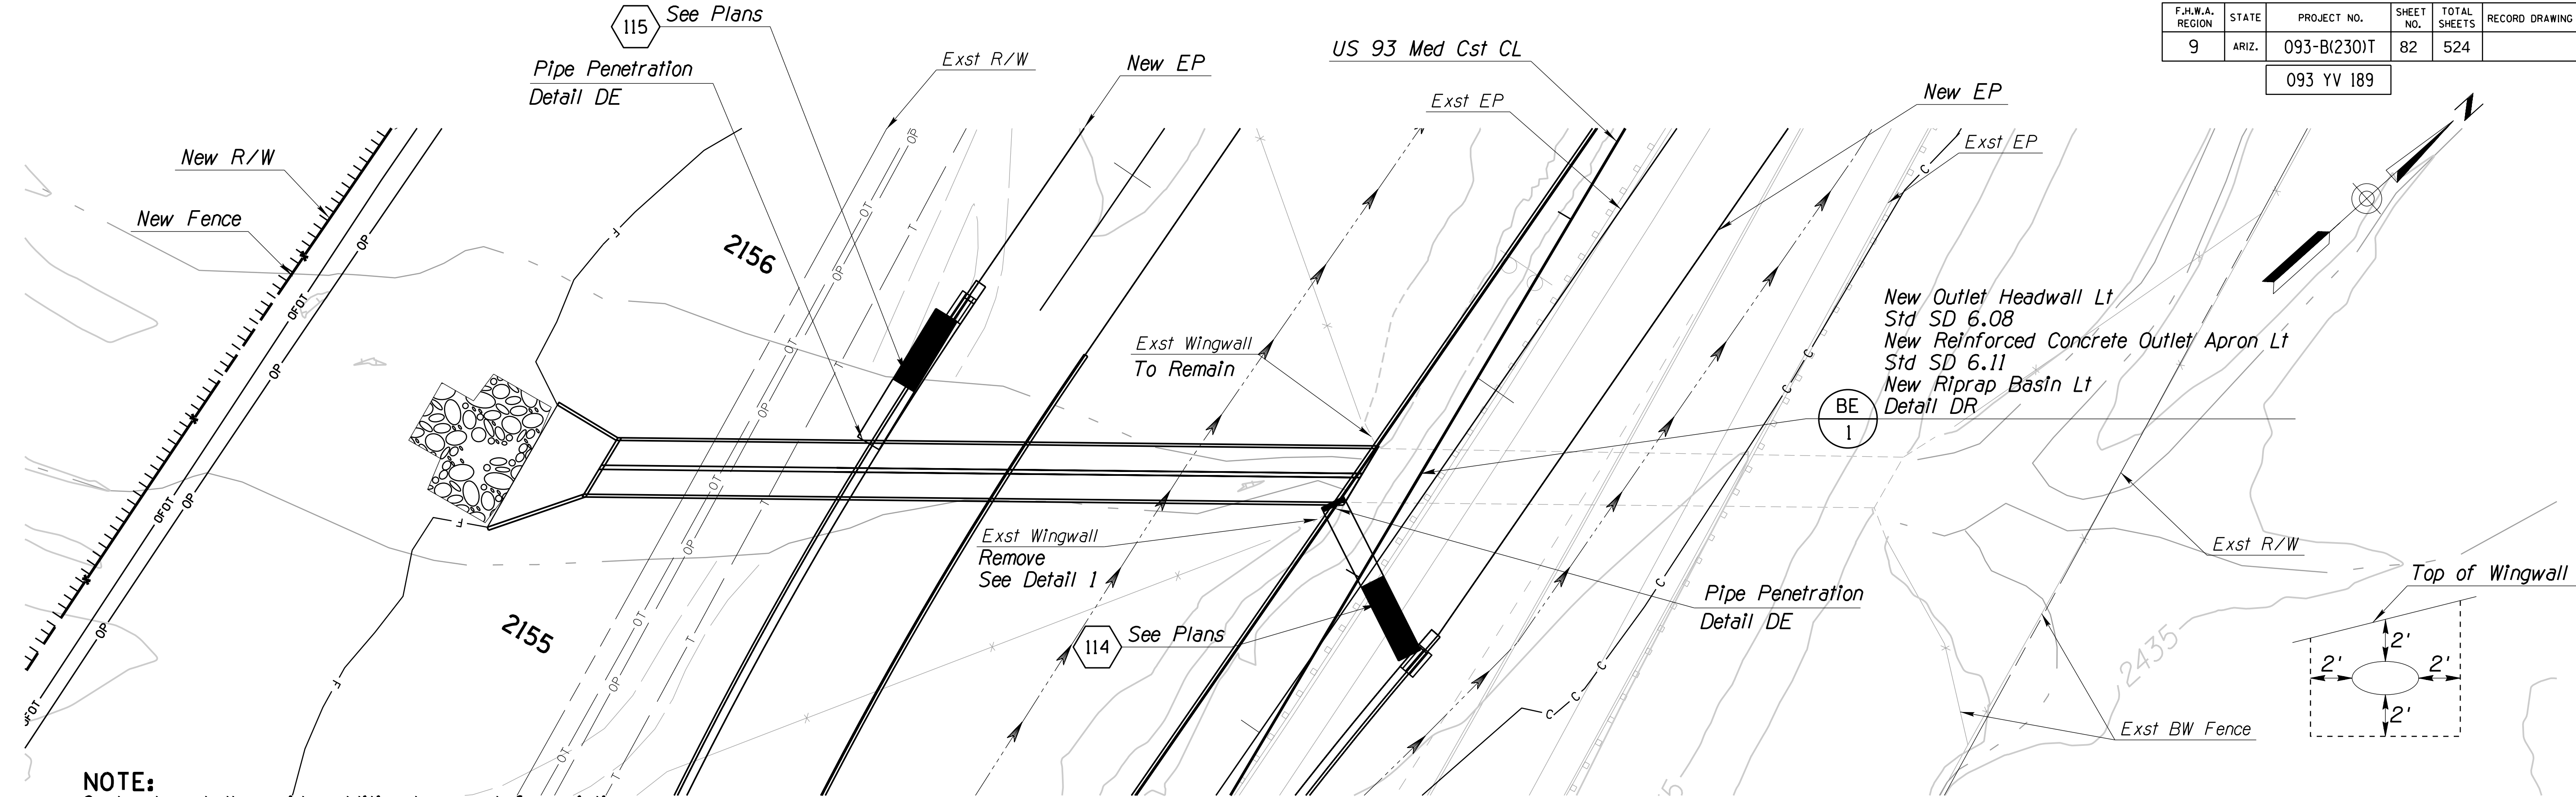



NOTE:
Contractor shall provide additional support for existing wingwall to remain in place during construction of the CBC extension.

NOTE:
Outlet Wingwall dimensions shall be based on 30° skew with 4:1 Slopes.

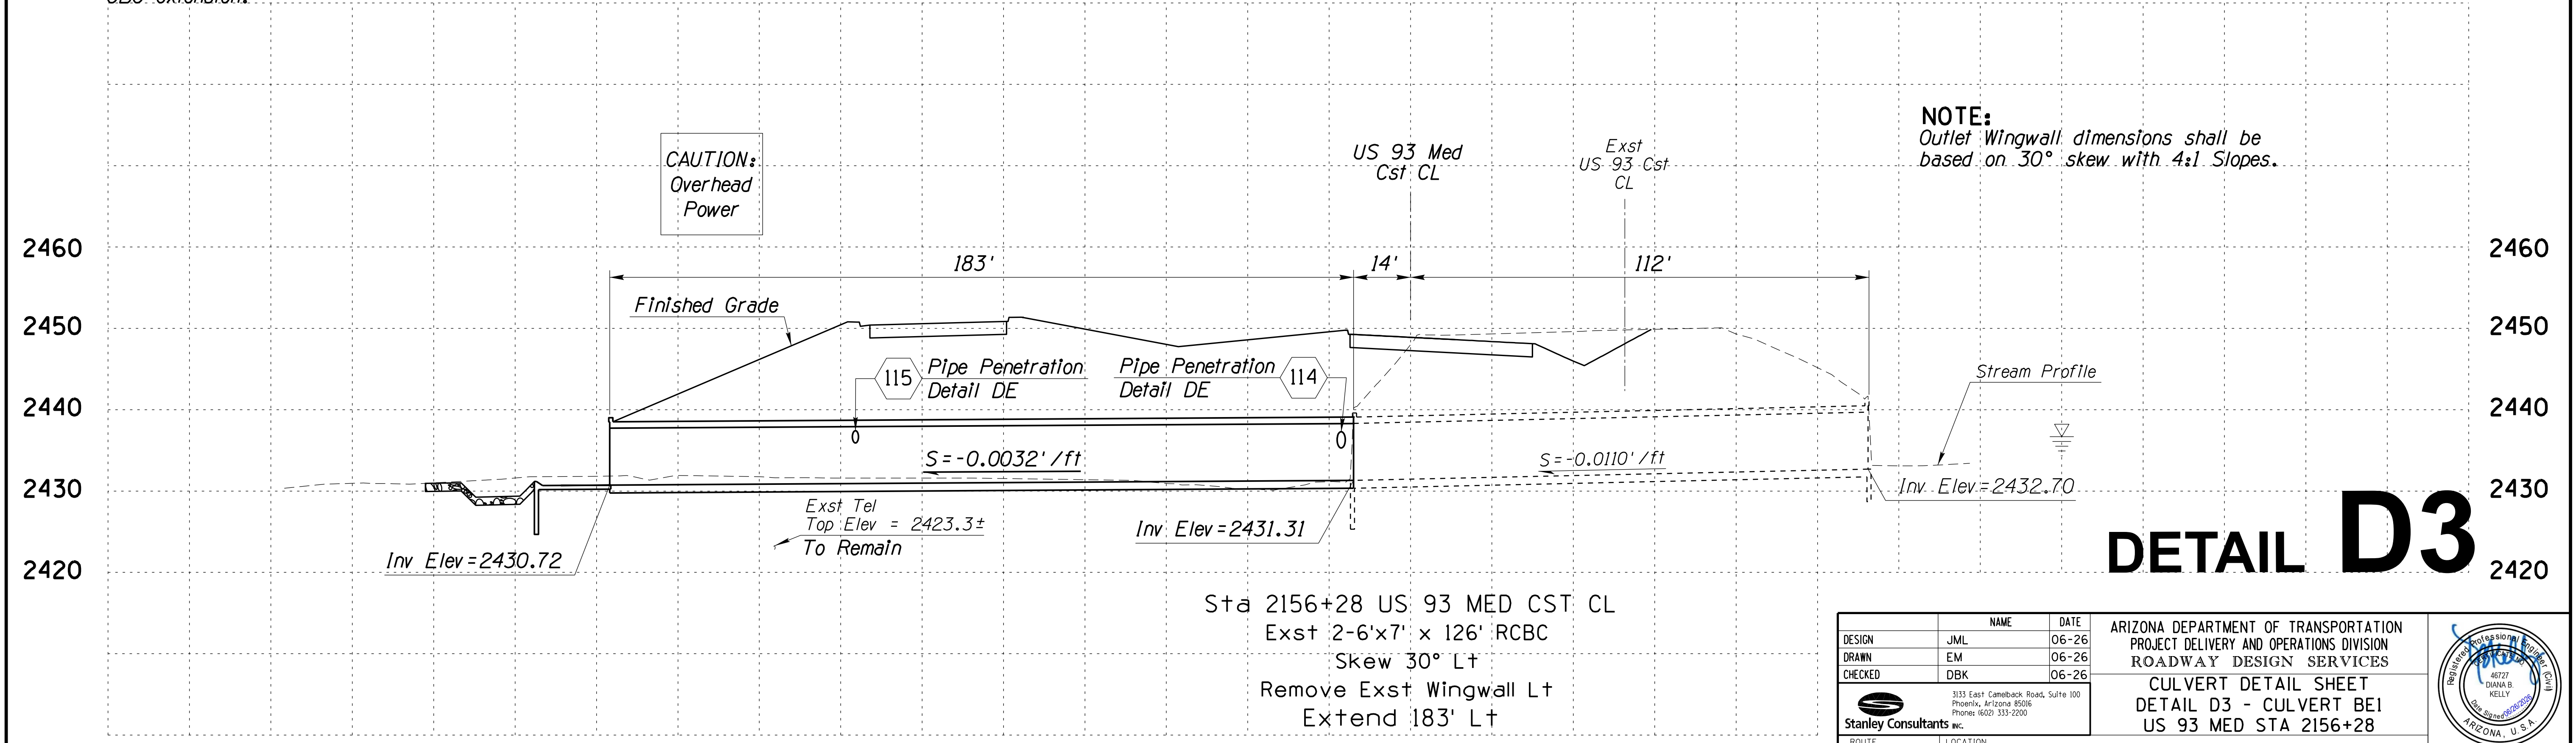

DETAIL D3


DESIGN	JML	DATE	06-26
DRAWN	EM	DATE	06-26
CHECKED	DBK	DATE	06-26
3133 East Camelback Road, Suite 100 Phoenix, Arizona 85016 Phone: (602) 333-2200 Stanley Consultants Inc.			
ROUTE	LOCATION	ARIZONA DEPARTMENT OF TRANSPORTATION PROJECT DELIVERY AND OPERATIONS DIVISION ROADWAY DESIGN SERVICES CULVERT DETAIL SHEET DETAIL D3 - CULVERT BE1 US 93 MED STA 2156+28	
US 93	WICKENBURG RANCH WAY TO VISTA ROYALE	DWG NO. D-2.03 OF	
TRACS NO. F0738 OIC		093-B(230)T	

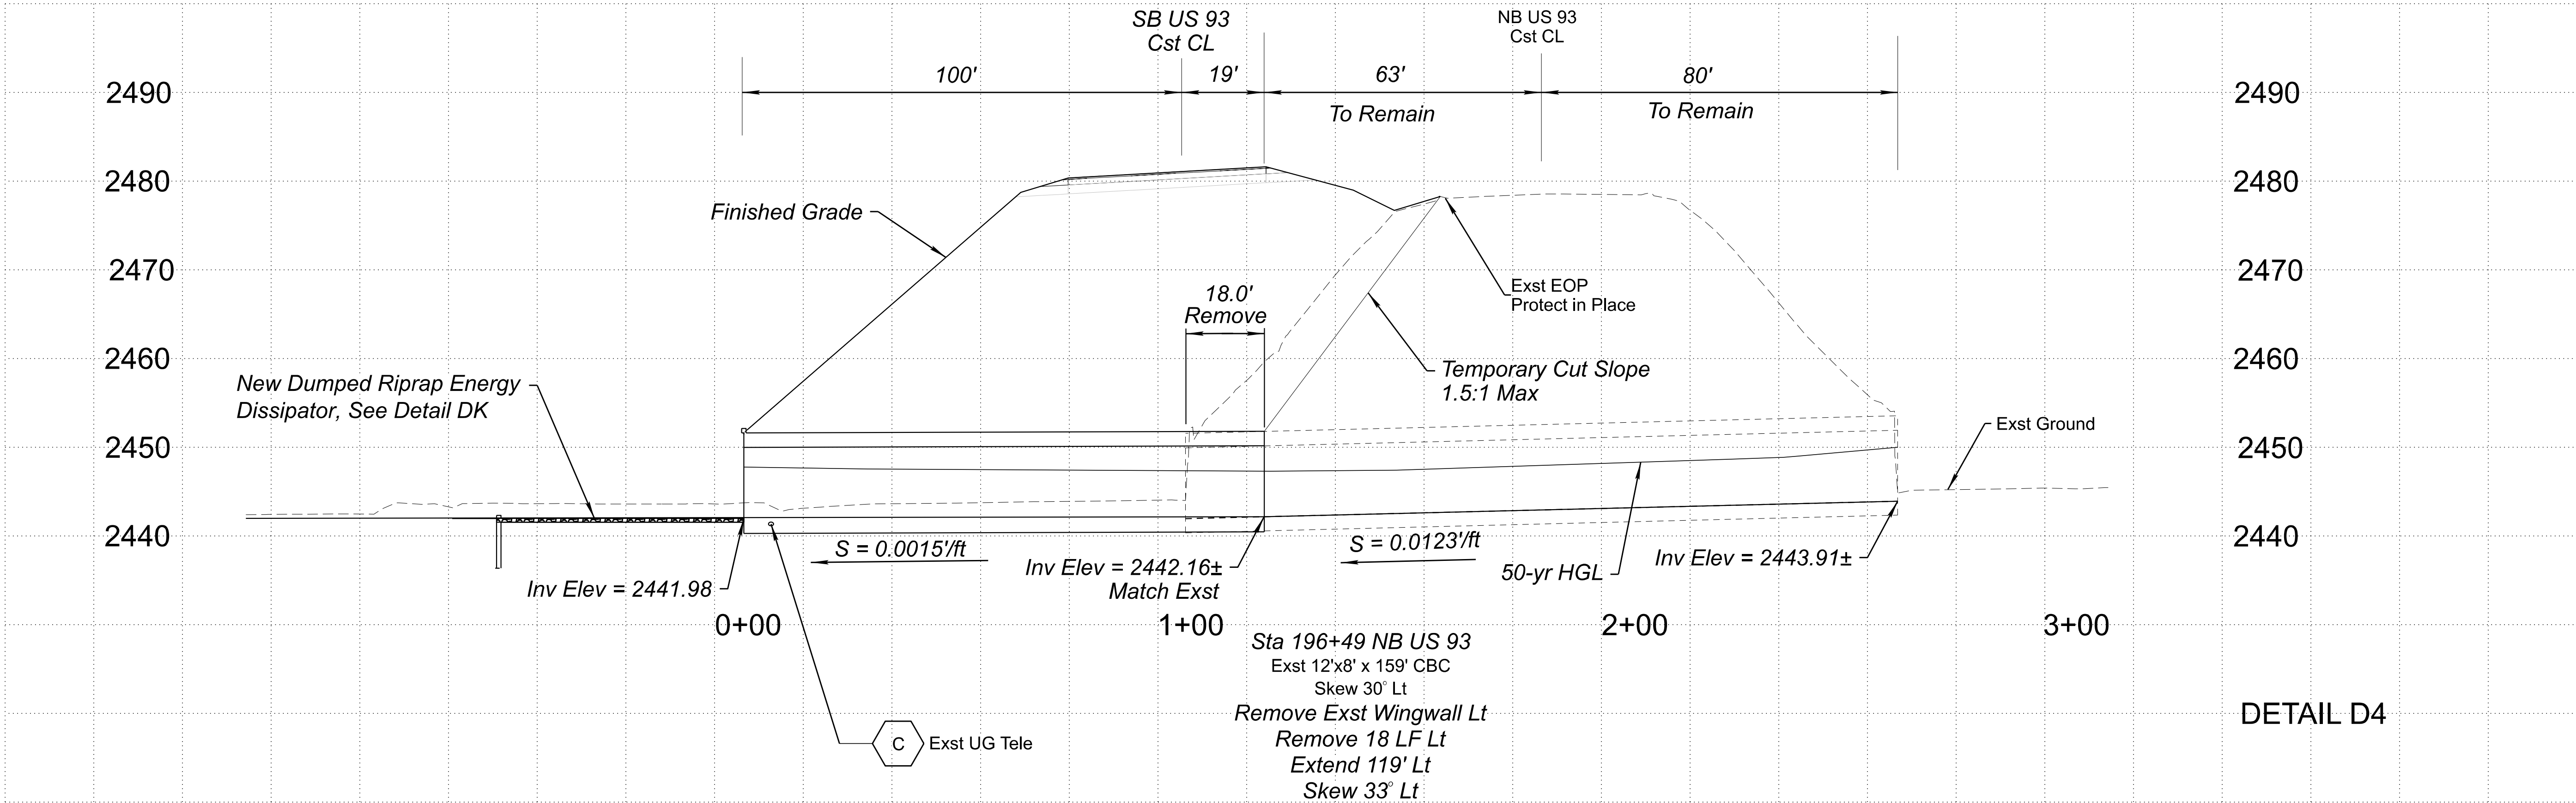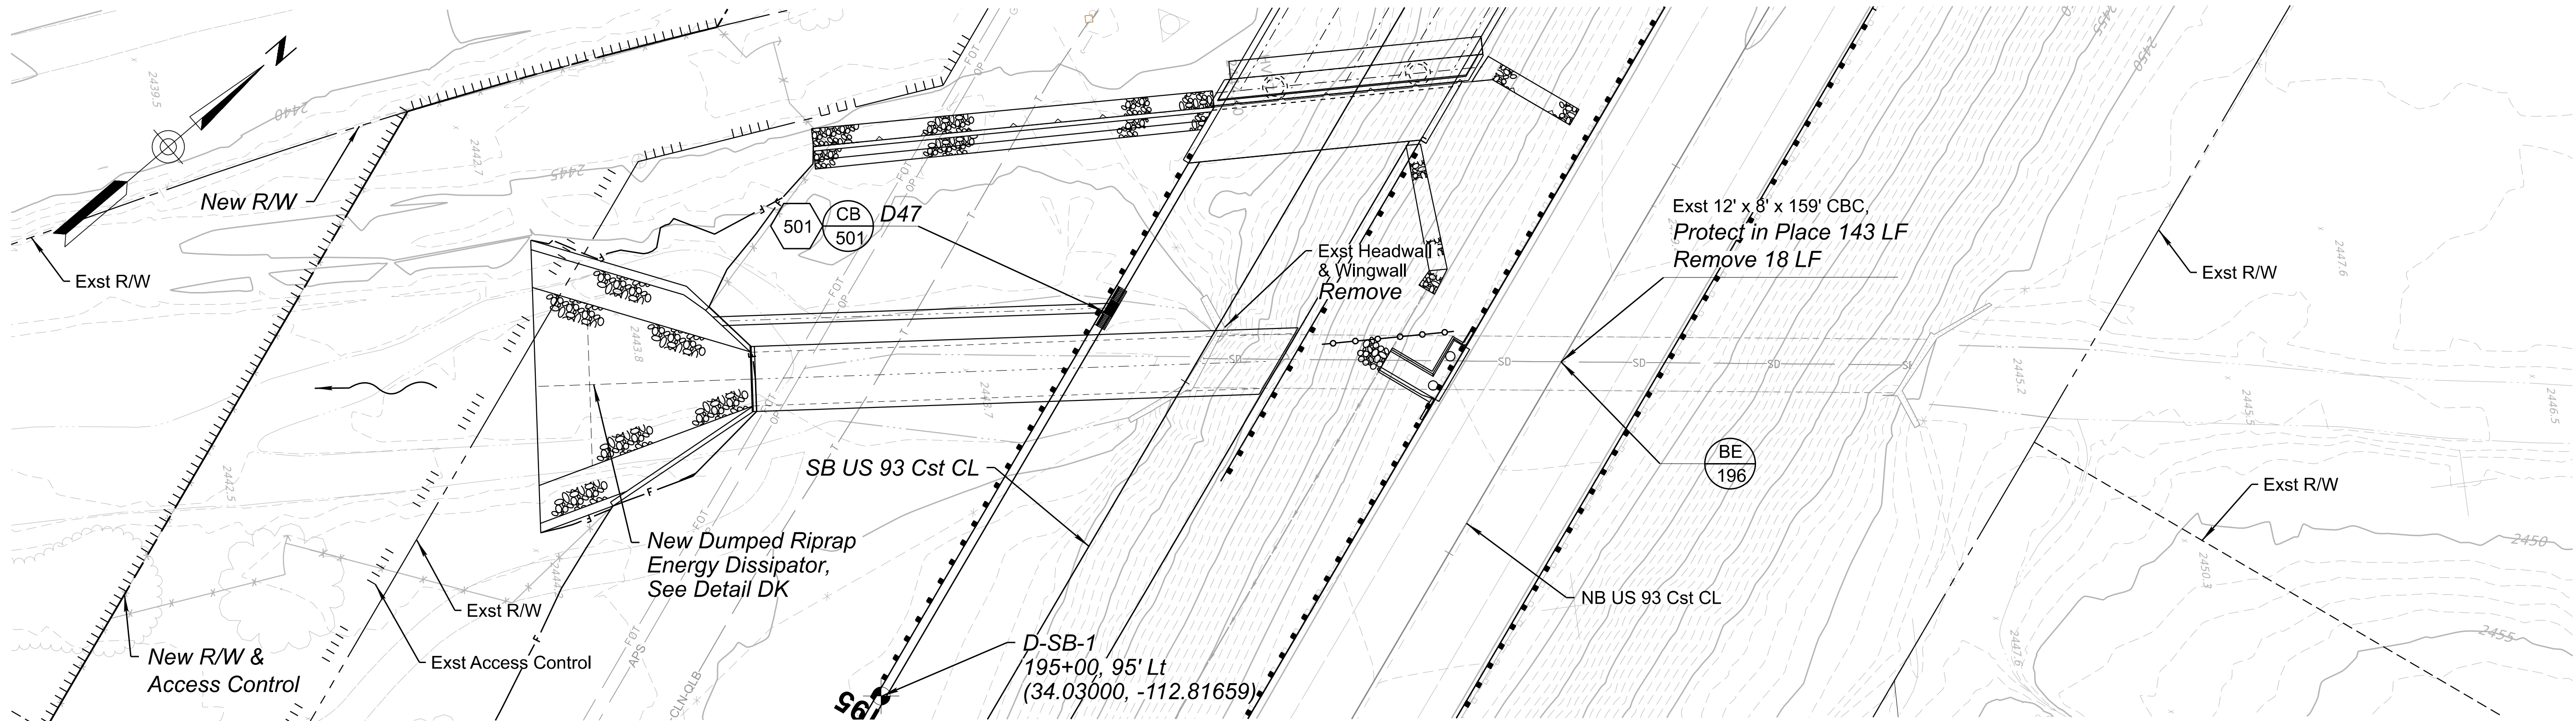

DETAIL D4

UTILITY DISPOSITION LEGEND

- A To Remain In Service - Protect in Place
- B Contractor to Relocate, Remove or Reset
- C To Be Relocated or Removed By Others
- D To Be Constructed By Others

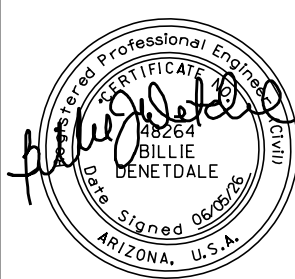

	NAME	DATE
DESIGN	K LEANDER	06/26
DRAWN	B LEANDER	06/26
CHECKED	B DENETDALE	06/26

TRANSPORTATION
AECOM TECHNICAL SERVICES, Inc.
7720 N. 16th St., Suite 100
Phoenix, Arizona 85020
T 602.371.1100

AECOM
www.aecom.com

ARIZONA DEPARTMENT OF TRANSPORTATION
PROJECT DELIVERY AND OPERATIONS DIVISION
ROADWAY DESIGN SERVICES
CULVERT DETAIL SHEET
DETAIL D4 - CULVERT BE 196
US 93 NB STA 196+49

ROUTE
US 93
MILEPOST
189.9
STRUCTURE NO.

F.H.W.A. Arizona Division

STATE
ARIZ.

PROJECT NO.
093 YV 189

FEDERAL ID NO.
093-B(230)T

SHEET
NO.
83

TOTAL
SHEETS
524



RECORD DRAWING

LOCATION WICKENBURG RANCH WAY TO VISTA ROYALE

TRACS NO. F0738 01C

DWG No. D-2.04

OF

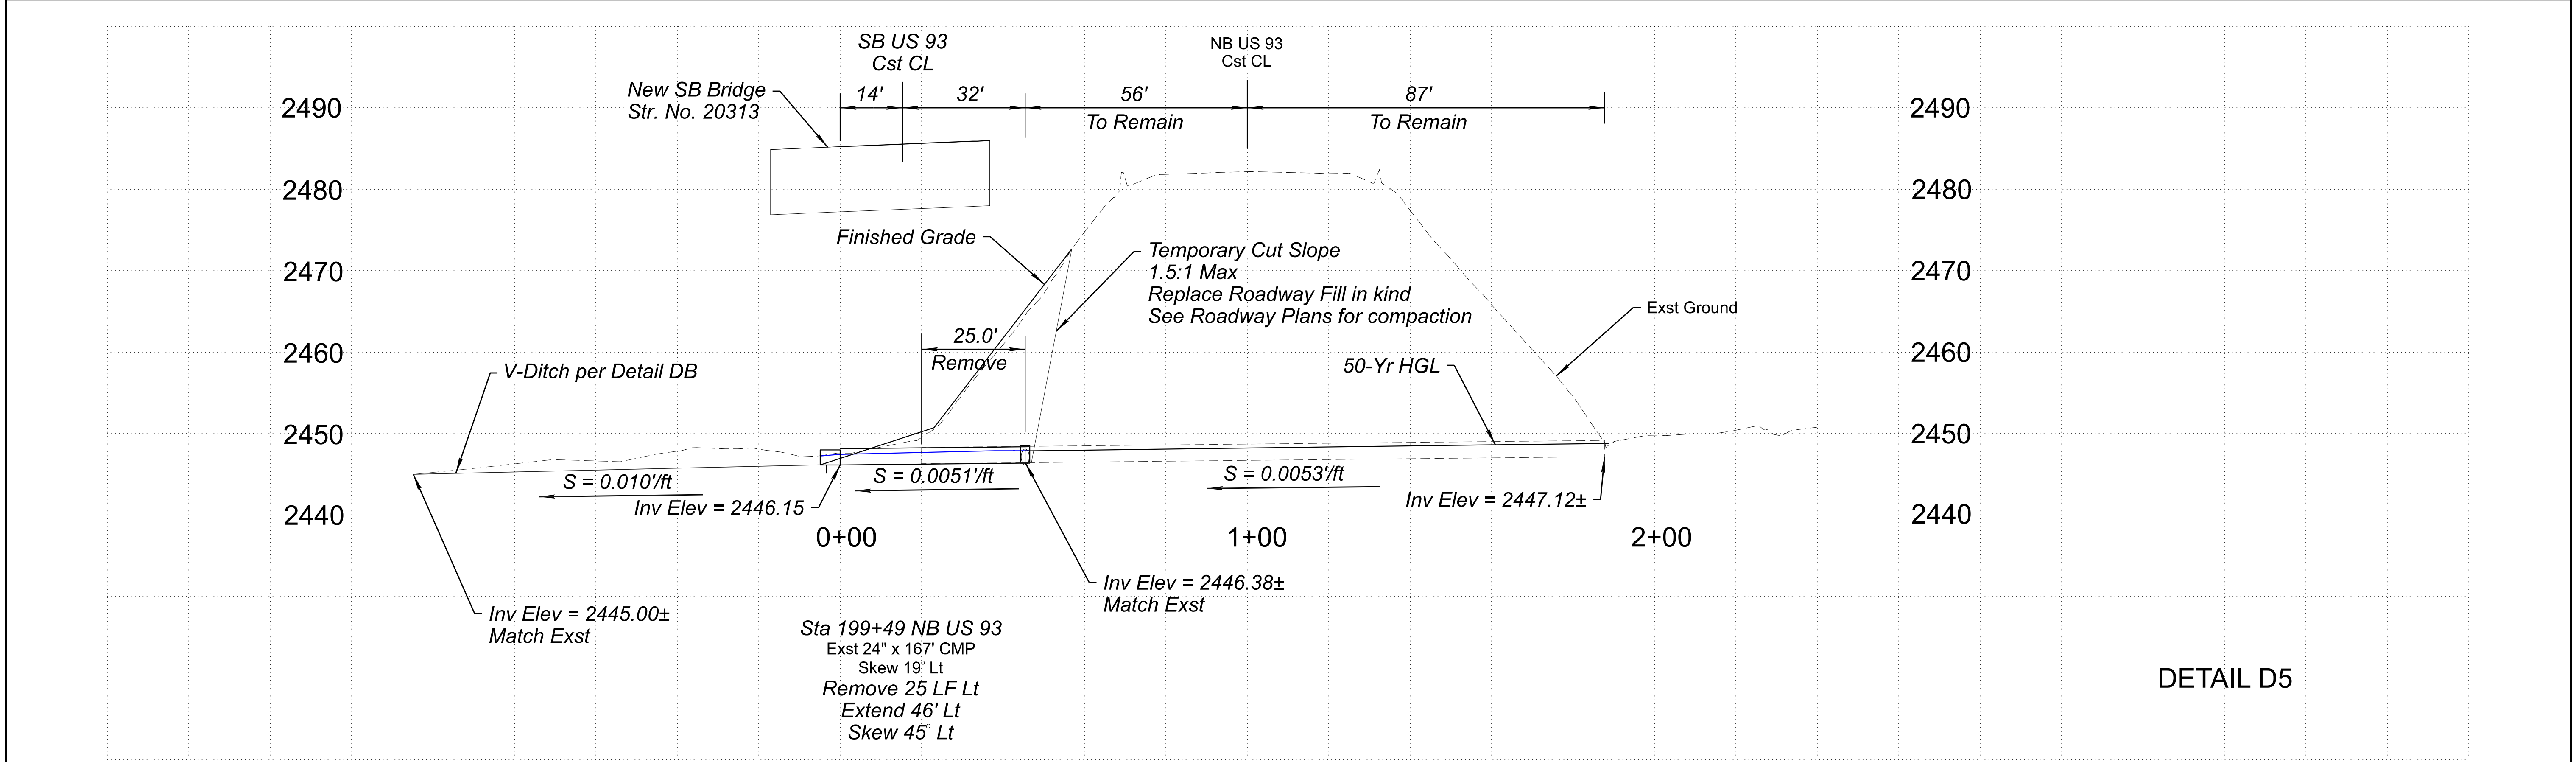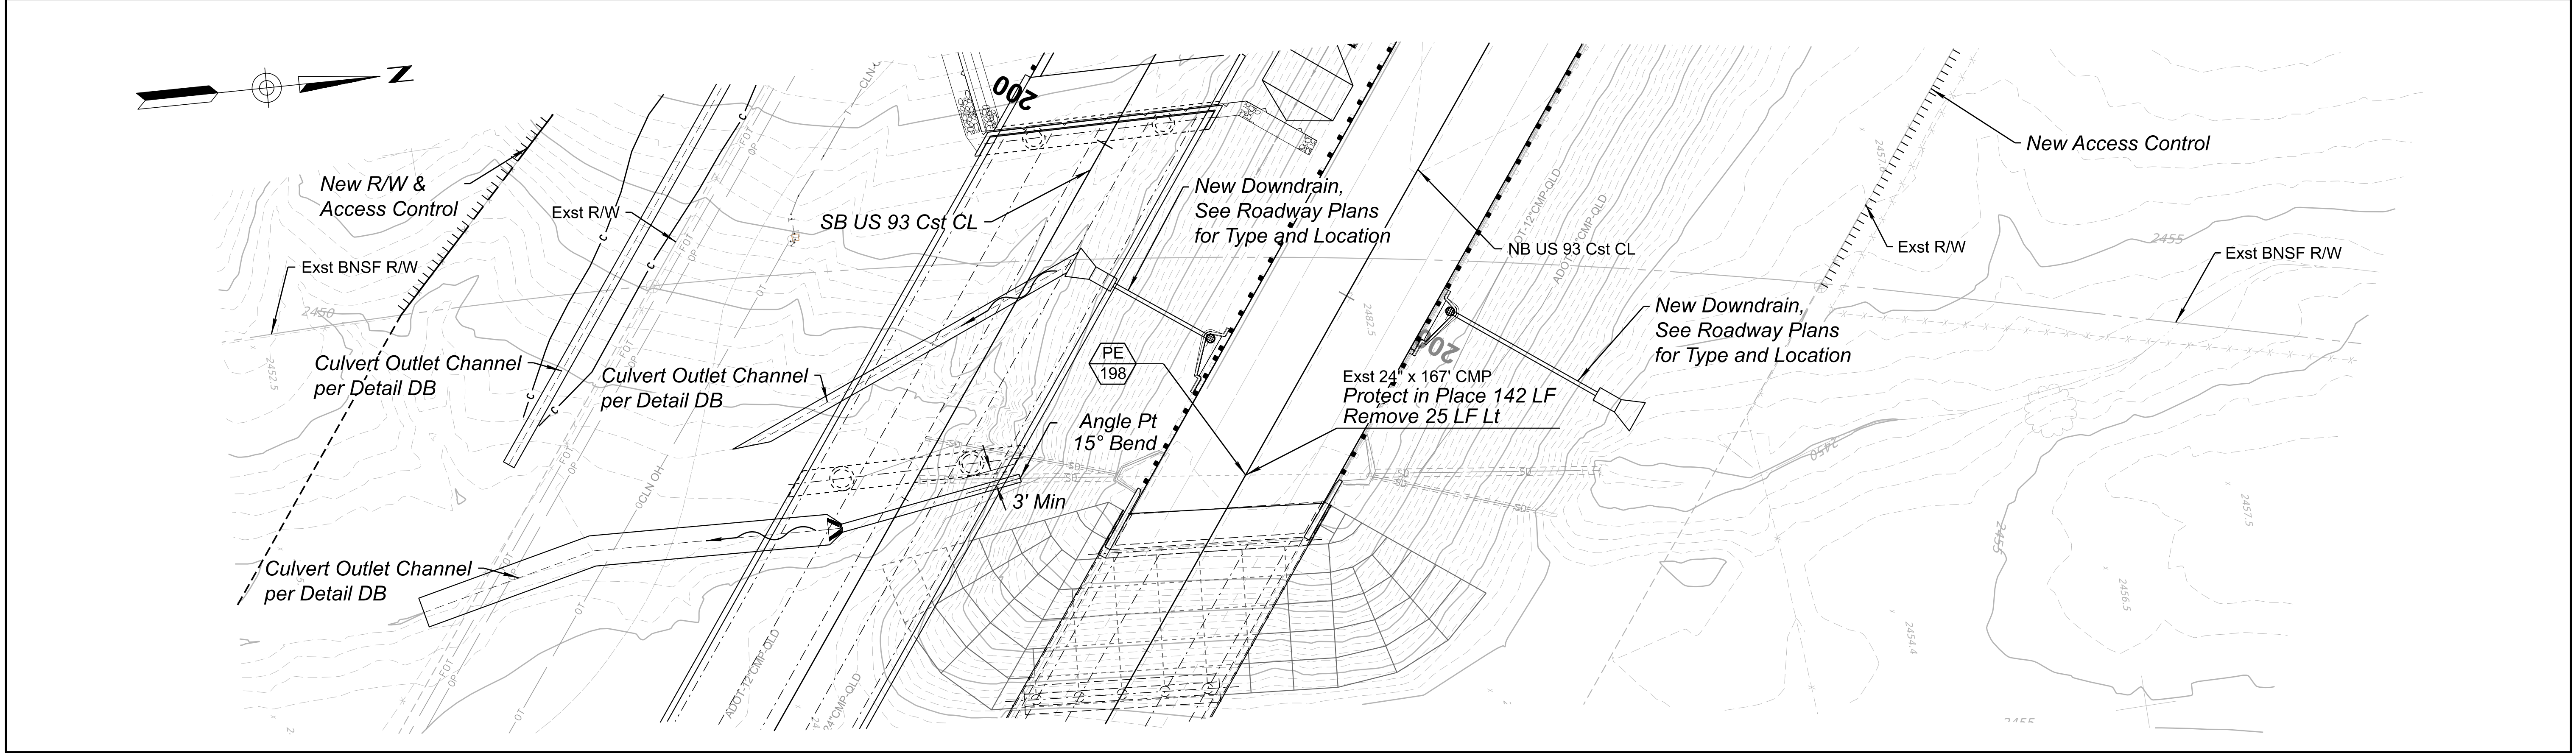

DETAIL D5

UTILITY DISPOSITION LEGEND

- A** To Remain In Service - Protect in Place
- B** Contractor to Relocate, Remove or Reset
- C** To Be Relocated or Removed By Others
- D** To Be Constructed By Others



	NAME	DATE
DESIGN	K LEANDER	06/26
DRAWN	B LEANDER	06/26
CHECKED	B DENETDALE	06/26

TRANSPORTATION
AECOM TECHNICAL SERVICES, Inc.
7720 N. 16th St., Suite 100
Phoenix, Arizona 85020
T 602.371.1100

AECOM
www.aecom.com



ARIZONA DEPARTMENT OF TRANSPORTATION
PROJECT DELIVERY AND OPERATIONS DIVISION
ROADWAY DESIGN SERVICES
CULVERT DETAIL SHEET
DETAIL D5 - CULVERT PE 198
NB US 93 STA 199+49

ROUTE US 93	F.H.W.A. Arizona Division	STATE ARIZ.	PROJECT NO. 093 YV 189	FEDERAL ID NO. 093-B(230)T	SHEET NO. 84	TOTAL SHEETS 524	RECORD DRAWING
MILEPOST 189.9	LOCATION WICKENBURG RANCH WAY TO VISTA ROYALE						DWG No. D-2.05 ____ OF ____
STRUCTURE NO.	TRACS NO. F0738 01C						

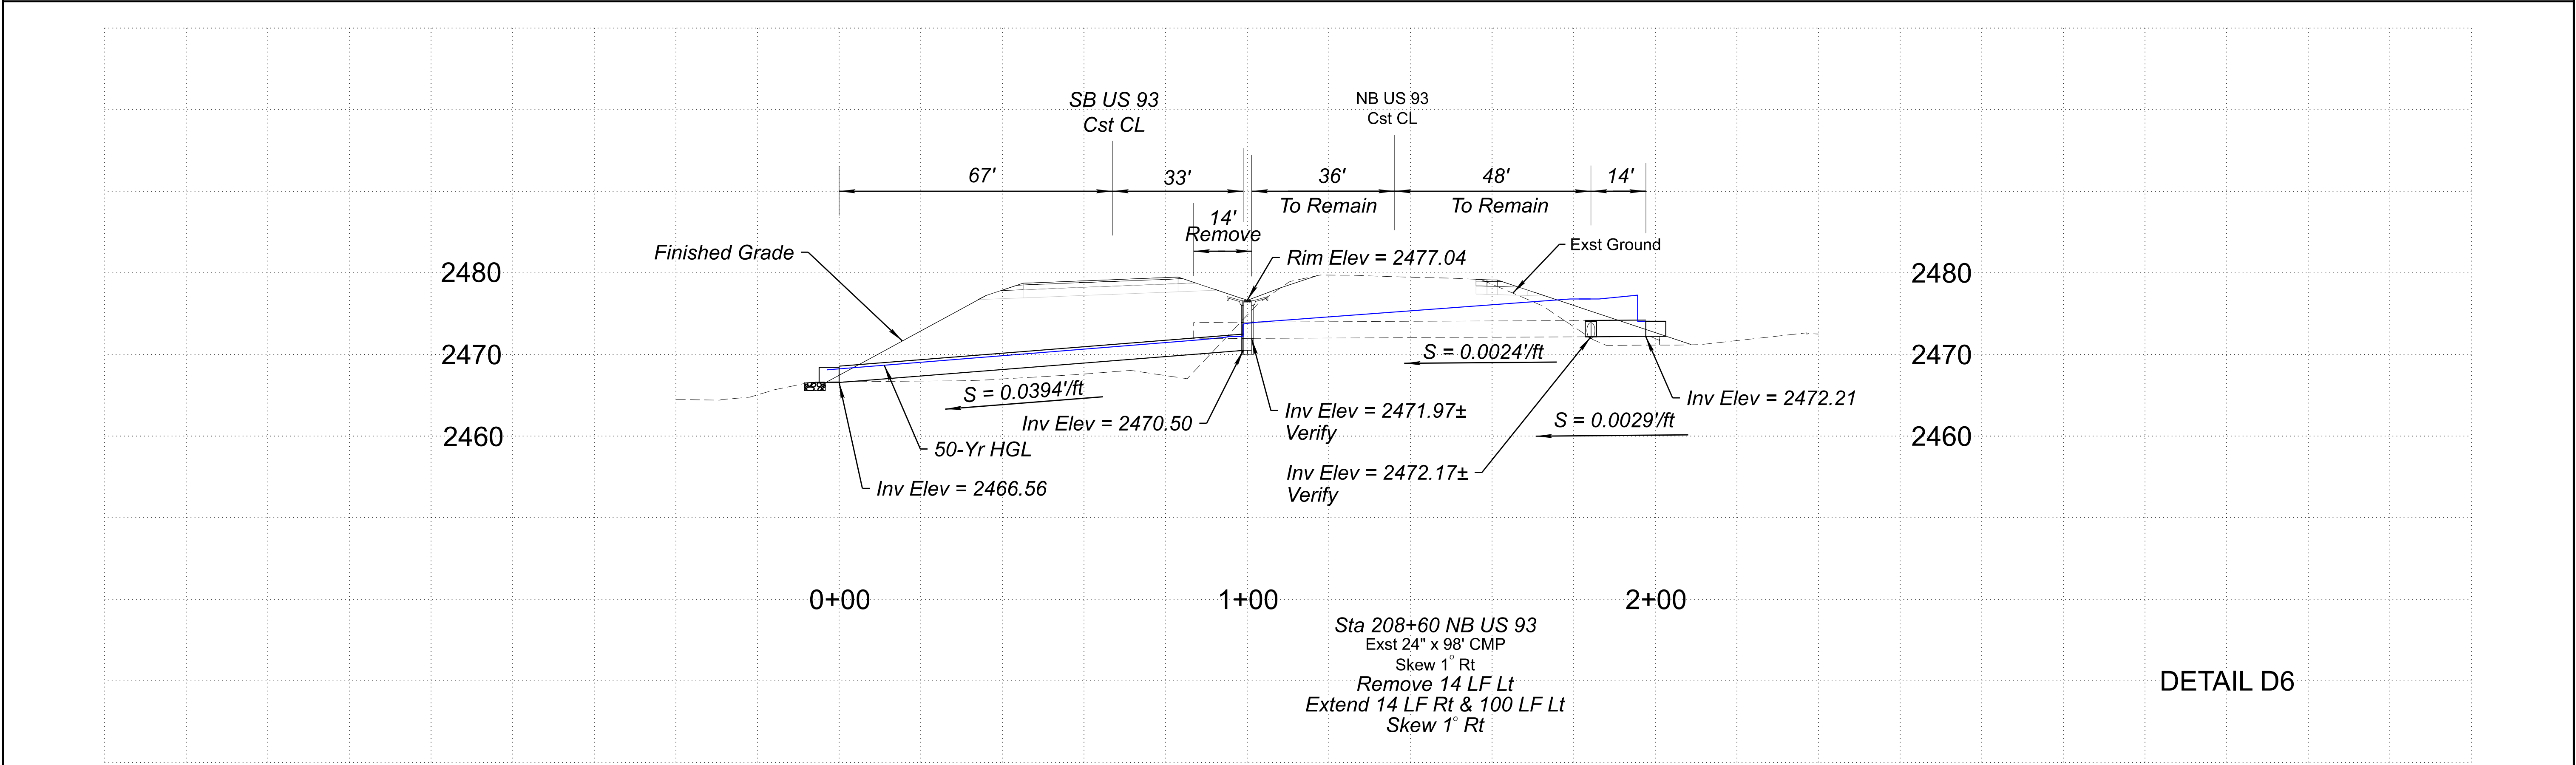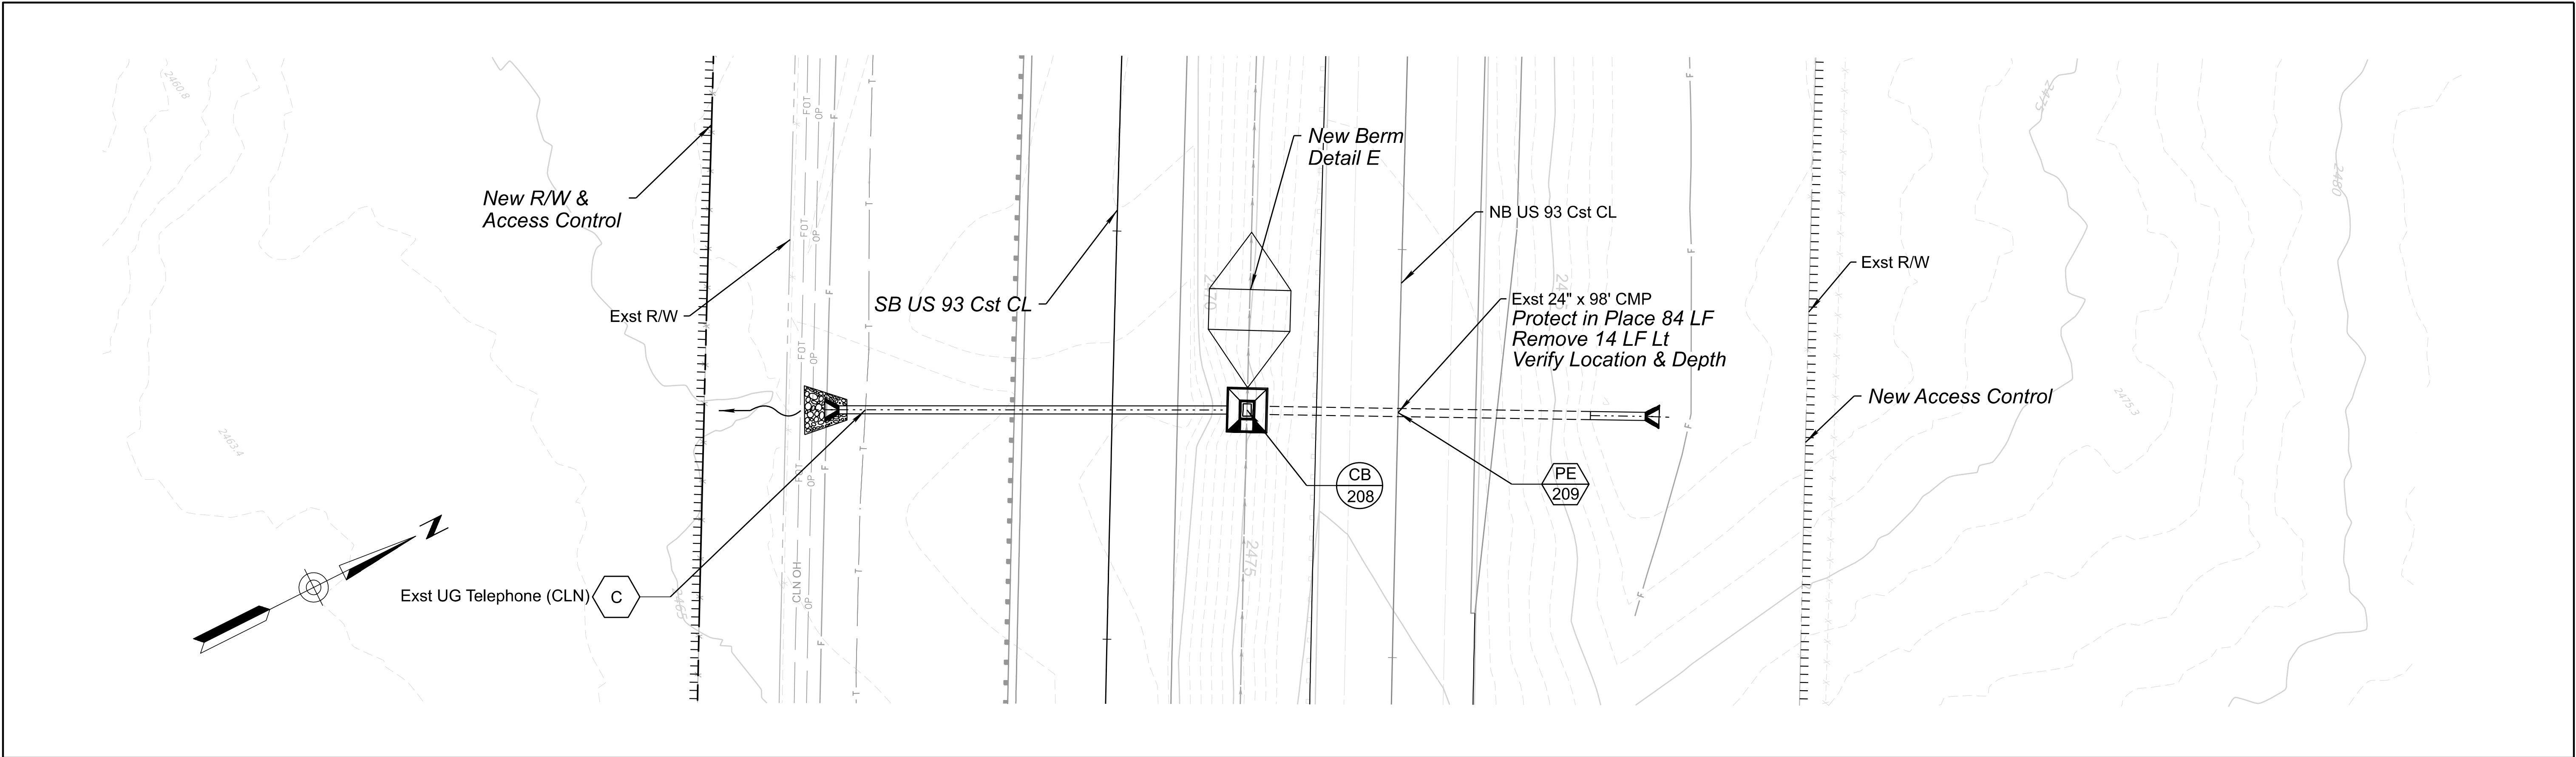

DETAIL D6

UTILITY DISPOSITION LEGEND A To Remain In Service - Protect in Place B Contractor to Relocate, Remove or Reset C To Be Relocated or Removed By Others D To Be Constructed By Others			<table><tr><th></th><th>NAME</th><th>DATE</th></tr><tr><td>DESIGN</td><td>K LEANDER</td><td>06/26</td></tr><tr><td>DRAWN</td><td>B LEANDER</td><td>06/26</td></tr><tr><td>CHECKED</td><td>B DENETDALE</td><td>06/26</td></tr></table>		NAME	DATE	DESIGN	K LEANDER	06/26	DRAWN	B LEANDER	06/26	CHECKED	B DENETDALE	06/26	TRANSPORTATION AECOM TECHNICAL SERVICES, Inc. 7720 N. 16th St., Suite 100 Phoenix, Arizona 85020 T 602.371.1100 AECOM www.aecom.com	ARIZONA DEPARTMENT OF TRANSPORTATION PROJECT DELIVERY AND OPERATIONS DIVISION ROADWAY DESIGN SERVICES CULVERT DETAIL SHEET DETAIL D6 - CULVERT PE 209 NB US 93 STA 208+60	<table><tr><td>ROUTE US 93</td><td rowspan="3">F.H.W.A. Arizona Division</td><td>STATE ARIZ.</td><td>PROJECT NO. 093 YV 189</td><td>FEDERAL ID NO. 093-B(230)T</td><td>SHEET NO. 85</td><td>TOTAL SHEETS 524</td><td>RECORD DRAWING</td></tr><tr><td>MILEPOST 189.9</td><td colspan="4">LOCATION WICKENBURG RANCH WAY TO VISTA ROYALE</td><td>DWG No. D-2.06</td></tr><tr><td>STRUCTURE NO.</td><td colspan="4">TRACS NO. F0738 01C</td><td>OF</td></tr></table>	ROUTE US 93	F.H.W.A. Arizona Division	STATE ARIZ.	PROJECT NO. 093 YV 189	FEDERAL ID NO. 093-B(230)T	SHEET NO. 85	TOTAL SHEETS 524	RECORD DRAWING	MILEPOST 189.9	LOCATION WICKENBURG RANCH WAY TO VISTA ROYALE				DWG No. D-2.06	STRUCTURE NO.	TRACS NO. F0738 01C				OF
	NAME	DATE																																				
DESIGN	K LEANDER	06/26																																				
DRAWN	B LEANDER	06/26																																				
CHECKED	B DENETDALE	06/26																																				
ROUTE US 93	F.H.W.A. Arizona Division	STATE ARIZ.	PROJECT NO. 093 YV 189	FEDERAL ID NO. 093-B(230)T	SHEET NO. 85	TOTAL SHEETS 524	RECORD DRAWING																															
MILEPOST 189.9		LOCATION WICKENBURG RANCH WAY TO VISTA ROYALE				DWG No. D-2.06																																
STRUCTURE NO.		TRACS NO. F0738 01C				OF																																

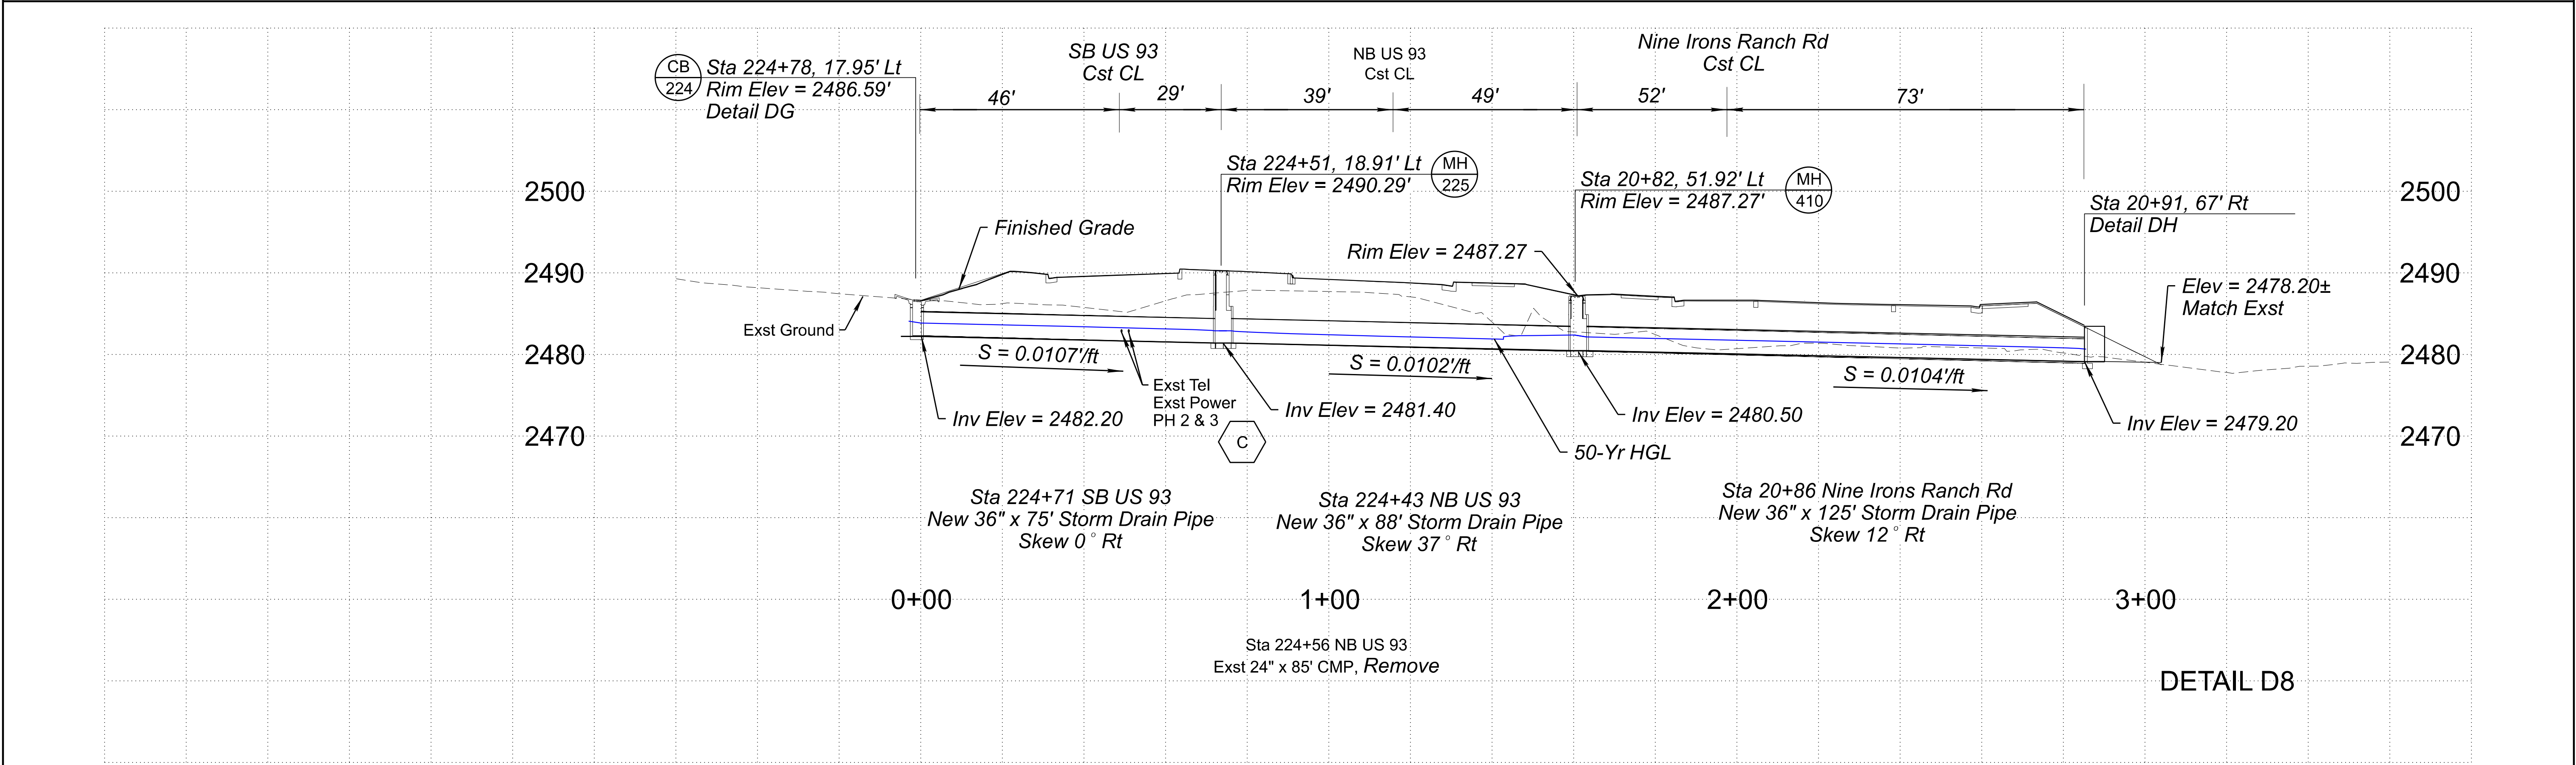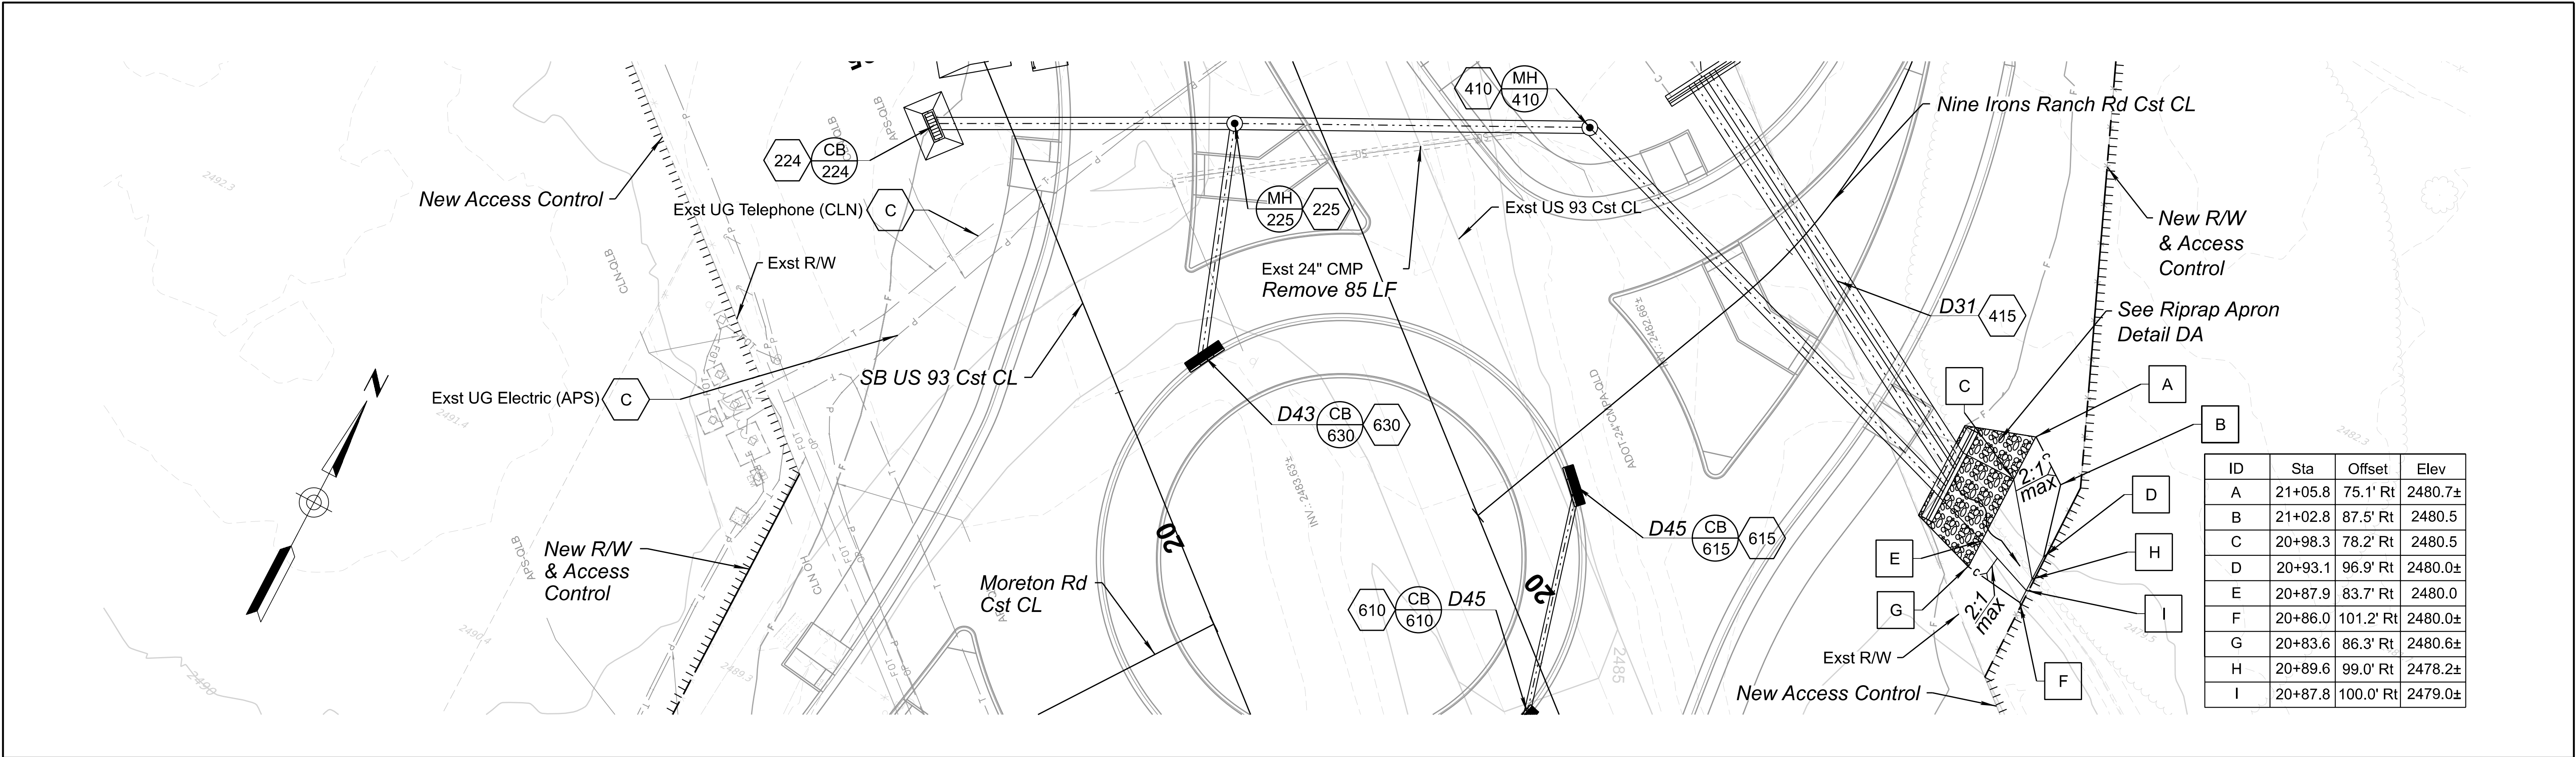

UTILITY DISPOSITION LEGEND		NAME	DATE	ARIZONA DEPARTMENT OF TRANSPORTATION PROJECT DELIVERY AND OPERATIONS DIVISION ROADWAY DESIGN SERVICES PIPE DETAIL SHEET DETAIL D8 - PIPES 224, 225, 410 SB US 93 STA 224+71	ROUTE US 93 MILEPOST 189.9 STRUCTURE NO.	F.H.W.A. Arizona Division ARIZ.	STATE	PROJECT NO. 093 YV 189	FEDERAL ID NO. 093-B(230)T	SHEET NO. 87	TOTAL SHEETS 524	RECORD DRAWING
A	B											
A	To Remain In Service - Protect in Place											
B	Contractor to Relocate, Remove or Reset											
C	To Be Relocated or Removed By Others											
D	To Be Constructed By Others											

TRANSPORTATION
AECOM TECHNICAL SERVICES, Inc.
7720 N. 16th St., Suite 100
Phoenix, Arizona 85020
T 602.371.1100



AECOM
www.aecom.com

WICKENBURG RANCH WAY TO VISTA ROYALE

TRACS NO. F0738 01C

DWG No. D-2.08


OF

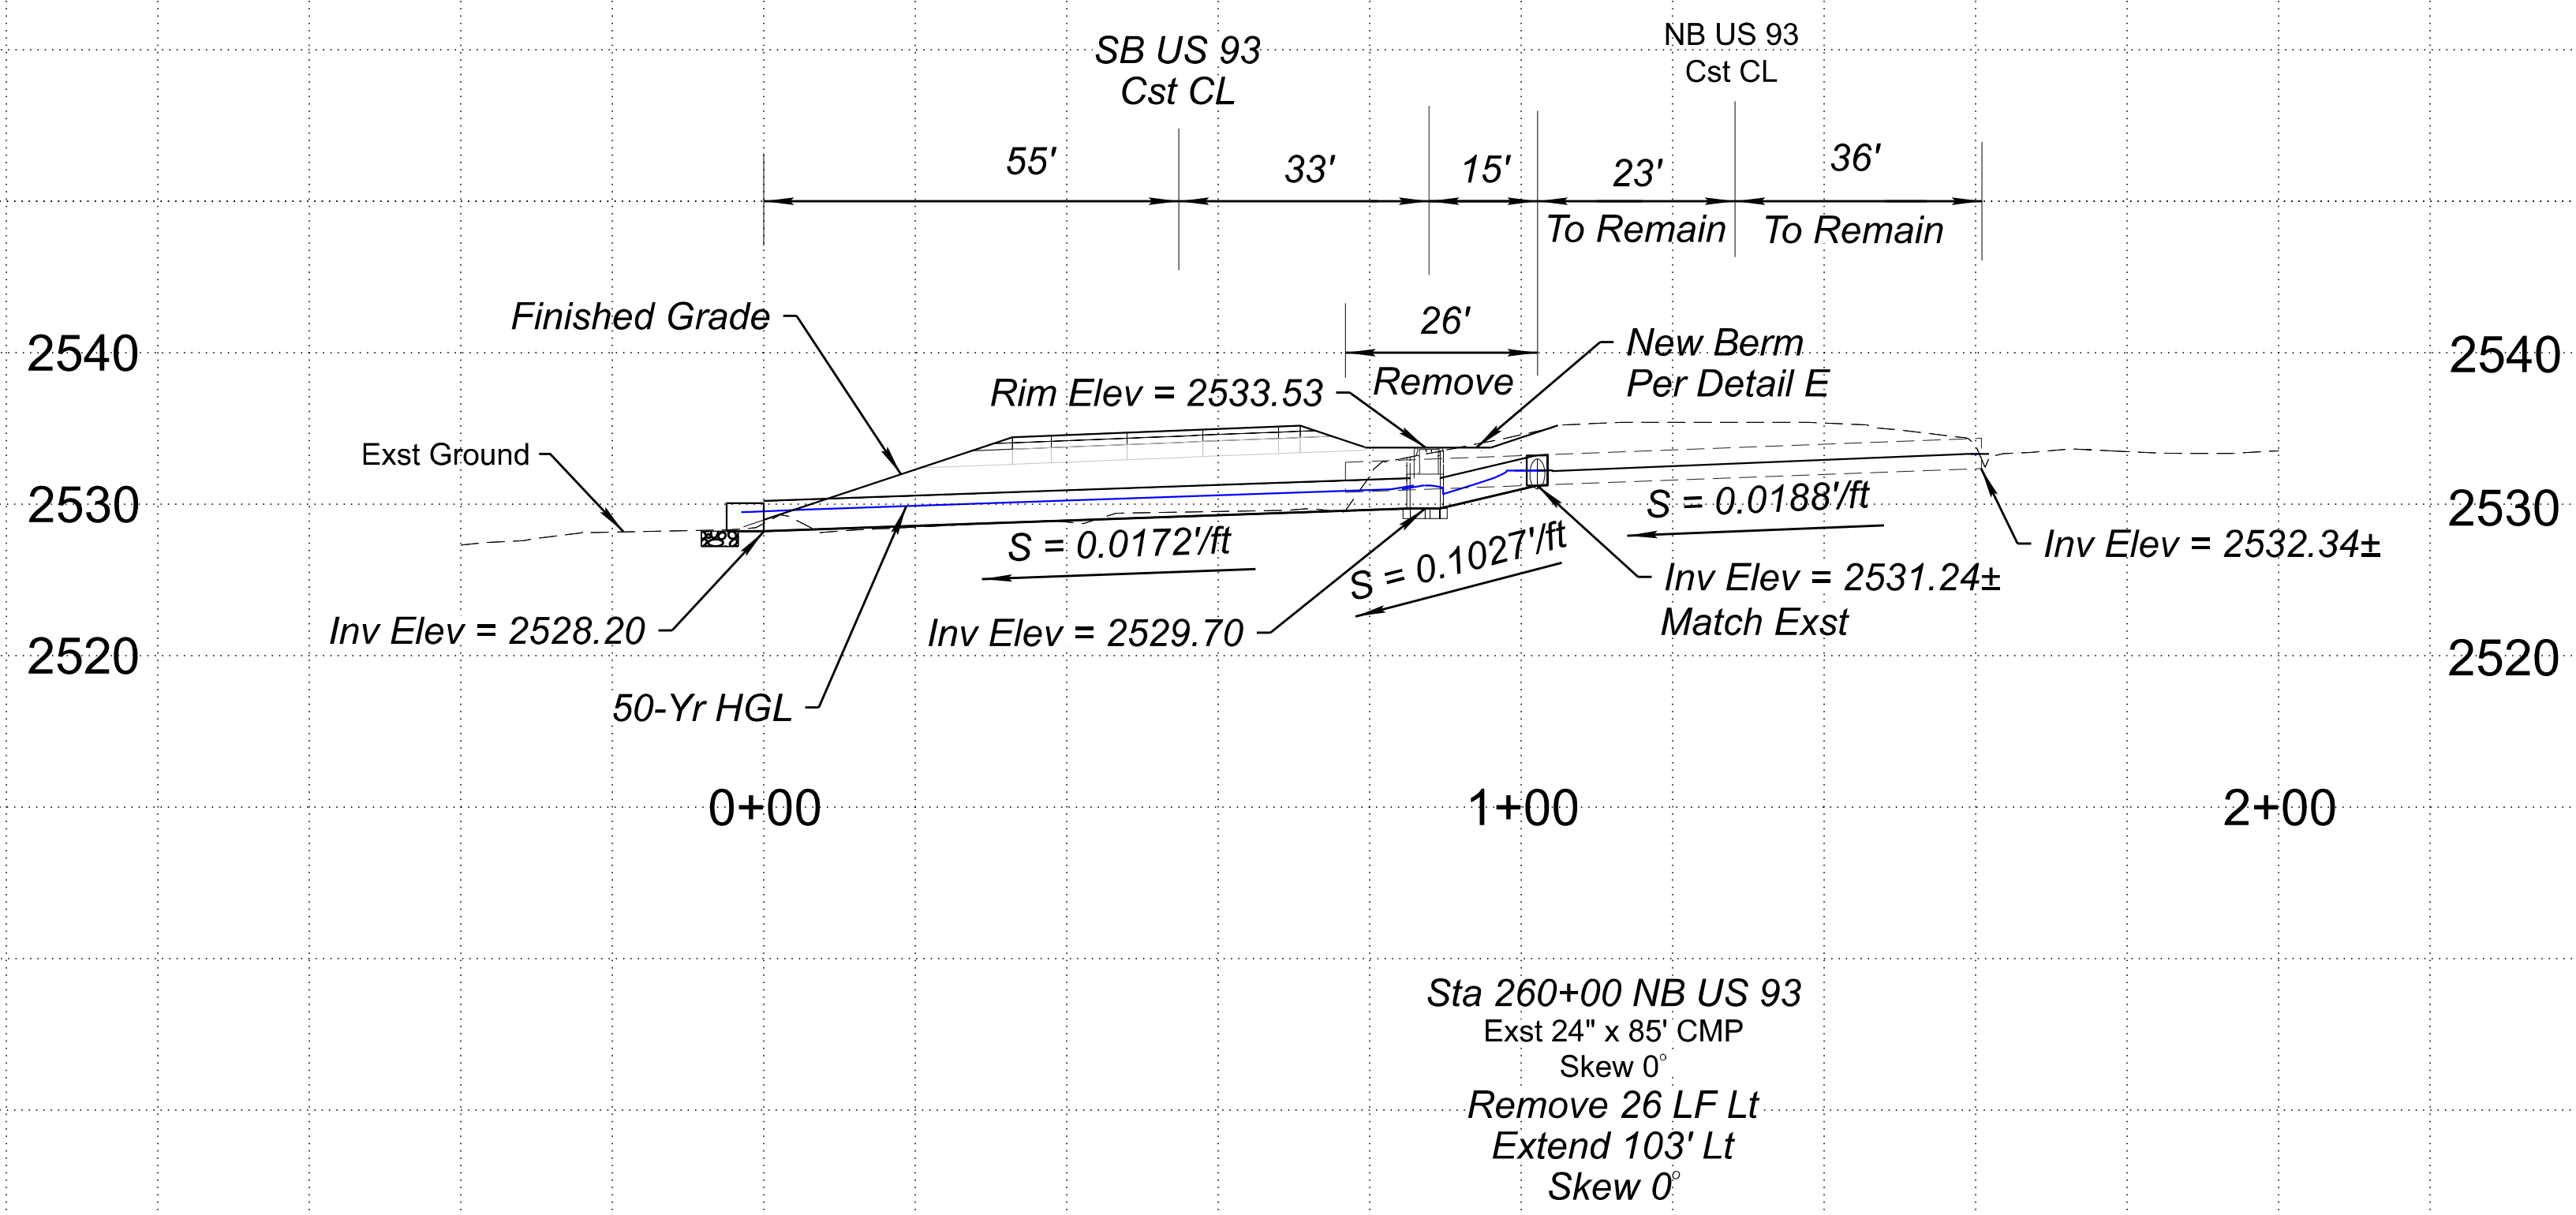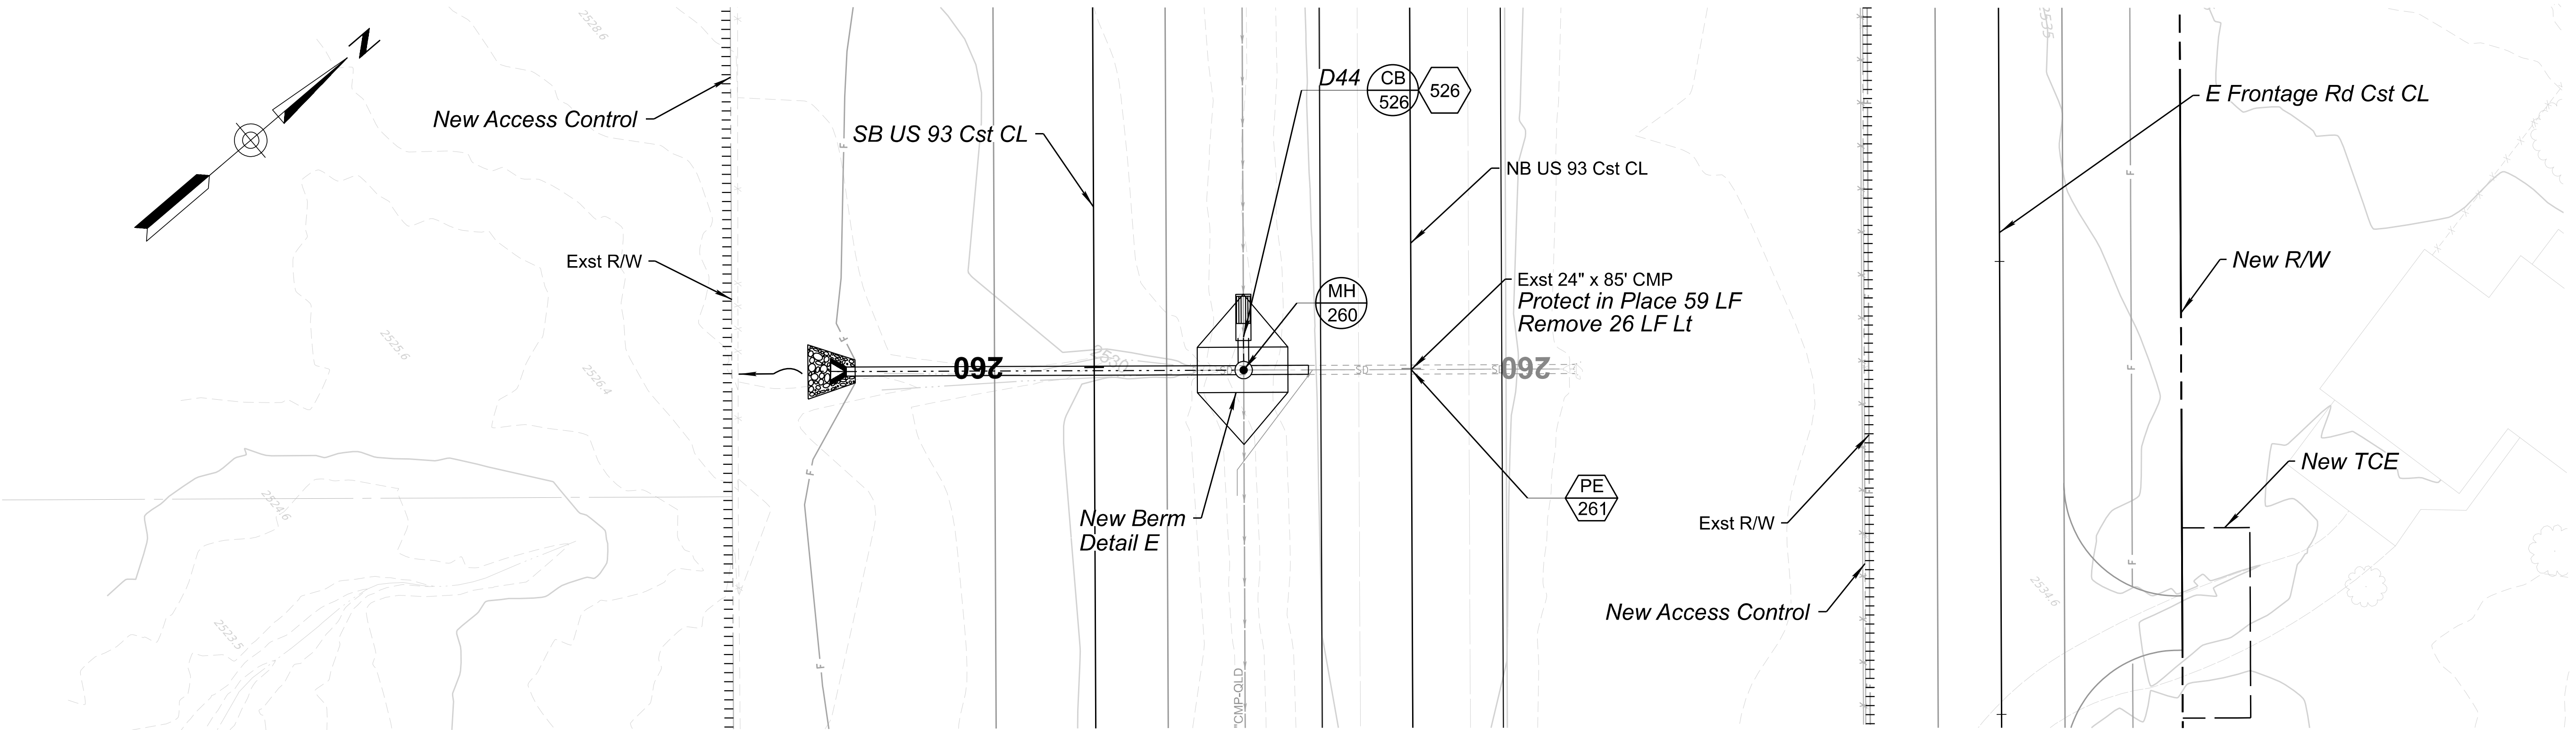

Sta 260+00 NB US 93
Exst 24" x 85' CMP
Skew 0°
Remove 26 LF Lt
Extend 103' Lt
Skew 0°

DETAIL D9

UTILITY DISPOSITION LEGEND	
A	To Remain In Service - Protect in Place
B	Contractor to Relocate, Remove or Reset
C	To Be Relocated or Removed By Others
D	To Be Constructed By Others

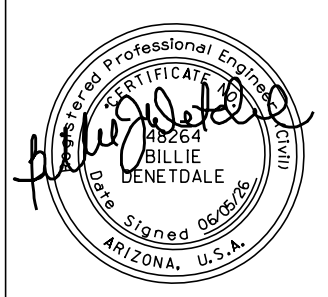



	NAME	DATE
DESIGN	K LEANDER	06/26
DRAWN	B LEANDER	06/26
CHECKED	B DENETDALE	06/26

TRANSPORTATION
AECOM TECHNICAL SERVICES, Inc.
7720 N. 16th St., Suite 100
Phoenix, Arizona 85020
T 602.371.1100



AECOM
www.aecom.com

ARIZONA DEPARTMENT OF TRANSPORTATION
PROJECT DELIVERY AND OPERATIONS DIVISION
ROADWAY DESIGN SERVICES
CULVERT DETAIL SHEET
DETAIL D9 - CULVERT PE 261
NB US 93 STA 260+00

ROUTE US 93	F.H.W.A. Arizona Division	STATE	PROJECT NO.	FEDERAL ID NO.	SHEET NO.	TOTAL SHEETS	RECORD DRAWING
MILEPOST 189.9		ARIZ.	093 YV 189	093-B(230)T	88	524	
	LOCATION WICKENBURG RANCH WAY TO VISTA ROYALE						DWG No. D-2.09
STRUCTURE NO.	TRACS NO. F0738 01C			____ OF ____			

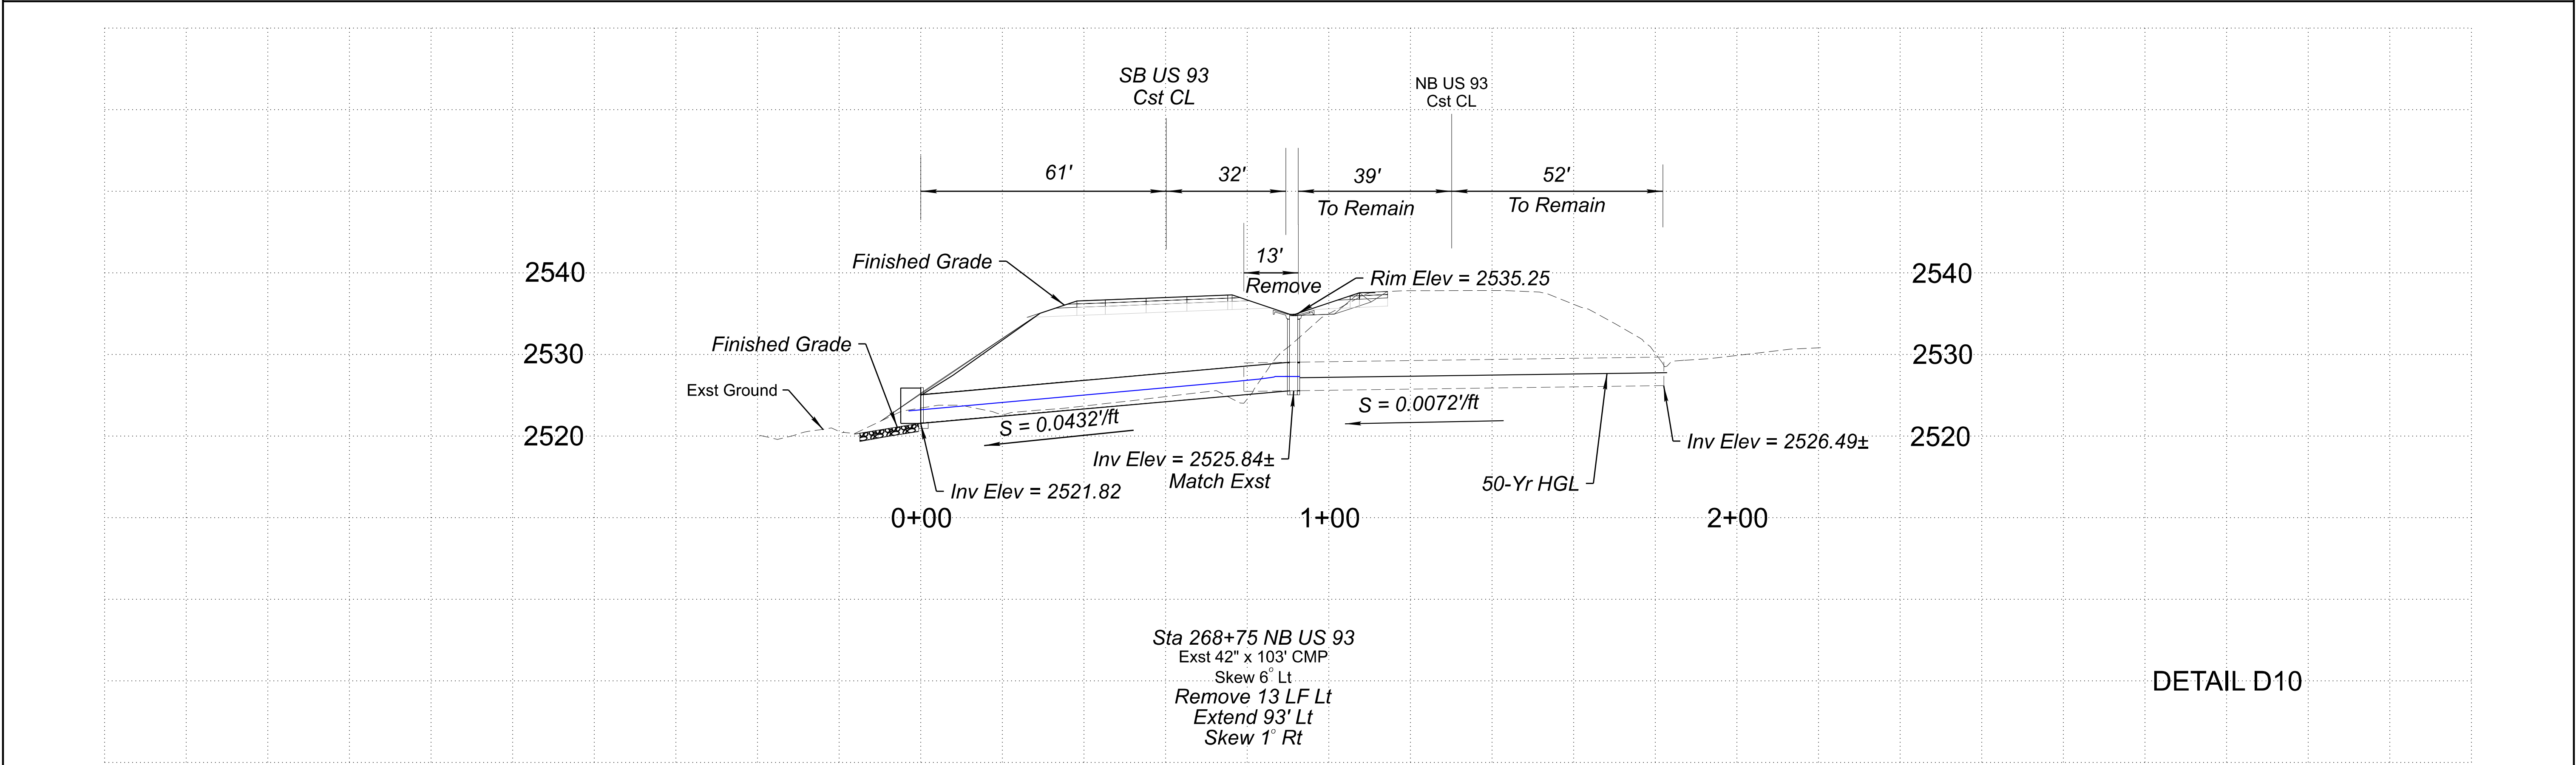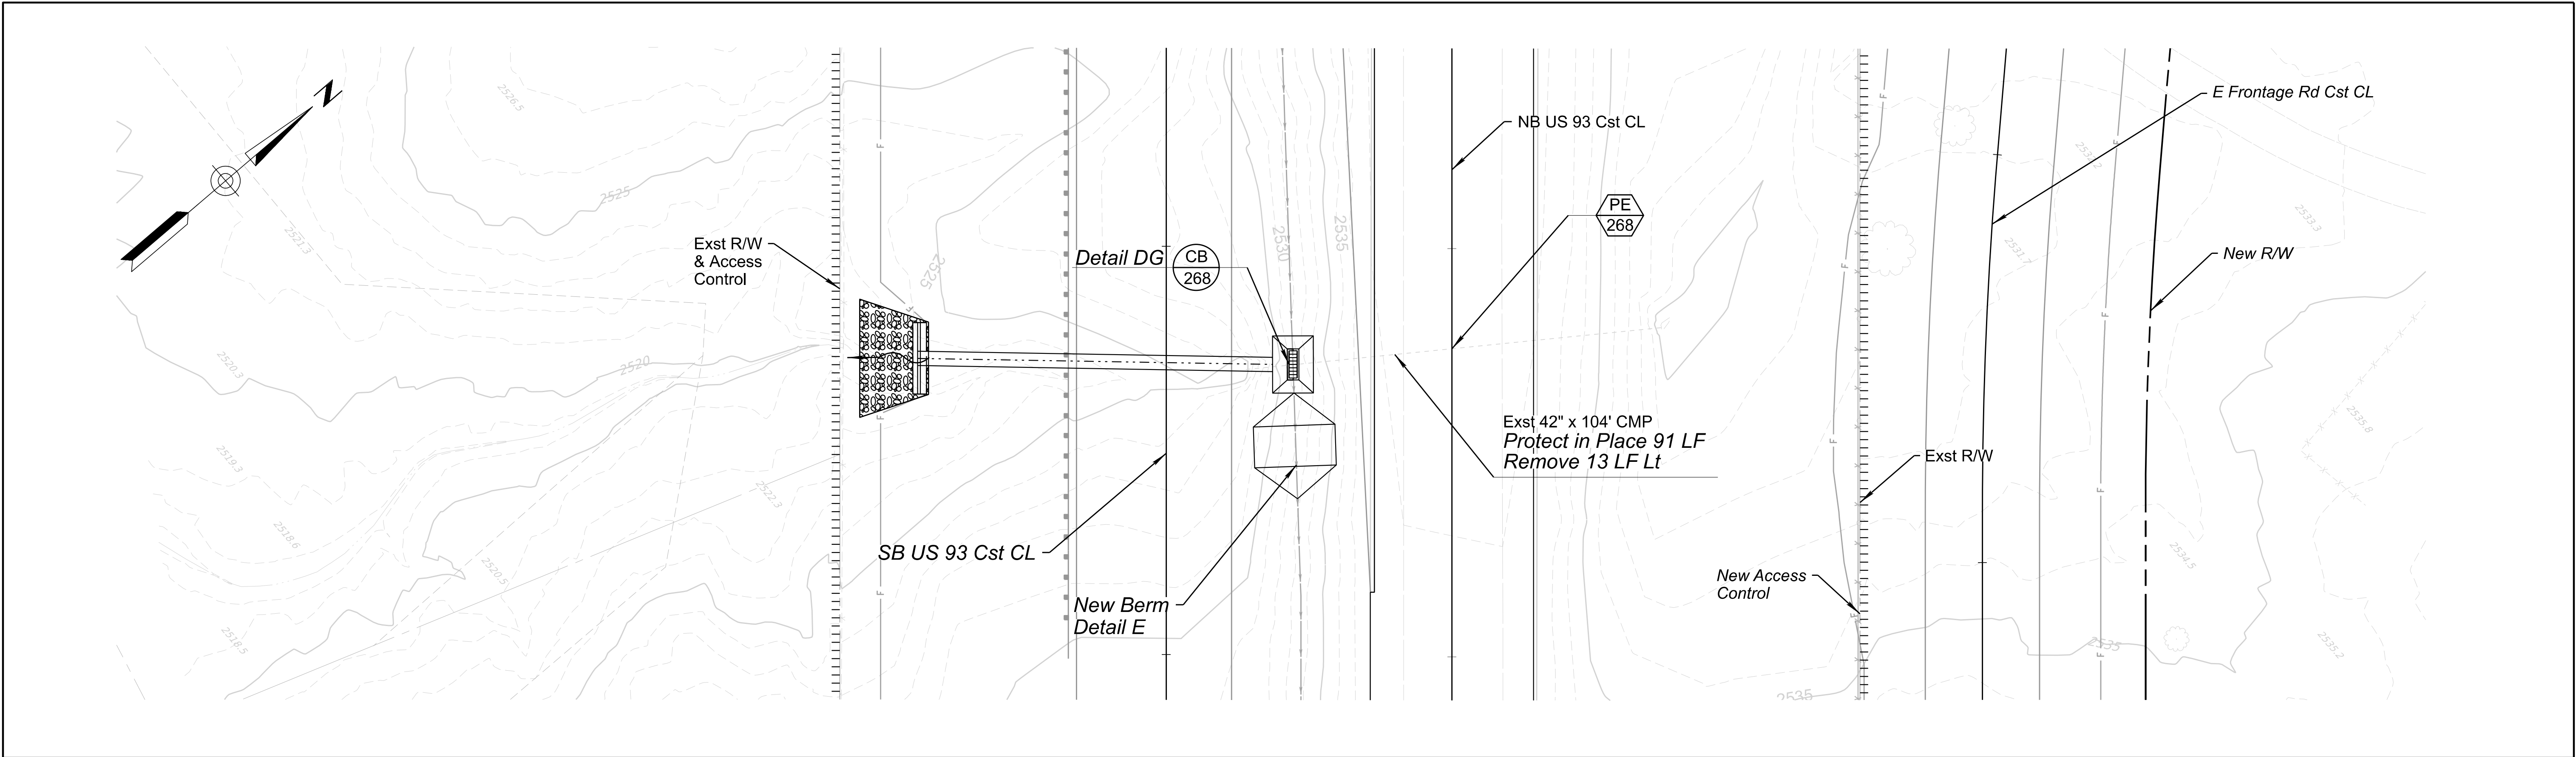


UTILITY DISPOSITION LEGEND A To Remain In Service - Protect in Place B Contractor to Relocate, Remove or Reset C To Be Relocated or Removed By Others D To Be Constructed By Others			<table><tr><td></td><td>NAME</td><td>DATE</td></tr><tr><td>DESIGN</td><td>K LEANDER</td><td>06/26</td></tr><tr><td>DRAWN</td><td>B LEANDER</td><td>06/26</td></tr><tr><td>CHECKED</td><td>B DENETDALE</td><td>06/26</td></tr></table>		NAME	DATE	DESIGN	K LEANDER	06/26	DRAWN	B LEANDER	06/26	CHECKED	B DENETDALE	06/26	ARIZONA DEPARTMENT OF TRANSPORTATION PROJECT DELIVERY AND OPERATIONS DIVISION ROADWAY DESIGN SERVICES CULVERT DETAIL SHEET DETAIL D10 - CULVERT PE 268 NB US 93 STA 268+75	<table><tr><td>ROUTE</td><td>US 93</td></tr><tr><td>MILEPOST</td><td>189.9</td></tr><tr><td>STRUCTURE NO.</td><td></td></tr></table>	ROUTE	US 93	MILEPOST	189.9	STRUCTURE NO.		<table><tr><td rowspan="2">F.H.W.A. Arizona Division</td><td rowspan="2">STATE ARIZ.</td><td>PROJECT NO.</td><td>093 YV 189</td><td>FEDERAL ID NO.</td><td>093-B(230)T</td><td>SHEET NO.</td><td>89</td><td>TOTAL SHEETS</td><td>524</td><td rowspan="2">RECORD DRAWING</td></tr><tr><td colspan="8">LOCATION WICKENBURG RANCH WAY TO VISTA ROYALE</td></tr><tr><td colspan="2">TRACS NO.</td><td colspan="8">F0738 01C</td><td>DWG No. D-2.10</td><td>OF</td></tr></table>	F.H.W.A. Arizona Division	STATE ARIZ.	PROJECT NO.	093 YV 189	FEDERAL ID NO.	093-B(230)T	SHEET NO.	89	TOTAL SHEETS	524	RECORD DRAWING	LOCATION WICKENBURG RANCH WAY TO VISTA ROYALE								TRACS NO.		F0738 01C								DWG No. D-2.10	OF
	NAME	DATE																																																					
DESIGN	K LEANDER	06/26																																																					
DRAWN	B LEANDER	06/26																																																					
CHECKED	B DENETDALE	06/26																																																					
ROUTE	US 93																																																						
MILEPOST	189.9																																																						
STRUCTURE NO.																																																							
F.H.W.A. Arizona Division	STATE ARIZ.	PROJECT NO.	093 YV 189	FEDERAL ID NO.	093-B(230)T	SHEET NO.	89	TOTAL SHEETS	524	RECORD DRAWING																																													
		LOCATION WICKENBURG RANCH WAY TO VISTA ROYALE																																																					
TRACS NO.		F0738 01C								DWG No. D-2.10	OF																																												

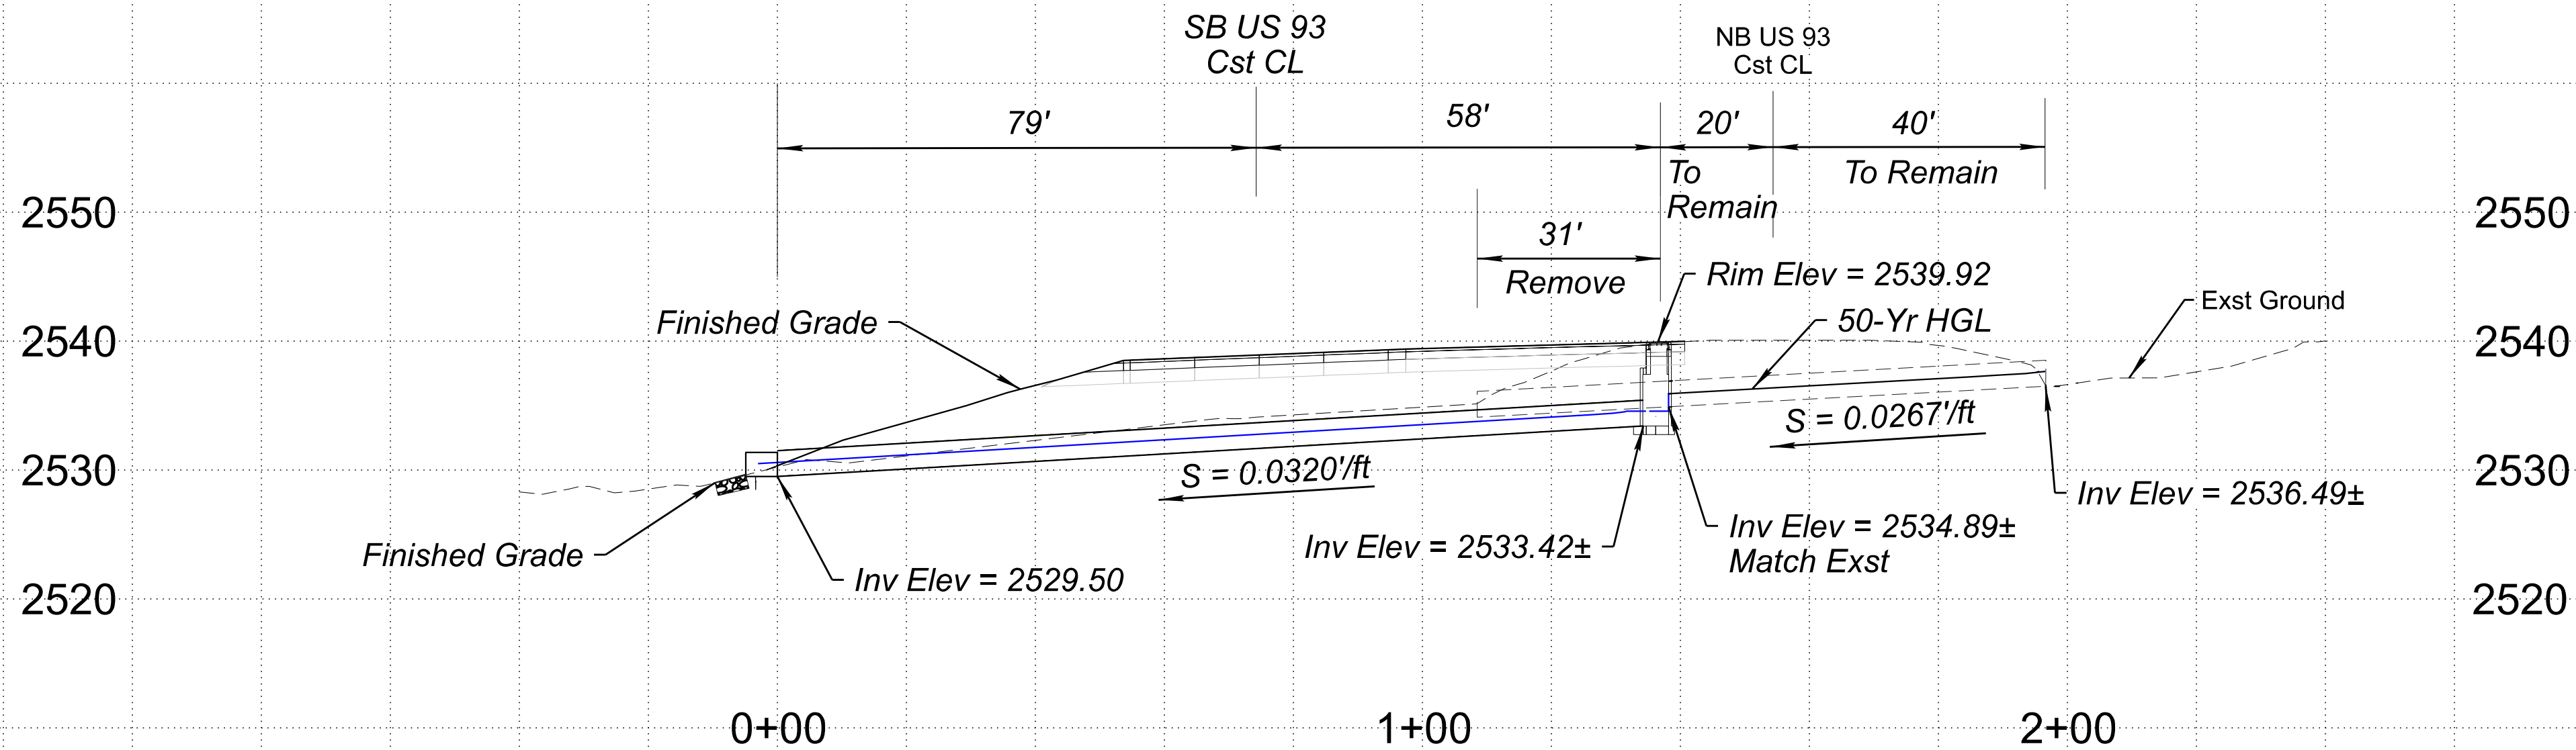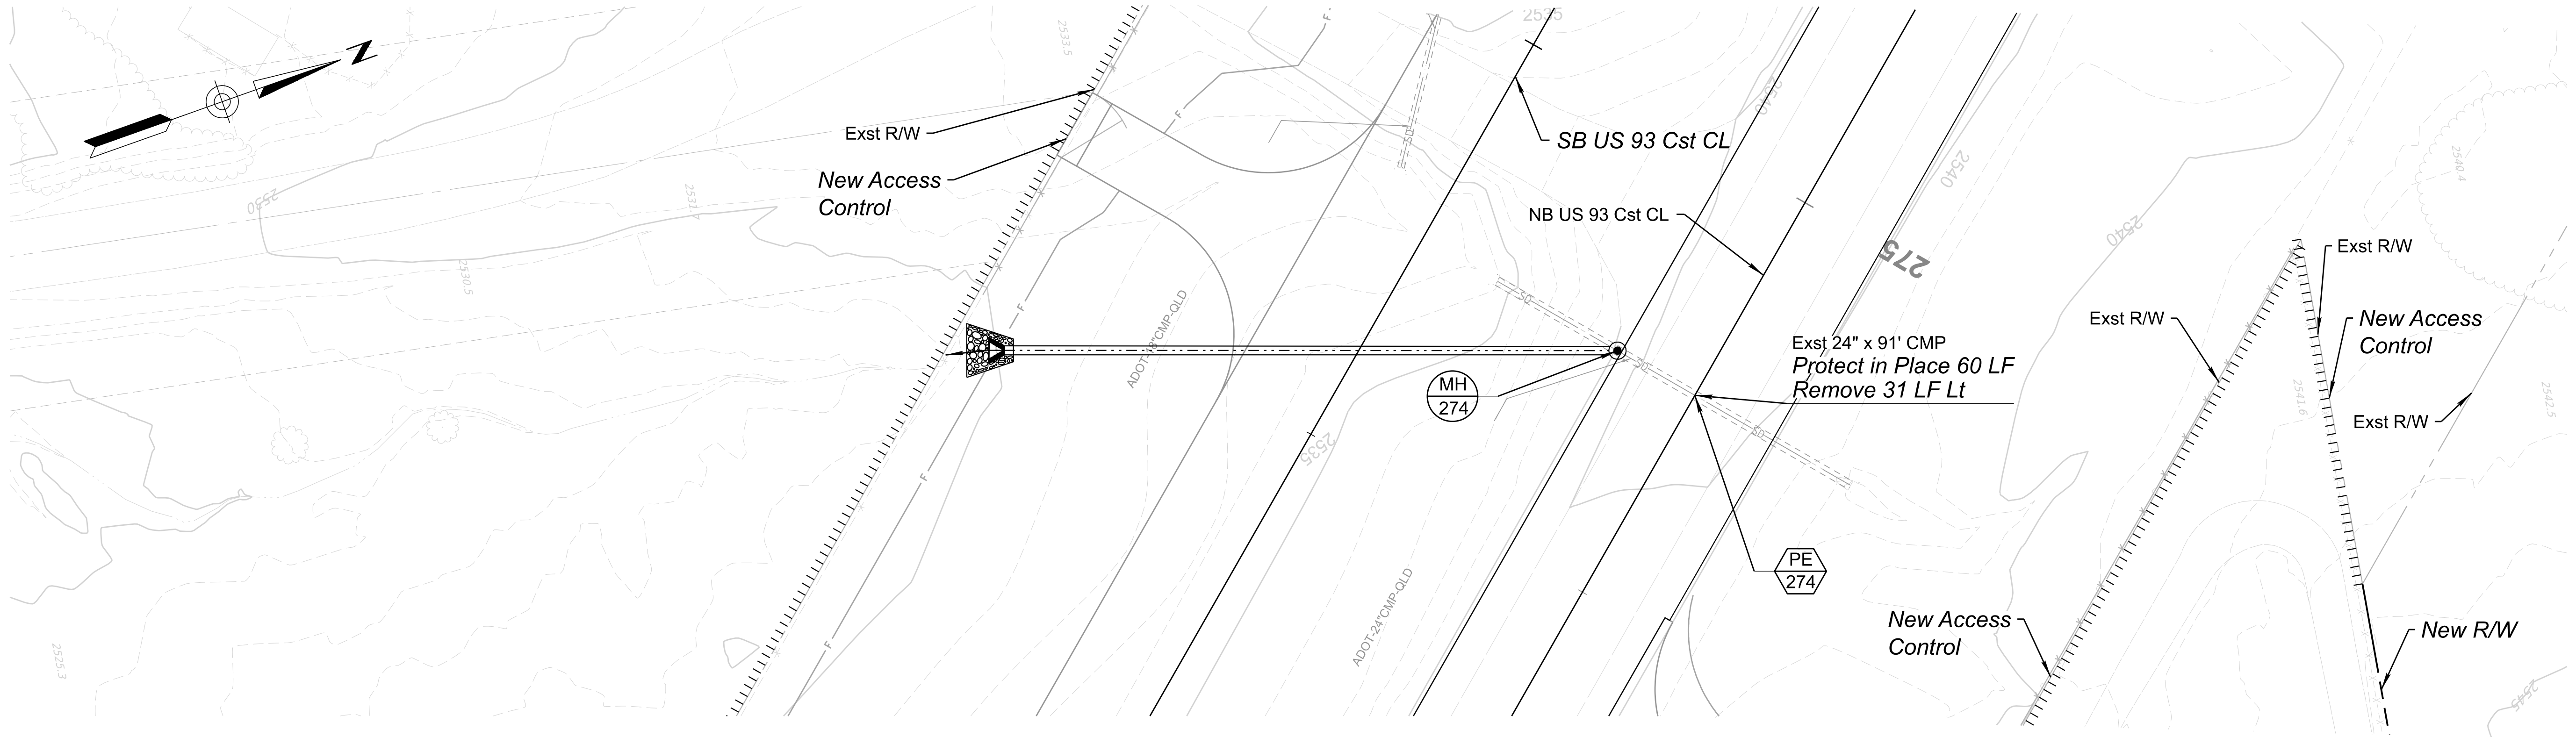

Sta 274+50 NB US 93
Exst 24" x 91' CMP
Skew 0° Rt
Remove 31 LF Lt
Extend 137' Lt
Skew 2° Lt

DETAIL D11


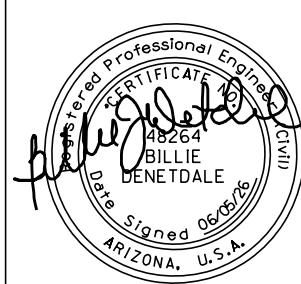


	NAME	DATE
DESIGN	K LEANDER	06/26
DRAWN	B LEANDER	06/26
CHECKED	B DENETDALE	06/26



TRANSPORTATION
AECOM TECHNICAL SERVICES, Inc.
7720 N. 16th St., Suite 100
Phoenix, Arizona 85020
T 602.371.1100
www.aecom.com

ARIZONA DEPARTMENT OF TRANSPORTATION
PROJECT DELIVERY AND OPERATIONS DIVISION
ROADWAY DESIGN SERVICES
CULVERT DETAIL SHEET
DETAIL D11 - CULVERT PE 274
NB US 93 STA 274+50


ROUTE US 93	F.H.W.A. Arizona Division	STATE ARIZ.	PROJECT NO. 093 YV 189	FEDERAL ID NO. 093-B(230)T	SHEET NO. 90	TOTAL SHEETS 524	RECORD DRAWING
MILEPOST 189.9	LOCATION WICKENBURG RANCH WAY TO VISTA ROYALE						DWG No. D-2.11
STRUCTURE NO.	TRACS NO. F0738 01C						___ OF ___

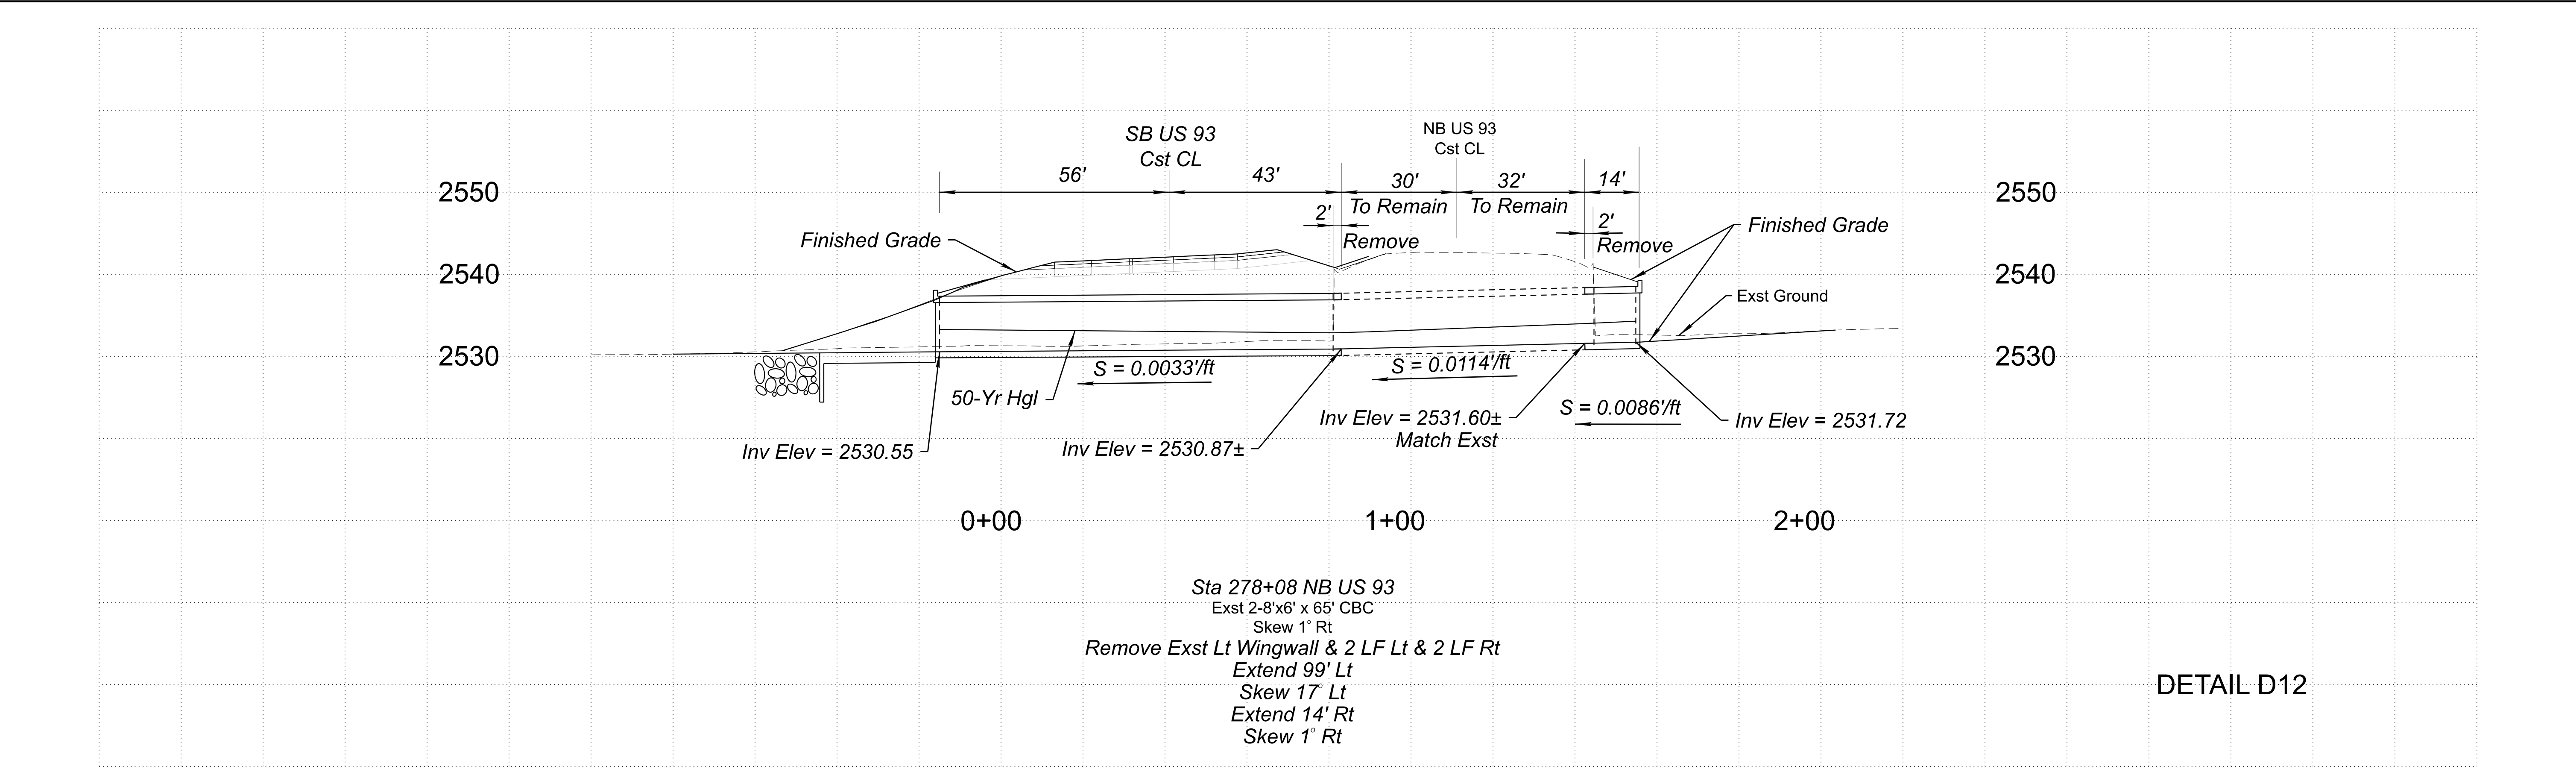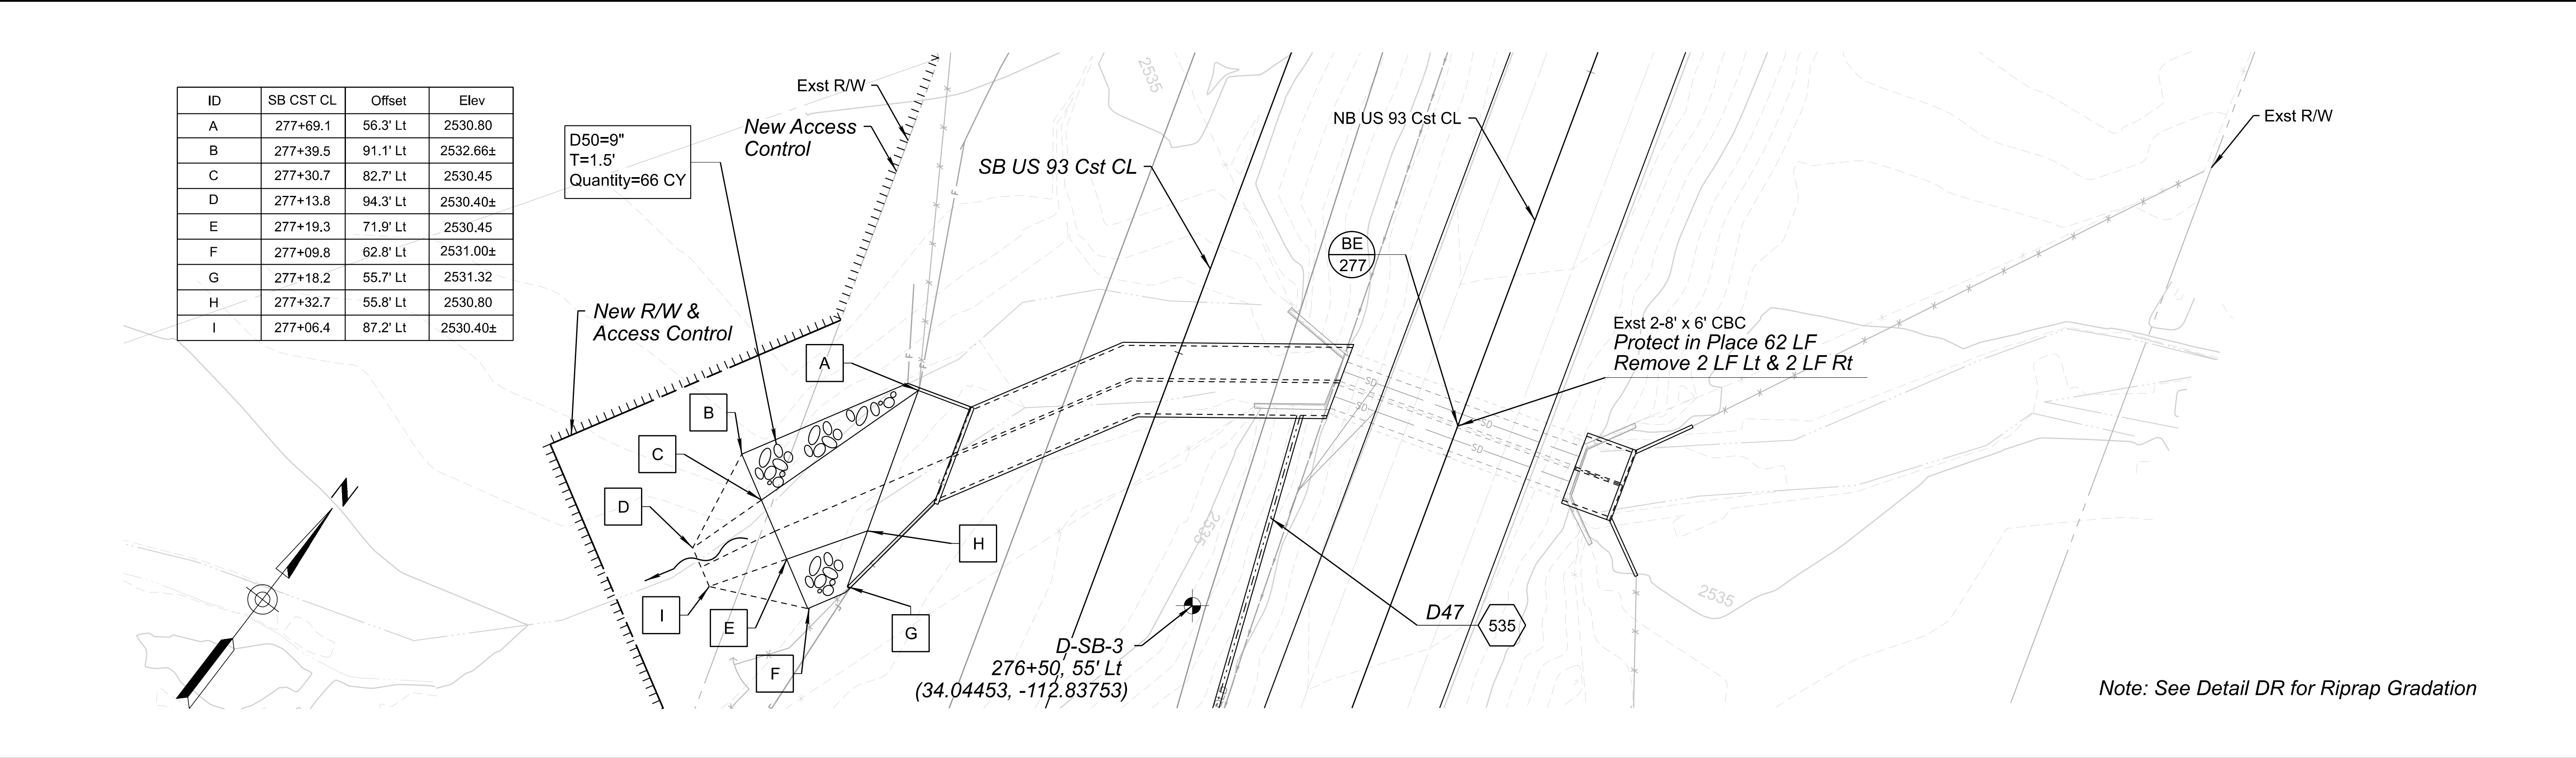

		NAME	DATE	ARIZONA DEPARTMENT OF TRANSPORTATION PROJECT DELIVERY AND OPERATIONS DIVISION ROADWAY DESIGN SERVICES CULVERT DETAIL SHEET DETAIL D12 - CULVERT BE 277 NB US 93 STA 278+08	ROUTE	US 93	F.H.W.A. Arizona Division	STATE	PROJECT NO.	FEDERAL ID NO.	SHEET NO.	TOTAL SHEETS	RECORD DRAWING	
	DESIGN	K LEANDER	06/26		ARIZ.			093 YV 189	093-B(230)T	91	524			
	DRAWN	B LEANDER	06/26		MILEPOST			189.9	LOCATION			WICKENBURG RANCH WAY TO VISTA ROYALE		DWG No. D-2.12
	CHECKED	B DENETDALE	06/26		STRUCTURE NO.				TRACS NO. F0738 01C					
TRANSPORTATION AECOM TECHNICAL SERVICES, Inc. 7720 N. 16th St., Suite 100 Phoenix, Arizona 85020 T 602.371.1100 www.aecom.com														

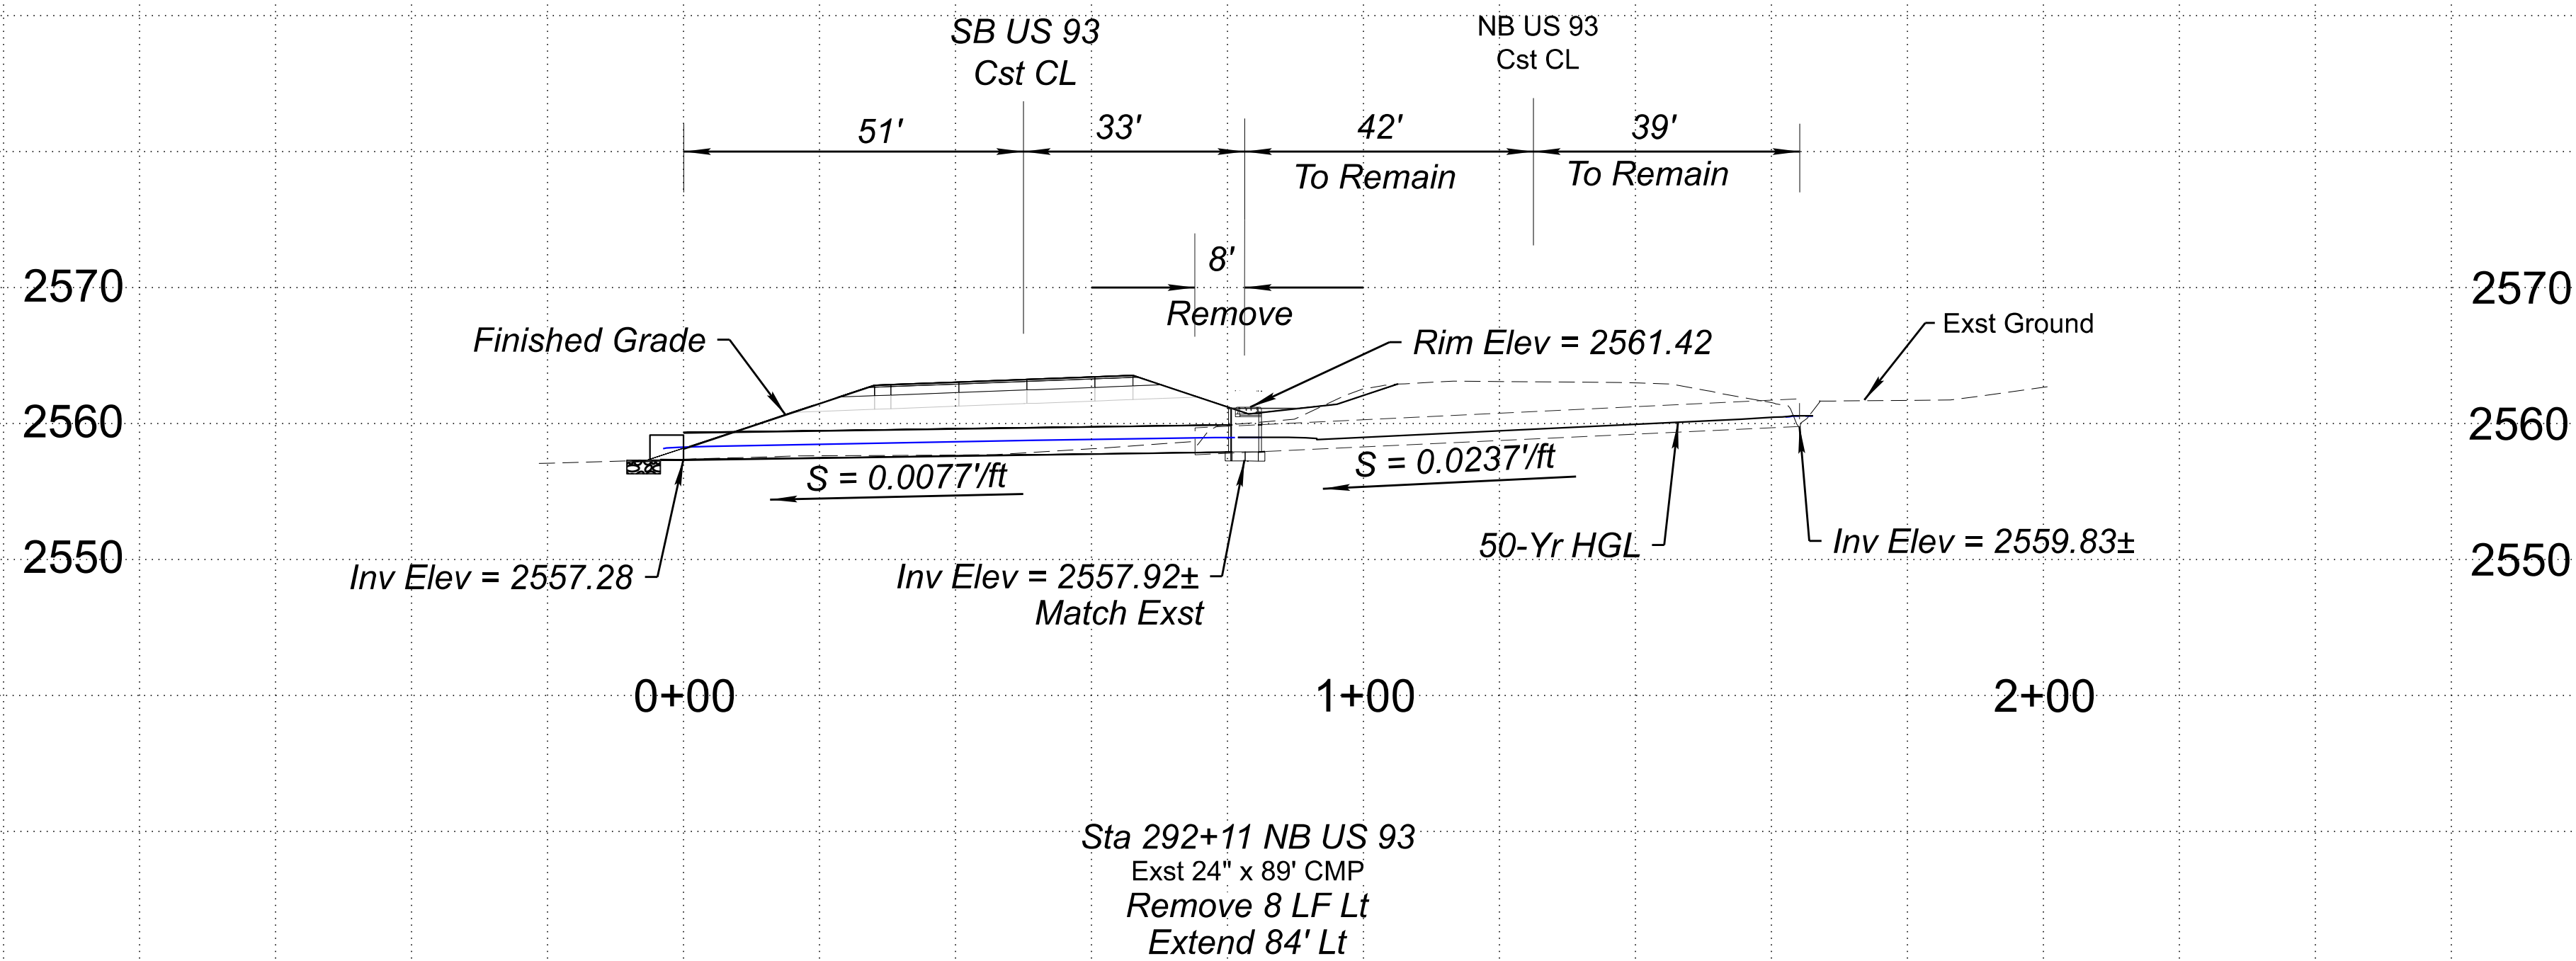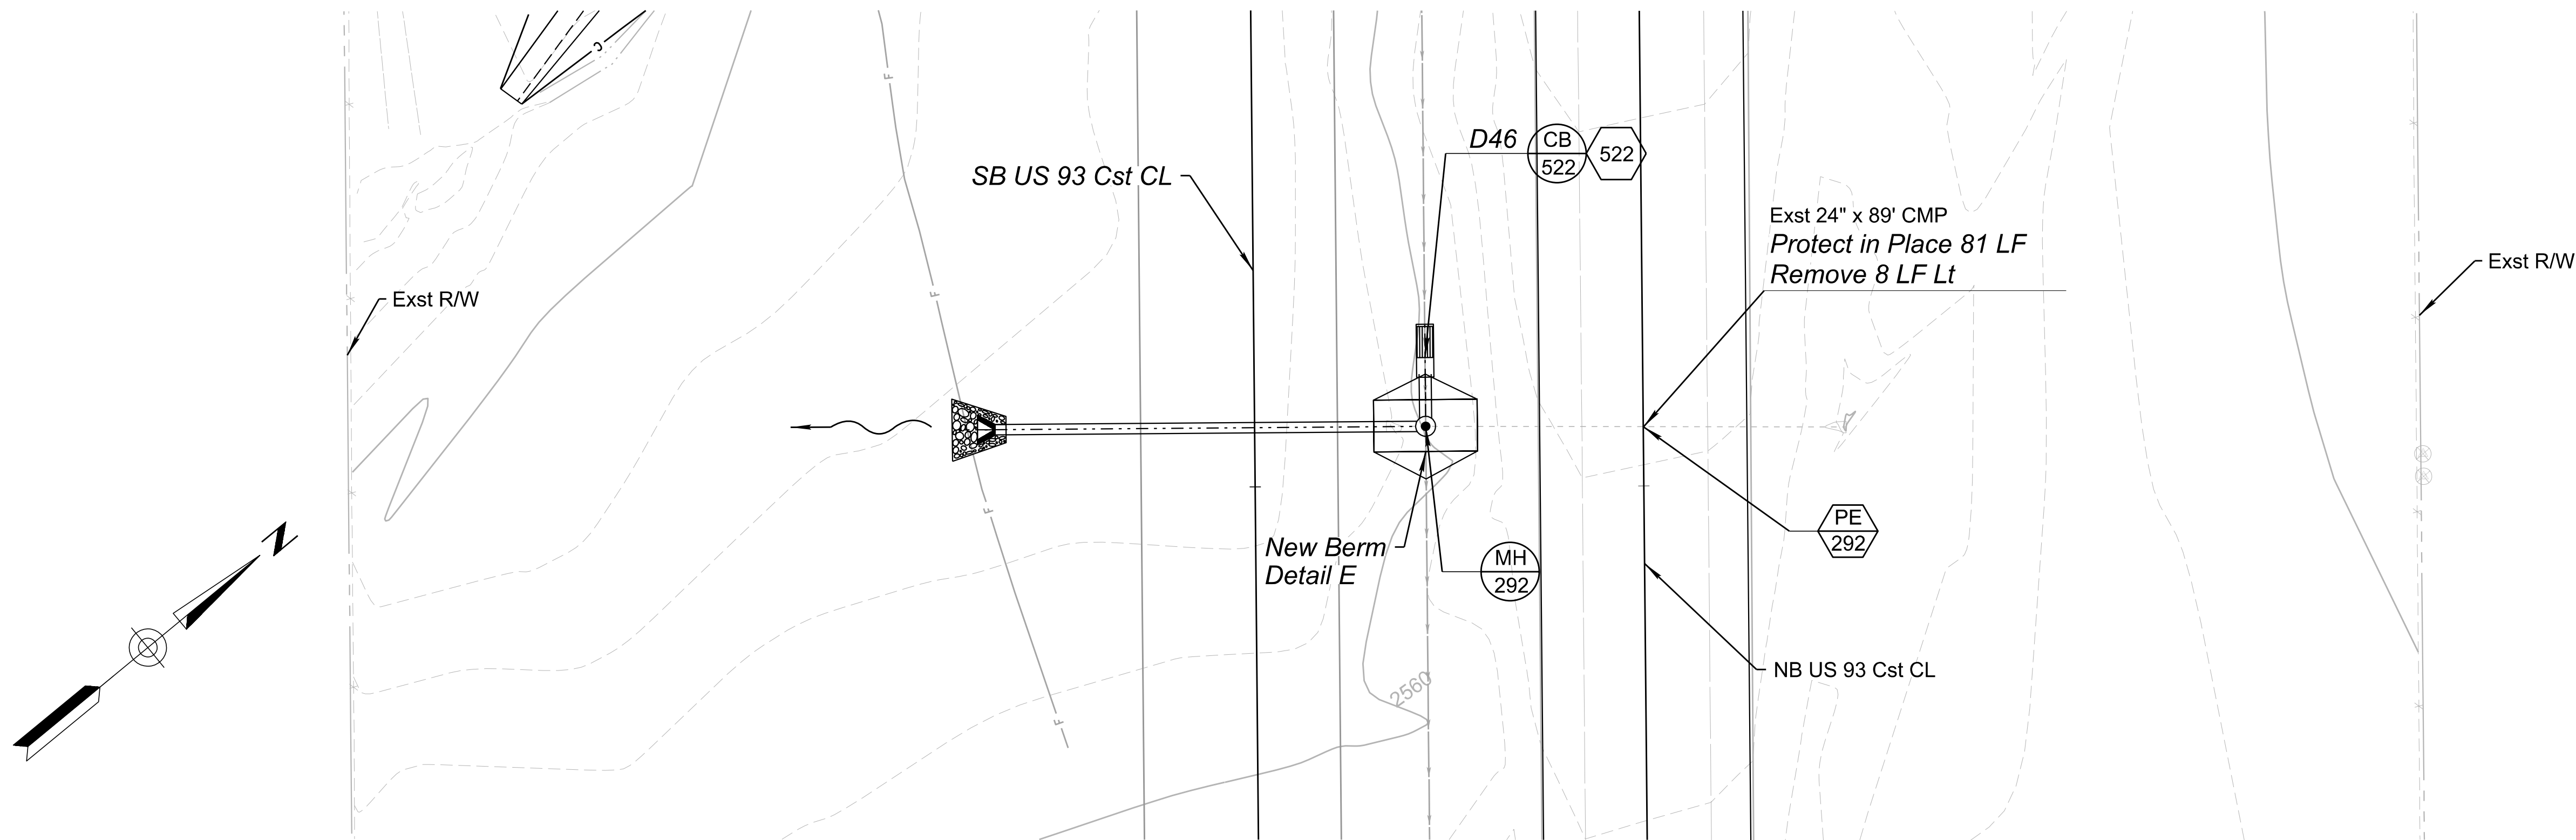

DETAIL D13

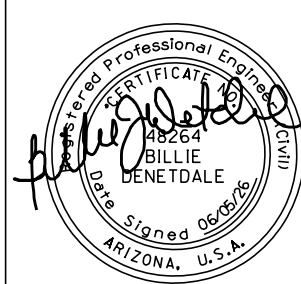



DESIGN	K LEANDER	06/26
DRAWN	B LEANDER	06/26
CHECKED	B DENETDALE	06/26

TRANSPORTATION
AECOM TECHNICAL SERVICES, Inc.
7720 N. 16th St., Suite 100
Phoenix, Arizona 85020
T 602.371.1100



AECOM
www.aecom.com

ARIZONA DEPARTMENT OF TRANSPORTATION
PROJECT DELIVERY AND OPERATIONS DIVISION
ROADWAY DESIGN SERVICES
CULVERT DETAIL SHEET
DETAIL D13 - CULVERT PE 292
NB US 93 STA 292+11



ROUTE US 93	F.H.W.A. Arizona Division	STATE ARIZ.	PROJECT NO. 093 YV 189	FEDERAL ID NO. 093-B(230)T	SHEET NO. 92	TOTAL SHEETS 524	RECORD DRAWING
MILEPOST 189.9	LOCATION WICKENBURG RANCH WAY TO VISTA ROYALE					DWG No. D-2.13	
STRUCTURE NO.	TRACS NO. F0738 01C					____ OF ____	

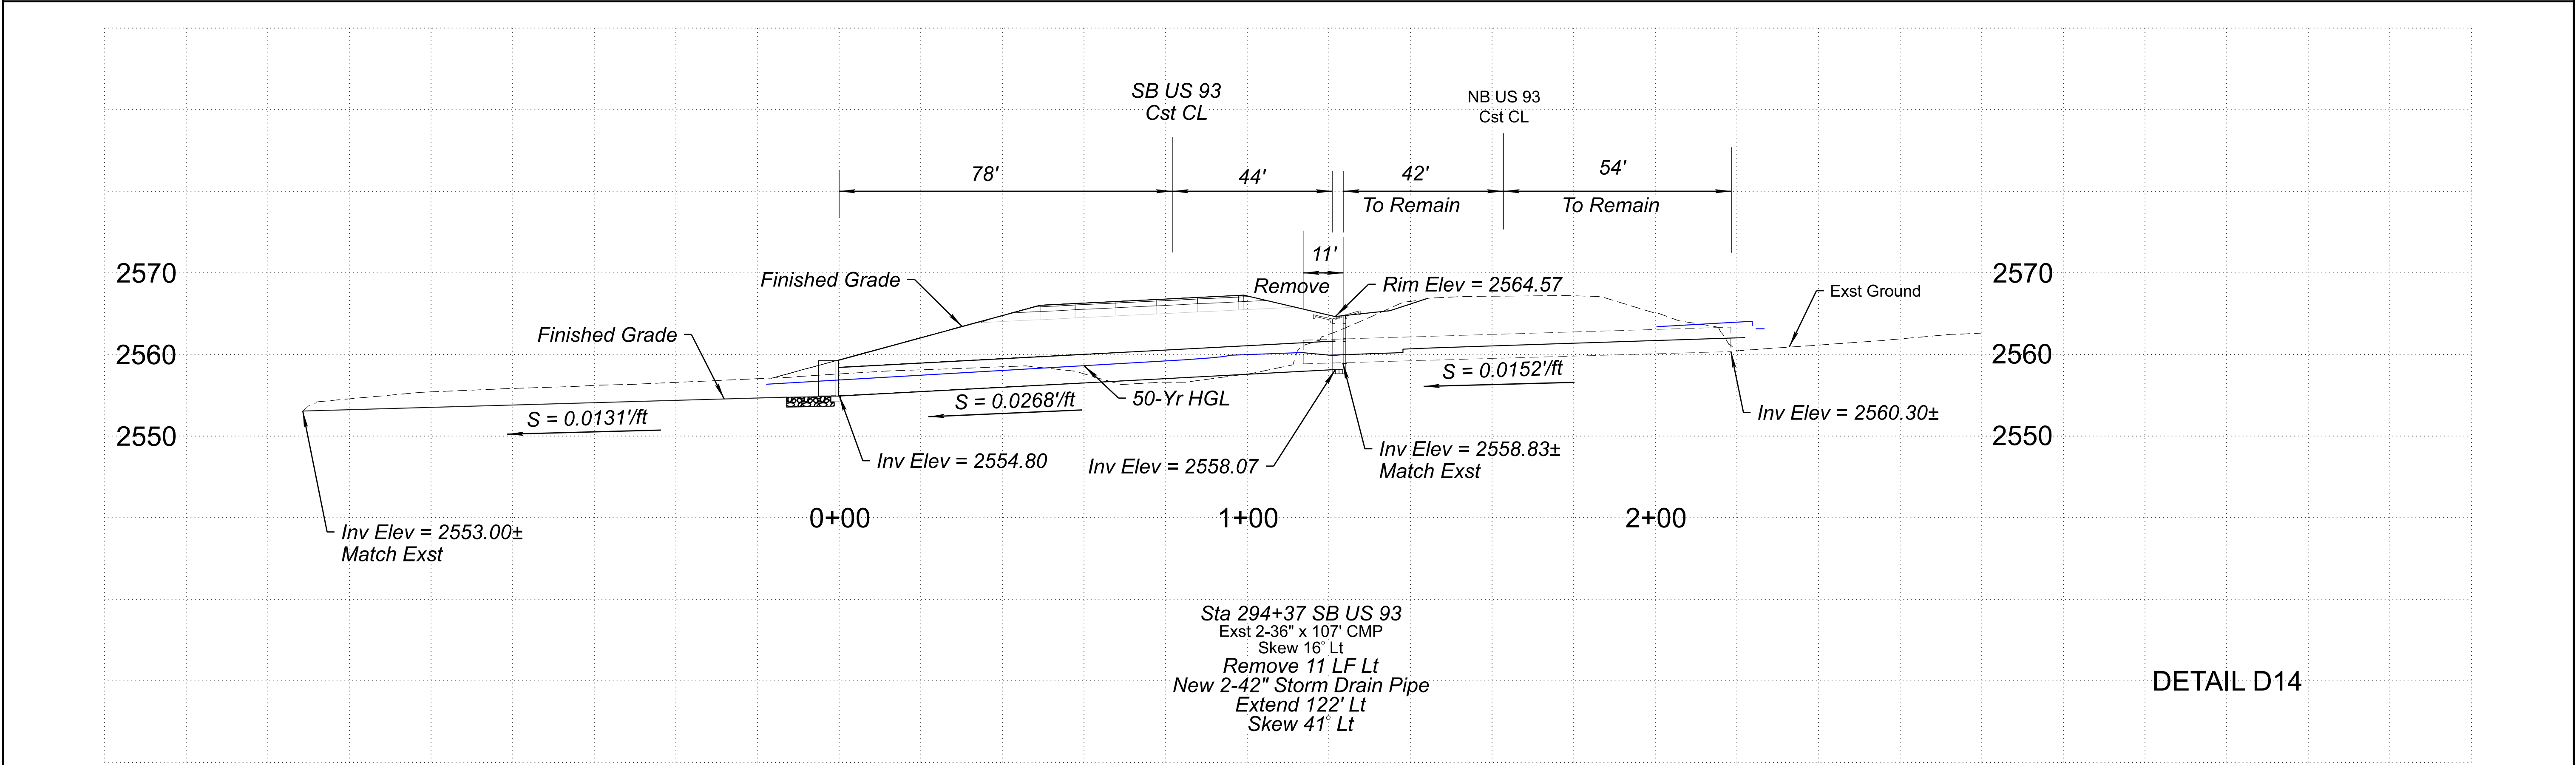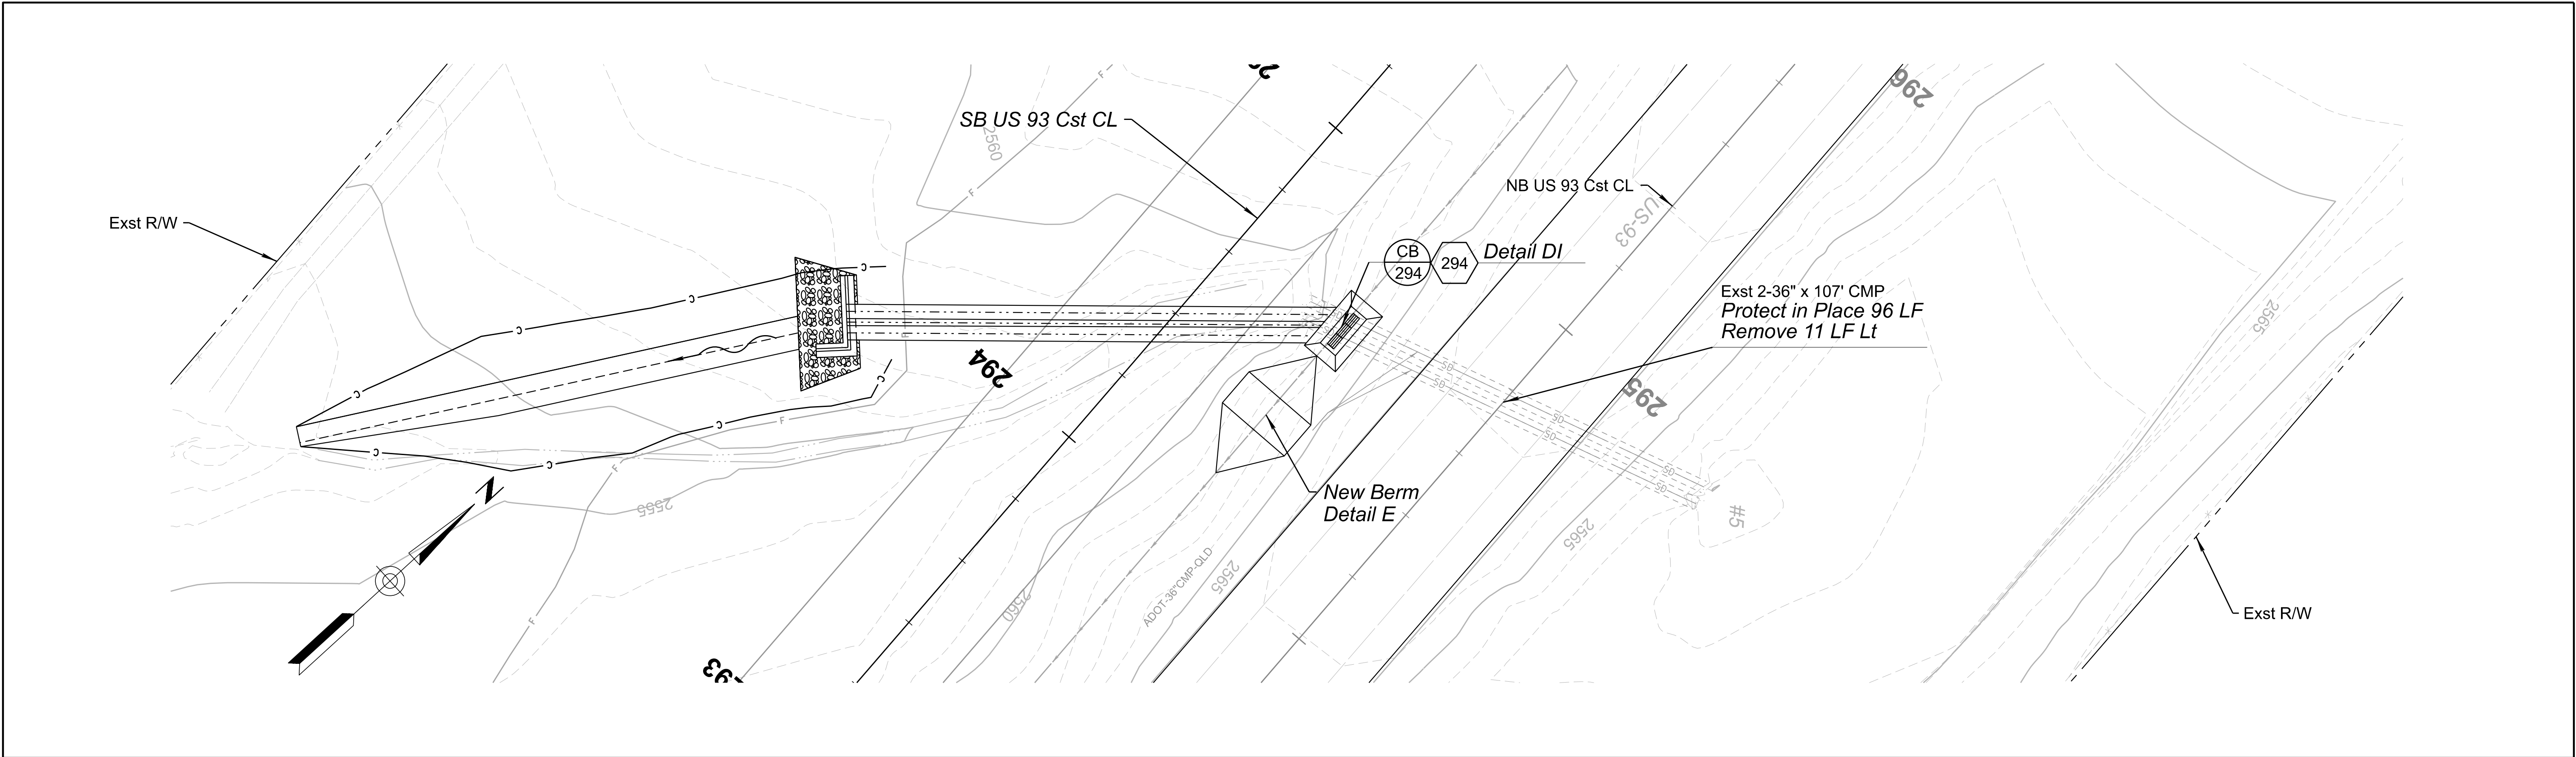

	<table><tr><td></td><td>NAME</td><td>DATE</td></tr><tr><td>DESIGN</td><td>K LEANDER</td><td>06/26</td></tr><tr><td>DRAWN</td><td>B LEANDER</td><td>06/26</td></tr><tr><td>CHECKED</td><td>B DENETDALE</td><td>06/26</td></tr></table>		NAME	DATE	DESIGN	K LEANDER	06/26	DRAWN	B LEANDER	06/26	CHECKED	B DENETDALE	06/26	<table><tr><td>TRANSPORTATION</td></tr><tr><td>AECOM TECHNICAL SERVICES, Inc.</td></tr><tr><td>1720 N. 16th St., Suite 100</td></tr><tr><td>Phoenix, Arizona 85020</td></tr><tr><td>T 602.371.1100</td></tr><tr><td></td></tr><tr><td>www.aecom.com</td></tr></table>	TRANSPORTATION	AECOM TECHNICAL SERVICES, Inc.	1720 N. 16th St., Suite 100	Phoenix, Arizona 85020	T 602.371.1100		www.aecom.com	ARIZONA DEPARTMENT OF TRANSPORTATION PROJECT DELIVERY AND OPERATIONS DIVISION ROADWAY DESIGN SERVICES		ROUTE US 93	F.H.W.A. Arizona Division	STATE ARIZ.	PROJECT NO.	FEDERAL ID NO.	SHEET NO.	TOTAL SHEETS	RECORD DRAWING
			NAME	DATE																											
		DESIGN	K LEANDER	06/26																											
		DRAWN	B LEANDER	06/26																											
CHECKED	B DENETDALE	06/26																													
TRANSPORTATION																															
AECOM TECHNICAL SERVICES, Inc.																															
1720 N. 16th St., Suite 100																															
Phoenix, Arizona 85020																															
T 602.371.1100																															
www.aecom.com																															
MILEPOST 189.9	093 YV 189	093-B(230)T	93	524																											
STRUCTURE NO.	LOCATION WICKENBURG RANCH WAY TO VISTA ROYALE										DWG No. D-2.14																				
	TRACS NO. F0738 01C										OF																				


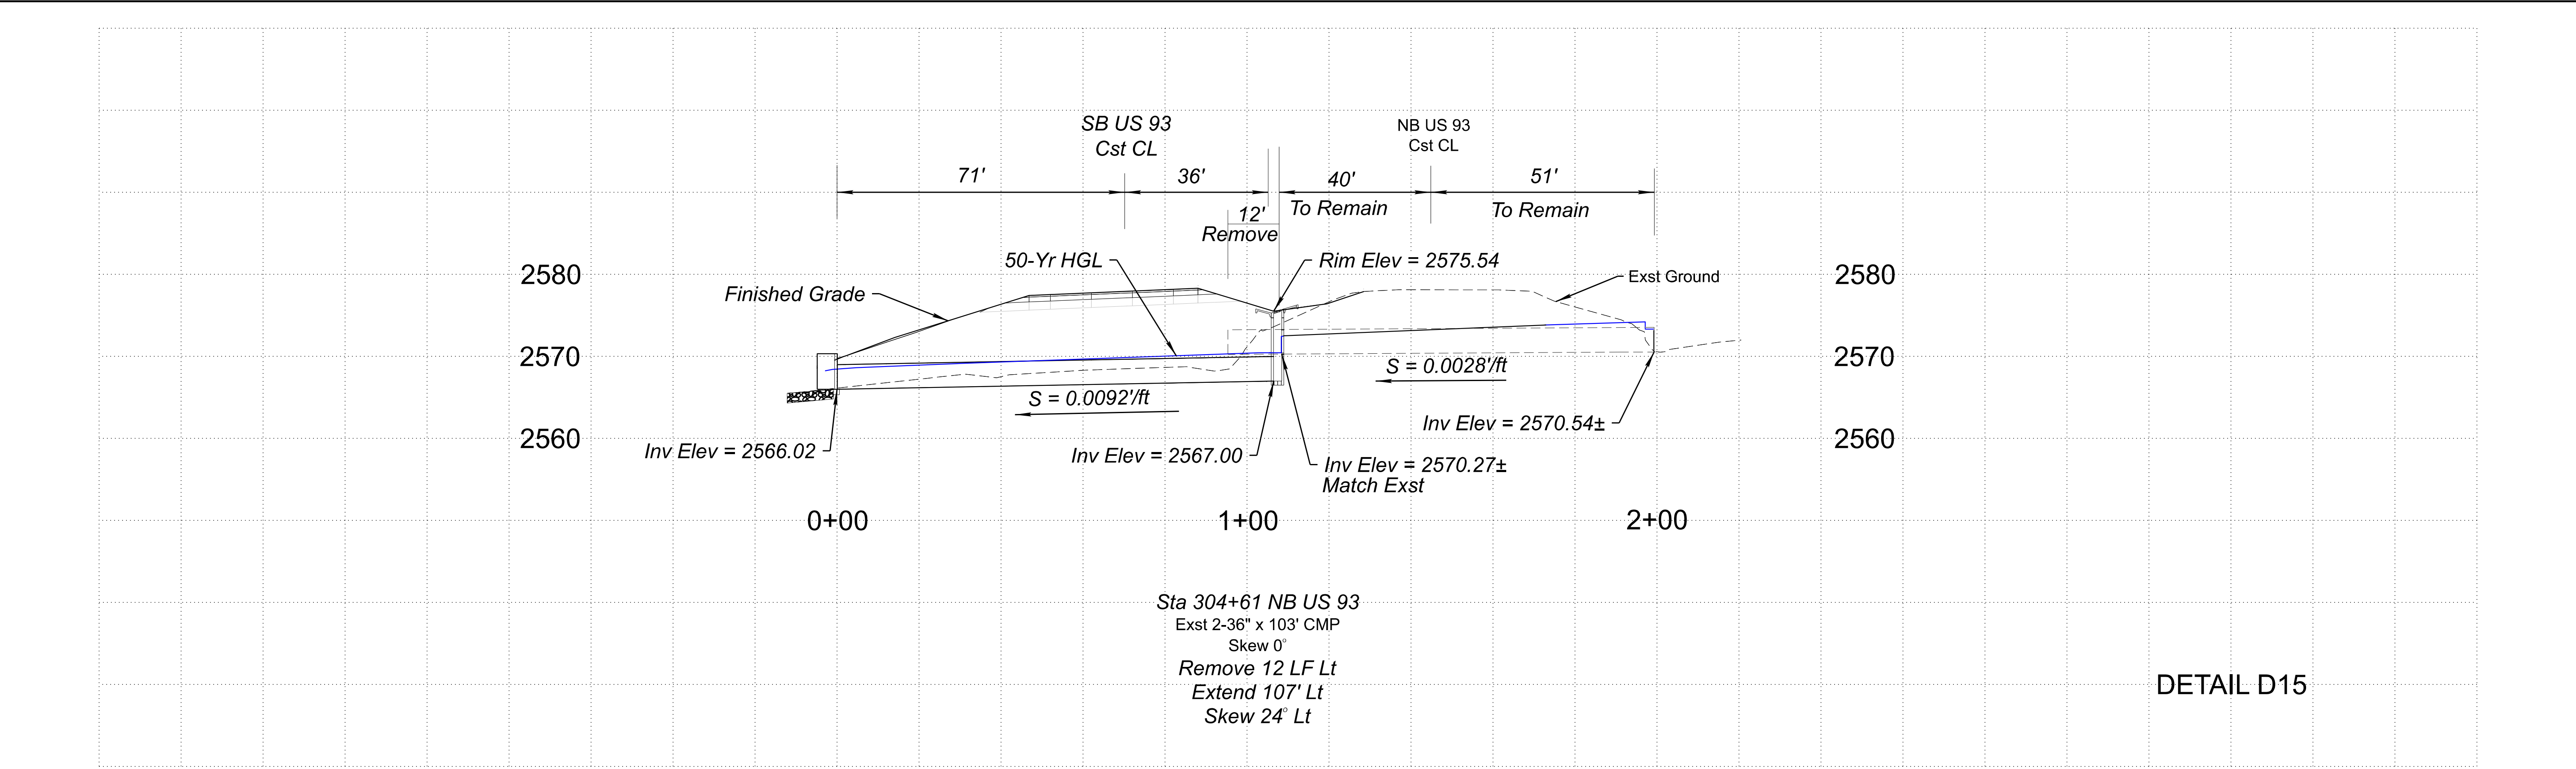
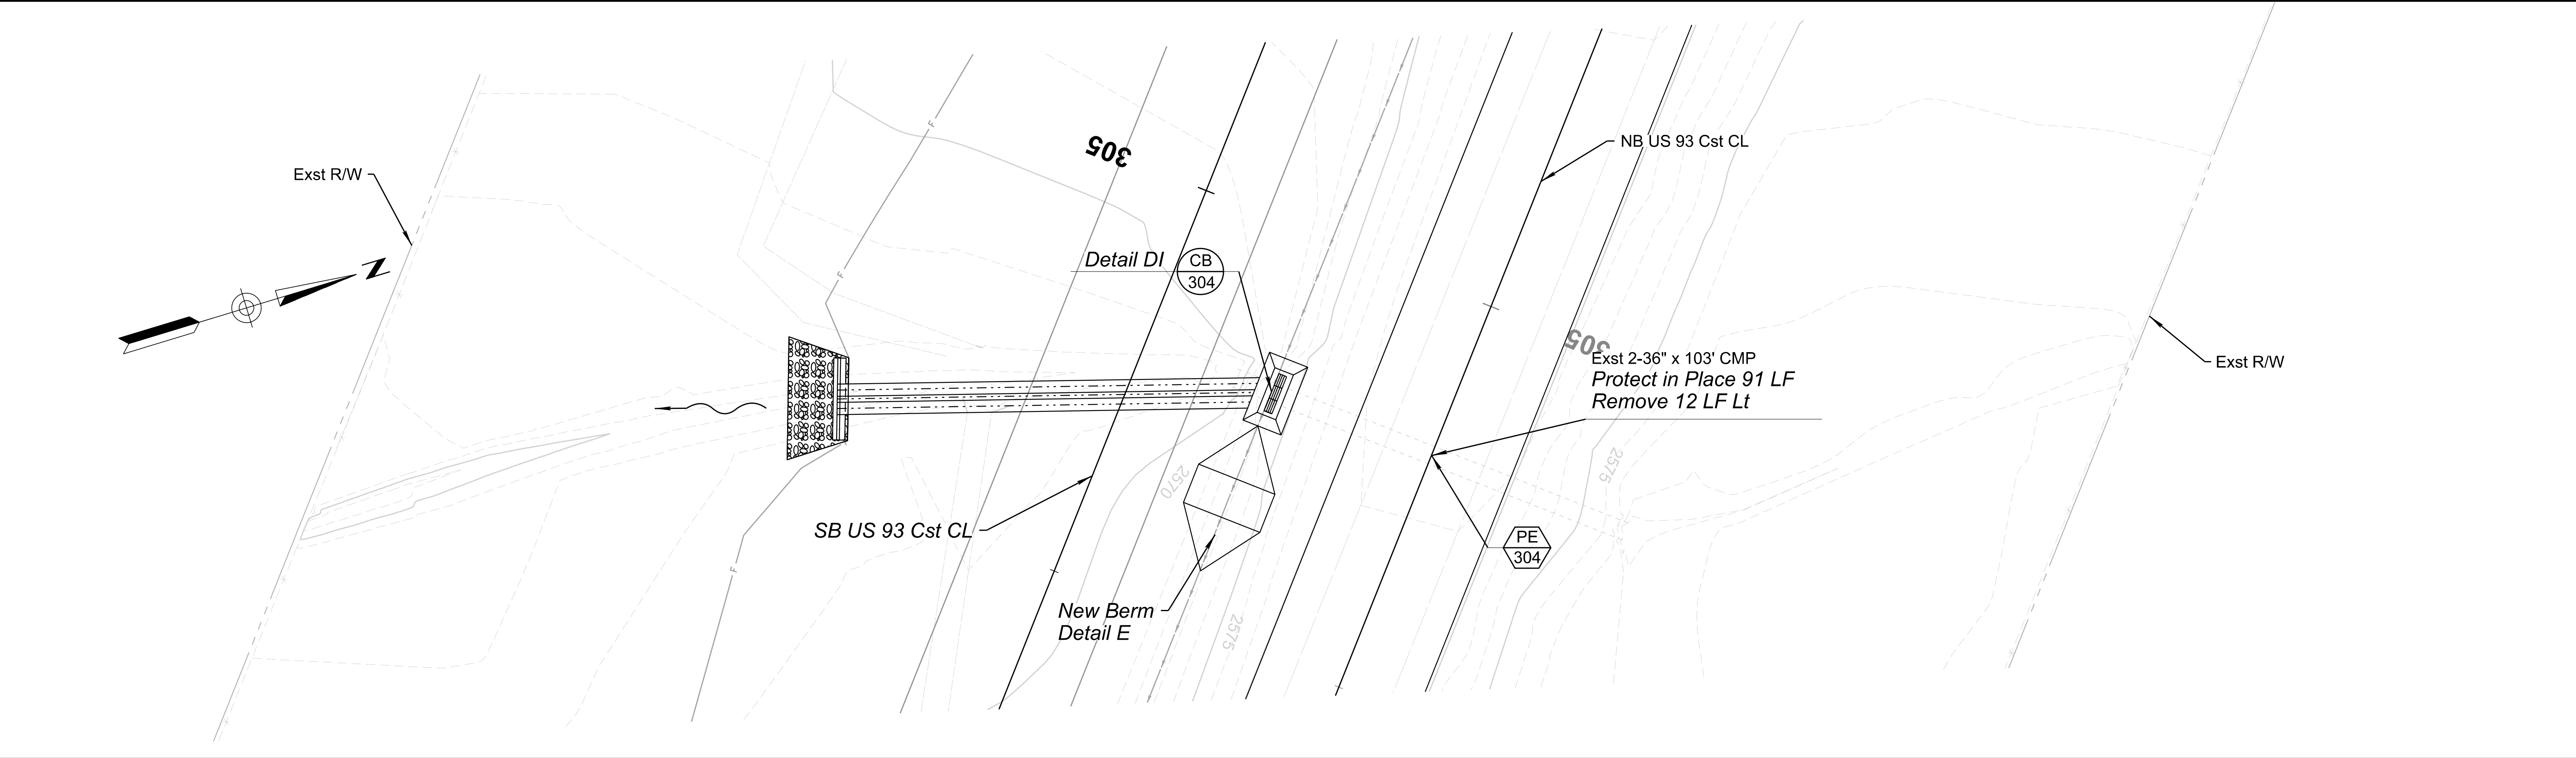


	<table><tr><td></td><td>NAME</td><td>DATE</td></tr><tr><td>DESIGN</td><td>K LEANDER</td><td>06/26</td></tr><tr><td>DRAWN</td><td>B LEANDER</td><td>06/26</td></tr><tr><td>CHECKED</td><td>B DENETDALE</td><td>06/26</td></tr></table>				NAME	DATE	DESIGN	K LEANDER	06/26	DRAWN	B LEANDER	06/26	CHECKED	B DENETDALE	06/26	<table><tr><td>ROUTE</td><td colspan="2">US 93</td></tr><tr><td>MILEPOST</td><td colspan="2">189.9</td></tr><tr><td>STRUCTURE NO.</td><td colspan="2"></td></tr></table>			ROUTE	US 93		MILEPOST	189.9		STRUCTURE NO.			<table><tr><td>F.H.W.A. Arizona Division</td><td>STATE</td><td>PROJECT NO.</td><td>FEDERAL ID NO.</td><td>SHEET NO.</td><td>TOTAL SHEETS</td><td>RECORD DRAWING</td></tr><tr><td></td><td>ARIZ.</td><td>093 YV 189</td><td>093-B(230)T</td><td>94</td><td>524</td><td></td></tr></table>		F.H.W.A. Arizona Division	STATE	PROJECT NO.	FEDERAL ID NO.	SHEET NO.	TOTAL SHEETS	RECORD DRAWING		ARIZ.	093 YV 189	093-B(230)T	94	524	
		NAME	DATE																																								
	DESIGN	K LEANDER	06/26																																								
	DRAWN	B LEANDER	06/26																																								
CHECKED	B DENETDALE	06/26																																									
ROUTE	US 93																																										
MILEPOST	189.9																																										
STRUCTURE NO.																																											
F.H.W.A. Arizona Division	STATE	PROJECT NO.	FEDERAL ID NO.	SHEET NO.	TOTAL SHEETS	RECORD DRAWING																																					
	ARIZ.	093 YV 189	093-B(230)T	94	524																																						
<table><tr><td>TRANSPORTATION</td><td>AECOM TECHNICAL SERVICES, Inc.</td><td>AECOM</td></tr><tr><td>7720 N. 16th St., Suite 100</td><td>Phoenix, Arizona 85020</td><td>www.aecom.com</td></tr><tr><td>TEL: 602.374.1100</td><td></td><td></td></tr></table>			TRANSPORTATION	AECOM TECHNICAL SERVICES, Inc.	AECOM	7720 N. 16th St., Suite 100	Phoenix, Arizona 85020	www.aecom.com	TEL: 602.374.1100			<table><tr><td colspan="2">LOCATION</td><td colspan="2">WICKENBURG RANCH WAY TO VISTA ROYALE</td><td colspan="2">DWG No. D-2.15</td></tr><tr><td colspan="2">TRACS NO.</td><td colspan="2">F0738 01C</td><td colspan="2">____ OF ____</td></tr></table>			LOCATION		WICKENBURG RANCH WAY TO VISTA ROYALE		DWG No. D-2.15		TRACS NO.		F0738 01C		____ OF ____																		
TRANSPORTATION	AECOM TECHNICAL SERVICES, Inc.	AECOM																																									
7720 N. 16th St., Suite 100	Phoenix, Arizona 85020	www.aecom.com																																									
TEL: 602.374.1100																																											
LOCATION		WICKENBURG RANCH WAY TO VISTA ROYALE		DWG No. D-2.15																																							
TRACS NO.		F0738 01C		____ OF ____																																							

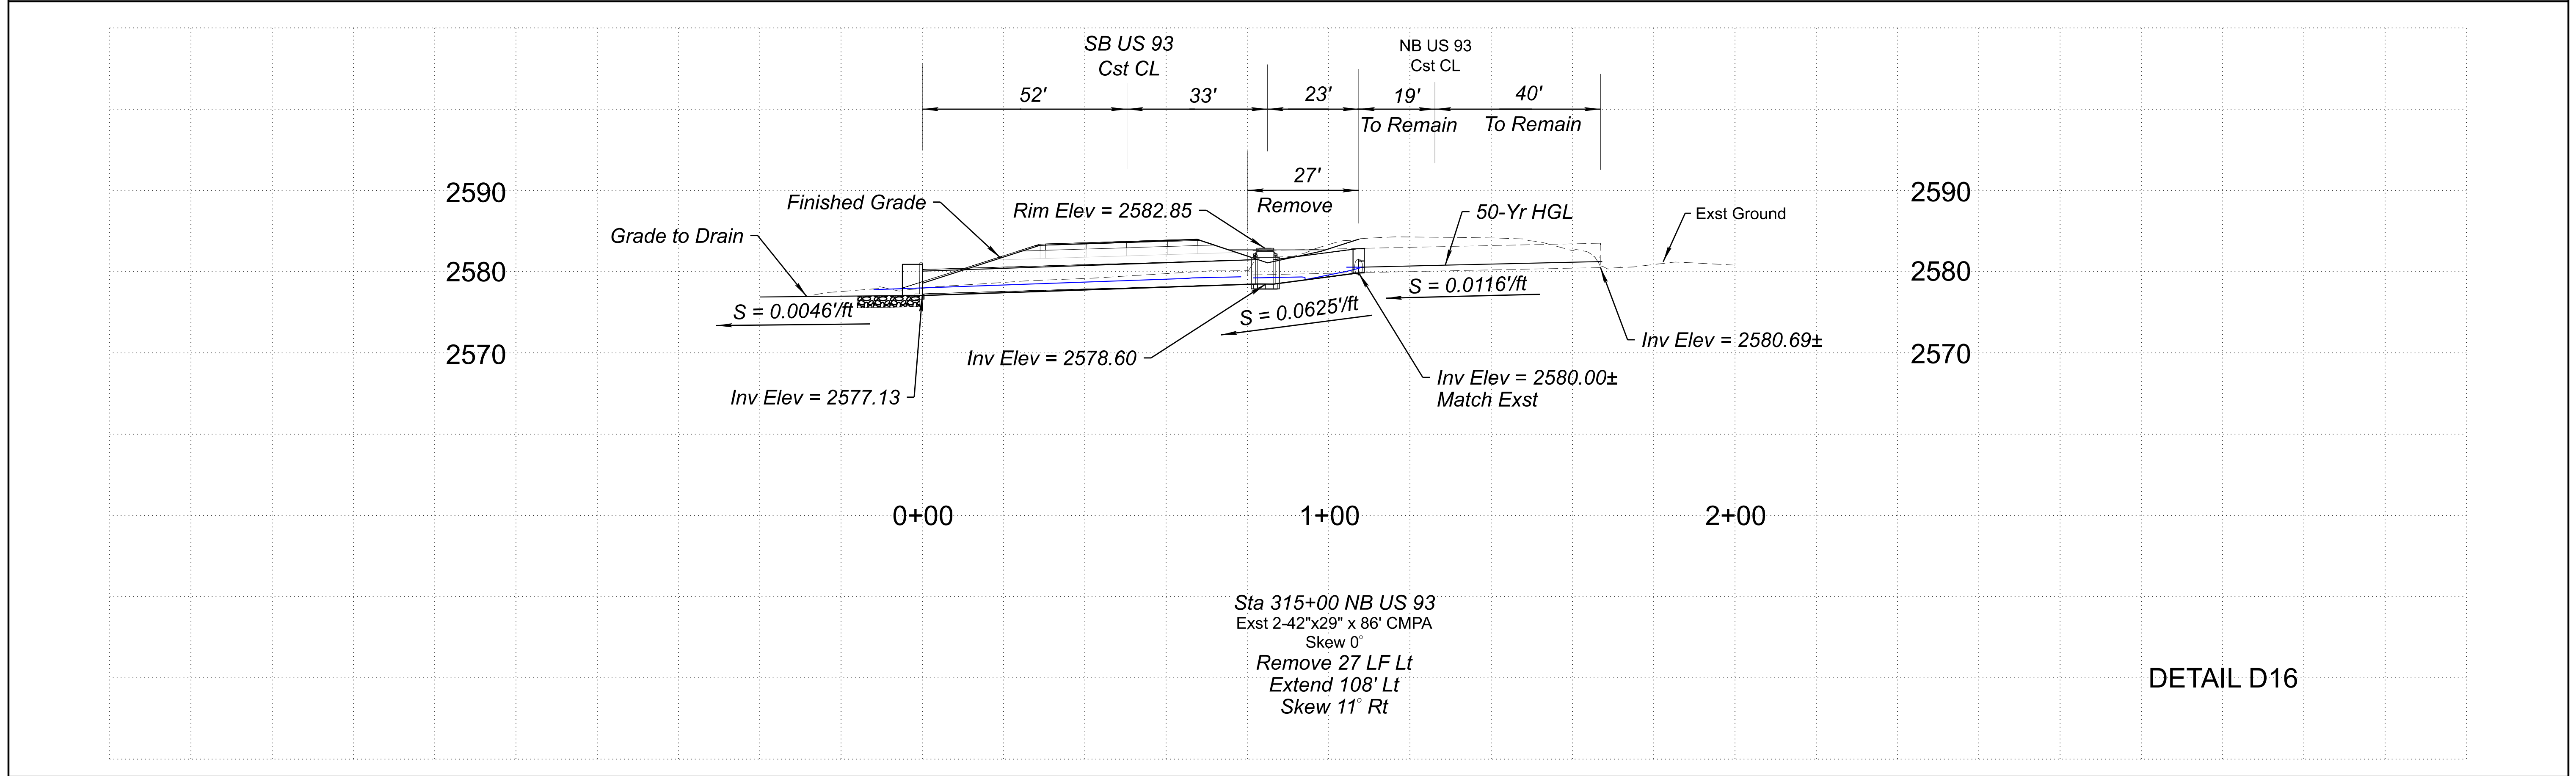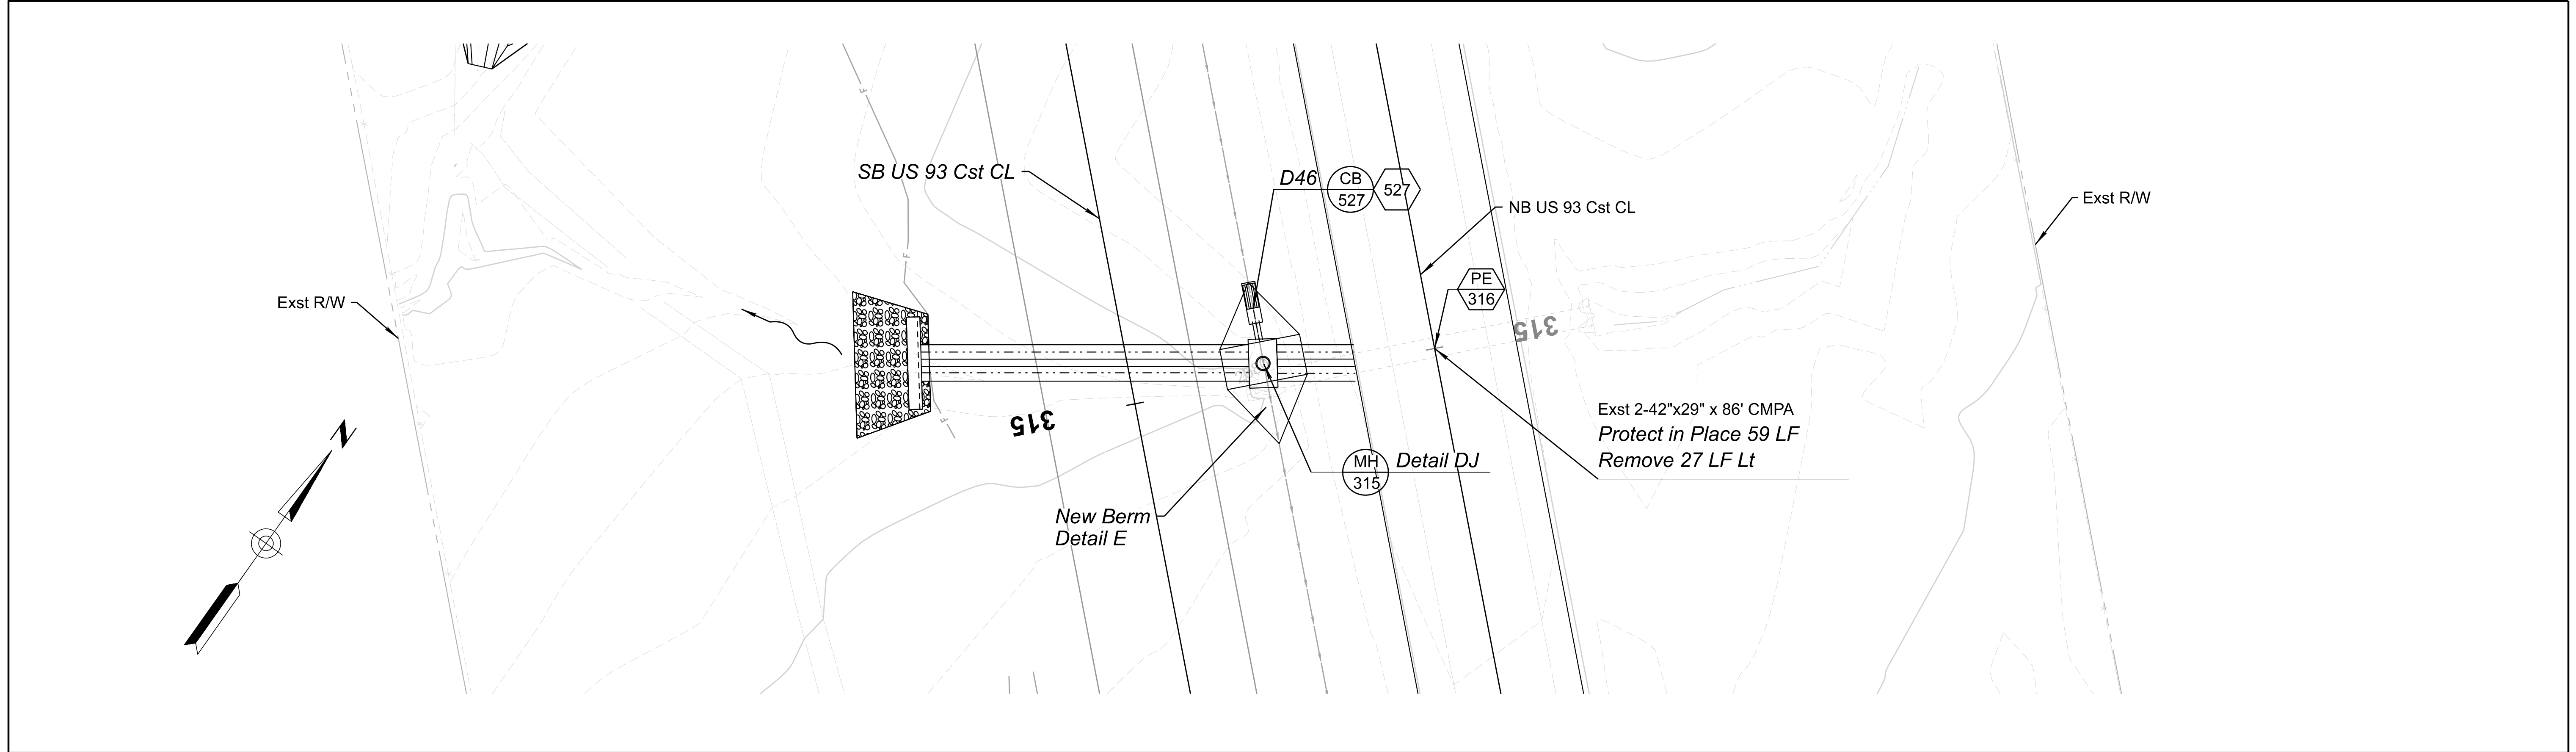

Sta 315+00 NB US 93
Exst 2-42"x29" x 86' CMPA
Skew 0°
Remove 27 LF Lt
Extend 108' Lt
Skew 11° Rt

	DESIGN	K LEANDER	06/26	ARIZONA DEPARTMENT OF TRANSPORTATION PROJECT DELIVERY AND OPERATIONS DIVISION ROADWAY DESIGN SERVICES	ROUTE	US 93	F.H.W.A. Arizona Division	STATE	ARIZ.	PROJECT NO.	093 YV 189	FEDERAL ID NO.	093-B(230)T	SHEET NO.	95	TOTAL SHEETS	524	RECORD DRAWING
	DRAWN	B LEANDER	06/26		MILEPOST	189.9												
	CHECKED	B DENETDALE	06/26		STRUCTURE NO.													
	TRANSPORTATION AECOM TECHNICAL SERVICES, Inc. 7720 N. 190th St., Suite 100 Phoenix, Arizona 85020 T 602.371-1100  www.aecom.com				CULVERT DETAIL SHEET DETAIL D16 - CULVERT PE 316 NB US 93 STA 315+00				LOCATION WICKENBURG RANCH WAY TO VISTA ROYALE DWG No. D-2.16 TRACS NO. F0738 01C OF									

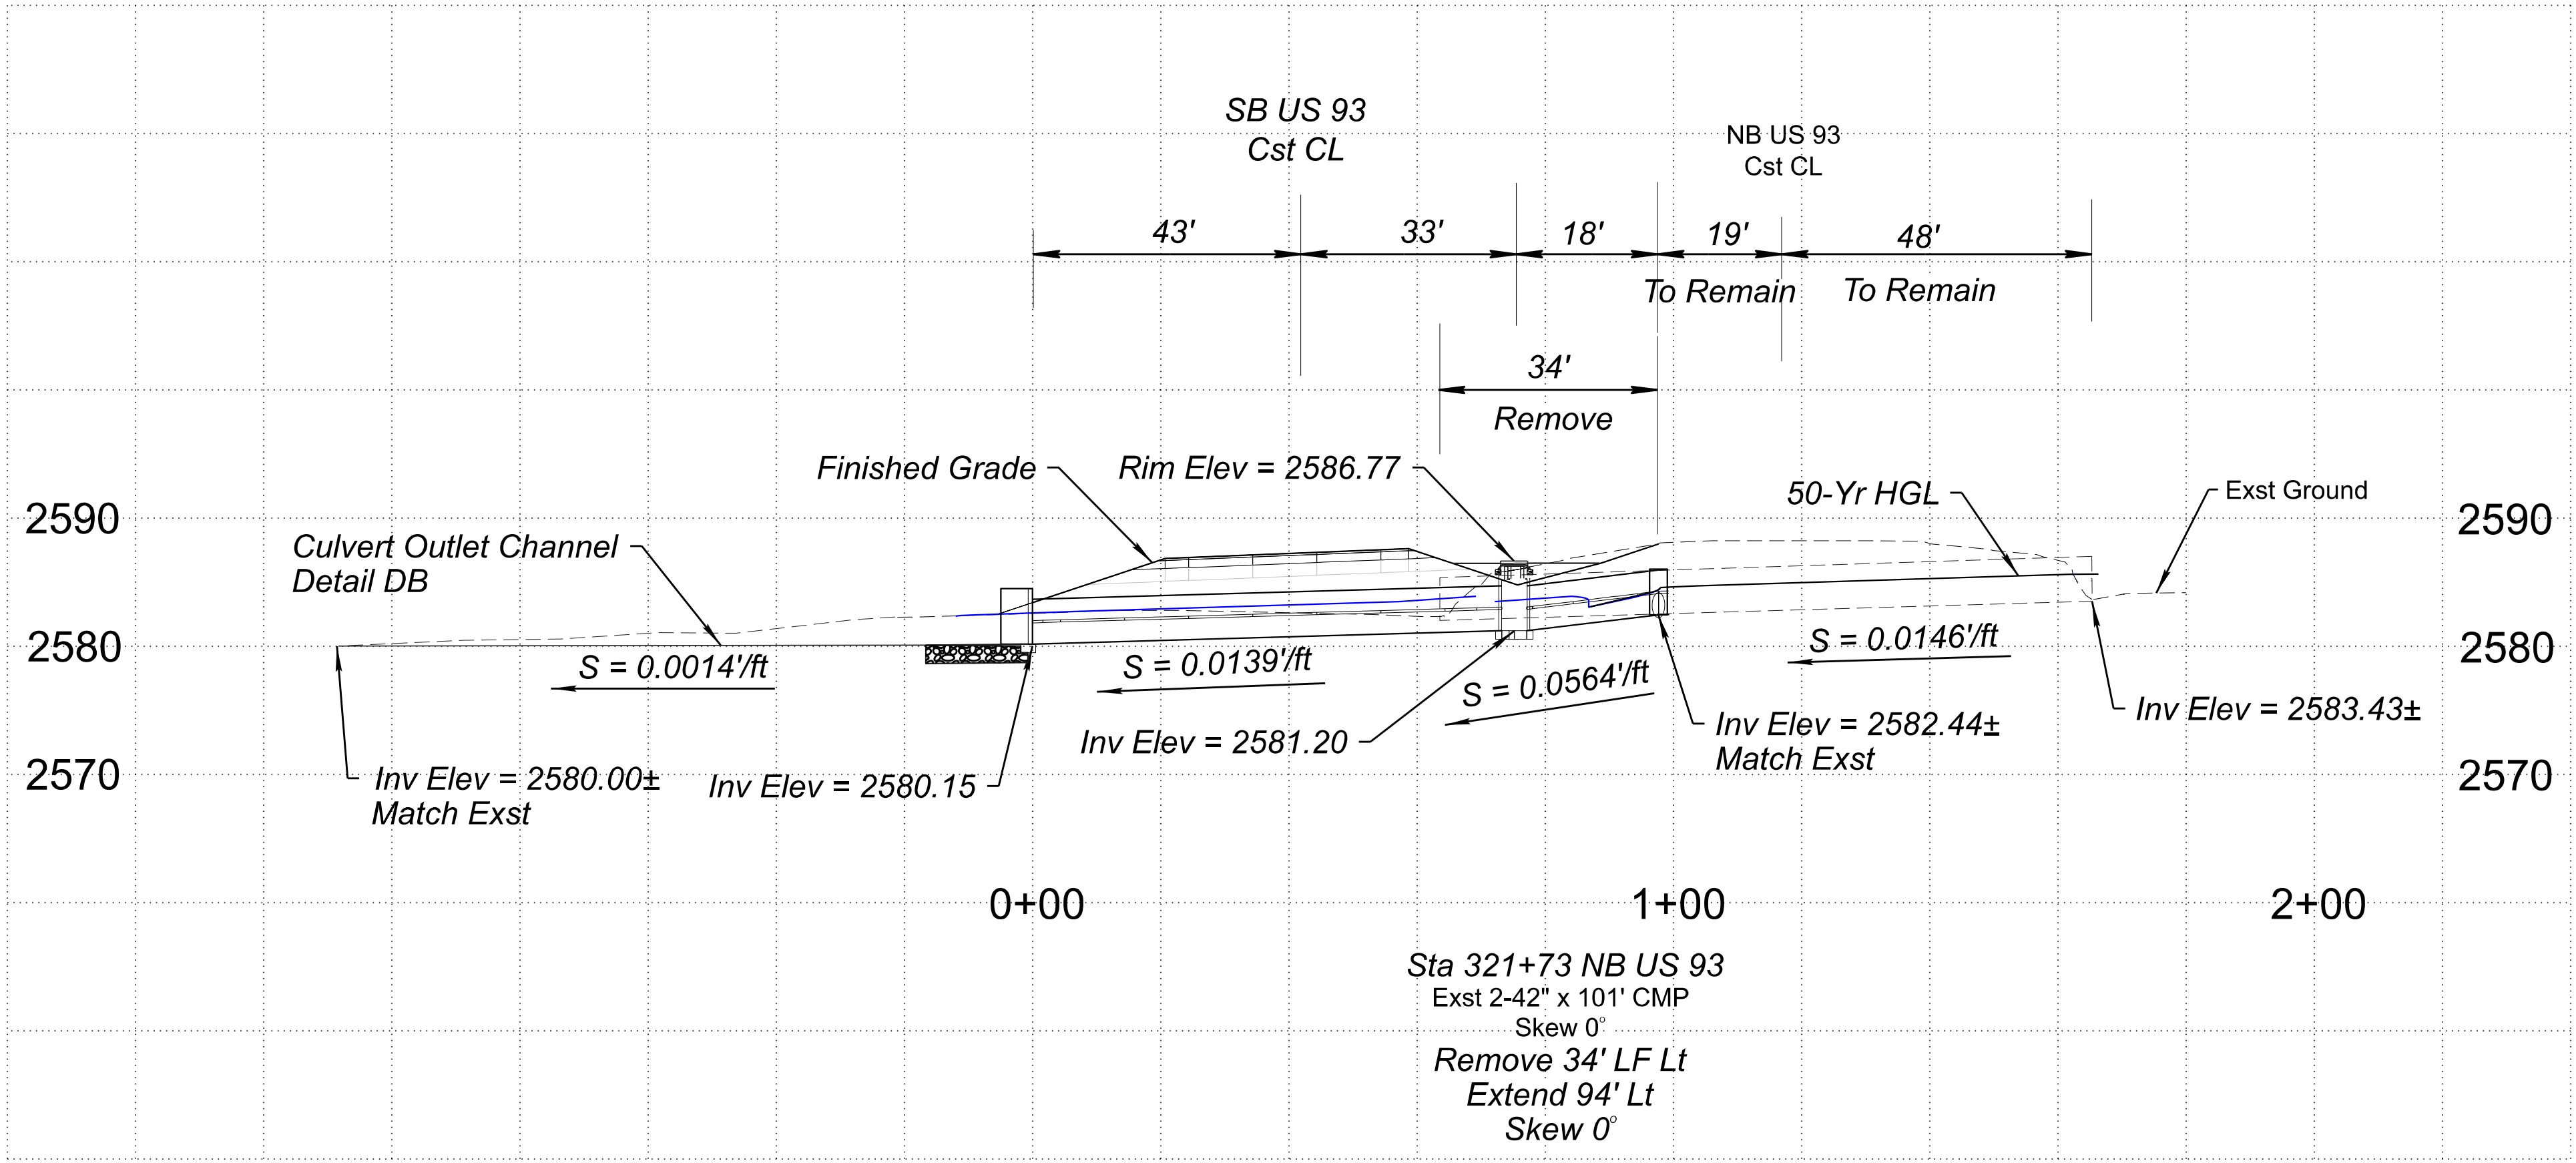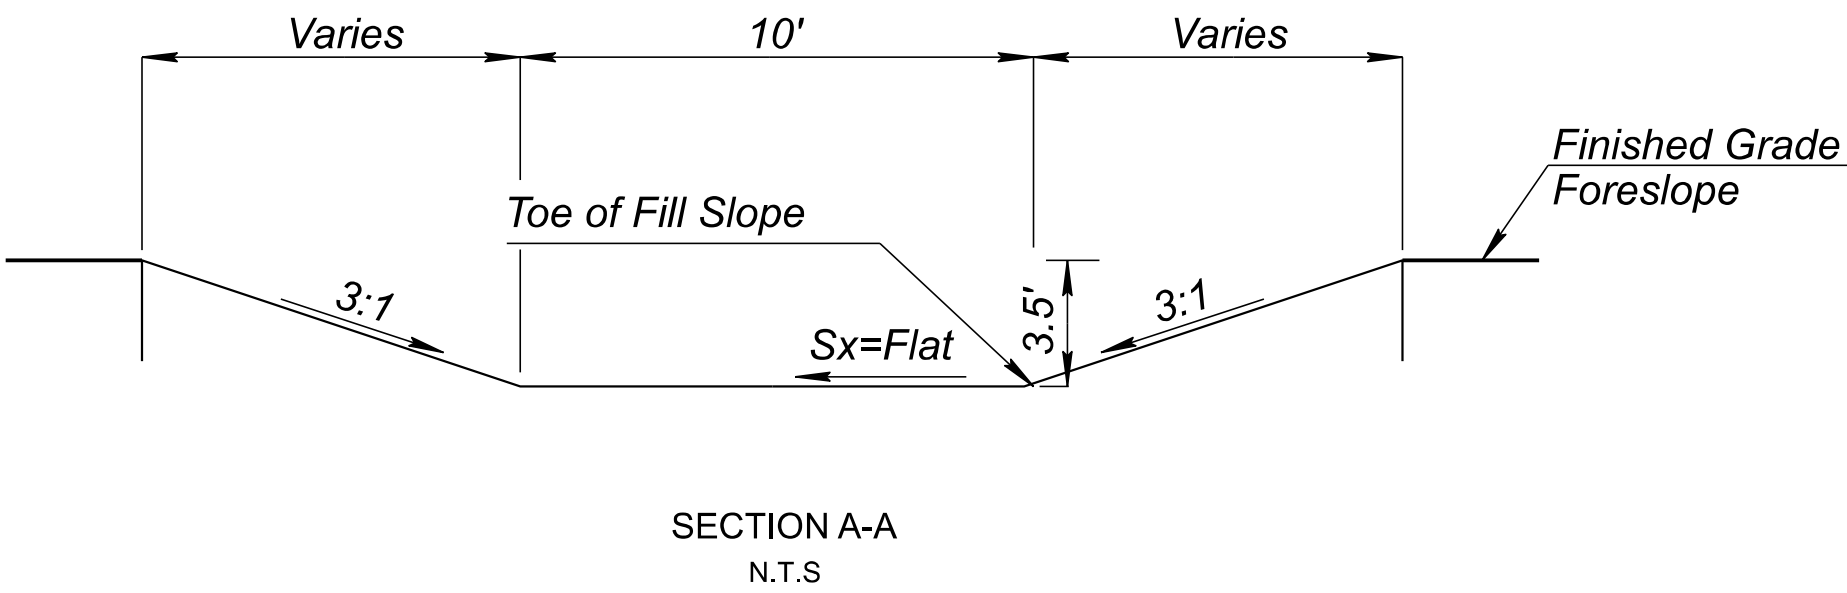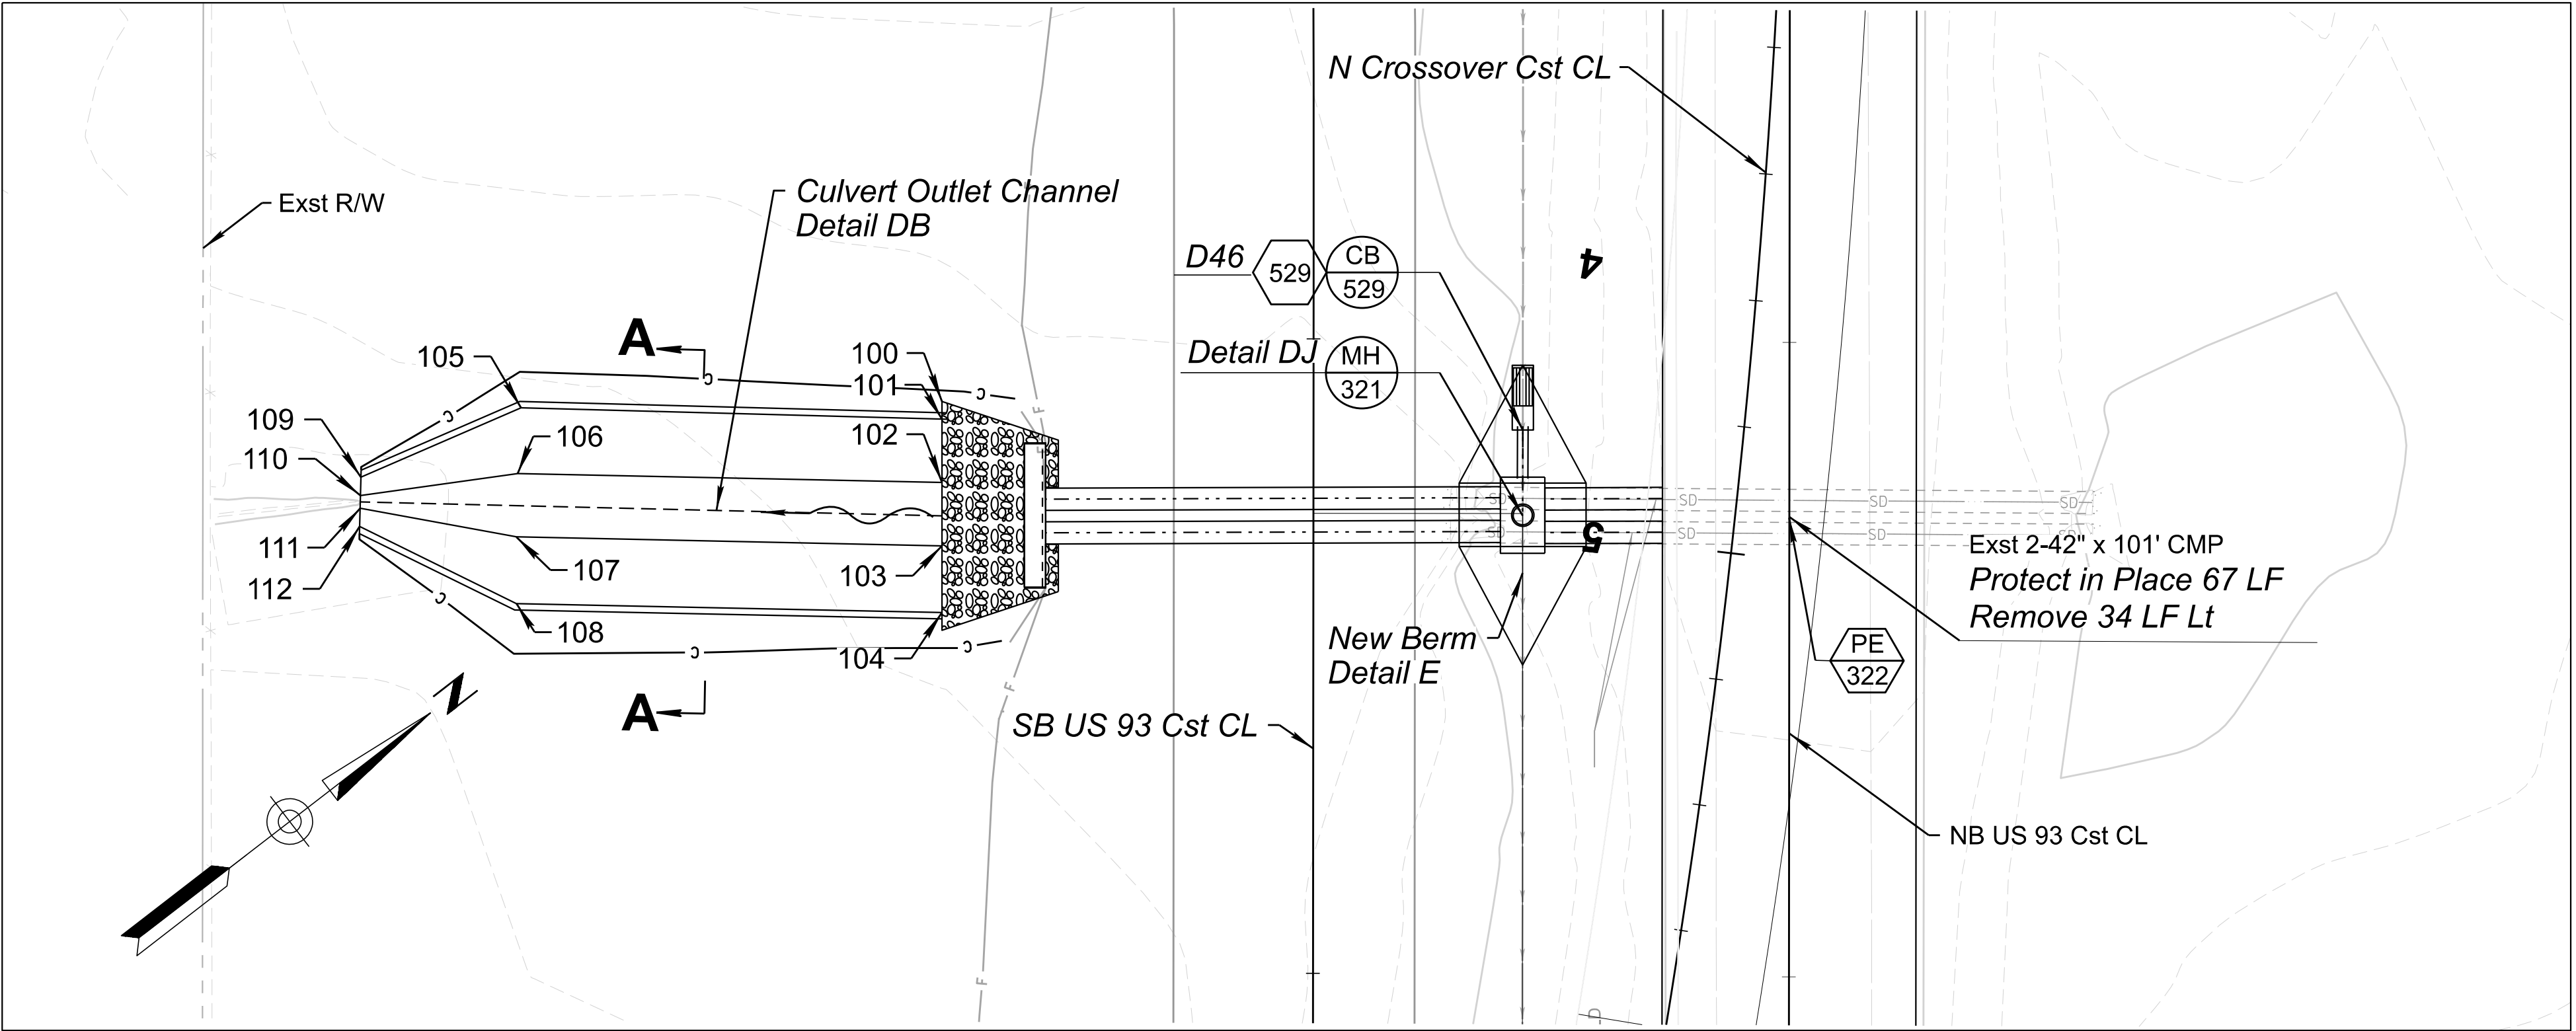

CHANNEL GRADING CONTROL POINTS			
Point No.	SBUS 93 CST CL	Offset Lt	Elev
100	321+90.10	58.52	2582.59
101	321+87.30	58.52	2582.49
102	321+77.32	58.52	2582.35
103	321+67.32	58.52	2582.24
104	321+56.82	58.52	2582.13
105	321+89.03	124.88	2581.81
106	321+78.68	125.40	2581.43
107	321+68.68	125.60	2581.45
108	321+58.18	125.60	2581.30
109	321+78.08	150.10	2580.71
110	321+75.19	150.17	2580.50
111	321+73.19	150.21	2580.54
112	321+70.29	150.28	2580.63

DETAIL D18





	NAME	DATE
DESIGN	K LEANDER	06/26
DRAWN	B LEANDER	06/26
CHECKED	B DENETDALE	06/26

TRANSPORTATION
AECOM TECHNICAL SERVICES, Inc.
7720 N. 16th St., Suite 100
Phoenix, Arizona 85020
T 602.371.1100



AECOM
www.aecom.com

ARIZONA DEPARTMENT OF TRANSPORTATION
PROJECT DELIVERY AND OPERATIONS DIVISION
ROADWAY DESIGN SERVICES
CULVERT DETAIL SHEET
DETAIL D18 - CULVERT PE 322
NB US 93 STA 321+73


ROUTE US 93	F.H.W.A. Arizona Division	STATE ARIZ.	PROJECT NO. 093 YV 189	FEDERAL ID NO. 093-B(230)T	SHEET NO. 97	TOTAL SHEETS 524	RECORD DRAWING
MILEPOST 189.9	LOCATION WICKENBURG RANCH WAY TO VISTA ROYALE						DWG No. D-2.18
STRUCTURE NO.	TRACS NO. F0738 01C						OF

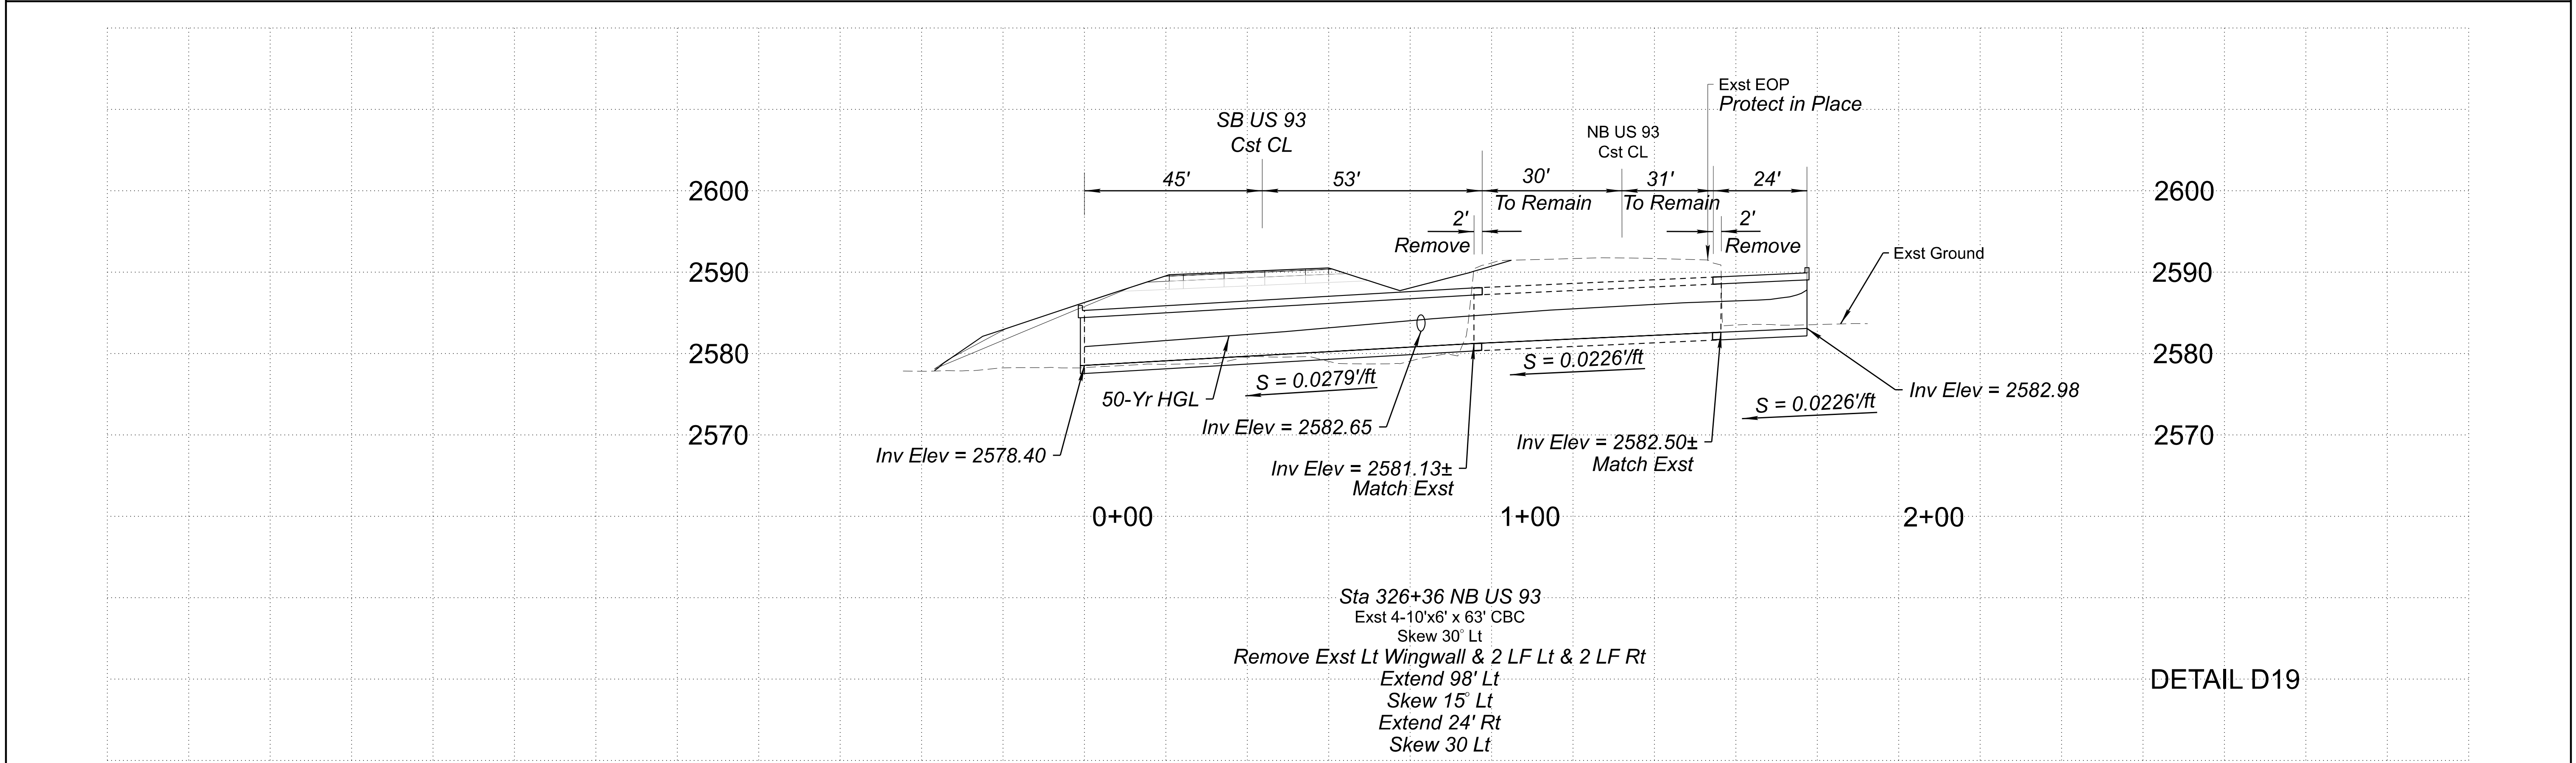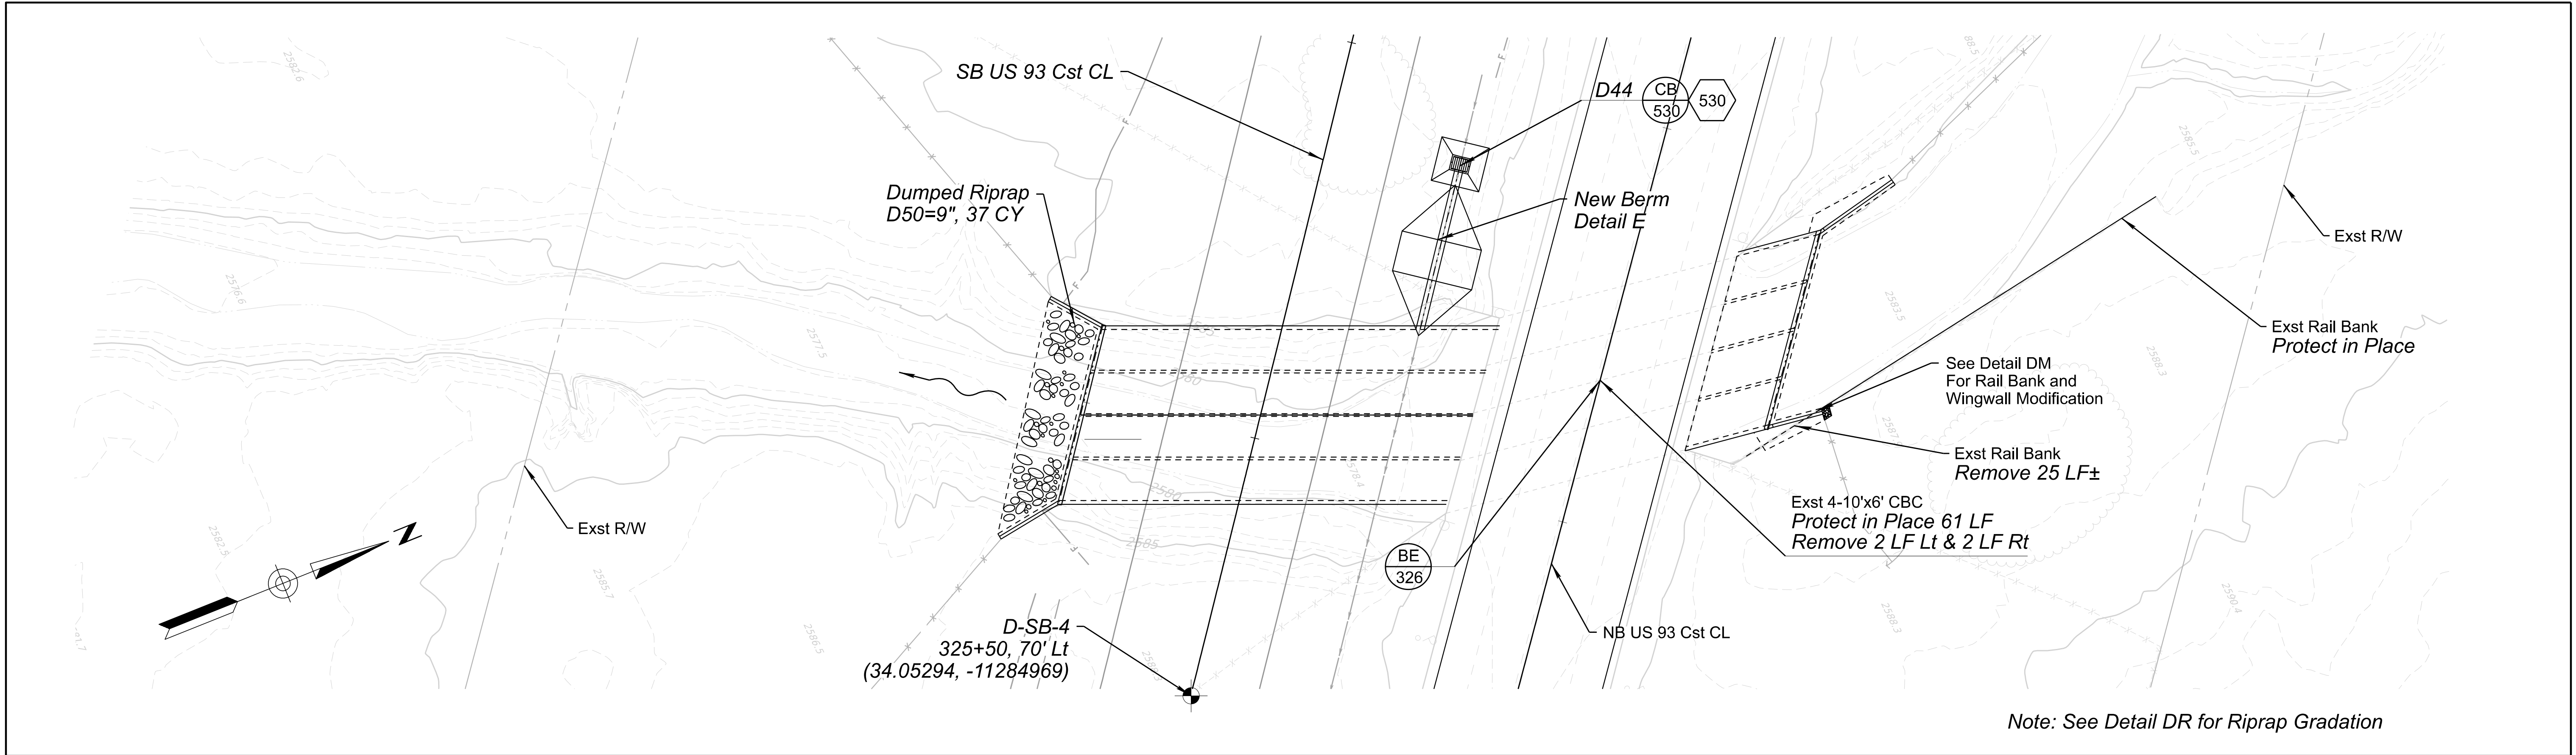

		NAME	DATE	ARIZONA DEPARTMENT OF TRANSPORTATION PROJECT DELIVERY AND OPERATIONS DIVISION ROADWAY DESIGN SERVICES CULVERT DETAIL SHEET DETAIL D19 - CULVERT BE 326 NB US 93 STA 326+36	ROUTE US 93 MILEPOST 189.9 STRUCTURE NO. 05003	F.H.W.A. Arizona Division ARIZ.	PROJECT NO.	FEDERAL ID NO.	SHEET NO.	TOTAL SHEETS	RECORD DRAWING	
	DESIGN	K LEANDER	06/26				093 YV 189	093-B(230)T	98	524		
	DRAWN	B LEANDER	06/26				WICKENBURG RANCH WAY TO VISTA ROYALE					DWG No. D-2.19
	CHECKED	B DENETDALE	06/26									
TRANSPORTATION AECOM TECHNICAL SERVICES, Inc. 7720 N. 16th St., Suite 100 Phoenix, Arizona 85020 T 602.371.1100 www.aecom.com						TRACS NO. F0738 01C				OF		

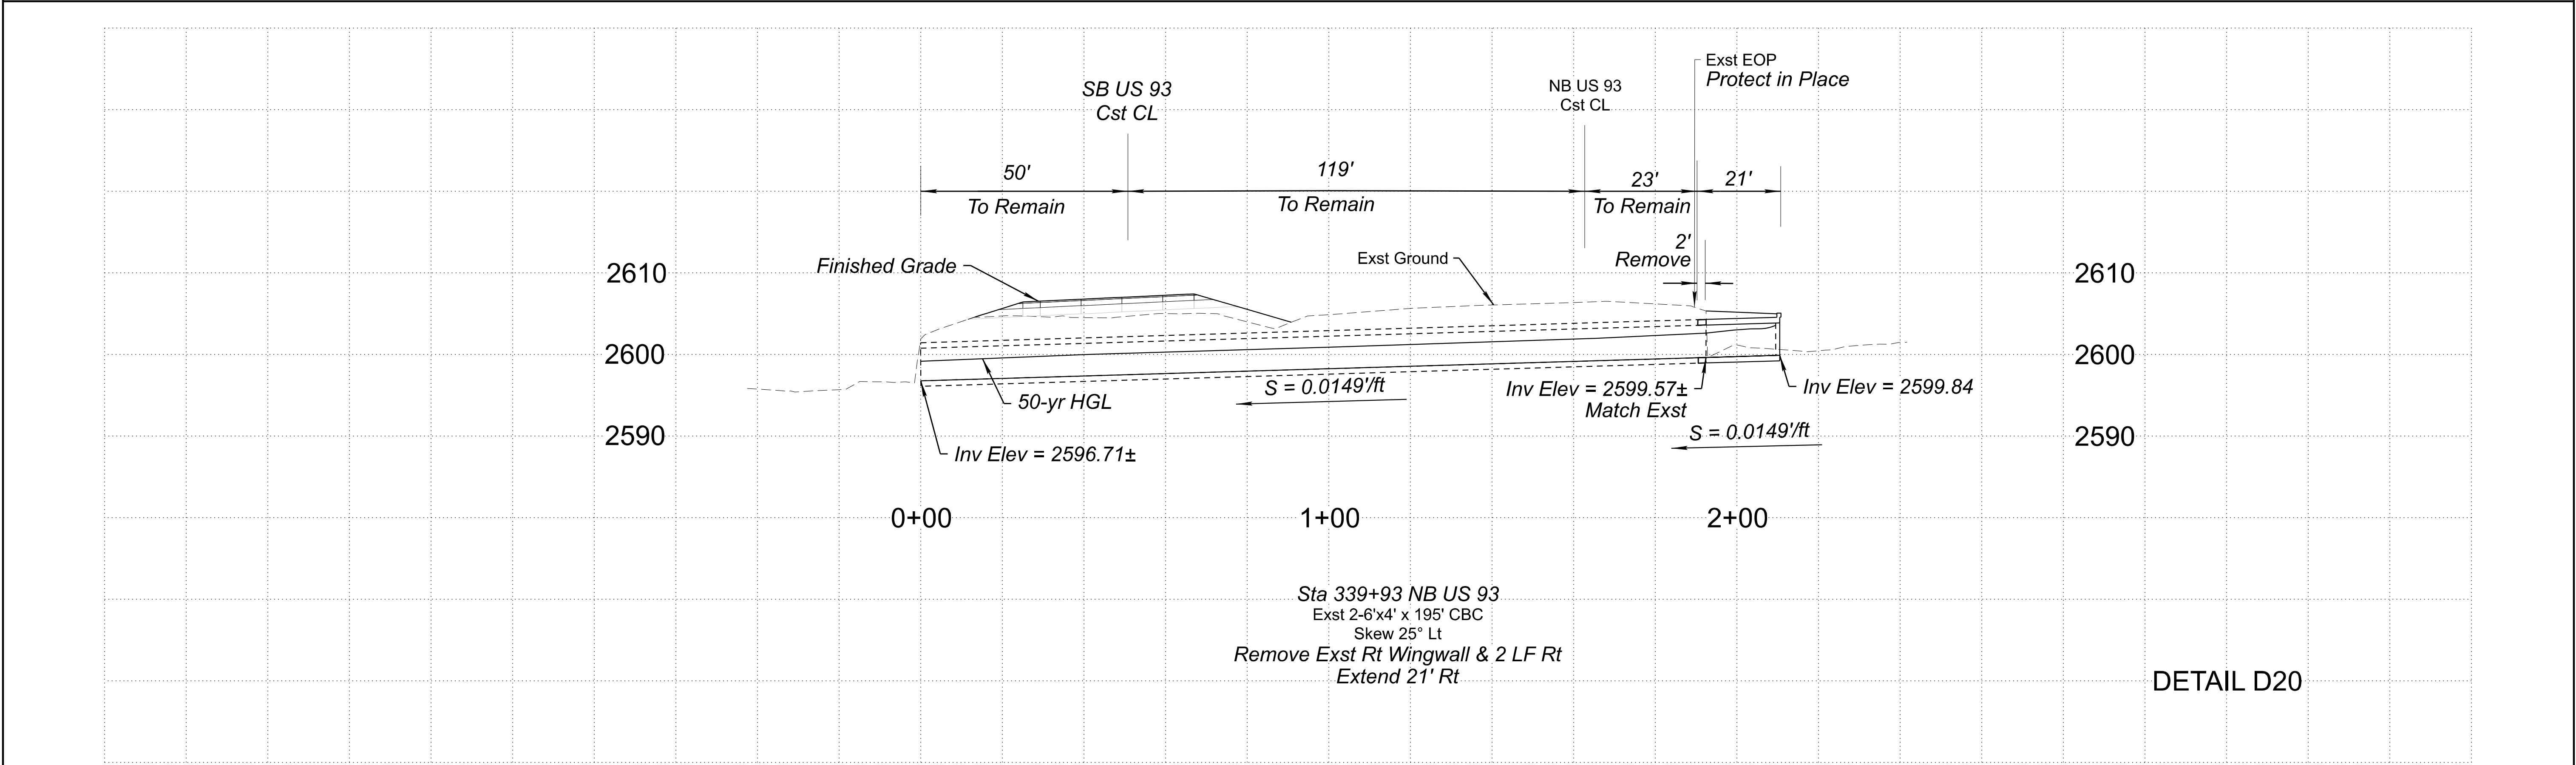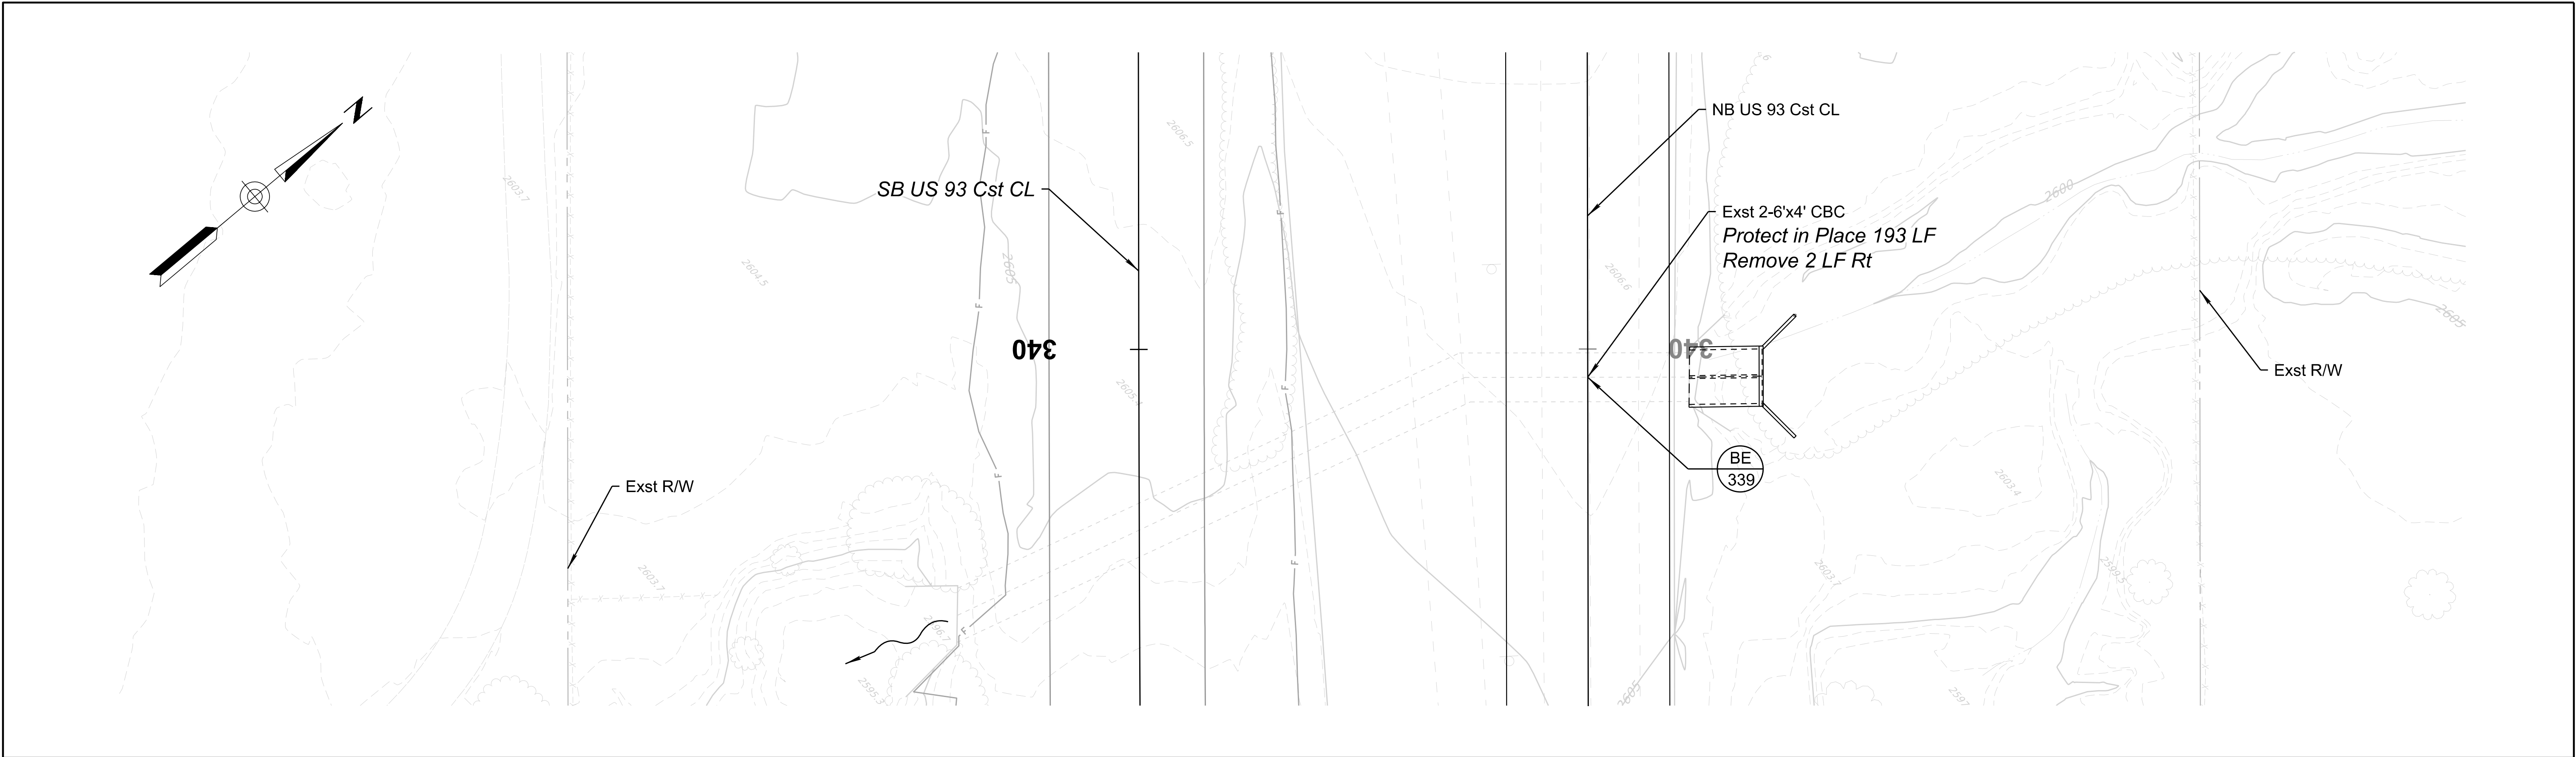

		NAME	DATE	ARIZONA DEPARTMENT OF TRANSPORTATION PROJECT DELIVERY AND OPERATIONS DIVISION ROADWAY DESIGN SERVICES CULVERT DETAIL SHEET DETAIL D20 - CULVERT BE 339 NB US 93 STA 339+93	ROUTE	US 93	F.H.W.A. Arizona Division	STATE	ARIZ.	PROJECT NO.	093 YV 189	FEDERAL ID NO.	093-B(230)T	SHEET NO.	99	TOTAL SHEETS	524	RECORD DRAWING			
	DESIGN	K LEANDER	06/26		MILEPOST	189.9		LOCATION		WICKENBURG RANCH WAY TO VISTA ROYALE											
	DRAWN	B LEANDER	06/26		TRANSPORTATION AECOM TECHNICAL SERVICES, Inc. 1720 N. 16th St., Suite 100 Phoenix, Arizona 85020 T 602.371.1100	STRUCTURE NO.		TRACS NO.		F0738 01C	DWG No. D-2.20 ____ OF ____										
	CHECKED	B DENETDALE	06/26																		AECOM www.aecom.com

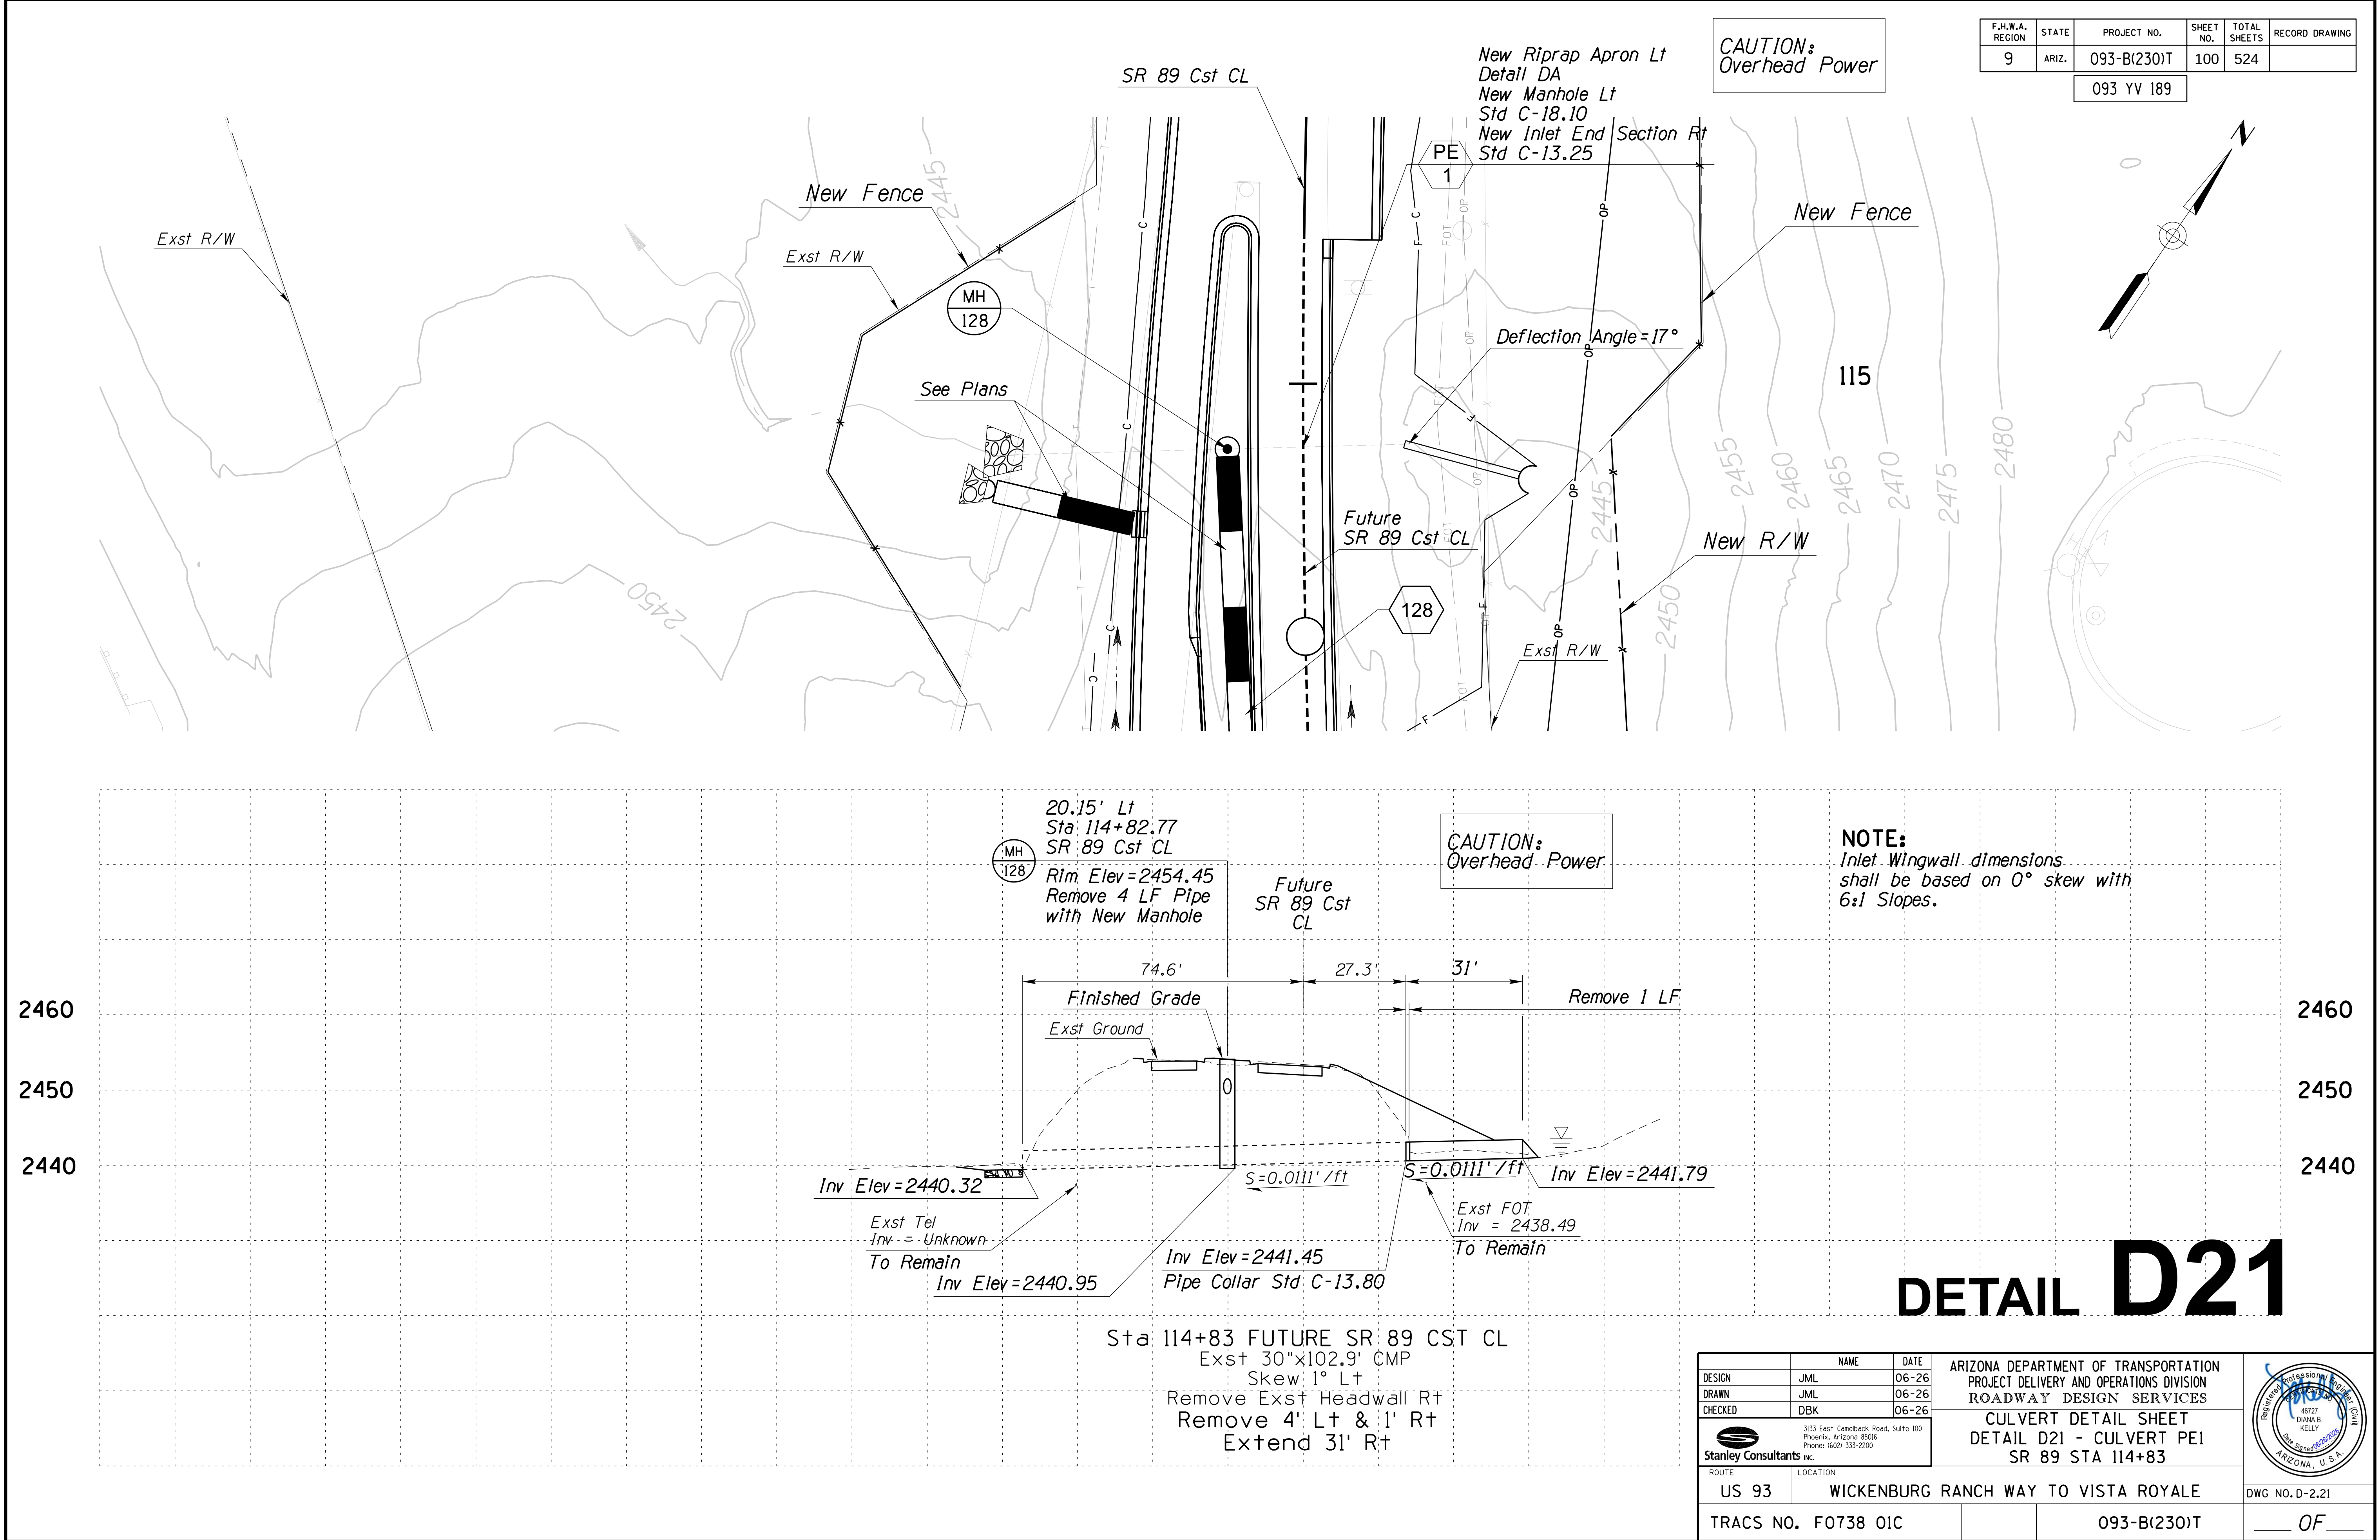

CAUTION:
Overhead Power

F.H.W.A. REGION	STATE	PROJECT NO.	SHEET NO.	TOTAL SHEETS	RECORD DRAWING
9	ARIZ.	093-B(230)T	100	524	
093 YV 189					


NOTE:
Inlet Wingwall dimensions
shall be based on 0° skew with
6:1 Slopes.

DETAIL D21


		NAME	DATE	ARIZONA DEPARTMENT OF TRANSPORTATION PROJECT DELIVERY AND OPERATIONS DIVISION ROADWAY DESIGN SERVICES CULVERT DETAIL SHEET DETAIL D21 - CULVERT PEI SR 89 STA 114+83	
DESIGN	JML	06-26			
DRAWN	JML	06-26			
CHECKED	DBK	06-26			
 3133 East Camelback Road, Suite 100 Phoenix, Arizona 85016 Phone: (602) 333-2200					
ROUTE		LOCATION			
US 93		WICKENBURG RANCH WAY TO VISTA ROYALE		DWG NO. D-2.21	
TRACS NO. F0738 OIC			093-B(230)T	___ OF ___	

F.H.W.A. REGION	STATE	PROJECT NO.	SHEET NO.	TOTAL SHEETS	RECORD DRAWING
9	ARIZ.	093-B(230)T	101	524	

093 YV 189

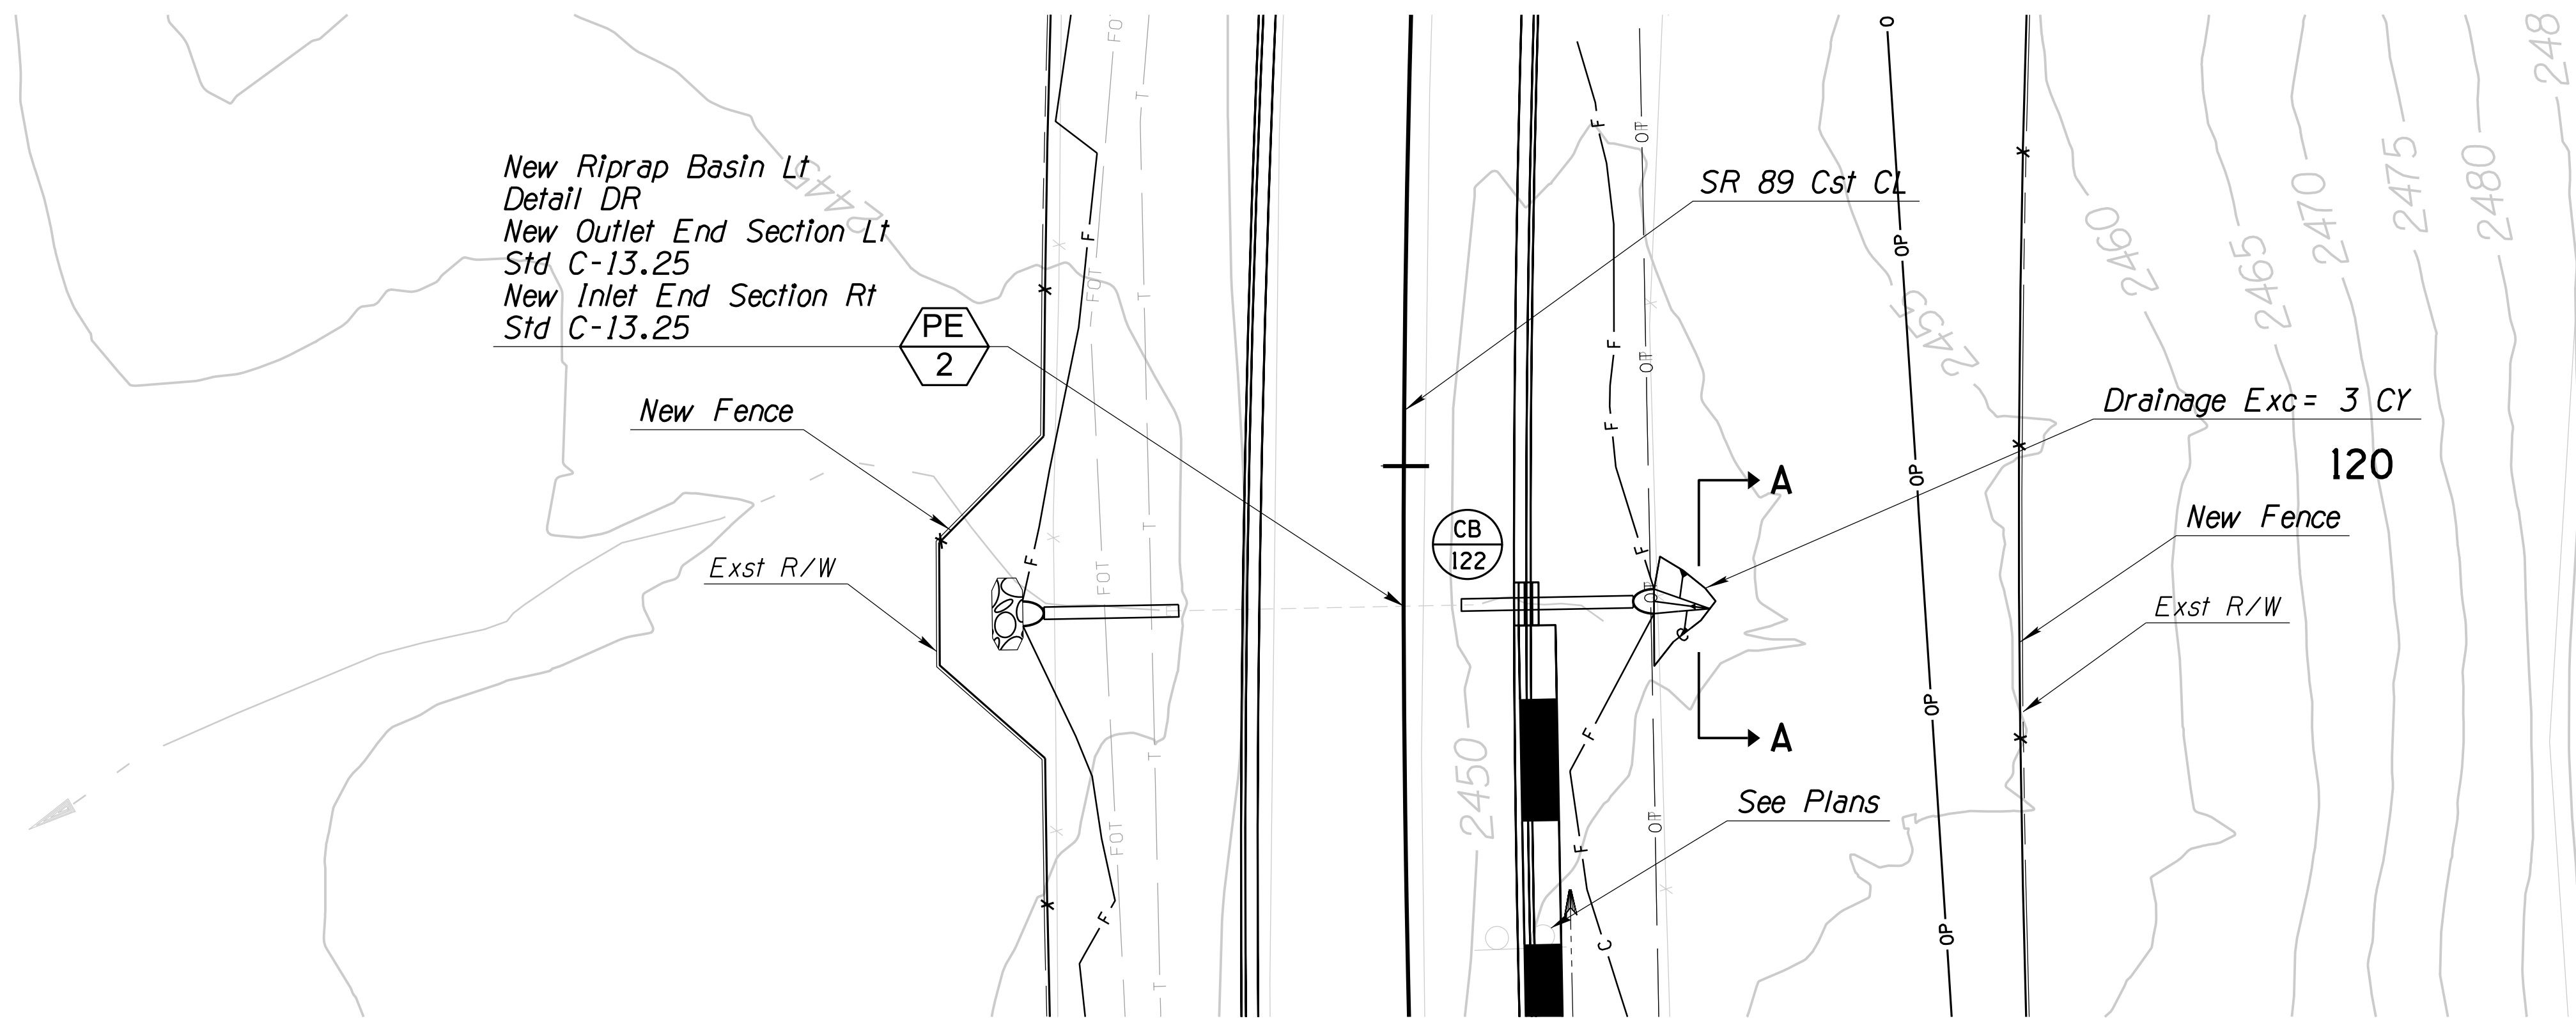

SECTION A-A


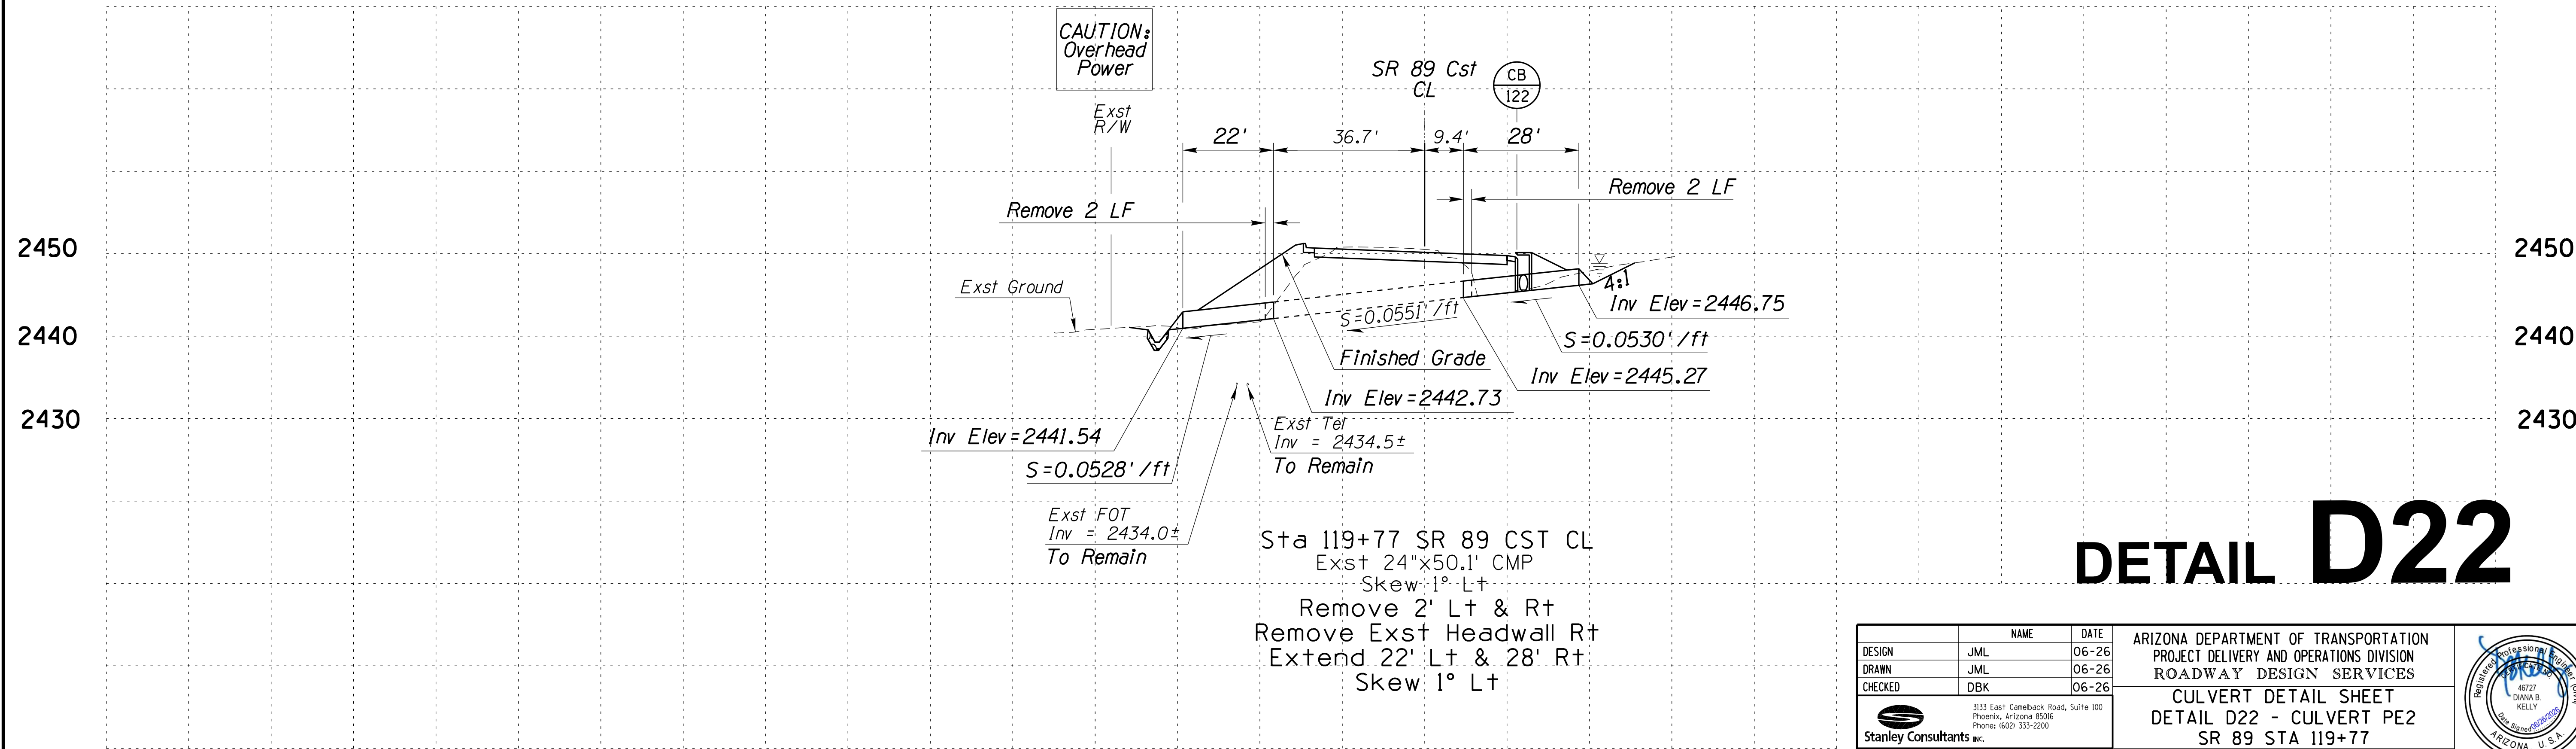


DESIGN	JML	DATE	06-26
DRAWN	JML	DATE	06-26
CHECKED	DBK	DATE	06-26
Stanley Consultants inc.			
3133 East Camelback Road, Suite 100 Phoenix, Arizona 85016 Phone: (602) 333-2200			
ROUTE	LOCATION		
US 93	WICKENBURG RANCH WAY TO VISTA ROYALE		
TRACS NO. F0738 OIC			093-B(230)T
			DWG NO. D-2.22
			OF



F.H.W.A. REGION	STATE	PROJECT NO.	SHEET NO.	TOTAL SHEETS	RECORD DRAWING
9	ARIZ.	093-B(230)T	102	524	

093 YV 189

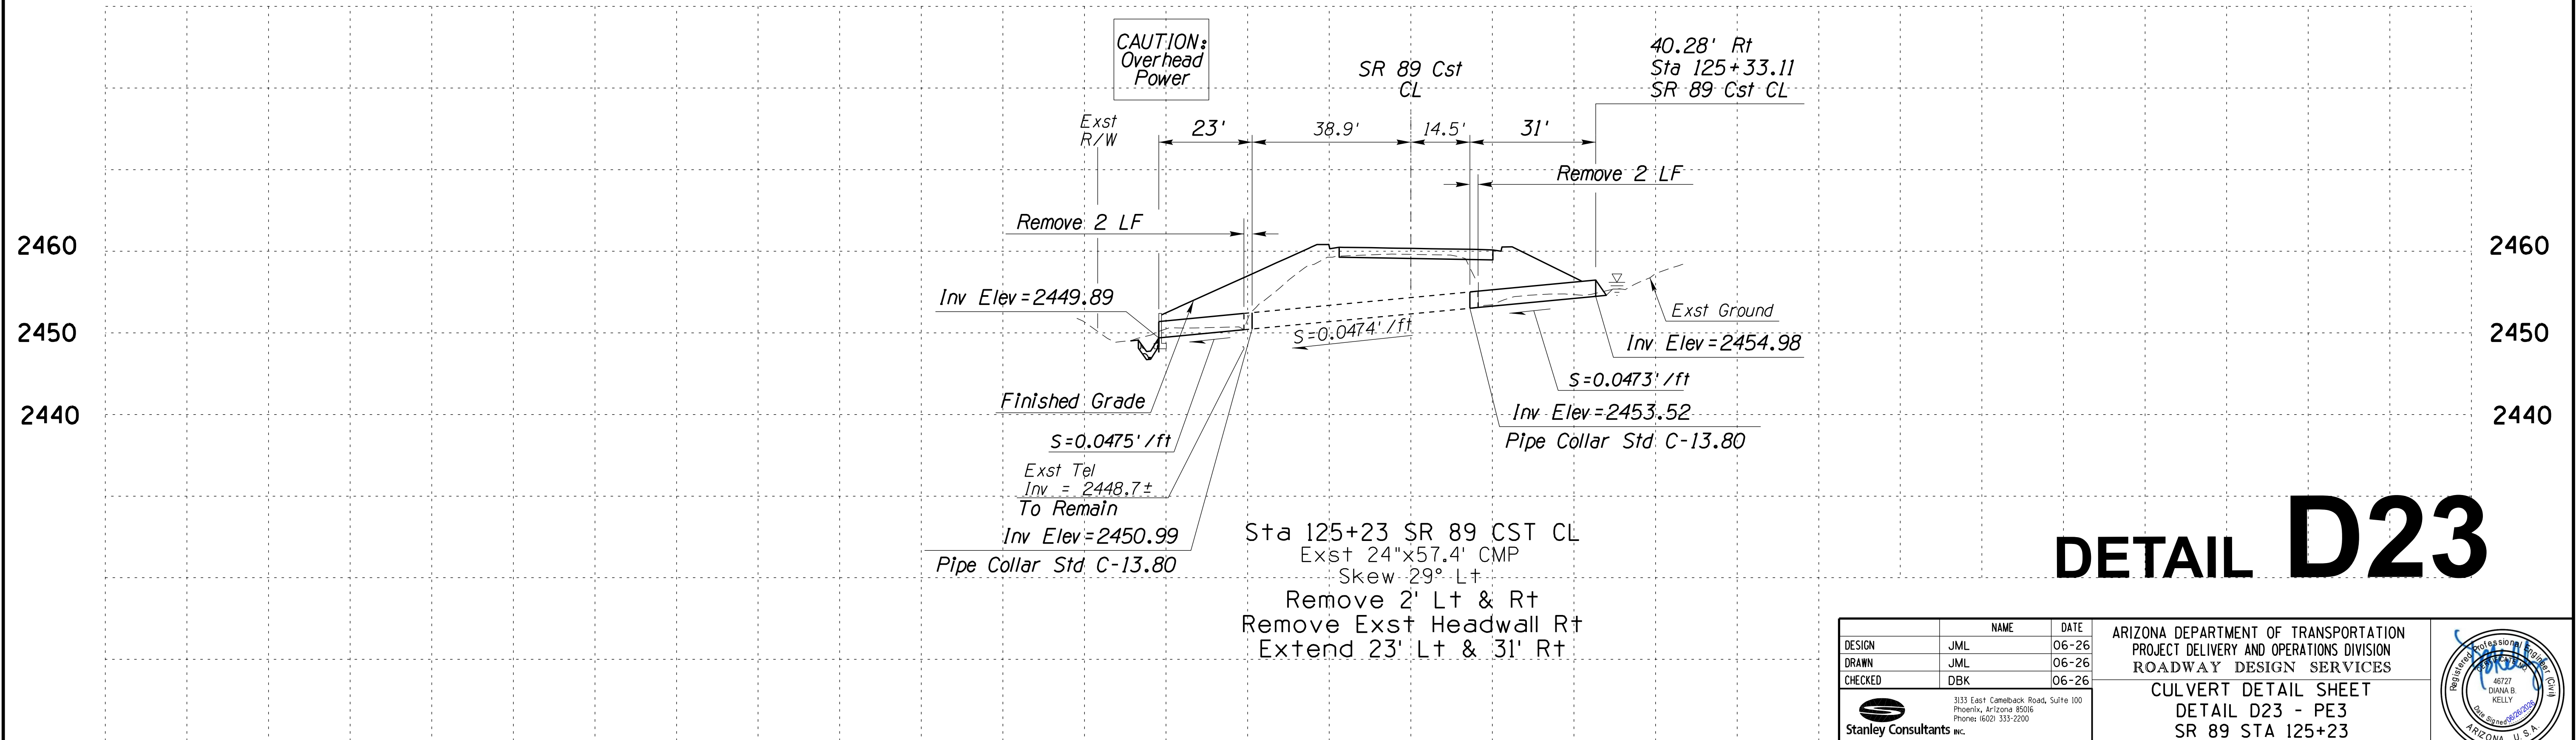
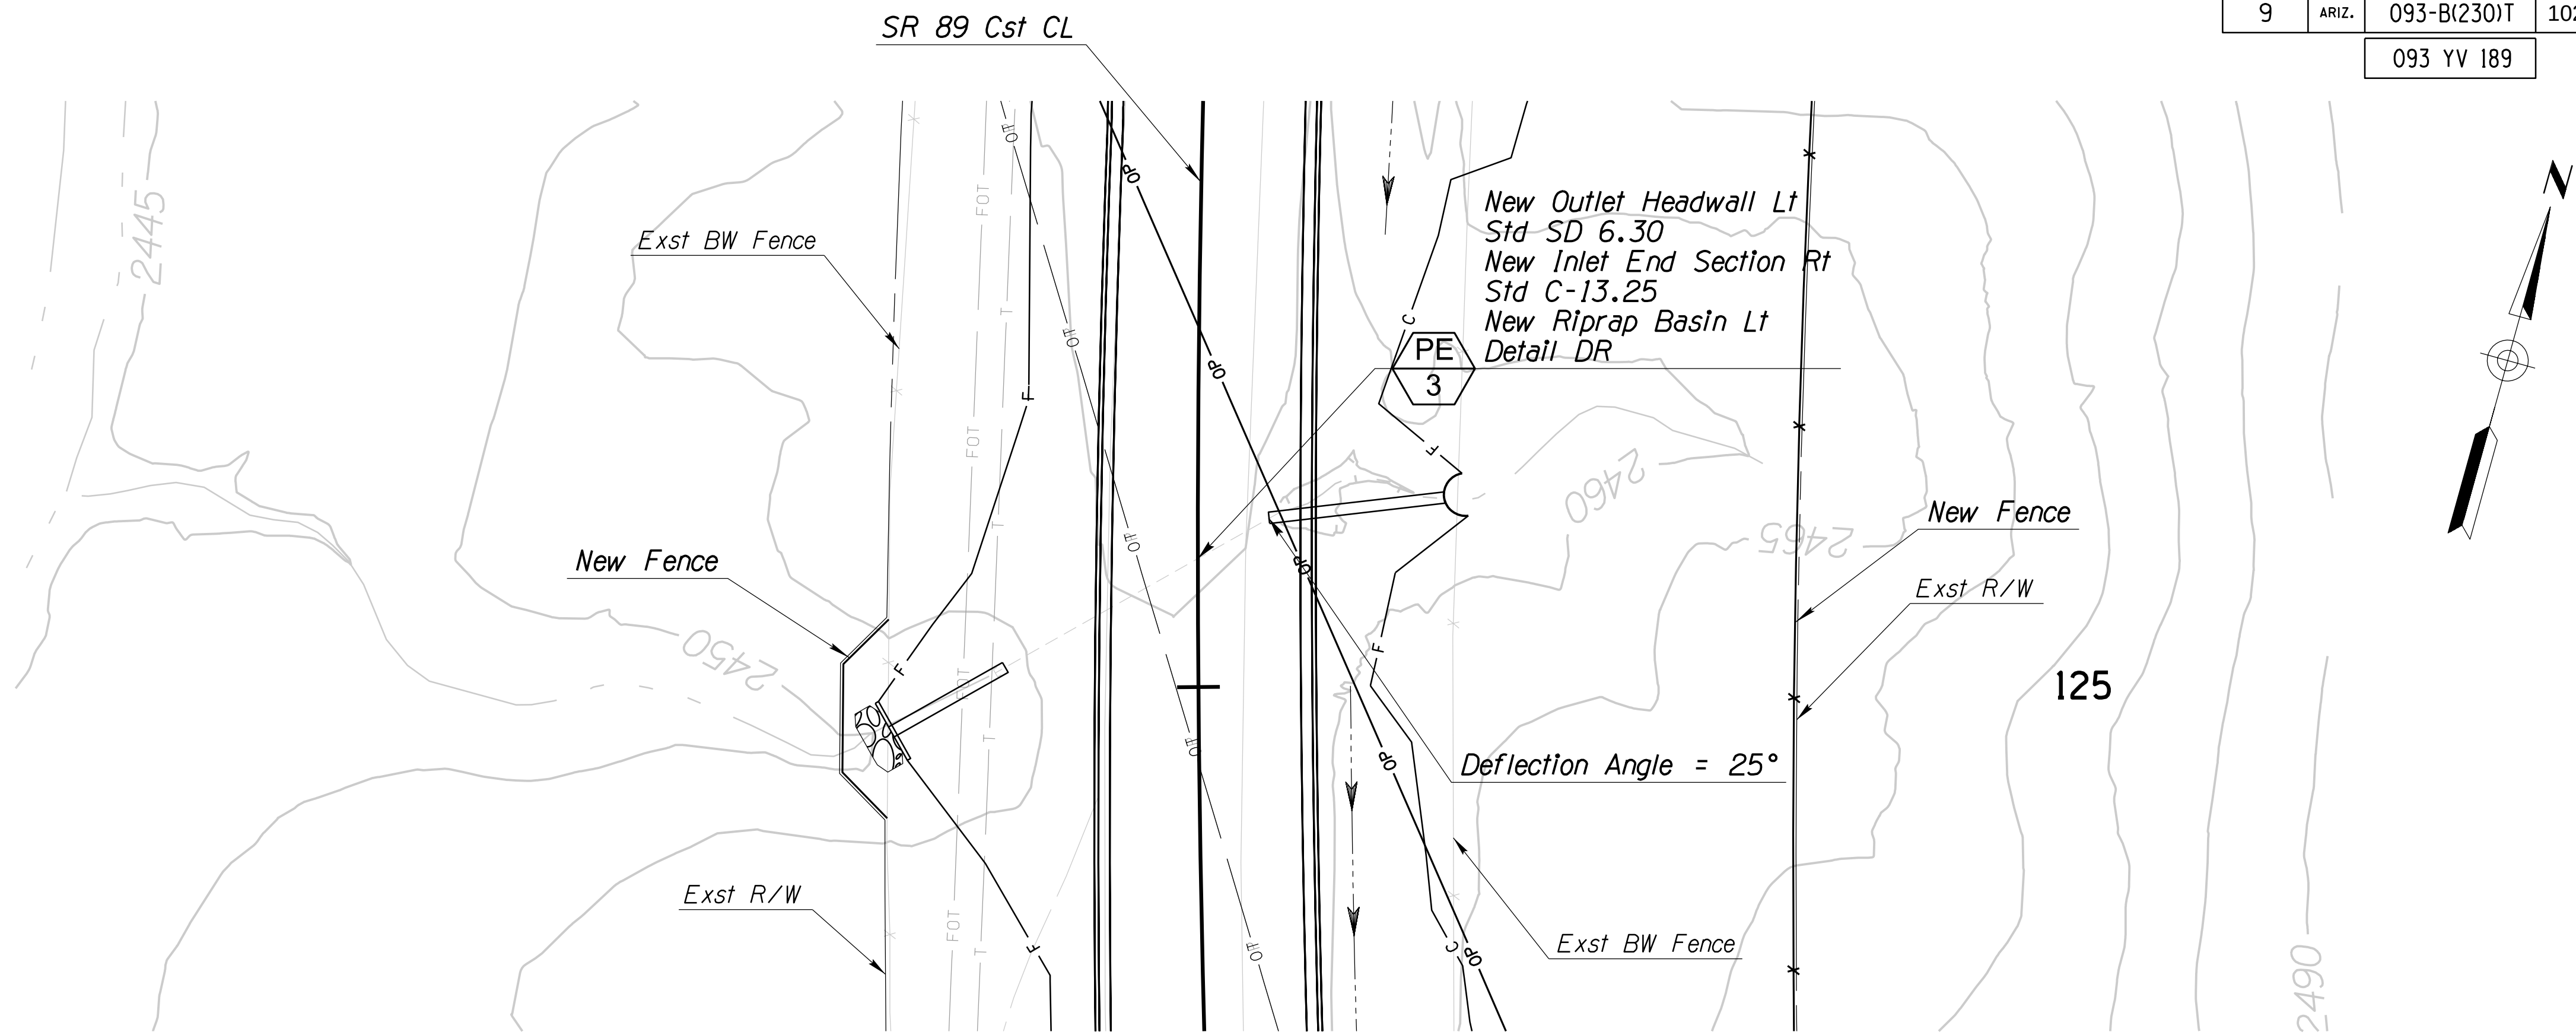


DETAIL D23

DESIGN	JML	DATE	06-26	ARIZONA DEPARTMENT OF TRANSPORTATION PROJECT DELIVERY AND OPERATIONS DIVISION ROADWAY DESIGN SERVICES	
DRAWN	JML	DATE	06-26		
CHECKED	DBK	DATE	06-26		
Stanley Consultants inc.				CULVERT DETAIL SHEET DETAIL D23 - PE3 SR 89 STA 125+23	
ROUTE	US 93			LOCATION	WICKENBURG RANCH WAY TO VISTA ROYALE
TRACS NO. F0738 OIC				093-B(230)T	DWG NO. D-2.23 OF

F.H.W.A. REGION	STATE	PROJECT NO.	SHEET NO.	TOTAL SHEETS	RECORD DRAWING
9	ARIZ.	093-B(230)T	103	524	



093 YV 189

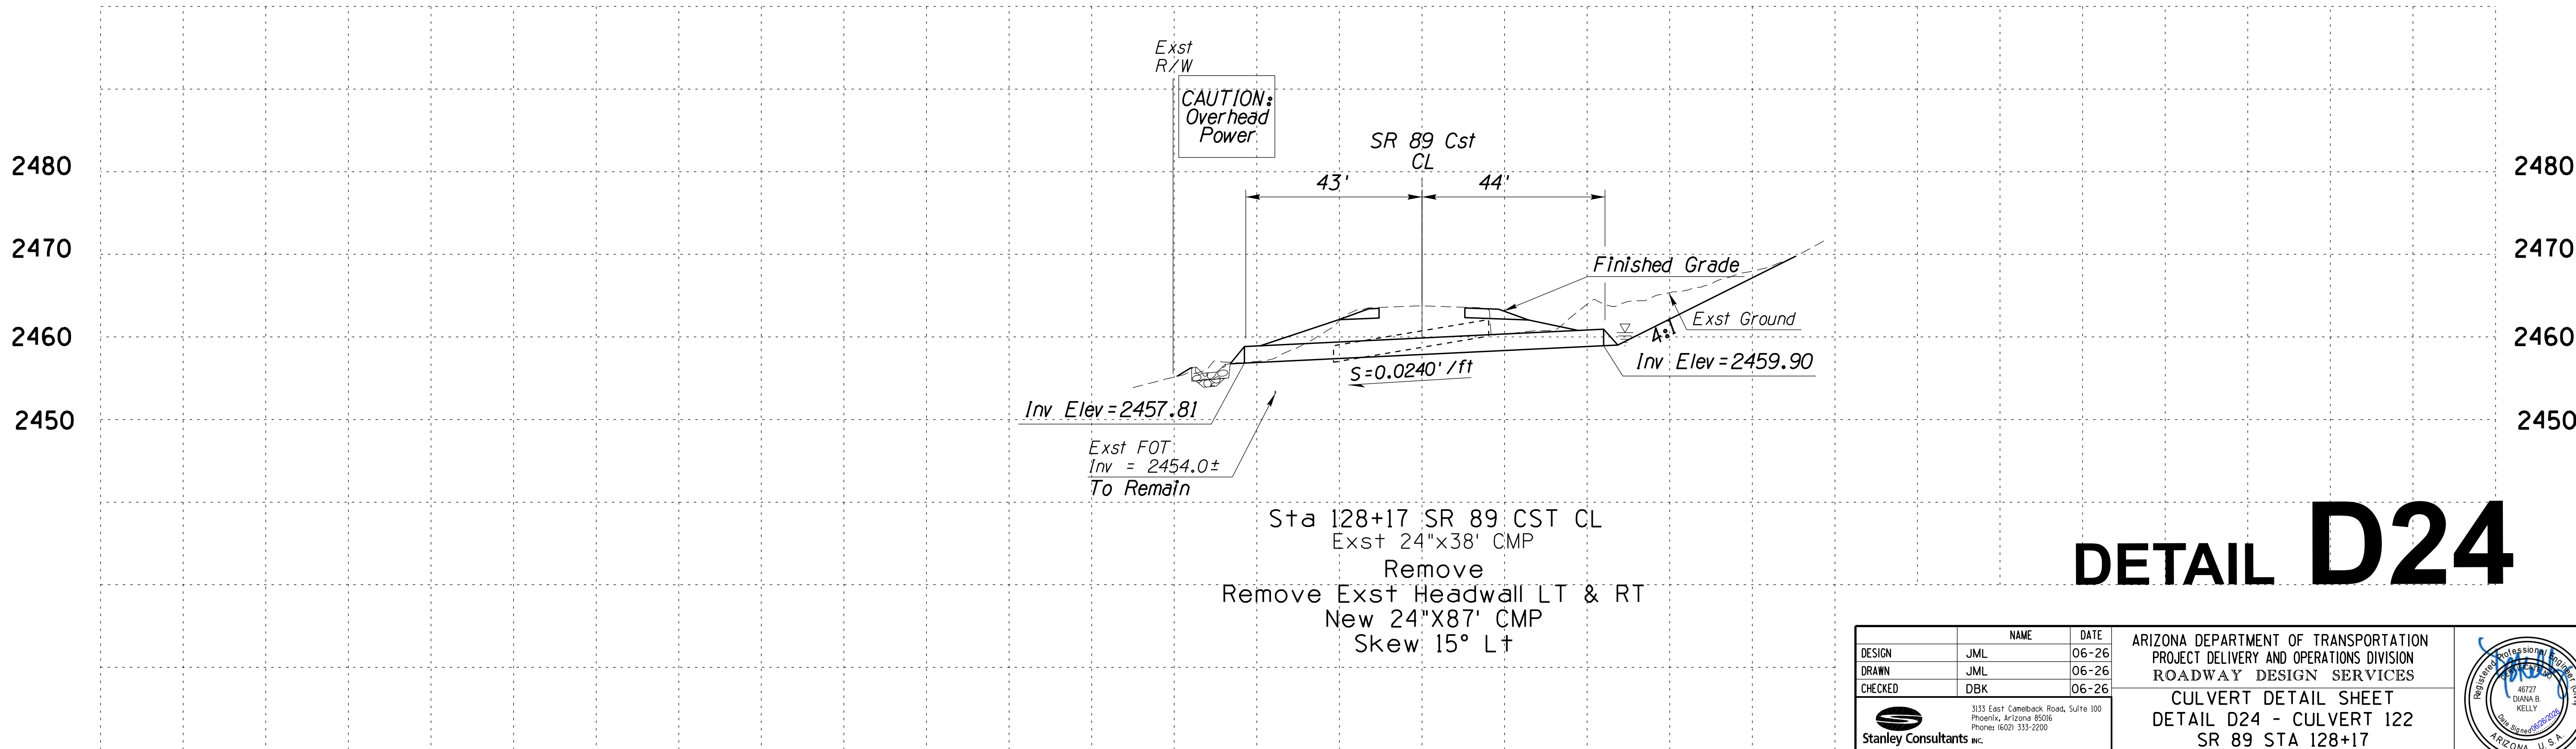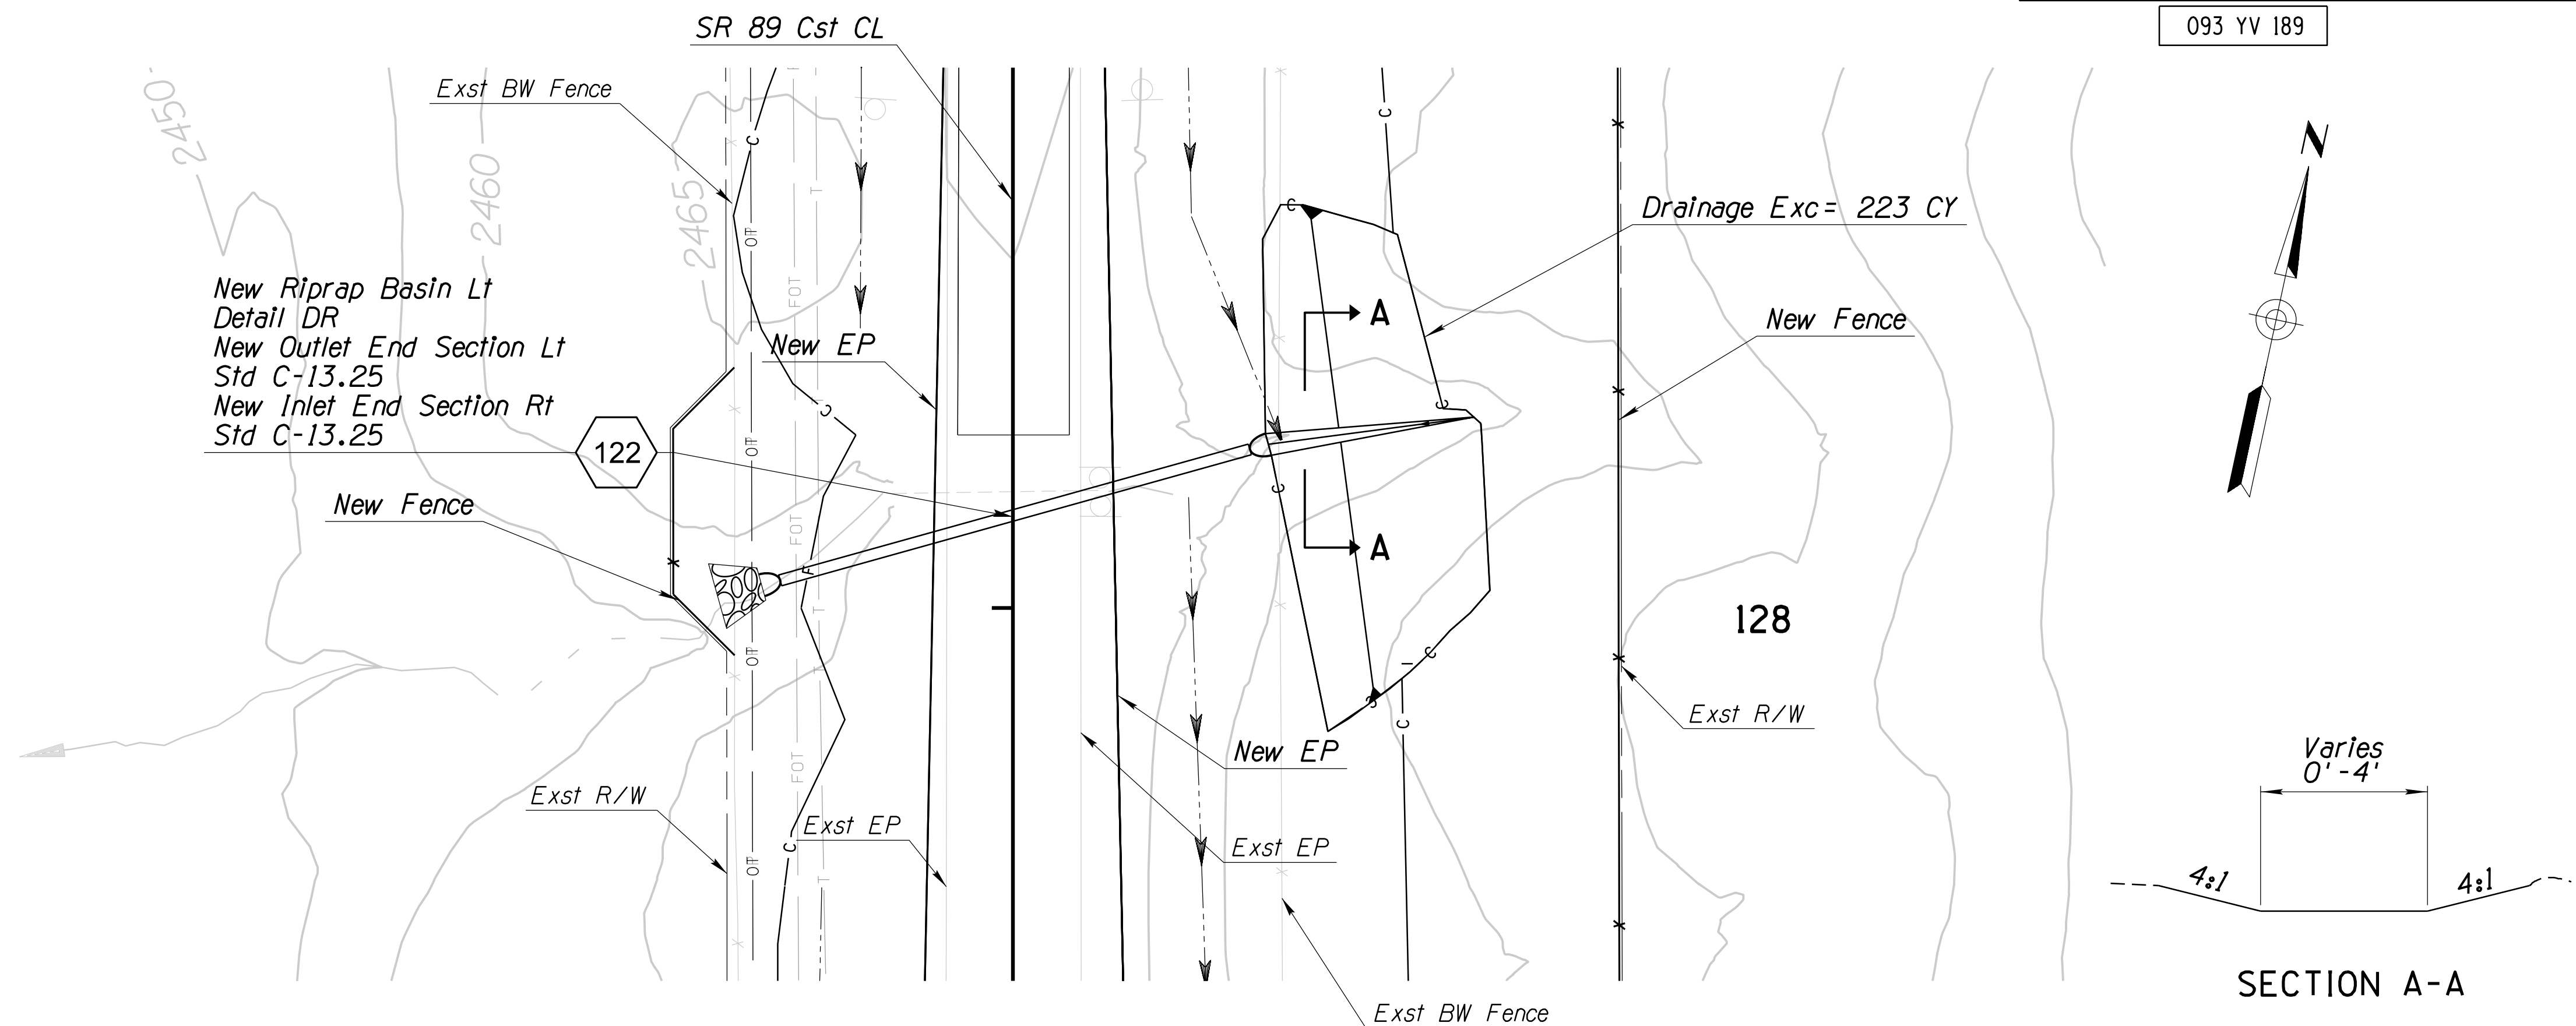

DESIGN	NAME	DATE	ARIZONA DEPARTMENT OF TRANSPORTATION PROJECT DELIVERY AND OPERATIONS DIVISION ROADWAY DESIGN SERVICES	
DRAWN	JML	06-26	CULVERT DETAIL SHEET DETAIL D24 - CULVERT 122 SR 89 STA 128+17	
CHECKED	DBK	06-26		
ROUTE	LOCATION		US 93 WICKENBURG RANCH WAY TO VISTA ROYALE	DWG NO. D-2.24
TRACS NO. F0738 OIC			093-B(230)T	OF

F.H.W.A. REGION	STATE	PROJECT NO.	SHEET NO.	TOTAL SHEETS	RECORD DRAWING
9	ARIZ.	093-B(230)T	104	524	

093 YV 189


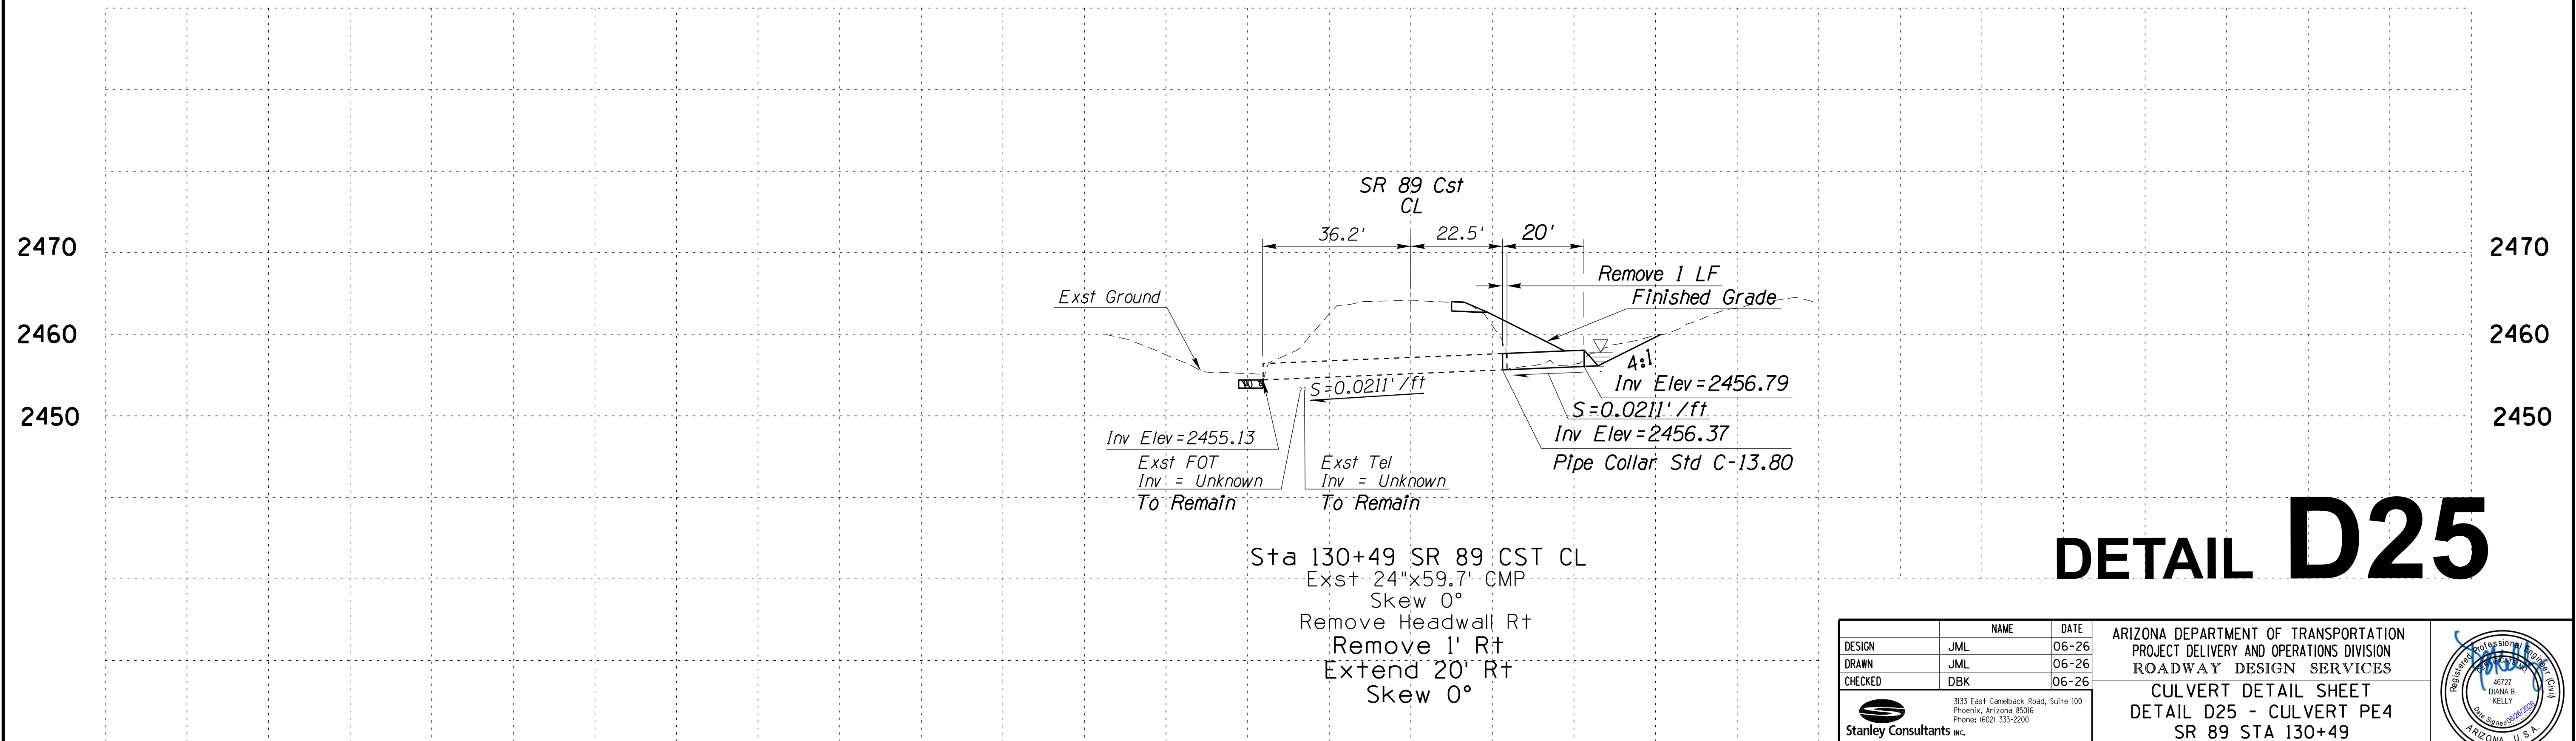
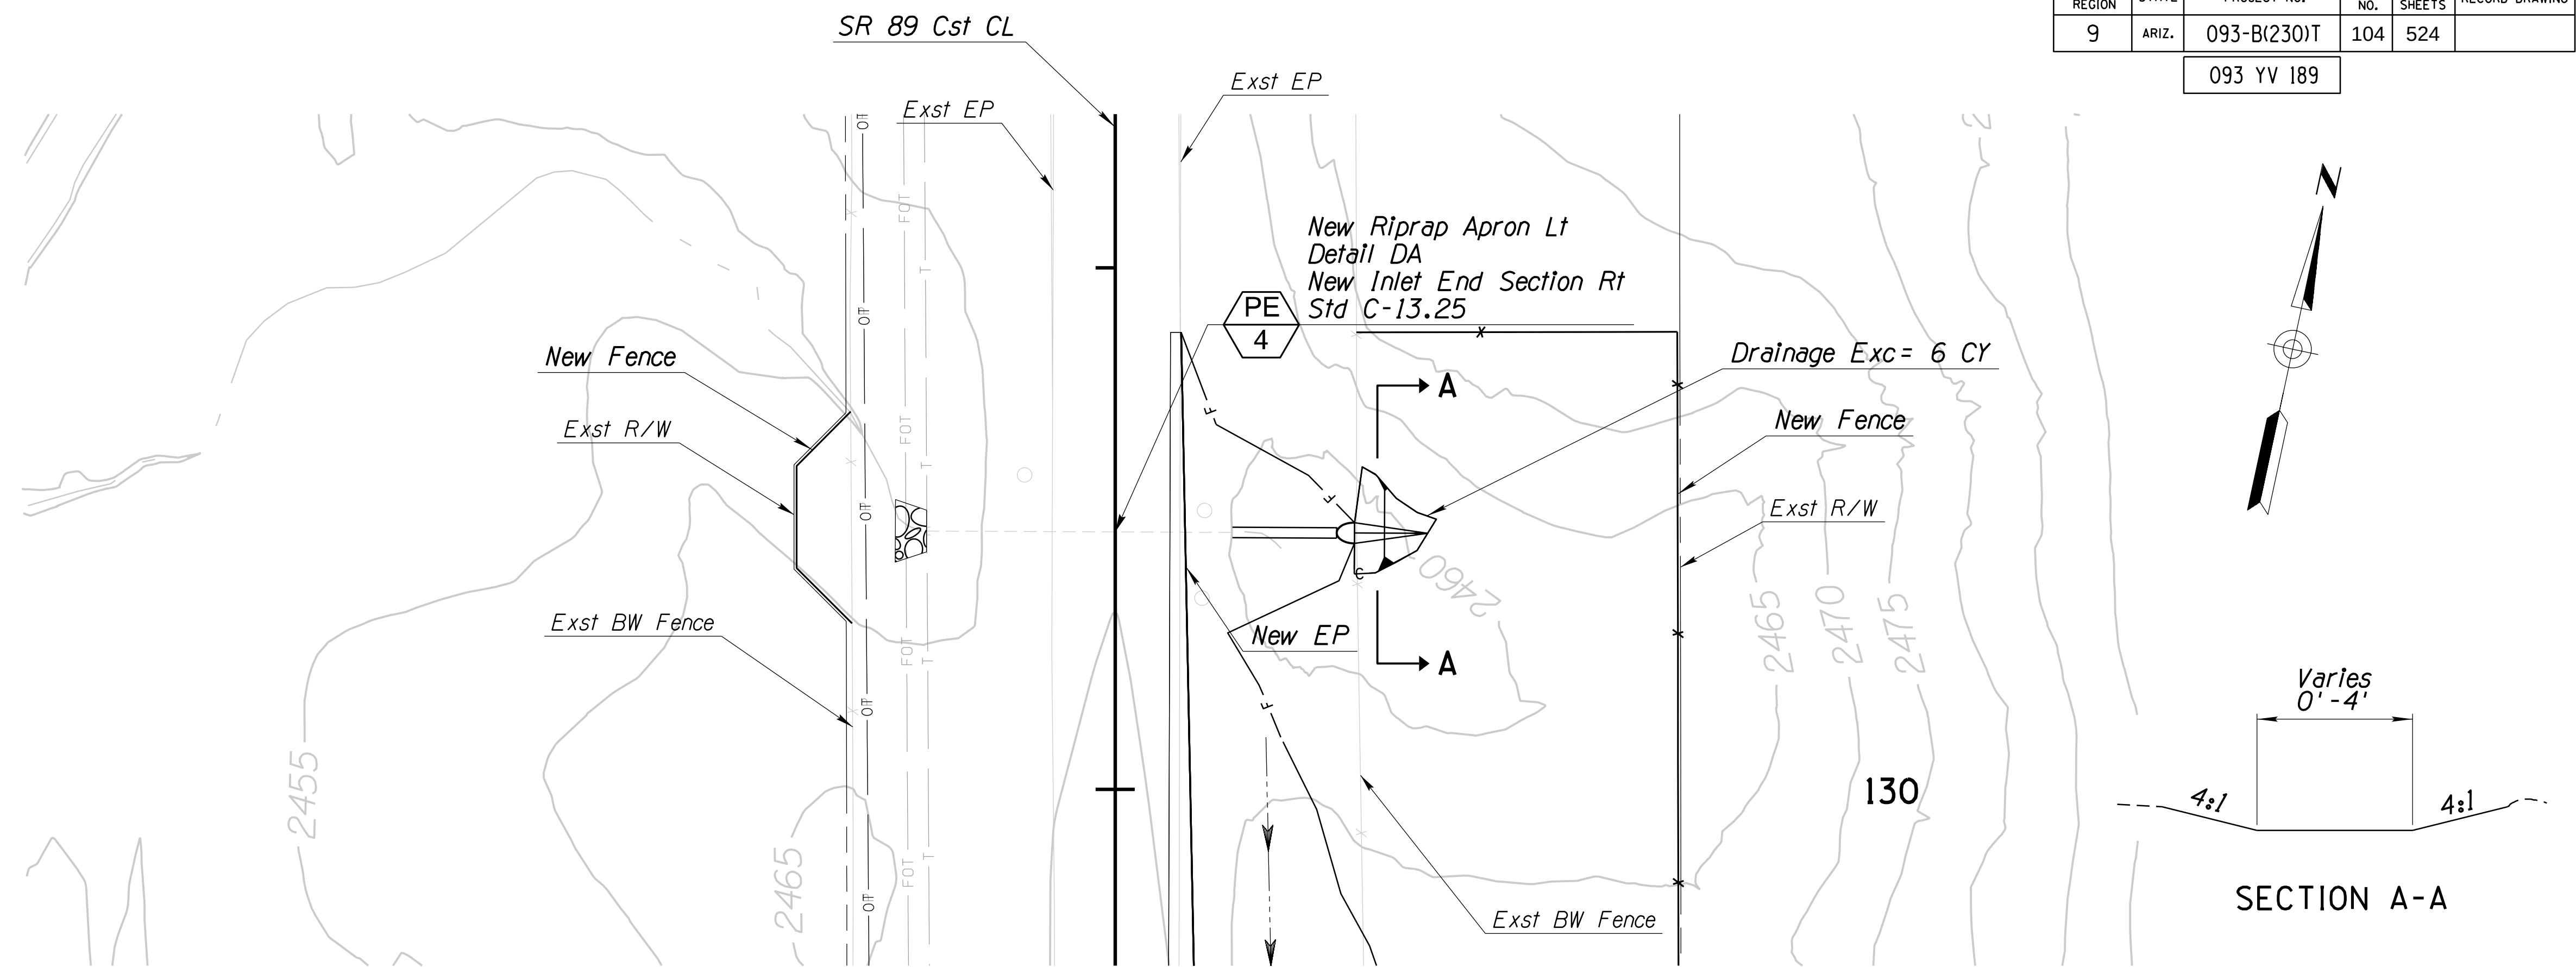


DETAIL D25

DESIGN	NAME	DATE	ARIZONA DEPARTMENT OF TRANSPORTATION PROJECT DELIVERY AND OPERATIONS DIVISION ROADWAY DESIGN SERVICES	
DRAWN	JML	06-26	CULVERT DETAIL SHEET DETAIL D25 - CULVERT PE4 SR 89 STA 130+49	
CHECKED	DBK	06-26	US 93 WICKENBURG RANCH WAY TO VISTA ROYALE	DWG NO. D-2.25
STANLEY CONSULTANTS INC. 3133 East Camelback Road, Suite 100 Phoenix, Arizona 85016 Phone: (602) 333-2200			TRACS NO. F0738 OIC	093-B(230)T

F.H.W.A. REGION	STATE	PROJECT NO.	SHEET NO.	TOTAL SHEETS	RECORD DRAWING
9	ARIZ.	093-B(230)T	105	524	

093 YV 189

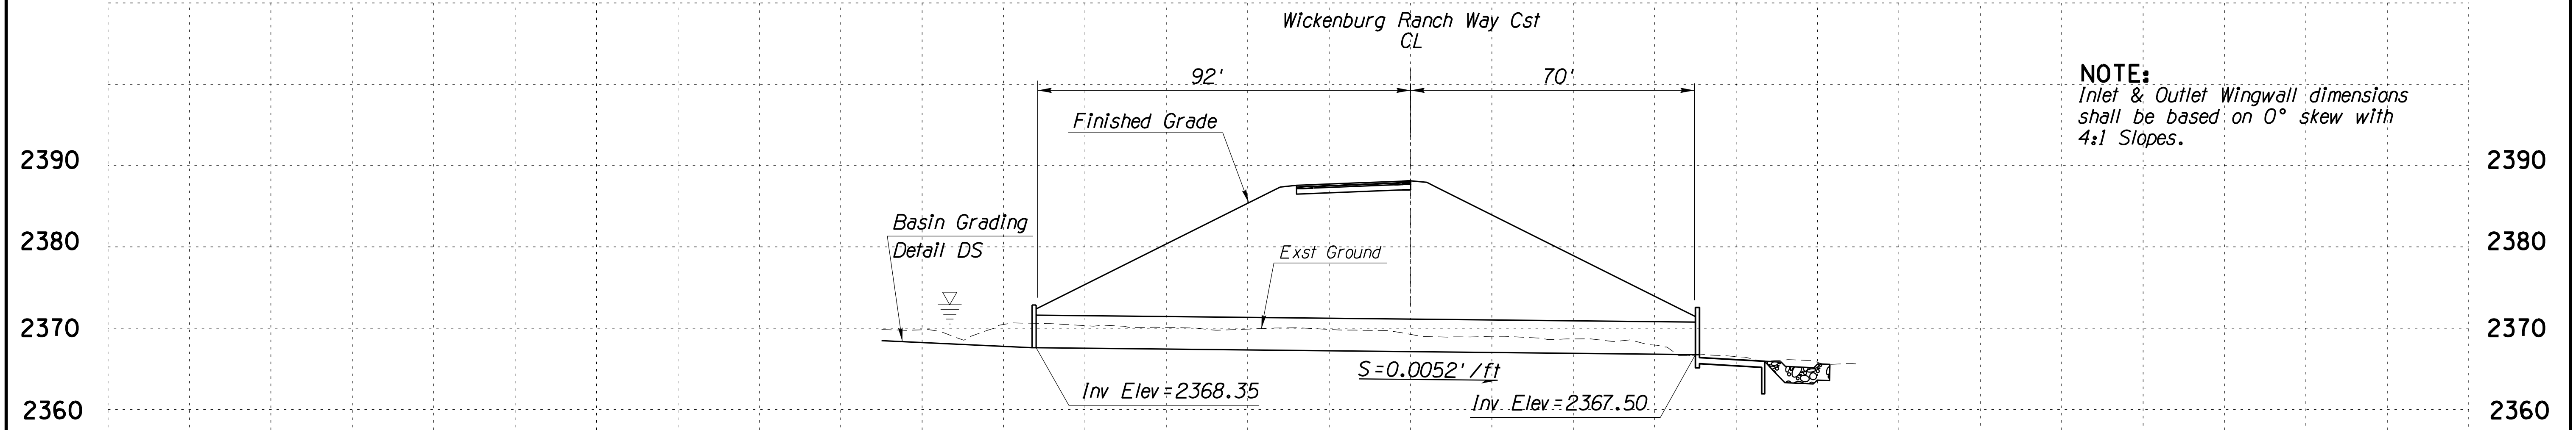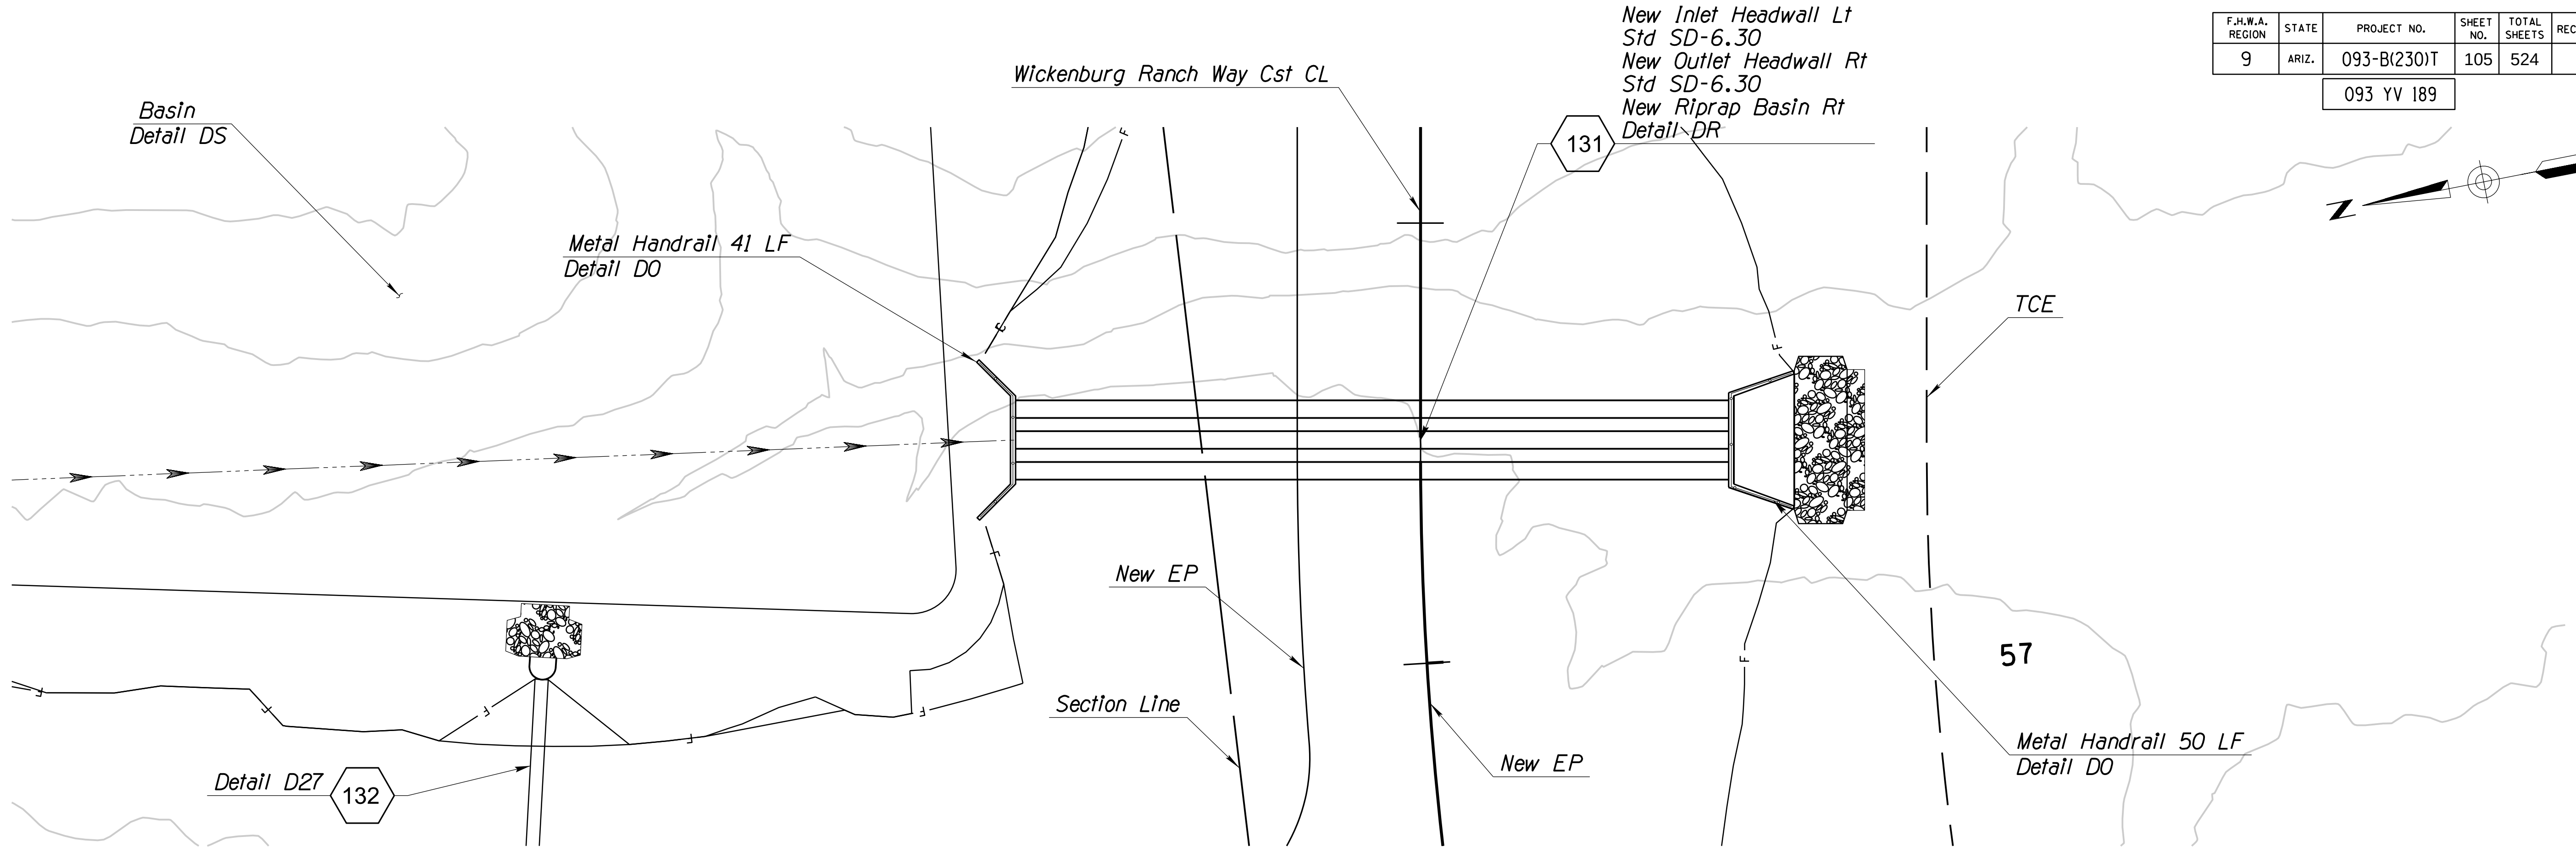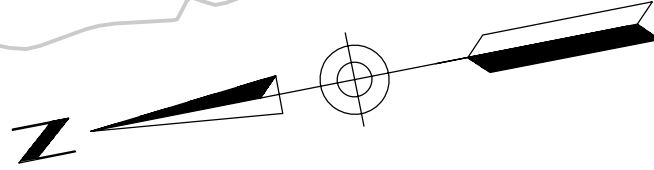

NOTE:
Inlet & Outlet Wingwall dimensions shall be based on 0° skew with 4:1 Slopes.

Sta 57+51 WICKENBURG RANCH WAY CST CL
Skew 0°
New 3-48"x 162' CMP

DETAIL D26

DESIGN	JML	DATE	06-26
DRAWN	JML	DATE	06-26
CHECKED	DBK	DATE	06-26

3133 East Camelback Road, Suite 100
Phoenix, Arizona 85016
Phone: (602) 333-2200

Stanley Consultants inc.

ARIZONA DEPARTMENT OF TRANSPORTATION
PROJECT DELIVERY AND OPERATIONS DIVISION
ROADWAY DESIGN SERVICES

CULVERT DETAIL SHEET
DETAIL D26 - CULVERT 131
WICKENBURG RANCH WAY STA 57+51

ROUTE US 93 LOCATION WICKENBURG RANCH WAY TO VISTA ROYALE

TRACS NO. F0738 OIC

093-B(230)T



DWG NO. D-2.26

OF

46727
DIANA B. KELLY
Professional Engineer
ARIZONA, U.S.A.

F.H.W.A. REGION	STATE	PROJECT NO.	SHEET NO.	TOTAL SHEETS	RECORD DRAWING
9	ARIZ.	093-B(230)T	106	524	

093 YV 189

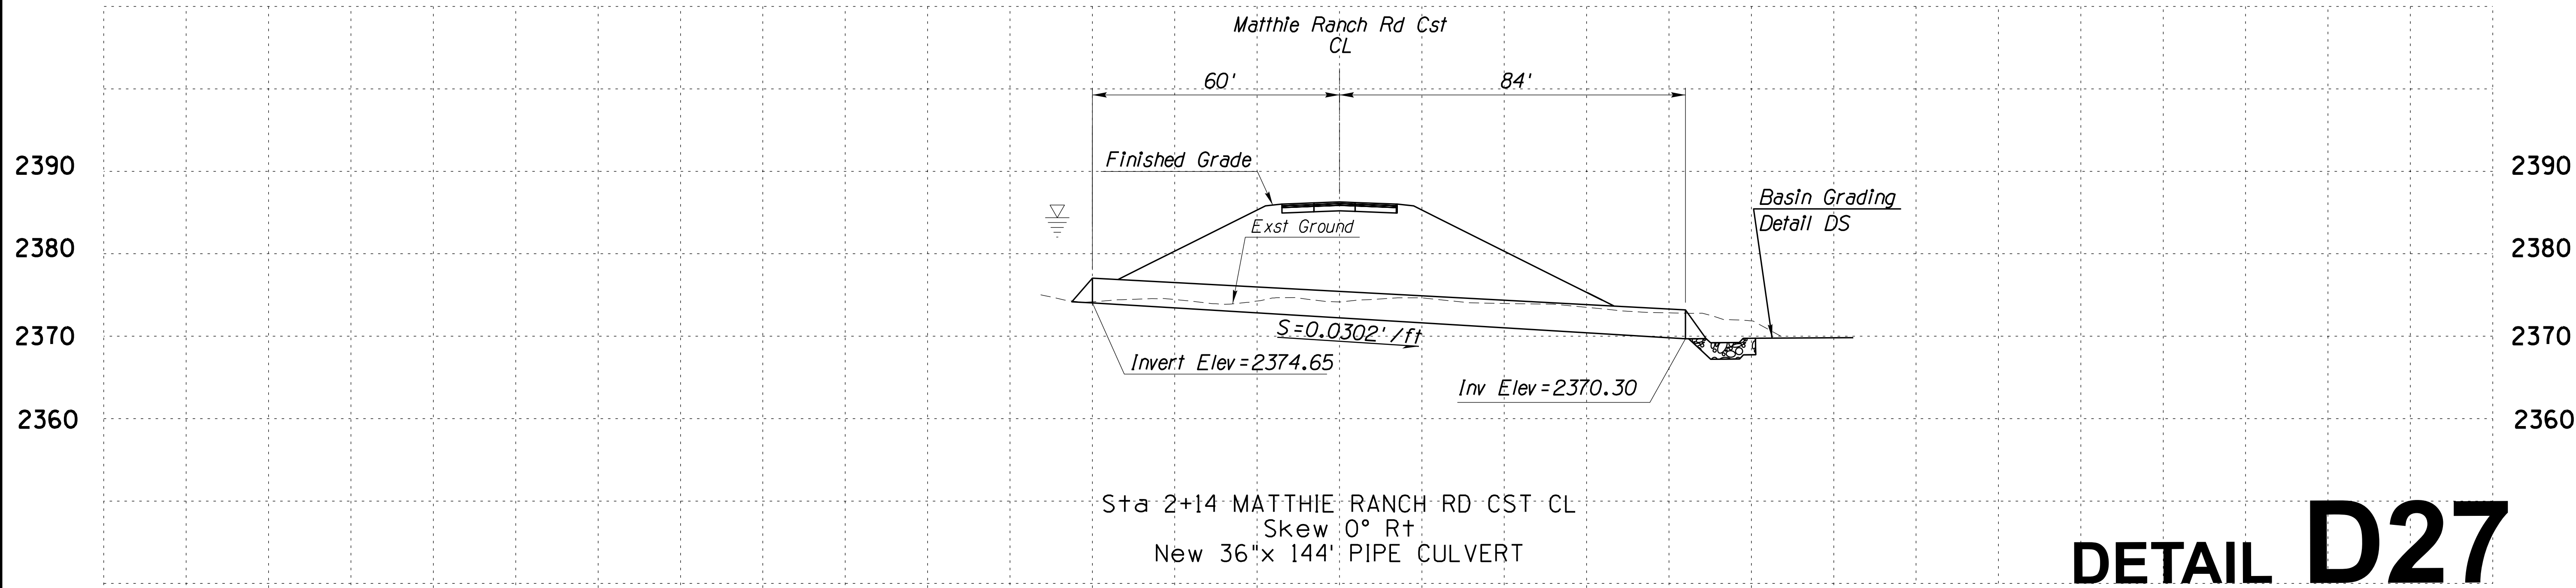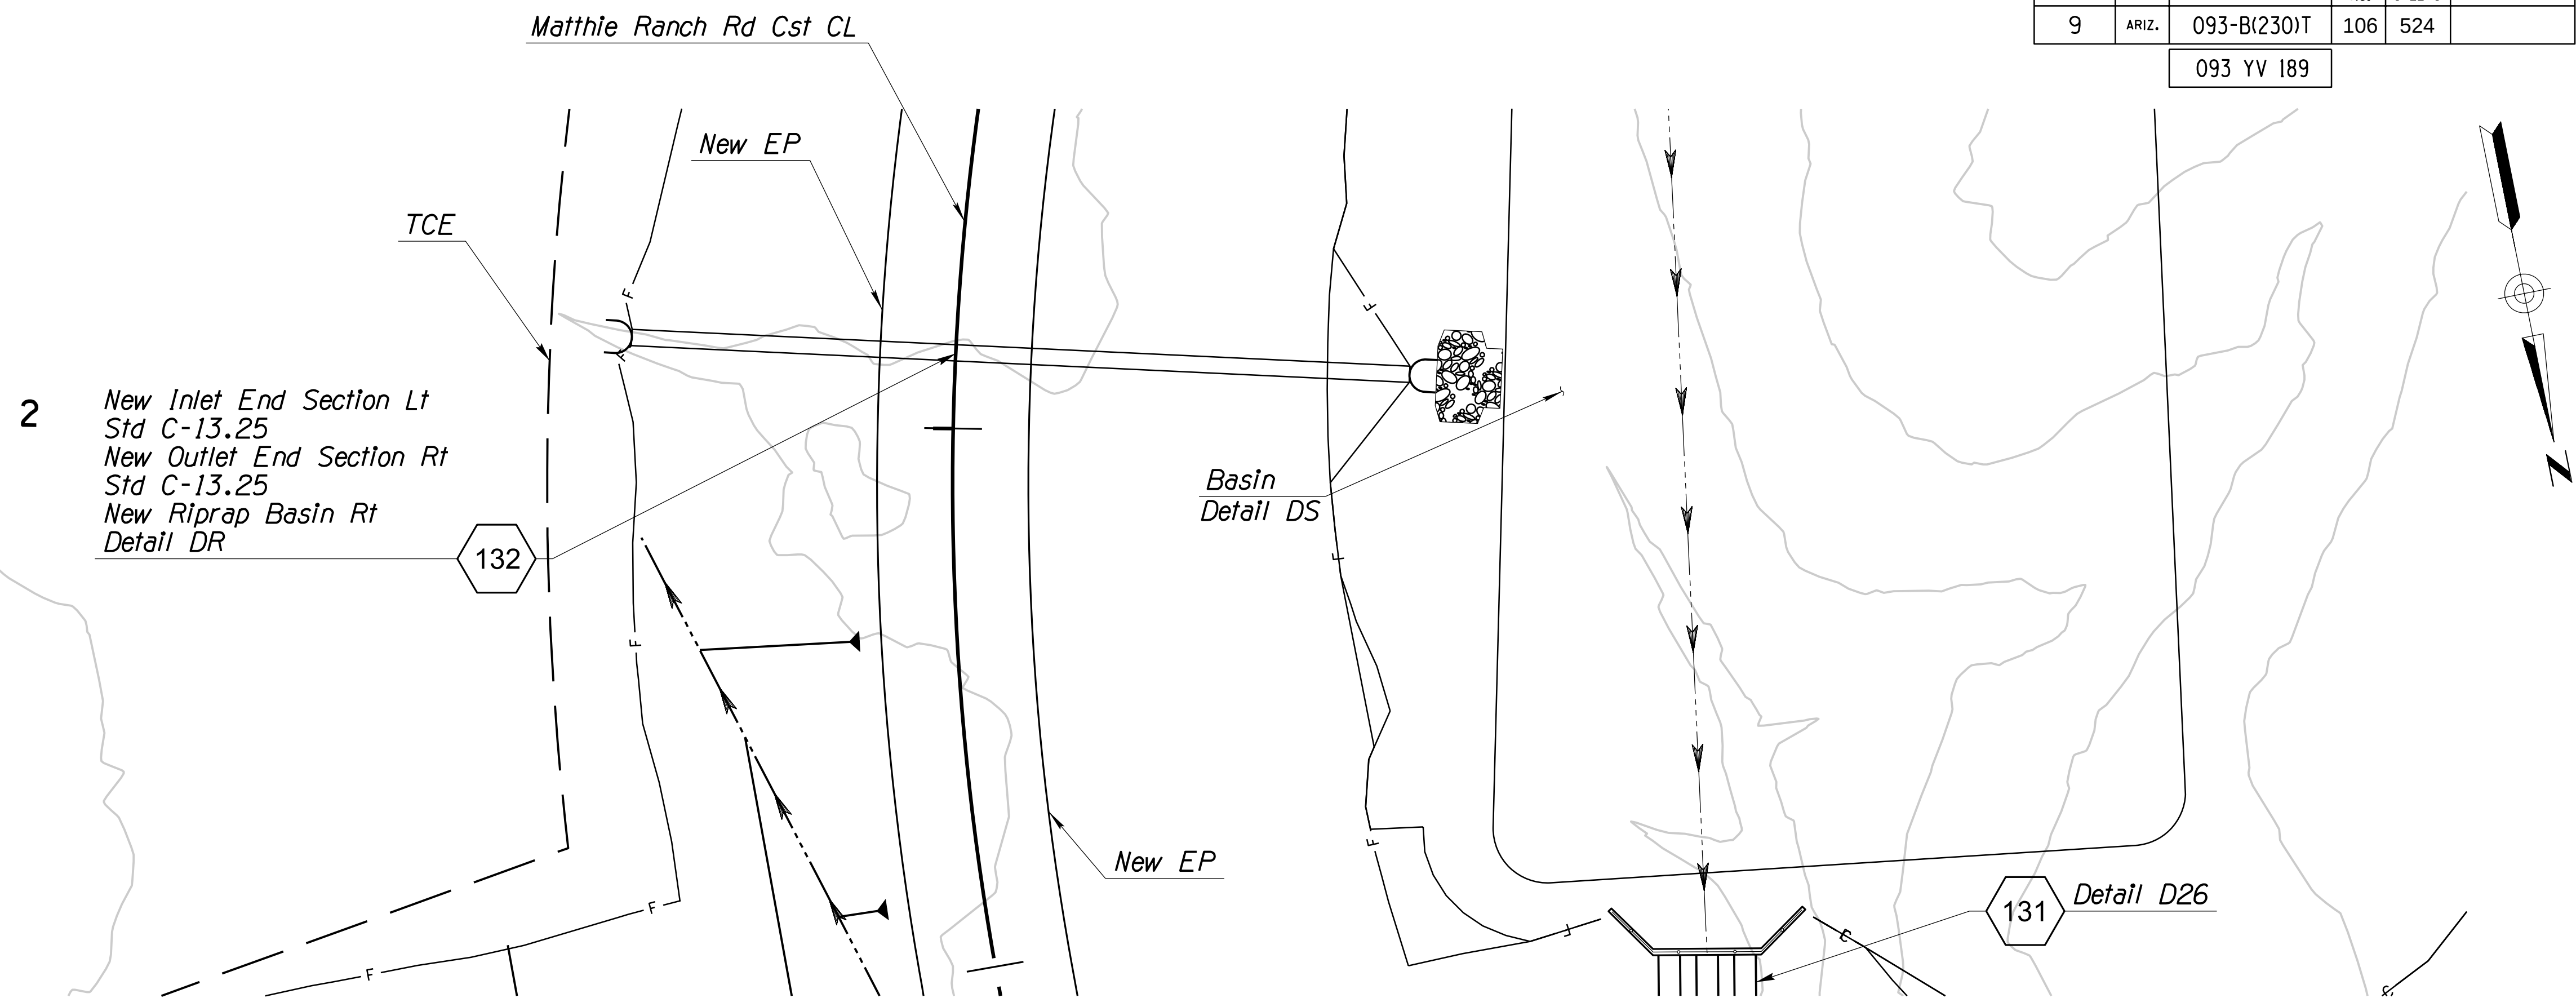

DESIGN	JML	DATE	06-26
DRAWN	JML	DATE	06-26
CHECKED	DBK	DATE	06-26
Stanley Consultants inc. 3133 East Camelback Road, Suite 100 Phoenix, Arizona 85016 Phone: (602) 333-2200			
ROUTE		LOCATION	
US 93		WICKENBURG RANCH WAY TO VISTA ROYALE	
TRACS NO. F0738 OIC		093-B(230)T	
		DWG NO. D-2.27	
		OF	



ARIZONA DEPARTMENT OF TRANSPORTATION
PROJECT DELIVERY AND OPERATIONS DIVISION
ROADWAY DESIGN SERVICES

CULVERT DETAIL SHEET
DETAIL D27 - CULVERT 132
MATTHIE RANCH RD STA 1+89

46727
DIANA B. KELLY
Professional Engineer
ARIZONA, U.S.A.

F.H.W.A. REGION	STATE	PROJECT NO.	SHEET NO.	TOTAL SHEETS	RECORD DRAWING
9	ARIZ.	093-B(230)T	107	524	



093 YV 189

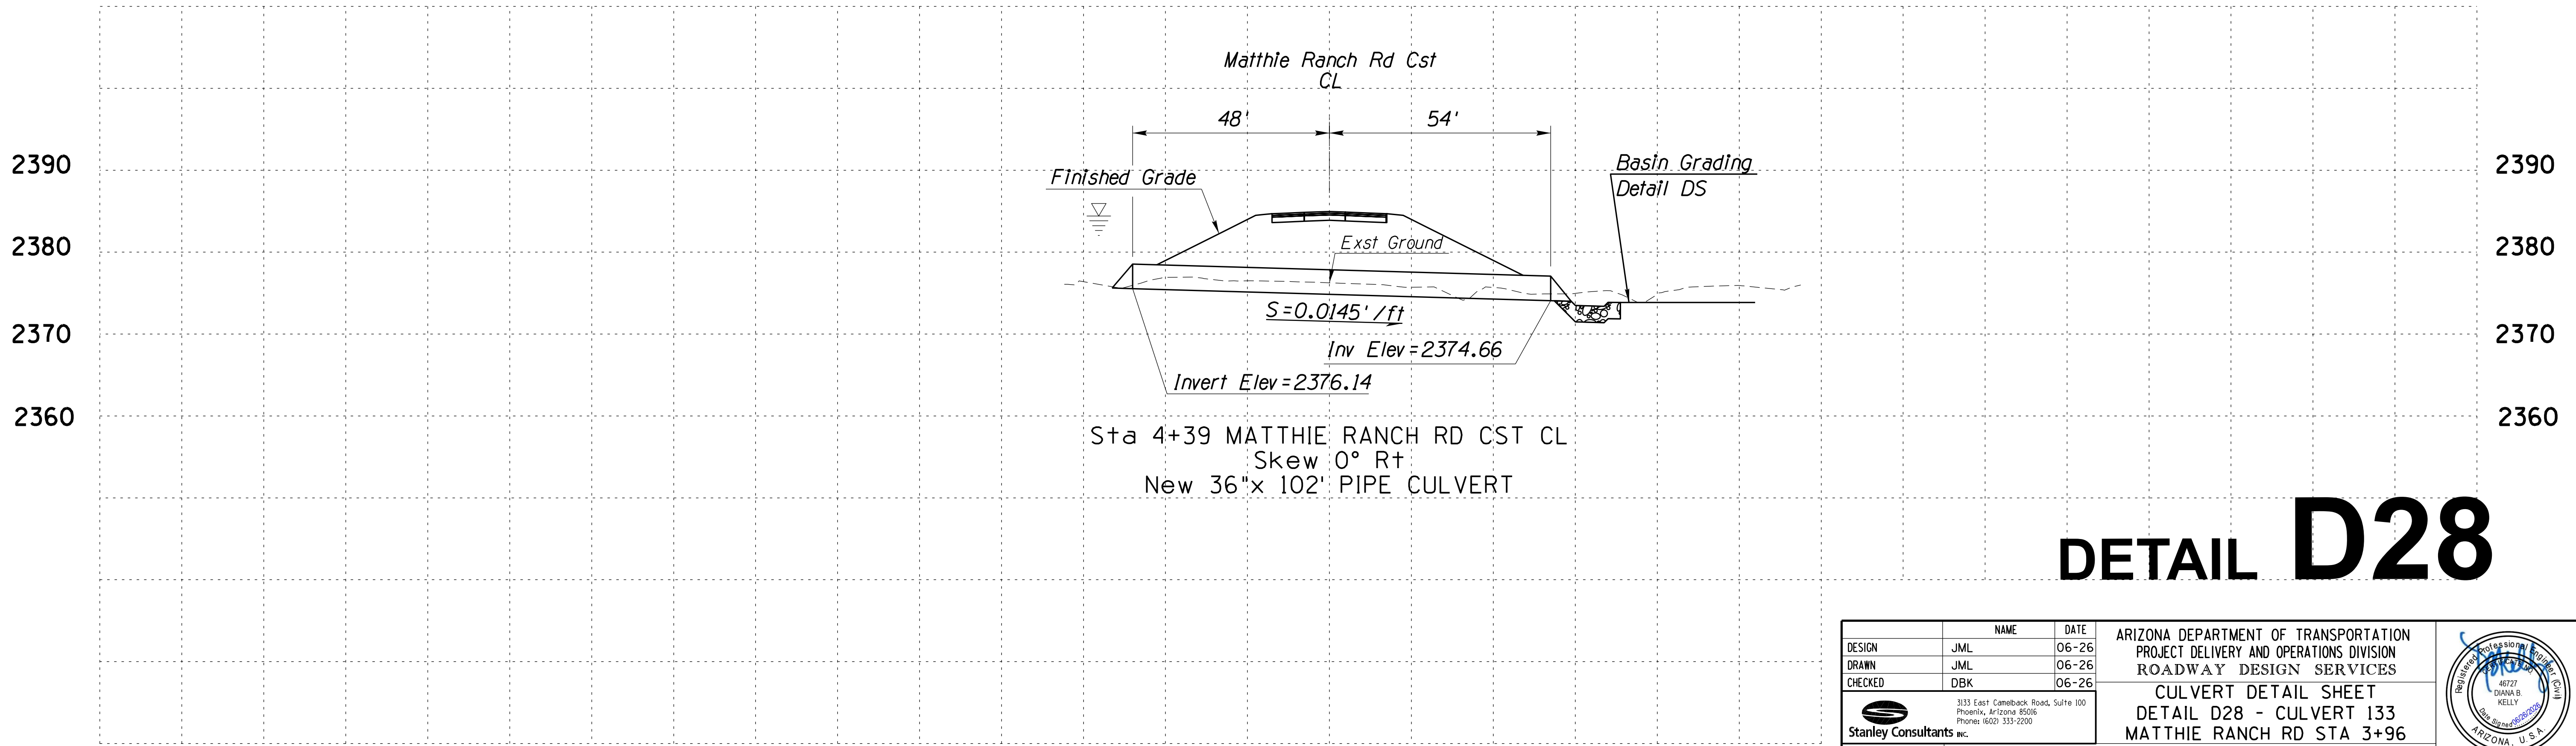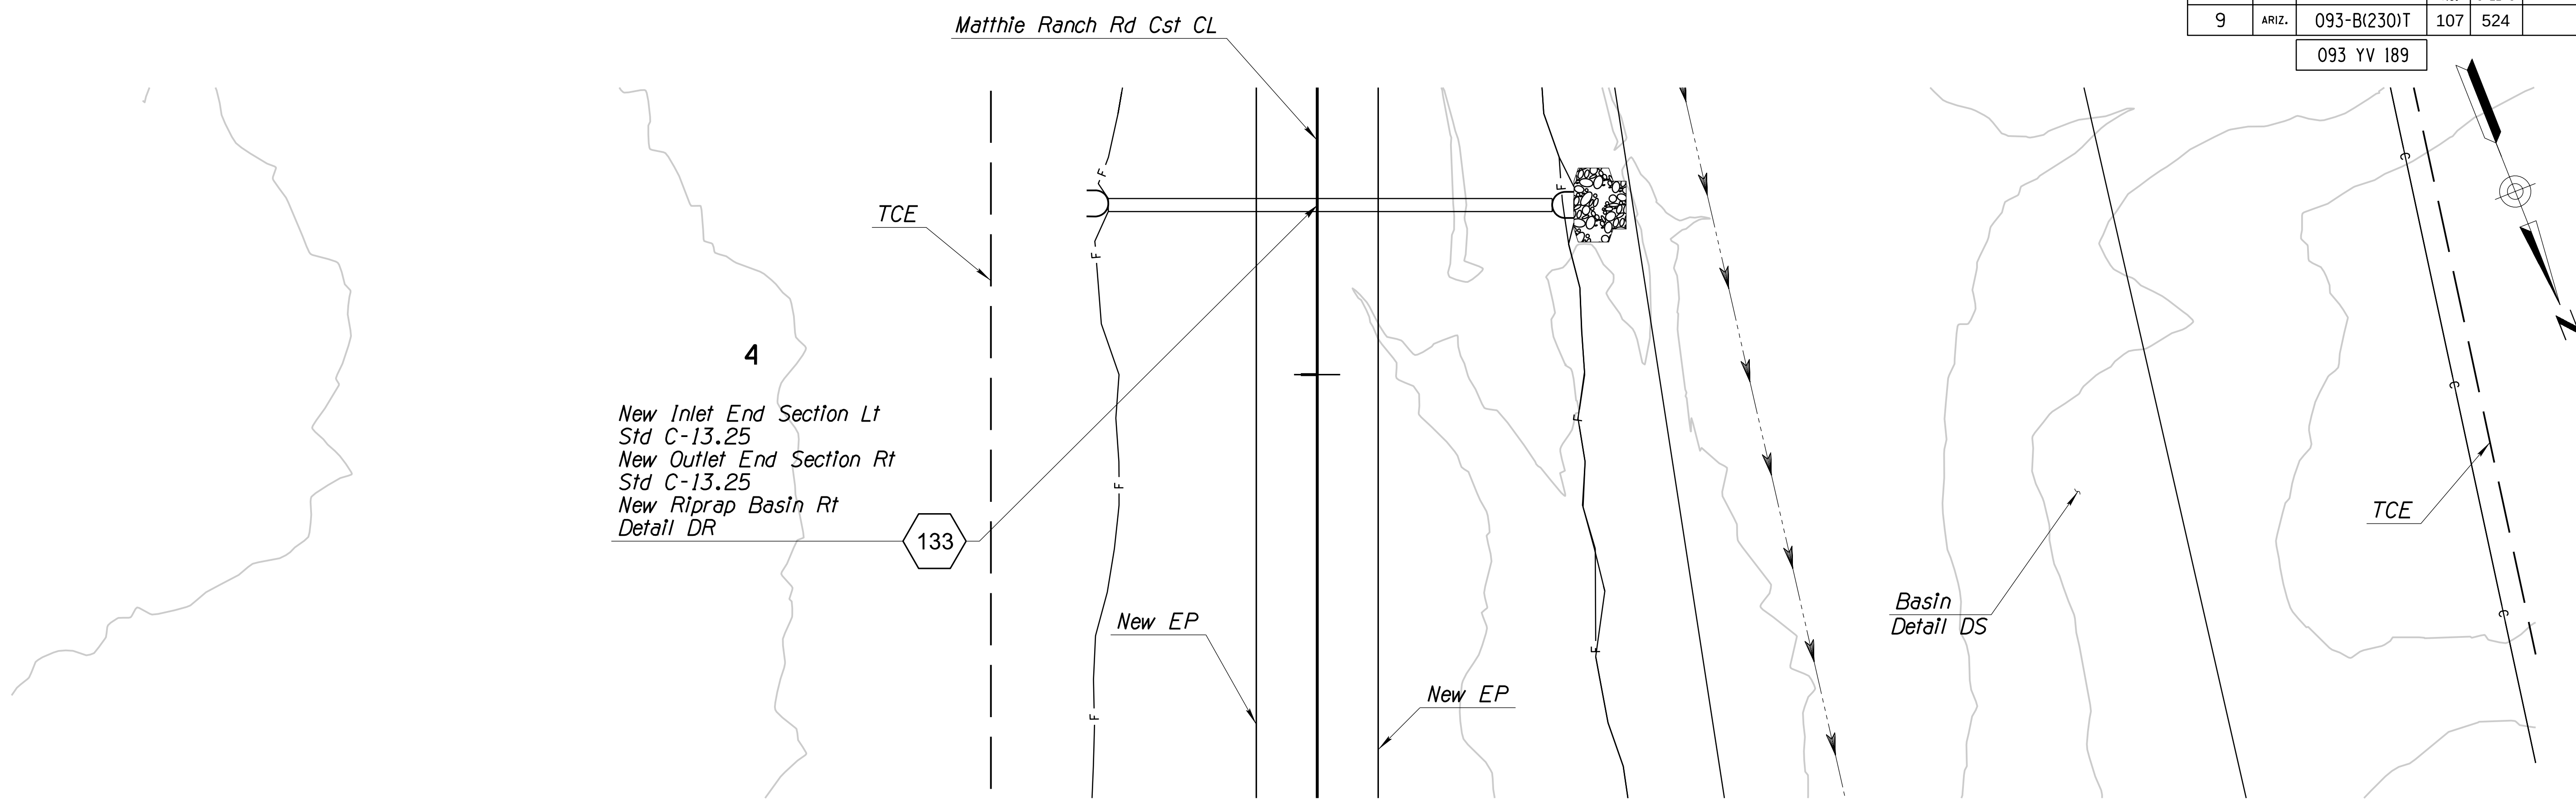

DESIGN	NAME	DATE	ARIZONA DEPARTMENT OF TRANSPORTATION PROJECT DELIVERY AND OPERATIONS DIVISION ROADWAY DESIGN SERVICES	
DRAWN	JML	06-26	CULVERT DETAIL SHEET	
CHECKED	DBK	06-26	DETAIL D28 - CULVERT 133	
			MATTHIE RANCH RD STA 3+96	
ROUTE	LOCATION		US 93 WICKENBURG RANCH WAY TO VISTA ROYALE	DWG NO. D-2.28
TRACS NO.	F0738 OIC		093-B(230)T	OF

F.H.W.A. REGION	STATE	PROJECT NO.	SHEET NO.	TOTAL SHEETS	RECORD DRAWING
9	ARIZ.	093-B(230)T	108	524	

093 YV 189

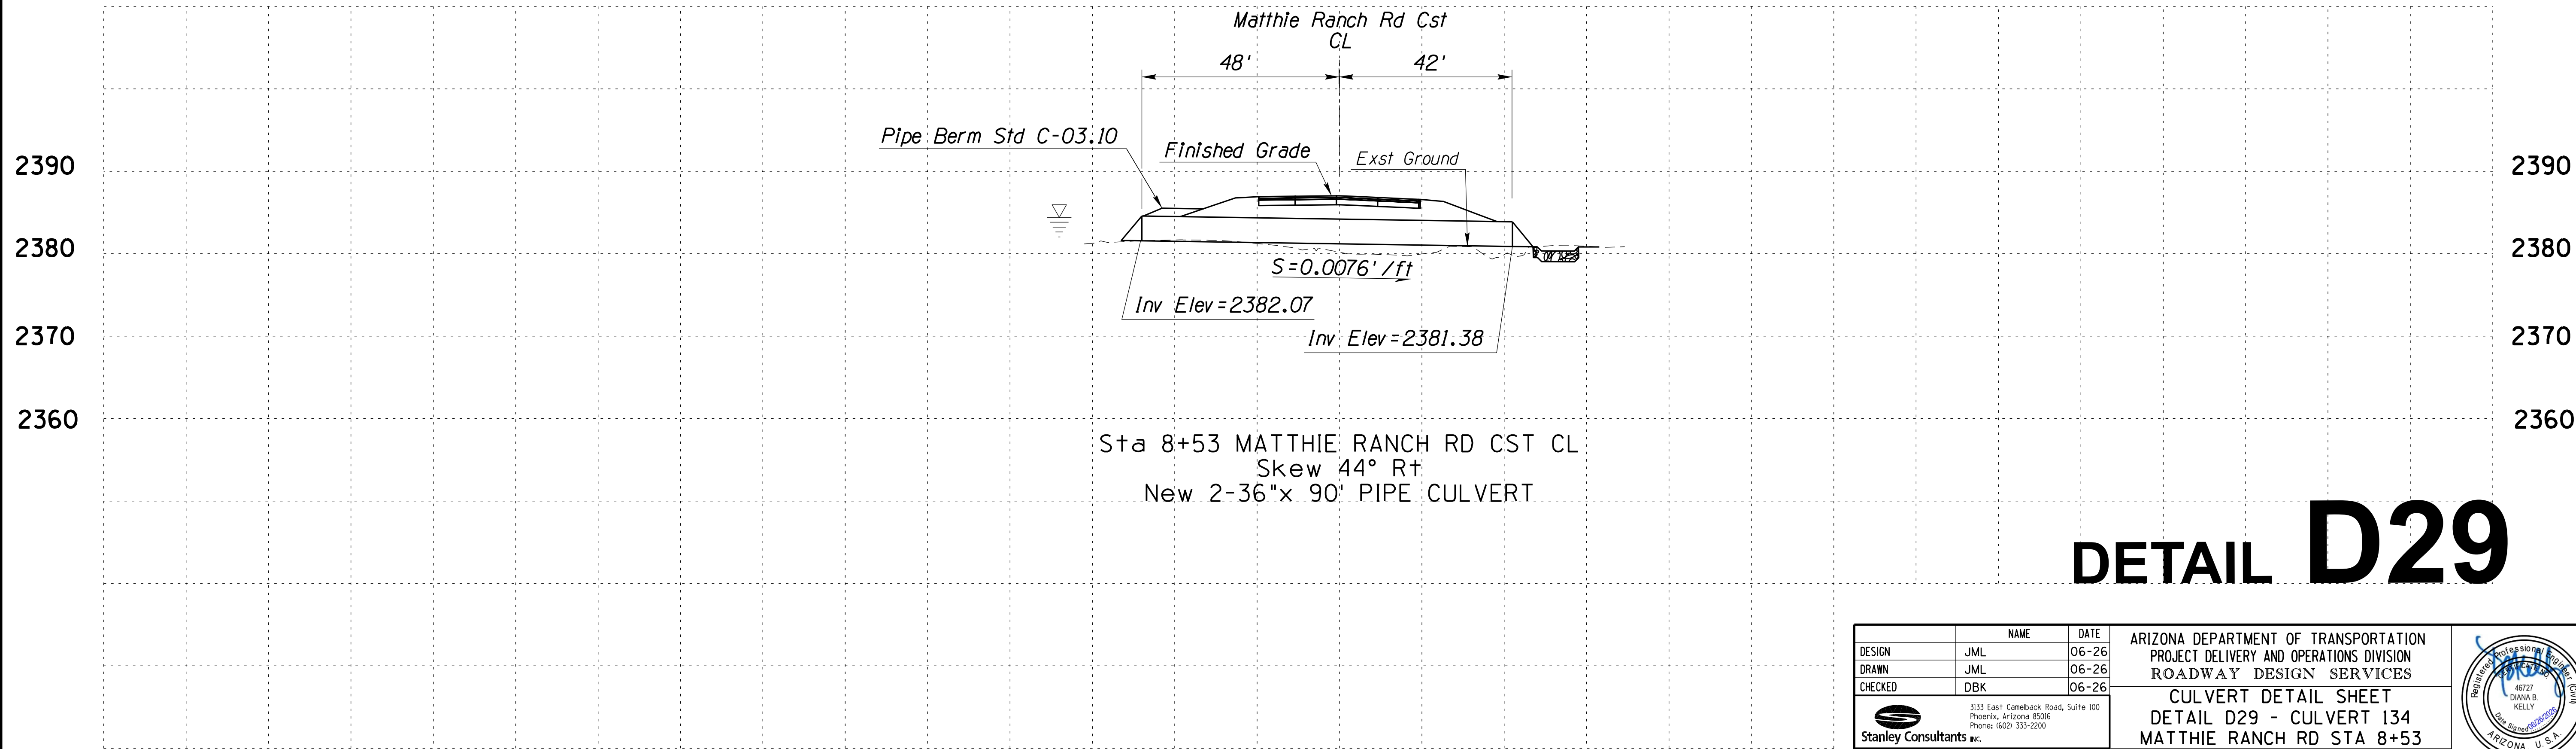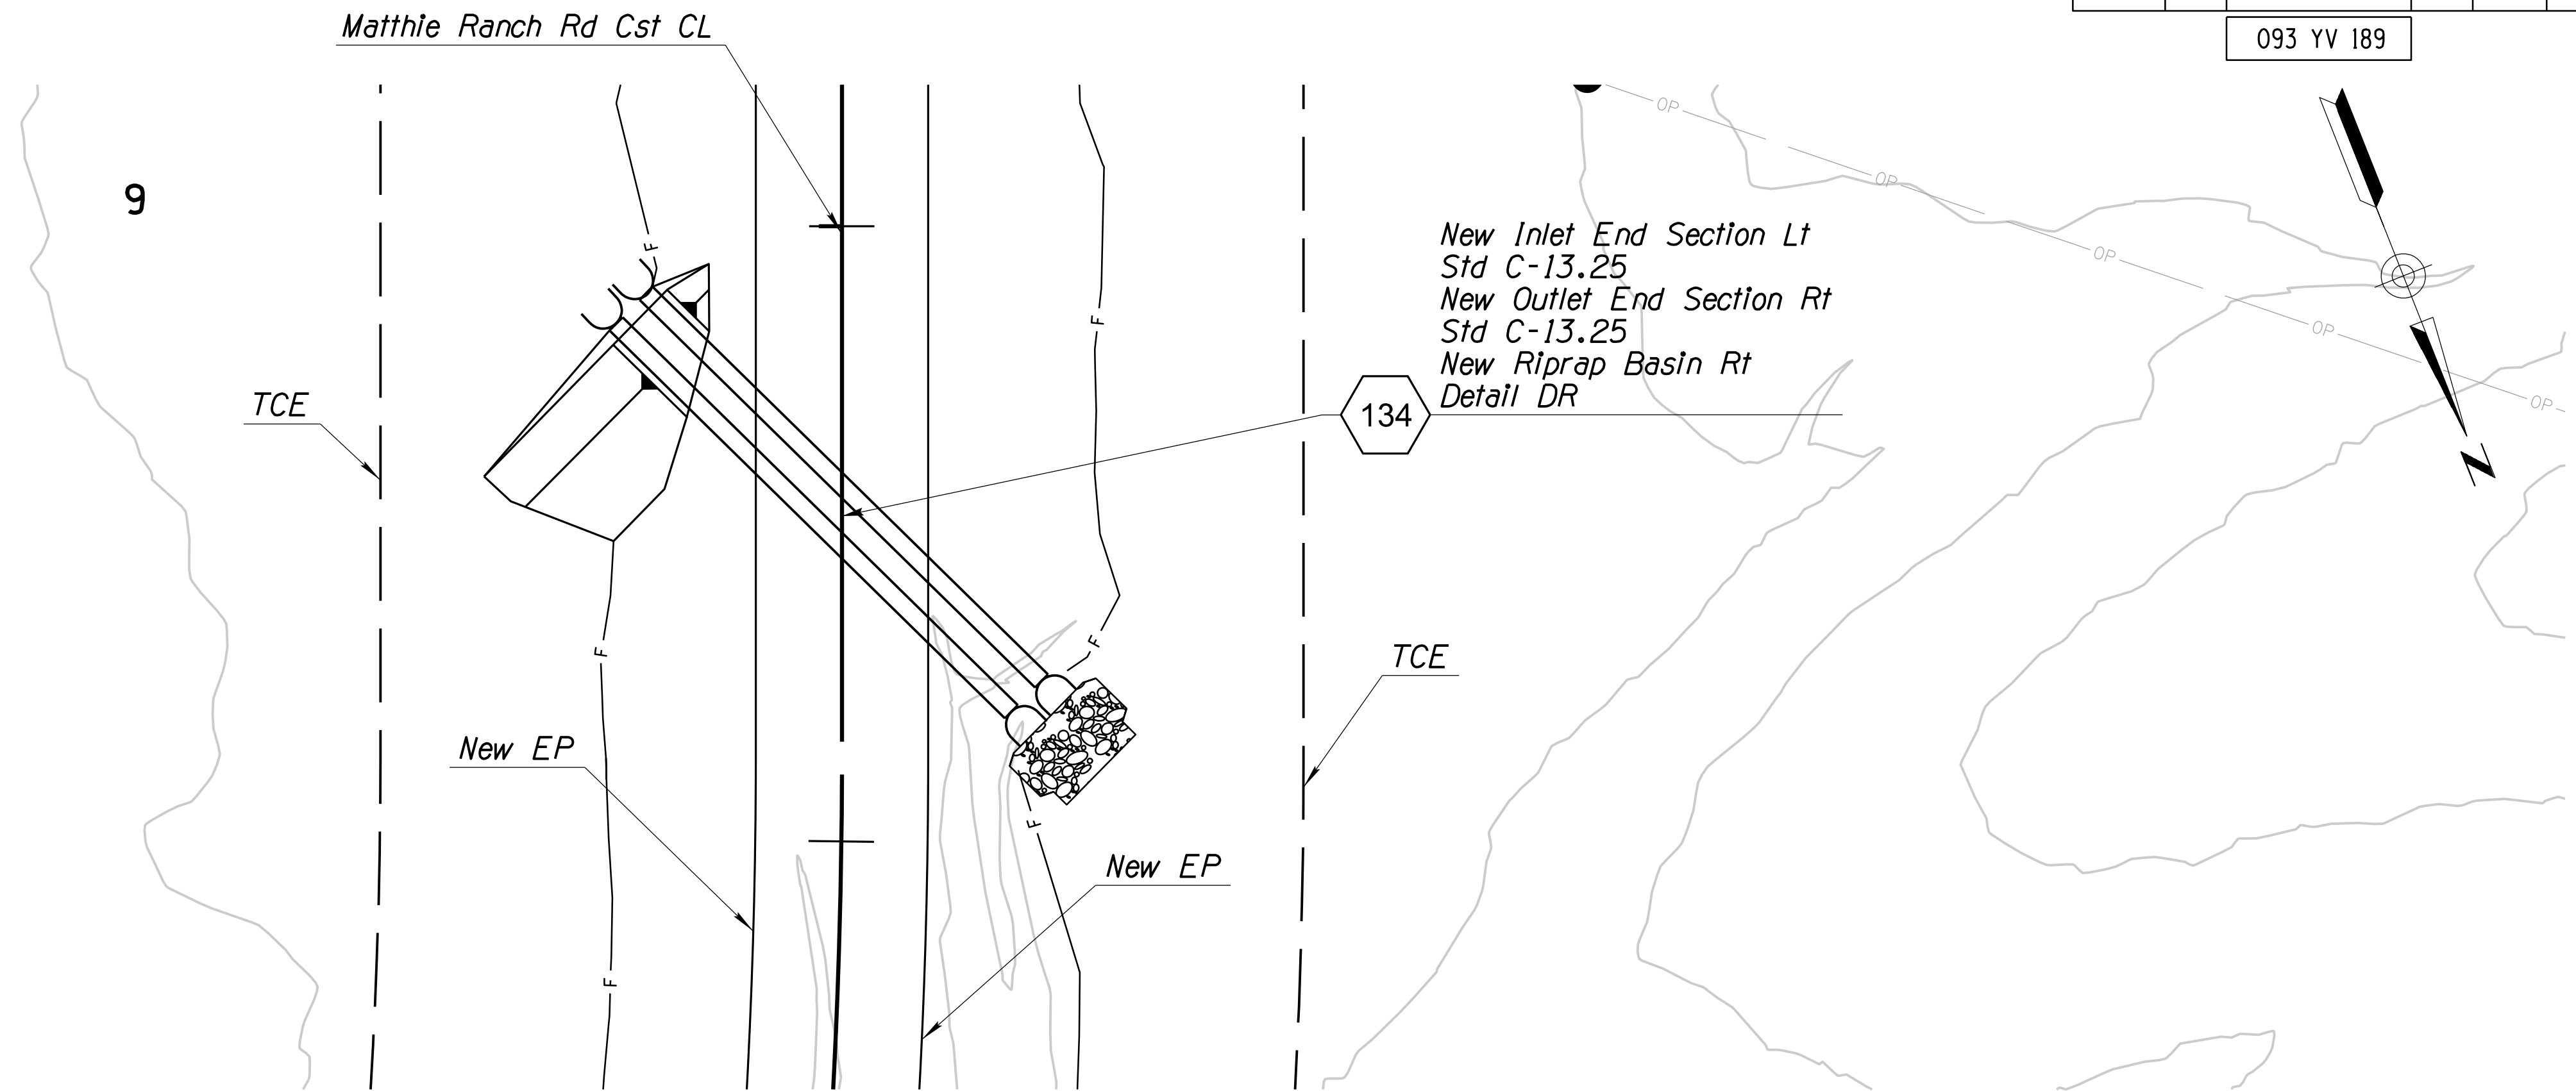


DETAIL D29



		NAME	DATE	ARIZONA DEPARTMENT OF TRANSPORTATION PROJECT DELIVERY AND OPERATIONS DIVISION ROADWAY DESIGN SERVICES CULVERT DETAIL SHEET DETAIL D29 - CULVERT 134 MATTHIE RANCH RD STA 8+53		
DESIGN	JML	06-26				
DRAWN	JML	06-26				
CHECKED	DBK	06-26				
 Stanley Consultants inc.		3133 East Camelback Road, Suite 100 Phoenix, Arizona 85016 Phone: (602) 333-2200				
ROUTE		LOCATION				
US 93		WICKENBURG RANCH WAY TO VISTA ROYALE				DWG NO. D-2.29
TRACS NO. F0738 OIC				093-B(230)T		___ OF ___

F.H.W.A. REGION	STATE	PROJECT NO.	SHEET NO.	TOTAL SHEETS	RECORD DRAWING
9	ARIZ.	093-B(230)T	109	524	

093 YV 189

15

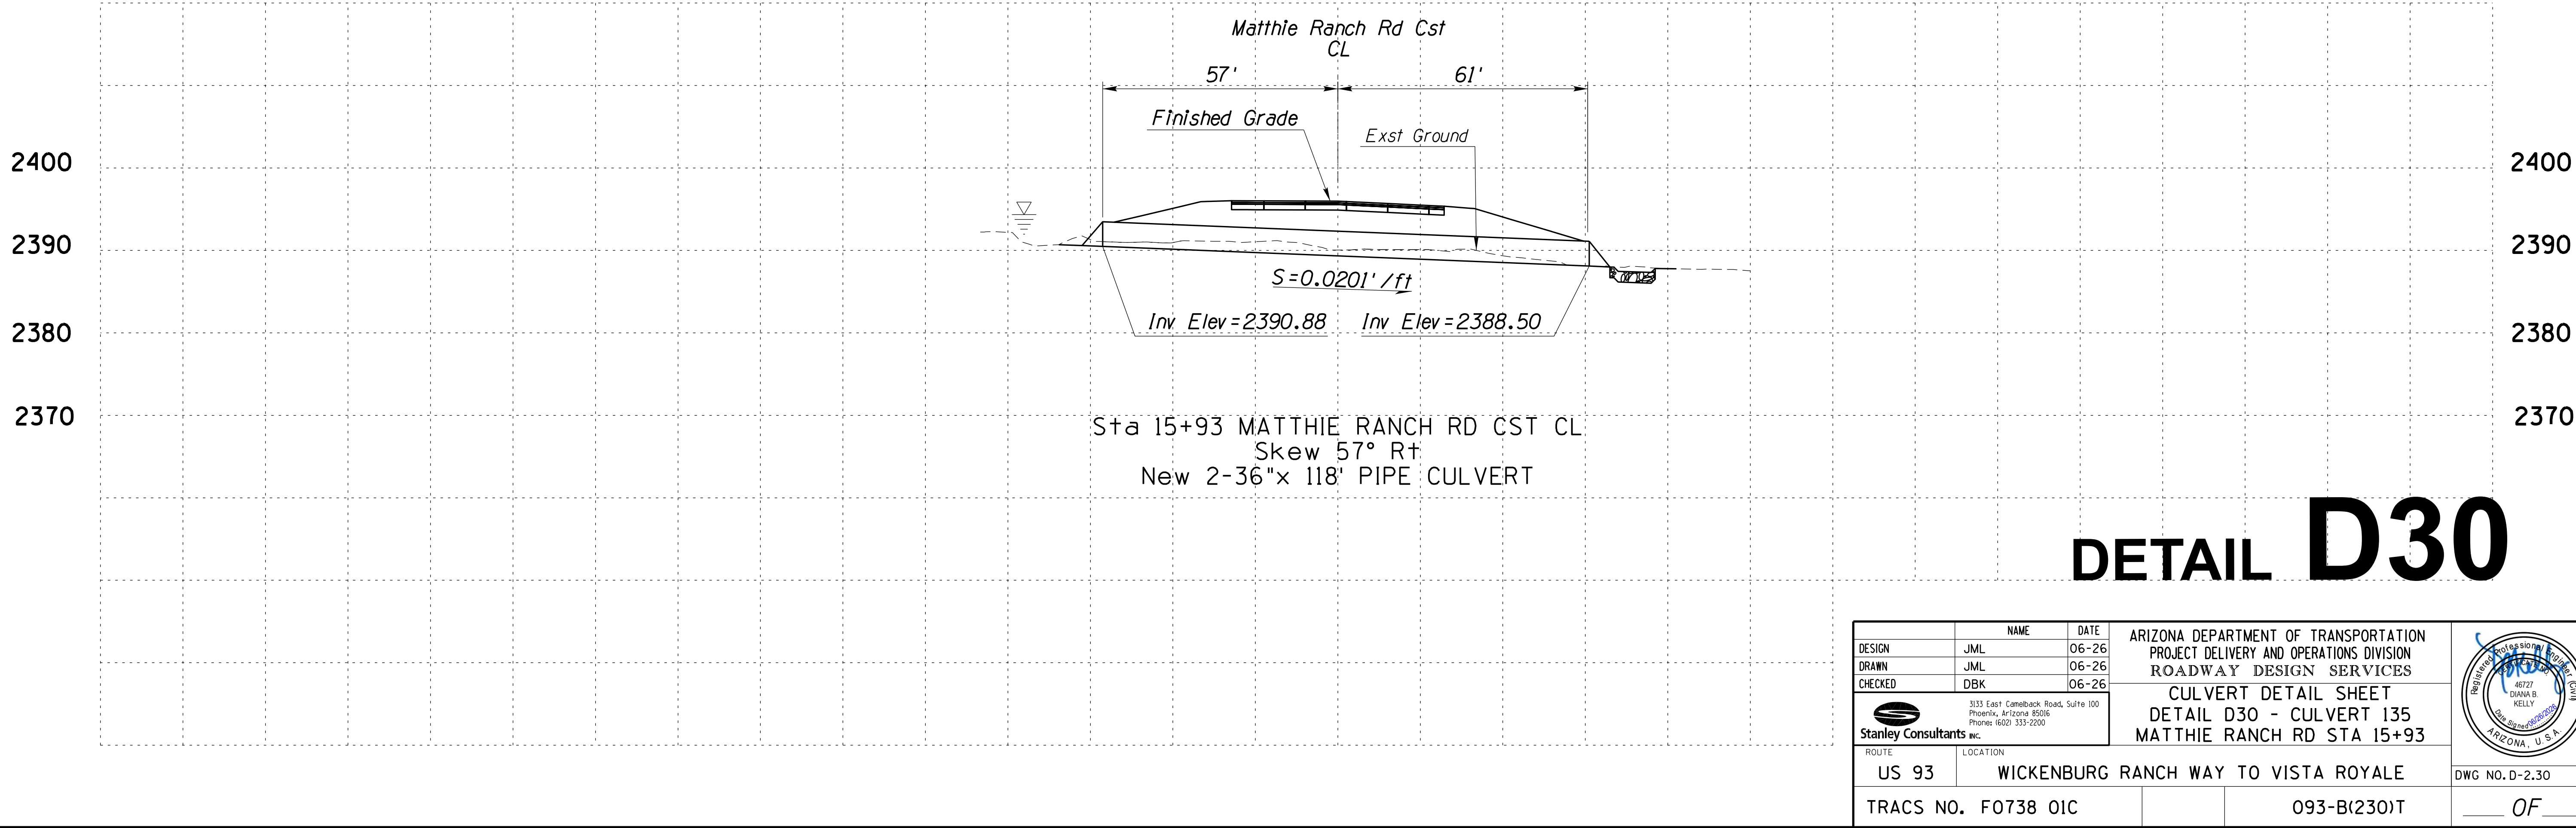

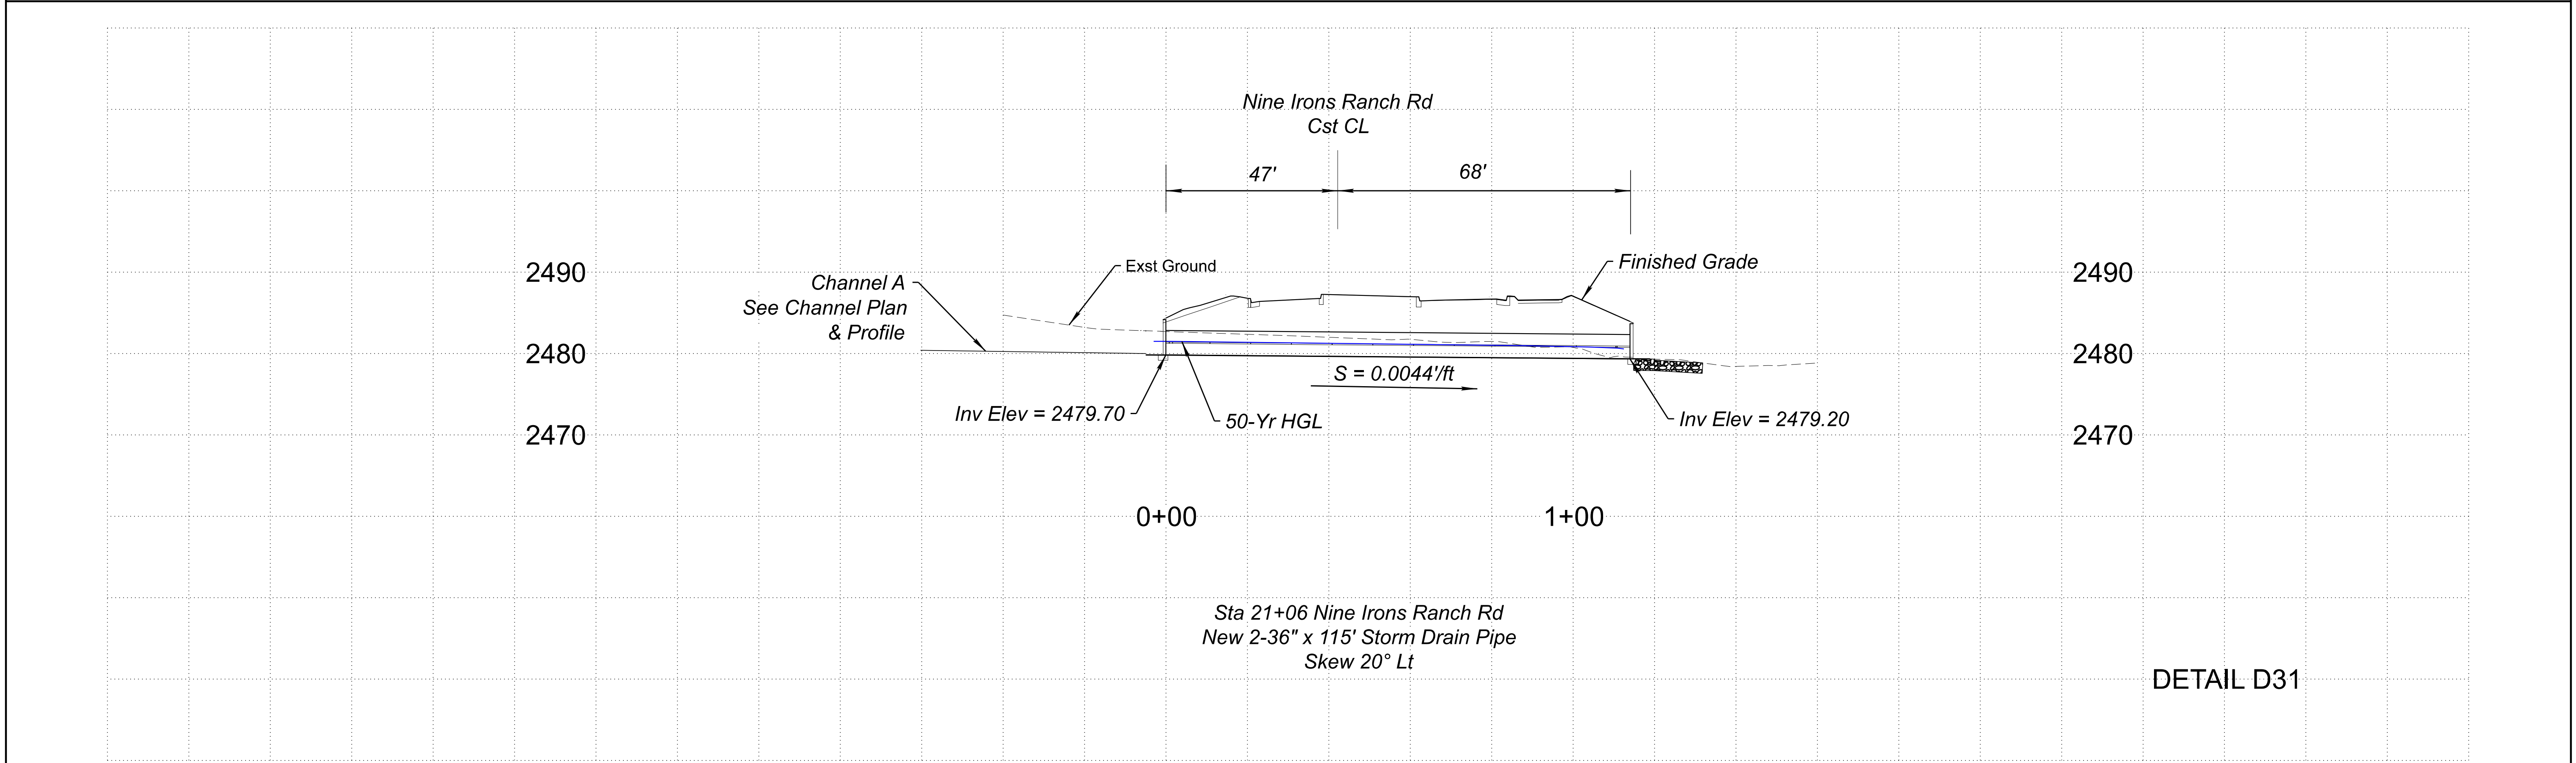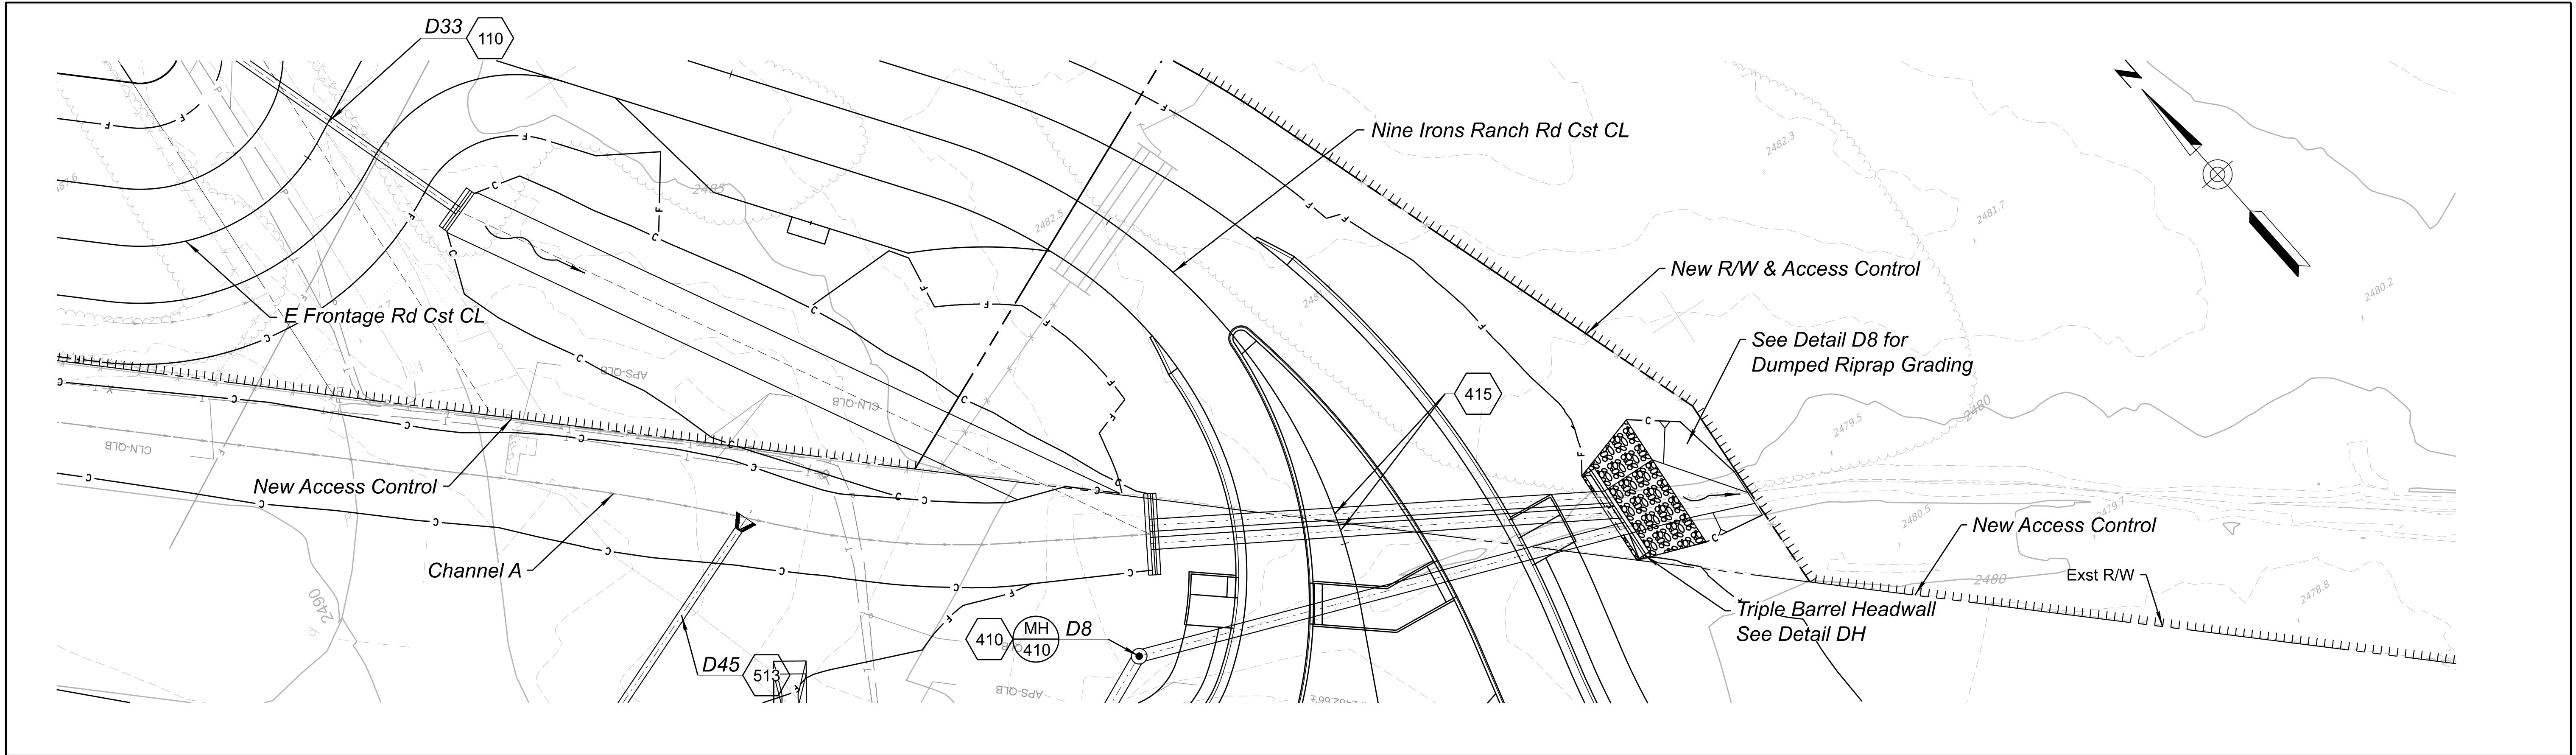

UTILITY DISPOSITION LEGEND

A

To Remain In Service - Protect in Place

B

Contractor to Relocate, Remove or Reset

C

To Be Relocated or Removed By Others

D

To Be Constructed By Others

Professional Engineer

12524

BLUE

BENETDALE

ARIZONA

U.S.A.

TRANSPORTATION
AECOM TECHNICAL SERVICES, INC.
7720 N. 16th St., Suite 100
Phoenix, Arizona 85027
T 602.371.1100

AECOM

www.aecom.com

DESIGN
DRAWN
CHECKED

NAME

K LEANDER
B LEANDER
B DENETDALE

DATE

06/26
06/26
06/26

ARIZONA DEPARTMENT OF TRANSPORTATION
PROJECT DELIVERY AND OPERATIONS DIVISION
ROADWAY DESIGN SERVICES
PIPE DETAIL SHEET
DETAIL D31 - PIPE 415
NINE IRONS RANCH RD STA 21+06

ROUTE
US 93
MILEPOST
189.9
STRUCTURE NO.

F.H.W.A. Arizona Division
ARIZ.
LOCATION
WICKENBURG RANCH WAY TO VISTA ROYALE
TRACS NO. F0738 01C

STATE
ARIZ.

PROJECT NO.
093 YV 189



FEDERAL ID NO.
093-B(230)T

SHEET NO.
110

TOTAL SHEETS
524


RECORD DRAWING

DWG No. D-2.31
OF

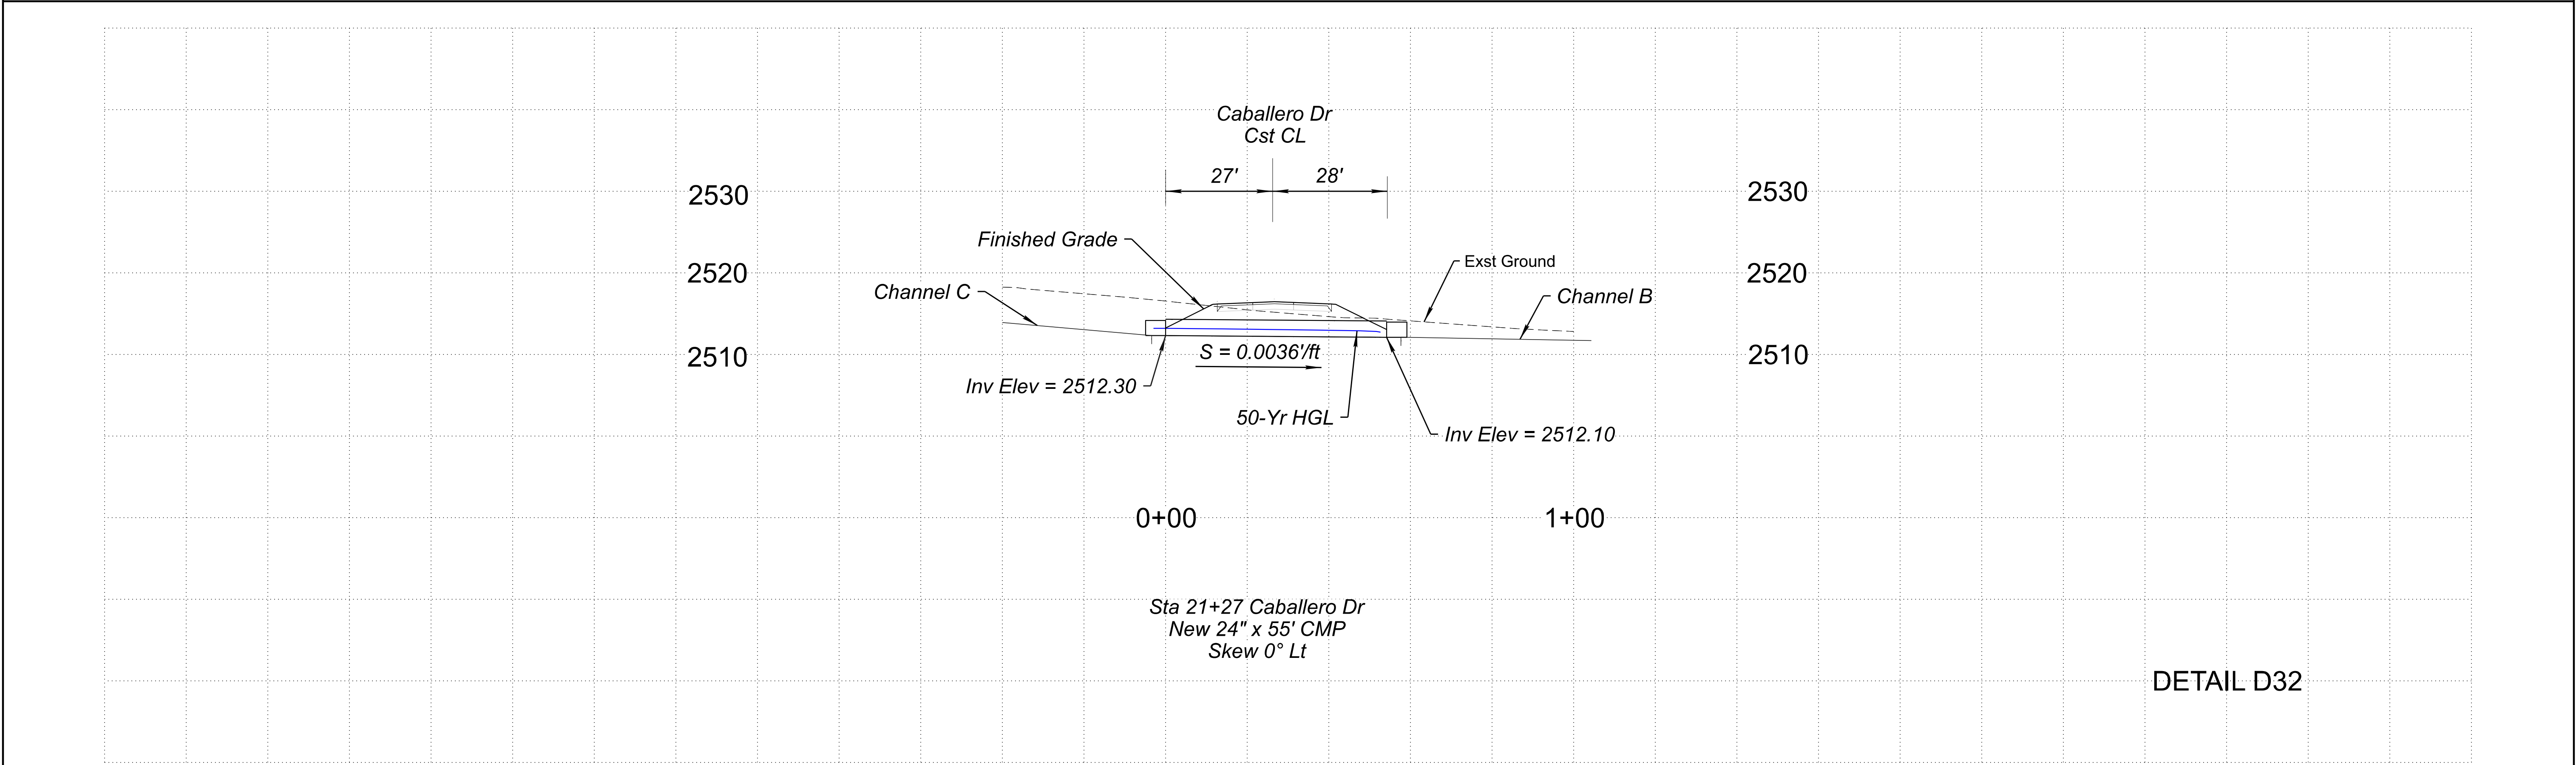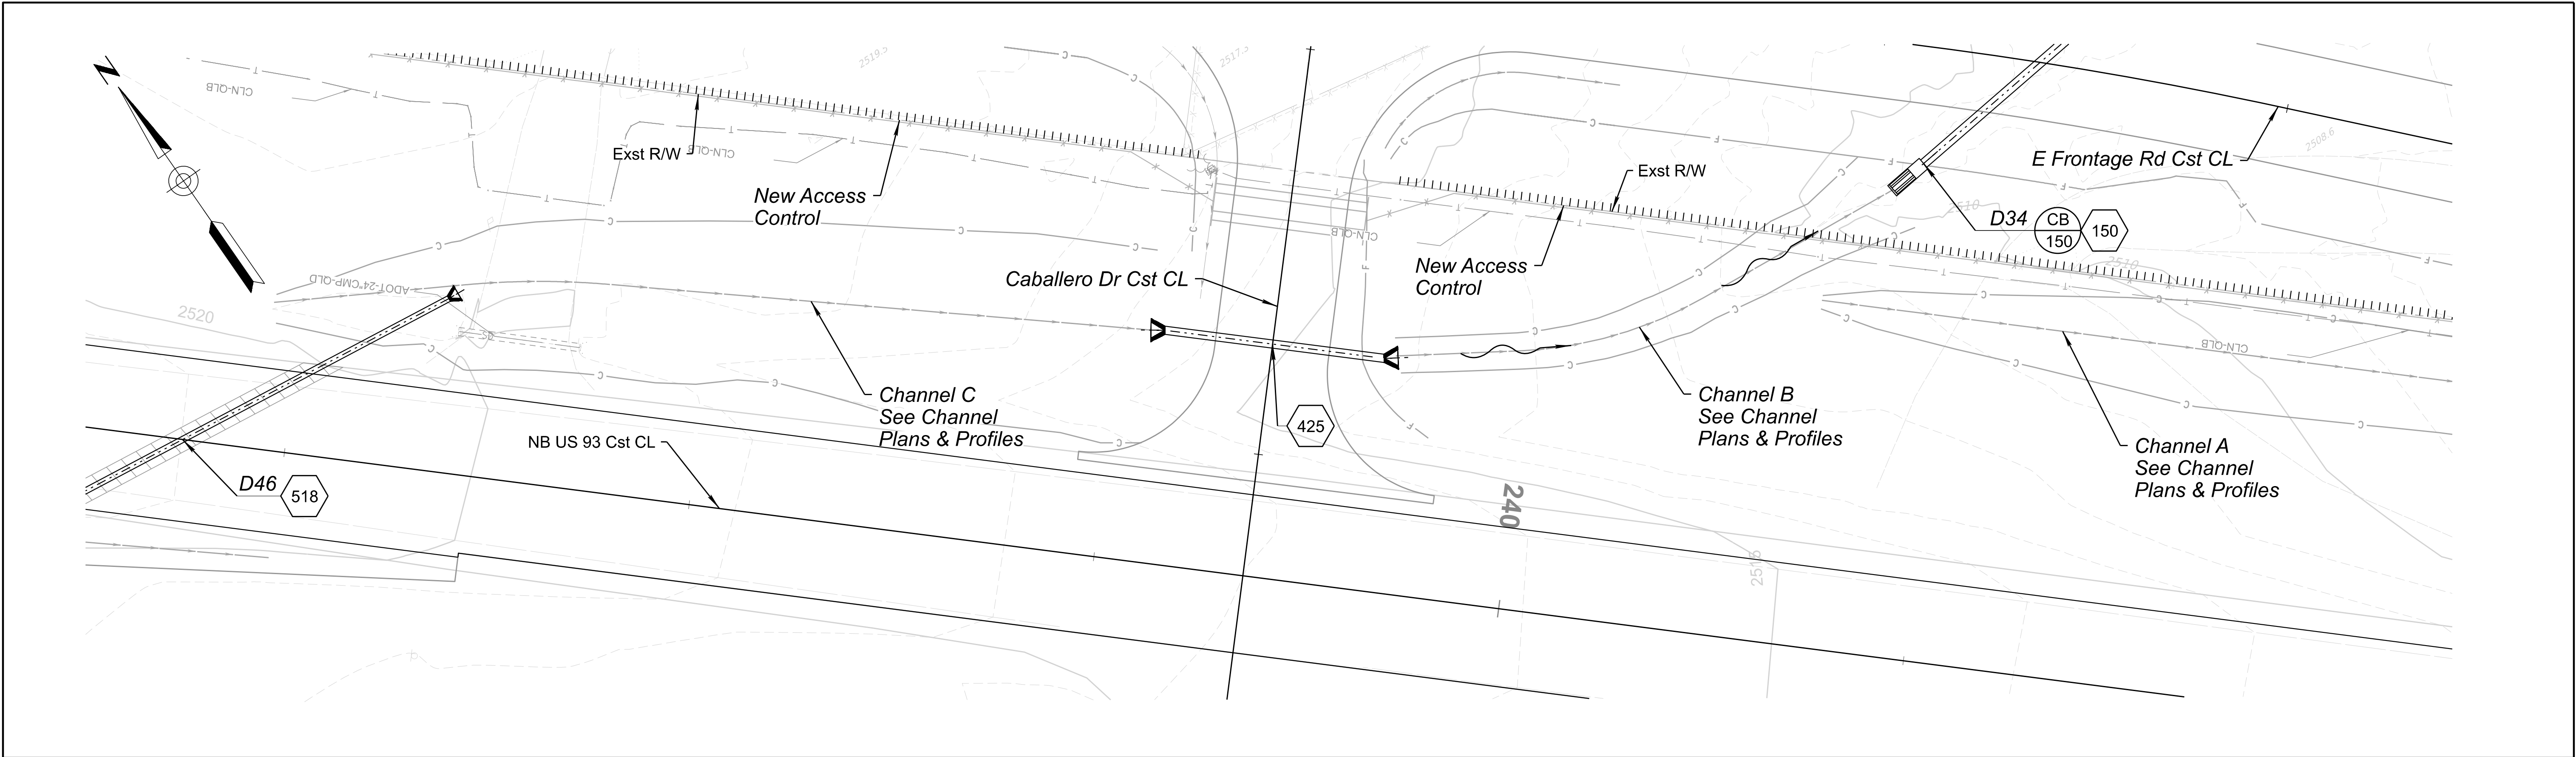



DETAIL D32

UTILITY DISPOSITION LEGEND					<table><thead><tr><th></th><th>NAME</th><th>DATE</th></tr></thead><tbody><tr><td>DESIGN</td><td>K LEANDER</td><td>06/26</td></tr><tr><td>DRAWN</td><td>B LEANDER</td><td>06/26</td></tr><tr><td>CHECKED</td><td>B DENETDALE</td><td>06/26</td></tr></tbody></table>		NAME	DATE	DESIGN	K LEANDER	06/26	DRAWN	B LEANDER	06/26	CHECKED	B DENETDALE	06/26	ARIZONA DEPARTMENT OF TRANSPORTATION PROJECT DELIVERY AND OPERATIONS DIVISION ROADWAY DESIGN SERVICES		ROUTE US 93	F.H.W.A. Arizona Division	STATE ARIZ.	PROJECT NO.	FEDERAL ID NO.	SHEET NO.	TOTAL SHEETS	RECORD DRAWING
	NAME	DATE																									
DESIGN	K LEANDER	06/26																									
DRAWN	B LEANDER	06/26																									
CHECKED	B DENETDALE	06/26																									
 To Remain In Service - Protect in Place	 Contractor to Relocate, Remove or Reset	 To Be Relocated or Removed By Others	 To Be Constructed By Others	PIPE DETAIL SHEET DETAIL D32 - PIPE 425 CABALLERO DR STA 21+27		MILEPOST 189.9	093 YV 189	093-B(230)T	111	524																	
							STRUCTURE NO.	LOCATION WICKENBURG RANCH WAY TO VISTA ROYALE					DWG No. D-2.32														
							TRACS NO. F0738 01C							___ OF ___													
				TRANSPORTATION AECOM TECHNICAL SERVICES, Inc. 7720 N. 16th St., Suite 100 Phoenix, Arizona 85020 T 602.371.1100  www.aecom.com																							

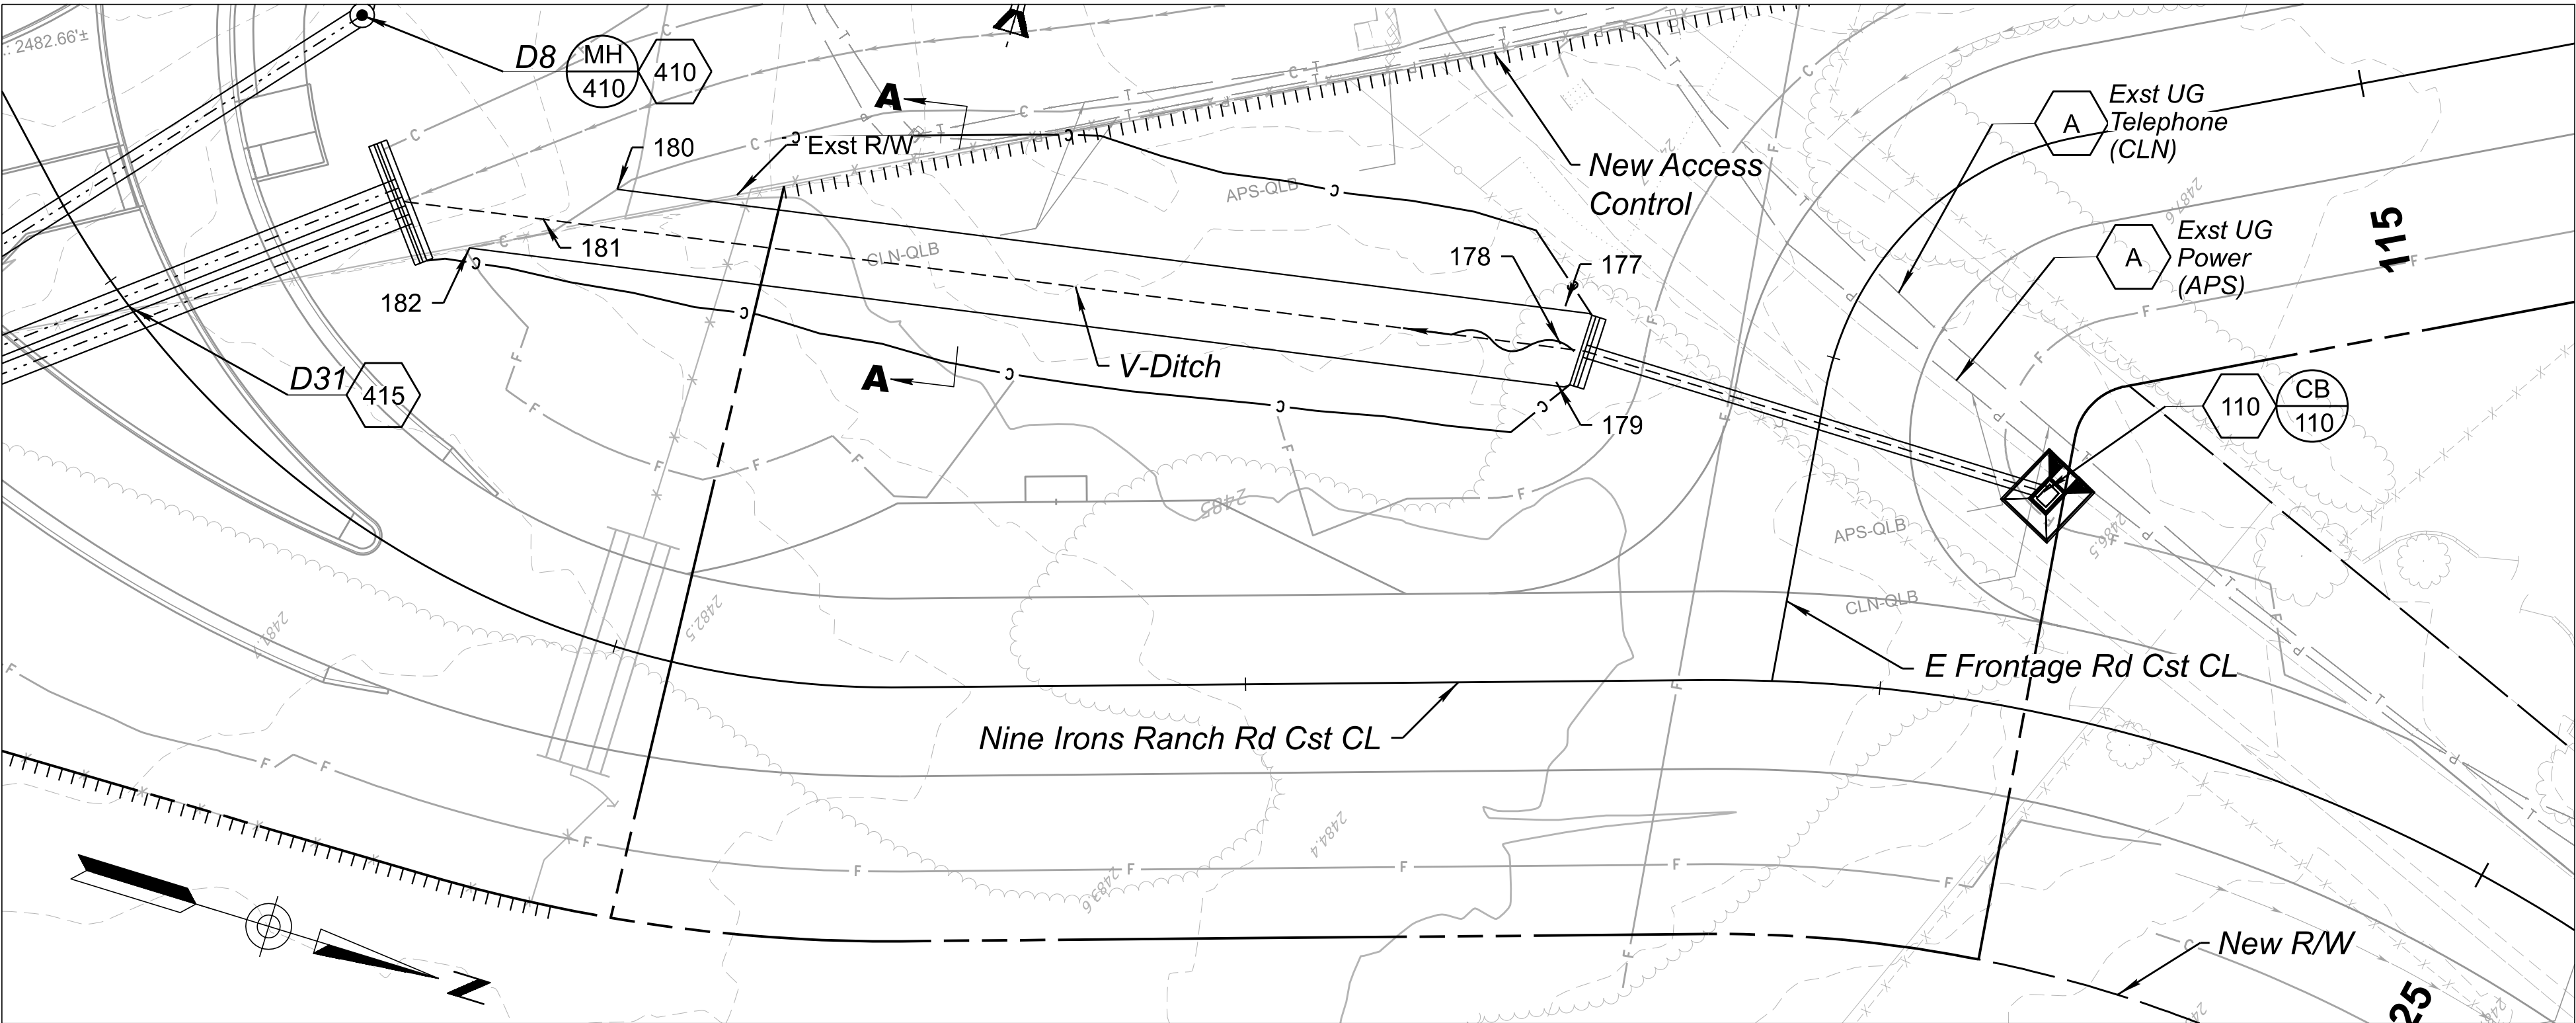

RIPRAP QUANTITIES 110		
X Sectional Area	11.99	sq ft
Length	184.51	ft
Volume	81.94	cu yd

Note: See Detail DR for Riprap Gradation

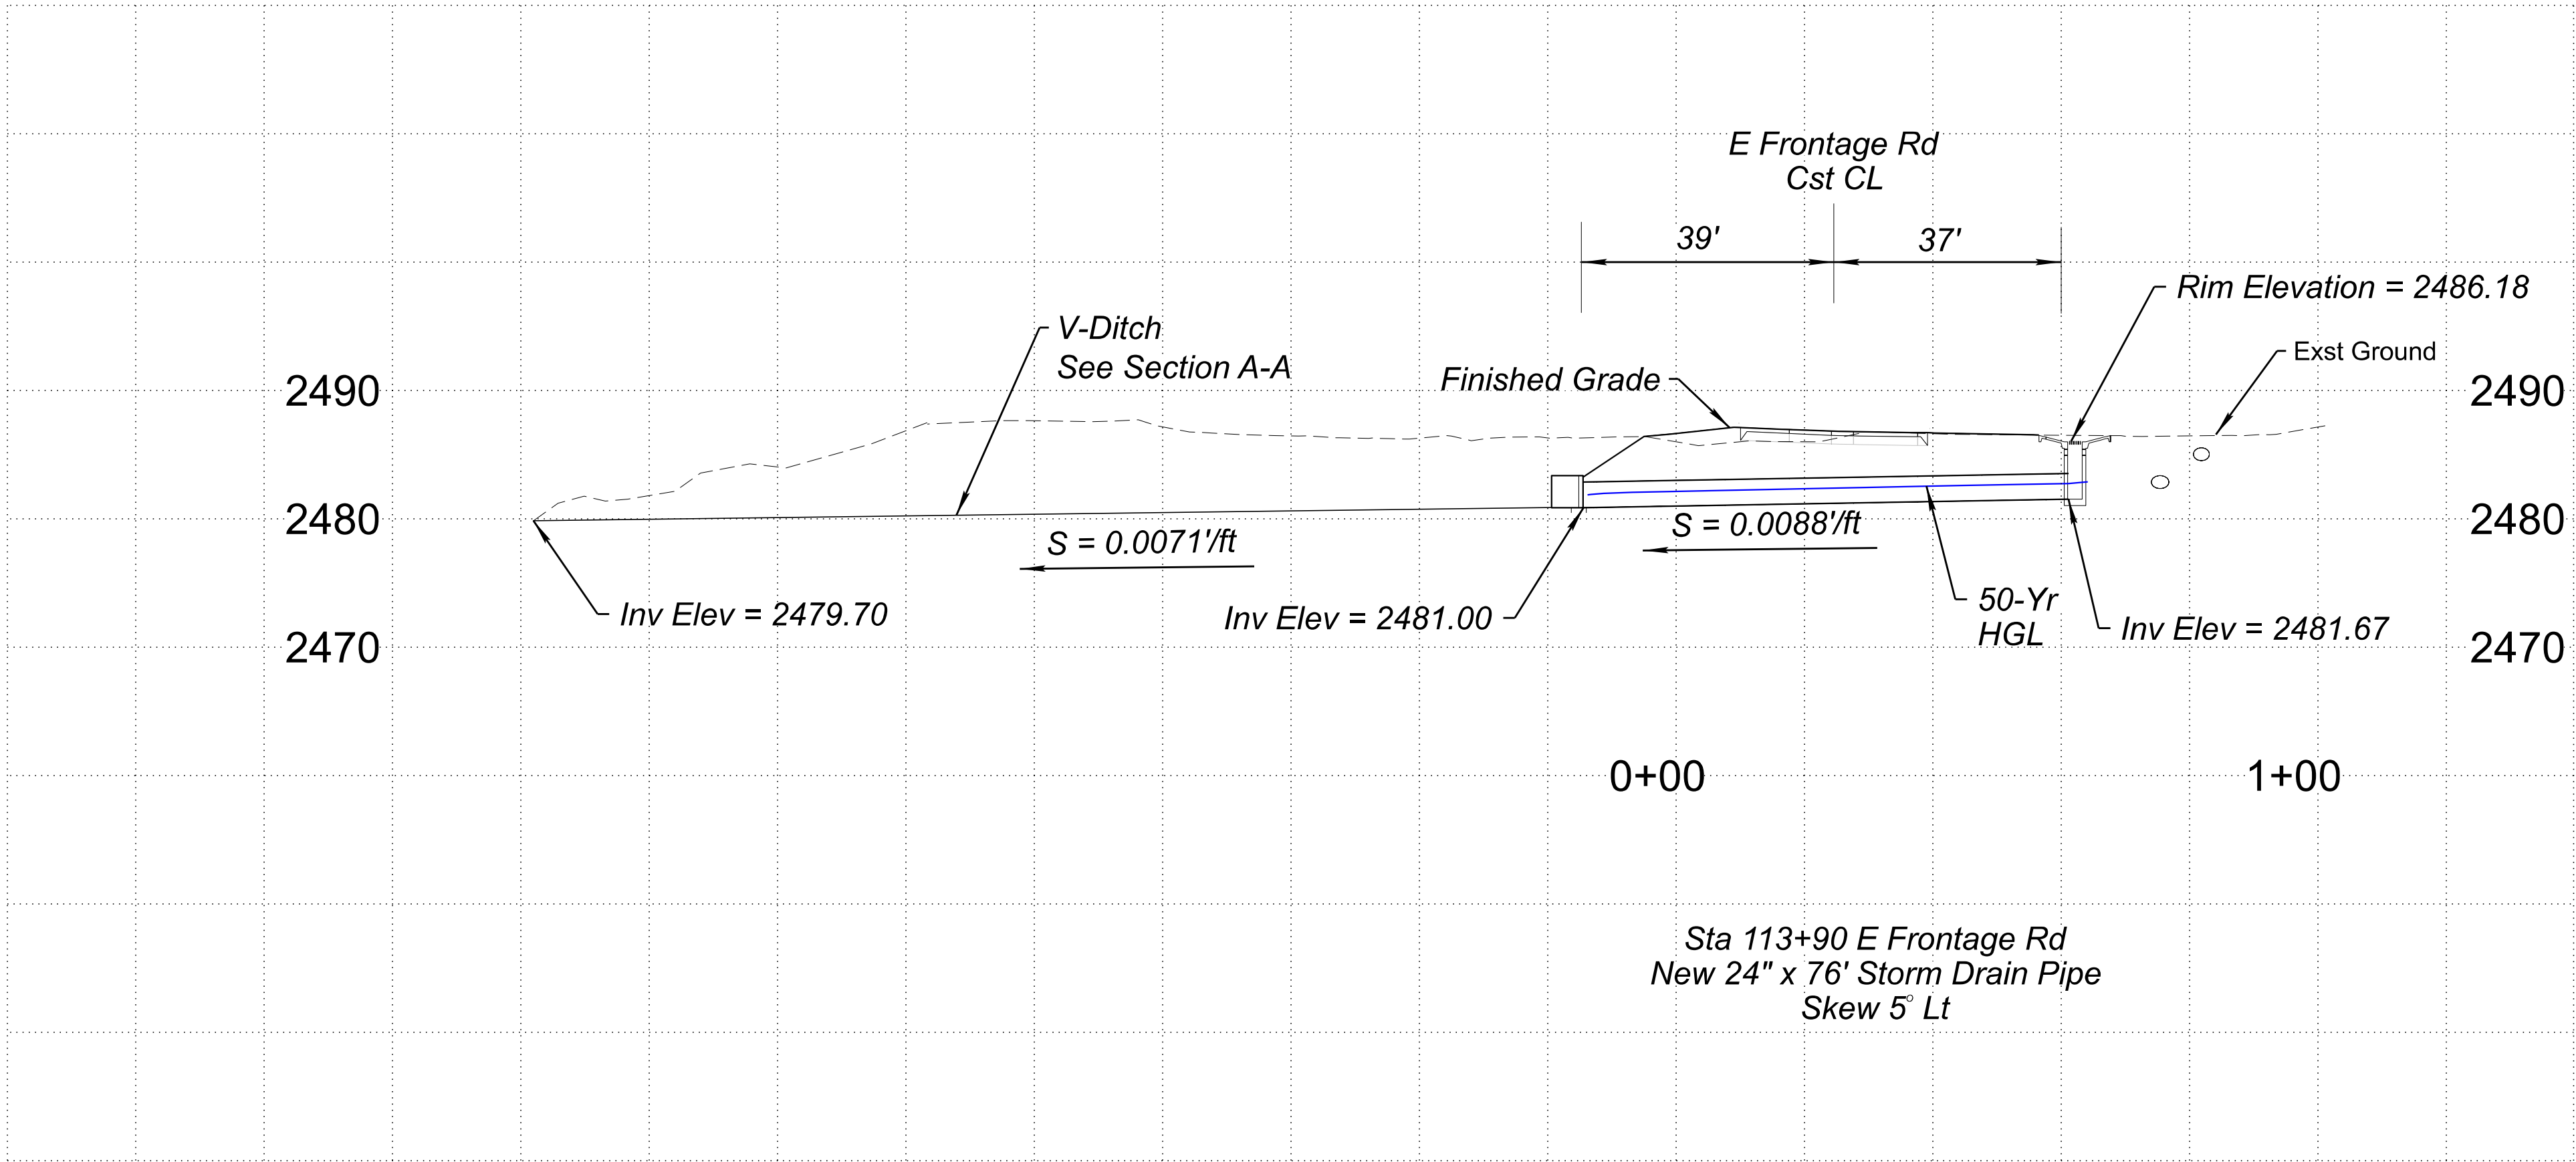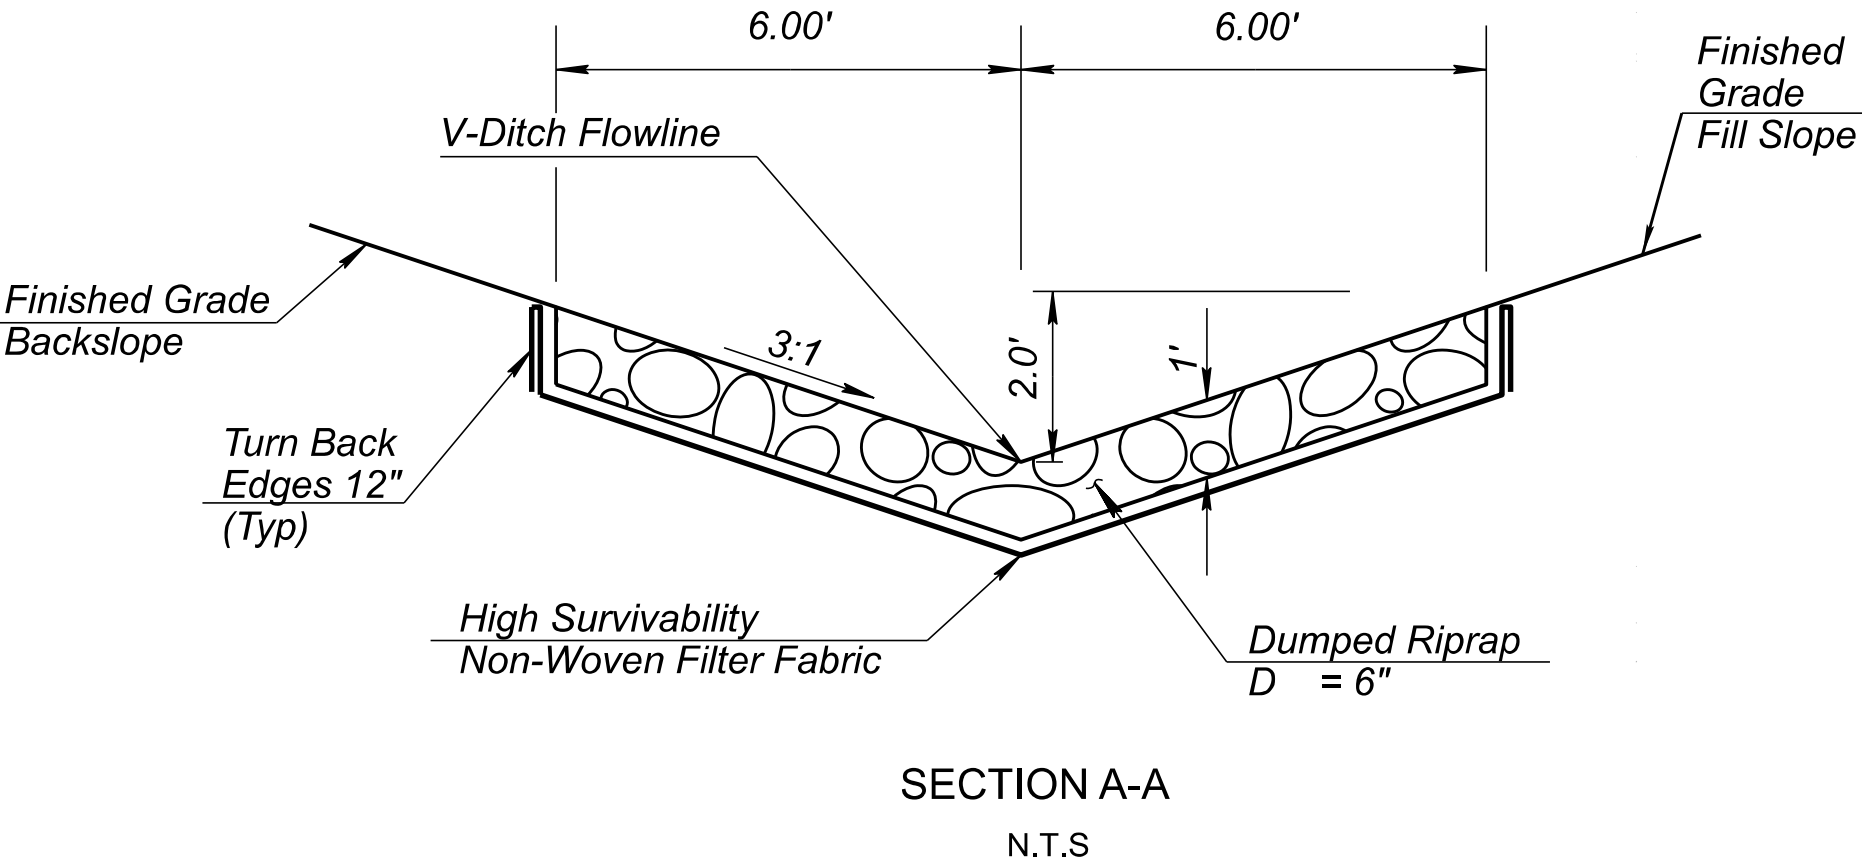

CHANNEL GRADING CONTROL POINTS			
Point No.	Nine Irons Ranch Rd Cst CL	Offset Lt	Elev
177	23+50.91	59.10	2486.23
178	23+50.13	53.15	2480.00
179	23+49.34	47.20	2486.21
180	21+62.78	66.45	2485.57
181	21+50.52	56.15	2479.74
182	21+40.74	45.35	2485.90

DETAIL D33

UTILITY DISPOSITION LEGEND

A

To Remain In Service - Protect in Place

B

Contractor to Relocate, Remove or Reset

C

To Be Relocated or Removed By Others

D

To Be Constructed By Others

Professional Engineer
19264
BILLY
DENETDALE
ARIZONA, U.S.A.

DESIGN	K LEANDER	06/26
DRAWN	B LEANDER	06/26
CHECKED	B DENETDALE	06/26

TRANSPORTATION
AECOM TECHNICAL SERVICES, Inc.
7720 N. 16th St., Suite 100
Phoenix, Arizona 85020
T 602.371.1100

AECOM

www.aecom.com



ARIZONA DEPARTMENT OF TRANSPORTATION
PROJECT DELIVERY AND OPERATIONS DIVISION
ROADWAY DESIGN SERVICES
PIPE DETAIL SHEET
DETAIL D33 - PIPE 110
E FRONTAGE RD STA 113+90

ROUTE	US 93
MILEPOST	189.9
STRUCTURE NO.	

F.H.W.A. Arizona Division	STATE	ARIZ.	PROJECT NO.	093 YV 189	FEDERAL ID NO.	093-B(230)T	SHEET NO.	112	TOTAL SHEETS	524	RECORD DRAWING
LOCATION		WICKENBURG RANCH WAY TO VISTA ROYALE								DWG No. D-2.33	
TRACS NO.		F0738 01C								____ OF ____	


LEANDERB 4/21/2026 10:01:31 AM

c:\pwworking\usaz\dms09621\0738_drpp20.dgn \ Model Name: Culvert_Frontage_111+43_1

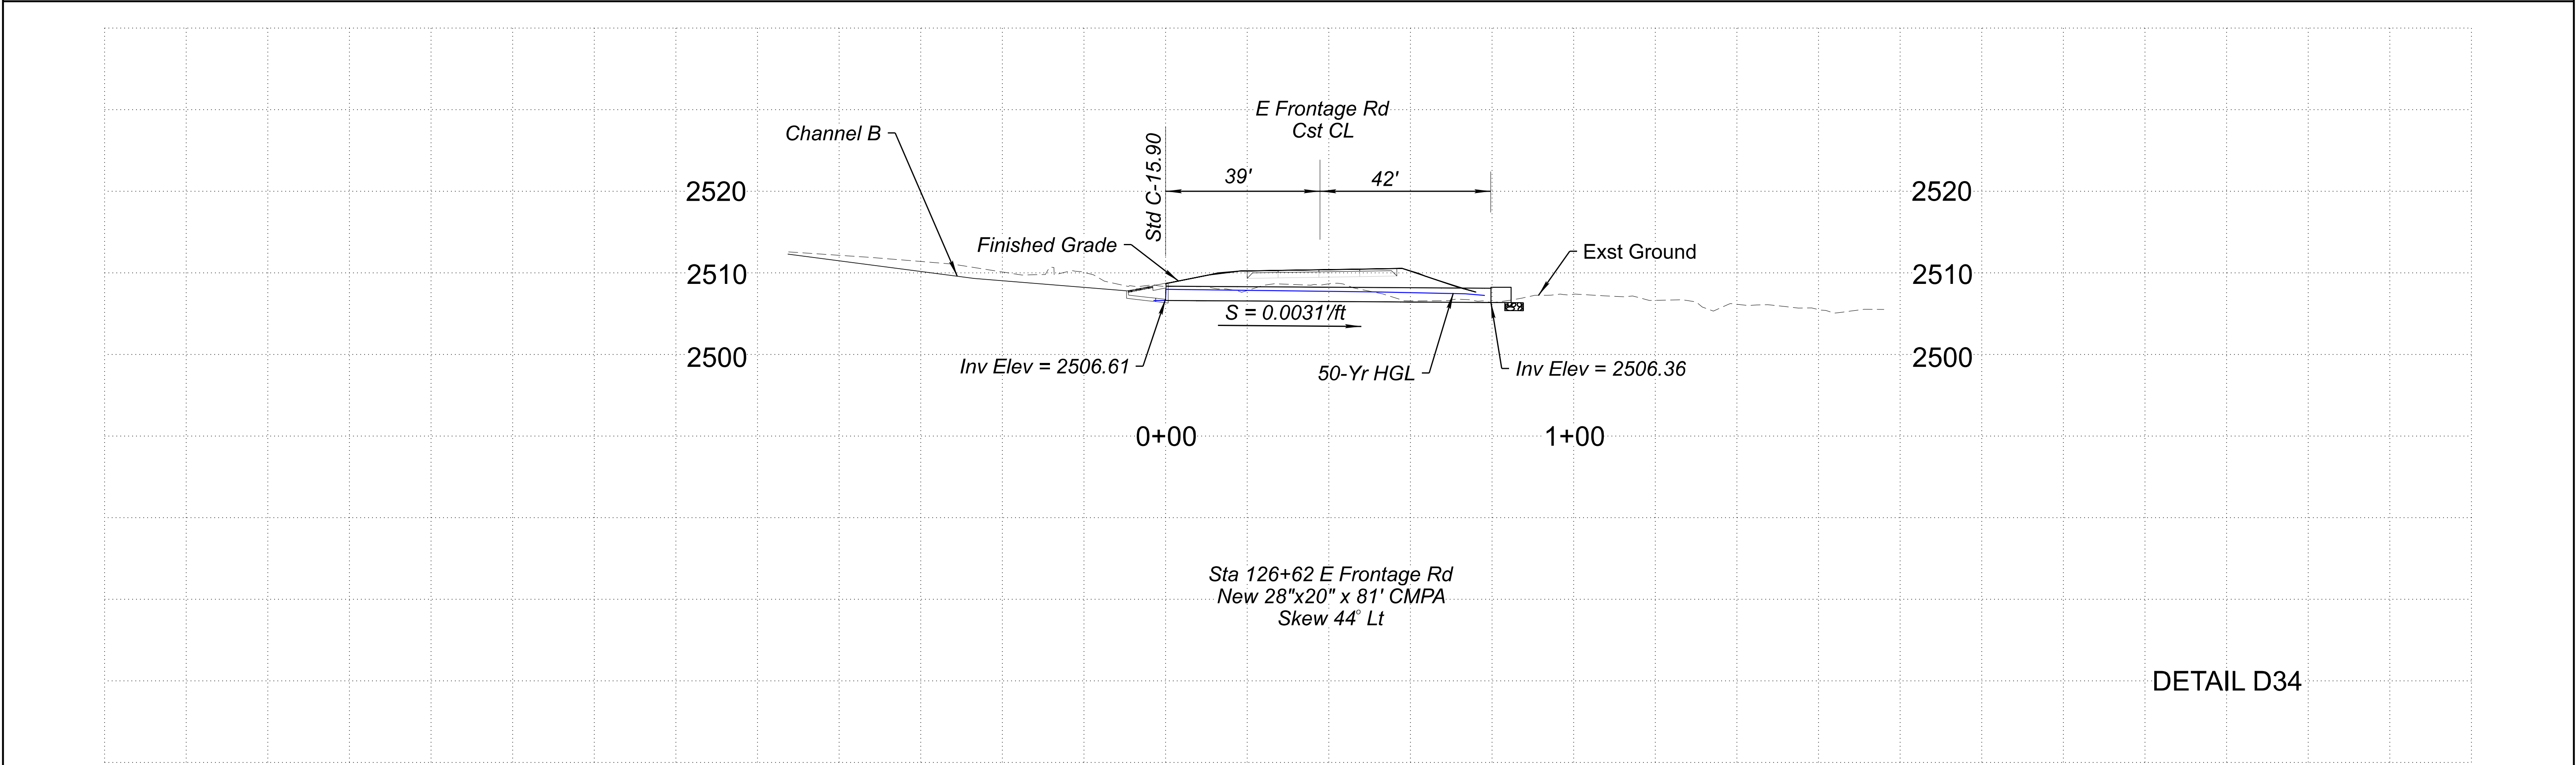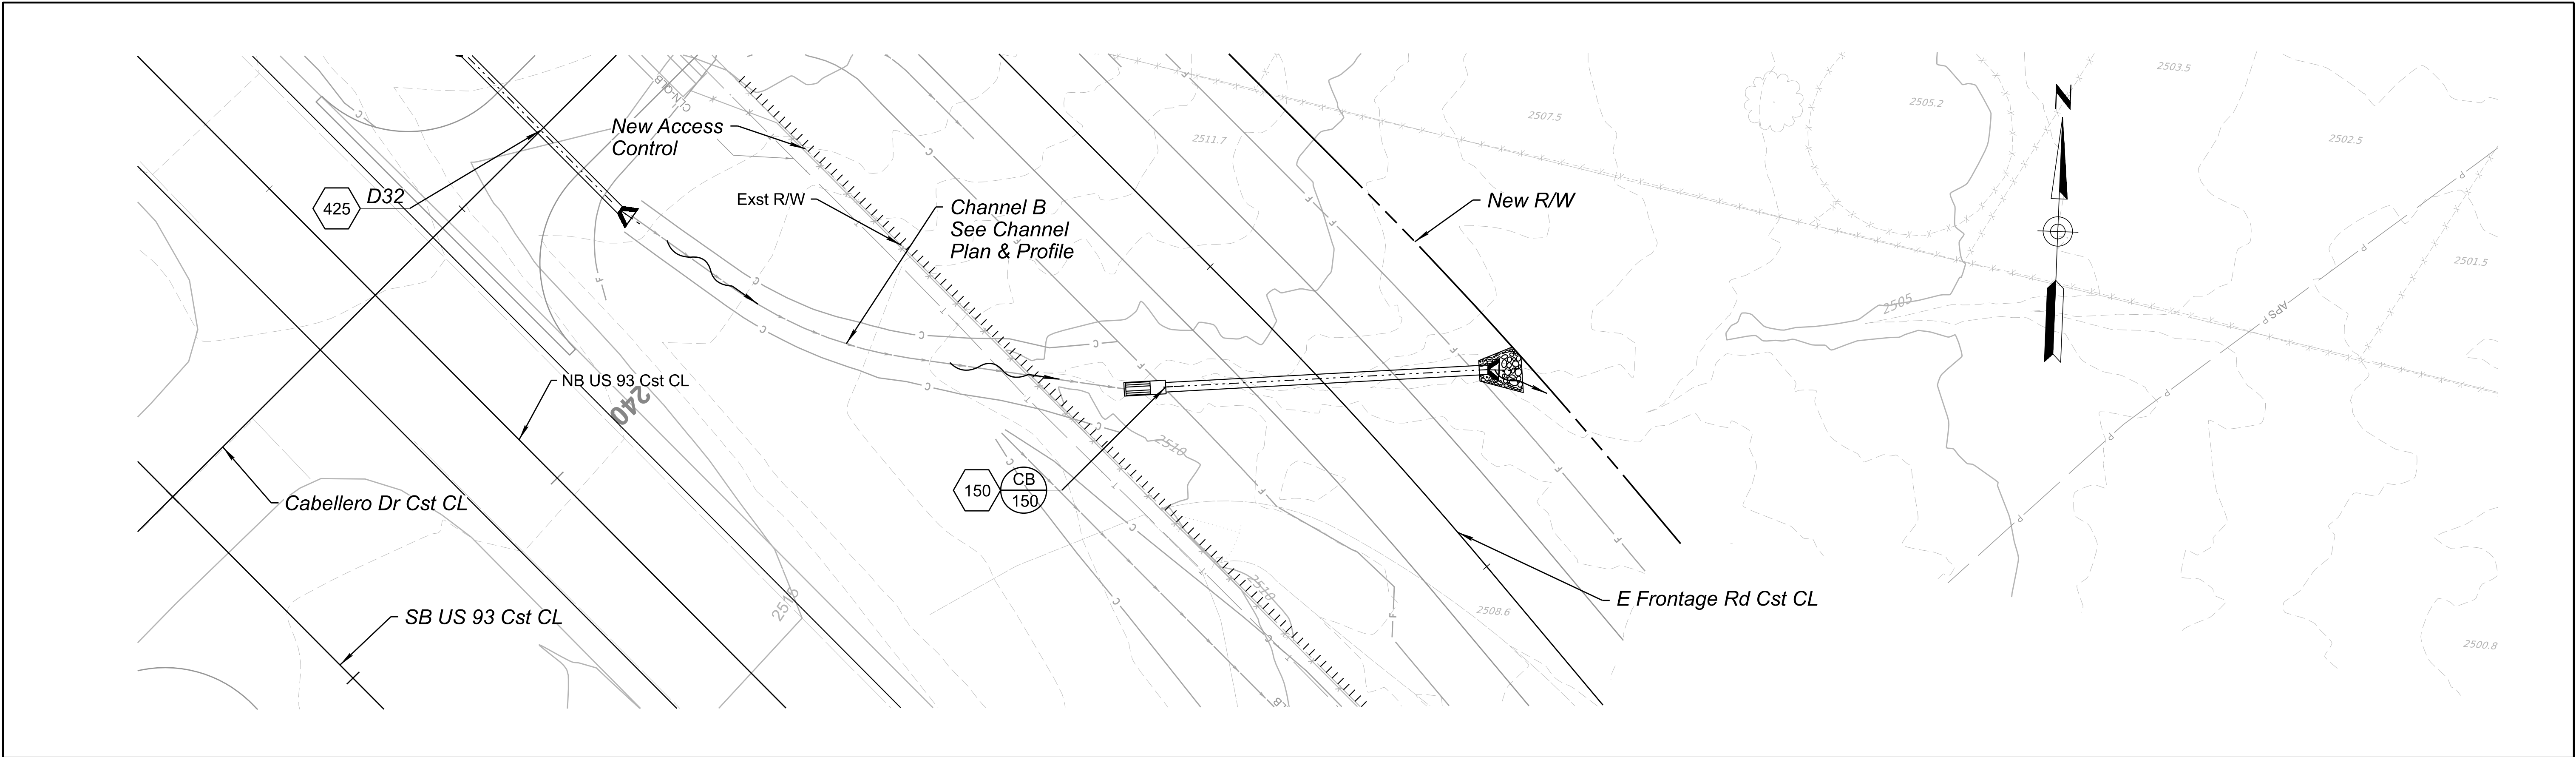


DETAIL D34

UTILITY DISPOSITION LEGEND A To Remain In Service - Protect in Place B Contractor to Relocate, Remove or Reset C To Be Relocated or Removed By Others D To Be Constructed By Others		<table><tr><th></th><th>NAME</th><th>DATE</th></tr><tr><td>DESIGN</td><td>K LEANDER</td><td>06/26</td></tr><tr><td>DRAWN</td><td>B LEANDER</td><td>06/26</td></tr><tr><td>CHECKED</td><td>B DENETDALE</td><td>06/26</td></tr></table>		NAME	DATE	DESIGN	K LEANDER	06/26	DRAWN	B LEANDER	06/26	CHECKED	B DENETDALE	06/26	TRANSPORTATION ARIZONA DEPARTMENT OF TRANSPORTATION PROJECT DELIVERY AND OPERATIONS DIVISION ROADWAY DESIGN SERVICES PIPE DETAIL SHEET DETAIL D34 - PIPE 150 E FRONTAGE RD STA 126+62	ROUTE US 93 MILEPOST 189.9 STRUCTURE NO.	F.H.W.A. Arizona Division STATE ARIZ. PROJECT NO. 093 YV 189 FEDERAL ID NO. 093-B(230)T SHEET NO. 113 TOTAL SHEETS 524 LOCATION WICKENBURG RANCH WAY TO VISTA ROYALE TRACS NO. F0738 01C	RECORD DRAWING DWG No. D-2.34 OF
				NAME	DATE													
			DESIGN	K LEANDER	06/26													
			DRAWN	B LEANDER	06/26													
CHECKED	B DENETDALE	06/26																

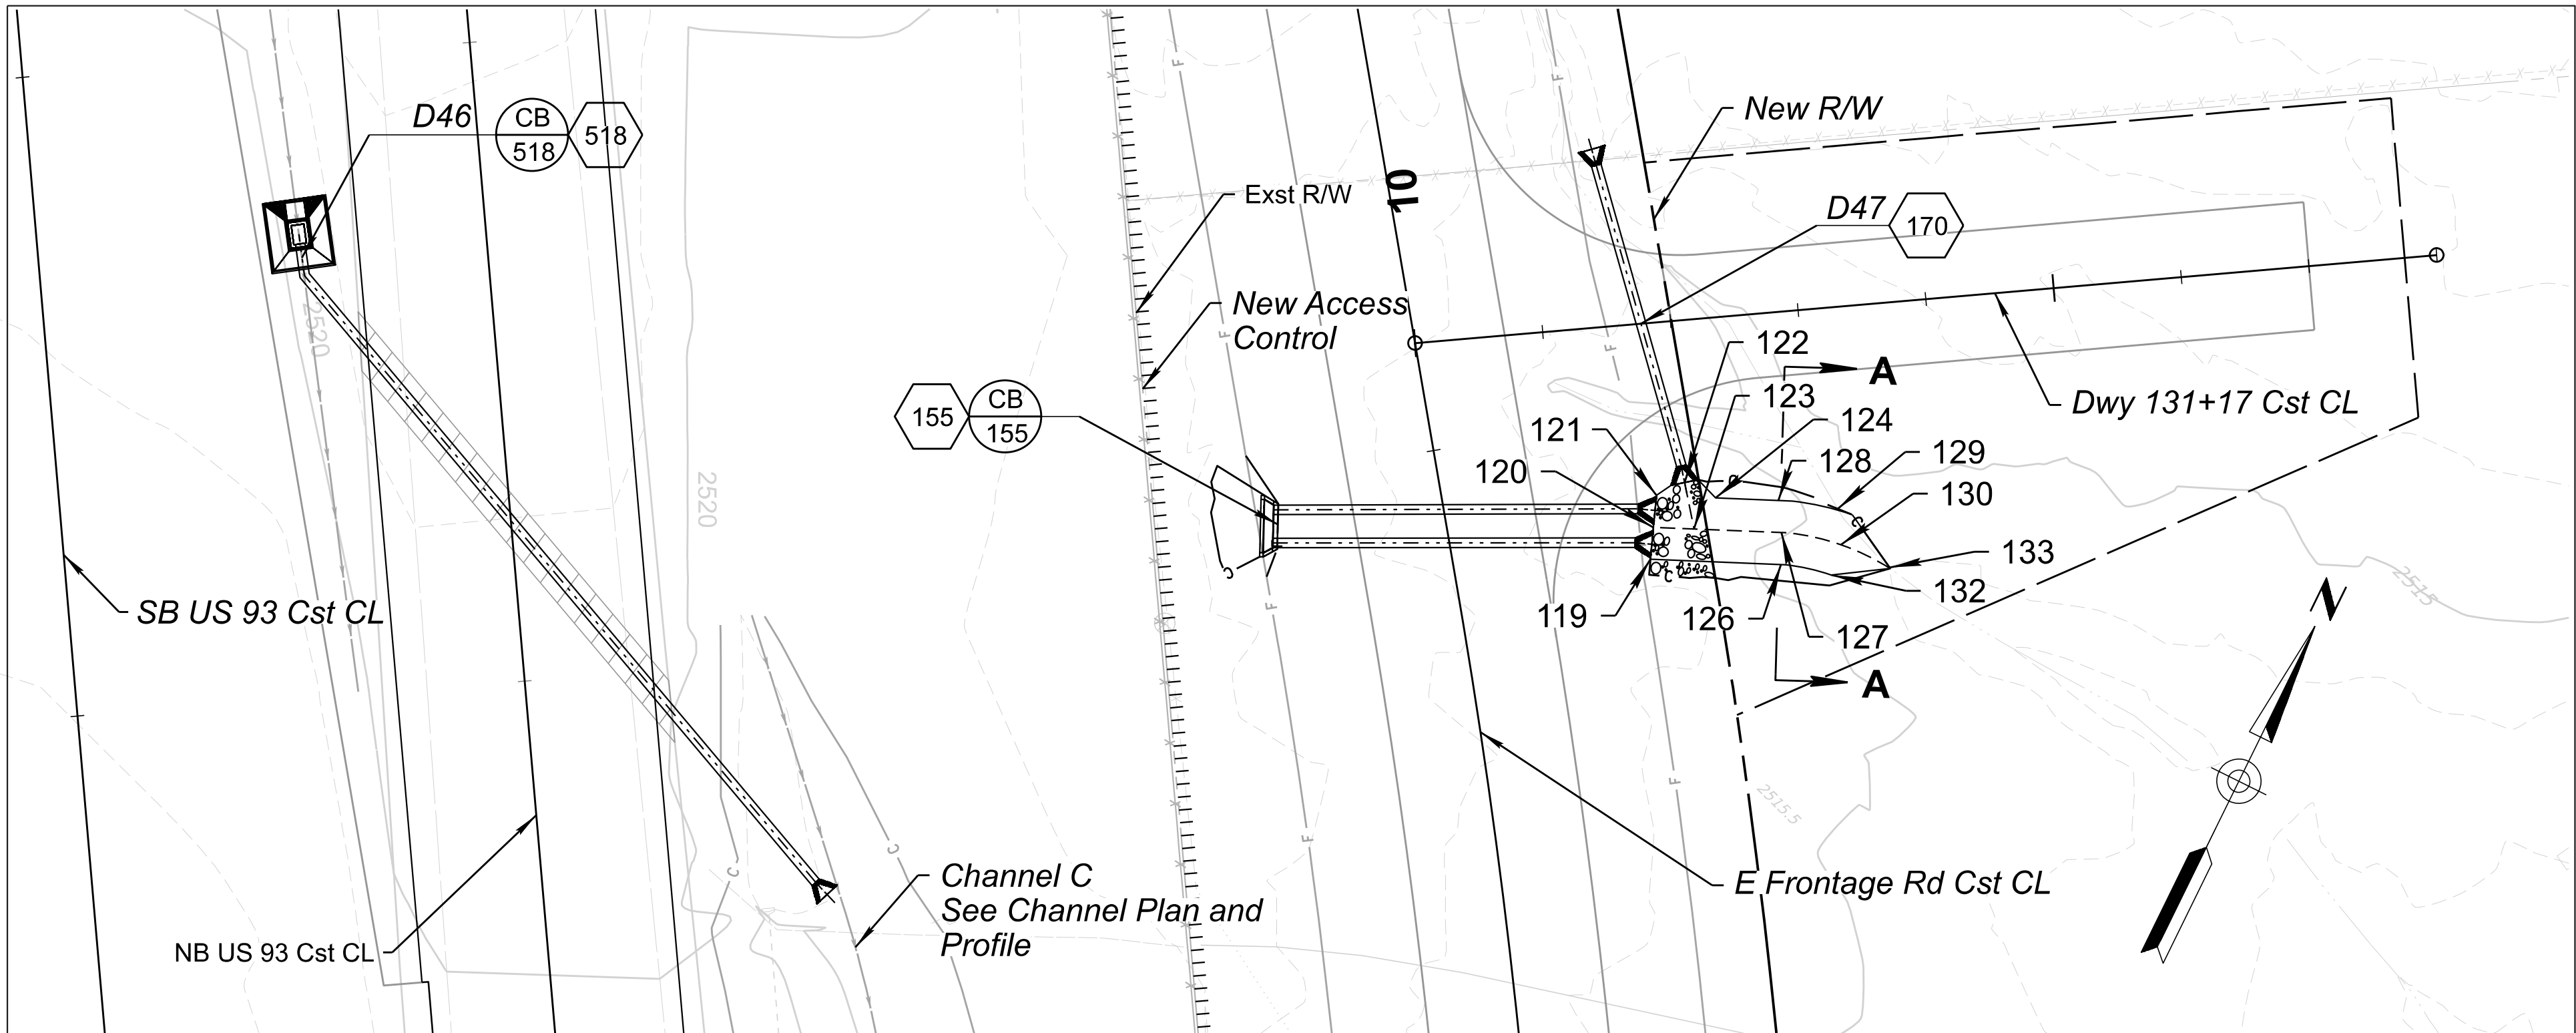


RIPRAP QUANTITIES 155/ 170		
Area	122.78	sq ft
Depth	1.00	ft
Volume	4.55	cu yd

Note: See Detail DR for Riprap Gradation

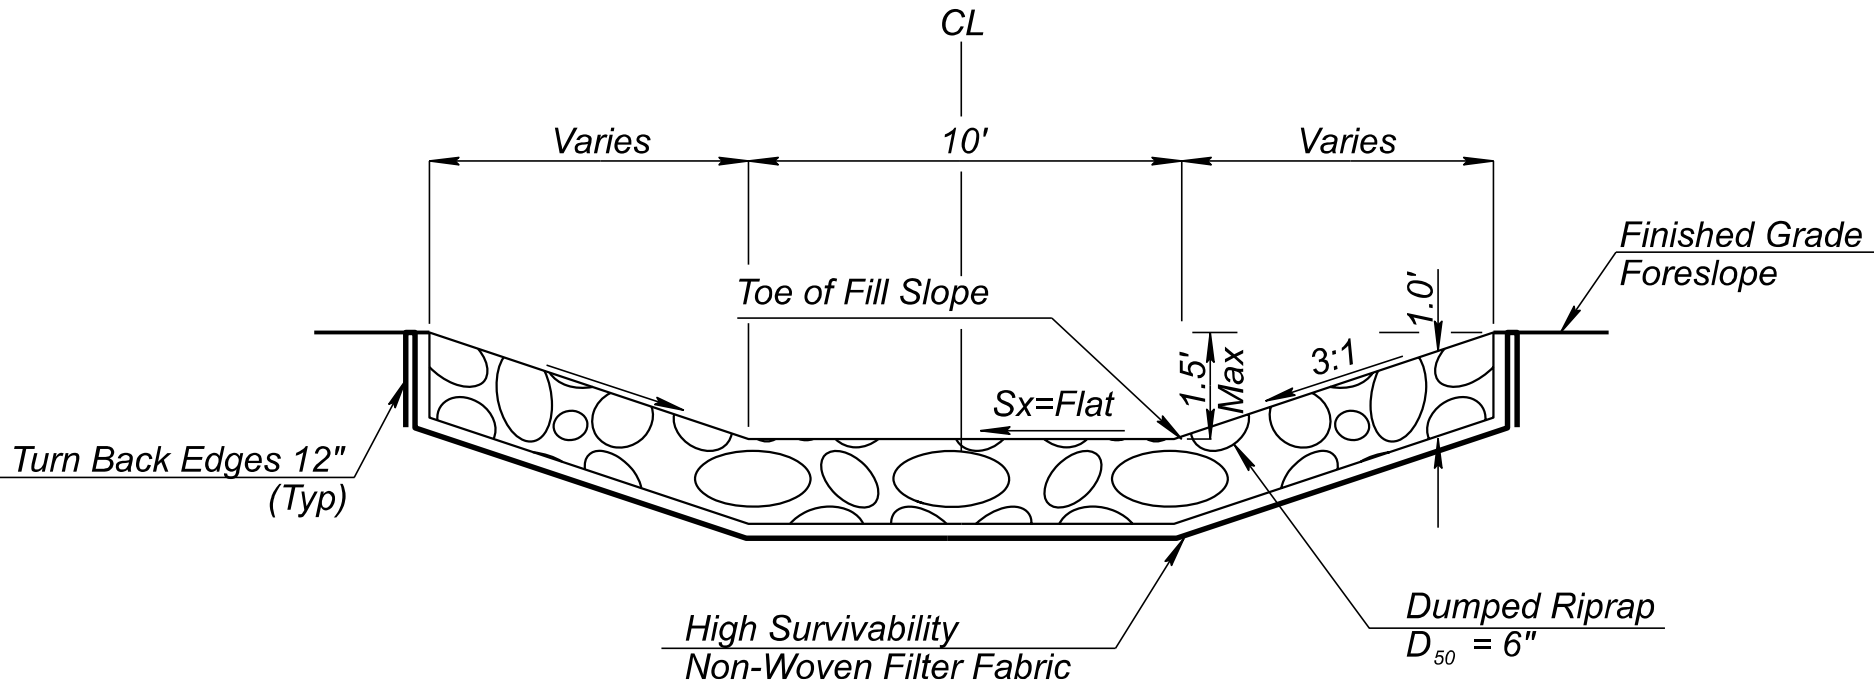


NOTE: RIPRAP ONLY WHERE SHOWN ON PLAN

SECTION A-A
N.T.S

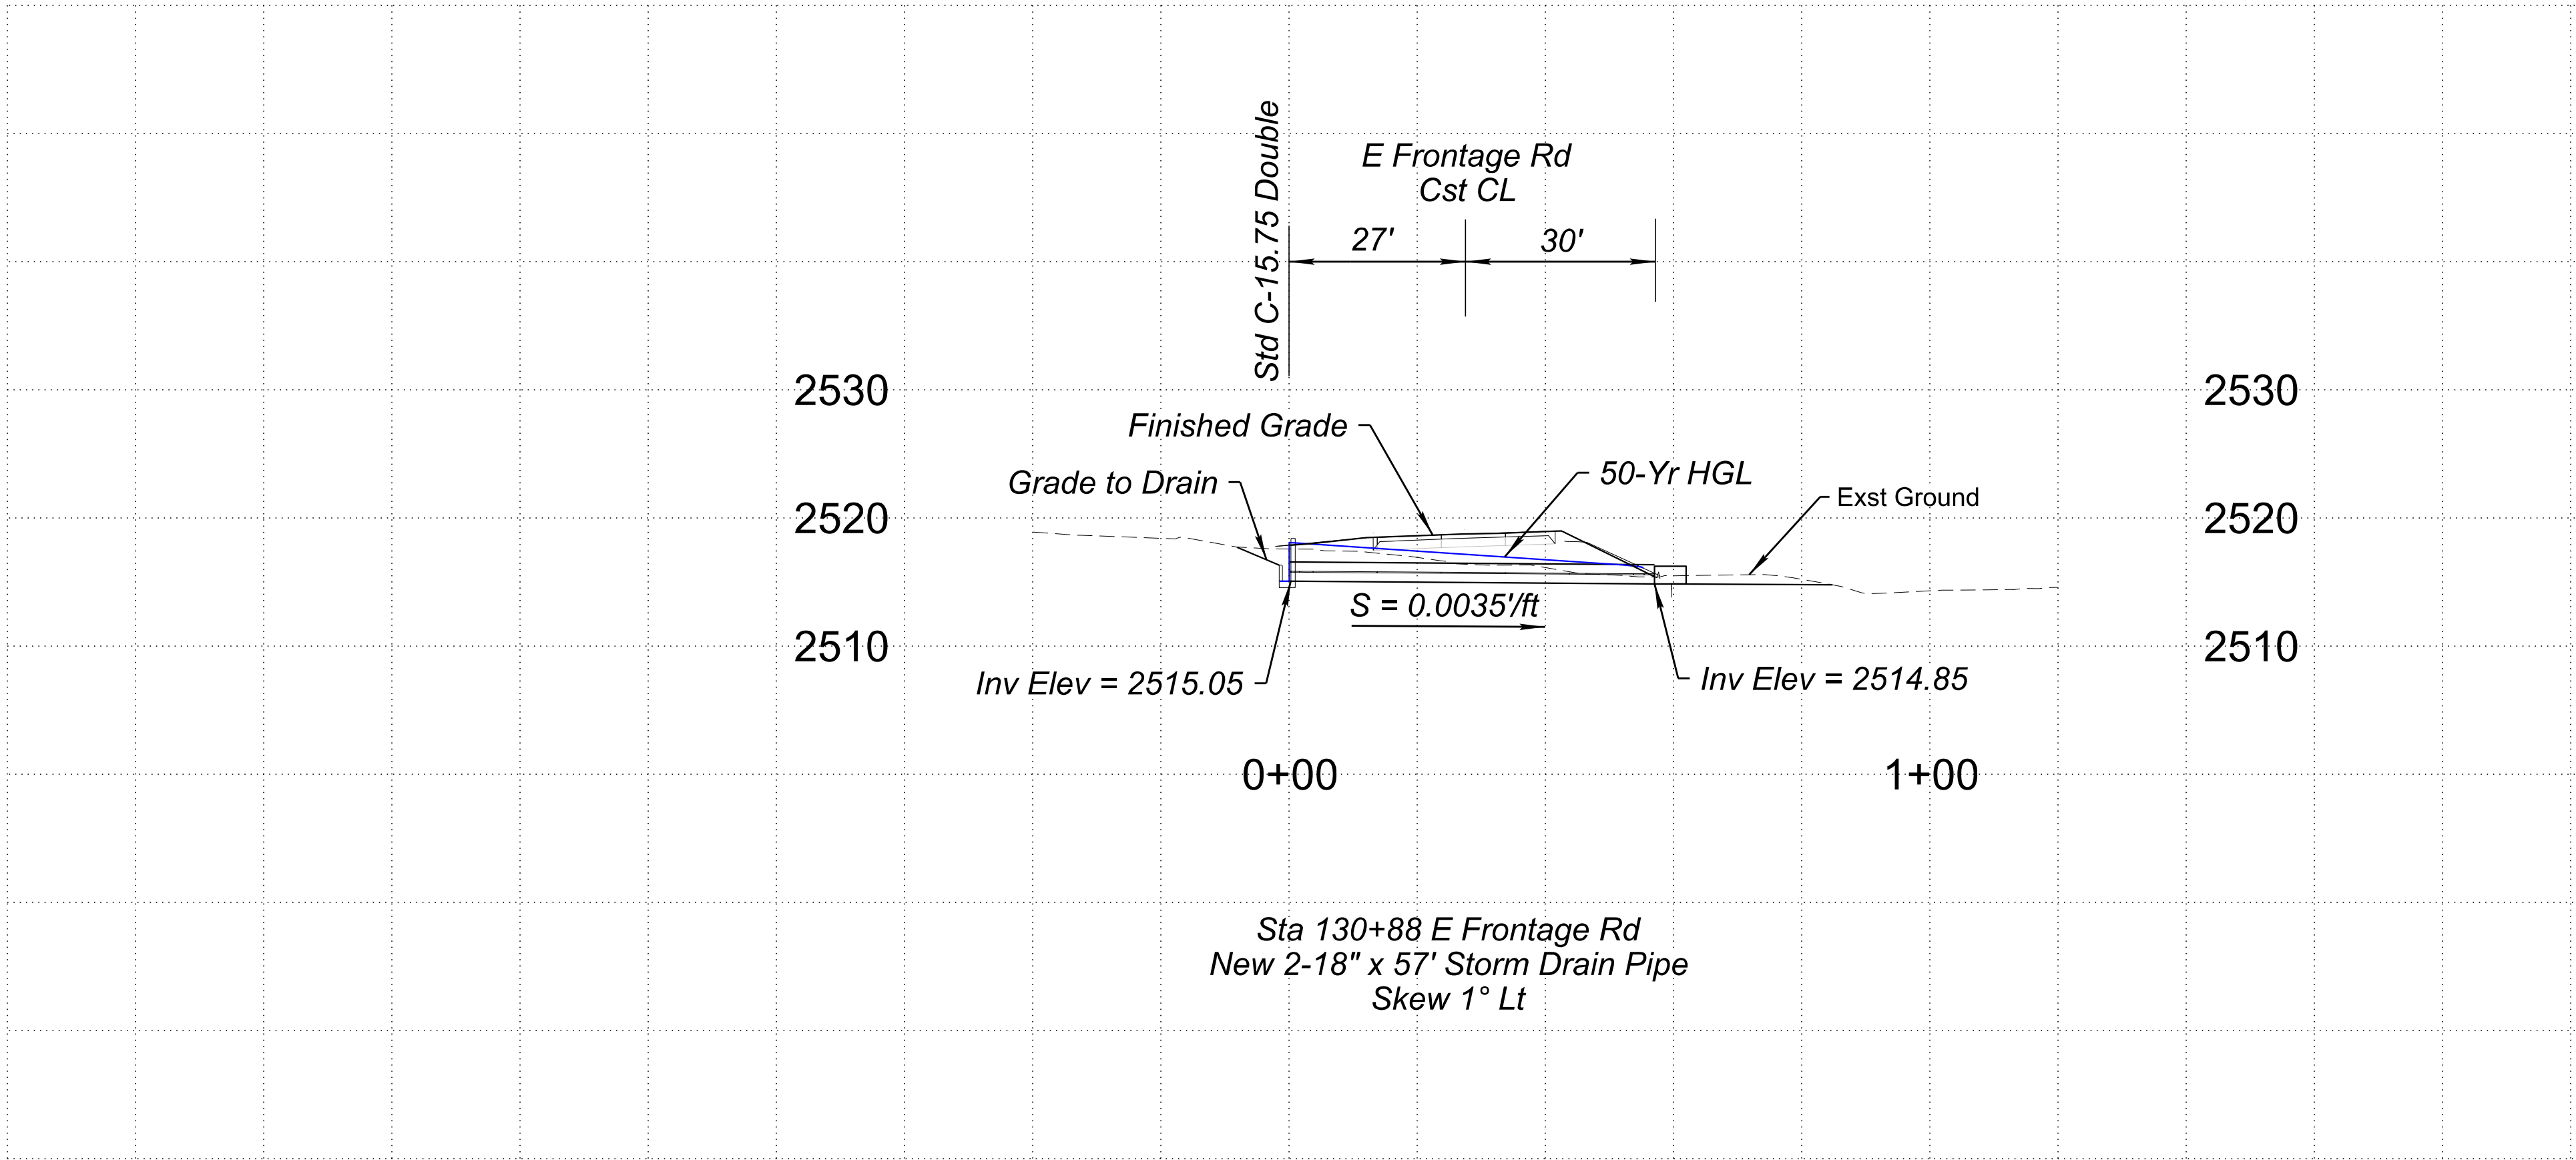

CHANNEL GRADING CONTROL POINTS			
Point No.	East Frontage Rd Cst CL	Offset Rt	Elev
119	130+77.56	30.48	2514.85
120	130+82.40	31.79	2514.85
121	130+87.23	33.10	2514.85
122	130+88.47	37.78	2515.00
123	130+81.06	37.99	2514.83
124	130+85.29	42.14	2514.64
126	130+73.49	50.27	2514.41
127	130+78.22	51.31	2514.41
128	130+83.10	52.36	2514.41
129	130+79.09	62.71	2514.18+/-
130	130+74.85	60.29	2514.19
132	130+70.70	57.88	2514.19
133	130+70.25	67.17	2514.00+/-

DETAIL D35

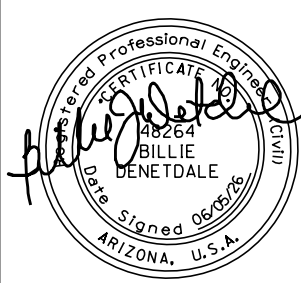

	NAME	DATE
DESIGN	K LEANDER	06/26
DRAWN	B LEANDER	06/26
CHECKED	B DENETDALE	06/26


TRANSPORTATION
AECOM TECHNICAL SERVICES, Inc.
7720 N. 16th St., Suite 100
Phoenix, Arizona 85027
T 602.371.1100
www.aecom.com

AECOM

ARIZONA DEPARTMENT OF TRANSPORTATION
PROJECT DELIVERY AND OPERATIONS DIVISION
ROADWAY DESIGN SERVICES
PIPE DETAIL SHEET
DETAIL D35 - PIPE 155
E FRONTAGE RD STA 130+88



ROUTE	US 93
MILEPOST	189.9
STRUCTURE NO.	

F.H.W.A. Arizona Division	STATE	PROJECT NO.	FEDERAL ID NO.	SHEET NO.	TOTAL SHEETS	RECORD DRAWING	
	ARIZ.	093 YV 189	093-B(230)T	114	524		
LOCATION					WICKENBURG RANCH WAY TO VISTA ROYALE		DWG No. D-2.35
TRACS NO.		F0738 01C				____ OF ____	

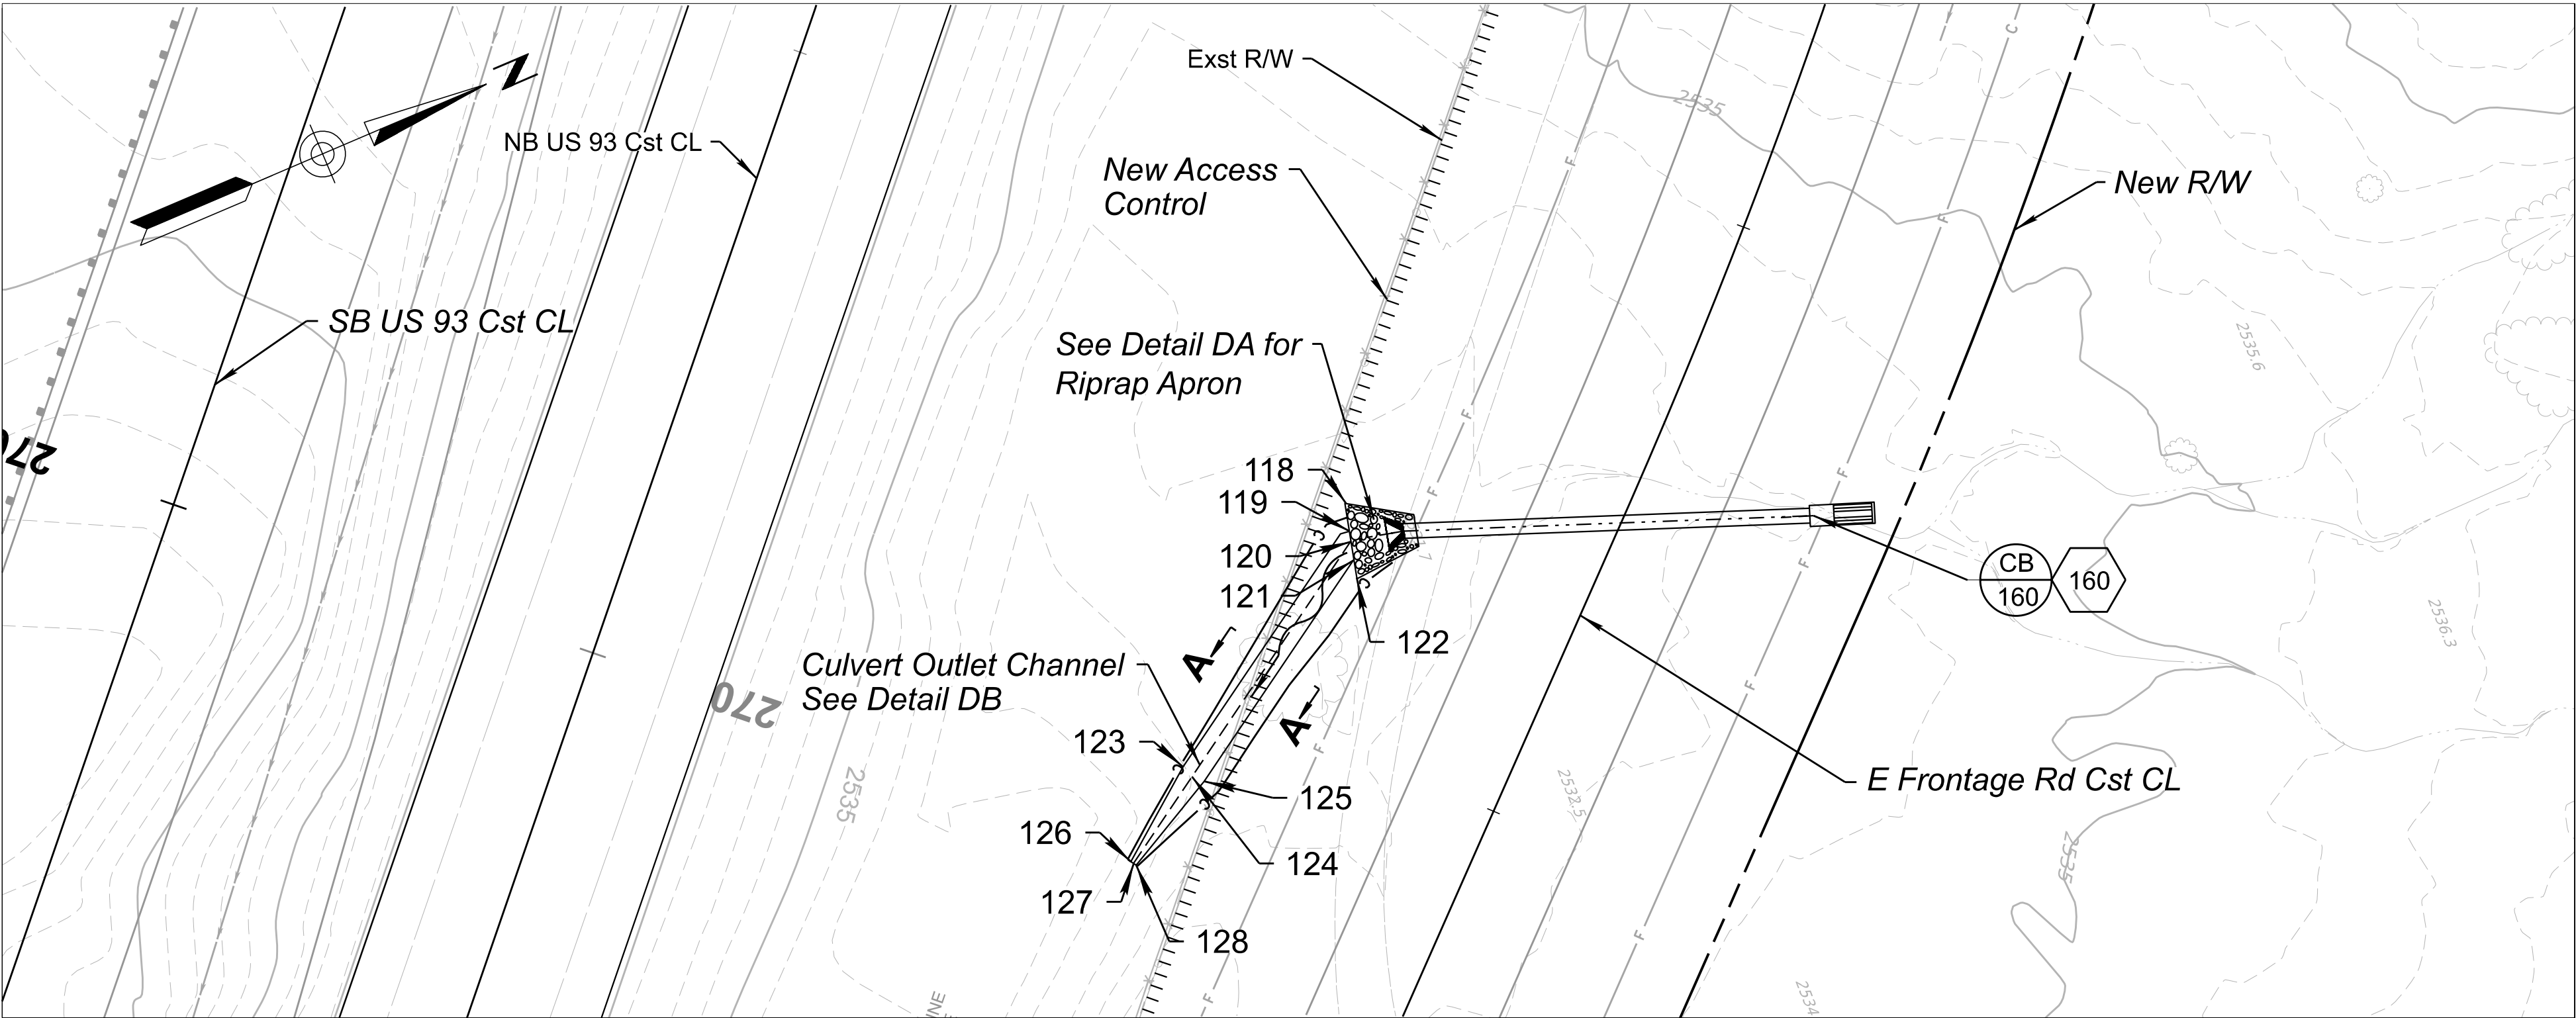


RIPRAP QUANTITIES 160		
Area	218.34	sq ft
Depth	1.00	ft
Volume*	8.09	cu yd

Note: See Detail DR for Riprap Gradation
* See Detail DA for Apron Quantity

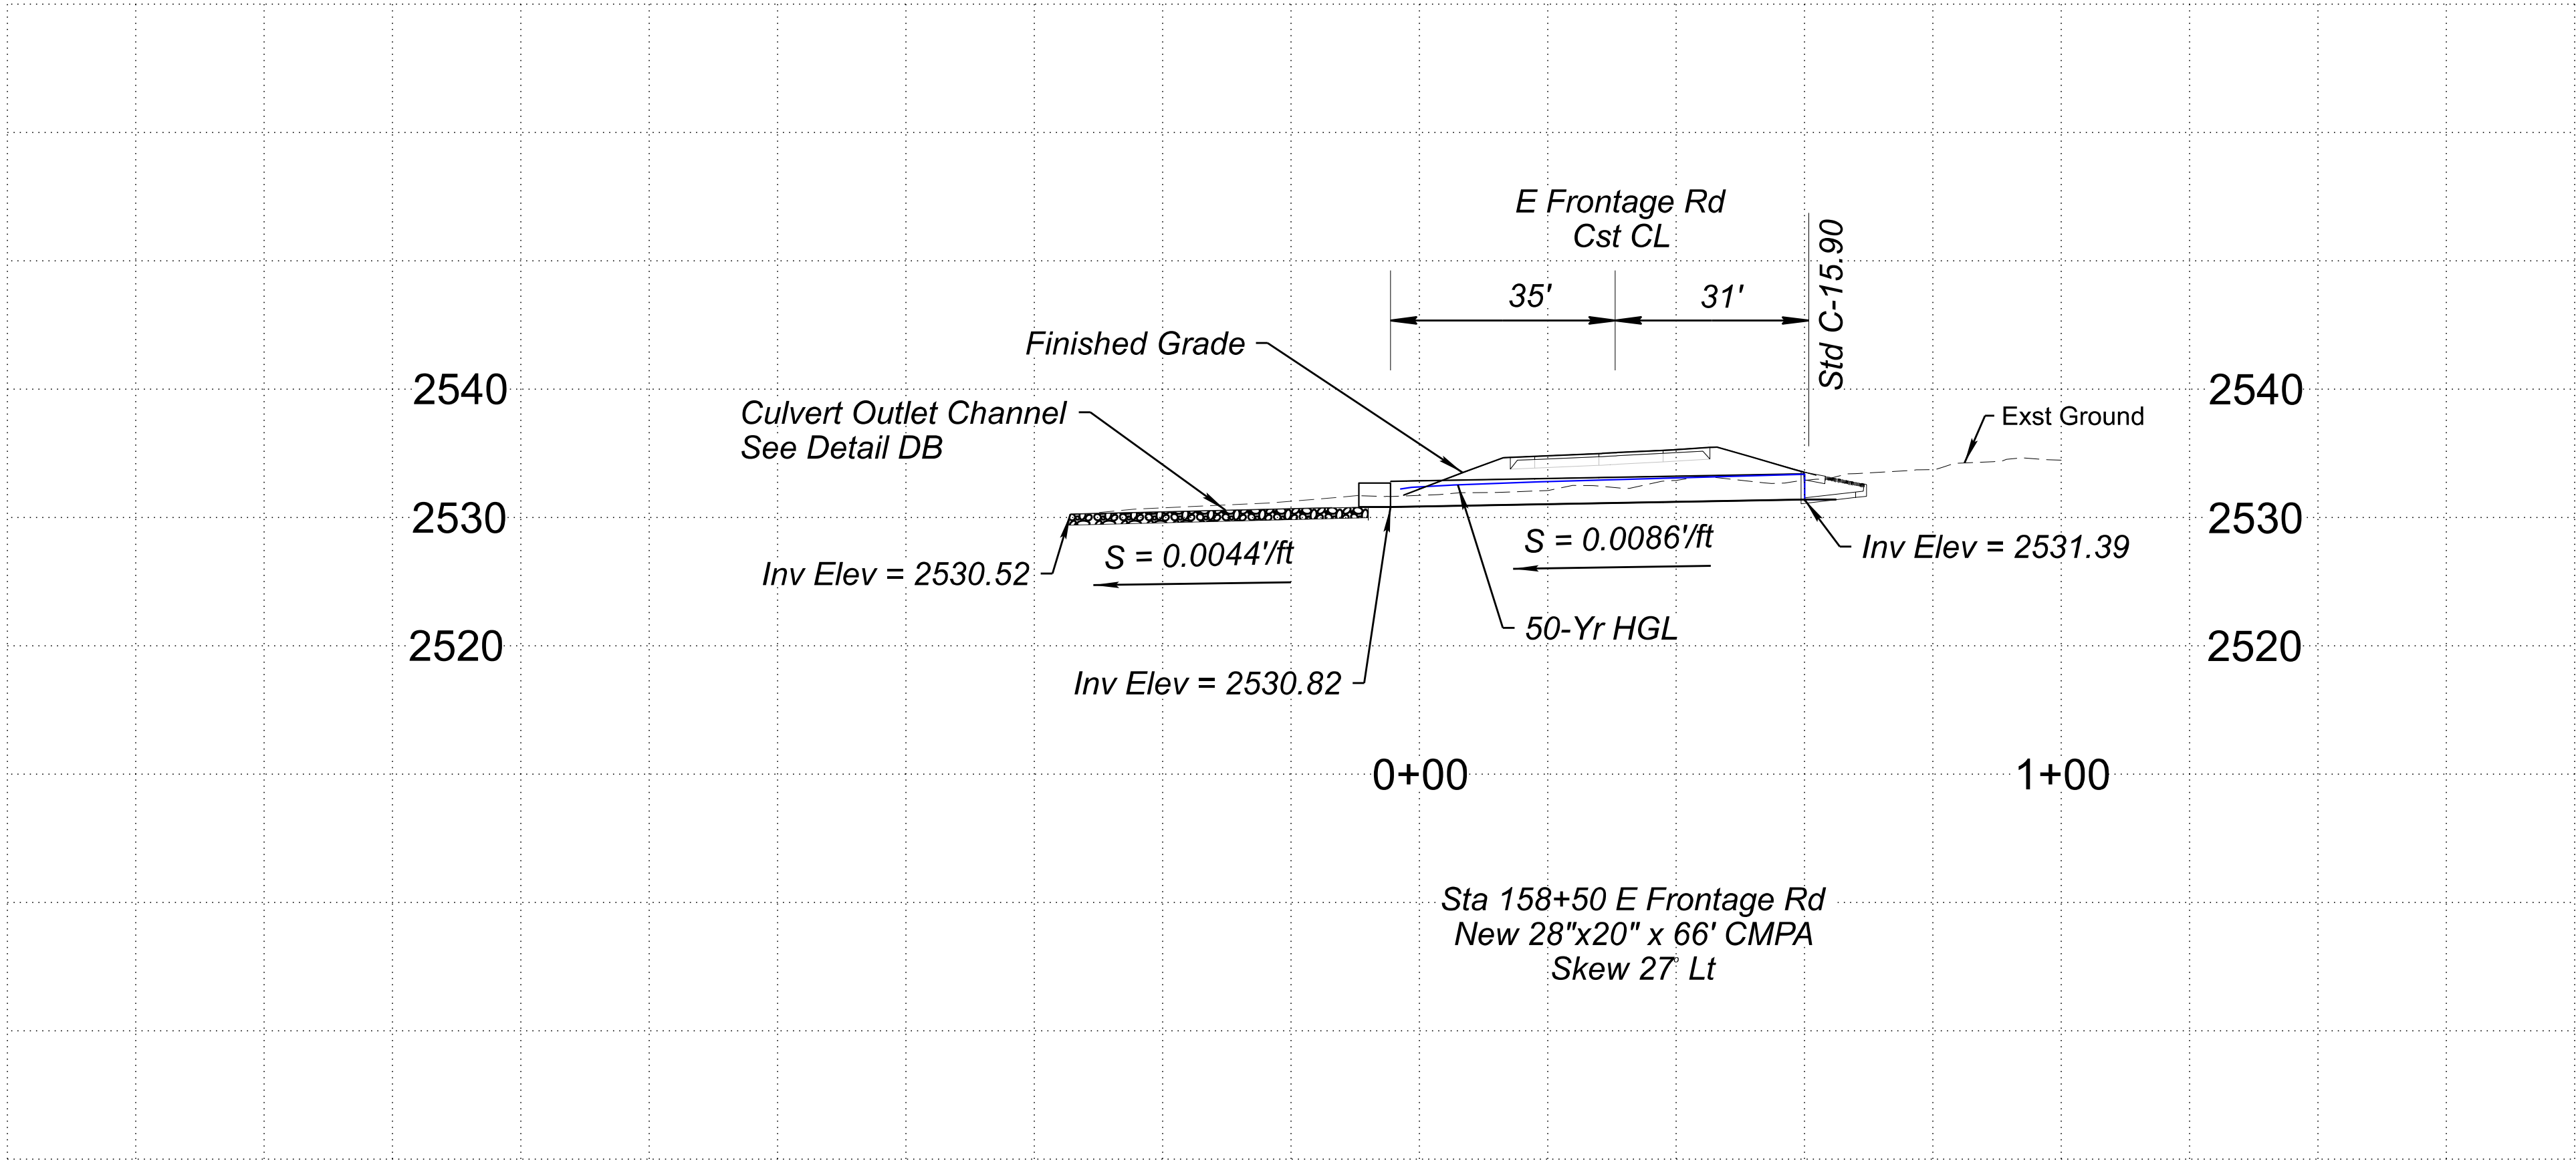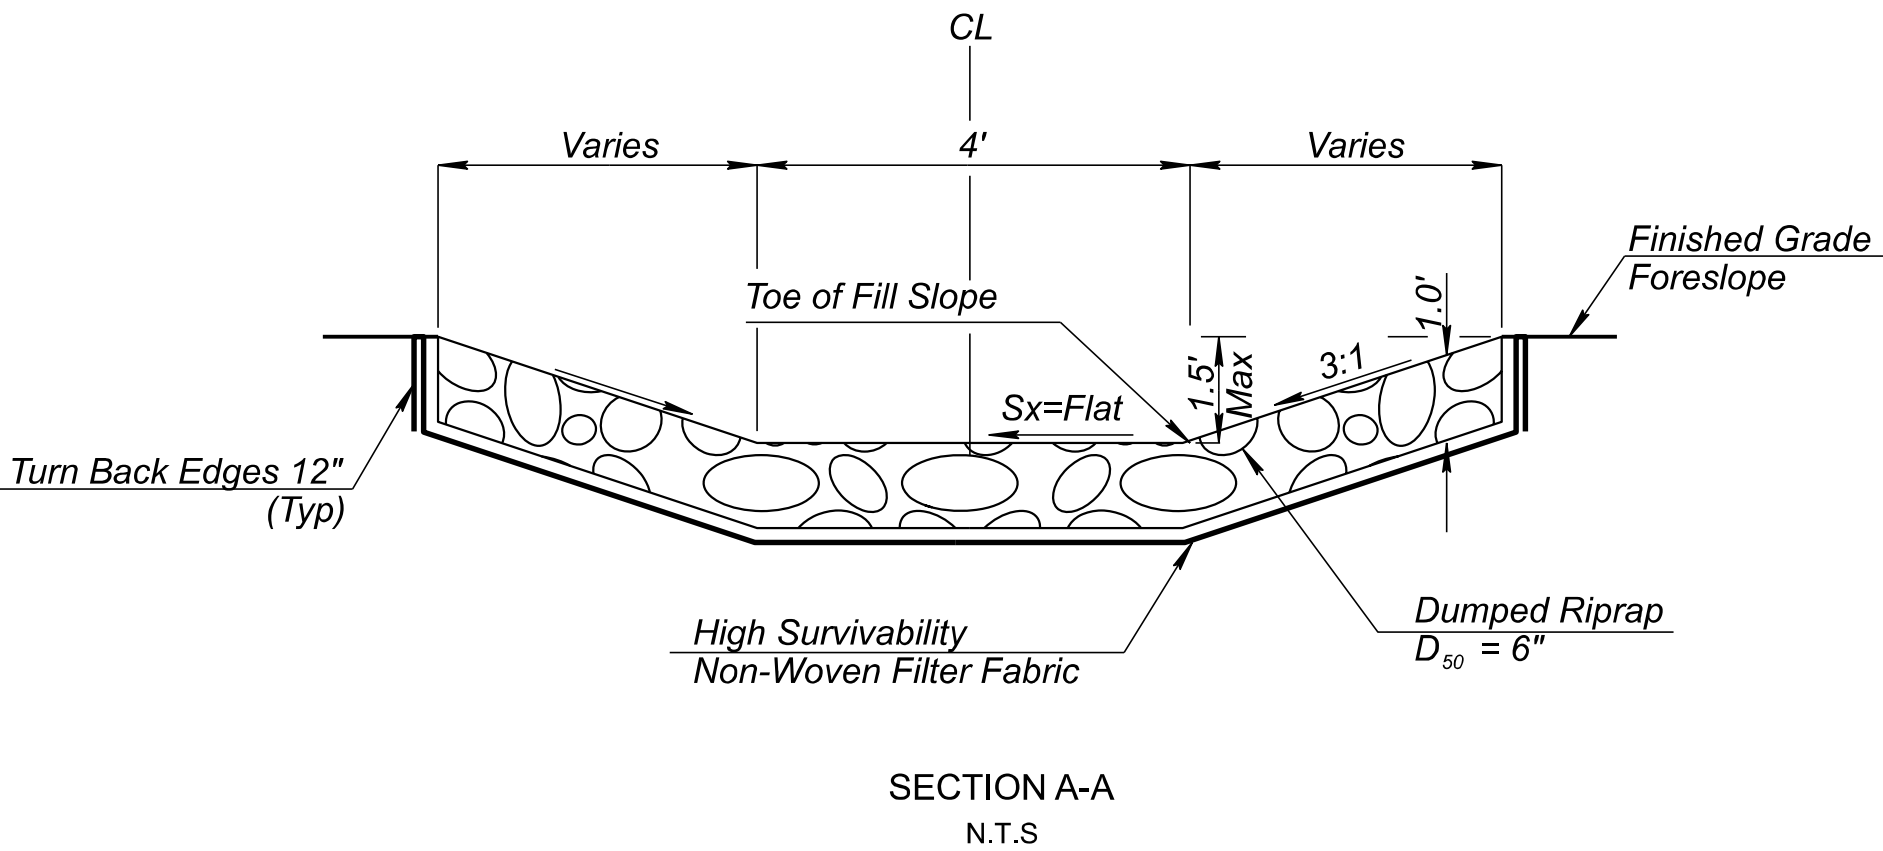

CHANNEL GRADING CONTROL POINTS			
Point No.	East Frontage Rd Cst CL	Offset Lt	Elev
118	158+34.86	40.99	2531.70
119	158+31.12	38.56	2531.77
120	158+29.83	37.72	2530.79
121	158+27.38	36.13	2531.86
122	158+24.80	34.45	2531.90
123	157+86.64	47.49	2530.76
124	157+86.28	45.52	2530.60
125	157+85.93	43.55	2531.22
126	157+69.68	49.00	2530.61
127	157+69.59	48.51	2530.52
128	157+69.50	48.02	2530.58

DETAIL D36

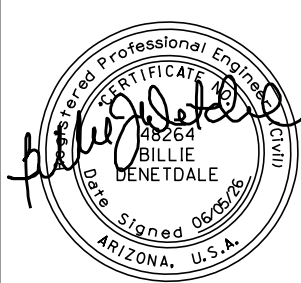

	NAME	DATE
DESIGN	K LEANDER	06/26
DRAWN	B LEANDER	06/26
CHECKED	B DENETDALE	06/26


TRANSPORTATION
AECOM TECHNICAL SERVICES, Inc.
7720 N. 168th St., Suite 100
Phoenix, Arizona 85020
T 602.371.1100

AECOM
www.aecom.com

ARIZONA DEPARTMENT OF TRANSPORTATION
PROJECT DELIVERY AND OPERATIONS DIVISION
ROADWAY DESIGN SERVICES
PIPE DETAIL SHEET
DETAIL D36 - PIPE 160
E FRONTAGE RD STA 158+50


ROUTE US 93	F.H.W.A. Arizona Division	STATE	PROJECT NO.	FEDERAL ID NO.	SHEET NO.	TOTAL SHEETS	RECORD DRAWING
MILEPOST 189.9		ARIZ.	093 YV 189	093-B(230)T	115	524	
	LOCATION WICKENBURG RANCH WAY TO VISTA ROYALE						DWG No. D-2.36
STRUCTURE NO.	TRACS NO. F0738 01C		OF				

093 YV 189

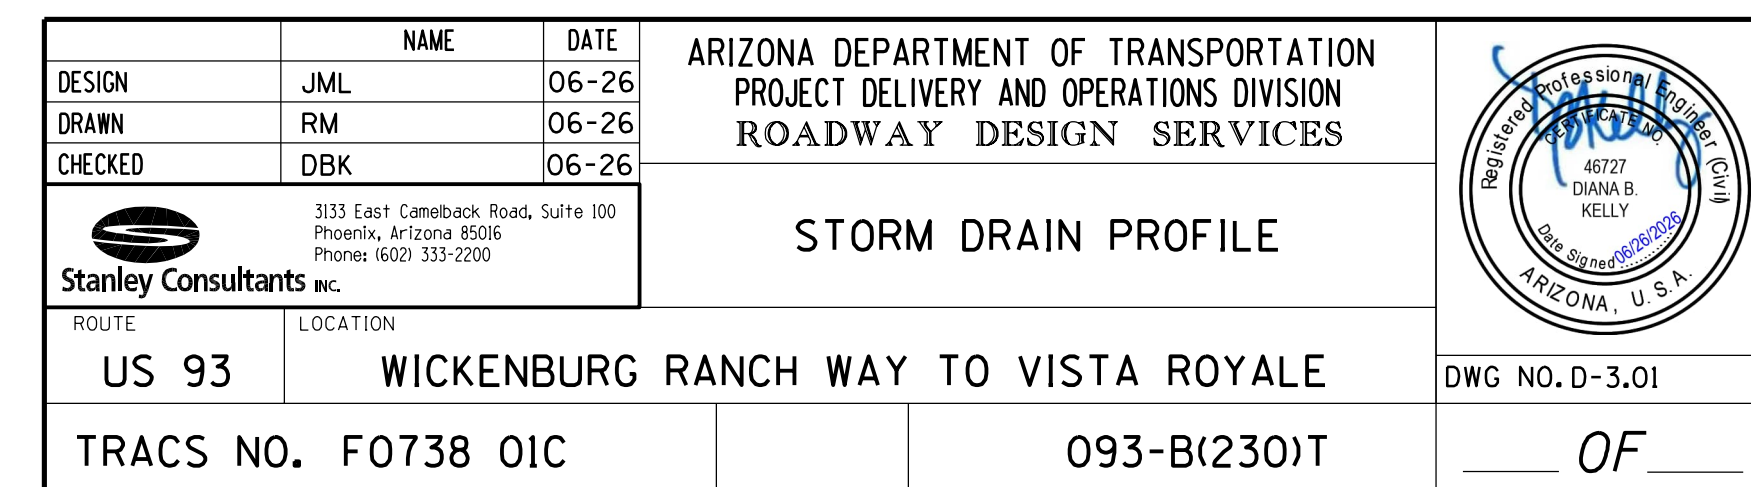

F.H.W.A. REGION	STATE	PROJECT NO.	SHEET NO.	TOTAL SHEETS	RECORD DRAWING
9	ARIZ.	093-B(230)T	117	524	

093 YV 189

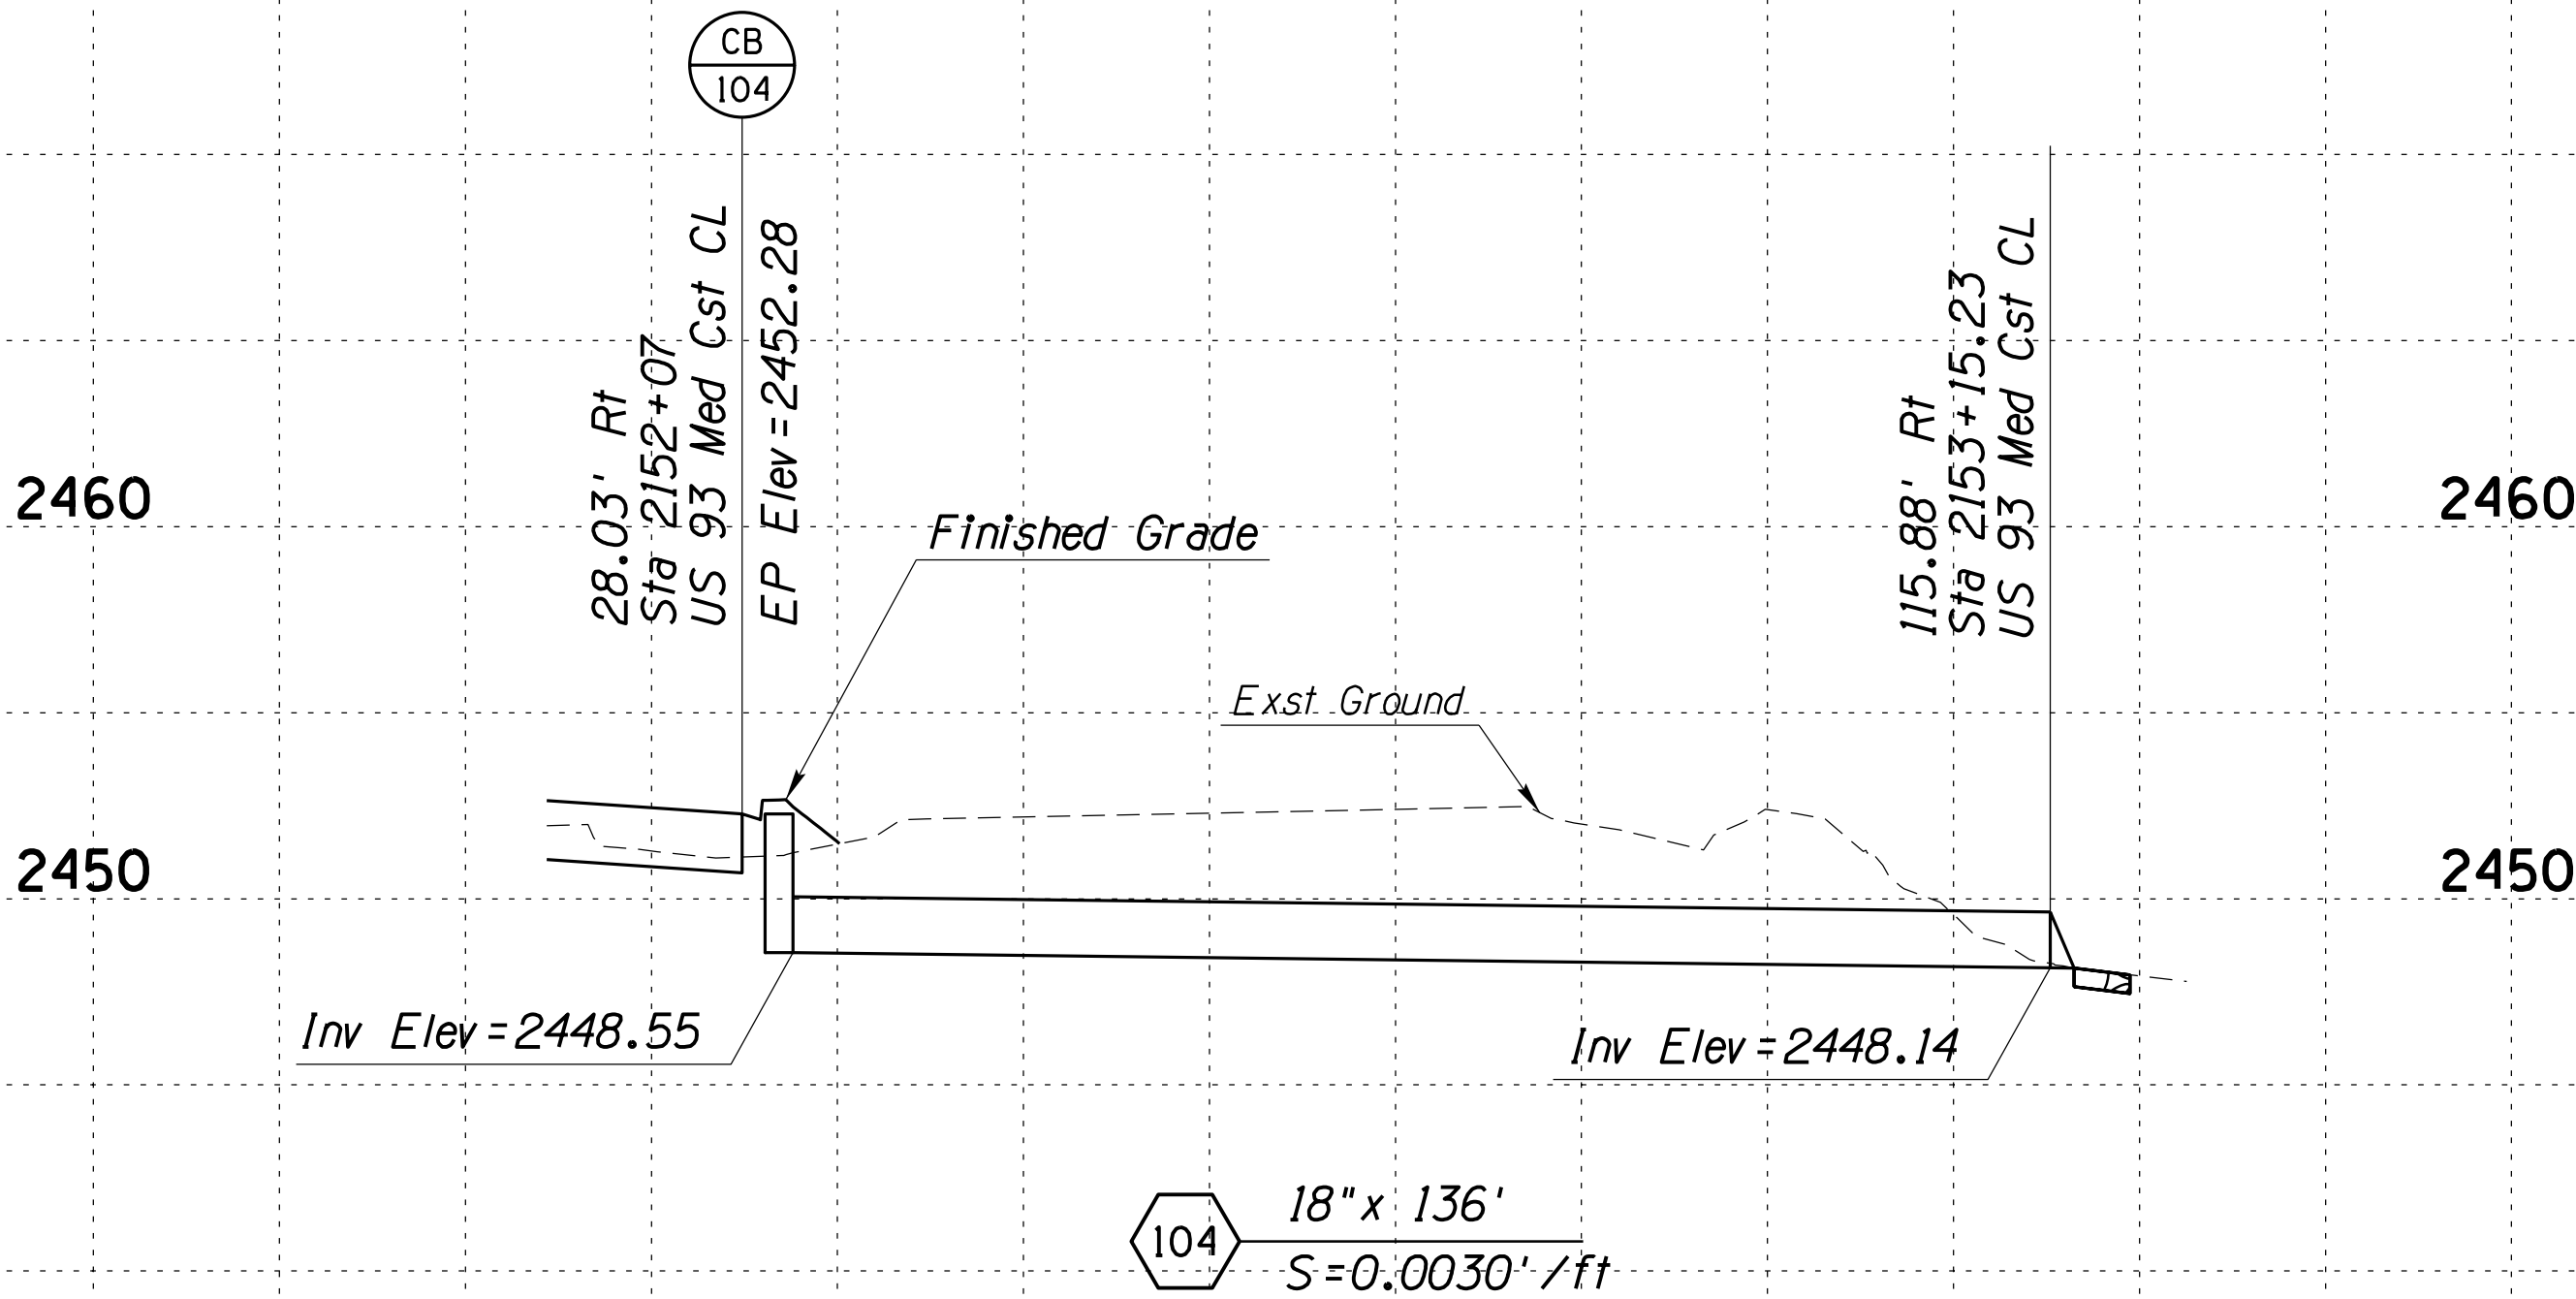

DESIGN	JML	DATE	06-26
DRAWN	RM	DATE	06-26
CHECKED	DBK	DATE	06-26



3133 East Camelback Road, Suite 100
Phoenix, Arizona 85016
Phone: (602) 333-2200

ARIZONA DEPARTMENT OF TRANSPORTATION
PROJECT DELIVERY AND OPERATIONS DIVISION
ROADWAY DESIGN SERVICES

ROUTE

US 93

LOCATION

WICKENBURG RANCH WAY TO VISTA ROYALE

TRACS NO.

F0738 OIC

093-B(230)T



DWG NO. D-3.02

OF



F.H.W.A. REGION	STATE	PROJECT NO.	SHEET NO.	TOTAL SHEETS	RECORD DRAWING
9	ARIZ.	093-B(230)T	119	524	


093 YV 189

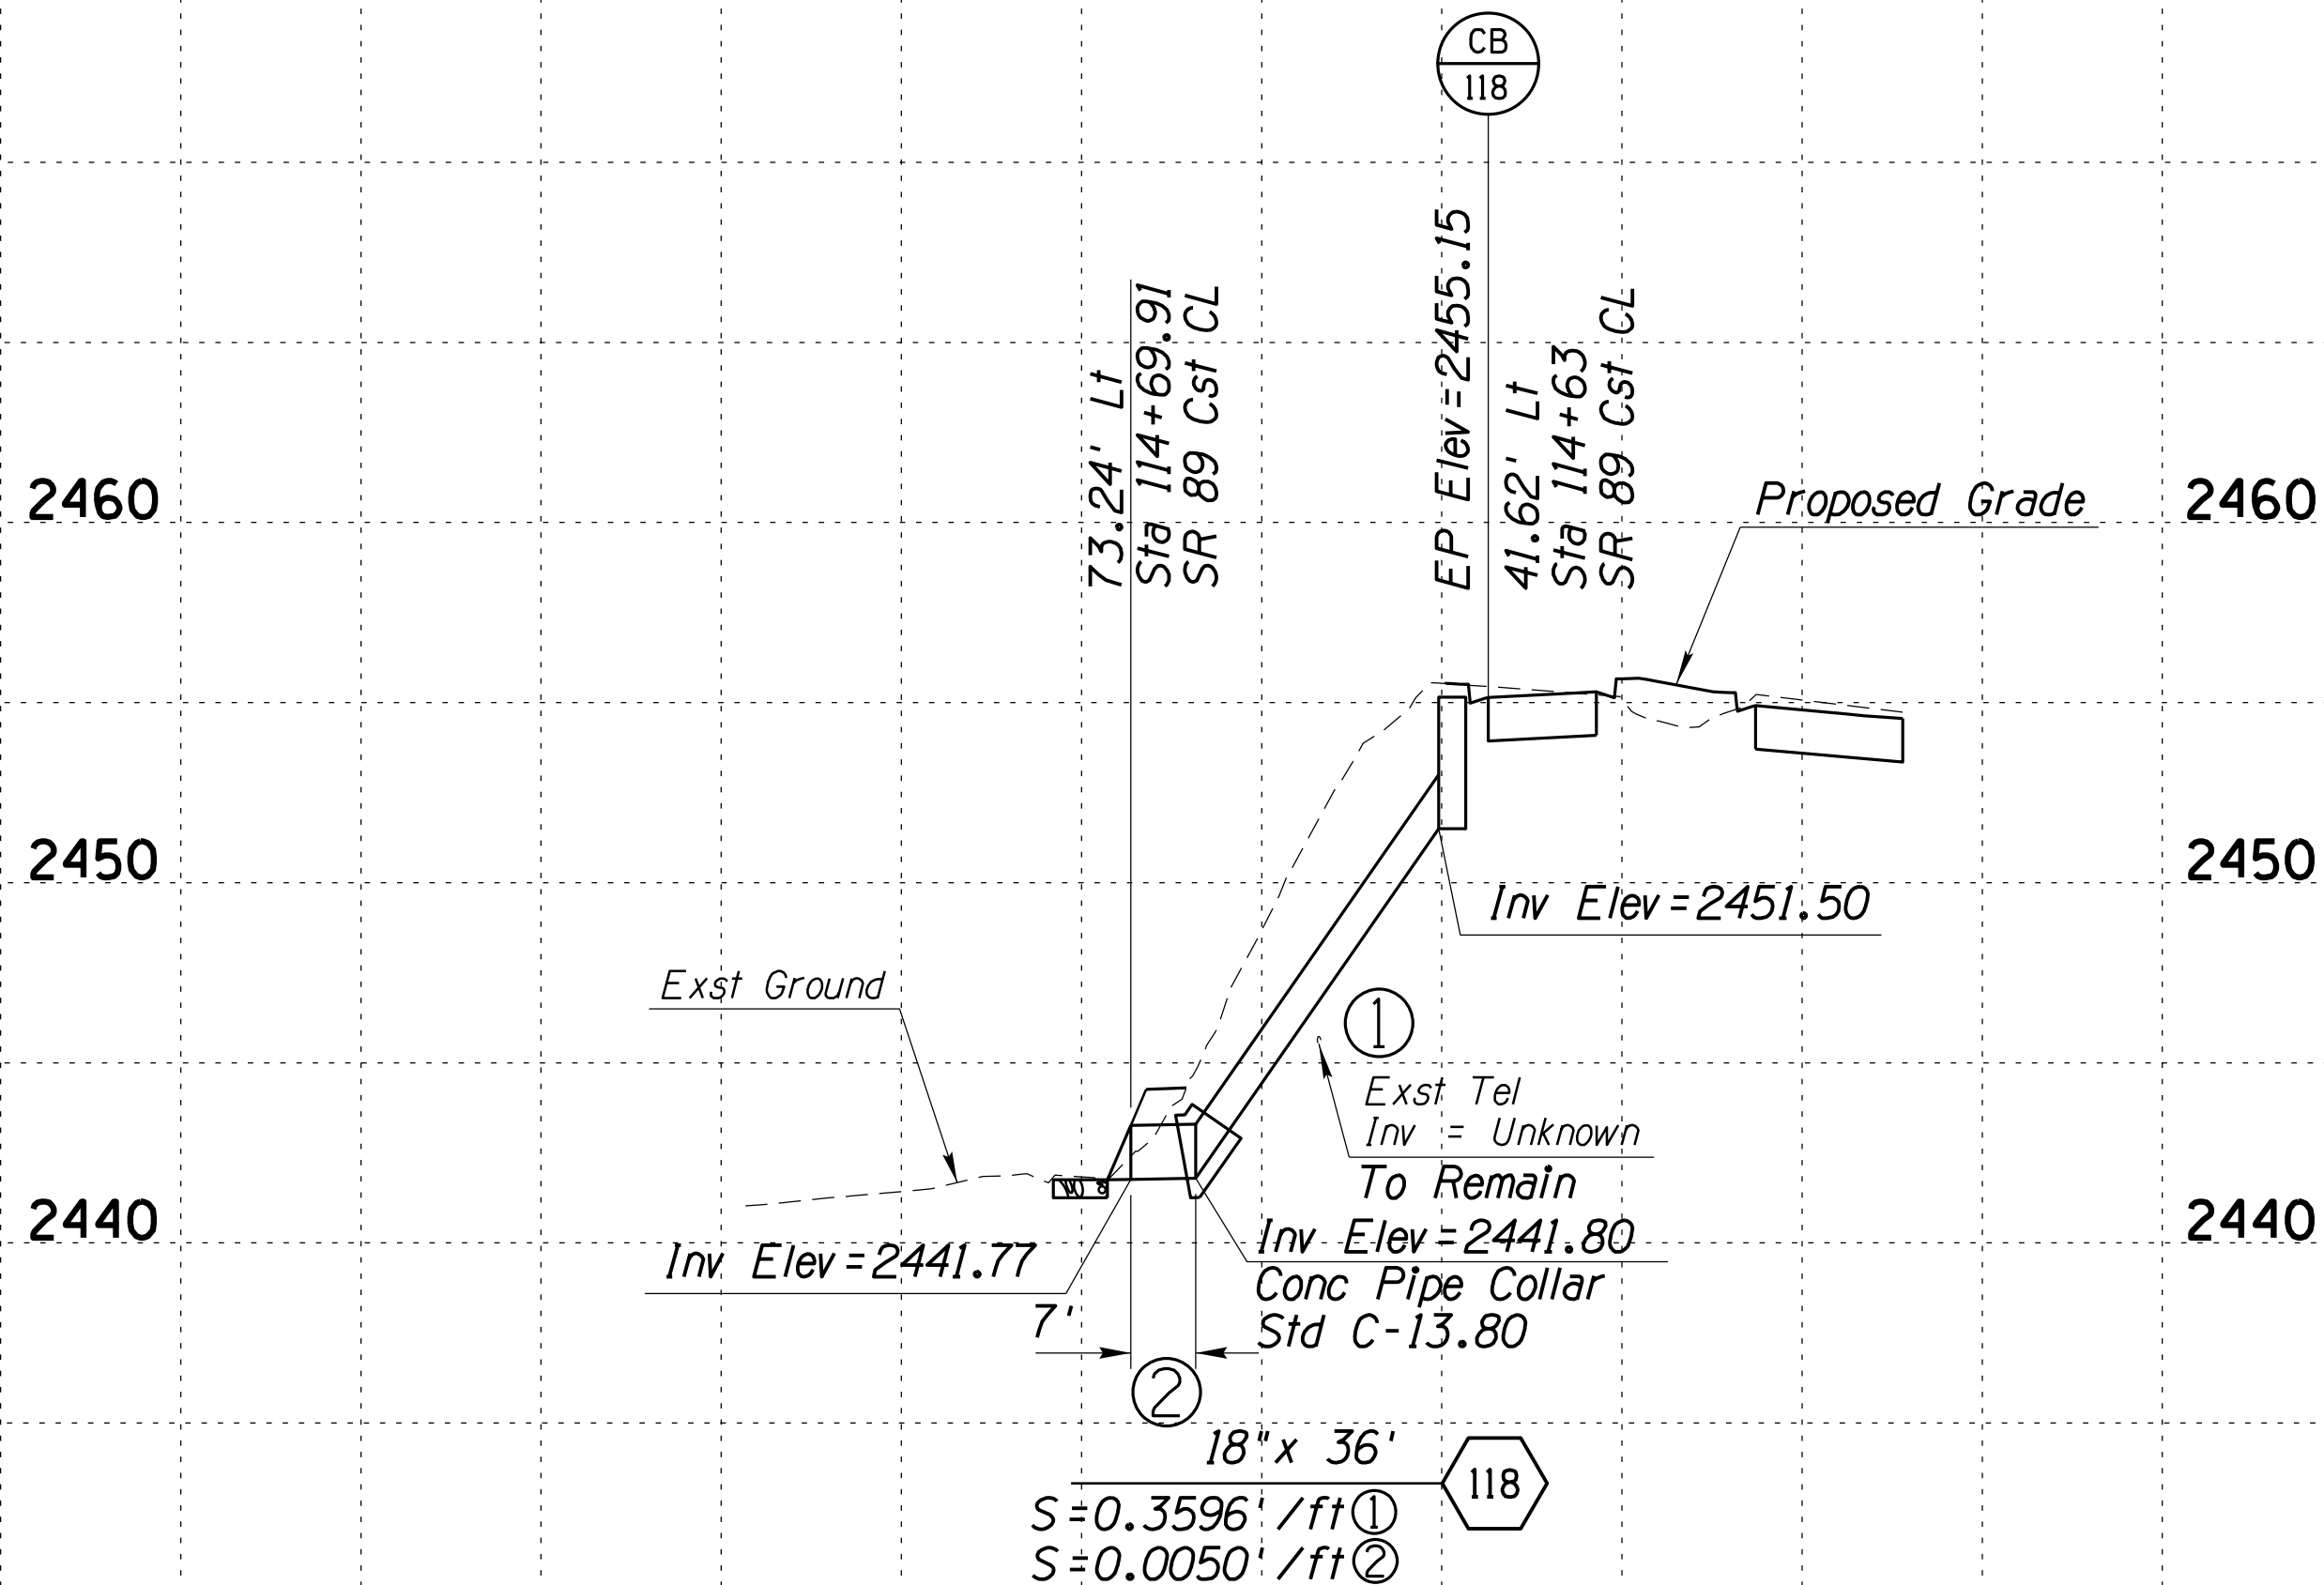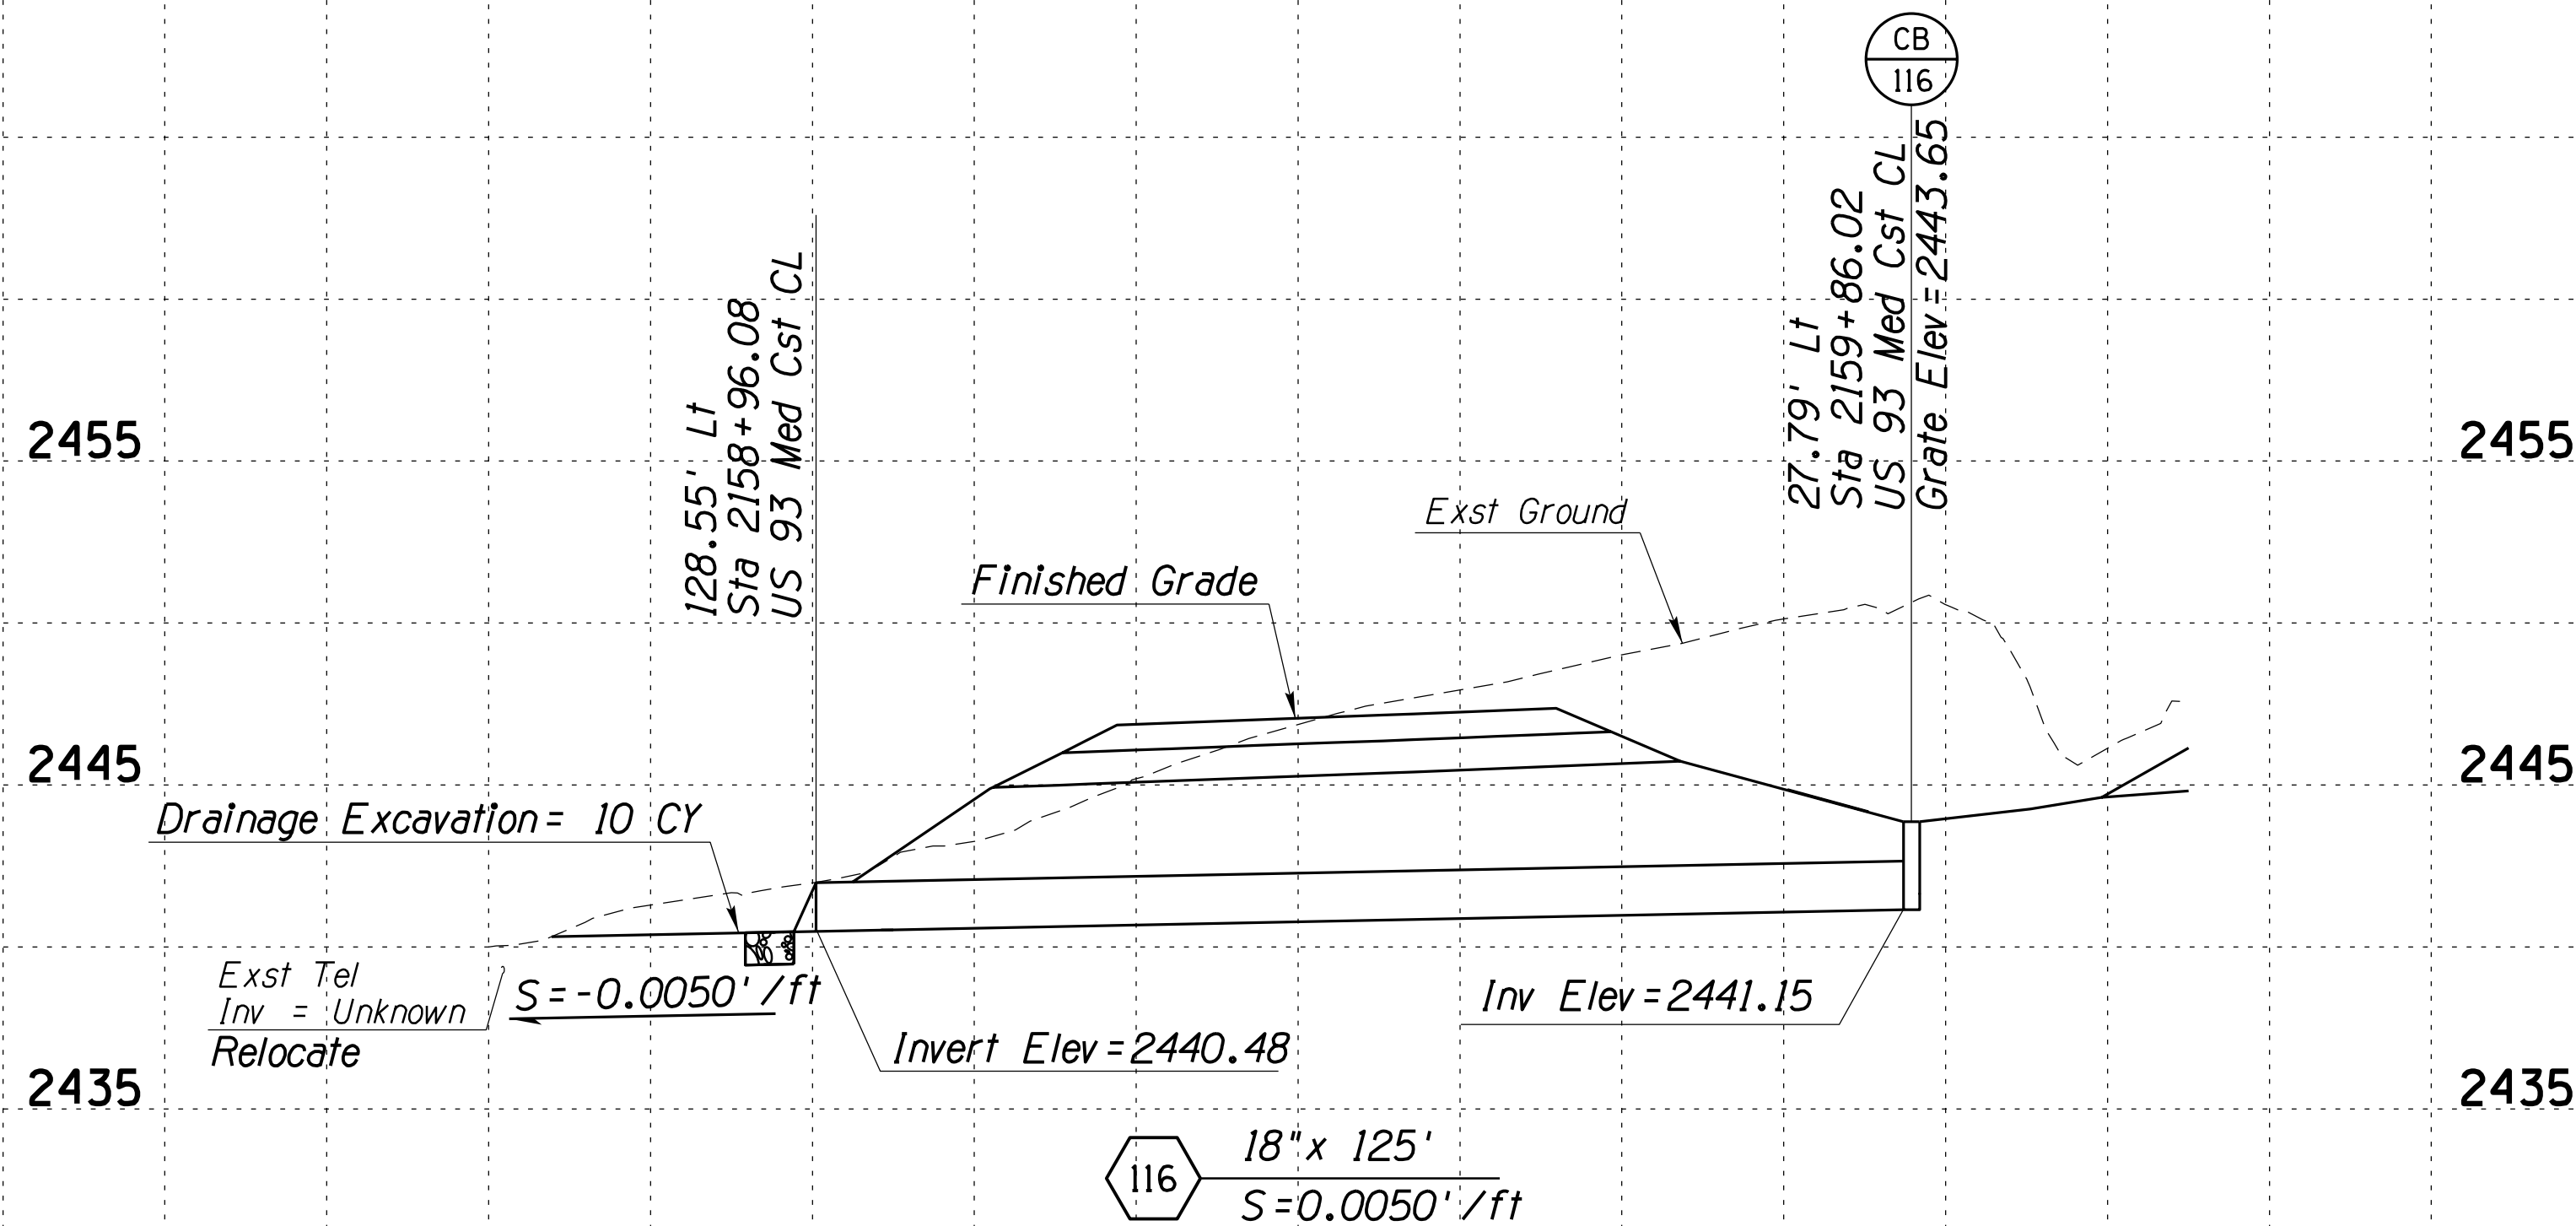

DESIGN	JML	DATE	06-26
DRAWN	RM	DATE	06-26
CHECKED	DBK	DATE	06-26
ARIZONA DEPARTMENT OF TRANSPORTATION PROJECT DELIVERY AND OPERATIONS DIVISION ROADWAY DESIGN SERVICES			
STORM DRAIN PROFILE			
ROUTE	LOCATION	DWG NO. D-3.04	
US 93	WICKENBURG RANCH WAY TO VISTA ROYALE	OF	
TRACS NO. F0738 OIC		093-B(230)T	

F.H.W.A. REGION	STATE	PROJECT NO.	SHEET NO.	TOTAL SHEETS	RECORD DRAWING
9	ARIZ.	093-B(230)T	120	524	


093 YV 189

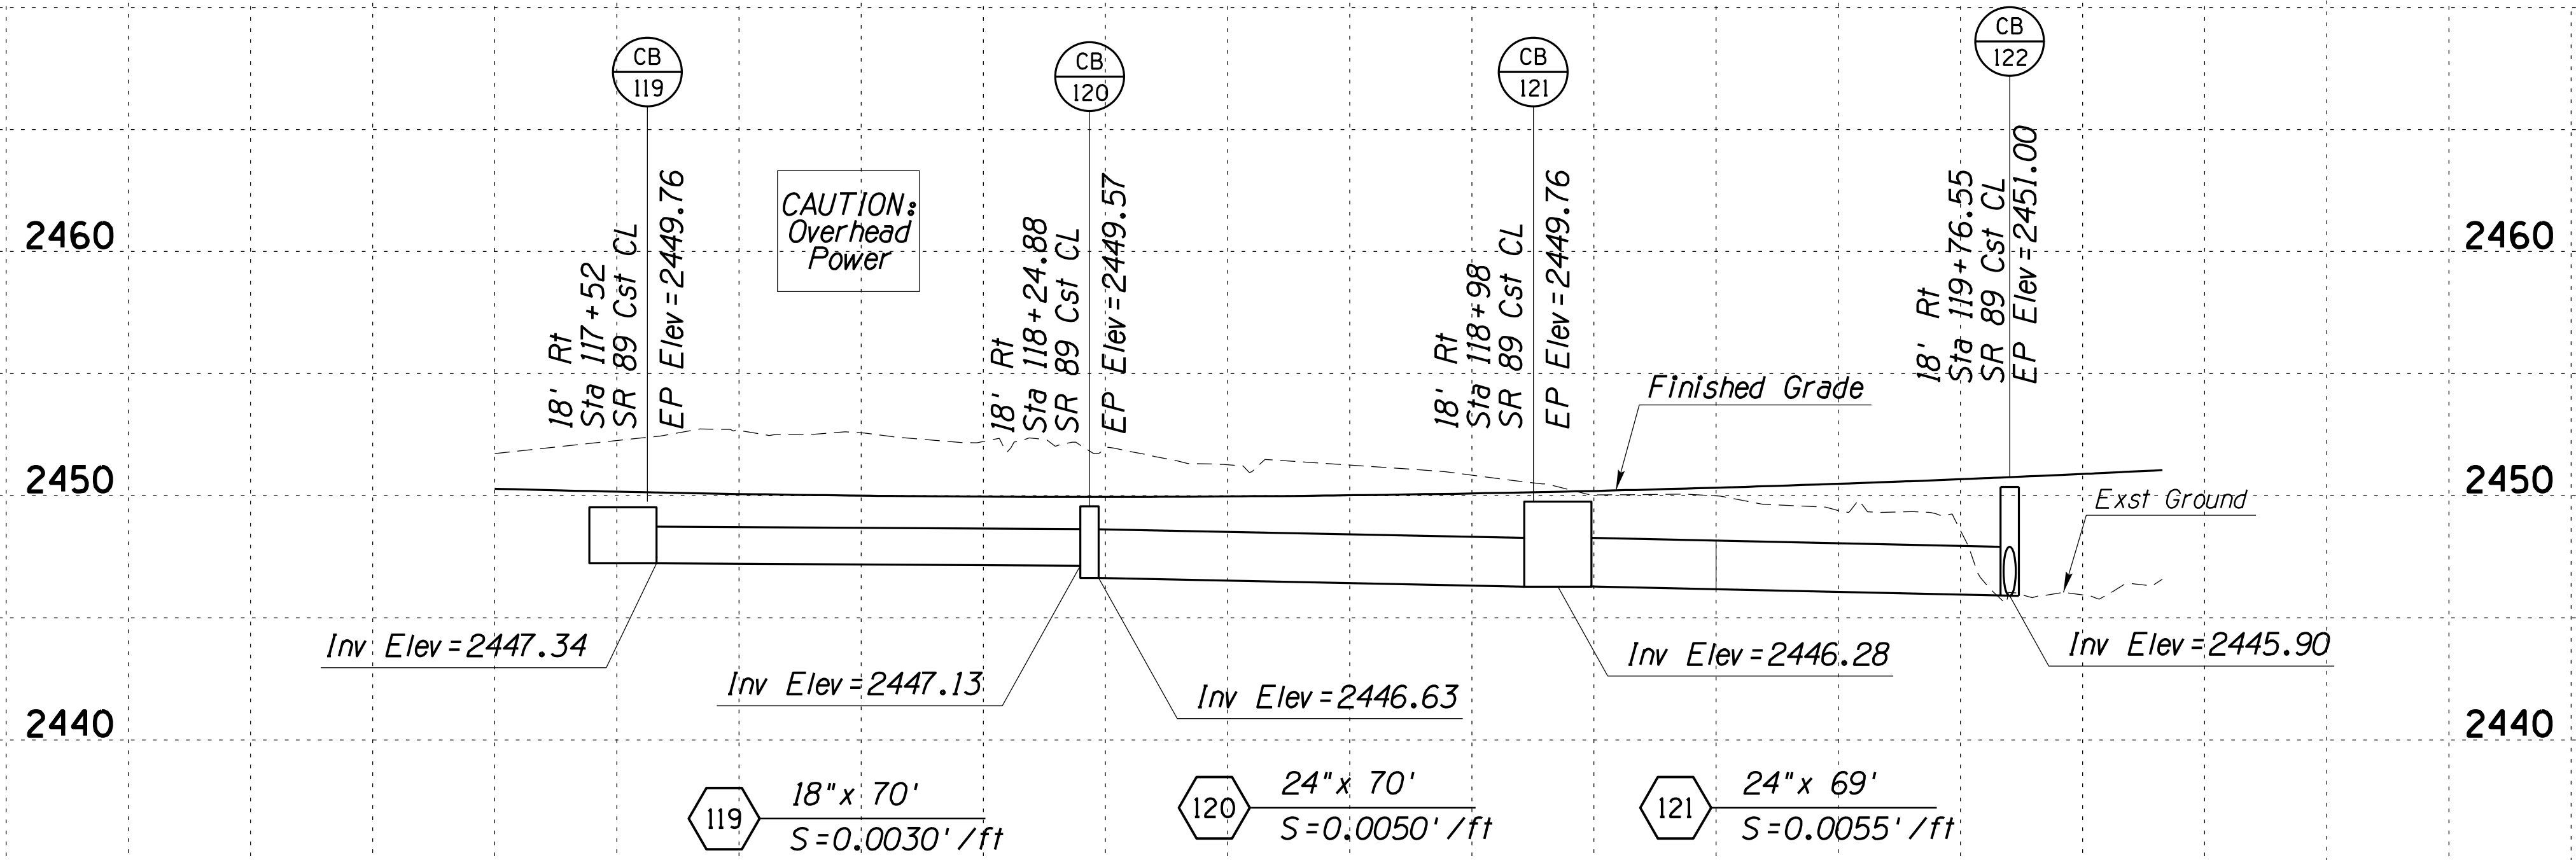


DESIGN		JML	06-26	ARIZONA DEPARTMENT OF TRANSPORTATION PROJECT DELIVERY AND OPERATIONS DIVISION ROADWAY DESIGN SERVICES	
DRAWN		RM	06-26		
CHECKED		DBK	06-26		
 3133 East Camelback Road, Suite 100 Phoenix, Arizona 85016 Phone: (602) 333-2200				STORM DRAIN PROFILE	
ROUTE		LOCATION		DWG NO. D-3.05	
US 93		WICKENBURG RANCH WAY TO VISTA ROYALE			
TRACS NO. F0738 OIC		093-B(230)T		OF	

F.H.W.A. REGION	STATE	PROJECT NO.	SHEET NO.	TOTAL SHEETS	RECORD DRAWING
9	ARIZ.	093-B(230)T	121	524	

093 YV 189




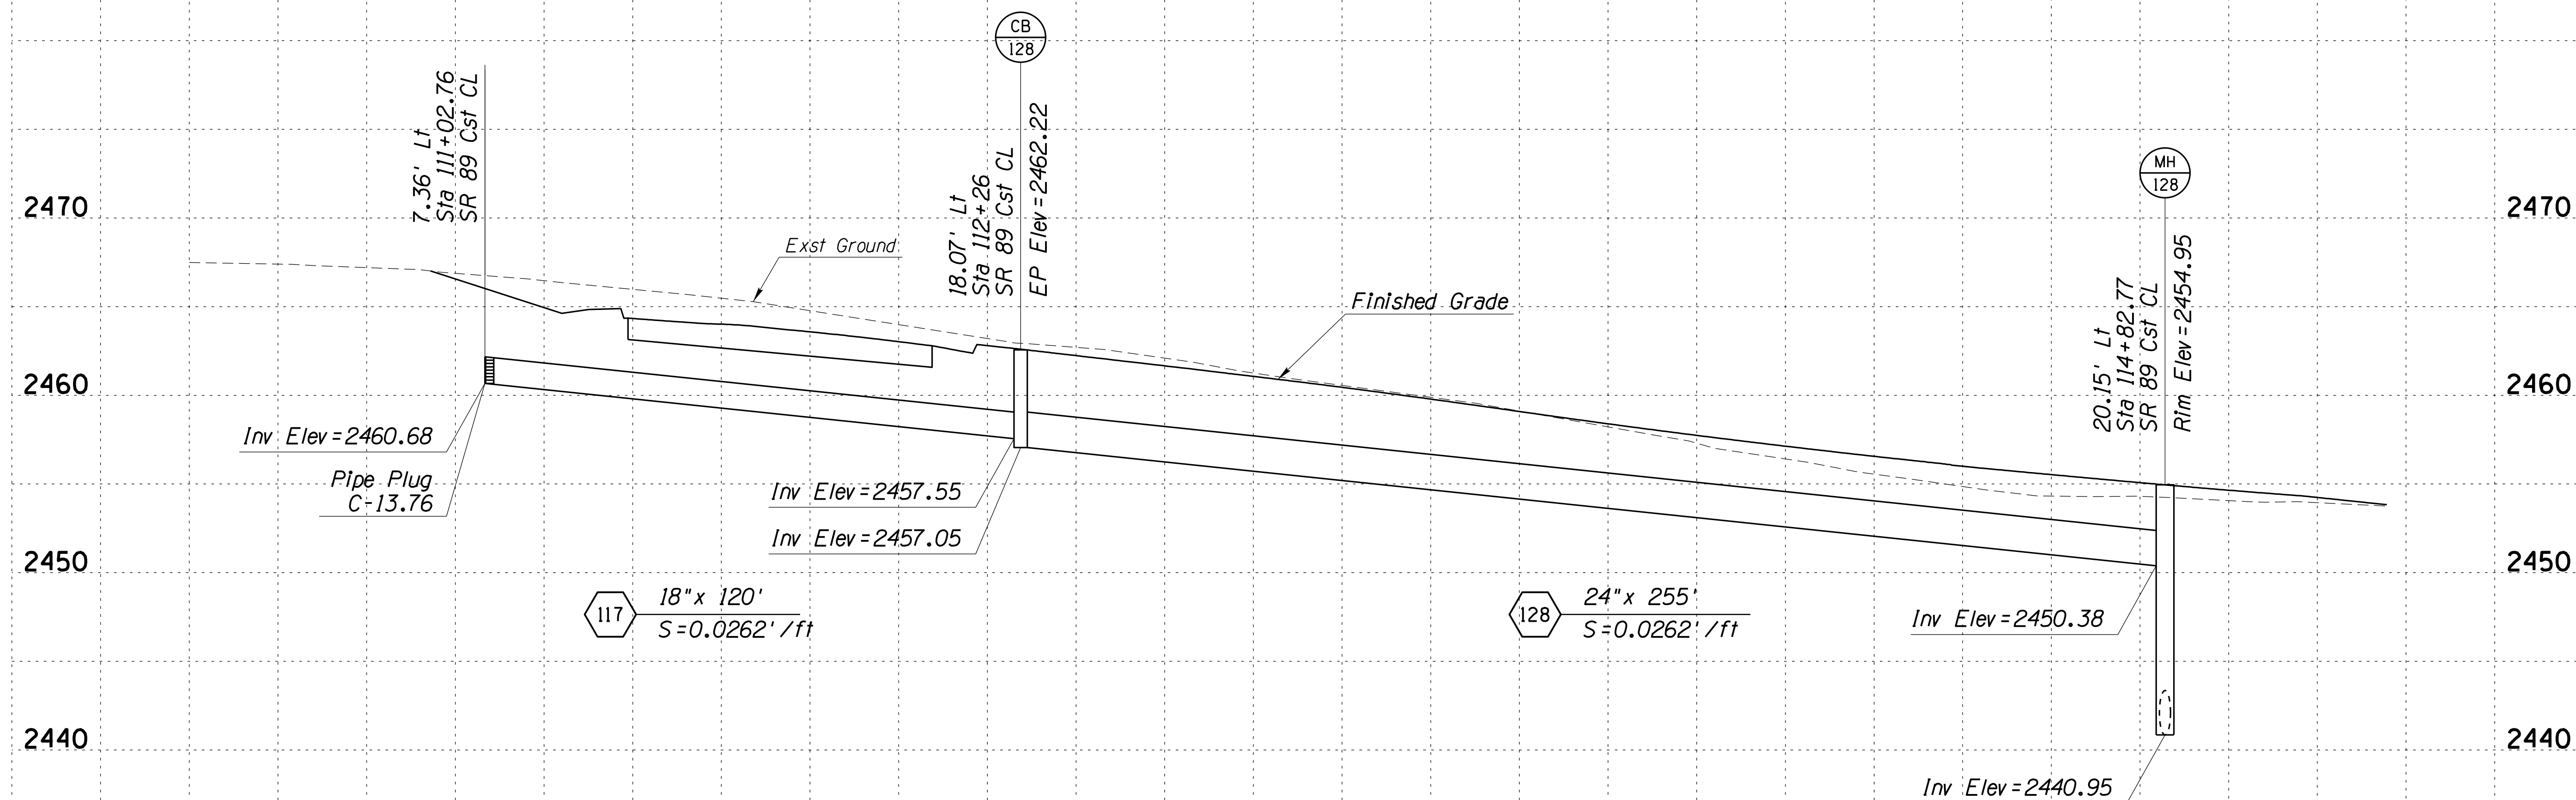



DESIGN	JML	DATE	06-26	ARIZONA DEPARTMENT OF TRANSPORTATION PROJECT DELIVERY AND OPERATIONS DIVISION ROADWAY DESIGN SERVICES	
DRAWN	RM	DATE	06-26		
CHECKED	DBK	DATE	06-26		
 3133 East Camelback Road, Suite 100 Phoenix, Arizona 85016 Phone: (602) 333-2200				STORM DRAIN PROFILE	
ROUTE		LOCATION		DWG NO. D-3.06	
US 93		WICKENBURG RANCH WAY TO VISTA ROYALE			
TRACS NO. F0738 OIC				093-B(230)T	
				OF	

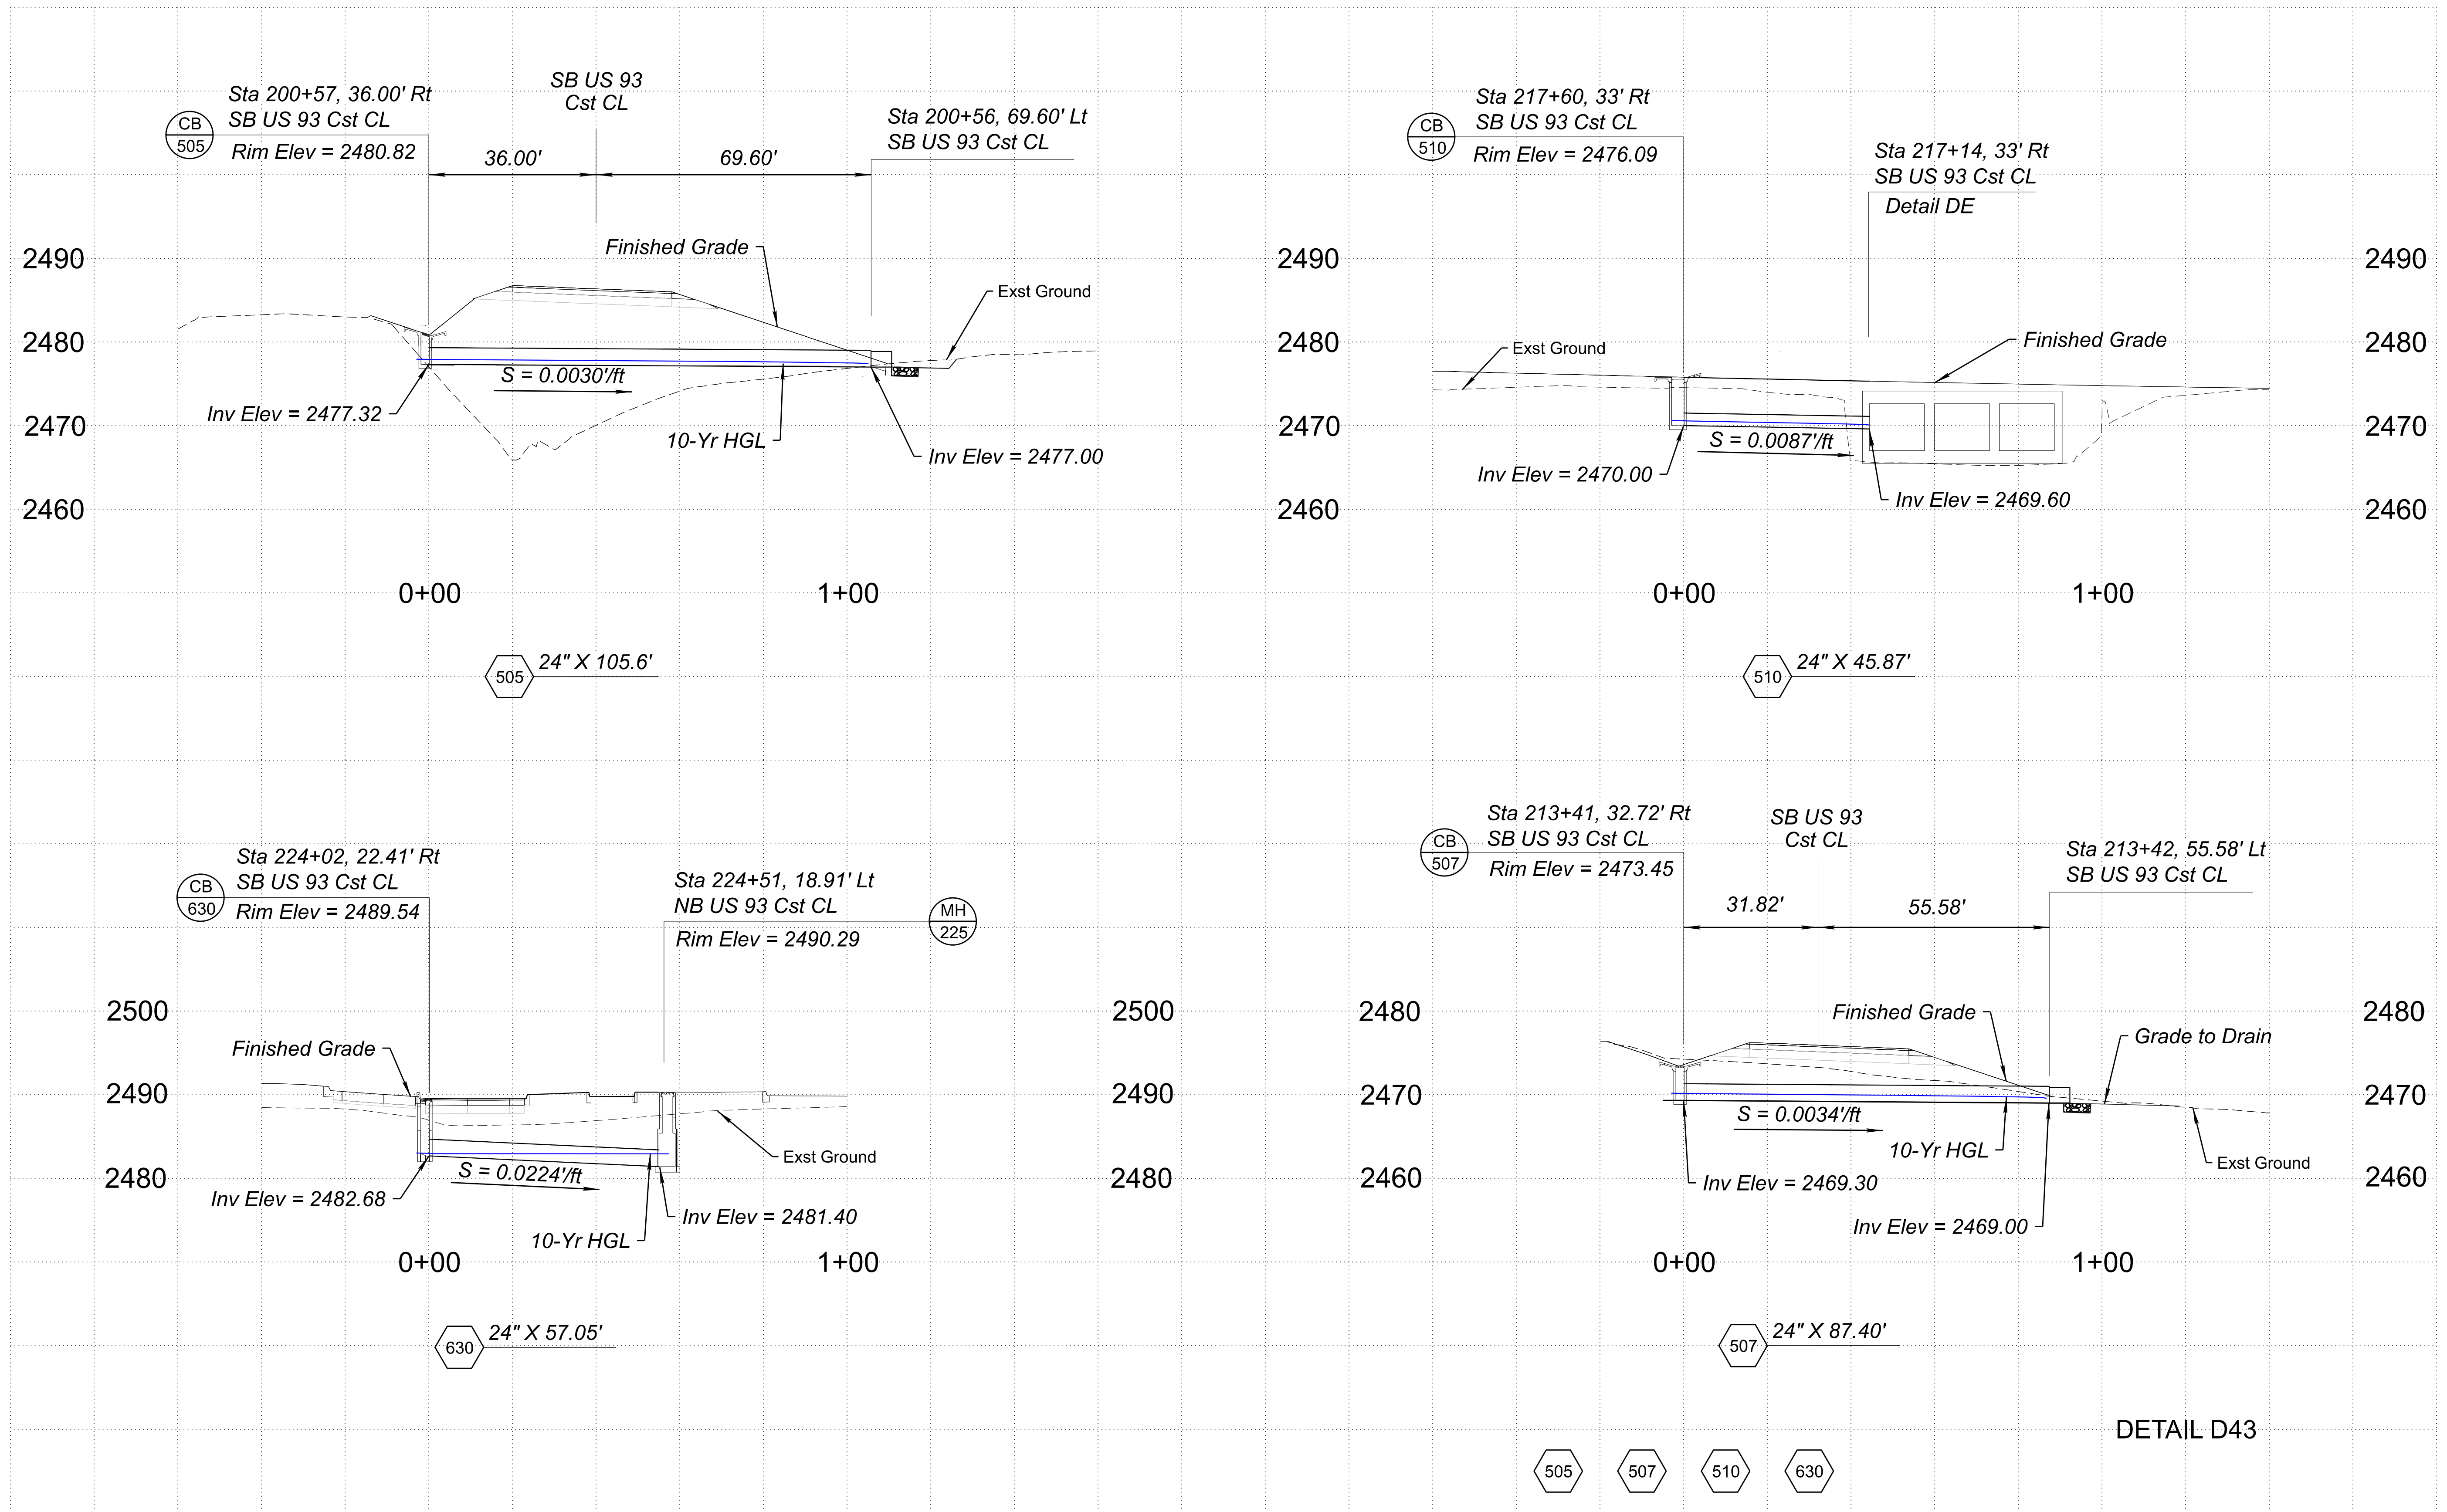


DETAIL D43

	NAME		DATE	ARIZONA DEPARTMENT OF TRANSPORTATION PROJECT DELIVERY AND OPERATIONS DIVISION ROADWAY DESIGN SERVICES	ROUTE	F.H.W.A. Arizona Division	STATE	PROJECT NO.	FEDERAL ID NO.	SHEET NO.	TOTAL SHEETS	RECORD DRAWING
	DESIGN	K LEANDER	06/26		US 93		ARIZ.	093 YV 189	093-B(230)T	122	524	
	DRAWN	B LEANDER	06/26		MILEPOST	LOCATION WICKENBURG RANCH WAY TO VISTA ROYALE						
	CHECKED	B DENETDALE	06/26	189.9	DWG No. D-3.07							
	TRANSPORTATION AECOM TECHNICAL SERVICES, Inc. 7720 N. 16th St., Suite 100 Phoenix, Arizona 85020 T 602.371.1100			AECOM www.aecom.com		STRUCTURE NO.	TRACS NO. F0738 01C		OF			
PROFILE SHEET DETAIL D43												

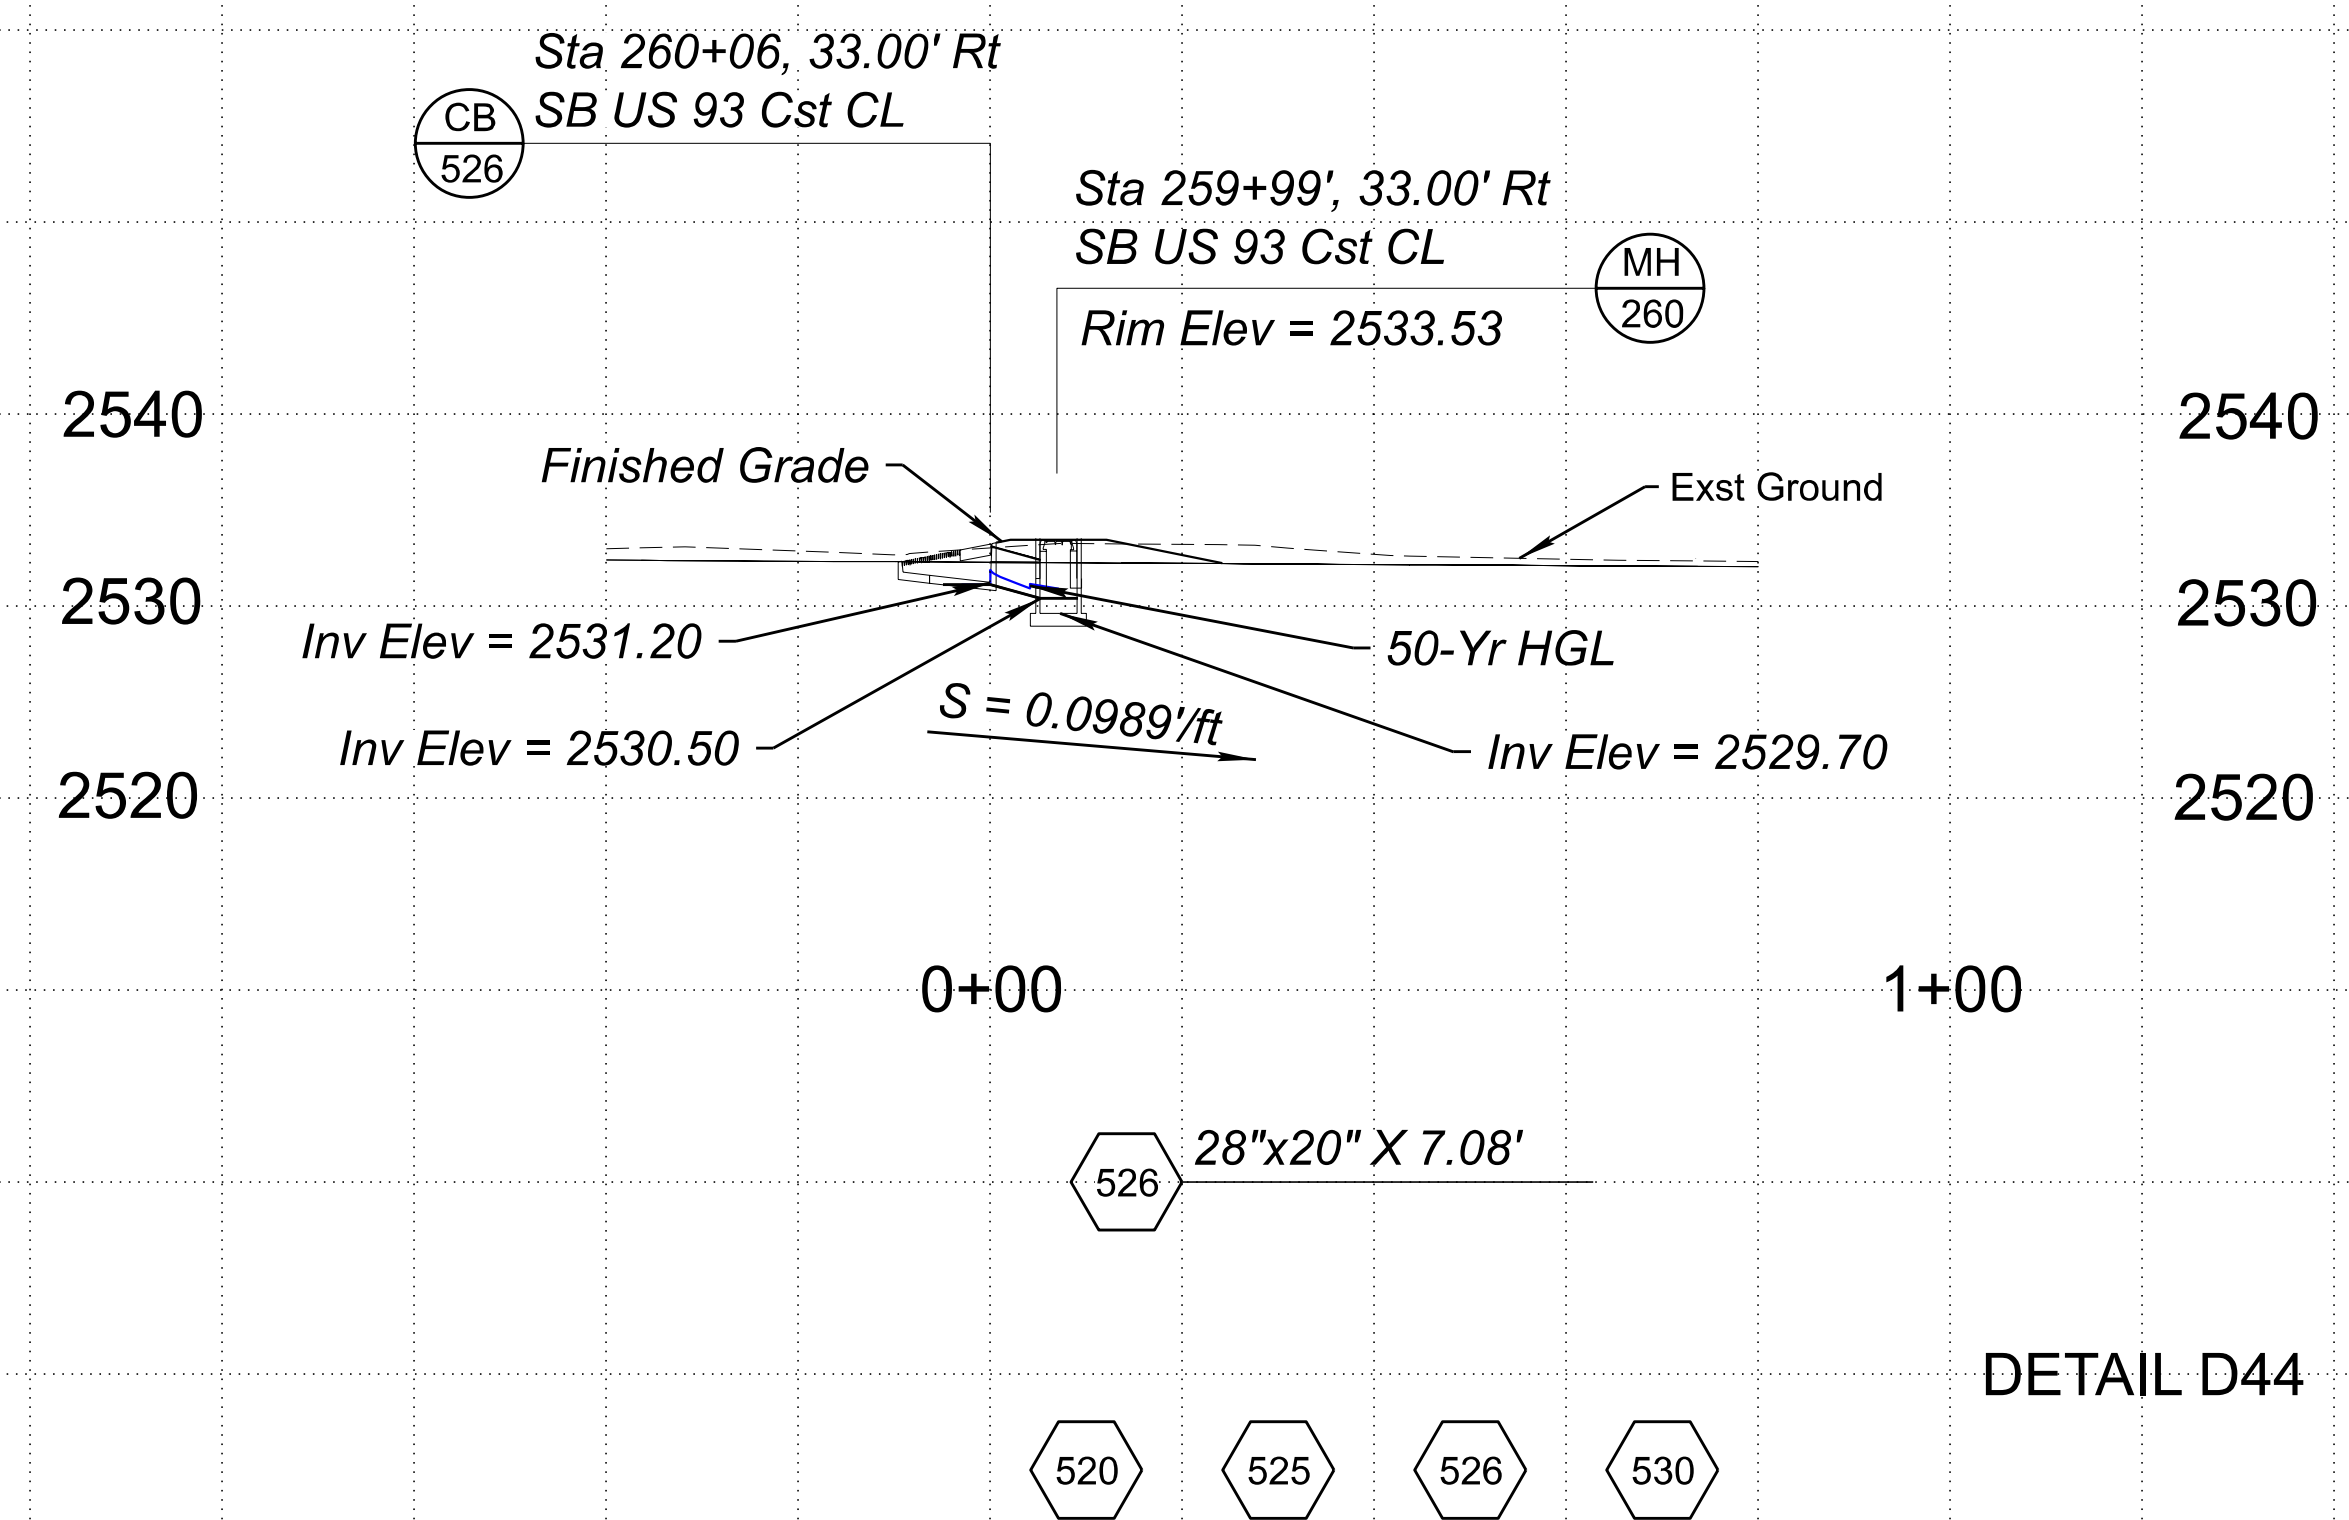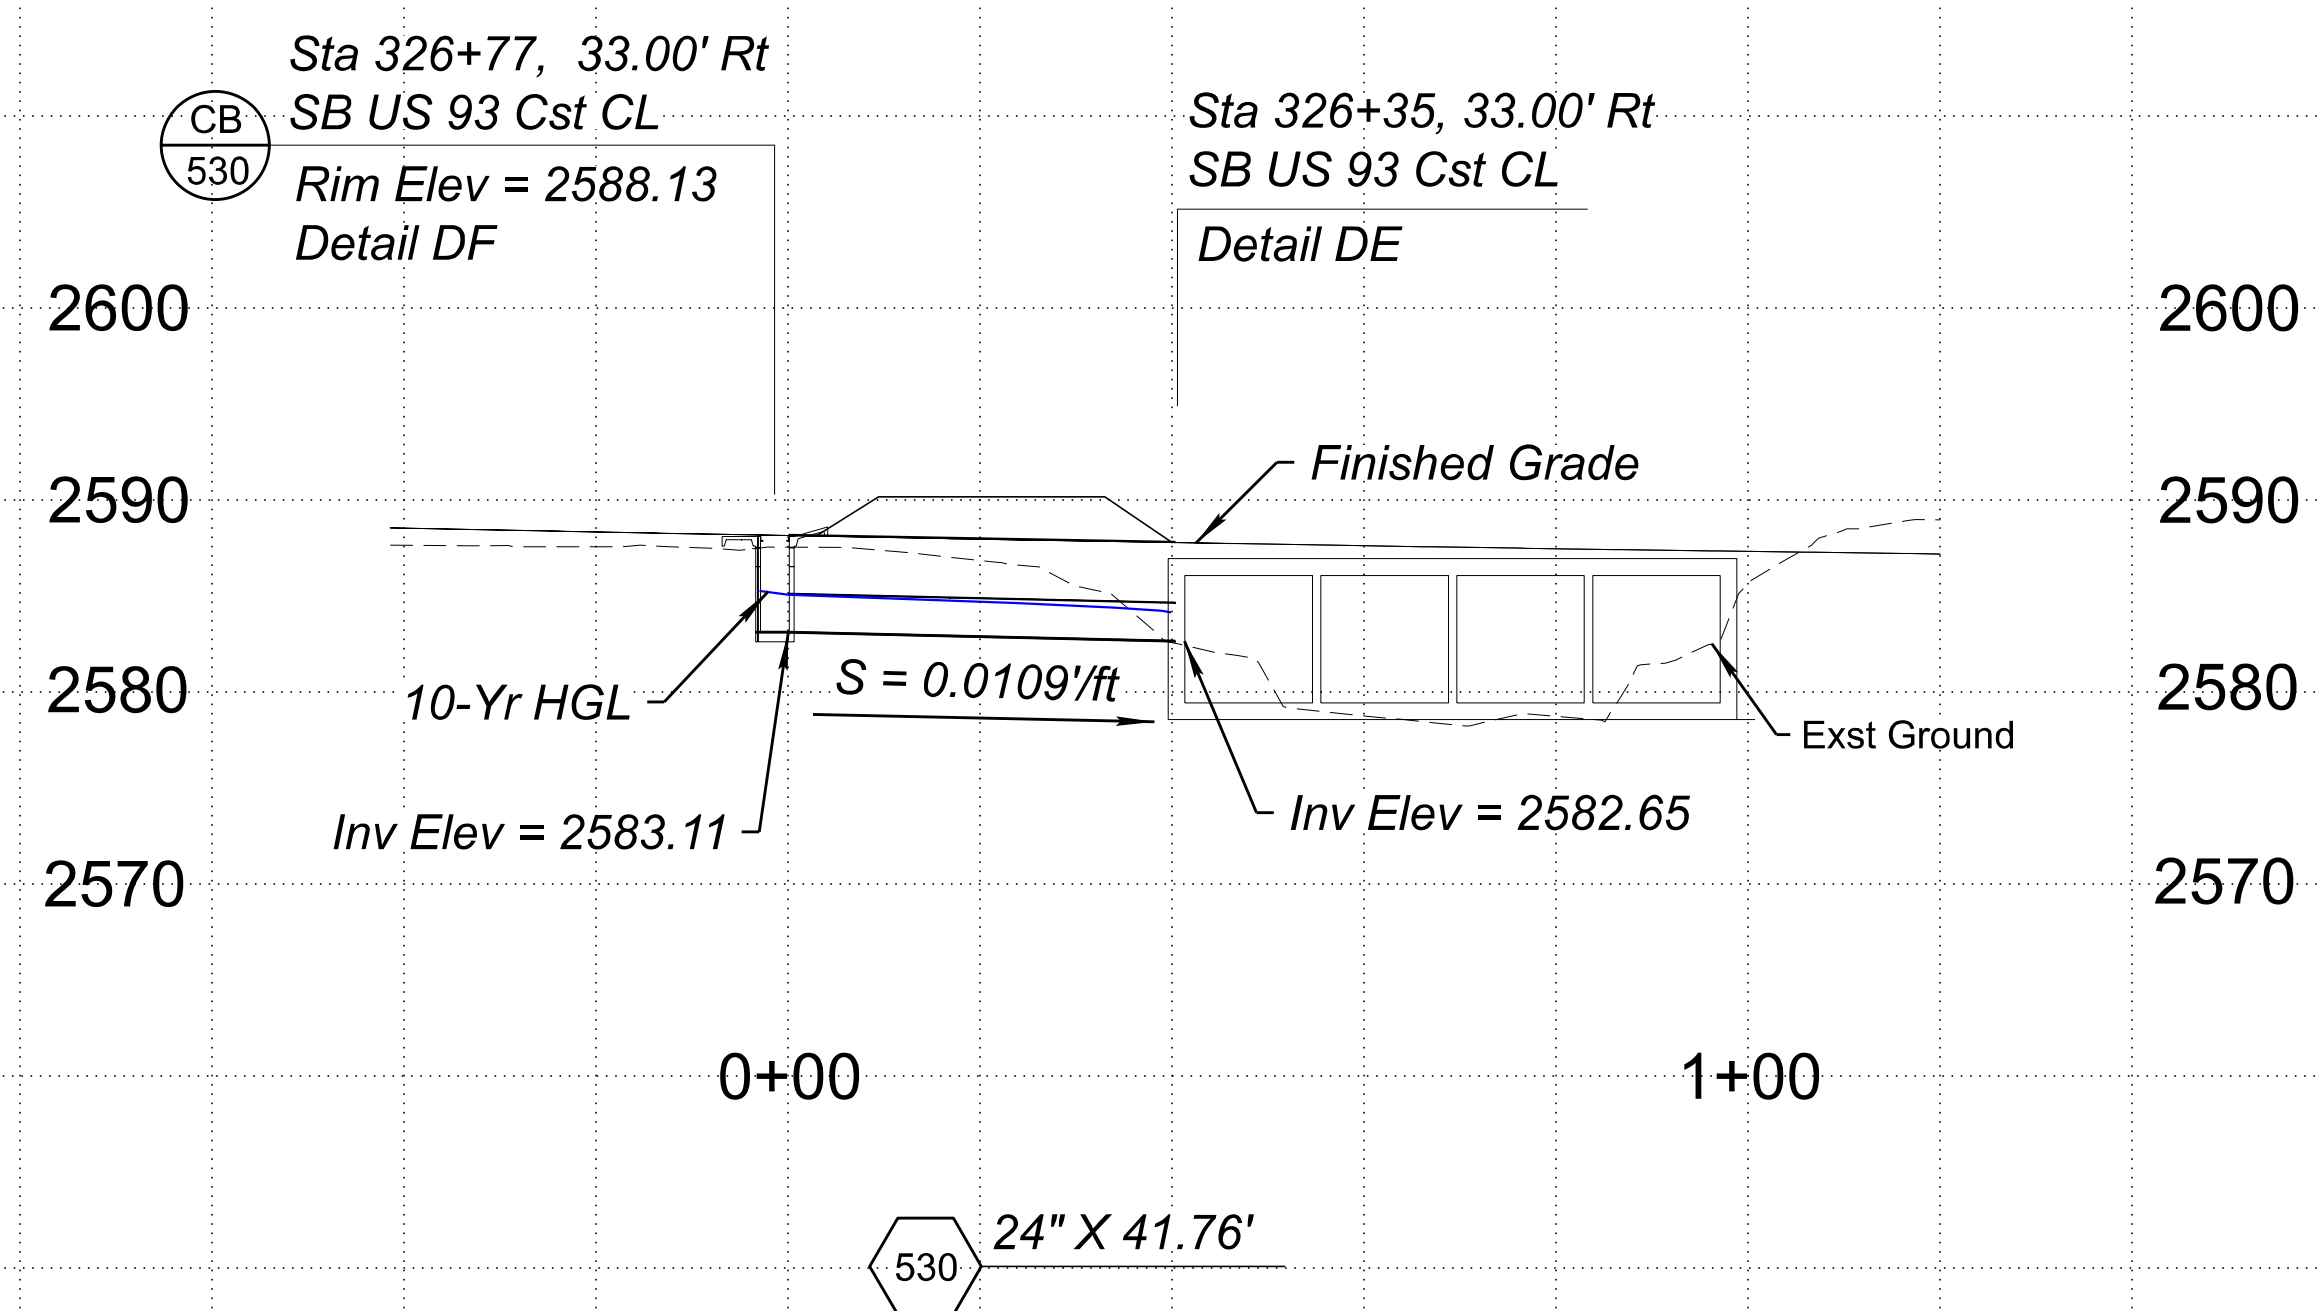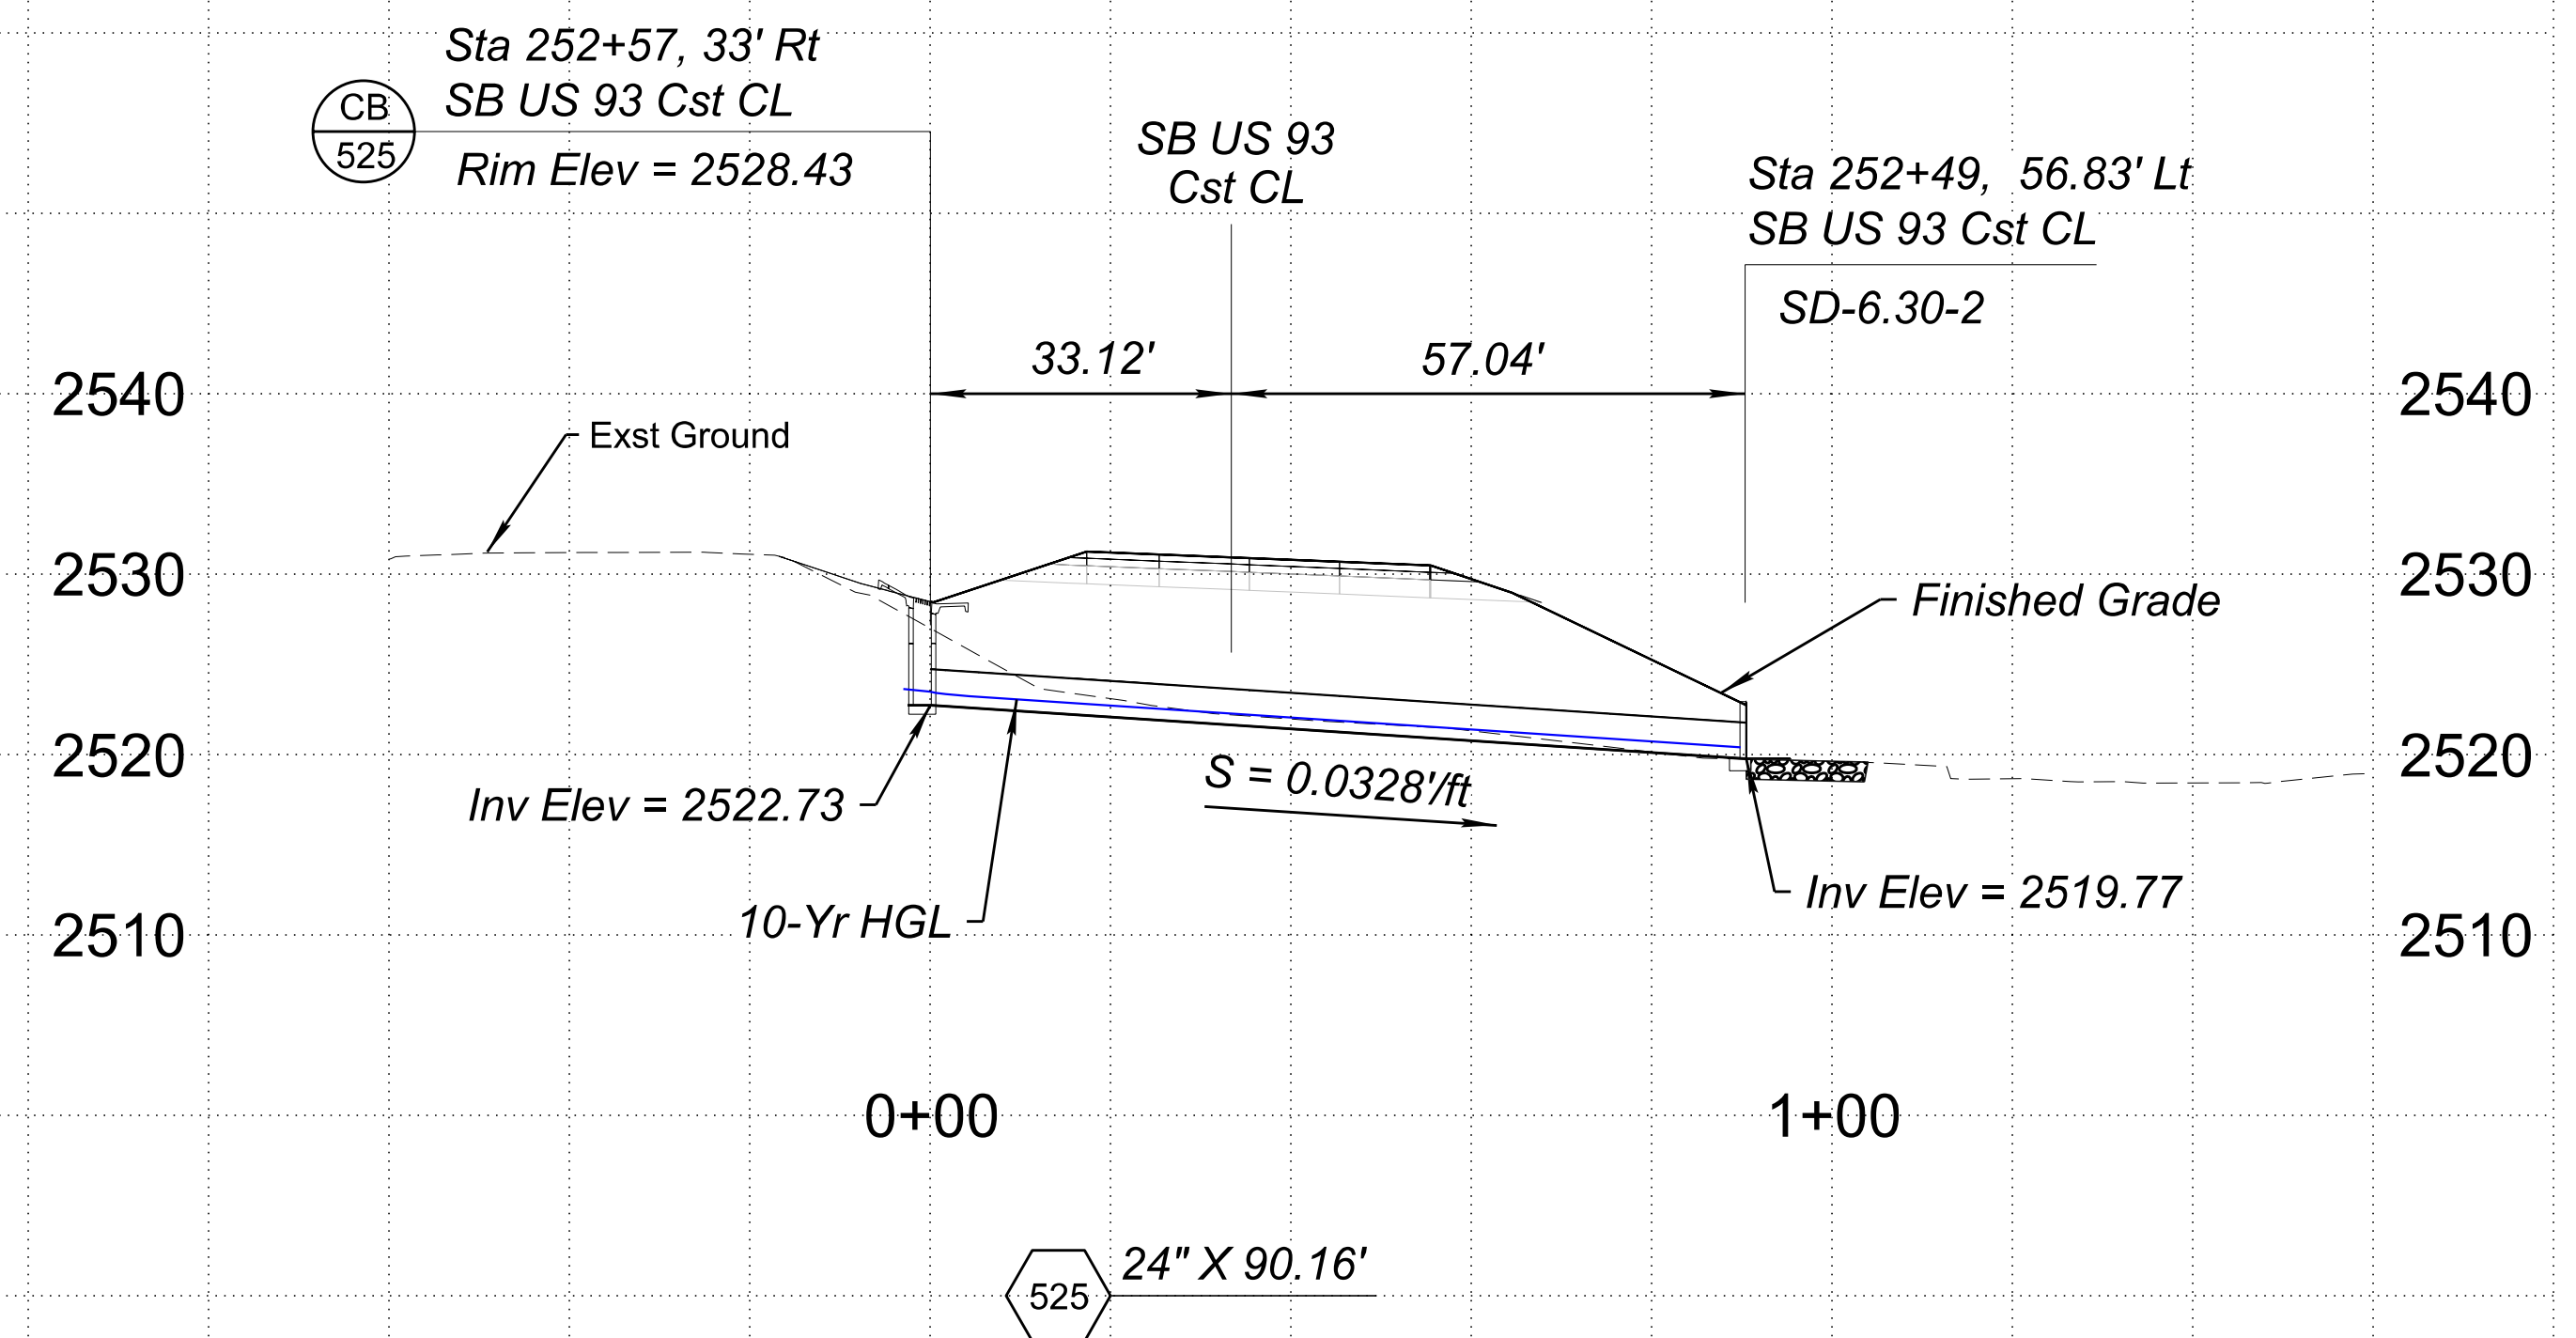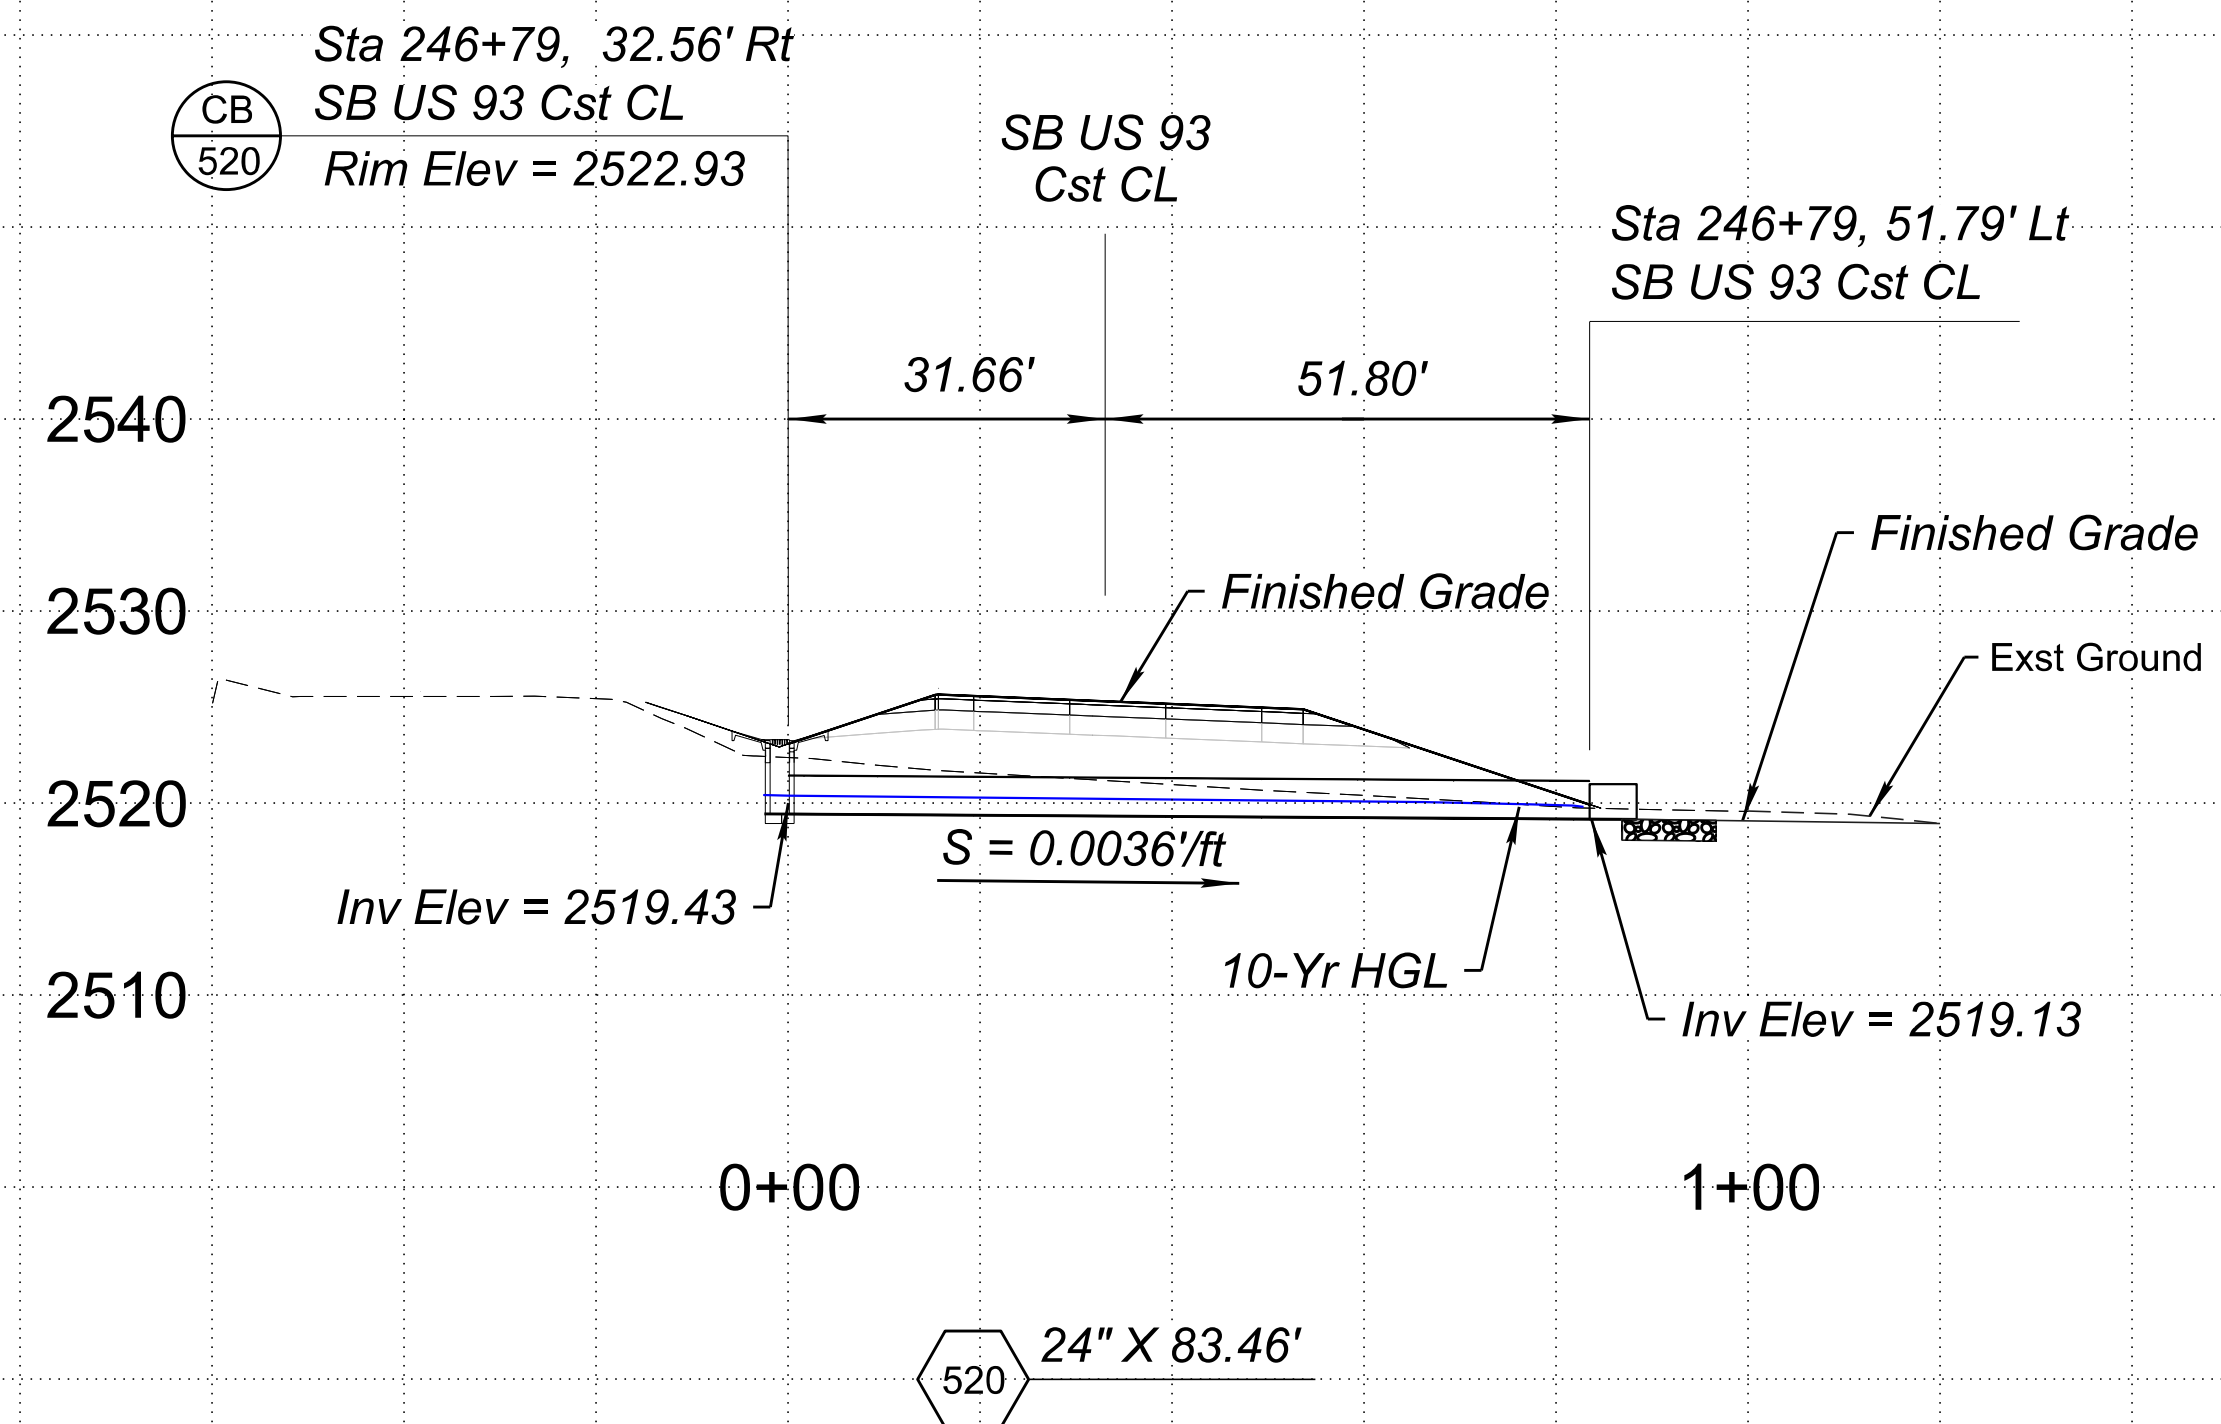

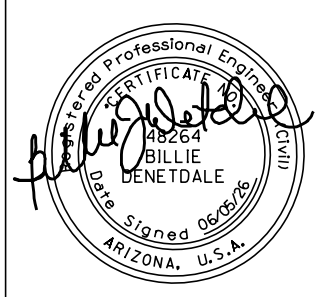	DESIGN	K LEANDER	06/26	ARIZONA DEPARTMENT OF TRANSPORTATION PROJECT DELIVERY AND OPERATIONS DIVISION ROADWAY DESIGN SERVICES	ROUTE	US 93	F.H.W.A. Arizona Division	STATE	ARIZ.	PROJECT NO.	093 YV 189	FEDERAL ID NO.	093-B(230)T	SHEET NO.	123	TOTAL SHEETS	524	RECORD DRAWING
	DRAWN	B LEANDER	06/26		MILEPOST	189.9		LOCATION	WICKENBURG RANCH WAY TO VISTA ROYALE							DWG No. D-3.08		
	CHECKED	B DENETDALE	06/26		STRUCTURE NO.			TRACS NO.	F0738 01C							OF		
	TRANSPORTATION AECOM TECHNICAL SERVICES, Inc. 7720 N. 16th St., Suite 100 Phoenix, Arizona 85020 T 602.371.1100 AECOM www.aecom.com																	

PROFILE SHEET
DETAIL D44

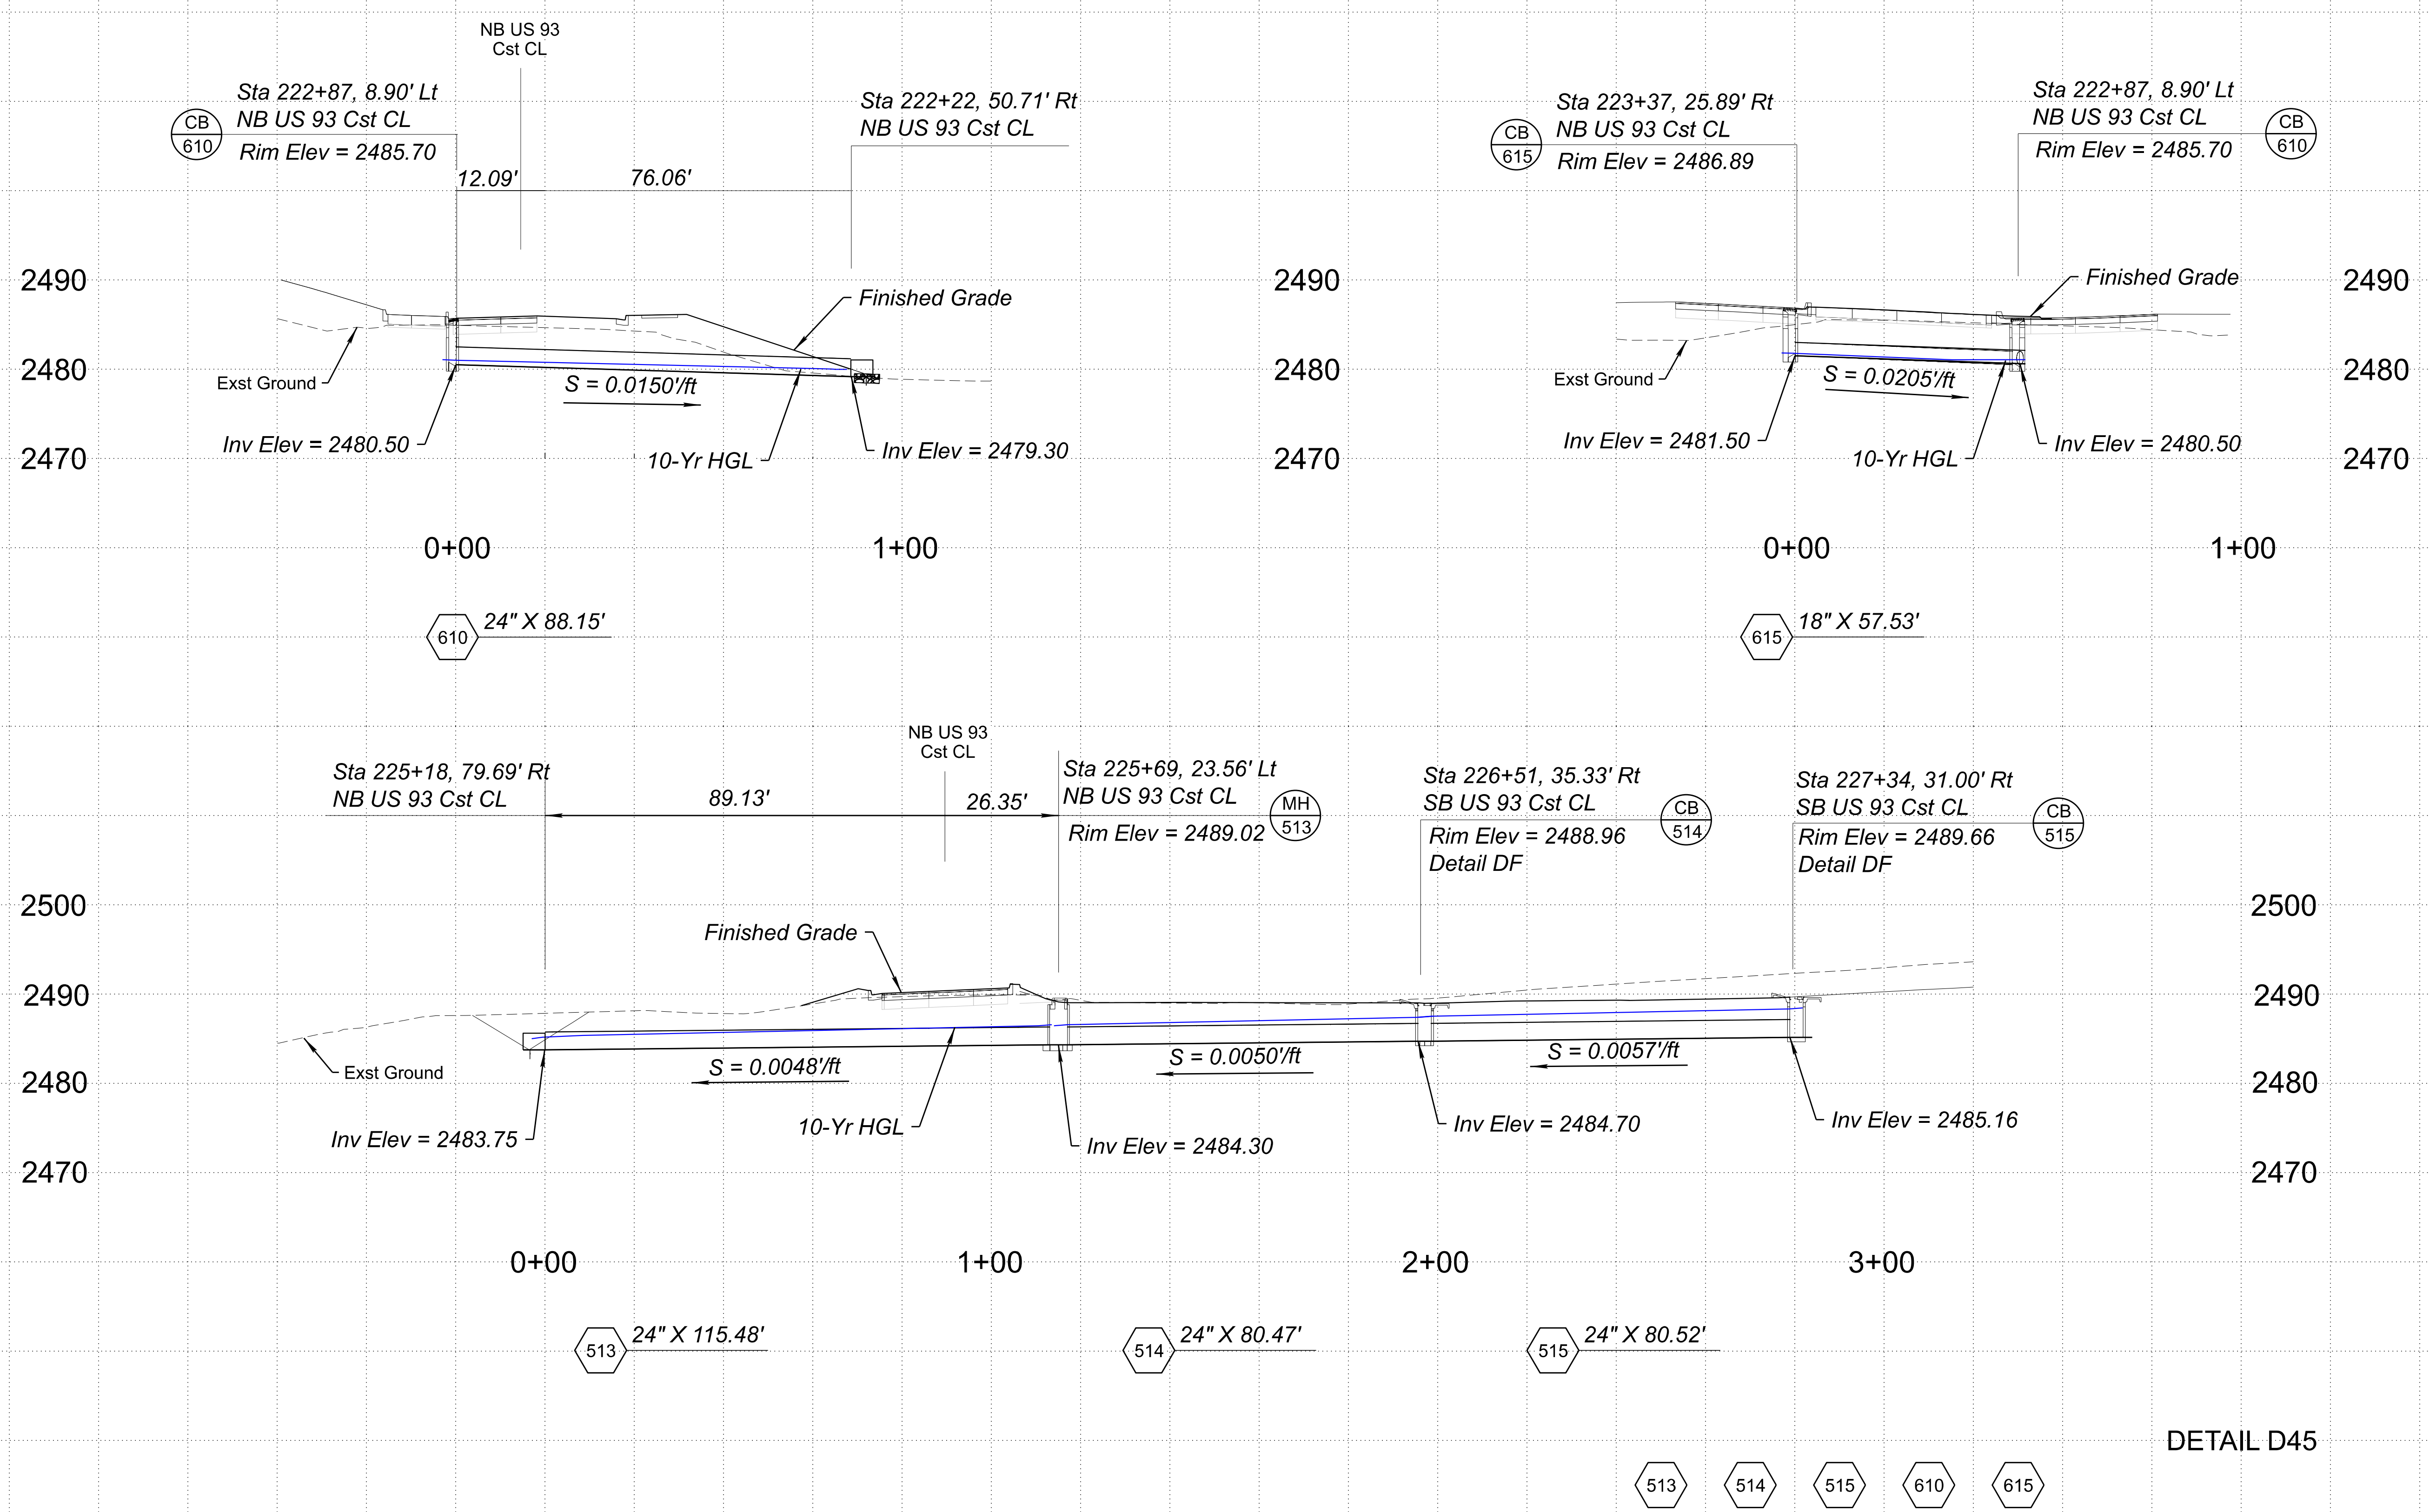


DETAIL D45

	DESIGN	K LEANDER	06/26	ARIZONA DEPARTMENT OF TRANSPORTATION PROJECT DELIVERY AND OPERATIONS DIVISION ROADWAY DESIGN SERVICES	ROUTE	US 93	F.H.W.A. Arizona Division	STATE	ARIZ.	PROJECT NO.	093 YV 189	FEDERAL ID NO.	093-B(230)T	SHEET NO.	124	TOTAL SHEETS	524	RECORD DRAWING
	DRAWN	B LEANDER	06/26		MILEPOST	189.9		LOCATION	WICKENBURG RANCH WAY TO VISTA ROYALE							DWG No. D-3.09		
	CHECKED	B DENETDALE	06/26		STRUCTURE NO.			TRACS NO.	F0738 01C							OF		


TRANSPORTATION
AECOM TECHNICAL SERVICES, Inc.
7720 N. 16th St., Suite 100
Phoenix, Arizona 85020
T 602.371.1100

AECOM
www.aecom.com



PROFILE SHEET
DETAIL D45

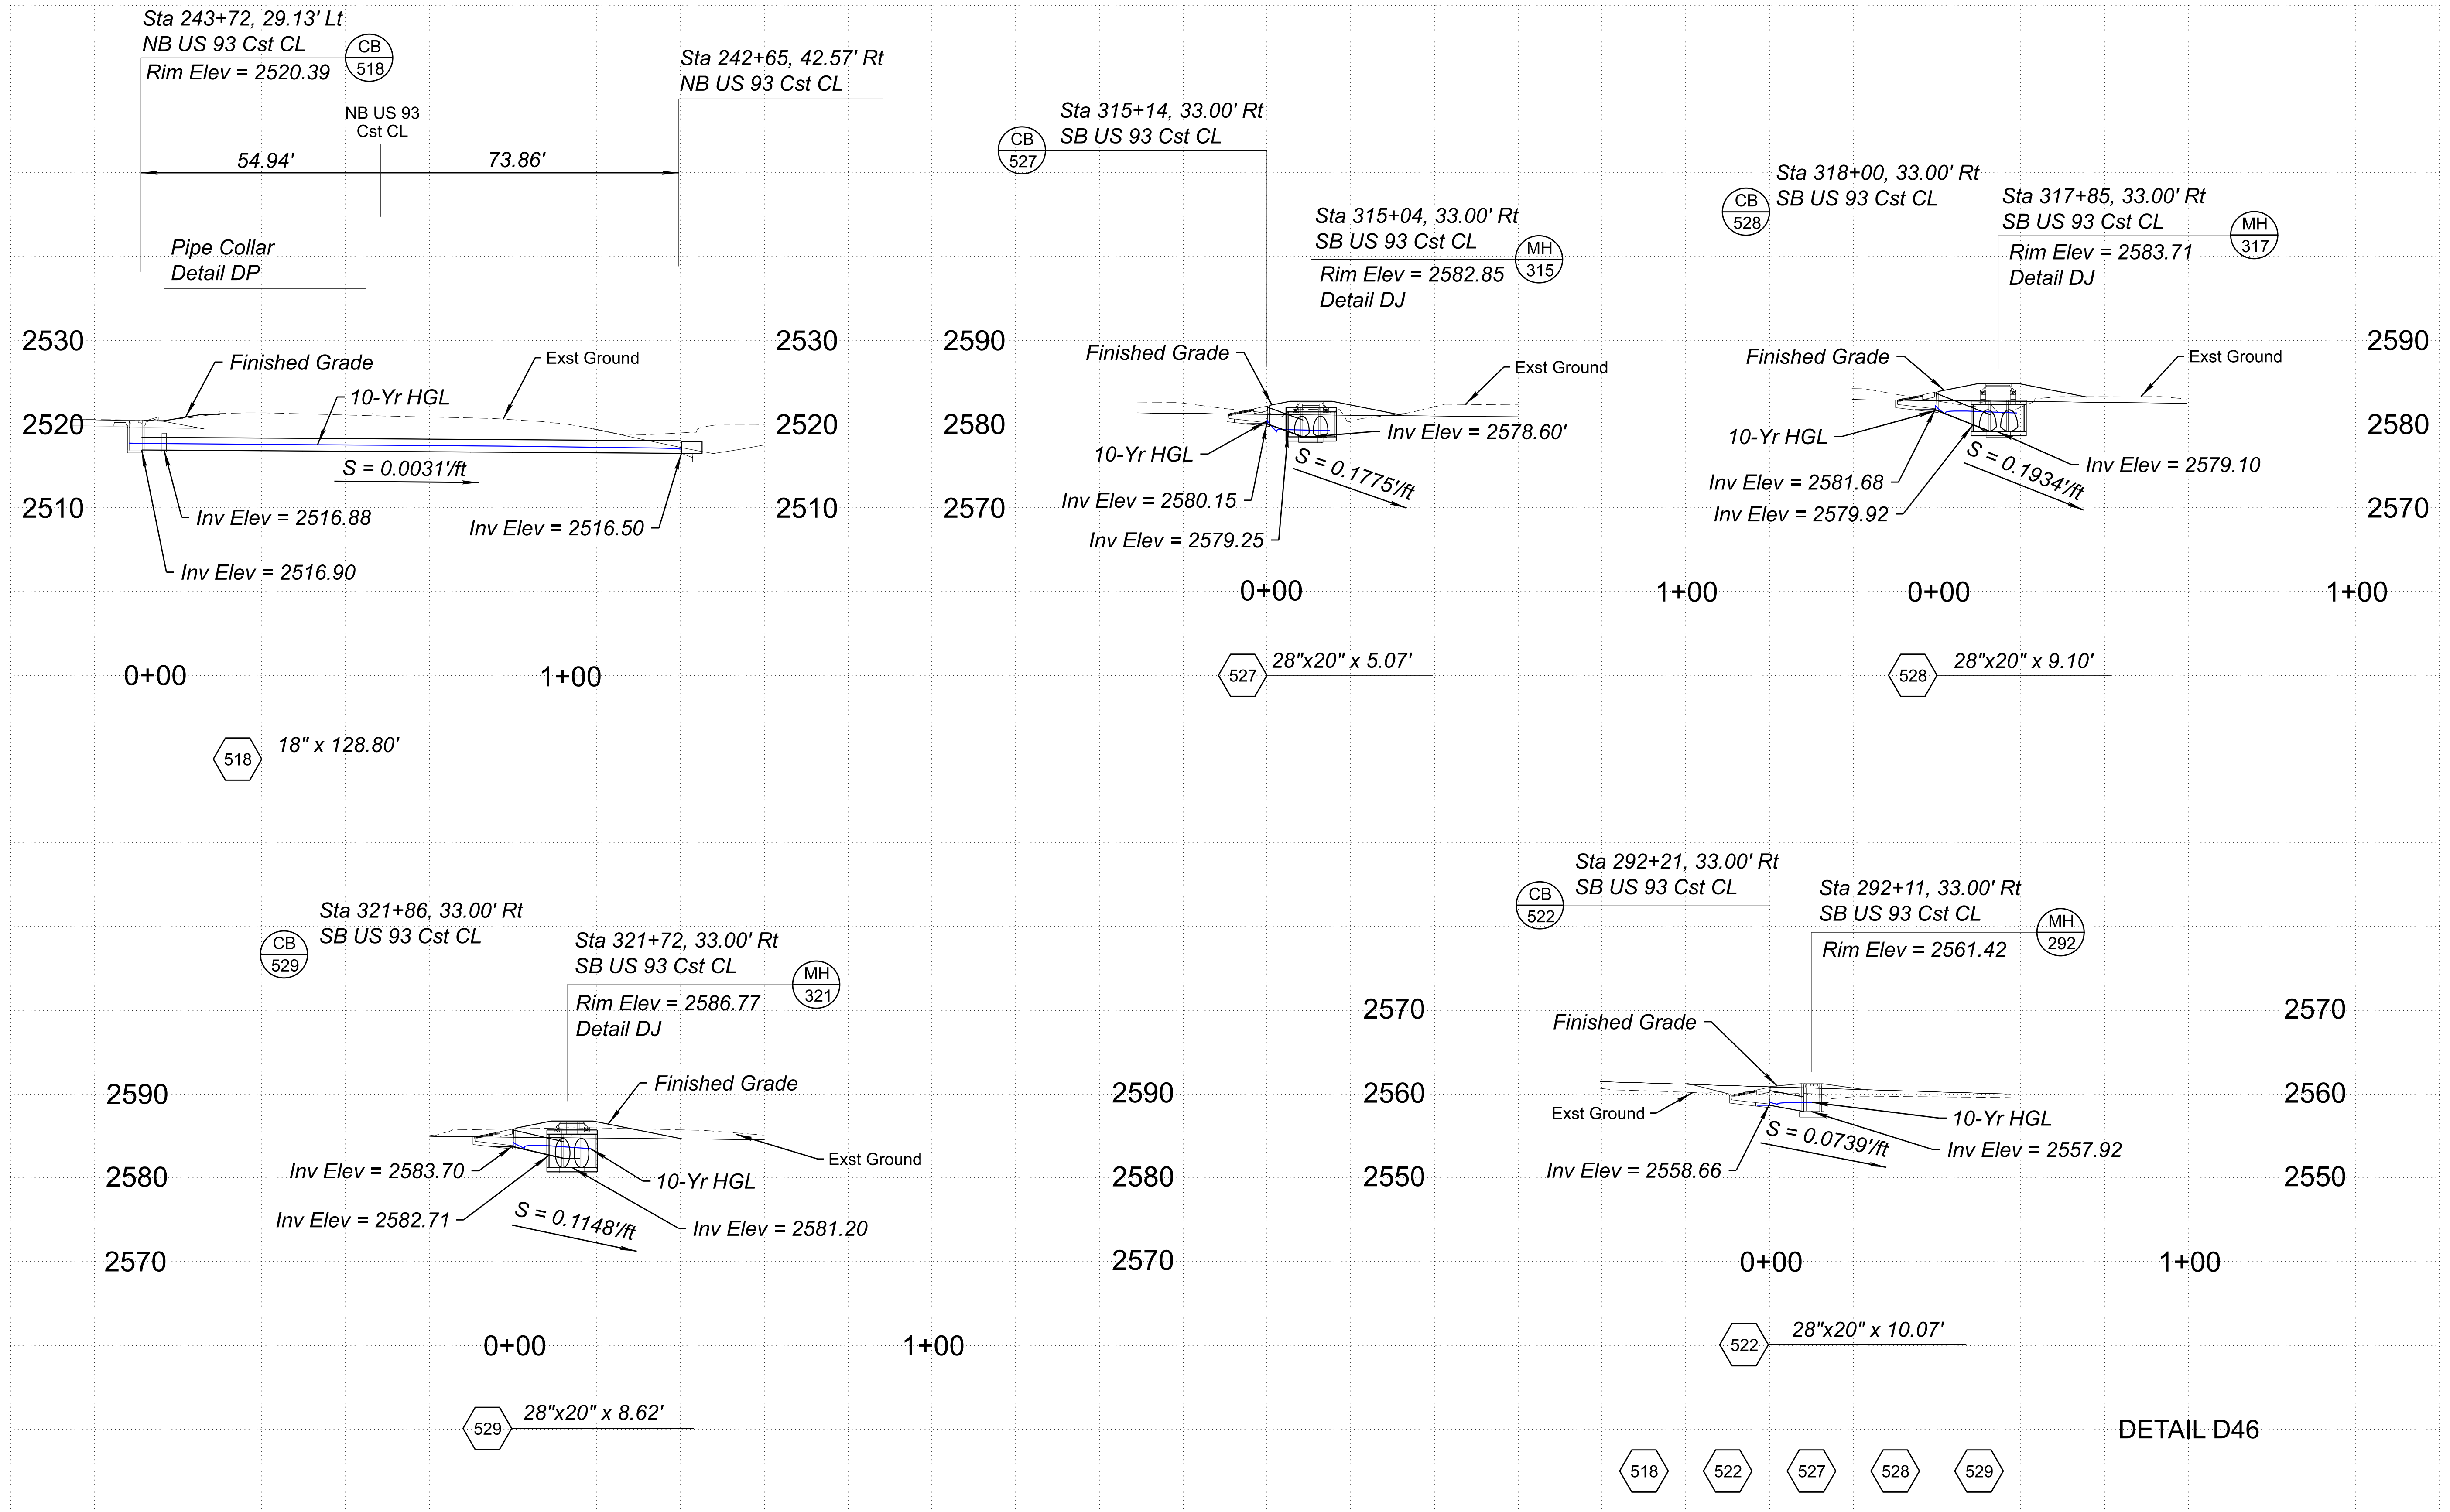



	NAME		DATE	ARIZONA DEPARTMENT OF TRANSPORTATION PROJECT DELIVERY AND OPERATIONS DIVISION ROADWAY DESIGN SERVICES		ROUTE		F.H.W.A. Arizona Division		STATE	PROJECT NO.	FEDERAL ID NO.	SHEET NO.	TOTAL SHEETS	RECORD DRAWING	
	DESIGN		K LEANDER			06/26	US 93				ARIZ.	093 YV 189	093-B(230)T	125	524	
	DRAWN		B LEANDER			06/26	MILEPOST		LOCATION		WICKENBURG RANCH WAY TO VISTA ROYALE				DWG No. D-3.10	
	CHECKED		B DENETDALE			06/26	STRUCTURE NO.		TRACS NO.		F0738 01C				OF	
TRANSPORTATION AECOM TECHNICAL SERVICES, Inc. 7720 N. 16th St., Suite 100 Phoenix, Arizona 85020 T 602.371.1100 www.aecom.com				PROFILE SHEET DETAIL D46												

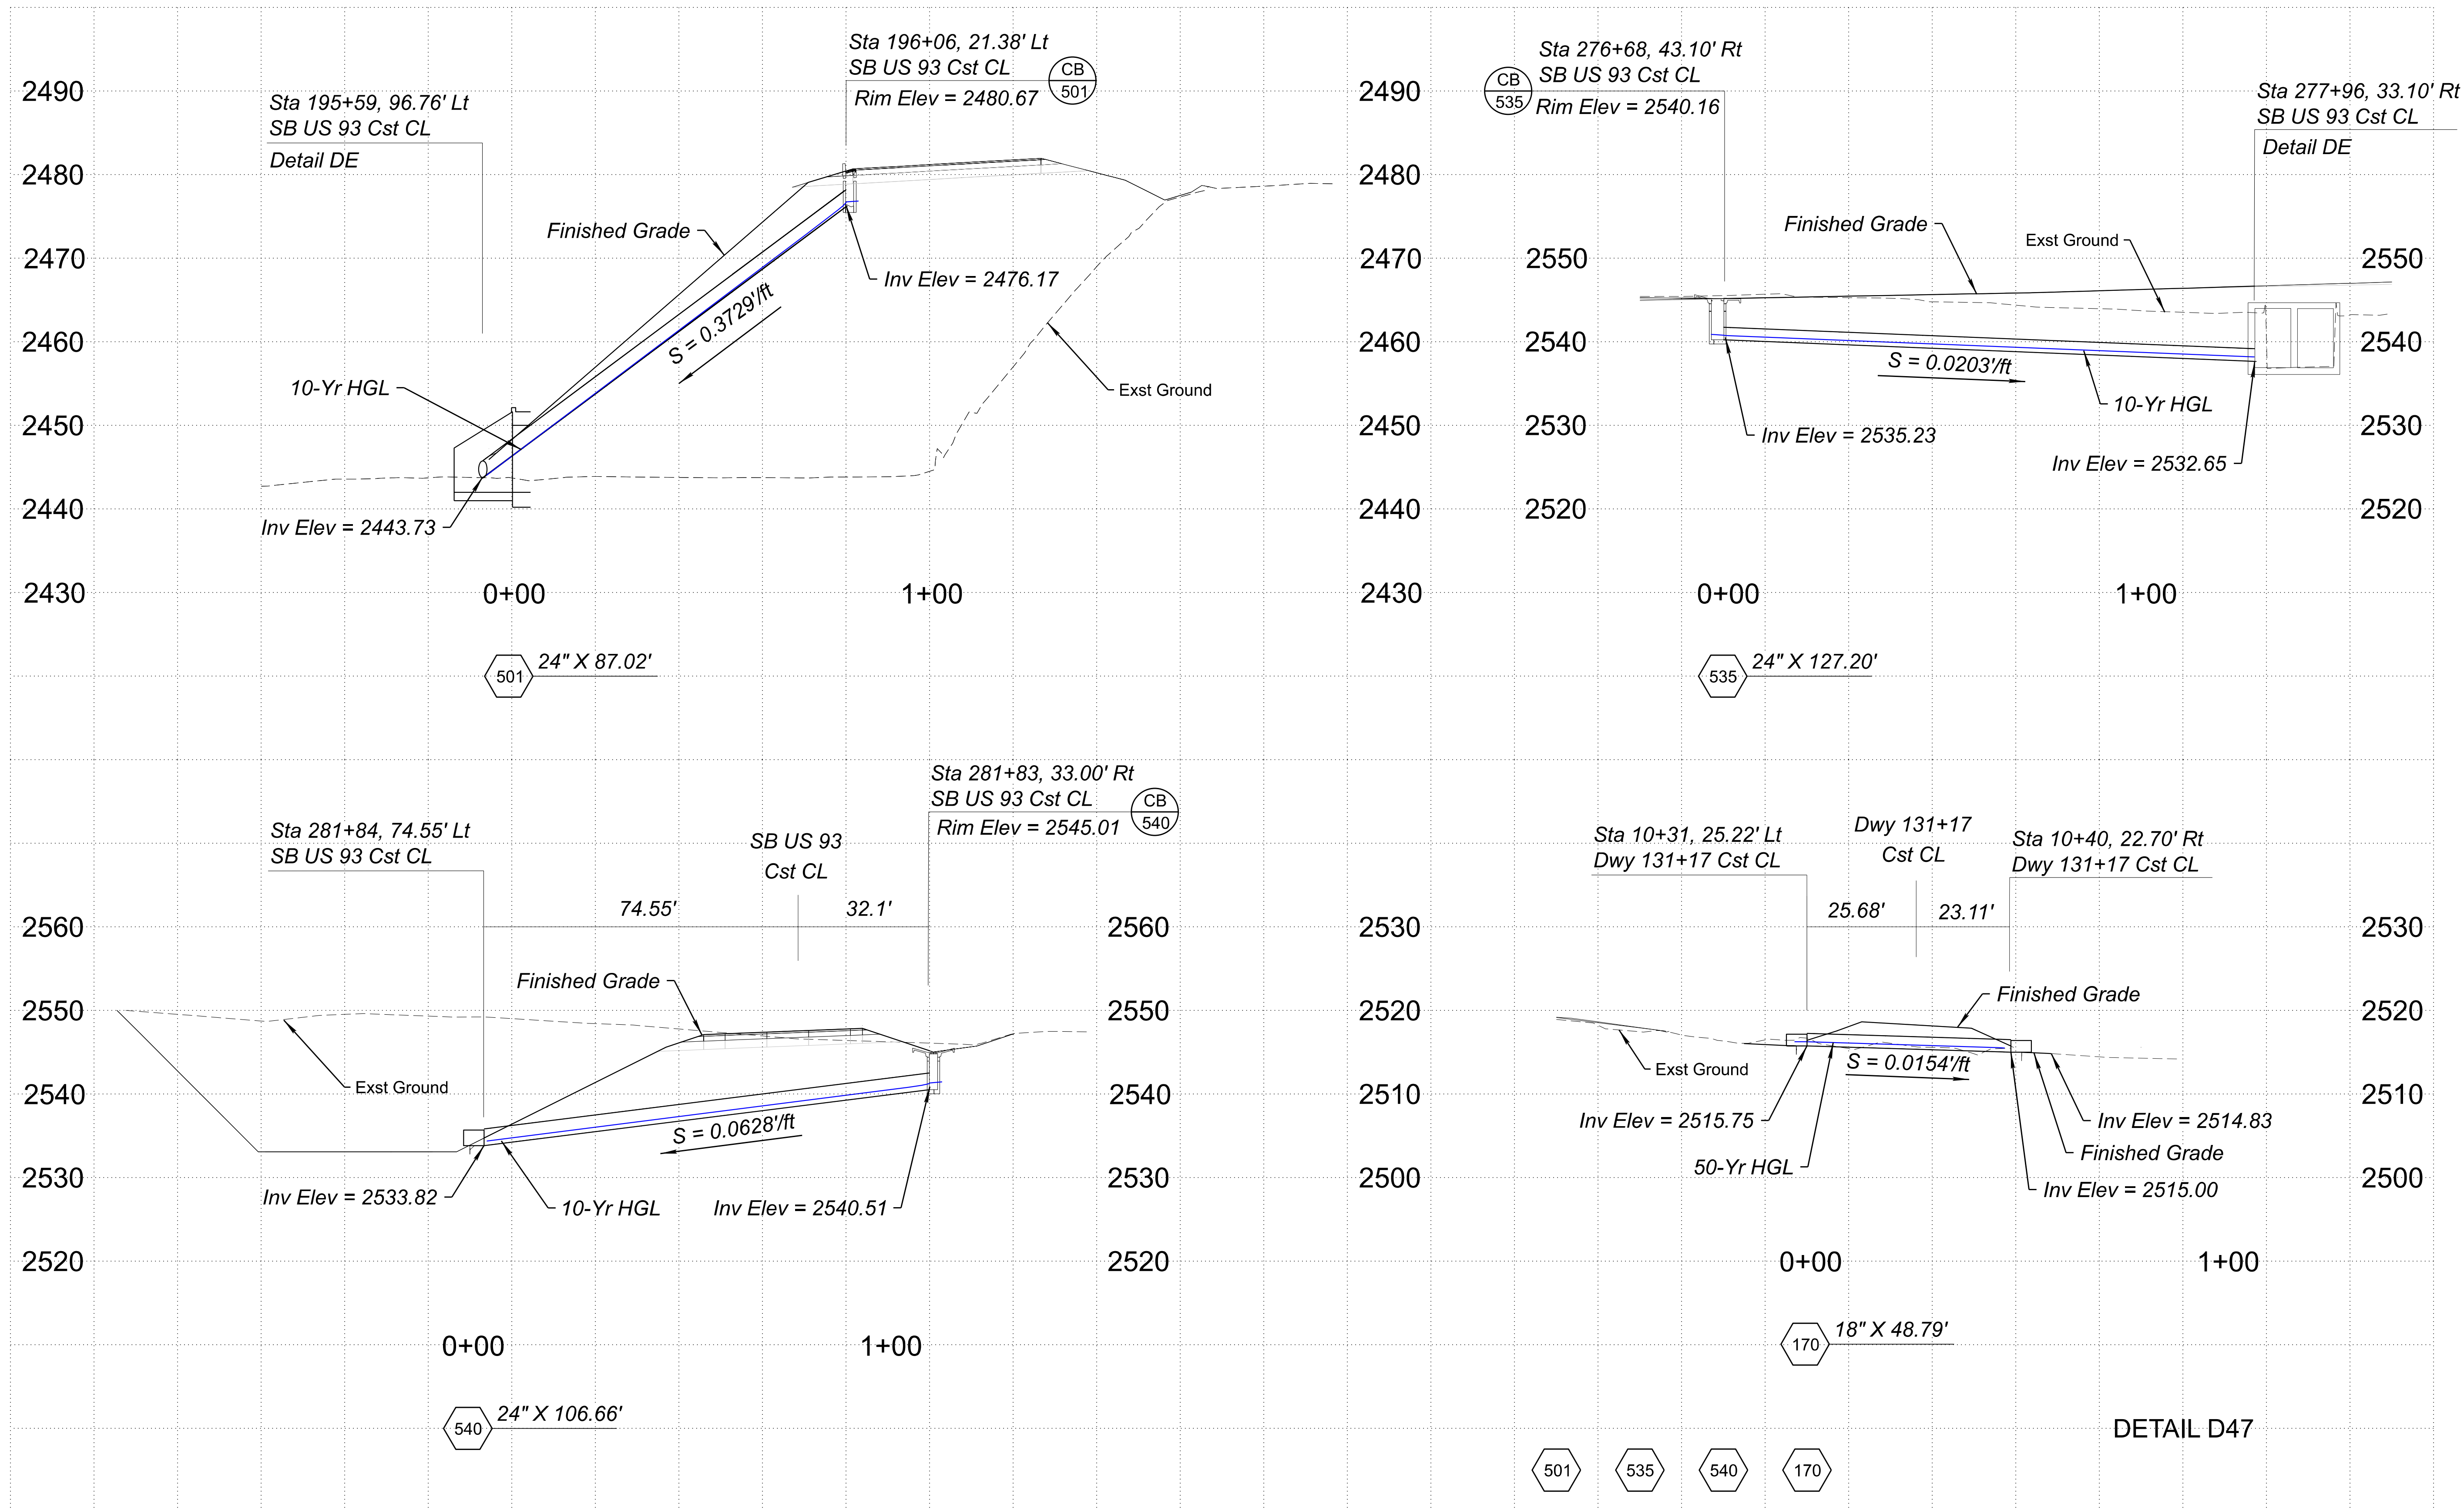

	NAME		DATE	ARIZONA DEPARTMENT OF TRANSPORTATION PROJECT DELIVERY AND OPERATIONS DIVISION ROADWAY DESIGN SERVICES		ROUTE	F.H.W.A. Arizona Division	STATE ARIZ.	PROJECT NO.	FEDERAL ID NO.	SHEET NO.	TOTAL SHEETS	RECORD DRAWING		
	DESIGN		K LEANDER			06/26			MILEPOST 189.9	LOCATION	WICKENBURG RANCH WAY TO VISTA ROYALE			DWG No. D-3.11	
	DRAWN		B LEANDER			06/26					STRUCTURE NO.	TRACS NO. F0738 01C			OF
	CHECKED		B DENETDALE	06/26											
TRANSPORTATION AECOM TECHNICAL SERVICES, Inc. 7720 N. 16th St., Suite 100 Phoenix, Arizona 85020 T 602.371.1100		AECOM www.aecom.com		PROFILE SHEET DETAIL D47											

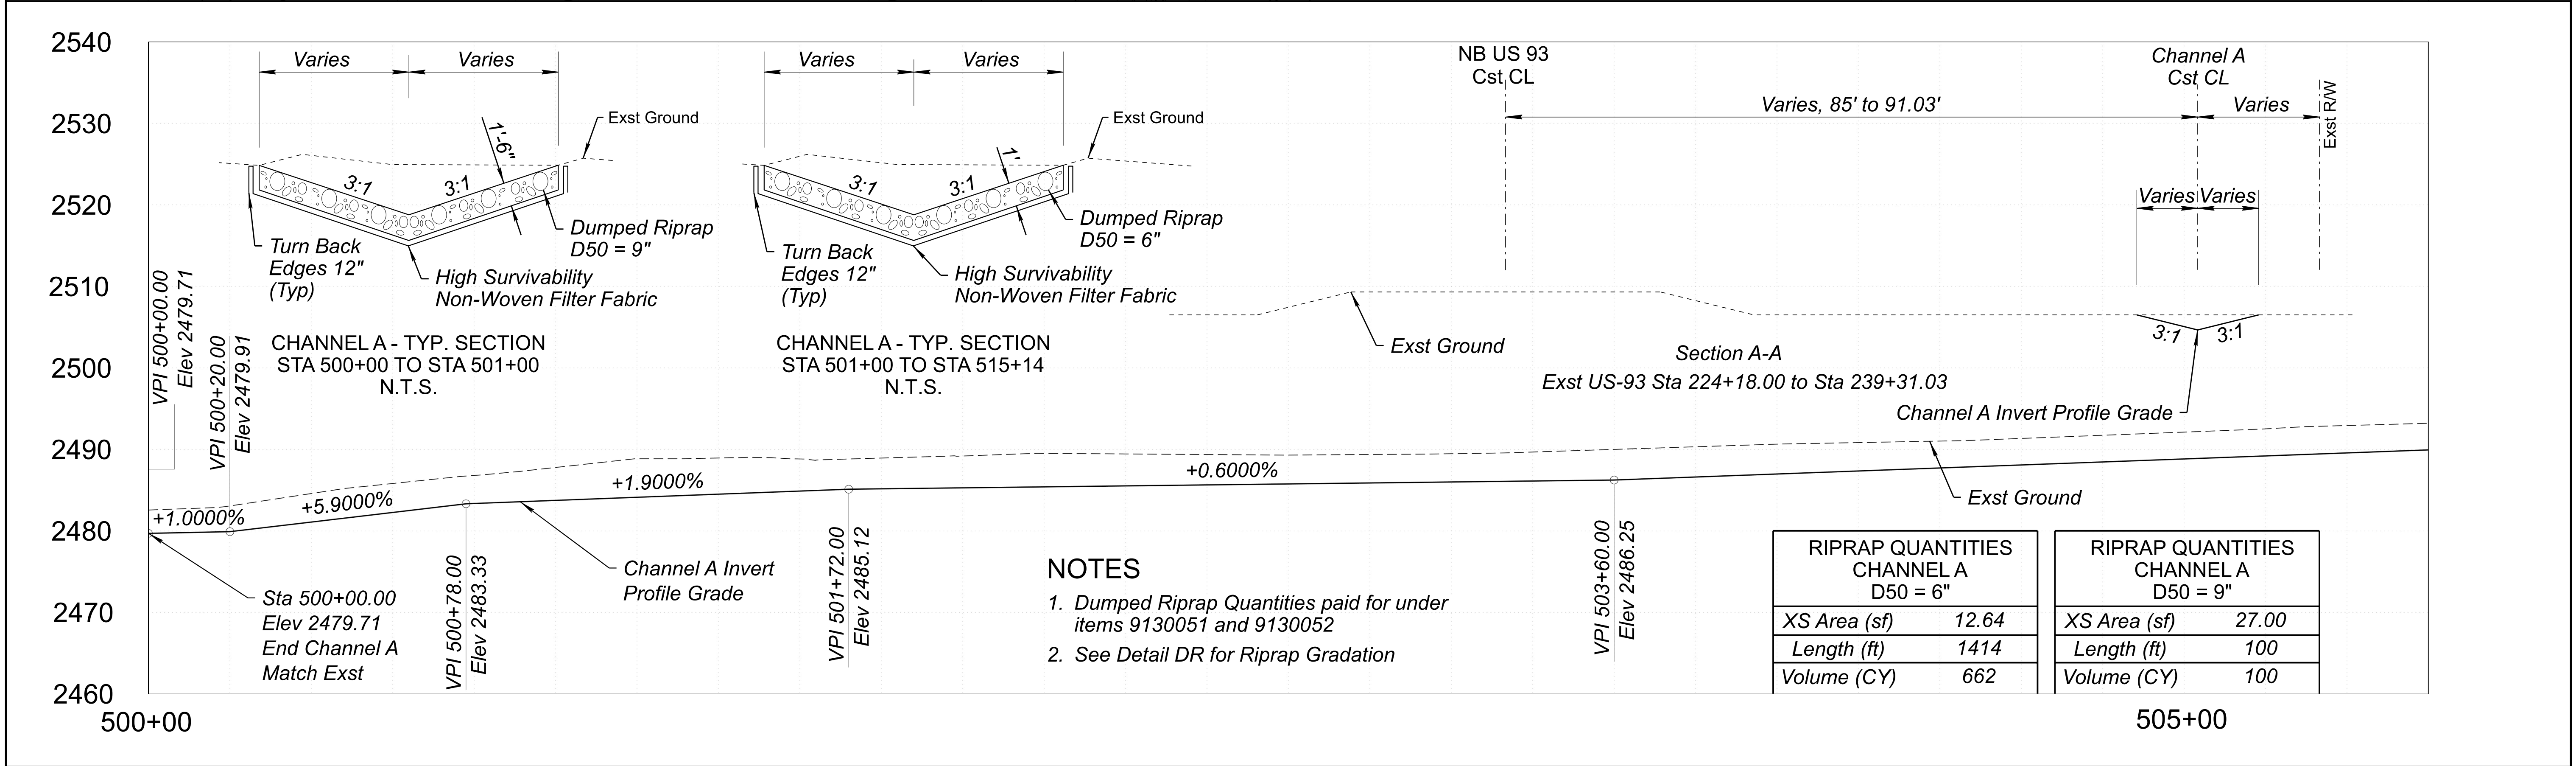
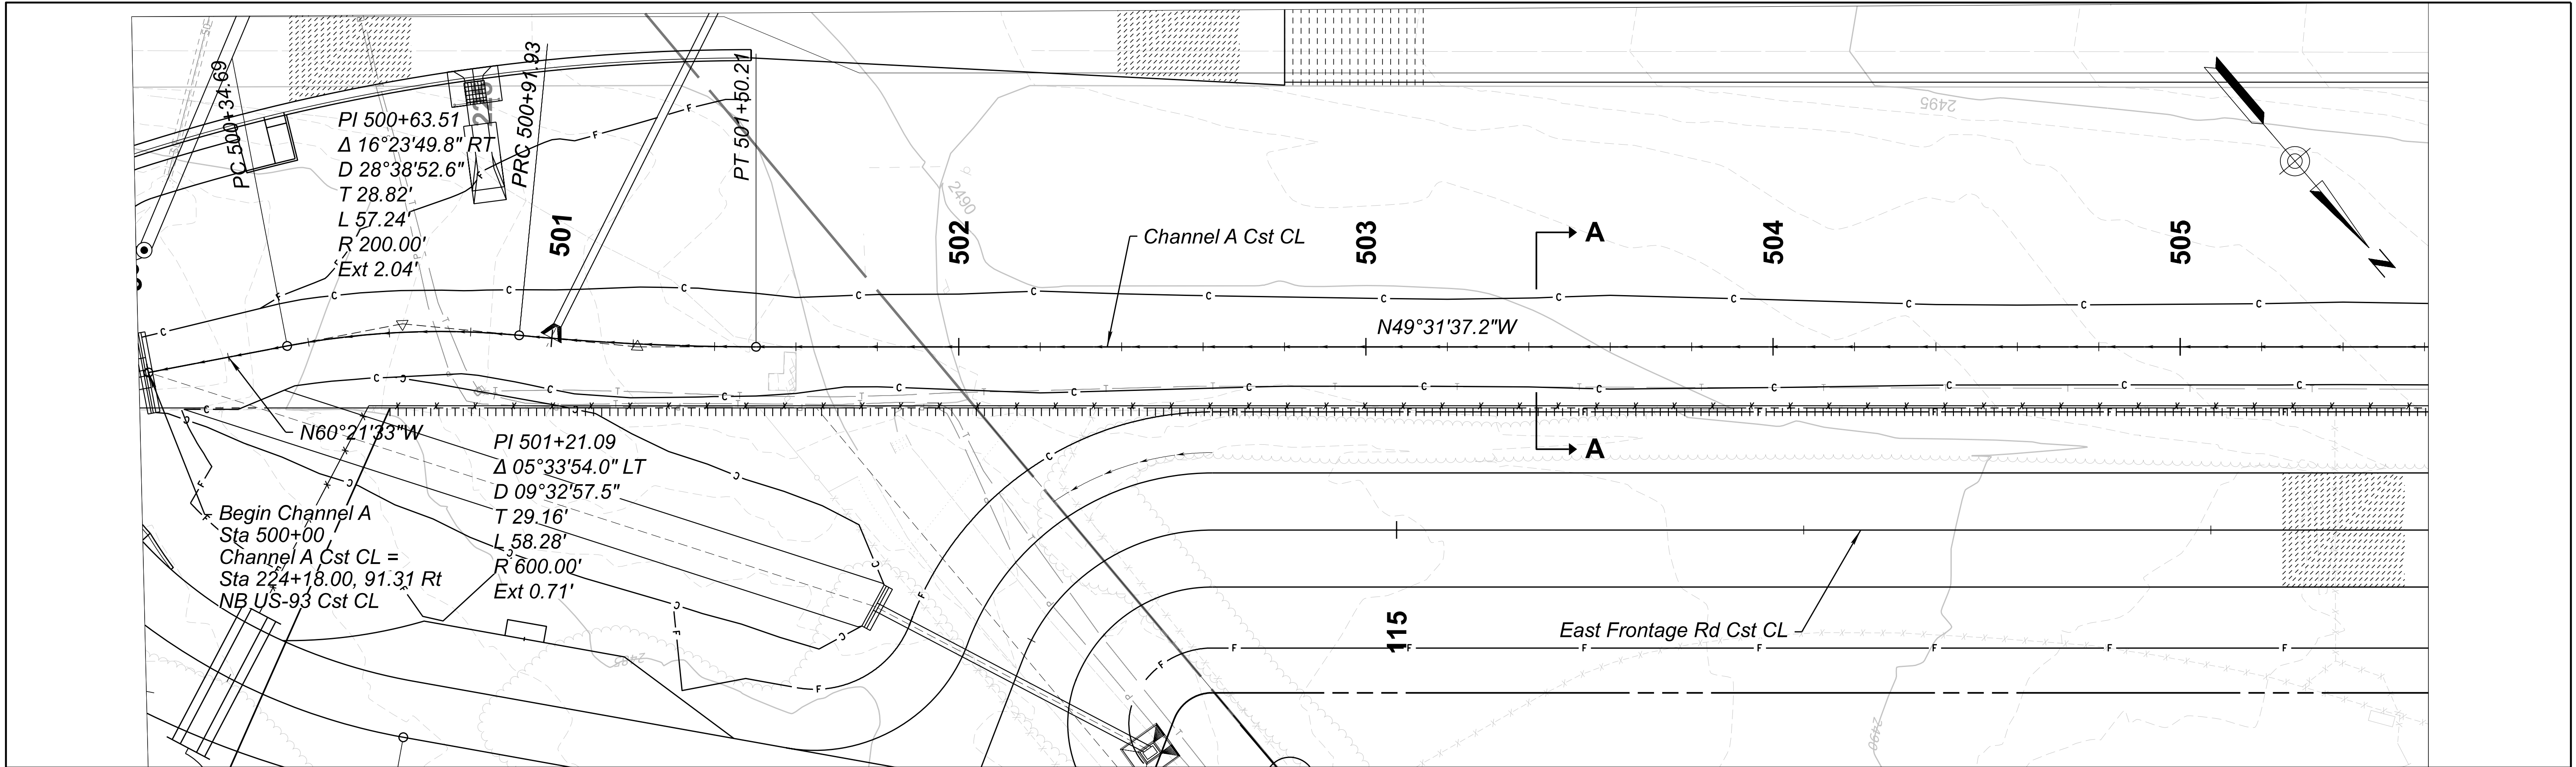


		NAME	DATE	ARIZONA DEPARTMENT OF TRANSPORTATION PROJECT DELIVERY AND OPERATIONS DIVISION ROADWAY DESIGN SERVICES		ROUTE	F.H.W.A. Arizona Division	STATE	PROJECT NO.	FEDERAL ID NO.	SHEET NO.	TOTAL SHEETS	RECORD DRAWING
	DESIGN	S Mutesi	06/26			US 93			093 YV 189	093-B(230)T	127	524	
	DRAWN	C VALENZUELA	06/26			MILEPOST 189.9	LOCATION	WICKENBURG RANCH WAY TO VISTA ROYALE			DWG No. D-4.01		
	CHECKED	D WIGGINS	06/26	STRUCTURE NO.	TRACS NO. F0738 01C							___ OF ___	
TRANSPORTATION AECOM TECHNICAL SERVICES, Inc. 7720 N. 16th St., Suite 100 Phoenix, Arizona 85020 T 602.371.1100				AECOM www.aecom.com		PLAN & PROFILE SHEET CHANNEL A							

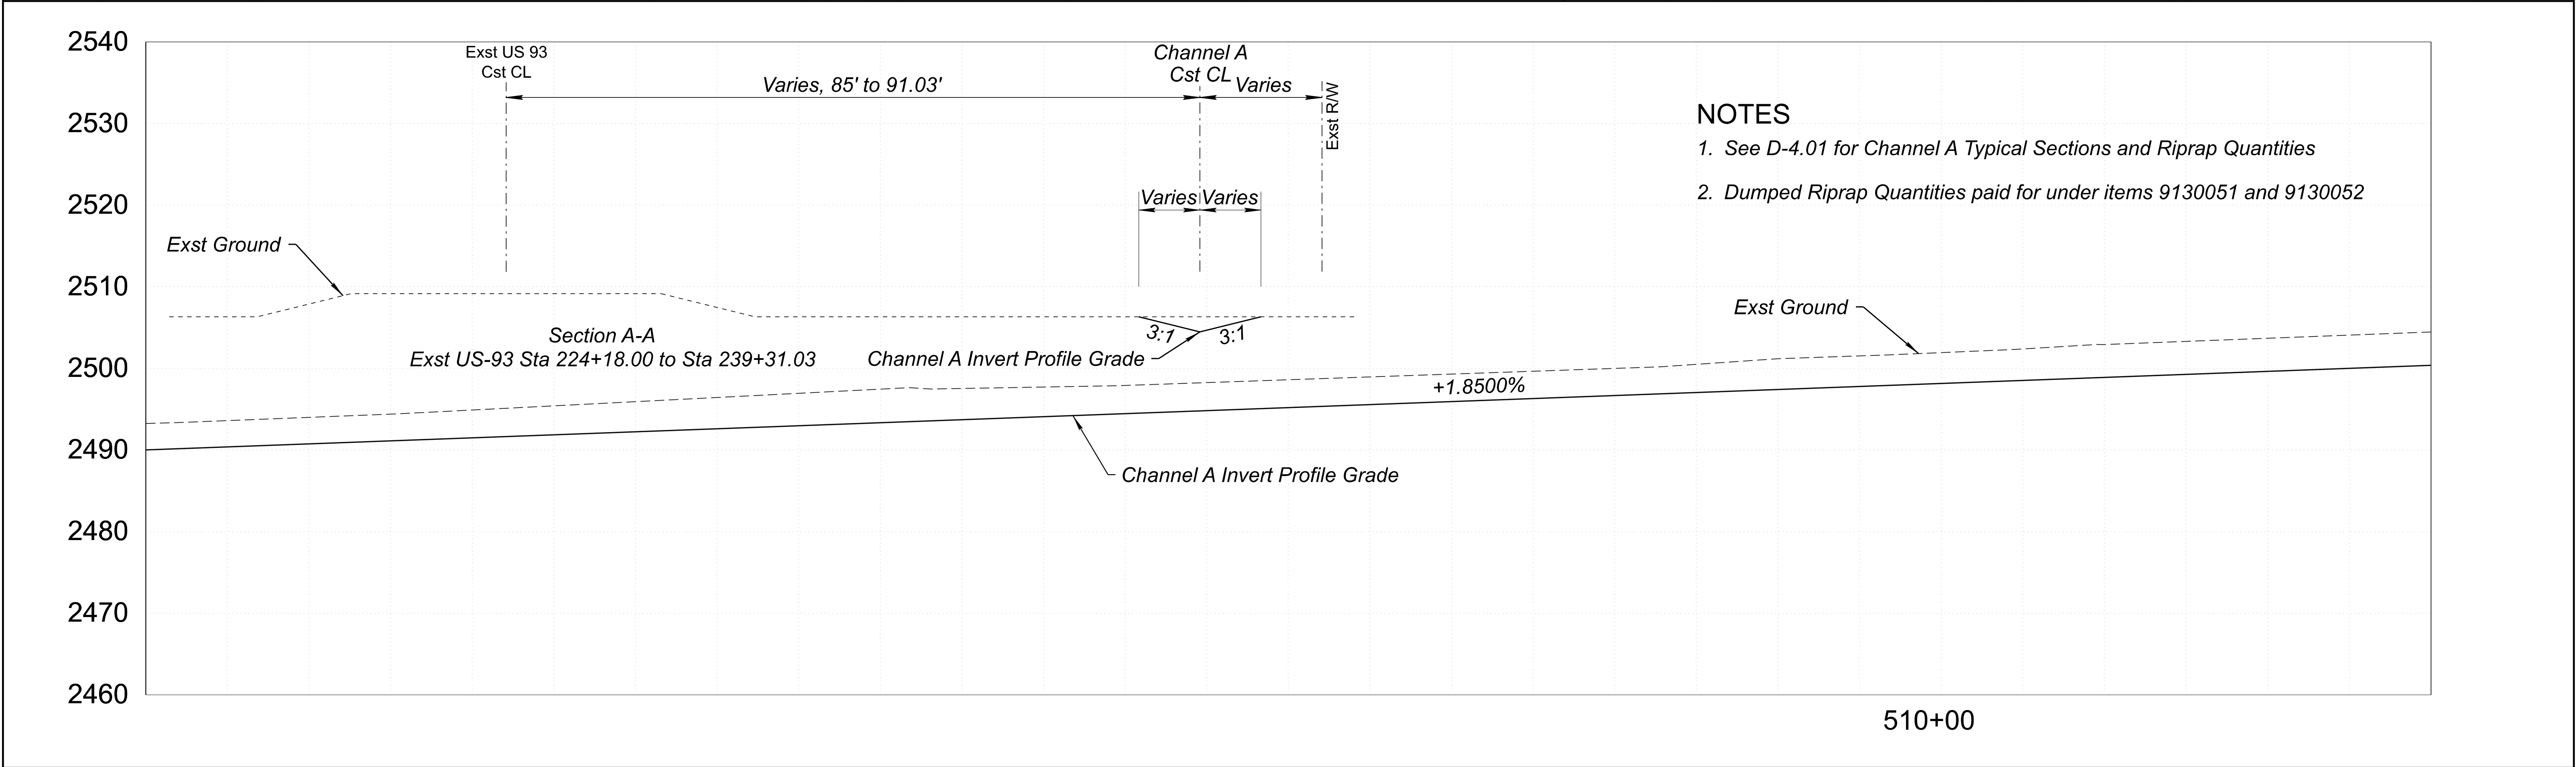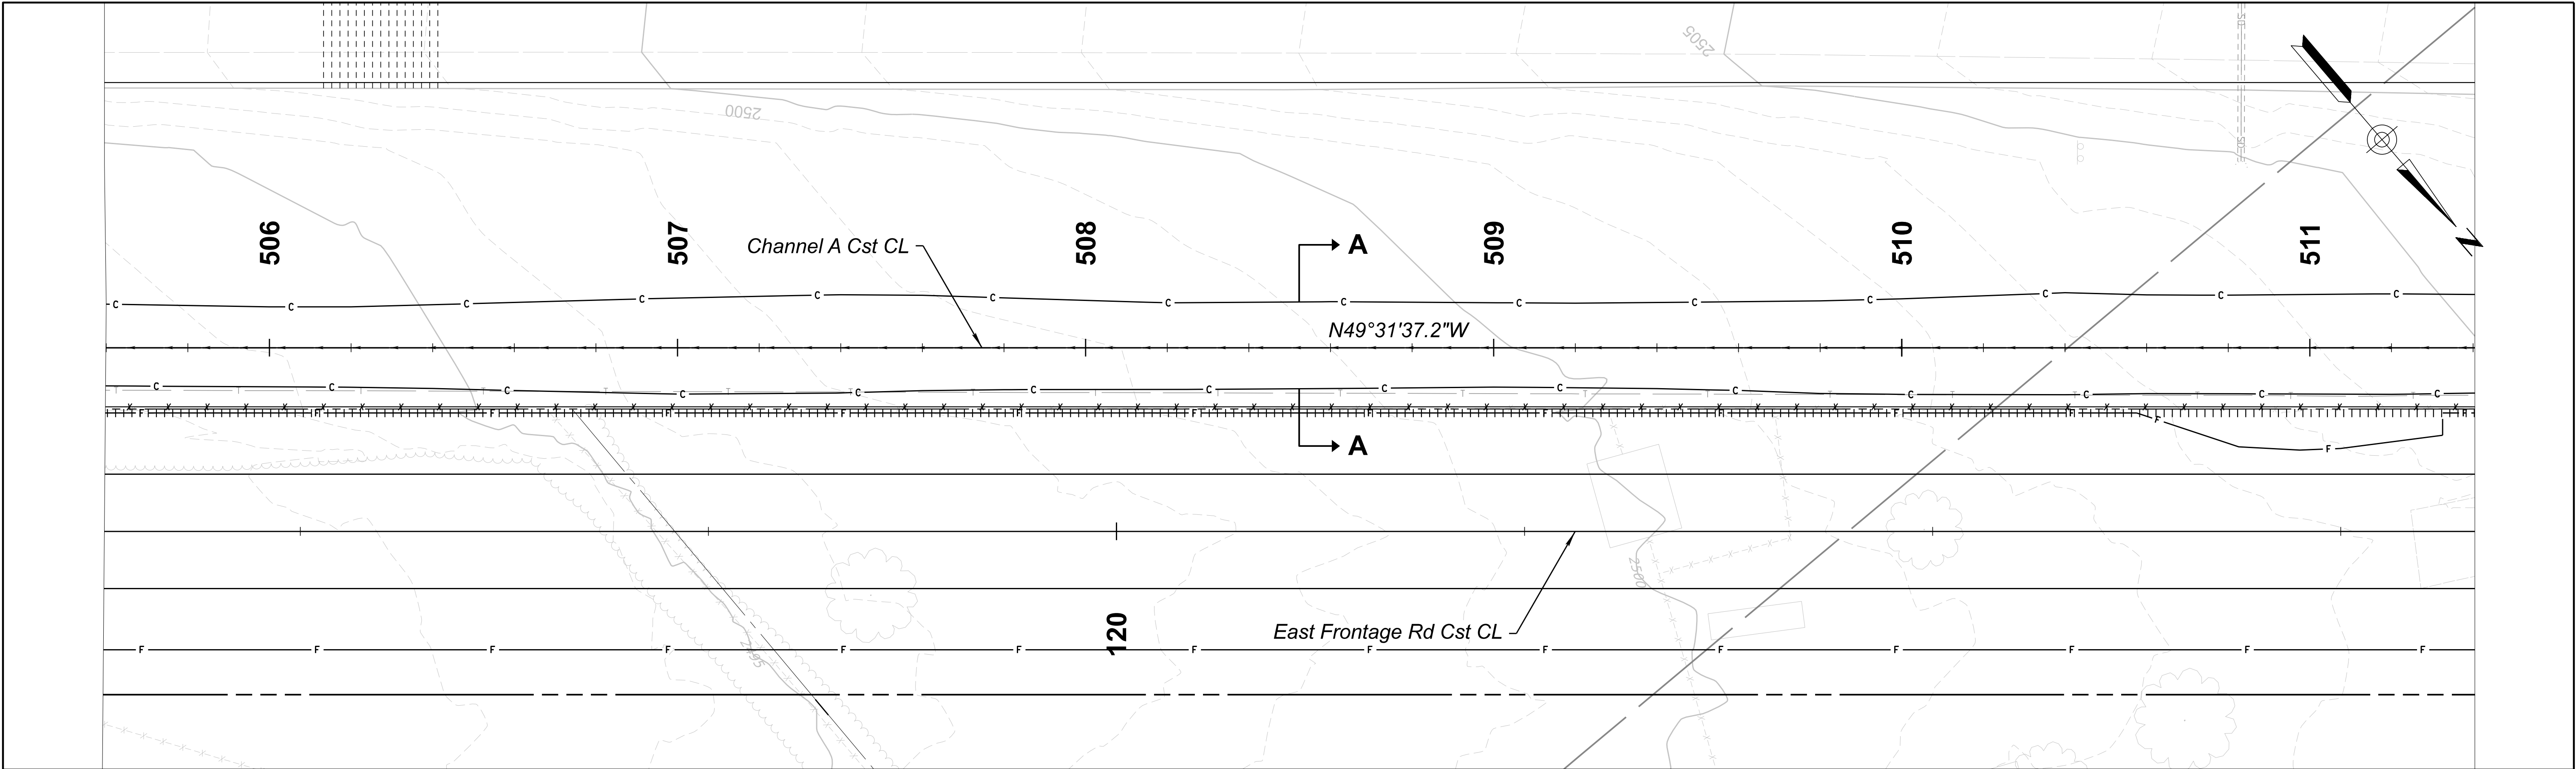




- NOTES**
- 1. See D-4.01 for Channel A Typical Sections and Riprap Quantities
 - 2. Dumped Riprap Quantities paid for under items 9130051 and 9130052

	NAME		DATE	ARIZONA DEPARTMENT OF TRANSPORTATION PROJECT DELIVERY AND OPERATIONS DIVISION ROADWAY DESIGN SERVICES	ROUTE	F.H.W.A. Arizona Division	STATE ARIZ.	PROJECT NO.	FEDERAL ID NO.	SHEET NO.	TOTAL SHEETS	RECORD DRAWING
	DESIGN	S Mutesi	06/26		MILEPOST 189.9			093 YV 189	093-B(230)T	128	524	
	DRAWN	C VALENZUELA	06/26									
	CHECKED	D WIGGINS	06/26									
	TRANSPORTATION AECOM TECHNICAL SERVICES, Inc. 7720 N. 16th St., Suite 100 Phoenix, Arizona 85020 T 602.371.1100			AECOM www.aecom.com		WICKENBURG RANCH WAY TO VISTA ROYALE						
PLAN & PROFILE SHEET CHANNEL A					STRUCTURE NO.		TRACS NO. F0738 01C		OF			

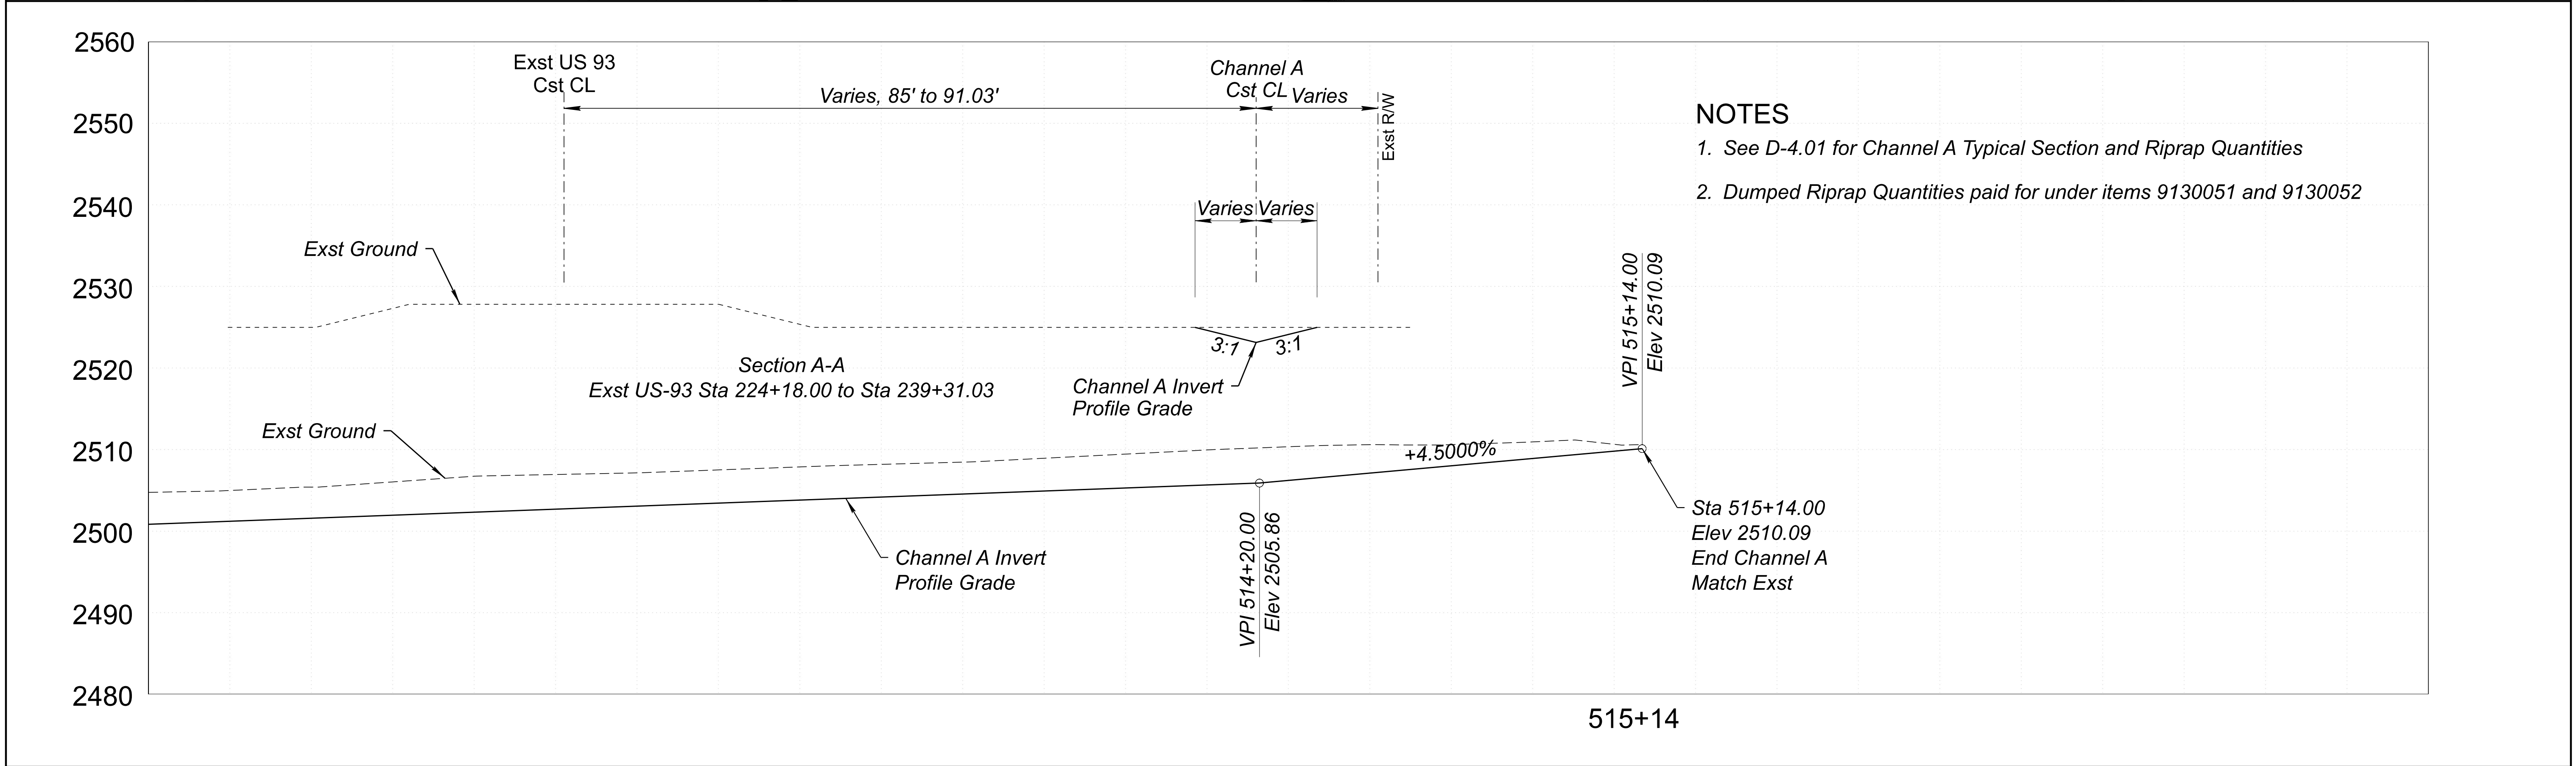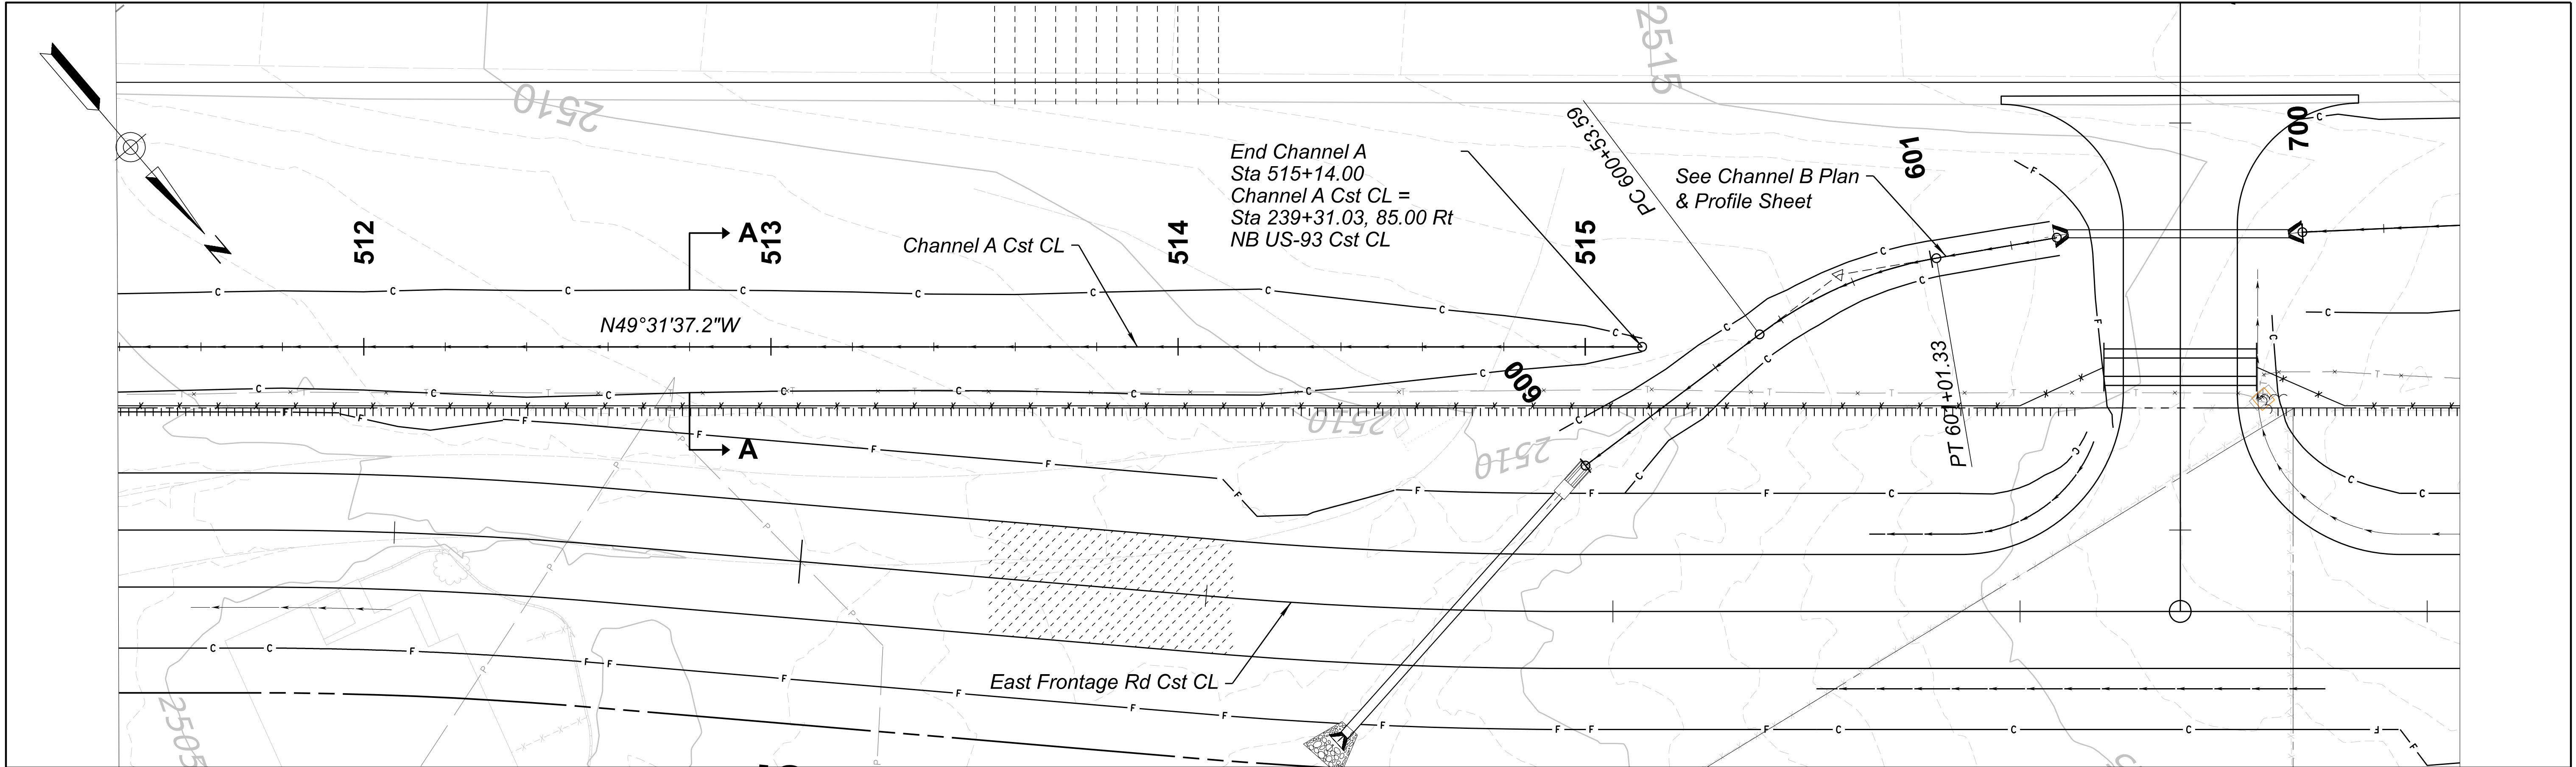

- NOTES**
- See D-4.01 for Channel A Typical Section and Riprap Quantities
 - Dumped Riprap Quantities paid for under items 9130051 and 9130052

		NAME	DATE	ARIZONA DEPARTMENT OF TRANSPORTATION PROJECT DELIVERY AND OPERATIONS DIVISION ROADWAY DESIGN SERVICES	ROUTE	F.H.W.A. Arizona Division	STATE	PROJECT NO.	FEDERAL ID NO.	SHEET NO.	TOTAL SHEETS	RECORD DRAWING
	DESIGN	S Mutesi	06/26		US 93							
	DRAWN	C VALENZUELA	06/26		MILEPOST	LOCATION	WICKENBURG RANCH WAY TO VISTA ROYALE	DWG No. D-4.03				
	CHECKED	D WIGGINS	06/26		189.9							
TRANSPORTATION AECOM TECHNICAL SERVICES, Inc. 7720 N. 169th St., Suite 100 Phoenix, Arizona 85029 T 602.376.1100  www.aecom.com				PLAN & PROFILE SHEET CHANNEL A	STRUCTURE NO.	TRACS NO.	F0738 01C	____ OF ____				

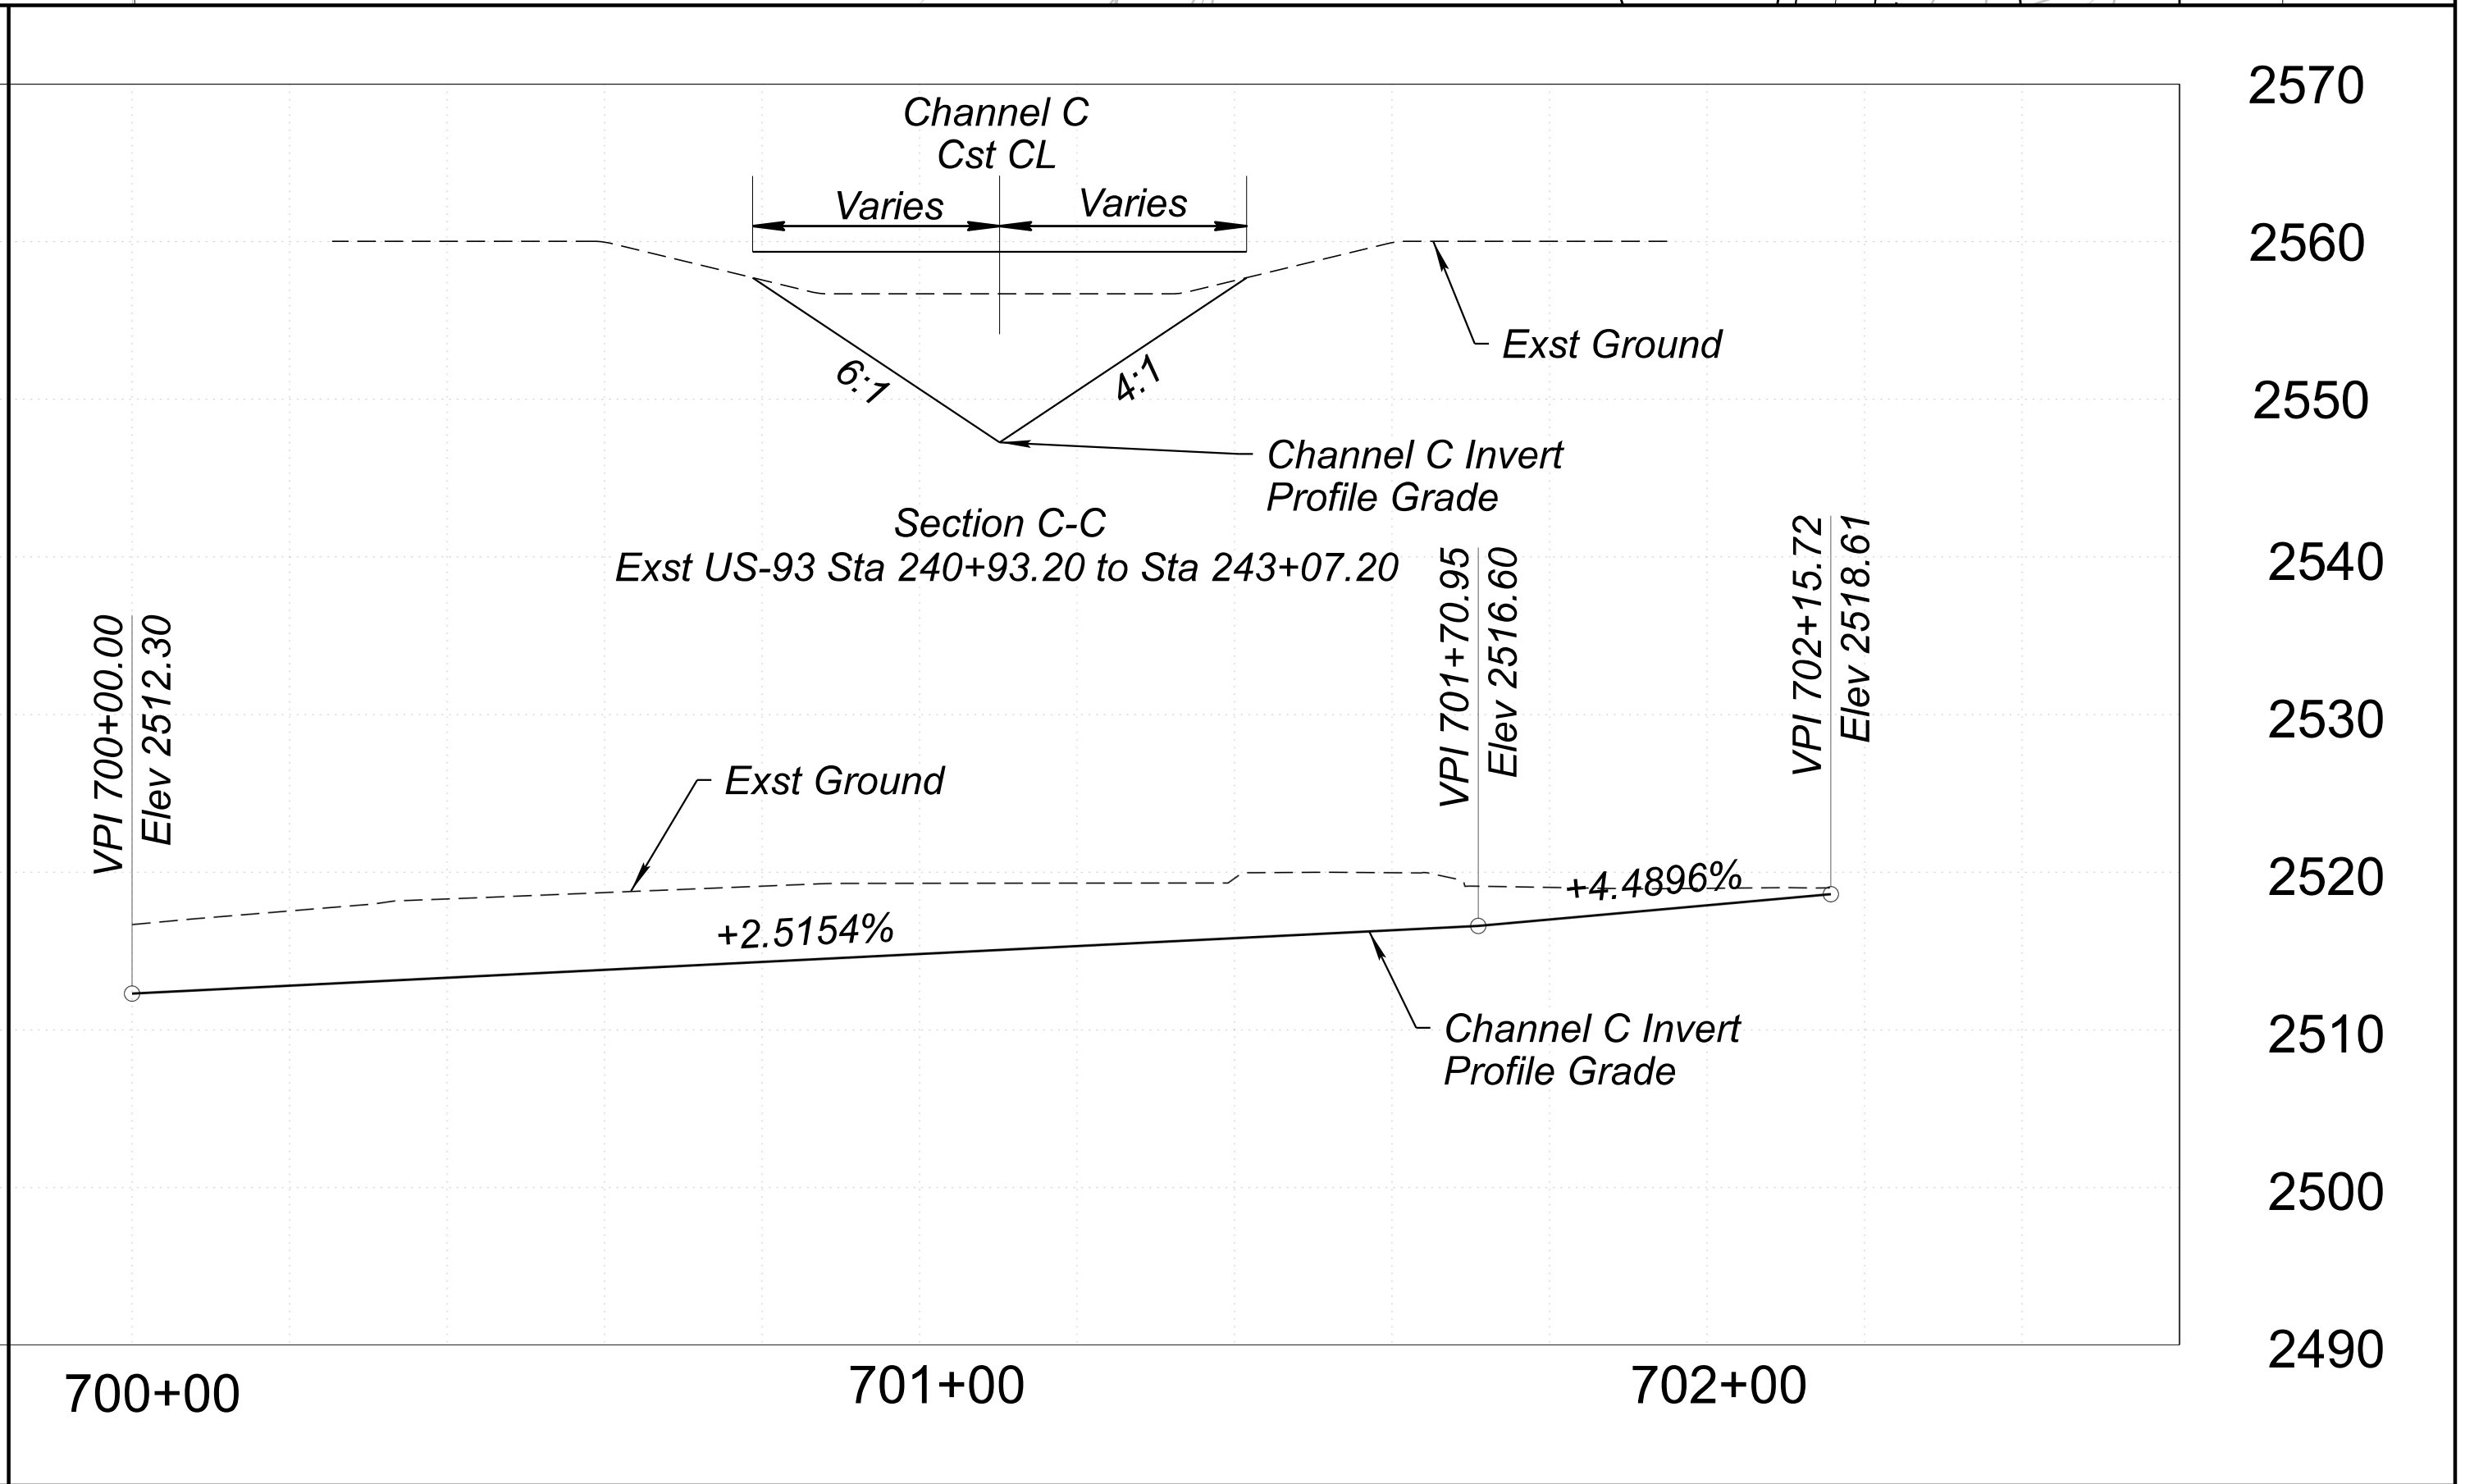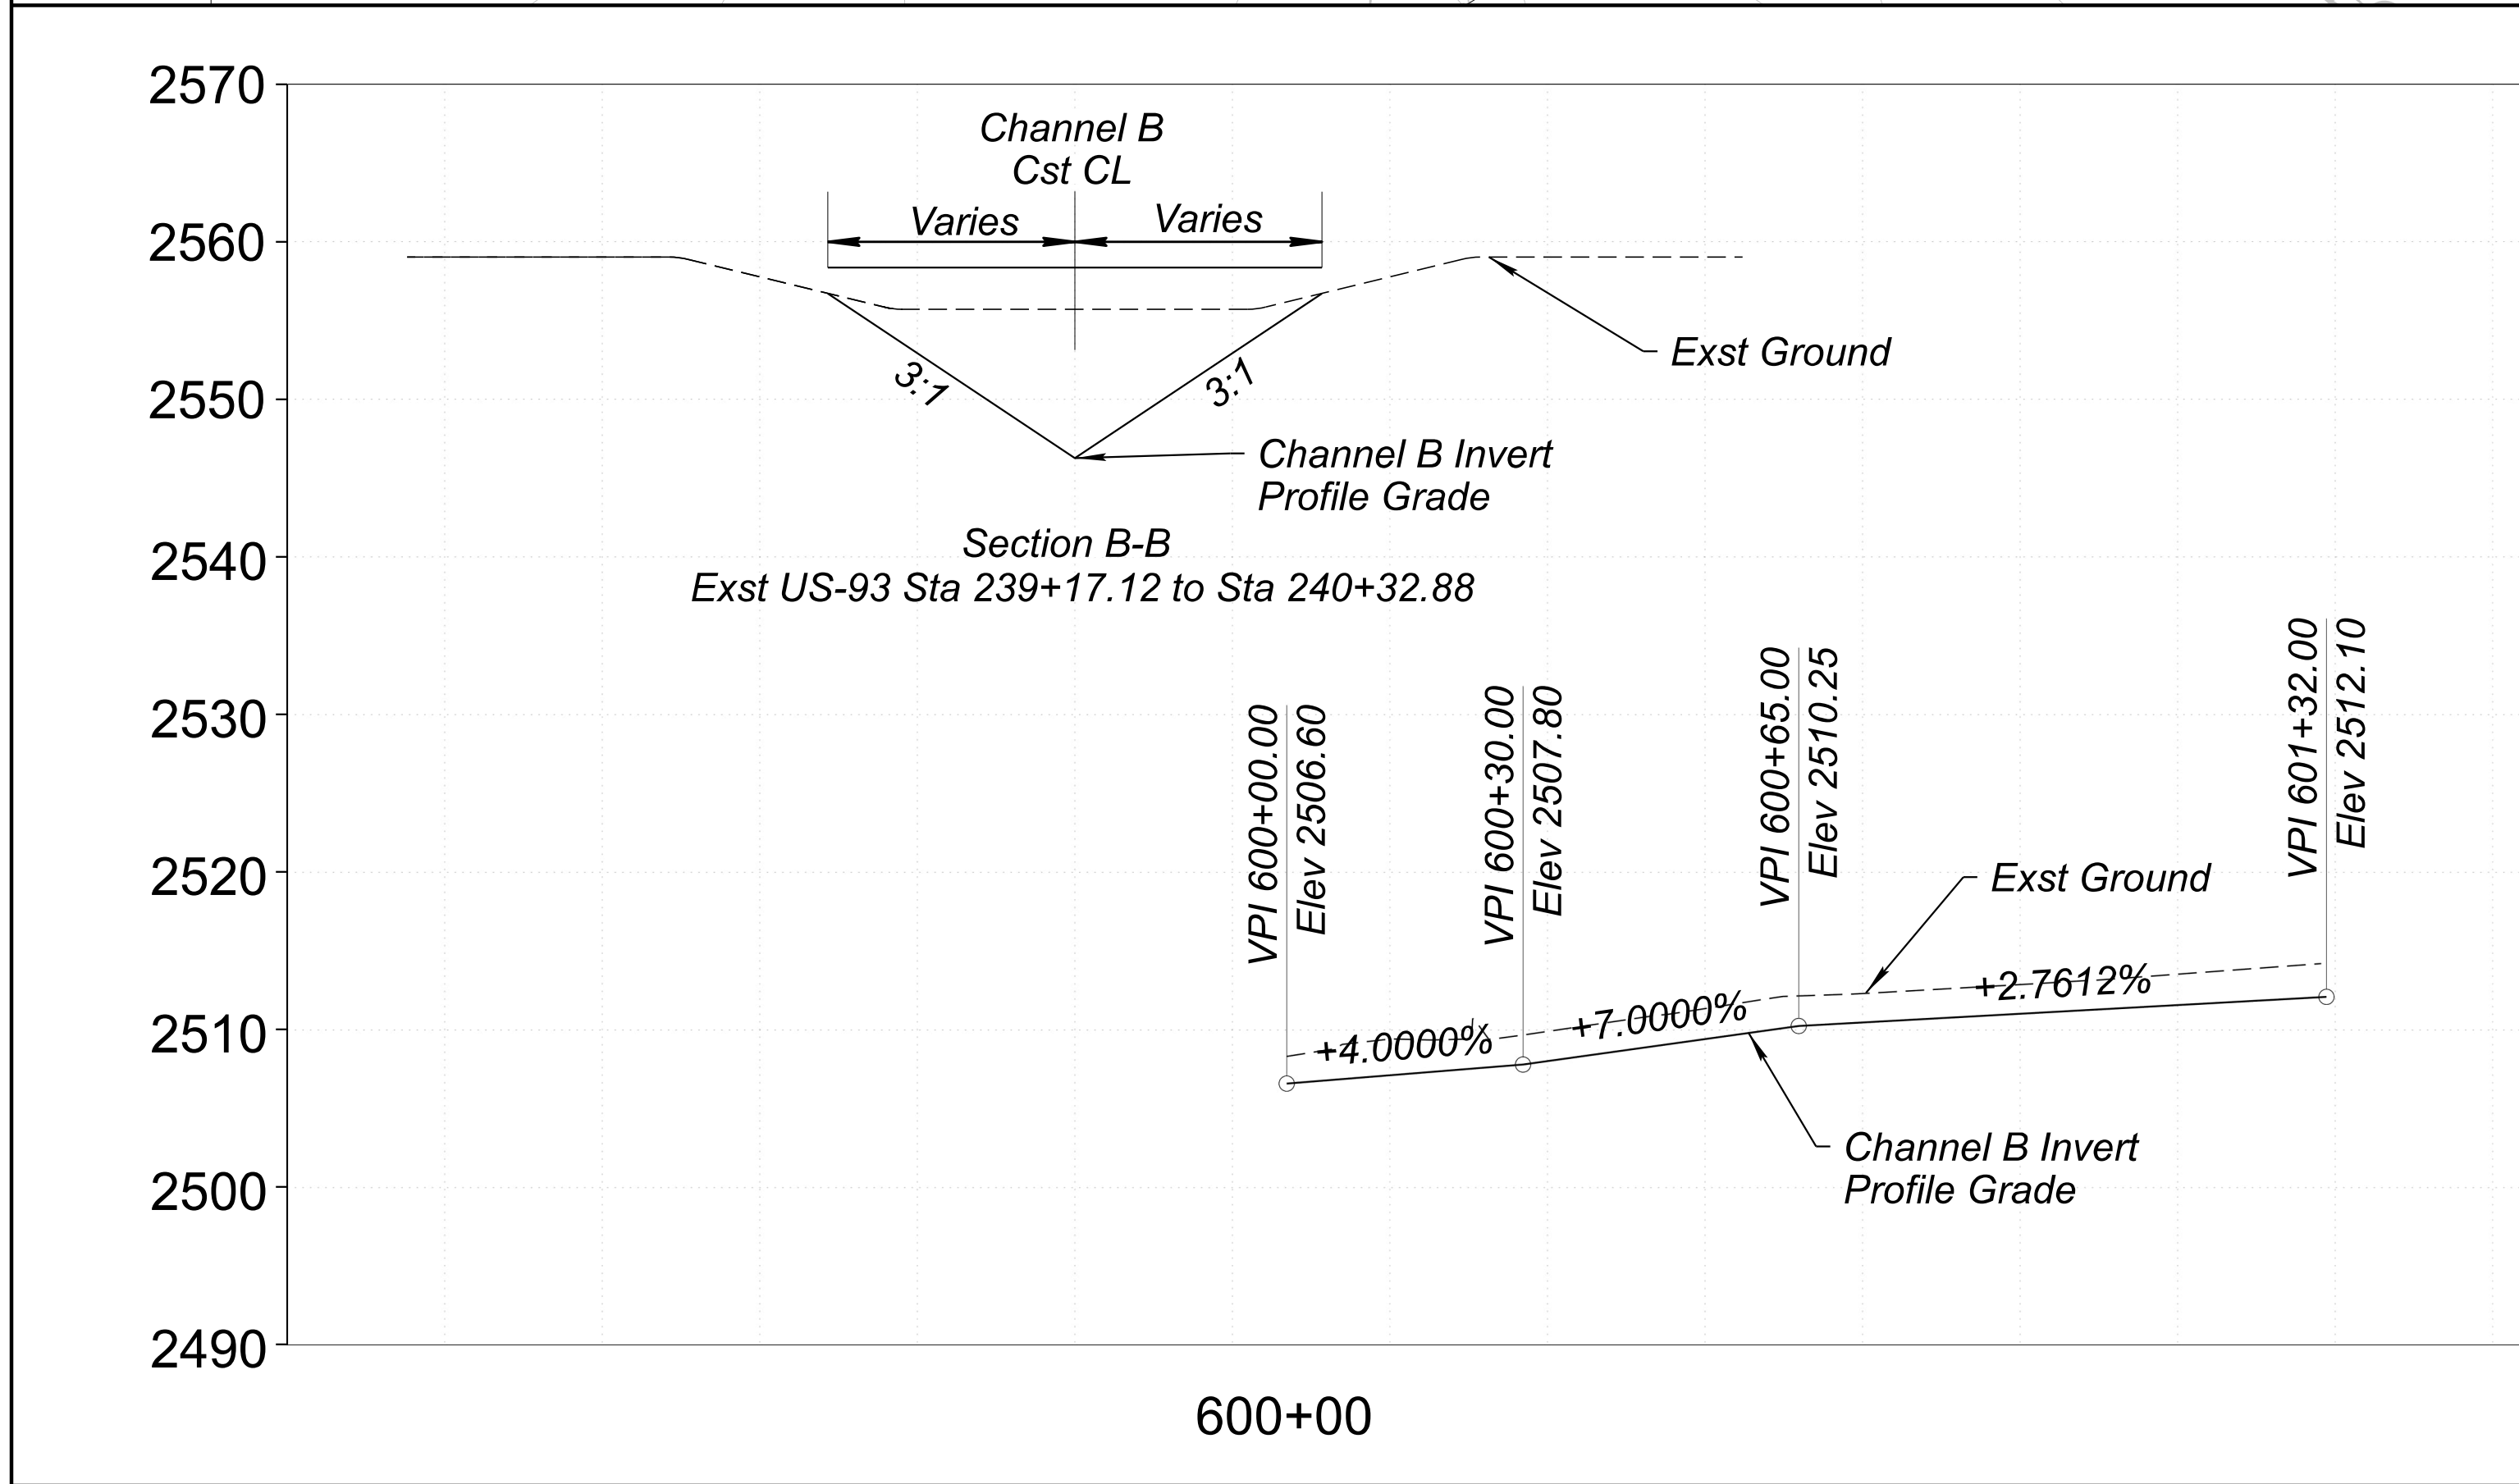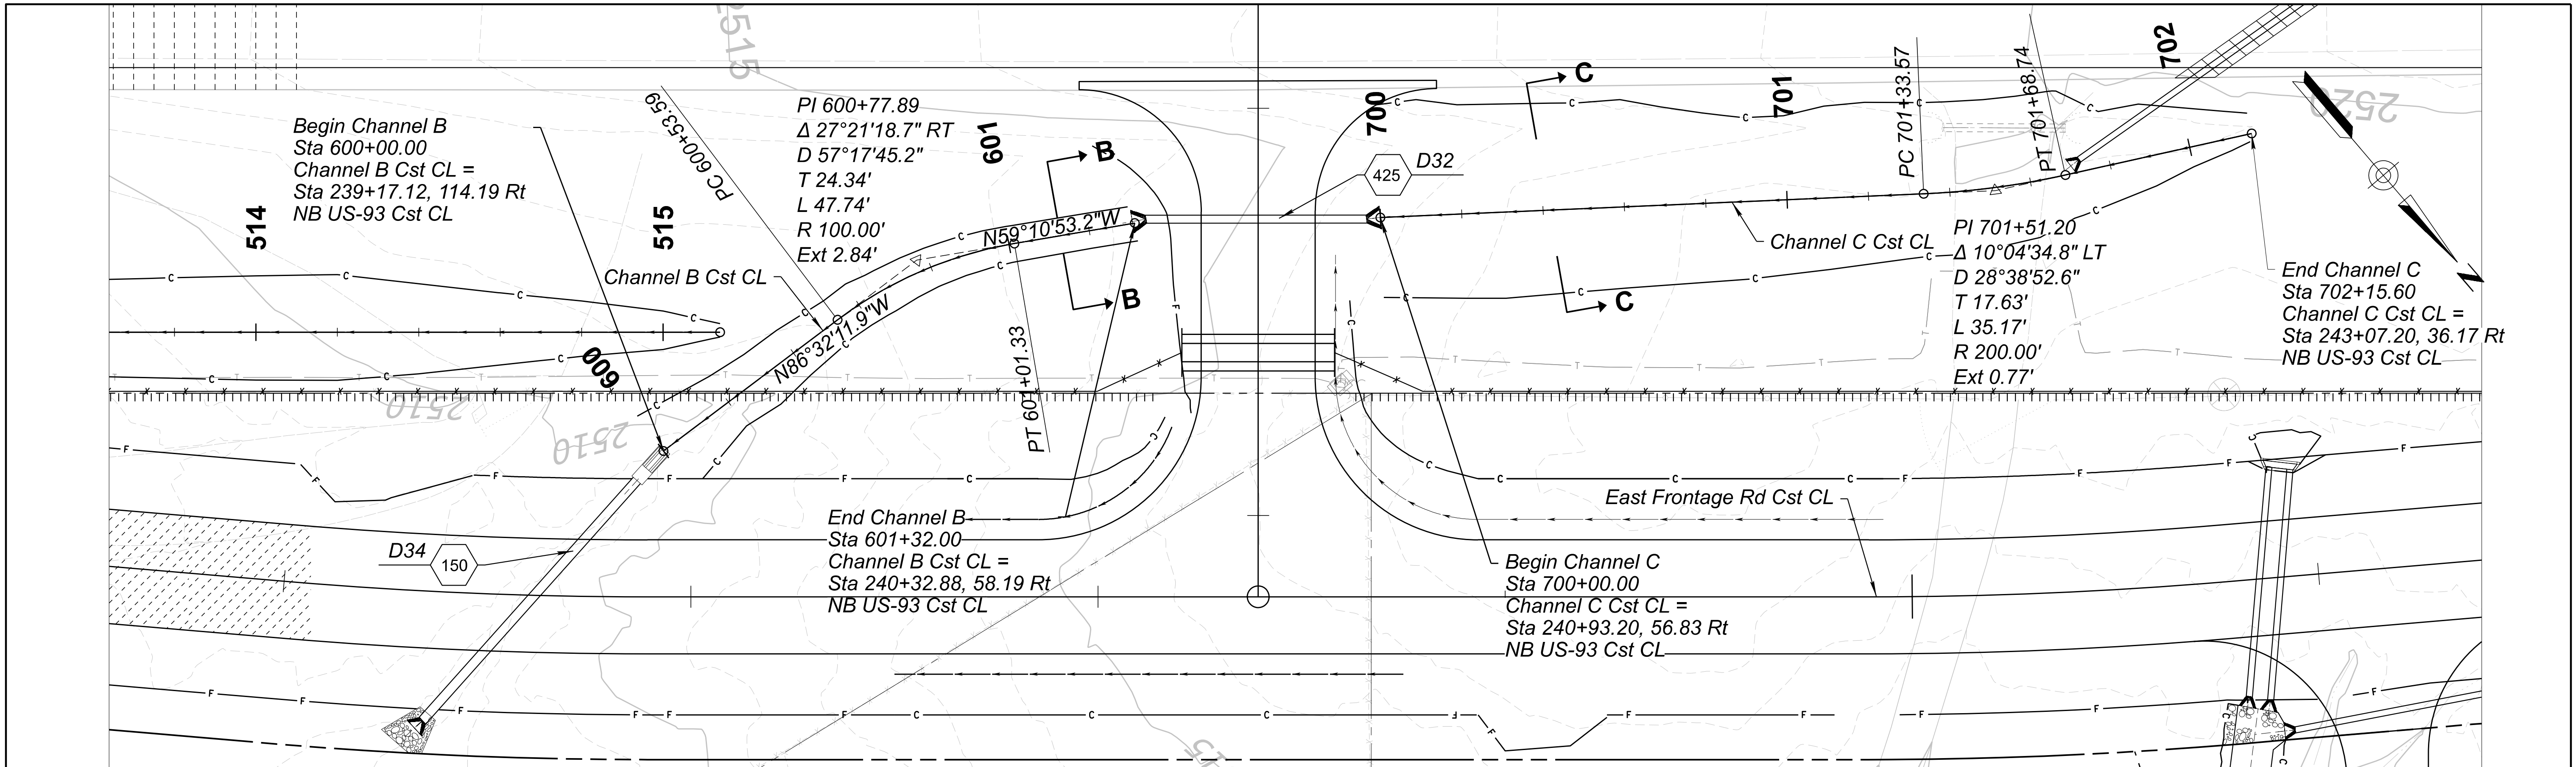

	<table><tr><th></th><th>NAME</th><th>DATE</th></tr><tr><td>DESIGN</td><td>S Mutesi</td><td>06/26</td></tr><tr><td>DRAWN</td><td>C VALENZUELA</td><td>06/26</td></tr><tr><td>CHECKED</td><td>D WIGGINS</td><td>06/26</td></tr></table>			NAME	DATE	DESIGN	S Mutesi	06/26	DRAWN	C VALENZUELA	06/26	CHECKED	D WIGGINS	06/26	<table><tr><td>TRANSPORTATION</td><td>AECOM TECHNICAL SERVICES, Inc.</td></tr><tr><td>7720 N. 16th St., Suite 100</td><td>Phoenix, Arizona 85020</td></tr><tr><td>T 602.371.1100</td><td></td></tr></table> 		TRANSPORTATION	AECOM TECHNICAL SERVICES, Inc.	7720 N. 16th St., Suite 100	Phoenix, Arizona 85020	T 602.371.1100		ARIZONA DEPARTMENT OF TRANSPORTATION PROJECT DELIVERY AND OPERATIONS DIVISION ROADWAY DESIGN SERVICES		ROUTE US 93		F.H.W.A. Arizona Division		STATE ARIZ.	PROJECT NO. 093 YV 189	FEDERAL ID NO. 093-B(230)T	SHEET NO. 130	TOTAL SHEETS 524	RECORD DRAWING
		NAME	DATE																															
	DESIGN	S Mutesi	06/26																															
	DRAWN	C VALENZUELA	06/26																															
CHECKED	D WIGGINS	06/26																																
TRANSPORTATION	AECOM TECHNICAL SERVICES, Inc.																																	
7720 N. 16th St., Suite 100	Phoenix, Arizona 85020																																	
T 602.371.1100																																		
PLAN & PROFILE SHEET CHANNEL B & C		MILEPOST 189.9		LOCATION WICKENBURG RANCH WAY TO VISTA ROYALE		TRACS NO. F0738 01C		DWG No. D-4.04		___ OF ___																								

PRIMARY / ADOT ESS JOB No. LS1470 CONTROL POINTS				
POINT ID	NORTHING	EASTING	ELEVATION	DESCRIPTION
SOL *	1124287.301	403479.046	2699.253	NGS ET0973
BALONEY *	1121209.003	407058.865	2682.096	5/8" REBAR
93 190 05	1113358.719	415681.853	2613.258	NGS ET0971
MP 190.56 **	1111597.494	417758.890	2579.734	5/8" REBAR
5543	1110073.909	420141.201	2566.016	3" AHD BC 19_
S 25	1111089.523	427020.709	2532.788	NGS ET0377
MP 192 **	1106774.505	423594.847	2519.547	5/8" REBAR
1126	1103853.386	427041.859	2455.535	3" AHD BC, POT 199+18.68
93 193 35	1102199.739	429504.806	2492.609	NGS ET0970
WHY **	1101889.490	429848.157	2455.759	5/8" REBAR

GENERAL NOTES

THE FOLLOWING PARAMETERS WERE SET FOR THE BASIS OF THIS SURVEY:

SYSTEM: UNITED STATES STATE PLANE 1983 (2011)
ZONE: ARIZONA CENTRAL ZONE 0202
DATUMS:
- HORIZONTAL: NORTH AMERICAN DATUM 1983 NAD83/2011 (G.A.F.= 1.000125268)
- VERTICAL: NORTH AMERICAN VERTICAL DATUM 1988 NAVD88
GEOID MODEL: GEOID12A
UNITS = INTERNATIONAL FEET (1 FOOT = 0.3048 METERS EXACTLY)

- * FROM F0031 (P&M 2902)
- ** FROM OPUS - VERIFIED WITH RTK GPS


GENERAL NOTES (Continued)

BASIS OF ELEVATIONS:
ADOT ENGINEERING SURVEY SERVICES (ESS) PROVIDED THE PRIMARY CONTROL ELEVATIONS PER ADOT JOB No. LS1470 TO BE USED AS A CONTROL FOR THIS PROJECT. THE FOLLOWING ADOT PROVIDED MONUMENTS WERE USED FOR BASIS OF ELEVATIONS FOR THIS PROJECT: BALONEY.

	DESIGN	J GILLIS	06/26	ARIZONA DEPARTMENT OF TRANSPORTATION PROJECT DELIVERY AND OPERATIONS DIVISION ROADWAY DESIGN SERVICES	ROUTE	F.H.W.A. Arizona Division	STATE ARIZ.	PROJECT NO.	FEDERAL ID NO.	SHEET NO.	TOTAL SHEETS	RECORD DRAWING	
	DRAWN	M SAMUELSON	06/26		MILEPOST			093 YV 189	093-B(230)T	131	524		
	CHECKED	D WIGGINS	06/26		STRUCTURE NO.	WICKENBURG RANCH WAY TO VISTA ROYALE					DWG No. C-1.01		
	TRANSPORTATION AECOM TECHNICAL SERVICES, Inc. 7720 N. 16th St., Suite 100 Phoenix, Arizona 85020 T 602.371.1100 www.aecom.com			SURVEY CONTROL SHEET		TRACS NO. F0738 01C		____ OF ____					

F.H.W.A. REGION	STATE	PROJECT NO.	SHEET NO.	TOTAL SHEETS	RECORD DRAWING
9	ARIZ.	093-B(230)T	132	524	



093 YV 189

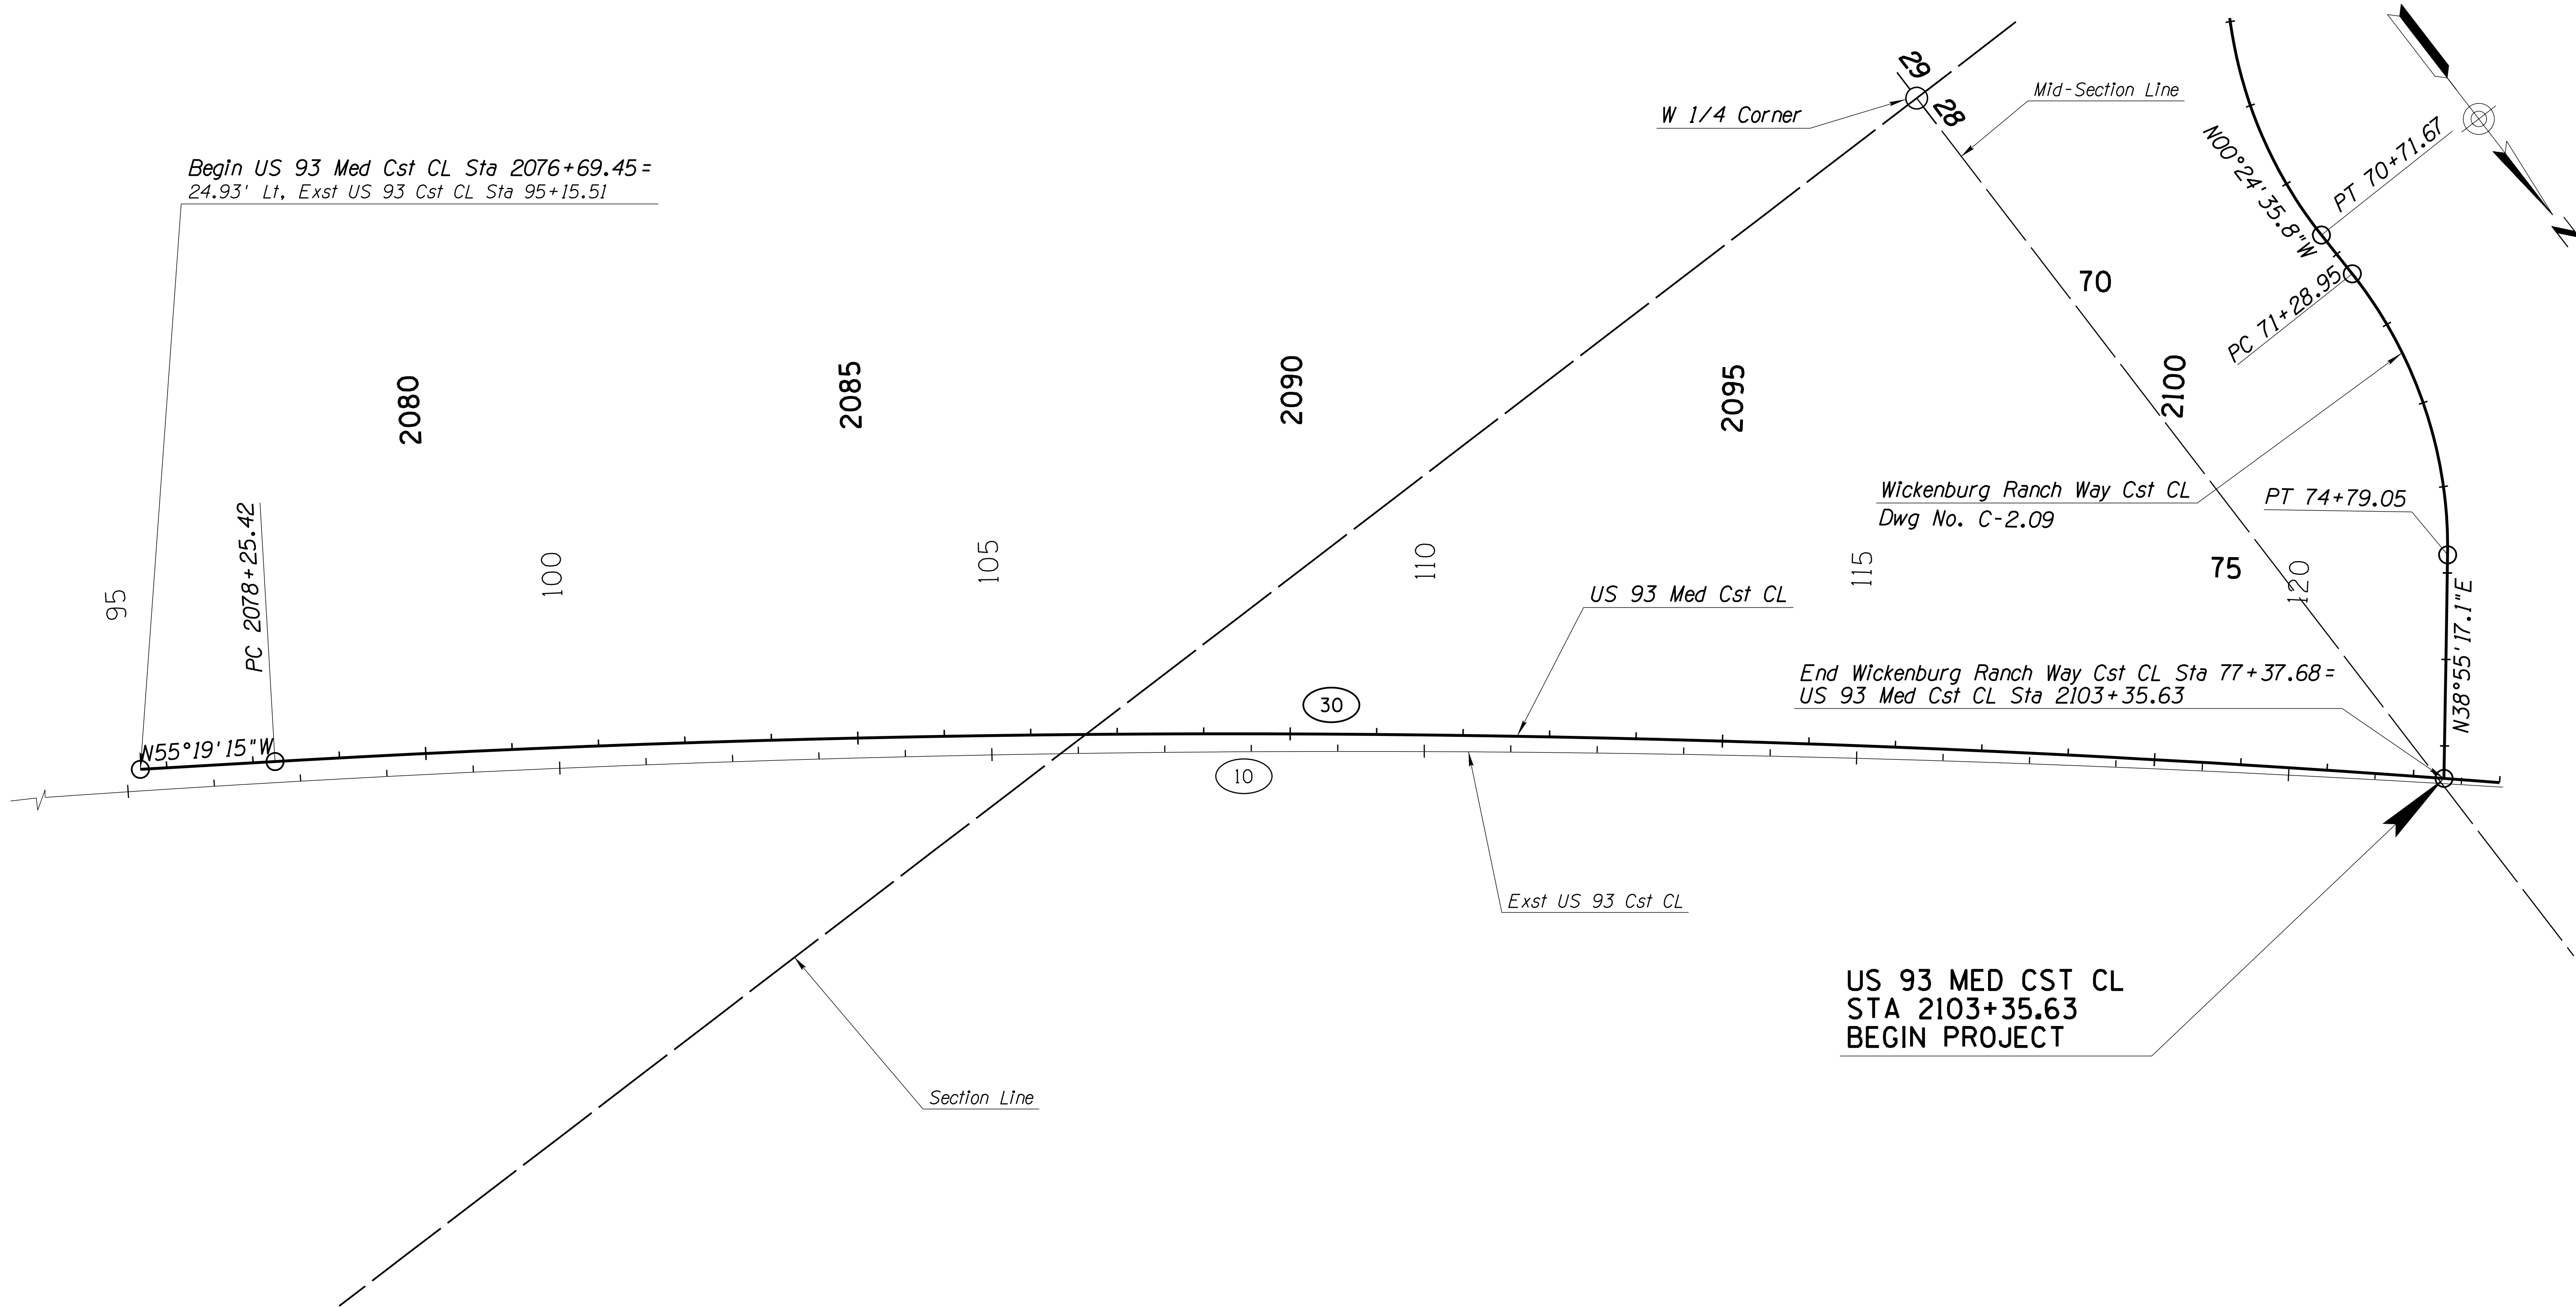

DESIGN	ZSZ	DATE	06-26	ARIZONA DEPARTMENT OF TRANSPORTATION PROJECT DELIVERY AND OPERATIONS DIVISION ROADWAY DESIGN SERVICES	
DRAWN	RM	DATE	06-26		
CHECKED	DBK	DATE	06-26		
3133 East Camelback Road, Suite 100 Phoenix, Arizona 85016 Phone: (602) 333-2200				US 93 GEOMETRIC LAYOUT PLAN STA 2026+69.45 TO STA 2104+00	
ROUTE		LOCATION		DWG NO. C-2.01	
US 93		WICKENBURG RANCH WAY TO VISTA ROYALE			
TRACS NO. F0738 OIC				093-B(230)T	
				OF	

F.H.W.A. REGION	STATE	PROJECT NO.	SHEET NO.	TOTAL SHEETS	RECORD DRAWING
9	ARIZ.	093-B(230)T	133	524	


093 YV 189

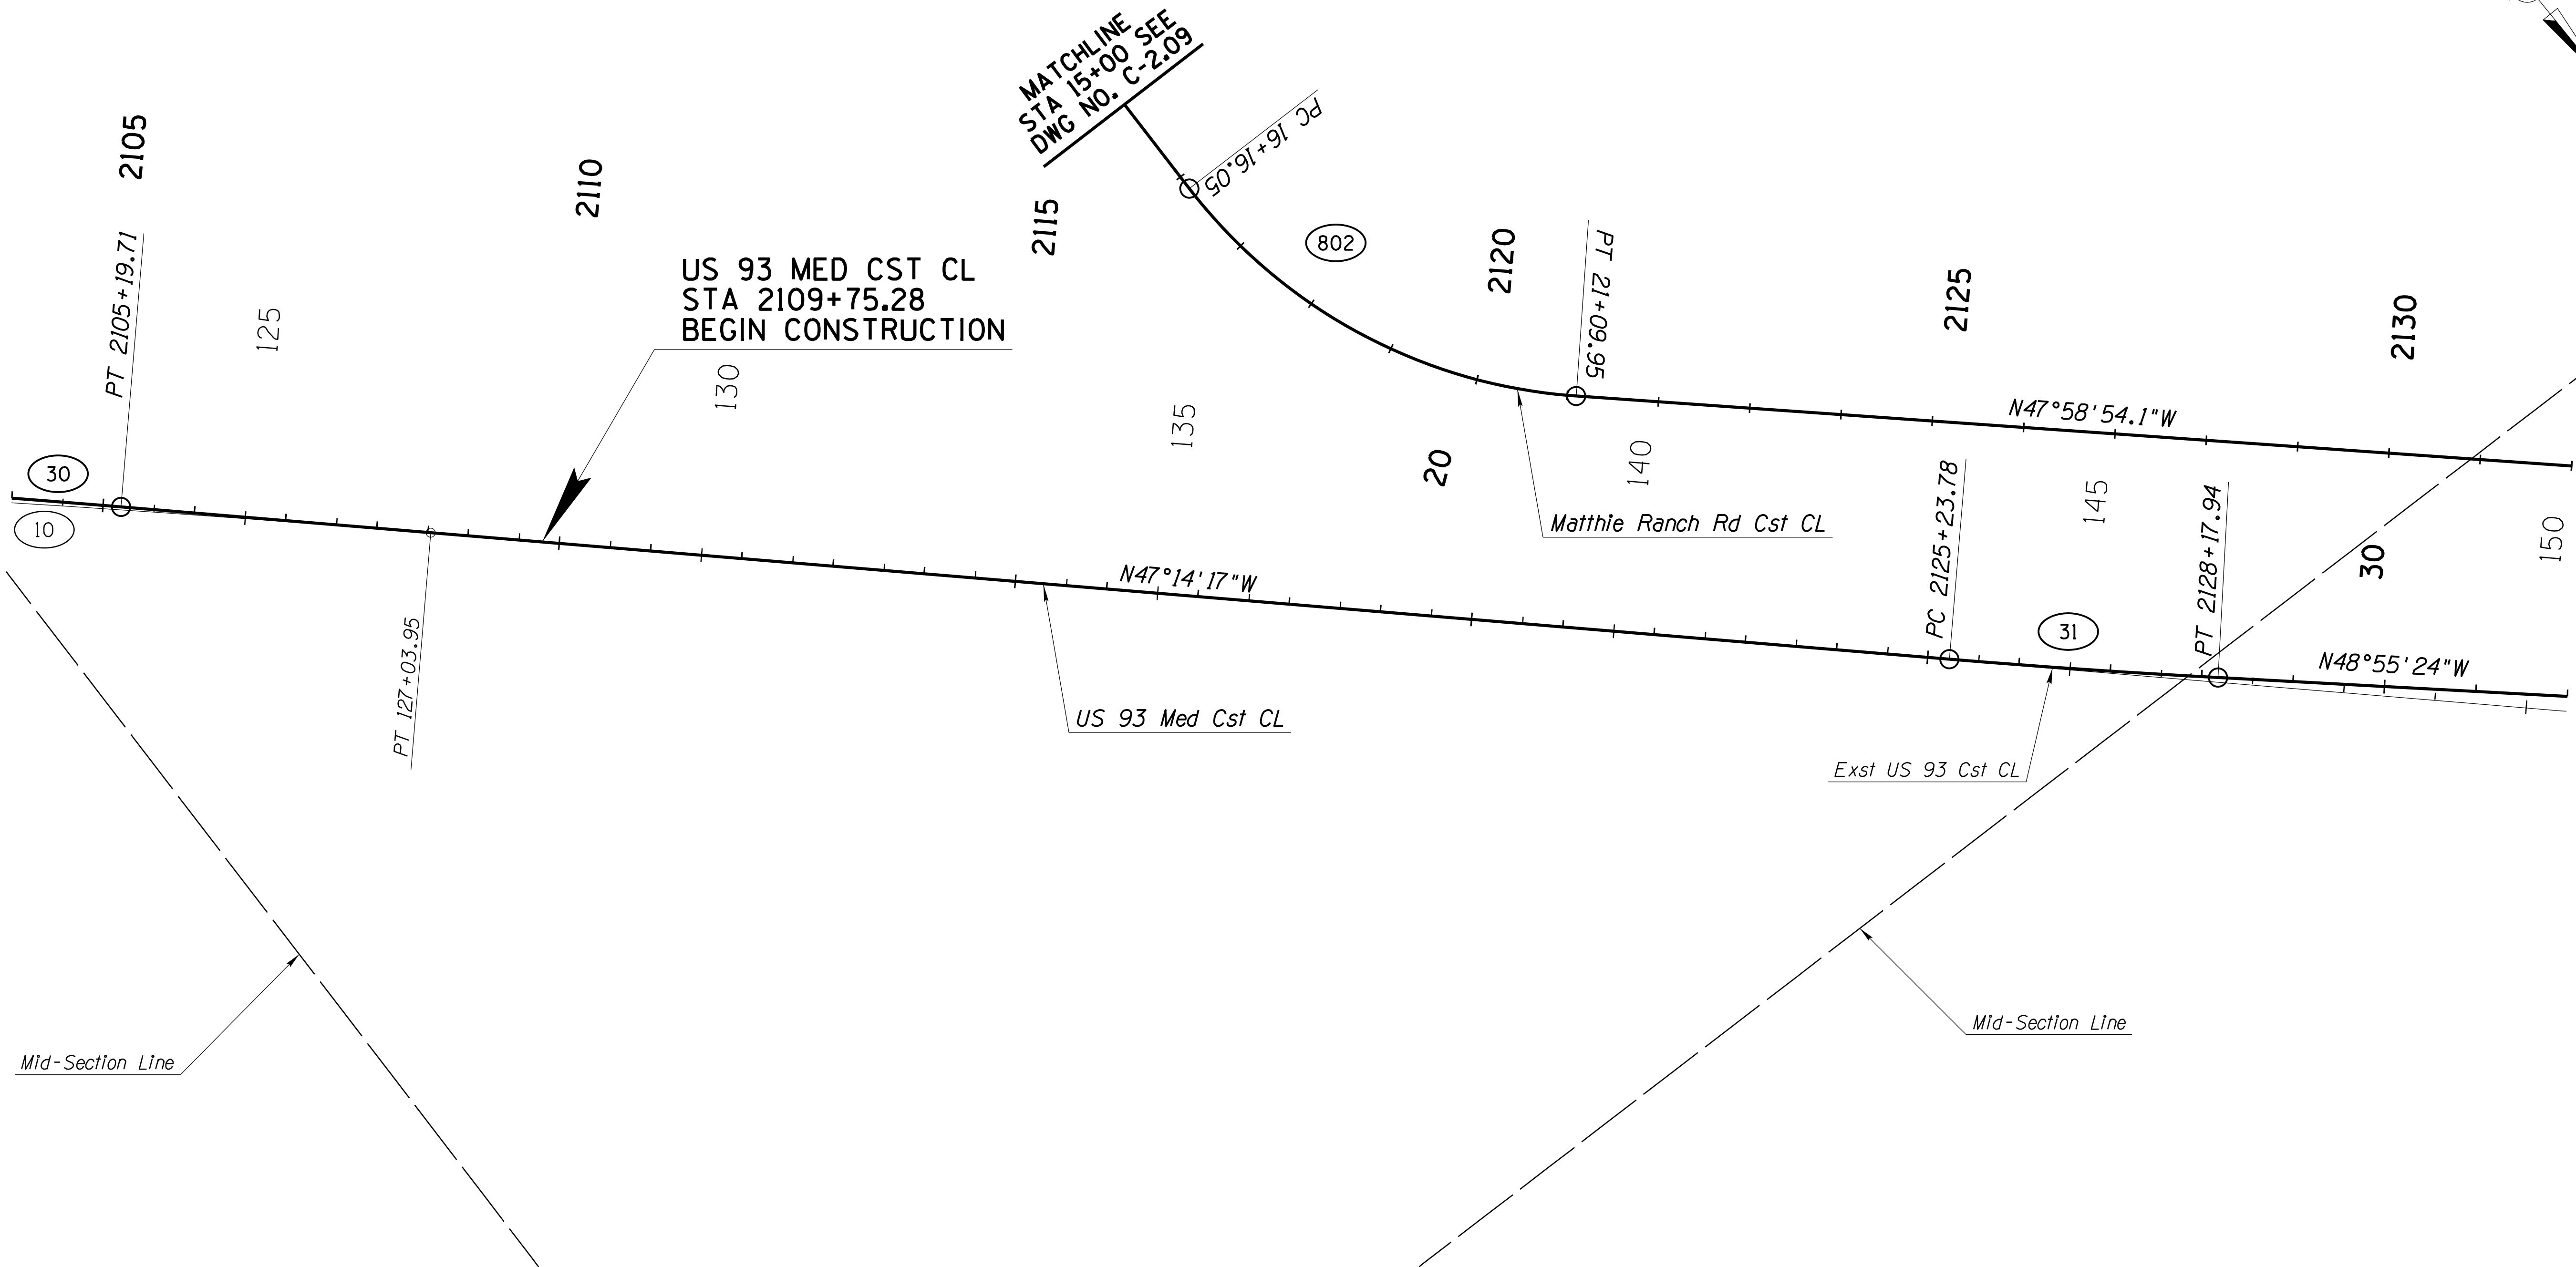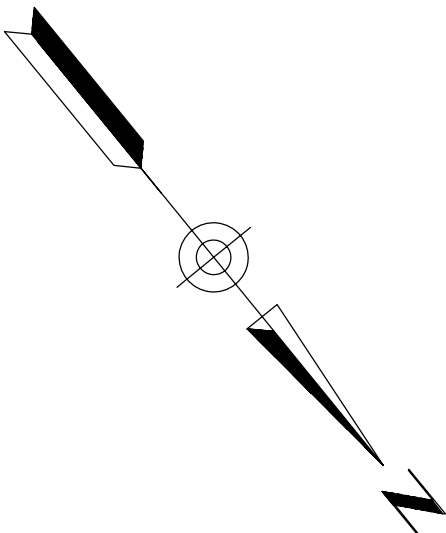

		NAME	DATE	ARIZONA DEPARTMENT OF TRANSPORTATION PROJECT DELIVERY AND OPERATIONS DIVISION ROADWAY DESIGN SERVICES	
DESIGN	ZSZ		06-26		
DRAWN	RM		06-26		
CHECKED	DBK		06-26		
 Stanley Consultants INC. 3133 East Camelback Road, Suite 100 Phoenix, Arizona 85016 Phone: (602) 333-2200				US 93	
				GEOMETRIC LAYOUT PLAN	
				STA 2104+00 TO STA 2132+00	
ROUTE		LOCATION			DWG NO. C-2.02
US 93		WICKENBURG RANCH WAY TO VISTA ROYALE			
TRACS NO. F0738 OIC				093-B(230)T	OF

F.H.W.A. REGION	STATE	PROJECT NO.	SHEET NO.	TOTAL SHEETS	RECORD DRAWING
9	ARIZ.	093-B(230)T	134	524	

093 YV 189

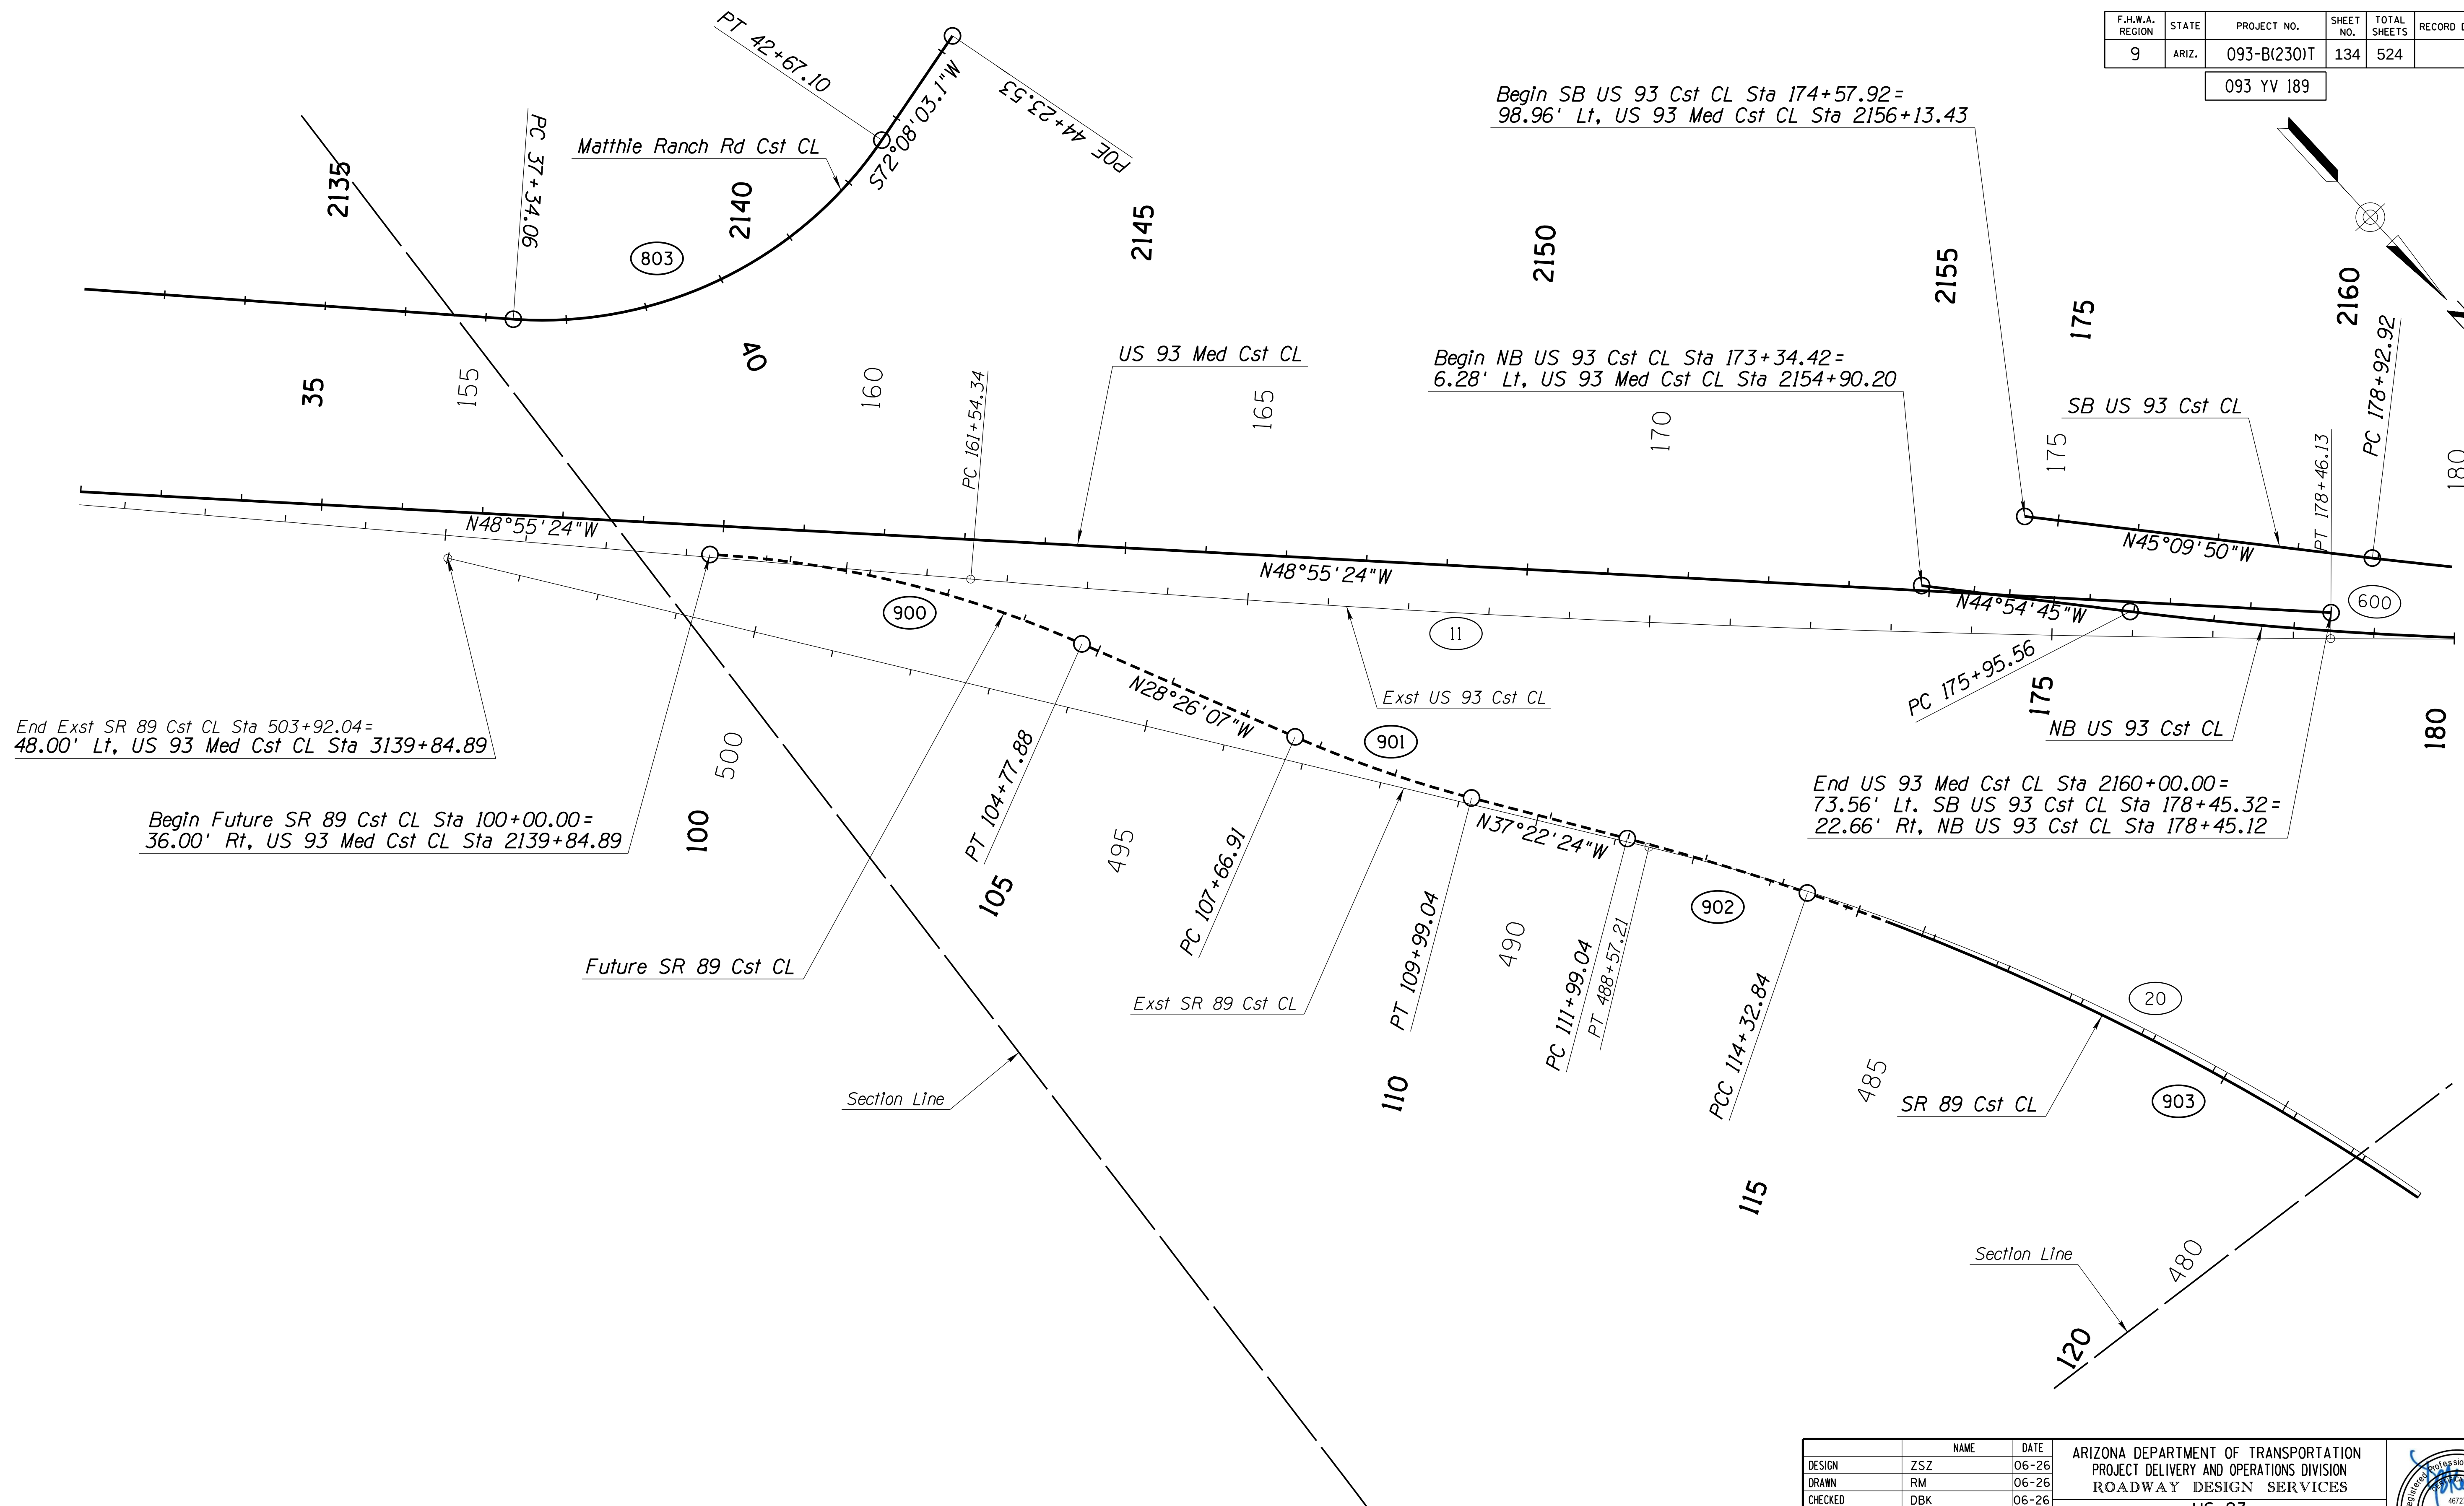

DESIGN	ZSZ	DATE	06-26
DRAWN	RM	DATE	06-26
CHECKED	DBK	DATE	06-26

ARIZONA DEPARTMENT OF TRANSPORTATION PROJECT DELIVERY AND OPERATIONS DIVISION ROADWAY DESIGN SERVICES	
US 93 GEOMETRIC LAYOUT PLAN STA 2132+00 TO STA 180+00	
ROUTE	LOCATION
US 93	WICKENBURG RANCH WAY TO VISTA ROYALE
TRACS NO. F0738 OIC	093-B(230)T
DWG NO. C-2.03	
OF	



Stanley Consultants inc.

3133 East Camelback Road, Suite 100
Phoenix, Arizona 85016
Phone: (602) 333-2200


46727
DIANA B. KELLY
Professional Engineer
ARIZONA, U.S.A.


F.H.W.A. REGION	STATE	PROJECT NO.	SHEET NO.	TOTAL SHEETS	RECORD DRAWING
9	ARIZ.	093-B(230)T	135	524	


093 YV 189

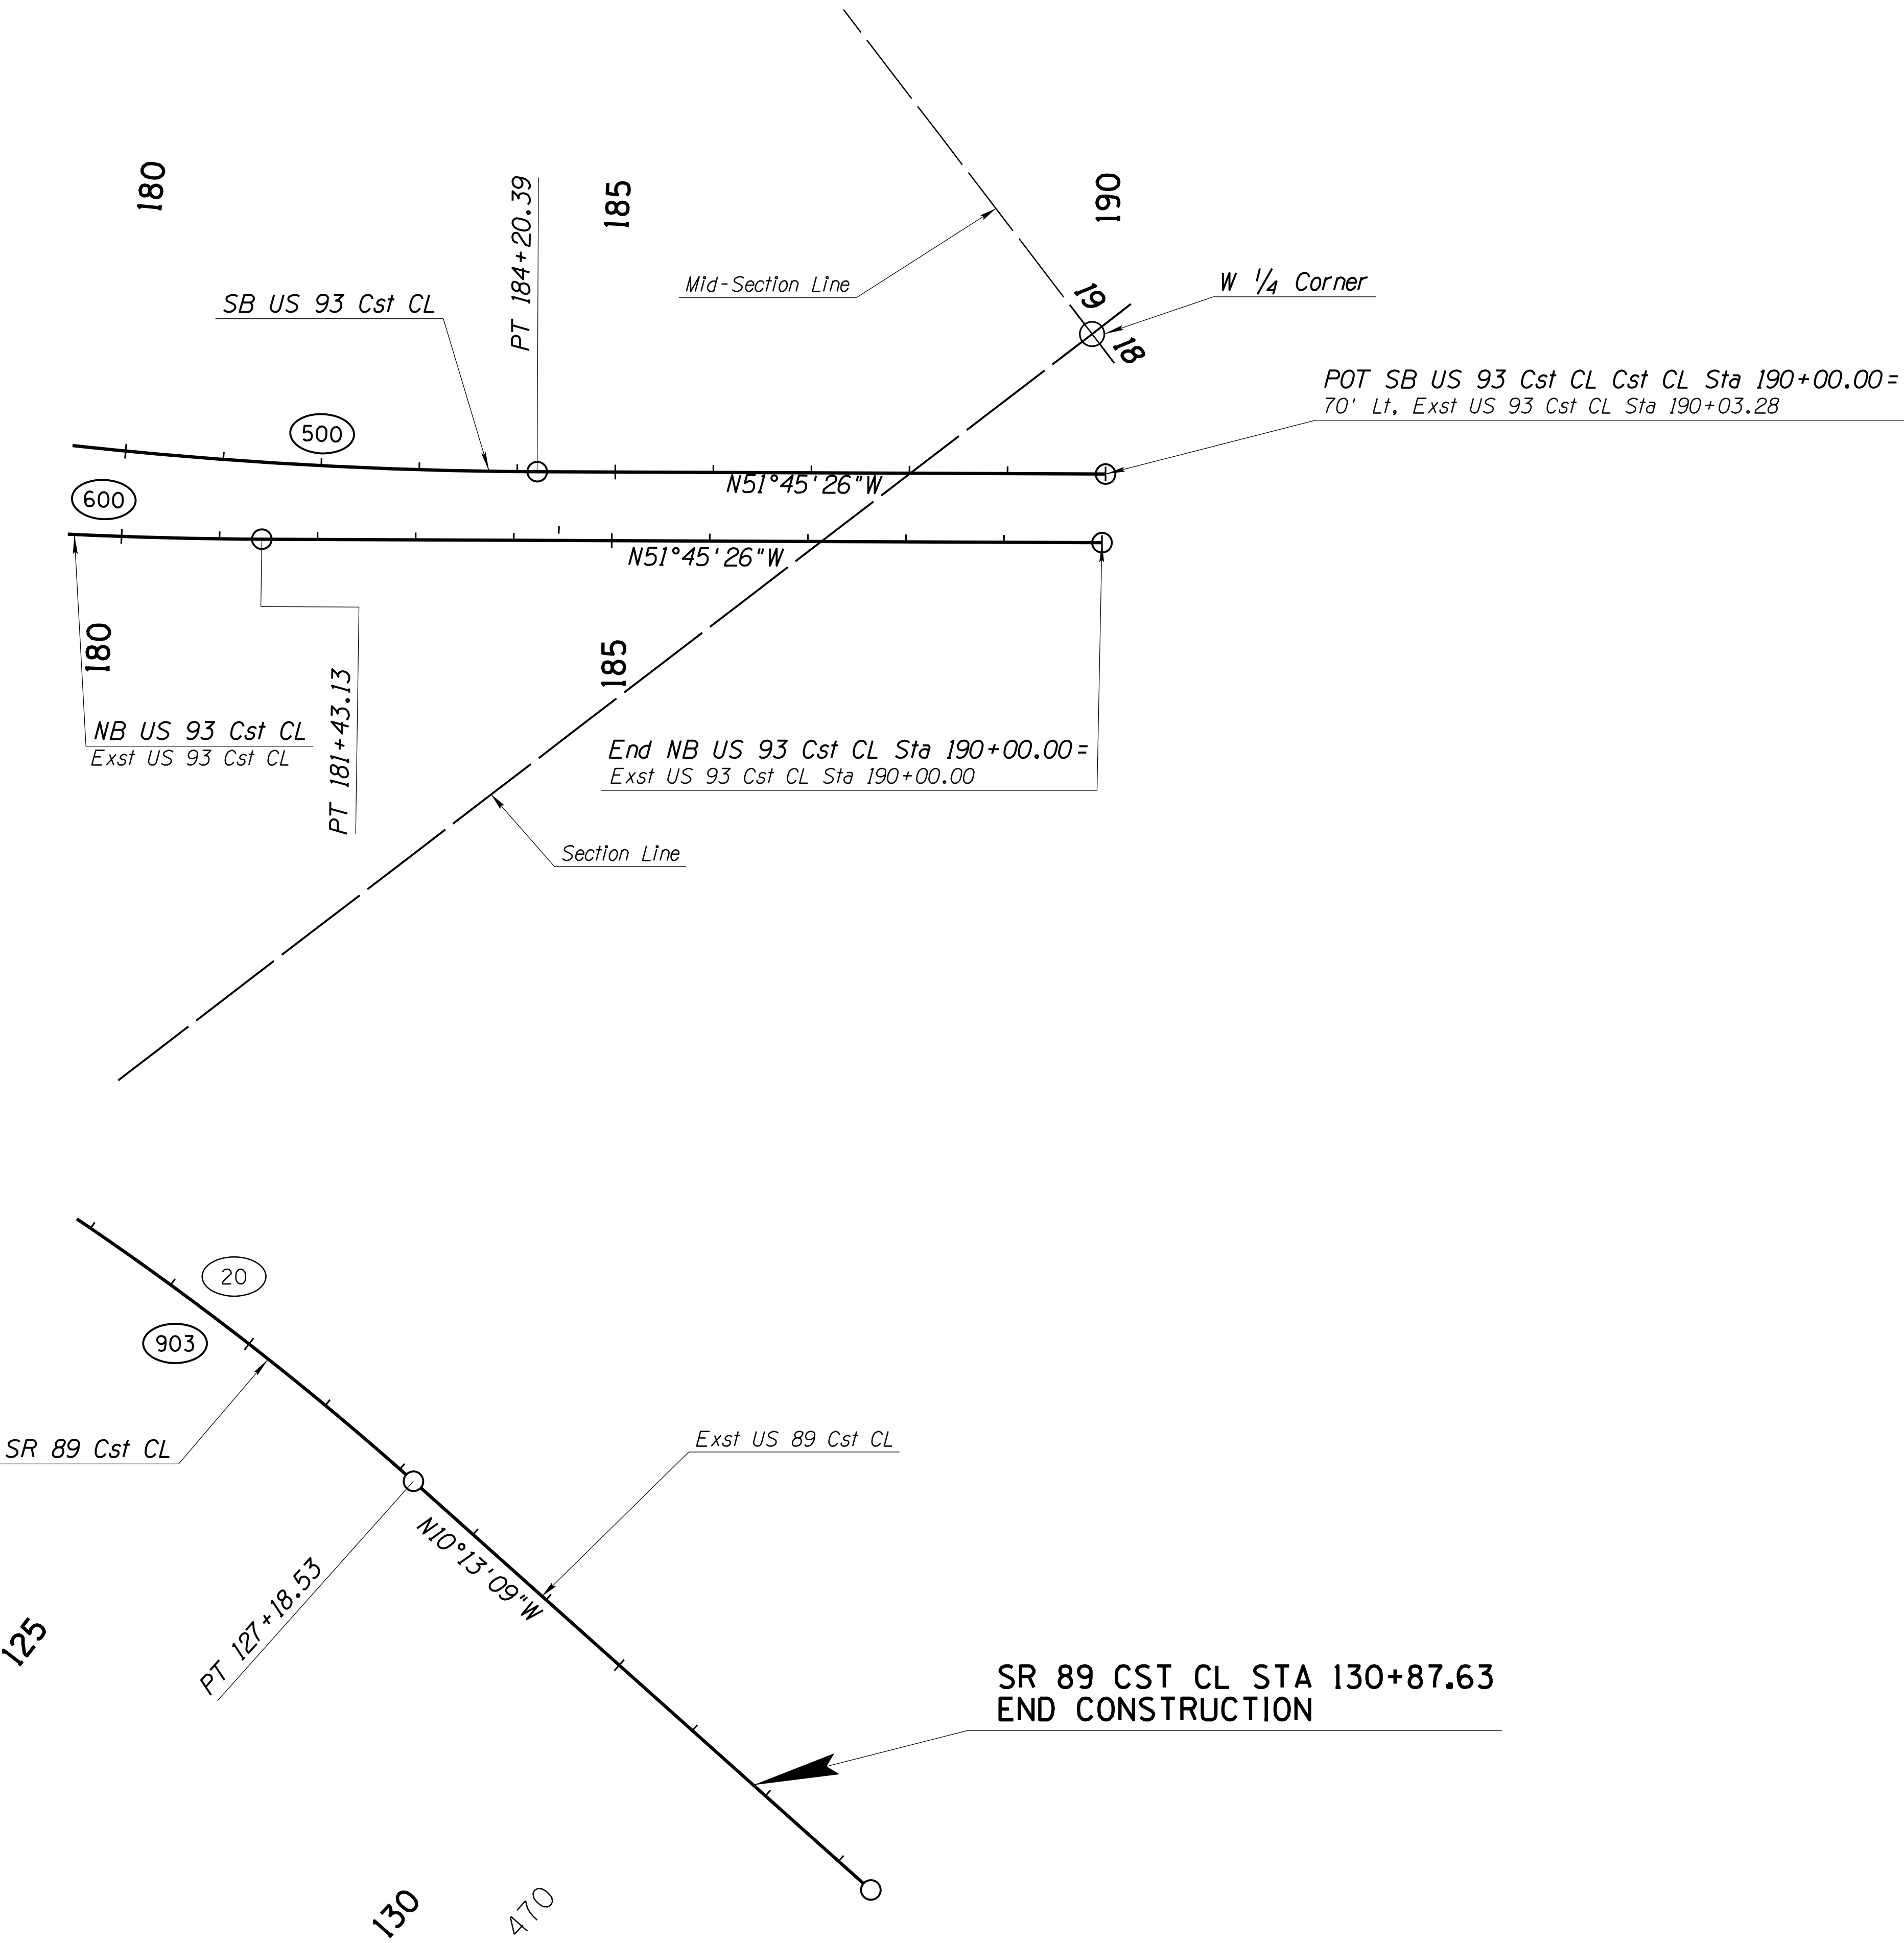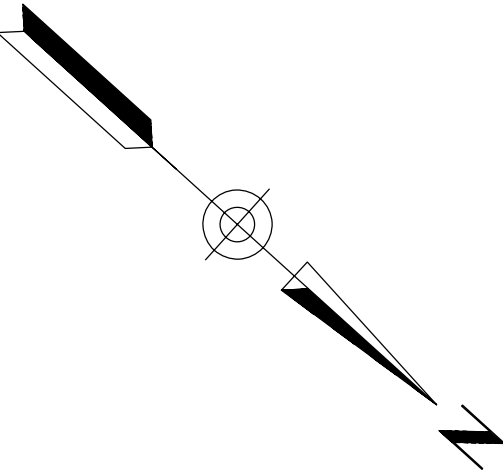

DESIGN	ZSZ	DATE	06-26	ARIZONA DEPARTMENT OF TRANSPORTATION PROJECT DELIVERY AND OPERATIONS DIVISION ROADWAY DESIGN SERVICES	
DRAWN	RM	DATE	06-26		
CHECKED	DBK	DATE	06-26		
 3133 East Camelback Road, Suite 100 Phoenix, Arizona 85016 Phone: (602) 333-2200				US 93 GEOMETRIC LAYOUT PLAN STA 180+00 TO STA 190+00	
ROUTE		LOCATION		DWG. NO. C-2.04	
US 93		WICKENBURG RANCH WAY TO VISTA ROYALE			
TRACS NO. F0738 OIC				093-B(230)T	
				OF	


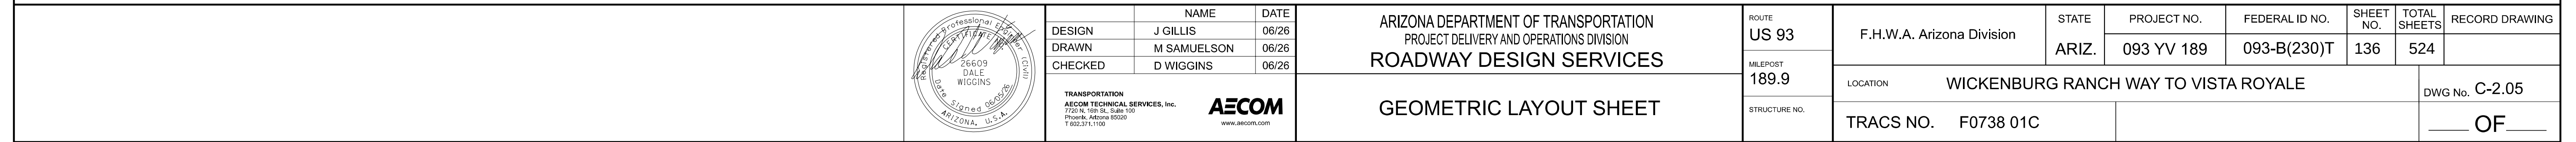


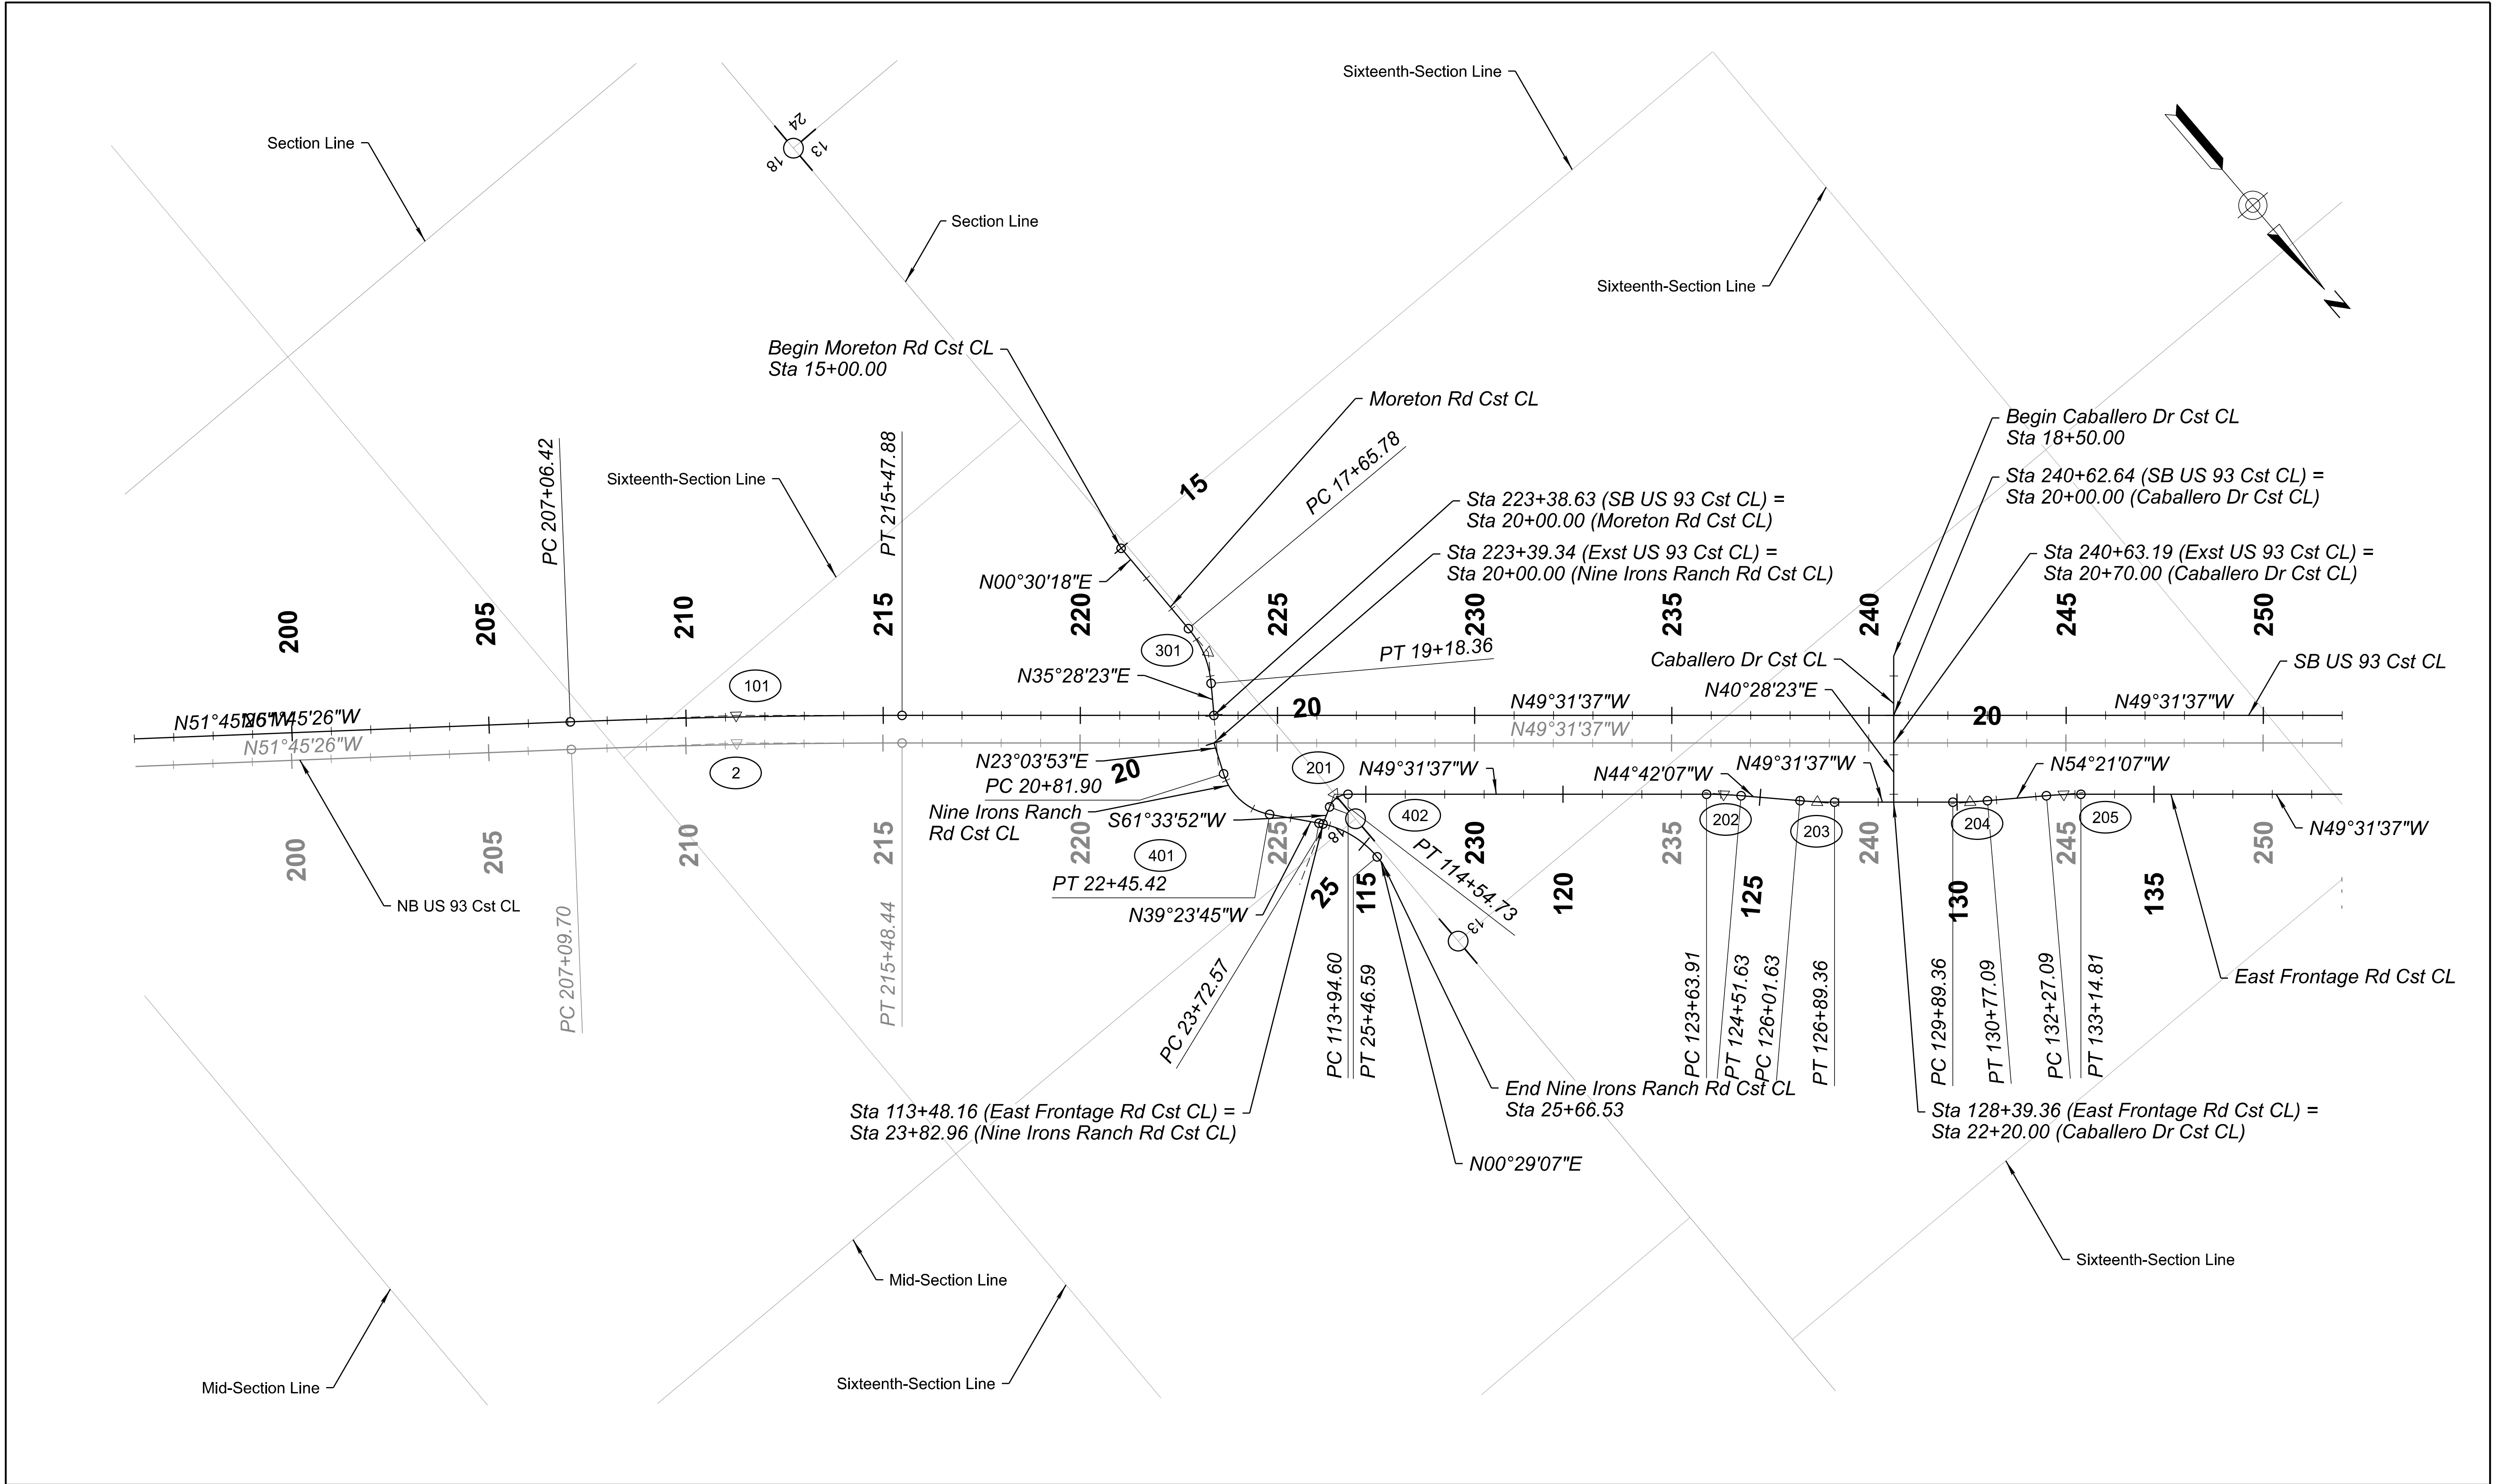

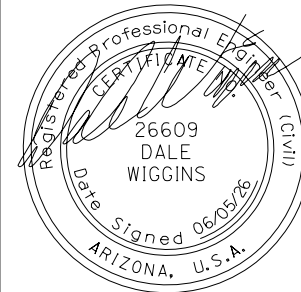	NAME		DATE	ARIZONA DEPARTMENT OF TRANSPORTATION PROJECT DELIVERY AND OPERATIONS DIVISION ROADWAY DESIGN SERVICES		ROUTE	F.H.W.A. Arizona Division	STATE	PROJECT NO.	FEDERAL ID NO.	SHEET NO.	TOTAL SHEETS	RECORD DRAWING
	DESIGN		J GILLIS	06/26		US 93	ARIZ.	093 YV 189	093-B(230)T	137	524		
	DRAWN		M SAMUELSON	06/26									
	CHECKED		D WIGGINS	06/26									
	TRANSPORTATION AECOM TECHNICAL SERVICES, Inc. 7720 N. 16th St., Suite 100 Phoenix, Arizona 85020 T 602.371.1100				AECOM www.aecom.com		LOCATION WICKENBURG RANCH WAY TO VISTA ROYALE DWG No. C-2.06						
				GEOMETRIC LAYOUT SHEET		STRUCTURE NO.		TRACS NO. F0738 01C		OF			

F.H.W.A. REGION	STATE	PROJECT NO.	SHEET NO.	TOTAL SHEETS	RECORD DRAWING
9	ARIZ.	093-B(230)T	140	524	

093 YV 189

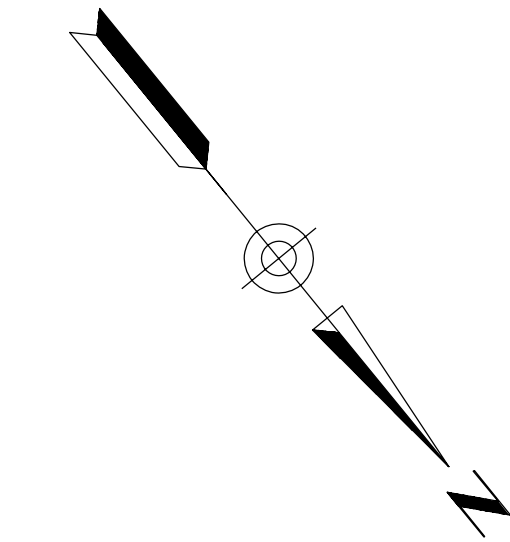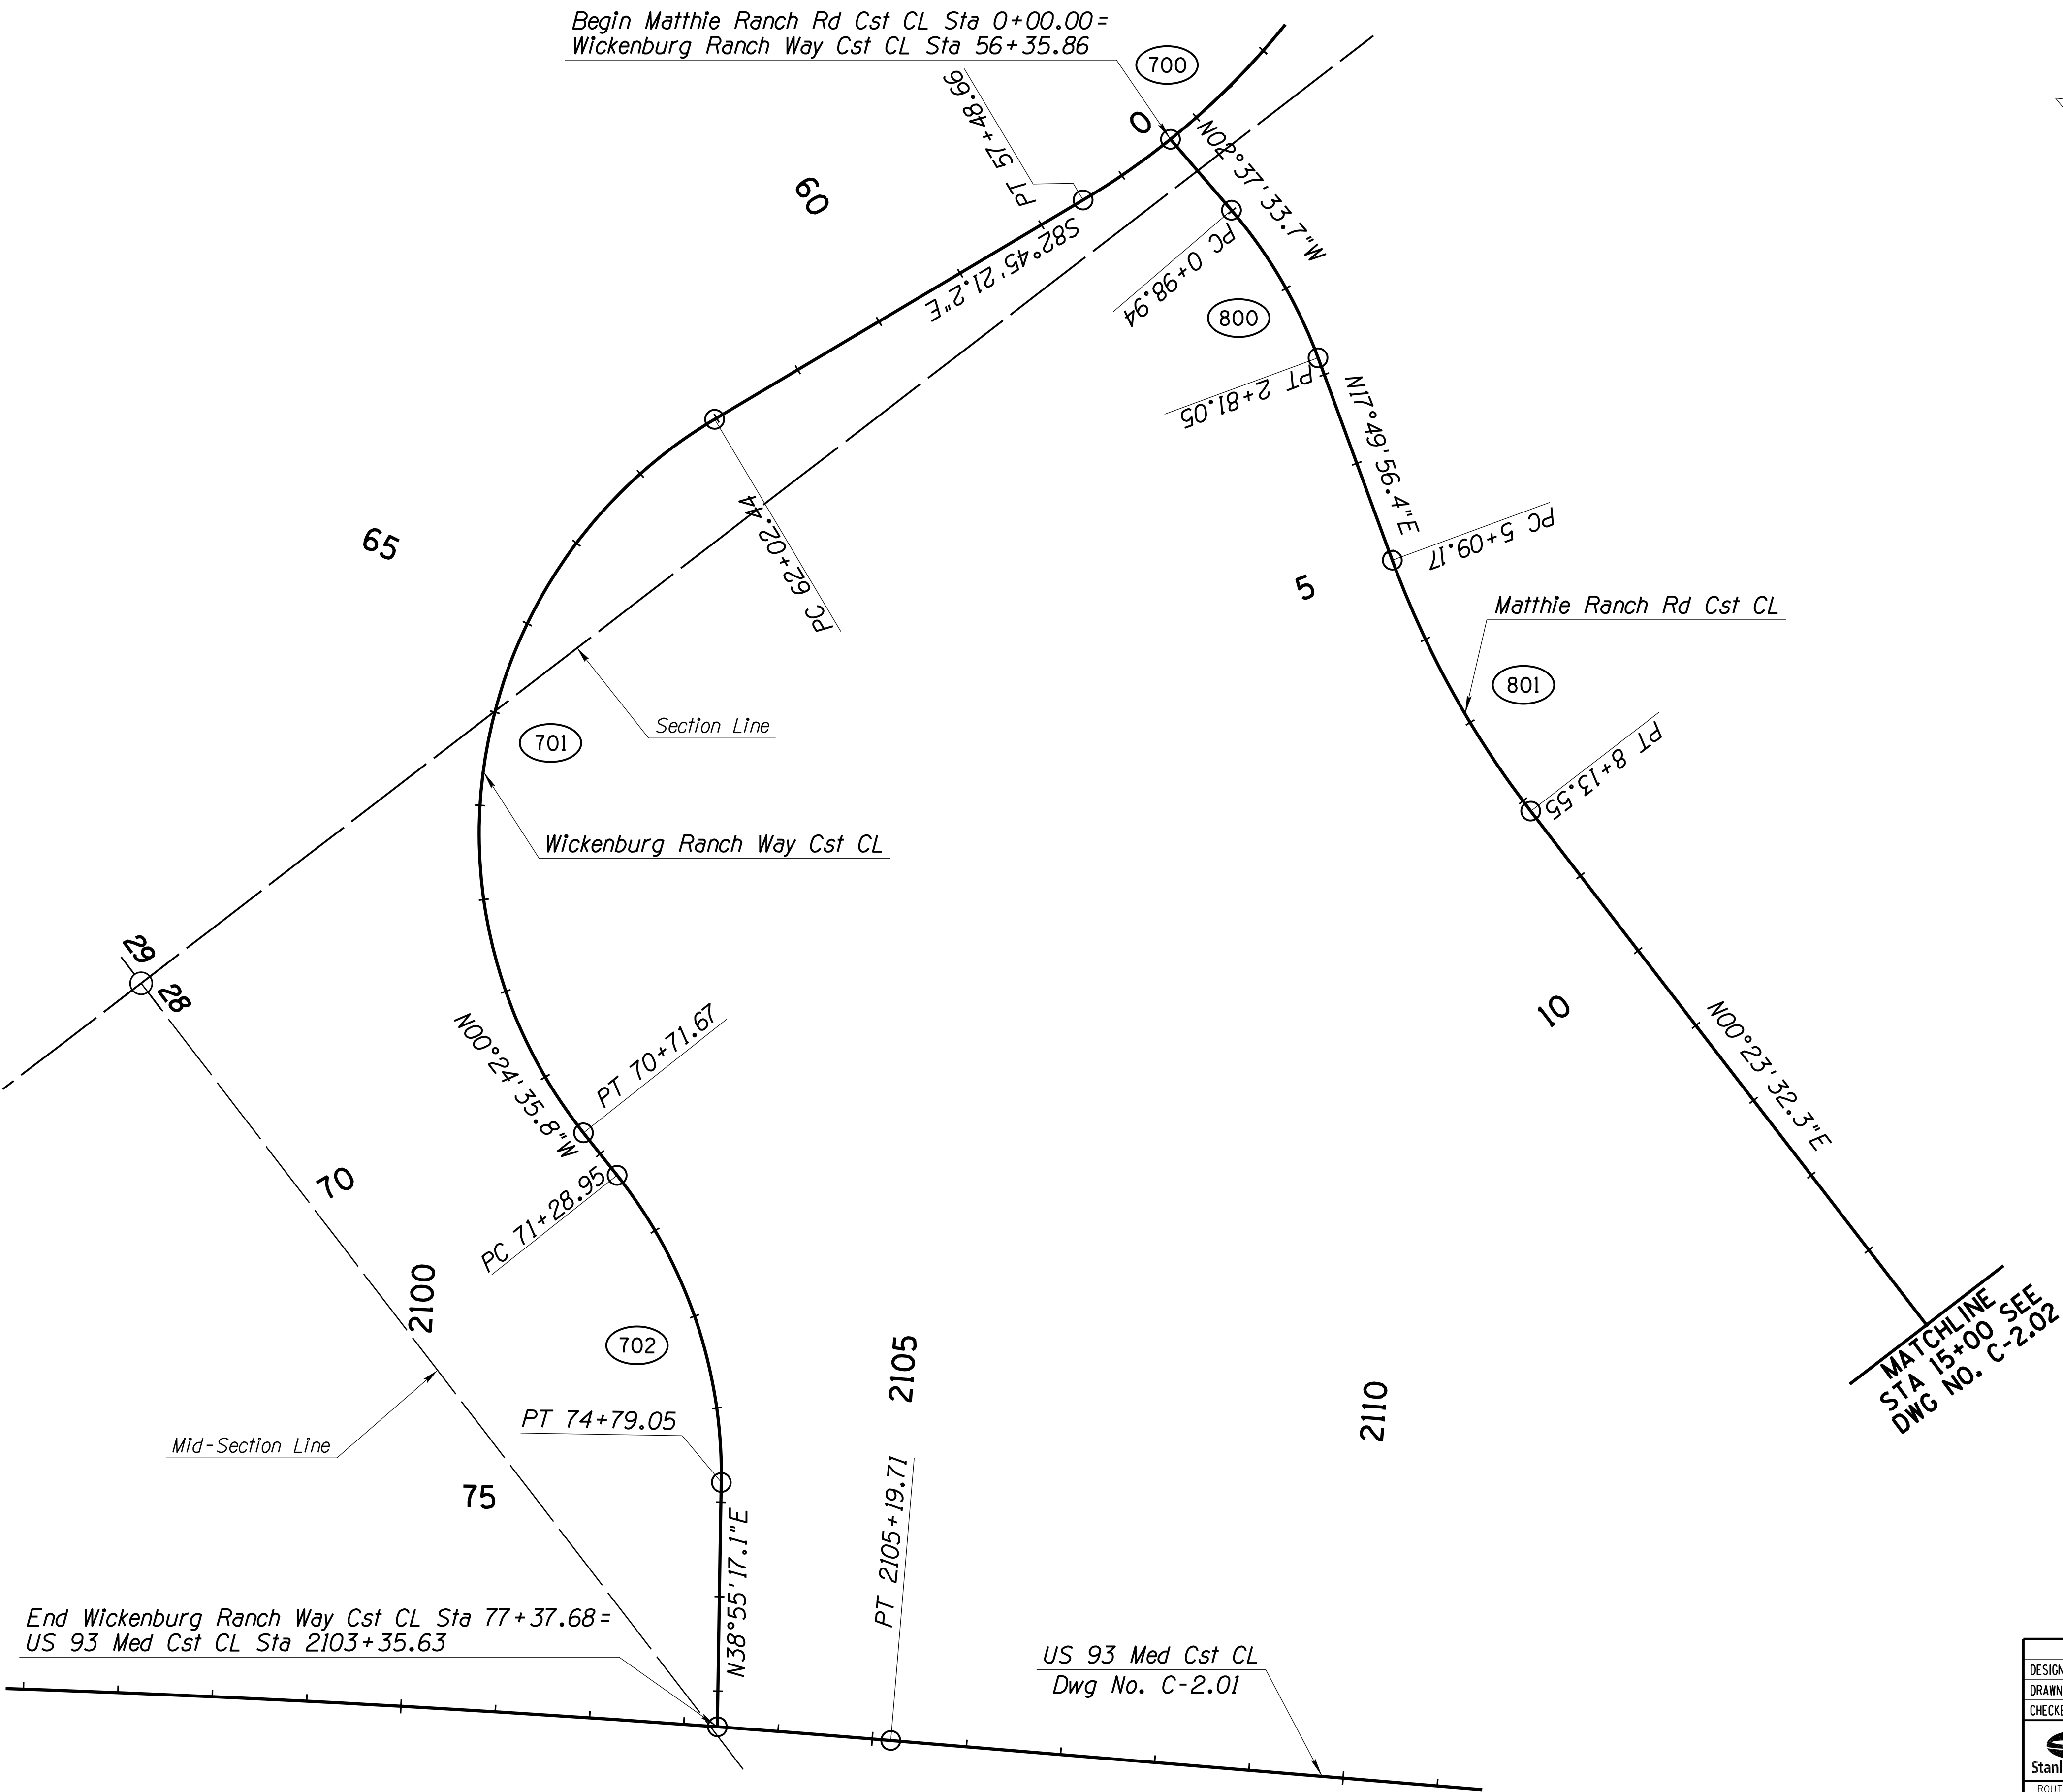

		NAME	DATE	ARIZONA DEPARTMENT OF TRANSPORTATION PROJECT DELIVERY AND OPERATIONS DIVISION ROADWAY DESIGN SERVICES		
DESIGN		ZSZ	06-26			
DRAWN		RM	06-26			
CHECKED		DBK	06-26	US 93		
		3133 East Camelback Road, Suite 100 Phoenix, Arizona 85016 Phone: (602) 333-2200		GEOMETRIC LAYOUT PLAN STA 2104+00 TO STA 2132+00		
Stanley Consultants INC.						
ROUTE		LOCATION		DWG NO. C-2.09		
US 93		WICKENBURG RANCH WAY TO VISTA ROYALE				
TRACS NO. F0738 OIC			093-B(230)T			<u> OF </u>

093 YV 189

CURVE DATA TABLE

10549 4/20/2026 3:49:30 PM c:\projects\sci-govstate\loc\common\dms20152\F0738A.q10.dgn

NB US 93 Cst CL

Element	Point Type	Point Number	Station	Northing	Easting	Radius	Length	Delta/Theta	Rotation Direction	K	P
Alignment Name:		Exst US 93 Cst CL									
Description:											
Style:		Alignment\Geom_Baseline									
Tangent	START		190+00.00	1103402.43	427855.73						
Tangent	PC		207+09.70	1104460.72	426512.94						
Arc	PC		207+09.70	1104460.72	426512.94						
Arc	HPI	2	211+29.12	1104720.34	426183.53	21548.08	838.74	02°13'48.69"	Right		
Arc	CC			1121384.46	439851.10						
Arc	PT		215+48.44	1104992.58	425864.47						
Tangent	PT		215+48.44	1104992.58	425864.47						
Tangent	END		360+00.00	1114372.94	414870.99						

SB US 93 Cst CL

Element	Point Type	Point Number	Station	Northing	Easting	Radius	Length	Delta/Theta	Rotation Direction	K	P
Alignment Name:		SB US 93 Cst CL									
Description:											
Style:		Alignment\Geom_Baseline_LEFT_ANNO									
Tangent	START		190+00.00	1103349.48	427809.82						
Tangent	PC		207+06.42	1104405.74	426469.61						
Arc	PC		207+06.42	1104405.74	426469.61						
Arc	HPI	101	211+27.20	1104666.21	426139.13	21618.08	841.47	02°13'48.69"	Right		
Arc	CC			1121384.46	439851.10						
Arc	PT		215+47.88	1104939.33	425819.03						
Tangent	PT		215+47.88	1104939.33	425819.03						
Tangent	HPI		280+00.00	1109127.34	420910.83						
Tangent	HPI		280+00.00	1109127.34	420910.83						
Tangent	HPI		283+81.98	1109371.45	420617.03						
Tangent	HPI		283+81.98	1109371.45	420617.03						
Tangent	PC		322+08.57	1111855.25	417706.10						
Arc	PC		322+08.57	1111855.25	417706.10						
Arc	HPI	102	326+56.47	1112145.98	417365.38	22918.31	895.68	02°14'21.12"	Left		
Arc	CC			1094421.02	402830.06						
Arc	PRC		331+04.25	1112423.17	417013.56						
Arc	PRC		331+04.25	1112423.17	417013.56						
Arc	HPI	103	335+52.15	1112700.36	416661.74	22918.31	895.68	02°14'21.12"	Right		
Arc	CC			1130425.32	431197.06						
Arc	PT		339+99.93	1112991.09	416321.02						
Tangent	PT		339+99.93	1112991.09	416321.02						
Tangent	END		360+00.00	1114289.31	414799.54						

SB US 93 Cst CL (cont.)

Element	Point Type	Point Number	Station	Northing	Easting	Radius	Length	Delta/Theta	Rotation Direction	K	P
Alignment Name:		SB US 93 Cst CL									
Description:											
Style:		Alignment\Geom_Baseline_LEFT_ANNO									
Arc	PRC		331+04.25	1112423.17	417013.56						
Arc	HPI	103	335+52.15	1112700.36	416661.74	22918.31	895.68	02°14'21.12"	Right		
Arc	CC			1130425.32	431197.06						
Arc	PT		339+99.93	1112991.09	416321.02						
Tangent	PT		339+99.93	1112991.09	416321.02						
Tangent	END		360+00.00	1114289.31	414799.54						

Moreton Rd Cst CL


Element	Point Type	Point Number	Station	Northing	Easting	Radius	Length	Delta/Theta	Rotation Direction	K	P
Alignment Name:		Moreton Airpark Rd Cst CL									
Description:											
Style:		Alignment\Geom_Baseline_LEFT_ANNO									
Tangent	START		15+00.00	1104977.46	425121.39						
Tangent	PC		17+65.78	1105243.24	425123.73						
Arc	PC		17+65.78	1105243.24	425123.73						
Arc	HPI	301	18+44.53	1105321.98	425124.42	250.00	152.58	34°58'04.84"	Right		
Arc	CC			1105241.03	425373.72						
Arc	PT		19+18.36	1105386.11	425170.12						
Tangent	PT		19+18.36	1105386.11	425170.12						
Tangent	END		20+00.00	1105452.60	425217.50						

Nine Irons Ranch Rd Cst CL

Element	Point Type	Point Number	Station	Northing	Easting	Radius	Length	Delta/Theta	Rotation Direction	K	P
Alignment Name:		Nine Irons Ranch Rd Cst CL									
Description:											
Style:		Alignment\Geom_Baseline_LEFT_ANNO									
Tangent	START		20+00.00	1105505.95	425262.82						
Tangent	PC		20+81.90	1105581.30	425294.90						
Arc	PC		20+81.90	1105581.30	425294.90						
Arc	HPI	401	21+72.85	1105664.98	425330.53	150.00	163.52	62°27'37.58"	Left		
Arc	CC			1105640.07	425156.89						
Arc	PT		22+45.42	1105735.27	425272.81						
Tangent	PT		22+45.42	1105735.27	425272.81						
Tangent	PC		23+72.57	1105833.53	425192.11						
Arc	PC		23+72.57	1105833.53	425192.11						
Arc	HPI	402	24+63.27	1105903.62	425134.54	250.00	174.01	39°52'51.81"	Right		
Arc	CC			1105992.20	425385.30						
Arc	PT		25+46.59	1105994.32	425135.31						
Tangent	PT		25+46.59	1105994.32	425135.31						
Tangent	END		25+66.53	1106014.26	425135.48						

NOTE

1. Existing US 93 Cst CL matches Existing R/W CL,
See Right-of-Way Project No. 093-B(0)T.

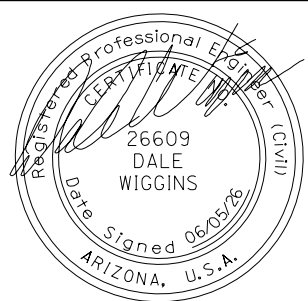

DESIGN	J GILLIS	06/26
DRAWN	M SAMUELSON	06/26
CHECKED	D WIGGINS	06/26
TRANSPORTATION AECOM TECHNICAL SERVICES, Inc. 7720 N. 16th St., Suite 100 Phoenix, Arizona 85020 T 602.371.1100		
AECOM www.aecom.com		

ARIZONA DEPARTMENT OF TRANSPORTATION PROJECT DELIVERY AND OPERATIONS DIVISION ROADWAY DESIGN SERVICES		ROUTE US 93	F.H.W.A. Arizona Division	STATE ARIZ.	PROJECT NO.	FEDERAL ID NO.	SHEET NO.	TOTAL SHEETS	RECORD DRAWING	
		093 YV 189			093-B(230)T	142	524			
GEOMETRIC DATA SHEET		MILEPOST 189.9	LOCATION WICKENBURG RANCH WAY TO VISTA ROYALE						DWG No. C-2.11	
		STRUCTURE NO.								

093 YV 189

CURVE DATA TABLE

10594 4/9/2026 11:40:12 AM c:\projects\sci-govstate\loc\common\dms20152\F0738A.q12.dgn

093 YV 189

CURVE DATA TABLE

10805 3/2/2026 5:34:17 PM c:\projects\sci-govstate\loc\common\dms20152\F0738A.q13.dgn

East Frontage Rd Cst CL

Element	Point Type	Point Number	Station	Northing	Easting	Radius	Length	Delta/Theta	Rotation Direction	K	P
Alignment Name:		East Frontage Rd Cst CL									
Description:											
Style:		Alignment\Geom_Baseline									
Tangent	START		113+48.16	1105841.69	425185.68						
Tangent	PC		113+94.60	1105819.58	425144.85						
Arc	PC		113+94.60	1105819.58	425144.85						
Arc	HPI	201	114+28.90	1105803.24	425114.68	50.00	60.13	68°54'30.71"	Right		
Arc	CC			1105863.54	425121.04						
Arc	PT		114+54.73	1105825.51	425088.58						
Tangent	PT		114+54.73	1105825.51	425088.58						
Tangent	PC		123+63.91	1106415.64	424396.96						
Arc	PC		123+63.91	1106415.64	424396.96						
Arc	HPI	202	124+07.80	1106444.13	424363.58	1041.74	87.73	04°49'29.85"	Right		
Arc	CC			1107208.11	425073.15						
Arc	PT		124+51.63	1106475.33	424332.71						
Tangent	PT		124+51.63	1106475.33	424332.71						
Tangent	PC		126+01.63	1106581.94	424227.19						
Arc	PC		126+01.63	1106581.94	424227.19						
Arc	HPI	203	126+45.52	1106613.14	424196.32	1041.74	87.73	04°49'29.85"	Left		
Arc	CC			1105849.16	423486.75						
Arc	PT		126+89.36	1106641.63	424162.93						
Tangent	PT		126+89.36	1106641.63	424162.93						
Tangent	PC		129+89.36	1106836.35	423934.72						
Arc	PC		129+89.36	1106836.35	423934.72						
Arc	HPI	204	130+33.25	1106864.84	423901.33	1041.74	87.73	04°49'29.85"	Left		
Arc	CC			1106043.89	423258.54						
Arc	PT		130+77.09	1106890.42	423865.67						
Tangent	PT		130+77.09	1106890.42	423865.67						
Tangent	PC		132+27.09	1106977.84	423743.78						
Arc	PC		132+27.09	1106977.84	423743.78						
Arc	HPI	205	132+70.98	1107003.42	423708.11	1041.74	87.73	04°49'29.85"	Right		
Arc	CC			1107824.37	424350.91						
Arc	PT		133+14.81	1107031.91	423674.72						
Tangent	PT		133+14.81	1107031.91	423674.72						
Tangent	PC		156+12.35	1108523.21	421926.96						
Arc	PC		156+12.35	1108523.21	421926.96						
Arc	HPI	206	156+56.23	1108551.70	421893.58	1041.74	87.73	04°49'29.85"	Right		
Arc	CC			1109315.68	422603.15						
Arc	PT		157+00.07	1108582.90	421862.70						

East Frontage Rd Cst CL (cont.)

Element	Point Type	Point Number	Station	Northing	Easting	Radius	Length	Delta/Theta	Rotation Direction	K	P
Tangent	PT		157+00.07	1108582.90	421862.70						
Tangent	PC		158+50.07	1108689.51	421757.19						
Arc	PC		158+50.07	1108689.51	421757.19						
Arc	HPI	207	158+93.96	1108720.71	421726.32	1041.74	87.73	04°49'29.85"	Left		
Arc	CC			1107956.73	421016.75						
Arc	PT		159+37.80	1108749.20	421692.93						
Tangent	PT		159+37.80	1108749.20	421692.93						
Tangent	PC		160+87.80	1108846.56	421578.83						
Arc	PC		160+87.80	1108846.56	421578.83						
Arc	HPI	208	161+37.80	1108879.01	421540.79	50.00	78.54	90°00'00.00"	Left		
Arc	CC			1108808.52	421546.37						
Arc	PT		161+66.34	1108840.98	421508.34						
Tangent	PT		161+66.34	1108840.98	421508.34						
Tangent	END		162+66.34	1108764.91	421443.43						

Caballero Dr Cst CL

Element	Point Type	Point Number	Station	Northing	Easting	Radius	Length	Delta/Theta	Rotation Direction	K	P
Alignment Name:		Caballero Dr Cst CL									
Description:											
Style:		Alignment\Geom_Baseline_LEFT_ANNO									
Tangent	START		18+50.00	1106457.53	423808.66						
Tangent	END		22+20.00	1106738.99	424048.83						

Dwy 129+89 Cst CL

Element	Point Type	Point Number	Station	Northing	Easting	Radius	Length	Delta / Theta	Rotation Direction	K	P
Alignment Name:		Dwy 129+89 Cst CL									
Description:											
Style:		Alignment\Geom_Baseline_Driveway									
Tangent	START		10+00.00	1106836.12	423935.00						
Tangent	PC		10+50.32	1106874.40	423967.66						
Arc	PC		10+50.32	1106874.40	423967.66						
Arc	HPI	601	10+59.45	1106881.34	423973.59	80	18.18	13°01'08.55"	Right		
Arc	CC			1106822.47	424028.52						
Arc	PT		10+68.50	1106886.77	423980.92						
Tangent	PT		10+68.50	1106886.77	423980.92						
Tangent	END		11+07.49	1106909.97	424012.26						

Dwy 133+30 Cst CL

Element	Point Type	Point Number	Station	Northing	Easting	Radius	Length	Delta/Theta	Rotation Direction	K	P
Alignment Name:		Dwy 133+30 Cst CL									
Description:											
Style:		Alignment\Geom_Baseline_Driveway									
Tangent	START		10+00.00	1107041.76	423663.17						
Tangent	PC		10+40.37	1107072.47	423689.38						
Arc	PC		10+40.37	1107072.47	423689.38						
Arc	HPI	602	10+48.79	1107078.88	423694.84	50.00	16.69	19°07'11.71"	Right		
Arc	CC			1107040.02	423727.41						
Arc	PT		10+57.05	1107083.14	423702.11						
Tangent	PT		10+57.05	1107083.14	423702.11						
Tangent	END		11+00.00	1107104.88	423739.15						

Dwy 135+95 Cst CL

Element	Point Type	Point Number	Station	Northing	Easting	Radius	Length	Delta/Theta	Rotation Direction	K	P
Alignment Name:		Dwy 135+95 Cst CL									
Description:											
Style:		Alignment\Geom_Baseline_Driveway									
Tangent	START		10+00.00	1107213.77	423461.59						
Tangent	END		10+90.00	1107282.24	423520.00						

Dwy 138+87 Cst CL

Element	Point Type	Point Number	Station	Northing	Easting	Radius	Length	Delta/Theta	Rotation Direction	K	P
Alignment Name:		Dwy 138+87 Cst CL									
Description:											
Style:		Alignment\Geom_Baseline_Driveway									
Tangent	START		10+00.00	1107403.31	423239.46						
Tangent	PC		10+27.44	1107424.18	423257.27						
Arc	PC		10+27.44	1107424.18	423257.27						
Arc	HPI	603	10+40.00	1107433.74	423265.42	50.00	24.60	28°11'38.21"	Left		
Arc	CC			1107456.64	423219.24						
Arc	PT		10+52.05	1107446.00	423268.09						
Tangent	PT		10+52.05	1107446.00	423268.09						
Tangent	END		10+70.75	1107464.28	423272.07						

Professional Engineer

DALE WIGGINS

26609

DALE WIGGINS

06/26

Arizona, U.S.A.

c:\pwworking\usaz\dms08894\0738_g07.dgn

6/23/2026

@5:14:20 PM

jason.heredia

Element	Point Type	Point Number	Station	Northing	Easting	Radius	Length	Delta/Theta	Rotation Direction	K	P
Alignment Name:		Dwy 154+00 Cst CL									
Description:											
Style:		Alignment\Geom_Baseline_Driveway									
Tangent	START		10+00.00	1108385.38	422088.50						
Tangent	END		10+80.00	1108446.24	422140.43						

Element	Point Type	Point Number	Station	Northing	Easting	Radius	Length	Delta/Theta	Rotation Direction	K	P
Alignment Name:		Dwy 154+00 Cst CL									
Description:											
Style:		Alignment\Geom_Baseline_Driveway									
Tangent	START		10+00.00	1108385.38	422088.50						
Tangent	END		10+80.00	1108446.24	422140.43						

	Point	Point						Delta /	Rotation		
Element	Type	Number	Station	Northing	Easting	Radius	Length	Theta	Direction	K	P
Alignment Name:		Dwy 274+34 Cst CL									
Description:											
Style:		Alignment\Geom_Baseline									
Tangent	START		9+00.00	1108683.88	421276.48						
Tangent	END		10+00.00	1108759.95	421341.39						


Element	Point	Point	Station	Northing	Easting	Radius	Length	Delta/ Theta	Rotation	K	P
	Type	Number							Direction		
Alignment Name:		Dwy319+02.37									
Description:											
Style:		Alignment\Geom_Baseline									
Tangent	START		10+00.00	1111656	417939						
Tangent	END		11+75.00	1111523	417825.4						

A DEPARTMENT OF TRANSPORTATION SUBJECT DELIVERY AND OPERATIONS DIVISION HIGHWAY DESIGN SERVICES GEOMETRIC DATA SHEET	ROUTE US 93	F.H.W.A. Arizona Division	STATE ARIZ.	PROJECT NO. 093 YV 189	FEDERAL ID NO. 093-B(230)T	SHEET NO. 147	TOTAL SHEETS 524	RECORD NO.
	MILEPOST 189.9	LOCATION WICKENBURG RANCH WAY TO VISTA ROYALE						DWG No. 0
	STRUCTURE NO.	TRACS NO. F0738 01C			_____			

c:\pwworking\usaz\dms08894\070738_g08.dgn
6/23/2026 @5:14:41 PM jason.heredia

NOTE:
See Dwg No. C-4.04 for Wickenburg Ranch Way.

F.H.W.A. REGION	STATE	PROJECT NO.	SHEET NO.	TOTAL SHEETS	RECORD DRAWING
9	ARIZ.	093-B(230)T	148	524	
093 YV 189					

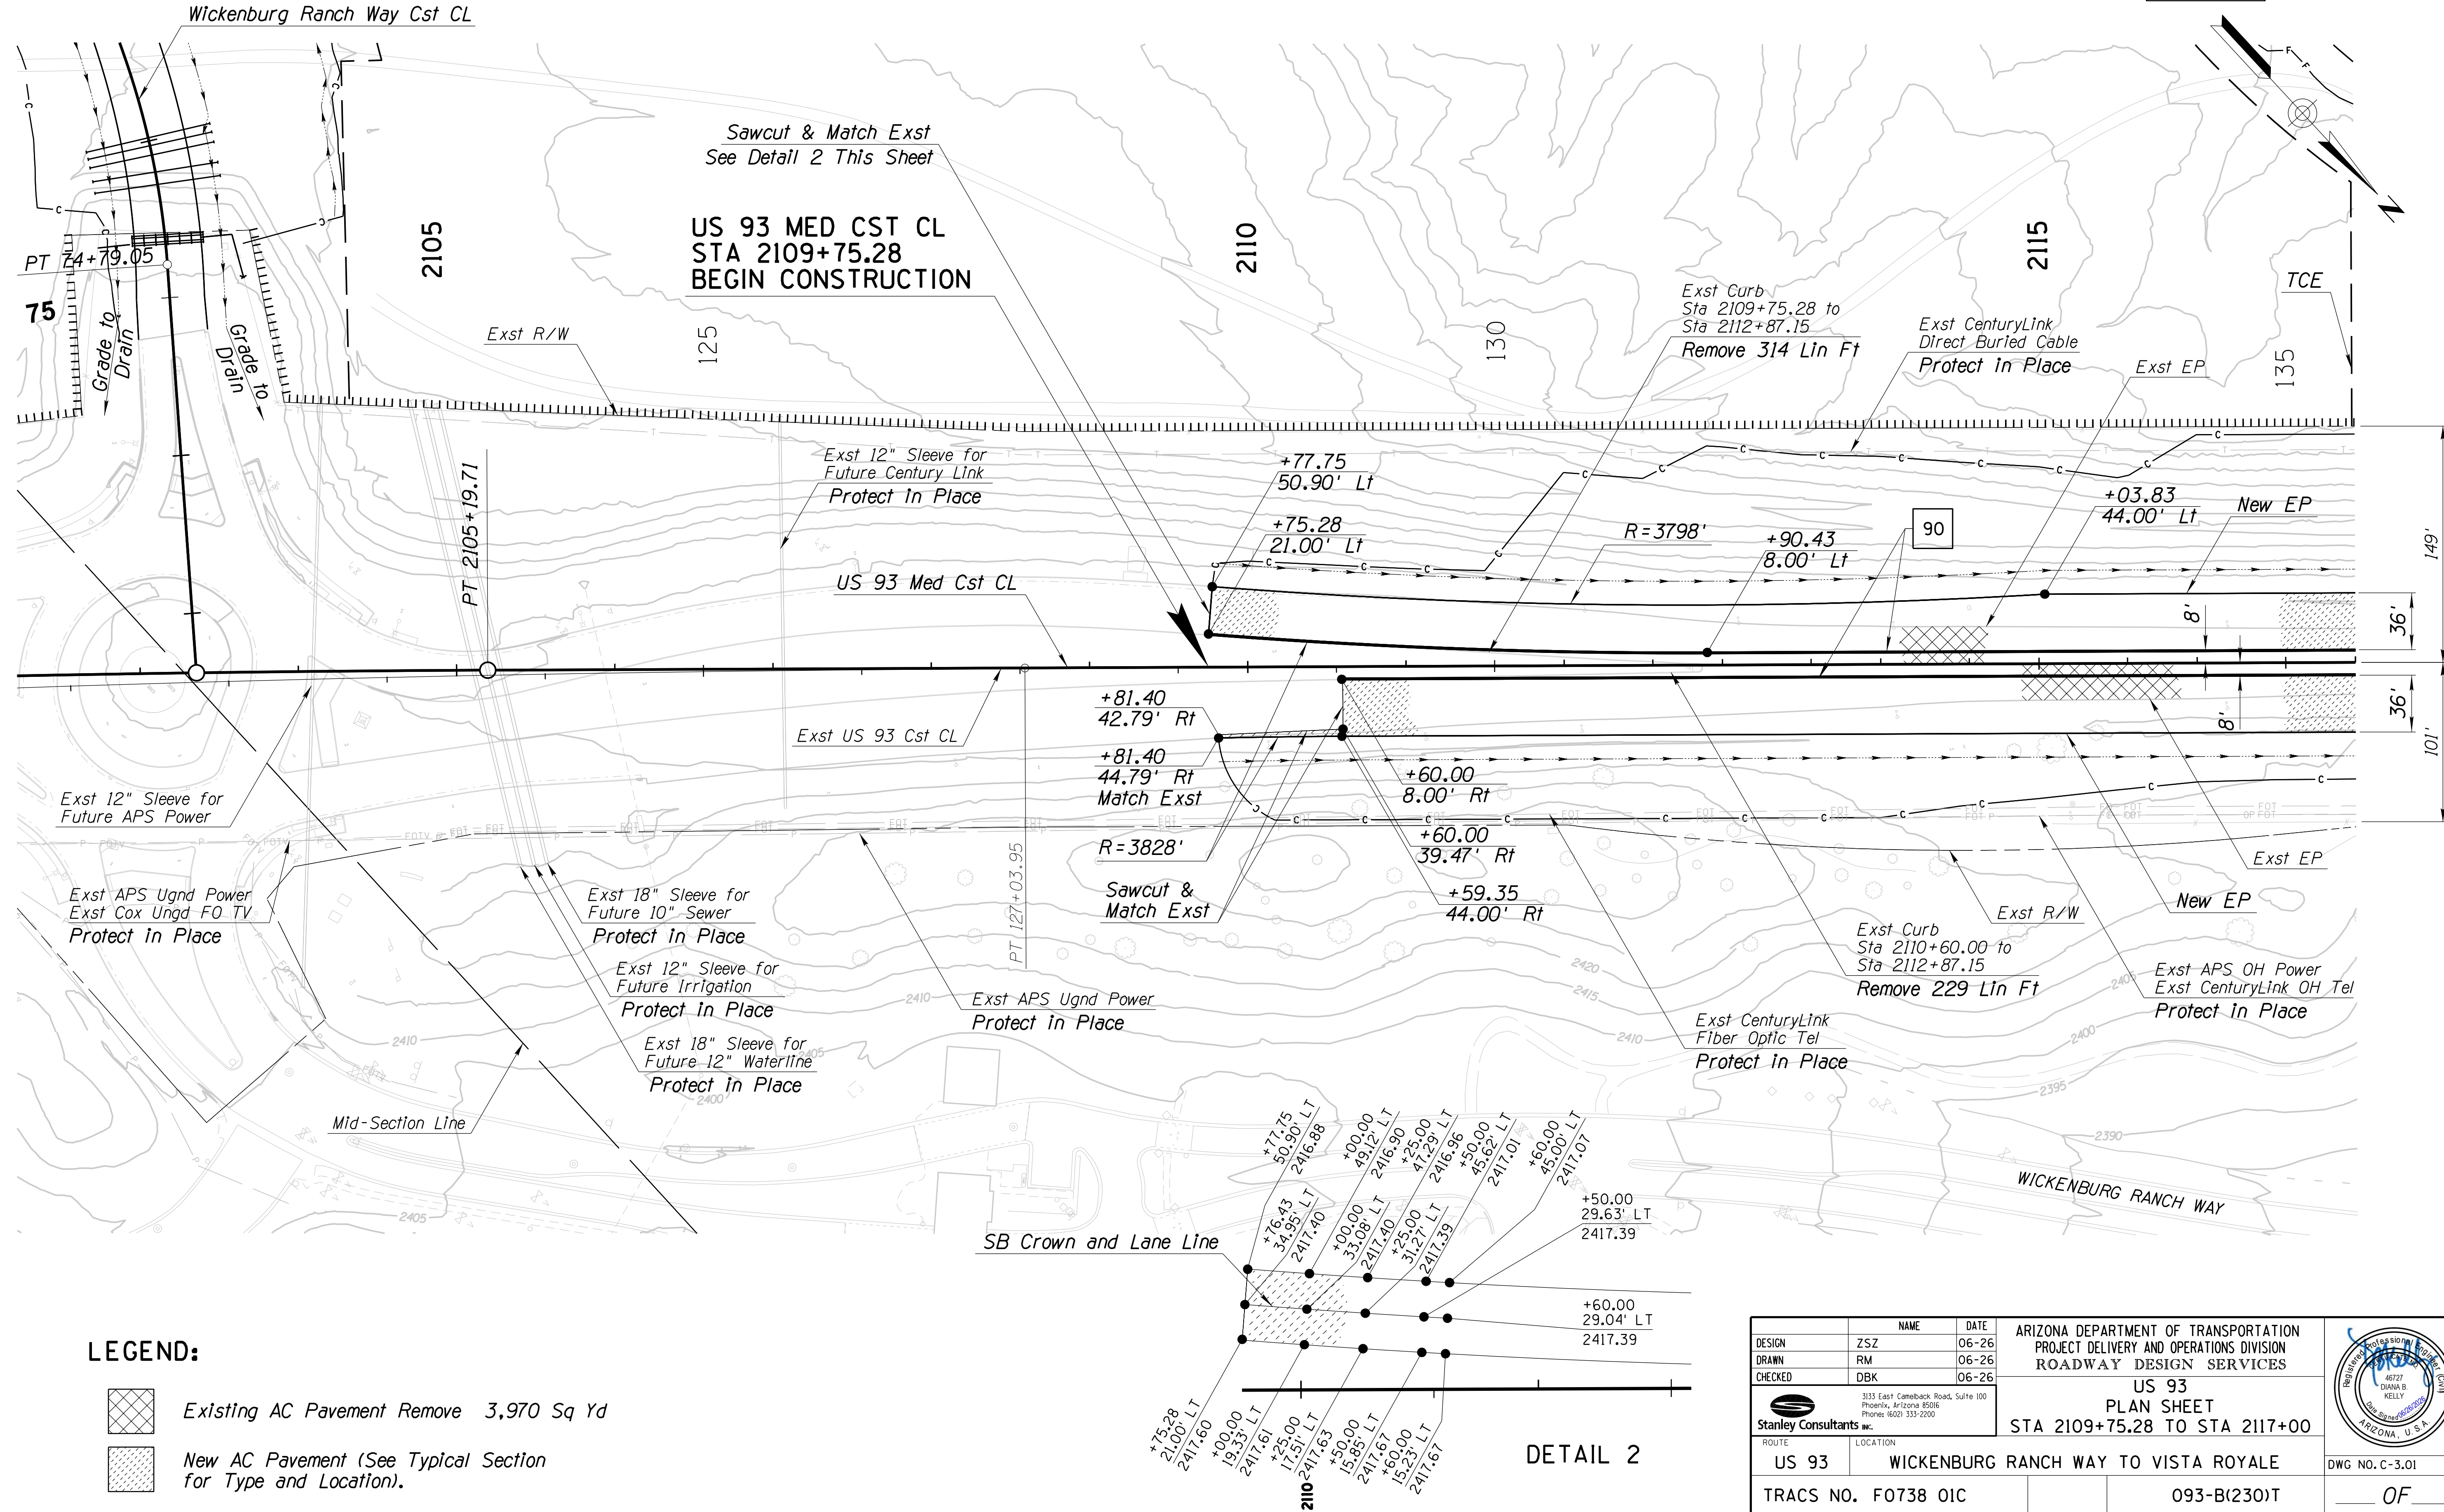

PT 2105+19.71

Sawcut & Match Exst
See Detail 2 This Sheet

US 93 MED CST CL
STA 2109+75.28
BEGIN CONSTRUCTION

Exst 12" Sleeve for
Future Century Link
Protect in Place

US 93 Med Cst CL

Exst US 93 Cst CL

Exst 12" Sleeve for
Future APS Power

Exst APS Ugd Power
Exst Cox Ugd FO TV
Protect in Place

Exst 18" Sleeve for
Future 10" Sewer
Protect in Place

Exst 12" Sleeve for
Future Irrigation
Protect in Place

Exst 18" Sleeve for
Future 12" Waterline
Protect in Place

Exst APS Ugd Power
Protect in Place

Sawcut &
Match Exst

Exst Curb
Sta 2109+75.28 to
Sta 2112+87.15
Remove 314 Lin Ft

Exst CenturyLink
Direct Buried Cable
Protect in Place

Exst EP

TCE

+03.83
44.00' Lt
New EP

R=3798'

+90.43
8.00' Lt

90

8'

8'

Exst EP

New EP

Exst Curb
Sta 2110+60.00 to
Sta 2112+87.15
Remove 229 Lin Ft

Exst CenturyLink
Fiber Optic Tel
Protect in Place

Exst APS OH Power
Exst CenturyLink OH Tel
Protect in Place

Mid-Section Line

SB Crown and Lane Line

WICKENBURG RANCH WAY

LEGEND:

- Existing AC Pavement Remove 3,970 Sq Yd
- New AC Pavement (See Typical Section for Type and Location).


DETAIL 2

DESIGN	NAME	DATE	ARIZONA DEPARTMENT OF TRANSPORTATION PROJECT DELIVERY AND OPERATIONS DIVISION ROADWAY DESIGN SERVICES		
DRAWN	ZSZ	06-26	US 93 PLAN SHEET STA 2109+75.28 TO STA 2117+00		
CHECKED	DBK	06-26			
Stanley Consultants inc.			3133 East Camelback Road, Suite 100 Phoenix, Arizona 85016 Phone: 602.333.2200		
ROUTE			LOCATION		
US 93			WICKENBURG RANCH WAY TO VISTA ROYALE		
TRACS NO. F0738 OIC			093-B(230)T		
			DWG NO. C-3.01		
			OF		




F.H.W.A. REGION	STATE	PROJECT NO.	SHEET NO.	TOTAL SHEETS	RECORD DRAWING
9	ARIZ.	093-B(230)T	149	524	

093 YV 189

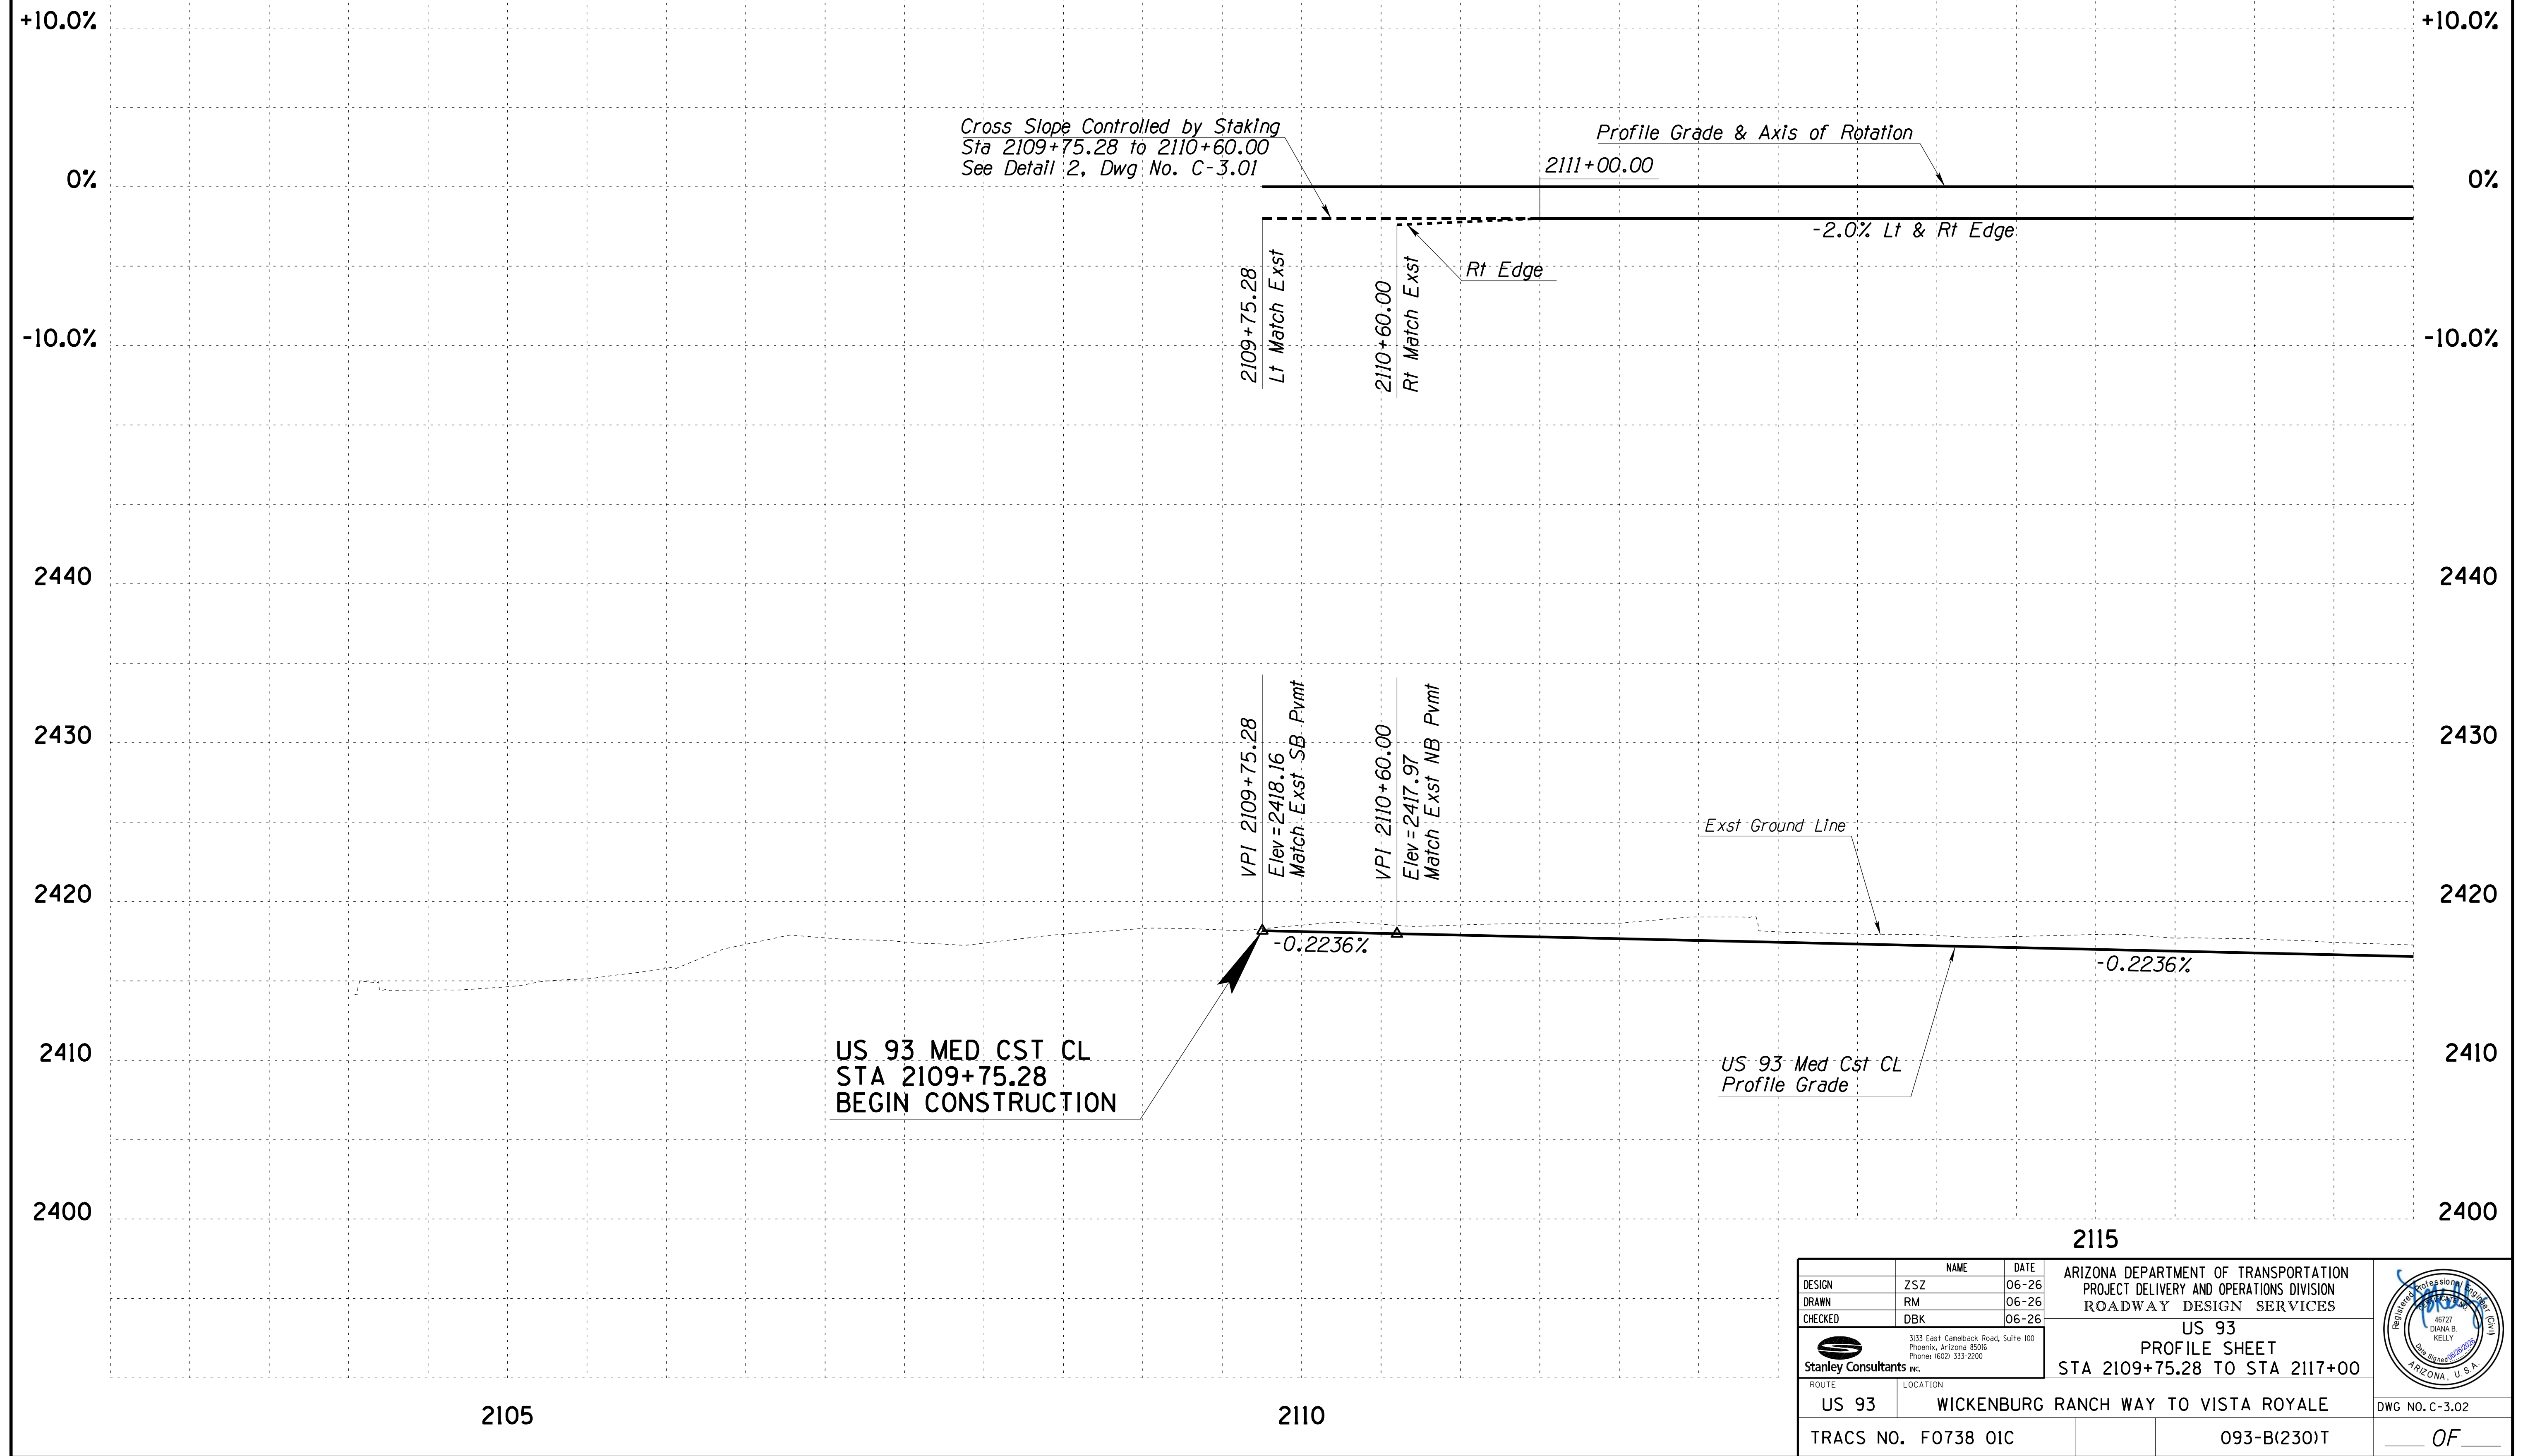


NOTE:
See Dwg No. C-4.08 for Matthe Ranch Road.


F.H.W.A. REGION	STATE	PROJECT NO.	SHEET NO.	TOTAL SHEETS	RECORD DRAWING
9	ARIZ.	093-B(230)T	150	524	
093 YV 189					

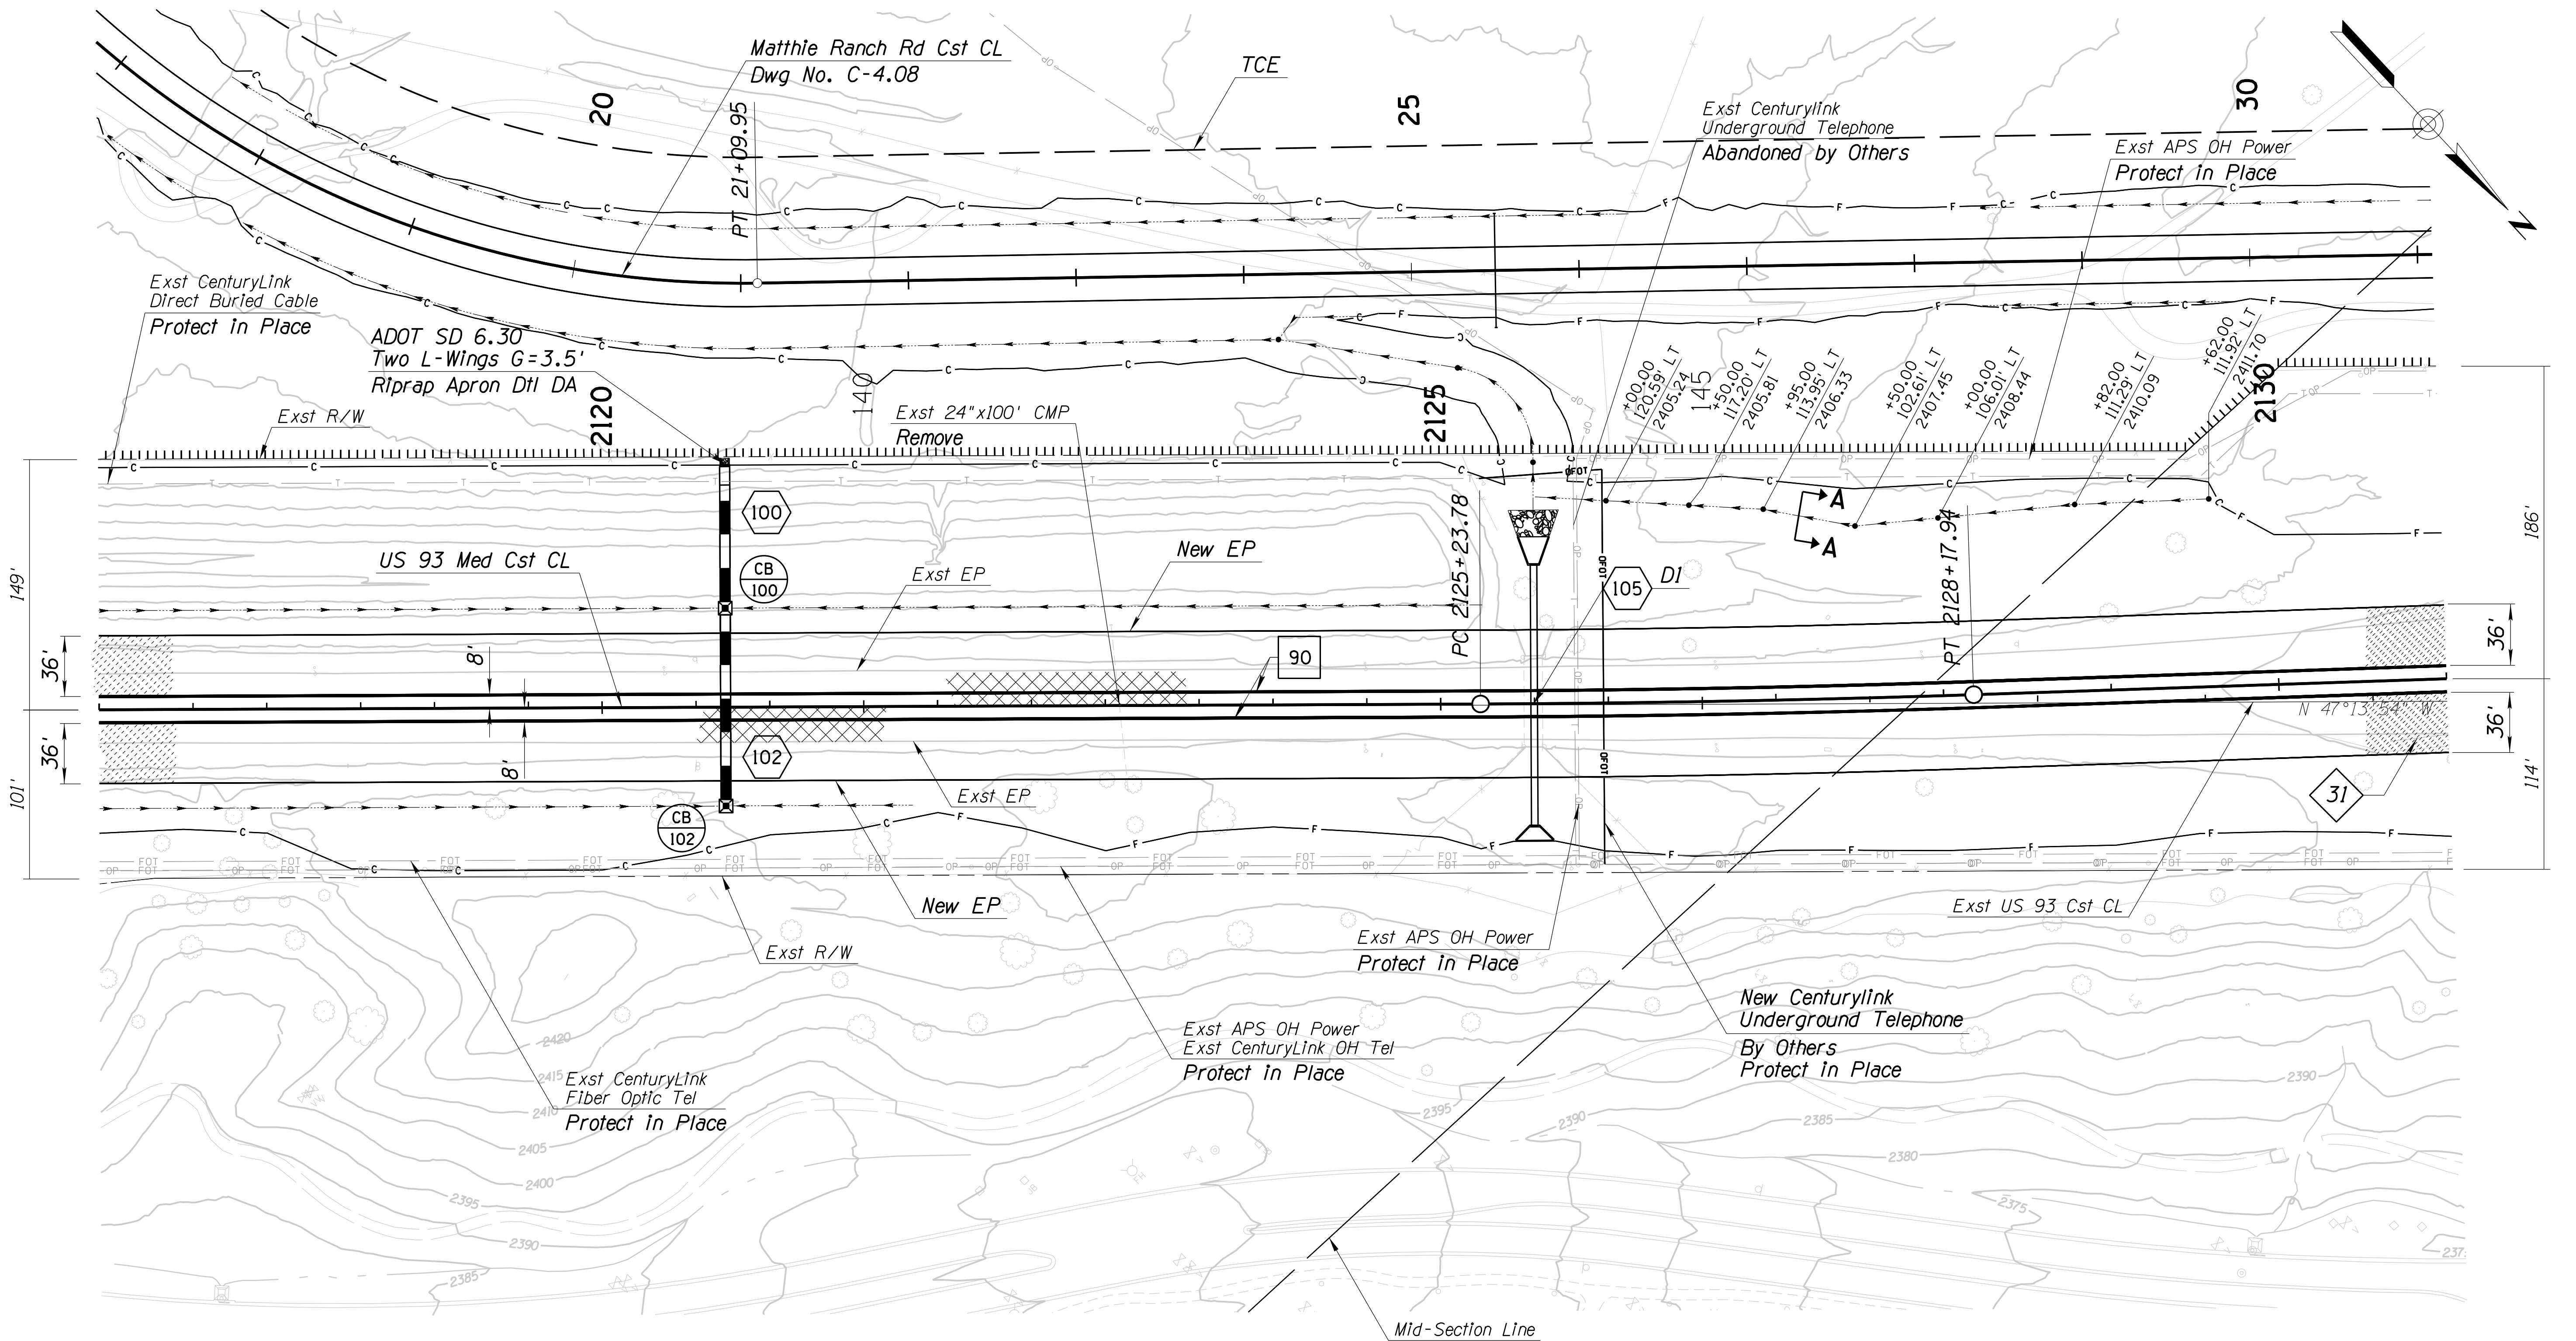

LEGEND:

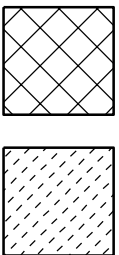

Existing AC Pavement Remove 7,040 Sq Yd
New AC Pavement (See Typical Section for Type and Location).

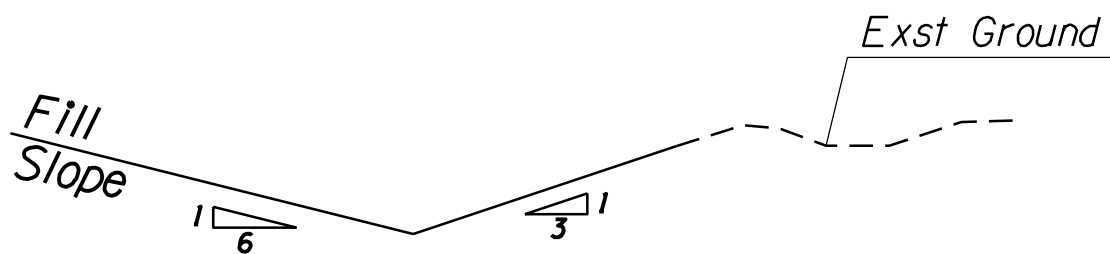


NOTE:
All station and offsets are from US 93 Med Cst CL unless noted.

		NAME	DATE	ARIZONA DEPARTMENT OF TRANSPORTATION PROJECT DELIVERY AND OPERATIONS DIVISION ROADWAY DESIGN SERVICES	
DESIGN	ZSZ		06-26		
DRAWN	RM		06-26		
CHECKED	DBK		06-26	US 93	
 Stanley Consultants INC.				PLAN SHEET	
3133 East Camelback Road, Suite 100 Phoenix, Arizona 85016 Phone: (602) 333-2200				STA 2117+00 TO STA 2131+00	
ROUTE		LOCATION			
US 93		WICKENBURG RANCH WAY TO VISTA ROYALE			
TRACS NO. F0738 OIC			093-B(230)T		
			___ OF ___		
			DWG NO. C-3.03		


F.H.W.A. REGION	STATE	PROJECT NO.	SHEET NO.	TOTAL SHEETS	RECORD DRAWING
9	ARIZ.	093-B(230)T	151	524	

093 YV 189

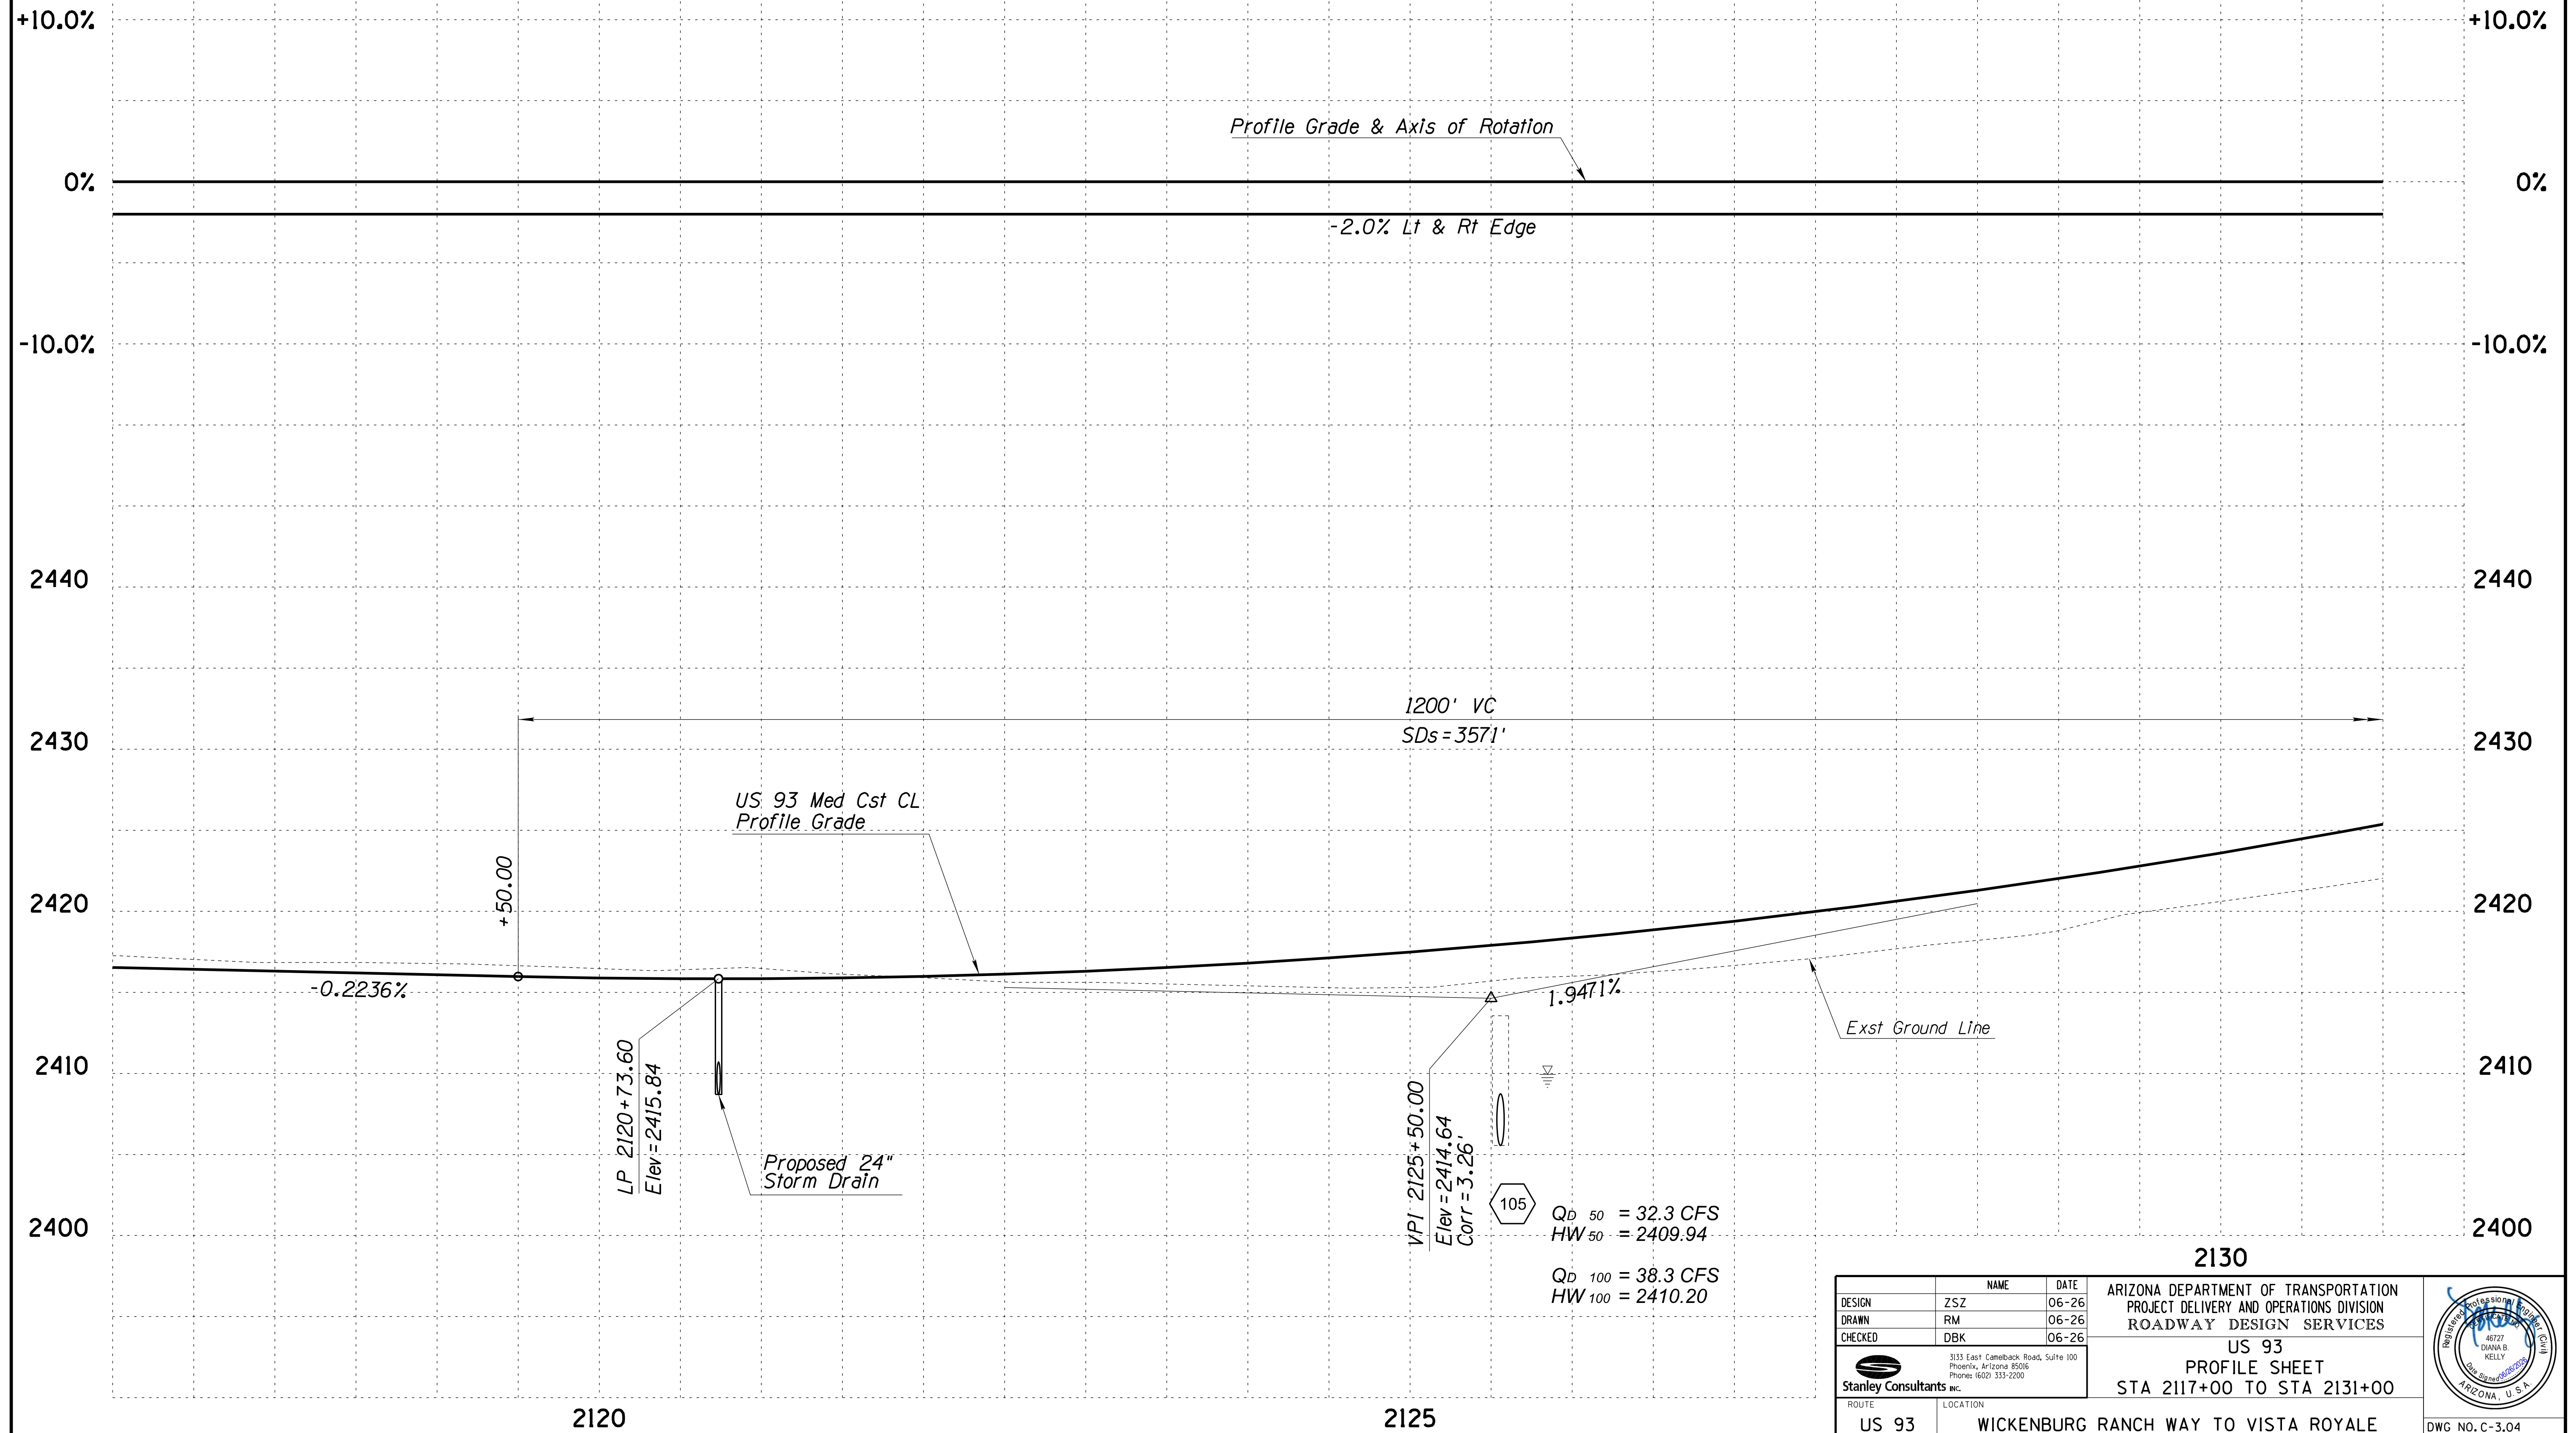


NOTE:
See Dwg No. C-4.10 for Matthe Ranch Road.

F.H.W.A. REGION	STATE	PROJECT NO.	SHEET NO.	TOTAL SHEETS	RECORD DRAWING
9	ARIZ.	093-B(230)T	152	524	
093 YV 189					

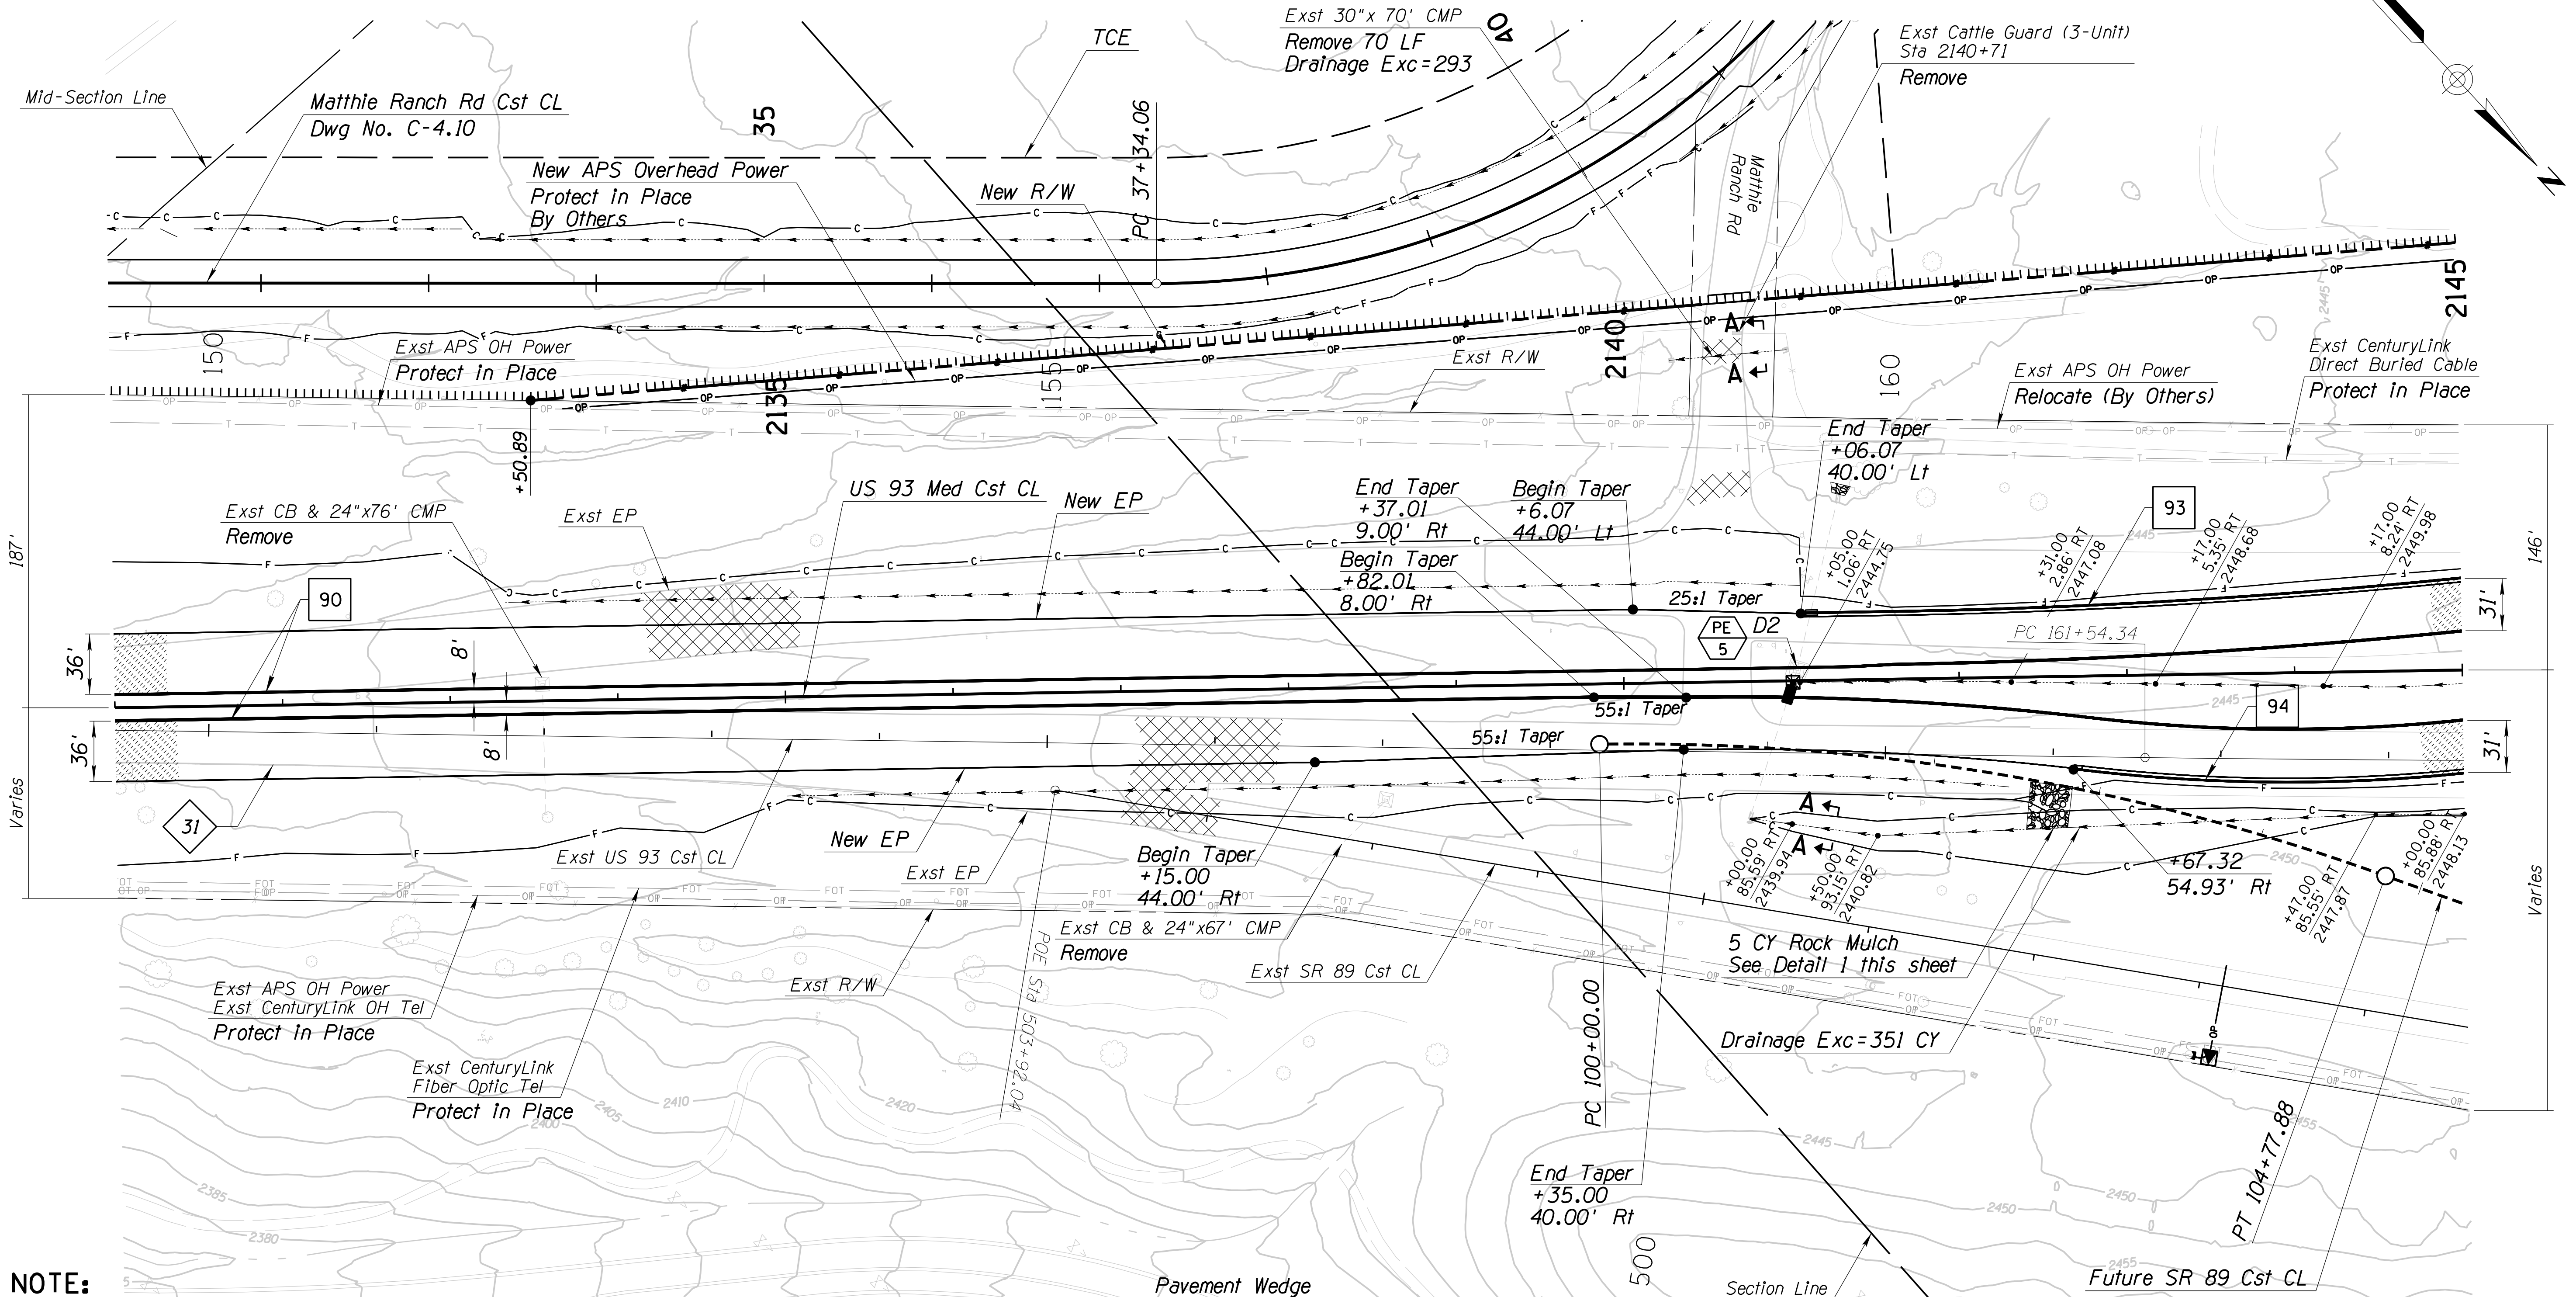

NOTE:
All station and offsets are from
US 93 Med Cst CL unless noted.


- LEGEND:
- Existing AC Pavement Remove 16,478 Sq Yd
 - New AC Pavement (See Typical Section for Type and Location).

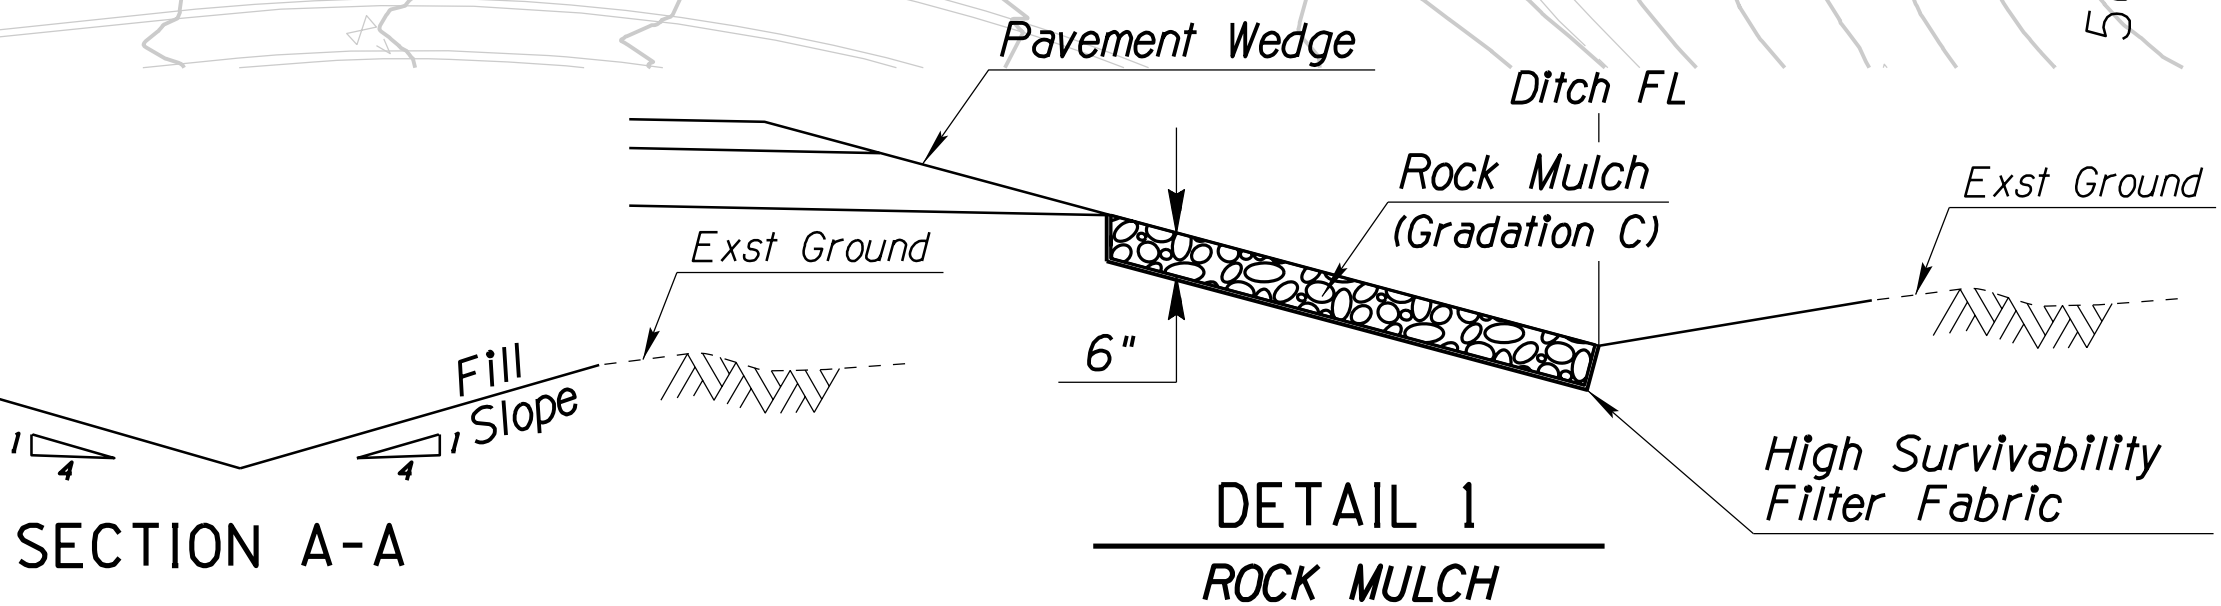

DESIGN	NAME	DATE	ARIZONA DEPARTMENT OF TRANSPORTATION PROJECT DELIVERY AND OPERATIONS DIVISION ROADWAY DESIGN SERVICES	
DRAWN	RM	06-26	US 93 PLAN SHEET STA 2131+00 TO STA 2145+00	
CHECKED	DBK	06-26	US 93 WICKENBURG RANCH WAY TO VISTA ROYALE	
ROUTE	LOCATION		US 93 WICKENBURG RANCH WAY TO VISTA ROYALE	
TRACS NO. F0738 OIC			093-B(230)T	DWG NO. C-3.05

F.H.W.A. REGION	STATE	PROJECT NO.	SHEET NO.	TOTAL SHEETS	RECORD DRAWING
9	ARIZ.	093-B(230)T	153	524	


093 YV 189

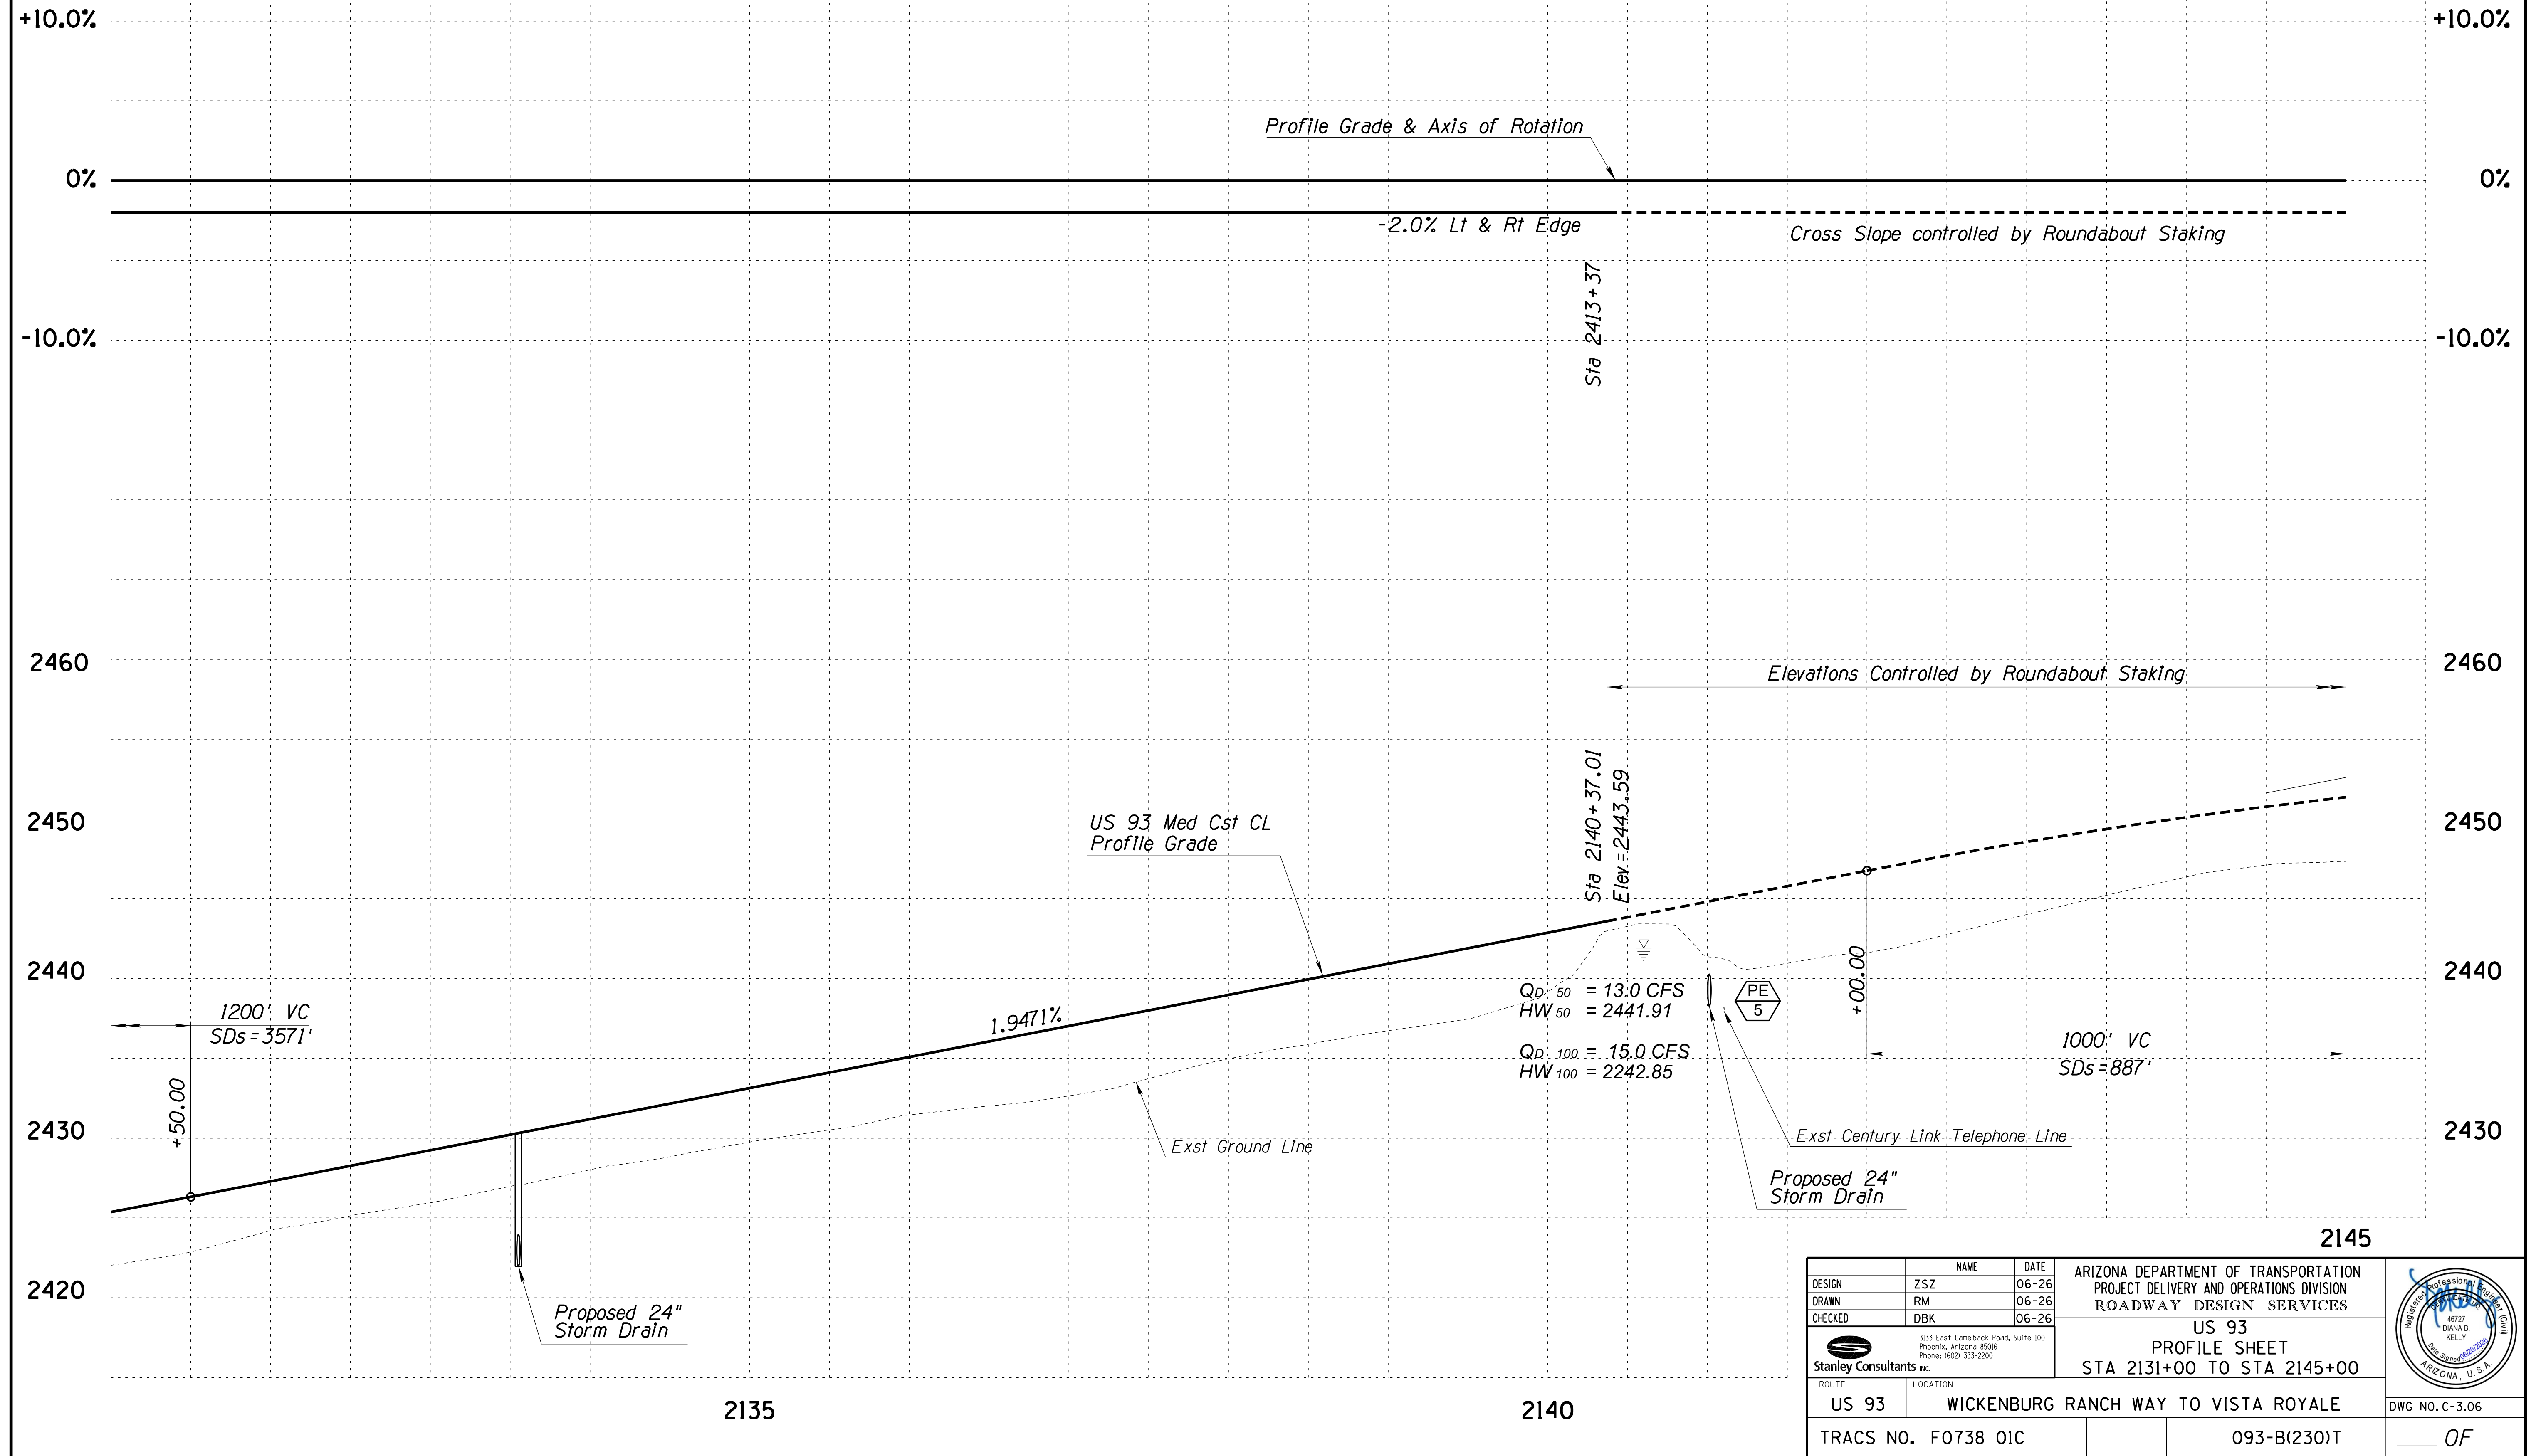

1. See Dwg No. C-3.41 for SR 89.
2. See Dwg No. C-5.01 to C-5.17 for US93/SR89 Roundabout Geometric Layout and Staking.


093 YV 189

093 YV 189

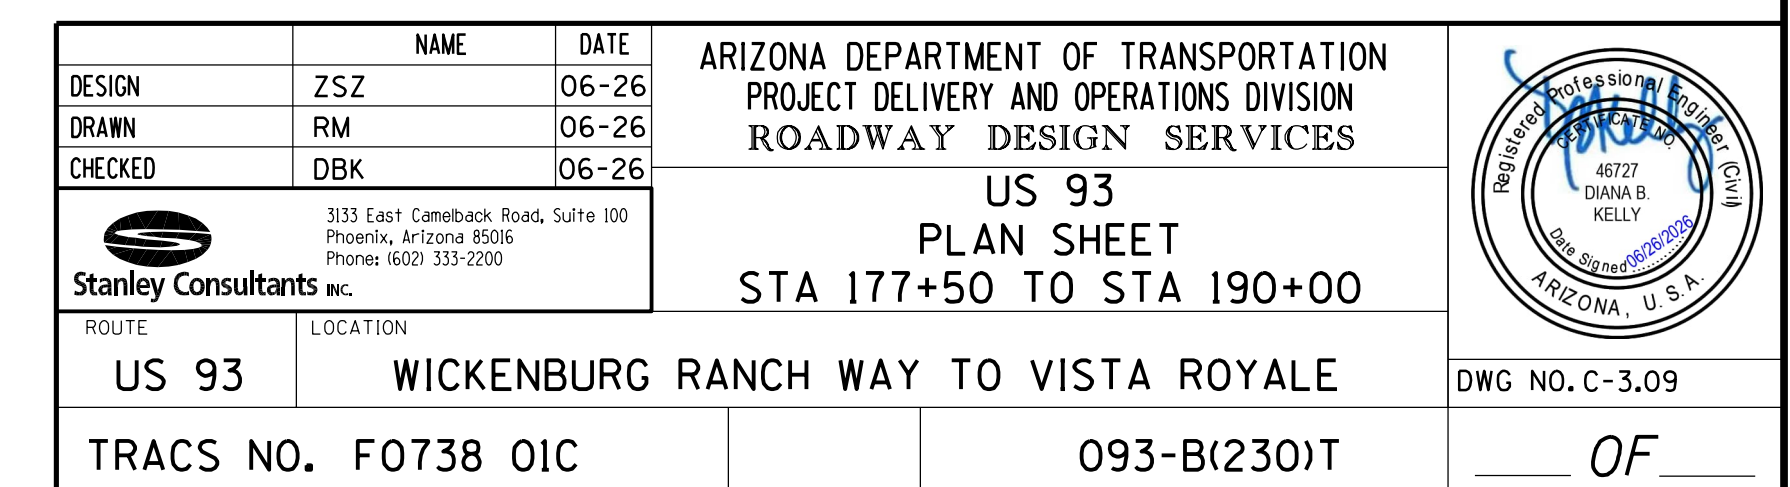093 YV 189

F.H.W.A. REGION	STATE	PROJECT NO.	SHEET NO.	TOTAL SHEETS	RECORD DRAWING
9	ARIZ.	093-B(230)T	157	524	

093 YV 189

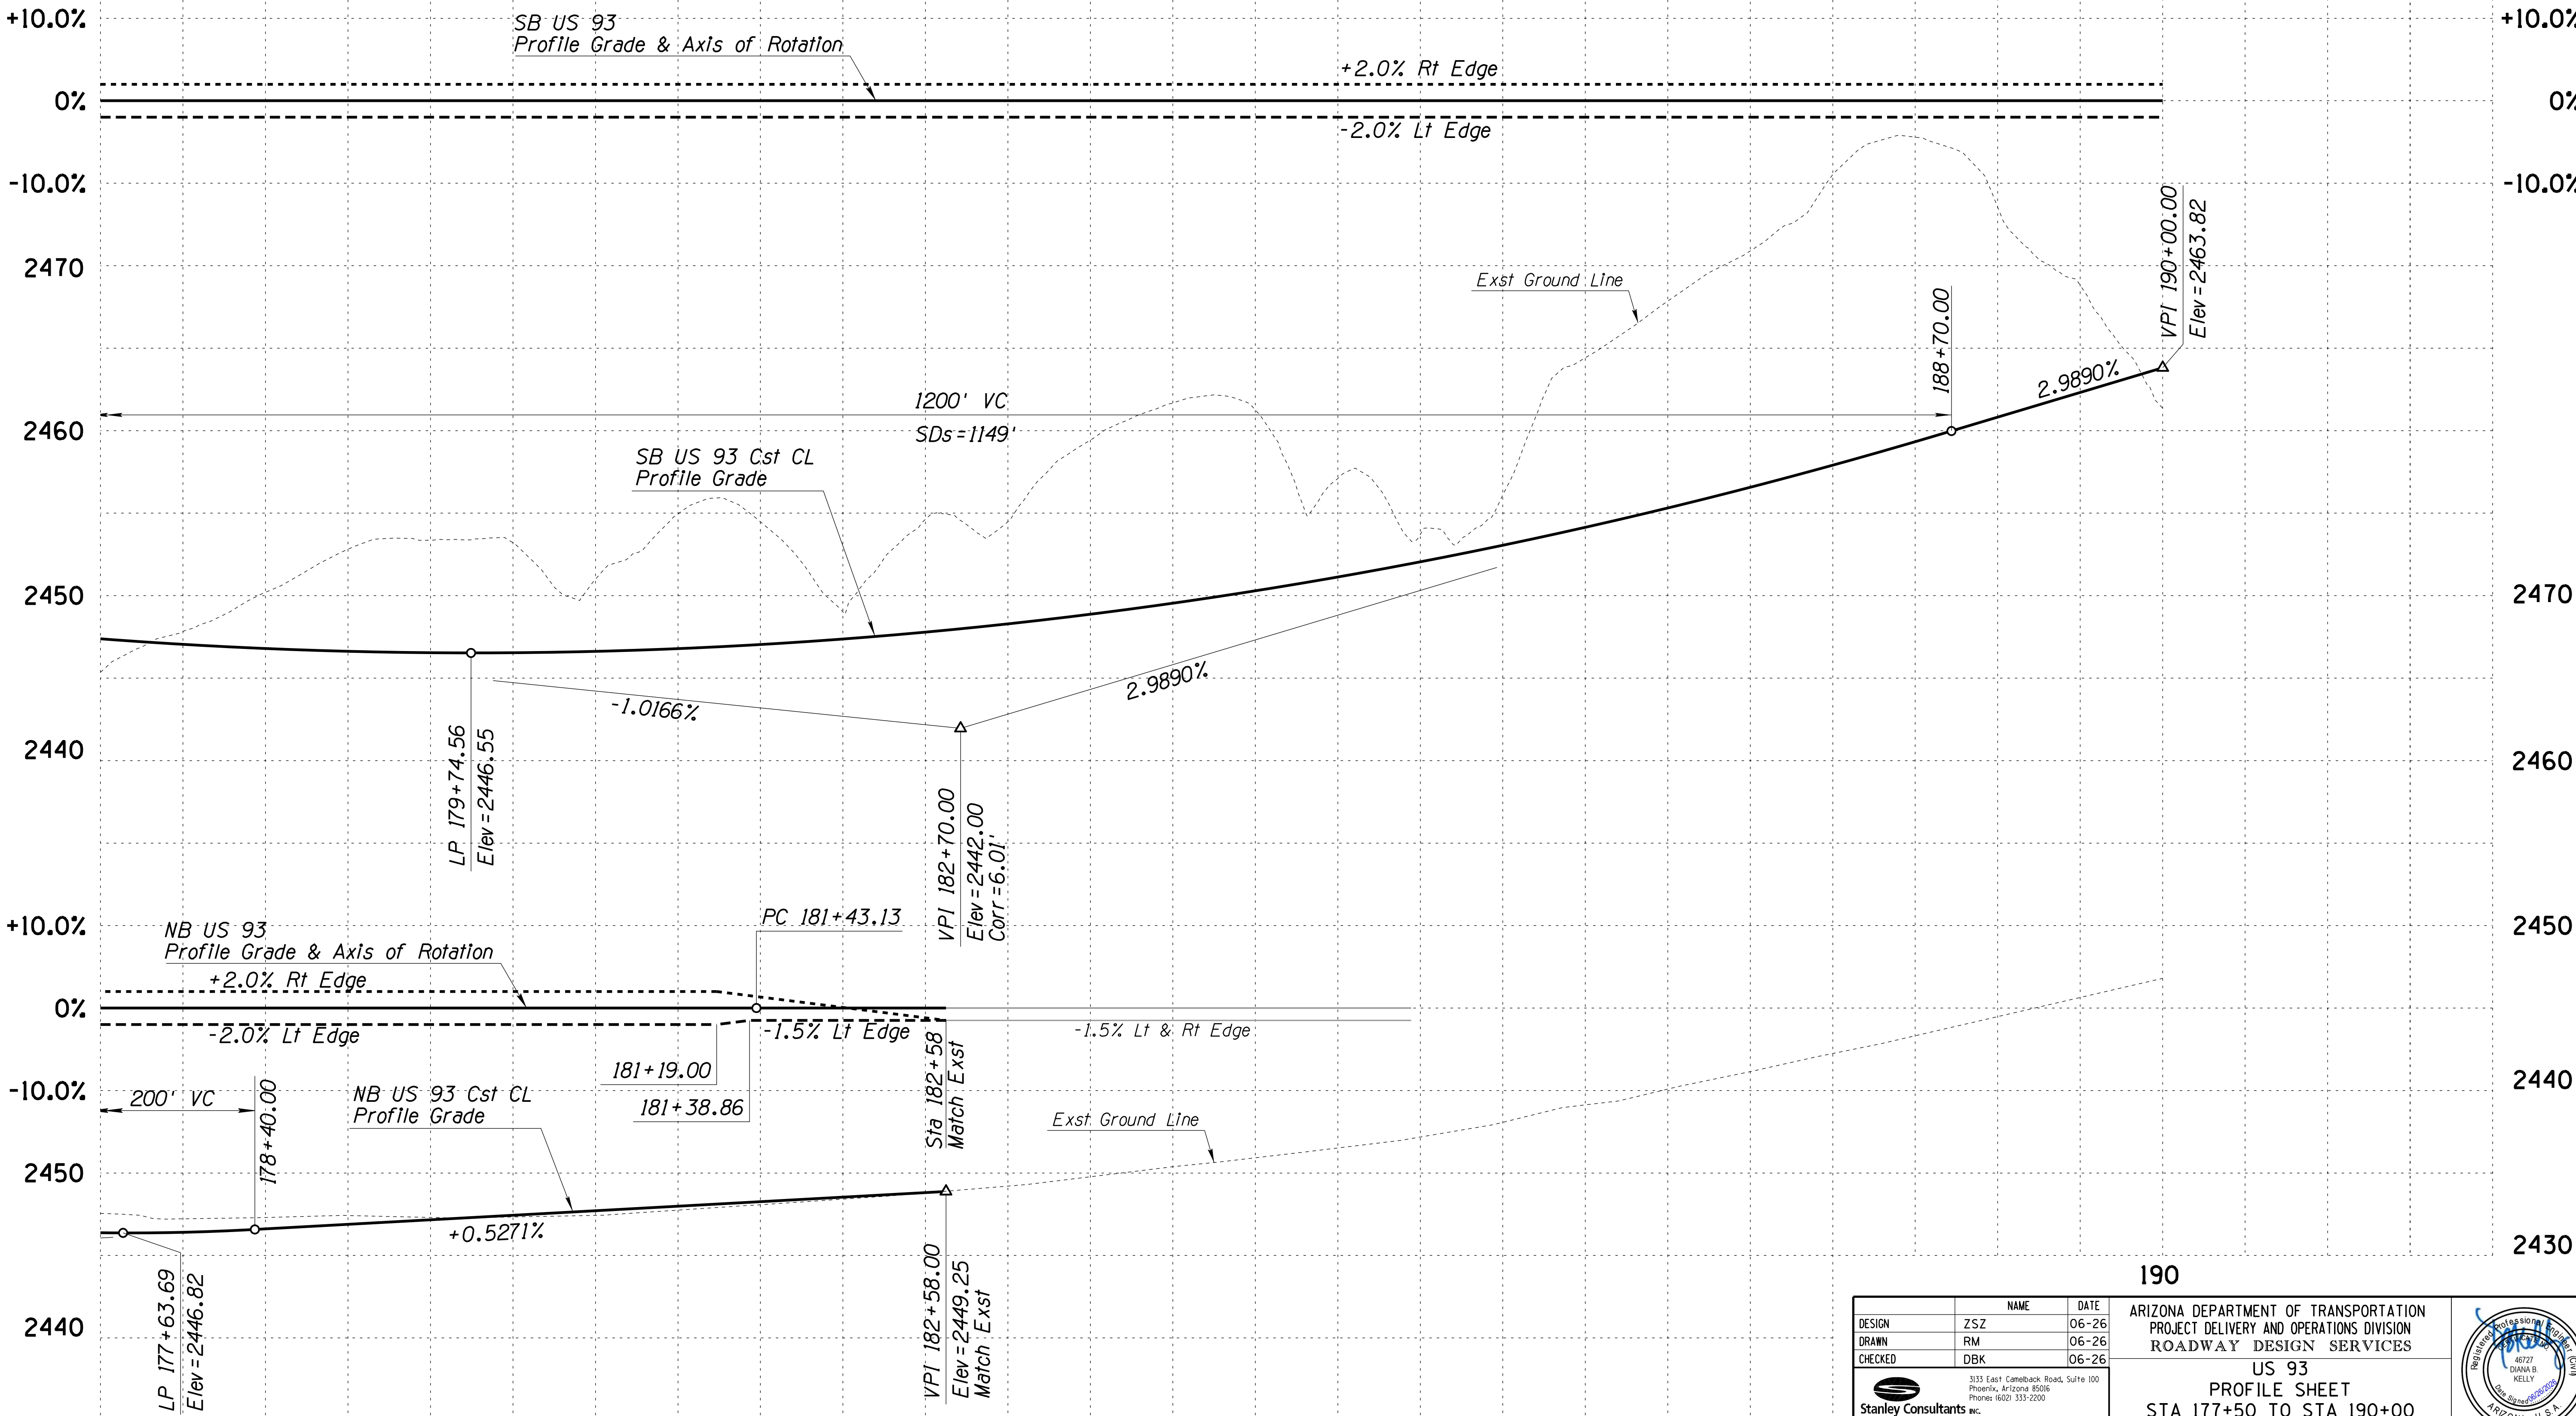

DESIGN	ZSZ	NAME	DATE
DRAWN	RM		06-26
CHECKED	DBK		06-26

333 East Camelback Road, Suite 100
Phoenix, Arizona 85016
Phone: (602) 333-2200

Stanley Consultants inc.

ARIZONA DEPARTMENT OF TRANSPORTATION
PROJECT DELIVERY AND OPERATIONS DIVISION
ROADWAY DESIGN SERVICES

US 93
PROFILE SHEET
STA 177+50 TO STA 190+00

46727
DIANA B. KELLY
Professional Engineer
ARIZONA, U.S.A.


ROUTE: US 93 LOCATION: WICKENBURG RANCH WAY TO VISTA ROYALE

TRACS NO. F0738 OIC


093-B(230)T

DWG NO. C-3.10

OF

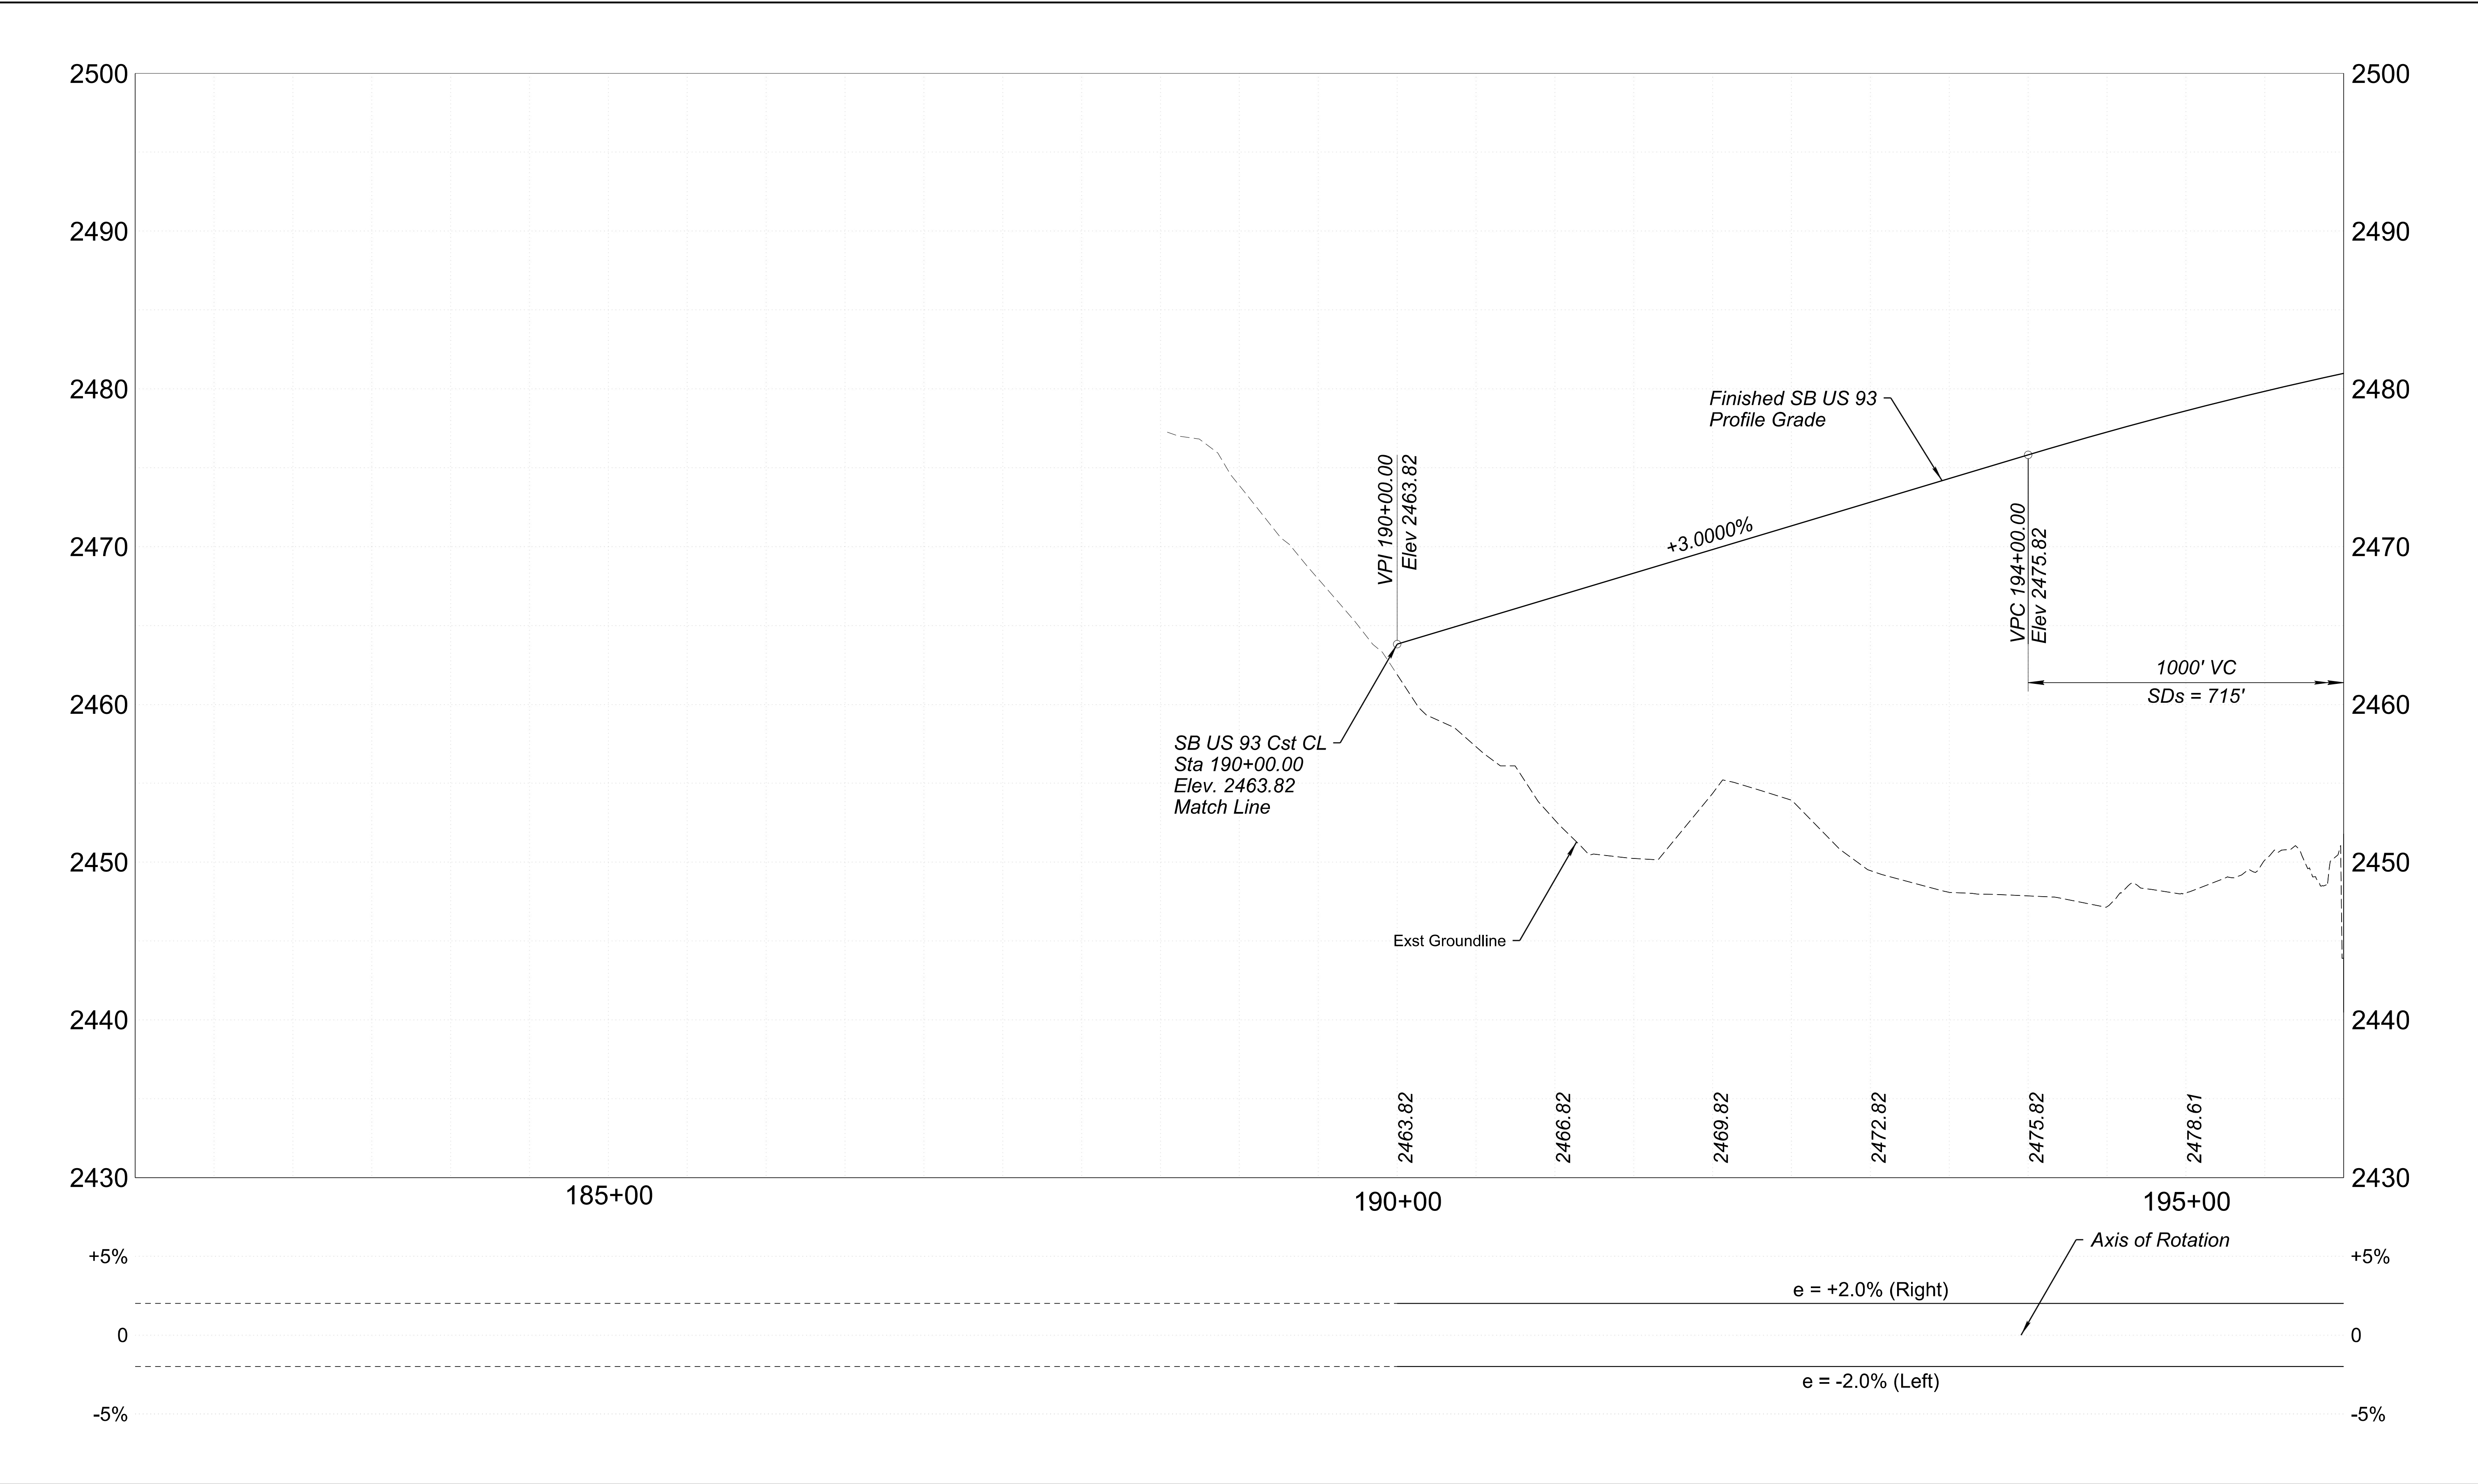


	NAME		DATE	ARIZONA DEPARTMENT OF TRANSPORTATION PROJECT DELIVERY AND OPERATIONS DIVISION ROADWAY DESIGN SERVICES			ROUTE	F.H.W.A. Arizona Division	STATE	PROJECT NO.	FEDERAL ID NO.	SHEET NO.	TOTAL SHEETS	RECORD DRAWING
	DESIGN	J GILLIS	06/26				US 93		ARIZ.	093 YV 189	093-B(230)T	159	524	
	DRAWN	M SAMUELSON	06/26				MILEPOST	LOCATION WICKENBURG RANCH WAY TO VISTA ROYALE						DWG No. C-3.12
	CHECKED	J BEMELEN	06/26	TRANSPORTATION AECOM TECHNICAL SERVICES, Inc. 7720 N. 16th St., Suite 100 Phoenix, Arizona 85020 T 602.371.1100 AECOM www.aecom.com			STRUCTURE NO.	TRACS NO. F0738 01C						____ OF ____
	PROFILE SHEET SB STA 190+00 TO STA 196+00													

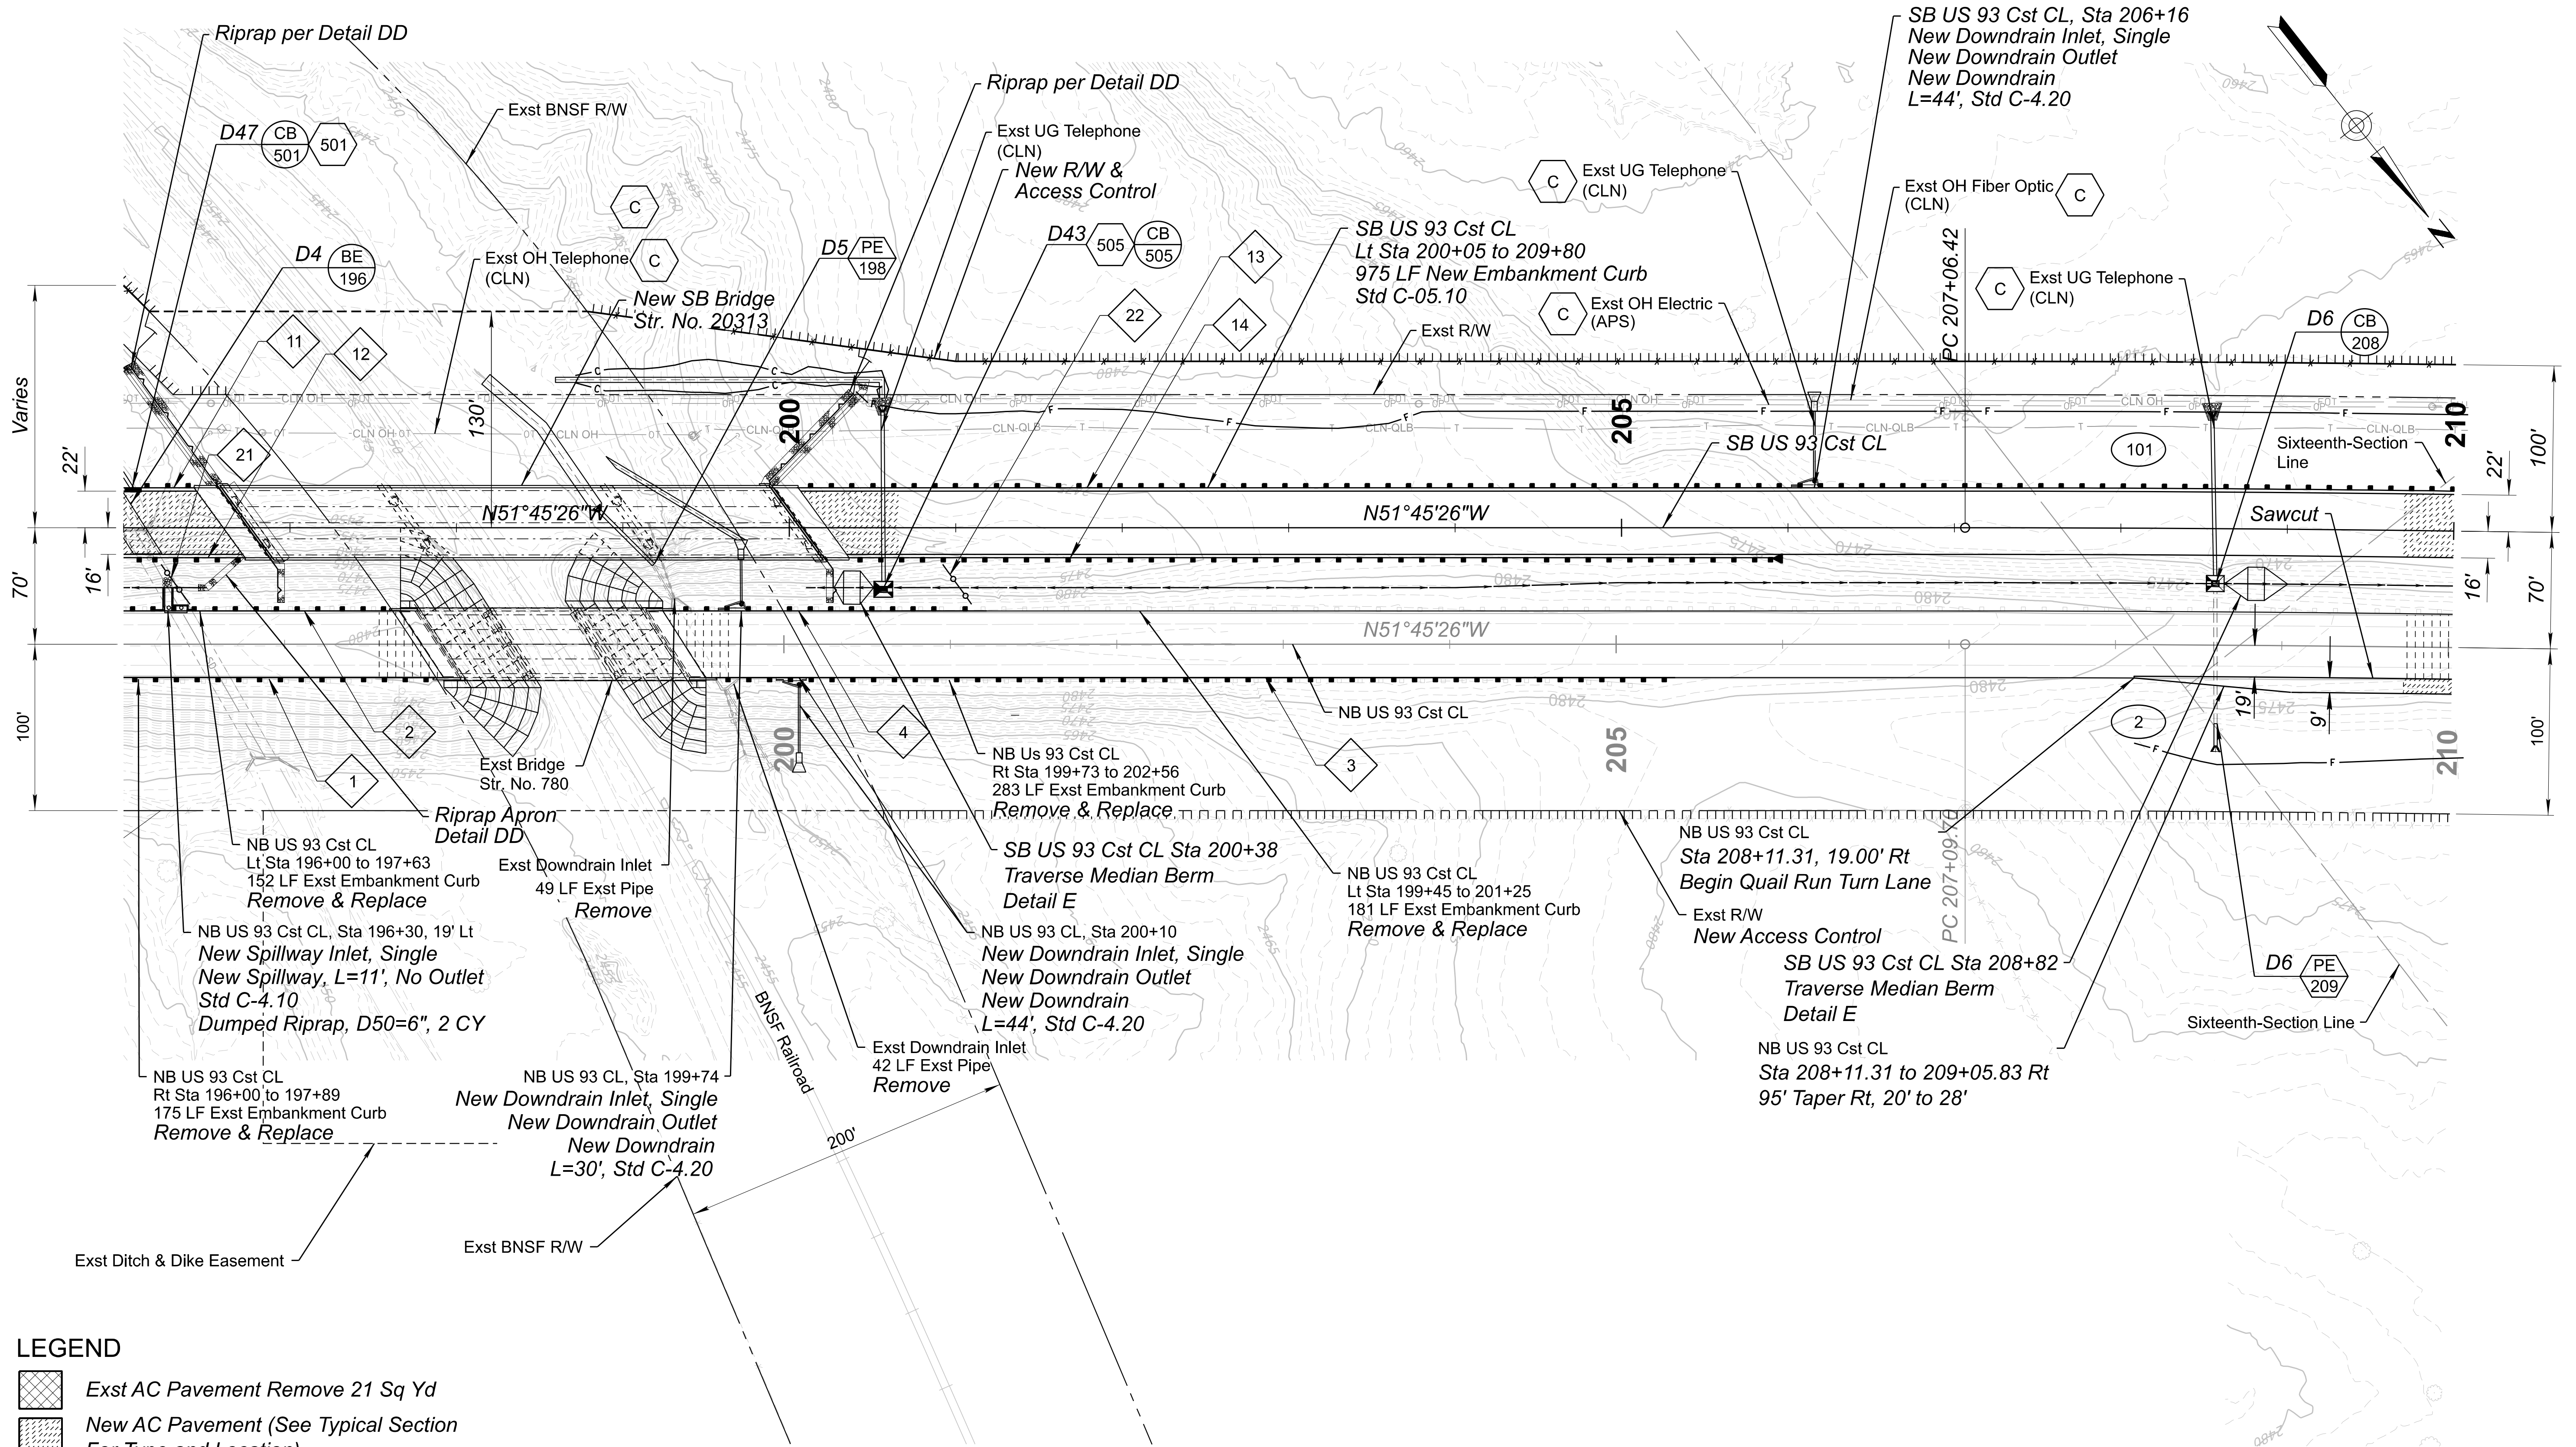


LEGEND

	Exst AC Pavement Remove 21 Sq Yd
	New AC Pavement (See Typical Section For Type and Location)
	Existing AC Pavement Mill


UTILITY DISPOSITION SHEETS LEGEND																					
A	To Remain in Service - Protect-In-Place				NAME		DATE	ARIZONA DEPARTMENT OF TRANSPORTATION PROJECT DELIVERY AND OPERATIONS DIVISION ROADWAY DESIGN SERVICES PLAN SHEET SB US 93 STA 196+00 TO STA 210+00				ROUTE		F.H.W.A. Arizona Division		STATE	PROJECT NO.	FEDERAL ID NO.	SHEET NO.	TOTAL SHEETS	RECORD DRAWING
B	Contractor to Relocate, Remove, or Reset				DESIGN		06/26					US 93		ARIZ.			093 YV 189	093-B(230)T	160	524	
C	To Be Relocated or Removed by Others				DRAWN		06/26					MILEPOST		LOCATION		WICKENBURG RANCH WAY TO VISTA ROYALE					DWG No. C-3.13
D	To Be Constructed By Others				CHECKED		06/26					STRUCTURE NO.		TRACS NO.		F0738 01C					

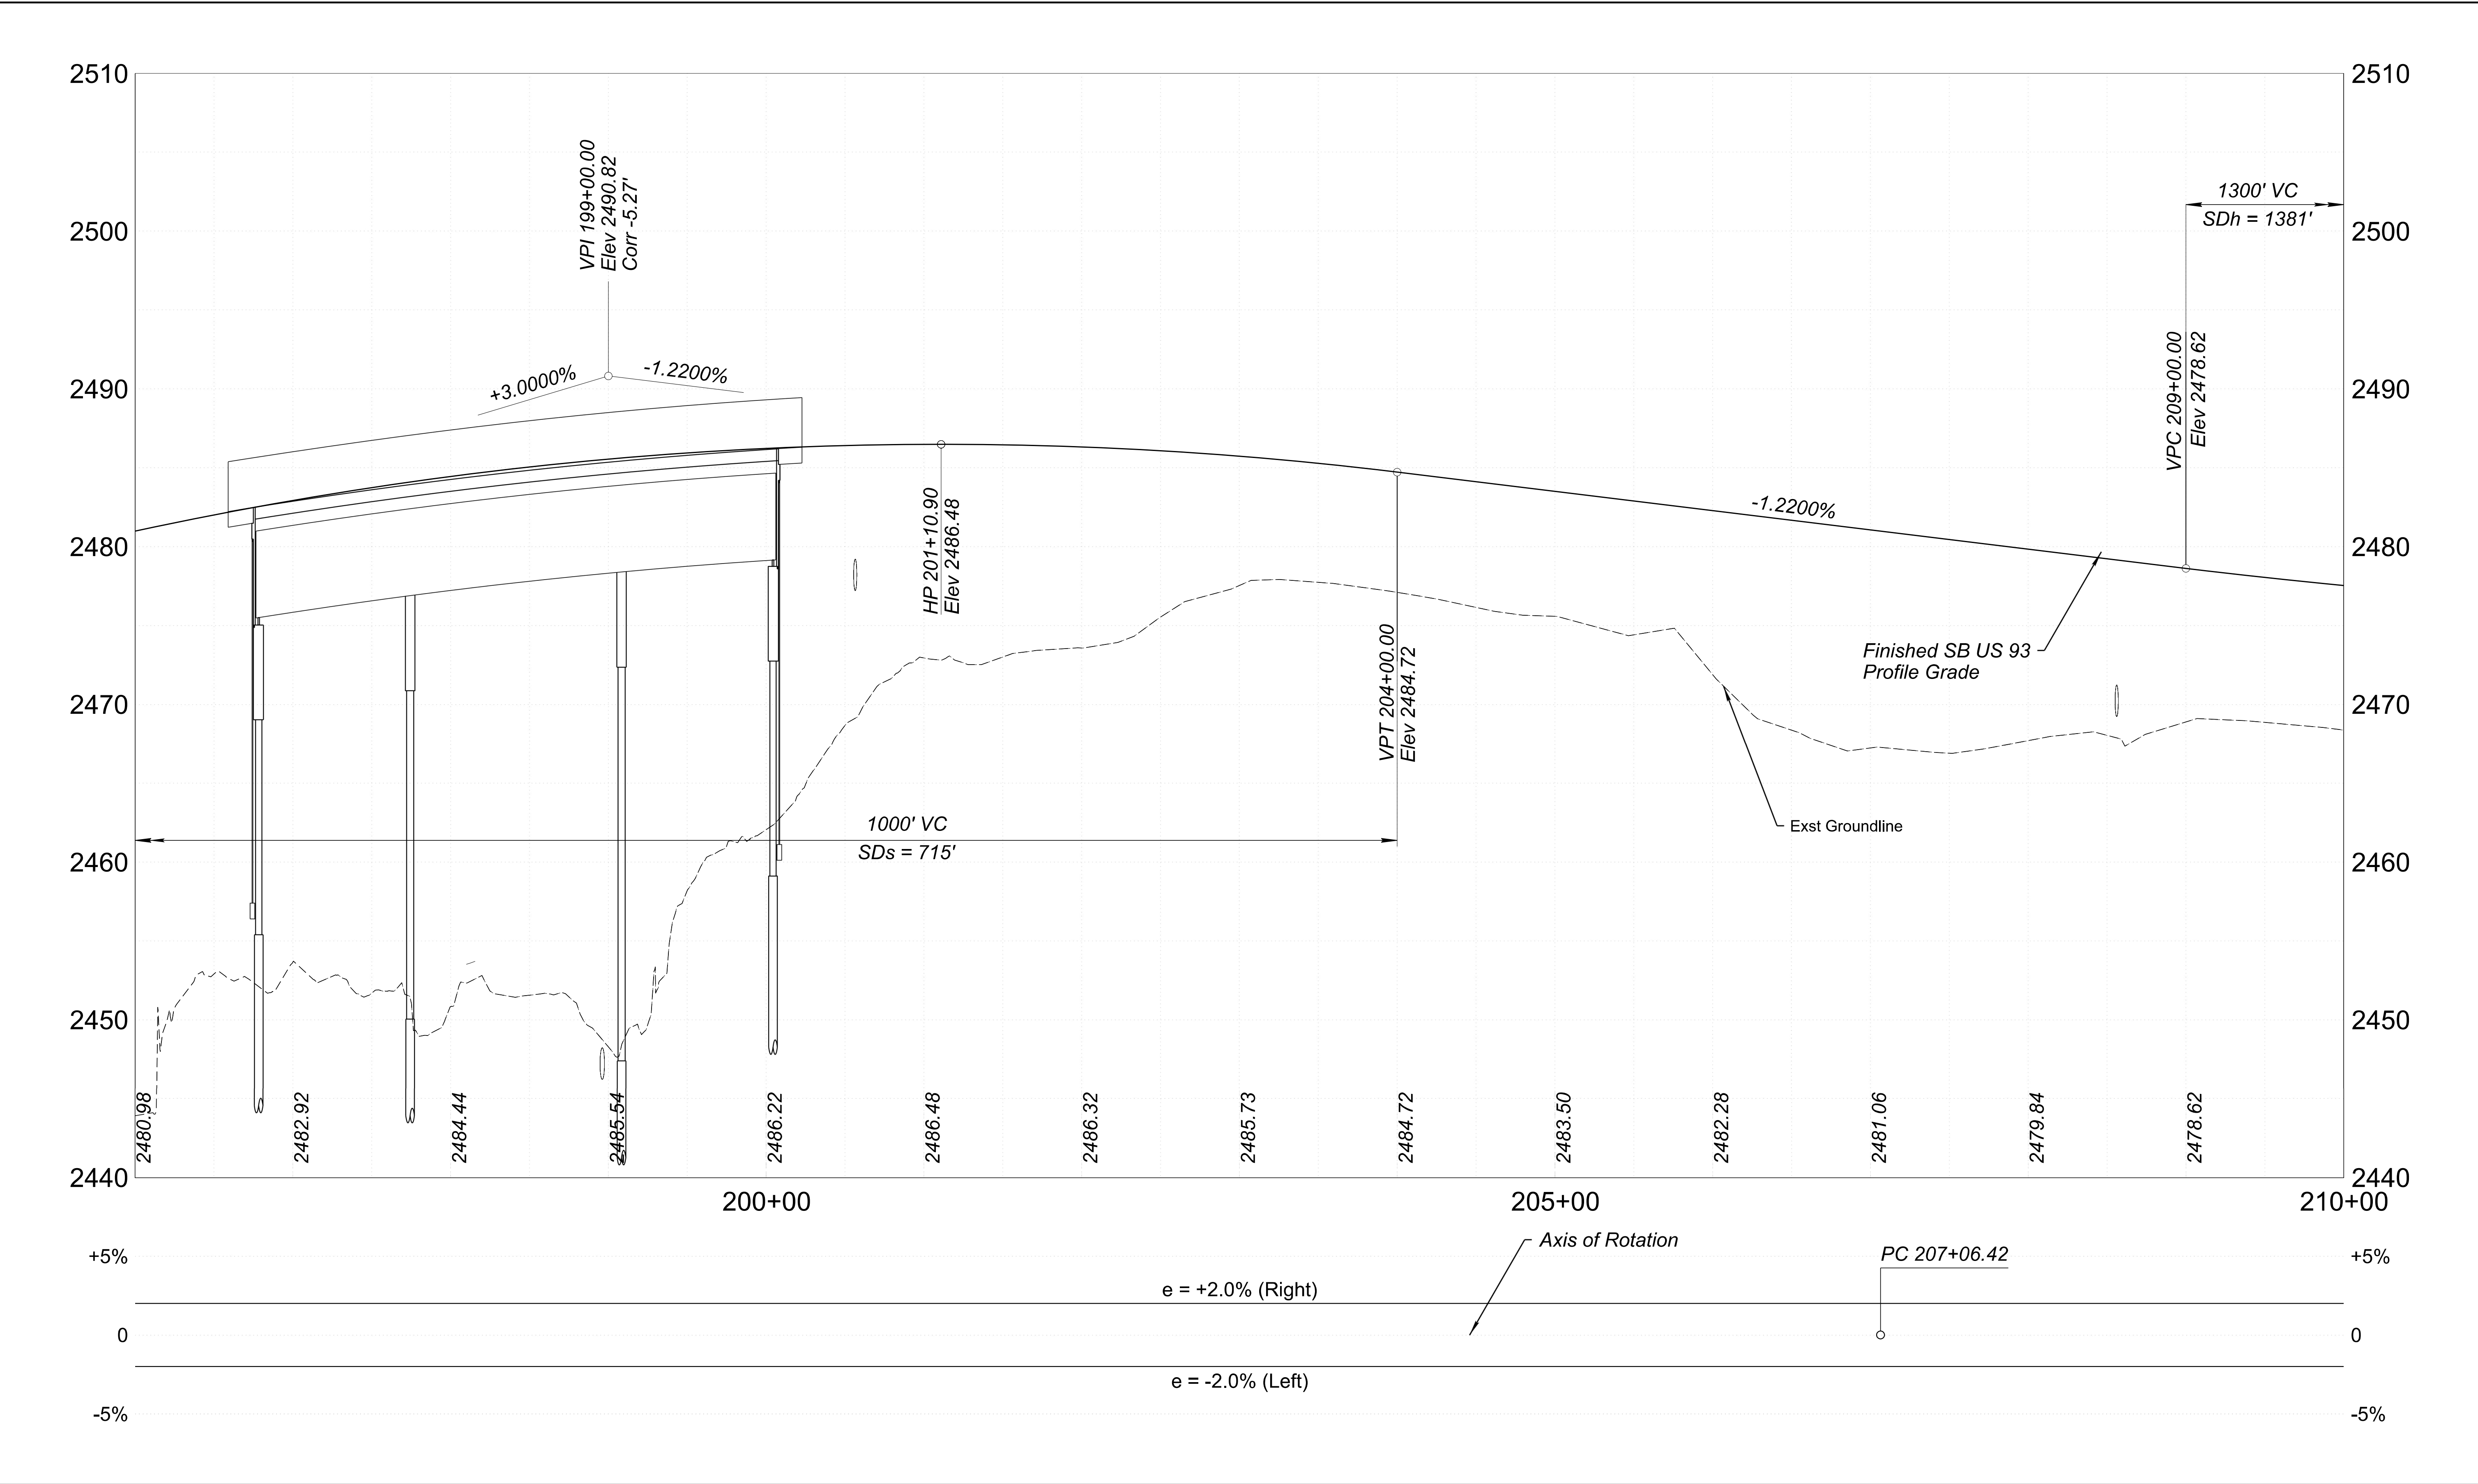

	NAME		DATE	ARIZONA DEPARTMENT OF TRANSPORTATION PROJECT DELIVERY AND OPERATIONS DIVISION ROADWAY DESIGN SERVICES			ROUTE	F.H.W.A. Arizona Division	STATE	PROJECT NO.	FEDERAL ID NO.	SHEET NO.	TOTAL SHEETS	RECORD DRAWING
	DESIGN	J GILLIS	06/26				US 93		ARIZ.	093 YV 189	093-B(230)T	161	524	
	DRAWN	M SAMUELSON	06/26				MILEPOST		WICKENBURG RANCH WAY TO VISTA ROYALE					DWG No. C-3.14
	CHECKED	J BEMELEN	06/26	TRANSPORTATION AECOM TECHNICAL SERVICES, Inc. 7720 N. 16th St., Suite 100 Phoenix, Arizona 85020 T 602.371.1100		AECOM www.aecom.com			TRACS NO. F0738 01C		____ OF ____			

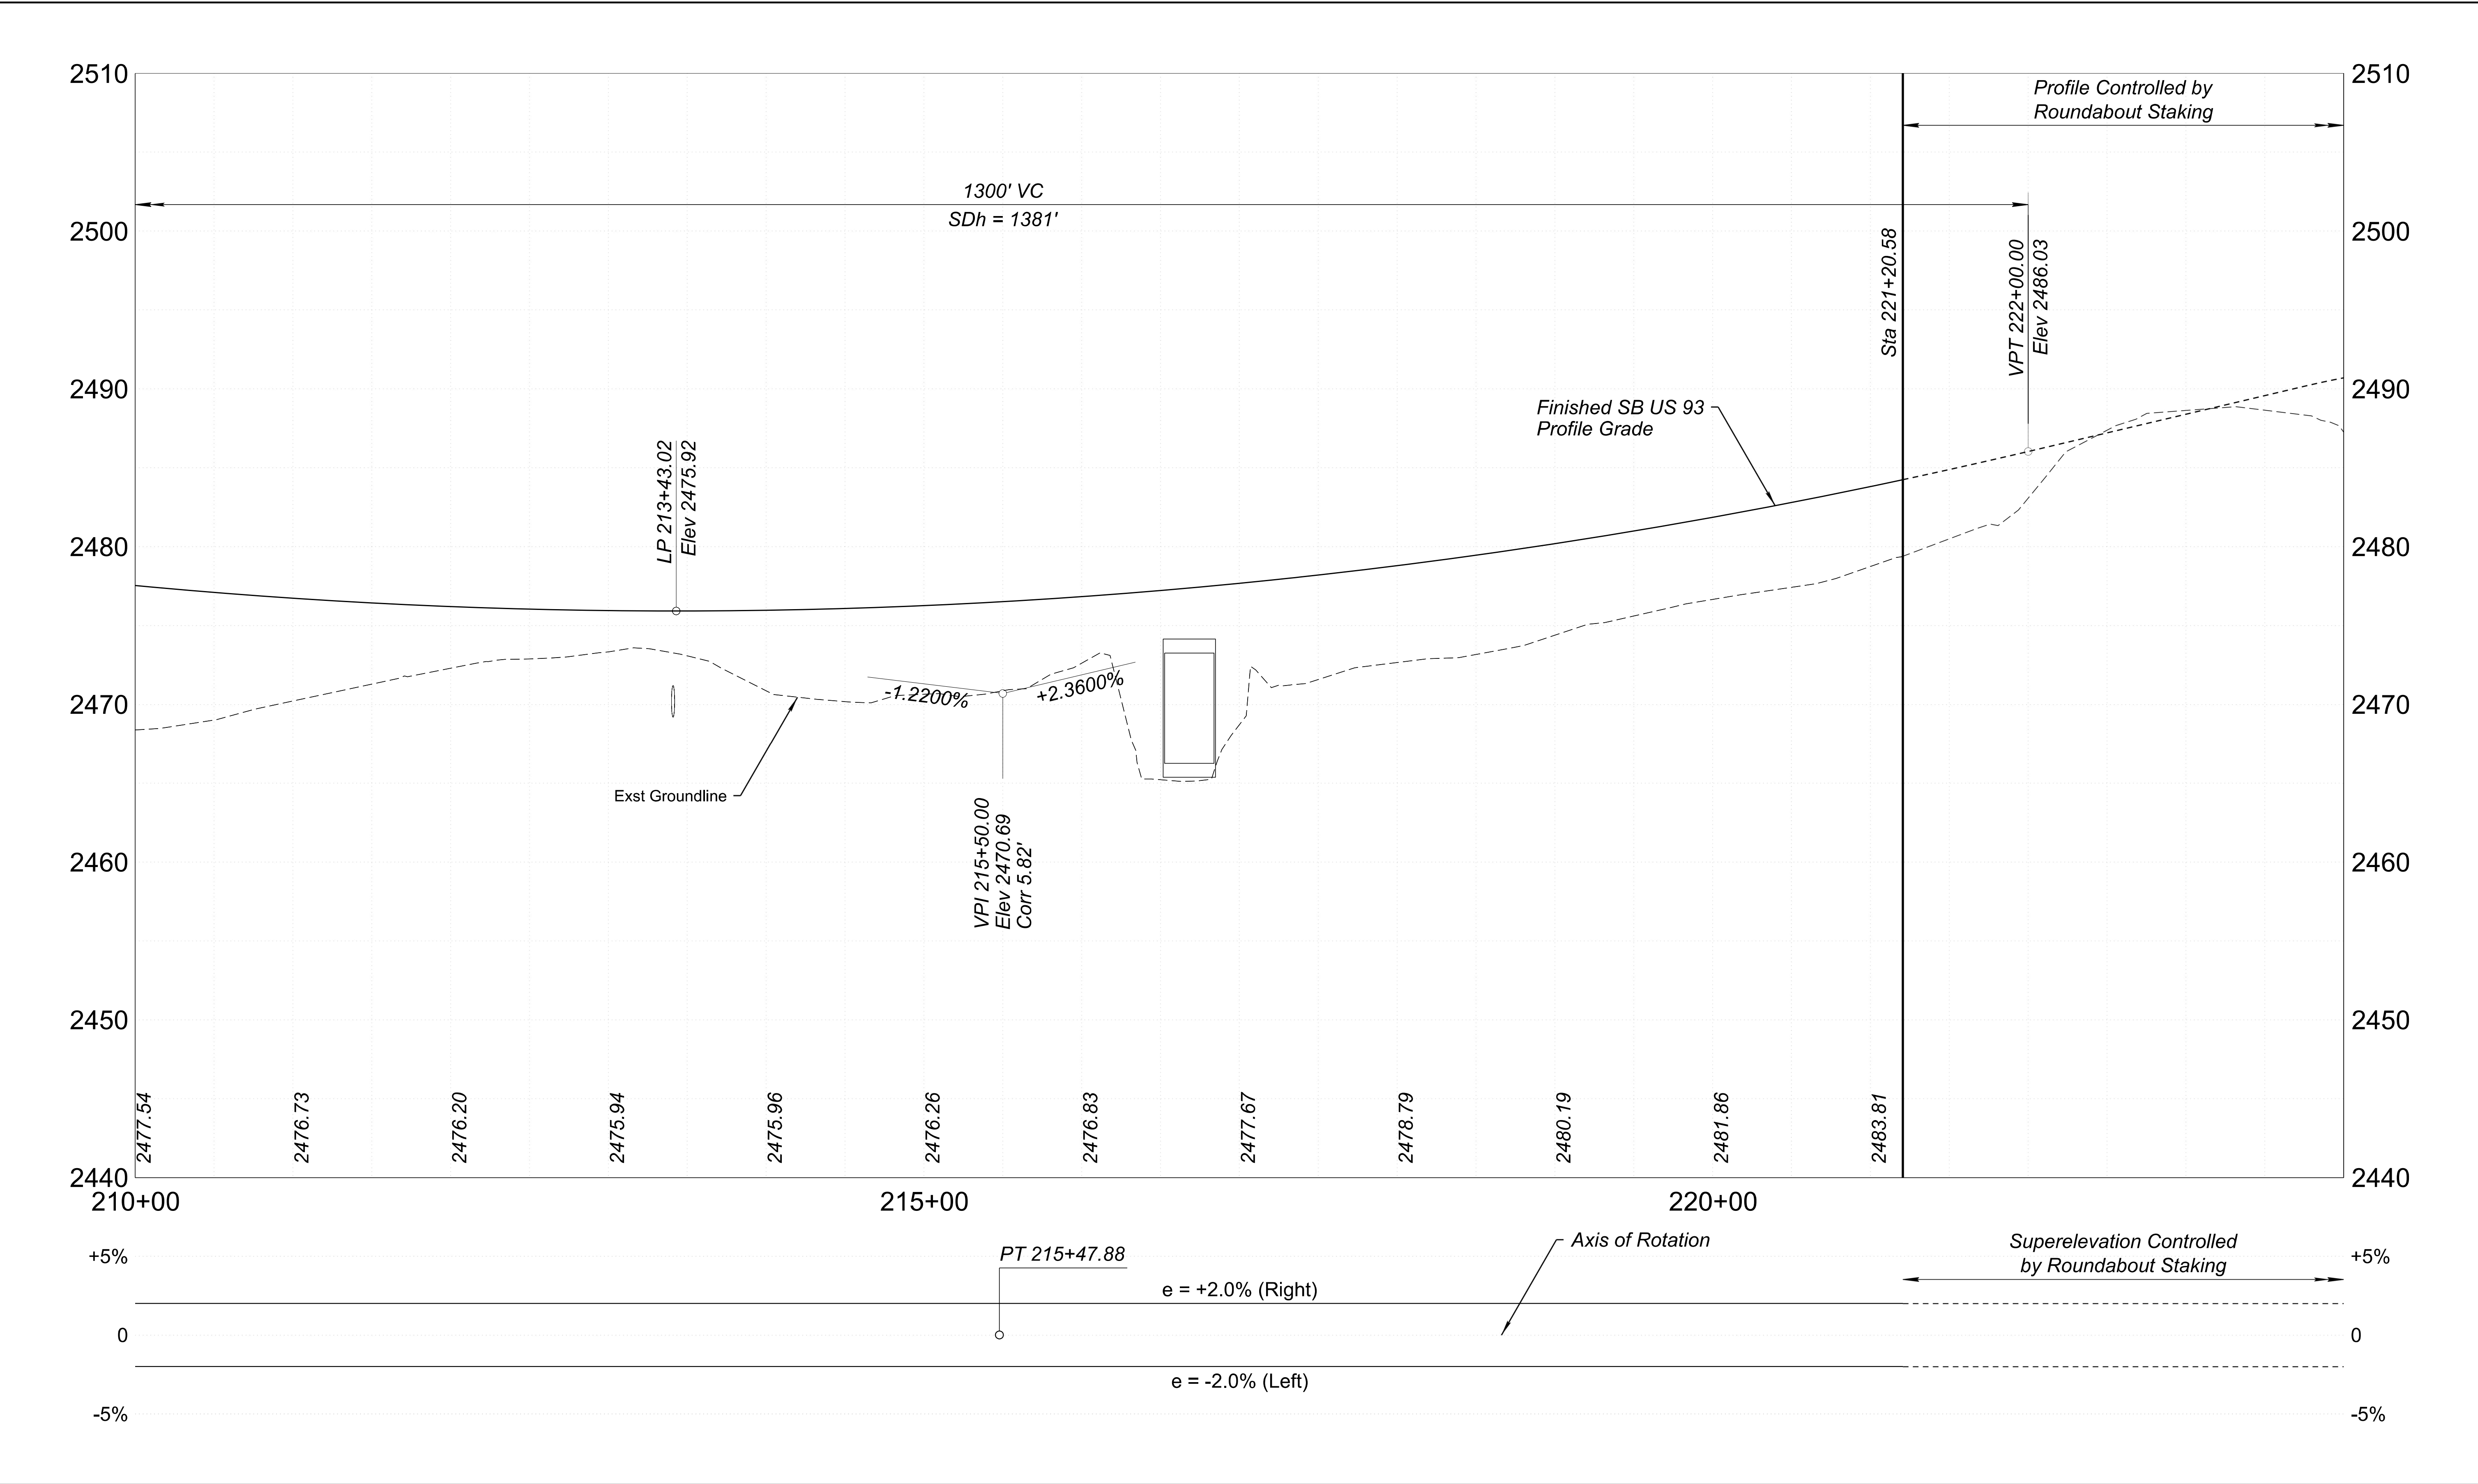

	NAME		DATE	ARIZONA DEPARTMENT OF TRANSPORTATION PROJECT DELIVERY AND OPERATIONS DIVISION ROADWAY DESIGN SERVICES		ROUTE	F.H.W.A. Arizona Division	STATE	PROJECT NO.	FEDERAL ID NO.	SHEET NO.	TOTAL SHEETS	RECORD DRAWING
	DESIGN	J GILLIS	06/26			US 93		ARIZ.	093 YV 189	093-B(230)T	163	524	
	DRAWN	M SAMUELSON	06/26			MILEPOST 189.9	WICKENBURG RANCH WAY TO VISTA ROYALE						
	CHECKED	J BEMELEN	06/26	TRANSPORTATION AECOM TECHNICAL SERVICES, Inc. 7720 N. 16th St., Suite 100 Phoenix, Arizona 85020 T 602.371.1100		STRUCTURE NO.	TRACS NO. F0738 01C		DWG No. C-3.16 ____ OF ____				

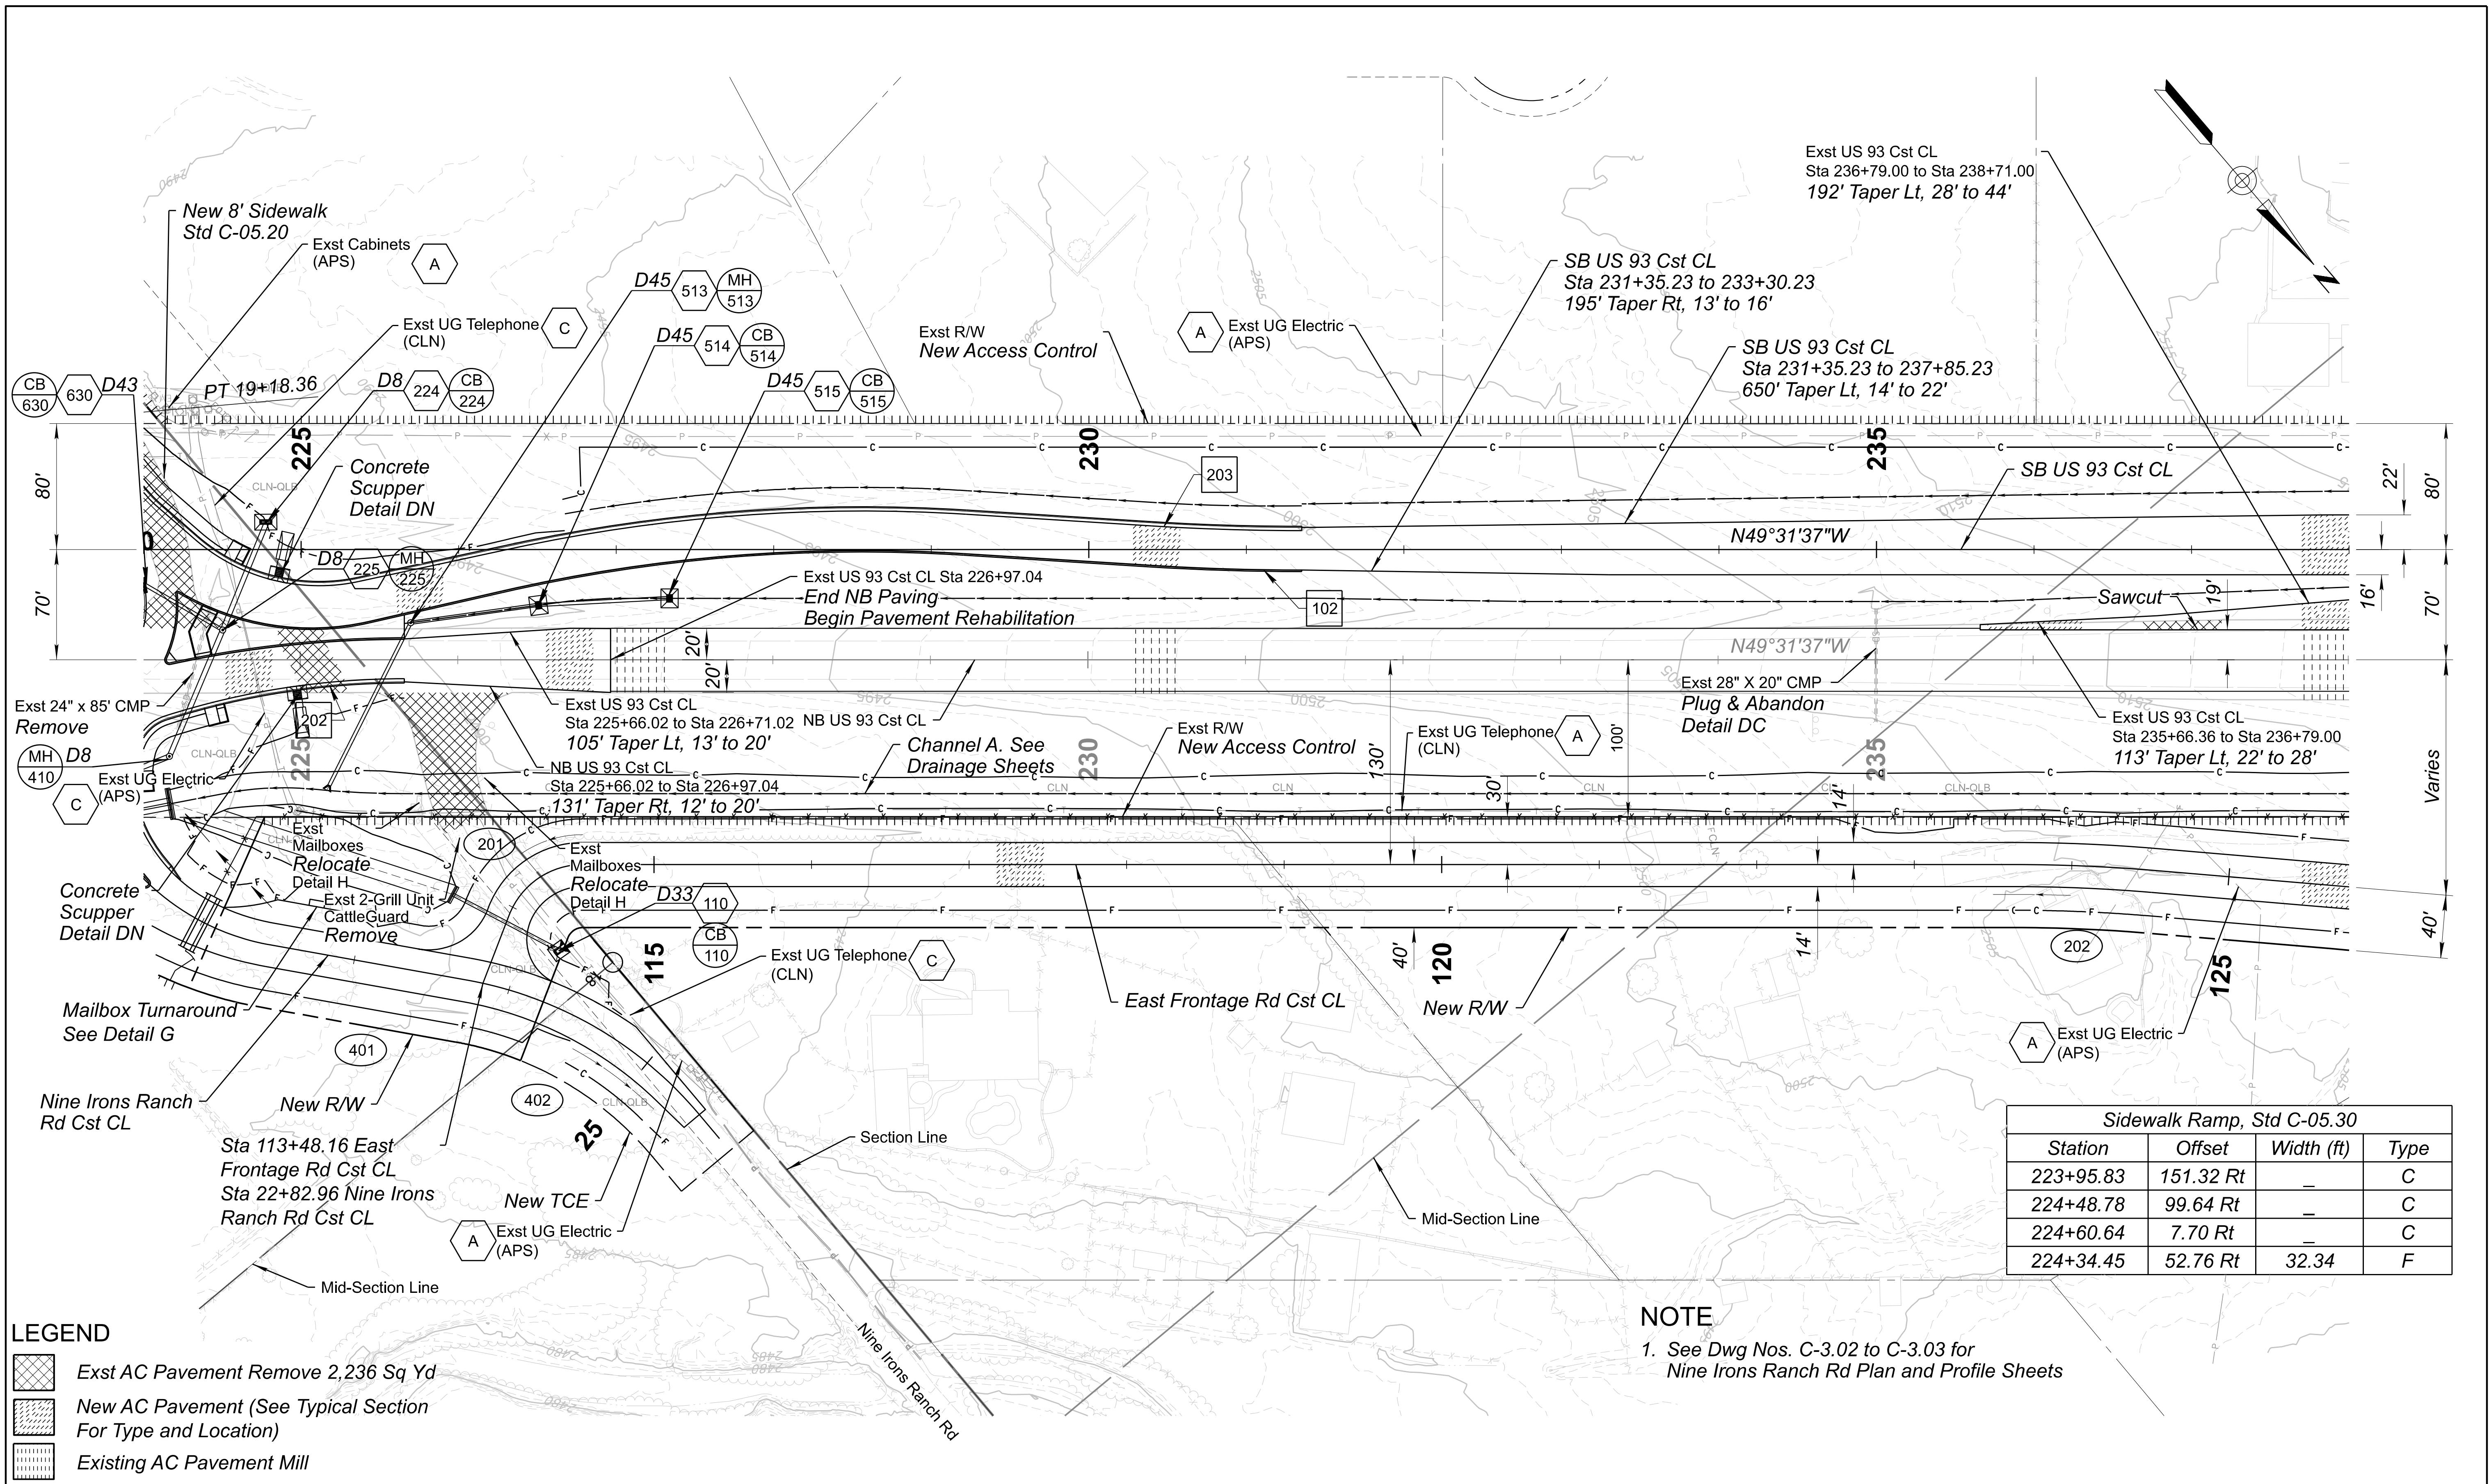

LEGEND


Exst AC Pavement Remove 2,236 Sq Yd

New AC Pavement (See Typical Section For Type and Location)

Existing AC Pavement Mill

UTILITY DISPOSITION SHEETS LEGEND	
	To Remain in Service - Protect-In-Place
	Contractor to Relocate, Remove, or Reset
	To Be Relocated or Removed by Others
	To Be Constructed By Others

c:\pwworking\usaz\dms08894\0738_p04.dgn
6/23/2026 @5:23:28 PM jason.heredia

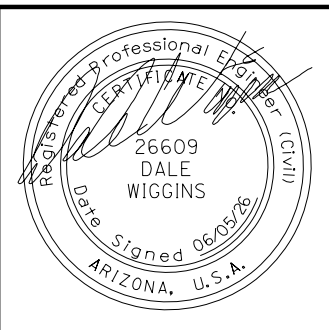


	NAME	DATE
DESIGN	J GILLIS	06/26
DRAWN	M SAMUELSON	06/26
CHECKED	D WIGGINS	06/26

TRANSPORTATION
AECOM TECHNICAL SERVICES, Inc.
7720 N. 16th St., Suite 100
Phoenix, Arizona 85020
T 602.371.1100



AECOM
www.aecom.com

ARIZONA DEPARTMENT OF TRANSPORTATION
PROJECT DELIVERY AND OPERATIONS DIVISION
ROADWAY DESIGN SERVICES
PLAN SHEET
SB US 93 STA 224+00 TO STA 238+00
E FRONTAGE RD STA 112+00 TO STA 126+00


ROUTE US 93	F.H.W.A. Arizona Division	STATE ARIZ.	PROJECT NO. 093 YV 189	FEDERAL ID NO. 093-B(230)T	SHEET NO. 164	TOTAL SHEETS 524	RECORD DRAWING
MILEPOST 189.9	LOCATION WICKENBURG RANCH WAY TO VISTA ROYALE					DWG No. C-3.17	
STRUCTURE NO.	TRACS NO. F0738 01C					OF	

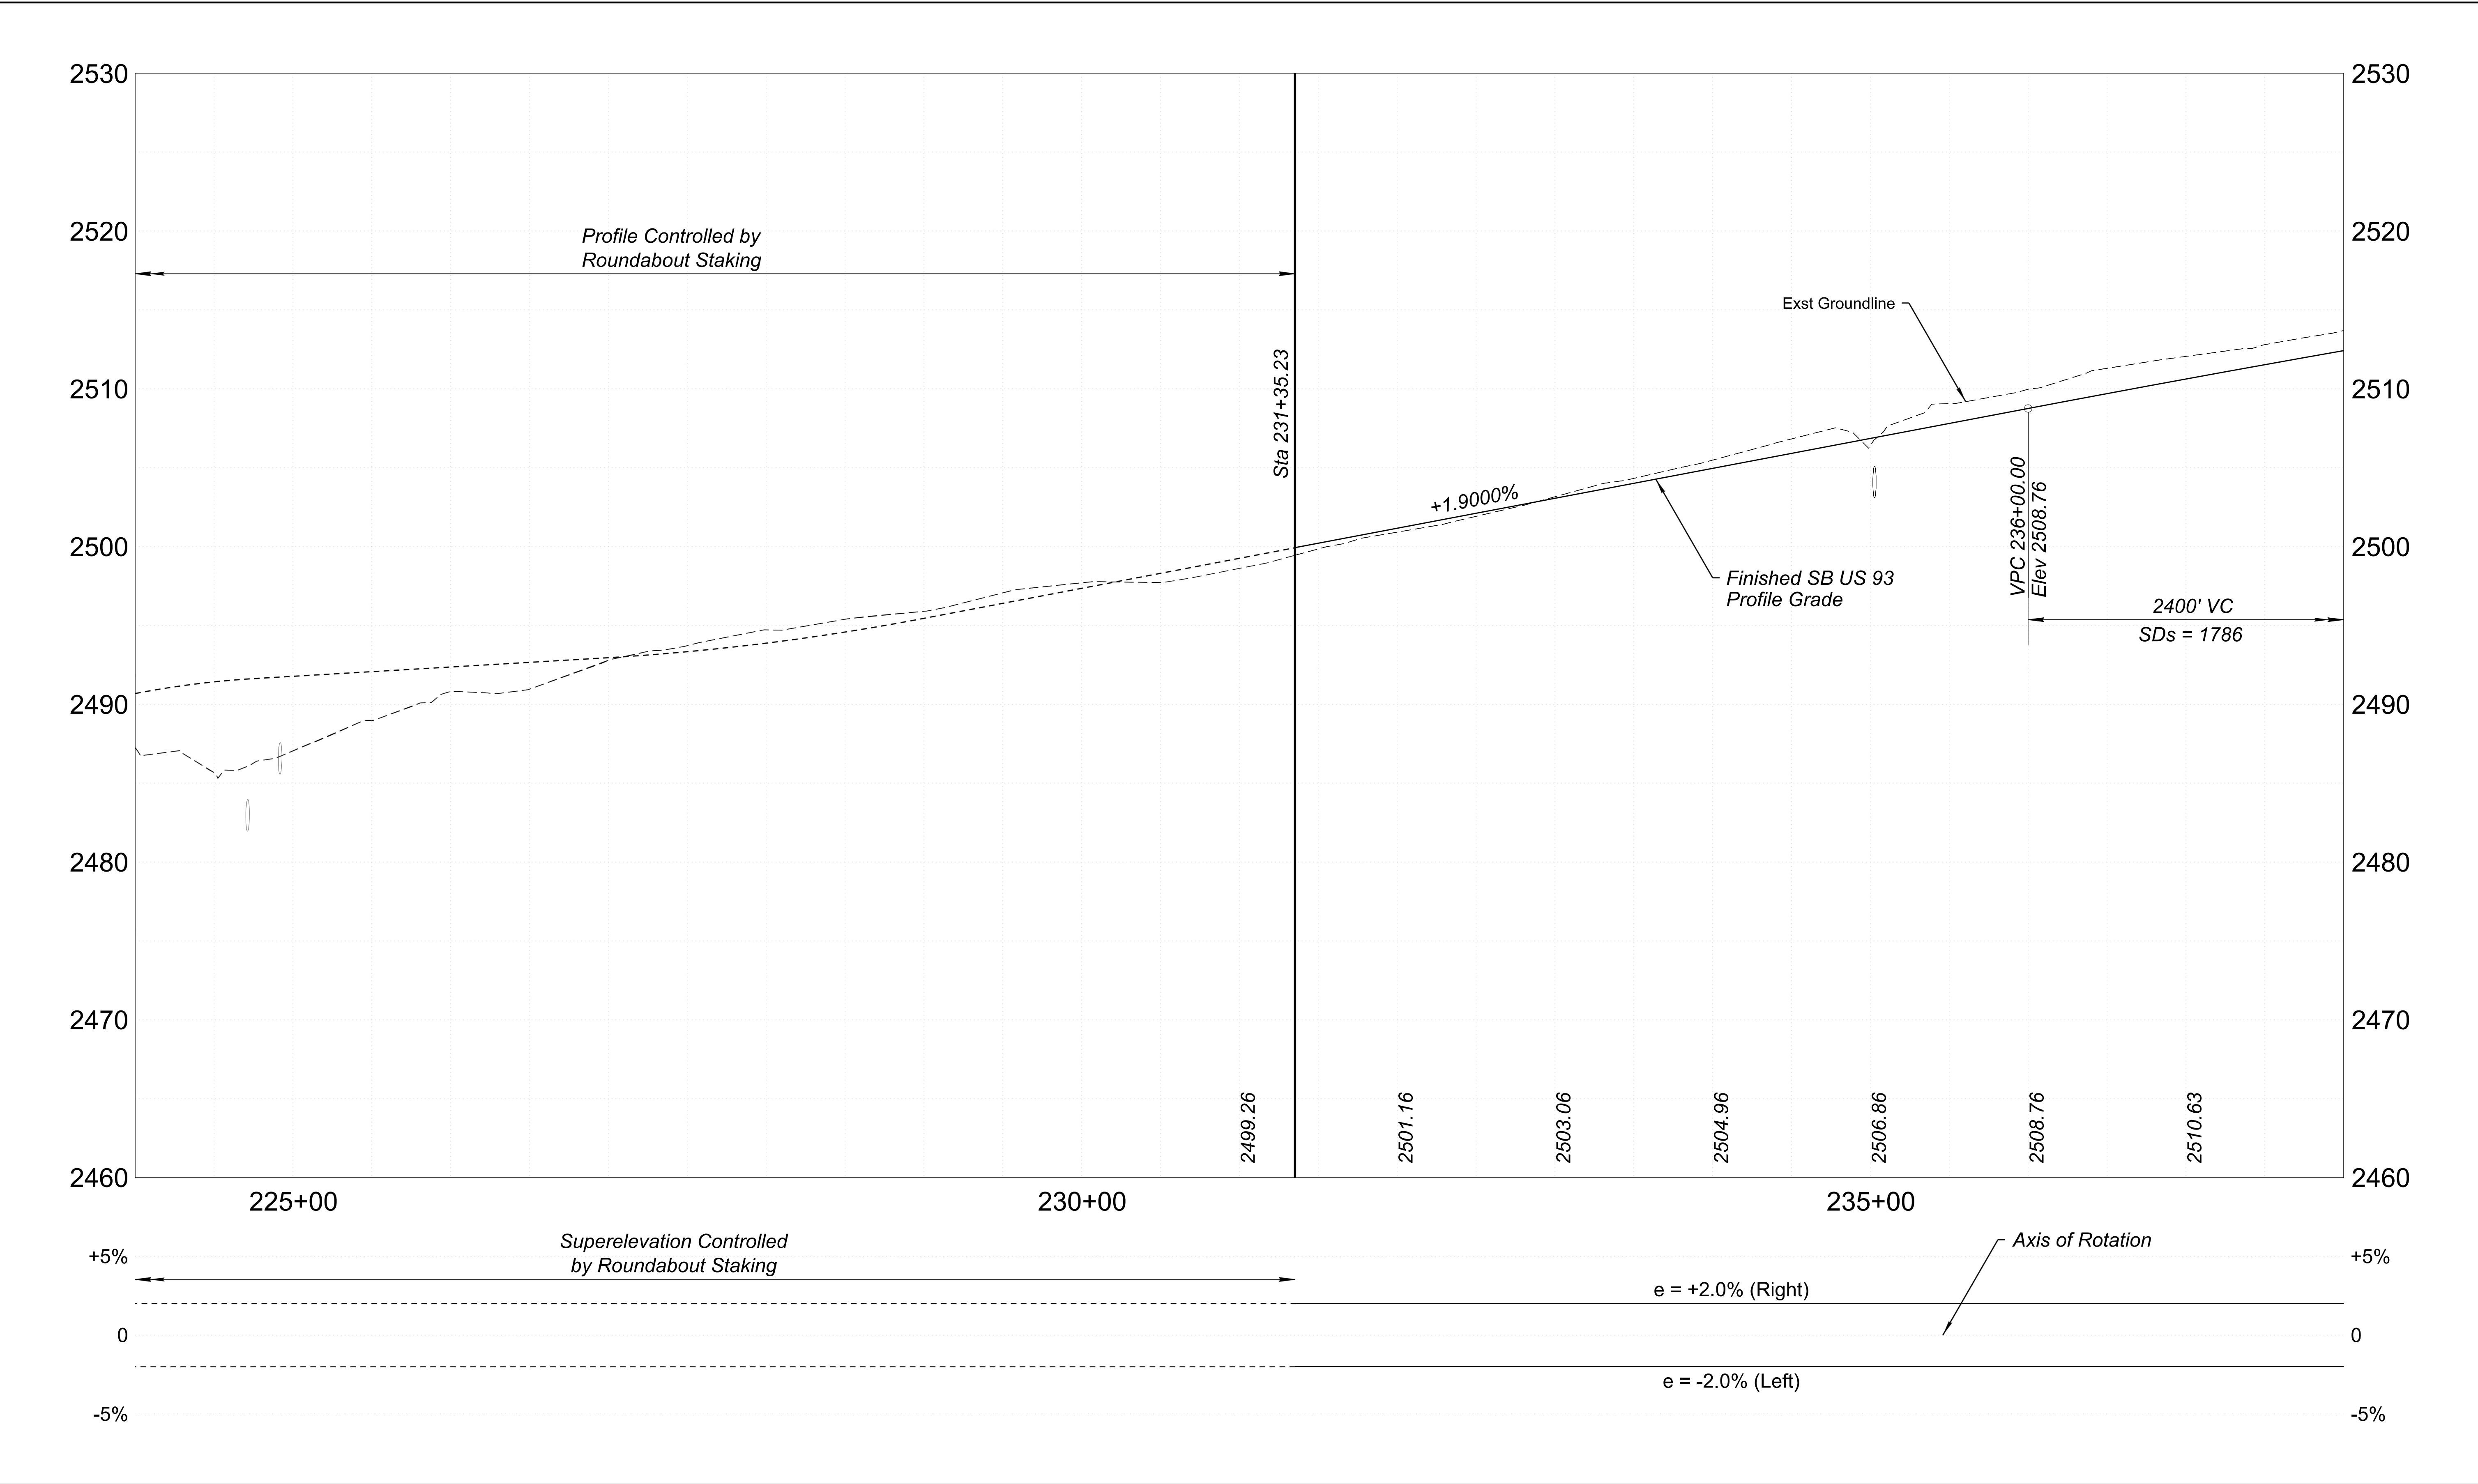

	NAME		DATE	ARIZONA DEPARTMENT OF TRANSPORTATION PROJECT DELIVERY AND OPERATIONS DIVISION ROADWAY DESIGN SERVICES		ROUTE	F.H.W.A. Arizona Division	STATE	PROJECT NO.	FEDERAL ID NO.	SHEET NO.	TOTAL SHEETS	RECORD DRAWING
	DESIGN	J GILLIS	06/26			US 93		ARIZ.	093 YV 189	093-B(230)T	165	524	
	DRAWN	M SAMUELSON	06/26			MILEPOST	189.9	LOCATION WICKENBURG RANCH WAY TO VISTA ROYALE					DWG No. C-3.18
	CHECKED	J BEMELEN	06/26	TRANSPORTATION AECOM TECHNICAL SERVICES, Inc. 7720 N. 16th St., Suite 100 Phoenix, Arizona 85020 T 602.371.1100  www.aecom.com		STRUCTURE NO.	TRACS NO. F0738 01C					OF	

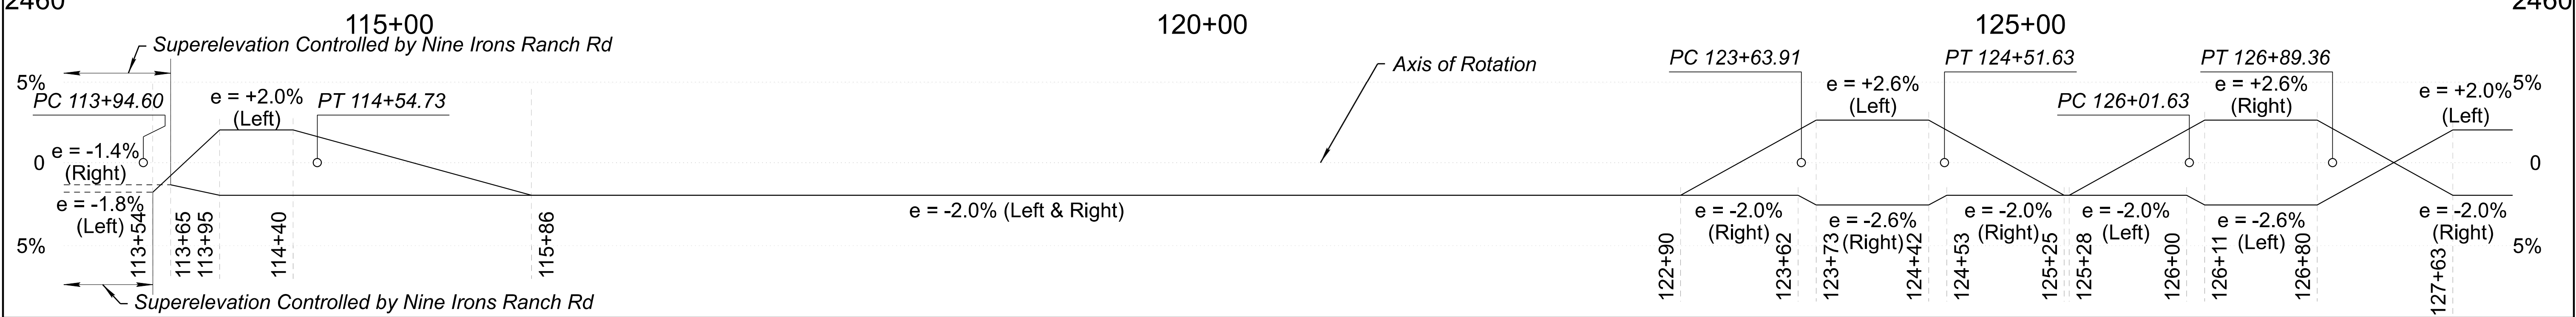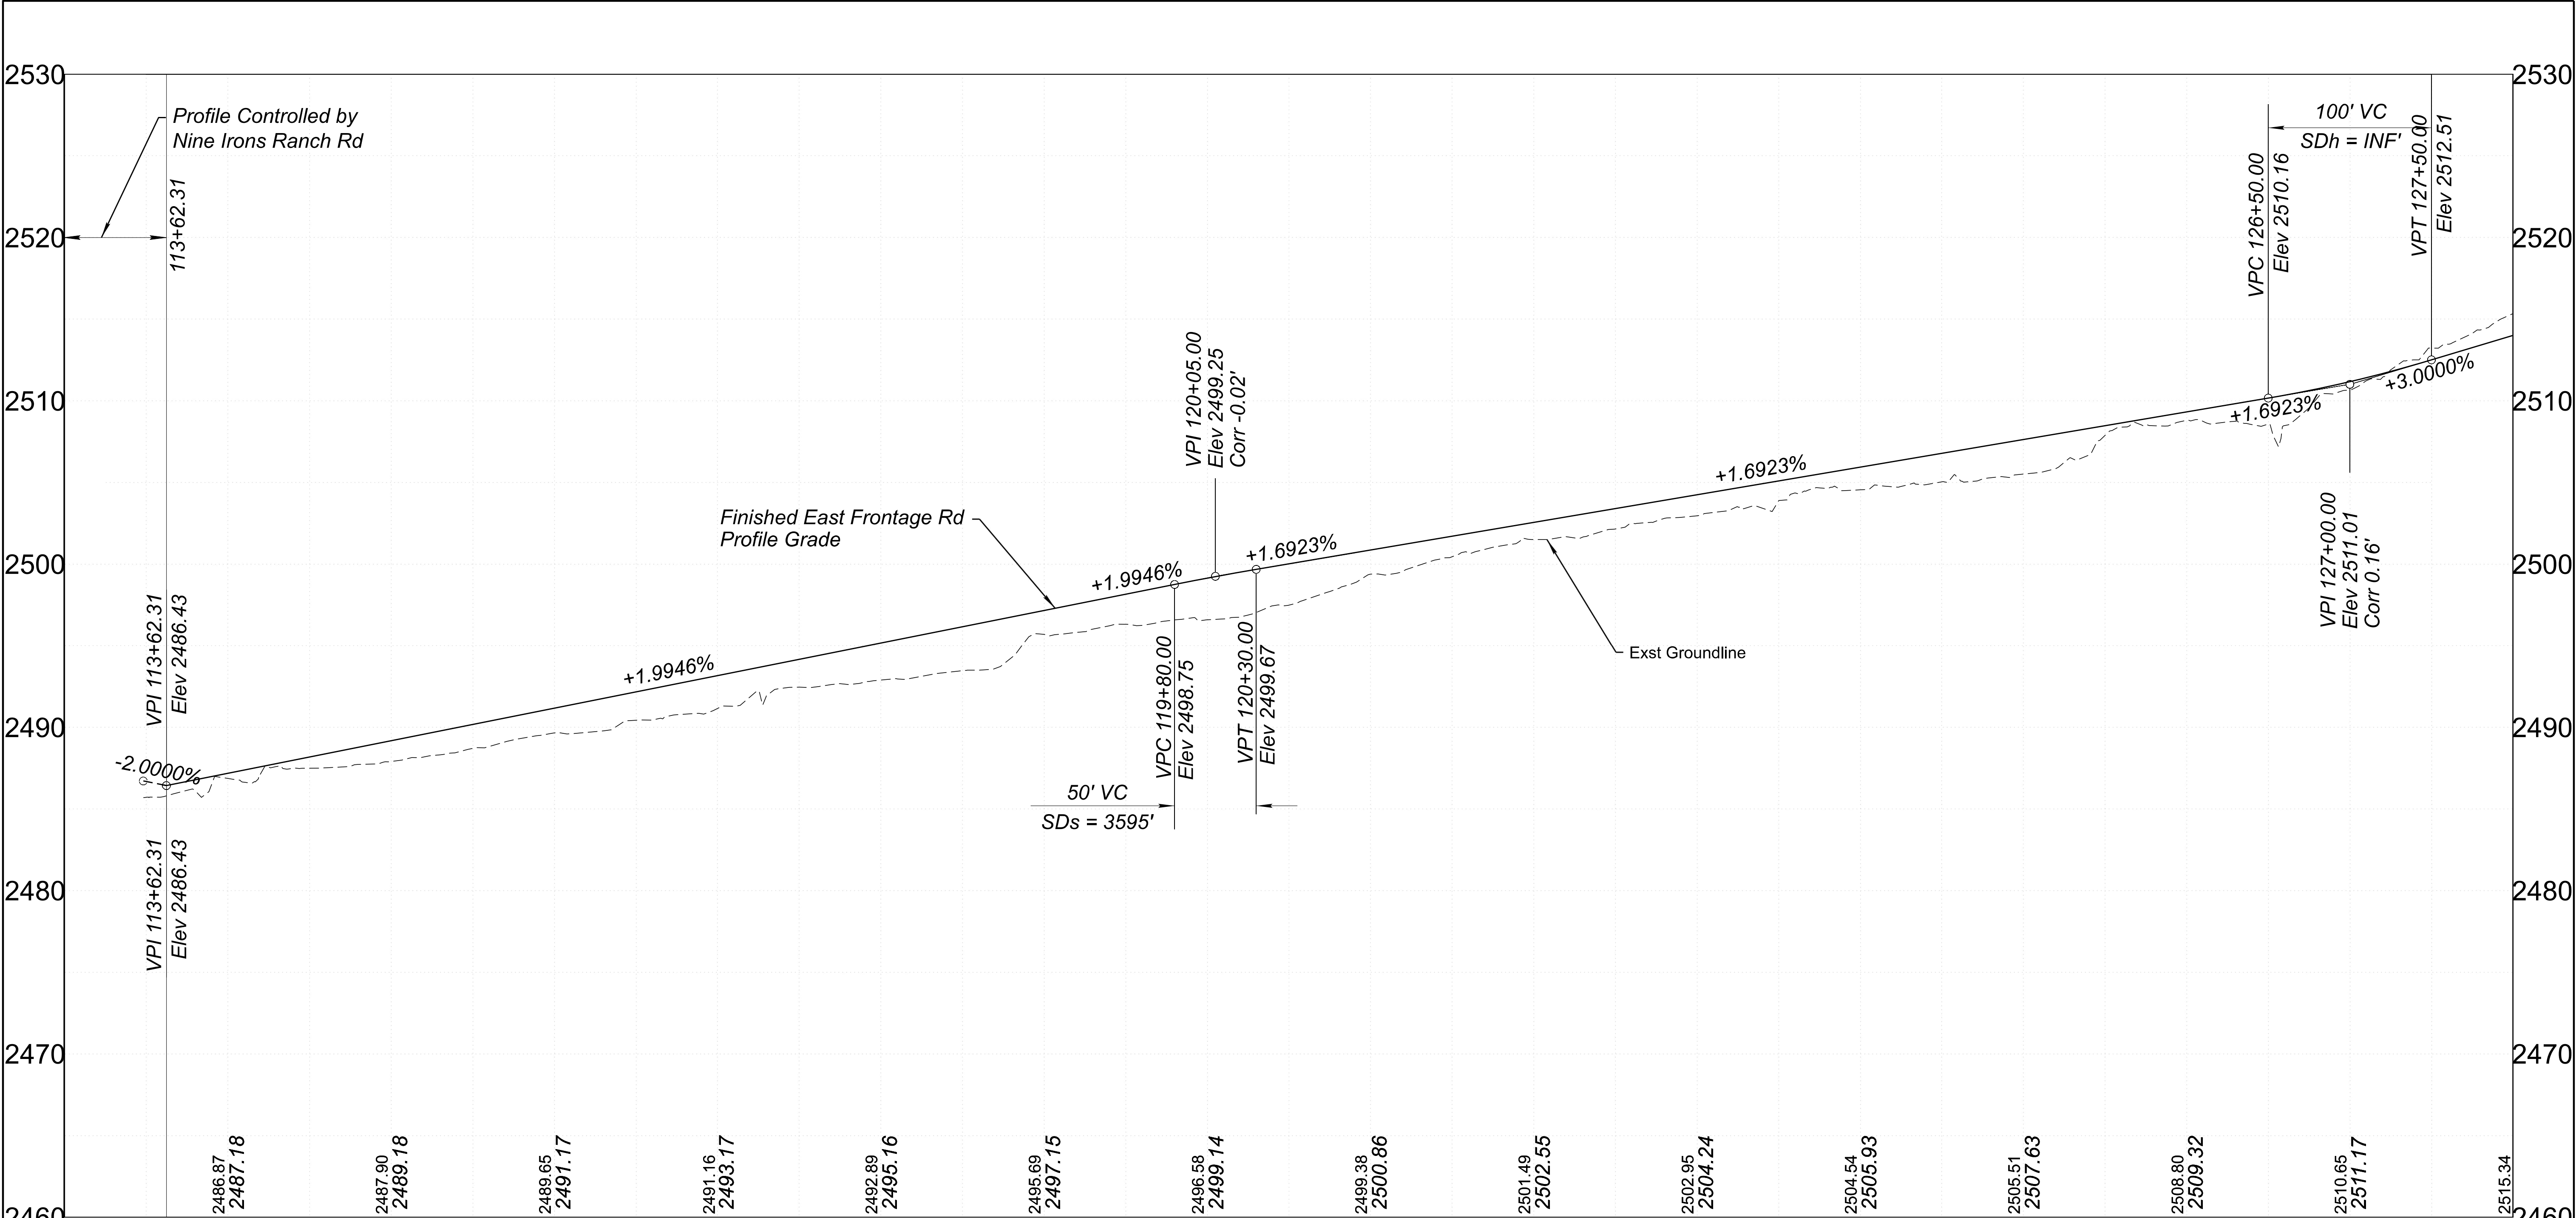

	NAME		DATE	ARIZONA DEPARTMENT OF TRANSPORTATION PROJECT DELIVERY AND OPERATIONS DIVISION ROADWAY DESIGN SERVICES	ROUTE	F.H.W.A. Arizona Division	STATE ARIZ.	PROJECT NO.	FEDERAL ID NO.	SHEET NO.	TOTAL SHEETS	RECORD DRAWING
	DESIGN J GILLIS		06/26		US 93			093 YV 189	093-B(230)T	166	524	
	DRAWN M SAMUELSON		06/26		MILEPOST 189.9	LOCATION WICKENBURG RANCH WAY TO VISTA ROYALE						
	CHECKED J BEMELEN		06/26	STRUCTURE NO.	TRACS NO. F0738 01C		OF					
TRANSPORTATION AECOM TECHNICAL SERVICES, Inc. 7720 N. 16th St., Suite 100 Phoenix, Arizona 85020 T 602.371.1100 www.aecom.com				PROFILE SHEET E FRONTAGE RD STA 112+00 TO STA 127+00								

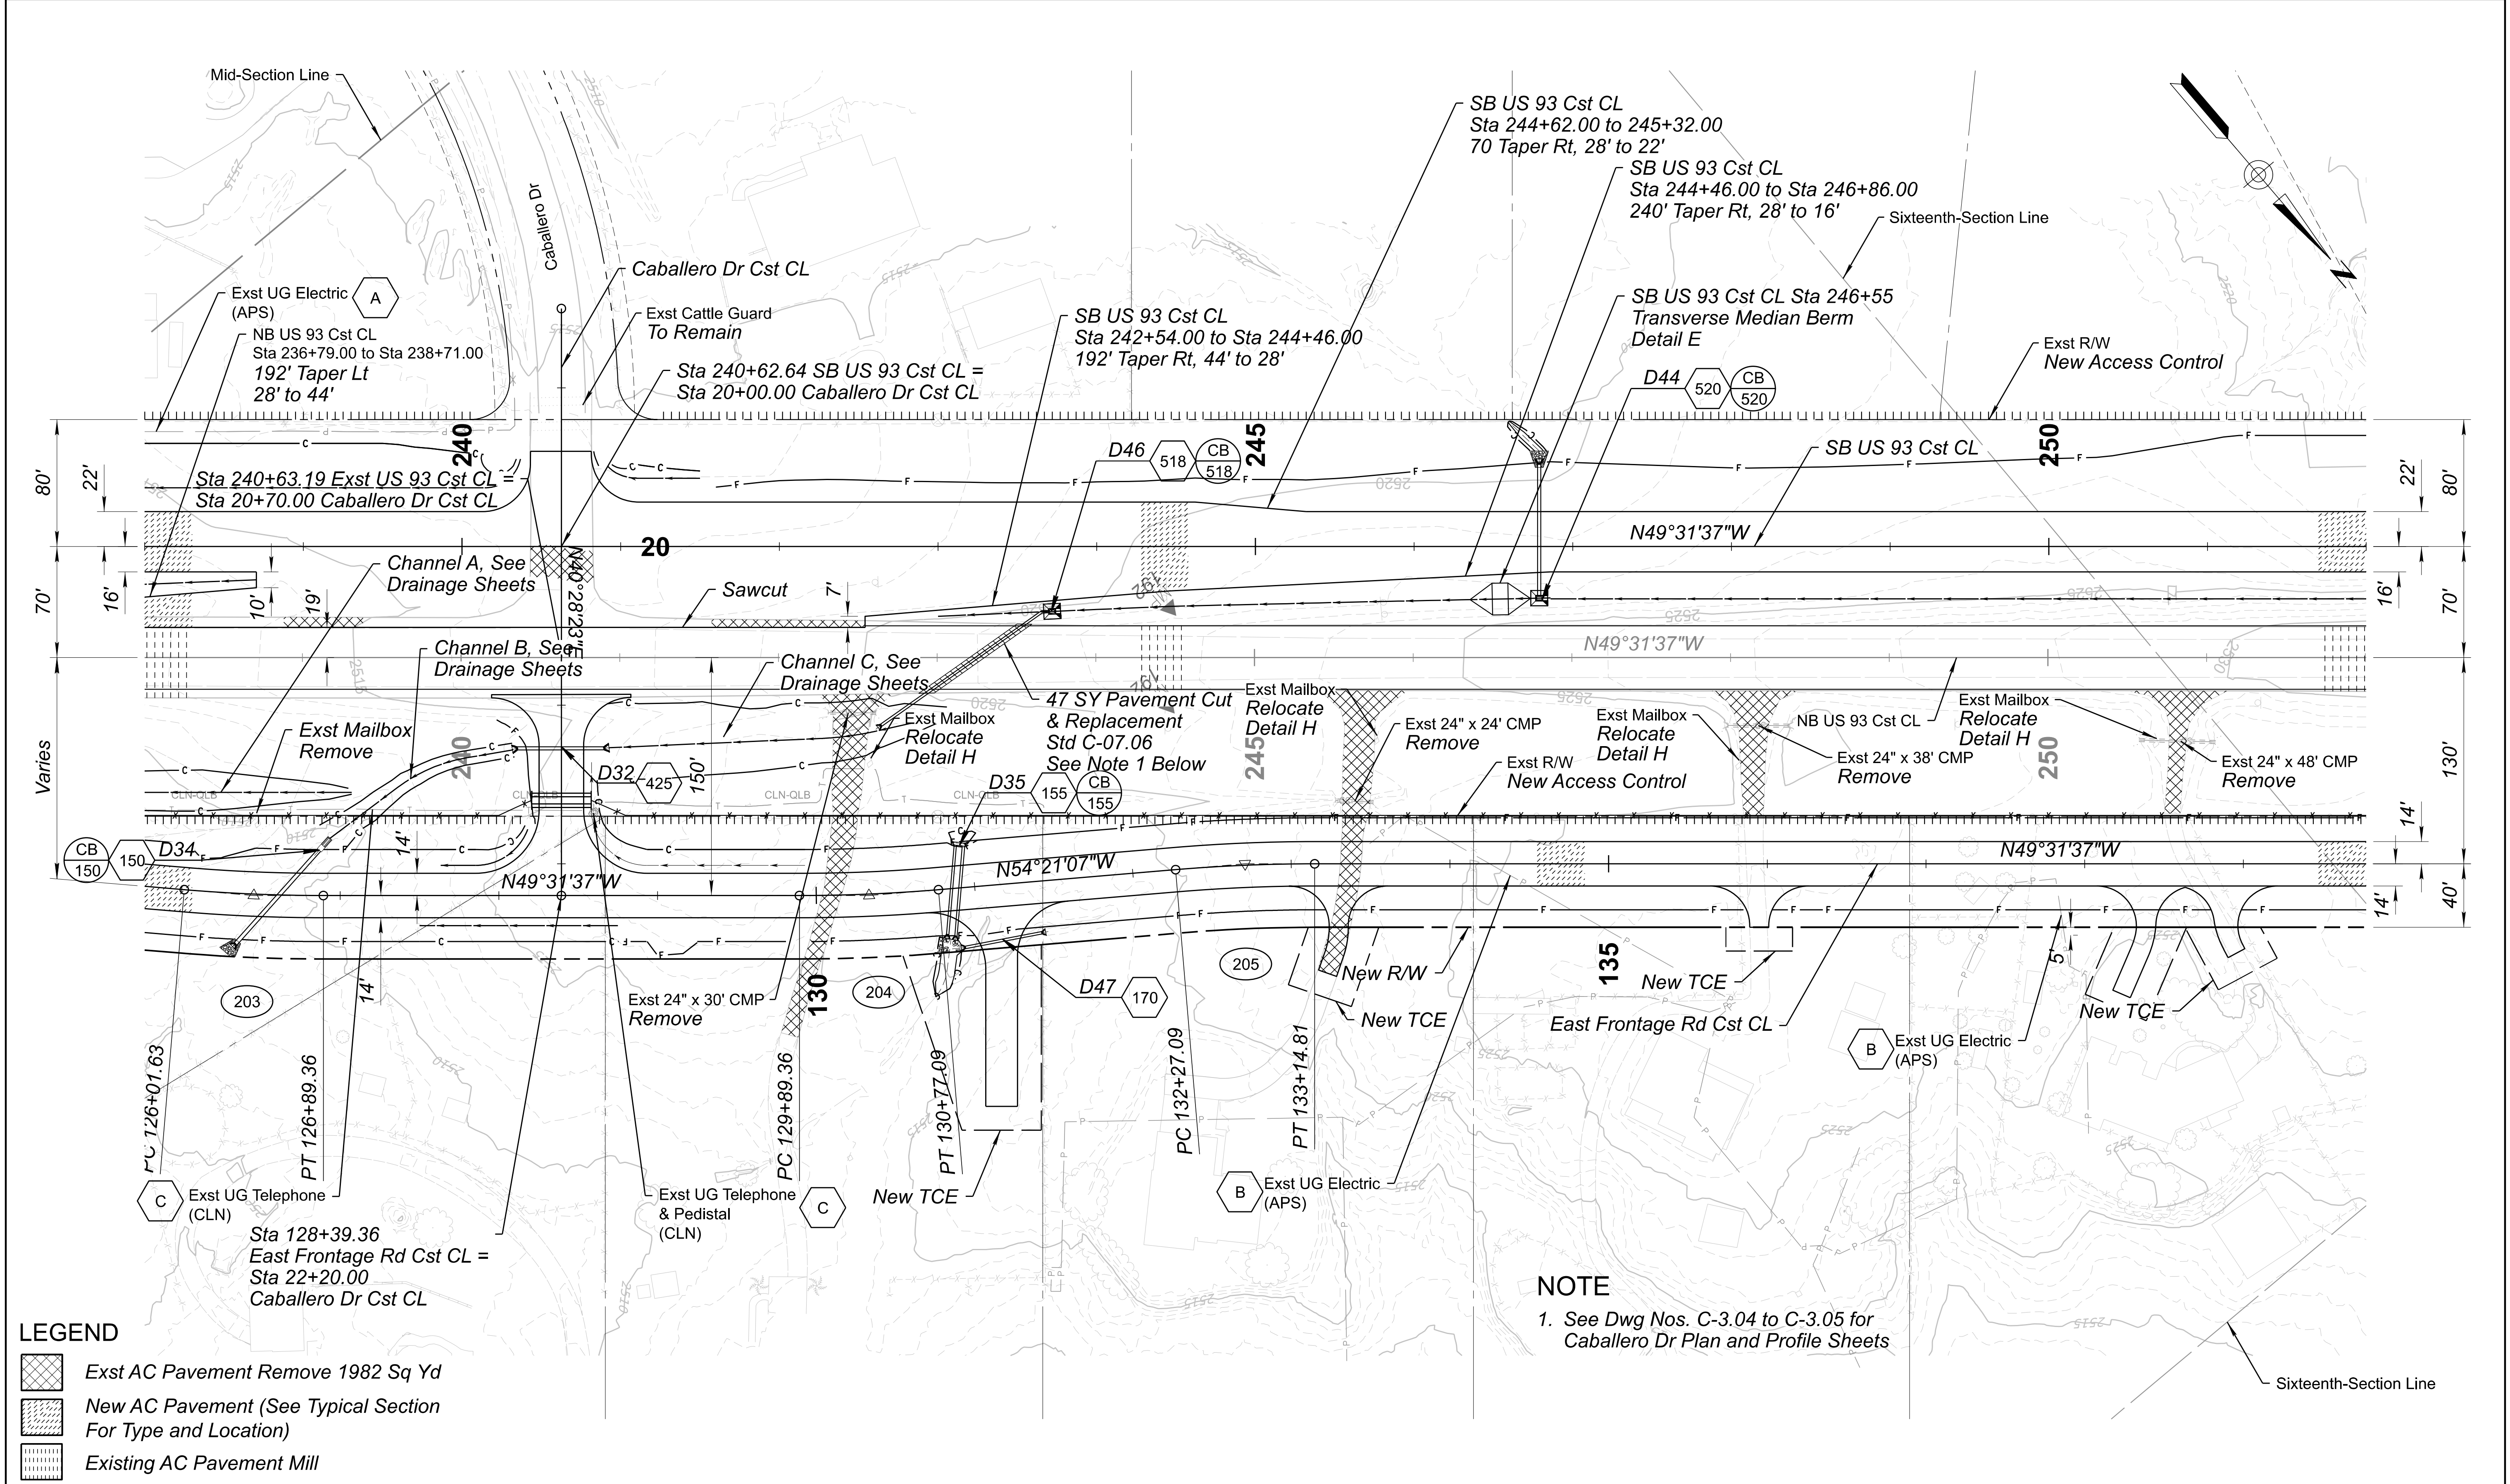

LEGEND

- Exst AC Pavement Remove 1982 Sq Yd
- New AC Pavement (See Typical Section For Type and Location)
- Existing AC Pavement Mill

UTILITY DISPOSITION SHEETS LEGEND

- To Remain in Service - Protect-In-Place
- Contractor to Relocate, Remove, or Reset
- To Be Relocated or Removed by Others
- To Be Constructed By Others

Note:
1. No measurement or payment will be made for the removal and replacement of the pavement, the cost being considered as included in the price of the contract items.

DESIGN	J GILLIS	06/26
DRAWN	M SAMUELSON	06/26
CHECKED	D WIGGINS	06/26


TRANSPORTATION
AECOM TECHNICAL SERVICES, Inc.
7720 N. 16th St., Suite 100
Phoenix, Arizona 85020
T 602.371.1100

AECOM
www.aecom.com


ARIZONA DEPARTMENT OF TRANSPORTATION
PROJECT DELIVERY AND OPERATIONS DIVISION
ROADWAY DESIGN SERVICES
PLAN SHEET
SB US 93 STA 238+00 TO STA 252+00
E FRONTAGE RD STA 126+00 TO STA 140+00


ROUTE	US 93
MILEPOST	189.9
STRUCTURE NO.	

F.H.W.A. Arizona Division	STATE	ARIZ.	PROJECT NO.	093 YV 189	FEDERAL ID NO.	093-B(230)T	SHEET NO.	167	TOTAL SHEETS	524	RECORD DRAWING
LOCATION											WICKENBURG RANCH WAY TO VISTA ROYALE
TRACS NO.											F0738 01C
DWG No.											C-3.20
											OF

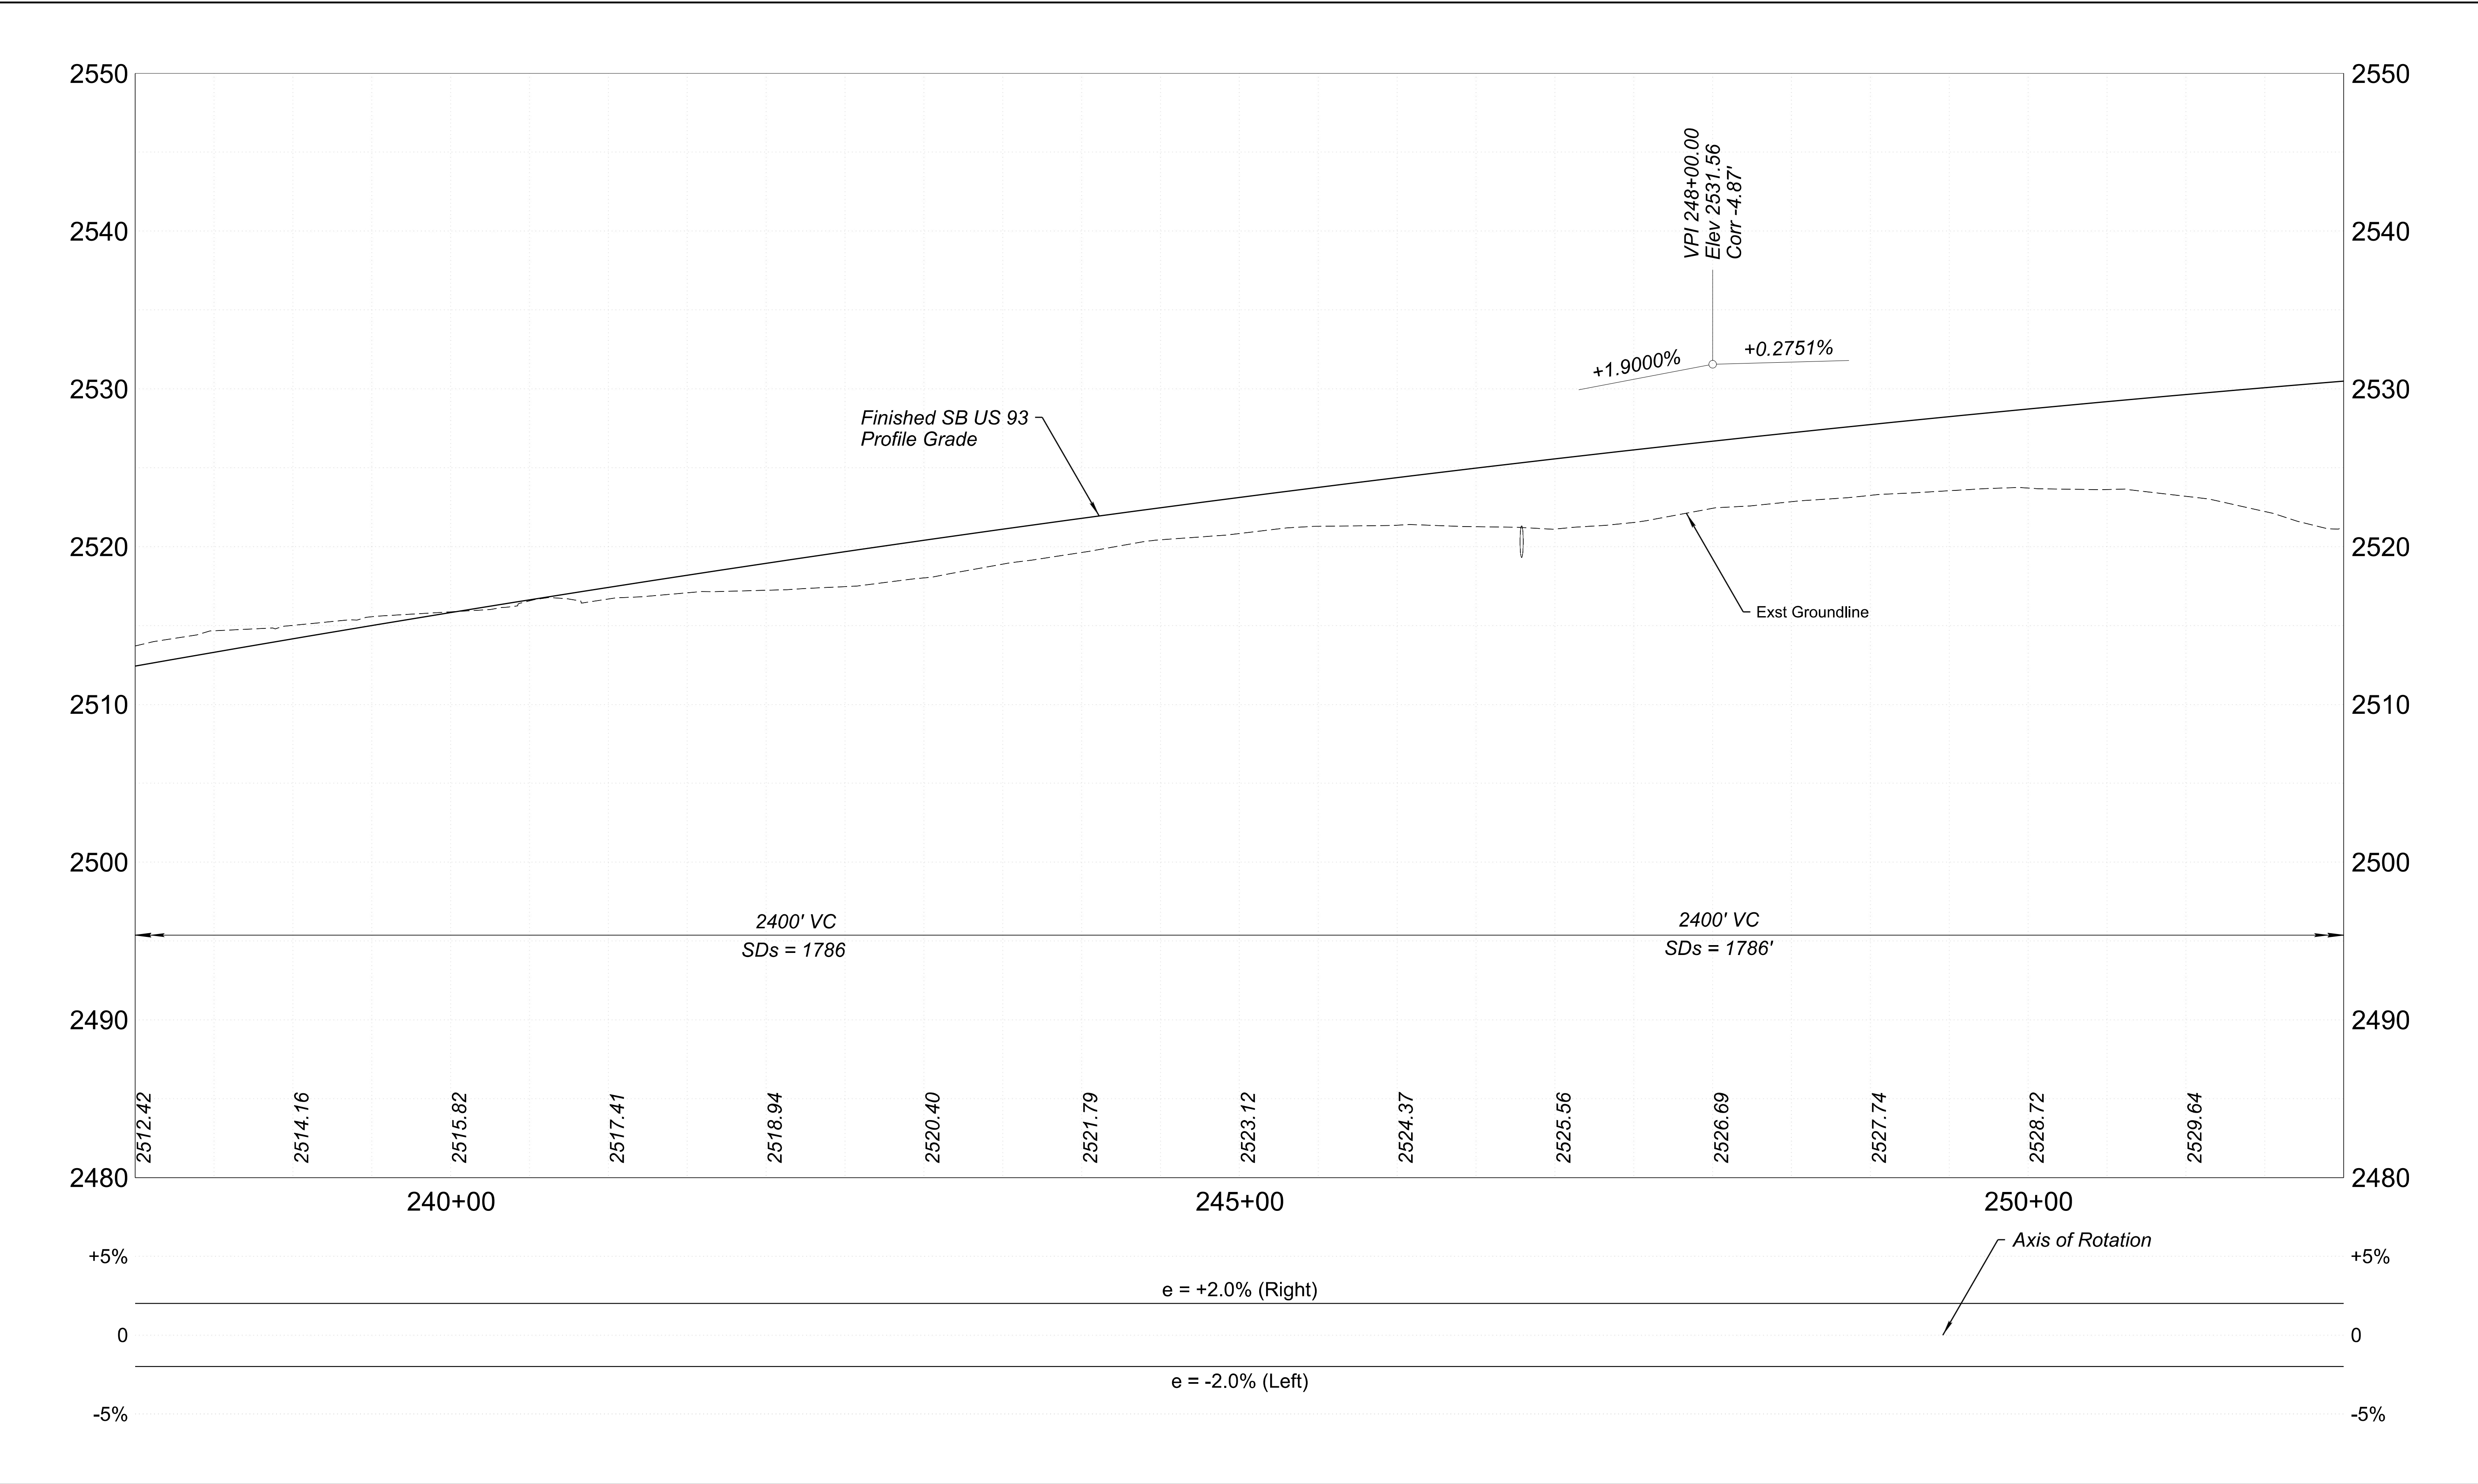

	<table><tr><th></th><th>NAME</th><th>DATE</th></tr><tr><td>DESIGN</td><td>J GILLIS</td><td>06/26</td></tr><tr><td>DRAWN</td><td>M SAMUELSON</td><td>06/26</td></tr><tr><td>CHECKED</td><td>J BEMELEN</td><td>06/26</td></tr></table>			NAME	DATE	DESIGN	J GILLIS	06/26	DRAWN	M SAMUELSON	06/26	CHECKED	J BEMELEN	06/26	ARIZONA DEPARTMENT OF TRANSPORTATION PROJECT DELIVERY AND OPERATIONS DIVISION ROADWAY DESIGN SERVICES		ROUTE US 93	F.H.W.A. Arizona Division	STATE ARIZ.	PROJECT NO.	FEDERAL ID NO.	SHEET NO.	TOTAL SHEETS	RECORD DRAWING
		NAME	DATE																					
	DESIGN	J GILLIS	06/26																					
	DRAWN	M SAMUELSON	06/26																					
	CHECKED	J BEMELEN	06/26																					
				MILEPOST 189.9	093 YV 189	093-B(230)T	168	524																
TRANSPORTATION AECOM TECHNICAL SERVICES, Inc. 7720 N. 16th St., Suite 100 Phoenix, Arizona 85020 T 602.371.1100 		PROFILE SHEET SB STA 238+00 TO STA 252+00		STRUCTURE NO.	LOCATION WICKENBURG RANCH WAY TO VISTA ROYALE DWG No. C-3.21																			
				TRACS NO. F0738 01C OF																				

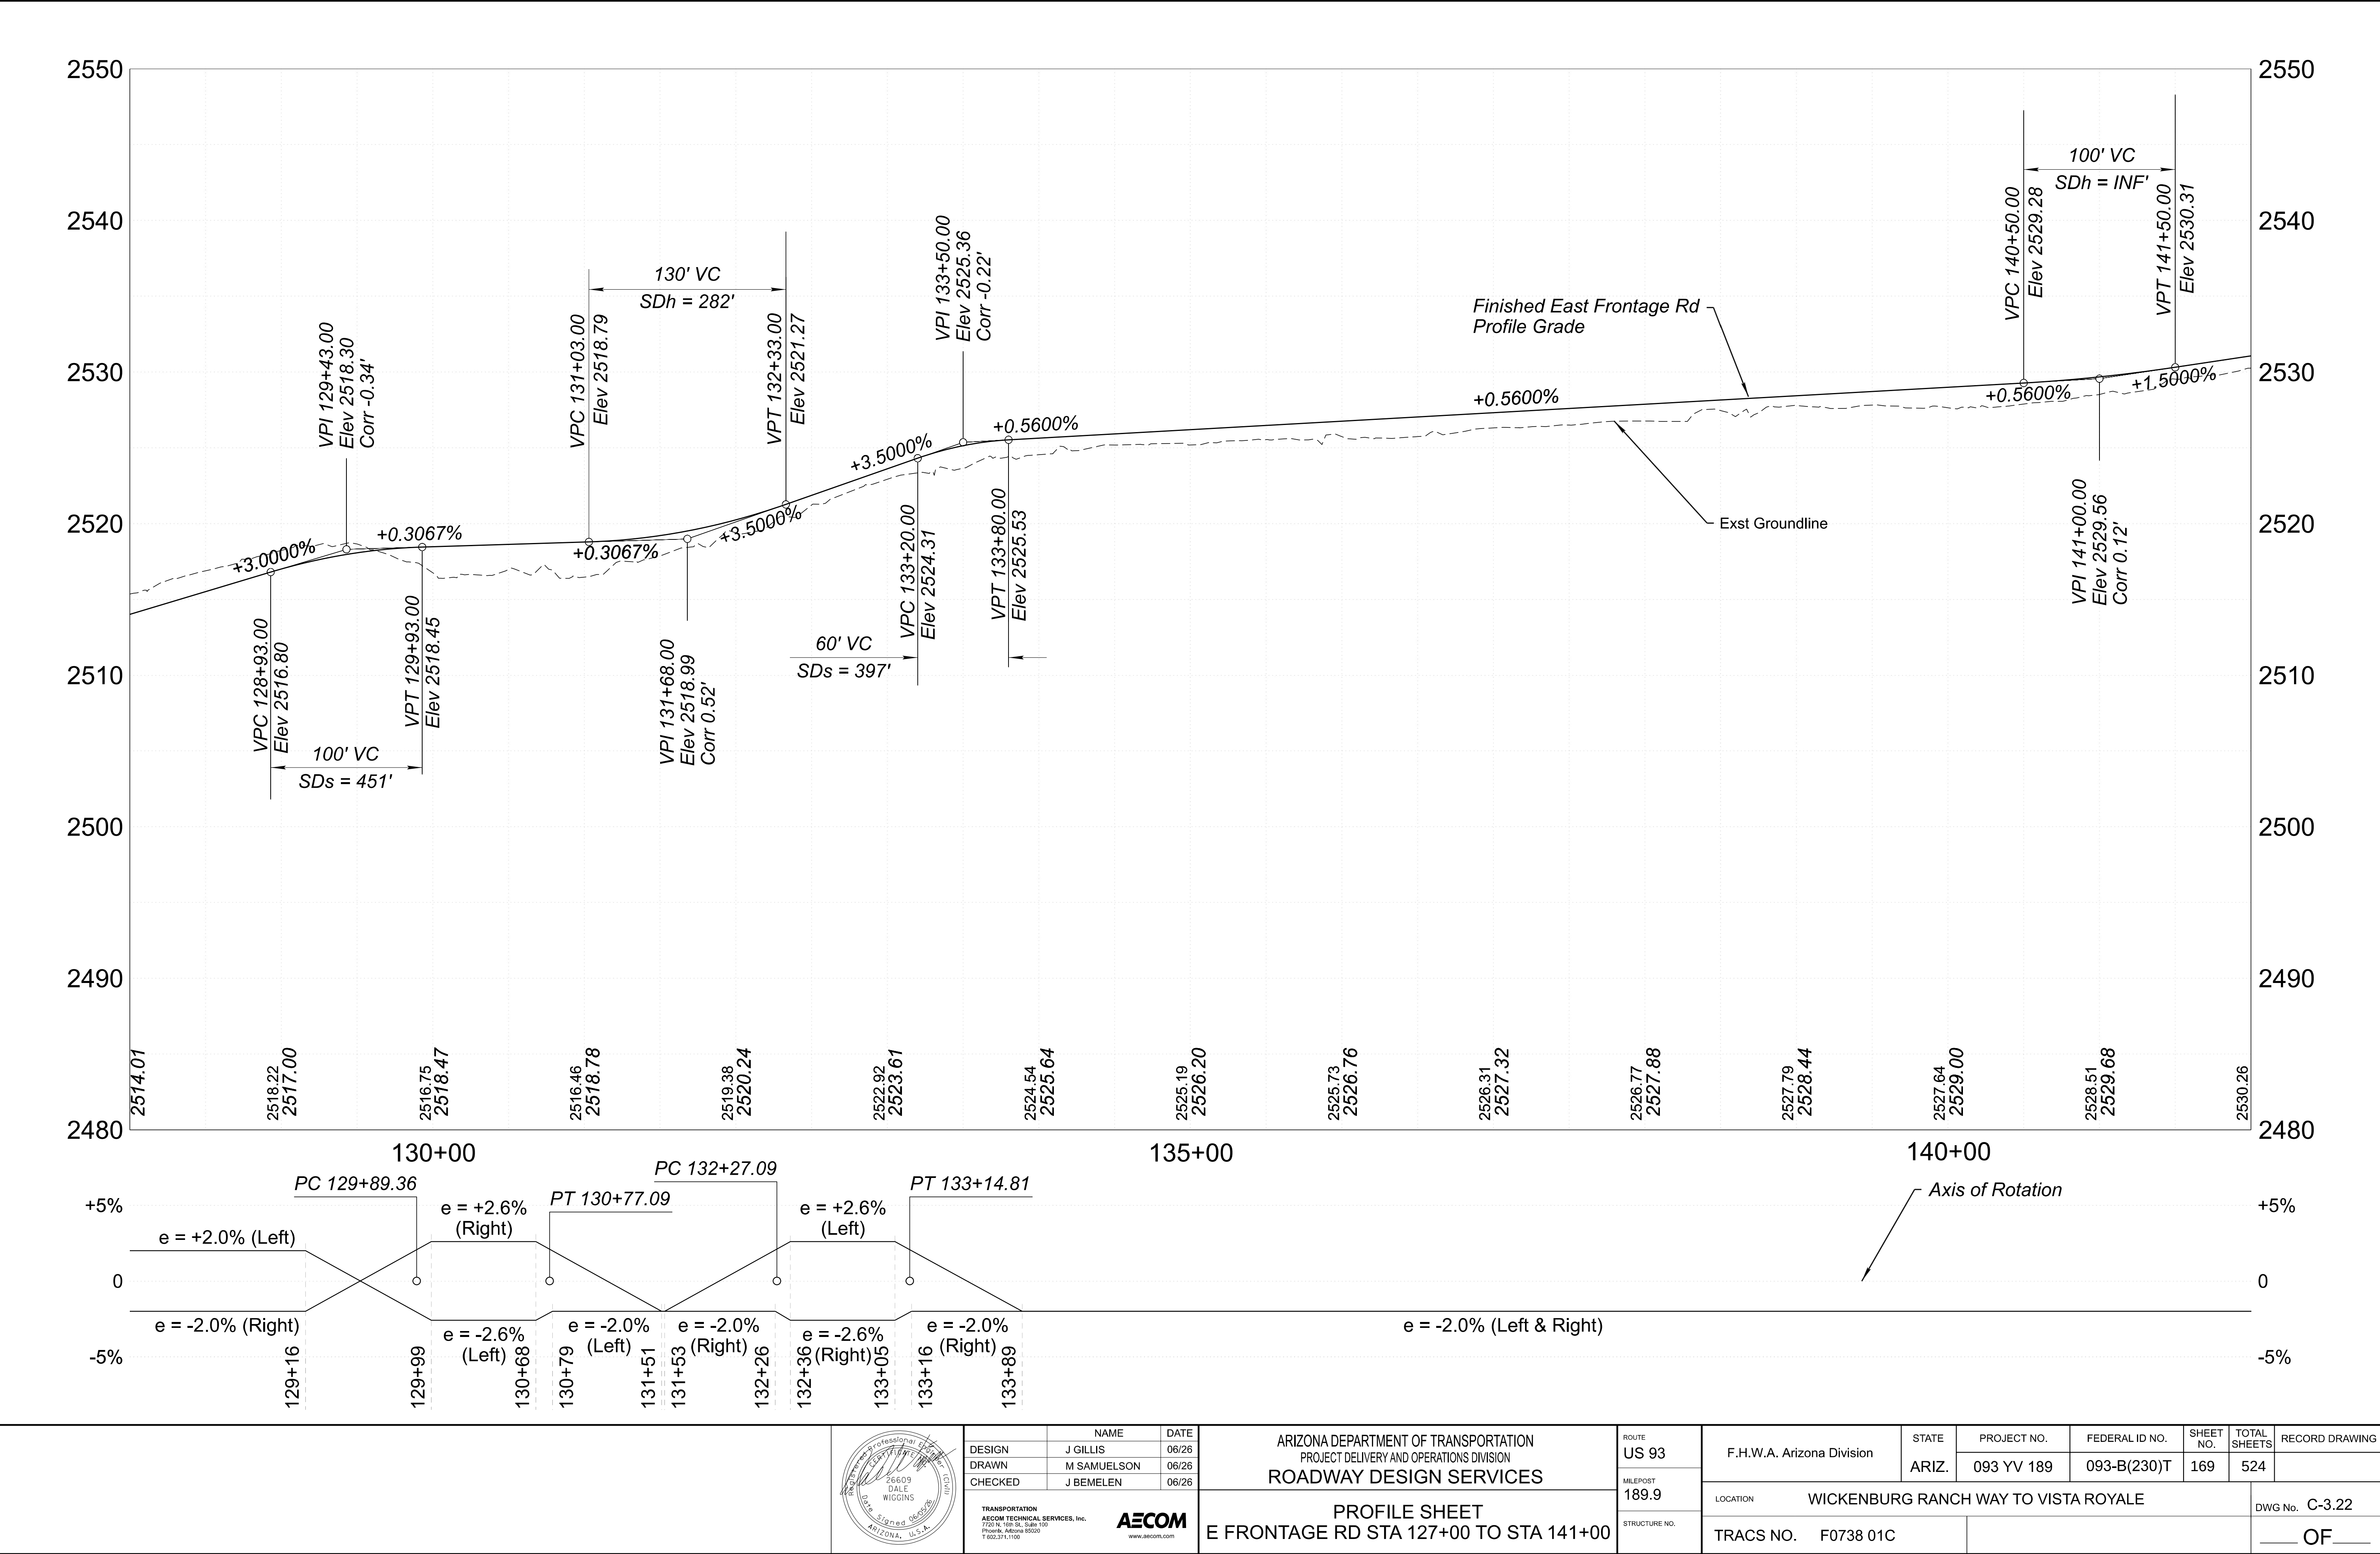


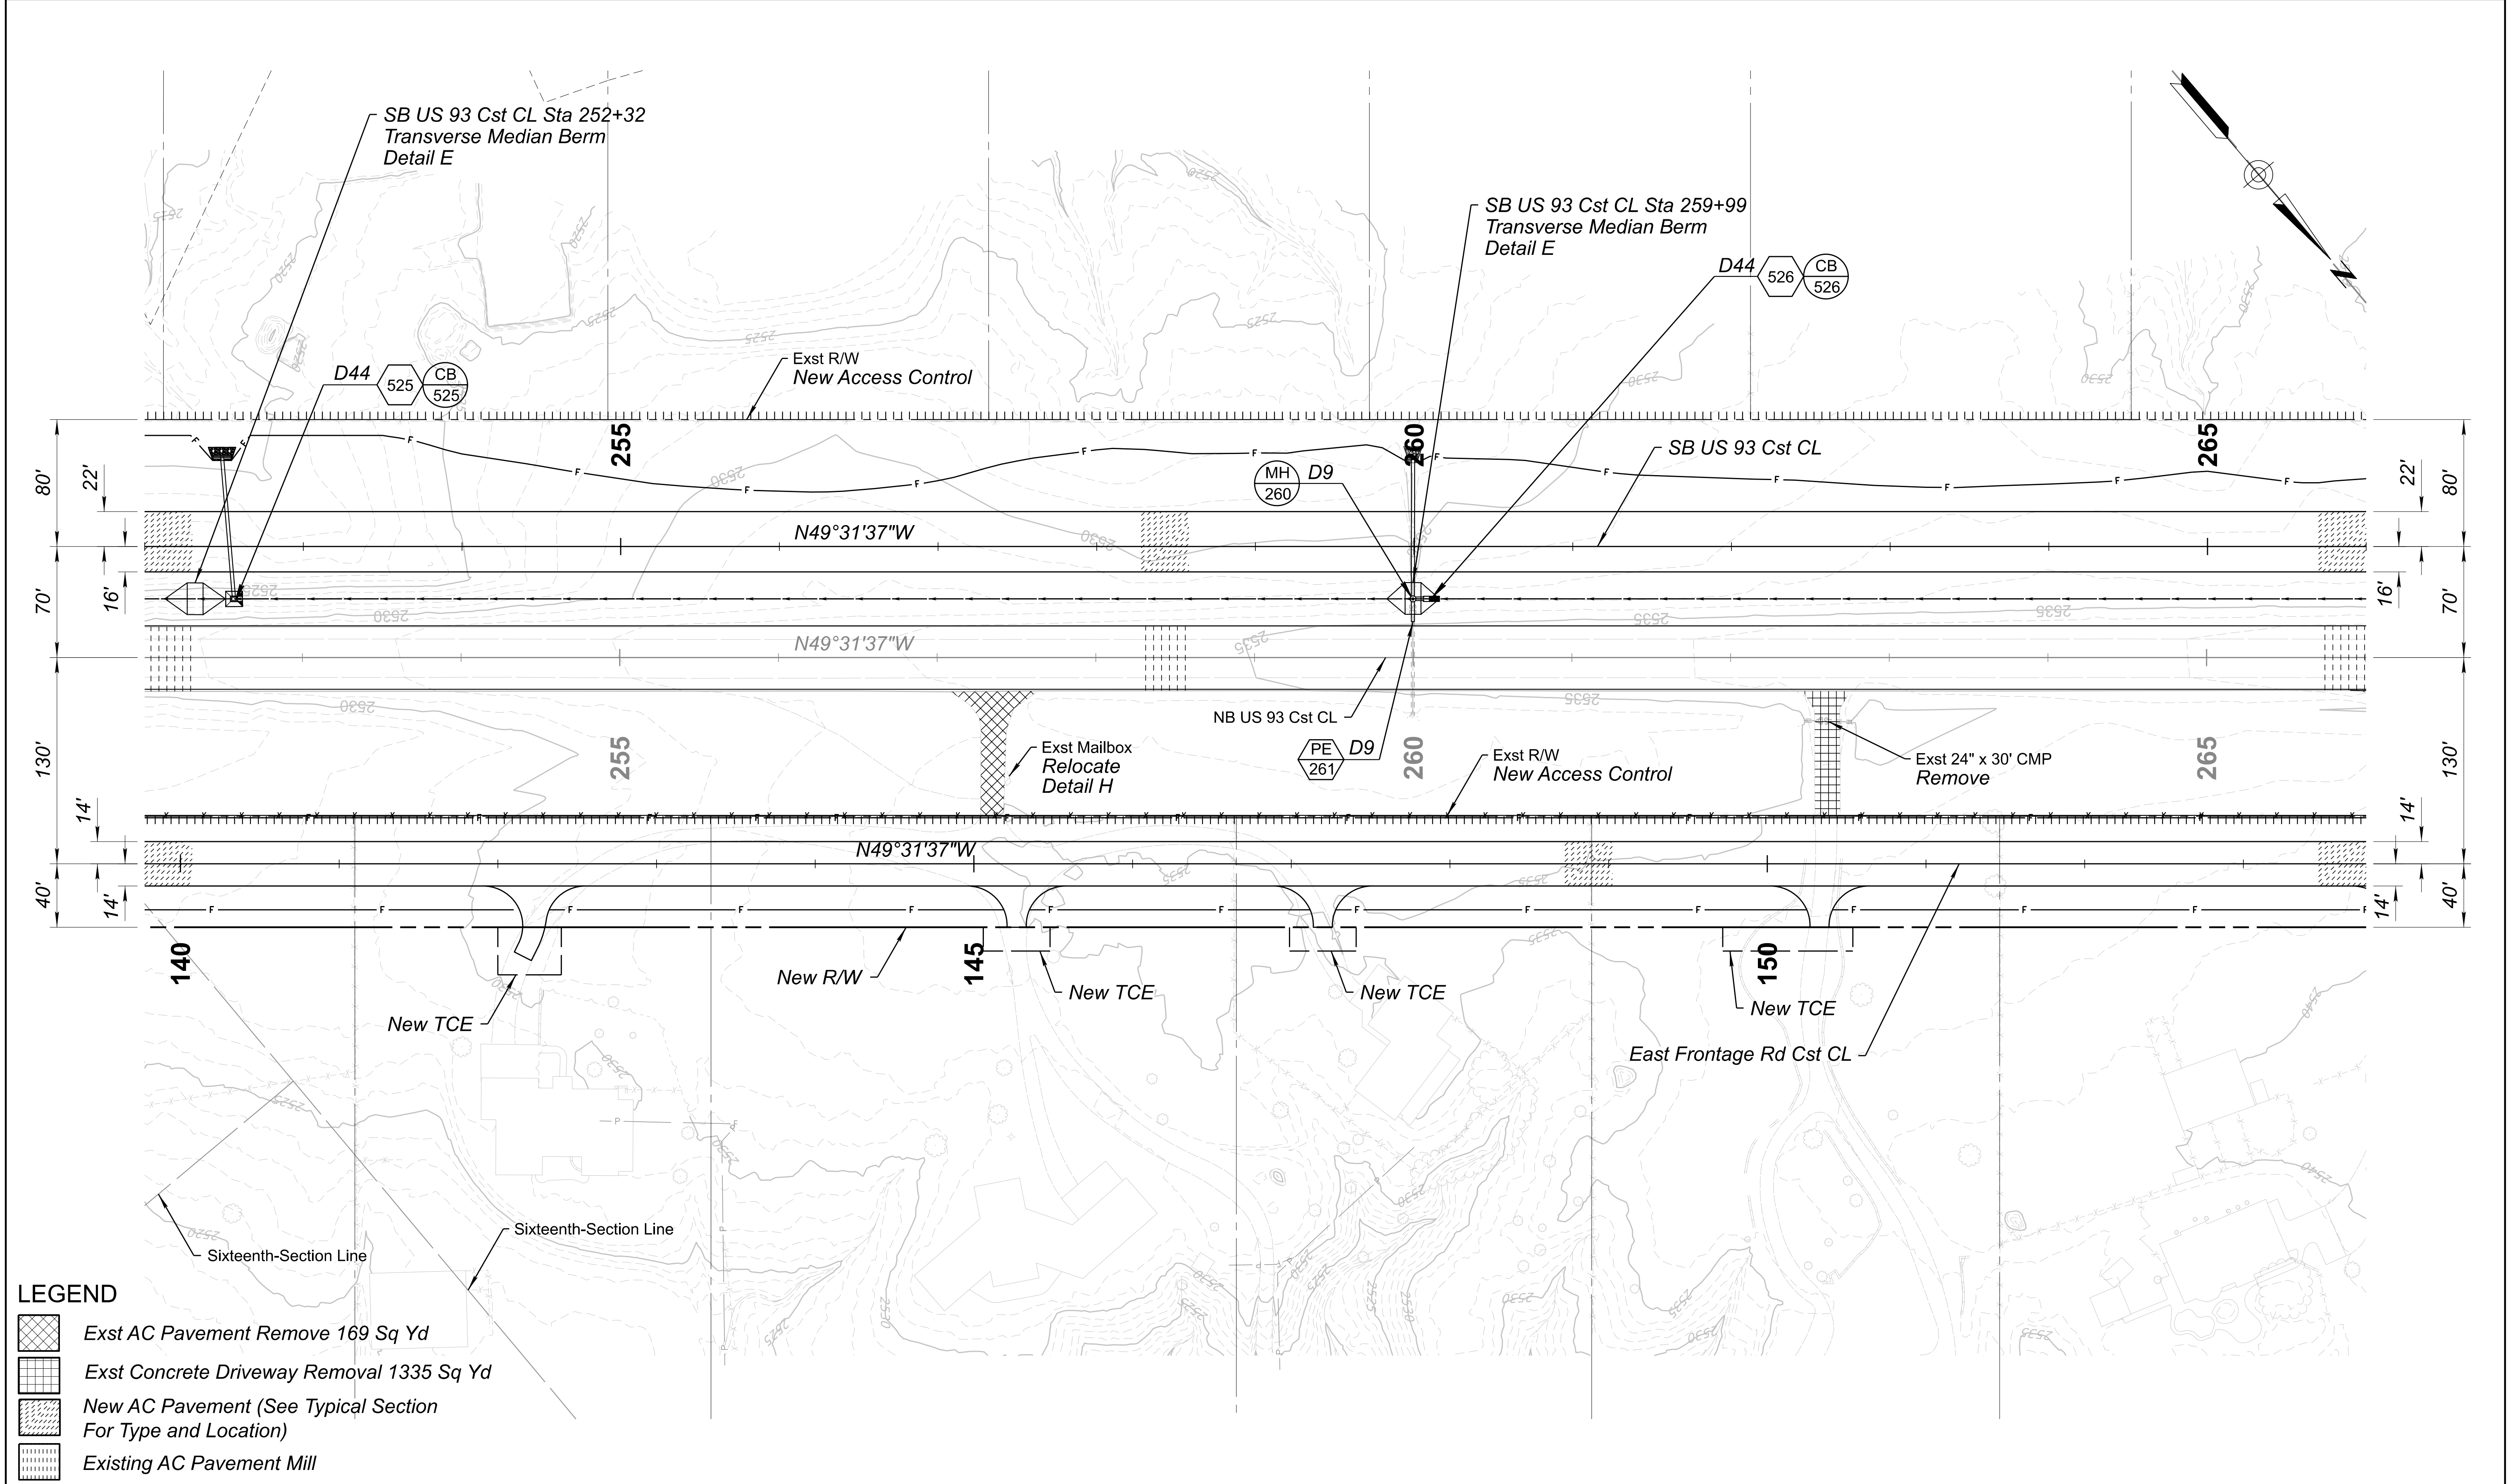


LEGEND

	Exst AC Pavement Remove 169 Sq Yd
	Exst Concrete Driveway Removal 1335 Sq Yd
	New AC Pavement (See Typical Section For Type and Location)
	Existing AC Pavement Mill

UTILITY DISPOSITION SHEETS LEGEND					ARIZONA DEPARTMENT OF TRANSPORTATION PROJECT DELIVERY AND OPERATIONS DIVISION ROADWAY DESIGN SERVICES	ROUTE	F.H.W.A. Arizona Division	STATE ARIZ.	PROJECT NO.	FEDERAL ID NO.	SHEET NO.	TOTAL SHEETS	RECORD DRAWING		
A	To Remain in Service - Protect-In-Place		DESIGN	J GILLIS		06/26			US 93	093 YV 189	093-B(230)T	170	524		
B	Contractor to Relocate, Remove, or Reset		DRAWN	M SAMUELSON		06/26			MILEPOST	LOCATION WICKENBURG RANCH WAY TO VISTA ROYALE					DWG No. C-3.23
C	To Be Relocated or Removed by Others		CHECKED	D WIGGINS		06/26			189.9						
D	To Be Constructed By Others		TRANSPORTATION AECOM TECHNICAL SERVICES, Inc. 7725 N. 18th St., Suite 100 Phoenix, Arizona 85020 T 602.376.1100  www.aecom.com			PLAN SHEET SB US 93 STA 252+00 TO STA 266+00 E FRONTAGE RD STA 140+00 TO STA 154+00			STRUCTURE NO.						

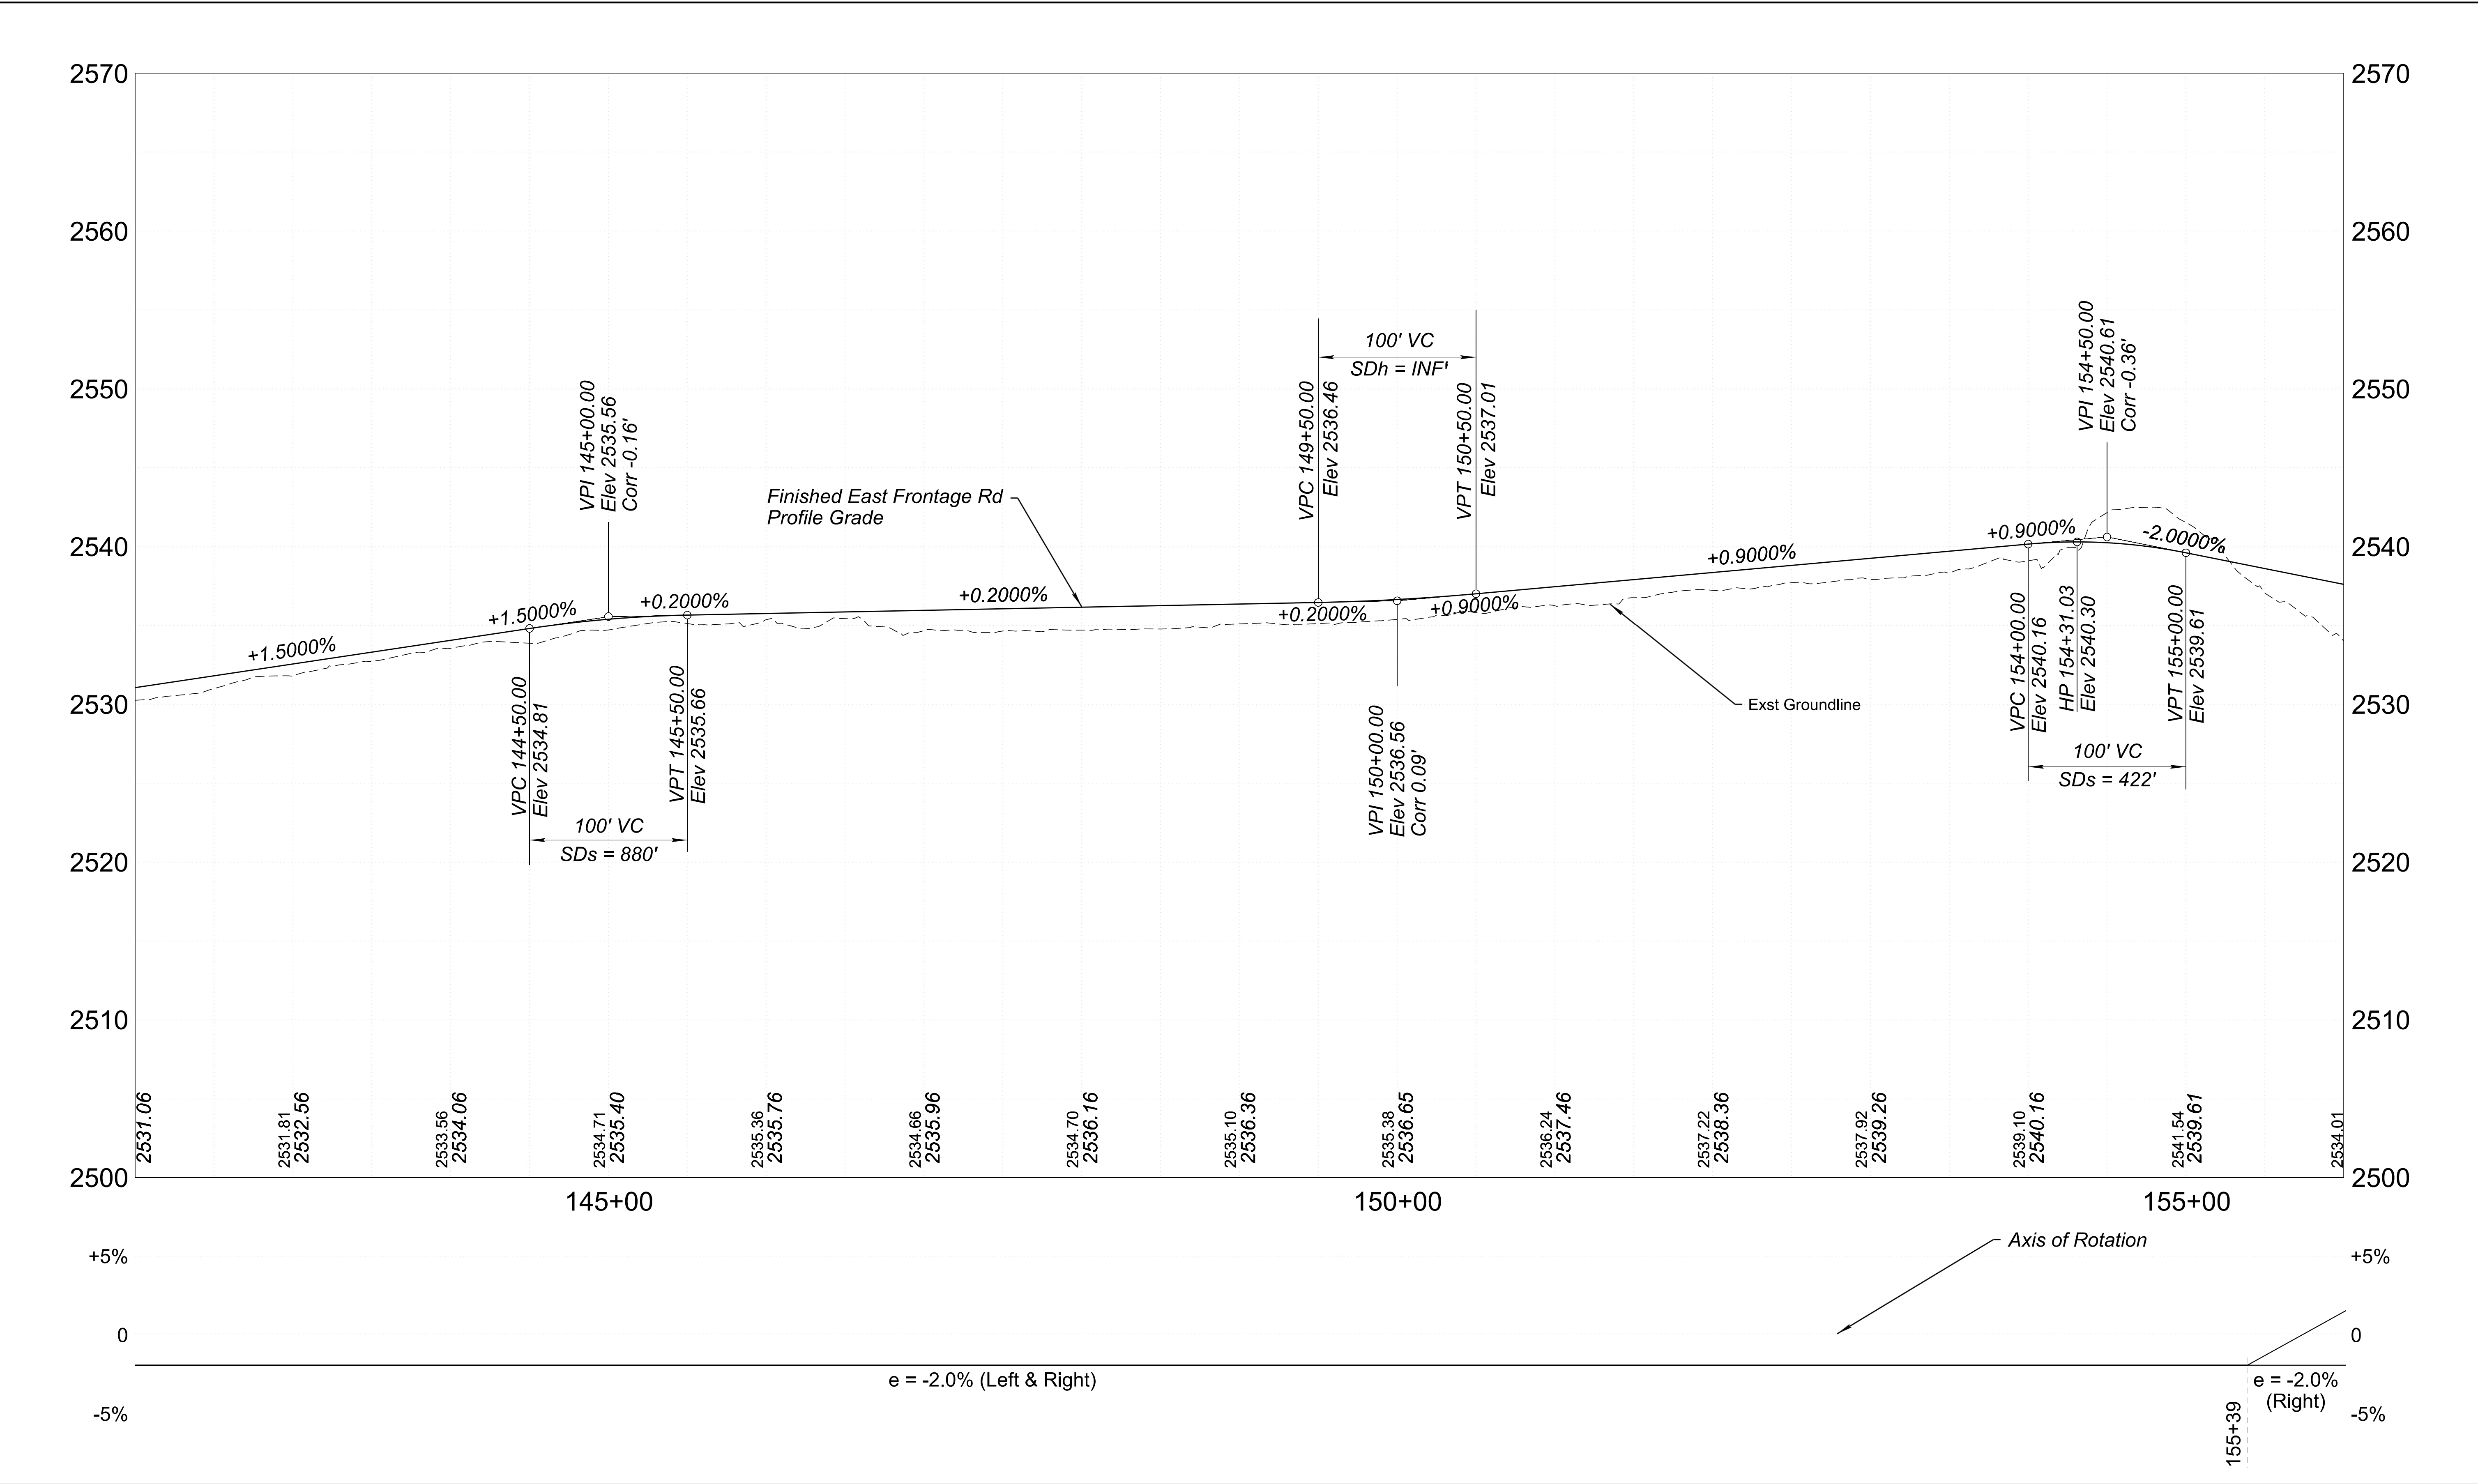



	NAME		DATE	ARIZONA DEPARTMENT OF TRANSPORTATION PROJECT DELIVERY AND OPERATIONS DIVISION ROADWAY DESIGN SERVICES	ROUTE	F.H.W.A. Arizona Division	STATE ARIZ.	PROJECT NO.	FEDERAL ID NO.	SHEET NO.	TOTAL SHEETS	RECORD DRAWING
	DESIGN		J GILLIS		06/26			US 93	093 YV 189	093-B(230)T	172	524
	DRAWN		M SAMUELSON		06/26	MILEPOST	189.9	LOCATION WICKENBURG RANCH WAY TO VISTA ROYALE				
	CHECKED		J BEMELEN	06/26	TRANSPORTATION AECOM TECHNICAL SERVICES, Inc. 7720 N. 16th St., Suite 100 Phoenix, Arizona 85020 T 602.371.1100		AECOM		STRUCTURE NO.		TRACS NO. F0738 01C	OF
117 182				www.aecom.com								
				E FRONTAGE RD STA 141+00 TO STA 155+00								

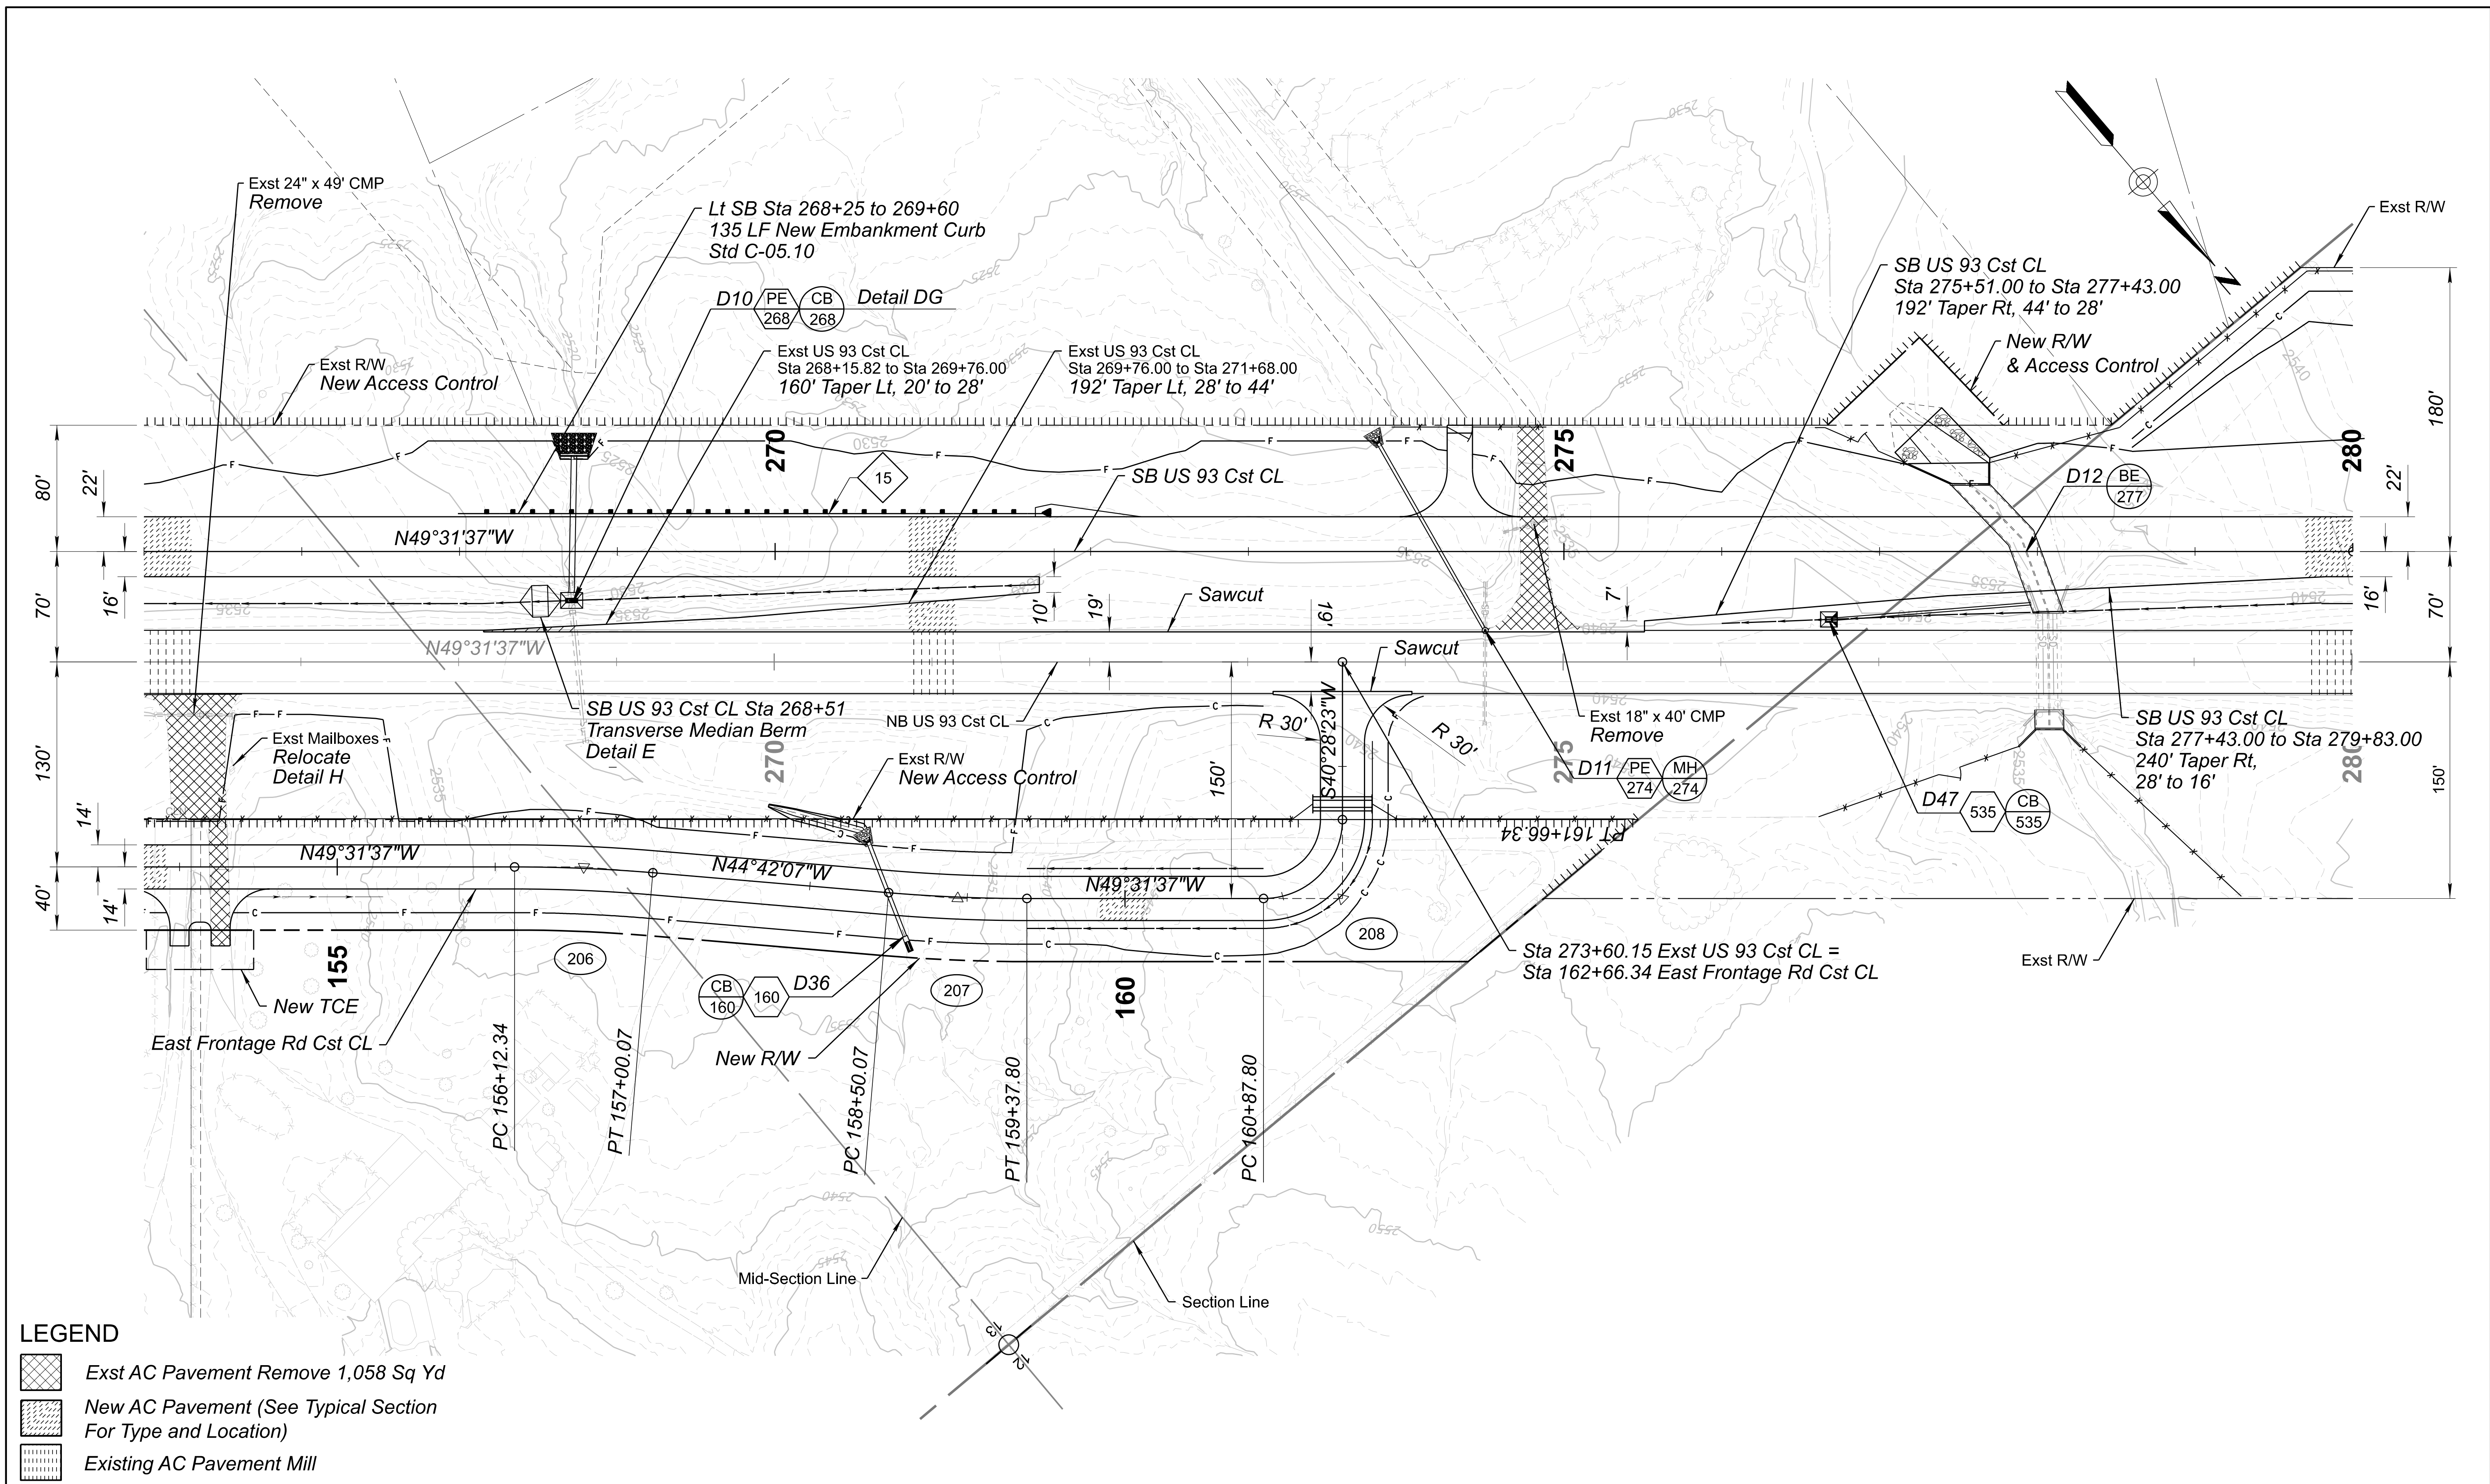


LEGEND

	Exst AC Pavement Remove 1,058 Sq Yd
	New AC Pavement (See Typical Section For Type and Location)
	Existing AC Pavement Mill

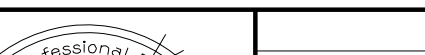UTILITY DISPOSITION SHEETS LEGEND					NAME		DATE	ARIZONA DEPARTMENT OF TRANSPORTATION PROJECT DELIVERY AND OPERATIONS DIVISION ROADWAY DESIGN SERVICES		ROUTE	F.H.W.A. Arizona Division	STATE ARIZ.	PROJECT NO. 093 YV 189	FEDERAL ID NO. 093-B(230)T	SHEET NO. 173	TOTAL SHEETS 524	RECORD DRAWING	
A	To Remain in Service - Protect-In-Place		B		Contractor to Relocate, Remove, or Reset		DESIGN	J GILLIS	06/26	US 93								
C	To Be Relocated or Removed by Others		D		To Be Constructed By Others		DRAWN	M SAMUELSON	06/26	MILEPOST 189.9								
					CHECKED	D WIGGINS	06/26	TRANSPORTATION AECOM TECHNICAL SERVICES, Inc. 7720 N. 16th St., Suite 100 Phoenix, Arizona 85020 T 602.371.1100 AECOM www.aecom.com		STRUCTURE NO.	LOCATION WICKENBURG RANCH WAY TO VISTA ROYALE		TRACS NO. F0738 01C		DWG No. C-3.26 ____ OF ____			
										PLAN SHEET								
										SB US 93 STA 266+00 TO STA 280+00 E FRONTAGE RD STA 154+00 TO STA 161+66								

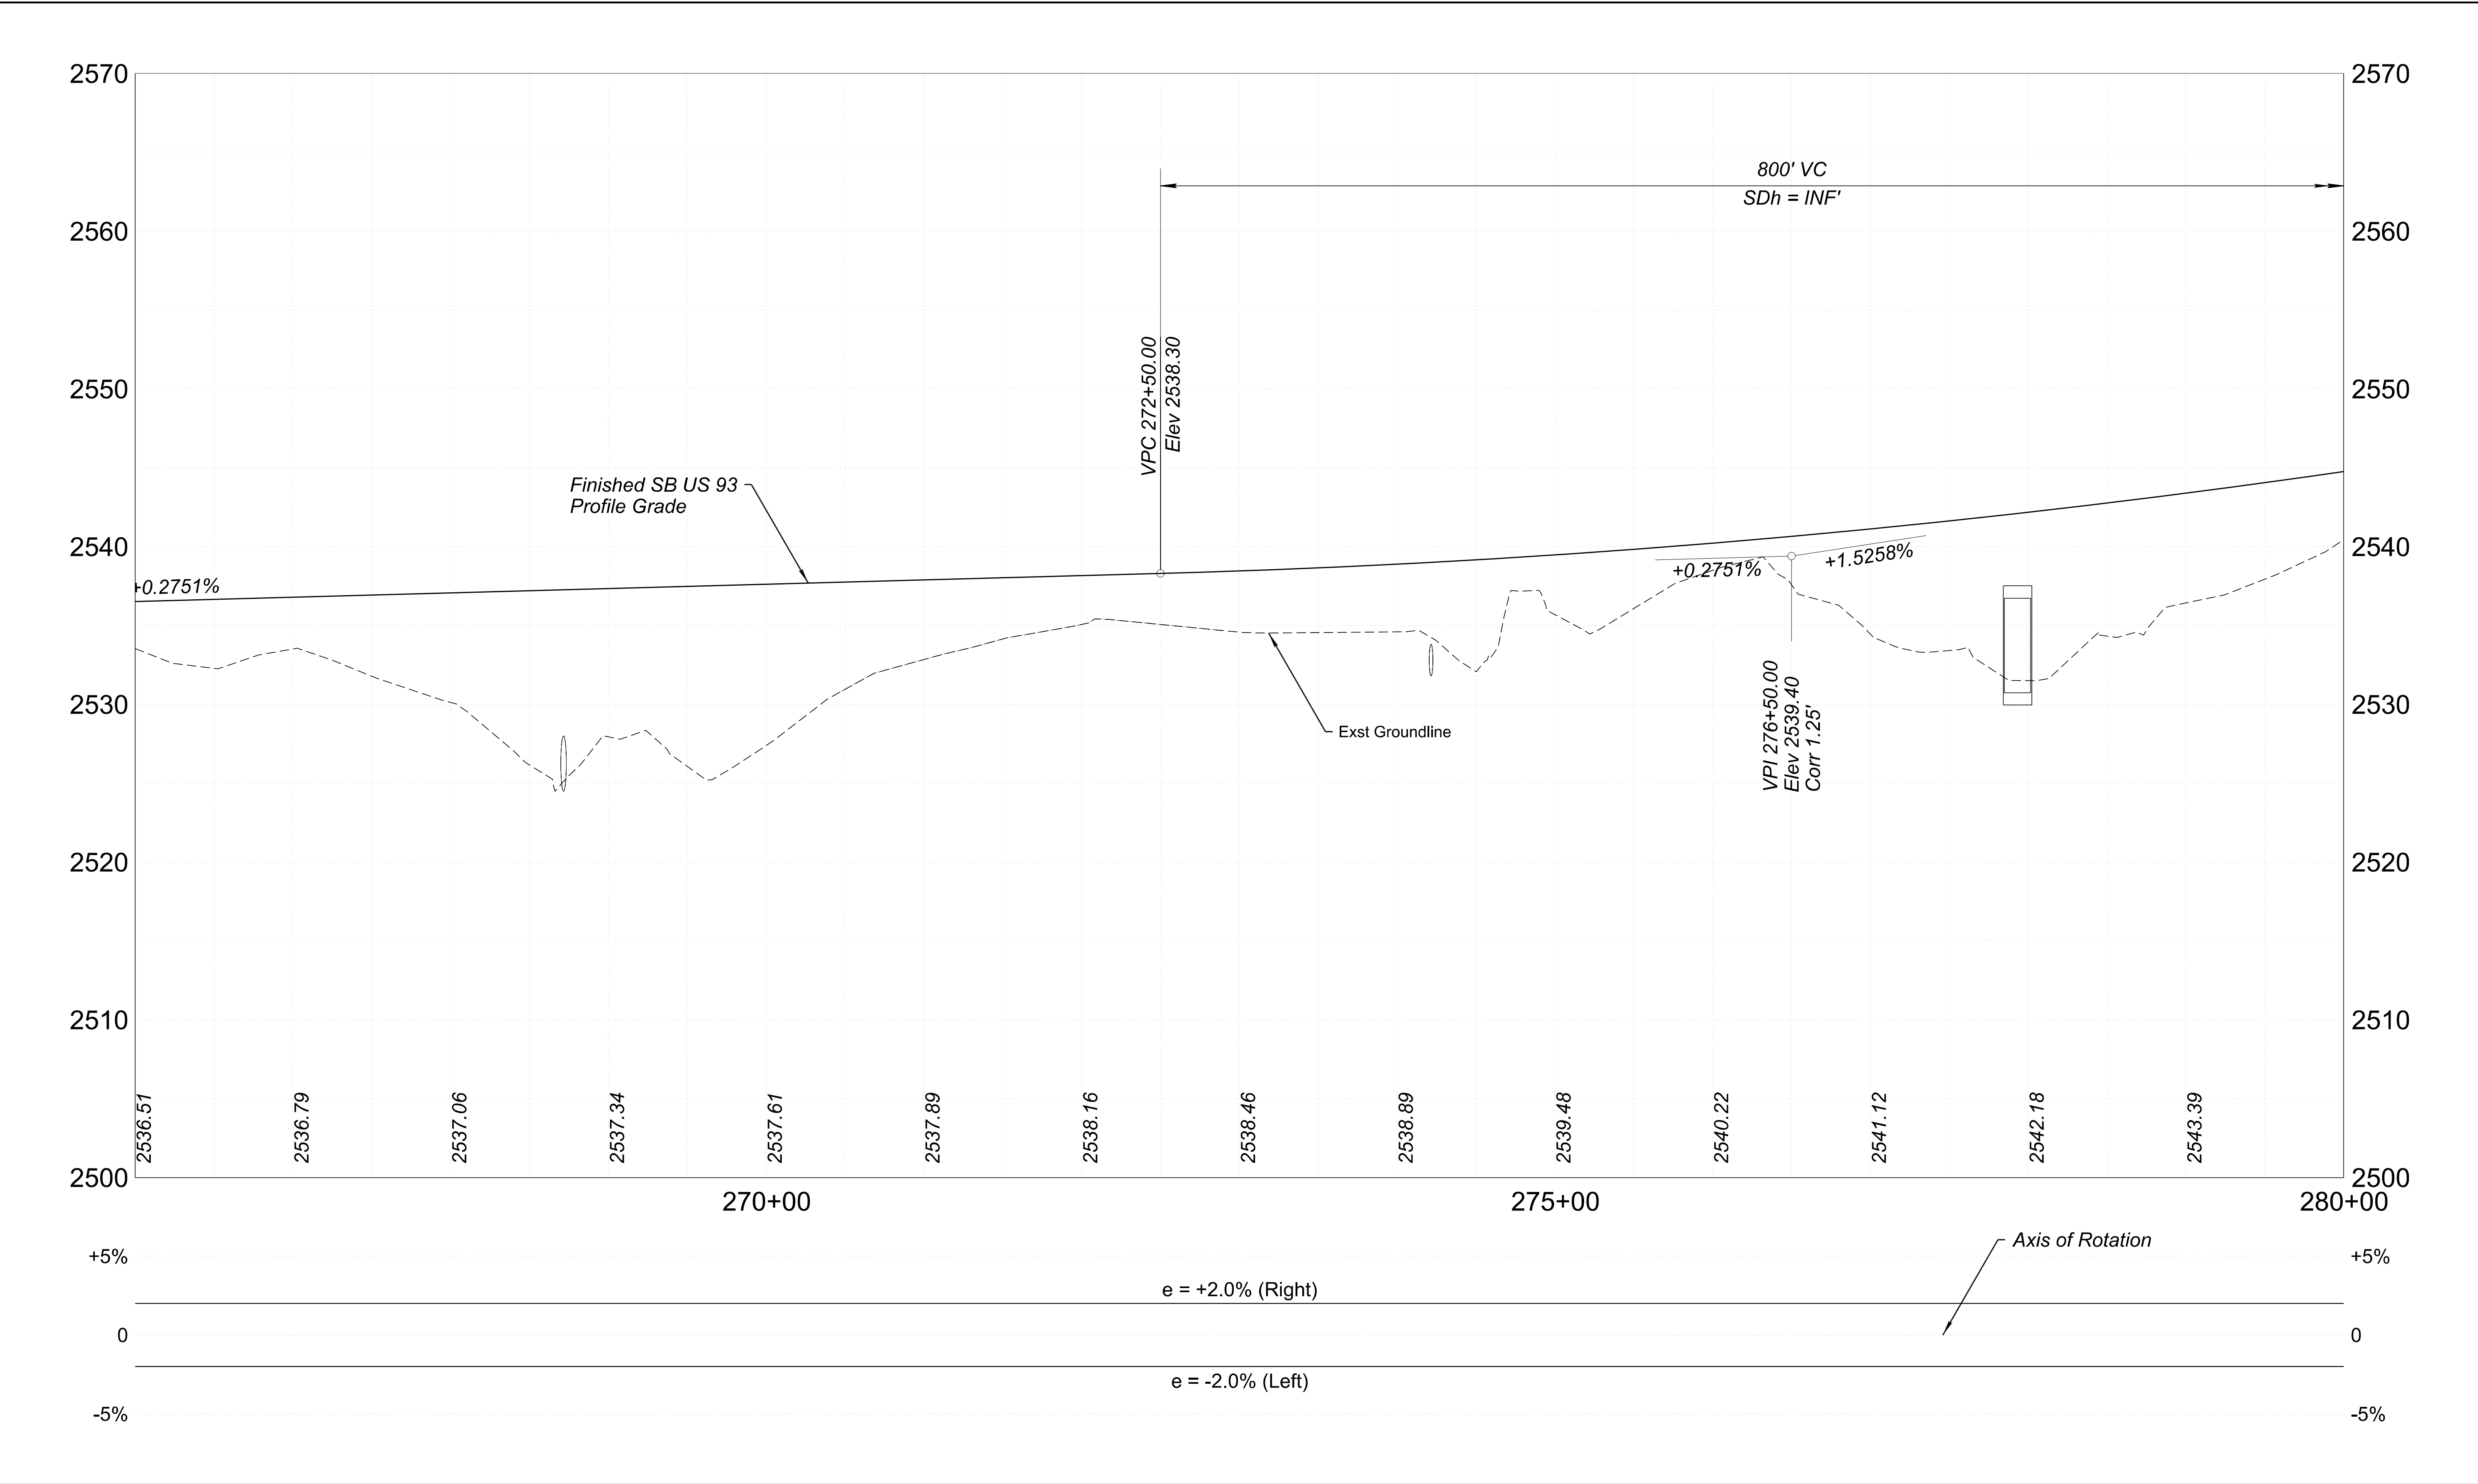

	<table><tr><th></th><th>NAME</th><th>DATE</th></tr><tr><td>DESIGN</td><td>J GILLIS</td><td>06/26</td></tr><tr><td>DRAWN</td><td>M SAMUELSON</td><td>06/26</td></tr><tr><td>CHECKED</td><td>J BEMELEN</td><td>06/26</td></tr></table>			NAME	DATE	DESIGN	J GILLIS	06/26	DRAWN	M SAMUELSON	06/26	CHECKED	J BEMELEN	06/26	ARIZONA DEPARTMENT OF TRANSPORTATION PROJECT DELIVERY AND OPERATIONS DIVISION ROADWAY DESIGN SERVICES PROFILE SHEET SB STA 266+00 TO STA 280+00		ROUTE US 93	F.H.W.A. Arizona Division	STATE ARIZ.	PROJECT NO.	FEDERAL ID NO.	SHEET NO.	TOTAL SHEETS	RECORD DRAWING
		NAME	DATE																					
	DESIGN	J GILLIS	06/26																					
	DRAWN	M SAMUELSON	06/26																					
CHECKED	J BEMELEN	06/26																						
MILEPOST 189.9	LOCATION WICKENBURG RANCH WAY TO VISTA ROYALE					093 YV 189	093-B(230)T	174	524															
TRANSPORTATION AECOM TECHNICAL SERVICES, Inc. 1720 N. 16th St., Suite 100 Phoenix, Arizona 85003 T 602.371-5100 www.aecom.com AECOM				STRUCTURE NO.								TRACS NO. F0738 01C	DWG No. C-3.27 ____ OF ____											

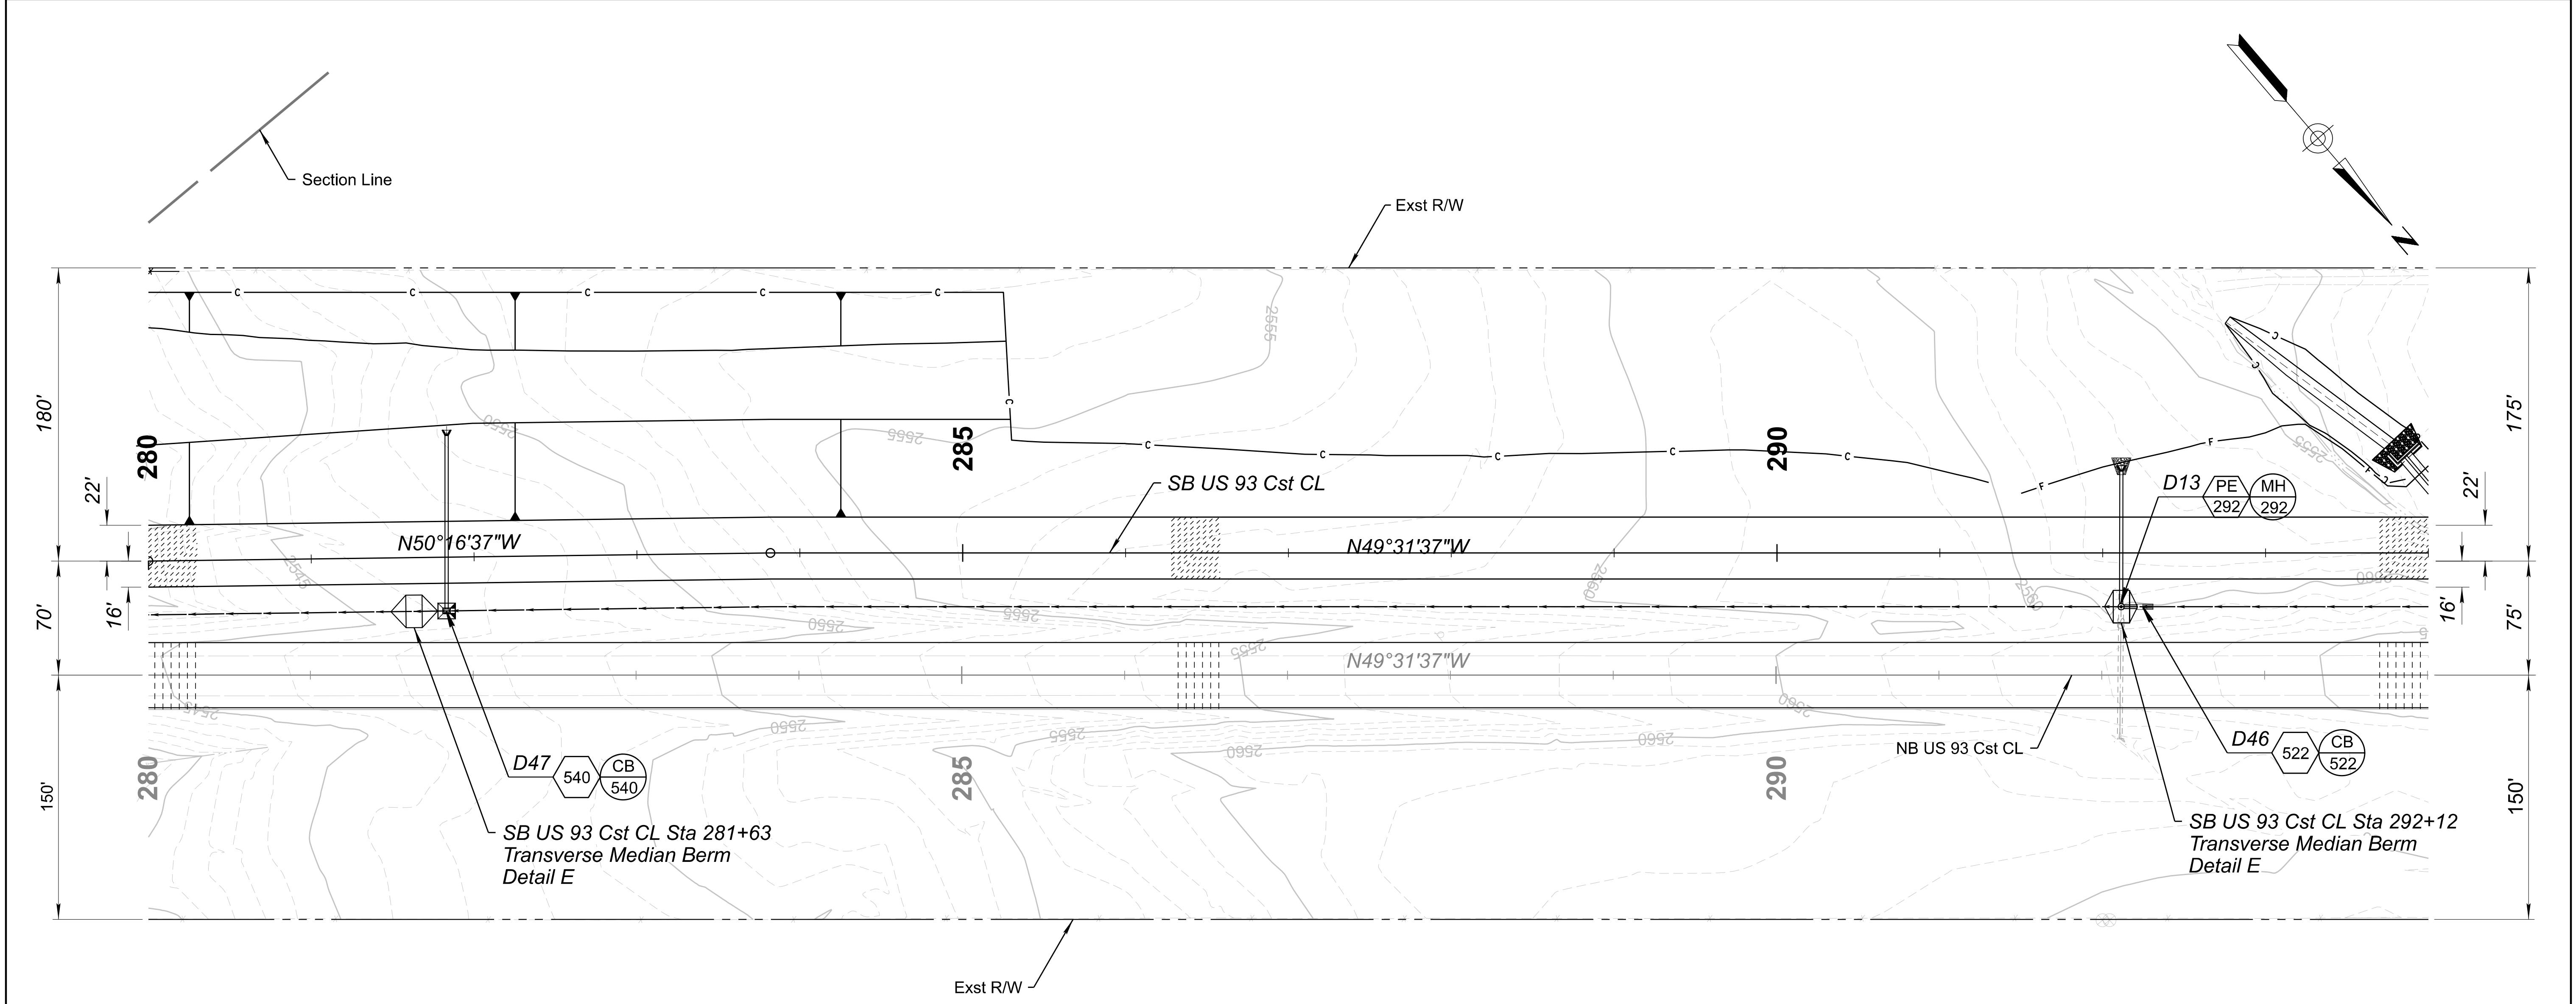

LEGEND

- New AC Pavement (See Typical Section For Type and Location)
- Existing AC Pavement Mill

UTILITY DISPOSITION SHEETS LEGEND

A	To Remain in Service - Protect-In-Place
B	Contractor to Relocate, Remove, or Reset
C	To Be Relocated or Removed by Others
D	To Be Constructed By Others

DESIGN	J GILLIS	06/26
DRAWN	M SAMUELSON	06/26
CHECKED	D WIGGINS	06/26

TRANSPORTATION
AECOM TECHNICAL SERVICES, Inc.
7720 N. 16th St., Suite 100
Phoenix, Arizona 85020
T 602.371.1100


www.aecom.com

ARIZONA DEPARTMENT OF TRANSPORTATION
PROJECT DELIVERY AND OPERATIONS DIVISION
ROADWAY DESIGN SERVICES


PLAN SHEET
SB US 93 STA 280+00 TO STA 294+00

ROUTE	US 93
MILEPOST	189.9
STRUCTURE NO.	

F.H.W.A. Arizona Division	STATE	ARIZ.	PROJECT NO.	093 YV 189	FEDERAL ID NO.	093-B(230)T	SHEET NO.	176	TOTAL SHEETS	524	RECORD DRAWING
LOCATION										WICKENBURG RANCH WAY TO VISTA ROYALE	
TRACS NO.										F0738 01C	
										DWG No. C-3.29	
										___ OF ___	

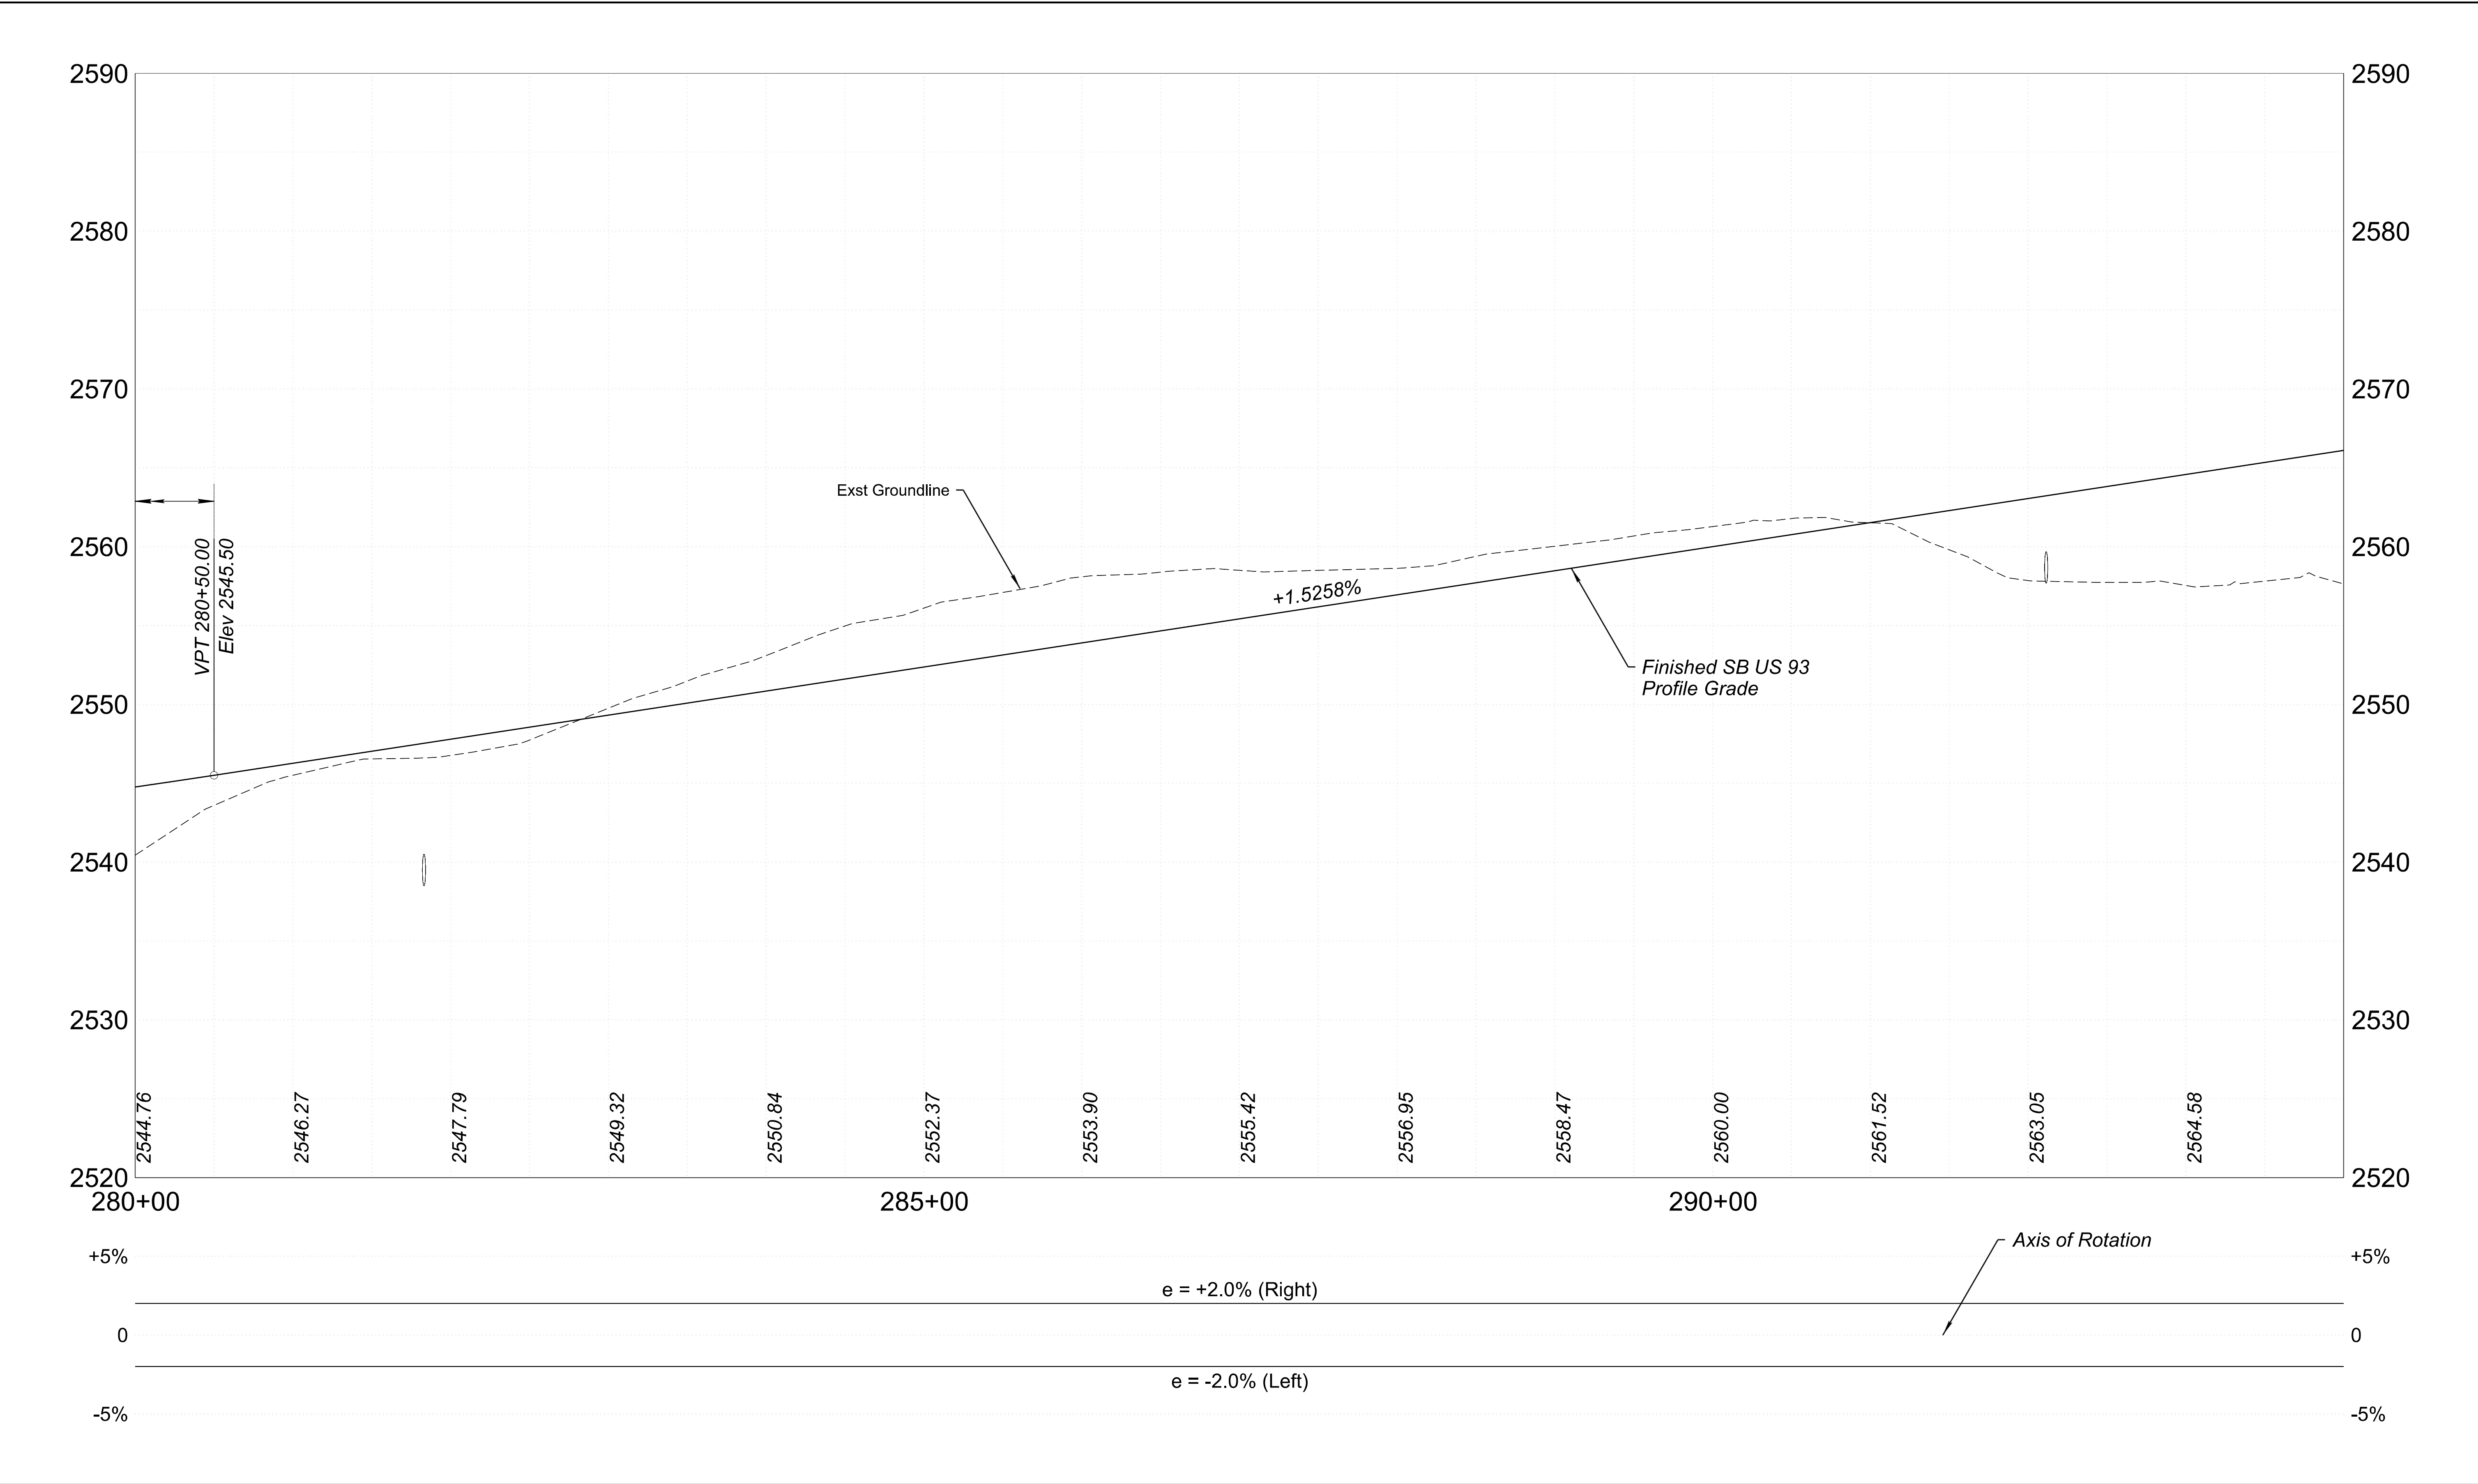

	<table><tr><th></th><th>NAME</th><th>DATE</th></tr><tr><td>DESIGN</td><td>J GILLIS</td><td>06/26</td></tr><tr><td>DRAWN</td><td>M SAMUELSON</td><td>06/26</td></tr><tr><td>CHECKED</td><td>J BEMELEN</td><td>06/26</td></tr></table>			NAME	DATE	DESIGN	J GILLIS	06/26	DRAWN	M SAMUELSON	06/26	CHECKED	J BEMELEN	06/26	TRANSPORTATION AECOM TECHNICAL SERVICES, Inc. 7720 N. 16th St., Suite 100 Phoenix, Arizona 85020 T 602.371.1100  www.aecom.com		ARIZONA DEPARTMENT OF TRANSPORTATION PROJECT DELIVERY AND OPERATIONS DIVISION ROADWAY DESIGN SERVICES		ROUTE US 93	F.H.W.A. Arizona Division	STATE ARIZ.	PROJECT NO. 093 YV 189	FEDERAL ID NO. 093-B(230)T	SHEET NO. 177	TOTAL SHEETS 524	RECORD DRAWING
		NAME	DATE																							
	DESIGN	J GILLIS	06/26																							
	DRAWN	M SAMUELSON	06/26																							
CHECKED	J BEMELEN	06/26																								
MILEPOST 189.9	PROFILE SHEET SB STA 280+00 TO STA 294+00					LOCATION WICKENBURG RANCH WAY TO VISTA ROYALE					DWG No. C-3.30															
STRUCTURE NO.						TRACS NO. F0738 01C					OF															

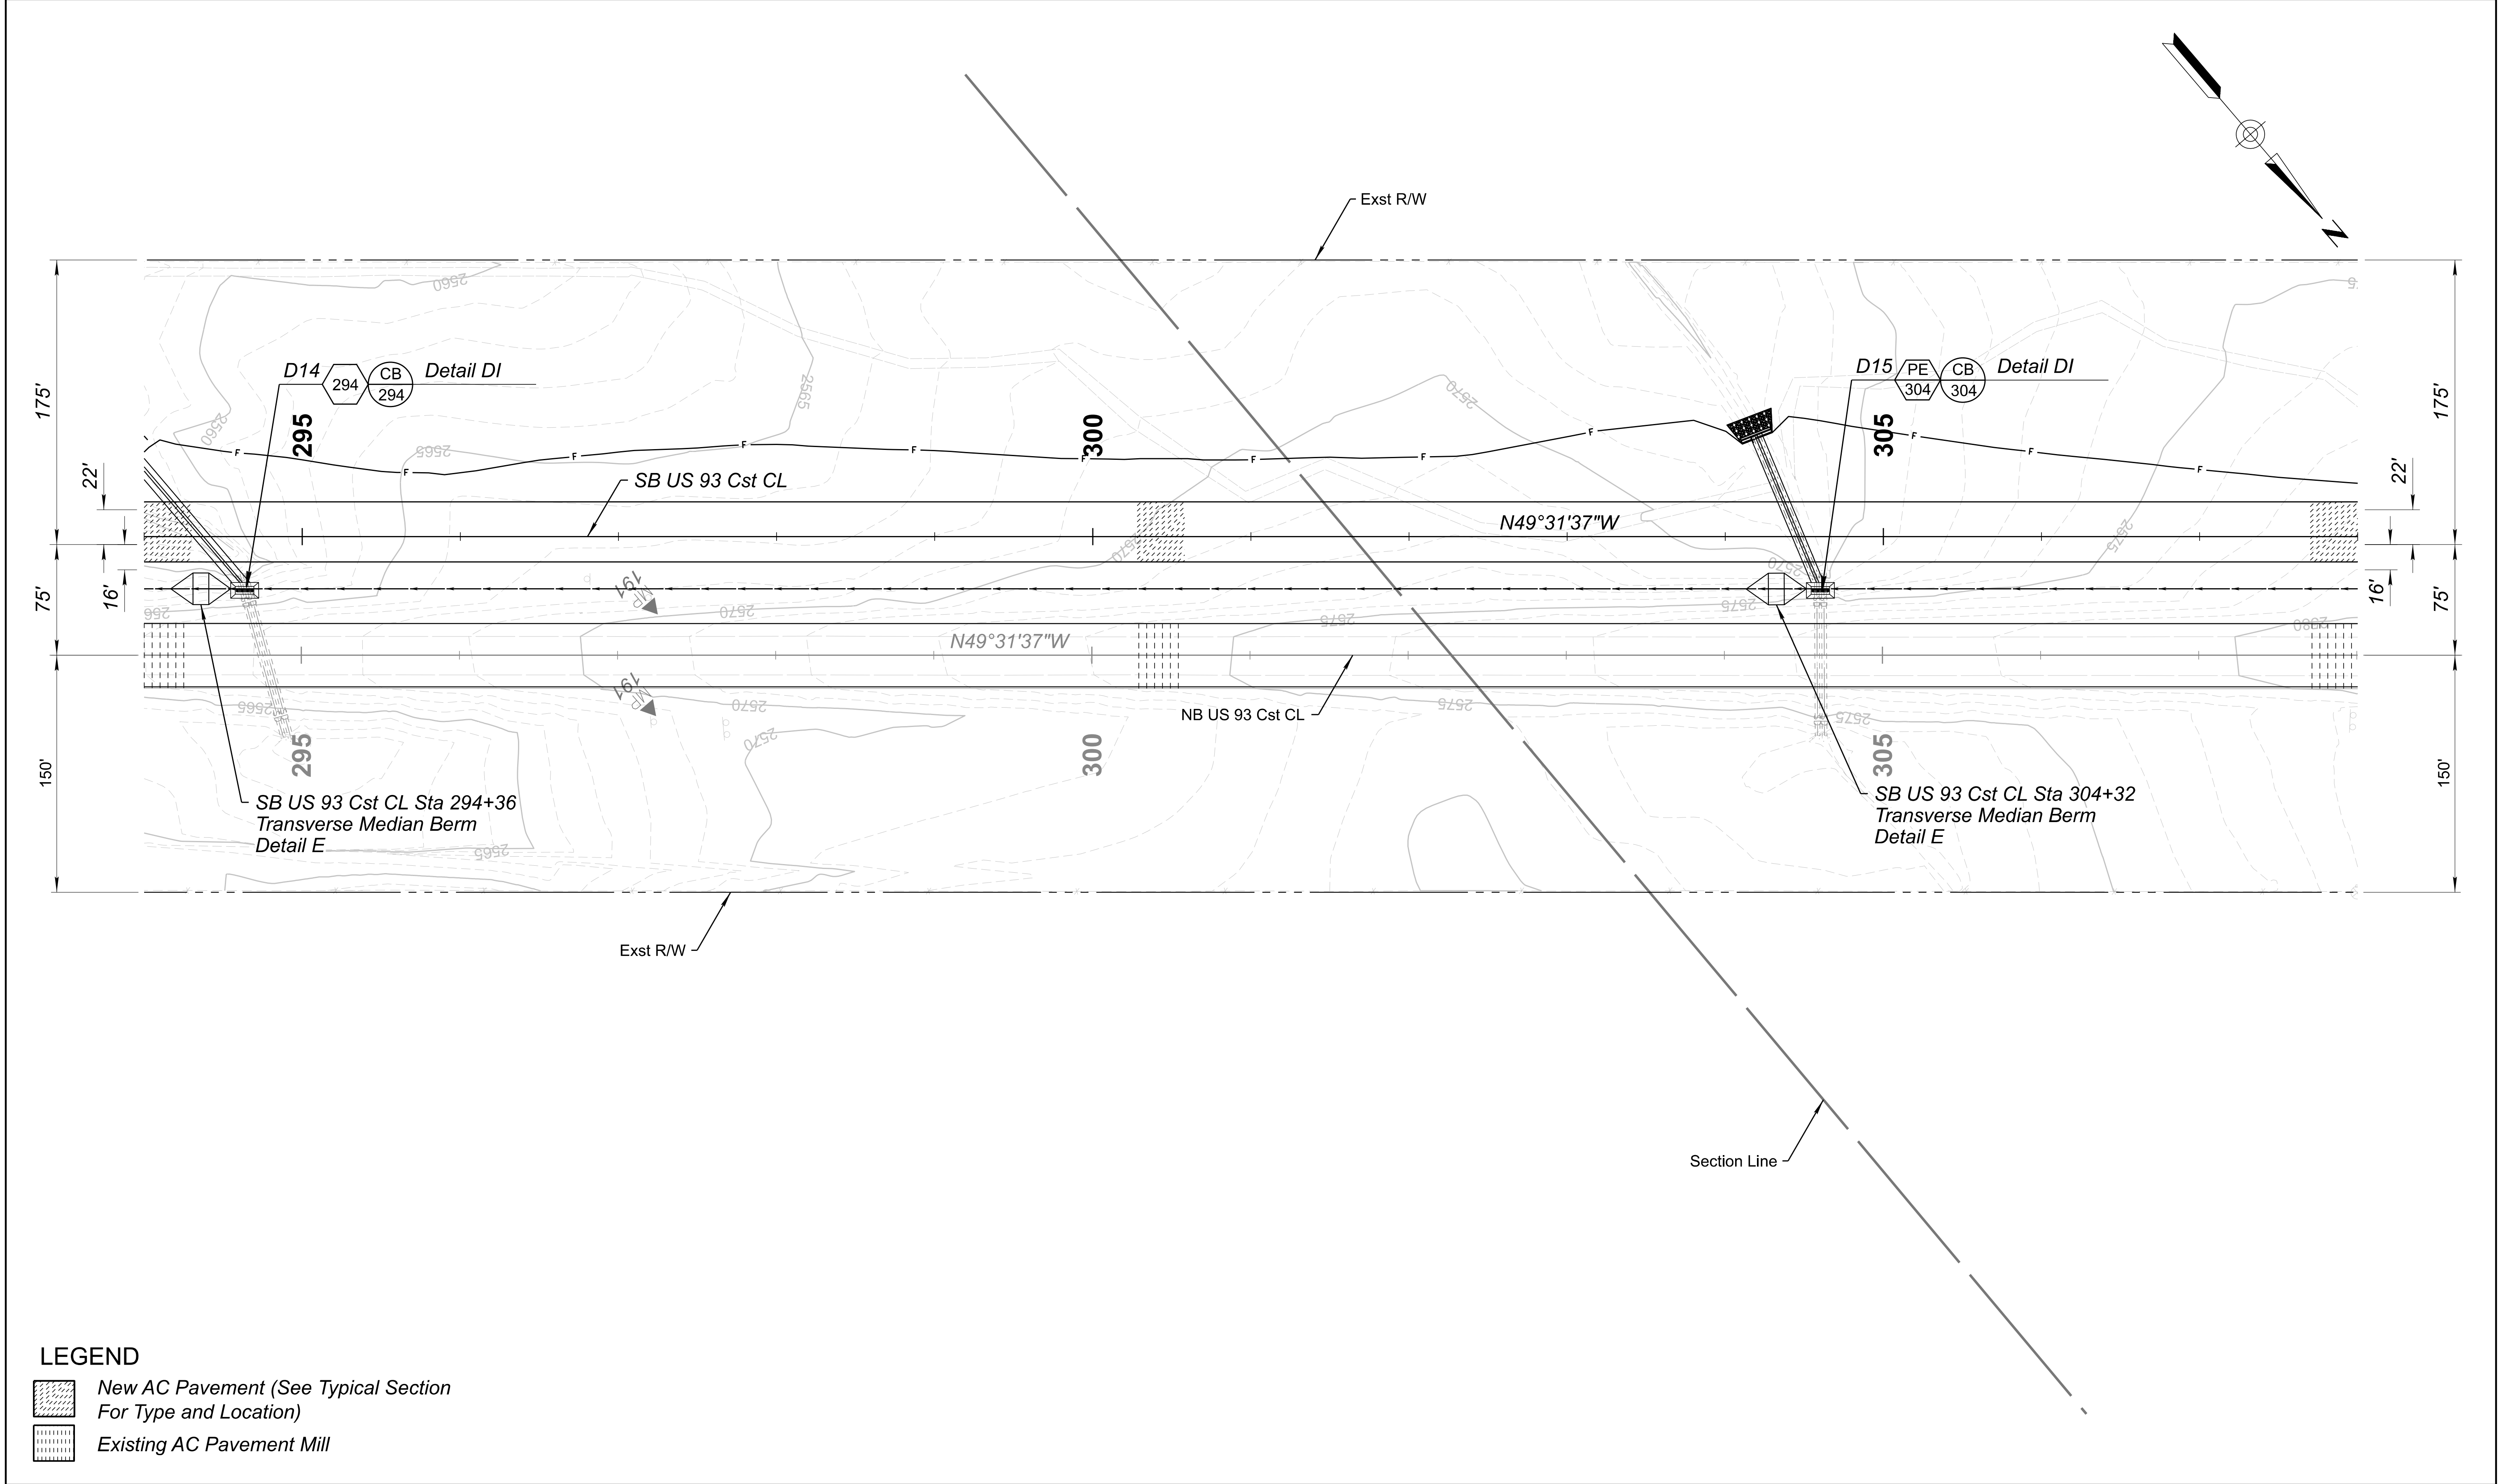


LEGEND


New AC Pavement (See Typical Section For Type and Location)

Existing AC Pavement Mill

UTILITY DISPOSITION SHEETS LEGEND					NAME		DATE	ARIZONA DEPARTMENT OF TRANSPORTATION PROJECT DELIVERY AND OPERATIONS DIVISION ROADWAY DESIGN SERVICES			ROUTE	F.H.W.A. Arizona Division	STATE ARIZ.	PROJECT NO.	FEDERAL ID NO.	SHEET NO.	TOTAL SHEETS	RECORD DRAWING
A	To Remain in Service - Protect-In-Place				DESIGN	J GILLIS	06/26	DRAWN	M SAMUELSON	06/26	US 93			093 YV 189	093-B(230)T	178	524	
B	Contractor to Relocate, Remove, or Reset				CHECKED	D WIGGINS	06/26	TRANSPORTATION AECOM TECHNICAL SERVICES, Inc. 7720 N. 16th St., Suite 100 Phoenix, Arizona 85020 T 602.371.1100  www.aecom.com			MILEPOST	WICKENBURG RANCH WAY TO VISTA ROYALE						DWG No. C-3.31
C	To Be Relocated or Removed by Others										189.9							
D	To Be Constructed By Others										STRUCTURE NO.	TRACS NO. F0738 01C						___ OF ___

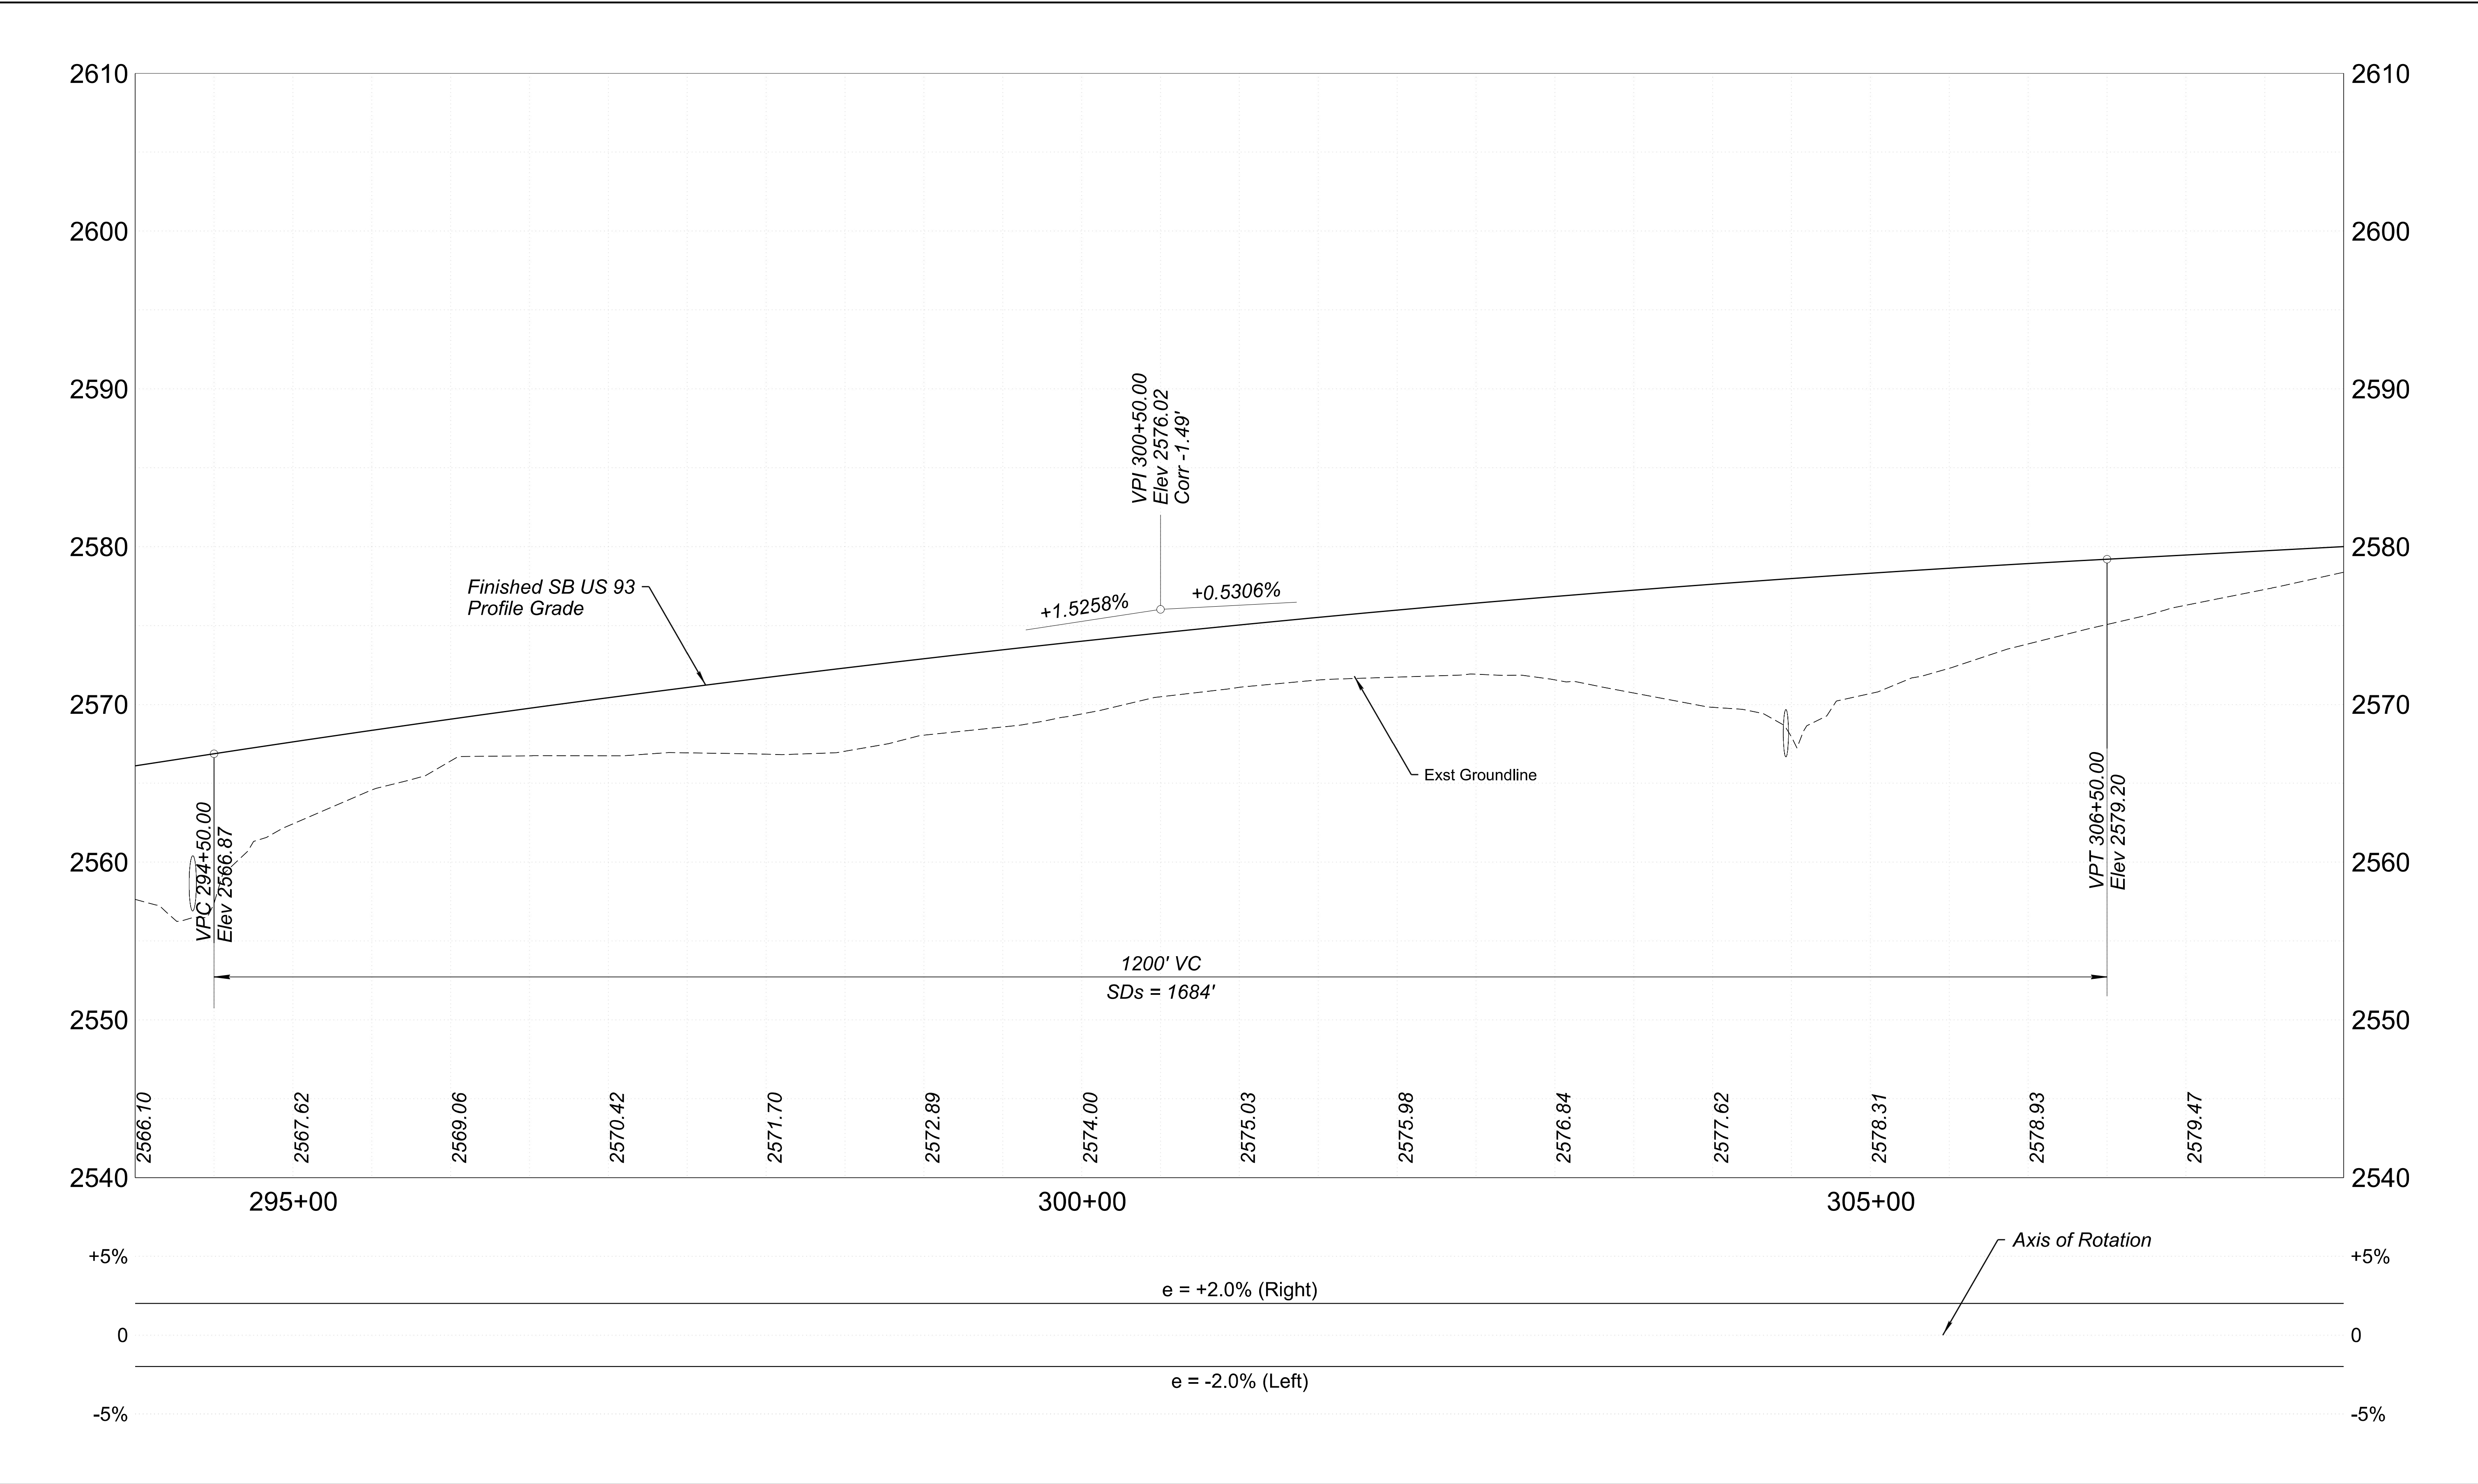



	NAME		DATE	ARIZONA DEPARTMENT OF TRANSPORTATION PROJECT DELIVERY AND OPERATIONS DIVISION ROADWAY DESIGN SERVICES	ROUTE	F.H.W.A. Arizona Division	STATE ARIZ.	PROJECT NO.	FEDERAL ID NO.	SHEET NO.	TOTAL SHEETS	RECORD DRAWING	
	DESIGN	J GILLIS	06/26		US 93			LOCATION WICKENBURG RANCH WAY TO VISTA ROYALE	093 YV 189	093-B(230)T	179	524	DWG No. C-3.32
	DRAWN	M SAMUELSON	06/26		MILEPOST								
	CHECKED	J BEMELEN	06/26	STRUCTURE NO.									
	TRANSPORTATION AECOM TECHNICAL SERVICES, Inc. 7720 N. 16th St., Suite 100 Phoenix, Arizona 85020 T 602.371.1100				AECOM www.aecom.com		TRACS NO. F0738 01C						
PROFILE SHEET SB STA 294+00 TO STA 308+00							OF						

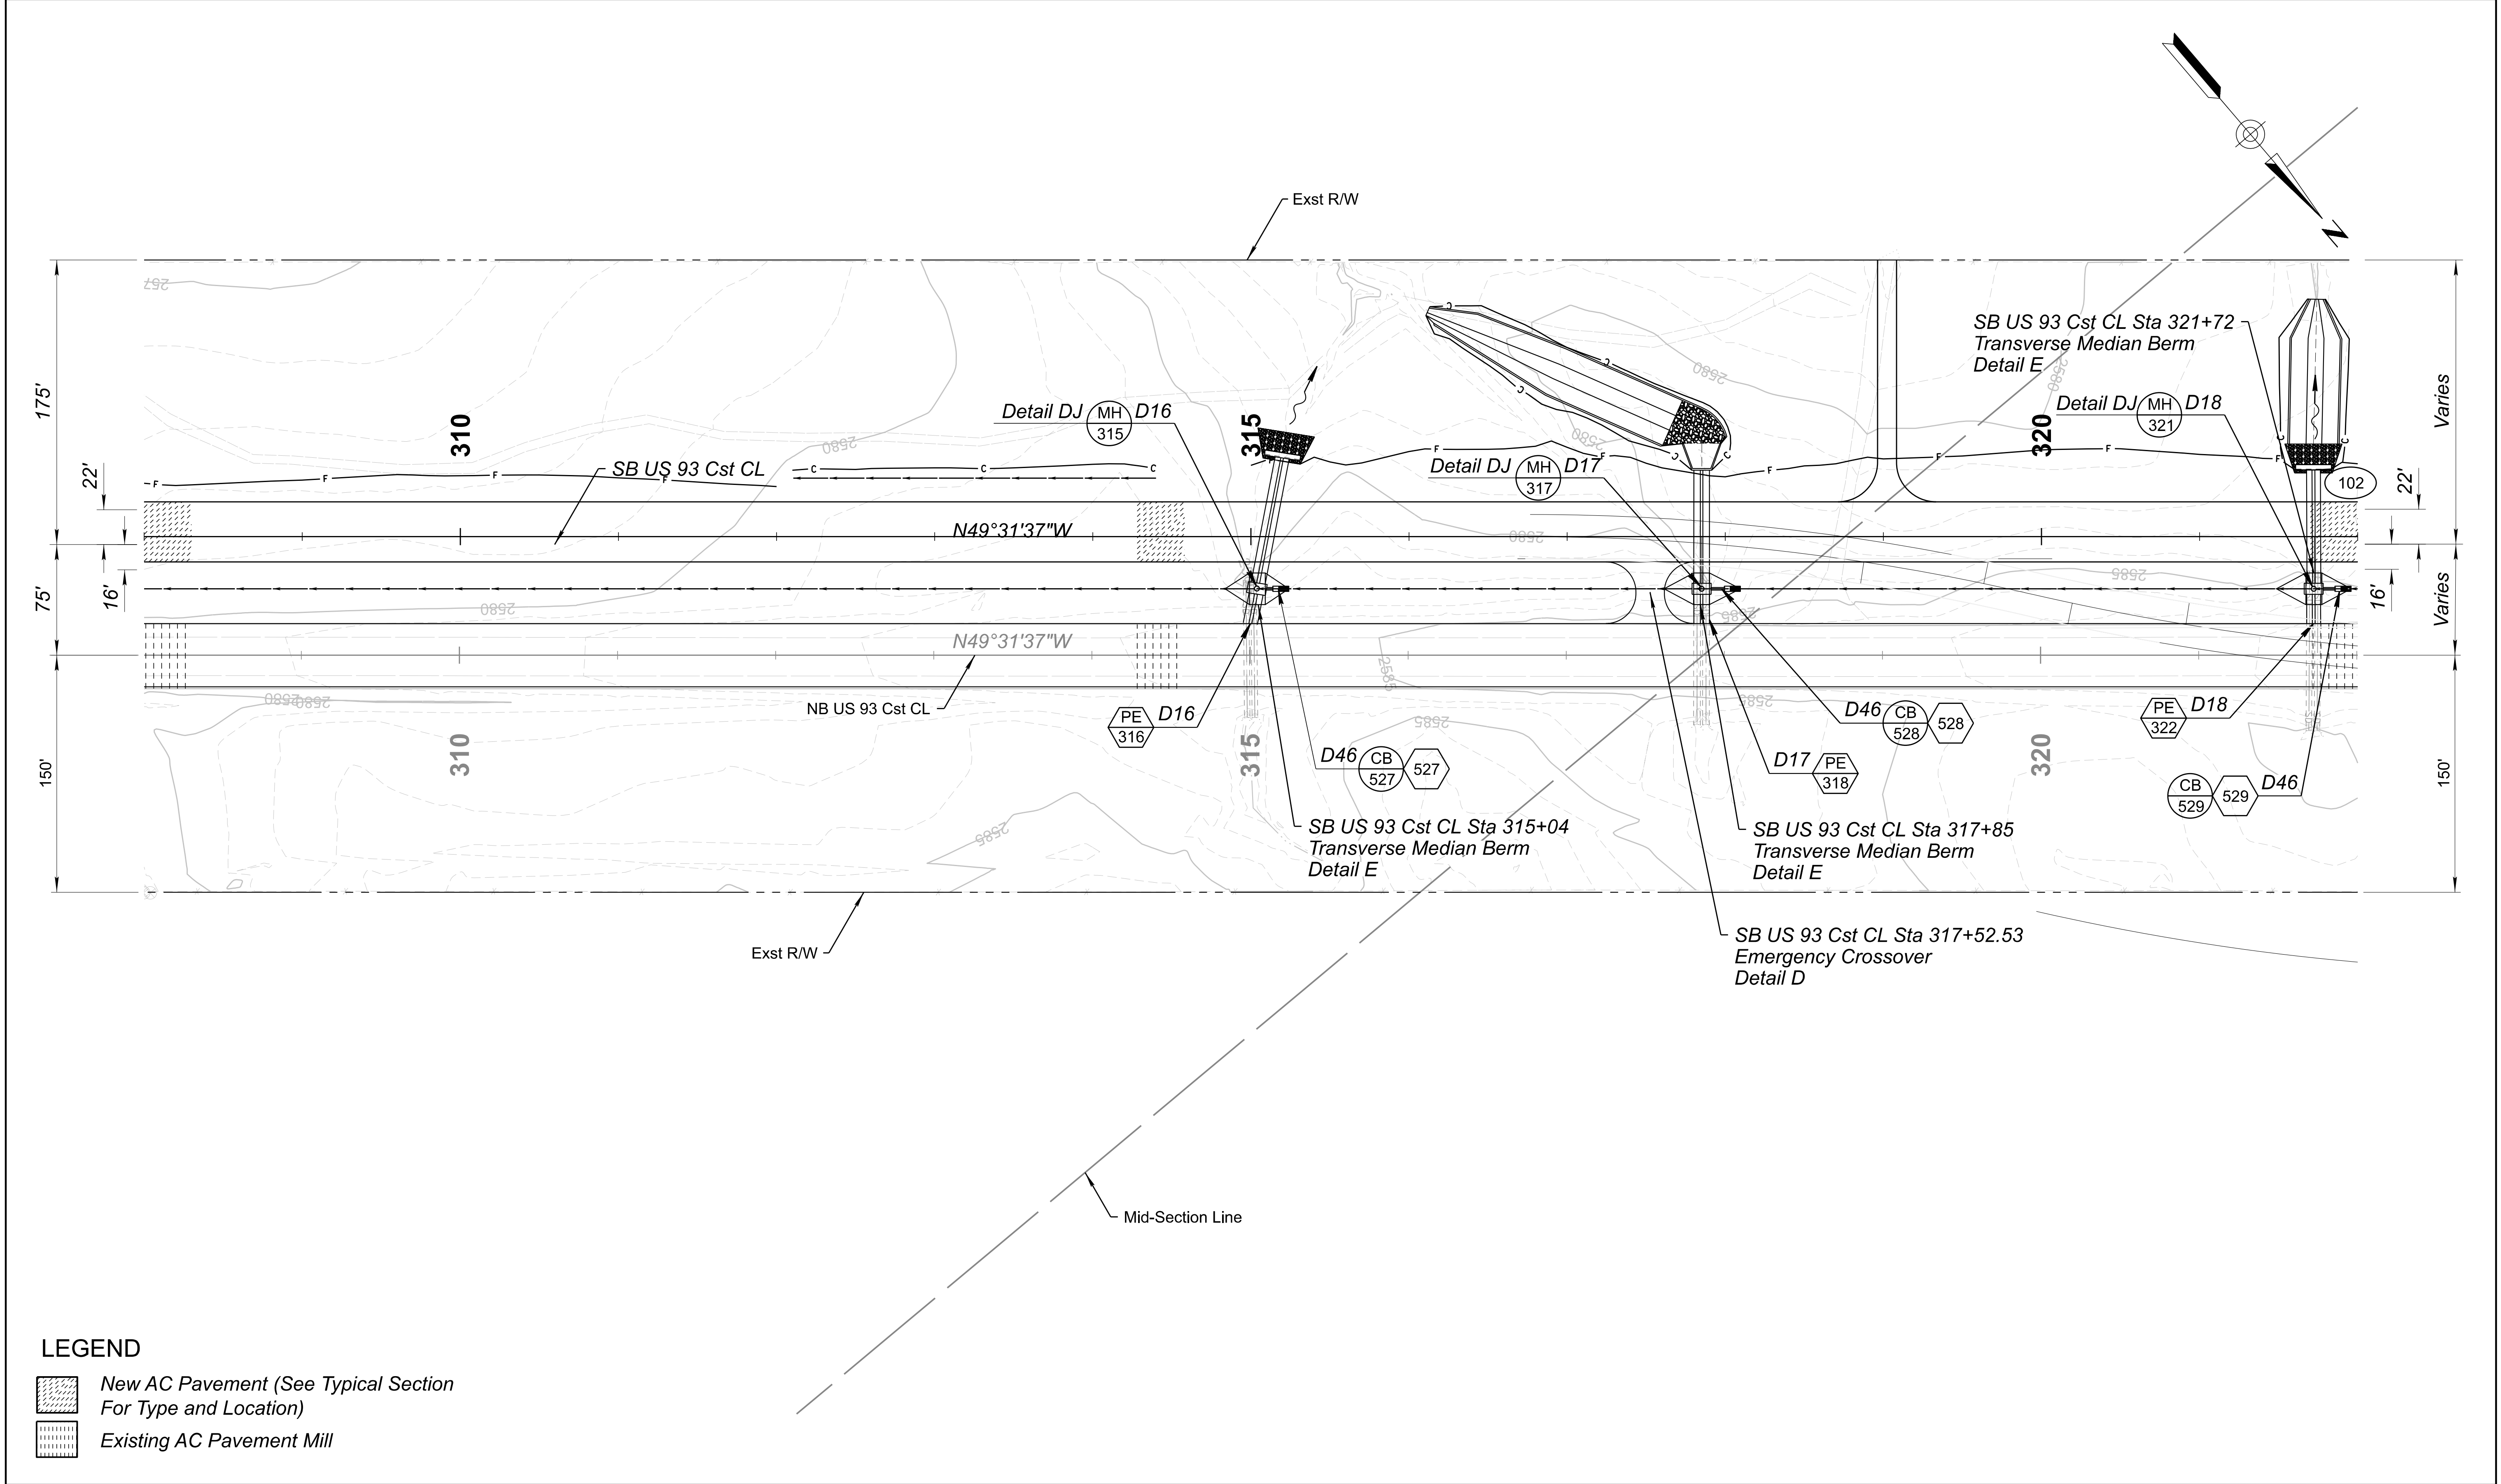


LEGEND

-  New AC Pavement (See Typical Section For Type and Location)
-  Existing AC Pavement Mill

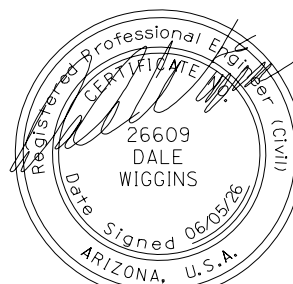UTILITY DISPOSITION SHEETS LEGEND					NAME		DATE	ARIZONA DEPARTMENT OF TRANSPORTATION PROJECT DELIVERY AND OPERATIONS DIVISION ROADWAY DESIGN SERVICES		ROUTE	F.H.W.A. Arizona Division	STATE ARIZ.	PROJECT NO.	FEDERAL ID NO.	SHEET NO.	TOTAL SHEETS	RECORD DRAWING	
A	B	C	D		DESIGN	J GILLIS	06/26			US 93			093 YV 189	093-B(230)T	180	524		
To Remain in Service - Protect-In-Place						DRAWN	M SAMUELSON	06/26	PLAN SHEET SB US 93 STA 308+00 TO STA 322+00	MILEPOST 189.9	LOCATION WICKENBURG RANCH WAY TO VISTA ROYALE							DWG No. C-3.33
Contractor to Relocate, Remove, or Reset						CHECKED	D WIGGINS	06/26		STRUCTURE NO.	TRACS NO. F0738 01C	OF						
To Be Relocated or Removed by Others				TRANSPORTATION AECOM TECHNICAL SERVICES, Inc. 7720 N. 18th St., Suite 101 Phoenix, Arizona 85029 T 602.371.1100 www.aecom.com														
To Be Constructed By Others																		

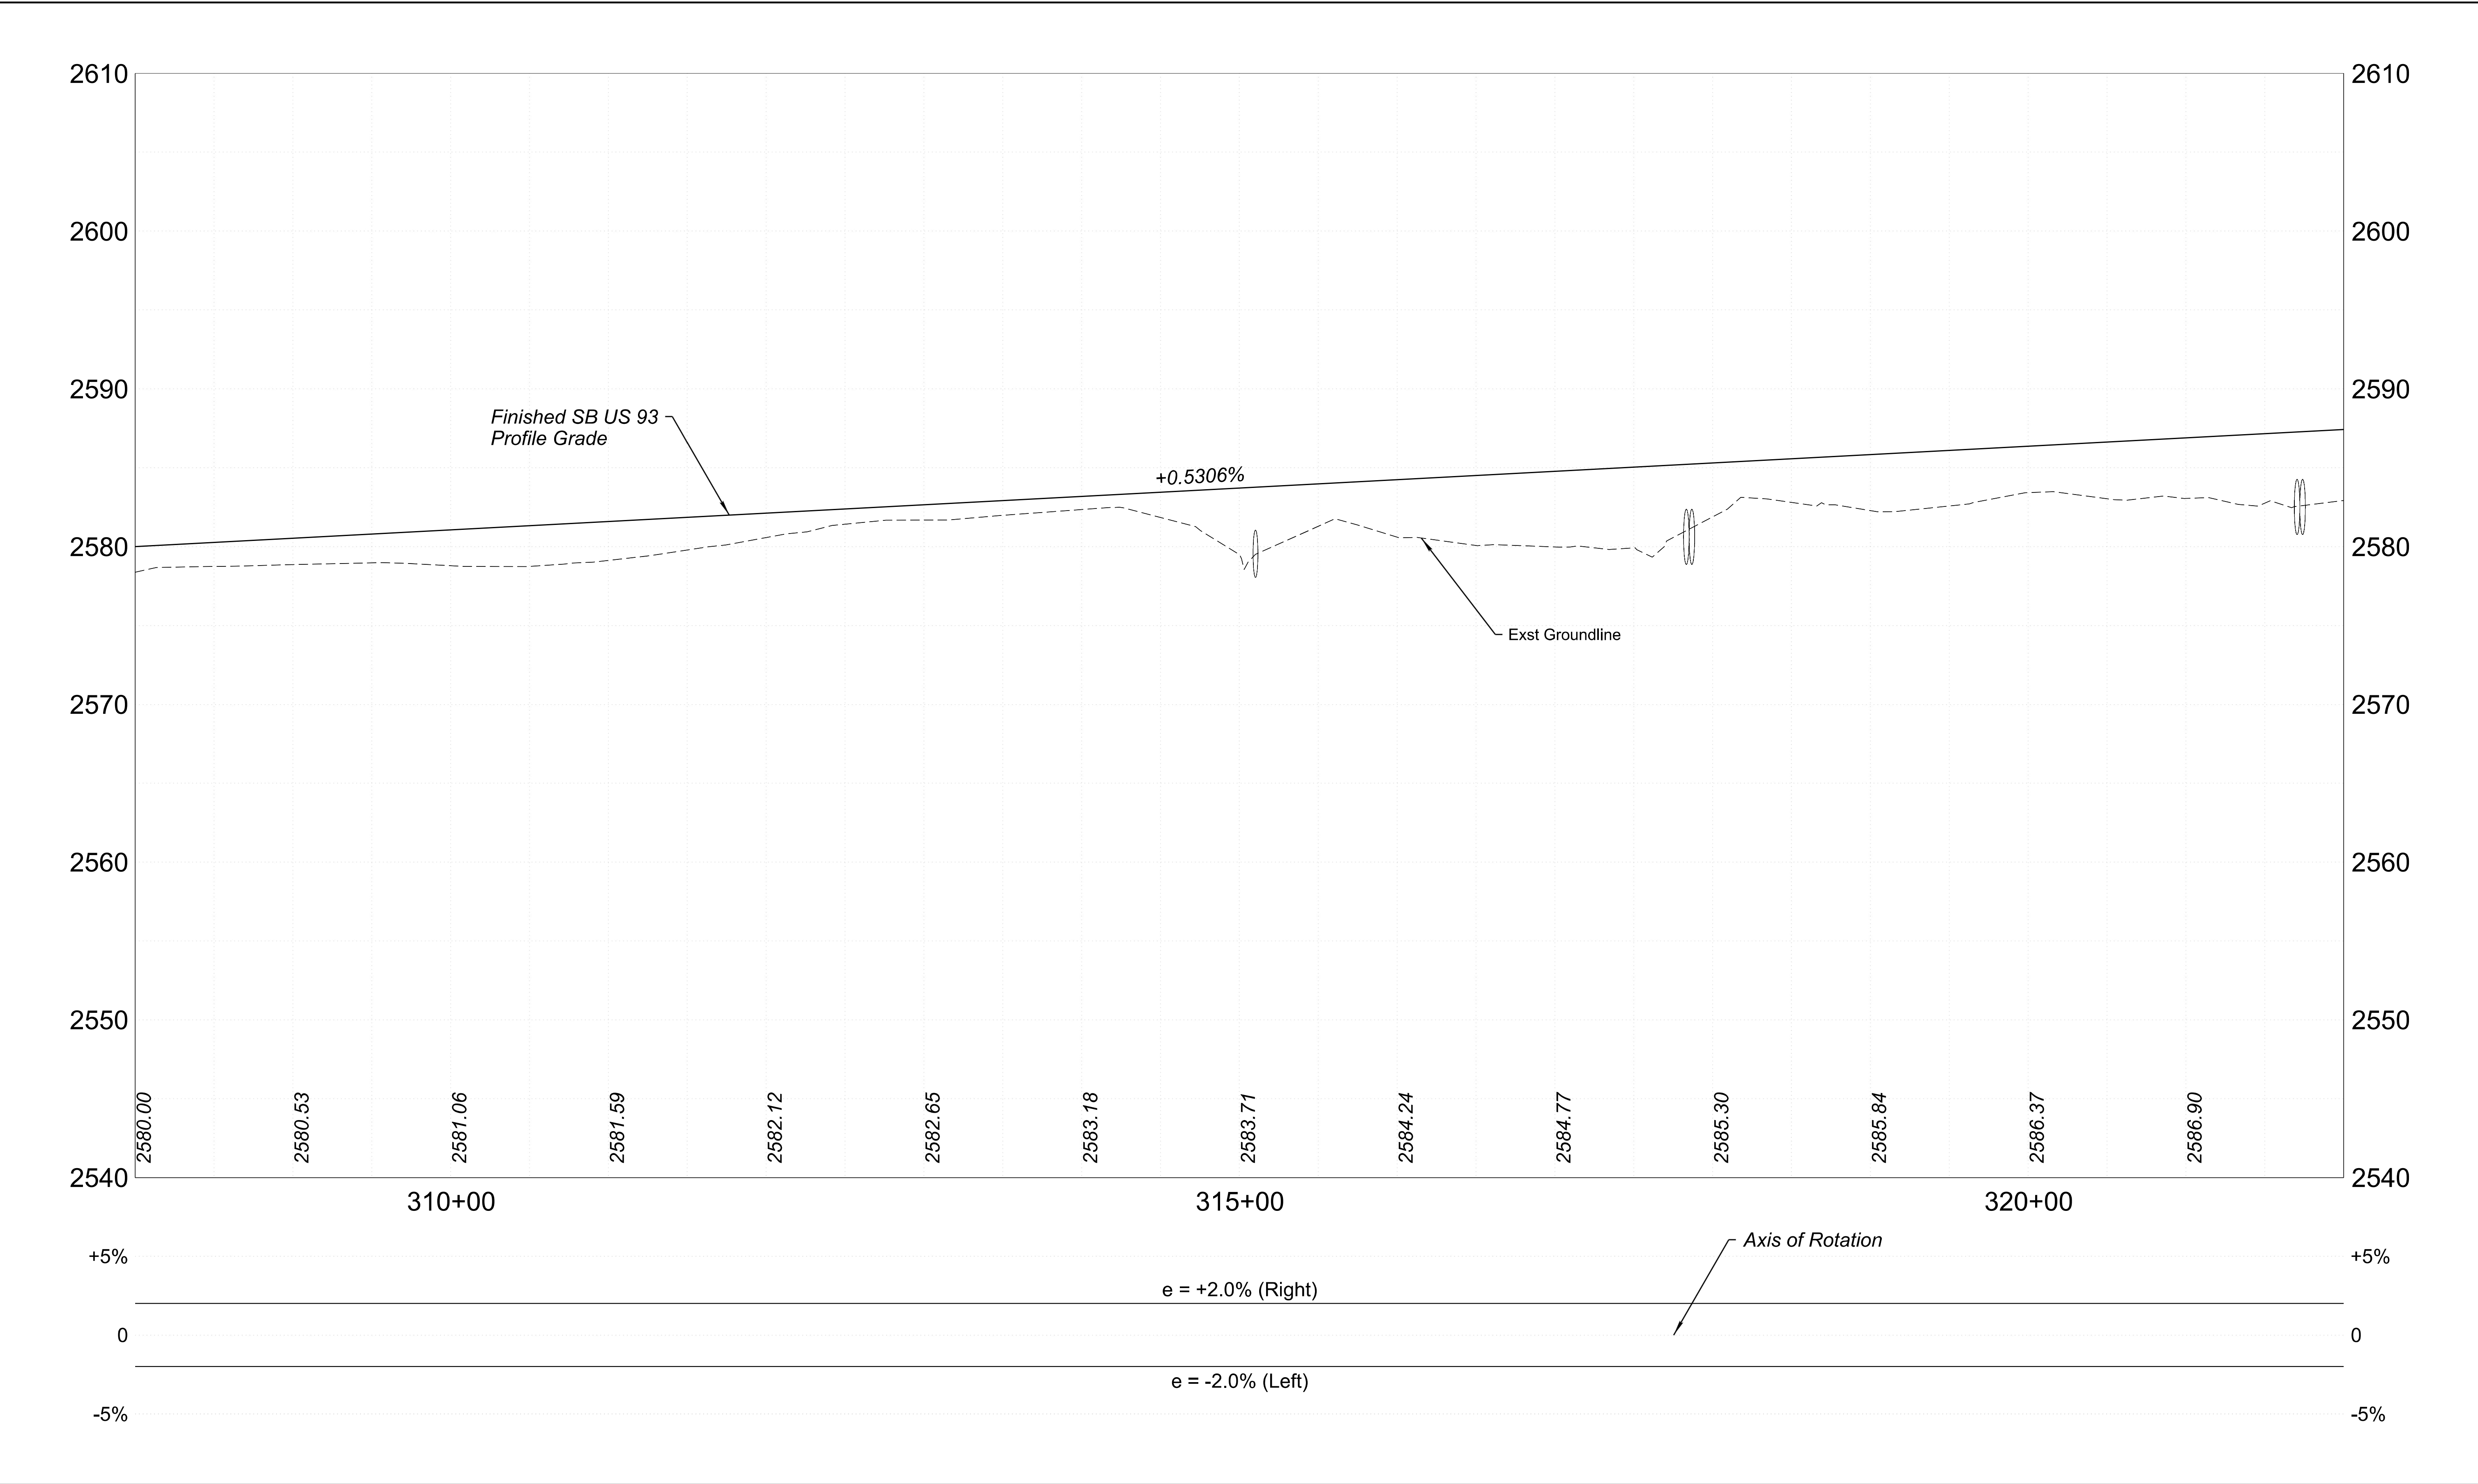


	<table><tr><th></th><th>NAME</th><th>DATE</th></tr><tr><td>DESIGN</td><td>J GILLIS</td><td>06/26</td></tr><tr><td>DRAWN</td><td>M SAMUELSON</td><td>06/26</td></tr><tr><td>CHECKED</td><td>J BEMELEN</td><td>06/26</td></tr></table>			NAME	DATE	DESIGN	J GILLIS	06/26	DRAWN	M SAMUELSON	06/26	CHECKED	J BEMELEN	06/26	ARIZONA DEPARTMENT OF TRANSPORTATION PROJECT DELIVERY AND OPERATIONS DIVISION ROADWAY DESIGN SERVICES		ROUTE US 93	F.H.W.A. Arizona Division	STATE ARIZ.	PROJECT NO. 093 YV 189	FEDERAL ID NO. 093-B(230)T	SHEET NO. 181	TOTAL SHEETS 524	RECORD DRAWING
		NAME	DATE																					
	DESIGN	J GILLIS	06/26																					
	DRAWN	M SAMUELSON	06/26																					
	CHECKED	J BEMELEN	06/26																					
<table><tr><td colspan="3">TRANSPORTATION AECOM TECHNICAL SERVICES, Inc. 7720 N. 16th St., Suite 100 Phoenix, Arizona 85020 T 602.371.1100  www.aecom.com</td></tr></table>		TRANSPORTATION AECOM TECHNICAL SERVICES, Inc. 7720 N. 16th St., Suite 100 Phoenix, Arizona 85020 T 602.371.1100  www.aecom.com			PROFILE SHEET SB STA 308+00 TO STA 322+00		MILEPOST 189.9	LOCATION WICKENBURG RANCH WAY TO VISTA ROYALE					DWG No. C-3.34											
TRANSPORTATION AECOM TECHNICAL SERVICES, Inc. 7720 N. 16th St., Suite 100 Phoenix, Arizona 85020 T 602.371.1100  www.aecom.com																								
STRUCTURE NO.	TRACS NO. F0738 01C						____ OF ____																	

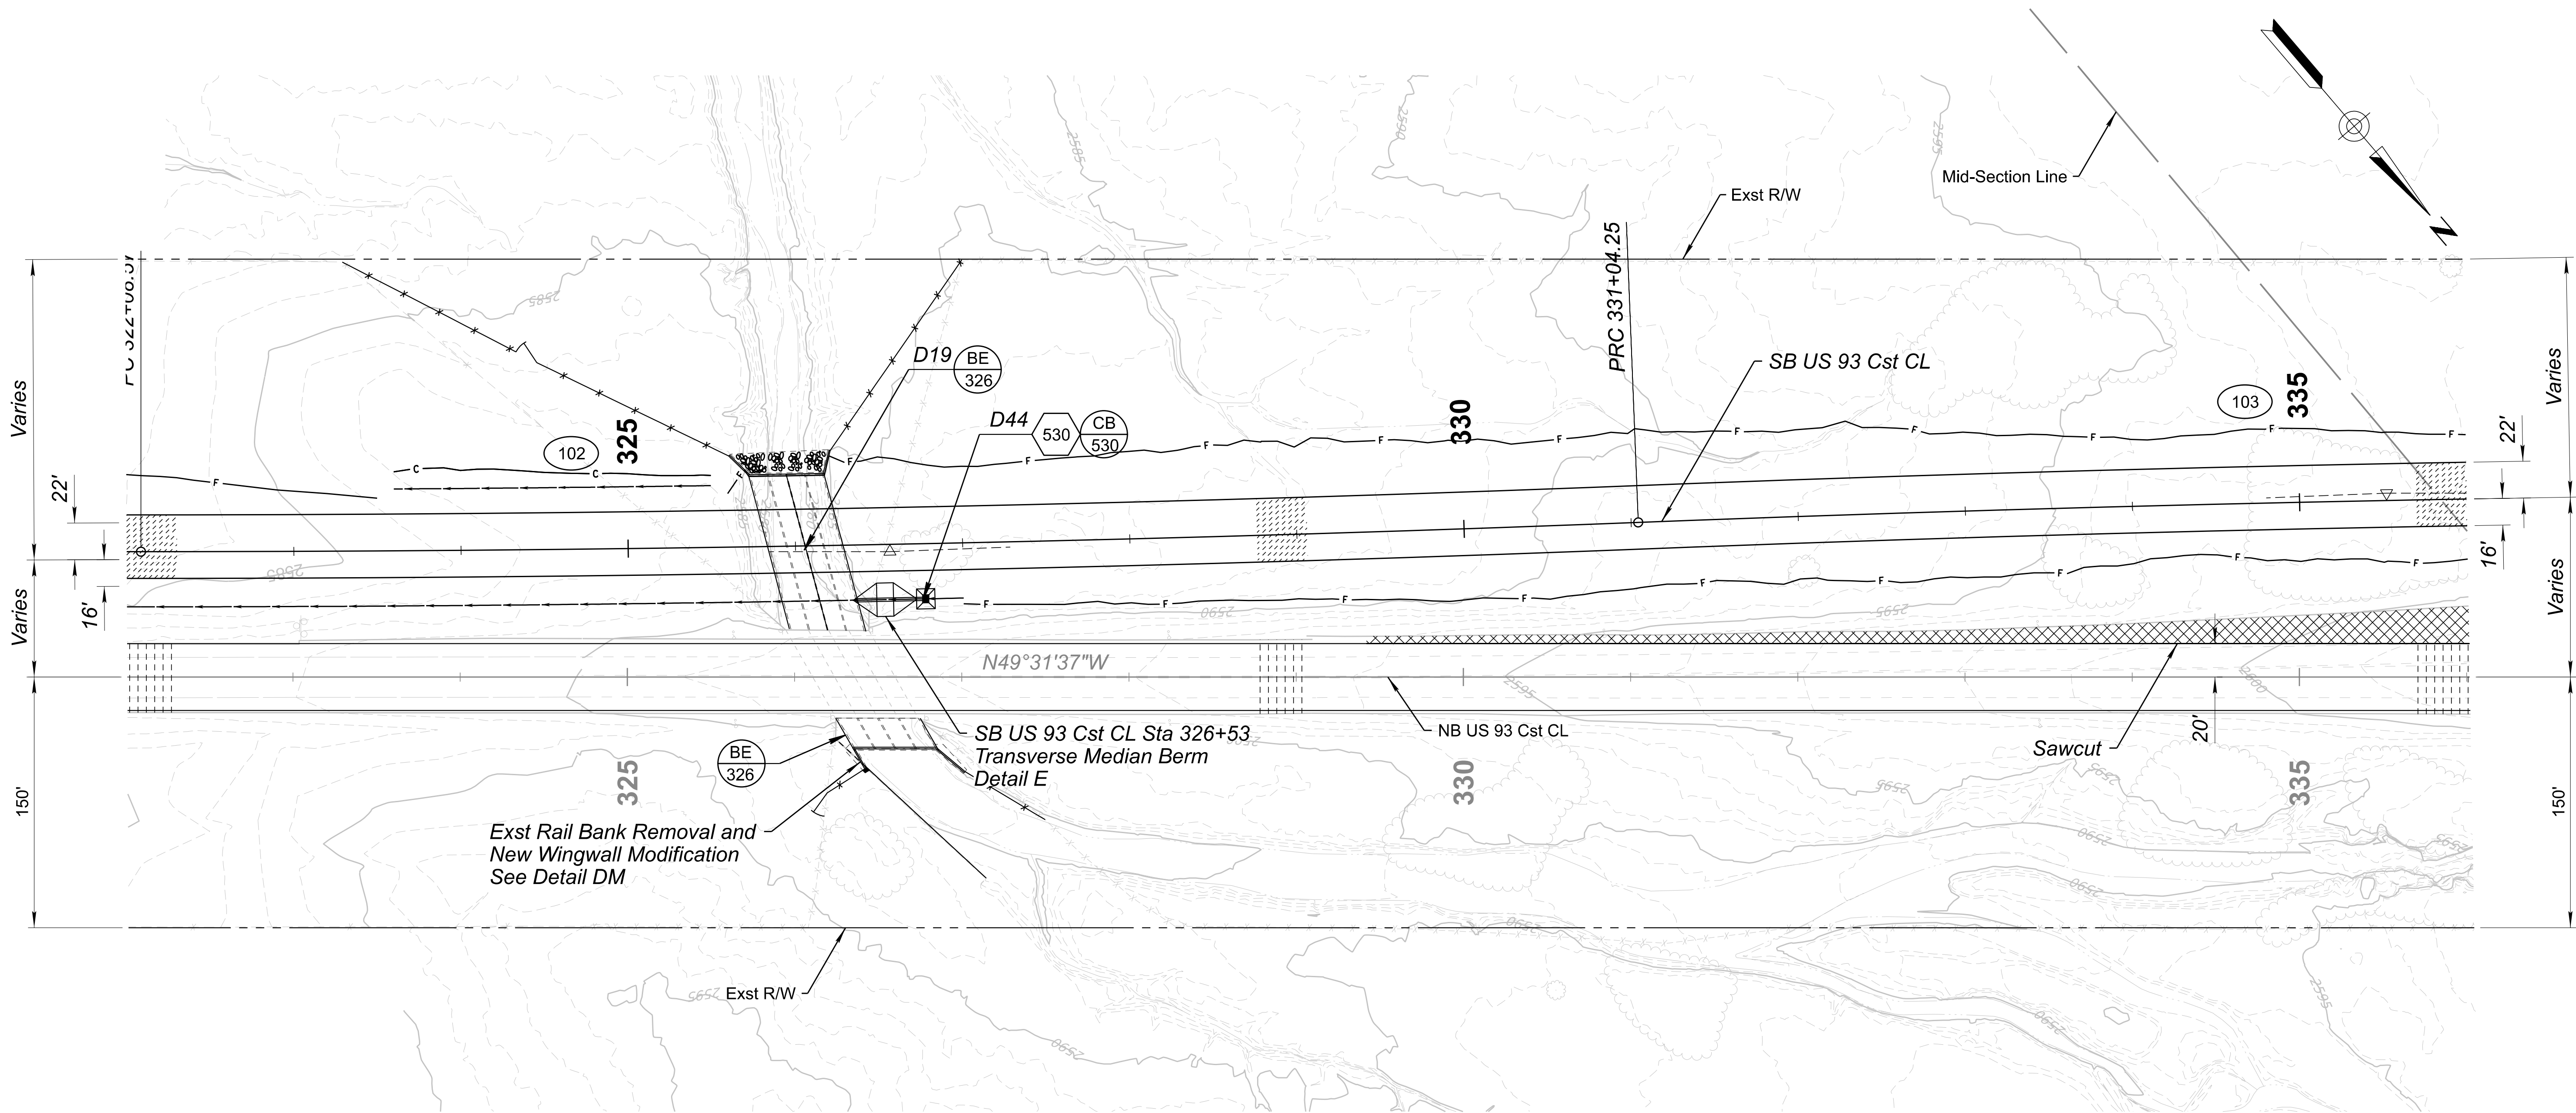


LEGEND

- Exst AC Pavement Remove 744 Sq Yd
- New AC Pavement (See Typical Section For Type and Location)
- Existing AC Pavement Mill

UTILITY DISPOSITION SHEETS LEGEND						TRANSPORTATION AECOM TECHNICAL SERVICES, Inc. 7720 N. 16th St., Suite 100 Phoenix, Arizona 85020 T 602.371.1100 www.aecom.com	ARIZONA DEPARTMENT OF TRANSPORTATION PROJECT DELIVERY AND OPERATIONS DIVISION ROADWAY DESIGN SERVICES		ROUTE	F.H.W.A. Arizona Division	STATE ARIZ.	PROJECT NO.	FEDERAL ID NO.	SHEET NO.	TOTAL SHEETS	RECORD DRAWING		
A	To Remain in Service - Protect-In-Place		DESIGN	J GILLIS			06/26 <th>US 93</th> <th>093 YV 189</th> <th>093-B(230)T</th> <th>182</th> <th>524</th>	US 93	093 YV 189			093-B(230)T	182	524				
B	Contractor to Relocate, Remove, or Reset		DRAWN	M SAMUELSON			06/26 <th>MILEPOST 189.9</th> <th colspan="10" rowspan="2">LOCATION WICKENBURG RANCH WAY TO VISTA ROYALE DWG No. C-3.35</th>	MILEPOST 189.9	LOCATION WICKENBURG RANCH WAY TO VISTA ROYALE DWG No. C-3.35									
C	To Be Relocated or Removed by Others		CHECKED	D WIGGINS			06/26 <th>STRUCTURE NO.</th> <th colspan="10">TRACS NO. F0738 01C</th>	STRUCTURE NO.										
D	To Be Constructed By Others						PLAN SHEET SB US 93 STA 322+00 TO STA 336+00		____ OF ____									

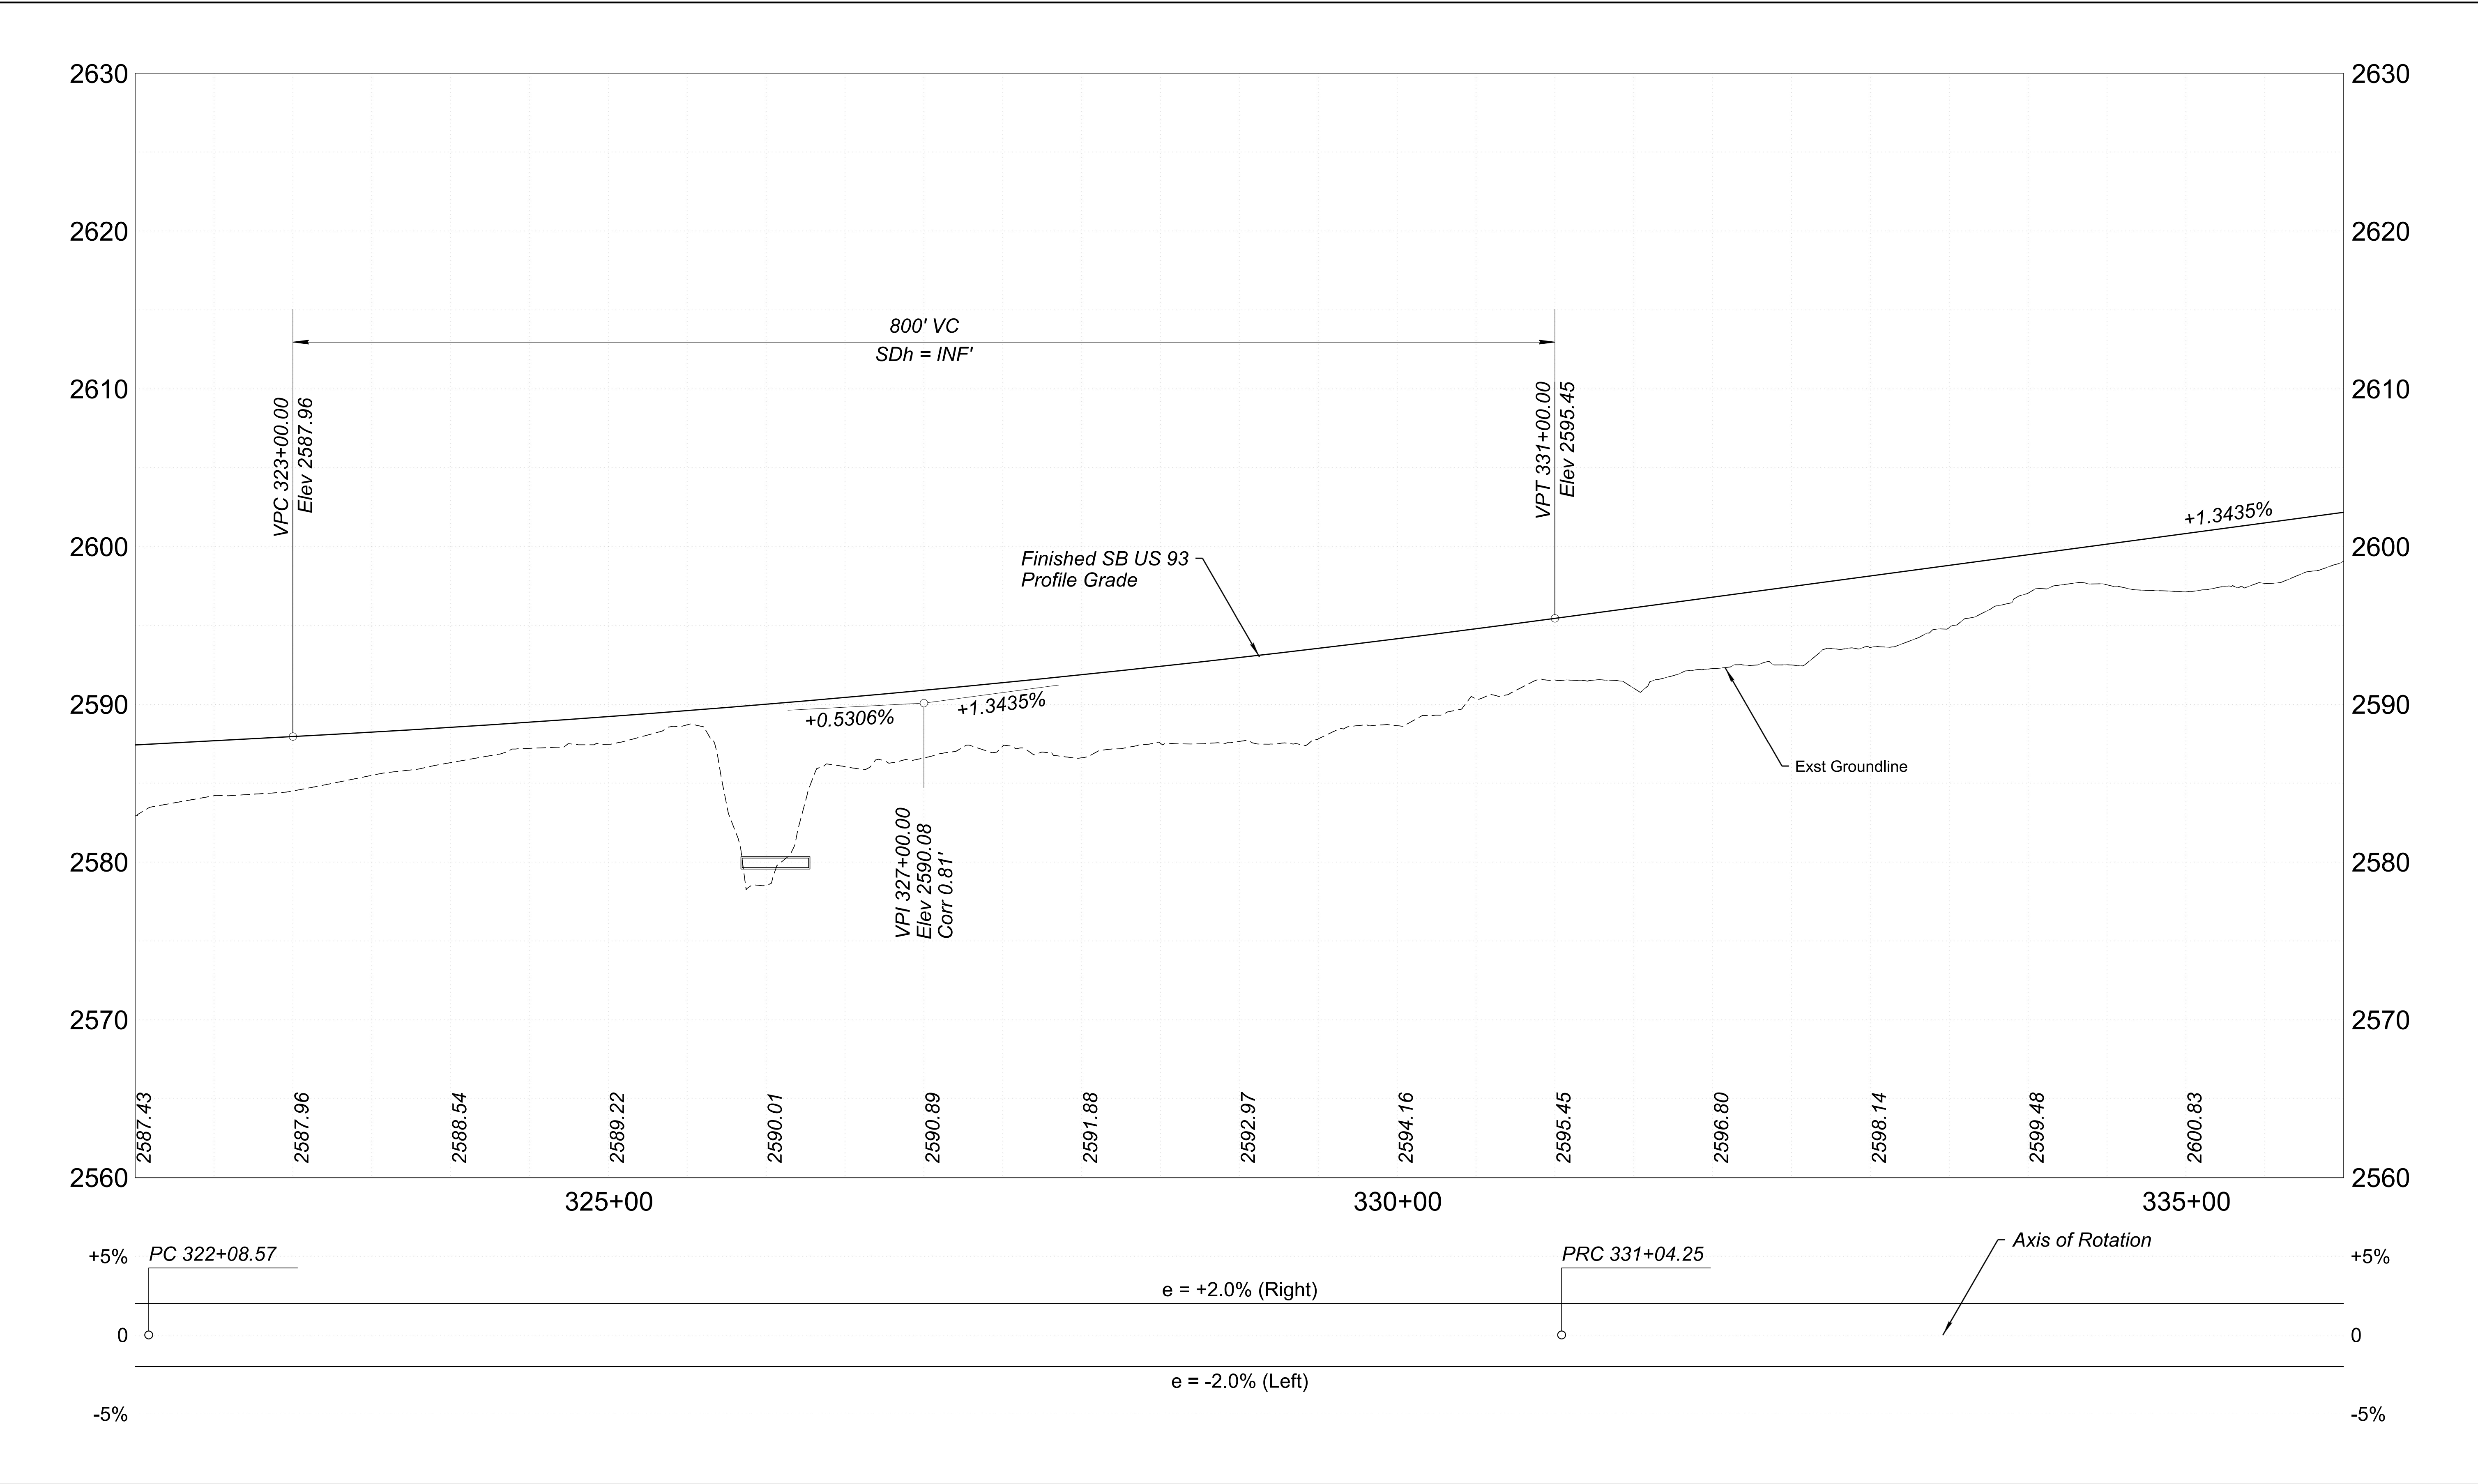

	NAME		DATE	ARIZONA DEPARTMENT OF TRANSPORTATION PROJECT DELIVERY AND OPERATIONS DIVISION ROADWAY DESIGN SERVICES		ROUTE	F.H.W.A. Arizona Division	STATE	PROJECT NO.	FEDERAL ID NO.	SHEET NO.	TOTAL SHEETS	RECORD DRAWING
	DESIGN	J GILLIS	06/26			US 93		ARIZ.	093 YV 189	093-B(230)T	183	524	
	DRAWN	M SAMUELSON	06/26			MILEPOST	LOCATION WICKENBURG RANCH WAY TO VISTA ROYALE						DWG No. C-3.36
	CHECKED	J BEMELEN	06/26	TRANSPORTATION AECOM TECHNICAL SERVICES, Inc. 7720 N. 16th St., Suite 100 Phoenix, Arizona 85020 T 602.371.1100		STRUCTURE NO.	TRACS NO. F0738 01C						____ OF ____

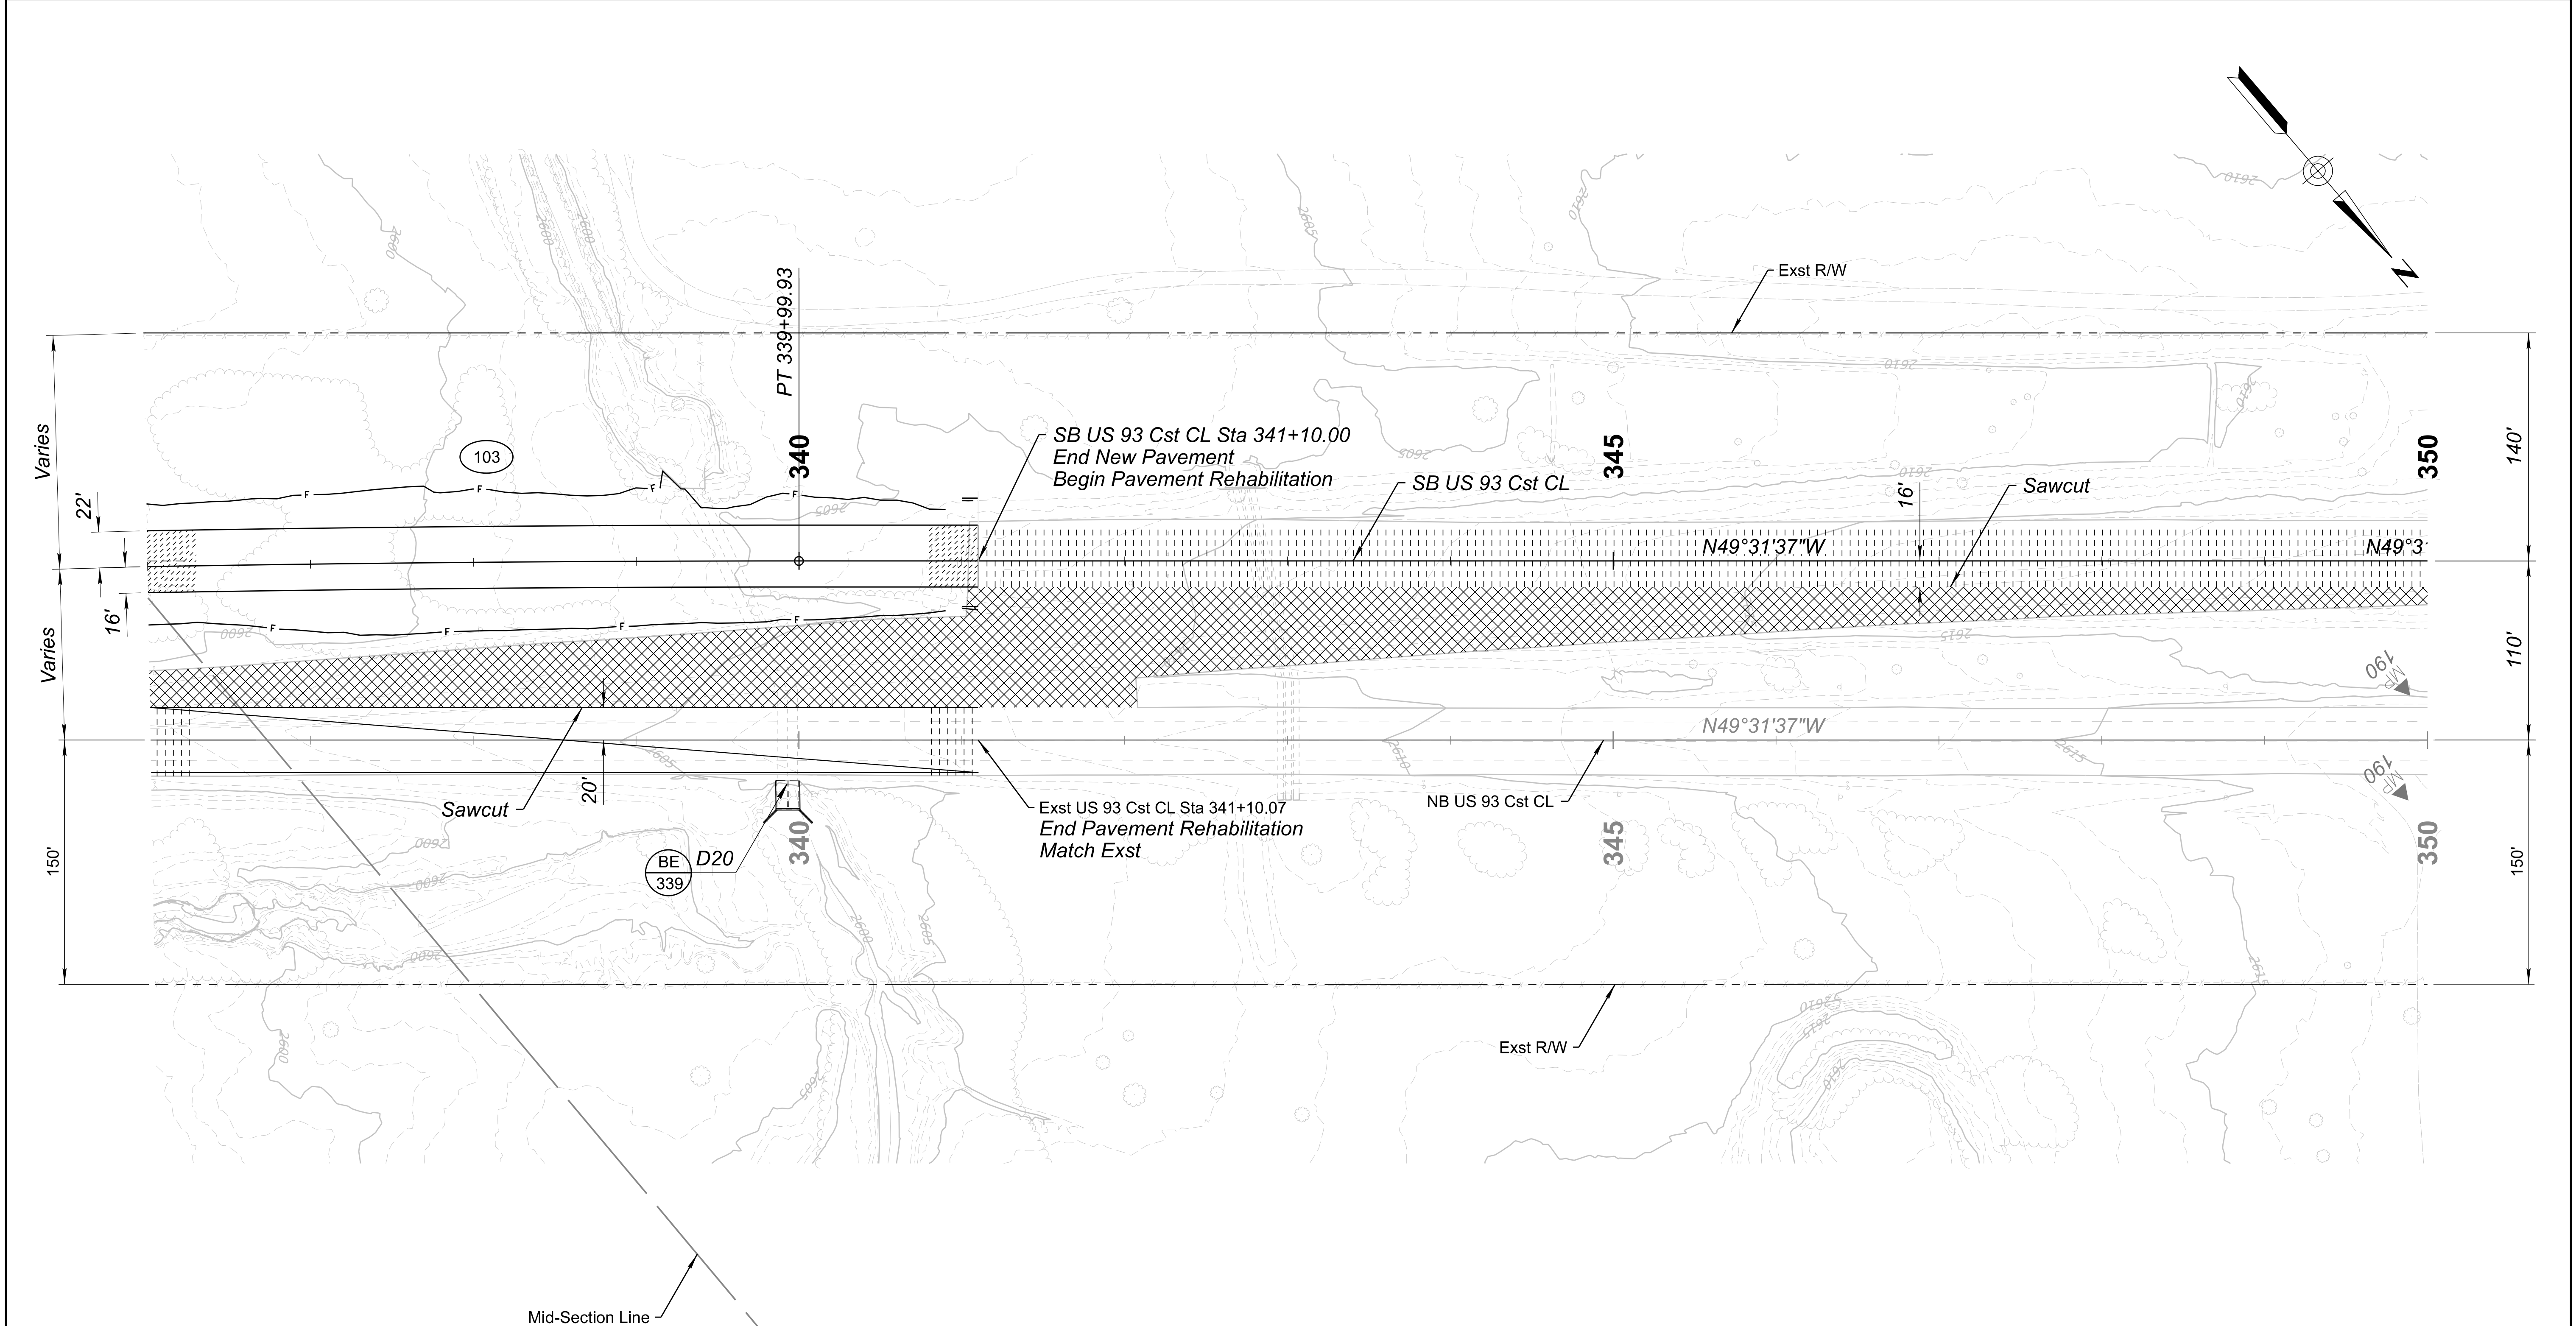

LEGEND

- Exst AC Pavement Remove 5,655 Sq Yd
- New AC Pavement (See Typical Section For Type and Location)
- Existing AC Pavement Mill

UTILITY DISPOSITION SHEETS LEGEND

A	To Remain in Service - Protect-In-Place
B	Contractor to Relocate, Remove, or Reset
C	To Be Relocated or Removed by Others
D	To Be Constructed By Others

DESIGN	J GILLIS	06/26
DRAWN	M SAMUELSON	06/26
CHECKED	D WIGGINS	06/26


TRANSPORTATION
AECOM TECHNICAL SERVICES, Inc.
7720 N. 16th St., Suite 100
Phoenix, Arizona 85020
T 602.371.1100

AECOM
www.aecom.com


ARIZONA DEPARTMENT OF TRANSPORTATION
PROJECT DELIVERY AND OPERATIONS DIVISION
ROADWAY DESIGN SERVICES

PLAN SHEET
SB US 93 STA 336+00 TO STA 350+00

ROUTE US 93	F.H.W.A. Arizona Division	STATE ARIZ.	PROJECT NO. 093 YV 189	FEDERAL ID NO. 093-B(230)T	SHEET NO. 184	TOTAL SHEETS 524	RECORD DRAWING
MILEPOST 189.9							
STRUCTURE NO.	WICKENBURG RANCH WAY TO VISTA ROYALE						DWG No. C-3.37
TRACS NO. F0738 01C			OF				

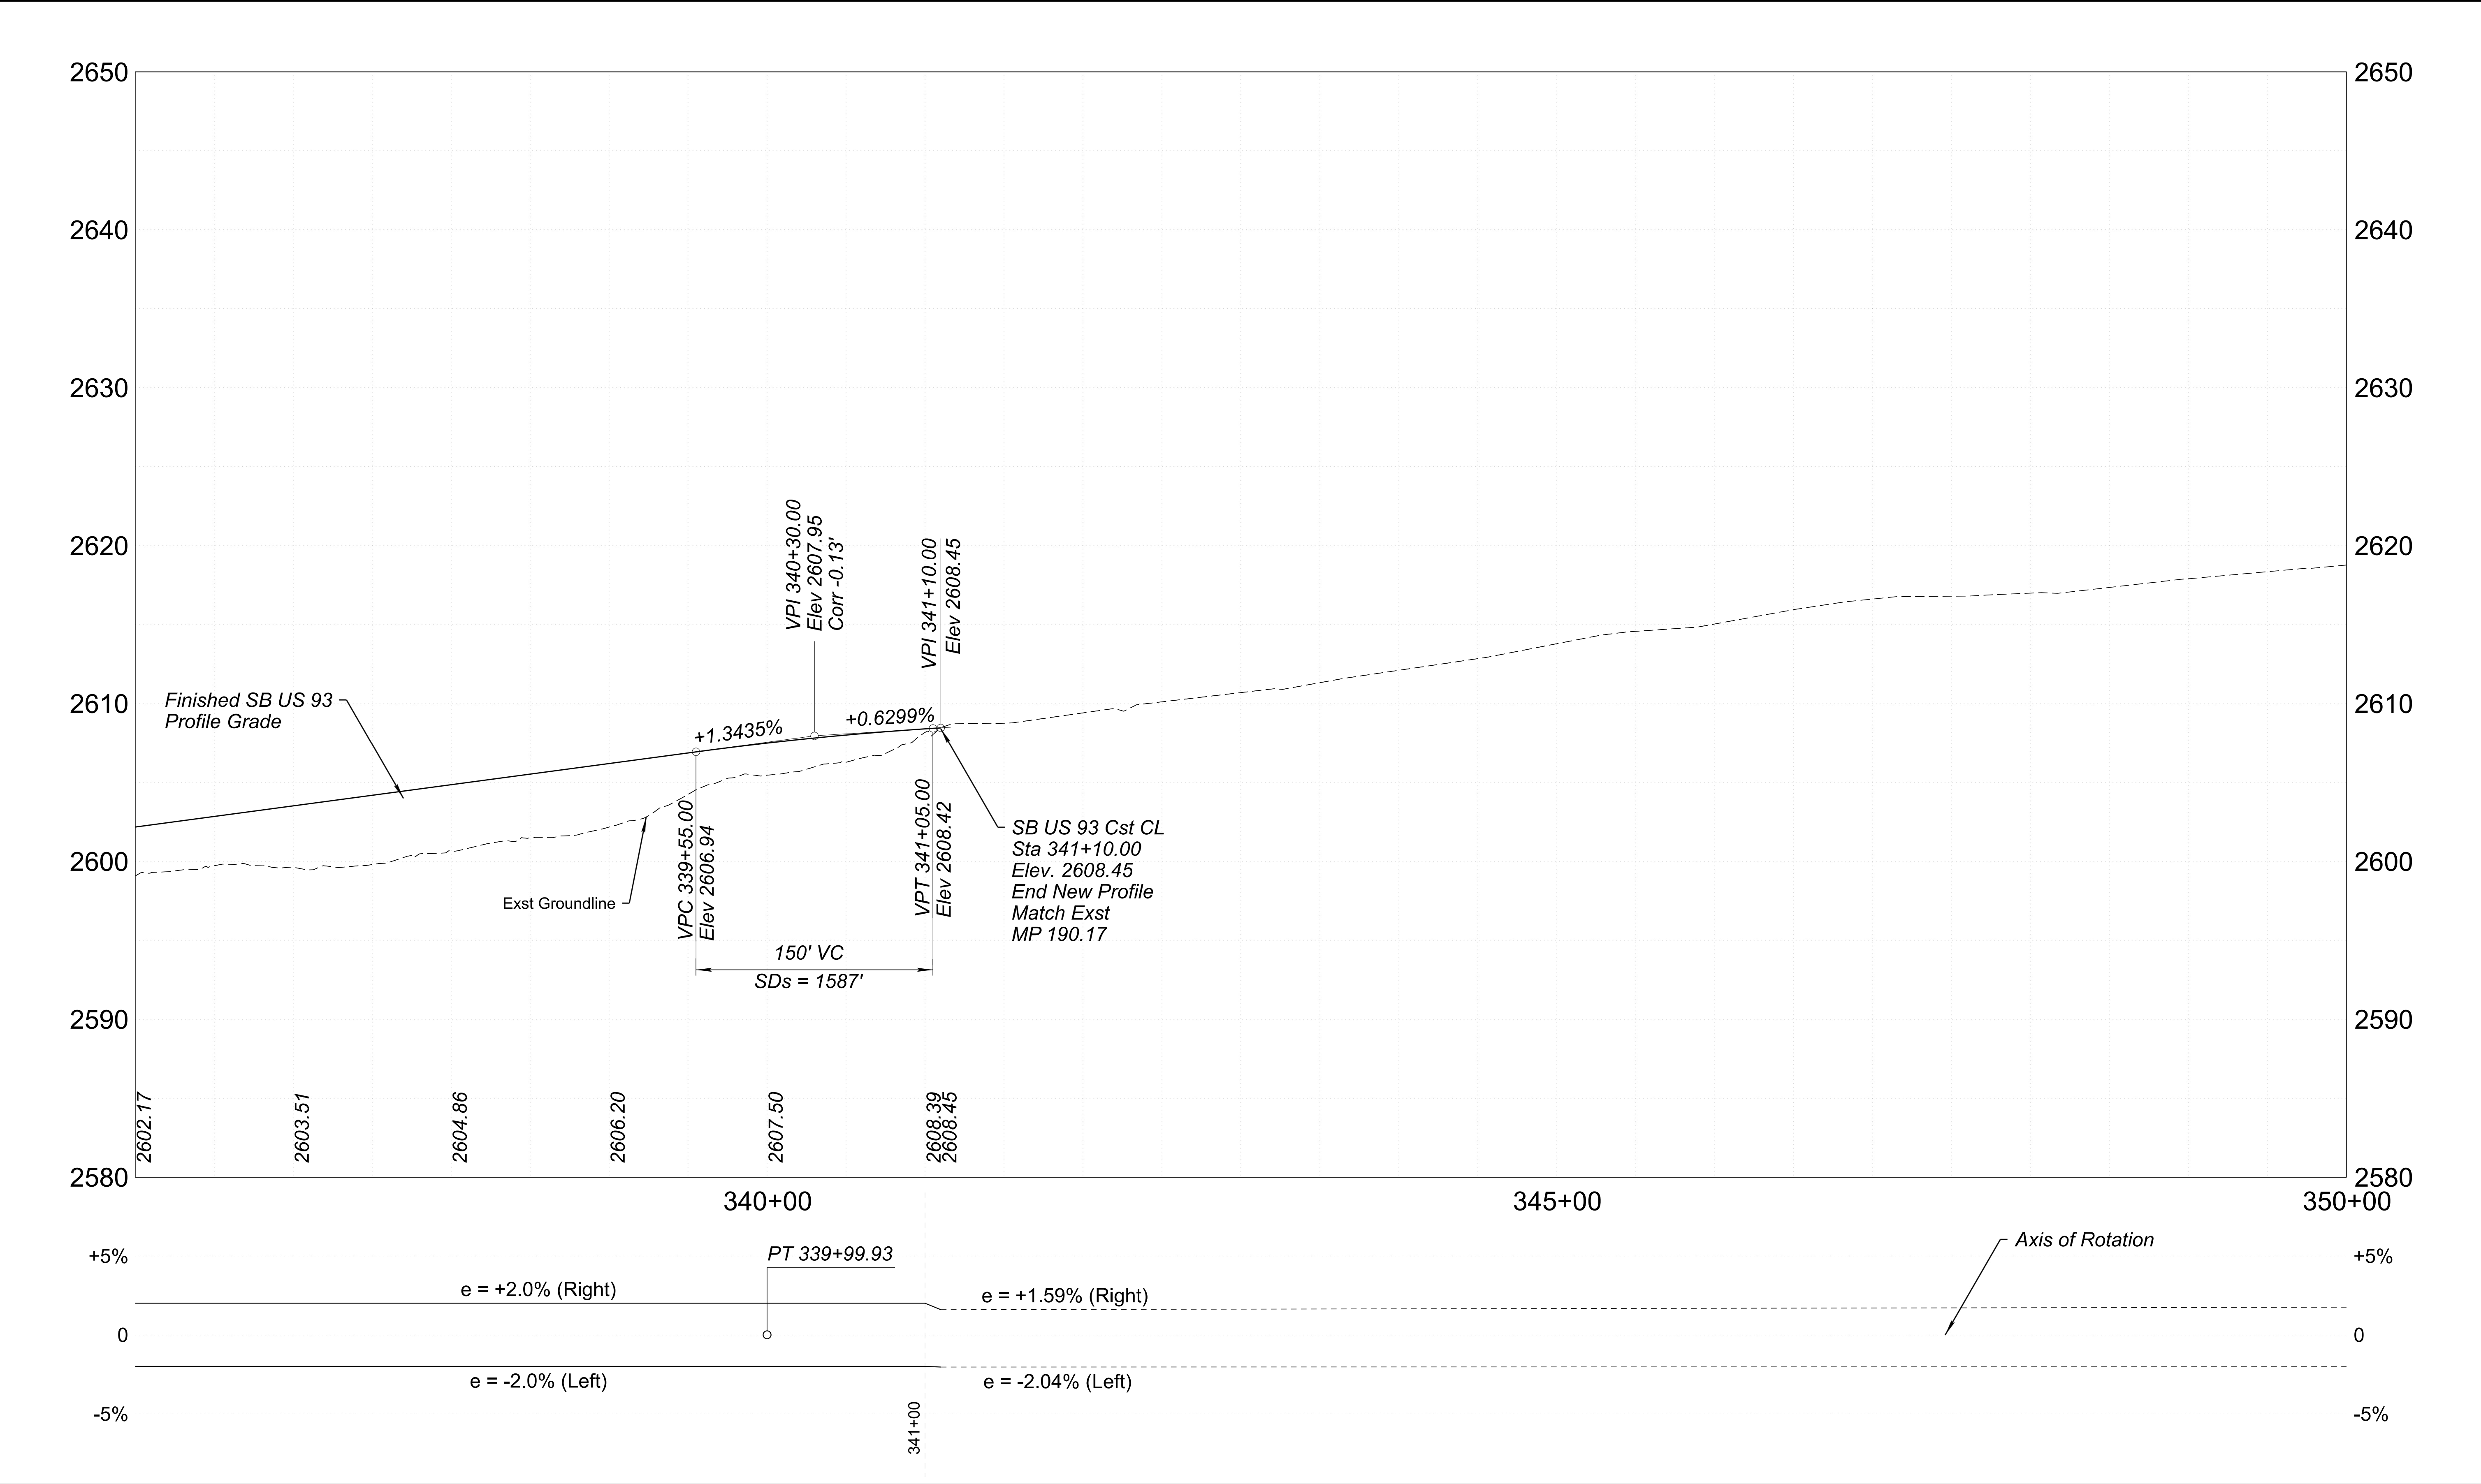


	DESIGN	J GILLIS	06/26	ARIZONA DEPARTMENT OF TRANSPORTATION PROJECT DELIVERY AND OPERATIONS DIVISION ROADWAY DESIGN SERVICES	ROUTE	F.H.W.A. Arizona Division	STATE ARIZ.	PROJECT NO.	FEDERAL ID NO.	SHEET NO.	TOTAL SHEETS	RECORD DRAWING
	DRAWN	M SAMUELSON	06/26		093 YV 189			093-B(230)T	185	524		
	CHECKED	J BEMELEN	06/26		MILEPOST 189.9	LOCATION WICKENBURG RANCH WAY TO VISTA ROYALE					DWG No. C-3.38	
	TRANSPORTATION AECOM TECHNICAL SERVICES, Inc. 7720 N. 16th St., Suite 100 Phoenix, Arizona 85020 T 602.371.1100  www.aecom.com				PROFILE SHEET SB STA 336+00 TO STA 350+00	STRUCTURE NO.	TRACS NO. F0738 01C					___ OF ___

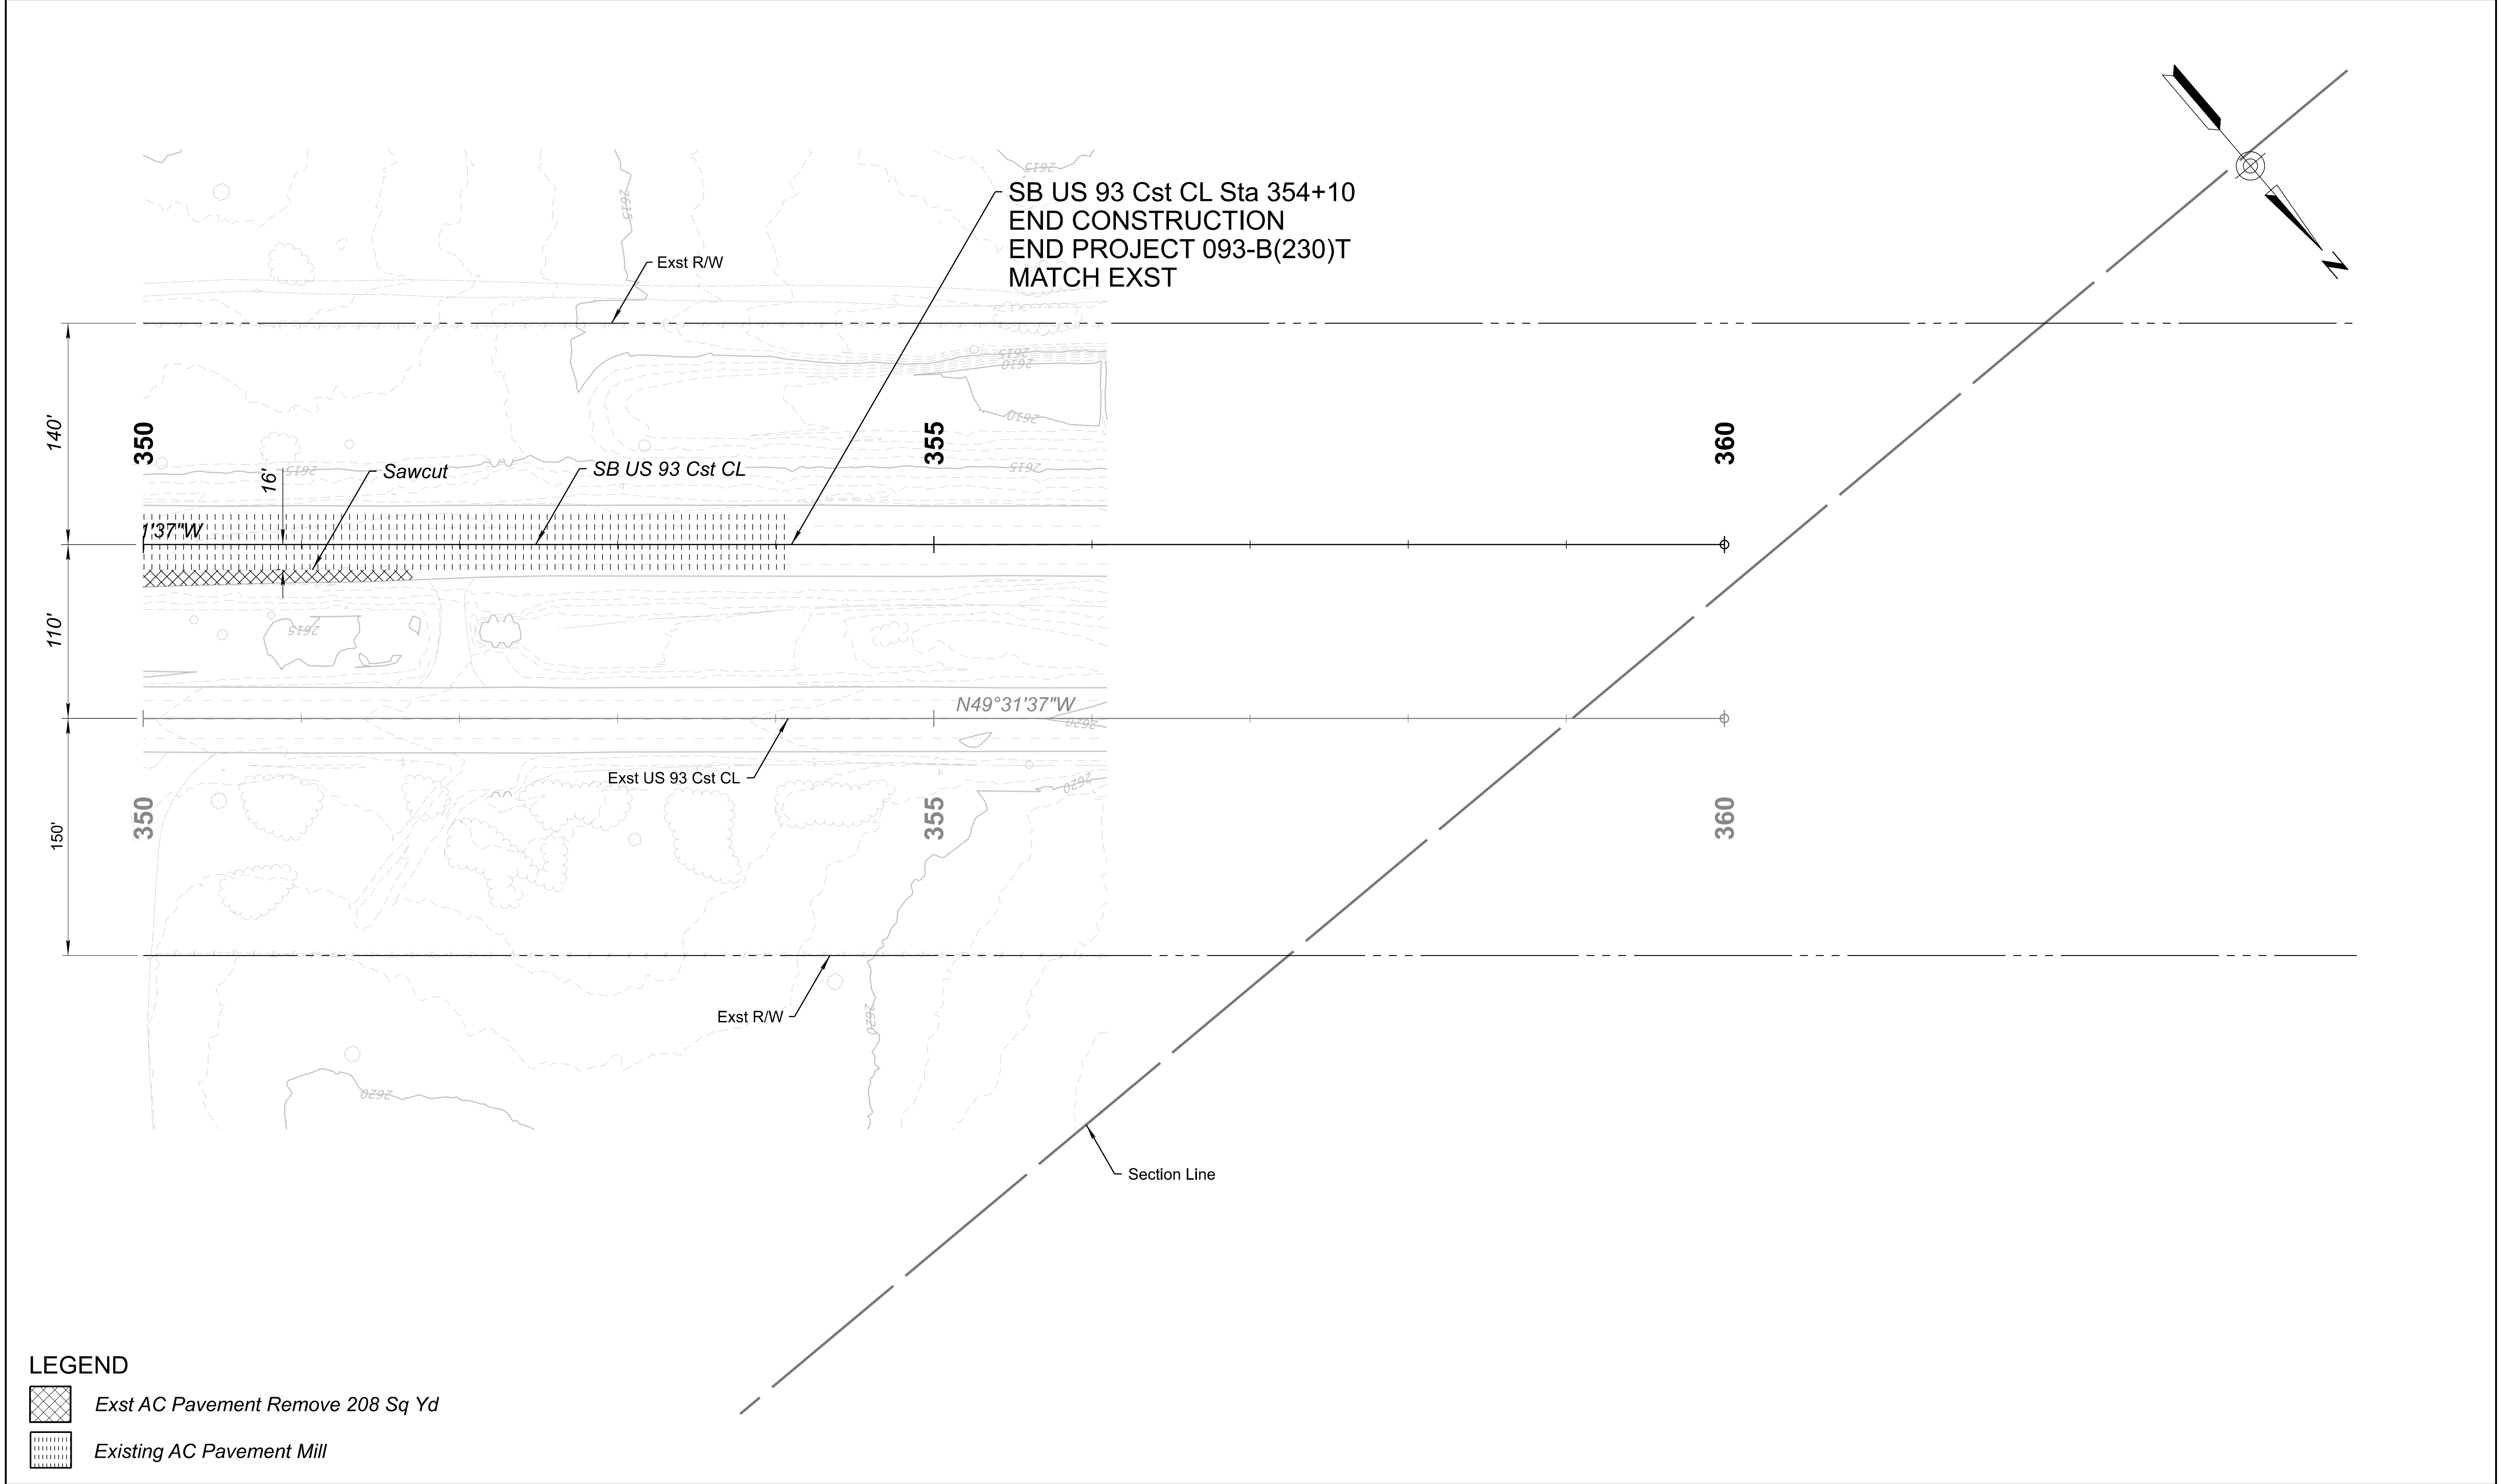

LEGEND


- Exst AC Pavement Remove 208 Sq Yd
- Existing AC Pavement Mill

UTILITY DISPOSITION SHEETS LEGEND																
A To Remain in Service - Protect-In-Place	B Contractor to Relocate, Remove, or Reset	C To Be Relocated or Removed by Others	D To Be Constructed By Others													

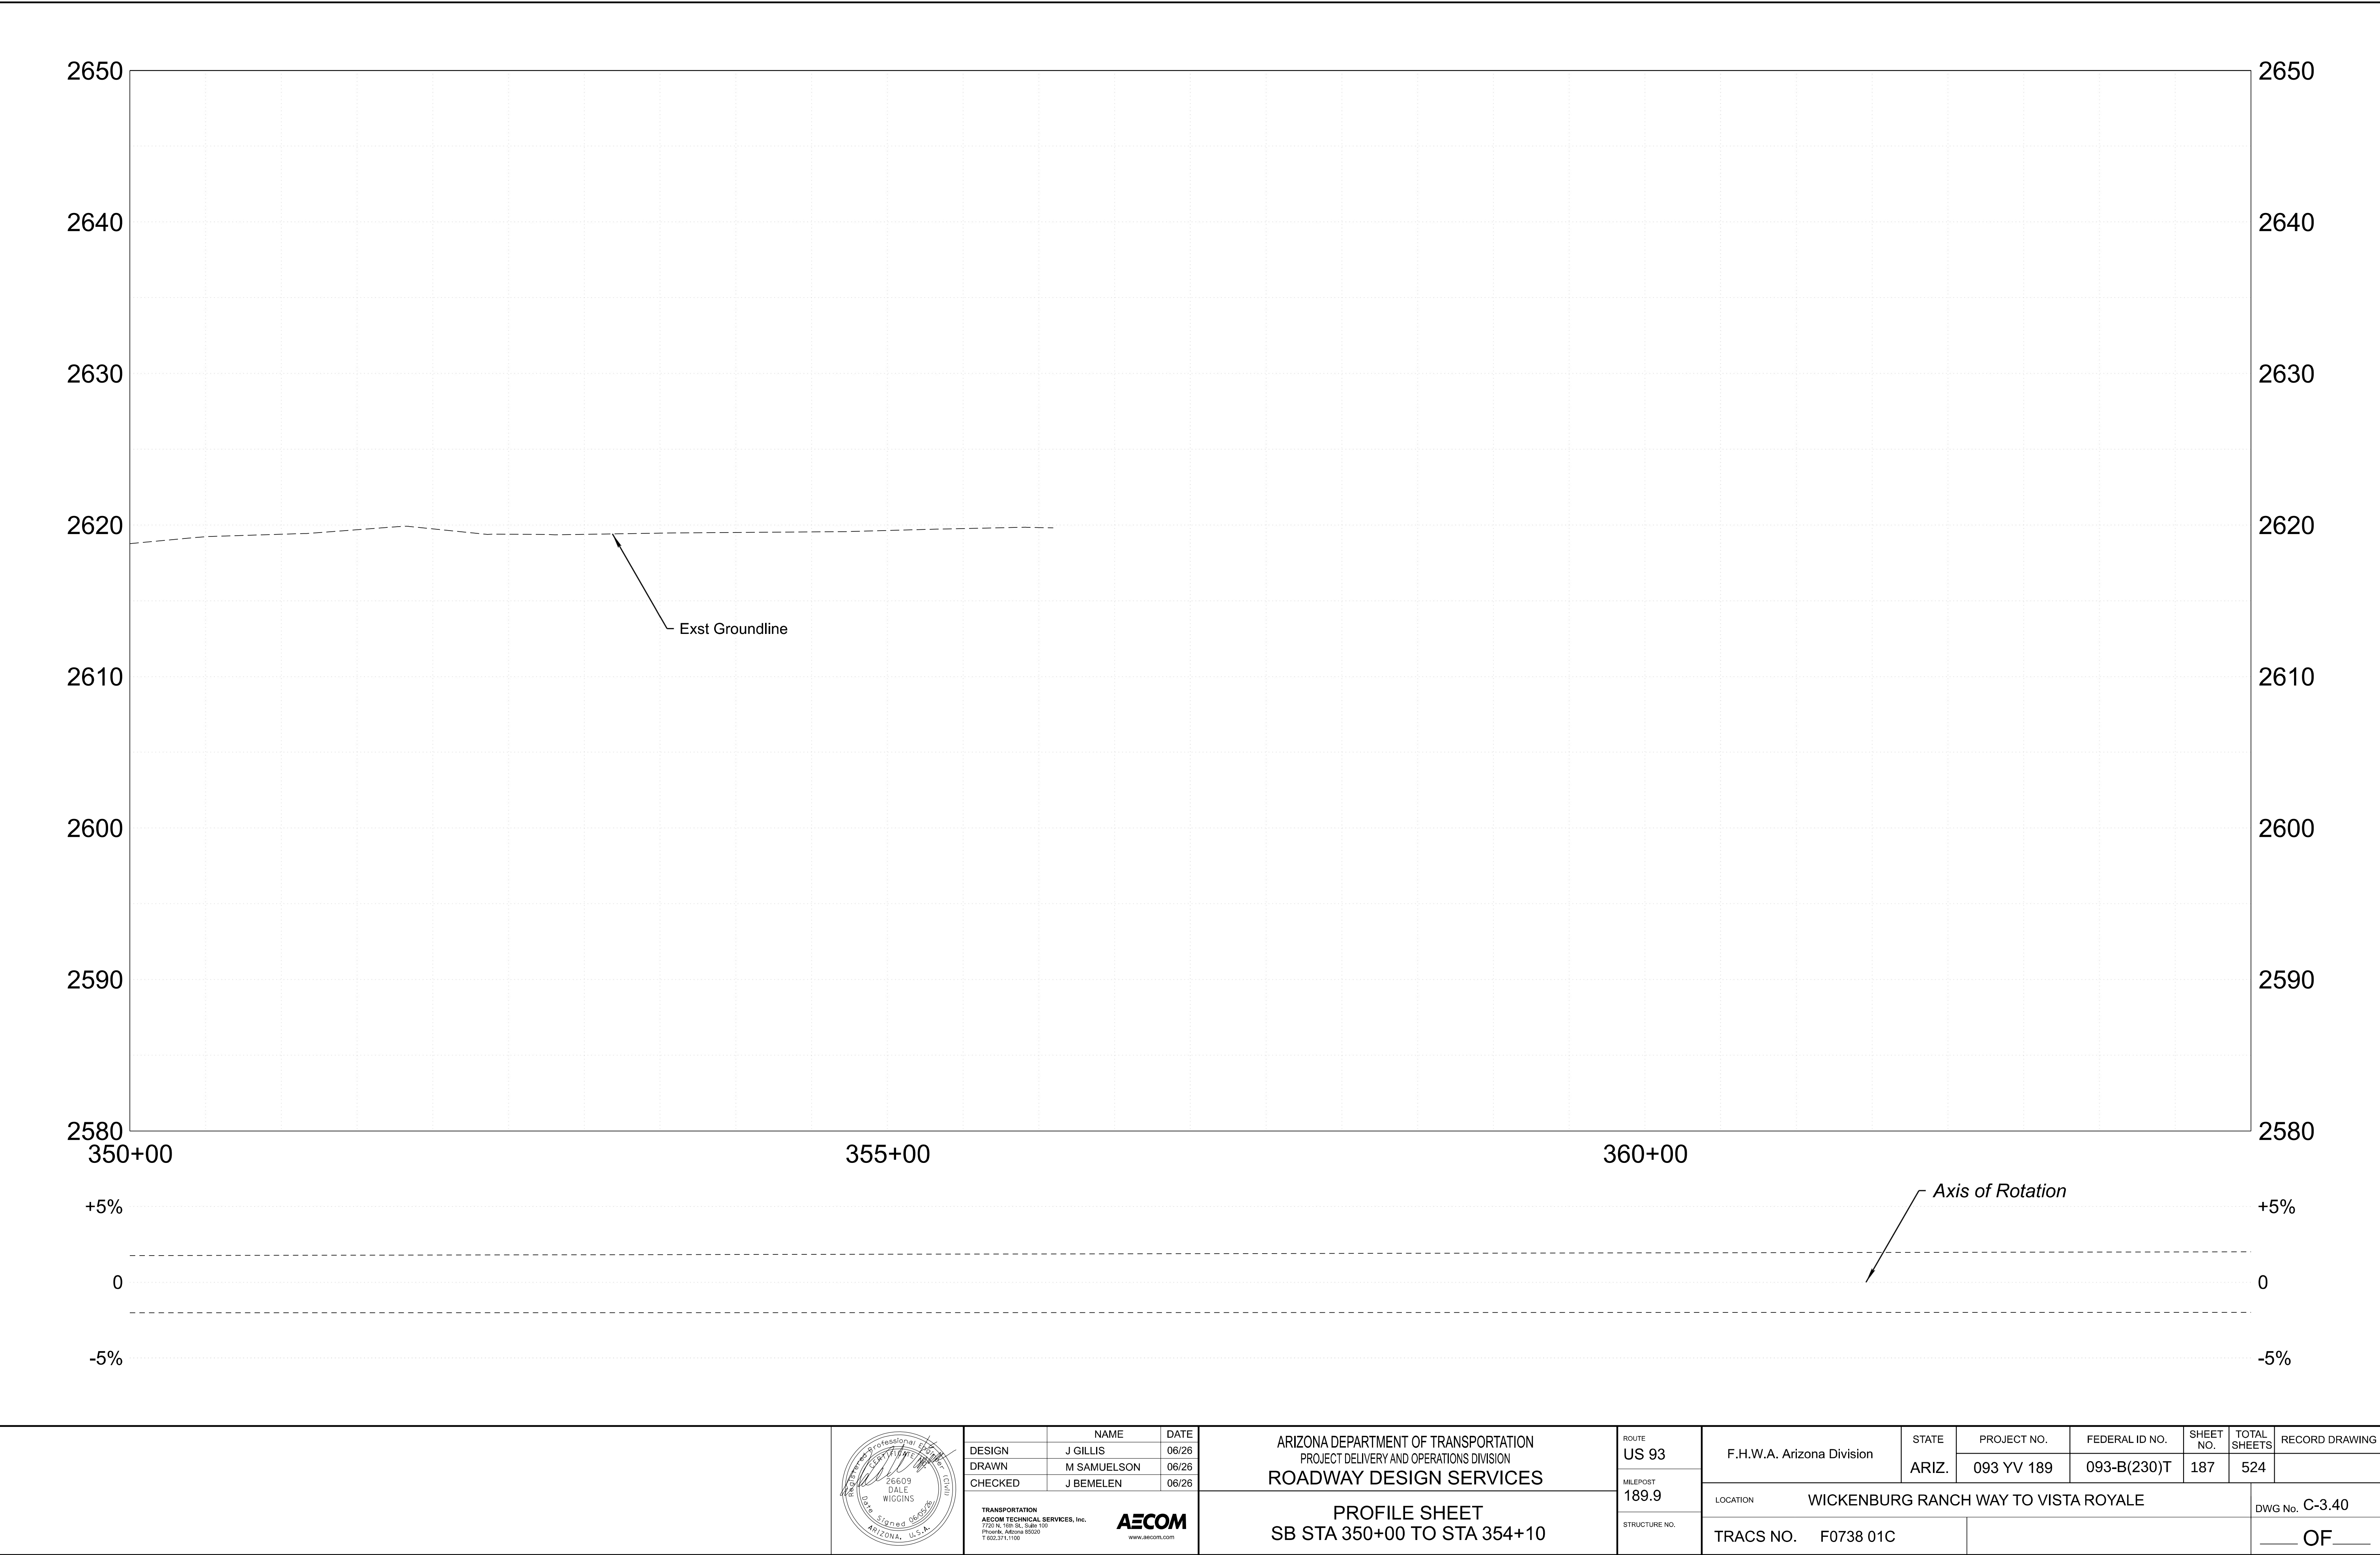

F.H.W.A. REGION	STATE	PROJECT NO.	SHEET NO.	TOTAL SHEETS	RECORD DRAWING
9	ARIZ.	093-B(230)T	188	524	

093 YV 189

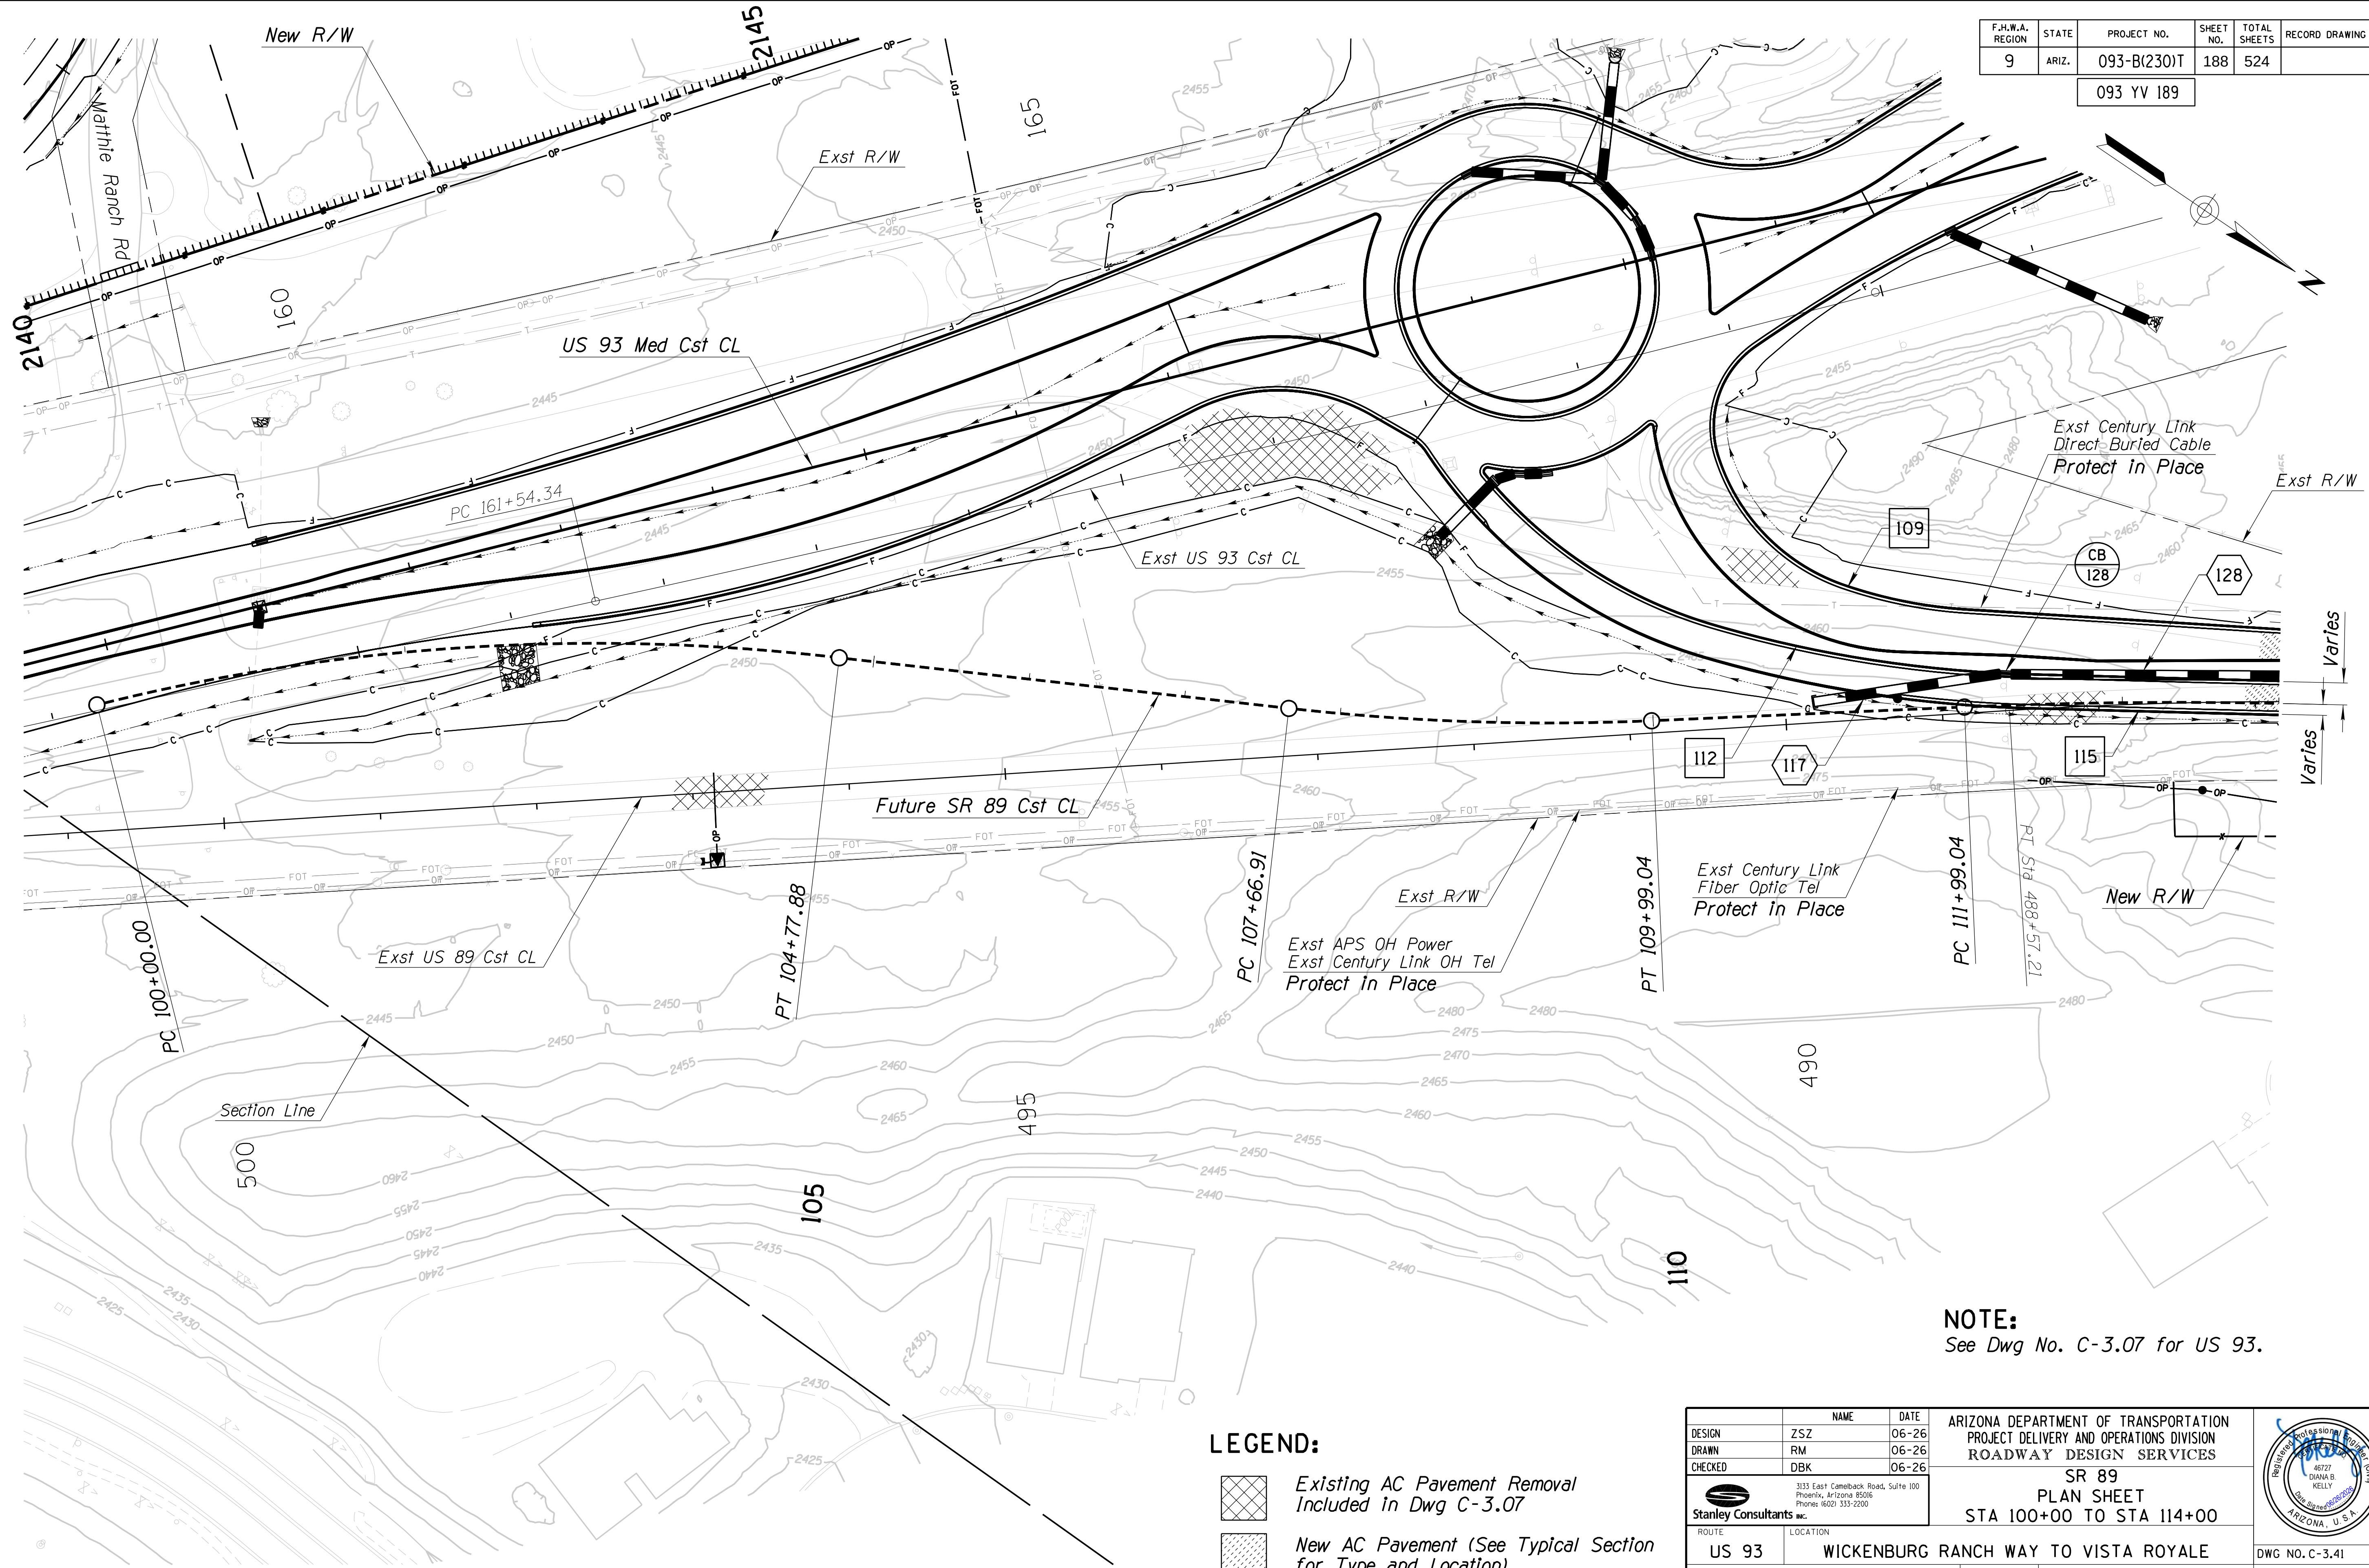

NOTE:
See Dwg No. C-3.07 for US 93.

- LEGEND:**
- Existing AC Pavement Removal Included in Dwg C-3.07
 - New AC Pavement (See Typical Section for Type and Location).

DESIGN		ZSZ	06-26
DRAWN		RM	06-26
CHECKED		DBK	06-26

Stanley Consultants Inc.
3133 East Camelback Road, Suite 100
Phoenix, Arizona 85016
Phone: 602.333.2200

ROUTE	LOCATION
US 93	WICKENBURG RANCH WAY TO VISTA ROYALE

TRACS NO. F0738 OIC

PROJECT NO.	093-B(230)T
-------------	-------------

093 YV 189

DESIGN	ZSZ	06-26
DRAWN	RM	06-26
CHECKED	DBK	06-26

ARIZONA DEPARTMENT OF TRANSPORTATION
PROJECT DELIVERY AND OPERATIONS DIVISION
ROADWAY DESIGN SERVICES

SR 89
PLAN SHEET
STA 100+00 TO STA 114+00


Stanley Consultants Inc.
46727
DIANA B. KELLY
Professional Engineer
ARIZONA, U.S.A.

DWG NO. C-3.41

OF

F.H.W.A. REGION	STATE	PROJECT NO.	SHEET NO.	TOTAL SHEETS	RECORD DRAWING
9	ARIZ.	093-B(230)T	189	524	

093 YV 189

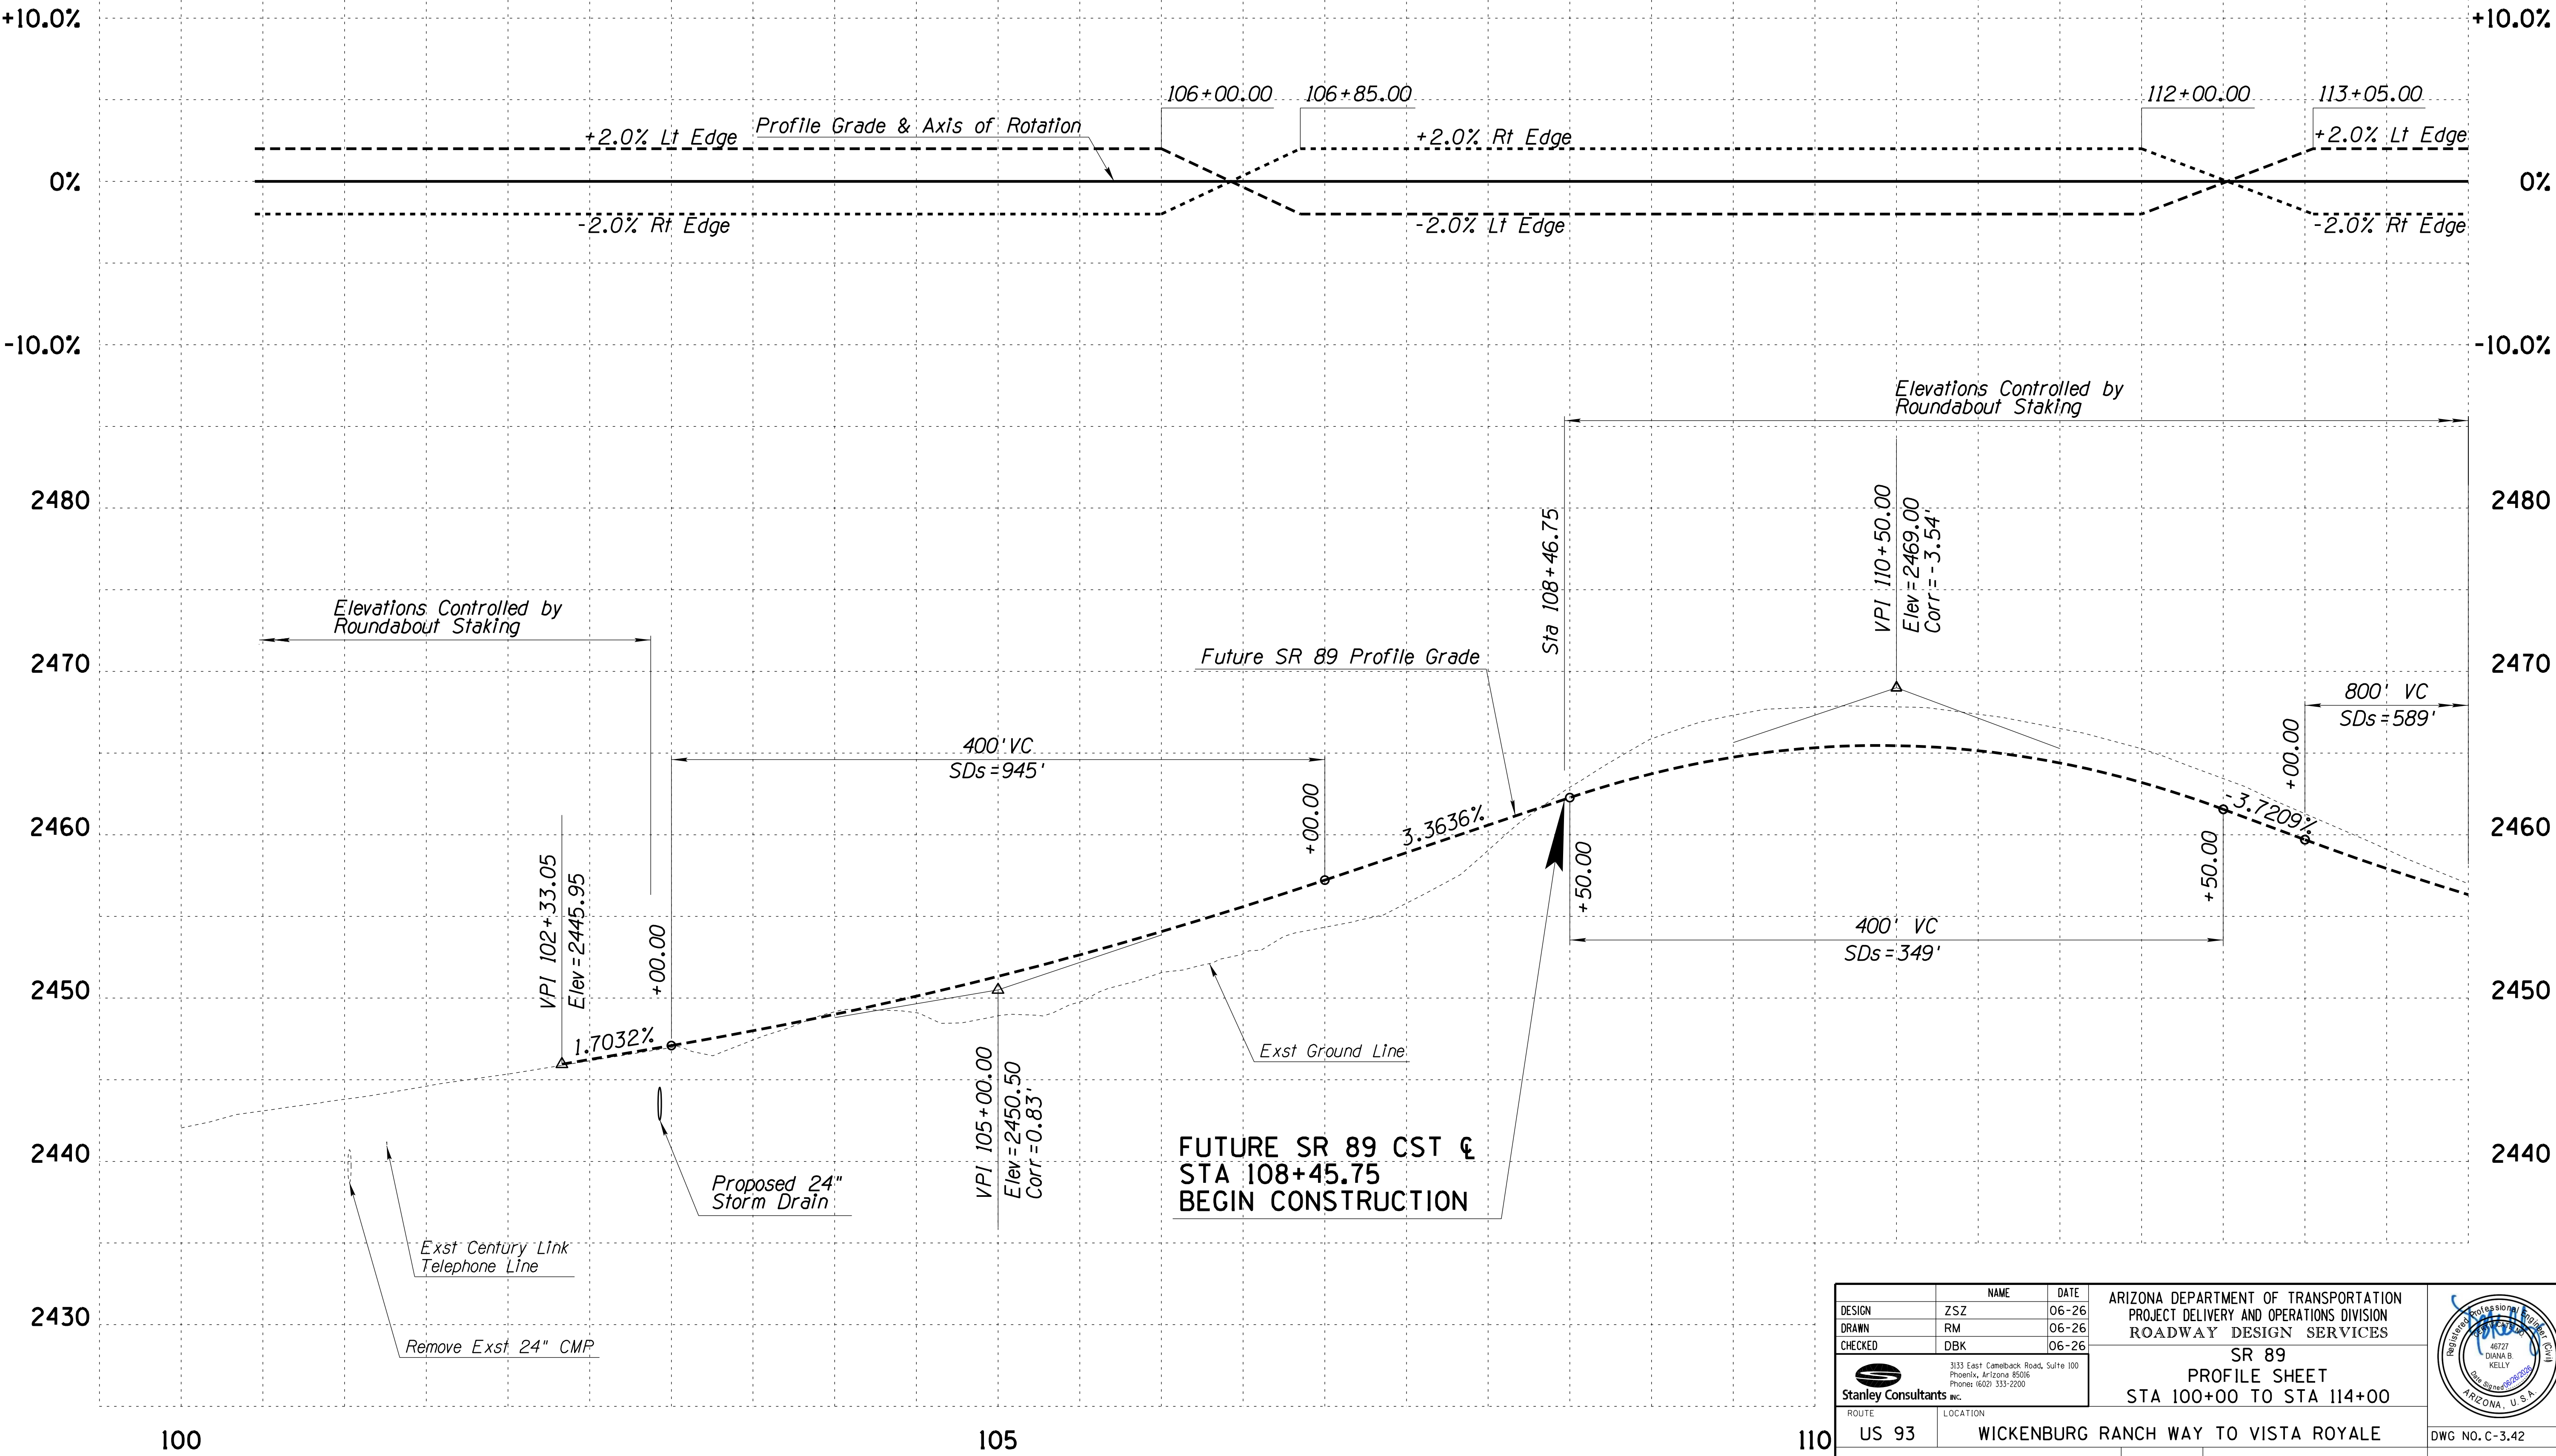


DESIGN	ZSZ	DATE	06-26
DRAWN	RM	DATE	06-26
CHECKED	DBK	DATE	06-26
ARIZONA DEPARTMENT OF TRANSPORTATION PROJECT DELIVERY AND OPERATIONS DIVISION ROADWAY DESIGN SERVICES			
SR 89 PROFILE SHEET STA 100+00 TO STA 114+00			
ROUTE	US 93	LOCATION	WICKENBURG RANCH WAY TO VISTA ROYALE
TRACS NO. F0738 OIC			093-B(230)T
			DWG NO. C-3.42
			OF



F.H.W.A. REGION	STATE	PROJECT NO.	SHEET NO.	TOTAL SHEETS	RECORD DRAWING
9	ARIZ.	093-B(230)T	191	524	

093 YV 189

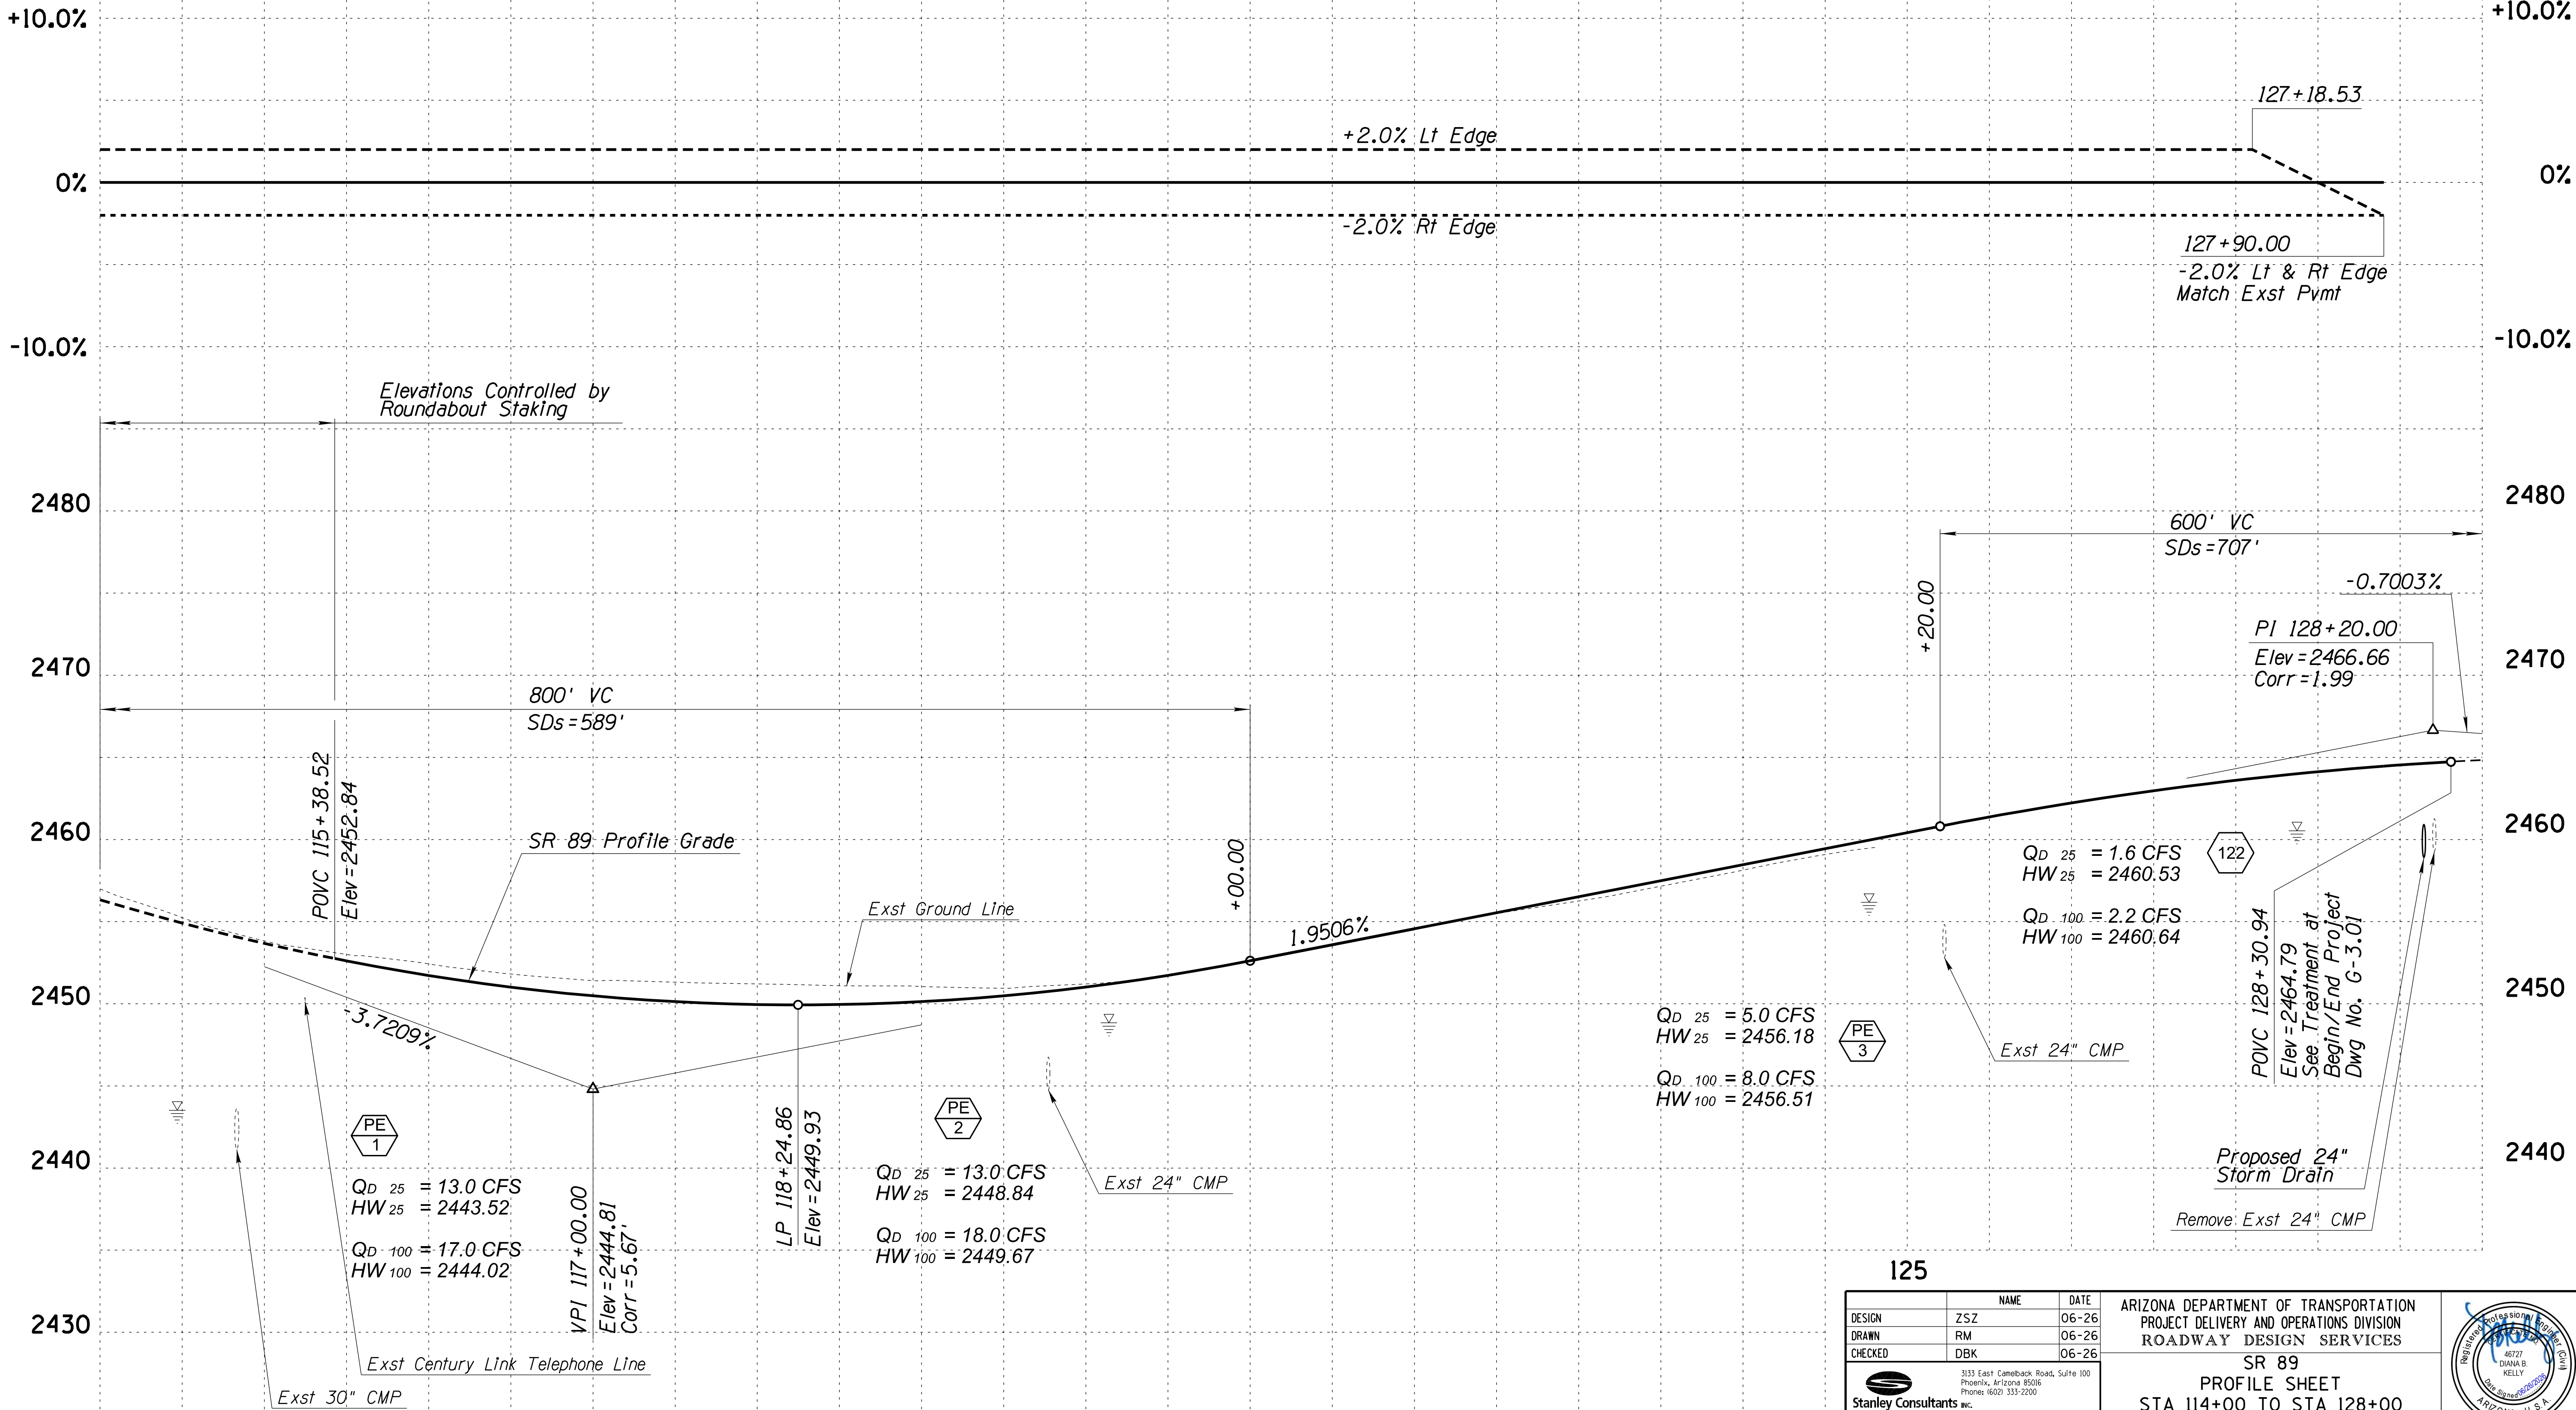

115

120

125

DESIGN	ZSZ	NAME	DATE
DRAWN	RM		06-26
CHECKED	DBK		06-26

ARIZONA DEPARTMENT OF TRANSPORTATION PROJECT DELIVERY AND OPERATIONS DIVISION ROADWAY DESIGN SERVICES	
SR 89 PROFILE SHEET STA 114+00 TO STA 128+00	
ROUTE US 93	LOCATION WICKENBURG RANCH WAY TO VISTA ROYALE
DWG NO. C-3.44	

TRACS NO. F0738 OIC	093-B(230)T	OF
---------------------	-------------	----



Stanley Consultants inc.

3133 East Camelback Road, Suite 100
Phoenix, Arizona 85016
Phone: (602) 333-2200

Professional Engineer
46727
DIANA B. KELLY
06/26/2026
ARIZONA, U.S.A.



F.H.W.A. REGION	STATE	PROJECT NO.	SHEET NO.	TOTAL SHEETS	RECORD DRAWING
9	ARIZ.	093-B(230)T	192	524	

093 YV 189

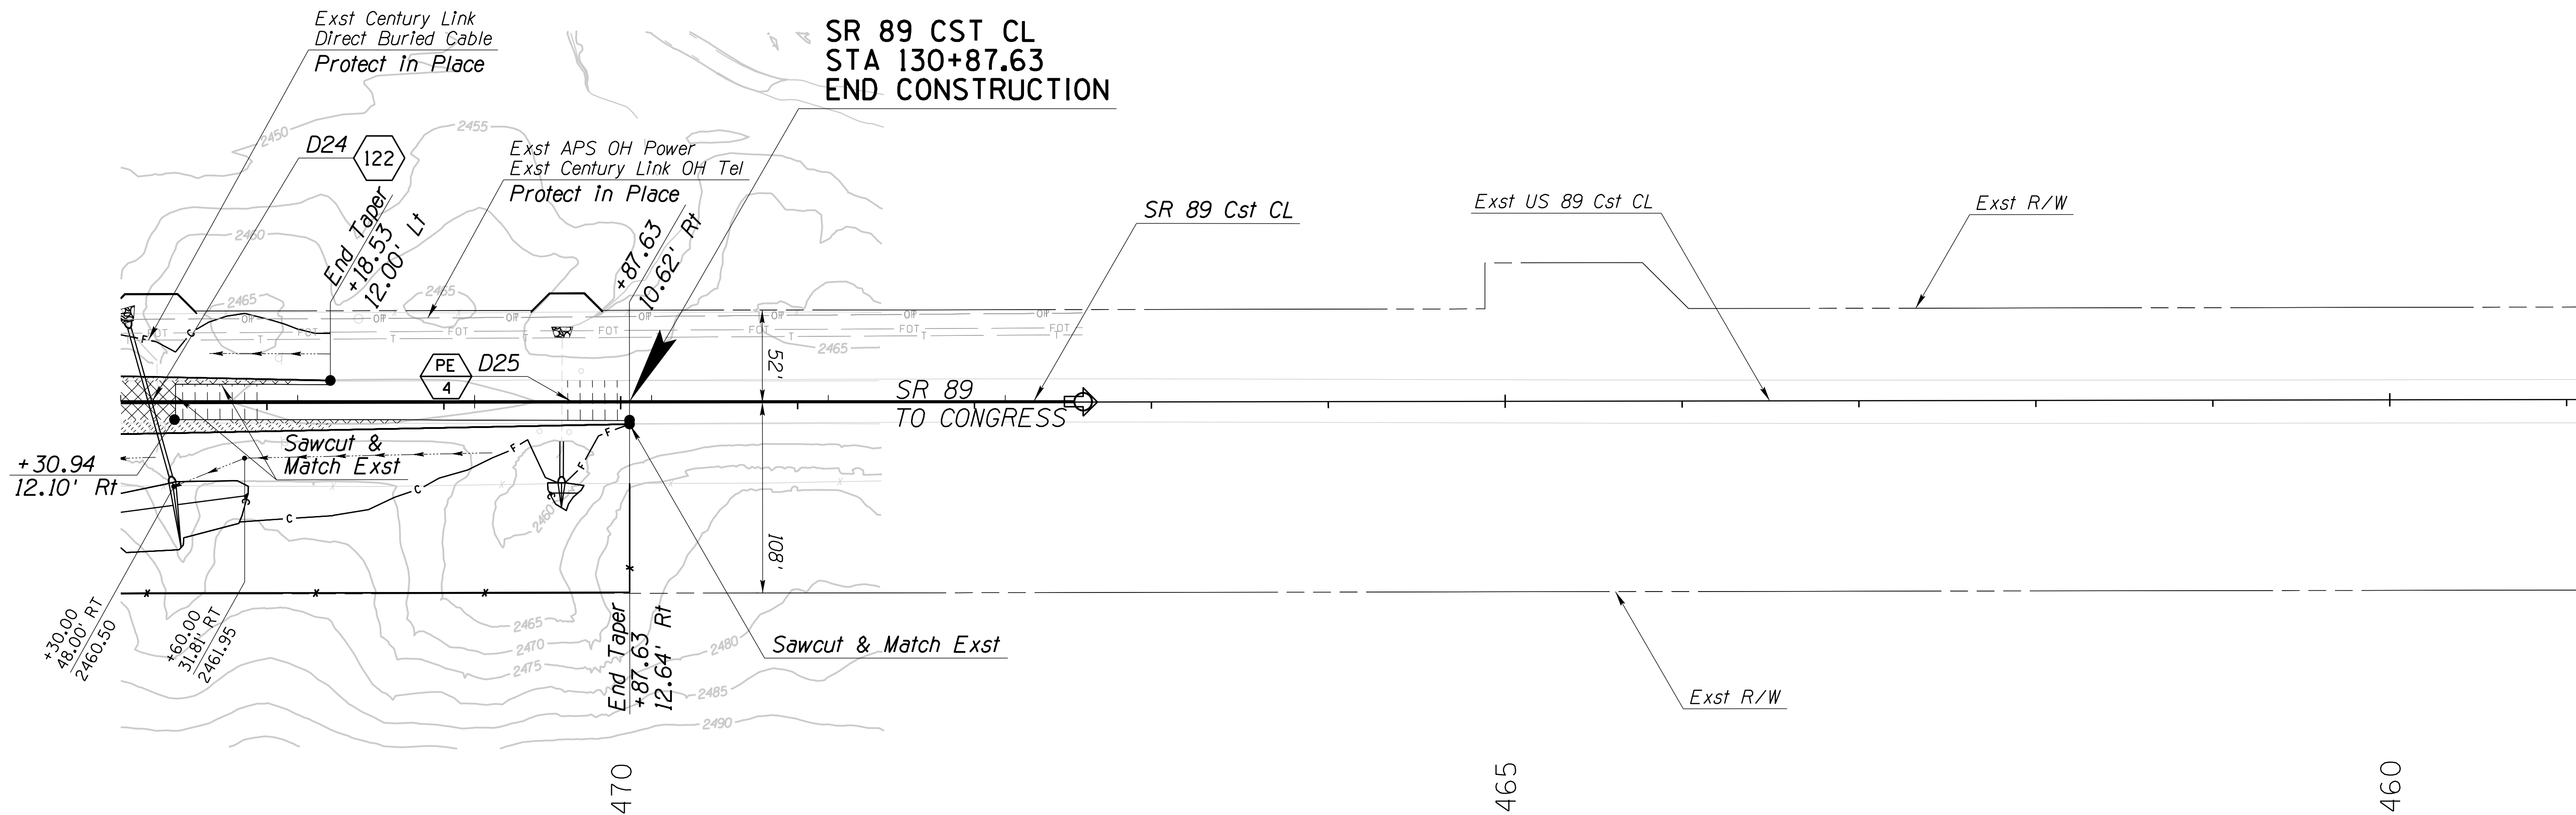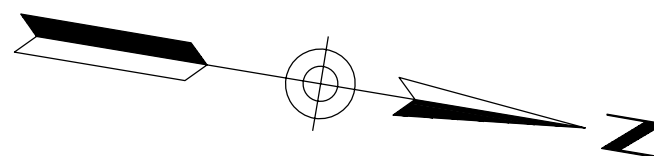

F.H.W.A. REGION	STATE	PROJECT NO.	SHEET NO.	TOTAL SHEETS	RECORD DRAWING
9	ARIZ.	093-B(230)T	193	524	

093 YV 189

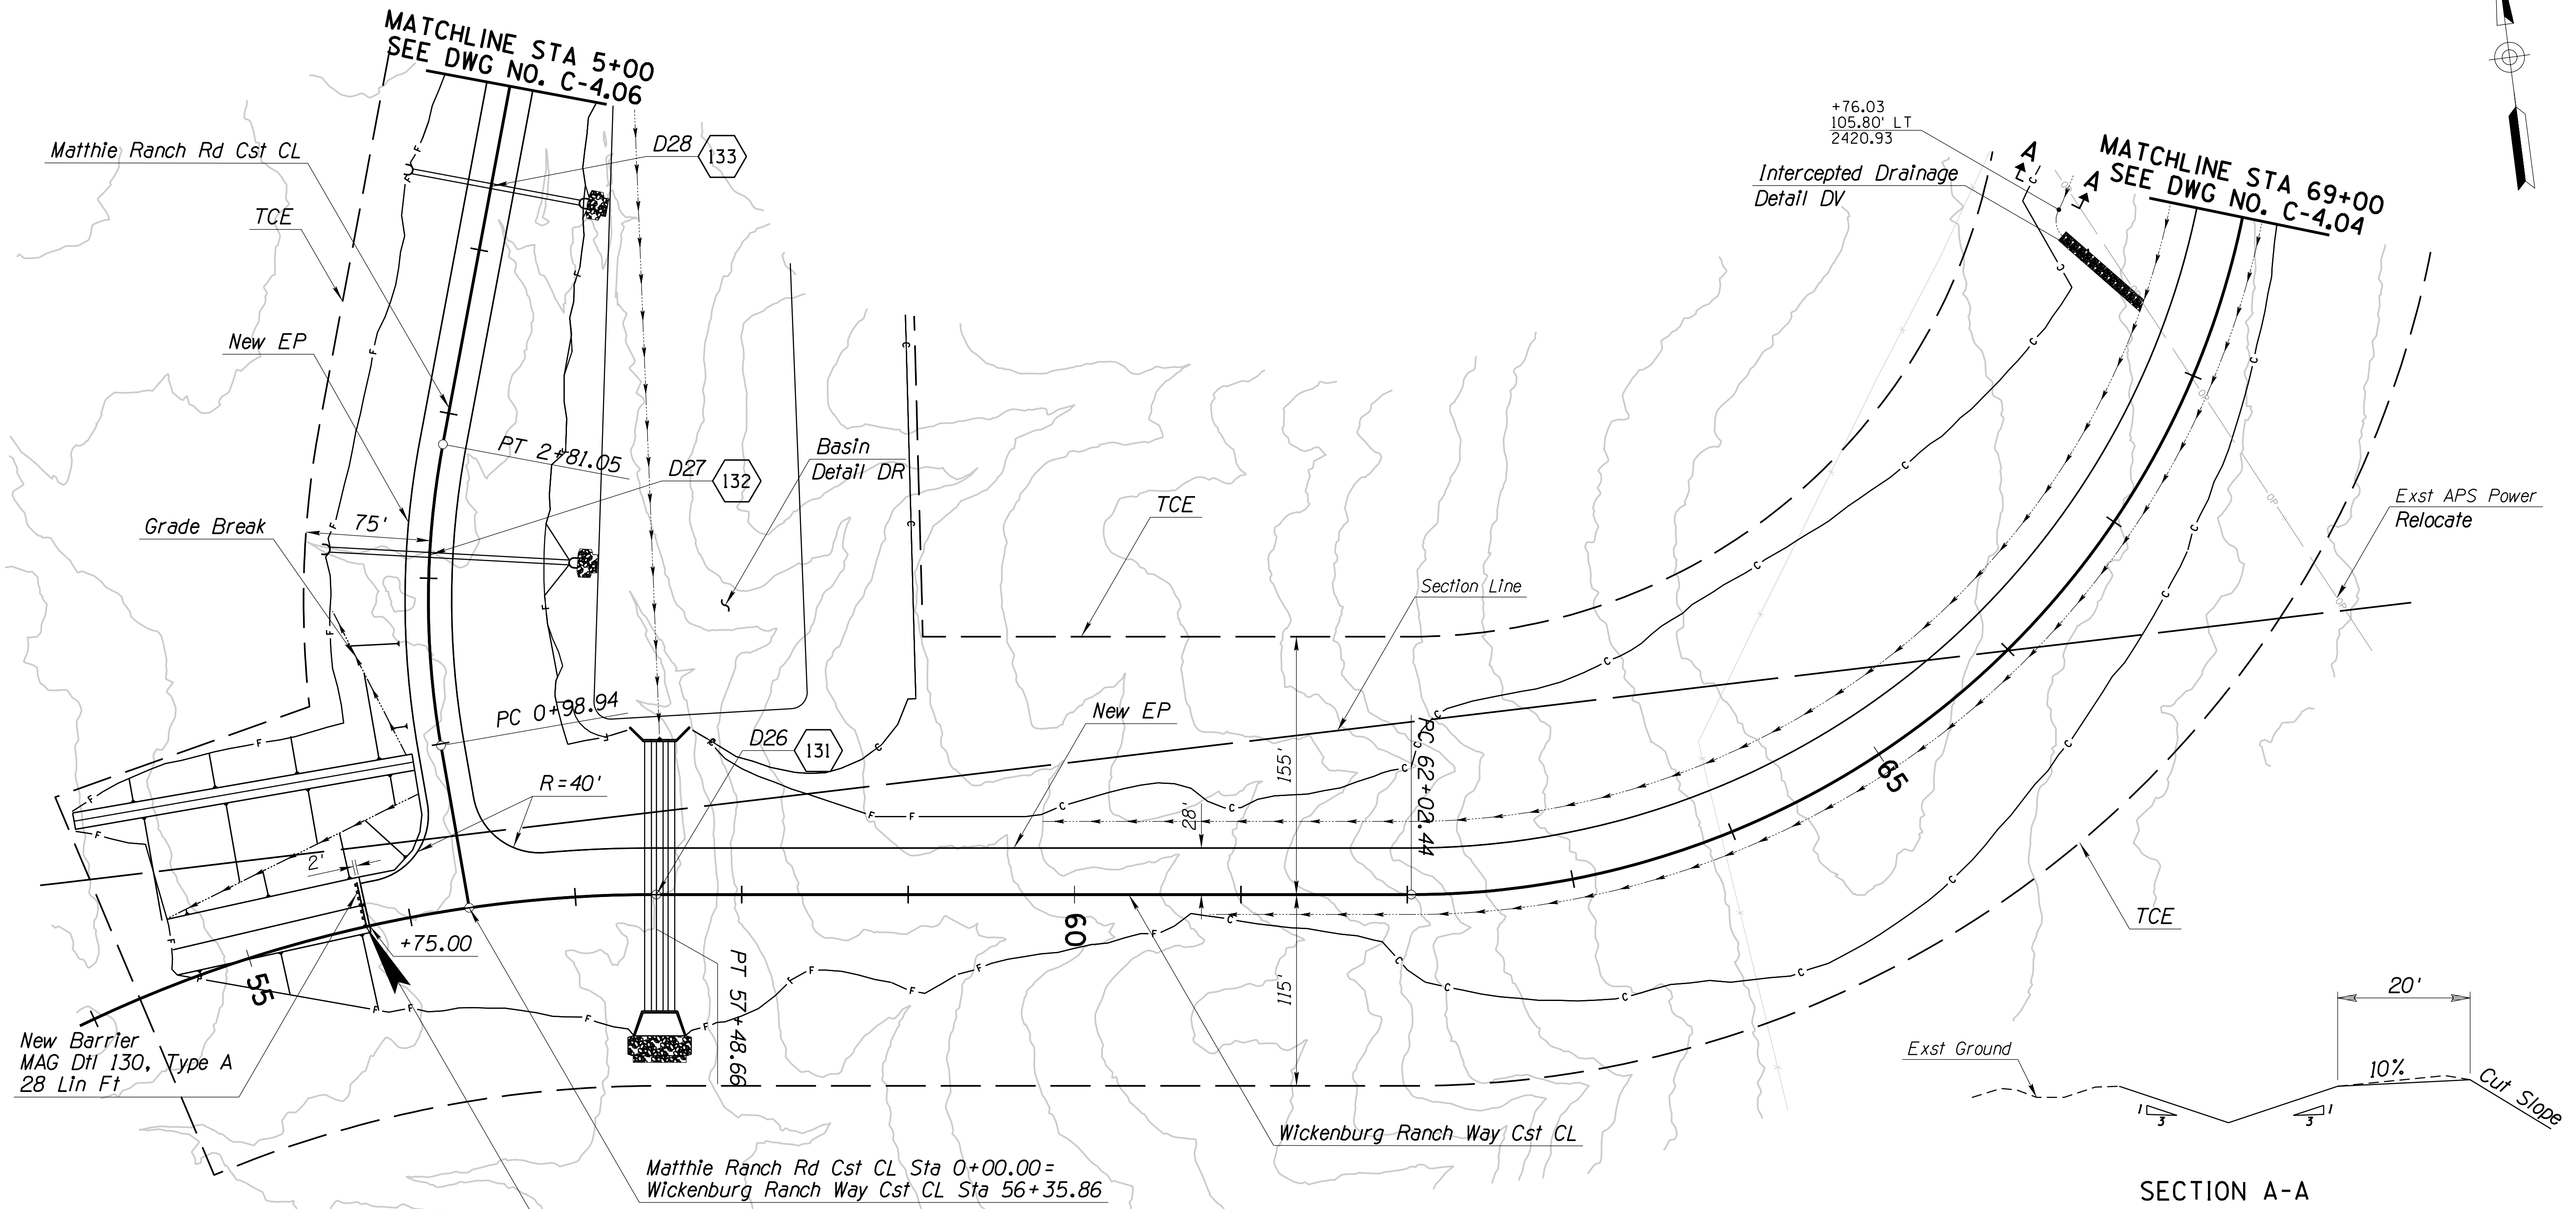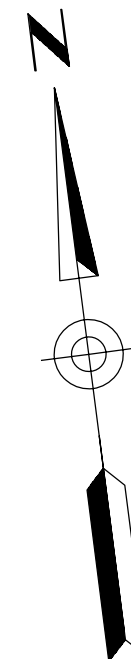


SECTION A-A

WICKENBURG RANCH WAY CST CL
STA 55+73.00
BEGIN CONSTRUCTION

DESIGN	ZSZ	DATE	06-26	ARIZONA DEPARTMENT OF TRANSPORTATION PROJECT DELIVERY AND OPERATIONS DIVISION ROADWAY DESIGN SERVICES	
DRAWN	RM	DATE	06-26		
CHECKED	DBK	DATE	06-26		
				WICKENBURG RANCH WAY/MATTHE RANCH ROAD PLAN SHEET STA 55+00 TO 69+00/STA 0+00 TO 5+00	
ROUTE		LOCATION		DWG NO. C-4.01	
US 93		WICKENBURG RANCH WAY TO VISTA ROYALE			
TRACS NO. F0738 OIC		093-B(230)T		OF	

F.H.W.A. REGION	STATE	PROJECT NO.	SHEET NO.	TOTAL SHEETS	RECORD DRAWING
9	ARIZ.	093-B(230)T	194	524	


093 YV 189

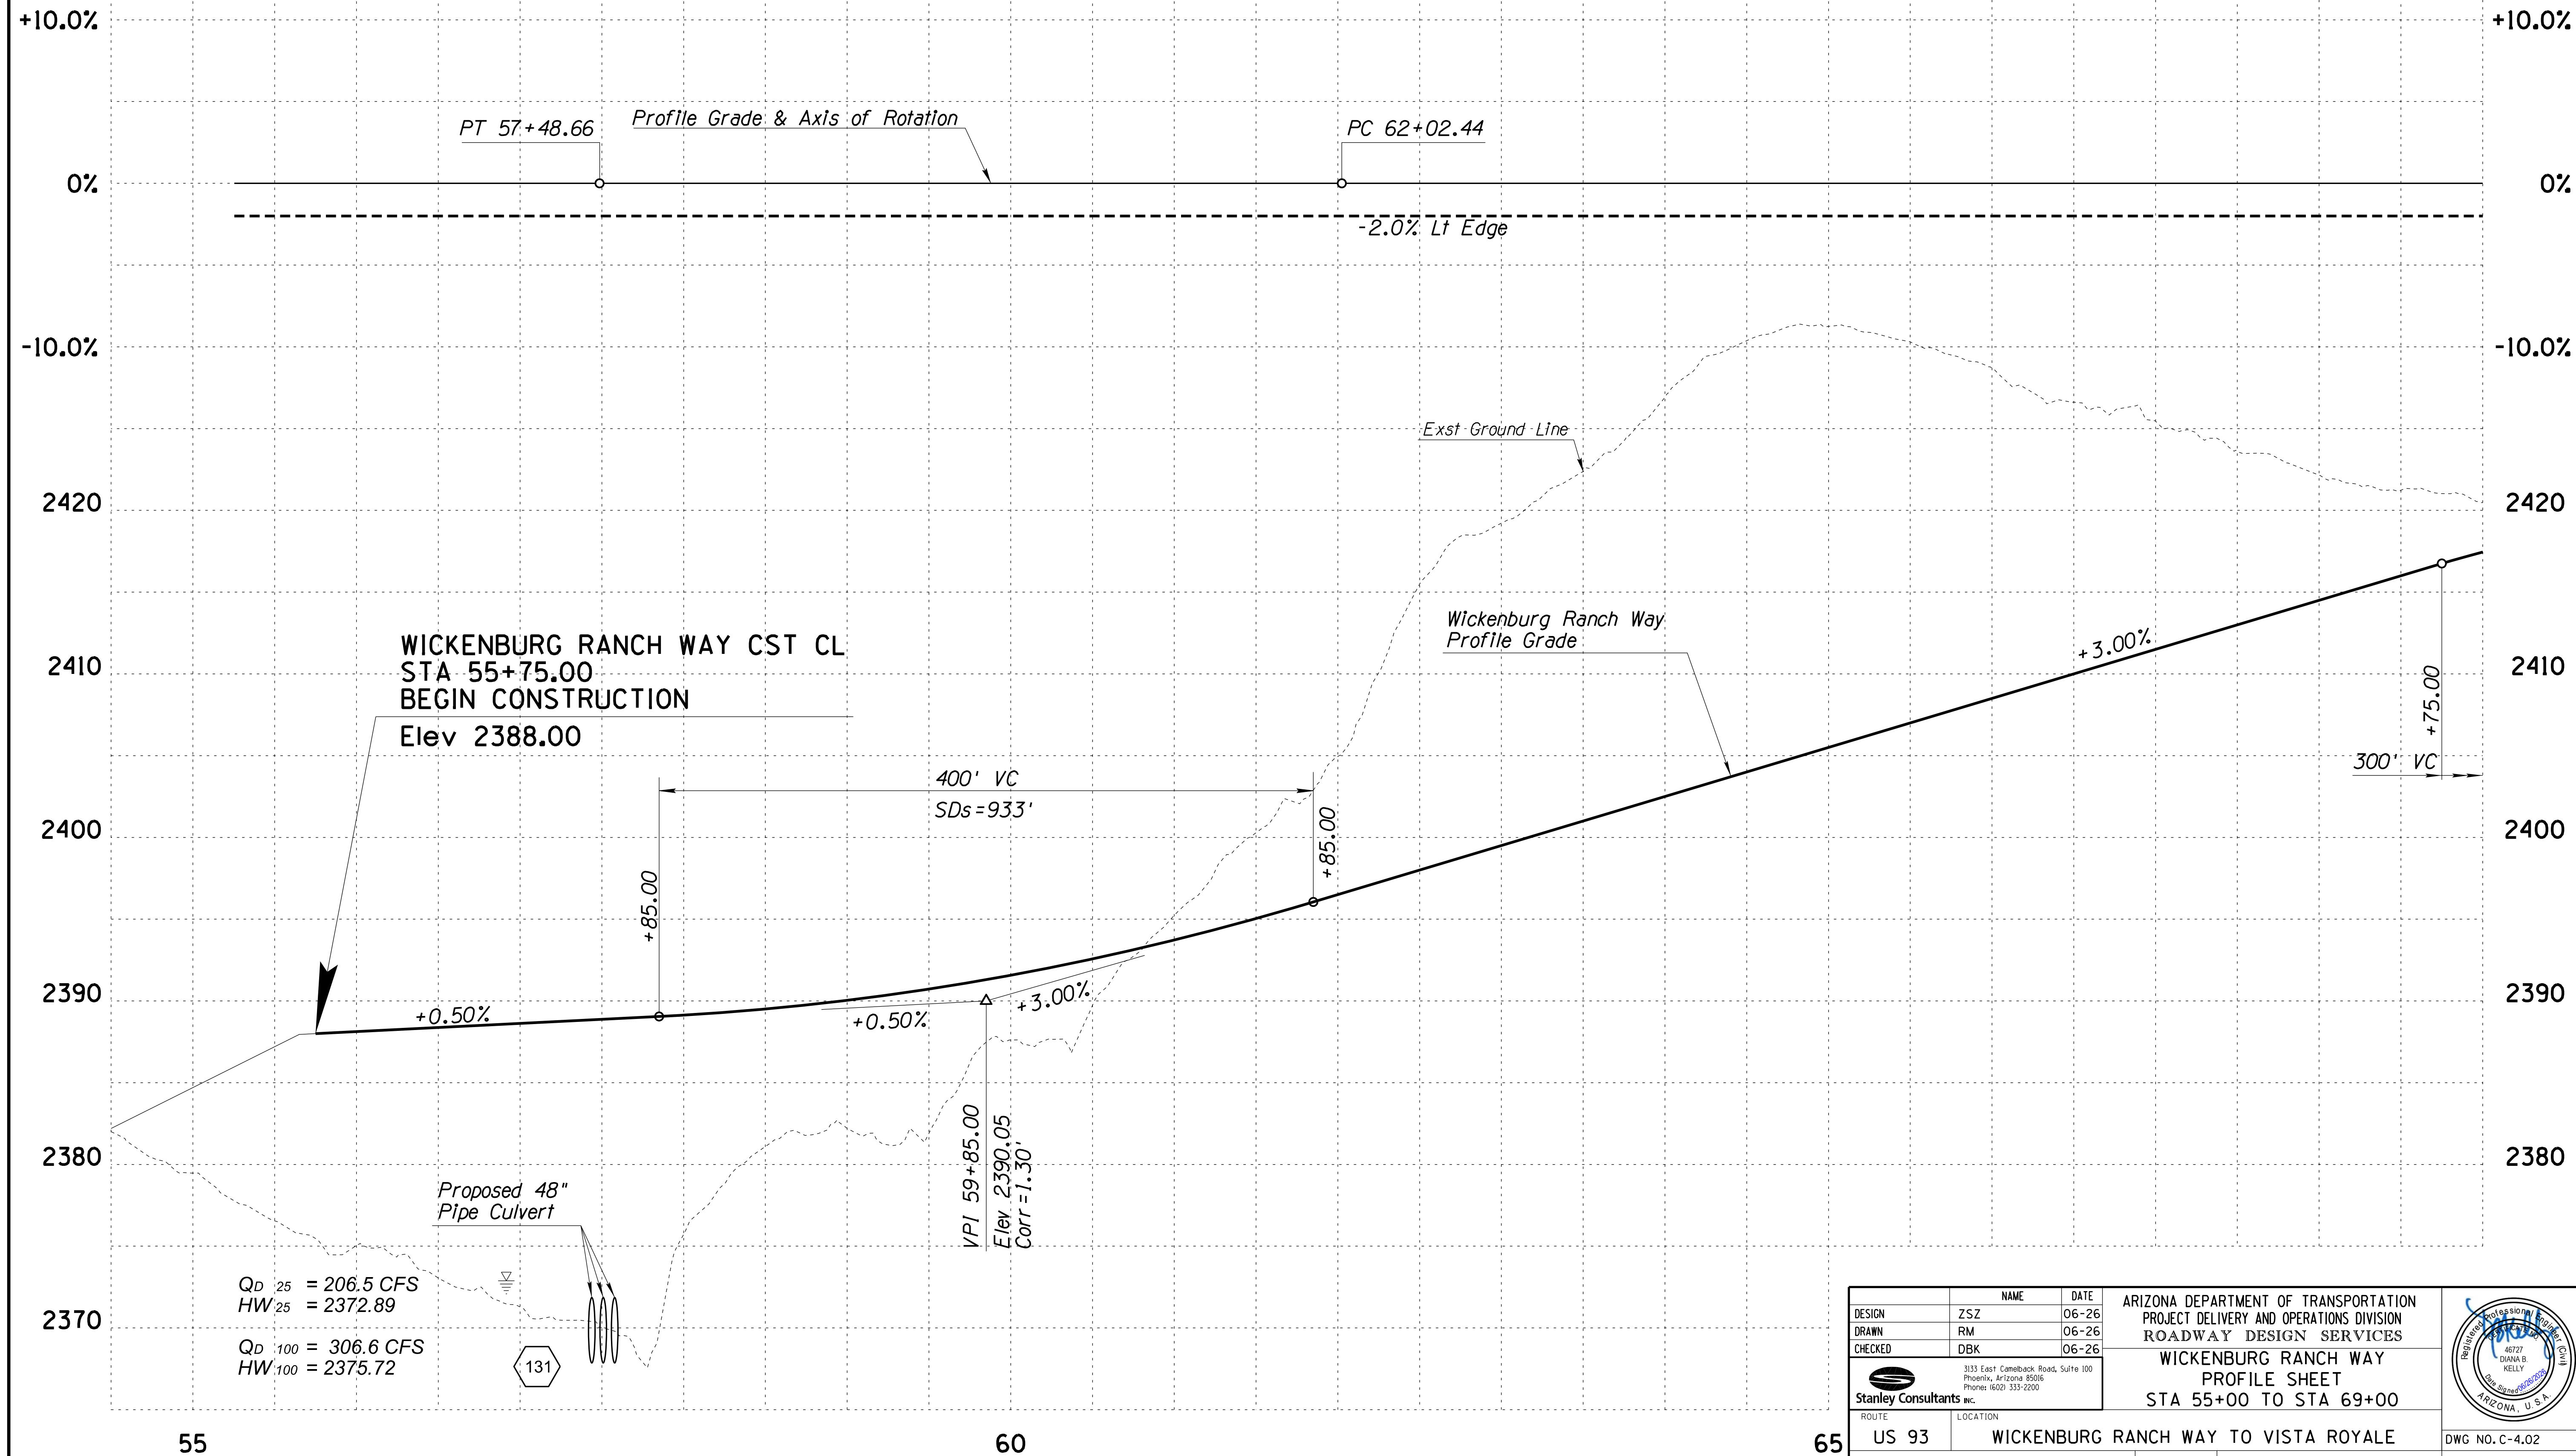

DESIGN	NAME	DATE	ARIZONA DEPARTMENT OF TRANSPORTATION PROJECT DELIVERY AND OPERATIONS DIVISION ROADWAY DESIGN SERVICES	
DRAWN	RM	06-26	WICKENBURG RANCH WAY PROFILE SHEET STA 55+00 TO STA 69+00	
CHECKED	DBK	06-26	US 93 WICKENBURG RANCH WAY TO VISTA ROYALE	DWG NO. C-4.02
Stanley Consultants Inc.			TRACS NO. F0738 OIC	093-B(230)T

F.H.W.A. REGION	STATE	PROJECT NO.	SHEET NO.	TOTAL SHEETS	RECORD DRAWING
9	ARIZ.	093-B(230)T	195	524	


093 YV 189

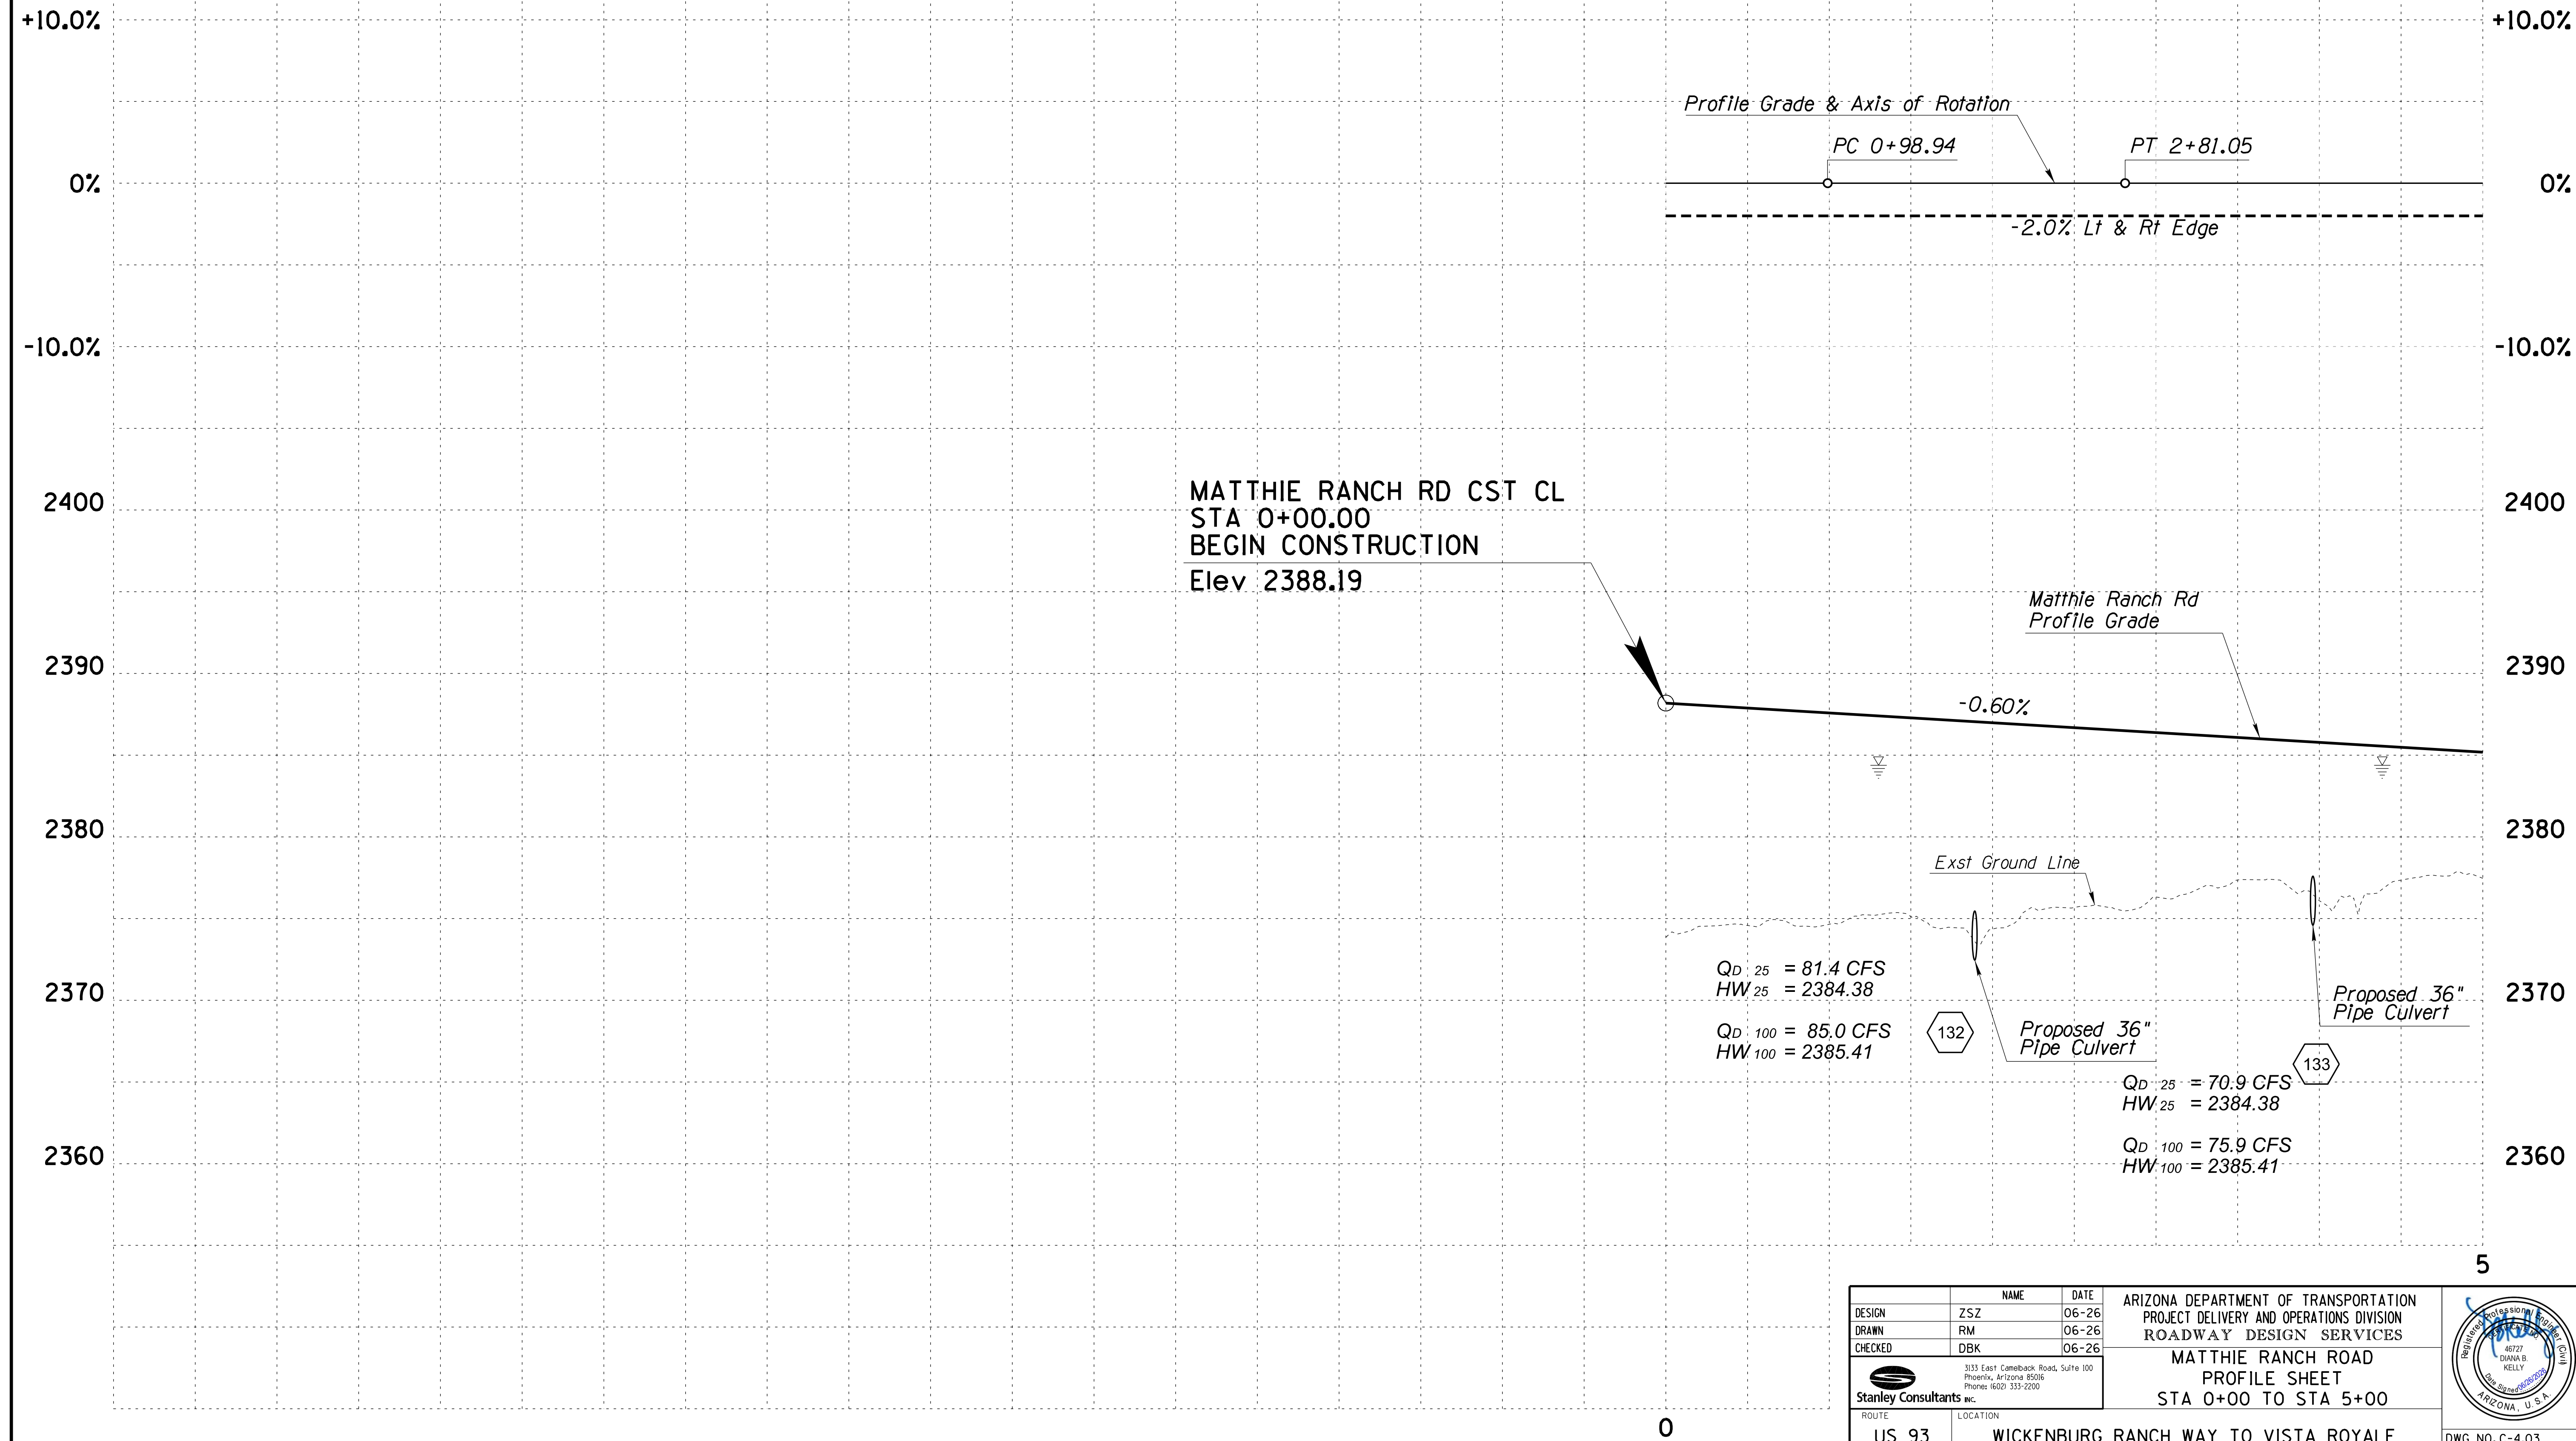

DESIGN	NAME	DATE	ARIZONA DEPARTMENT OF TRANSPORTATION PROJECT DELIVERY AND OPERATIONS DIVISION ROADWAY DESIGN SERVICES	
DRAWN	ZSZ	06-26	MATTHE RANCH ROAD PROFILE SHEET STA 0+00 TO STA 5+00	
CHECKED	DBK	06-26	US 93 WICKENBURG RANCH WAY TO VISTA ROYALE	DWG NO. C-4.03
Stanley Consultants inc. 3133 East Camelback Road, Suite 100 Phoenix, Arizona 85016 Phone: (602) 333-2200			TRACS NO. F0738 OIC	093-B(230)T

F.H.W.A. REGION	STATE	PROJECT NO.	SHEET NO.	TOTAL SHEETS	RECORD DRAWING
9	ARIZ.	093-B(230)T	196	524	

093 YV 189

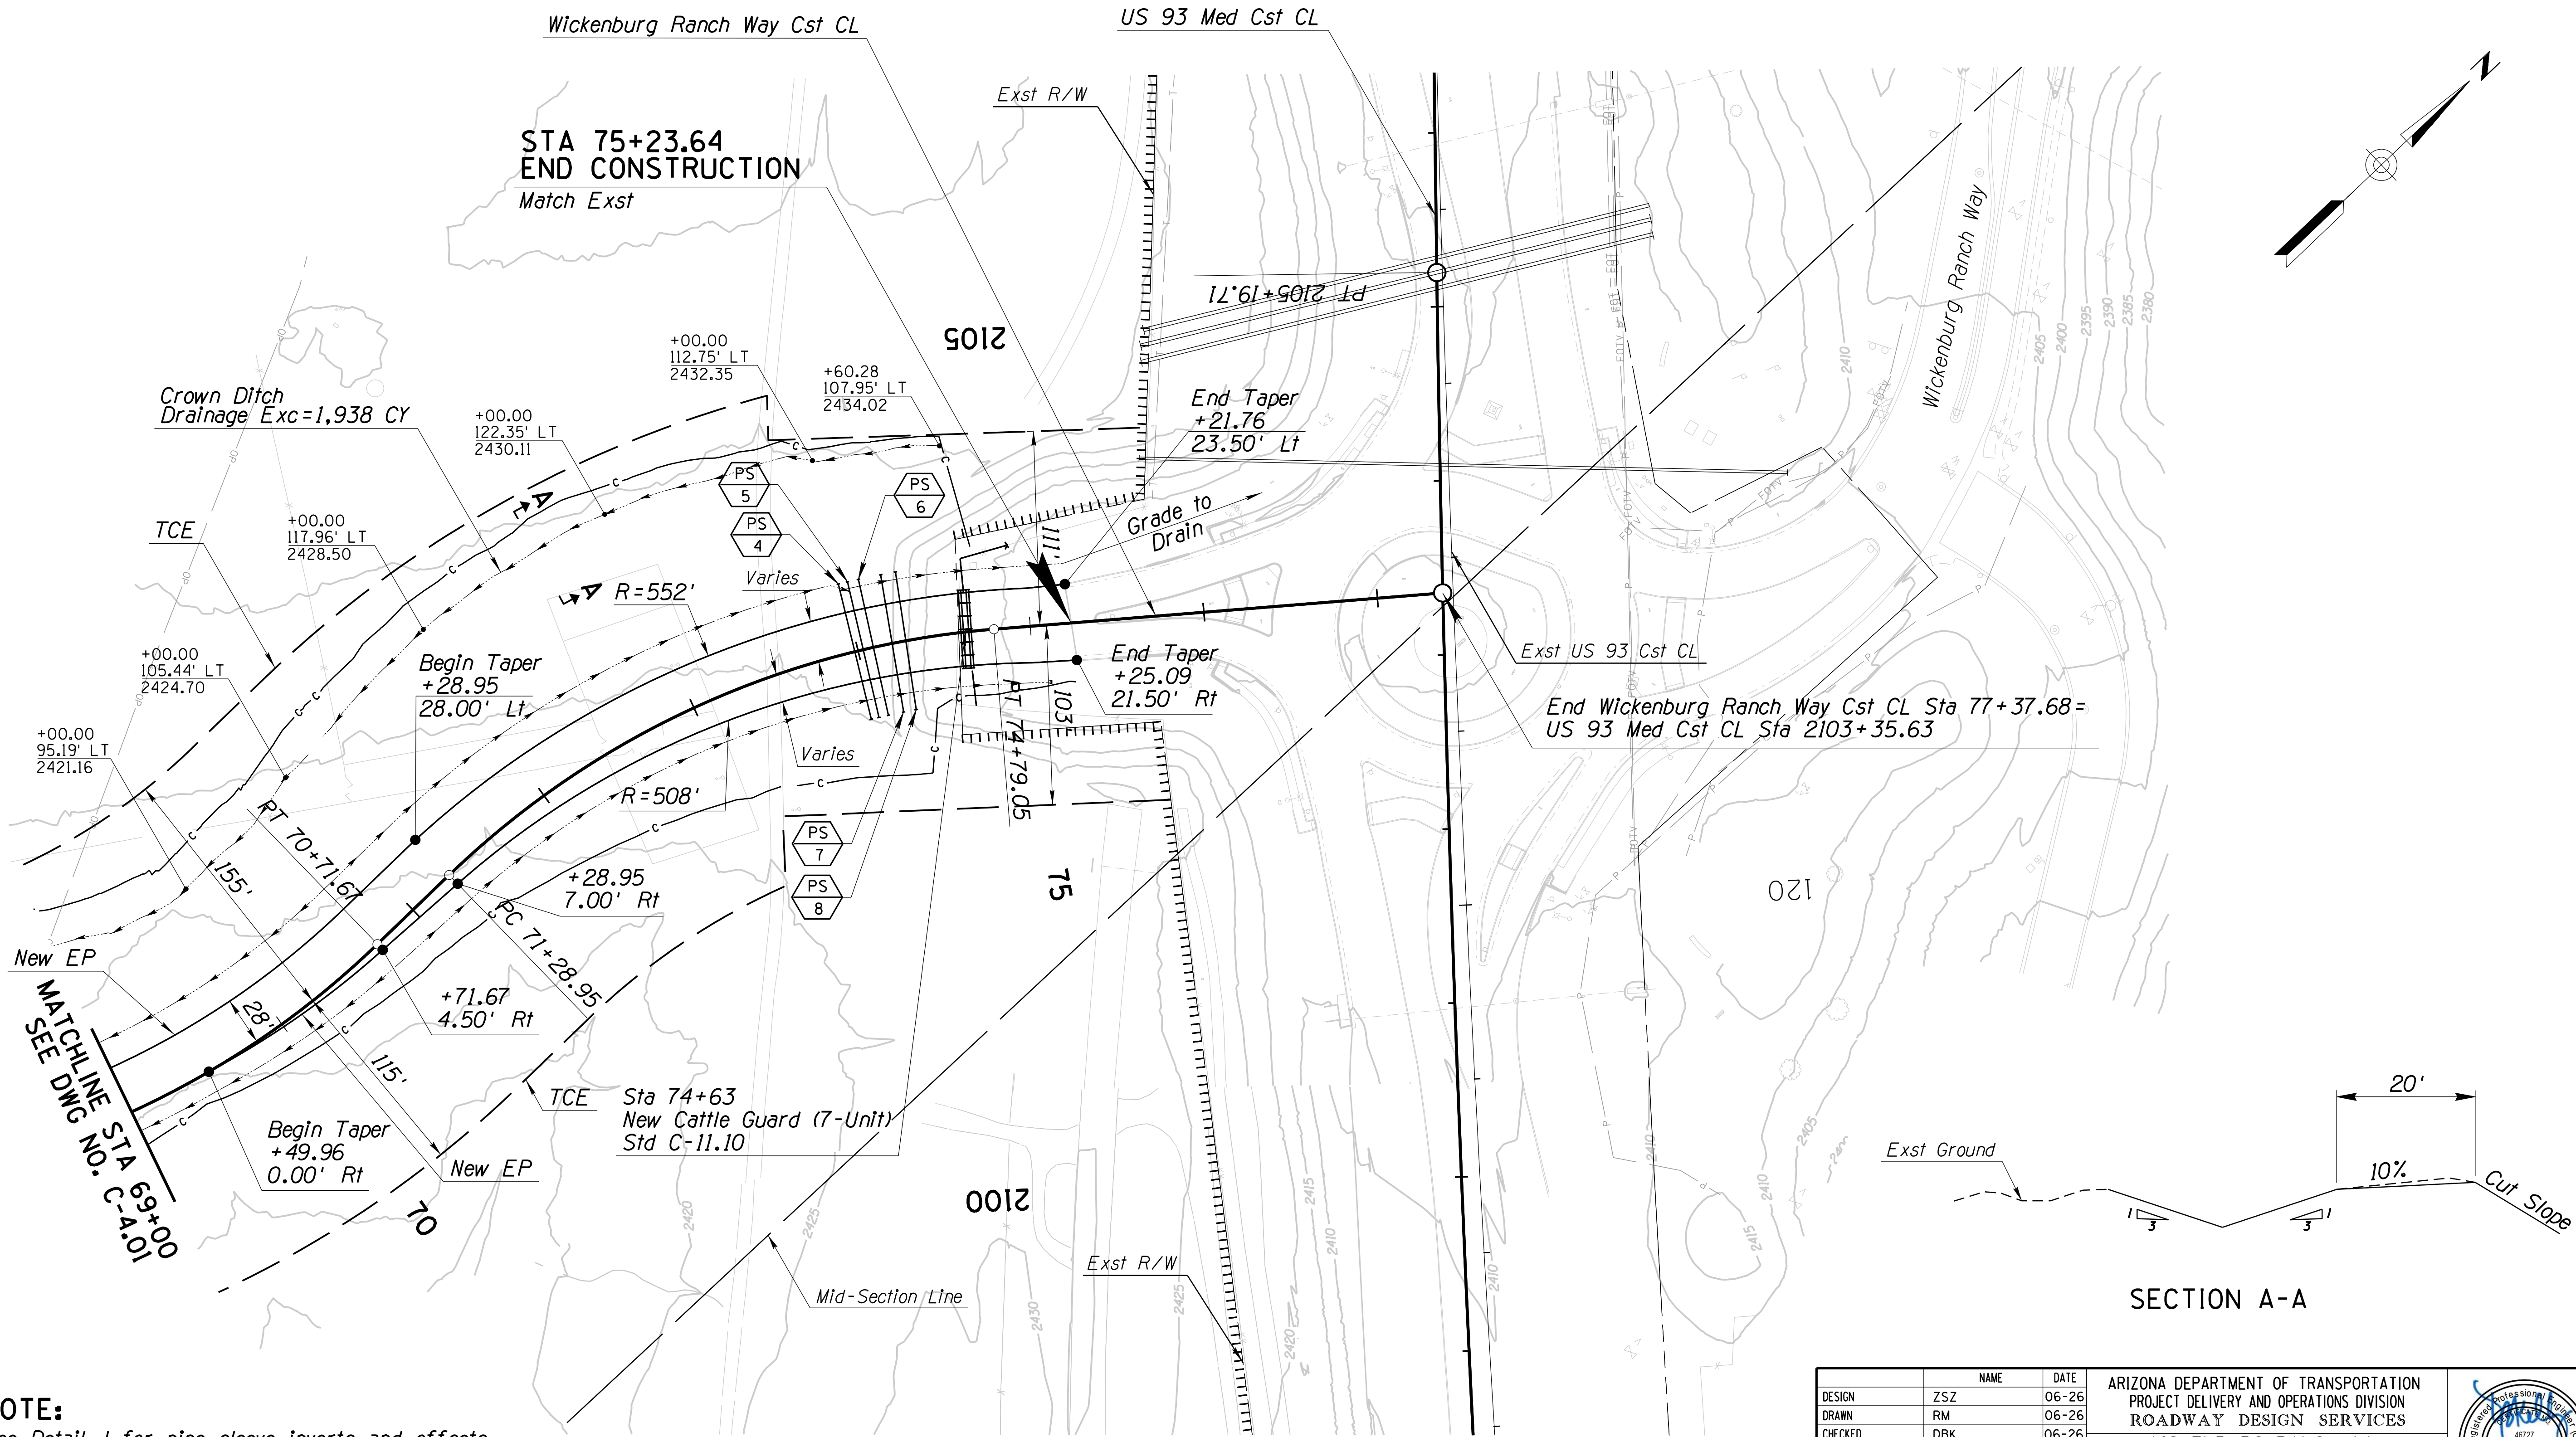


SECTION A-A

NOTE:
See Detail J for pipe sleeve inverts and offsets.

DESIGN	NAME	DATE	ARIZONA DEPARTMENT OF TRANSPORTATION PROJECT DELIVERY AND OPERATIONS DIVISION ROADWAY DESIGN SERVICES	
DRAWN	RM	06-26	WICKENBURG RANCH WAY PLAN SHEET STA 69+00 TO STA 76+00	
CHECKED	DBK	06-26	US 93 WICKENBURG RANCH WAY TO VISTA ROYALE	DWG NO. C-4.04
Stanley Consultants inc.			093-B(230)T	OF

F.H.W.A. REGION	STATE	PROJECT NO.	SHEET NO.	TOTAL SHEETS	RECORD DRAWING
9	ARIZ.	093-B(230)T	197	524	


093 YV 189

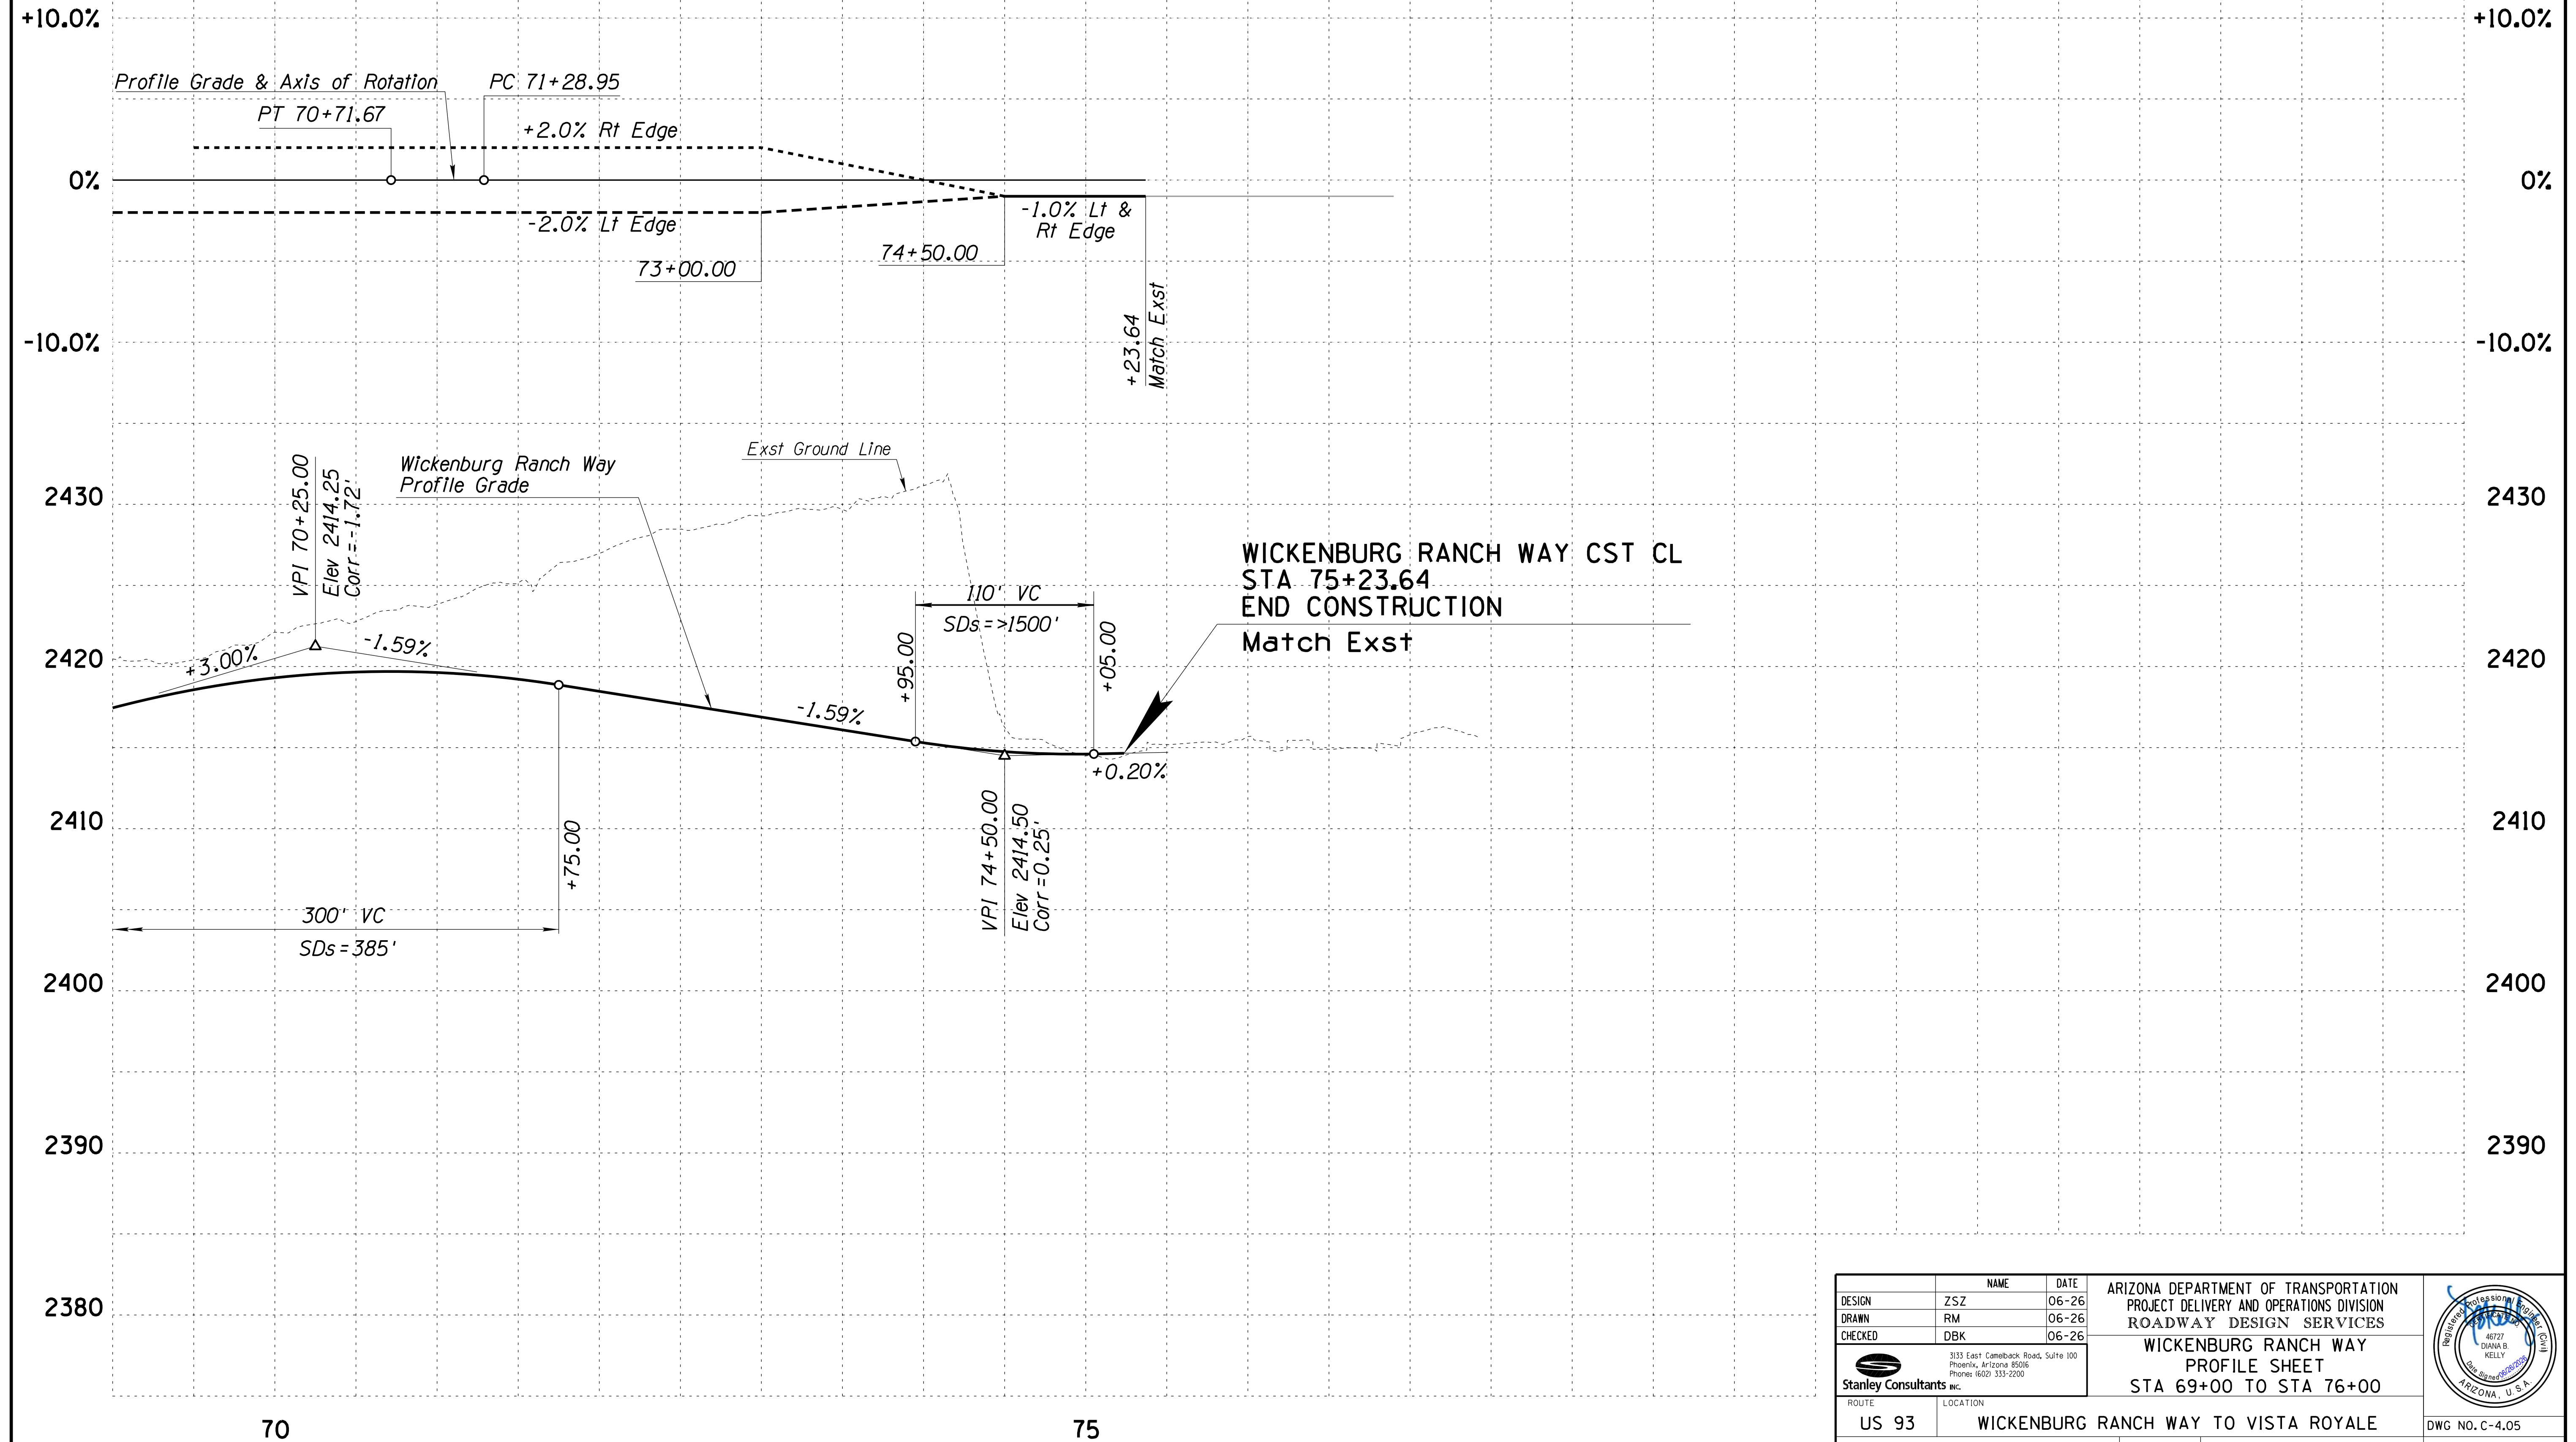

DESIGN	ZSZ	NAME	DATE	ARIZONA DEPARTMENT OF TRANSPORTATION PROJECT DELIVERY AND OPERATIONS DIVISION ROADWAY DESIGN SERVICES	
DRAWN	RM		06-26	WICKENBURG RANCH WAY PROFILE SHEET STA 69+00 TO STA 76+00	
CHECKED	DBK		06-26	STA 69+00 TO STA 76+00	
Stanley Consultants inc. 3133 East Camelback Road, Suite 100 Phoenix, Arizona 85016 Phone: (602) 333-2200					
ROUTE US 93		LOCATION WICKENBURG RANCH WAY TO VISTA ROYALE		DWG NO. C-4.05	
TRACS NO. F0738 OIC		093-B(230)T		OF	

F.H.W.A. REGION	STATE	PROJECT NO.	SHEET NO.	TOTAL SHEETS	RECORD DRAWING
9	ARIZ.	093-B(230)T	198	524	


093 YV 189

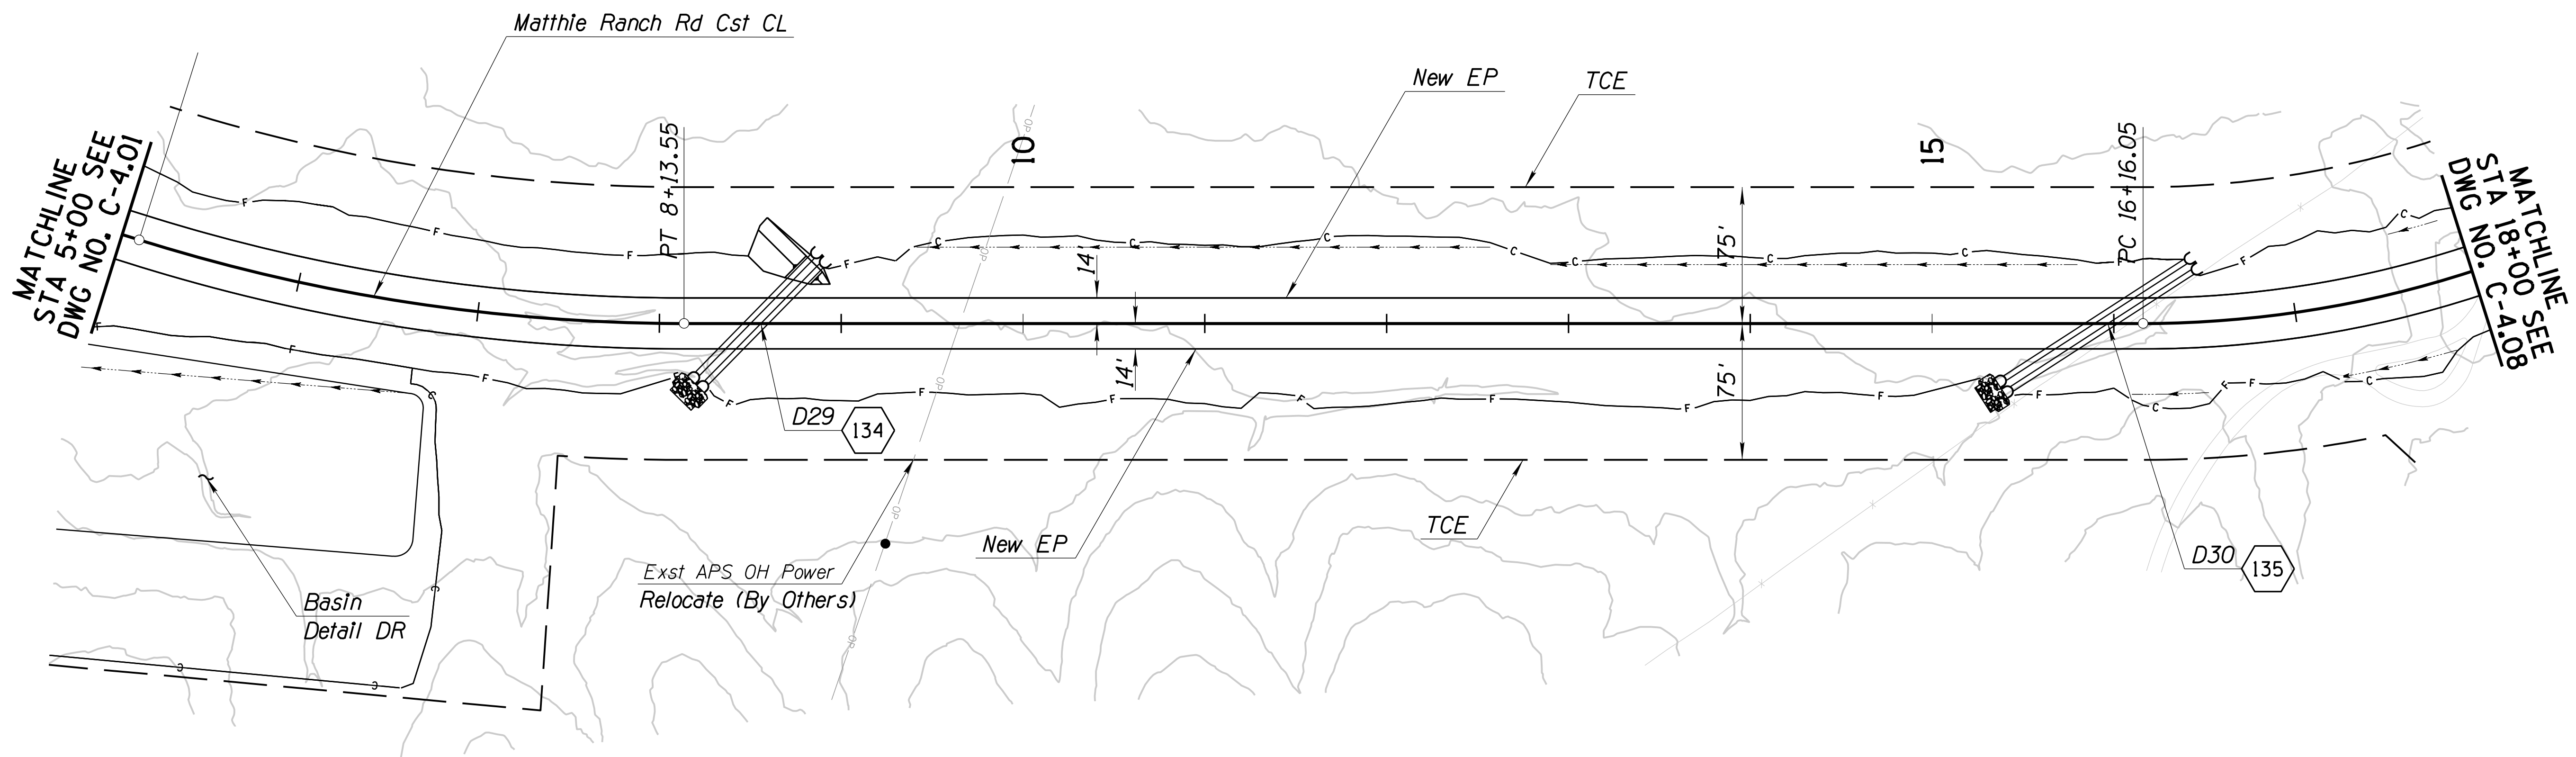

		NAME	DATE	ARIZONA DEPARTMENT OF TRANSPORTATION PROJECT DELIVERY AND OPERATIONS DIVISION ROADWAY DESIGN SERVICES MATTHE RANCH ROAD PLAN SHEET STA 5+00 TO STA 18+00	
DESIGN	ZSZ		06-26		
DRAWN	RM		06-26		
CHECKED	DBK		06-26		
 3133 East Camelback Road, Suite 100 Phoenix, Arizona 85016 Phone: 602.335.2200					
ROUTE		LOCATION			
US 93		WICKENBURG RANCH WAY TO VISTA ROYALE		DWG NO. C-4.06	
TRACS NO. F0738 OIC				093-B(230)T	<u> OF </u>

F.H.W.A. REGION	STATE	PROJECT NO.	SHEET NO.	TOTAL SHEETS	RECORD DRAWING
9	ARIZ.	093-B(230)T	199	524	

093 YV 189

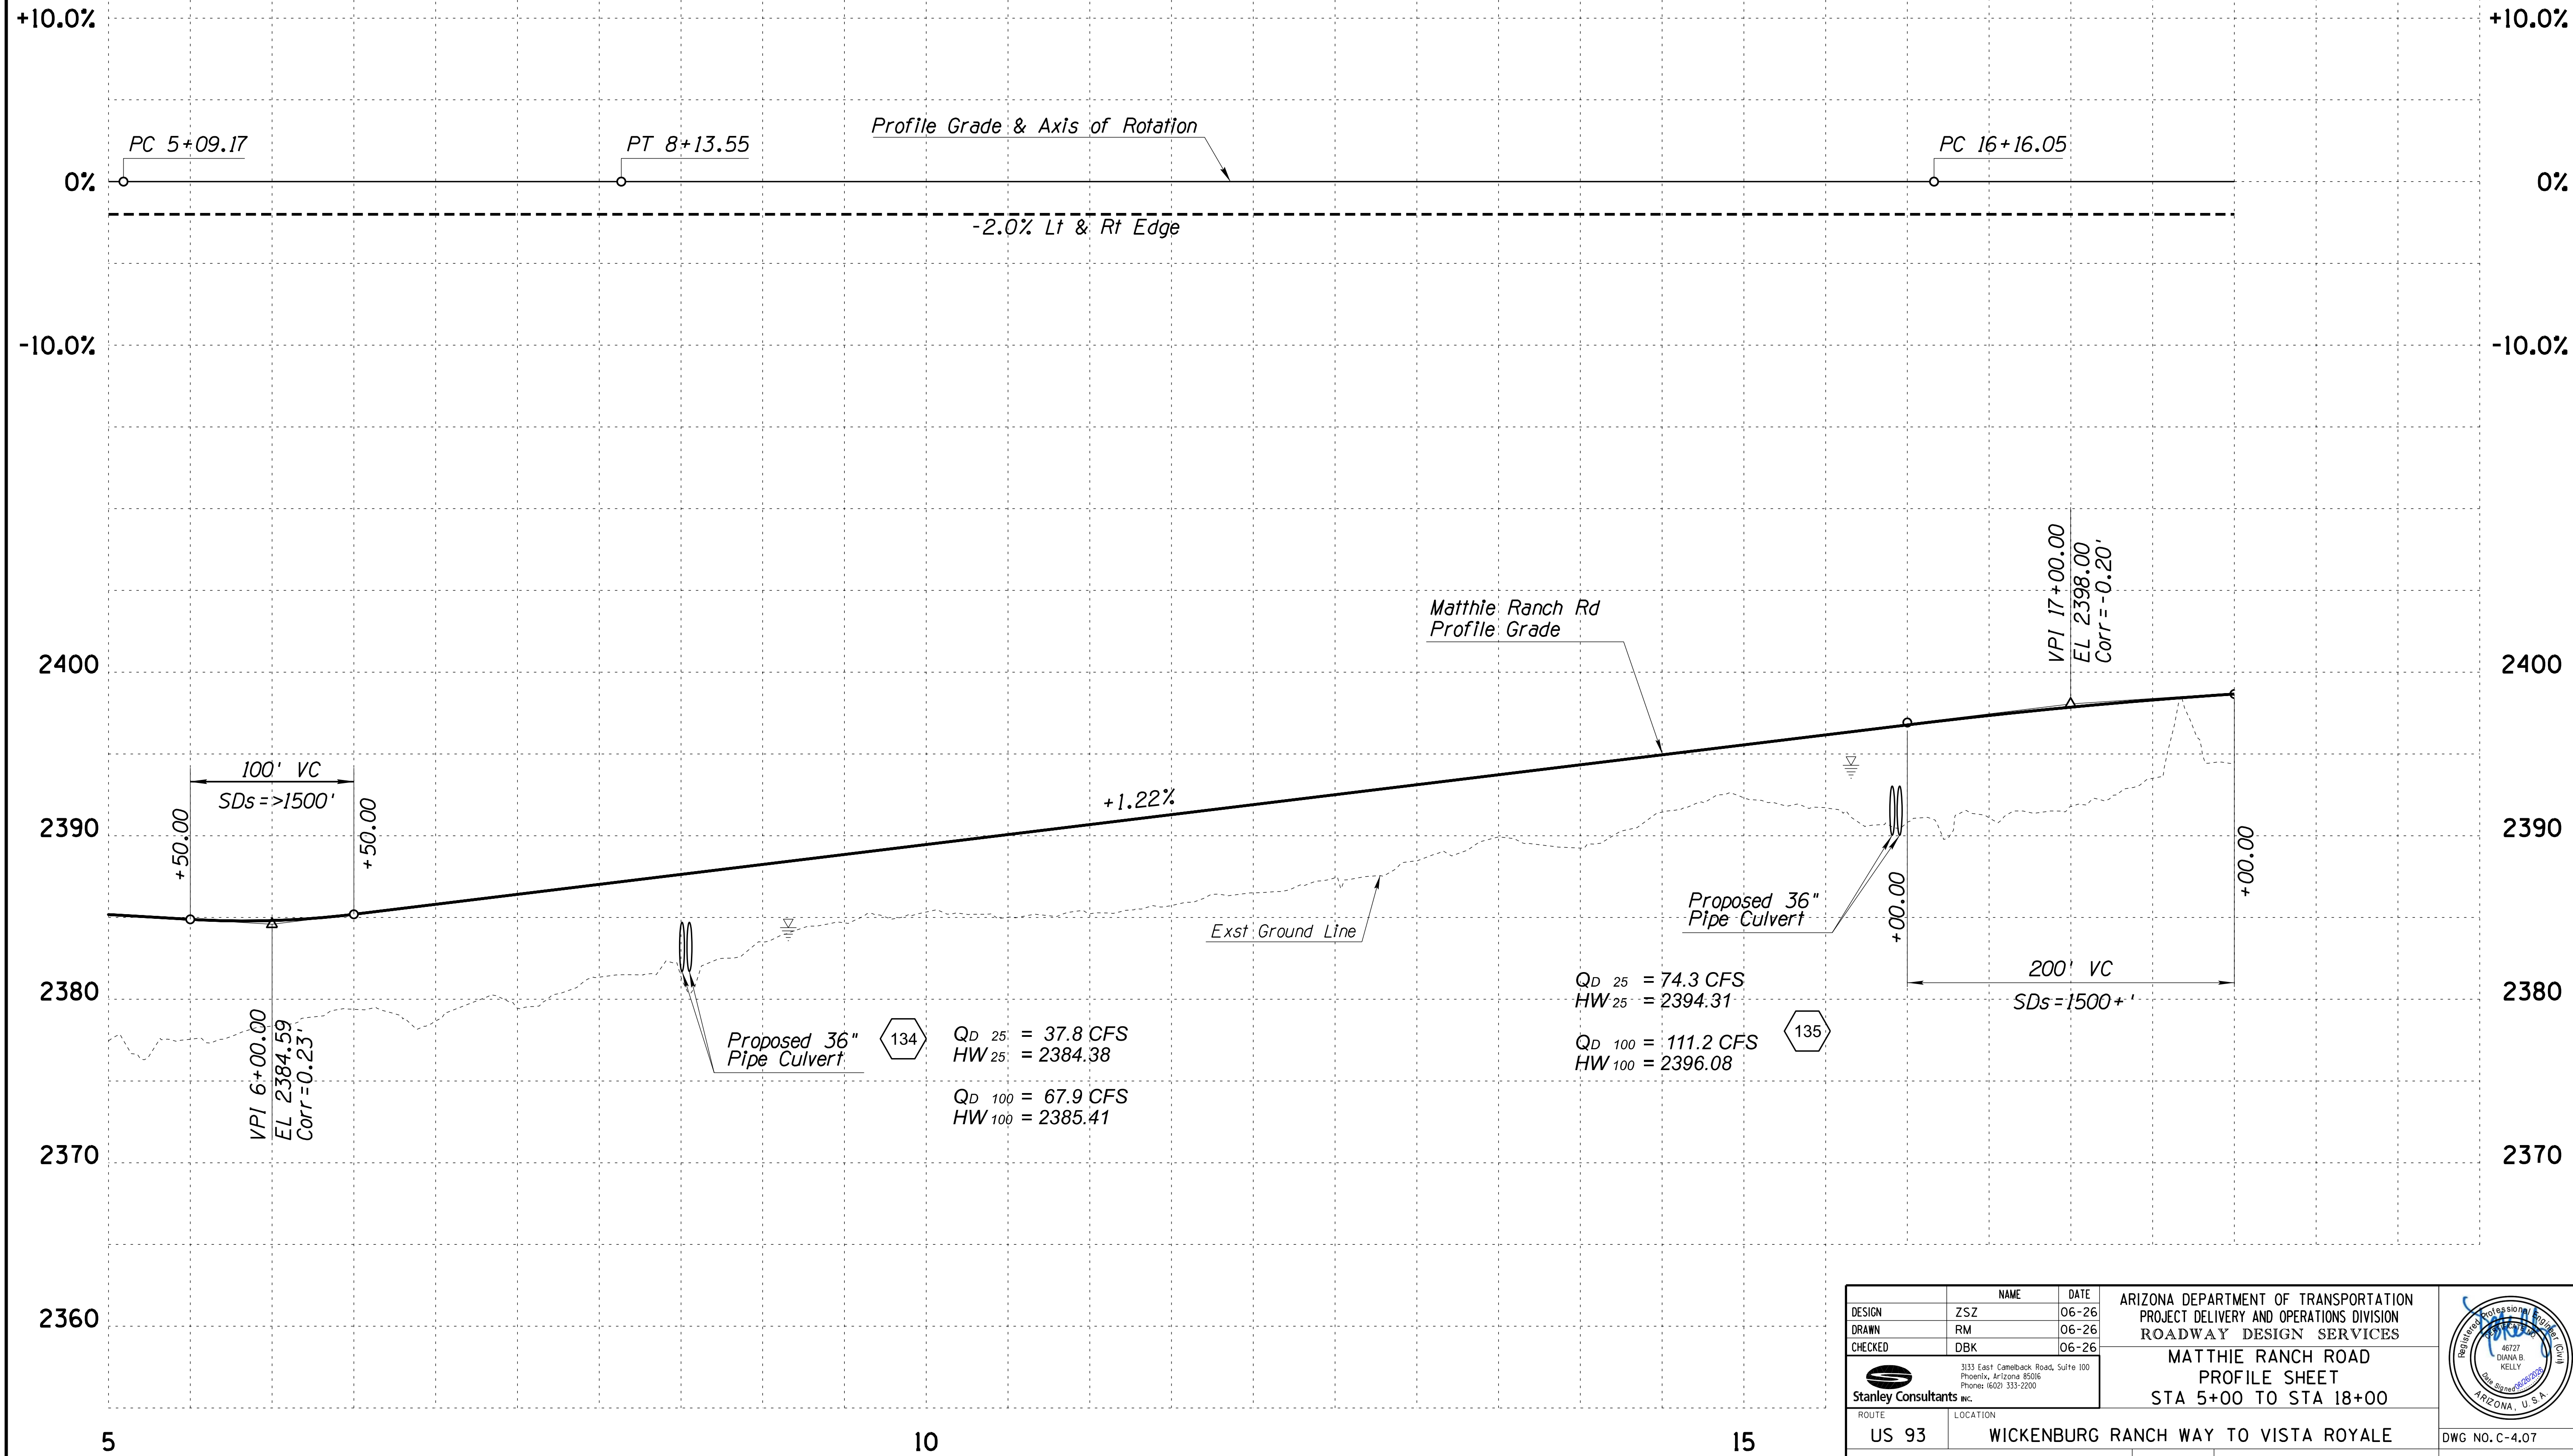


DESIGN	NAME	DATE	ARIZONA DEPARTMENT OF TRANSPORTATION PROJECT DELIVERY AND OPERATIONS DIVISION ROADWAY DESIGN SERVICES MATTHE RANCH ROAD PROFILE SHEET STA 5+00 TO STA 18+00	
DRAWN	RM	06-26		
CHECKED	DBK	06-26		
Stanley Consultants inc. 3133 East Camelback Road, Suite 100 Phoenix, Arizona 85016 Phone: (602) 333-2200				
ROUTE	LOCATION		DWG NO. C-4.07	
US 93		WICKENBURG RANCH WAY TO VISTA ROYALE		
TRACS NO. F0738 OIC			093-B(230)T	OF

NOTES:

1. See Dwg No. C-3.03 for US 93.
2. See Detail J for pipe sleeve inverts and offsets.

F.H.W.A. REGION	STATE	PROJECT NO.	SHEET NO.	TOTAL SHEETS	RECORD DRAWING
9	ARIZ.	093-B(230)T	200	524	

093 YV 189

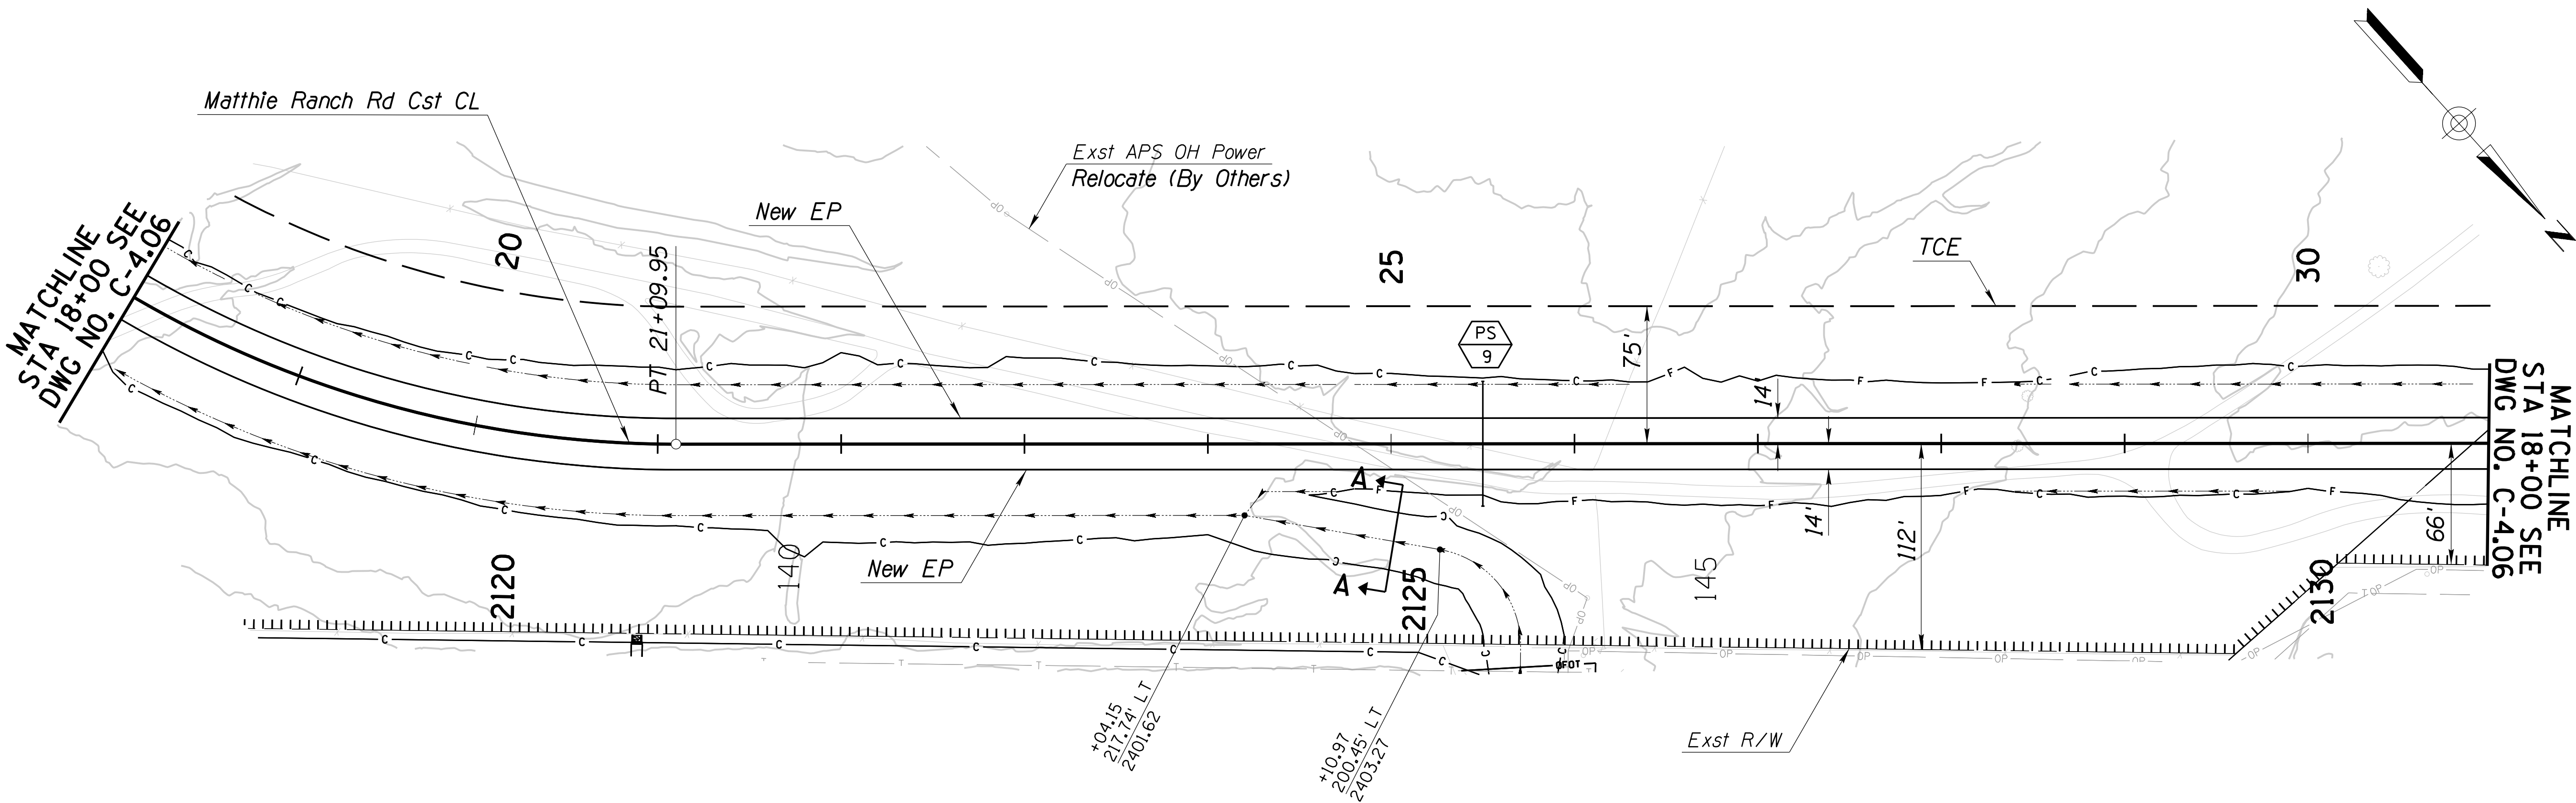

SECTION A-A


NOTE:

See Detail J for pipe sleeve inverts and offsets.

		NAME	DATE	ARIZONA DEPARTMENT OF TRANSPORTATION PROJECT DELIVERY AND OPERATIONS DIVISION ROADWAY DESIGN SERVICES MATTHE RANCH ROAD PLAN SHEET STA 18+00 TO STA 31+00	
DESIGN		ZSZ	06-26		
DRAWN		RM	06-26		
CHECKED		DBK	06-26		
		3133 East Camelback Road, Suite 100 Phoenix, Arizona 85016 Phone: (602) 333-2200			
Stanley Consultants inc.					
ROUTE		LOCATION			
US 93		WICKENBURG RANCH WAY TO VISTA ROYALE		DWG NO. C-4.08	
TRACS NO. F0738 OIC				093-B(230)T	OF


F.H.W.A. REGION	STATE	PROJECT NO.	SHEET NO.	TOTAL SHEETS	RECORD DRAWING
9	ARIZ.	093-B(230)T	201	524	

093 YV 189

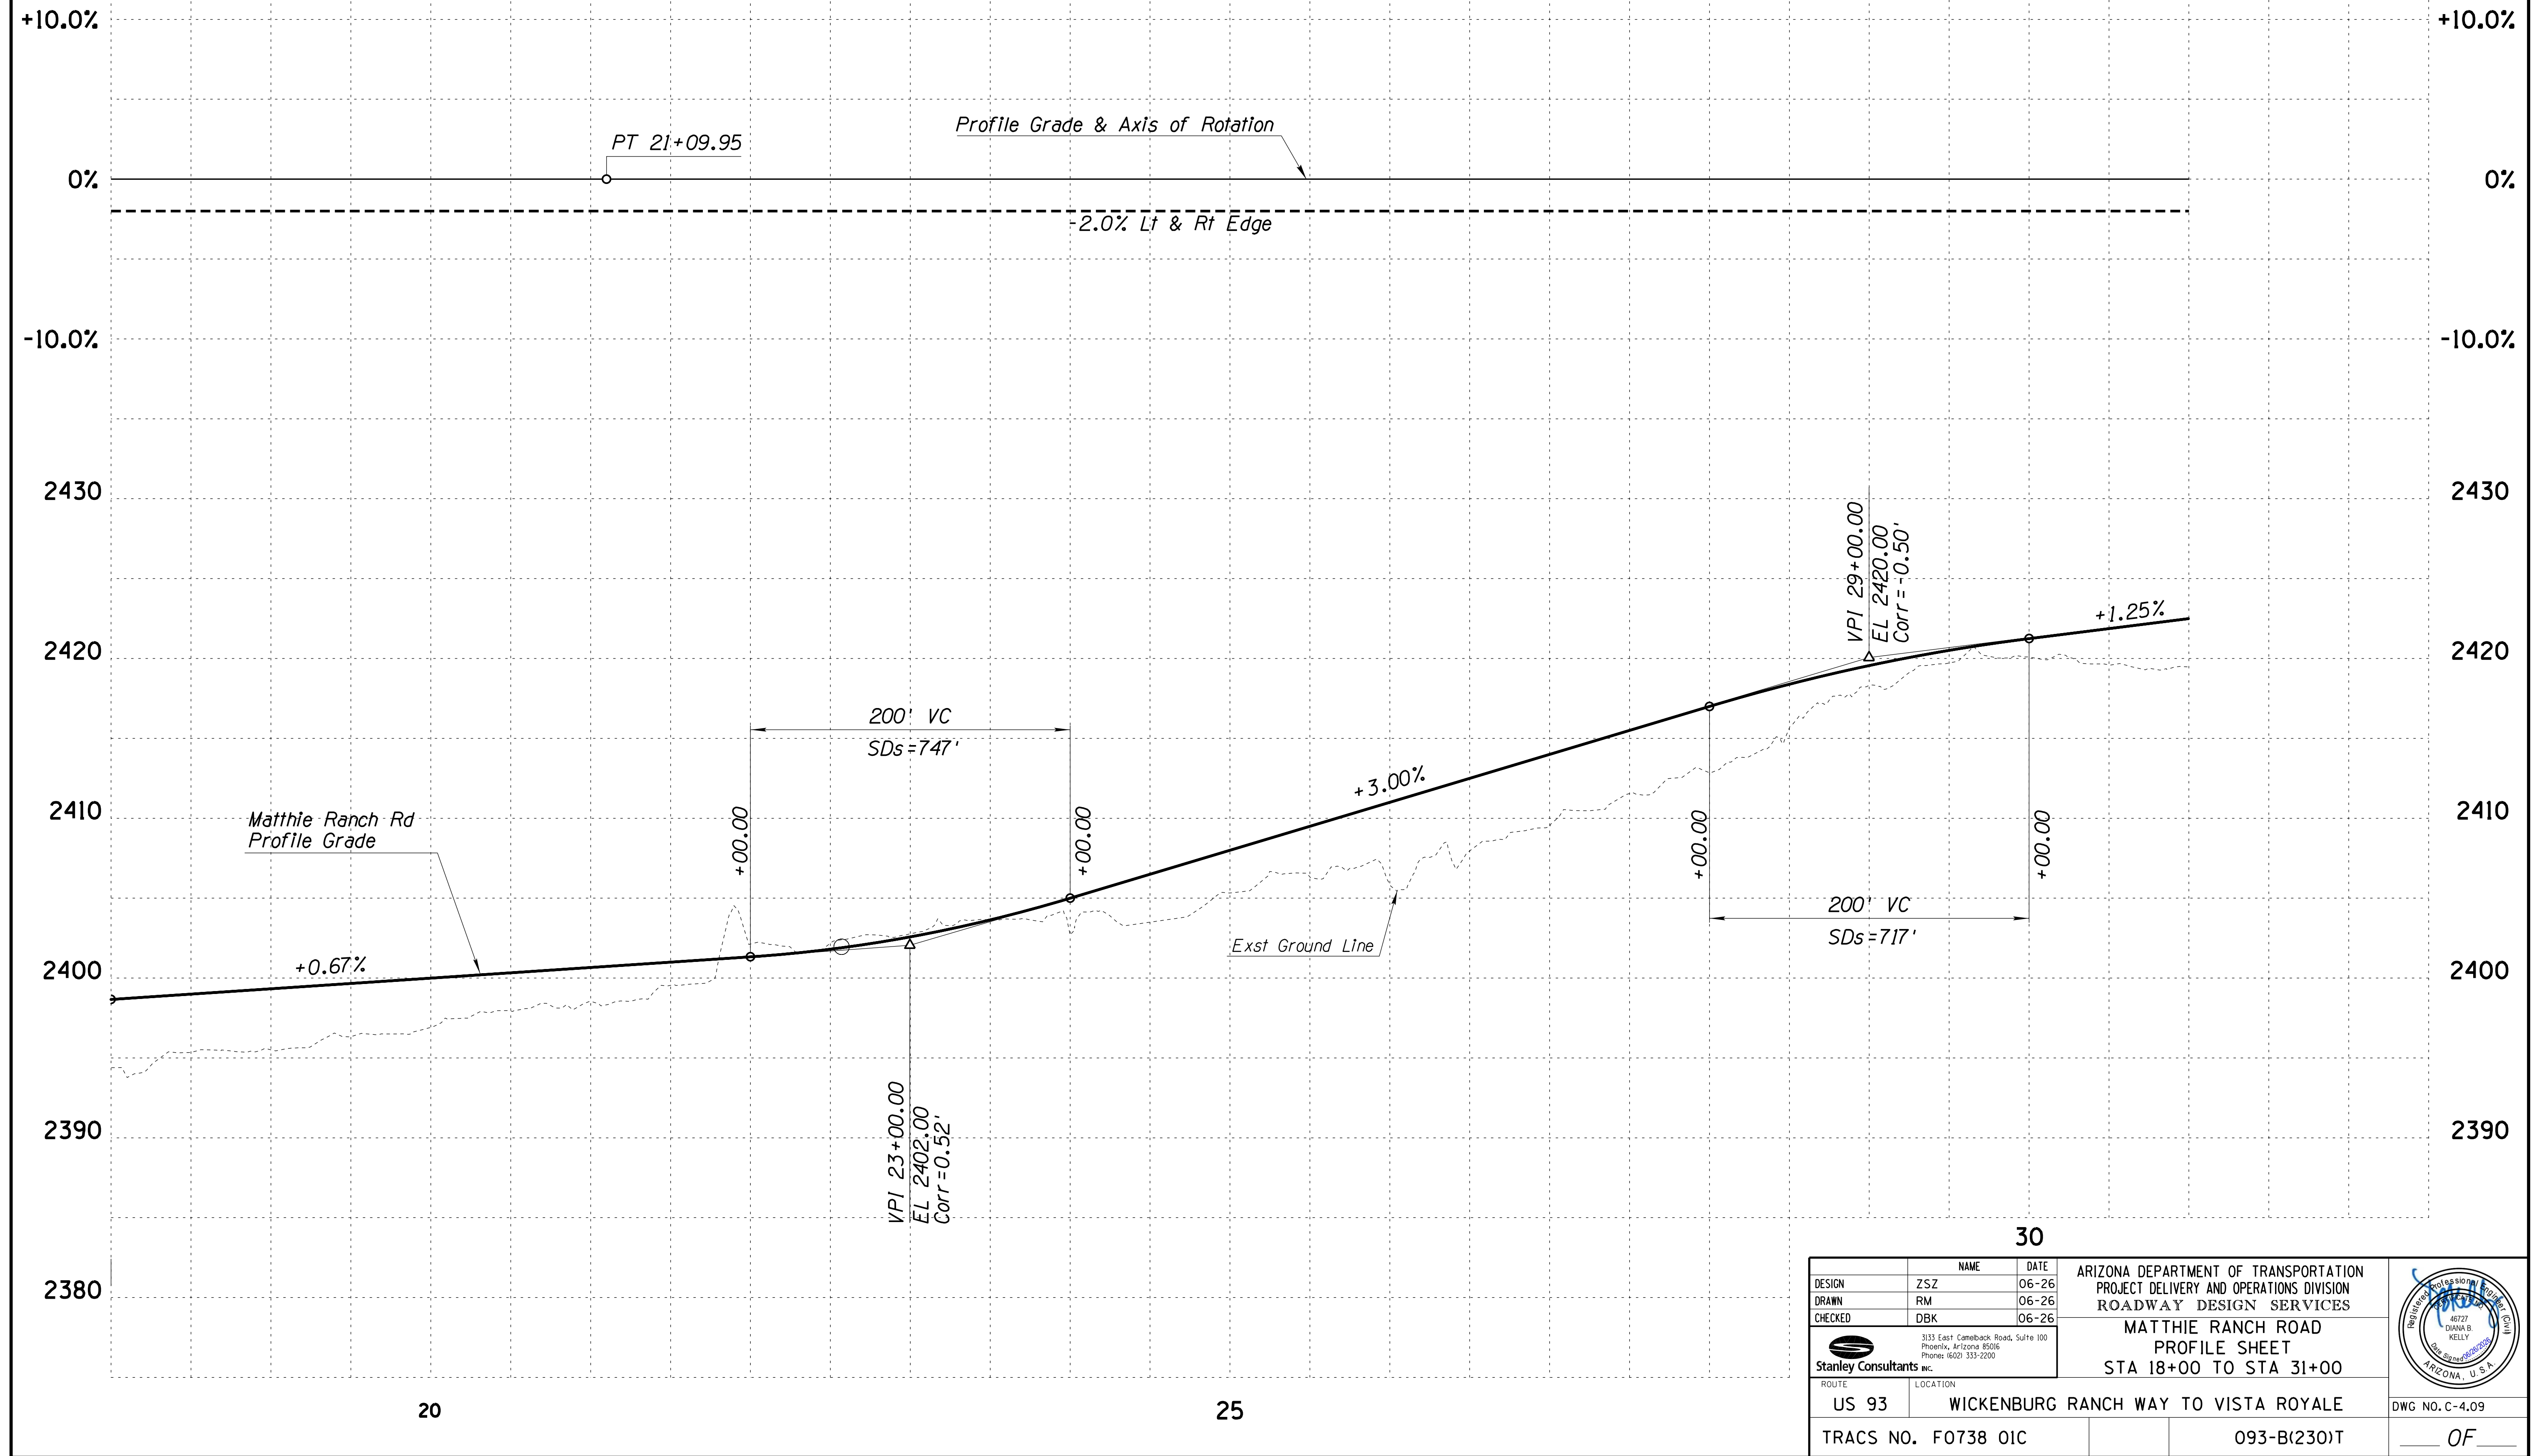


F.H.W.A. REGION	STATE	PROJECT NO.	SHEET NO.	TOTAL SHEETS	RECORD DRAWING
9	ARIZ.	093-B(230)T	202	524	

093 YV 189

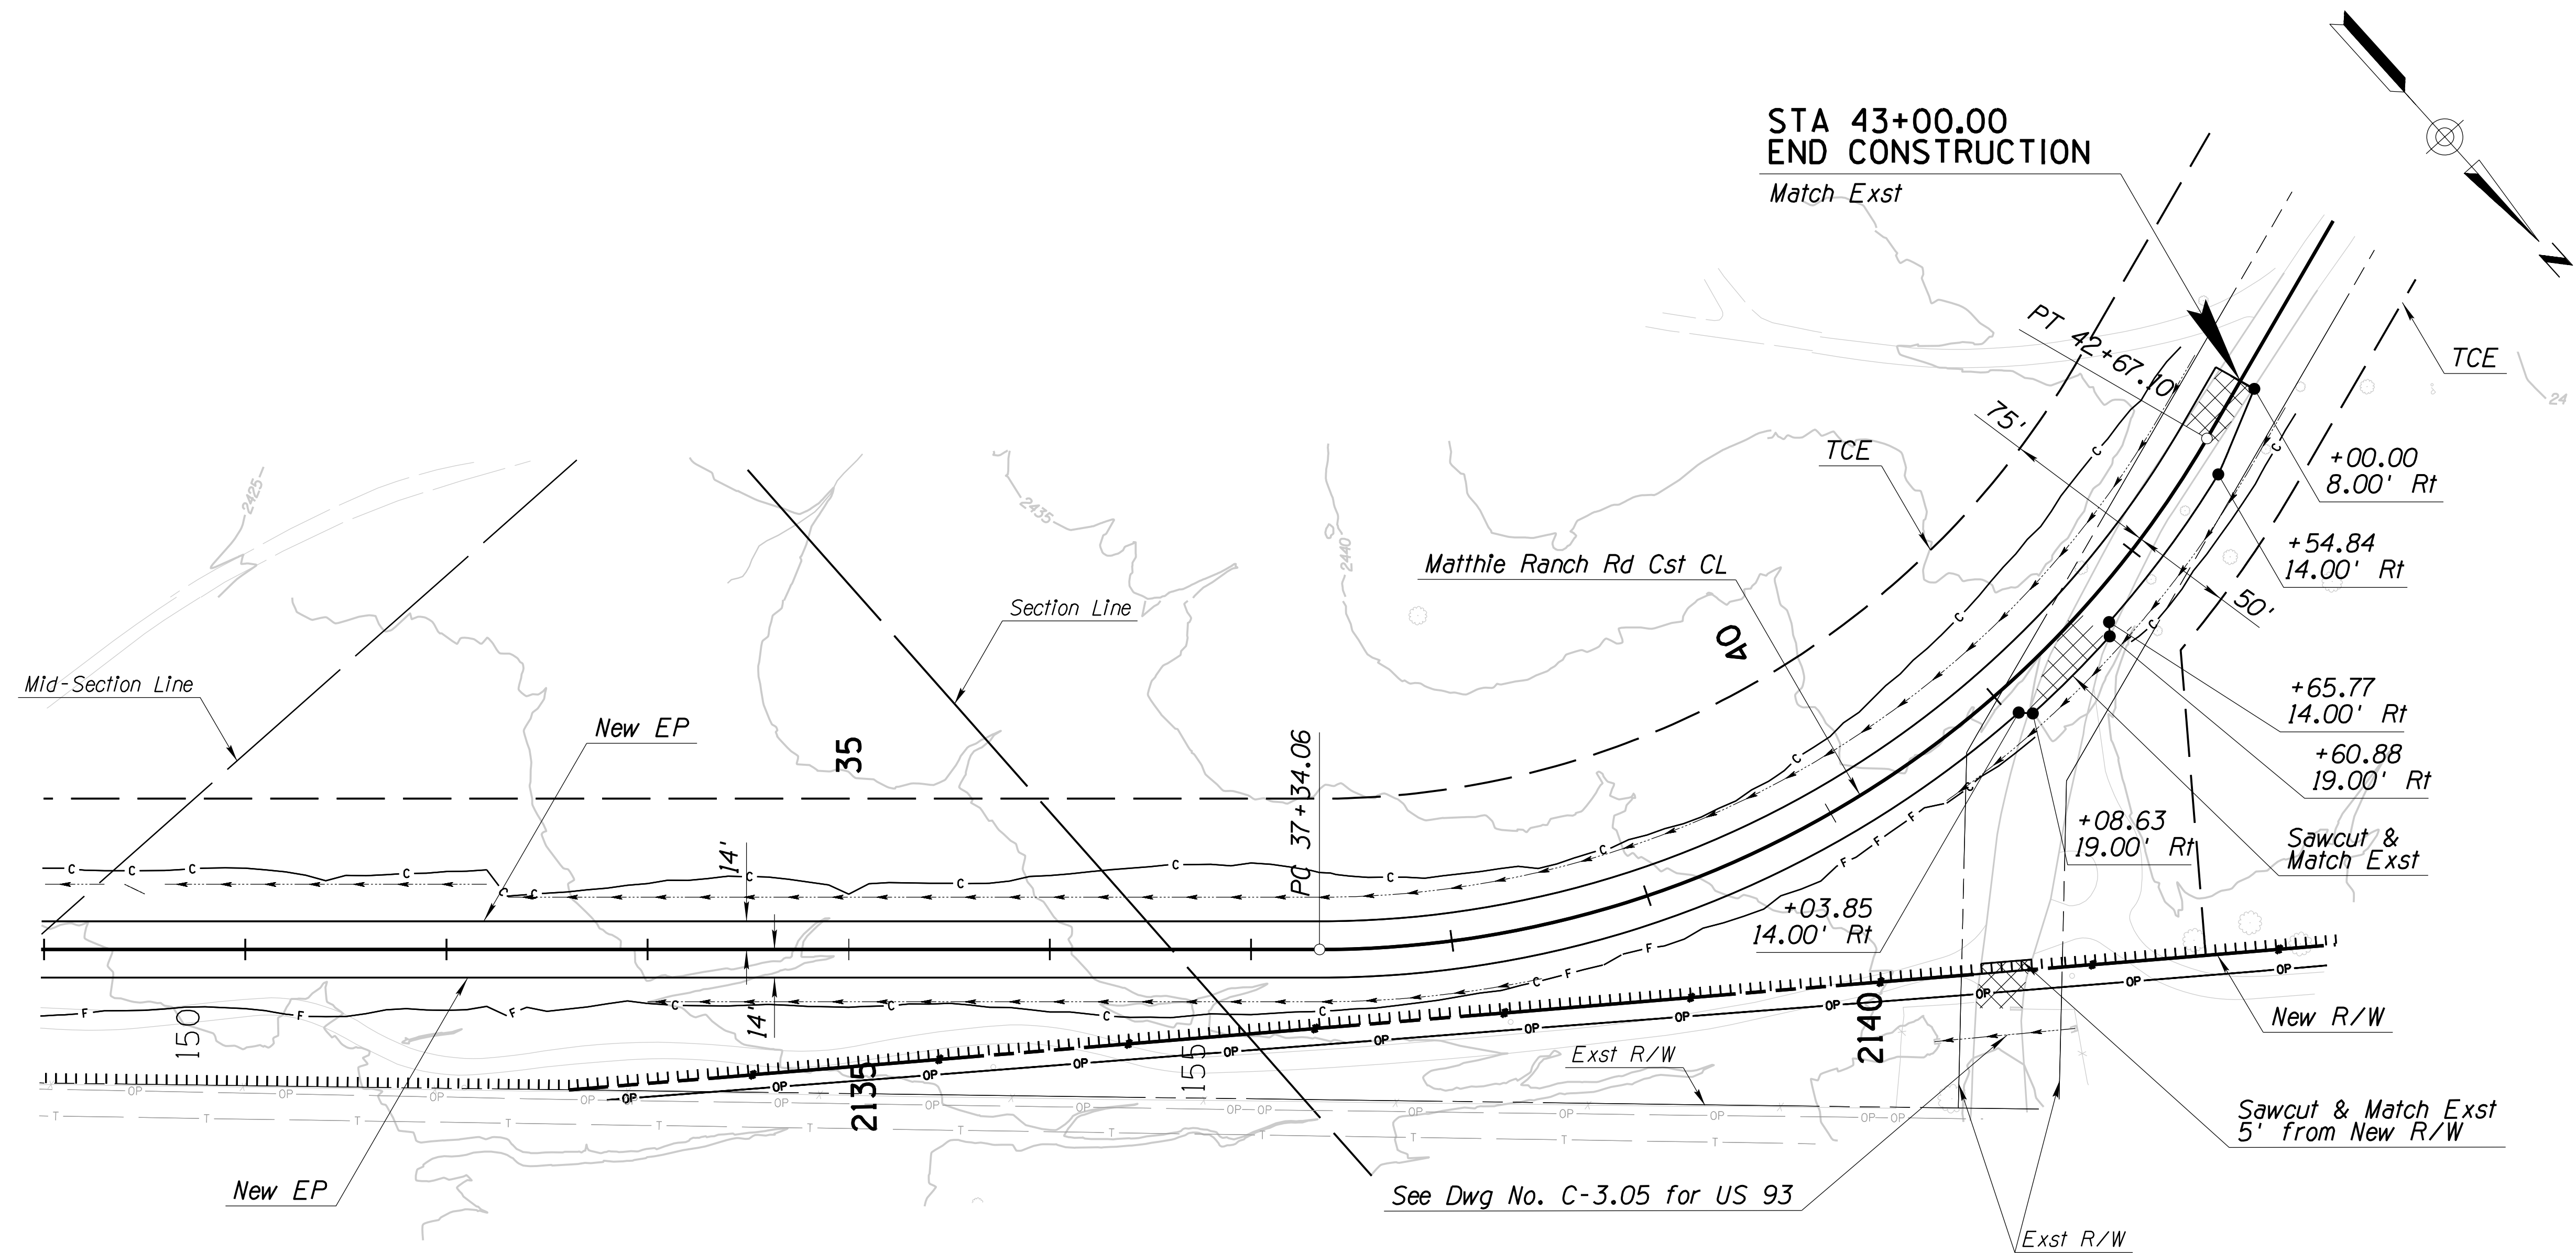


LEGEND:

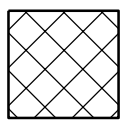 Existing AC Pavement Remove 455 Sq Yd

DESIGN	ZSZ	DATE	06-26	ARIZONA DEPARTMENT OF TRANSPORTATION PROJECT DELIVERY AND OPERATIONS DIVISION ROADWAY DESIGN SERVICES	
DRAWN	RM	DATE	06-26		
CHECKED	DBK	DATE	06-26		
 3133 East Camelback Road, Suite 100 Phoenix, Arizona 85016 Phone: (602) 333-2200				MATTHIE RANCH ROAD PLAN SHEET STA 31+00 TO 43+00	
ROUTE		LOCATION		DWG NO. C-4.10	
US 93		WICKENBURG RANCH WAY TO VISTA ROYALE			
TRACS NO. F0738 OIC			093-B(230)T		
			OF		


F.H.W.A. REGION	STATE	PROJECT NO.	SHEET NO.	TOTAL SHEETS	RECORD DRAWING
9	ARIZ.	093-B(230)T	203	524	


093 YV 189

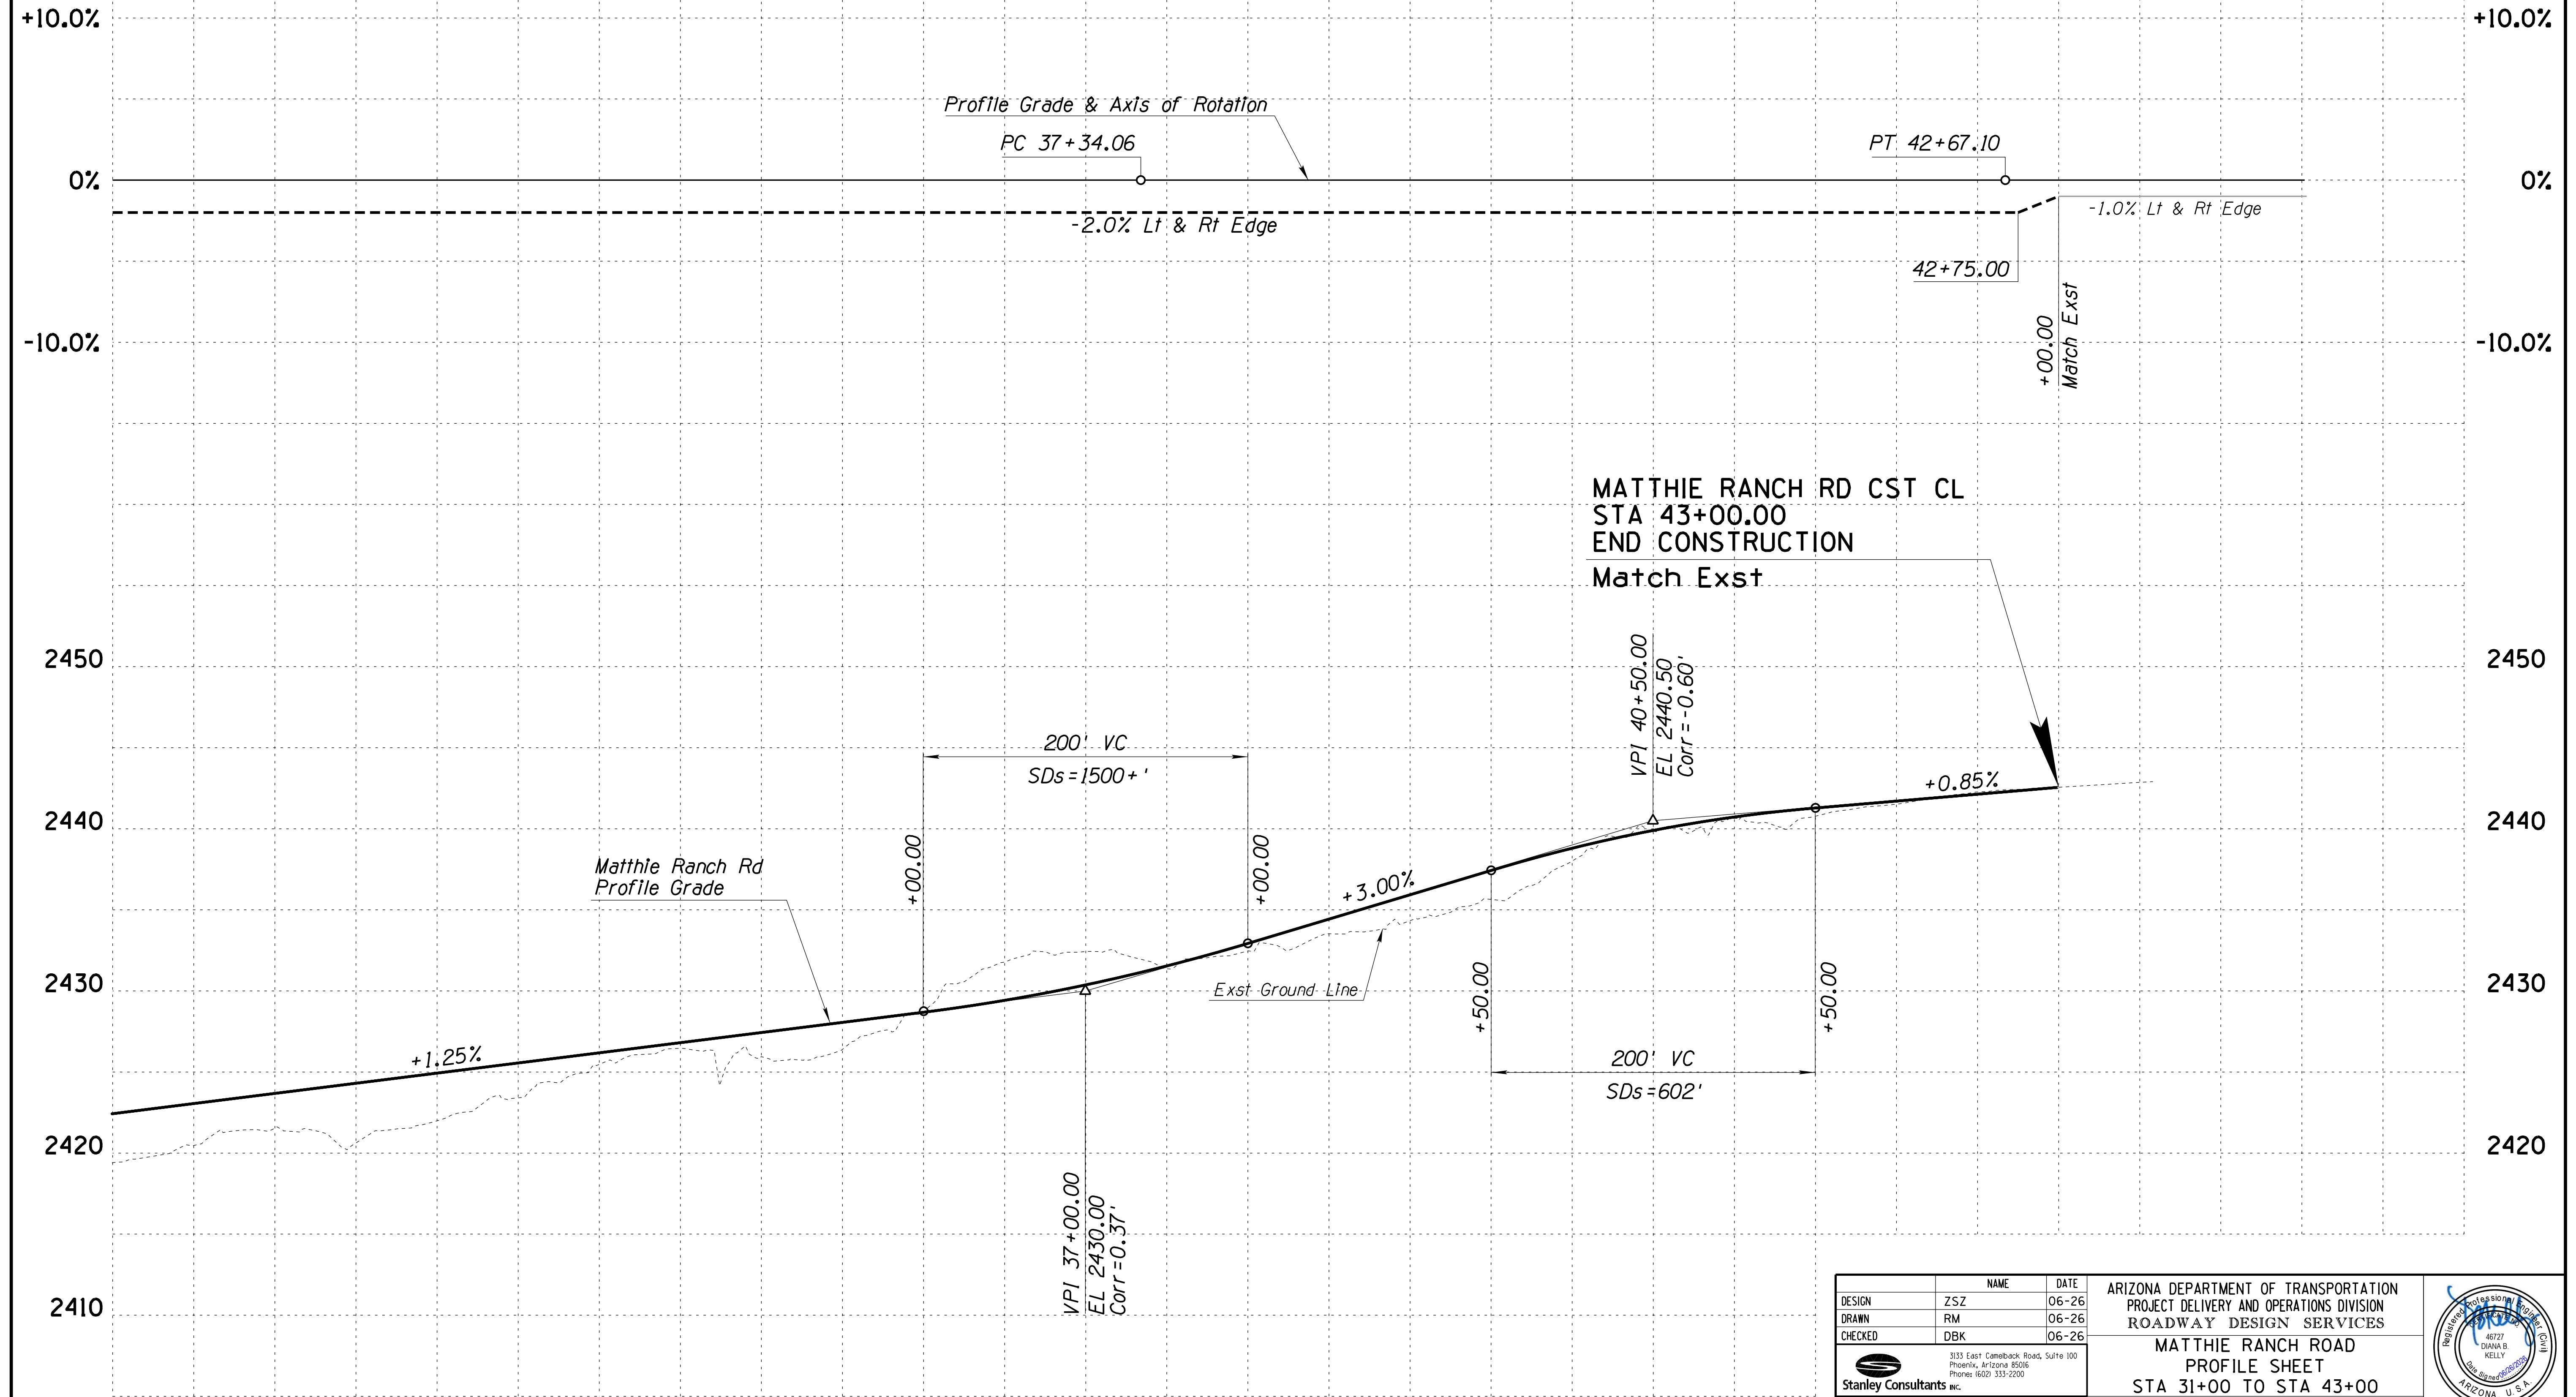


DESIGN	ZSZ	DATE	06-26
DRAWN	RM	DATE	06-26
CHECKED	DBK	DATE	06-26
ARIZONA DEPARTMENT OF TRANSPORTATION PROJECT DELIVERY AND OPERATIONS DIVISION ROADWAY DESIGN SERVICES			
MATTHIE RANCH ROAD PROFILE SHEET STA 31+00 TO STA 43+00			
ROUTE	US 93	LOCATION	WICKENBURG RANCH WAY TO VISTA ROYALE
TRACS NO.	F0738 OIC		093-B(230)T
			DWG NO. C-4.11
			OF



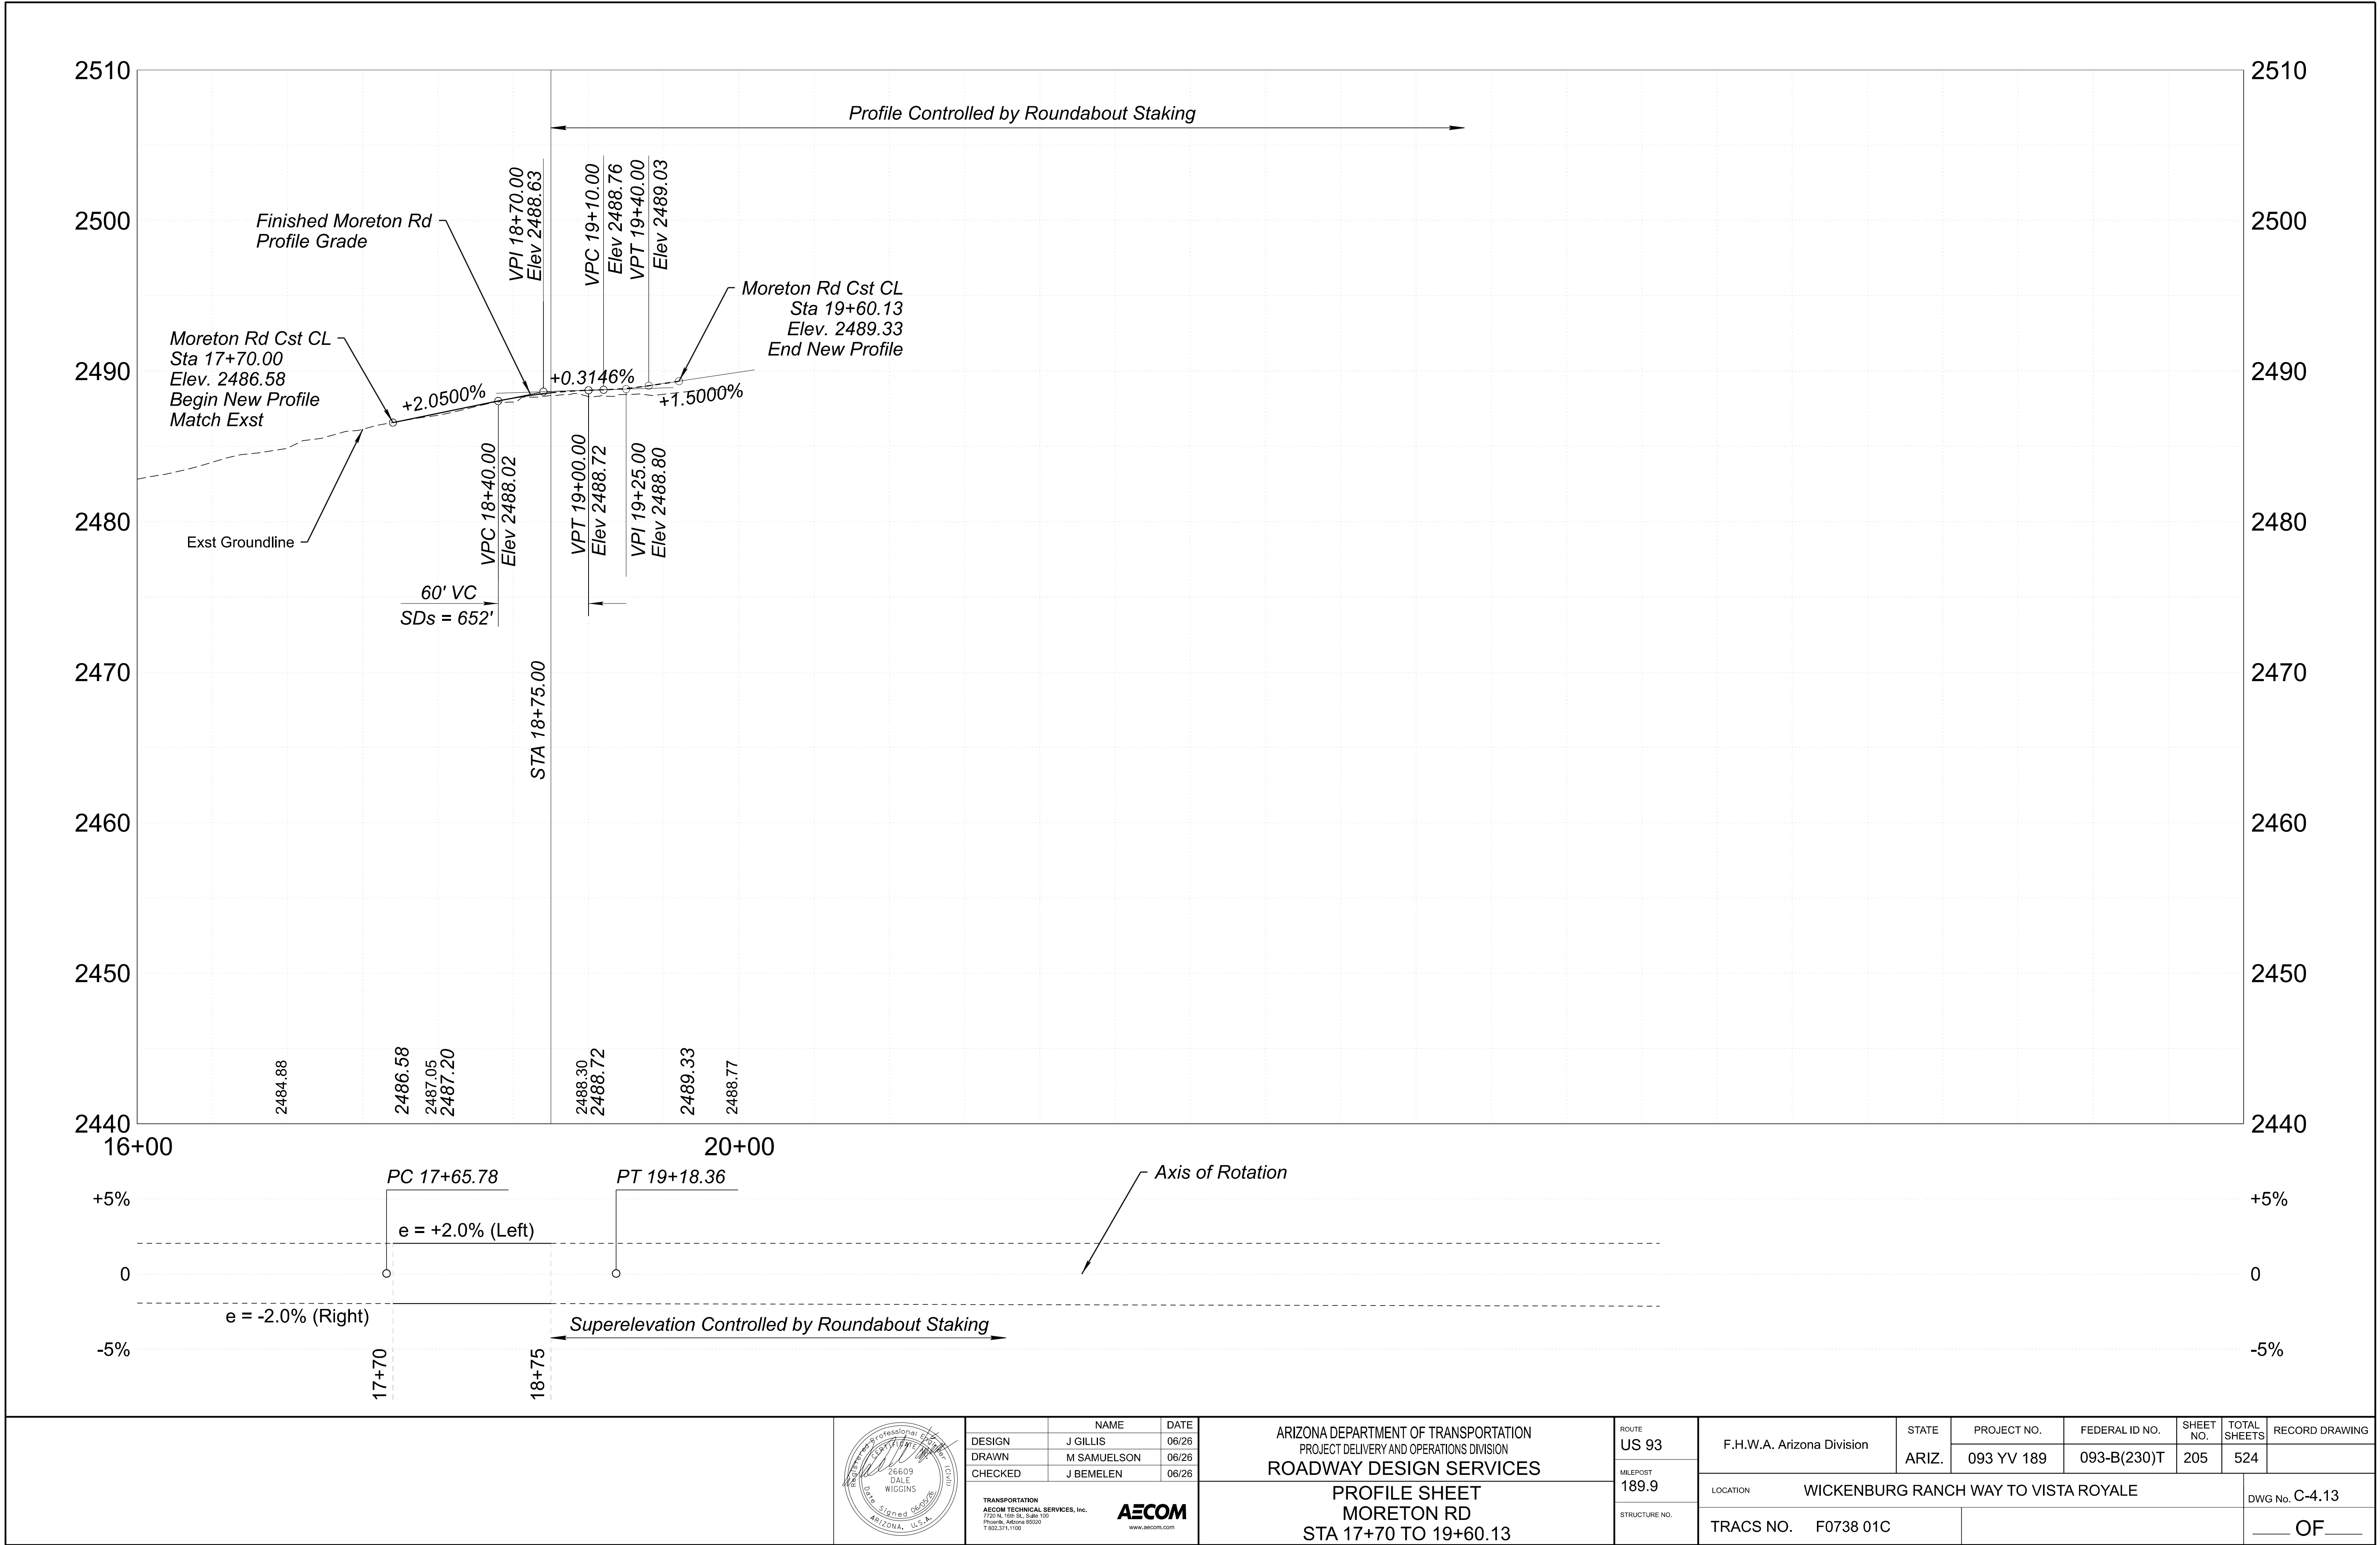

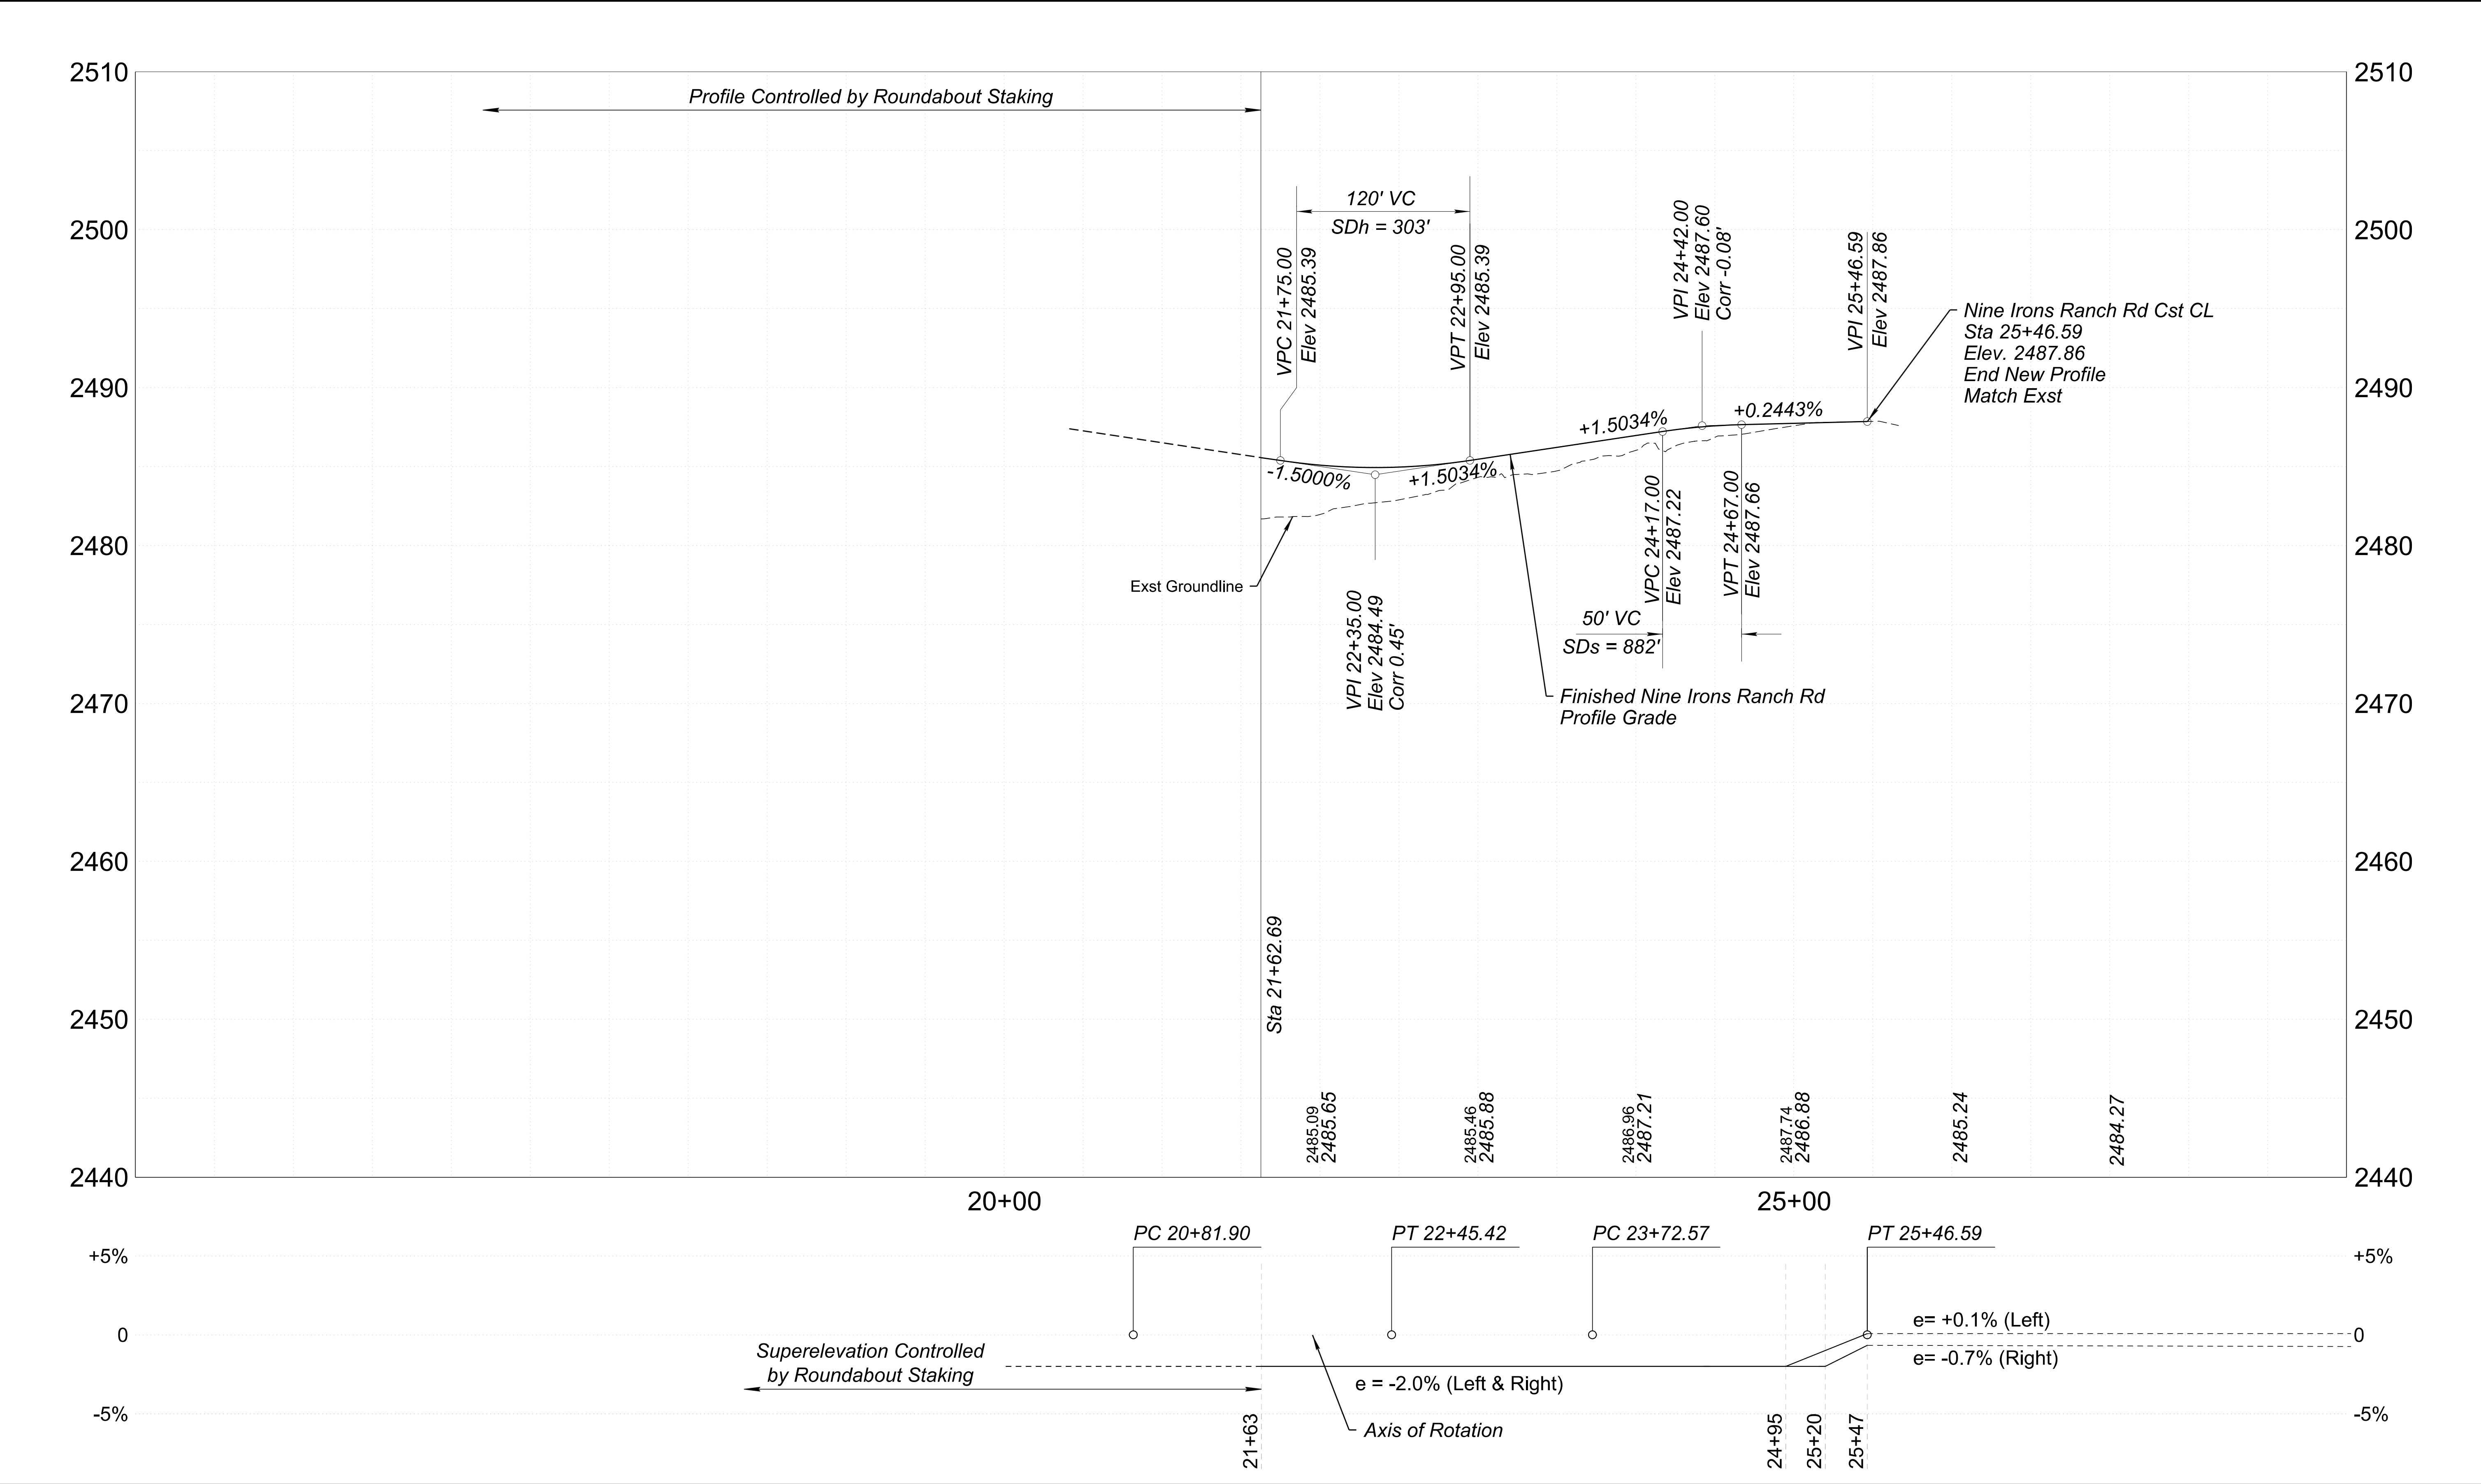

	NAME		DATE	ARIZONA DEPARTMENT OF TRANSPORTATION PROJECT DELIVERY AND OPERATIONS DIVISION ROADWAY DESIGN SERVICES				ROUTE		F.H.W.A. Arizona Division	STATE ARIZ.	PROJECT NO.	FEDERAL ID NO.	SHEET NO.	TOTAL SHEETS	RECORD DRAWING			
	DESIGN		J GILLIS	06/26	US 93				093 YV 189			093-B(230)T	206	524					
	DRAWN		M SAMUELSON	06/26															
	CHECKED		J BEMELEN	06/26					MILEPOST					189.9					
							STRUCTURE NO.												
TRANSPORTATION AECOM TECHNICAL SERVICES, Inc. 7720 N. 16th St., Suite 100 Phoenix, Arizona 85020 T 602.371.1100 www.aecom.com www.aecom.com				PROFILE SHEET NINE IRONS RANCH RD STA 20+39 TO 27+34				LOCATION				WICKENBURG RANCH WAY TO VISTA ROYALE				DWG No. C-4.14			
								TRACS NO. F0738 01C								____ OF ____			

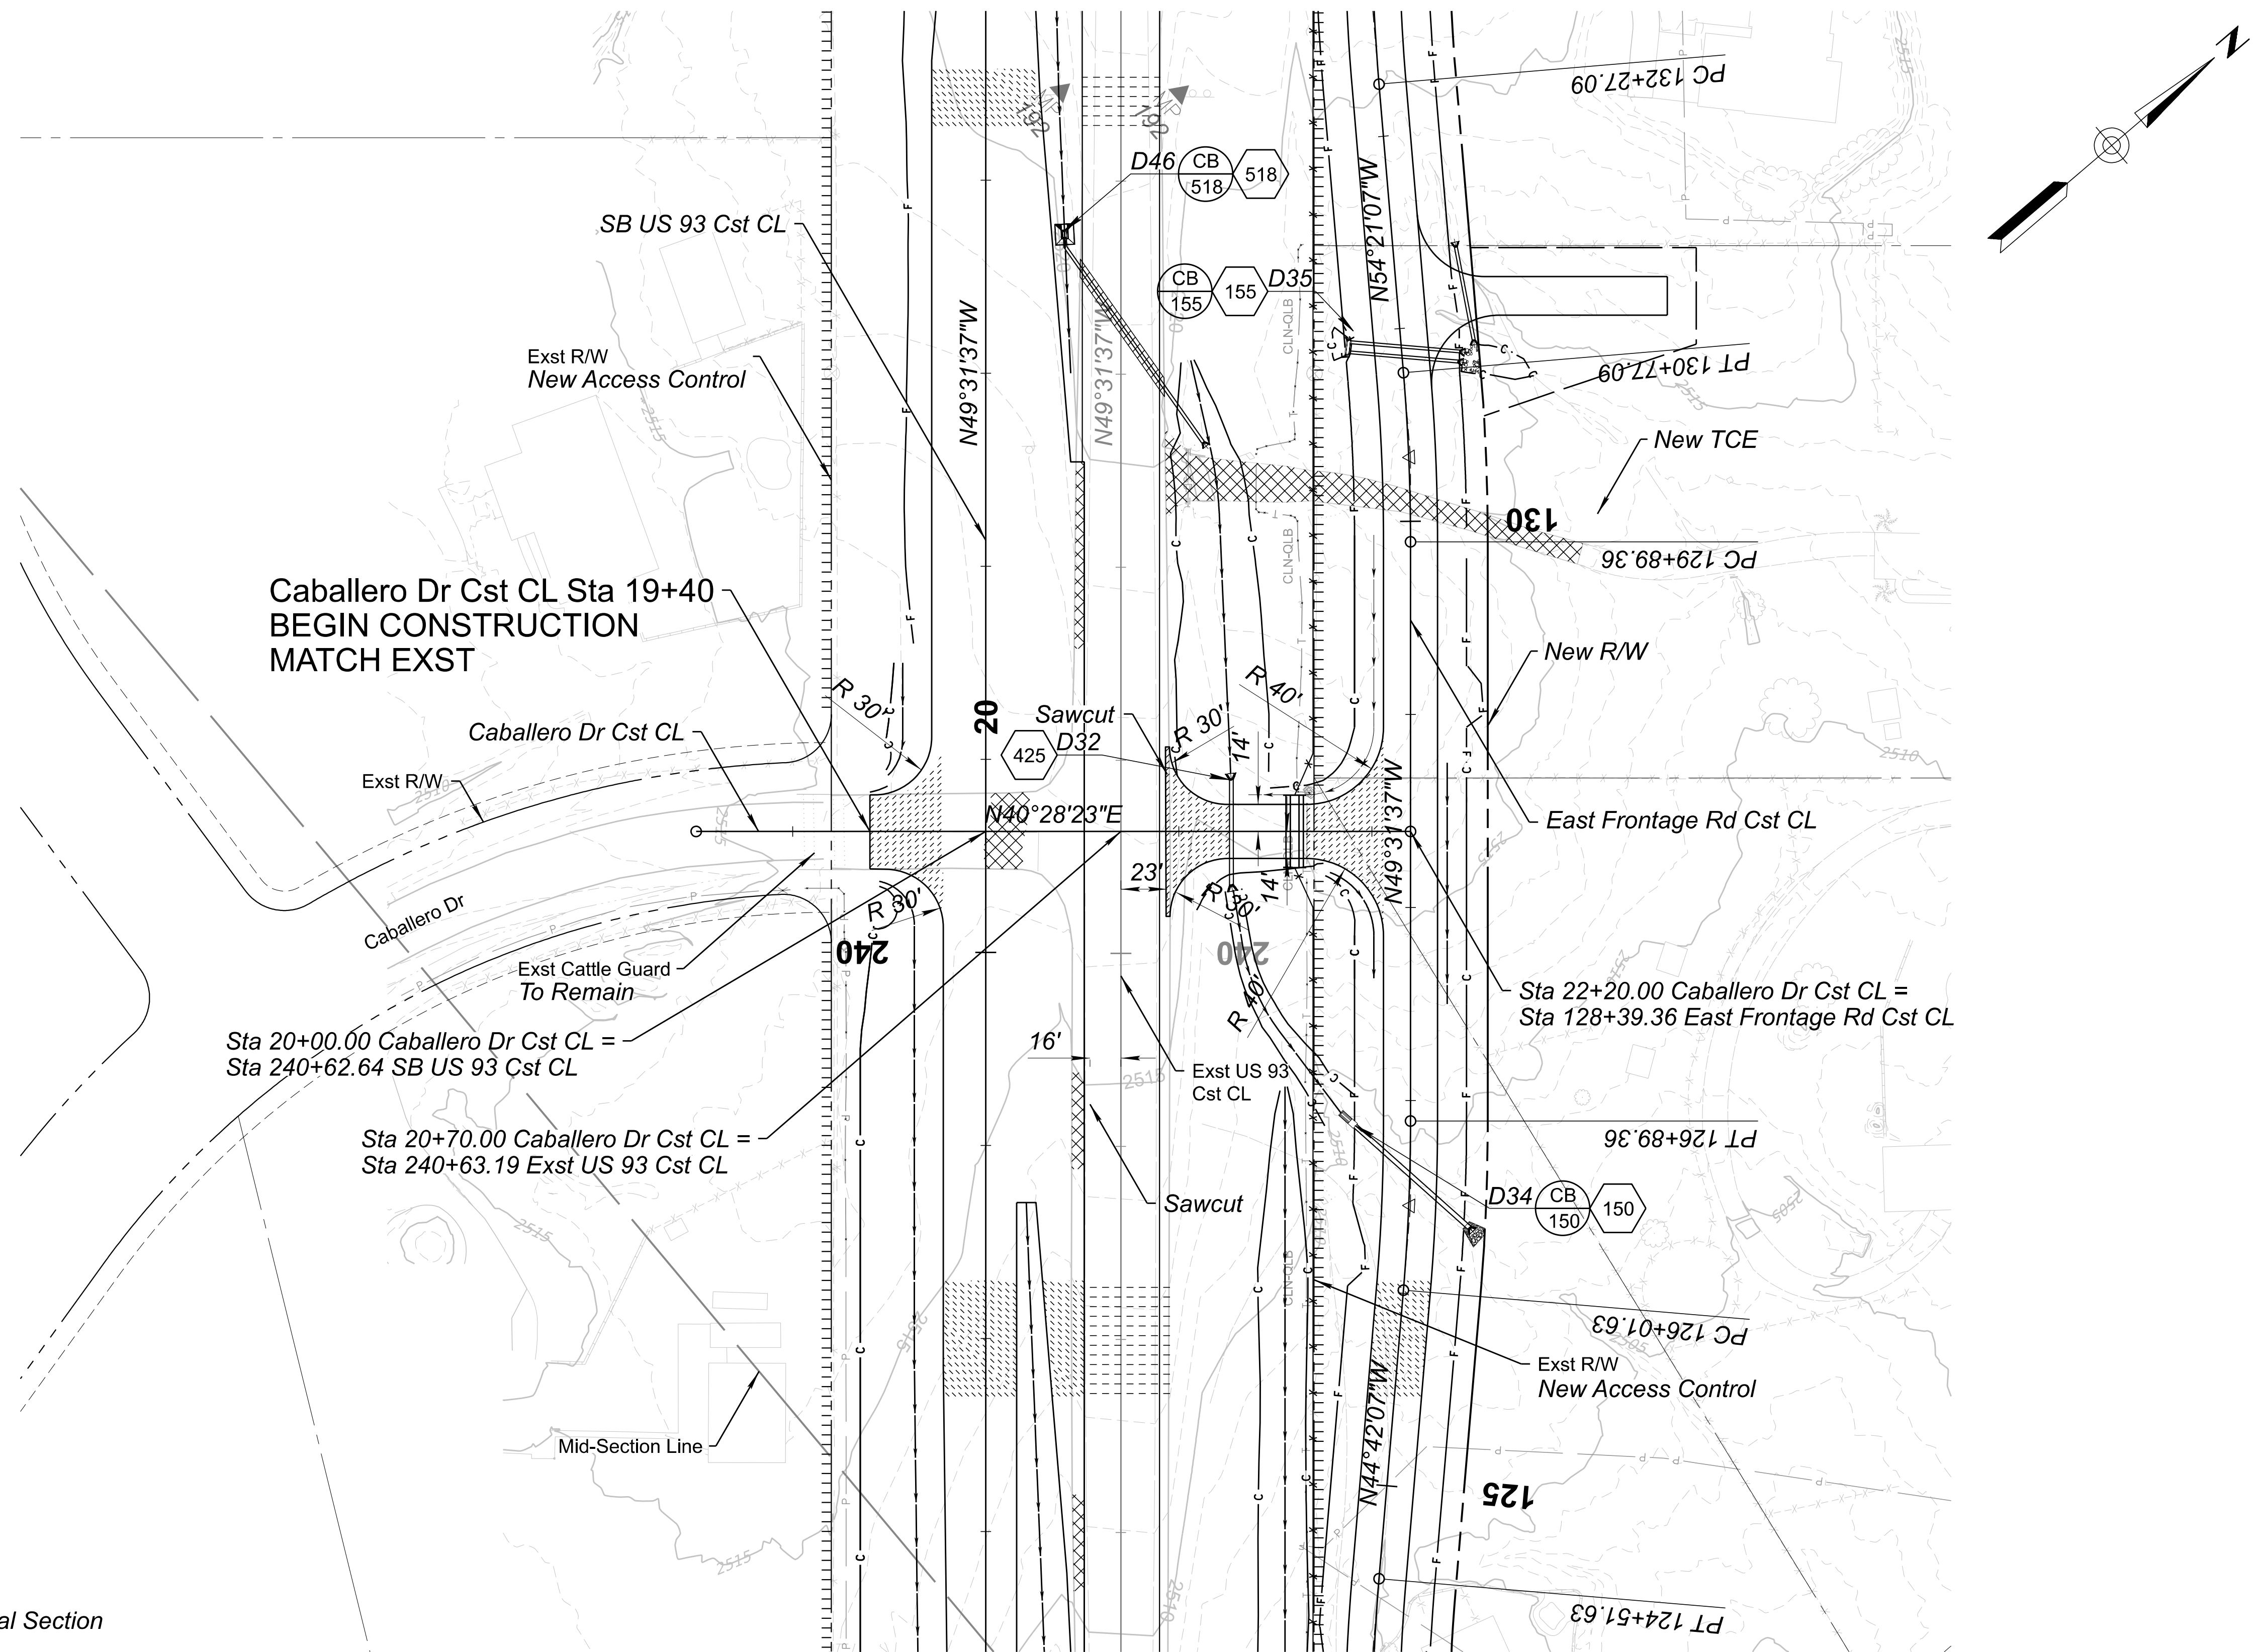


LEGEND

 Exst AC Pavement Remove

 New AC Pavement (See Typical Section For Type and Location)

 Existing AC Pavement Mill

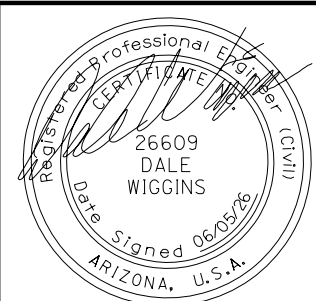

	NAME	DATE
DESIGN	J GILLIS	06/26
DRAWN	M SAMUELSON	06/26
CHECKED	D WIGGINS	06/26


TRANSPORTATION
AECOM TECHNICAL SERVICES, Inc.
7720 N. 16th St., Suite 100
Phoenix, Arizona 85020
T 602.371.1100




AECOM
www.aecom.com

ARIZONA DEPARTMENT OF TRANSPORTATION
PROJECT DELIVERY AND OPERATIONS DIVISION
ROADWAY DESIGN SERVICES





PLAN SHEET
CABALLERO DR
STA 19+40 TO STA 22+20


ROUTE US 93	F.H.W.A. Arizona Division	STATE ARIZ.	PROJECT NO. 093 YV 189	FEDERAL ID NO. 093-B(230)T	SHEET NO. 207	TOTAL SHEETS 524	RECORD DRAWING
MILEPOST 189.9	LOCATION WICKENBURG RANCH WAY TO VISTA ROYALE					DWG No. C-4.15	
STRUCTURE NO.	TRACS NO. F0738 01C					___ OF ___	




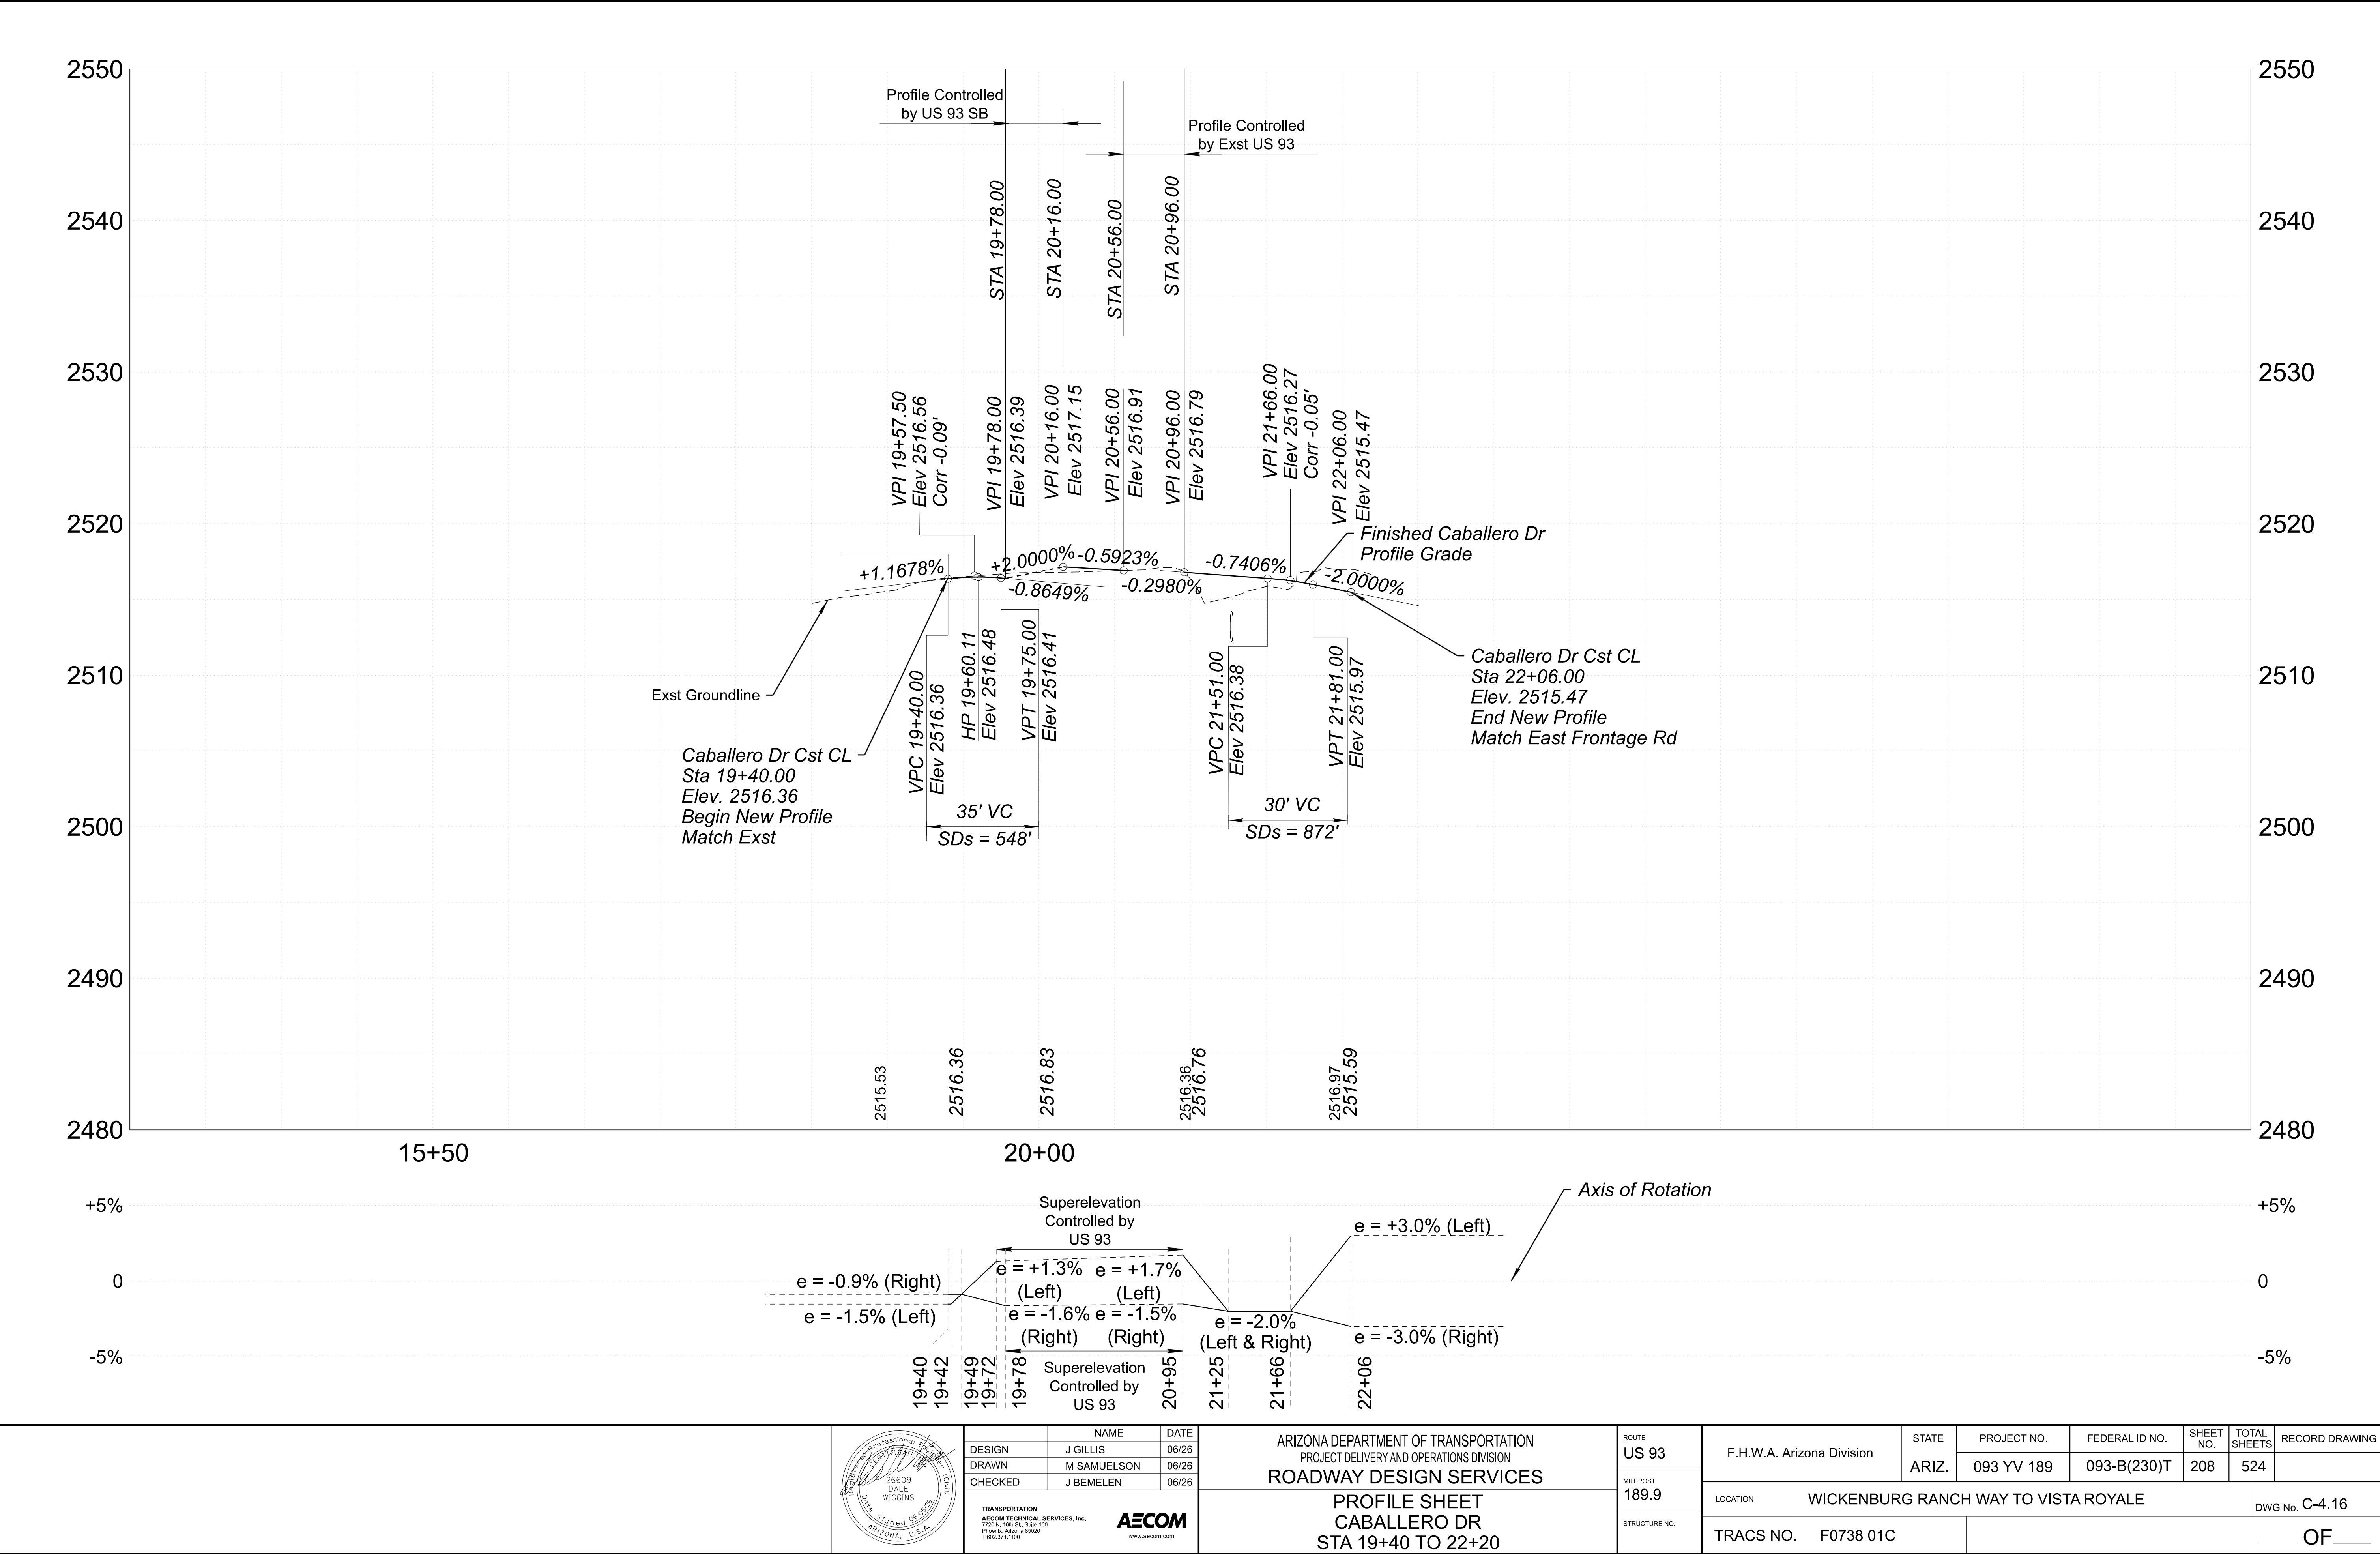


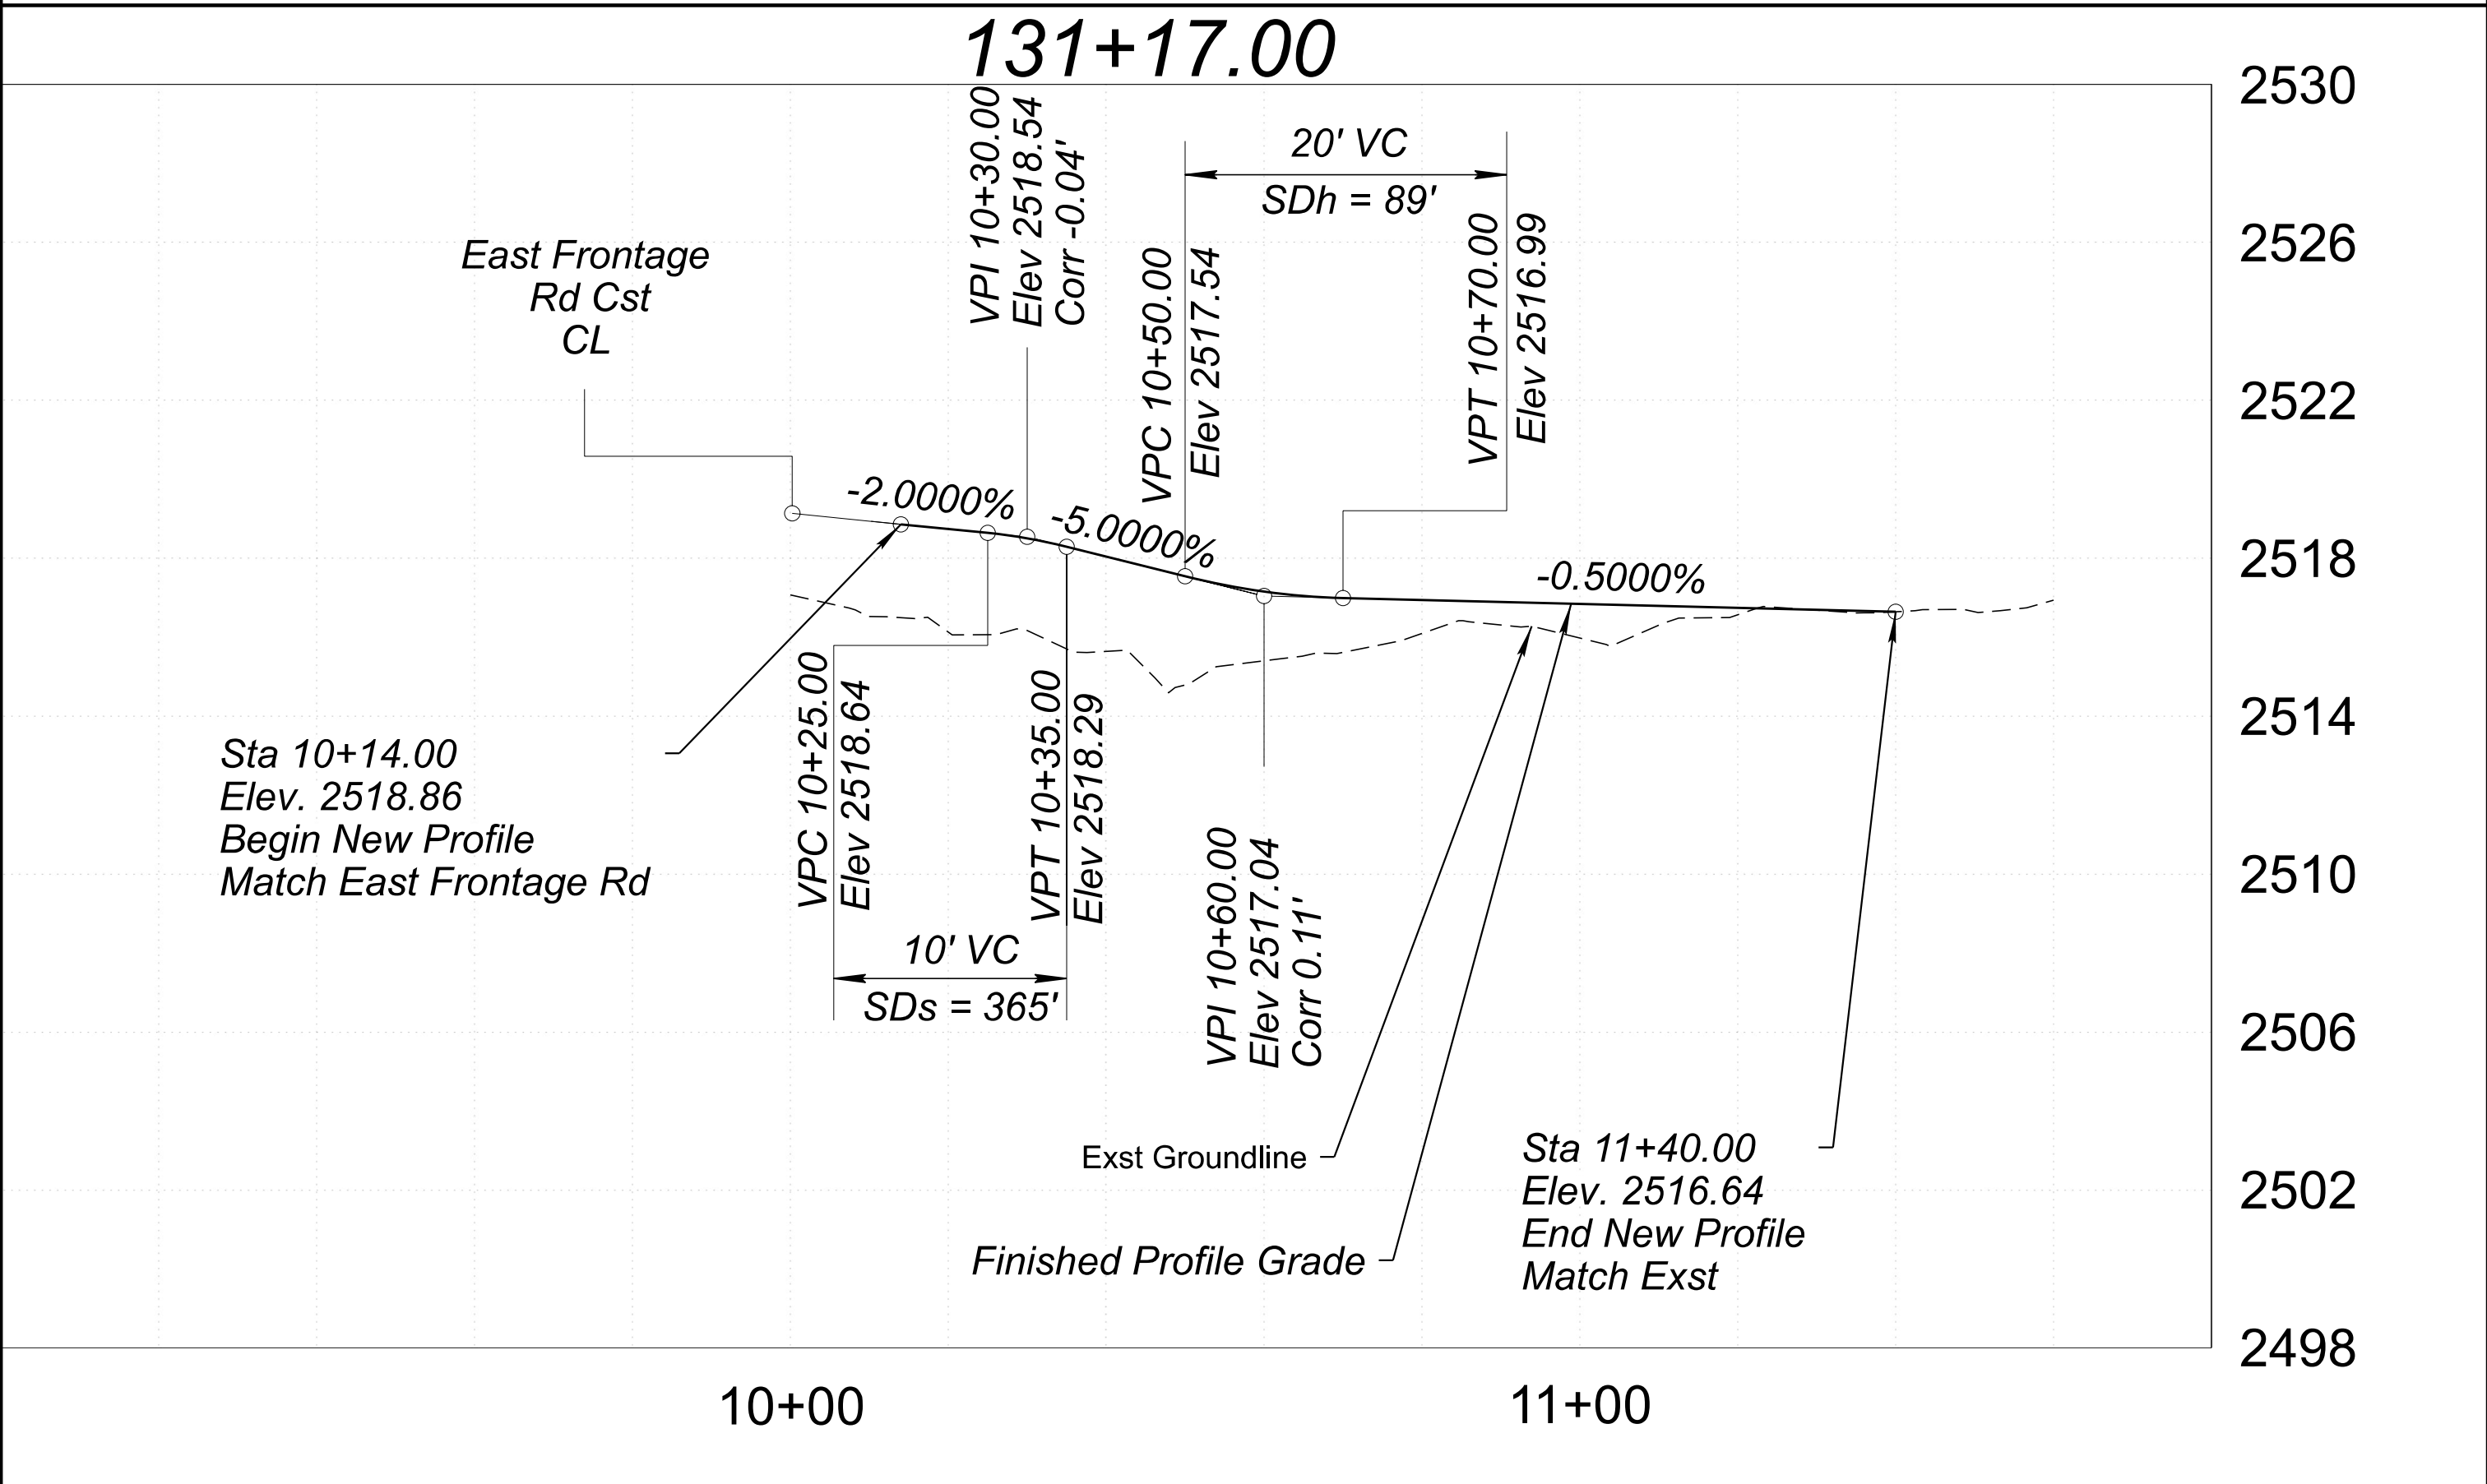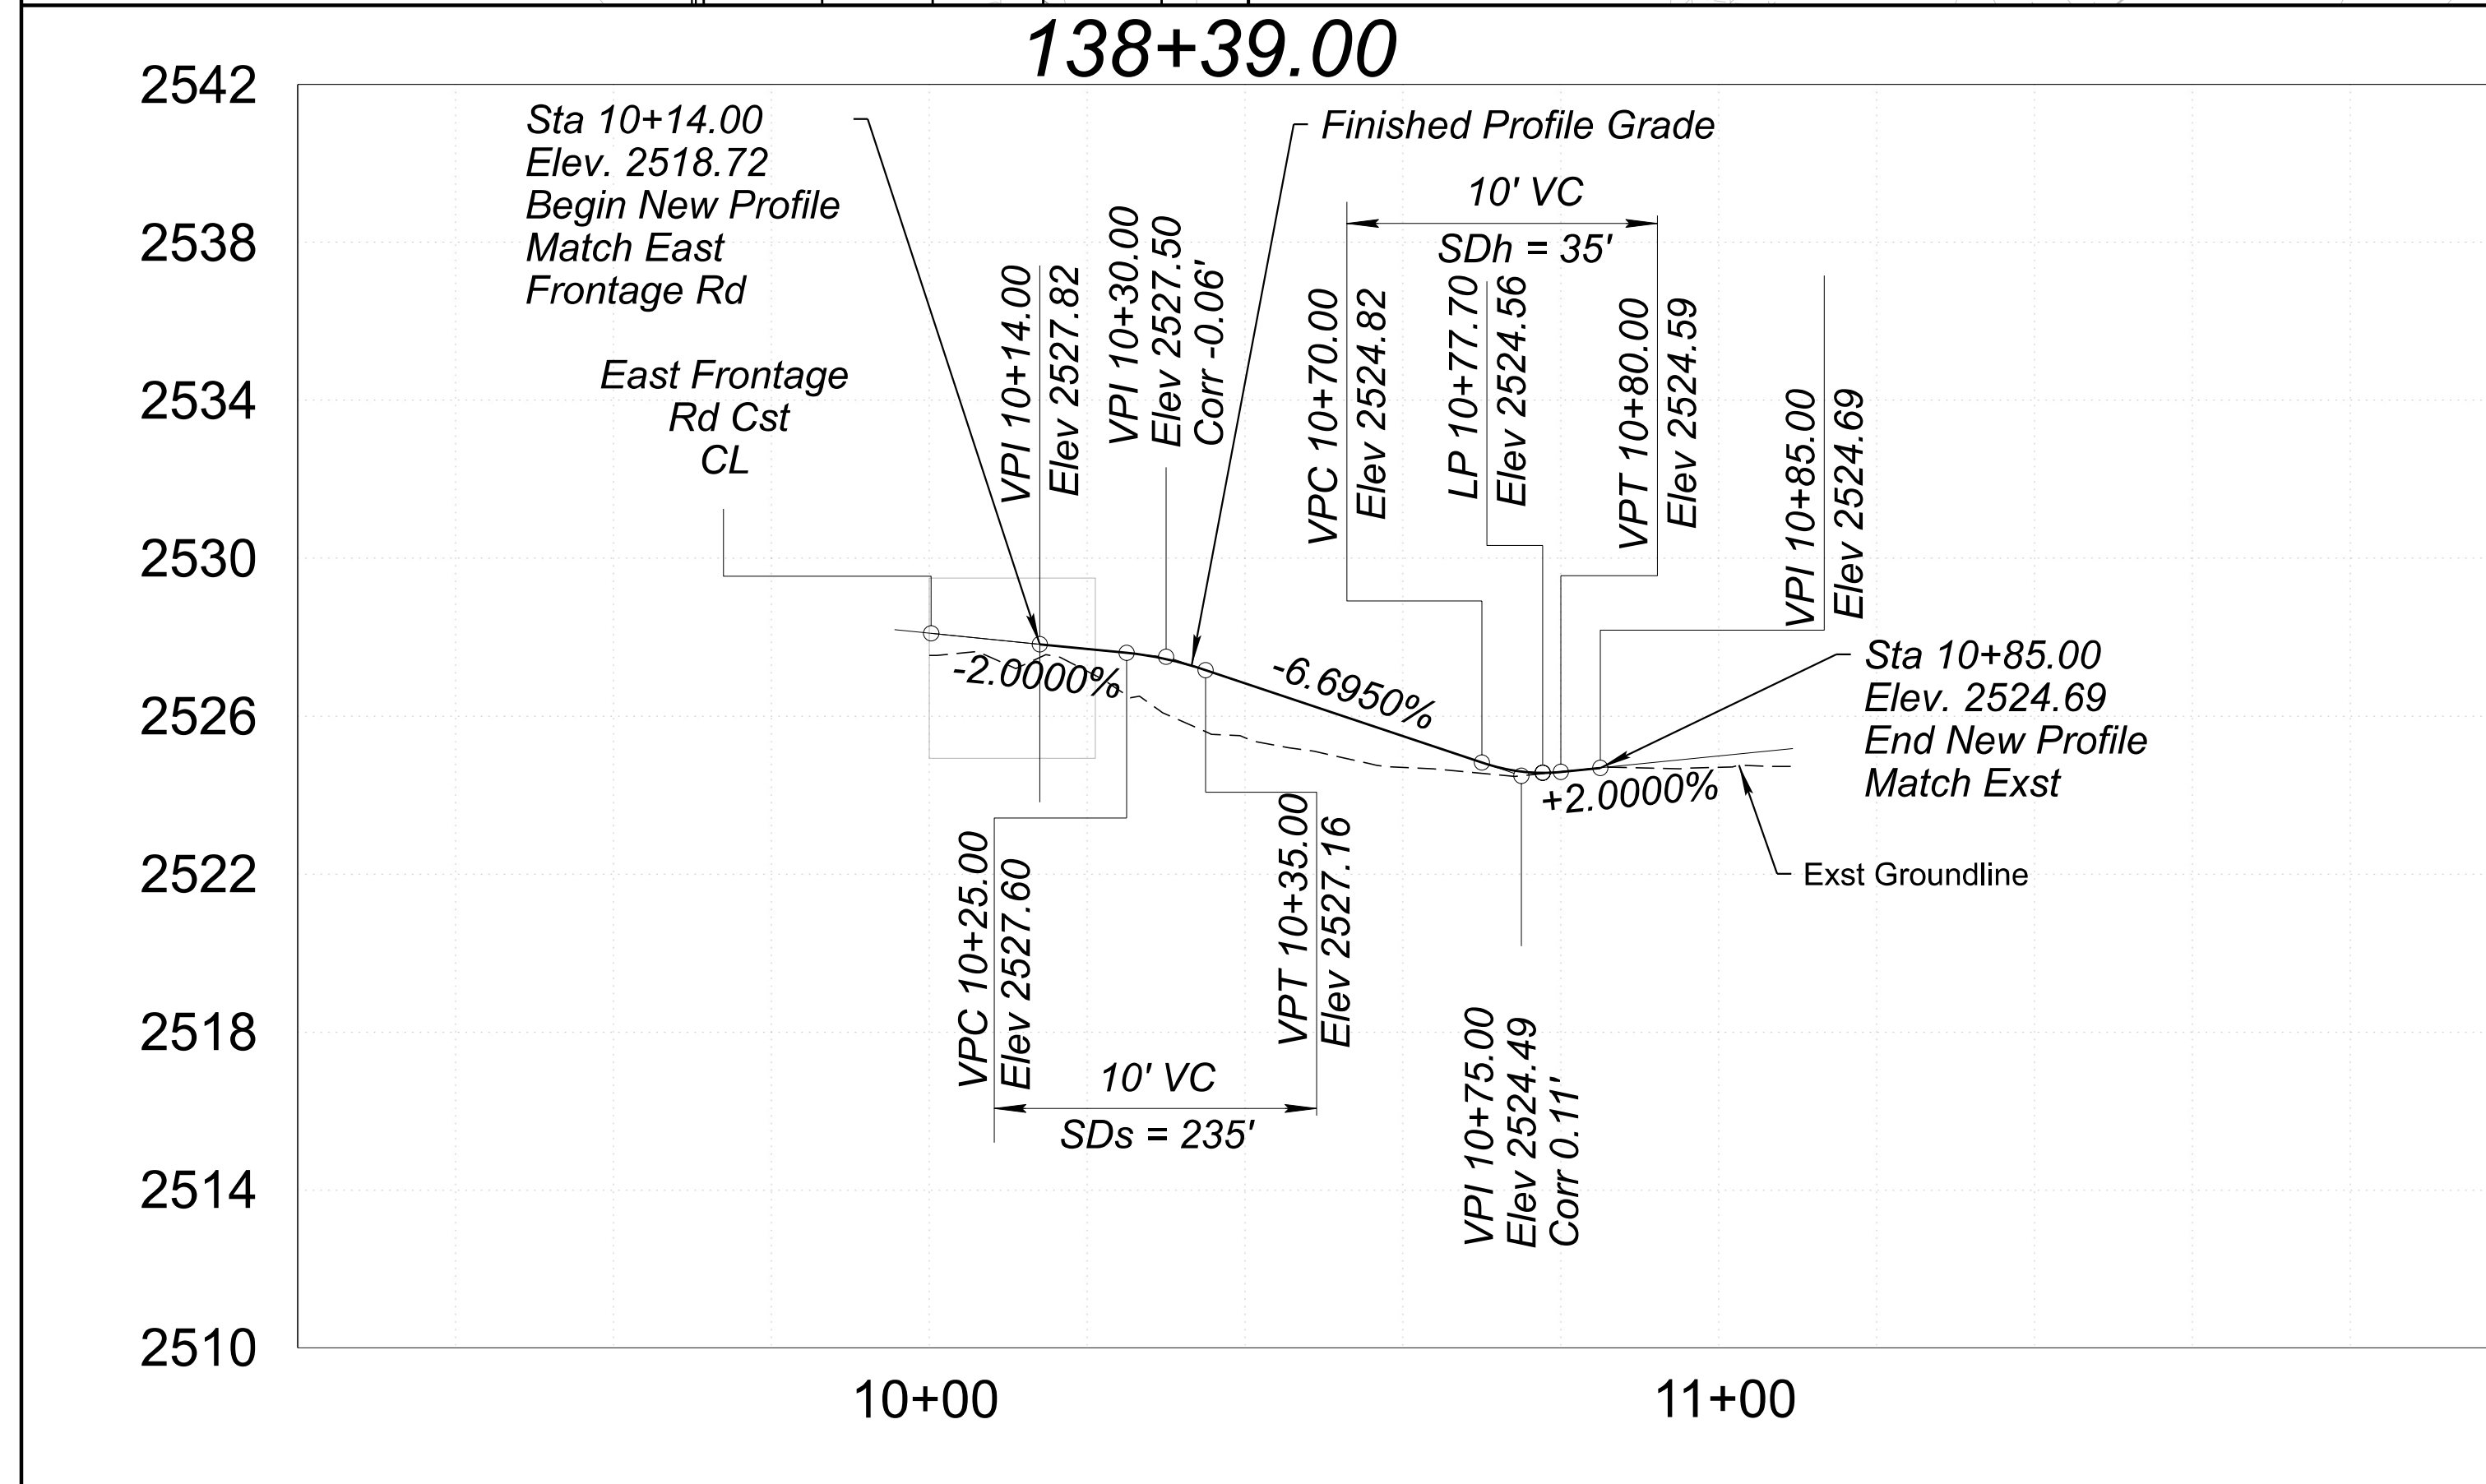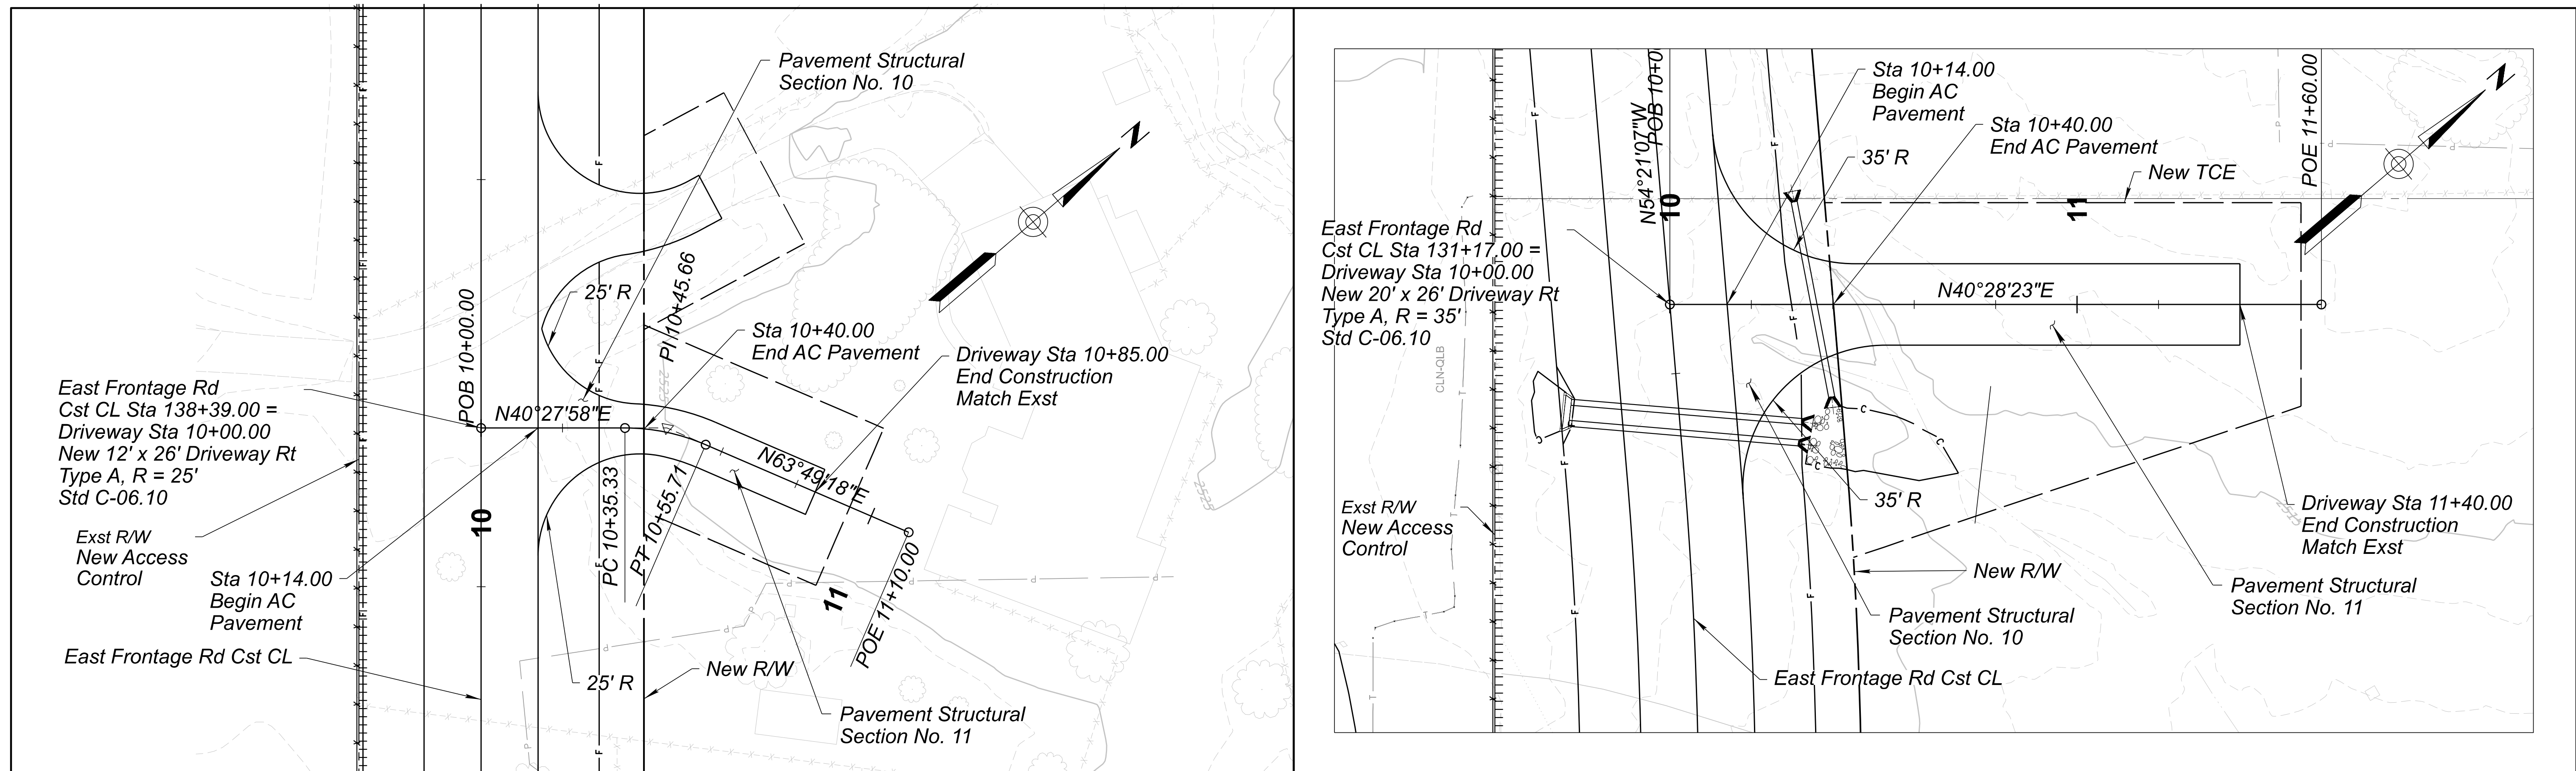




		NAME	DATE	ARIZONA DEPARTMENT OF TRANSPORTATION PROJECT DELIVERY AND OPERATIONS DIVISION ROADWAY DESIGN SERVICES	ROUTE	F.H.W.A. Arizona Division	STATE	PROJECT NO.	FEDERAL ID NO.	SHEET NO.	TOTAL SHEETS	RECORD DRAWING
	DESIGN	S Mutesi	06/26		US 93							
	DRAWN	C VALENZUELA	06/26		MILEPOST	189.9						
	CHECKED	D WIGGINS	06/26		STRUCTURE NO.							
TRANSPORTATION AECOM TECHNICAL SERVICES, Inc. 7720 N. 16th St., Suite 100 Phoenix, Arizona 85020 T 602.371.1100  www.aecom.com				PLAN & PROFILE SHEET DRIVEWAY - EAST FRONTAGE RD 138+39 DRIVEWAY - EAST FRONTAGE RD 131+17	LOCATION WICKENBURG RANCH WAY TO VISTA ROYALE							DWG No. C-4.17
						TRACS NO. F0738 01C		OF				

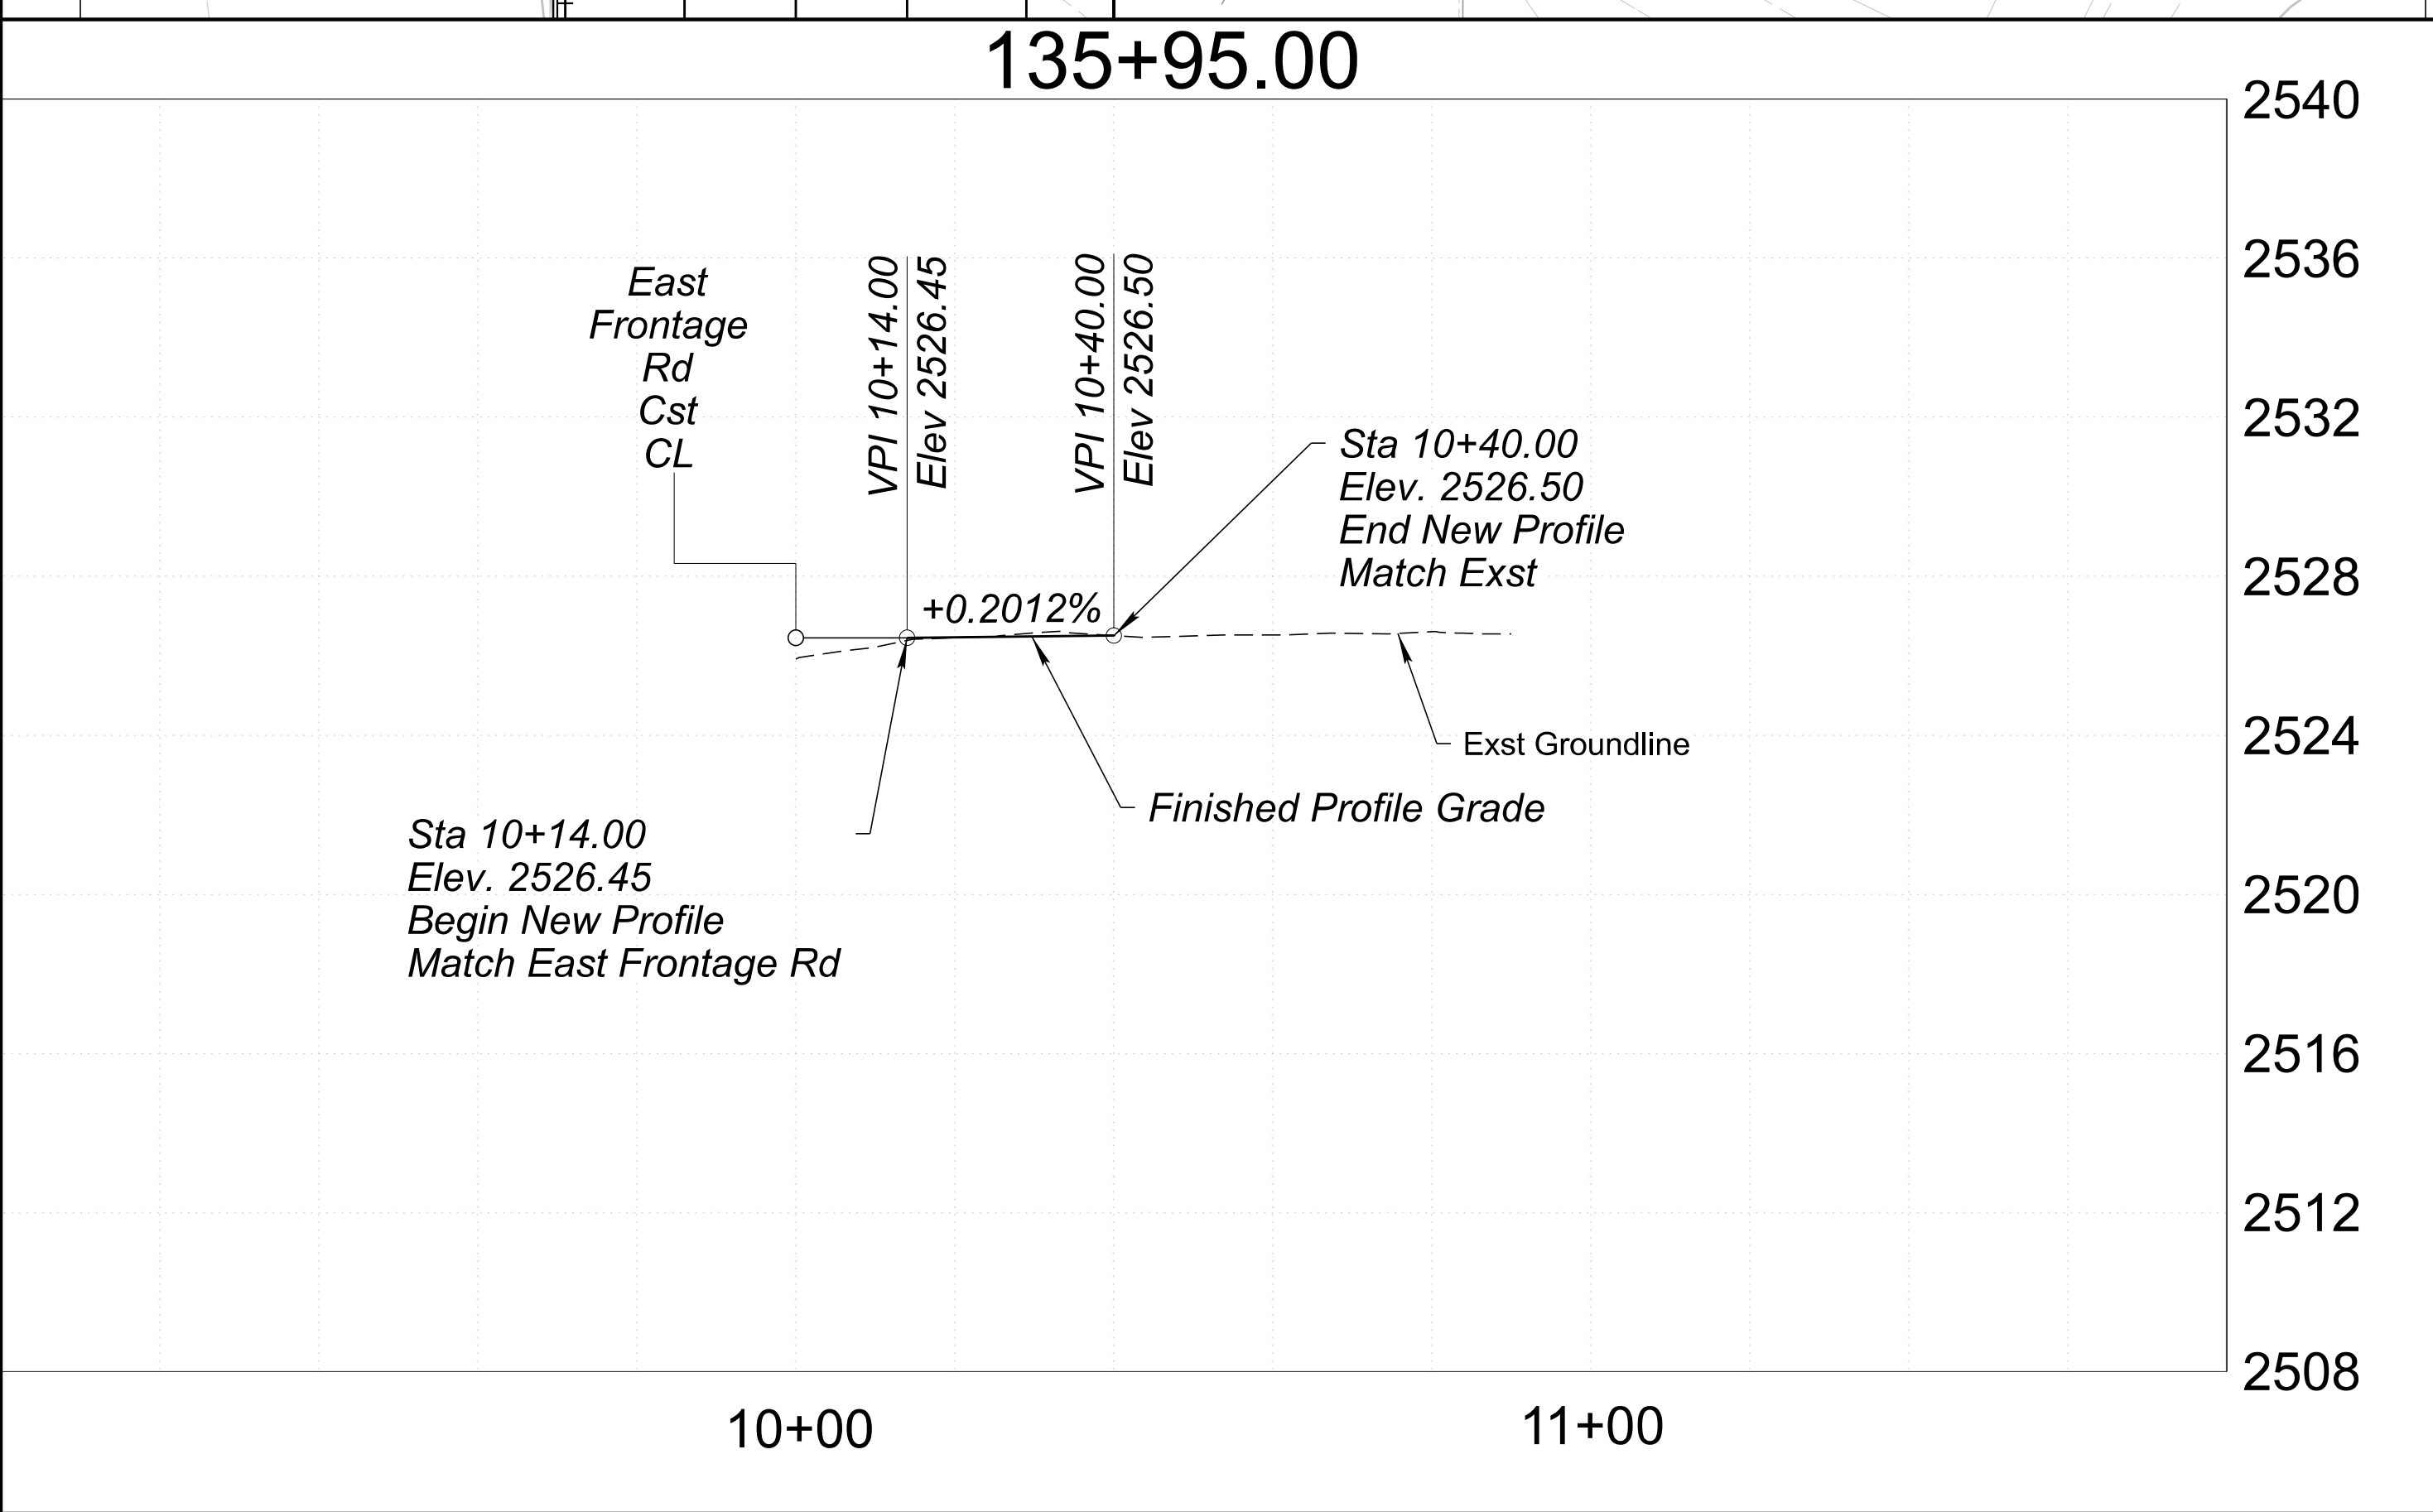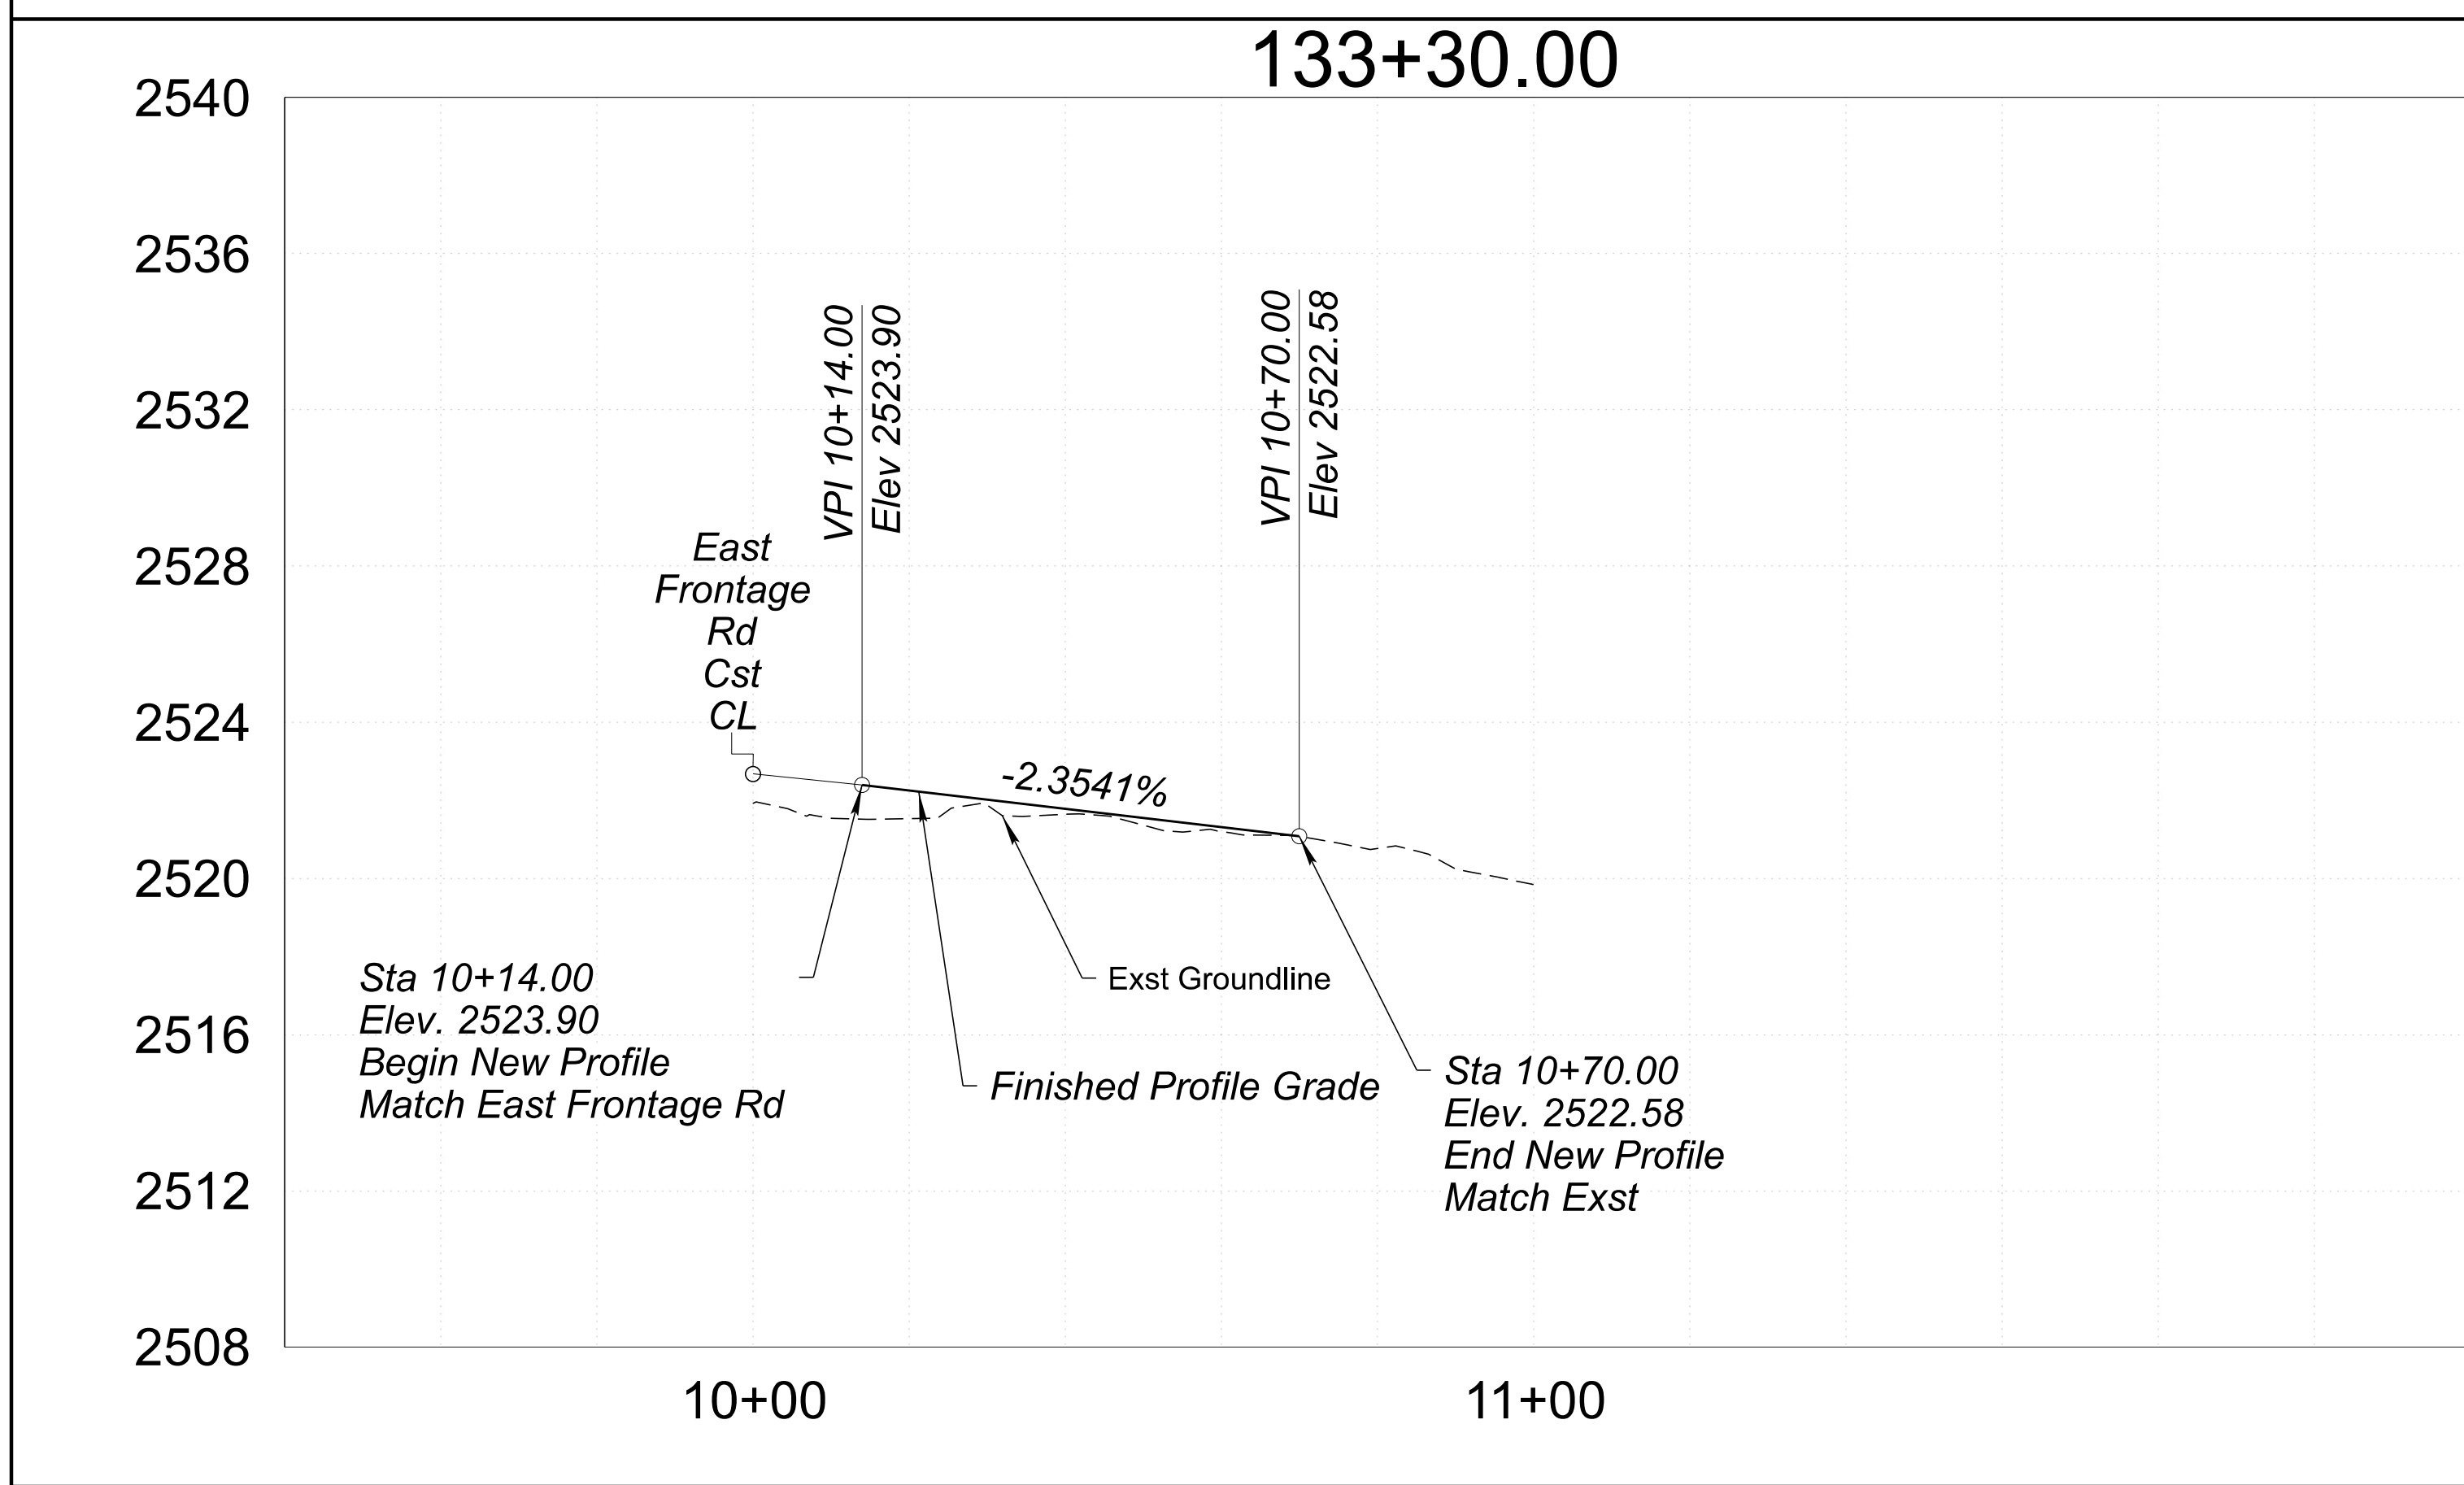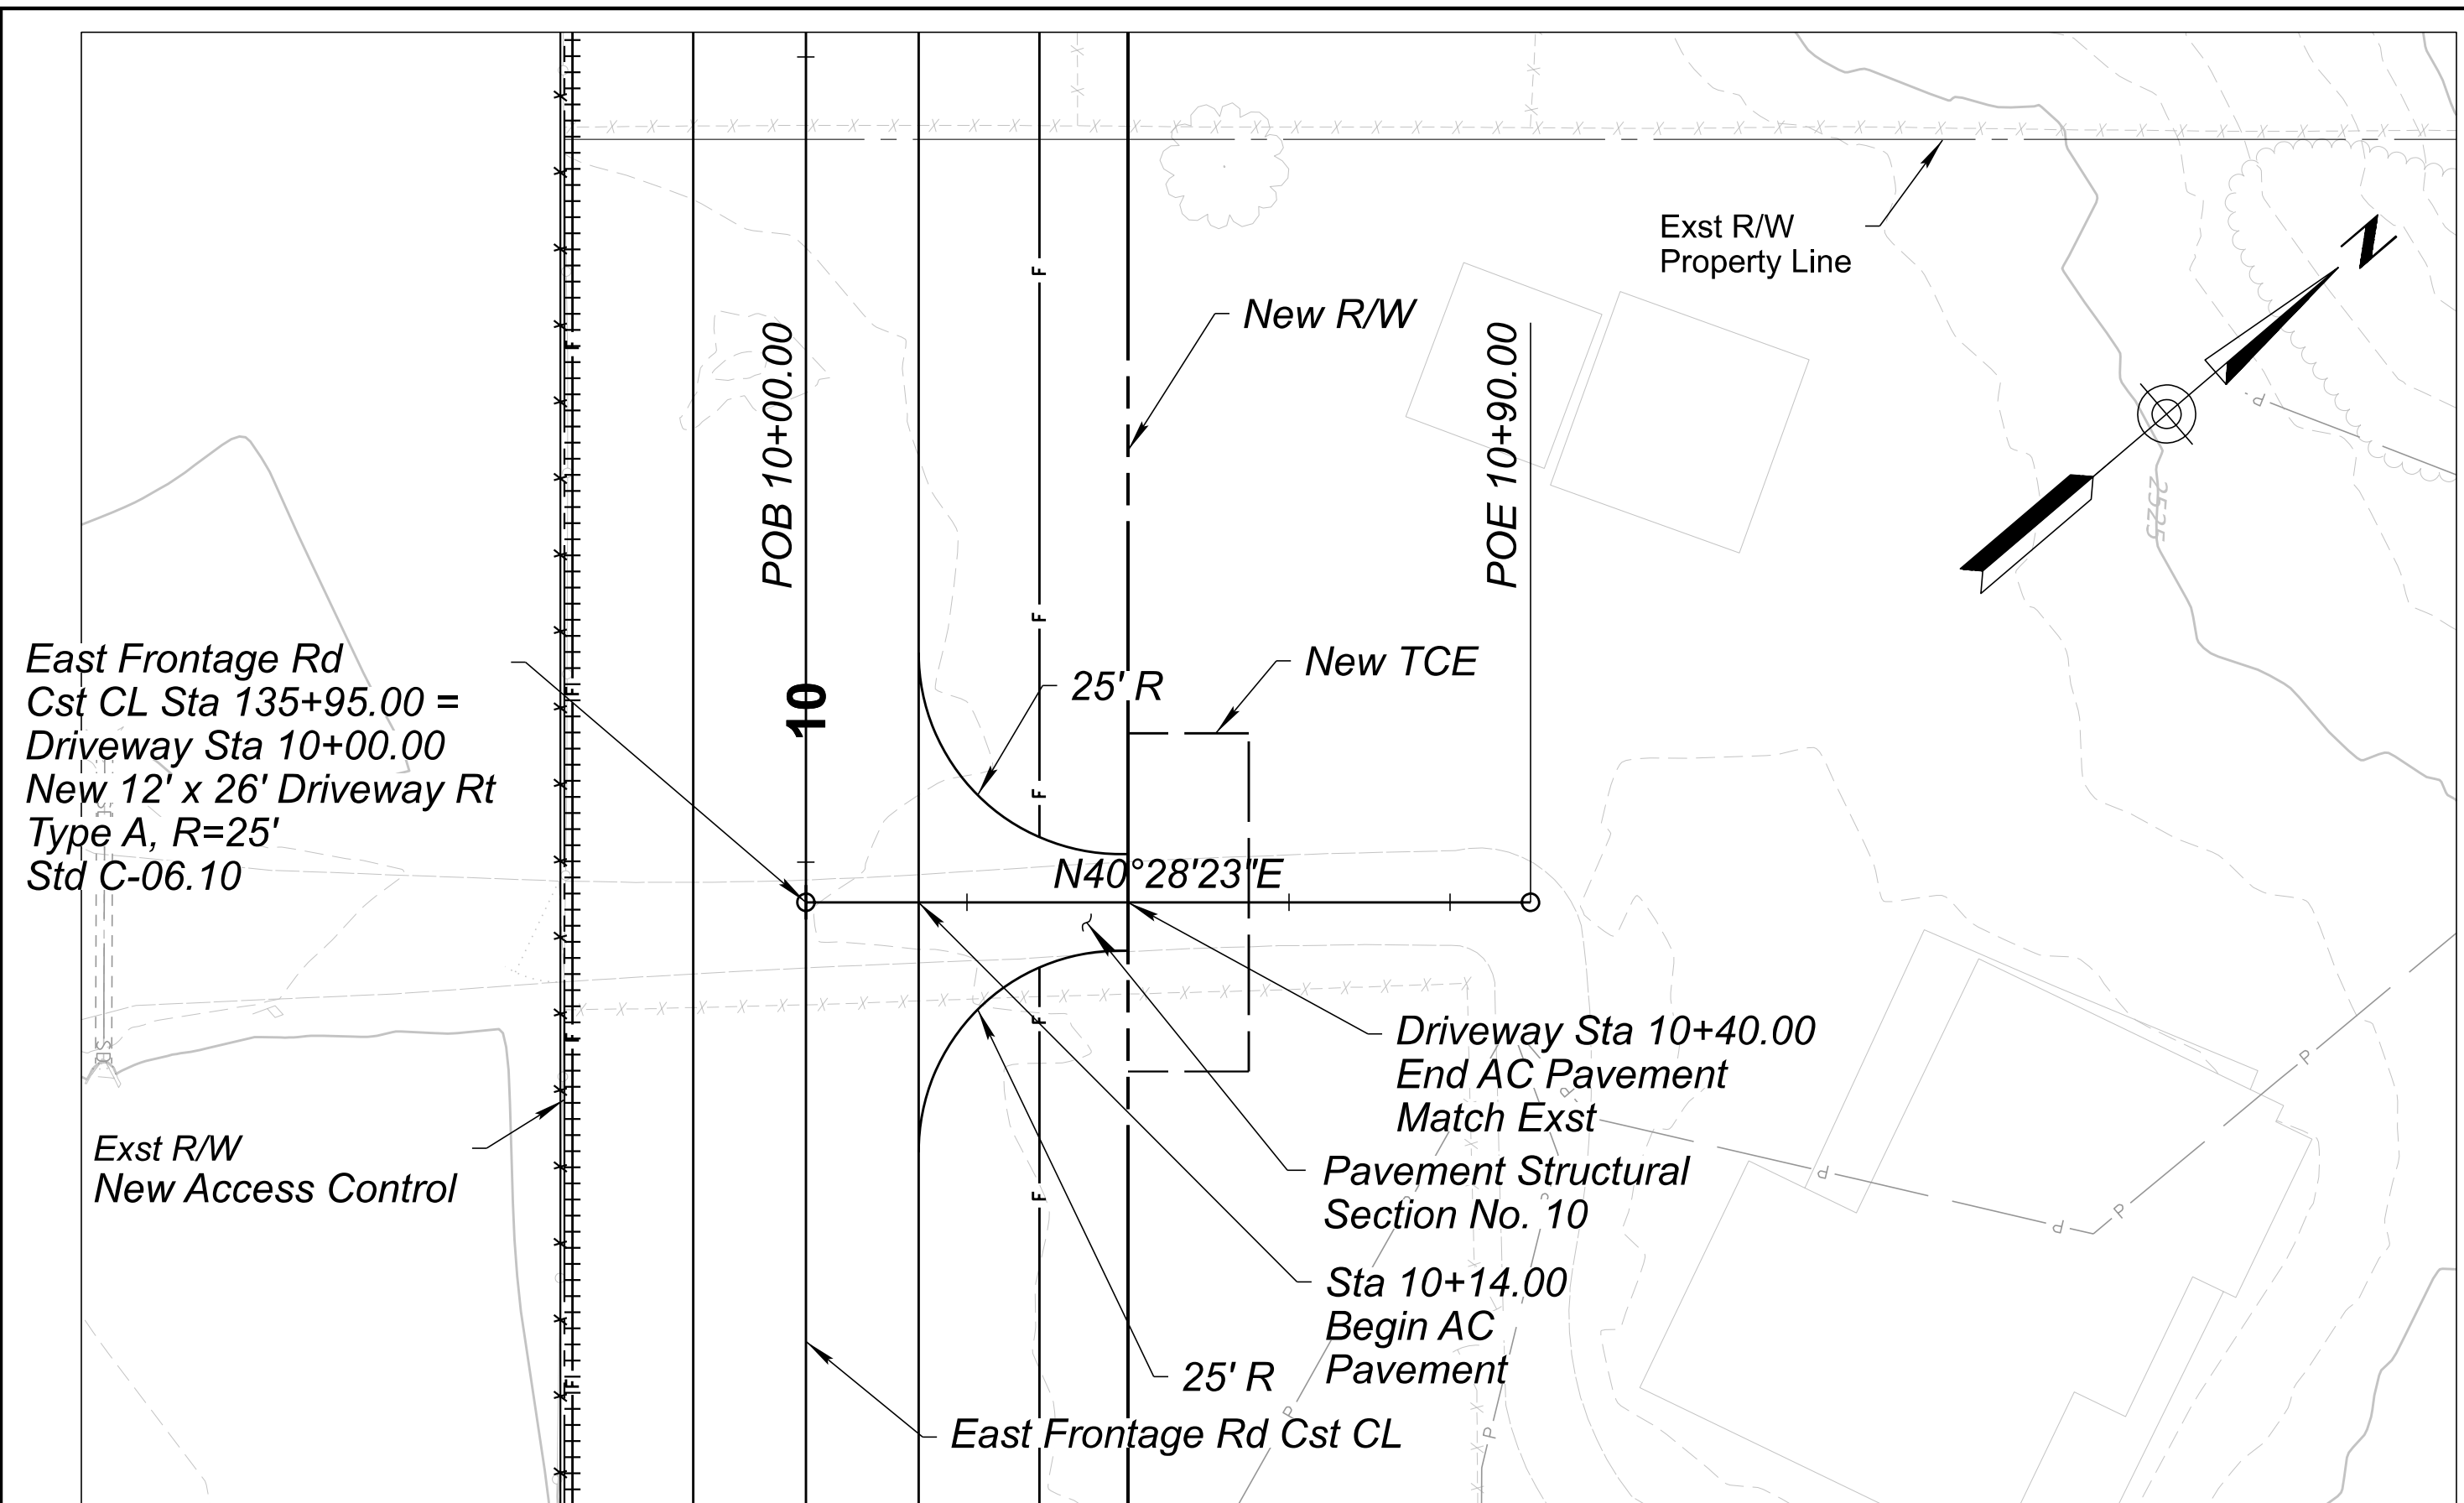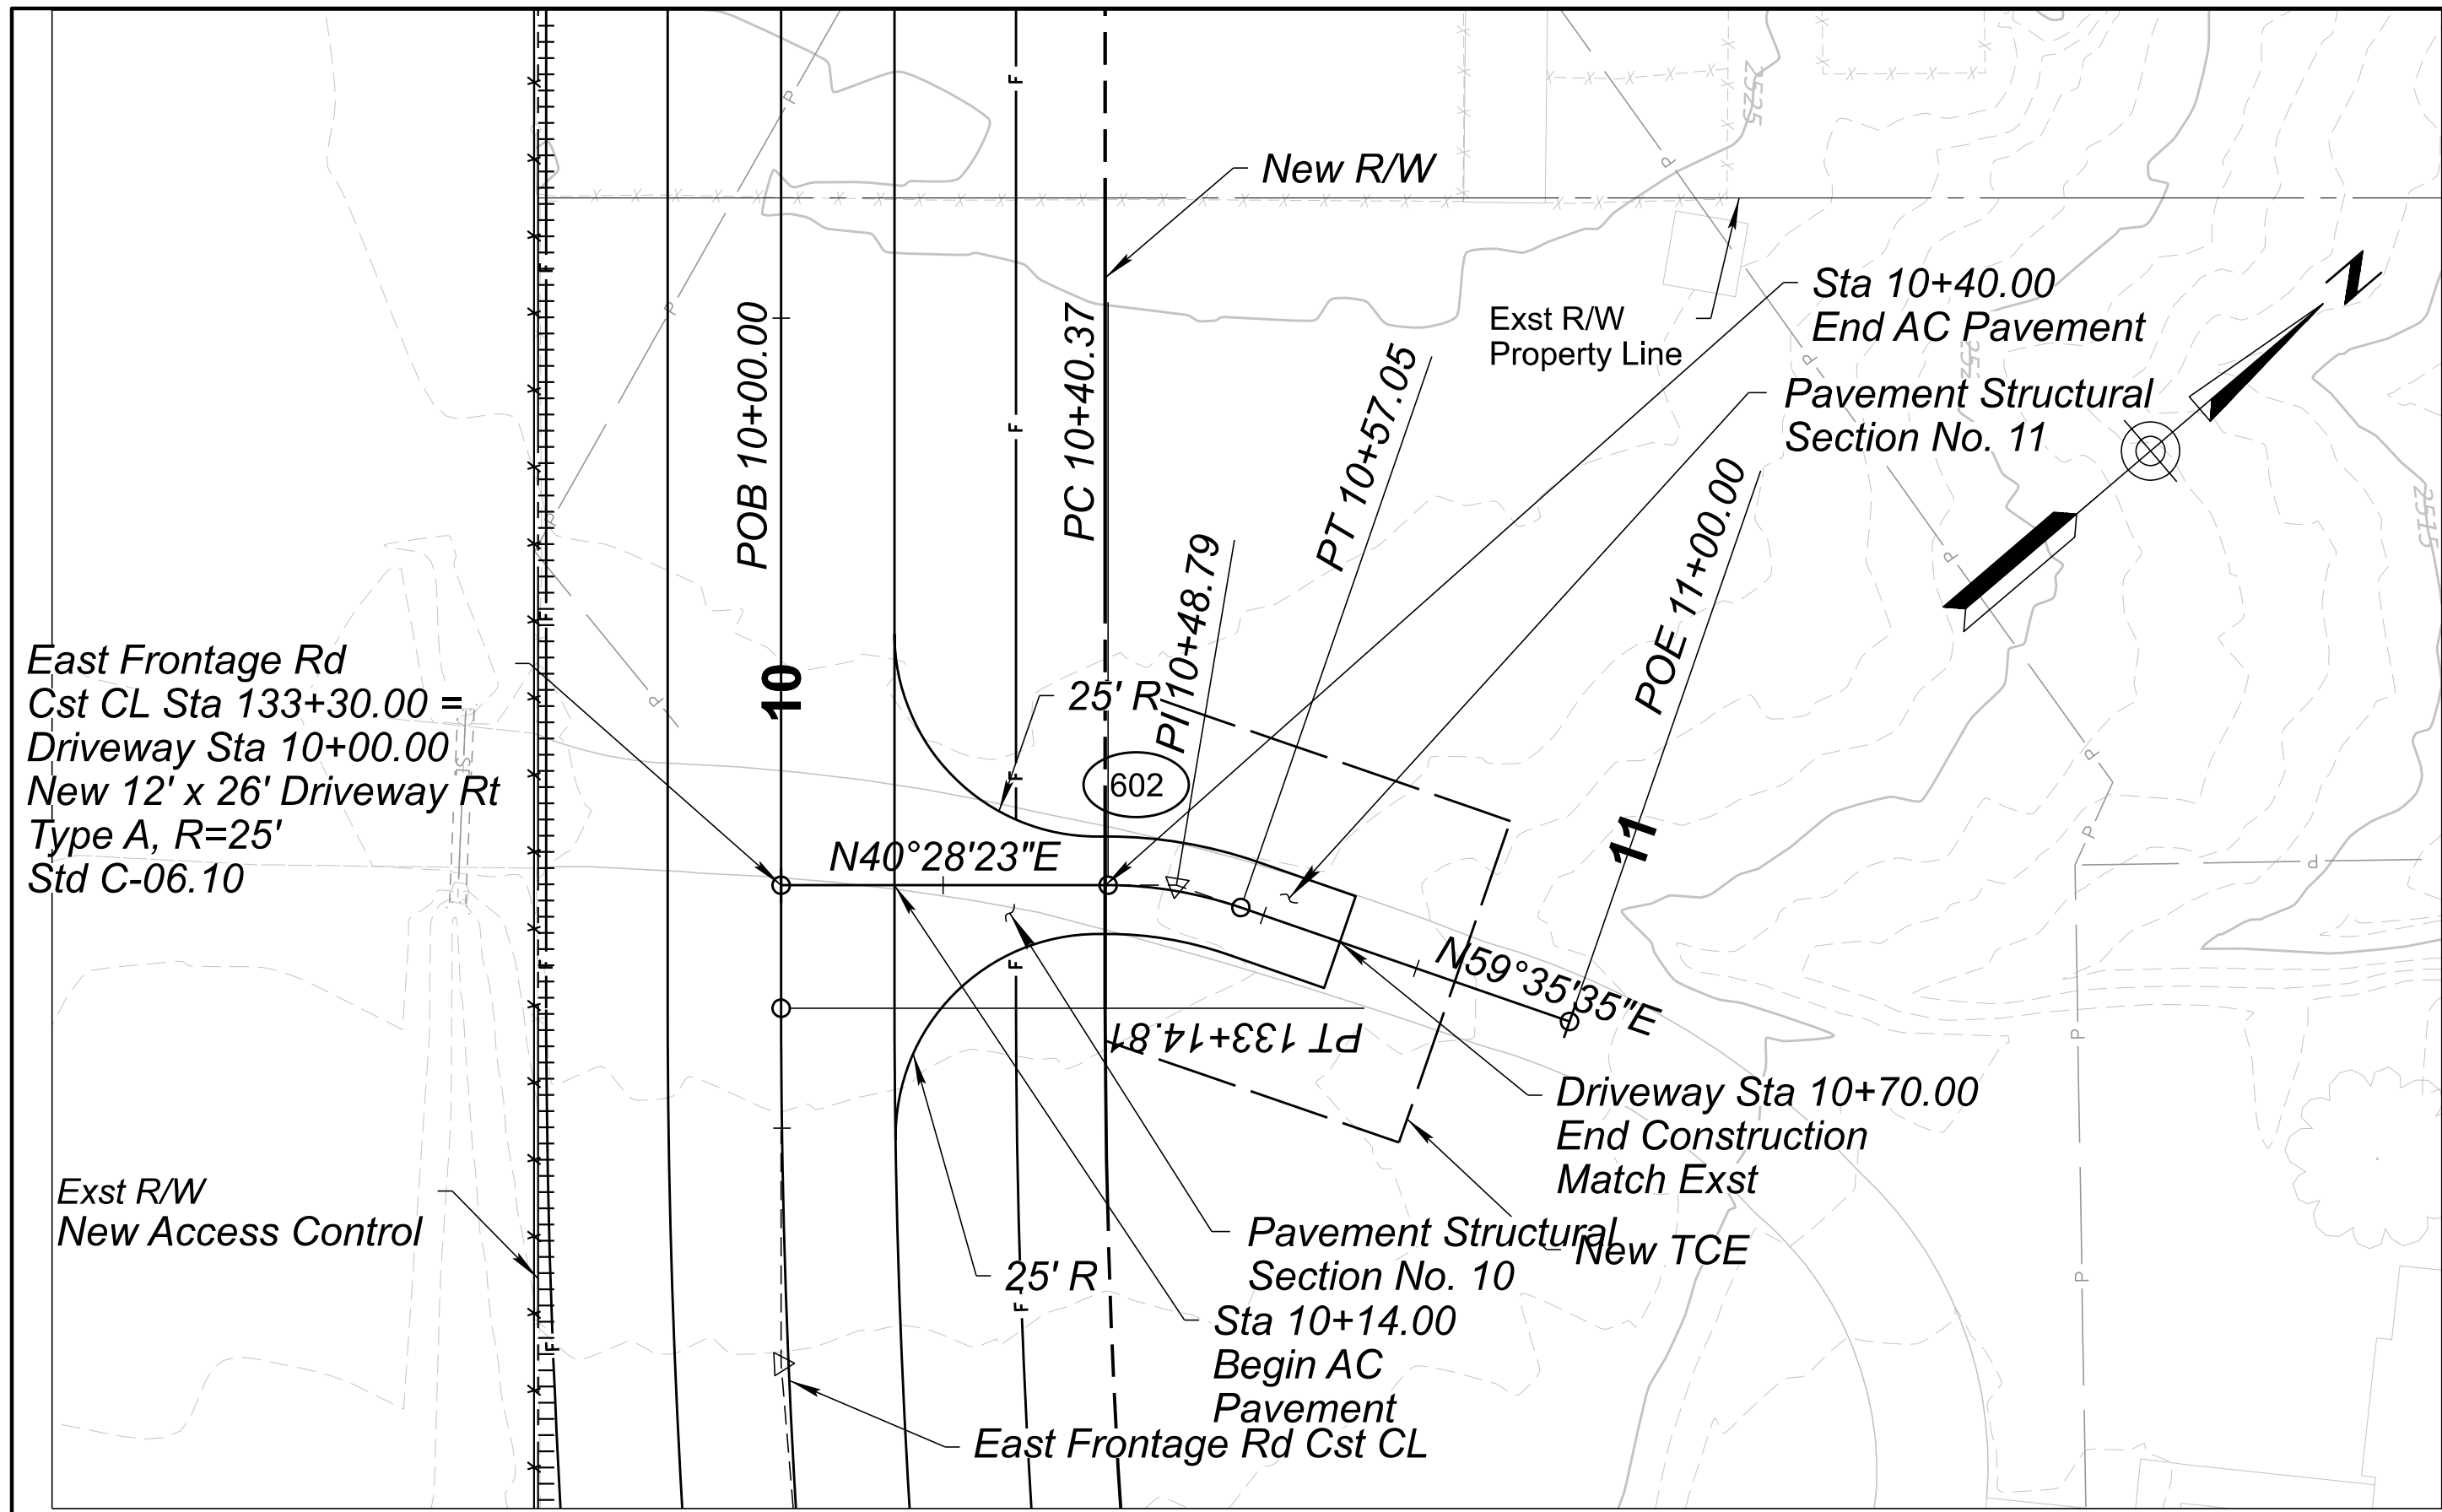


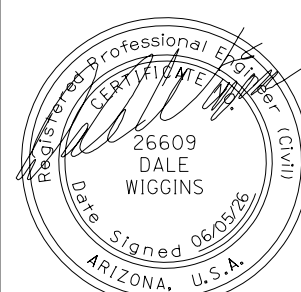
		NAME	DATE	ARIZONA DEPARTMENT OF TRANSPORTATION PROJECT DELIVERY AND OPERATIONS DIVISION ROADWAY DESIGN SERVICES		ROUTE US 93	F.H.W.A. Arizona Division ARIZ.	STATE	PROJECT NO.	FEDERAL ID NO.	SHEET NO.	TOTAL SHEETS	RECORD DRAWING
	DESIGN	S Mutesi	06/26			MILEPOST 189.9		LOCATION WICKENBURG RANCH WAY TO VISTA ROYALE	ARIZ.	093 YV 189	093-B(230)T	210	524
	DRAWN	C VALENZUELA	06/26			STRUCTURE NO.	TRACS NO. F0738 01C						
	CHECKED	D WIGGINS	06/26										
	TRANSPORTATION AECOM TECHNICAL SERVICES, Inc. 7700 N. 16th St., Suite 100 Phoenix, Arizona 85020 T 602.271.1100 www.aecom.com		AECOM		PLAN & PROFILE SHEET DRIVEWAY - EAST FRONTAGE RD 133+30 DRIVEWAY - EAST FRONTAGE RD 135+95						DWG No. C-4.18		
											OF		

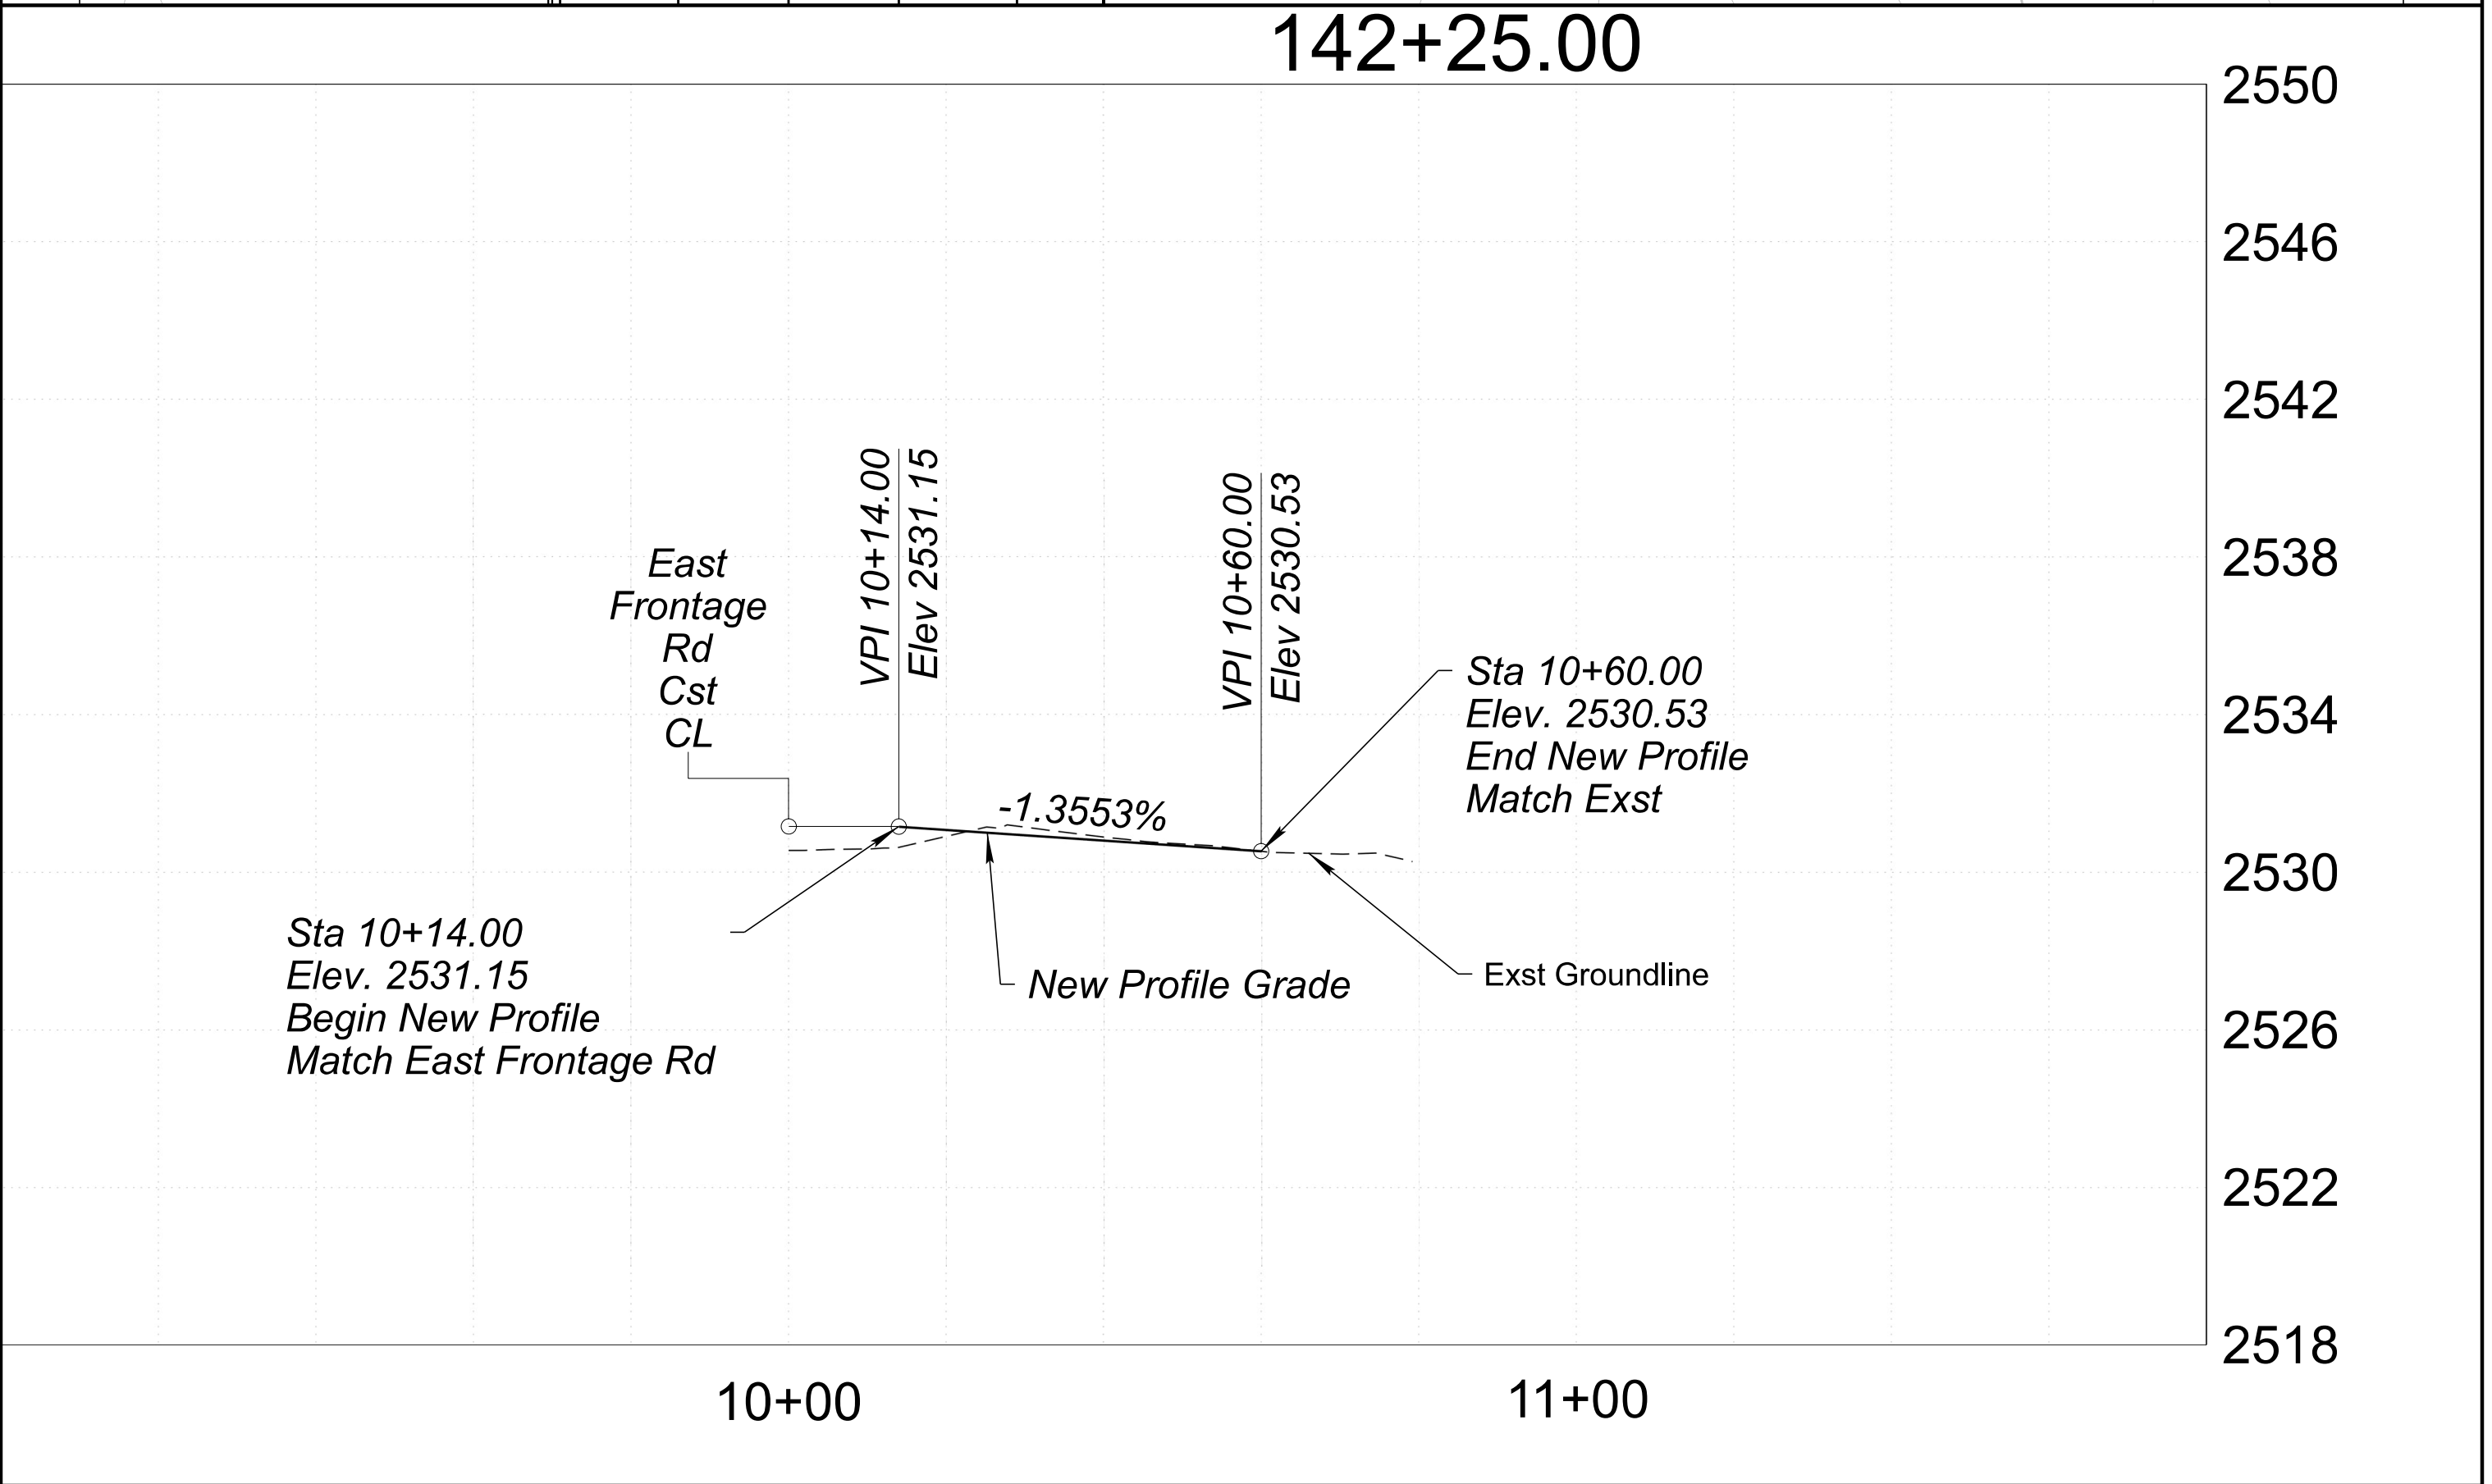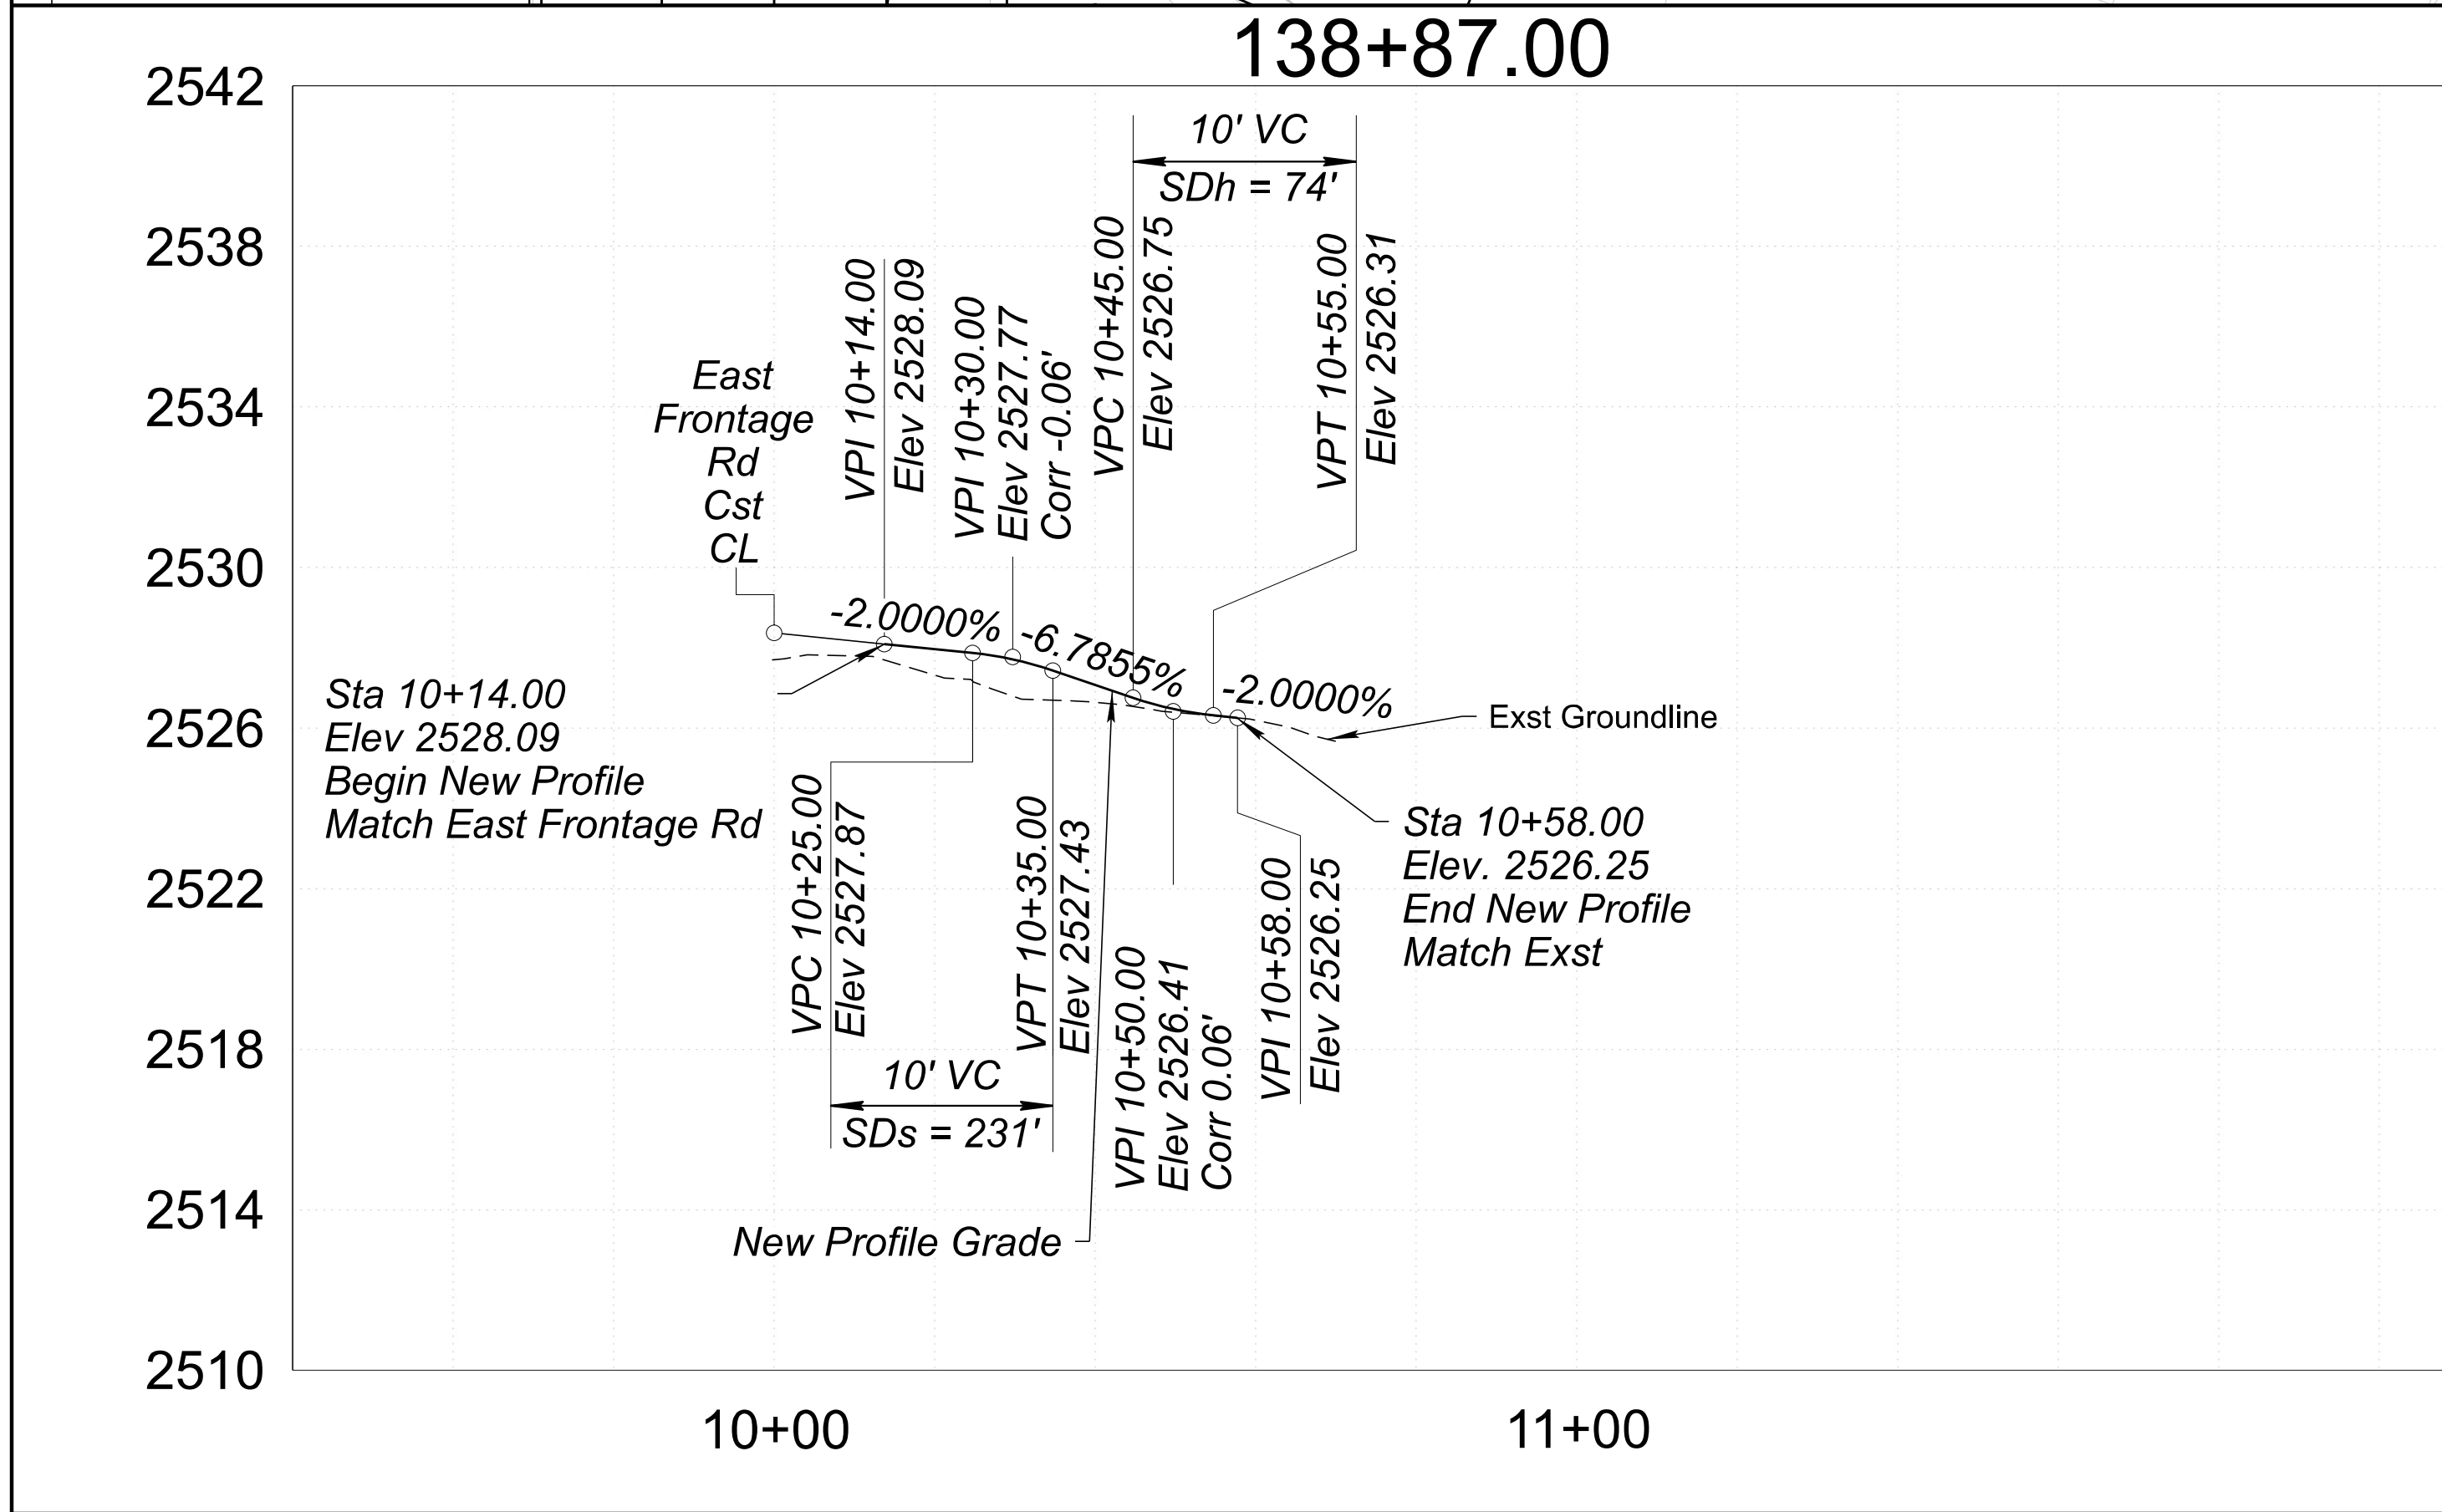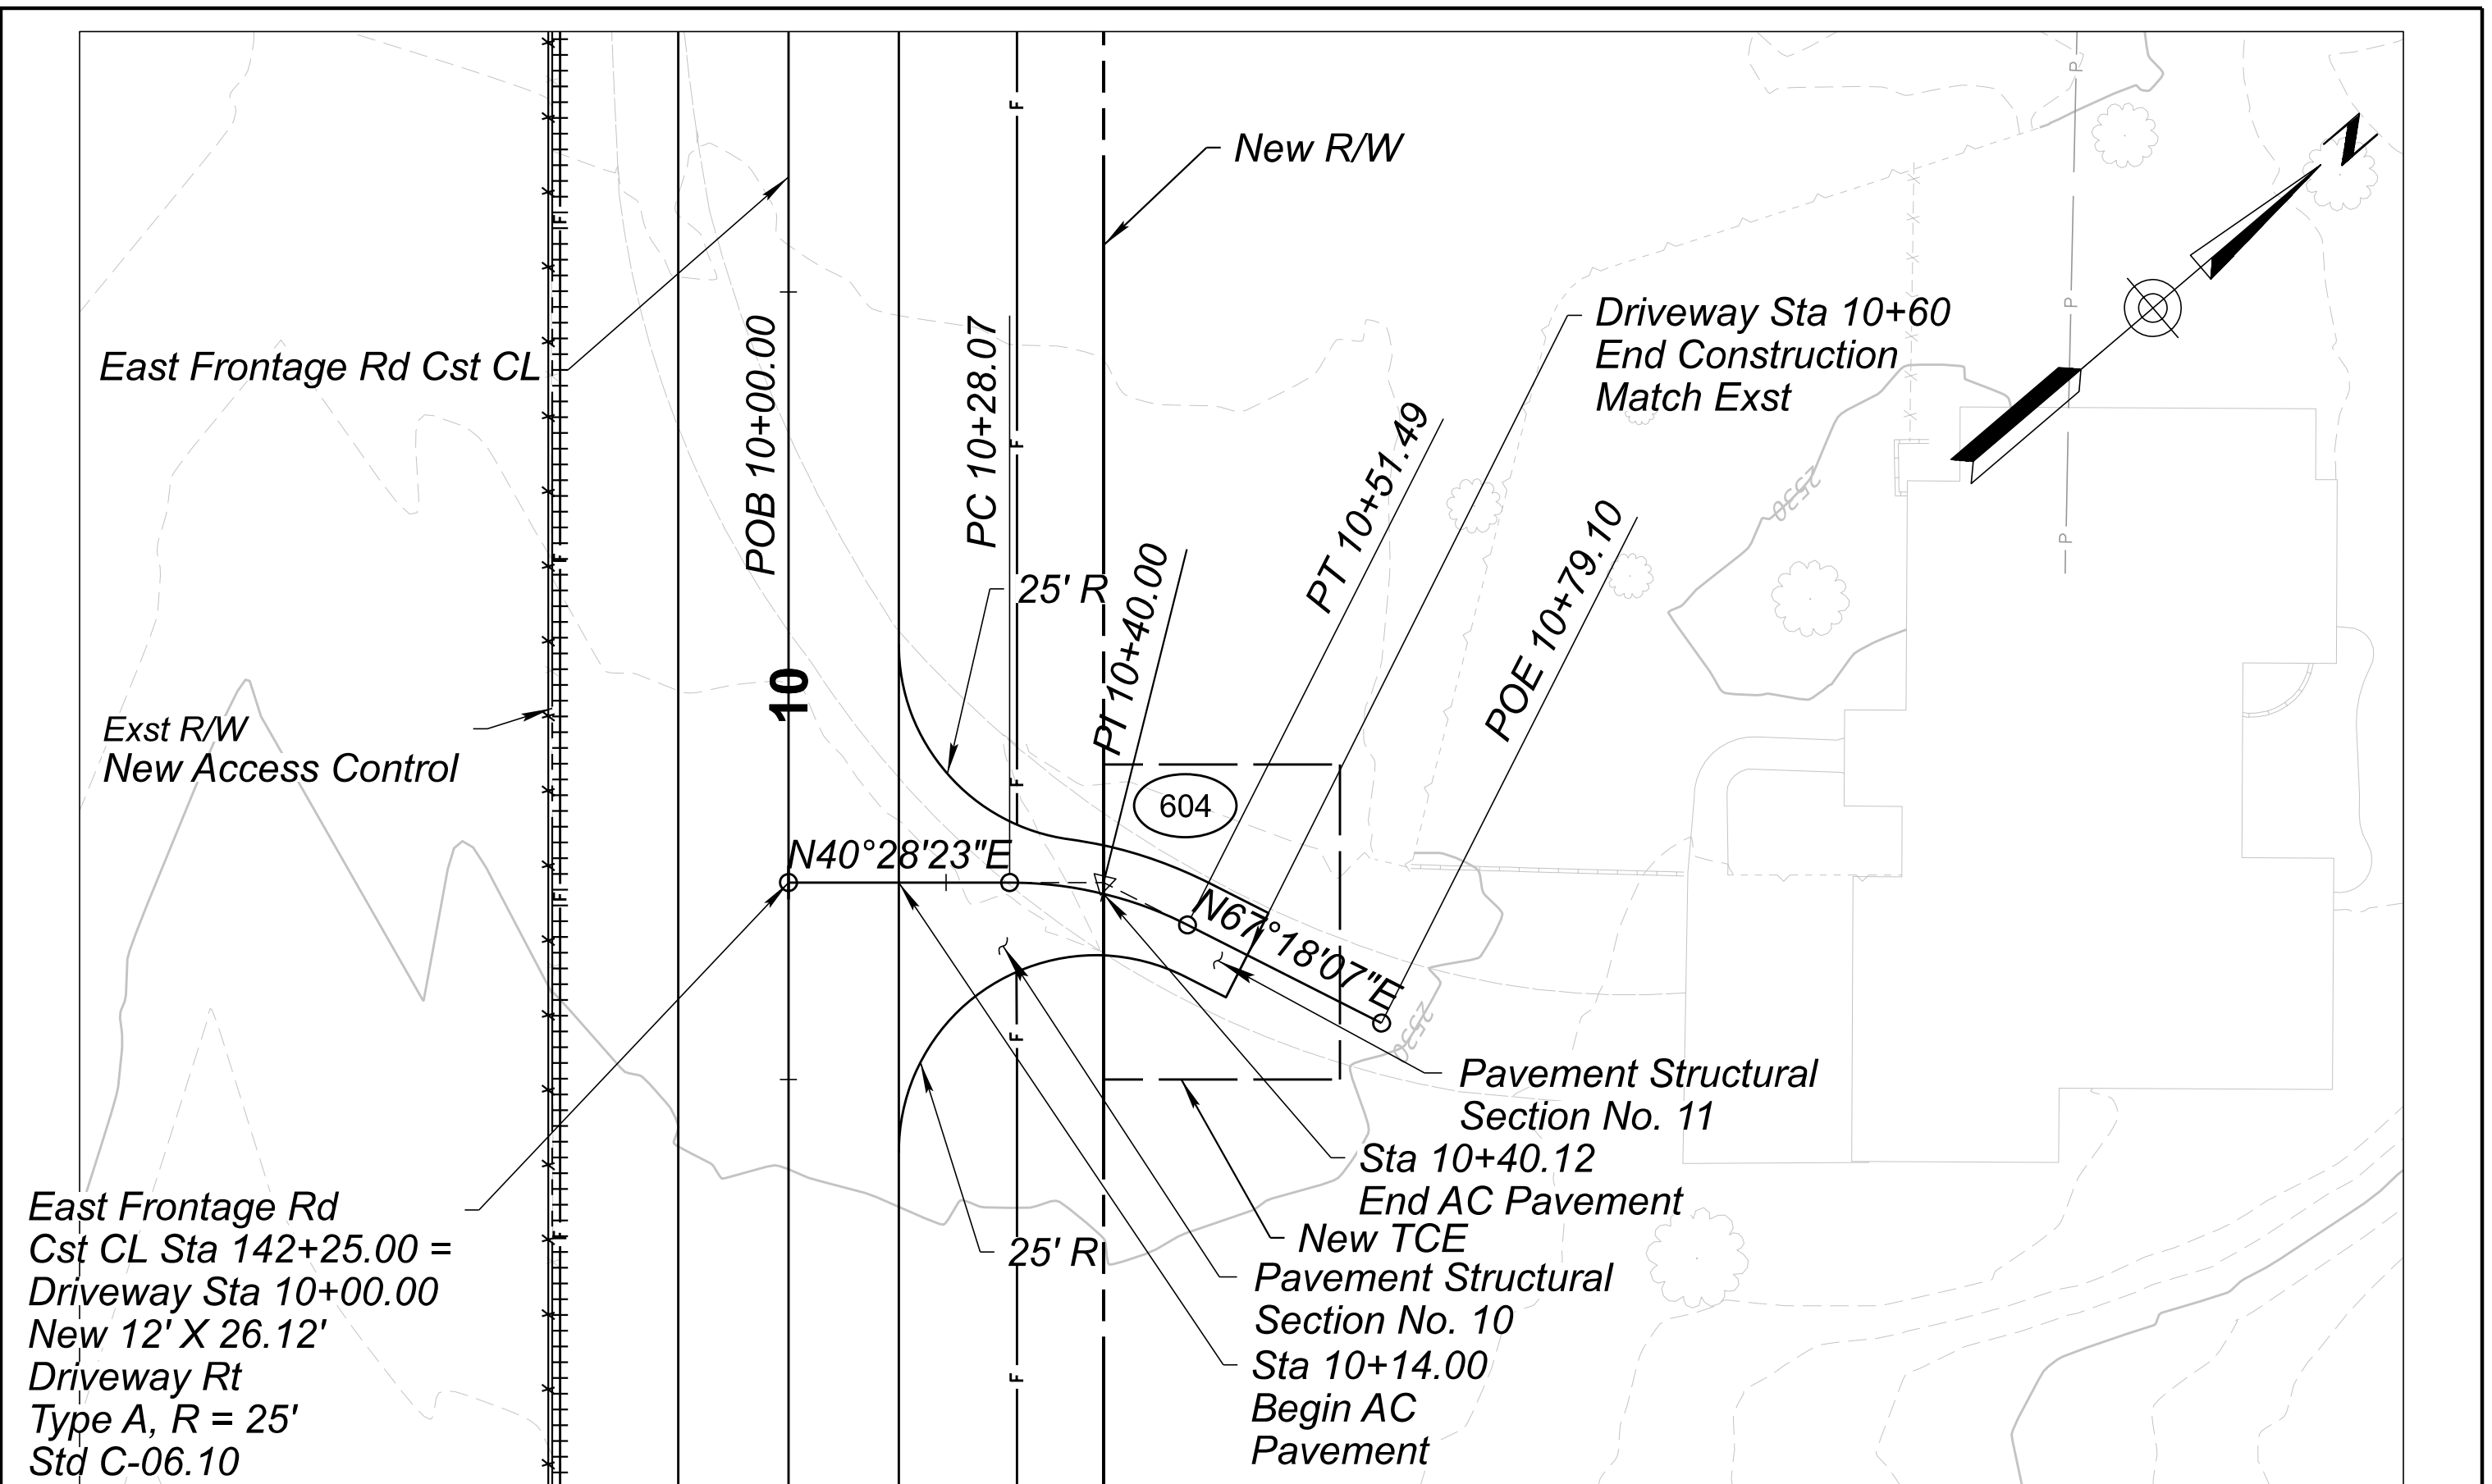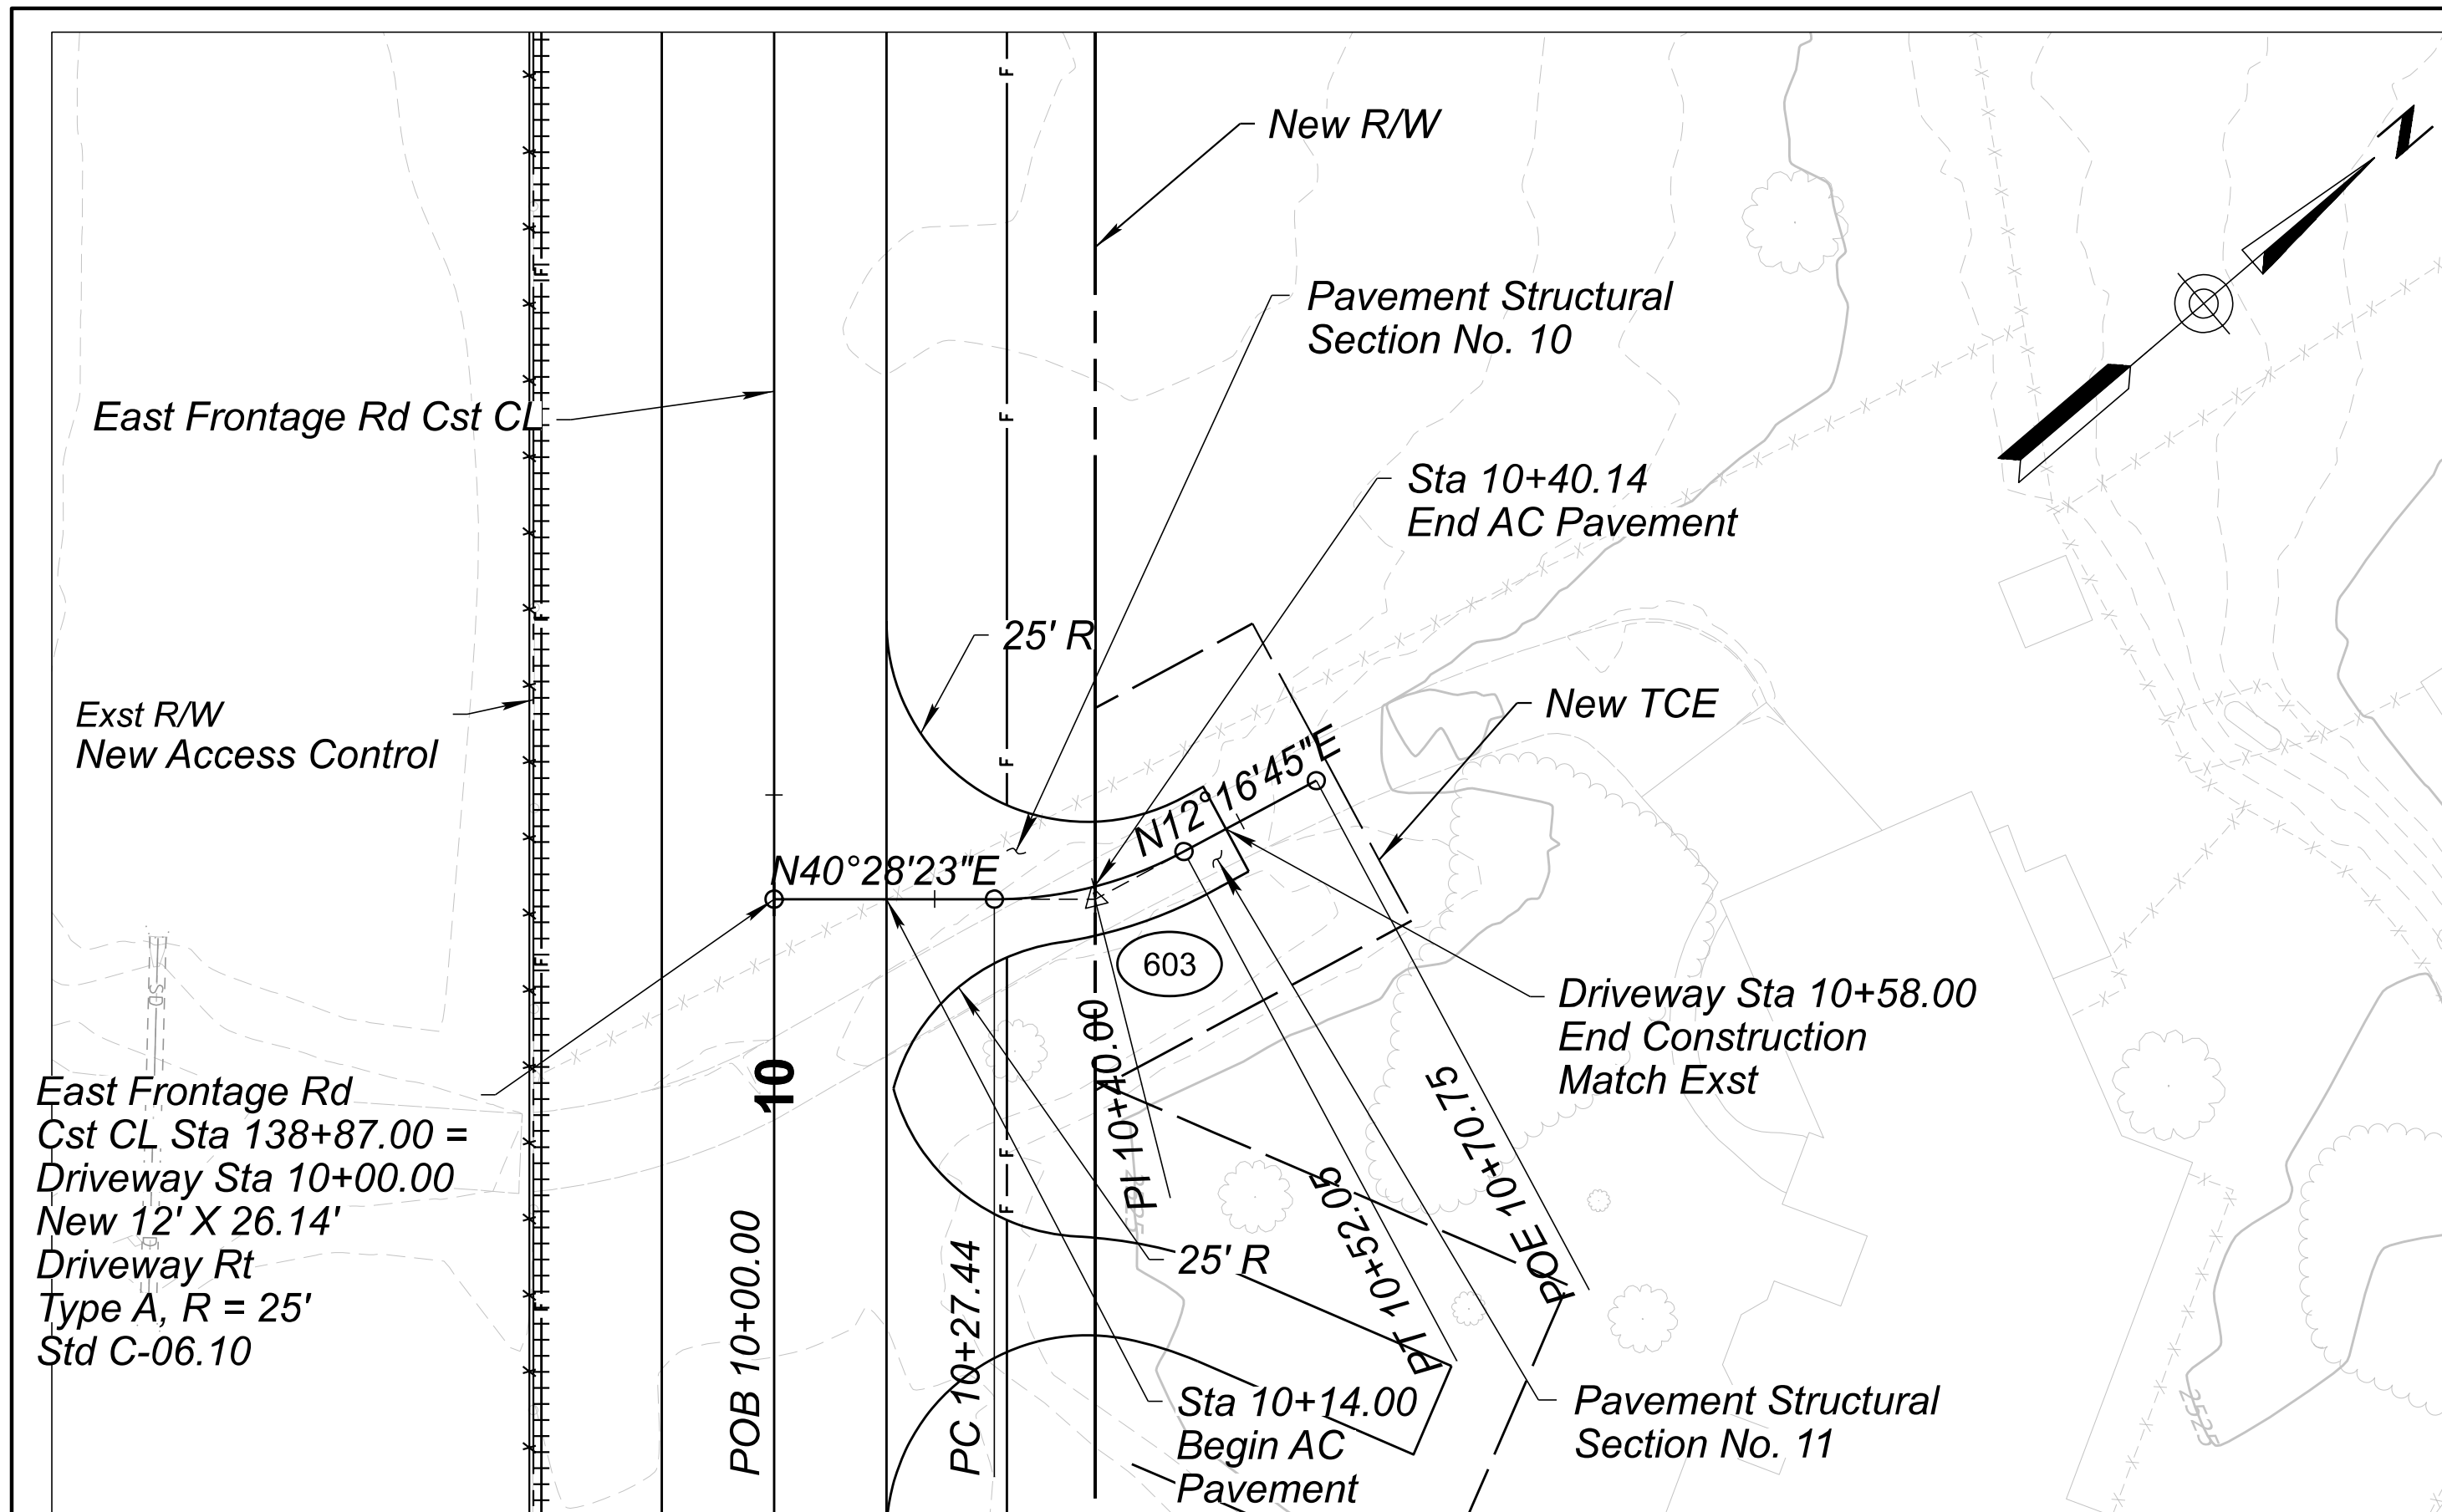


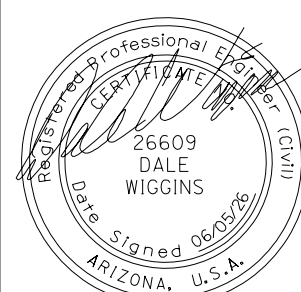
	NAME		DATE	ARIZONA DEPARTMENT OF TRANSPORTATION PROJECT DELIVERY AND OPERATIONS DIVISION ROADWAY DESIGN SERVICES PLAN & PROFILE SHEET DRIVEWAY - EAST FRONTAGE RD 138+87 DRIVEWAY - EAST FRONTAGE RD 142+25			ROUTE US 93 MILEPOST 189.9 STRUCTURE NO.	F.H.W.A. Arizona Division ARIZ.	STATE	PROJECT NO.	FEDERAL ID NO.	SHEET NO.	TOTAL SHEETS	RECORD DRAWING		
	DESIGN		S Mutesi							06/26	093 YV 189	093-B(230)T	211	524		
	DRAWN		C VALENZUELA							06/26	WICKENBURG RANCH WAY TO VISTA ROYALE					DWG No. C-4.19
	CHECKED		D WIGGINS							06/26						
TRANSPORTATION AECOM TECHNICAL SERVICES, Inc. 7720 N. 16th St., Suite 100 Phoenix, Arizona 85020 T 602.371.1100				 www.aecom.com		TRACS NO. F0738 01C					____ OF ____					

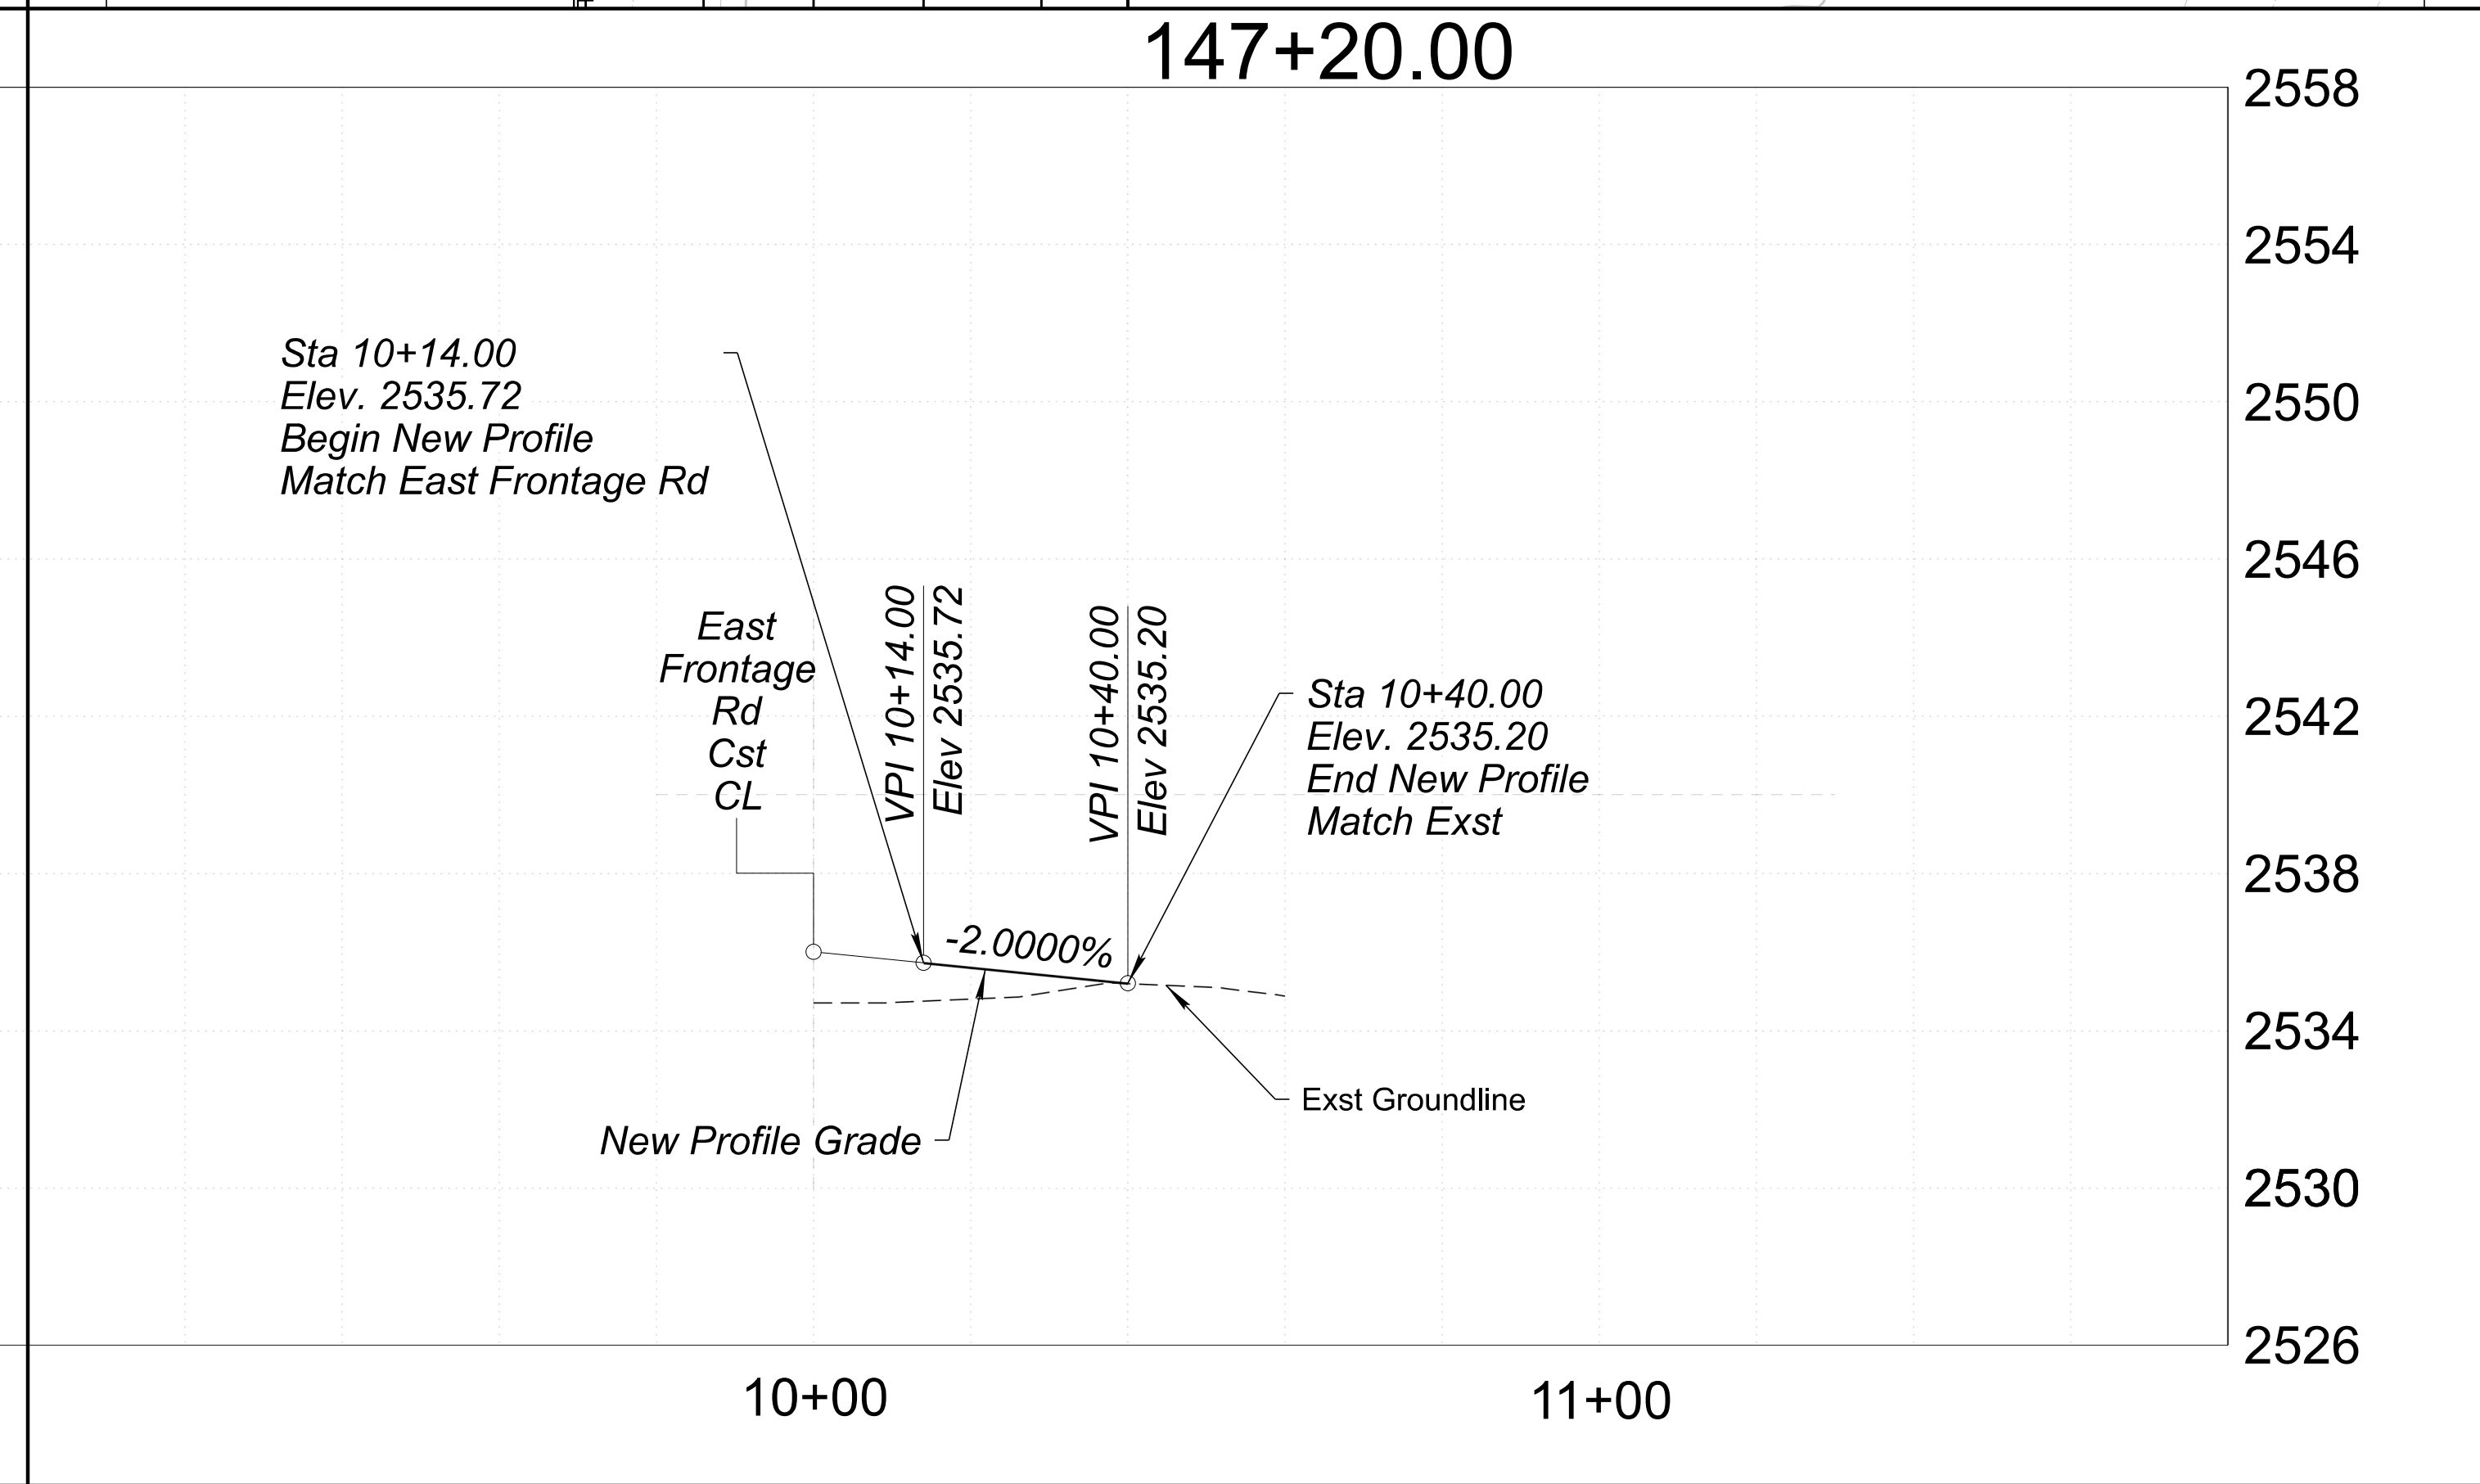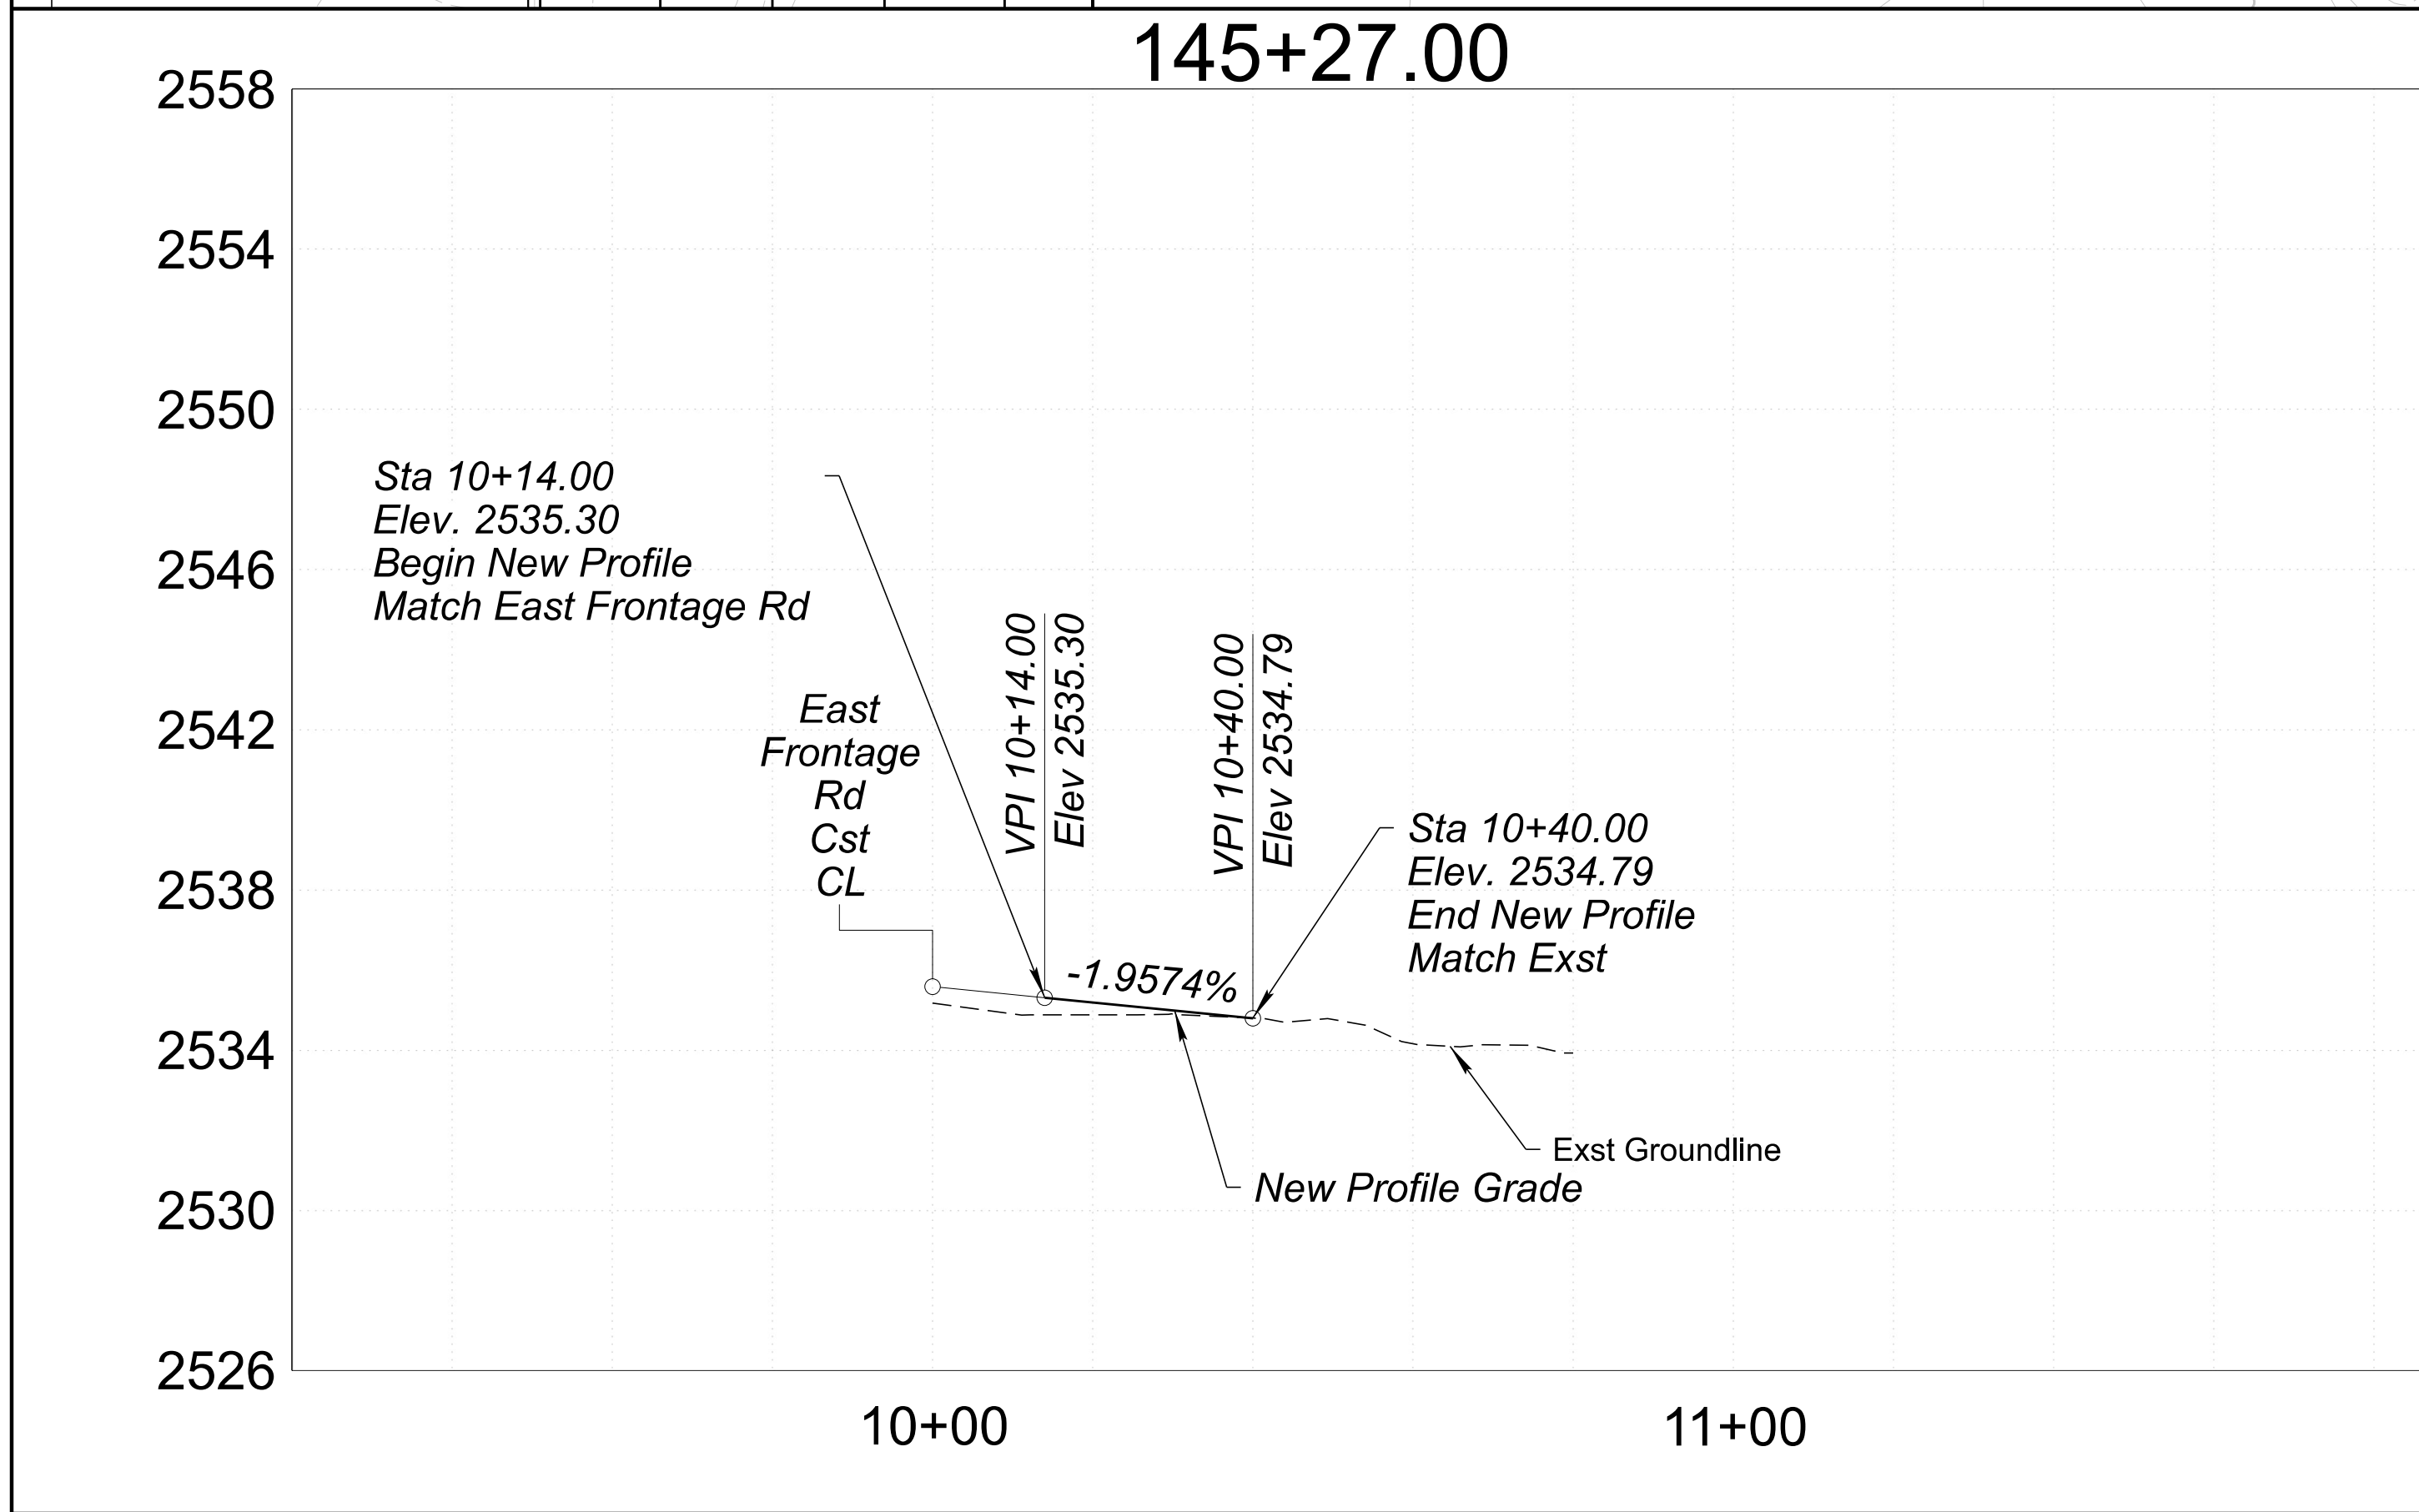



			NAME	DATE	ARIZONA DEPARTMENT OF TRANSPORTATION PROJECT DELIVERY AND OPERATIONS DIVISION ROADWAY DESIGN SERVICES PLAN & PROFILE SHEET DRIVEWAY - EAST FRONTAGE RD 145+27 DRIVEWAY - EAST FRONTAGE RD 147+20	ROUTE	F.H.W.A. Arizona Division ARIZ.	PROJECT NO.	FEDERAL ID NO.	SHEET NO.	TOTAL SHEETS	RECORD DRAWING
	DESIGN	S Mutesi	06/26	US 93		093 YV 189		093-B(230)T	212	524		
	DRAWN	C VALENZUELA	06/26	MILEPOST		LOCATION WICKENBURG RANCH WAY TO VISTA ROYALE					DWG No. C-4.20	
	CHECKED	D WIGGINS	06/26	189.9		TRACS NO. F0738 01C					___ OF ___	
TRANSPORTATION AECOM TECHNICAL SERVICES, Inc. 2700 N. 18th St., Suite 100 Phoenix, Arizona 85020 1-800-371-1108		AECOM www.aecom.com				STRUCTURE NO.						

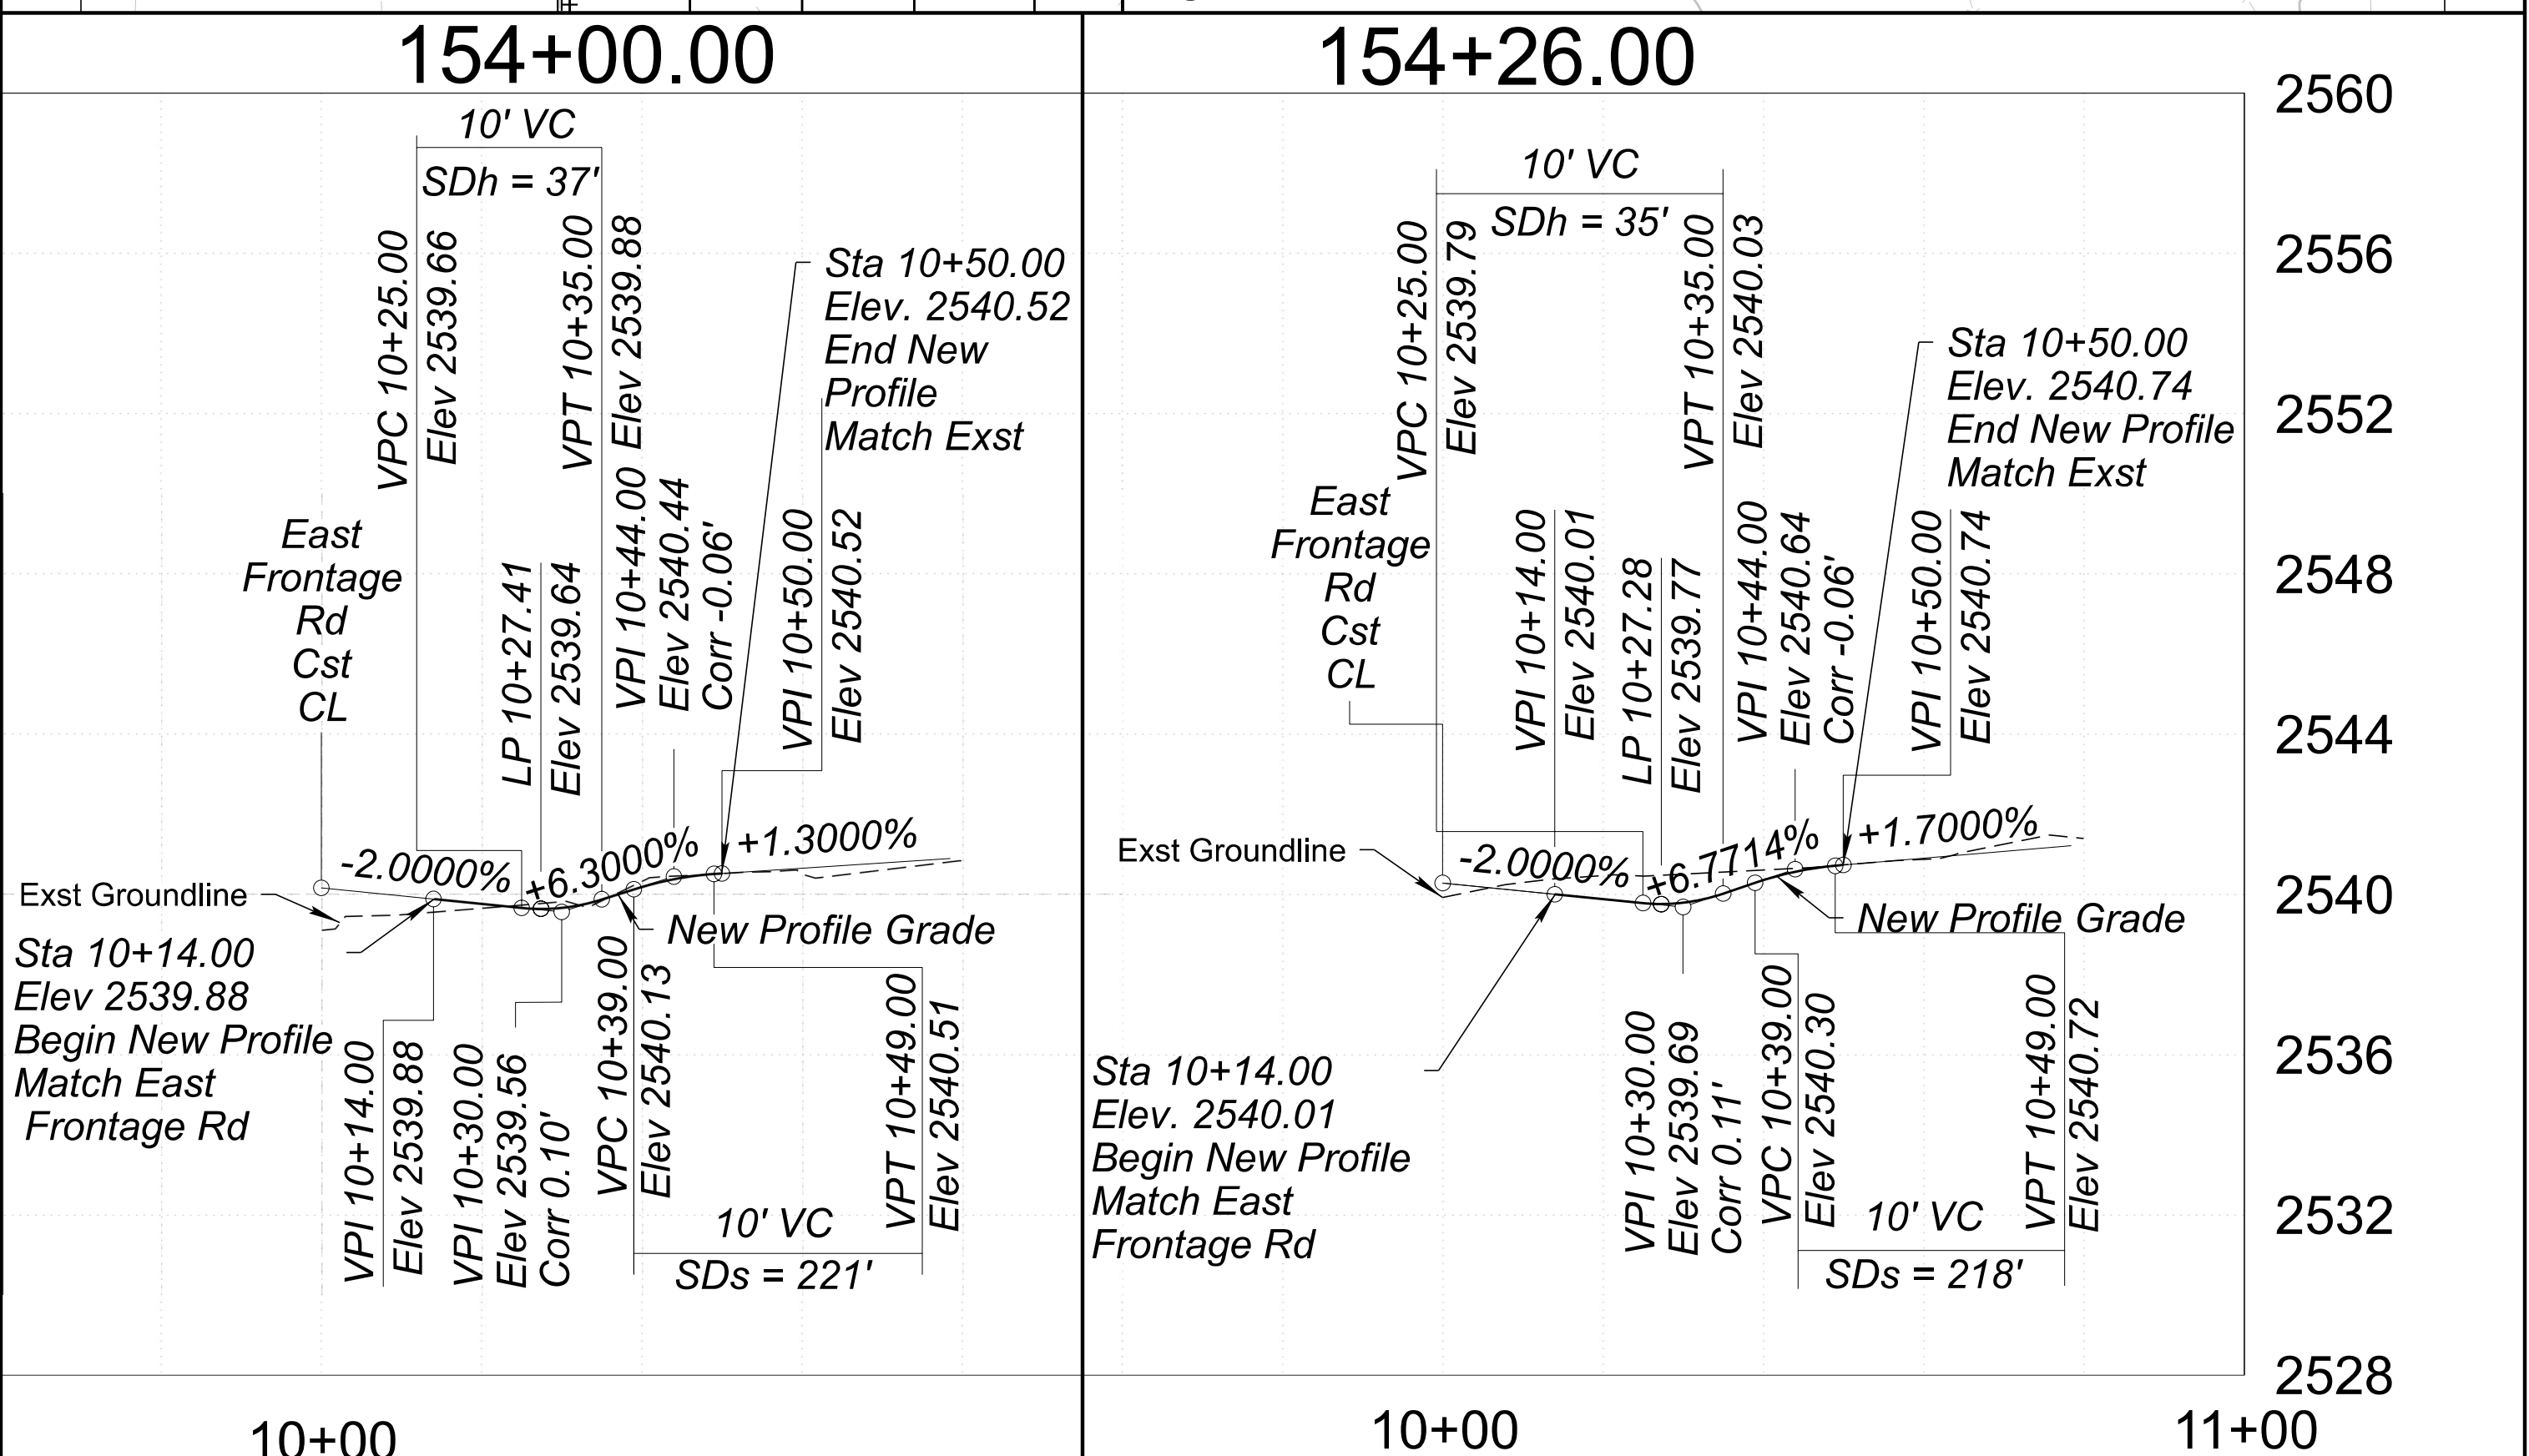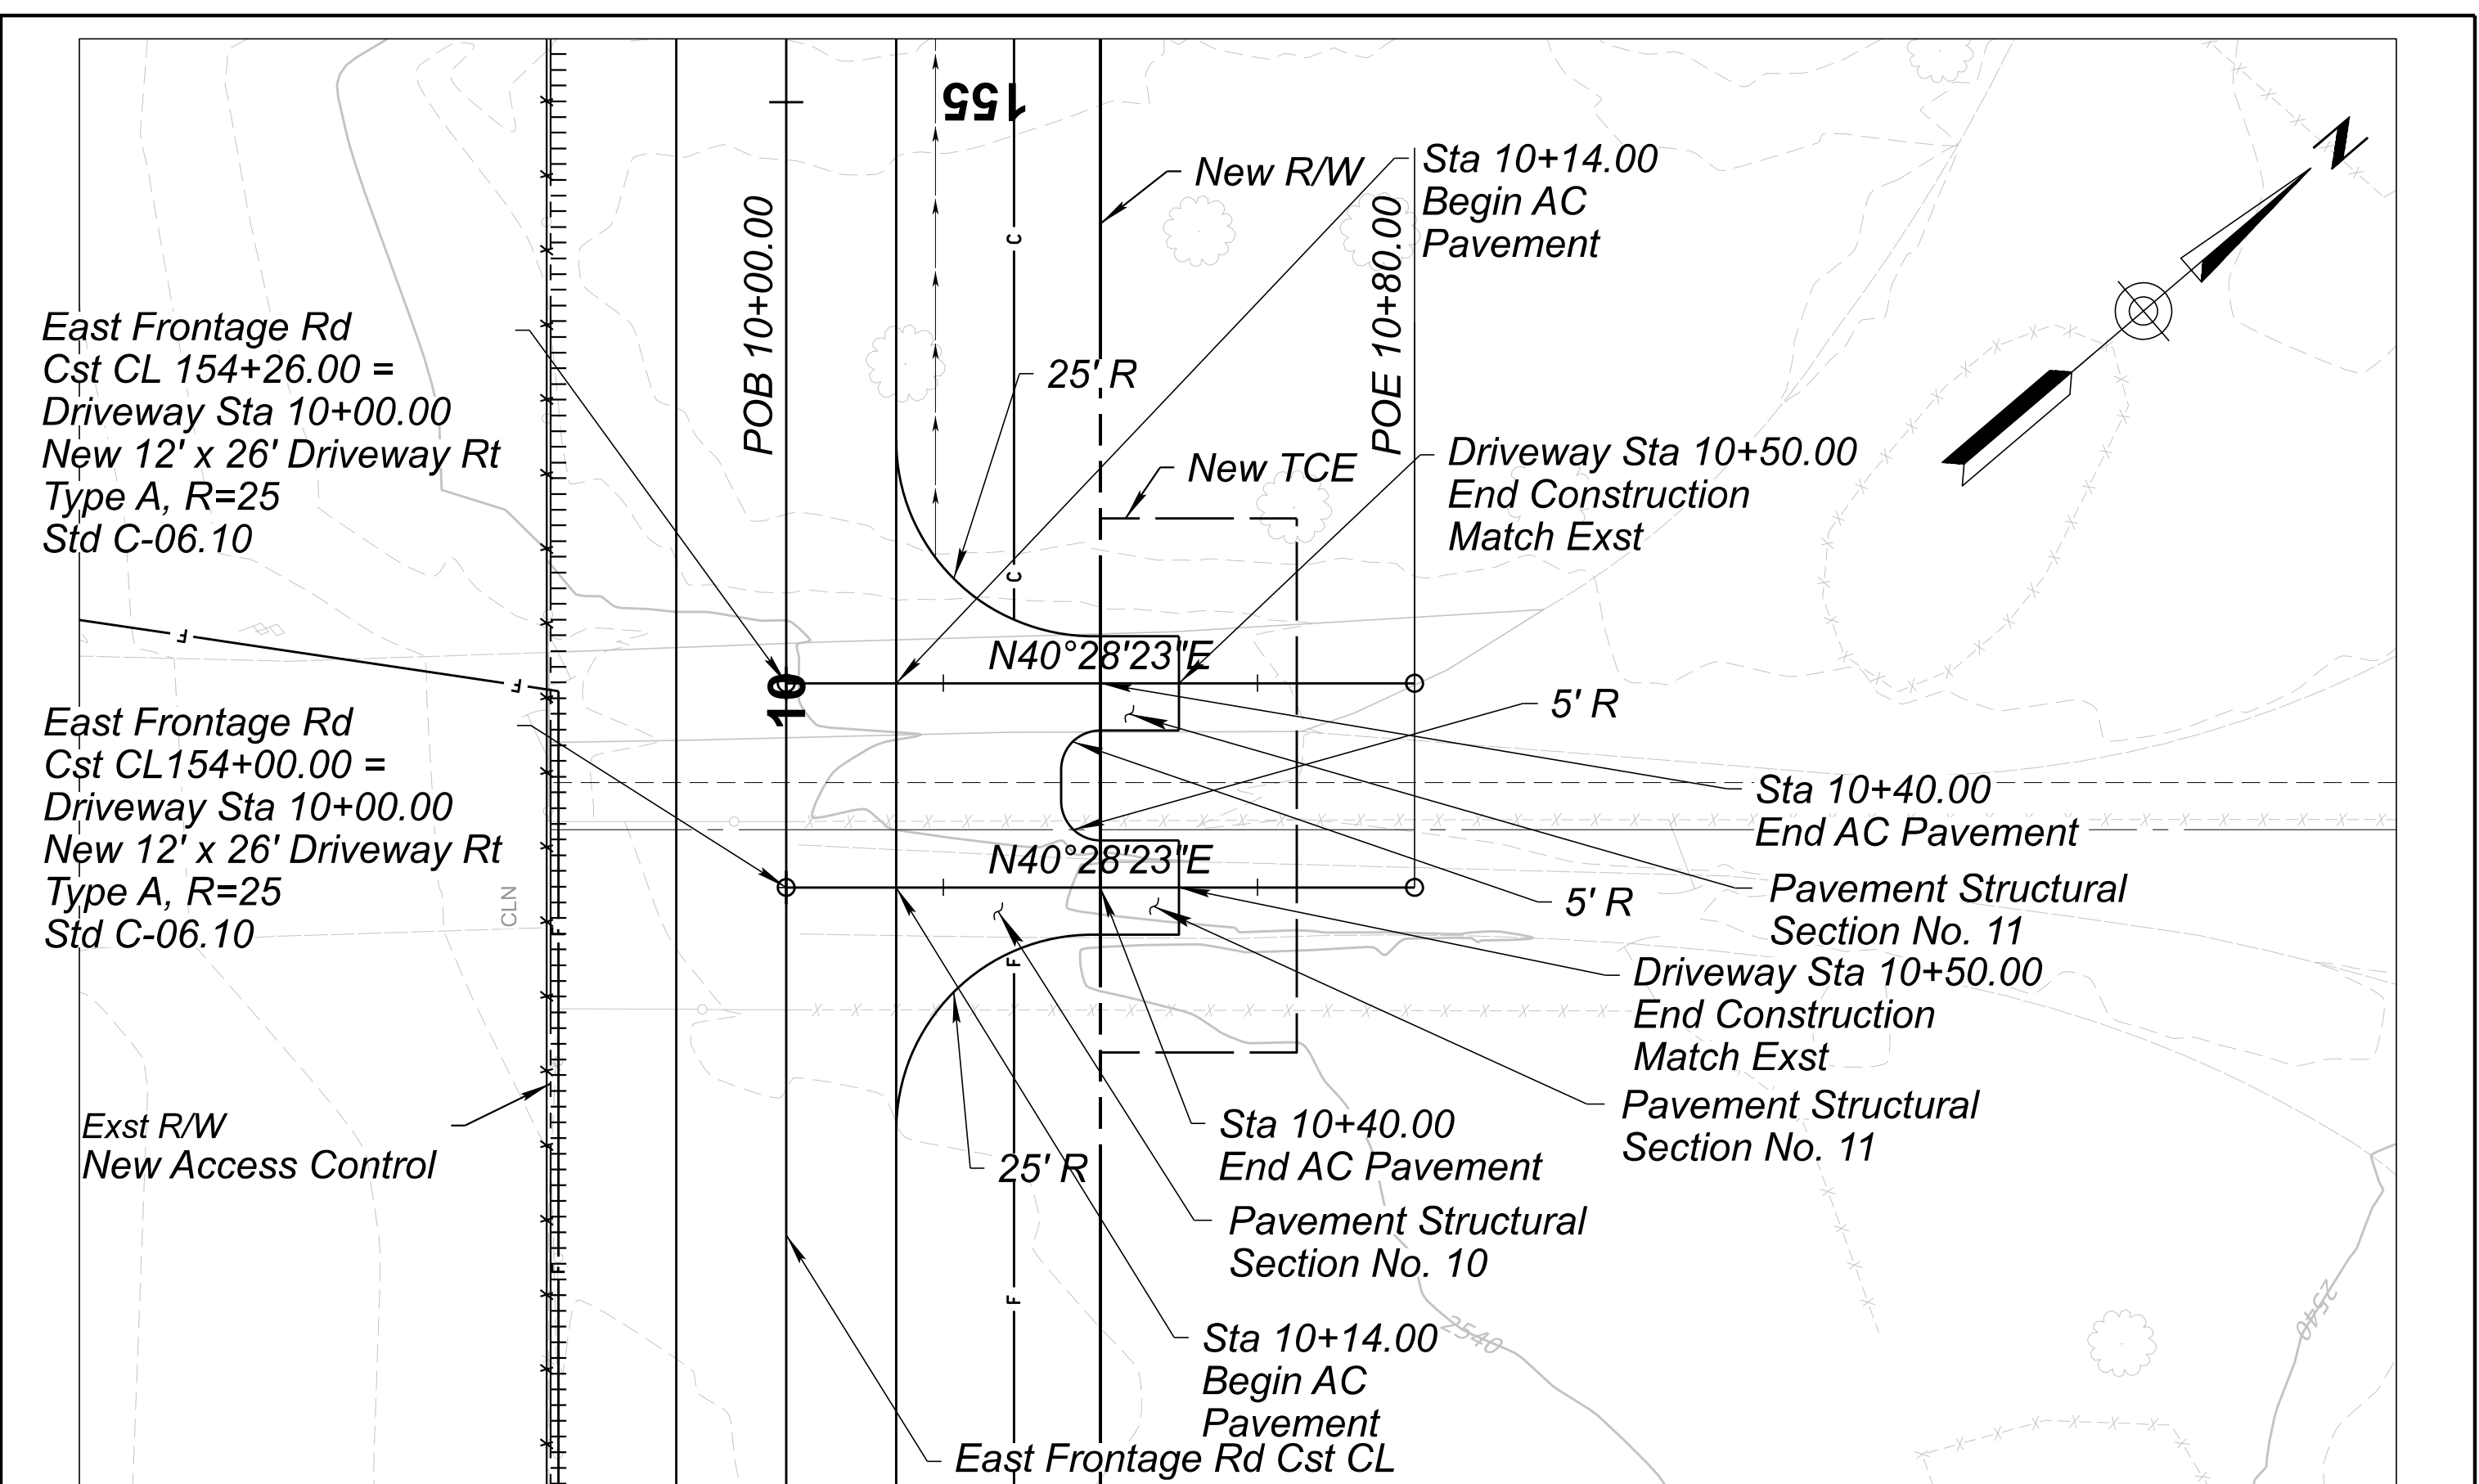

		NAME	DATE	ARIZONA DEPARTMENT OF TRANSPORTATION PROJECT DELIVERY AND OPERATIONS DIVISION ROADWAY DESIGN SERVICES PLAN & PROFILE SHEET DWY - EAST FRONTAGE RD 150+33 DWY - EAST FRONTAGE RD 154+00 & 154+26	ROUTE	F.H.W.A. Arizona Division	STATE	PROJECT NO.	FEDERAL ID NO.	SHEET NO.	TOTAL SHEETS	RECORD DRAWING	
	DESIGN	S Mutesi	06/26		US 93		ARIZ.	093 YV 189	093-B(230)T	213	524		
	DRAWN	C VALENZUELA	06/26		MILEPOST	189.9	LOCATION WICKENBURG RANCH WAY TO VISTA ROYALE						DWG No. C-4.21
	CHECKED	D WIGGINS	06/26		STRUCTURE NO.		TRACS NO. F0738 01C	OF					
TRANSPORTATION AECOM TECHNICAL SERVICES, Inc. 7732 N. 169 St., Suite 100 Phoenix, Arizona 85020 T 603.371.1199  www.aecom.com													

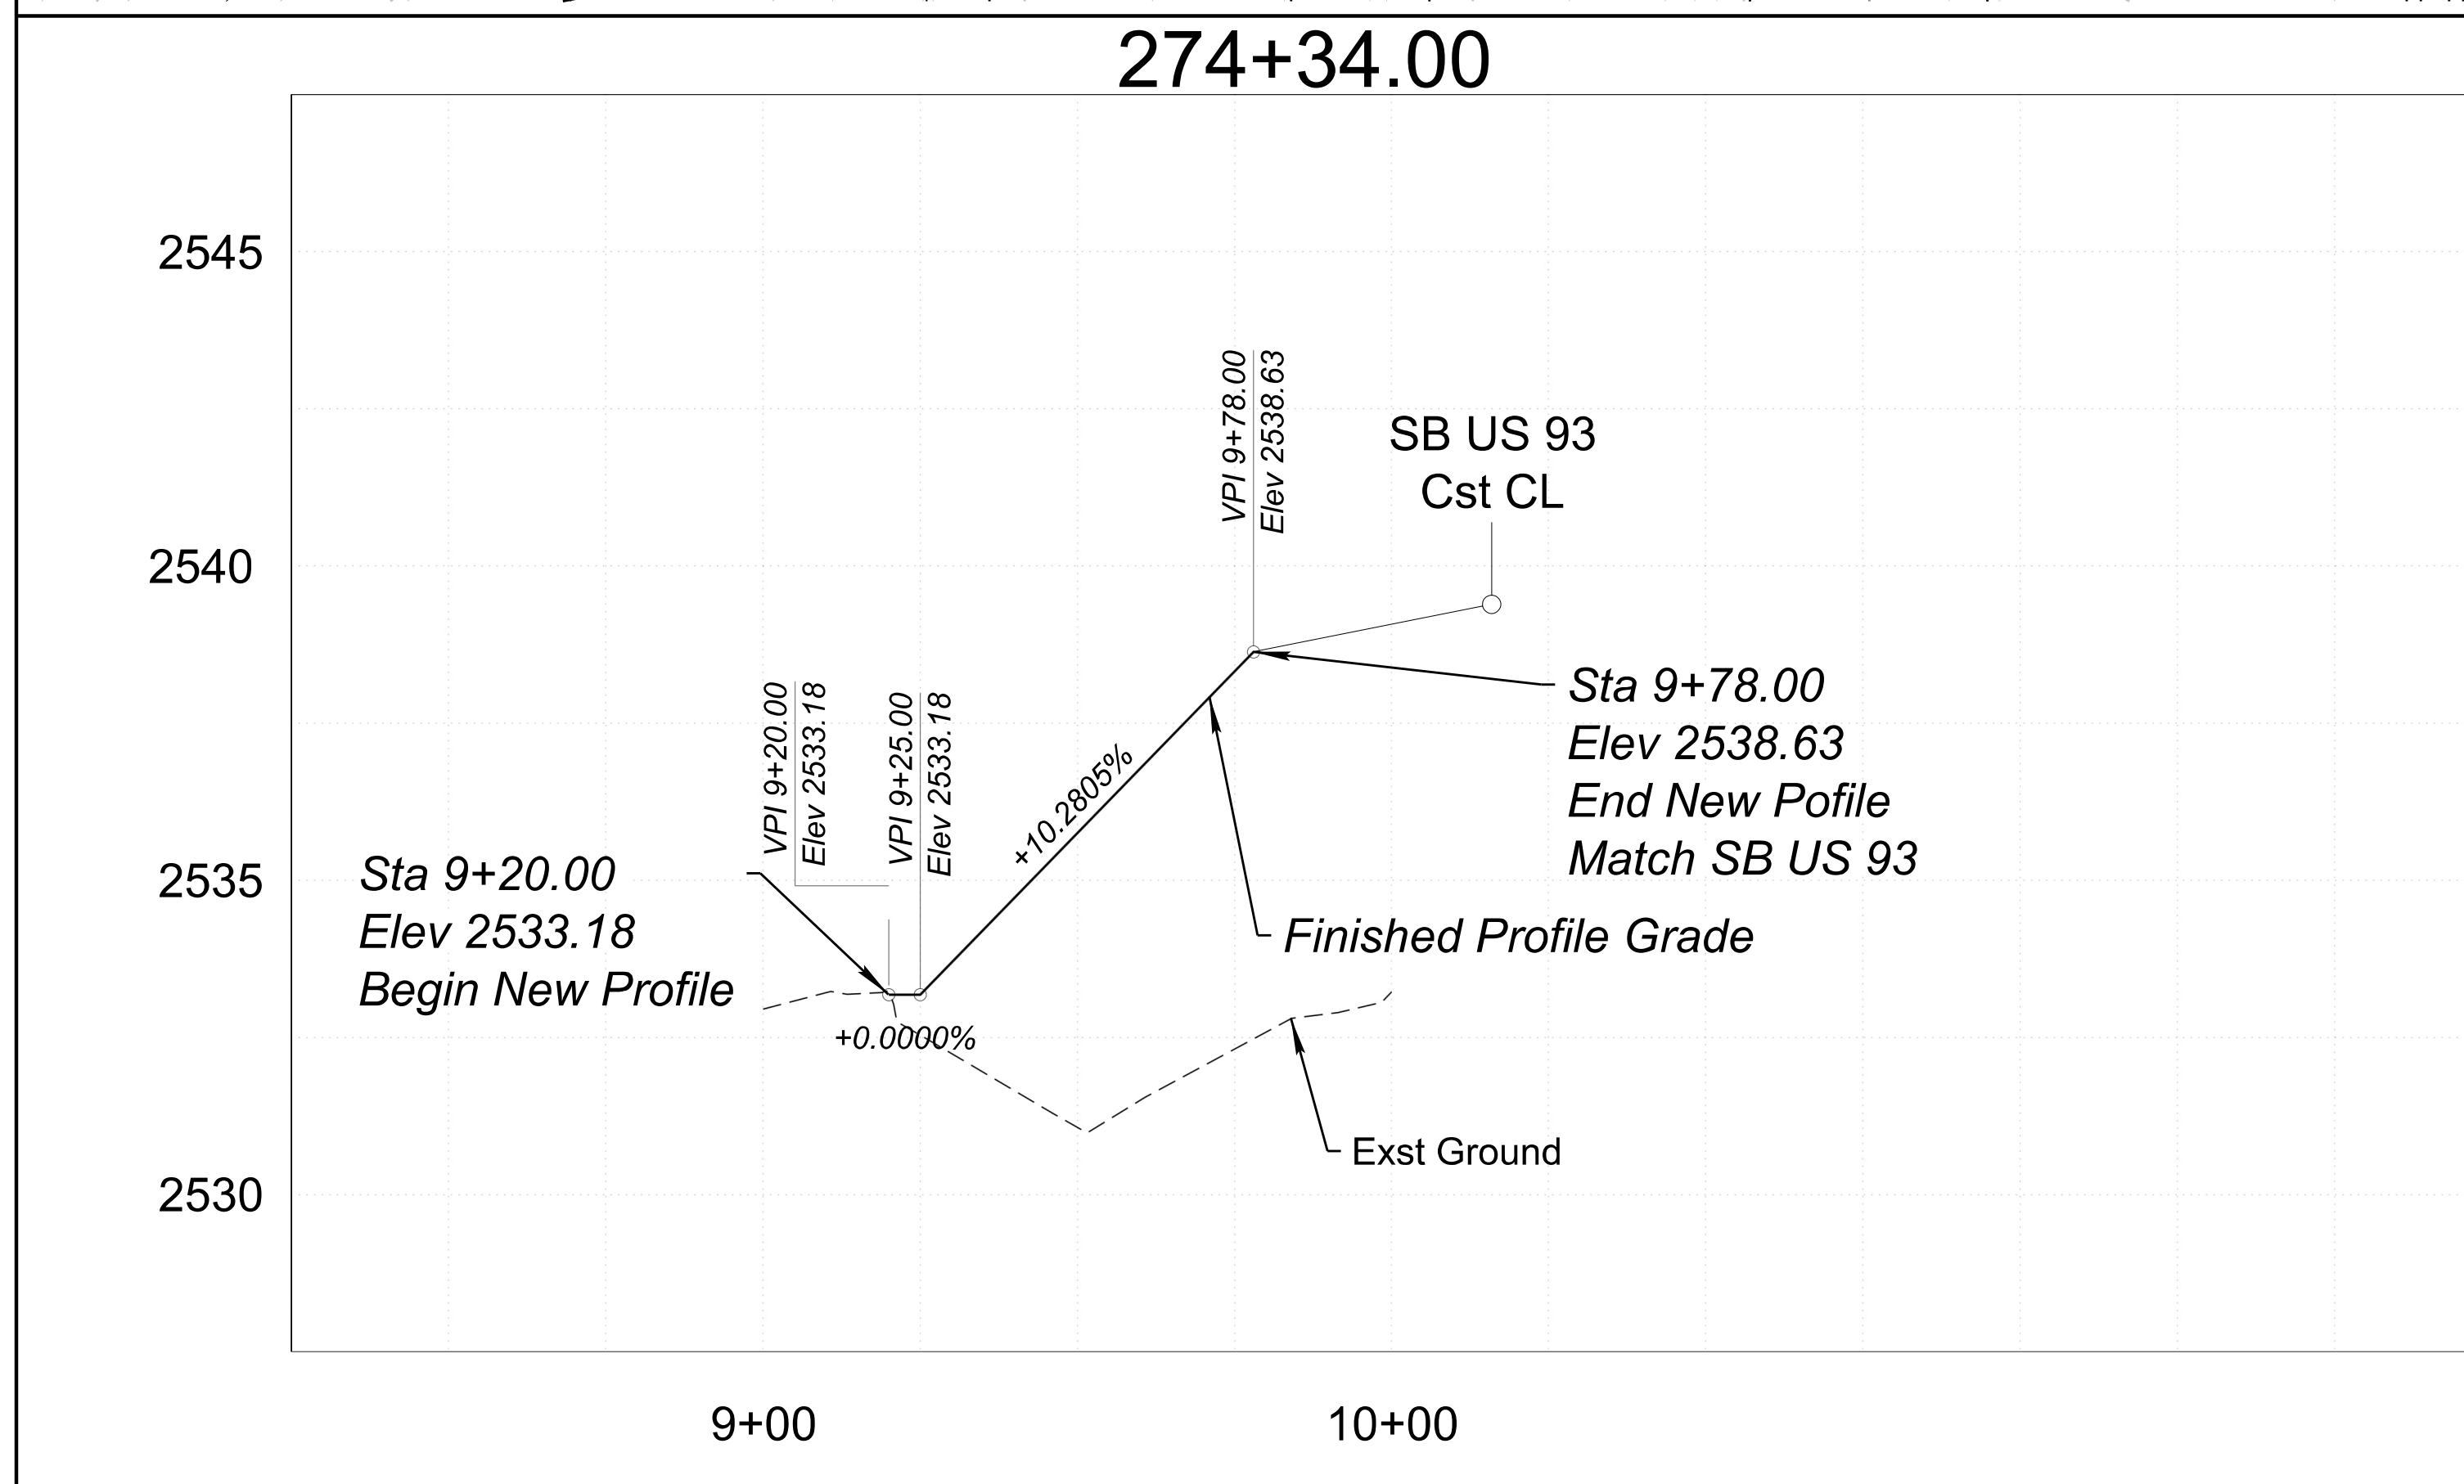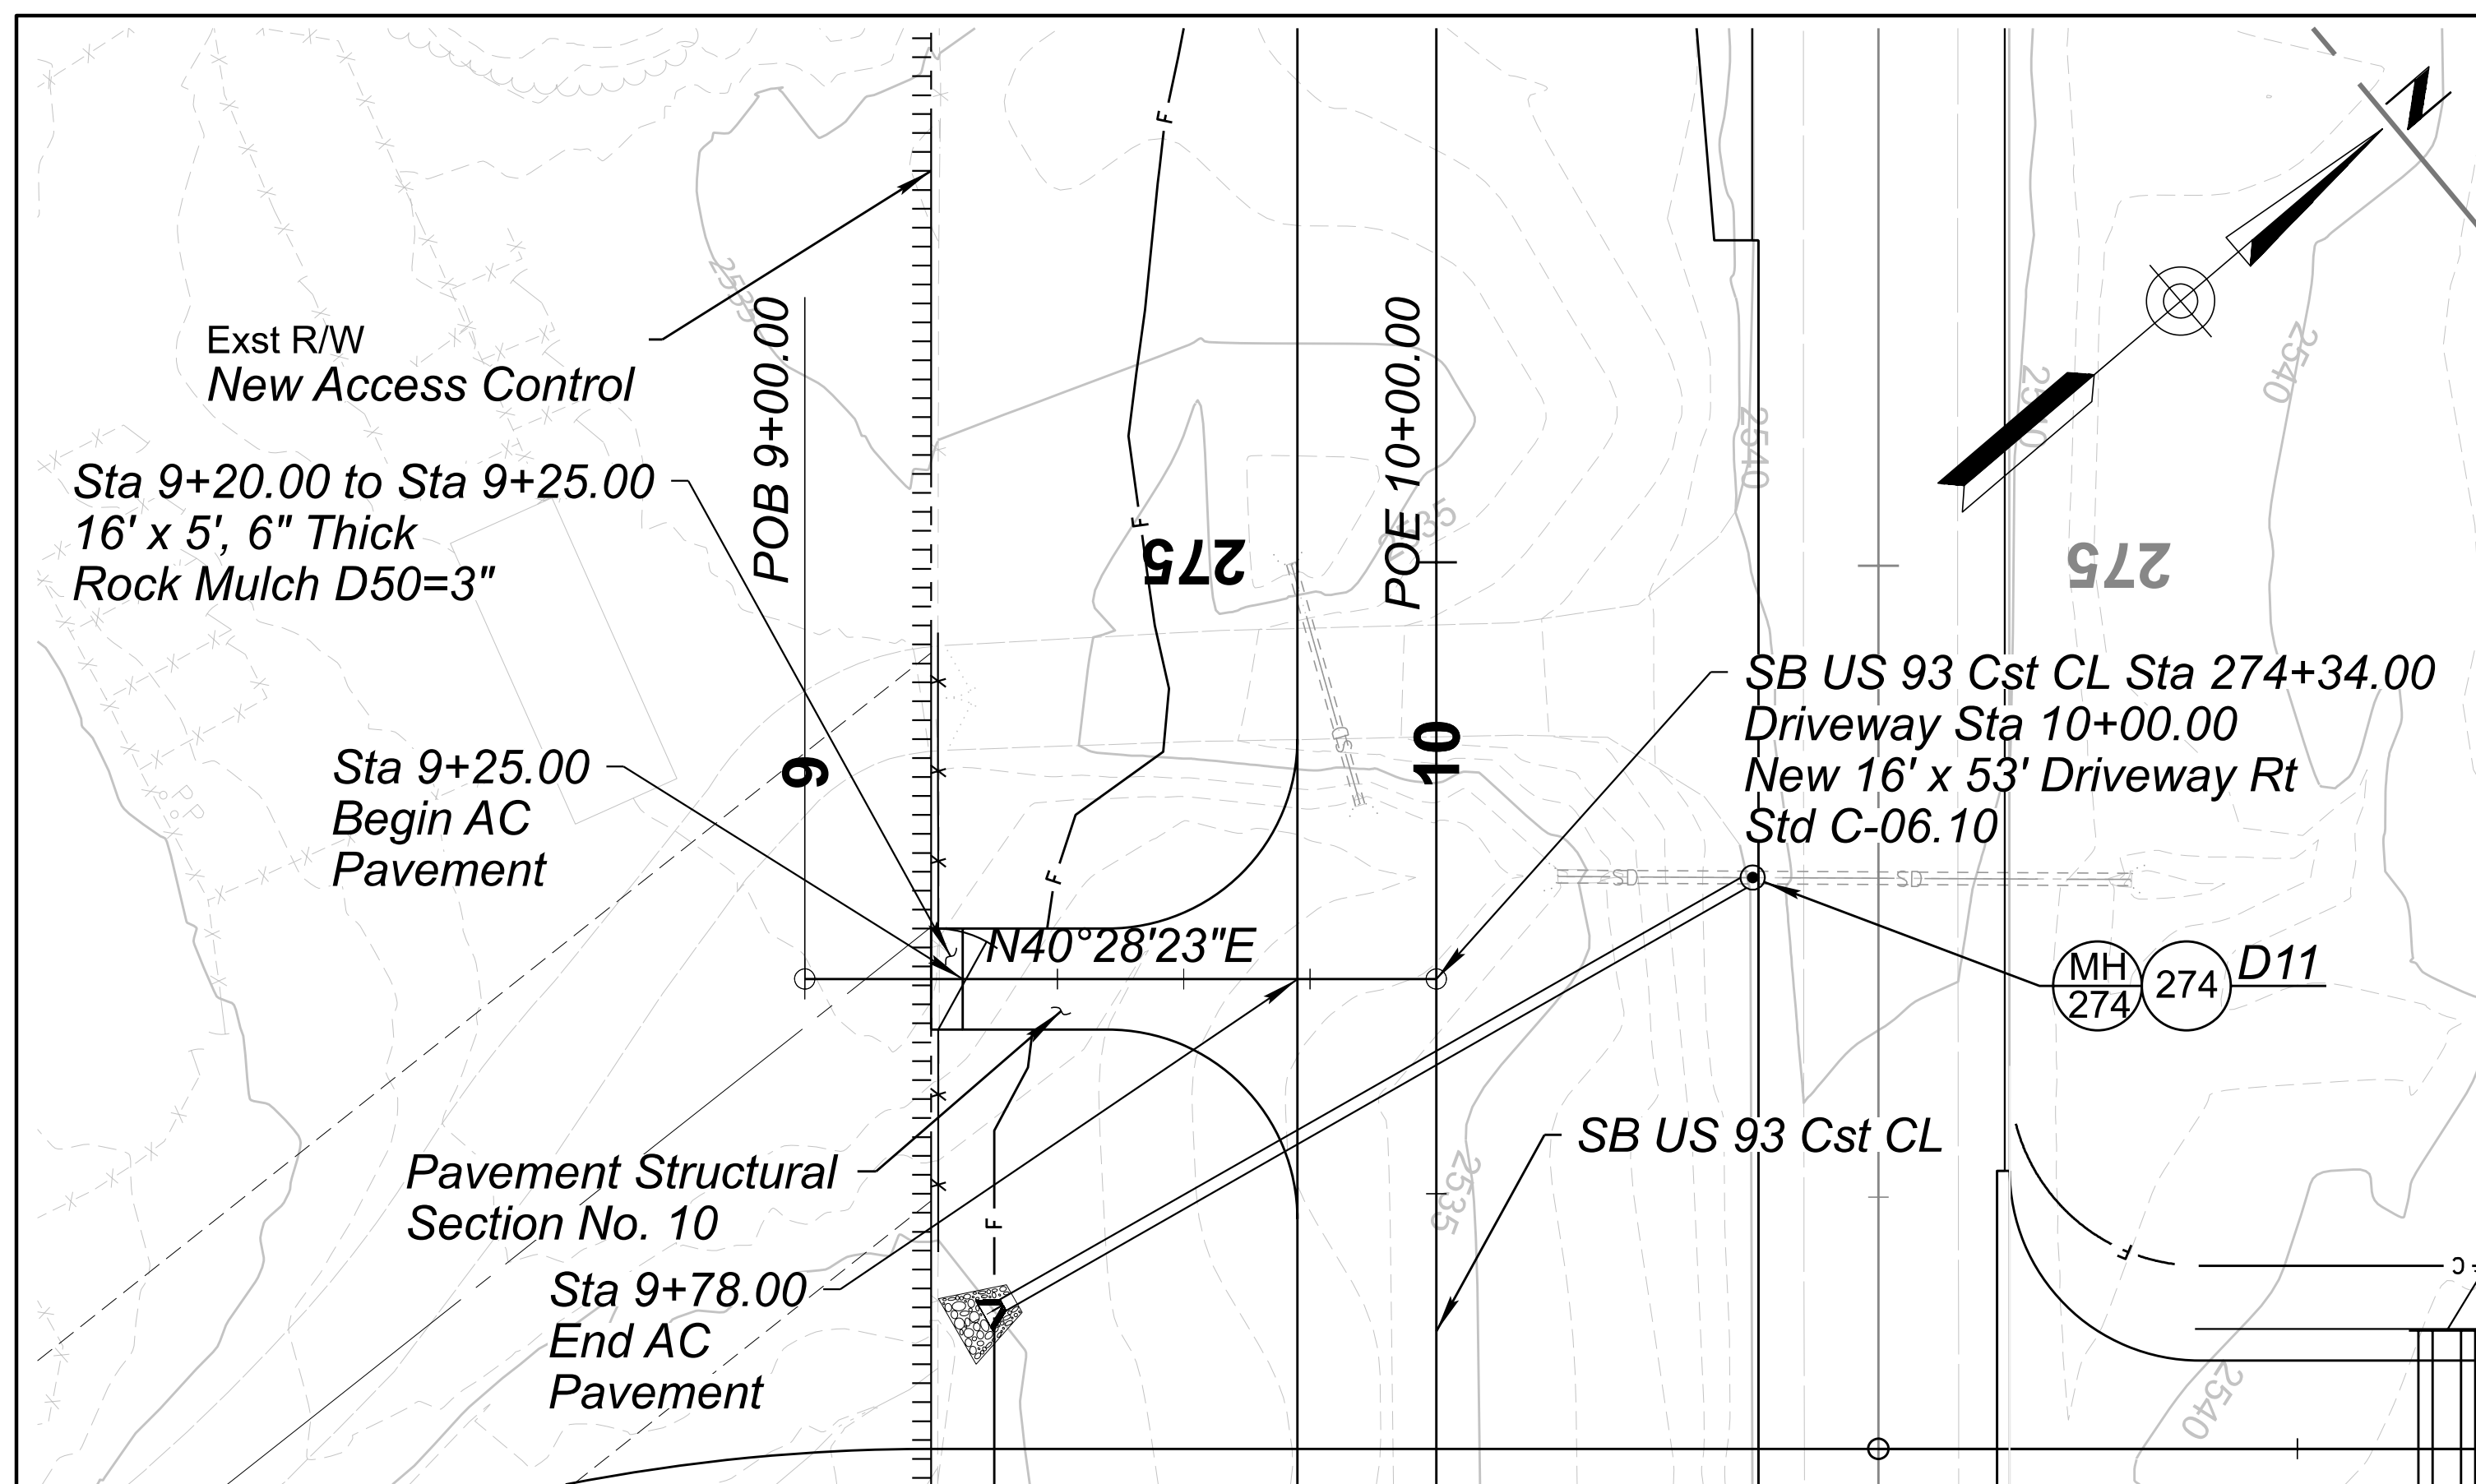


		NAME	DATE	ARIZONA DEPARTMENT OF TRANSPORTATION PROJECT DELIVERY AND OPERATIONS DIVISION ROADWAY DESIGN SERVICES	ROUTE	F.H.W.A. Arizona Division	STATE	PROJECT NO.	FEDERAL ID NO.	SHEET NO.	TOTAL SHEETS	RECORD DRAWING
	DESIGN	S Mutesi	06/26		US 93	ARIZ.	093 YV 189	093-B(230)T	214	524		
	DRAWN	C VALENZUELA	06/26		MILEPOST							
	CHECKED	D WIGGINS	06/26		189.9							
	TRANSPORTATION AECOM TECHNICAL SERVICES, Inc. 7702 N. 19th St., Suite 100 Phoenix, Arizona 85020 T 602.371.1199 AECOM www.aecom.com			PLAN & PROFILE SHEET DRIVEWAY SB US 93 274+34	STRUCTURE NO.	LOCATION WICKENBURG RANCH WAY TO VISTA ROYALE					DWG No. C-4.22	
						TRACS NO. F0738 01C						OF

  

c:\pwworking\usaz\dms08894\0738_dw07.dgn
6/23/2026 @5:37:25 PM jason.heredia

F.H.W.A. REGION	STATE	PROJECT NO.	SHEET NO.	TOTAL SHEETS	RECORD DRAWING
9	ARIZ.	093-B(230)T	216	524	

093 YV 189

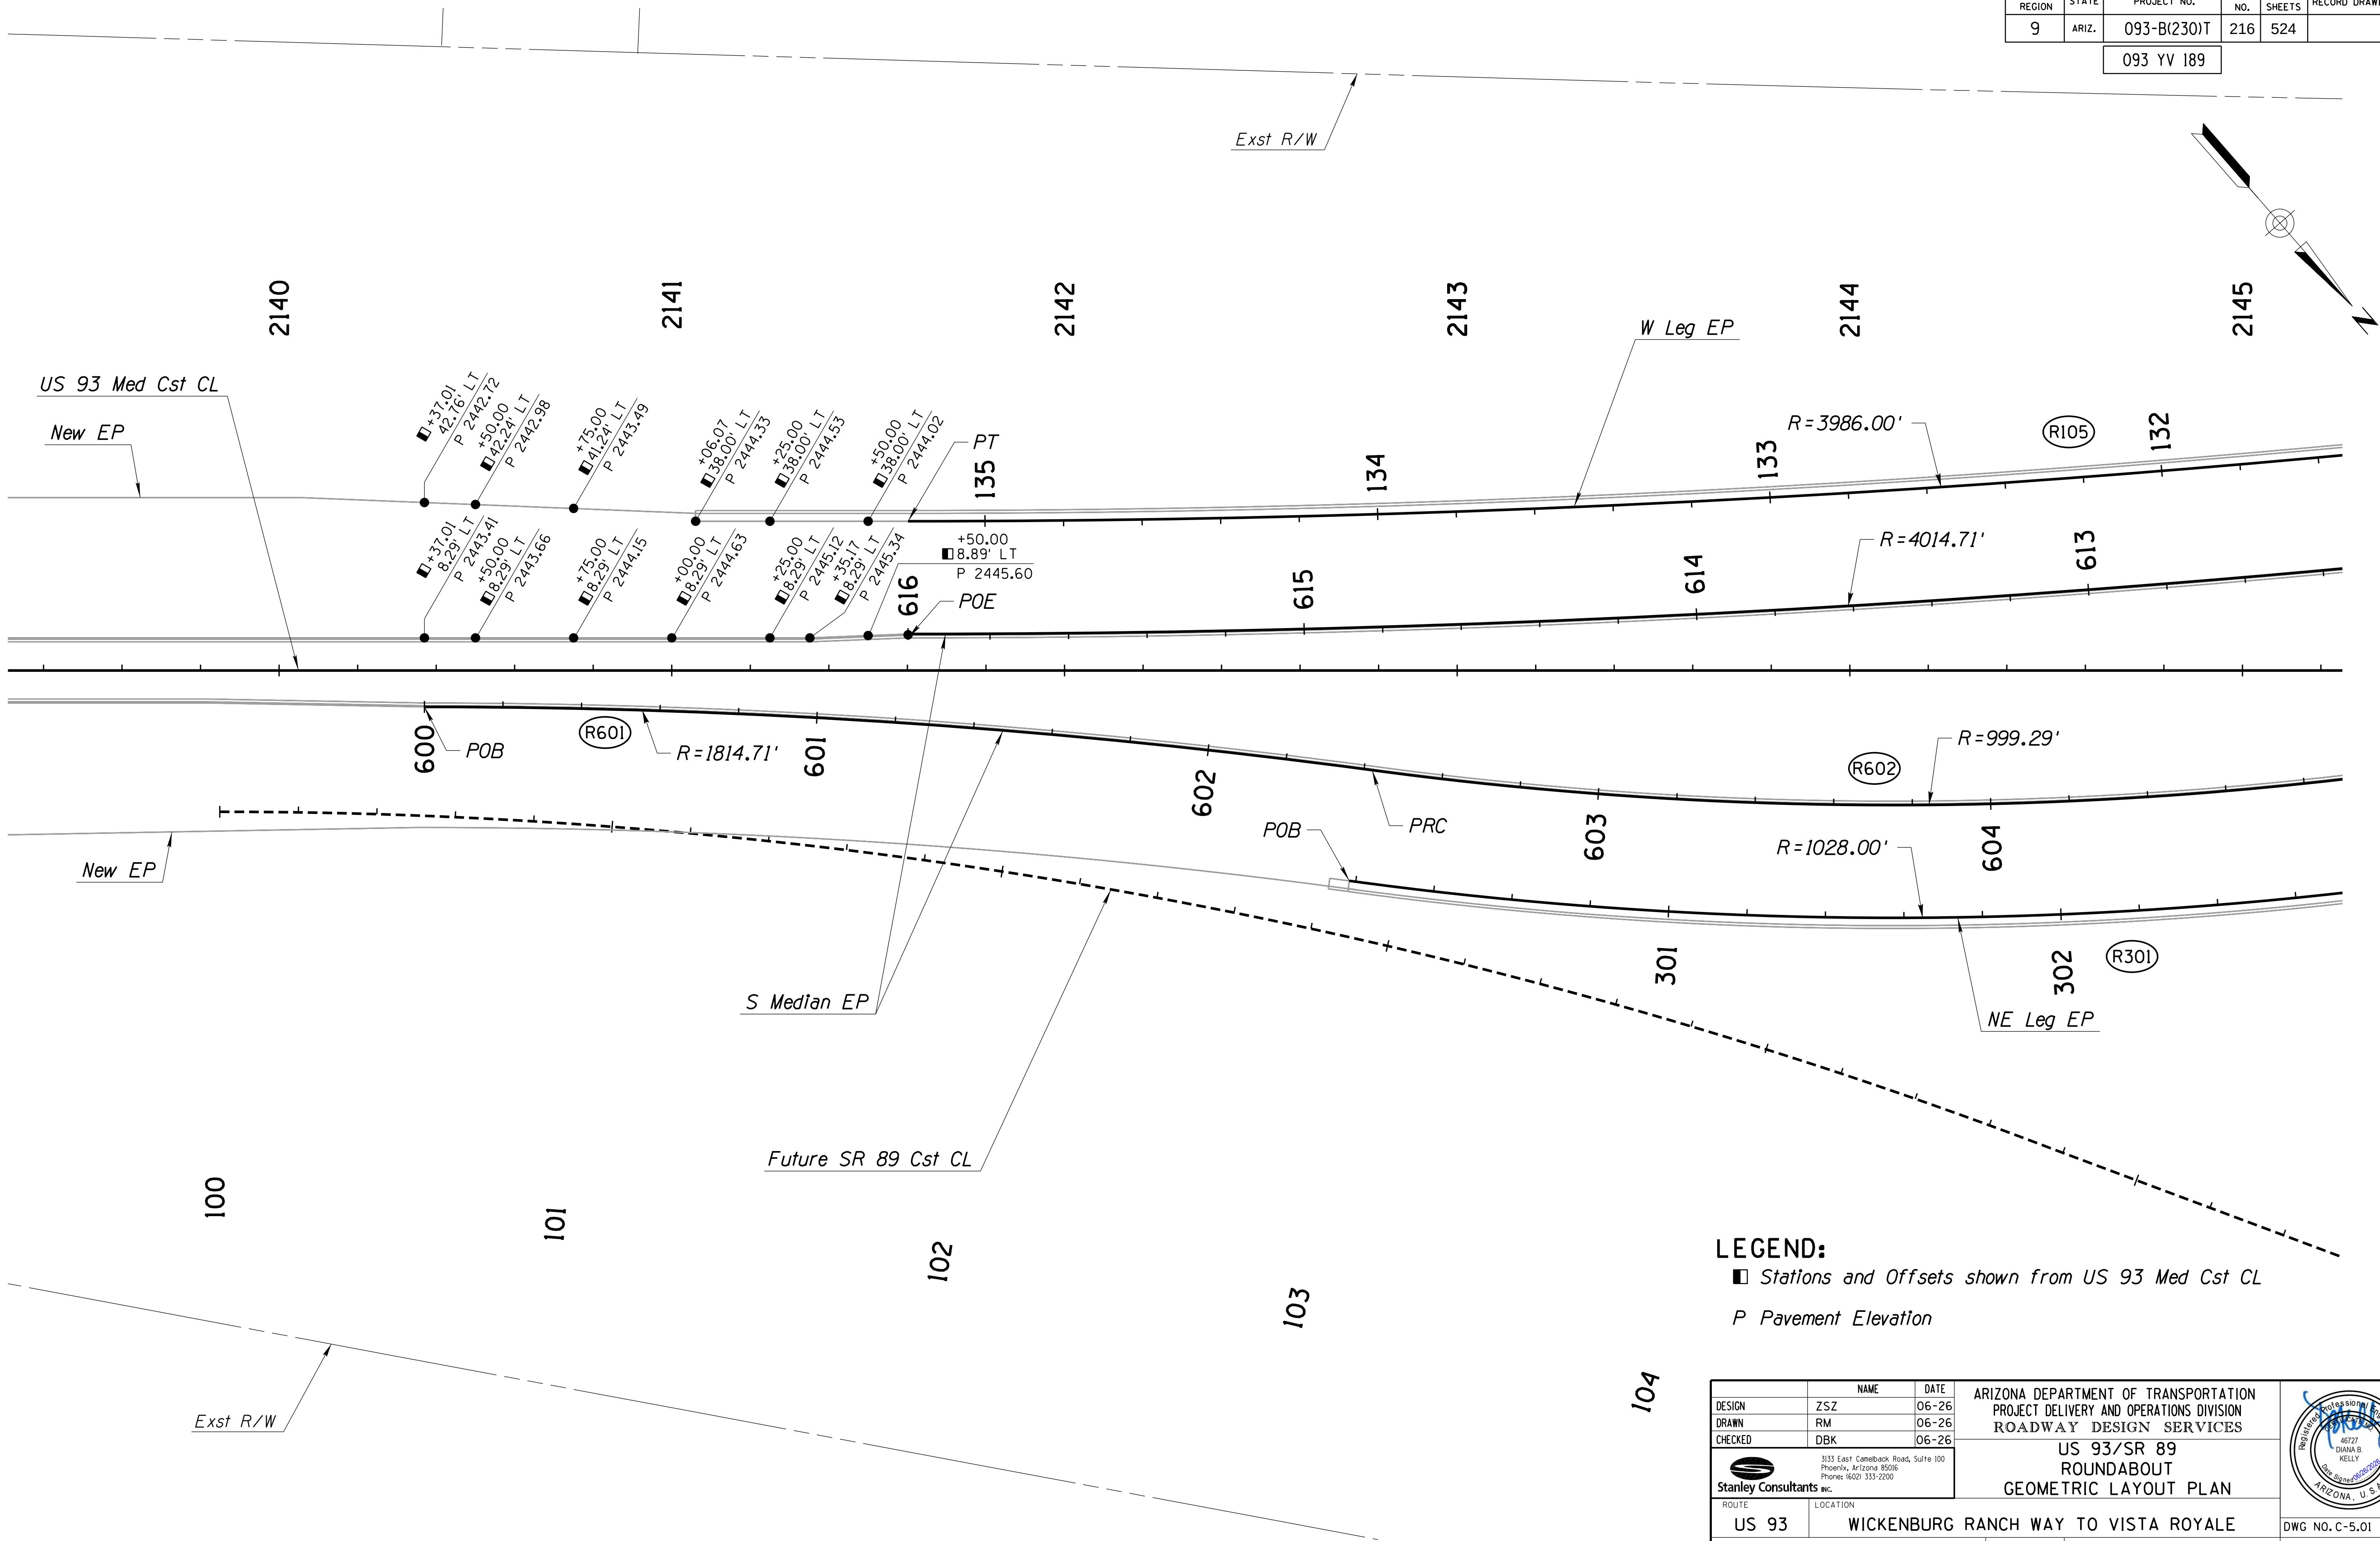


LEGEND:

- Stations and Offsets shown from US 93 Med Cst CL
- P Pavement Elevation

DESIGN	ZSZ	DATE	06-26	ARIZONA DEPARTMENT OF TRANSPORTATION PROJECT DELIVERY AND OPERATIONS DIVISION ROADWAY DESIGN SERVICES	
DRAWN	RM	DATE	06-26		
CHECKED	DBK	DATE	06-26		
 3133 East Camelback Road, Suite 100 Phoenix, Arizona 85016 Phone: (602) 333-2200				US 93/SR 89 ROUNDABOUT GEOMETRIC LAYOUT PLAN	
ROUTE		LOCATION		DWG NO. C-5.01	
US 93		WICKENBURG RANCH WAY TO VISTA ROYALE			
TRACS NO. F0738 OIC				093-B(230)T	
				OF	

F.H.W.A. REGION	STATE	PROJECT NO.	SHEET NO.	TOTAL SHEETS	RECORD DRAWING
9	ARIZ.	093-B(230)T	217	524	


093 YV 189

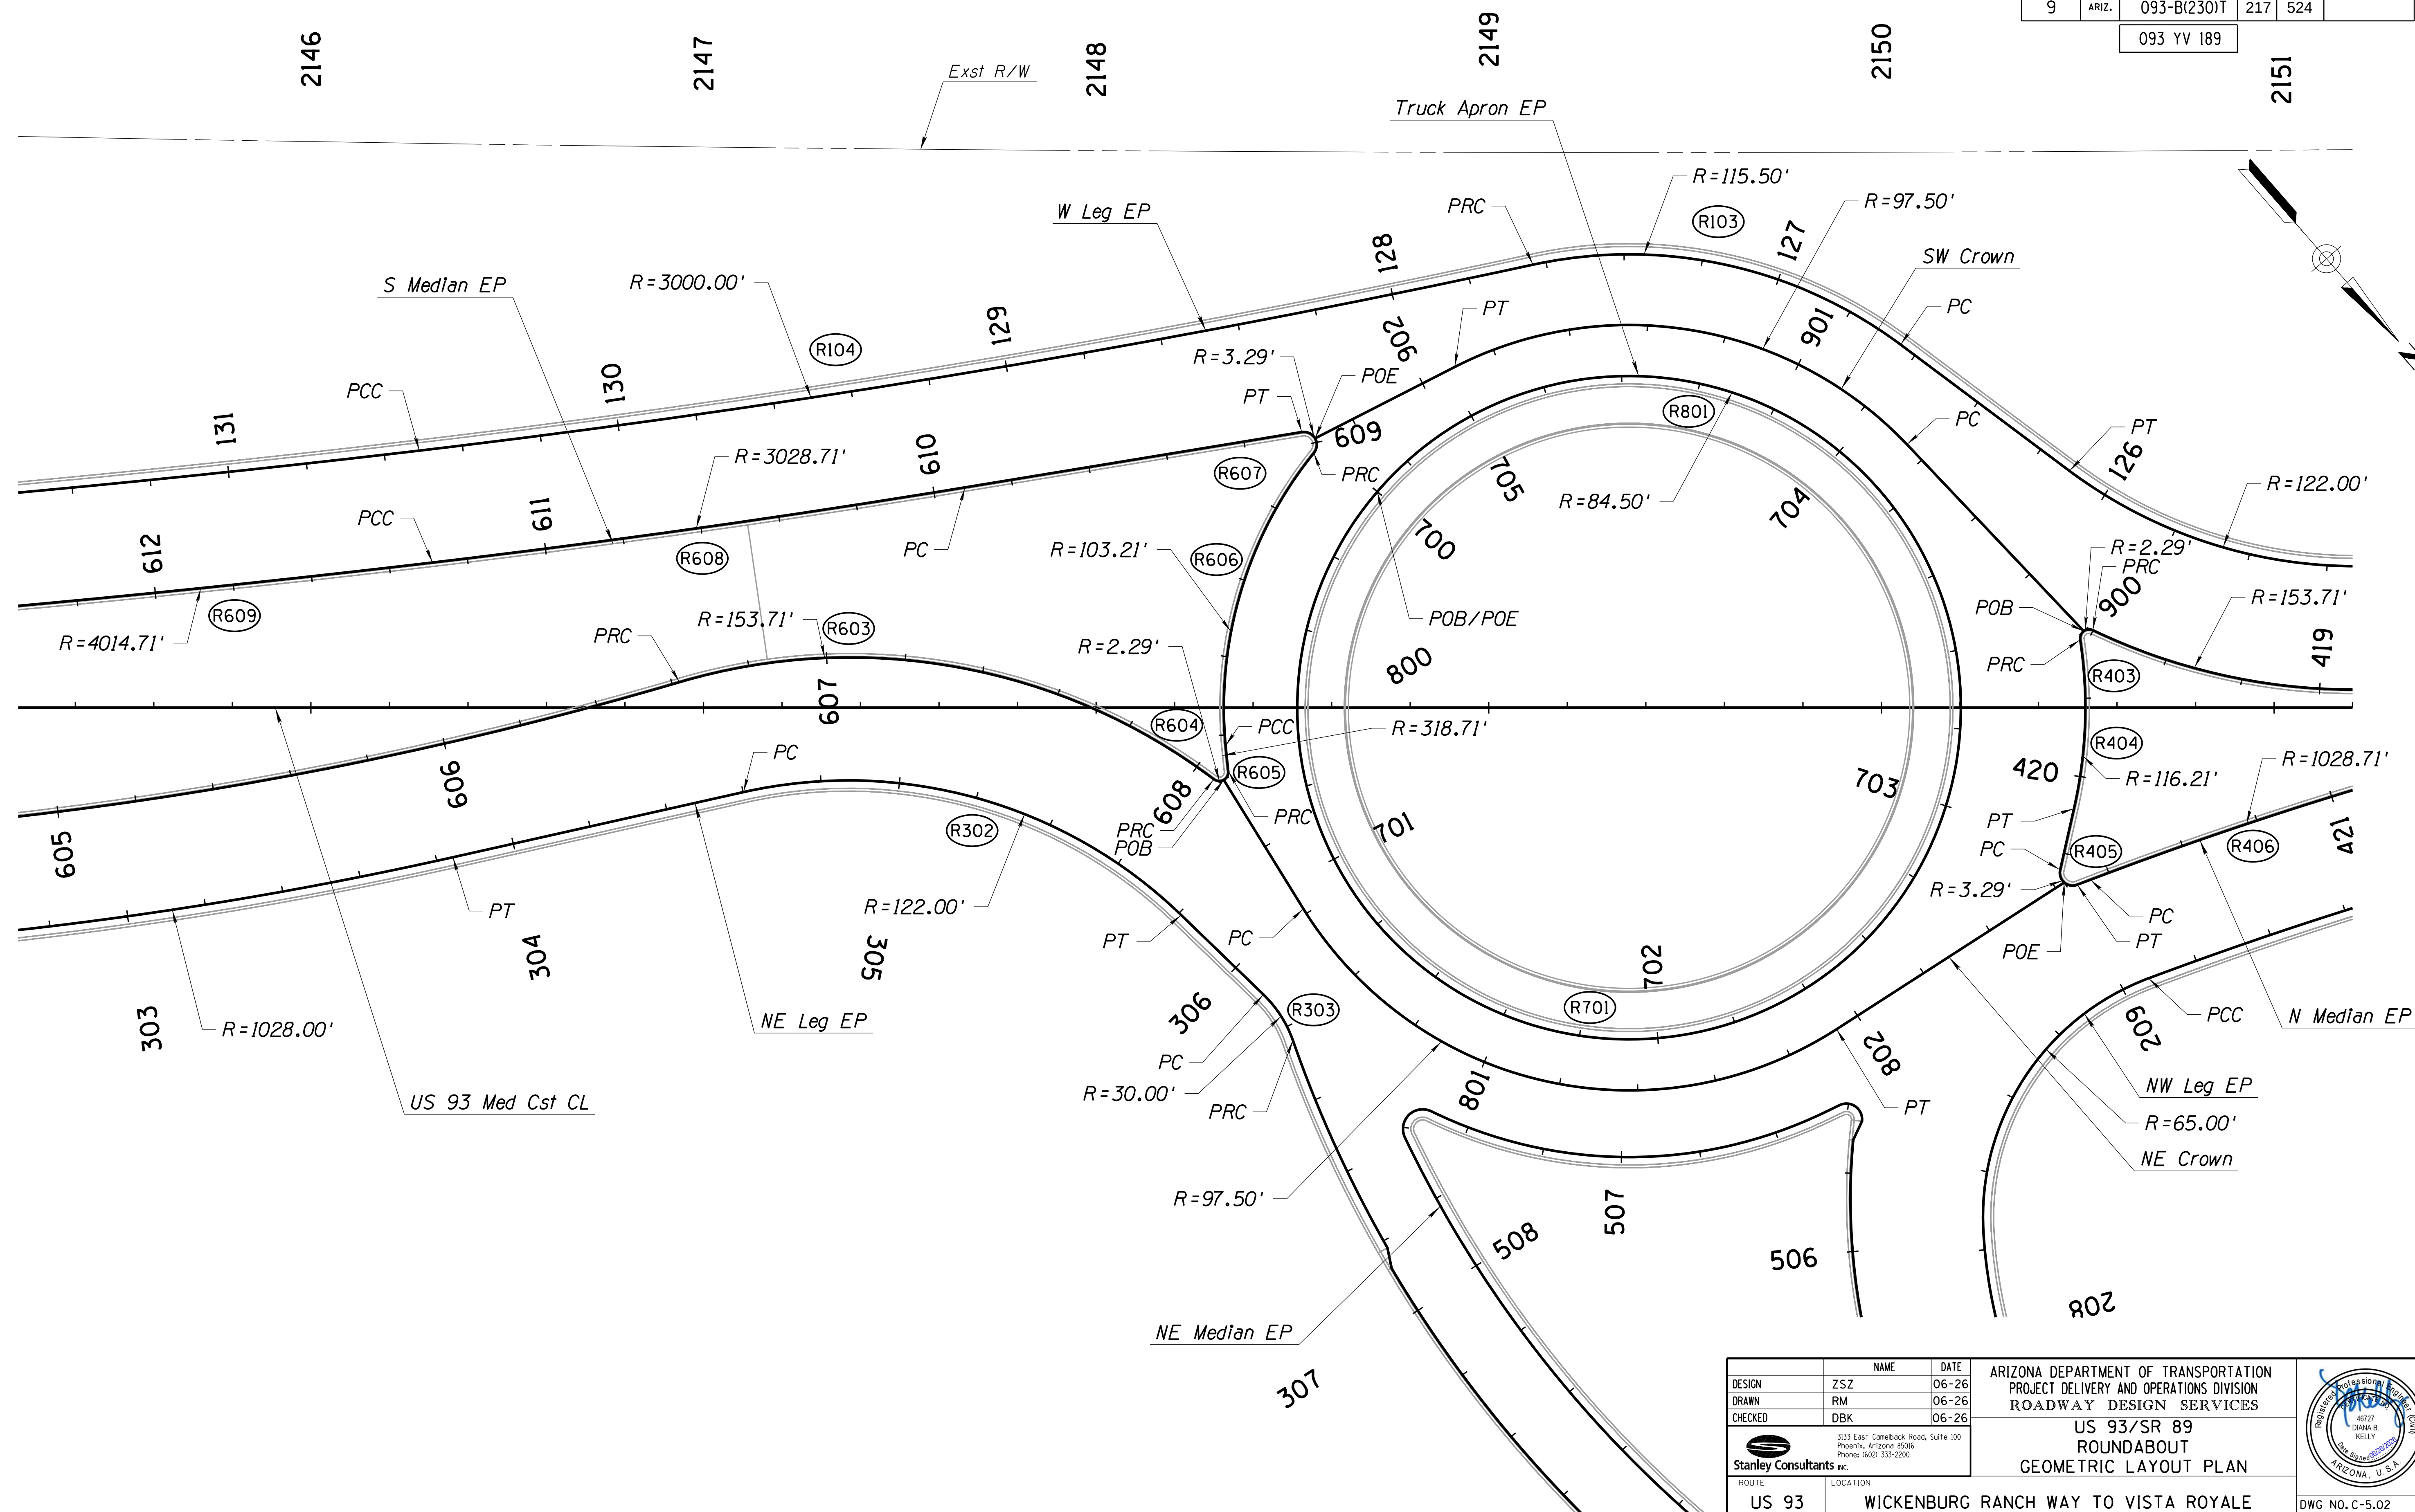

		NAME _____ DATE _____ DESIGN ZSZ 06-26 DRAWN RMN 06-26 CHECKED DBK 06-26		ARIZONA DEPARTMENT OF TRANSPORTATION PROJECT DELIVERY AND OPERATIONS DIVISION ROADWAY DESIGN SERVICES US 93/SR 89 ROUNDABOUT GEOMETRIC LAYOUT PLAN			
 Stanley Consultants Inc.		333 East Camelback Road, Suite 100 Phoenix, Arizona 85016 Phone: (602) 333-2200				DWG NO. C-5.02	
ROUTE LOCATION US 93 WICKENBURG RANCH WAY TO VISTA ROYALE						OF _____	
TRACS NO. F0738 OIC				093-B(230)T			

F.H.W.A. REGION	STATE	PROJECT NO.	SHEET NO.	TOTAL SHEETS	RECORD DRAWING
9	ARIZ.	093-B(230)T	218	524	

093 YV 189


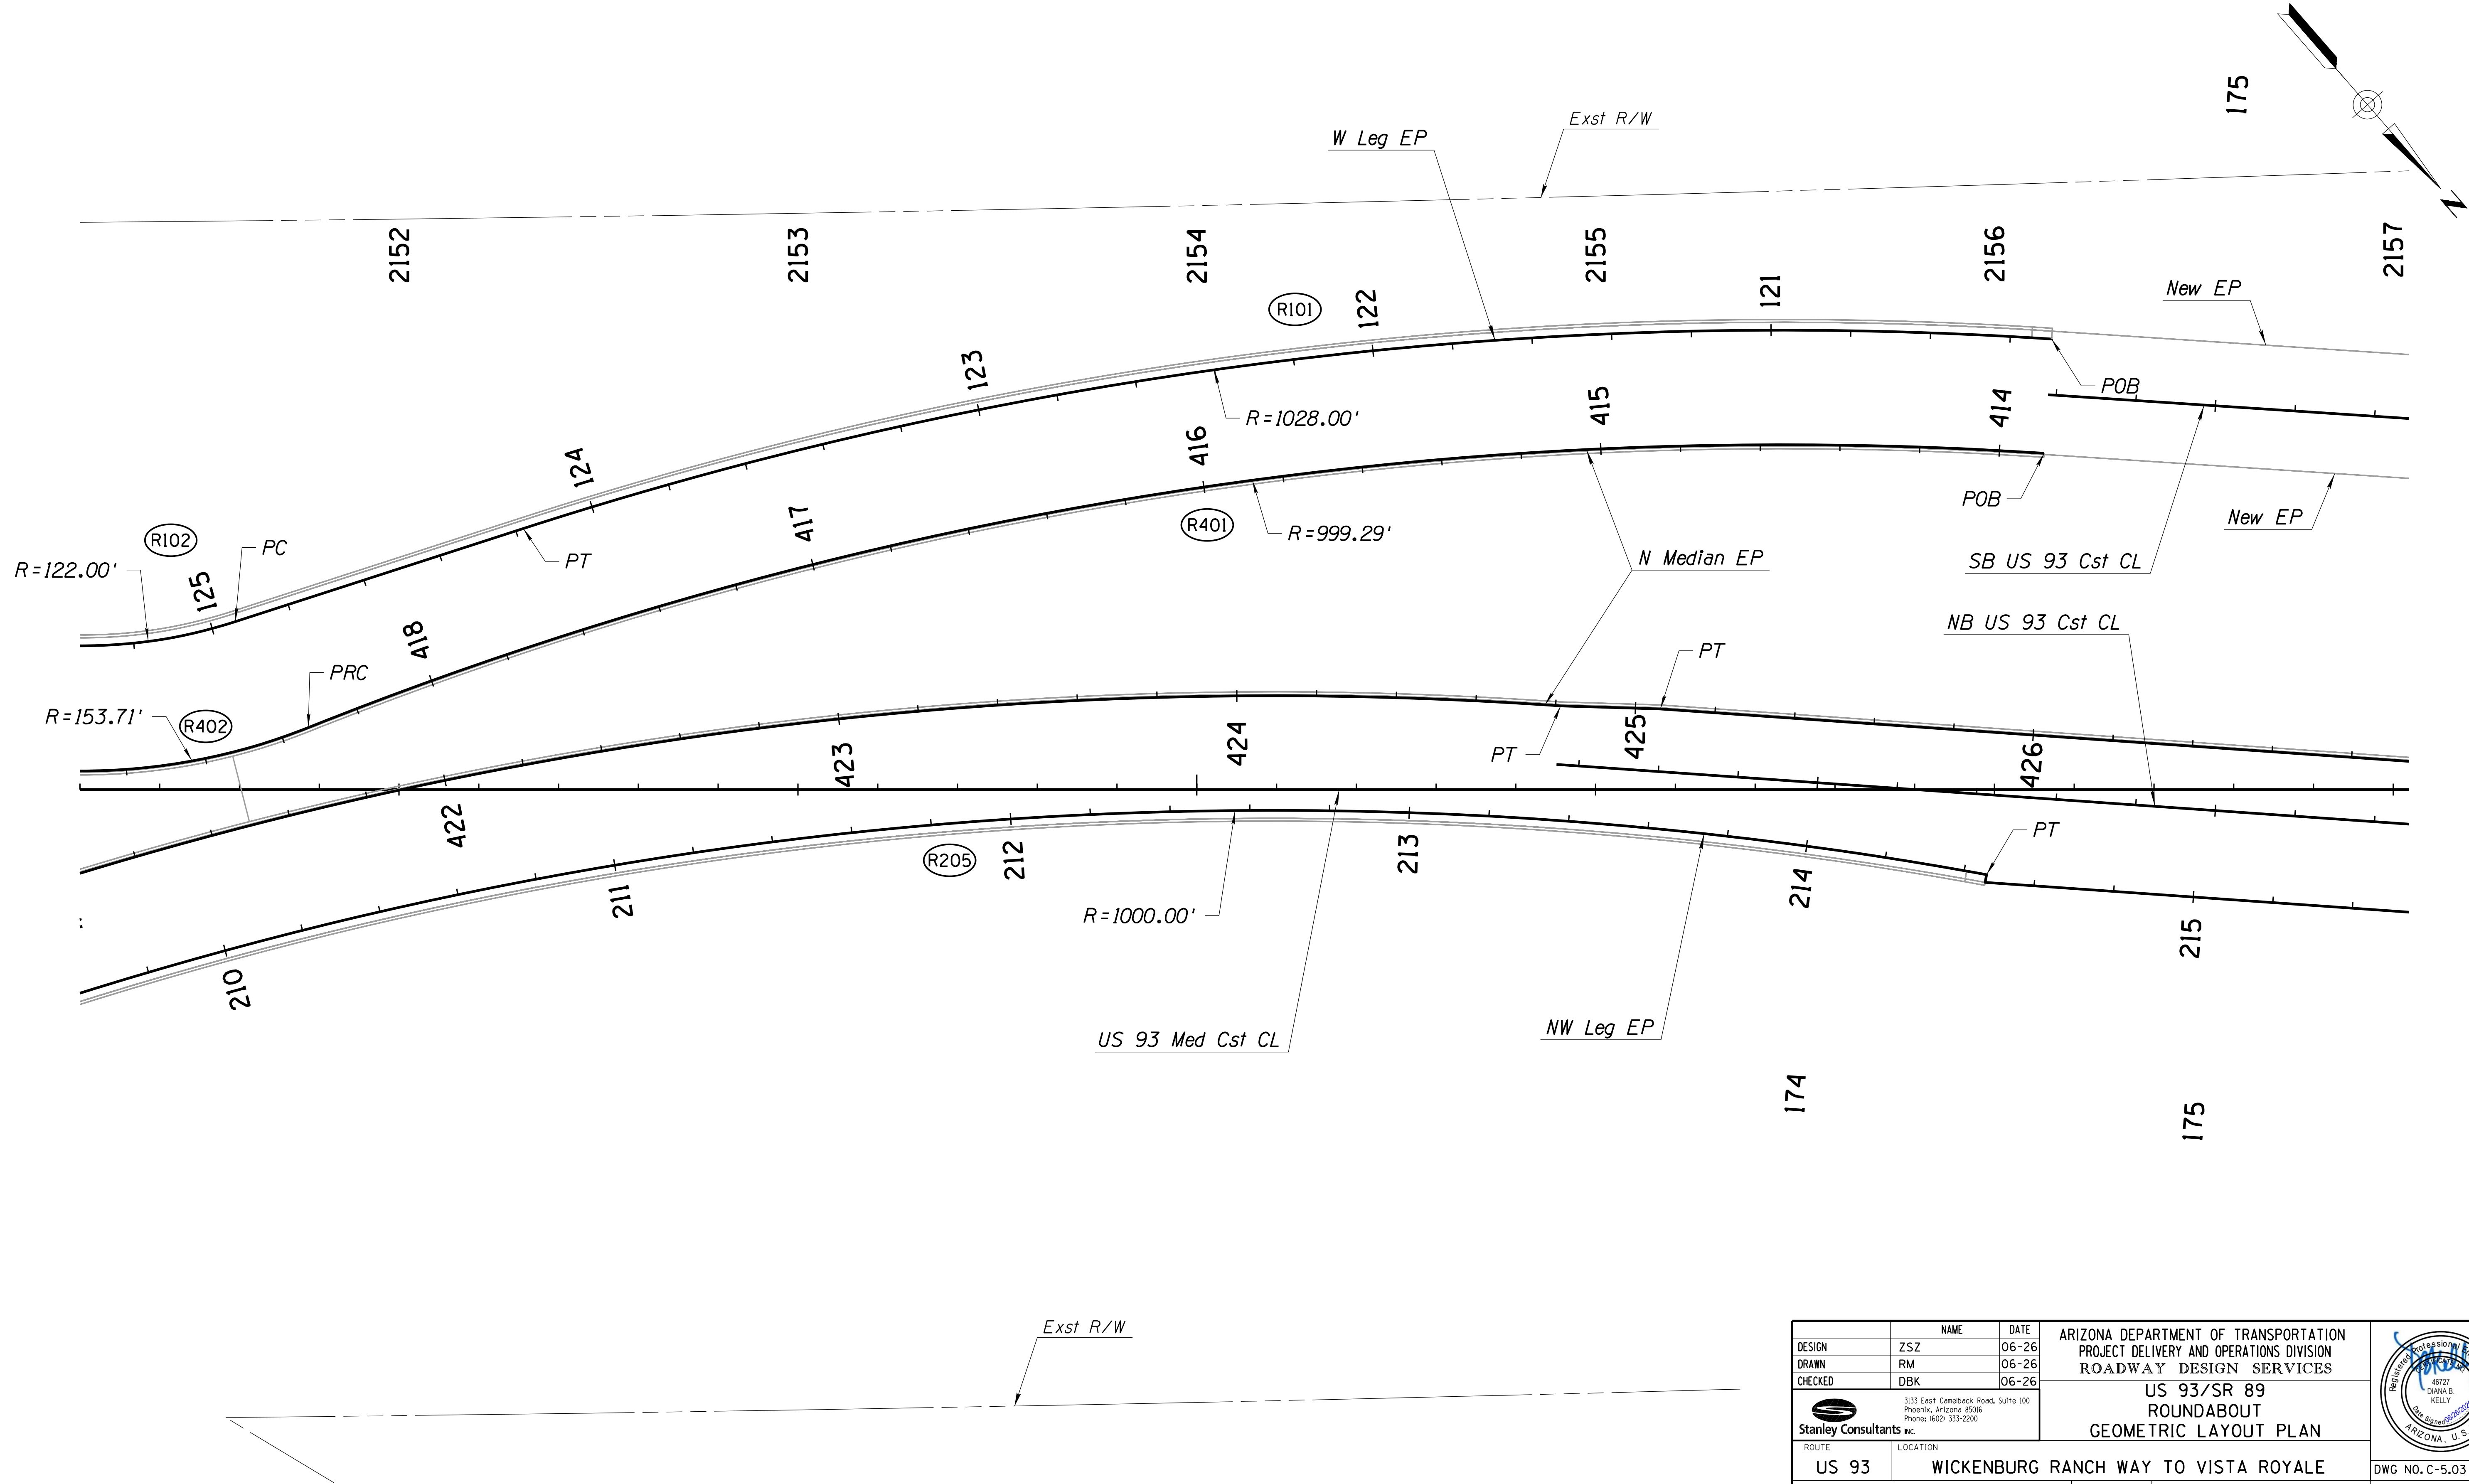


DESIGN	ZSZ	DATE	06-26
DRAWN	RM	DATE	06-26
CHECKED	DBK	DATE	06-26
Stanley Consultants inc. 3133 East Camelback Road, Suite 100 Phoenix, Arizona 85016 Phone: (602) 333-2200			
ROUTE		LOCATION	
US 93		WICKENBURG RANCH WAY TO VISTA ROYALE	
TRACS NO. F0738 OIC			093-B(230)T
			DWG NO. C-5.03
			OF



F.H.W.A. REGION	STATE	PROJECT NO.	SHEET NO.	TOTAL SHEETS	RECORD DRAWING
9	ARIZ.	093-B(230)T	219	524	

093 YV 189

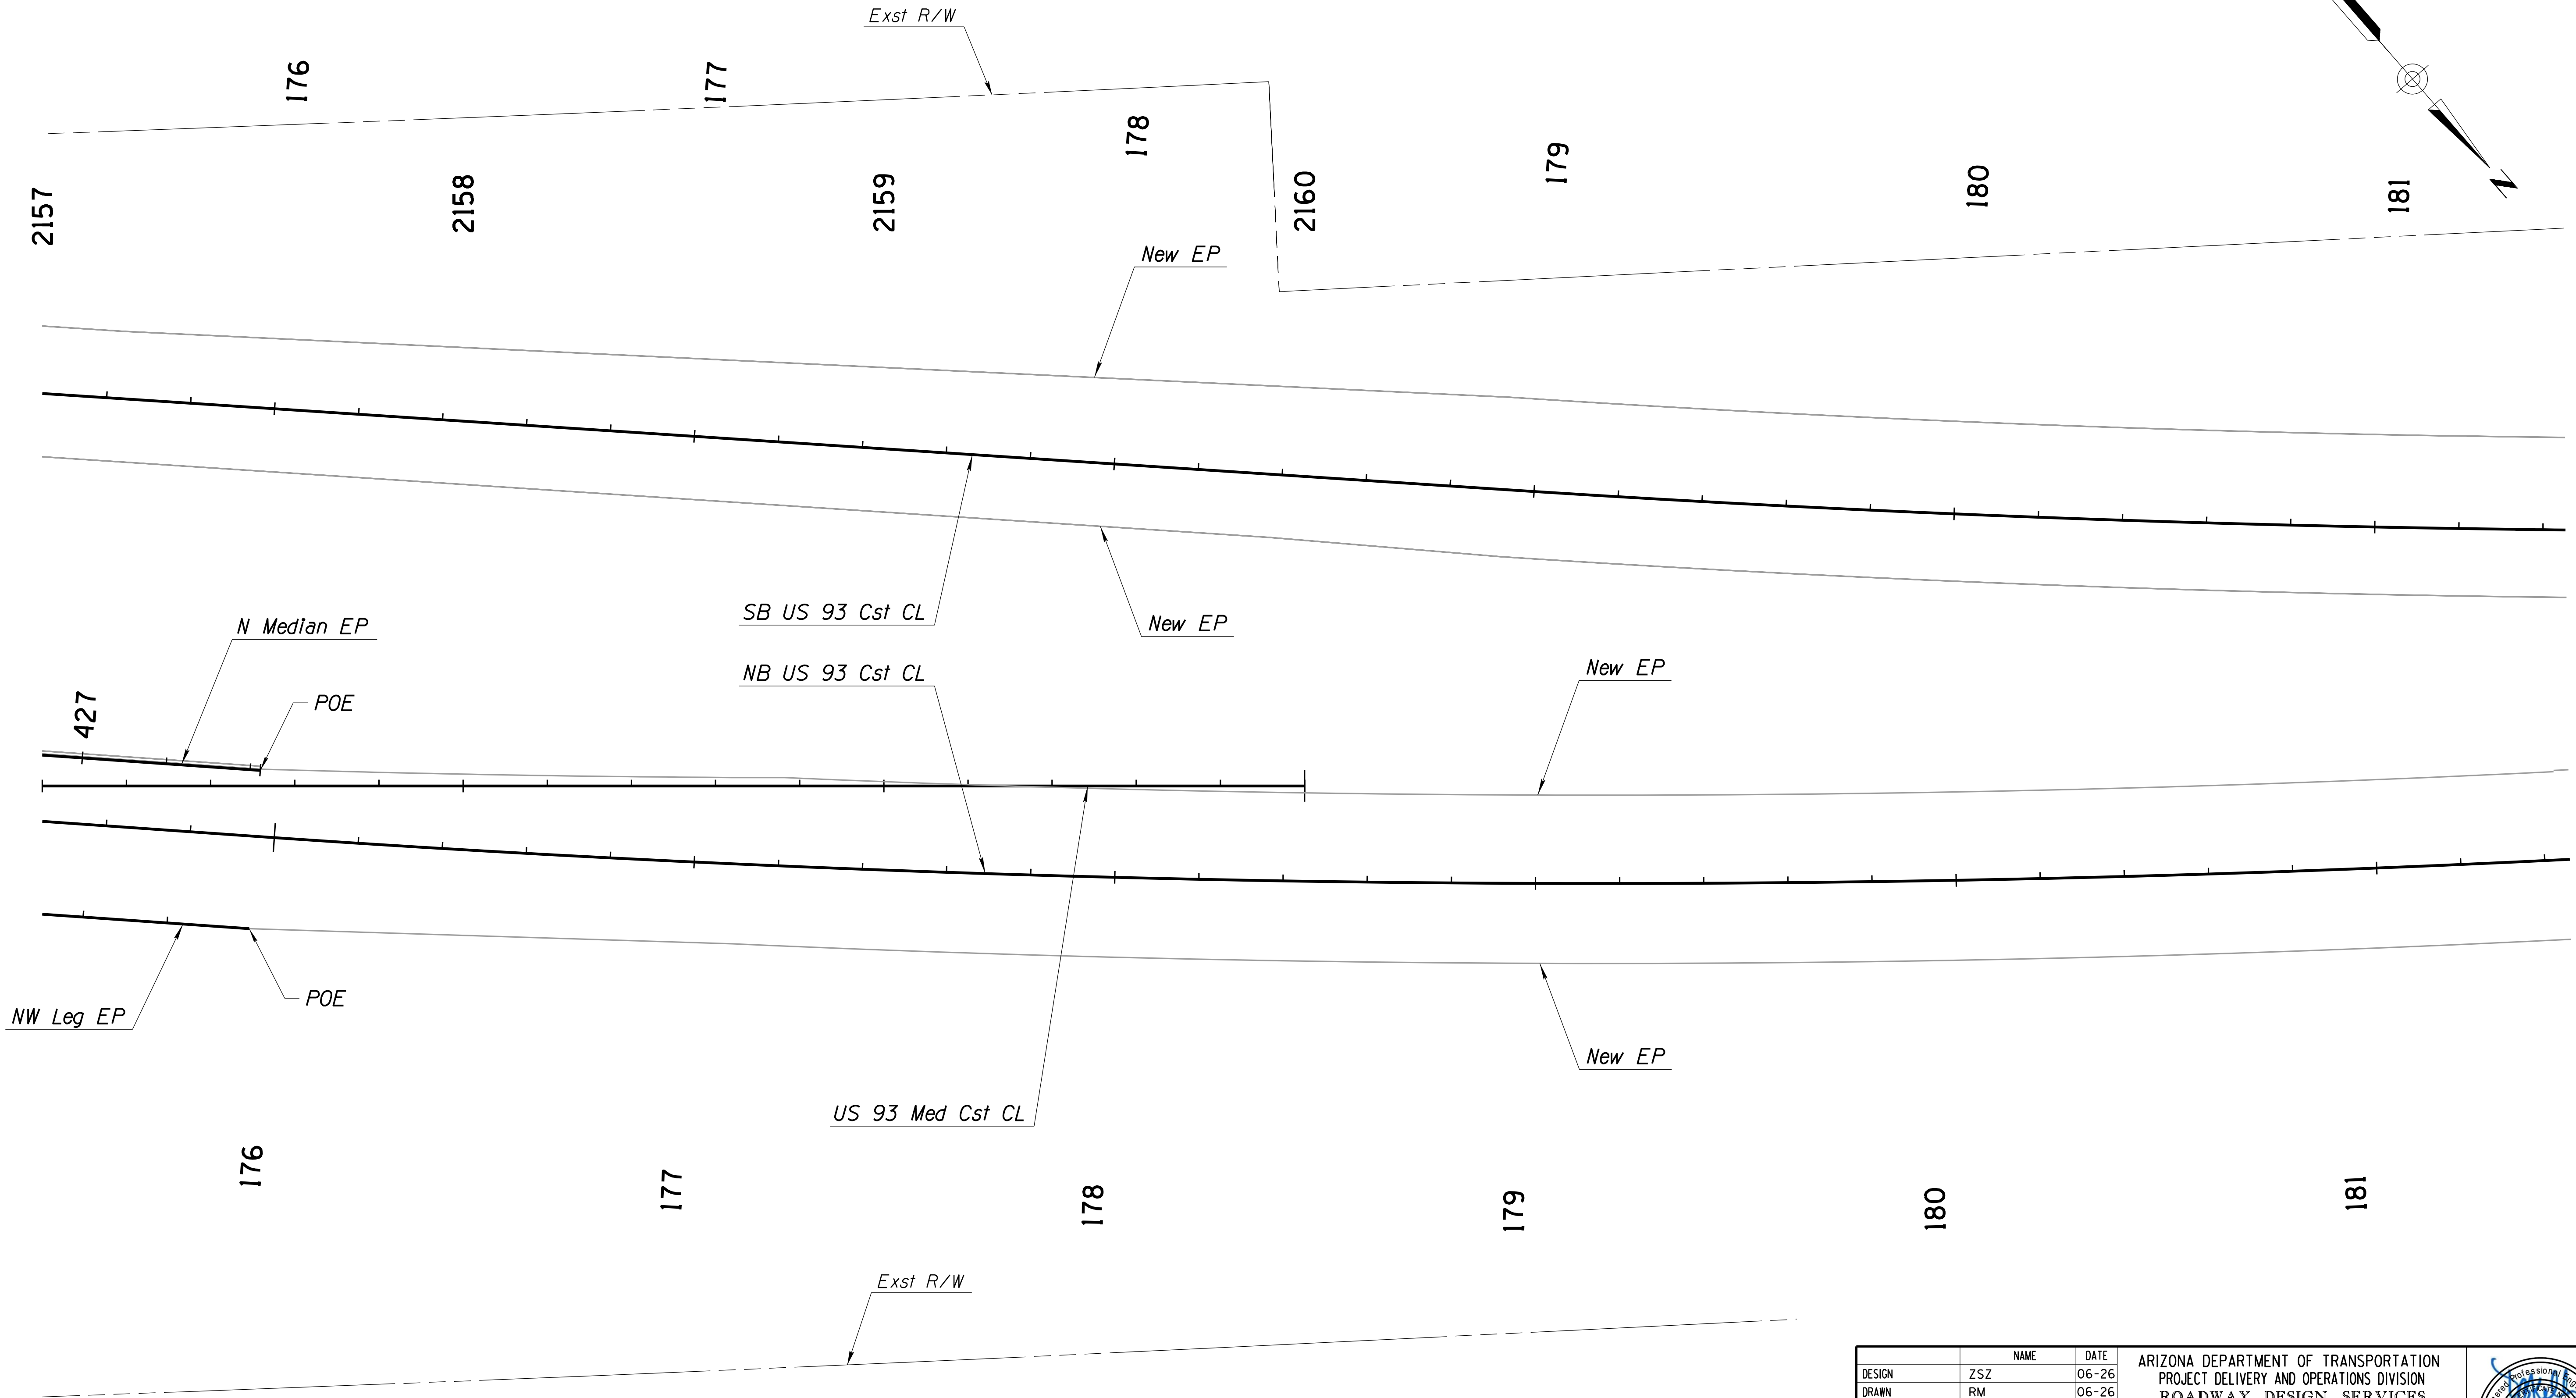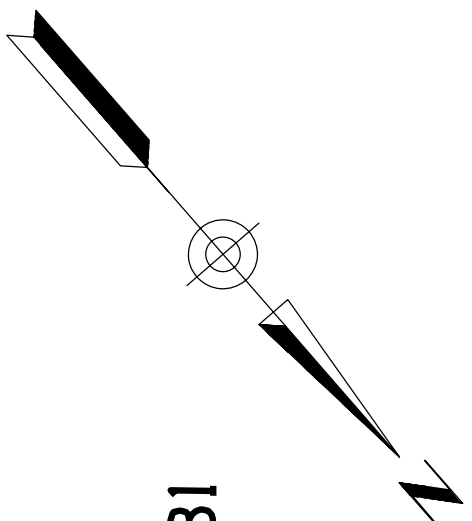


DESIGN	ZSZ	NAME	DATE	ARIZONA DEPARTMENT OF TRANSPORTATION PROJECT DELIVERY AND OPERATIONS DIVISION ROADWAY DESIGN SERVICES	
DRAWN	RM		06-26		
CHECKED	DBK		06-26		
Stanley Consultants inc.		3133 East Camelback Road, Suite 100 Phoenix, Arizona 85016 Phone: (602) 333-2200		US 93/SR 89 ROUNDABOUT GEOMETRIC LAYOUT PLAN	
ROUTE		LOCATION		DWG NO. C-5.04	
US 93		WICKENBURG RANCH WAY TO VISTA ROYALE			
TRACS NO. F0738 OIC				093-B(230)T	
				OF	



F.H.W.A. REGION	STATE	PROJECT NO.	SHEET NO.	TOTAL SHEETS	RECORD DRAWING
9	ARIZ.	093-B(230)T	220	524	



093 YV 189

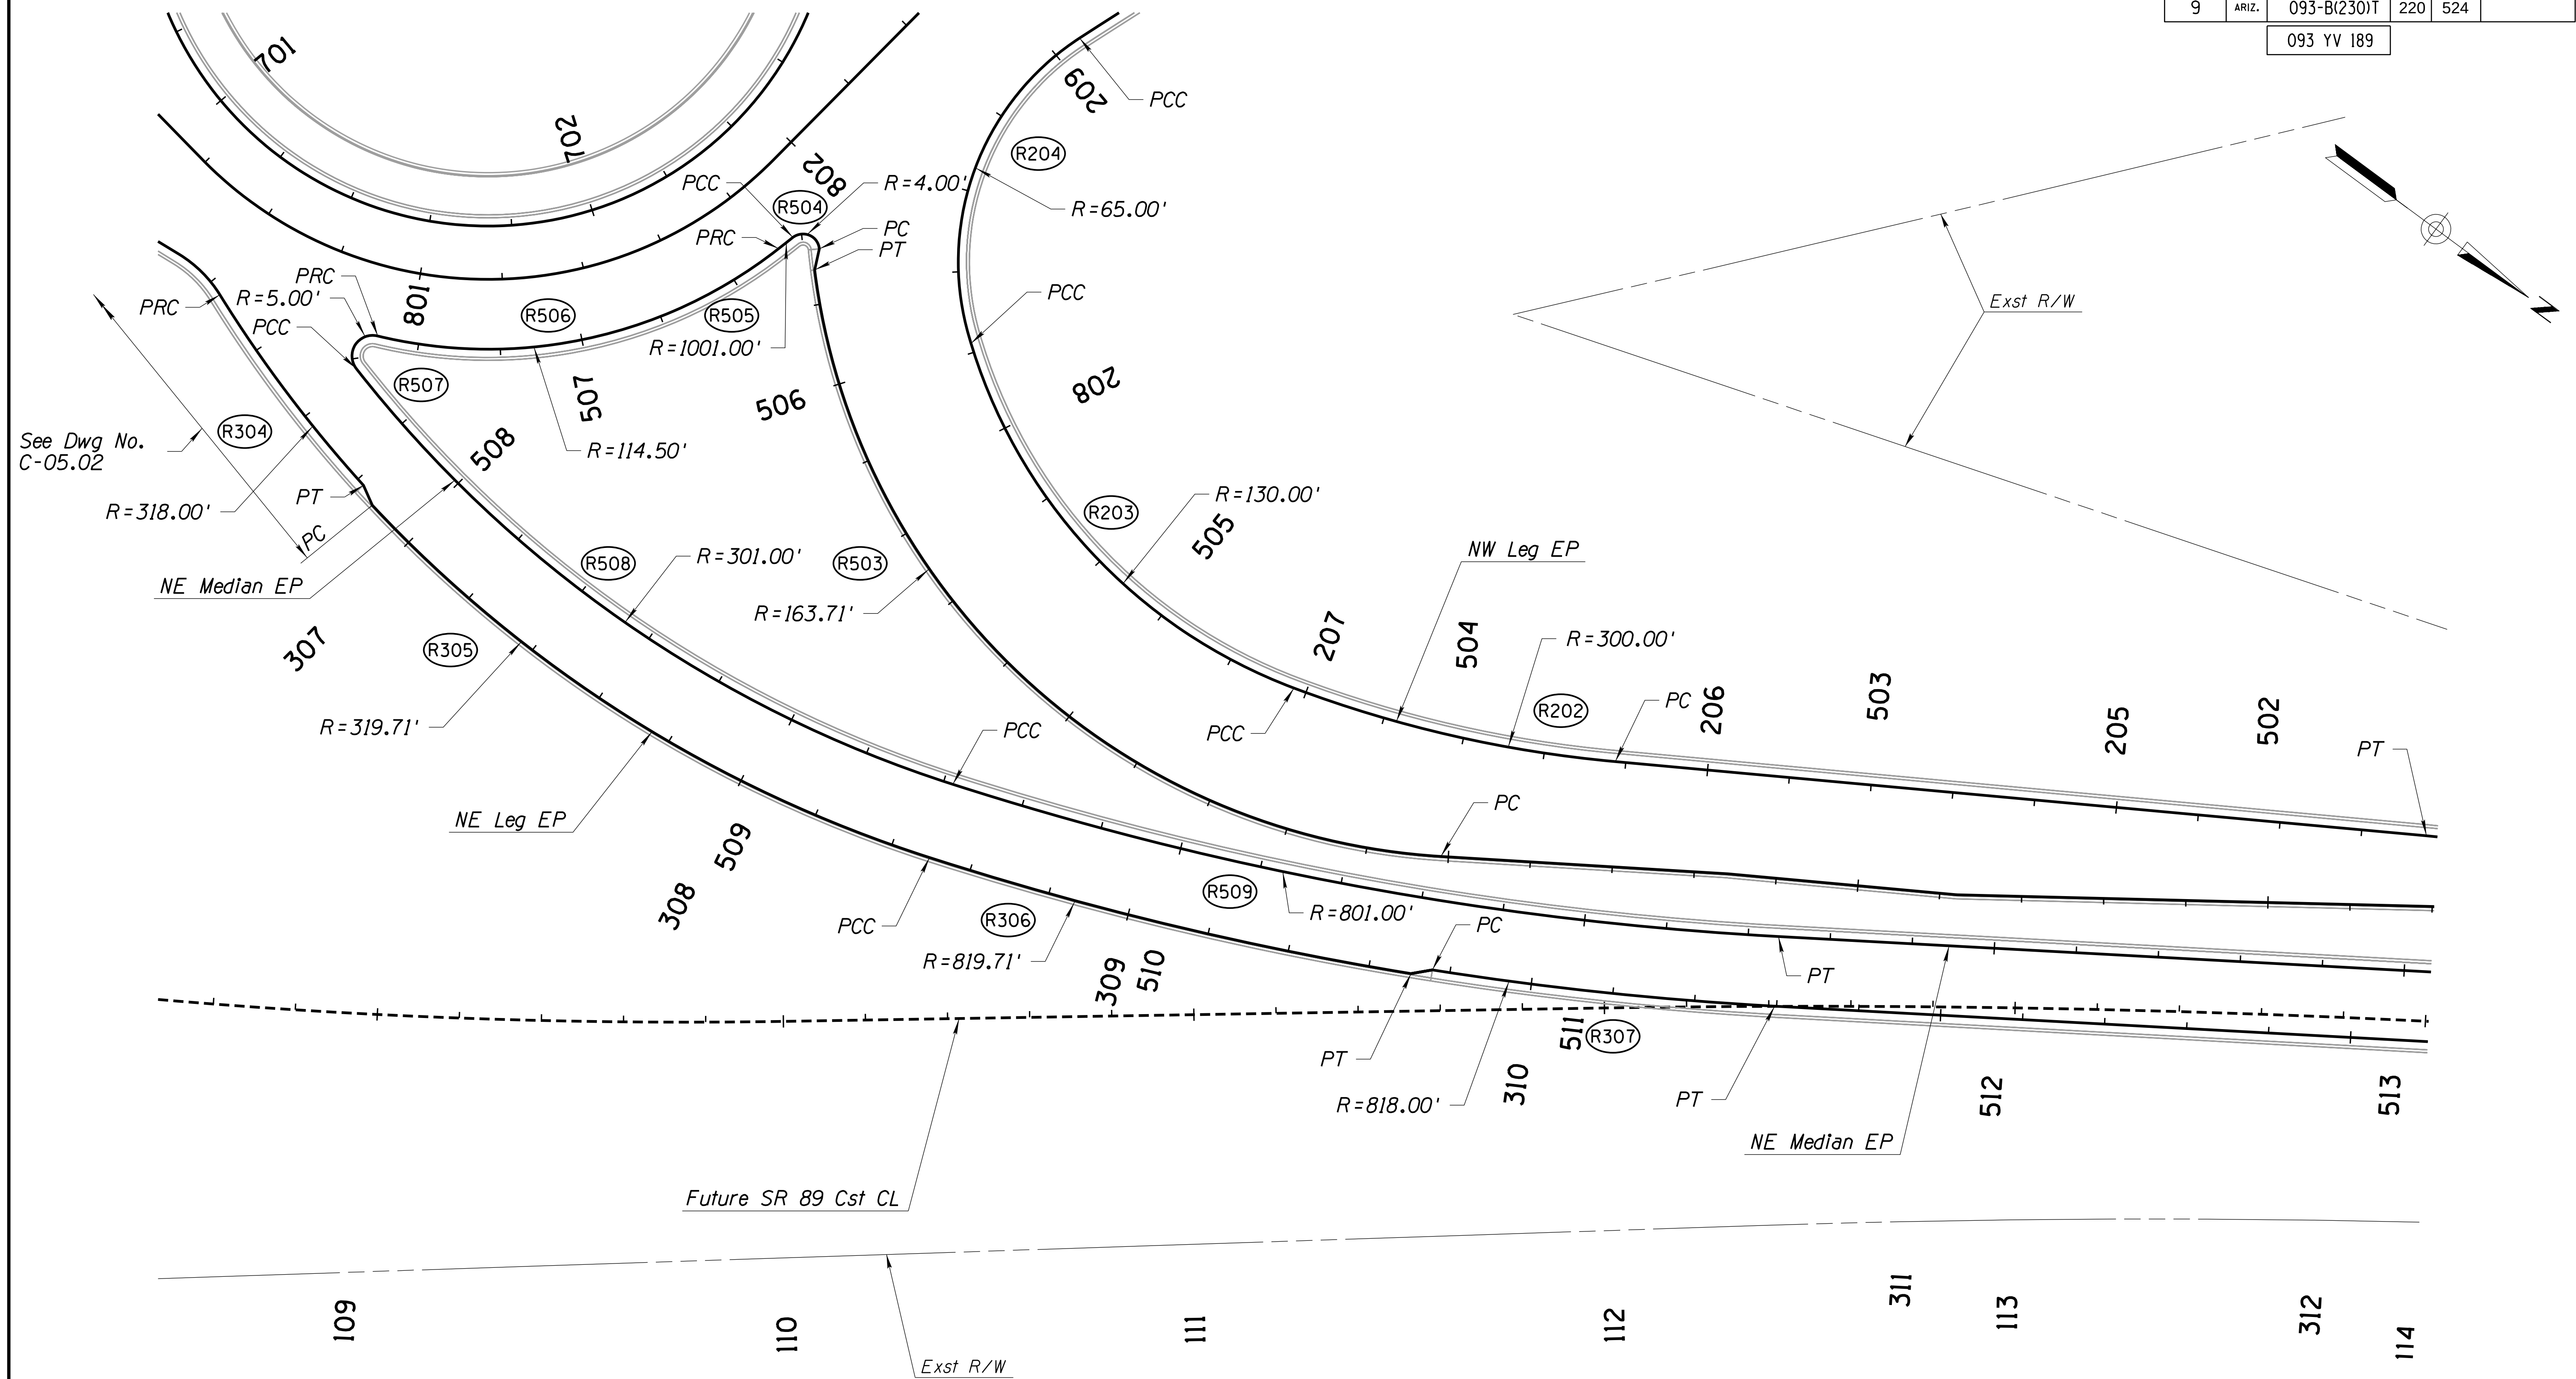

DESIGN	ZSZ	DATE	06-26	ARIZONA DEPARTMENT OF TRANSPORTATION PROJECT DELIVERY AND OPERATIONS DIVISION ROADWAY DESIGN SERVICES	
DRAWN	RM	DATE	06-26		
CHECKED	DBK	DATE	06-26		
 3133 East Camelback Road, Suite 100 Phoenix, Arizona 85016 Phone: (602) 333-2200				US 93/SR 89 ROUNDABOUT GEOMETRIC LAYOUT PLAN	
ROUTE		LOCATION		DWG NO. C-5.05	
US 93		WICKENBURG RANCH WAY TO VISTA ROYALE			
TRACS NO. F0738 OIC				093-B(230)T	
				OF	

F.H.W.A. REGION	STATE	PROJECT NO.	SHEET NO.	TOTAL SHEETS	RECORD DRAWING
9	ARIZ.	093-B(230)T	221	524	

093 YV 189

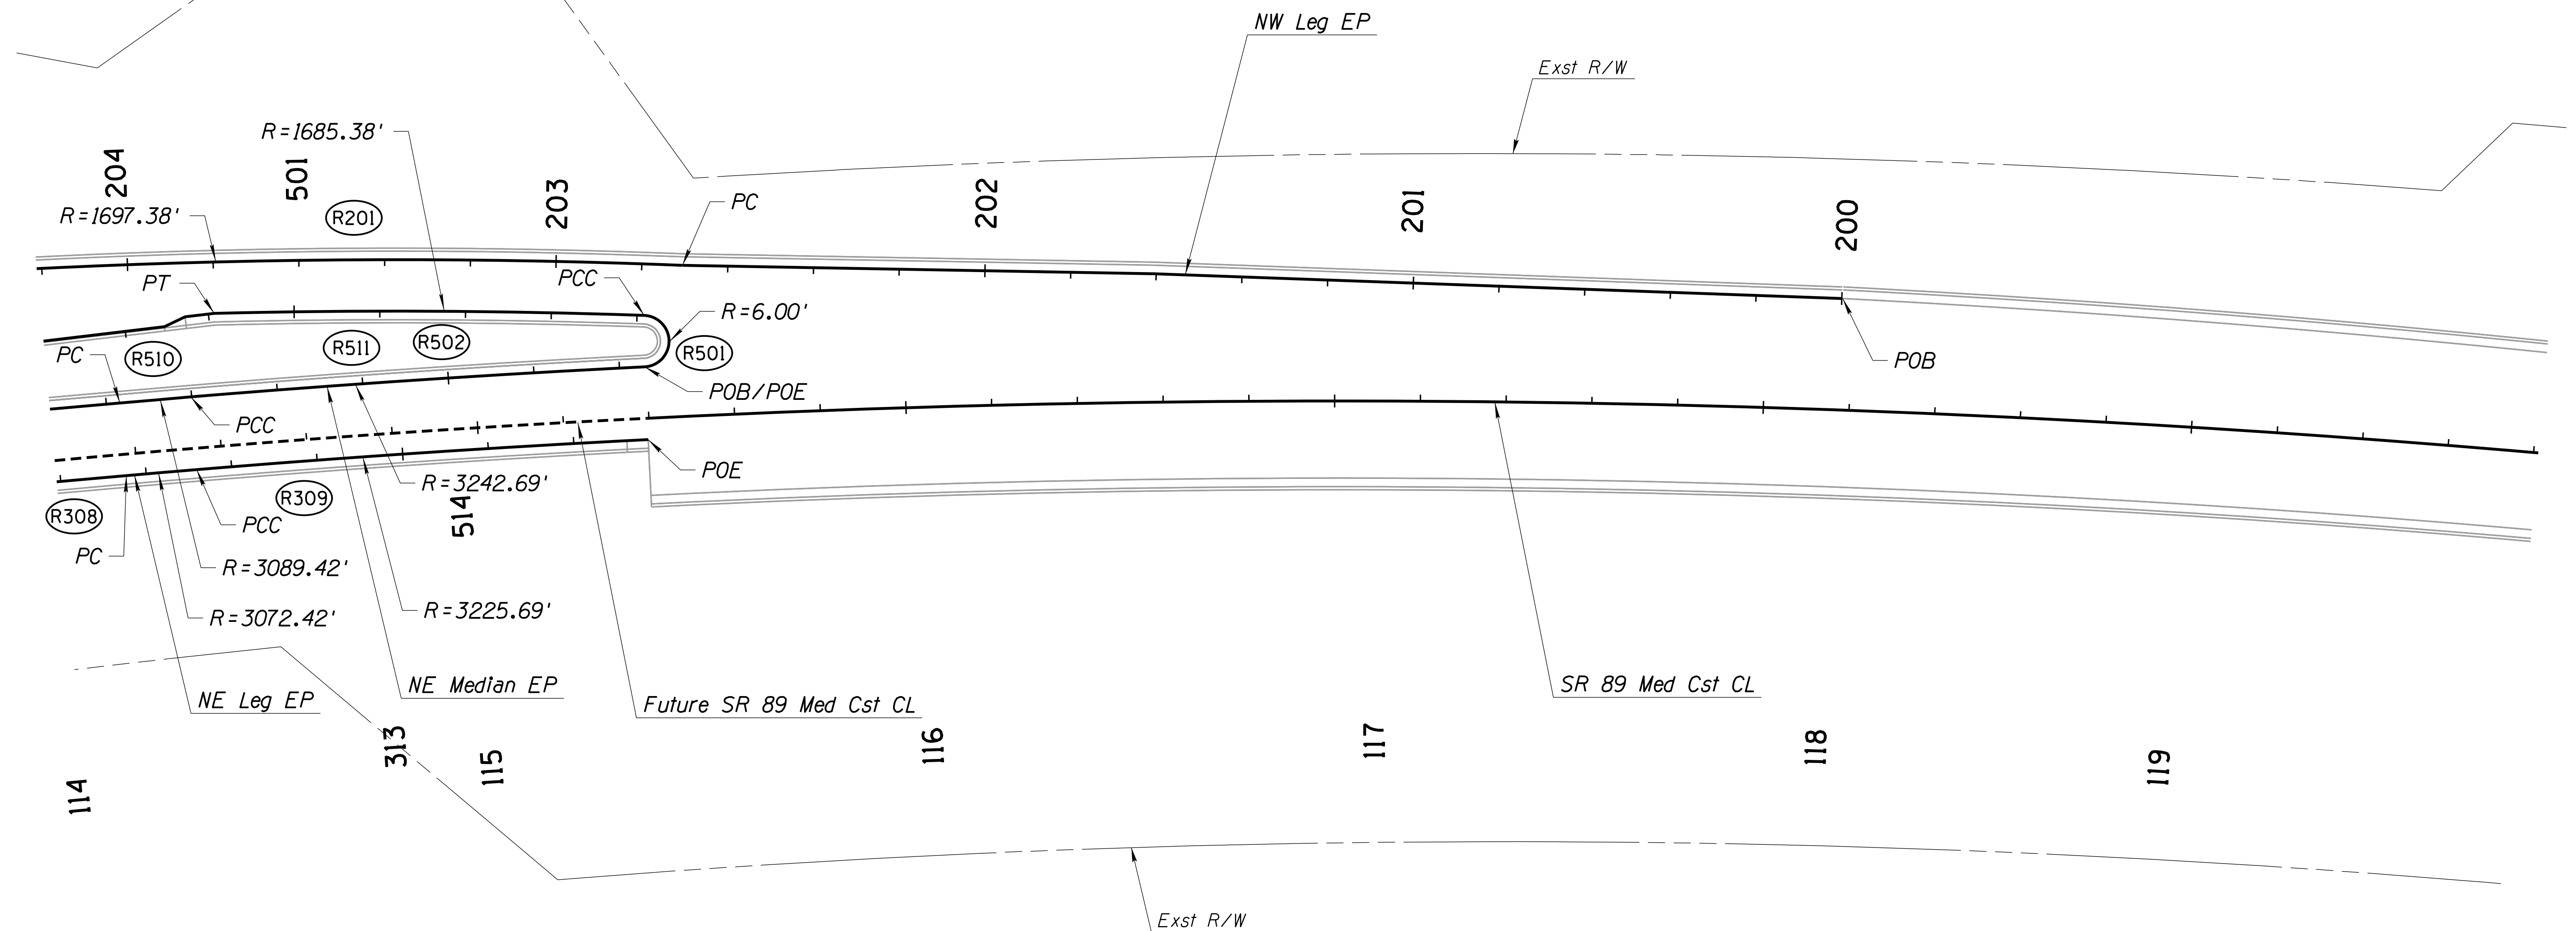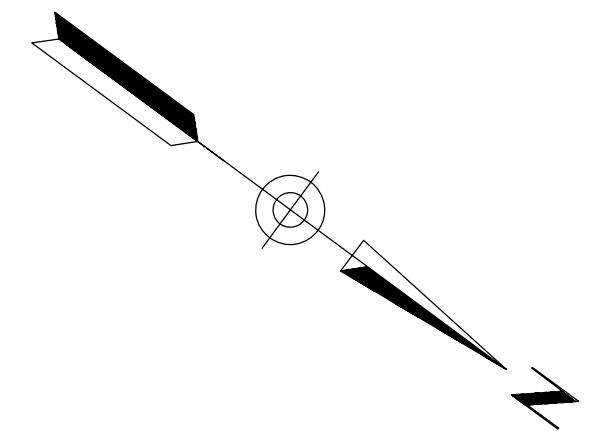

 3133 East Camelback Road, Suite 100 Phoenix, Arizona 85016 Phone: (602) 933-2200		ARIZONA DEPARTMENT OF TRANSPORTATION PROJECT DELIVERY AND OPERATIONS DIVISION ROADWAY DESIGN SERVICES		
NAME DESIGN ZSZ DRAWN RM CHECKED DBK		DATE 06-26 06-26 06-26		
ROUTE US 93		LOCATION WICKENBURG RANCH WAY TO VISTA ROYALE		
TRACS NO. F0738 OIC		093-B(230)T		DWG NO. C-5.06 _____ OF _____

CURB ALIGNMENT	POINT DESC	STATION	NORTHING	EASTING	RADIUS	LENGTH	DELTA	BEARING
Truck Apron EP	POB	700+00.00	1101880.09	429556.18				
					84.5	530.93	360°00'00" Lt	
	CC		1101963.70	429544.00				
	POE	705+30.93	1101880.09	429556.18				

CURB ALIGNMENT	POINT DESC	STATION	NORTHING	EASTING	RADIUS	LENGTH	DELTA	BEARING
W Leg EP	POB/PC	120+29.60	1102324.47	428958.24				
R101	PI	122+26.17	1102185.87	429097.63	1028	388.45	21°39'01" Lt	
	CC		1103053.45	429683.06				
	PT	124+18.05	1102108.48	429278.32				S 66°50'15"E
	PC	124+93.91	1102078.64	429348.07				
R102	PI	125+57.31	1102053.93	429406.46	122	116.95	54°55'18" Rt	
	CC		1101966.29	429300.52				
	PT	126+10.86	1101991.94	429419.79				S12°08'15"E
	PC	126+64.58	1101939.42	429431.08				
R103	PI	127+17.23	1101887.94	429442.15	115.5	98.81	49°00'54" Lt	
	CC		1101963.70	429544.00				
	PRC	127+63.38	1101862.54	429488.28				
R104	PI	129+07.33	1101793.09	429614.36	3000	287.68	5°29'39" Rt	
	CC		1099234.82	428040.84				
	PCC	130+51.06	1101711.88	429733.22				
R105	PI	132+85.60	1101579.57	429926.87	3986	468.54	6°44'06" Rt	
	CC		1098420.69	427484.61				
	POE/PT	135+19.60	1101425.46	430103.68				

CURB ALIGNMENT	POINT DESC	STATION	NORTHING	EASTING	RADIUS	LENGTH	DELTA	BEARING
NW Leg EP	POB	200+00.00	1102858.55	429256.18				
	PI	201+60.49	1102714.58	429327.09				
	PC	202+70.51	1102616.78	429377.49				
R201	PI	203+47.40	1102547.69	429411.23	1697.38	153.66	5°11'13" Lt	
	CC		1103361.59	430902.73				
	PT	204+24.18	1102481.94	429451.07				S 31°12'52"E
	PC	206+22.58	1102312.25	429553.90				
R202	PI	206+63.07	1102277.62	429574.88	300	80.49	15°22'20" Rt	
	CC		1102156.78	429297.33				
	PCC	207+03.07	1102238.67	429585.93				
R203	PI	207+68.57	1102175.67	429603.81	130	121.34	53°28'41" Rt	
	CC		1102203.19	429460.87				
	PCC	208+24.41	1102123.80	429563.82				
R204	PI	208+72.40	1102085.80	429534.51	65	82.68	72°52'40" Rt	
	CC		1102163.49	429512.34				
	PCC	209+07.09	1102102.62	429489.56				
R205	PI	211+83.09	1102199.34	429231.06	1000	538.6	30°51'34" Rt	
	CC		1103039.20	429840.00				
	PT	214+45.69	1102414.96	429058.77				N 51°13'51"E
	PI	214+47.69	1102416.21	429060.33				
	POE	215+99.56	1102523.77	428953.1				

NOTE:
Radius and Length dimensions are shown in feet unless otherwise noted.

DESIGN	ZSZ	DATE	06-26	ARIZONA DEPARTMENT OF TRANSPORTATION PROJECT DELIVERY AND OPERATIONS DIVISION ROADWAY DESIGN SERVICES	
DRAWN	RM	DATE	06-26		
CHECKED	DBK	DATE	06-26		
 Stanley Consultants Inc.		3133 East Camelback Road, Suite 100 Phoenix, Arizona 85016 Phone: (602) 333-2200		US 93/SR 89 ROUNDBOUT GEOMETRIC DATA SHEET	DWG NO. C-5.07
ROUTE	LOCATION				
US 93		WICKENBURG RANCH WAY TO VISTA ROYALE			
TRACS NO. F0738 OIC			093-B(230)T		OF

CURB ALIGNMENT	POINT DESC	STATION	NORTHING	EASTING	RADIUS	LENGTH	DELTA	BEARING
NE MEDIAN EP	POB	500+00.00	1102620.20	429402.52				
R501	PI	501+42.25	1102741.94	429328.95	6.00	18.34	175°10'09" Lt	
	CC		1102617.10	429397.39				
	PCC	500+18.34	1102614.44	429392.01				
R502	PI	500+68.52	1102569.46	429414.25	1685.38	100.32	3°24'37" Lt	
	CC		1103361.59	430902.73				
	PT	501+18.66	1102525.89	429439.13				S 35°01'42"W
	PI	501+25.50	1102520.30	429443.06				
	PI	501+30.78	1102517.18	429447.32				
	PI	502+75.82	1102398.41	429530.57				
	PI	503+31.72	1102350.60	429559.55				
	PC	504+01.83	1102291.79	429597.69				
R503	PI	505+37.55	1102177.91	429671.54	163.71	226.64	79°19'15" Rt	
	CC		1102202.71	429460.34				
	PT	506+28.47	1102084.24	429573.32				S 66°11'10"W
	PC	506+33.73	1102082.12	429568.51				
R504	PI	506+41.01	1102077.25	429563.08	4.00	8.55	122°28'27" Lt	
	CC		1102079.14	429571.18				
	PCC	506+42.28	1102075.29	429570.10				
R505	PI	506+44.49	1102074.69	429572.23	1001.00	4.43	0°15'12" Lt	
	CC		1103039.26	429839.85				
	PRC	506+46.70	1102074.10	429574.37				
R506	PI	507+02.30	1102059.36	429627.97	114.50	103.51	51°47'45" Rt	
	CC		1101963.71	429544.00				
	PRC	507+50.21	1102008.12	429649.54				
R507	PI	507+64.58	1101994.88	429655.11	5.00	12.36	141°37'08" Lt	
	CC		1102010.06	429654.14				
	PCC	507+62.57	1102008.72	429658.96				
R508	PI	508+55.23	1102097.99	429683.81	301.00	179.78	34°13'16" Lt	
	CC		1102089.45	429368.99				
	PCC	509+42.35	1102185.77	429654.16				
R509	PI	510+45.42	1102283.42	429621.18	801.00	205	14°39'50" Lt	
	CC		1101929.43	428895.28				
	PT	511+47.35	1102369.53	429564.55				S 33°19'41"W
	PC	513+23.19	1102516.45	429467.94				
R510	PI	513+31.48	1102523.37	429463.38	3089.42	16.59	0°18'27" Rt	
	CC		1104213.88	432049.27				
	PCC	513+39.77	1102530.33	429458.87				
R511	PI	513+92.81	1102574.80	429429.96	3242.69	106.08	1°52'28" Rt	
	CC		1104297.40	432177.78				
	POE	514+45.85	1102620.20	429402.52				

CURB ALIGNMENT	POINT DESC	STATION	NORTHING	EASTING	RADIUS	LENGTH	DELTA	BEARING
S MEDIAN EP	POB	600+00.00	1101380.19	430227.59				
R601	PI	601+21.22	1101459.84	430136.21	1814.71	242.08	7°38'35" Rt	
	CC		1102748.18	431419.98				
	PRC	602+42.08	1101550.93	430056.24				
R602	PI	604+55.14	1101711.05	429915.67	999.29	419.85	24°04'21" Lt	
	CC		1100891.66	429305.28				
	PRC	606+61.92	1101799.90	429722.02				
R603	PI	607+39.36	1101832.20	429651.63	153.71	143.47	53°28'52" Rt	
	CC		1101939.61	429786.12				
	PRC	608+05.40	1101907.99	429635.70				
R604	PI	608+10.74	1101913.22	429634.60	2.29	5.34	133°36'13" Lt	
	CC		1101907.52	429633.46				
	PRC	608+10.74	1101908.82	429631.57				
R605	PI	608+14.00	1101906.13	429629.72	318.71	6.52	1°10'17" Rt	
	CC		1102089.45	429368.99				
	PCC	608+17.26	1101903.48	429627.82				
R606	PI	608+59.31	1101869.33	429603.28	103.21	79.87	44°20'29" Rt	
	CC		1101963.70	429544.00				
	PRC	608+97.13	1101862.05	429561.86				
R607	PI	609+05.77	1101860.56	429553.35	3.29	7.95	138°17'11" Lt	
	CC		1101858.81	429562.43				
	PT	609+05.07	1101856.01	429560.69				S 58°14'56"W
	PC	609+92.03	1101810.25	429634.64				
R608	PI	610+60.51	1101774.22	429692.87	3028.71	136.94	2°35'26" Rt	
	CC		1099234.82	428040.84				
	PCC	611+28.97	1101735.58	429749.41				
R609	PI	613+65.20	1101602.32	429944.46	4014.71	471.92	6°44'06" Rt	
	CC		1098420.69	427484.61				
	POE	616+00.88	1101447.10	430122.54				

CURB ALIGNMENT	POINT DESC	STATION	NORTHING	EASTING	RADIUS	LENGTH	DELTA	BEARING
NE CROWN	POB	800+00.00	1101909.76	429633.91				
	PC	800+38.55	1101947.80	429640.19				
R701	PI	801+38.00	1102045.92	429656.42	97.50	155.09	91°08'07" Lt	
	CC		1101963.71	429544.00				
	PT	801+93.64	1102060.20	429558.00				
	POE	802+62.64	1102070.10	429489.71				

CURB ALIGNMENT	POINT DESC	STATION	NORTHING	EASTING	RADIUS	LENGTH	DELTA	BEARING
SW CROWN	POB	900+00.00	1102025.09	429443.87				
	PC	900+65.48	1101959.67	429446.58				
R801	PI	901+38.45	1101886.75	429449.61	97.50	125.29	73°37'43" Lt	
	CC		1101963.71	429544.00				
	PT	901+90.77	1101869.10	429520.42				
	POE	902+30.74	1101859.43	429559.19				

NOTE:
Radius and Length dimensions are shown in feet unless otherwise noted.

DESIGN	ZSZ	NAME	DATE	ARIZONA DEPARTMENT OF TRANSPORTATION PROJECT DELIVERY AND OPERATIONS DIVISION ROADWAY DESIGN SERVICES US 93/SR 89 ROUNDABOUT GEOMETRIC DATA SHEET	
DRAWN	RM		06-26		
CHECKED	DBK		06-26		
 3133 East Camelback Road, Suite 100 Phoenix, Arizona 85018 Phone: (602) 333-2200					
ROUTE		LOCATION		DWG NO. C-5.09	
US 93		WICKENBURG RANCH WAY TO VISTA ROYALE			
TRACS NO. F0738 OIC				093-B(230)T	
				OF	

CURB ALIGNMENT	STATION	ELEV
<i>W Leg EP</i>	<i>120+29.60</i>	<i>2449.98</i>
	<i>120+30.00</i>	<i>2449.98</i>
	<i>120+35.00</i>	<i>2450.03</i>
	<i>120+40.00</i>	<i>2450.07</i>
	<i>120+45.00</i>	<i>2450.11</i>
	<i>120+50.00</i>	<i>2450.15</i>
	<i>120+55.00</i>	<i>2450.19</i>
	<i>120+60.00</i>	<i>2450.23</i>
	<i>120+65.00</i>	<i>2450.27</i>
	<i>120+70.00</i>	<i>2450.31</i>
	<i>120+75.00</i>	<i>2450.35</i>
	<i>120+80.00</i>	<i>2450.38</i>
	<i>120+85.00</i>	<i>2450.42</i>
	<i>120+90.00</i>	<i>2450.46</i>
	<i>120+95.00</i>	<i>2450.50</i>
	<i>121+00.00</i>	<i>2450.53</i>
	<i>121+05.00</i>	<i>2450.57</i>
	<i>121+10.00</i>	<i>2450.61</i>
	<i>121+15.00</i>	<i>2450.64</i>
	<i>121+20.00</i>	<i>2450.68</i>
	<i>121+25.00</i>	<i>2450.72</i>
	<i>121+30.00</i>	<i>2450.75</i>
	<i>121+35.00</i>	<i>2450.79</i>
	<i>121+40.00</i>	<i>2450.82</i>
	<i>121+45.00</i>	<i>2450.86</i>
	<i>121+50.00</i>	<i>2450.89</i>
	<i>121+55.00</i>	<i>2450.92</i>
	<i>121+60.00</i>	<i>2450.96</i>
	<i>121+65.00</i>	<i>2450.99</i>
	<i>121+70.00</i>	<i>2451.02</i>
	<i>121+75.00</i>	<i>2451.05</i>
	<i>121+80.00</i>	<i>2451.09</i>
	<i>121+85.00</i>	<i>2451.12</i>
	<i>121+90.00</i>	<i>2451.15</i>
	<i>121+95.00</i>	<i>2451.18</i>
	<i>122+00.00</i>	<i>2451.21</i>
	<i>122+05.00</i>	<i>2451.24</i>
	<i>122+10.00</i>	<i>2451.27</i>
	<i>122+15.00</i>	<i>2451.30</i>
	<i>122+20.00</i>	<i>2451.33</i>
	<i>122+25.00</i>	<i>2451.36</i>
	<i>122+30.00</i>	<i>2451.40</i>
	<i>122+35.00</i>	<i>2451.43</i>
	<i>122+40.00</i>	<i>2451.46</i>
	<i>122+45.00</i>	<i>2451.49</i>
	<i>122+50.00</i>	<i>2451.52</i>
	<i>122+55.00</i>	<i>2451.55</i>
	<i>122+60.00</i>	<i>2451.58</i>
	<i>122+65.00</i>	<i>2451.61</i>
	<i>122+70.00</i>	<i>2451.64</i>
	<i>122+75.00</i>	<i>2451.67</i>
	<i>122+80.00</i>	<i>2451.70</i>
	<i>122+85.00</i>	<i>2451.73</i>
	<i>122+90.00</i>	<i>2451.76</i>
	<i>122+95.00</i>	<i>2451.79</i>
	<i>123+00.00</i>	<i>2451.82</i>
	<i>123+05.00</i>	<i>2451.85</i>
	<i>123+10.00</i>	<i>2451.88</i>
	<i>123+15.00</i>	<i>2451.92</i>
	<i>123+20.00</i>	<i>2451.95</i>
	<i>123+25.00</i>	<i>2451.98</i>
	<i>123+30.00</i>	<i>2452.01</i>
	<i>123+35.00</i>	<i>2452.04</i>
	<i>123+40.00</i>	<i>2452.07</i>
	<i>123+45.00</i>	<i>2452.10</i>

CURB ALIGNMENT	STATION	ELEV
<i>W Leg EP</i>	<i>123+50.00</i>	<i>2452.13</i>
	<i>123+55.00</i>	<i>2452.16</i>
	<i>123+60.00</i>	<i>2452.19</i>
	<i>123+65.00</i>	<i>2452.22</i>
	<i>123+70.00</i>	<i>2452.25</i>
	<i>123+75.00</i>	<i>2452.28</i>
	<i>123+80.00</i>	<i>2452.31</i>
	<i>123+85.00</i>	<i>2452.34</i>
	<i>123+90.00</i>	<i>2452.37</i>
	<i>123+95.00</i>	<i>2452.40</i>
	<i>124+00.00</i>	<i>2452.44</i>
	<i>124+05.00</i>	<i>2452.47</i>
	<i>124+10.00</i>	<i>2452.50</i>
	<i>124+15.00</i>	<i>2452.53</i>
	<i>124+20.00</i>	<i>2452.56</i>
	<i>124+25.00</i>	<i>2452.59</i>
	<i>124+30.00</i>	<i>2452.62</i>
	<i>124+35.00</i>	<i>2452.65</i>
	<i>124+40.00</i>	<i>2452.68</i>
	<i>124+45.00</i>	<i>2452.71</i>
	<i>124+50.00</i>	<i>2452.74</i>
	<i>124+55.00</i>	<i>2452.77</i>
	<i>124+60.00</i>	<i>2452.80</i>
	<i>124+65.00</i>	<i>2452.83</i>
	<i>124+70.00</i>	<i>2452.86</i>
	<i>124+75.00</i>	<i>2452.89</i>
	<i>126+05.00</i>	<i>2454.22</i>
	<i>126+10.00</i>	<i>2454.28</i>
	<i>126+15.00</i>	<i>2454.34</i>
	<i>126+20.00</i>	<i>2454.41</i>
	<i>126+25.00</i>	<i>2454.47</i>
	<i>126+30.00</i>	<i>2454.53</i>
	<i>126+35.00</i>	<i>2454.60</i>
	<i>126+40.00</i>	<i>2454.66</i>
	<i>126+45.00</i>	<i>2454.72</i>
	<i>126+50.00</i>	<i>2454.77</i>
	<i>126+55.00</i>	<i>2454.82</i>
	<i>126+60.00</i>	<i>2454.86</i>
	<i>126+65.00</i>	<i>2454.91</i>
	<i>126+70.00</i>	<i>2454.94</i>

CURB ALIGNMENT	STATION	ELEV
<i>W Leg EP</i>	<i>126+75.00</i>	<i>2454.98</i>
	<i>126+80.00</i>	<i>2455.01</i>
	<i>126+85.00</i>	<i>2455.03</i>
	<i>126+90.00</i>	<i>2455.05</i>
	<i>126+95.00</i>	<i>2455.08</i>
	<i>127+00.00</i>	<i>2455.10</i>
	<i>127+05.00</i>	<i>2455.12</i>
	<i>127+10.00</i>	<i>2455.15</i>
	<i>127+15.00</i>	<i>2455.17</i>
	<i>127+20.00</i>	<i>2455.19</i>
	<i>127+25.00</i>	<i>2455.22</i>
	<i>127+30.00</i>	<i>2455.24</i>
	<i>127+35.00</i>	<i>2455.26</i>
	<i>127+40.00</i>	<i>2455.29</i>
	<i>127+45.00</i>	<i>2455.31</i>
	<i>127+50.00</i>	<i>2455.33</i>
	<i>127+55.00</i>	<i>2455.36</i>
	<i>127+60.00</i>	<i>2455.38</i>
	<i>127+65.00</i>	<i>2455.40</i>
	<i>127+70.00</i>	<i>2455.43</i>
	<i>127+75.00</i>	<i>2455.45</i>
	<i>127+80.00</i>	<i>2455.47</i>
	<i>127+85.00</i>	<i>2455.49</i>
	<i>127+90.00</i>	<i>2455.52</i>
	<i>127+95.00</i>	<i>2455.54</i>
	<i>128+00.00</i>	<i>2455.56</i>
	<i>128+05.00</i>	<i>2455.59</i>
	<i>128+10.00</i>	<i>2455.61</i>
	<i>128+15.00</i>	<i>2455.63</i>
	<i>128+20.00</i>	<i>2455.65</i>
	<i>128+25.00</i>	<i>2455.64</i>
	<i>128+30.00</i>	<i>2455.61</i>
	<i>128+35.00</i>	<i>2455.57</i>
	<i>128+40.00</i>	<i>2455.50</i>
	<i>129+70.00</i>	<i>2451.51</i>
	<i>129+75.00</i>	<i>2451.44</i>
	<i>129+80.00</i>	<i>2451.39</i>
	<i>129+85.00</i>	<i>2451.36</i>
	<i>129+90.00</i>	<i>2451.33</i>
	<i>129+95.00</i>	<i>2451.30</i>

CURB ALIGNMENT	STATION	ELEV
<i>W Leg EP</i>	<i>130+00.00</i>	<i>2451.27</i>
	<i>130+05.00</i>	<i>2451.24</i>
	<i>130+10.00</i>	<i>2451.21</i>
	<i>130+15.00</i>	<i>2451.19</i>
	<i>130+20.00</i>	<i>2451.16</i>
	<i>130+25.00</i>	<i>2451.13</i>
	<i>130+30.00</i>	<i>2451.10</i>
	<i>130+35.00</i>	<i>2451.07</i>
	<i>130+40.00</i>	<i>2451.04</i>
	<i>130+45.00</i>	<i>2451.01</i>
	<i>130+50.00</i>	<i>2450.98</i>
	<i>130+55.00</i>	<i>2450.96</i>
	<i>130+60.00</i>	<i>2450.93</i>
	<i>130+65.00</i>	<i>2450.90</i>
	<i>130+70.00</i>	<i>2450.87</i>
	<i>130+75.00</i>	<i>2450.84</i>
	<i>130+80.00</i>	<i>2450.81</i>
	<i>130+85.00</i>	<i>2450.78</i>
	<i>130+90.00</i>	<i>2450.76</i>
	<i>130+95.00</i>	<i>2450.73</i>
	<i>131+00.00</i>	<i>2450.70</i>
	<i>131+05.00</i>	<i>2450.67</i>
	<i>131+10.00</i>	<i>2450.64</i>
	<i>131+15.00</i>	<i>2450.61</i>
	<i>131+20.00</i>	<i>2450.58</i>
	<i>131+25.00</i>	<i>2450.56</i>
	<i>131+30.00</i>	<i>2450.53</i>
	<i>131+35.00</i>	<i>2450.50</i>
	<i>131+40.00</i>	<i>2450.47</i>
	<i>131+45.00</i>	<i>2450.44</i>
	<i>131+50.00</i>	<i>2450.41</i>
	<i>131+55.00</i>	<i>2450.38</i>
	<i>131+60.00</i>	<i>2450.36</i>
	<i>131+65.00</i>	<i>2450.33</i>
	<i>131+70.00</i>	<i>2450.30</i>
	<i>131+75.00</i>	<i>2450.27</i>
	<i>131+80.00</i>	<i>2450.24</i>
	<i>131+85.00</i>	<i>2450.21</i>
	<i>131+90.00</i>	<i>2450.18</i>
	<i>131+95.00</i>	<i>2450.15</i>
	<i>132+00.00</i>	<i>2450.13</i>
	<i>132+05.00</i>	<i>2450.10</i>
	<i>132+10.00</i>	<i>2450.07</i>
	<i>132+15.00</i>	<i>2450.04</i>
	<i>132+20.00</i>	<i>2450.01</i>
	<i>132+25.00</i>	<i>2449.98</i>
	<i>132+30.00</i>	<i>2449.95</i>
	<i>132+35.00</i>	<i>2449.93</i>
	<i>132+40.00</i>	<i>2449.90</i>
	<i>132+45.00</i>	<i>2449.87</i>
	<i>132+50.00</i>	<i>2449.83</i>
	<i>132+55.00</i>	<i>2449.80</i>
	<i>132+60.00</i>	<i>2449.76</i>
	<i>132+65.00</i>	<i>2449.71</i>
	<i>132+70.00</i>	<i>2449.67</i>

F.H.W.A. REGION	STATE	PROJECT NO.	SHEET NO.	TOTAL SHEETS	RECORD DRAWING
9	ARIZ.	093-B(230)T	225	524	

093 YV 189

CURB ALIGNMENT	STATION	ELEV
<i>W Leg EP</i>	<i>132+75.00</i>	<i>2449.62</i>
	<i>132+80.00</i>	<i>2449.56</i>
	<i>132+85.00</i>	<i>2449.50</i>
	<i>132+90.00</i>	<i>2449.44</i>
	<i>132+95.00</i>	<i>2449.38</i>
	<i>133+00.00</i>	<i>2449.31</i>
	<i>133+05.00</i>	<i>2449.23</i>
	<i>133+10.00</i>	<i>2449.16</i>
	<i>133+15.00</i>	<i>2449.08</i>
	<i>133+20.00</i>	<i>2449.00</i>
	<i>133+25.00</i>	<i>2448.91</i>
	<i>133+30.00</i>	<i>2448.82</i>
	<i>133+35.00</i>	<i>2448.72</i>
	<i>133+40.00</i>	<i>2448.63</i>
	<i>133+45.00</i>	<i>2448.53</i>
	<i>133+50.00</i>	<i>2448.43</i>
	<i>133+55.00</i>	<i>2448.33</i>
	<i>133+60.00</i>	<i>2448.23</i>
	<i>133+65.00</i>	<i>2448.13</i>
	<i>133+70.00</i>	<i>2448.03</i>
	<i>133+75.00</i>	<i>2447.93</i>
	<i>133+80.00</i>	<i>2447.83</i>
	<i>133+85.00</i>	<i>2447.73</i>
	<i>133+90.00</i>	<i>2447.63</i>
	<i>133+95.00</i>	<i>2447.53</i>
	<i>134+00.00</i>	<i>2447.43</i>
	<i>134+05.00</i>	<i>2447.33</i>
	<i>134+10.00</i>	<i>2447.23</i>
	<i>134+15.00</i>	<i>2447.13</i>
	<i>134+20.00</i>	<i>2447.03</i>
	<i>134+25.00</i>	<i>2446.93</i>
	<i>134+30.00</i>	<i>2446.83</i>
	<i>134+35.00</i>	<i>2</i>

CURB ALIGNMENT	STATION	ELEV
NW Leg EP	200+00.00	2450.46
	200+05.00	2450.46
	200+10.00	2450.47
	200+15.00	2450.48
	200+20.00	2450.50
	200+25.00	2450.52
	200+30.00	2450.54
	200+35.00	2450.57
	200+40.00	2450.60
	200+45.00	2450.63
	200+50.00	2450.67
	200+55.00	2450.70
	200+60.00	2450.74
	200+65.00	2450.77
	200+70.00	2450.80
	200+75.00	2450.84
	200+80.00	2450.87
	200+85.00	2450.91
	200+90.00	2450.94
	200+95.00	2450.98
	201+00.00	2451.02
	201+05.00	2451.07
	201+10.00	2451.11
	201+15.00	2451.15
	201+20.00	2451.20
	201+25.00	2451.25
	201+30.00	2451.30
	201+35.00	2451.35
	201+40.00	2451.40
	201+45.00	2451.46
	201+50.00	2451.51
	201+55.00	2451.57
	201+60.00	2451.63
	201+65.00	2451.69
	201+70.00	2451.75
	201+75.00	2451.81
	201+80.00	2451.88
	201+85.00	2451.94
	201+90.00	2452.01
	201+95.00	2452.08
	202+00.00	2452.15
	202+05.00	2452.22
	202+10.00	2452.30
	202+15.00	2452.37
	202+20.00	2452.45
	202+25.00	2452.53
	202+30.00	2452.61
	202+35.00	2452.69
	202+40.00	2452.77
	202+45.00	2452.86
	202+50.00	2452.94
	202+55.00	2453.03
	202+60.00	2453.12
	202+65.00	2453.21
	202+70.00	2453.30
	202+75.00	2453.39
	202+80.00	2453.49
	202+85.00	2453.59
	202+90.00	2453.68
	202+95.00	2453.78
	203+00.00	2453.88
	203+05.00	2453.99
	203+10.00	2454.09
	203+15.00	2454.20
	203+20.00	2454.30

CURB ALIGNMENT	STATION	ELEV
NW Leg EP	203+25.00	2454.41
	203+30.00	2454.52
	203+35.00	2454.63
	203+40.00	2454.75
	203+45.00	2454.86
	203+50.00	2454.98
	203+55.00	2455.10
	203+60.00	2455.22
	203+65.00	2455.34
	203+70.00	2455.46
	203+75.00	2455.58
	203+80.00	2455.71
	203+85.00	2455.83
	203+90.00	2455.96
	203+95.00	2456.09
	204+00.00	2456.22
	204+05.00	2456.36
	204+10.00	2456.49
	204+15.00	2456.63
	204+20.00	2456.76
	204+25.00	2456.90
	204+30.00	2457.04
	204+35.00	2457.19
	204+40.00	2457.33
	204+45.00	2457.47
	204+50.00	2457.62
	204+55.00	2457.77
	204+60.00	2457.92
	204+65.00	2458.07
	204+70.00	2458.22
	204+75.00	2458.38
	204+80.00	2458.53
	204+85.00	2458.69
	204+90.00	2458.85
	204+95.00	2459.01
	205+00.00	2459.17
	205+05.00	2459.33
	205+10.00	2459.50
	205+15.00	2459.66
	205+20.00	2459.83
	205+25.00	2460.00
	205+30.00	2460.17
	205+35.00	2460.34
	205+40.00	2460.51
	205+45.00	2460.68
	205+50.00	2460.85
	205+55.00	2461.02
	205+60.00	2461.19
	205+65.00	2461.36
	205+70.00	2461.53
	205+75.00	2461.70
	205+80.00	2461.87
	205+85.00	2462.04
	205+90.00	2462.21
	205+95.00	2462.38
	206+00.00	2462.55
	206+05.00	2462.71
	206+10.00	2462.85
	206+15.00	2462.98
	206+20.00	2463.09
	206+25.00	2463.18
	206+30.00	2463.25
	206+35.00	2463.31
	206+40.00	2463.34
	206+45.00	2463.36

CURB ALIGNMENT	STATION	ELEV
NW Leg EP	206+50.00	2463.37
	206+55.00	2463.35
	206+60.00	2463.32
	206+65.00	2463.27
	206+70.00	2463.20
	206+75.00	2463.11
	206+80.00	2463.01
	206+85.00	2462.89
	206+90.00	2462.75
	206+95.00	2462.59
	207+00.00	2462.42
	207+05.00	2462.23
	207+10.00	2462.05
	207+15.00	2461.87
	207+20.00	2461.68
	207+25.00	2461.50
	207+30.00	2461.32
	207+35.00	2461.13
	207+40.00	2460.95
	207+45.00	2460.77
	207+50.00	2460.58
	207+55.00	2460.40
	207+60.00	2460.22
	207+65.00	2460.03
	207+70.00	2459.85
	207+75.00	2459.67
	207+80.00	2459.48
	207+85.00	2459.30
	207+90.00	2459.12
	207+95.00	2458.93
	208+00.00	2458.75
	208+05.00	2458.57
	208+10.00	2458.38
	208+15.00	2458.20
	208+20.00	2458.02
	208+25.00	2457.83
	208+30.00	2457.65
	208+35.00	2457.47
	208+40.00	2457.28
	208+45.00	2457.10
	208+50.00	2456.92
	208+55.00	2456.73
	208+60.00	2456.55
	208+65.00	2456.37
	208+70.00	2456.18
	208+75.00	2456.00
	208+80.00	2455.82
	208+85.00	2455.63
	208+90.00	2455.45
	208+95.00	2455.27
	209+00.00	2455.08
	209+05.00	2454.90
	209+10.00	2454.72
	209+15.00	2454.53
	209+20.00	2454.35
	209+25.00	2454.17
	209+30.00	2453.99
	209+35.00	2453.83
	209+40.00	2453.68
	209+45.00	2453.54
	209+50.00	2453.42
	209+55.00	2453.31
	209+60.00	2453.22
	209+65.00	2453.14
	209+70.00	2453.07

CURB ALIGNMENT	STATION	ELEV
NW Leg EP	209+75.00	2453.01
	209+80.00	2452.97
	209+85.00	2452.92
	209+90.00	2452.87
	209+95.00	2452.82
	210+00.00	2452.78
	210+05.00	2452.73
	210+10.00	2452.68
	210+15.00	2452.63
	210+20.00	2452.59
	210+25.00	2452.54
	210+30.00	2452.49
	210+35.00	2452.44
	210+40.00	2452.40
	210+45.00	2452.35
	210+50.00	2452.30
	210+55.00	2452.26
	210+60.00	2452.21
	210+65.00	2452.16
	210+70.00	2452.11
	210+75.00	2452.07
	210+80.00	2452.02
	210+85.00	2451.97
	210+90.00	2451.92
	210+95.00	2451.88
	211+00.00	2451.83
	211+05.00	2451.78
	211+10.00	2451.73
	211+15.00	2451.69
	211+20.00	2451.64
	211+25.00	2451.59
	211+30.00	2451.54
	211+35.00	2451.50
	211+40.00	2451.45
	211+45.00	2451.40
	211+50.00	2451.36
	211+55.00	2451.31
	211+60.00	2451.26
	211+65.00	2451.21
	211+70.00	2451.17
	211+75.00	2451.12
	211+80.00	2451.07
	211+85.00	2451.02
	211+90.00	2450.98
	211+95.00	2450.93
	212+00.00	2450.88
	212+05.00	2450.83
	212+10.00	2450.79
	212+15.00	2450.74
	212+20.00	2450.69
	212+25.00	2450.64
	212+30.00	2450.60
	212+35.00	2450.55
	212+40.00	2450.50
	212+45.00	2450.46

F.H.W.A. REGION	STATE	PROJECT NO.	SHEET NO.	TOTAL SHEETS	RECORD DRAWING
9	ARIZ.	093-B(230)T	226	524	

093 YV 189

CURB ALIGNMENT	STATION	ELEV
NW Leg EP	212+50.00	2450.41
	212+55.00	2450.36
	212+60.00	2450.31
	212+65.00	2450.27
	212+70.00	2450.22
	212+75.00	2450.17
	212+80.00	2450.12
	212+85.00	2450.08
	212+90.00	2450.03
	212+95.00	2449.98
	213+00.00	2449.93
	213+05.00	2449.89
	213+10.00	2449.84
	213+15.00	2449.79
	213+20.00	2449.74
	213+25.00	2449.70
	213+30.00	2449.65
	213+35.00	2449.60
	213+40.00	2449.56
	213+45.00	2449.51
	213+50.00	2449.46
	213+55.00	2449.41
	213+60.00	2449.37
	213+65.00	2449.32
	213+70.00	2449.27
	213+75.00	2449.22
	213+80.00	2449.18
	213+85.00	2449.13
	213+90.00	2449.08
	213+95.00	2449.03
	214+00.00	2448.99
	214+05.00	2448.94
	214+10.00	2448.89
	214+15.00	2448.84
	214+20.00	2448.80
	214+25.00	2448.75
	214+30.00	2448.70
	214+35.00	2448.66
	214+40.00	2448.61
	214+45.00	2448.56
	214+50.00	2448.51
	214+55.00	2448.47
	214+60.00	2448.42
	214+65.00	2448.37
	214+70.00	2448.32
	214+75.00	2448.28
	214+80.00	2448.23
	214+85.00	2448.21
	214+90.00	2448.20
	214+95.00	2448.20

DESIGN	ZSZ	NAME	DATE	ARIZONA DEPARTMENT OF TRANSPORTATION PROJECT DELIVERY AND OPERATIONS DIVISION ROADWAY DESIGN SERVICES	
DRAWN	RM		06-26		
CHECKED	DBK		06-26		
 Stanley Consultants inc.		3133 East Camelback Road, Suite 100 Phoenix, Arizona 85016 Phone: (602) 333-2200		US 93/SR 89 ROUNDBOUT STAKING TABLES	
ROUTE		LOCATION		DWG NO. C-5.11	
US 93		WICKENBURG RANCH WAY TO VISTA ROYALE			
TRACS NO. F0738 OIC				093-B(230)T	
				OF	

CURB ALIGNMENT	STATION	ELEV
NW Leg EP	215+00.00	2448.19
	215+05.00	2448.18
	215+10.00	2448.17
	215+15.00	2448.16
	215+20.00	2448.16
	215+25.00	2448.15
	215+30.00	2448.14
	215+35.00	2448.13
	215+40.00	2448.12
	215+45.00	2448.12
	215+50.00	2448.11
	215+55.00	2448.10
	215+60.00	2448.09
	215+65.00	2448.08
	215+70.00	2448.08
	215+75.00	2448.07
	215+80.00	2448.06
	215+85.00	2448.05
	215+90.00	2448.04
	215+95.00	2448.03
	215+99.56	2448.03

CURB ALIGNMENT	STATION	ELEV
NE Leg EP	300+18.33	2447.02
	300+20.00	2447.04
	300+25.00	2447.11
	300+30.00	2447.18
	300+35.00	2447.25
	300+40.00	2447.32
	300+45.00	2447.39
	300+50.00	2447.47

CURB ALIGNMENT	STATION	ELEV
NE Leg EP	300+55.00	2447.54
	300+60.00	2447.61
	300+65.00	2447.68
	300+70.00	2447.75
	300+75.00	2447.82
	300+80.00	2447.89
	300+85.00	2447.96
	300+90.00	2448.03
	300+95.00	2448.10
	301+00.00	2448.17
	301+05.00	2448.24
	301+10.00	2448.31
	301+15.00	2448.38
	301+20.00	2448.45
	301+25.00	2448.52
	301+30.00	2448.59
	301+35.00	2448.66
	301+40.00	2448.73
	301+45.00	2448.80
	301+50.00	2448.88
	301+55.00	2448.95
	301+60.00	2449.02
	301+65.00	2449.09
	301+70.00	2449.16
	301+75.00	2449.23
	301+80.00	2449.30
	301+85.00	2449.37
	301+90.00	2449.44
	301+95.00	2449.51
	302+00.00	2449.58
	302+05.00	2449.65
	302+10.00	2449.72
	302+15.00	2449.79
	302+20.00	2449.86
	302+25.00	2449.93
	302+30.00	2450.00
	302+35.00	2450.07
	302+40.00	2450.14
	302+45.00	2450.21
	302+50.00	2450.29
	302+55.00	2450.36
	302+60.00	2450.43
	302+65.00	2450.50
	302+70.00	2450.57
	302+75.00	2450.64
	302+80.00	2450.71
	302+85.00	2450.78
	302+90.00	2450.85
	302+95.00	2450.92
	303+00.00	2450.99
	303+05.00	2451.06
	303+10.00	2451.13
	303+15.00	2451.20
	303+20.00	2451.27
	303+25.00	2451.34
	303+30.00	2451.41
	303+35.00	2451.48
	303+40.00	2451.55
	303+45.00	2451.62
	303+50.00	2451.70
	303+55.00	2451.77
	303+60.00	2451.84
	303+65.00	2451.92
	303+70.00	2451.99
	303+75.00	2452.07

CURB ALIGNMENT	STATION	ELEV
NE Leg EP	303+80.00	2452.16
	303+85.00	2452.24
	303+90.00	2452.33
	303+95.00	2452.42
	304+00.00	2452.51
	304+05.00	2452.60
	304+10.00	2452.69
	304+15.00	2452.79
	304+20.00	2452.89
	304+25.00	2452.99
	304+30.00	2453.10
	304+35.00	2453.20
	304+40.00	2453.31
	304+45.00	2453.42
	304+50.00	2453.53
	304+55.00	2453.64
	304+60.00	2453.76
	304+65.00	2453.87
	304+70.00	2453.98
	304+75.00	2454.10
	304+80.00	2454.21
	304+85.00	2454.32
	304+90.00	2454.43
	304+95.00	2454.55
	305+00.00	2454.66
	305+05.00	2454.77
	305+10.00	2454.89
	305+15.00	2455.00
	305+20.00	2455.11
	305+25.00	2455.23
	305+30.00	2455.34
	305+35.00	2455.45
	305+40.00	2455.57
	305+45.00	2455.68
	305+50.00	2455.79
	305+55.00	2455.90
	305+60.00	2456.02
	305+65.00	2456.13
	305+70.00	2456.24
	305+75.00	2456.35
	305+80.00	2456.45
	305+85.00	2456.56
	305+90.00	2456.67
	305+95.00	2456.77
	306+00.00	2456.88
	306+05.00	2456.98
	306+10.00	2457.08
	306+15.00	2457.18
	306+20.00	2457.28
	306+25.00	2457.38
	306+30.00	2457.48
	306+35.00	2457.58
	306+40.00	2457.67
	306+45.00	2457.77
	306+50.00	2457.86

CURB ALIGNMENT	STATION	ELEV
NE Leg EP	306+55.00	2457.96
	306+60.00	2458.05
	306+65.00	2458.15
	306+70.00	2458.24
	306+75.00	2458.34
	306+80.00	2458.43
	306+85.00	2458.52
	306+90.00	2458.62
	306+95.00	2458.71
	307+00.00	2458.81
	307+05.00	2458.90
	307+10.00	2459.00
	307+15.00	2459.11
	307+20.00	2459.22
	307+25.00	2459.33
	307+30.00	2459.45
	307+35.00	2459.58
	307+40.00	2459.70
	307+45.00	2459.84
	307+50.00	2459.97
	307+55.00	2460.11
	307+60.00	2460.26
	307+65.00	2460.41
	307+70.00	2460.56
	307+75.00	2460.72
	307+80.00	2460.89
	307+85.00	2461.05
	307+90.00	2461.23
	307+95.00	2461.40
	308+00.00	2461.58
	308+05.00	2461.77
	308+10.00	2461.95
	308+15.00	2462.13
	308+20.00	2462.32
	308+25.00	2462.50
	308+30.00	2462.68
	308+35.00	2462.87
	308+40.00	2463.05
	308+45.00	2463.23
	308+50.00	2463.42
	308+55.00	2463.59
	308+60.00	2463.76
	308+65.00	2463.91
	308+70.00	2464.05
	308+75.00	2464.17
	308+80.00	2464.28
	308+85.00	2464.38
	308+90.00	2464.46
	308+95.00	2464.54
	309+00.00	2464.60

F.H.W.A. REGION	STATE	PROJECT NO.	SHEET NO.	TOTAL SHEETS	RECORD DRAWING
9	ARIZ.	093-B(230)T	227	524	
		093 YV 189			

DESIGN	ZSZ	NAME	DATE	ARIZONA DEPARTMENT OF TRANSPORTATION PROJECT DELIVERY AND OPERATIONS DIVISION ROADWAY DESIGN SERVICES	
DRAWN	RM		06-26		
CHECKED	DBK		06-26		
 Stanley Consultants inc.		3133 East Camelback Road, Suite 100 Phoenix, Arizona 85016 Phone: (602) 333-2200		US 93/SR 89 ROUNDABOUT STAKING TABLES	
ROUTE		LOCATION		US 93 WICKENBURG RANCH WAY TO VISTA ROYALE	
TRACS NO. F0738 OIC				093-B(230)T	DWG NO. C-5.12 OF



CURB ALIGNMENT	STATION	ELEV
NE Leg EP	309+05.00	2464.64
	309+10.00	2464.67
	309+15.00	2464.69
	309+20.00	2464.70
	309+25.00	2464.69
	309+30.00	2464.67
	309+35.00	2464.64
	309+40.00	2464.59
	309+45.00	2464.54
	309+50.00	2464.46
	309+55.00	2464.38
	309+60.00	2464.31
	309+65.00	2464.23
	309+70.00	2464.15
	309+75.00	2464.07
	309+80.00	2464.08
	309+85.00	2463.97
	309+90.00	2463.86
	309+95.00	2463.75
	310+00.00	2463.64
	310+05.00	2463.52
	310+10.00	2463.40
	310+15.00	2463.27
	310+20.00	2463.13
	310+25.00	2462.99
	310+30.00	2462.85
	310+35.00	2462.70
	310+40.00	2462.55
	310+45.00	2462.39
	310+50.00	2462.23
	310+55.00	2462.06
	310+60.00	2461.89
	310+65.00	2461.71
	310+70.00	2461.53
	310+75.00	2461.34
	310+80.00	2461.15
	310+85.00	2460.96
	310+90.00	2460.77
	310+95.00	2460.58
	311+00.00	2460.39
	311+05.00	2460.20
	311+10.00	2460.00
	311+15.00	2459.81
	311+20.00	2459.62
	311+25.00	2459.42
	311+30.00	2459.24
	311+35.00	2459.05
	311+40.00	2458.87
	311+45.00	2458.69
	311+50.00	2458.51
	311+55.00	2458.33
	311+60.00	2458.16
	311+65.00	2457.98
	311+70.00	2457.81
	311+75.00	2457.64
	311+80.00	2457.47
	311+85.00	2457.31
	311+90.00	2457.15
	311+95.00	2456.98
	312+00.00	2456.82
	312+05.00	2456.67
	312+10.00	2456.51
	312+15.00	2456.36
	312+20.00	2456.20
	312+25.00	2456.05

CURB ALIGNMENT	STATION	ELEV
NE Leg EP	312+30.00	2455.91
	312+35.00	2455.76
	312+40.00	2455.62
	312+45.00	2455.47
	312+50.00	2455.33
	312+55.00	2455.19
	312+60.00	2455.06
	312+65.00	2454.92
	312+70.00	2454.79
	312+75.00	2454.66
	312+80.00	2454.53
	312+85.00	2454.40
	312+90.00	2454.27
	312+95.00	2454.15
	313+00.00	2454.02
	313+05.00	2453.84
	313+10.00	2453.73
	313+15.00	2453.63
	313+20.00	2453.52
	313+25.00	2453.43
	313+30.00	2453.31
	313+35.00	2453.21
	313+40.00	2453.10
	313+45.00	2453.00
	313+50.00	2452.89
	313+55.00	2452.79
	313+57.37	2452.75

CURB ALIGNMENT	STATION	ELEV
N Median EP	413+88.76	2450.59
	413+90.00	2450.60
	413+95.00	2450.64
	414+00.00	2450.68
	414+05.00	2450.72
	414+10.00	2450.76
	414+15.00	2450.80
	414+20.00	2450.84
	414+25.00	2450.88
	414+30.00	2450.92
	414+35.00	2450.96
	414+40.00	2451.00
	414+45.00	2451.04
	414+50.00	2451.08
	414+55.00	2451.11
	414+60.00	2451.15
	414+65.00	2451.18
	414+70.00	2451.22
	414+75.00	2451.25
	414+80.00	2451.29
	414+85.00	2451.32
	414+90.00	2451.36
	414+95.00	2451.39
	415+00.00	2451.42
	415+05.00	2451.45
	415+10.00	2451.49
	415+15.00	2451.52
	415+20.00	2451.55
	415+25.00	2451.58
	415+30.00	2451.62
	415+35.00	2451.65
	415+40.00	2451.68
	415+45.00	2451.71
	415+50.00	2451.74
	415+55.00	2451.78

CURB ALIGNMENT	STATION	ELEV
N Median EP	415+60.00	2451.81
	415+65.00	2451.84
	415+70.00	2451.87
	415+75.00	2451.91
	415+80.00	2451.94
	415+85.00	2451.97
	415+90.00	2452.00
	415+95.00	2452.03
	416+00.00	2452.07
	416+05.00	2452.10
	416+10.00	2452.13
	416+15.00	2452.16
	416+20.00	2452.20
	416+25.00	2452.23
	416+30.00	2452.26
	416+35.00	2452.29
	416+40.00	2452.32
	416+45.00	2452.36
	416+50.00	2452.39
	416+55.00	2452.42
	416+60.00	2452.45
	416+65.00	2452.49
	416+70.00	2452.52
	416+75.00	2452.55
	416+80.00	2452.58
	416+85.00	2452.61
	416+90.00	2452.65
	416+95.00	2452.68
	417+00.00	2452.71
	417+05.00	2452.74
	417+10.00	2452.78
	417+15.00	2452.81
	417+20.00	2452.84
	417+25.00	2452.87
	417+30.00	2452.90
	417+35.00	2452.94
	417+40.00	2452.97
	417+45.00	2453.00
	417+50.00	2453.03
	417+55.00	2453.07
	417+60.00	2453.10
	417+65.00	2453.13
	417+70.00	2453.16
	417+75.00	2453.19
	417+80.00	2453.23
	417+85.00	2453.26
	417+90.00	2453.29
	417+95.00	2453.32
	418+00.00	2453.36
	418+05.00	2453.39
	418+10.00	2453.42
	418+15.00	2453.45
	418+20.00	2453.48
	418+25.00	2453.52
	418+30.00	2453.55
	418+35.00	2453.58
	418+40.00	2453.61
	418+45.00	2453.65
	418+50.00	2453.68
	418+55.00	2453.71
	418+60.00	2453.74
	418+65.00	2453.77
	418+70.00	2453.81
	418+75.00	2453.84
	418+80.00	2453.87

CURB ALIGNMENT	STATION	ELEV
N Median EP	418+85.00	2453.90
	418+90.00	2453.94
	418+95.00	2453.97
	419+00.00	2454.00
	419+05.00	2454.03
	419+10.00	2454.06
	419+15.00	2454.10
	419+20.00	2454.13
	419+25.00	2454.16
	419+30.00	2454.19
	419+35.00	2454.23
	419+40.00	2454.26
	419+45.00	2454.32
	419+50.00	2454.40
	419+55.00	2454.51
	419+60.00	2454.65
	419+65.00	2454.80
	419+70.00	2454.96
	419+75.00	2455.13
	419+80.00	2455.29
	419+85.00	2455.45
	419+90.00	2455.59
	419+95.00	2455.71
	420+00.00	2455.80
	420+05.00	2455.86
	420+10.00	2455.89
	420+15.00	2455.89
	420+20.00	2455.86
	420+25.00	2455.81
	420+30.00	2455.72
	420+35.00	2455.61
	420+40.00	2455.48
	420+45.00	2455.35
	420+50.00	2455.22
	420+55.00	2455.09
	420+60.00	2454.96
	420+65.00	2454.84
	420+70.00	2454.71
	420+75.00	2454.58
	420+80.00	2454.45
	420+85.00	2454.32
	420+90.00	2454.19
	420+95.00	2454.06
	421+00.00	2453.94
	421+05.00	2453.81
	421+10.00	2453.68
	421+15.00	2453.57
	421+20.00	2453.47
	421+25.00	2453.38
	421+30.00	2453.30
	421+35.00	2453.23
	421+40.00	2453.18
	421+45.00	2453.13
	421+50.00	2453.09
	421+55.00	2453.05

F.H.W.A. REGION	STATE	PROJECT NO.	SHEET NO.	TOTAL SHEETS	RECORD DRAWING
9	ARIZ.	093-B(230)T	228	524	

093 YV 189

CURB ALIGNMENT	STATION	ELEV
N Median EP	421+60.00	2453.00
	421+65.00	2452.96
	421+70.00	2452.92
	421+75.00	2452.88
	421+80.00	2452.84
	421+85.00	2452.80
	421+90.00	2452.76
	421+95.00	2452.72
	422+00.00	2452.67
	422+05.00	2452.63
	422+10.00	2452.59
	422+15.00	2452.55
	422+20.00	2452.51
	422+25.00	2452.47
	422+30.00	2452.43
	422+35.00	2452.38
	422+40.00	2452.34
	422+45.00	2452.30
	422+50.00	2452.26
	422+55.00	2452.22
	422+60.00	2452.18
	422+65.00	2452.14
	422+70.00	2452.10
	422+75.00	2452.05
	422+80.00	2452.01
	422+85.00	2451.97
	422+90.00	2451.93
	422+95.00	2451.89
	423+00.00	2451.85
	423+05.00	2451.81
	423+10.00	2451.77
	423+15.00	2451.72
	423+20.00	2451.68
	423+25.00	2451.64
	423+30.00	2451.60
	423+35.00	2451.56
	423+40.00	2451.52
	423+45.00	2451.48
	423+50.00	2451.43
	423+55.00	2451.39
	423+60.00	2451.35

CURB ALIGNMENT	STATION	ELEV
<i>N Median EP</i>	424+15.00	2450.90
	424+20.00	2450.86
	424+25.00	2450.82
	424+30.00	2450.77
	424+35.00	2450.73
	424+40.00	2450.69
	424+45.00	2450.65
	424+50.00	2450.61
	424+55.00	2450.57
	424+60.00	2450.53
	424+65.00	2450.48
	424+70.00	2450.44
	424+75.00	2450.40
	424+80.00	2450.36
	424+85.00	2450.32
	424+90.00	2450.28
	424+95.00	2450.24
	425+00.00	2450.20
	425+05.00	2450.15
	425+10.00	2450.11
	425+15.00	2450.07
	425+20.00	2450.03
	425+25.00	2449.99
	425+30.00	2449.95
	425+35.00	2449.91
	425+40.00	2449.87
	425+45.00	2449.82
	425+50.00	2449.78
	425+55.00	2449.74
	425+60.00	2449.70
	425+65.00	2449.66
	425+70.00	2449.62
	425+75.00	2449.58
	425+80.00	2449.53
	425+85.00	2449.49
	425+90.00	2449.45
	425+95.00	2449.41
	426+00.00	2449.37
	426+05.00	2449.33
	426+10.00	2449.29
	426+15.00	2449.25
	426+20.00	2449.20
	426+25.00	2449.16
	426+30.00	2449.09
	426+35.00	2449.02
	426+40.00	2448.95
	426+45.00	2448.88
	426+50.00	2448.81
	426+55.00	2448.74
	426+60.00	2448.67
	426+65.00	2448.61
	426+70.00	2448.54
	426+75.00	2448.47
	426+80.00	2448.40
	426+85.00	2448.33
	426+90.00	2448.26
	426+95.00	2448.19
	427+00.00	2448.12
	427+05.00	2448.05
	427+10.00	2447.98
	427+15.00	2447.91
	427+20.00	2447.84
	427+25.00	2447.77
	427+30.00	2447.70

CURB ALIGNMENT	STATION	ELEV
<i>N Median EP</i>	427+35.00	2447.63
	427+40.00	2447.57
	427+42.41	2447.54

CURB ALIGNMENT	STATION	ELEV
<i>NE Median EP</i>	500+00.00	2453.08
	500+05.00	2453.14
	500+10.00	2453.2
	500+15.00	2453.27
	500+20.00	2453.35
	500+25.00	2453.47
	500+30.00	2453.60
	500+35.00	2453.72
	500+40.00	2453.85
	500+45.00	2453.97
	500+50.00	2454.10
	500+55.00	2454.22
	500+60.00	2454.35
	500+65.00	2454.47
	500+70.00	2454.60
	500+75.00	2454.73
	500+80.00	2454.86
	500+85.00	2455.00
	500+90.00	2455.13
	500+95.00	2455.27
	501+00.00	2455.41
	501+05.00	2455.56
	501+10.00	2455.70
	501+15.00	2455.85
	501+20.00	2456.00
	501+25.00	2456.15
	501+30.00	2456.31
	501+35.00	2456.47
	501+40.00	2456.63
	501+45.00	2456.79
	501+50.00	2456.95
	501+55.00	2457.11
	501+60.00	2457.27
	501+65.00	2457.43
	501+70.00	2457.59
	501+75.00	2457.75
	501+80.00	2457.91
	501+85.00	2458.07
	501+90.00	2458.23
	501+95.00	2458.39
	502+00.00	2458.55
	502+05.00	2458.71
	502+10.00	2458.87
	502+15.00	2459.03
	502+20.00	2459.20
	502+25.00	2459.36
	502+30.00	2459.52
	502+35.00	2459.68
	502+40.00	2459.84
	502+45.00	2460.00
	502+50.00	2460.16
	502+55.00	2460.32
	502+60.00	2460.48
	502+65.00	2460.64
	502+70.00	2460.80
	502+75.00	2460.96
	502+80.00	2461.12
	502+85.00	2461.28
	502+90.00	2461.44

CURB ALIGNMENT	STATION	ELEV
<i>NE Median EP</i>	502+95.00	2461.60
	503+00.00	2461.76
	503+05.00	2461.92
	503+10.00	2462.08
	503+15.00	2462.24
	503+20.00	2462.40
	503+25.00	2462.56
	503+30.00	2462.72
	503+35.00	2462.89
	503+40.00	2463.05
	503+45.00	2463.20
	503+50.00	2463.34
	503+55.00	2463.46
	503+60.00	2463.57
	503+65.00	2463.66
	503+70.00	2463.74
	503+75.00	2463.80
	503+80.00	2463.84
	503+85.00	2463.88
	503+90.00	2463.89
	503+95.00	2463.89
	504+00.00	2463.88
	504+05.00	2463.85
	504+10.00	2463.81
	504+15.00	2463.75
	504+20.00	2463.67
	504+25.00	2463.58
	504+30.00	2463.48
	504+35.00	2463.36
	504+40.00	2463.22
	504+45.00	2463.08
	504+50.00	2462.94
	504+55.00	2462.79
	504+60.00	2462.65
	504+65.00	2462.51
	504+70.00	2462.36
	504+75.00	2462.22
	504+80.00	2462.08
	504+85.00	2461.94
	504+90.00	2461.79
	504+95.00	2461.65
	505+00.00	2461.51
	505+05.00	2461.36
	505+10.00	2461.22
	505+15.00	2461.08
	505+20.00	2460.93
	505+25.00	2460.79
	505+30.00	2460.65
	505+35.00	2460.51
	505+40.00	2460.36
	505+45.00	2460.22
	505+50.00	2460.08
	505+55.00	2459.93
	505+60.00	2459.79
	505+65.00	2459.65
	505+70.00	2459.51
	505+75.00	2459.36
	505+80.00	2459.22
	505+85.00	2459.08
	505+90.00	2458.93
	505+95.00	2458.80
	506+00.00	2458.67
	506+05.00	2458.56
	506+10.00	2458.45
	506+15.00	2458.36

CURB ALIGNMENT	STATION	ELEV
<i>NE Median EP</i>	506+20.00	2458.28
	506+25.00	2458.20
	506+30.00	2458.14
	506+35.00	2458.10
	506+40.00	2458.06
	506+45.00	2458.03
	506+50.00	2457.99
	506+55.00	2457.96
	506+60.00	2457.93
	506+65.00	2457.90
	506+70.00	2457.86
	506+75.00	2457.83
	506+80.00	2457.80
	506+85.00	2457.77
	506+90.00	2457.73
	506+95.00	2457.70
	507+00.00	2457.67
	507+05.00	2457.64
	507+10.00	2457.60
	507+15.00	2457.57
	507+20.00	2457.54
	507+25.00	2457.53
	507+30.00	2457.52
	507+35.00	2457.52
	507+40.00	2457.54
	507+45.00	2457.56
	507+50.00	2457.60
	507+55.00	2457.64
	507+60.00	2457.70
	507+65.00	2457.76
	507+70.00	2457.83
	507+75.00	2457.90
	507+80.00	2457.97
	507+85.00	2458.04
	507+90.00	2458.12
	507+95.00	2458.20
	508+00.00	2458.29
	508+05.00	2458.38
	508+10.00	2458.48
	508+15.00	2458.58
	508+20.00	2458.70
	508+25.00	2458.82
	508+30.00	2458.94
	508+35.00	2459.07
	508+40.00	2459.21
	508+45.00	2459.36
	508+50.00	2459.51
	508+55.00	2459.67
	508+60.00	2459.83
	508+65.00	2460.00
	508+70.00	2460.18
	508+75.00	2460.36
	508+80.00	2460.55
	508+85.00	2460.75
	508+90.00	2460.95

F.H.W.A. REGION	STATE	PROJECT NO.	SHEET NO.	TOTAL SHEETS	RECORD DRAWING
9	ARIZ.	093-B(230)T	229	524	
093 YV 189					

CURB ALIGNMENT	STATION	ELEV
<i>NE Median EP</i>	508+95.00	2461.15
	509+00.00	2461.35
	509+05.00	2461.55
	509+10.00	2461.75
	509+15.00	2461.95
	509+20.00	2462.15
	509+25.00	2462.33
	509+30.00	2462.51
	509+35.00	2462.68
	509+40.00	2462.84
	509+45.00	2462.99
	509+50.00	2463.13
	509+55.00	2463.26
	509+60.00	2463.38
	509+65.00	2463.50
	509+70.00	2463.60
	509+75.00	2463.70
	509+80.00	2463.78
	509+85.00	2463.86
	509+90.00	2463.93
	509+95.00	2463.99
	510+00.00	2464.04
	510+05.00	2464.08
	510+10.00	2464.11
	510+15.00	2464.14
	510+20.00	2464.15
	510+25.00	2464.15
	510+30.00	2464.15
	510+35.00	2464.14
	510+40.00	2464.12
	510+45.00	2464.08
	510+50.00	2464.04
	510+55.00	2463.99
	510+60.00	2463.94
	510+65.00	2463.87
	510+70.00	2463.79
	510+75.00	2463.71
	510+80.00	2463.61
	510+85.00	2463.51
	510+90.00	2463.39
	510+95.00	2463.27
	511+00.00	2463.14
	511+05.00	2463.00
	511+10.00	2462.86
	511+15.00	2462.71
	511+20.00	2462.57
	511+25.00	2462.42
	511+30.00	2462.28
	511+35.00	2462.13
	511+40.00	2461.99

		NAME	DATE	ARIZONA DEPARTMENT OF TRANSPORTATION PROJECT DELIVERY AND OPERATIONS DIVISION ROADWAY DESIGN SERVICES		
DESIGN		ZSZ	06-26			
DRAWN		RM	06-26			
CHECKED		DBK	06-26	US 93/SR 89 ROUNDABOUT STAKING TABLES		DWG NO. C-5.14 OF
 Stanley Consultants inc.		3133 East Camelback Road, Suite 100 Phoenix, Arizona 85016 Phone: (602) 333-2200				
ROUTE		LOCATION				
US 93		WICKENBURG RANCH WAY TO VISTA ROYALE				
TRACS NO. F0738 OIC				093-B(230)T		

CURB ALIGNMENT	STATION	ELEV
NE Median EP	511+45.00	2461.84
	511+50.00	2461.70
	511+55.00	2461.55
	511+60.00	2461.41
	511+65.00	2461.26
	511+70.00	2461.12
	511+75.00	2460.97
	511+80.00	2460.81
	511+85.00	2460.66
	511+90.00	2460.50
	511+95.00	2460.34
	512+00.00	2460.18
	512+05.00	2460.01
	512+10.00	2459.84
	512+15.00	2459.67
	512+20.00	2459.49
	512+25.00	2459.31
	512+30.00	2459.13
	512+35.00	2458.95
	512+40.00	2458.77
	512+45.00	2458.58
	512+50.00	2458.39
	512+55.00	2458.21
	512+60.00	2458.03
	512+65.00	2457.85
	512+70.00	2457.68
	512+75.00	2457.51
	512+80.00	2457.34
	512+85.00	2457.18
	512+90.00	2457.02
	512+95.00	2456.86
	513+00.00	2456.71
	513+05.00	2456.55
	513+10.00	2456.41
	513+15.00	2456.26
	513+20.00	2456.12
	513+25.00	2455.99
	513+30.00	2455.85
	513+35.00	2455.72
	513+40.00	2455.60
	513+45.00	2455.47
	513+50.00	2455.35
	513+55.00	2455.23
	513+60.00	2455.11
	513+65.00	2455.00
	513+70.00	2454.88
	513+75.00	2454.76
	513+80.00	2454.64
	513+85.00	2454.52
	513+90.00	2454.40
	513+95.00	2454.29
	514+00.00	2454.17
	514+05.00	2454.05
	514+10.00	2453.93
	514+15.00	2453.81
	514+20.00	2453.69
	514+25.00	2453.57
	514+30.00	2453.46
	514+35.00	2453.34
	514+40.00	2453.22
	514+45.00	2453.10
	514+45.85	2453.08

CURB ALIGNMENT	STATION	ELEV
S Median EP	600+00.00	2443.41
	600+05.00	2443.50
	600+10.00	2443.60
	600+15.00	2443.70
	600+20.00	2443.79
	600+25.00	2443.89
	600+30.00	2443.99
	600+35.00	2444.09
	600+40.00	2444.18
	600+45.00	2444.28
	600+50.00	2444.38
	600+55.00	2444.48
	600+60.00	2444.57
	600+65.00	2444.67
	600+70.00	2444.77
	600+75.00	2444.87
	600+80.00	2444.96
	600+85.00	2445.06
	600+90.00	2445.16
	600+95.00	2445.26
	601+00.00	2445.35
	601+05.00	2445.45
	601+10.00	2445.55
	601+15.00	2445.64
	601+20.00	2445.74
	601+25.00	2445.84
	601+30.00	2445.94
	601+35.00	2446.03
	601+40.00	2446.13
	601+45.00	2446.23
	601+50.00	2446.33
	601+55.00	2446.42
	601+60.00	2446.52
	601+65.00	2446.61
	601+70.00	2446.70
	601+75.00	2446.79
	601+80.00	2446.88
	601+85.00	2446.97
	601+90.00	2447.06
	601+95.00	2447.14
	602+00.00	2447.22
	602+05.00	2447.30
	602+10.00	2447.38
	602+15.00	2447.46
	602+20.00	2447.54
	602+25.00	2447.61
	602+30.00	2447.68
	602+35.00	2447.75
	602+40.00	2447.82
	602+45.00	2447.89
	602+50.00	2447.96
	602+55.00	2448.03
	602+60.00	2448.09
	602+65.00	2448.16
	602+70.00	2448.22
	602+75.00	2448.29
	602+80.00	2448.36
	602+85.00	2448.42
	602+90.00	2448.49
	602+95.00	2448.55
	603+00.00	2448.62
	603+05.00	2448.69
	603+10.00	2448.75
	603+15.00	2448.82
	603+20.00	2448.88

CURB ALIGNMENT	STATION	ELEV
S Median EP	603+25.00	2448.95
	603+30.00	2449.02
	603+35.00	2449.08
	603+40.00	2449.15
	603+45.00	2449.21
	603+50.00	2449.28
	603+55.00	2449.35
	603+60.00	2449.41
	603+65.00	2449.48
	603+70.00	2449.54
	603+75.00	2449.61
	603+80.00	2449.68
	603+85.00	2449.74
	603+90.00	2449.81
	603+95.00	2449.87
	604+00.00	2449.94
	604+05.00	2450.01
	604+10.00	2450.07
	604+15.00	2450.14
	604+20.00	2450.20
	604+25.00	2450.27
	604+30.00	2450.34
	604+35.00	2450.40
	604+40.00	2450.47
	604+45.00	2450.53
	604+50.00	2450.60
	604+55.00	2450.67
	604+60.00	2450.73
	604+65.00	2450.80
	604+70.00	2450.86
	604+75.00	2450.93
	604+80.00	2451.00
	604+85.00	2451.06
	604+90.00	2451.13
	604+95.00	2451.19
	605+00.00	2451.26
	605+05.00	2451.33
	605+10.00	2451.39
	605+15.00	2451.46
	605+20.00	2451.52
	605+25.00	2451.59
	605+30.00	2451.66
	605+35.00	2451.73
	605+40.00	2451.80
	605+45.00	2451.87
	605+50.00	2451.94
	605+55.00	2452.02
	605+60.00	2452.10
	605+65.00	2452.18
	605+70.00	2452.26
	605+75.00	2452.35
	605+80.00	2452.44
	605+85.00	2452.52
	605+90.00	2452.62
	605+95.00	2452.71
	606+00.00	2452.80
	606+05.00	2452.90
	606+10.00	2453.00
	606+15.00	2453.10
	606+20.00	2453.20
	606+25.00	2453.31
	606+30.00	2453.41
	606+35.00	2453.52
	606+40.00	2453.62
	606+45.00	2453.73

CURB ALIGNMENT	STATION	ELEV
S Median EP	606+50.00	2453.83
	606+55.00	2453.94
	606+60.00	2454.04
	606+65.00	2454.15
	606+70.00	2454.26
	606+75.00	2454.36
	606+80.00	2454.47
	606+85.00	2454.57
	606+90.00	2454.68
	606+95.00	2454.78
	607+00.00	2454.89
	607+05.00	2454.99
	607+10.00	2455.10
	607+15.00	2455.21
	607+20.00	2455.31
	607+25.00	2455.42
	607+30.00	2455.52
	607+35.00	2455.63
	607+40.00	2455.73
	607+45.00	2455.84
	607+50.00	2455.94
	607+55.00	2456.05
	607+60.00	2456.16
	607+65.00	2456.26
	607+70.00	2456.36
	607+75.00	2456.44
	607+80.00	2456.52
	607+85.00	2456.59
	607+90.00	2456.64
	607+95.00	2456.69
	608+00.00	2456.73
	608+05.00	2456.76
	608+10.00	2456.77
	608+15.00	2456.78
	608+20.00	2456.78
	608+25.00	2456.77
	608+30.00	2456.75
	608+35.00	2456.72
	608+40.00	2456.68
	608+45.00	2456.64
	608+50.00	2456.60
	608+55.00	2456.56
	608+60.00	2456.52
	608+65.00	2456.48
	608+70.00	2456.44
	608+75.00	2456.40
	608+80.00	2456.36
	608+85.00	2456.32
	608+90.00	2456.28
	608+95.00	2456.24
	609+00.00	2456.20
	609+05.00	2456.16
	609+10.00	2456.12
	609+15.00	2456.08
	609+20.00	2456.01

F.H.W.A. REGION	STATE	PROJECT NO.	SHEET NO.	TOTAL SHEETS	RECORD DRAWING
9	ARIZ.	093-B(230)T	230	524	

093 YV 189

CURB ALIGNMENT	STATION	ELEV
S Median EP	609+25.00	2455.90
	609+30.00	2455.77
	609+35.00	2455.61
	609+40.00	2455.42
	609+45.00	2455.22
	609+50.00	2455.03
	609+55.00	2454.83
	609+60.00	2454.64
	609+65.00	2454.44
	609+70.00	2454.25
	609+75.00	2454.05
	609+80.00	2453.86
	609+85.00	2453.68
	609+90.00	2453.50
	609+95.00	2453.34
	610+00.00	2453.18
	610+05.00	2453.03
	610+10.00	2452.89
	610+15.00	2452.76
	610+20.00	2452.64
	610+25.00	2452.52
	610+30.00	2452.41
	610+35.00	2452.32
	610+40.00	2452.23
	610+45.00	2452.15
	610+50.00	2452.07
	610+55.00	2452.01
	610+60.00	2451.95
	610+65.00	2451.91
	610+70.00	2451.87
	610+75.00	2451.84
	610+80.00	2451.81
	610+85.00	2451.78
	610+90.00	2451.76
	610+95.00	2451.73
	611+00.00	2451.70
	611+05.00	2451.68
	611+10.00	2451.65
	611+15.00	2451.62
	611+20.00	2451.60
	611+25.00	2451.57
	611+30.00	2451.55
	611+35.00	245

CURB ALIGNMENT	STATION	ELEV
<i>S Median EP</i>	611+75.00	2451.31
	611+80.00	2451.28
	611+85.00	2451.25
	611+90.00	2451.23
	611+95.00	2451.20
	612+00.00	2451.18
	612+05.00	2451.15
	612+10.00	2451.12
	612+15.00	2451.10
	612+20.00	2451.07
	612+25.00	2451.04
	612+30.00	2451.02
	612+35.00	2450.99
	612+40.00	2450.96
	612+45.00	2450.94
	612+50.00	2450.91
	612+55.00	2450.88
	612+60.00	2450.86
	612+65.00	2450.83
	612+70.00	2450.80
	612+75.00	2450.78
	612+80.00	2450.75
	612+85.00	2450.72
	612+90.00	2450.69
	612+95.00	2450.66
	613+00.00	2450.62
	613+05.00	2450.59
	613+10.00	2450.55
	613+15.00	2450.51
	613+20.00	2450.47
	613+25.00	2450.42
	613+30.00	2450.38
	613+35.00	2450.33
	613+40.00	2450.28
	613+45.00	2450.23
	613+50.00	2450.18
	613+55.00	2450.13
	613+60.00	2450.07
	613+65.00	2450.01
	613+70.00	2449.95
	613+75.00	2449.89
	613+80.00	2449.83
	613+85.00	2449.76
	613+90.00	2449.69
	613+95.00	2449.63
	614+00.00	2449.56
	614+05.00	2449.48
	614+10.00	2449.41
	614+15.00	2449.33
	614+20.00	2449.26
	614+25.00	2449.18
	614+30.00	2449.09
	614+35.00	2449.01
	614+40.00	2448.93
	614+45.00	2448.84
	614+50.00	2448.75
	614+55.00	2448.66
	614+60.00	2448.57
	614+65.00	2448.47
	614+70.00	2448.38
	614+75.00	2448.28
	614+80.00	2448.18
	614+85.00	2448.08
	614+90.00	2447.99
	614+95.00	2447.89

CURB ALIGNMENT	STATION	ELEV
<i>S Median EP</i>	615+00.00	2447.79
	615+05.00	2447.69
	615+10.00	2447.59
	615+15.00	2447.49
	615+20.00	2447.40
	615+25.00	2447.30
	615+30.00	2447.20
	615+35.00	2447.10
	615+40.00	2447.00
	615+45.00	2446.90
	615+50.00	2446.80
	615+55.00	2446.71
	615+60.00	2446.61
	615+65.00	2446.51
	615+70.00	2446.41
	615+75.00	2446.31
	615+80.00	2446.21
	615+85.00	2446.12
	615+90.00	2446.02
	615+95.00	2445.92
	616+00.00	2445.82
	616+00.88	2445.80

CURB ALIGNMENT	STATION	ELEV
<i>Truck Apron EP</i>	700+00.00	2455.85
	700+05.00	2455.88
	700+10.00	2455.91
	700+15.00	2455.95
	700+20.00	2455.98
	700+25.00	2456.02
	700+30.00	2456.07
	700+35.00	2456.11
	700+40.00	2456.16
	700+45.00	2456.21
	700+50.00	2456.26
	700+55.00	2456.31
	700+60.00	2456.36
	700+65.00	2456.42
	700+70.00	2456.49
	700+75.00	2456.56
	700+80.00	2456.64
	700+85.00	2456.72
	700+90.00	2456.80
	700+95.00	2456.88
	701+00.00	2456.96
	701+05.00	2457.04
	701+10.00	2457.12
	701+15.00	2457.20
	701+20.00	2457.28
	701+25.00	2457.36
	701+30.00	2457.44
	701+35.00	2457.50
	701+40.00	2457.56
	701+45.00	2457.61
	701+50.00	2457.65
	701+55.00	2457.67
	701+60.00	2457.70
	701+65.00	2457.72
	701+70.00	2457.75
	701+75.00	2457.77
	701+80.00	2457.80
	701+85.00	2457.82
	701+90.00	2457.84
	701+95.00	2457.85

CURB ALIGNMENT	STATION	ELEV
<i>Truck Apron EP</i>	702+00.00	2457.84
	702+05.00	2457.83
	702+10.00	2457.79
	702+15.00	2457.75
	702+20.00	2457.70
	702+25.00	2457.63
	702+30.00	2457.55
	702+35.00	2457.46
	702+40.00	2457.35
	702+45.00	2457.23
	702+50.00	2457.10
	702+55.00	2456.96
	702+60.00	2456.81
	702+65.00	2456.64
	702+70.00	2456.47
	702+75.00	2456.29
	702+80.00	2456.12
	702+85.00	2455.95
	702+90.00	2455.78
	702+95.00	2455.60
	703+00.00	2455.43
	703+05.00	2455.26
	703+10.00	2455.08
	703+15.00	2454.92
	703+20.00	2454.78
	703+25.00	2454.67
	703+30.00	2454.58
	703+35.00	2454.51
	703+40.00	2454.46
	703+45.00	2454.44
	703+50.00	2454.44
	703+55.00	2454.47
	703+60.00	2454.51
	703+65.00	2454.57
	703+70.00	2454.63
	703+75.00	2454.69
	703+80.00	2454.75
	703+85.00	2454.80
	703+90.00	2454.86
	703+95.00	2454.92
	704+00.00	2454.98
	704+05.00	2455.03
	704+10.00	2455.08
	704+15.00	2455.12
	704+20.00	2455.16
	704+25.00	2455.19
	704+30.00	2455.22
	704+35.00	2455.25
	704+40.00	2455.28
	704+45.00	2455.31
	704+50.00	2455.35
	704+55.00	2455.38
	704+60.00	2455.41
	704+65.00	2455.44
	704+70.00	2455.47
	704+75.00	2455.50
	704+80.00	2455.53
	704+85.00	2455.56
	704+90.00	2455.59
	704+95.00	2455.63
	705+00.00	2455.66
	705+05.00	2455.69
	705+10.00	2455.72
	705+15.00	2455.75
	705+20.00	2455.78

CURB ALIGNMENT	STATION	ELEV
<i>Truck Apron EP</i>	705+25.00	2455.81
	705+30.00	2455.84
	705+30.92	2455.85

CURB ALIGNMENT	STATION	ELEV
<i>NE Crown</i>	800+00.00	2456.77
	800+05.00	2456.84
	800+10.00	2456.91
	800+15.00	2456.98
	800+20.00	2457.04
	800+25.00	2457.11
	800+30.00	2457.18
	800+35.00	2457.25
	800+40.00	2457.32
	800+45.00	2457.39
	800+50.00	2457.46
	800+55.00	2457.53
	800+60.00	2457.59
	800+65.00	2457.66
	800+70.00	2457.71
	800+75.00	2457.76
	800+80.00	2457.79
	800+85.00	2457.82
	800+90.00	2457.84
	800+95.00	2457.85
	801+00.00	2457.86
	801+05.00	2457.88
	801+10.00	2457.89
	801+15.00	2457.90
	801+20.00	2457.91
	801+25.00	2457.93
	801+30.00	2457.94
	801+35.00	2457.95
	801+40.00	2457.96
	801+45.00	2457.98
	801+50.00	2457.99
	801+55.00	2457.99
	801+60.00	2457.99
	801+65.00	2457.97
	801+70.00	2457.94
	801+75.00	2457.90
	801+80.00	2457.85
	801+85.00	2457.79
	801+90.00	2457.71
	801+95.00	2457.62
	802+00.00	2457.53
	802+05.00	2457.42
	802+10.00	2457.32
	802+15.00	2457.21
	802+20.00	2457.09
	802+25.00	2456.96
	802+30.00	2456.82
	802+35.00	2456.67
	802+40.00	2456.51

F.H.W.A. REGION	STATE	PROJECT NO.	SHEET NO.	TOTAL SHEETS	RECORD DRAWING
9	ARIZ.	093-B(230)T	231	524	
093 YV 189					


CURB ALIGNMENT	STATION	ELEV
<i>NE Crown</i>	802+45.00	2456.34
	802+50.00	2456.18
	802+55.00	2456.01
	802+60.00	2455.85
	802+62.64	2455.76

DESIGN	ZSZ	NAME	DATE	ARIZONA DEPARTMENT OF TRANSPORTATION PROJECT DELIVERY AND OPERATIONS DIVISION ROADWAY DESIGN SERVICES	
DRAWN	RM				
CHECKED	DBK				
 Stanley Consultants inc.		3133 East Camelback Road, Suite 100 Phoenix, Arizona 85016 Phone: (602) 333-2200		US 93/SR 89 ROUNDABOUT STAKING TABLES	
ROUTE		LOCATION		DWG NO. C-5.16	
US 93		WICKENBURG RANCH WAY TO VISTA ROYALE			
TRACS NO. F0738 OIC				093-B(230)T	
				____OF____	

CURB ALIGNMENT	STATION	ELEV
SW Crown	900+00.00	2454.72
	900+05.00	2454.75
	900+10.00	2454.78
	900+15.00	2454.82
	900+20.00	2454.85
	900+25.00	2454.88
	900+30.00	2454.91
	900+35.00	2454.94
	900+40.00	2454.97
	900+45.00	2455.01
	900+50.00	2455.04
	900+55.00	2455.07
	900+60.00	2455.10
	900+65.00	2455.13
	900+70.00	2455.17
	900+75.00	2455.20
	900+80.00	2455.23
	900+85.00	2455.26
	900+90.00	2455.29
	900+95.00	2455.33
	901+00.00	2455.36
	901+05.00	2455.39
	901+10.00	2455.42
	901+15.00	2455.45
	901+20.00	2455.48
	901+25.00	2455.52
	901+30.00	2455.55
	901+35.00	2455.58
	901+40.00	2455.61
	901+45.00	2455.64
	901+50.00	2455.68
	901+55.00	2455.71
	901+60.00	2455.74
	901+65.00	2455.77
	901+70.00	2455.80
	901+75.00	2455.83
	901+80.00	2455.87
	901+85.00	2455.90
	901+90.00	2455.93
	901+95.00	2455.96
	902+00.00	2455.99
	902+05.00	2456.03
	902+10.00	2456.06
	902+15.00	2456.09
	902+20.00	2456.12
	902+25.00	2456.15
	902+30.00	2456.19
	902+30.73	2456.19


F.H.W.A. REGION	STATE	PROJECT NO.	SHEET NO.	TOTAL SHEETS	RECORD DRAWING
9	ARIZ.	093-B(230)T	232	524	
093 YV 189					



		NAME	DATE	ARIZONA DEPARTMENT OF TRANSPORTATION PROJECT DELIVERY AND OPERATIONS DIVISION ROADWAY DESIGN SERVICES		
DESIGN	ZSZ		06-26			
DRAWN	RM		06-26			
CHECKED	DBK		06-26			
 Stanley Consultants inc.		3133 East Camelback Road, Suite 100 Phoenix, Arizona 85016 Phone: (602) 333-2200		US 93/SR 89 ROUNDBOUT STAKING TABLES		
ROUTE		LOCATION		DWG NO. C-5.17		
US 93		WICKENBURG RANCH WAY TO VISTA ROYALE				
TRACS NO. F0738 OIC			093-B(230)T		OF	

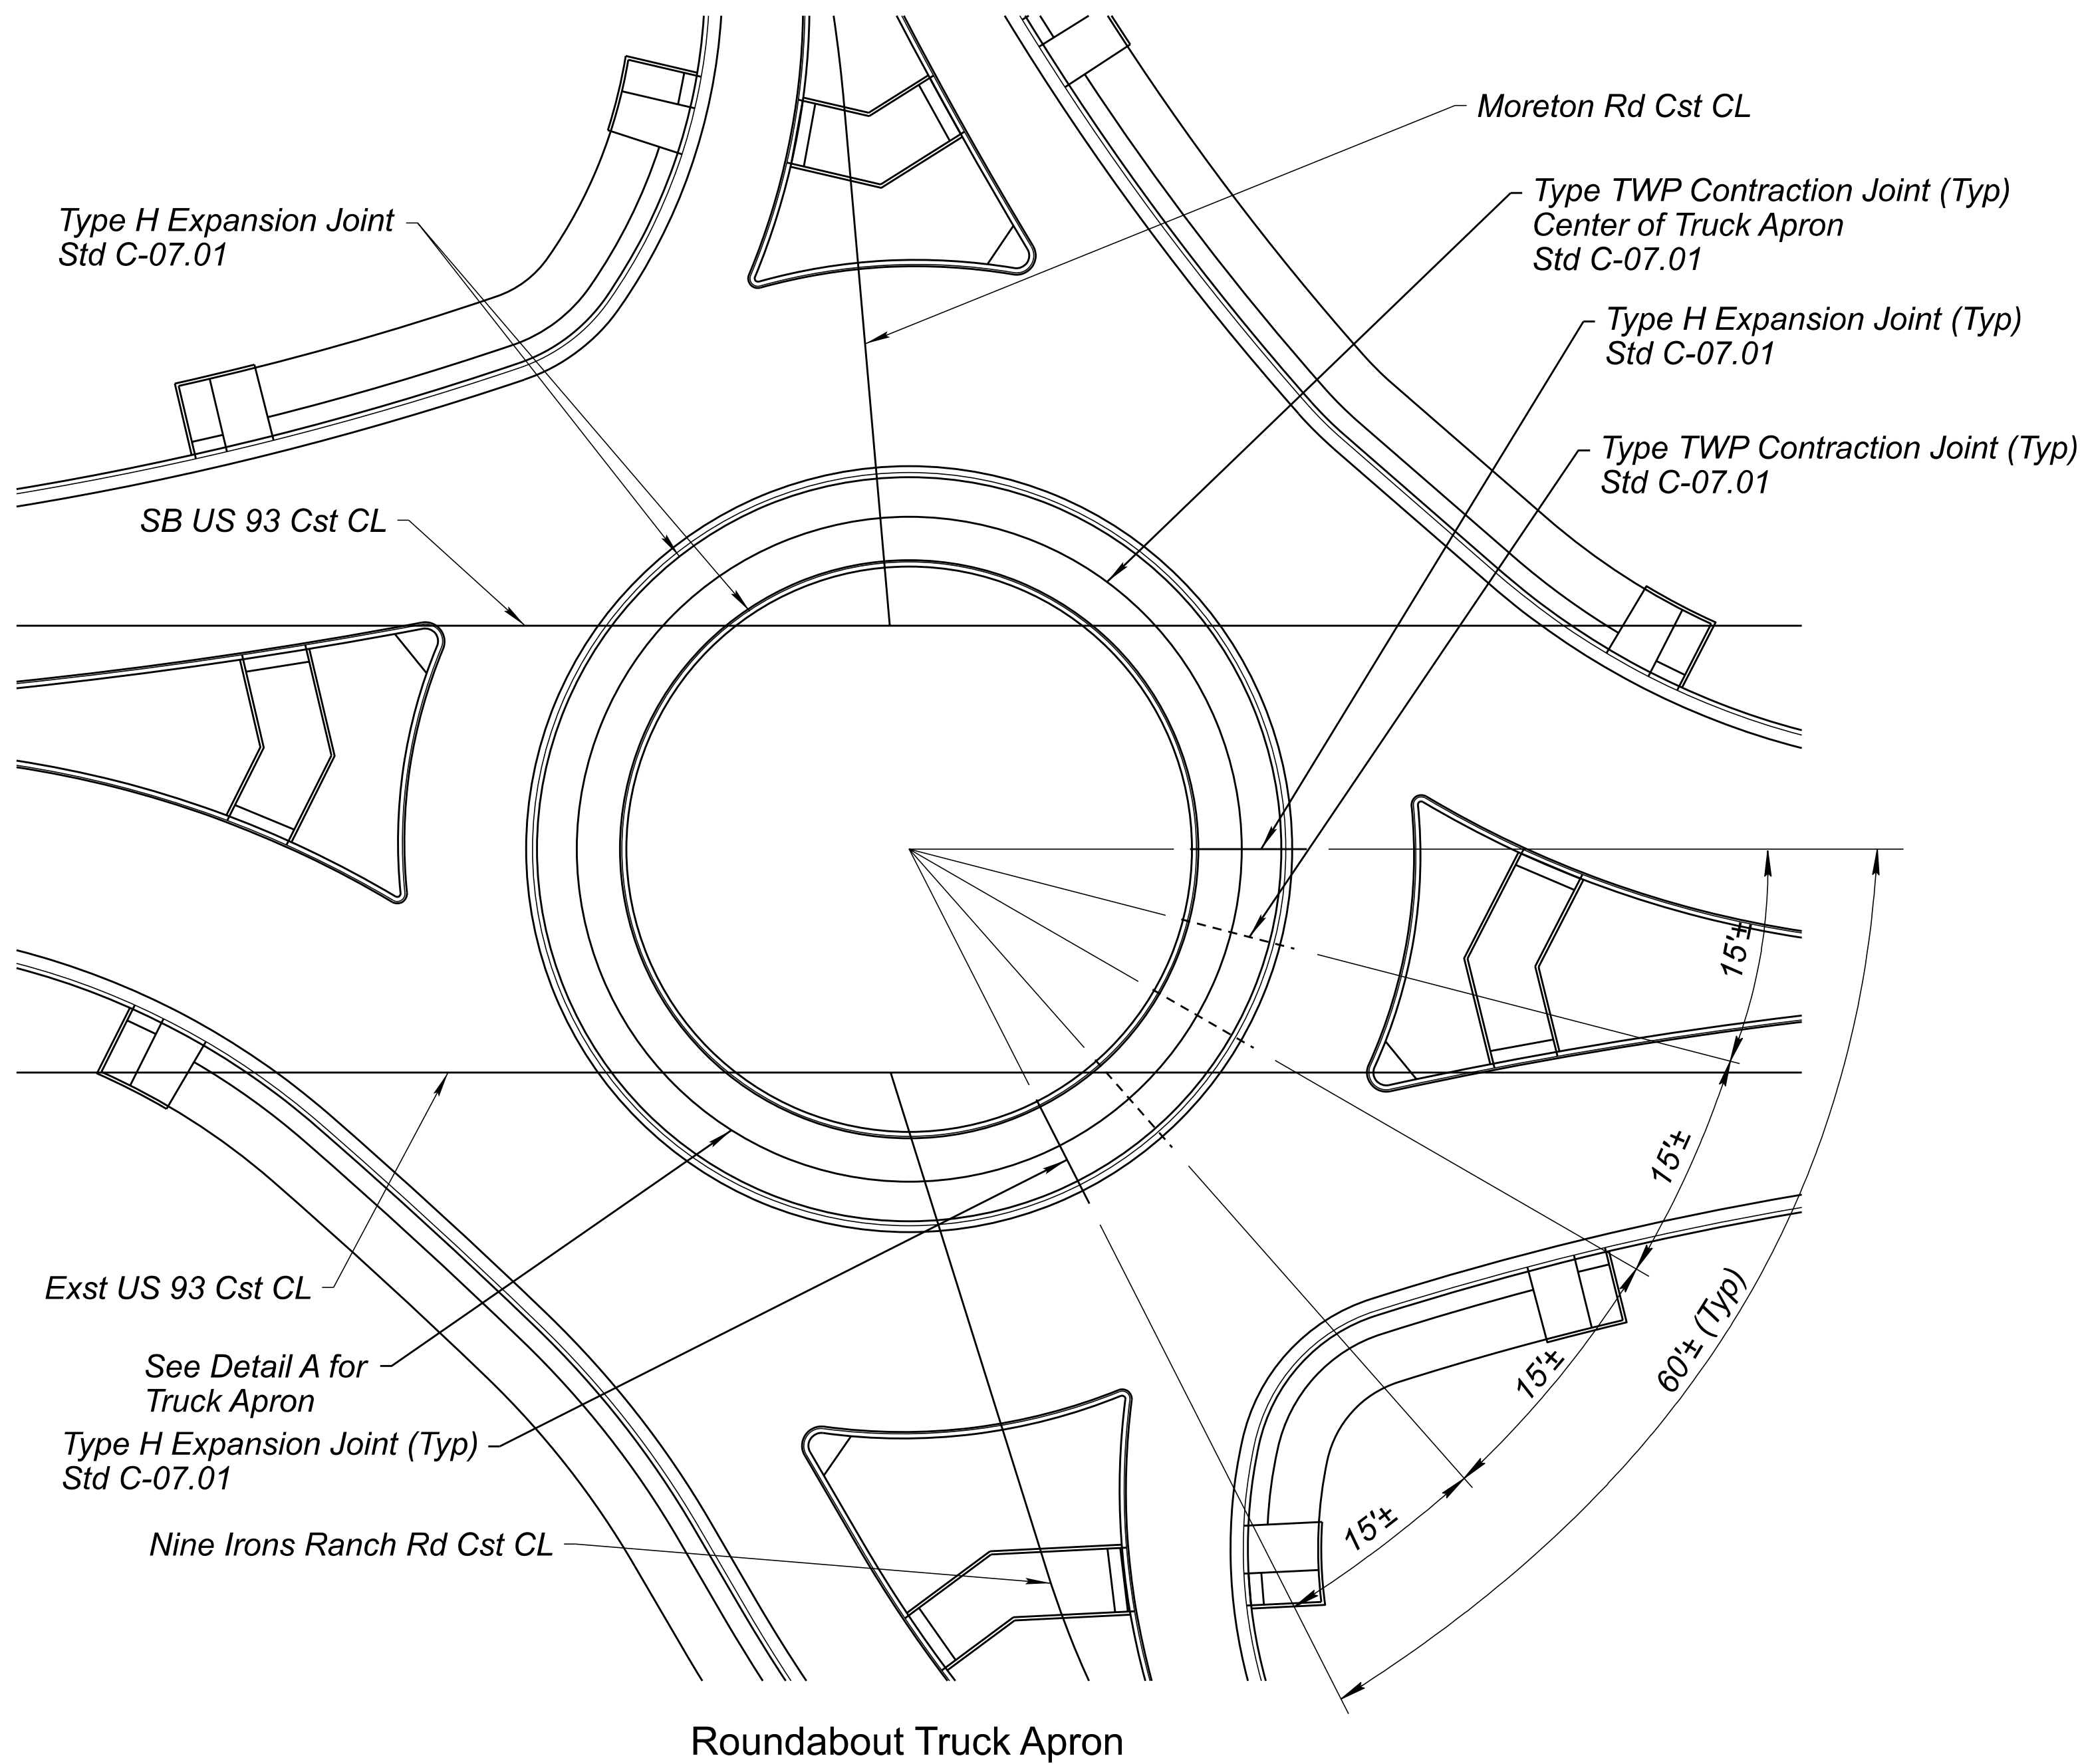

- NOTES**
1. Truck Apron for Roundabout Shall be Paid for under Bid Item 9080245 - CONCRETE (TRUCK APRON - DETAIL A).
 2. Curb & Gutter Shall be Paid Separately as Item No. 9080085 and 9080086.
 3. Curb Shall be Paid Separately as Item No. 9080042.
 4. The contraction and expansion joints shown in this detail shall also be applied to the US 93 / SR 89 roundabout.

	NAME		DATE	ARIZONA DEPARTMENT OF TRANSPORTATION PROJECT DELIVERY AND OPERATIONS DIVISION ROADWAY DESIGN SERVICES MORETON RD / NINE IRON RANCH RD ROUNDABOUT TRUCK APRON JOINT LAYOUT	ROUTE	F.H.W.A. Arizona Division	STATE	PROJECT NO.	FEDERAL ID NO.	SHEET NO.	TOTAL SHEETS	RECORD DRAWING	
	DESIGN		J GILLIS		06/26		US 93	ARIZ.	093 YV 189	093-B(230)T	236	524	
	DRAWN		M SAMUELSON		06/26	MILEPOST	LOCATION WICKENBURG RANCH WAY TO VISTA ROYALE						
	CHECKED		D WIGGINS		06/26	189.9	DWG No. C-6.04						
TRANSPORTATION AECOM TECHNICAL SERVICES, Inc. 7720 N. 16th St., Suite 100 Phoenix, Arizona 85020 T 602.371.1100 www.aecom.com					STRUCTURE NO.	TRACS NO. F0738 01C		OF					

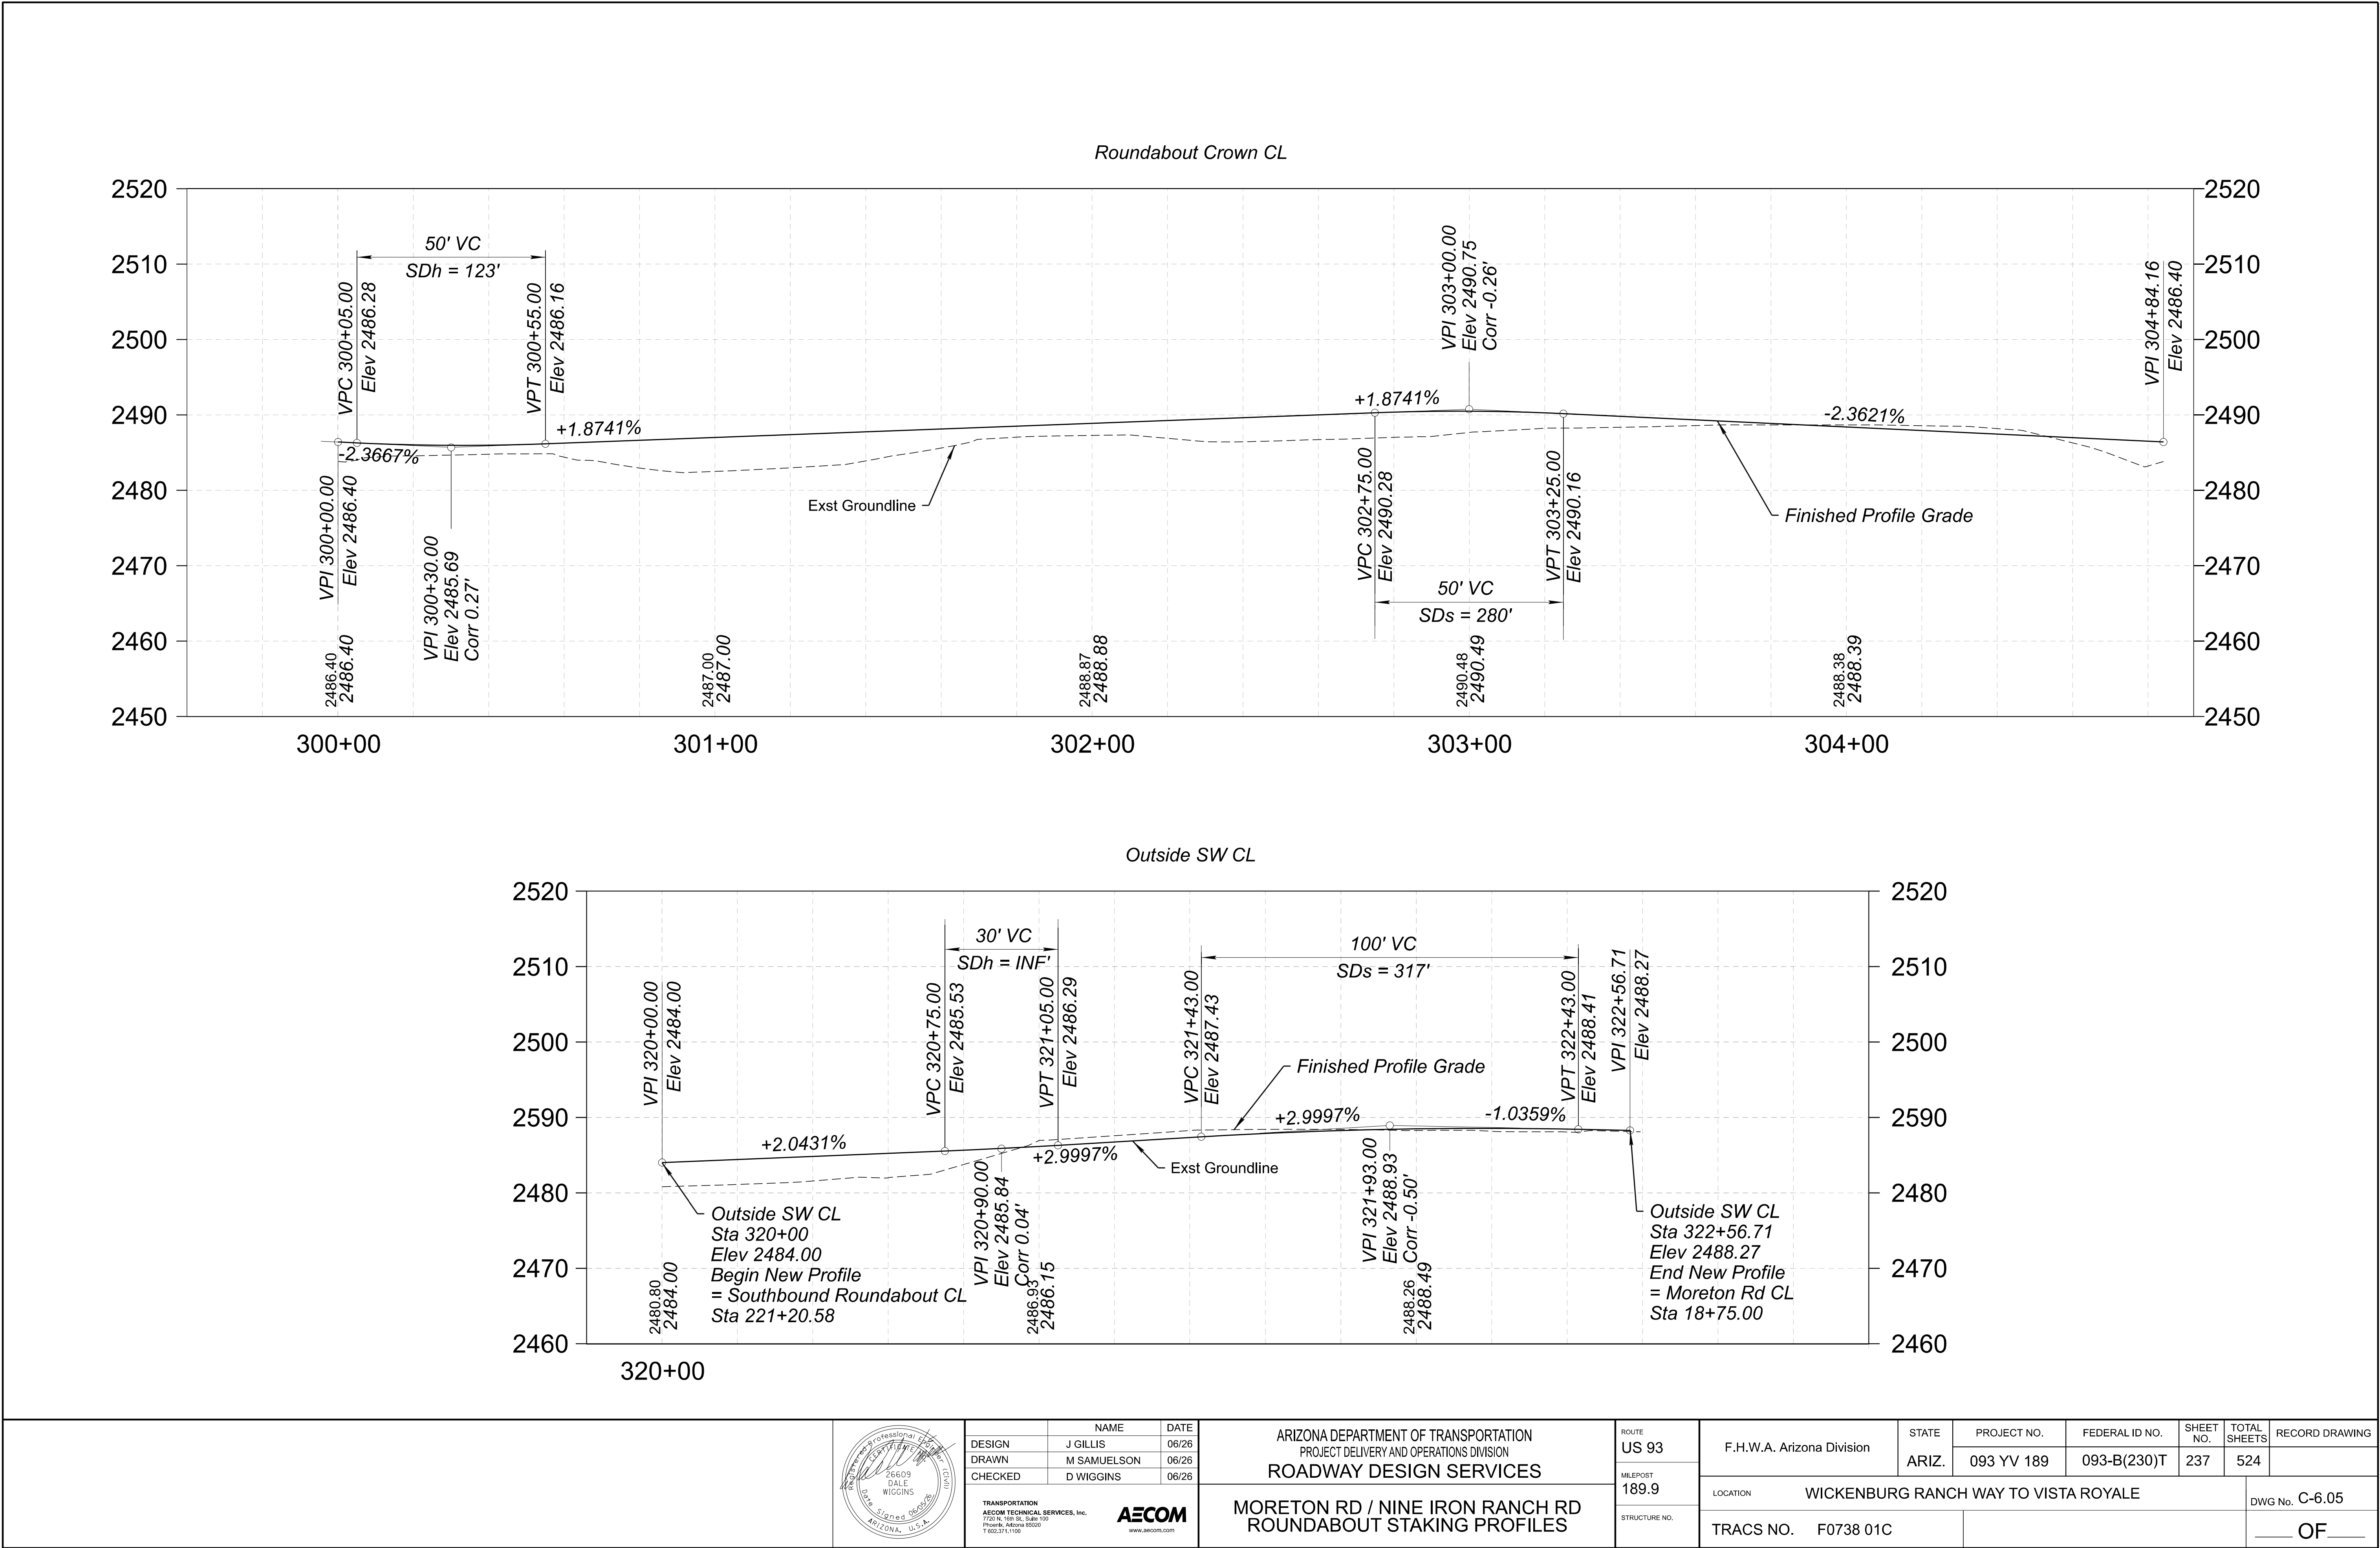

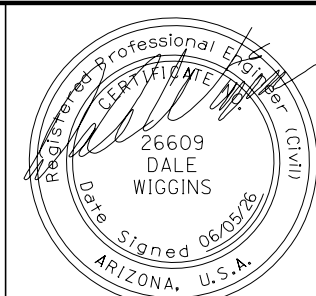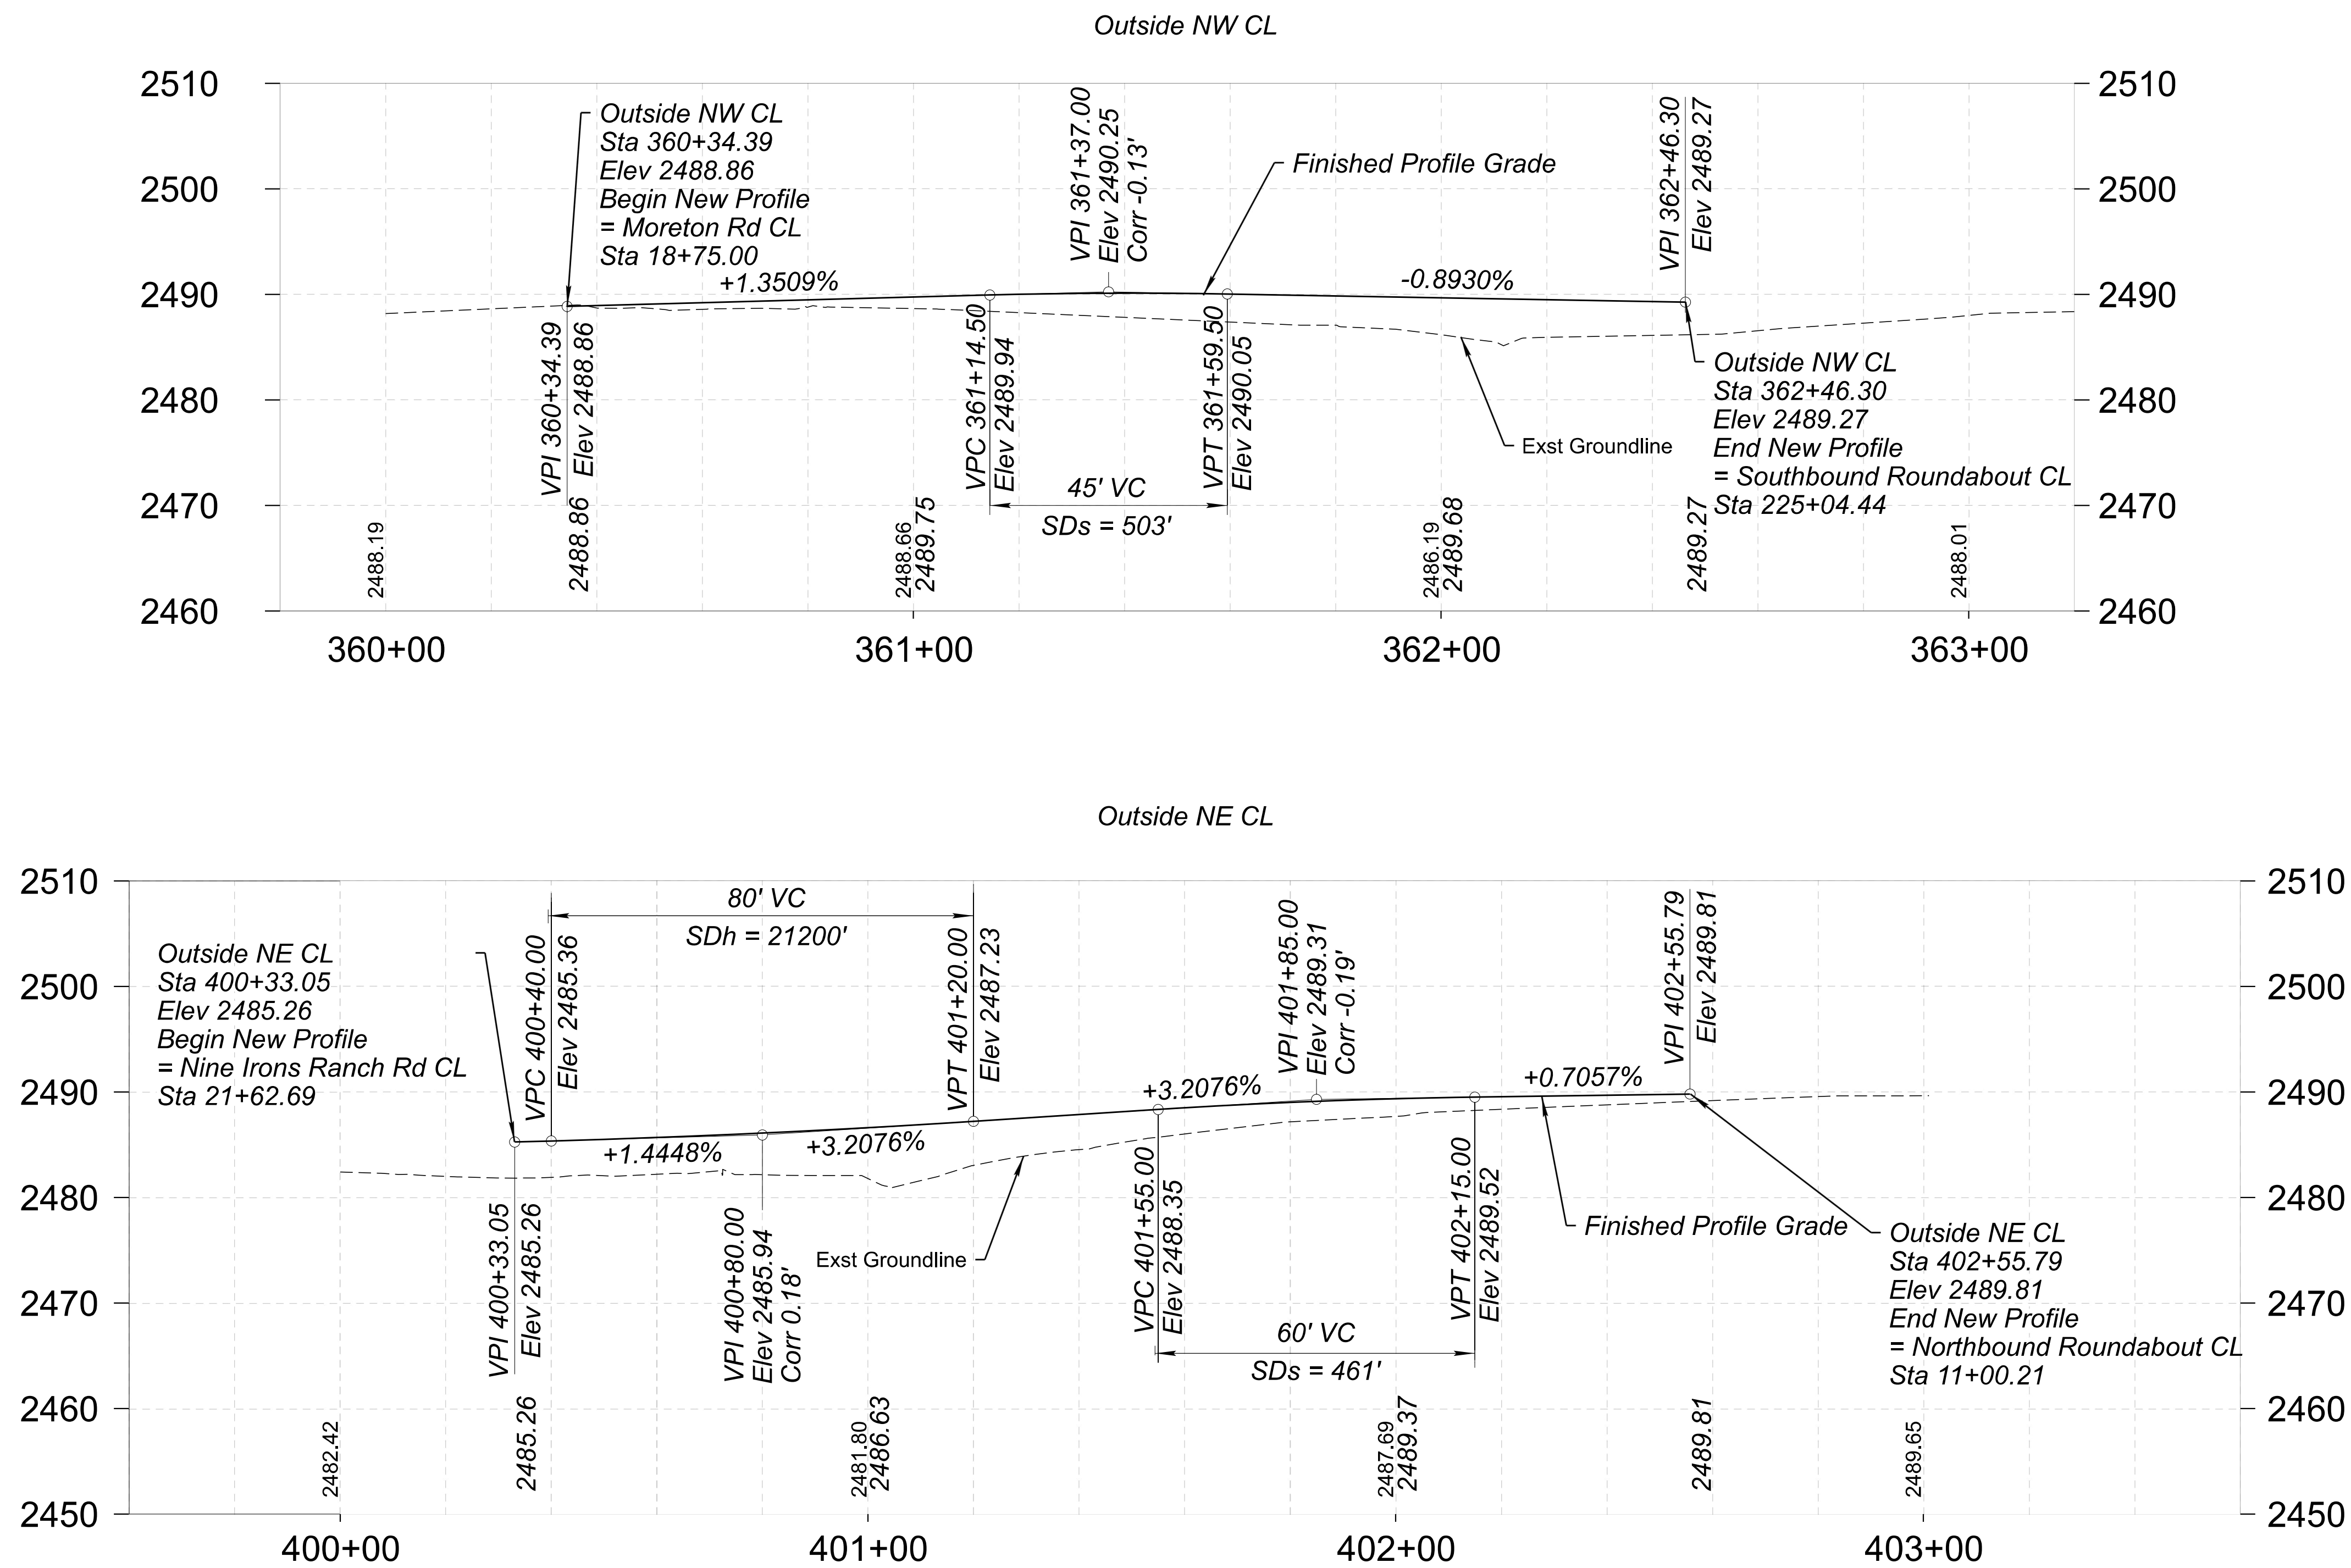


	NAME	DATE
DESIGN	J GILLIS	06/26
DRAWN	M SAMUELSON	06/26
CHECKED	D WIGGINS	06/26

TRANSPORTATION
AECOM TECHNICAL SERVICES, Inc.
7720 N. 16th St., Suite 100
Phoenix, Arizona 85020
T 602.371.1100

AECOM
www.aecom.com

ARIZONA DEPARTMENT OF TRANSPORTATION PROJECT DELIVERY AND OPERATIONS DIVISION ROADWAY DESIGN SERVICES	ROUTE US 93 MILEPOST 189.9 STRUCTURE NO.
MORETON RD / NINE IRON RANCH RD ROUNDAABOUT STAKING PROFILES	

F.H.W.A. Arizona Division	STATE ARIZ.	PROJECT NO. 093 YV 189	FEDERAL ID NO. 093-B(230)T	SHEET NO. 238	TOTAL SHEETS 524	RECORD DRAWING
LOCATION WICKENBURG RANCH WAY TO VISTA ROYALE	DWG No. C-6.06					
TRACS NO. F0738 01C	OF					

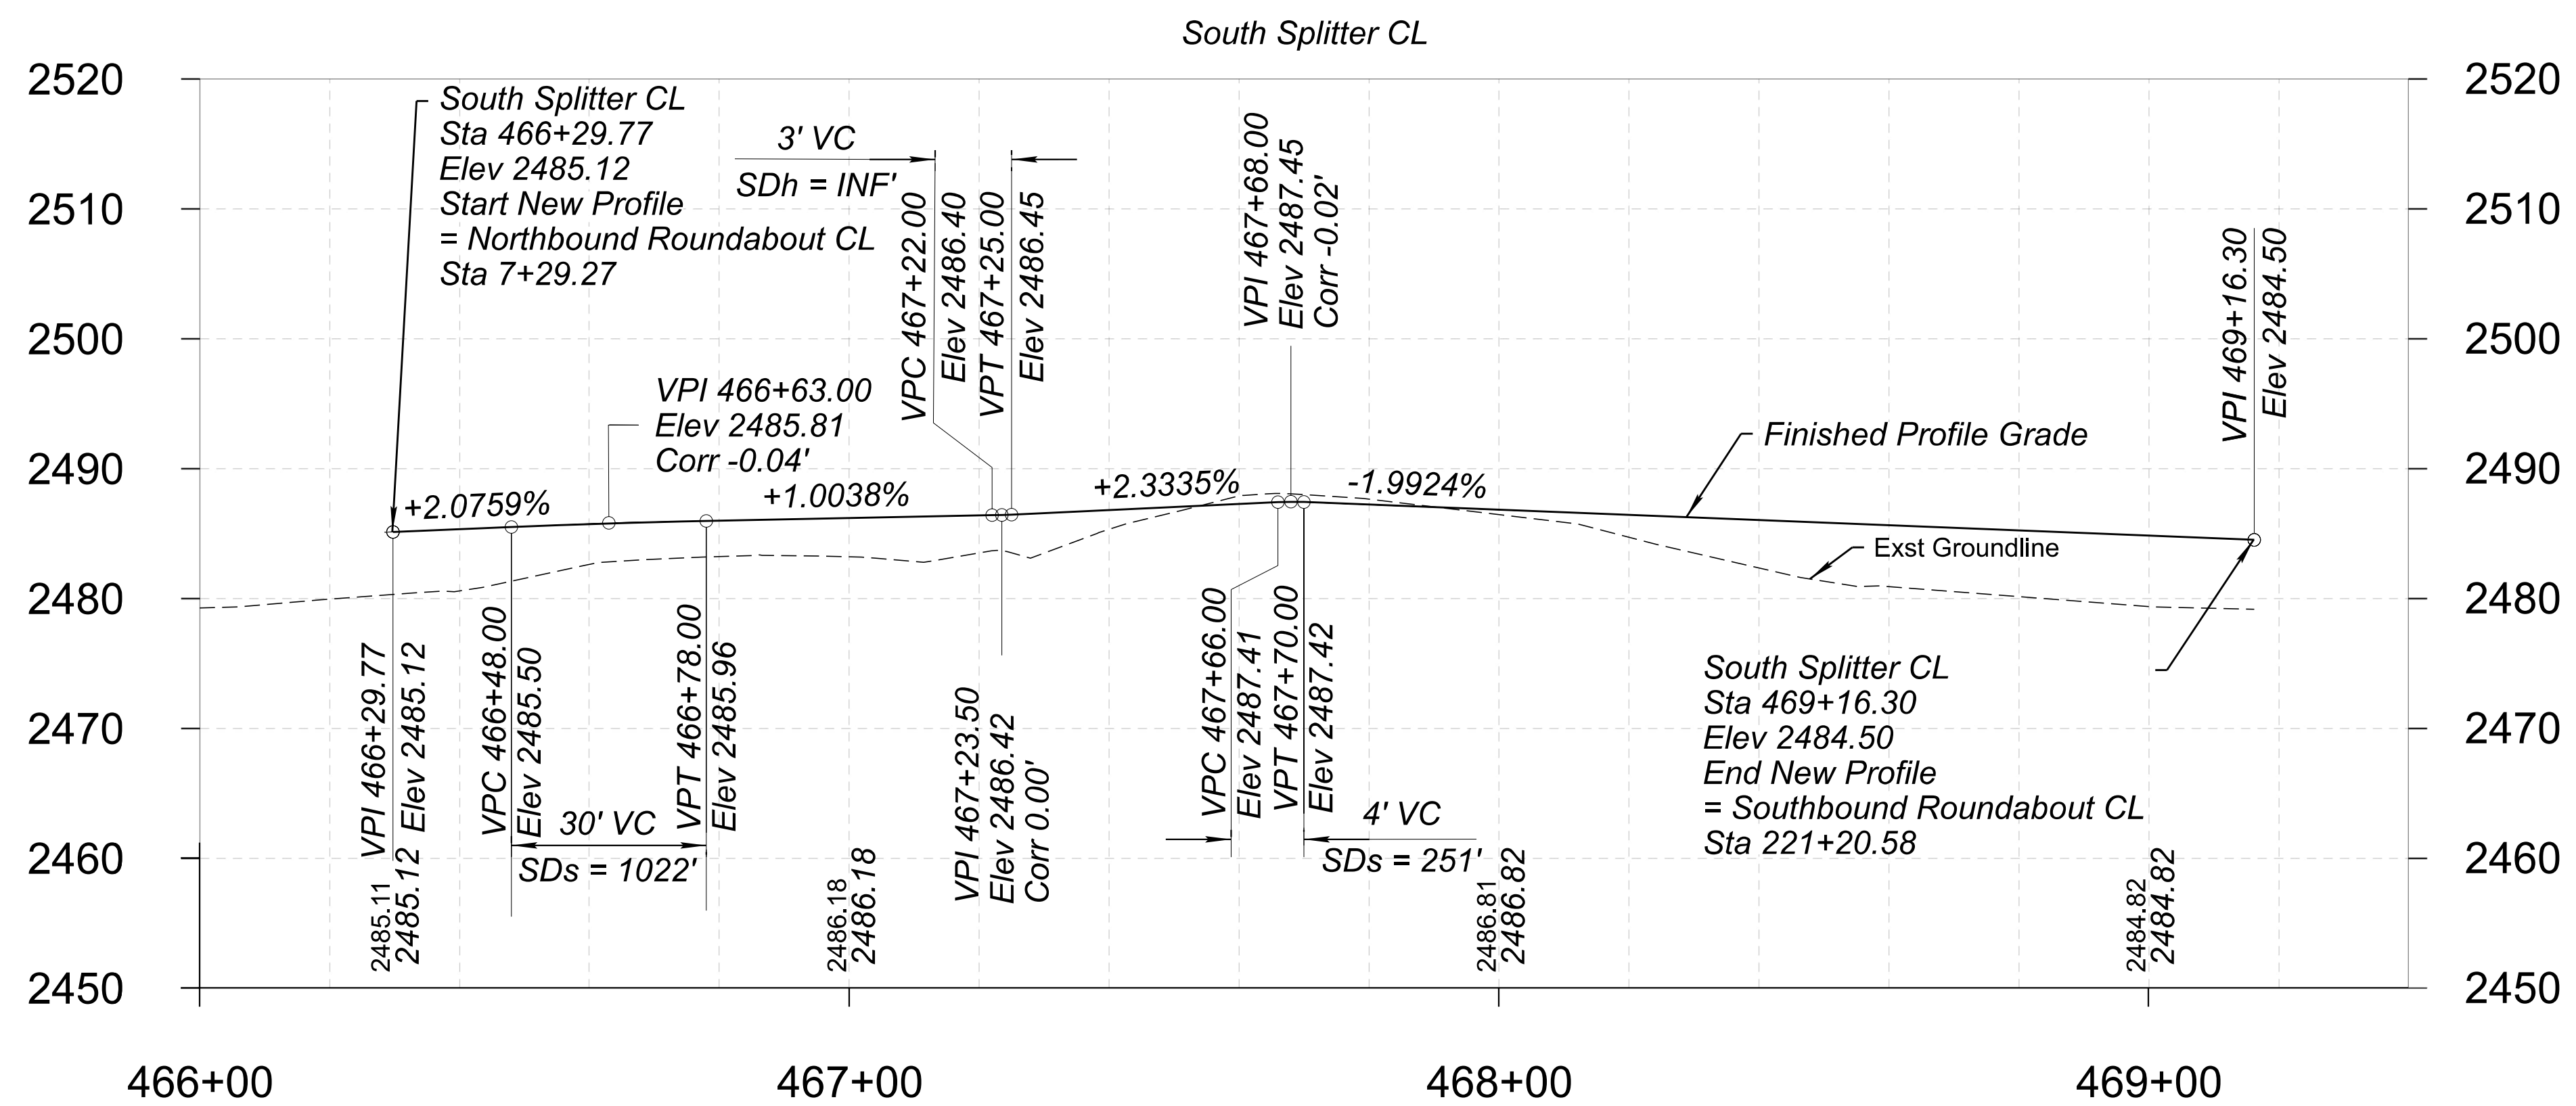

	NAME	DATE
DESIGN	J GILLIS	06/26
DRAWN	M SAMUELSON	06/26
CHECKED	D WIGGINS	06/26




TRANSPORTATION
AECOM TECHNICAL SERVICES, Inc.
 7720 N. 16th St., Suite 100
 Phoenix, Arizona 85020
 T 602.371.1100

AECOM
www.aecom.com

ARIZONA DEPARTMENT OF TRANSPORTATION
PROJECT DELIVERY AND OPERATIONS DIVISION
ROADWAY DESIGN SERVICES

MORETON RD / NINE IRON RANCH RD
 ROUNDABOUT STAKING PROFILES

ROUTE US 93	F.H.W.A. Arizona Division	STATE	PROJECT NO.	FEDERAL ID NO.	SHEET NO.	TOTAL SHEETS	RECORD DRAWING
MILEPOST 189.9		ARIZ.	093 YV 189	093-B(230)T	239	524	
	LOCATION WICKENBURG RANCH WAY TO VISTA ROYALE						DWG No. C-6.07
STRUCTURE NO.	TRACS NO. F0738 01C						OF

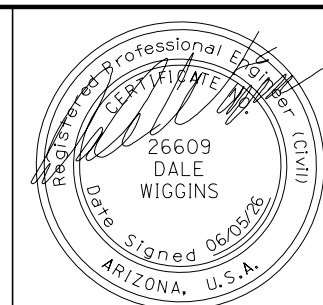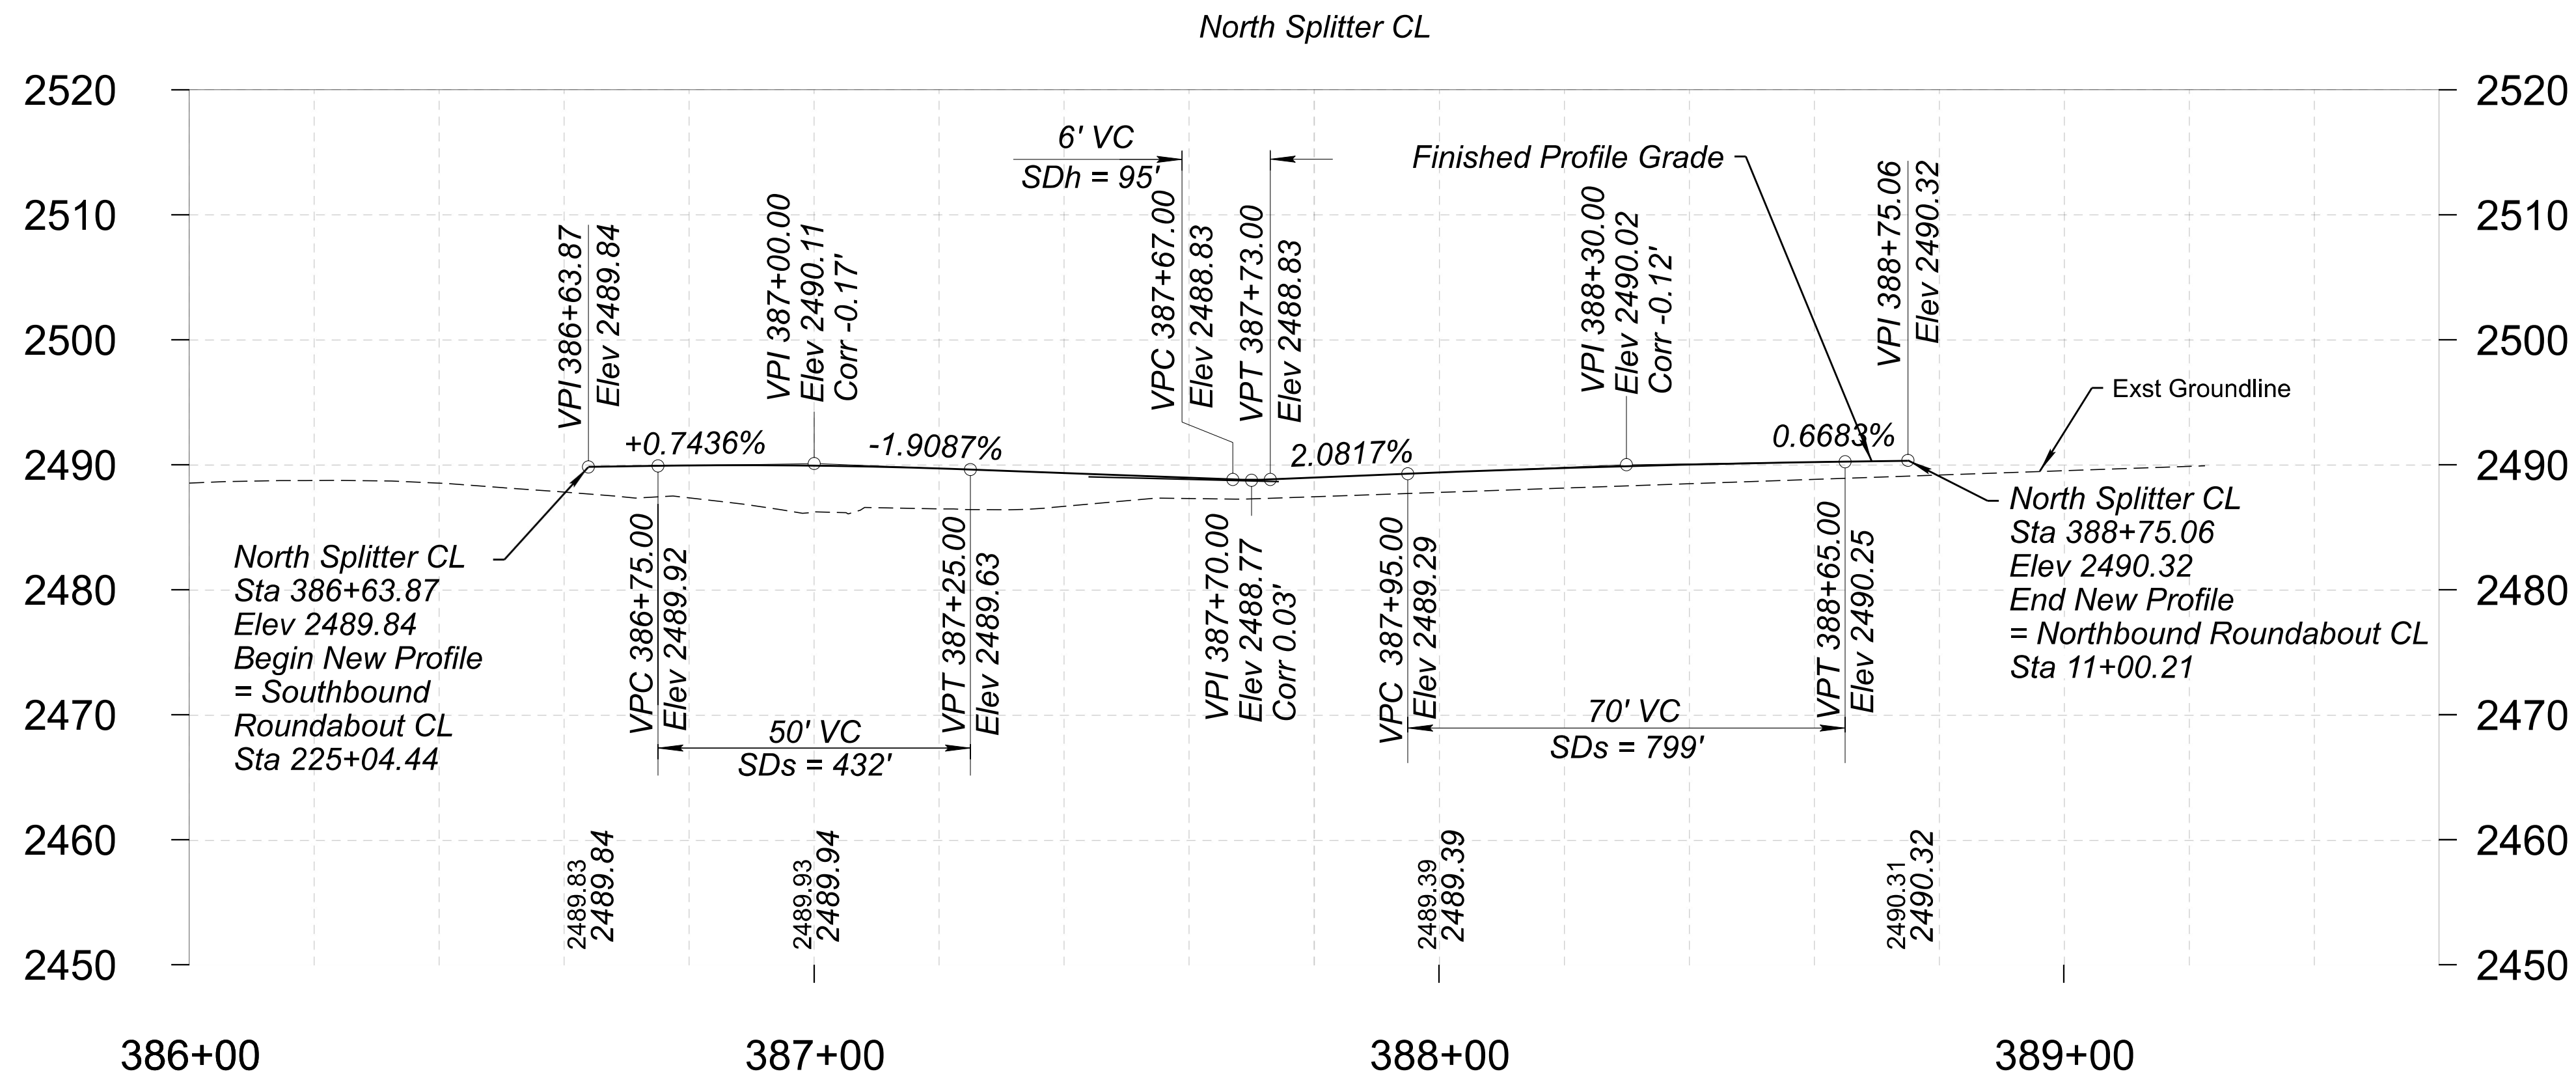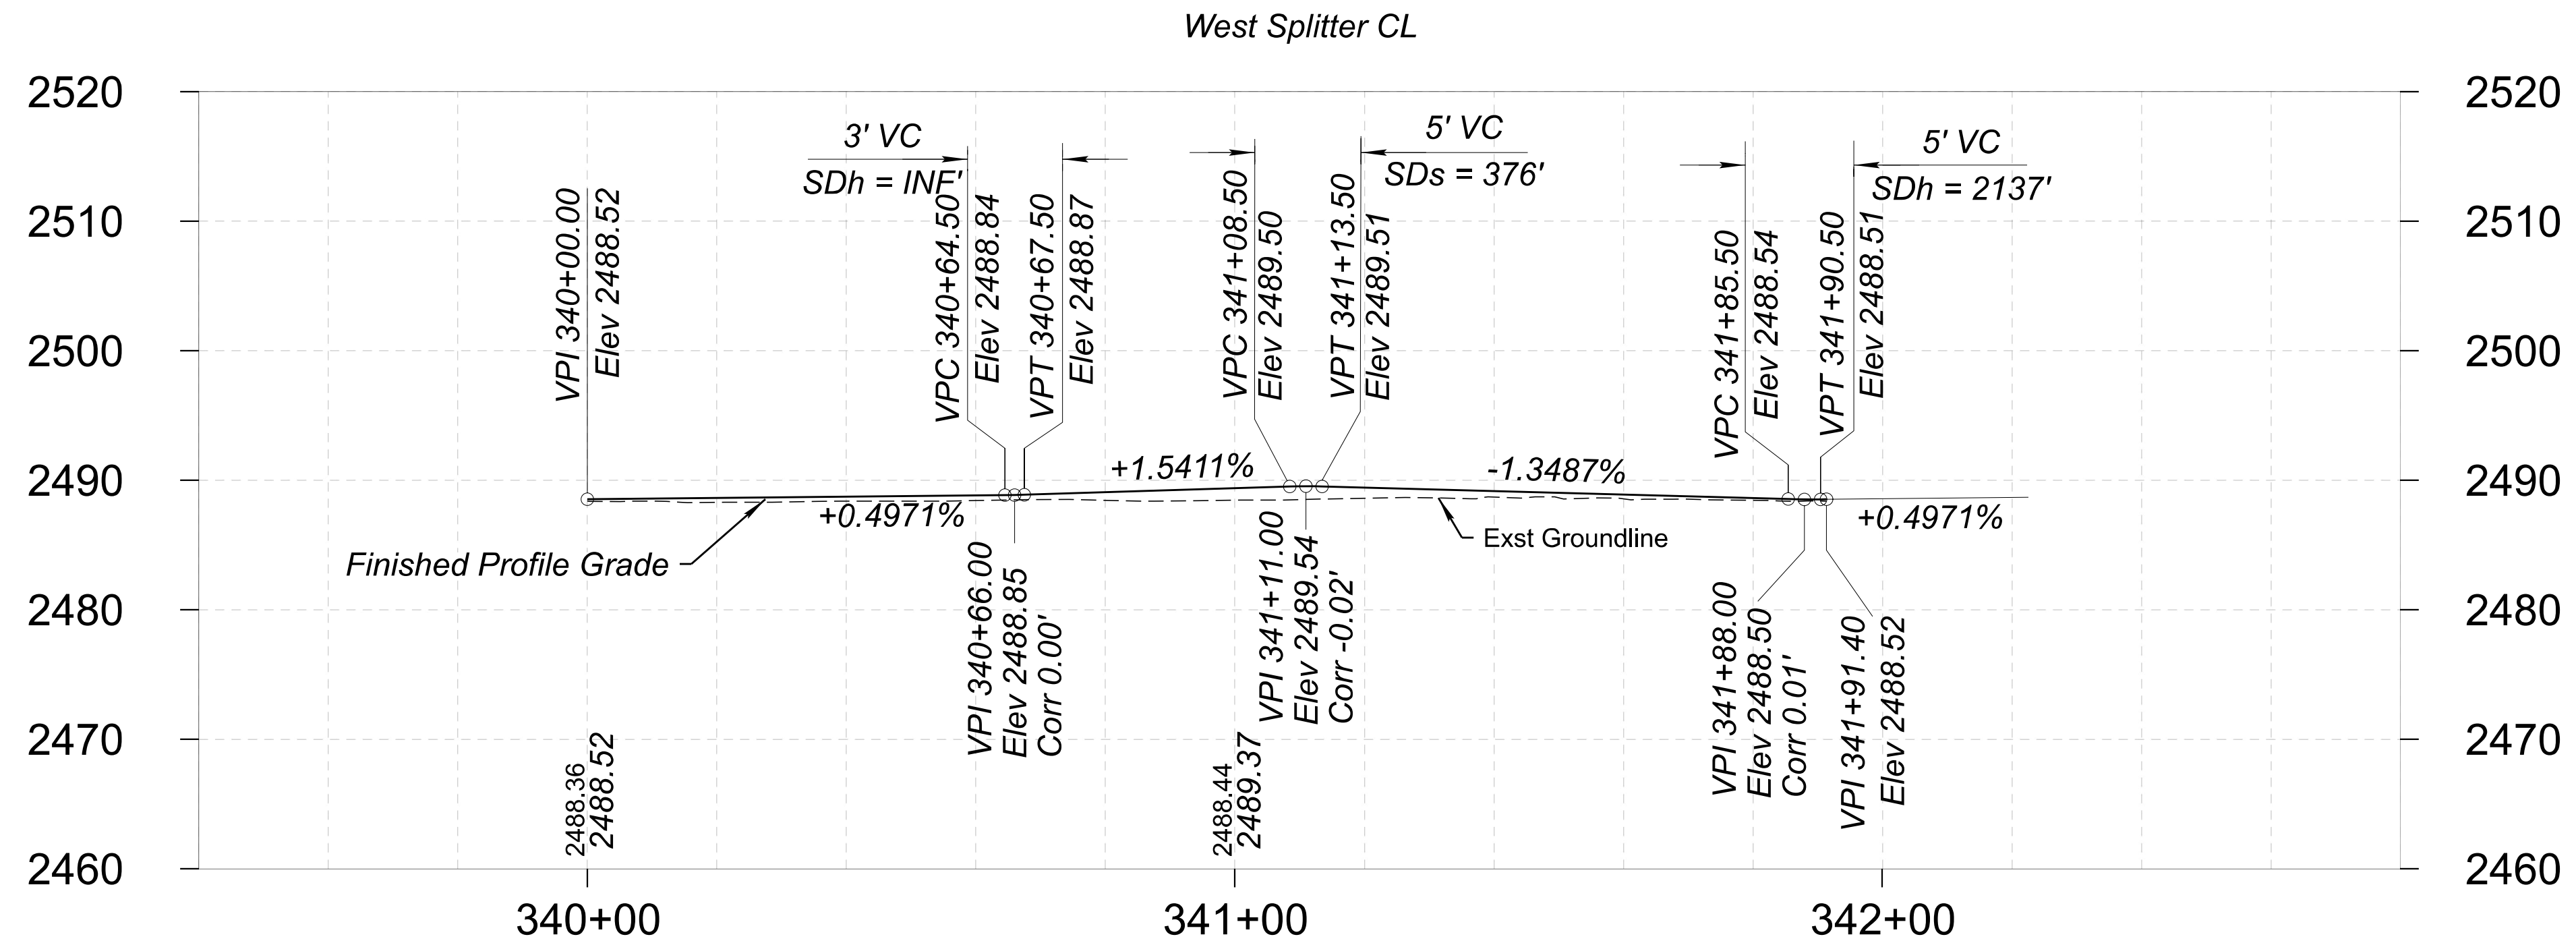


	NAME	DATE
DESIGN	J GILLIS	06/26
DRAWN	M SAMUELSON	06/26
CHECKED	D WIGGINS	06/26

TRANSPORTATION
AECOM TECHNICAL SERVICES, Inc.
7720 N. 16th St., Suite 100
Phoenix, Arizona 85020
T 602.371.1100
www.aecom.com


AECOM

ARIZONA DEPARTMENT OF TRANSPORTATION PROJECT DELIVERY AND OPERATIONS DIVISION ROADWAY DESIGN SERVICES
MORETON RD / NINE IRON RANCH RD ROUNDAABOUT STAKING PROFILES

ROUTE US 93	F.H.W.A. Arizona Division	STATE ARIZ.	PROJECT NO. 093 YV 189	FEDERAL ID NO. 093-B(230)T	SHEET NO. 240	TOTAL SHEETS 524	RECORD DRAWING
MILEPOST 189.9	WICKENBURG RANCH WAY TO VISTA ROYALE					DWG No. C-6.08	
STRUCTURE NO.	TRACS NO. F0738 01C					____ OF ____	

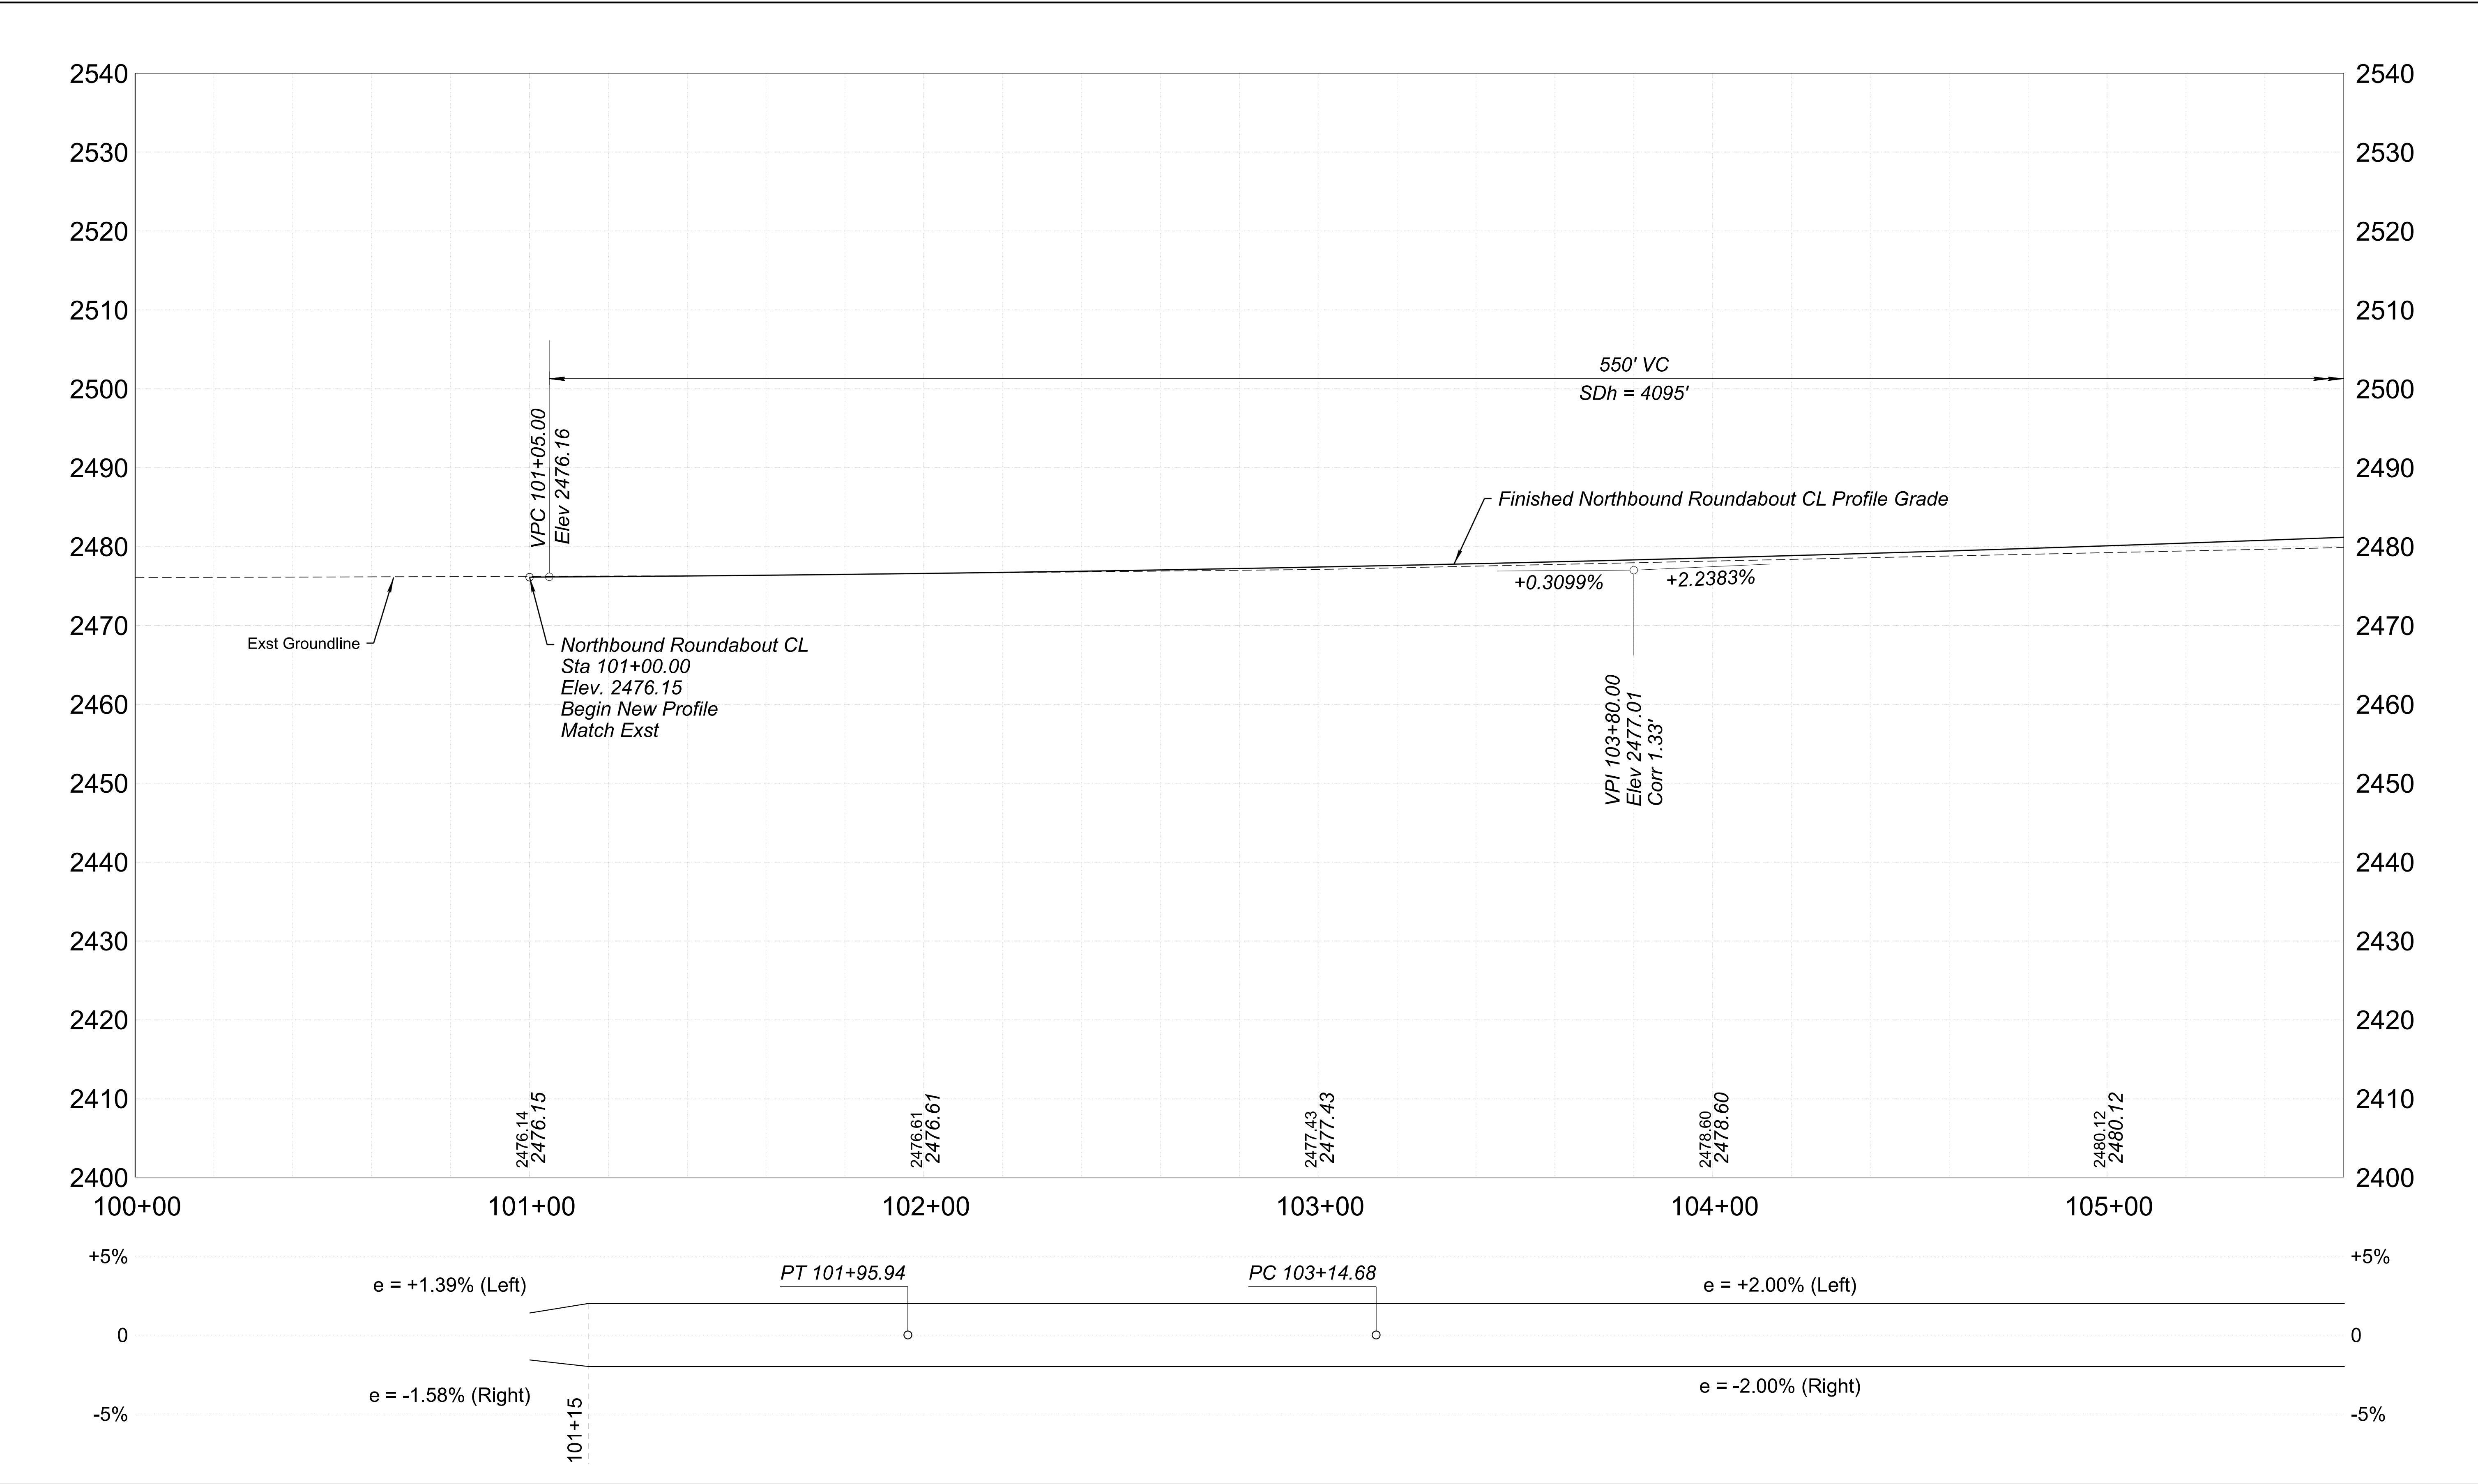

	<table><tr><th></th><th>NAME</th><th>DATE</th></tr><tr><td>DESIGN</td><td>J GILLIS</td><td>06/26</td></tr><tr><td>DRAWN</td><td>M SAMUELSON</td><td>06/26</td></tr><tr><td>CHECKED</td><td>J BEMELEN</td><td>06/26</td></tr></table>			NAME	DATE	DESIGN	J GILLIS	06/26	DRAWN	M SAMUELSON	06/26	CHECKED	J BEMELEN	06/26	<table><tr><td colspan="2">ARIZONA DEPARTMENT OF TRANSPORTATION PROJECT DELIVERY AND OPERATIONS DIVISION ROADWAY DESIGN SERVICES</td></tr><tr><td colspan="2">TRANSPORTATION AECOM TECHNICAL SERVICES, Inc. 7720 N. 16th St., Suite 100 Phoenix, Arizona 85020 T 602.371.1100 www.aecom.com</td></tr><tr><td colspan="2"></td></tr><tr><td colspan="2">MORETON RD / NINE IRON RANCH RD ROUNDAABOUT STAKING PROFILES</td></tr></table>		ARIZONA DEPARTMENT OF TRANSPORTATION PROJECT DELIVERY AND OPERATIONS DIVISION ROADWAY DESIGN SERVICES		TRANSPORTATION AECOM TECHNICAL SERVICES, Inc. 7720 N. 16th St., Suite 100 Phoenix, Arizona 85020 T 602.371.1100 www.aecom.com				MORETON RD / NINE IRON RANCH RD ROUNDAABOUT STAKING PROFILES		<table><tr><td>ROUTE</td><td>F.H.W.A. Arizona Division</td><td>STATE</td><td>PROJECT NO.</td><td>FEDERAL ID NO.</td><td>SHEET NO.</td><td>TOTAL SHEETS</td><td>RECORD DRAWING</td></tr><tr><td>US 93</td><td rowspan="2">ARIZ.</td><td>093 YV 189</td><td>093-B(230)T</td><td>242</td><td>524</td><td></td><td></td></tr><tr><td>MILEPOST 189.9</td><td colspan="5">LOCATION WICKENBURG RANCH WAY TO VISTA ROYALE</td><td>DWG No. C-6.10</td></tr><tr><td>STRUCTURE NO.</td><td colspan="2">TRACS NO. F0738 01C</td><td colspan="4"></td><td>___ OF ___</td></tr></table>	ROUTE	F.H.W.A. Arizona Division	STATE	PROJECT NO.	FEDERAL ID NO.	SHEET NO.	TOTAL SHEETS	RECORD DRAWING	US 93	ARIZ.	093 YV 189	093-B(230)T	242	524			MILEPOST 189.9	LOCATION WICKENBURG RANCH WAY TO VISTA ROYALE					DWG No. C-6.10	STRUCTURE NO.	TRACS NO. F0738 01C						___ OF ___
		NAME	DATE																																																					
	DESIGN	J GILLIS	06/26																																																					
	DRAWN	M SAMUELSON	06/26																																																					
	CHECKED	J BEMELEN	06/26																																																					
ARIZONA DEPARTMENT OF TRANSPORTATION PROJECT DELIVERY AND OPERATIONS DIVISION ROADWAY DESIGN SERVICES																																																								
TRANSPORTATION AECOM TECHNICAL SERVICES, Inc. 7720 N. 16th St., Suite 100 Phoenix, Arizona 85020 T 602.371.1100 www.aecom.com																																																								
																																																								
MORETON RD / NINE IRON RANCH RD ROUNDAABOUT STAKING PROFILES																																																								
ROUTE	F.H.W.A. Arizona Division	STATE	PROJECT NO.	FEDERAL ID NO.	SHEET NO.	TOTAL SHEETS	RECORD DRAWING																																																	
US 93	ARIZ.	093 YV 189	093-B(230)T	242	524																																																			
MILEPOST 189.9		LOCATION WICKENBURG RANCH WAY TO VISTA ROYALE					DWG No. C-6.10																																																	
STRUCTURE NO.	TRACS NO. F0738 01C						___ OF ___																																																	

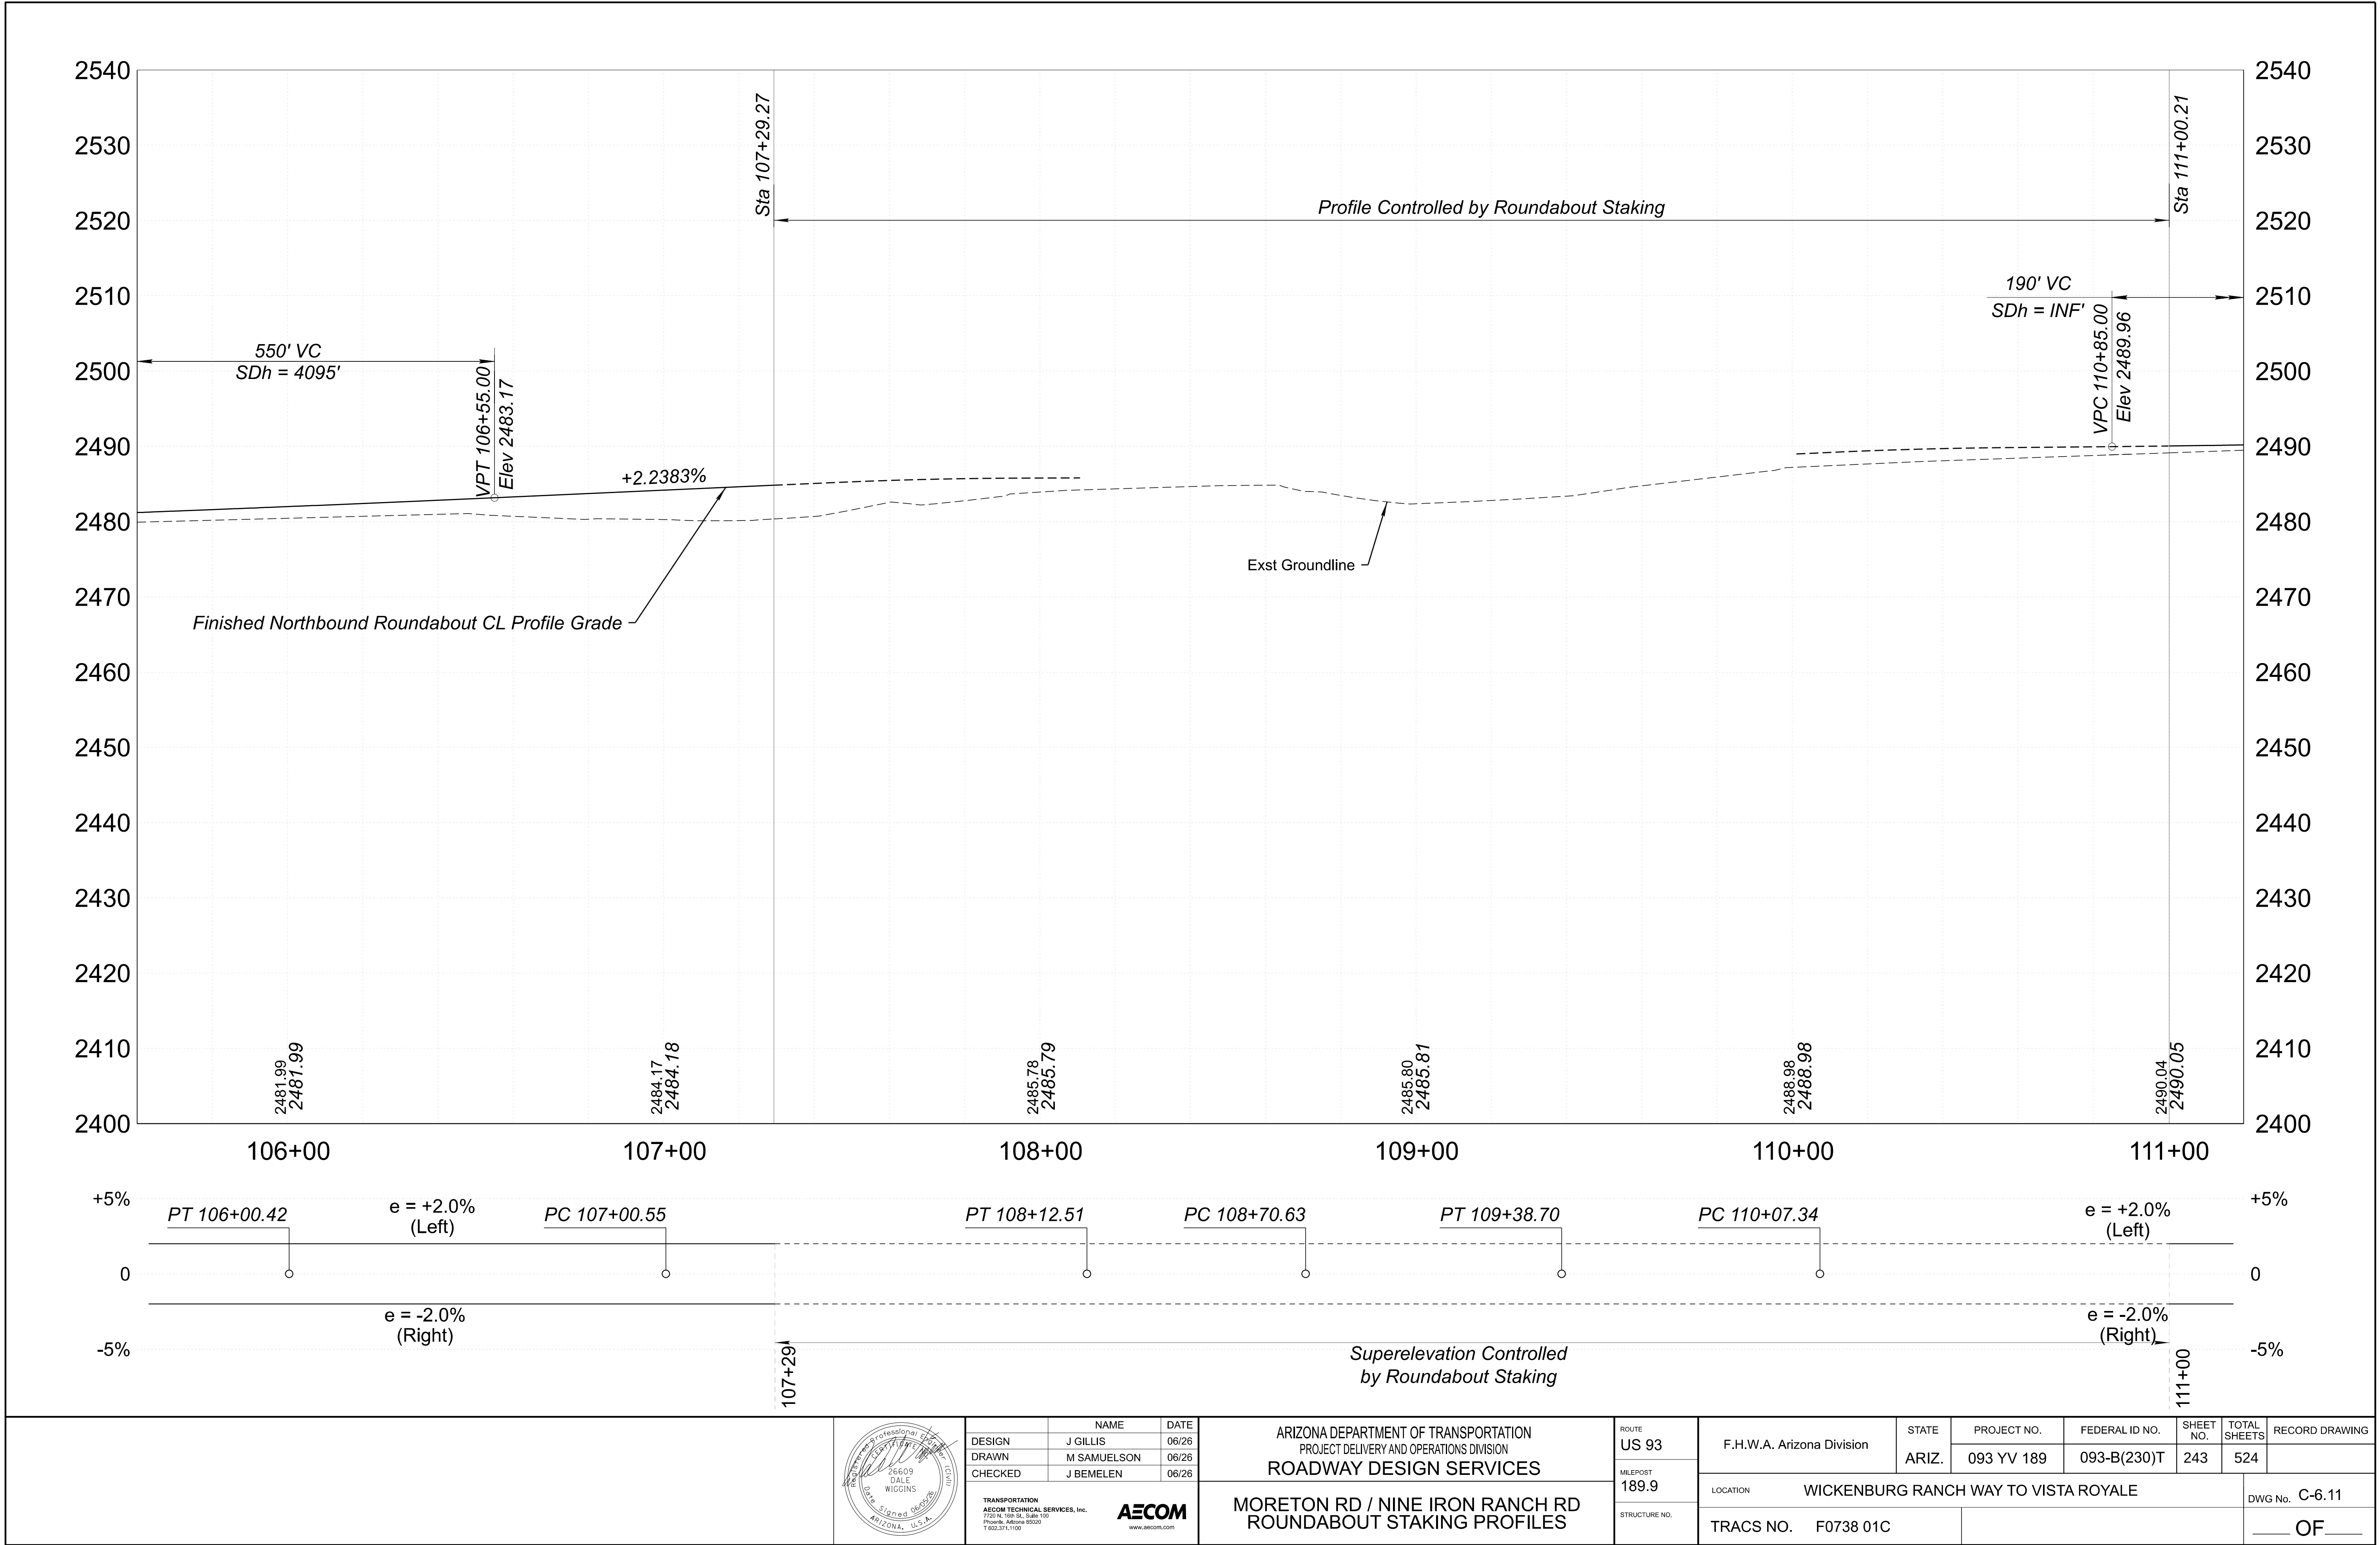


	NAME	DATE
DESIGN	J GILLIS	06/26
DRAWN	M SAMUELSON	06/26
CHECKED	J BEMELEN	06/26


TRANSPORTATION
AECOM TECHNICAL SERVICES, Inc.
7720 N. 16th St., Suite 100
Phoenix, Arizona 85020
T 602.371.1100

AECOM
www.aecom.com


ARIZONA DEPARTMENT OF TRANSPORTATION PROJECT DELIVERY AND OPERATIONS DIVISION ROADWAY DESIGN SERVICES
MORETON RD / NINE IRON RANCH RD ROUNDAABOUT STAKING PROFILES

ROUTE US 93	F.H.W.A. Arizona Division	STATE ARIZ.	PROJECT NO. 093 YV 189	FEDERAL ID NO. 093-B(230)T	SHEET NO. 243	TOTAL SHEETS 524	RECORD DRAWING
MILEPOST 189.9	LOCATION WICKENBURG RANCH WAY TO VISTA ROYALE	TRACS NO. F0738 01C	DWG No. C-6.11	OF			
STRUCTURE NO.							

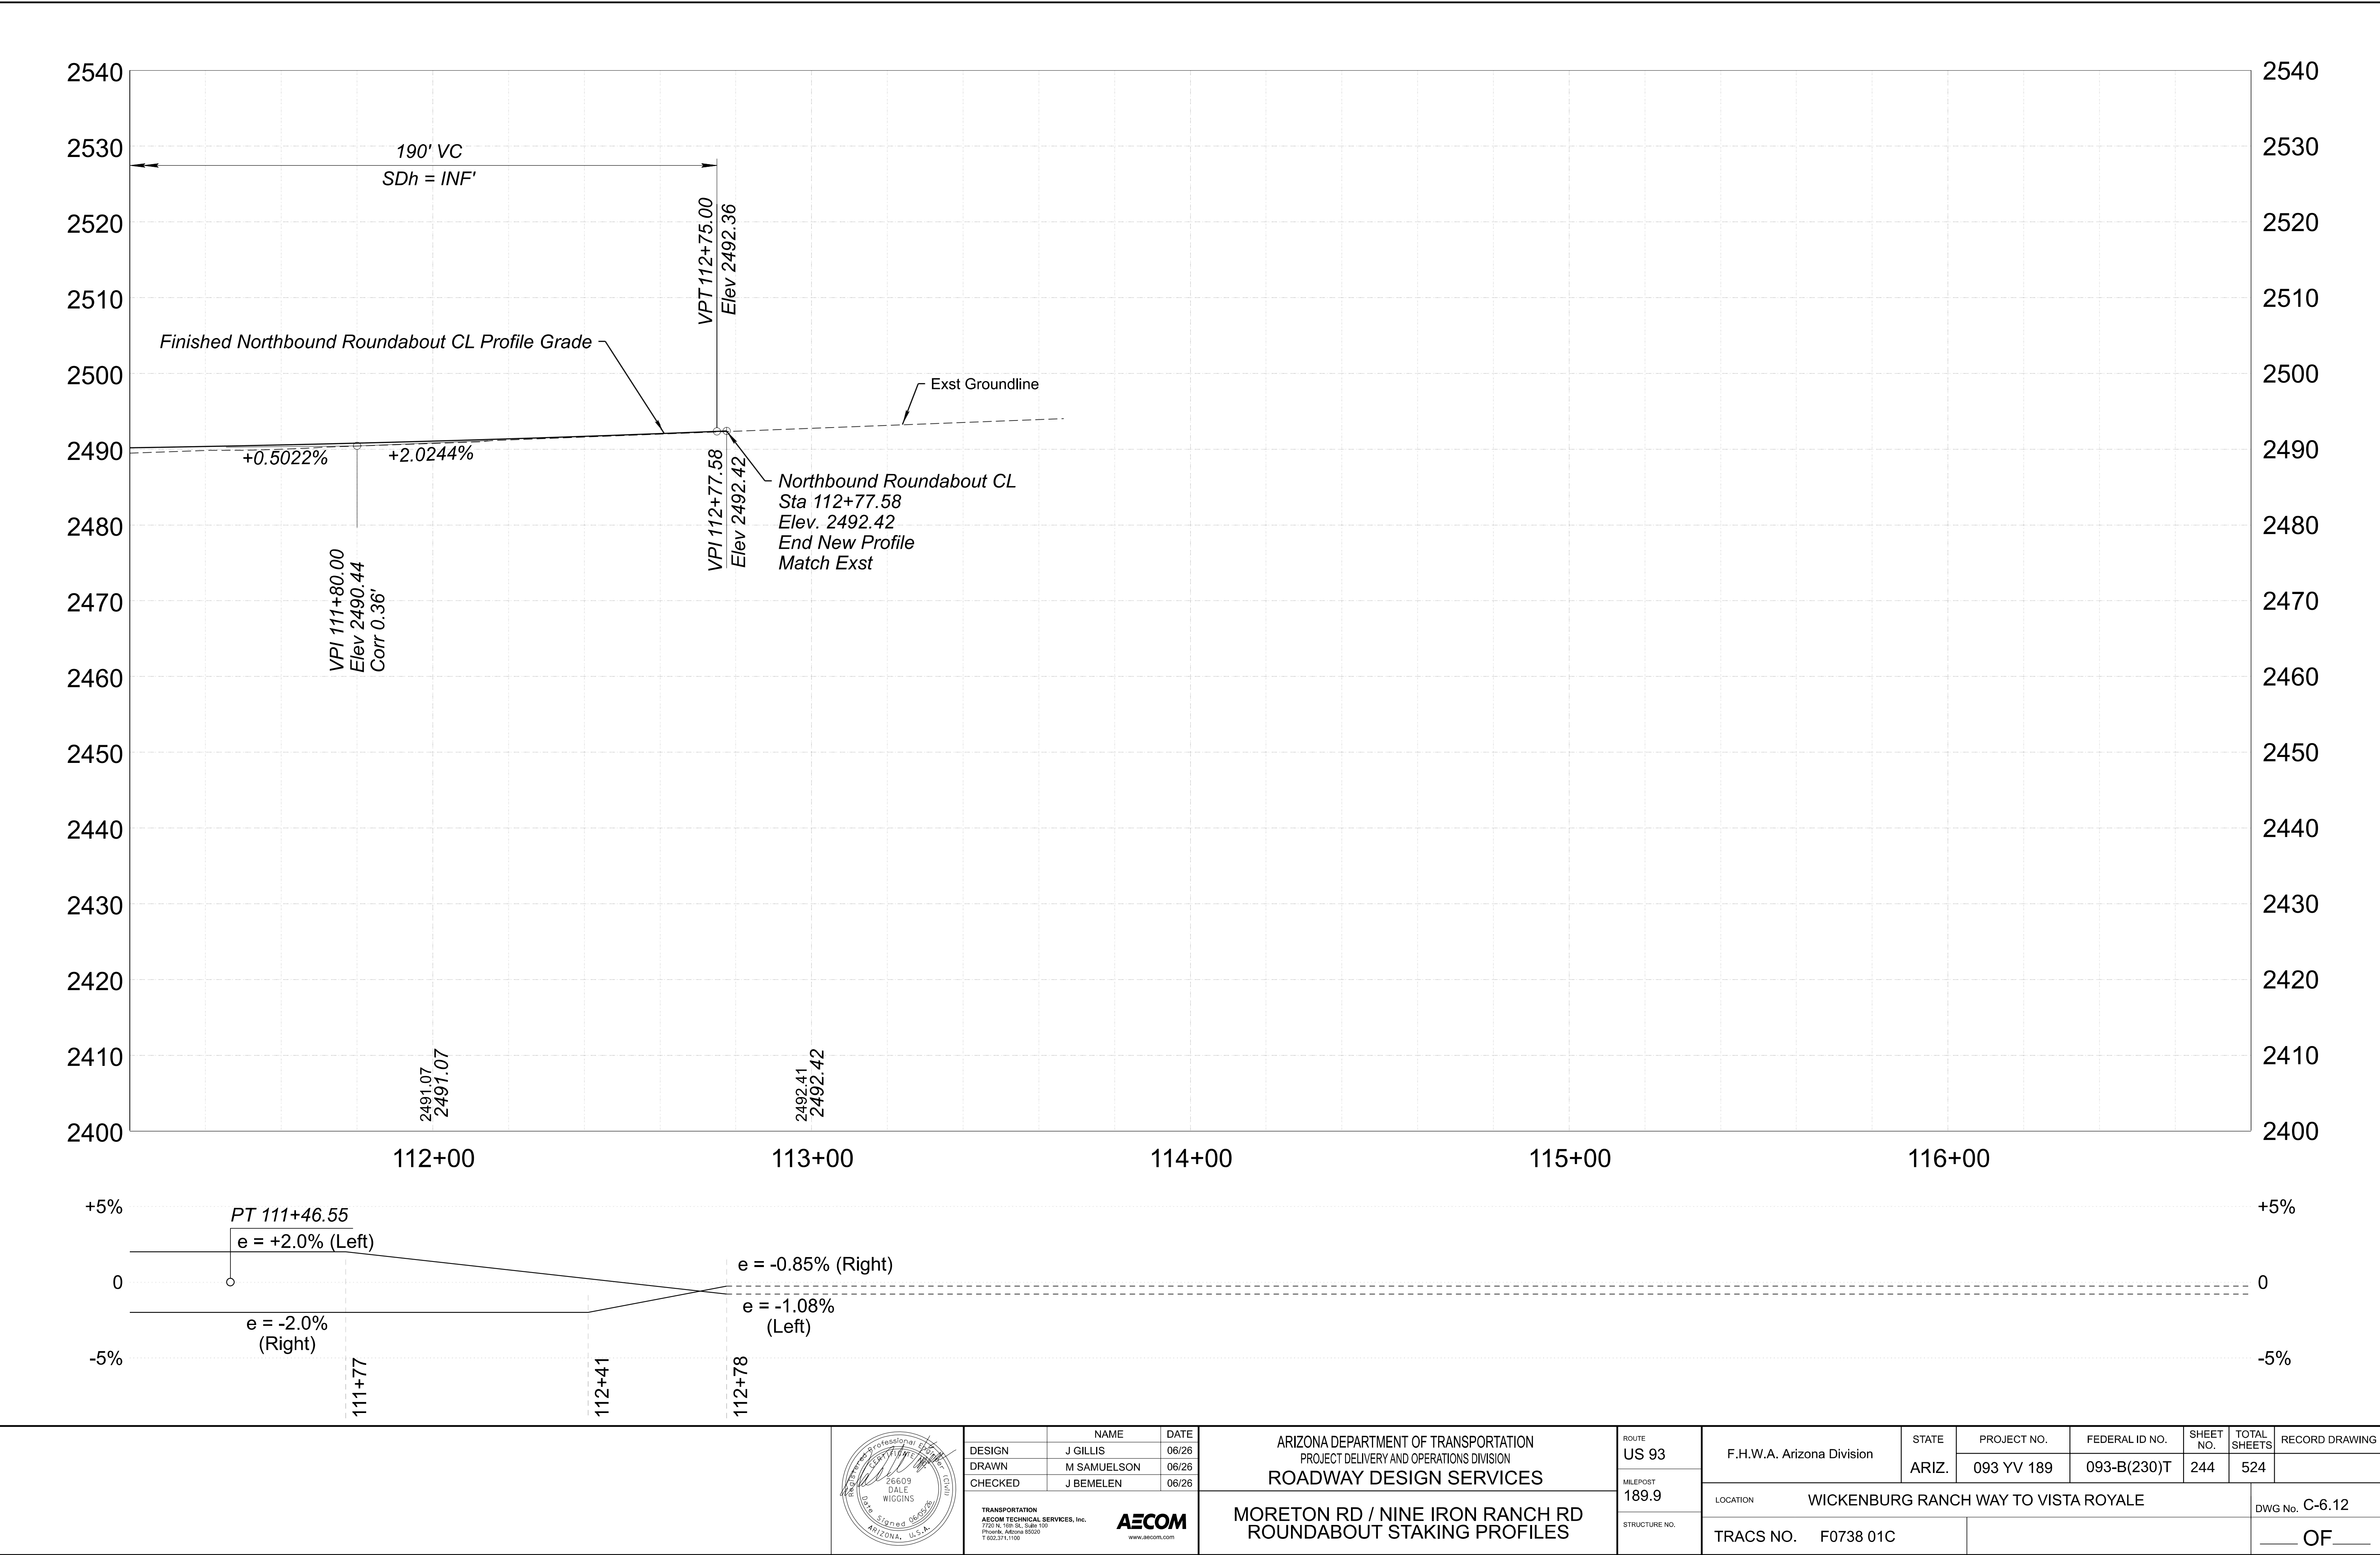

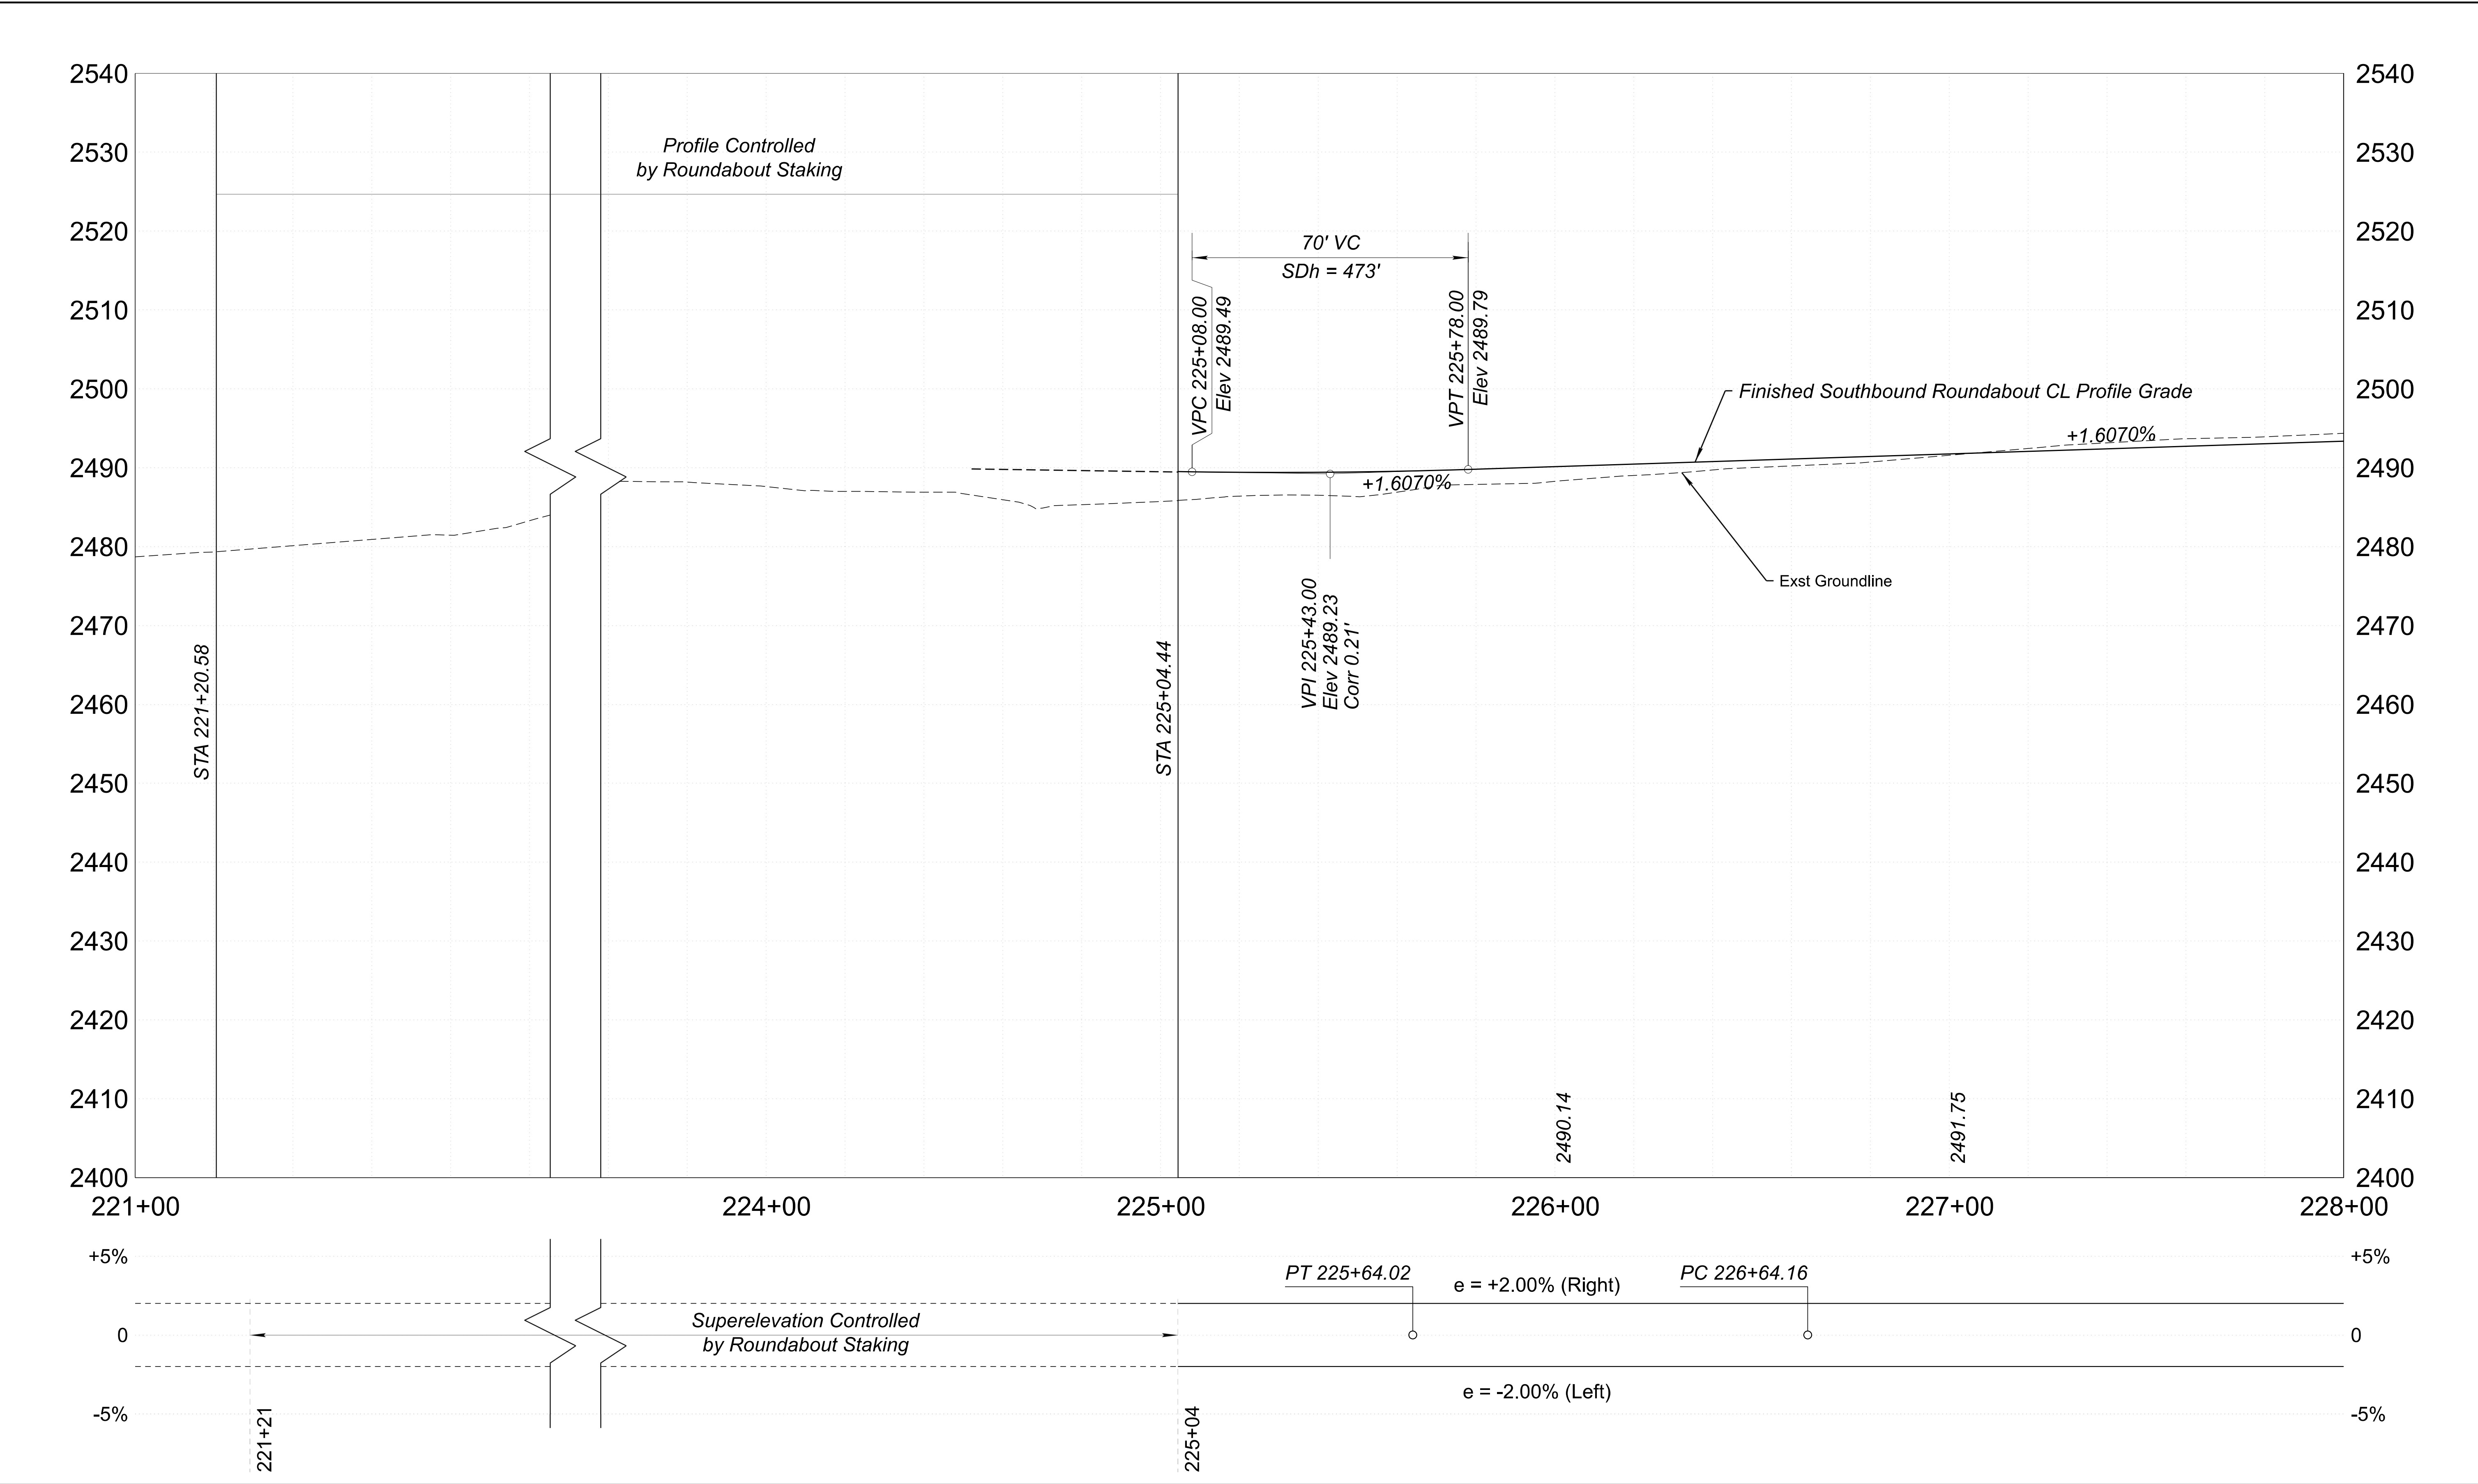

	<table><tr><th></th><th>NAME</th><th>DATE</th></tr><tr><td>DESIGN</td><td>J GILLIS</td><td>06/26</td></tr><tr><td>DRAWN</td><td>M SAMUELSON</td><td>06/26</td></tr><tr><td>CHECKED</td><td>J BEMELEN</td><td>06/26</td></tr></table>			NAME	DATE	DESIGN	J GILLIS	06/26	DRAWN	M SAMUELSON	06/26	CHECKED	J BEMELEN	06/26	<table><tr><td colspan="2">ARIZONA DEPARTMENT OF TRANSPORTATION PROJECT DELIVERY AND OPERATIONS DIVISION ROADWAY DESIGN SERVICES</td></tr><tr><td colspan="2">TRANSPORTATION AECOM TECHNICAL SERVICES, Inc. 7720 N. 16th St., Suite 100 Phoenix, Arizona 85020 T 602.371.1100</td></tr><tr><td colspan="2"> www.aecom.com</td></tr><tr><td colspan="2">MORETON RD / NINE IRON RANCH RD ROUNDAABOUT STAKING PROFILES</td></tr></table>		ARIZONA DEPARTMENT OF TRANSPORTATION PROJECT DELIVERY AND OPERATIONS DIVISION ROADWAY DESIGN SERVICES		TRANSPORTATION AECOM TECHNICAL SERVICES, Inc. 7720 N. 16th St., Suite 100 Phoenix, Arizona 85020 T 602.371.1100		 www.aecom.com		MORETON RD / NINE IRON RANCH RD ROUNDAABOUT STAKING PROFILES		<table><tr><td>ROUTE</td><td>F.H.W.A. Arizona Division</td><td>STATE</td><td>PROJECT NO.</td><td>FEDERAL ID NO.</td><td>SHEET NO.</td><td>TOTAL SHEETS</td><td>RECORD DRAWING</td></tr><tr><td>US 93</td><td rowspan="3">ARIZ.</td><td>093 YV 189</td><td>093-B(230)T</td><td>245</td><td>524</td><td></td><td></td></tr><tr><td>MILEPOST</td><td colspan="5">LOCATION WICKENBURG RANCH WAY TO VISTA ROYALE</td><td>DWG No. C-6.13</td></tr><tr><td>189.9</td><td colspan="5">TRACS NO. F0738 01C</td><td>___ OF ___</td></tr><tr><td>STRUCTURE NO.</td><td colspan="6"></td><td></td></tr></table>	ROUTE	F.H.W.A. Arizona Division	STATE	PROJECT NO.	FEDERAL ID NO.	SHEET NO.	TOTAL SHEETS	RECORD DRAWING	US 93	ARIZ.	093 YV 189	093-B(230)T	245	524			MILEPOST	LOCATION WICKENBURG RANCH WAY TO VISTA ROYALE					DWG No. C-6.13	189.9	TRACS NO. F0738 01C					___ OF ___	STRUCTURE NO.							
		NAME	DATE																																																												
	DESIGN	J GILLIS	06/26																																																												
	DRAWN	M SAMUELSON	06/26																																																												
CHECKED	J BEMELEN	06/26																																																													
ARIZONA DEPARTMENT OF TRANSPORTATION PROJECT DELIVERY AND OPERATIONS DIVISION ROADWAY DESIGN SERVICES																																																															
TRANSPORTATION AECOM TECHNICAL SERVICES, Inc. 7720 N. 16th St., Suite 100 Phoenix, Arizona 85020 T 602.371.1100																																																															
 www.aecom.com																																																															
MORETON RD / NINE IRON RANCH RD ROUNDAABOUT STAKING PROFILES																																																															
ROUTE	F.H.W.A. Arizona Division	STATE	PROJECT NO.	FEDERAL ID NO.	SHEET NO.	TOTAL SHEETS	RECORD DRAWING																																																								
US 93	ARIZ.	093 YV 189	093-B(230)T	245	524																																																										
MILEPOST		LOCATION WICKENBURG RANCH WAY TO VISTA ROYALE					DWG No. C-6.13																																																								
189.9		TRACS NO. F0738 01C					___ OF ___																																																								
STRUCTURE NO.																																																															

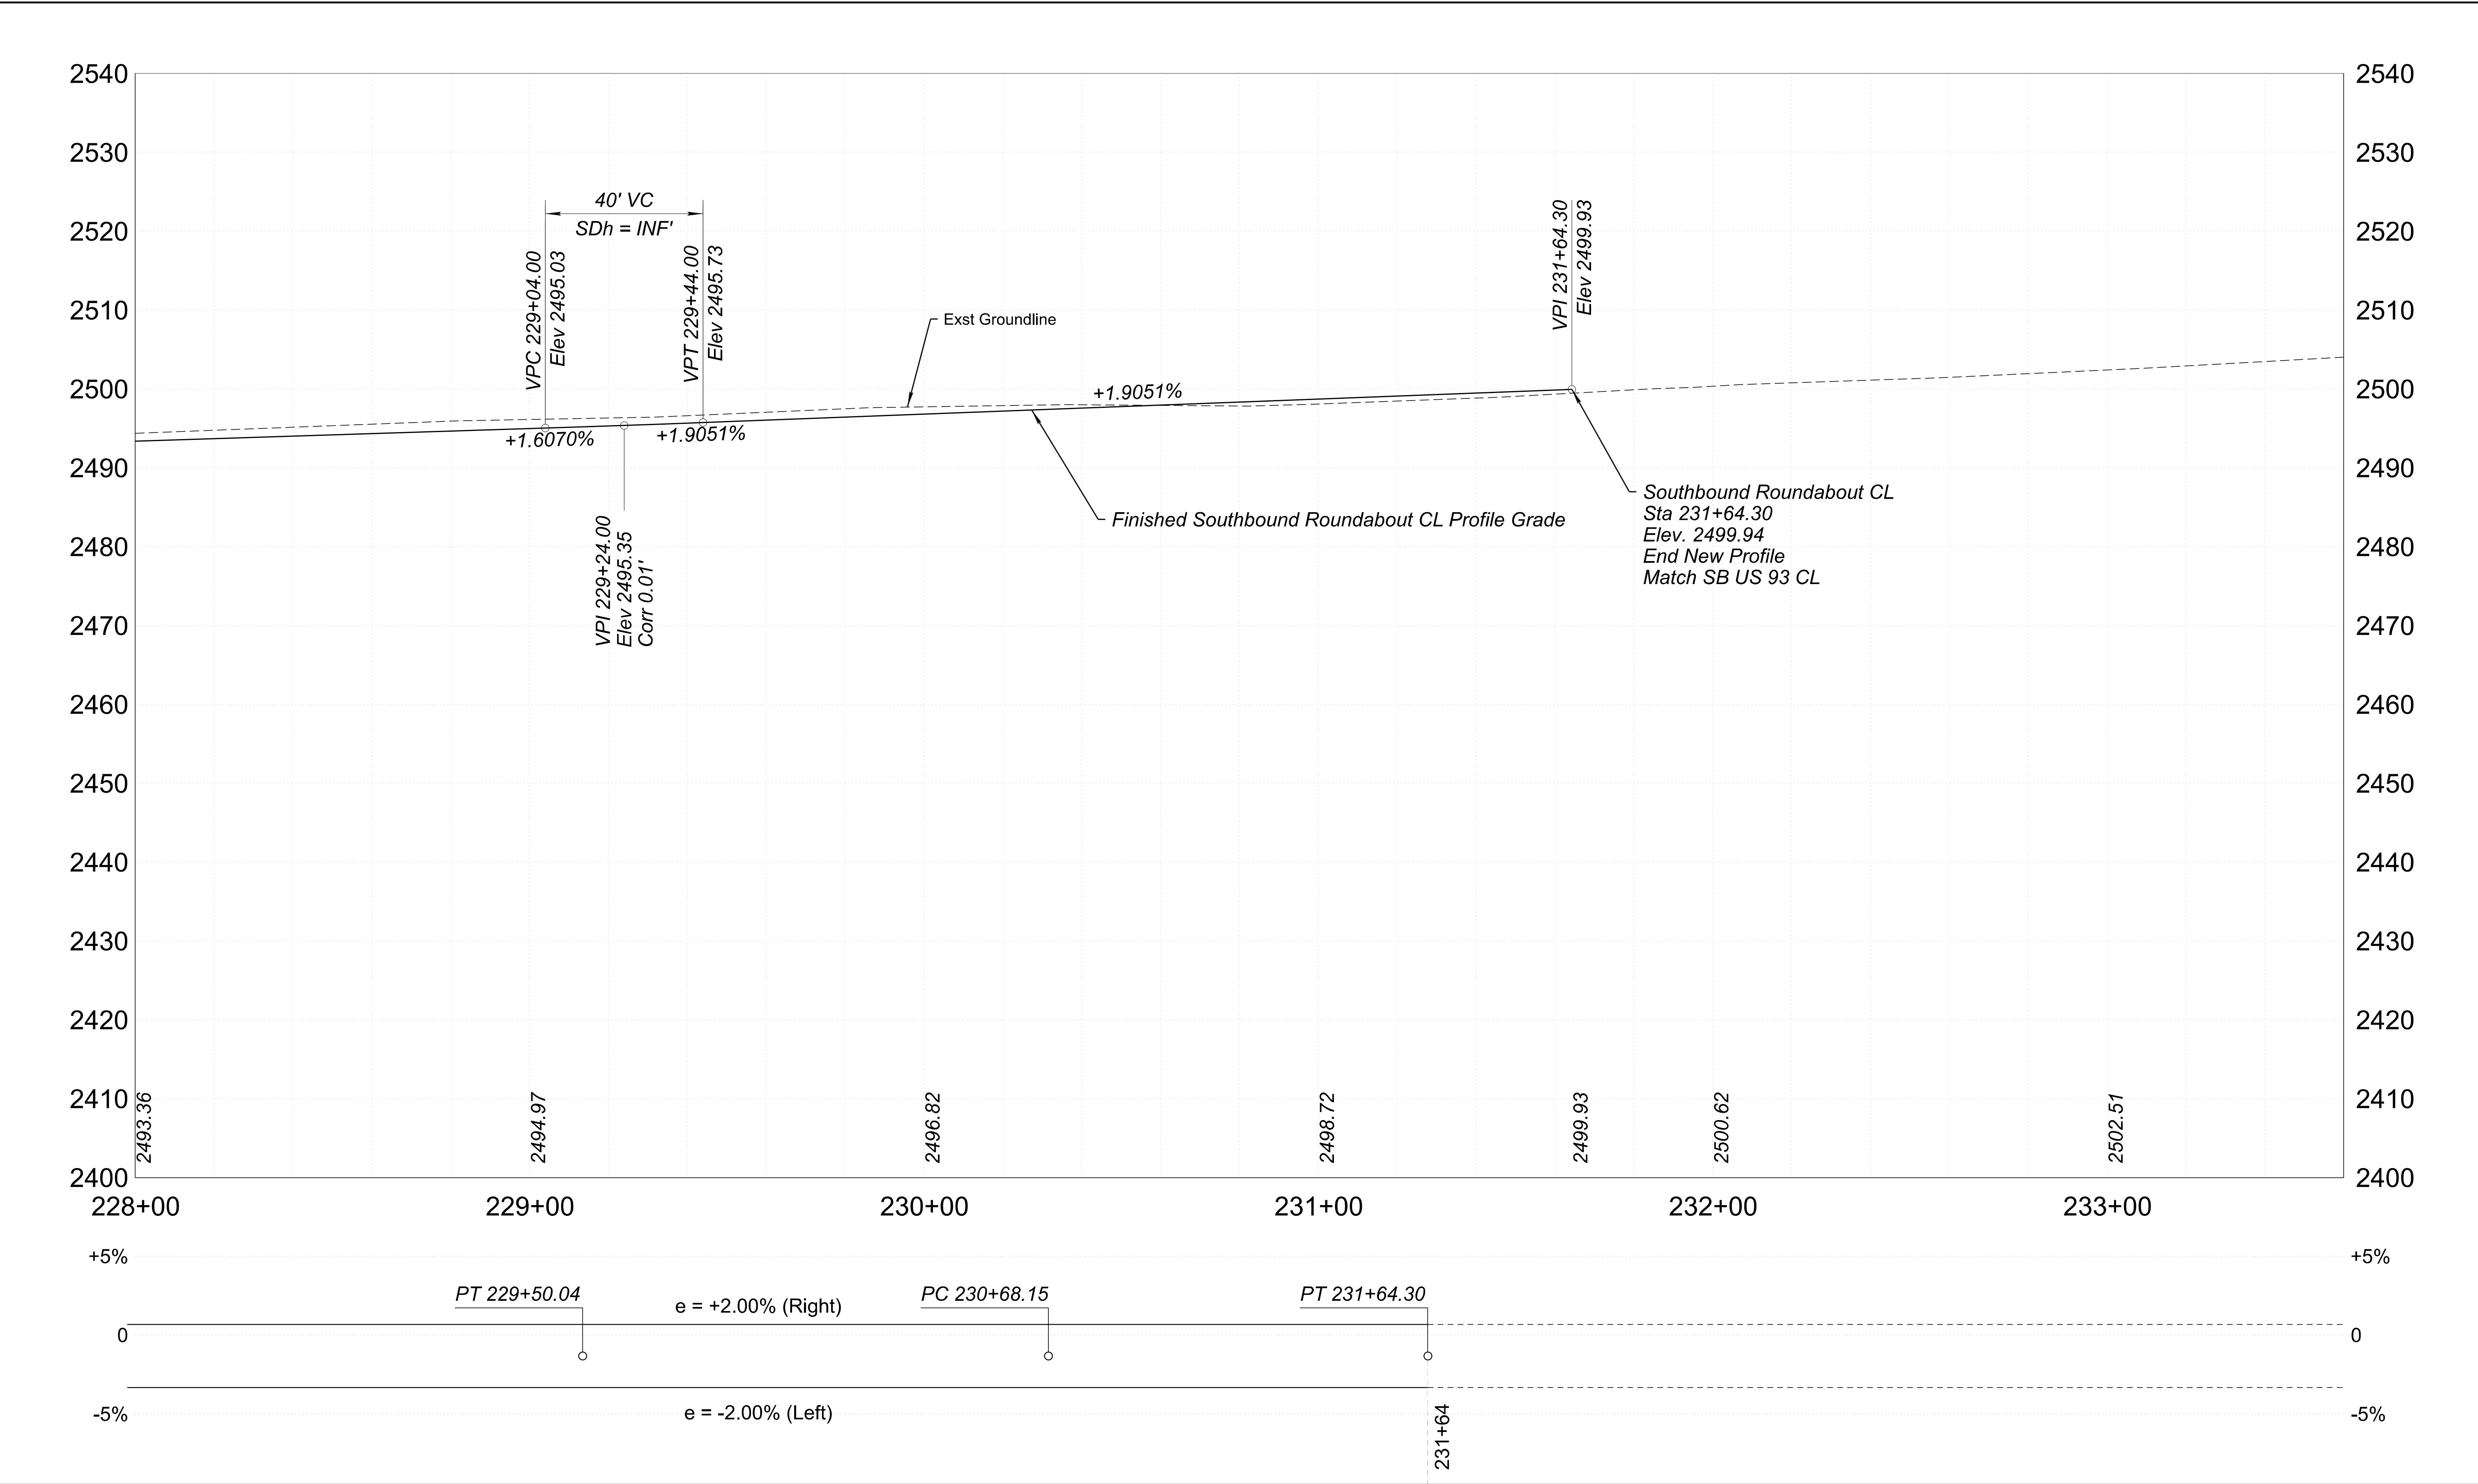

	<table><tr><th></th><th>NAME</th><th>DATE</th></tr><tr><td>DESIGN</td><td>J GILLIS</td><td>06/26</td></tr><tr><td>DRAWN</td><td>M SAMUELSON</td><td>06/26</td></tr><tr><td>CHECKED</td><td>J BEMELEN</td><td>06/26</td></tr></table>			NAME	DATE	DESIGN	J GILLIS	06/26	DRAWN	M SAMUELSON	06/26	CHECKED	J BEMELEN	06/26	ARIZONA DEPARTMENT OF TRANSPORTATION PROJECT DELIVERY AND OPERATIONS DIVISION ROADWAY DESIGN SERVICES MORETON RD / NINE IRON RANCH RD ROUNDAABOUT STAKING PROFILES		ROUTE US 93 MILEPOST 189.9 STRUCTURE NO.	F.H.W.A. Arizona Division STATE ARIZ.	PROJECT NO. 093 YV 189 FEDERAL ID NO. 093-B(230)T	SHEET NO. 246	TOTAL SHEETS 524	RECORD DRAWING
		NAME	DATE																			
	DESIGN	J GILLIS	06/26																			
	DRAWN	M SAMUELSON	06/26																			
	CHECKED	J BEMELEN	06/26																			
				LOCATION WICKENBURG RANCH WAY TO VISTA ROYALE		DWG No. C-6.14																
				TRACS NO. F0738 01C		____ OF ____																

Outside NW CL

Element	Point Type	Point Number	Station	Northing	Easting	Radius	Length	Delta / Theta	Rotation Direction	K	P
Alignment Name:		Outside NW									
Description:											
Style:		Alignment\Geom_Baseline									
Arc	PC	2000	360+00.00	1105322.41	425124.69						
Arc	HPI	2001	360+75.20	1105393.71	425148.61	435.00	148.94	19°37'01"	Left		
Arc	CC			1105460.78	424712.28						
Arc	PCC	2002	361+48.94	1105468.90	425147.21						
Arc	PCC	2002	361+48.94	1105468.90	425147.21						
Arc	HPI	2003	361+52.83	1105472.79	425147.14	60.00	7.77	07°25'27"	Left		
Arc	CC			1105467.78	425087.22						
Arc	PT	2004	361+56.71	1105476.64	425146.56						
Tangent	PT	2004	361+56.71	1105476.64	425146.56						
Tangent	PC	2005	361+89.04	1105508.62	425141.78						
Arc	PC	2005	361+89.04	1105508.62	425141.78						
Arc	HPI	2006	362+49.14	1105568.06	425132.91	120.00	111.43	53°12'07"	Left		
Arc	CC			1105490.90	425023.10						
Arc	PT	2007	363+00.47	1105596.55	425080.00						
Tangent	PT	2007	363+00.47	1105596.55	425080.00						
Tangent	PC	2008	364+00.61	1105644.03	424991.83						
Arc	PC	2008	364+00.61	1105644.03	424991.83						
Arc	HPI	2009	365+46.12	1105713.02	424863.72	1051.00	289.18	15°45'54"	Right		
Arc	CC			1106569.37	425490.17						
Arc	PT	2010	366+89.79	1105814.23	424759.17						
Tangent	PT	2010	366+89.79	1105814.23	424759.17						
Tangent	PC	2011	368+07.90	1105896.38	424674.31						
Arc	PC	2011	368+07.90	1105896.38	424674.31						
Arc	HPI	2012	368+55.61	1105929.56	424640.02	1520.00	95.40	03°35'45"	Left		
Arc	CC			1104804.25	423617.11						
Arc	PT	2013	369+03.30	1105960.54	424603.73						

Outside NE CL

Element	Point Type	Point Number	Station	Northing	Easting	Radius	Length	Delta / Theta	Rotation Direction	K	P
Alignment Name:		Outside_NE									
Description:											
Style:		Alignment\Geom_Baseline									
Arc	PC	2500	400+00.00	1105690.47	425283.21						
Arc	HPI	2501	400+30.50	1105662.14	425294.51	100.00	59.21	33°55'24"	Right		
Arc	CC			1105653.41	425190.33						
Arc	PCC	2502	400+59.21	1105632.33	425288.08						
Arc	PCC	2502	400+59.21	1105632.33	425288.08						
Arc	HPI	2503	400+88.70	1105603.50	425281.86	80.00	56.51	40°28'27"	Right		
Arc	CC			1105649.19	425209.88						
Arc	PCC	2504	401+15.72	1105585.60	425258.42						

Outside NE CL (cont.)

Element	Point Type	Point Number	Station	Northing	Easting	Radius	Length	Delta / Theta	Rotation Direction	K	P
Alignment Name:		Outside_NE									
Description:											
Style:		Alignment\Geom_Baseline									
Arc	PCC	2504	401+15.72	1105585.60	425258.42						
Arc	HPI	2505	401+33.11	1105575.05	425244.59	30.00	31.52	60°12'12"	Right		
Arc	CC			1105609.45	425240.22						
Arc	PCC	2506	401+47.24	1105581.80	425228.57						
Arc	PCC	2506	401+47.24	1105581.80	425228.57						
Arc	HPI	2507	402+24.76	1105611.90	425157.14	500.00	153.80	17°37'28"	Right		
Arc	CC			1106042.57	425422.72						
Arc	PT	2508	403+01.04	1105662.21	425098.17						

Outside SE CL

Element	Point Type	Point Number	Station	Northing	Easting	Radius	Length	Delta / Theta	Rotation Direction	K	P
Alignment Name:		Outside_SE									
Description:											
Style:		Alignment\Geom_Baseline									
Arc	PC	3000	440+00.00	1105001.71	425872.25						
Arc	HPI	3001	440+47.61	1105032.62	425836.04	1520.00	95.19	03°35'17"	Right		
Arc	CC			1106157.99	426858.87						
Arc	PT	3002	440+95.19	1105065.72	425801.82						
Tangent	PT	3002	440+95.19	1105065.72	425801.82						
Tangent	PC	3003	442+13.93	1105148.30	425716.50						
Arc	PC	3003	442+13.93	1105148.30	425716.50						
Arc	HPI	3004	443+59.36	1105249.44	425611.99	1051.00	289.04	15°45'25"	Left		
Arc	CC			1104393.05	424985.61						
Arc	PT	3005	445+02.97	1105318.40	425483.94						
Tangent	PT	3005	445+02.97	1105318.40	425483.94						
Tangent	PC	3006	446+03.10	1105365.88	425395.77						
Arc	PC	3006	446+03.10	1105365.88	425395.77						
Arc	HPI	3007	446+63.19	1105394.37	425342.87	120.00	111.42	53°12'04"	Right		
Arc	CC			1105471.53	425452.67						
Arc	PCC	3008	447+14.53	1105453.80	425333.99						
Arc	PCC	3008	447+14.53	1105453.80	425333.99						
Arc	HPI	3009	447+37.81	1105476.83	425330.55	906.00	46.55	02°56'38"	Right		
Arc	CC			1105587.64	426230.05						
Arc	PCC	3010	447+61.08	1105500.00	425328.30						
Arc	PCC	3010	447+61.08	1105500.00	425328.30						
Arc	HPI	3011	447+81.88	1105520.70	425326.29	150.00	41.33	15°47'13"	Right		
Arc	CC			1105514.51	425477.59						
Arc	PT	3012	448+02.41	1105541.17	425329.98						

Outside SE CL (cont.)

Element	Point Type	Point Number	Station	Northing	Easting	Radius	Length	Delta / Theta	Rotation Direction	K	P
Alignment Name:		Outside_SE									
Description:											
Style:		Alignment\Geom_Baseline									
Tangent	PT	3012	448+02.41	1105541.17	425329.98						
Tangent	PC	3013	448+17.27	1105555.79	425332.62						
Arc	PC	3013	448+17.27	1105555.79	425332.62						
Arc	HPI	3014	448+96.74	1105634.00	425346.75	231.87	153.14	37°50'28"	Left		
Arc	CC			1105596.99	425104.44						
Arc	PT	3015	449+70.40	1105704.43	425309.92						

South Splitter CL

Element	Point Type	Point Number	Station	Northing	Easting	Radius	Length	Delta / Theta	Rotation Direction	K	P
Alignment Name:		South_Splitter									
Description:											
Style:		Alignment\Geom_Baseline									
Arc	PC	3500	460+00.00	1104980.58	425854.22						
Arc	HPI	3501	460+19.72	1104994.11	425839.88	3089.61	39.44	00°43'53"	Right		
Arc	CC			1107228.02	427974.30						
Arc	PT	3502	460+39.44	1105007.82	425825.71						
Tangent	PT	3502	460+39.44	1105007.82	425825.71						
Tangent	PC	3503	462+15.60	1105130.33	425699.11						
Arc	PC	3503	462+15.60	1105130.33	425699.11						
Arc	HPI	3504	463+64.02	1105233.55	425592.46	1026.00	294.79	16°27'44"	Left		
Arc	CC			1104393.05	424985.61						
Arc	PT	3505	465+10.39	1105302.31	425460.93						
Tangent	PT	3505	465+10.39	1105302.31	425460.93						
Tangent	PC	3506	465+97.06	1105342.46	425384.12						
Arc	PC	3506	465+97.06	1105342.46	425384.12						
Arc	HPI	3507	466+62.67	1105372.85	425325.98	164.00	124.81	43°36'19"	Right		
Arc	CC			1105487.80	425460.10						
Arc	PRC	3508	467+21.88	1105434.96	425304.85						
Arc	PRC	3508	467+21.88	1105434.96	425304.85						
Arc	HPI	3509	467+24.85	1105437.77	425303.89	1.50	3.31	126°27'38"	Left		
Arc	CC			1105434.47	425303.43						
Arc	PRC	3510	467+25.19	1105435.33	425302.19						

South Splitter CL (cont.)

Element	Point Type	Point Number	Station	Northing	Easting	Radius	Length	Delta / Theta	Rotation Direction	K	P
Alignment Name:		South_Splitter									
Description:											
Style:		Alignment\Geom_Baseline									
Arc	PRC	3510	467+25.19	1105435.33	425302.19						
Arc	HPI	3511	467+45.13	1105418.94	425290.83	79.00	39.06	28°19'51"	Right		
Arc	CC			1105480.35	425237.28						
Arc	PRC	3512	467+64.25	1105409.91	425273.05						
Arc	PRC	3512	467+64.25	1105409.91	425273.05						
Arc	HPI	3513	467+69.81	1105407.40	425268.10	3.00	6.45	123°16'03"	Left		
Arc	CC			1105407.24	425274.41						
Arc	PRC	3514	467+70.71	1105404.64	425272.92						
Arc	PRC	3514	467+70.71	1105404.64	425272.92						
Arc	HPI	3515	468+43.71	1105368.35	425336.27	782.11	145.60	10°39'58"	Right		
Arc	CC			1104726.00	424884.15						
Arc	PT	3516	469+16.30	1105320.96	425391.81						

West Splitter CL

Element	Point Type	Point Number	Station	Northing	Easting	Radius	Length	Delta / Theta	Rotation Direction	K	P
Alignment Name:		West_Splitter									
Description:											
Style:		Alignment\Geom_Baseline									
Arc	PC	4000	340+00.00	1105352.84	425152.67						
Arc	HPI	4001	340+33.04	1105381.49	425169.13	111.00	64.22	33°08'53"	Right		
Arc	CC			1105297.54	425248.91						
Arc	PRC	4002	340+64.22	1105396.47	425198.57						
Arc	PRC	4002	340+64.22	1105396.47	425198.57						
Arc	HPI	4003	340+67.30	1105397.87	425201.32	1.50	3.35	128°08'30"	Left		
Arc	CC			1105397.81	425197.89						
Arc	PRC	4004	340+67.57	1105399.17	425198.52						
Arc	PRC	4004	340+67.57	1105399.17	425198.52						
Arc	HPI	4005	340+87.89	1105407.72	425180.09	91.00	39.98	25°10'30"	Right		
Arc	CC			1105481.72	425236.82						
Arc	PRC	4006	341+07.56	1105423.30	425167.05						
Arc	PRC	4006	341+07.56	1105423.30	425167.05						
Arc	HPI	4007	341+14.09	1105428.30	425162.86	3.00	6.84	130°38'27"	Left		
Arc	CC			1105421.37	425164.75						
Arc	PRC	4008	341+14.40	1105421.86	425161.79						

West Splitter CL (cont.)

Element	Point Type	Point Number	Station	Northing	Easting	Radius	Length	Delta / Theta	Rotation Direction	K	P
Alignment Name:		West_Splitter									
Description:											
Style:		Alignment\Geom_Baseline									
Arc	PRC	4008	341+14.40	1105421.86	425161.79						
Arc	HPI	4009	341+48.60	1105388.12	425156.19	669.00	68.35	05°51'13"	Right		
Arc	CC			1105531.39	424501.81						
Arc	PRC	4010	341+82.74	1105355.13	425147.18						
Arc	PRC	4010	341+82.74	1105355.13	425147.18						
Arc	HPI	4011	342+06.15	1105332.55	425141.01	3.00	8.66	165°23'38"	Left		
Arc	CC			1105354.34	425150.07						
Arc	PT	4012	341+91.40	1105352.84	425152.67						

North Splitter CL

Element	Point Type	Point Number	Station	Northing	Easting	Radius	Length	Delta / Theta	Rotation Direction	K	P
Alignment Name:		North_Splitter									
Description:											
Style:		Alignment\Geom_Baseline									
Arc	PC	4500	380+00.00	1105979.55	424619.96						
Arc	HPI	4501	380+48.50	1105948.07	424656.85	1545.00	96.97	03°35'45"	Right		
Arc	CC			1104804.25	423617.11						
Arc	PT	4502	380+96.97	1105914.34	424691.70						
Tangent	PT	4502	380+96.97	1105914.34	424691.70						
Tangent	PC	4503	382+15.08	1105832.19	424776.56						
Arc	PC	4503	382+15.08	1105832.19	424776.56						
Arc	HPI	4504	383+63.57	1105728.91	424883.25	1026.00	294.93	16°28'12"	Left		
Arc	CC			1106569.37	425490.17						
Arc	PT	4505	385+10.01	1105660.12	425014.84						
Tangent	PT	4505	385+10.01	1105660.12	425014.84						
Tangent	PC	4506	385+96.68	1105619.97	425091.65						
Arc	PC	4506	385+96.68	1105619.97	425091.65						
Arc	HPI	4507	386+62.28	1105589.58	425149.79	164.00	124.81	43°36'19"	Right		
Arc	CC			1105474.63	425015.67						
Arc	PRC	4508	387+21.49	1105527.47	425170.93						
Arc	PRC	4508	387+21.49	1105527.47	425170.93						
Arc	HPI	4509	387+24.46	1105524.66	425171.88	1.50	3.31	126°25'07"	Left		
Arc	CC			1105527.95	425172.35						
Arc	PRC	4510	387+24.80	1105527.10	425173.58						
Arc	PRC	4510	387+24.80	1105527.10	425173.58						
Arc	HPI	4511	387+46.10	1105544.59	425185.73	79.00	41.61	30°10'36"	Right		
Arc	CC			1105482.03	425238.46						
Arc	PRC	4512	387+66.41	1105553.60	425205.03						

North Splitter CL (cont.)

Element	Point Type	Point Number	Station		Easting	Radius	Length	Delta / Theta	Rotation Direction	K	P
Alignment Name:		North_Splitter									
Description:											
Style:		Alignment\Geom_Baseline									
Arc	PRC	4512	387+66.41	1105553.60	425205.03						
Arc	HPI	4513	387+72.39	1105556.14	425210.45	3.00	6.64	126°43'49"	Left		
Arc	CC			1105556.32	425203.76						
Arc	PRC	4514	387+73.04	1105558.97	425205.17						
Arc	PRC	4514	387+73.04	1105558.97	425205.17						
Arc	HPI	4515	388+48.10	1105594.47	425139.04	700.00	149.55	12°14'27"	Right		
Arc	CC			1106175.69	425536.31						
Arc	PT	4516	389+22.59	1105643.19	425081.94						

East Splitter CL

Element	Point Type	Point Number	Station	Northing	Easting	Radius	Length	Delta / Theta	Rotation Direction	K	P
Alignment Name:		East_Splitter									
Description:											
Style:		Alignment\Geom_Baseline									
Arc	PC	5000	420+00.00	1105654.46	425304.32						
Arc	HPI	5001	420+38.50	1105615.96	425304.68	114.00	74.26	37°19'18"	Right		
Arc	CC			1105653.41	425190.33						
Arc	PCC	5002	420+74.26	1105585.13	425281.62						
Arc	PCC	5002	420+74.26	1105585.13	425281.62						
Arc	HPI	5003	420+84.88	1105576.63	425275.26	110.00	21.17	11°01'42"	Right		
Arc	CC			1105651.01	425193.53						
Arc	PRC	5004	420+95.43	1105569.50	425267.39						
Arc	PRC	5004	420+95.43	1105569.50	425267.39						
Arc	HPI	5005	420+97.99	1105567.78	425265.49	1.50	3.12	119°16'45"	Left		
Arc	CC			1105568.38	425268.40						
Arc	PRC	5006	420+98.55	1105566.96	425267.92						
Arc	PRC	5006	420+98.55	1105566.96	425267.92						
Arc	HPI	5007	421+22.63	1105559.30	425290.75	91.00	47.08	29°38'31"	Right		
Arc	CC			1105480.69	425238.98						
Arc	PRC	5008	421+45.63	1105541.36	425306.80						
Arc	PRC	5008	421+45.63	1105541.36	425306.80						
Arc	HPI	5009	421+51.78	1105536.78	425310.90	3.00	6.70	127°56'55"	Left		
Arc	CC			1105543.36	425309.04						
Arc	PT	5010	421+52.33	1105542.83	425311.99						
Tangent	PT	5010	421+52.33	1105542.83	425311.99						
Tangent	PC	5011	421+68.75	1105558.99	425314.91						

DESIGN

J GILLIS

06/26

DRAWN

M SAMUELSON

06/26

CHECKED

D WIGGINS

06/26

TRANSPORTATION
AECOM TECHNICAL SERVICES, Inc.
7720 N. 16th St., Suite 100
Phoenix, Arizona 85020
T 602.371.1100

AECOM

www.aecom.com

ARIZONA DEPARTMENT OF TRANSPORTATION
PROJECT DELIVERY AND OPERATIONS DIVISION
ROADWAY DESIGN SERVICES

MORETON RD / NINE IRON RANCH RD
ROUNABOUT STAKING DATA SHEET

ROUTE
US 93

MILEPOST
189.9

STRUCTURE NO.

F.H.W.A. Arizona Division

ARIZ.

LOCATION
WICKENBURG RANCH WAY TO VISTA ROYALE

TRACS NO. F0738 01C

STATE

PROJECT NO.
093 YV 189

FEDERAL ID NO.
093-B(230)T

SHEET NO.
250

TOTAL SHEETS
524

RECORD DRAWING

DWG No. C-6.18

____ OF ____

c:\pwworking\usaz\dms08894\0738_int17.dgn
6/23/2026 @5:42:23 PM jason.heredia

East Splitter CL (cont.)

Element	Point Type	Point Number	Station	Northing	Easting	Radius	Length	Delta / Theta	Rotation Direction	K	P
Alignment Name:		East_Splitter									
Description:											
Style:		Alignment\Geom_Baseline									
Arc	PC	5011	421+68.75	1105558.99	425314.91						
Arc	HPI	5012	422+18.25	1105607.69	425323.70	213.87	97.27	26°03'31"	Left		
Arc	CC			1105596.99	425104.44						
Arc	PCC	5013	422+66.02	1105655.31	425310.21						
Arc	PCC	5013	422+66.02	1105655.31	425310.21						
Arc	HPI	5014	422+88.37	1105676.80	425304.12	3.00	8.62	164°42'21"	Left		
Arc	CC			1105654.49	425307.32						
Arc	PT	5015	420+00.00	1105654.46	425304.32						

Northbound Roundabout CL

Element	Point Type	Point Number	Station	Northing	Easting	Radius	Length	Delta / Theta	Rotation Direction	K	P
Alignment Name:		NB_RA									
Description:											
Style:		Alignment\Geom_Baseline									
Arc	PC	5500	100+00.00	1104927.85	425940.69						
Arc	HPI	5501	100+50.00	1104960.13	425902.50	21548.07	100.00	00°15'57"	Right		
Arc	CC			1121384.45	439851.09						
Arc	PCC	5502	101+00.00	1104992.58	425864.46						
Arc	PCC	5502	101+00.00	1104992.58	425864.46						
Arc	HPI	5503	101+47.97	1105023.73	425827.96	1532.00	95.94	03°35'17"	Right		
Arc	CC			1106157.99	426858.87						
Arc	PT	5504	101+95.94	1105057.10	425793.48						
Tangent	PT	5504	101+95.94	1105057.10	425793.48						
Tangent	PC	5505	103+14.68	1105139.68	425708.15						
Arc	PC	5505	103+14.68	1105139.68	425708.15						
Arc	HPI	5506	104+58.46	1105239.66	425604.84	1039.00	285.74	15°45'26"	Left		
Arc	CC			1104393.05	424985.61						
Arc	PT	5507	106+00.42	1105307.83	425478.25						
Tangent	PT	5507	106+00.42	1105307.83	425478.25						
Tangent	PC	5508	107+00.55	1105355.31	425390.08						
Arc	PC	5508	107+00.55	1105355.31	425390.08						
Arc	HPI	5509	107+60.15	1105383.57	425337.62	132.00	111.95	48°35'38"	Right		
Arc	CC			1105471.53	425452.67						
Arc	PT	5510	108+12.51	1105441.61	425324.11						
Tangent	PT	5510	108+12.51	1105441.61	425324.11						
Tangent	PC	5511	108+70.63	1105498.21	425310.93						

Northbound Roundabout CL (cont.)

Element	Point Type	Point Number	Station	Northing	Easting	Radius	Length	Delta / Theta	Rotation Direction	K	P
Alignment Name:		NB_RA									
Description:											
Style:		Alignment\Geom_Baseline									
Arc	PC	5511	108+70.63	1105498.21	425310.93						
Arc	HPI	5512	109+07.21	1105533.85	425302.64	75.00	68.07	52°00'11"	Left		
Arc	CC			1105481.21	425237.89						
Arc	PT	5513	109+38.70	1105549.25	425269.24						
Tangent	PT	5513	109+38.70	1105549.25	425269.24						
Tangent	PC	5514	110+07.34	1105578.14	425207.19						
Arc	PC	5514	110+07.34	1105578.14	425207.19						
Arc	HPI	5515	110+77.38	1105607.62	425143.66	512.00	139.21	15°34'43"	Right		
Arc	CC			1106042.57	425422.72						
Arc	PT	5516	111+46.55	1105653.08	425090.38						
Tangent	PT	5516	111+46.55	1105653.08	425090.38						
Tangent	END	5517	113+66.55	1105795.88	424923.03						

Southbound Roundabout CL

Element	Point Type	Point Number	Station	Northing	Easting	Radius	Length	Delta / Theta	Rotation Direction	K	P
Alignment Name:		SB RA									
Description:											
Style:		Alignment\Geom_Baseline									
Tangent	START	6000	215+47.88	1104939.33	425819.03						
Tangent	PC	6001	221+20.58	1105311.07	425383.37						
Arc	PC	6001	221+20.58	1105311.07	425383.37						
Arc	HPI	6002	221+93.58	1105358.45	425327.84	512.00	145.03	16°13'47"	Left		
Arc	CC			1104921.58	425051.04						
Arc	PT	6003	222+65.61	1105388.43	425261.27						
Tangent	PT	6003	222+65.61	1105388.43	425261.27						
Tangent	PC	6004	223+25.03	1105412.83	425207.09						
Arc	PC	6004	223+25.03	1105412.83	425207.09						
Arc	HPI	6005	223+62.14	1105428.07	425173.25	75.00	68.93	52°39'17"	Right		
Arc	CC			1105481.21	425237.89						
Arc	PT	6006	223+93.95	1105464.21	425164.84						
Tangent	PT	6006	223+93.95	1105464.21	425164.84						
Tangent	PC	6007	224+52.07	1105520.82	425151.66						

Southbound Roundabout CL (cont.)


Element	Point Type	Point Number	Station	Northing	Easting	Radius	Length	Delta / Theta	Rotation Direction	K	P
Alignment Name:		SB_RA									
Description:											
Style:		Alignment\Geom_Baseline									
Arc	PC	6007	224+52.07	1105520.82	425151.66						
Arc	HPI	6008	225+11.66	1105578.86	425138.16	132.00	111.95	48°35'39"	Left		
Arc	CC			1105490.90	425023.10						
Arc	PT	6009	225+64.02	1105607.11	425085.69						
Tangent	PT	6009	225+64.02	1105607.11	425085.69						
Tangent	PC	6010	226+64.16	1105654.59	424997.52						
Arc	PC	6010	226+64.16	1105654.59	424997.52						
Arc	HPI	6011	228+08.01	1105722.80	424870.87	1039.00	285.88	15°45'54"	Right		
Arc	CC			1106569.37	425490.17						
Arc	PT	6012	229+50.04	1105822.85	424767.52						
Tangent	PT	6012	229+50.04	1105822.85	424767.52						
Tangent	PC	6013	230+68.15	1105905.00	424682.65						
Arc	PC	6013	230+68.15	1105905.00	424682.65						
Arc	HPI	6014	231+16.24	1105938.45	424648.10	1532.00	96.15	03°35'46"	Left		
Arc	CC			1104804.25	423617.11						
Arc	PT	6015	231+64.30	1105969.66	424611.52						

NOTE:

See Dwg No. C-7.23 for fence along Wickenburg Ranch Way.

F.H.W.A. REGION	STATE	PROJECT NO.	SHEET NO.	TOTAL SHEETS	RECORD DRAWING
9	ARIZ.	093-B(230)T	253	524	


093 YV 189

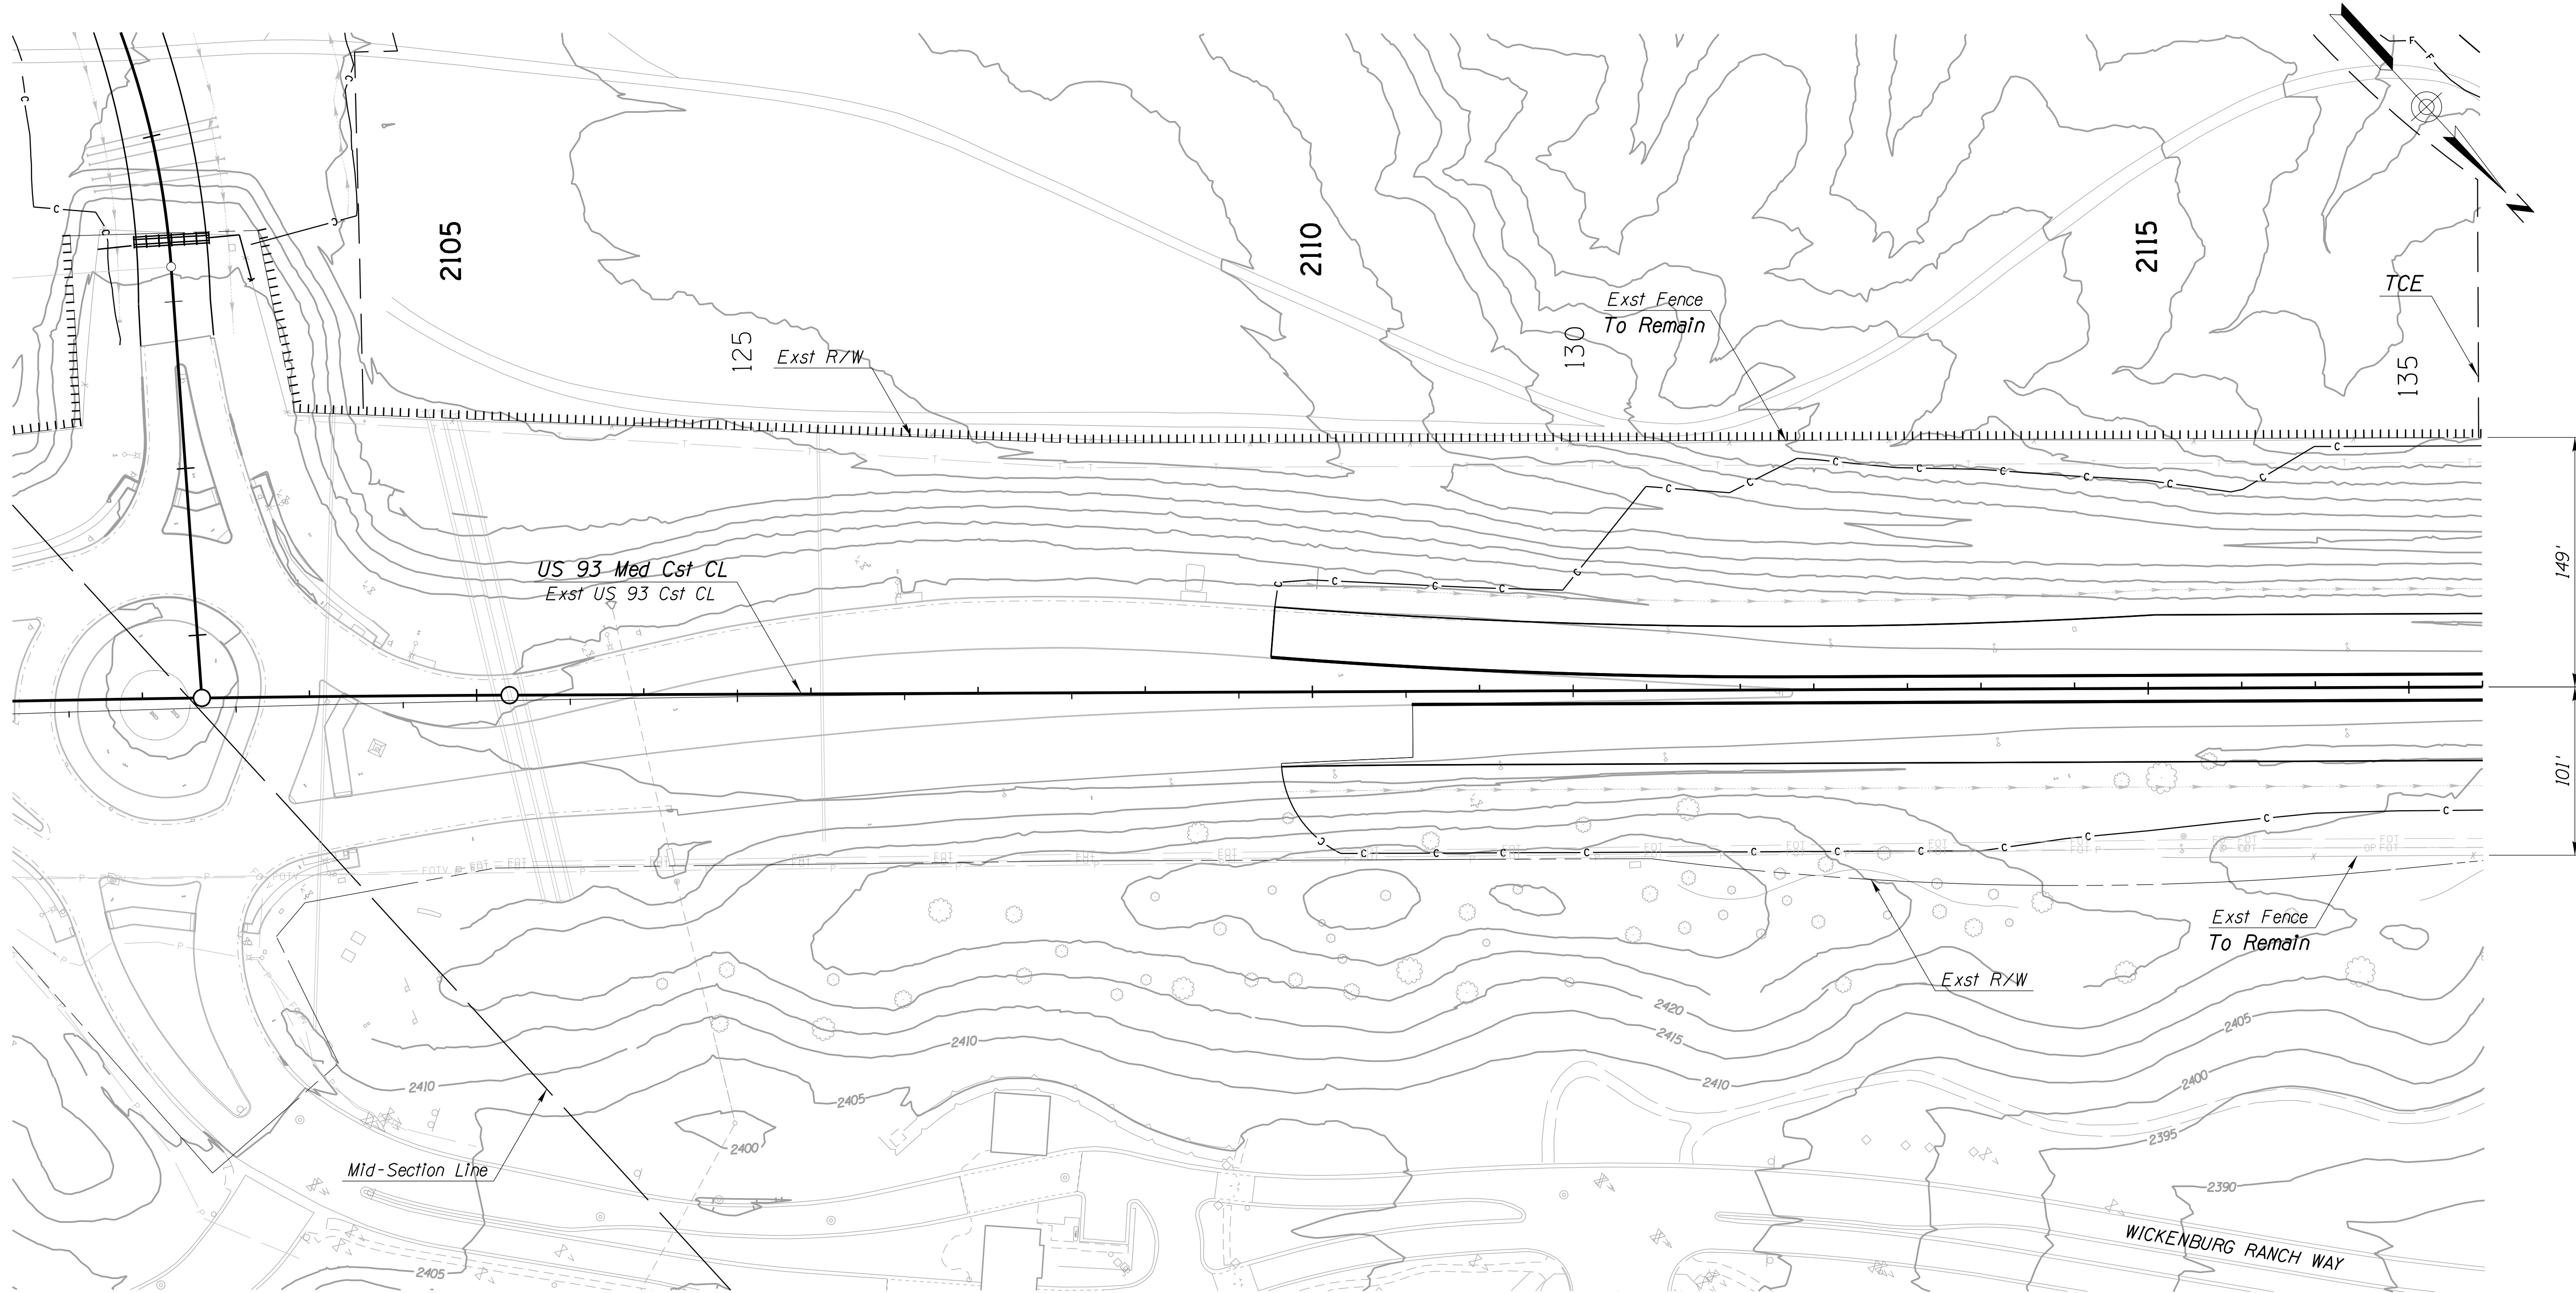

DESIGN	ZSZ	DATE	06-26	ARIZONA DEPARTMENT OF TRANSPORTATION PROJECT DELIVERY AND OPERATIONS DIVISION ROADWAY DESIGN SERVICES	
DRAWN	RM	DATE	06-26		
CHECKED	DBK	DATE	06-26		
 3133 East Camelback Road, Suite 100 Phoenix, Arizona 85016 Phone: 602.333.2200				US 93 FENCE SHEET STA 2109+75.28 TO STA 2117+00	
ROUTE		LOCATION		DWG NO. C-7.01	
US 93		WICKENBURG RANCH WAY TO VISTA ROYALE			
TRACS NO. F0738 OIC		093-B(230)T		OF	

F.H.W.A. REGION	STATE	PROJECT NO.	SHEET NO.	TOTAL SHEETS	RECORD DRAWING
9	ARIZ.	093-B(230)T	254	524	

093 YV 189

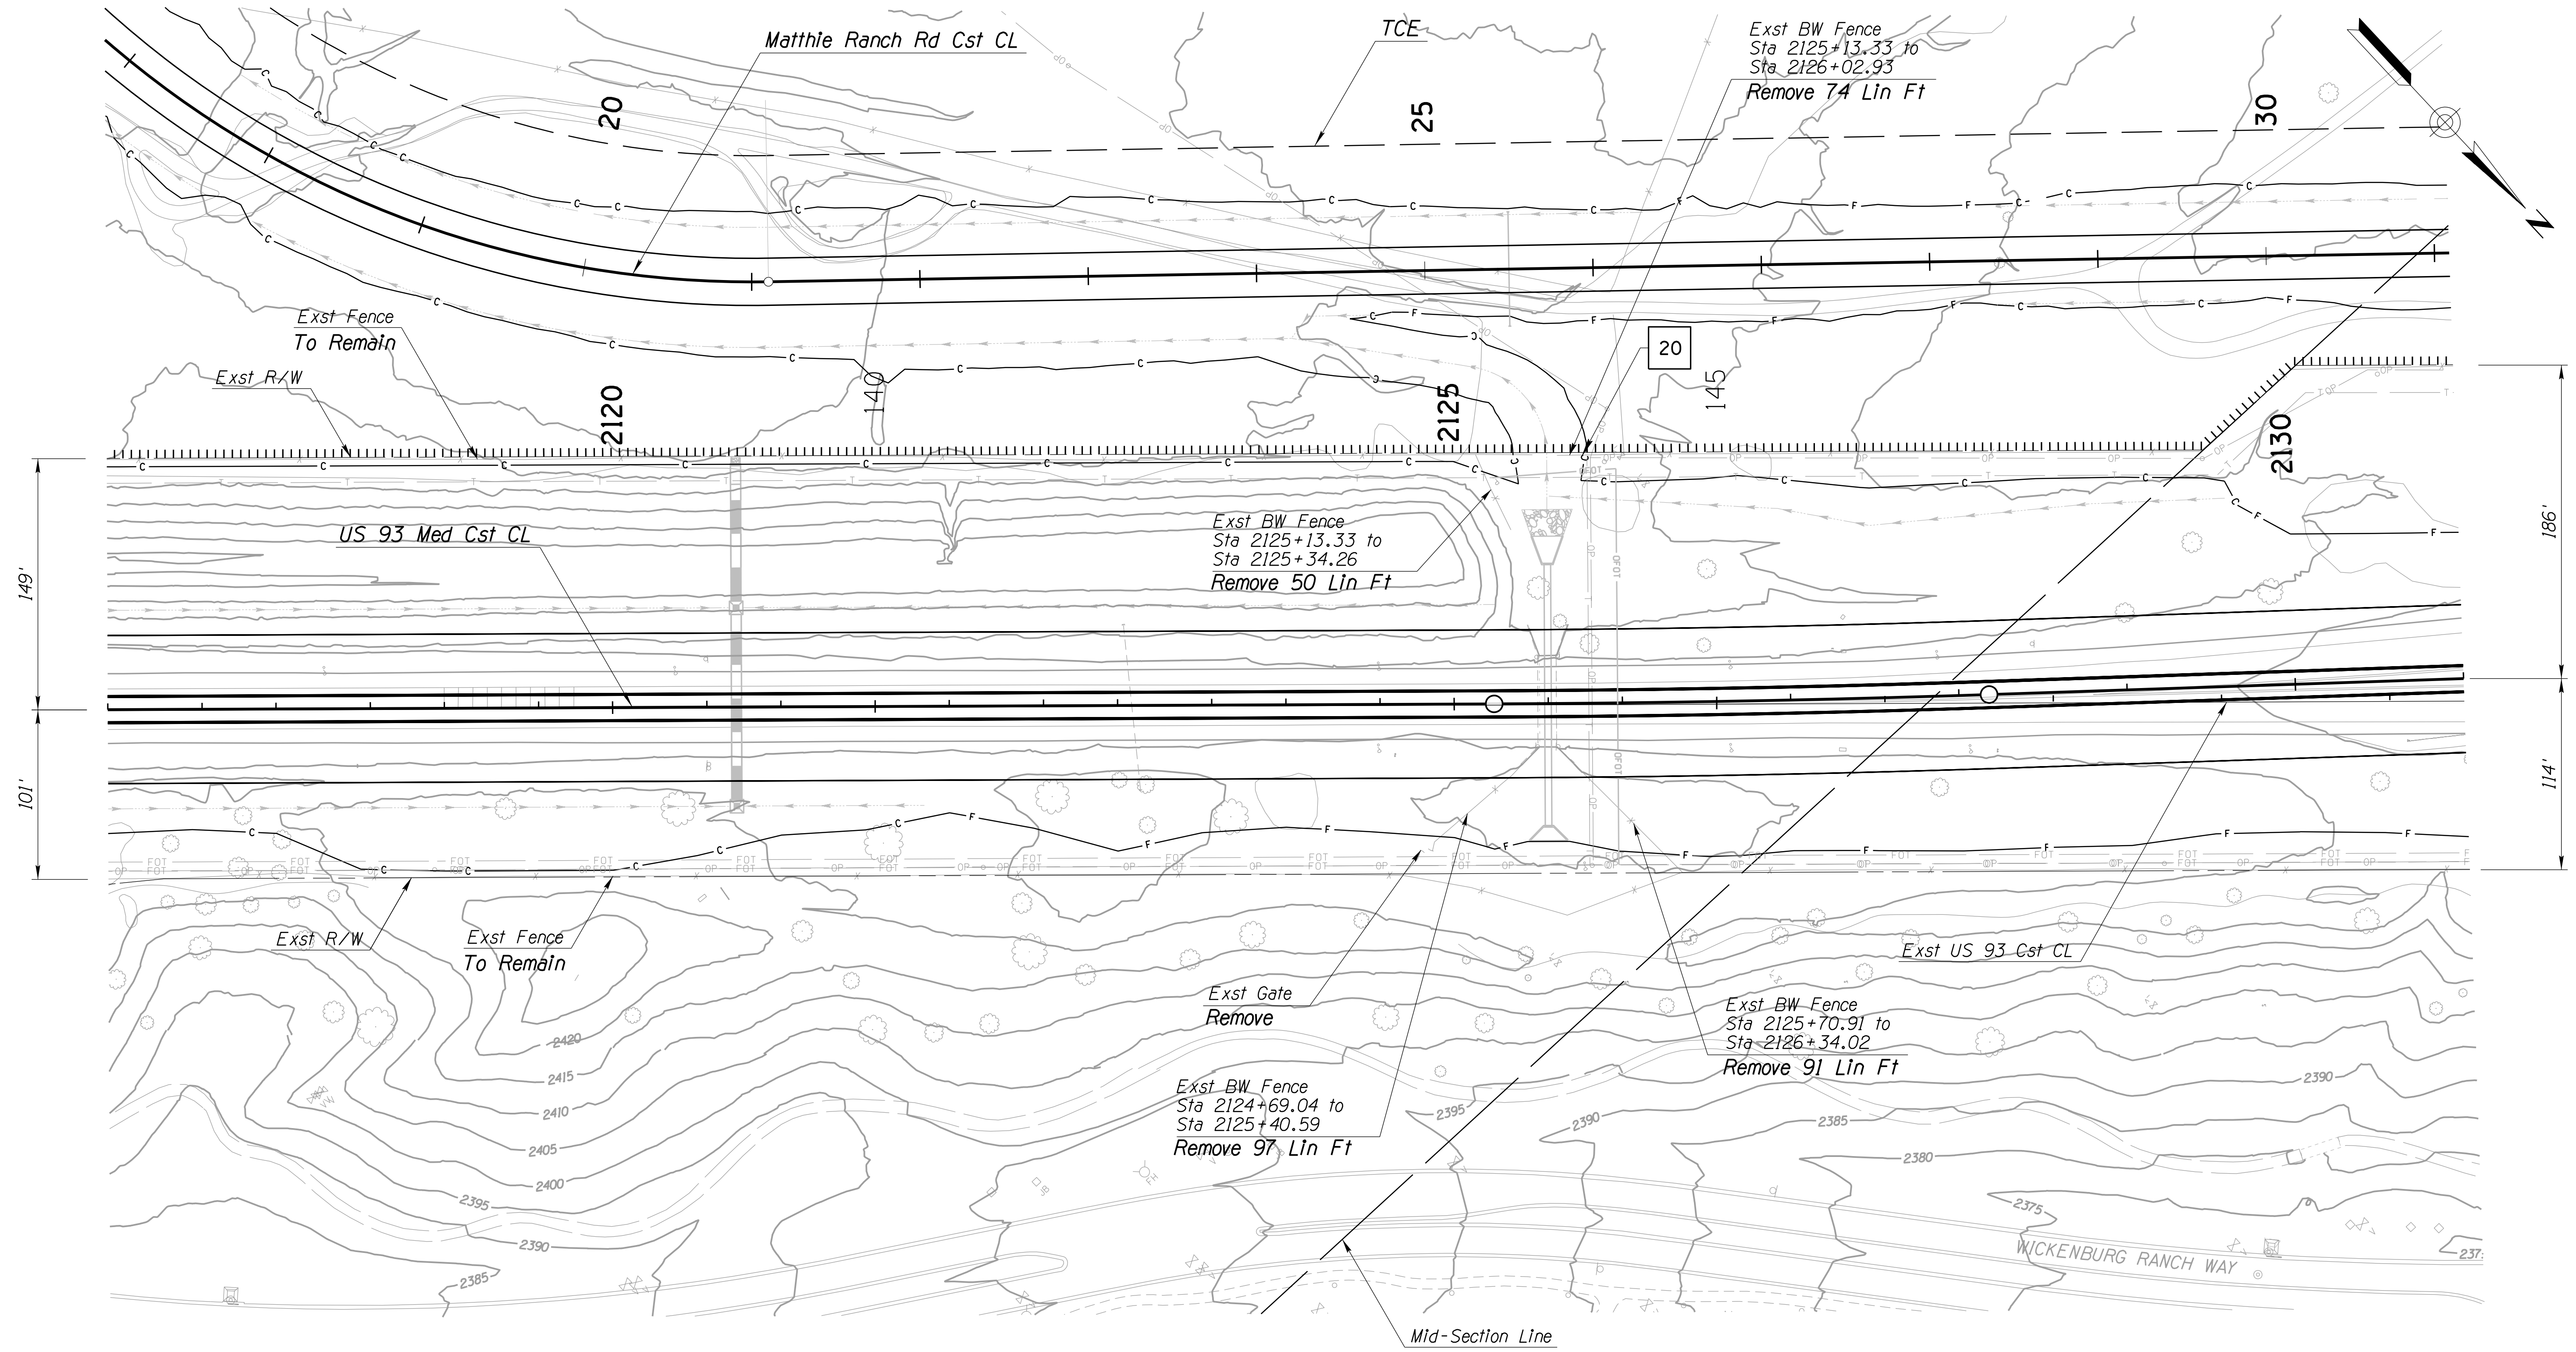

DESIGN	ZSZ	NAME	DATE
DRAWN	RM		06-26
CHECKED	DBK		06-26

ARIZONA DEPARTMENT OF TRANSPORTATION
PROJECT DELIVERY AND OPERATIONS DIVISION
ROADWAY DESIGN SERVICES

US 93
FENCE SHEET
STA 2117+00 TO STA 2131+00

Stanley Consultants inc.
3133 East Camelback Road, Suite 100
Phoenix, Arizona 85016
Phone: (602) 333-2200

WICKENBURG RANCH WAY TO VISTA ROYALE

TRACS NO. F0738 OIC

093-B(230)T


DWG NO. C-7.02

OF

46727
DIANA B. KELLY
Professional Engineer
ARIZONA, U.S.A.

F.H.W.A. REGION	STATE	PROJECT NO.	SHEET NO.	TOTAL SHEETS	RECORD DRAWING
9	ARIZ.	093-B(230)T	255	524	

093 YV 189

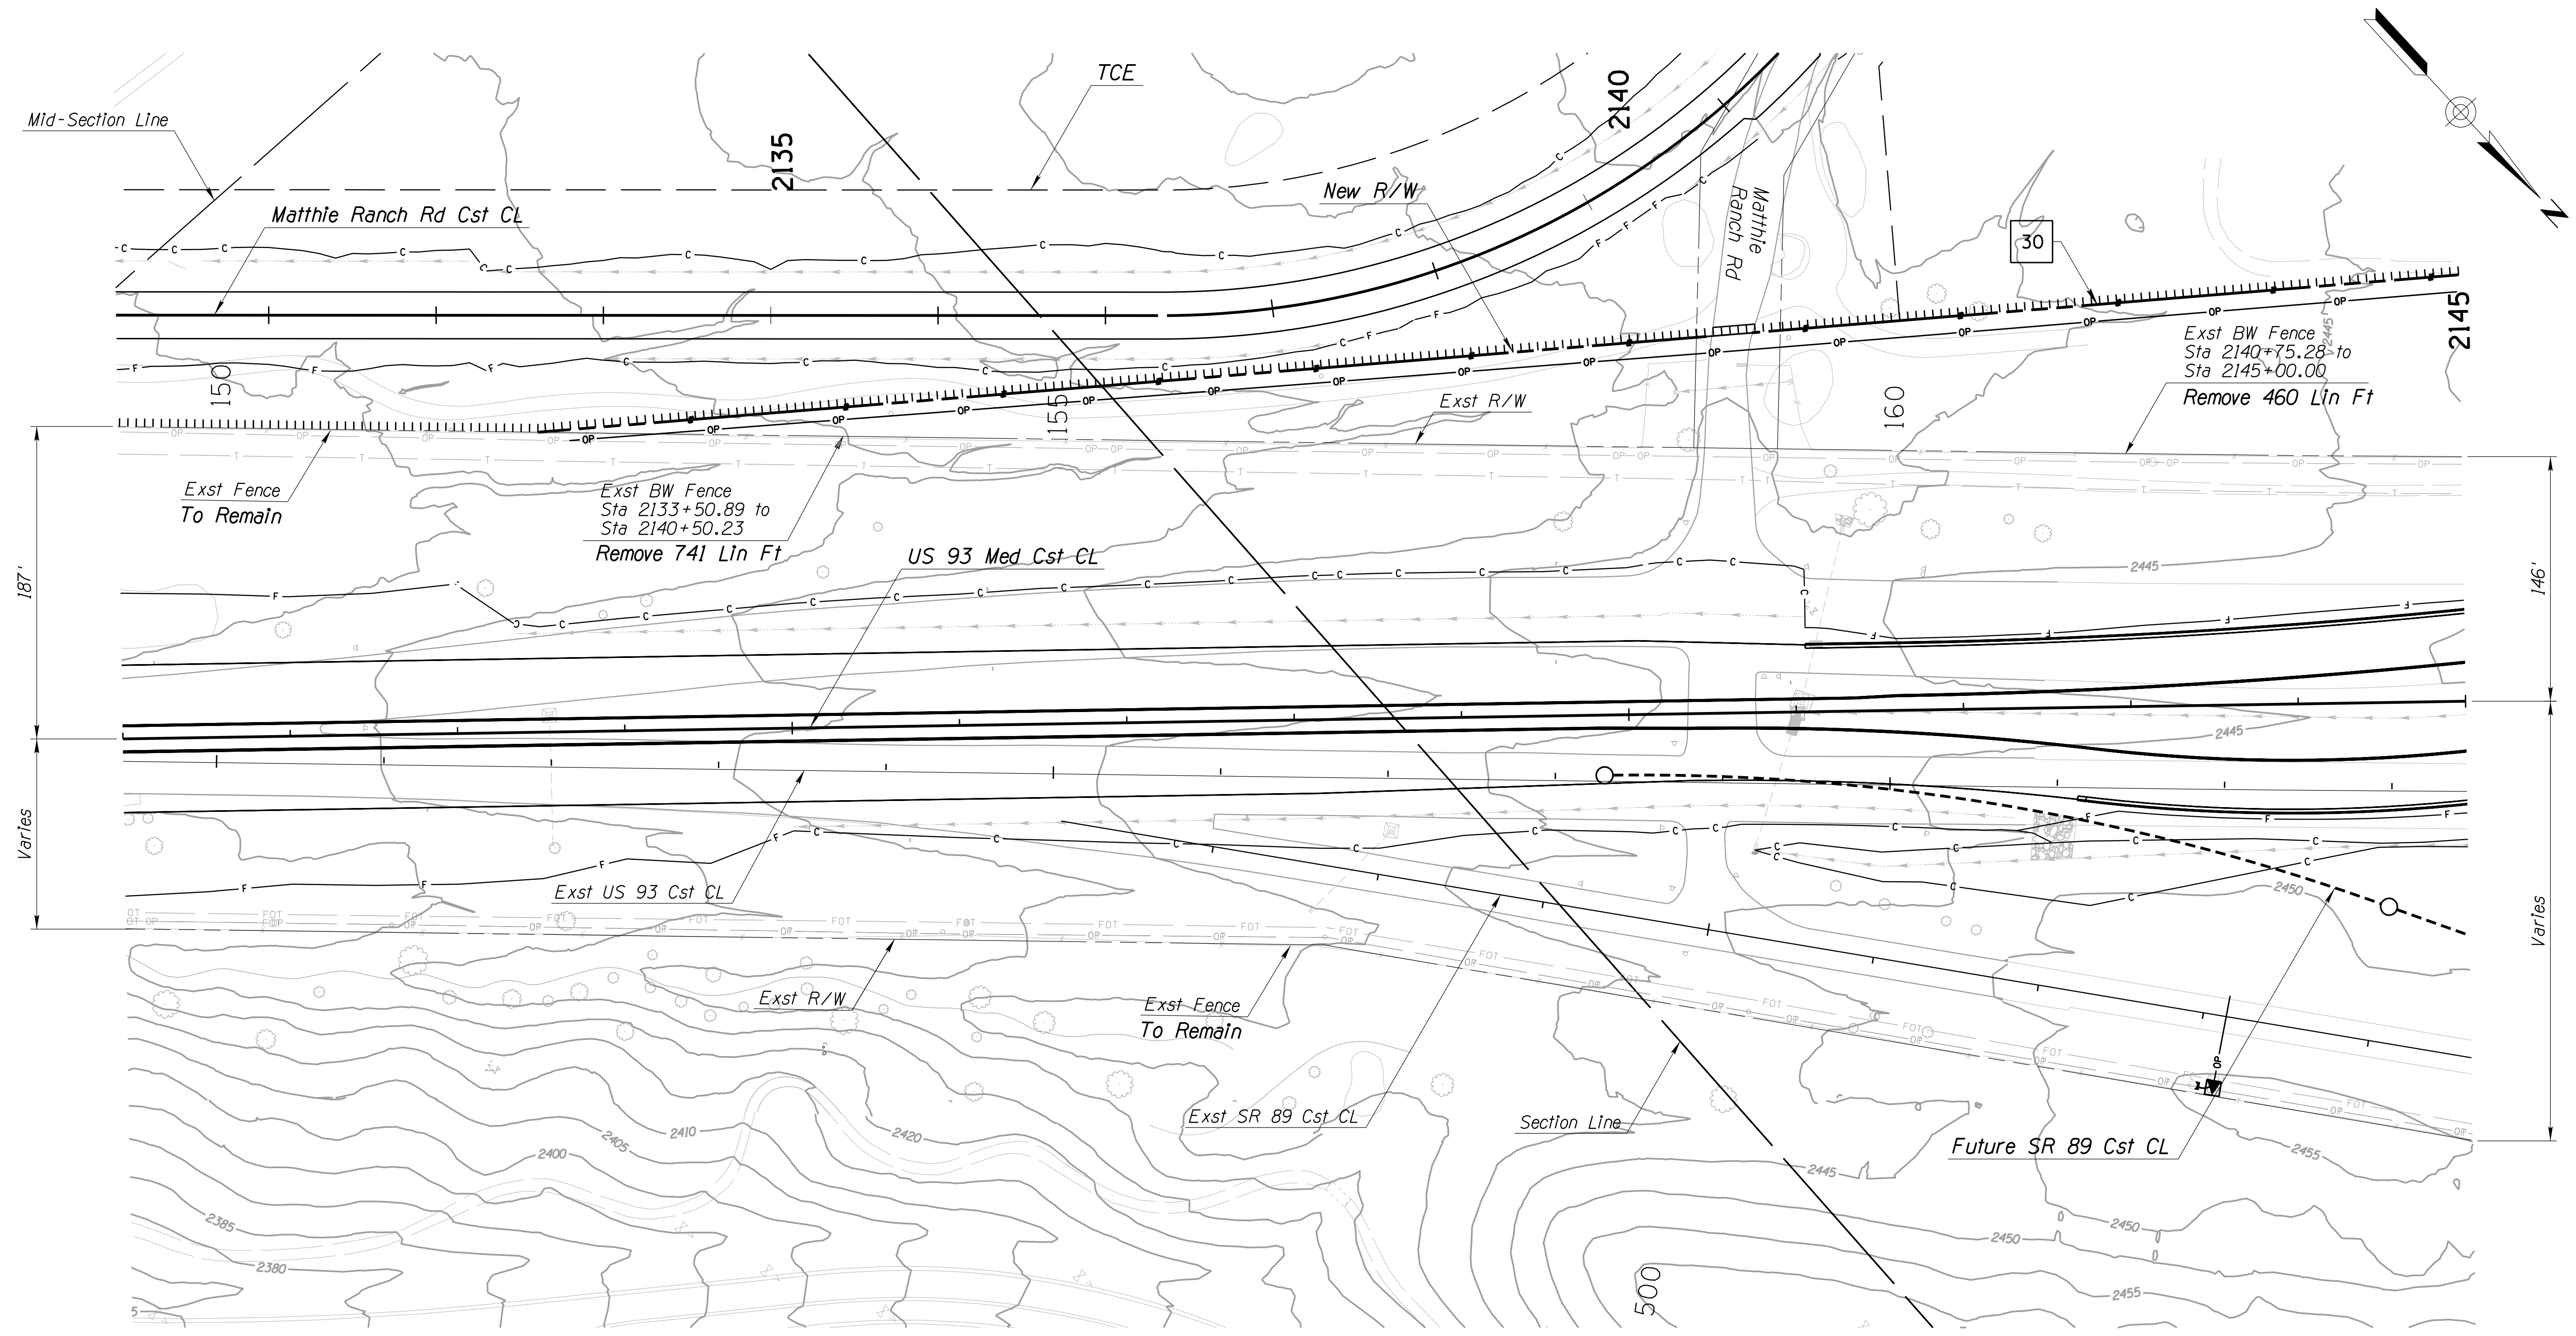

DESIGN	ZSZ	DATE	06-26
DRAWN	RM	DATE	06-26
CHECKED	DBK	DATE	06-26

3133 East Camelback Road, Suite 100
Phoenix, Arizona 85018
Phone: (602) 333-2200

Stanley Consultants inc.

ARIZONA DEPARTMENT OF TRANSPORTATION
PROJECT DELIVERY AND OPERATIONS DIVISION
ROADWAY DESIGN SERVICES

**US 93
FENCE SHEET
STA 2131+00 TO STA 2145+00**

ROUTE: US 93 LOCATION: WICKENBURG RANCH WAY TO VISTA ROYALE

TRACS NO. F0738 OIC

093-B(230)T

DWG NO. C-7.03


OF

46727
DIANA B. KELLY
Professional Engineer
ARIZONA, U.S.A.

NOTE:
See Dwg No. C-7.19 for fence along SR 89.

F.H.W.A. REGION	STATE	PROJECT NO.	SHEET NO.	TOTAL SHEETS	RECORD DRAWING
9	ARIZ.	093-B(230)T	256	524	

093 YV 189

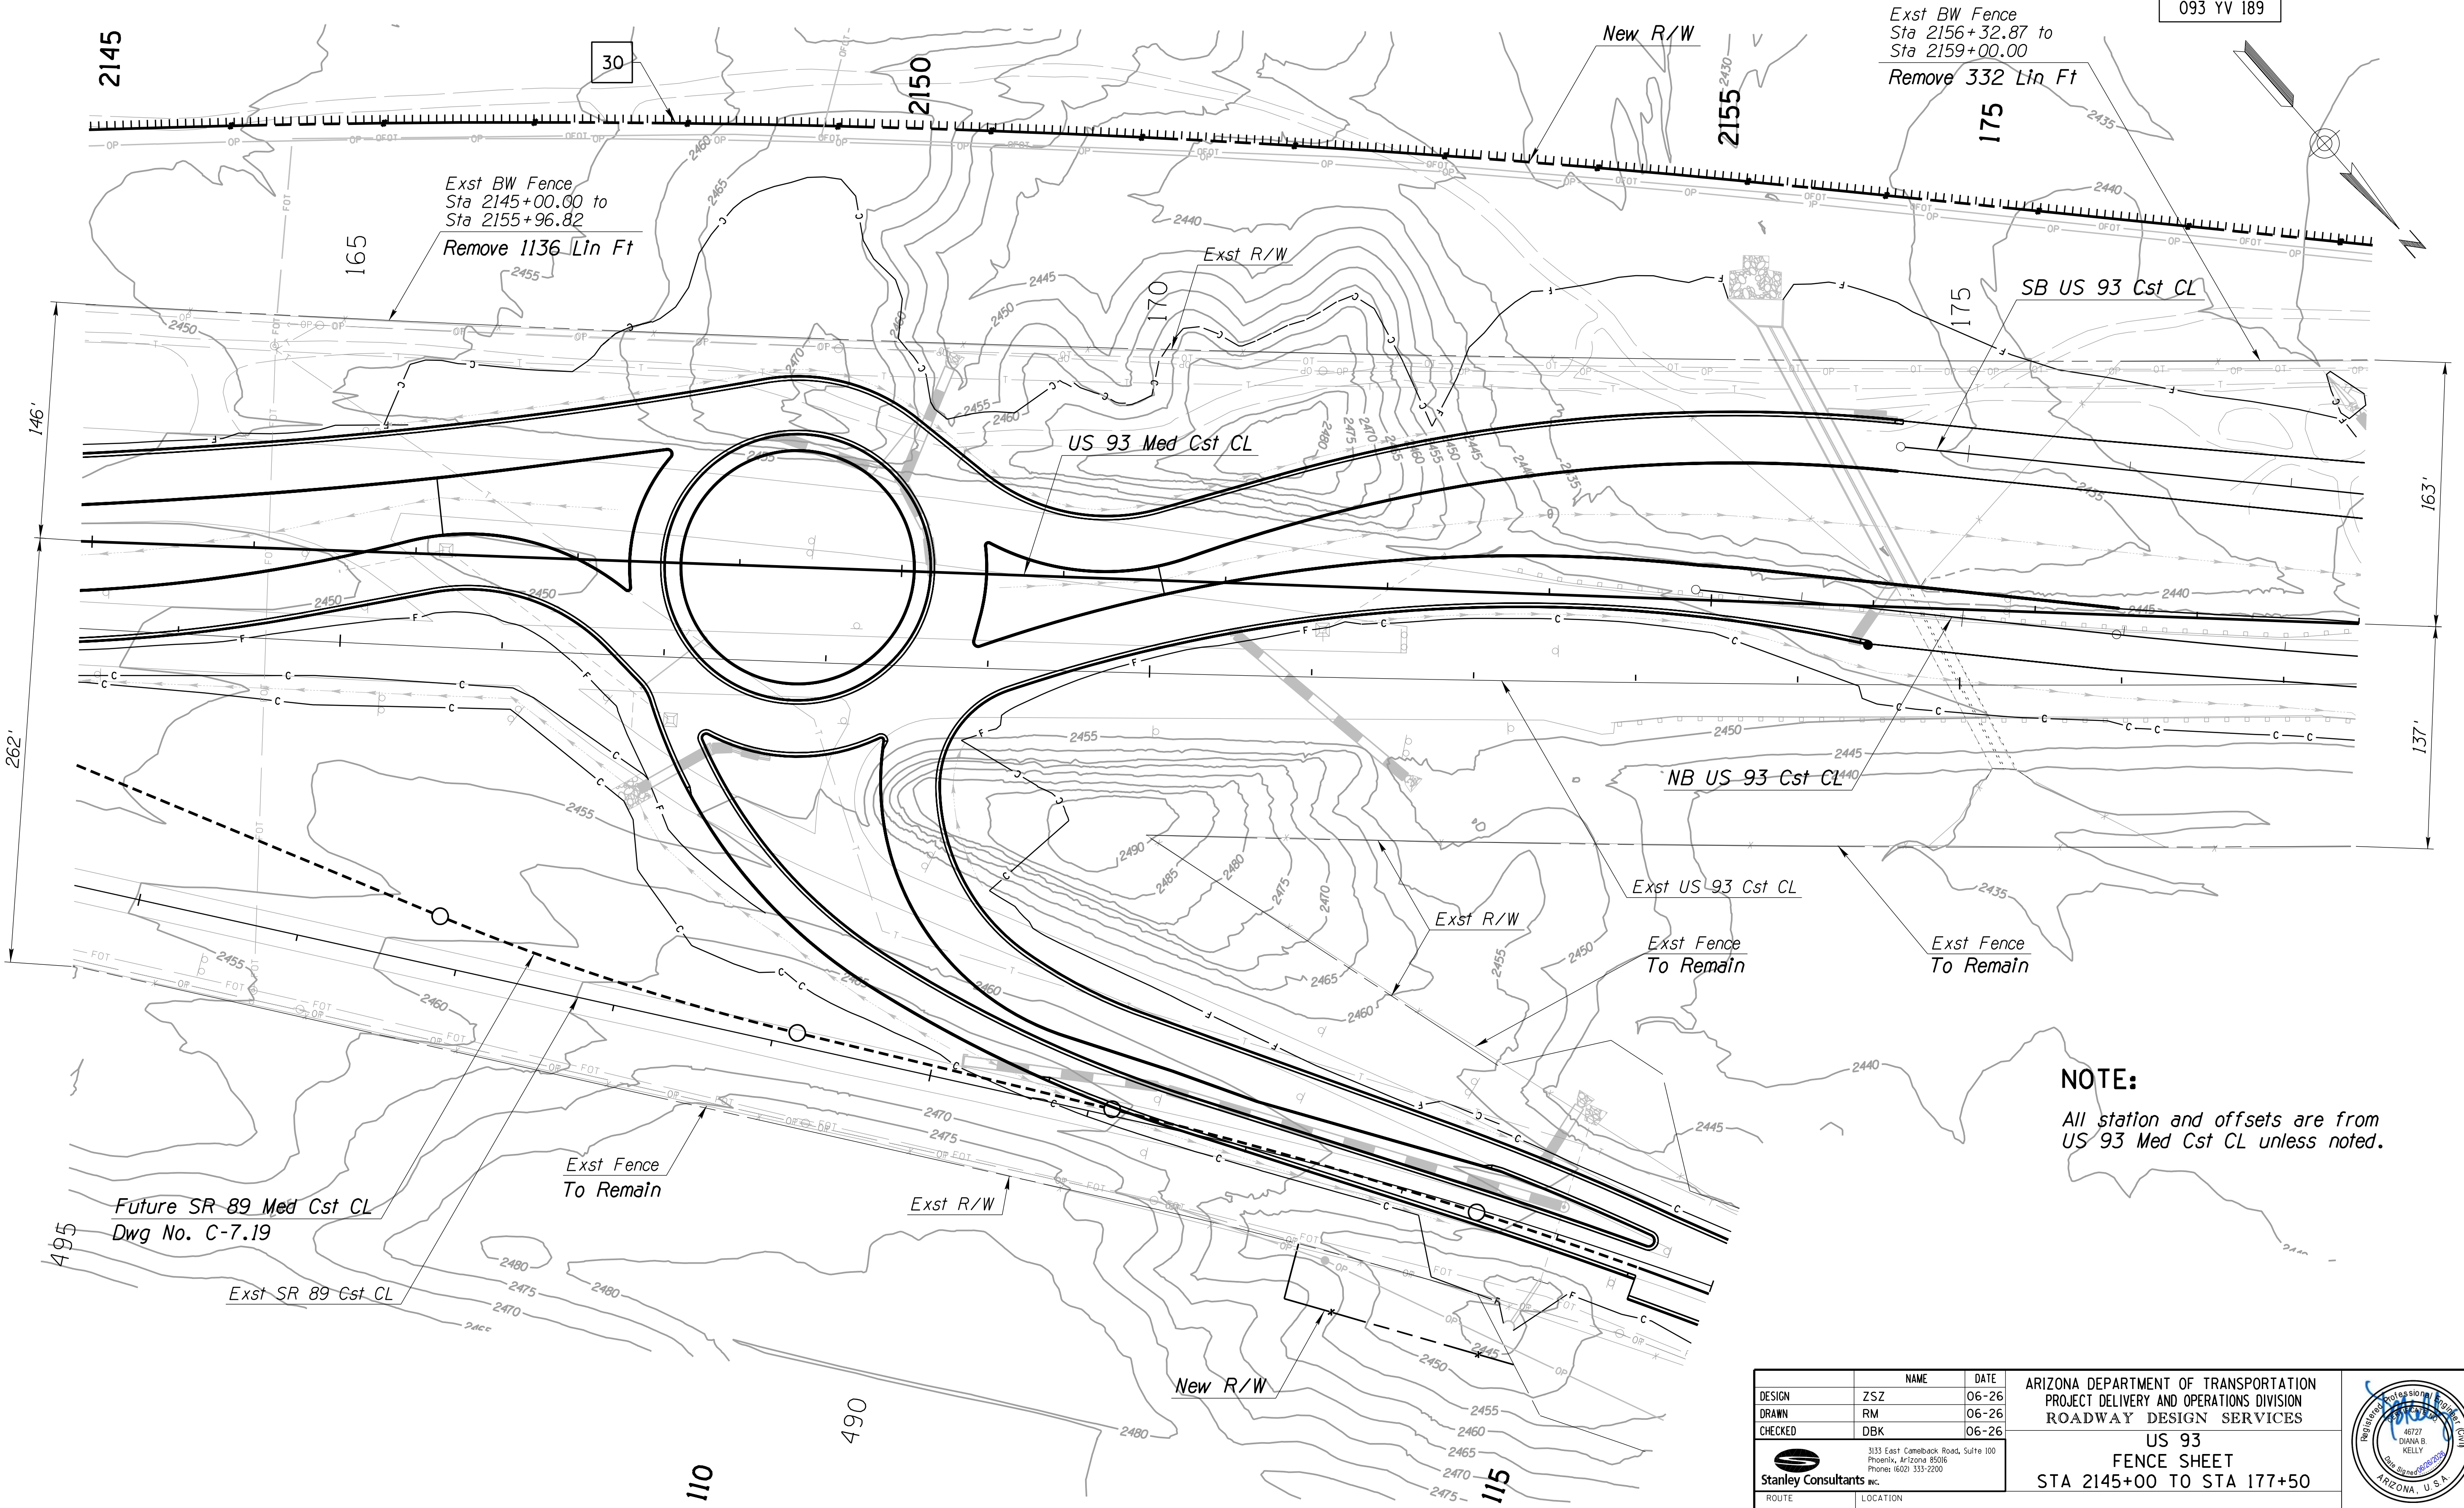

Exst BW Fence
Sta 2156+32.87 to
Sta 2159+00.00
Remove 332 Lin Ft

Exst BW Fence
Sta 2145+00.00 to
Sta 2155+96.82
Remove 1136 Lin Ft

NOTE:
All station and offsets are from
US 93 Med Cst CL unless noted.


DESIGN	ZSZ	DATE	06-26	ARIZONA DEPARTMENT OF TRANSPORTATION PROJECT DELIVERY AND OPERATIONS DIVISION ROADWAY DESIGN SERVICES	
DRAWN	RM	DATE	06-26		
CHECKED	DBK	DATE	06-26		
				3133 East Camelback Road, Suite 100 Phoenix, Arizona 85016 Phone: (602) 333-2200	
ROUTE	US 93			LOCATION	WICKENBURG RANCH WAY TO VISTA ROYALE
TRACS NO. F0738 OIC				093-B(230)T	DWG NO. C-7.04

US 93
FENCE SHEET
STA 2145+00 TO STA 177+50

OF

F.H.W.A. REGION	STATE	PROJECT NO.	SHEET NO.	TOTAL SHEETS	RECORD DRAWING
9	ARIZ.	093-B(230)T	257	524	

093 YV 189

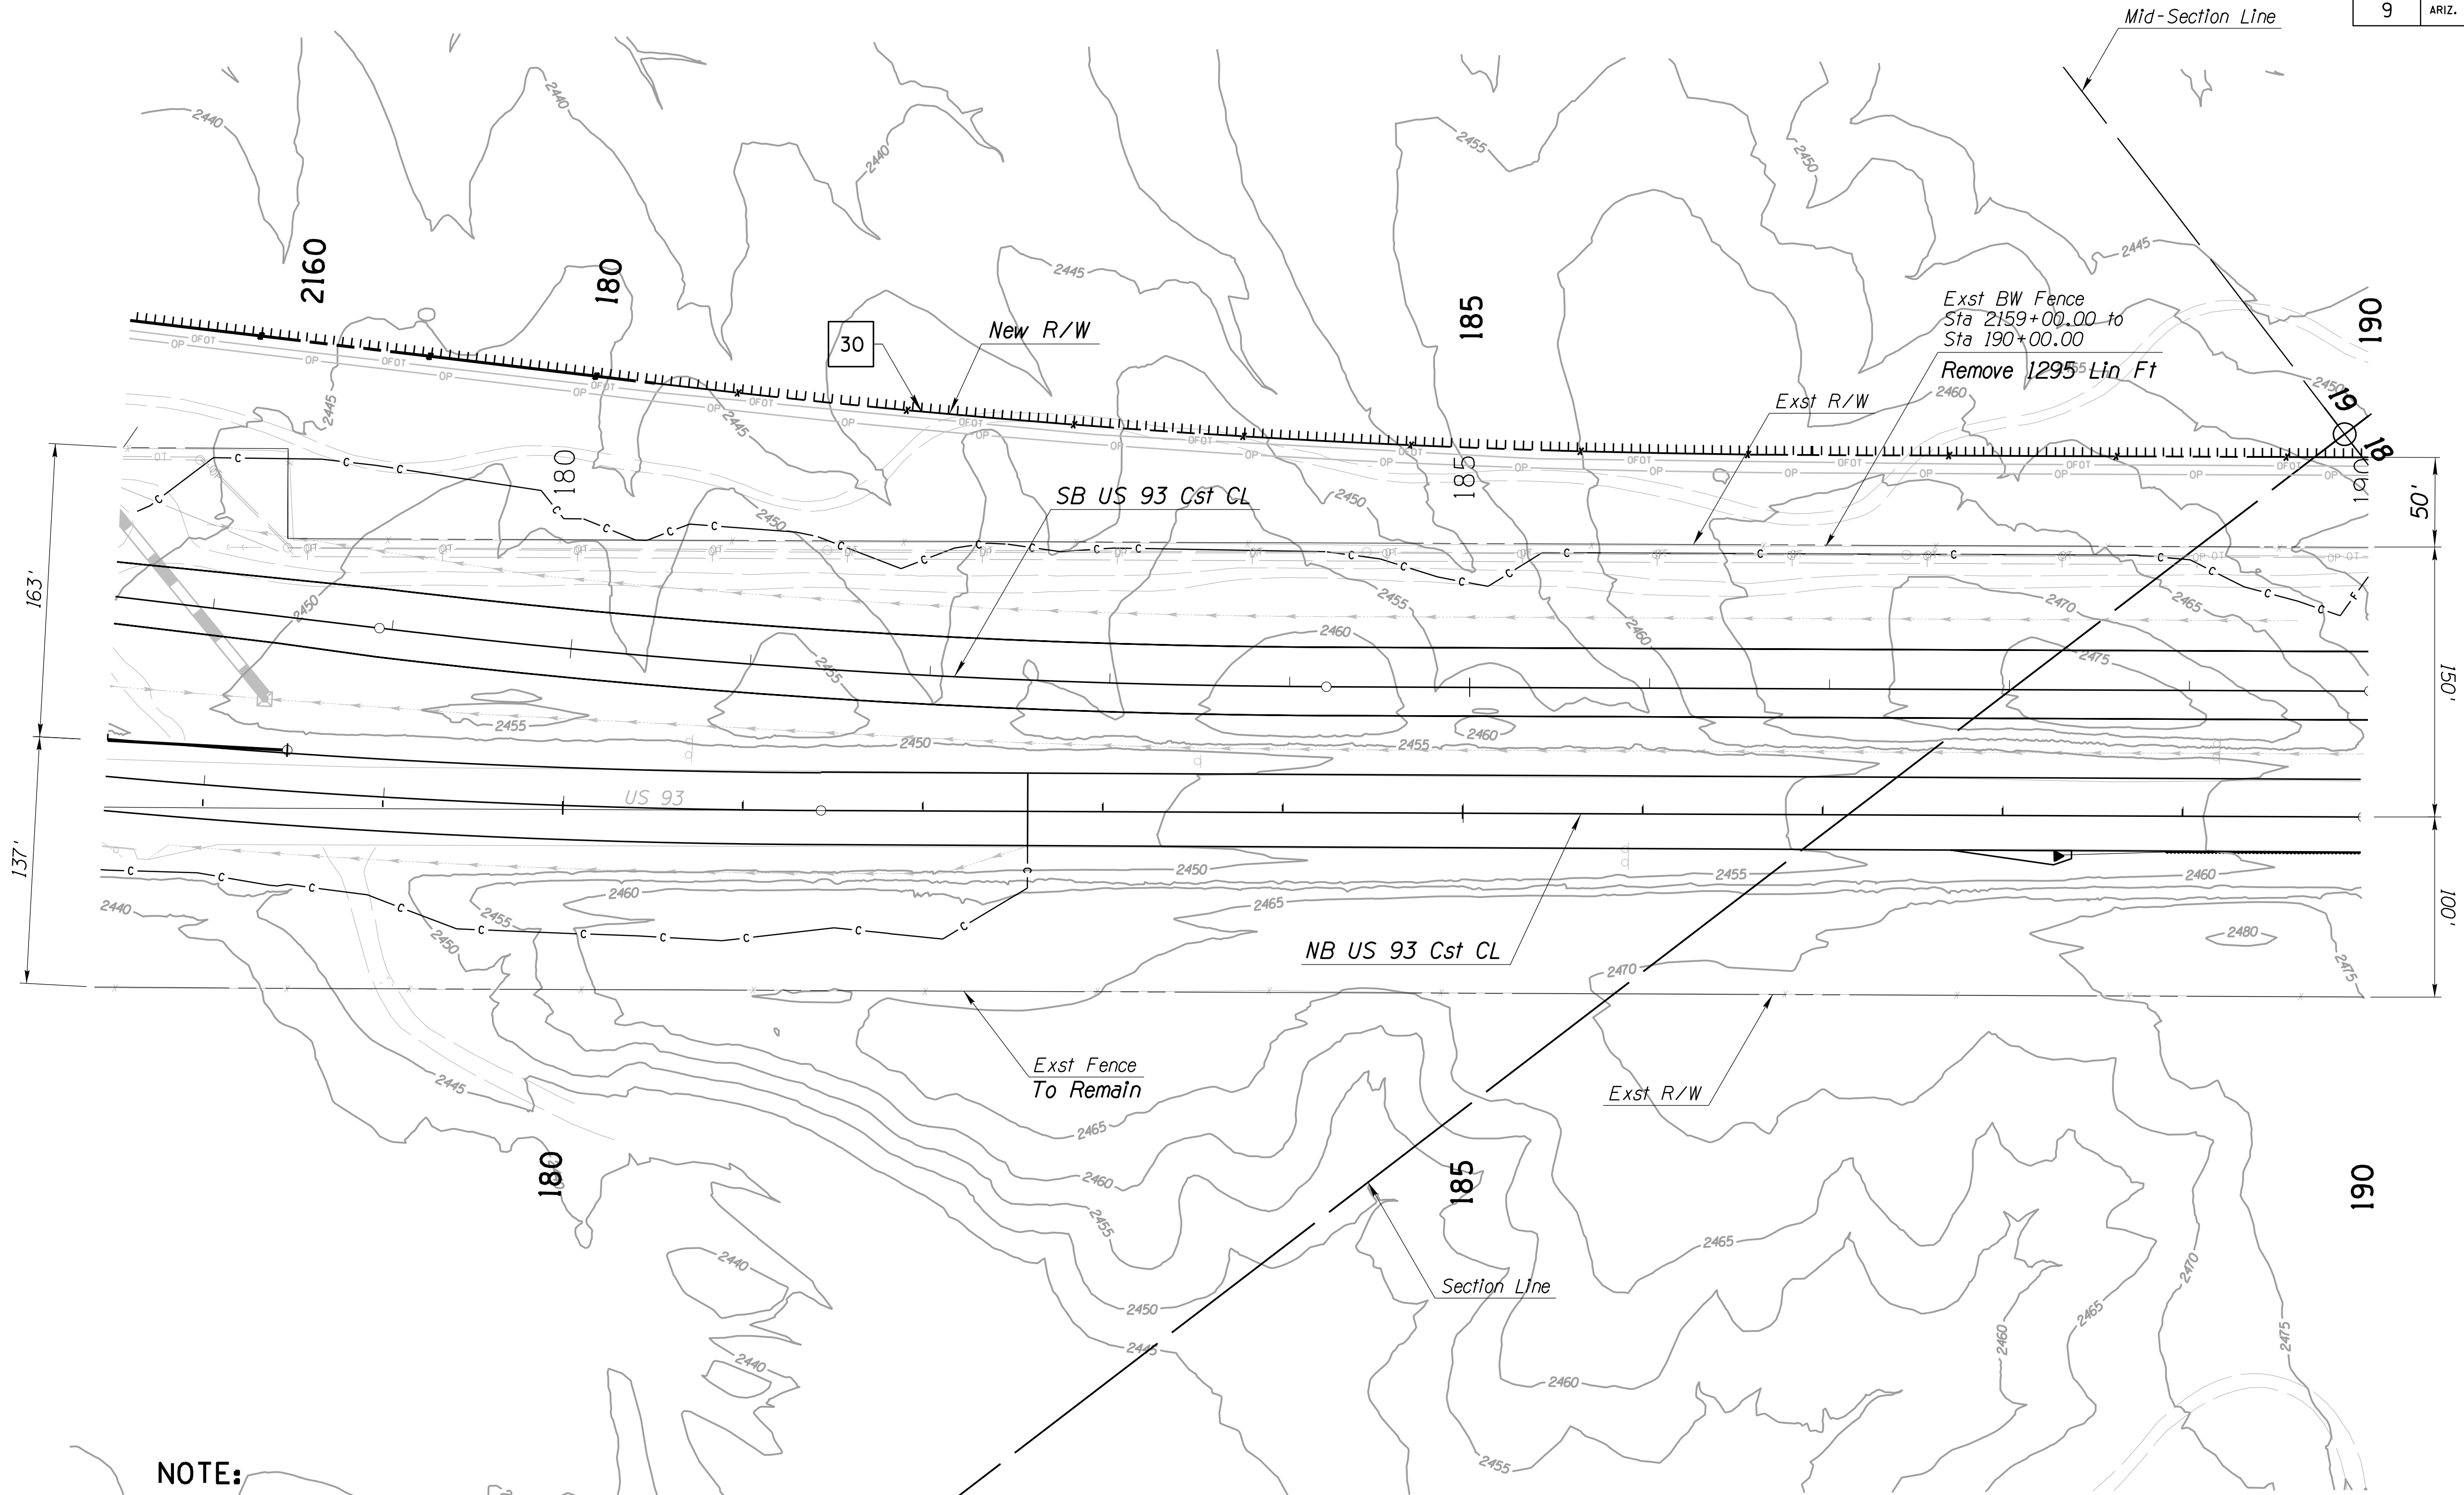


NOTE:
All station and offsets are from
US 93 Med Cst CL unless noted.


DESIGN	ZSZ	DATE	06-26
DRAWN	RM	DATE	06-26
CHECKED	DBK	DATE	06-26


ARIZONA DEPARTMENT OF TRANSPORTATION PROJECT DELIVERY AND OPERATIONS DIVISION ROADWAY DESIGN SERVICES	
US 93 FENCE SHEET STA 177+50 TO STA 190+00	
ROUTE	LOCATION
US 93	WICKENBURG RANCH WAY TO VISTA ROYALE
TRACS NO. F0738 OIC	093-B(230)T


3133 East Camelback Road, Suite 100 Phoenix, Arizona 85016 Phone: (602) 333-2200	45727 DIANA B. KELLY Professional Engineer ARIZONA, U.S.A.
Stanley Consultants inc.	DWG NO. C-7.05 OF

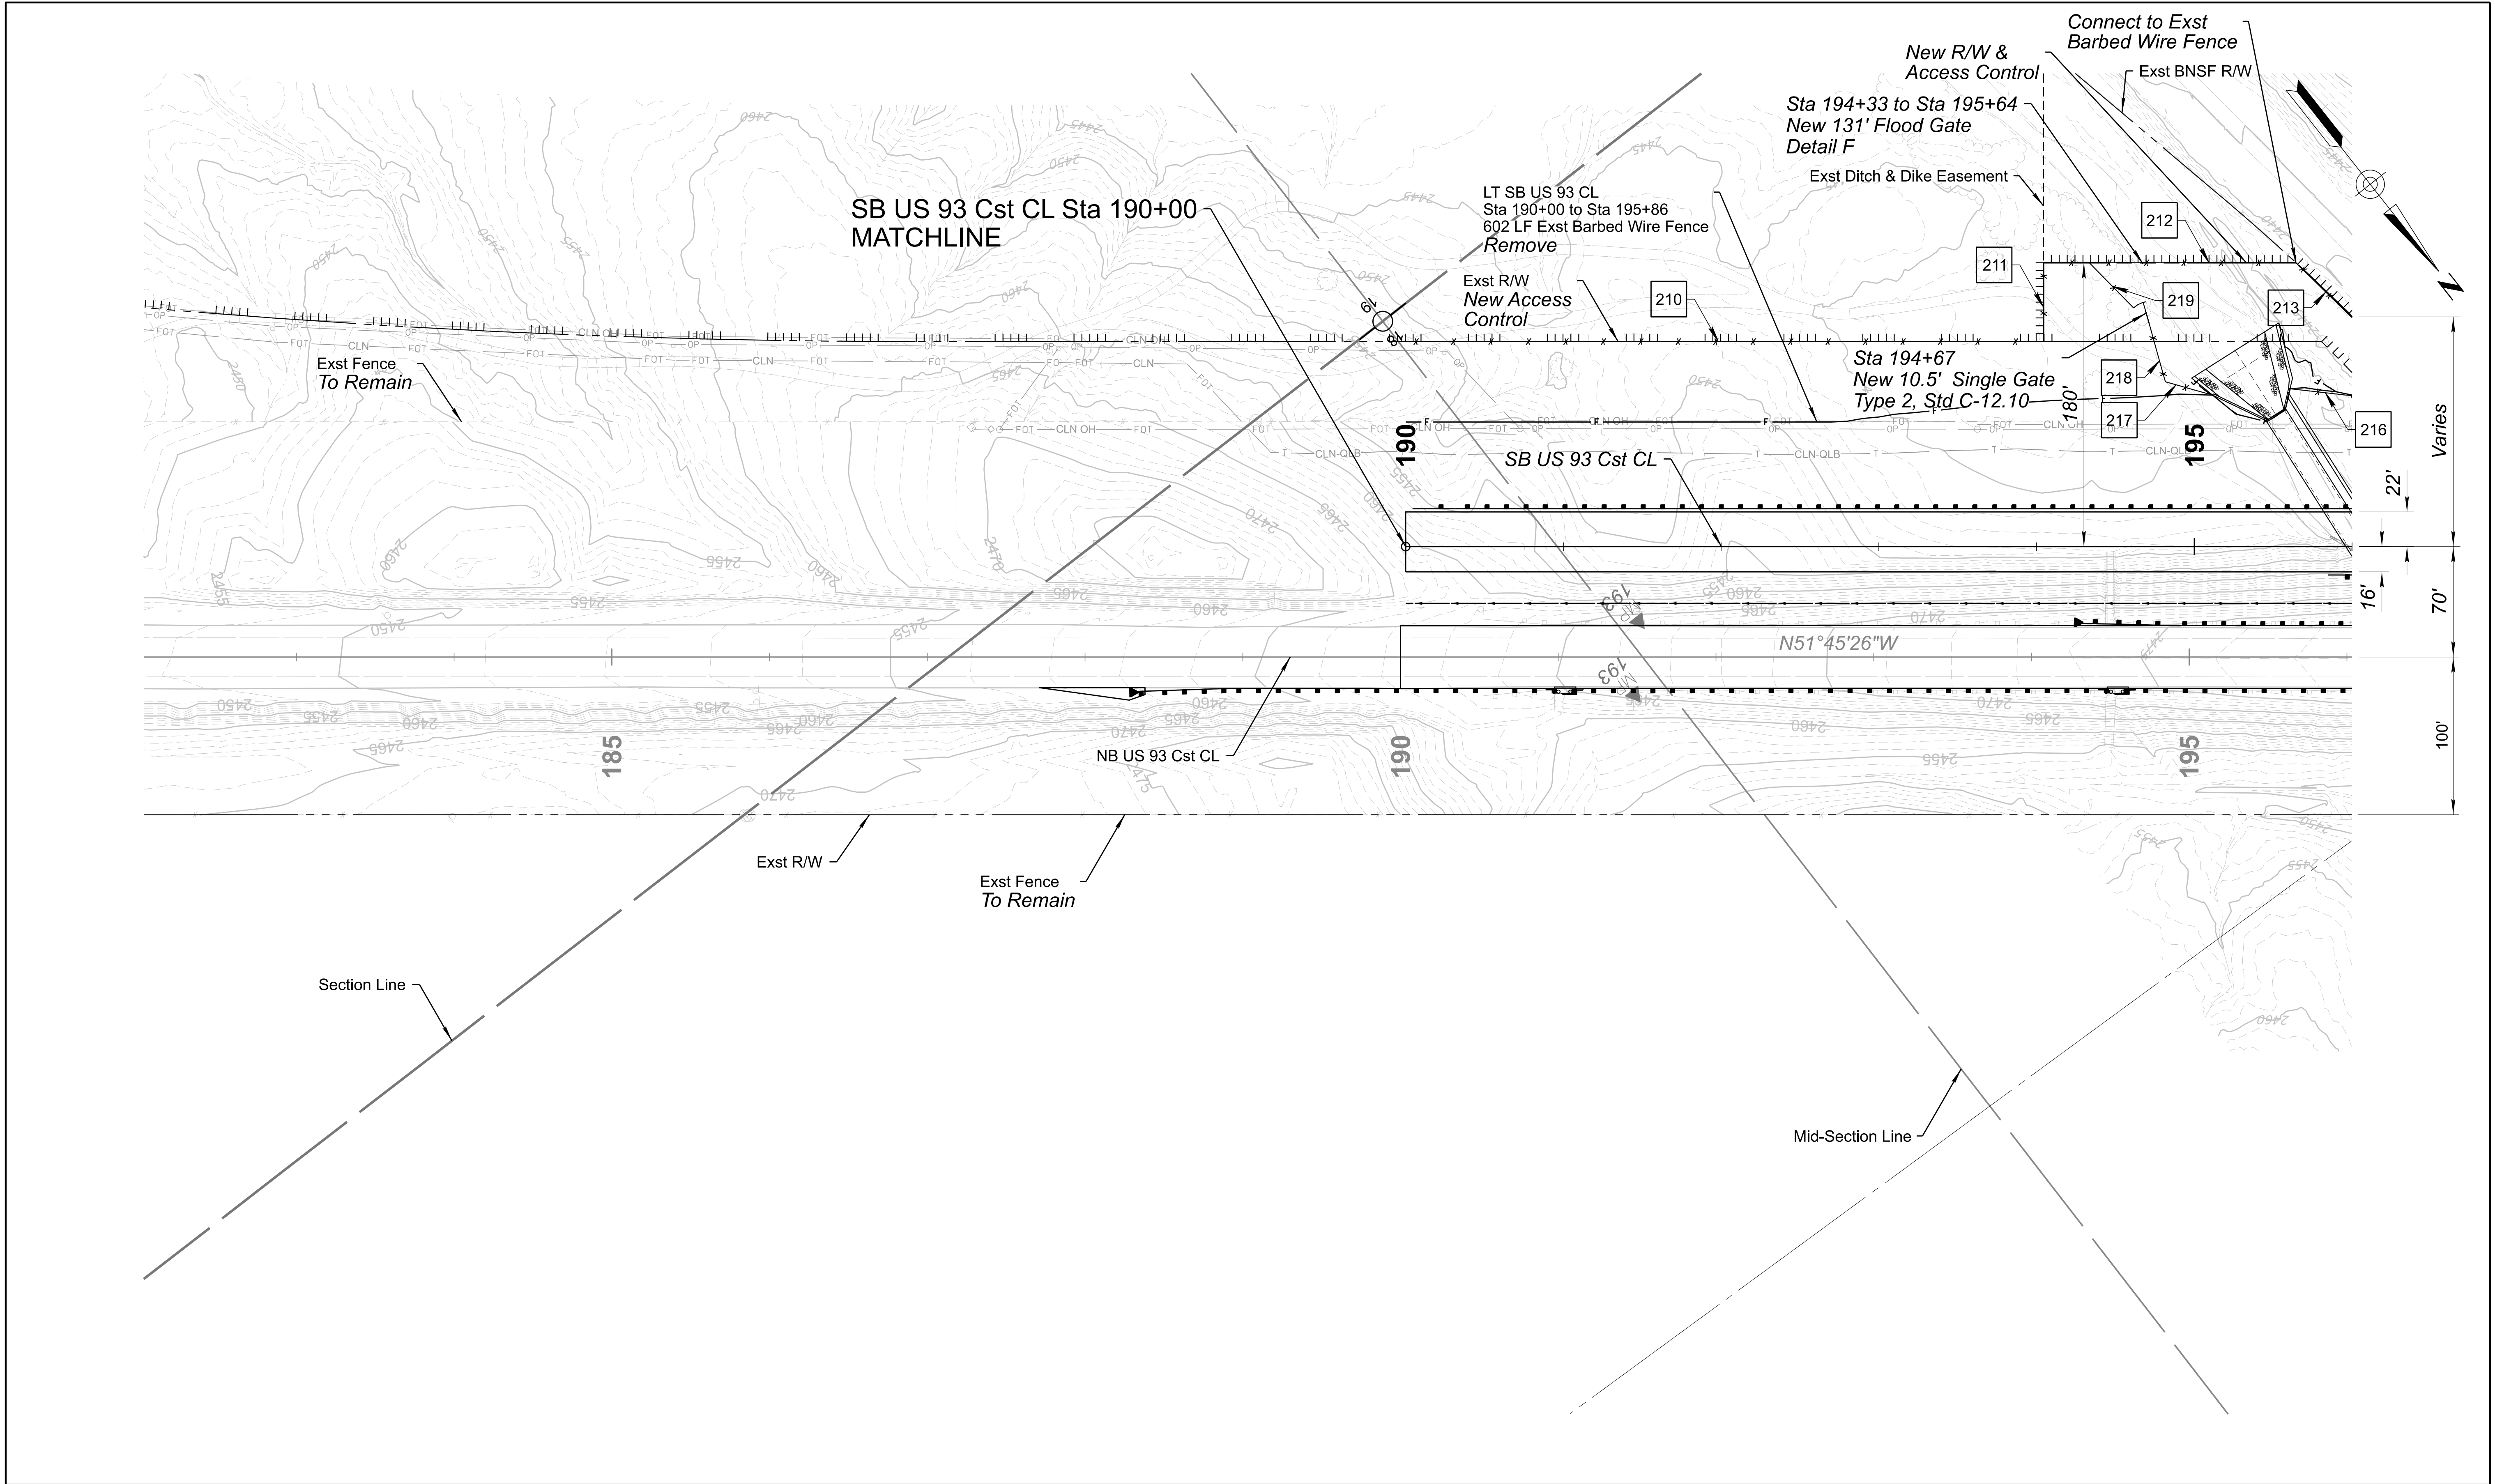


	NAME		DATE	ARIZONA DEPARTMENT OF TRANSPORTATION PROJECT DELIVERY AND OPERATIONS DIVISION ROADWAY DESIGN SERVICES	ROUTE US 93	F.H.W.A. Arizona Division	STATE ARIZ.	PROJECT NO.	FEDERAL ID NO.	SHEET NO.	TOTAL SHEETS	RECORD DRAWING
	DESIGN	J GILLIS	06/26					093 YV 189	093-B(230)T	258	524	
	DRAWN	M SAMUELSON	06/26					LOCATION WICKENBURG RANCH WAY TO VISTA ROYALE				
	CHECKED	D WIGGINS	06/26	TRANSPORTATION AECOM TECHNICAL SERVICES, Inc. 7720 N. 16th St., Suite 100 Phoenix, Arizona 85020 T 602.371.1100 www.aecom.com			FENCE PLAN SHEET SB US 93 STA 190+00 TO STA 196+00		TRACS NO. F0738 01C		DWG No. C-7.06 ____ OF ____	

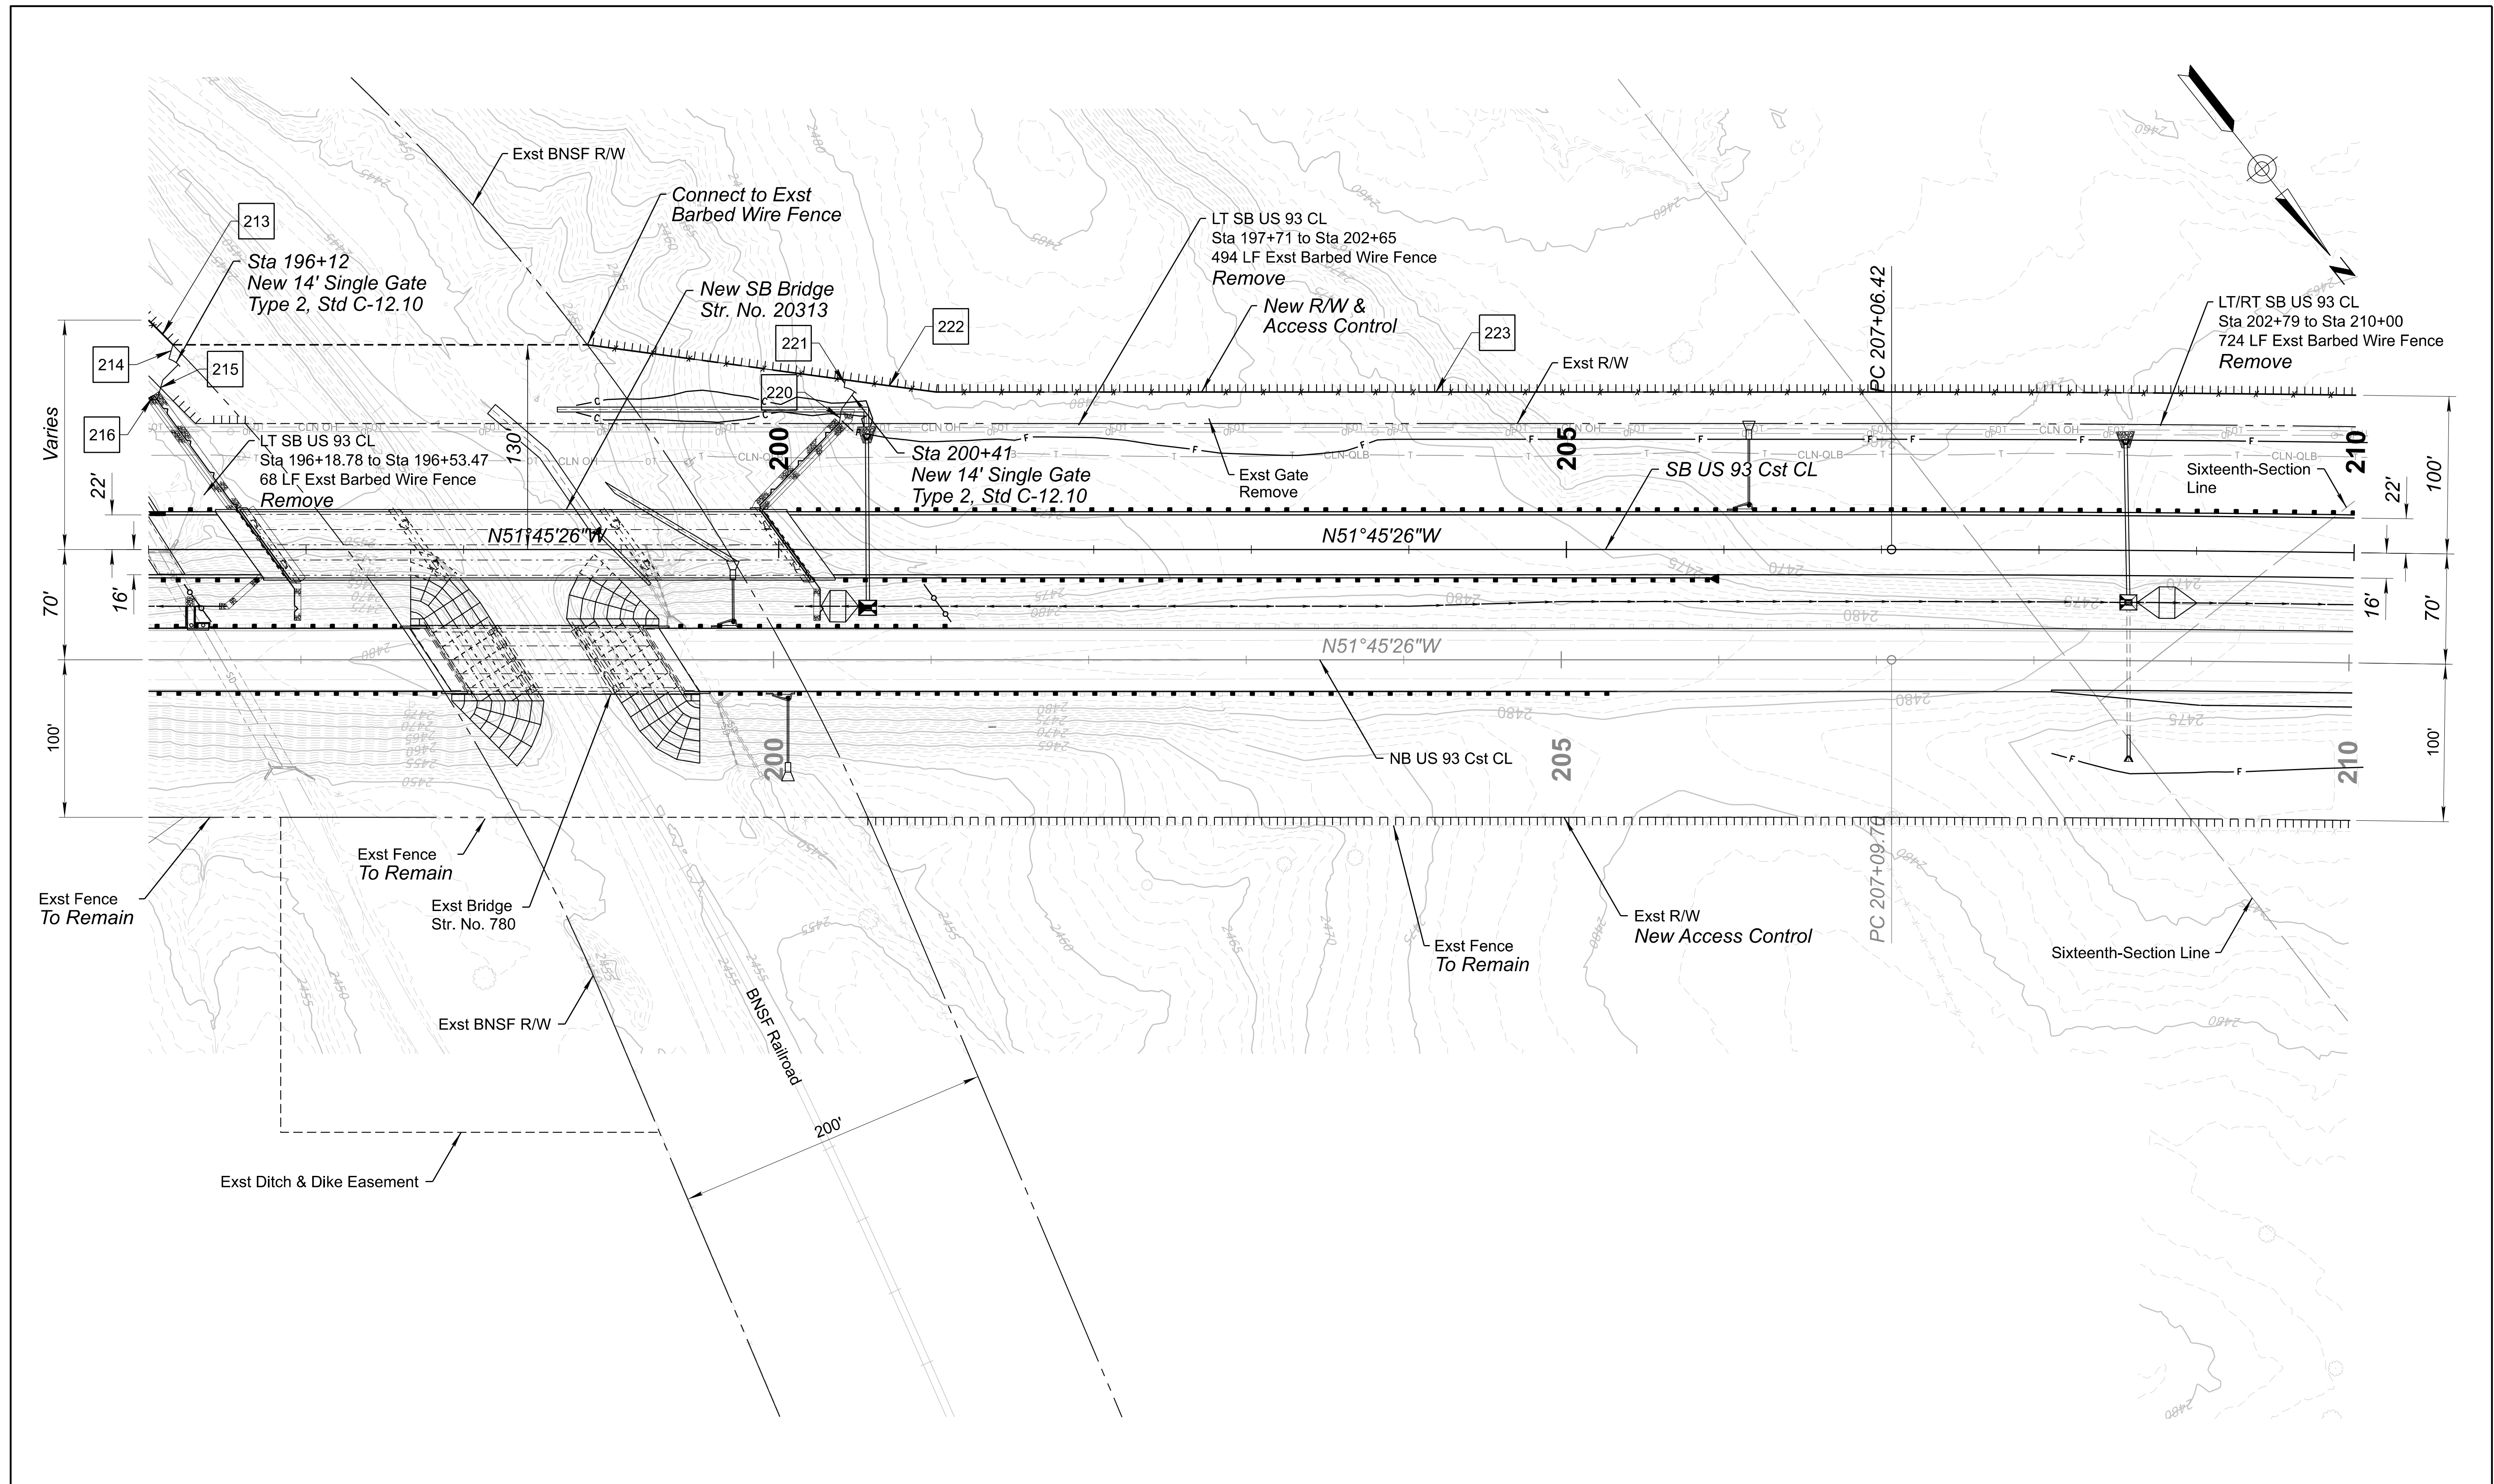

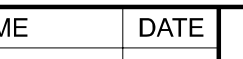
		NAME	DATE	ARIZONA DEPARTMENT OF TRANSPORTATION PROJECT DELIVERY AND OPERATIONS DIVISION ROADWAY DESIGN SERVICES	ROUTE	F.H.W.A. Arizona Division	STATE ARIZ.	PROJECT NO.	FEDERAL ID NO.	SHEET NO.	TOTAL SHEETS	RECORD DRAWING	
	DESIGN	J GILLIS	06/26		US 93			093 YV 189	093-B(230)T	259	524		
	DRAWN	M SAMUELSON	06/26		MILEPOST			WICKENBURG RANCH WAY TO VISTA ROYALE					
	CHECKED	D WIGGINS	06/26		189.9								
	TRANSPORTATION AECOM TECHNICAL SERVICES, Inc. 7720 N. 16th St., Suite 100 Phoenix, Arizona 85020 T 602.371.1100  www.aecom.com				STRUCTURE NO.			DWG No. C-7.07					
FENCE PLAN SHEET SB US 93 STA 196+00 TO STA 210+00				TRACS NO. F0738 01C								OF	

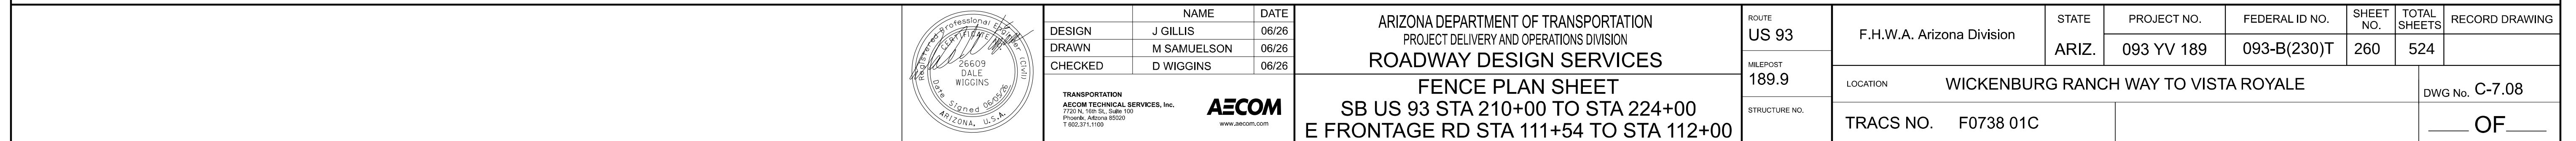


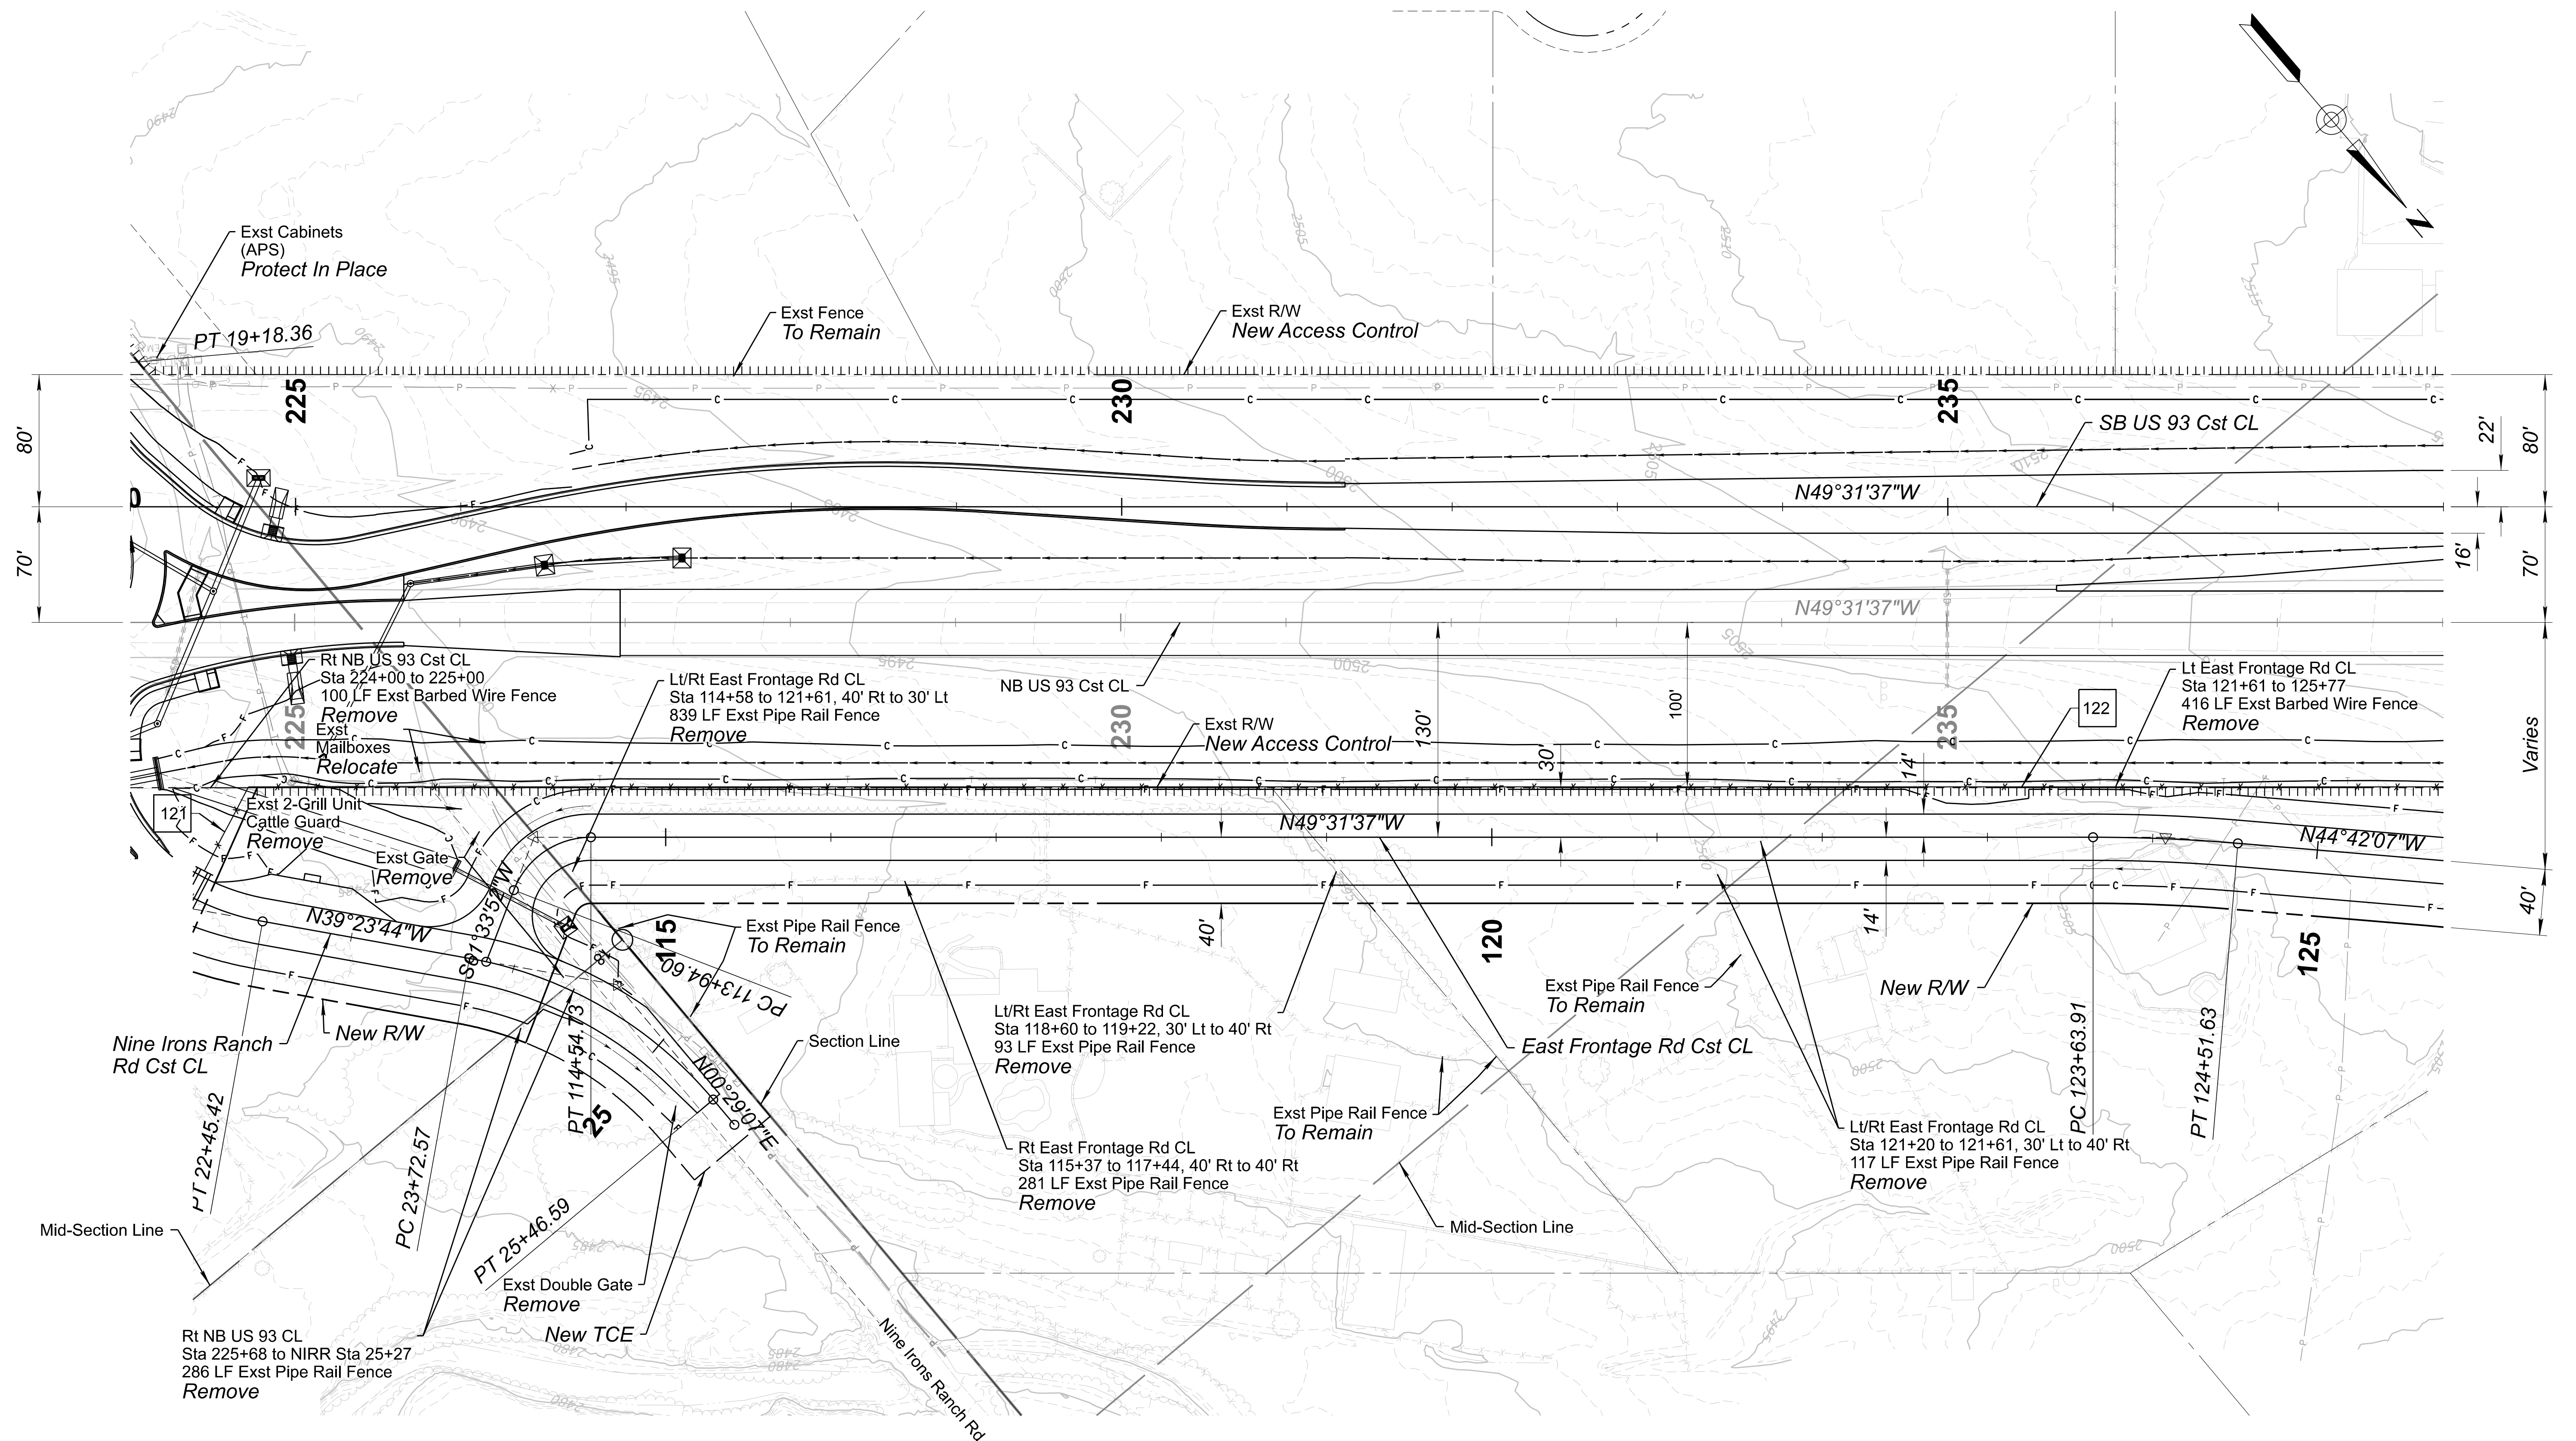



Registered Professional Engineer
 CERTIFICATE NO. 26609
 DALE WIGGINS
 Date Signed 06/09/26
 ARIZONA, U.S.A.


ARIZONA DEPARTMENT OF TRANSPORTATION PROJECT DELIVERY AND OPERATIONS DIVISION ROADWAY DESIGN SERVICES
FENCE SHEET SB US 93 STA 224+00 TO STA 238+00 E FRONTAGE RD STA 112+00 TO STA 125+77

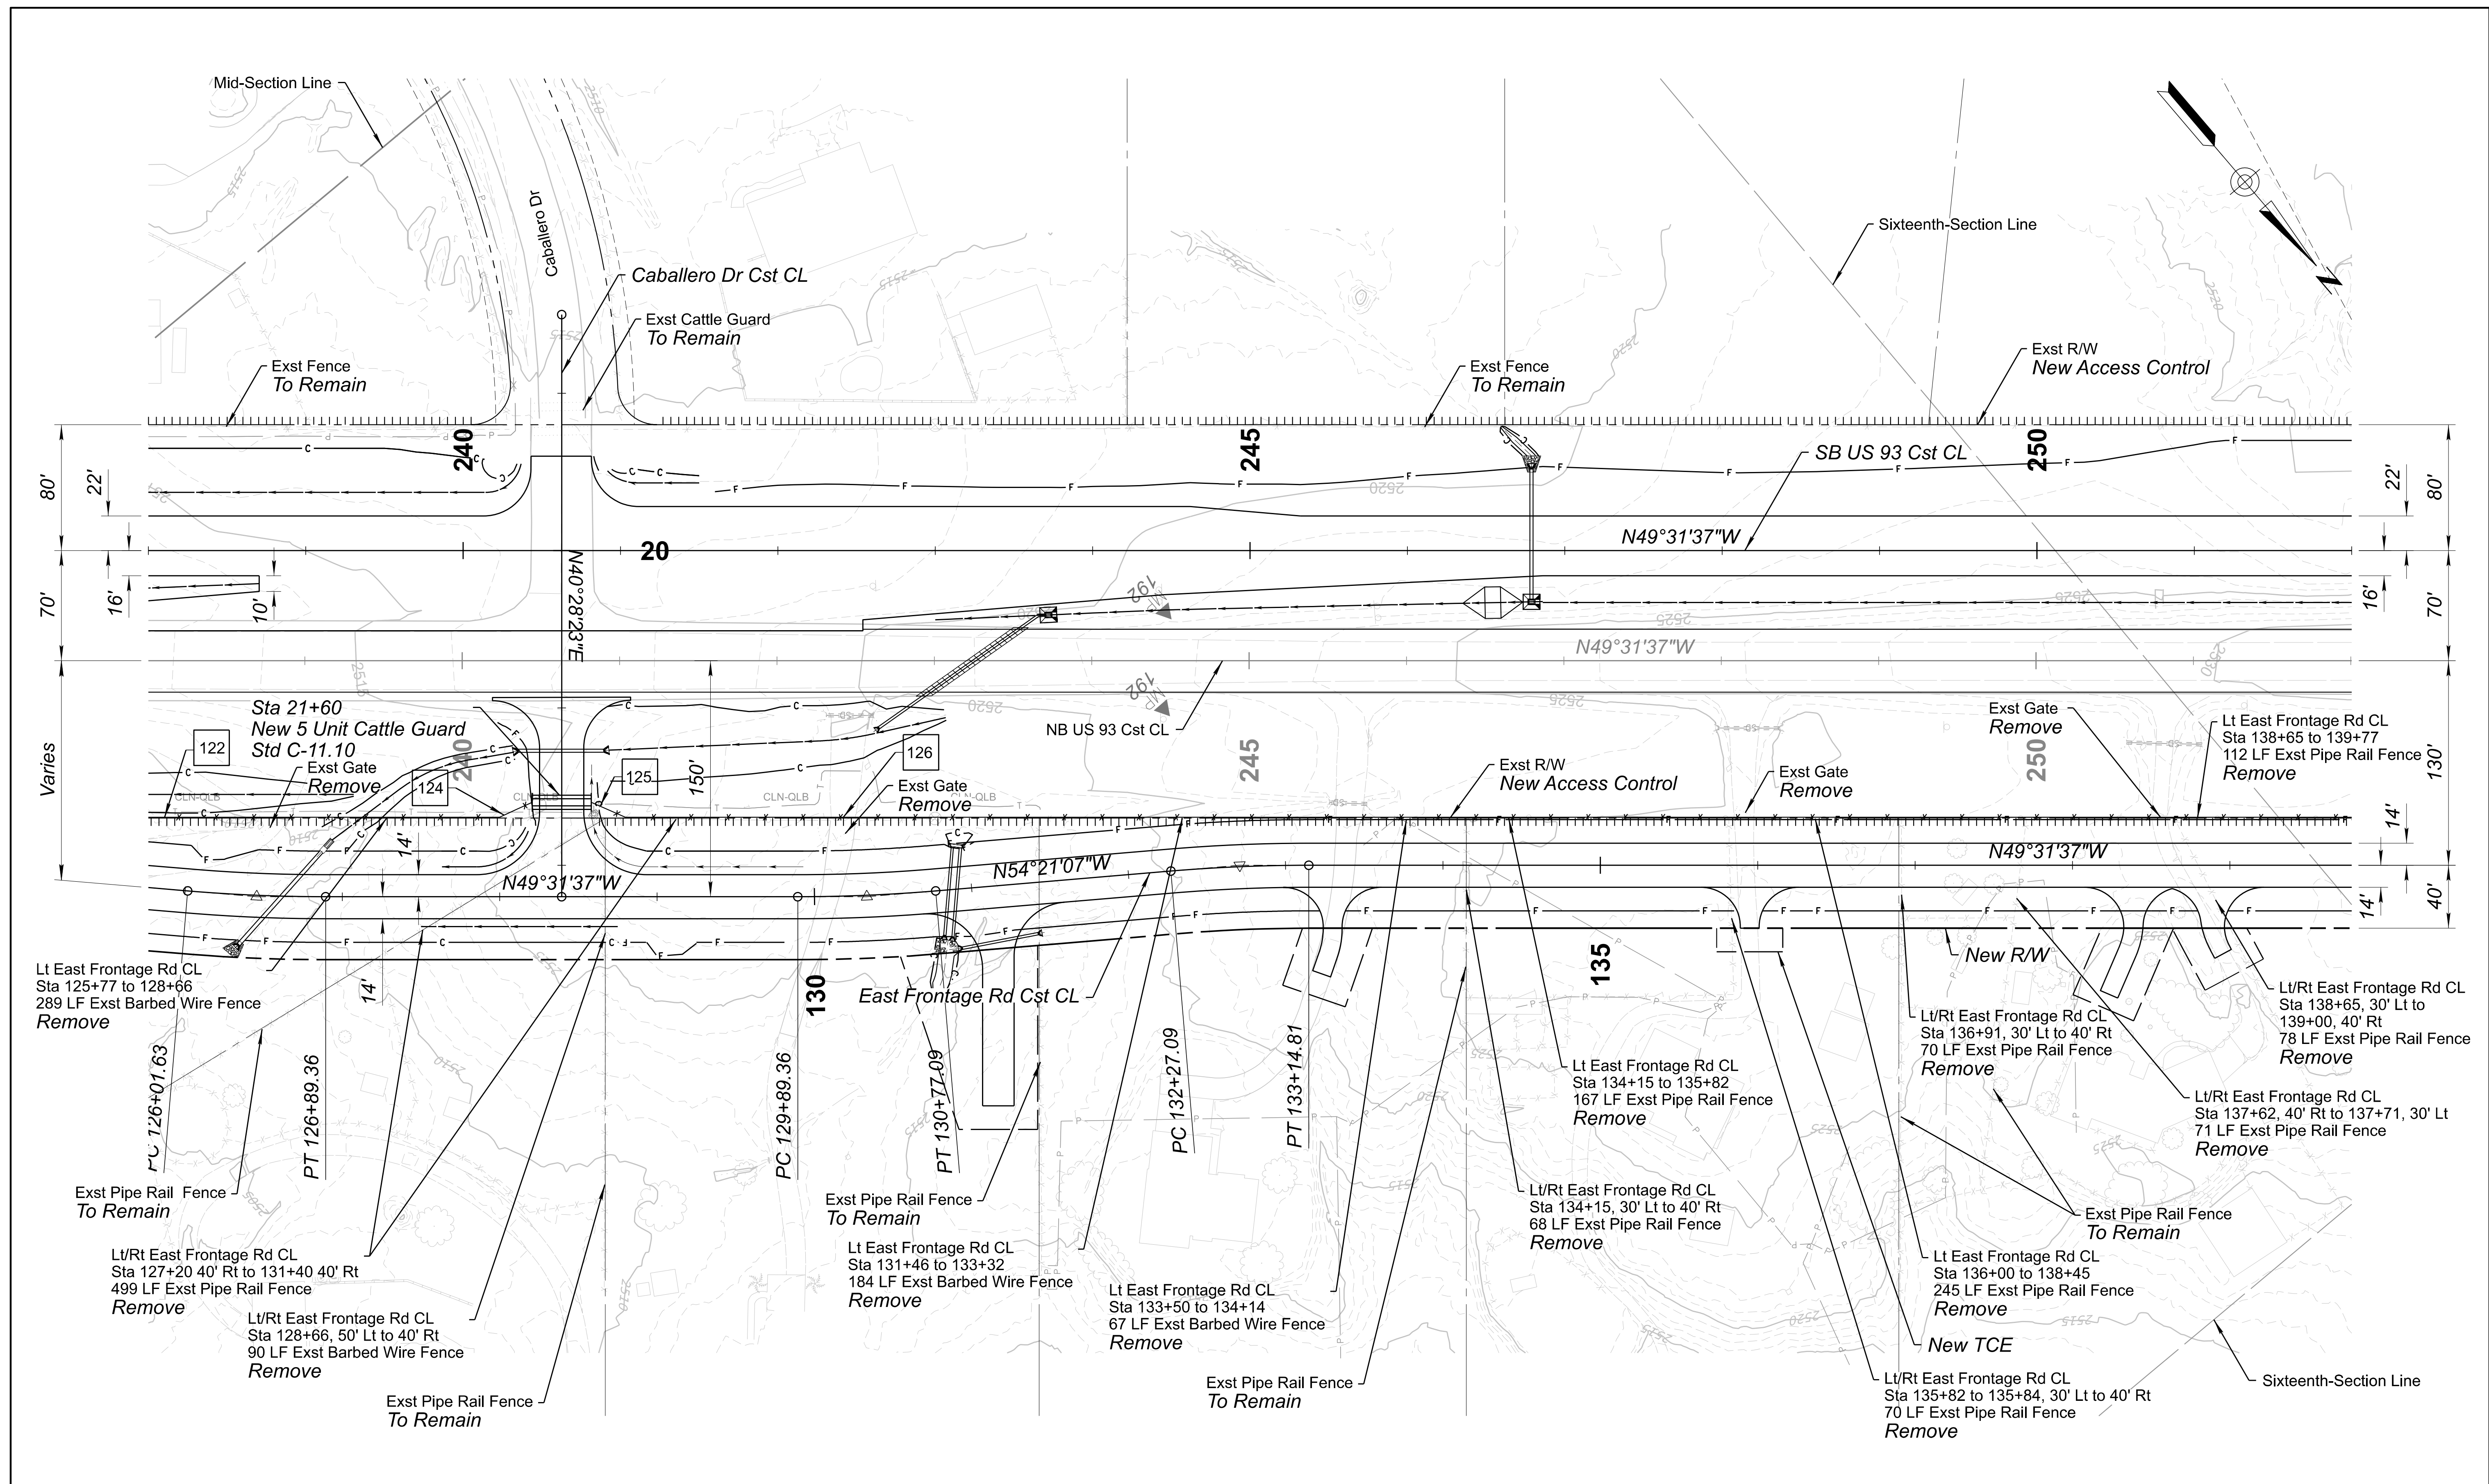


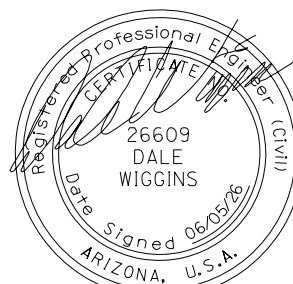
	<table><tr><th>NAME</th><th>DATE</th></tr><tr><td>J GILLIS</td><td>06/26</td></tr><tr><td>M SAMUELSON</td><td>06/26</td></tr><tr><td>D WIGGINS</td><td>06/26</td></tr></table>		NAME	DATE	J GILLIS	06/26	M SAMUELSON	06/26	D WIGGINS	06/26	<table><tr><td colspan="2">ARIZONA DEPARTMENT OF TRANSPORTATION</td></tr><tr><td colspan="2">PROJECT DELIVERY AND OPERATIONS DIVISION</td></tr><tr><td colspan="2">ROADWAY DESIGN SERVICES</td></tr><tr><td colspan="2">FENCE SHEET</td></tr><tr><td colspan="2">SB US 93 STA 238+00 TO STA 252+00</td></tr><tr><td colspan="2">E FRONTAGE RD STA 125+77 TO STA 139+77</td></tr></table>	ARIZONA DEPARTMENT OF TRANSPORTATION		PROJECT DELIVERY AND OPERATIONS DIVISION		ROADWAY DESIGN SERVICES		FENCE SHEET		SB US 93 STA 238+00 TO STA 252+00		E FRONTAGE RD STA 125+77 TO STA 139+77		<table><tr><td>ROUTE</td><td>US 93</td></tr><tr><td>MILEPOST</td><td>189.9</td></tr><tr><td>STRUCTURE NO.</td><td></td></tr></table>	ROUTE	US 93	MILEPOST	189.9	STRUCTURE NO.		<table><tr><td>F.H.W.A. Arizona Division</td><td>STATE</td><td>PROJECT NO.</td><td>FEDERAL ID NO.</td><td>SHEET NO.</td><td>TOTAL SHEETS</td><td>RECORD DRAWING</td></tr><tr><td>ARIZ.</td><td>093 YV 189</td><td>093-B(230)T</td><td>262</td><td>524</td><td></td><td></td></tr><tr><td colspan="5">LOCATION</td><td colspan="2">DWG No. C-7.10</td></tr><tr><td colspan="5">TRACS NO. F0738 01C</td><td colspan="2">OF</td></tr></table>	F.H.W.A. Arizona Division	STATE	PROJECT NO.	FEDERAL ID NO.	SHEET NO.	TOTAL SHEETS	RECORD DRAWING	ARIZ.	093 YV 189	093-B(230)T	262	524			LOCATION					DWG No. C-7.10		TRACS NO. F0738 01C					OF	
	NAME	DATE																																																									
	J GILLIS	06/26																																																									
	M SAMUELSON	06/26																																																									
D WIGGINS	06/26																																																										
ARIZONA DEPARTMENT OF TRANSPORTATION																																																											
PROJECT DELIVERY AND OPERATIONS DIVISION																																																											
ROADWAY DESIGN SERVICES																																																											
FENCE SHEET																																																											
SB US 93 STA 238+00 TO STA 252+00																																																											
E FRONTAGE RD STA 125+77 TO STA 139+77																																																											
ROUTE	US 93																																																										
MILEPOST	189.9																																																										
STRUCTURE NO.																																																											
F.H.W.A. Arizona Division	STATE	PROJECT NO.	FEDERAL ID NO.	SHEET NO.	TOTAL SHEETS	RECORD DRAWING																																																					
ARIZ.	093 YV 189	093-B(230)T	262	524																																																							
LOCATION					DWG No. C-7.10																																																						
TRACS NO. F0738 01C					OF																																																						
<table><tr><td colspan="2">TRANSPORTATION</td></tr><tr><td colspan="2">AECOM TECHNICAL SERVICES, Inc.</td></tr><tr><td colspan="2">7700 N. 16th St., Suite 100</td></tr><tr><td colspan="2">Phoenix, Arizona 85020</td></tr><tr><td colspan="2">T 602.371.1100</td></tr></table>		TRANSPORTATION		AECOM TECHNICAL SERVICES, Inc.		7700 N. 16th St., Suite 100		Phoenix, Arizona 85020		T 602.371.1100																																																	
TRANSPORTATION																																																											
AECOM TECHNICAL SERVICES, Inc.																																																											
7700 N. 16th St., Suite 100																																																											
Phoenix, Arizona 85020																																																											
T 602.371.1100																																																											

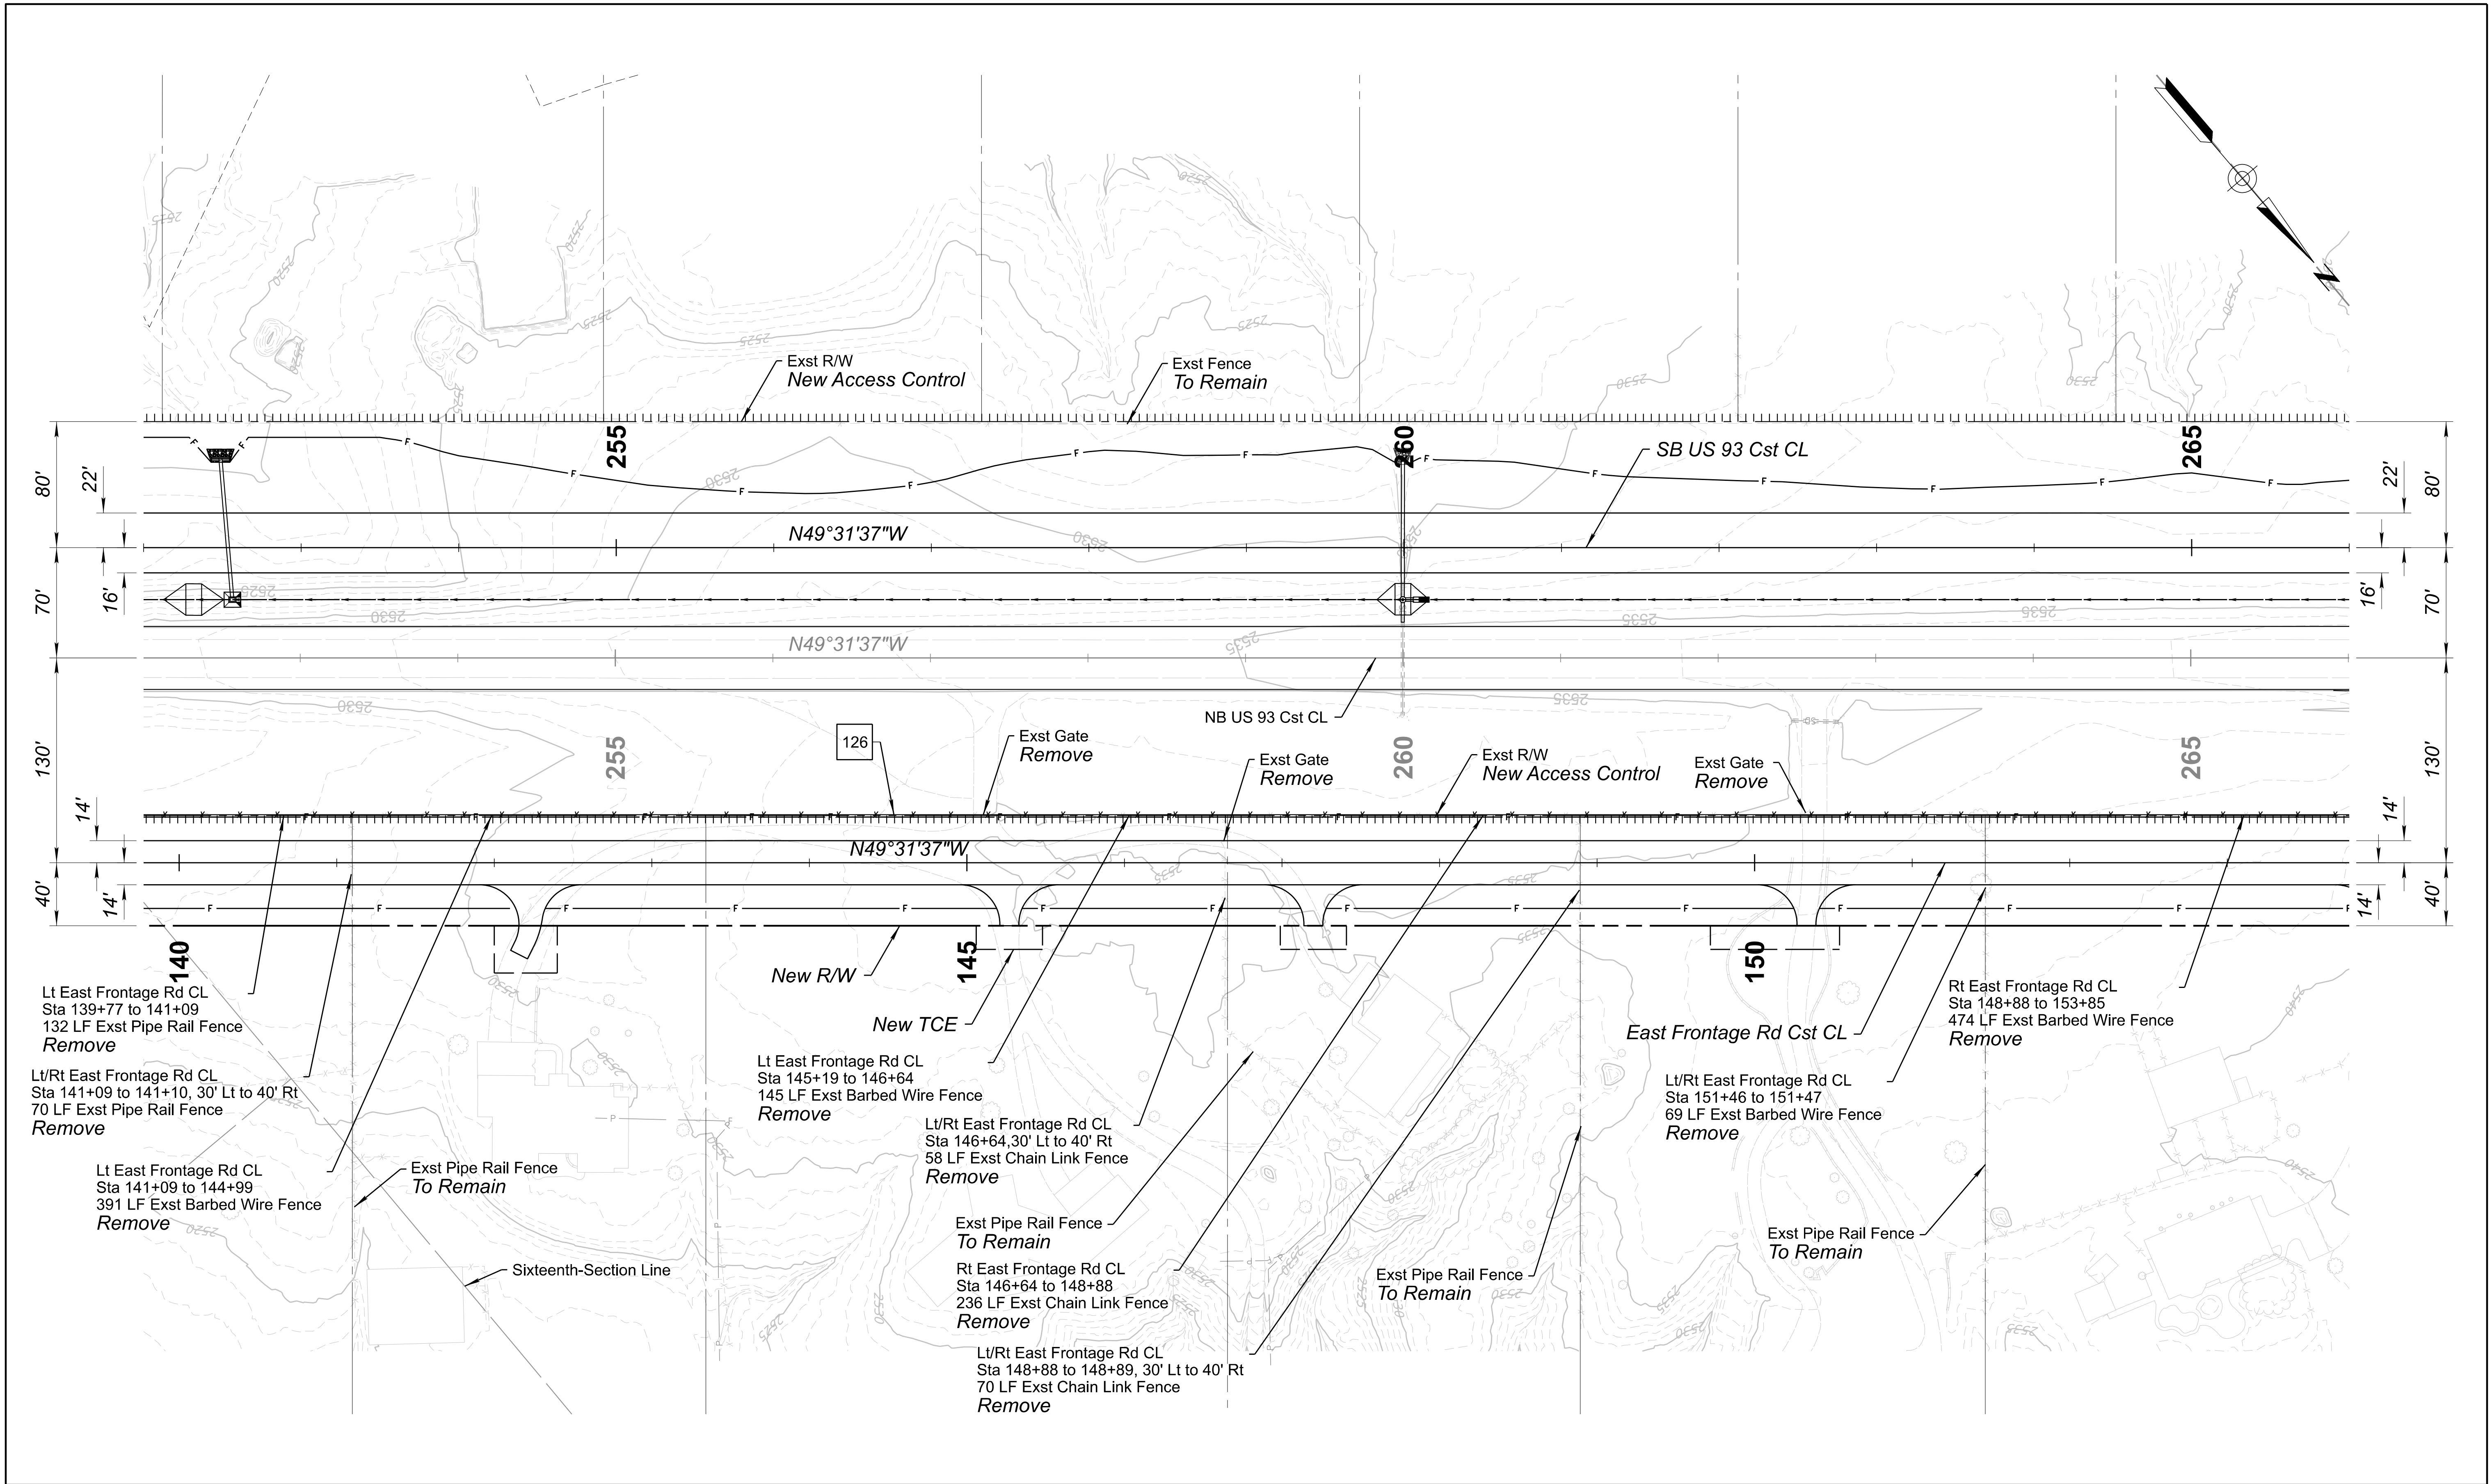


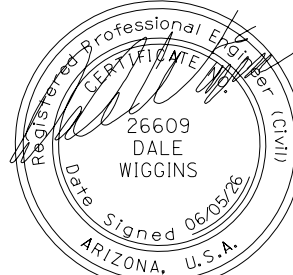
	<table><tr><th></th><th>NAME</th><th>DATE</th></tr><tr><td>DESIGN</td><td>J GILLIS</td><td>06/26</td></tr><tr><td>DRAWN</td><td>M SAMUELSON</td><td>06/26</td></tr><tr><td>CHECKED</td><td>D WIGGINS</td><td>06/26</td></tr></table>			NAME	DATE	DESIGN	J GILLIS	06/26	DRAWN	M SAMUELSON	06/26	CHECKED	D WIGGINS	06/26	<table><tr><td colspan="2">TRANSPORTATION AECOM TECHNICAL SERVICES, Inc. 7720 N. 16th St., Suite 100 Phoenix, Arizona 85020 T 602.371.1100 www.aecom.com</td><td colspan="2"></td></tr></table>		TRANSPORTATION AECOM TECHNICAL SERVICES, Inc. 7720 N. 16th St., Suite 100 Phoenix, Arizona 85020 T 602.371.1100 www.aecom.com				<table><tr><td colspan="2">ARIZONA DEPARTMENT OF TRANSPORTATION PROJECT DELIVERY AND OPERATIONS DIVISION ROADWAY DESIGN SERVICES</td></tr><tr><td colspan="2">FENCE SHEET SB US 93 STA 252+00 TO STA 266+00 E FRONTAGE RD STA 139+77 TO STA 153+77</td></tr></table>		ARIZONA DEPARTMENT OF TRANSPORTATION PROJECT DELIVERY AND OPERATIONS DIVISION ROADWAY DESIGN SERVICES		FENCE SHEET SB US 93 STA 252+00 TO STA 266+00 E FRONTAGE RD STA 139+77 TO STA 153+77		<table><tr><td>ROUTE</td><td>US 93</td></tr><tr><td>MILEPOST</td><td>189.9</td></tr><tr><td>STRUCTURE NO.</td><td></td></tr></table>	ROUTE	US 93	MILEPOST	189.9	STRUCTURE NO.		<table><tr><td rowspan="2">F.H.W.A. Arizona Division</td><td rowspan="2">STATE</td><td rowspan="2">ARIZ.</td><td>PROJECT NO.</td><td>FEDERAL ID NO.</td><td>SHEET NO.</td><td>TOTAL SHEETS</td><td rowspan="2">RECORD DRAWING</td></tr><tr><td>093 YV 189</td><td>093-B(230)T</td><td>263</td><td>524</td></tr><tr><td colspan="7">LOCATION</td><td colspan="2">WICKENBURG RANCH WAY TO VISTA ROYALE</td><td colspan="2">DWG No. C-7.11</td></tr><tr><td colspan="7">TRACS NO. F0738 01C</td><td colspan="5">___ OF ___</td></tr></table>	F.H.W.A. Arizona Division	STATE	ARIZ.	PROJECT NO.	FEDERAL ID NO.	SHEET NO.	TOTAL SHEETS	RECORD DRAWING	093 YV 189	093-B(230)T	263	524	LOCATION							WICKENBURG RANCH WAY TO VISTA ROYALE		DWG No. C-7.11		TRACS NO. F0738 01C							___ OF ___				
		NAME	DATE																																																																		
	DESIGN	J GILLIS	06/26																																																																		
	DRAWN	M SAMUELSON	06/26																																																																		
CHECKED	D WIGGINS	06/26																																																																			
TRANSPORTATION AECOM TECHNICAL SERVICES, Inc. 7720 N. 16th St., Suite 100 Phoenix, Arizona 85020 T 602.371.1100 www.aecom.com																																																																					
ARIZONA DEPARTMENT OF TRANSPORTATION PROJECT DELIVERY AND OPERATIONS DIVISION ROADWAY DESIGN SERVICES																																																																					
FENCE SHEET SB US 93 STA 252+00 TO STA 266+00 E FRONTAGE RD STA 139+77 TO STA 153+77																																																																					
ROUTE	US 93																																																																				
MILEPOST	189.9																																																																				
STRUCTURE NO.																																																																					
F.H.W.A. Arizona Division	STATE	ARIZ.	PROJECT NO.	FEDERAL ID NO.	SHEET NO.	TOTAL SHEETS	RECORD DRAWING																																																														
			093 YV 189	093-B(230)T	263	524																																																															
LOCATION							WICKENBURG RANCH WAY TO VISTA ROYALE		DWG No. C-7.11																																																												
TRACS NO. F0738 01C							___ OF ___																																																														

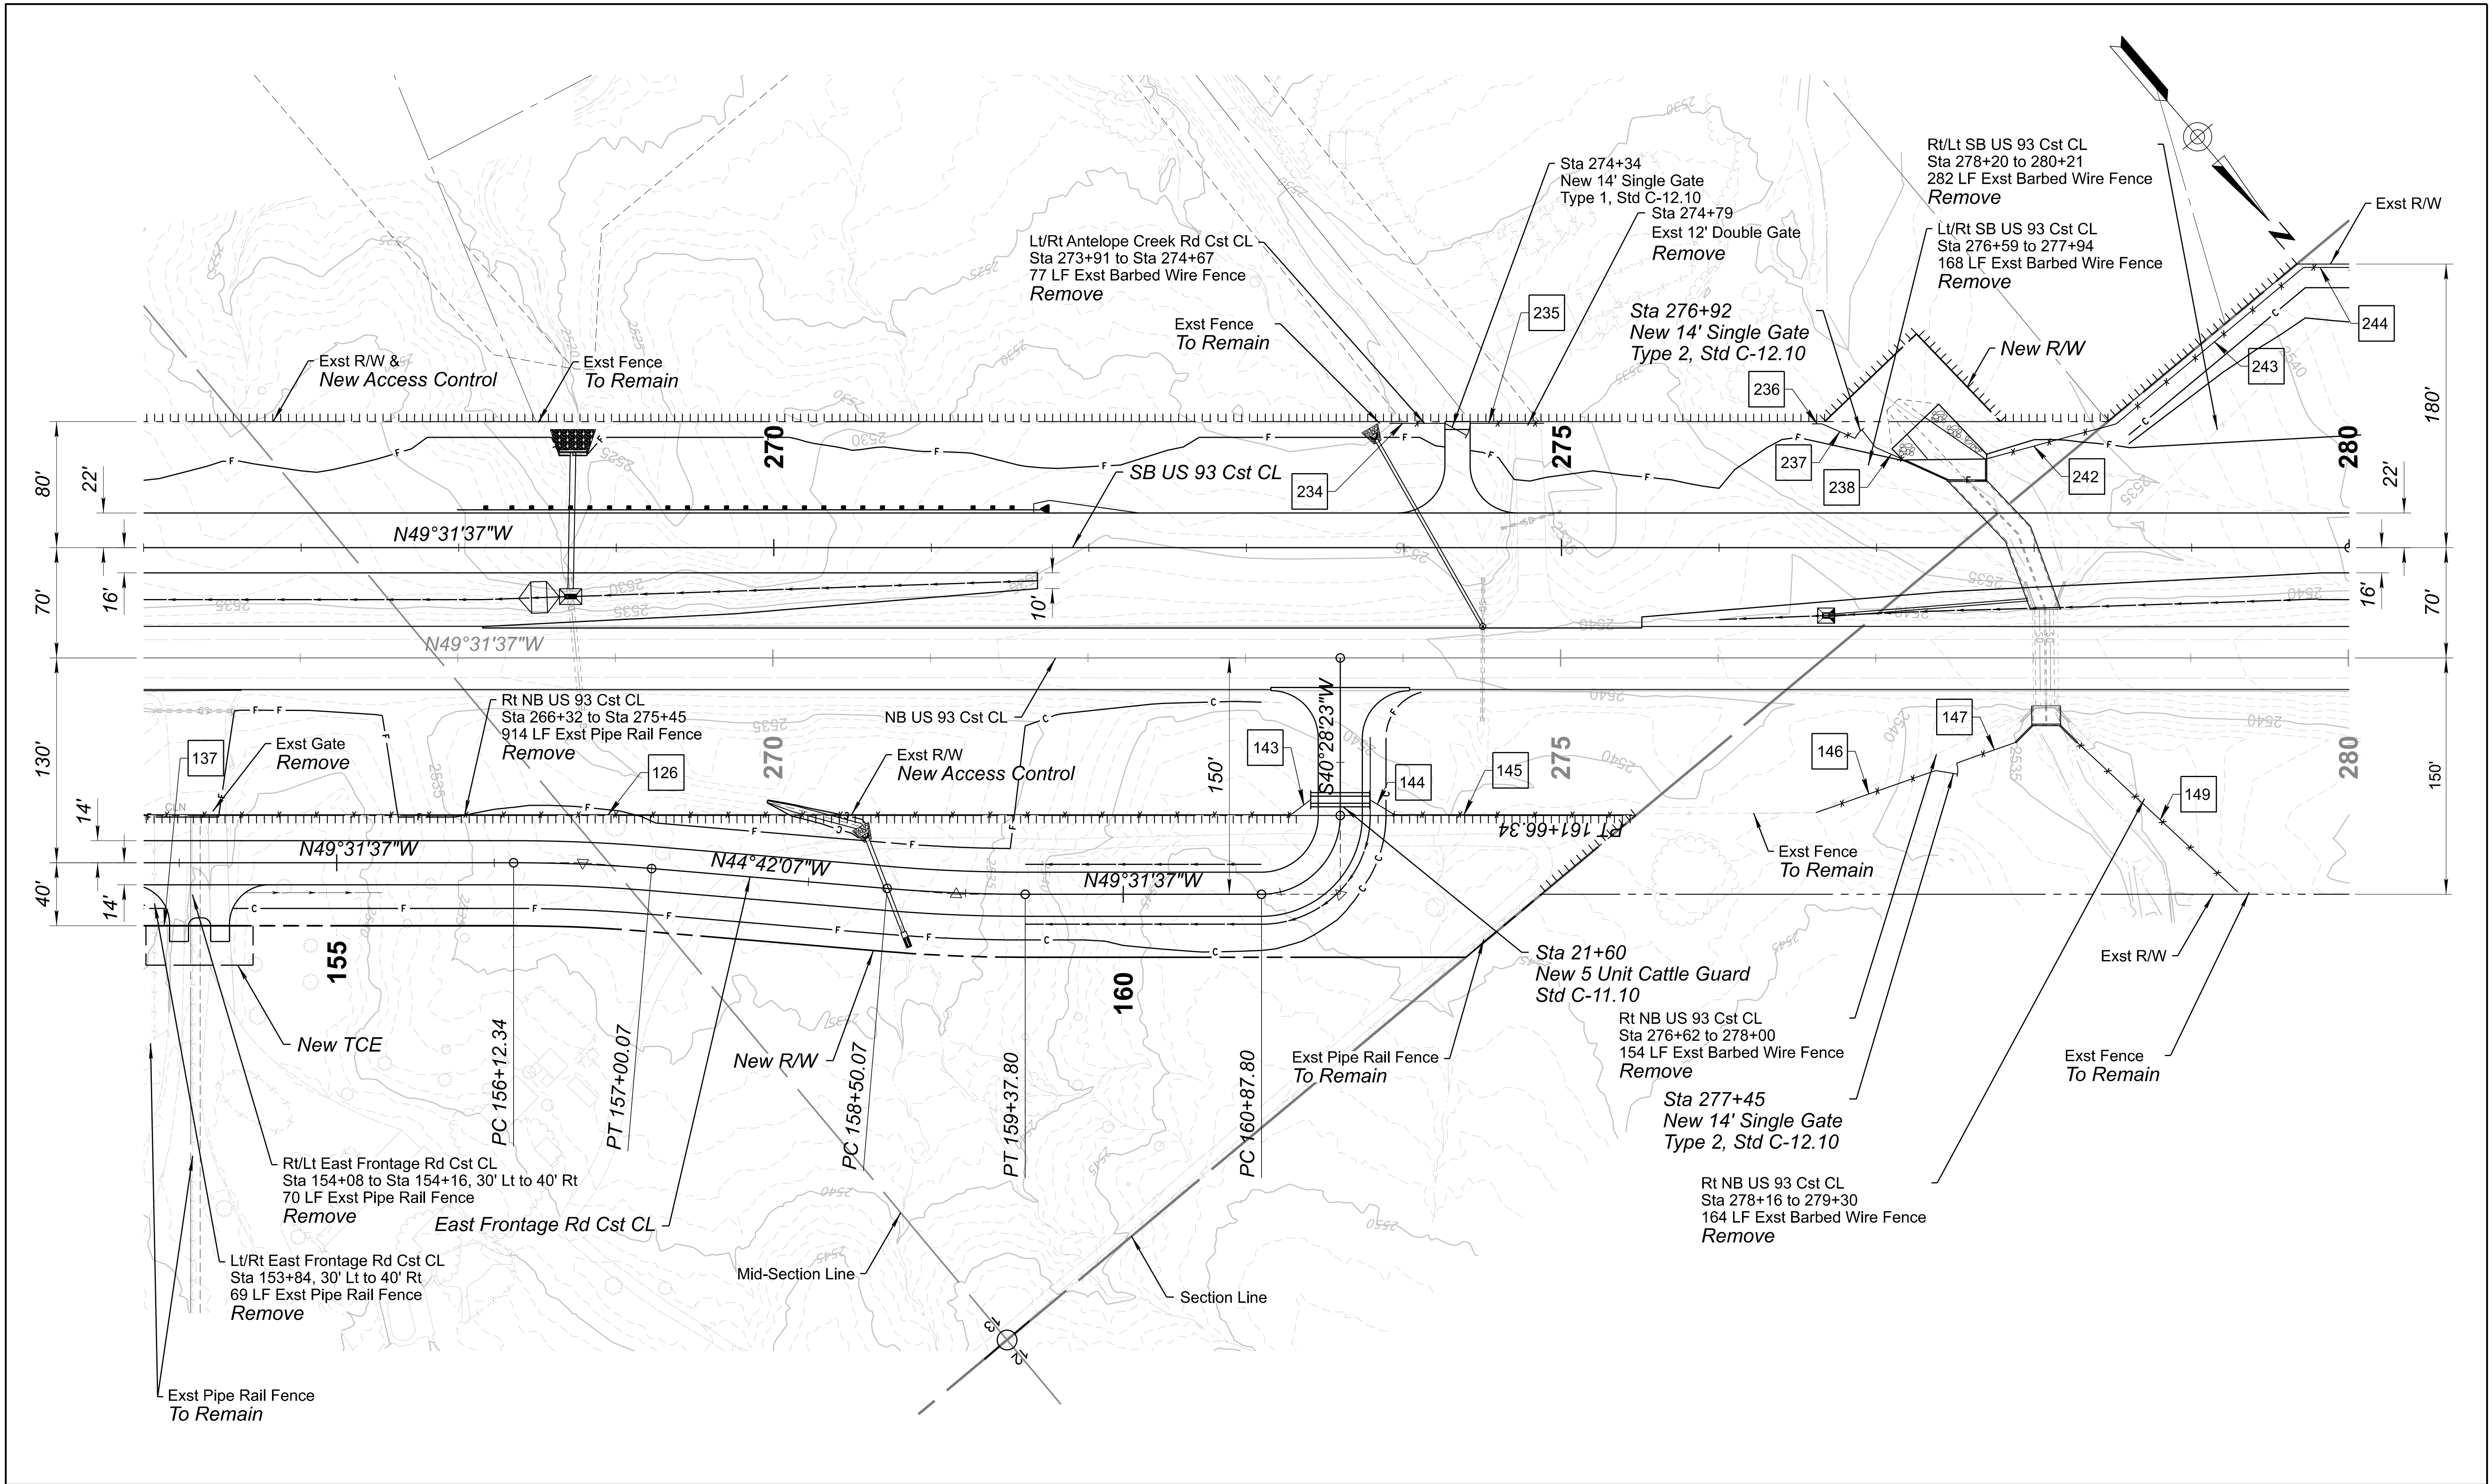

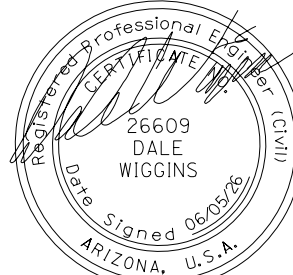	<table><tr><th>DESIGN</th><td>J GILLIS</td><td>06/26</td></tr><tr><th>DRAWN</th><td>M SAMUELSON</td><td>06/26</td></tr><tr><th>CHECKED</th><td>D WIGGINS</td><td>06/26</td></tr></table>	DESIGN	J GILLIS	06/26	DRAWN	M SAMUELSON	06/26	CHECKED	D WIGGINS	06/26	<table><tr><th>NAME</th><td>J GILLIS</td><td>06/26</td></tr><tr><th>DATE</th><td>M SAMUELSON</td><td>06/26</td></tr><tr><th>DATE</th><td>D WIGGINS</td><td>06/26</td></tr></table>	NAME	J GILLIS	06/26	DATE	M SAMUELSON	06/26	DATE	D WIGGINS	06/26	TRANSPORTATION AECOM TECHNICAL SERVICES, Inc. 7720 N. 16th St., Suite 100 Phoenix, Arizona 85020 T 602.371.1100 AECOM www.aecom.com	ARIZONA DEPARTMENT OF TRANSPORTATION PROJECT DELIVERY AND OPERATIONS DIVISION ROADWAY DESIGN SERVICES FENCE SHEET SB US 93 STA 266+00 TO STA 280+00 E FRONTAGE RD STA 153+77 TO STA 161+66	<table><tr><td>ROUTE</td><td>US 93</td></tr><tr><td>MILEPOST</td><td>189.9</td></tr><tr><td>STRUCTURE NO.</td><td></td></tr></table>	ROUTE	US 93	MILEPOST	189.9	STRUCTURE NO.		<table><tr><td>F.H.W.A. Arizona Division</td><td>STATE</td><td>ARIZ.</td><td>PROJECT NO.</td><td>093 YV 189</td><td>FEDERAL ID NO.</td><td>093-B(230)T</td><td>SHEET NO.</td><td>264</td><td>TOTAL SHEETS</td><td>524</td><td>RECORD DRAWING</td></tr><tr><td colspan="11">LOCATION</td><td>WICKENBURG RANCH WAY TO VISTA ROYALE</td></tr><tr><td colspan="11">TRACS NO.</td><td>F0738 01C</td></tr></table>	F.H.W.A. Arizona Division	STATE	ARIZ.	PROJECT NO.	093 YV 189	FEDERAL ID NO.	093-B(230)T	SHEET NO.	264	TOTAL SHEETS	524	RECORD DRAWING	LOCATION											WICKENBURG RANCH WAY TO VISTA ROYALE	TRACS NO.											F0738 01C	<table><tr><td>DWG No.</td><td>C-7.12</td></tr><tr><td>OF</td><td></td></tr></table>	DWG No.	C-7.12	OF	
	DESIGN	J GILLIS	06/26																																																																				
	DRAWN	M SAMUELSON	06/26																																																																				
	CHECKED	D WIGGINS	06/26																																																																				
NAME	J GILLIS	06/26																																																																					
DATE	M SAMUELSON	06/26																																																																					
DATE	D WIGGINS	06/26																																																																					
ROUTE	US 93																																																																						
MILEPOST	189.9																																																																						
STRUCTURE NO.																																																																							
F.H.W.A. Arizona Division	STATE	ARIZ.	PROJECT NO.	093 YV 189	FEDERAL ID NO.	093-B(230)T	SHEET NO.	264	TOTAL SHEETS	524	RECORD DRAWING																																																												
LOCATION											WICKENBURG RANCH WAY TO VISTA ROYALE																																																												
TRACS NO.											F0738 01C																																																												
DWG No.	C-7.12																																																																						
OF																																																																							

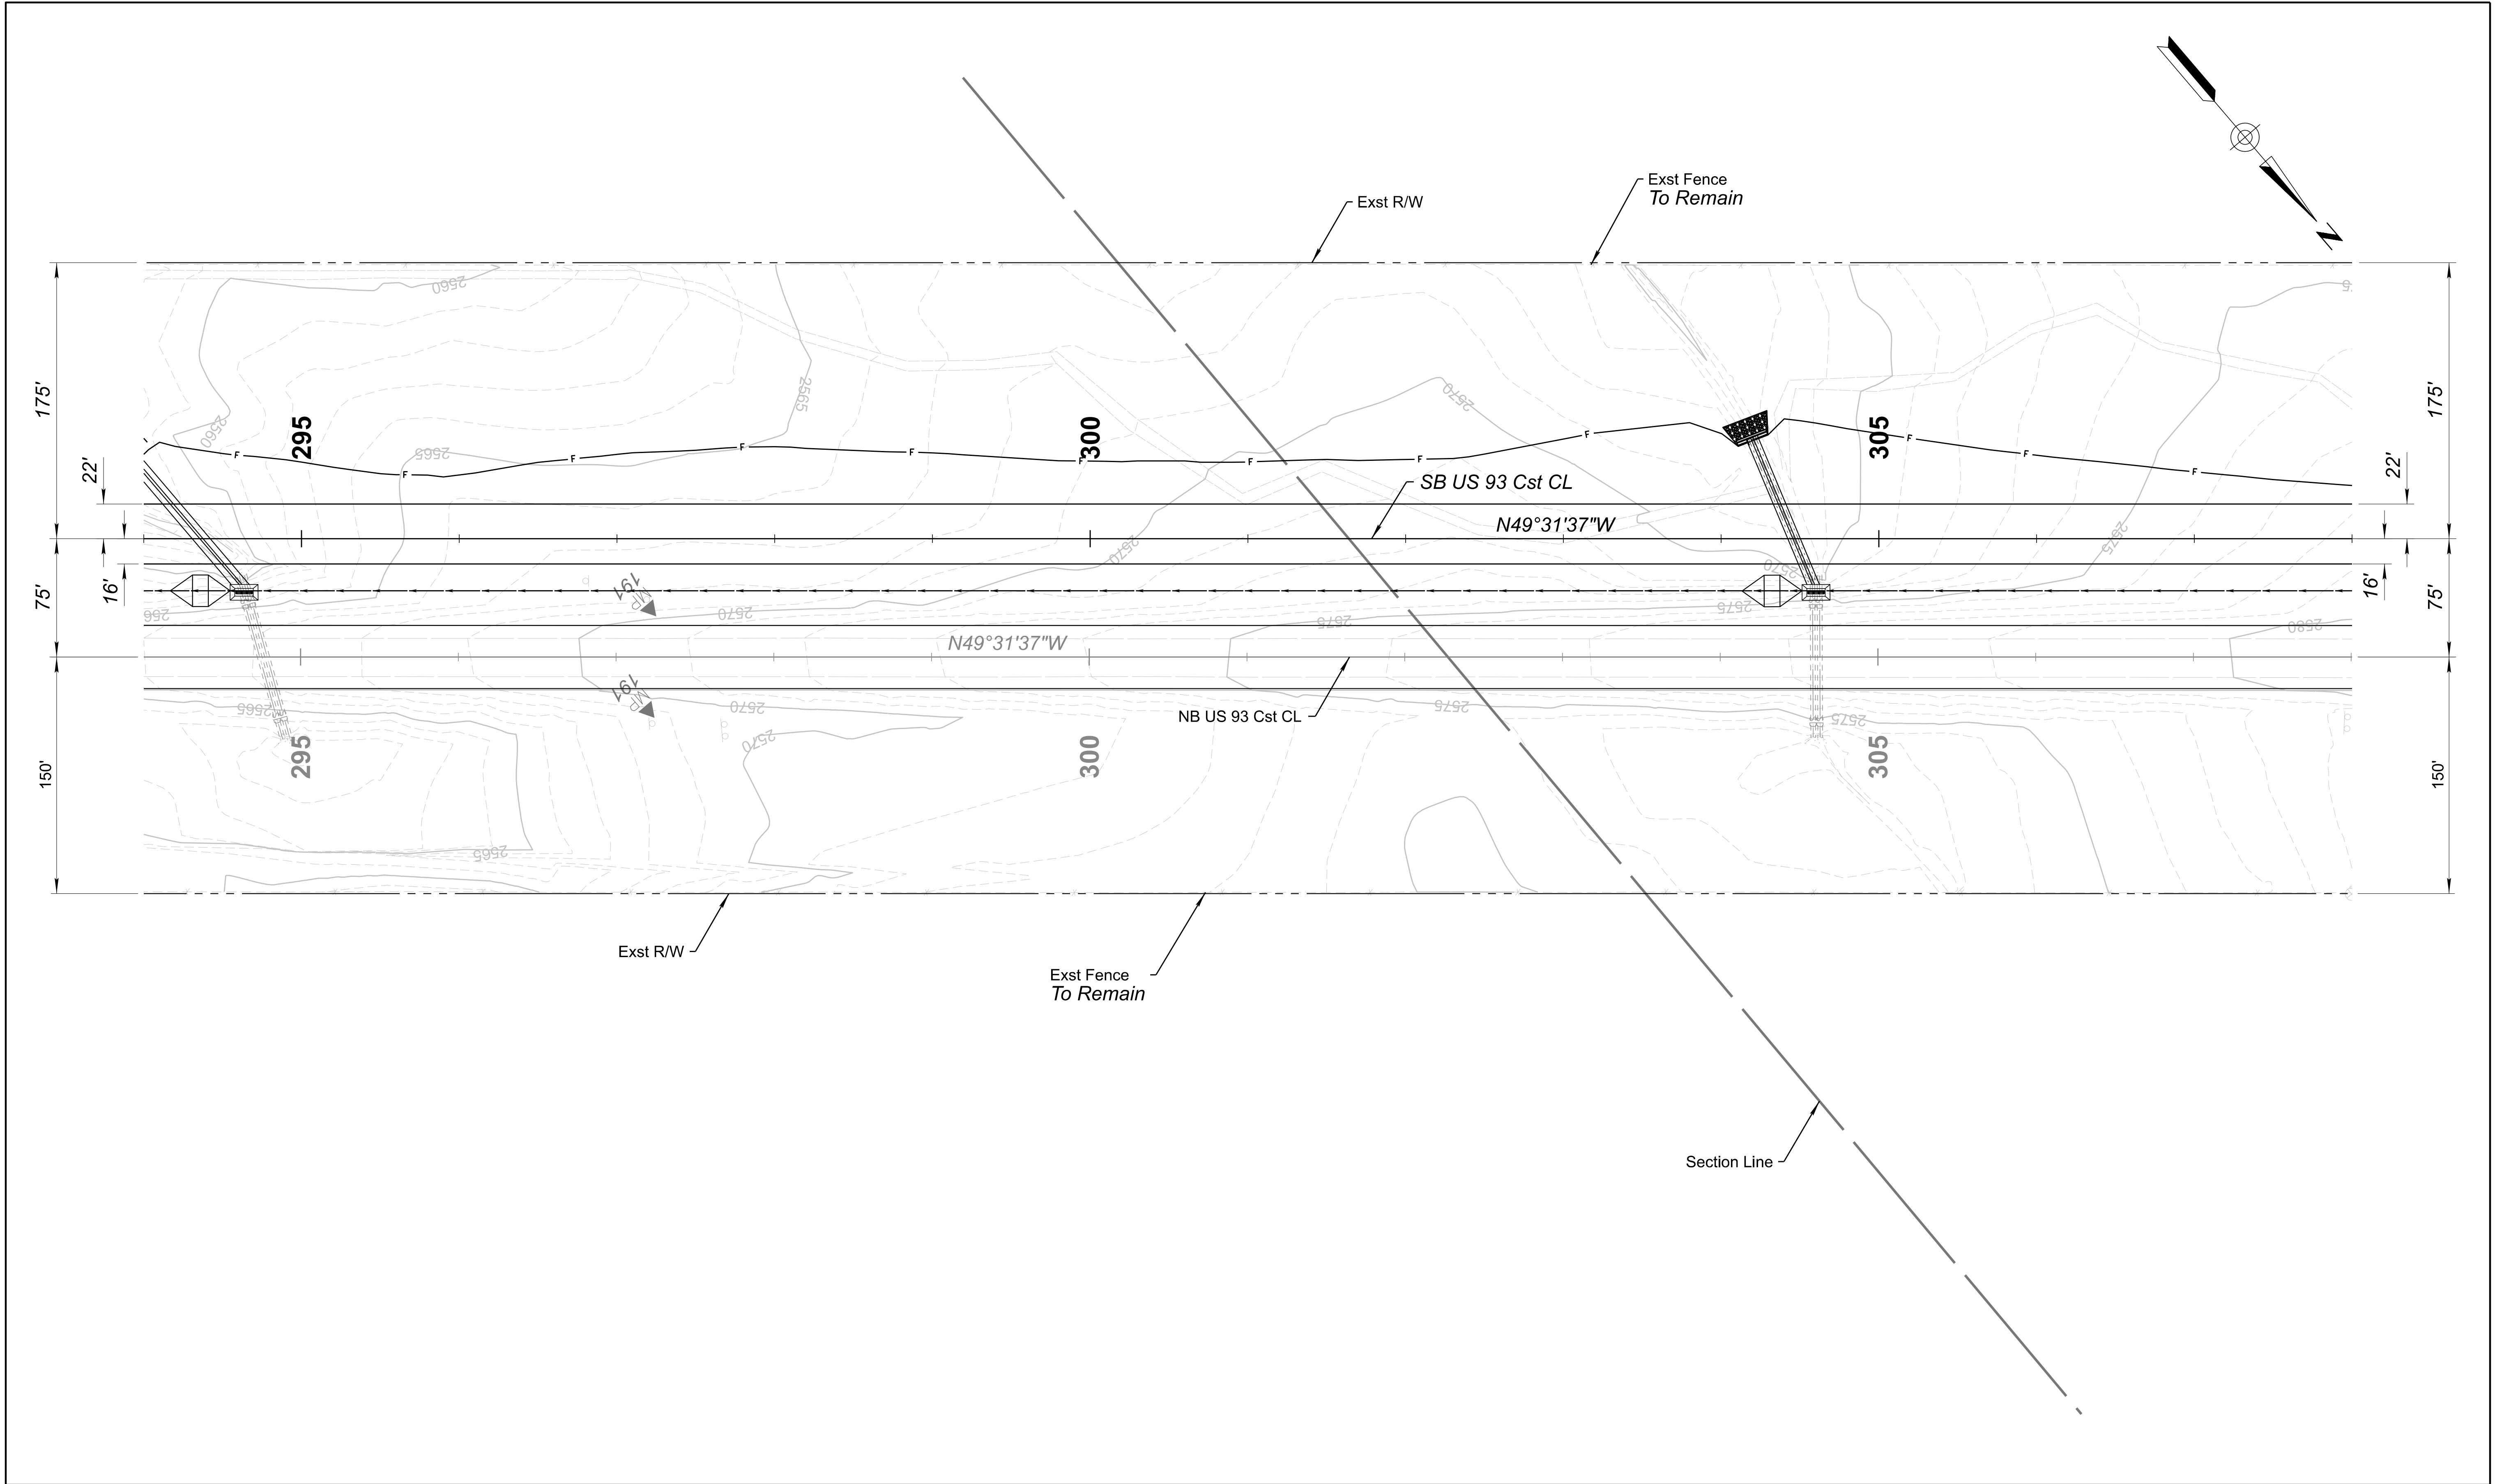

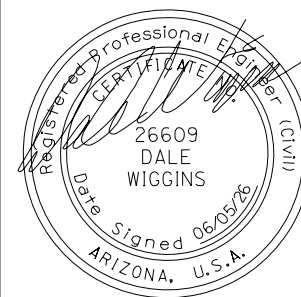	NAME		DATE	ARIZONA DEPARTMENT OF TRANSPORTATION PROJECT DELIVERY AND OPERATIONS DIVISION ROADWAY DESIGN SERVICES				ROUTE		F.H.W.A. Arizona Division	STATE ARIZ.	PROJECT NO.	FEDERAL ID NO.	SHEET NO.	TOTAL SHEETS	RECORD DRAWING
	DESIGN	J GILLIS	06/26					US 93				093 YV 189	093-B(230)T	266	524	
	DRAWN	M SAMUELSON	06/26					MILEPOST 189.9				LOCATION WICKENBURG RANCH WAY TO VISTA ROYALE				
	CHECKED	D WIGGINS	06/26													
	TRANSPORTATION AECOM TECHNICAL SERVICES, Inc. 7720 N. 16th St., Suite 100 Phoenix, Arizona 85020 T 602.371.1100 www.aecom.com				FENCE SHEET SB US 93 STA 294+00 TO STA 308+00				STRUCTURE NO.		TRACS NO. F0738 01C		DWG No. C-7.14 ____ OF ____			

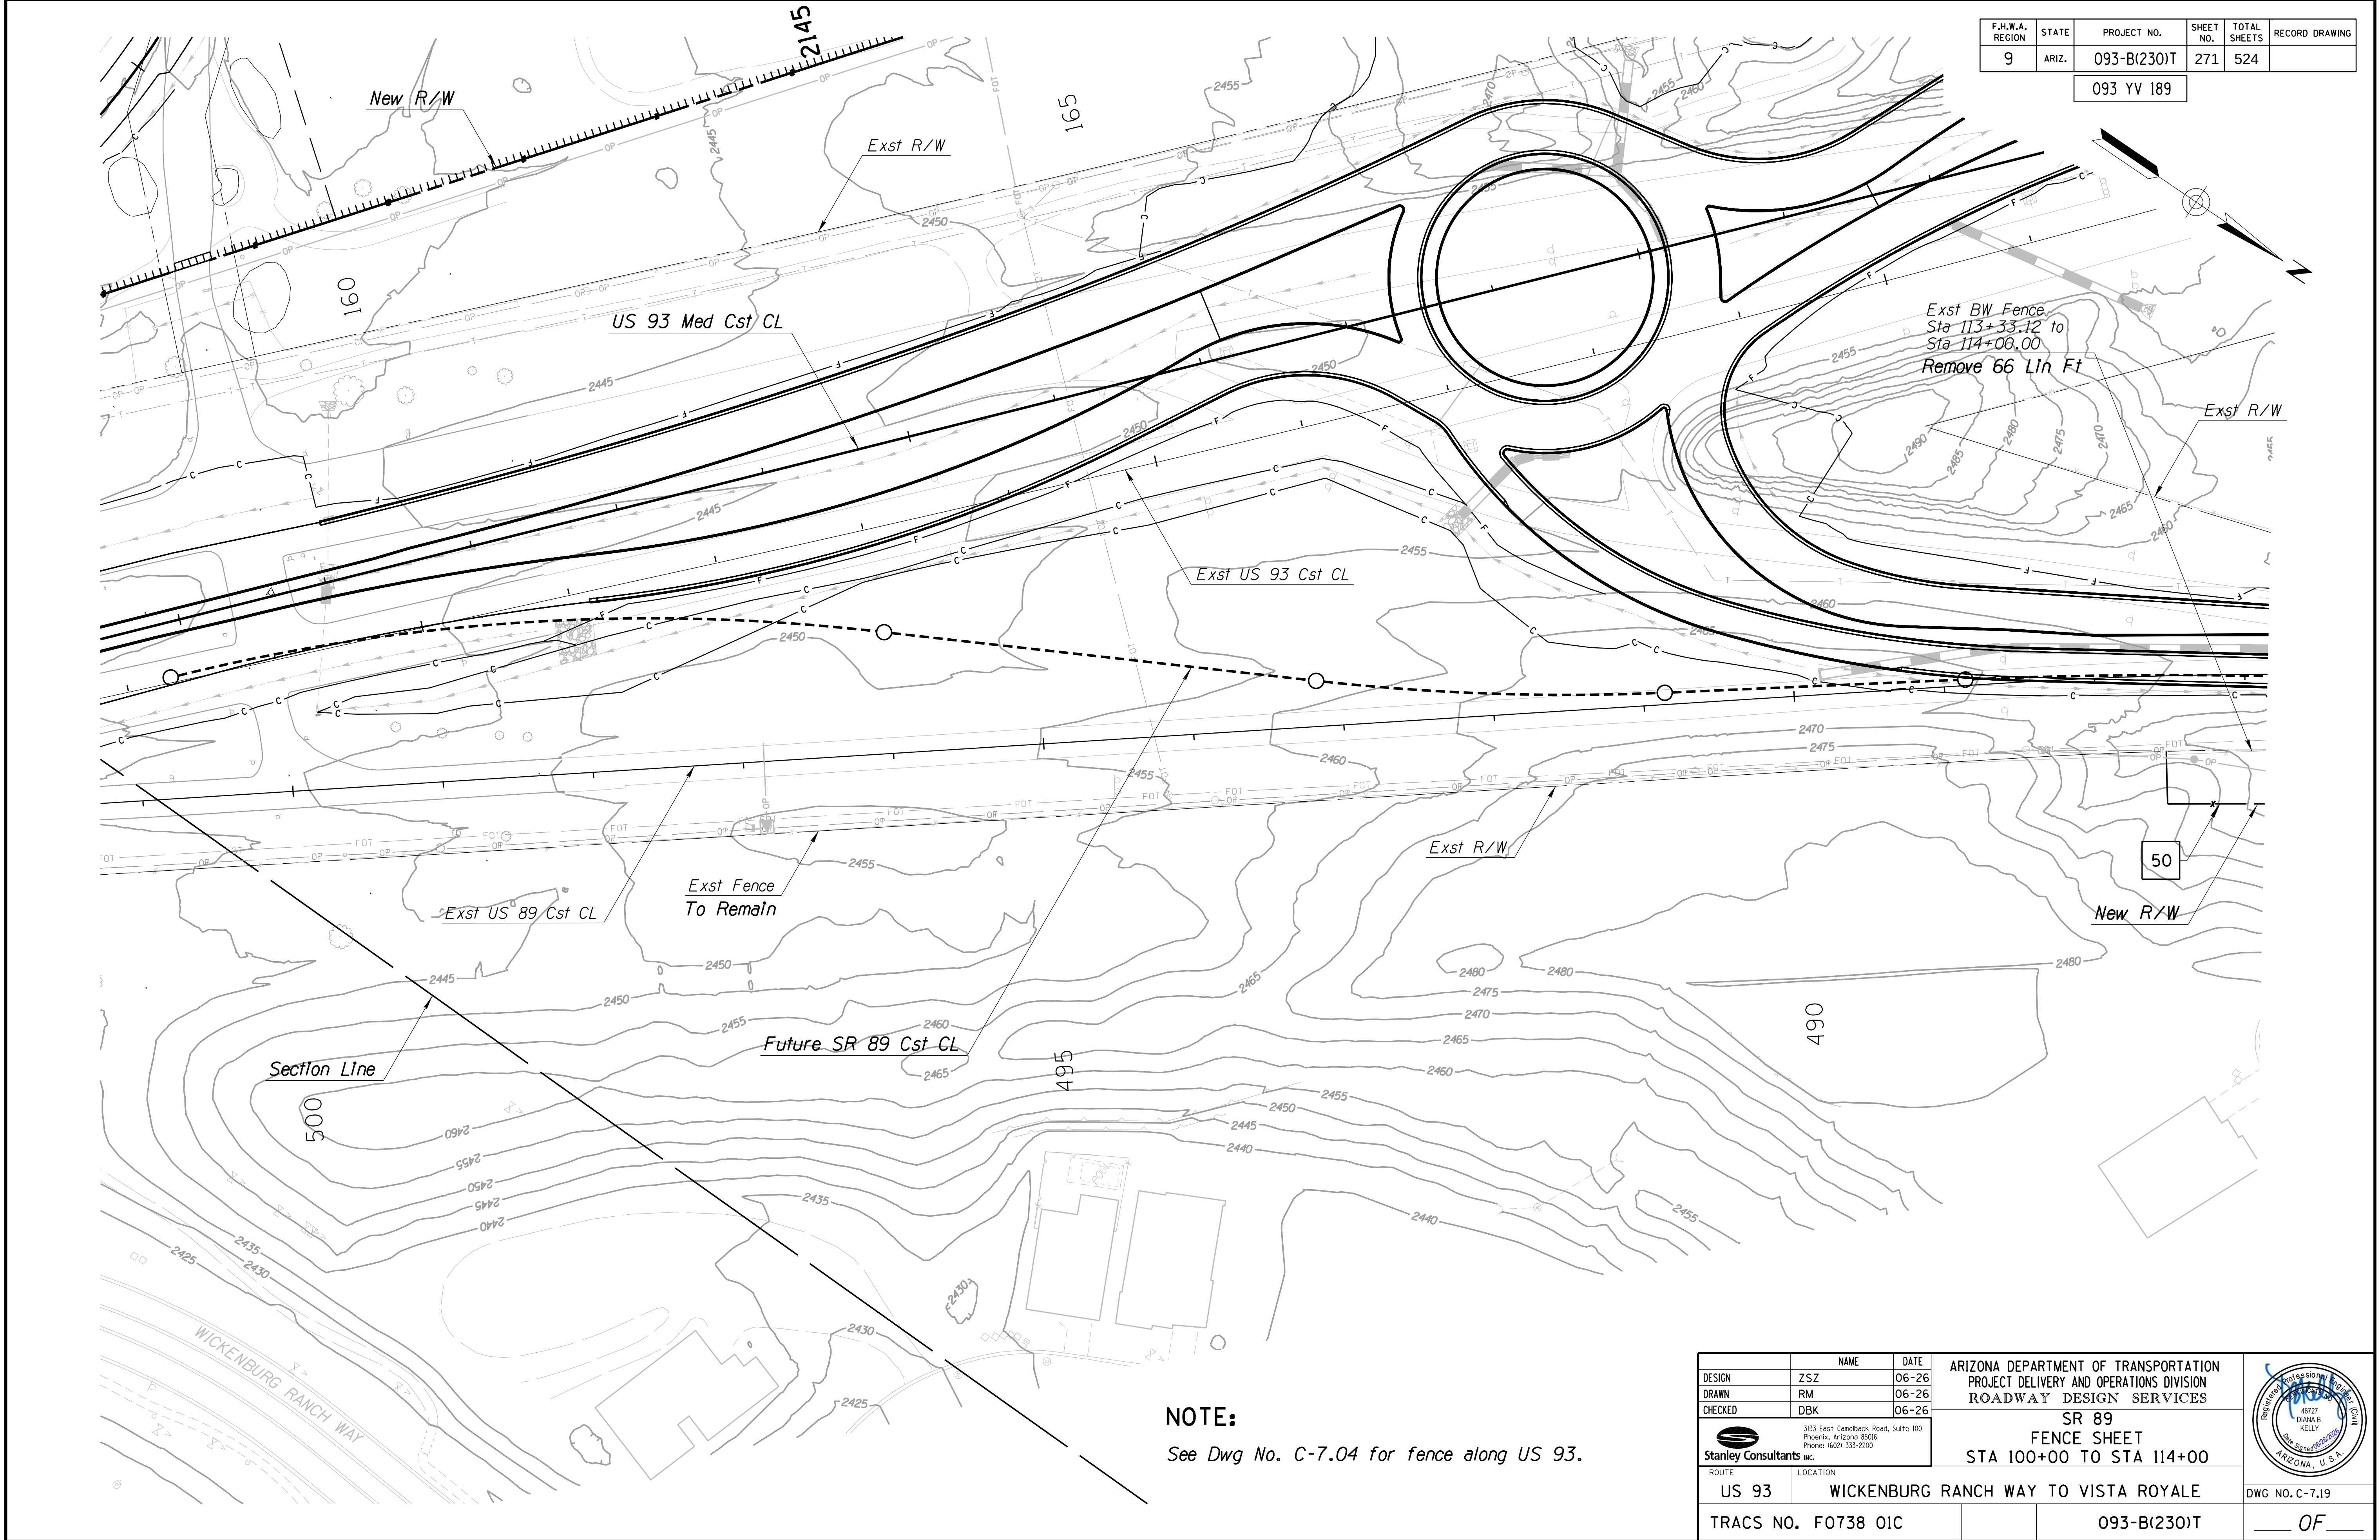


F.H.W.A. REGION	STATE	PROJECT NO.	SHEET NO.	TOTAL SHEETS	RECORD DRAWING
9	ARIZ.	093-B(230)T	271	524	
093 YV 189					

DESIGN		ZSZ	DATE	06-26	ARIZONA DEPARTMENT OF TRANSPORTATION PROJECT DELIVERY AND OPERATIONS DIVISION ROADWAY DESIGN SERVICES	
DRAWN		RM	DATE	06-26		
CHECKED		DBK	DATE	06-26		
ROUTE		LOCATION		SR 89 FENCE SHEET STA 100+00 TO STA 114+00		
US 93		WICKENBURG RANCH WAY TO VISTA ROYALE		DWG NO. C-7.19		
TRACS NO. F0738 OIC		093-B(230)T		OF		

Stanley Consultants Inc. 3133 East Camelback Road, Suite 100 Phoenix, Arizona 85016 Phone: (602) 333-2200



F.H.W.A. REGION	STATE	PROJECT NO.	SHEET NO.	TOTAL SHEETS	RECORD DRAWING
9	ARIZ.	093-B(230)T	272	524	

093 YV 189

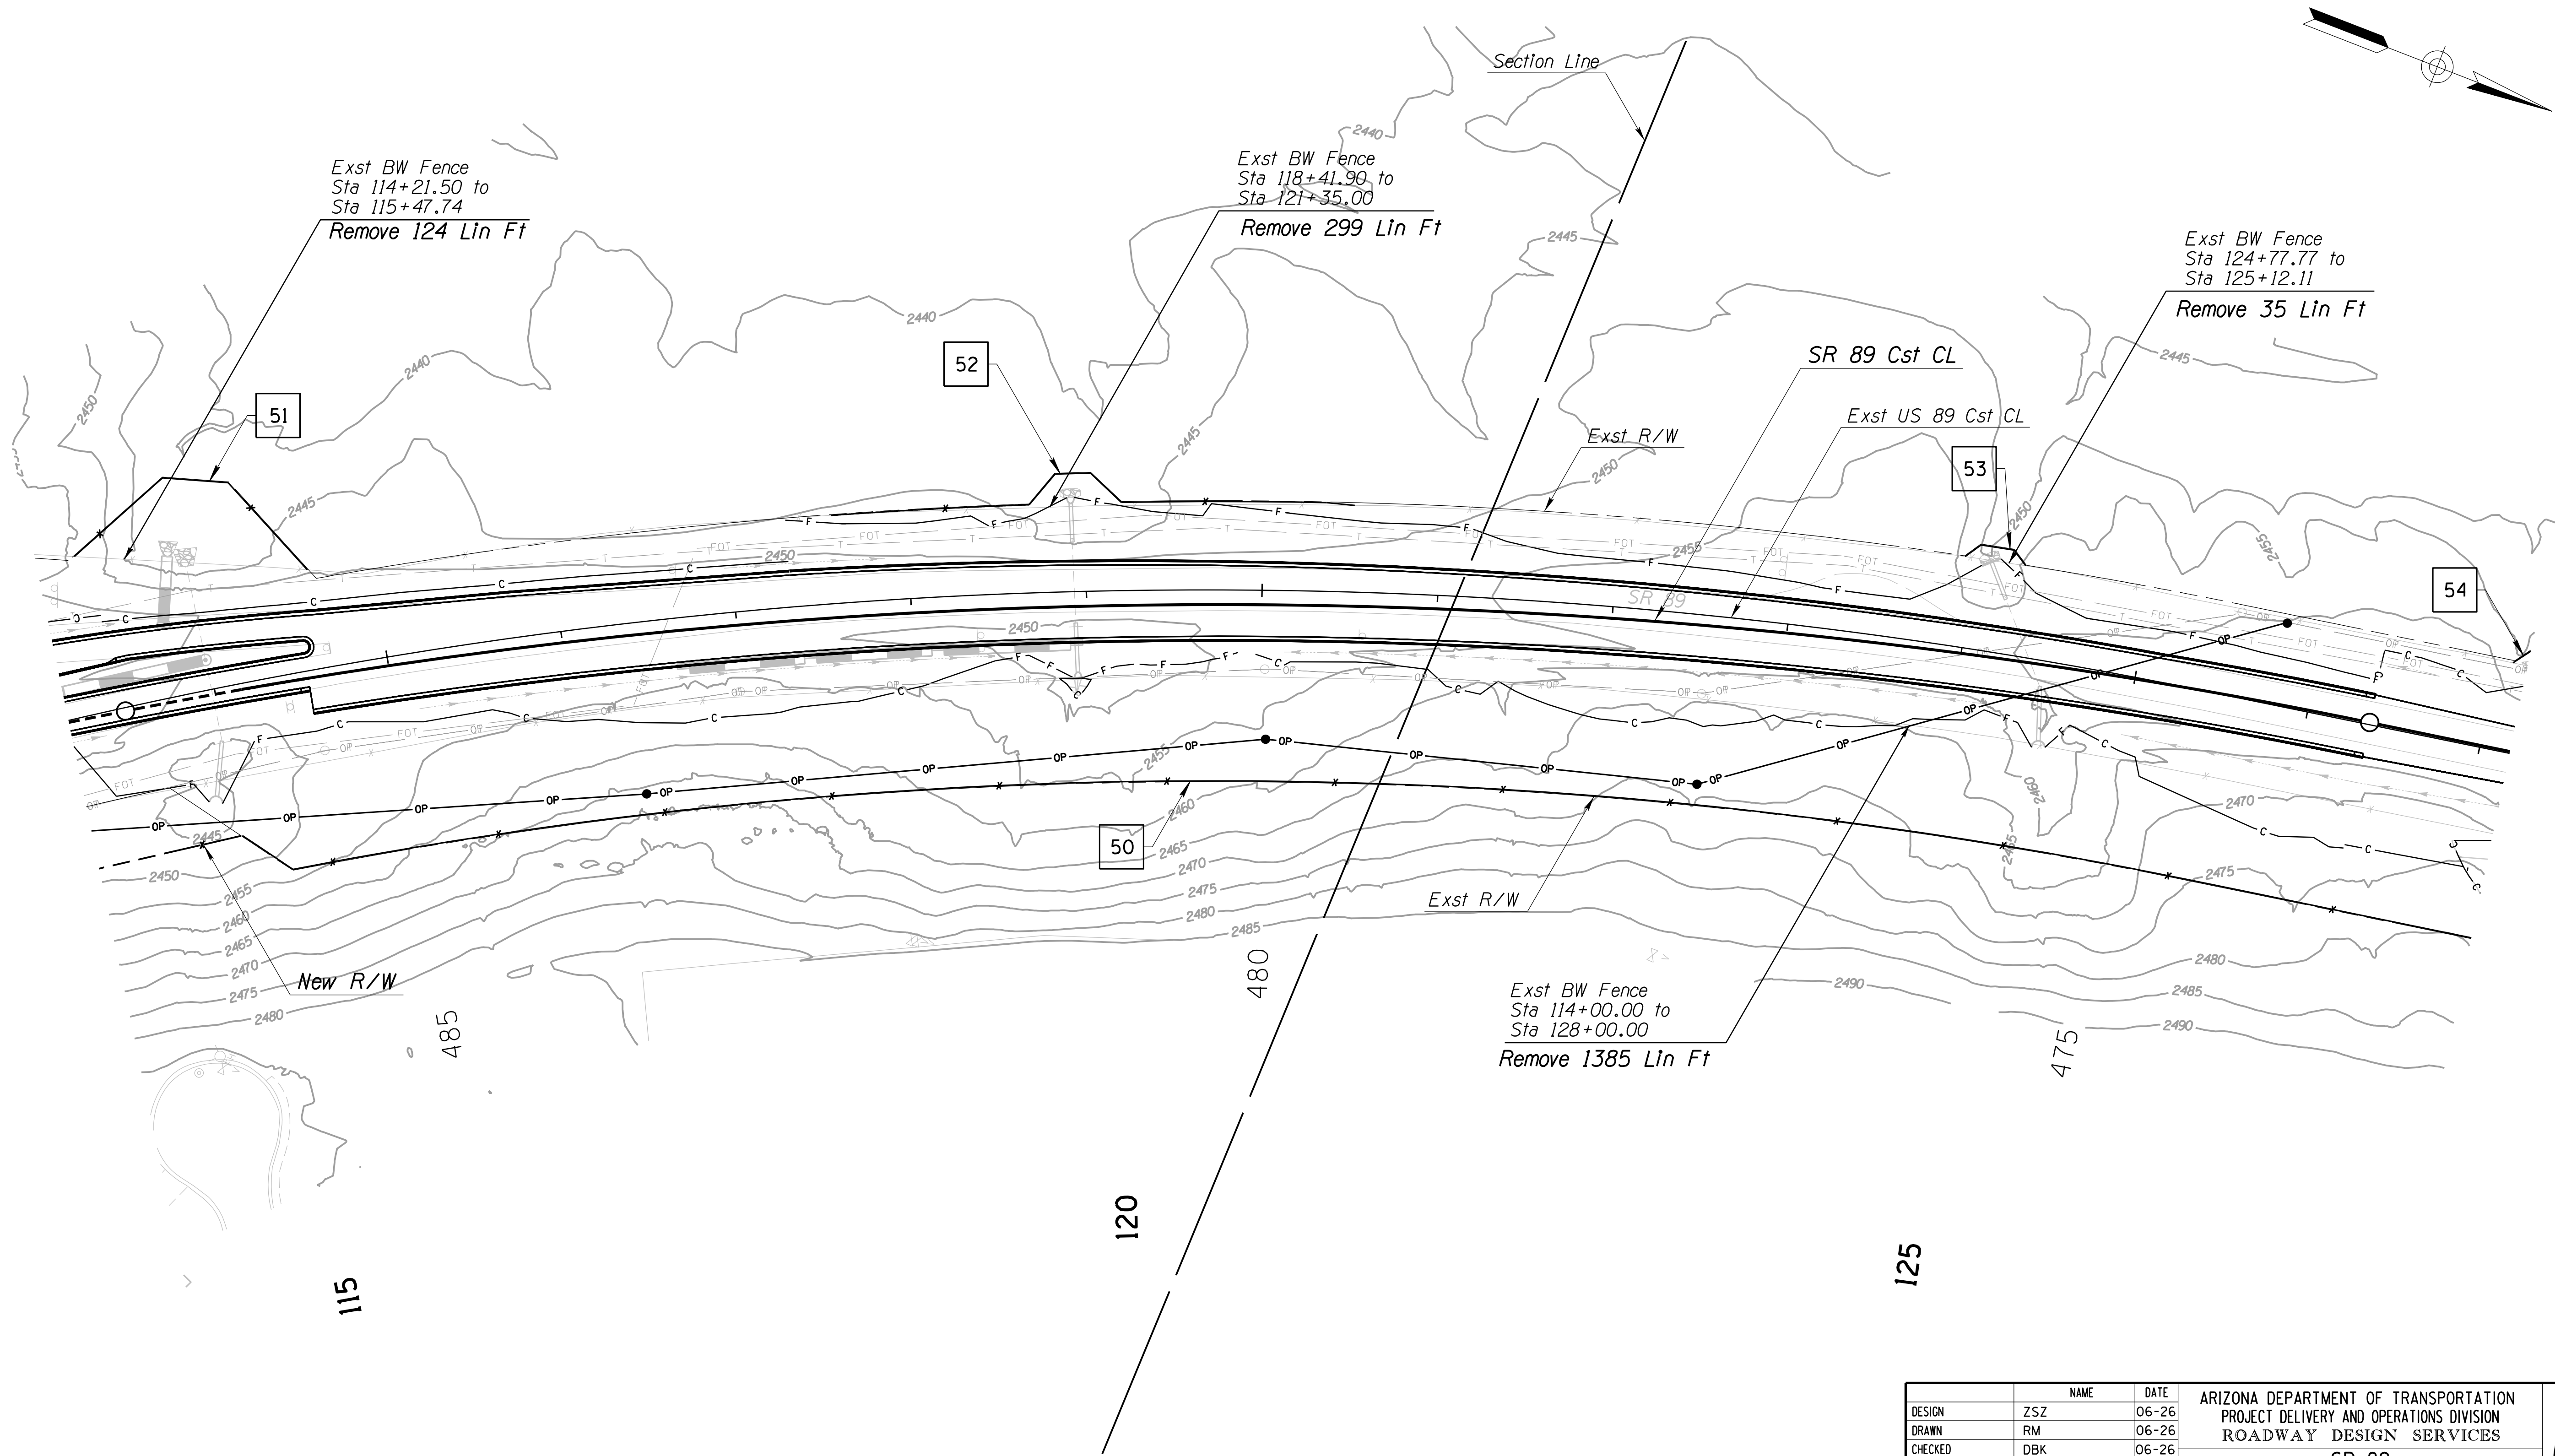

F.H.W.A. REGION	STATE	PROJECT NO.	SHEET NO.	TOTAL SHEETS	RECORD DRAWING
9	ARIZ.	093-B(230)T	273	524	



093 YV 189

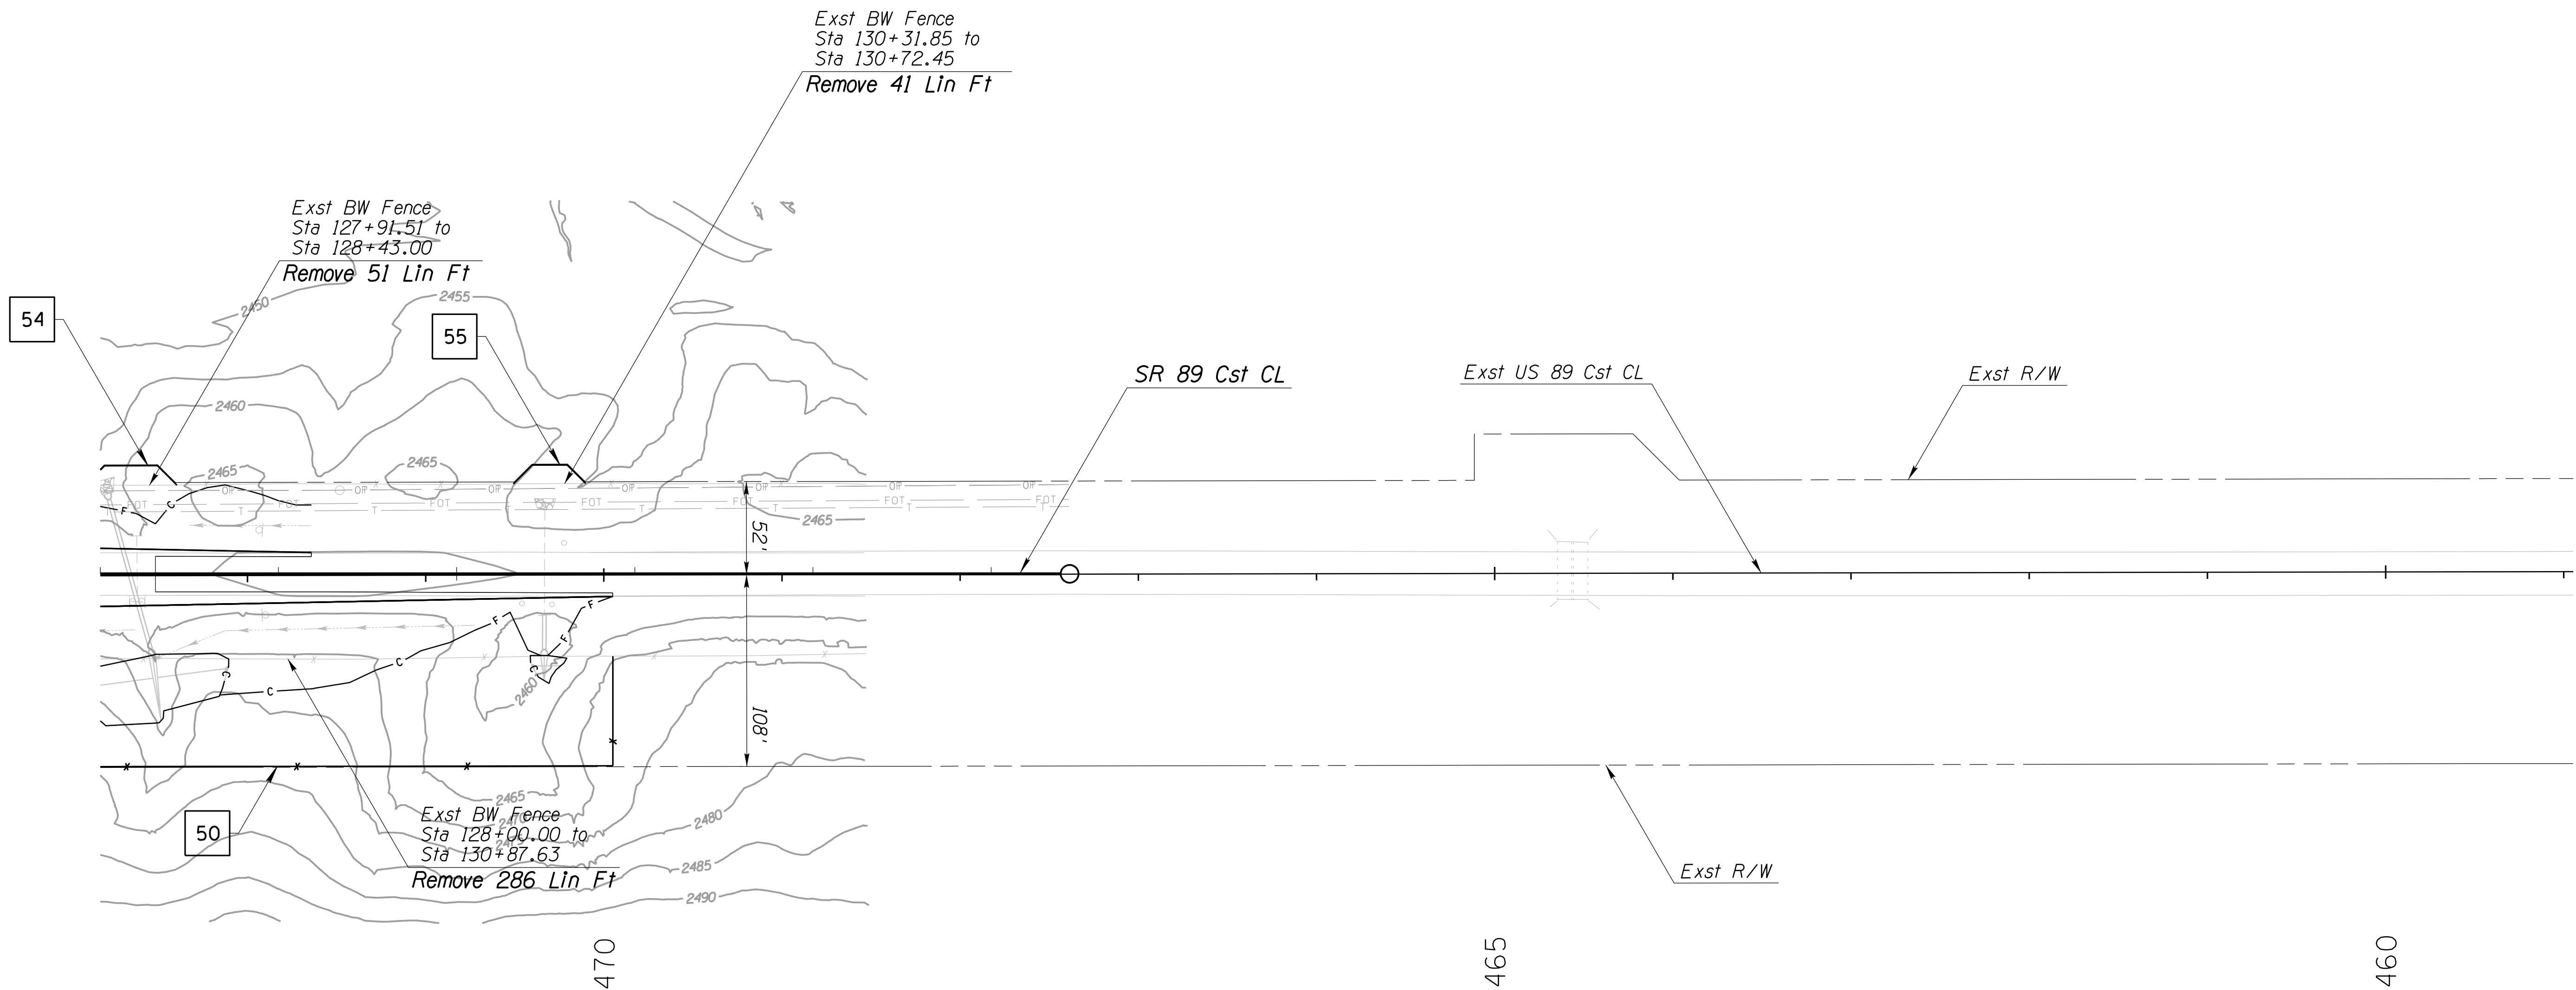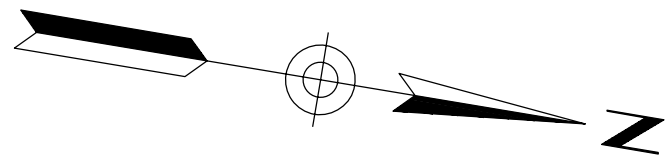

		NAME	DATE	ARIZONA DEPARTMENT OF TRANSPORTATION PROJECT DELIVERY AND OPERATIONS DIVISION ROADWAY DESIGN SERVICES		
DESIGN	ZSZ		06-26			
DRAWN	RM		06-26			
CHECKED	DBK		06-26			
		3133 East Camelback Road, Suite 100 Phoenix, Arizona 85016 Phone: (602) 333-2200		SR 89 FENCE SHEET STA 128+00 TO STA 133+44.07		
ROUTE		LOCATION				DWG NO. C-7.21
US 93		WICKENBURG RANCH WAY TO VISTA ROYALE				
TRACS NO. F0738 OIC			093-B(230)T			___ OF ___

F.H.W.A. REGION	STATE	PROJECT NO.	SHEET NO.	TOTAL SHEETS	RECORD DRAWING
9	ARIZ.	093-B(230)T	274	524	


093 YV 189

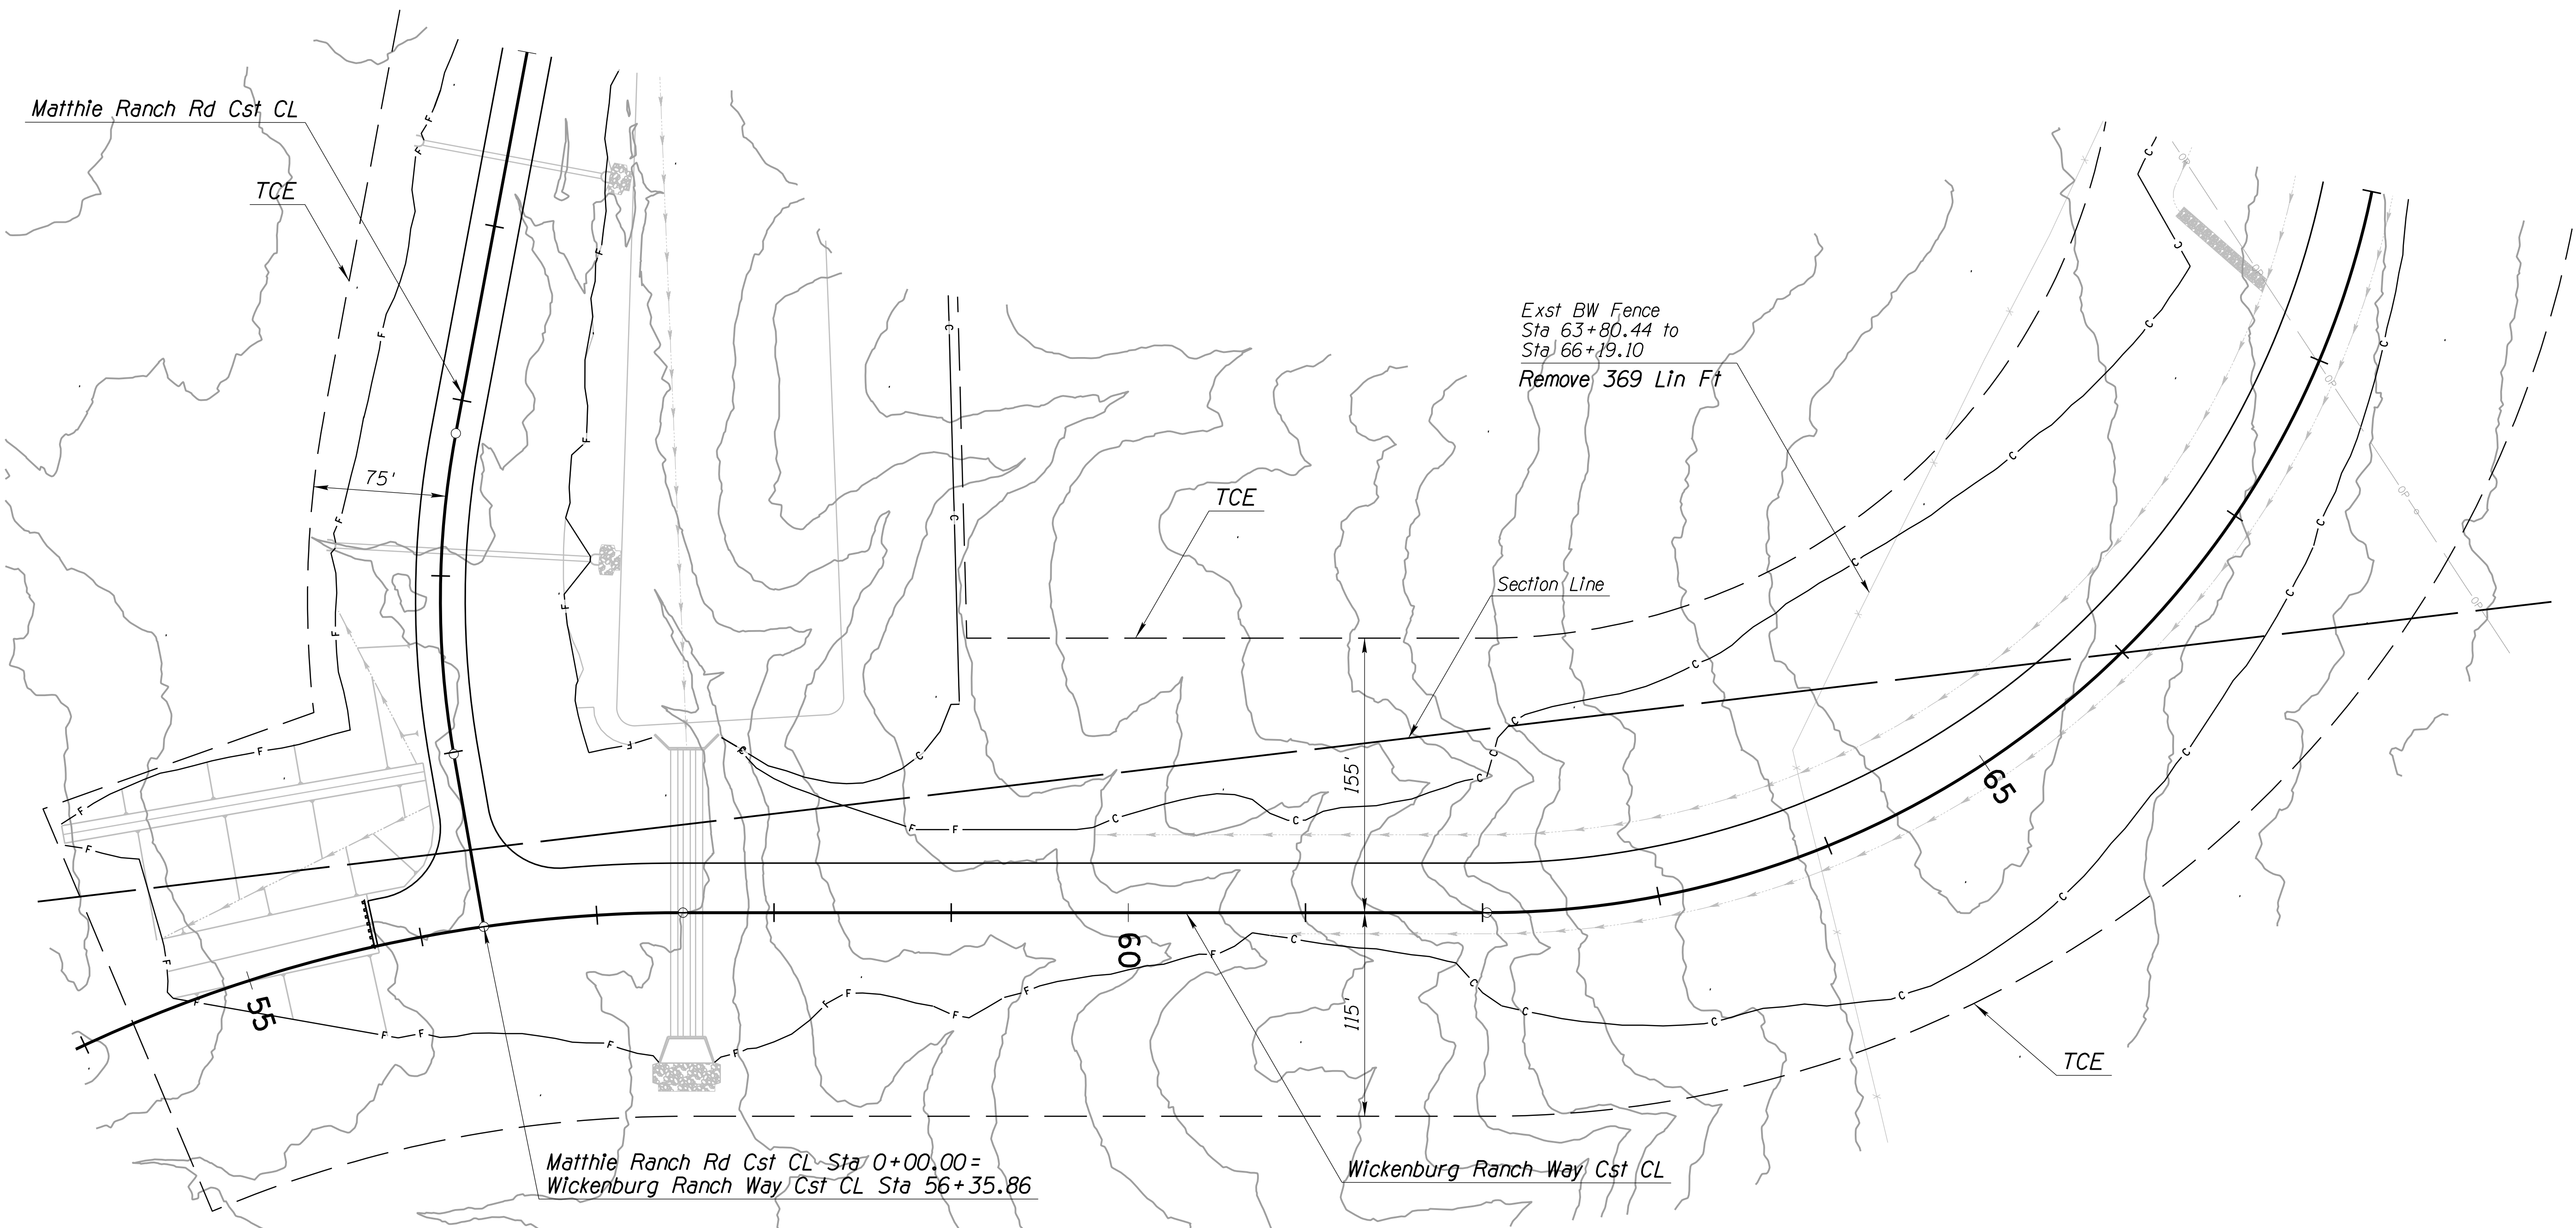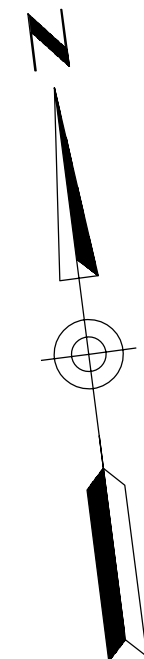

DESIGN	ZSZ	NAME	DATE	ARIZONA DEPARTMENT OF TRANSPORTATION PROJECT DELIVERY AND OPERATIONS DIVISION ROADWAY DESIGN SERVICES	
DRAWN	RM		06-26	WICKENBURG RANCH WAY/MATTHIE RANCH ROAD	
CHECKED	DBK		06-26	FENCE SHEET	
				STA 55+00 TO 69+00/STA 0+00 TO 5+00	
ROUTE	US 93	LOCATION	WICKENBURG RANCH WAY TO VISTA ROYALE	TRACS NO. F0738 OIC	DWG NO. C-7.22
				093-B(230)T	OF

F.H.W.A. REGION	STATE	PROJECT NO.	SHEET NO.	TOTAL SHEETS	RECORD DRAWING
9	ARIZ.	093-B(230)T	275	524	
093 YV 189					

NOTE:
See Dwg No. C-7.01 for fence along US 93.

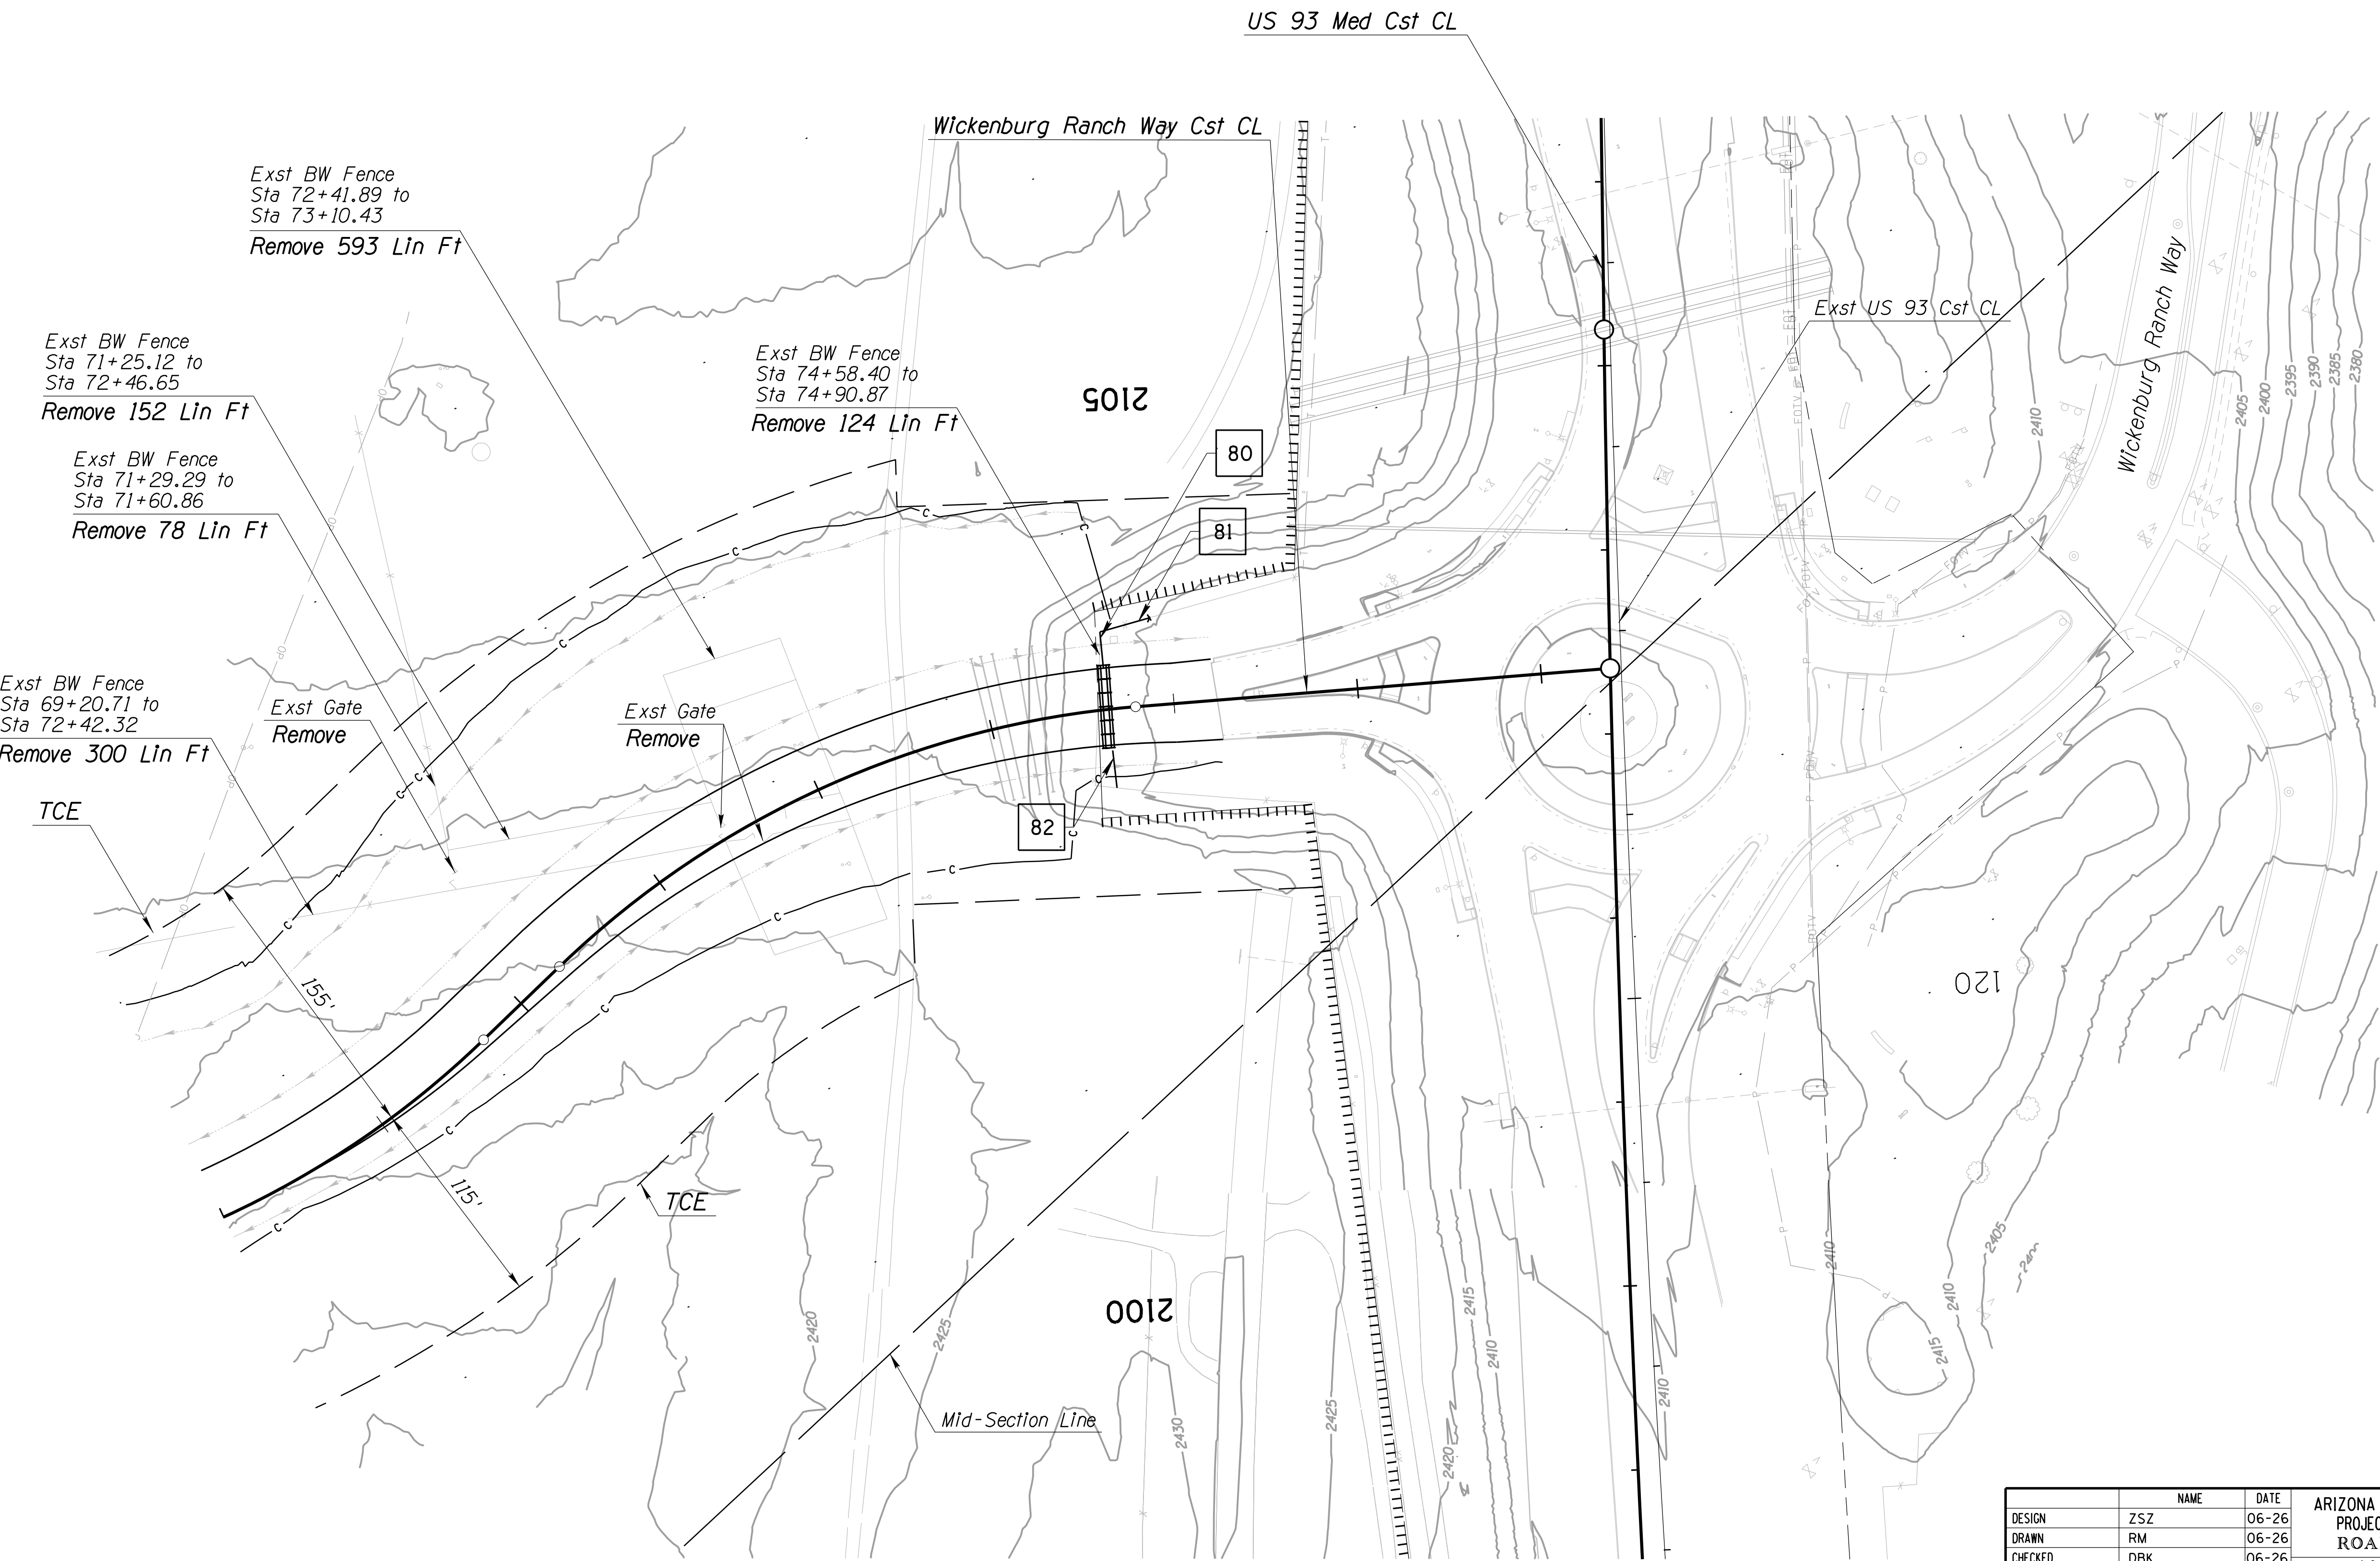

		NAME		DATE		ARIZONA DEPARTMENT OF TRANSPORTATION PROJECT DELIVERY AND OPERATIONS DIVISION ROADWAY DESIGN SERVICES WICKENBURG RANCH WAY FENCE SHEET STA 69+00 TO STA 76+00	
DESIGN		ZSZ		06-26			
DRAWN		RM		06-26			
CHECKED		DBK		06-26			
 Stanley Consultants Inc.		3155 East Camelback Road, Suite 100 Phoenix, Arizona 85016 Phone: (602) 353-2200					
ROUTE		LOCATION					
US 93		WICKENBURG RANCH WAY TO VISTA ROYALE				DWG NO. C-7.23	
TRACS NO. F0738 OIC				093-B(230)T		OF	

F.H.W.A. REGION	STATE	PROJECT NO.	SHEET NO.	TOTAL SHEETS	RECORD DRAWING
9	ARIZ.	093-B(230)T	276	524	

093 YV 189

NOTES:

1. See Dwg No. G-3.01 for Pavement Structural Sections.
2. Temporary AC removal will be measured and paid for under Item No. 2020029 - Removal of Asphaltic Concrete.

SECTION A-A

(See Section D-D for Rumble Strip Removal)

Detour
CL

7'-18'

Exst Roadway

Match Exst

<u>Match</u>	<u>Exst</u>	<u>AC</u>	<u>Pvmt</u>
--------------	-------------	-----------	-------------

*Pavement Structural
Section No. 9*

SECTION A-A

(See Section D-D for Rumble Strip Removal)

$$\frac{US\ 93\ Med\ Cst\ CL}{Exst\ US\ 93\ Cst\ CL}$$

US 93 Detour Cst CL

Begin US 93 Detour Cst CL Sta 200+00.00 =
7.84' Lt US 93 Med Cst CL Sta 2112+40.16

 $Exst\ R/W$ Exst R/W

WICKENBURG RANCH WAY

Exst Shoulder Stripe

Exst Roadway

*Pavement Structural
Section No. 15*

SECTION D-D



1

 
US 93 Detour
PI Sta 200+54.39
N=1099537.39
E=432258.52
 $\Delta=5^{\circ}59'15''Rt$
 $D=5^{\circ}30'33''$
 $R=1040.00'$
 $L=108.68'$
 $T=54.39'$
 $Ext=1.42'$

2

US 93 Detour
Pl Sta 201+91.92
N=1099645.56
E=432173.43
 $\Delta=9^{\circ}02'53''Lt$
 $D=5^{\circ}26'47''$
 $R=1052.00'$
 $L=166.13'$
 $T=83.24'$
 $Ext=3.29'$

LEGEND:

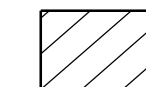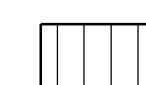


			ARIZONA DEPARTMENT OF TRANSPORTATION PROJECT DELIVERY AND OPERATIONS DIVISION ROADWAY DESIGN SERVICES		
DESIGN	ZSZ	06-26	PHASE 1 DETOUR PLAN		
DRAWN	RM	06-26			
CHECKED	DBK	06-26			
		3133 East Camelback Road, Suite 100 Phoenix, Arizona 85016 Phone: (602) 333-2200			
ROUTE US 93		LOCATION WICKENBURG RANCH WAY TO VISTA ROYALE		DWG NO. C-8.01	
TRACS NO. F0738 OIC			093-B(230)T		OF

F.H.W.A. REGION	STATE	PROJECT NO.	SHEET NO.	TOTAL SHEETS	RECORD DRAWING
9	ARIZ.	093-B(230)T	277	524	


093 YV 189

NOTES:

1. See Dwg No. G-3.01 for Pavement Structural Sections.
2. See Dwg No. C-8.01 for Section D-D
3. Temporary AC removal will be measured and paid for under Item No. 2020029 - Removal of Asphaltic Concrete.

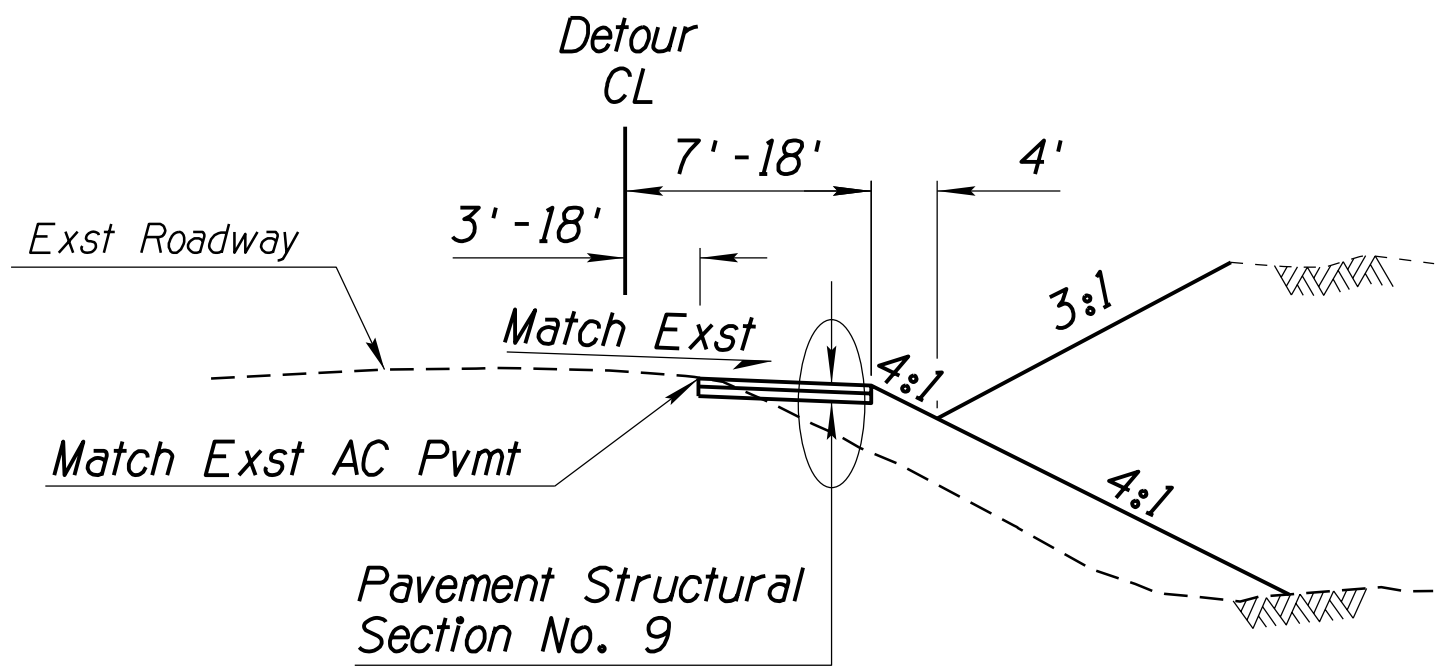

SECTION A-A
(See Section D-D for Rumble Strip Removal)

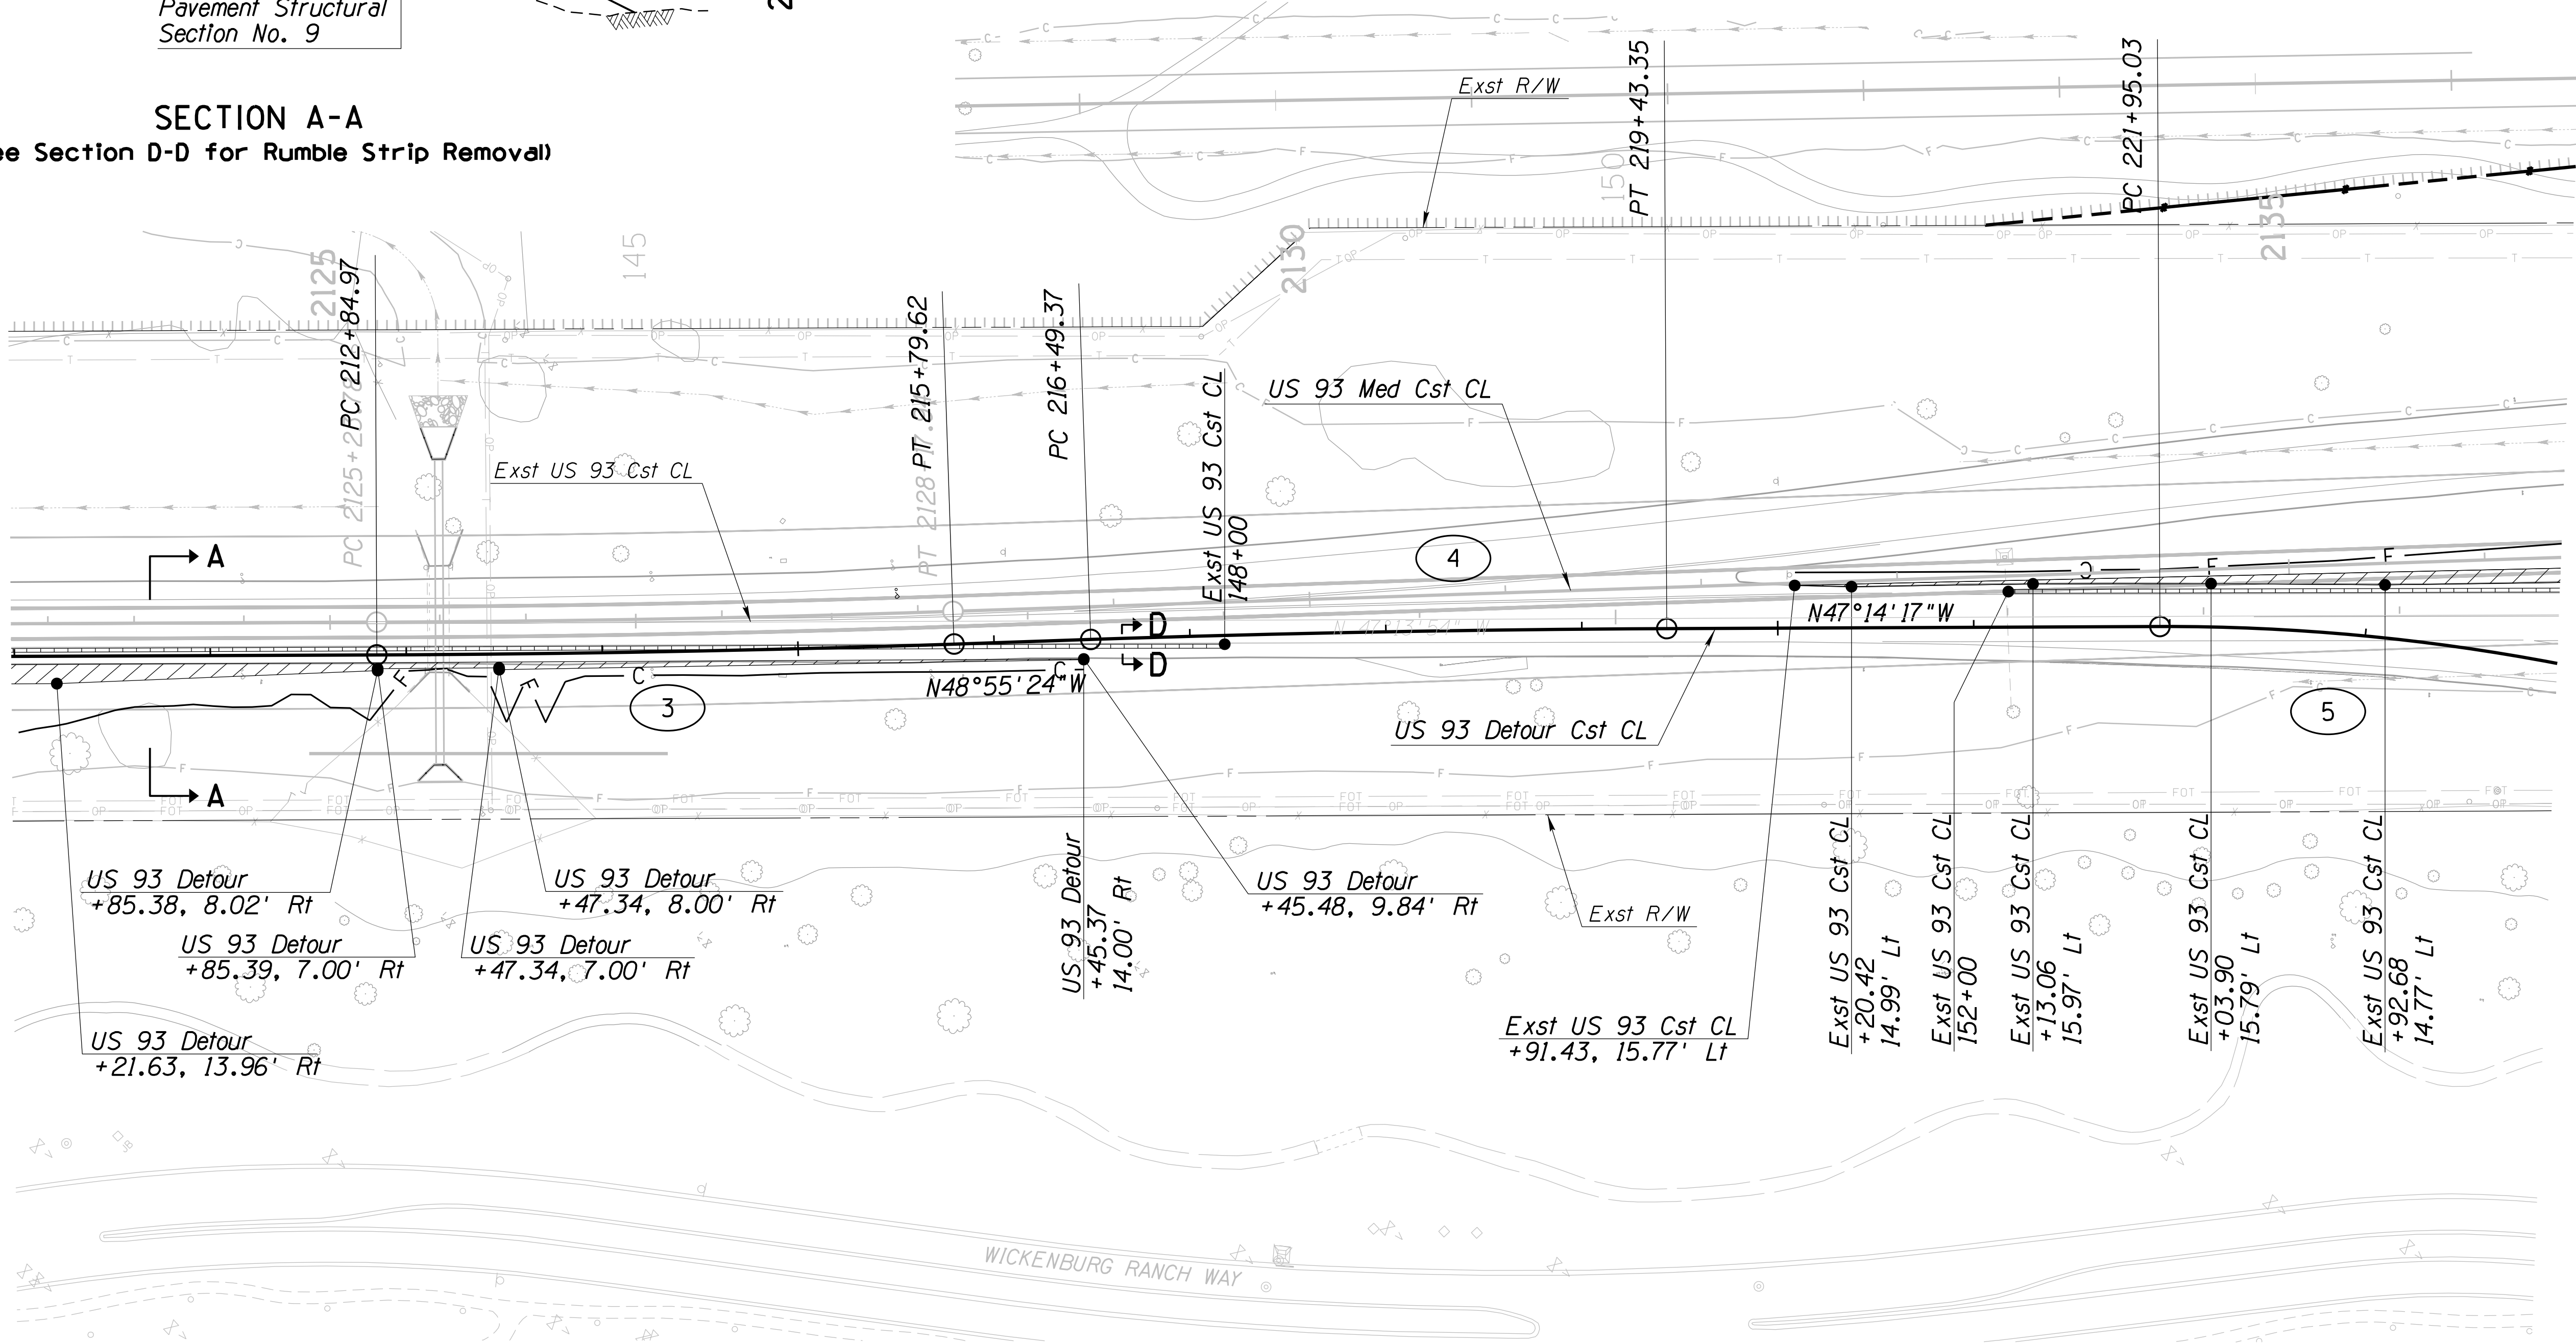

3 US 93 Detour
PI Sta 214+32.30
N=1100487.96
E=431262.50
Δ=1°41'07" Lt
D=0°34'19"
R=10016.71'
L=294.65'
T=147.33'
Ext=1.08'

4 US 93 Detour
PI Sta 217+96.37
N=1100727.19
E=430988.04
Δ=1°41'07" Rt
D=0°34'24"
R=9994.00'
L=293.98'
T=147.00'
Ext=1.08'

5 US 93 Detour
PI Sta 223+09.84
N=1101075.83
E=430611.05
Δ=12°27'26" Rt
D=5°26'47"
R=1052.00'
L=228.73'
T=114.82'
Ext=6.25'


LEGEND:

- Exst AC Pavement Mill
- Temporary Paving

		NAME	DATE	ARIZONA DEPARTMENT OF TRANSPORTATION PROJECT DELIVERY AND OPERATIONS DIVISION ROADWAY DESIGN SERVICES	
DESIGN	ZSZ	06-26			
DRAWN	RM	06-26			
CHECKED	DBK	06-26			
 Stanley Consultants INC.		3133 East Camelback Road, Suite 100 Phoenix, Arizona 85016 Phone: (602) 333-2200		PHASE 1 DETOUR PLAN	
ROUTE		LOCATION			
US 93		WICKENBURG RANCH WAY TO VISTA ROYALE			
TRACS NO. F0738 OIC				093-B(230)T	DWG NO. C-8.02
					___ OF ___

6 US 93 Detour
PI Sta 224+57.30
N= 1101197.69
E= 430526.41
Δ= 3°41'42" Lt
D= 5°30'33"
R=1040.00'
L=67.07'
T=33.55'
Ext=0.54'

F.H.W.A. REGION	STATE	PROJECT NO.	SHEET NO.	TOTAL SHEETS	RECORD DRAWING
9	ARIZ.	093-B(230)T	278	524	
093 YV 189					

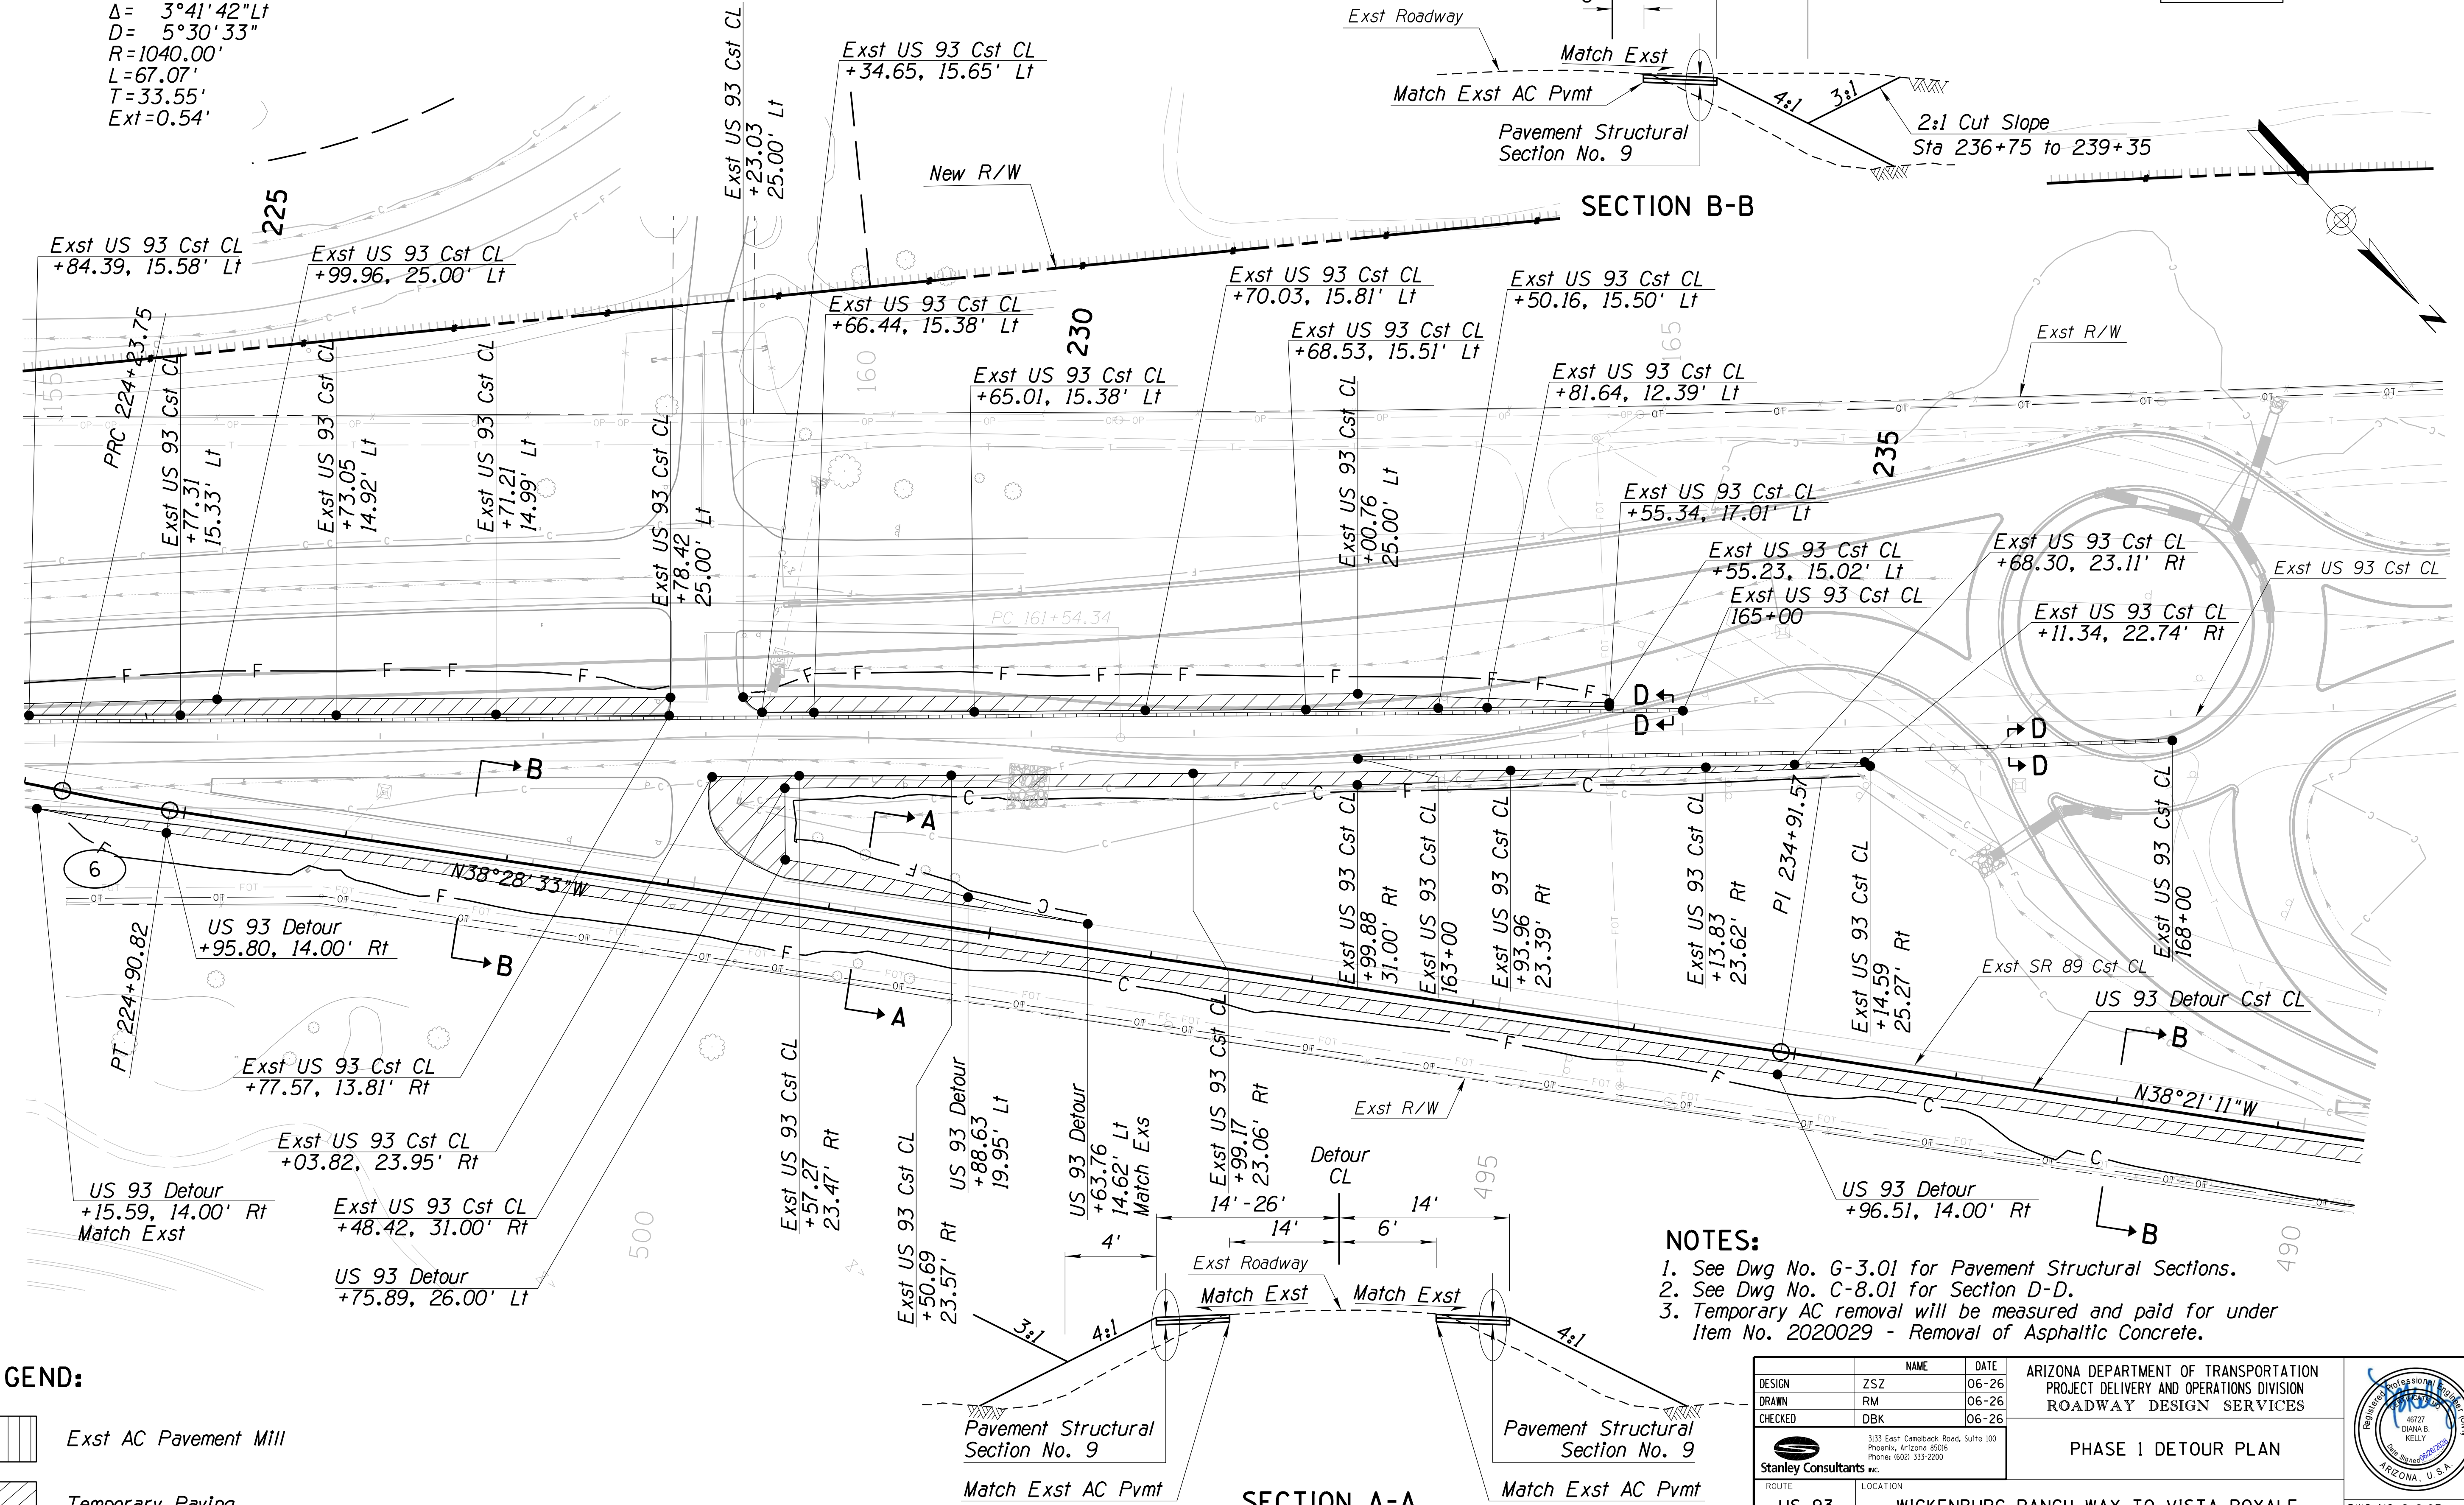

- NOTES:**
- See Dwg No. G-3.01 for Pavement Structural Sections.
 - See Dwg No. C-8.01 for Section D-D.
 - Temporary AC removal will be measured and paid for under Item No. 2020029 - Removal of Asphaltic Concrete.

LEGEND:

- Exst AC Pavement Mill
- Temporary Paving

SECTION A-A
(See Section D-D for Rumble Strip Removal)

DESIGN	ZSZ	DATE	06-26
DRAWN	RM	DATE	06-26
CHECKED	DBK	DATE	06-26

3133 East Camelback Road, Suite 100
Phoenix, Arizona 85016
Phone: (602) 333-2200

Stanley Consultants Inc.

ROUTE: US 93 LOCATION: WICKENBURG RANCH WAY TO VISTA ROYALE

TRACS NO. F0738 OIC

093-B(230)T

093 YV 189

PHASE 1 DETOUR PLAN


ARIZONA DEPARTMENT OF TRANSPORTATION
PROJECT DELIVERY AND OPERATIONS DIVISION
ROADWAY DESIGN SERVICES

DWG NO. C-8.03

OF

F.H.W.A. REGION	STATE	PROJECT NO.	SHEET NO.	TOTAL SHEETS	RECORD DRAWING
9	ARIZ.	093-B(230)T	279	524	

093 YV 189

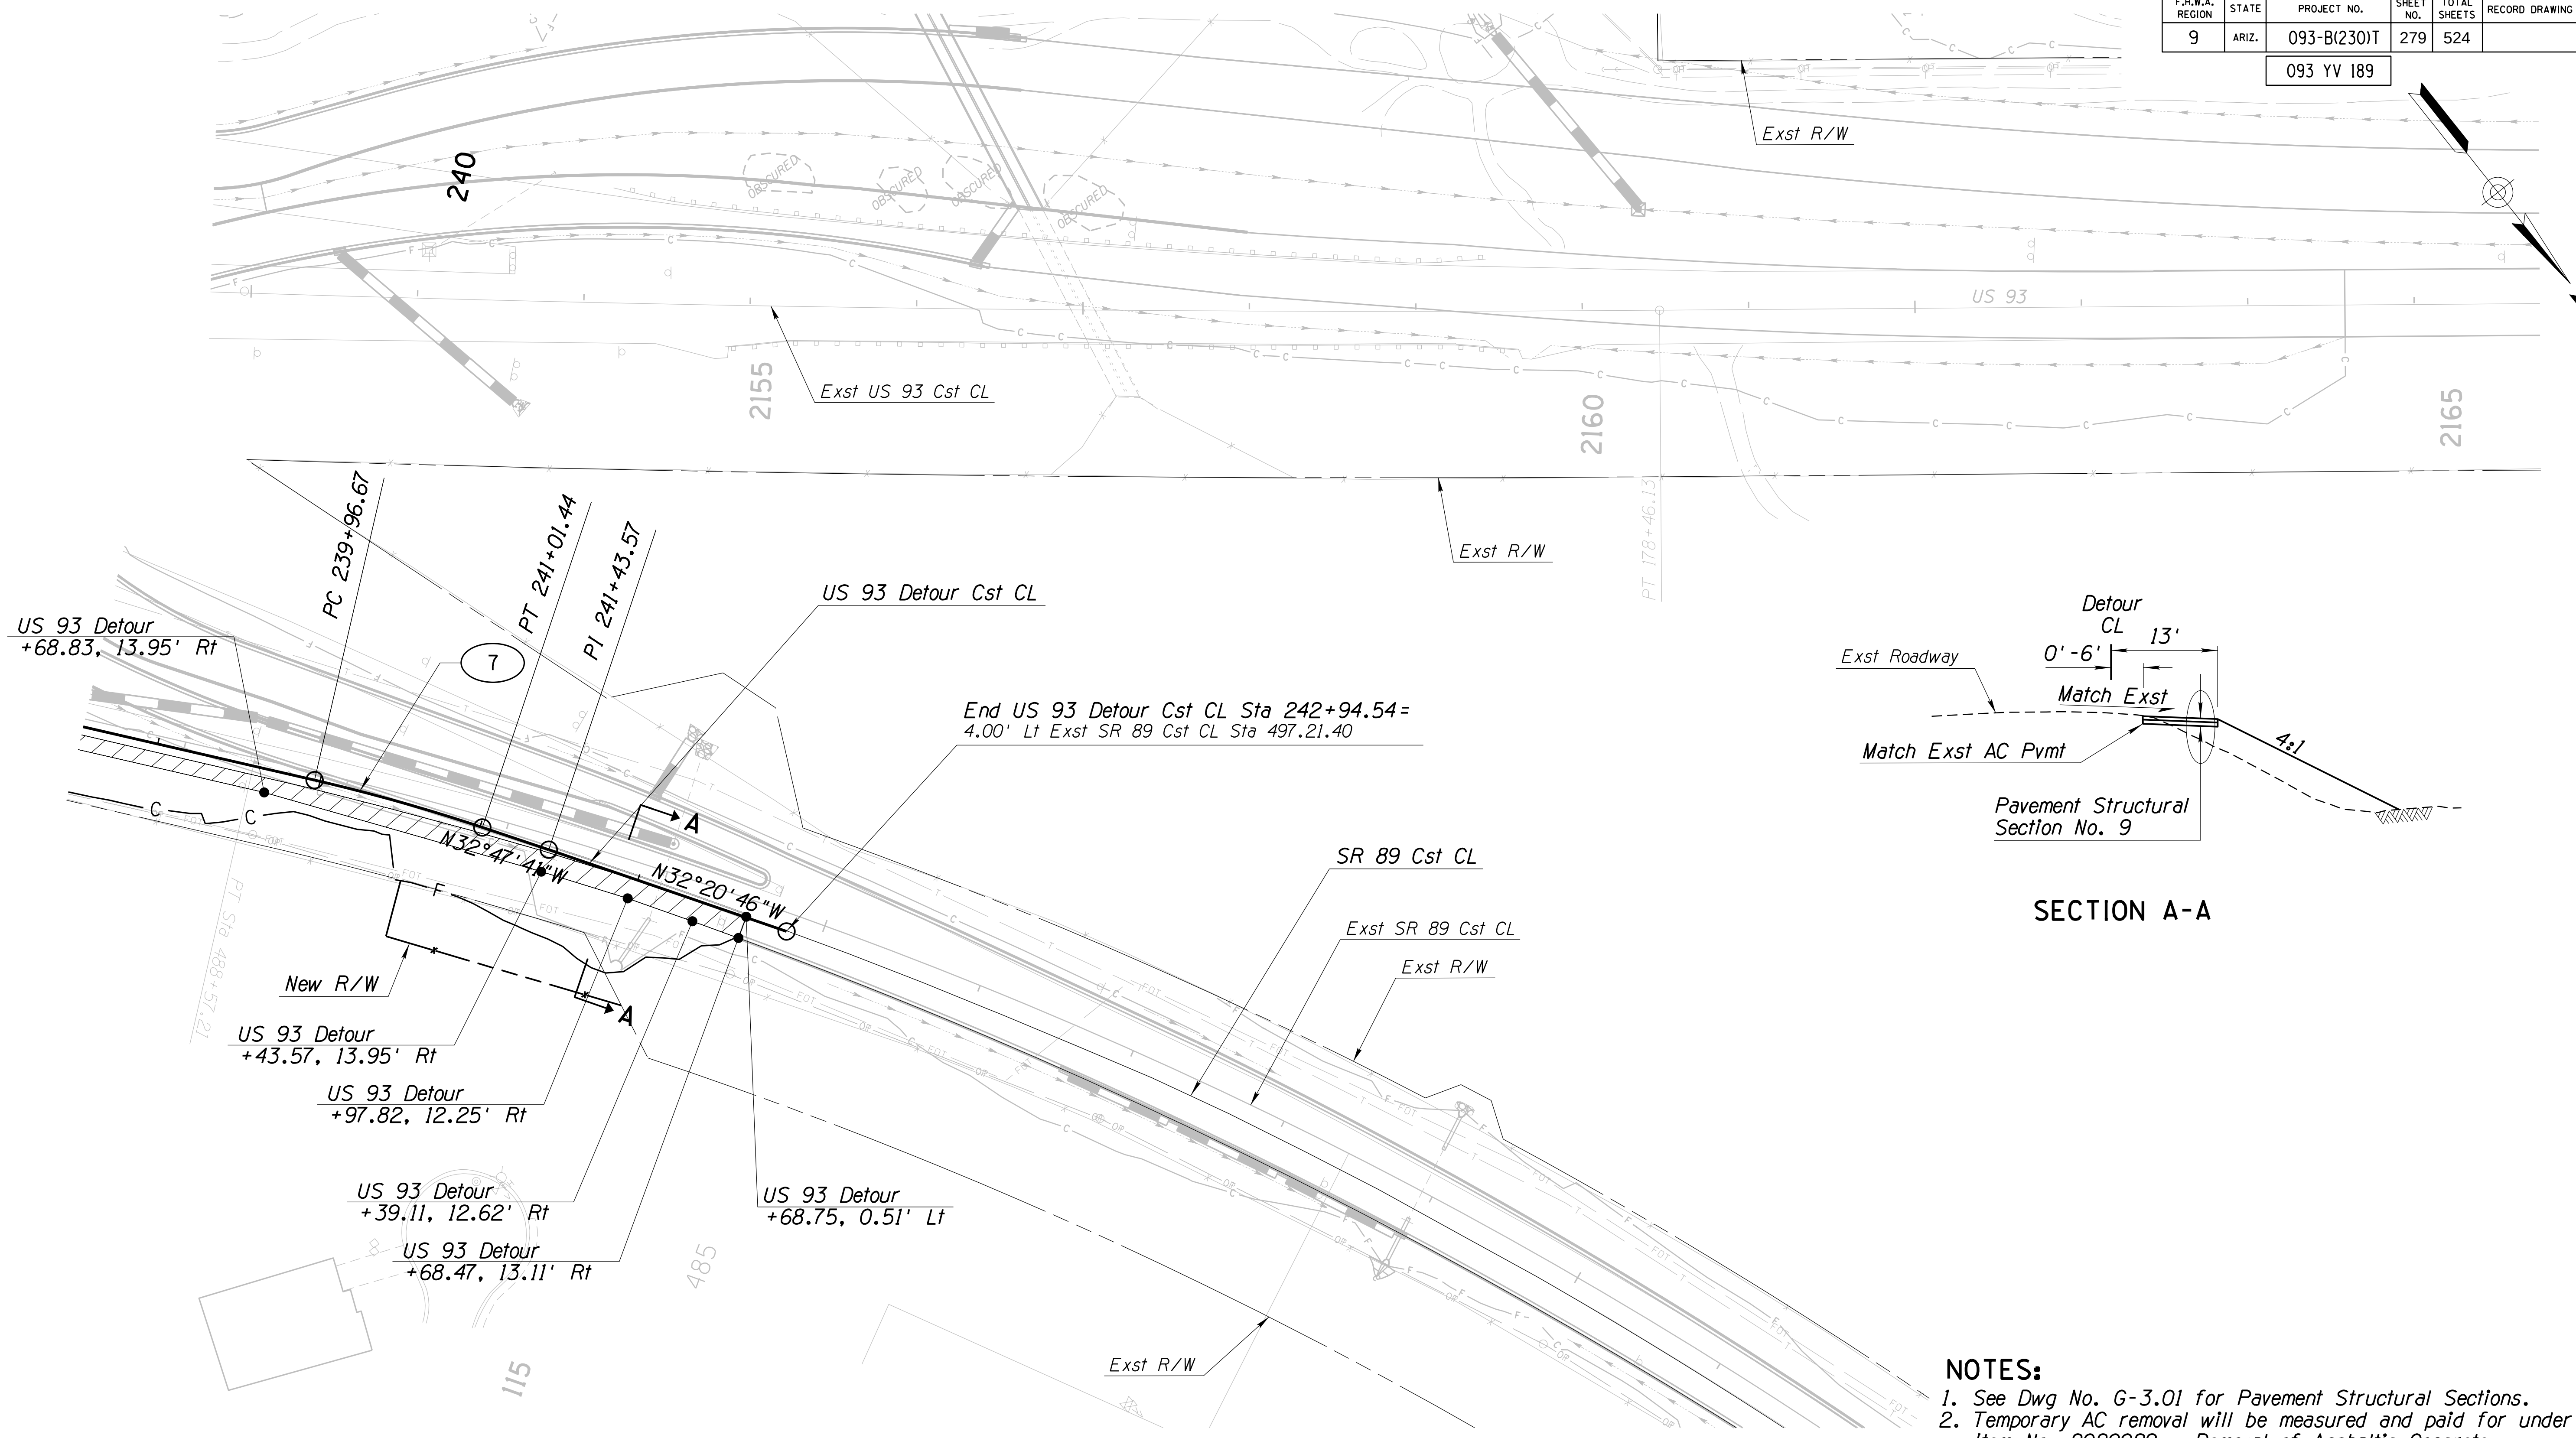

SECTION A-A

NOTES:

- See Dwg No. G-3.01 for Pavement Structural Sections.
- Temporary AC removal will be measured and paid for under Item No. 2020029 - Removal of Asphaltic Concrete.

7 US 93 Detour
PI Sta 240+49.10
N=1102444.62
E=429536.94
Δ=5°33'30"Rt
D=5°18'19"
R=1080.00'
L=104.77'
T=52.43'
Ext=1.27'

LEGEND:

Temporary Paving


DESIGN	ZSZ	DATE	06-26	ARIZONA DEPARTMENT OF TRANSPORTATION PROJECT DELIVERY AND OPERATIONS DIVISION ROADWAY DESIGN SERVICES	
DRAWN	RM	DATE	06-26		
CHECKED	DBK	DATE	06-26		
Stanley Consultants inc.				PHASE 1 DETOUR PLAN	
ROUTE	US 93	LOCATION	WICKENBURG RANCH WAY TO VISTA ROYALE		DWG NO. C-8.04
TRACS NO. F0738 OIC		093-B(230)T		OF	

NOTES:


1. See Dwg No. G-3.01 for Pavement Structural Sections.
2. See Dwg No. C-8.03 for Section B-B.
3. Temporary AC removal will be measured and paid for under Item No. 2020029 - Removal of Asphaltic Concrete.

F.H.W.A. REGION	STATE	PROJECT NO.	SHEET NO.	TOTAL SHEETS	RECORD DRAWING
9	ARIZ.	093-B(230)T	280	524	


093 YV 189

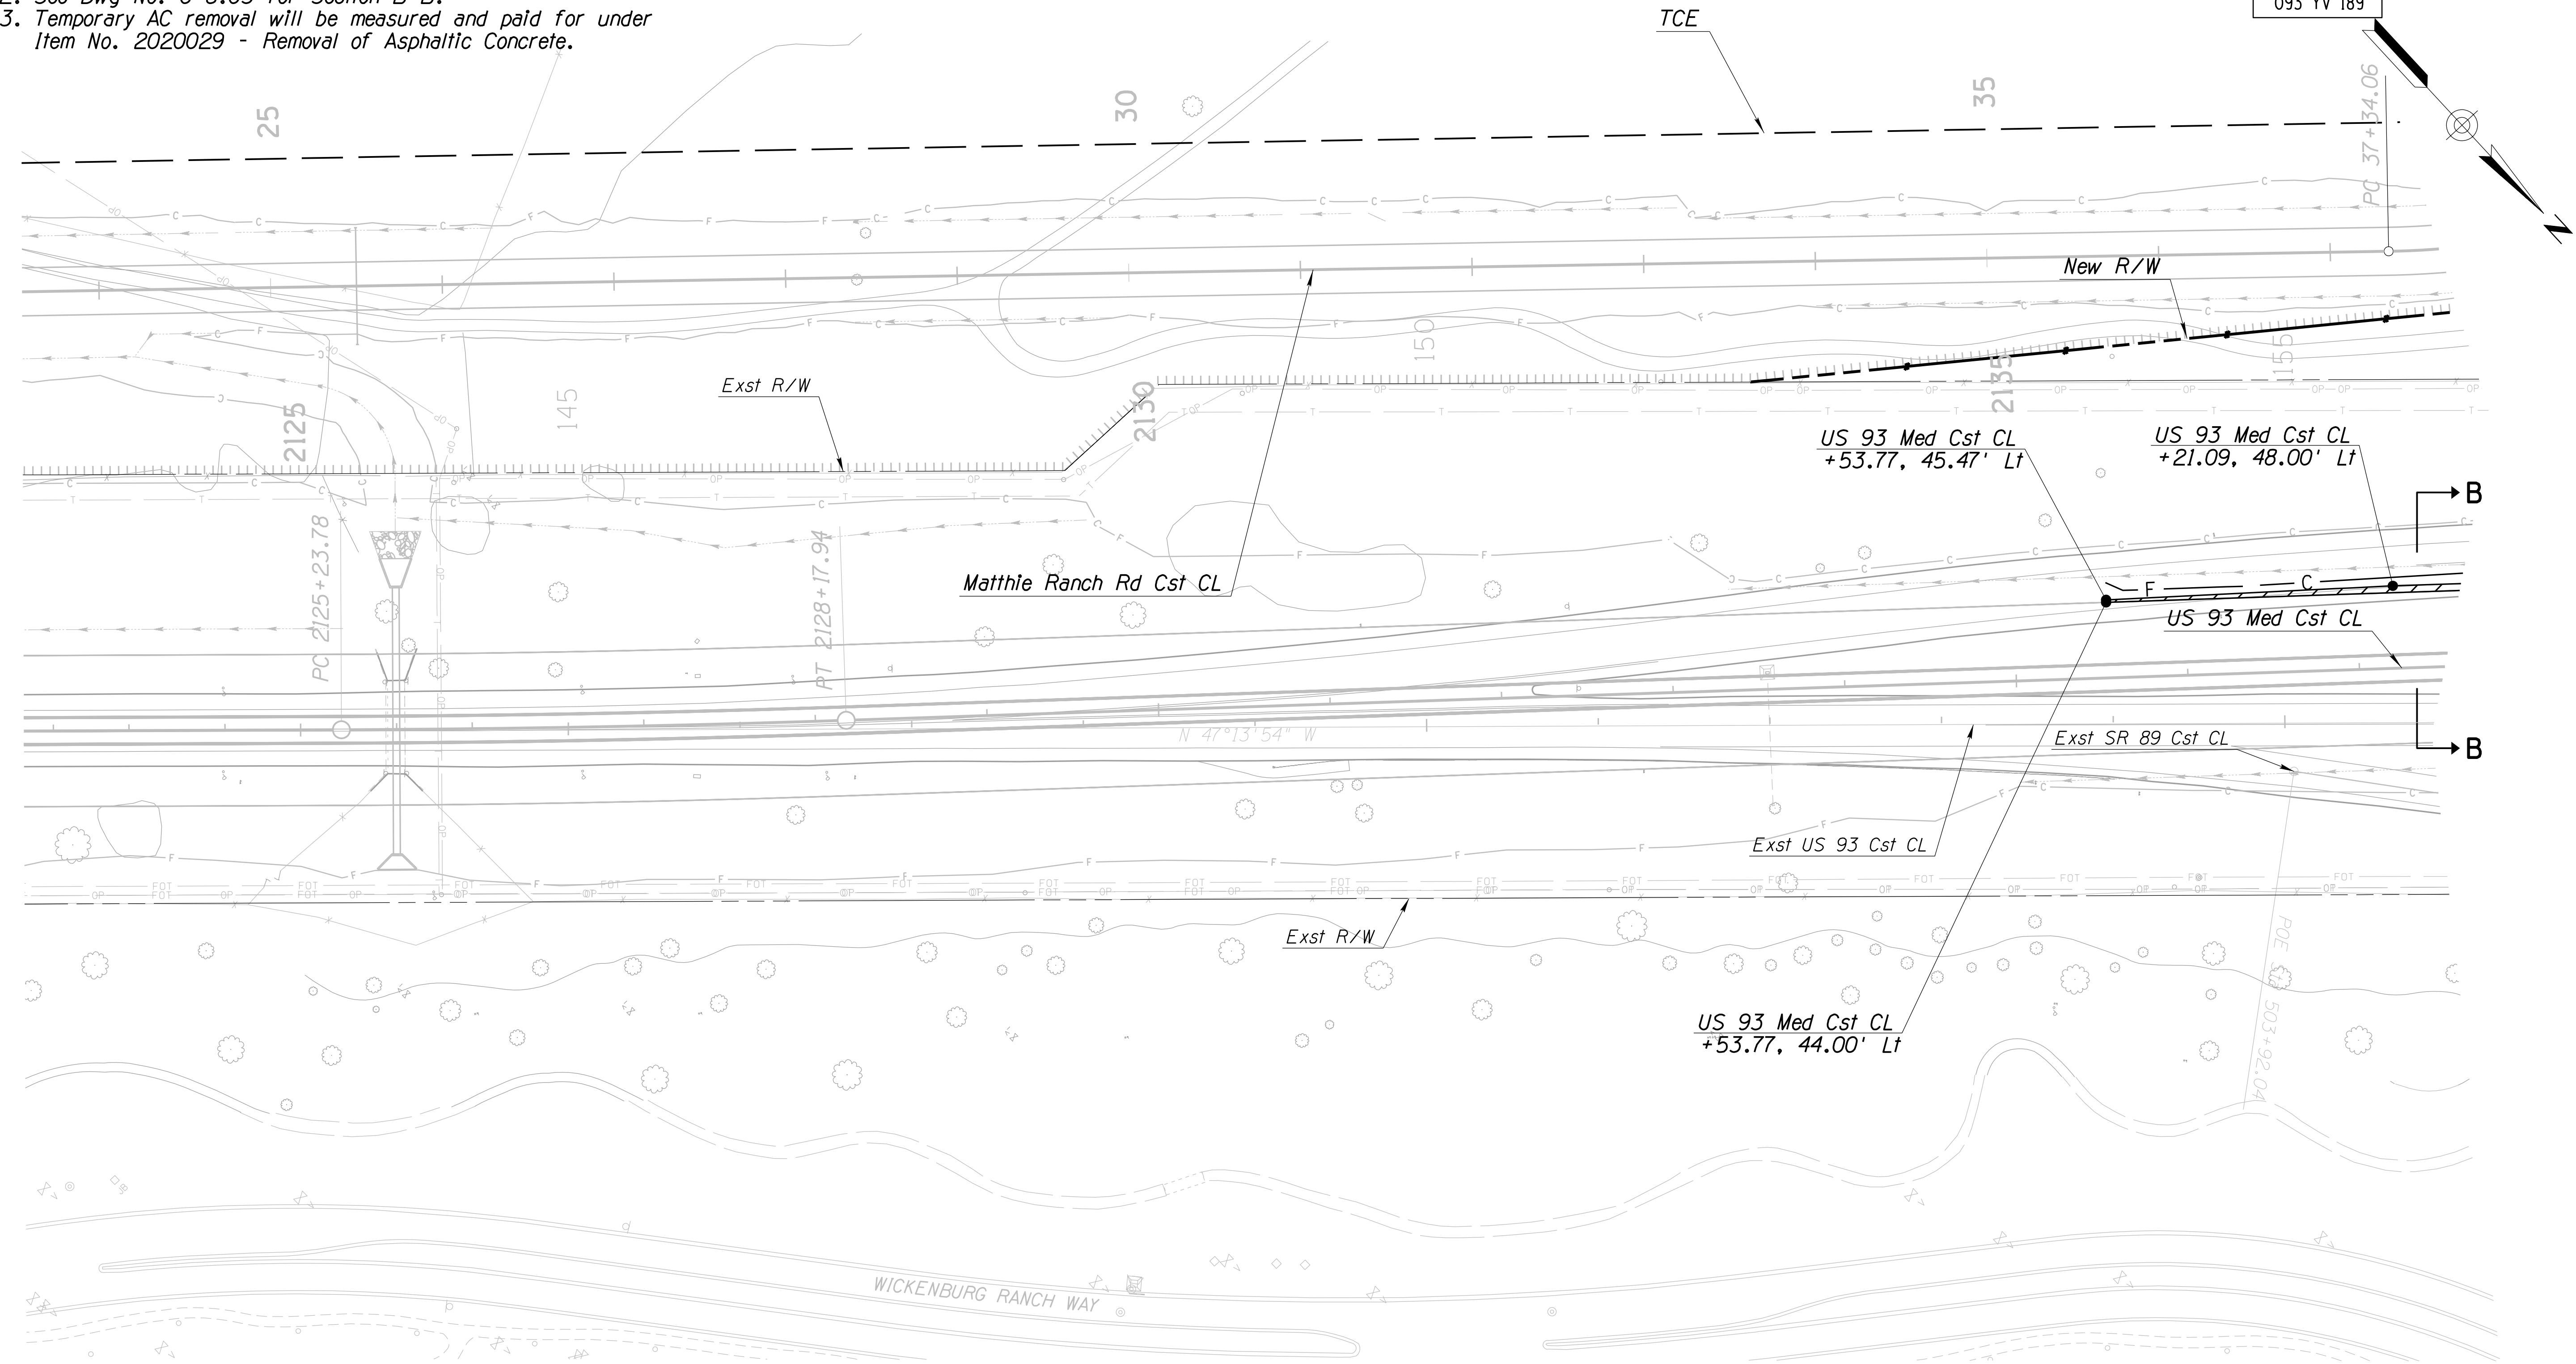

LEGEND:

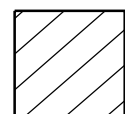 Temporary Paving

DESIGN	NAME	DATE	ARIZONA DEPARTMENT OF TRANSPORTATION PROJECT DELIVERY AND OPERATIONS DIVISION ROADWAY DESIGN SERVICES	
DRAWN	RM	06-26	PHASE 2 DETOUR PLAN	
CHECKED	DBK	06-26		
Stanley Consultants inc. 3133 East Camelback Road, Suite 100 Phoenix, Arizona 85016 Phone: (602) 333-2200			ROUTE US 93 LOCATION WICKENBURG RANCH WAY TO VISTA ROYALE	DWG NO. C-8.05
TRACS NO. F0738 OIC			093-B(230)T	OF

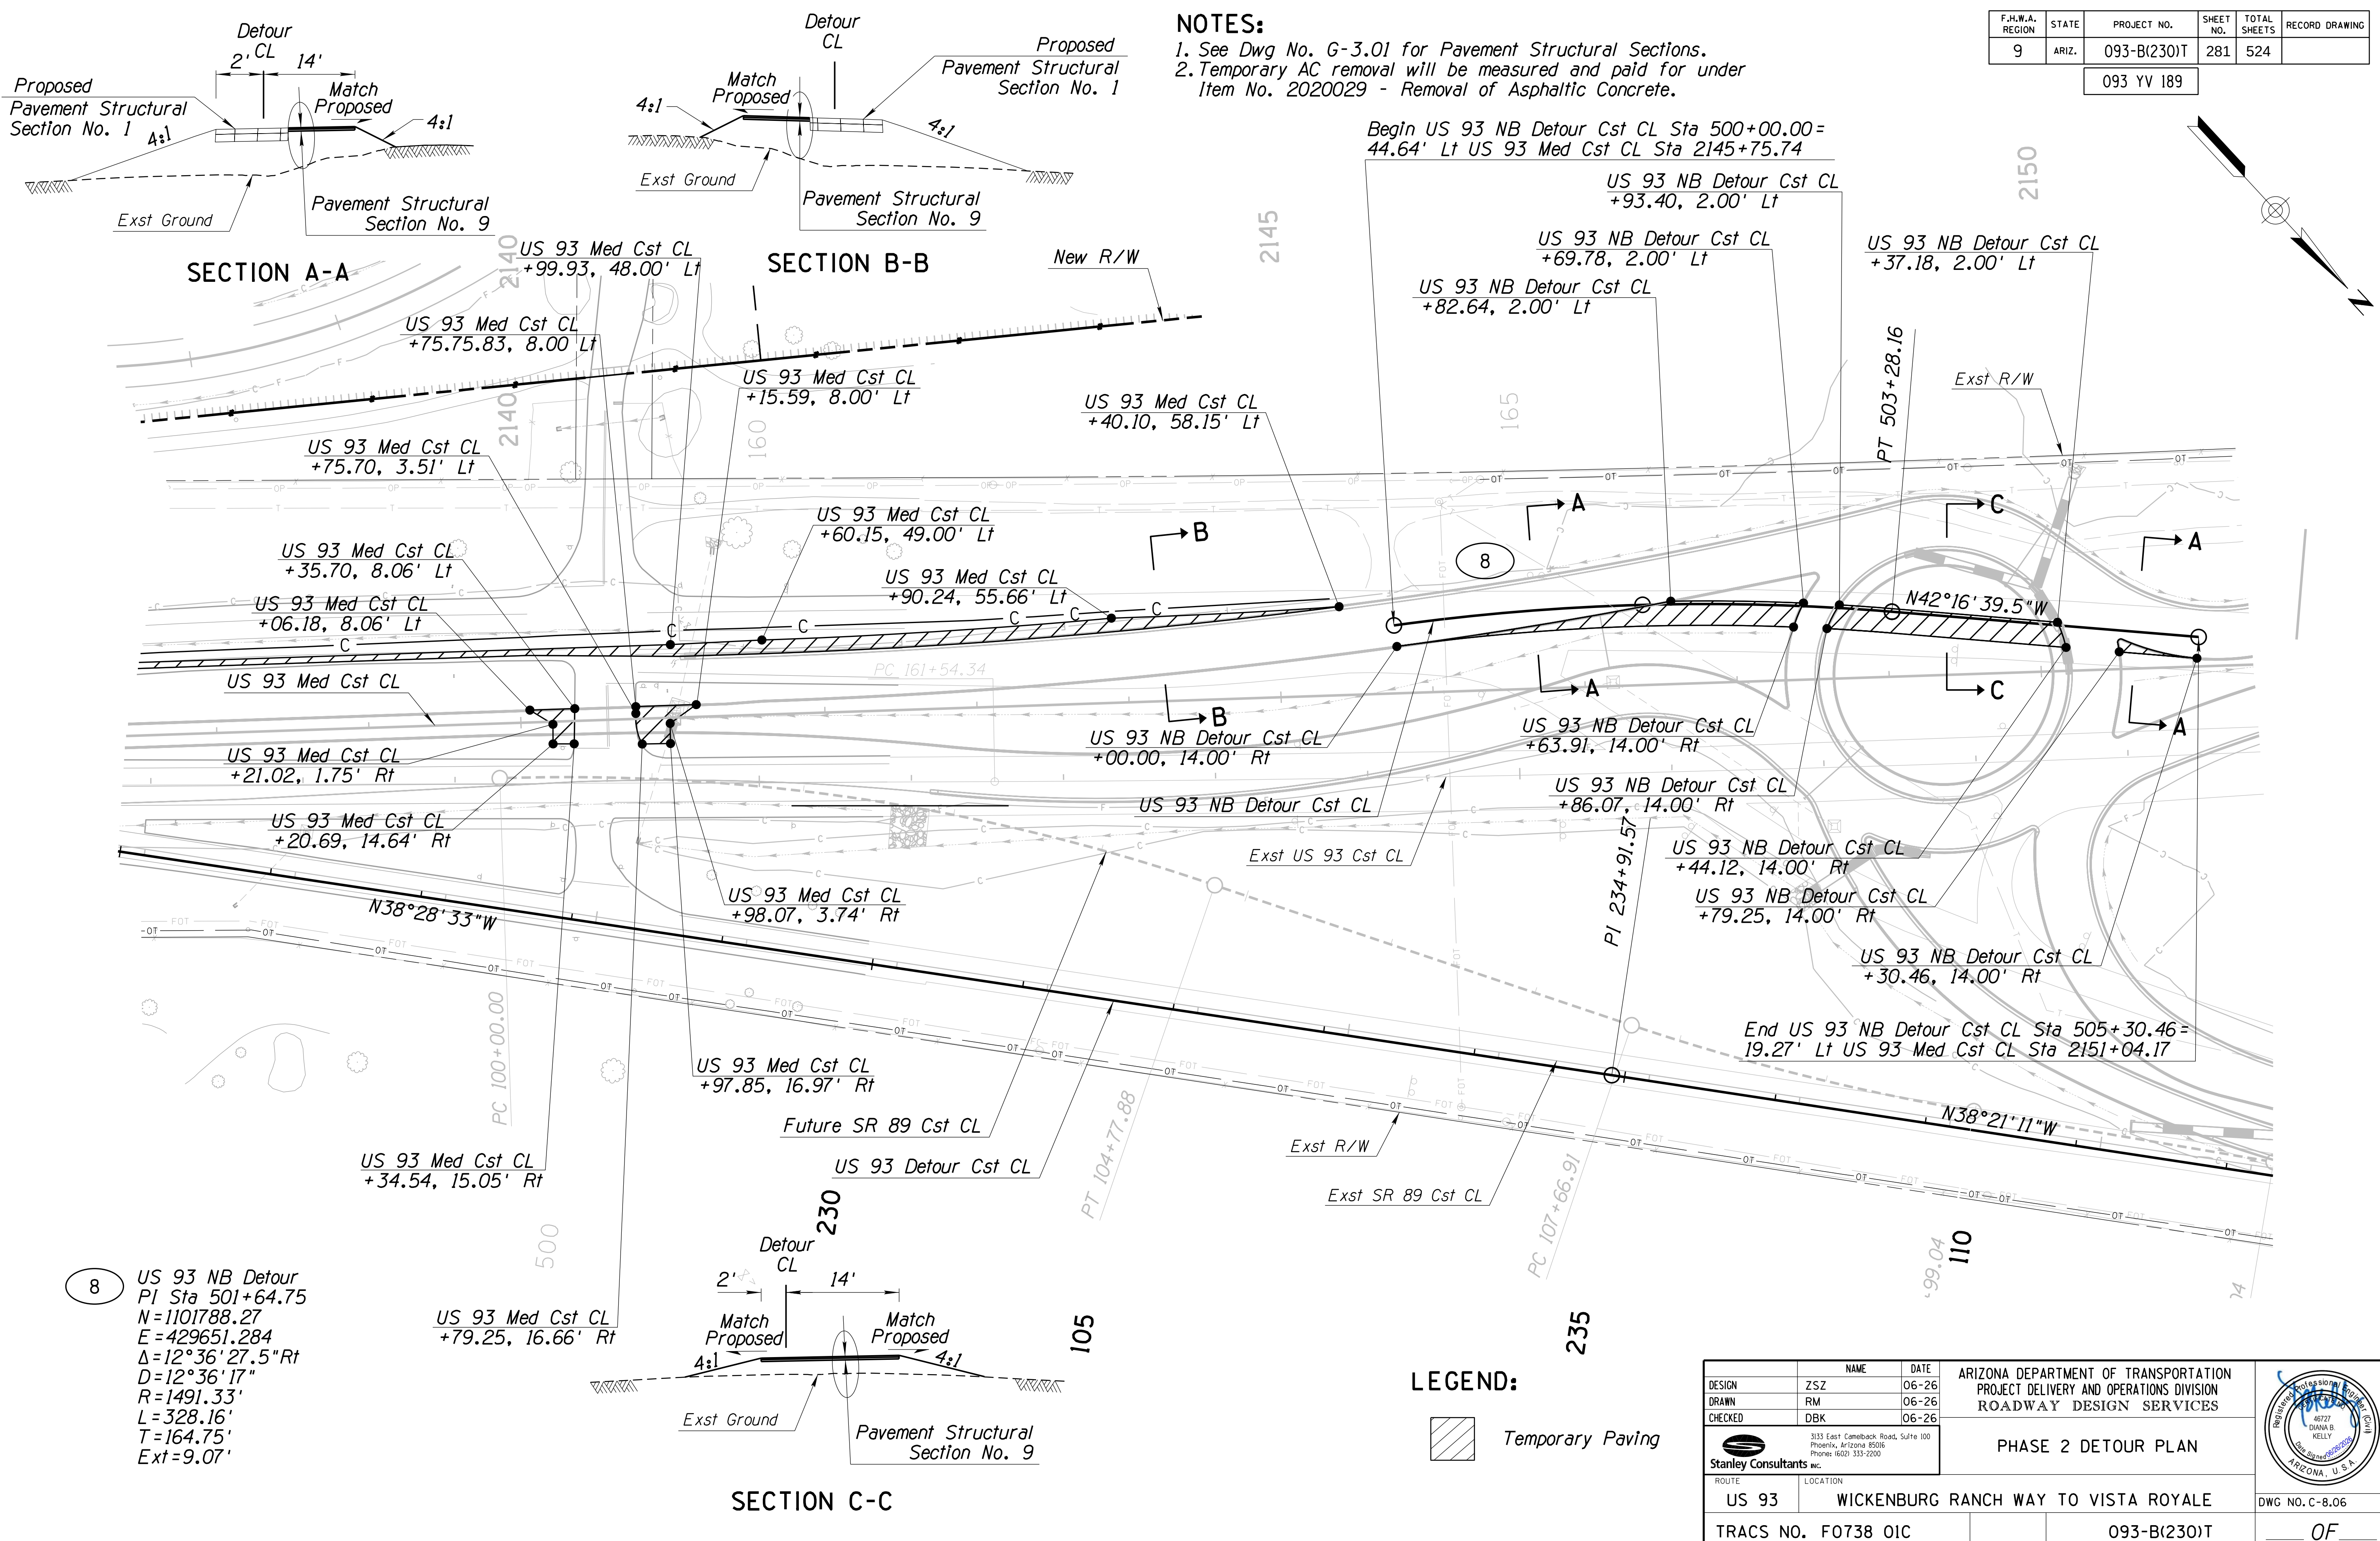



NOTES:
1. See Dwg No. G-3.01 for Pavement Structural Sections.
2. Temporary AC removal will be measured and paid for under Item No. 2020029 - Removal of Asphaltic Concrete.

F.H.W.A. REGION	STATE	PROJECT NO.	SHEET NO.	TOTAL SHEETS	RECORD DRAWING
9	ARIZ.	093-B(230)T	281	524	
093 YV 189					

8 US 93 NB Detour
PI Sta 501+64.75
N=1101788.27
E=429651.284
Δ=12°36'27.5"Rt
D=12°36'17"
R=1491.33'
L=328.16'
T=164.75'
Ext=9.07'

LEGEND:
Temporary Paving

DESIGN	ZSZ	DATE	06-26	ARIZONA DEPARTMENT OF TRANSPORTATION PROJECT DELIVERY AND OPERATIONS DIVISION ROADWAY DESIGN SERVICES	
DRAWN	RM	DATE	06-26		
CHECKED	DBK	DATE	06-26		
Stanley Consultants Inc. 3133 East Camelback Road, Suite 100 Phoenix, Arizona 85016 Phone: (602) 333-2200				PHASE 2 DETOUR PLAN	
ROUTE		LOCATION		DWG NO. C-8.06	
US 93		WICKENBURG RANCH WAY TO VISTA ROYALE			
TRACS NO. F0738 OIC		093-B(230)T		OF	


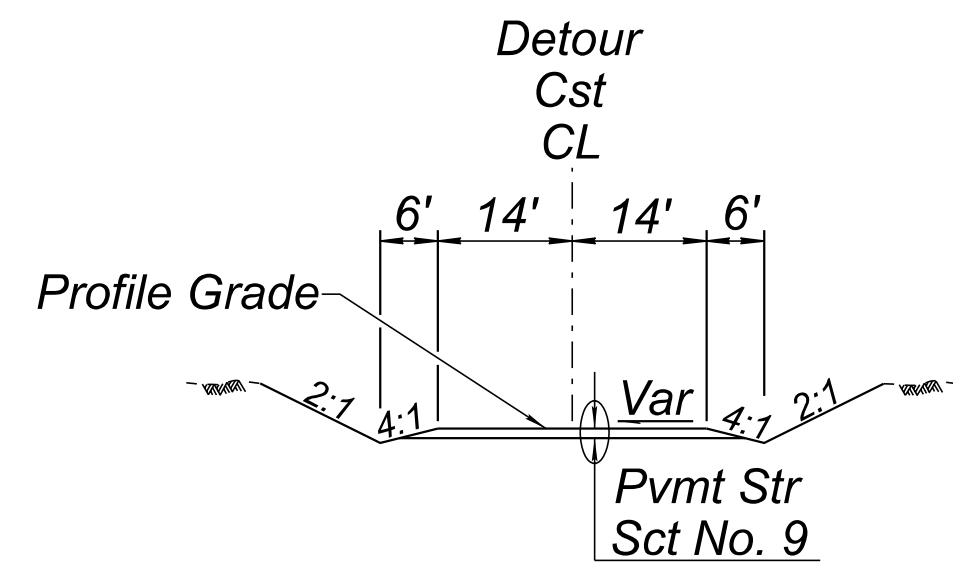
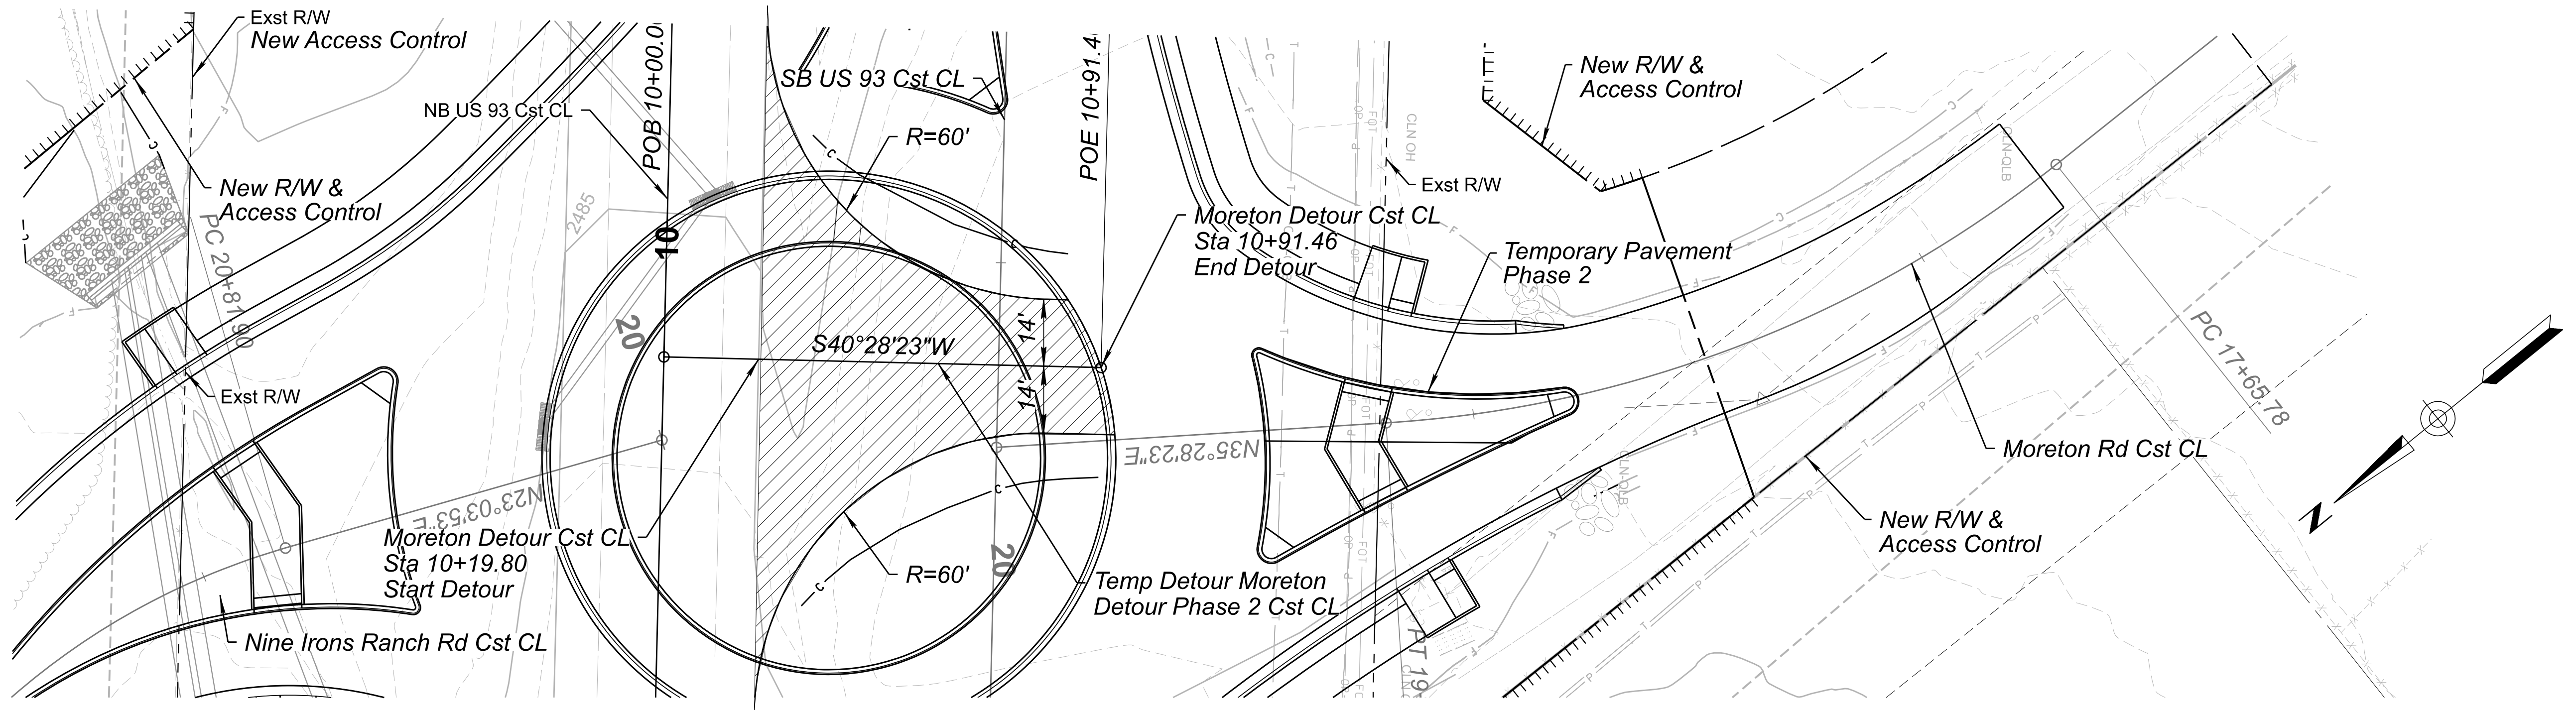


TYPICAL SECTION
Moreton Rd Detour

LEGEND



Note: Removal of Temporary Paving will be measured and paid for under Item 2020029

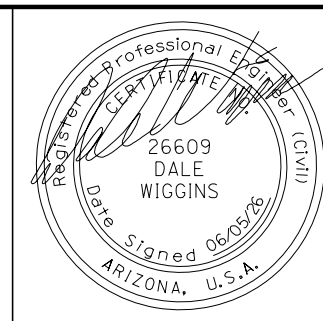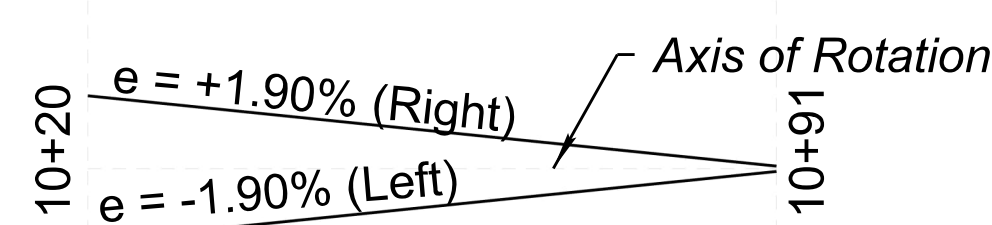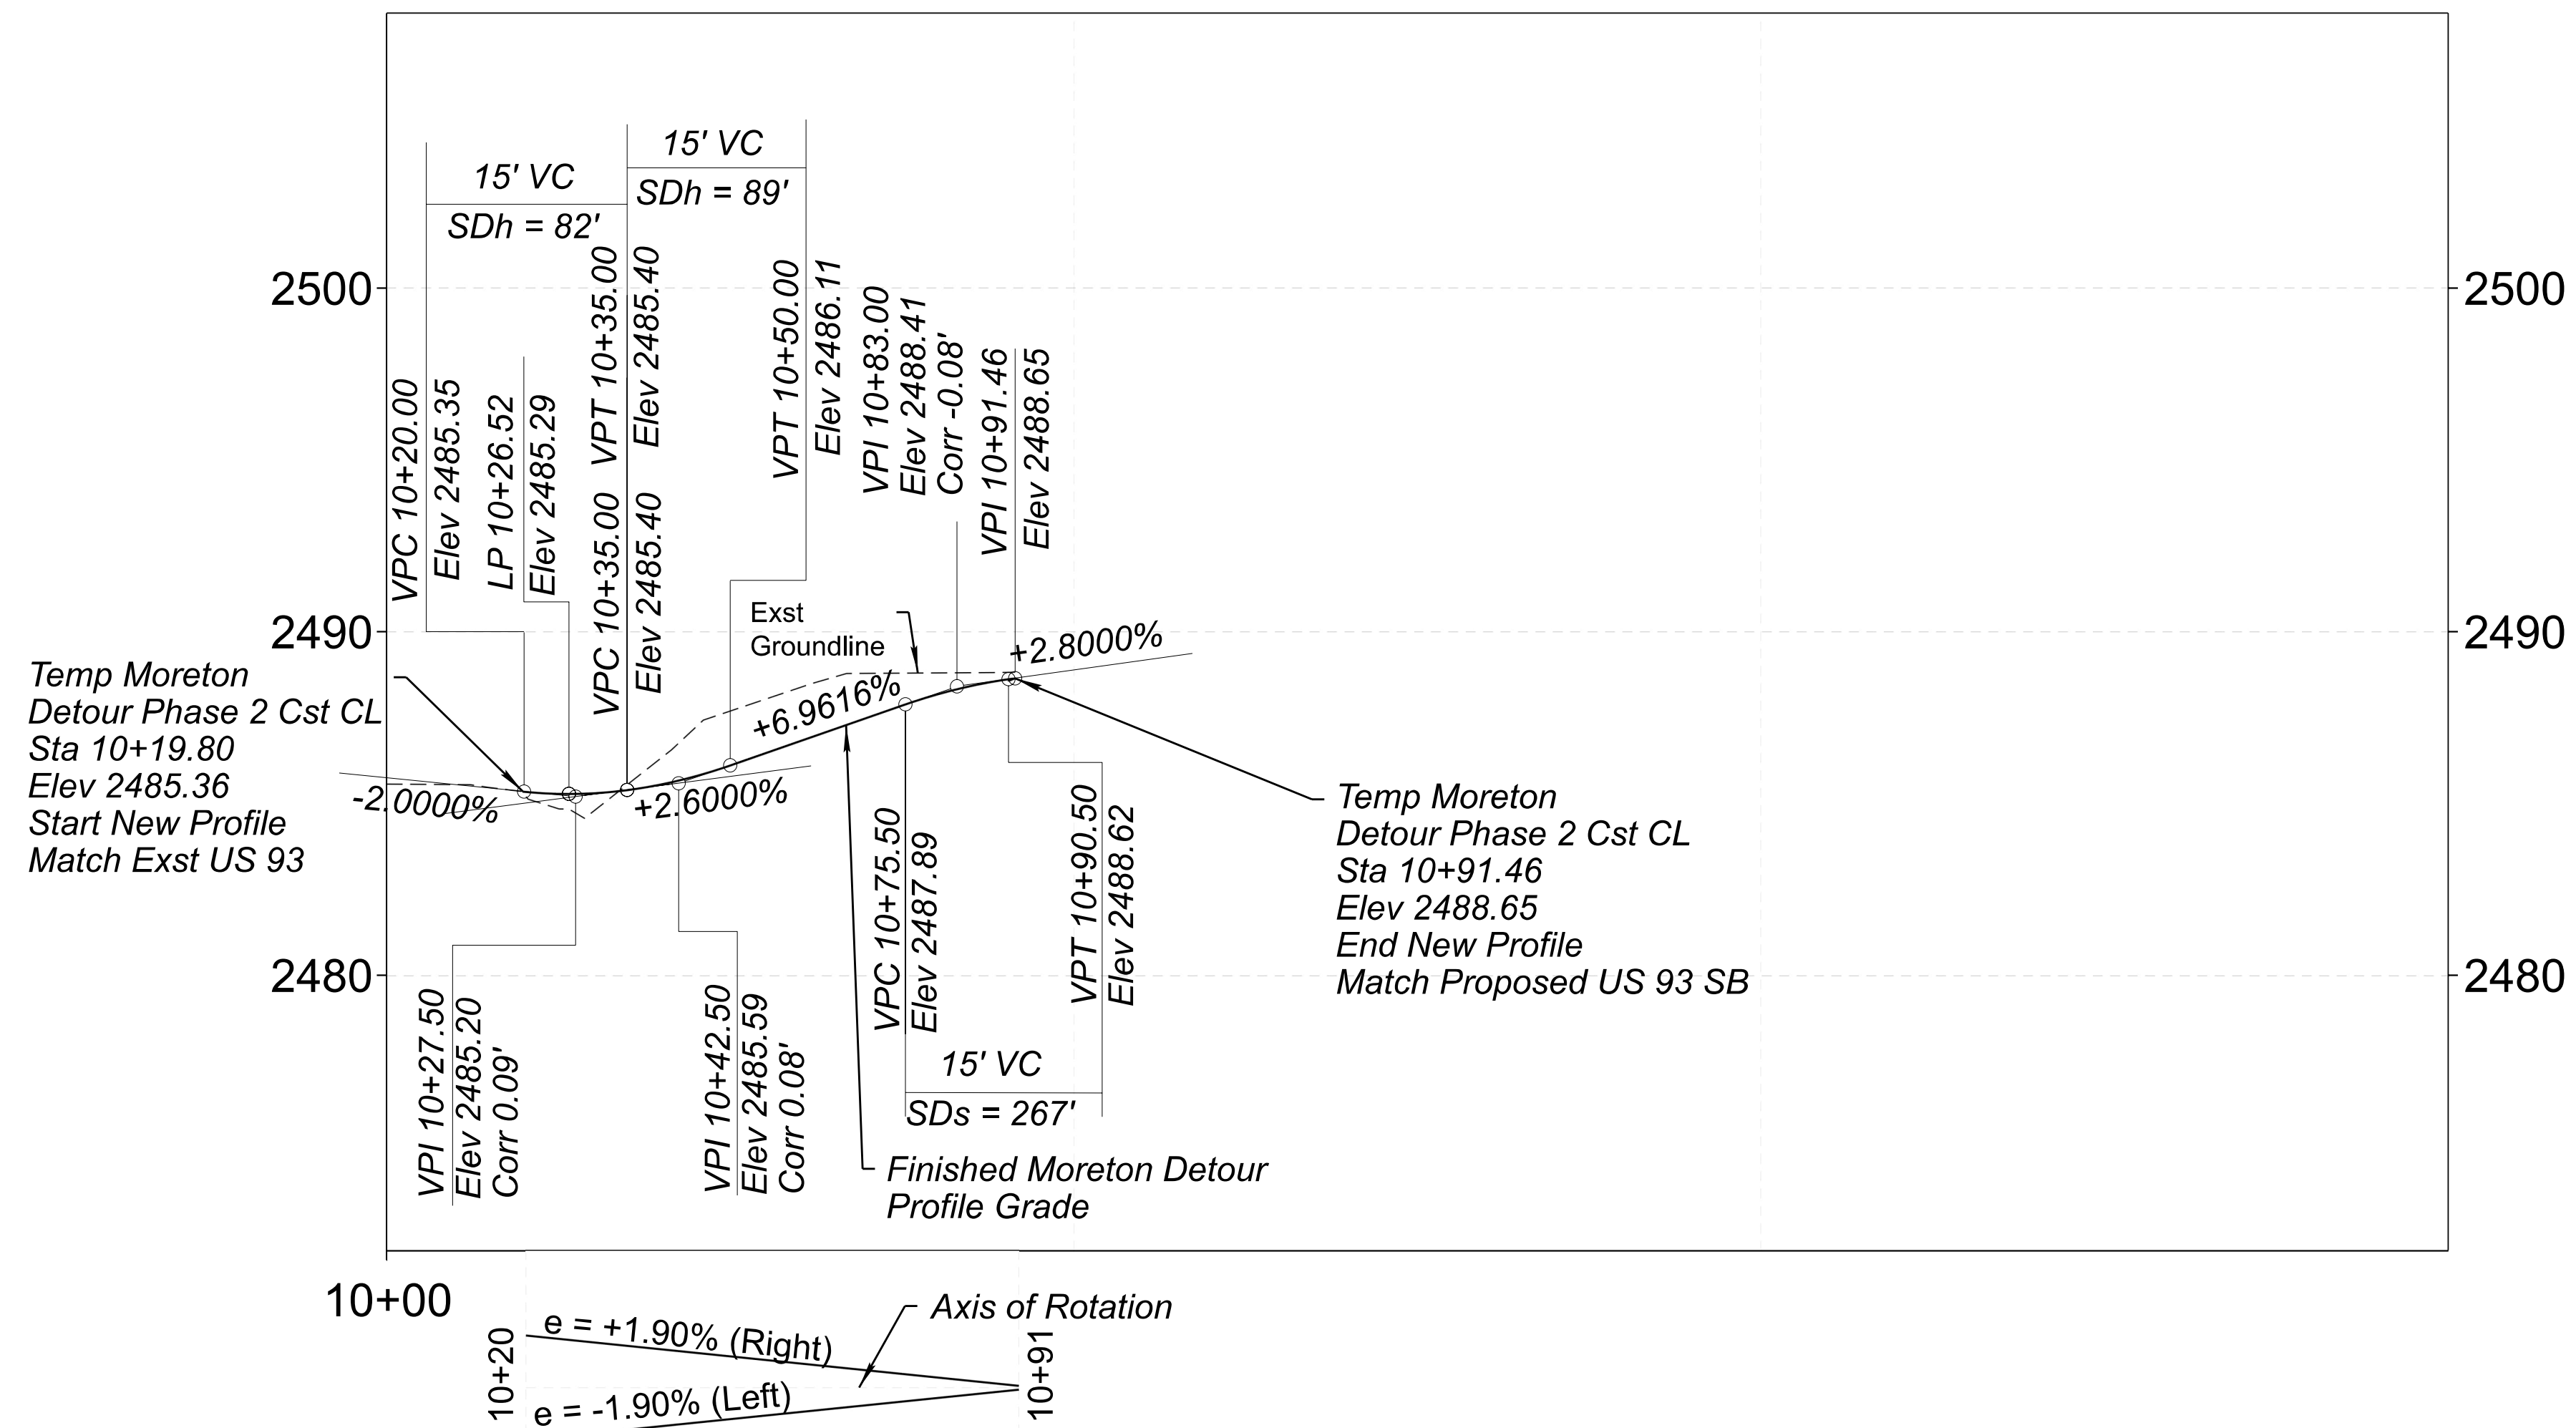


DESIGN	NAME	DATE
J GILLIS	J GILLIS	06/26
M SAMUELSON	M SAMUELSON	06/26
D WIGGINS	D WIGGINS	06/26

ARIZONA DEPARTMENT OF TRANSPORTATION PROJECT DELIVERY AND OPERATIONS DIVISION ROADWAY DESIGN SERVICES	ROUTE US 93
TEMP DETOUR - PHASE 2 MORETON RD	MILEPOST 189.9
	STRUCTURE NO.


F.H.W.A. Arizona Division	STATE ARIZ.	PROJECT NO. 093 YV 189	FEDERAL ID NO. 093-B(230)T	SHEET NO. 282	TOTAL SHEETS 524	RECORD DRAWING
LOCATION WICKENBURG RANCH WAY TO VISTA ROYALE	TRACS NO. F0738 01C	DWG No. C-8.07	OF			

F.H.W.A. REGION	STATE	PROJECT NO.	SHEET NO.	TOTAL SHEETS	RECORD DRAWING
9	ARIZ.	093-B(230)T			
093 YV 189					


NOTES:
 1. See Dwg No. G-3.01 for Pavement Structural Sections.
 2. Temporary AC removal will be measured and paid for under Item No. 2020029 - Removal of Asphaltic Concrete.

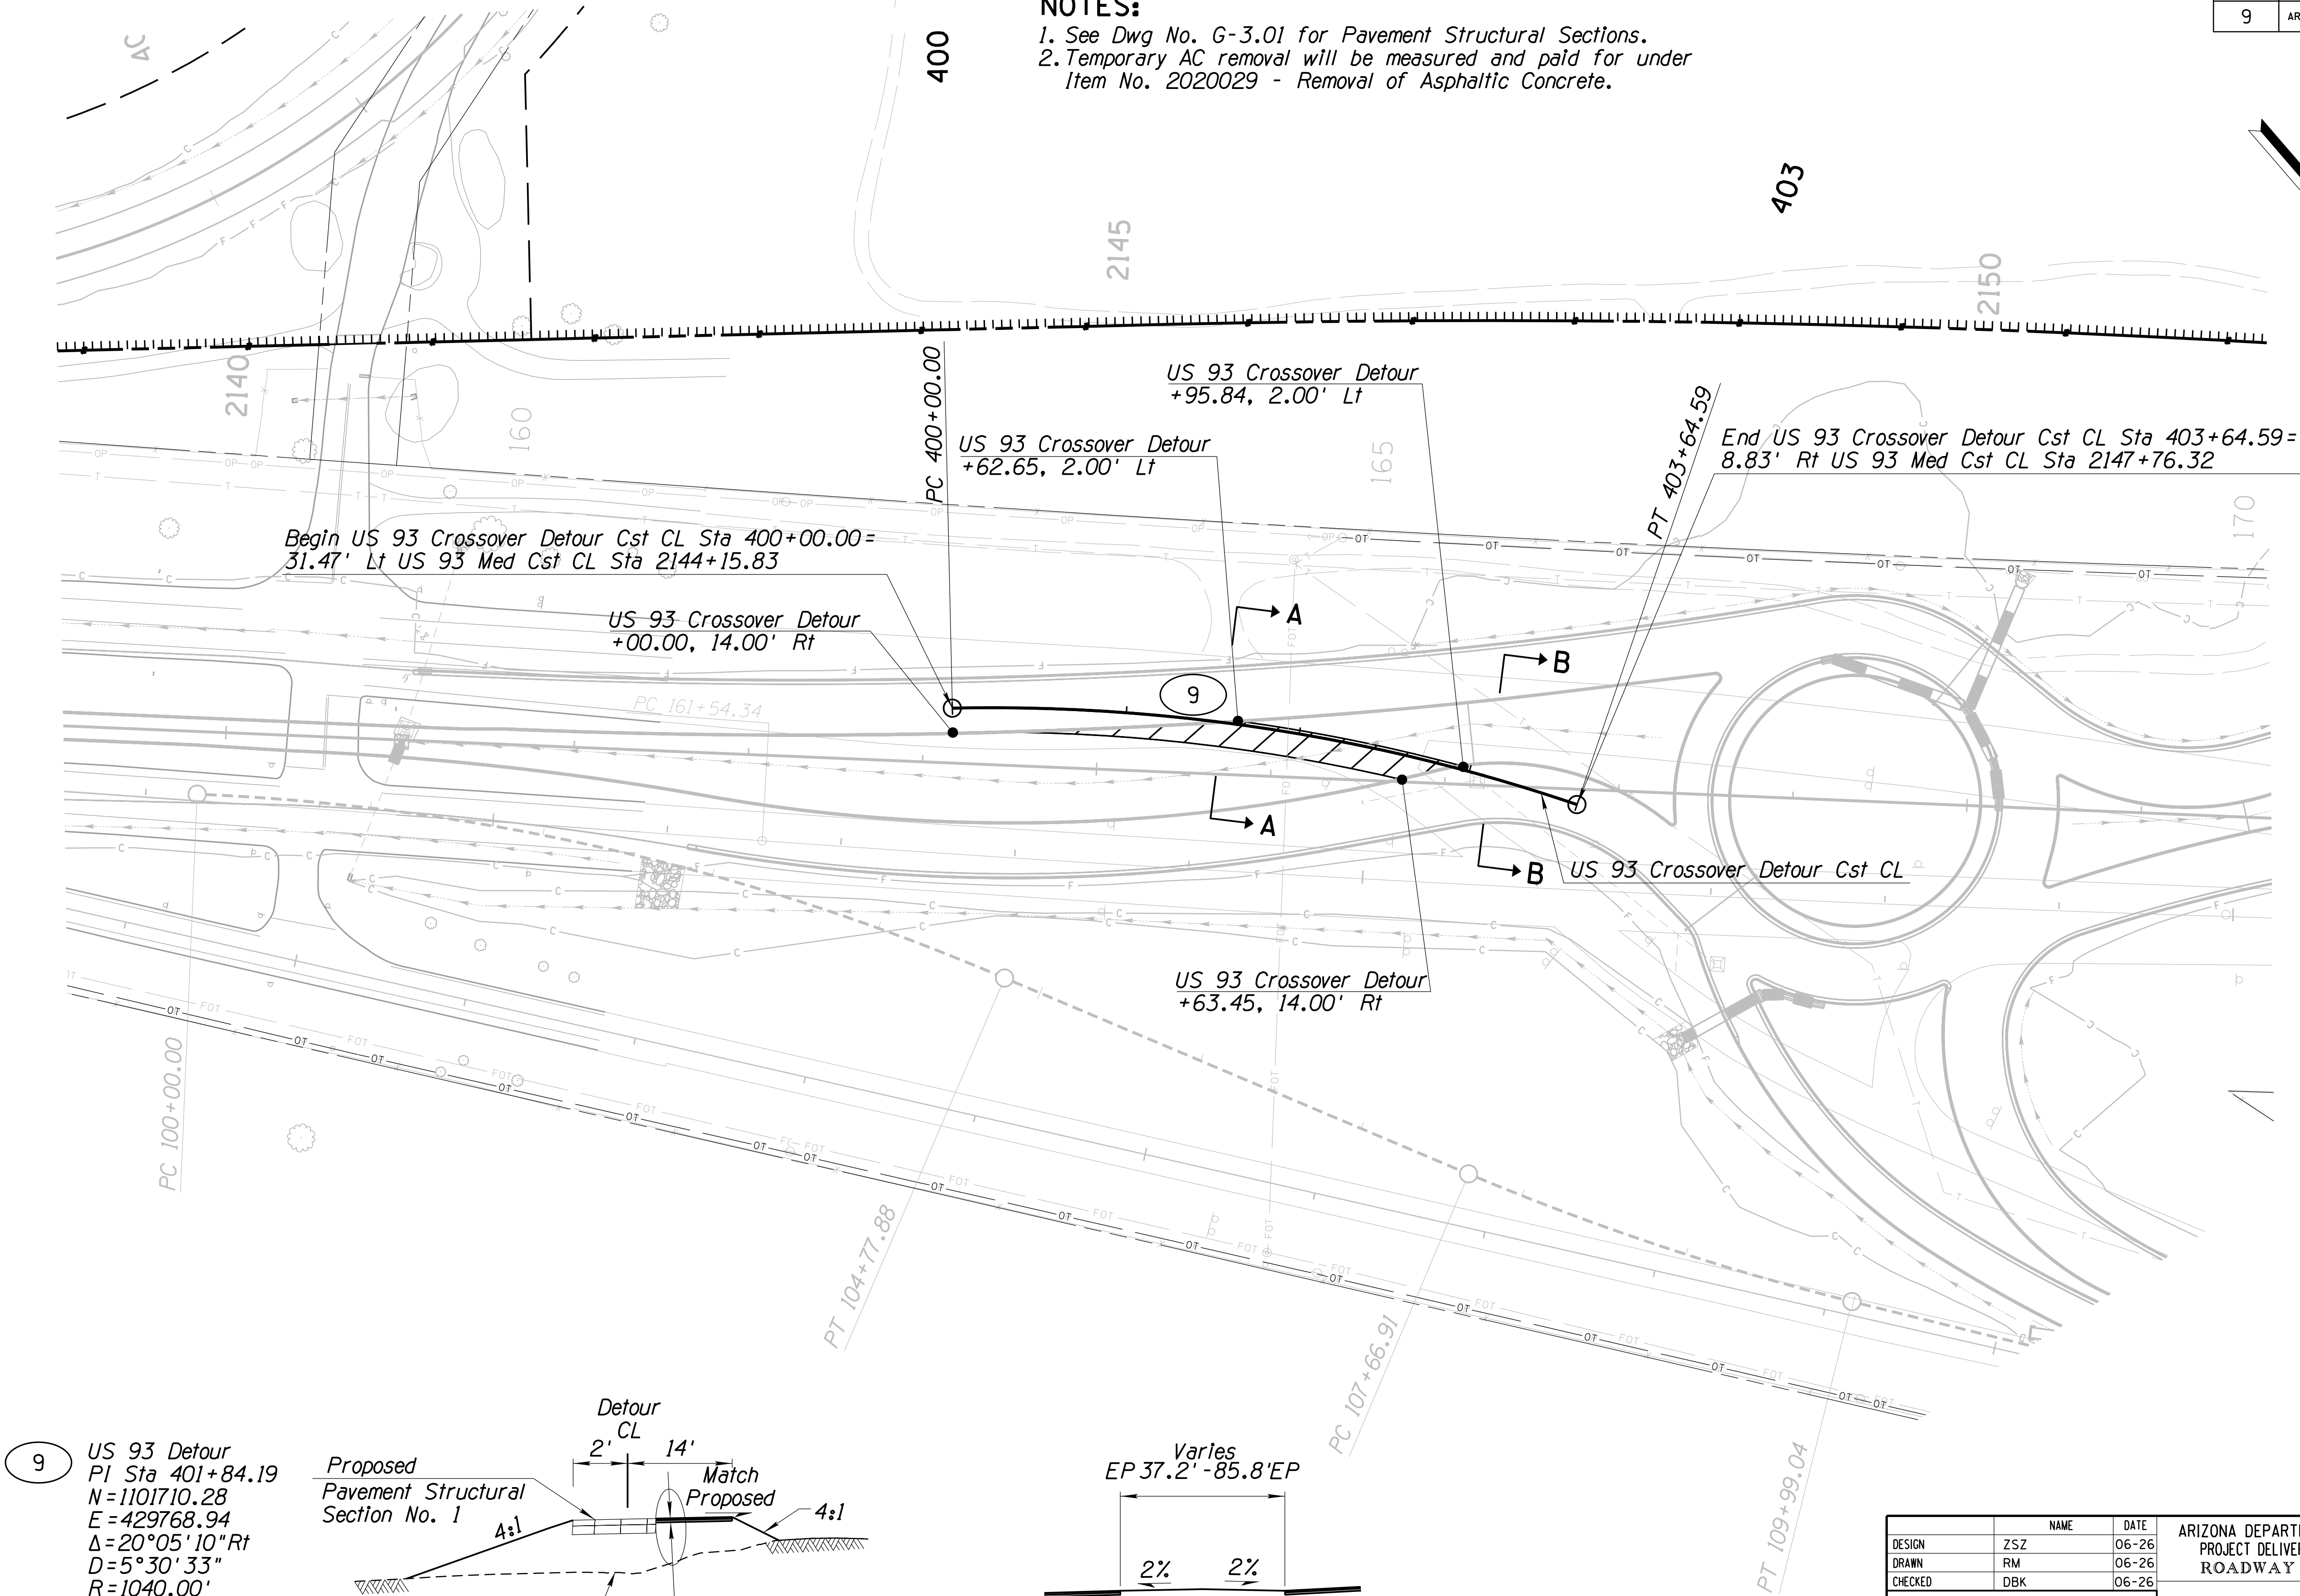

9 US 93 Detour
 PI Sta 401+84.19
 N=1101710.28
 E=429768.94
 $\Delta=20^{\circ}05'10''$ Rt
 D=5°30'33"
 R=1040.00'
 L=364.59'
 T=184.19'
 Ext=16.18'

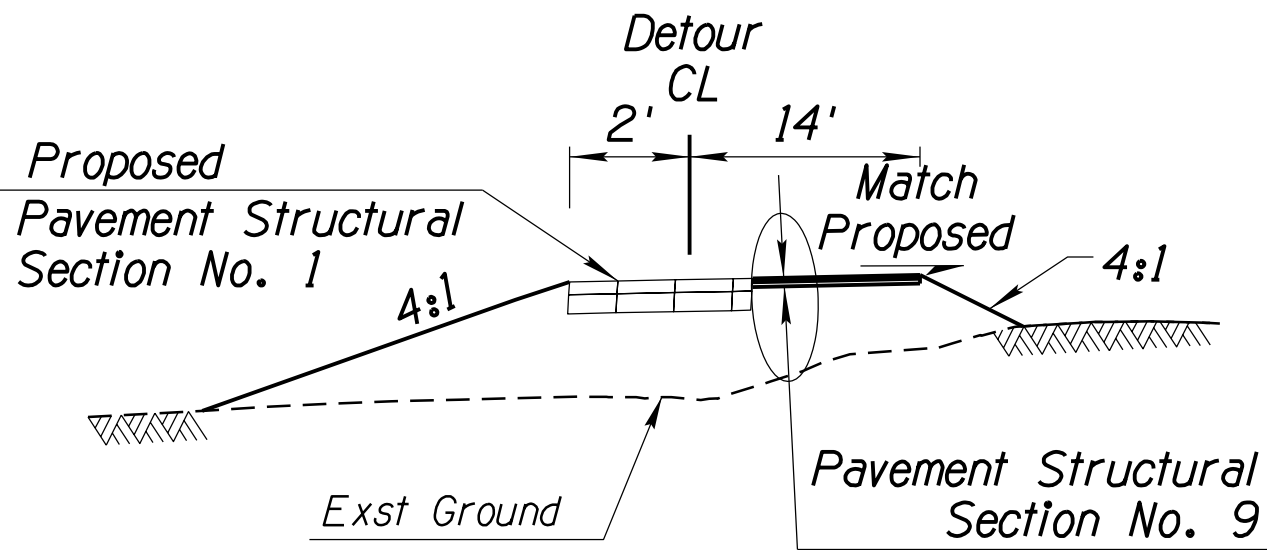



SECTION A-A

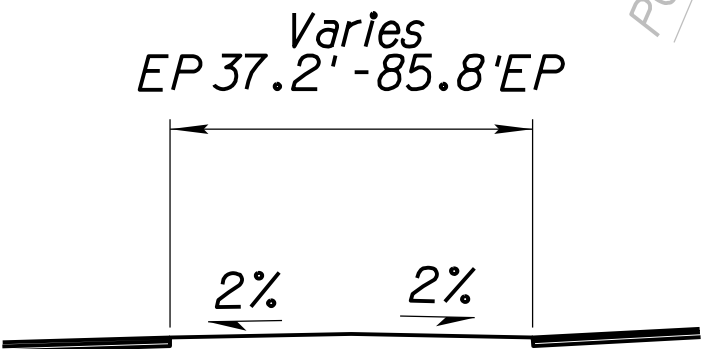


SECTION B-B

LEGEND:
 Temporary Paving

		NAME	DATE	ARIZONA DEPARTMENT OF TRANSPORTATION PROJECT DELIVERY AND OPERATIONS DIVISION ROADWAY DESIGN SERVICES	 46727 DIANA B. KELLY Registered Professional Engineer ARIZONA, U.S.A.	
DESIGN		ZSZ	06-26			
DRAWN		RM	06-26			
CHECKED		DBK	06-26			
 Stanley Consultants Inc. 3133 East Camelback Road, Suite 100 Phoenix, Arizona 85016 Phone: (602) 333-2200				PHASE 3 DETOUR PLAN		
ROUTE		LOCATION				DWG NO. C-8.08
US 93		WICKENBURG RANCH WAY TO VISTA ROYALE				
TRACS NO. F0738 OIC				093-B(230)T		
					___ OF ___	

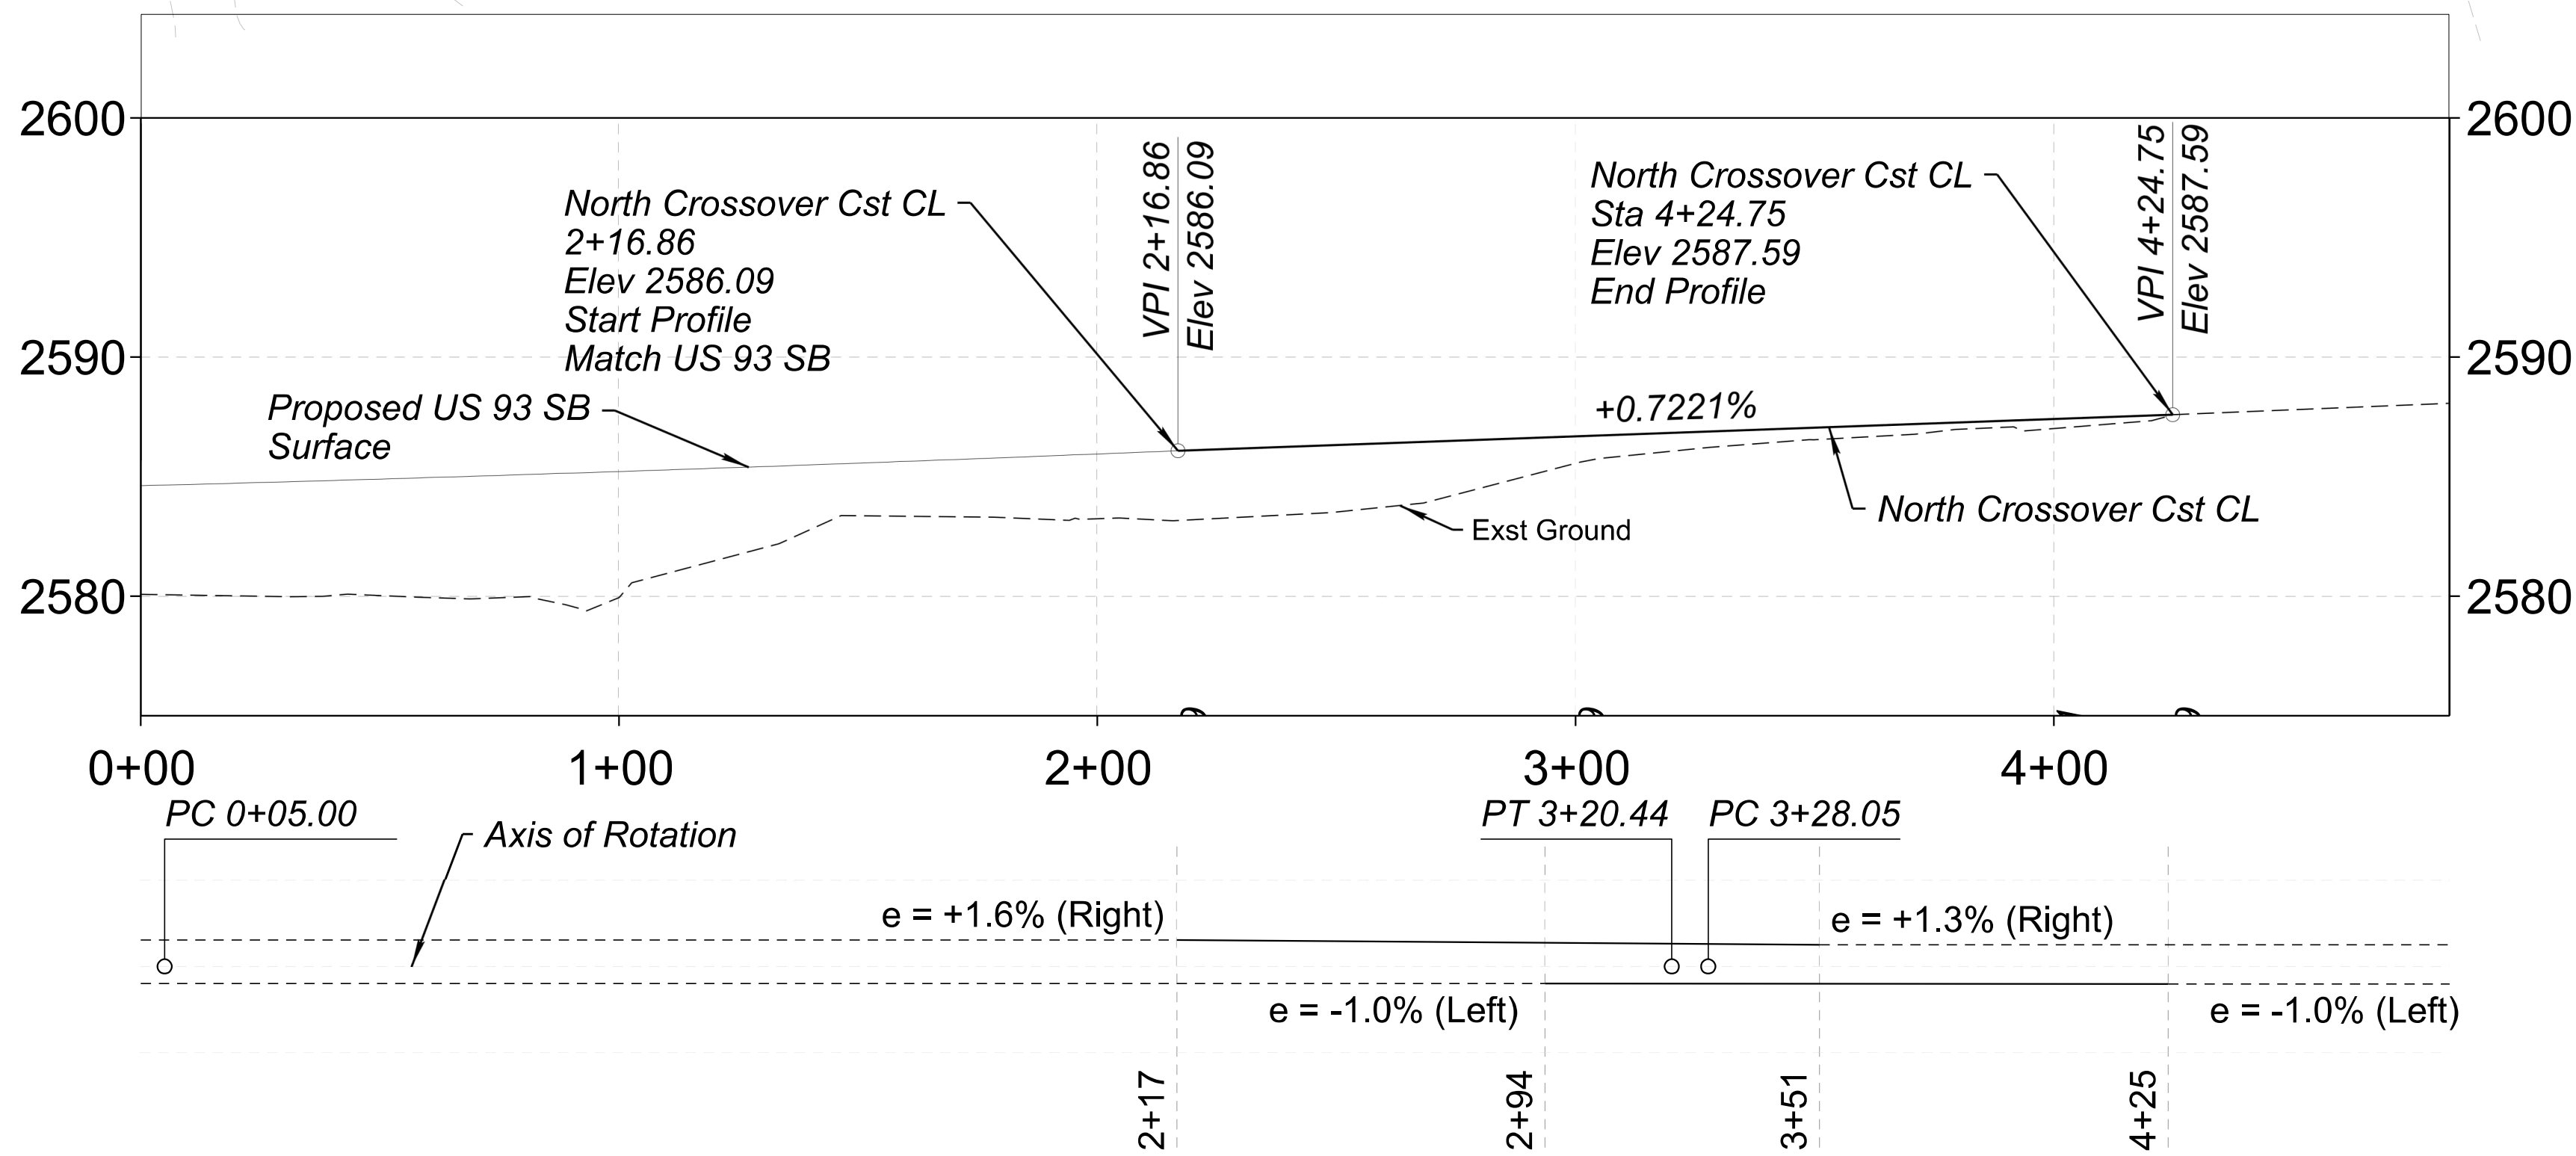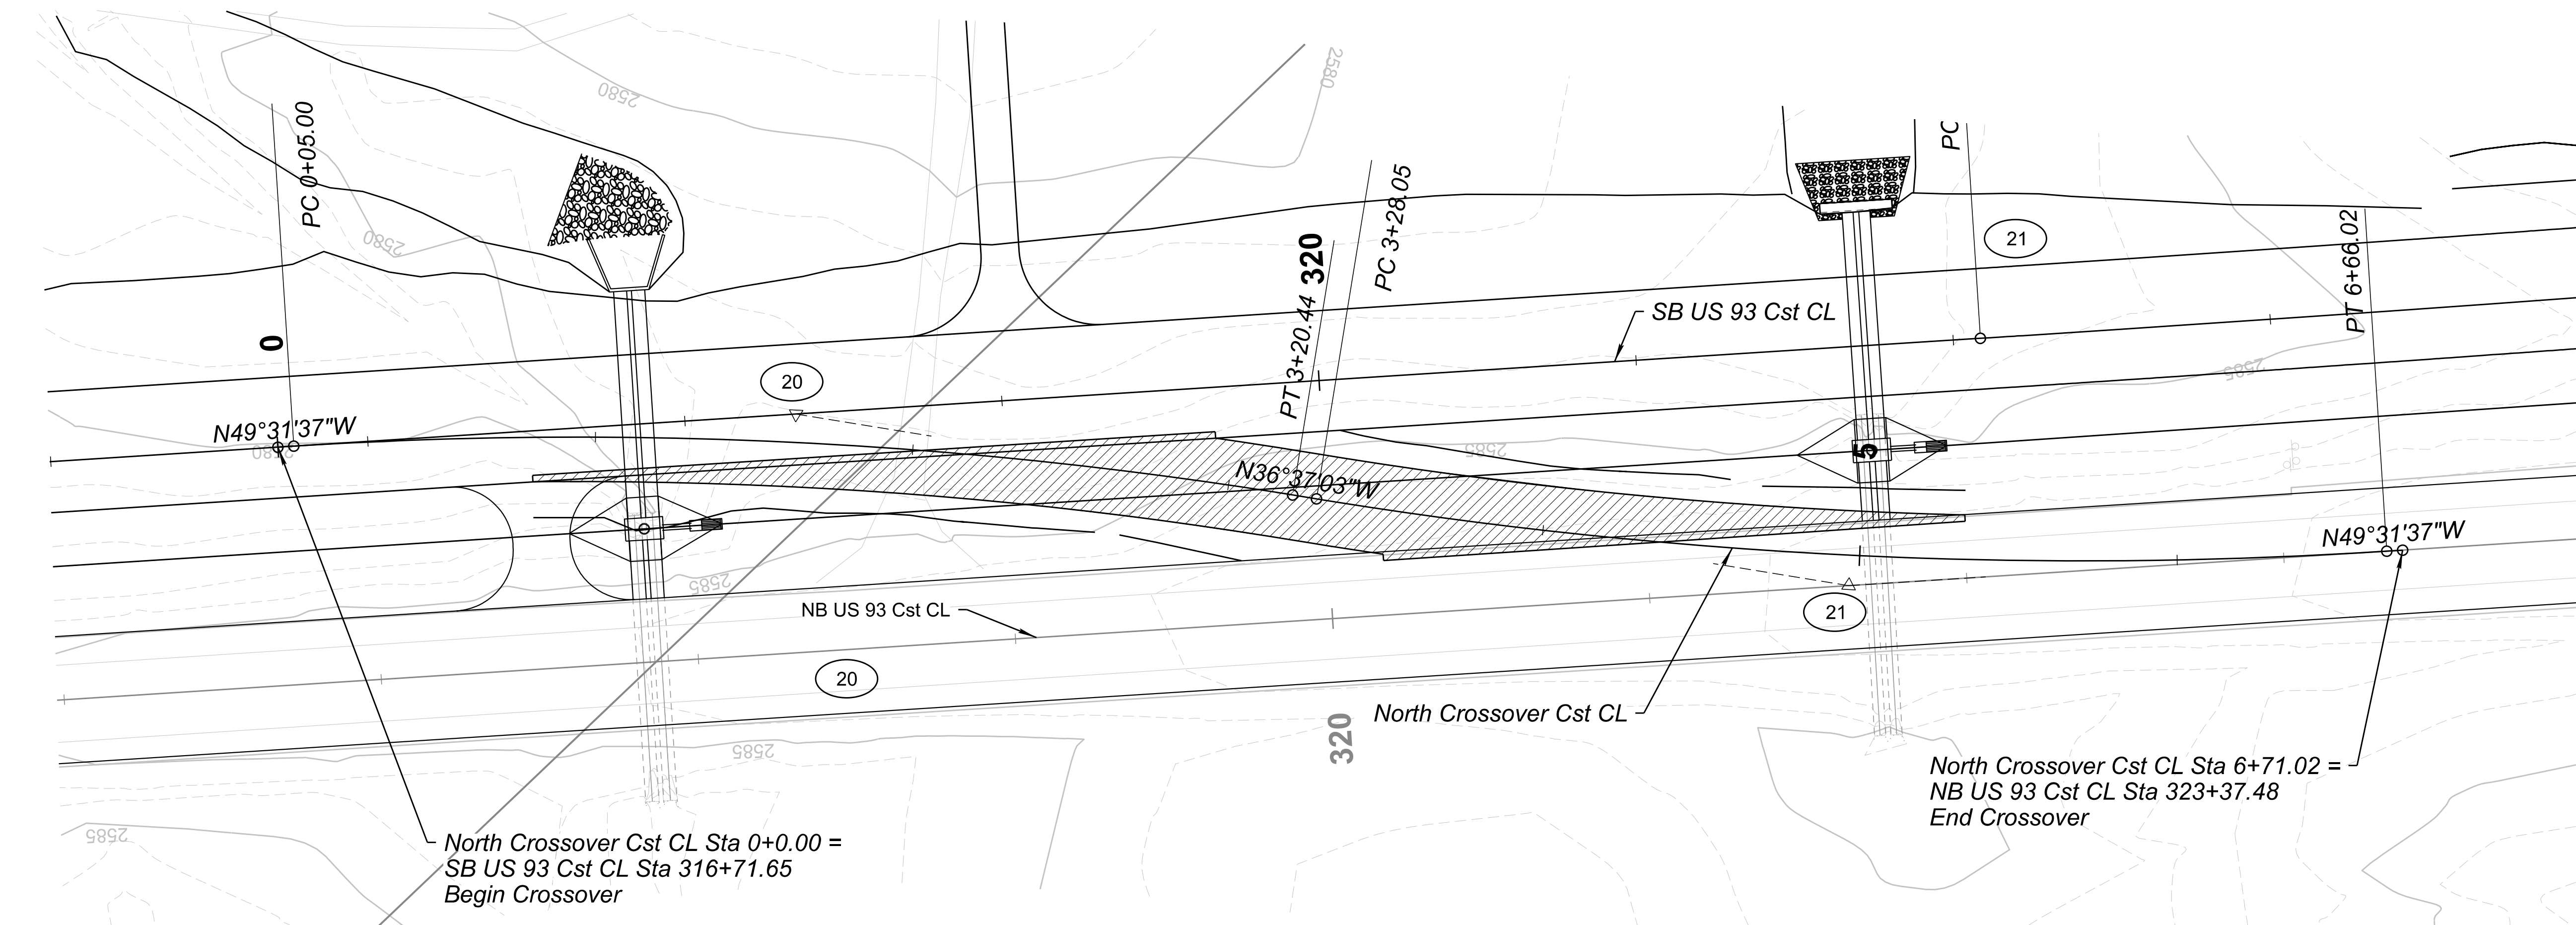


20	PI 1+63.39 Δ 12°54'34.5" RT D 04°05'33.2" T 158.39' L 314.77' R 1400.00' Ext 8.93'	21	PI 4+97.75 Δ 12°54'34.5" LT D 03°49'11.0" T 169.70' L 337.97' R 1500.00' Ext 9.57'
----	---	----	---

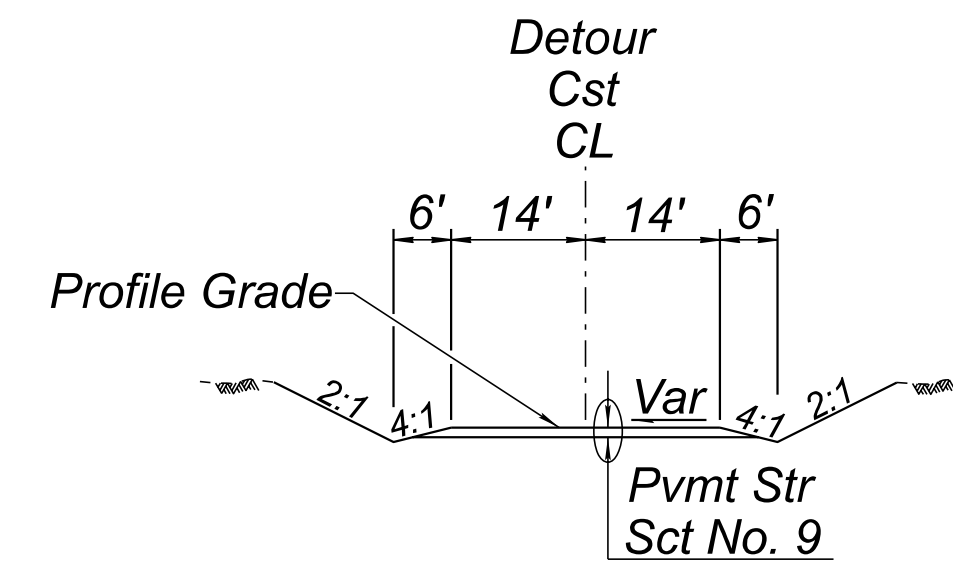

TYPICAL SECTION
Crossover Detour

Note: Removal of Temporary Pavement will be measured and paid for under Item 2020029

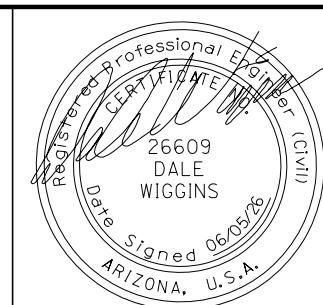

	NAME	DATE
DESIGN	J GILLIS	06/26
DRAWN	M SAMUELSON	06/26
CHECKED	D WIGGINS	06/26

TRANSPORTATION
AECOM TECHNICAL SERVICES, Inc.
7720 N. 16th St., Suite 100
Phoenix, Arizona 85020
T 602.371.1100
www.aecom.com

AECOM

ARIZONA DEPARTMENT OF TRANSPORTATION
PROJECT DELIVERY AND OPERATIONS DIVISION
ROADWAY DESIGN SERVICES

NORTH CROSSOVER
STA 1+96.27 TO STA 4+29.35

ROUTE US 93	F.H.W.A. Arizona Division	STATE ARIZ.	PROJECT NO. 093 YV 189	FEDERAL ID NO. 093-B(230)T	SHEET NO. 284	TOTAL SHEETS 524	RECORD DRAWING
MILEPOST 189.9	LOCATION WICKENBURG RANCH WAY TO VISTA ROYALE					DWG No. C-8.09	
STRUCTURE NO.	TRACS NO. F0738 01C					OF	

DATE- LOCATION- REVISIONS- FINISHED PLANS- SURVEY NO. DATE- LOCATION- REVISIONS- FINISHED PLANS- SURVEY NO.

TRAFFIC CONTROL GENERAL NOTES:

1. The traffic control plans represent a suggested method for traffic control during construction. The contractor may prepare another traffic control plan in accordance with Section 701 of the Specifications. All traffic control plans are subject to the approval of the Engineer before beginning construction.
2. Adjustments to the details of these traffic control plans and requirements may be necessary due to the construction activities or as directed by the Engineer.
3. All signing, striping, barrier, barricades, and lane closures shall be in accordance with the 2023 edition of the Manual on Uniform Traffic Control Devices (MUTCD) including the Arizona Supplement to the 2023 MUTCD and the 2025 ADOT Traffic Control Design Guidelines (TCDG).
4. All drawings are schematic only and not to scale.
5. All existing signs in conflict with the construction signs shall be removed, relocated, or covered in place, as directed by the Engineer. The contractor shall store and reinstall items which have been removed or relocated in a manner approved by the Engineer at no additional cost to the department. Any signs damaged by the contractor or contractor activities shall be replaced at no additional cost to the department.
6. The retroreflective sheeting on all construction signs shall meet criteria established in Section 1007 of the Specifications.
7. All long-term signs shown on the plans shall be mounted on embedded posts. Signs installed on embedded posts shall be mounted at a minimum height of 7 feet as measured from the bottom of the sign to the near edge of the pavement. All other short-term signs may be installed on portable stands at the height recommended by the portable stand manufacturer.
8. The nearest edge or corner of a sign shall be approximately 12 feet from the nearest edge of pavement for all signs mounted on embedded posts.
9. Flags shall be mounted on top of all construction signs except the "END ROAD WORK THANK YOU" sign.
10. Type A flashing warning lights shall be required on all nighttime construction signs except the "END ROAD WORK THANK YOU" sign.
11. Type C steady-burning yellow lights shall be mounted on every barricade when used as channelizing devices during nighttime activities.
12. Channelizing devices shall be placed 40 feet on center in tapers and 80 feet on center in tangents, except as otherwise noted on plans.
13. Construction signs shall not be displayed to traffic more than 24 hours prior to the actual start of construction. These signs may be installed sooner but they must be covered or turned away from traffic. The cost of covering or turning them shall be considered part of the sign installation cost. No further compensation will be made. These signs shall be removed within 24 hours after the completion of construction activities.
14. All construction signs shall have black letters on an orange background, except as otherwise noted.
15. Speed limit signing is preliminary and is subject to review and change by the Engineer as dictated by field conditions.
16. For temporary concrete barrier details, see ADOT Standard Drawing C-3. For temporary concrete barrier markers, see ADOT Standard Drawing M-32 barrier markers. Markers shall be installed at 20 foot spacing. The installed price for the markers shall be considered part of the barrier cost.
17. When traffic control devices are not in use, they shall be moved at least 30 feet from the roadway.
18. An adequate number of Type 3 barricades shall be placed across each roadway to be closed. A 48 x 30 inch "ROAD CLOSED" or "RAMP CLOSED" sign, as appropriate, shall be attached to one of the Type 3 barricades closing the roadway. A Type A flashing warning light shall be mounted on each end of the Type 3 barricades.
19. When stripe obliteration is necessary, it shall be accomplished by an approved method. Painting over striping, removal of pavement, and overlaying pavement do not constitute stripe obliteration. The contractor shall obliterate striping as shown on the plans and as needed to ensure no conflicting striping is present.

20. Existing pavement markers shall be removed. Removal of existing pavement markers will not be measured and paid for separately. Cost for removal of existing pavement markers shall be included in the cost for removal of existing pavement markings.
21. The contractor shall install signing for "Fines Double Workers Present" in work zones, when allowed by the Engineer, which shall generally conform to Figure SA-12 of ADOT 2025 TCDG. Such signing shall only be in place during working periods when workers are present. The contractor shall remove "Fines Double Workers Present" signage when workers are not present.
22. The contractor shall install changeable message boards as directed by the Engineer. The messages shall be displayed such that the entire message can be read twice at operating speed from no further than 650 feet. The contractor shall locate the changeable message boards just off the paved roadway in compliance with the clear zone requirements or as directed by the Engineer. The Engineer will determine the messages on the changeable message boards to coincide with construction activities. Changeable message boards shall be in place at least 14 days prior to construction activities. For each changeable message board used on the project, the contractor shall position Type 2 barricades per ADOT TCDG Figure SA-13 through SA-17 around the changeable message board. Each Type 2 barricade shall be affixed with a Type C steady-burning light for nighttime use. The contractor shall only position changeable message boards where and when approved by the Engineer.
23. The contractor shall utilize a flashing arrow panel in the sequential chevron mode for each closure of a through lane. The contractor shall not utilize a flashing arrow panel in connection with any shifting taper.
24. The contractor shall provide flagger and enforcement officers as directed by the Engineer.
25. Temporary concrete barrier shall not be placed until work is imminent and shall be removed as soon as practical, as reviewed and approved by the Engineer.
26. The contractor shall submit a Final Pavement Marking Sequence Plan for US 93 and SR 89 to the Engineer at the preconstruction meeting. The plan shall identify each final pavement line and/or area to be installed, and where the traffic lanes and movements will be accommodated. Lane closures and restrictions will only be allowed during low volume off-peak time periods. The final pavement marking work cannot be scheduled until the Final Pavement Marking Sequence Plan is approved by the Engineer.
27. All temporary striping shall be temporary paint, except as otherwise noted.
28. The sequential flashing warning lights shall have a minimum mounting height of 36 inches measured from pavement to bottom of light.
29. The successive flashing of the lights shall occur from the upstream end of the merging taper to the downstream end of the merging taper in order to identify the desired vehicle path.
30. Channelizing devices shall be placed in accordance with ADOT Traffic Control Design Guidelines and MUTCD based on posted speed limit, except as otherwise noted on plans.

F.H.W.A. REGION	STATE	PROJECT NO.	SHEET NO.	TOTAL SHEETS	RECORD DRAWING
9	ARIZ.	093-B(230)T	285	524	
093 YV 189					

DESIGN	ME1	DATE	06/26	ARIZONA DEPARTMENT OF TRANSPORTATION PROJECT DELIVERY AND OPERATIONS DIVISION TRAFFIC DESIGN SERVICES	
DRAWN	SRH	DATE	06/26		
CHECKED	BMT	DATE	06/26		
 Stanley Consultants inc.		3133 East Camelback Road, Suite 100 Phoenix, Arizona 85016 Phone: (602) 333-2200		US 93 TRAFFIC CONTROL GENERAL NOTES	
ROUTE		LOCATION		DWG NO. T-1.01	
US 93		WICKENBURG RANCH WAY TO VISTA ROYALE			
TRACS NO. F0738 OIC				093-B(230)T	
				OF	

ESTIMATED QUANTITIES

Item No.	Item Description	Unit	Adv. Signing	Phase 1	Phase 2	Phase 3	Phase 4A	Phase 4B	Phase 5	Total
7015010	TEMPORARY CONCRETE BARRIER (INSTALLATION AND REMOVAL)	L.FT.	0	0	9,460	5,414	1,540	0	0	16,414
7010025	TEMPORARY IMPACT ATTENUATION DEVICE (IN-LINE ENERGY ABSORBING TERM.)	EACH	0	0	49	4	4	0	0	57
7010026	TEMPORARY IMPACT ATTENUATION DEVICE (IN-LINE ENERGY ABSORBING TERM.) (IN USE)	EACH-DAY	0	0	8,122	287	64	0	0	8,473
7015036	TEMPORARY PREFORMED MARKING (ARROW, SYMBOL OR LEGEND)	EACH	0	0	3	5	0	0	0	8
7015052	OBLITERATE PAVEMENT MARKING (STRIPE)	L.FT.	0	0	27,353	9,455	3,147	0	0	39,955
7015091	SPECIALTY SIGNS	SQ.FT.	0	0	80	30	0	0	0	110
7016020	TEMPORARY CONCRETE BARRIER (IN USE)	L.FT.-DAY	0	0	2,121,460	121,100	14,128	0	0	2,256,688
7016030	BARRICADE (TYPE 1, TYPE 2, VERT.PANEL, TUBULAR MARKER)	EACH-DAY	19,150	8,582	128,128	104,794	25,559	6,399	1,350	293,961
7016031	BARRICADE (TYPE 3, HIGH LEVEL FLAG TREE)	EACH-DAY	0	0	1,572	965	253	189	0	2,979
7016032	PORTABLE SIGN STAND (RIGID)	EACH-DAY	0	258	1,834	977	184	216	0	3,469
7016033	PORTABLE SIGN STAND (SPRING TYPE)	EACH-DAY	4,684	365	11,442	3,526	706	552	870	22,145
7016035	WARNING LIGHTS (TYPE A)	EACH-DAY	16,392	623	15,372	6,433	1,396	768	870	41,854
7016037	WARNING LIGHTS (TYPE C)	EACH-DAY	19,150	7,633	128,128	103,309	25,248	6,399	1,350	291,217
7016039	EMBEDDED SIGN POST	EACH-DAY	27,170	0	0	0	0	0	0	27,170
7016050	TRUCK-MOUNTED ATTENUATOR	EACH-DAY	20	0	818	16	16	43	26	939
7016051	TEMPORARY SIGN (LESS THAN 10 S.F.)	EACH-DAY	4	769	8,568	4,971	1,212	576	385	16,485
7016052	TEMPORARY SIGN (10 S.F. OR MORE)	EACH-DAY	17,804	0	1,644	1,152	0	2,016	1,845	24,461
7016061	FLASHING ARROW PANEL	EACH-DAY	4	0	0	110	23	51	75	263
7016067	CHANGEABLE MESSAGE BOARD (CONTRACTOR FURNISHED)	EACH-DAY	1,915	0	0	0	0	27	0	1,942
7016071	PILOT VEHICLE WITH DRIVER	HOURL	0	0	72	0	0	0	0	72
7016075	FLAGGING SERVICES (CIVILIAN)	HOURL	0	336	0	336	0	448	0	1,120
7016081	FLAGGING SERVICES (DPS)	HOURL	40	0	160	240	33	148	0	621
7016082	FLAGGING SERVICES (LOCAL ENFORCEMENT OFFICER)(WITH AGENCY VEHICLE)	HOURL	40	0	160	240	33	148	0	621
7017030	SEQUENTIAL FLASHING WARNING LIGHT	EACH-DAY	0	0	0	1,485	311	0	0	1,796
7080203	WATERBORNE-TYPE I PAVEMENT MARKING (PAINTED) (WHITE OR YELLOW)	L.FT.	0	0	40,479	89,683	7,773	0	0	137,935

	DESIGN	NAME	DATE	ARIZONA DEPARTMENT OF TRANSPORTATION PROJECT DELIVERY AND OPERATIONS DIVISION TRAFFIC DESIGN SERVICES	ROUTE	F.H.W.A. Arizona Division	STATE	PROJECT NO.	FEDERAL ID NO.	SHEET NO.	TOTAL SHEETS	RECORD DRAWING
	DRAWN	I ROBLES	06/26		US 93							
	CHECKED	C VALENCIA	06/26		MILEPOST 190.5							
	TRANSPORTATION AECOM TECHNICAL SERVICES, Inc. 7720 N. 16th St., Suite 100 Phoenix, Arizona 85020 T 602.371.1100 www.aecom.com				TRAFFIC CONTROL ESTIMATED QUANTITIES		STRUCTURE NO.		LOCATION		VISTA ROYALE	
						TRACS NO. F0738 01C						____ OF ____

MAINTENANCE OF TRAFFIC			
Activity No.	CONSTRUCTION ACTIVITY	TRAFFIC CONTROL	COMMENTS
Preliminary Activity	On US 93: - Provide Advanced Warning Signage - Place temporary concrete barrier at night as defined in these traffic control plans	- Provide standard long term advance warning signs and changeable message signs per these traffic control plans.	- Install CMB 14 calendar days prior to the start of construction. CMBs are to remain in place for the duration of construction.
Phase 1	On US 93: - Construct temporary AC pavement. - Mill and fill existing rumble strip. See Phase 1 Detour Plans for locations. On Matthie Ranch Road: - Construct extension of Wickenburg Ranch Way and re-aligned Matthie Ranch Rd.	- Maintain traffic on existing US 93 mainline. - Maintain access on Matthie Ranch Road per MUTCD TA-10 during contruction of tie-in point between Sta. 40+00 and Sta. 43+00.	- See DWG. Nos. T-2.01 thru T-2.06 for closure of shoulders.
Phase 2	On US 93: - Construct proposed southbound US 93 mainline bridge. - Construct proposed southbound US 93 mainline and culvert extensions. - Construct temporary pavement for US 93 mainline crossover on north end of project near Sta 320+00. - Construct proposed frontage road. - Construct proposed residential driveways. - Construct minor road at Caballero Dr. - Construct portion of roundabout and temporary pavement at existing Moreton Rd and US 93 from station 220+00 to 224+20. - Construct portion of SR 89 roundabout including NB and SB SR 89 from roundabout to Sta. 475+65. - Construct temporary pavement along SB US 93 between Sta. 154+00 and Sta. 167+00. - Do not construct SMA final surface course on proposed SB alignment until Phase 4B. Phase 2A: - Construct second portion of Moreton Rd roundabout.	- Maintain traffic on existing US 93 mainline. - Detour SB SR 89 traffic onto NB SR 89 slip ramp to access US 93 at Matthie Ranch Road intersection. - Maintain access to Nine Irons Ranch Rd. - Maintain access to Moreton Rd. - Maintain access to the private driveway at Antelope Creek Rd. - Maintain access on Caballero Rd by constructing in halves utilizing a flagging operation per Figure SA-3 of the Arizona Department of Transportation, Temporary Traffic Control Design Guidelines. - US 93 right shoulder closures shall be as per figure 6H-5 of the 2023 MUTCD "SHOULDER CLOSURE ON A FREEWAY WITH CHANNELIZING DEVICES (TA-5)". - A 3-day single-lane closure of the existing mainline US 93 southbound lane is required to set girders on the proposed southbound bridge. Traffic shall be maintained on US 93 utilizing a flagging operation with a pilot car per Figure SA-3 of the Arizona Department of Transportation, Temporary Traffic Control Design Guidelines. Phase 2A: - Maintain traffic on existing US 93 mainline.	- Maintain at least 1 travel lane in each direction of US 93 for the duration of construction, except during the single-lane US 93 mainline closure while girders are being set on the proposed SB US 93 bridge. See DWG. Nos. T-2.07 thru T-2.12. - See DWG. No. T-2.13 for phasing detail of first portion of Moreton Rd. - See DWG. No. T-2.14 for phasing detail at Caballero Rd. - See DWG. No. T-2.15 for phasing detail at Antelope Creek Rd. Phase 2A: - See DWG. No. T-2.16 for phasing detail of second portion of Moreton Rd.

CONSTRUCTION DURATION

Calendar Days per Activity:

Preliminary Activity: 21 Days

Phase 1: 74 Days

Phase 2: 253 Days

Phase 2a: 10 Days

	<table><tr><th></th><th>NAME</th><th>DATE</th></tr><tr><td>DESIGN</td><td>I ROBLES</td><td>06/26</td></tr><tr><td>DRAWN</td><td>C VALENCIA</td><td>06/26</td></tr><tr><td>CHECKED</td><td>C RICKETTS</td><td>06/26</td></tr></table>		NAME	DATE	DESIGN	I ROBLES	06/26	DRAWN	C VALENCIA	06/26	CHECKED	C RICKETTS	06/26	ARIZONA DEPARTMENT OF TRANSPORTATION PROJECT DELIVERY AND OPERATIONS DIVISION TRAFFIC DESIGN SERVICES	<table><tr><td>ROUTE</td><td>US 93</td><td rowspan="2"><table><tr><td>F.H.W.A. Arizona Division</td><td>STATE</td><td>PROJECT NO.</td><td>FEDERAL ID NO.</td><td>SHEET NO.</td><td>TOTAL SHEETS</td><td>RECORD DRAWING</td></tr><tr><td></td><td>ARIZ.</td><td>093 YV 190</td><td>093-B-NFA</td><td>287</td><td>524</td><td></td></tr></table></td></tr><tr><td>MILEPOST</td><td>190.5</td><td colspan="5" rowspan="2"><table><tr><td>LOCATION</td><td colspan="5">VISTA ROYALE</td><td>DWG No.</td><td>T-1.03</td></tr><tr><td>STRUCTURE NO.</td><td colspan="5">TRACS NO. F0738 01C</td><td colspan="2">___ OF ___</td></tr></table></td></tr></table>	ROUTE	US 93	<table><tr><td>F.H.W.A. Arizona Division</td><td>STATE</td><td>PROJECT NO.</td><td>FEDERAL ID NO.</td><td>SHEET NO.</td><td>TOTAL SHEETS</td><td>RECORD DRAWING</td></tr><tr><td></td><td>ARIZ.</td><td>093 YV 190</td><td>093-B-NFA</td><td>287</td><td>524</td><td></td></tr></table>	F.H.W.A. Arizona Division	STATE	PROJECT NO.	FEDERAL ID NO.	SHEET NO.	TOTAL SHEETS	RECORD DRAWING		ARIZ.	093 YV 190	093-B-NFA	287	524		MILEPOST	190.5	<table><tr><td>LOCATION</td><td colspan="5">VISTA ROYALE</td><td>DWG No.</td><td>T-1.03</td></tr><tr><td>STRUCTURE NO.</td><td colspan="5">TRACS NO. F0738 01C</td><td colspan="2">___ OF ___</td></tr></table>					LOCATION	VISTA ROYALE					DWG No.	T-1.03	STRUCTURE NO.	TRACS NO. F0738 01C					___ OF ___	
		NAME	DATE																																																				
	DESIGN	I ROBLES	06/26																																																				
	DRAWN	C VALENCIA	06/26																																																				
CHECKED	C RICKETTS	06/26																																																					
ROUTE	US 93	<table><tr><td>F.H.W.A. Arizona Division</td><td>STATE</td><td>PROJECT NO.</td><td>FEDERAL ID NO.</td><td>SHEET NO.</td><td>TOTAL SHEETS</td><td>RECORD DRAWING</td></tr><tr><td></td><td>ARIZ.</td><td>093 YV 190</td><td>093-B-NFA</td><td>287</td><td>524</td><td></td></tr></table>	F.H.W.A. Arizona Division	STATE	PROJECT NO.	FEDERAL ID NO.	SHEET NO.	TOTAL SHEETS	RECORD DRAWING		ARIZ.	093 YV 190	093-B-NFA	287	524																																								
F.H.W.A. Arizona Division	STATE		PROJECT NO.	FEDERAL ID NO.	SHEET NO.	TOTAL SHEETS	RECORD DRAWING																																																
	ARIZ.	093 YV 190	093-B-NFA	287	524																																																		
MILEPOST	190.5	<table><tr><td>LOCATION</td><td colspan="5">VISTA ROYALE</td><td>DWG No.</td><td>T-1.03</td></tr><tr><td>STRUCTURE NO.</td><td colspan="5">TRACS NO. F0738 01C</td><td colspan="2">___ OF ___</td></tr></table>					LOCATION	VISTA ROYALE					DWG No.	T-1.03	STRUCTURE NO.	TRACS NO. F0738 01C					___ OF ___																																		
LOCATION	VISTA ROYALE						DWG No.	T-1.03																																															
STRUCTURE NO.	TRACS NO. F0738 01C					___ OF ___																																																	
TRANSPORTATION AECOM TECHNICAL SERVICES, Inc. 1720 N. 16th St., Suite 300 Phoenix, Arizona 85029 T 602.371.1100 www.aecom.com	 MAINTENANCE OF TRAFFIC TABLE (SHEET 1 OF 2)																																																						

MAINTENANCE OF TRAFFIC																																																								
Activity No.	CONSTRUCTION ACTIVITY			TRAFFIC CONTROL				COMMENTS																																																
Phase 3	On US 93: - Construct culvert extensions on existing US 93 mainline. - Construct northbound US 93 mainline bridge improvements. - Remove temporary AC pavement no longer in use. - Construct NB US 93 right-turn lane into Quail Run Trail. - Do not construct SMA final surface course on proposed NB alignment until Phase 4B.			- Shift traffic onto constructed proposed SB US 93 using temporary crossover on north end of project near Sta 320+00. - Detour SB SR 89 traffic onto NB SR 89 slip ramp to access US 93 at Matthie Ranch Road intersection. Phase 3A: - Maintain Frontage Road access to US 93 using Caballero Drive intersection while constructing Nine Irons Ranch Rd and Antelope Creek Rd. Phase 3B: - Maintain Frontage Road access to US 93 using Nine Irons Ranch Rd and Antelope Creek Rd while constructing Caballero Drive. - Shift NB traffic back onto existing US 93 mainline at the end of the phase. Maintain 1 open lane per direction.				- Maintain at least 1 travel lane in each direction of US 93 for the duration of construction. See DWG. Nos. T-2.17 thru T-2.25. - See DWG. No. T-2.24 for phasing details at Moreton Rd. - See DWG. No. T-2.25 for North Crossover details.																																																
Phase 4A	On US 93: - Remove temporary pavement no longer in use. - Construct final portion of Moreton Rd roundabout. On SR 89: - Construct SB SR 89 from Sta.474+00 to Sta. 490+00. - Construct remaining portion of NB US 93 at SR 89 Roundabout.			- Maintain just one lane of traffic on SB US 93 mainline on proposed SB alignment using crossover on northern side of project near Sta 320+00. - Maintain one lane in each direction along SB US 93 while utilizing temporary pavement between Sta. 130+00 and the SR 89 roundabout. Open roundabout at SR 89 and maintain one lane in each direction for US 93 through roundabout. North of SR 89 roundabout and Sta. 180+00, maintain one lane in each direction on newly constructed NB and SB US 93. - NB SR 89 traffic continue to use slip ramp to access US 93 at Matthie Ranch Road intersections. SB SR 89 traffic to utilize newly constructed SB 89 to access US 93 via roundabout. Maintain access to SR 89 per MUTCD TA-10 during construction of Tie-in point between Sta. 475+00 and Sta. 480+00.				- See DWG. No. T-2.33 for traffic control at Moreton Rd roundabout. See DWG. Nos. T-2.26 thru T-2.32 for traffic control along US 93 and SR 89.																																																
Phase 4B	On US 93: - Remove temporary pavement no longer in use. - Construct SMA final surface course. On SR 89: - Construct remaining portion of NB US 93 at Old Matthie Ranch Road intersection. - Remove temporary pavement no longer in use.			- Maintain one lane in each direction along SB US 93 while utilizing temporary pavement between Sta. 130+00 and the SR 89 roundabout. Maintain one in each direction for US 93 through roundabout. North of SR 89 roundabout and Sta. 180+00, maintain one lane in each direction on newly constructed NB and SB US 93. - Construct SMA final surface course while maintaining one lane in each direction of US 93 on their respective NB and SB alignments. Utilize Figure SA-5(L) and Figure SA-5(R) from the Arizona Department of Transportation, Temporary Traffic Control Design Guidelines as needed to maintain one lane of travel. - NB and SB SR 89 traffic utilize newly constructed SR 89 to access US 93 via roundabout.				- See DWG. Nos. T-2.34 thru T-2.36 for traffic control along US 93 and SR 89.																																																
Phase 5	- Construct remaining portion of NB and SB SR 93 between Sta. 128+00 and 134+00. - Install final pavement markings, rumble strips, and signing. - Install Seeding on the ground disturb area. - Remove Temporary Pavement crossover on north end of project near Sta. 320+00.			- Maintain one lane in each direction along NB and SB US 93 on their respective alignments. - Traffic control will be in accordance with Figures SA-5(L) and SA-5(R) (Lane closure divided highway) from the Arizona Department of Transportation, Temporary Traffic Control Design Guidelines. - Striping shall be in accordance with figure SA-19A (Work zone traffic control for mobile operation) of the Arizona Department of Transportation, Temporary Traffic Control Design Guidelines.				- See DWG. Nos T-2.37 thru T-02.43 for traffic control along US 93.																																																
CONSTRUCTION DURATION Calendar Days per Activity: Phase 3: 96 Days Phase 4A: 16 Days Phase 4B: 24 Days Phase 5: 60 Days Total Calendar Days Duration: 469 Days																																																								
Professional Engineer 00100 Craig J. Ricketts, Jr. 06/26/2026 Arizona, U.S.A.			<table><tr><td></td><td>NAME</td><td>DATE</td></tr><tr><td>DESIGN</td><td>I ROBLES</td><td>06/26</td></tr><tr><td>DRAWN</td><td>C VALENCIA</td><td>06/26</td></tr><tr><td>CHECKED</td><td>C RICKETTS</td><td>06/26</td></tr></table>		NAME	DATE	DESIGN	I ROBLES	06/26	DRAWN	C VALENCIA	06/26	CHECKED	C RICKETTS	06/26	TRANSPORTATION AECOM TECHNICAL SERVICES, Inc. 7720 N. 16th St., Suite 100 Phoenix, Arizona 85020 T 602.371.1100 AECOM www.aecom.com	ARIZONA DEPARTMENT OF TRANSPORTATION PROJECT DELIVERY AND OPERATIONS DIVISION TRAFFIC DESIGN SERVICES MAINTENANCE OF TRAFFIC TABLE (SHEET 2 OF 2)	<table><tr><td>ROUTE</td><td>US 93</td></tr><tr><td>MILEPOST</td><td>190.5</td></tr><tr><td>STRUCTURE NO.</td><td></td></tr></table>	ROUTE	US 93	MILEPOST	190.5	STRUCTURE NO.		<table><tr><td>F.H.W.A. Arizona Division</td><td>STATE</td><td>PROJECT NO.</td><td>FEDERAL ID NO.</td><td>SHEET NO.</td><td>TOTAL SHEETS</td><td>RECORD DRAWING</td></tr><tr><td></td><td>ARIZ.</td><td>093 YV 190</td><td>093-B-NFA</td><td>288</td><td>524</td><td></td></tr></table>	F.H.W.A. Arizona Division	STATE	PROJECT NO.	FEDERAL ID NO.	SHEET NO.	TOTAL SHEETS	RECORD DRAWING		ARIZ.	093 YV 190	093-B-NFA	288	524		<table><tr><td colspan="5">LOCATION</td><td>VISTA ROYALE</td><td>DWG No.</td><td>T-1.04</td></tr><tr><td colspan="5">TRACS NO.</td><td>F0738 01C</td><td colspan="2">OF</td></tr></table>	LOCATION					VISTA ROYALE	DWG No.	T-1.04	TRACS NO.					F0738 01C	OF	
	NAME	DATE																																																						
DESIGN	I ROBLES	06/26																																																						
DRAWN	C VALENCIA	06/26																																																						
CHECKED	C RICKETTS	06/26																																																						
ROUTE	US 93																																																							
MILEPOST	190.5																																																							
STRUCTURE NO.																																																								
F.H.W.A. Arizona Division	STATE	PROJECT NO.	FEDERAL ID NO.	SHEET NO.	TOTAL SHEETS	RECORD DRAWING																																																		
	ARIZ.	093 YV 190	093-B-NFA	288	524																																																			
LOCATION					VISTA ROYALE	DWG No.	T-1.04																																																	
TRACS NO.					F0738 01C	OF																																																		

F.H.W.A. REGION	STATE	PROJECT NO.	SHEET NO.	TOTAL SHEETS	RECORD DRAWING
9	ARIZ.	093-B(230)T	289	524	
093 YV 189					

CMB SUGGESTED MESSAGES:

A

ROAD WORK AHEAD


(DATE) TO (DATE)

NOTES:

- The contractor will coordinate message with the Engineer 14 days prior to closure.
- Changeable message boards shall be installed 14 days prior to closures.

SIGN LEGEND:

1

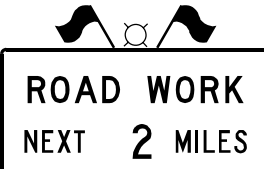
Sign No. G20-1
(72" X 36")

2


Sign No. W3-5aAZ
(48" X 48")

3


Sign No. R2-1(45)
(36" X 48")
Black on White


4


Sign No. R2-1(35)
(36" X 48")
Black on White

5


Sign No. W20-1
(48" X 48")

6

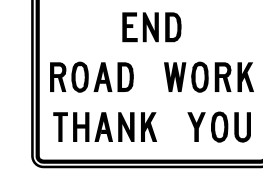
Sign No. G20-2AZ
(48" X 36")



7


Sign No. R2-1(55)
(36" X 48")
Black on White



8


Sign No. R2-1(65)
(36" X 48")
Black on White

LEGEND:

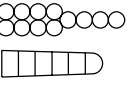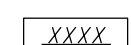	Direction Of Travel		Temporary Concrete Barrier
	Temporary Impact Attenuation Device		Temporary Pavement
	Sign On Spring Stand		Constructed Pavement
	Sign On Rigid Stand		Work Zone
	Sign On Embedded Posts		CMB - Changeable Message Board
	Type 2 Barricade		Flashing Light & Warning Flags
	Type 3 Barricade		Vertical Panel

DESIGN	ME1	DATE	06/26	ARIZONA DEPARTMENT OF TRANSPORTATION PROJECT DELIVERY AND OPERATIONS DIVISION TRAFFIC DESIGN SERVICES US 93 TRAFFIC CONTROL PROJECT ADVANCED SIGNING	
DRAWN	SRH	DATE	06/26		
CHECKED	BMT	DATE	06/26		
 3133 East Camelback Road, Suite 100 Phoenix, Arizona 85016 Phone: (602) 333-2200				DWG NO. T-1.05	
ROUTE		LOCATION		OF	
US 93		WICKENBURG RANCH WAY TO VISTA ROYALE			
TRACS NO. F0738 OIC		093-B(230)T			

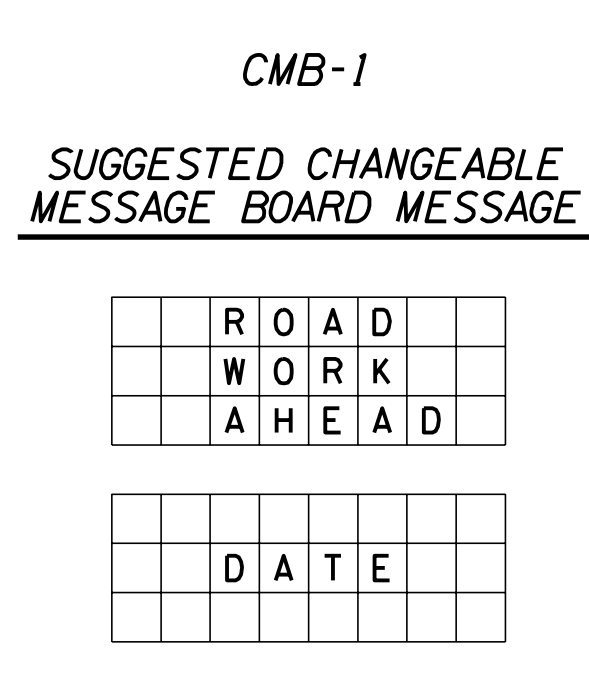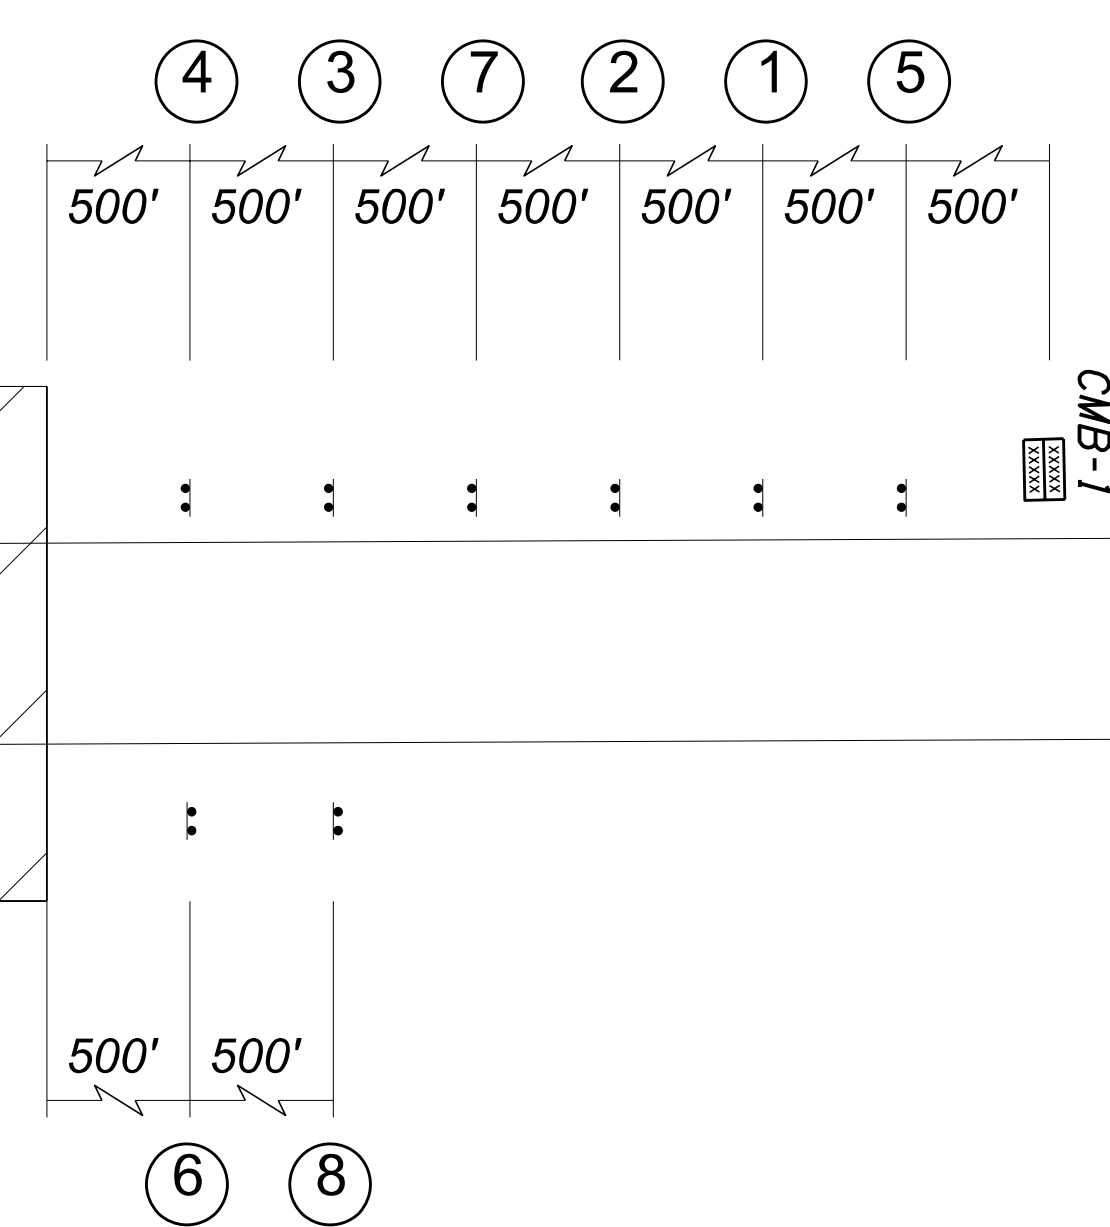

1. CONTRACTOR SHALL USE EXISTING DMS BOARDS FOR MESSAGING DURING THE DURATION OF THIS PROJECT.
2. DURING PHASE 2, THE POSTED SPEED REDUCTION TO 35 MPH, DESIGNATED BY SIGN 4 ON THIS SHEET, IS ONLY REQUIRED DURING CONSTRUCTION OF THE TEMPORARY CROSSOVER AND TEMPORARY DRIVEWAYS. FOR OTHER PHASE 2 ACTIVITIES OUTSIDE THE CLEAR ZONE, THE POSTED SPEED MAY REMAIN AT 65 MPH. DURING PHASE 3, 4, AND 5, THE POSTED SPEED SHALL BE REDUCED TO 55 MPH UNLESS OTHERWISE STATED IN THESE TRAFFIC CONTROL PLANS.
3. ADVANCED WARNING SIGNAGE SOUTH OF THIS PROJECT IS SHOWN ON SEPARATE SHEET.

c:\pwworking\usaz\dms09242\t0738mot03.dgn
6/10/2026 @2:40:05 PM ValenciaReyesC

PHASE 1


F.H.W.A. REGION	STATE	PROJECT NO.	SHEET NO.	TOTAL SHEETS	RECORD DRAWING
9	ARIZ.	093-B(230)T	291	524	

093 YV 189

PHASE 1

CONSTRUCTION ACTIVITY	MAINTENANCE OF TRAFFIC
- Construct extension of Wickenburg Ranch Way and re-aligned Matthie Ranch Road. - Construct Temporary AC Pavement. Mill and Fill existing Rumble Strip along Detour.	Maintain traffic on existing lanes, close shoulder(s) per Dwg. Nos. T-2.01 thru T-2.06. Maintain access on Matthie Ranch Road per MUTCD TA-10 during construction of tie-in point between Sta 40+00 and Sta 43+00.

Note:
For Detour Temporary Paving and AC Milling
See Dwg Nos. C-8.01 to C-8.09

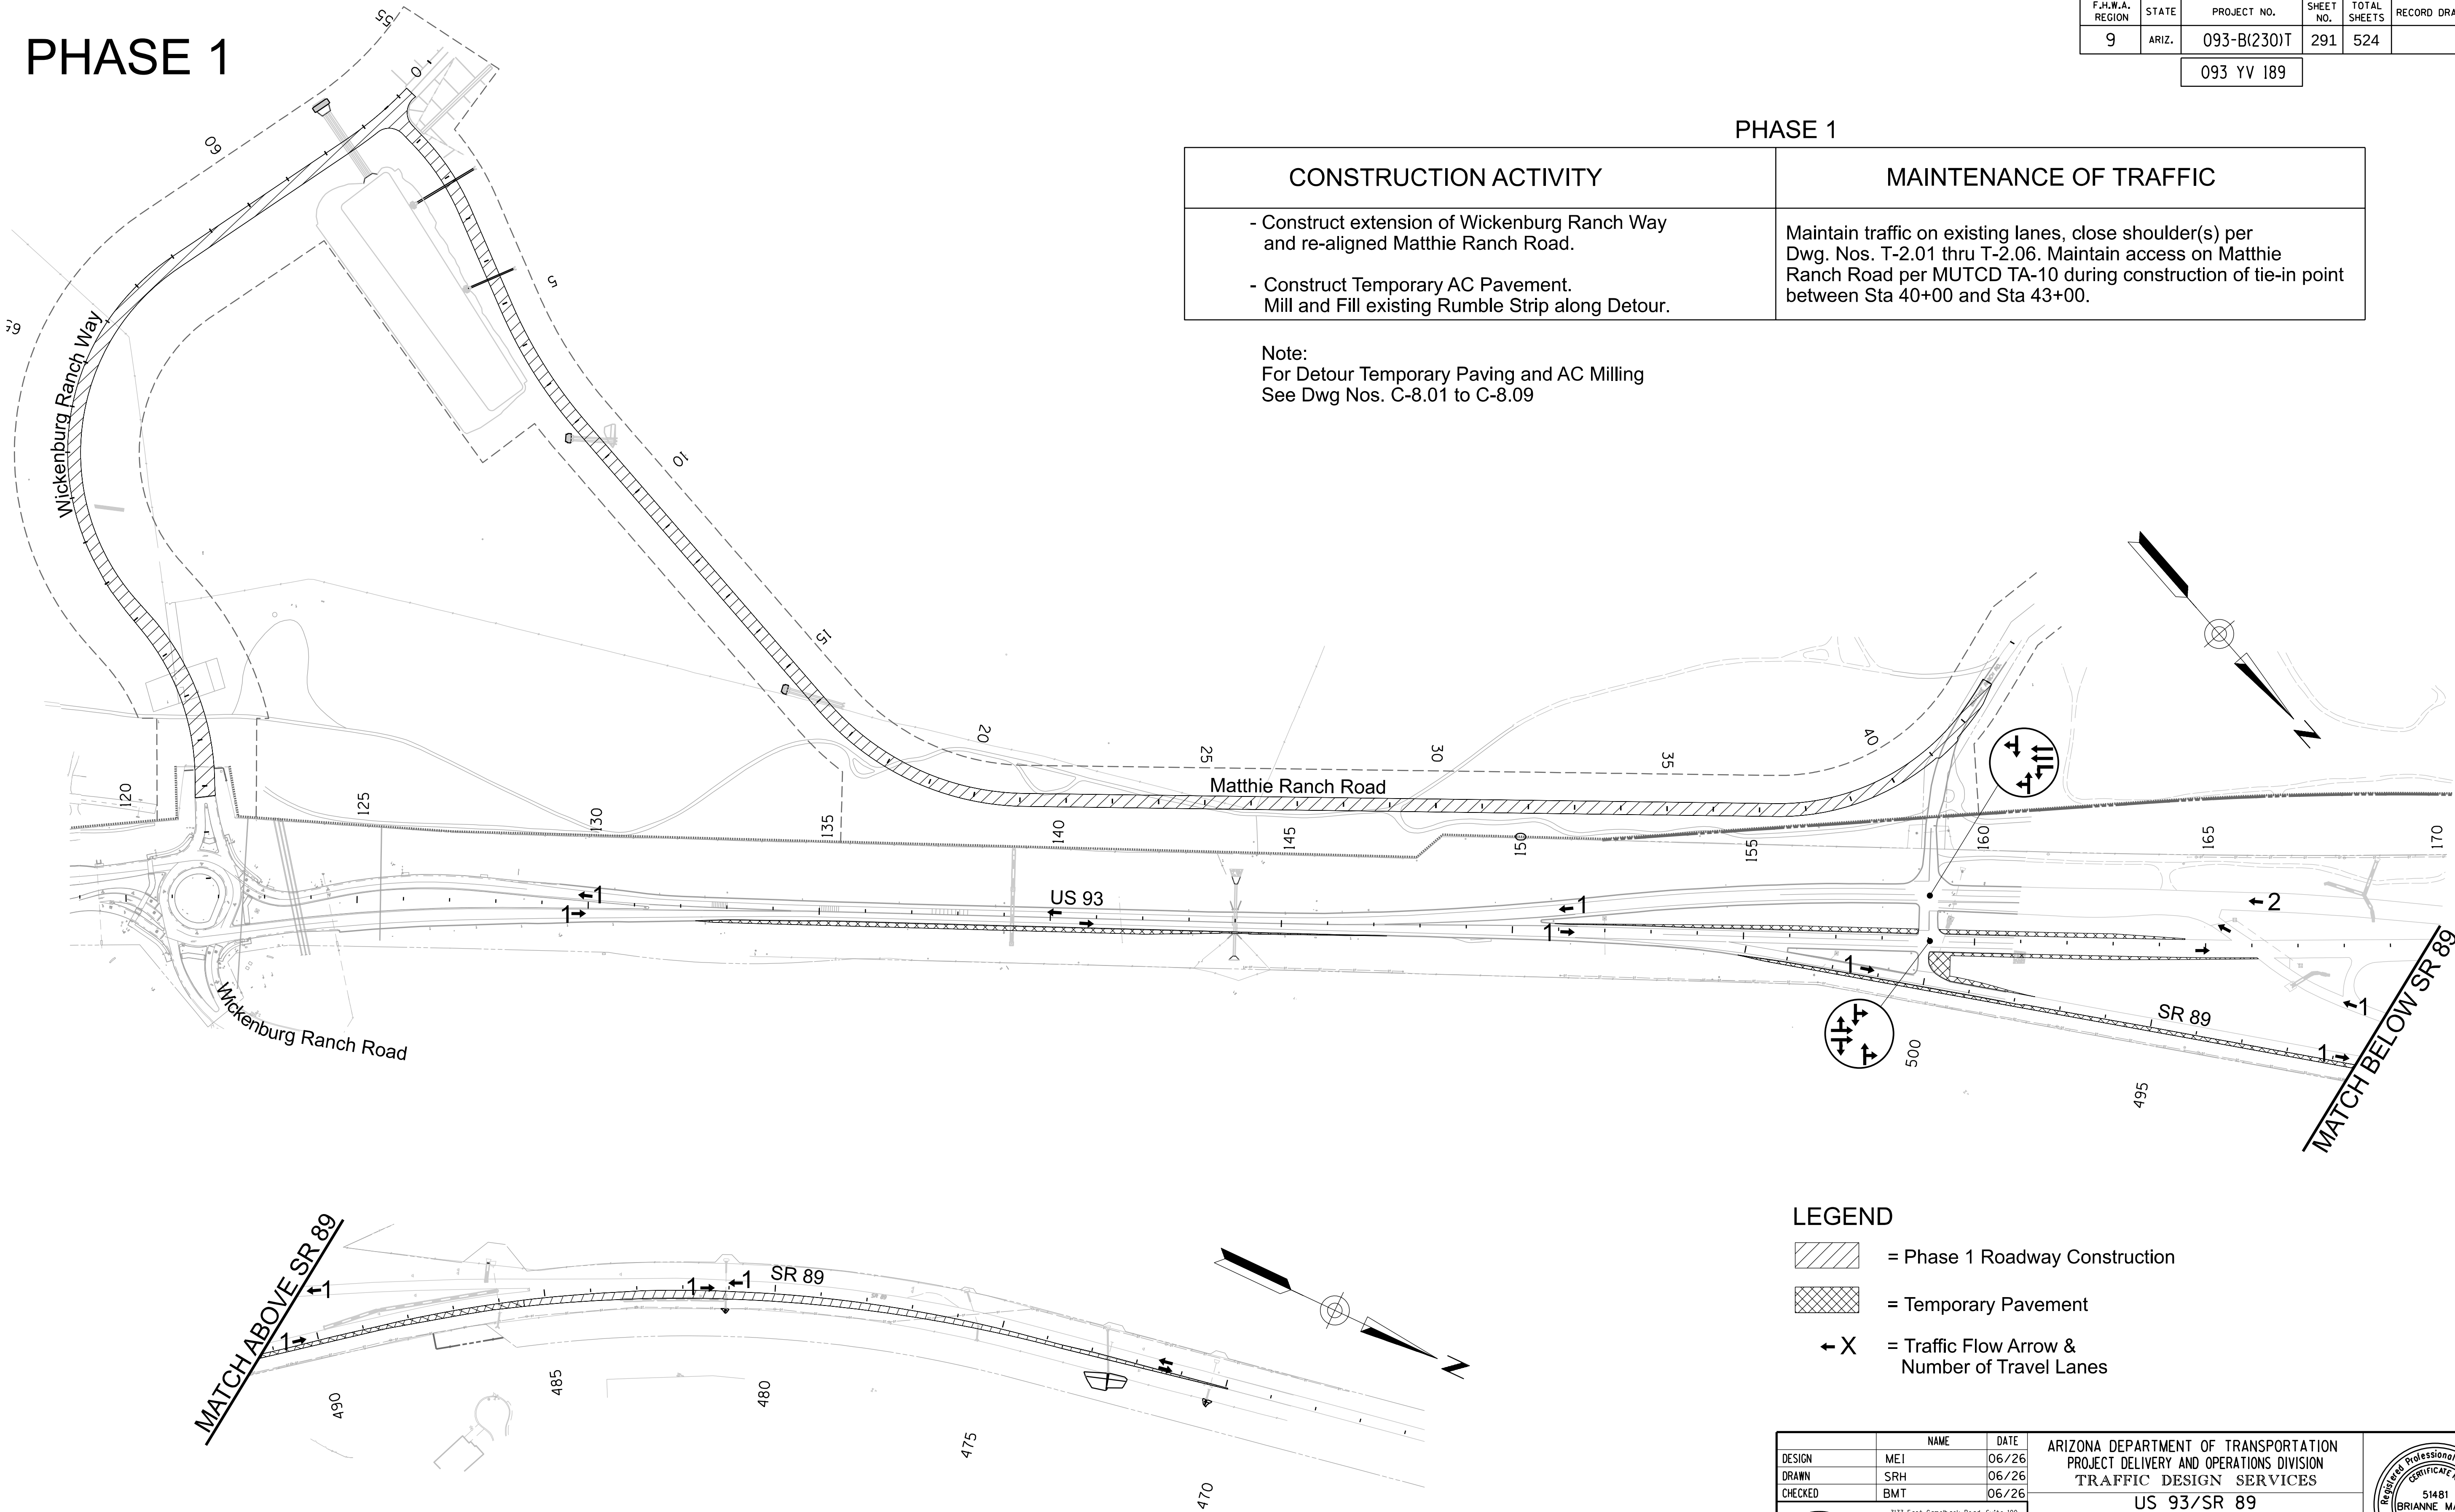

LEGEND

= Phase 1 Roadway Construction


= Temporary Pavement

= Traffic Flow Arrow & Number of Travel Lanes

DESIGN	ME1	DATE	06/26	ARIZONA DEPARTMENT OF TRANSPORTATION PROJECT DELIVERY AND OPERATIONS DIVISION TRAFFIC DESIGN SERVICES	
DRAWN	SRH	DATE	06/26		
CHECKED	BMT	DATE	06/26		
 3133 East Camelback Road, Suite 100 Phoenix, Arizona 85016 Phone: (602) 333-2200				US 93/SR 89 CONSTRUCTION SEQUENCING PLAN PHASE 1	
ROUTE		LOCATION		DWG NO. T-1.07	
US 93		WICKENBURG RANCH WAY TO VISTA ROYALE			
TRACS NO. F0738 OIC			093-B(230)T		


PHASE 2

F.H.W.A. REGION	STATE	PROJECT NO.	SHEET NO.	TOTAL SHEETS	RECORD DRAWING
9	ARIZ.	093-B(230)T	292	524	
093 YV 189					

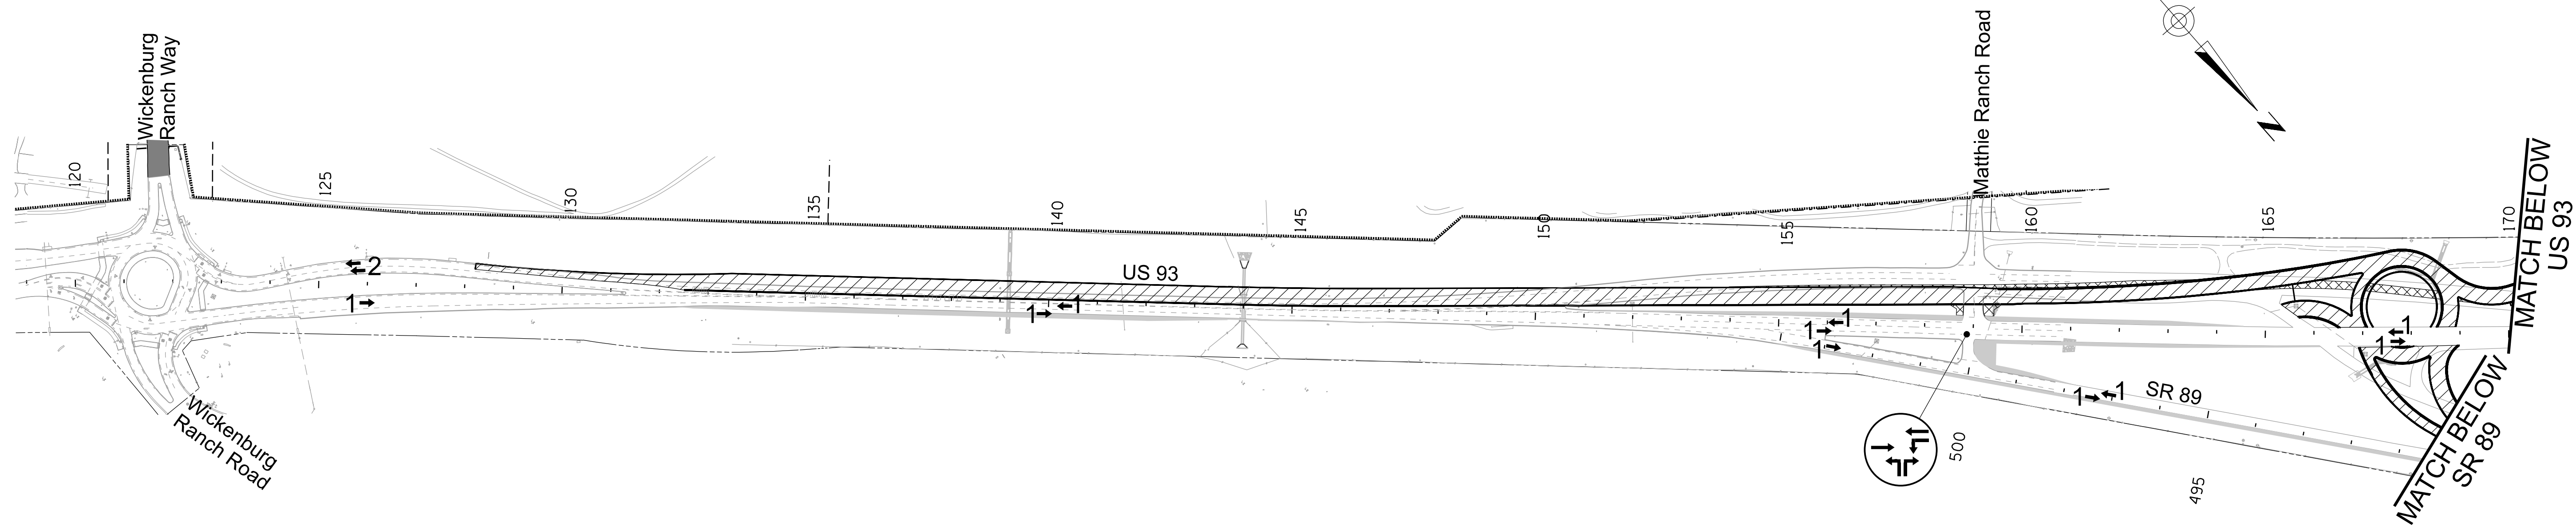

LEGEND

- = Previously Constructed
- = Temporary Pavement
- = Phase 2 Roadway Construction
- = Phase 2 Temporary Pavement
- = Traffic Flow Arrow & Number of Travel Lanes

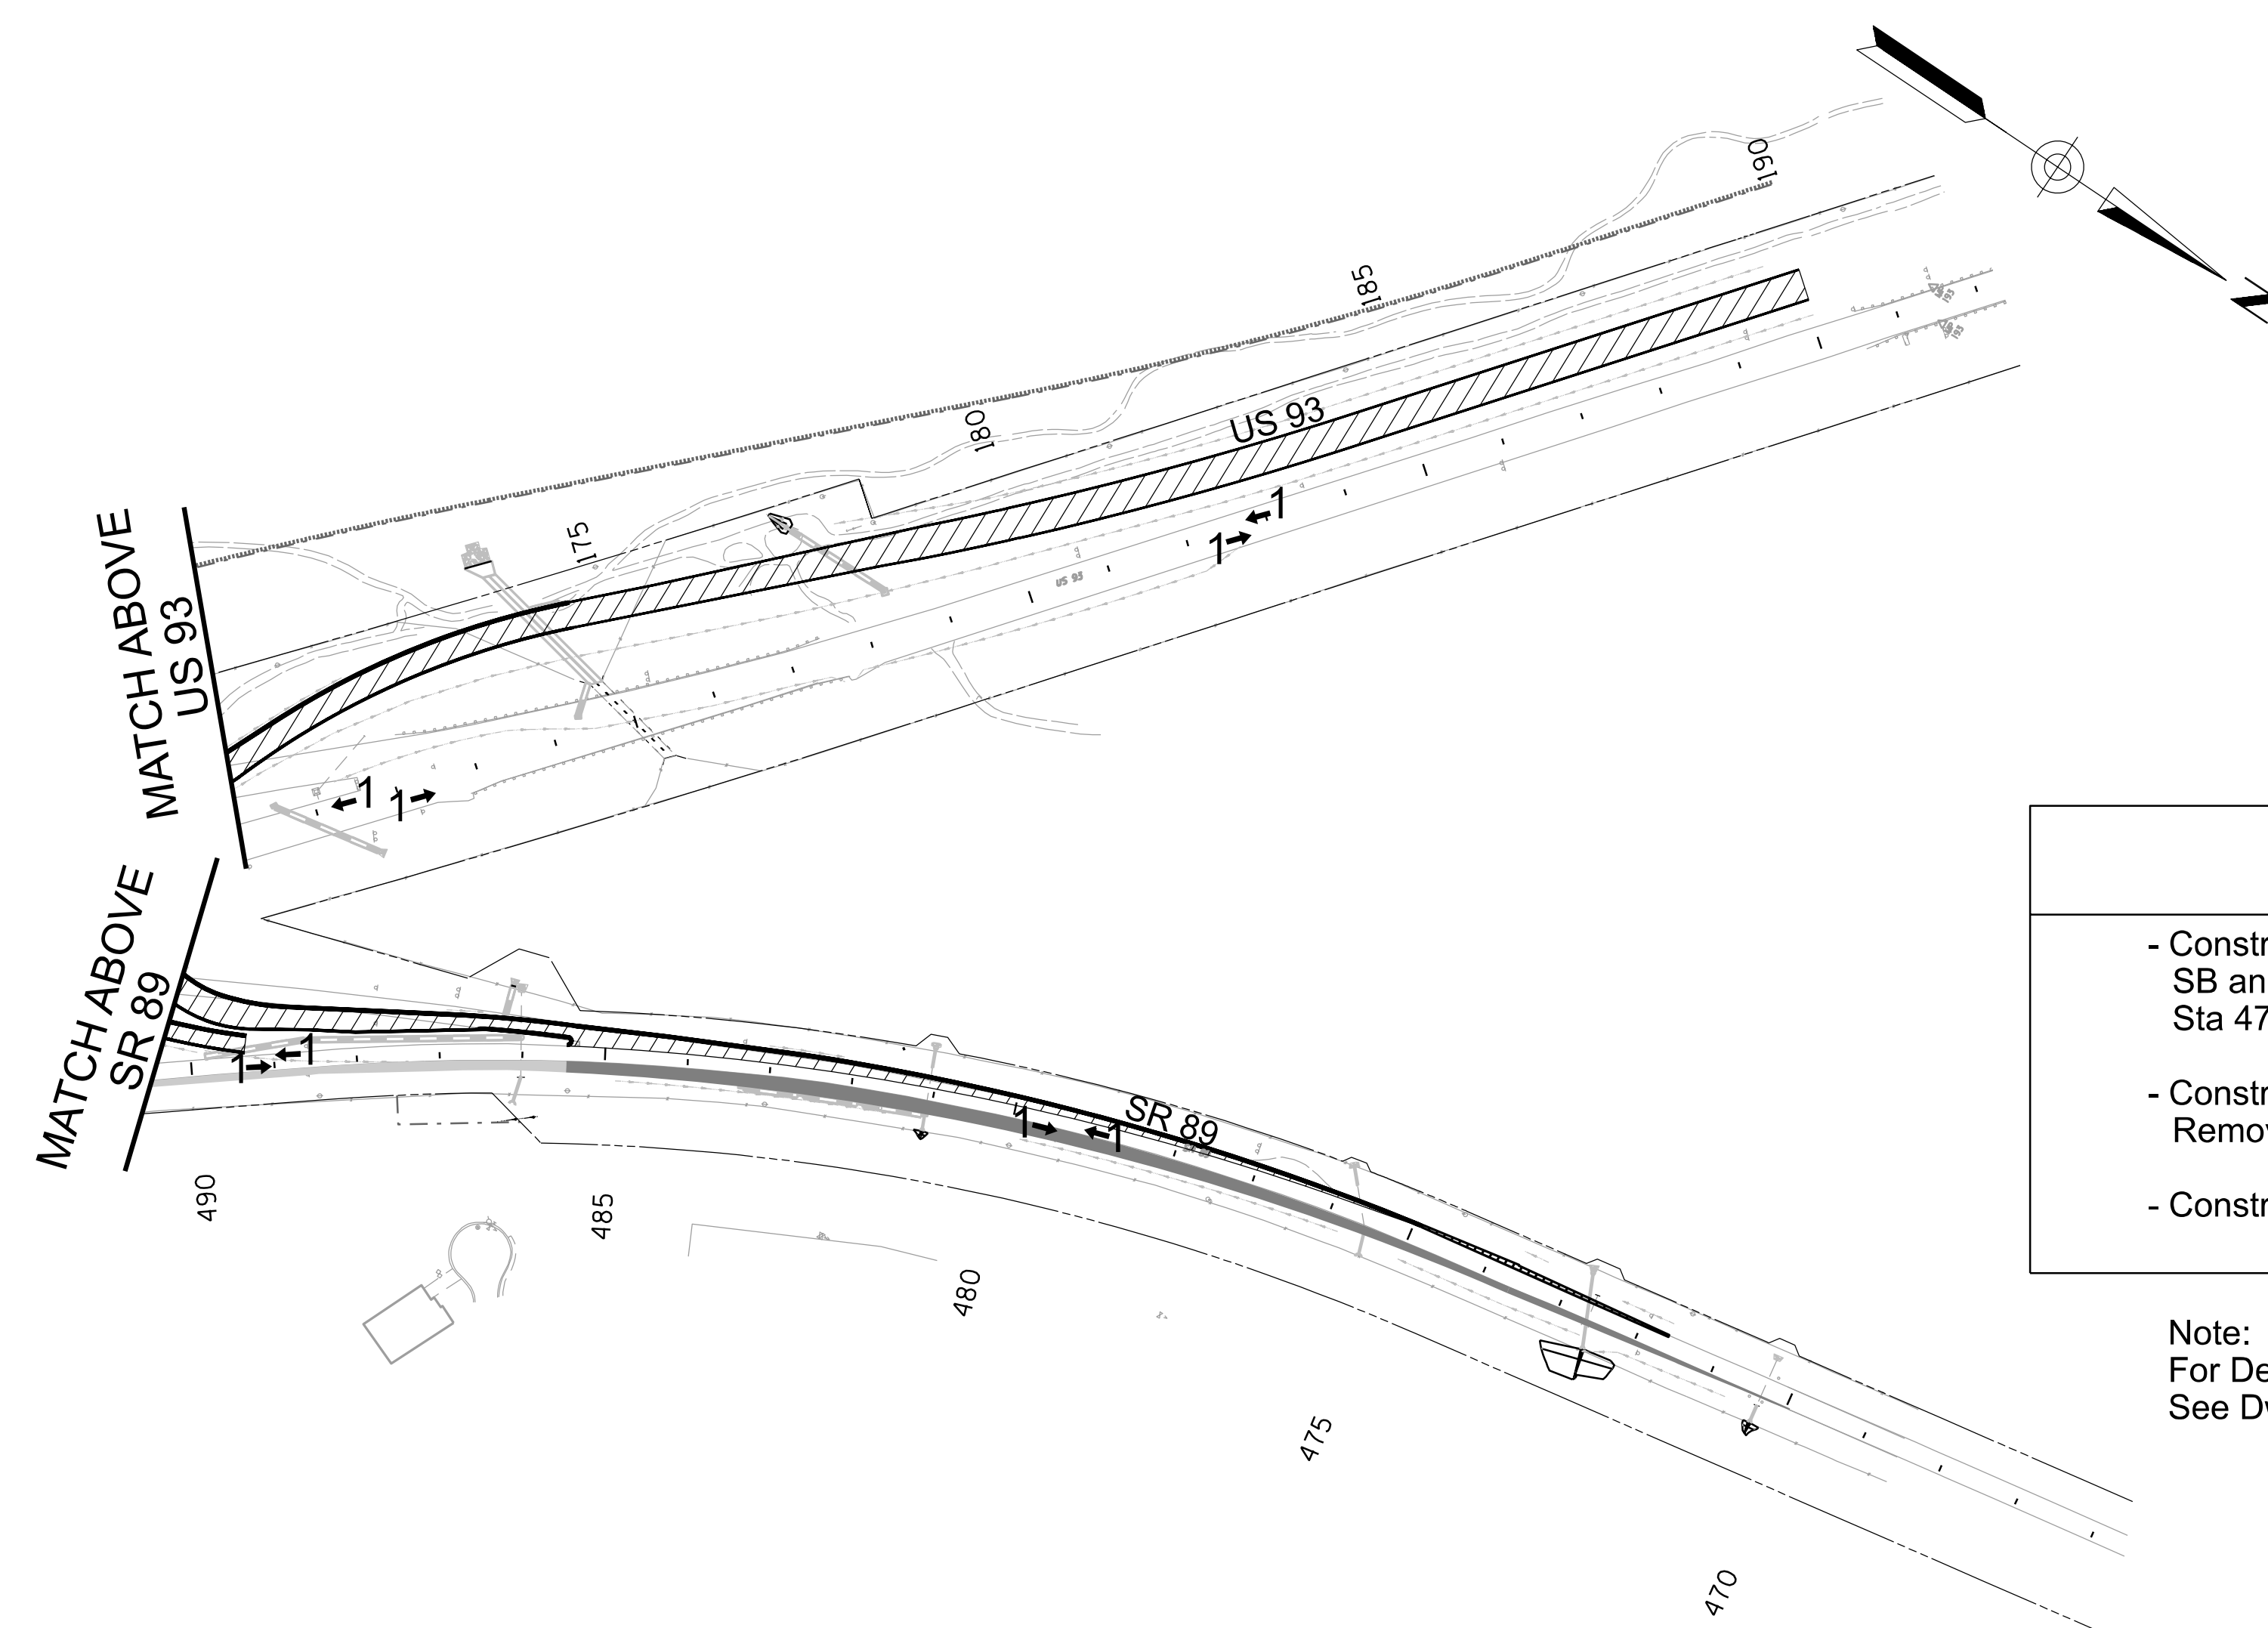


PHASE 2

CONSTRUCTION ACTIVITY	MAINTENANCE OF TRAFFIC
- Construct SB US 93 and portion of roundabout, SB and NB SR 89 from the roundabout north to Sta 475+65 - Construct Temporary AC Pavement. Remove existing SB US 93 pavement not in use. - Construct culvert extensions.	Maintain one lane of traffic in each direction on existing NB US 93 and Temporary Pavement per Dwg. Nos. T-2.07 thru T-2.15A. Detour SB SR 89 traffic onto NB SR 89 slip ramp to access US 93 at Matthie Ranch Rd intersection.

Note:
For Detour Temporary Paving and AC Milling
See Dwg Nos. C-8.01 to C-8.09

DESIGN		ME1	DATE	06/26	ARIZONA DEPARTMENT OF TRANSPORTATION PROJECT DELIVERY AND OPERATIONS DIVISION TRAFFIC DESIGN SERVICES US 93/SR 89 CONSTRUCTION SEQUENCING PLAN PHASE 2		
DRAWN		SRH	DATE	06/26			
CHECKED		BMT	DATE	06/26			
ROUTE		LOCATION		US 93 WICKENBURG RANCH WAY TO VISTA ROYALE			DWG NO. T-1.08
TRACS NO.		F0738 OIC		093-B(230)T			

PHASE 2

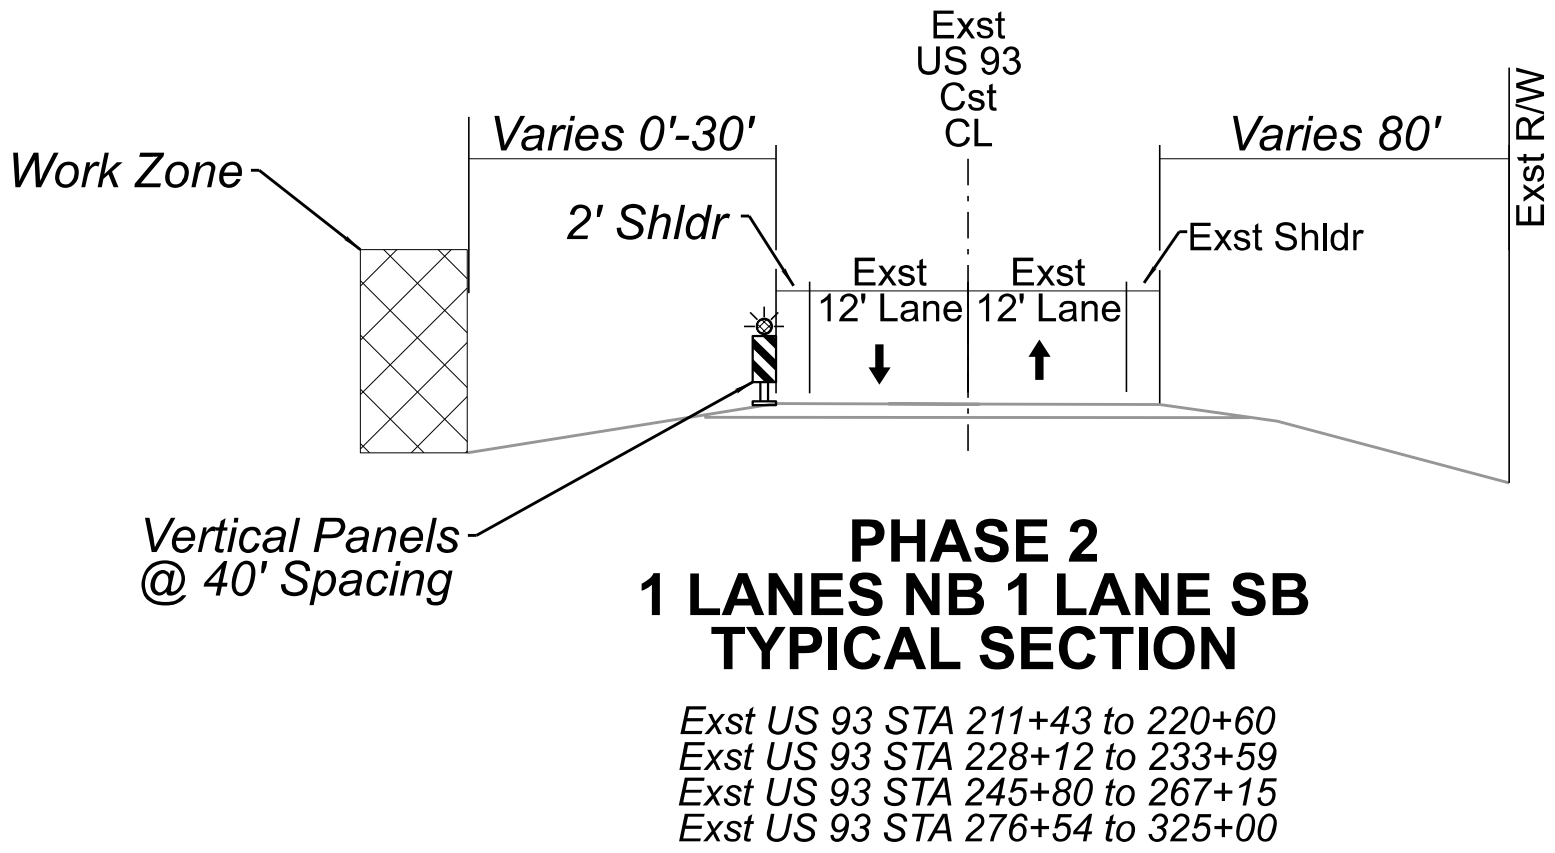


Phase 2

CONSTRUCTION ACTIVITY	MAINTENANCE OF TRAFFIC
- Construct proposed southbound US 93 mainline bridge. - Construct proposed southbound US 93 mainline from Sta 190+00 to Sta 340+110, and culvert extensions. - Construct roundabout around existing Moreton Rd and US 93 from station 220+00 to 224+20. - Construct minor road as Caballero Dr. - Construct proposed residential driveways. - Construct proposed frontage road. - Do not construct SMA final surface course on proposed SB alignment until Phase 4B.	- Maintain traffic on existing northbound US 93 mainline. - Maintain traffic to Nine Irons Ranch Rd. - Maintain traffic to Moreton Rd. - Maintain access to the private driveway at Antelope Creek Rd. - Maintain access on Caballero Rd by constructing in halves utilizing a flagging operation per Figure SA-3 of the Arizona Department of Transportation, Temporary Traffic Control Design Guidelines. - US 93 right shoulder closures shall be as per figure 6H-5 of the 2023 MUTCD "SHOULDER CLOSURE ON A FREEWAY WITH CHANNELIZING DEVICES (TA-5)".

MAINTENANCE OF TRAFFIC (cont.)
- A 3-day single-lane closure of the existing mainline US 93 southbound lane is required to set girders on the proposed southbound bridge. Traffic shall be maintained on US 93 utilizing a flagging operation with a pilot car per Figure SA-3 of the Arizona Department of Transportation, Temporary Traffic Control Design Guidelines.E4

LEGEND

- Phase 2 Roadway Construction
- Phase 2 Temporary Pavement
- Traffic Flow Arrow & Number of Travel Lanes

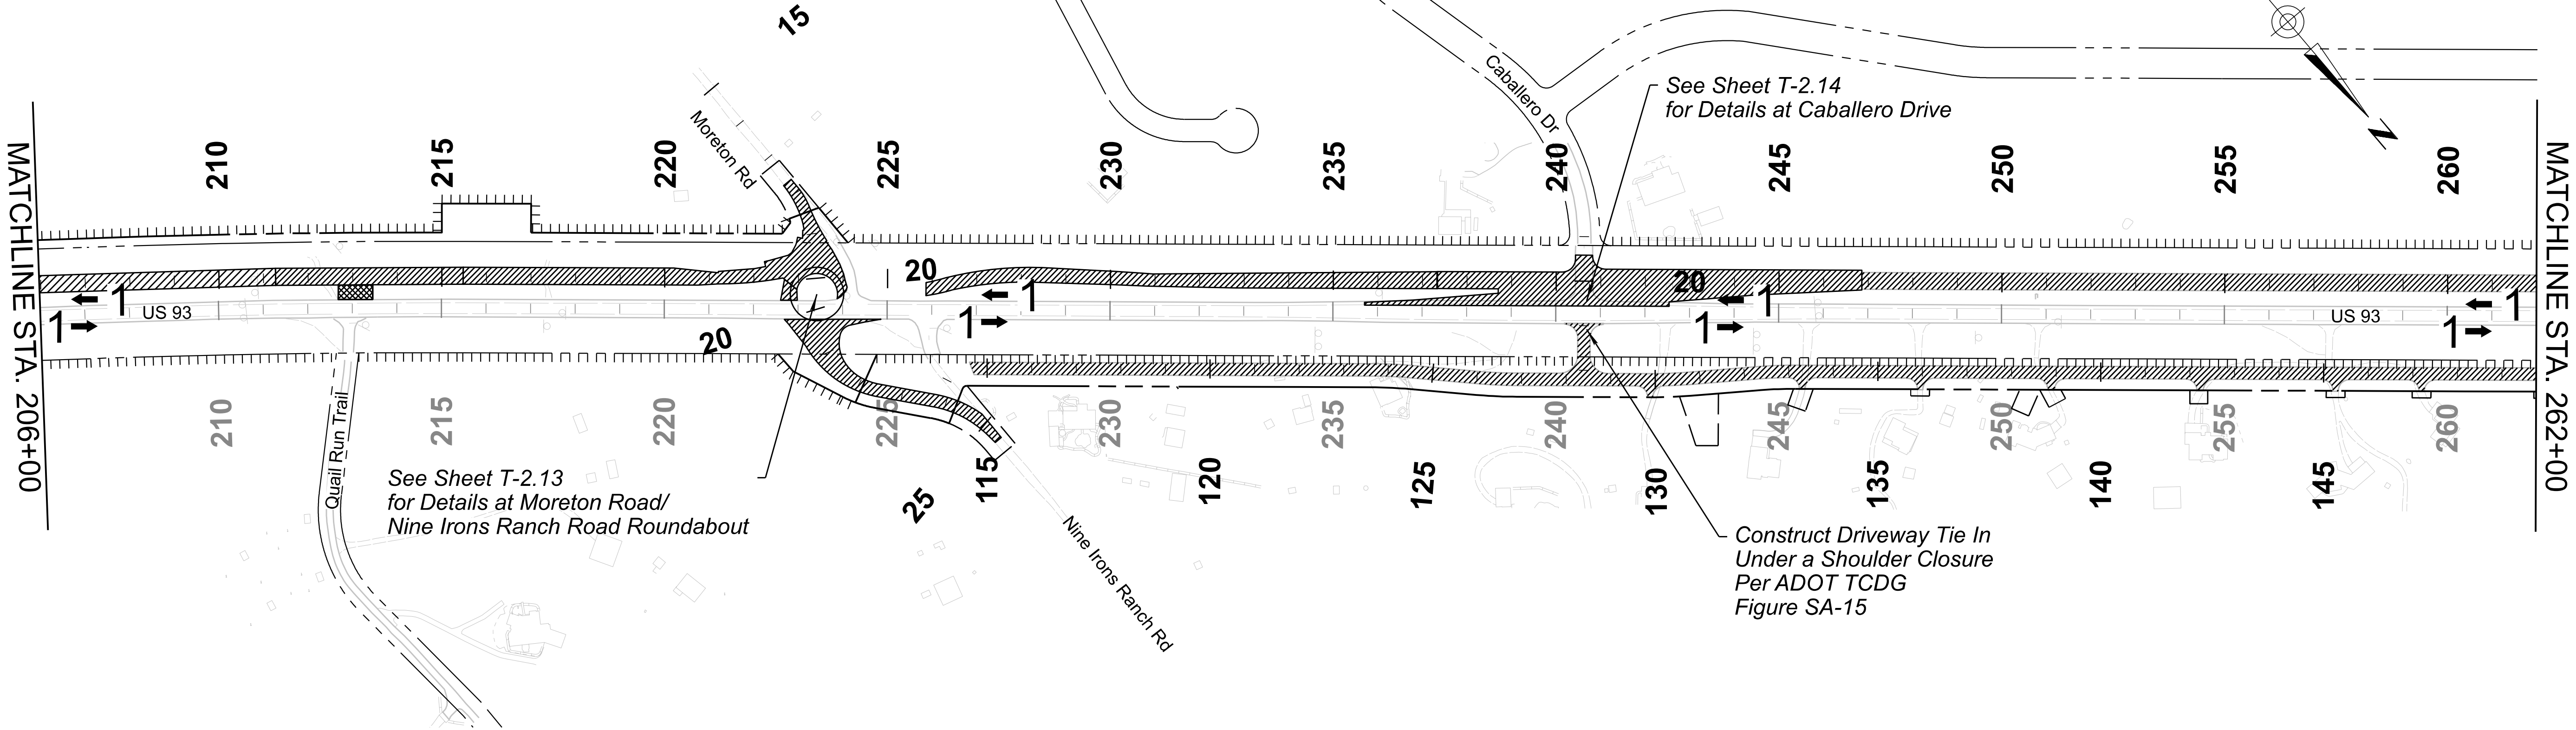

	NAME	DATE
DESIGN	I ROBLES	06/26
DRAWN	C VALENCIA	06/26
CHECKED	C RICKETTS	06/26


TRANSPORTATION
AECOM TECHNICAL SERVICES, Inc.
7720 N. 16th St., Suite 100
Phoenix, Arizona 85020
T 602.371.1100

AECOM
www.aecom.com



ARIZONA DEPARTMENT OF TRANSPORTATION PROJECT DELIVERY AND OPERATIONS DIVISION TRAFFIC DESIGN SERVICES TRAFFIC CONTROL SEQUENCING PHASE 2 SHEET 1 OF 2
--

ROUTE US 93	F.H.W.A. Arizona Division	STATE	PROJECT NO.	FEDERAL ID NO.	SHEET NO.	TOTAL SHEETS	RECORD DRAWING
MILEPOST 190.5		ARIZ.	093 YV 190	093-B-NFA	293	524	
STRUCTURE NO.	LOCATION VISTA ROYALE						DWG No. T-1.09
	TRACS NO. F0738 01C						____ OF ____

PHASE 2

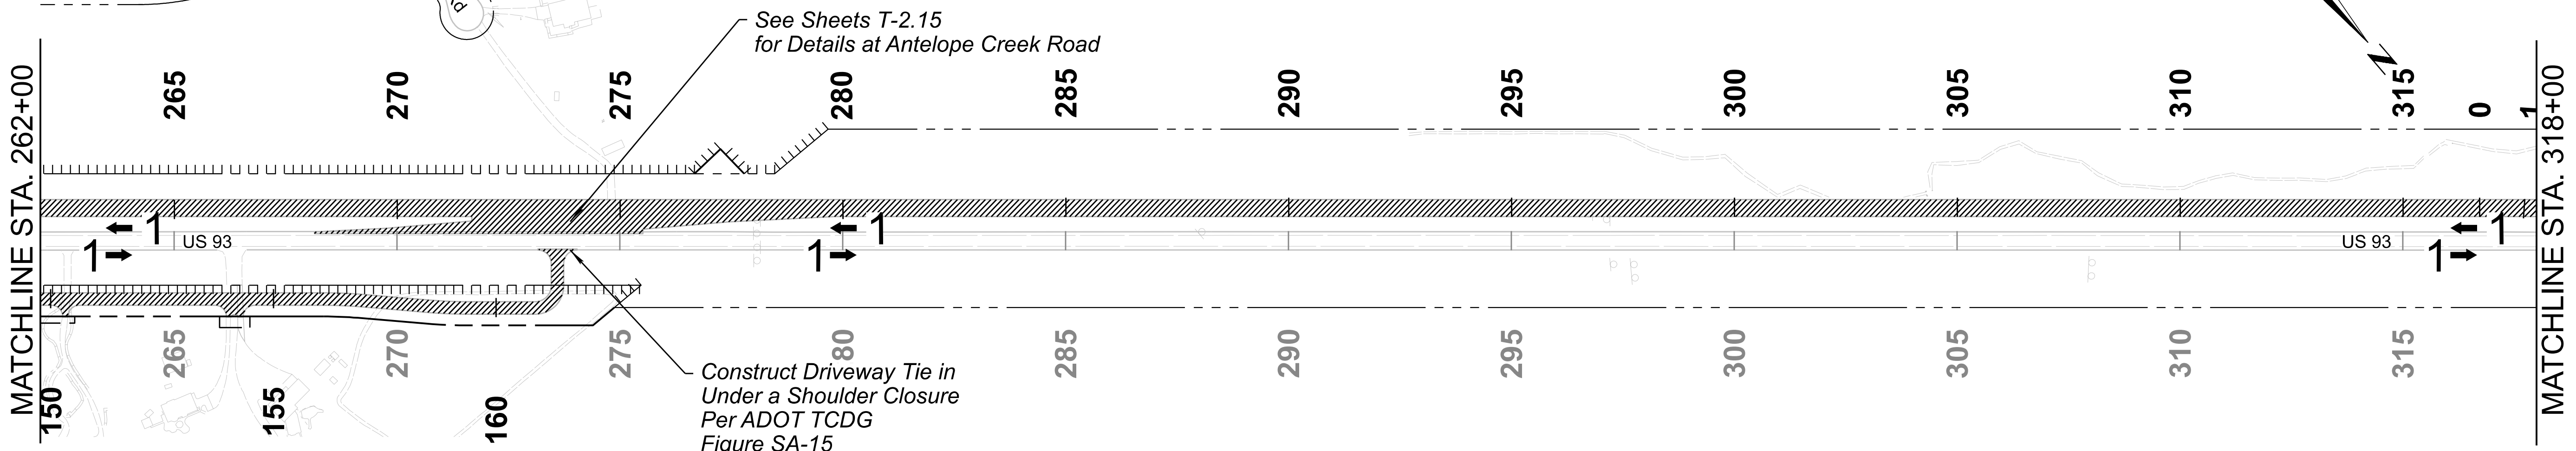

CONSTRUCTION ACTIVITY	MAINTENANCE OF TRAFFIC
- Construct proposed southbound US 93 mainline from Sta 190+00 to Sta 340+110. - Construct proposed residential driveways. - Construct proposed frontage road. - Construct temporary pavement for US 93 mainline crossover on north end of project near Sta 320+00.	- Maintain traffic on existing northbound US 93 mainline. - Maintain traffic on driveways by constructing driveways in two phases.

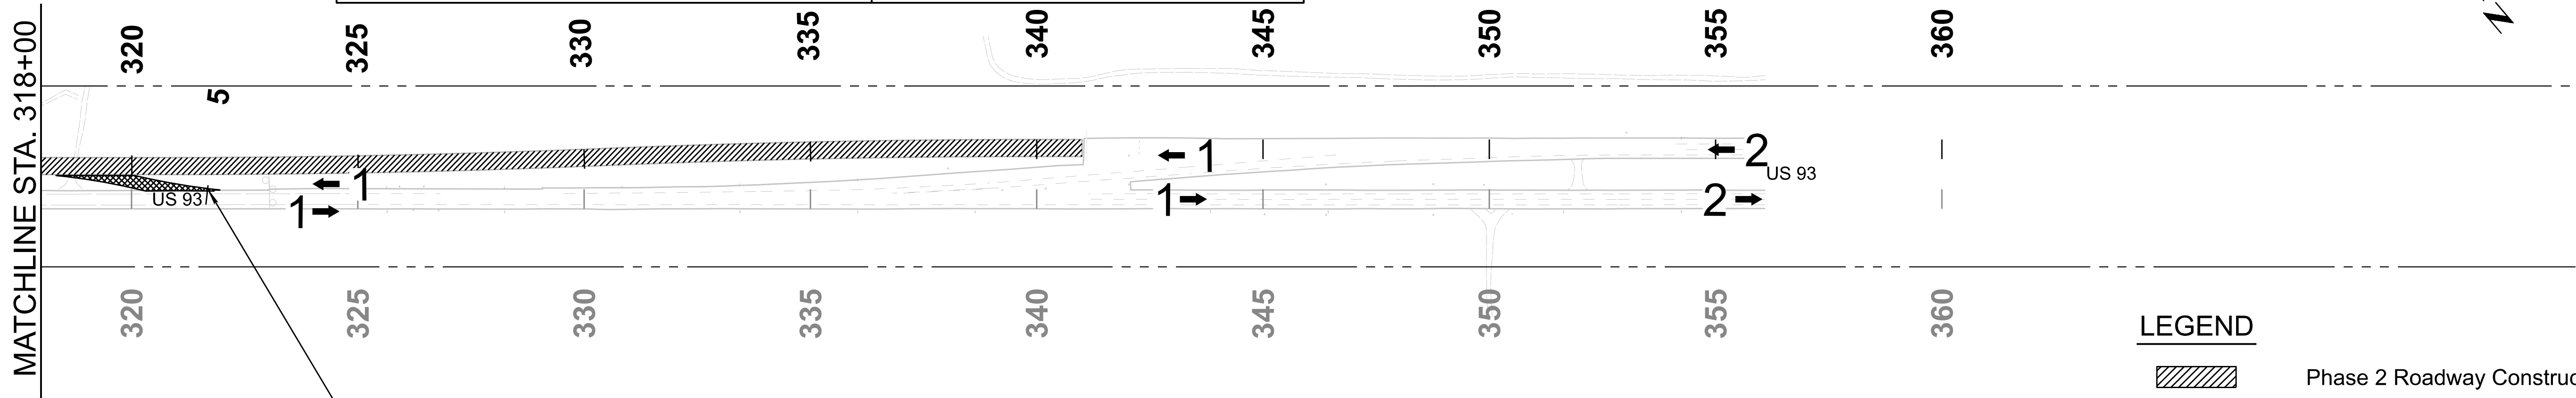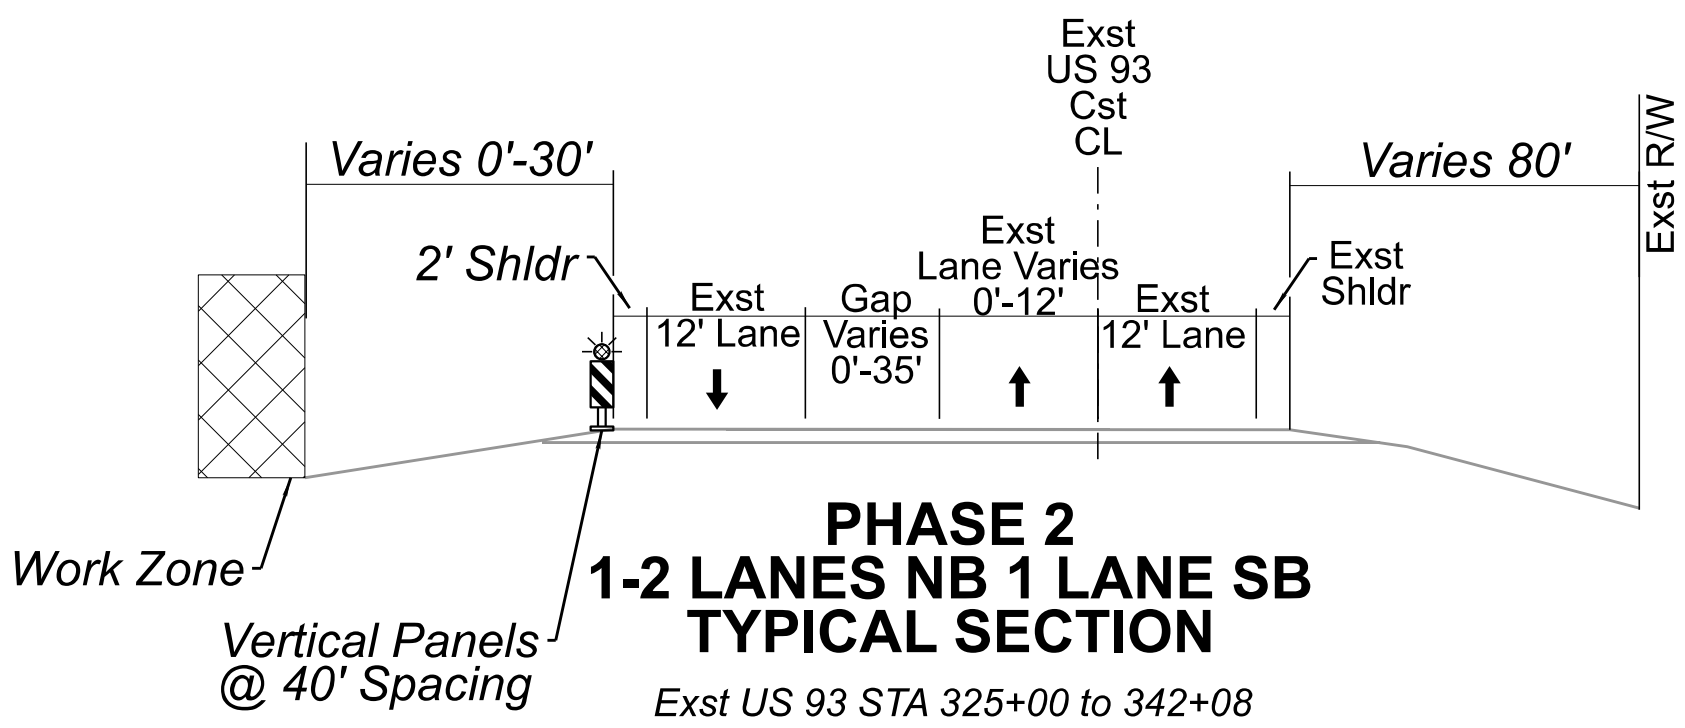

LEGEND

- Phase 2 Roadway Construction
- Phase 2 Temporary Pavement
- Traffic Flow Arrow & Number of Travel Lanes

DESIGN	I ROBLES	06/26
DRAWN	C VALENCIA	06/26
CHECKED	C RICKETTS	06/26


TRANSPORTATION
AECOM TECHNICAL SERVICES, Inc.
7720 N. 16th St., Suite 100
Phoenix, Arizona 85020
T 602.371.1100

AECOM
www.aecom.com

ARIZONA DEPARTMENT OF TRANSPORTATION
PROJECT DELIVERY AND OPERATIONS DIVISION
TRAFFIC DESIGN SERVICES
TRAFFIC CONTROL SEQUENCING
PHASE 2
SHEET 2 OF 2

ROUTE US 93	F.H.W.A. Arizona Division	STATE ARIZ.	PROJECT NO. 093 YV 190	FEDERAL ID NO. 093-B-NFA	SHEET NO. 294	TOTAL SHEETS 524	RECORD DRAWING
MILEPOST 190.5	LOCATION VISTA ROYALE						DWG No. T-1.10 ____ OF ____
STRUCTURE NO.	TRACS NO. F0738 01C						


PHASE 2A

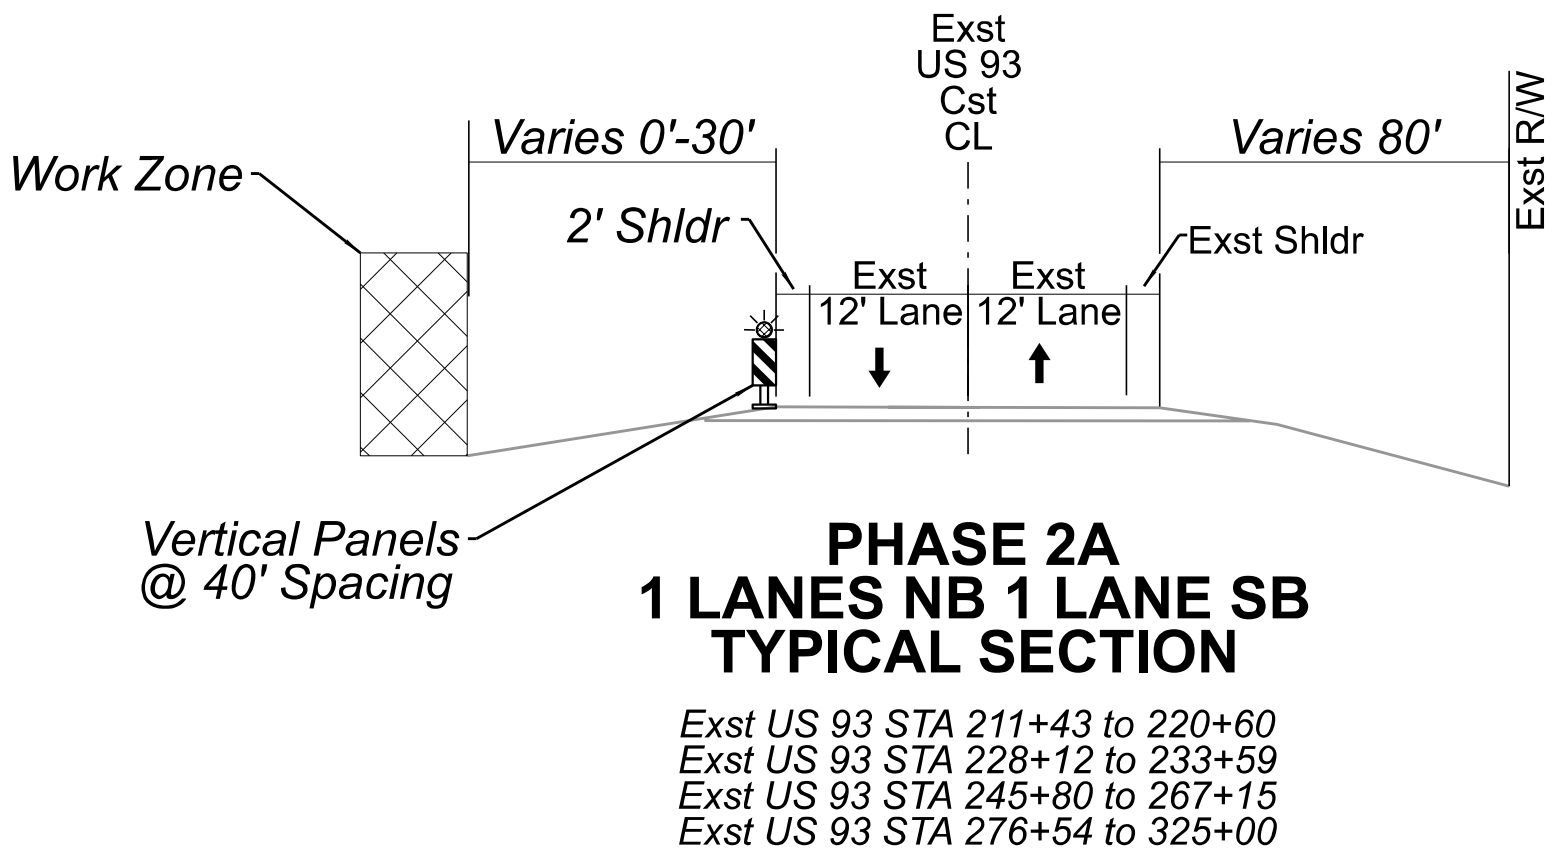

Phase 2A	
CONSTRUCTION ACTIVITY	MAINTENANCE OF TRAFFIC
- Construct second portion of Moreton Rd roundabout	- Maintain traffic on existing northbound US 93 mainline.


LEGEND

- Phase 2A Roadway Construction
- Phase 2A Temporary Pavement
- Traffic Flow Arrow & Number of Travel Lanes

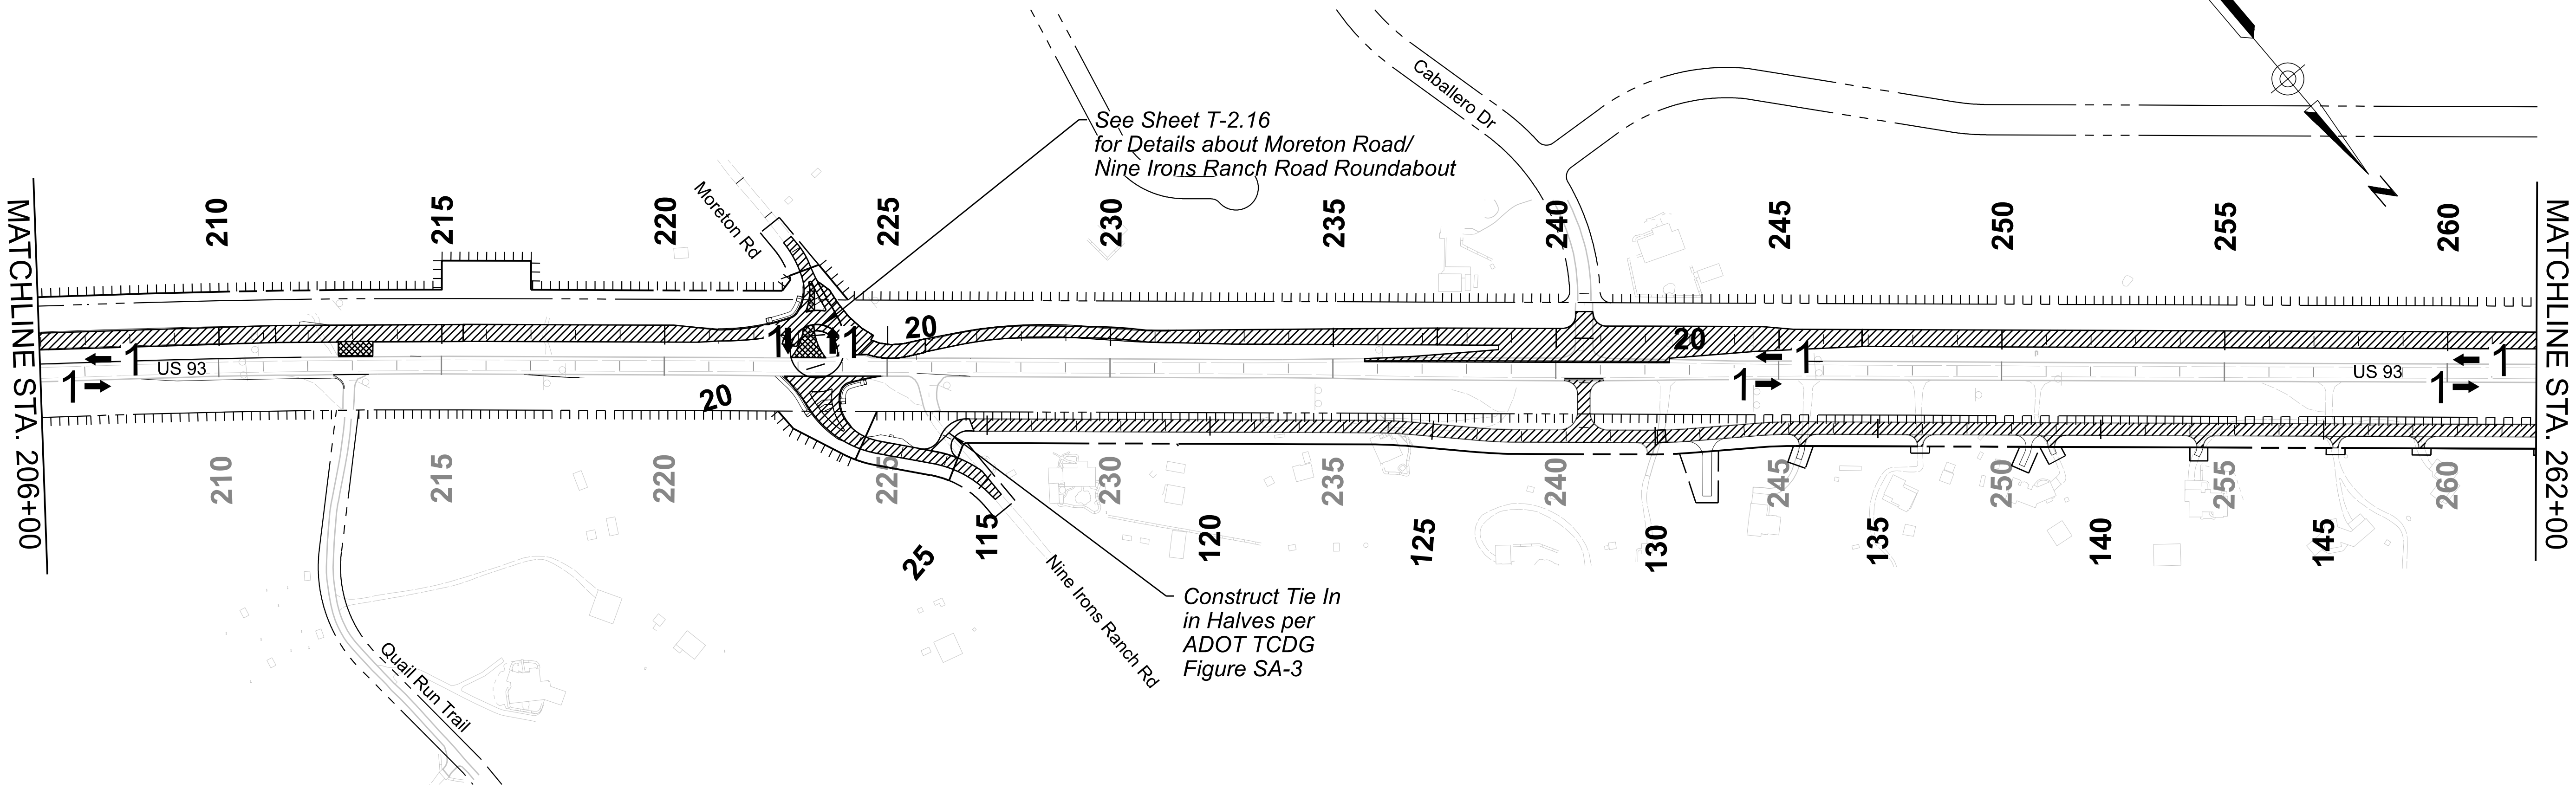



	DESIGN	I ROBLES	06/26	ARIZONA DEPARTMENT OF TRANSPORTATION PROJECT DELIVERY AND OPERATIONS DIVISION TRAFFIC DESIGN SERVICES	ROUTE	US 93	F.H.W.A. Arizona Division	STATE	ARIZ.	PROJECT NO.	093 YV 190	FEDERAL ID NO.	093-B-NFA	SHEET NO.	295	TOTAL SHEETS	524	RECORD DRAWING
	DRAWN	C VALENCIA	06/26		TRAFFIC CONTROL SEQUENCING	MILEPOST		190.5	LOCATION	VISTA ROYALE						DWG No.	T-1.11	
	CHECKED	C RICKETTS	06/26		PHASE 2A	STRUCTURE NO.			TRACS NO.	F0738 01C						OF		
	TRANSPORTATION AECOM TECHNICAL SERVICES, Inc. 7720 N. 16th St., Suite 100 Phoenix, Arizona 85020 T 602.371.1100				AECOM www.aecom.com		SHEET 1 OF 2											

PHASE 2A

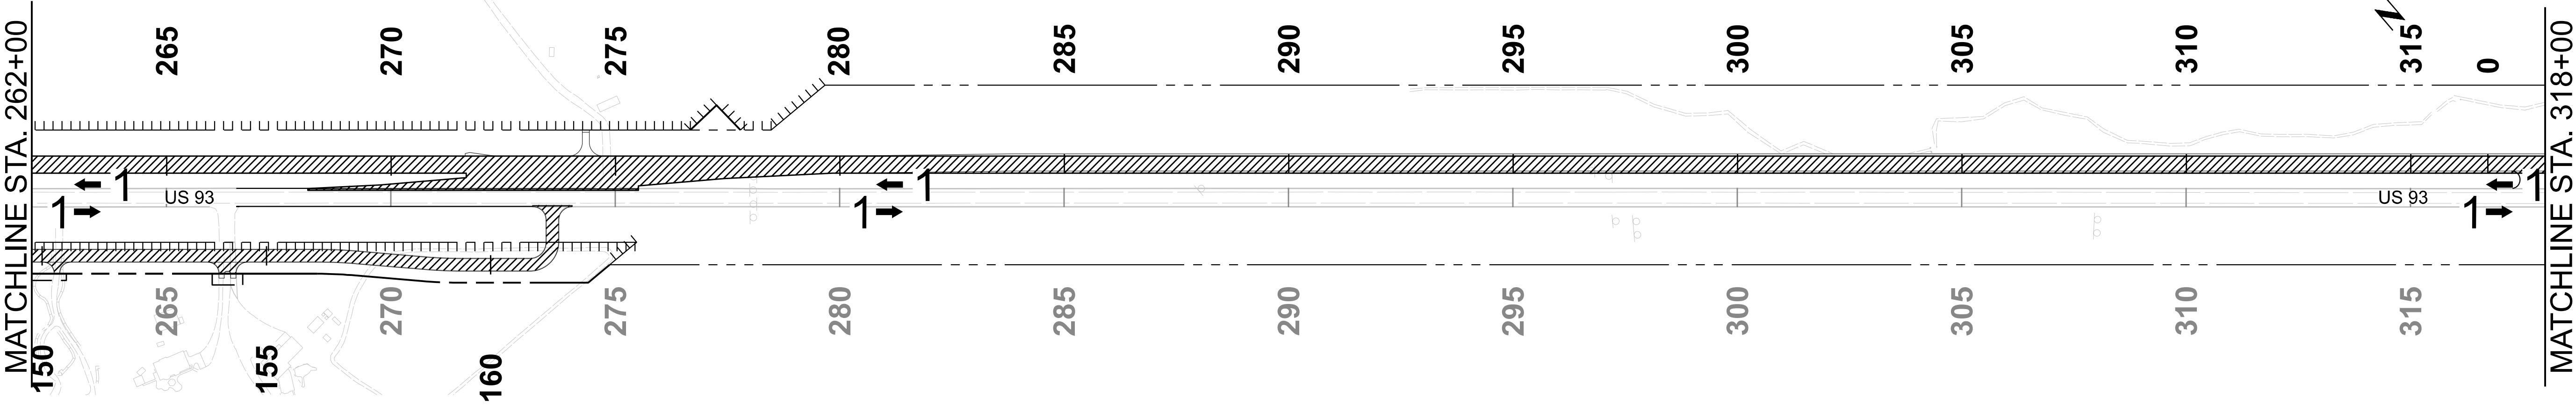

Phase 2A

CONSTRUCTION ACTIVITY	MAINTENANCE OF TRAFFIC
- Construct proposed southbound US 93 mainline from Sta 190+00 to Sta 340+110. - Construct proposed residential driveways. - Construct proposed frontage road. - Construct temporary pavement for US 93 mainline crossover.	- Maintain traffic on existing northbound US 93 mainline. - Maintain traffic on driveways by constructing driveways in two phases.

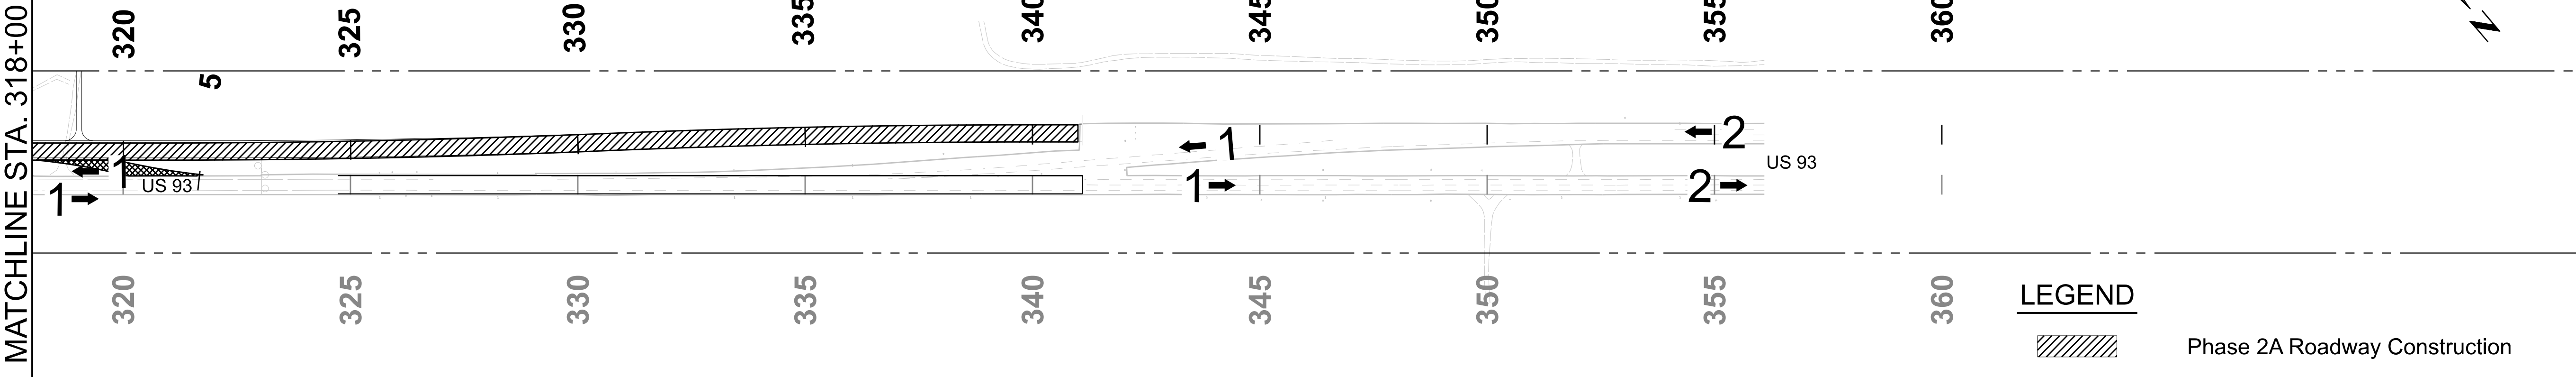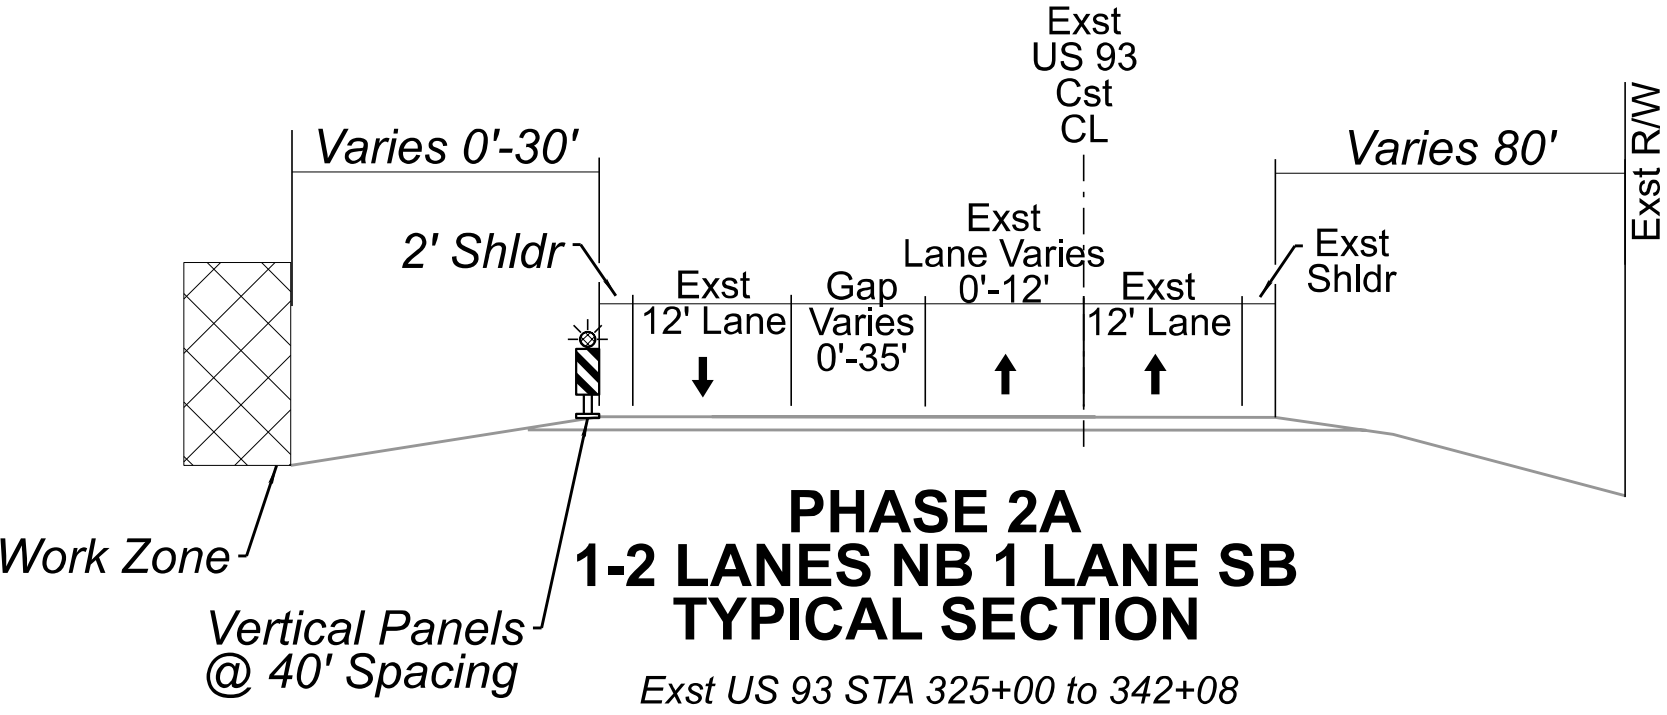

LEGEND

- Phase 2A Roadway Construction
- Phase 2A Temporary Pavement
- Traffic Flow Arrow & Number of Travel Lanes



	NAME	DATE
DESIGN	I ROBLES	06/26
DRAWN	C VALENCIA	06/26
CHECKED	C RICKETTS	06/26

TRANSPORTATION
AECOM TECHNICAL SERVICES, Inc.
7720 N. 16th St., Suite 100
Phoenix, Arizona 85020
T 602.371.1100

AECOM
www.aecom.com

ARIZONA DEPARTMENT OF TRANSPORTATION
PROJECT DELIVERY AND OPERATIONS DIVISION
TRAFFIC DESIGN SERVICES
TRAFFIC CONTROL SEQUENCING
PHASE 2A
SHEET 2 OF 2

ROUTE US 93	F.H.W.A. Arizona Division	STATE ARIZ.	PROJECT NO. 093 YV 190	FEDERAL ID NO. 093-B-NFA	SHEET NO. 296	TOTAL SHEETS 524	RECORD DRAWING
MILEPOST 190.5	LOCATION	VISTA ROYALE				DWG No.	T-1.12
STRUCTURE NO.	TRACS NO.	F0738 01C				OF	


Plan view of the proposed US 93 widening project. The diagram shows the road layout, including intersections with Wickenburg Ranch Road, Wickenburg Ranch Way, and Matthei Ranch Road. The widening is indicated by a shaded area between the existing road (dashed line) and the proposed road (solid line). Station markers are provided every 5 units from 120 to 170. A north arrow is located in the upper right corner. Match lines are shown at both ends of the project segment.

 = Previously Constructed
 = Temporary Pavement
 = Phase 3 Roadway Construction
 = Phase 3 Temporary Pavement
 = Traffic Flow Arrow & Number of Travel Lanes

MAINTENANCE OF TRAFFIC



- Construct NB US 93 and portion of roundabout.
- Remove temporary paving no longer in use.
- Construct culvert extensions.

Maintain one lane of traffic in each direction on newly constructed SB US 93 and Temporary Pavement per Dwg Nos. T-2.17 thru T-2.23. Detour SB SR 89 traffic onto NB SR 89 slip ramp. NB and SB SR 89 traffic to access US 93 via Matthie Ranch Road intersection.

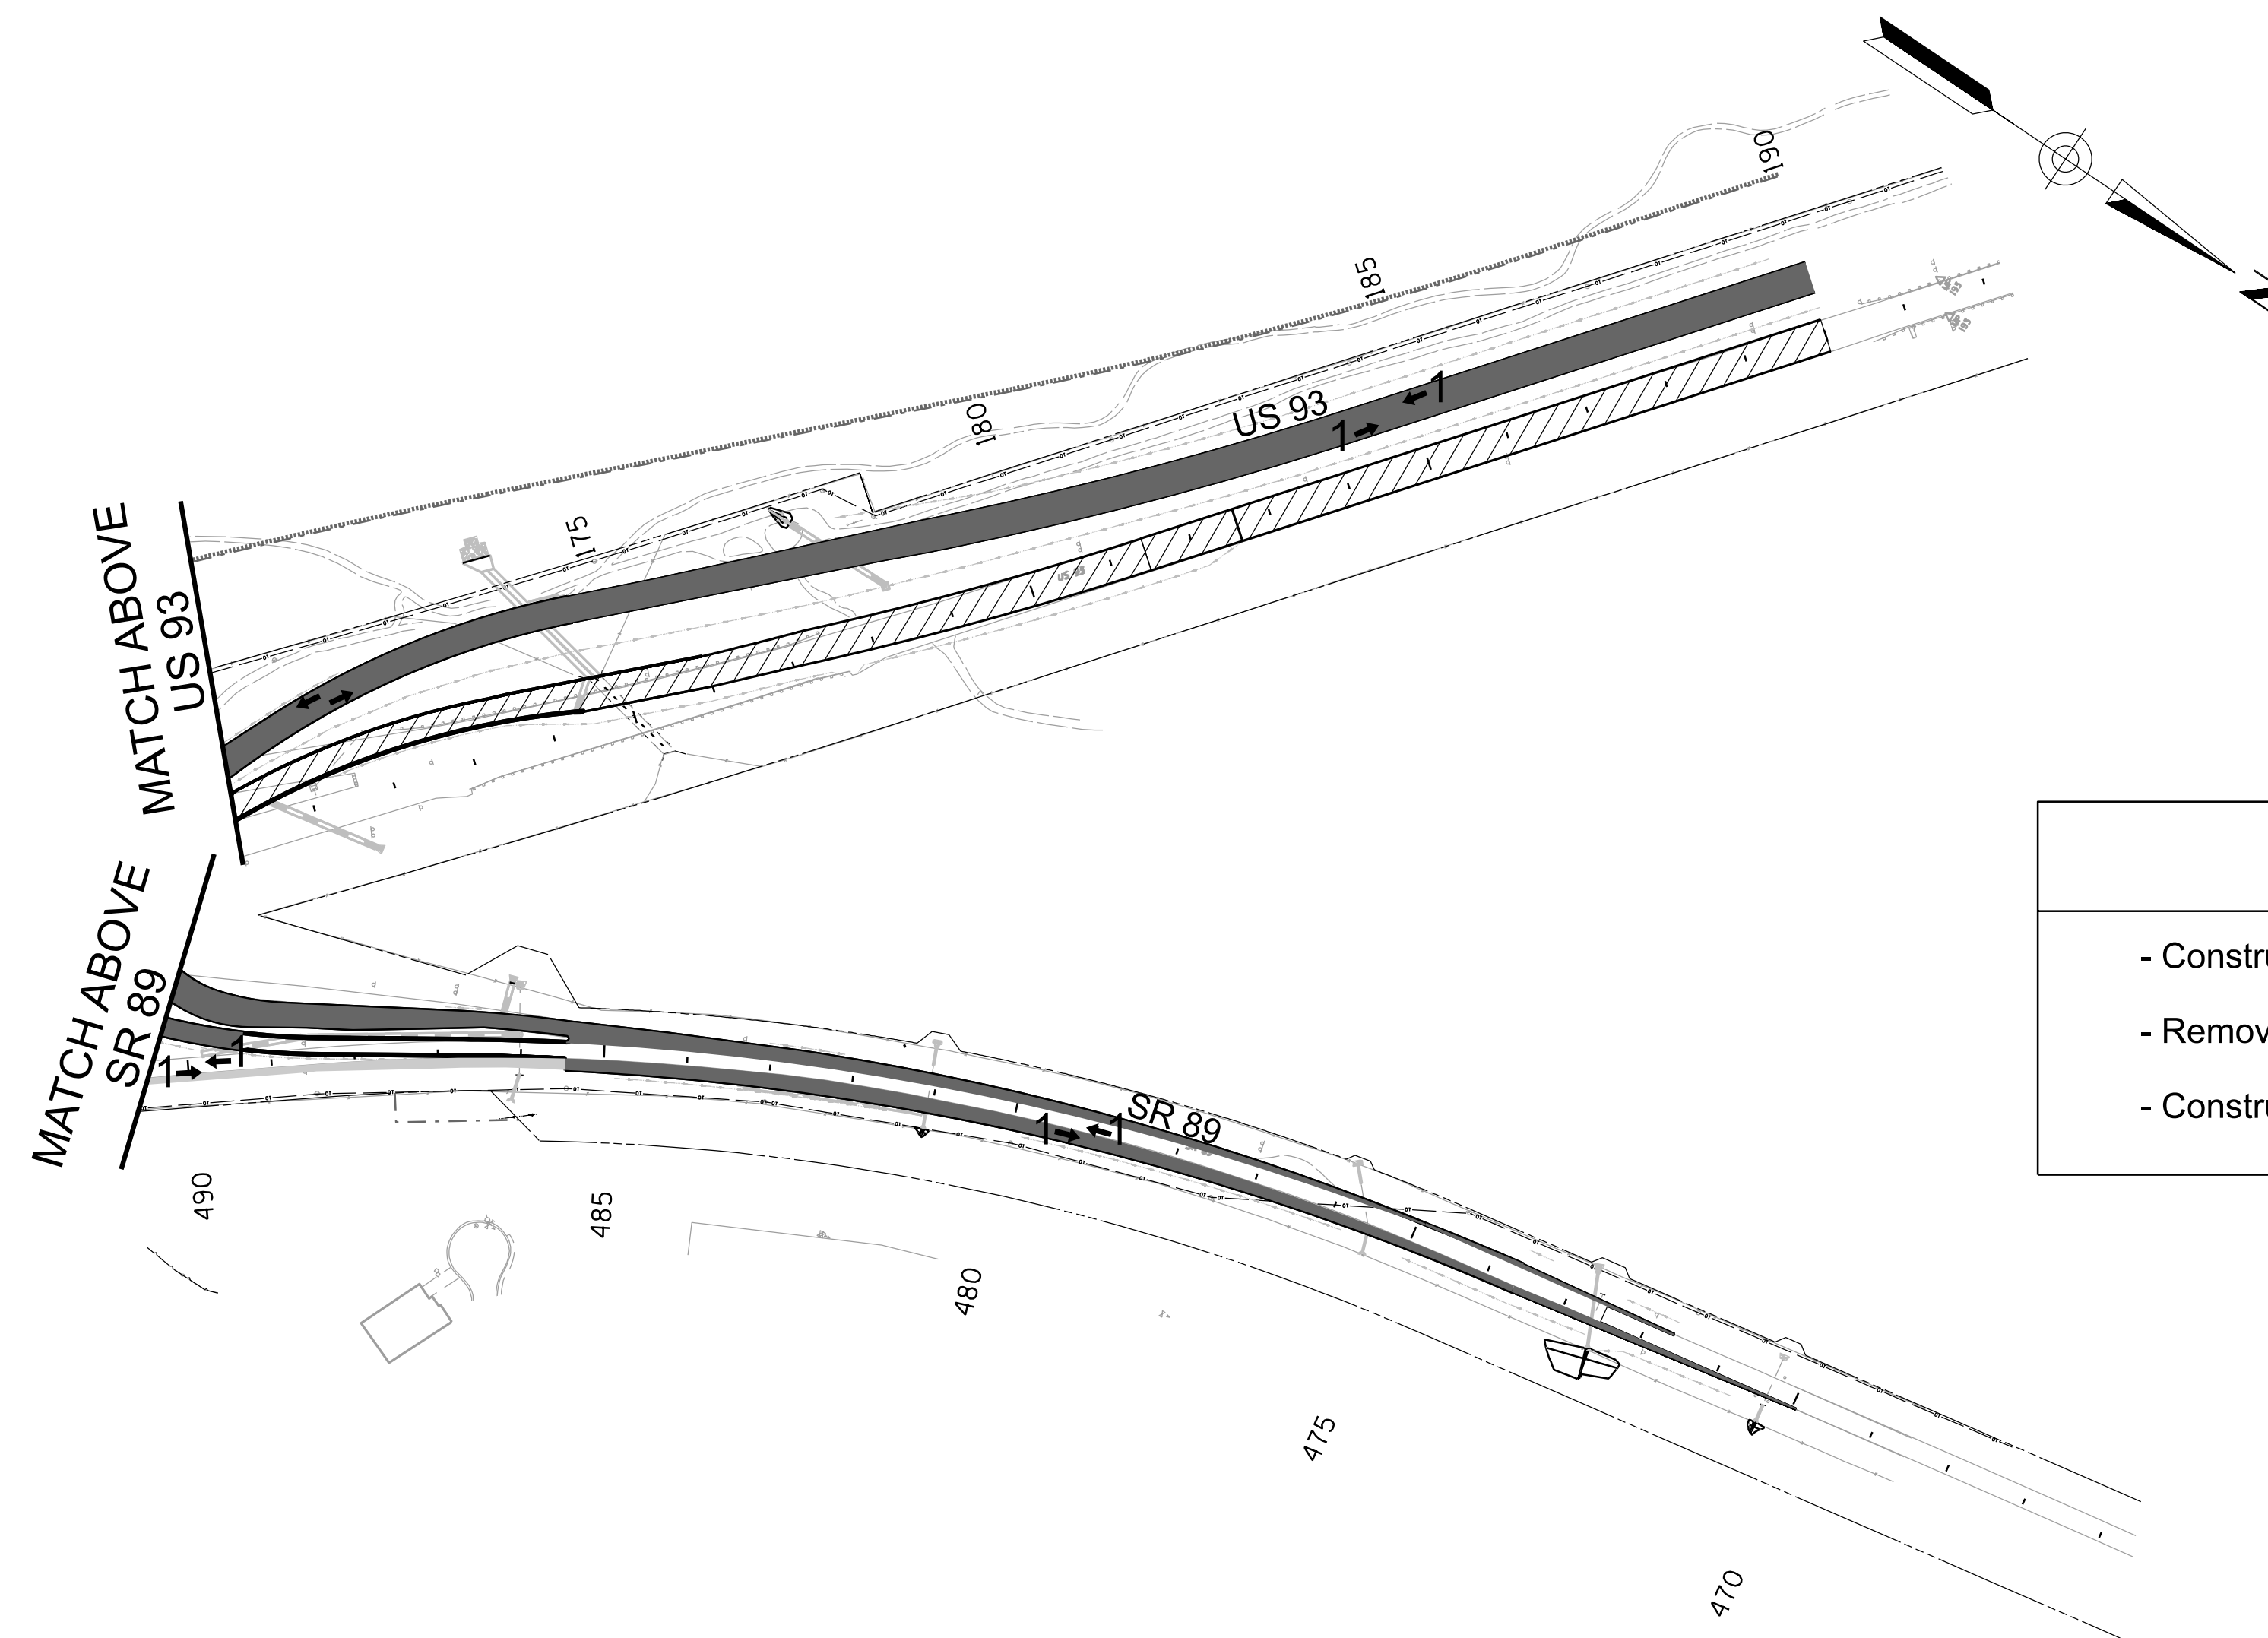

6/11/2026 ... \MOT\t0738A Conseq03.dgn T-1.15

PHASE 3

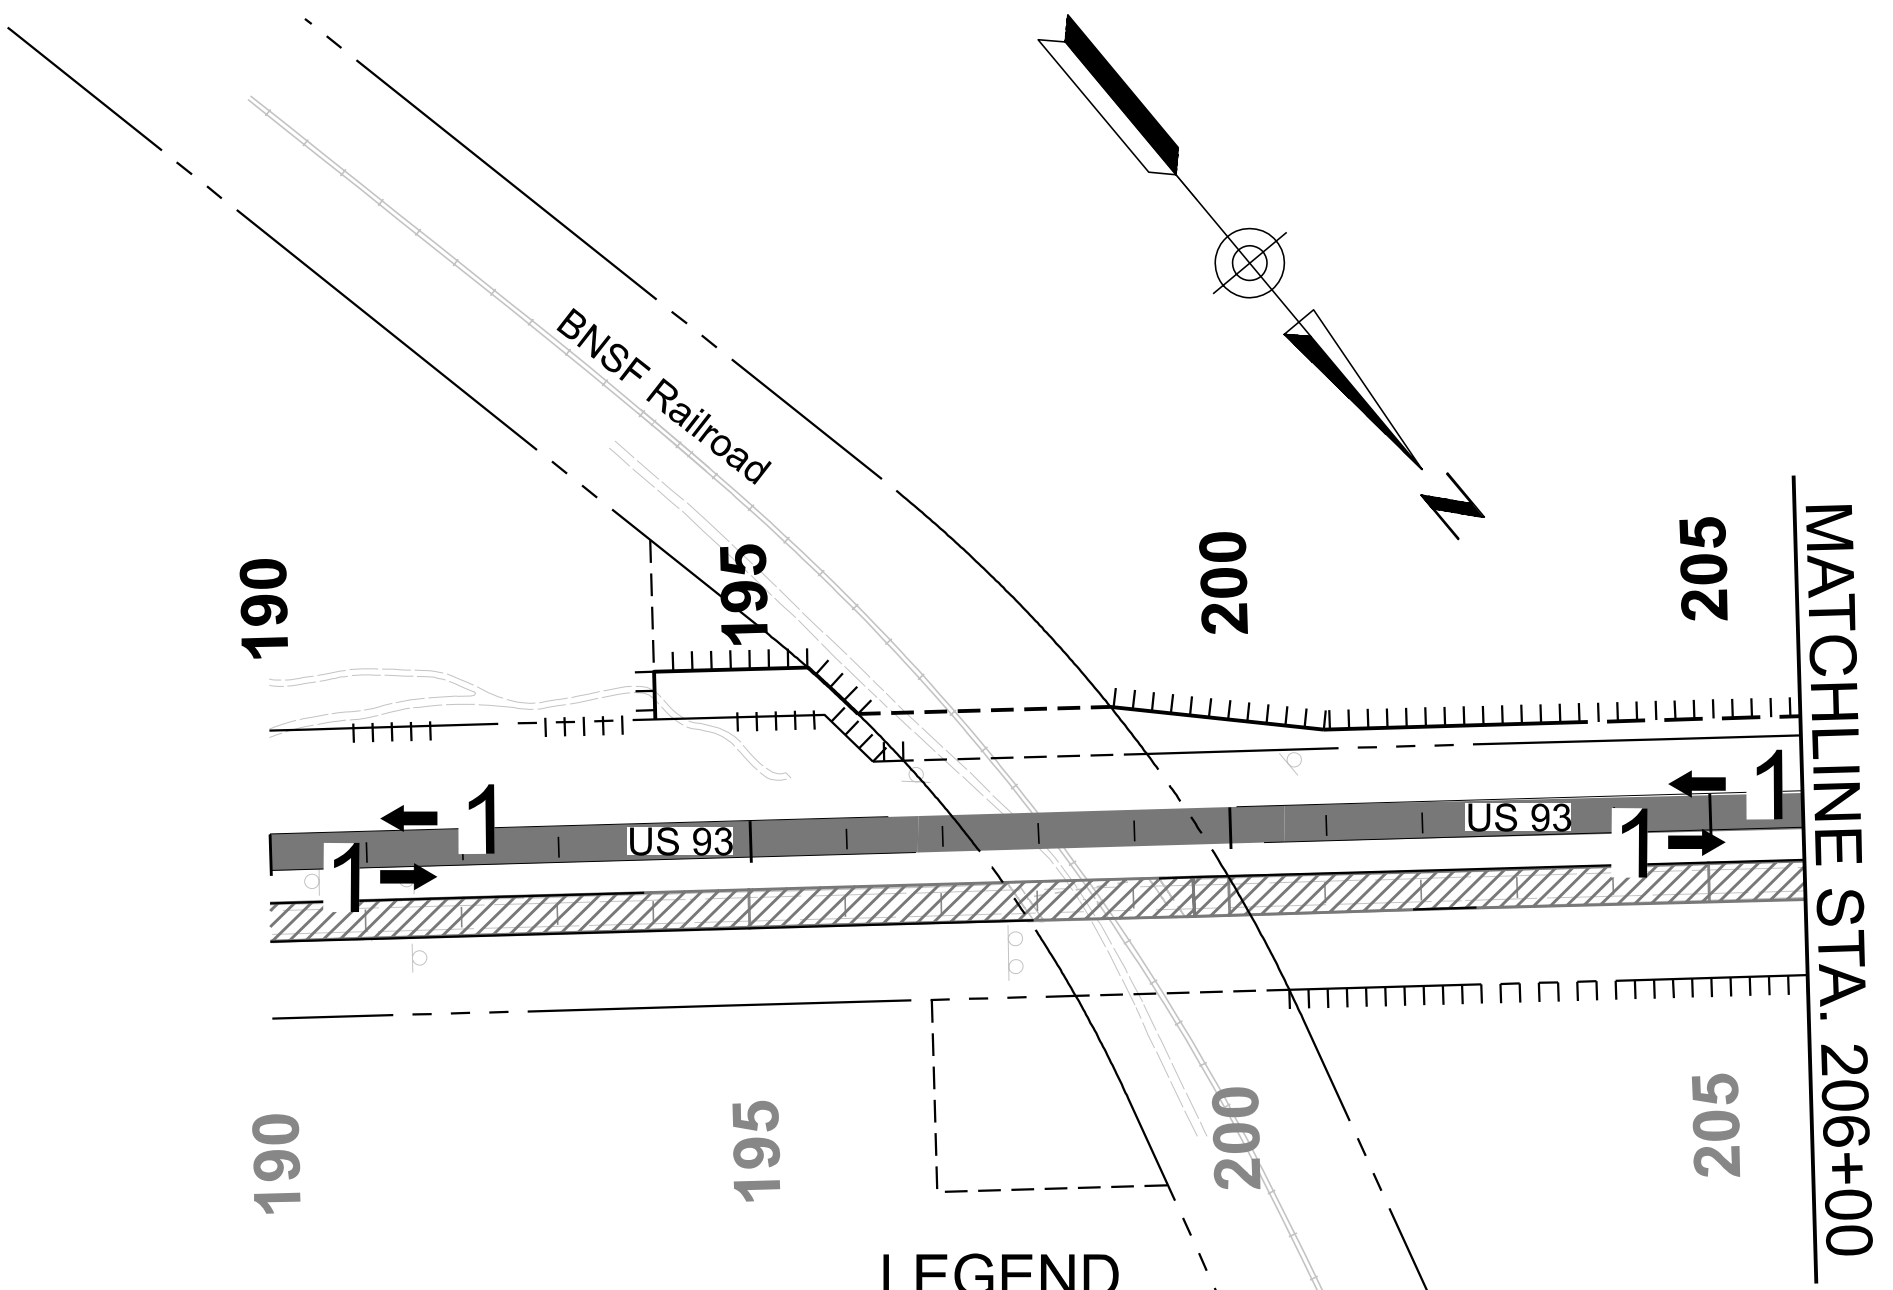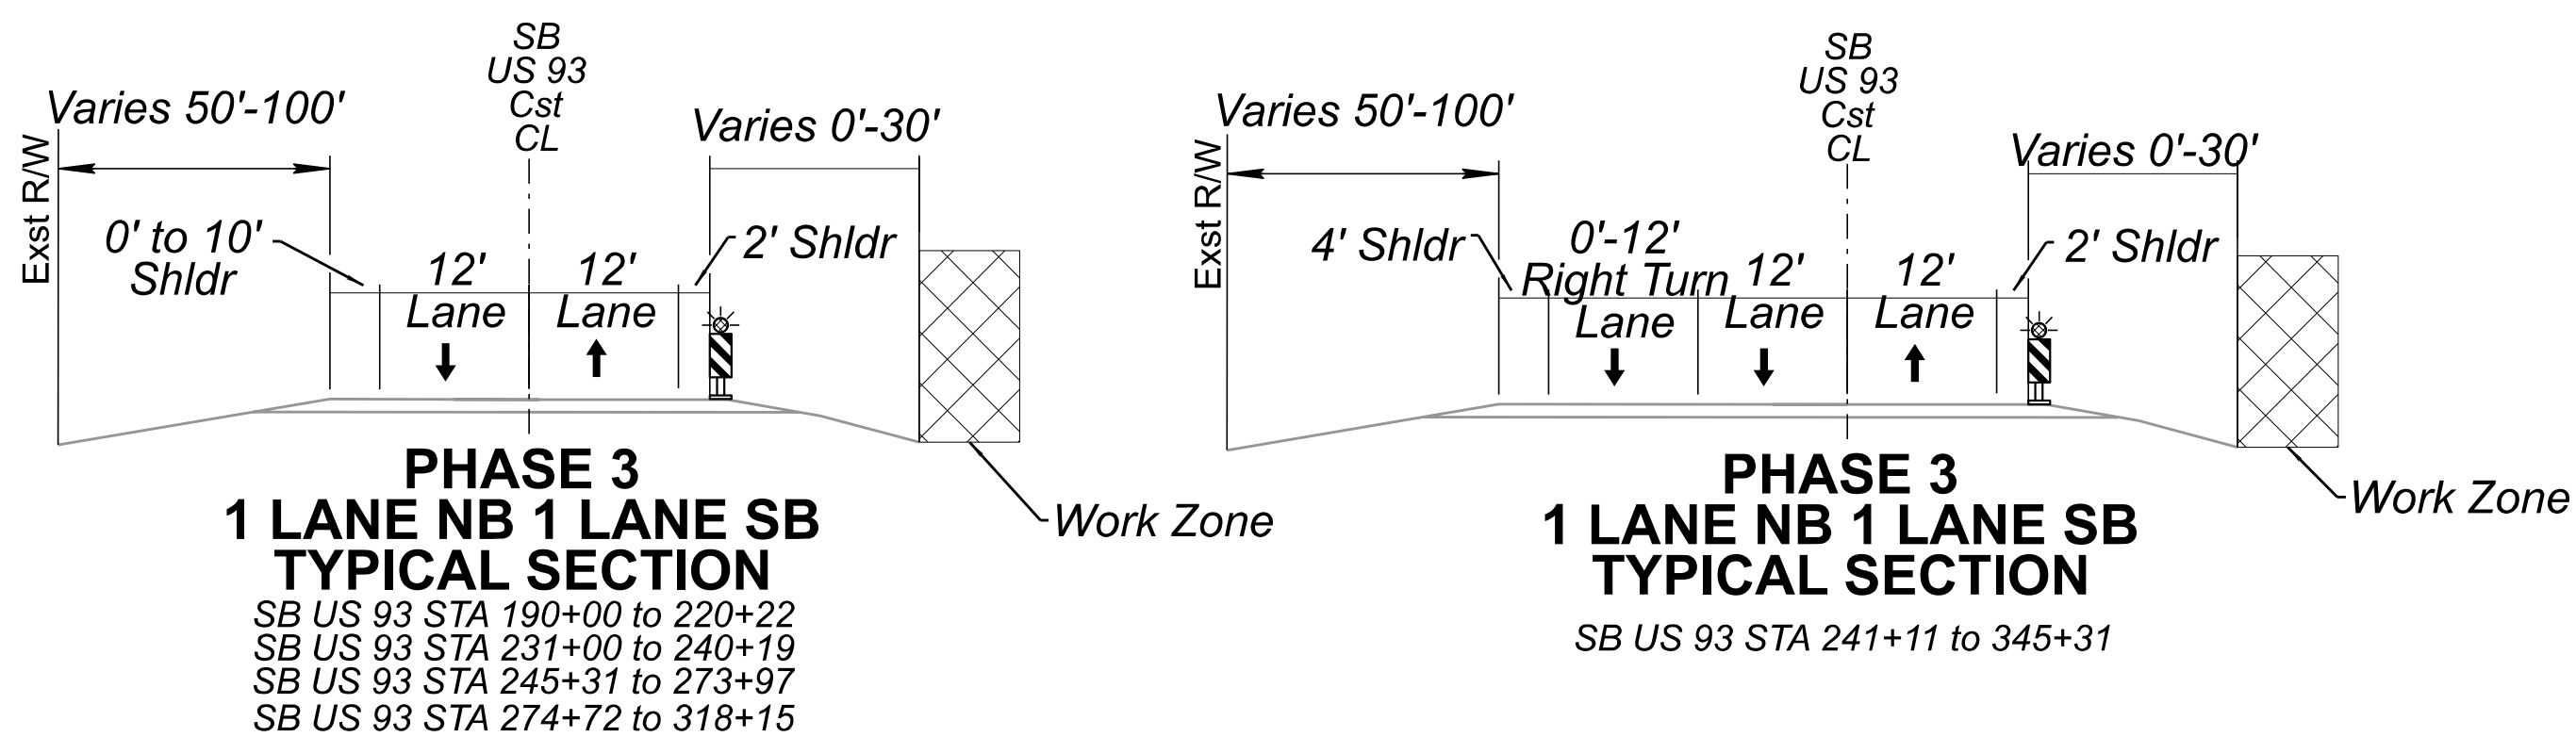


Phase 3

CONSTRUCTION ACTIVITY	MAINTENANCE OF TRAFFIC
- Construct new pavement on existing US 93 mainline including final pavement surface. - Construct proposed northbound US 93 mainline bridge improvements.	- Shift traffic onto constructed proposed SB US 93 using temporary crossovers. - Maintain access through Quail Run Trail. - Maintain access to Frontage Road by limiting construction of access point to US 93 to no more than two of the following three locations at the same time: Nine Irons Ranch Rd, Antelope Creek Rd, and Caballero Dr.

LEGEND

- Previously Constructed
- Phase 3 Roadway Construction
- Phase 3 Temporary Pavement
- Traffic Flow Arrow & Number of Travel Lanes

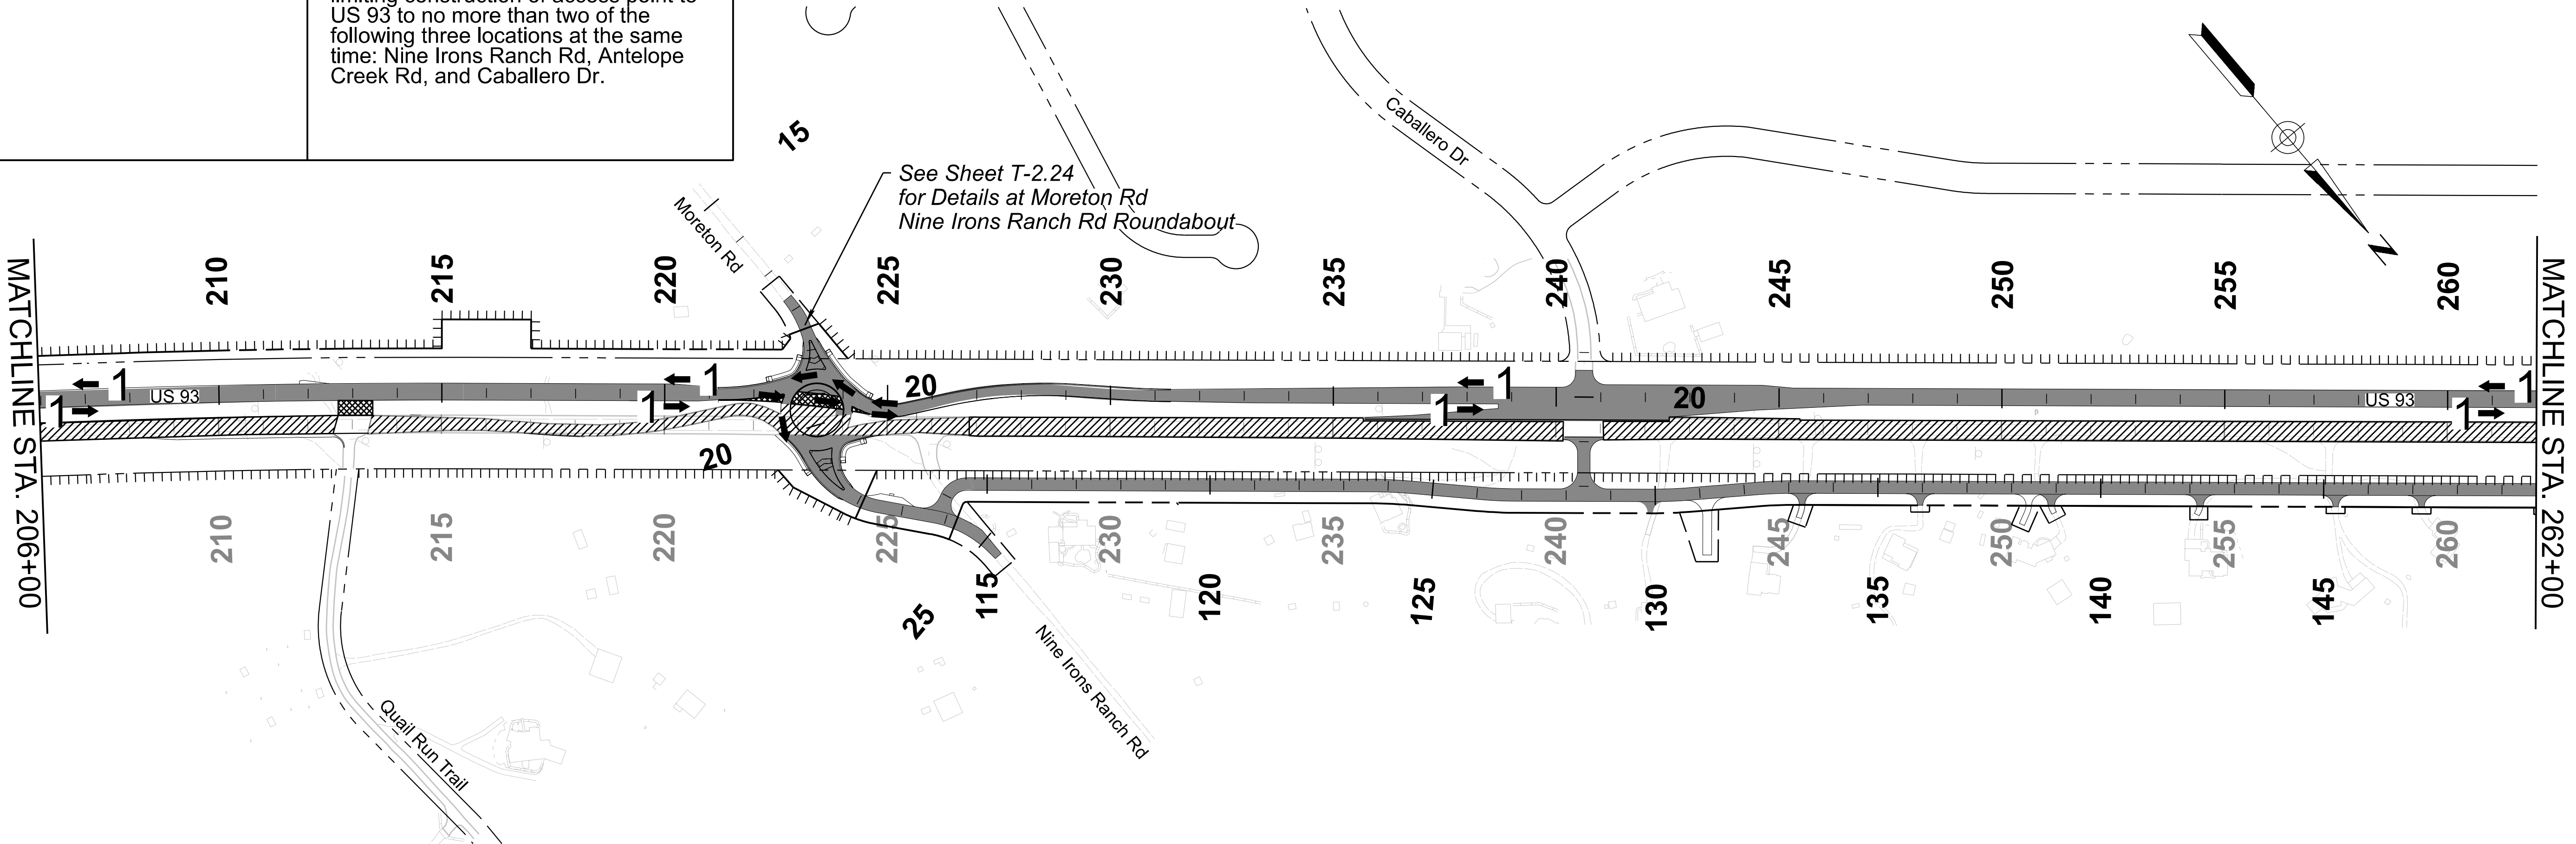

	NAME	DATE
DESIGN	I ROBLES	06/26
DRAWN	C VALENCIA	06/26
CHECKED	C RICKETTS	06/26


TRANSPORTATION
AECOM TECHNICAL SERVICES, Inc.
7720 N. 16th St., Suite 100
Phoenix, Arizona 85020
T 602.371.1100

AECOM
www.aecom.com




ARIZONA DEPARTMENT OF TRANSPORTATION
PROJECT DELIVERY AND OPERATIONS DIVISION
TRAFFIC DESIGN SERVICES
TRAFFIC CONTROL SEQUENCING
PHASE 3
SHEET 1 OF 2

ROUTE US 93	F.H.W.A. Arizona Division	STATE ARIZ.	PROJECT NO. 093 YV 190	FEDERAL ID NO. 093-B-NFA	SHEET NO. 298	TOTAL SHEETS 524	RECORD DRAWING
MILEPOST 190.5	LOCATION VISTA ROYALE						DWG No. T-1.14
STRUCTURE NO.	TRACS NO. F0738 01C						OF

PHASE 3

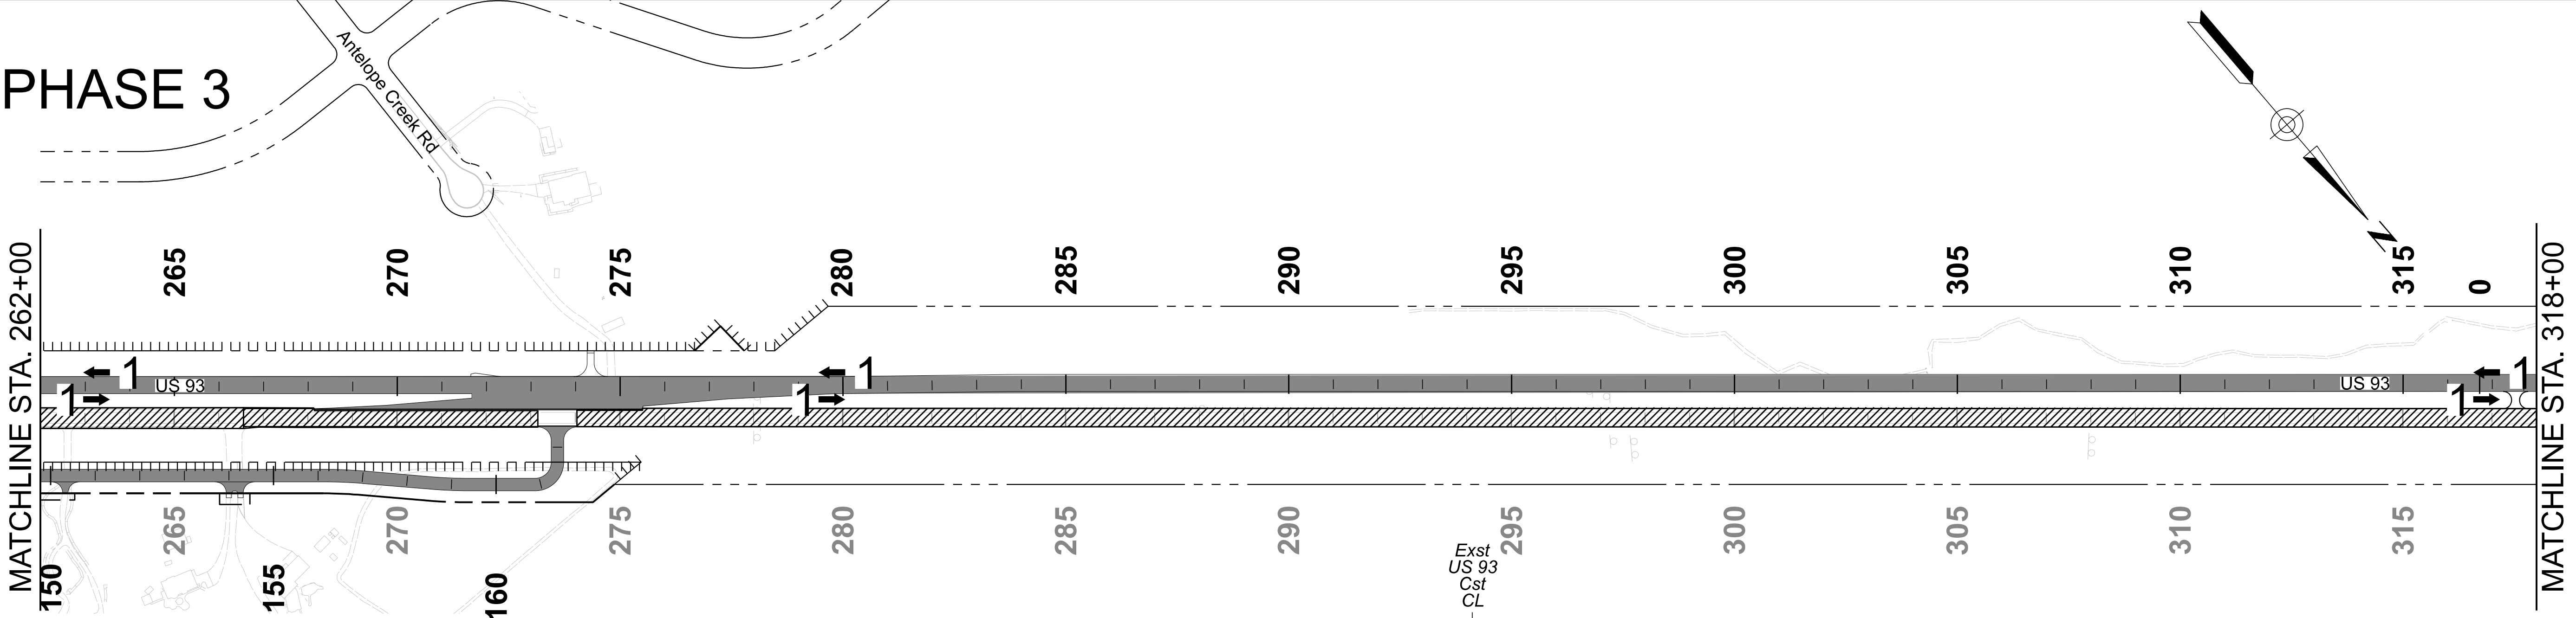

CONSTRUCTION ACTIVITY	MAINTENANCE OF TRAFFIC
- Construct new pavement on existing US 93 mainline including final pavement surface.	- Maintain access to Frontage Road by limiting construction of access points to US 93 to no more than two of the following three locations at the same time: Nine Irons Ranch Rd, Antelope Creek Rd, and Caballero Dr.

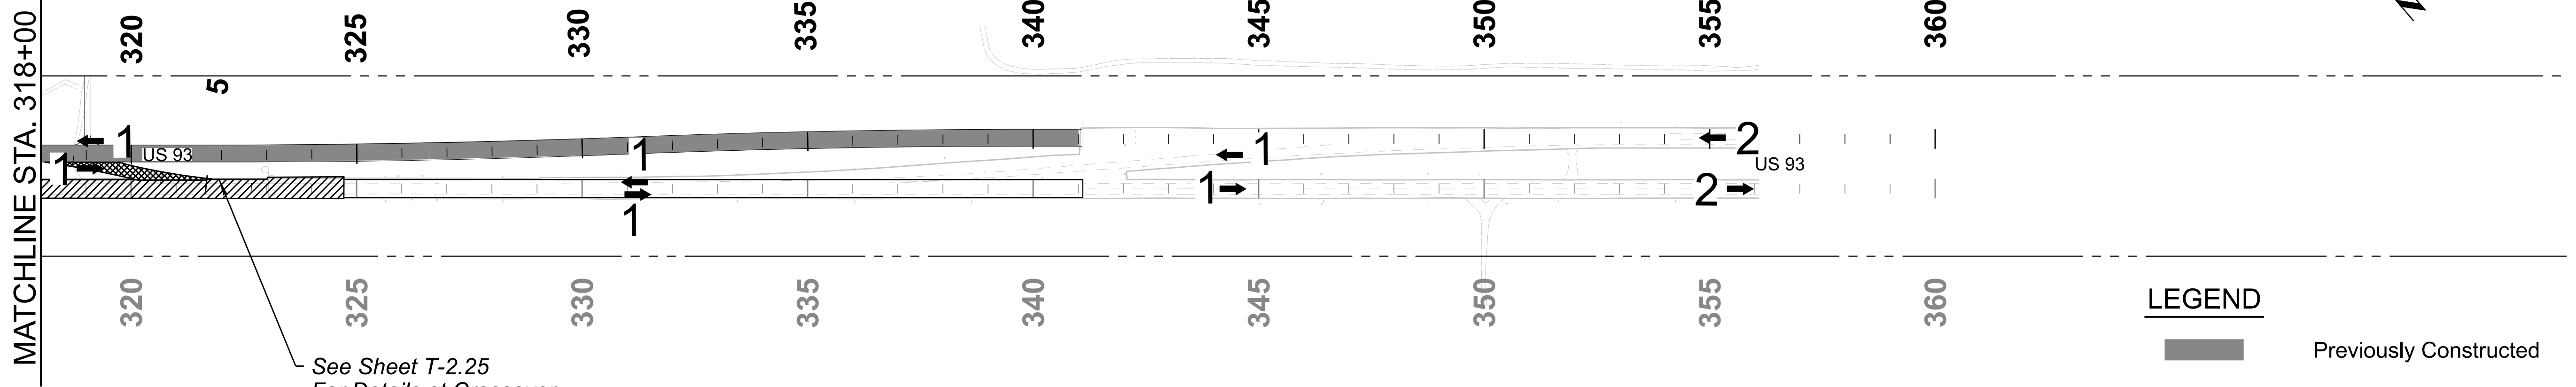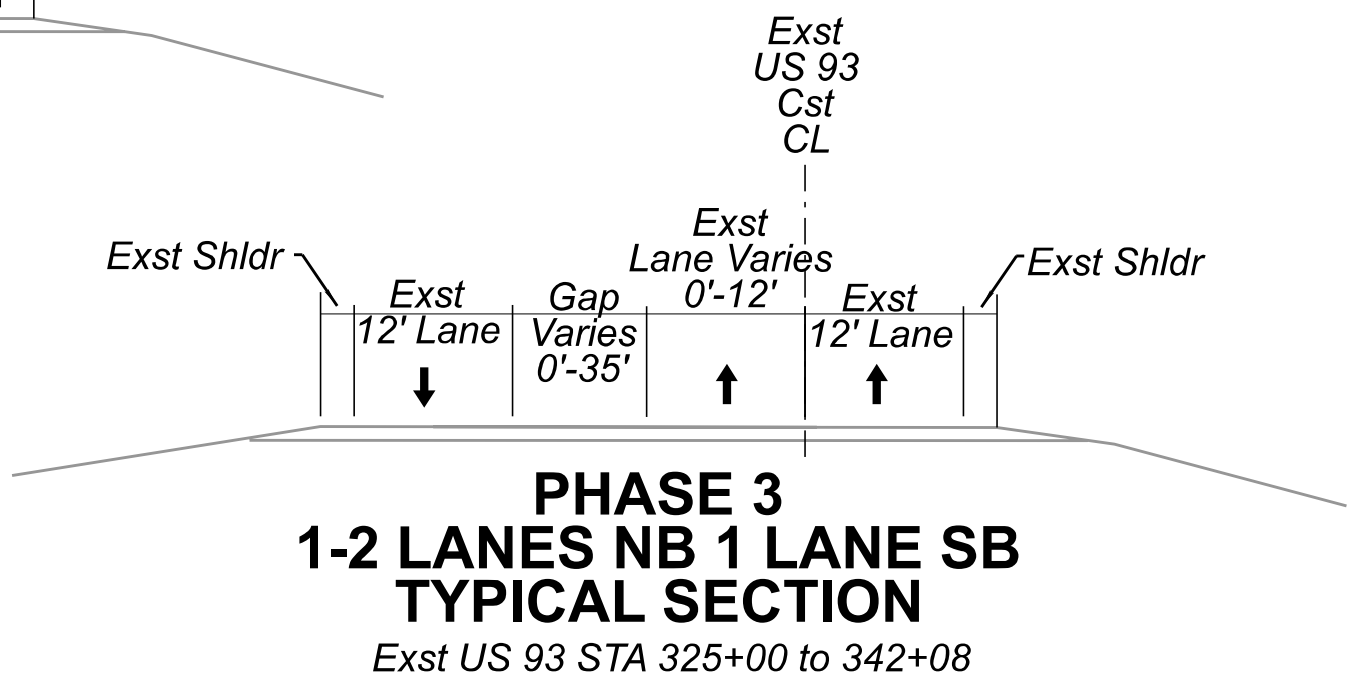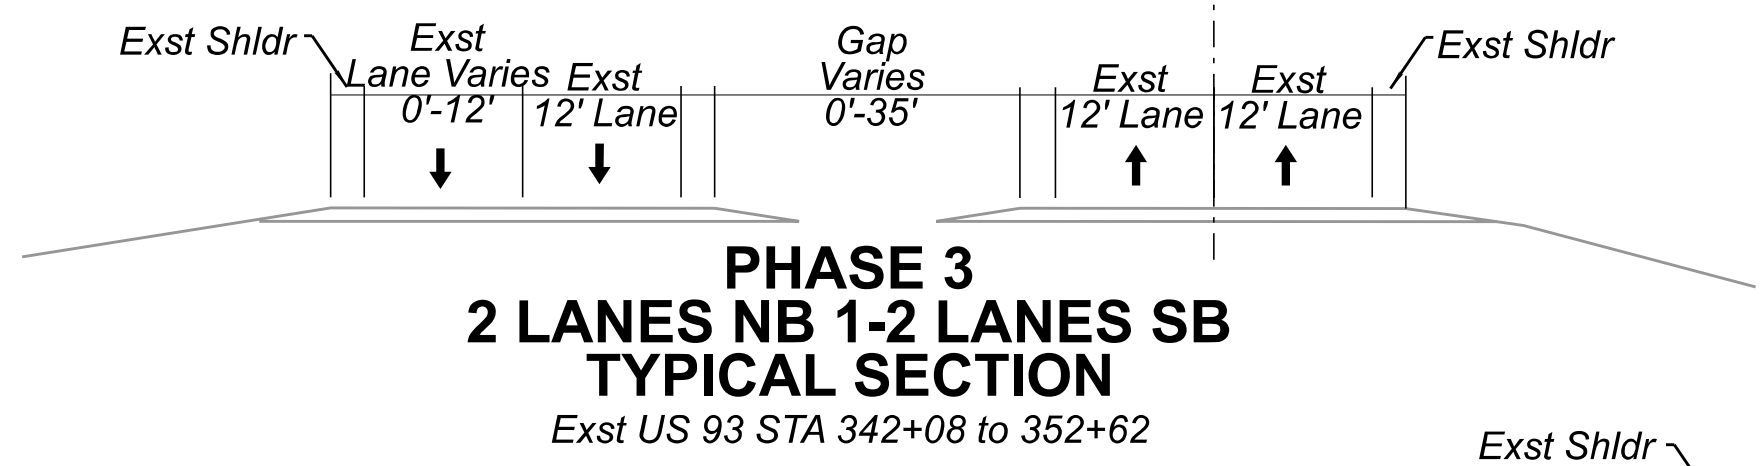



LEGEND

- Previously Constructed
- Phase 3 Roadway Construction
- Phase 3 Temporary Pavement
- Traffic Flow Arrow & Number of Travel Lanes

		NAME	DATE	ARIZONA DEPARTMENT OF TRANSPORTATION PROJECT DELIVERY AND OPERATIONS DIVISION TRAFFIC DESIGN SERVICES		ROUTE	F.H.W.A. Arizona Division	STATE	PROJECT NO.	FEDERAL ID NO.	SHEET NO.	TOTAL SHEETS	RECORD DRAWING	
	DESIGN	I ROBLES	06/26	TRANSPORTATION AECOM TECHNICAL SERVICES, Inc. 7720 N. 16th St., Suite 100 Phoenix, Arizona 85020 T 602.371.1100 www.aecom.com		US 93		ARIZ.	093 YV 190	093-B-NFA	299	524		
	DRAWN	C VALENCIA	06/26			MILEPOST	LOCATION VISTA ROYALE DWG No. T-1.15							
	CHECKED	C RICKETTS	06/26			190.5								
				TRAFFIC CONTROL SEQUENCING PHASE 3 SHEET 2 OF 2		STRUCTURE NO.	TRACS NO. F0738 01C		____ OF ____					

PHASE 4A

F.H.W.A. REGION	STATE	PROJECT NO.	SHEET NO.	TOTAL SHEETS	RECORD DRAWING
9	ARIZ.	093-B(230)T	300	524	
093 YV 189					

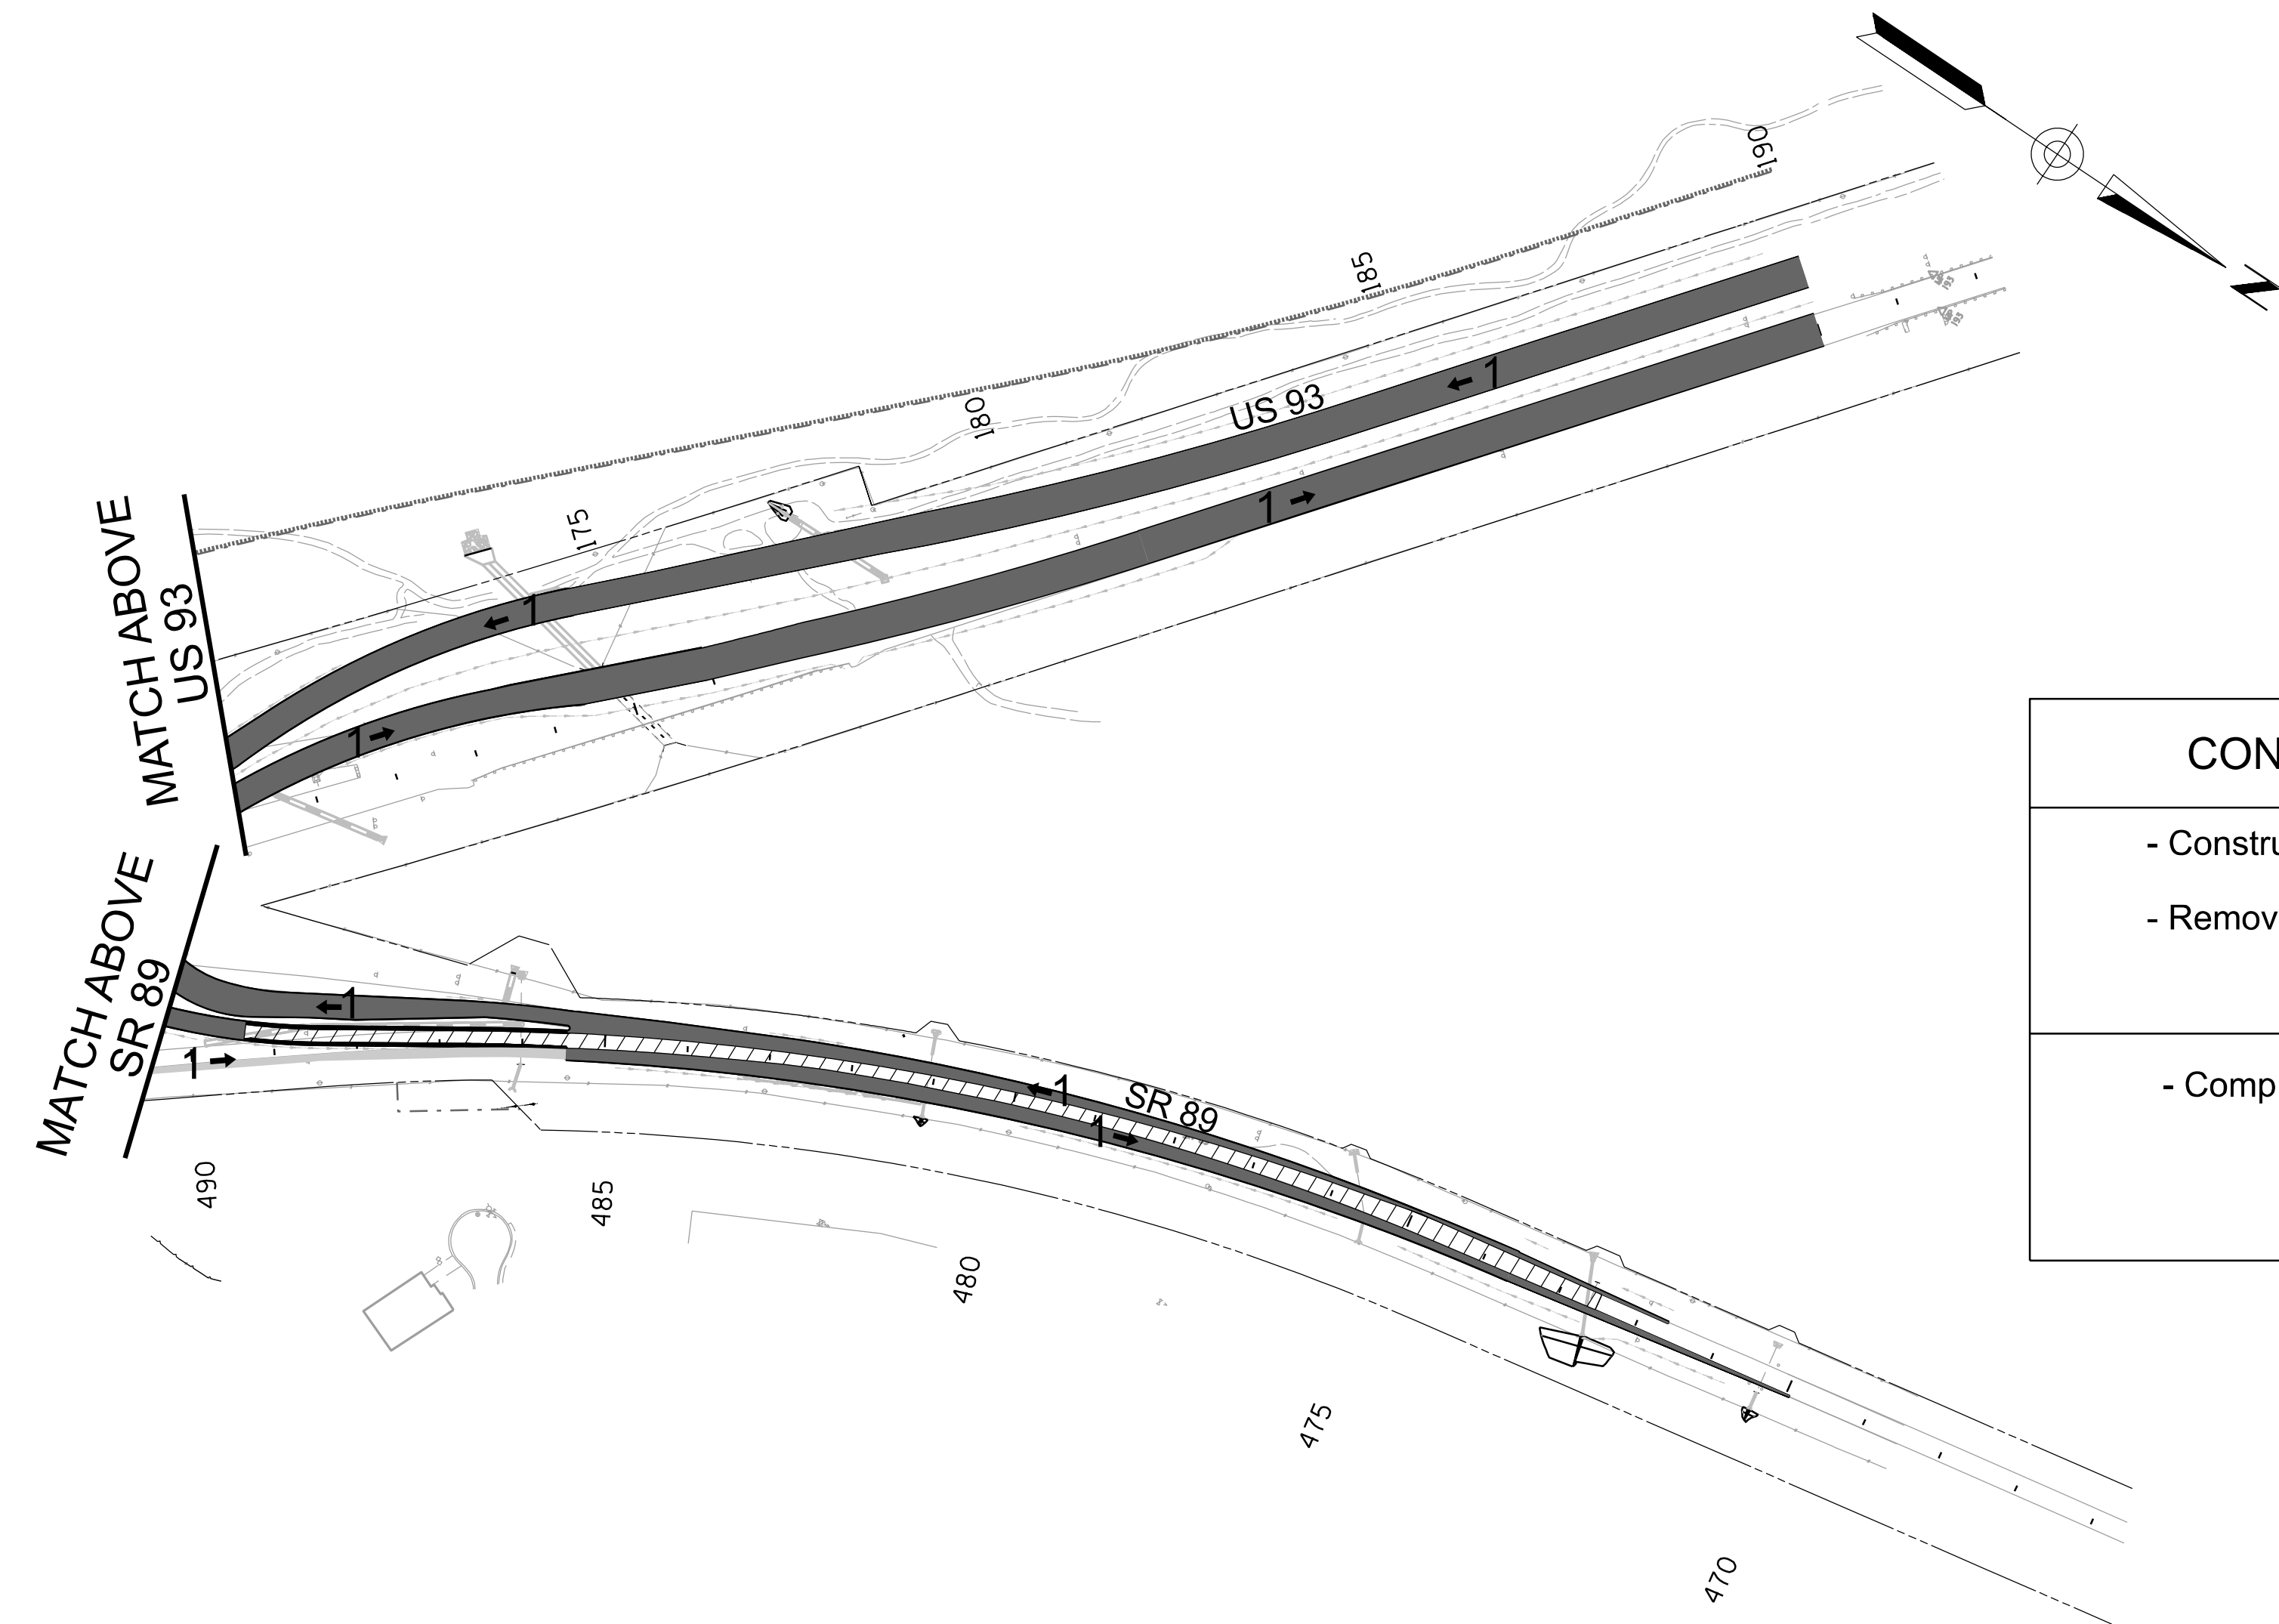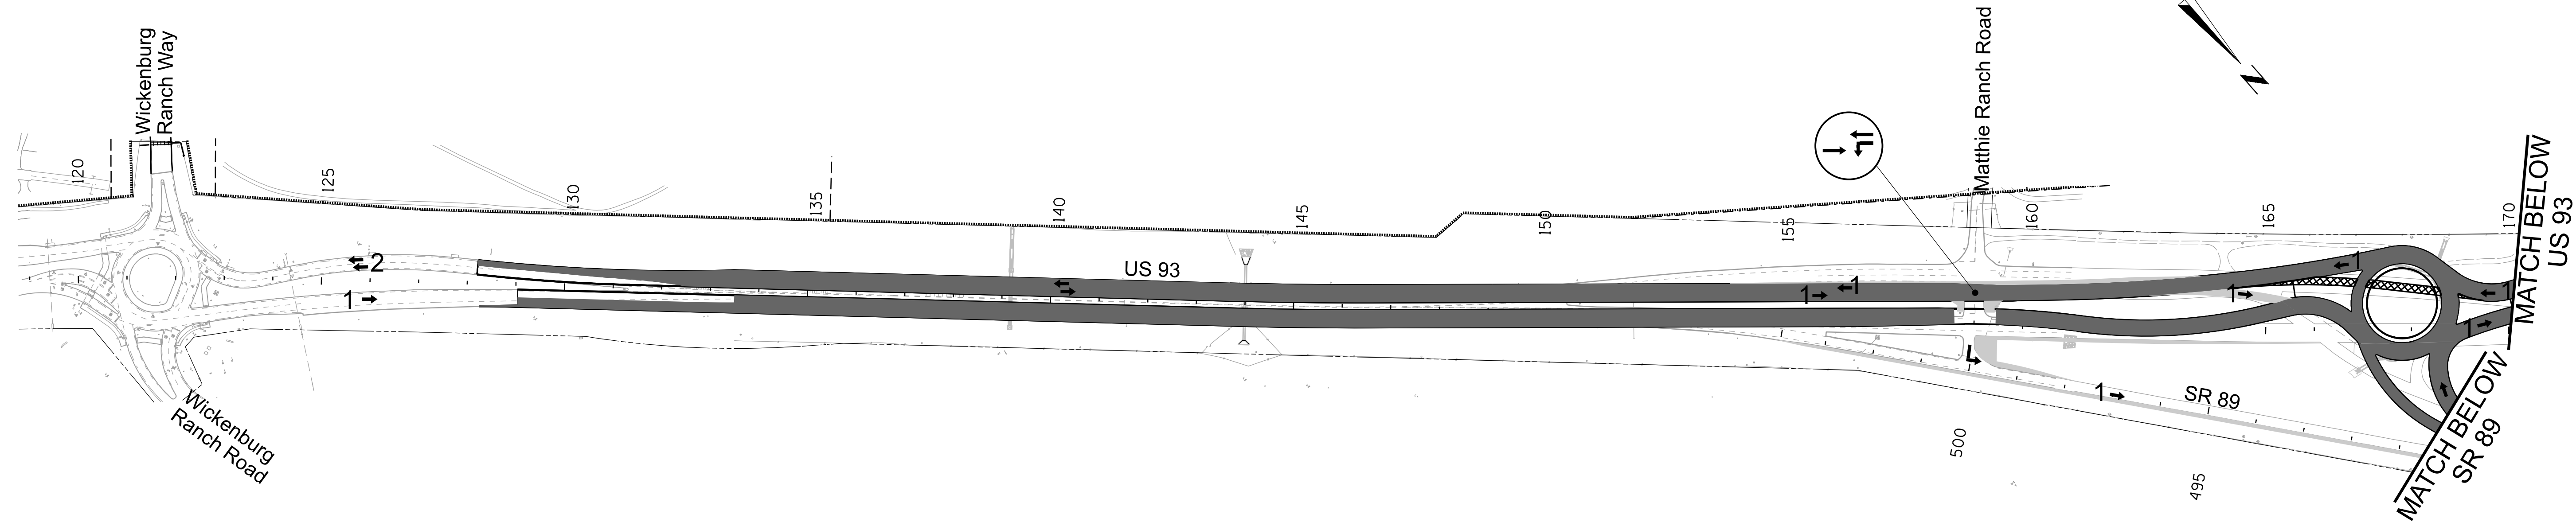

LEGEND




- = Previously Constructed
- = Temporary Pavement
- = Phase 4A Roadway Construction
- = Temporary Pavement Removal
- = Traffic Flow Arrow & Number of Travel Lanes

PHASE 4A

CONSTRUCTION ACTIVITY	MAINTENANCE OF TRAFFIC
- Construct portion of US 93 NB. - Remove temporary paving no longer in use.	Maintain traffic per Dwg. Nos. T-2.26 thru T-2.32. Open roundabout and maintain one lane. South of roundabout maintain one lane of traffic in each direction on newly constructed SB US 93 and Temporary Pavement. North of roundabout maintain one lane in each direction on newly constructed NB and SB US 93.
- Complete improvements on SR 89	NB SR 89 traffic continue to use slip ramp to access US 93 at Matthie Ranch Road intersection. SB SR 89 traffic to utilize newly constructed SB SR 89 to access US 93 via roundabout. Maintain access to SR 89 per MUTCD TA-10 during construction of tie-in point between Sta 470+00 and Sta 480+00.

		NAME	DATE	ARIZONA DEPARTMENT OF TRANSPORTATION PROJECT DELIVERY AND OPERATIONS DIVISION TRAFFIC DESIGN SERVICES	
DESIGN		MEI	06/26		
DRAWN		SRH	06/26		
CHECKED		BMT	06/26		
 3133 East Camelback Road, Suite 100 Phoenix, Arizona 85016 Phone: 1602 333-2200				US 93/SR 89 CONSTRUCTION SEQUENCING PLAN PHASE 4A	
ROUTE		LOCATION			
US 93		WICKENBURG RANCH WAY TO VISTA ROYALE			DWG NO. T-1.16
TRACS NO. F0738 OIC			093-B(230)T		OF

Phase 4A

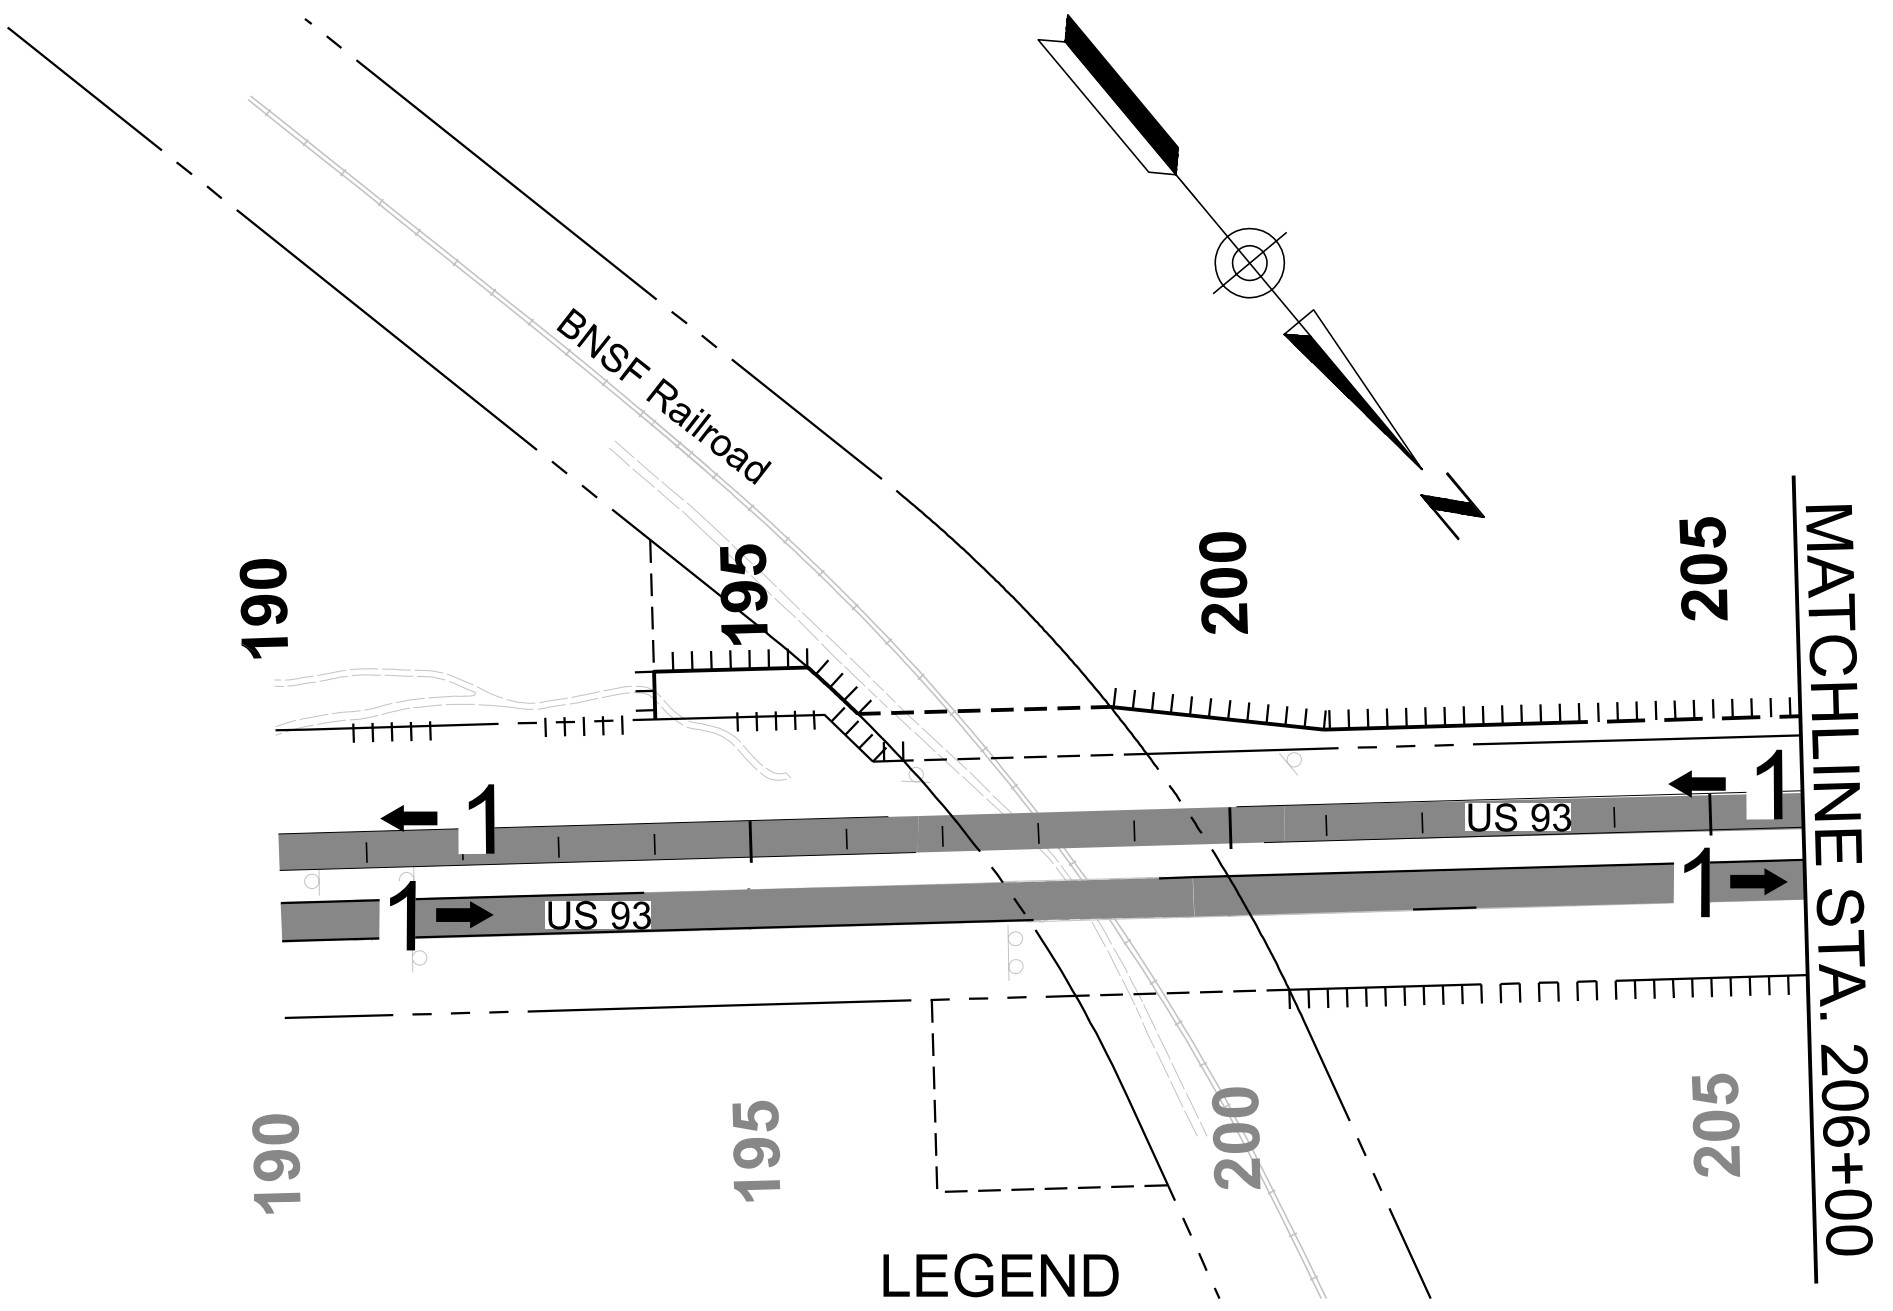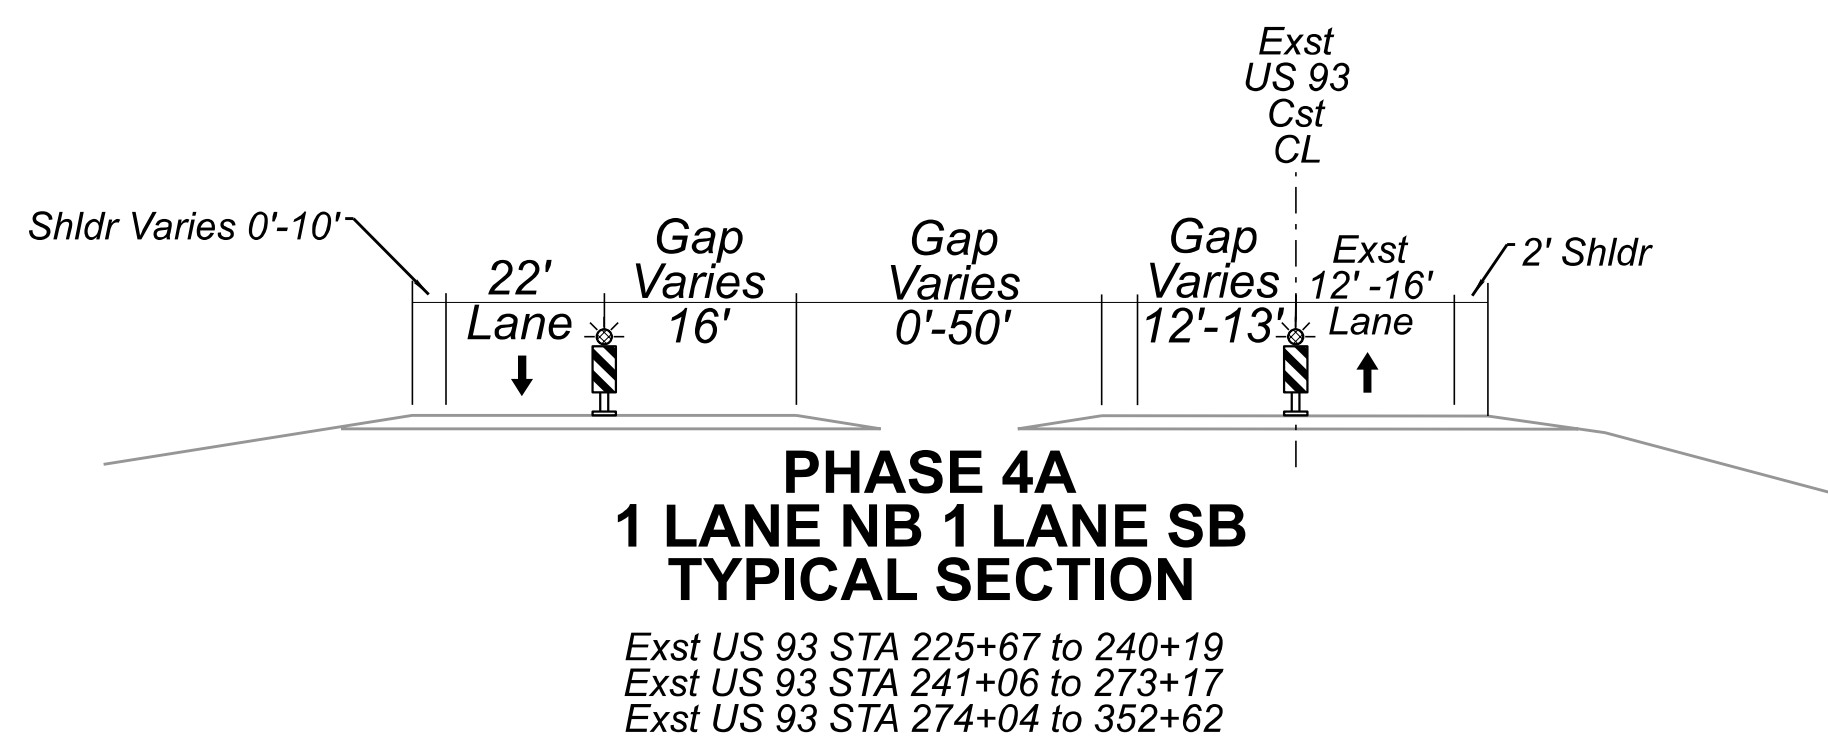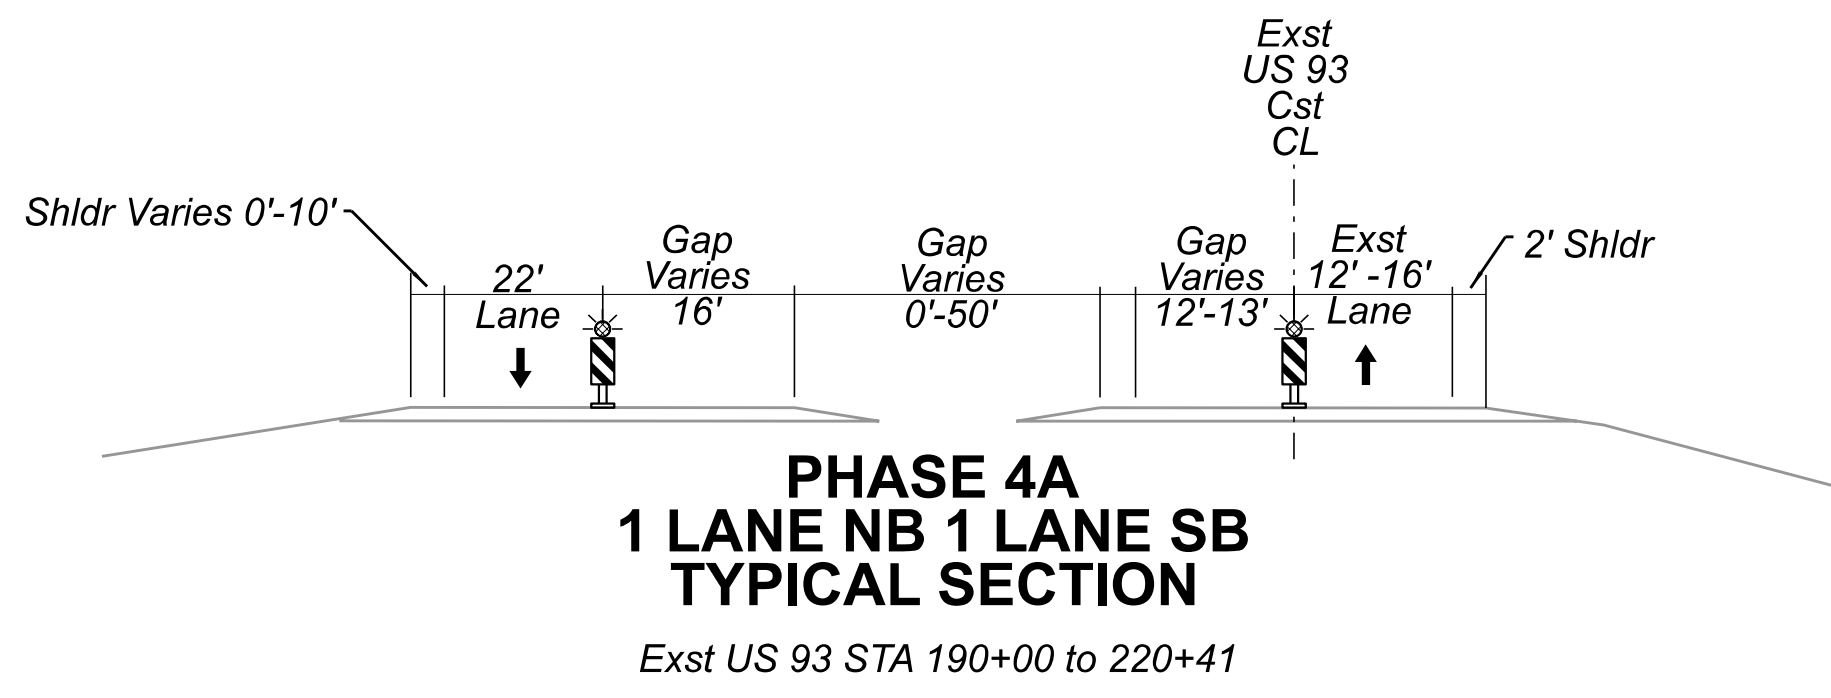


Phase 4A

CONSTRUCTION ACTIVITY	MAINTENANCE OF TRAFFIC
'On US 93: - Remove temporary pavement no longer in use. - Construct final portion of Moreton Rd roundabout.	- Maintain one lane of traffic on each northbound and southbound proposed US 93 travel lanes.

LEGEND

- Previously Constructed
- Phase 4A Roadway Construction
- Phase 4A Temporary Pavement
- Traffic Flow Arrow & Number of Travel Lanes

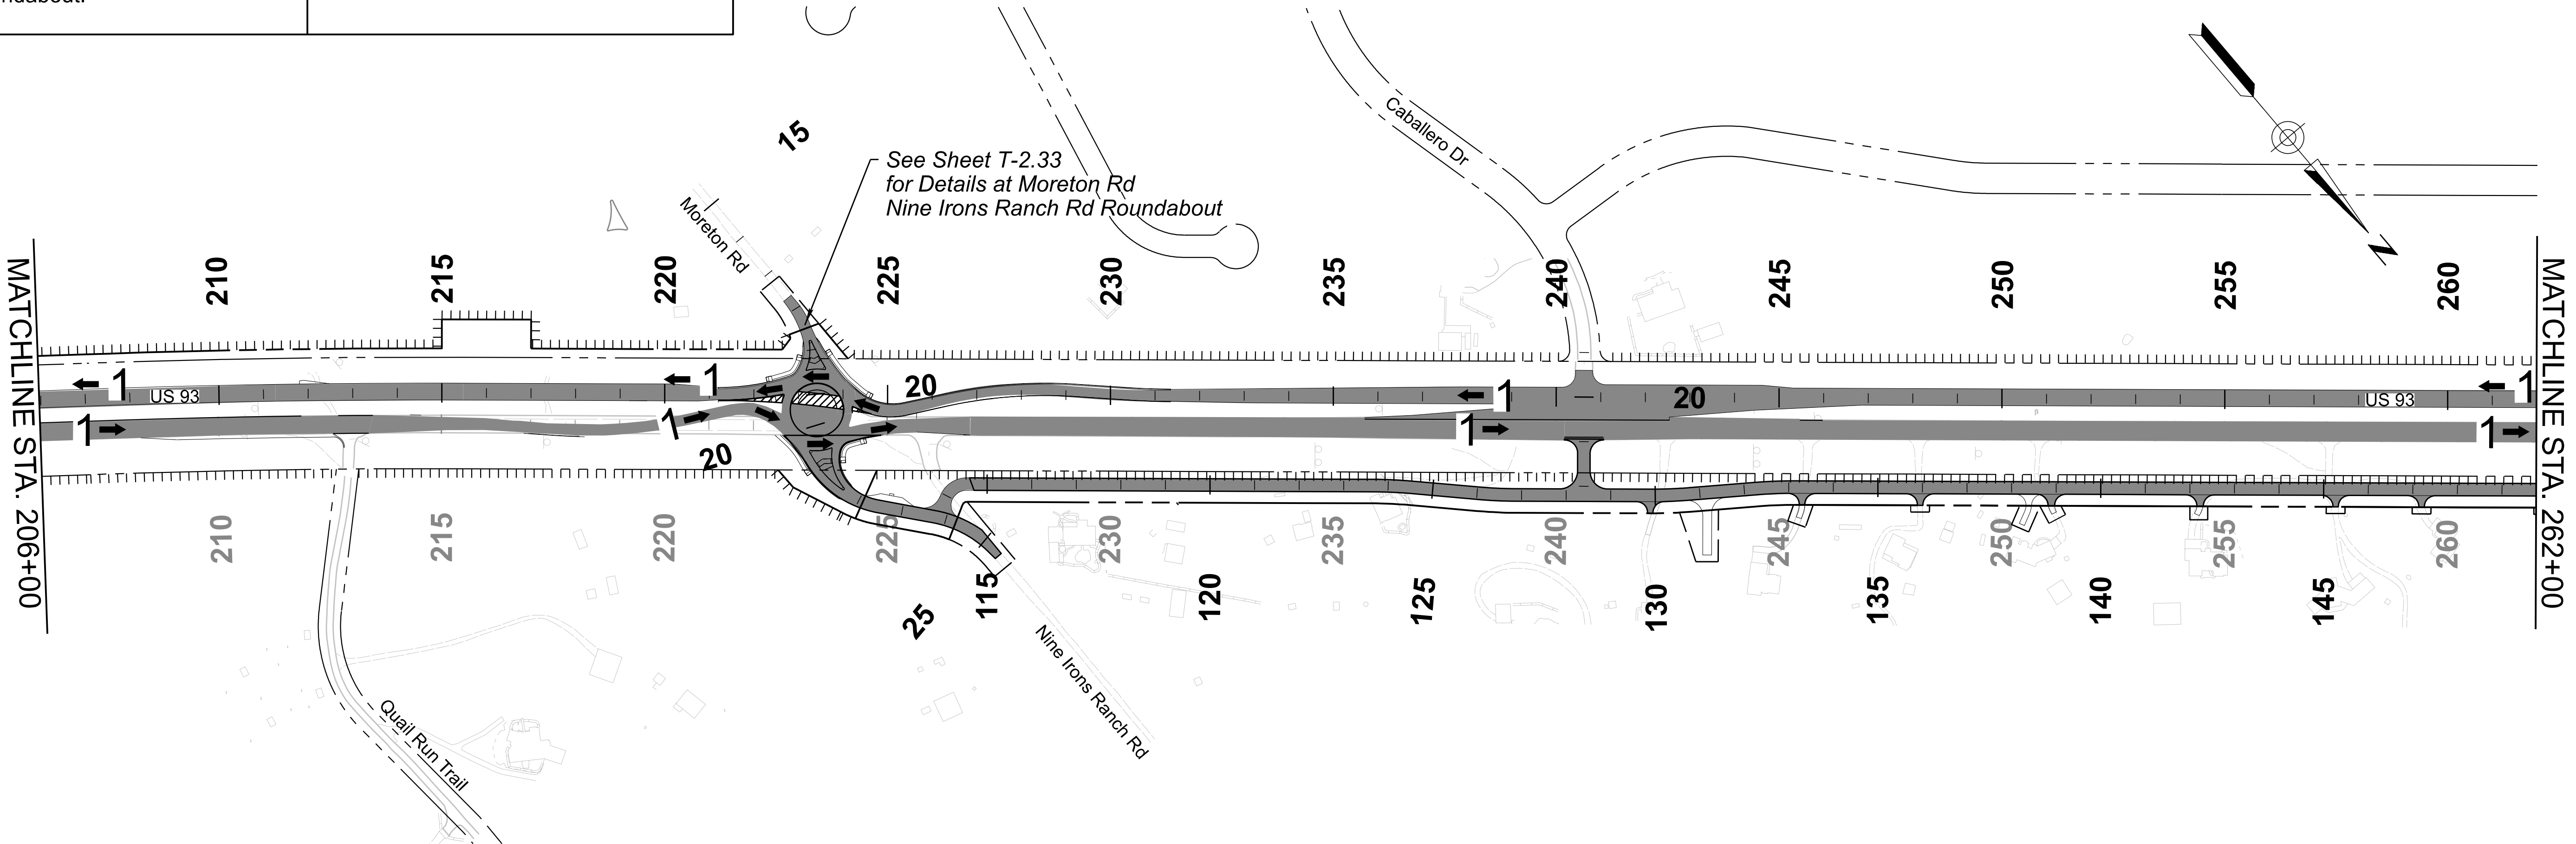

	NAME	DATE
DESIGN	I ROBLES	06/26
DRAWN	C VALENCIA	06/26
CHECKED	C RICKETTS	06/26


TRANSPORTATION
AECOM TECHNICAL SERVICES, Inc.
7720 N. 16th St., Suite 100
Phoenix, Arizona 85020
T 602.371.1100

AECOM
www.aecom.com

ARIZONA DEPARTMENT OF TRANSPORTATION
PROJECT DELIVERY AND OPERATIONS DIVISION
TRAFFIC DESIGN SERVICES
TRAFFIC CONTROL SEQUENCING
PHASE 4A
SHEET 1 OF 2

ROUTE US 93		F.H.W.A. Arizona Division	STATE	PROJECT NO.	FEDERAL ID NO.	SHEET NO.	TOTAL SHEETS	RECORD DRAWING
MILEPOST 190.5			ARIZ.	093 YV 190	093-B-NFA	301	524	
		LOCATION VISTA ROYALE						DWG No. T-1.17
STRUCTURE NO.		TRACS NO. F0738 01C			____ OF ____			


PHASE 4A

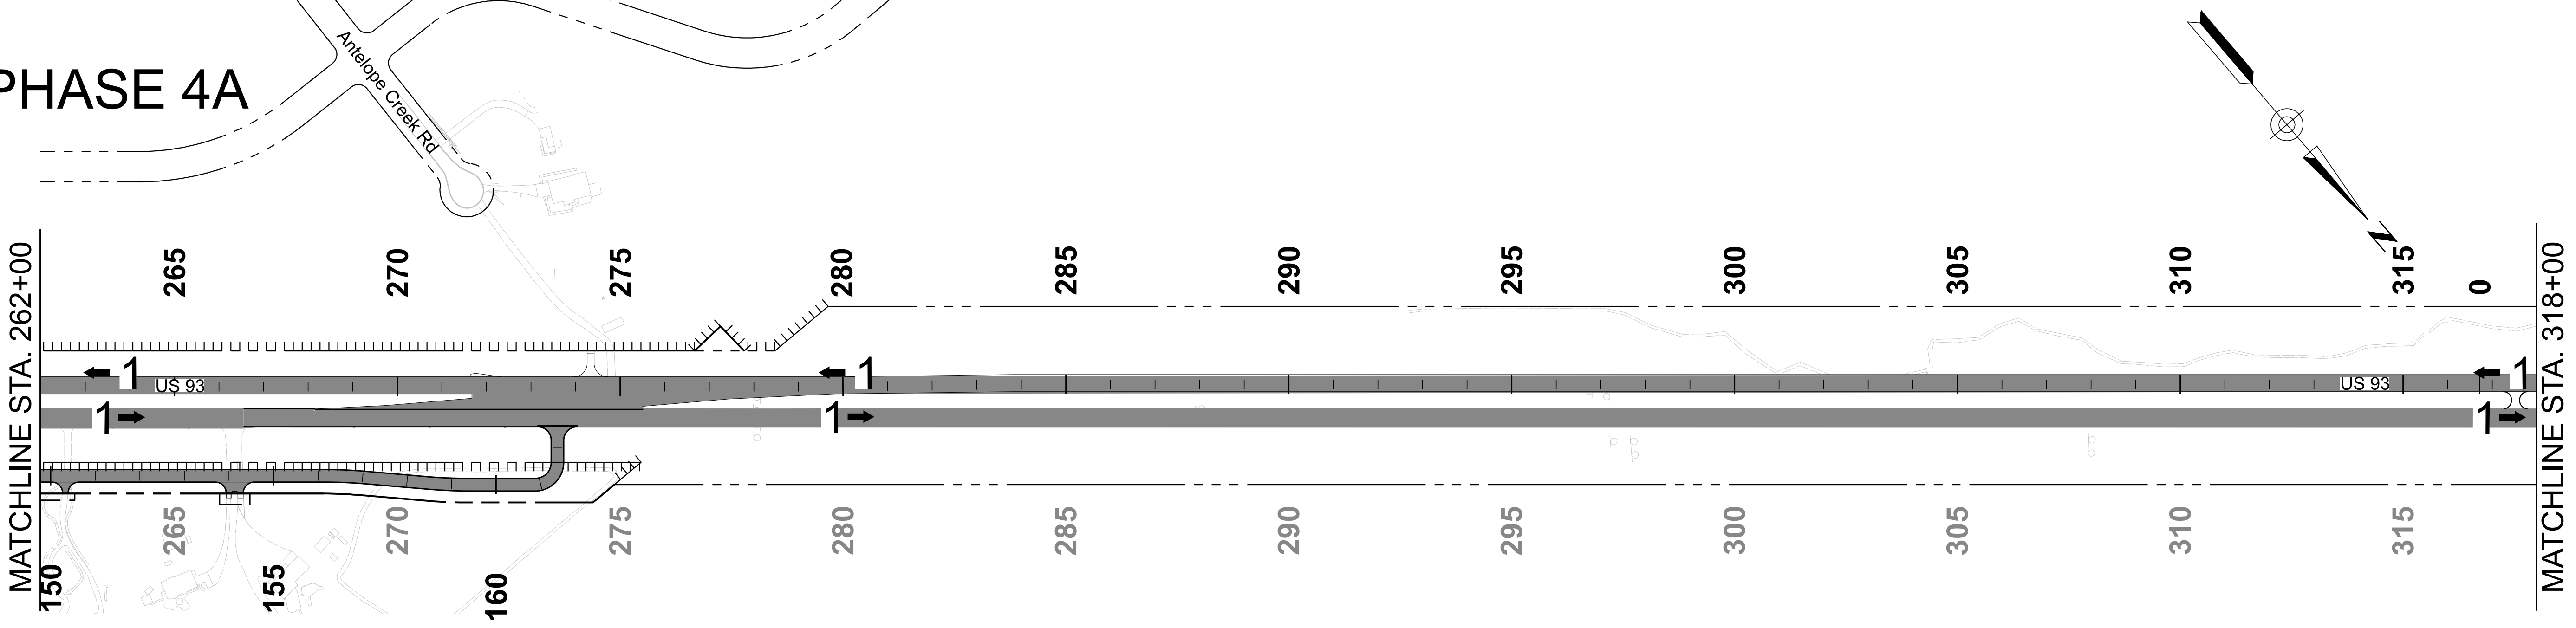


CONSTRUCTION ACTIVITY	MAINTENANCE OF TRAFFIC
- Remove crossover temporary pavement.	- Traffic use proposed pavement to maintain one lane in each direction of US 93.

LEGEND


- Previously Constructed
- Phase 4A Roadway Construction
- Phase 4A Temporary Pavement
- Traffic Flow Arrow & Number of Travel Lanes

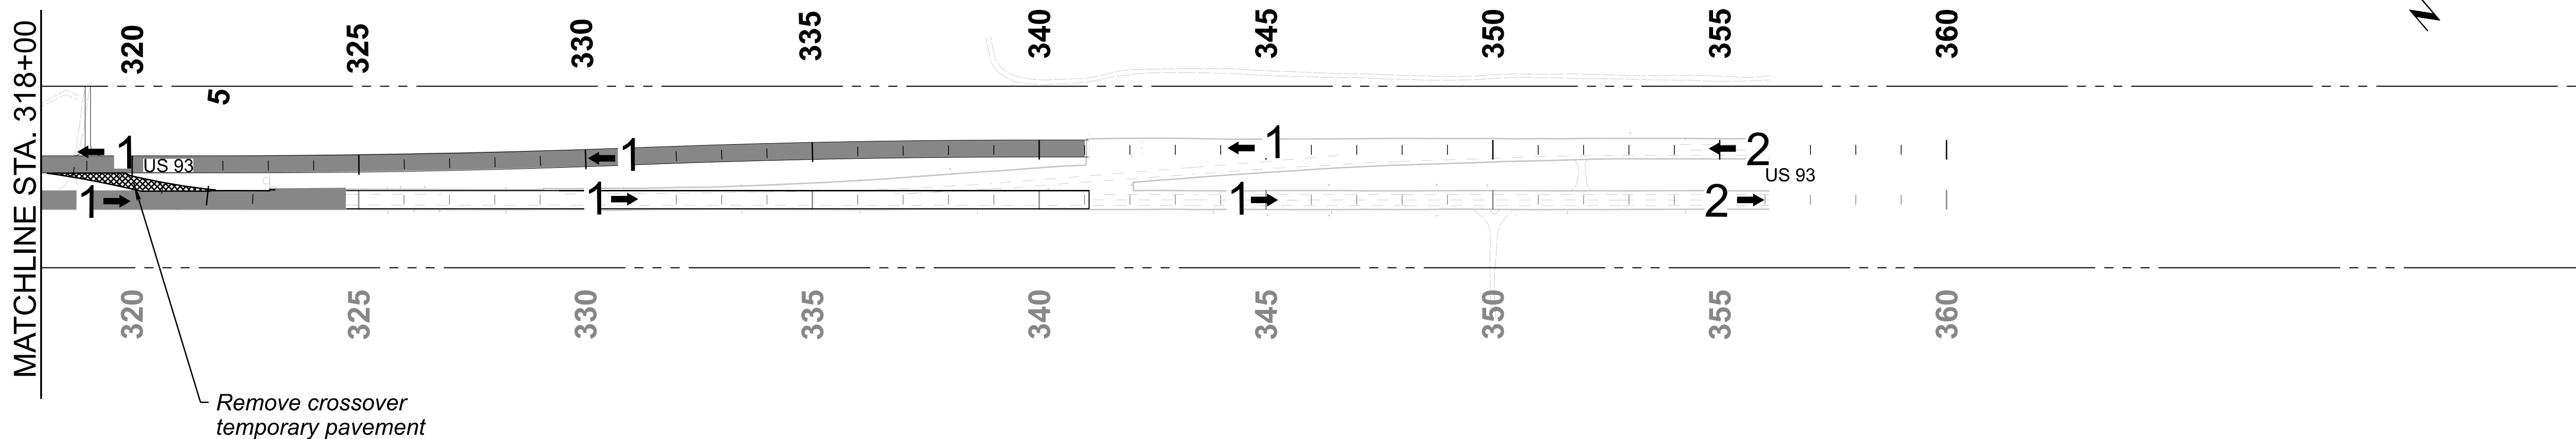

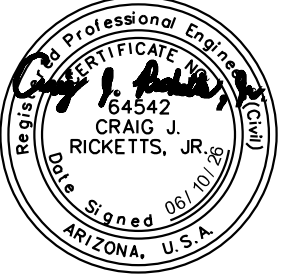	DESIGN	NAME	DATE	ARIZONA DEPARTMENT OF TRANSPORTATION PROJECT DELIVERY AND OPERATIONS DIVISION TRAFFIC DESIGN SERVICES TRAFFIC CONTROL SEQUENCING PHASE 4A SHEET 2 OF 2	ROUTE	F.H.W.A. Arizona Division	STATE	PROJECT NO.	FEDERAL ID NO.	SHEET NO.	TOTAL SHEETS	RECORD DRAWING
	DRAWN	C VALENCIA	06/26		US 93	ARIZ.	093 YV 190	093-B-NFA	302	524		
	CHECKED	C RICKETTS	06/26		MILEPOST	190.5	LOCATION				VISTA ROYALE	DWG No. T-1.18
	TRANSPORTATION AECOM TECHNICAL SERVICES, Inc. 7720 N. 16th St., Suite 100 Phoenix, Arizona 85020 T 602.371.1100 www.aecom.com				STRUCTURE NO.	TRACS NO. F0738 01C				____ OF ____		

PHASE 4B

F.H.W.A. REGION	STATE	PROJECT NO.	SHEET NO.	TOTAL SHEETS	RECORD DRAWING
9	ARIZ.	093-B(230)T	303	524	
093 YV 189					

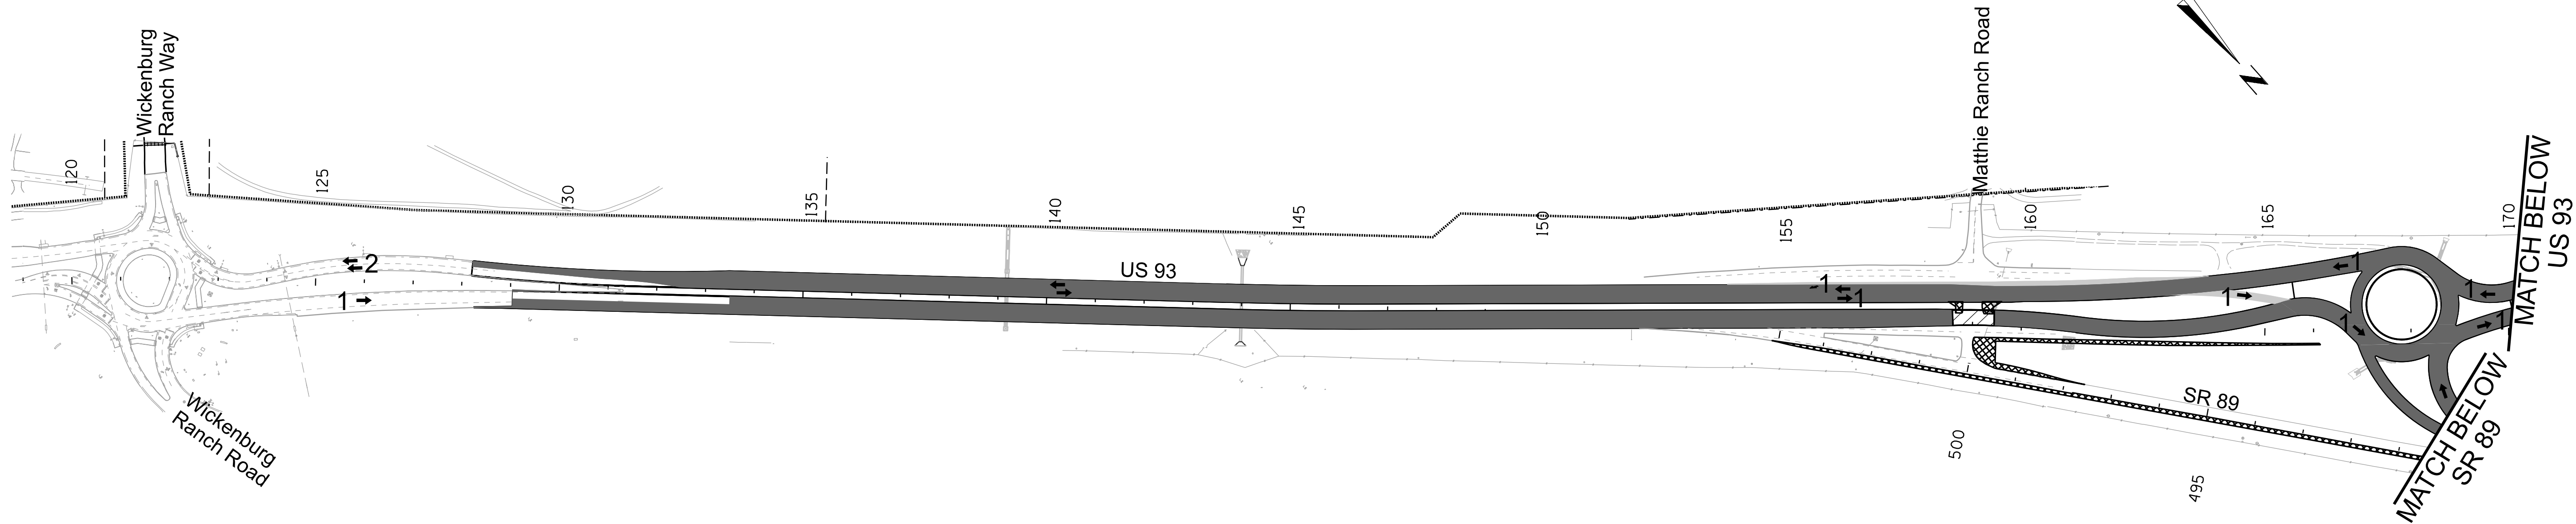


LEGEND

- = Previously Constructed
- = Temporary Pavement
- = Phase 4B Roadway Construction
- = Temporary Pavement Removal
- = Traffic Flow Arrow & Number of Travel Lanes

PHASE 4B



CONSTRUCTION ACTIVITY	MAINTENANCE OF TRAFFIC
- Construct remaining portion of NB US 93 at old Matthie Ranch Road intersection. - Remove temporary paving no longer in use.	Maintain traffic per Dwg. Nos. T-2.34 thru T-2.36. Open roundabout and maintain one lane. South of roundabout maintain one lane of traffic in each direction on newly constructed SB US 93 and Temporary Pavement. North of roundabout maintain one lane in each direction on newly constructed NB and SB US 93. NB and SB SR 89 traffic utilize newly constructed SR 89 to access US 93 via roundabout.

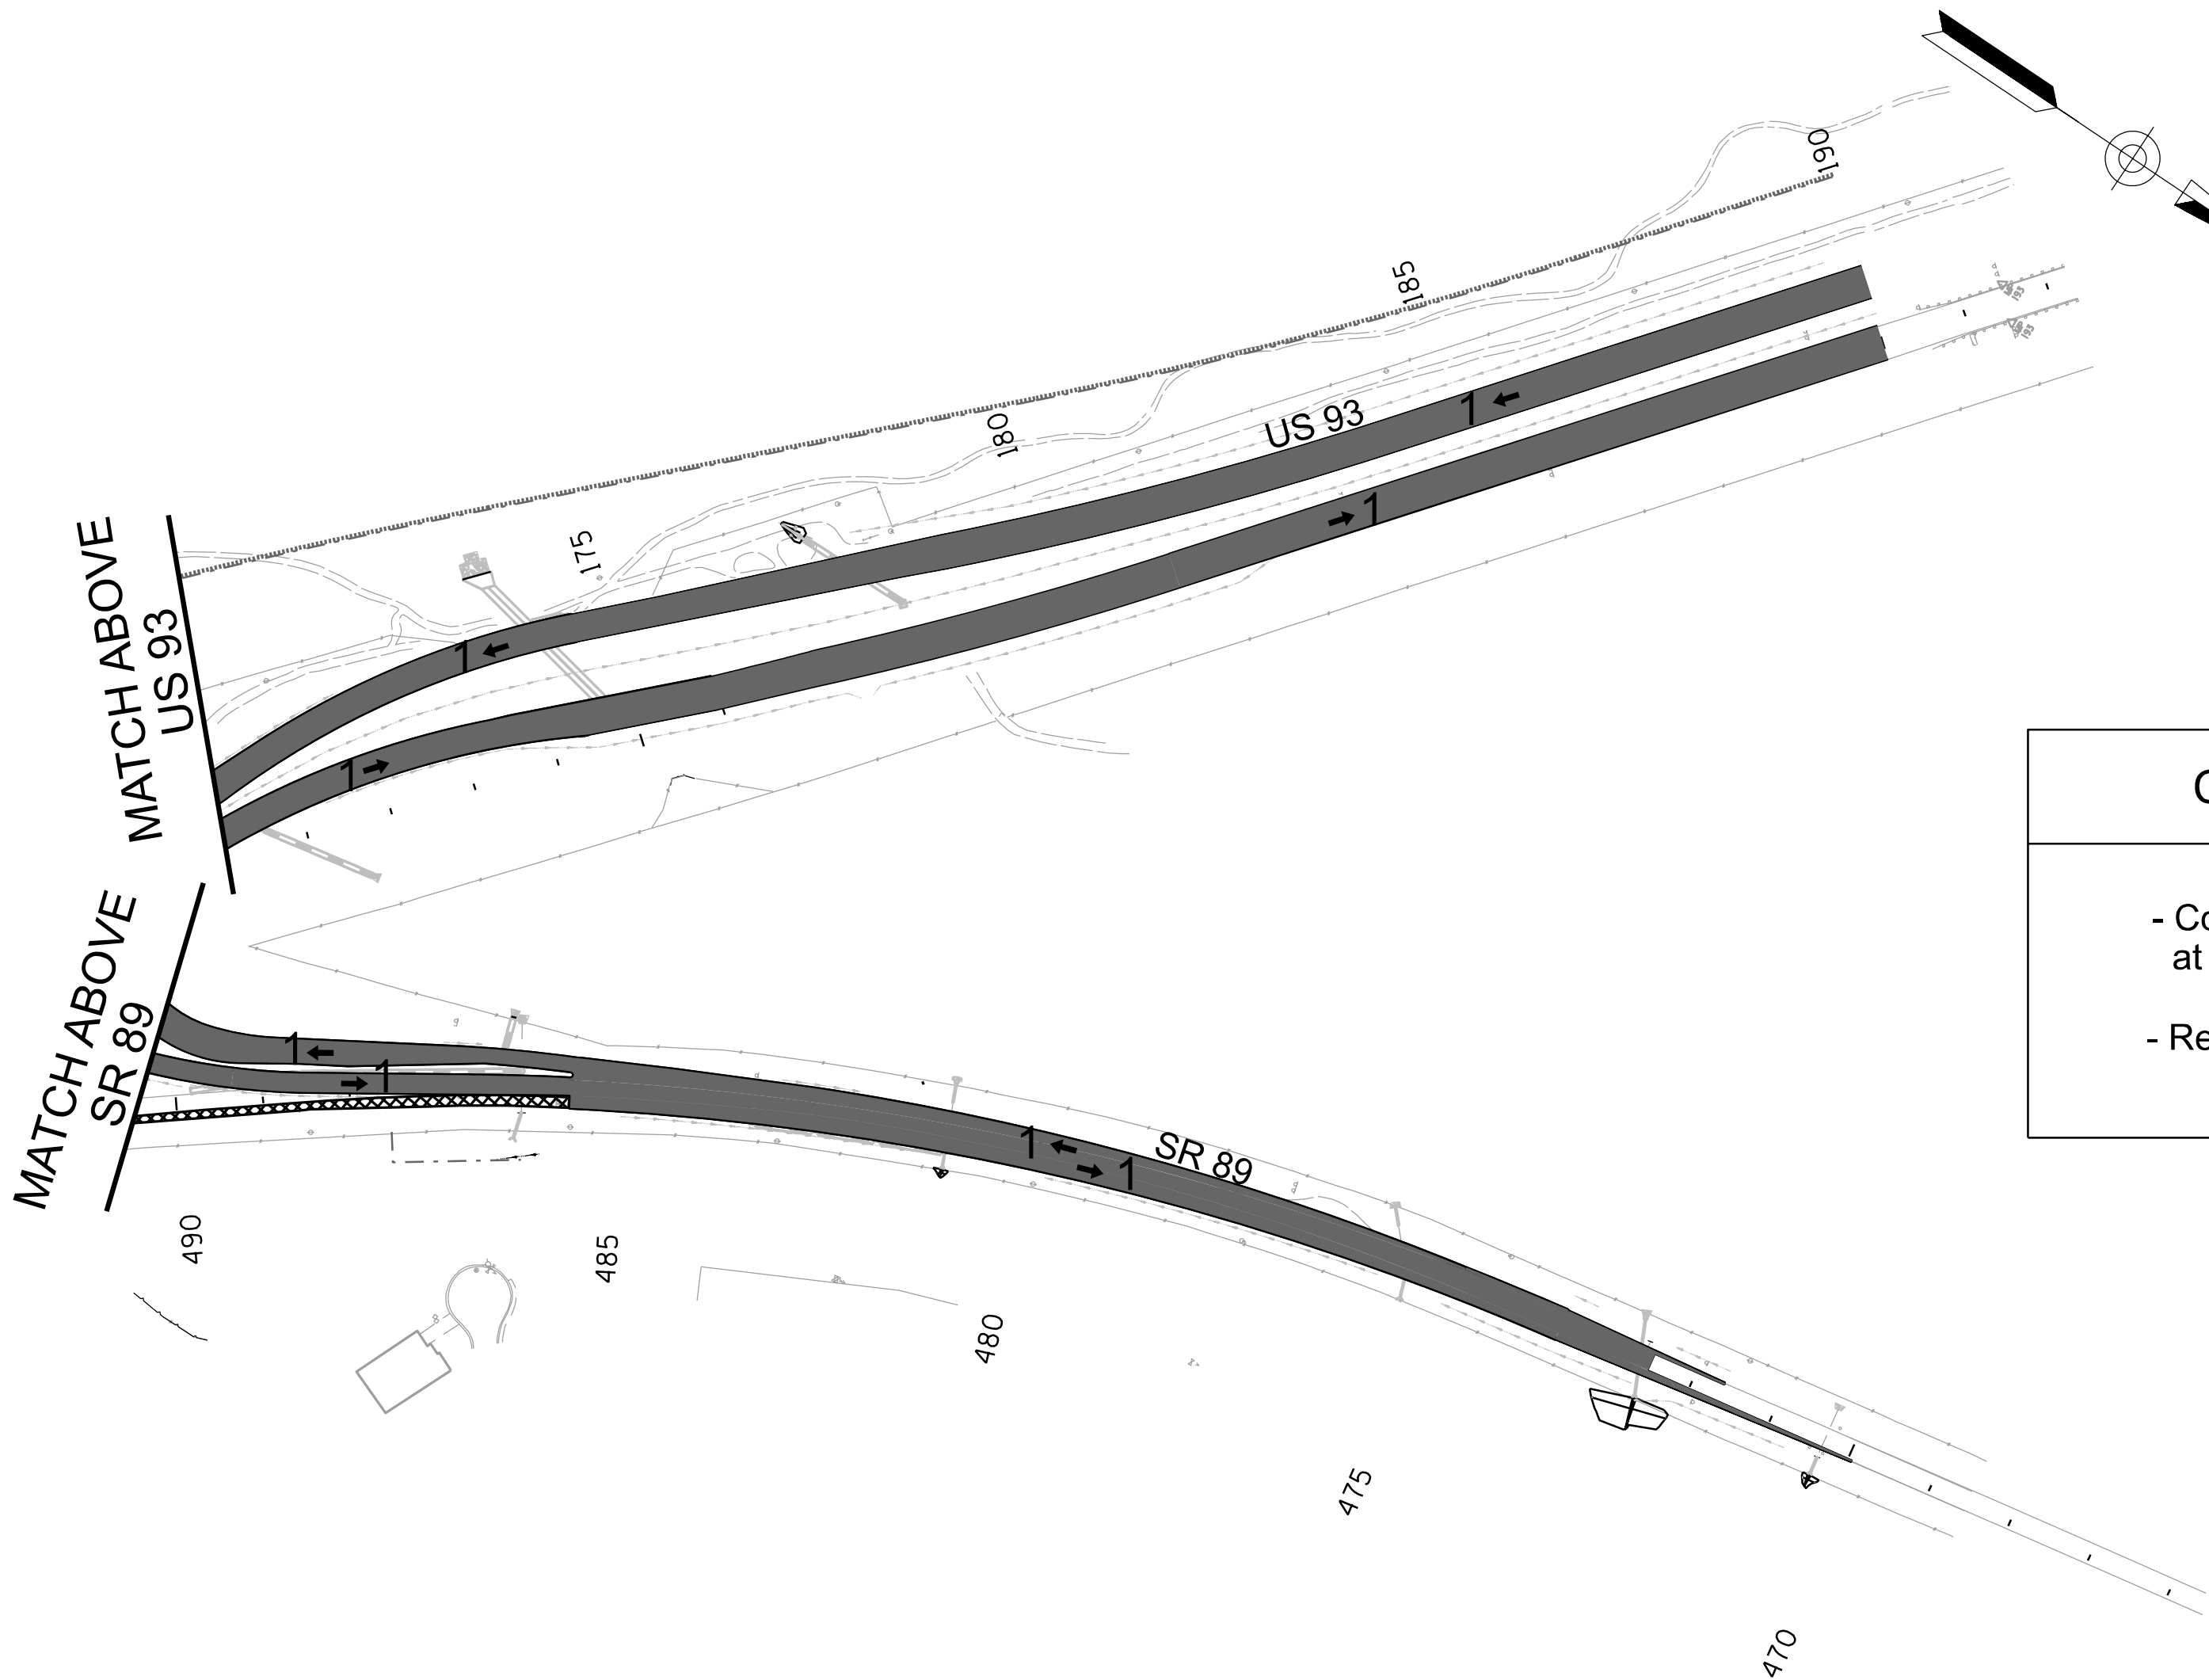

		NAME	DATE	ARIZONA DEPARTMENT OF TRANSPORTATION PROJECT DELIVERY AND OPERATIONS DIVISION TRAFFIC DESIGN SERVICES	
DESIGN		MEI	06/26		
DRAWN		SRH	06/26		
CHECKED		BMT	06/26		
 Stanley Consultants Inc.		3133 East Camelback Road, Suite 100 Phoenix, Arizona 85016 Phone: (602) 333-2200		US 93/SR 89 CONSTRUCTION SEQUENCING PLAN PHASE 4B	
ROUTE		LOCATION			
US 93		WICKENBURG RANCH WAY TO VISTA ROYALE		DWG NO. T-1.19	
TRACS NO. F0738 OIC				093-B(230)T	<u> OF </u>

PHASE 5

F.H.W.A. REGION	STATE	PROJECT NO.	SHEET NO.	TOTAL SHEETS	RECORD DRAWING
9	ARIZ.	093-B(230)T	304	524	
093 YV 189					

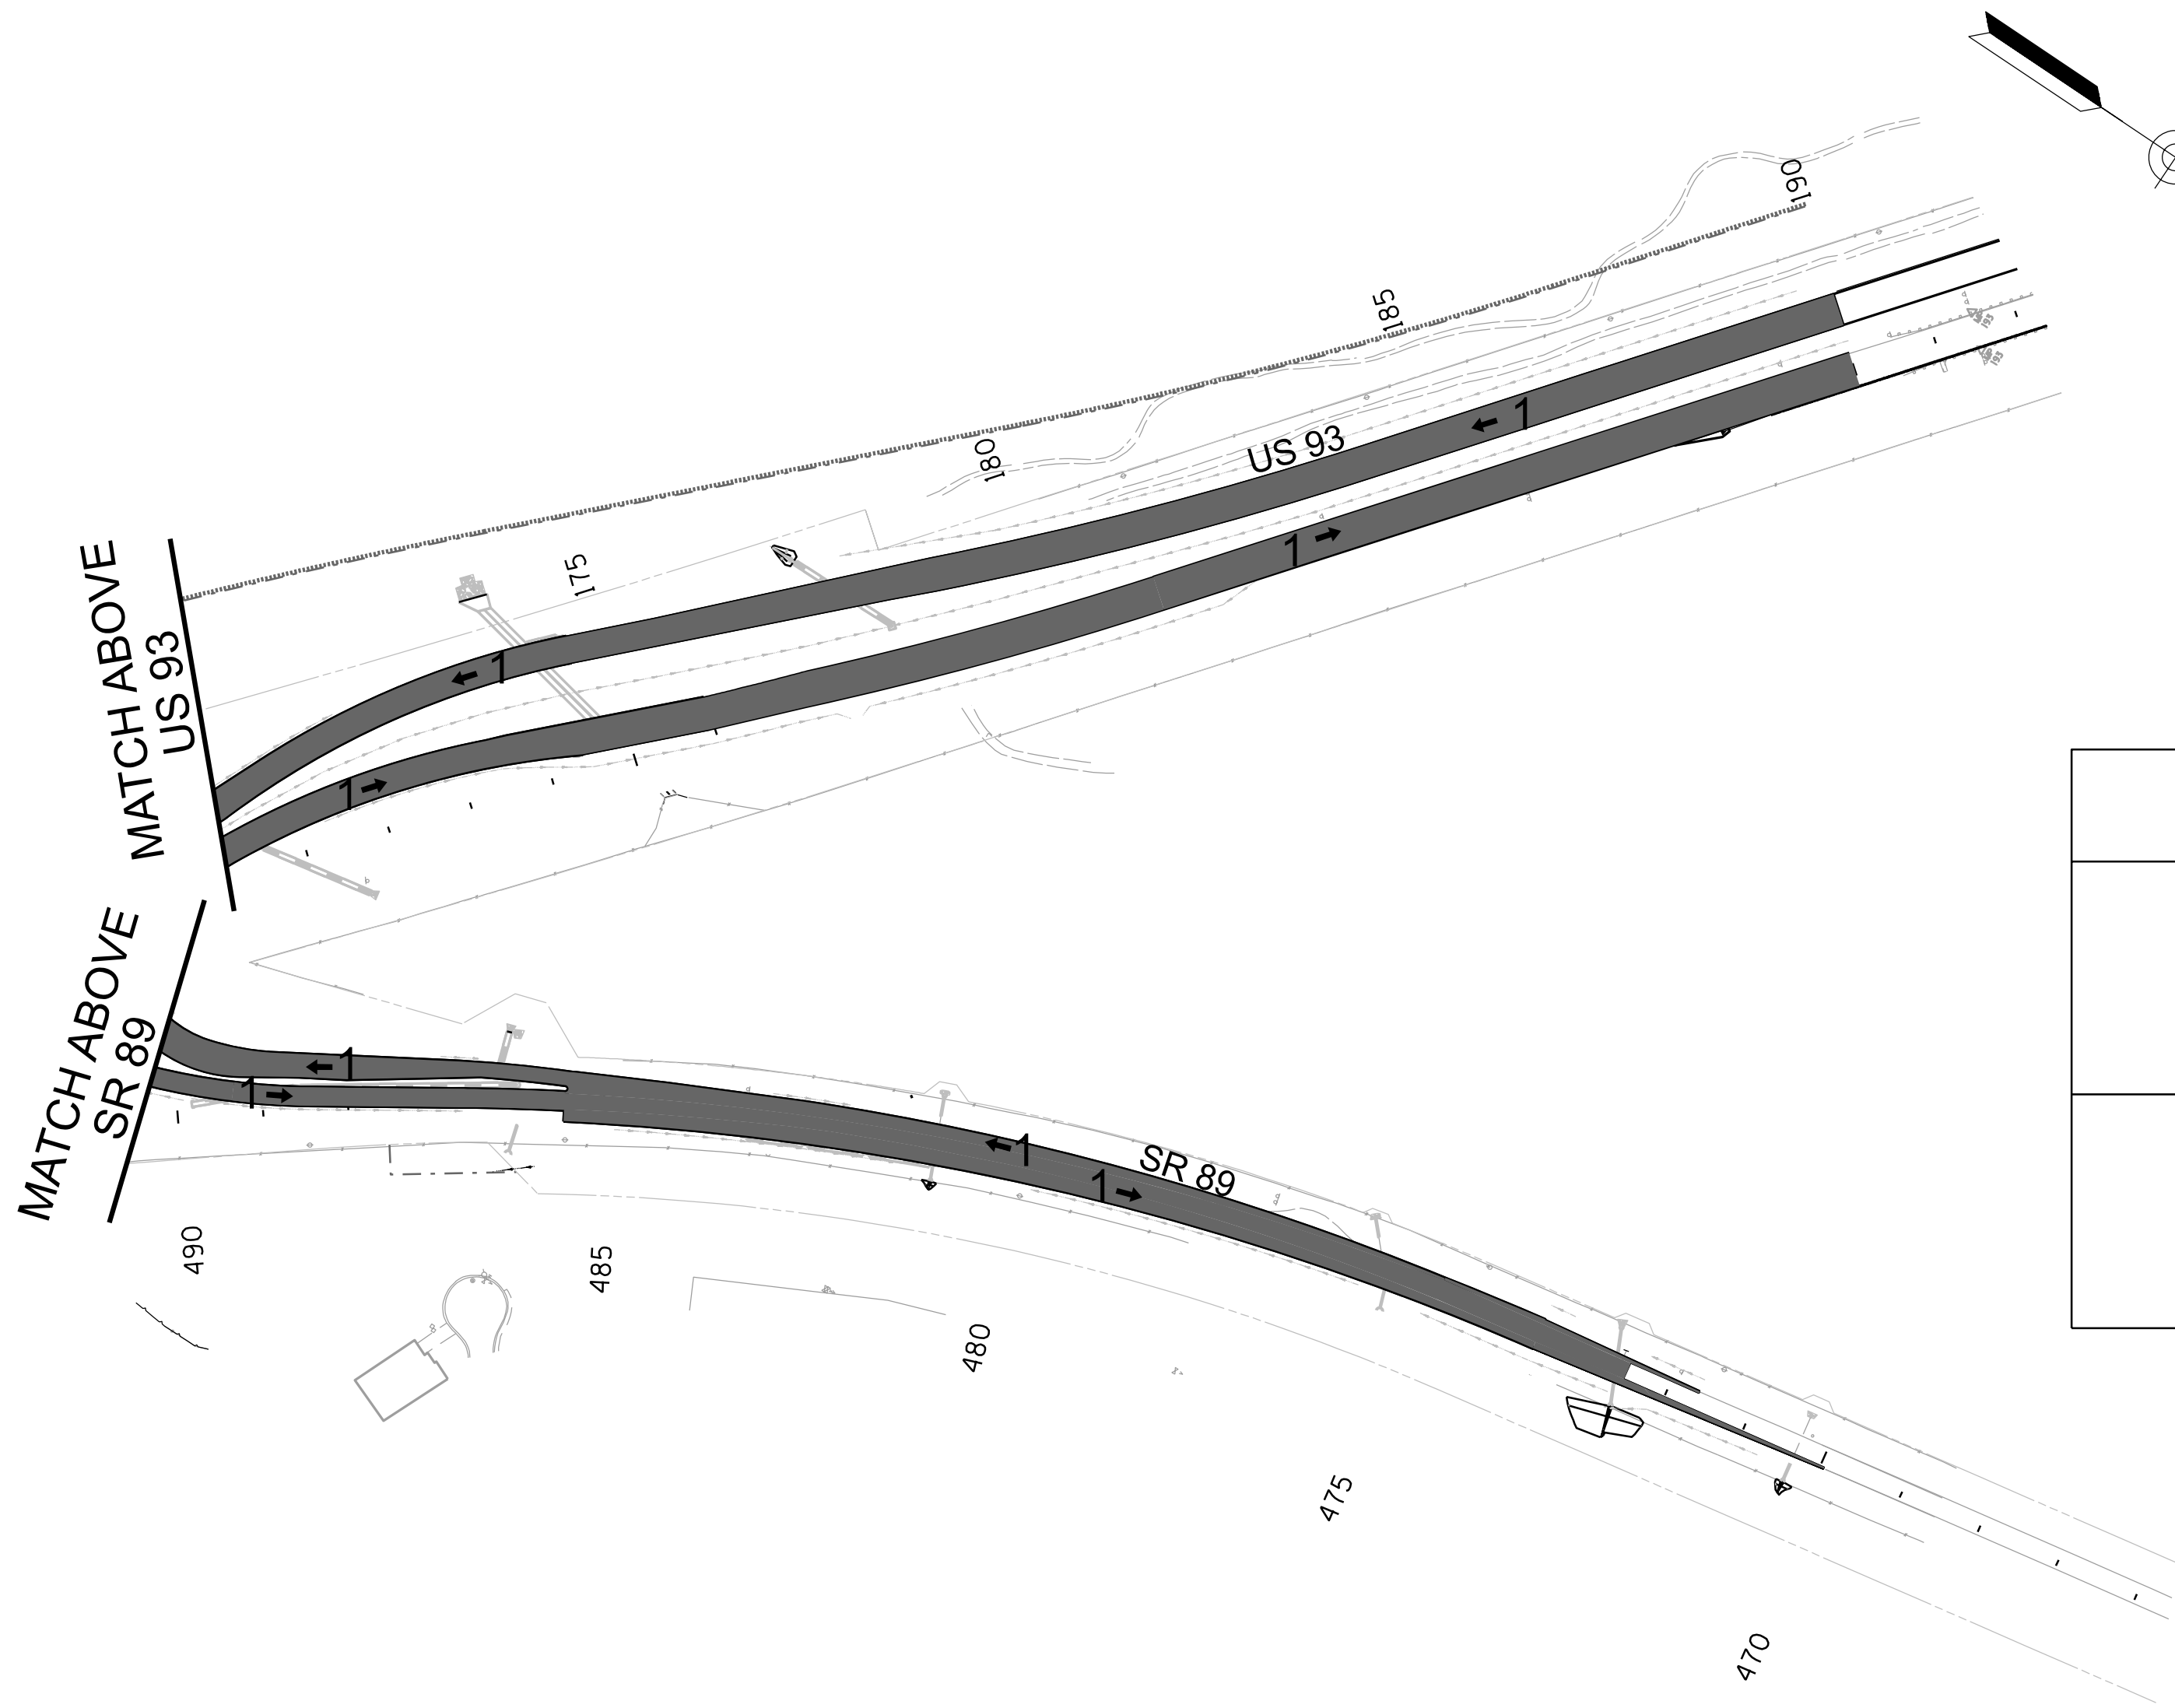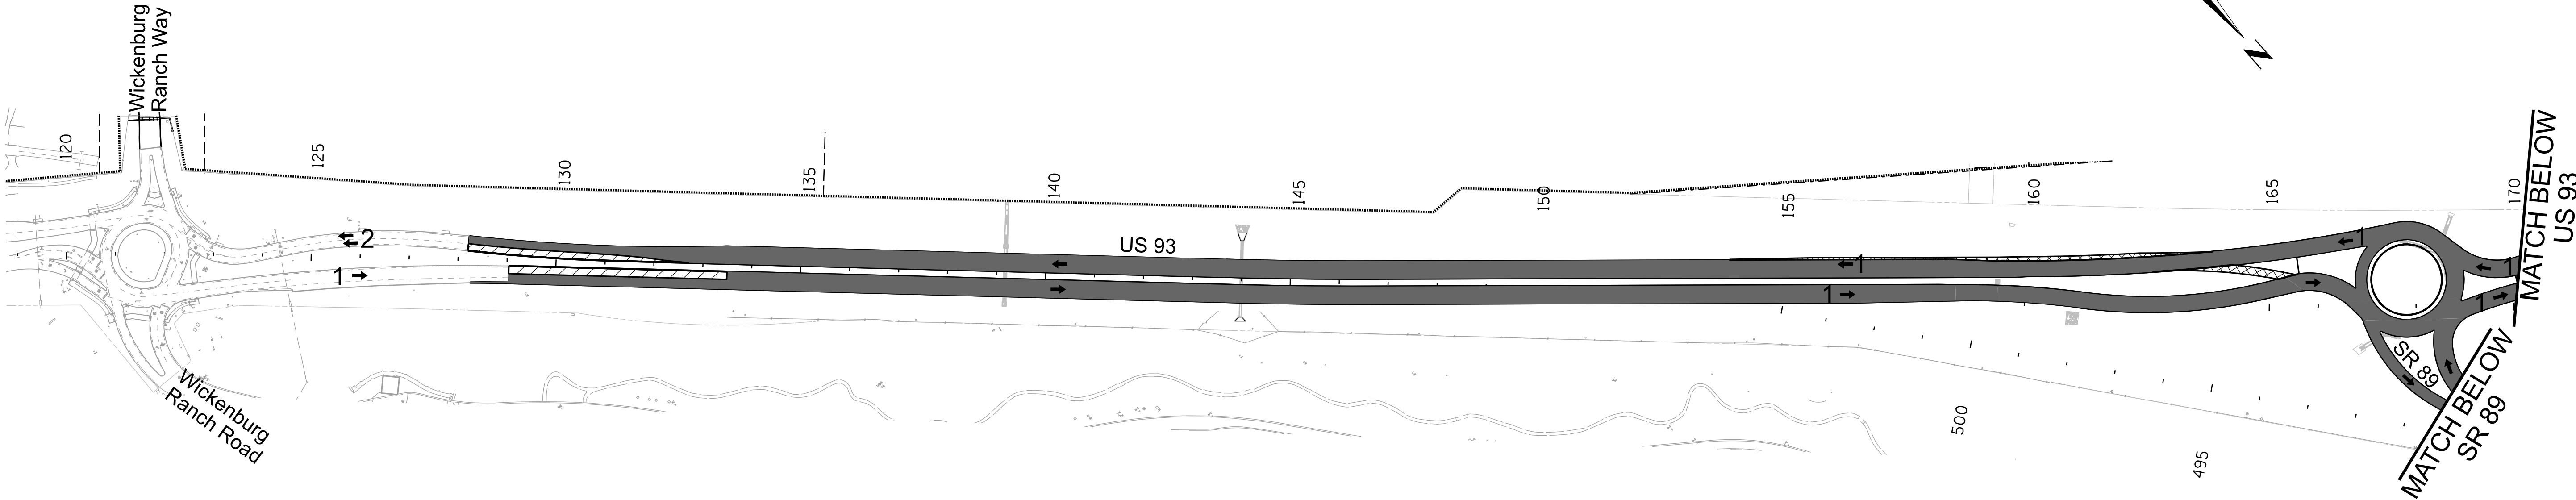

LEGEND

- = Previously Constructed
- = Temporary Pavement
- = Phase 5 Roadway Construction
- = Temporary Pavement Removal
- = Traffic Flow Arrow & Number of Travel Lanes

PHASE 5





CONSTRUCTION ACTIVITY	MAINTENANCE OF TRAFFIC
- Construct remaining portion of NB and SB US 93 between Sta. 128+22 and Sta. 133+48. - Remove temporary paving no longer in use.	NB and SB US 93 traffic utilize newly constructed US 93 maintaining one lane in each direction per Dwg. Nos. T-2.37 thru T-2.43. NB and SB SR 89 traffic utilize newly constructed SR 89 to access US 93 via roundabout.
- Pave Final AC lift (SMA). Install US 93 ATR Loops.	Install final AC lift per MUTCD TA-10 and ADOT Traffic Control Guidelines SA-5.


		NAME	DATE	ARIZONA DEPARTMENT OF TRANSPORTATION PROJECT DELIVERY AND OPERATIONS DIVISION TRAFFIC DESIGN SERVICES	
DESIGN	MEI		06/26		
DRAWN	SRH		06/26		
CHECKED	BMT		06/26		
 3133 East Camelback Road, Suite 100 Phoenix, Arizona 85016 Phone: 1602 333-2200				US 93/SR 89 CONSTRUCTION SEQUENCING PLAN PHASE 5	
ROUTE		LOCATION			
US 93		WICKENBURG RANCH WAY TO VISTA ROYALE			
TRACS NO. F0738 OIC			093-B(230)T		DWG NO. T-1.20
					OF

PHASE 1

F.H.W.A. REGION	STATE	PROJECT NO.	SHEET NO.	TOTAL SHEETS	RECORD DRAWING
9	ARIZ.	093-B(230)T	305	524	
093 YV 189					

 LEGEND:

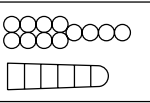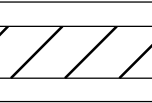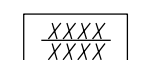	Direction Of Travel		Temporary Concrete Barrier
	Temporary Impact Attenuation Device		Temporary Pavement Work Zone
	Sign On Spring Stand		Permanent Pavement Work Zone
	Sign On Rigid Stand		CMB - Changeable Message Board
	Sign On Embedded Posts		Flashing Light & Warning Flags
	Type 2 Barricade		Vertical Panel
	Type 3 Barricade		

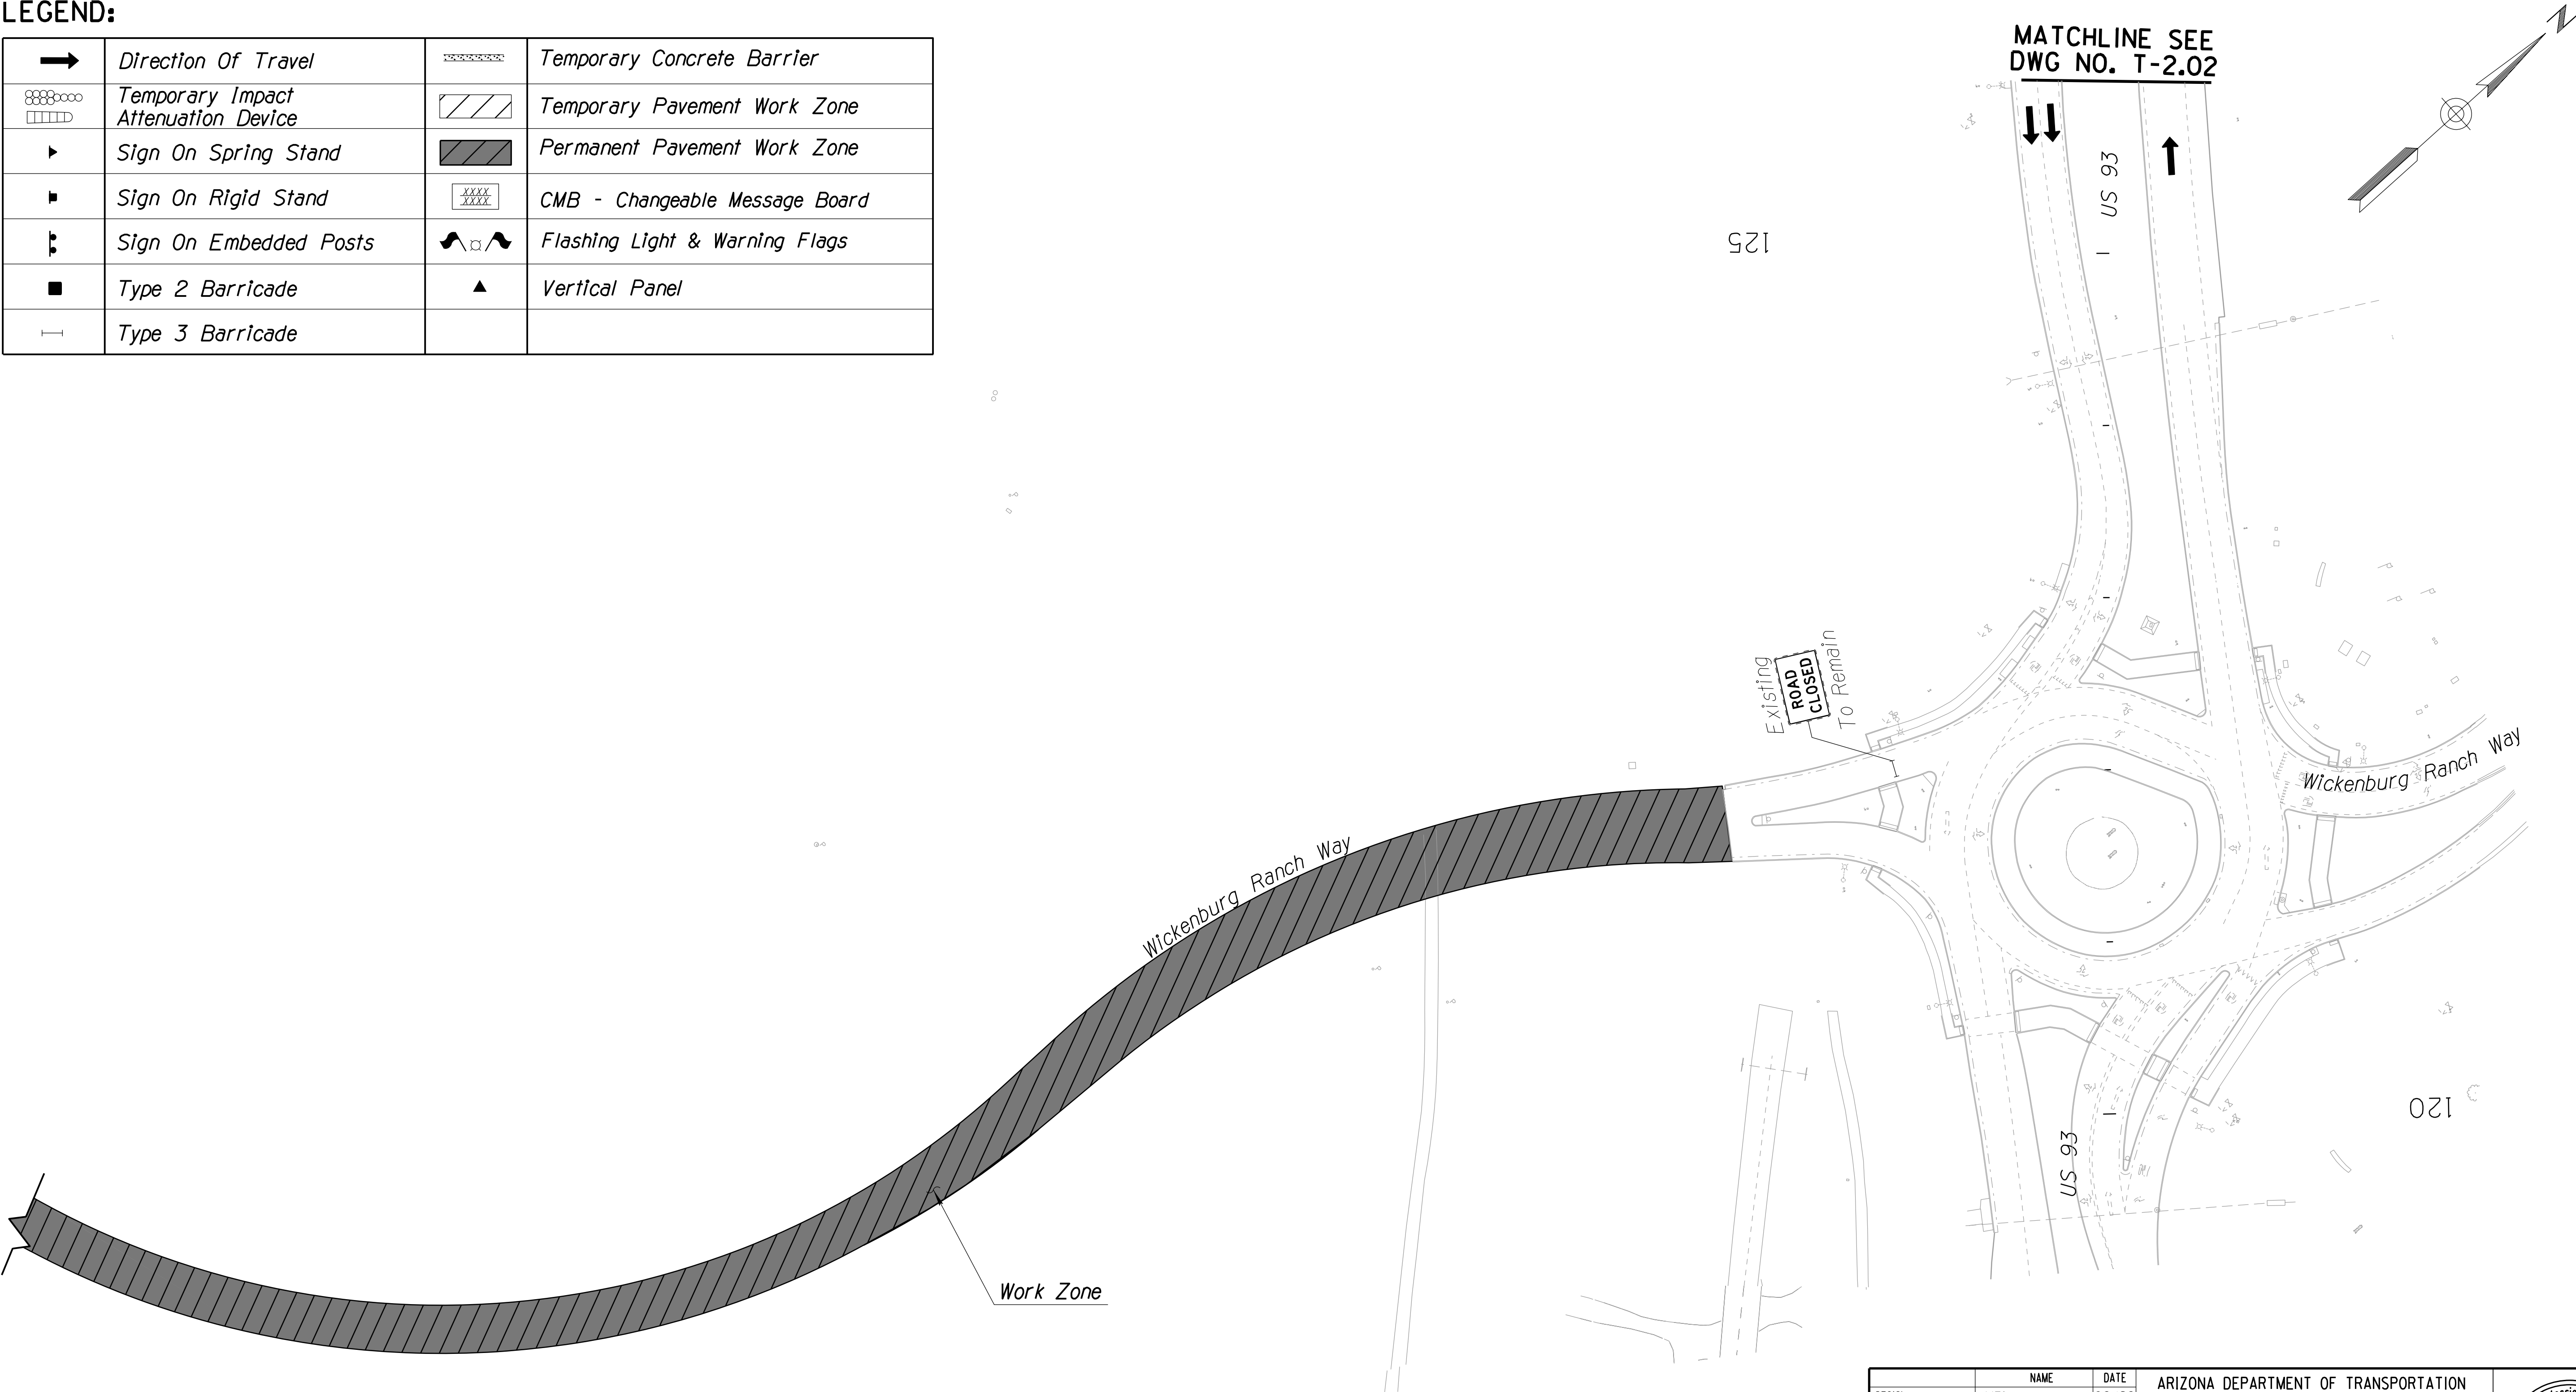


		NAME	DATE	ARIZONA DEPARTMENT OF TRANSPORTATION PROJECT DELIVERY AND OPERATIONS DIVISION TRAFFIC DESIGN SERVICES		
DESIGN		ME1	06/26			
DRAWN		SRH	06/26			
CHECKED		BMT	06/26			
 Stanley Consultants inc.		3133 East Camelback Road, Suite 100 Phoenix, Arizona 85016 Phone: (602) 333-2200		US 93 PHASE 1 TRAFFIC CONTROL WICKENBURG RANCH WAY		
ROUTE		LOCATION		DWG NO. T-2.01		
US 93		WICKENBURG RANCH WAY TO VISTA ROYALE				
TRACS NO. F0738 OIC				093-B(230)T	<u> OF </u>	

PHASE 1


F.H.W.A. REGION	STATE	PROJECT NO.	SHEET NO.	TOTAL SHEETS	RECORD DRAWING
9	ARIZ.	093-B(230)T	306	524	

093 YV 189

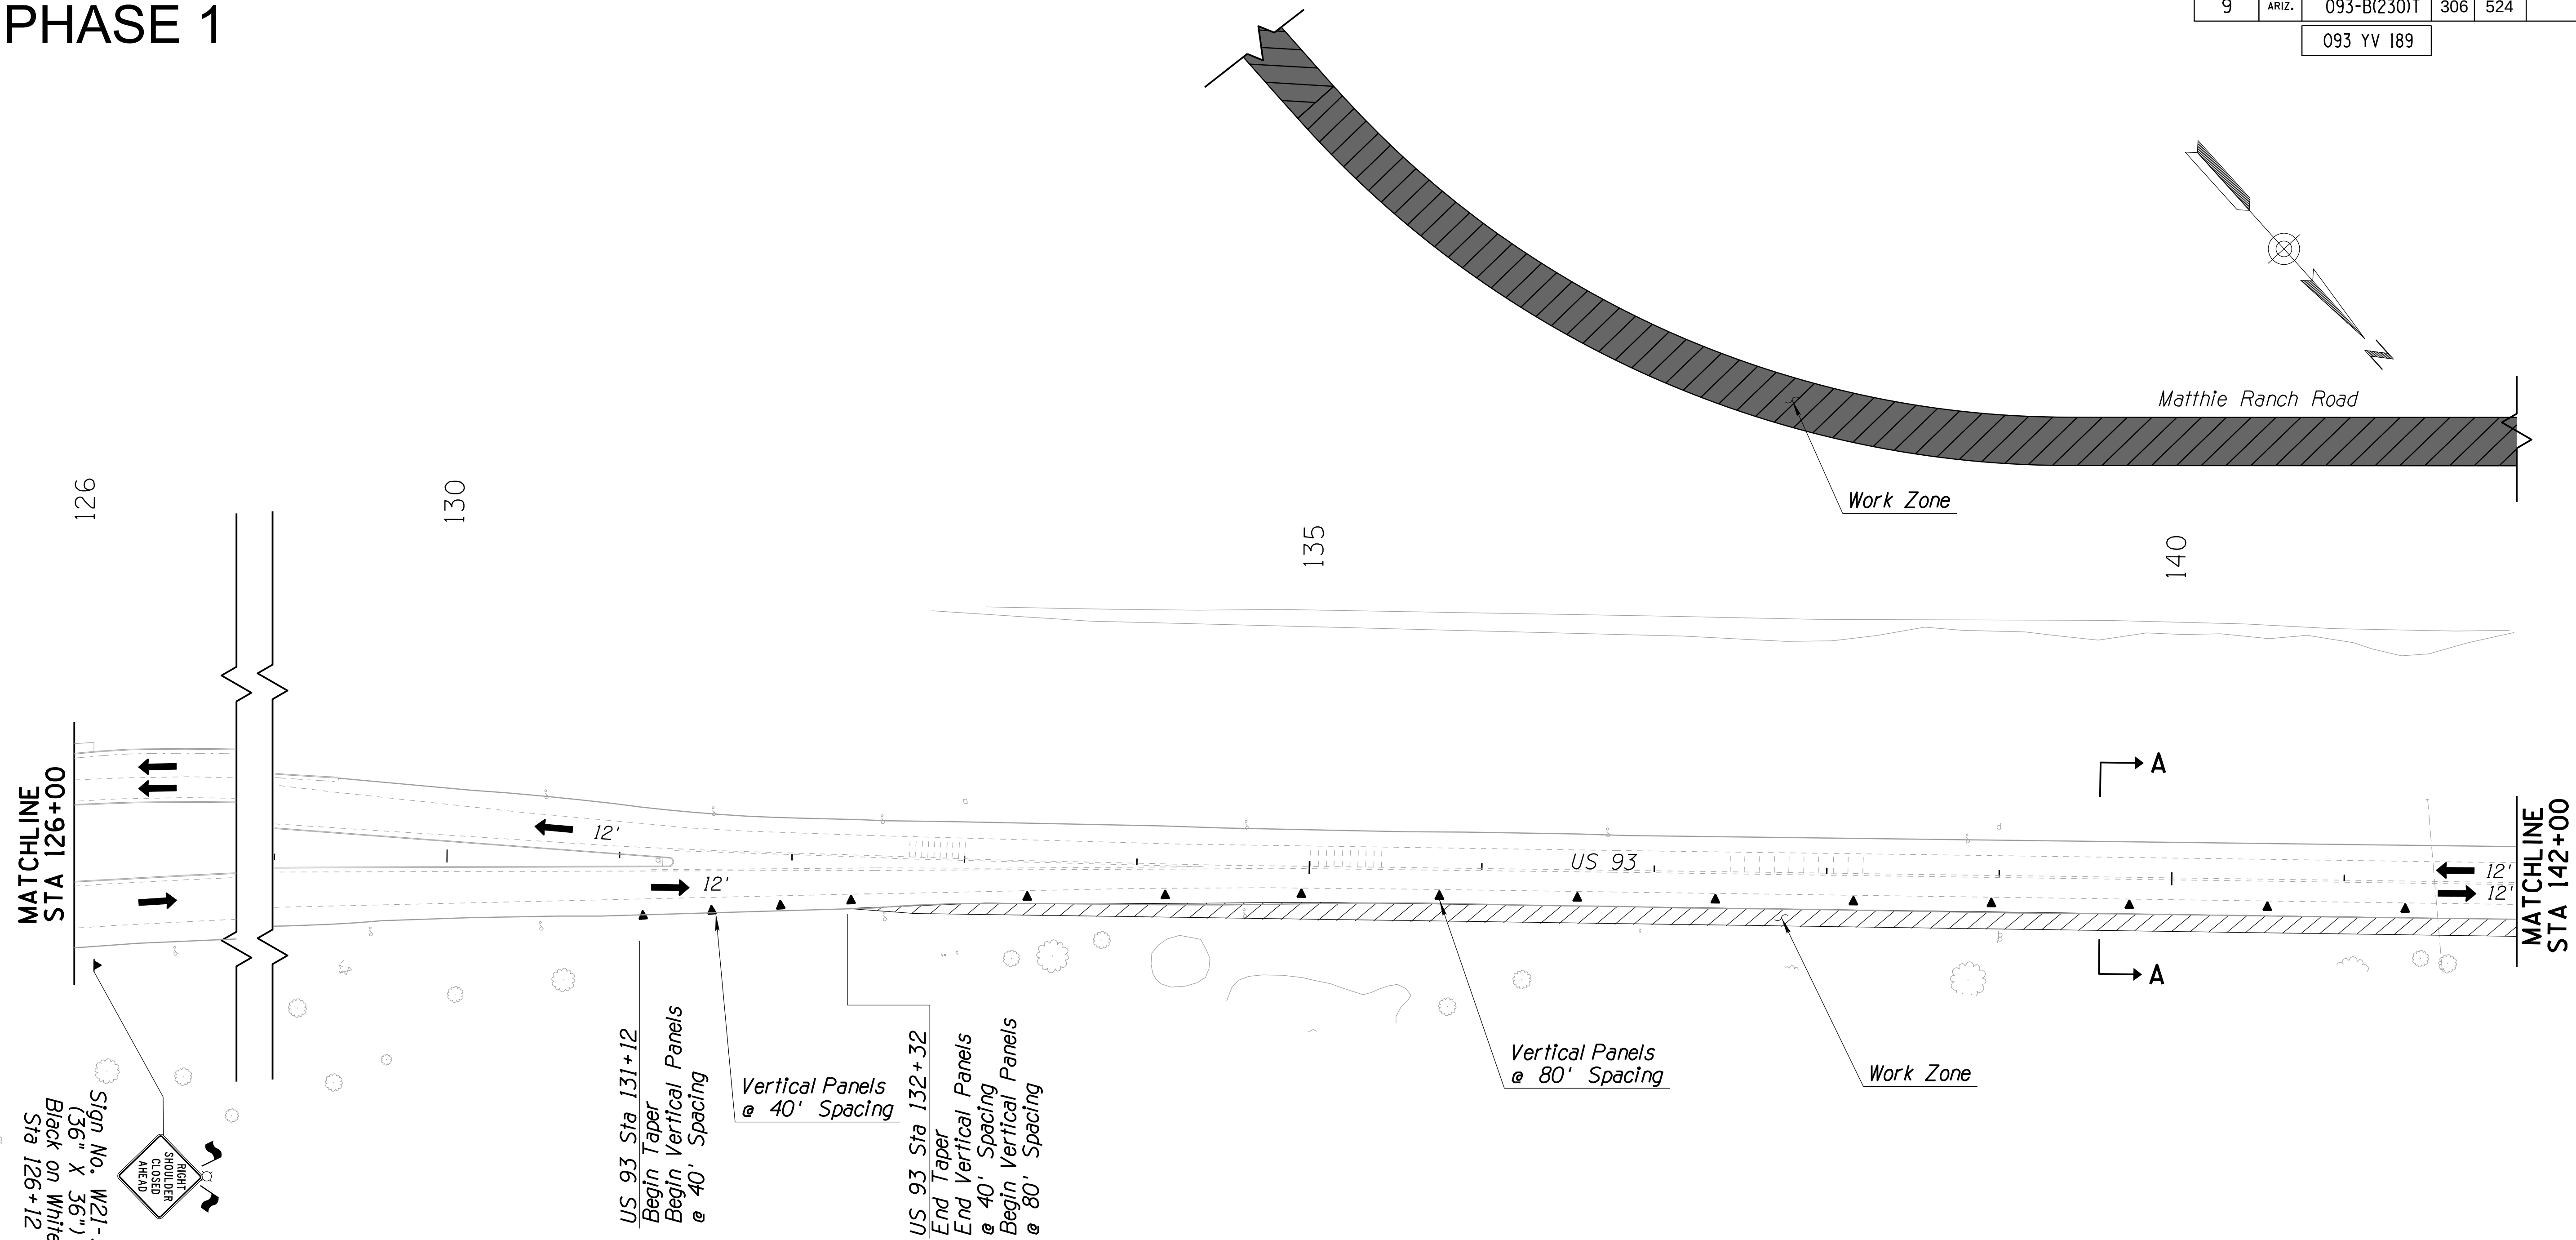

LEGEND:

	Direction Of Travel		Temporary Concrete Barrier
	Temporary Impact Attenuation Device		Temporary Pavement Work Zone
	Sign On Spring Stand		Permanent Pavement Work Zone
	Sign On Rigid Stand		CMB - Changeable Message Board
	Sign On Embedded Posts		Flashing Light & Warning Flags
	Type 2 Barricade		Vertical Panel
	Type 3 Barricade		

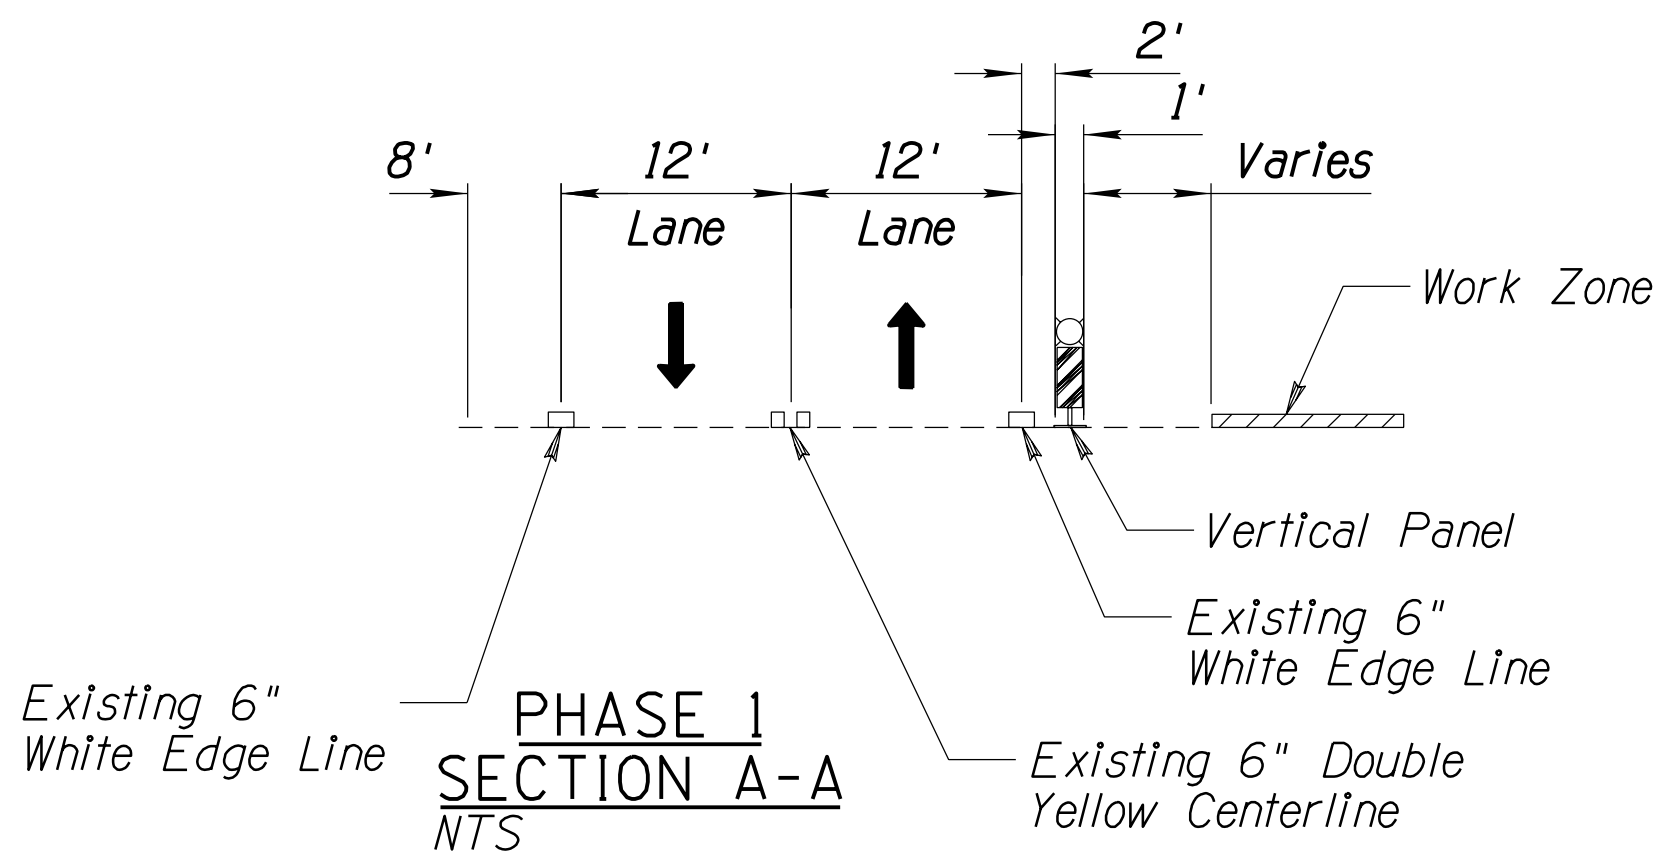

DESIGN	NAME	DATE	ARIZONA DEPARTMENT OF TRANSPORTATION PROJECT DELIVERY AND OPERATIONS DIVISION TRAFFIC DESIGN SERVICES US 93 PHASE 1 TRAFFIC CONTROL STA 126+00 TO STA 142+00	
DRAWN	ME1	06/26		
CHECKED	SRH	06/26		
Stanley Consultants inc.			3133 East Camelback Road, Suite 100 Phoenix, Arizona 85016 Phone: (602) 333-2200	
ROUTE	LOCATION	DWG NO. T-2.02		
US 93	WICKENBURG RANCH WAY TO VISTA ROYALE			
TRACS NO. F0738 OIC		093-B(230)T		OF

093 YV 189



The diagram illustrates the proposed Phase 1 construction for Section C-C of the road. It shows a cross-section with two travel lanes, each 12 feet wide (6 feet travel lane + 6 feet shoulder). The existing 6-inch white edge line is shown as a dashed line. The proposed 6-inch yellow edge line is shown as a solid line, indicating a 6-foot shoulder. The vertical panel is shown as a hatched area. The existing guardrail is shown as a hatched area. The proposed guardrail is shown as a hatched area. The diagram includes labels for 'Existing 6" White Edge Line', 'Existing 6" Yellow Edge Line', 'Vertical Panel', 'Existing Guardrail', 'Proposed Guardrail', 'Travel Lane', 'Shoulder', 'Work Zone', and 'Phase 1 Section C-C'. Dimensions are given in feet (1', 2', 6', 12').

... \t0738A tc_Phsl_03.dgn T-2.08

LEGEND:

Existing 6"
Yellow Edge Line


PHASE 1
SECTION B-B
NTS

		NAME		DATE		ARIZONA DEPARTMENT OF TRANSPORTATION PROJECT DELIVERY AND OPERATIONS DIVISION TRAFFIC DESIGN SERVICES			
DESIGN		MEI		06/26		US 93 PHASE 1 TRAFFIC CONTROL STA 154+00 TO STA 167+00		DWG NO. T-204 OF	
DRAWN		SRH		06/26					
CHECKED		BMT		06/26					
 Stanley Consultants INC.		3133 East Camelback Road, Suite 100 Phoenix, Arizona 85016 Phone: (602) 333-2200							
ROUTE		LOCATION							
US 93		WICKENBURG RANCH WAY TO VISTA ROYALE							
TRACS NO. F0738 OIC								093-B(230)T	

PHASE 1


F.H.W.A. REGION	STATE	PROJECT NO.	SHEET NO.	TOTAL SHEETS	RECORD DRAWING
9	ARIZ.	093-B(230)T	309	524	

093 YV 189

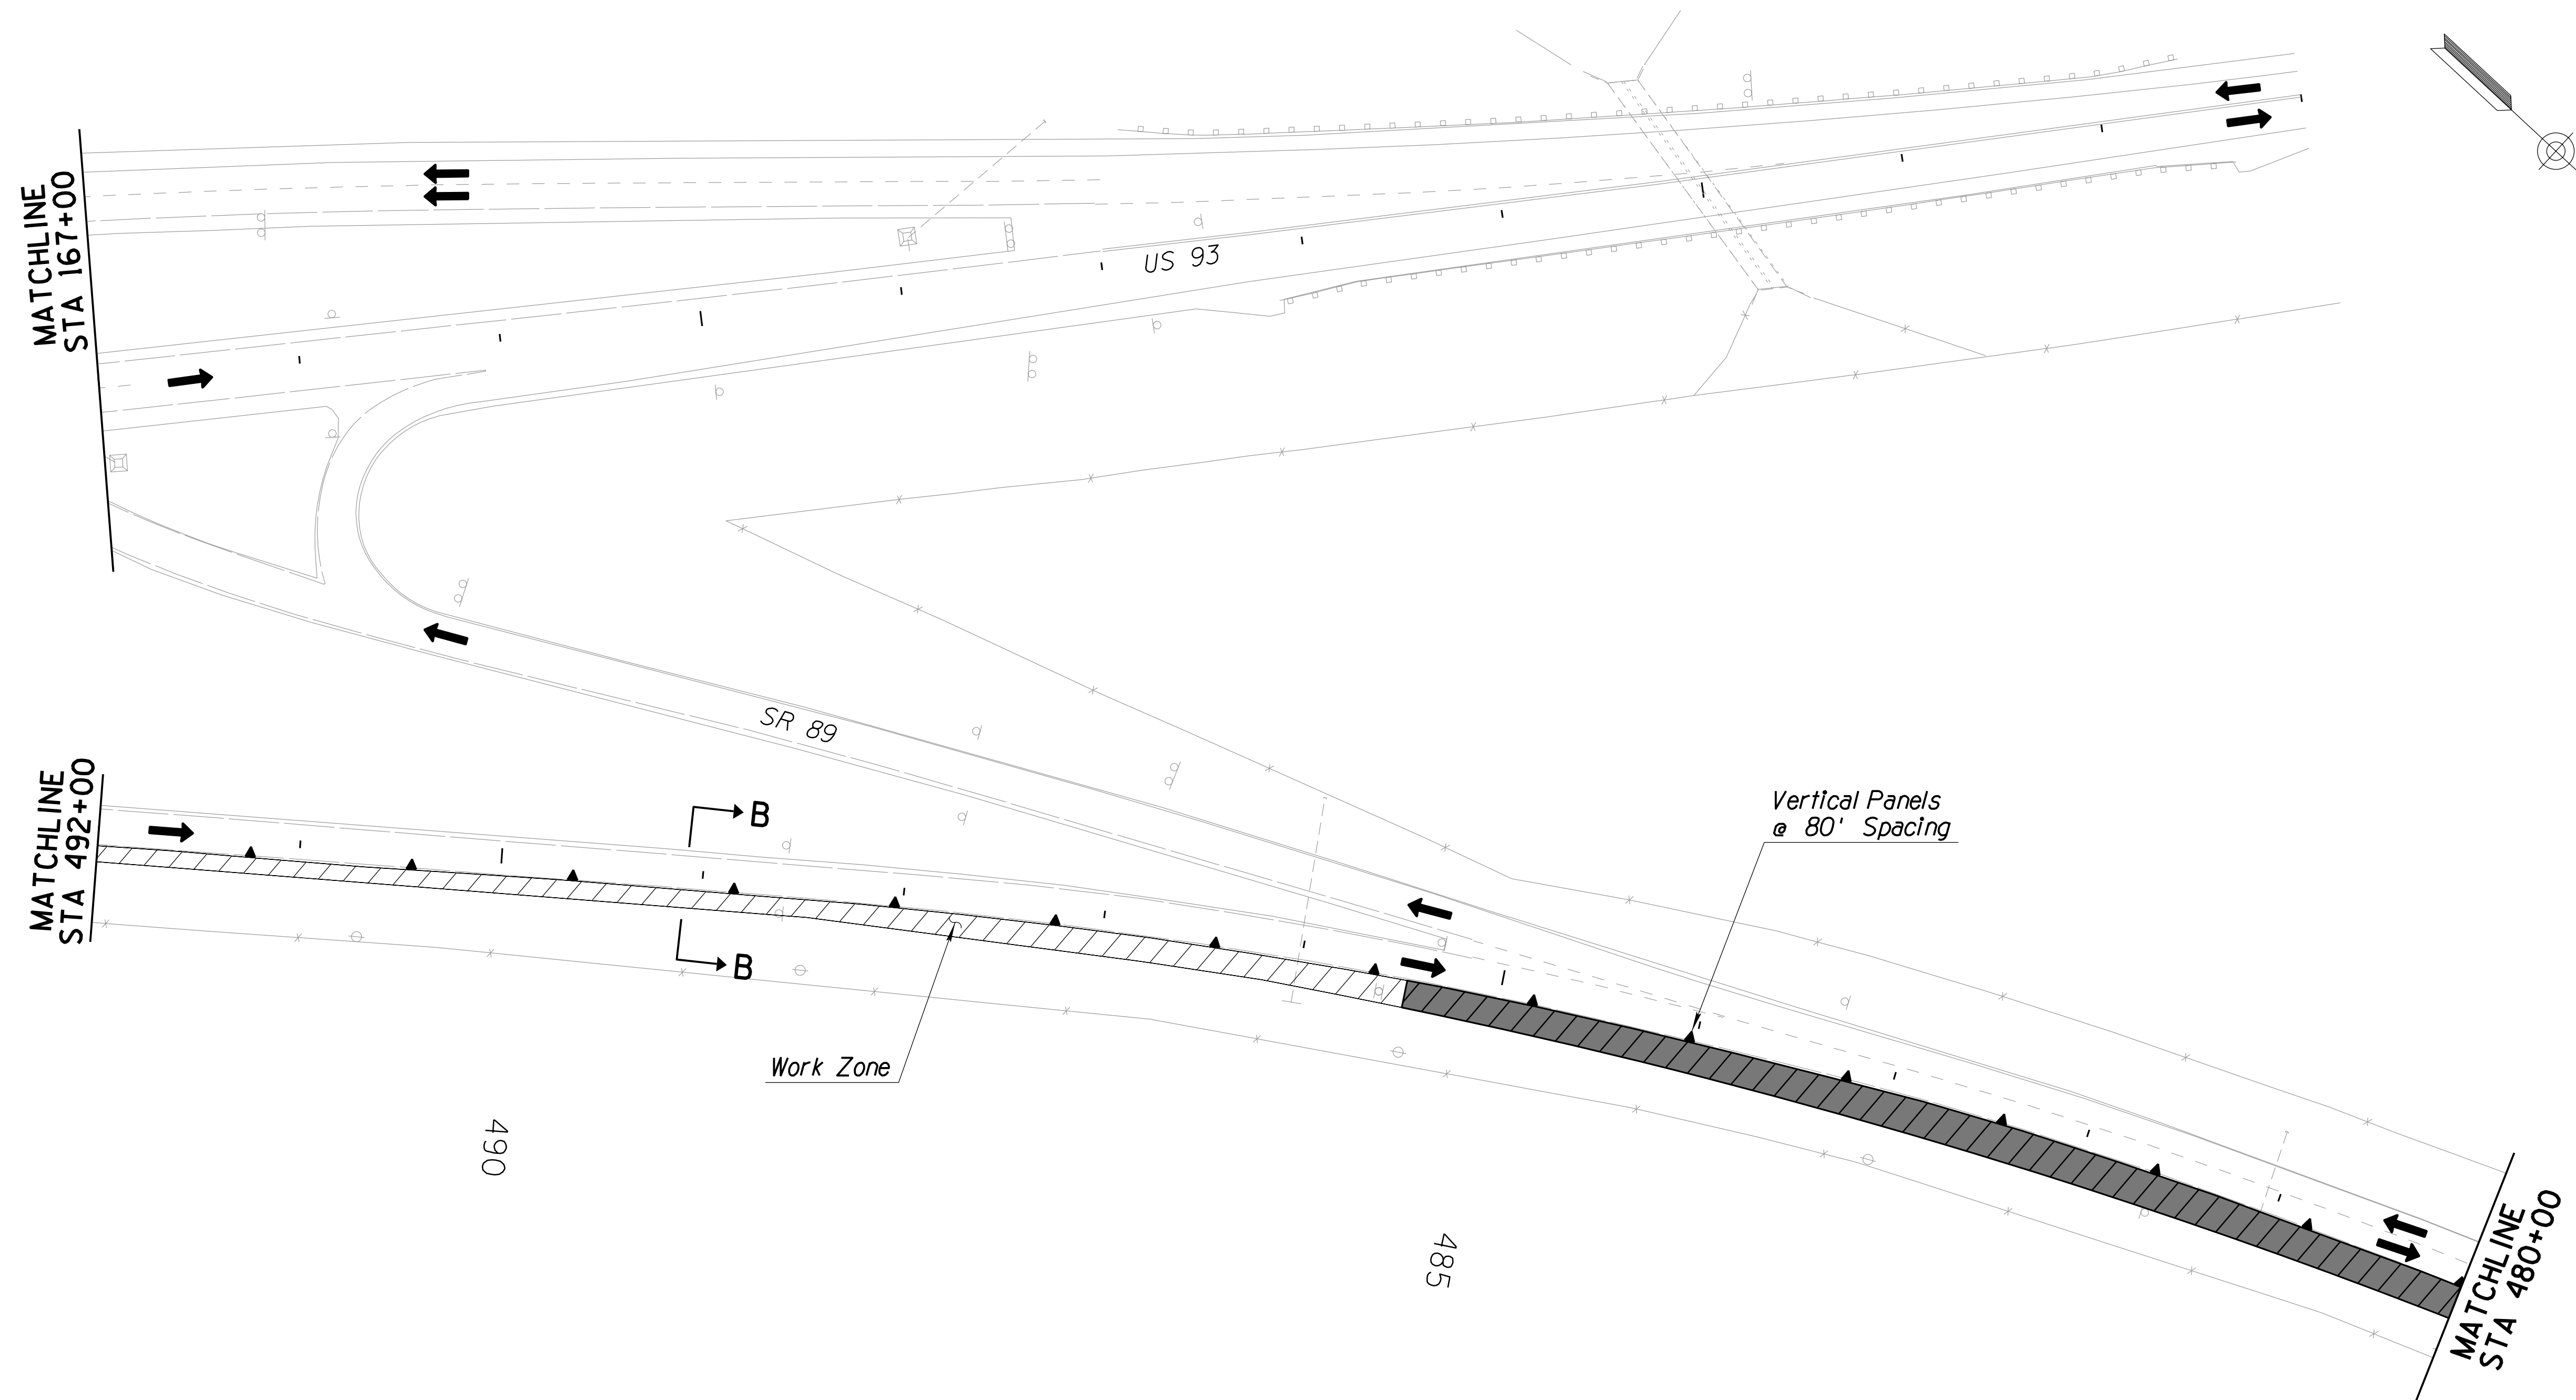

LEGEND:


	Direction Of Travel		Temporary Concrete Barrier
	Temporary Impact Attenuation Device		Temporary Pavement Work Zone
	Sign On Spring Stand		Permanent Pavement Work Zone
	Sign On Rigid Stand		CMB - Changeable Message Board
	Sign On Embedded Posts		Flashing Light & Warning Flags
	Type 2 Barricade		Vertical Panel
	Type 3 Barricade		

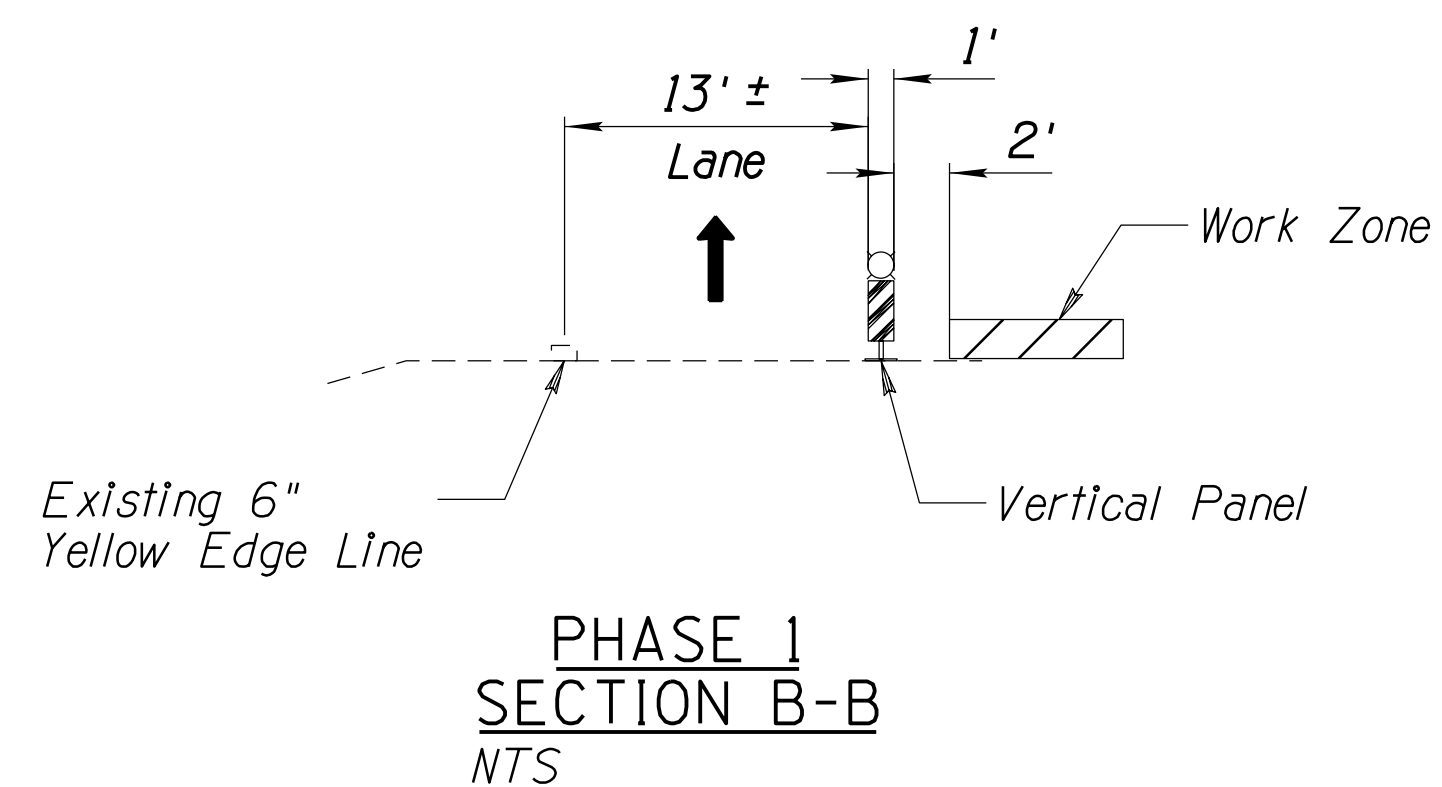

DESIGN	ME1	DATE	06/26	ARIZONA DEPARTMENT OF TRANSPORTATION PROJECT DELIVERY AND OPERATIONS DIVISION TRAFFIC DESIGN SERVICES	
DRAWN	SRH	DATE	06/26		
CHECKED	BMT	DATE	06/26		
ROUTE		LOCATION		US 93 & SR 89 PHASE 1 TRAFFIC CONTROL STA 167+00 TO STA 178+00	
US 93		WICKENBURG RANCH WAY TO VISTA ROYALE		DWG NO. T-2.05	
TRACS NO. F0738 OIC		093-B(230)T		OF	

PHASE 1

F.H.W.A. REGION	STATE	PROJECT NO.	SHEET NO.	TOTAL SHEETS	RECORD DRAWING
9	ARIZ.	093-B(230)T	310	524	
093 YV 189					

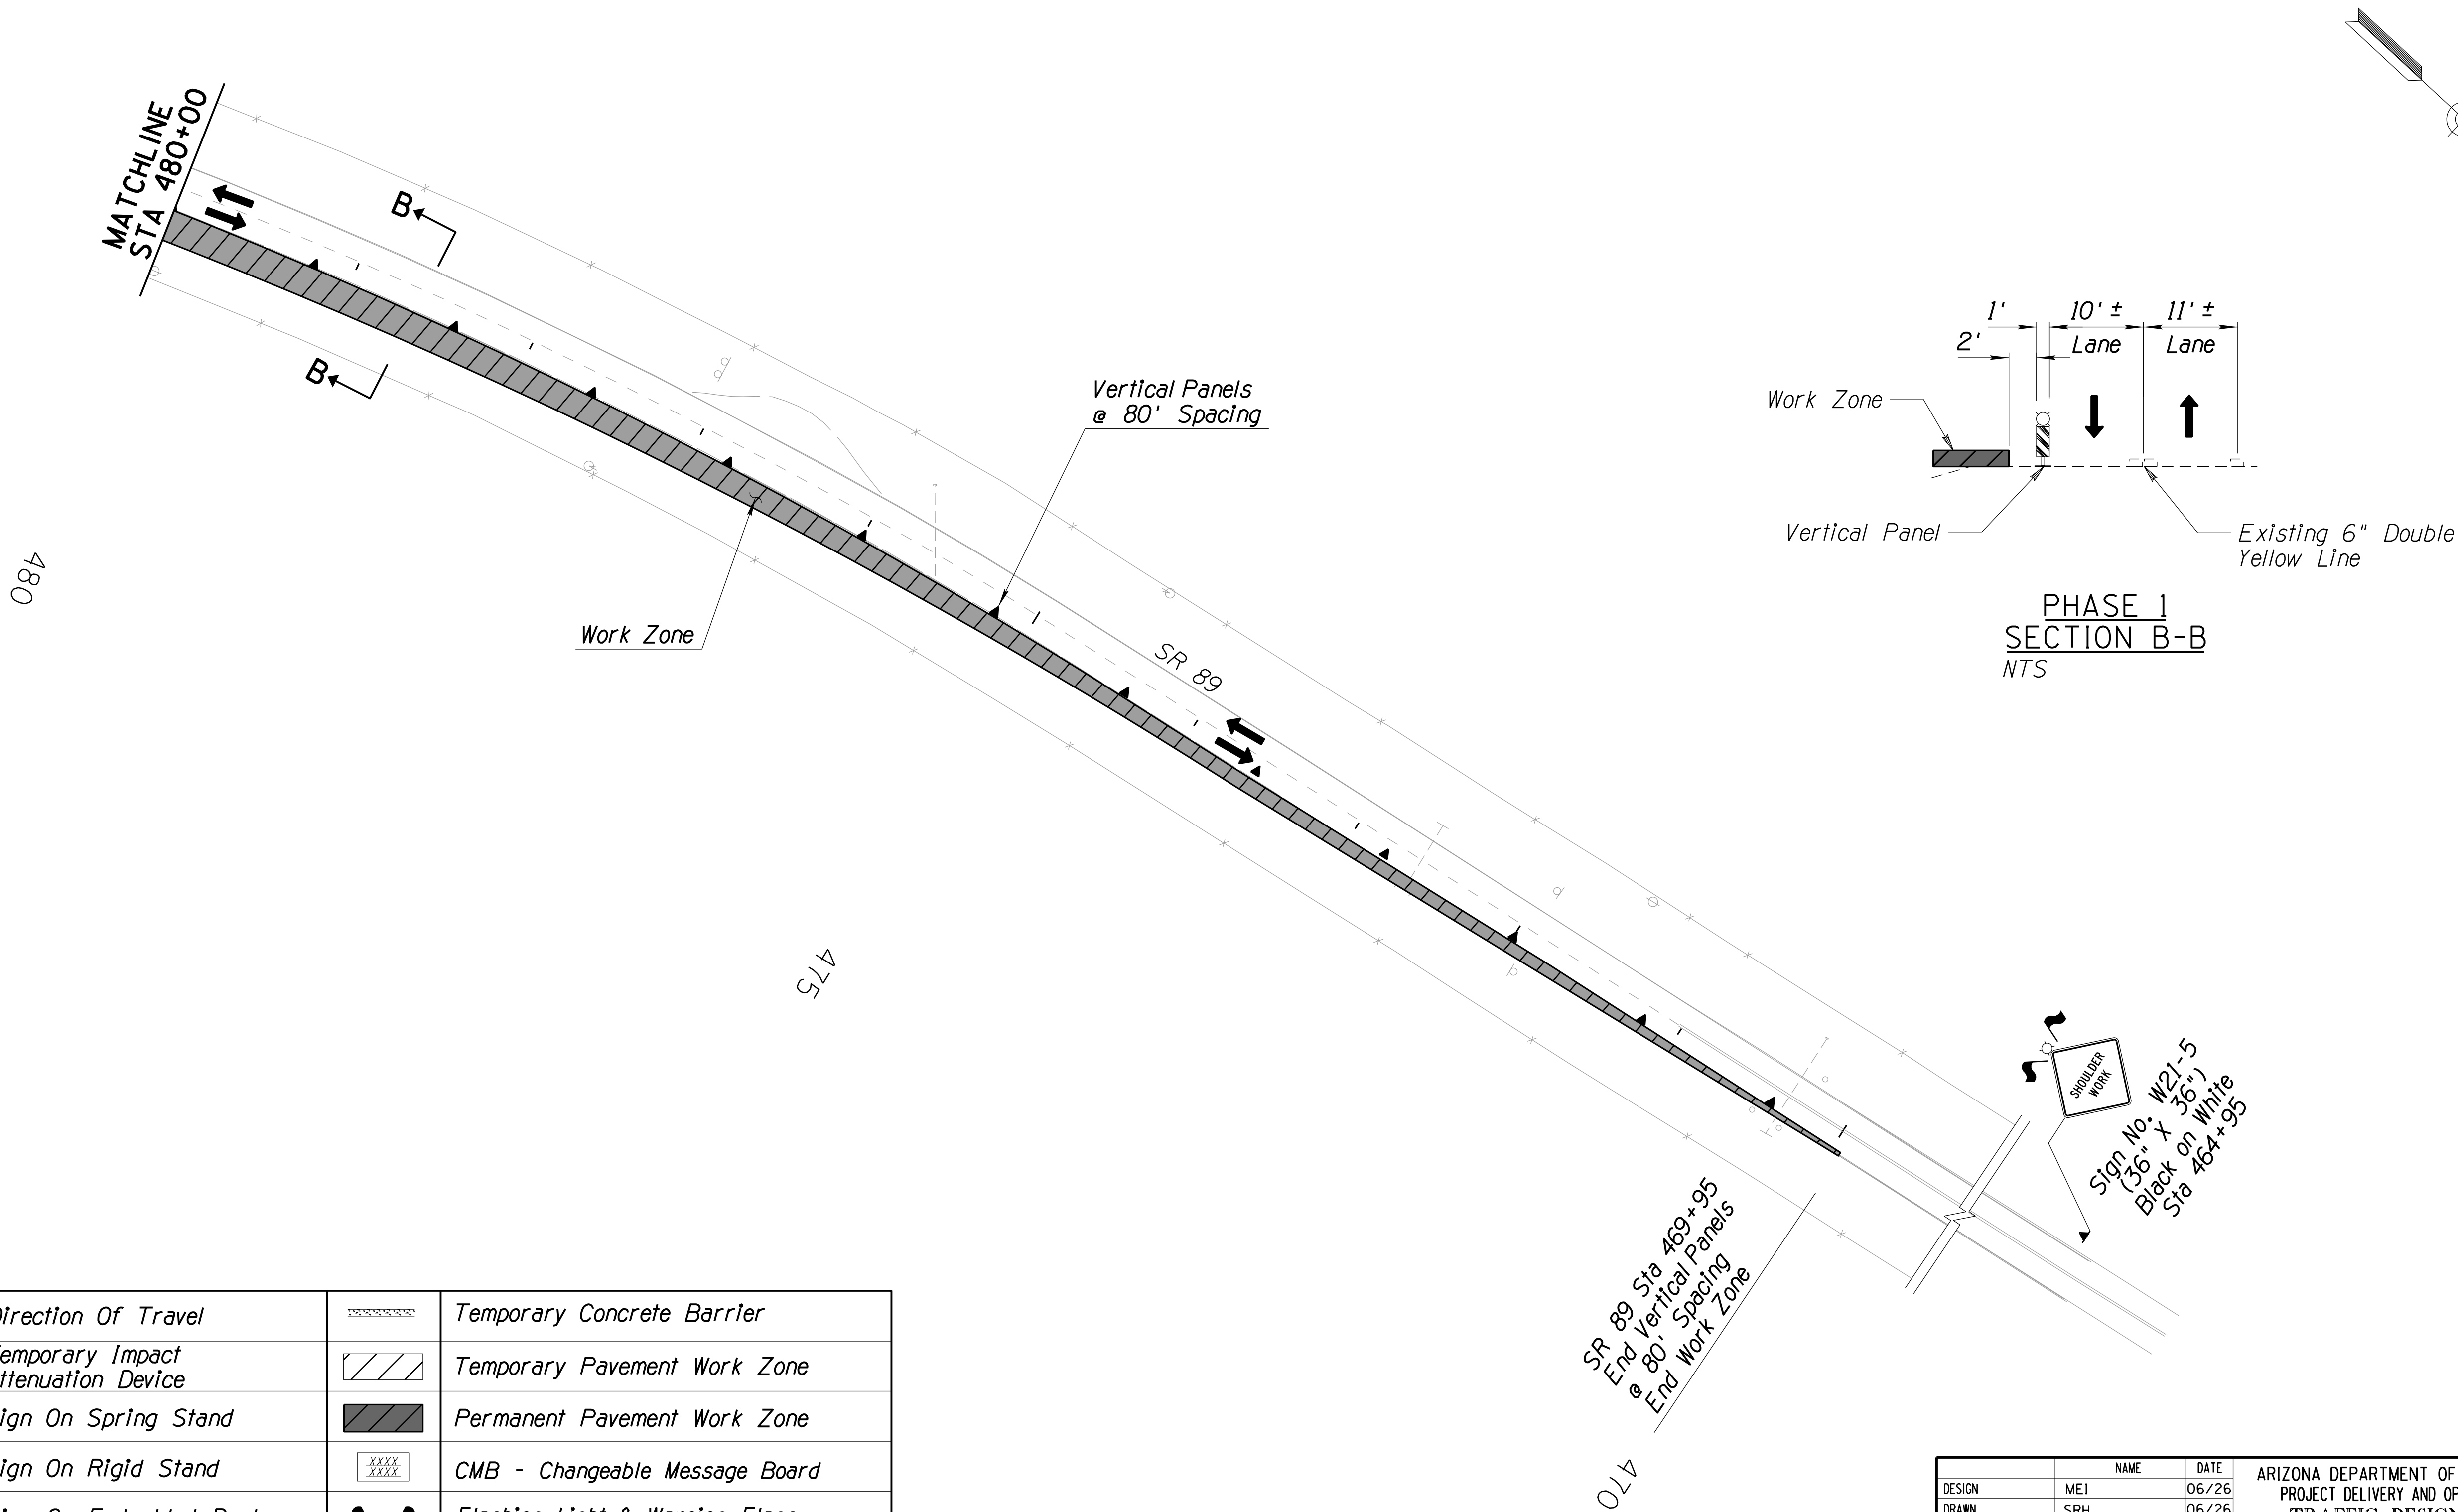

LEGEND:


	Direction Of Travel		Temporary Concrete Barrier
	Temporary Impact Attenuation Device		Temporary Pavement Work Zone
	Sign On Spring Stand		Permanent Pavement Work Zone
	Sign On Rigid Stand		CMB - Changeable Message Board
	Sign On Embedded Posts		Flashing Light & Warning Flags
	Type 2 Barricade		Vertical Panel
	Type 3 Barricade		

		NAME	DATE	ARIZONA DEPARTMENT OF TRANSPORTATION PROJECT DELIVERY AND OPERATIONS DIVISION TRAFFIC DESIGN SERVICES US 93 & SR 89 PHASE 1 TRAFFIC CONTROL STA 470+00 TO STA 480+00		
DESIGN		ME1	06/26			
DRAWN		SRH	06/26			
CHECKED		BMT	06/26			
 Stanley Consultants Inc. 3133 East Camelback Road, Suite 100 Phoenix, Arizona 85016 Phone: (602) 333-2200				DWG NO. T-2.06		
ROUTE		LOCATION				
US 93		WICKENBURG RANCH WAY TO VISTA ROYALE				
TRACS NO. F0738 OIC			093-B(230)T		___ OF ___	

PHASE 2


F.H.W.A. REGION	STATE	PROJECT NO.	SHEET NO.	TOTAL SHEETS	RECORD DRAWING
9	ARIZ.	093-B(230)T	311	524	

093 YV 189

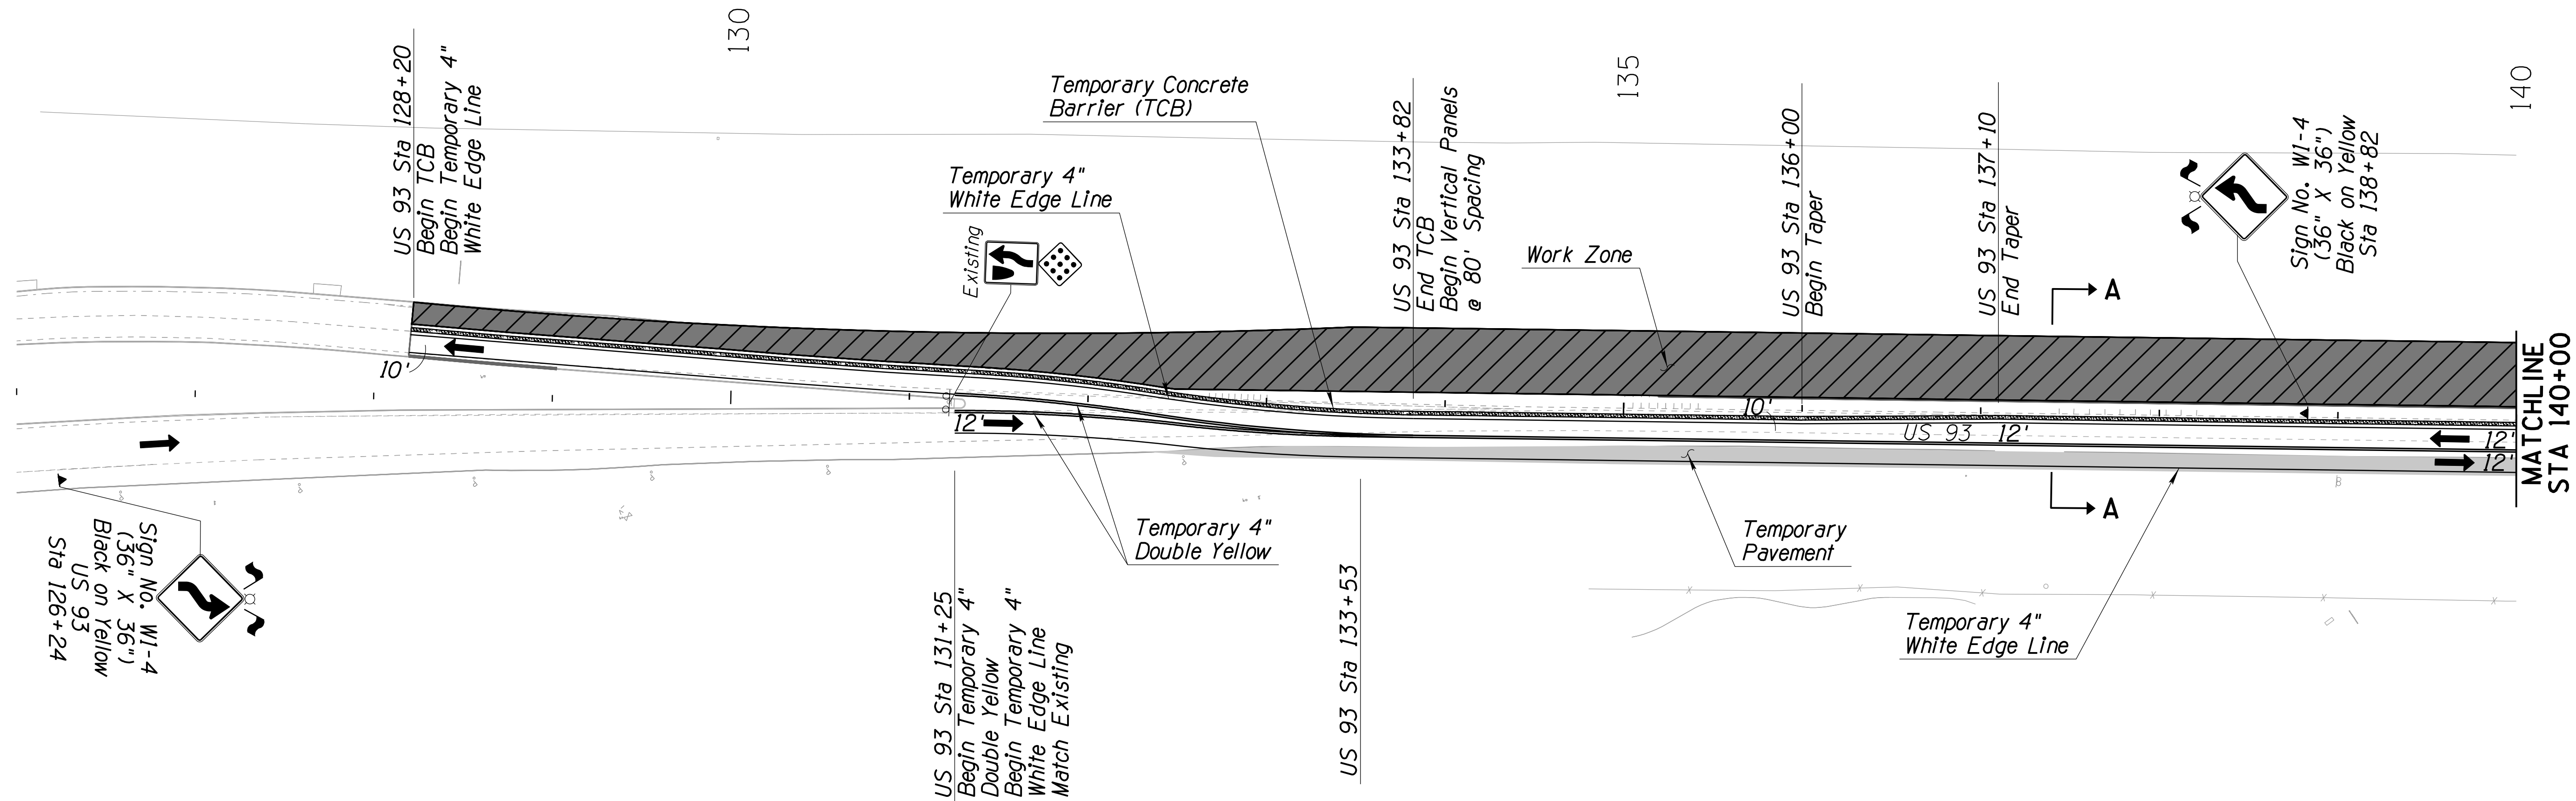

LEGEND:

	Direction Of Travel		Temporary Concrete Barrier
	Temporary Impact Attenuation Device		Temporary Pavement Work Zone
	Sign On Spring Stand		Permanent Pavement Work Zone
	Sign On Rigid Stand		CMB - Changeable Message Board
	Sign On Embedded Posts		Flashing Light & Warning Flags
	Type 2 Barricade		Vertical Panel
	Type 3 Barricade		Temporary Pavement Phase 1
			Constructed Pavement Phase 1

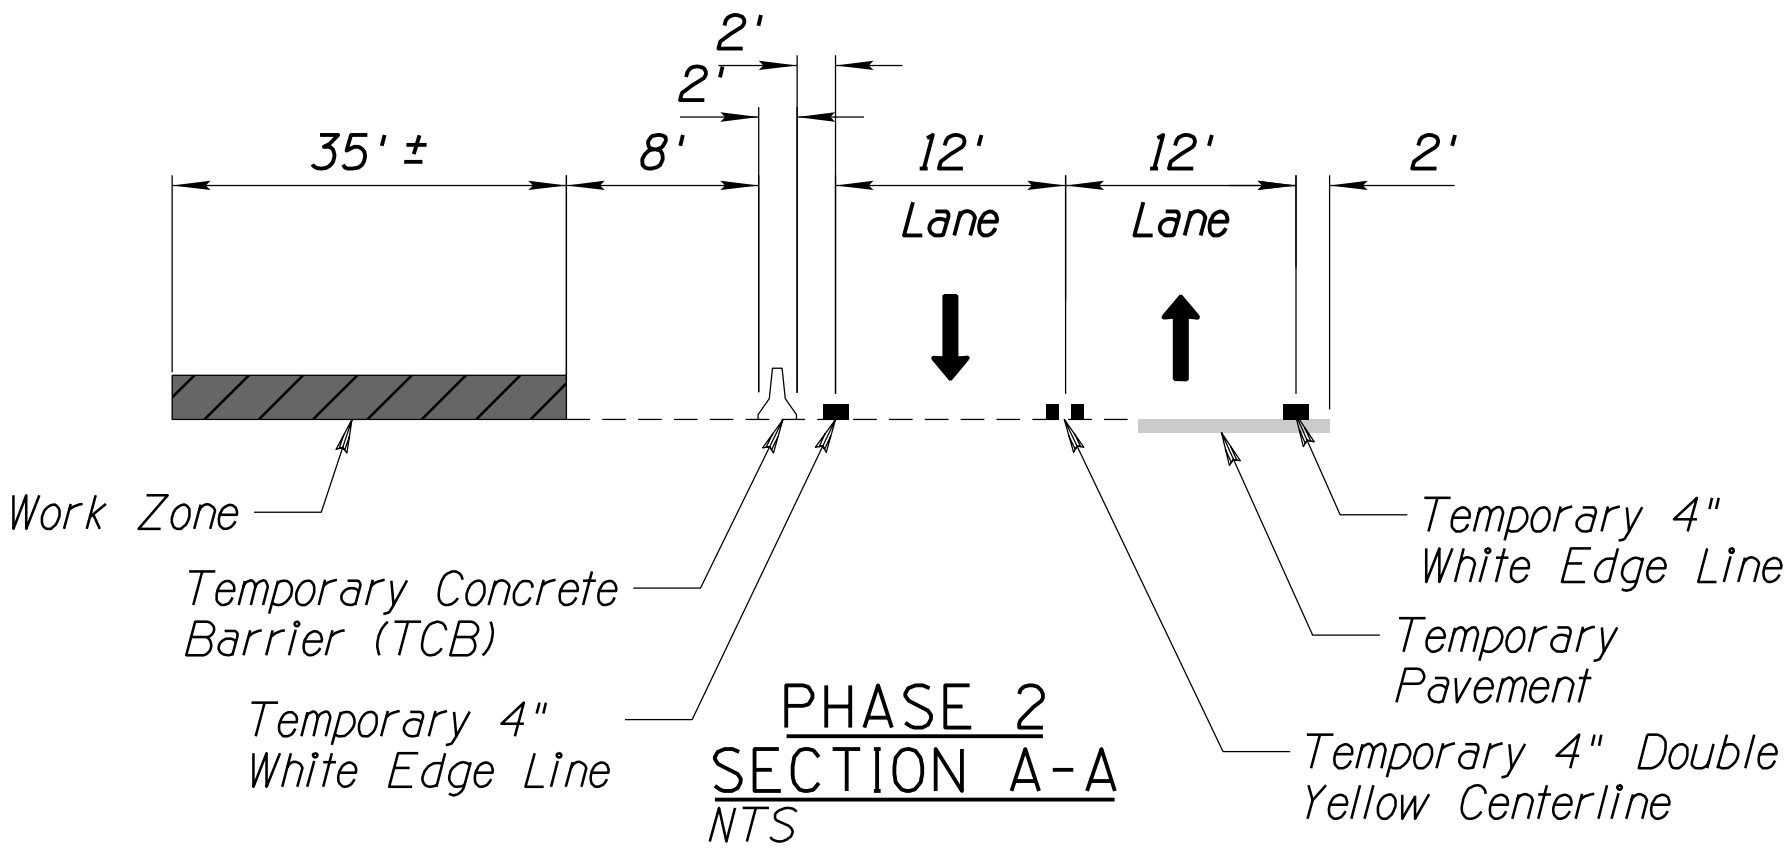

NOTE:



1. Obliterate all existing pavement marking in conflict with Phase 2 temporary pavement marking on US 93 Sta 128+20 to Sta 180+32 and SR 89 Sta 503+92 to Sta 476+36.

DESIGN	NAME	DATE	ARIZONA DEPARTMENT OF TRANSPORTATION PROJECT DELIVERY AND OPERATIONS DIVISION TRAFFIC DESIGN SERVICES US 93 & SR 89 PHASE 2 TRAFFIC CONTROL STA 126+00 TO STA 140+00	
DRAWN	ME1	06/26		
CHECKED	SRH	06/26		
	BMT	06/26		
Stanley Consultants inc. 3133 East Camelback Road, Suite 100 Phoenix, Arizona 85016 Phone: (602) 333-2200				
ROUTE US 93		LOCATION WICKENBURG RANCH WAY TO VISTA ROYALE		DWG NO. T-2.07
TRACS NO. F0738 OIC		093-B(230)T		OF

PHASE 2


F.H.W.A. REGION	STATE	PROJECT NO.	SHEET NO.	TOTAL SHEETS	RECORD DRAWING
9	ARIZ.	093-B(230)T	312	524	

093 YV 189

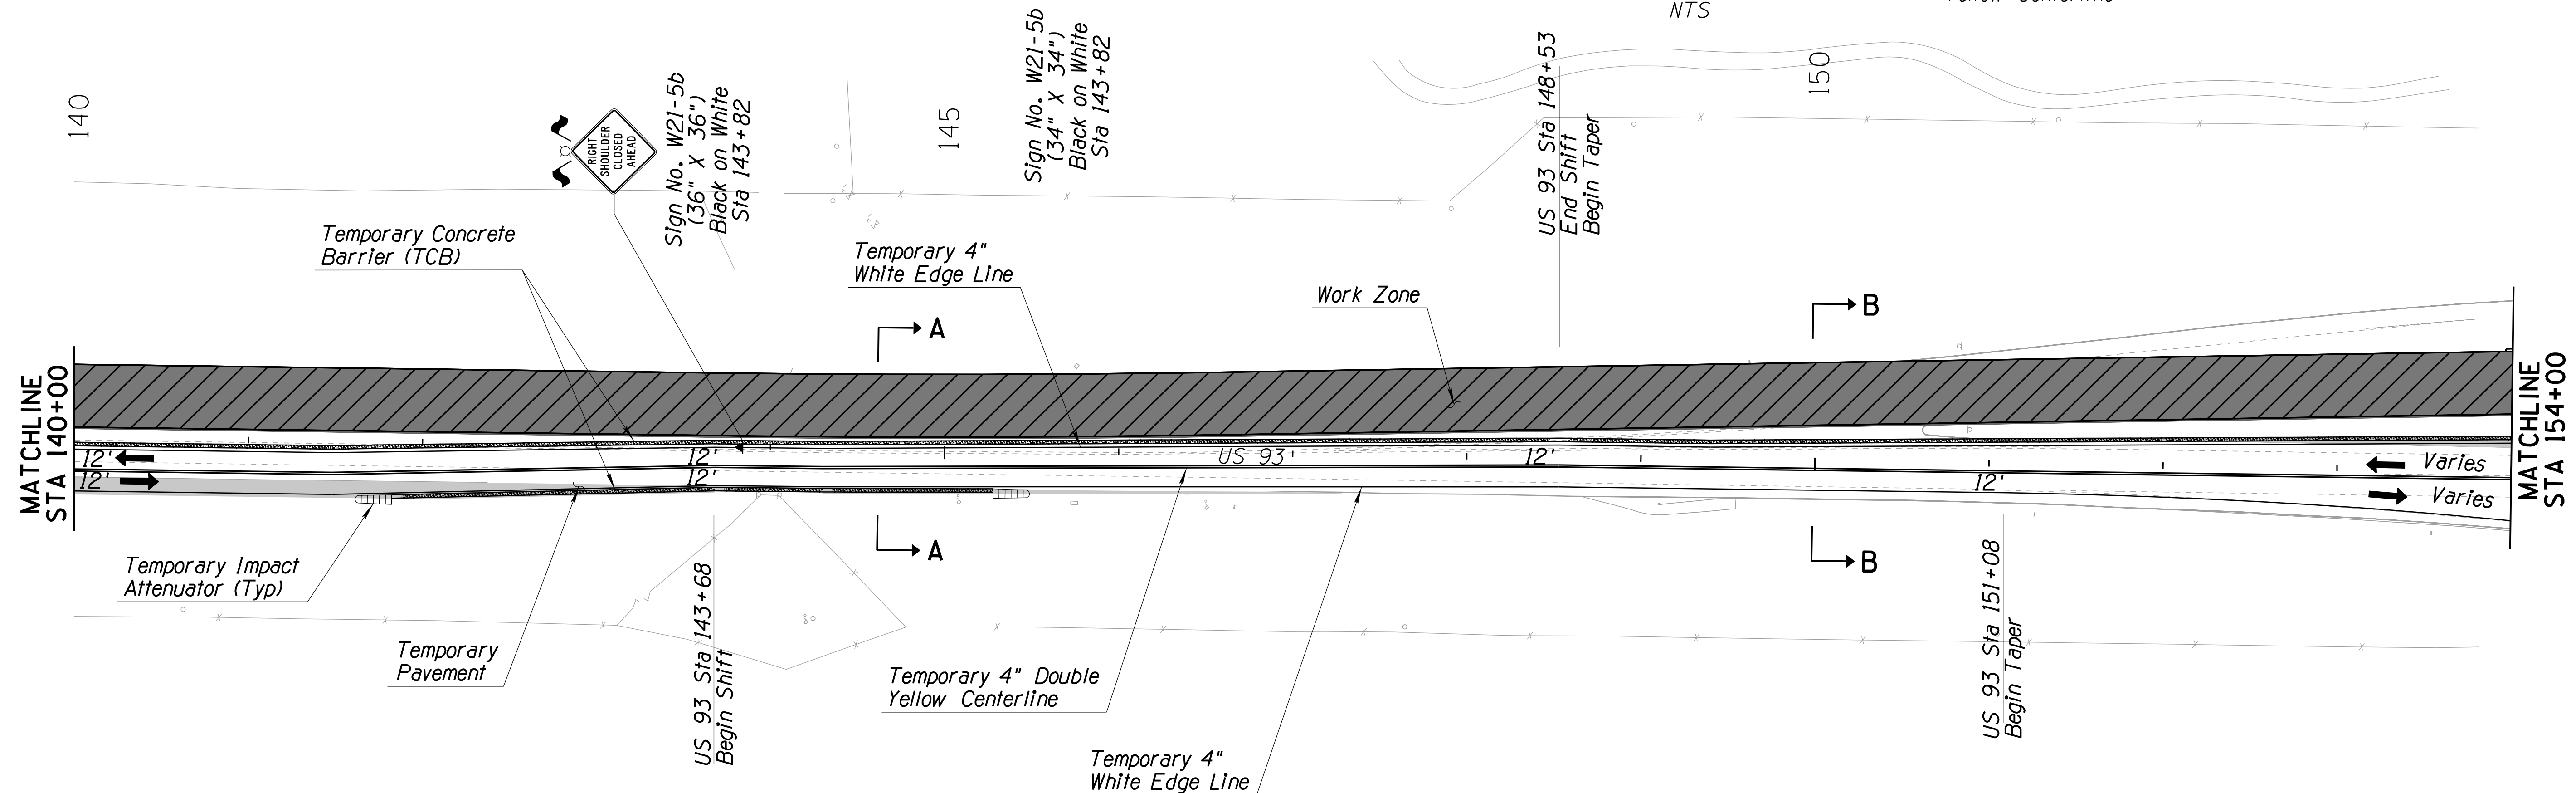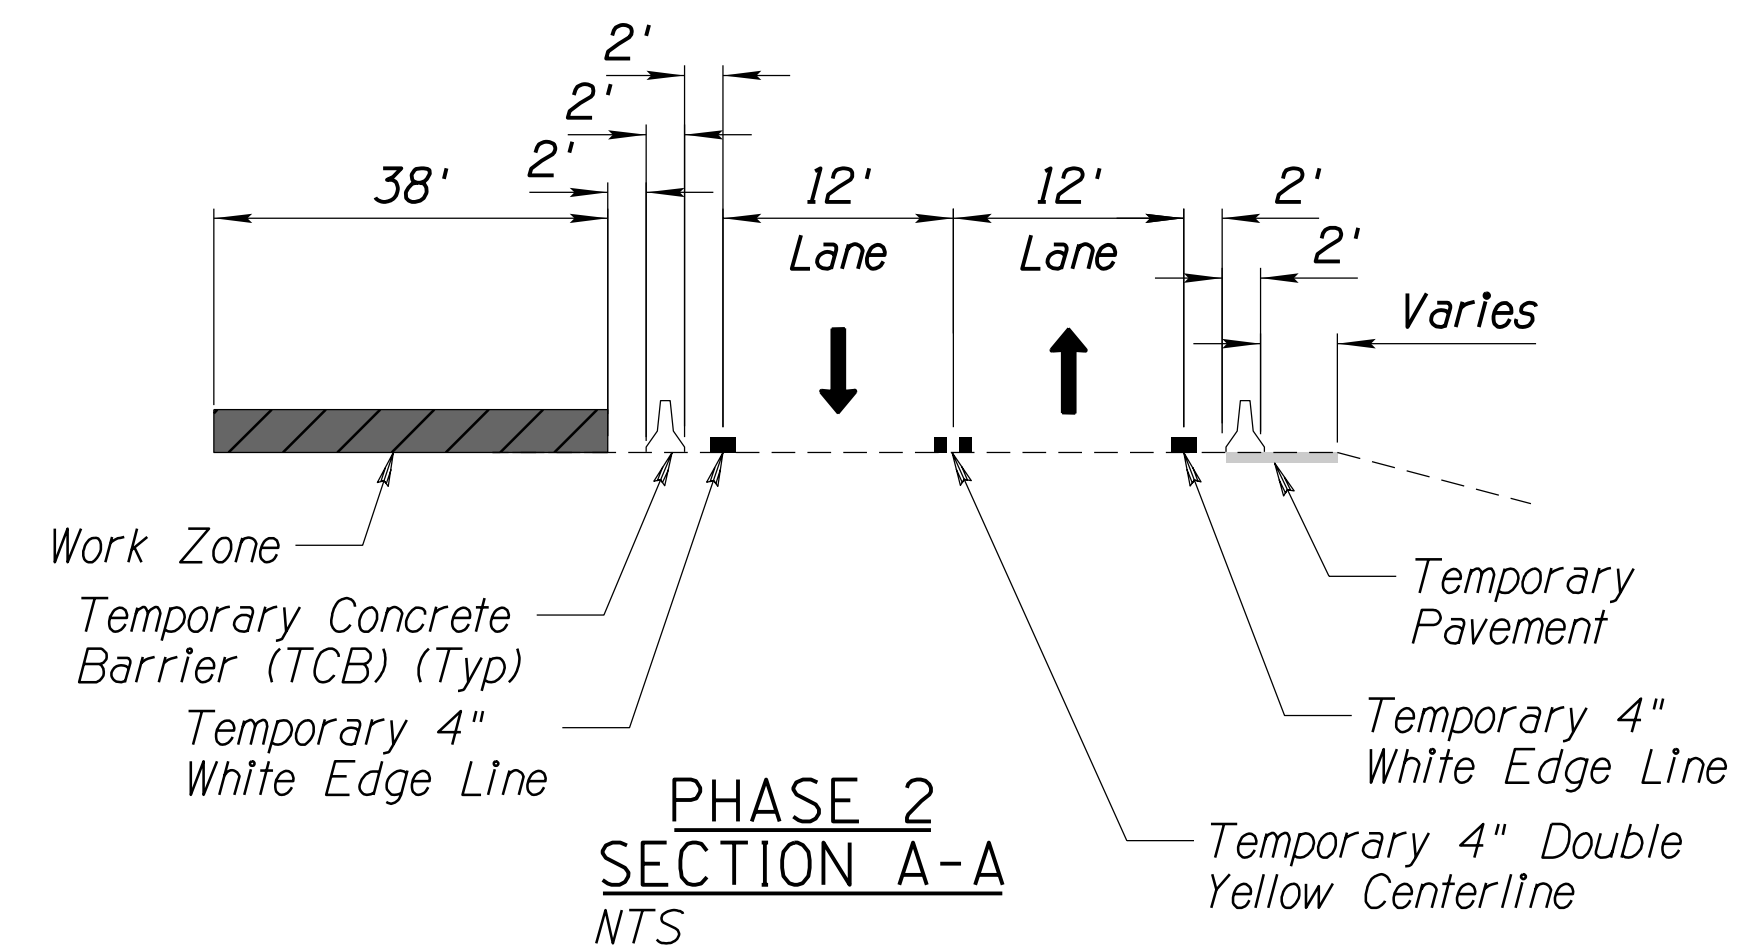

LEGEND:

➔	Direction Of Travel	▨	Temporary Concrete Barrier
⊘	Temporary Impact Attenuation Device	▨	Temporary Pavement Work Zone
▶	Sign On Spring Stand	▨	Permanent Pavement Work Zone
▢	Sign On Rigid Stand	▨	CMB - Changeable Message Board
⚡	Sign On Embedded Posts	⚡	Flashing Light & Warning Flags
■	Type 2 Barricade	▲	Vertical Panel
┃	Type 3 Barricade	▨	Temporary Pavement Phase 1
		▨	Constructed Pavement Phase 1

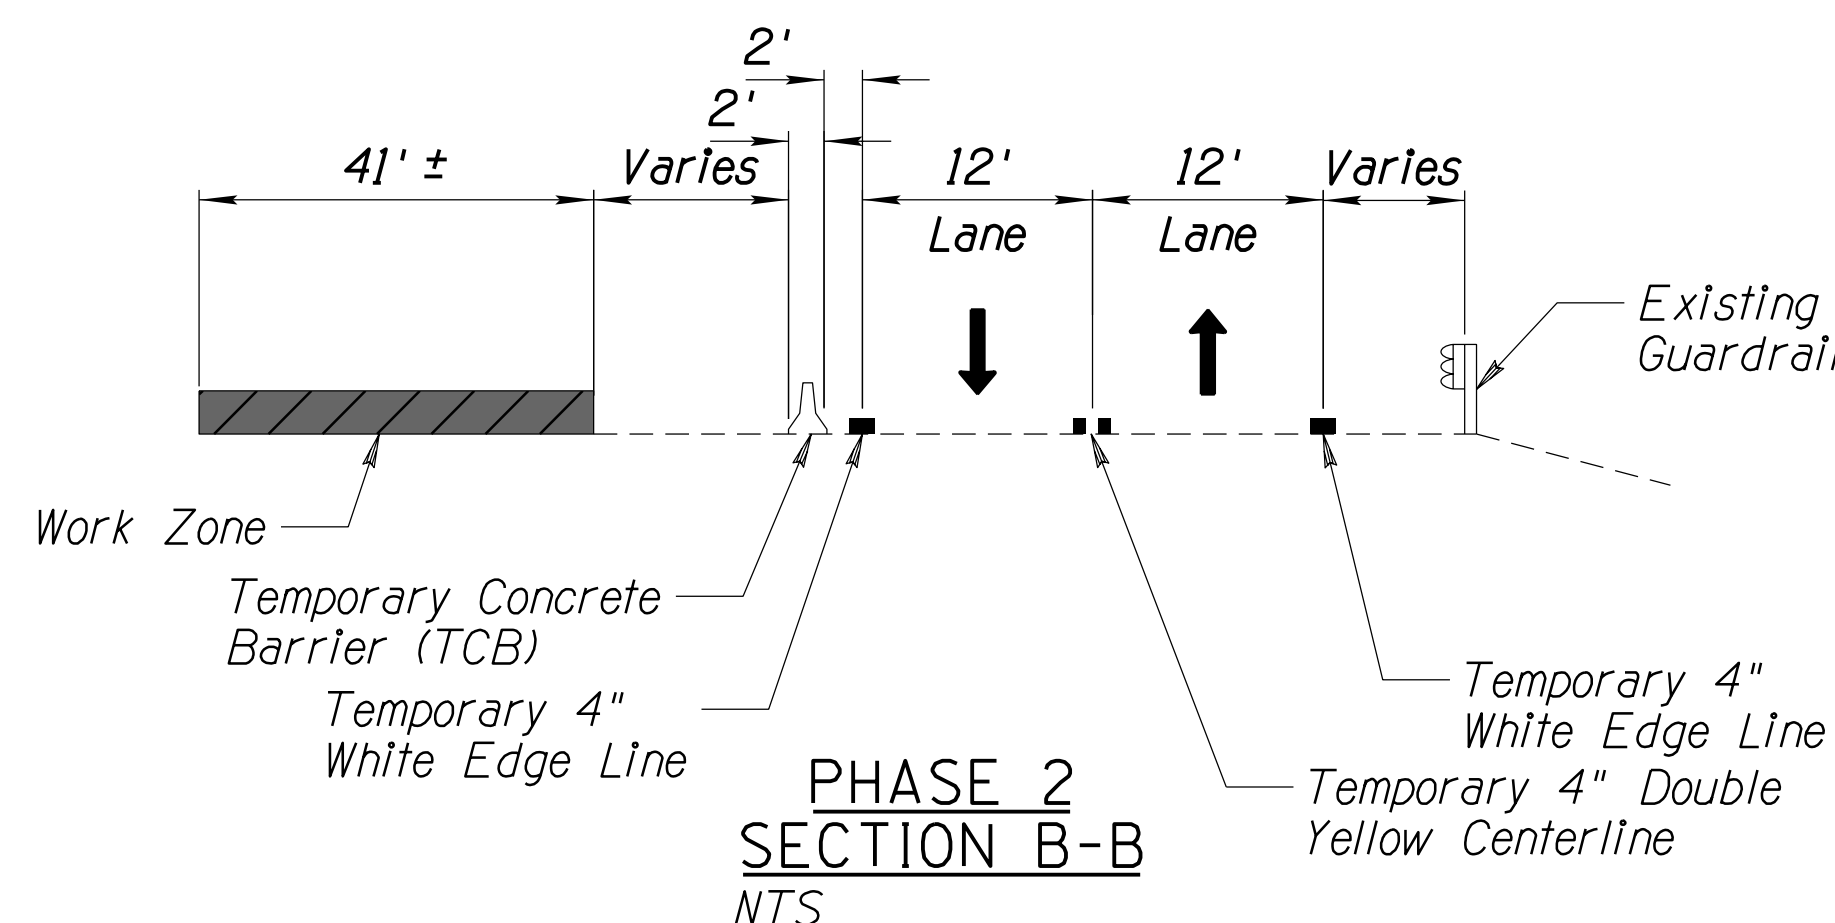

NOTE:



- Obliterate all existing pavement marking in conflict with Phase 2 temporary pavement marking on US 93 Sta 128+20 to Sta 180+32 and SR 89 Sta 503+92 to Sta 476+36.

DESIGN	NAME	DATE	ARIZONA DEPARTMENT OF TRANSPORTATION PROJECT DELIVERY AND OPERATIONS DIVISION TRAFFIC DESIGN SERVICES	
DRAWN	ME1	06/26	US 93 & SR 89 PHASE 2 TRAFFIC CONTROL STA 140+00 TO STA 154+00	
CHECKED	SRH	06/26		
	BMT	06/26		
ROUTE 093			WICKENBURG RANCH WAY TO VISTA ROYALE	DWG NO. T-2.08
TRACS NO. F0738 OIC			093-B(230)T	OF

PHASE 2

F.H.W.A. REGION	STATE	PROJECT NO.	SHEET NO.	TOTAL SHEETS	RECORD DRAWING
9	ARIZ.	093-B(230)T	313	524	

093 YV 189

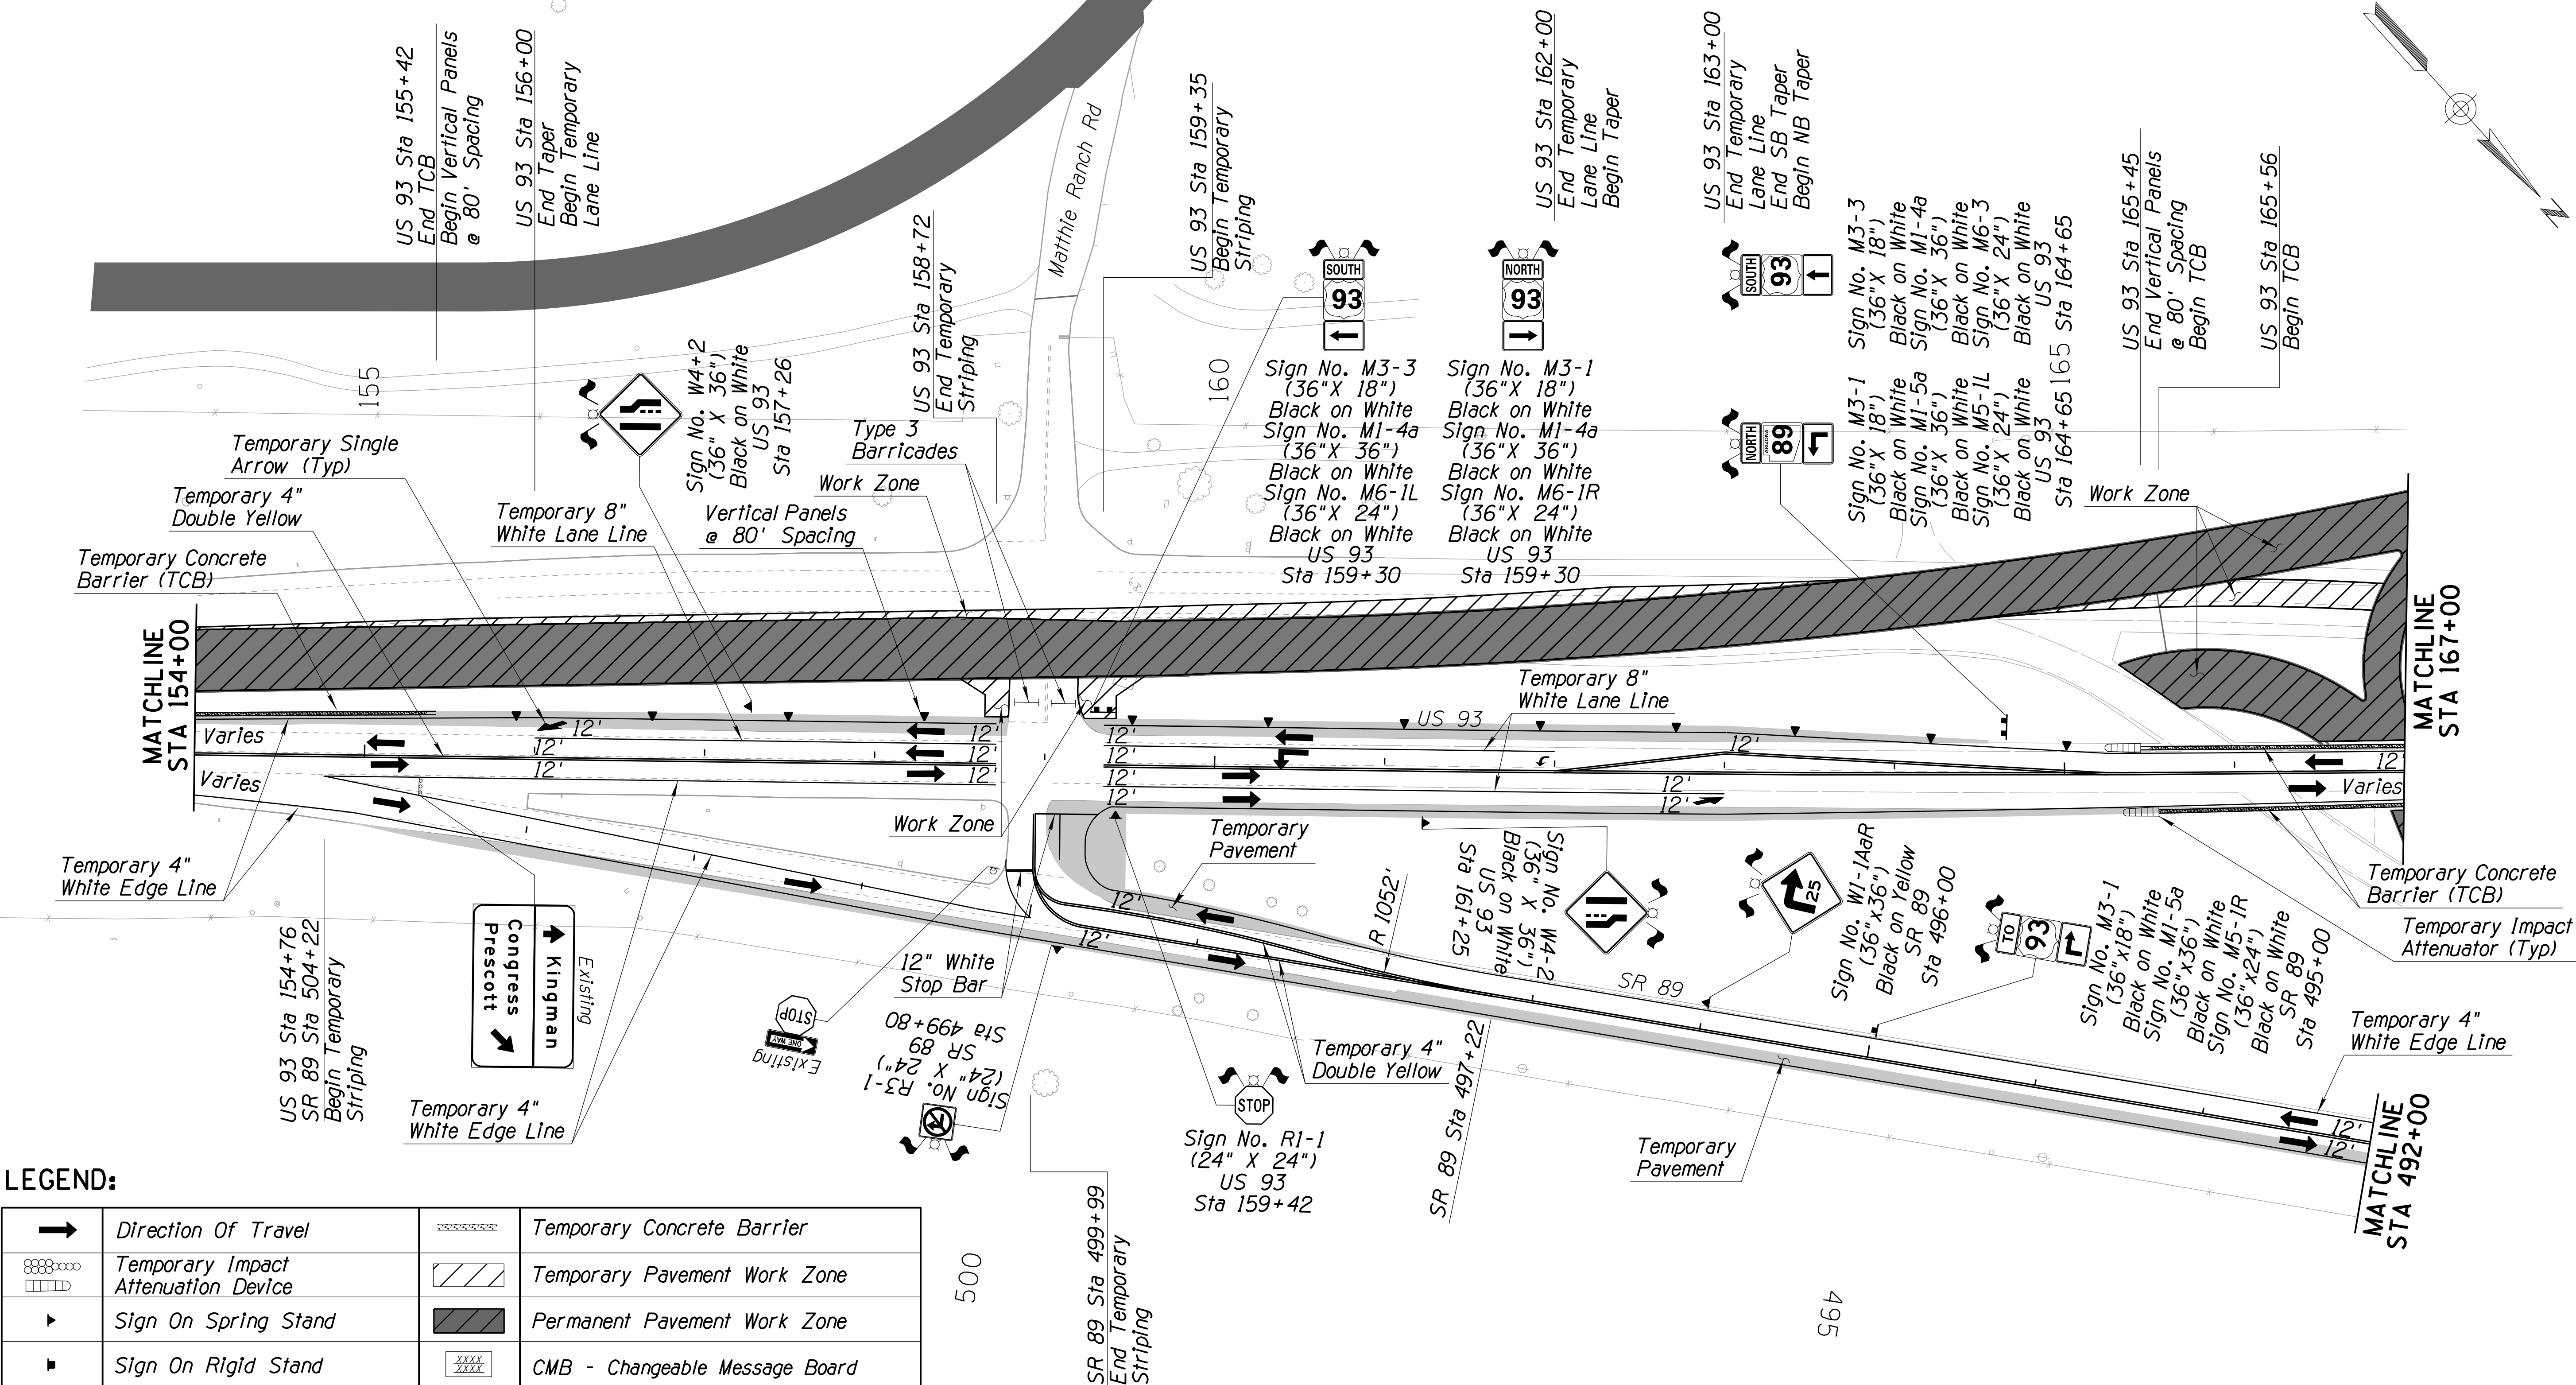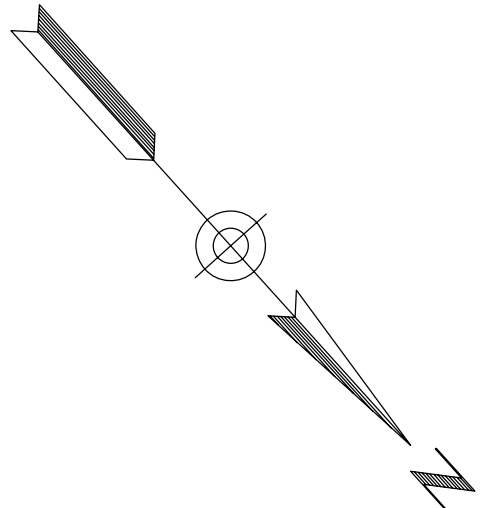

LEGEND:

	Direction Of Travel		Temporary Concrete Barrier
	Temporary Impact Attenuation Device		Temporary Pavement Work Zone
	Sign On Spring Stand		Permanent Pavement Work Zone
	Sign On Rigid Stand		CMB - Changeable Message Board
	Sign On Embedded Posts		Flashing Light & Warning Flags
	Type 2 Barricade		Vertical Panel
	Type 3 Barricade		Temporary Pavement Phase 1
			Constructed Pavement Phase 1

NOTE:

1. Obliterate all existing pavement marking in conflict with Phase 2 temporary pavement marking on US 93 Sta 128+20 to Sta 180+32 and SR 89 Sta 503+92 to Sta 476+36.

DESIGN	ME1	DATE	06/26
DRAWN	SRH	DATE	06/26
CHECKED	BMT	DATE	06/26

3133 East Camelback Road, Suite 100
Phoenix, Arizona 85016
Phone: (602) 333-2200

Stanley Consultants Inc.

ROUTE: US 93 LOCATION: WICKENBURG RANCH WAY TO VISTA ROYALE

TRACS NO. F0738 OIC

093-B(230)T

093 YV 189

US 93 & SR 89
PHASE 2 TRAFFIC CONTROL
STA 154+00 TO STA 167+00

ARIZONA DEPARTMENT OF TRANSPORTATION
PROJECT DELIVERY AND OPERATIONS DIVISION
TRAFFIC DESIGN SERVICES


DWG NO. T-2.09

OF

51481
BRIANNE MARIE
TURPIN
REGISTERED PROFESSIONAL ENGINEER
ARIZONA, U.S.A.

PHASE 2

F.H.W.A. REGION	STATE	PROJECT NO.	SHEET NO.	TOTAL SHEETS	RECORD DRAWING
9	ARIZ.	093-B(230)T	314	524	
093 YV 189					

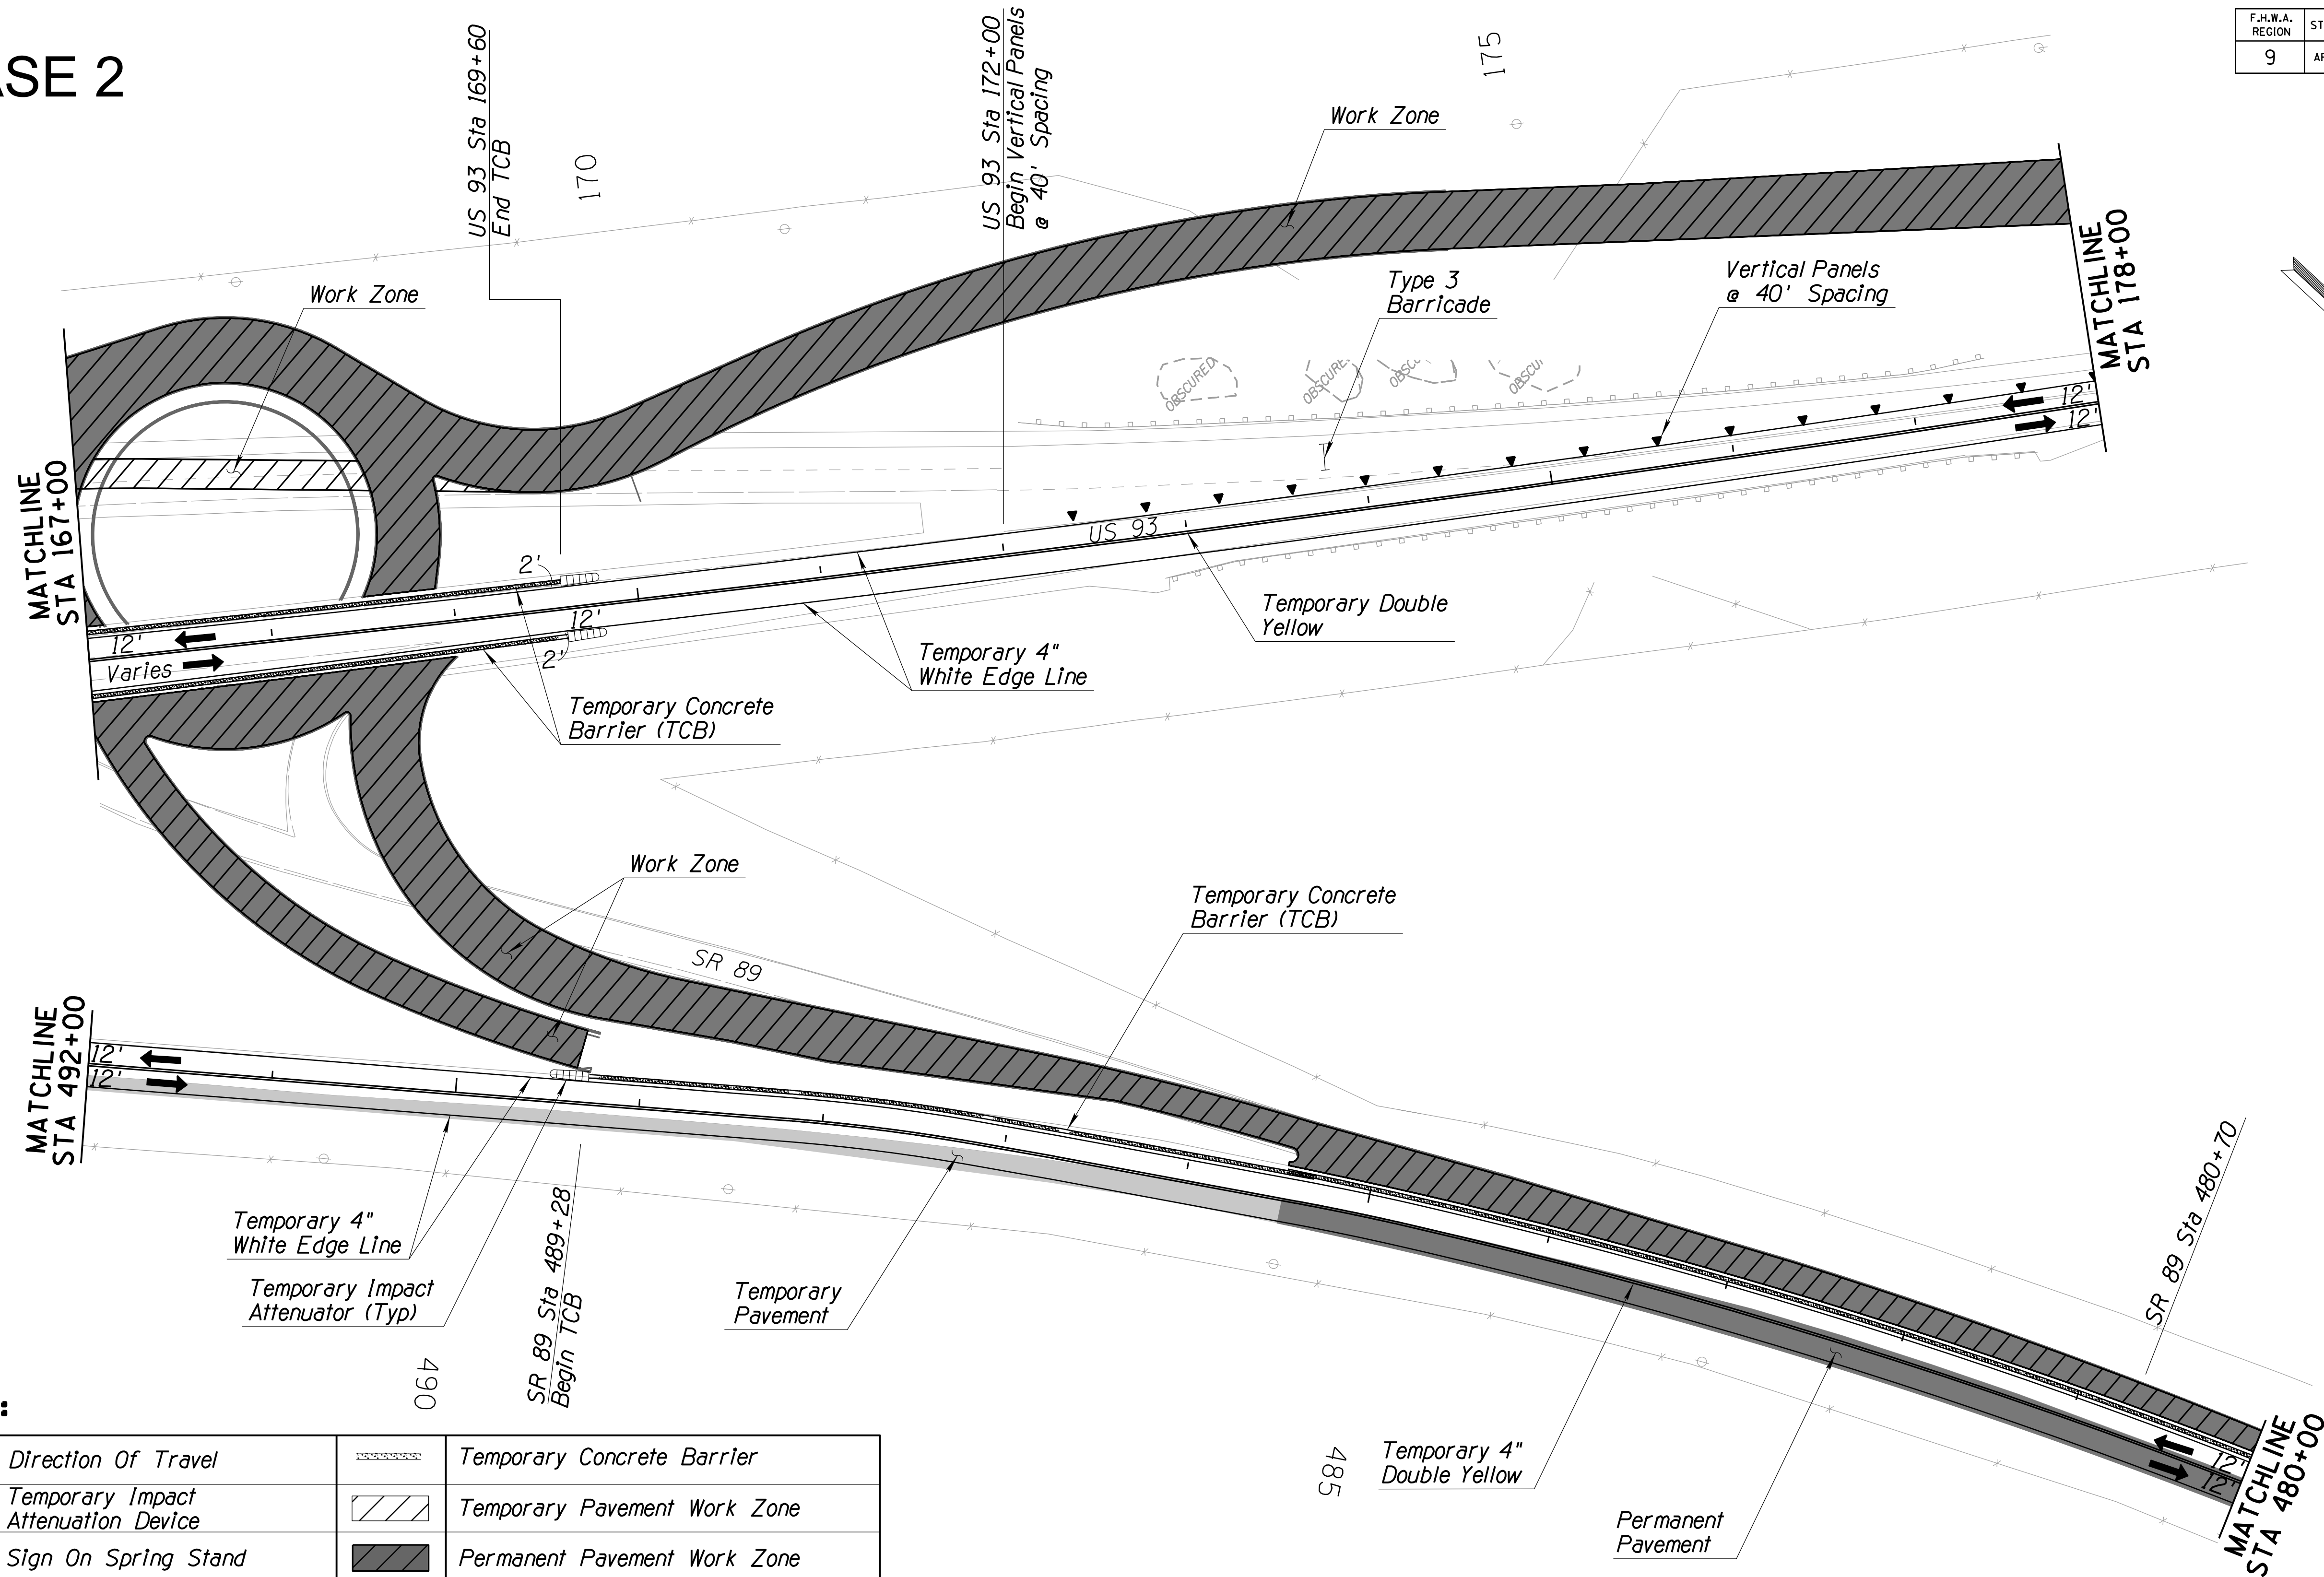

LEGEND:

➔	Direction Of Travel	▨	Temporary Concrete Barrier
⊙⊙⊙⊙	Temporary Impact Attenuation Device	▨	Temporary Pavement Work Zone
▤	Sign On Spring Stand	▨	Permanent Pavement Work Zone
▥	Sign On Rigid Stand	XXXX	CMB - Changeable Message Board
⚡	Sign On Embedded Posts	⚡	Flashing Light & Warning Flags
■	Type 2 Barricade	▲	Vertical Panel
—	Type 3 Barricade	▨	Temporary Pavement Phase 1
		▨	Constructed Pavement Phase 1

NOTE:


- Obliterate all existing pavement marking in conflict with Phase 2 temporary pavement marking on US 93 Sta 128+20 to Sta 180+32 and SR 89 Sta 503+92 to Sta 476+36.

		NAME	DATE	ARIZONA DEPARTMENT OF TRANSPORTATION PROJECT DELIVERY AND OPERATIONS DIVISION TRAFFIC DESIGN SERVICES US 93 & SR 89 PHASE 2 TRAFFIC CONTROL STA 167+00 TO STA 178+00		
DESIGN	MEI	06/26				
DRAWN	SRH	06/26				
CHECKED	BMT	06/26				
		3133 East Camelback Road, Suite 100 Phoenix, Arizona 85016 Phone: (602) 333-2200				
Stanley Consultants inc.						
ROUTE		LOCATION		DWG NO. T-2.10		
US 93		WICKENBURG RANCH WAY TO VISTA ROYALE				
TRACS NO. F0738 OIC			093-B(230)T			
			OF			

PHASE 2

F.H.W.A. REGION	STATE	PROJECT NO.	SHEET NO.	TOTAL SHEETS	RECORD DRAWING
9	ARIZ.	093-B(230)T	315	524	

093 YV 189

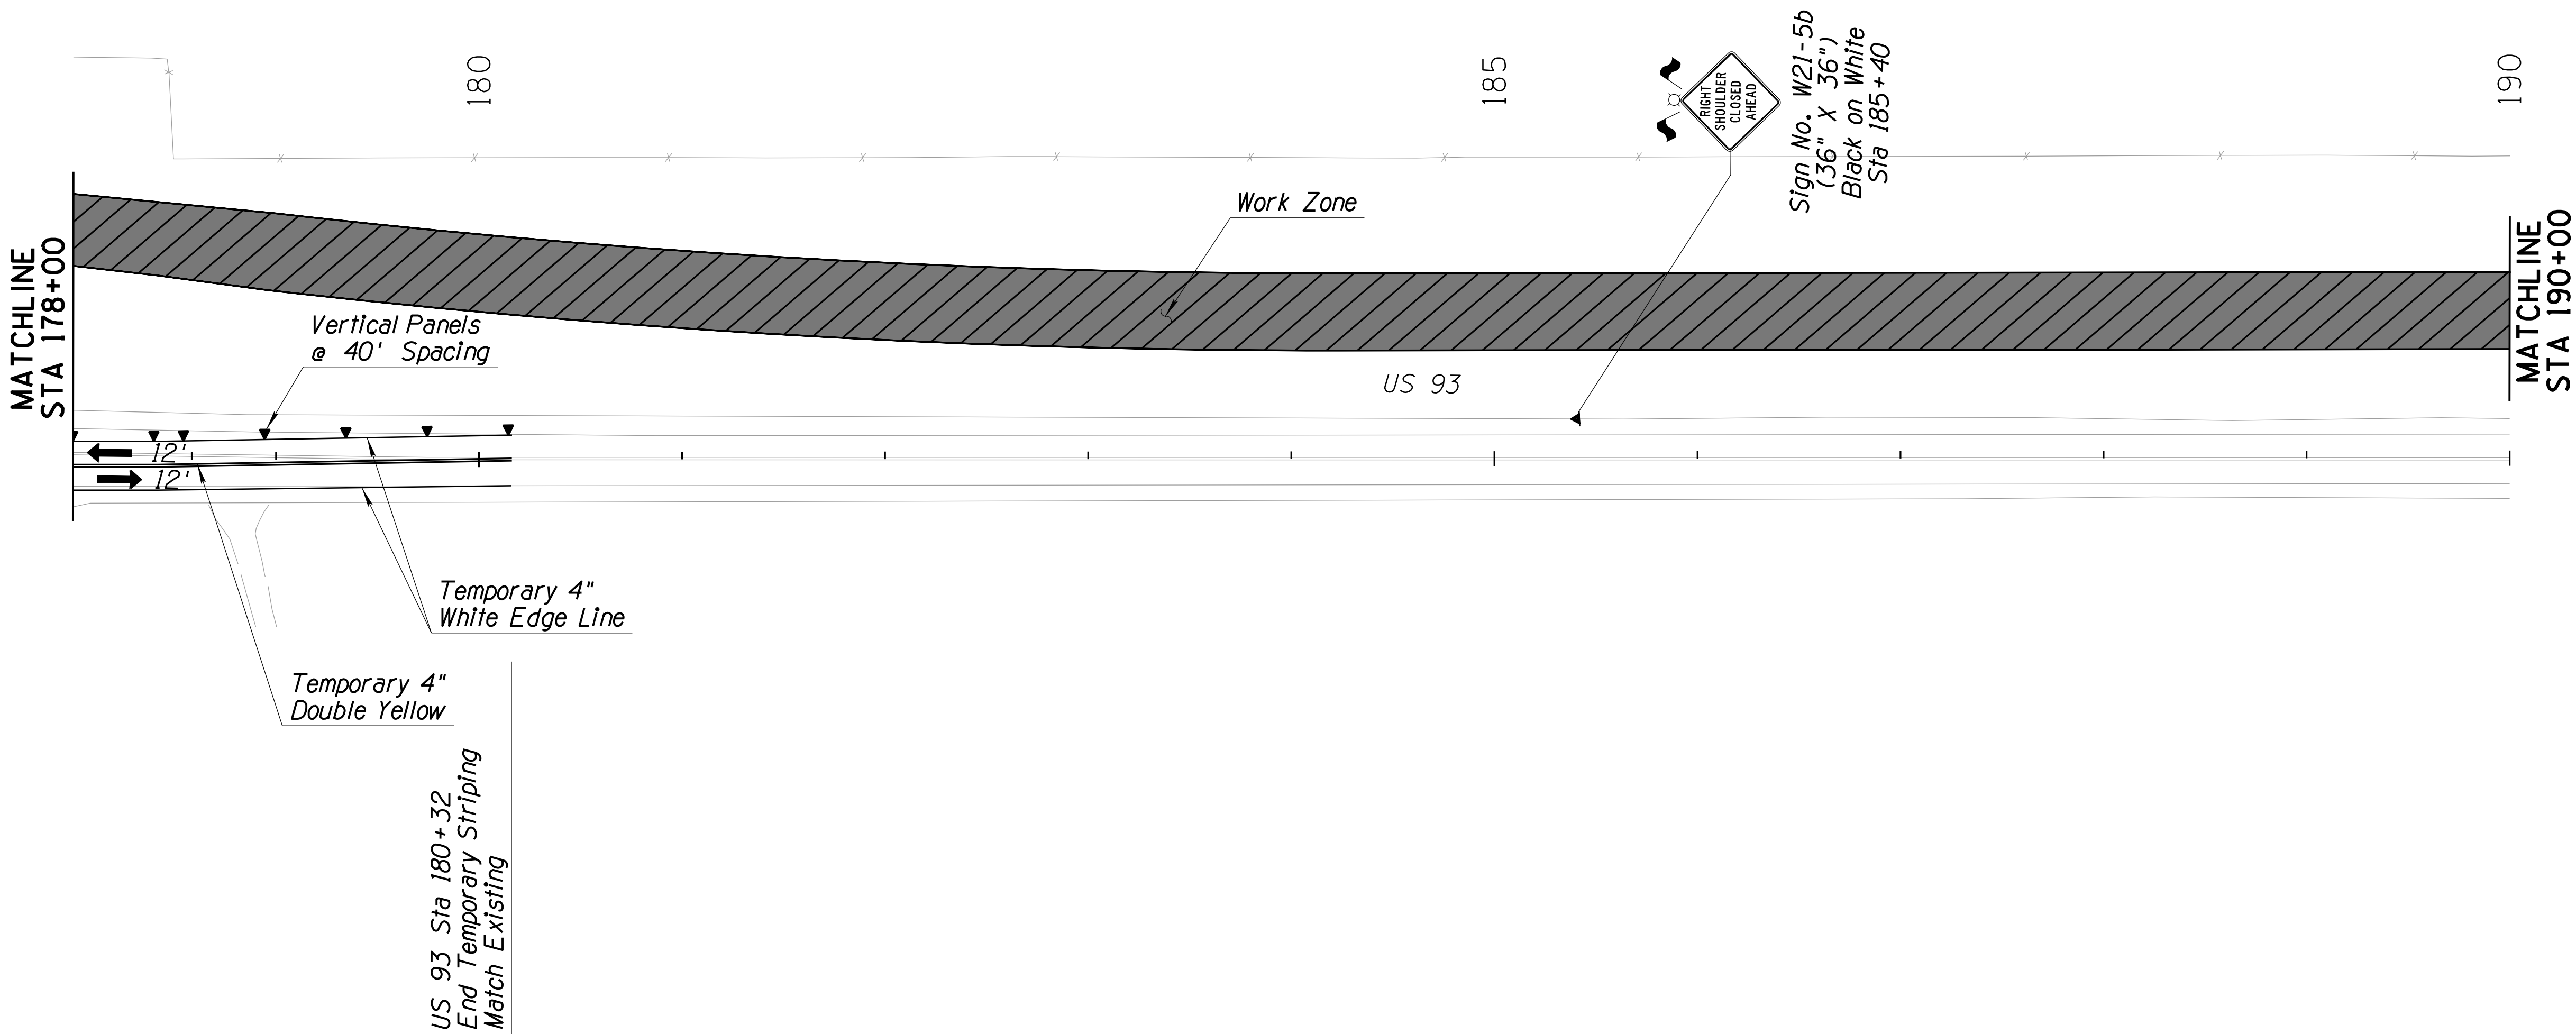

LEGEND:

	Direction Of Travel		Temporary Concrete Barrier
	Temporary Impact Attenuation Device		Temporary Pavement Work Zone
	Sign On Spring Stand		Permanent Pavement Work Zone
	Sign On Rigid Stand		CMB - Changeable Message Board
	Sign On Embedded Posts		Flashing Light & Warning Flags
	Type 2 Barricade		Vertical Panel
	Type 3 Barricade		Temporary Pavement Phase 1
			Constructed Pavement Phase 1


NOTE:

1. Obliterate all existing pavement marking in conflict with Phase 2 temporary pavement marking on US 93 Sta 128+20 to Sta 180+32 and SR 89 Sta 503+92 to Sta 476+36.

		NAME		DATE		ARIZONA DEPARTMENT OF TRANSPORTATION PROJECT DELIVERY AND OPERATIONS DIVISION TRAFFIC DESIGN SERVICES	
DESIGN		ME1		06/26			
DRAWN		SRH		06/26			
CHECKED		BMT		06/26			
 Stanley Consultants inc.		3133 East Camelback Road, Suite 100 Phoenix, Arizona 85016 Phone: (602) 333-2200				US 93 PHASE 2 TRAFFIC CONTROL STA 178+00 TO STA 190+00	
ROUTE		LOCATION					
US 93		WICKENBURG RANCH WAY TO VISTA ROYALE					
TRACS NO. F0738 OIC						093-B(230)T	DWG NO. T-2.11
							OF

PHASE 2

F.H.W.A. REGION	STATE	PROJECT NO.	SHEET NO.	TOTAL SHEETS	RECORD DRAWING
9	ARIZ.	093-B(230)T	316	524	
093 YV 189					

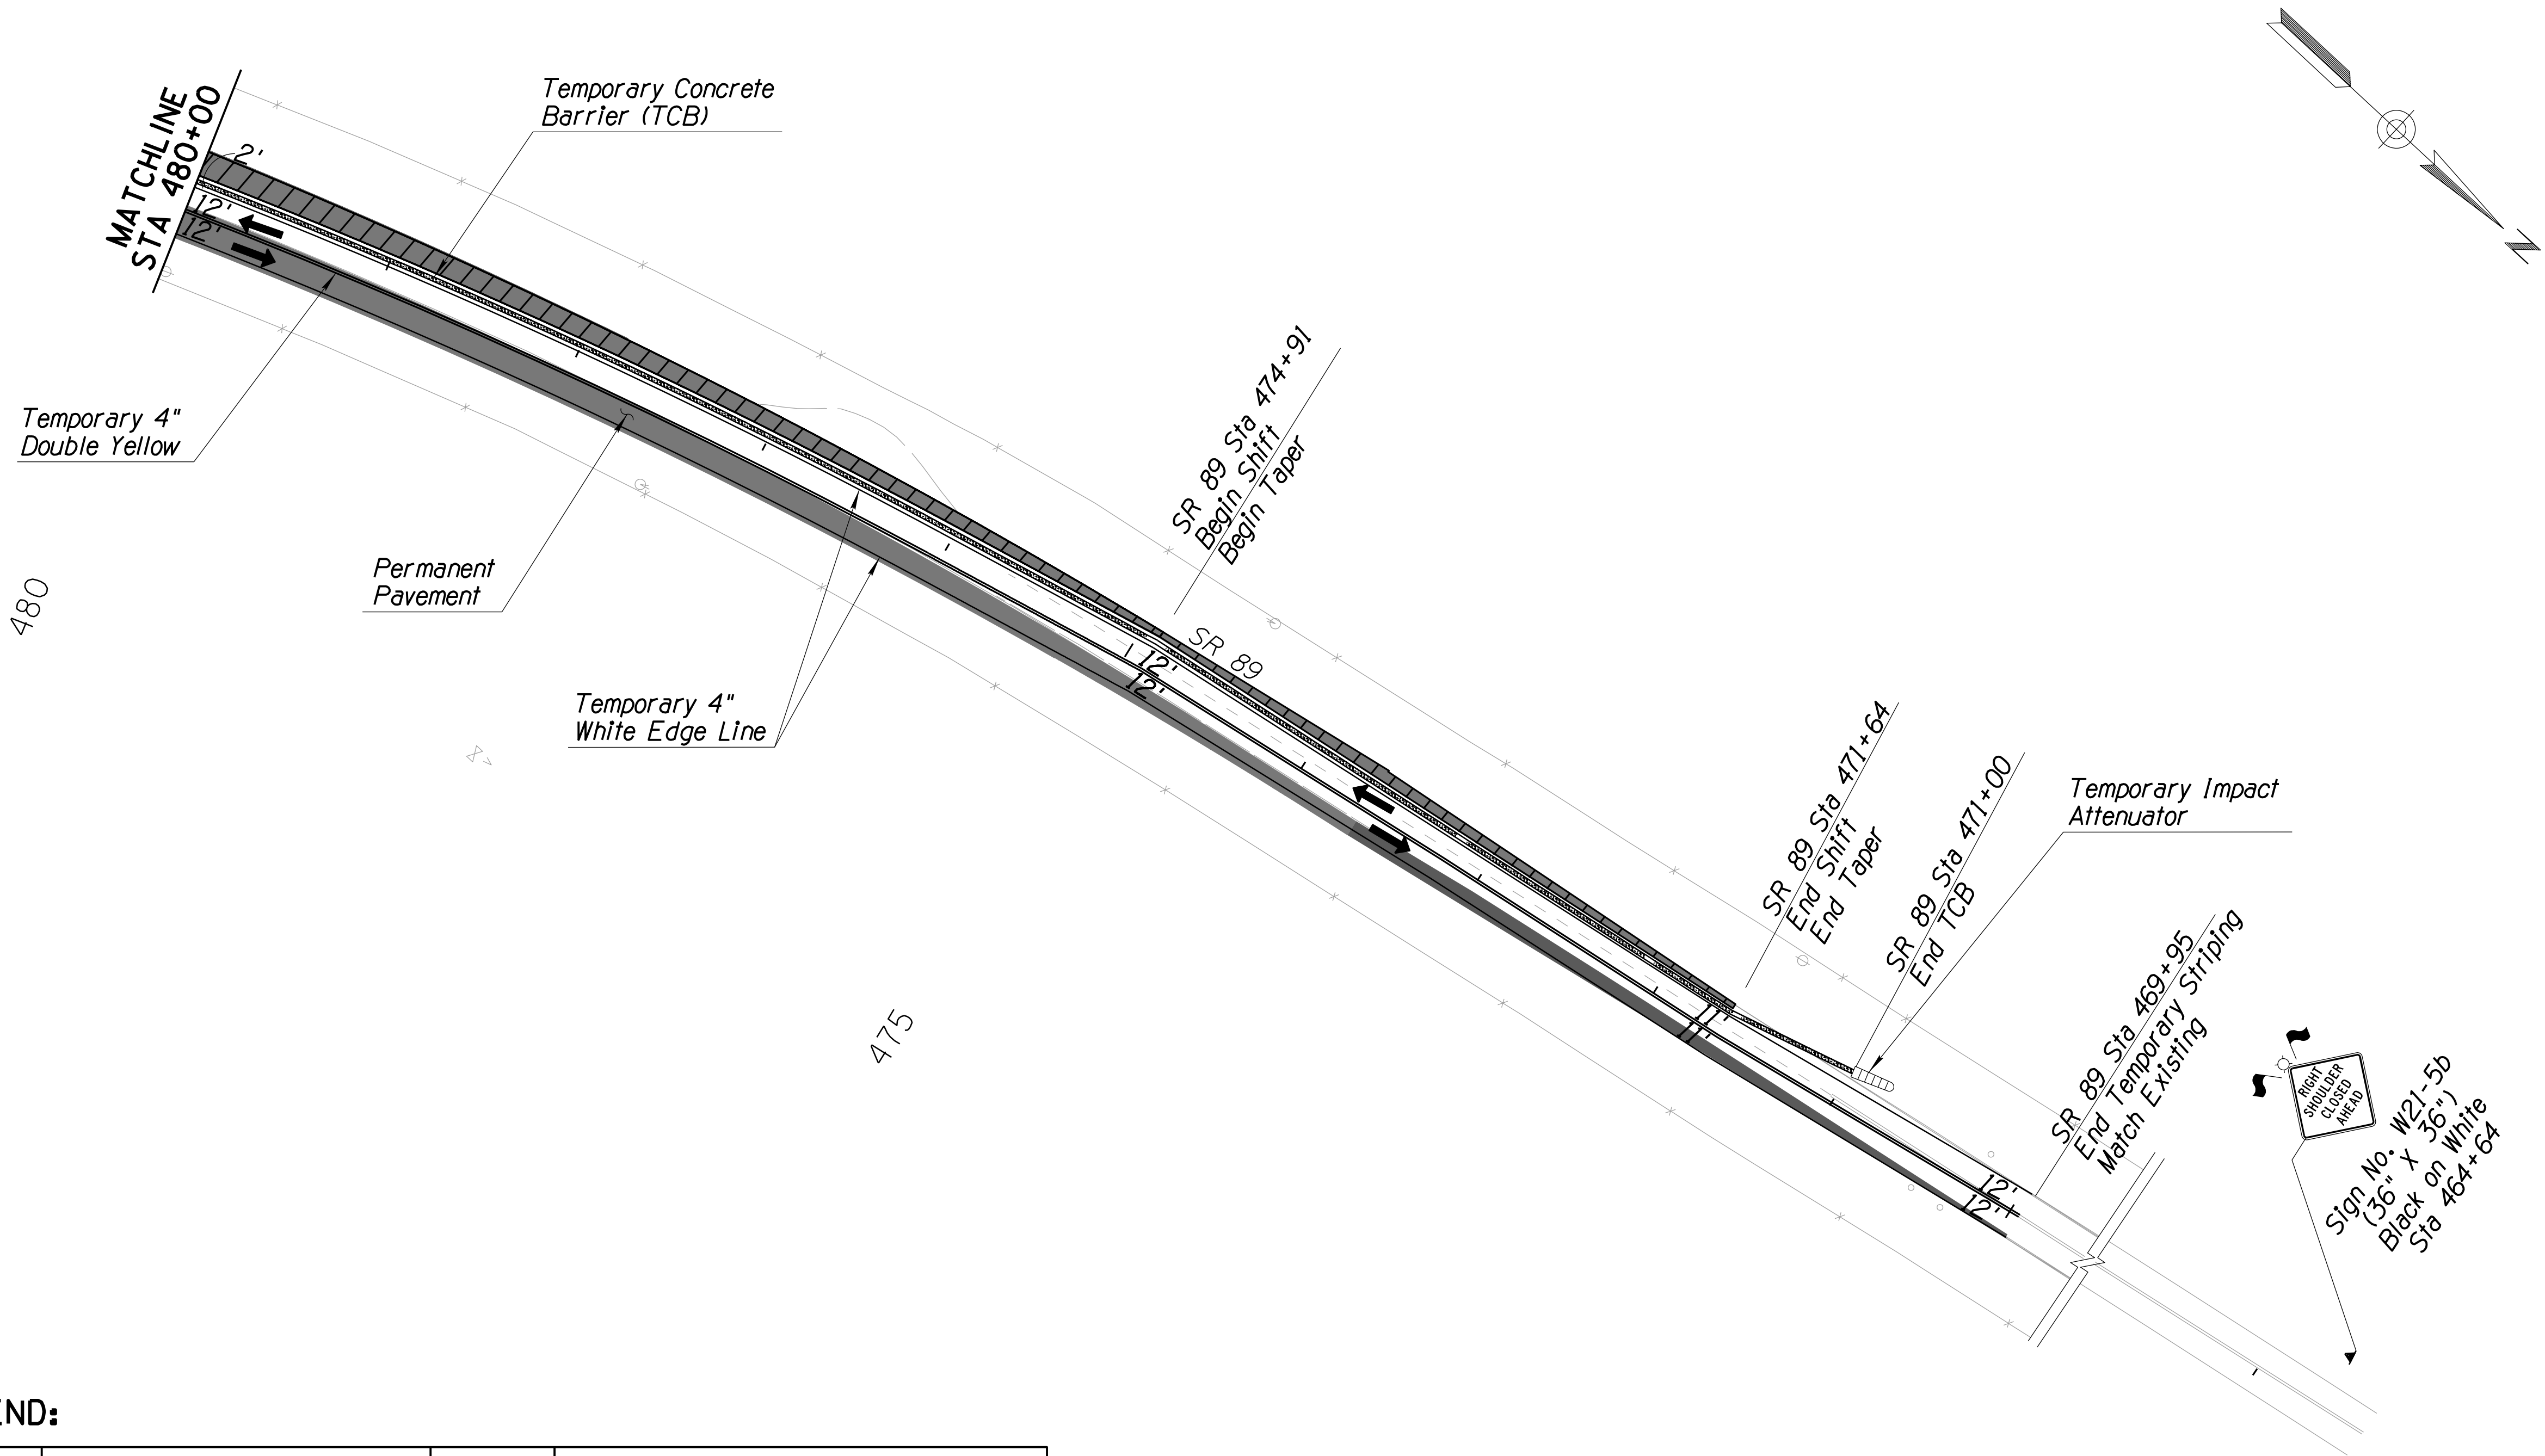

LEGEND:

	Direction Of Travel		Temporary Concrete Barrier
	Temporary Impact Attenuation Device		Temporary Pavement Work Zone
	Sign On Spring Stand		Permanent Pavement Work Zone
	Sign On Rigid Stand		CMB - Changeable Message Board
	Sign On Embedded Posts		Flashing Light & Warning Flags
	Type 2 Barricade		Vertical Panel
	Type 3 Barricade		Temporary Pavement Phase 1
			Constructed Pavement Phase 1

NOTE:


1. Obliterate all existing pavement marking in conflict with Phase 2 temporary pavement marking on US 93 Sta 128+20 to Sta 180+32 and SR 89 Sta 503+92 to Sta 476+36.

NAME		DATE	ARIZONA DEPARTMENT OF TRANSPORTATION PROJECT DELIVERY AND OPERATIONS DIVISION TRAFFIC DESIGN SERVICES	
DESIGN	ME1	06/26		
DRAWN	SRH	06/26		
CHECKED	BMT	06/26		
 3133 East Camelback Road, Suite 100 Phoenix, Arizona 85016 Phone: (602) 333-2200			SR 89 PHASE 2 TRAFFIC CONTROL STA 470+00 TO STA 480+00	
ROUTE	US 93	LOCATION	WICKENBURG RANCH WAY TO VISTA ROYALE	
TRACS NO. F0738 OIC			093-B(230)T	DWG NO. T-2.12 OF



PHASE 2

*Construct Moreton Rd Tie-in
area in Halves to Maintain Access.
Tie-in to be last section constructed in
Phase 2 before moving to Phase 2A.*

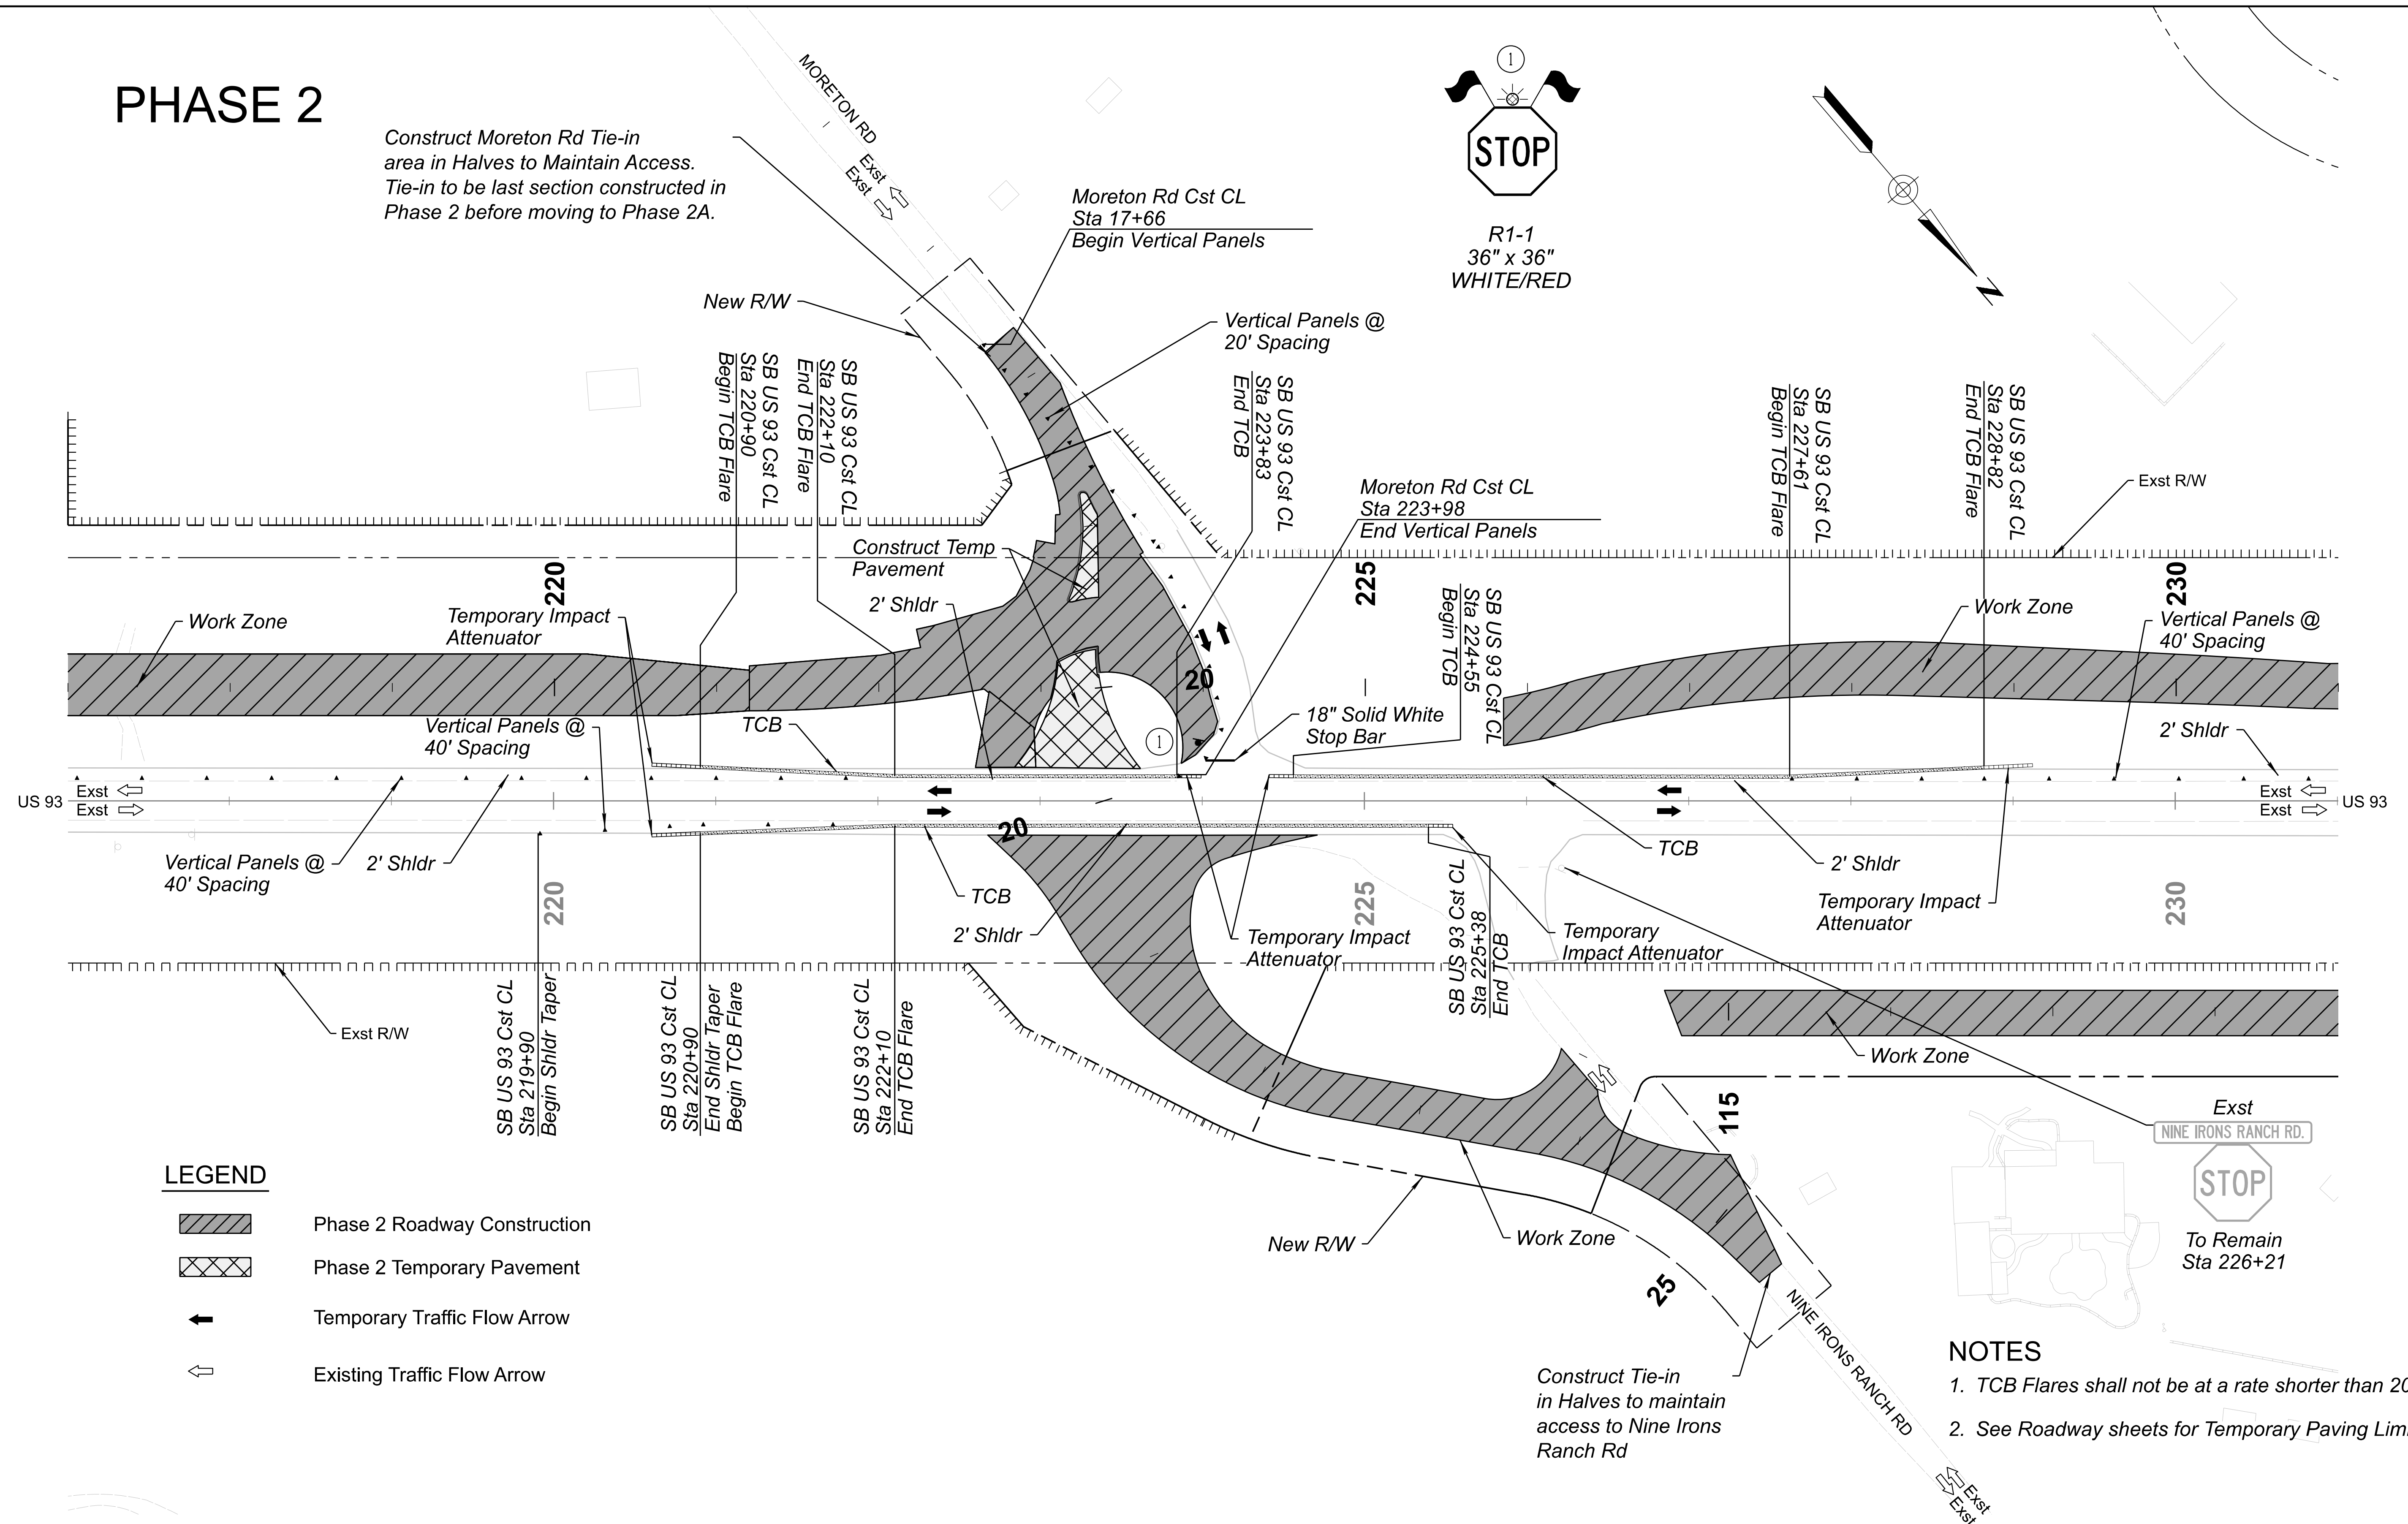

NOTES

1. TCB Flares shall not be at a rate shorter than 20:1.
2. See Roadway sheets for Temporary Paving Limits

A circular professional engineer seal for the State of Arizona. The outer ring contains the text "Professional Engineer" at the top and "ARIZONA, U.S.A." at the bottom. The inner ring contains "REGISTERED" at the top and "DATE SIGNED" at the bottom. The center of the seal contains the name "CRAIG J. RICKETTS, JR." and the number "64542". A handwritten signature, "Craig J. Ricketts, Jr.", is written across the seal. To the right of the seal, the text "(CMV)" is printed.

	NAME	DATE
DESIGN	I ROBLES	06/20/2011
DRAWN	C VALENCIA	06/20/2011
CHECKED	C RICKETTS	06/20/2011

TRANSPORTATION
AECOM TECHNICAL SERVICES, Inc.
 7720 N. 19th St., Suite 100
 Phoenix, Arizona 85020
 T 602.371-1100
www.aecom.com


AECOM

ARIZONA DEPARTMENT OF TRANSPORTATION
PROJECT DELIVERY AND OPERATIONS DIVISION
TRAFFIC DESIGN SERVICES

PHASE 2 - ROUNDABOUT
DETAIL SHEET STA 217+00 TO 231+00

ROUTE US 93	F.H.W.A. Arizona Division	STATE ARIZ.	PROJECT NO. 093 YV 190	FEDERAL ID NO. 093-B-NFA	SHEET NO. 317	TOTAL SHEETS 524	RECORD DRAWING
MILEPOST 190.5	LOCATION VISTA ROYALE						DWG No. T-2.13
STRUCTURE NO.	TRACS NO. F0738 01C						— OF —

PHASE 2

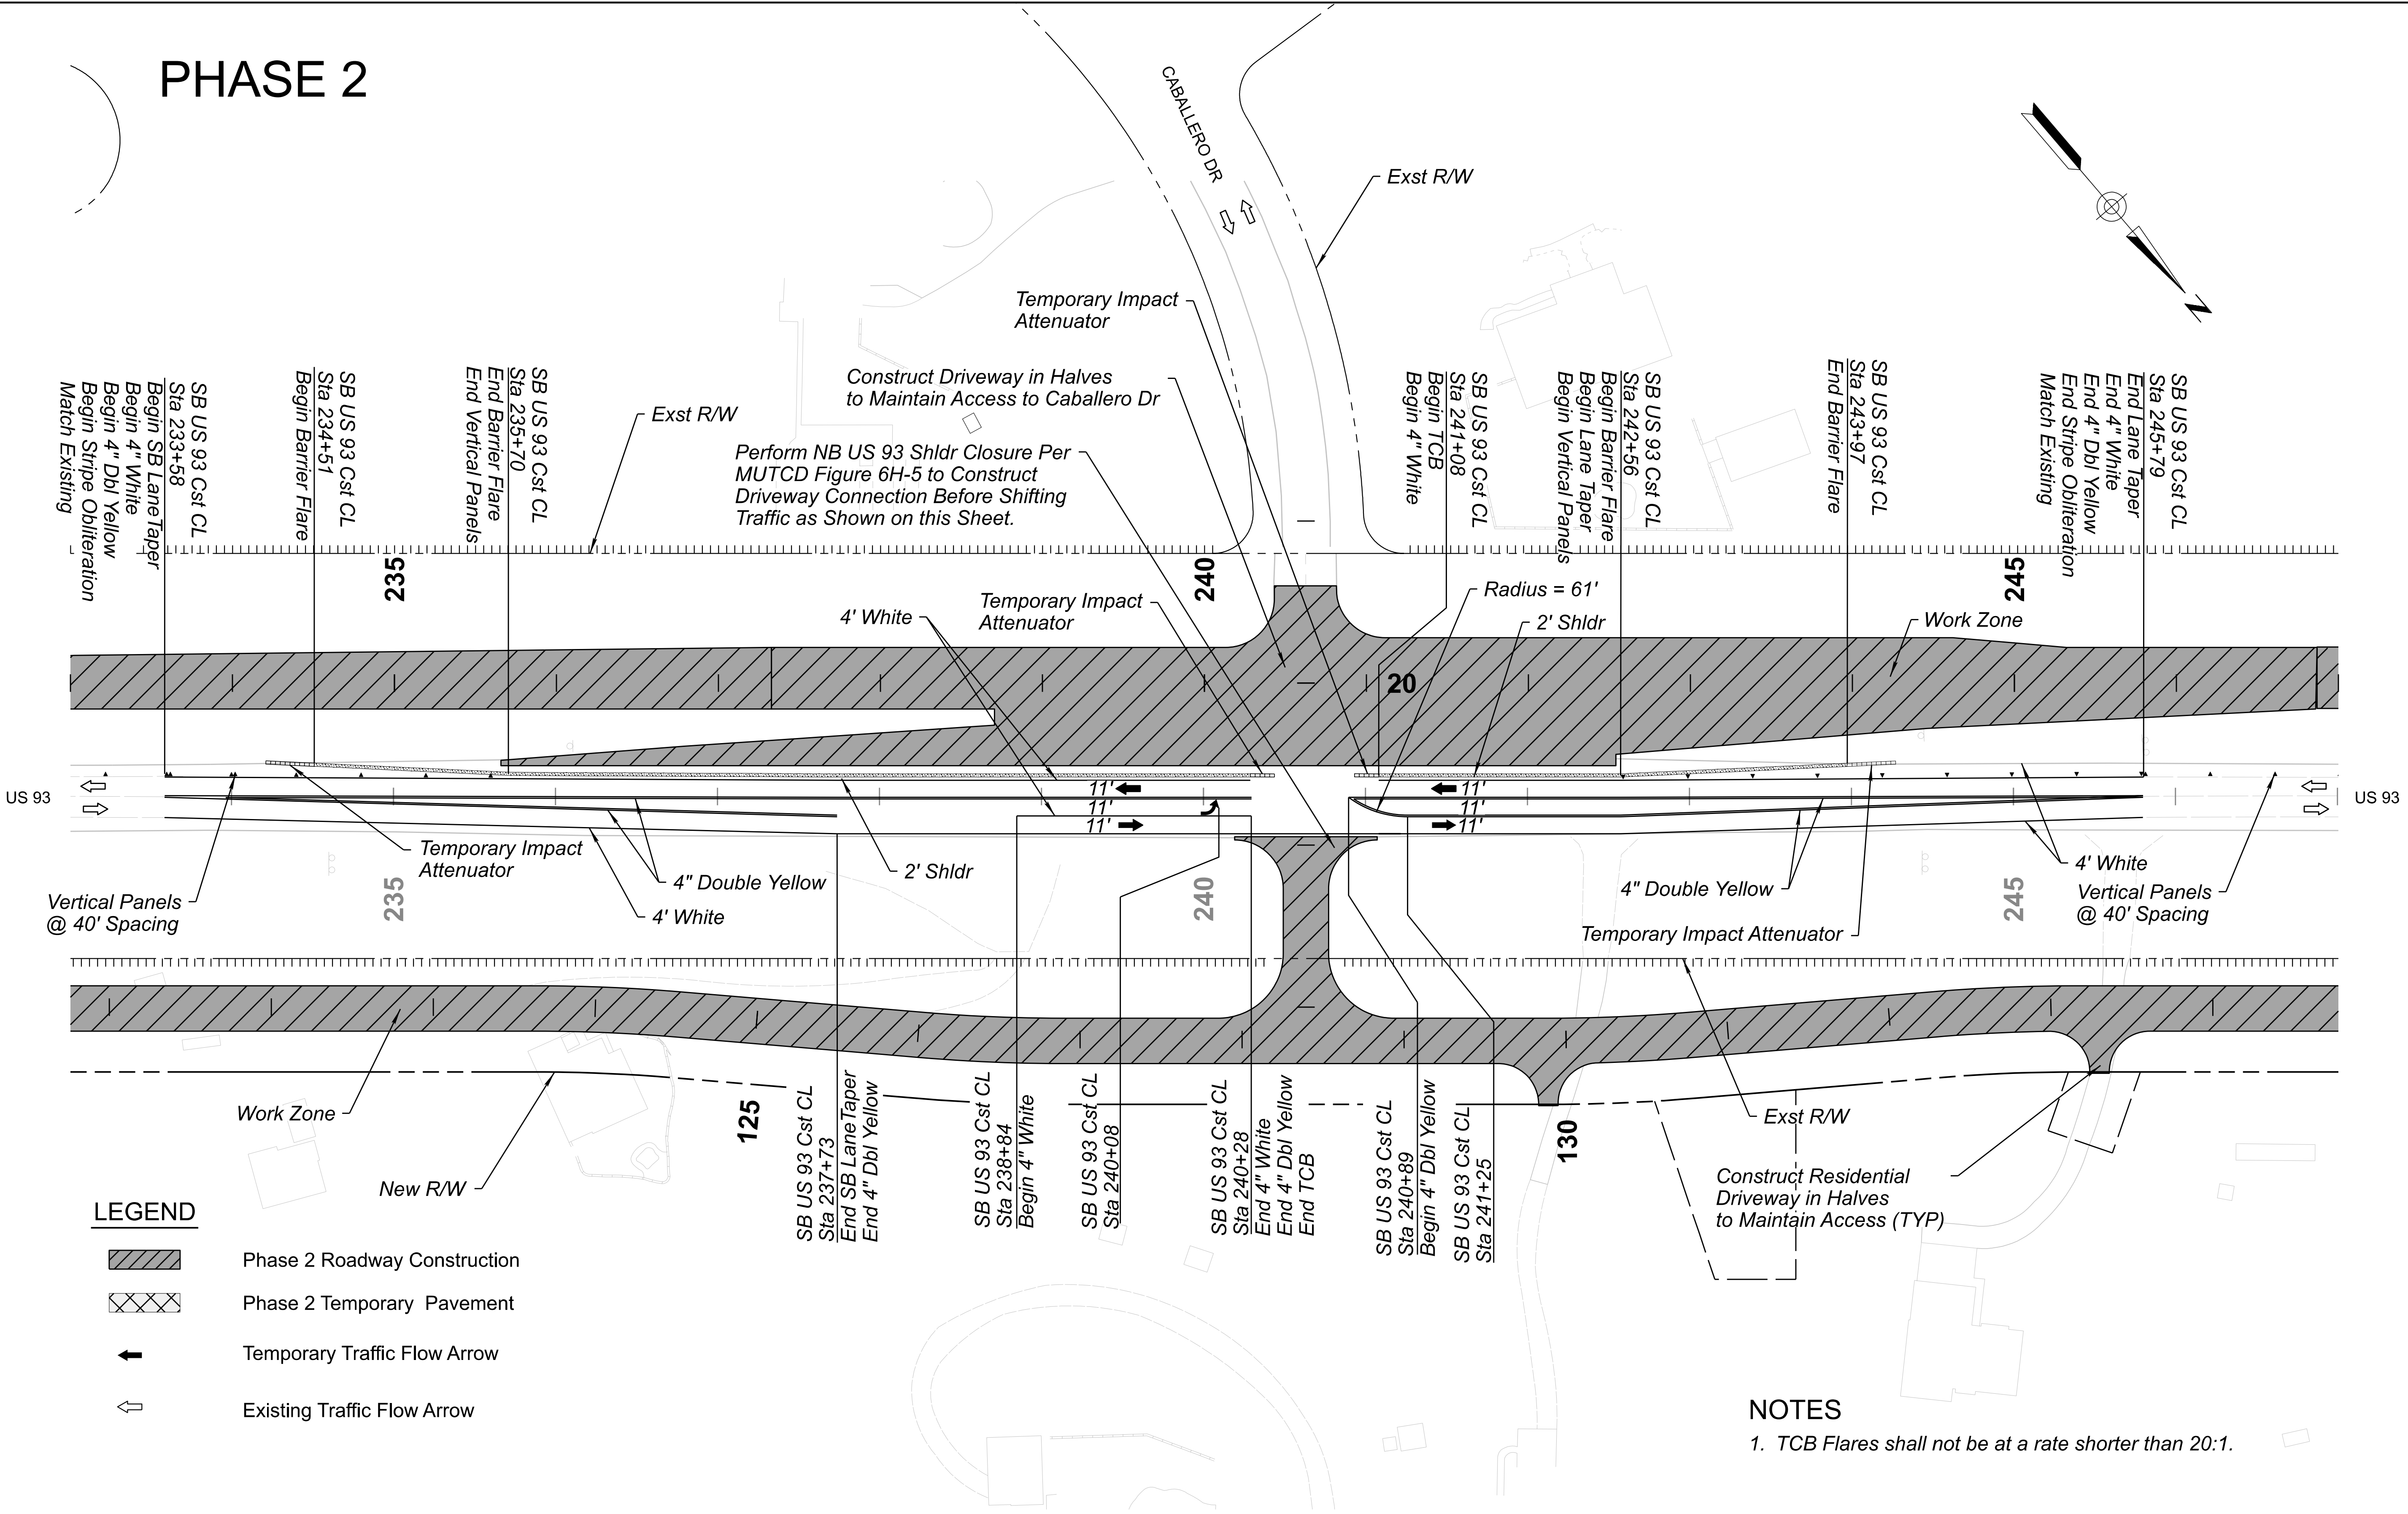

LEGEND

- Phase 2 Roadway Construction
- Phase 2 Temporary Pavement
- Temporary Traffic Flow Arrow
- Existing Traffic Flow Arrow

NOTES

1. TCB Flares shall not be at a rate shorter than 20:1.



	NAME	DATE
DESIGN	I ROBLES	06/26
DRAWN	C VALENCIA	06/26
CHECKED	C RICKETTS	06/26


TRANSPORTATION
AECOM TECHNICAL SERVICES, Inc.
7720 N. 16th St., Suite 100
Phoenix, Arizona 85020
T 602.371.1100
www.aecom.com

AECOM

ARIZONA DEPARTMENT OF TRANSPORTATION PROJECT DELIVERY AND OPERATIONS DIVISION TRAFFIC DESIGN SERVICES
PHASE 2 - CABALLERO ROAD DETAIL SHEET STA 233+00 TO 247+00


ROUTE US 93	F.H.W.A. Arizona Division	STATE ARIZ.	PROJECT NO. 093 YV 190	FEDERAL ID NO. 093-B-NFA	SHEET NO. 318	TOTAL SHEETS 524	RECORD DRAWING
MILEPOST 190.5		LOCATION VISTA ROYALE					
STRUCTURE NO.	TRACS NO. F0738 01C			____ OF ____			

PHASE 2

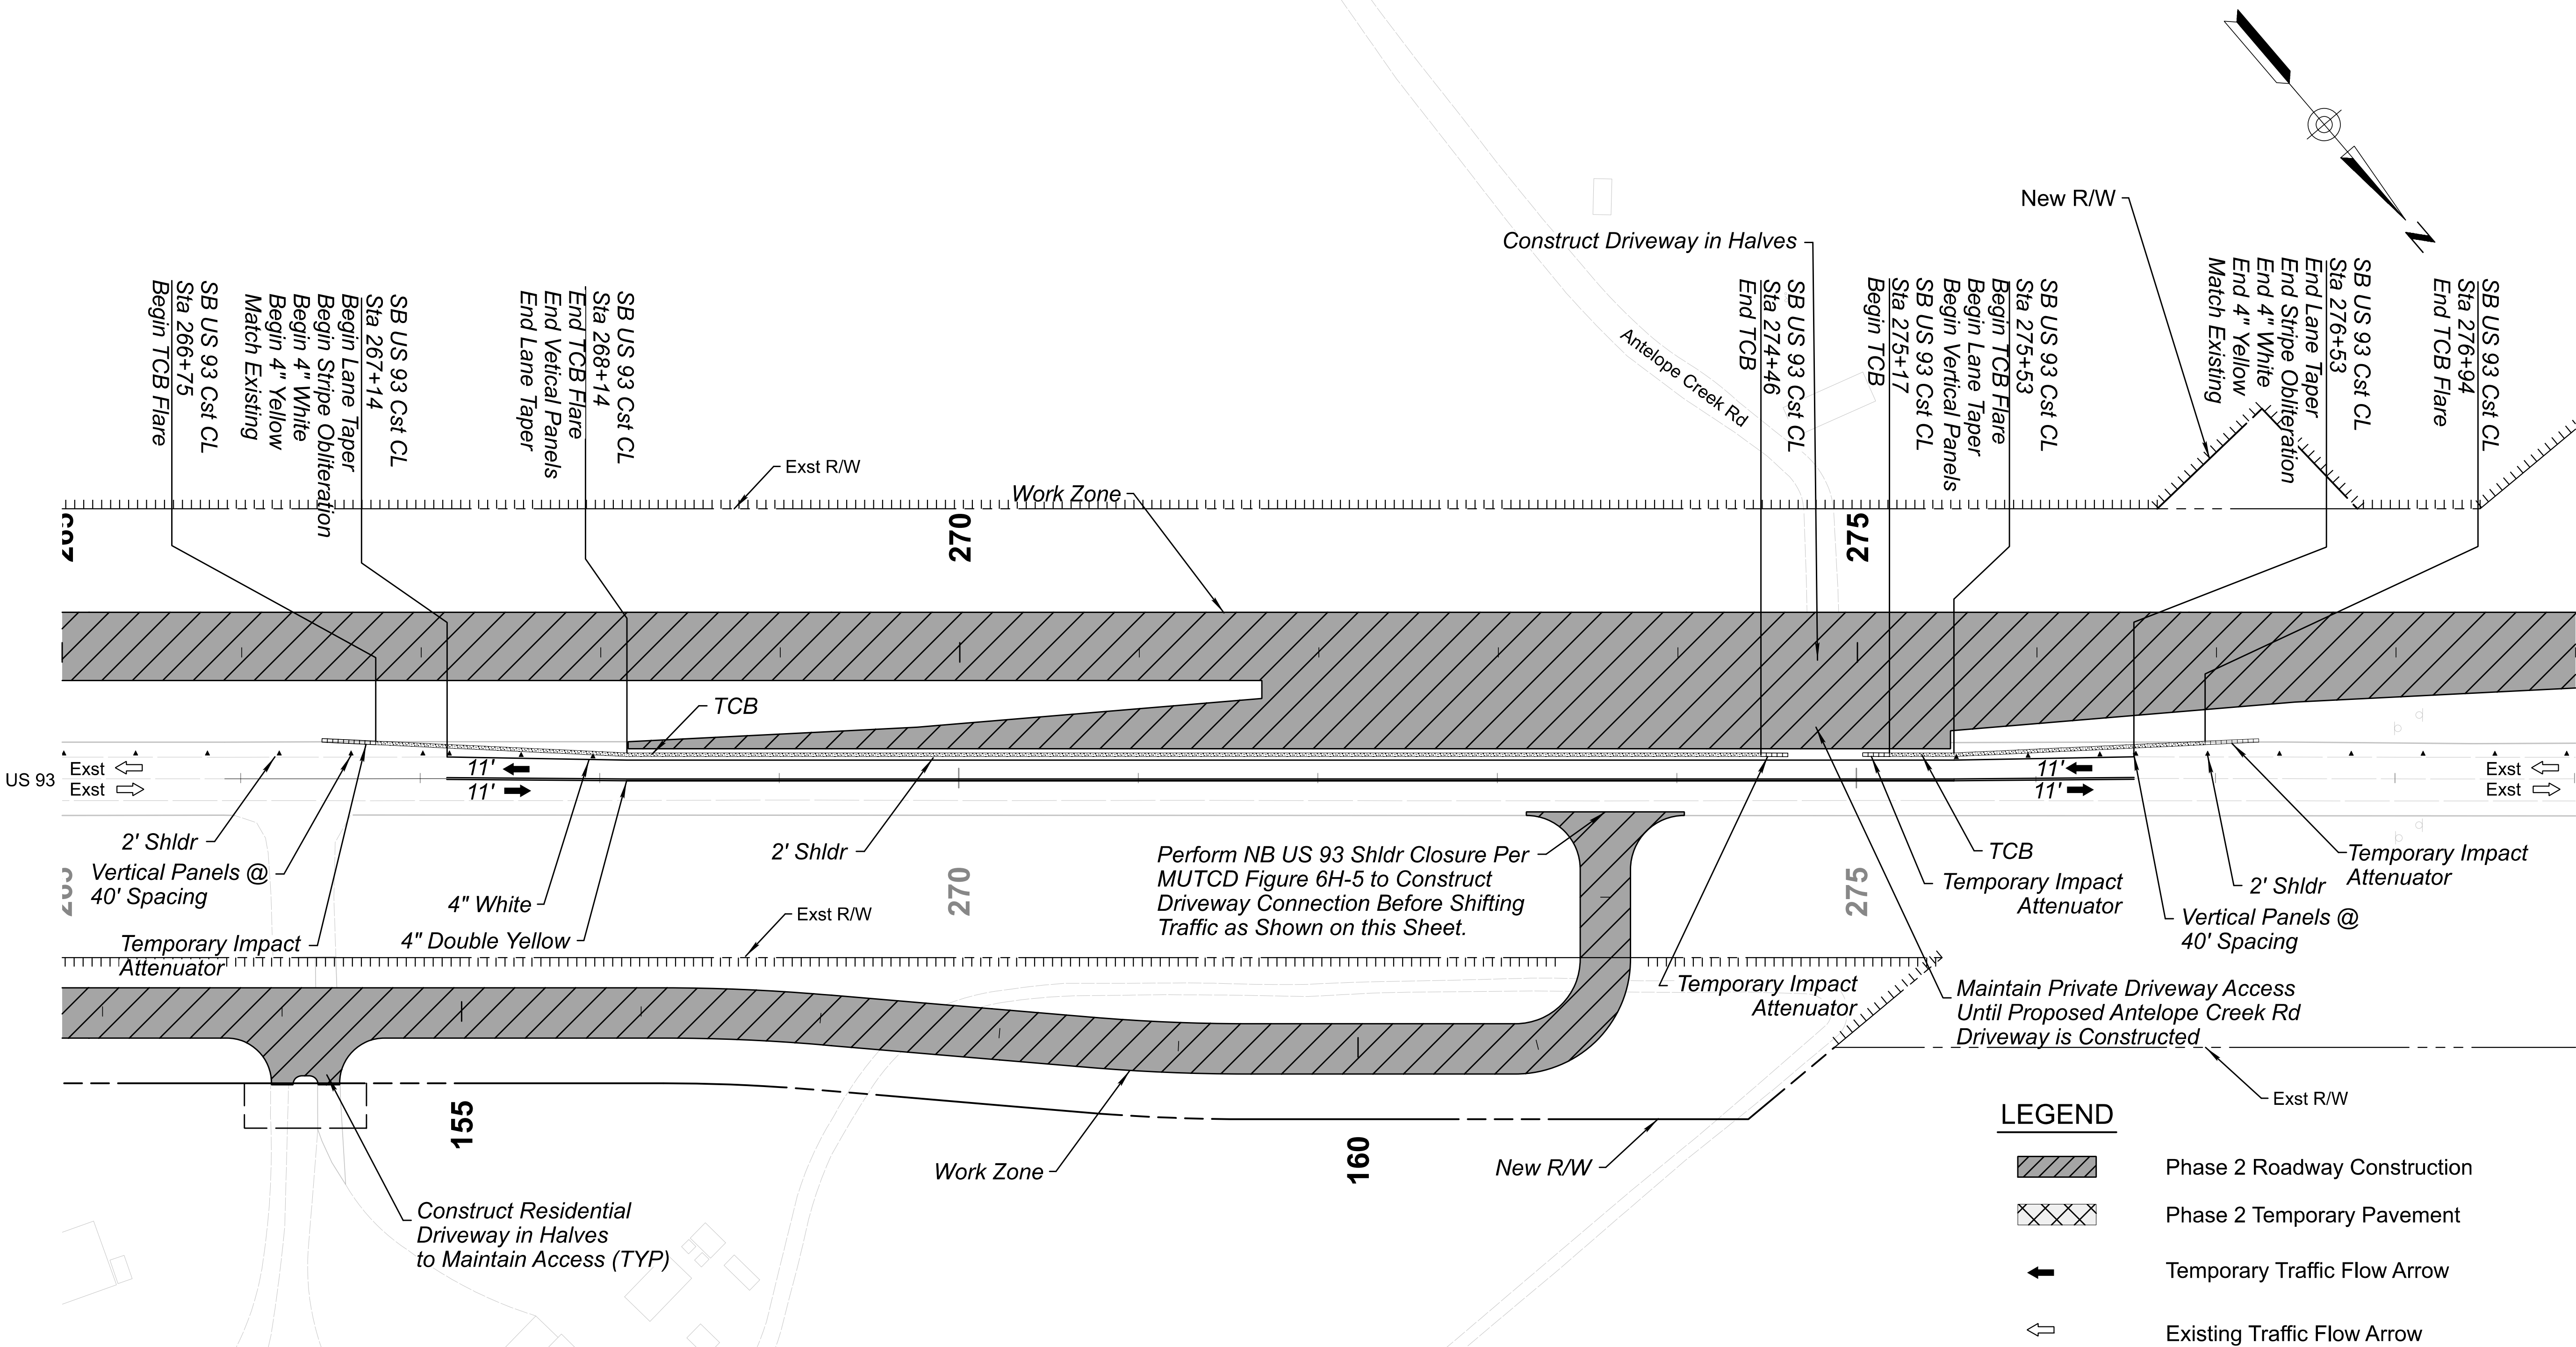

NOTES

1. TCB Flares shall not be at a rate shorter than 20:1.

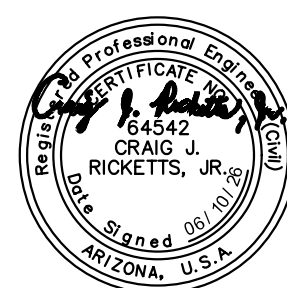

	NAME	DATE
DESIGN	I ROBLES	06/26
DRAWN	C VALENCIA	06/26
CHECKED	C RICKETTS	06/26

TRANSPORTATION
AECOM TECHNICAL SERVICES, Inc.
7720 N. 18th St., Suite 100
Phoenix, Arizona 85021
T 602.371.1100


AECOM
www.aecom.com

ARIZONA DEPARTMENT OF TRANSPORTATION
PROJECT DELIVERY AND OPERATIONS DIVISION
TRAFFIC DESIGN SERVICES

PHASE 2- ANTELOPE CREEK ROAD
DETAIL SHEET STA 265+00 TO 279+00

ROUTE US 93	F.H.W.A. Arizona Division	STATE ARIZ.	PROJECT NO. 093 YV 190	FEDERAL ID NO. 093-B-NFA	SHEET NO. 319	TOTAL SHEETS 524	RECORD DRAWING
MILEPOST 190.5							
STRUCTURE NO.	LOCATION VISTA ROYALE						DWG No. T-2.15
	TRACS NO. F0738 01C						___ OF ___

PHASE 2A

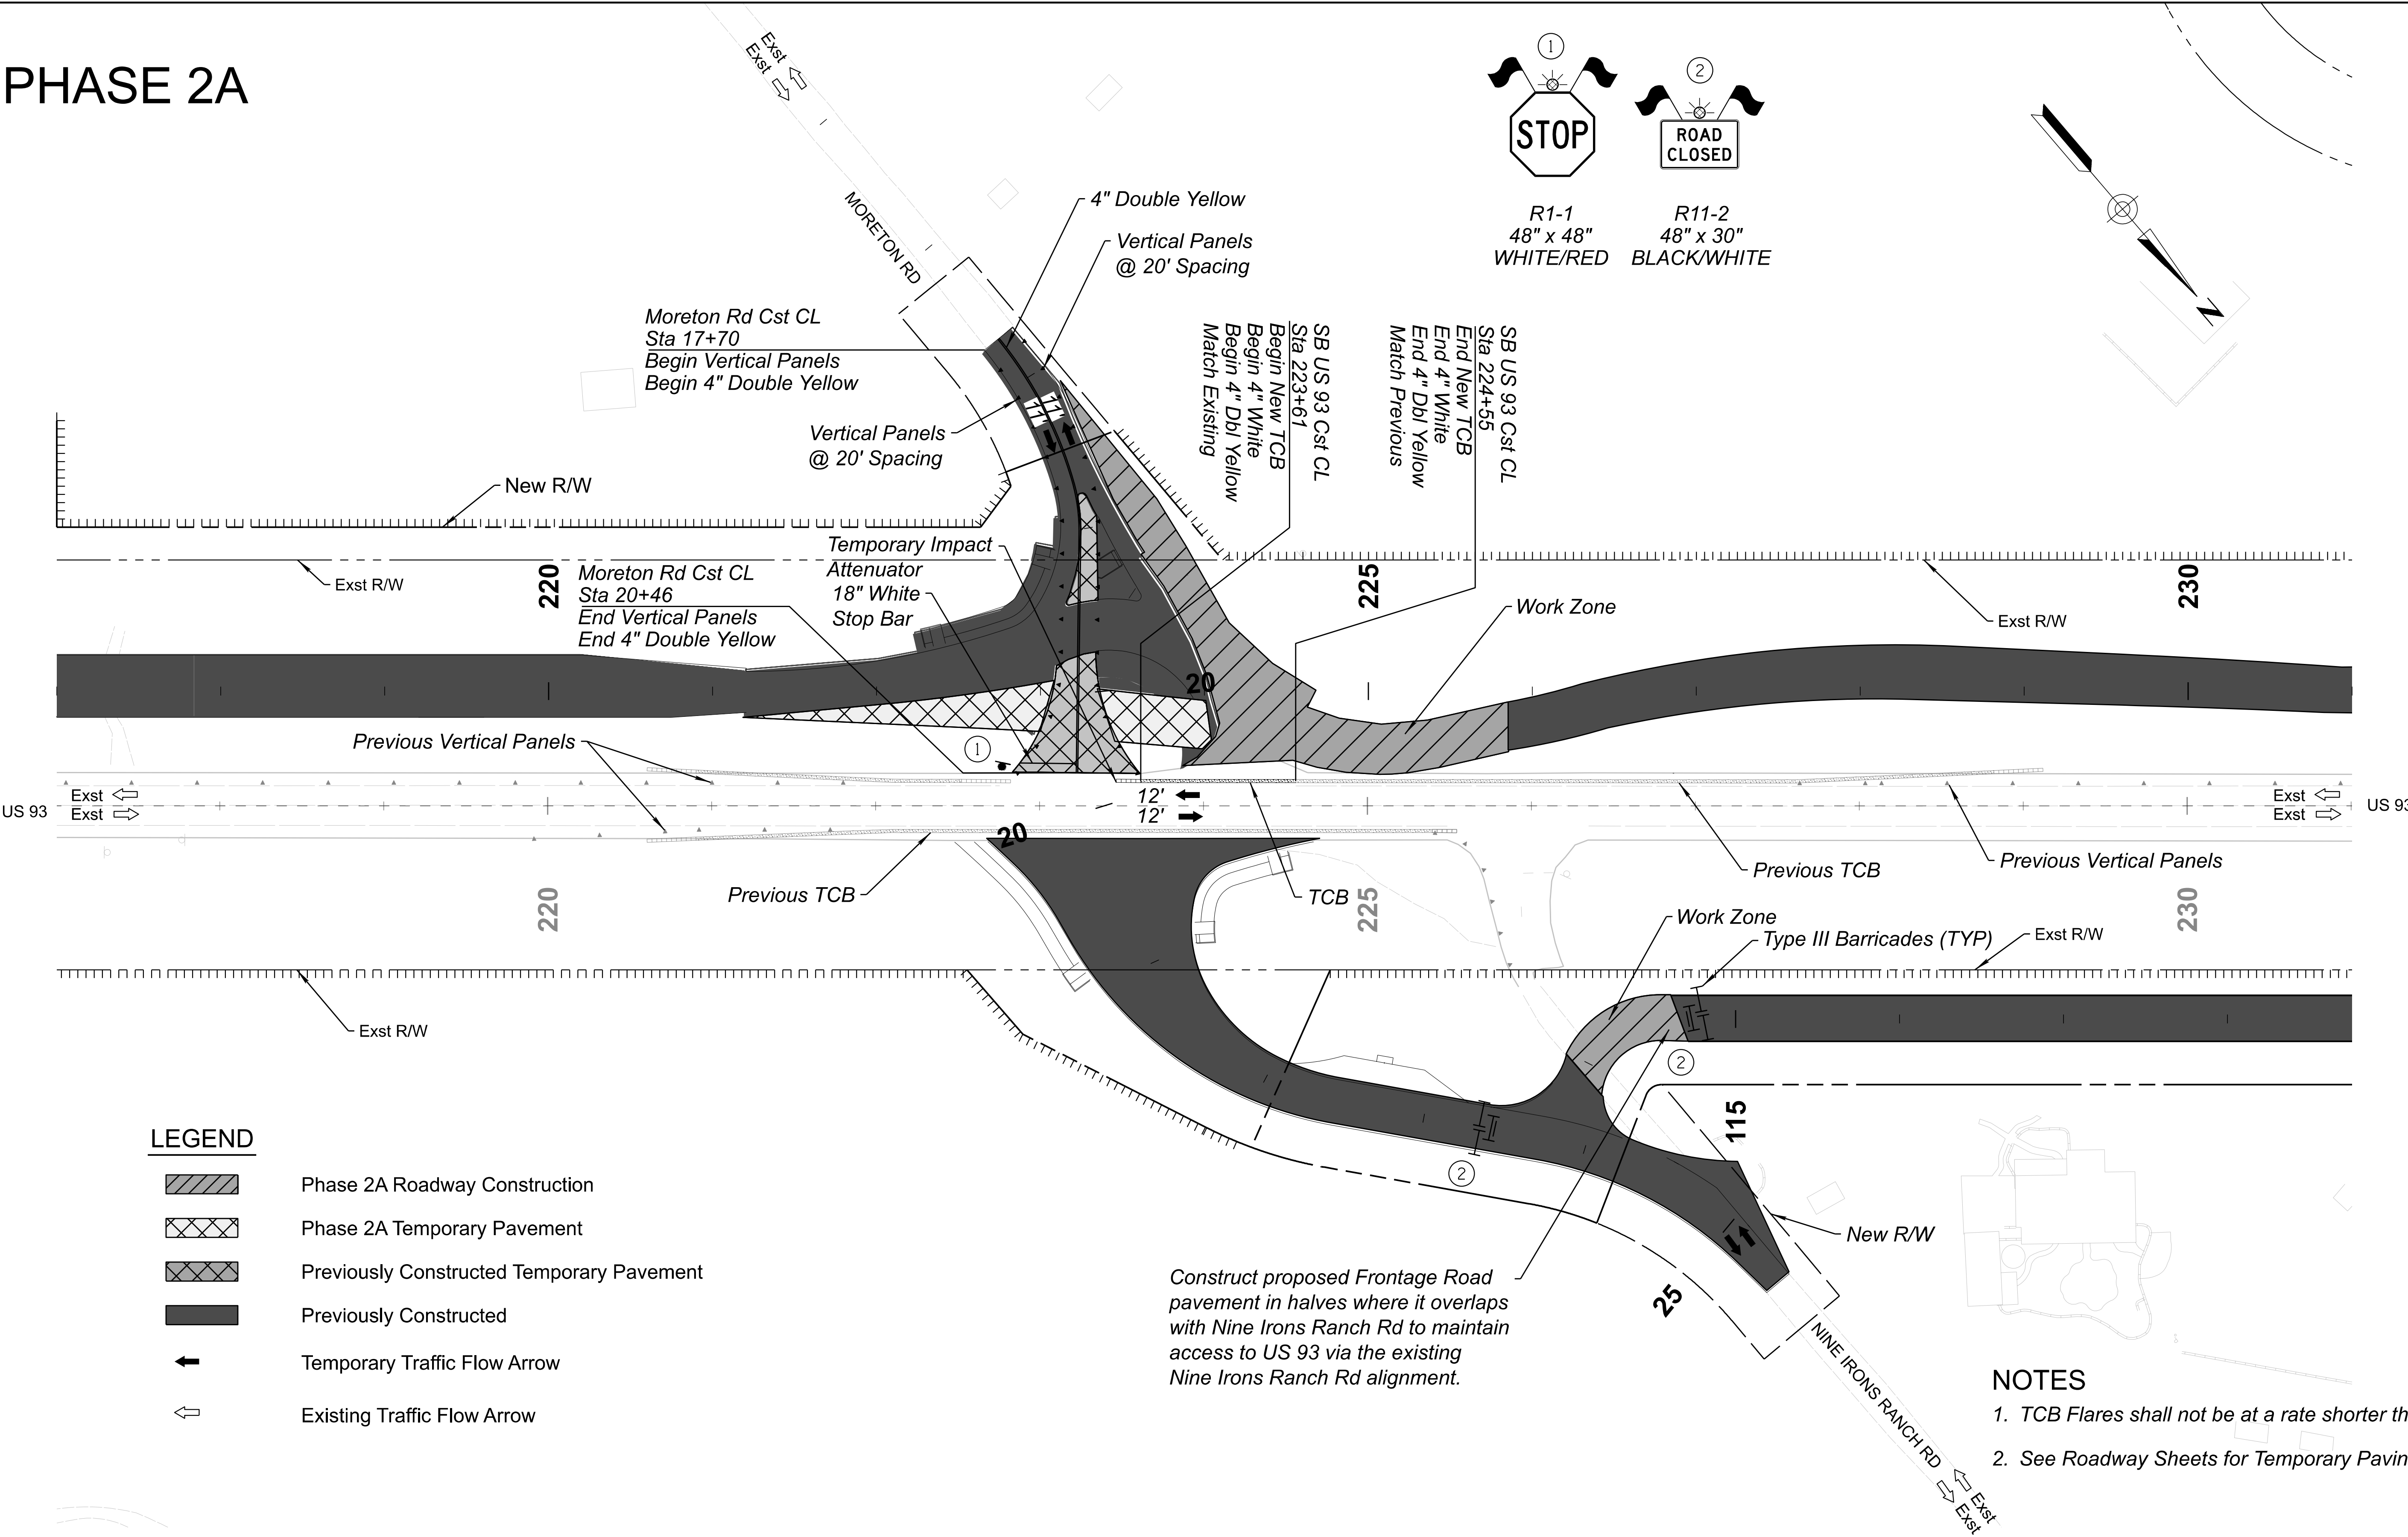

LEGEND

- Phase 2A Roadway Construction
- Phase 2A Temporary Pavement
- Previously Constructed Temporary Pavement
- Previously Constructed
- Temporary Traffic Flow Arrow
- Existing Traffic Flow Arrow

NOTES

- TCB Flares shall not be at a rate shorter than 20:1.
- See Roadway Sheets for Temporary Paving Limits.



	NAME	DATE
DESIGN	I ROBLES	06/26
DRAWN	C VALENCIA	06/26
CHECKED	C RICKETTS	06/26

TRANSPORTATION
AECOM TECHNICAL SERVICES, Inc.
7720 N. 16th St., Suite 100
Phoenix, Arizona 85020
T 602.371.1100


AECOM
www.aecom.com

ARIZONA DEPARTMENT OF TRANSPORTATION PROJECT DELIVERY AND OPERATIONS DIVISION TRAFFIC DESIGN SERVICES
PHASE 2A - ROUNDABOUT DETAIL SHEET STA 217+00 TO STA 231+00

ROUTE US 93	F.H.W.A. Arizona Division	STATE	PROJECT NO.	FEDERAL ID NO.	SHEET NO.	TOTAL SHEETS	RECORD DRAWING
MILEPOST 190.5		ARIZ.	093 YV 190	093-B-NFA	320	524	
	LOCATION VISTA ROYALE						DWG No. T-2.16
STRUCTURE NO.	TRACS NO. F0738 01C						OF

PHASE 3

F.H.W.A. REGION	STATE	PROJECT NO.	SHEET NO.	TOTAL SHEETS	RECORD DRAWING
9	ARIZ.	093-B(230)T	321	524	
093 YV 189					

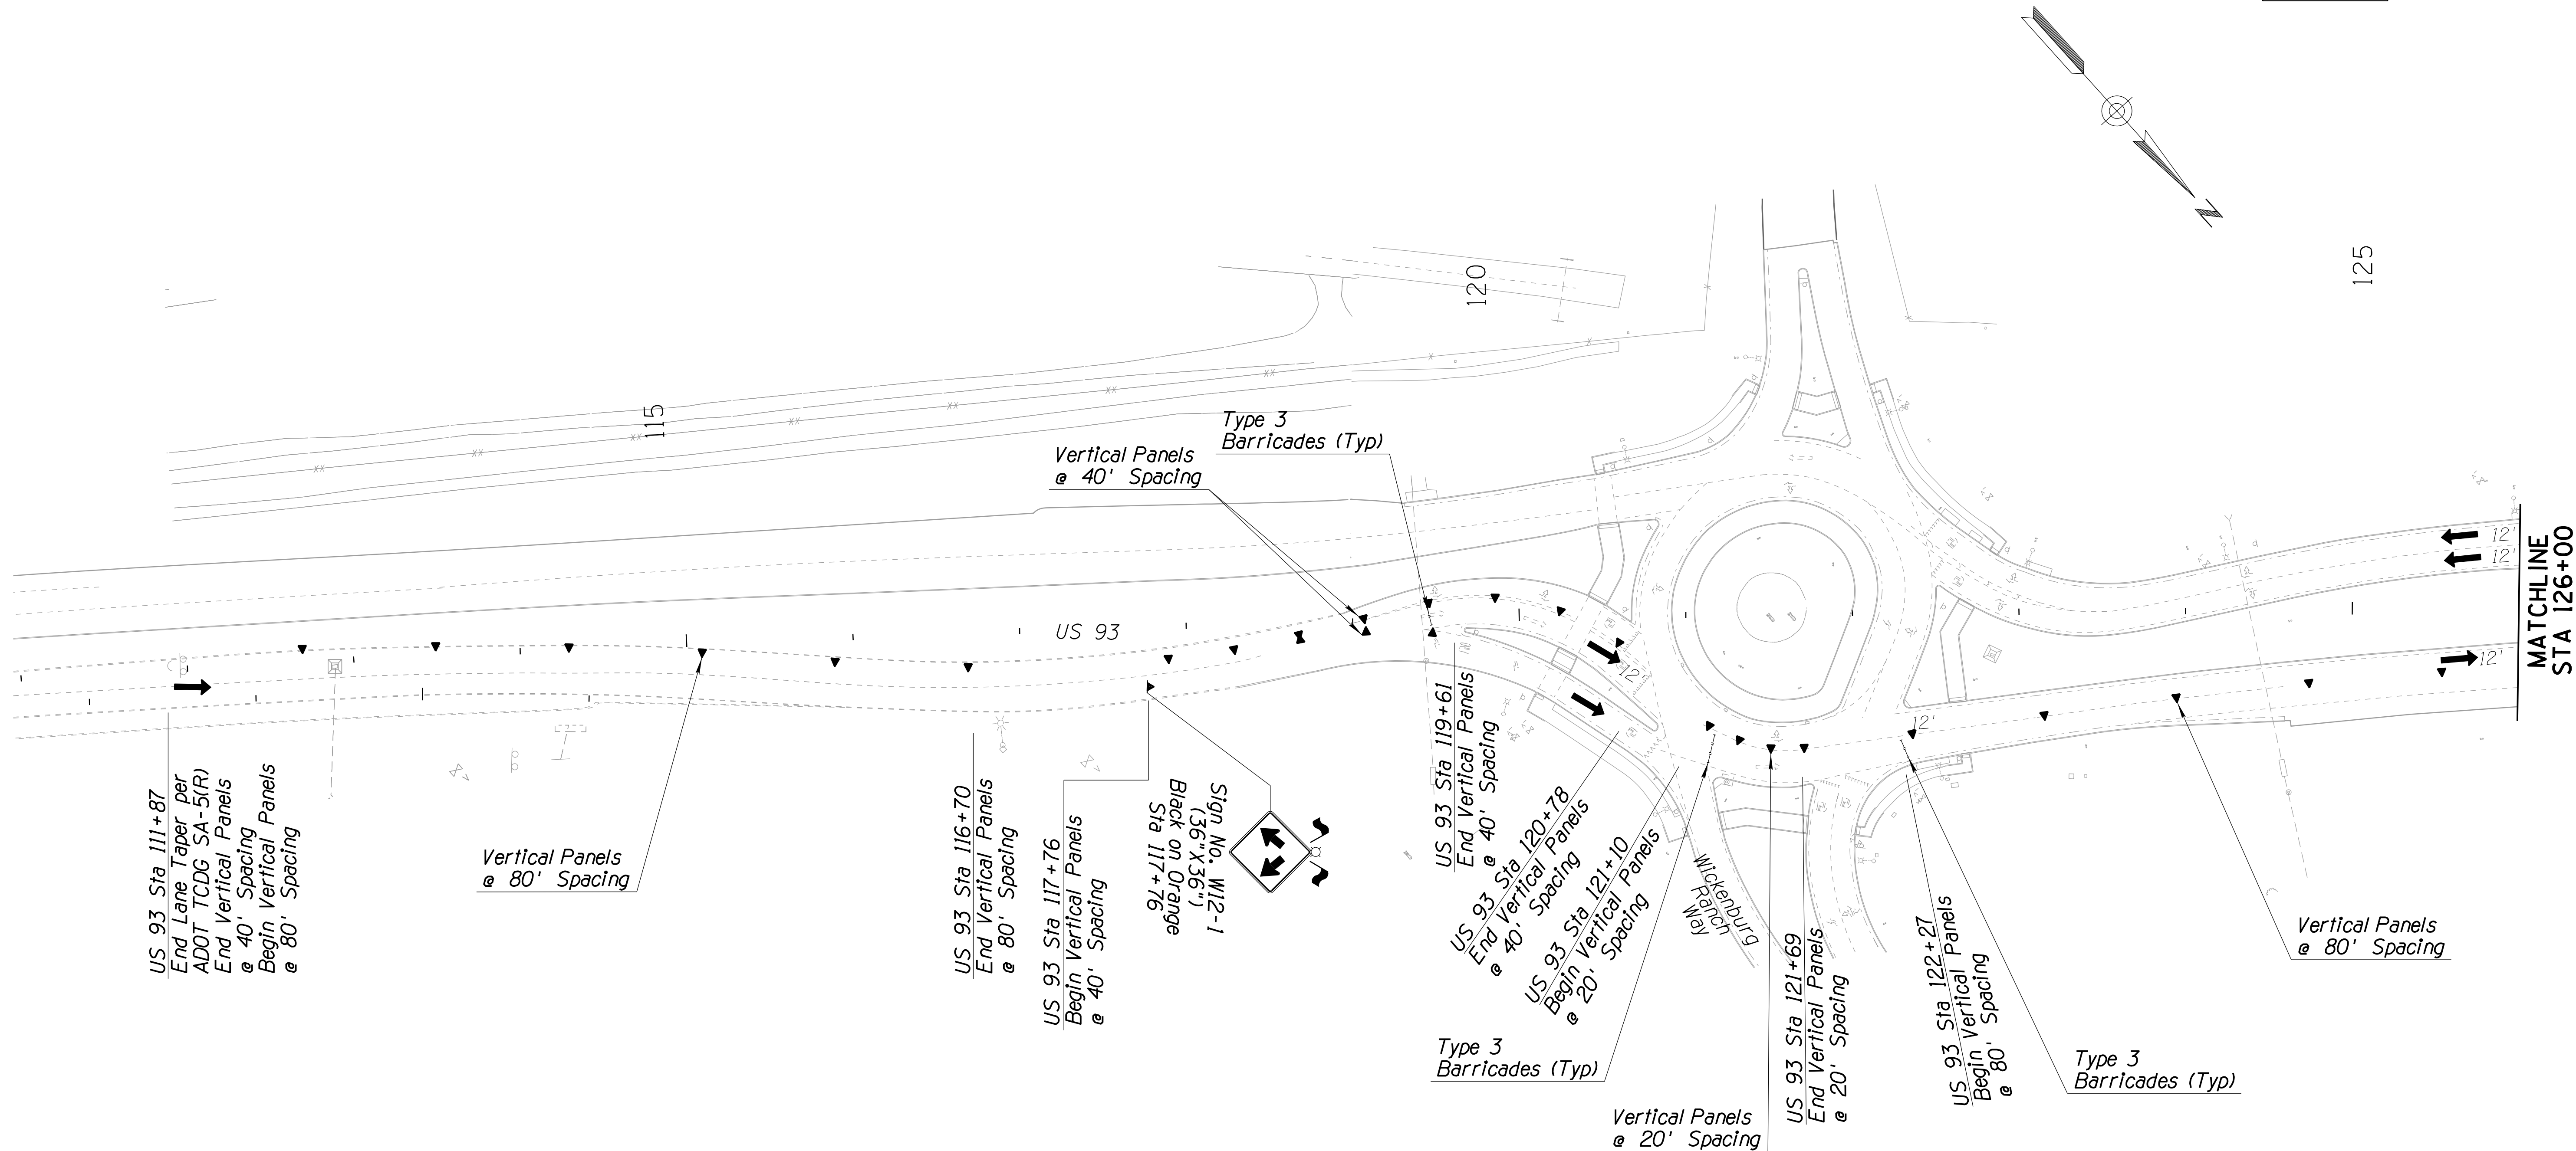


LEGEND:

	Direction Of Travel		Temporary Concrete Barrier
	Temporary Impact Attenuation Device		Temporary Pavement Work Zone
	Sign On Spring Stand		Permanent Pavement Work Zone
	Sign On Rigid Stand		CMB - Changeable Message Board
	Sign On Embedded Posts		Flashing Light & Warning Flags
	Type 2 Barricade		Vertical Panel
	Type 3 Barricade		Temporary Pavement Phase 1 & 2
			Constructed Pavement Phase 1 & 2

DESIGN	ME1	DATE	06/26	ARIZONA DEPARTMENT OF TRANSPORTATION PROJECT DELIVERY AND OPERATIONS DIVISION TRAFFIC DESIGN SERVICES US 93 & SR 89 PHASE 3 TRAFFIC CONTROL STA 111+87 TO STA 126+00	
DRAWN	SRH	DATE	06/26		
CHECKED	BMT	DATE	06/26		
ROUTE		LOCATION		DWG NO. T-2.17	
US 93		WICKENBURG RANCH WAY TO VISTA ROYALE			
TRACS NO. F0738 OIC				093-B(230)T	

PHASE 3

F.H.W.A. REGION	STATE	PROJECT NO.	SHEET NO.	TOTAL SHEETS	RECORD DRAWING
9	ARIZ.	093-B(230)T	322	524	
093 YV 189					

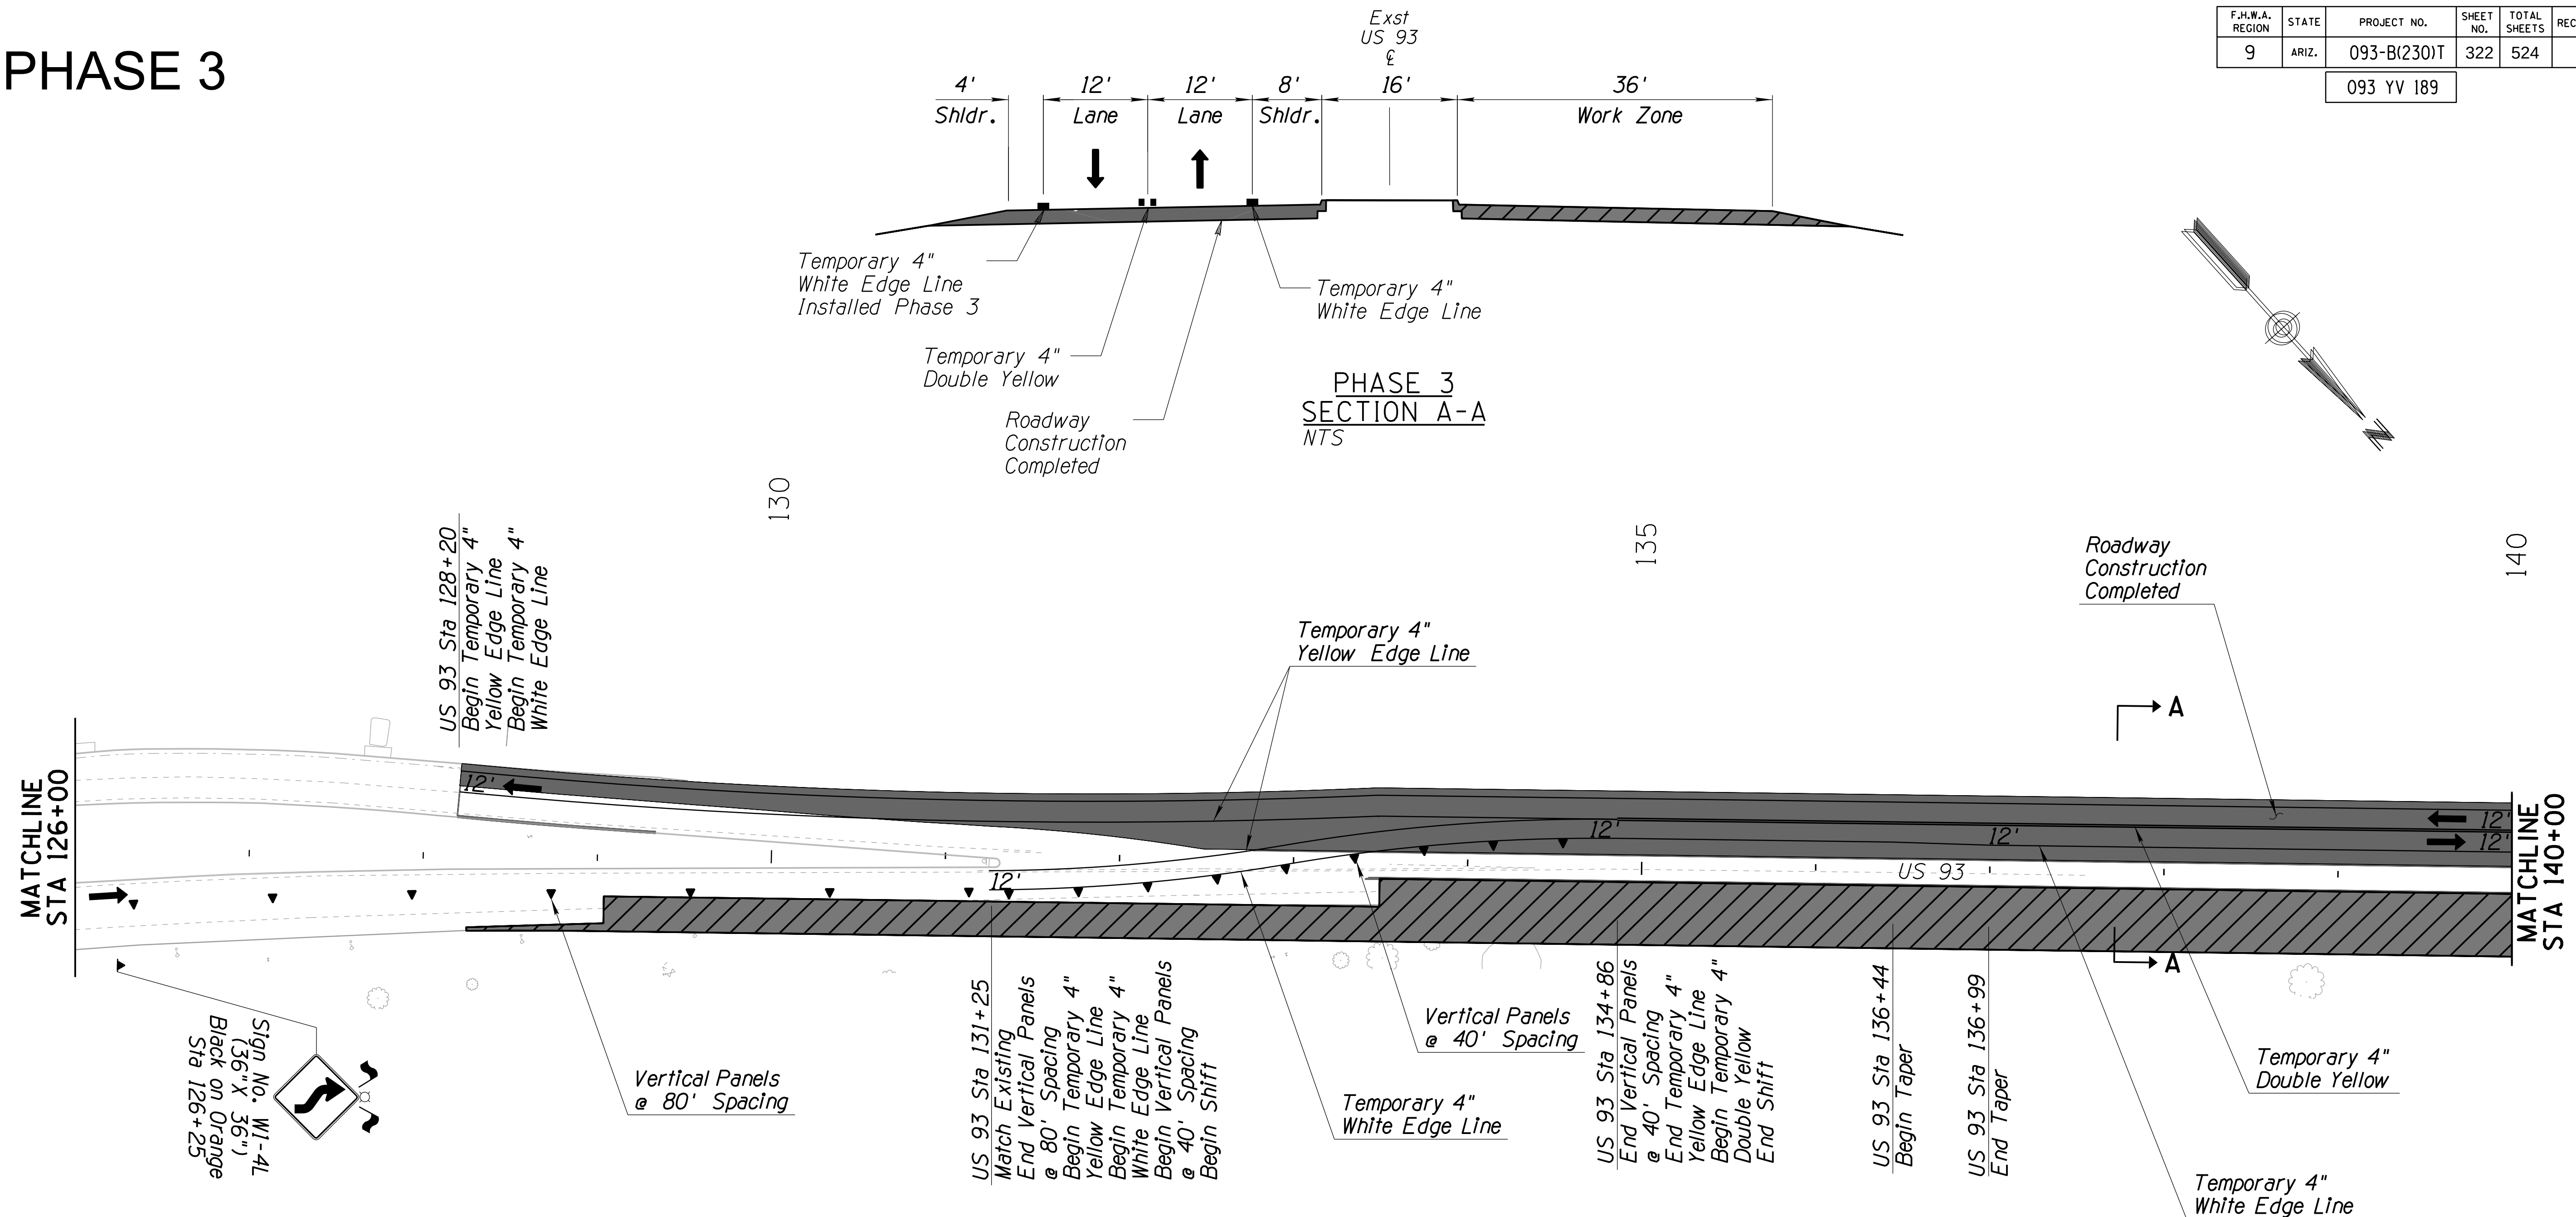

LEGEND:


➔	Direction Of Travel	▨	Temporary Concrete Barrier
⊞	Temporary Impact Attenuation Device	▨	Temporary Pavement Work Zone
▶	Sign On Spring Stand	▨	Permanent Pavement Work Zone
▮	Sign On Rigid Stand	XXXX	CMB - Changeable Message Board
⚡	Sign On Embedded Posts	⚡	Flashing Light & Warning Flags
■	Type 2 Barricade	▲	Vertical Panel
⊥	Type 3 Barricade	▨	Temporary Pavement Phase 1 & 2
		▨	Constructed Pavement Phase 1 & 2

NOTE:

1. Obliterate all existing, Phase 2 pavement marking in conflict with Phase 3 temporary pavement marking on US 93 Sta 128+20 to Sta 190+00, and on SR 89 Sta 473+64 to Sta 503+91.

DESIGN	NAME	DATE	ARIZONA DEPARTMENT OF TRANSPORTATION PROJECT DELIVERY AND OPERATIONS DIVISION TRAFFIC DESIGN SERVICES	
DRAWN	ME1	06/26	US 93 & SR 89 PHASE 3 TRAFFIC CONTROL STA 126+00 TO STA 140+00	
CHECKED	SRH	06/26	Stanley Consultants inc. 3133 East Camelback Road, Suite 100 Phoenix, Arizona 85016 Phone: (602) 333-2200	
ROUTE	LOCATION		US 93 WICKENBURG RANCH WAY TO VISTA ROYALE	DWG NO. T-2.18
TRACS NO.	F0738 OIC		093-B(230)T	OF

PHASE 3

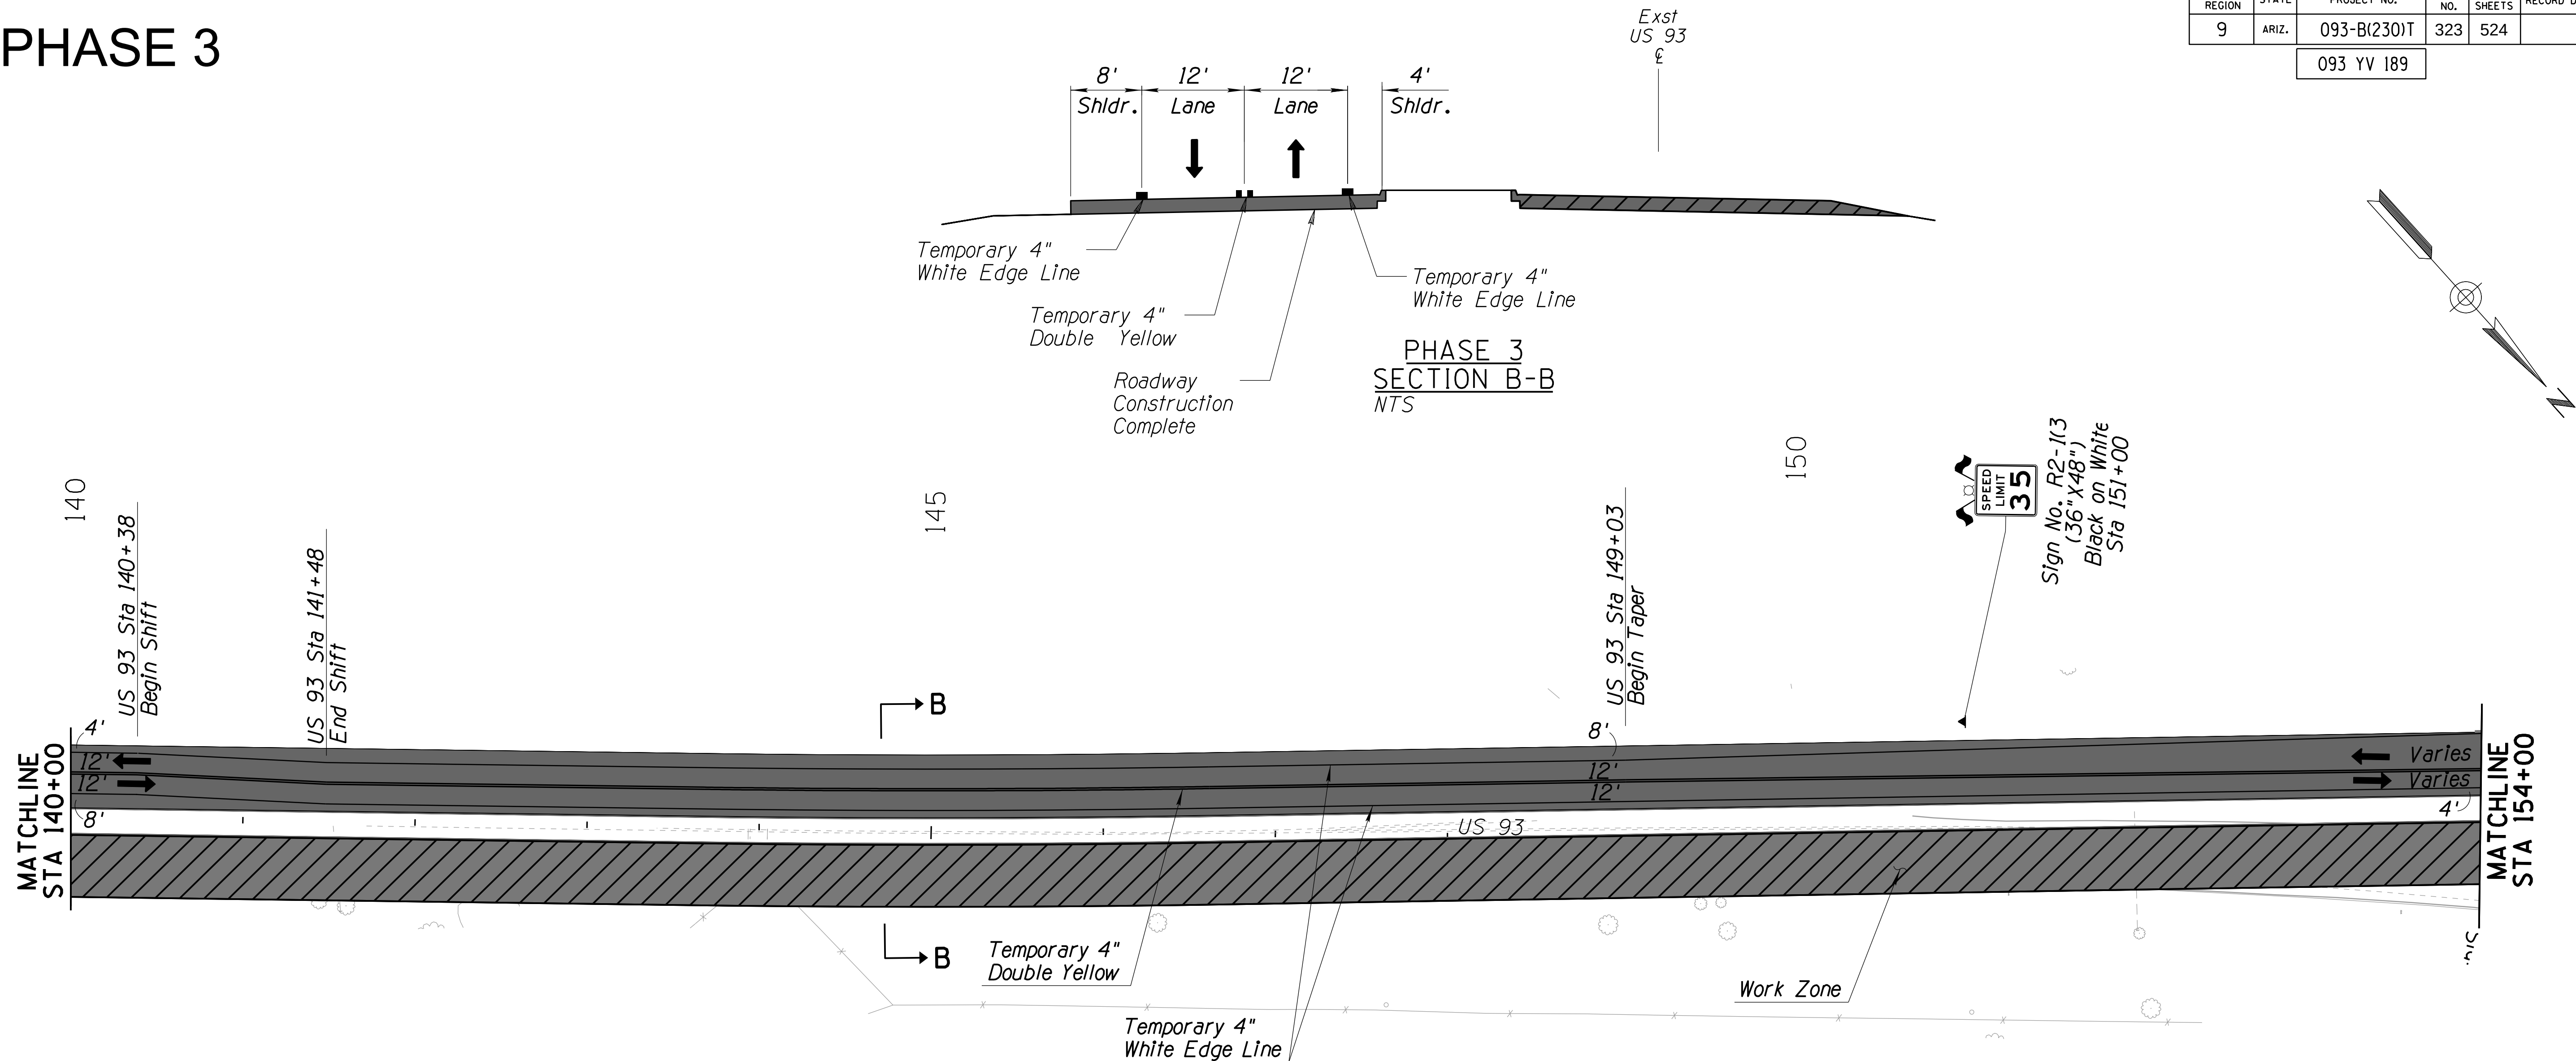

LEGEND:


	Direction Of Travel		Temporary Concrete Barrier
	Temporary Impact Attenuation Device		Temporary Pavement Work Zone
	Sign On Spring Stand		Permanent Pavement Work Zone
	Sign On Rigid Stand		CMB - Changeable Message Board
	Sign On Embedded Posts		Flashing Light & Warning Flags
	Type 2 Barricade		Vertical Panel
	Type 3 Barricade		Temporary Pavement Phase 1 & 2
			Constructed Pavement Phase 1 & 2

NOTE:
1. Obliterate all existing, Phase 2 pavement marking in conflict with Phase 3 temporary pavement marking on US 93 Sta 128+20 to Sta 190+00, and on SR 89 Sta 473+64 to Sta 503+91.

DESIGN		ME1	06/26	ARIZONA DEPARTMENT OF TRANSPORTATION PROJECT DELIVERY AND OPERATIONS DIVISION TRAFFIC DESIGN SERVICES	
DRAWN		SRH	06/26		
CHECKED		BMT	06/26		
ROUTE		LOCATION		US 93 & SR 89 PHASE 3 TRAFFIC CONTROL STA 140+00 TO STA 154+00	
US 93		WICKENBURG RANCH WAY TO VISTA ROYALE		DWG NO. T-2.19	
TRACS NO. F0738 OIC		093-B(230)T		OF	


PHASE 3

F.H.W.A. REGION	STATE	PROJECT NO.	SHEET NO.	TOTAL SHEETS	RECORD DRAWING
9	ARIZ.	093-B(230)T	324	524	
093 YV 189					

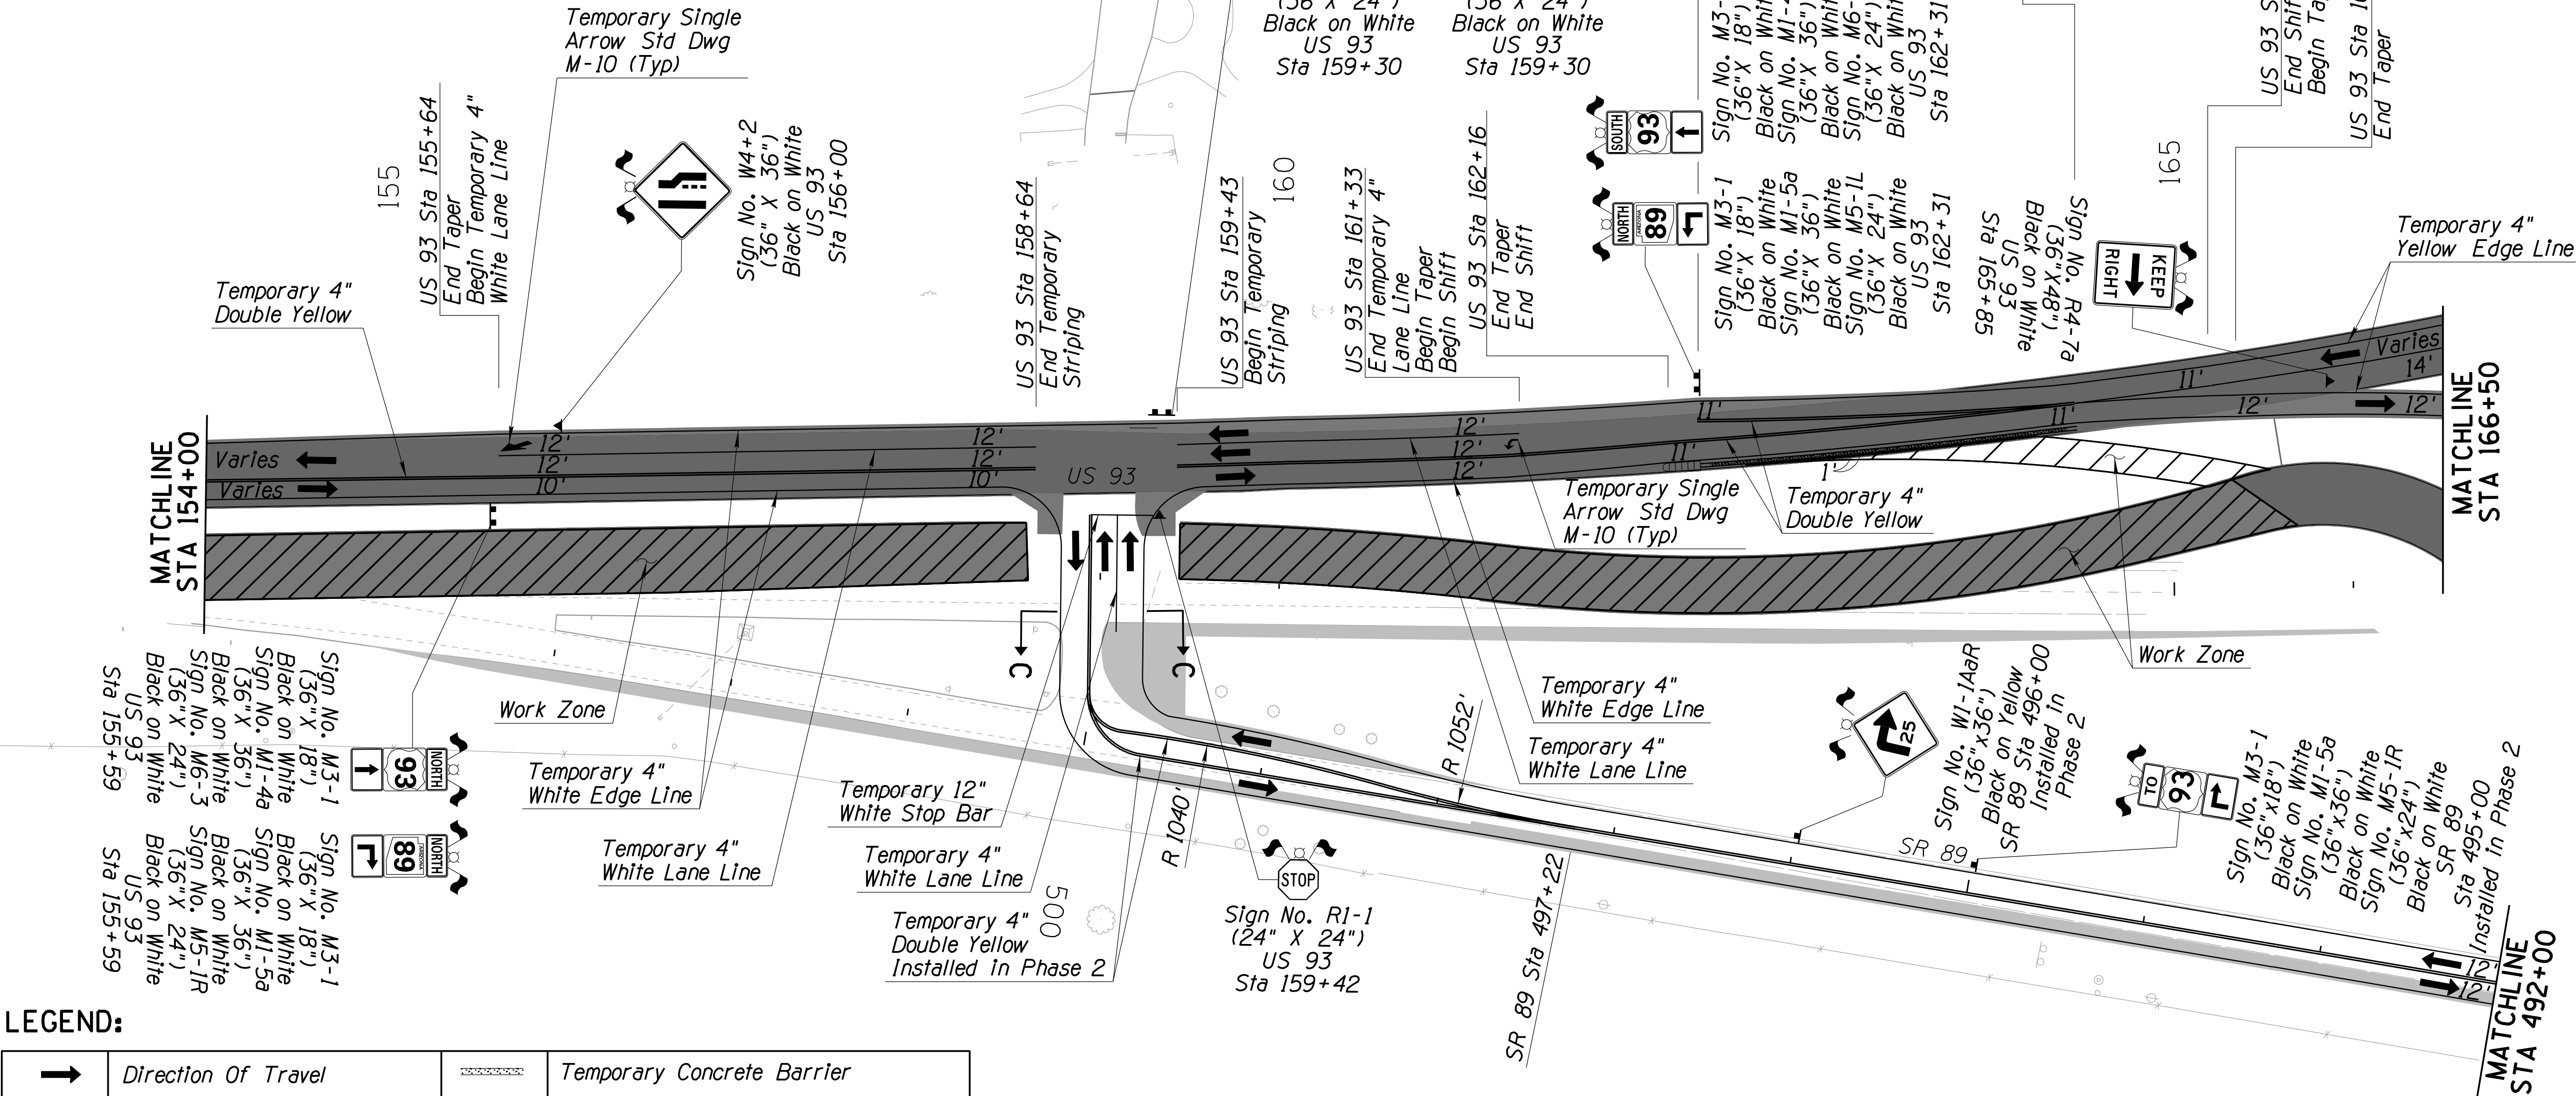

LEGEND:

	Direction Of Travel		Temporary Concrete Barrier
	Temporary Impact Attenuation Device		Temporary Pavement Work Zone
	Sign On Spring Stand		Permanent Pavement Work Zone
	Sign On Rigid Stand		CMB - Changeable Message Board
	Sign On Embedded Posts		Flashing Light & Warning Flags
	Type 2 Barricade		Vertical Panel
	Type 3 Barricade		Temporary Pavement Phase 1 & 2
			Constructed Pavement Phase 1 & 2

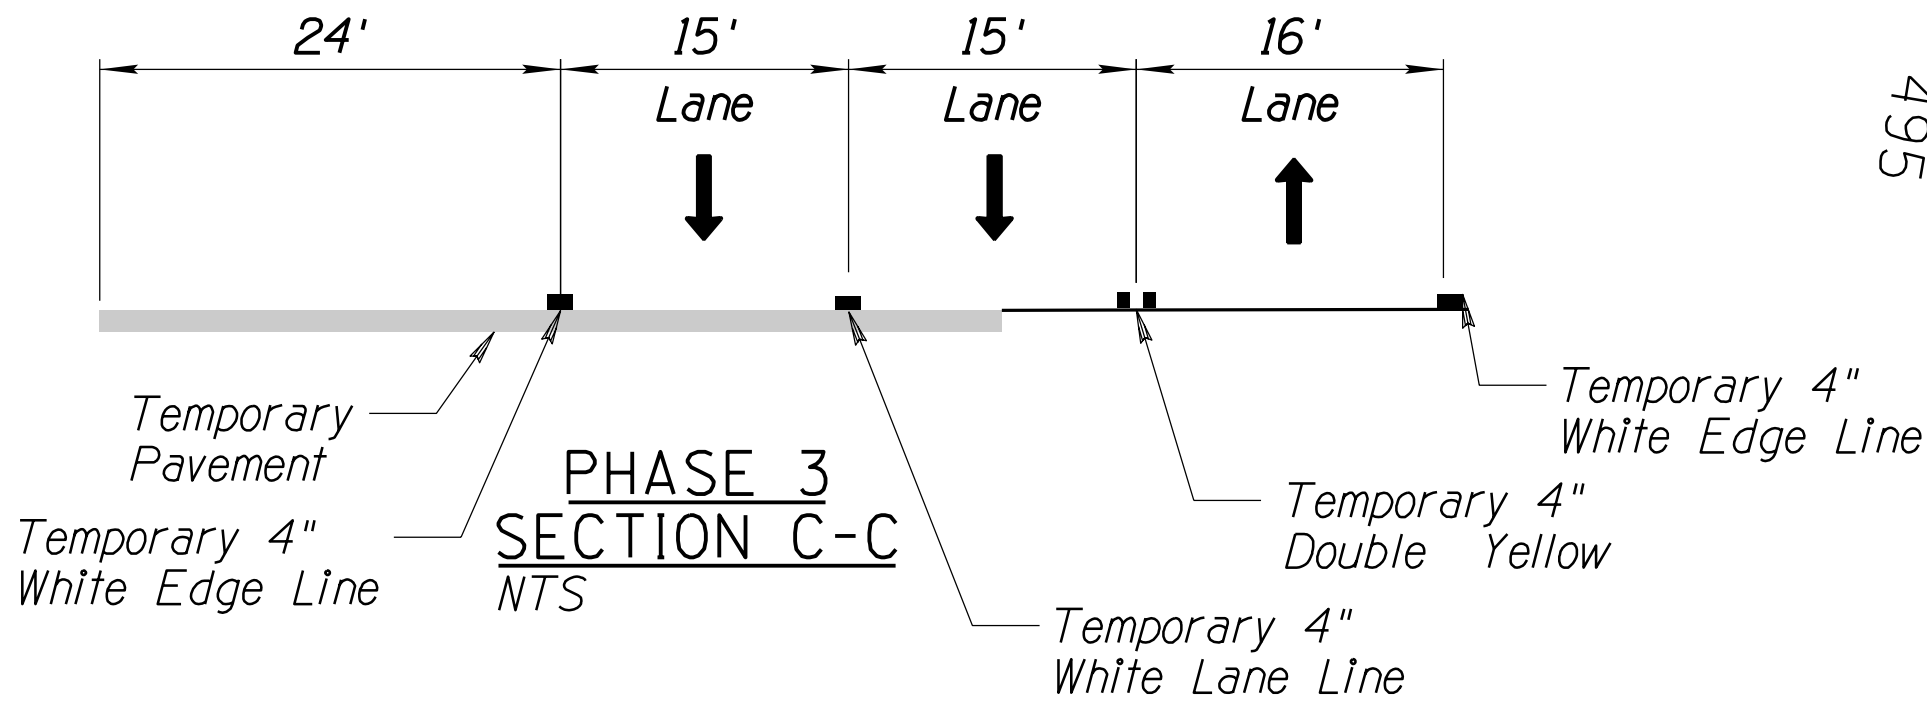

NOTE:


1. Obliterate all existing, Phase 2 pavement marking in conflict with Phase 3 temporary pavement marking on US 93 Sta 128+20 to Sta 190+00, and on SR 89 Sta 473+64 to Sta 503+91.

		NAME	DATE	ARIZONA DEPARTMENT OF TRANSPORTATION PROJECT DELIVERY AND OPERATIONS DIVISION TRAFFIC DESIGN SERVICES	
DESIGN		MEI	06/26		
DRAWN		SRH	06/26		
CHECKED		BMT	06/26		
		3133 East Camelback Road, Suite 100 Phoenix, Arizona 85016 Phone: 602/ 333-2200		US 93 & SR 89 PHASE 3 TRAFFIC CONTROL STA 154+00 TO STA 166+50	
ROUTE		LOCATION		DWG NO. T-2.20	
US 93		WICKENBURG RANCH WAY TO VISTA ROYALE			
TRACS NO. F0738 OIC			093-B(230)T		OF

PHASE 3

F.H.W.A. REGION	STATE	PROJECT NO.	SHEET NO.	TOTAL SHEETS	RECORD DRAWING
9	ARIZ.	093-B(230)T	325	524	

093 YV 189

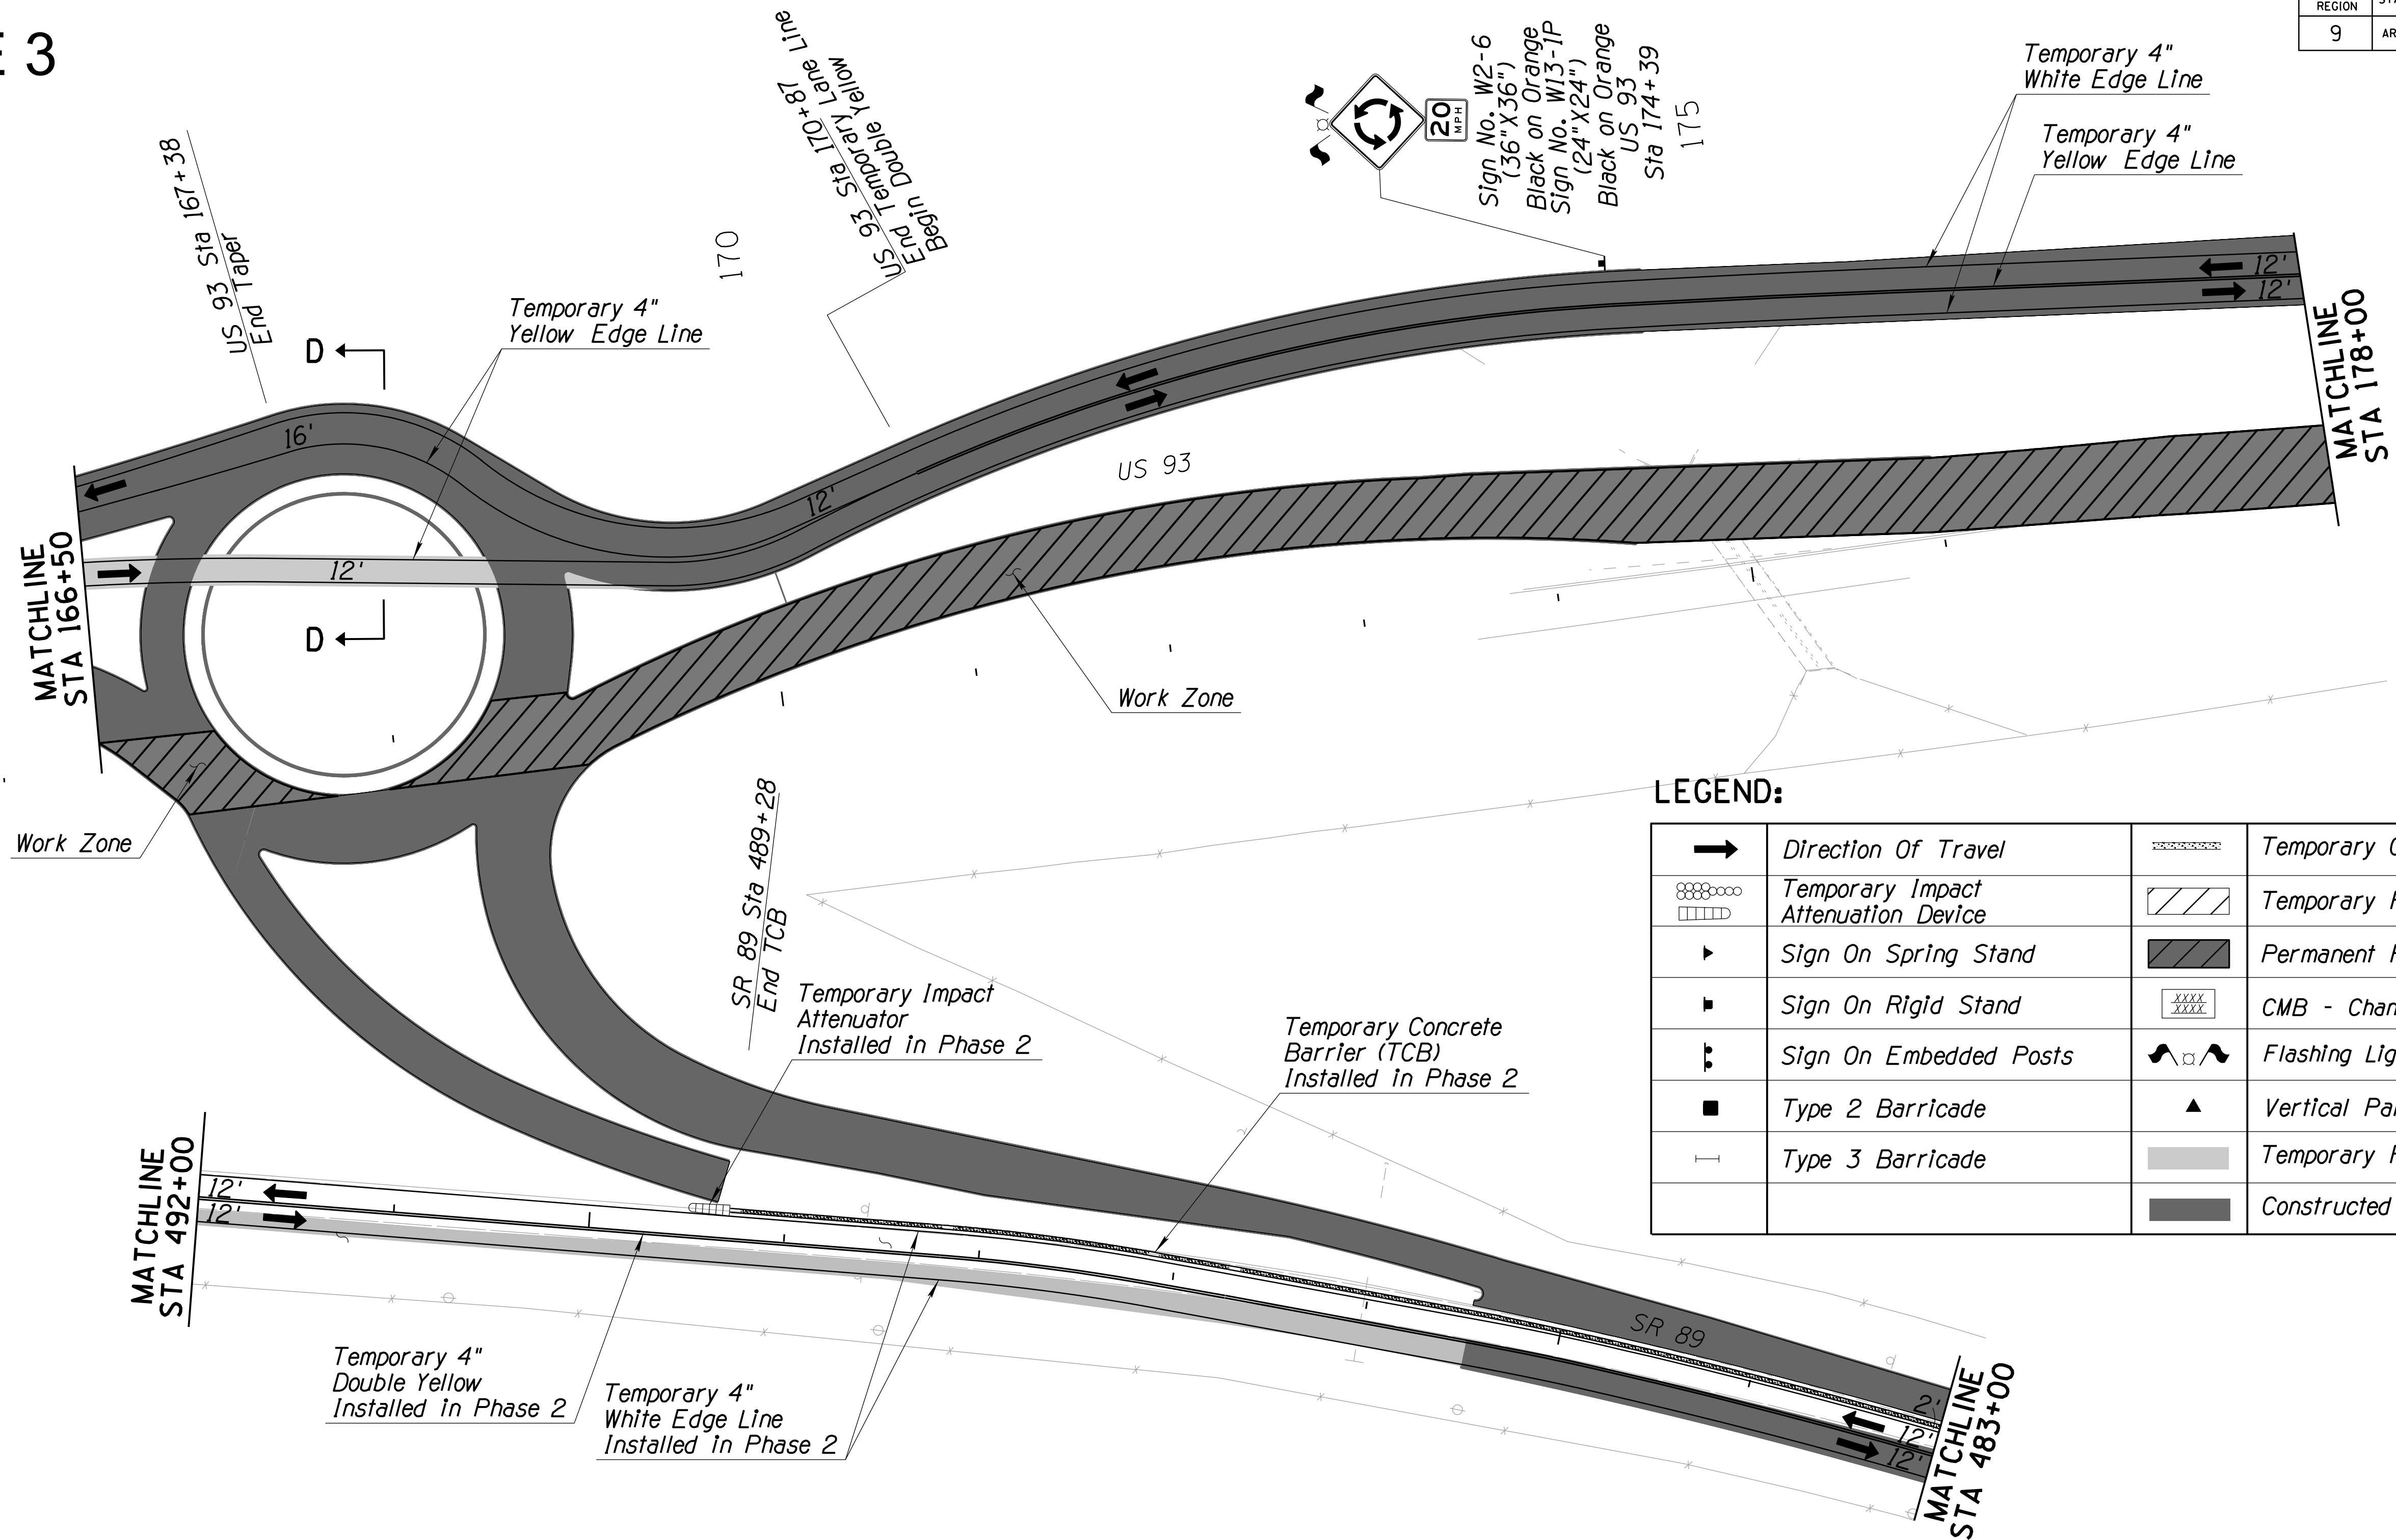


LEGEND:

→	Direction Of Travel	-----	Temporary Concrete Barrier
⊗	Temporary Impact Attenuation Device	▨	Temporary Pavement Work Zone
▶	Sign On Spring Stand	▩	Permanent Pavement Work Zone
▮	Sign On Rigid Stand	XXXX	CMB - Changeable Message Board
⚡	Sign On Embedded Posts	⚡	Flashing Light & Warning Flags
■	Type 2 Barricade	▲	Vertical Panel
⊥	Type 3 Barricade	▬	Temporary Pavement Phase 1 & 2
		▬	Constructed Pavement Phase 1 & 2

NOTE:

1. Obliterate all existing, Phase 2 pavement marking in conflict with Phase 3 temporary pavement marking on US 93 Sta 128+20 to Sta 190+00, and on SR 89 Sta 473+64 to Sta 503+91.

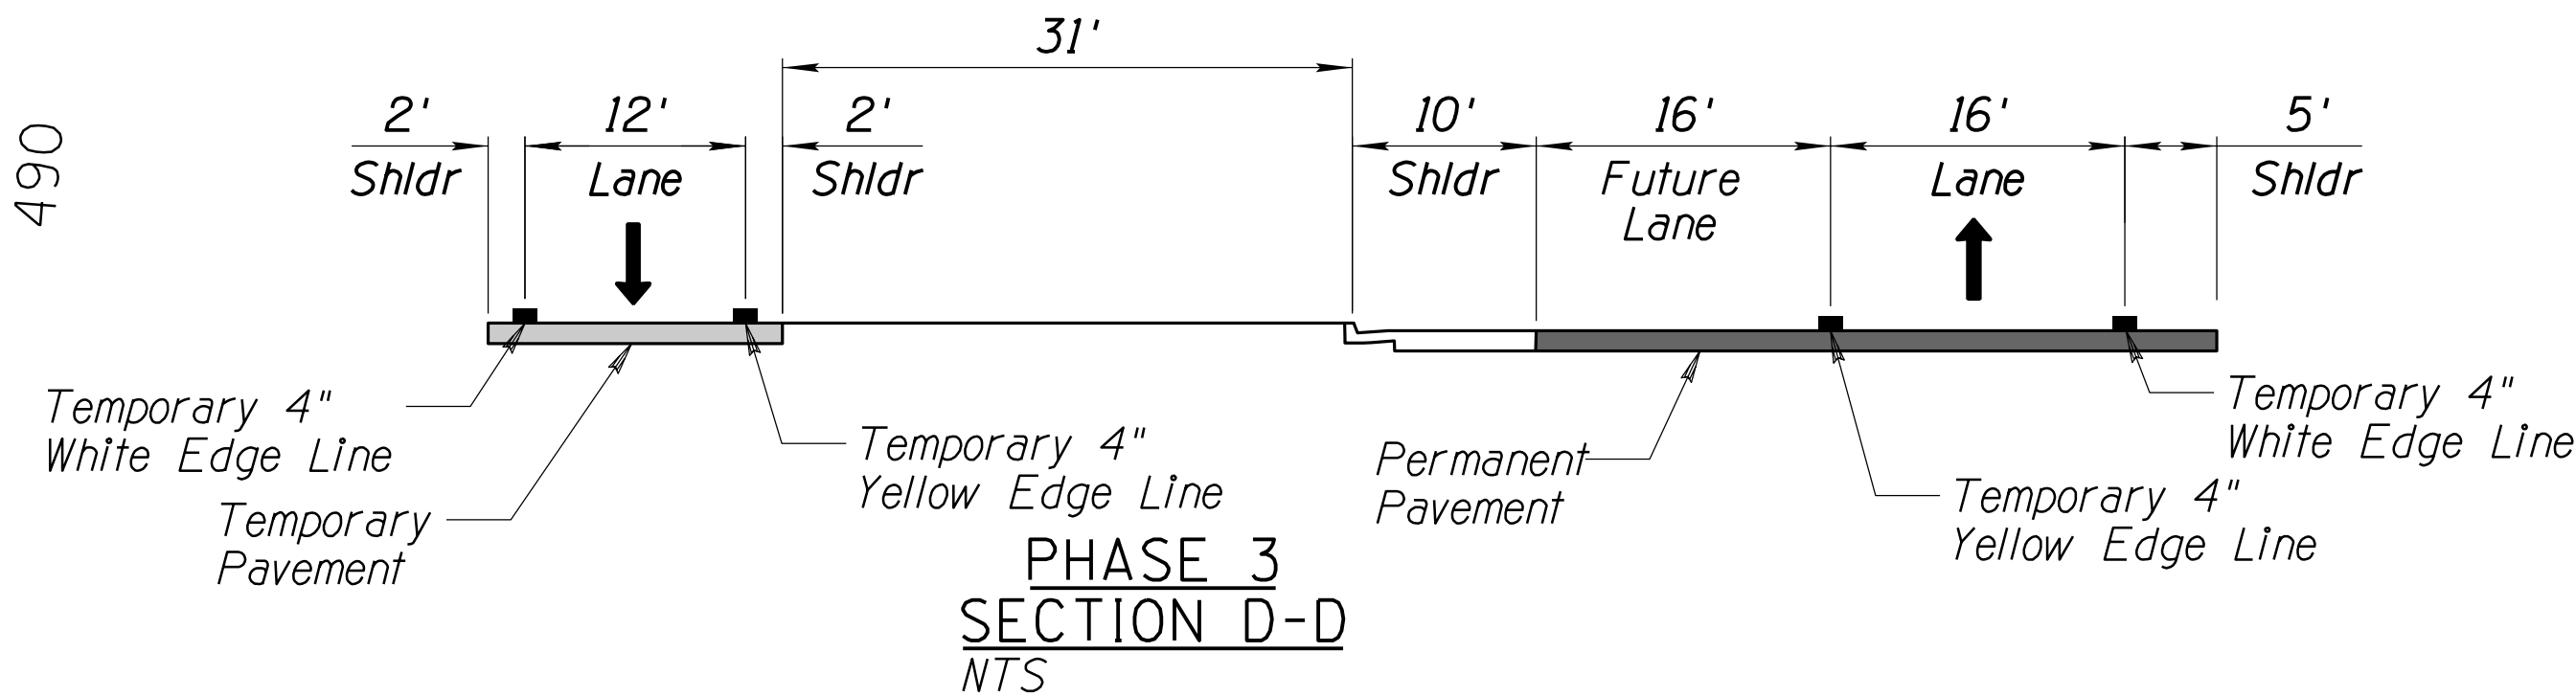


DESIGN	NAME	DATE	ARIZONA DEPARTMENT OF TRANSPORTATION PROJECT DELIVERY AND OPERATIONS DIVISION TRAFFIC DESIGN SERVICES US 93 & SR 89 PHASE 3 TRAFFIC CONTROL STA 166+50 TO STA 178+00	
DRAWN	ME1	06/26		
CHECKED	SRH	06/26		
Stanley Consultants Inc. 3133 East Camelback Road, Suite 100 Phoenix, Arizona 85016 Phone: (602) 333-2200			DWG NO. T-2.21	
ROUTE US 93			LOCATION WICKENBURG RANCH WAY TO VISTA ROYALE	
TRACS NO. F0738 OIC			093-B(230)T	

PHASE 3

F.H.W.A. REGION	STATE	PROJECT NO.	SHEET NO.	TOTAL SHEETS	RECORD DRAWING
9	ARIZ.	093-B(230)T	326	524	

093 YV 189

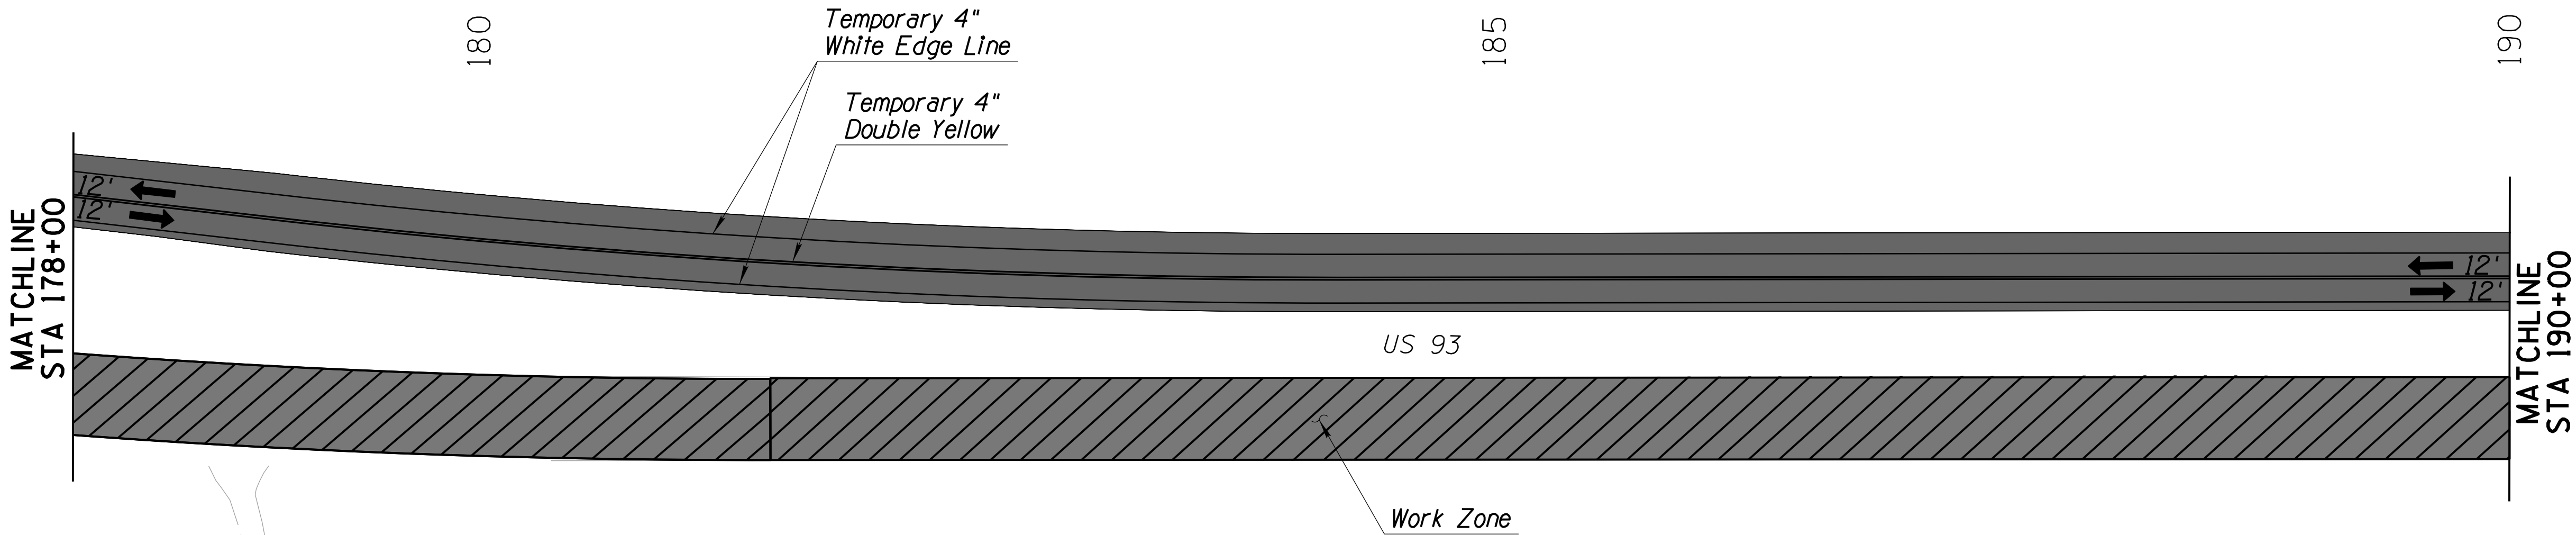

LEGEND:

	Direction Of Travel		Temporary Concrete Barrier
	Temporary Impact Attenuation Device		Temporary Pavement Work Zone
	Sign On Spring Stand		Permanent Pavement Work Zone
	Sign On Rigid Stand		CMB - Changeable Message Board
	Sign On Embedded Posts		Flashing Light & Warning Flags
	Type 2 Barricade		Vertical Panel
	Type 3 Barricade		Temporary Pavement Phase 1 & 2
			Constructed Pavement Phase 1 & 2


NOTE:

1. Obliterate all existing, Phase 2 pavement marking in conflict with Phase 3 temporary pavement marking on US 93 Sta 128+20 to Sta 190+00, and on SR 89 Sta 473+64 to Sta 503+91.

DESIGN	ME1	NAME	DATE	ARIZONA DEPARTMENT OF TRANSPORTATION PROJECT DELIVERY AND OPERATIONS DIVISION TRAFFIC DESIGN SERVICES	
DRAWN	SRH		06/26		
CHECKED	BMT		06/26		
ROUTE		LOCATION		US 93 WICKENBURG RANCH WAY TO VISTA ROYALE	DWG NO. T-2.22
US 93					
TRACS NO. F0738 OIC				093-B(230)T	OF

PHASE 3

F.H.W.A. REGION	STATE	PROJECT NO.	SHEET NO.	TOTAL SHEETS	RECORD DRAWING
9	ARIZ.	093-B(230)T	327	524	
093 YV 189					

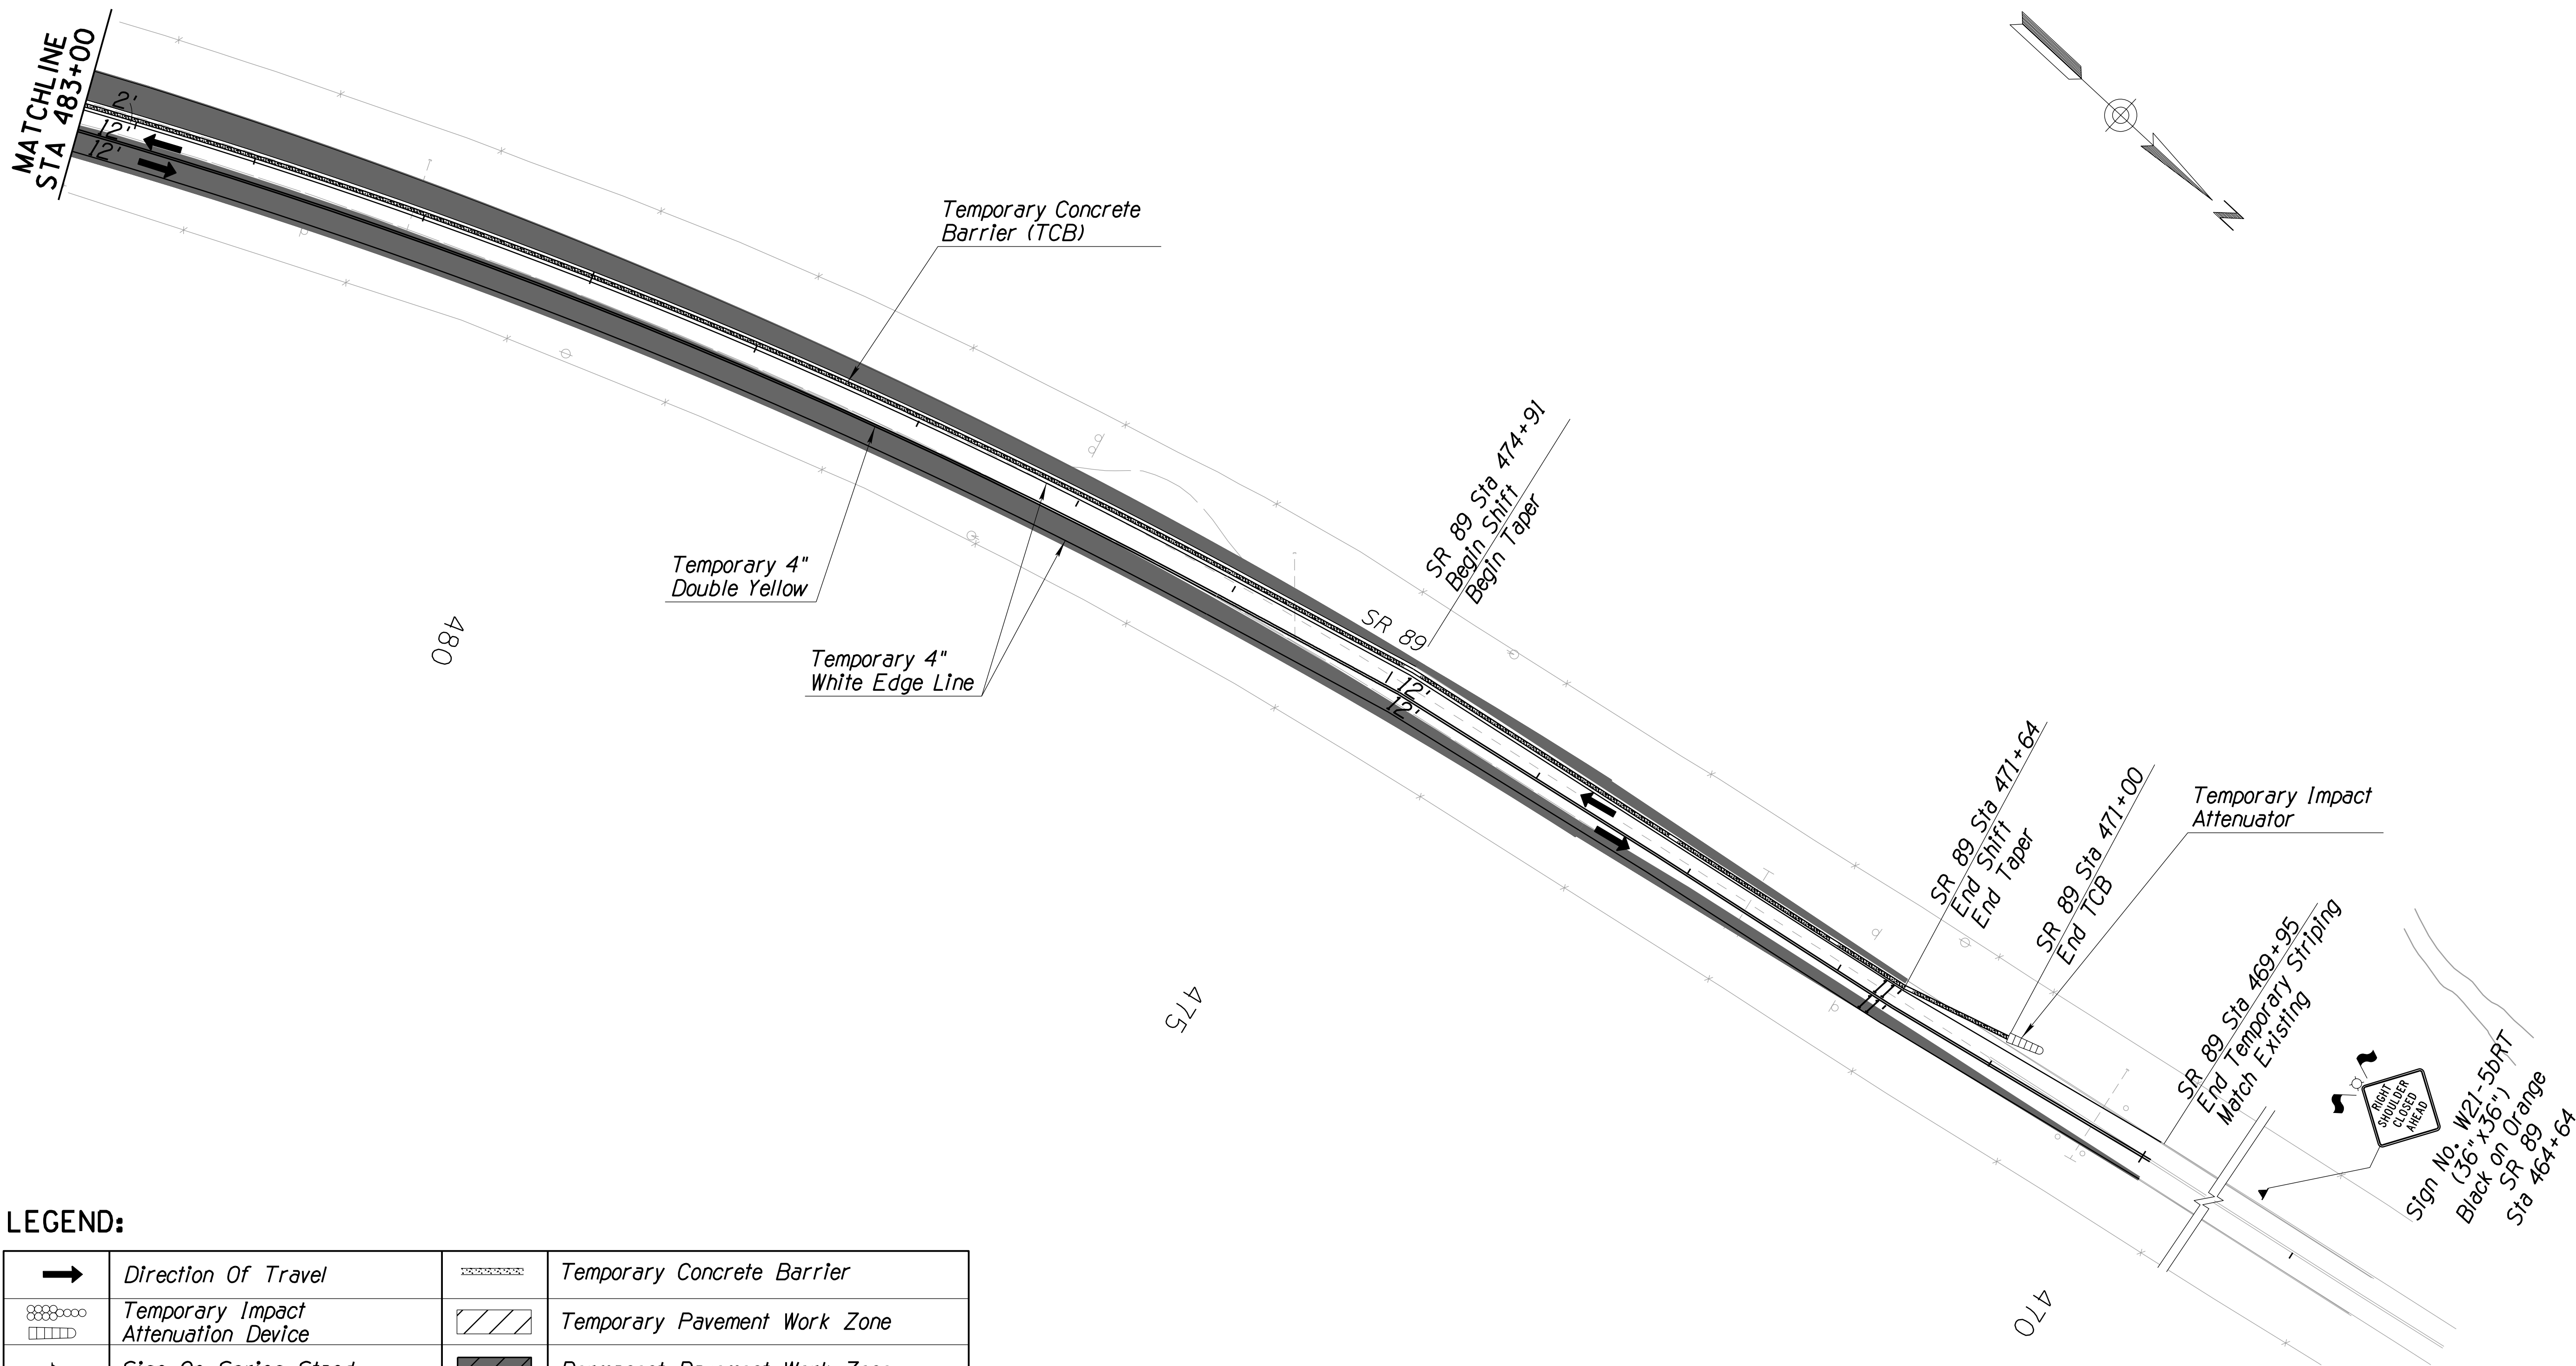


LEGEND:

	Direction Of Travel		Temporary Concrete Barrier
	Temporary Impact Attenuation Device		Temporary Pavement Work Zone
	Sign On Spring Stand		Permanent Pavement Work Zone
	Sign On Rigid Stand		CMB - Changeable Message Board
	Sign On Embedded Posts		Flashing Light & Warning Flags
	Type 2 Barricade		Vertical Panel
	Type 3 Barricade		Temporary Pavement Phase 1 & 2
			Constructed Pavement Phase 1 & 2

NOTE:
1. Obliterate all existing, Phase 2 pavement marking in conflict with Phase 3 temporary pavement marking on US 93 Sta 128+20 to Sta 190+00, and on SR 89 Sta 473+64 to Sta 503+91.

DESIGN		ME1	DATE	06/26	ARIZONA DEPARTMENT OF TRANSPORTATION PROJECT DELIVERY AND OPERATIONS DIVISION TRAFFIC DESIGN SERVICES	
DRAWN		SRH	DATE	06/26		
CHECKED		BMT	DATE	06/26		
		3133 East Camelback Road, Suite 100 Phoenix, Arizona 85016 Phone: (602) 333-2200		US 93 & SR 89 PHASE 3 TRAFFIC CONTROL STA 470+00 TO STA 483+00		DWG NO. T-2.23 <u>OF</u>
ROUTE		LOCATION				
US 93		WICKENBURG RANCH WAY TO VISTA ROYALE				
TRACS NO. F0738 OIC				093-B(230)T		

PHASE 3

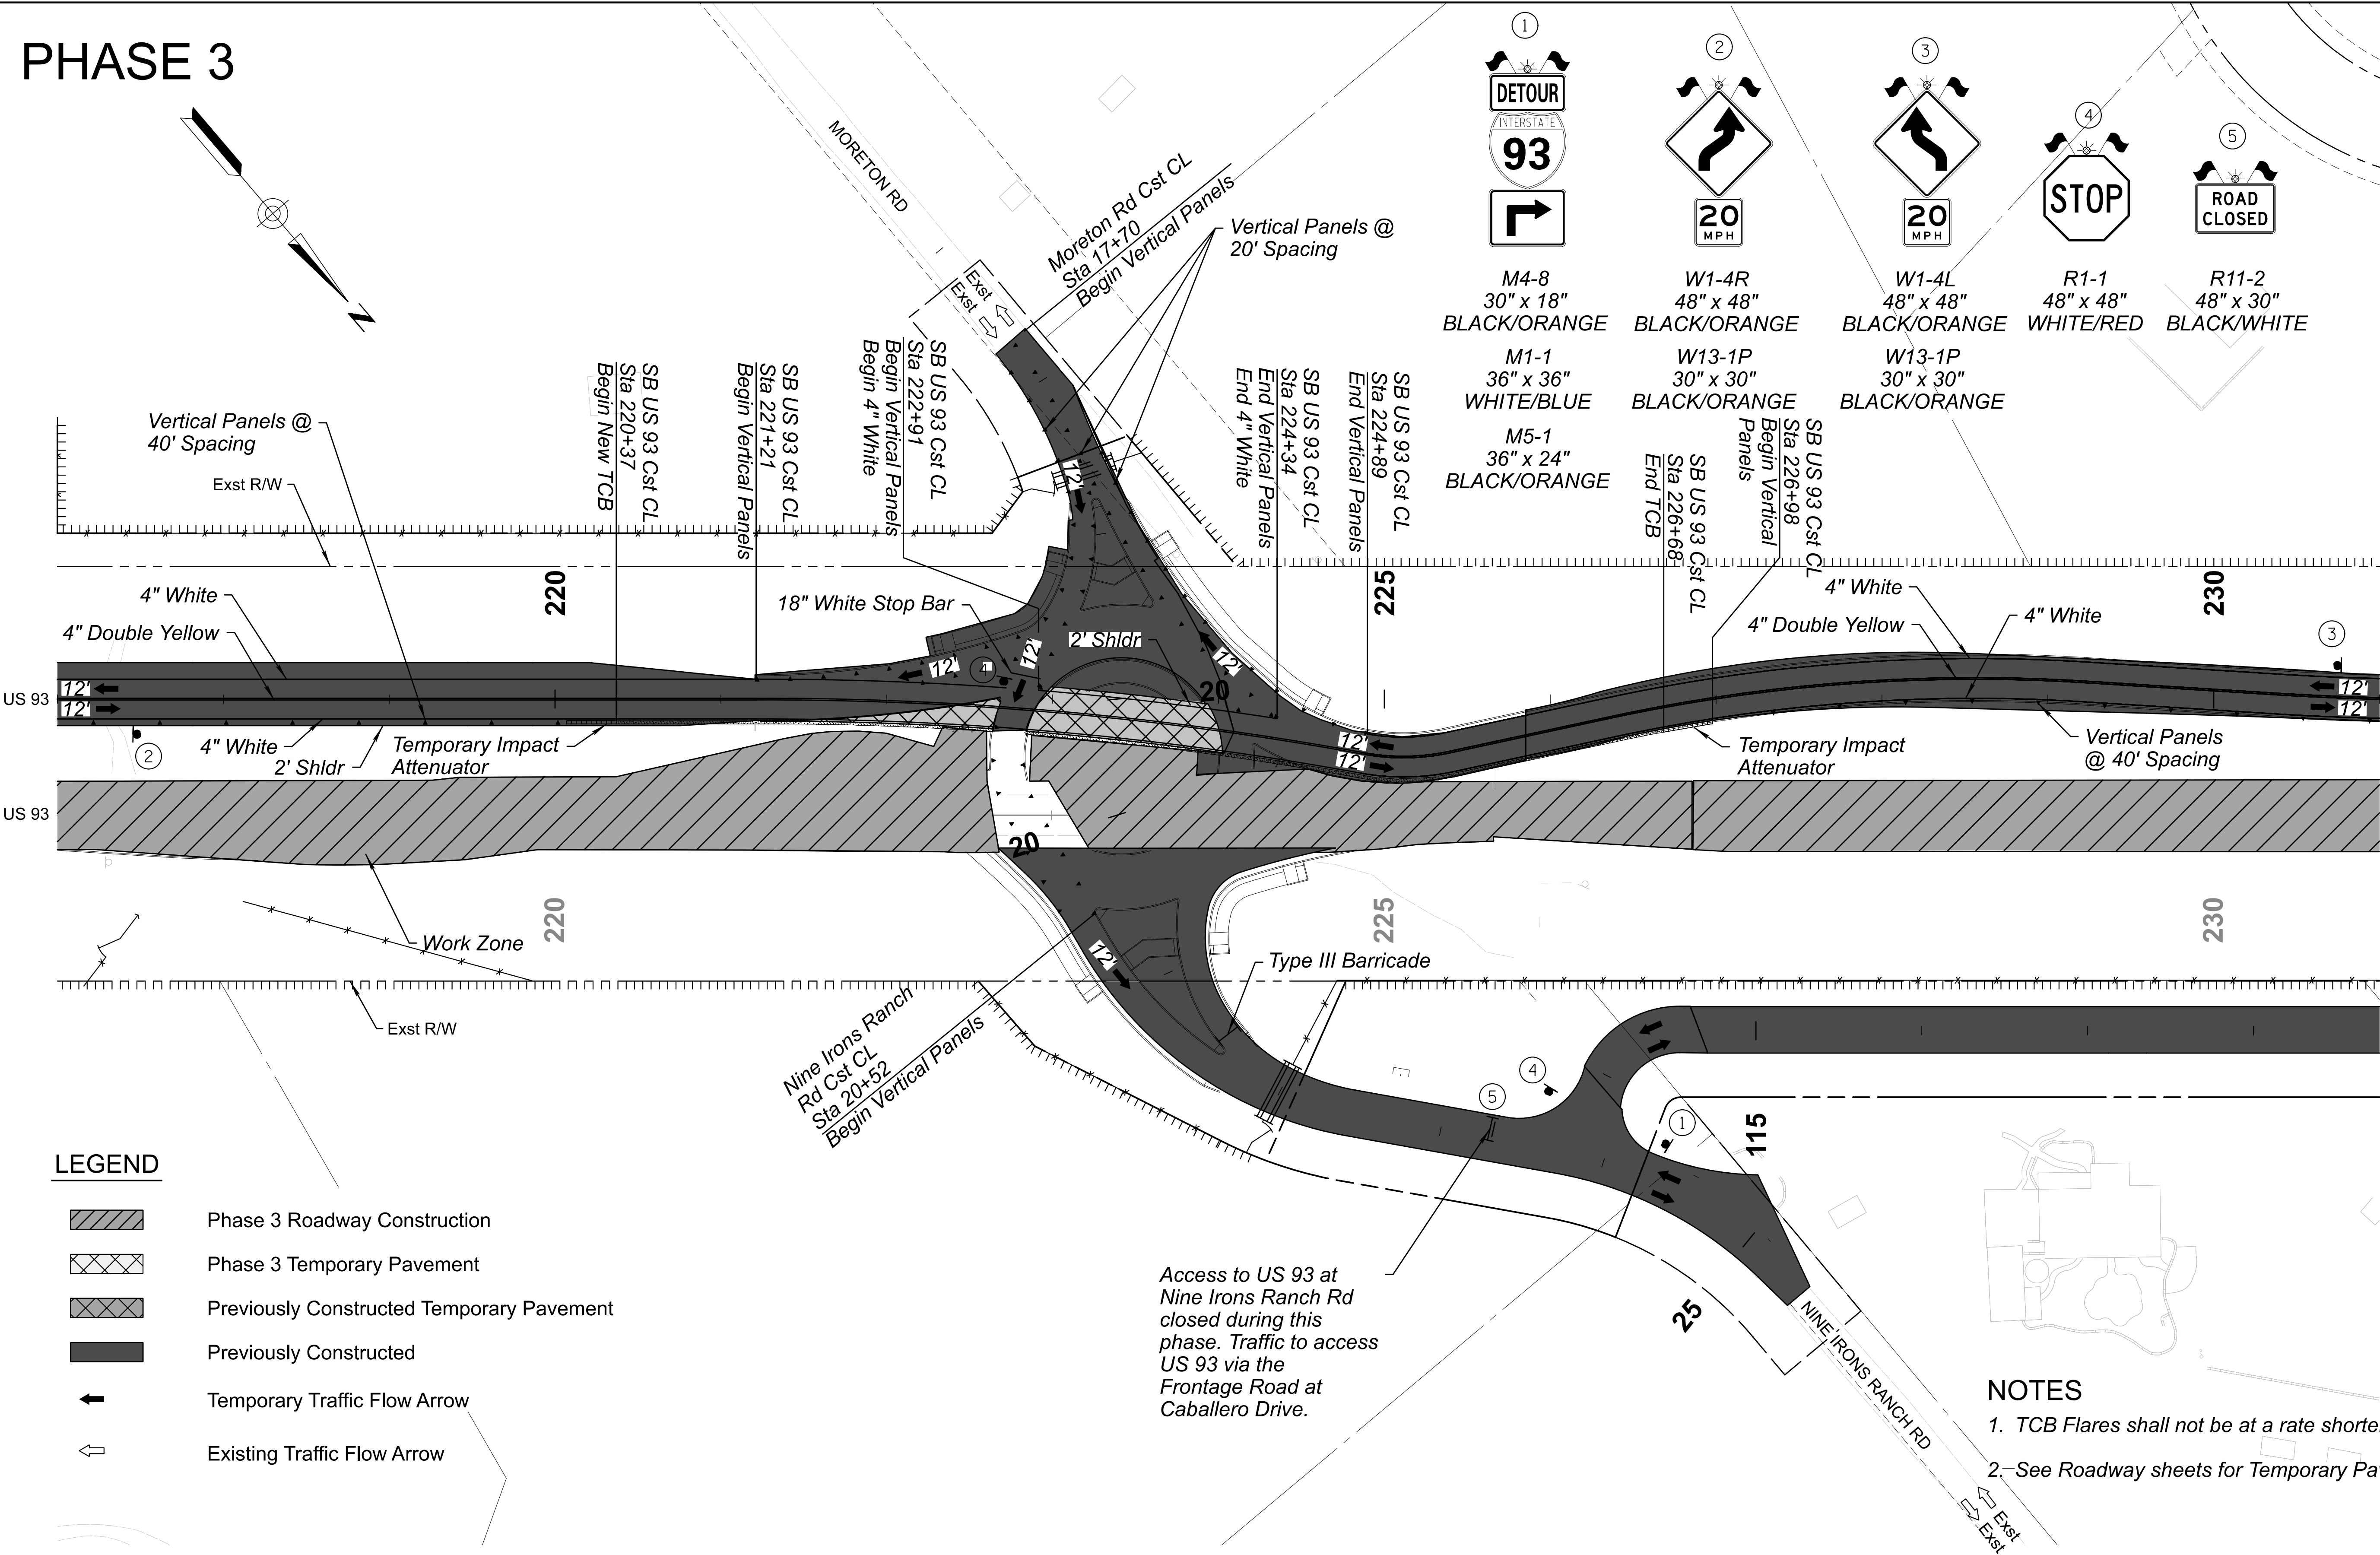

LEGEND

- Phase 3 Roadway Construction
- Phase 3 Temporary Pavement
- Previously Constructed Temporary Pavement
- Previously Constructed
- Temporary Traffic Flow Arrow
- Existing Traffic Flow Arrow

①

M4-8
30" x 18"
BLACK/ORANGE

M1-1
36" x 36"
WHITE/BLUE

M5-1
36" x 24"
BLACK/ORANGE

②

W1-4R
48" x 48"
BLACK/ORANGE

W13-1P
30" x 30"
BLACK/ORANGE

SB US 93 Cst CL
Sta 224+89
End Vertical Panels

③

W1-4L
48" x 48"
BLACK/ORANGE

W13-1P
30" x 30"
BLACK/ORANGE

SB US 93 Cst CL
Sta 226+98
Begin Vertical Panels

④

R1-1
48" x 48"
WHITE/RED

SB US 93 Cst CL
Sta 226+98
Begin Vertical Panels


⑤

R11-2
48" x 30"
BLACK/WHITE

SB US 93 Cst CL
Sta 226+98
Begin Vertical Panels

NOTES

- TCB Flares shall not be at a rate shorter than 20:1.
- See Roadway sheets for Temporary Paving Limits.

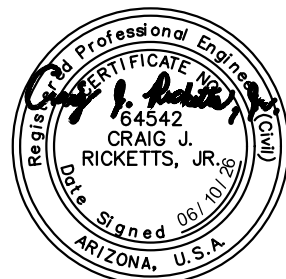

	NAME	DATE
DESIGN	I ROBLES	06/26
DRAWN	C VALENCIA	06/26
CHECKED	C RICKETTS	06/26

TRANSPORTATION
AECOM TECHNICAL SERVICES, Inc.
7720 N. 16th St., Suite 100
Phoenix, Arizona 85020
T 602.371.1100


AECOM
www.aecom.com

ARIZONA DEPARTMENT OF TRANSPORTATION
PROJECT DELIVERY AND OPERATIONS DIVISION
TRAFFIC DESIGN SERVICES


PHASE 3 - ROUNDABOUT
DETAIL SHEET STA 217+00 TO 231+00

ROUTE US 93	F.H.W.A. Arizona Division	STATE	PROJECT NO.	FEDERAL ID NO.	SHEET NO.	TOTAL SHEETS	RECORD DRAWING
MILEPOST 190.5		ARIZ.	093 YV 190	093-B-NFA	328	524	
	LOCATION VISTA ROYALE						DWG No. T-2.24
STRUCTURE NO.	TRACS NO. F0738 01C						____ OF ____



PHASE 3

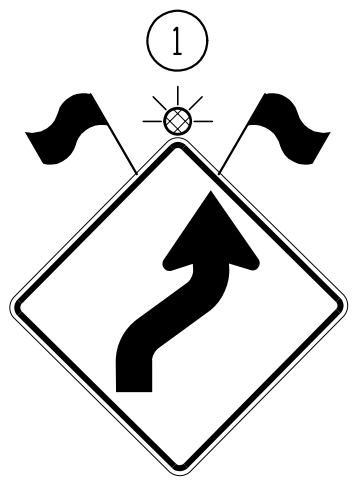

W1-4R
48" x 48"
BLACK/ORANGE

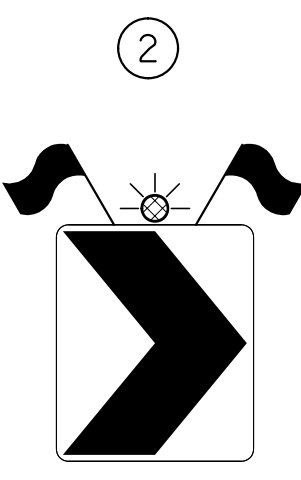


W1-8R
36" x 48"
BLACK/ORANGE

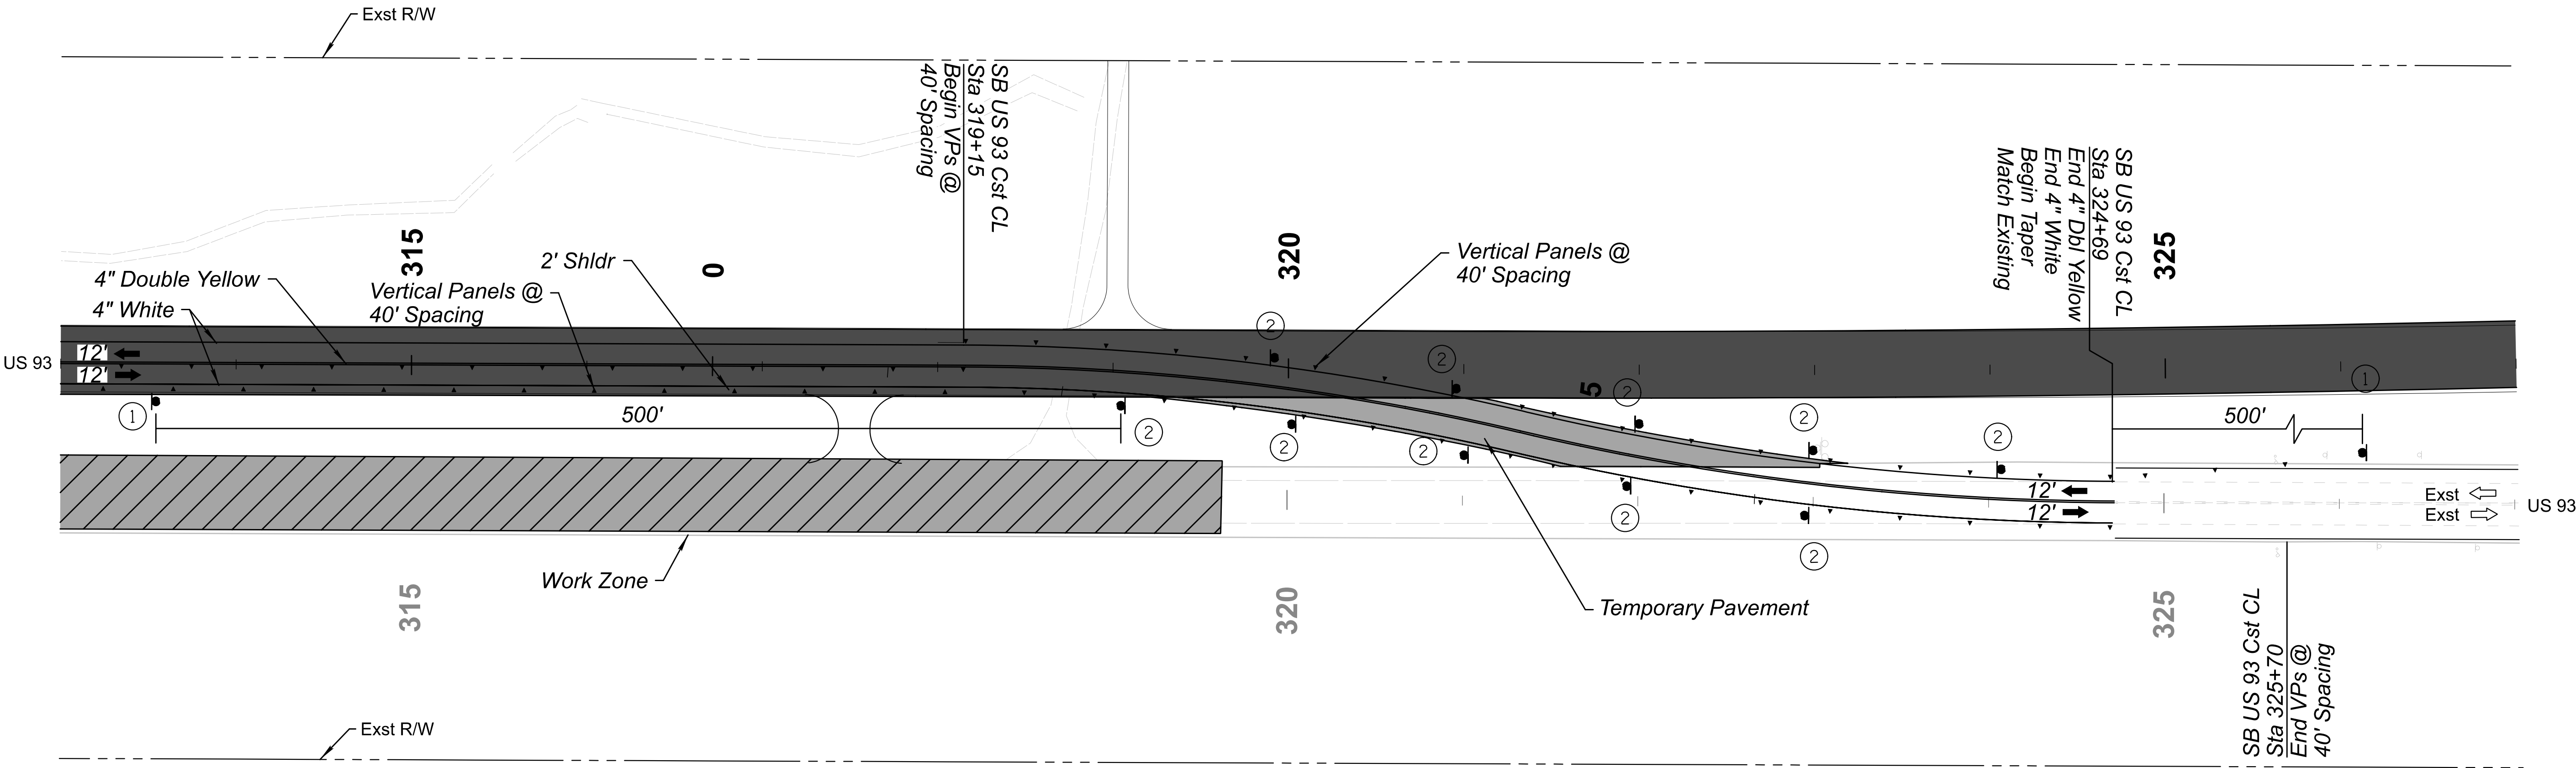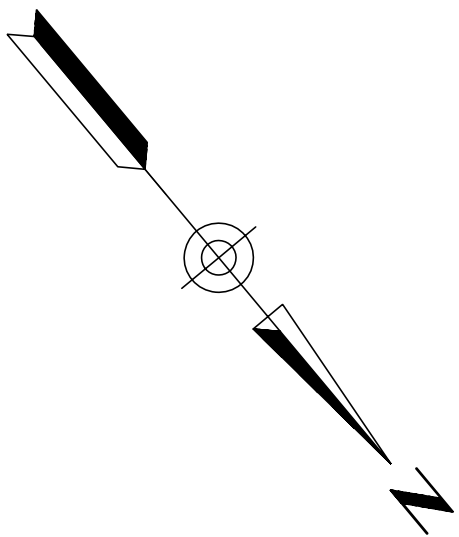

LEGEND

- Phase 3 Roadway Construction
- Phase 3 Temporary Paving
- Previously Constructed Temporary Paving
- Previously Constructed
- Temporary Traffic Flow Arrow
- Existing Traffic Flow Arrow

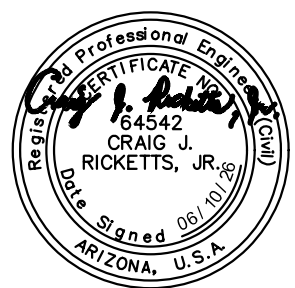

	NAME	DATE
DESIGN	I ROBLES	06/26
DRAWN	C VALENCIA	06/26
CHECKED	C RICKETTS	06/26

TRANSPORTATION
AECOM TECHNICAL SERVICES, Inc.
7720 N. 18th St., Suite 100
Phoenix, Arizona 85020
T 602.371.1100
AECOM
www.aecom.com


ARIZONA DEPARTMENT OF TRANSPORTATION
PROJECT DELIVERY AND OPERATIONS DIVISION
TRAFFIC DESIGN SERVICES

PHASE 3 - NORTH CROSSOVER
DETAIL SHEET STA 313+00 TO 327+00

ROUTE US 93	F.H.W.A. Arizona Division	STATE ARIZ.	PROJECT NO. 093 YV 190	FEDERAL ID NO. 093-B-NFA	SHEET NO. 329	TOTAL SHEETS 524	RECORD DRAWING
MILEPOST 190.5	LOCATION VISTA ROYALE						DWG No. T-2.25
STRUCTURE NO.	TRACS NO. F0738 01C						OF

PHASE 4A

F.H.W.A. REGION	STATE	PROJECT NO.	SHEET NO.	TOTAL SHEETS	RECORD DRAWING
9	ARIZ.	093-B(230)T	330	524	
093 YV 189					

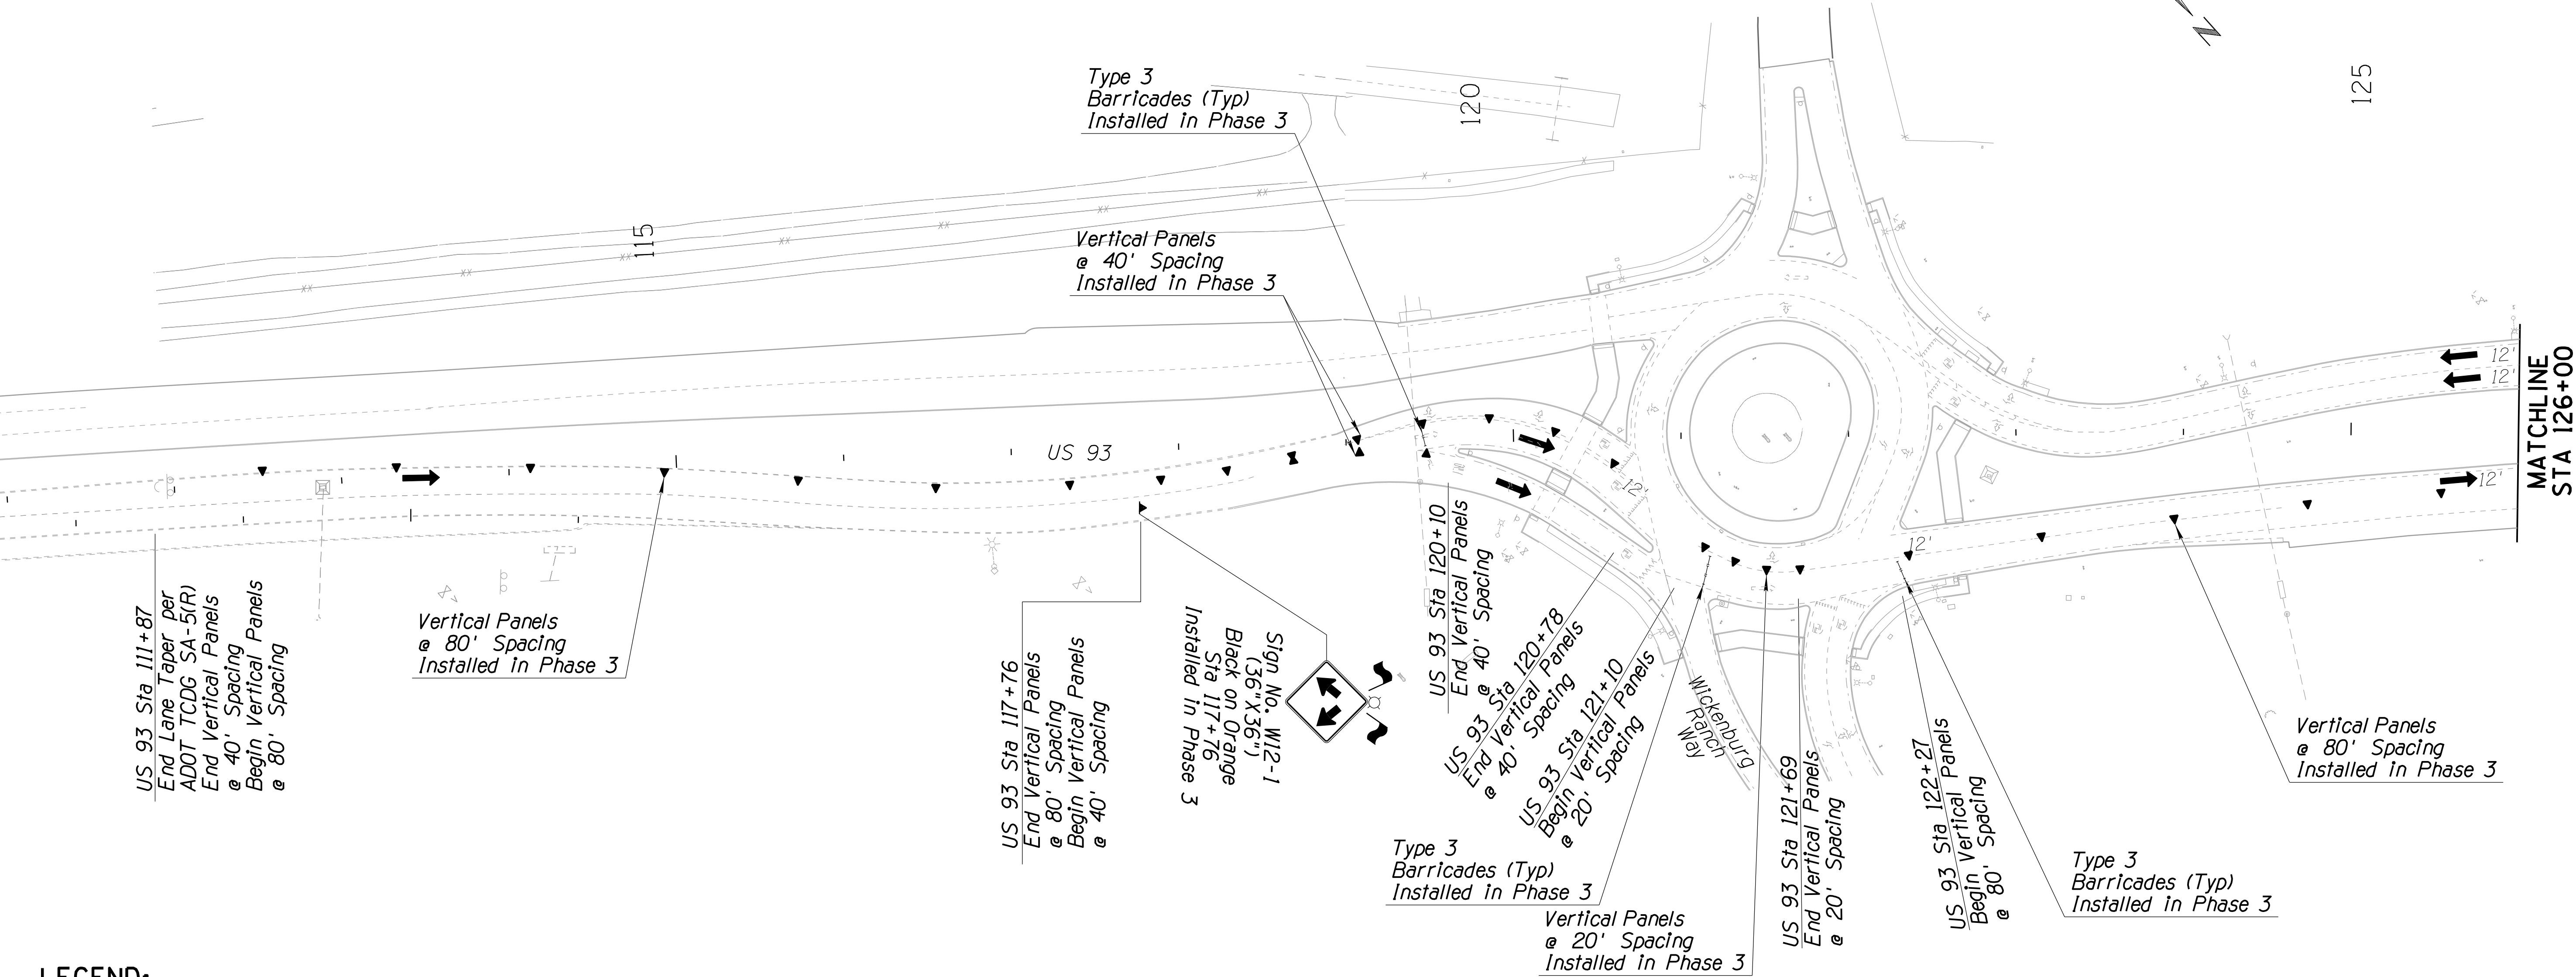

LEGEND:

	Direction Of Travel		Temporary Concrete Barrier
	Temporary Impact Attenuation Device		Temporary Pavement Work Zone
	Sign On Spring Stand		Permanent Pavement Work Zone
	Sign On Rigid Stand		CMB - Changeable Message Board
	Sign On Embedded Posts		Flashing Light & Warning Flags
	Type 2 Barricade		Vertical Panel
	Type 3 Barricade		Temporary Pavement Phase 1, 2 & 3
			Constructed Pavement Phase 1, 2 & 3

DESIGN
DRAWN
CHECKED

ME1
SRH
BMT

06/26
06/26
06/26

NAME

DATE

ARIZONA DEPARTMENT OF TRANSPORTATION
PROJECT DELIVERY AND OPERATIONS DIVISION
TRAFFIC DESIGN SERVICES

US 93 & SR 89
PHASE 4A TRAFFIC CONTROL
STA 111+87 TO STA 126+00

Stanley Consultants inc.

3133 East Camelback Road, Suite 100
Phoenix, Arizona 85016
Phone: (602) 333-2200

ROUTE

LOCATION

US 93WICKENBURG RANCH WAY TO VISTA ROYALE

TRACS NO.

F0738 OIC

093-B(230)T

DWG NO.

T-2.26


OF

Professional Engineer Seal

51481
BRIANNE MARIE
TURPIN
ARIZONA, U.S.A.

PHASE 4A

F.H.W.A. REGION	STATE	PROJECT NO.	SHEET NO.	TOTAL SHEETS	RECORD DRAWING
9	ARIZ.	093-B(230)T	331	524	
093 YV 189					

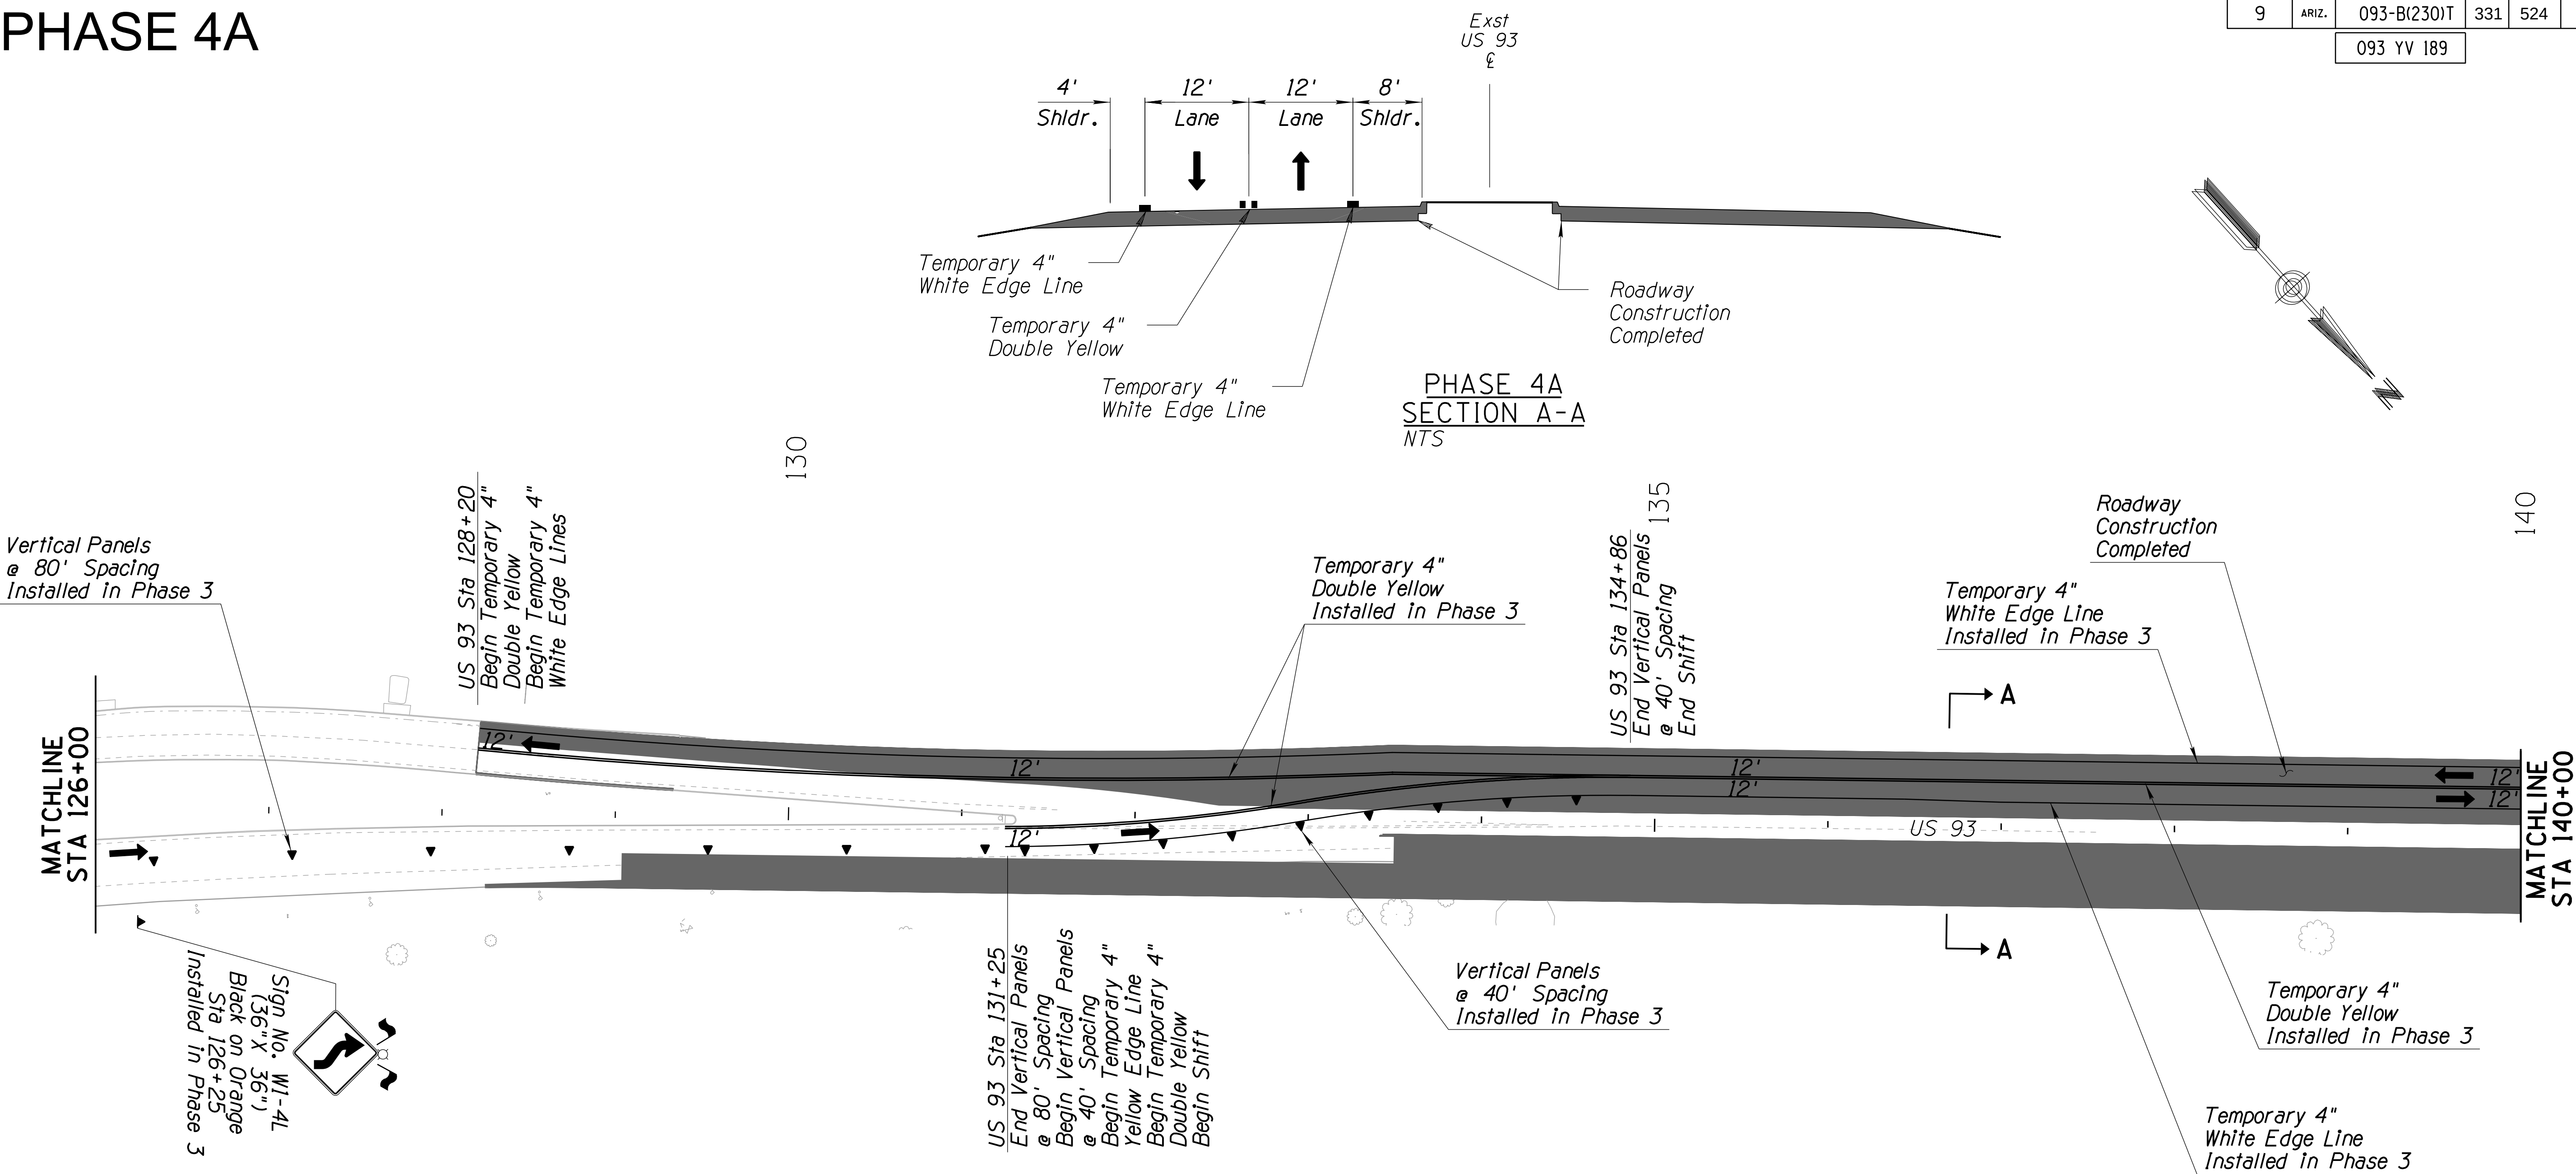


LEGEND:

→	Direction Of Travel	XXXXXX	Temporary Concrete Barrier
○○○○○○	Temporary Impact Attenuation Device	XXXXXX	Temporary Pavement Work Zone
▶	Sign On Spring Stand	XXXXXX	Permanent Pavement Work Zone
■	Sign On Rigid Stand	XXXXXX	CMB - Changeable Message Board
■	Sign On Embedded Posts	XXXXXX	Flashing Light & Warning Flags
■	Type 2 Barricade	▲	Vertical Panel
—	Type 3 Barricade	XXXXXX	Temporary Pavement Phase 1, 2 & 3
		XXXXXX	Constructed Pavement Phase 1, 2 & 3

NOTE:
1. Obliterate all existing, Phase 1, Phase 2, and Phase 3 pavement marking in conflict with Phase 4A temporary pavement marking on US 93 Sta 128+20 to Sta 190+00, and on SR 89 Sta 473+64 to Sta 503+91.

DESIGN	ME1	DATE	06/26	ARIZONA DEPARTMENT OF TRANSPORTATION PROJECT DELIVERY AND OPERATIONS DIVISION TRAFFIC DESIGN SERVICES	
DRAWN	SRH	DATE	06/26		
CHECKED	BMT	DATE	06/26		
Stanley Consultants Inc. 3133 East Camelback Road, Suite 100 Phoenix, Arizona 85016 Phone: (602) 333-2200				US 93 & SR 89 PHASE 4A TRAFFIC CONTROL STA 126+00 TO STA 140+00	
ROUTE		LOCATION		DWG NO. T-2.27	
US 93		WICKENBURG RANCH WAY TO VISTA ROYALE			
TRACS NO. F0738 OIC		093-B(230)T		OF	

PHASE 4A

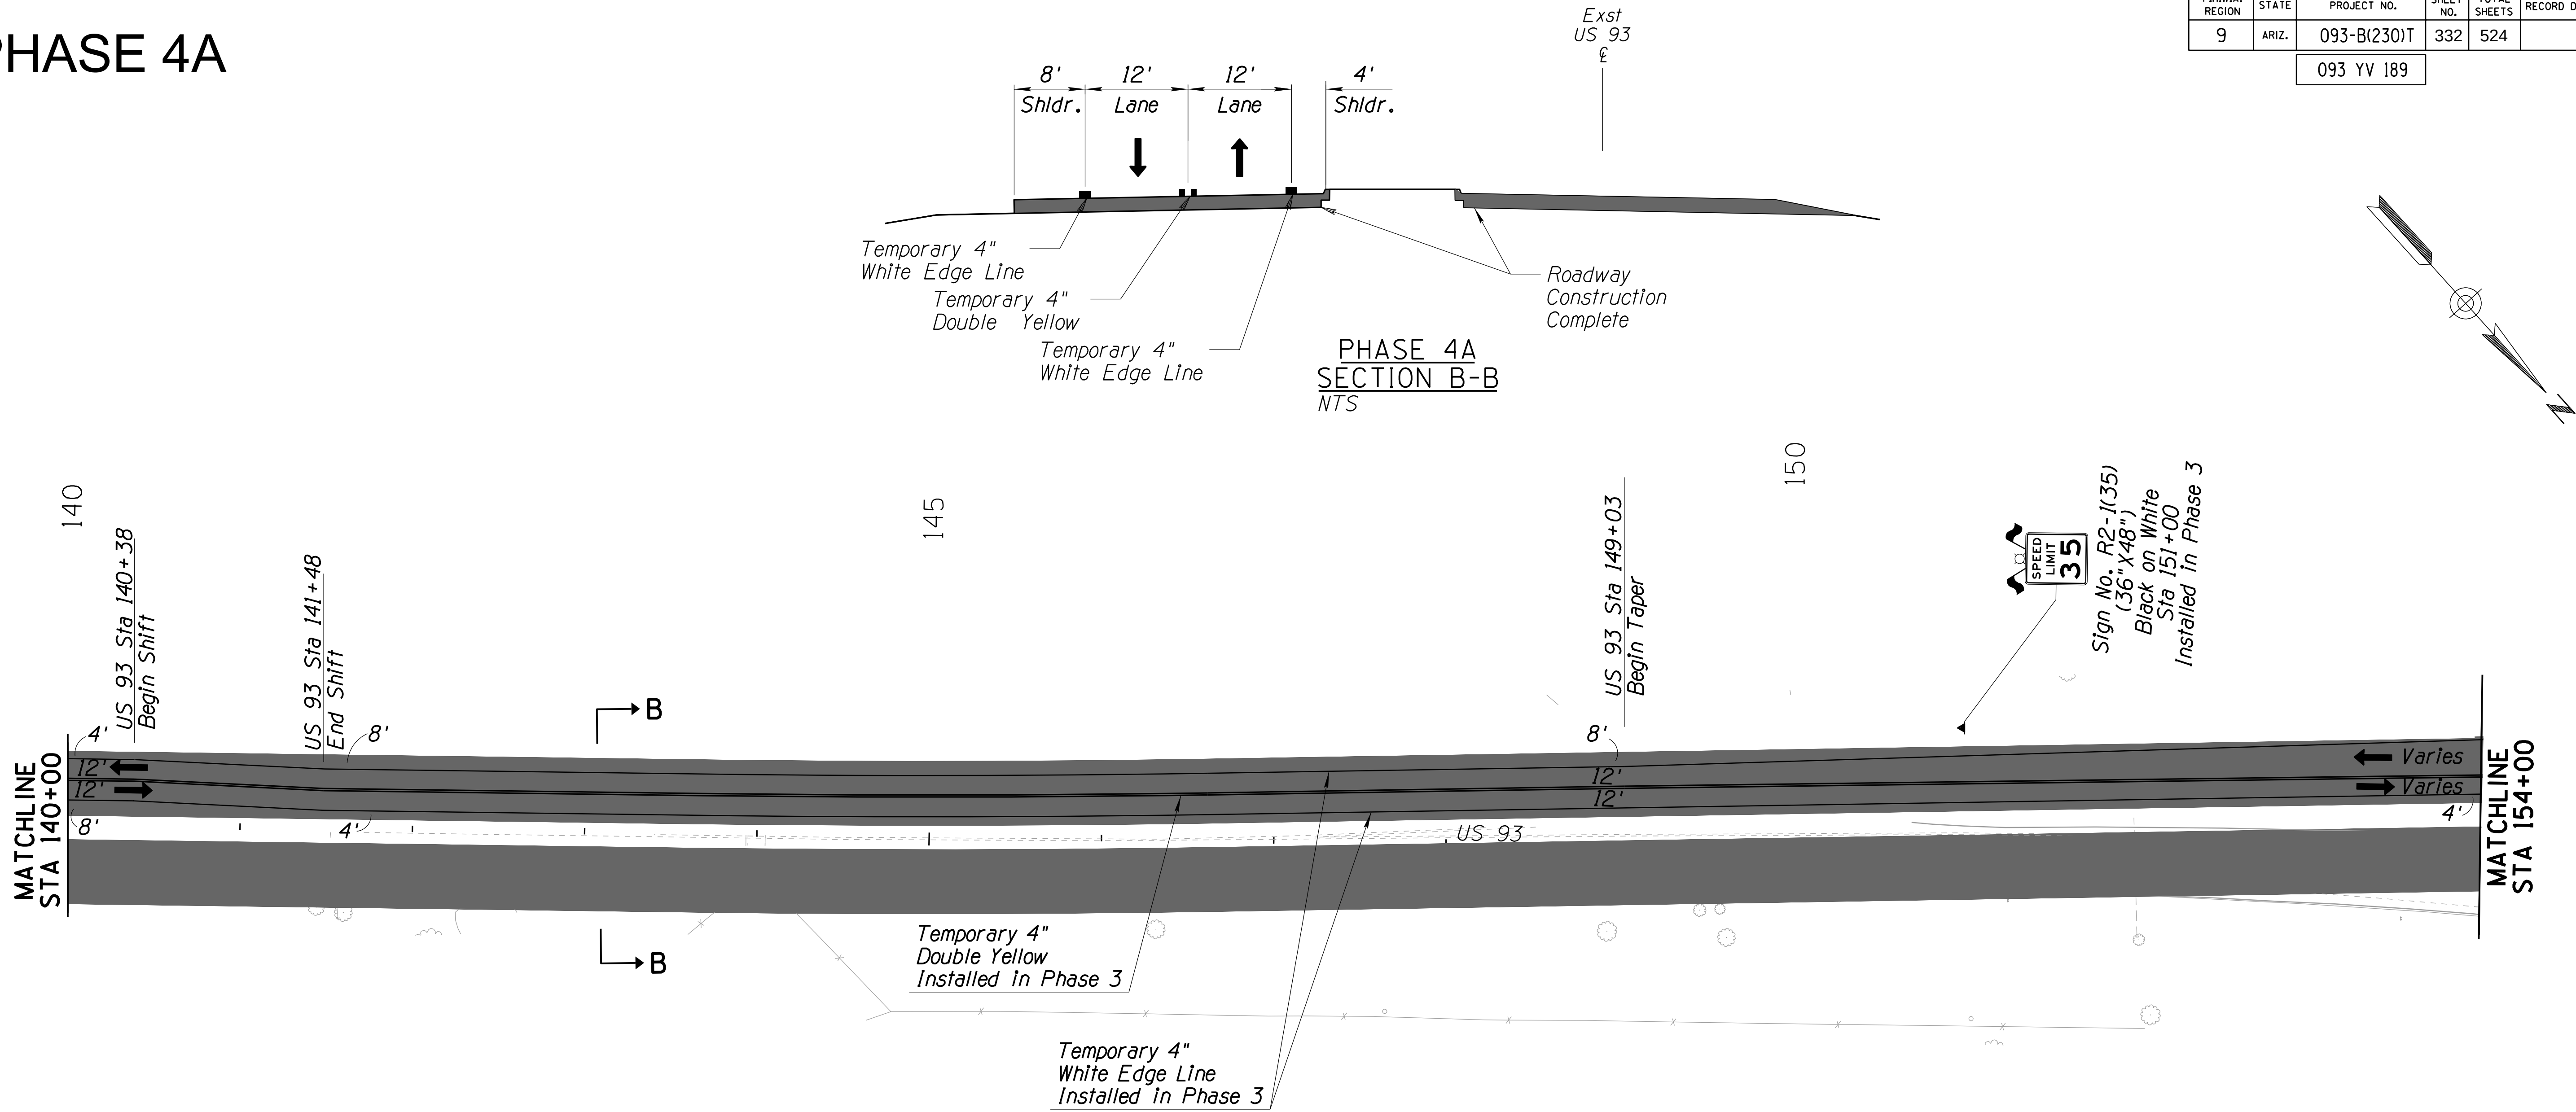

LEGEND:

	Direction Of Travel		Temporary Concrete Barrier
	Temporary Impact Attenuation Device		Temporary Pavement Work Zone
	Sign On Spring Stand		Permanent Pavement Work Zone
	Sign On Rigid Stand		CMB - Changeable Message Board
	Sign On Embedded Posts		Flashing Light & Warning Flags
	Type 2 Barricade		Vertical Panel
	Type 3 Barricade		Temporary Pavement Phase 1, 2 & 3
			Constructed Pavement Phase 1, 2 & 3

NOTE:

1. Obliterate all existing, Phase 1, Phase 2, and Phase 3 pavement marking in conflict with Phase 4A temporary pavement marking on US 93 Sta 128+20 to Sta 190+00, and on SR 89 Sta 473+64 to Sta 503+91.

DESIGNME106/26

DRAWNSRH06/26

CHECKEDBMT06/26

NAME

DATE

ARIZONA DEPARTMENT OF TRANSPORTATION
PROJECT DELIVERY AND OPERATIONS DIVISION
TRAFFIC DESIGN SERVICES

Stanley Consultants inc.
3133 East Camelback Road, Suite 100
Phoenix, Arizona 85016
Phone: (602) 333-2200

ROUTEUS 93

LOCATIONWICKENBURG RANCH WAY TO VISTA ROYALE

US 93 & SR 89
PHASE 4A TRAFFIC CONTROL
STA 140+00 TO STA 154+00

TRACS NO. F0738 OIC


093-B(230)T

DWG NO. T-2.28

OF

PHASE 4A

F.H.W.A. REGION	STATE	PROJECT NO.	SHEET NO.	TOTAL SHEETS	RECORD DRAWING
9	ARIZ.	093-B(230)T	333	524	
093 YV 189					

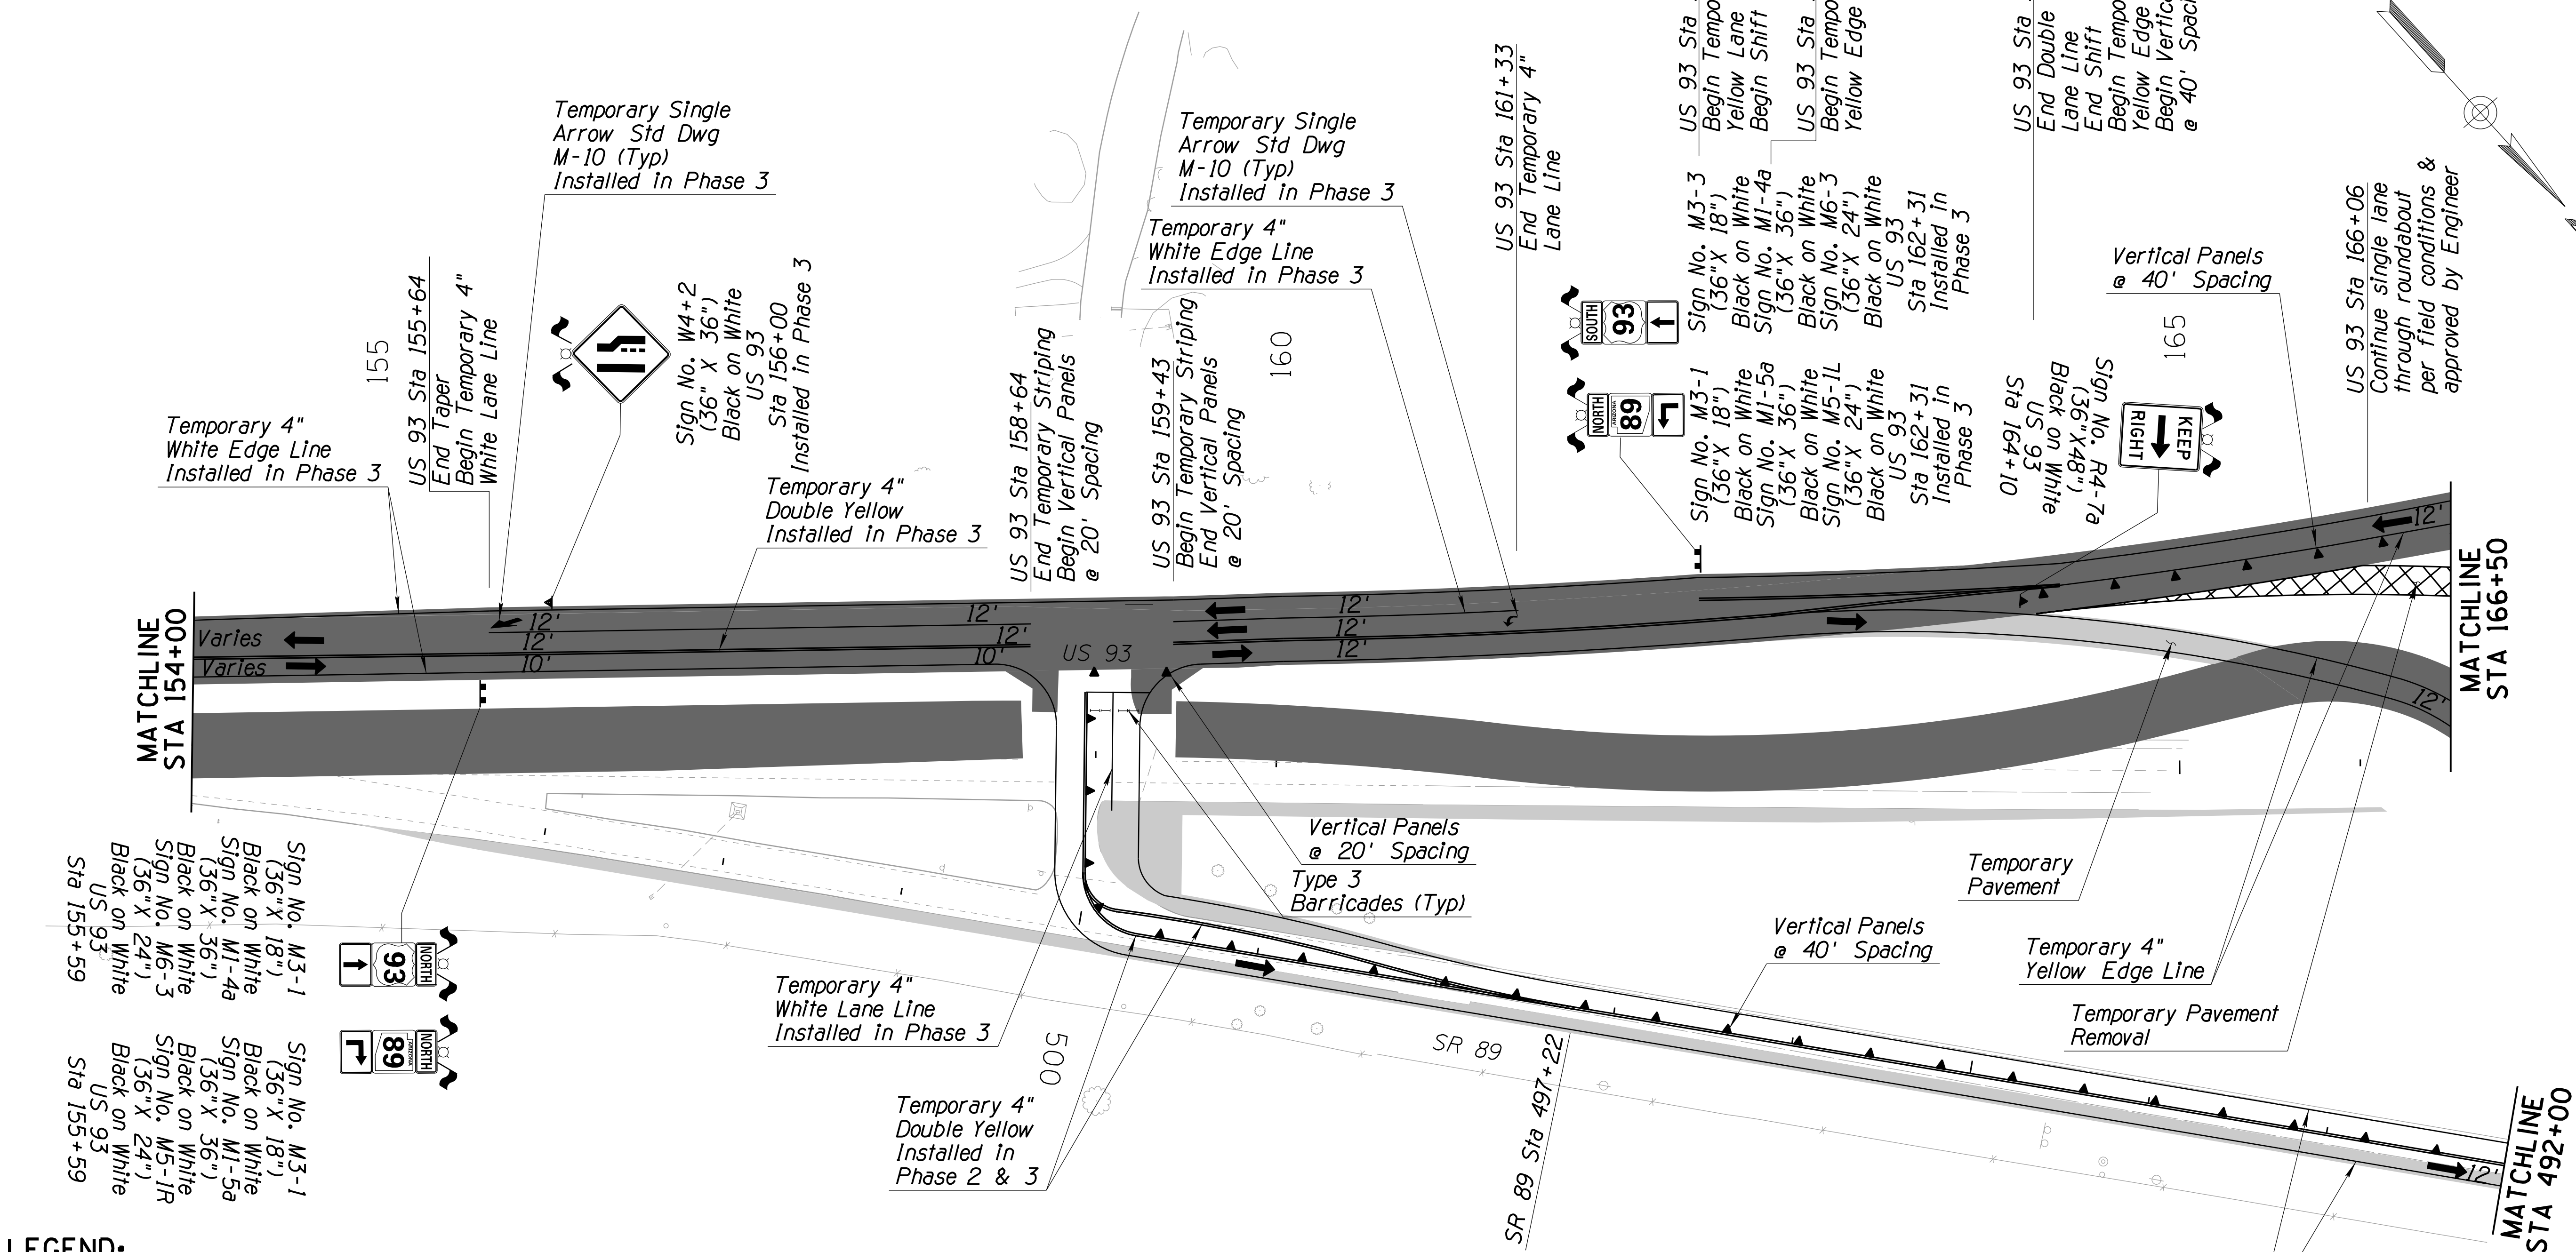

LEGEND:

	Direction Of Travel		Temporary Concrete Barrier
	Temporary Impact Attenuation Device		Temporary Pavement Work Zone
	Sign On Spring Stand		Permanent Pavement Work Zone
	Sign On Rigid Stand		CMB - Changeable Message Board
	Sign On Embedded Posts		Flashing Light & Warning Flags
	Type 2 Barricade		Vertical Panel
	Type 3 Barricade		Temporary Pavement Phase 1, 2 & 3
	Temporary Pavement Removal		Constructed Pavement Phase 1, 2 & 3

NOTE:


1. Obliterate all existing, Phase 1, Phase 2, and Phase 3 pavement marking in conflict with Phase 4A temporary pavement marking on US 93 Sta 128+20 to Sta 190+00, and on SR 89 Sta 473+64 to Sta 503+91.

		NAME	DATE	ARIZONA DEPARTMENT OF TRANSPORTATION PROJECT DELIVERY AND OPERATIONS DIVISION TRAFFIC DESIGN SERVICES US 93 & SR 89 PHASE 4A TRAFFIC CONTROL STA 154+00 TO STA 166+50	
DESIGN		ME1	06/26		
DRAWN		SRH	06/26		
CHECKED		BMT	06/26		
 Stanley Consultants Inc. 3133 East Camelback Road, Suite 100 Phoenix, Arizona 85016 Phone: (602) 333-2200					
ROUTE		LOCATION			
US 93		WICKENBURG RANCH WAY TO VISTA ROYALE			DWG NO. T-2.29
TRACS NO. F0738 OIC			093-B(230)T		OF

PHASE 4A

F.H.W.A. REGION	STATE	PROJECT NO.	SHEET NO.	TOTAL SHEETS	RECORD DRAWING
9	ARIZ.	093-B(230)T	334	524	

093 YV 189

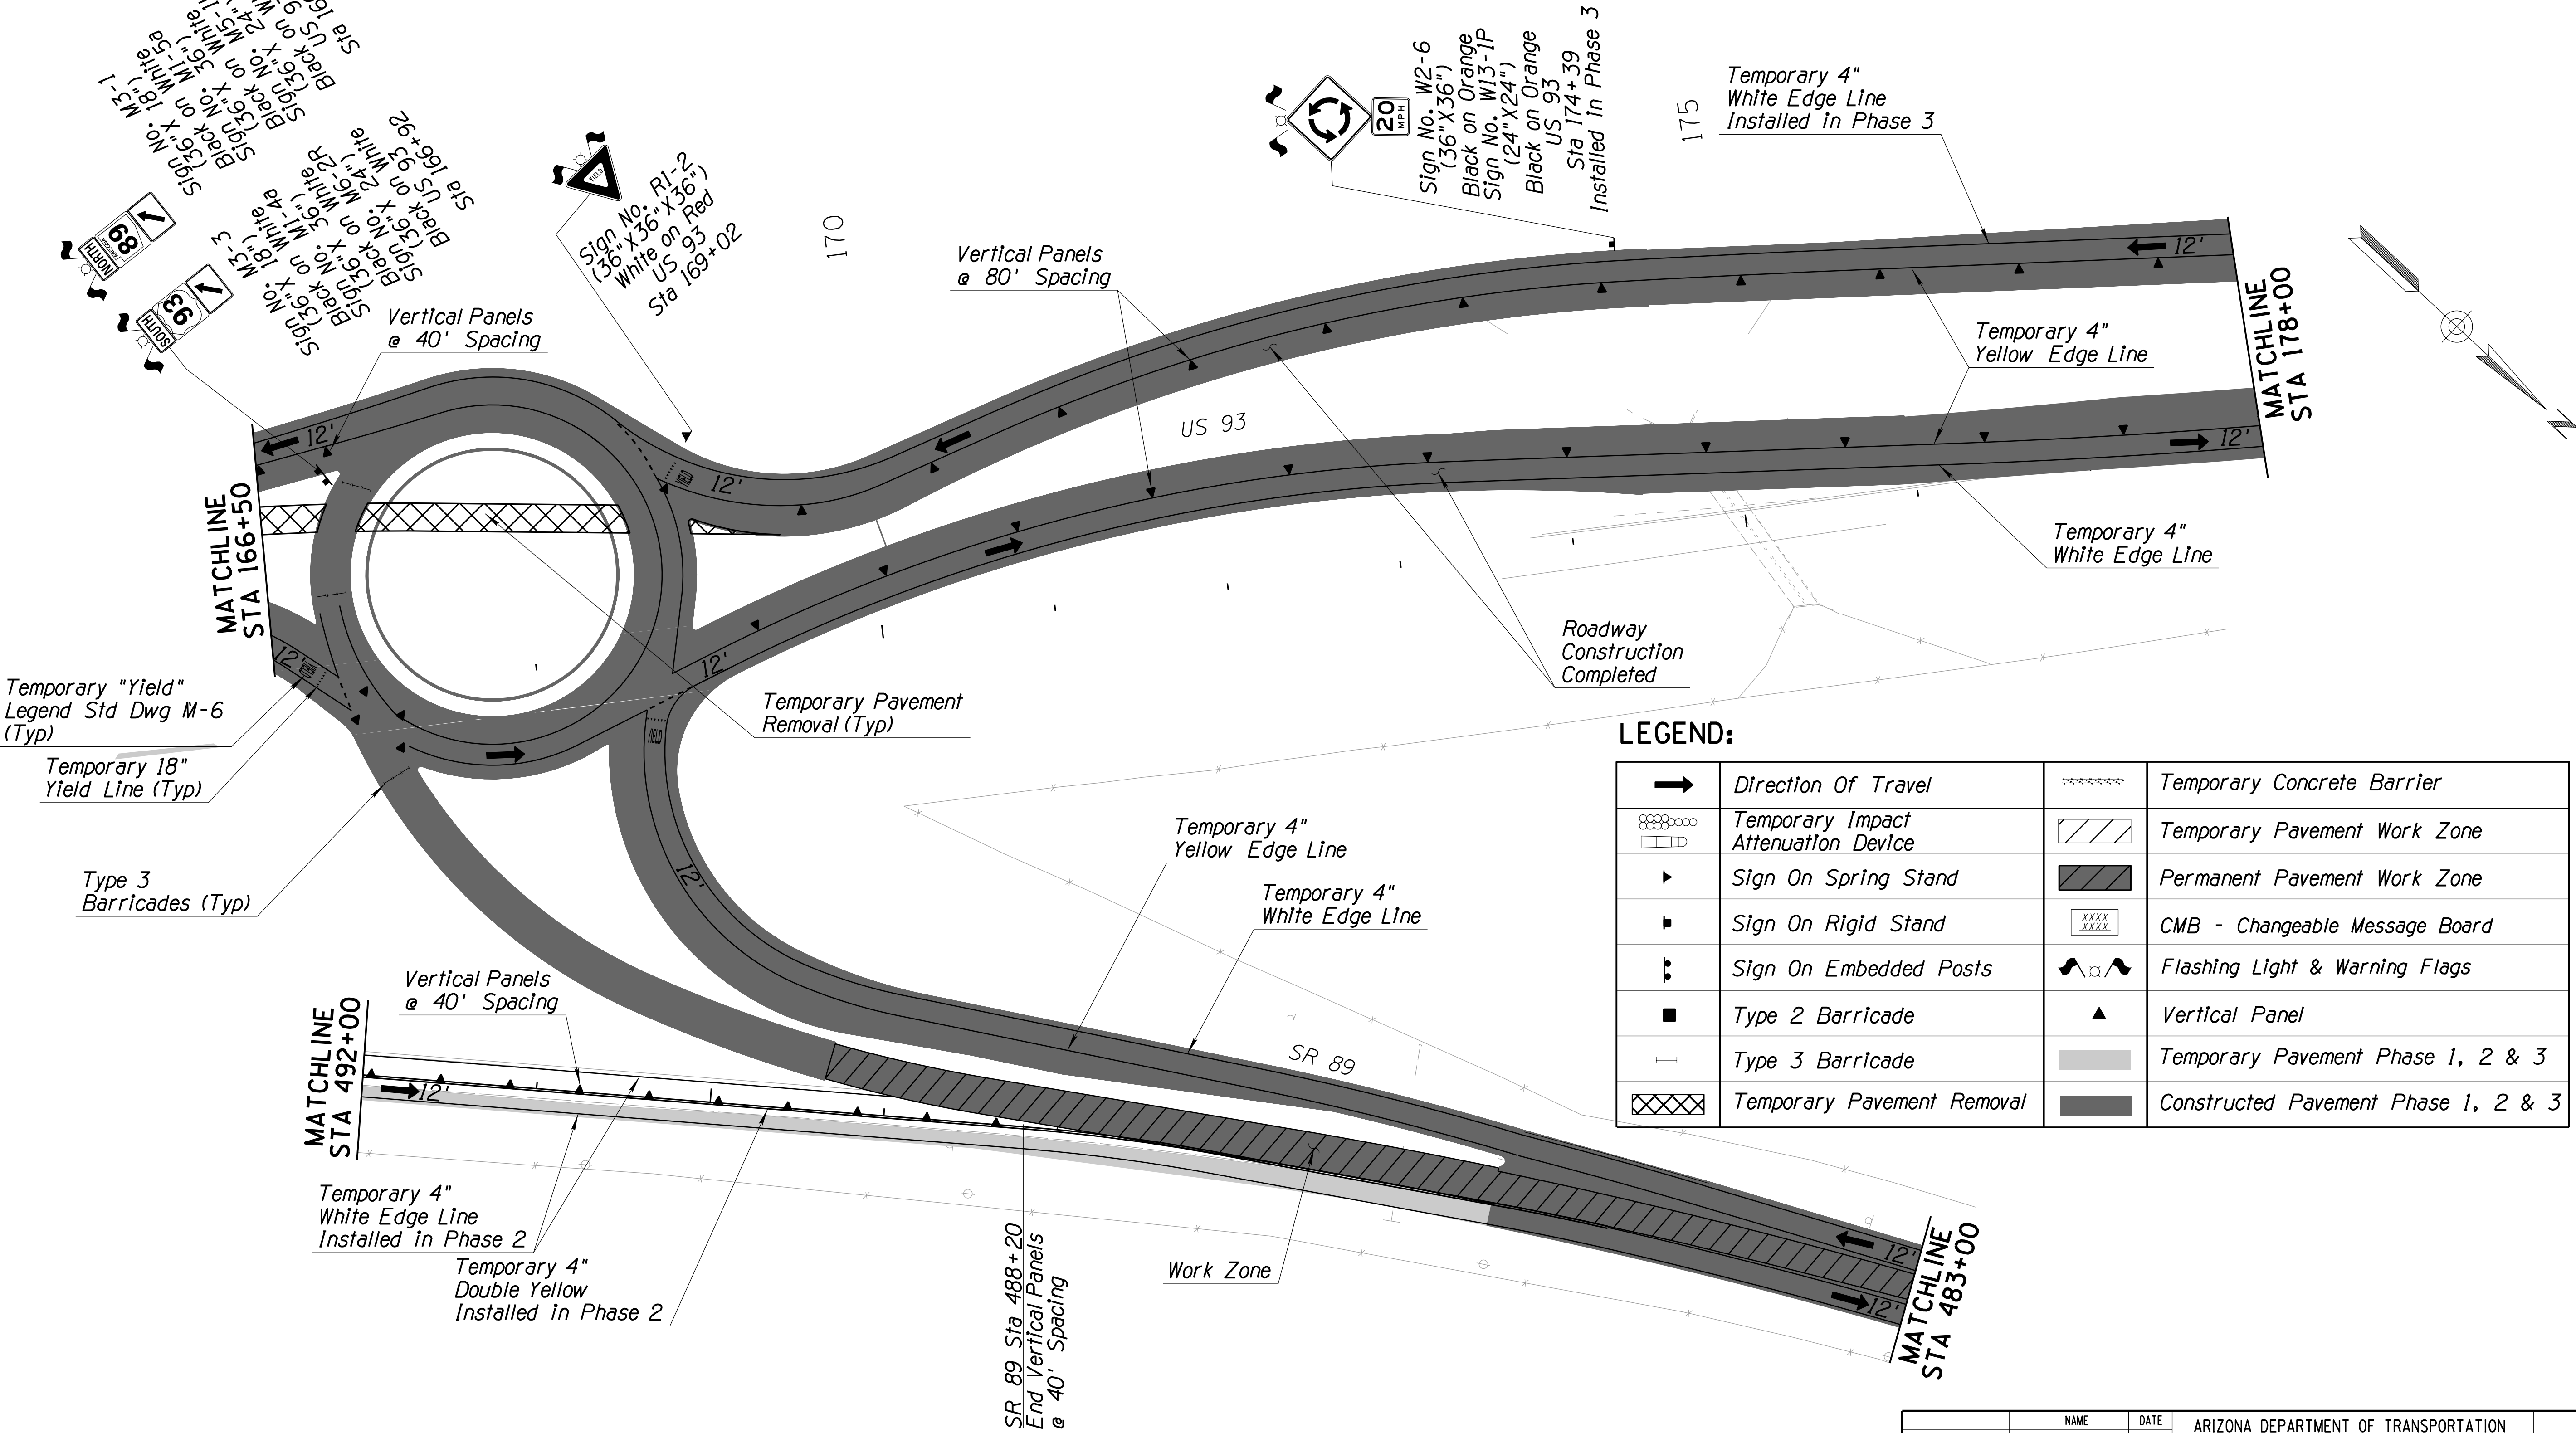


NOTE:
1. Obliterate all existing, Phase 1, Phase 2, and Phase 3 pavement marking in conflict with Phase 4A temporary pavement marking on US 93 Sta 128+20 to Sta 190+00, and on SR 89 Sta 473+64 to Sta 503+91.

		NAME	DATE	ARIZONA DEPARTMENT OF TRANSPORTATION PROJECT DELIVERY AND OPERATIONS DIVISION TRAFFIC DESIGN SERVICES	
DESIGN	MEI		06/26		
DRAWN	SRH		06/26		
CHECKED	BMT		06/26		
 Stanley Consultants inc.		3133 East Camelback Road, Suite 100 Phoenix, Arizona 85016 Phone: (602) 333-2200		US 93 & SR 89 PHASE 4A TRAFFIC CONTROL STA 166+50 TO STA 178+00	
ROUTE		LOCATION			
US 93		WICKENBURG RANCH WAY TO VISTA ROYALE		DWG NO. T-2.30	
TRACS NO. F0738 OIC				093-B(230)T	<u> OF </u>

PHASE 4A

F.H.W.A. REGION	STATE	PROJECT NO.	SHEET NO.	TOTAL SHEETS	RECORD DRAWING
9	ARIZ.	093-B(230)T	335	524	
093 YV 189					

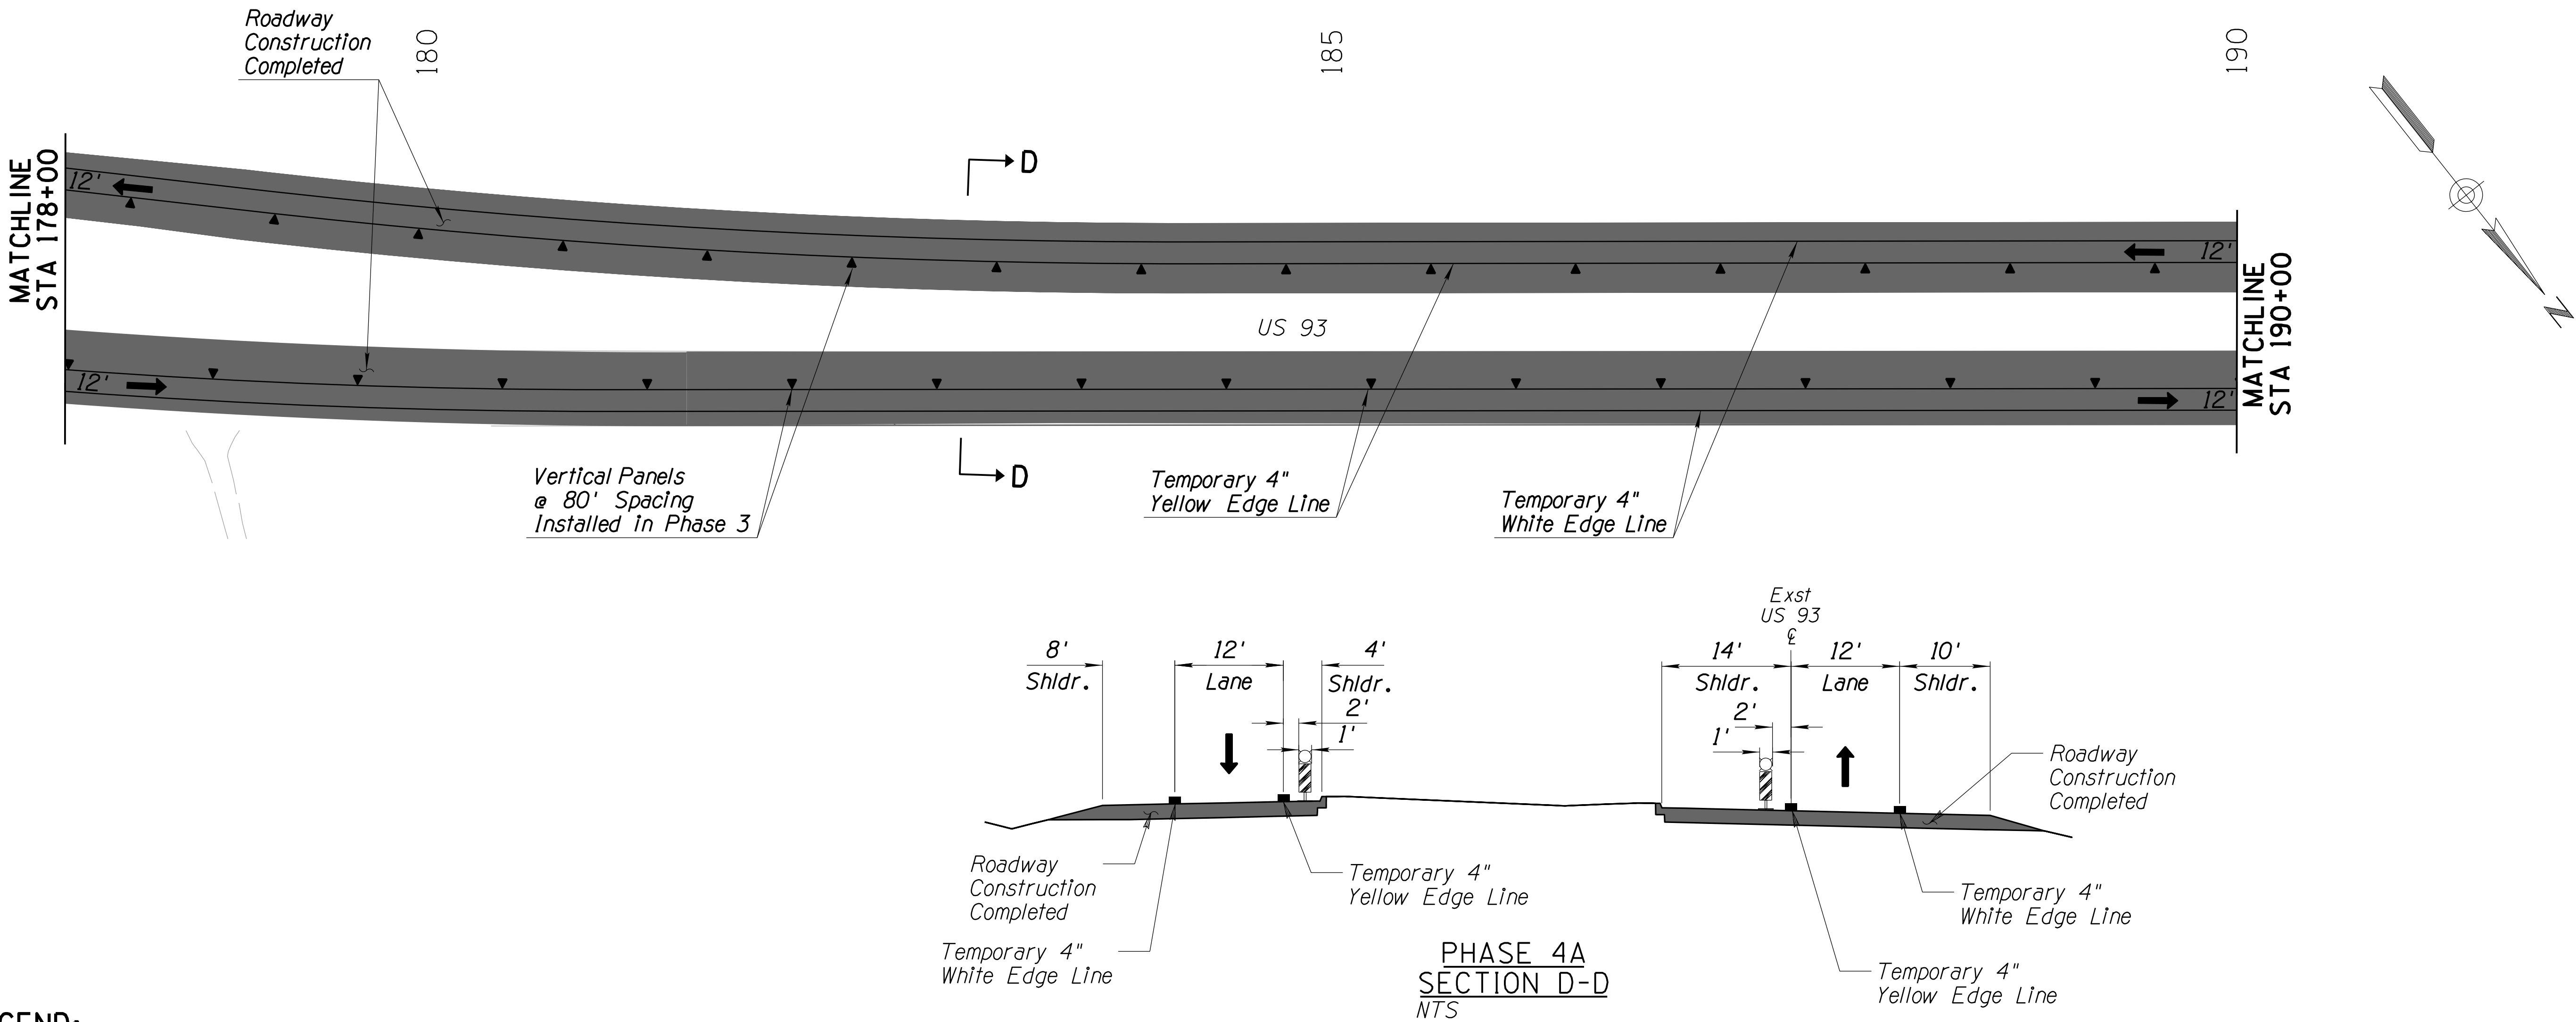

LEGEND:

→	Direction Of Travel	Temporary Concrete Barrier
Temporary Impact Attenuation Device	Temporary Pavement Work Zone	
Sign On Spring Stand	Permanent Pavement Work Zone	
Sign On Rigid Stand	CMB - Changeable Message Board	
Sign On Embedded Posts	Flashing Light & Warning Flags	
Type 2 Barricade	Vertical Panel	
Type 3 Barricade	Temporary Pavement Phase 1, 2 & 3	
Temporary Pavement Removal	Constructed Pavement Phase 1, 2 & 3	


NOTE:

1. Obliterate all existing, Phase 1, Phase 2, and Phase 3 pavement marking in conflict with Phase 4A temporary pavement marking on US 93 Sta 128+20 to Sta 190+00, and on SR 89 Sta 473+64 to Sta 503+91.

		NAME		DATE	ARIZONA DEPARTMENT OF TRANSPORTATION PROJECT DELIVERY AND OPERATIONS DIVISION TRAFFIC DESIGN SERVICES	
DESIGN	ME1		06/26			
DRAWN	SRH		06/26			
CHECKED	BMT		06/26			
			3133 East Camelback Road, Suite 100 Phoenix, Arizona 85016 Phone: (602) 333-2200			US 93 PHASE 4A TRAFFIC CONTROL STA 178+00 TO STA 190+00
ROUTE			LOCATION			
US 93			WICKENBURG RANCH WAY TO VISTA ROYALE			
TRACS NO. F0738 OIC				093-B(230)T		DWG NO. T-2.31
						OF

PHASE 4A

F.H.W.A. REGION	STATE	PROJECT NO.	SHEET NO.	TOTAL SHEETS	RECORD DRAWING
9	ARIZ.	093-B(230)T	336	524	
093 YV 189					

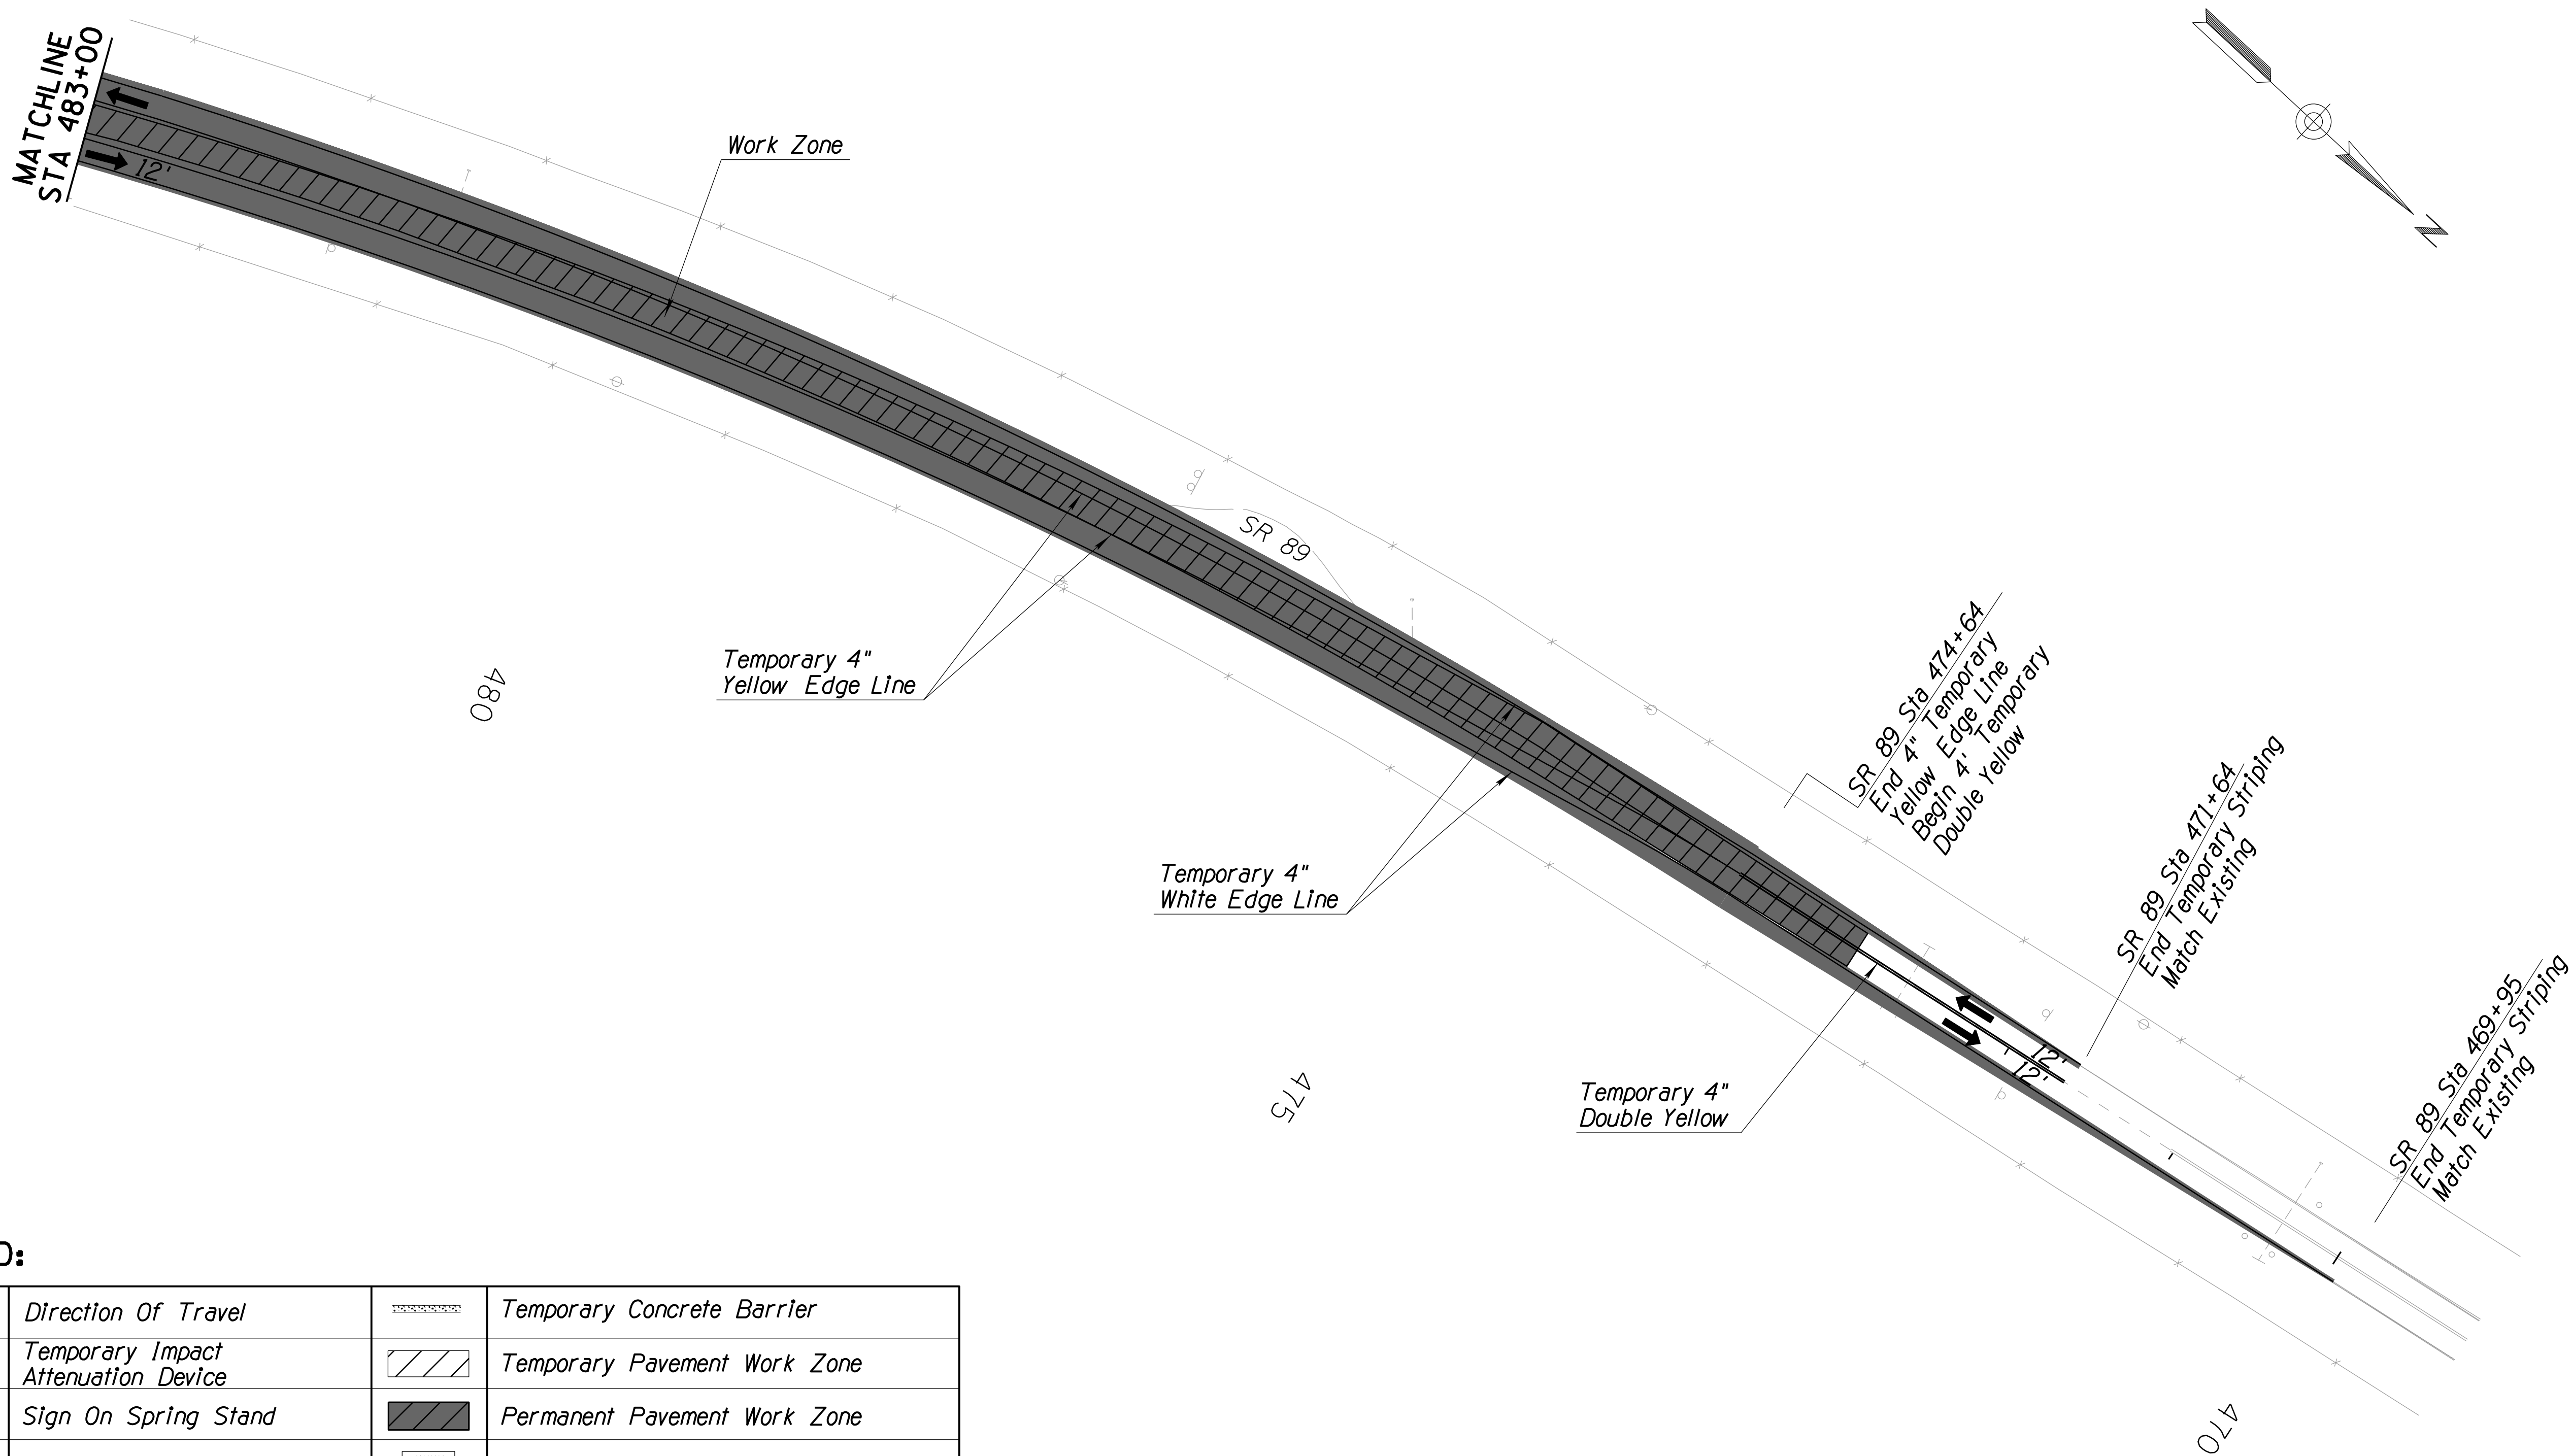

LEGEND:


	Direction Of Travel		Temporary Concrete Barrier
	Temporary Impact Attenuation Device		Temporary Pavement Work Zone
	Sign On Spring Stand		Permanent Pavement Work Zone
	Sign On Rigid Stand		CMB - Changeable Message Board
	Sign On Embedded Posts		Flashing Light & Warning Flags
	Type 2 Barricade		Vertical Panel
	Type 3 Barricade		Temporary Pavement Phase 1, 2 & 3
	Temporary Pavement Removal		Constructed Pavement Phase 1, 2 & 3

NOTE:

1. Obliterate all existing, Phase 1, Phase 2, and Phase 3 pavement marking in conflict with Phase 4A temporary pavement marking on US 93 Sta 128+20 to Sta 190+00, and on SR 89 Sta 473+64 to Sta 503+91.

		NAME	DATE	ARIZONA DEPARTMENT OF TRANSPORTATION PROJECT DELIVERY AND OPERATIONS DIVISION TRAFFIC DESIGN SERVICES		
DESIGN		ME1	06/26			
DRAWN		SRH	06/26			
CHECKED		BMT	06/26			
 Stanley Consultants Inc.		3133 East Camelback Road, Suite 100 Phoenix, Arizona 85016 Phone: (602) 333-2200		US 93 & SR 89 PHASE 4A TRAFFIC CONTROL STA 470+00 TO STA 483+00		
ROUTE		LOCATION				DWG NO. T-2.32 ____ OF ____
US 93		WICKENBURG RANCH WAY TO VISTA ROYALE				
TRACS NO. F0738 OIC				093-B(230)T		

PHASE 4A

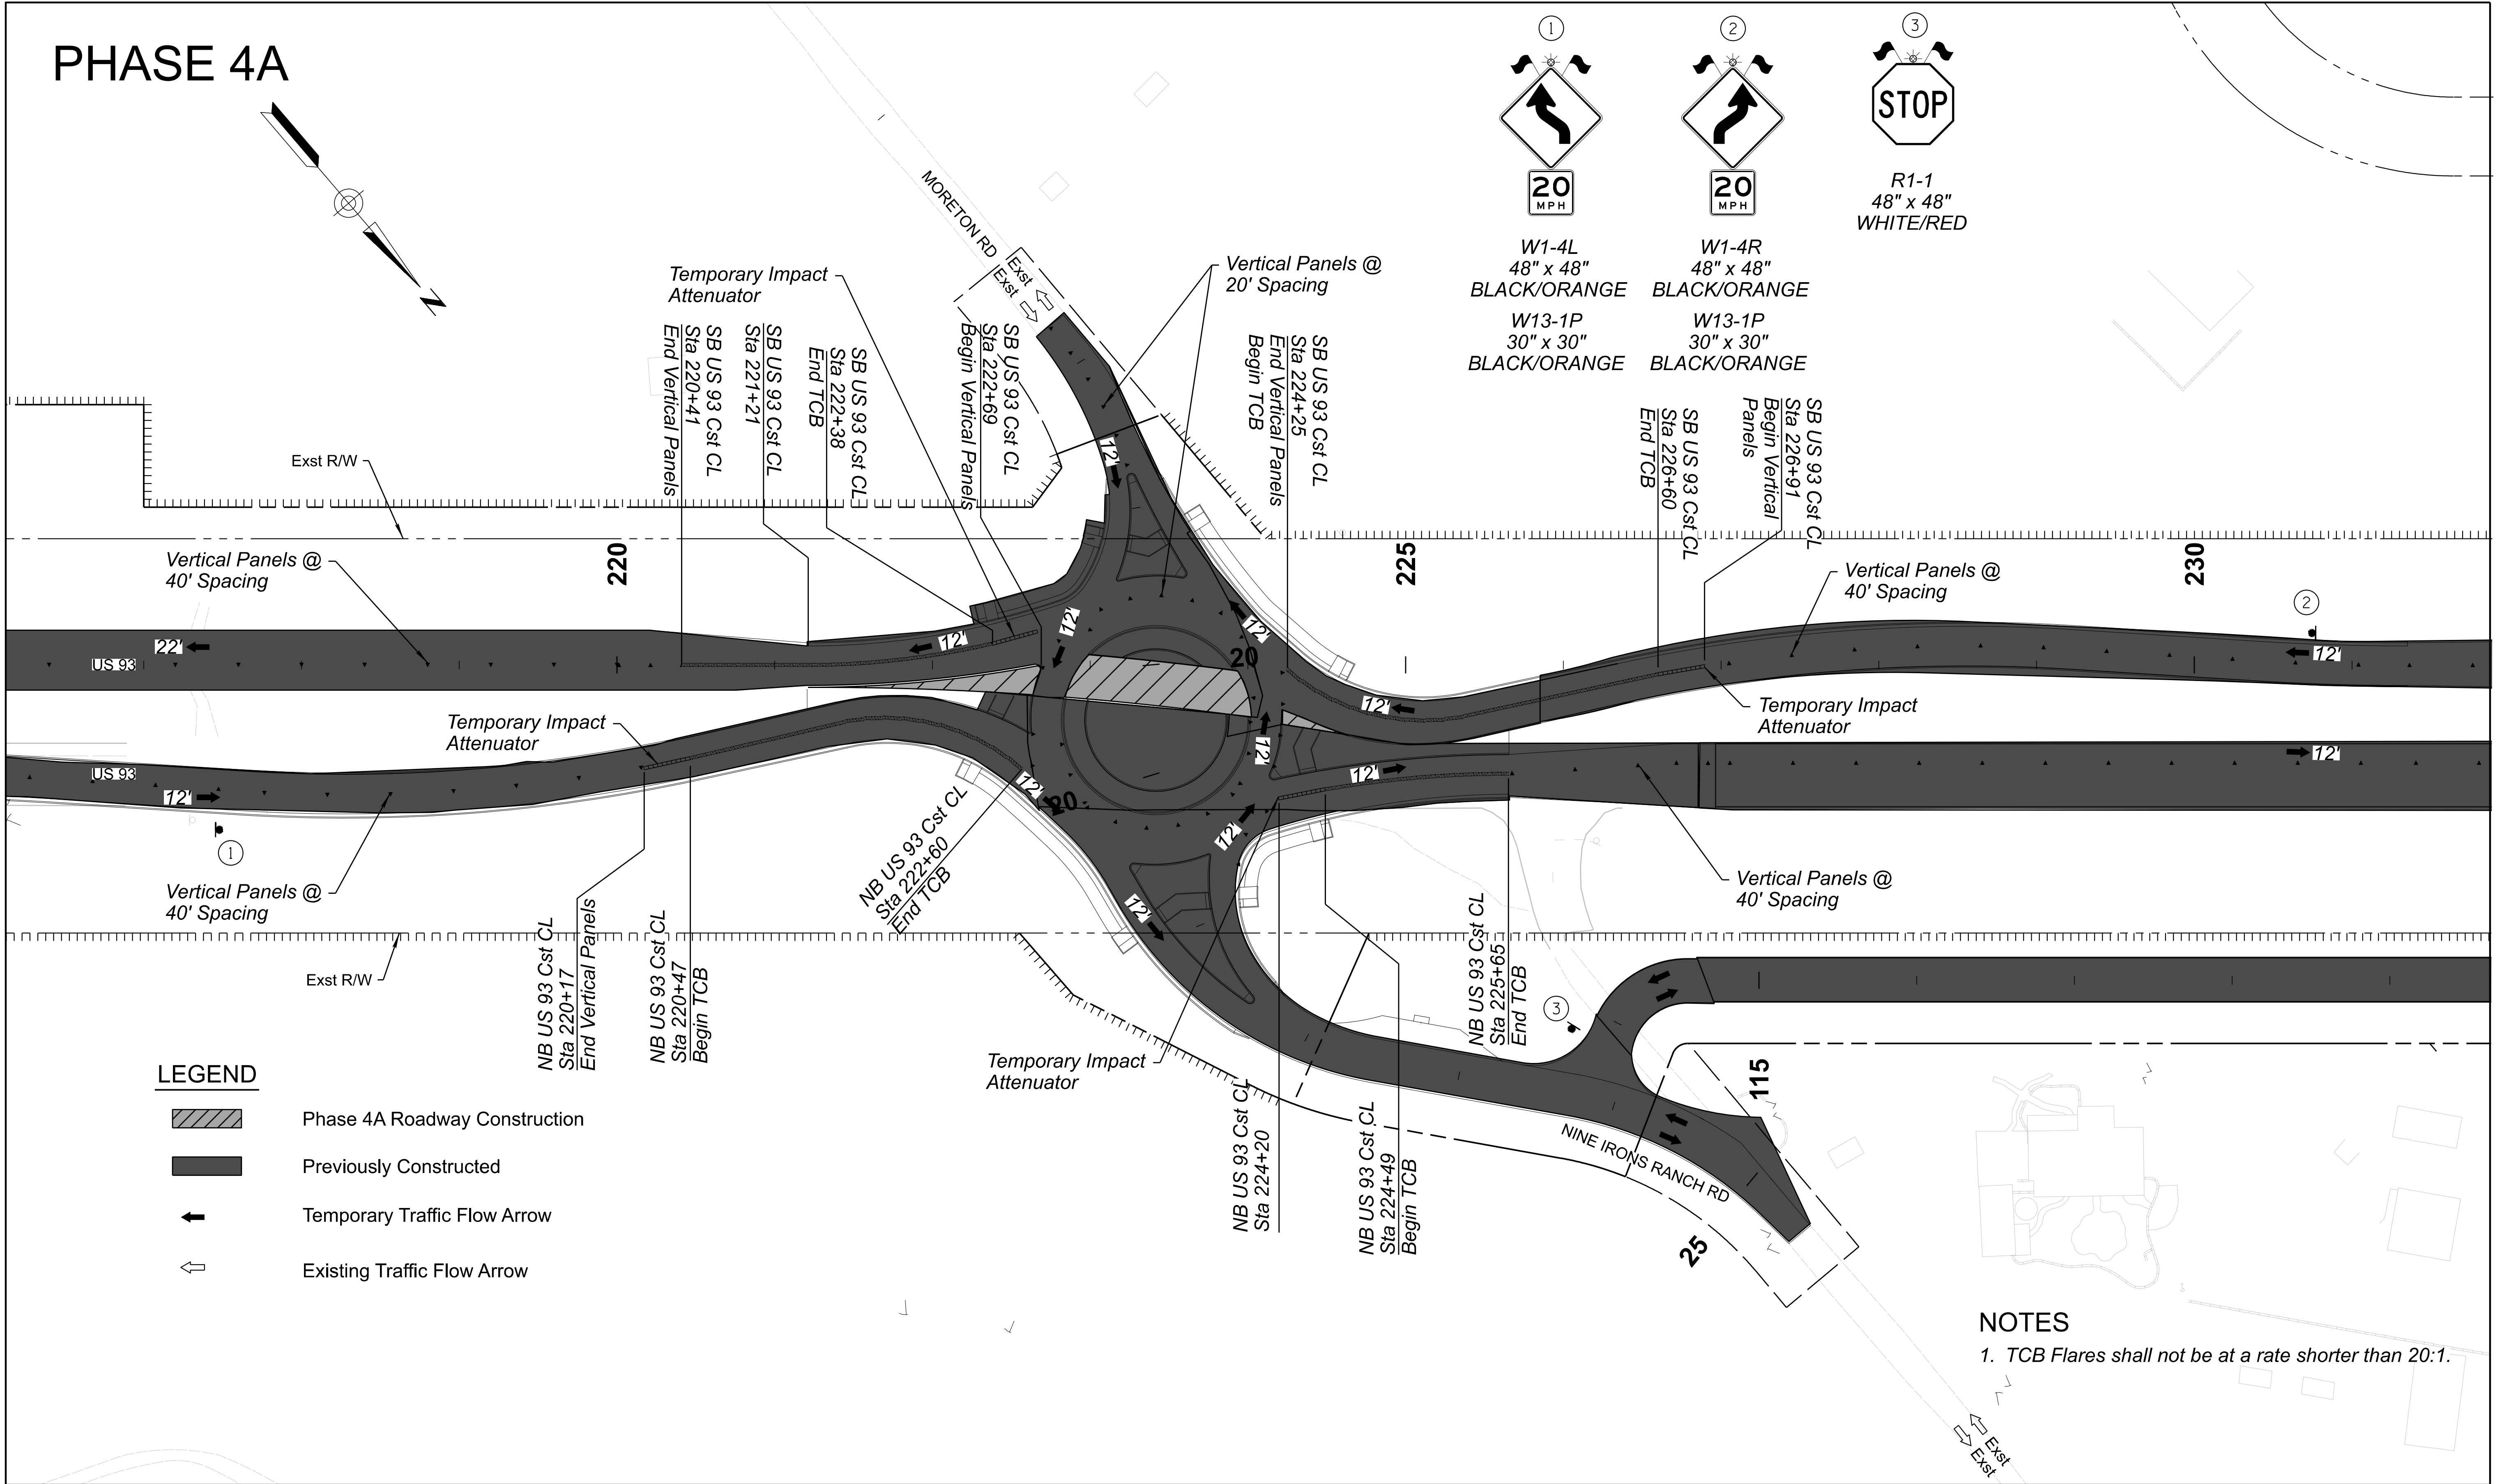

LEGEND

- Phase 4A Roadway Construction
- Previously Constructed
- Temporary Traffic Flow Arrow
- Existing Traffic Flow Arrow

NOTES

1. TCB Flares shall not be at a rate shorter than 20:1.



	NAME	DATE
DESIGN	I ROBLES	06/26
DRAWN	C VALENCIA	06/26
CHECKED	C RICKETTS	06/26

TRANSPORTATION
AECOM TECHNICAL SERVICES, Inc.
7720 N. 16th St., Suite 100
Phoenix, Arizona 85020
T 602.371.1100

AECOM
www.aecom.com



ARIZONA DEPARTMENT OF TRANSPORTATION PROJECT DELIVERY AND OPERATIONS DIVISION TRAFFIC DESIGN SERVICES
PHASE 4A - ROUNDABOUT DETAIL SHEET STA 217+00 TO 231+00

ROUTE US 93	F.H.W.A. Arizona Division	STATE ARIZ.	PROJECT NO. 093 YV 190	FEDERAL ID NO. 093-B-NFA	SHEET NO. 337	TOTAL SHEETS 524	RECORD DRAWING
MILEPOST 190.5		LOCATION VISTA ROYALE					
STRUCTURE NO.	TRACS NO. F0738 01C			____ OF ____			

PHASE 4B

F.H.W.A. REGION	STATE	PROJECT NO.	SHEET NO.	TOTAL SHEETS	RECORD DRAWING
9	ARIZ.	093-B(230)T	338	524	

093 YV 189

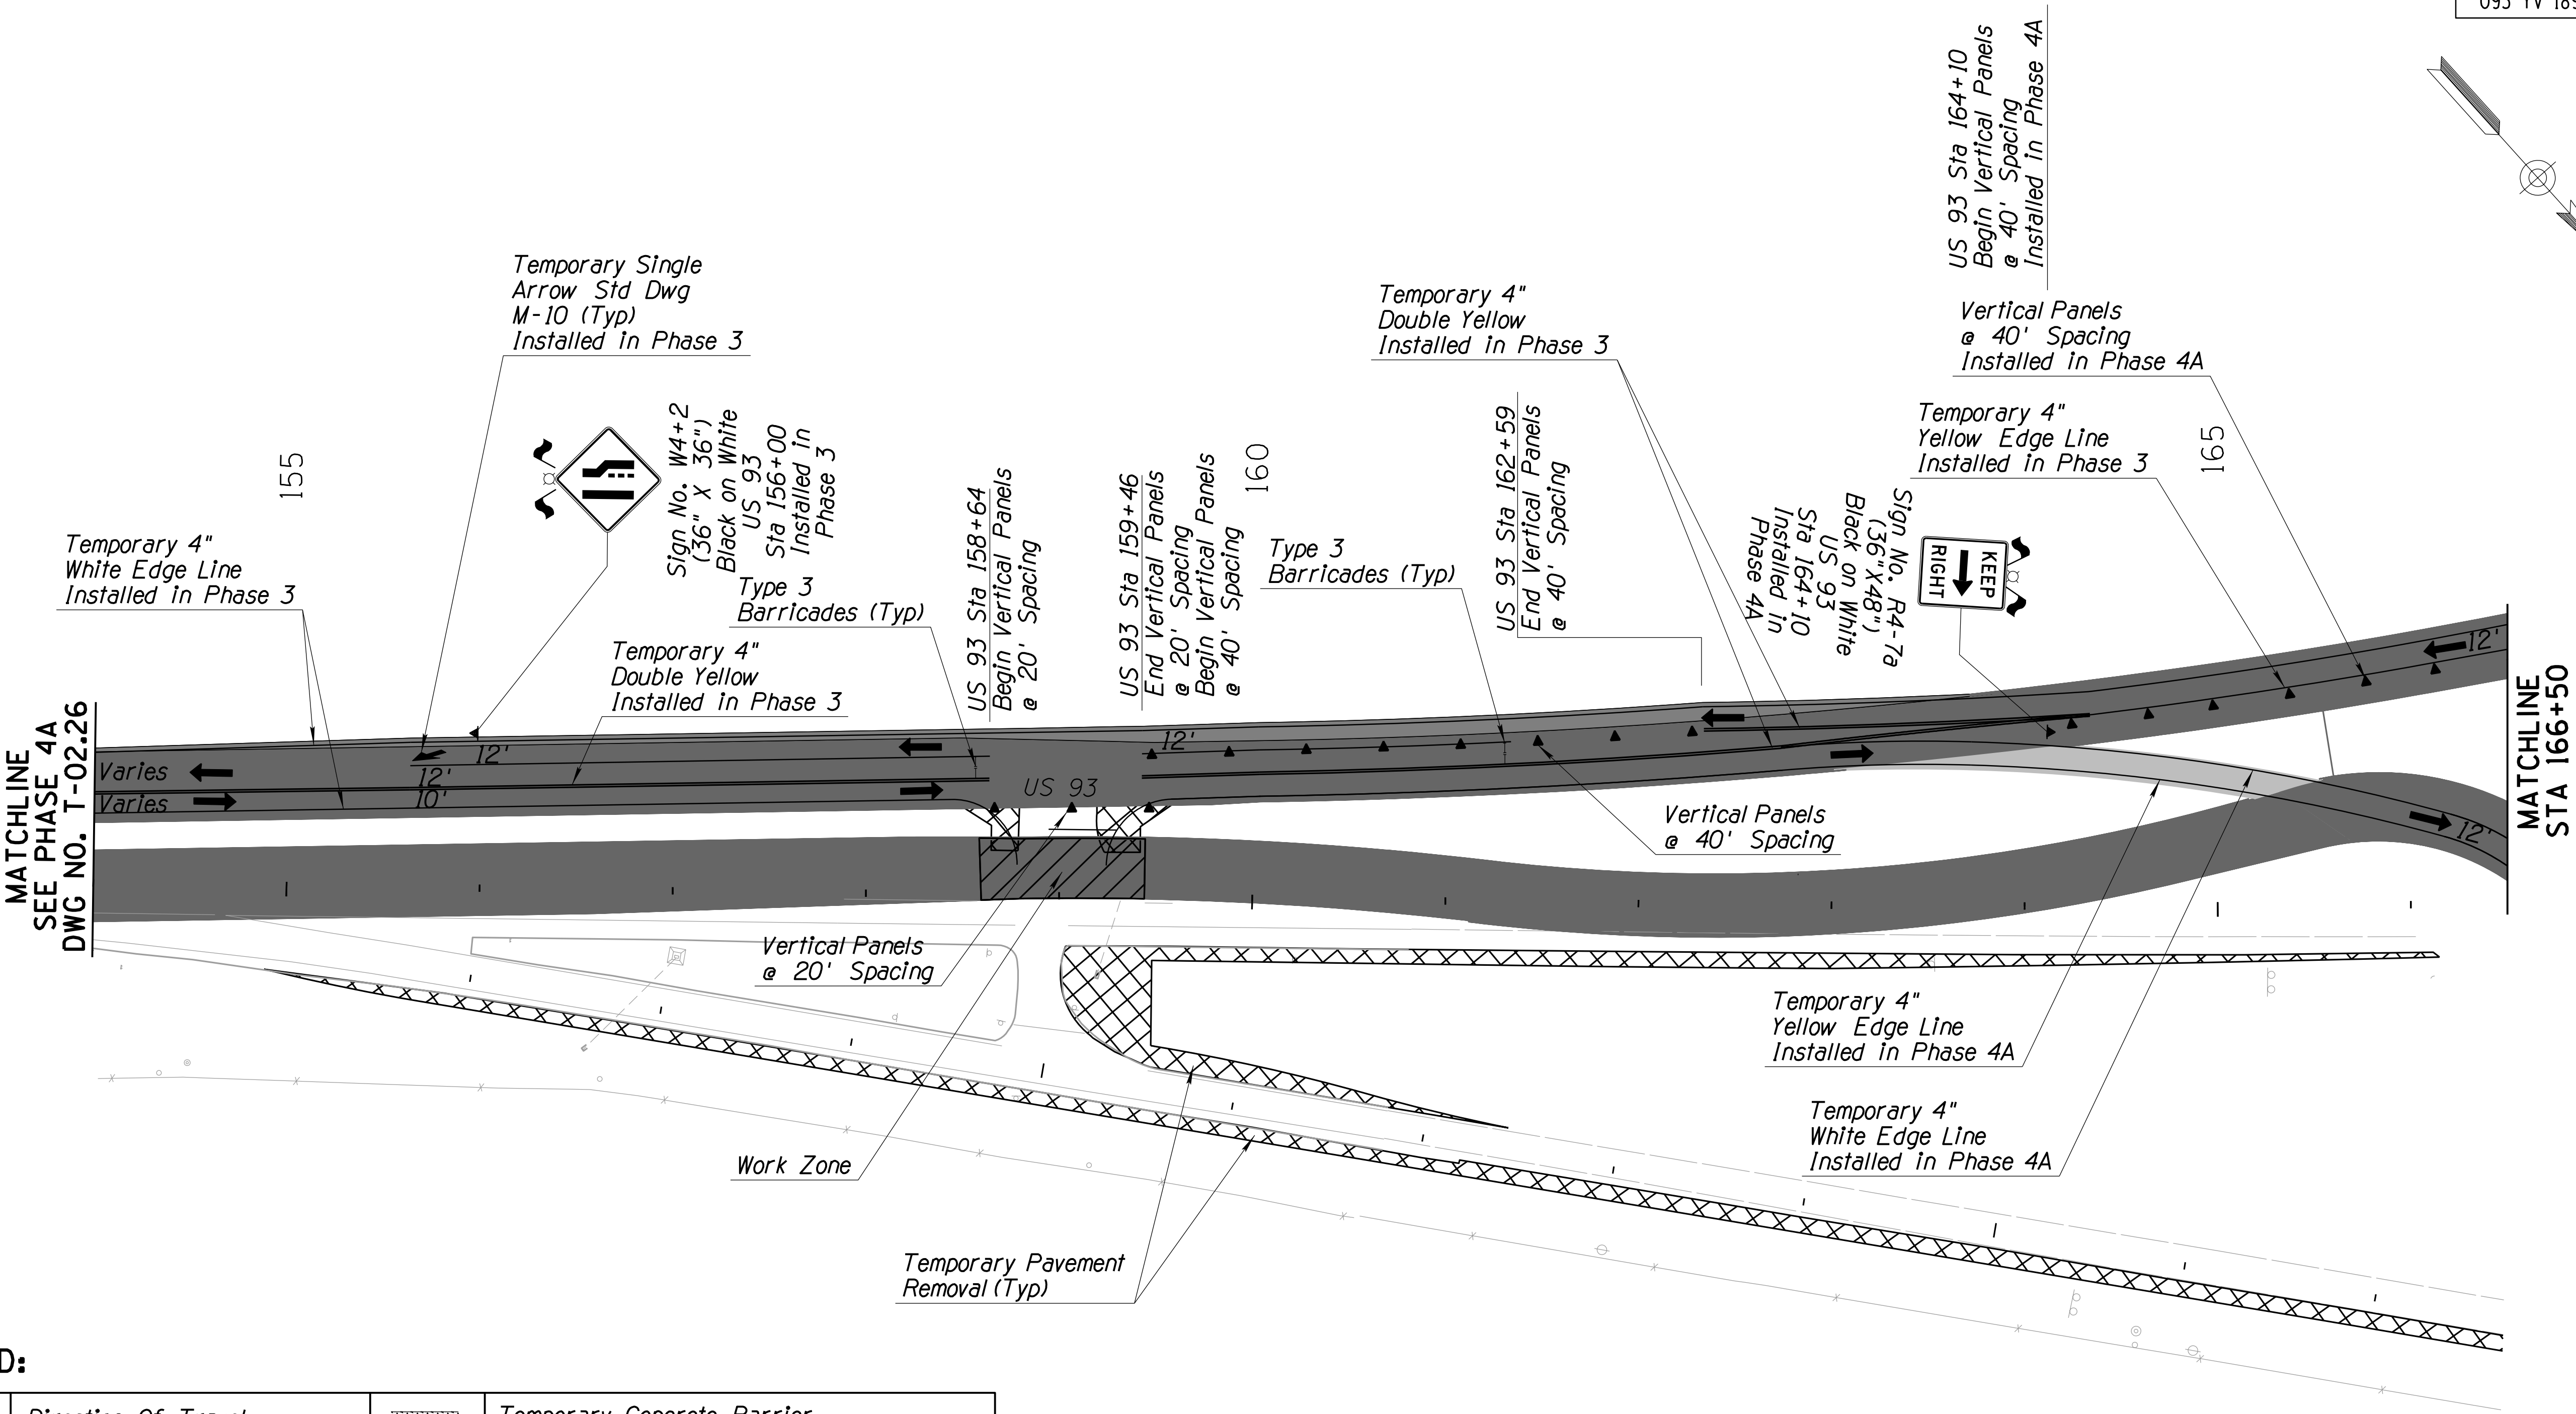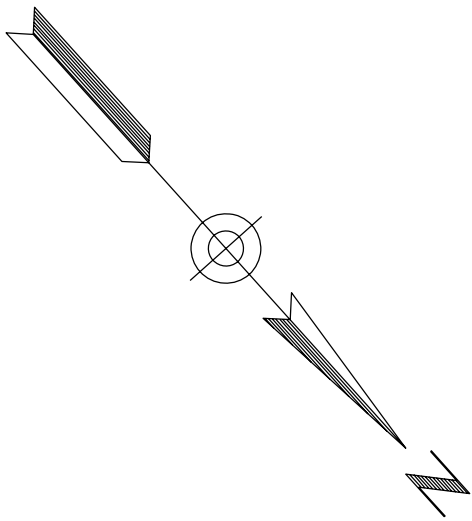

LEGEND:


	Direction Of Travel		Temporary Concrete Barrier
	Temporary Impact Attenuation Device		Temporary Pavement Work Zone
	Sign On Spring Stand		Permanent Pavement Work Zone
	Sign On Rigid Stand		CMB - Changeable Message Board
	Sign On Embedded Posts		Flashing Light & Warning Flags
	Type 2 Barricade		Vertical Panel
	Type 3 Barricade		Temporary Pavement Phase 1, 2, 3 & 4A
	Temporary Pavement Removal		Constructed Pavement Phase 1, 2, 3 & 4A

NOTE:

1. Obliterate all existing pavement marking in conflict with Phase 4B temporary pavement marking.

DESIGN	ME1	DATE	06/26	ARIZONA DEPARTMENT OF TRANSPORTATION PROJECT DELIVERY AND OPERATIONS DIVISION TRAFFIC DESIGN SERVICES	
DRAWN	SRH	DATE	06/26		
CHECKED	BMT	DATE	06/26		
 3133 East Camelback Road, Suite 100 Phoenix, Arizona 85016 Phone: (602) 333-2200				US 93 & SR 89 PHASE 4B TRAFFIC CONTROL STA 154+00 TO STA 166+50	
ROUTE		LOCATION		DWG NO. T-2.34	
US 93		WICKENBURG RANCH WAY TO VISTA ROYALE			
TRACS NO. F0738 OIC		093-B(230)T		OF	

F.H.W.A. REGION	STATE	PROJECT NO.	SHEET NO.	TOTAL SHEETS	RECORD DRAWING
9	ARIZ.	093-B(230)T	339	524	
093 YV 189					

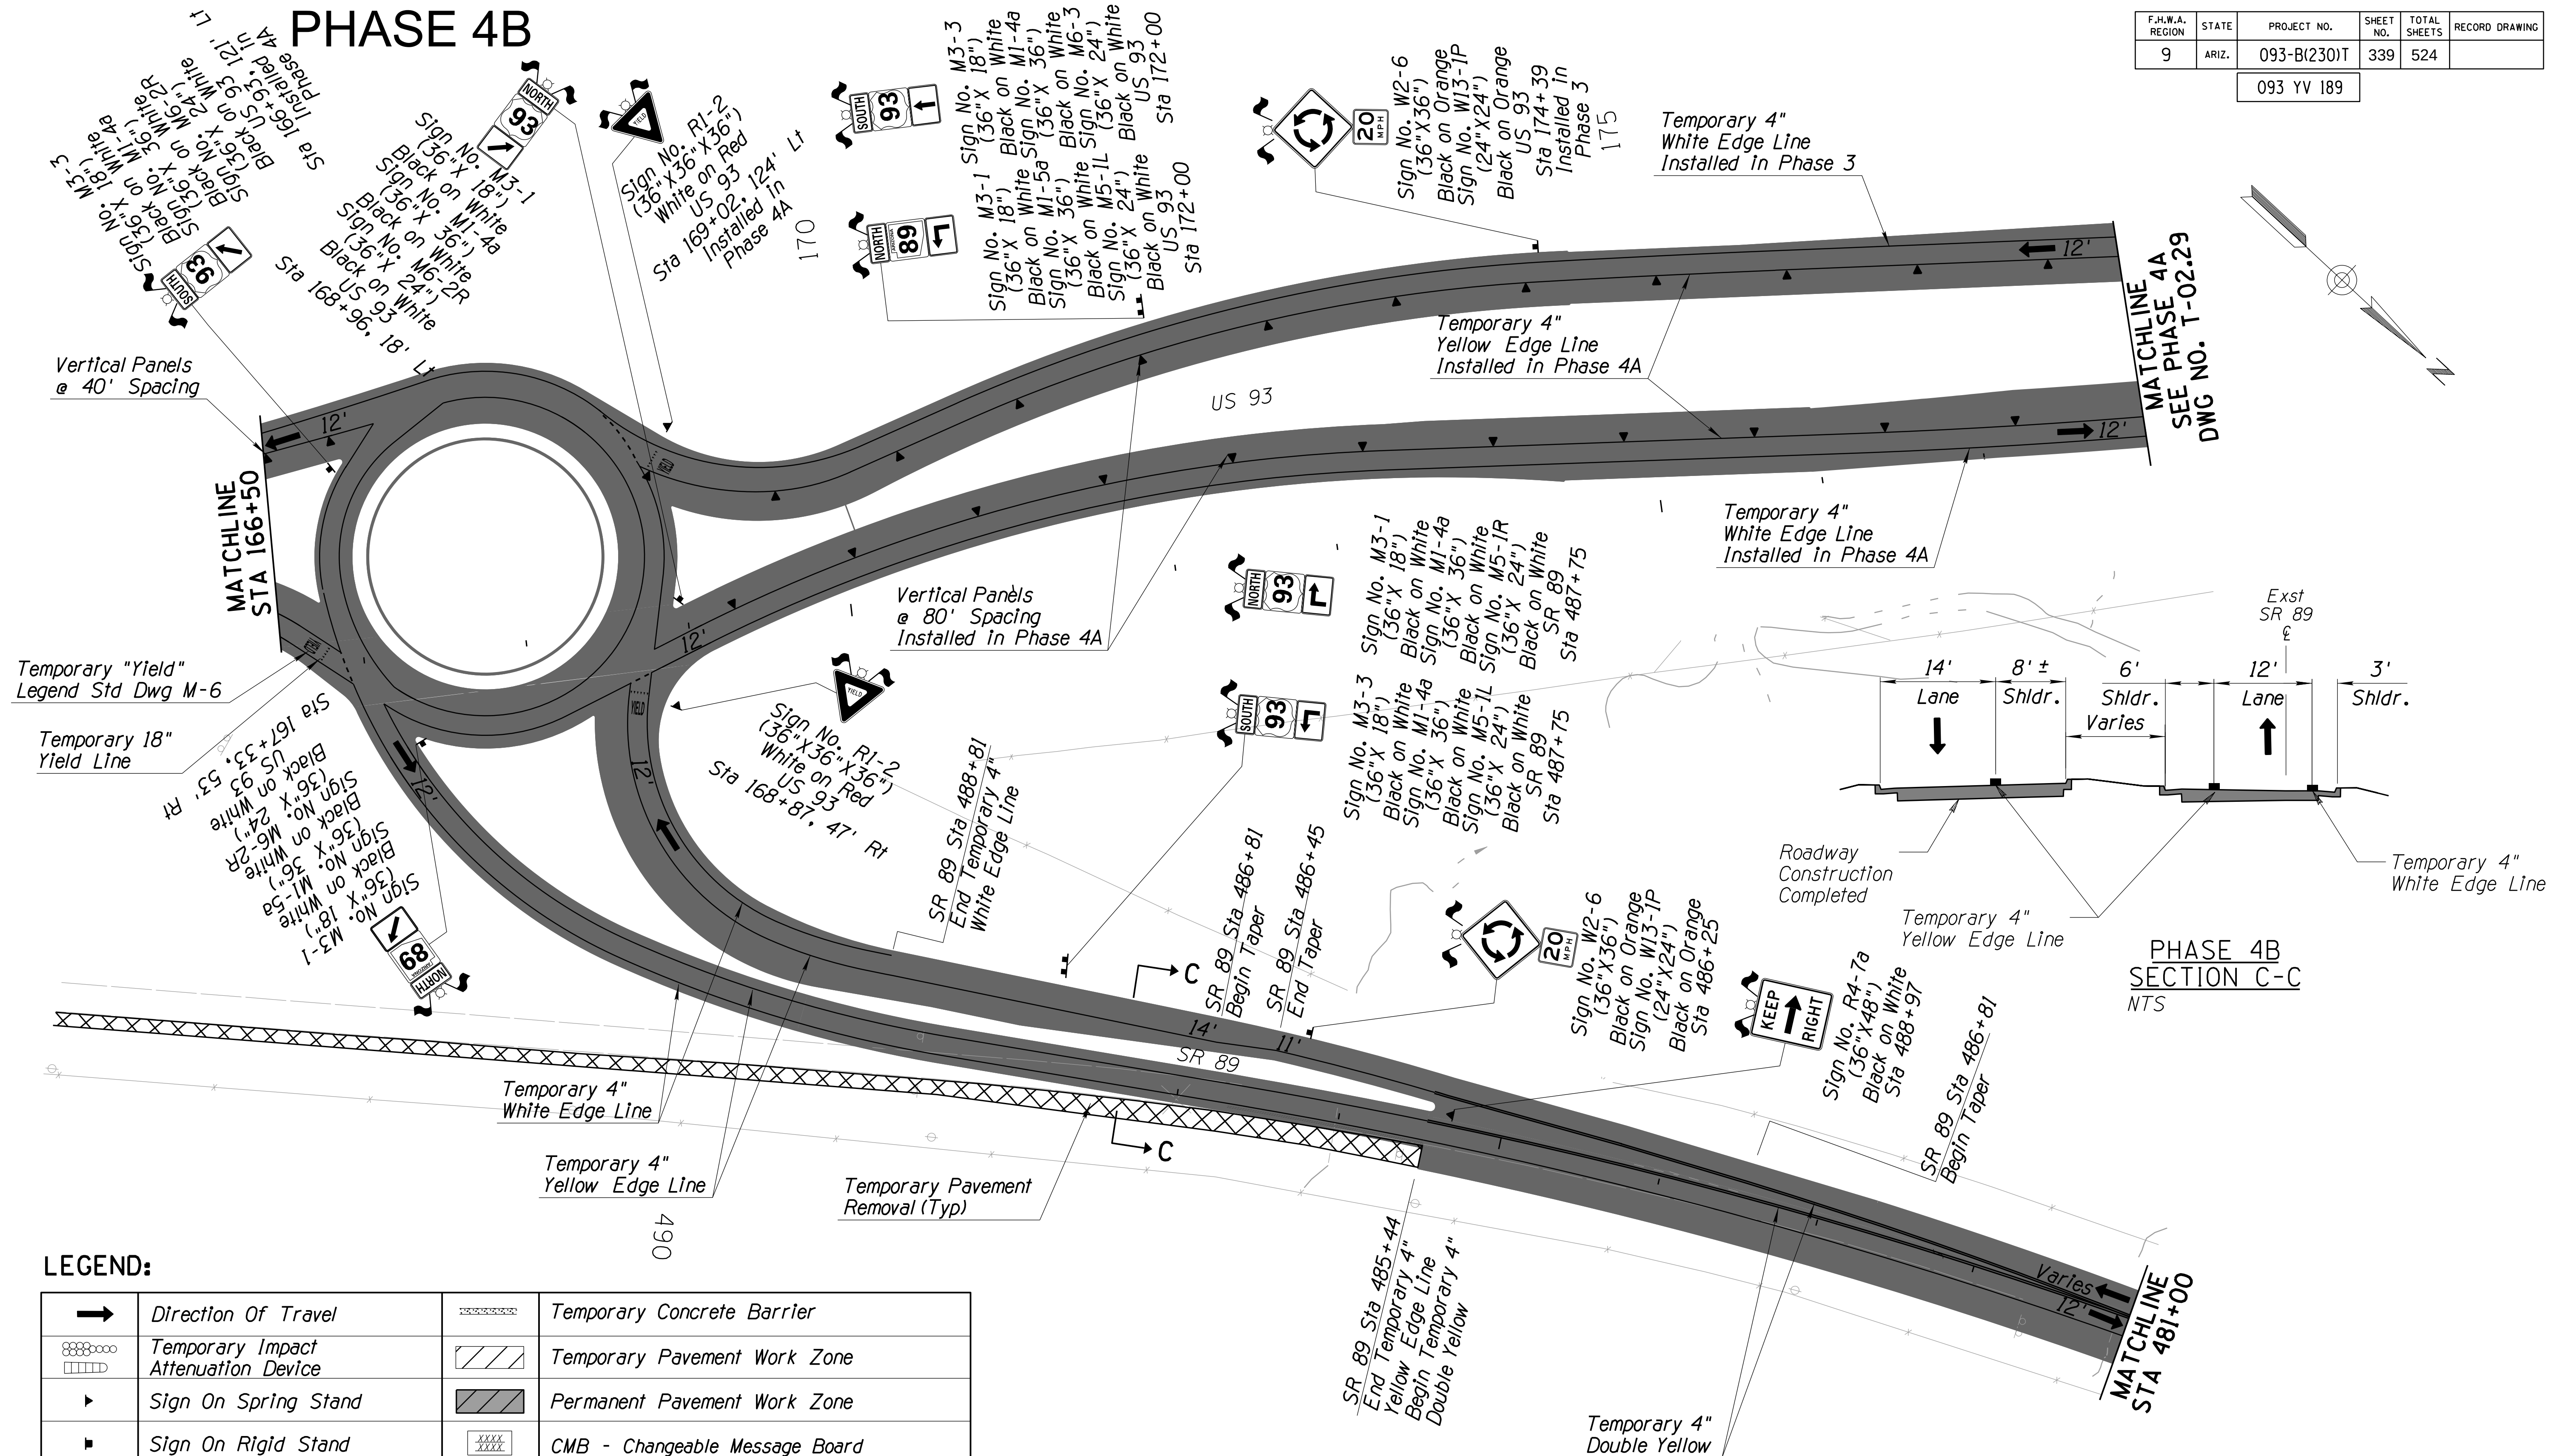

LEGEND:

	Direction Of Travel		Temporary Concrete Barrier
	Temporary Impact Attenuation Device		Temporary Pavement Work Zone
	Sign On Spring Stand		Permanent Pavement Work Zone
	Sign On Rigid Stand		CMB - Changeable Message Board
	Sign On Embedded Posts		Flashing Light & Warning Flags
	Type 2 Barricade		Vertical Panel
	Type 3 Barricade		Temporary Pavement Phase 1, 2, 3 & 4A
	Temporary Pavement Removal		Constructed Pavement Phase 1, 2, 3 & 4A

NOTE:


1. Obliterate all existing pavement marking in conflict with Phase 4B temporary pavement marking.

		NAME	DATE	ARIZONA DEPARTMENT OF TRANSPORTATION PROJECT DELIVERY AND OPERATIONS DIVISION TRAFFIC DESIGN SERVICES US 93 & SR 89 PHASE 4B TRAFFIC CONTROL STA 166+50 TO STA 178+00	
DESIGN		MEI	06/26		
DRAWN		SRH	06/26		
CHECKED		BMT	06/26		
 Stanley Consultants Inc.		3133 East Camelback Road, Suite 100 Phoenix, Arizona 85016 Phone: (602) 933-2200			
ROUTE		LOCATION			
US 93		WICKENBURG RANCH WAY TO VISTA ROYALE			
TRACS NO. F0738 OIC			093-B(230)T		DWG NO. T-2.35 ___ OF ___

PHASE 4B

F.H.W.A. REGION	STATE	PROJECT NO.	SHEET NO.	TOTAL SHEETS	RECORD DRAWING
9	ARIZ.	093-B(230)T	340	524	

093 YV 189

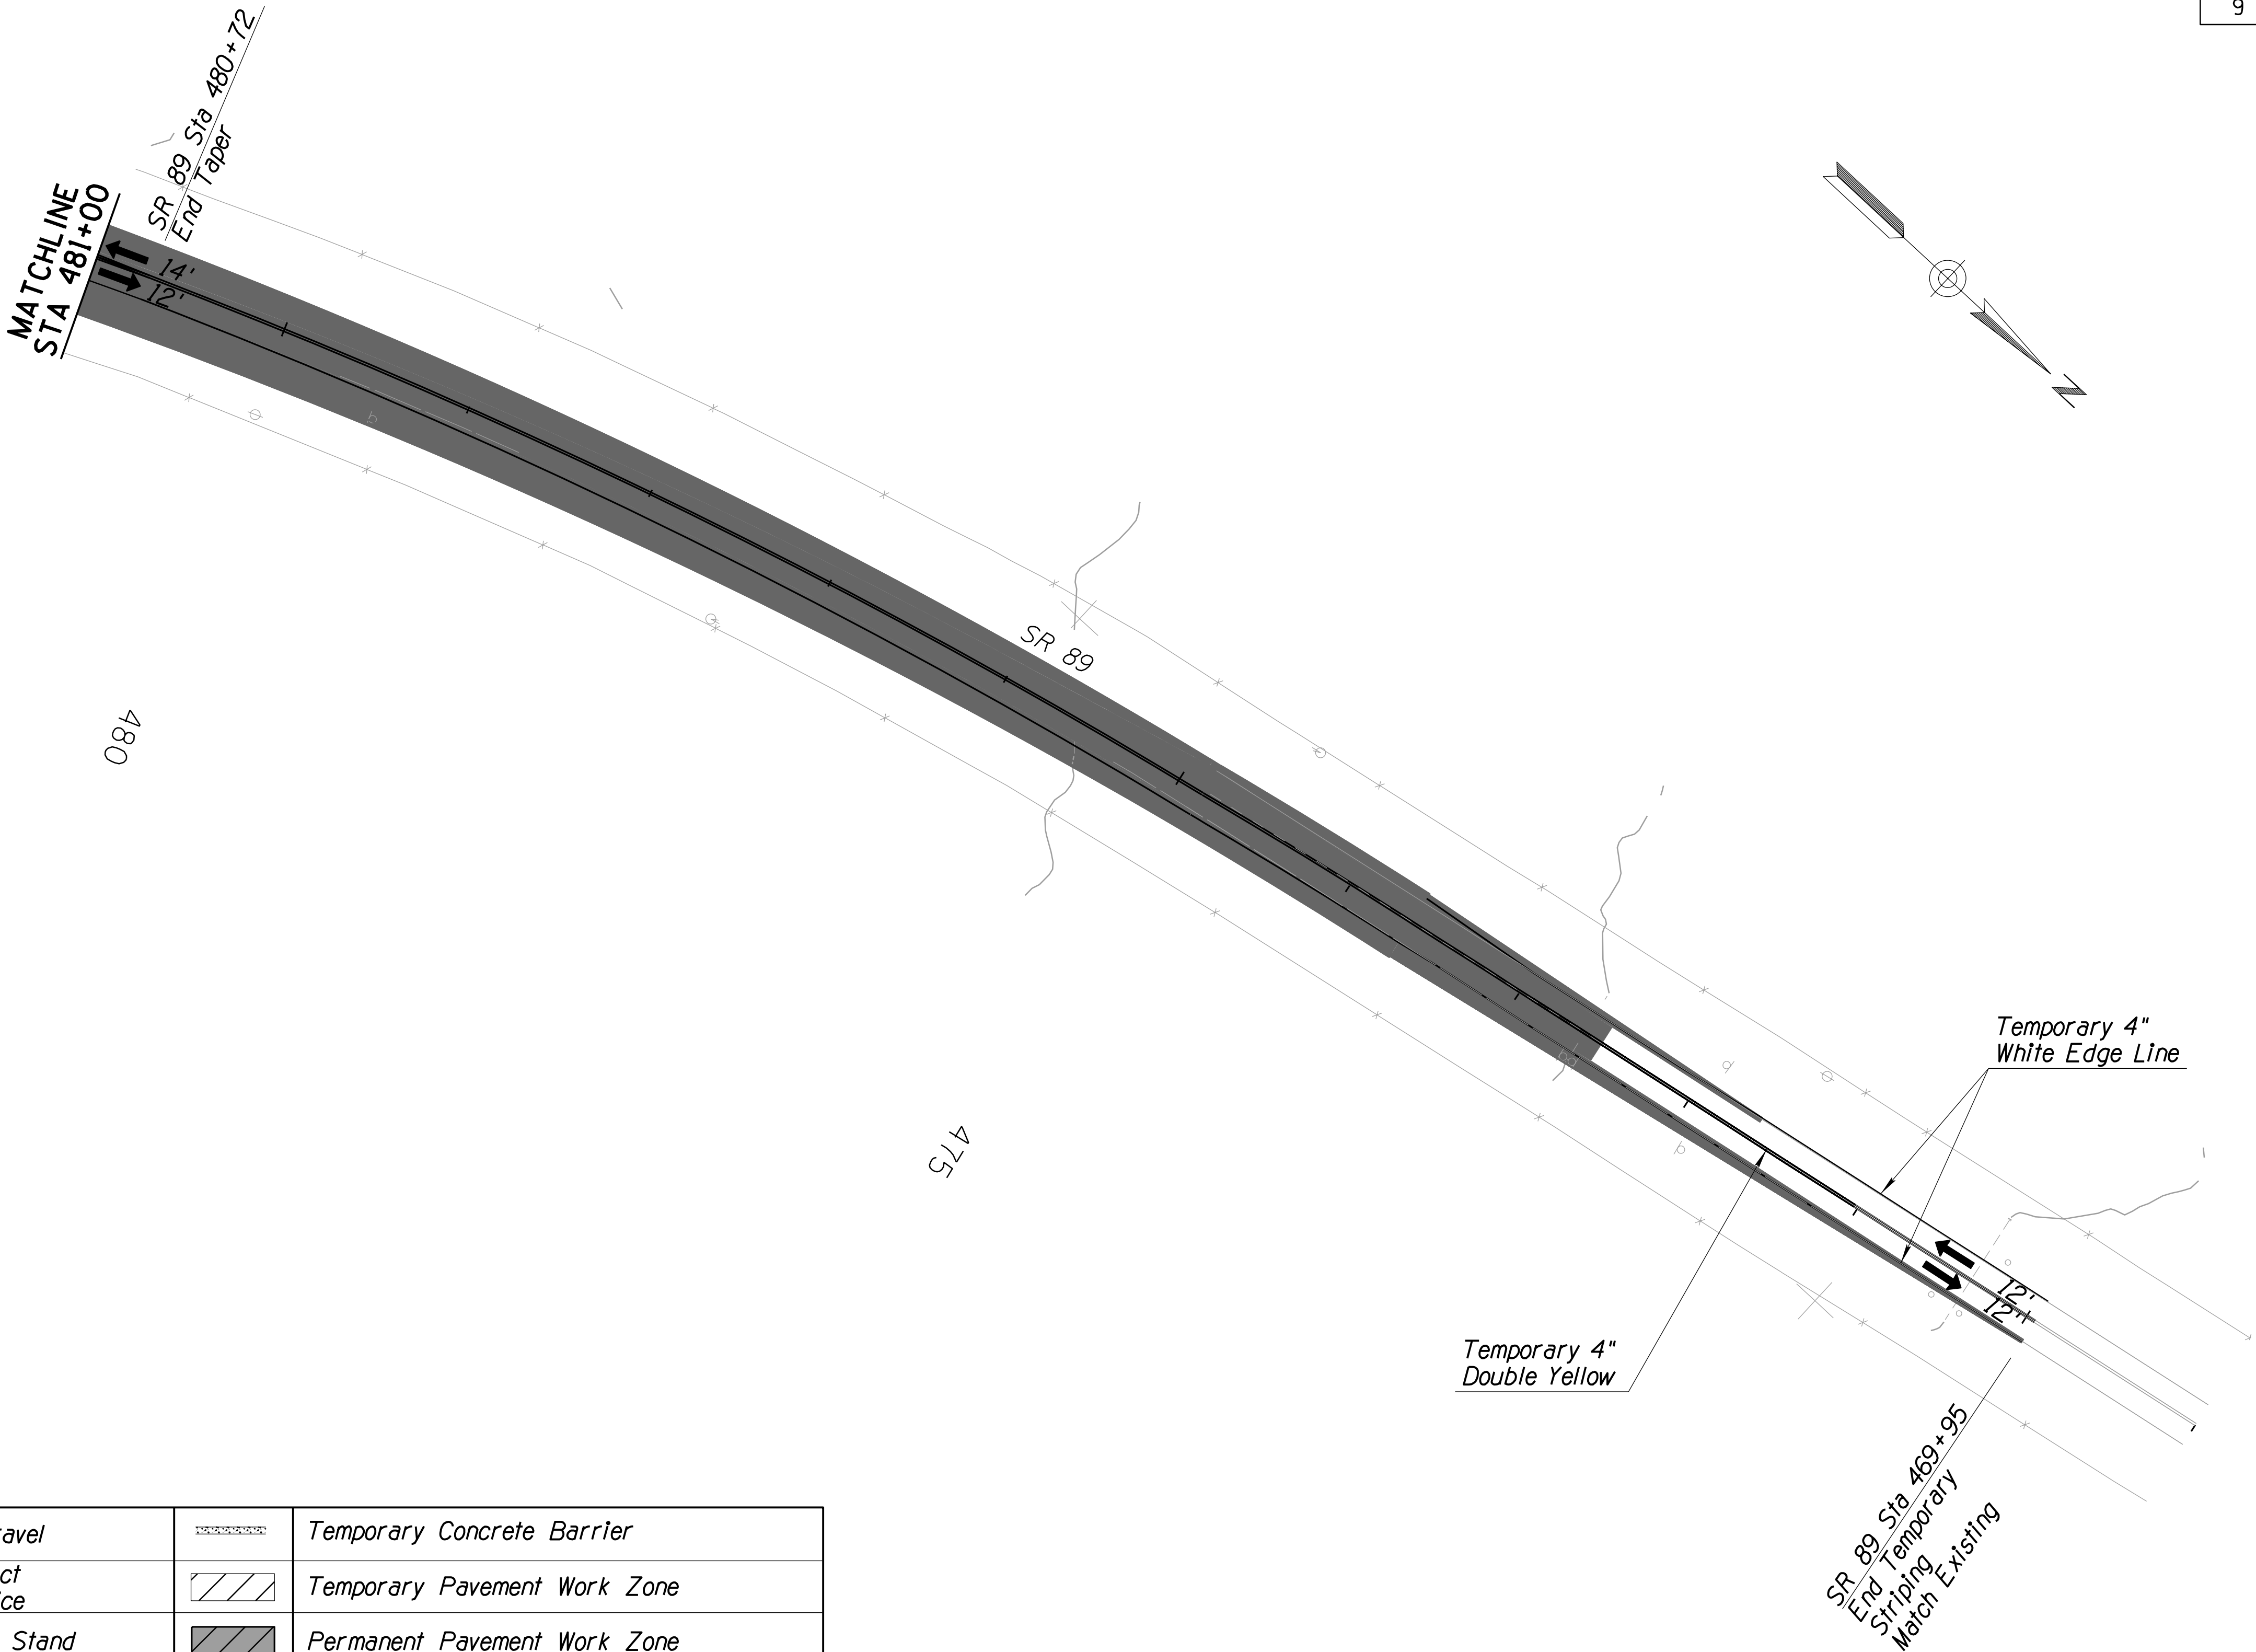

LEGEND:

➔	Direction Of Travel	XXXXXX	Temporary Concrete Barrier
⊗⊗⊗⊗⊗	Temporary Impact Attenuation Device	XXXXXX	Temporary Pavement Work Zone
▶	Sign On Spring Stand	XXXXXX	Permanent Pavement Work Zone
■	Sign On Rigid Stand	XXXXXX	CMB - Changeable Message Board
⚡	Sign On Embedded Posts	⚡	Flashing Light & Warning Flags
■	Type 2 Barricade	▲	Vertical Panel
I	Type 3 Barricade	XXXXXX	Temporary Pavement Phase 1, 2, 3 & 4A
XXXXXX	Temporary Pavement Removal	XXXXXX	Constructed Pavement Phase 1, 2, 3 & 4A


NOTE:

1. Obliterate all existing pavement marking in conflict with Phase 4B temporary pavement marking.

DESIGN	ME1	DATE	06/26	ARIZONA DEPARTMENT OF TRANSPORTATION PROJECT DELIVERY AND OPERATIONS DIVISION TRAFFIC DESIGN SERVICES	
DRAWN	SRH	DATE	06/26		
CHECKED	BMT	DATE	06/26		
Stanley Consultants inc.				US 93 & SR 89 PHASE 4B TRAFFIC CONTROL STA 470+00 TO STA 481+00	
ROUTE	US 93	LOCATION	WICKENBURG RANCH WAY TO VISTA ROYALE		DWG NO. T-2.36
TRACS NO. F0738 OIC		093-B(230)T		OF	

PHASE 5

F.H.W.A. REGION	STATE	PROJECT NO.	SHEET NO.	TOTAL SHEETS	RECORD DRAWING
9	ARIZ.	093-B(230)T	341	524	
093 YV 189					

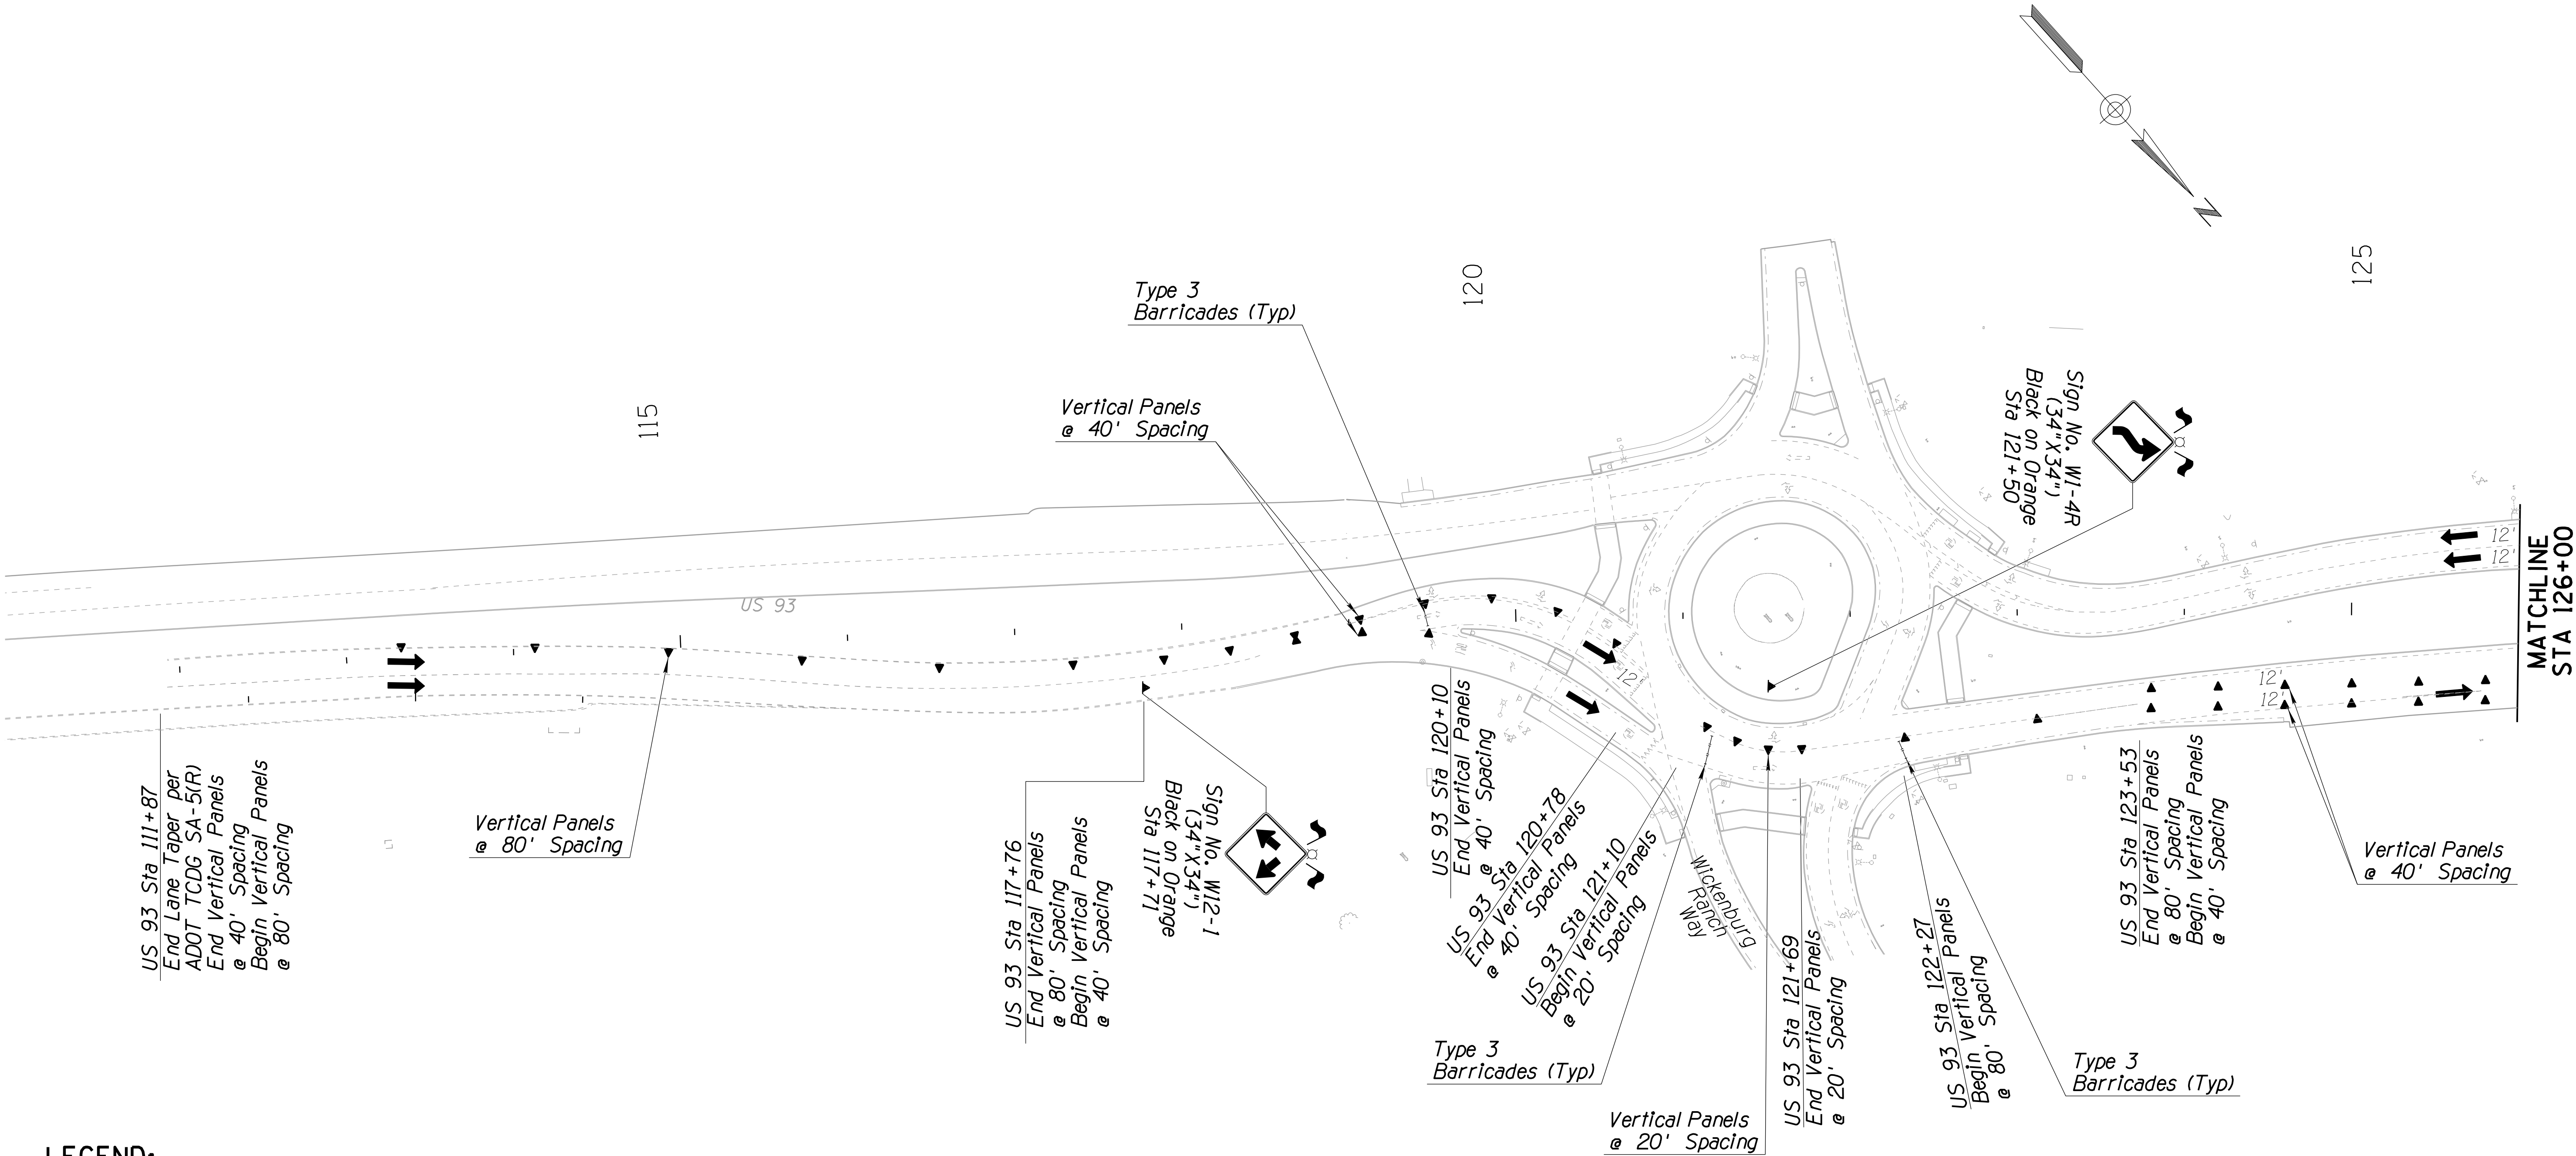


LEGEND:

	Direction Of Travel		Temporary Concrete Barrier
	Temporary Impact Attenuation Device		Temporary Pavement Work Zone
	Sign On Spring Stand		Permanent Pavement Work Zone
	Sign On Rigid Stand		CMB - Changeable Message Board
	Sign On Embedded Posts		Flashing Light & Warning Flags
	Type 2 Barricade		Vertical Panel
	Type 3 Barricade		Temporary Pavement Phase 1, 2, 3, 4A & 4B
	Temporary Pavement Removal		Constructed Pavement Phase 1, 2, 3, 4A & 4B

DESIGN	ME1	DATE	06/26	ARIZONA DEPARTMENT OF TRANSPORTATION PROJECT DELIVERY AND OPERATIONS DIVISION TRAFFIC DESIGN SERVICES US 93 & SR 89 PHASE 5 TRAFFIC CONTROL STA 111+87 TO STA 126+00	
DRAWN	SRH	DATE	06/26		
CHECKED	BMT	DATE	06/26		
 3133 East Camelback Road, Suite 100 Phoenix, Arizona 85016 Phone: (602) 333-2200					
ROUTE	US 93			LOCATION	WICKENBURG RANCH WAY TO VISTA ROYALE
TRACS NO. F0738 OIC				093-B(230)T	DWG NO. T-2.37 OF

PHASE 5

F.H.W.A. REGION	STATE	PROJECT NO.	SHEET NO.	TOTAL SHEETS	RECORD DRAWING
9	ARIZ.	093-B(230)T	342	524	
093 YV 189					

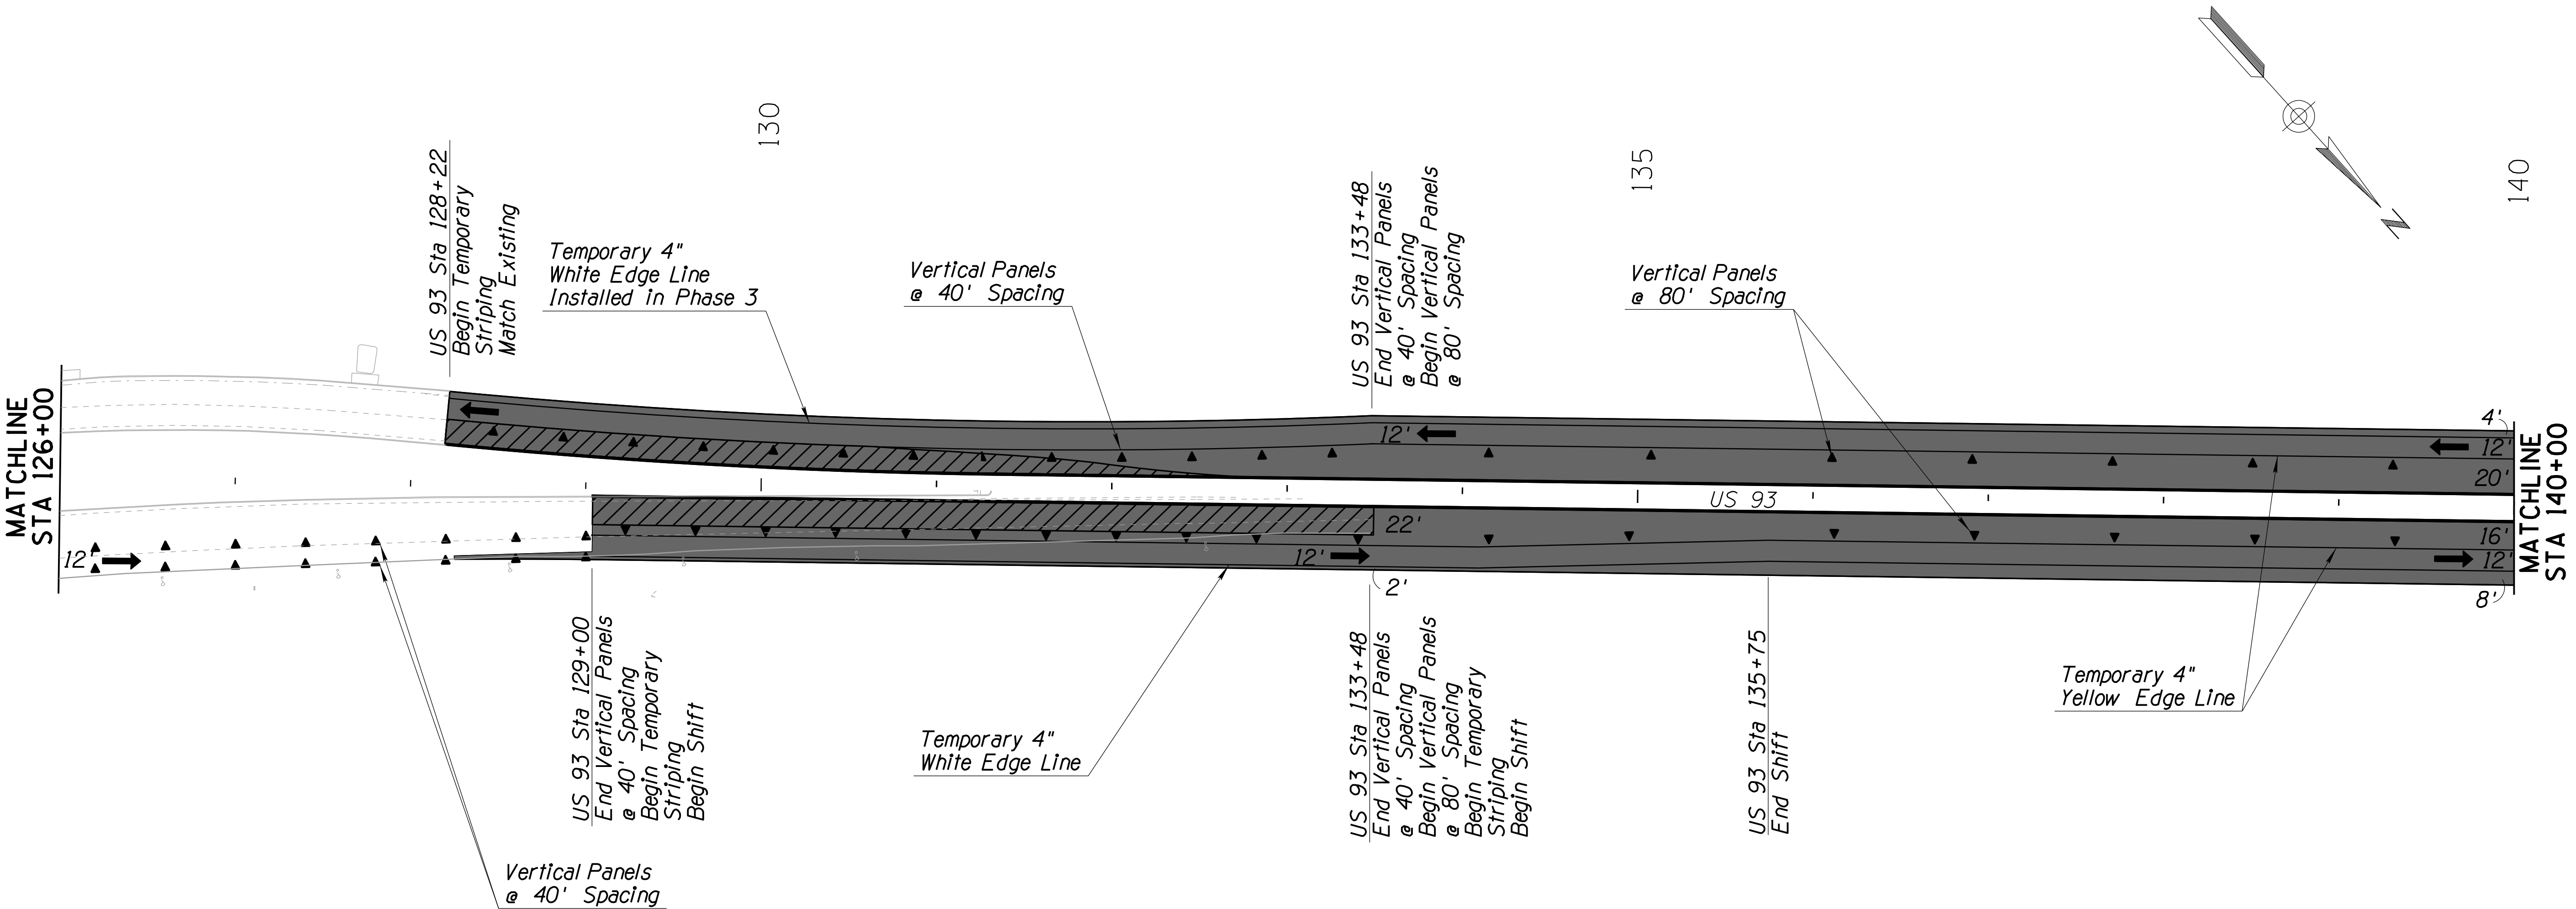

LEGEND:

	Direction Of Travel		Temporary Concrete Barrier
	Temporary Impact Attenuation Device		Temporary Pavement Work Zone
	Sign On Spring Stand		Permanent Pavement Work Zone
	Sign On Rigid Stand		CMB - Changeable Message Board
	Sign On Embedded Posts		Flashing Light & Warning Flags
	Type 2 Barricade		Vertical Panel
	Type 3 Barricade		Temporary Pavement Phase 1, 2, 3, 4A & 4B
	Temporary Pavement Removal		Constructed Pavement Phase 1, 2, 3, 4A & 4B


NOTE:

1. Obliterate all existing pavement marking in conflict with Phase 5 temporary pavement marking.

DESIGN	ME1	NAME	DATE	ARIZONA DEPARTMENT OF TRANSPORTATION PROJECT DELIVERY AND OPERATIONS DIVISION TRAFFIC DESIGN SERVICES	
DRAWN	SRH		06/26		
CHECKED	BMT		06/26		
 3133 East Camelback Road, Suite 100 Phoenix, Arizona 85016 Phone: (602) 333-2200				US 93 & SR 89 PHASE 5 TRAFFIC CONTROL STA 126+00 TO STA 140+00	
ROUTE	US 93	LOCATION	WICKENBURG RANCH WAY TO VISTA ROYALE		DWG NO. T-2.38
TRACS NO. F0738 OIC		093-B(230)T		OF	

PHASE 5

F.H.W.A. REGION	STATE	PROJECT NO.	SHEET NO.	TOTAL SHEETS	RECORD DRAWING
9	ARIZ.	093-B(230)T	343	524	
093 YV 189					

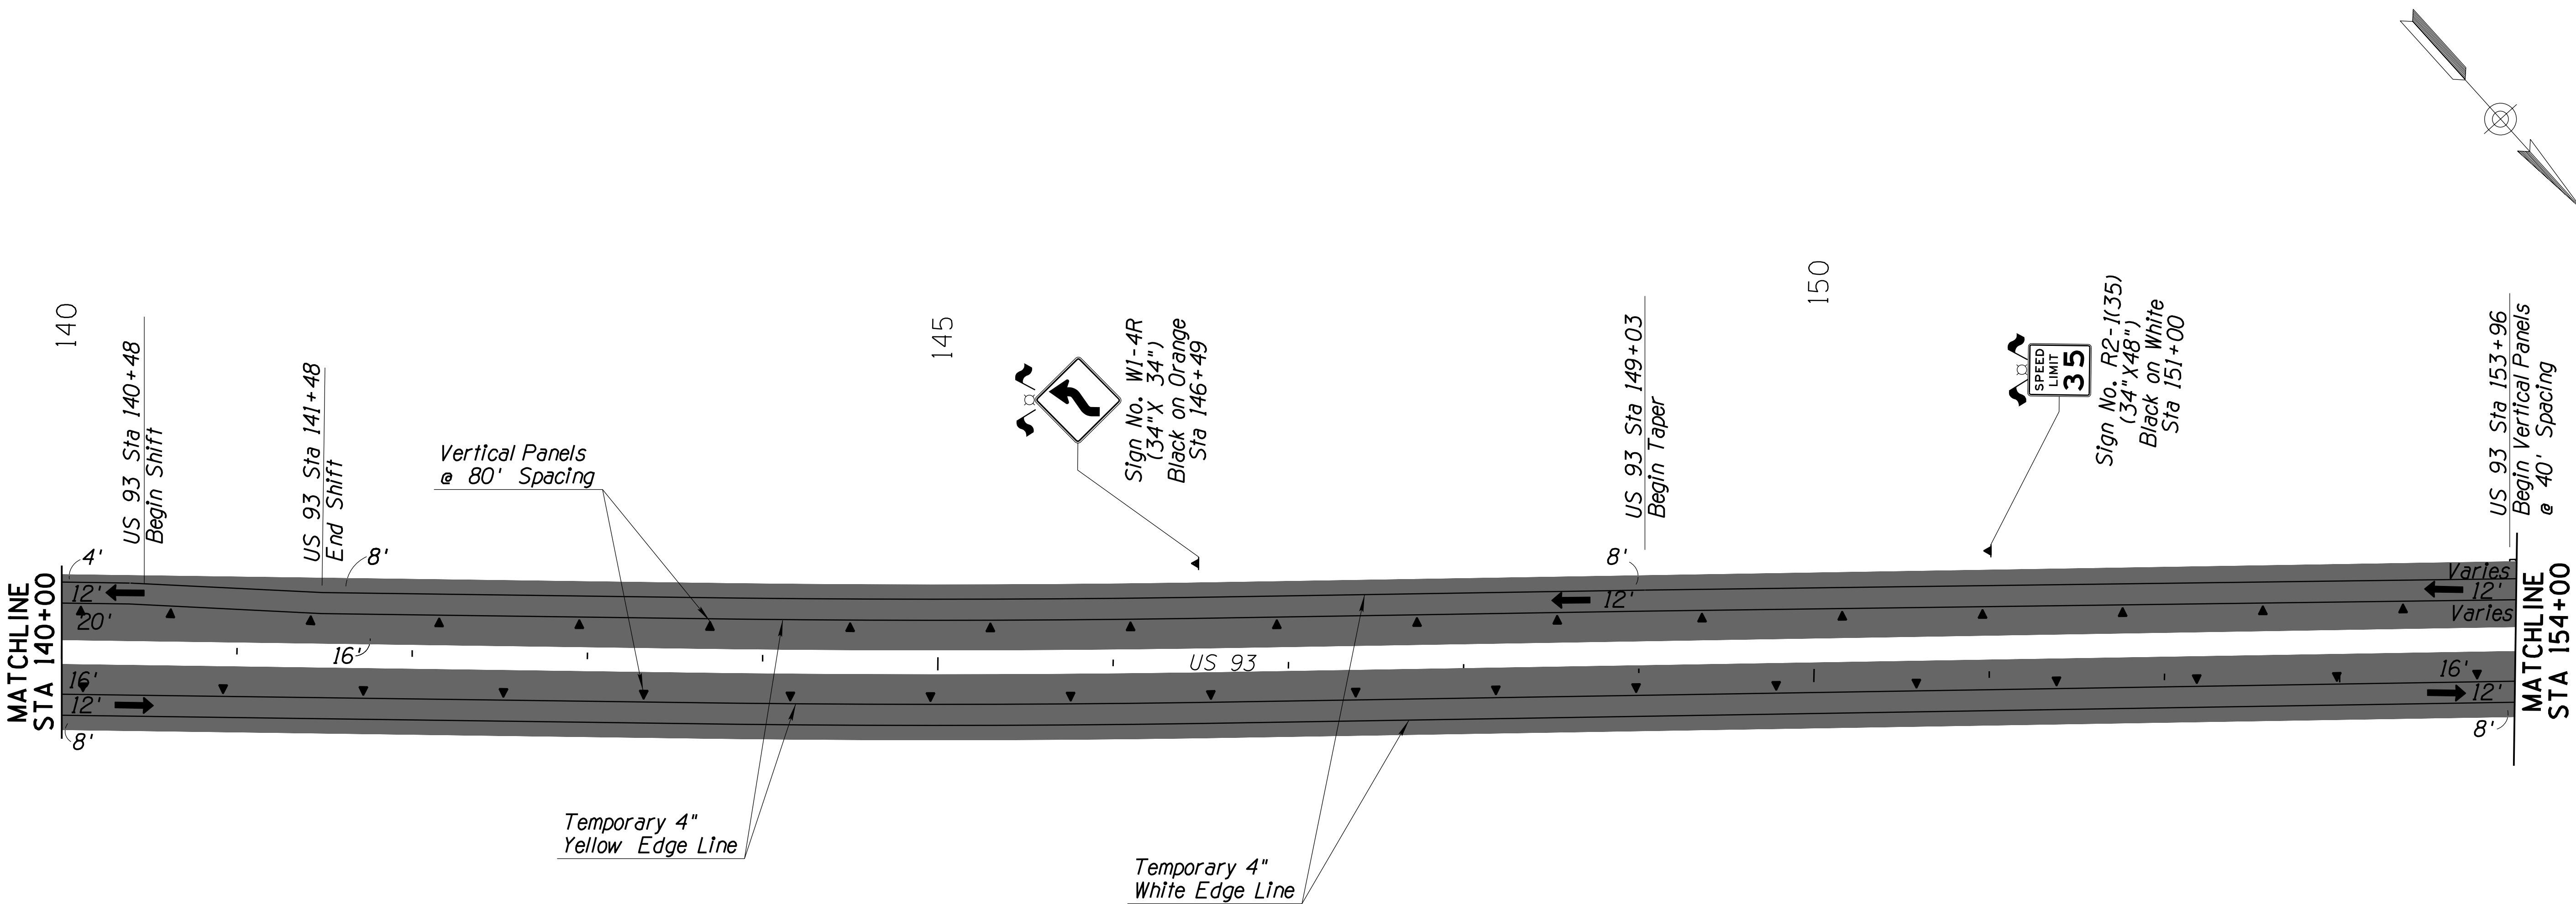

LEGEND:

	Direction Of Travel		Temporary Concrete Barrier
	Temporary Impact Attenuation Device		Temporary Pavement Work Zone
	Sign On Spring Stand		Permanent Pavement Work Zone
	Sign On Rigid Stand		CMB - Changeable Message Board
	Sign On Embedded Posts		Flashing Light & Warning Flags
	Type 2 Barricade		Vertical Panel
	Type 3 Barricade		Temporary Pavement Phase 1, 2, 3, 4A & 4B
	Temporary Pavement Removal		Constructed Pavement Phase 1, 2, 3, 4A & 4B


NOTE:

1. Obliterate all existing pavement marking in conflict with Phase 5 temporary pavement marking.

		NAME		DATE		ARIZONA DEPARTMENT OF TRANSPORTATION PROJECT DELIVERY AND OPERATIONS DIVISION TRAFFIC DESIGN SERVICES US 93 & SR 89 PHASE 5 TRAFFIC CONTROL STA 140+00 TO STA 154+00		
DESIGN		ME1		06/26				
DRAWN		SRH		06/26				
CHECKED		BMT		06/26				
 Stanley Consultants Inc.		3133 East Camelback Road, Suite 100 Phoenix, Arizona 85016 Phone: (602) 333-2200						
ROUTE		LOCATION						
US 93		WICKENBURG RANCH WAY TO VISTA ROYALE						DWG NO. T-2.39
TRACS NO. F0738 OIC				093-B(230)T				___ OF ___

PHASE 5

F.H.W.A. REGION	STATE	PROJECT NO.	SHEET NO.	TOTAL SHEETS	RECORD DRAWING
9	ARIZ.	093-B(230)T	344	524	
093 YV 189					

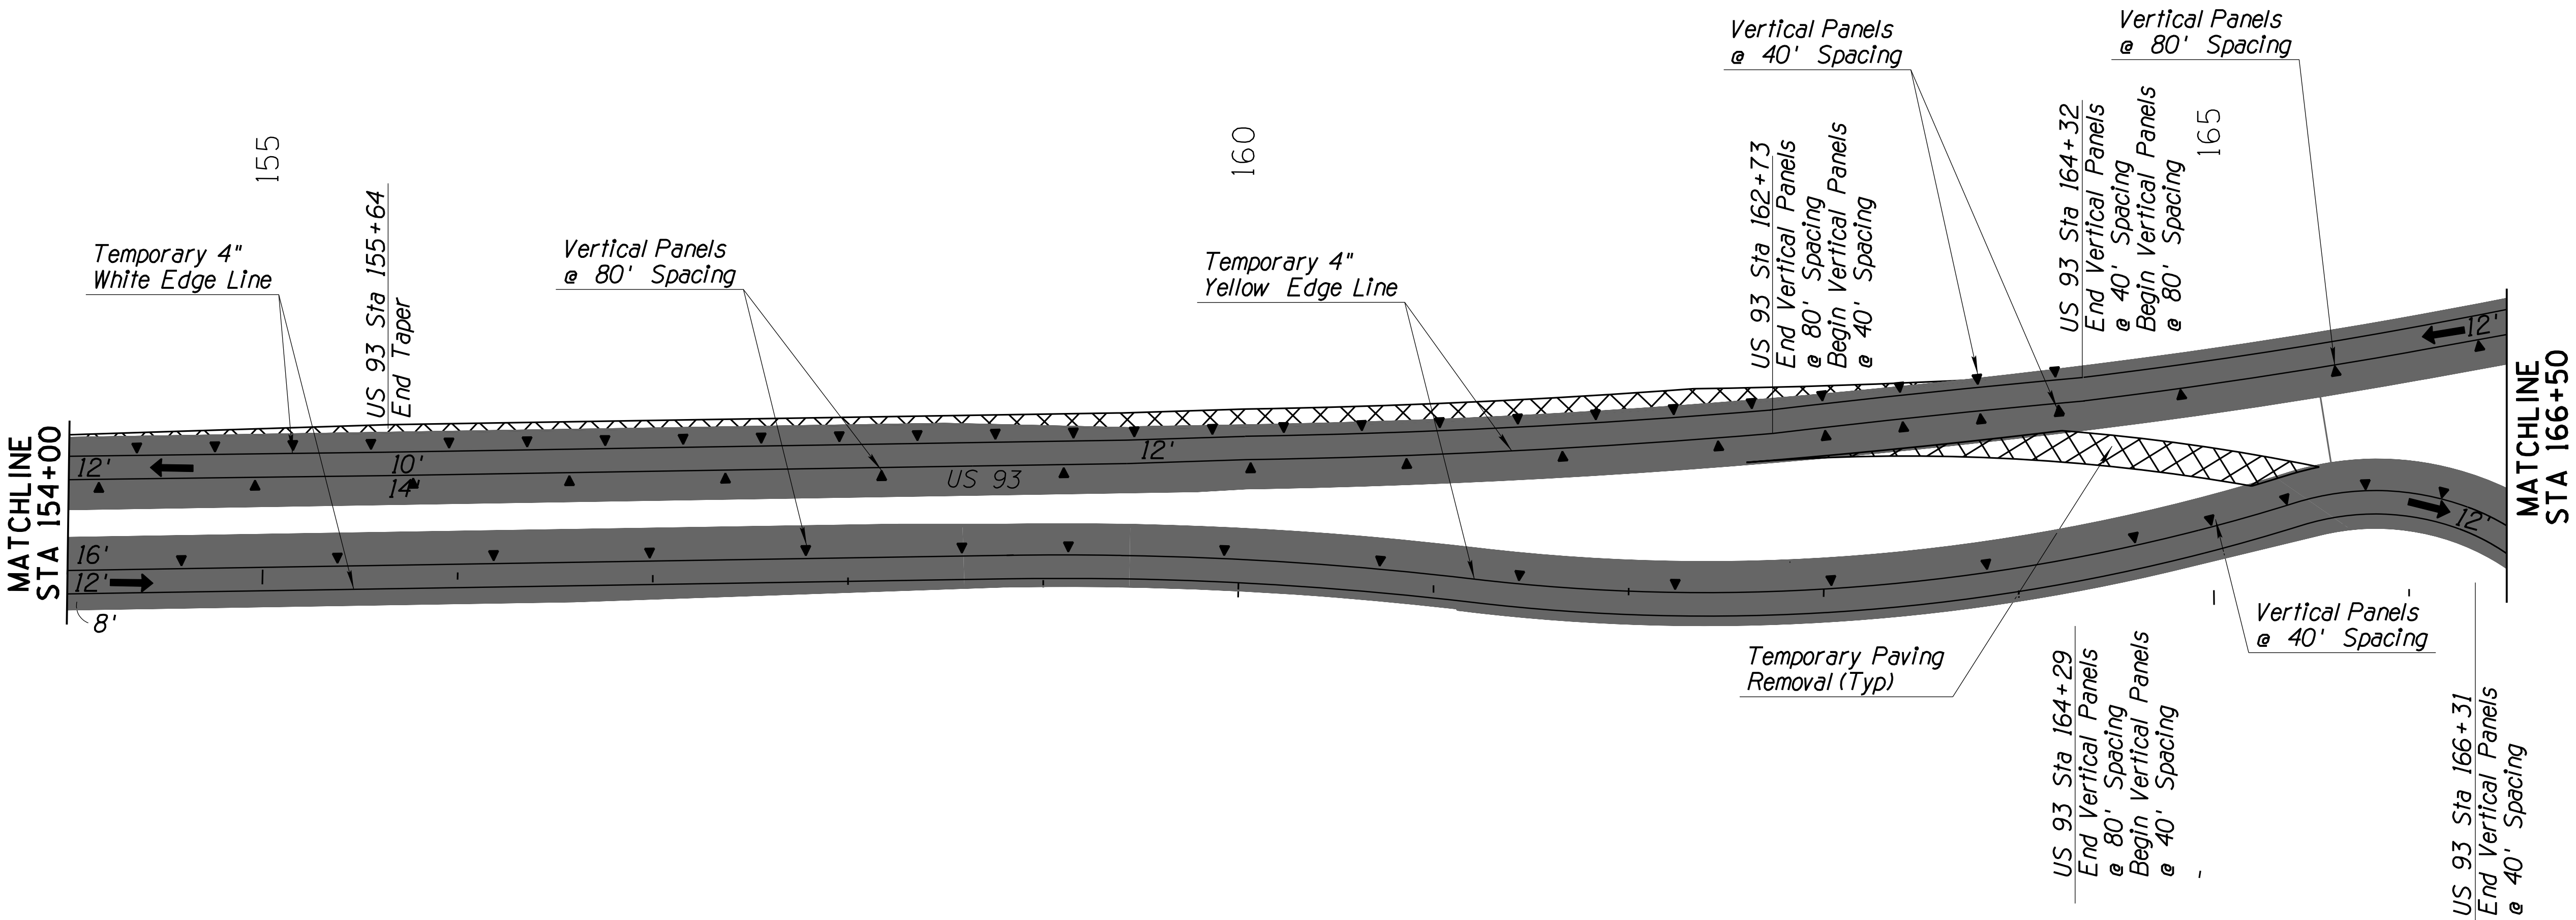

LEGEND:

	Direction Of Travel		Temporary Concrete Barrier
	Temporary Impact Attenuation Device		Temporary Pavement Work Zone
	Sign On Spring Stand		Permanent Pavement Work Zone
	Sign On Rigid Stand		CMB - Changeable Message Board
	Sign On Embedded Posts		Flashing Light & Warning Flags
	Type 2 Barricade		Vertical Panel
	Type 3 Barricade		Temporary Pavement Phase 1, 2, 3, 4A & 4B
	Temporary Pavement Removal		Constructed Pavement Phase 1, 2, 3, 4A & 4B


NOTE:

1. Obliterate all existing pavement marking in conflict with Phase 5 temporary pavement marking.

		NAME		DATE		ARIZONA DEPARTMENT OF TRANSPORTATION PROJECT DELIVERY AND OPERATIONS DIVISION TRAFFIC DESIGN SERVICES US 93 & SR 89 PHASE 5 TRAFFIC CONTROL STA 154+00 TO STA 166+50	
DESIGN	ME1		06/26				
DRAWN	SRH		06/26				
CHECKED	BMT		06/26				
		3133 East Camelback Road, Suite 100 Phoenix, Arizona 85016 Phone: (602) 333-2200					
Stanley Consultants Inc.							
ROUTE		LOCATION					
US 93		WICKENBURG RANCH WAY TO VISTA ROYALE				DWG NO. T-2.40	
TRACS NO. F0738 OIC			093-B(230)T			OF	

F.H.W.A. REGION	STATE	PROJECT NO.	SHEET NO.	TOTAL SHEETS	RECORD DRAWING
9	ARIZ.	093-B(230)T	345	524	

093 YV 189

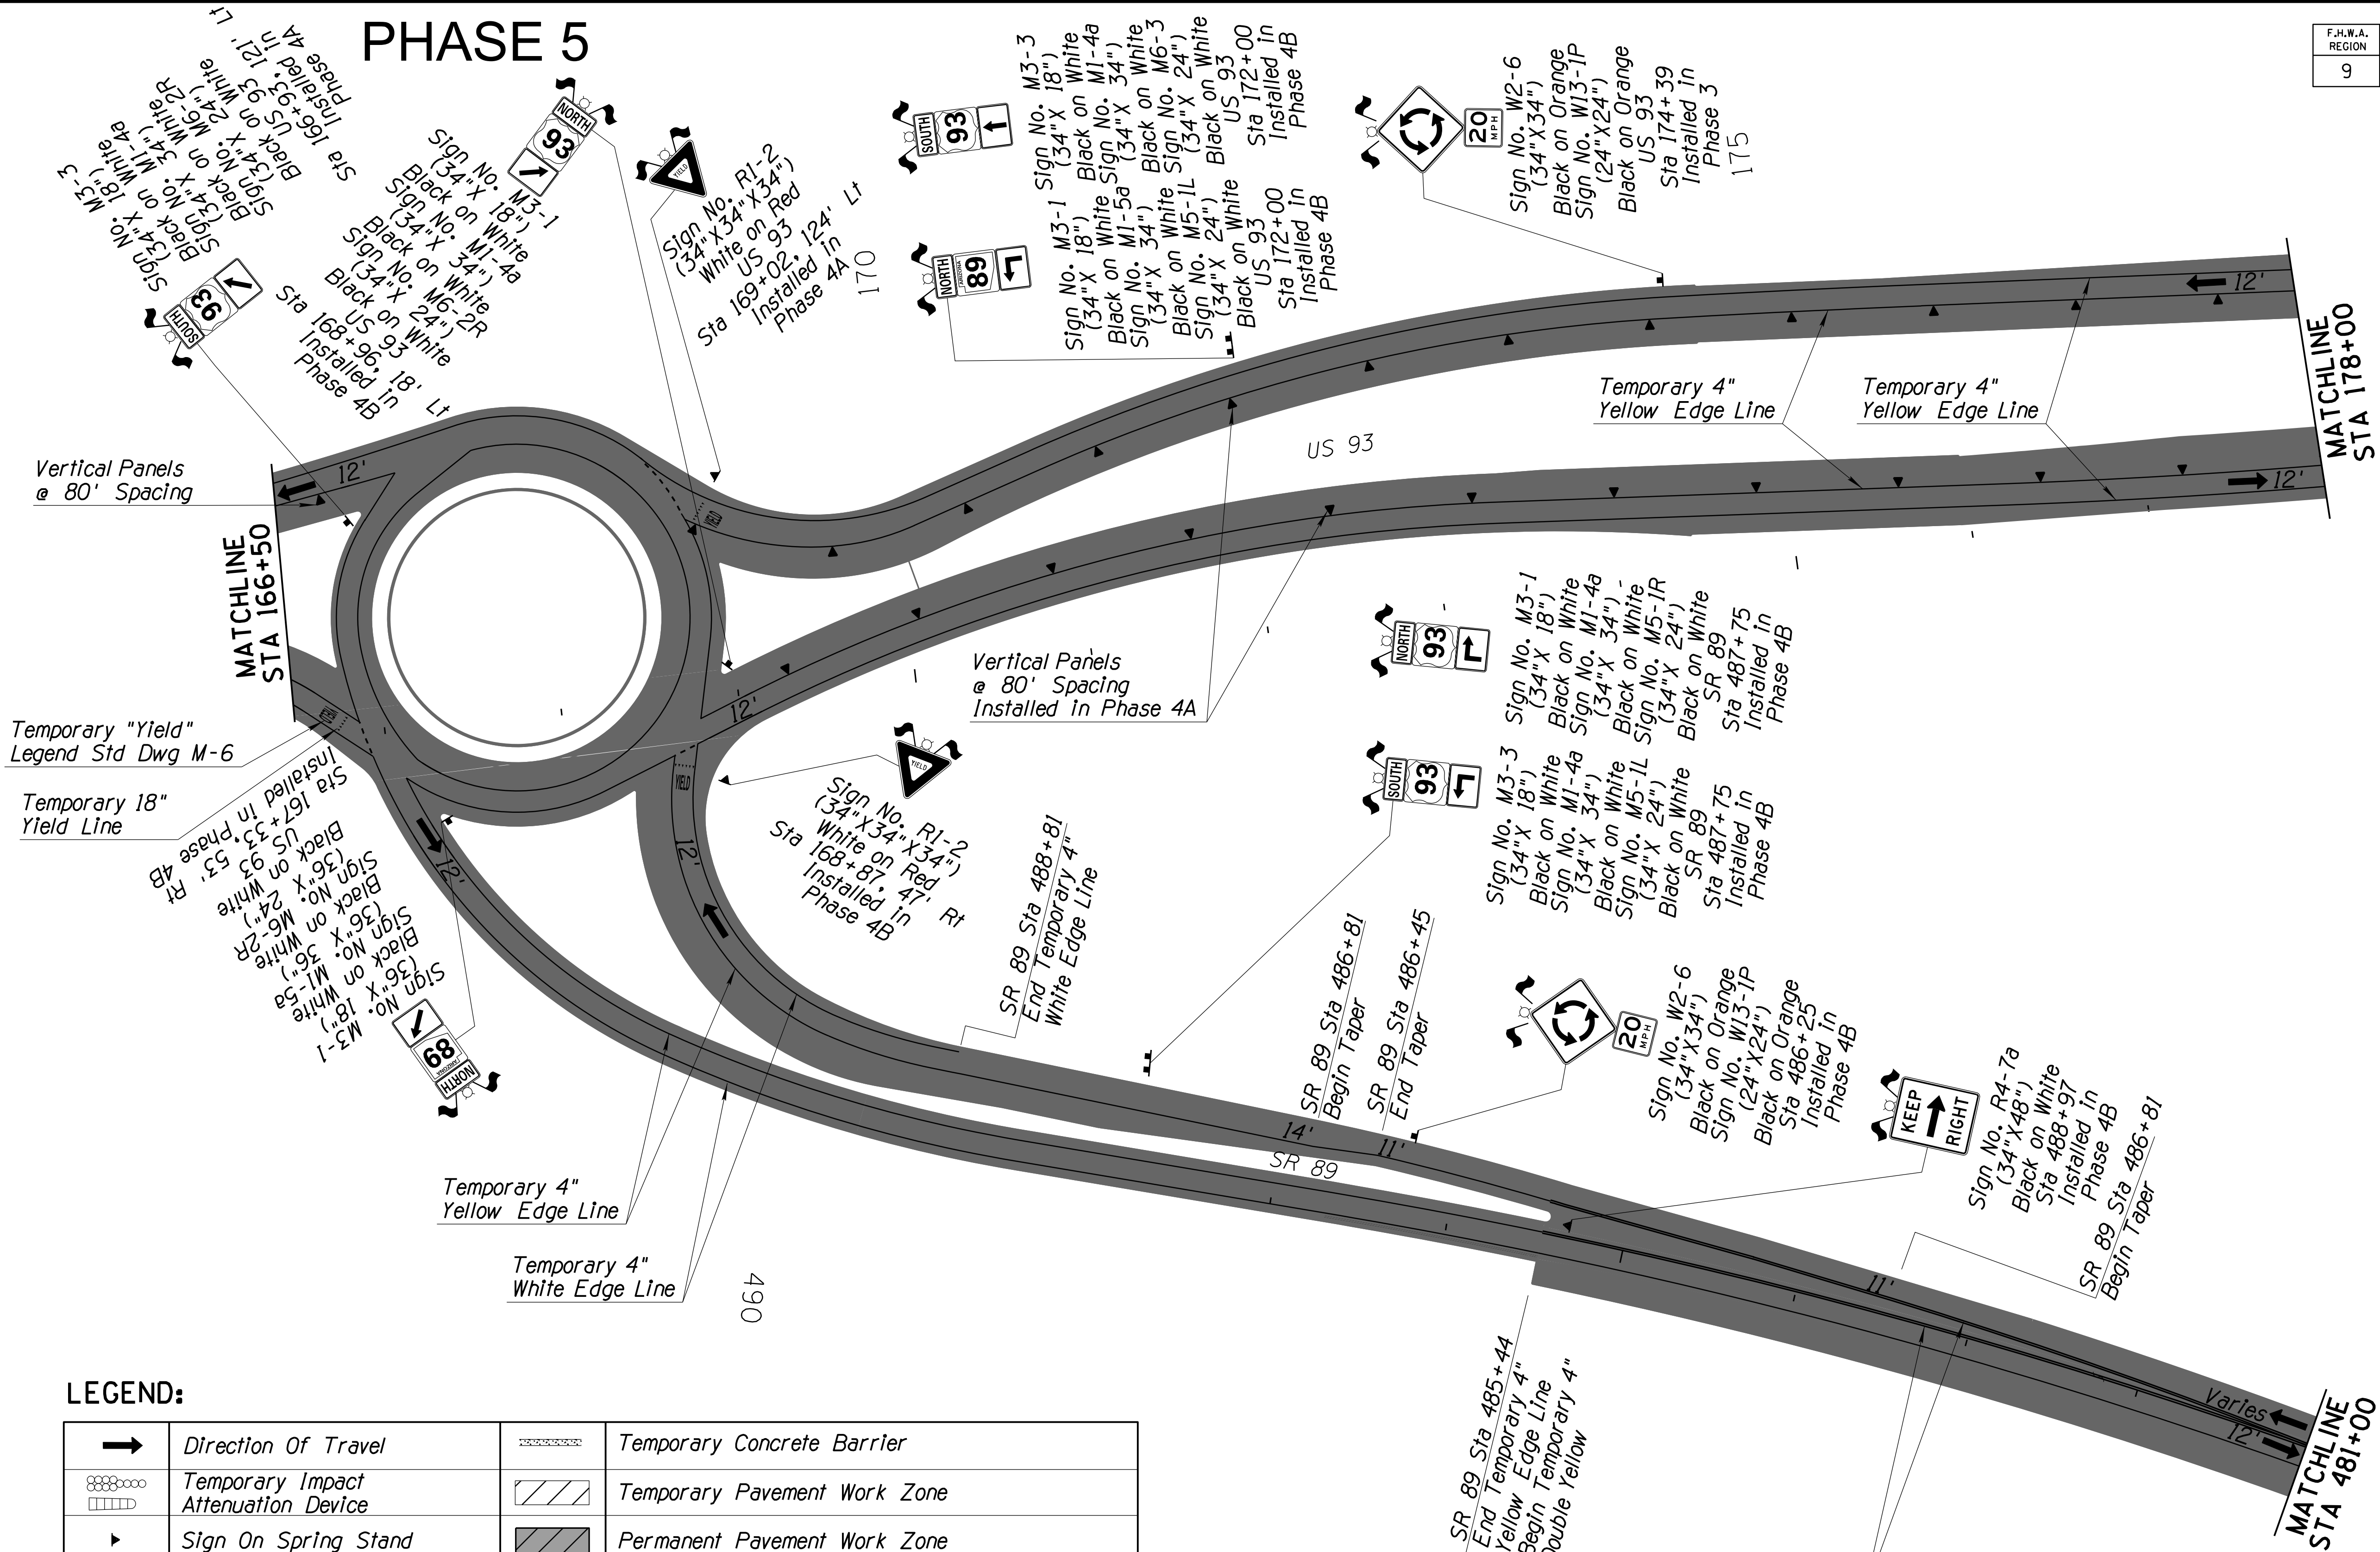

LEGEND:

	Direction Of Travel		Temporary Concrete Barrier
	Temporary Impact Attenuation Device		Temporary Pavement Work Zone
	Sign On Spring Stand		Permanent Pavement Work Zone
	Sign On Rigid Stand		CMB - Changeable Message Board
	Sign On Embedded Posts		Flashing Light & Warning Flags
	Type 2 Barricade		Vertical Panel
	Type 3 Barricade		Temporary Pavement Phase 1, 2, 3, 4A & 4B
	Temporary Pavement Removal		Constructed Pavement Phase 1, 2, 3, 4A & 4B


NOTE:

1. Obliterate all existing pavement marking in conflict with Phase 5 temporary pavement marking.

DESIGN	ME1	DATE	06/26	ARIZONA DEPARTMENT OF TRANSPORTATION PROJECT DELIVERY AND OPERATIONS DIVISION TRAFFIC DESIGN SERVICES US 93 & SR 89 PHASE 5 TRAFFIC CONTROL STA 166+50 TO STA 178+00	
DRAWN	SRH	DATE	06/26		
CHECKED	BMT	DATE	06/26		
ROUTE: US 93				LOCATION: WICKENBURG RANCH WAY TO VISTA ROYALE	DWG NO. T-2.41
TRACS NO. F0738 OIC				093-B(230)T	OF

PHASE 5

F.H.W.A. REGION	STATE	PROJECT NO.	SHEET NO.	TOTAL SHEETS	RECORD DRAWING
9	ARIZ.	093-B(230)T	346	524	
093 YV 189					

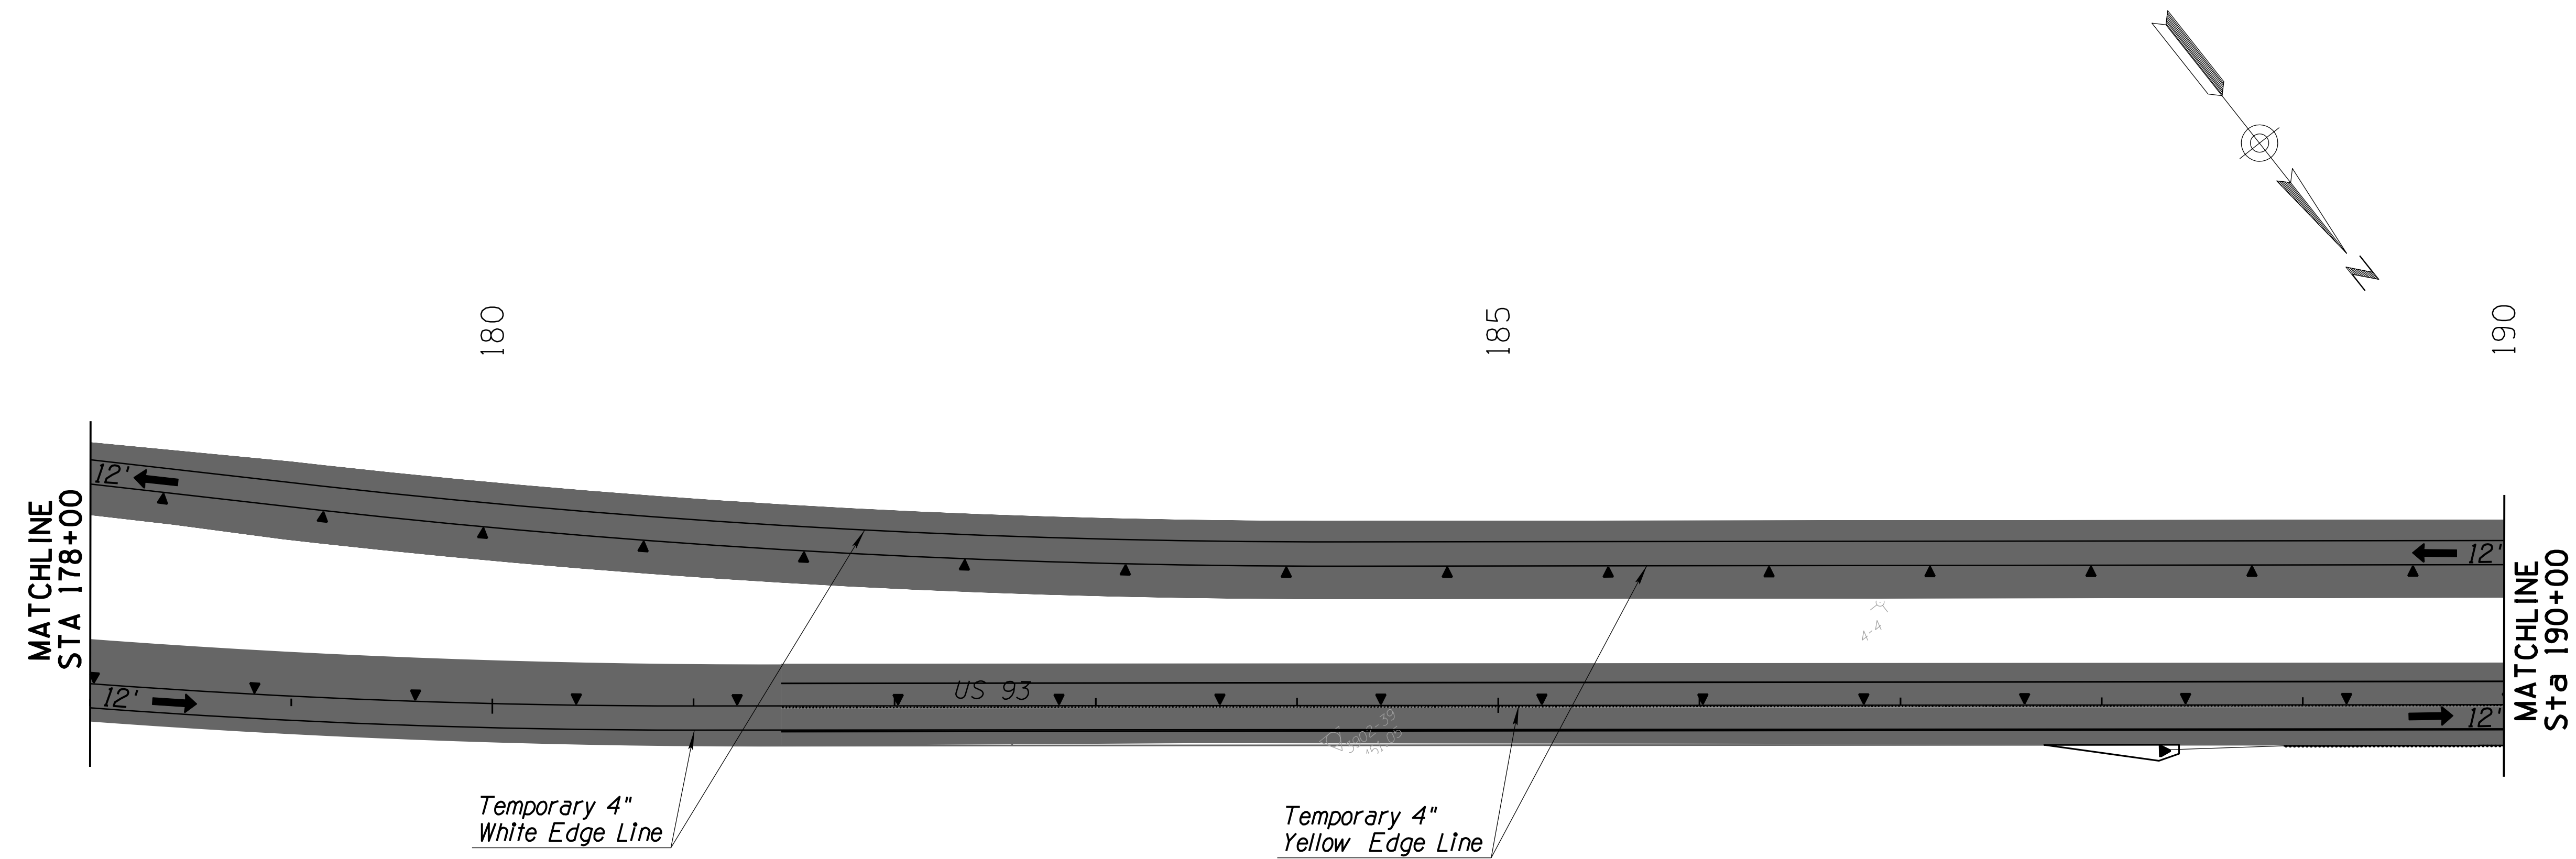

LEGEND:

	Direction Of Travel		Temporary Concrete Barrier
	Temporary Impact Attenuation Device		Temporary Pavement Work Zone
	Sign On Spring Stand		Permanent Pavement Work Zone
	Sign On Rigid Stand		CMB - Changeable Message Board
	Sign On Embedded Posts		Flashing Light & Warning Flags
	Type 2 Barricade		Vertical Panel
	Type 3 Barricade		Temporary Pavement Phase 1, 2, 3, 4A & 4B
	Temporary Pavement Removal		Constructed Pavement Phase 1, 2, 3, 4A & 4B

NOTE:


1. Obliterate all existing pavement marking in conflict with Phase 5 temporary pavement marking.

		NAME	DATE	ARIZONA DEPARTMENT OF TRANSPORTATION PROJECT DELIVERY AND OPERATIONS DIVISION TRAFFIC DESIGN SERVICES	
DESIGN		ME1	06/26		
DRAWN		SRH	06/26		
CHECKED		BMT	06/26	US 93 & SR 89 PHASE 5 TRAFFIC CONTROL STA 178+00 TO STA 190+00	
 3133 East Camelback Road, Suite 100 Phoenix, Arizona 85016 Phone: (602) 333-2200					
Stanley Consultants Inc.					
ROUTE		LOCATION		US 93	WICKENBURG RANCH WAY TO VISTA ROYALE
TRACS NO. F0738 OIC				093-B(230)T	DWG NO. T-2.42
					OF

PHASE 5

F.H.W.A. REGION	STATE	PROJECT NO.	SHEET NO.	TOTAL SHEETS	RECORD DRAWING
9	ARIZ.	093-B(230)T	347	524	

093 YV 189

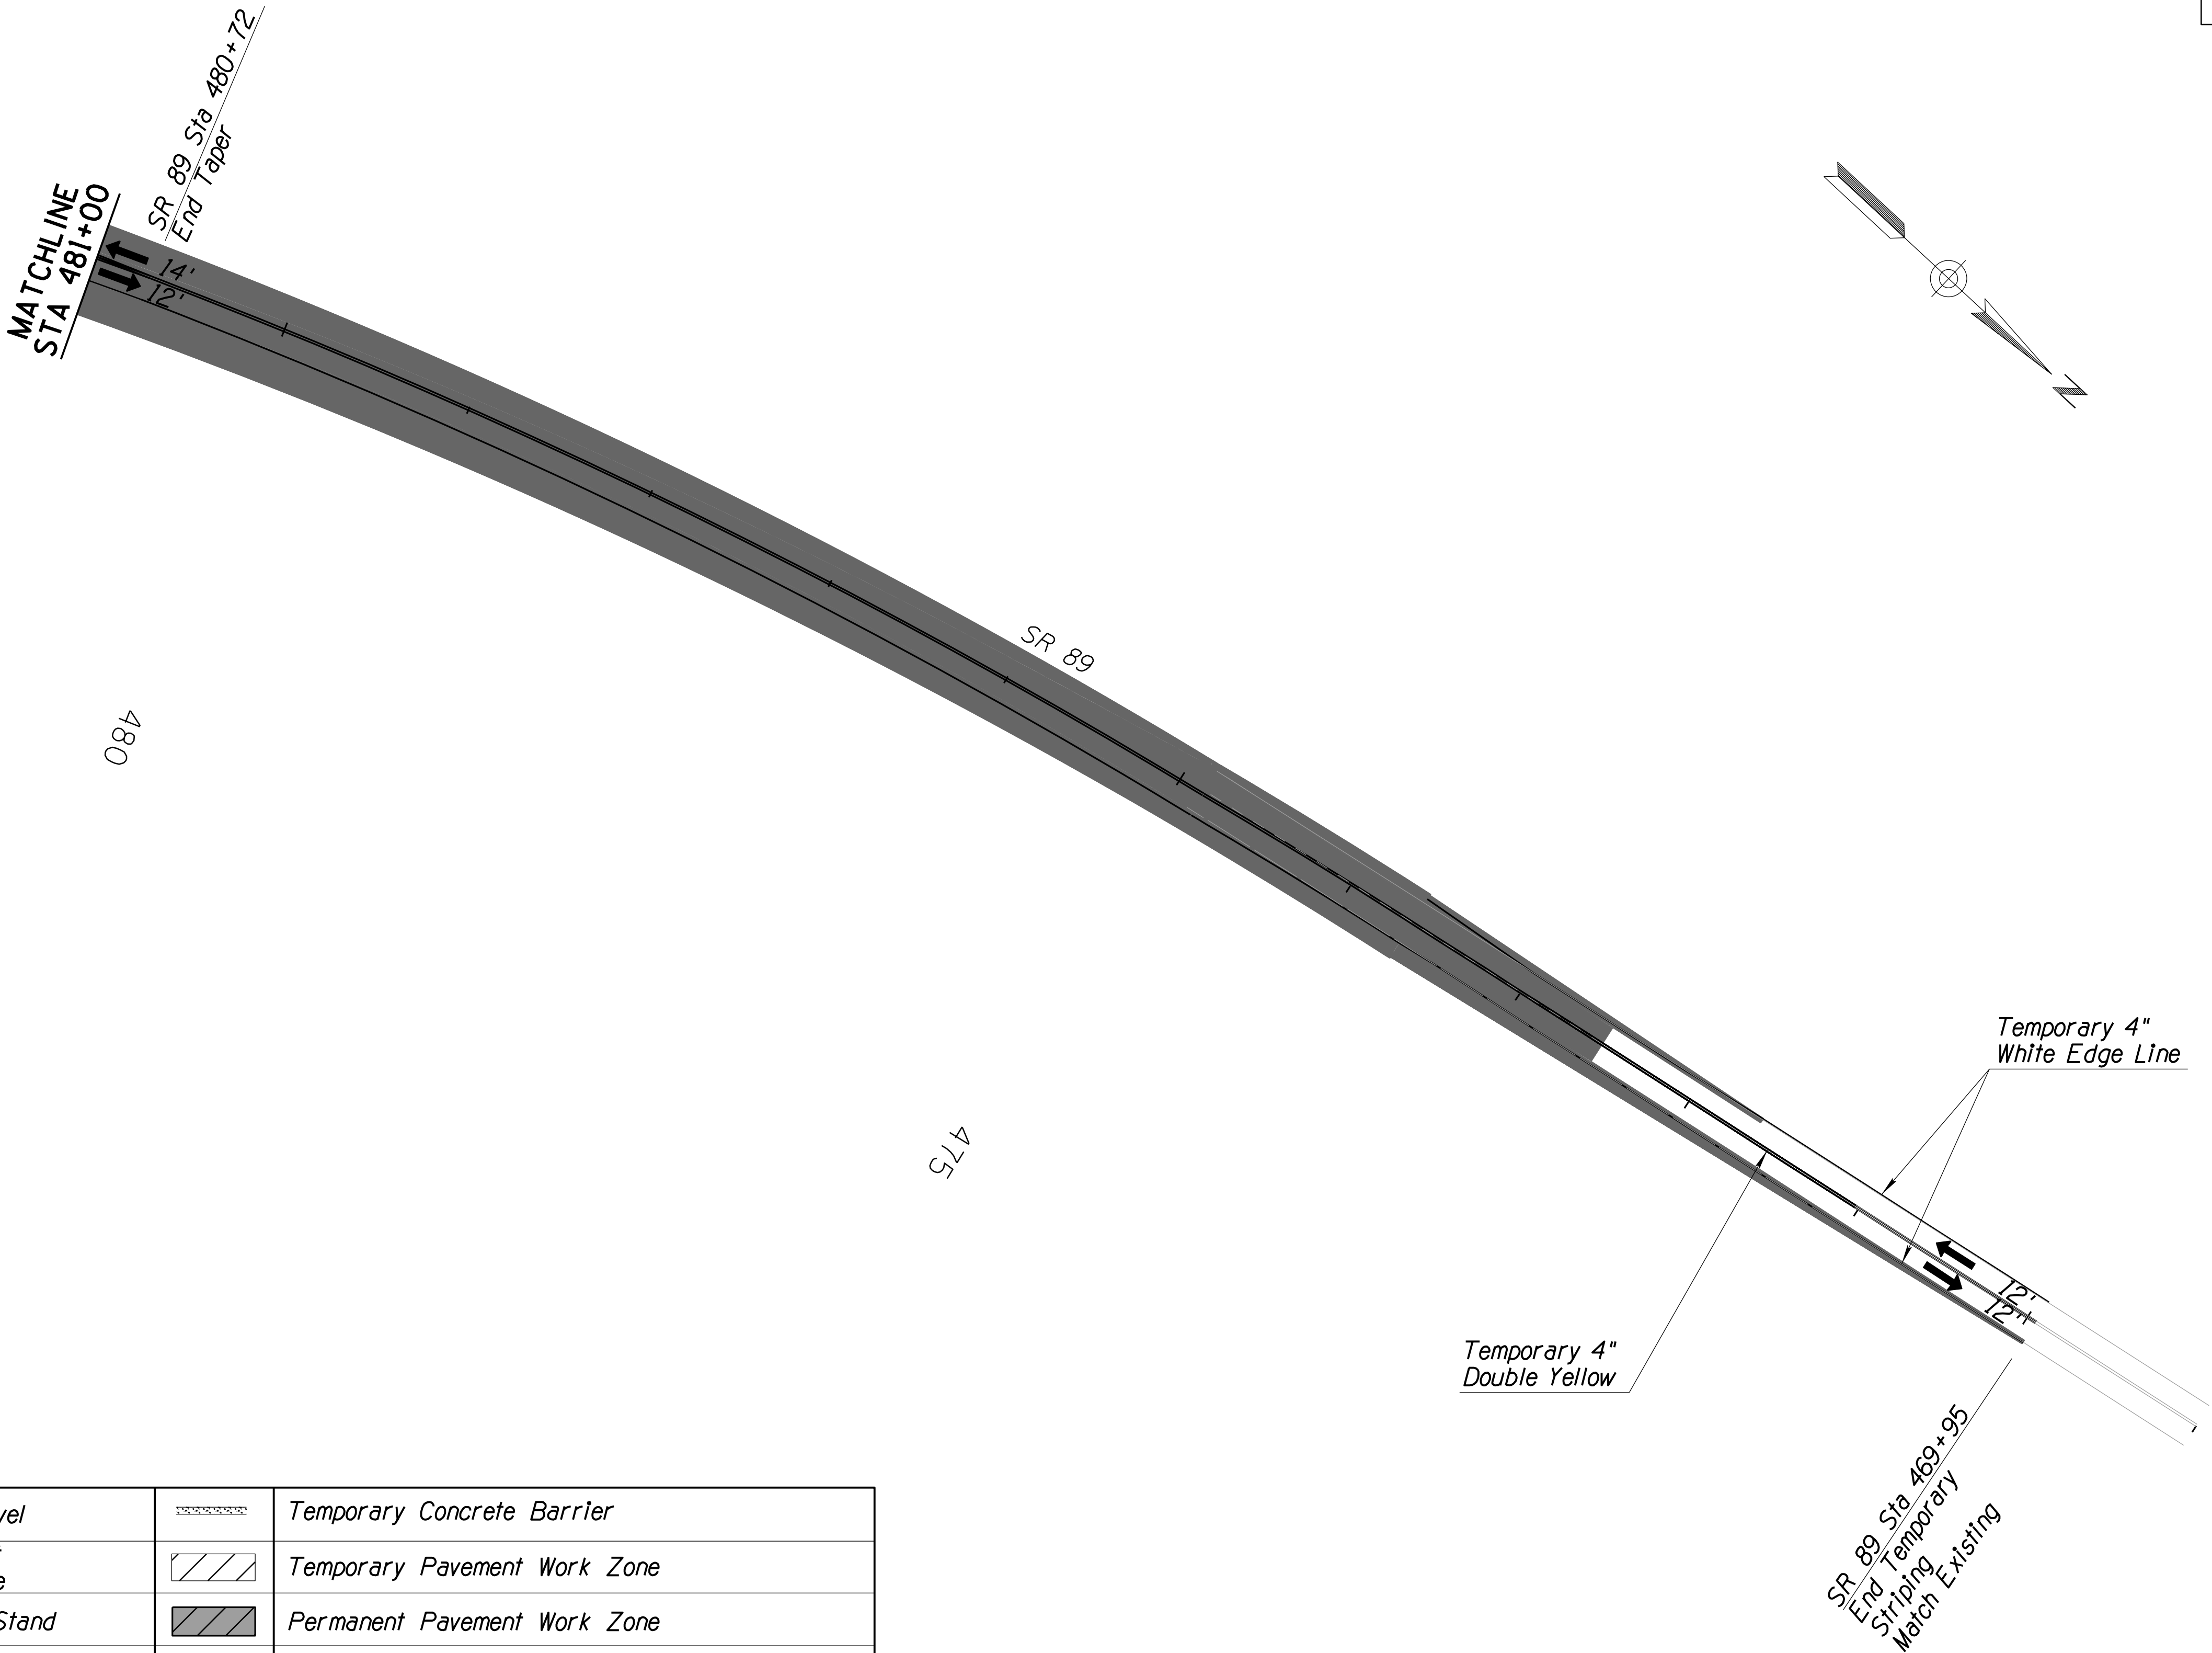

LEGEND:

	Direction Of Travel		Temporary Concrete Barrier
	Temporary Impact Attenuation Device		Temporary Pavement Work Zone
	Sign On Spring Stand		Permanent Pavement Work Zone
	Sign On Rigid Stand		CMB - Changeable Message Board
	Sign On Embedded Posts		Flashing Light & Warning Flags
	Type 2 Barricade		Vertical Panel
	Type 3 Barricade		Temporary Pavement Phase 1, 2, 3, 4A & 4B
	Temporary Pavement Removal		Constructed Pavement Phase 1, 2, 3, 4A & 4B

NOTE:

1. Obliterate all existing pavement marking in conflict with Phase 5 temporary pavement marking.

		NAME	DATE	ARIZONA DEPARTMENT OF TRANSPORTATION PROJECT DELIVERY AND OPERATIONS DIVISION TRAFFIC DESIGN SERVICES		
DESIGN	ME1		06/26	US 93 & SR 89 PHASE 5 TRAFFIC CONTROL STA 470+00 TO STA 481+00		
DRAWN	SRH		06/26			
CHECKED	BMT		06/26			
		3133 East Camelback Road, Suite 100 Phoenix, Arizona 85016 Phone: (602) 333-2200		DWG NO. T-2.43 OF		
Stanley Consultants inc.						
ROUTE	LOCATION					
US 93		WICKENBURG RANCH WAY TO VISTA ROYALE				
TRACS NO. F0738 OIC			093-B(230)T			

DATE- LOCATION- REVISIONS- FINISHED PLANS- SURVEY NO. DATE- LOCATION- REVISIONS- FINISHED PLANS- SURVEY NO.

F.H.W.A. REGION	STATE	PROJECT NO.	SHEET NO.	TOTAL SHEETS	RECORD DRAWING
9	ARIZ.	093-B(230)T	348	524	
093 YV 189					

SIGNING GENERAL NOTES:

1. All signs shall be in compliance with the 2023 Manual on Uniform Traffic Control Devices (MUTCD) including the Arizona Supplement, ADOT Signing and Marking Standard Drawings, Traffic Engineering Manual of Approved Signs, ADOT Standard Specifications, these plans, and the Special Provisions.
2. The Engineer may modify the signing plans.
3. The sign locations and the post lengths are approximate. The contractor shall verify the sign locations and actual post lengths with the Engineer prior to installing the signs.
4. Unless otherwise noted, the bottom of each ground-mounted sign assembly shall be at least 7 feet above the nearest edge of pavement and at least 7 feet above the ground under the sign.
5. Normal offset for all signs is 12 feet from the near edge of sign to the edge of pavement or back of curb. Signs behind concrete barrier, guardrail or vertical curb shall have a minimum offset of two feet from back of barrier or back of guardrail to the near edge of the sign unless otherwise noted in the sign summary or the plan sheets.
6. The retroreflective sheeting on all new signs shall meet criteria established in Section 1007 of the Specifications and in Section 380 of ADOT's Traffic Engineering Guidelines and Processes.
7. The contractor shall remove existing signing where indicated on the plans and in the sign summary.
8. Foundations of existing signs that are to be removed or relocated shall be removed a minimum of two feet below finished grade.
9. Existing signs not indicated in the sign summary that do not need to be removed or relocated, shall remain. If construction activities require a sign assembly removal not noted in the plan, the sign assembly shall be replaced as new and placed as near as possible to the existing location as directed by the Engineer. The removal or replacement of sign assemblies for any construction activity shall be included in the cost of that activity. No further compensation shall be made.
10. The contractor shall preserve all existing roadway sign panels, sign posts, object markers, milepost markers and foundations for sign posts to remain. The contractor shall replace any signs, sign supports, and markers damaged as a result of the construction at the contractor's expense.
11. The contractor shall inventory all signs to be removed and reinstalled or covered, and note damaged signs to the Engineer at the time of covering or removal. All signs damaged by covering, removal, or reinstallation shall be replaced by the contractor at the contractor's expense.
12. All new signs shall be fabricated with aluminum extrusions or flat sheet aluminum with direct applied copy or screen printed legend as indicated in Section 608 of the Specifications.
13. All new signs shall be installed on new posts with foundations as indicated on the plans in accordance with the ADOT Standard Drawings.
14. Shop Drawings will be required for all signs.
15. All relocated signs shall have new sign post and foundations.
16. All metal hardware shall be stainless steel, galvanized cadmium plated or aluminum to prevent rust.
17. Where indicated on the sign summary, and as indicated by the Engineer, new slip bases shall be installed as shown on ADOT Std Dwg S-1.
18. Existing reference location mile markers (D10-3) shall be surveyed prior to sign removal and the new reference location mile marker shall be placed in the same location, laterally, as it was previously located.
19. Adjust location of signage foundations per AZ811 and as approved by Engineer.

DESIGN		ME1	06/26	ARIZONA DEPARTMENT OF TRANSPORTATION PROJECT DELIVERY AND OPERATIONS DIVISION TRAFFIC DESIGN SERVICES	
DRAWN		SRH	06/26		
CHECKED		BMT	06/26		
 Stanley Consultants inc.		3133 East Camelback Road, Suite 100 Phoenix, Arizona 85016 Phone: (602) 333-2200		SIGNING NOTES & QUANTITIES	
ROUTE		LOCATION		DWG NO. T-3.01	
US 93		WICKENBURG RANCH WAY TO VISTA ROYALE			
TRACS NO. F0738 OIC				093-B(230)T	
				OF	

APPROXIMATE SIGNING QUANTITIES			
BID ITEM NO.	ITEM	UNITS	TOTAL
2020047	REMOVAL OF SIGNS	EACH	138
2020115	REMOVE (DELINEATOR)	EACH	61
2020155	REMOVE (SIGN PANEL)	EACH	3
6070002	BREAKAWAY SIGN POST S4X7.7	L. FT.	20
6070004	BREAKAWAY SIGN POST W6X12	L. FT.	202
6070006	BREAKAWAY SIGN POST W8X18	L. FT.	108
6070022	FOUNDATION FOR BREAKAWAY SIGN POST S4x7.7	EACH	2
6070024	FOUNDATION FOR BREAKAWAY SIGN POST W6X12	EACH	13
6070026	FOUNDATION FOR BREAKAWAY SIGN POST W8X18	EACH	6
6070038	SLIP BASE	EACH	151
6070054	SIGN POST (PERFORATED) (2 S)	L. FT.	44
6070055	SIGN POST (PERFORATED) (2 1/2S)	L. FT.	723
6070057	SIGN POST (PERFORATED) (2 1/2T)	L. FT.	1,357
6070060	FOUNDATION FOR SIGN POST (CONCRETE)	EACH	167
6080005	REGULATORY, WARNING, OR MARKER SIGN PANEL	SQ. FT.	1,042
6080018	EXTRUDED ALUMINUM SIGN PANEL	SQ. FT.	1,157
6080025	FLAT SHEET ALUMINUM SIGN PANEL	SQ. FT.	162
6080055	SIGN PANEL (RELOCATE)	EACH	4
7030080	OBJECT MARKER (M-23) (TYPE 3)	EACH	14
7030084	OBJECT MARKER (M-23) (TYPE 1 OR 4)	EACH	5
7030095	MILEPOST MARKER (S-10)	EACH	10

APPROXIMATE ELECTRICAL & ITS QUANTITIES			
BID ITEM NO.	ITEM	UNITS	TOTAL
7310197	BREAKAWAY BASE FOR LIGHTING POLE OR SIGNAL FLASHER	EACH	2
7330410	POLE FLASHER	EACH	2
7350021	LOOP DETECTOR (SPEED/CLASSIFICATION)	EACH	1
7350040	LOOP DETECTOR (SPEED/CLASSIFICATION) (RELOCATE)	EACH	1

NOTES



1. See sheet T-5.22 for Pole Flasher locations.

c:\pwworking\usaz\dms09242\10738pn01.dgn
6/10/2026 @2:43:19 PM ValenciaReyesC

PAVEMENT MARKING GENERAL NOTES:

1. All pavement markings shall be in compliance with the ADOT Signing and Marking Standard Drawings and the 2023 Manual on Uniform Traffic Control Devices (MUTCD), including the Arizona Supplement.
2. The pavement marking drawings are schematic only and not to scale. The contractor shall follow all dimensions and details when installing pavement markings and markers.
3. The pavement marking dimensions are to the center of the striping or in the case of double striping to the center of the double striping and are to the face of curb, face of barrier, or edge of pavement, unless otherwise noted.
4. It is the contractor's responsibility to ensure that the final surface course is placed so that the striping is offset one foot (1'-0") clear of the construction joint, unless otherwise directed by the Engineer.
5. The Initial striping shall be 15 mil (0.015 Inch wet) thick pavement marking paint in accordance with Section 708 of the specifications. The striping shall be installed on the roadway surface after the installation of the final pavement surface of this project and maintained until application of final extruded thermoplastic reflectorized striping.
6. The contractor shall apply one application of waterborne traffic paint as a temporary stop bar on the same day the final surface course covers an existing stop bar.
7. The contractor shall be responsible for the layout and installation of permanent pavement markings on the final surface course following control points that have been set no more than 50 feet apart along the lines to be striped.
8. The permanent pavement marking plans may be modified as directed by the Engineer.
9. When stripe obliteration is necessary, it shall be accomplished by approved methods. Painting over striping, removal of pavement and overlaying pavement does not constitute stripe obliteration.
10. All reflective raised pavement markers shall have an abrasion-resistant coating on the face of the prismatic reflectors and shall conform to the details of ADOT Std. Dwg. M-19. They shall be installed with a bituminous adhesive which is on the ADOT Approved Products List.
11. All reflective raised pavement markers shall be installed so that the reflective face of each marker is facing the direction of traffic and is perpendicular to the direction of traffic flow. Type C pavement markers shall be installed so that the clear reflective face of each marker is facing approaching traffic and is perpendicular to the direction of traffic flow.
12. Raised pavement markers shall be installed at a minimum of 30 calendar days after completion of the final pavement surface of this project, or as directed by the Engineer.
13. Where raised pavement markers are placed along solid striping, the nearest edge of each marker shall be offset two inches from the nearest edge of the striping.
14. The contractor shall break the centerlines and edge lines adjacent to turnouts across any intersections with dedicated roadways, or as otherwise directed by the Engineer. In addition, the contractor shall not place any centerlines within 10 feet of the nearest edge of pavement of the intersecting roadway.
15. The contractor shall preserve all existing pavement markings and raised pavement markers that are to remain except where noted otherwise, and shall replace any damaged markings as a result of the construction at the contractor's expense.
16. All legends and pavement arrows shall be Type IV preformed pavement marking in accordance with Section 705 of the specifications. Single arrows and "ONLY" legends shall be installed in accordance with ADOT Std Dwgs M-6, M-10, and M-11.

17. All final striping of skip striping and yield lines along ADOT maintained facilities shall be Type IV preformed pavement markings in accordance with Section 705 of the specifications.
18. All other final striping shall be 90 mil (0.090 inches) thick alkyd extruded thermoplastic reflectorized striping placed over the existing striping, placed at a minimum of 30 calendar days after the initial striping. All other markings shall be applied at the same time.
19. At the completion of the final pavement surface of this project each day, center lines, lane lines, edge lines and stop bars shall be striped with one application of waterborne paint at the locations of the permanent striping. The paint shall have a maximum thickness specified in note 5.
20. The contractor shall install ground-in rumble strips continuously along edge lines, except on concrete surfaces or on bridges, with no more than half an inch of SMA. The ground-in rumble strips shall conform to the details shown on ADOT Std. Dwg. M-22.
21. The contractor shall clean the roadway surface to the satisfaction of the Engineer, by sweeping and air-jet blowing, immediately prior to the placement of all pavement markings. The roadway surface shall be dry and the air and pavement temperatures shall be a minimum of 55 degree F and rising for the placement of thermoplastic striping. The roadway surface shall be dry and the air and pavement temperatures shall not be less than 60 degrees F for the installation of Type IV pavement marking tape. Type I tape shall not be installed if rain is anticipated 48 hours prior to or after intended installation date.
22. The contractor shall delineate all new guardrail end treatments in accordance with the ADOT Standard Drawings and ADOT Standard Specifications. There shall be no measurement or payment for the guardrail end treatment delineation.
23. For painted bullnoses, see ADOT Std. Dwg. M-1.
24. All striping dimensions are to the face of curb or edge of pavement, unless otherwise noted.

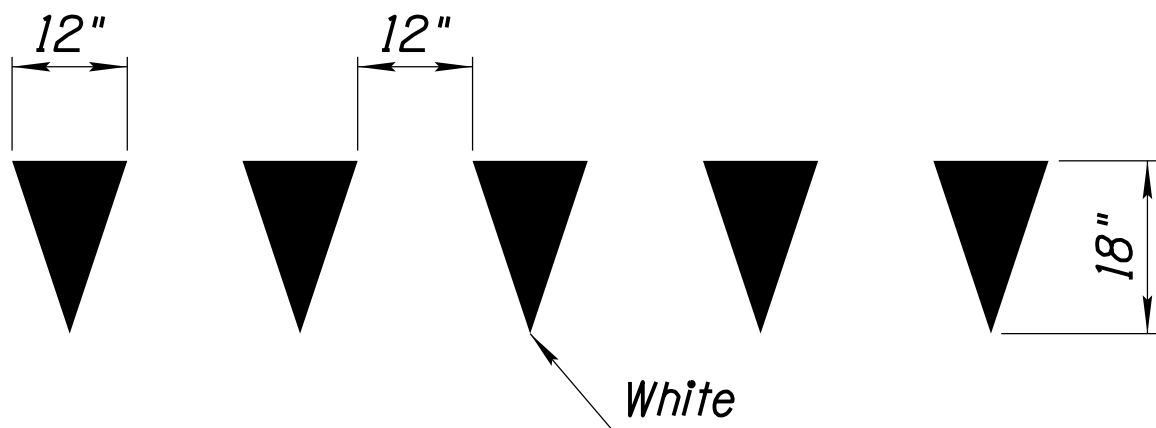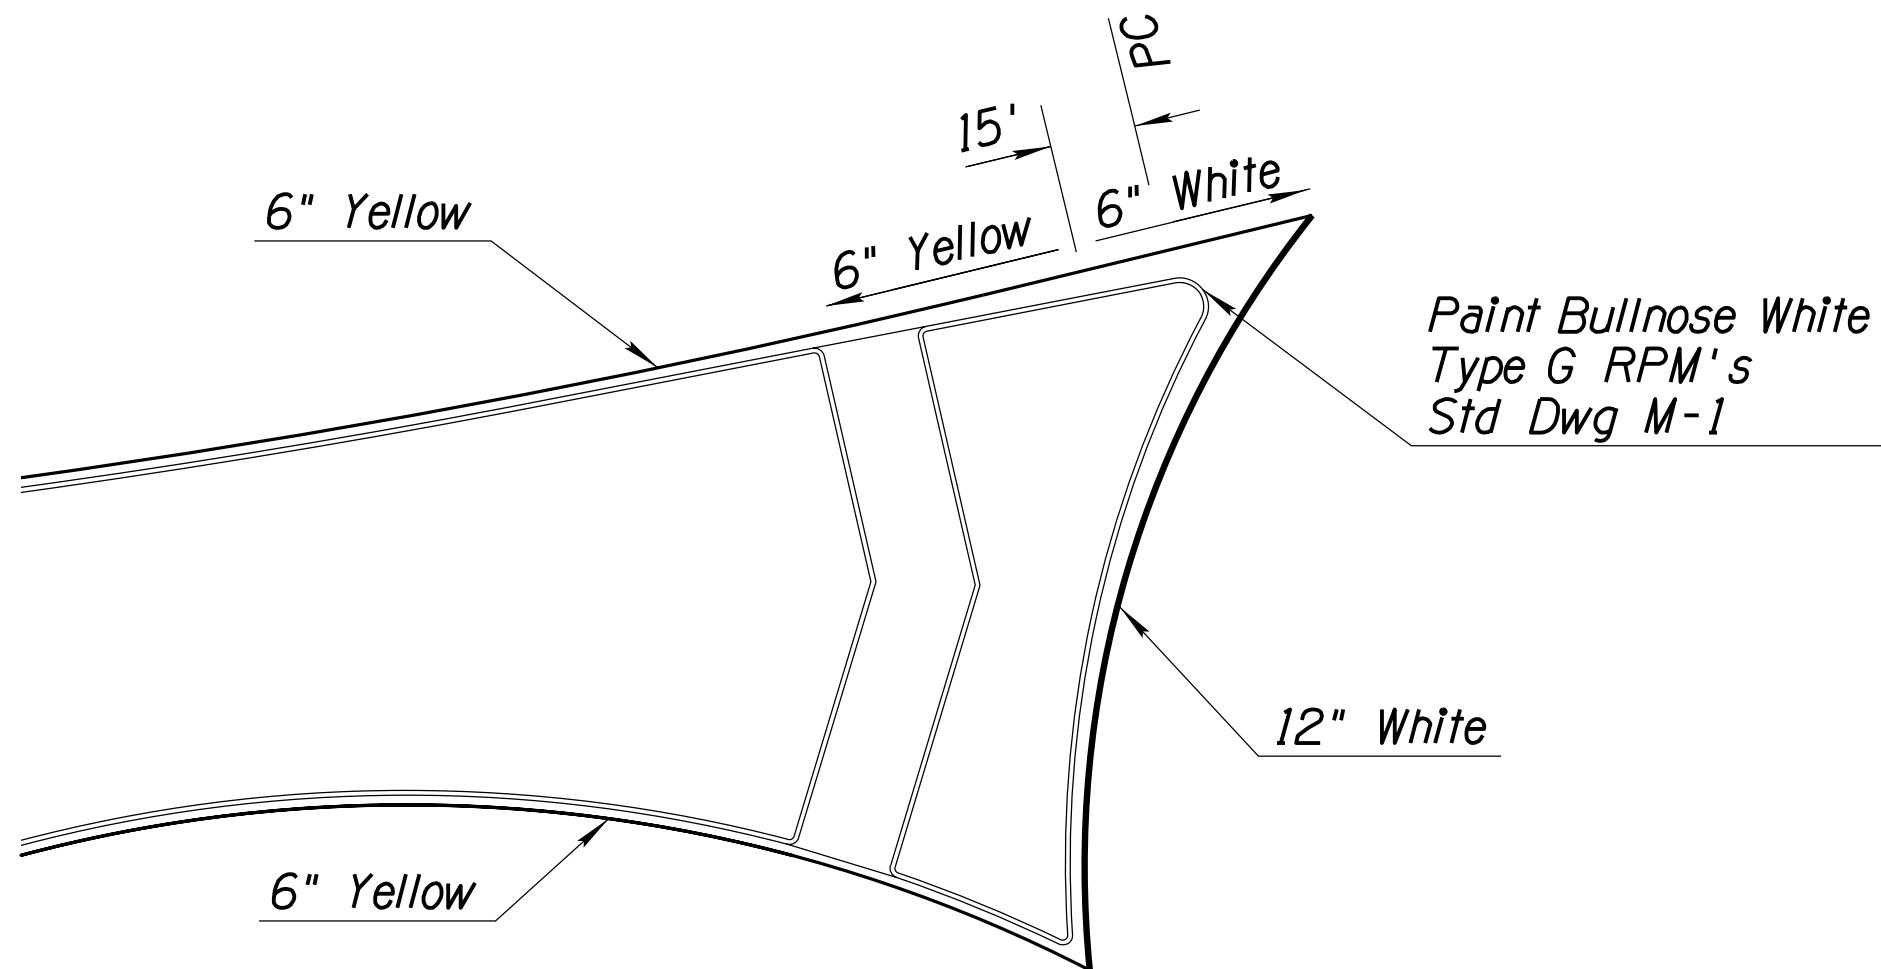

ROUNDABOUT BULLNOSE DETAIL
NTS

YIELD LINE DETAIL
NTS

DESIGN		ME1	06/26	ARIZONA DEPARTMENT OF TRANSPORTATION PROJECT DELIVERY AND OPERATIONS DIVISION TRAFFIC DESIGN SERVICES	
DRAWN		SRH	06/26		
CHECKED		BMT	06/26		
ROUTE		LOCATION		PAVEMENT MARKING NOTES	
US 93		WICKENBURG RANCH WAY TO VISTA ROYALE		DWG NO. T-3.03	
TRACS NO. F0738 OIC		093-B(230)T		OF	



APPROXIMATE PAVEMENT MARKING QUANTITIES			
BID ITEM NO.	ITEM	UNITS	Total Quantity
7015052	OBLITERATE PAVEMENT MARKING (STRIPE)	L. FT	82
7040005	PAVEMENT MARKING (WHITE EXTRUDED THERMOPLASTIC) (0.090")	L. FT	130,294*
7040006	PAVEMENT MARKING (YELLOW EXTRUDED THERMOPLASTIC) (0.090")	L. FT	91,635*
7040072	PAVEMENT MARKING (TRANSVERSE)(THERMOPLASTIC)(ALKYD)(0.090")	L. FT	144*
7050060	PAVEMENT MARKING, PREFORMED, LEGEND, TYPE IV	EACH	13
7050062	PAVEMENT MARKING, PREFORMED, WHITE STRIPE, TYPE IV	L. FT	454*
7050067	PAVEMENT MARKING, PREFORMED, SYMBOL, TYPE IV	EACH	46
7050069	PAVEMENT MARKING, PREFORMED, TRANSVERSE, TYPE IV	L. FT	2,715*
7060013	PAVEMENT MARKER, RAISED, TYPE C	EACH	1,262
7060017	PAVEMENT MARKER, RAISED, TYPE E	EACH	176
7080201	WATERBORNE-TYPE I PAVEMENT MARKING (PAINTED) (WHITE)	L. FT	90,998*
7080202	WATERBORNE-TYPE I PAVEMENT MARKING (PAINTED) (YELLOW)	L. FT	61,085*
7080204	WATERBORNE-TYPE I PAVEMENT MARKING (PAINTED SYMBOL)	EACH	46
7080208	WATERBORNE-TYPE I PAVEMENT MARKING (PAINTED LEGEND) (ONLY)	EACH	13
7080301	PAINT BULL NOSE	EACH	5
9280036	GROUND-IN RUMBLE STRIP (8 INCH)	L. FT	19,017
9280037	GROUND-IN RUMBLE STRIP (12 INCH)	L. FT	56,248

NOTES

1. Quantity totals with an asterisk * are provided in 4-inch equivalent lengths.

	DESIGN	NAME	DATE	ARIZONA DEPARTMENT OF TRANSPORTATION PROJECT DELIVERY AND OPERATIONS DIVISION TRAFFIC DESIGN SERVICES	ROUTE	F.H.W.A. Arizona Division	STATE	PROJECT NO.	FEDERAL ID NO.	SHEET NO.	TOTAL SHEETS	RECORD DRAWING
	DRAWN	C VALENCIA	06/26		US 93							
	CHECKED	C RICKETTS	06/26		MILEPOST 190.5							
	TRANSPORTATION AECOM TECHNICAL SERVICES, Inc. 7720 N. 16th St., Suite 100 Phoenix, Arizona 85020 T 602.371.1100 www.aecom.com				PAVEMENT MARKING QUANTITIES		STRUCTURE NO.	VISTA ROYALE			DWG No. T-3.04	
							TRACS NO. F0738 01C		____ OF ____			

MADE BY DATE	NO.2 DESCRIPTION OF REVISION	MADE BY DATE	NO.1 DESCRIPTION OF REVISION	Plan Sht No.	Sign Number	MOAS Sign Code	Work					Offset (ft)	Mounting Height (ft)	Background Color	Panel					Ground Mounted					Overhead		F.H.W.A. REGION	STATE	PROJECT NO.	SHEET NO.	TOTAL SHEETS	RECORD DRAWING																																																																																																					
							Existing								Legend	Width (in.)	Height (in.)	Area (sq. ft.)	Type	Bid Item Number	Foundations	Posts		New Slipbases	Stringer		Structure Type	Number of Lights	9	ARIZ.	093-B(230)T	352	524																																																																																																				
							New	Replace Panel	Relocate Panel	Modify Legend	Remove											To Remain	Type		Total length (ft)	Type									Total Length (ft)																																																																																																		
Northbound US-93																																																																																																																																					
T-5.01					N194.47A		Guide		X						Wickenburg Ranch Way/US-93 Roundabout										2020155										Remove existing sign panel																																																																																																		
																																																				Replace with new panel																																																																																	
																																																								See N194.47B																																																																													
T-5.01					N194.29		W4-2				X				Lane Ends												2020047																																																																																																										
T-5.01					N194.23		M2-101						X		JUNCTION																																																																																																																						
T-5.02					N194.04		R2-1				X				SPEED LIMIT 55												2020047																																																																																																										
T-5.02					N194.00A		D10-3				X				Mile Post 194												2020047																																																																																																										
T-5.02					N194.00B		D14-101				X				Adopt A Highway												2020047																																																																																																										
T-5.02					N193.92		D7-101				X				Granite Mtn Hotshots												6080055								Relocate to N193.93																																																																																																		
T-5.02					N193.91R		OM3				X				Type 3 Object Marker												2020047																																																																																																										
T-5.02					N193.91L		OM3				X				Type 3 Object Marker												2020047																																																																																																										
T-5.02					N193.86		D1-2				X				Straight Arrow Kingman, Congress												2020047																																																																																																										
T-5.03					N193.77A		R4-7				X				Keep Right Symbol												2020047																																																																																																										
					+		OM1-2				X				Type 1 Object Marker																																																																																																																						
T-5.03					N193.77B		M1-4				X				US-93												2020047																																																																																																										
					+		M6-3				X				Straight Arrow																																																																																																																						
					+		M1-5a(89)				X				ARIZONA 89																																																																																																																						
					+		M5-2				X				45 Degree Advance Turn Arrow																																																																																																																						
T-5.03					N193.73		M1-4				X				US-93												2020047																																																																																																										
					+		M6-3				X				Straight Arrow																																																																																																																						
					+		M1-5a(89)				X				ARIZONA 89																																																																																																																						
					+		M6-2				X				Diagonal Arrow																																																																																																																						
Notes: 1. The Engineer shall verify post lengths and elevations. 2. The Engineer may shift a sign in order to achieve a more desirable location. 3. Quantities are approximate and for the contractor's information only. Panel Types: RWM: Regulatory, Warning or Marker F-DA: Flat-sheet aluminum with direct applied or silk-screened characters F-Dem: Flat-sheet aluminum with demountable characters Ext: Aluminum extrusions Sheeting Type: See Special Provisions Section 1007 Colors: RD - Red BK - Black BL - Blue GR - Green YL - Yellow BR - Brown WH - White Stringer Types: P: Square-tube post T: T-Section Post Types: 2S-2" Single 2T-2" Telescoping 2 1/2S-2 1/2" Single 2 1/2T-2 1/2" Telescoping																																																																																																																																					
<table><tr><td colspan="2">DESIGN</td><td colspan="2">NAME</td><td colspan="2">DATE</td><td colspan="12">ARIZONA DEPARTMENT OF TRANSPORTATION PROJECT DELIVERY AND OPERATIONS DIVISION TRAFFIC DESIGN SERVICES</td><td colspan="6" rowspan="2"></td></tr><tr><td colspan="2">DRAWN</td><td colspan="2">MEI</td><td colspan="2">06/26</td></tr><tr><td colspan="2">CHECKED</td><td colspan="2">SRH</td><td colspan="2">06/26</td><td colspan="12">US 93 EXISTING SIGN SUMMARY NORTHBOUND</td><td colspan="6">DWG NO. T-4.01</td></tr><tr><td colspan="4">ROUTE</td><td colspan="4">LOCATION</td><td colspan="12">US 93 WICKENBURG RANCH WAY TO VISTA ROYALE</td><td colspan="6"></td></tr><tr><td colspan="4">TRACS NO. F0738 OIC</td><td colspan="4"></td><td colspan="12">093-B(230)T</td><td colspan="6">OF</td></tr></table>																												DESIGN		NAME		DATE		ARIZONA DEPARTMENT OF TRANSPORTATION PROJECT DELIVERY AND OPERATIONS DIVISION TRAFFIC DESIGN SERVICES																		DRAWN		MEI		06/26		CHECKED		SRH		06/26		US 93 EXISTING SIGN SUMMARY NORTHBOUND												DWG NO. T-4.01						ROUTE				LOCATION				US 93 WICKENBURG RANCH WAY TO VISTA ROYALE																		TRACS NO. F0738 OIC								093-B(230)T												OF					
DESIGN		NAME		DATE		ARIZONA DEPARTMENT OF TRANSPORTATION PROJECT DELIVERY AND OPERATIONS DIVISION TRAFFIC DESIGN SERVICES																																																																																																																															
DRAWN		MEI		06/26																																																																																																																																	
CHECKED		SRH		06/26		US 93 EXISTING SIGN SUMMARY NORTHBOUND												DWG NO. T-4.01																																																																																																																			
ROUTE				LOCATION				US 93 WICKENBURG RANCH WAY TO VISTA ROYALE																																																																																																																													
TRACS NO. F0738 OIC								093-B(230)T												OF																																																																																																																	
6/11/2026 6/11/2026 ...\\t0738A ssum02.dgn T-4.01																																																																																																																																					

MADE BY DATE	NO.2 DESCRIPTION OF REVISION	MADE BY DATE	NO.1 DESCRIPTION OF REVISION	Plan Sht No.	Sign Number	MOAS Sign Code	Work					Offset (ft)	Mounting Height (ft)	Background Color	Panel					Ground Mounted					Overhead		F.H.W.A. REGION	STATE	PROJECT NO.	SHEET NO.	TOTAL SHEETS	RECORD DRAWING																																	
							Existing								Legend	Width (in.)	Height (in.)	Area (sq. ft.)	Type	Bid Item Number	Foundations	Posts		New Slipbases	Stringer		Structure Type	Number of Lights	9	ARIZ.	093-B(230)T	354	524																																
							New	Replace Panel	Relocate Panel	Modify Legend	Remove To Remain											Type	Total length (ft)		Type	Total Length (ft)																																							
Remarks																																																																	
				T-5.04	S193.37	R4-7					X					Keep Right Symbol						2020047																																											
					+	OM1-2					X					Type 1 Object Marker																																																	
				T-5.04	S193.45	W4-1L					X					Left Merge Symbol						2020047																																											
				T-5.04	S193.48	R1-1					X					STOP						2020047																																											
				T-5.04	S193.49	R1-1					X					STOP						2020047																																											
					+	R6-3a					X					DIVIDED HIGHWAY (T-Int Symbol)																			Back to Back																														
					-	R5-1					X					DO NOT ENTER																																																	
				T-5.04	S193.51A	Guide					X					Left Arrow Wickenburg						2020047																																											
				T-5.04	S193.51B	R5-1					X					DO NOT ENTER						2020047																																											
				T-5.04	S193.51C	R1-2					X					YIELD						2020047																																											
				T-5.04	S193.54R	R5-1a					X					WRONG WAY						2020047																																											
				T-5.04	S193.54L	R5-1a					X					WRONG WAY						2020047																																											
				T-5.03	S193.60	M4-5					X					T0						2020047																																											
					+	M3-1					X					NORTH																																																	
					+	M1-5a					X					SR-89																																																	
					+	M6-1L					X					Left Arrow																																																	
					+	M3-3					X					SOUTH																																																	
					+	M1-4					X					US-93																																																	
					+	M6-3					X					Straight Arrow																																																	
				T-5.03	S193.61	R3-5L					X					Left Turn Arrow ONLY						2020047																																											
					+	R3-5bP					X					LEFT LANE																																																	
				T-5.03	S193.64R	W6-2					X					Divided Highway Ends Symbol						2020047																																											
				T-5.03	S193.64L	W6-2					X					Divided Highway Ends Symbol						2020047																																											
				T-5.03	S193.70R	W4-2					X					Lane Ends						2020047																																											
				T-5.03	S193.70L	W4-2					X					Lane Ends						2020047																																											
				Notes: 1. The Engineer shall verify post lengths and elevations. 2. The Engineer may shift a sign in order to achieve a more desirable location. 3. Quantities are approximate and for the contractor's information only.												Panel Types: RWM: Regulatory, Warning or Marker F-DA: Flat-sheet aluminum with direct applied or silk-screened characters F-Dem: Flat-sheet aluminum with demountable characters Ext: Aluminum extrusions				Sheeting Type: See Special Provisions Section 1007		Colors: RD - Red BK - Black BL - Blue GR - Green YL - Yellow BR - Brown WH - White		Stringer Types: P: Square-tube post T: T-Section Post Types: 2S-2" Single 2T-2" Telescoping 2 1/2S-2 1/2" Single 2 1/2T-2 1/2" Telescoping		<table><tr><td>DESIGN</td><td>ME1</td><td>NAME</td><td>DATE</td></tr><tr><td>DRAWN</td><td>SRH</td><td></td><td>06/26</td></tr><tr><td>CHECKED</td><td>BMT</td><td></td><td>06/26</td></tr></table>  3133 East Camelback Road, Suite 100 Phoenix, Arizona 85016 Phone: (602) 333-2200 <table><tr><td>ROUTE</td><td>LOCATION</td></tr><tr><td>US 93</td><td>WICKENBURG RANCH WAY TO VISTA ROYALE</td></tr><tr><td colspan="2">TRACS NO. F0738 OIC</td></tr></table> <table><tr><td colspan="2">ARIZONA DEPARTMENT OF TRANSPORTATION PROJECT DELIVERY AND OPERATIONS DIVISION TRAFFIC DESIGN SERVICES</td></tr><tr><td colspan="2">US 93 EXISTING SIGN SUMMARY SOUTHBOUND</td></tr><tr><td colspan="2">093-B(230)T</td></tr></table> <table><tr><td colspan="2">51481 BRIANNE MARIE TURPIN REGISTERED PROFESSIONAL ENGINEER ARIZONA, U.S.A.</td></tr><tr><td colspan="2">DWG NO. T-4.03</td></tr><tr><td colspan="2">OF</td></tr></table>										DESIGN	ME1	NAME	DATE	DRAWN	SRH		06/26	CHECKED	BMT		06/26	ROUTE	LOCATION	US 93	WICKENBURG RANCH WAY TO VISTA ROYALE	TRACS NO. F0738 OIC		ARIZONA DEPARTMENT OF TRANSPORTATION PROJECT DELIVERY AND OPERATIONS DIVISION TRAFFIC DESIGN SERVICES		US 93 EXISTING SIGN SUMMARY SOUTHBOUND		093-B(230)T		51481 BRIANNE MARIE TURPIN REGISTERED PROFESSIONAL ENGINEER ARIZONA, U.S.A.		DWG NO. T-4.03		OF	
DESIGN	ME1	NAME	DATE																																																														
DRAWN	SRH		06/26																																																														
CHECKED	BMT		06/26																																																														
ROUTE	LOCATION																																																																
US 93	WICKENBURG RANCH WAY TO VISTA ROYALE																																																																
TRACS NO. F0738 OIC																																																																	
ARIZONA DEPARTMENT OF TRANSPORTATION PROJECT DELIVERY AND OPERATIONS DIVISION TRAFFIC DESIGN SERVICES																																																																	
US 93 EXISTING SIGN SUMMARY SOUTHBOUND																																																																	
093-B(230)T																																																																	
51481 BRIANNE MARIE TURPIN REGISTERED PROFESSIONAL ENGINEER ARIZONA, U.S.A.																																																																	
DWG NO. T-4.03																																																																	
OF																																																																	

[illegible]

Plan Sht No.	Sign Number	Sign Code	Work					Offset (ft)	Mounting Height (ft)	Background Color	Panel					Ground Mounted			Stringer				Remarks			
			New	Existing							Legend	Width (in)	Height (in)	Area (sq. ft.)	Type	Bid Item Number	Foundations	Posts		New Slipbases	Stringer			Overhead		
				Replace Panel	Relocate Panel	Relocate Str	Remove											To Remain	Type		Total length (ft)	Type		Total Length (ft)	Structure Type	# of Lights
T-5.13	N01-1	R2-1					x					SPEED LIMIT 65					2020047									
T-5.13	N01-2	R2-1	x						12	7	WH	SPEED LIMIT 45	36	48	12.0	RWM	6080005	1	2 1/2T	13	1					
T-5.13	N01-3	D10-3					x					Mile Marker 193					2020047									
T-5.13	N01-4	D10-3	x						12	4	GR	Mile Marker 193					7030095									
T-5.14	N02-1	D2-3					x					Jct 71 11 / Wikieup 69 / Kingman 121					2020047									
T-5.14	N02-2	D2-3	x						12	7	GR	Jct 71 11 / Wikieup 69 / Kingman 121	14	8	112.0	Ext	6080018	2	W6X12	34						
T-5.14	N02-3	R3-5P	x						12	7	WH	Right Lane	30	12	2.5	RWM	6080005	1	2 1/2T	13	1					
		R3-5R	x							WH	Right Turn Only	30	36	7.5	RWM	6080005										
T-5.15	N03-1	W2-6	x						12	7	YL	Roundabout	36	36	9.0	RWM	6080005	2	2 1/2T	29	2					
		W13-1P	x							YL	20 M.P.H	24	24	4.0	RWM	6080005										
T-5.15	N03-2	D3-1					x					Quail Run Trl					2020047									
		R1-1					x					STOP					2020047									
T-5.15	N03-3	D3-1	x						12	7	BR	Quail Run Trl	60	12	5.0	F-DA	6080025	2	2 1/2T	27	2					
		R1-1	x							RD	STOP	36	36	7.5	RWM	6080005										
T-5.15	N03-4	Guide	x						12	7	GR	North 93 / Moreton Rd / Nine Irons Ranch Rd	222	108	166.5	Ext	6080018	3	W8X18	54						
T-5.15	N03-5	OM3-R					x					Type 3 Object Marker					2020047									
T-5.15	N03-6	OM3-R					x					Type 3 Object Marker					2020047									
T-5.15	N03-7	R3-6L	x						12	7	WH	Through-Left	30	36	7.5	RWM	6080005	1	2 1/2S	12	1					
T-5.15	N03-8	R3-6R	x						12	7	WH	Through-Right	30	36	7.5	RWM	6080005	1	2 1/2S	12	1					

Notes: 1. The Engineer shall verify post lengths and elevations. 2. The engineer may shift a sign in order to achieve a more desirable location. 3. Quantities are approximate and for the contractor's information only. 4. Minimum sheeting type shall be Type IX or XI for all signs.	Panel Types: RWM: Regulatory, Warning, or Marker F-DA: Flat-sheet aluminum with direct applied or silk-screened characters F-Dem: Flat-sheet aluminum with demountable characters Ext: Aluminum extrusions Incr: Aluminum sheet increment Over: Overhead (New overlaid extrusions)		Stringer Types:	P: Square-tube Post T: T-section (WT 3x6)	Post S: Single perforated Types: T: Telescoping perforated
		BRF:	Overhead Bridge Fascia Sign Structure		
		Colors:	BK - BLACK BL - BLUE BR - BROWN	GR - GREEN RD - RED WH - WHITE	YL - FLUORESCENT YELLOW

	DESIGN	I ROBLES	06/26	ARIZONA DEPARTMENT OF TRANSPORTATION PROJECT DELIVERY AND OPERATIONS DIVISION TRAFFIC DESIGN SERVICES	ROUTE	US 93	F.H.W.A. Arizona Division	STATE ARIZ.	PROJECT NO.	093 YV 190	FEDERAL ID NO.	093-B-NFA	SHEET NO.	360	TOTAL SHEETS	524	RECORD DRAWING
	DRAWN	C VALENCIA	06/26		MILEPOST	190.5			LOCATION	VISTA ROYALE							DWG No. T-4.09
	CHECKED	C RICKETTS	06/26		STRUCTURE NO.		TRACS NO.	F0738 01C	____ OF ____								
	TRANSPORTATION AECOM TECHNICAL SERVICES, Inc. 1722 N. 18th St., Suite 100 Phoenix, Arizona 85020 T 602.371-1700 www.aecom.com				SIGN SUMMARY US 93 NORTHBOUND												


Plan Sht No.	Sign Number	Sign Code	Work						Offset (ft)	Mounting Height (ft)	Background Color	Panel					Ground Mounted			Stringer				Remarks		
			New	Existing								Legend	Width (in)	Height (in)	Area (sq. ft.)	Type	Bid Item Number	Foundations	Posts							
				Replace Panel	Relocate Panel	Relocate Str	Remove	To Remain											Type	Total length (ft)						
				Structure Type	# of Lights																					
T-5.15	N03-9	W11-2	x					12	7	YL	Pedestrian	36	36	9.0	RWM	6080005	1	2 1/2T	12	1						
		W16-7PR	x							YL	Diagonal Downward Arrow (Plaque)	21	15	2.2	RWM	6080005										
T-5.15	N03-10	W11-2	x					12	7	YL	Pedestrian	36	36	9.0	RWM	6080005	1	2 1/2T	12	1						
		W16-7PL	x							YL	Diagonal Downward Arrow (Plaque)	21	15	2.2	RWM	6080005										
T-5.15	N03-11	R1-2	x					12	7	RD	Yield	48	48	6.9	RWM	6080005	2	2 1/2T	27	2						
T-5.15	N03-12	R1-2	x					12	7	RD	Yield	48	48	6.9	RWM	6080005	2	2 1/2T	27	2						
T-5.15	N03-13	R6-4b	x					12	7	WH	Roundabout Directional (4 Cheverons)	60	24	10.0	RWM	6080005	2	2 1/2S	23	2						
T-5.15	N03-14	D1-1d	x					12	7	GR	Nine Irons Ranch Rd	120	18	12.0	RWM	6080005	2	2 1/2S	23	2						
T-5.15	N03-15	W11-2	x					12	7	YL	Pedestrian	36	36	9.0	RWM	6080005	1	2 1/2T	12	1						
		W16-7PR	x							YL	Diagonal Downward Arrow (Plaque)	21	15	2.2	RWM	6080005										
T-5.15	N03-16	R6-4b	x					12	7	WH	Roundabout Directional (4 Cheverons)	60	24	10.0	RWM	6080005	2	2 1/2S	23	2						
T-5.15	N03-17	R1-1					x				STOP					2020047										
		Special					x				Reflector					2020047										
T-5.15	N03-18	R4-7	x					12	7	WH	Keep Right	24	30	5.0	RWM	6080005	1	2 1/2T	15	1						
		OM3	x							YL	Type 3 Object Marker	12	36	12.0	RWM	6080005										
T-5.15	N03-19	W11-2	x					12	7	YL	Pedestrian	30	30	6.3	RWM	6080005	1	2 1/2T	12	1						
		W16-7PL	x							YL	Diagonal Downward Arrow (Plaque)	21	15	2.2	RWM	6080005										
T-5.16	N04-1	R1-2	x					12	7	RD	Yield	48	48	6.9	RWM	6080005	2	2 1/2T	27	2						
T-5.16	N04-2	E4-101a	x					12	7	GR	US 93 / North / Kingman	7	3	21.0	Ext	6080018	2	2 1/2 T	25	2						
T-5.16	N04-3	W11-2	x					12	7	YL	Pedestrian	36	36	9.0	RWM	6080005	1	2 1/2T	12	1						
		W16-7PL	x							YL	Diagonal Downward Arrow (Plaque)	21	15	2.2	RWM	6080005										

Notes: 1. The Engineer shall verify post lengths and elevations. 2. The engineer may shift a sign in order to achieve a more desirable location. 3. Quantities are approximate and for the contractor's information only. 4. Minimum sheeting type shall be Type IX or XI for all signs.	Panel Types: RWM: Regulatory, Warning, or Marker F-DA: Flat-sheet aluminum with direct applied or silk-screened characters F-Dem: Flat-sheet aluminum with demountable characters Ext: Aluminum extrusions Incr: Aluminum sheet increment Over: Overhead (New overlaid extrusions)		Stringer Types:	P: Square-tube Post T: T-section (WT 3x6)	Post Types:	S: Single perforated T: Telescoping perforated
		BRF: Overhead Bridge Fascia Sign Structure				
		Colors:	BK - BLACK BL - BLUE BR - BROWN	GR - GREEN RD - RED WH - WHITE	YL - FLUORESCENT YELLOW	

		NAME	DATE	ARIZONA DEPARTMENT OF TRANSPORTATION PROJECT DELIVERY AND OPERATIONS DIVISION TRAFFIC DESIGN SERVICES	ROUTE	F.H.W.A. Arizona Division	STATE ARIZ.	PROJECT NO.	FEDERAL ID NO.	SHEET NO.	TOTAL SHEETS	RECORD DRAWING
	DESIGN	I ROBLES	06/26		US 93			093 YV 190	093-B-NFA	361	524	
	DRAWN	C VALENCIA	06/26		MILEPOST			VISTA ROYALE				
	CHECKED	C RICKETTS	06/26	190.5								
	TRANSPORTATION AECOM TECHNICAL SERVICES, Inc. 7720 N. 16th St., Suite 100 Phoenix, Arizona 85020 T 602.371.1100	 www.aecom.com		SIGN SUMMARY US 93 NORTHBOUND	STRUCTURE NO.	TRACS NO. F0738 01C		____ OF ____				

Plan Sht No.	Sign Number	Sign Code	Work						Offset (ft)	Mounting Height (ft)	Background Color	Panel					Ground Mounted			Stringer				Remarks		
			New	Existing								Legend	Width (in)	Height (in)	Area (sq. ft.)	Type	Bid Item Number	Foundations	Posts		New Slipbases	Stringer			Overhead	
				Replace Panel	Relocate Panel	Relocate Str	Remove	To Remain											Type	Total length (ft)		Type	Total Length (ft)		Structure Type	# of Lights
T-5.16	N04-4	W11-2	x					12	7	YL	Pedestrian	36	36	9.0	RWM	6080005	1	2 1/2T	12	1						
		W16-7PR	x							YL	Diagonal Downward Arrow (Plaque)	21	15	2.2	RWM	6080005										
T-5.16	N04-5	D3-1					x				Nine Irons Ranch Rd					2020047										
		R1-1					x				STOP					2020047										
		Special					x				Reflector					2020047										
T-5.16	N04-6	R2-1	x					12	7	WH	SPEED LIMIT 45	36	48	12.0	RWM	6080005	1	2 1/2T	13	1						
T-5.16	N04-7	R2-1	x					12	7	WH	SPEED LIMIT 25	30	36	7.5	RWM	6080005	1	2 1/2S	12	1						
T-5.16	N04-8	E3-101	x					12	7	GR	Caballero Dr	84	18	10.5	RWM	6080005	2	2 1/2S	22	2						
T-5.16	N04-9	E3-101					x				Caballero Dr					2020047										
T-5.16	N04-10	W14-3					x				No Passing Zone					2020047										
T-5.16	N04-11	R3-5bP	x					12	7	WH	Left Lane	30	12	2.5	RWM	6080005	1	2 1/2T	13	1						
		R3-5L	x							WH	Left Turn Only	30	36	7.5	RWM	6080005										
T-5.19	N05-1	D3-1	x					12	7	BR	Caballero Dr	60	12	5.0	F-DA	6080025	2	2 1/2T	27	2						
		R1-1	x							RD	STOP	36	36	7.5	RWM	6080005										
T-5.19	N05-2	Special					x				Reflector					2020047										
T-5.19	N05-3	R16-10					x				Begin Daytime Headlight Section					2020047										
		R101-4aP					x				Next 30 Miles					2020047										
T-5.19	N05-4	D10-3					x				Mile Marker 192					2020047										
T-5.19	N05-5	D10-3	x					12	4	GR	Mile Marker 192					7030095										
T-5.19	N05-6	D14-101	x					12	7	BL	Adopt a Highway	24	12	2.0	F-DA	6080025	1	2S	10	1						

Notes: 1. The Engineer shall verify post lengths and elevations. 2. The engineer may shift a sign in order to achieve a more desirable location. 3. Quantities are approximate and for the contractor's information only. 4. Minimum sheeting type shall be Type IX or XI for all signs.	Panel Types: RWM: Regulatory, Warning, or Marker F-DA: Flat-sheet aluminum with direct applied or silk-screened characters F-Dem: Flat-sheet aluminum with demountable characters Ext: Aluminum extrusions Incr: Aluminum sheet increment Over: Overhead (New overlaid extrusions)		Stringer Types:	P: Square-tube Post T: T-section (WT 3x6)	Post Types:	S: Single perforated T: Telescoping perforated
		BRF: Overhead Bridge Fascia Sign Structure				
		Colors:	BK - BLACK BL - BLUE BR - BROWN	GR - GREEN RD - RED WH - WHITE	YL - FLUORESCENT YELLOW	

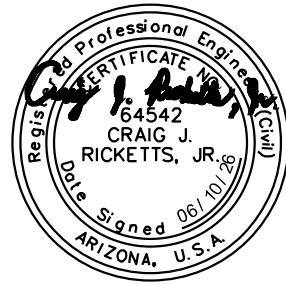	DESIGN	I ROBLES	06/26	ARIZONA DEPARTMENT OF TRANSPORTATION PROJECT DELIVERY AND OPERATIONS DIVISION TRAFFIC DESIGN SERVICES	ROUTE	US 93		F.H.W.A. Arizona Division	STATE	PROJECT NO.	FEDERAL ID NO.	SHEET NO.	TOTAL SHEETS	RECORD DRAWING							
	DRAWN	C VALENCIA	06/26		MILEPOST	190.5															
	CHECKED	C RICKETTS	06/26		STRUCTURE NO.																
	TRANSPORTATION AECOM TECHNICAL SERVICES, Inc. 1722 N. 18th St., Suite 100 Phoenix, Arizona 85020 T 602.371.1700 www.aecom.com 			SIGN SUMMARY US 93 NORTHBOUND											TRACS NO. F0738 01C				DWG No. T-4.11 ____ OF ____		

Plan Sht No.	Sign Number	Sign Code	Work					Offset (ft)	Mounting Height (ft)	Background Color	Panel					Ground Mounted							Remarks			
			New	Existing							Legend	Width (in)	Height (in)	Area (sq. ft.)	Type	Bid Item Number	Foundations	Posts						New Slipbases	Stringer	
				Replace Panel	Relocate Panel	Relocate Str	Remove											To Remain	Type	Total length (ft)	Type	Total Length (ft)			Overhead	
				Structure Type	# of Lights																					
T-5.19	N05-7	D14-101					x				Adopt a Highway					2020047										
T-5.21	N07-1	Special					x				Reflector					2020047										
T-5.21	N07-2	E3-101	x						12	7	GR	Antelope Creek Rd	120	18	15.0	F-DA	6080025	2	2 1/2S	23	2					
T-5.21	N07-3	R3-5bP	x						12	7	WH	Left Lane	30	12	2.5	RWM	6080005	1	2 1/2T	13	1					
		R3-5L	x								WH	Left Turn Only	30	36	7.5	RWM	6080005									
T-5.21	N07-4	D3-1	x						12	7	GR	Antelope Creek Rd	84	12	7.0	F-DA	6080025	2	2 1/2T	22	2					
		R1-1	x								RD	STOP	36	36	7.5	RWM	6080005									
T-5.21	N07-5	OM3-R					x				Type 3 Object Marker					2020047										
T-5.21	N07-6	OM3-R					x				Type 3 Object Marker					2020047										
T-5.22	N08-1	R2-1	x						12	7	WH	SPEED LIMIT 65	48	60	20.0	RWM	6080005	2	2 1/2T	29	2					
T-5.23	N09-1	D10-3					x				Mile Marker 191					2020047										
T-5.23	N09-2	D10-3	x						12	4	GR	Mile Marker 191					7030095									
T-5.23	N09-3	W6-3					x				Two-Way Traffic					2020047										
T-5.23	N09-4	Special					x				Adopt a Highway / Group Name					2020047										
T-5.23	N09-5	Special	x						12	7	GR	Adopt a Highway / Group Name	60	24	10.0	F-DA	6080025	2	2 1/2S	23	2					
T-5.23	N09-6	W6-1					x				Divided Highway					2020047										
		R101-2P					x				1/2 Mile Ahead					2020047										
T-5.25	N11-1	W14-3					x				No Passing Zone					2020047										
T-5.25	N11-2	OM3-R					x				Type 3 Object Marker					2020047										

Notes: 1. The Engineer shall verify post lengths and elevations. 2. The engineer may shift a sign in order to achieve a more desirable location. 3. Quantities are approximate and for the contractor's information only. 4. Minimum sheeting type shall be Type IX or XI for all signs.	Panel Types: RWM: Regulatory, Warning, or Marker F-DA: Flat-sheet aluminum with direct applied or silk-screened characters F-Dem: Flat-sheet aluminum with demountable characters Ext: Aluminum extrusions Incr: Aluminum sheet increment Over: Overhead (New overlaid extrusions)		Stringer P: Square-tube Post Types: T: T-section (WT 3x6)	Post S: Single perforated Types: T: Telescoping perforated
		BRF: Overhead Bridge Fascia Sign Structure		
		Colors:	BK - BLACK BL - BLUE BR - BROWN	GR - GREEN RD - RED WH - WHITE

	DESIGN	NAME	DATE	ARIZONA DEPARTMENT OF TRANSPORTATION PROJECT DELIVERY AND OPERATIONS DIVISION TRAFFIC DESIGN SERVICES			ROUTE	F.H.W.A. Arizona Division	STATE	PROJECT NO.	FEDERAL ID NO.	SHEET NO.	TOTAL SHEETS	RECORD DRAWING
	DRAWN	C VALENCIA	06/26				US 93		ARIZ.	093 YV 190	093-B-NFA	363	524	
	CHECKED	C RICKETTS	06/26				MILEPOST 190.5	LOCATION VISTA ROYALE						
	TRANSPORTATION AECOM TECHNICAL SERVICES, Inc. 7720 N. 16th St., Suite 100 Phoenix, Arizona 85027 T 602.371.1100 			SIGN SUMMARY US 93 NORTHBOUND			STRUCTURE NO.	TRACS NO. F0738 01C		DWG No. T-4.12 ____ OF ____				

Plan Sht No.	Sign Number	Sign Code	Work					Offset (ft)	Mounting Height (ft)	Background Color	Panel					Ground Mounted							Remarks			
			New	Existing							Legend	Width (in)	Height (in)	Area (sq. ft.)	Type	Bid Item Number	Foundations	Posts						New Slipbases	Stringer	
				Replace Panel	Relocate Panel	Relocate Str	Remove											To Remain	Type	Total length (ft)	Type	Total Length (ft)			Overhead	
				Structure Type	# of Lights																					
T-5.25	N11-3	OM3-R	x					6	4	YL	Type 3 Object Marker					7030080										
T-5.25	N11-4	OM3-R	x					6	4	YL	Type 3 Object Marker					7030080										
T-5.25	N11-5	OM3-R					x				Type 3 Object Marker					2020047										
T-5.26	N12-1	R4-7					x				Keep Right					2020047										
		OM1-2					x				Type 1 Object Marker					2020047										
T-5.26	N12-2	OM3-R					x				Type 3 Object Marker					2020047										
T-5.26	N12-3	M3-1					x				North					2020047										
		M1-4					x				US 93					2020047										
T-5.26	N12-4	M3-1	x					12	7	WH	North	24	12	2.0	RWM	6080005	1	2 1/2S	12	1						
		M1-4	x							WH	US 93	24	24	4.0	RWM	6080005										
T-5.26	N12-5	R5-1a					x				Wrong Way					2020047										
T-5.26	N12-6	R5-1a					x				Wrong Way					2020047										
T-5.26	N12-7	R5-1					x				Do Not Enter					2020047										
T-5.26	N12-8	R5-1					x				Do Not Enter					2020047										
T-5.26	N12-9	D10-3					x				Mile Marker 190					2020047										
T-5.26	N12-10	D10-3	x					12	4	GR	Mile Marker 190					7030095										
T-5.27	N13-1	R1-1					x				STOP					2020047										
T-5.27	N13-2	R1-1	x					12	7	RD	STOP	36	36	7.5	RWM	6080005	1	2 1/2T	12	1						
T-5.27	N13-3	R2-1					x				SPEED LIMIT 65					2020047										

Notes:
1. The Engineer shall verify post lengths and elevations.

2. The engineer may shift a sign in order to achieve a more desirable location.

3. Quantities are approximate and for the contractor's information only.

4. Minimum sheeting type shall be Type IX or XI for all signs.

Panel Types:
RWM: Regulatory, Warning, or Marker
F-DA: Flat-sheet aluminum with direct applied or silk-screened characters
F-Dem: Flat-sheet aluminum with demountable characters
Ext: Aluminum extrusions
Incr: Aluminum sheet increment
Over: Overhead (New overlaid extrusions)

Stringer Types: P: Square-tube Post
T: T-section (WT 3x6)

Post Types: S: Single perforated
T: Telescoping perforated

BRF: Overhead Bridge Fascia Sign Structure

Colors: BK - BLACK
BL - BLUE
BR - BROWNGR - GREEN
RD - RED
WH - WHITEYL - FLUORESCENT
YELLOW

	DESIGN			NAME	DATE	ARIZONA DEPARTMENT OF TRANSPORTATION PROJECT DELIVERY AND OPERATIONS DIVISION TRAFFIC DESIGN SERVICES			ROUTE	US 93	F.H.W.A. Arizona Division	STATE ARIZ.	PROJECT NO. 093 YV 190	FEDERAL ID NO. 093-B-NFA	SHEET NO. 364	TOTAL SHEETS 524	RECORD DRAWING
	DRAWN			C VALENCIA	06/26				MILEPOST	190.5							
	CHECKED			C RICKETTS	06/26				STRUCTURE NO.								
				SIGN SUMMARY US 93 NORTHBOUND			VISTA ROYALE			TRACS NO. F0738 01C			DWG No. T-4.13 ____ OF ____				

c:\pwworking\usaz\dms09242\i0738_ss05.dgn
6/10/2026 @2:44:51 PM ValenciaReyesC

Plan Sht No.	Sign Number	Sign Code	Work					Offset (ft)	Mounting Height (ft)	Background Color	Panel					Ground Mounted							Remarks		
			New	Existing							Legend	Width (in)	Height (in)	Area (sq. ft.)	Type	Bid Item Number	Foundations	Posts						New Slipbases	Stringer
				Replace Panel	Relocate Panel	Relocate Str	Remove											To Remain	Type	Total length (ft)	Total Length (ft)	Overhead			
				Structure Type	# of Lights																				
T-5.13	S01-1	D14-101					x					Adopt A Highway					2020047								
		Special					x					TCS ADOT					2020047								
T-5.13	S01-2	D14-101	x						12	7	BL	Adopt a Highway	24	12	2.0	F-DA	6080025	1	2S	11	1				
		Special	x								GR	TCS ADOT	12	12	1.0	F-DA	6080025								
T-5.13	S01-3	D10-3					x					Mile Marker 193					2020047								
T-5.13	S01-4	D10-3	x						12	4	GR	Mile Marker 193					7030095								
T-5.13	S01-5	R2-1					x					SPEED LIMIT 55					2020047								
T-5.13	S01-6	M2-101	x						12	7	GR	JUNCTION / SR 89 / 1/2 MILE	48	60	20.0	F-DA	6080025	2	2 1/2T	29	2				
T-5.15	S03-1	W3-5aAZ					x					Speed Reduced Ahead					2020047								
T-5.15	S03-2	W14-3					x					No Passing Zone					2020047								
T-5.15	S03-3	E4-101a	x						12	7	GR	93 South / Wickenburg	7	3	21.0	Ext	6080018	2	2 1/2 T	25	2				
T-5.15	S03-4	R2-1	x						12	7	WH	SPEED LIMIT 45	36	48	12.0	RWM	6080005	1	2 1/2T	13	1				
T-5.15	S03-5	W11-2	x						12	7	YL	Pedestrian	36	36	9.0	RWM	6080005	1	2 1/2T	12	1				
		W16-7PR	x								YL	Diagonal Downward Arrow (Plaque)	21	15	2.2	RWM	6080005								
T-5.15	S03-6	OM3-R					x					Type 3 Object Marker					2020047								
T-5.15	S03-7	OM3-R					x					Type 3 Object Marker					2020047								
T-5.15	S03-8	R1-2	x						12	7	RD	Yield	48	48	6.9	RWM	6080005	2	2 1/2T	27	2				

Notes:

1. The Engineer shall verify post lengths and elevations.

2. The engineer may shift a sign in order to achieve a more desirable location.

3. Quantities are approximate and for the contractor's information only.

4. Minimum sheeting type shall be Type IX or XI for all signs.

Panel Types:

RWM: Regulatory, Warning, or Marker

F-DA: Flat-sheet aluminum with direct applied or silk-screened characters

F-Dem: Flat-sheet aluminum with demountable characters

Ext: Aluminum extrusions

Incr: Aluminum sheet increment

Over: Overhead (New overlaid extrusions)

Stringer Types:

P: Square-tube Post

T: T-section (WT 3x6)

Post Types:

S: Single perforated

T: Telescoping perforated

BRF: Overhead Bridge Fascia Sign Structure

Colors:

BK - BLACK

BL - BLUE

BR - BROWN

GR - GREEN

RD - RED

WH - WHITE

YL - FLUORESCENT YELLOW

DESIGN

DRAWN

CHECKED

NAME

I ROBLES

C VALENCIA

C RICKETTS

DATE

06/26

06/26

06/26

TRANSPORTATION

AECOM TECHNICAL SERVICES, Inc.

7720 N. 16th St., Suite 100

Phoenix, Arizona 85020

T 602.371.1100

AECOM

www.aecom.com

ARIZONA DEPARTMENT OF TRANSPORTATION

PROJECT DELIVERY AND OPERATIONS DIVISION

TRAFFIC DESIGN SERVICES

ROUTE

US 93

MILEPOST

190.5

STRUCTURE NO.

F.H.W.A. Arizona Division

STATE

ARIZ.

PROJECT NO.

093 YV 190

FEDERAL ID NO.

093-B-NFA

SHEET NO.

365

TOTAL SHEETS

524

RECORD DRAWING

LOCATION

VISTA ROYALE

TRACS NO.

F0738 01C

DWG No.

T-4.14

OF

Plan Sht No.	Sign Number	Sign Code	Work						Offset (ft)	Mounting Height (ft)	Background Color	Panel					Ground Mounted							Remarks			
			New	Existing								Legend	Width (in)	Height (in)	Area (sq. ft.)	Type	Bid Item Number	Foundations	Posts						Stringer		
				Replace Panel	Relocate Panel	Relocate Str	Remove	To Remain											Type	Total length (ft)	New Slipbases	Total Length (ft)	Overhead				
																							Structure Type		# of Lights		
T-5.15	S03-9	W11-2	x						12	7	YL	Pedestrian	36	36	9.0	RWM	6080005	1	2 1/2T	12	1						
		W16-7PL	x								YL	Diagonal Downward Arrow (Plaque)	21	15	2.2	RWM	6080005										
T-5.15	S03-10	R6-4b	x						12	7	WH	Roundabout Directional (4 Cheverons)	60	24	10.0	RWM	6080005	2	2 1/2S	23	2						
T-5.15	S03-11	R6-4b	x						12	7	WH	Roundabout Directional (4 Cheverons)	60	24	10.0	RWM	6080005	2	2 1/2S	23	2						
T-5.15	S03-12	D1-1d	x						12	7	GR	Moreton Rd	84	18	10.5	F-DA	6080025	2	2 1/2S	22	2						
T-5.15	S03-13	W11-2	x						12	7	YL	Pedestrian	30	30	6.3	RWM	6080005	1	2 1/2T	14	1						
		W16-7PL	x								YL	Diagonal Downward Arrow (Plaque)	21	15	2.2	RWM	6080005										
T-5.15	S03-14	R4-7	x						12	7	WH	Keep Right	24	30	5.0	RWM	6080005	1	2 1/2S	12	1						
T-5.15	S03-15	W11-2	x						12	7	YL	Pedestrian	36	36	9.0	RWM	6080005	1	2 1/2T	12	1						
		W16-7PL	x								YL	Diagonal Downward Arrow (Plaque)	21	15	2.2	RWM	6080005										
T-5.16	S04-1	R1-2	x						12	7	RD	Yield	48	48	6.9	RWM	6080005	2	2 1/2T	27	2						
T-5.16	S04-2	R1-2	x						12	7	RD	Yield	48	48	6.9	RWM	6080005	2	2 1/2T	27	2						
T-5.16	S04-3	W11-2	x						12	7	YL	Pedestrian	36	36	9.0	RWM	6080005	1	2 1/2T	12	1						
		W16-7PL	x								YL	Diagonal Downward Arrow (Plaque)	21	15	2.2	RWM	6080005										
T-5.16	S04-4	W11-2	x						12	7	YL	Pedestrian	36	36	9.0	RWM	6080005	1	2 1/2T	12	1						
		W16-7PR	x								YL	Diagonal Downward Arrow (Plaque)	21	15	2.2	RWM	6080005										
T-5.16	S04-5	R3-6R	x						12	7	WH	Through-Right	30	36	7.5	RWM	6080005	1	2 1/2S	12	1						
T-5.16	S04-6	R3-6L	x						12	7	WH	Through-Left	30	36	7.5	RWM	6080005	1	2 1/2S	12	1						
T-5.16	S04-7	Guide	x						12	7	GR	North 93 / Moreton Rd / Nine Irons Ranch Rd	222	108	166.5	Ext	6080018	3	W8X18	54							

Notes: 1. The Engineer shall verify post lengths and elevations. 2. The engineer may shift a sign in order to achieve a more desirable location. 3. Quantities are approximate and for the contractor's information only. 4. Minimum sheeting type shall be Type IX or XI for all signs.	Panel Types: RWM: Regulatory, Warning, or Marker F-DA: Flat-sheet aluminum with direct applied or silk-screened characters F-Dem: Flat-sheet aluminum with demountable characters Ext: Aluminum extrusions Incr: Aluminum sheet increment Over: Overhead (New overlaid extrusions)		Stringer P: Square-tube Post Types: T: T-section (WT 3x6)	Post S: Single perforated Types: T: Telescoping perforated	
		BRF:	Overhead Bridge Fascia Sign Structure		
		Colors:	BK - BLACK BL - BLUE BR - BROWN	GR - GREEN RD - RED WH - WHITE	YL - FLUORESCENT YELLOW

		NAME	DATE	ARIZONA DEPARTMENT OF TRANSPORTATION PROJECT DELIVERY AND OPERATIONS DIVISION TRAFFIC DESIGN SERVICES	ROUTE	F.H.W.A. Arizona Division	STATE	PROJECT NO.	FEDERAL ID NO.	SHEET NO.	TOTAL SHEETS	RECORD DRAWING
	DESIGN	I ROBLES	06/26		MILEPOST			190.5	LOCATION	VISTA ROYALE	DWG No. T-4.15	
	DRAWN	C VALENCIA	06/26		STRUCTURE NO.							TRACS NO. F0738 01C
	CHECKED	C RICKETTS	06/26									
	TRANSPORTATION AECOM TECHNICAL SERVICES, Inc. 7720 N. 16th St., Suite 100 Phoenix, Arizona 85020 T 602.371.1100				SIGN SUMMARY US 93 SOUTHBOUND							

Plan Sht No.	Sign Number	Sign Code	Work						Offset (ft)	Mounting Height (ft)	Background Color	Panel					Ground Mounted			Stringer				Remarks			
			New	Existing								Legend	Width (in)	Height (in)	Area (sq. ft.)	Type	Bid Item Number	Foundations	Posts		New Slipbases	Stringer			Overhead		
				Replace Panel	Relocate Panel	Relocate Str	Remove	To Remain											Type	Total length (ft)		Type	Total Length (ft)		Structure Type	# of Lights	
T-5.16	S04-8	W2-6	x					12	7	YL	Roundabout	48	48	16.0	RWM	6080005	2	2 1/2T	29	2							
		W13-1P	x							YL	20 M.P.H	30	30	6.3	RWM	6080005											
T-5.19	S05-1	R8-3					x				No Parking (Symbol)					2020047											
		R8-3					x				No Parking (Symbol)					2020047											
T-5.19	S05-2	R1-1					x				STOP					2020047											
		Special					x				Reflector					2020047											
T-5.19	S05-3	D3-1	x					12	7	BR	Caballero Dr	60	12	5.0	F-DA	6080025	2	2 1/2T	27	2							
		R1-1	x							RD	STOP	36	36	7.5	RWM	6080005											
T-5.19	S05-4	R8-3					x				No Parking (Symbol)					2020047											
		R8-3					x				No Parking (Symbol)					2020047											
T-5.19	S05-5	R3-5bP	x					12	7	WH	Left Lane	30	12	2.5	RWM	6080005	1	2 1/2T	13	1							
		R3-5L	x							WH	Left Turn Only	30	36	7.5	RWM	6080005											
T-5.19	S05-6	R3-5fP	x					12	7	WH	Right Lane	30	12	2.5	RWM	6080005	1	2 1/2T	13	1							
		R3-5R	x							WH	Right Turn Only	30	36	7.5	RWM	6080005											
		D10-3	x							GR	Mile Marker 192					7030095											
T-5.19	S05-7	R16-11					x				End Daytime Headlight Section					2020047											
T-5.19	S05-8	D10-3					x				Mile Marker 192					2020047											
T-5.19	S05-9	E3-101					x				Caballero Dr					2020047											
T-5.19	S05-10	E3-101	x					12	7	GR	Caballero Dr	84	18	10.5	RWM	6080005	2	2 1/2S	22	2							
T-5.19	S05-11	W14-3					x				No Passing Zone					2020047											
T-5.20	S06-1	R2-1	x					12	7	WH	SPEED LIMIT 45	36	48	12.0	RWM	6080005	1	2 1/2T	13	1							

Notes: 1. The Engineer shall verify post lengths and elevations. 2. The engineer may shift a sign in order to achieve a more desirable location. 3. Quantities are approximate and for the contractor's information only. 4. Minimum sheeting type shall be Type IX or XI for all signs.	Panel Types: RWM: Regulatory, Warning, or Marker F-DA: Flat-sheet aluminum with direct applied or silk-screened characters F-Dem: Flat-sheet aluminum with demountable characters Ext: Aluminum extrusions Incr: Aluminum sheet increment Over: Overhead (New overlaid extrusions)		Stringer Types:	P: Square-tube Post T: T-section (WT 3x6)	Post Types:	S: Single perforated T: Telescoping perforated	
		BRF:	Overhead Bridge Fascia Sign Structure				
		Colors:	BK - BLACK BL - BLUE BR - BROWN	GR - GREEN RD - RED WH - WHITE	YL - FLUORESCENT YELLOW		


	DESIGN	I ROBLES	06/26	ARIZONA DEPARTMENT OF TRANSPORTATION PROJECT DELIVERY AND OPERATIONS DIVISION TRAFFIC DESIGN SERVICES	ROUTE	F.H.W.A. Arizona Division		STATE	PROJECT NO.	FEDERAL ID NO.	SHEET NO.	TOTAL SHEETS	RECORD DRAWING
	DRAWN	C VALENCIA	06/26		US 93	ARIZ.		093 YV 190	093-B-NFA	367	524		
	CHECKED	C RICKETTS	06/26		MILEPOST	VISTA ROYALE							
	TRANSPORTATION AECOM TECHNICAL SERVICES, Inc. 7720 N. 16th St., Suite 100 Phoenix, Arizona 85020 T 602.371.1100			SIGN SUMMARY US 93 SOUTHBOUND		STRUCTURE NO.		TRACS NO. F0738 01C		DWG No. T-4.16 ____ OF ____			

Plan Sht No.	Sign Number	Sign Code	Work							Mounting Height (ft)	Background Color	Panel					Ground Mounted							Remarks		
			New	Existing					Legend			Width (in)	Height (in)	Area (sq. ft.)	Type	Bid Item Number	Foundations	Posts							New Slipbases	Stringer
				Replace Panel	Relocate Panel	Relocate Str	Remove	To Remain										Type	Total length (ft)	Total Length (ft)	Overhead					
				Offset (ft)	Structure Type	# of Lights																				
T-5.21	S07-1	R2-1	x						12	7	WH	SPEED LIMIT 25	30	36	7.5	RWM	6080005	1	2 1/2S	12	1					
T-5.21	S07-2	D3-1	x						12	7	BR	Antelope Creek Rd	84	12	7.0	F-DA	6080025	2	2 1/2T	22	2					
		R1-1	x								RD	STOP	36	36	7.5	RWM	6080005									
T-5.21	S07-3	R3-5bP	x						12	7	WH	Left Lane	30	12	2.5	RWM	6080005	1	2 1/2T	13	1					
		R3-5L	x								WH	Left Turn Only	30	36	7.5	RWM	6080005									
T-5.21	S07-4	OM3-R					x					Type 3 Object Marker					2020047									
T-5.21	S07-5	OM3-R					x					Type 3 Object Marker					2020047									
T-5.22	S08-1	E3-101	x						12	7	GR	Antelope Creek Rd	120	18	15.0	F-DA	6080025	2	2 1/2S	23	2					
T-5.22	S08-2	R2-1	x						12	7	WH	SPEED LIMIT 45	48	60	20.0	RWM	6080005	2	2 1/2T	29	2					
T-5.22	S08-3	W3-5	x						12	7	YL	Reduced Speed Limit Ahead (45)	48	48	16.0	RWM	6080005									Mount on Advanced Warning Flasher Pole
T-5.22	S08-4	W3-5	x						12	7	YL	Reduced Speed Limit Ahead (45)	48	48	16.0	RWM	6080005									Mount on Advanced Warning Flasher Pole
T-5.23	S09-1	D14-101					x					Adopt A Highway					2020047									
T-5.23	S09-2	D10-3	x						12	4	GR	Mile Marker 191					7030095									
T-5.23	S09-3	W6-3					x					Two Way Traffic					2020047									
T-5.23	S09-4	D10-3					x					Mile Marker 191					2020047									
T-5.24	S10-1	R2-1	x						12	7	WH	SPEED LIMIT 55	48	60	20.0	RWM	6080005	2	2 1/2T	29	2					
T-5.25	S11-1	OM3-R	x						6	4	YL	Type 3 Object Marker					7030080									
T-5.25	S11-2	OM3-R	x						6	4	YL	Type 3 Object Marker					7030080									

Notes: 1. The Engineer shall verify post lengths and elevations. 2. The engineer may shift a sign in order to achieve a more desirable location. 3. Quantities are approximate and for the contractor's information only. 4. Minimum sheeting type shall be Type IX or XI for all signs.	Panel Types: RWM: Regulatory, Warning, or Marker F-DA: Flat-sheet aluminum with direct applied or silk-screened characters F-Dem: Flat-sheet aluminum with demountable characters Ext: Aluminum extrusions Incr: Aluminum sheet increment Over: Overhead (New overlaid extrusions)		Stringer Types:	P: Square-tube Post T: T-section (WT 3x6)	Post Types:	S: Single perforated T: Telescoping perforated
		BRF: Overhead Bridge Fascia Sign Structure				
		Colors:	BK - BLACK BL - BLUE BR - BROWN	GR - GREEN RD - RED WH - WHITE	YL - FLUORESCENT YELLOW	

	DESIGN	I ROBLES	06/26	ARIZONA DEPARTMENT OF TRANSPORTATION PROJECT DELIVERY AND OPERATIONS DIVISION TRAFFIC DESIGN SERVICES	ROUTE	F.H.W.A. Arizona Division	STATE ARIZ.	PROJECT NO. 093 YV 190	FEDERAL ID NO. 093-B-NFA	SHEET NO. 368	TOTAL SHEETS 524	RECORD DRAWING
	DRAWN	C VALENCIA	06/26		MILEPOST							
	CHECKED	C RICKETTS	06/26		190.5							
	TRANSPORTATION AECOM TECHNICAL SERVICES, Inc. 7720 N. 16th St., Suite 100 Phoenix, Arizona 85020 T 602.371.1100  www.aecom.com				SIGN SUMMARY US 93 SOUTHBOUND		LOCATION VISTA ROYALE		DWG No. T-4.17			
					STRUCTURE NO.	TRACS NO. F0738 01C				____ OF ____		



Plan Sht No.	Sign Number	Sign Code	Work					Offset (ft)	Mounting Height (ft)	Background Color	Panel					Ground Mounted							Remarks			
			New	Existing							Legend	Width (in)	Height (in)	Area (sq. ft.)	Type	Bid Item Number	Foundations	Posts						New Slipbases	Stringer	
				Replace Panel	Relocate Panel	Relocate Str	Remove											To Remain	Type	Total length (ft)	Type	Total Length (ft)				
																									Structure Type	# of Lights
T-5.25	S11-3	OM3-R					x				Type 3 Object Marker					2020047										
T-5.25	S11-4	OM3-R					x				Type 3 Object Marker					2020047										
T-5.26	S12-1	R5-1					x				Do Not Enter					2020047										
T-5.26	S12-2	W6-3					x				Two-Way Traffic					2020047										
T-5.26	S12-3	W6-3					x				Two-Way Traffic					2020047										
T-5.26	S12-4	R5-1a					x				Wrong Way					2020047										
T-5.26	S12-5	R5-1a					x				Wrong Way					2020047										
T-5.26	S12-6	D10-3					x				Mile Marker 190					2020047										
T-5.26	S12-7	D10-3	x					12	4	GR	Mile Marker 190					7030095										
T-5.27	S13-1	W1-4					x				Horizontal Alignment					2020047										

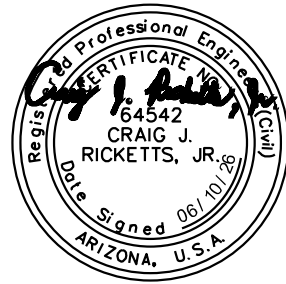Notes: 1. The Engineer shall verify post lengths and elevations. 2. The engineer may shift a sign in order to achieve a more desirable location. 3. Quantities are approximate and for the contractor's information only. 4. Minimum sheeting type shall be Type IX or XI for all signs.	Panel Types: RWM: Regulatory, Warning, or Marker F-DA: Flat-sheet aluminum with direct applied or silk-screened characters F-Dem: Flat-sheet aluminum with demountable characters Ext: Aluminum extrusions Incr: Aluminum sheet increment Over: Overhead (New overlaid extrusions)					Stringer P: Square-tube Post Types: T: T-section (WT 3x6)		Post S: Single perforated Types: T: Telescoping perforated																	
				BRF: Overhead Bridge Fascia Sign Structure																					
				Colors:		BK - BLACK BL - BLUE BR - BROWN		GR - GREEN RD - RED WH - WHITE		YL - FLUORESCENT YELLOW															
			<table><tr><td>DESIGN</td><td>I ROBLES</td><td>06/26</td></tr><tr><td>DRAWN</td><td>C VALENCIA</td><td>06/26</td></tr><tr><td>CHECKED</td><td>C RICKETTS</td><td>06/26</td></tr></table> TRANSPORTATION AECOM TECHNICAL SERVICES, Inc. 7720 N. 16th St., Suite 100 Phoenix, Arizona 85020 T 602.371.1100 AECOM www.aecom.com		DESIGN	I ROBLES	06/26	DRAWN	C VALENCIA	06/26	CHECKED	C RICKETTS	06/26	ARIZONA DEPARTMENT OF TRANSPORTATION PROJECT DELIVERY AND OPERATIONS DIVISION TRAFFIC DESIGN SERVICES		ROUTE		F.H.W.A. Arizona Division		STATE	PROJECT NO.	FEDERAL ID NO.	SHEET NO.	TOTAL SHEETS	RECORD DRAWING
					DESIGN	I ROBLES	06/26																		
					DRAWN	C VALENCIA	06/26																		
					CHECKED	C RICKETTS	06/26																		
US 93		ARIZ.		093 YV 190	093-B-NFA	369	524																		
MILEPOST		VISTA ROYALE																							
190.5																									
STRUCTURE NO.		SIGN SUMMARY US 93 SOUTHBOUND				TRACS NO. F0738 01C						DWG No. T-4.18													
														____ OF ____											

[illegible]

F.H.W.A. REGION	STATE	PROJECT NO.	SHEET NO.	TOTAL SHEETS	RECORD DRAWING
9	ARIZ.	093-B(230)T	375	524	

093 YV 189

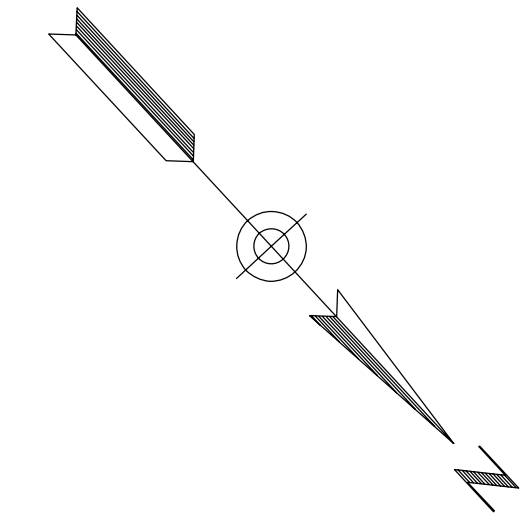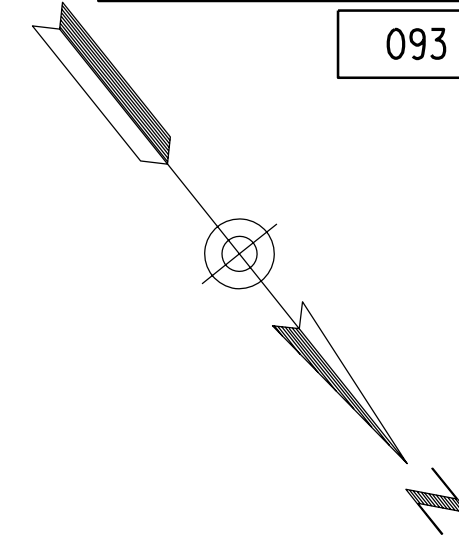

MATCH LINE SEE BELOW LEFT

MATCH LINE
STA 135+00




		NAME		DATE		ARIZONA DEPARTMENT OF TRANSPORTATION PROJECT DELIVERY AND OPERATIONS DIVISION TRAFFIC DESIGN SERVICES			
DESIGN		MEI		06/26		US 93 EXISTING SIGNING BEGIN PROJECT TO STA 135+00		DWG NO. T-5.01 _____ <i>OF</i> _____	
DRAWN		SRH		06/26					
CHECKED		BMT		06/26					
 Stanley Consultants INC.		3133 East Camelback Road, Suite 100 Phoenix, Arizona 85016 Phone: (602) 333-2200							
ROUTE		LOCATION							
US 93		WICKENBURG RANCH WAY TO VISTA ROYALE							
TRACS NO. F0738 OIC						093-B(230)T			

NOTES

1. Remove existing flexible delineators between Sta. 126+00 and Sta. 147+00 along both NB and SB US 93.


6/11/2026

... \t0738A sq_rem01.dgn EX SIGNS T-5.01

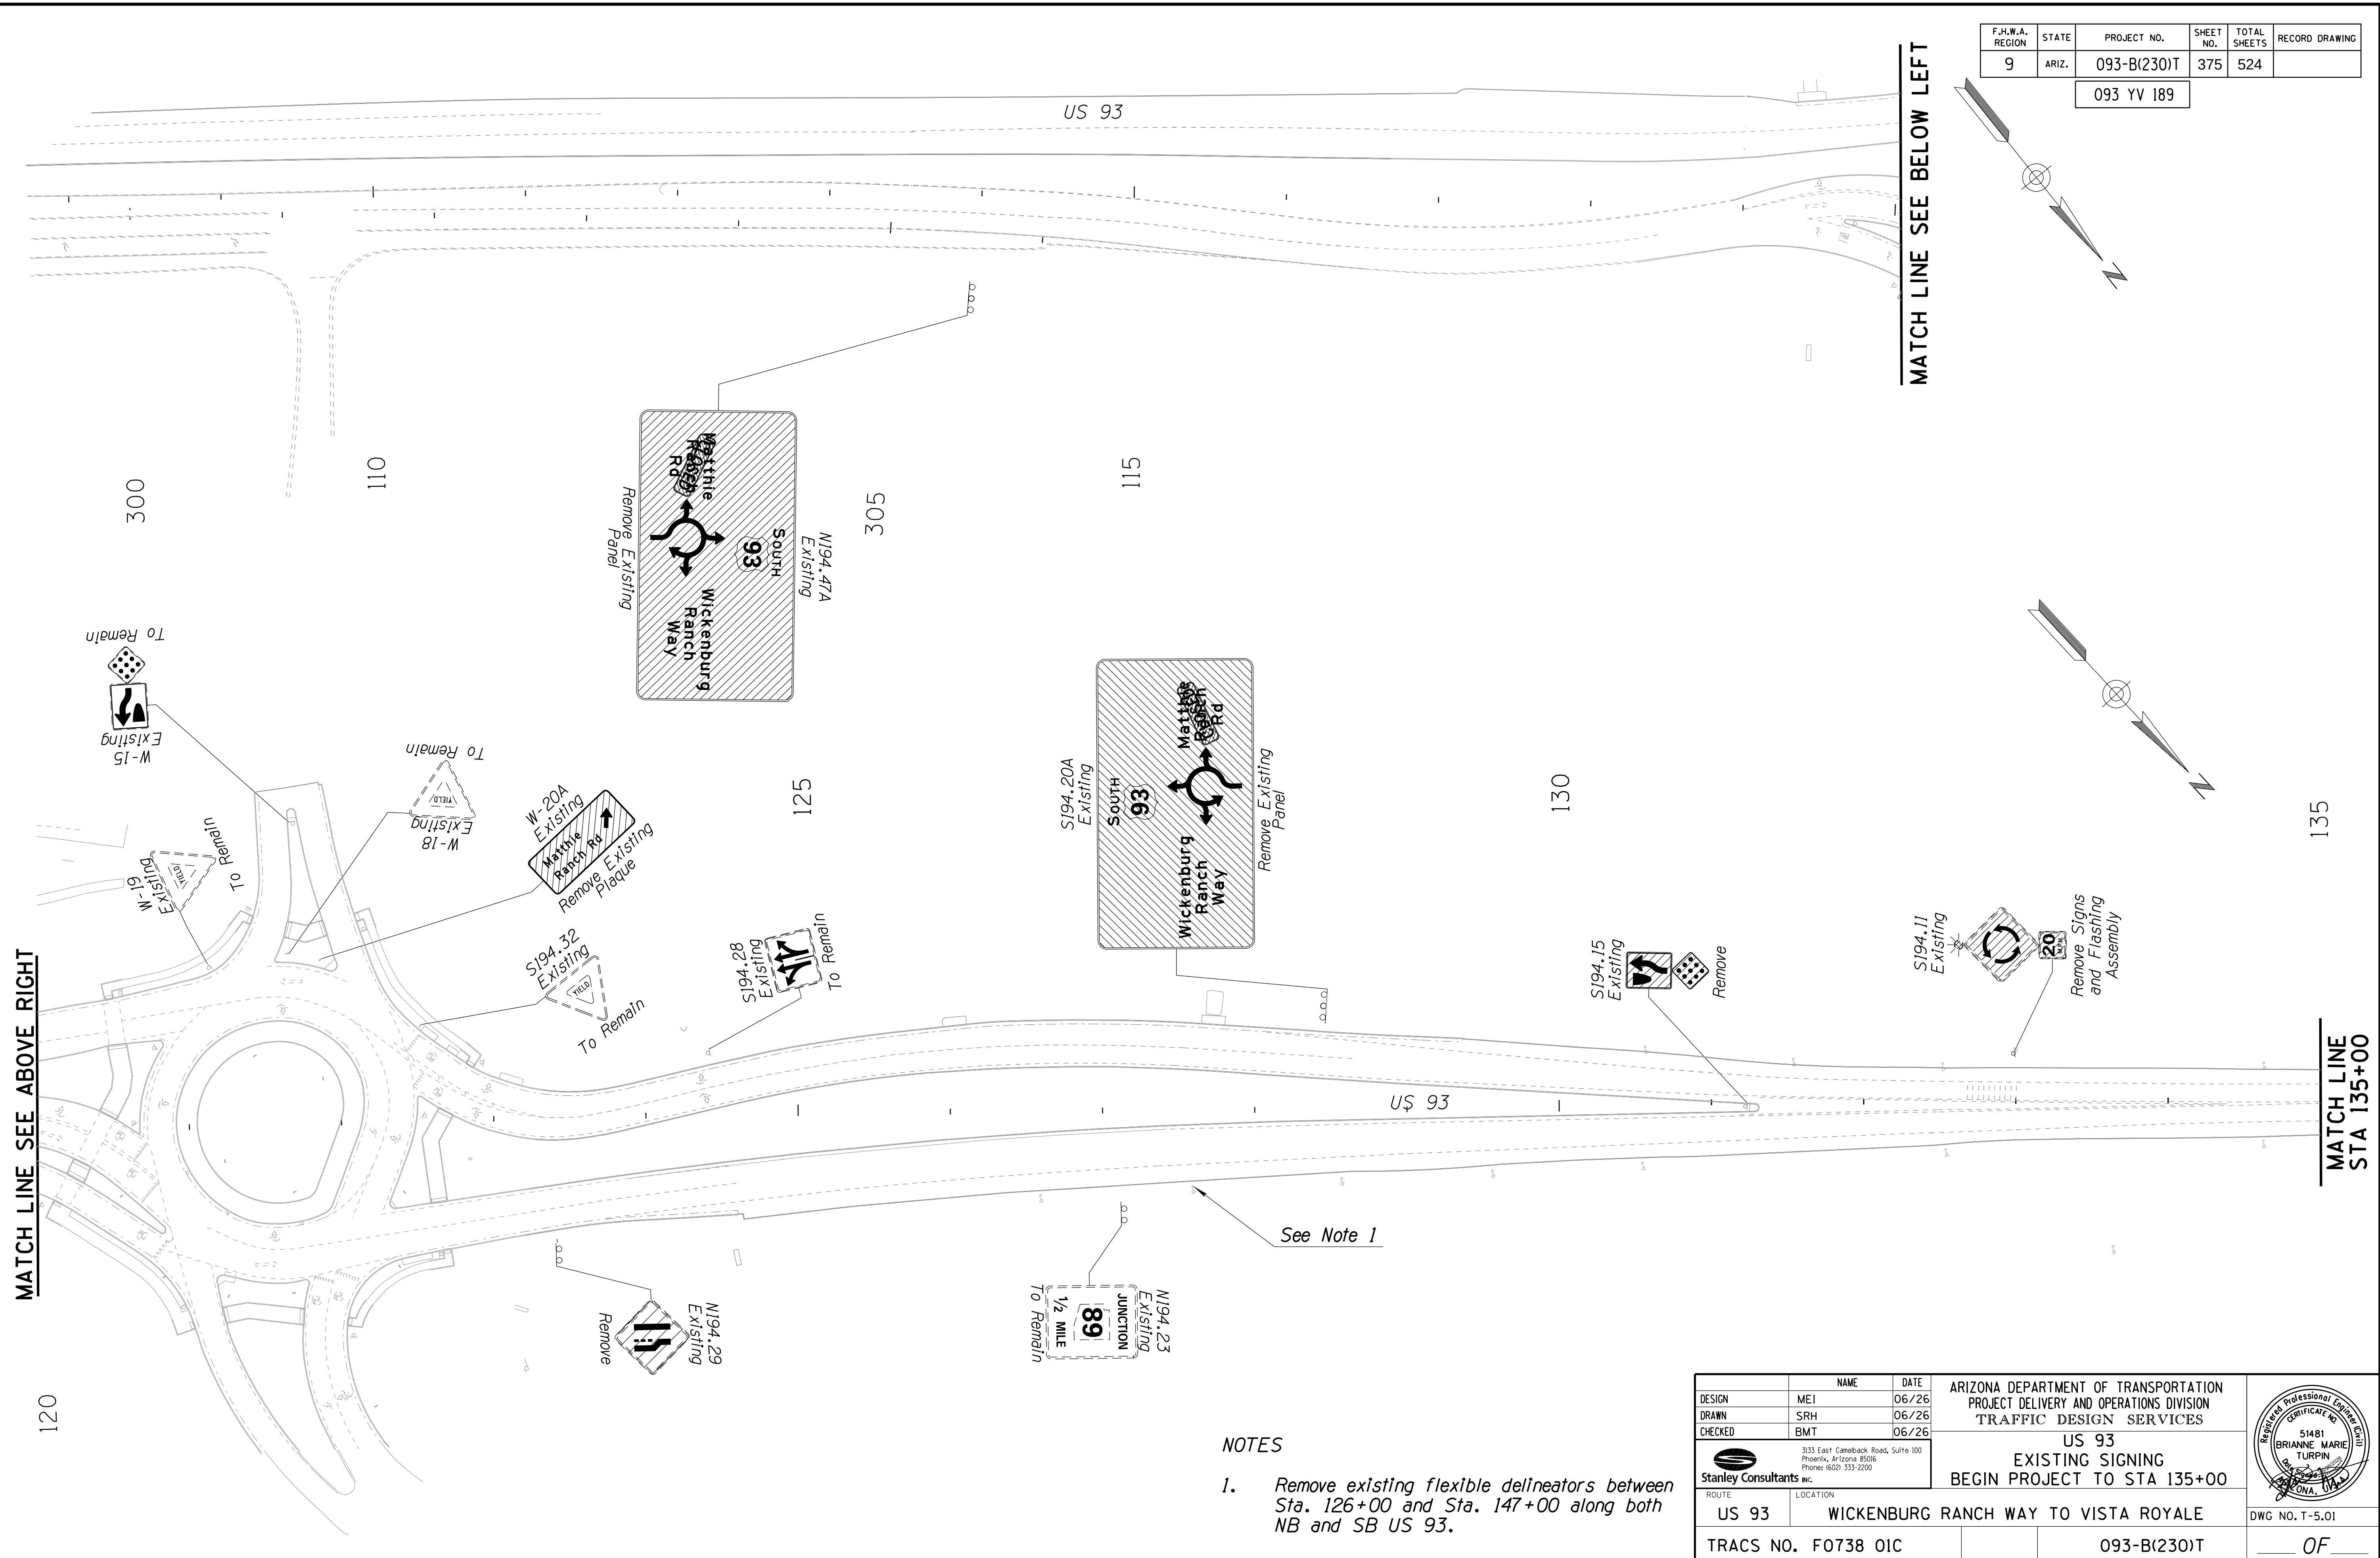

F.H.W.A. REGION	STATE	PROJECT NO.	SHEET NO.	TOTAL SHEETS	RECORD DRAWING
9	ARIZ.	093-B(230)T	376	524	

093 YV 189

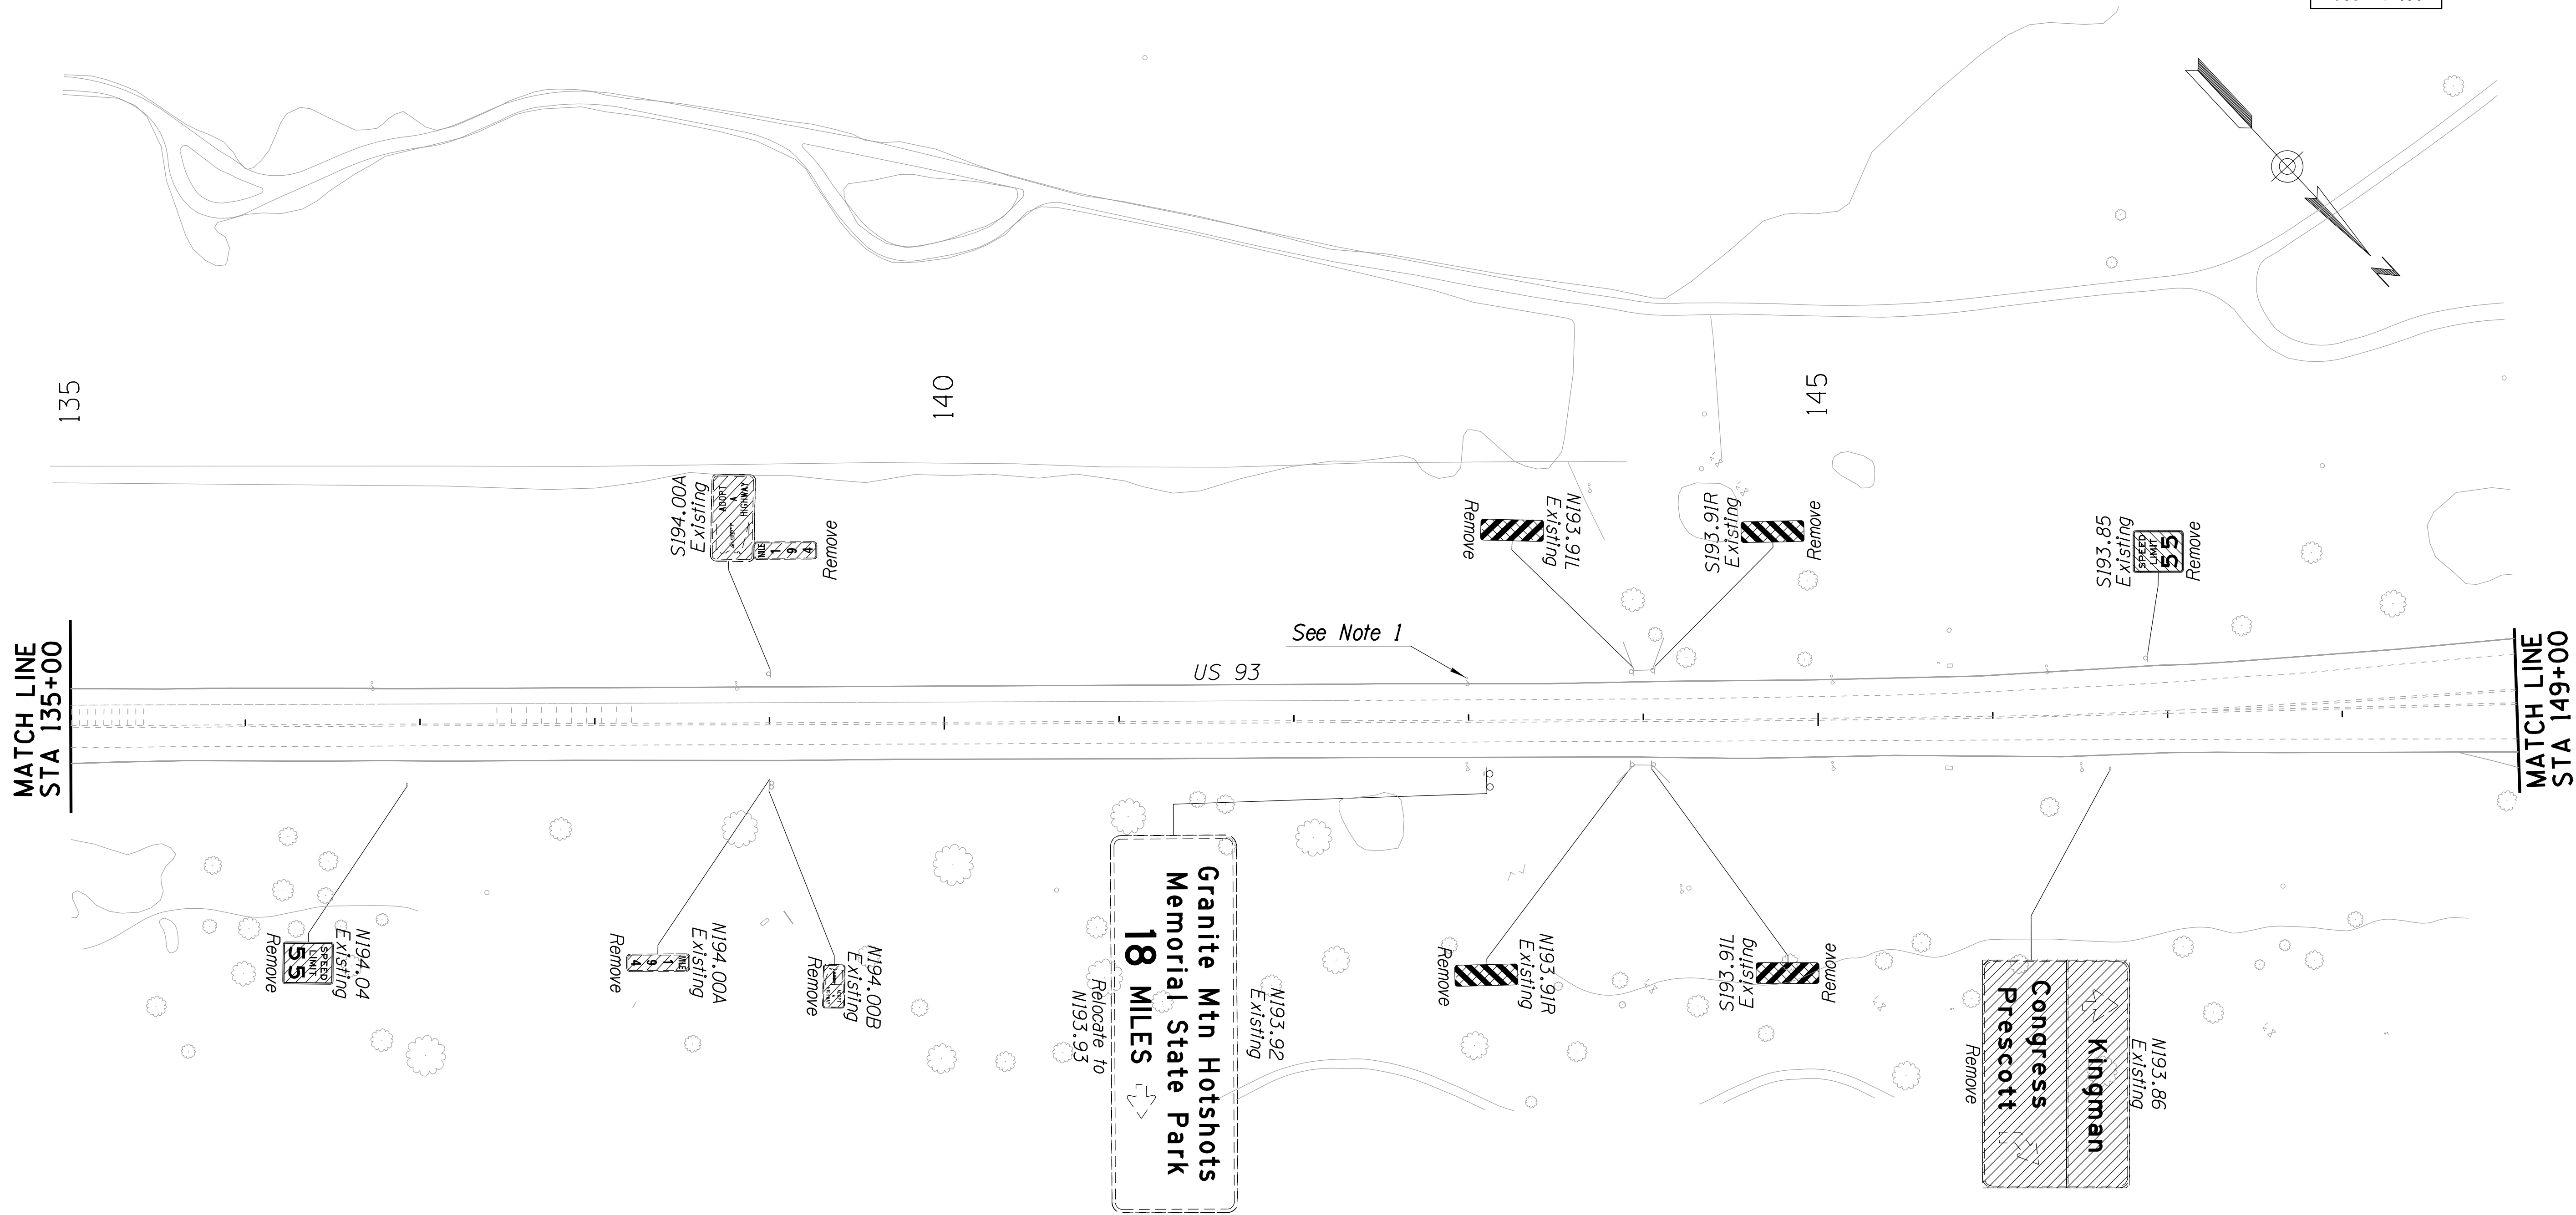


NOTES

1. Remove existing flexible delineators between Sta. 126+00 and Sta. 147+00 along both NB and SB US 93.

		NAME		DATE	ARIZONA DEPARTMENT OF TRANSPORTATION PROJECT DELIVERY AND OPERATIONS DIVISION TRAFFIC DESIGN SERVICES US 93 EXISTING SIGNING STA 135+00 TO STA 149+00	
DESIGN		ME1		06/26		
DRAWN		SRH		06/26		
CHECKED		BMT		06/26		
 Stanley Consultants Inc.		3133 East Camelback Road, Suite 100 Phoenix, Arizona 85016 Phone: (602) 333-2200				
ROUTE		LOCATION				DWG NO. T-5.02
US 93		WICKENBURG RANCH WAY TO VISTA ROYALE				
TRACS NO. F0738 OIC			093-B(230)T			OF

F.H.W.A. REGION	STATE	PROJECT NO.	SHEET NO.	TOTAL SHEETS	RECORD DRAWING
9	ARIZ.	093-B(230)T	377	524	


093 YV 189

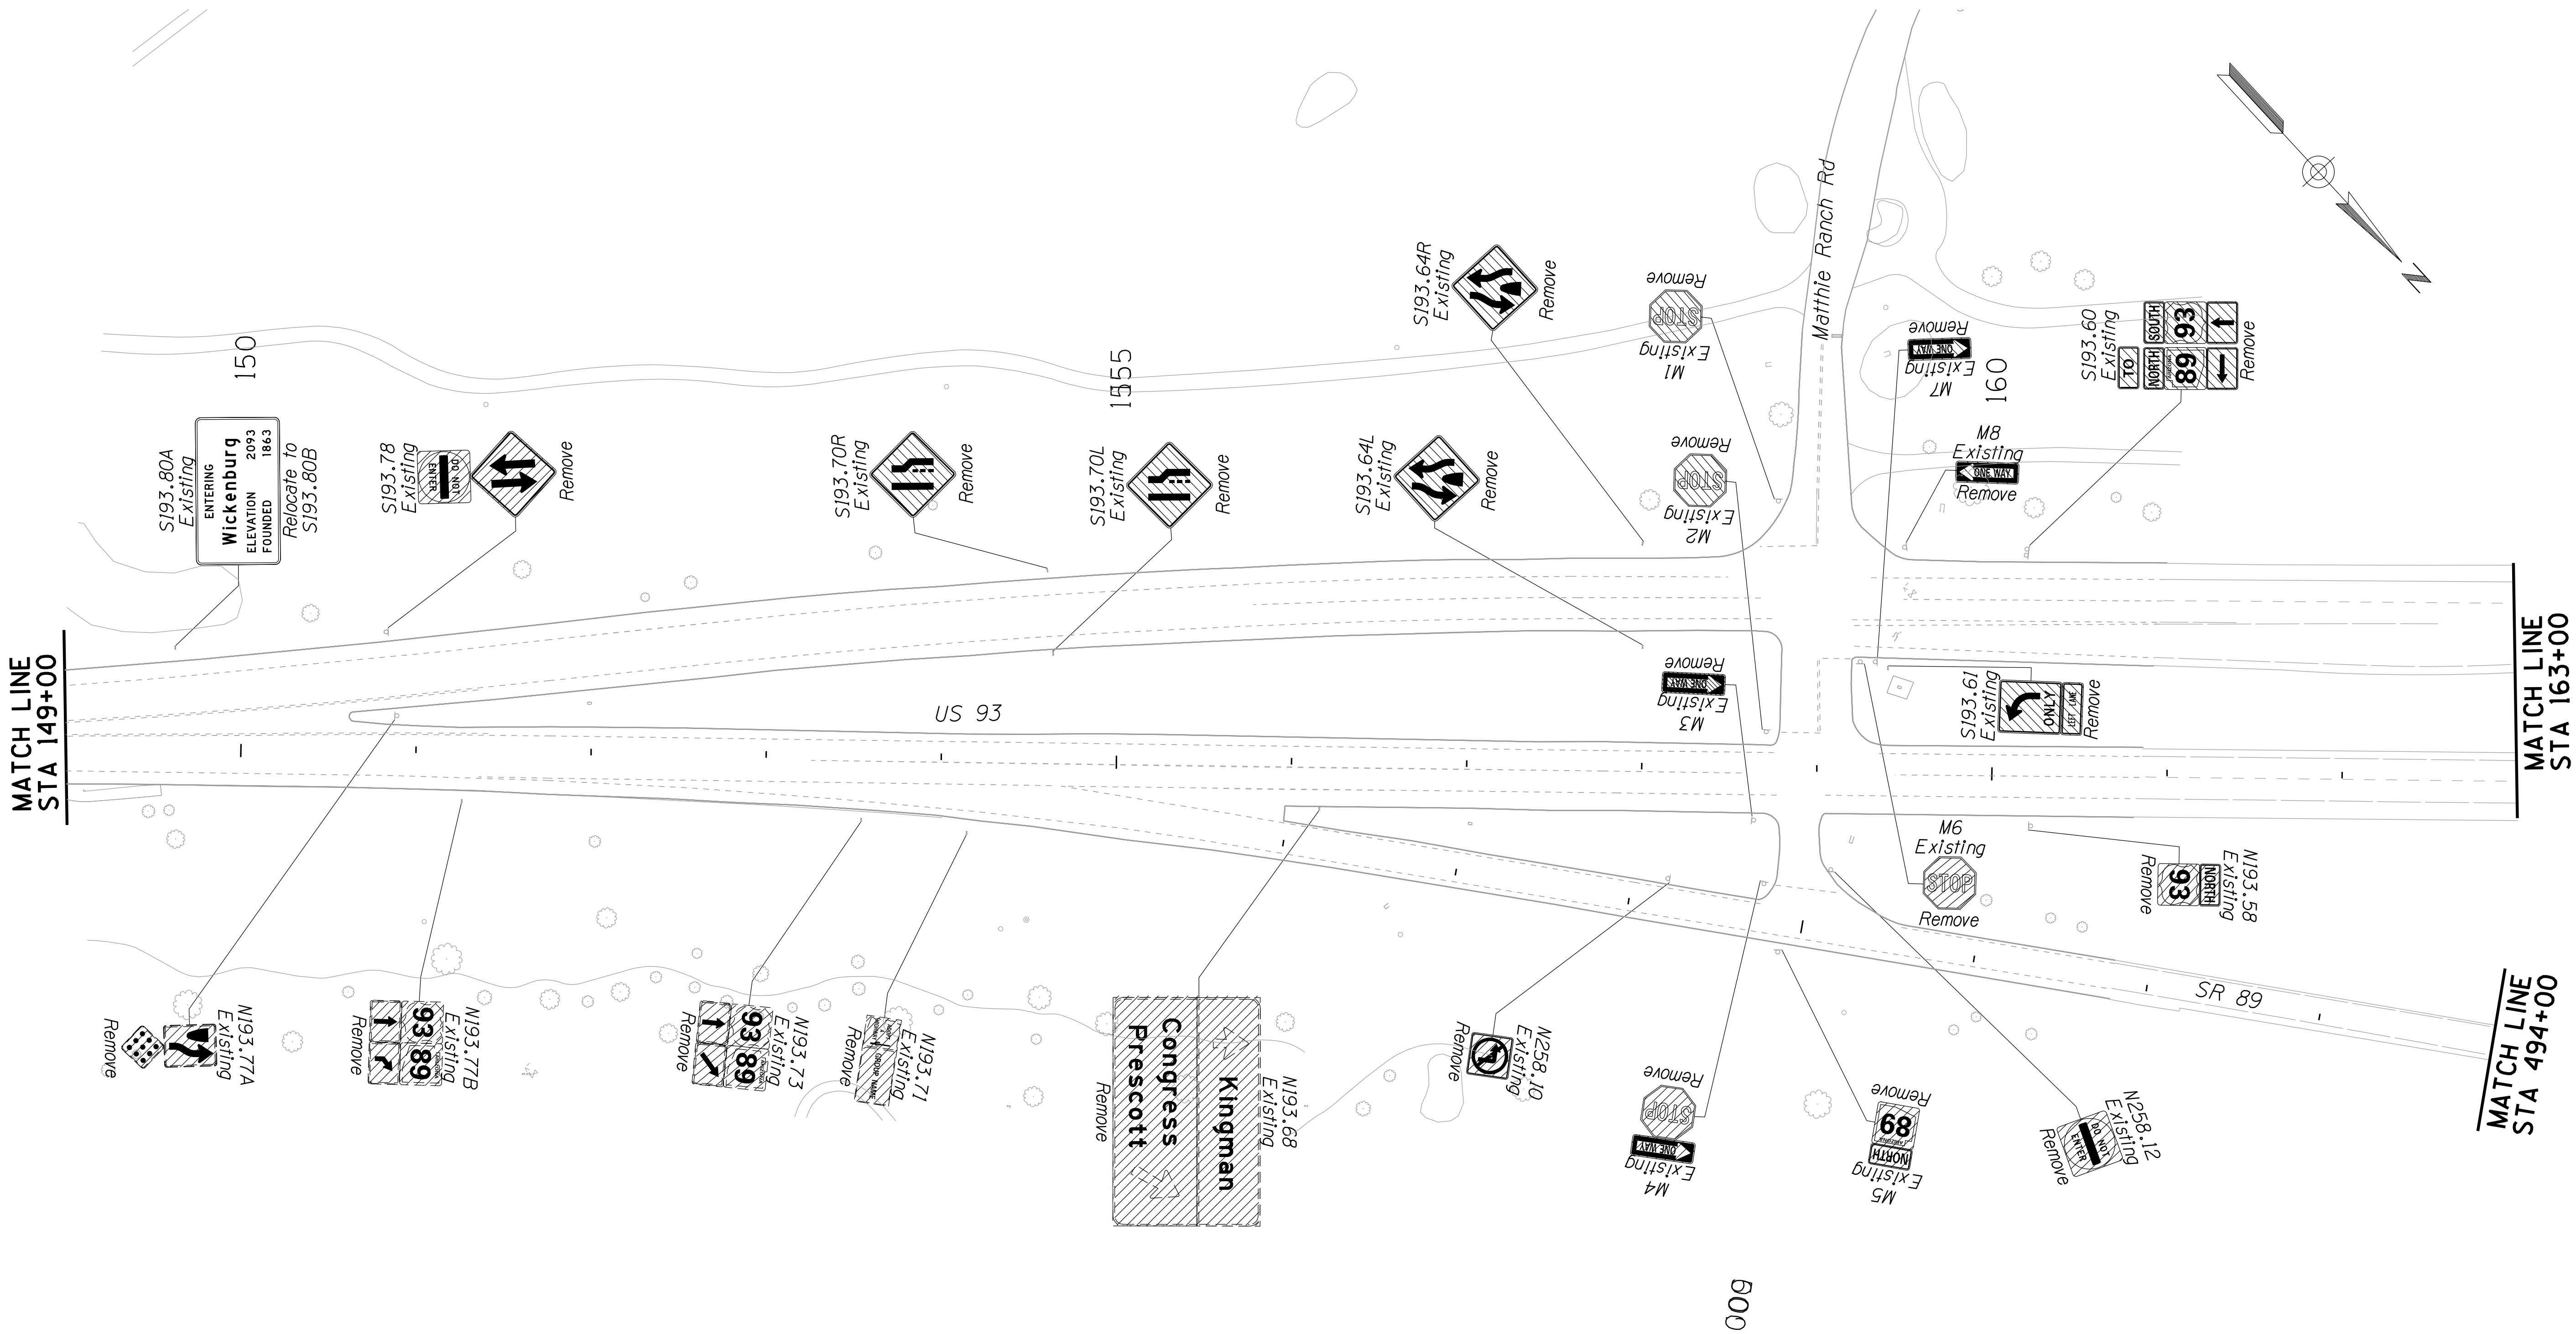

DESIGN	ME1	DATE	06/26	ARIZONA DEPARTMENT OF TRANSPORTATION PROJECT DELIVERY AND OPERATIONS DIVISION TRAFFIC DESIGN SERVICES	
DRAWN	SRH	DATE	06/26		
CHECKED	BMT	DATE	06/26		
 3133 East Camelback Road, Suite 100 Phoenix, Arizona 85016 Phone: (602) 333-2200				US 93 EXISTING SIGNING STA 149+00 TO STA 163+00	
ROUTE		LOCATION		DWG NO. T-5.03	
US 93		WICKENBURG RANCH WAY TO VISTA ROYALE		093-B(230)T	
TRACS NO. F0738 OIC				OF	

F.H.W.A. REGION	STATE	PROJECT NO.	SHEET NO.	TOTAL SHEETS	RECORD DRAWING
9	ARIZ.	093-B(230)T	378	524	

093 YV 189

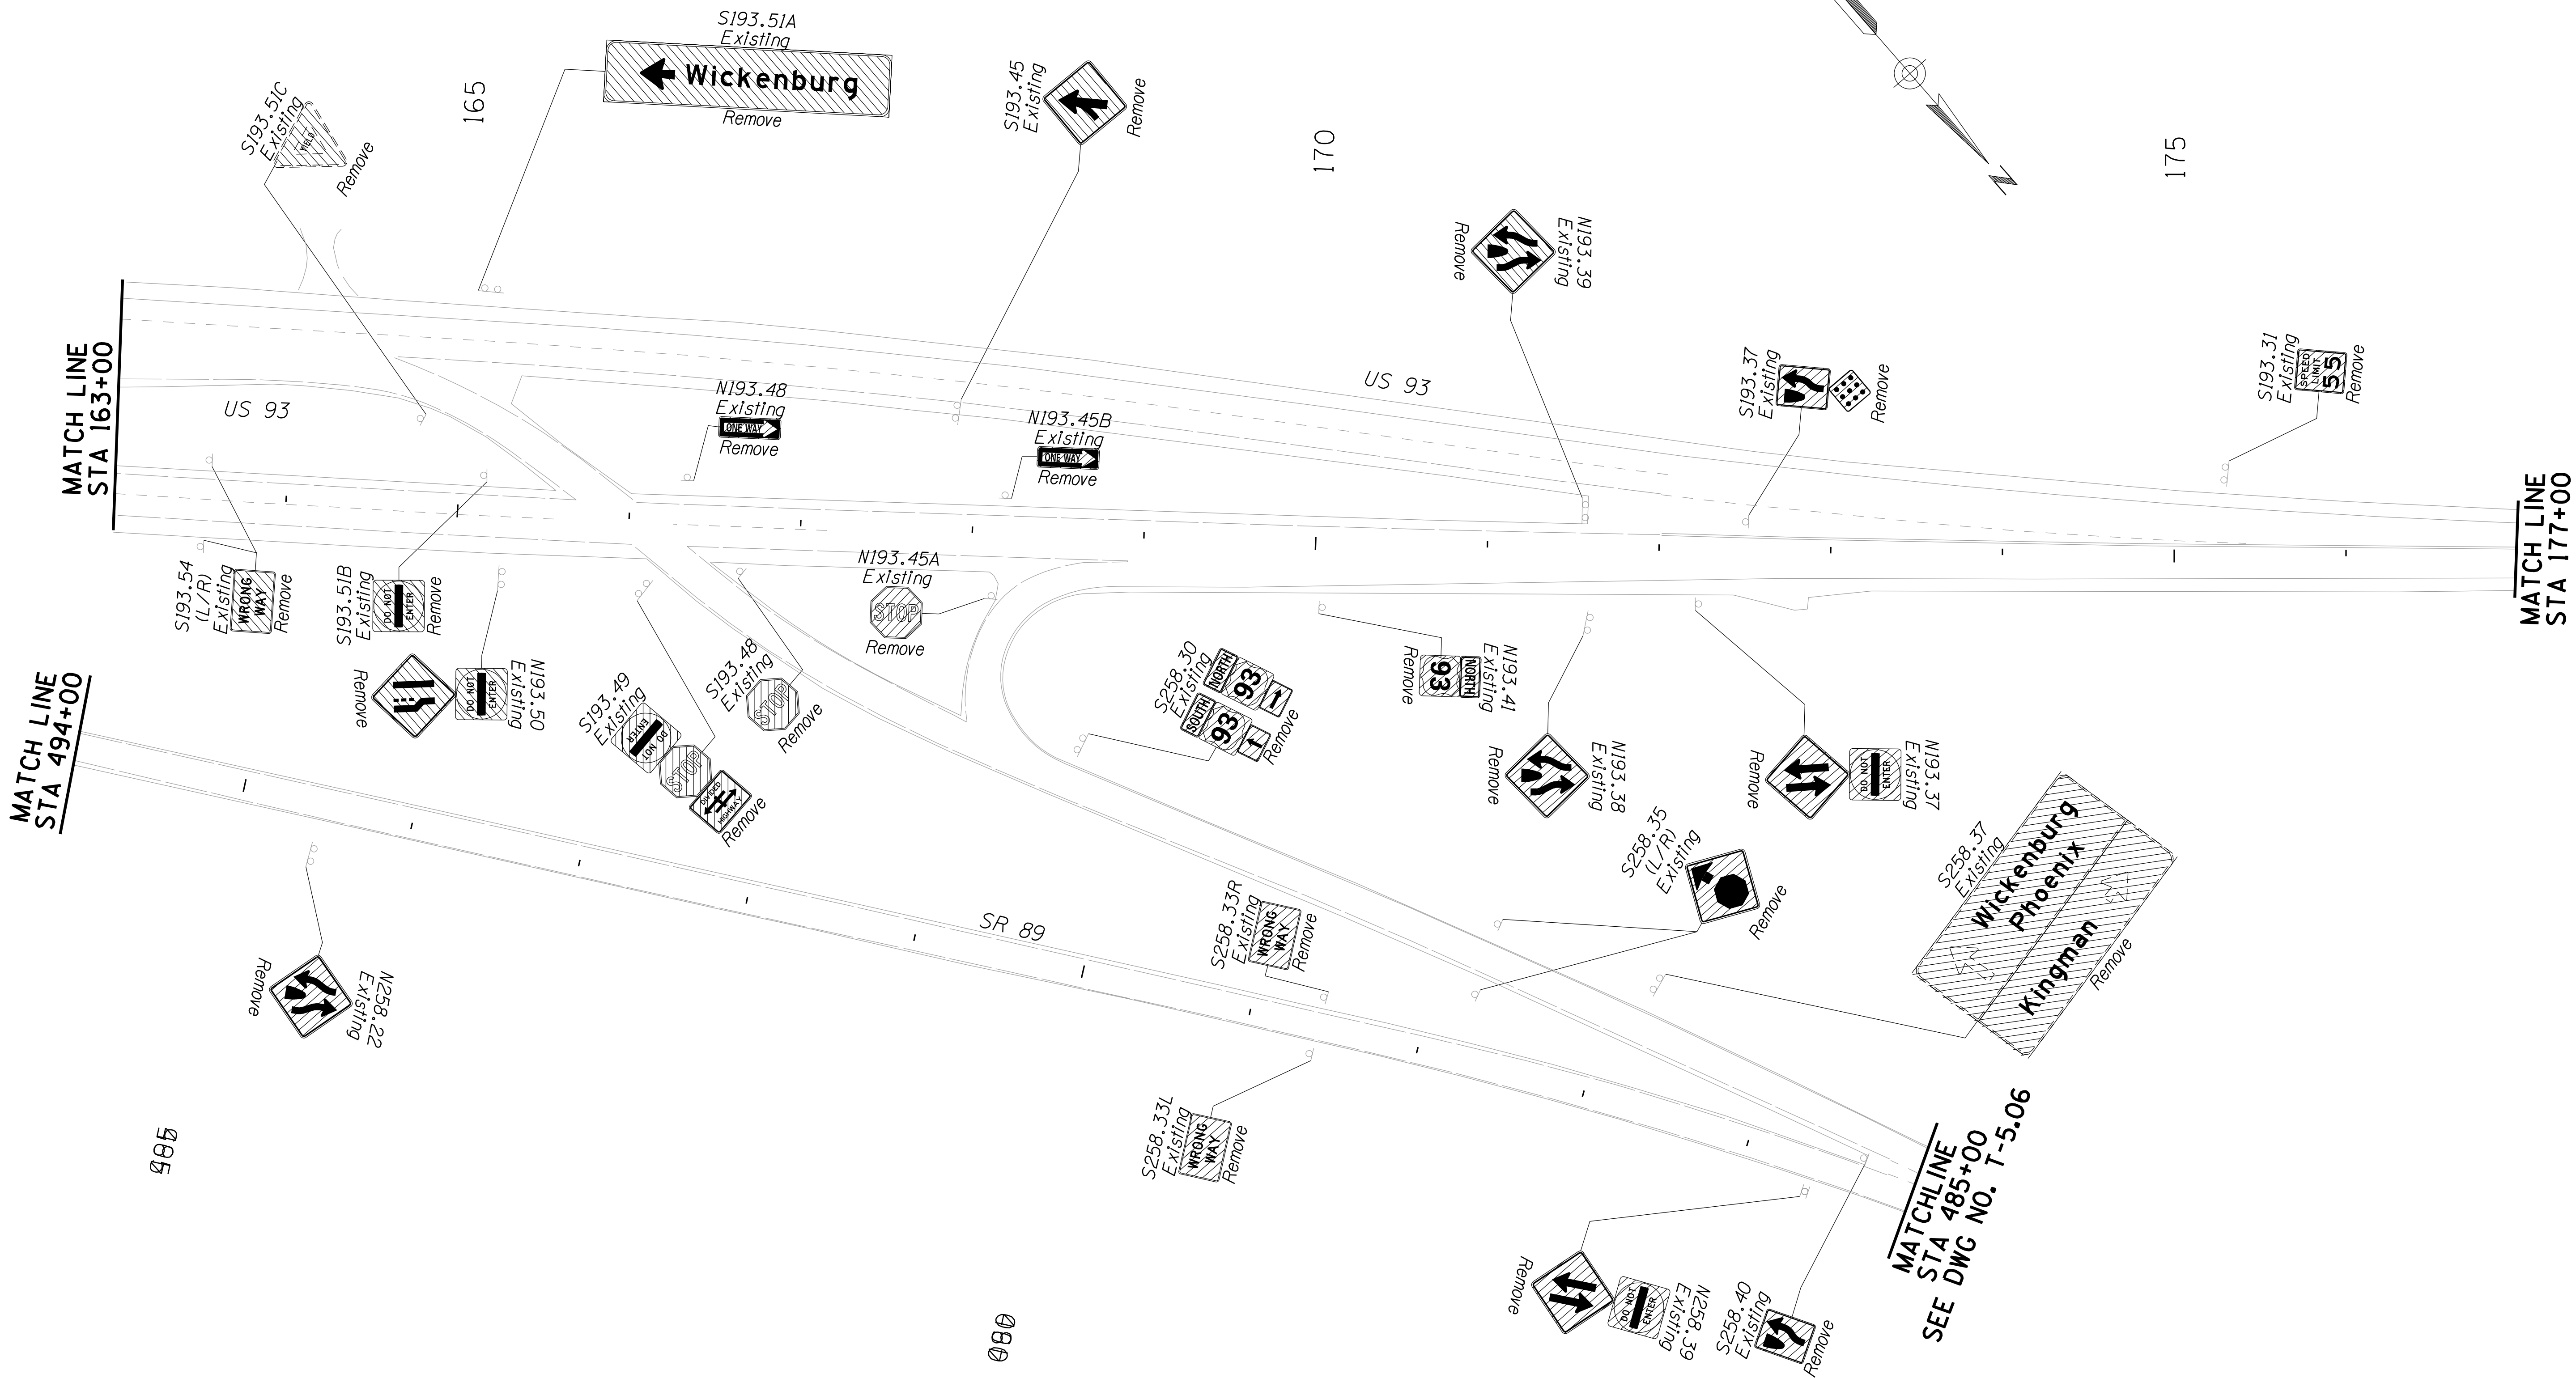

		NAME	DATE	ARIZONA DEPARTMENT OF TRANSPORTATION PROJECT DELIVERY AND OPERATIONS DIVISION TRAFFIC DESIGN SERVICES US 93 EXISTING SIGNING STA 163+00 TO STA 177+00	
DESIGN		MEI	06/26		
DRAWN		SRH	06/26		
CHECKED		BMT	06/26		
 3133 East Camelback Road, Suite 100 Phoenix, Arizona 85016 Phone: (602) 333-2200				DWG NO. T-5.04	
ROUTE		LOCATION			
US 93		WICKENBURG RANCH WAY TO VISTA ROYALE			
TRACS NO. F0738 OIC			093-B(230)T	OF	


F.H.W.A. REGION	STATE	PROJECT NO.	SHEET NO.	TOTAL SHEETS	RECORD DRAWING
9	ARIZ.	093-B(230)T	379	524	

093 YV 189

MATCH LINE
STA 177+00

180

S193.21
Existing

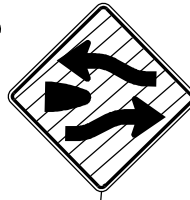

Remove

S193.15
Existing



Remove

US 93


S193.11
Existing




Remove

190

S193.05
Existing

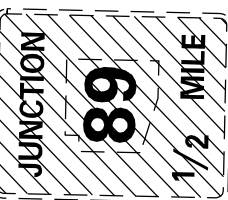

Remove

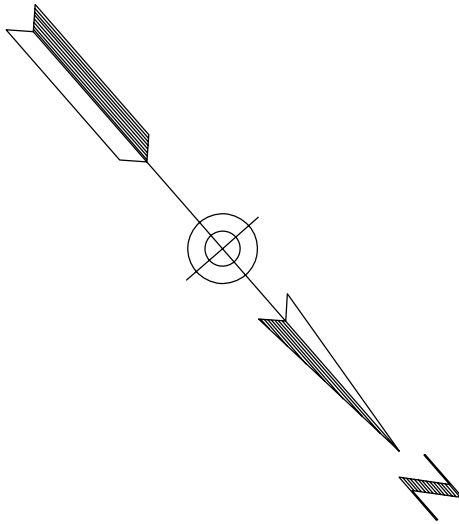



DESIGN		ME1	06/26	ARIZONA DEPARTMENT OF TRANSPORTATION PROJECT DELIVERY AND OPERATIONS DIVISION TRAFFIC DESIGN SERVICES	
DRAWN		SRH	06/26		
CHECKED		BMT	06/26		
ROUTE		LOCATION		US 93 EXISTING SIGNING STA 177+00 TO STA 190+00	
US 93		WICKENBURG RANCH WAY TO VISTA ROYALE		DWG NO. T-5.05	
TRACS NO. F0738 OIC				093-B(230)T	
				OF	

Stanley Consultants inc.

3133 East Camelback Road, Suite 100
Phoenix, Arizona 85016
Phone: (602) 333-2200

F.H.W.A. REGION	STATE	PROJECT NO.	SHEET NO.	TOTAL SHEETS	RECORD DRAWING
9	ARIZ.	093-B(230)T	380	524	

093 YV 189

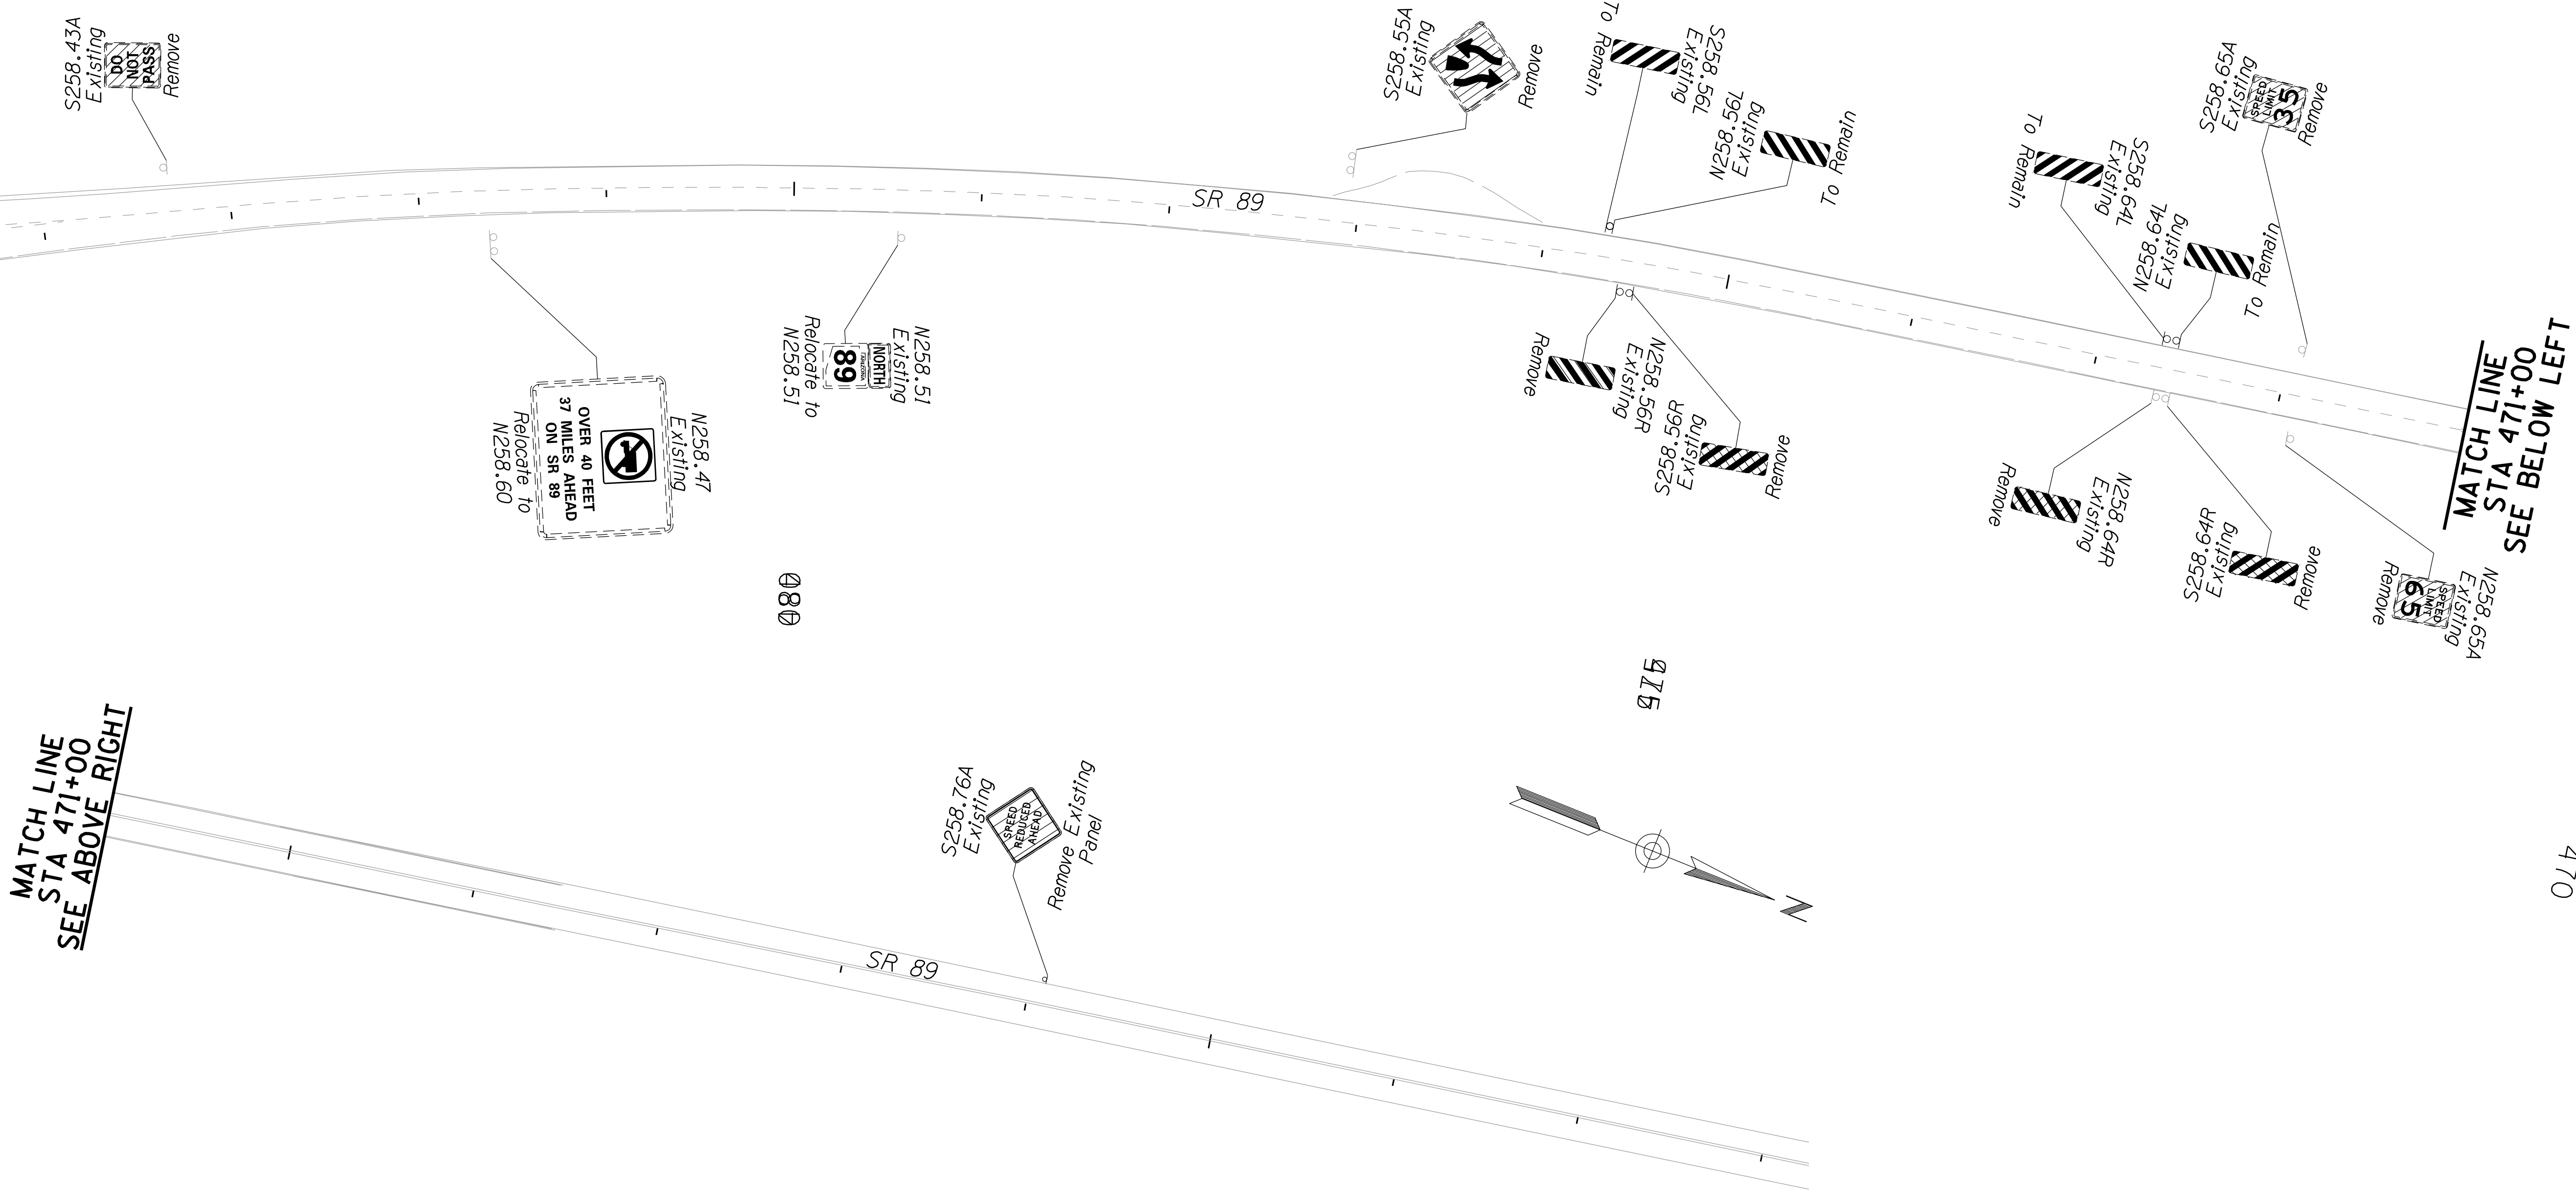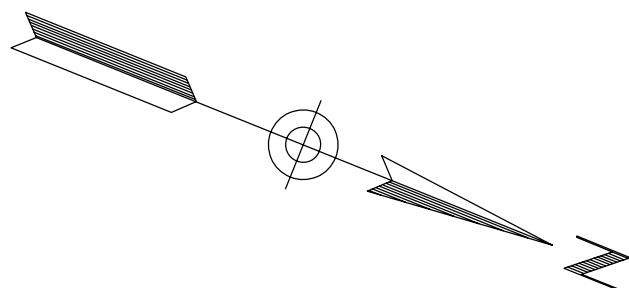


DESIGN	ME1	DATE	06/26	ARIZONA DEPARTMENT OF TRANSPORTATION PROJECT DELIVERY AND OPERATIONS DIVISION TRAFFIC DESIGN SERVICES	
DRAWN	SRH	DATE	06/26		
CHECKED	BMT	DATE	06/26		
Stanley Consultants inc. 3133 East Camelback Road, Suite 100 Phoenix, Arizona 85016 Phone: (602) 333-2200				SR 89 EXISTING SIGNING STA 485+00 TO STA 470+00	
ROUTE		LOCATION		DWG NO. T-5.06	
US 93		WICKENBURG RANCH WAY TO VISTA ROYALE		093-B(230)T	
TRACS NO. F0738 OIC				OF	

F.H.W.A. REGION	STATE	PROJECT NO.	SHEET NO.	TOTAL SHEETS	RECORD DRAWING
9	ARIZ.	093-B(230)T	381	524	

093 YV 189

MATCHLINE SEE BELOW LEFT

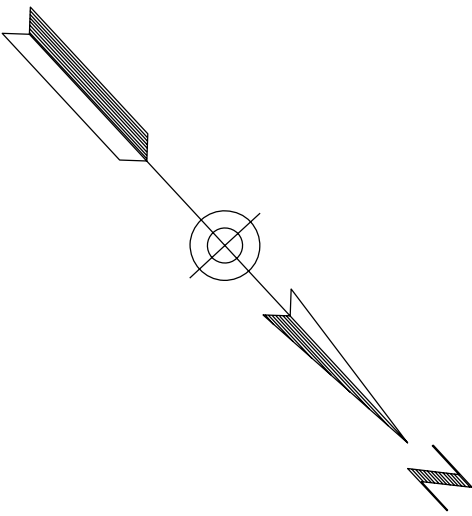

MATCHLINE SEE ABOVE RIGHT

MATCHLINE STA 2117+00

2090

2095

2100

2105

2110

2115

For Wickenburg Ranch Way
Signing and Pavement Marking
See Dwg No. T-5.31

W-20B
New
Wickenburg
Ranch Rd
Wickenburg
Ranch Way
Sta 76+38

Sta 2110+18
Wickenburg
Ranch
Way
South
93
New
N194.47B

S194.28
Existing
To Remain

S194.24
New

Sta 2107+52
Mount on
Light Pole

Obliterate Existing
Edge Line
Sta 2109+03
Begin White Edge Line
Sta 2109+63
Begin Existing Edge
Line Obliteration

S194.20B
New

South
93
Wickenburg
Ranch
Way
Sta 2110+18

S194.11
(L/R)
New

Sta 2113+50
End Inside
Shoulder Taper

Sta 2114+57

Sta 2115+04
End Outside
Shoulder Taper
End 8" Shoulder
Rumble Strips
Begin 12" Shoulder
Rumble Strips

12" Shoulder
Rumble Strips

Wickenburg Ranch Road

Obliterate Existing
Striping Between
Crosswalk

Sta 2106+24
Match Existing
Striping
Begin 12" Shoulder
Rumble Strips

N194.23
Existing
JUNCTION
1/2 MILE
89
To Remain

Sta 2110+59

8" Shoulder
Rumble Strips

6" White

6" White
10' Stripe, 30' Space

Type C RPMs
@ 40' Spacing

6" Yellow

DESIGN	NAME	DATE
ME1		06/26
DRAWN	SRH	06/26
CHECKED	BMT	06/26

ARIZONA DEPARTMENT OF TRANSPORTATION
PROJECT DELIVERY AND OPERATIONS DIVISION
TRAFFIC DESIGN SERVICES

US 93
SIGNING AND PAVEMENT MARKING
BEGIN PROJECT TO STA 2117+00



ROUTE
US 93

LOCATION
WICKENBURG RANCH WAY TO VISTA ROYALE

DWG NO. T-5.07


TRACS NO. F0738 OIC

093-B(230)T

OF

F.H.W.A. REGION	STATE	PROJECT NO.	SHEET NO.	TOTAL SHEETS	RECORD DRAWING
9	ARIZ.	093-B(230)T	382	524	




093 YV 189

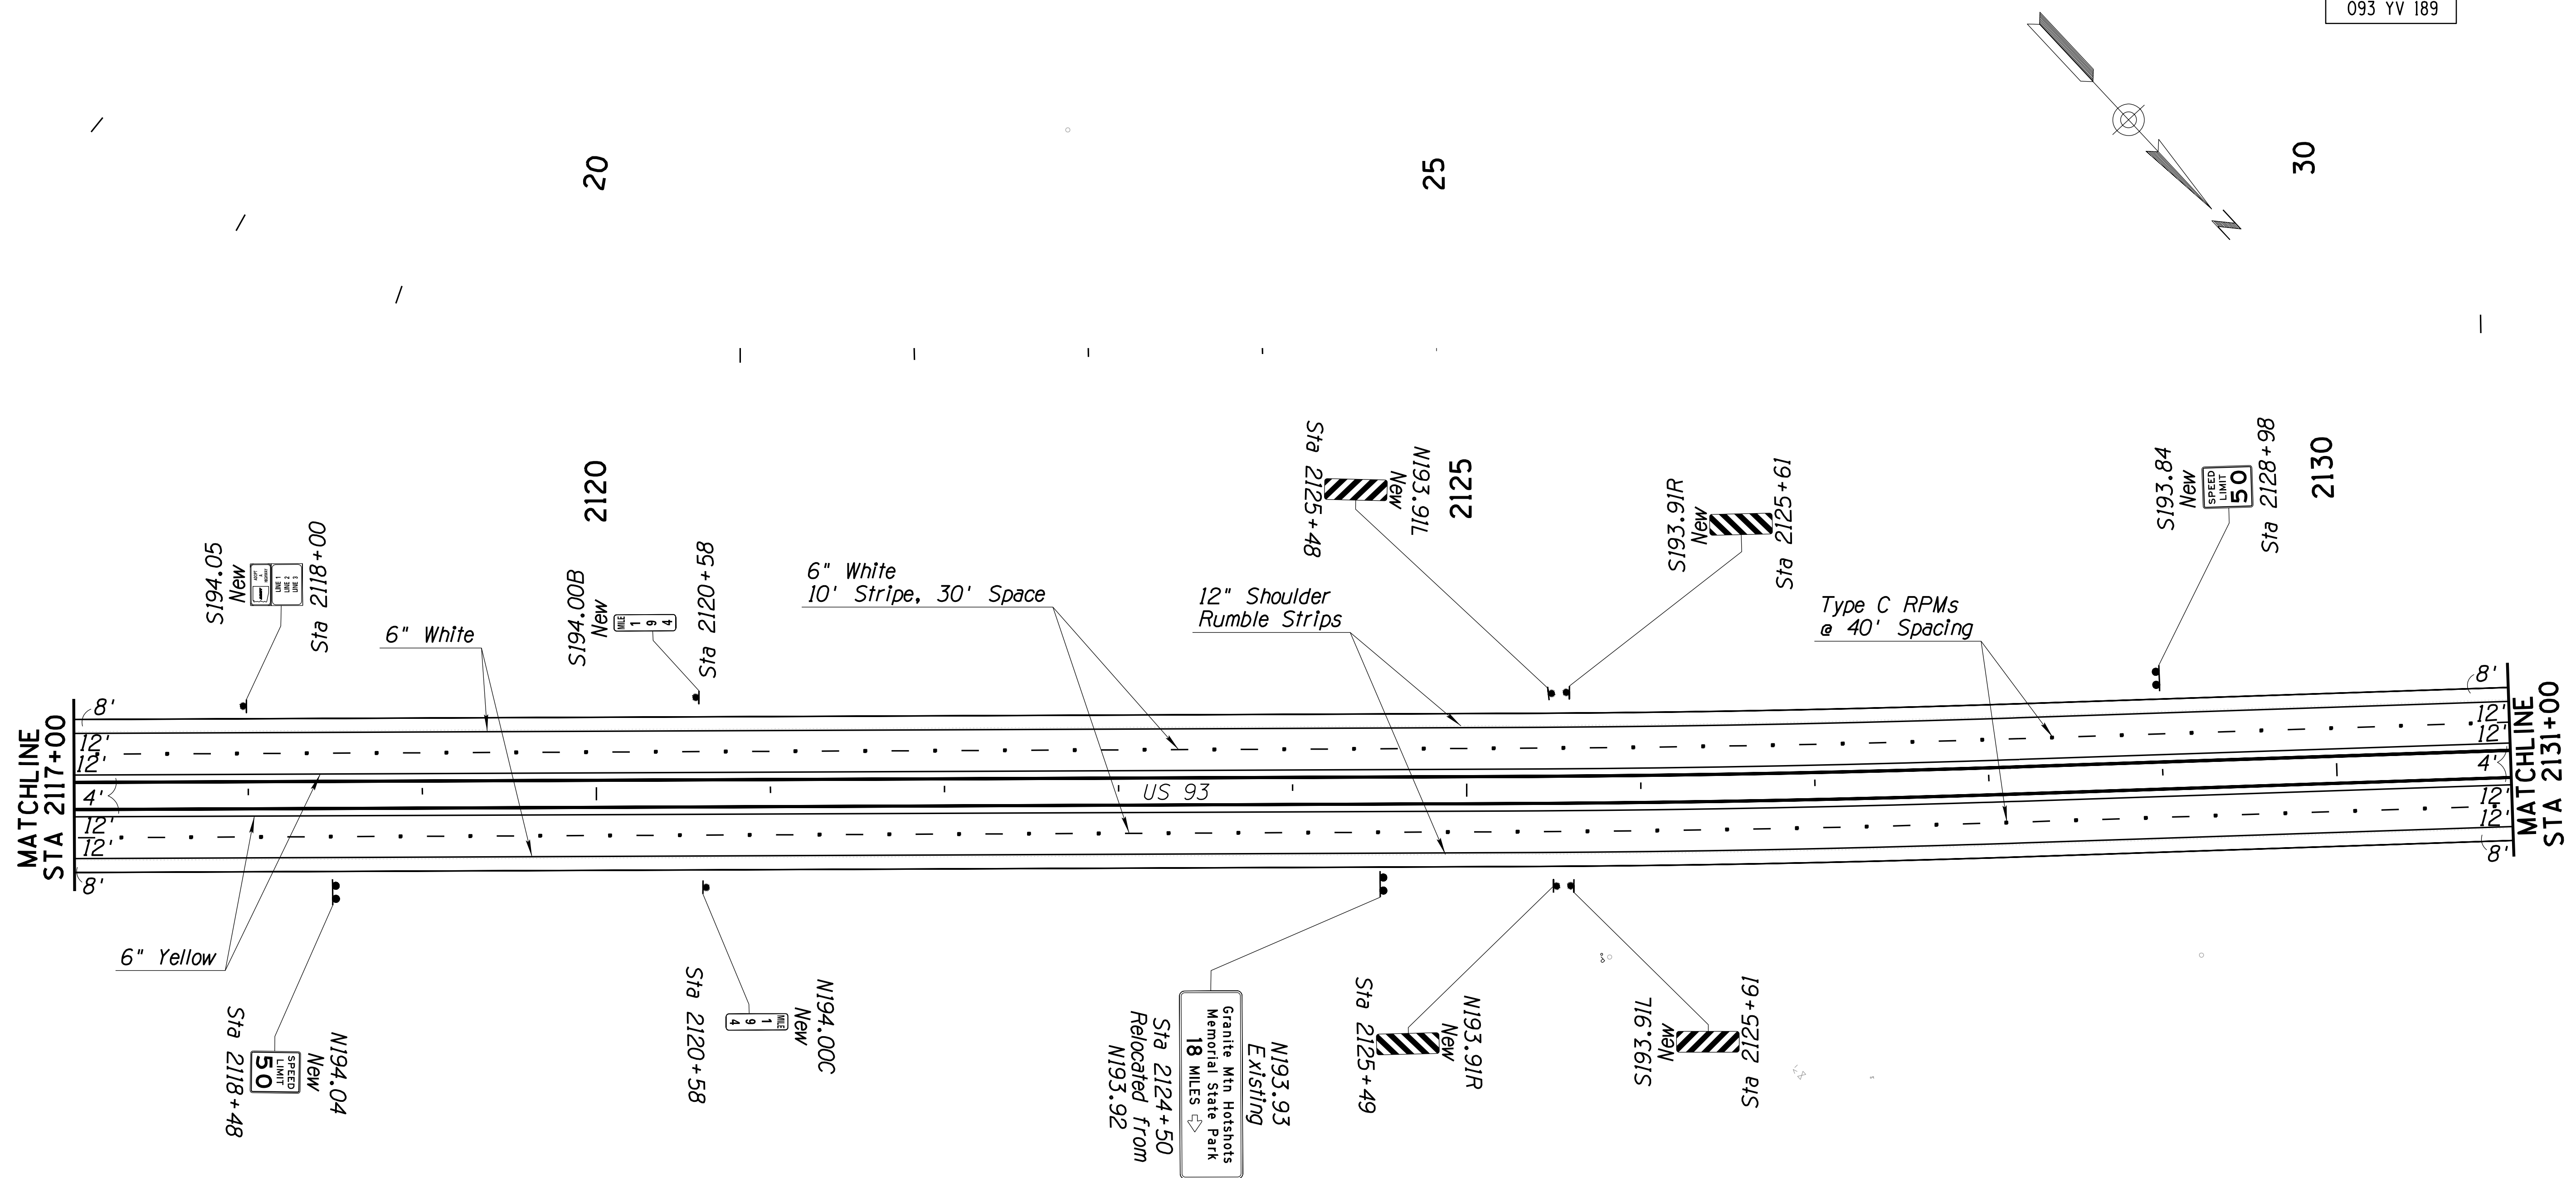


		NAME	DATE	ARIZONA DEPARTMENT OF TRANSPORTATION PROJECT DELIVERY AND OPERATIONS DIVISION TRAFFIC DESIGN SERVICES		
DESIGN	MEI	06/26		US 93 SIGNING AND PAVEMENT MARKING STA 21I7+00 TO STA 2131+00		
DRAWN	SRH	06/26				
CHECKED	BMT	06/26				
 Stanley Consultants inc.		5133 East Camelback Road, Suite 100 Phoenix, Arizona 85018 Phones: (602) 333-2200				
ROUTE		LOCATION				DWG NO. T-5.08 ____ OF ____
US 93		WICKENBURG RANCH WAY TO VISTA ROYALE				
TRACS NO. F0738 OIC				093-B(230)T		

F.H.W.A. REGION	STATE	PROJECT NO.	SHEET NO.	TOTAL SHEETS	RECORD DRAWING
9	ARIZ.	093-B(230)T	383	524	

093 YV 189

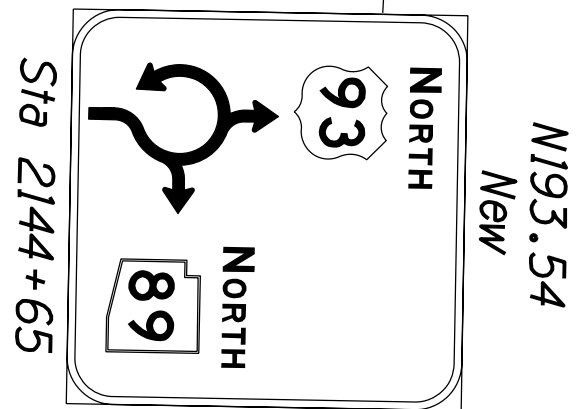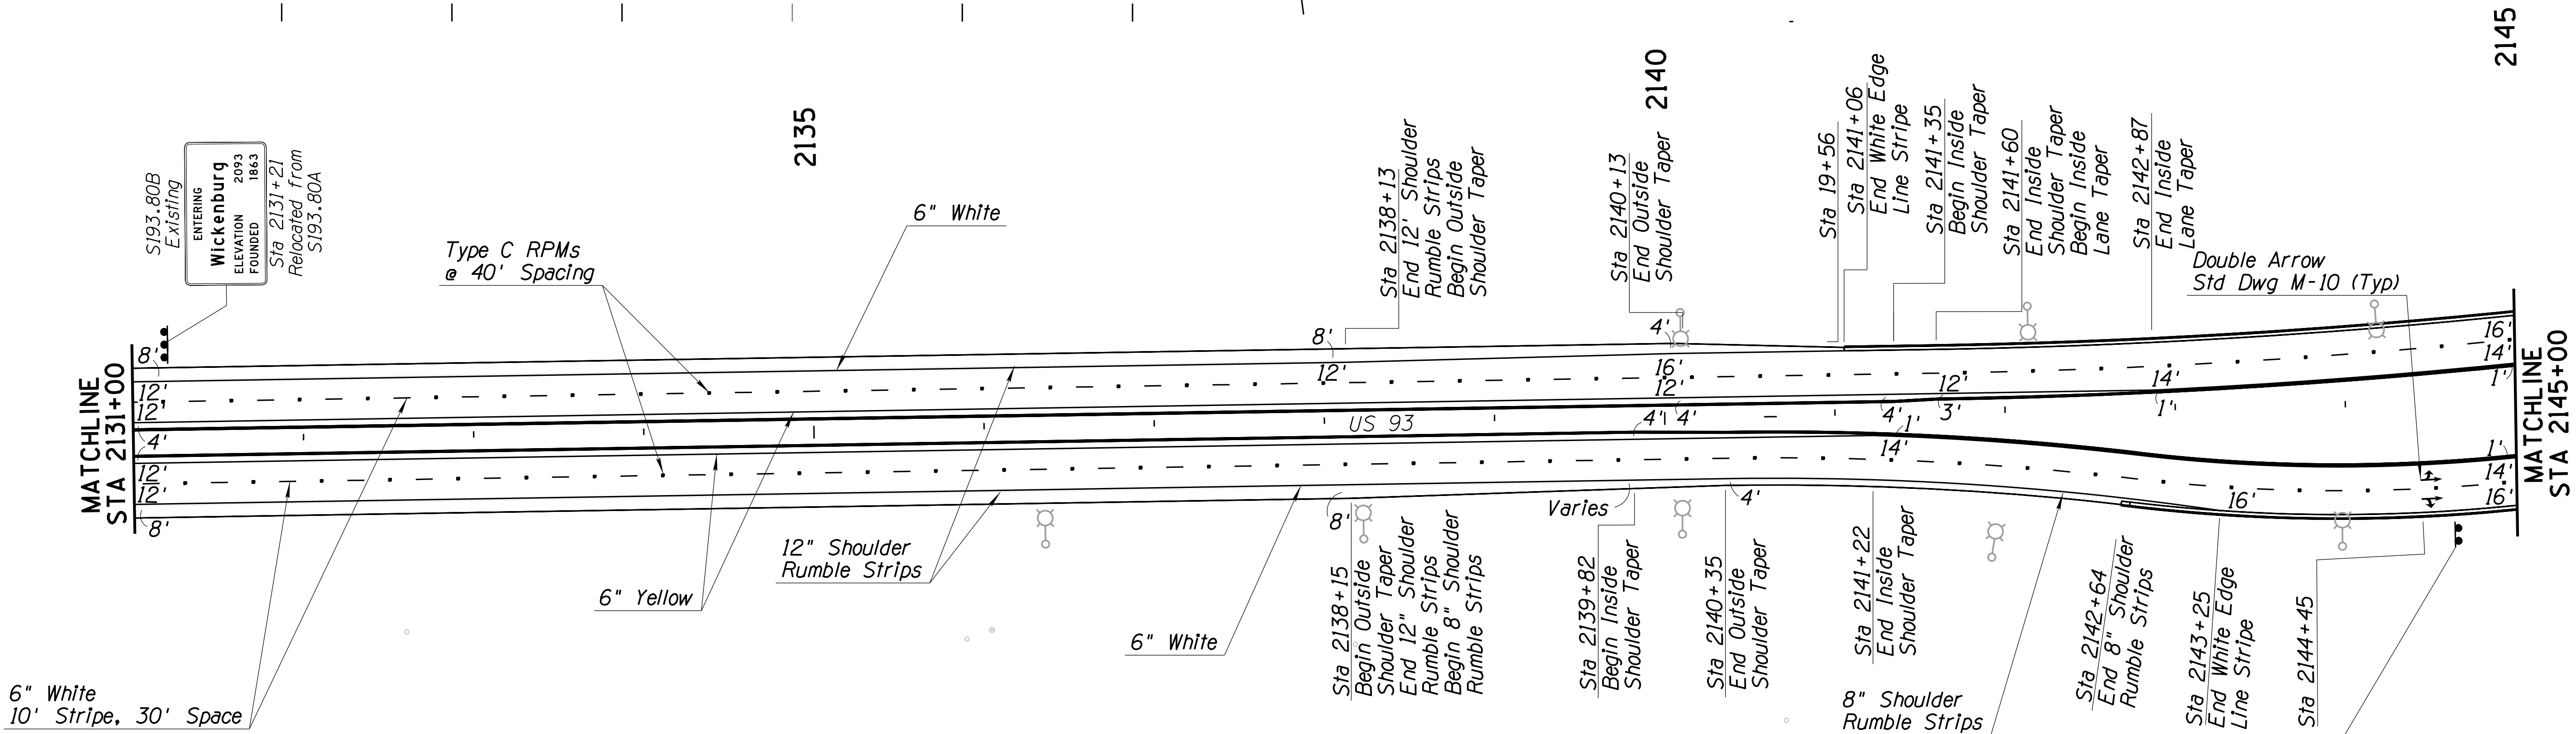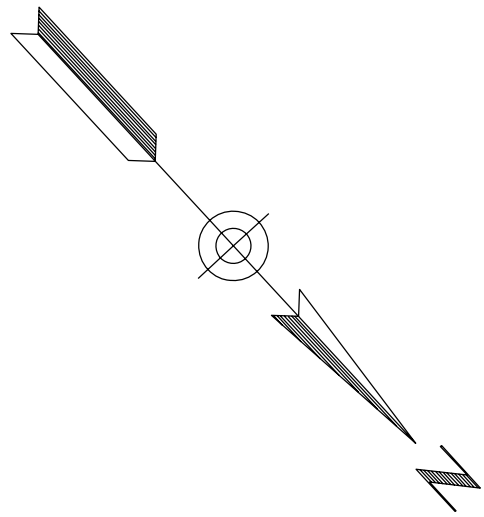

DESIGN	ME1	DATE	06/26	ARIZONA DEPARTMENT OF TRANSPORTATION PROJECT DELIVERY AND OPERATIONS DIVISION TRAFFIC DESIGN SERVICES US 93 SIGNING AND PAVEMENT MARKING STA 2131+00 TO STA 2145+00	
DRAWN	SRH	DATE	06/26		
CHECKED	BMT	DATE	06/26		
ROUTE		LOCATION		DWG NO. T-5.09	
US 93		WICKENBURG RANCH WAY TO VISTA ROYALE			
TRACS NO. F0738 OIC		093-B(230)T			OF

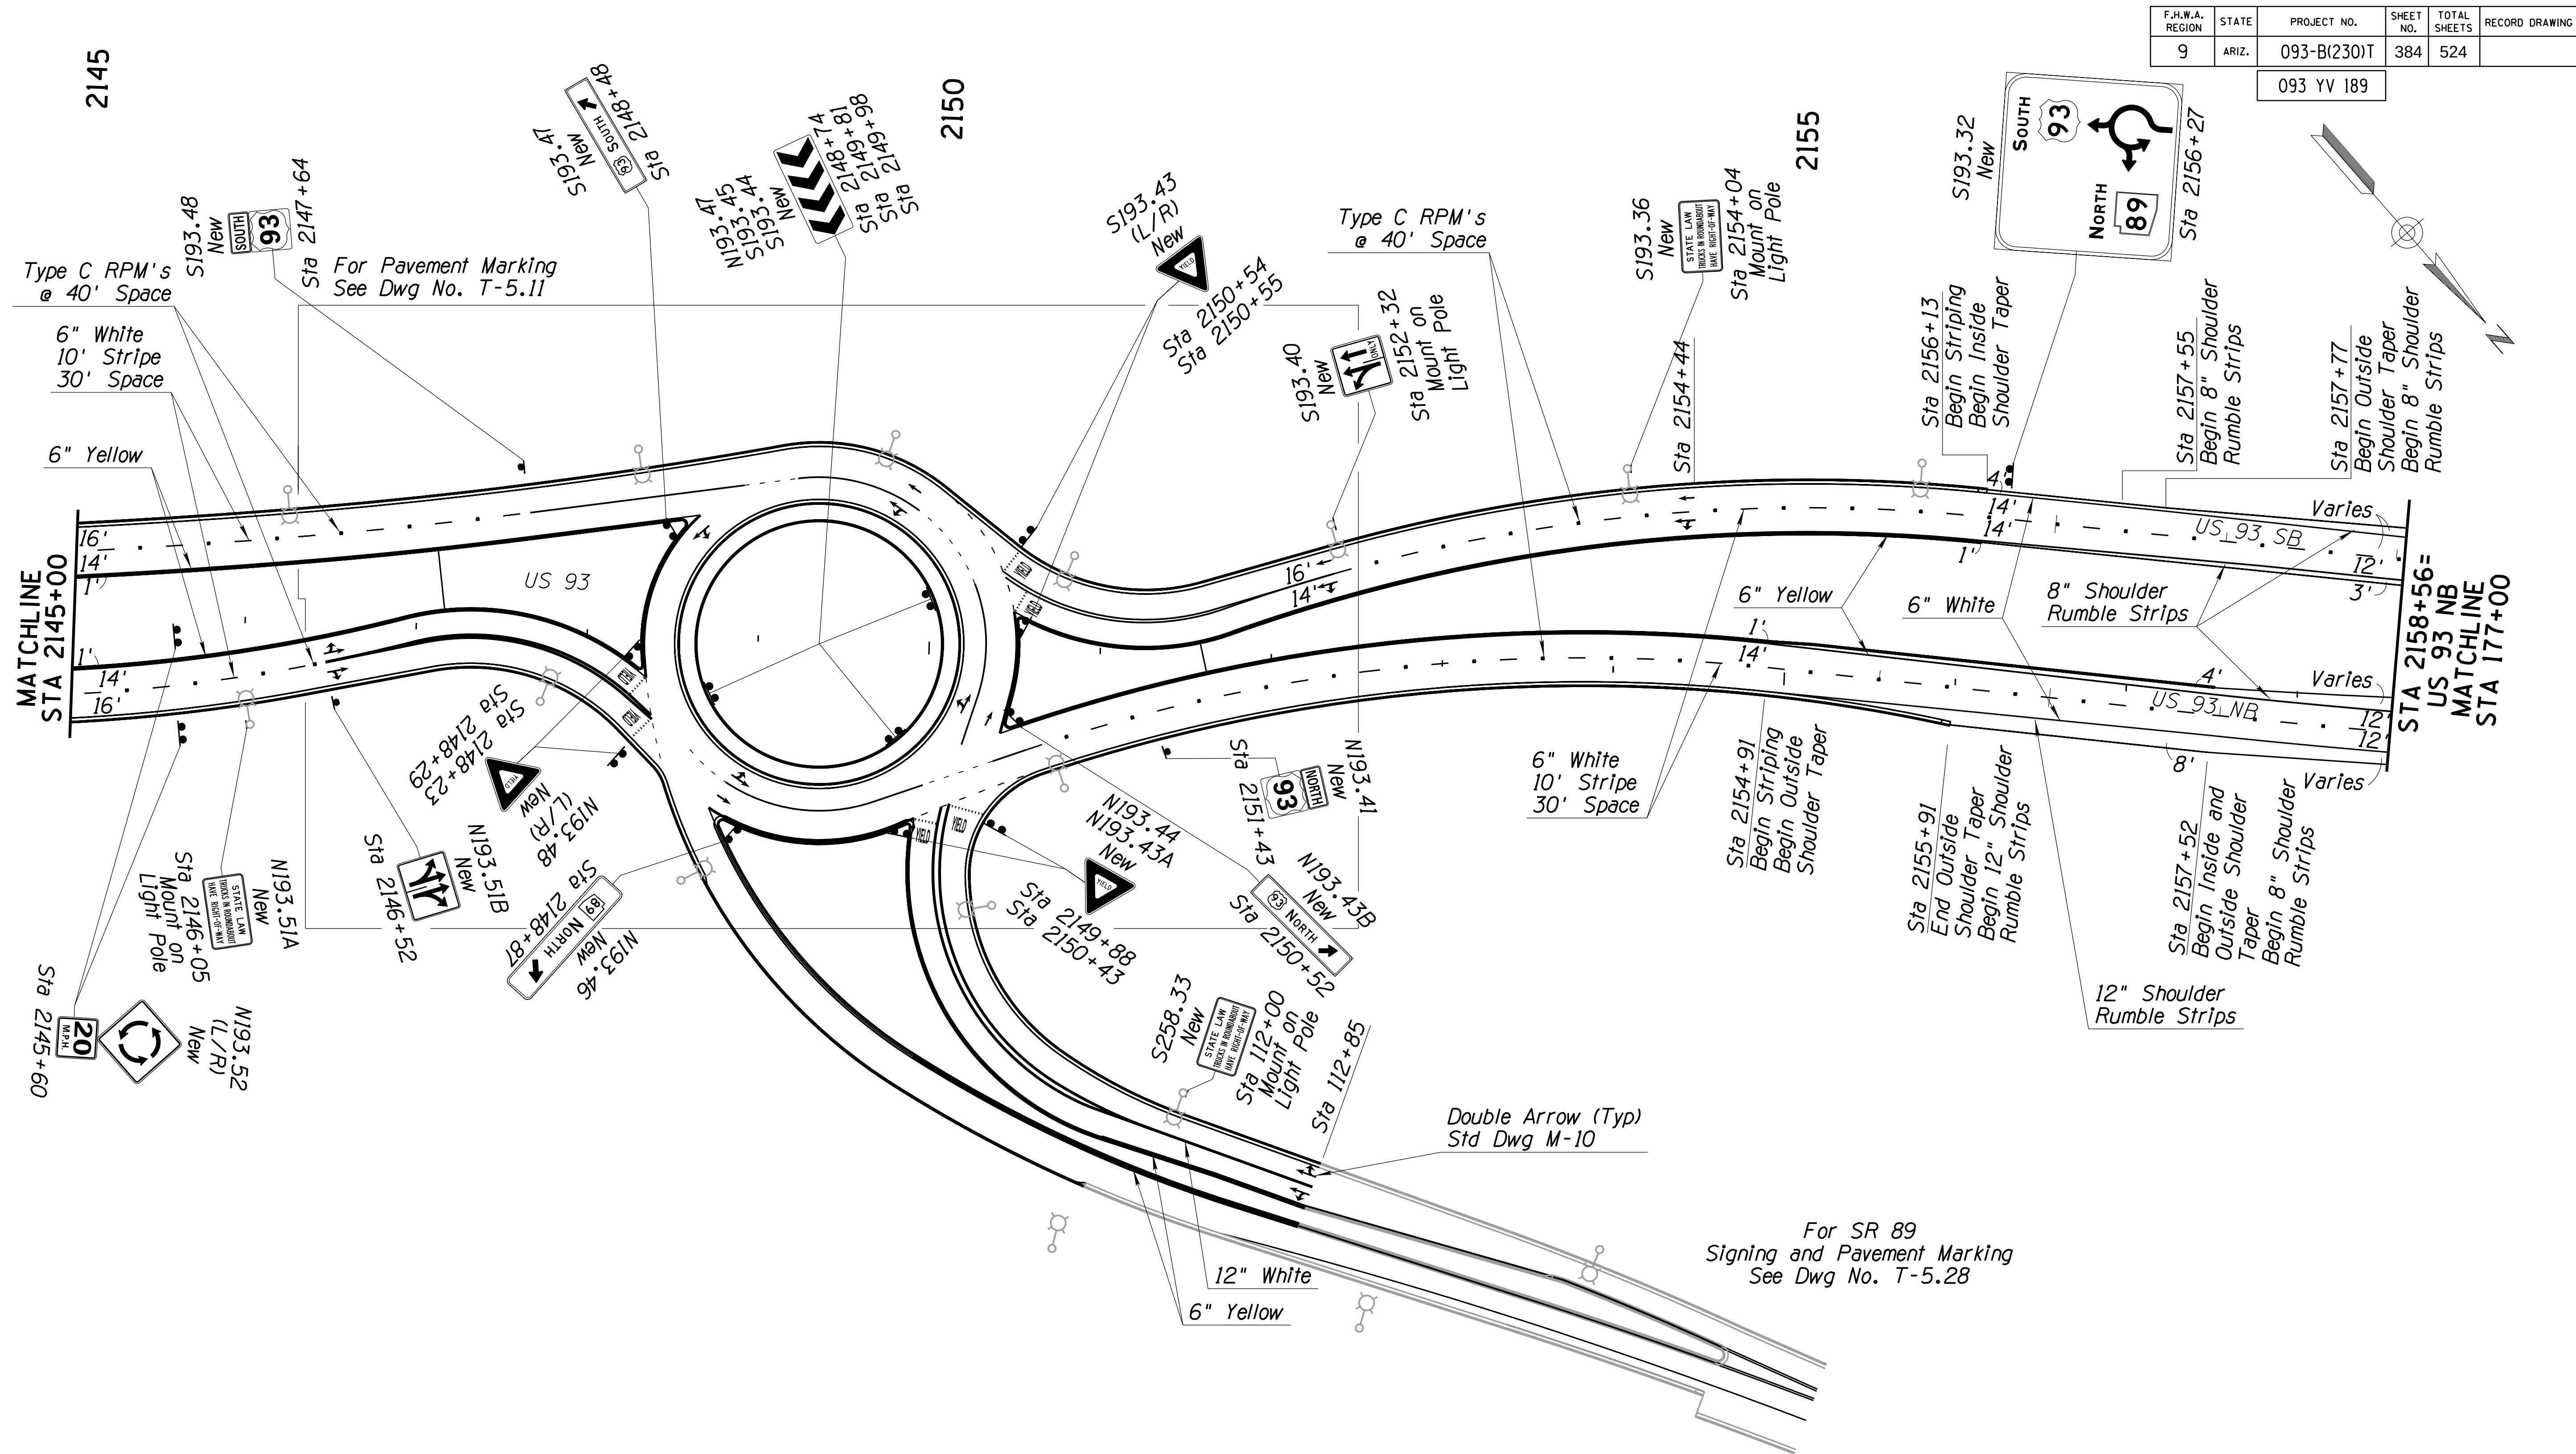

F.H.W.A. REGION	STATE	PROJECT NO.	SHEET NO.	TOTAL SHEETS	RECORD DRAWING
9	ARIZ.	093-B(230)T	384	524	

093 YV 189

DESIGN	ME1	DATE	06/26
DRAWN	SRH	DATE	06/26
CHECKED	BMT	DATE	06/26

ROUTE	LOCATION
US 93	WICKENBURG RANCH WAY TO VISTA ROYALE

TRACS NO. F0738 OIC	093-B(230)T
---------------------	-------------

NAME	DATE
ME1	06/26
SRH	06/26
BMT	06/26

ARIZONA DEPARTMENT OF TRANSPORTATION
PROJECT DELIVERY AND OPERATIONS DIVISION
TRAFFIC DESIGN SERVICES

US 93
SIGNING AND PAVEMENT MARKING
STA 2145+00 TO STA 2159+00


Stanley Consultants inc.
3133 East Camelback Road, Suite 100
Phoenix, Arizona 85016
Phone: (602) 333-2200

51481
BRIANNE MARIE
TURPIN
REGISTERED PROFESSIONAL ENGINEER
ARIZONA, U.S.A.

DWG NO. T-5.10
OF

DATE: LOCATION: REVISIONS: FINISHED PLANS: SURVEY NO. DATE: LOCATION: REVISIONS: FINISHED PLANS: SURVEY NO.

F.H.W.A. REGION	STATE	PROJECT NO.	SHEET NO.	TOTAL SHEETS	RECORD DRAWING
9	ARIZ.	093-B(230)T	385	524	
093 YV 189					

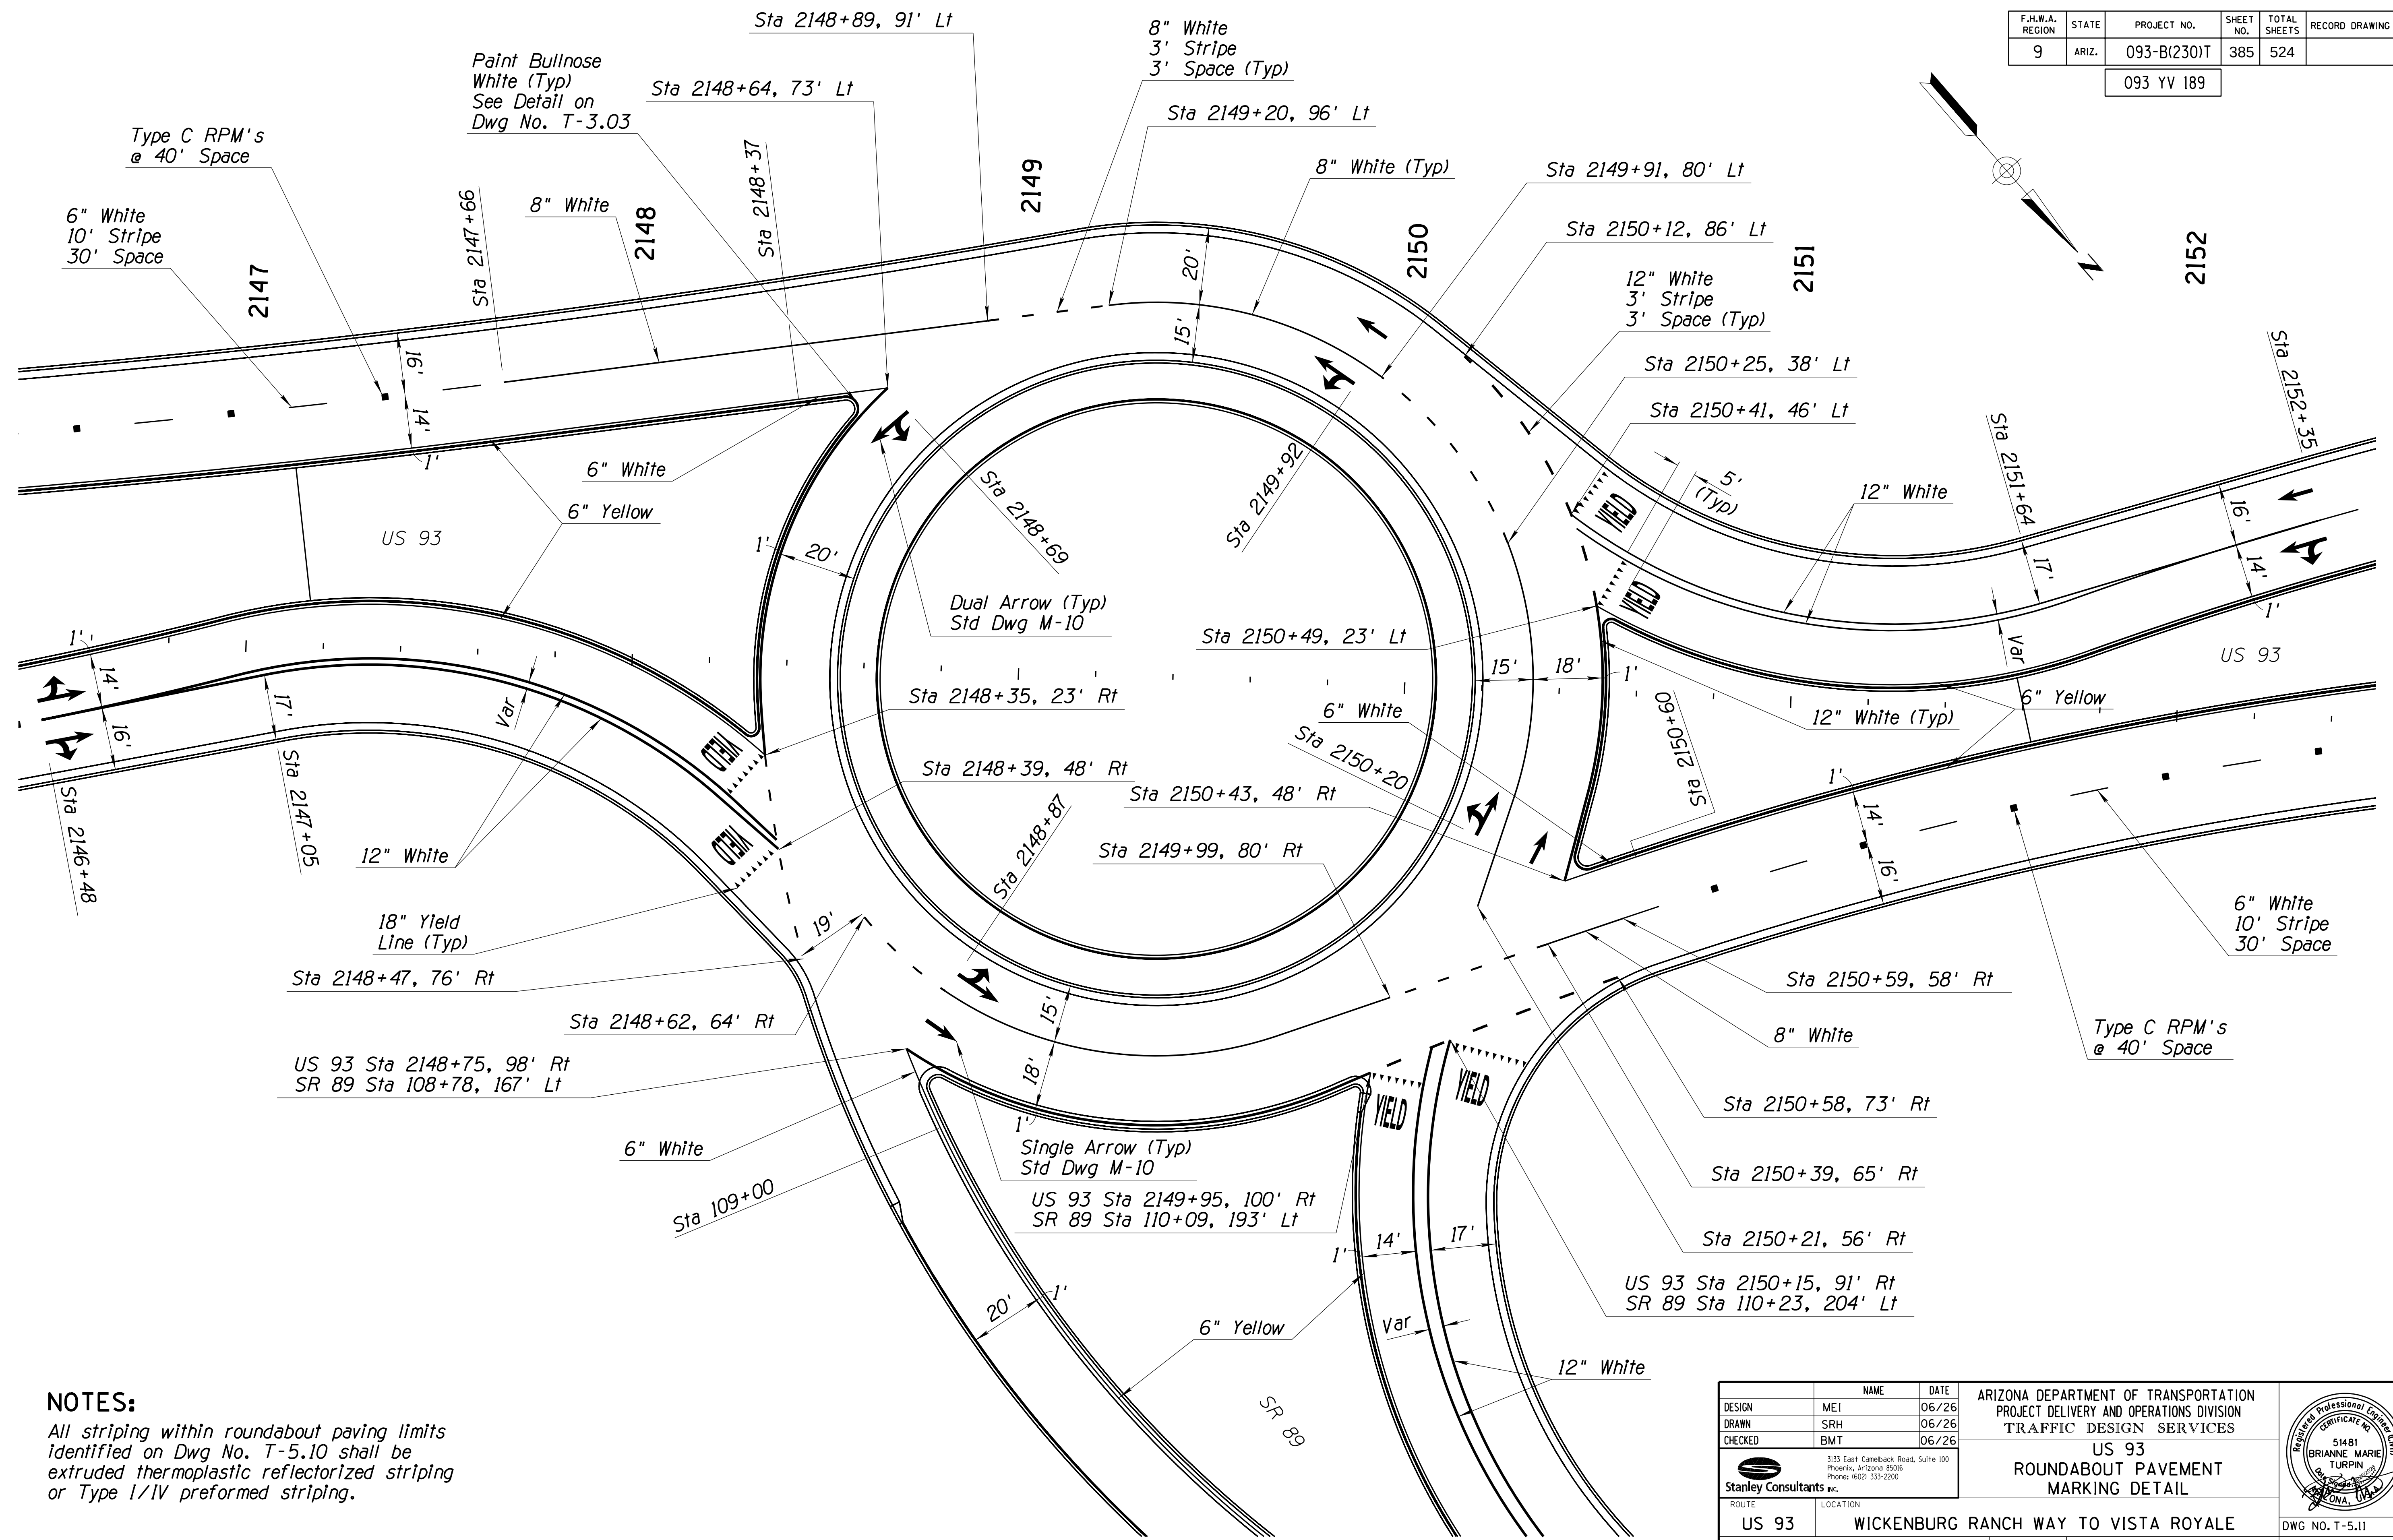


NOTES:
All striping within roundabout paving limits identified on Dwg No. T-5.10 shall be extruded thermoplastic reflectorized striping or Type I/IV preformed striping.

DESIGN	ME1	DATE	06/26	ARIZONA DEPARTMENT OF TRANSPORTATION PROJECT DELIVERY AND OPERATIONS DIVISION TRAFFIC DESIGN SERVICES	
DRAWN	SRH	DATE	06/26		
CHECKED	BMT	DATE	06/26		
 3133 East Camelback Road, Suite 100 Phoenix, Arizona 85016 Phone: (602) 333-2200				US 93 ROUNDABOUT PAVEMENT MARKING DETAIL	
ROUTE		LOCATION		DWG NO. T-5.11	
US 93		WICKENBURG RANCH WAY TO VISTA ROYALE			
TRACS NO. F0738 OIC		093-B(230)T		OF	

F.H.W.A. REGION	STATE	PROJECT NO.	SHEET NO.	TOTAL SHEETS	RECORD DRAWING
9	ARIZ.	093-B(230)T	386	524	

093 YV 189

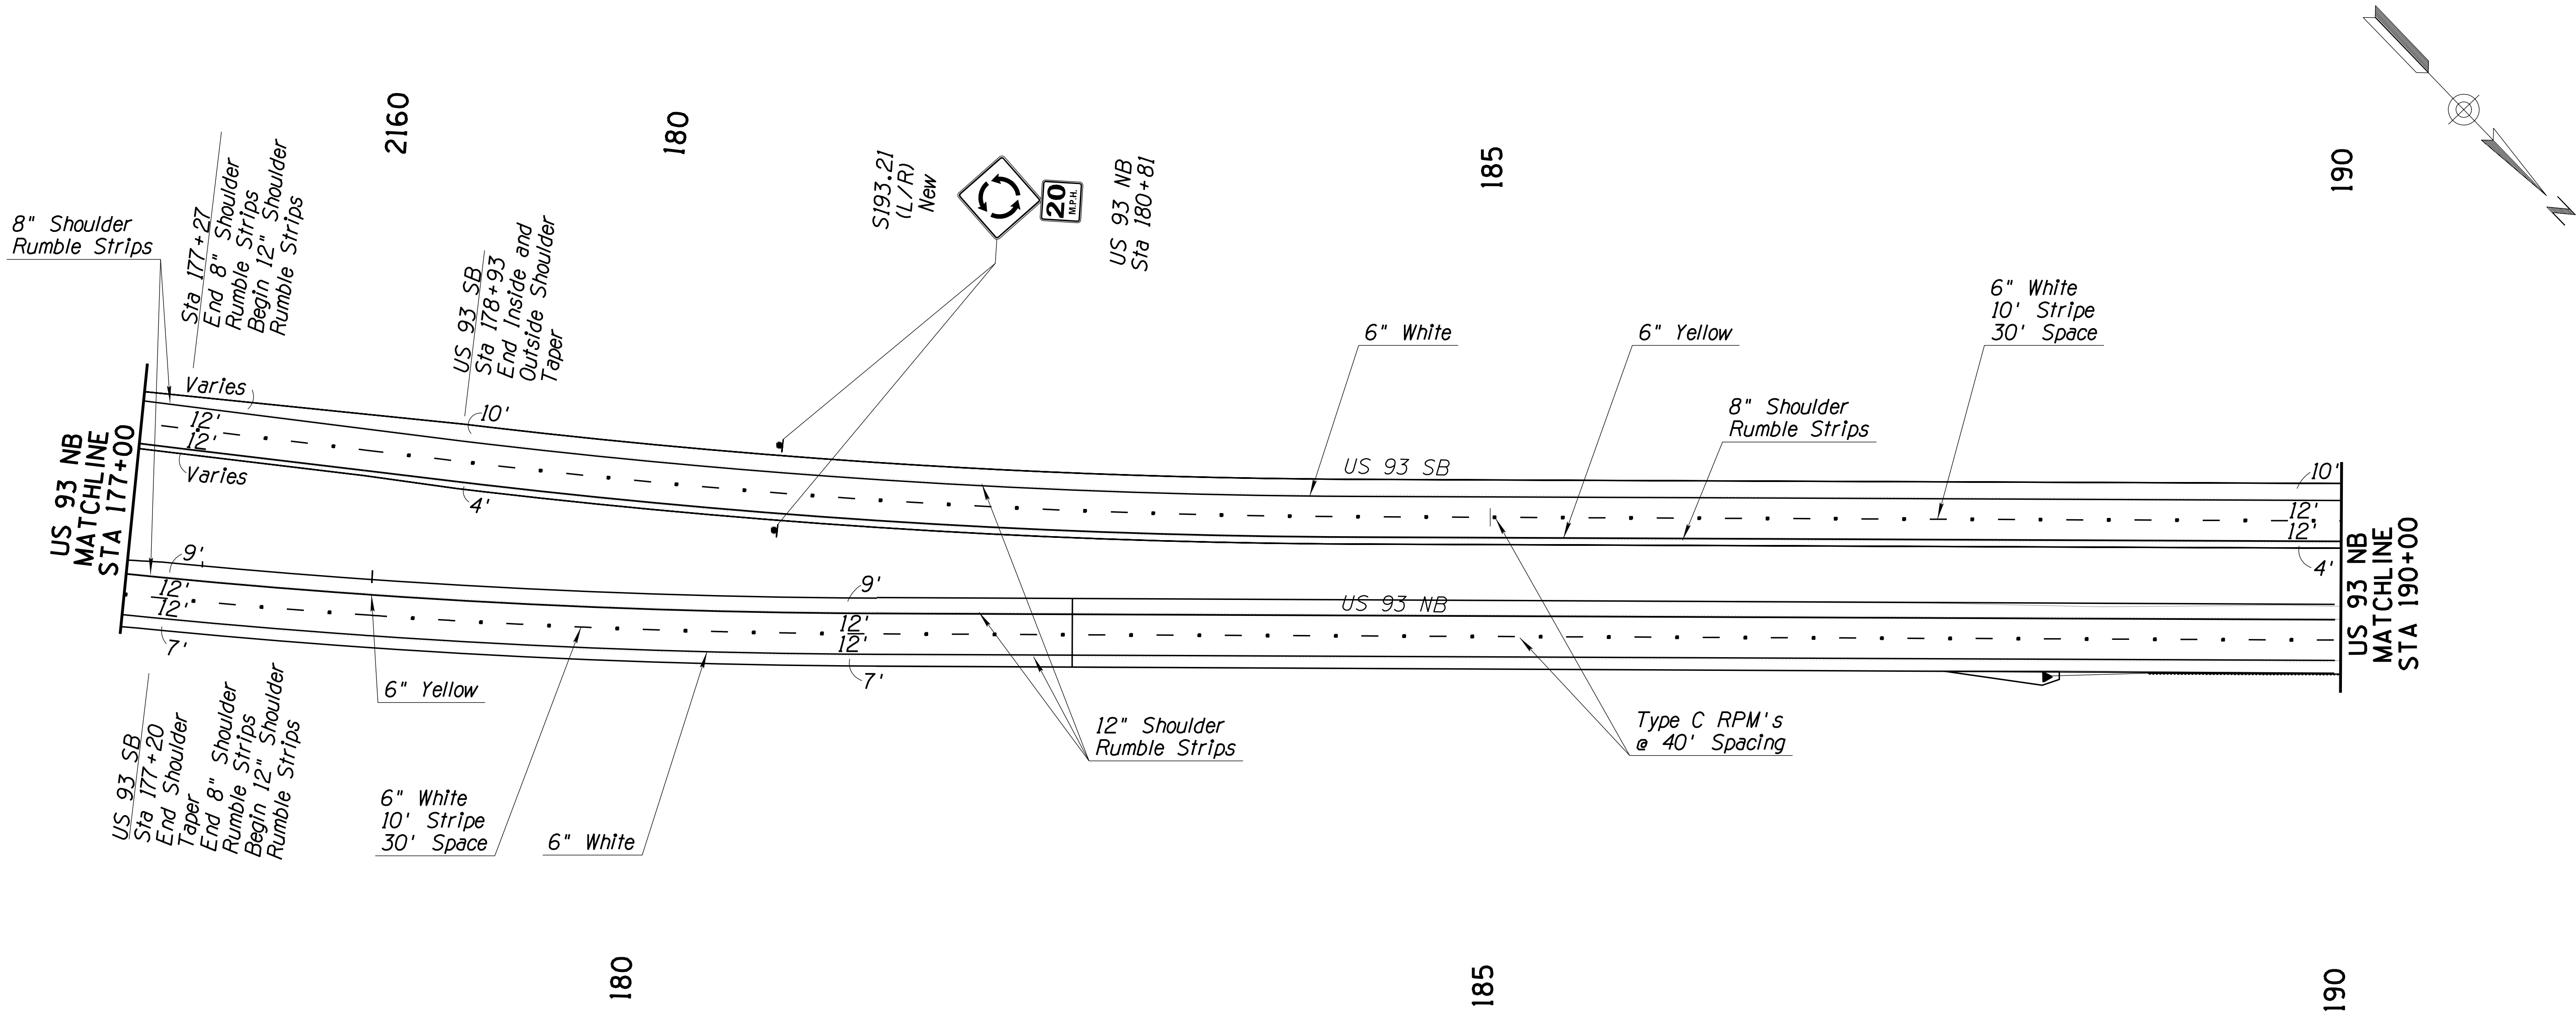


DESIGN		ME1	06/26	ARIZONA DEPARTMENT OF TRANSPORTATION PROJECT DELIVERY AND OPERATIONS DIVISION TRAFFIC DESIGN SERVICES	
DRAWN		SRH	06/26		
CHECKED		BMT	06/26		
ROUTE		US 93			DWG NO. T-5.12
LOCATION		WICKENBURG RANCH WAY TO VISTA ROYALE			
TRACS NO.		F0738 OIC		093-B(230)T	OF



3133 East Camelback Road, Suite 100
Phoenix, Arizona 85016
Phone: (602) 333-2200


US 93
SIGNING AND PAVEMENT MARKING
STA 177+00 TO STA 190+00

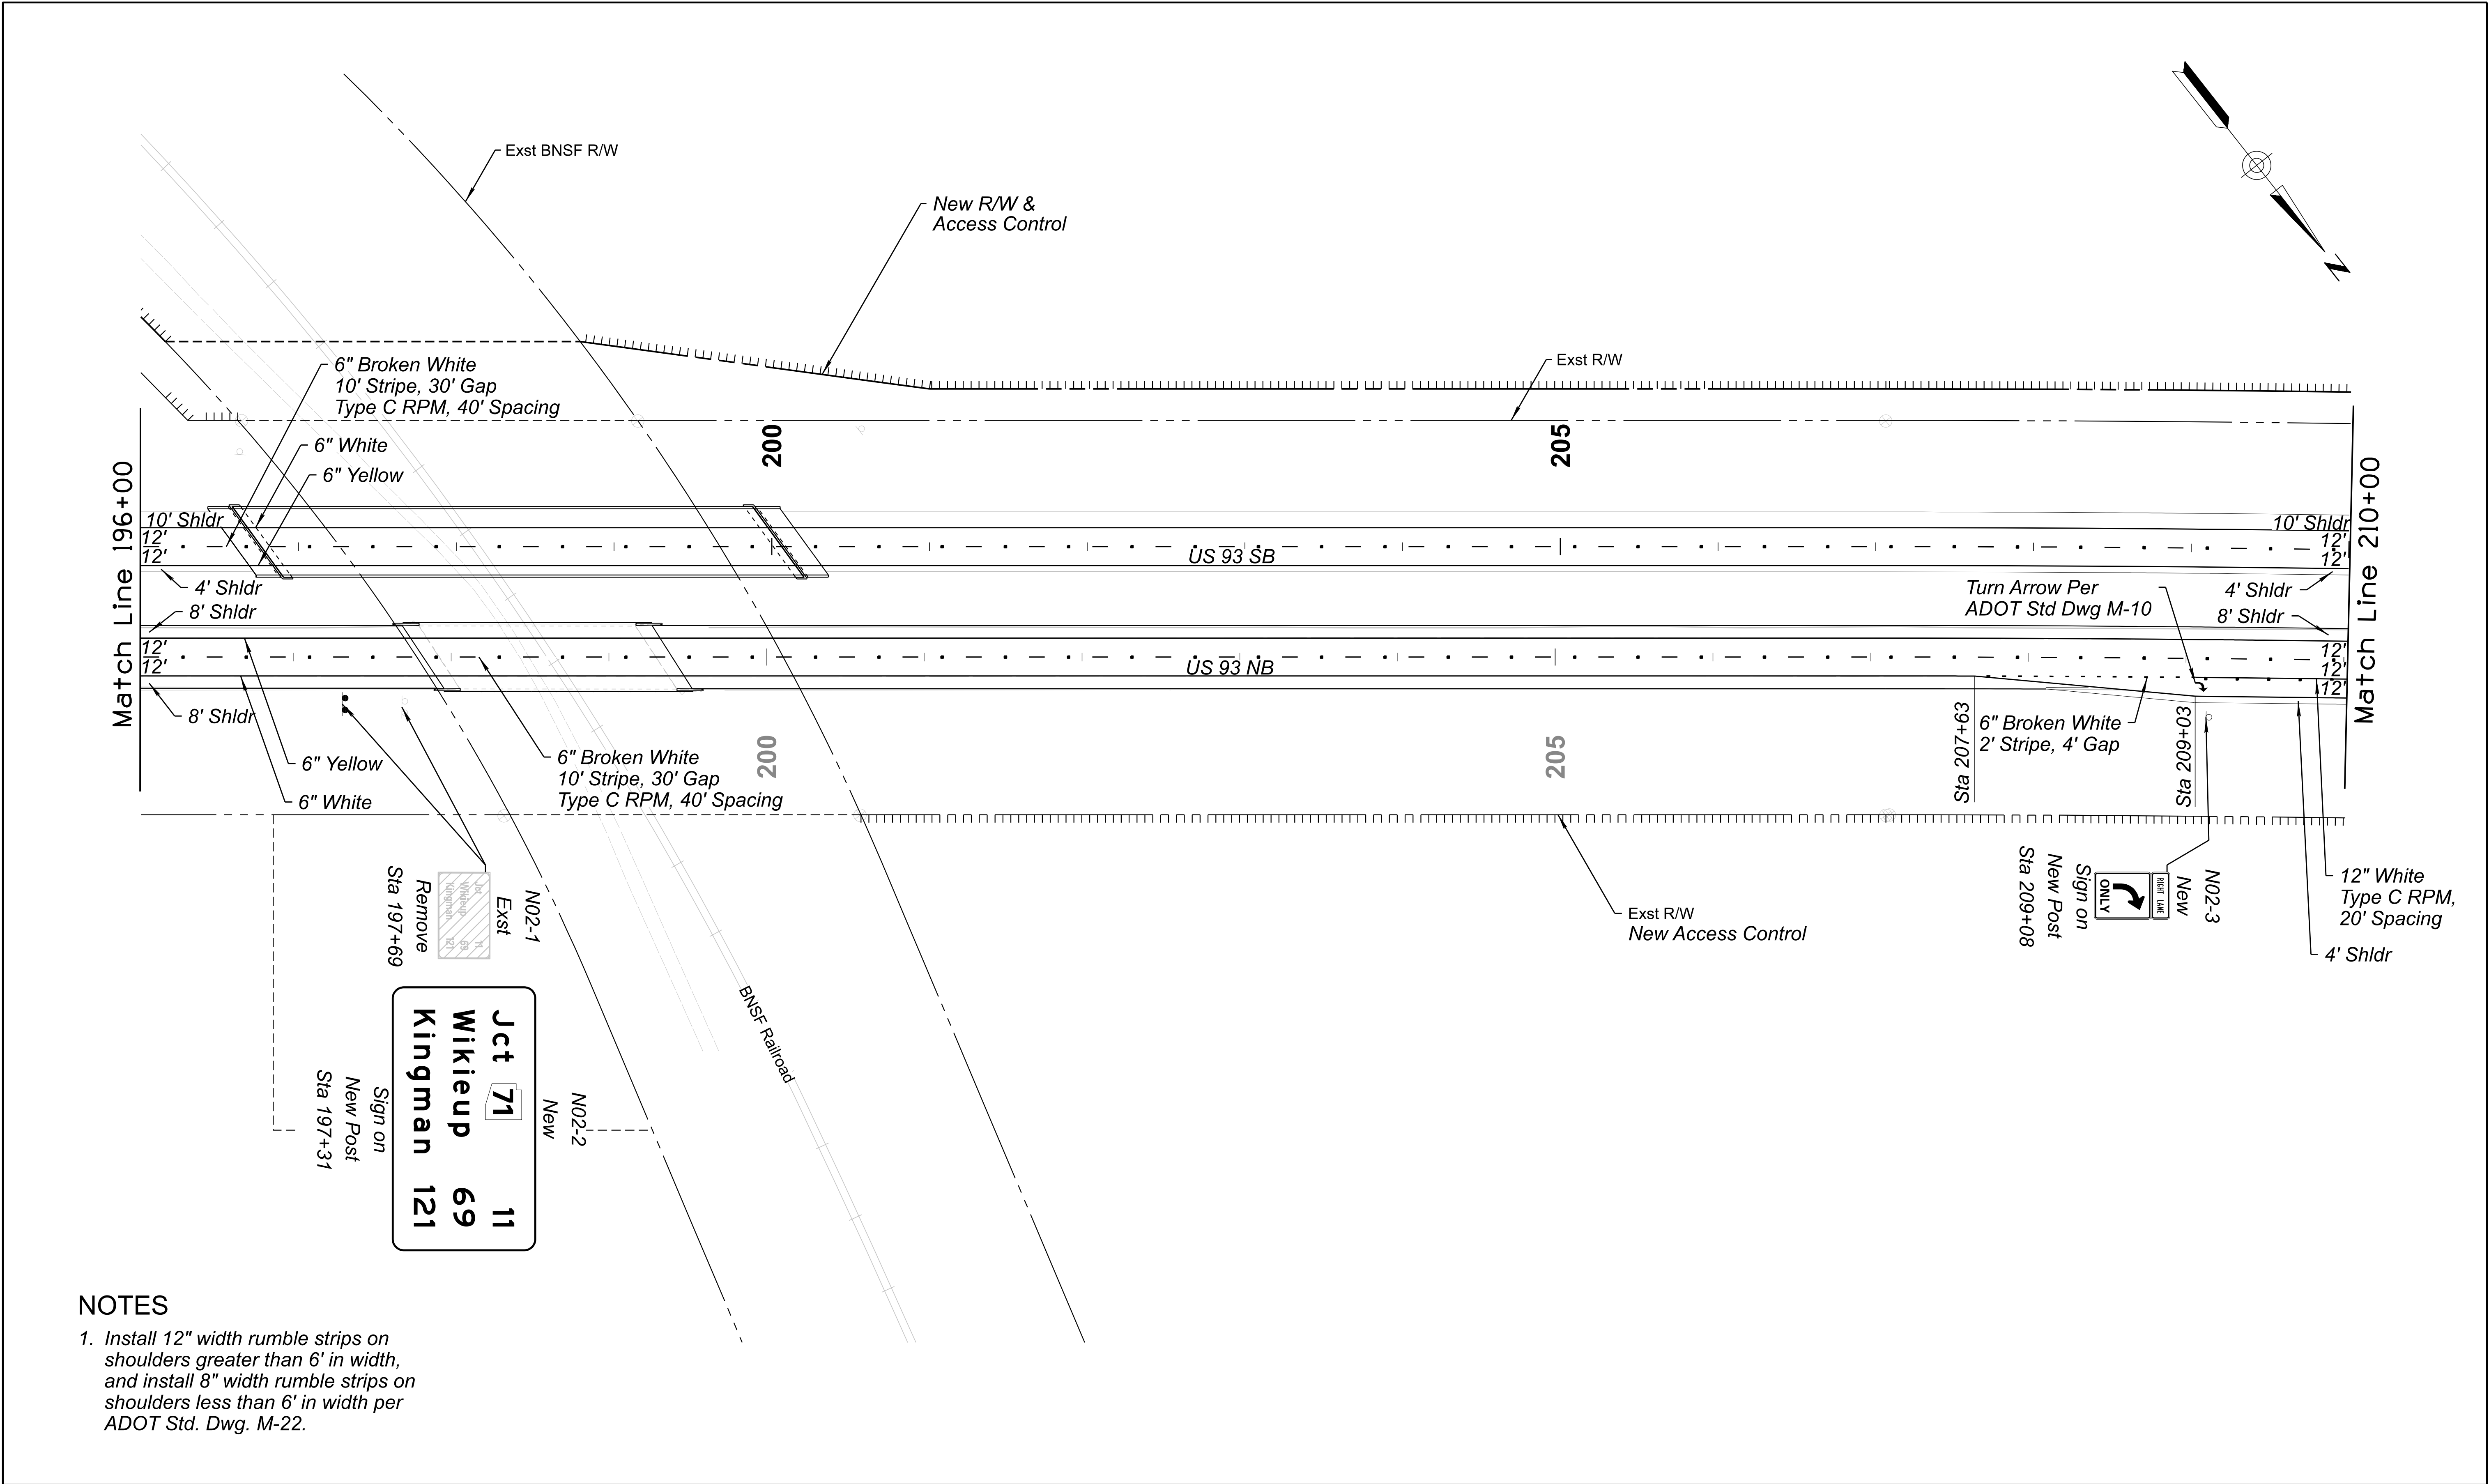

NOTES

1. Install 12" width rumble strips on shoulders greater than 6' in width, and install 8" width rumble strips on shoulders less than 6' in width per ADOT Std. Dwg. M-22.

	NAME		DATE	ARIZONA DEPARTMENT OF TRANSPORTATION PROJECT DELIVERY AND OPERATIONS DIVISION TRAFFIC DESIGN SERVICES		ROUTE		F.H.W.A. Arizona Division	STATE	PROJECT NO.	FEDERAL ID NO.	SHEET NO.	TOTAL SHEETS	RECORD DRAWING						
	DESIGN	I ROBLES	06/26			MILEPOST	190.5			093 YV 190	093-B-NFA	388	524							
	DRAWN	C VALENCIA	06/26																	
	CHECKED	C RICKETTS	06/26	TRANSPORTATION AECOM TECHNICAL SERVICES, Inc. 7720 N. 16th St., Suite 100 Phoenix, Arizona 85020 T 602.371.1100  www.aecom.com		STRUCTURE NO.		LOCATION				VISTA ROYALE			DWG No. T-5.14					
					SIGNING AND PAVEMENT MARKING SB US 93 STA 196+00 TO STA 210+00							TRACS NO. F0738 01C					____ OF ____			

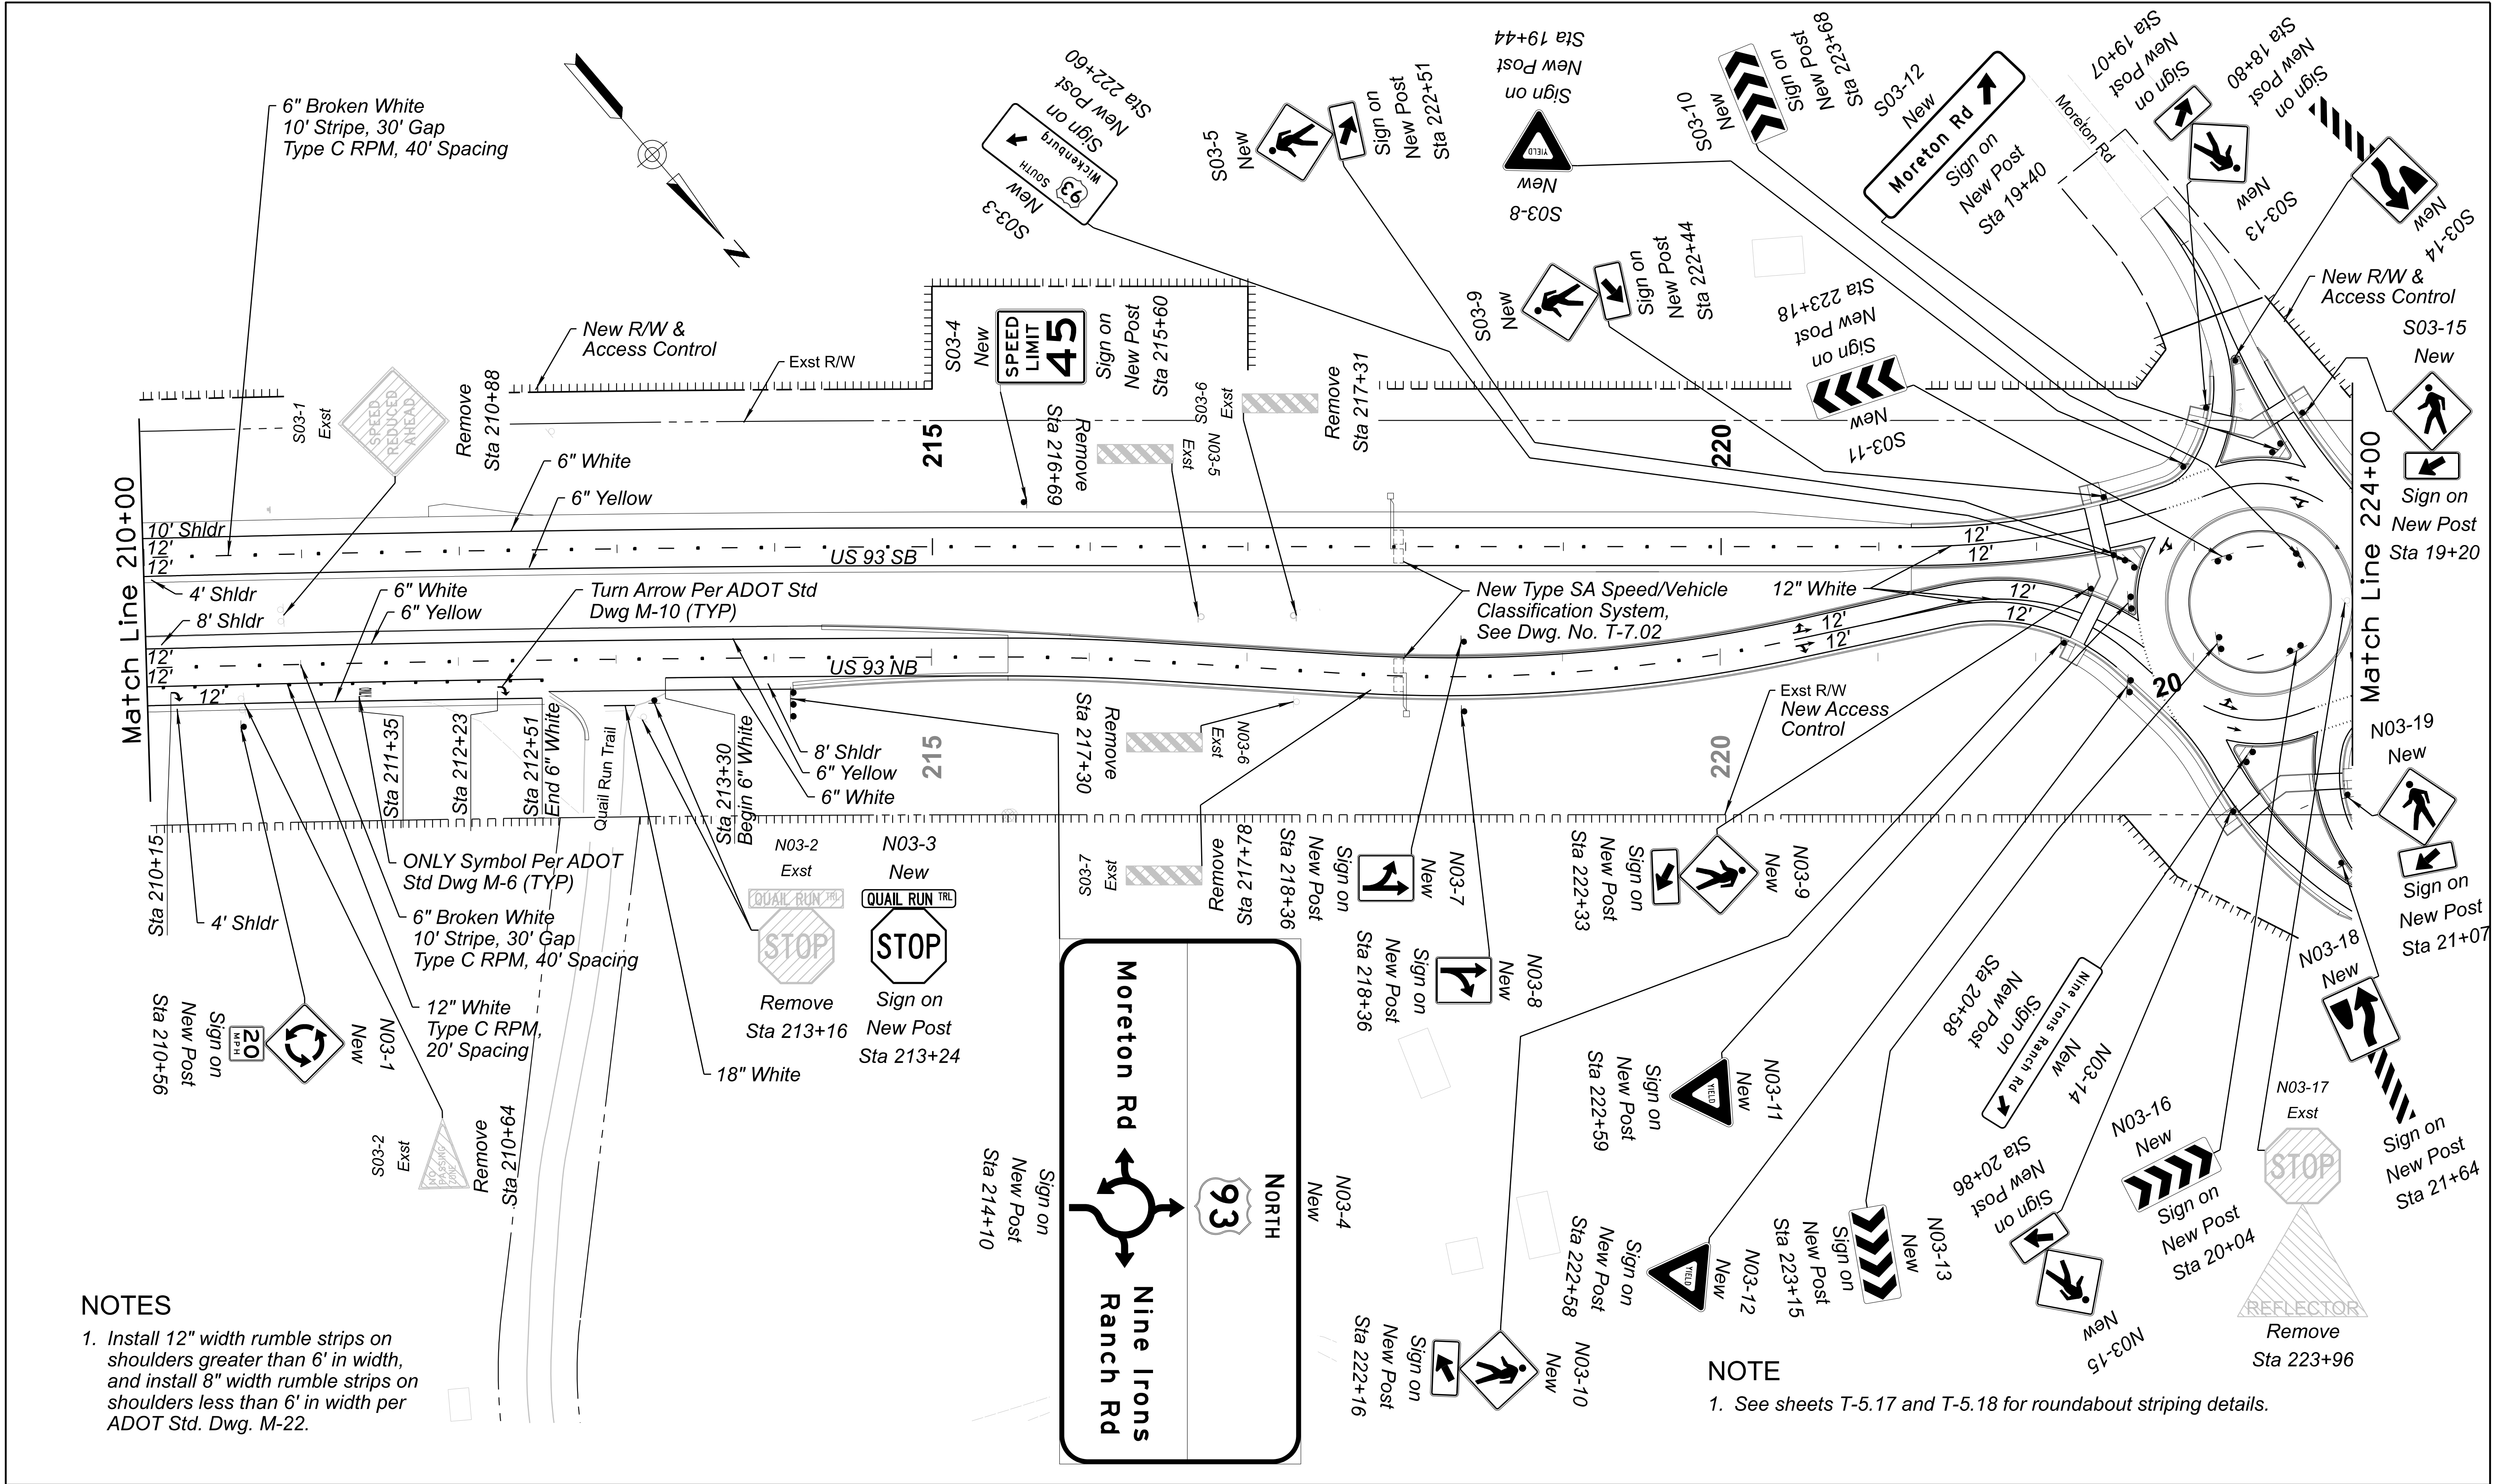

NOTES

1. Install 12" width rumble strips on shoulders greater than 6' in width, and install 8" width rumble strips on shoulders less than 6' in width per ADOT Std. Dwg. M-22.

NOTE

1. See sheets T-5.17 and T-5.18 for roundabout striping details.




DESIGN	NAME	DATE
DRAWN	I ROBLES	06/26
CHECKED	C VALENCIA	06/26
	C RICKETTS	06/26

TRANSPORTATION
AECOM TECHNICAL SERVICES, Inc.
7720 N. 16th St., Suite 100
Phoenix, Arizona 85020
T 602.371.1100
www.aecom.com

AECOM

ARIZONA DEPARTMENT OF TRANSPORTATION PROJECT DELIVERY AND OPERATIONS DIVISION TRAFFIC DESIGN SERVICES	ROUTE US 93 MILEPOST 190.5 STRUCTURE NO.
SIGNING AND PAVEMENT MARKING SB US 93 STA 210+00 TO STA 224+00	

STATE	PROJECT NO.	FEDERAL ID NO.	SHEET NO.	TOTAL SHEETS	RECORD DRAWING
ARIZ.	093 YV 190	093-B-NFA	389	524	
LOCATION	VISTA ROYALE				DWG No. T-5.15
TRACS NO.	F0738 01C				OF

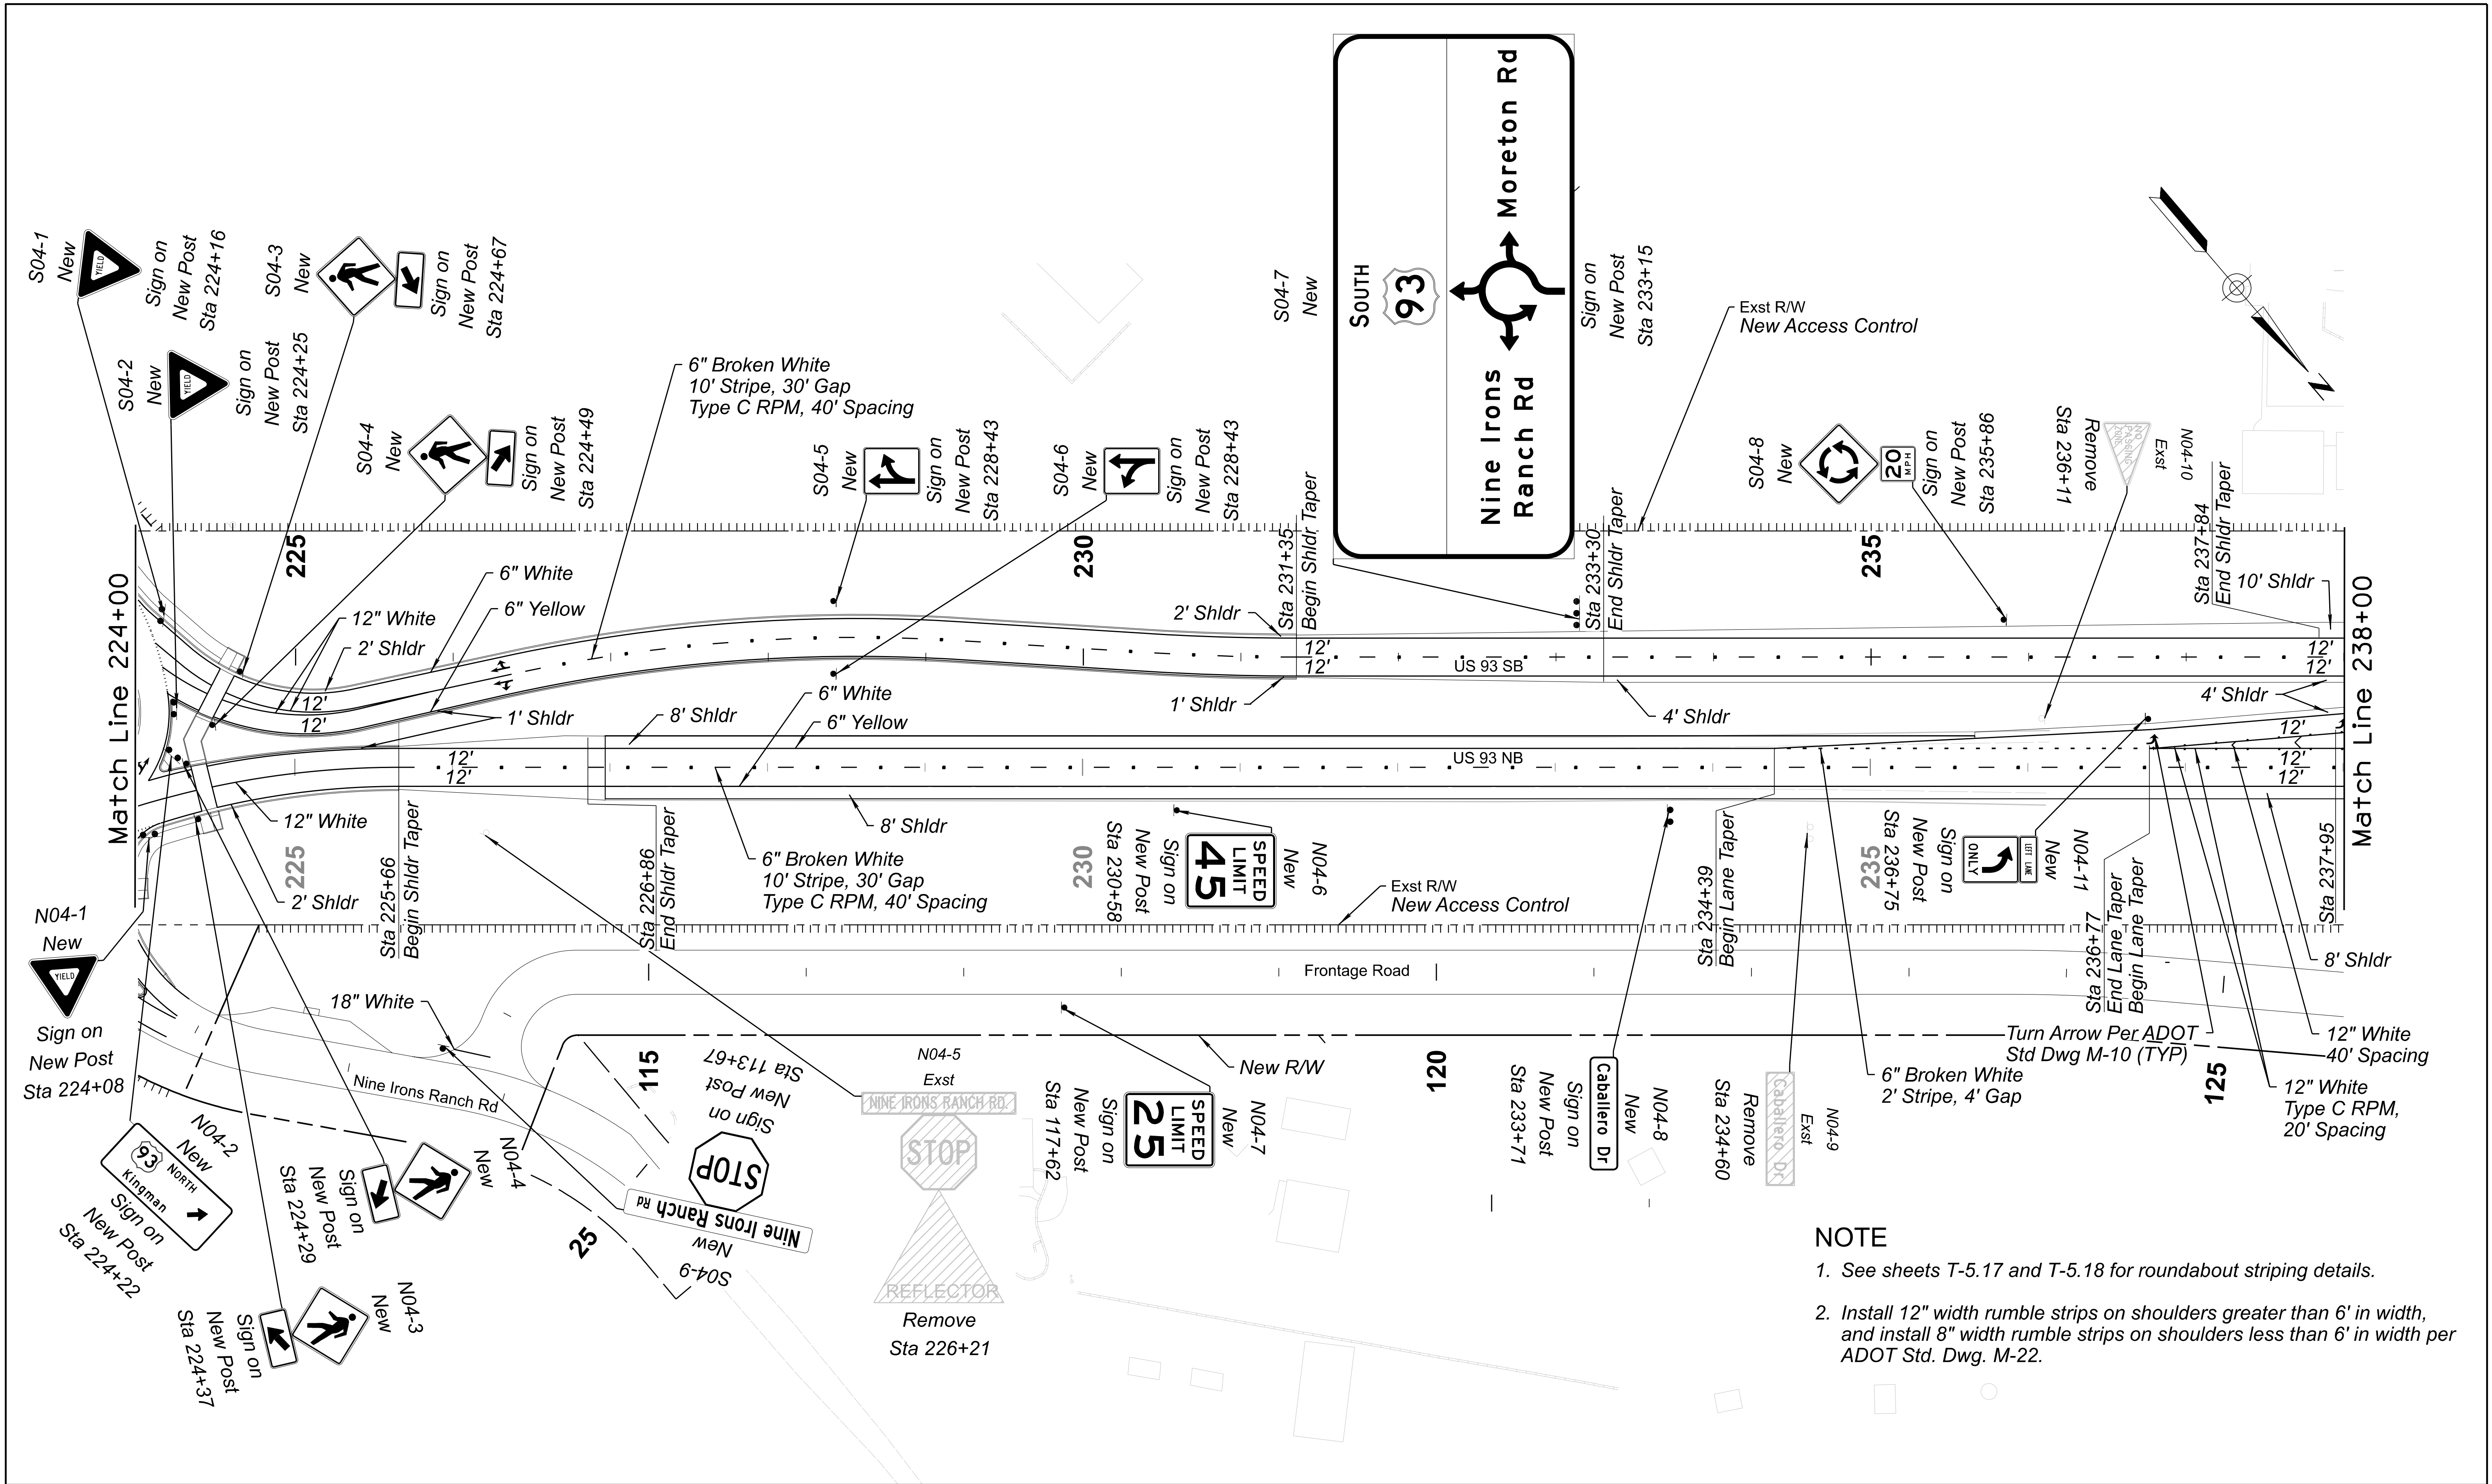



NOTE

1. See sheets T-5.17 and T-5.18 for roundabout striping details.

2. Install 12" width rumble strips on shoulders greater than 6' in width, and install 8" width rumble strips on shoulders less than 6' in width per ADOT Std. Dwg. M-22.

	DESIGN	I ROBLES	06/26	ARIZONA DEPARTMENT OF TRANSPORTATION PROJECT DELIVERY AND OPERATIONS DIVISION TRAFFIC DESIGN SERVICES	ROUTE	US 93	F.H.W.A. Arizona Division	STATE	PROJECT NO.	FEDERAL ID NO.	SHEET NO.	TOTAL SHEETS	RECORD DRAWING				
	DRAWN	C VALENCIA	06/26		MILEPOST	190.5			093 YV 190	093-B-NFA	390	524					
	CHECKED	C RICKETTS	06/26		TRANSPORTATION AECOM TECHNICAL SERVICES, Inc. 7720 N. 16th St., Suite 100 Phoenix, Arizona 85020 T 602.371.1100 www.aecom.com	SIGNING AND PAVEMENT MARKING SB US 93 STA 224+00 TO STA 238+00	STRUCTURE NO.	LOCATION							VISTA ROYALE		T-5.16
	TRACS NO.		F0738 01C				DWG No.						OF				

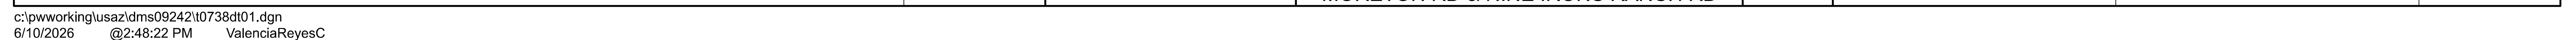


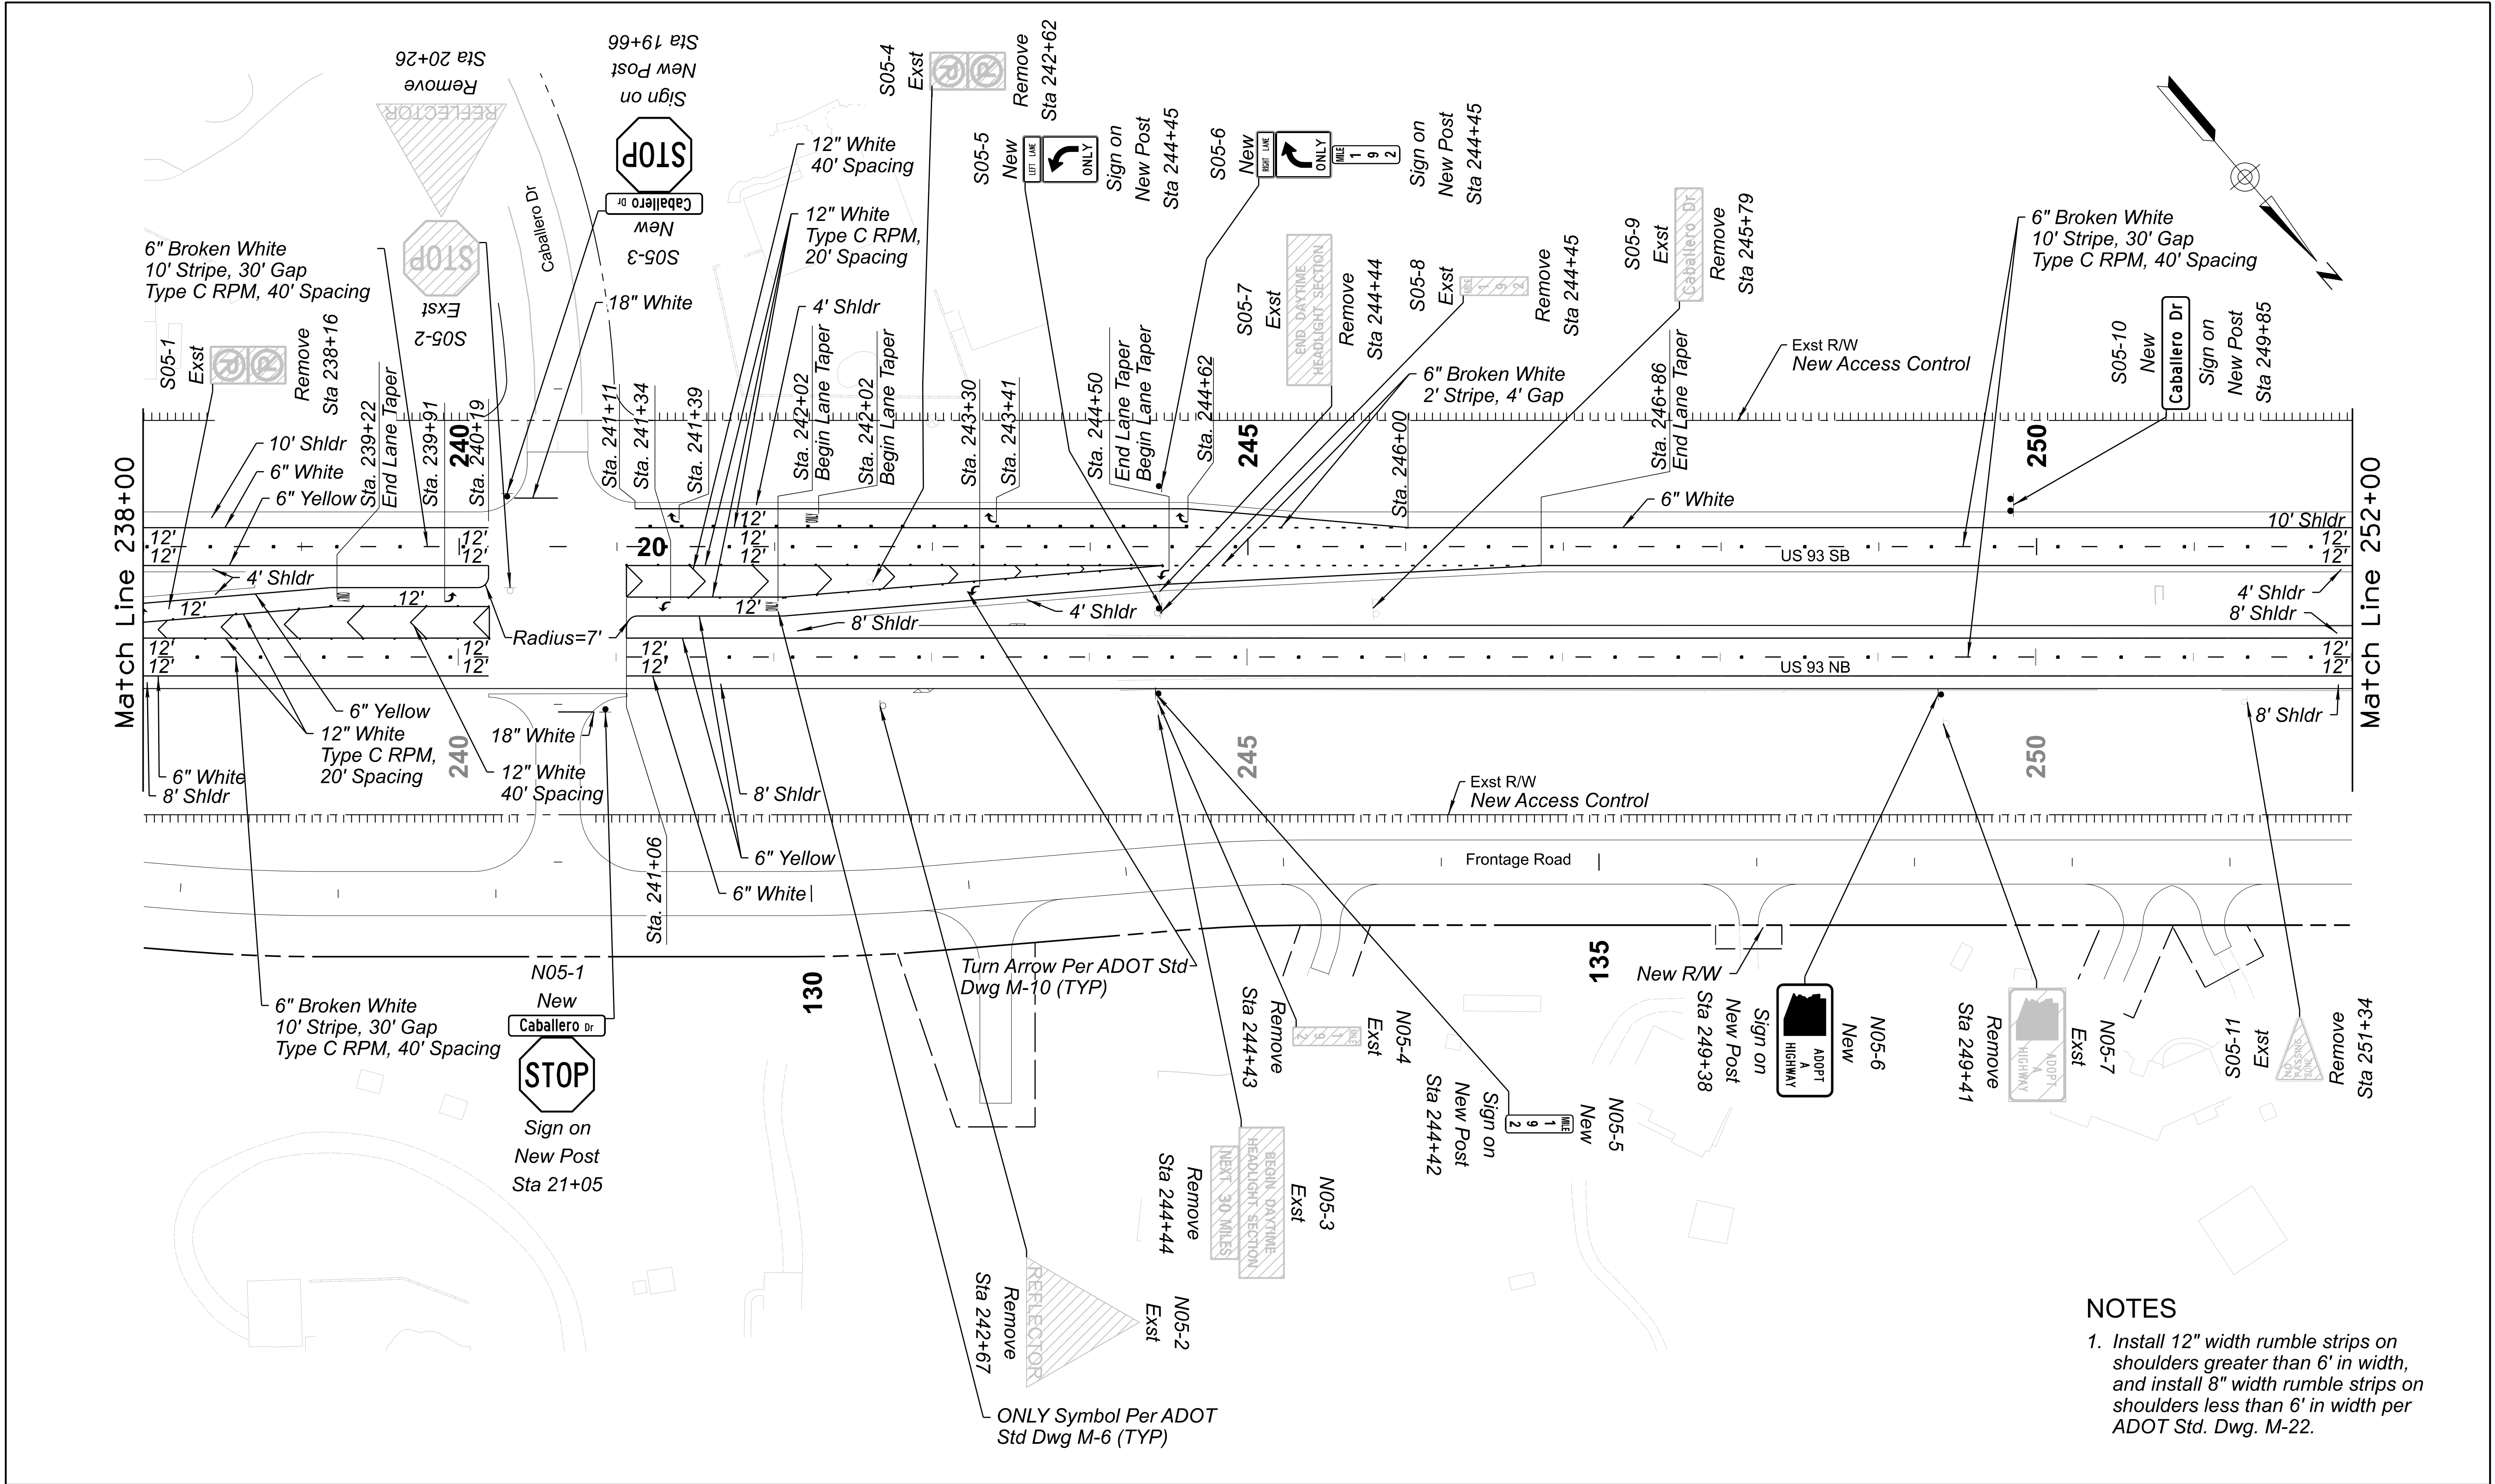

NOTES


1. Install 12" width rumble strips on shoulders greater than 6' in width, and install 8" width rumble strips on shoulders less than 6' in width per ADOT Std. Dwg. M-22.


	NAME		DATE	ARIZONA DEPARTMENT OF TRANSPORTATION PROJECT DELIVERY AND OPERATIONS DIVISION TRAFFIC DESIGN SERVICES	ROUTE	F.H.W.A. Arizona Division	STATE ARIZ.	PROJECT NO.	FEDERAL ID NO.	SHEET NO.	TOTAL SHEETS	RECORD DRAWING	
	DESIGN		I ROBLES		06/26			US 93	093 YV 190	093-B-NFA	393	524	
	DRAWN		C VALENCIA		06/26			MILEPOST					
	CHECKED		C RICKETTS	06/26	190.5								
TRANSPORTATION AECOM TECHNICAL SERVICES, Inc. 7720 N. 16th St., Suite 100 Phoenix, Arizona 85020 T 602.371.1100 				SIGNING AND PAVEMENT MARKING SB US 93 STA 238+00 TO STA 252+00	STRUCTURE NO.	LOCATION VISTA ROYALE						DWG No. T-5.19	
TRACS NO. F0738 01C						OF							

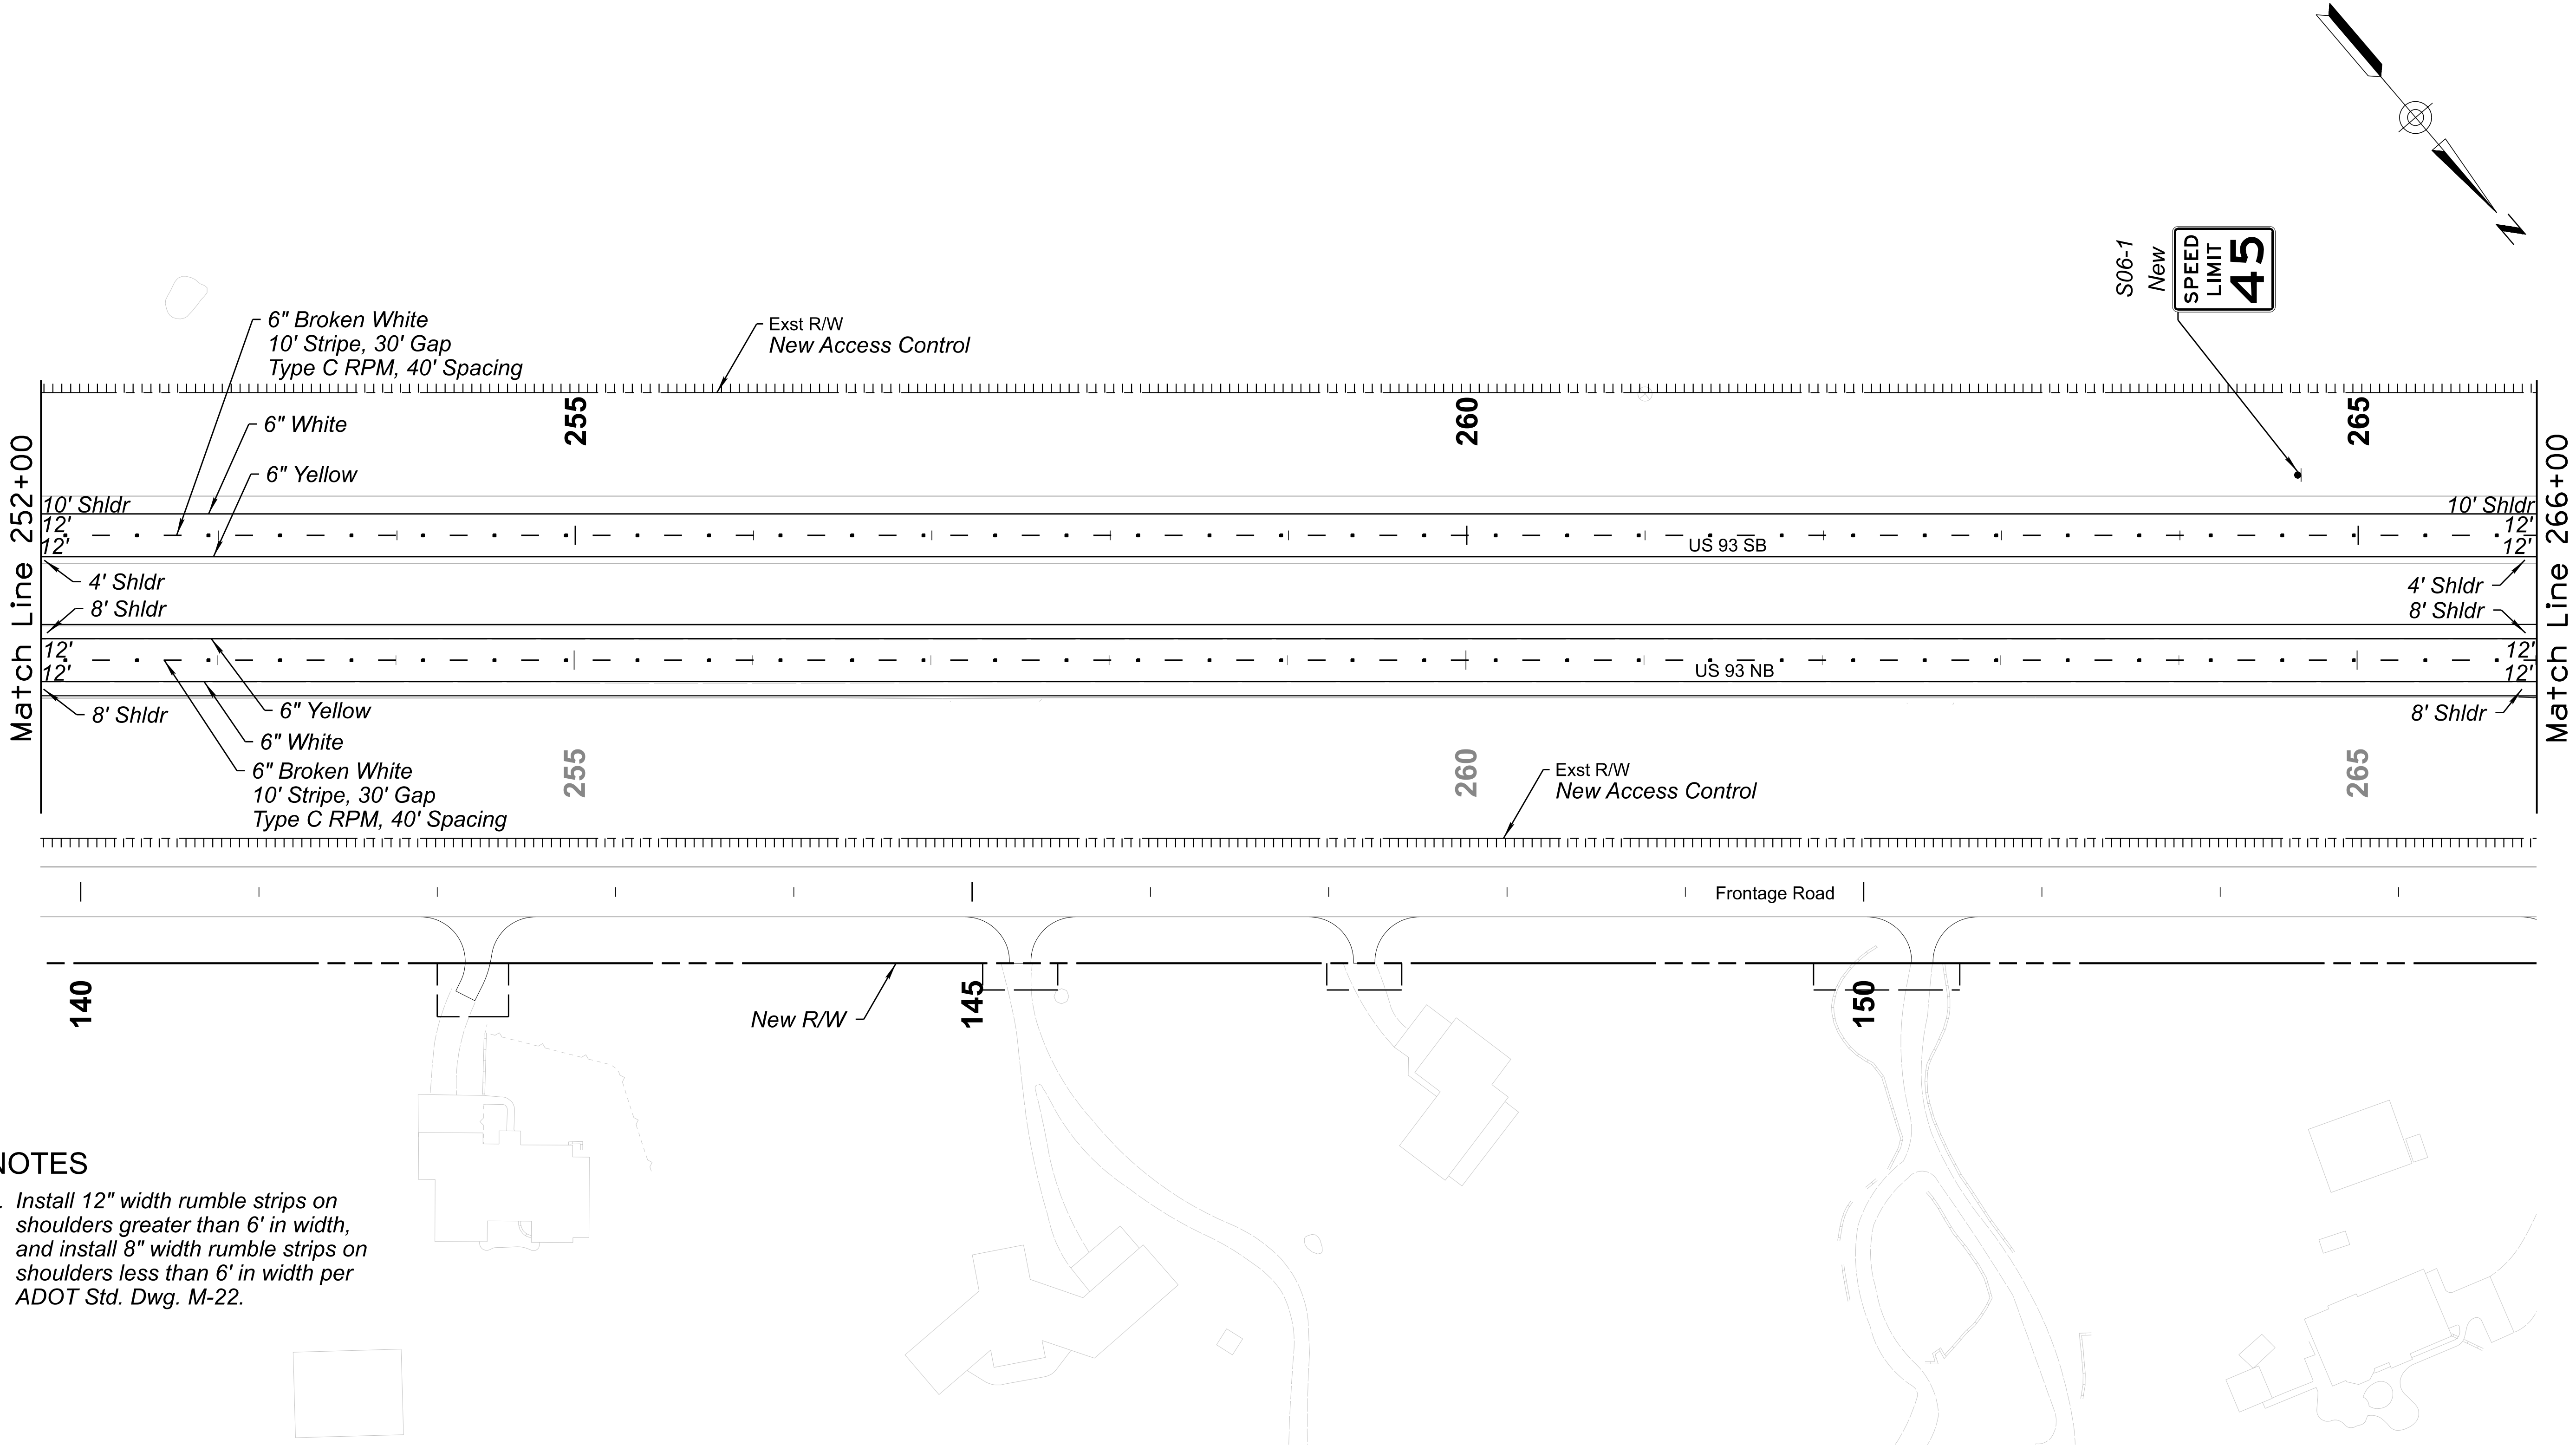

NOTES


- 1. Install 12" width rumble strips on shoulders greater than 6' in width, and install 8" width rumble strips on shoulders less than 6' in width per ADOT Std. Dwg. M-22.

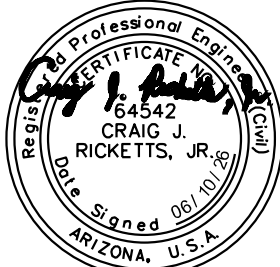	NAME		DATE	ARIZONA DEPARTMENT OF TRANSPORTATION PROJECT DELIVERY AND OPERATIONS DIVISION TRAFFIC DESIGN SERVICES		ROUTE	F.H.W.A. Arizona Division	STATE	PROJECT NO.	FEDERAL ID NO.	SHEET NO.	TOTAL SHEETS	RECORD DRAWING
	DESIGN	I ROBLES	06/26			US 93	ARIZ.	093 YV 190	093-B-NFA	394	524	DWG No. T-5.20	
	DRAWN	C VALENCIA	06/26			MILEPOST							
	CHECKED	C RICKETTS	06/26			190.5							
TRANSPORTATION AECOM TECHNICAL SERVICES, Inc. 7720 N. 16th St., Suite 100 Phoenix, Arizona 85020 T 602.371.1100 www.aecom.com				SIGNING AND PAVEMENT MARKING SB US 93 STA 252+00 TO STA 266+00		STRUCTURE NO.	TRACS NO. F0738 01C		OF				

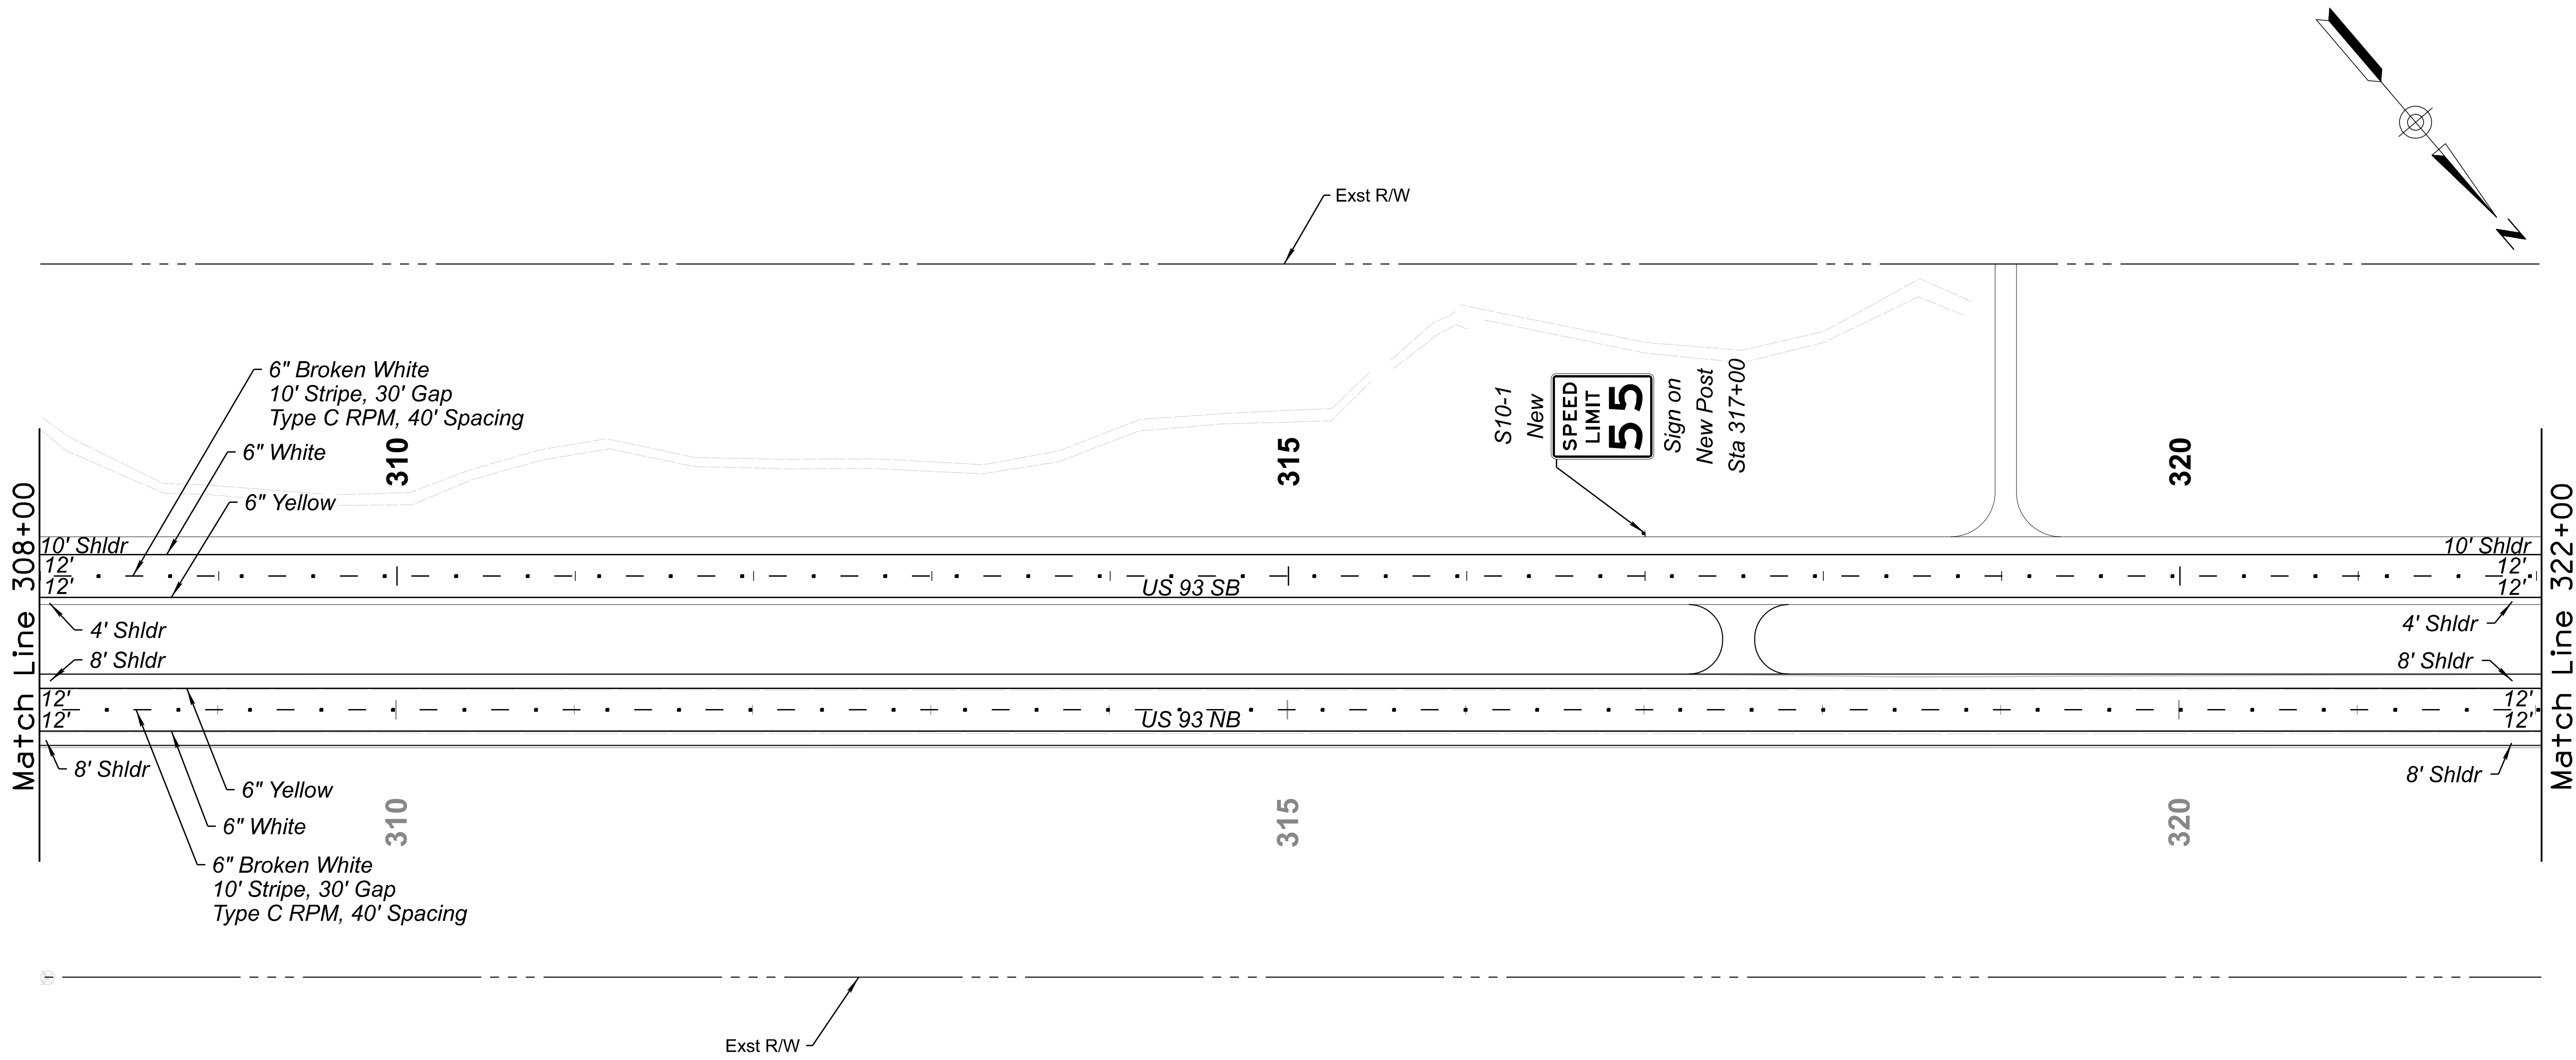


NOTES

- 1. Install 12" width rumble strips on shoulders greater than 6' in width, and install 8" width rumble strips on shoulders less than 6' in width per ADOT Std. Dwg. M-22.

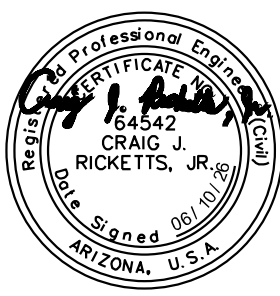	<table><tr><th></th><th>NAME</th><th>DATE</th></tr><tr><td>DESIGN</td><td>I ROBLES</td><td>06/26</td></tr><tr><td>DRAWN</td><td>C VALENCIA</td><td>06/26</td></tr><tr><td>CHECKED</td><td>C RICKETTS</td><td>06/26</td></tr></table>		NAME	DATE	DESIGN	I ROBLES	06/26	DRAWN	C VALENCIA	06/26	CHECKED	C RICKETTS	06/26	TRANSPORTATION AECOM TECHNICAL SERVICES, Inc. 7720 N. 16th St., Suite 100 Phoenix, Arizona 85020 T 602.371.1100 www.aecom.com	ARIZONA DEPARTMENT OF TRANSPORTATION PROJECT DELIVERY AND OPERATIONS DIVISION TRAFFIC DESIGN SERVICES		ROUTE US 93	F.H.W.A. Arizona Division	STATE ARIZ.	PROJECT NO. 093 YV 190	FEDERAL ID NO. 093-B-NFA	SHEET NO. 398	TOTAL SHEETS 524	RECORD DRAWING
		NAME	DATE																					
	DESIGN	I ROBLES	06/26																					
	DRAWN	C VALENCIA	06/26																					
CHECKED	C RICKETTS	06/26																						
MILEPOST 190.5	LOCATION VISTA ROYALE										DWG No. T-5.24													
STRUCTURE NO.	TRACS NO. F0738 01C											OF												

c:\pwworking\usaz\dms09242\t0738pm11.dgn
6/10/2026 @2:49:54 PM ValenciaReyesC

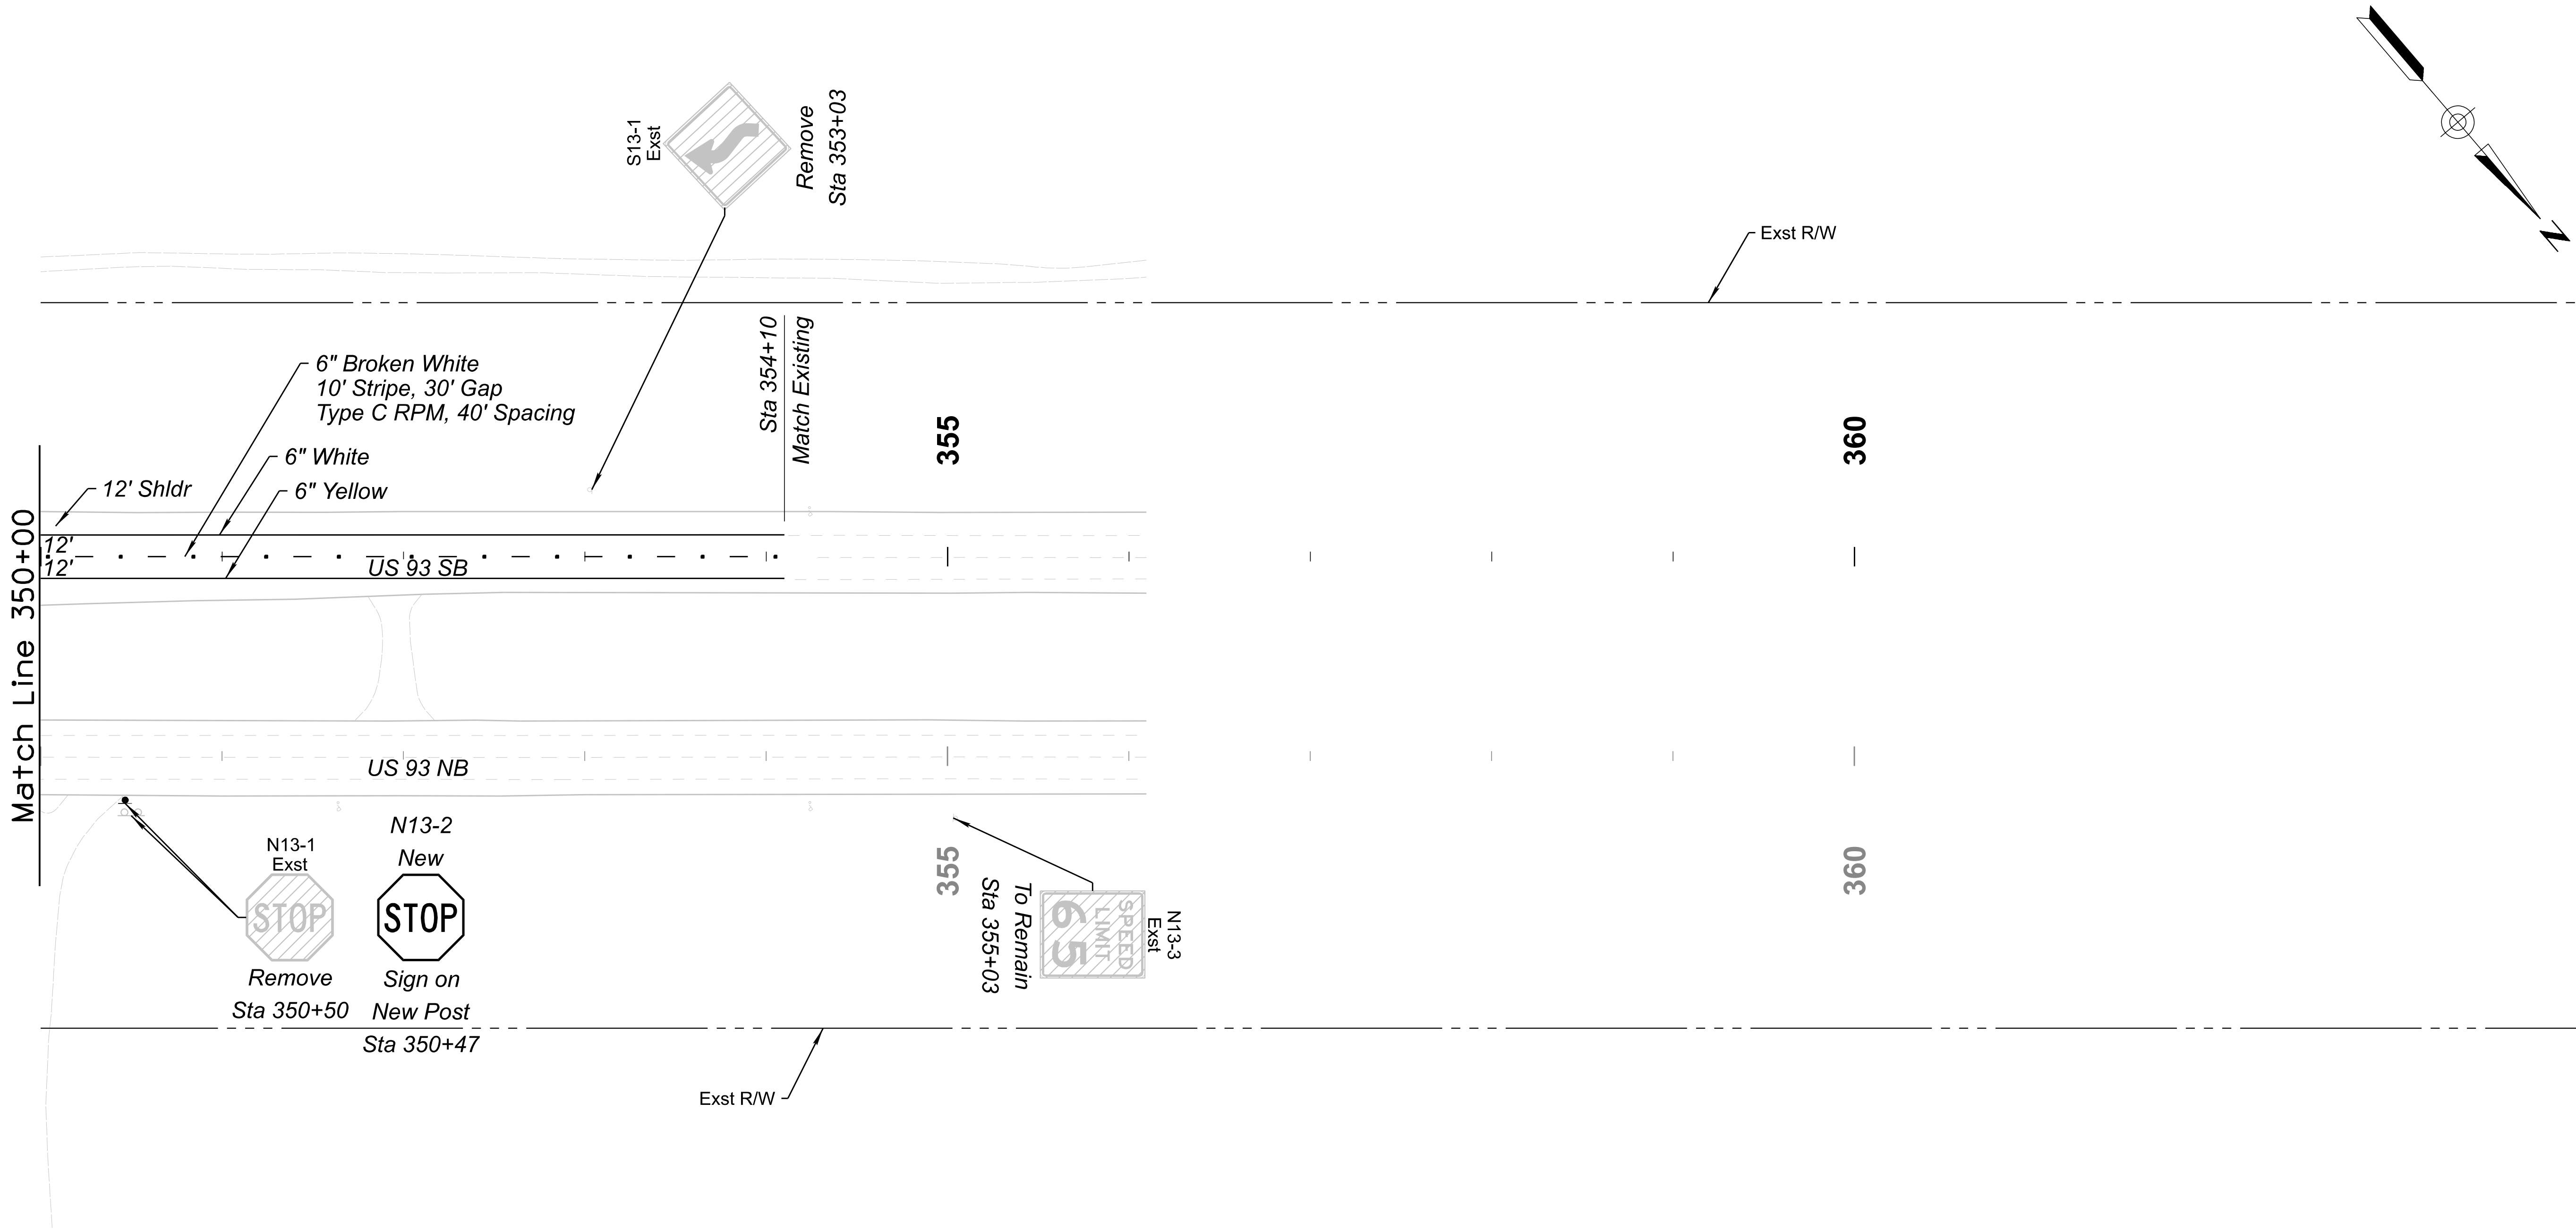

NOTES

1. Install 12" width rumble strips on shoulders greater than 6' in width, and install 8" width rumble strips on shoulders less than 6' in width per ADOT Std. Dwg. M-22.

		NAME	DATE	ARIZONA DEPARTMENT OF TRANSPORTATION PROJECT DELIVERY AND OPERATIONS DIVISION TRAFFIC DESIGN SERVICES	ROUTE	F.H.W.A. Arizona Division	STATE	PROJECT NO.	FEDERAL ID NO.	SHEET NO.	TOTAL SHEETS	RECORD DRAWING
	DESIGN	I ROBLES	06/26		MILEPOST		ARIZ.	093 YV 190	093-B-NFA	401	524	
	DRAWN	C VALENCIA	06/26		STRUCTURE NO.							
	CHECKED	C RICKETTS	06/26	SIGNING AND PAVEMENT MARKING SB US 93 STA 350+00 TO STA 354+10								
	TRANSPORTATION AECOM TECHNICAL SERVICES, Inc. 7720 N. 16th St., Suite 100 Phoenix, Arizona 85020 T 602.371.1100  www.aecom.com											



2145

2150

2155

F.H.W.A. REGION	STATE	PROJECT NO.	SHEET NO.	TOTAL SHEETS	RECORD DRAWING
9	ARIZ.	093-B(230)T	402	524	

093 YV 189

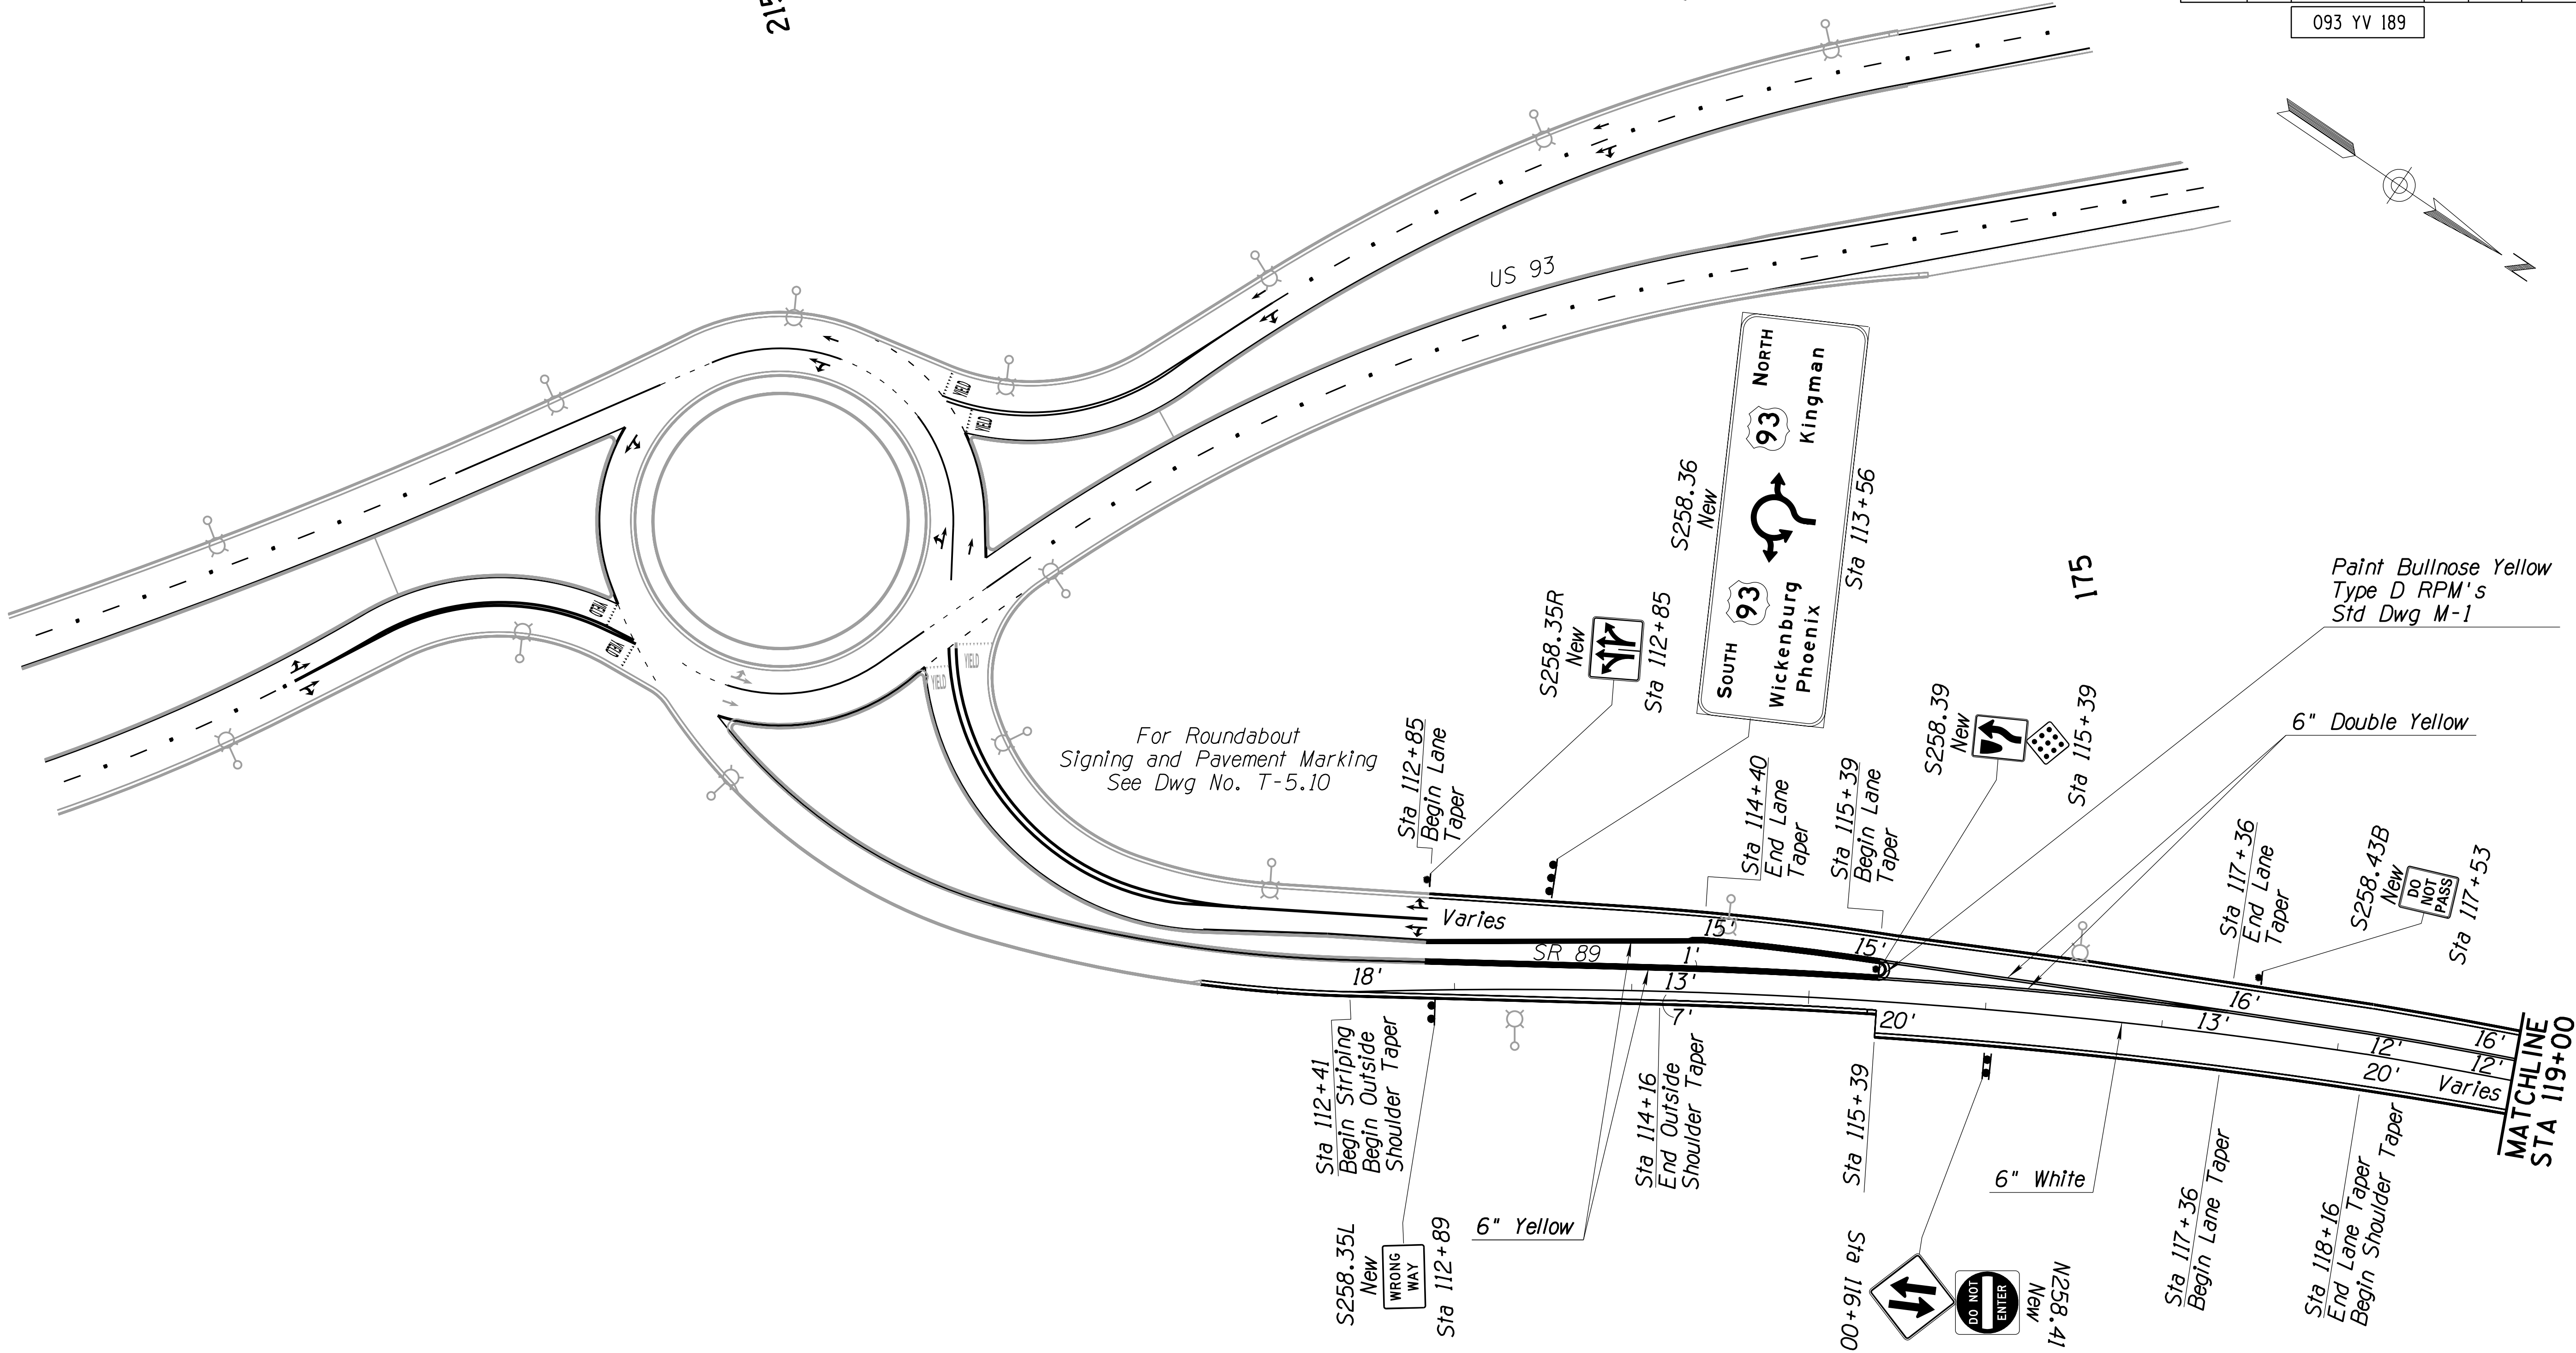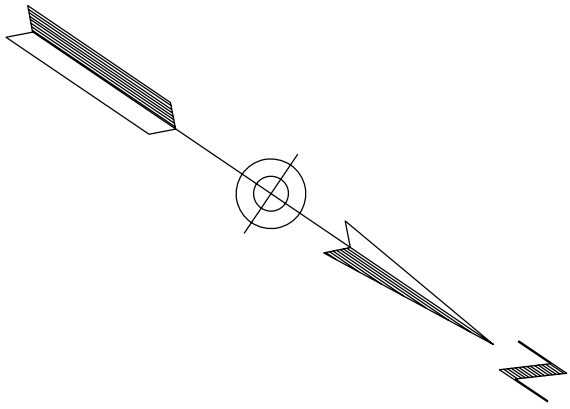

For Roundabout
Signing and Pavement Marking
See Dwg No. T-5.10

Paint Bullnose Yellow
Type D RPM's
Std Dwg M-1

6" Double Yellow

S258.43B
New
DO NOT
PASS
Sta 117+53

S258.39
New
Sta 115+39

175

S258.36
New
Sta 113+56

SOUTH 93 WICKENBURG PHOENIX
NORTH 93 KINGMAN

S258.35R
New
Sta 112+85

S258.35L
New
Sta 112+89

6" Yellow

S258.35L
New
Sta 112+89

Sta 112+41
Begin Striping
Begin Outside
Shoulder Taper

Sta 112+89

Sta 114+16
End Outside
Shoulder Taper

Sta 115+39

6" White

N258.41
New
DO NOT
ENTER

Sta 117+36
Begin Lane Taper

Sta 118+16
End Lane Taper
Begin Shoulder Taper

Sta 117+36
End Lane Taper



Sta 119+00
MATCHLINE

115

DESIGN	ME1	DATE	06/26	ARIZONA DEPARTMENT OF TRANSPORTATION PROJECT DELIVERY AND OPERATIONS DIVISION TRAFFIC DESIGN SERVICES SR 89 SIGNING AND PAVEMENT MARKING STA 105+00 TO STA 119+00	
DRAWN	SRH	DATE	06/26		
CHECKED	BMT	DATE	06/26		
				3133 East Camelback Road, Suite 100 Phoenix, Arizona 85016 Phone: (602) 333-2200	
ROUTE		LOCATION		DWG NO. T-5.28	
US 93		WICKENBURG RANCH WAY TO VISTA ROYALE			
TRACS NO. F0738 OIC		093-B(230)T		OF	

F.H.W.A. REGION	STATE	PROJECT NO.	SHEET NO.	TOTAL SHEETS	RECORD DRAWING
9	ARIZ.	093-B(230)T	403	524	



093 YV 189

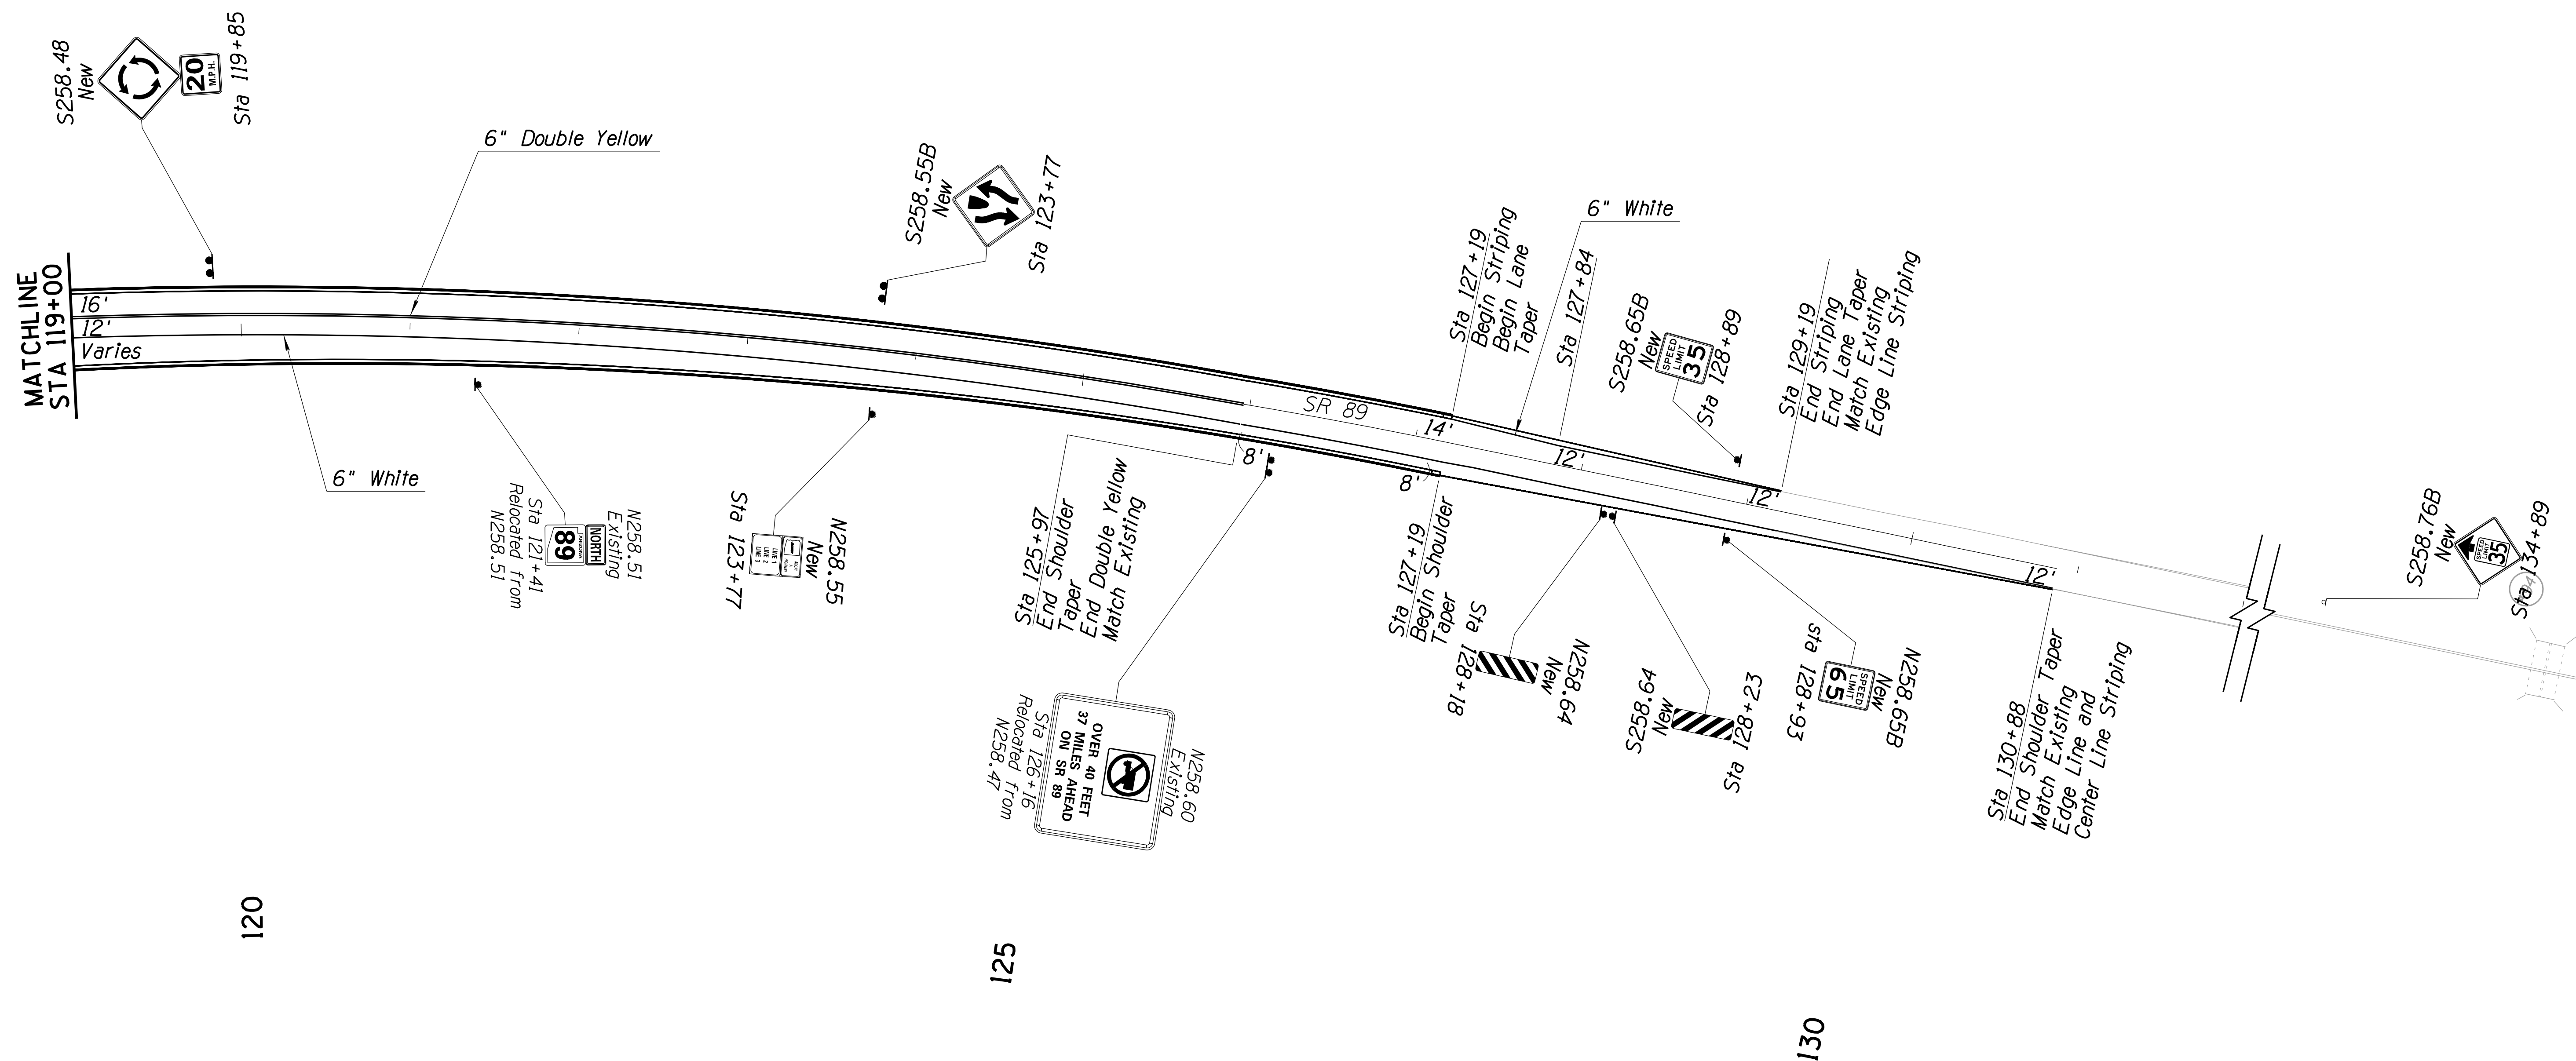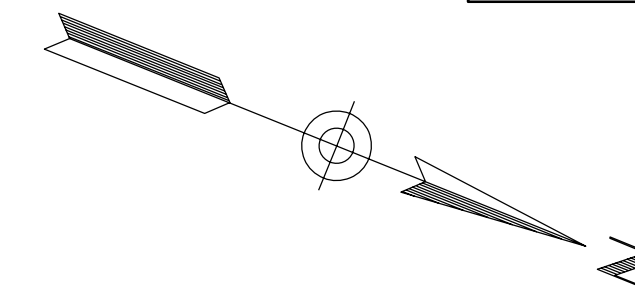

		NAME		DATE		ARIZONA DEPARTMENT OF TRANSPORTATION PROJECT DELIVERY AND OPERATIONS DIVISION TRAFFIC DESIGN SERVICES			
DESIGN		MEI		06/26					
DRAWN		SRH		06/26					
CHECKED		BMT		06/26		SR 89			
 Stanley Consultants INC.		3133 East Camelback Road, Suite 100 Phoenix, Arizona 85006 Phone: (602) 333-2200				SIGNING AND PAVEMENT MARKINGS STA 119+00 TO STA 130+88			
		ROUTE		LOCATION					
US 93				WICKENBURG RANCH WAY TO VISTA ROYALE				DWG NO. T-529	
TRACS NO. F0738 OIC						093-B(230)T		_____ OF _____	

F.H.W.A. REGION	STATE	PROJECT NO.	SHEET NO.	TOTAL SHEETS	RECORD DRAWING
9	ARIZ.	093-B(230)T	404	524	



093 YV 189

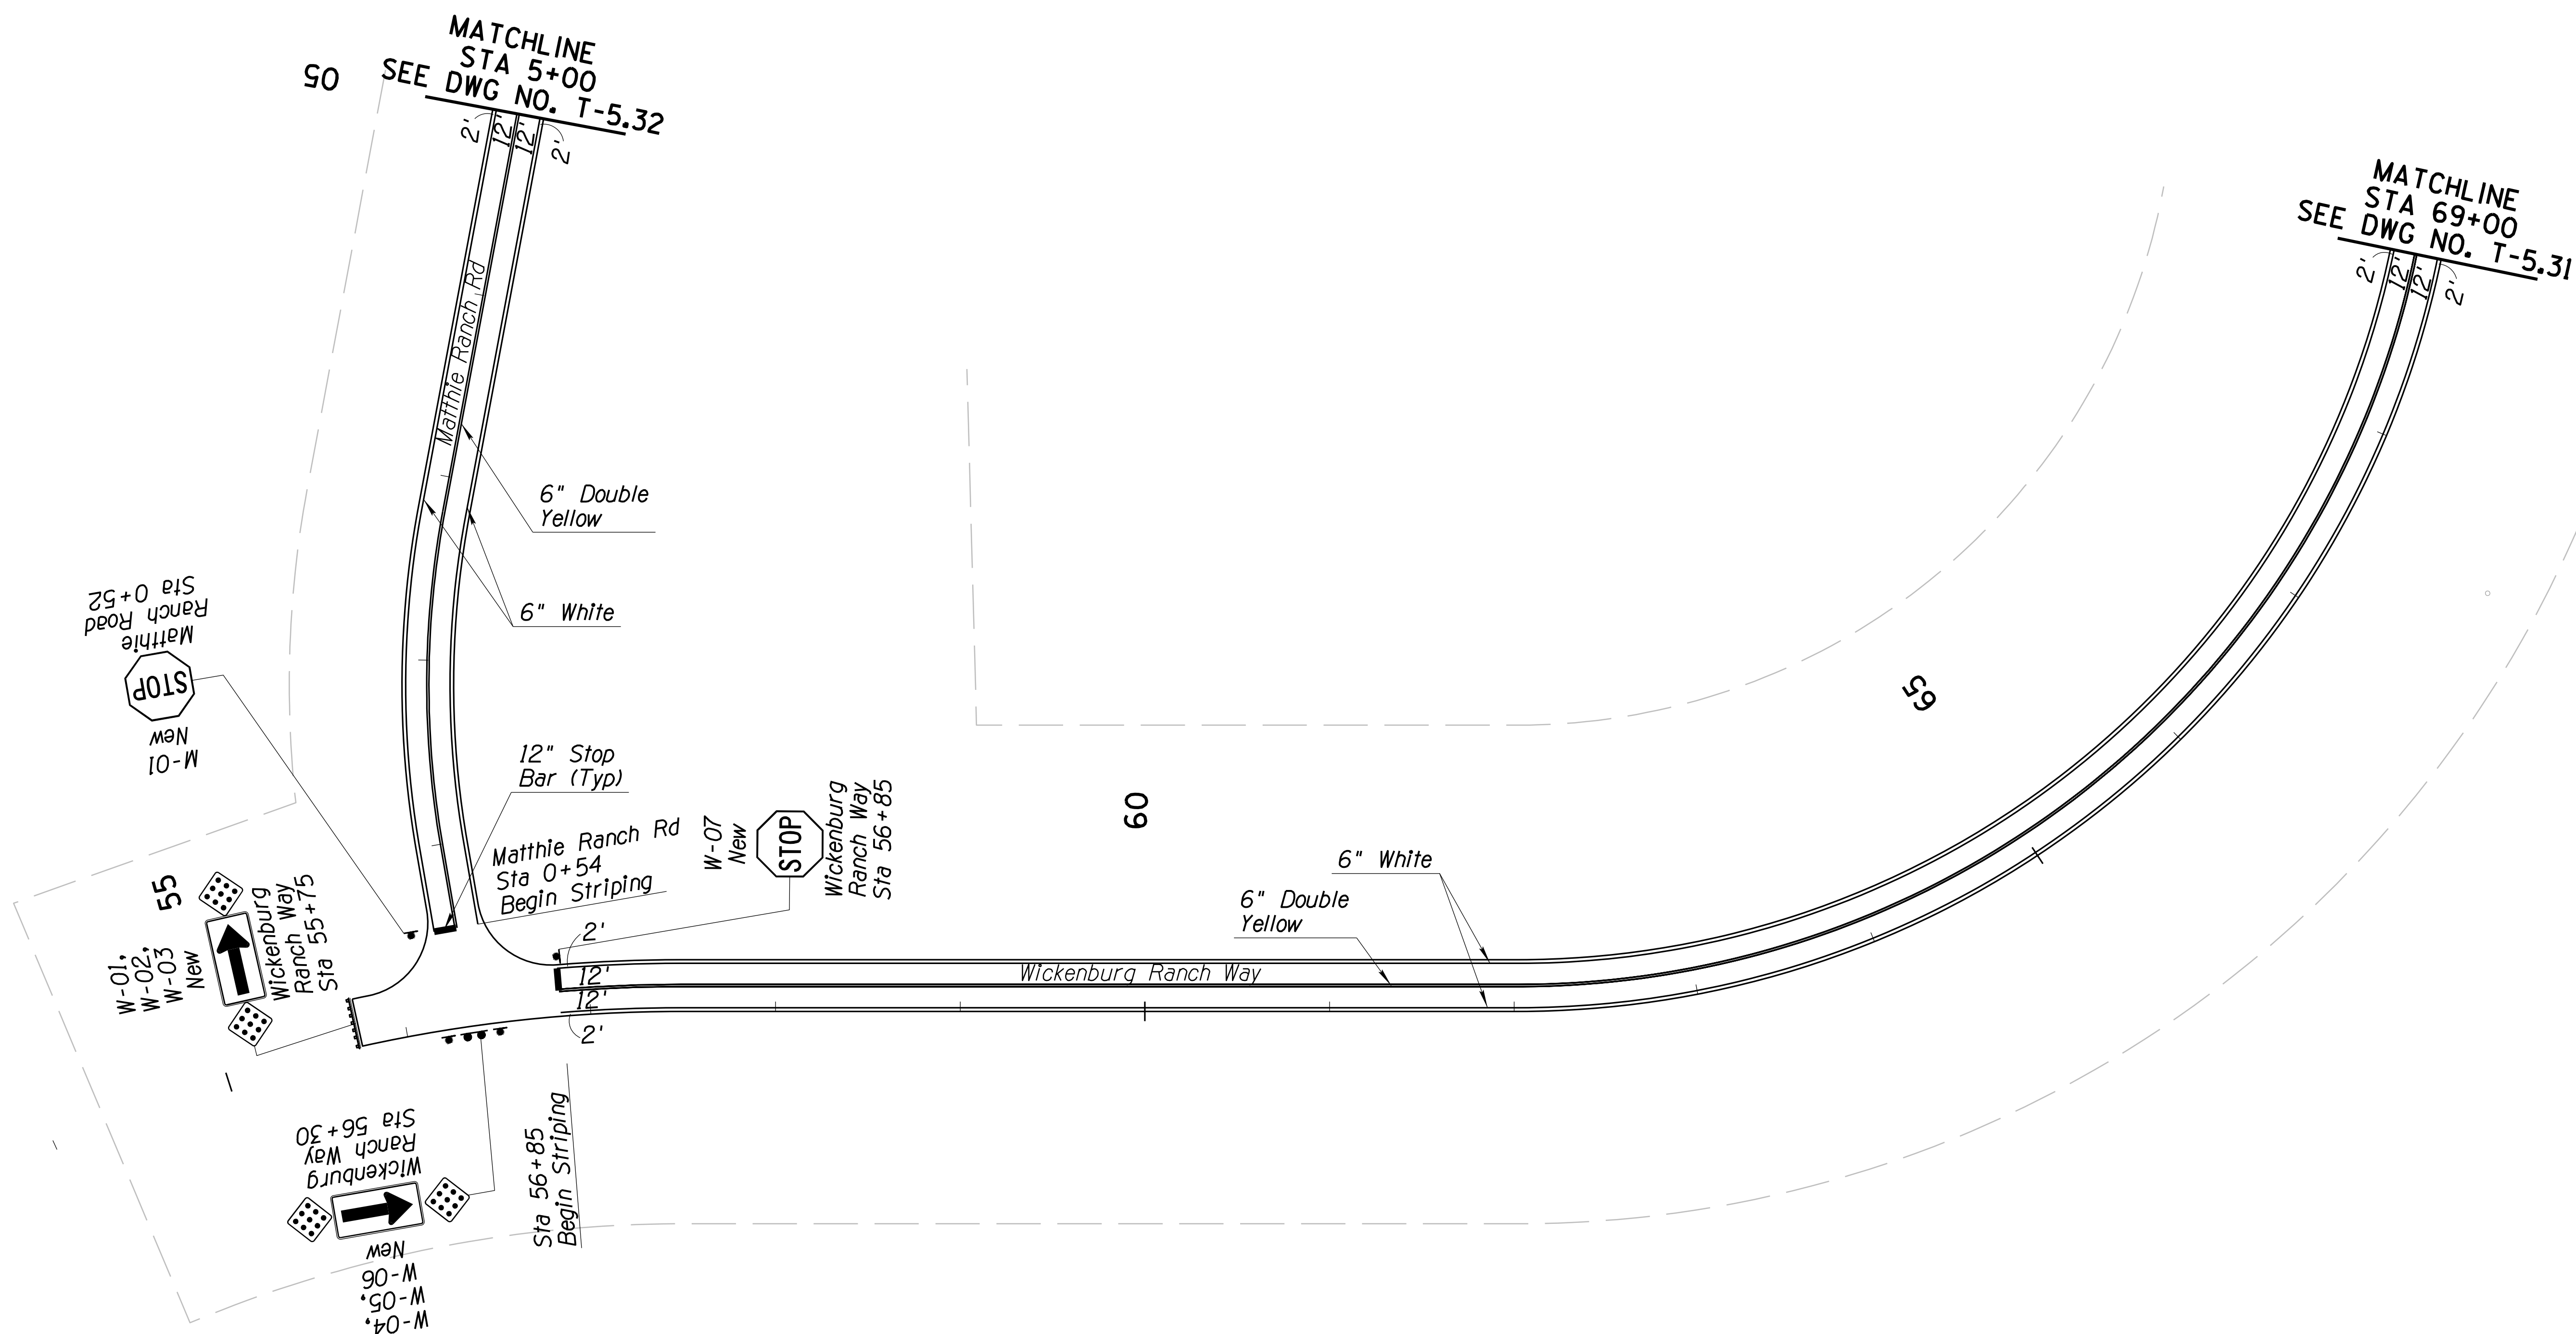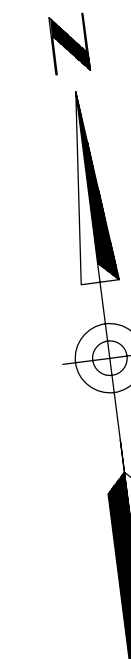

		NAME	DATE	ARIZONA DEPARTMENT OF TRANSPORTATION PROJECT DELIVERY AND OPERATIONS DIVISION TRAFFIC DESIGN SERVICES		
DESIGN	MEI	06/26				
DRAWN	SRH	06/26				
CHECKED	BMT	06/26		WICKENBURG RANCH WAY SIGNING AND PAVEMENT MARKING STA 56+00 TO 69+00		
 Stanley Consultants inc.		5133 East Camelback Road, Suite 100 Phoenix, Arizona 85018 Phone: (602) 333-2200				
ROUTE		LOCATION		DWG NO. T-5.30		
US 93		WICKENBURG RANCH WAY TO VISTA ROYALE				
TRACS NO. F0738 OIC				093-B(230)T		___ OF

F.H.W.A. REGION	STATE	PROJECT NO.	SHEET NO.	TOTAL SHEETS	RECORD DRAWING
9	ARIZ.	093-B(230)T	405	524	


093 YV 189

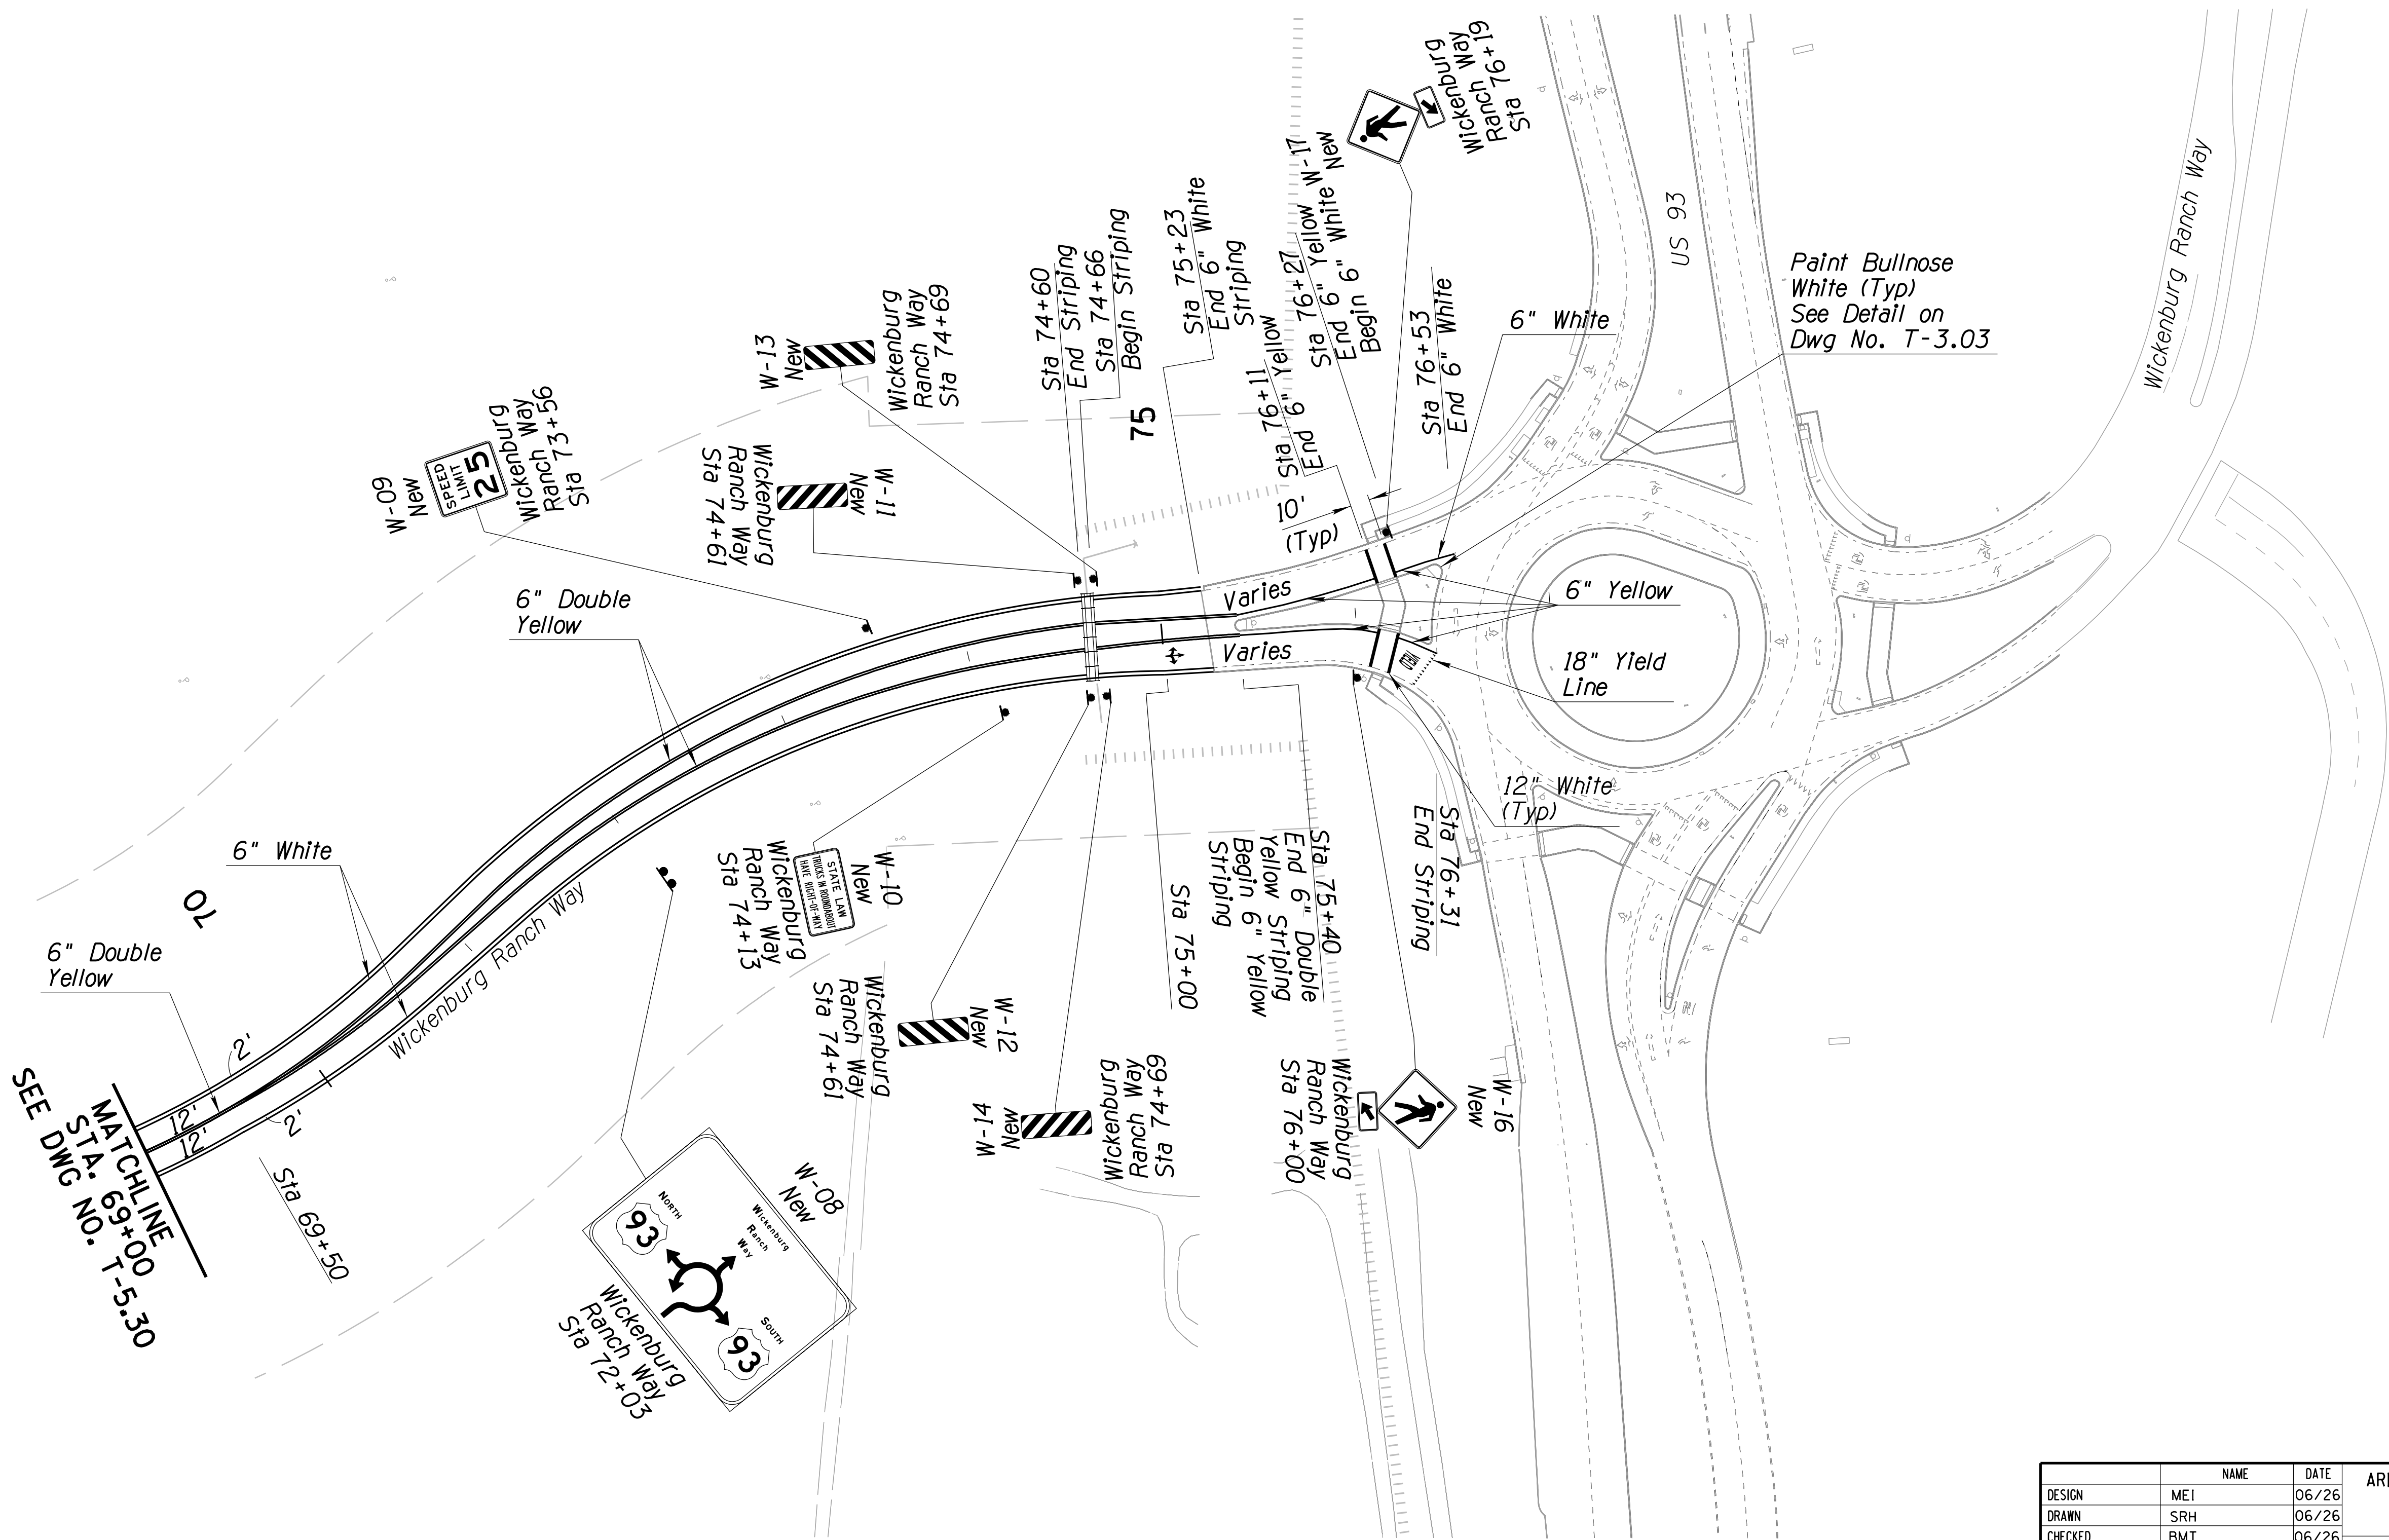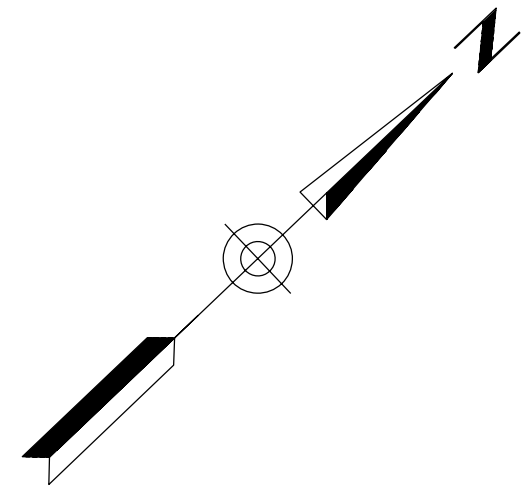

DESIGN	ME1	DATE	06/26	ARIZONA DEPARTMENT OF TRANSPORTATION PROJECT DELIVERY AND OPERATIONS DIVISION TRAFFIC DESIGN SERVICES WICKENBURG RANCH WAY SIGNING AND PAVEMENT MARKING BEGIN STA 69+00 TO STA 76+00	
DRAWN	SRH	DATE	06/26		
CHECKED	BMT	DATE	06/26		
ROUTE		LOCATION		DWG NO. T-5.31	
US 93		WICKENBURG RANCH WAY TO VISTA ROYALE			
TRACS NO. F0738 OIC		093-B(230)T		OF	

F.H.W.A. REGION	STATE	PROJECT NO.	SHEET NO.	TOTAL SHEETS	RECORD DRAWING
9	ARIZ.	093-B(230)T	406	524	


093 YV 189

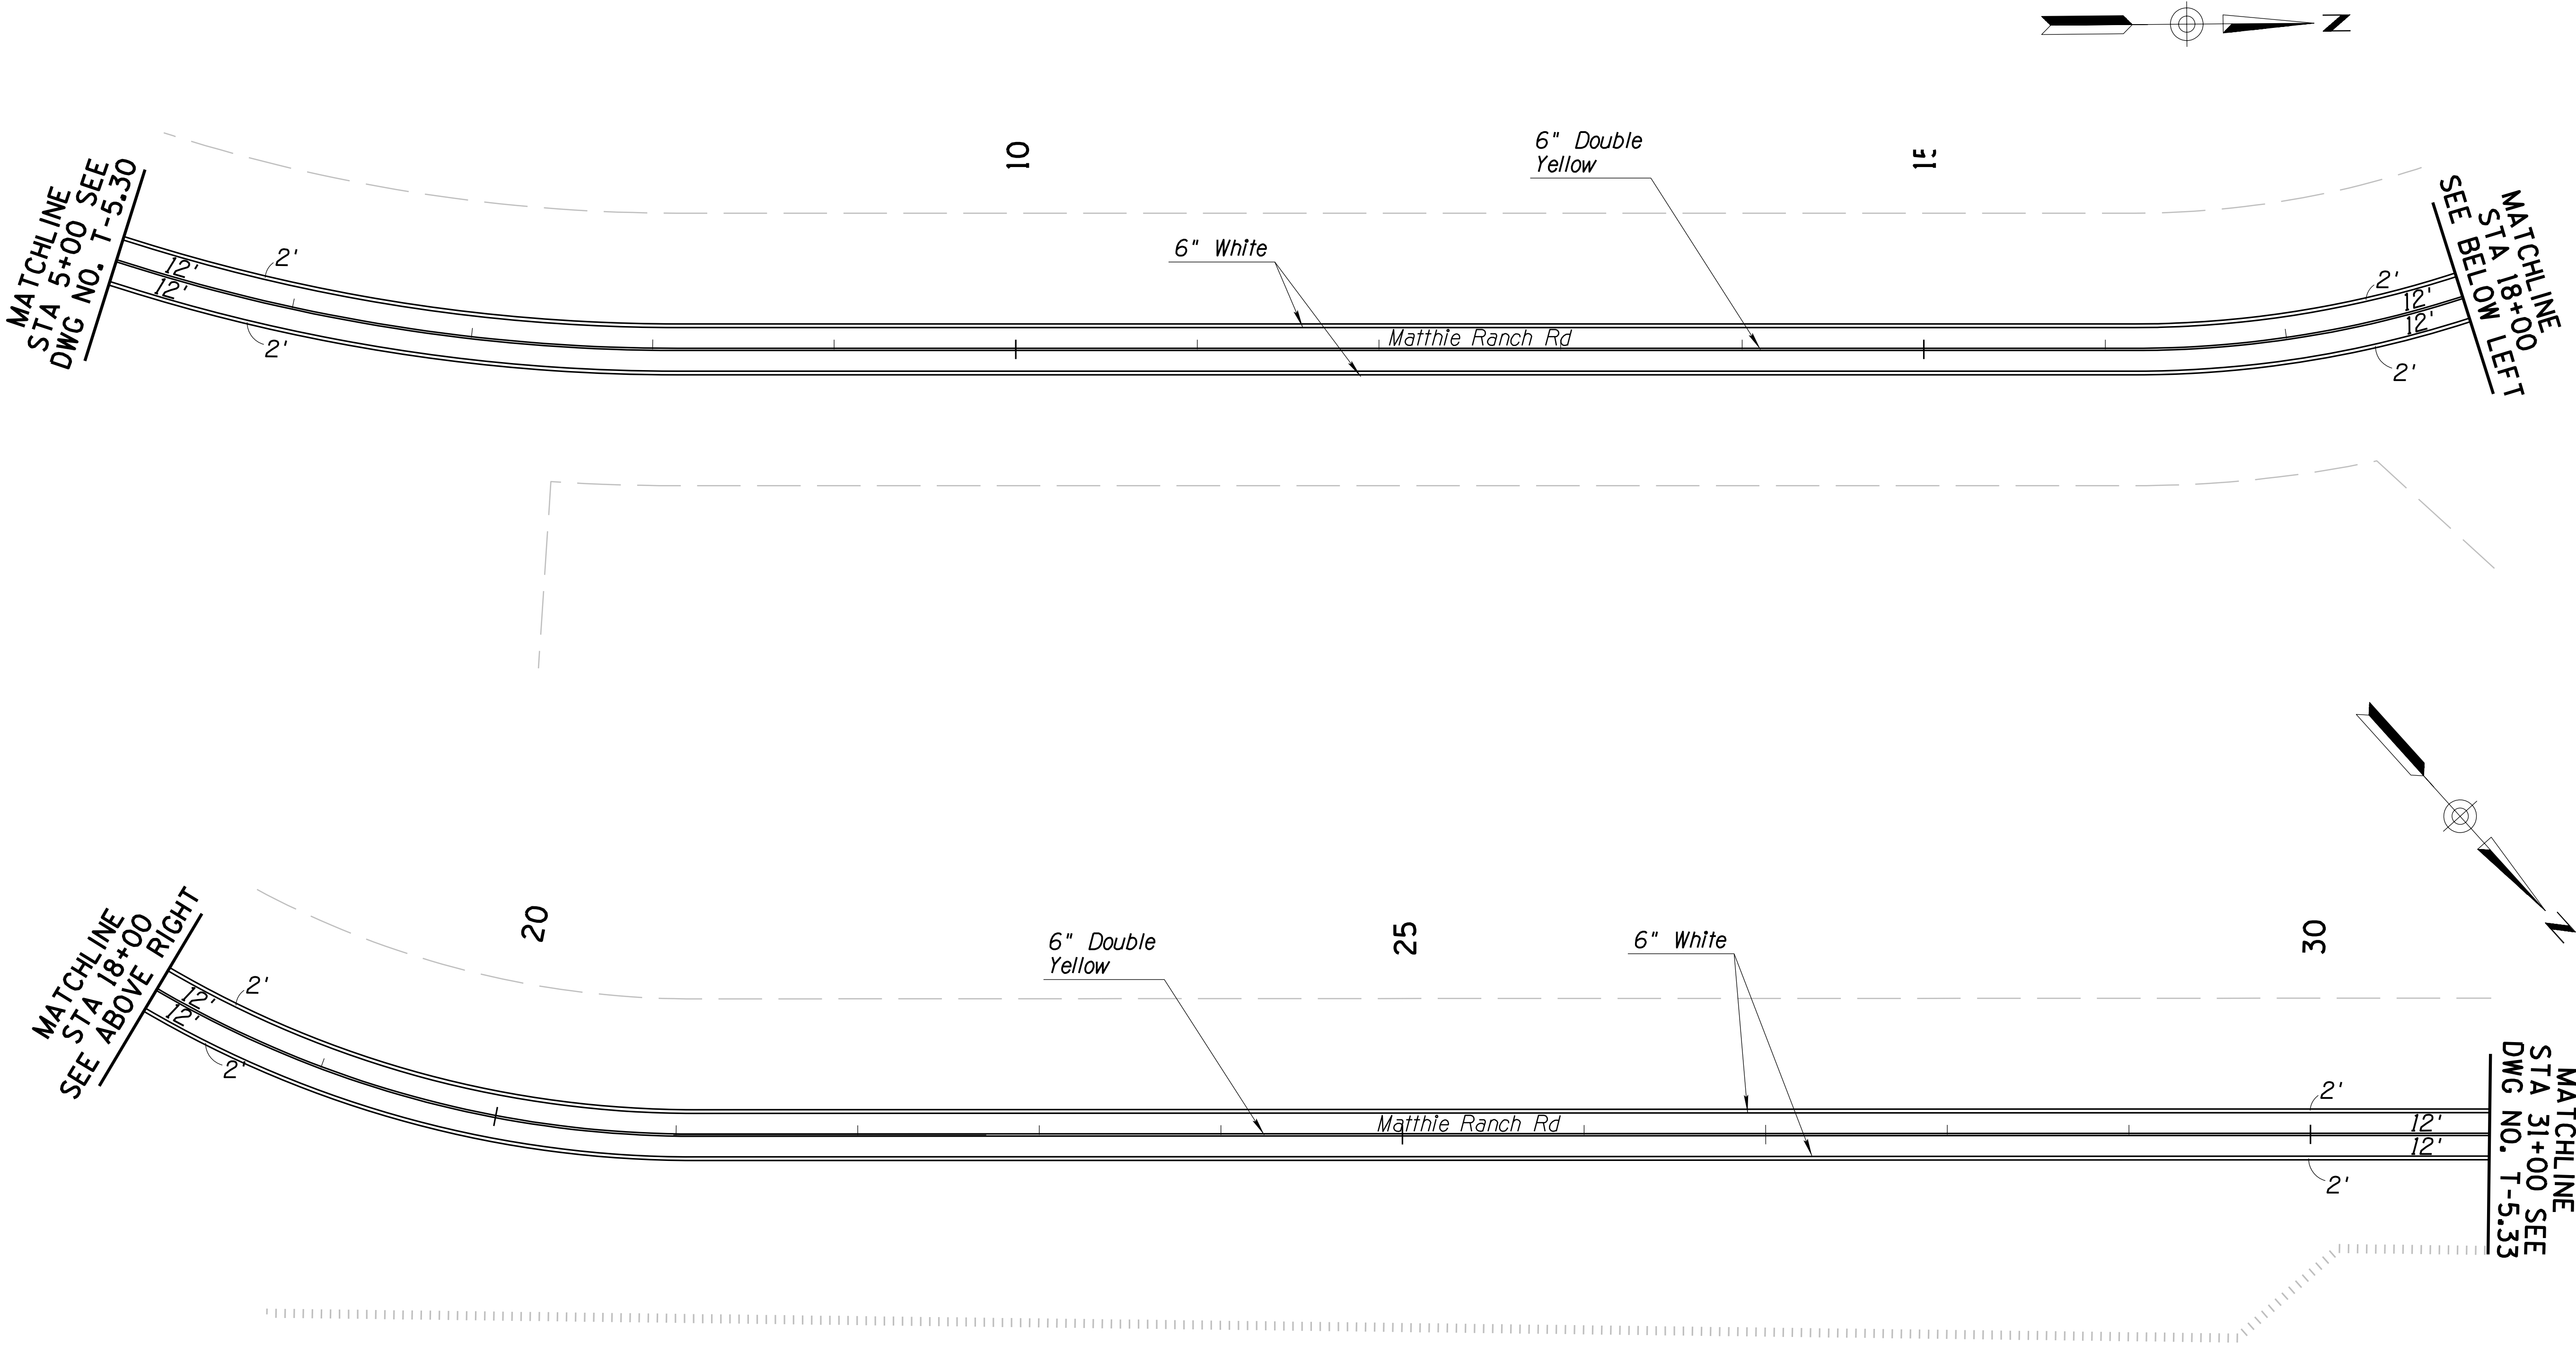


DESIGN		ME1	06/26	ARIZONA DEPARTMENT OF TRANSPORTATION PROJECT DELIVERY AND OPERATIONS DIVISION TRAFFIC DESIGN SERVICES MATTHE RANCH ROAD SIGNING AND PAVEMENT MARKING STA 5+00 TO STA 31+00	
DRAWN		SRH	06/26		
CHECKED		BMT	06/26		
ROUTE		LOCATION		DWG NO. T-5.32	
US 93		WICKENBURG RANCH WAY TO VISTA ROYALE			
TRACS NO. F0738 OIC				093-B(230)T	OF

F.H.W.A. REGION	STATE	PROJECT NO.	SHEET NO.	TOTAL SHEETS	RECORD DRAWING
9	ARIZ.	093-B(230)T	407	524	


093 YV 189

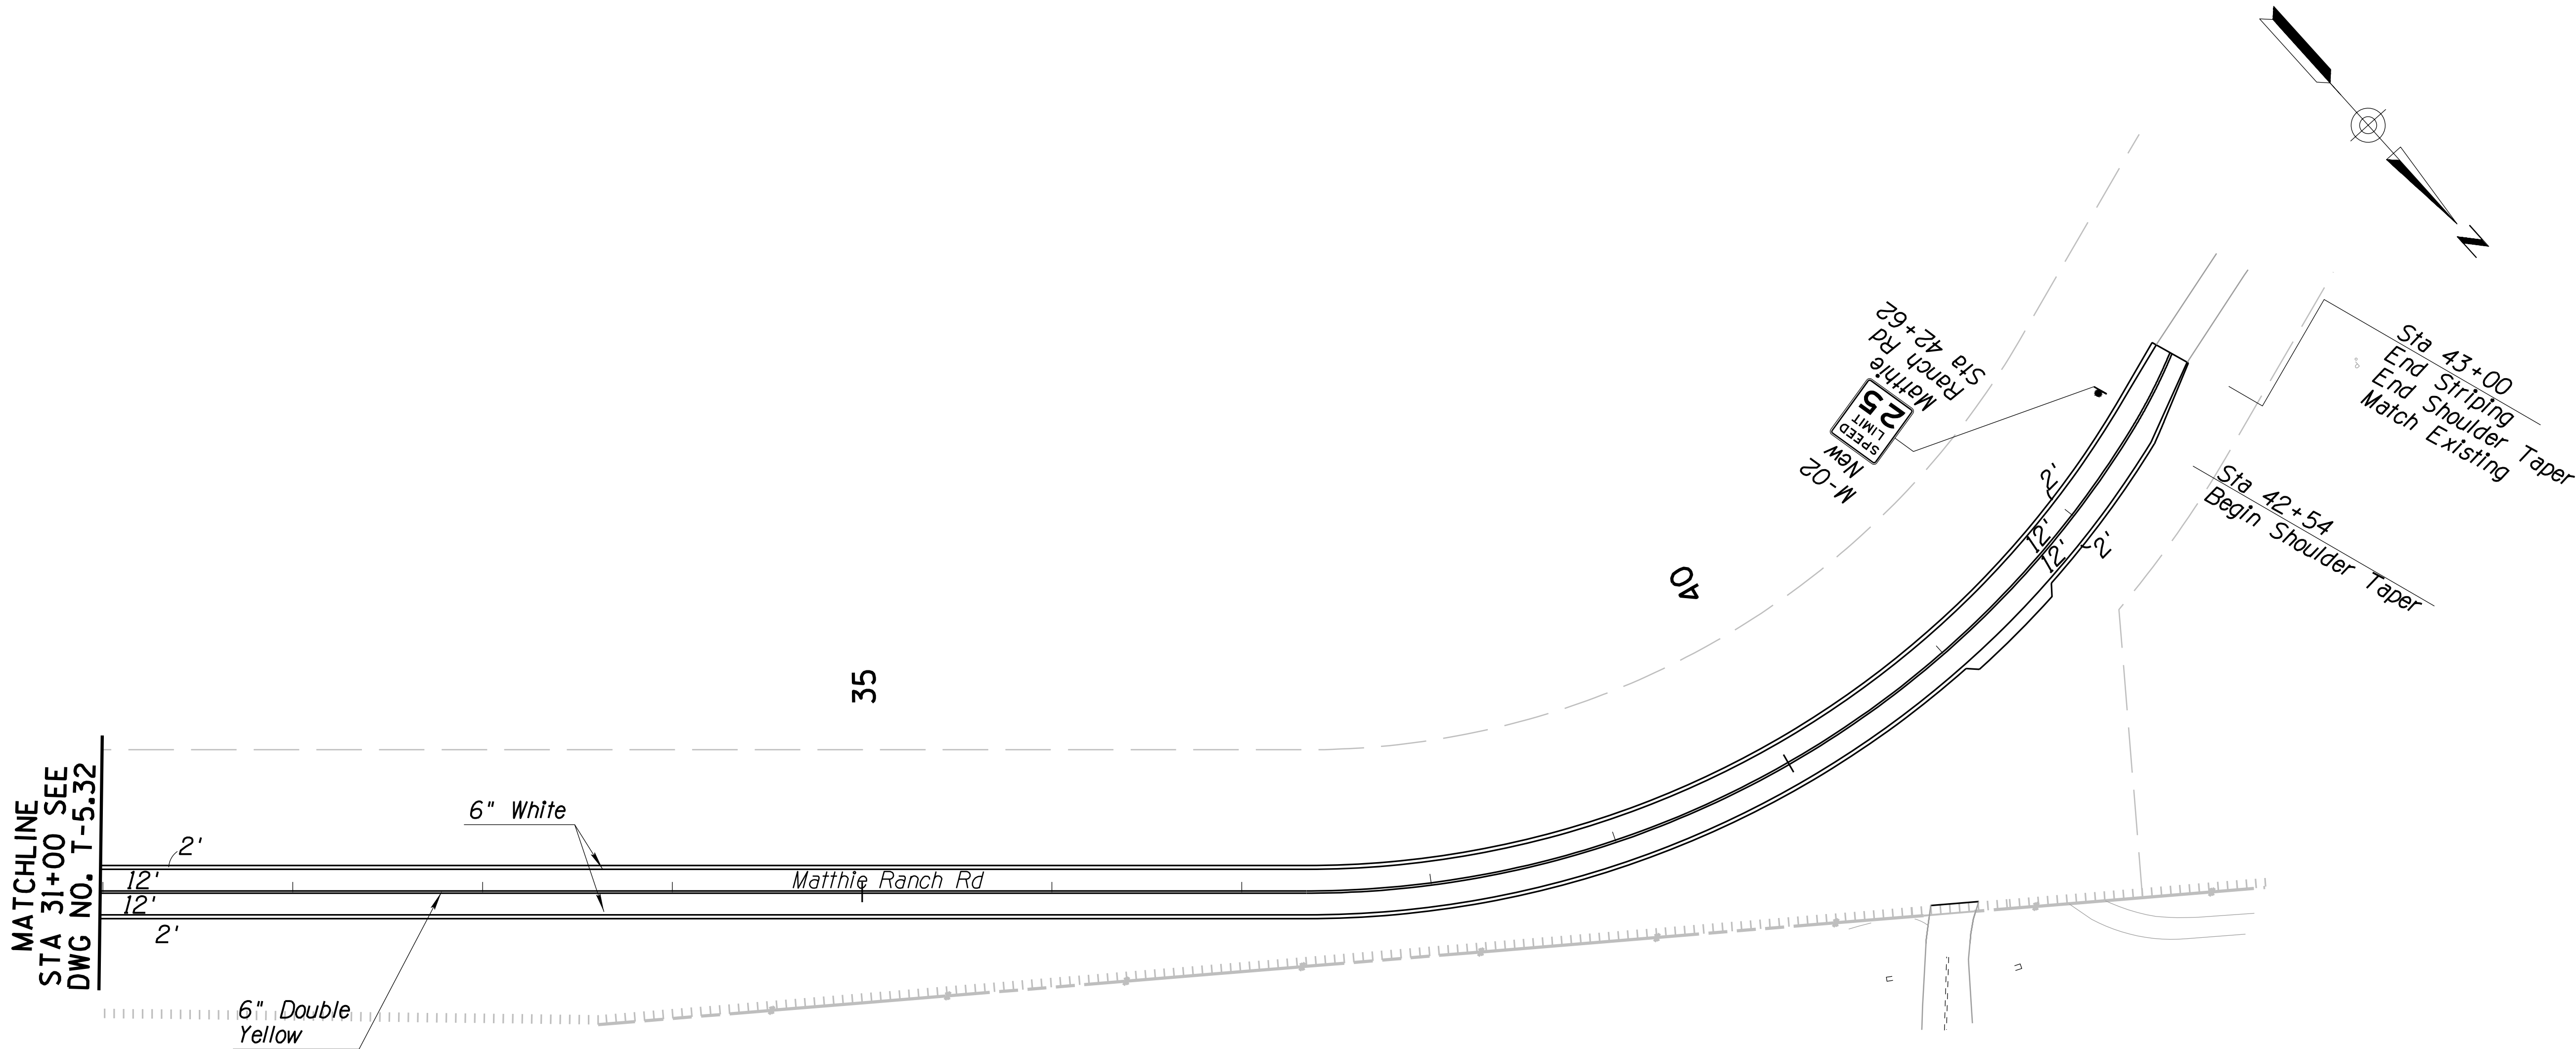


DESIGN		ME1	06/26	ARIZONA DEPARTMENT OF TRANSPORTATION PROJECT DELIVERY AND OPERATIONS DIVISION TRAFFIC DESIGN SERVICES MATTHIE RANCH ROAD SIGNING AND PAVEMENT MARKING STA 31+00 TO EOP	
DRAWN		SRH	06/26		
CHECKED		BMT	06/26		
Stanley Consultants inc.		3133 East Camelback Road, Suite 100 Phoenix, Arizona 85016 Phone: (602) 333-2200		DWG NO. T-5.33	
ROUTE		LOCATION		OF	
US 93		WICKENBURG RANCH WAY TO VISTA ROYALE		093-B(230)T	
TRACS NO. F0738 OIC					

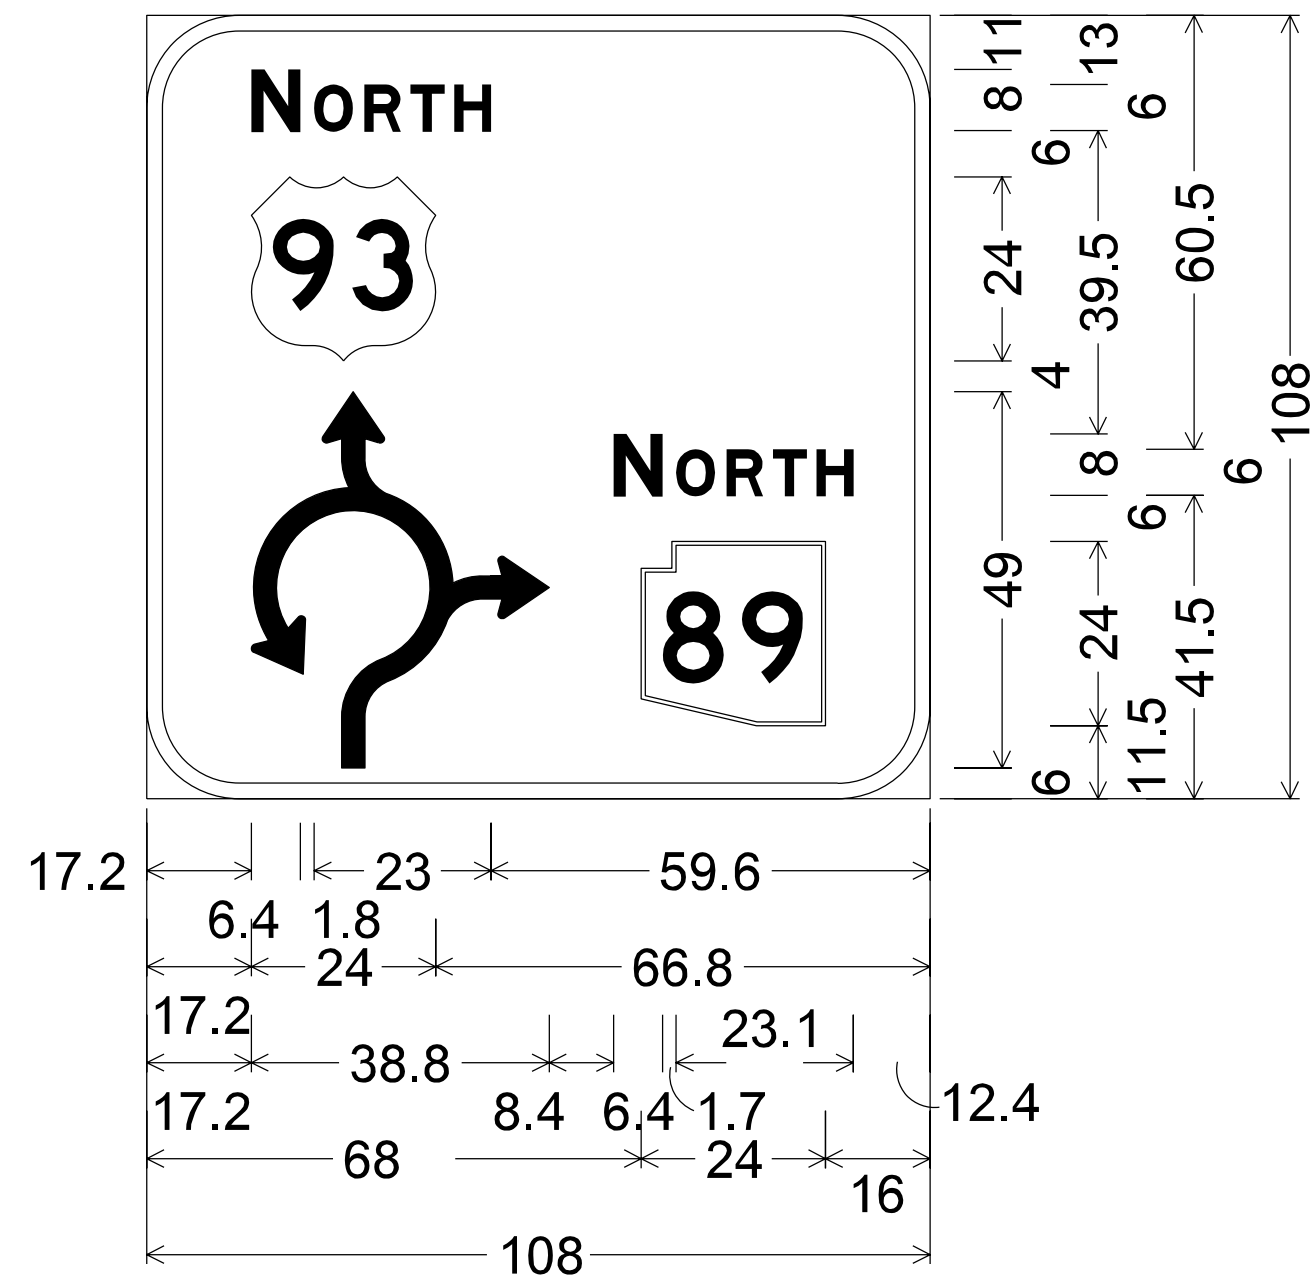


N193.54
12.0" Radius, 2.0" Border, White on Green;
[NORTH] E Mod;
Roundabout Graphic 1;
[NORTH] E Mod;
State Highway 89 M1-5c;

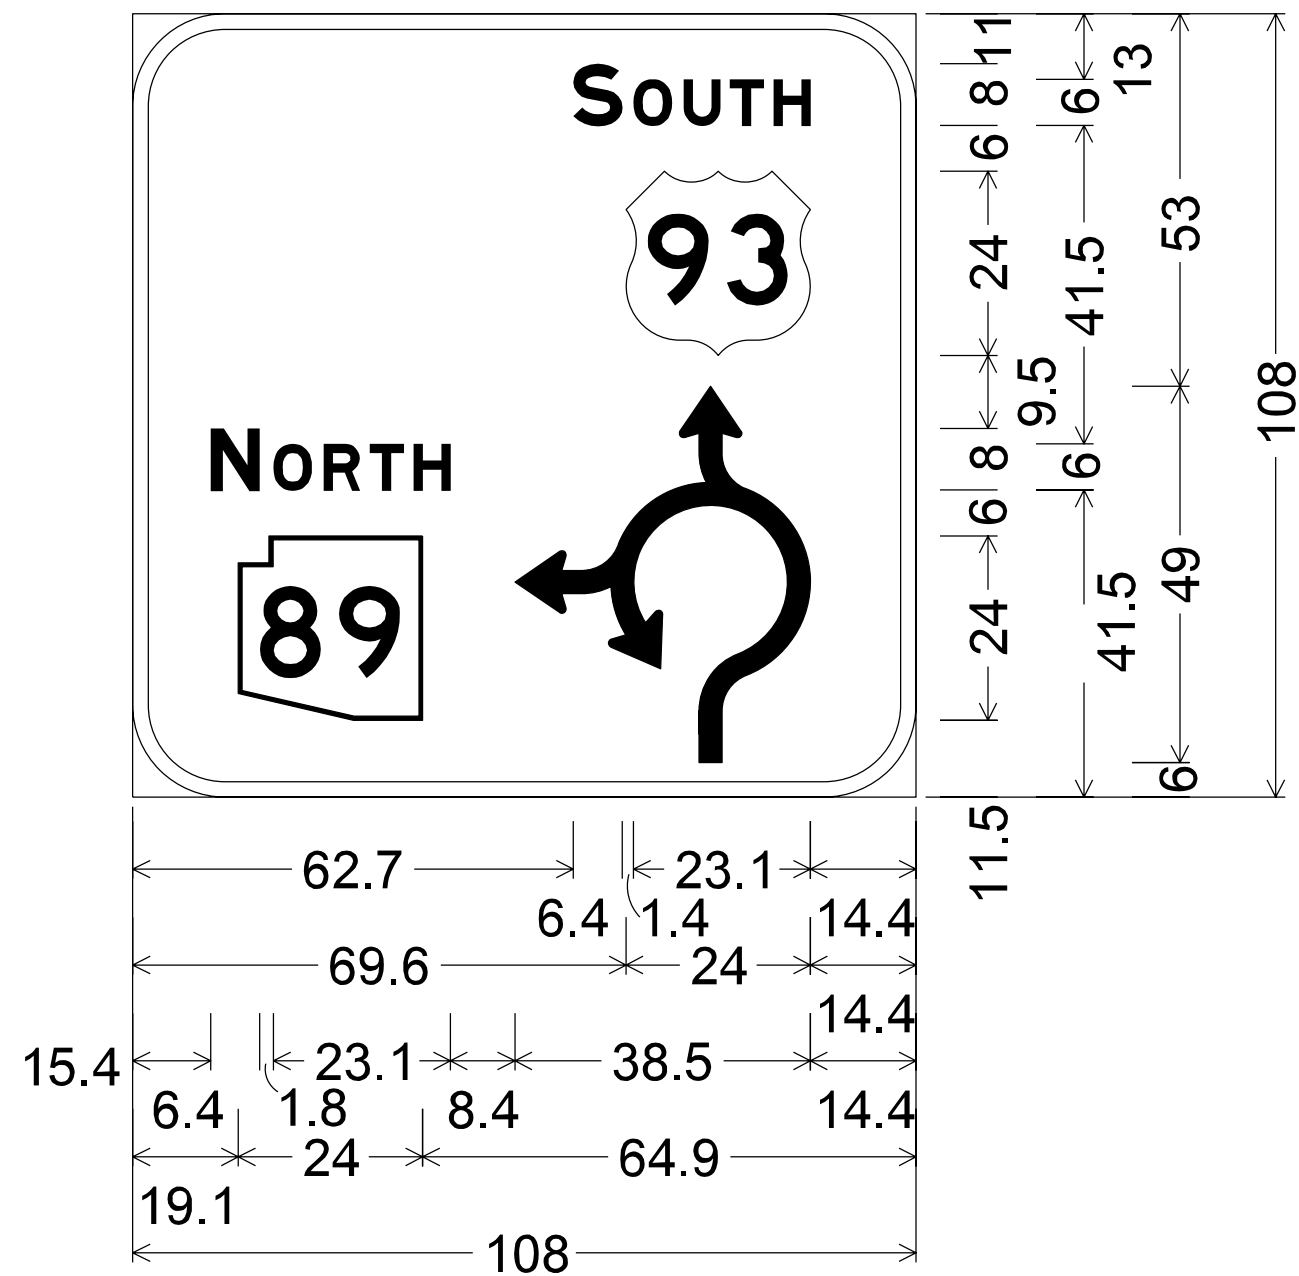


S193.32
12.0" Radius, 2.0" Border, White on Green;
[SOUTH] E Mod;
[NORTH] E Mod;
State Highway 89 M1-5c;
Roundabout Graphic 2;

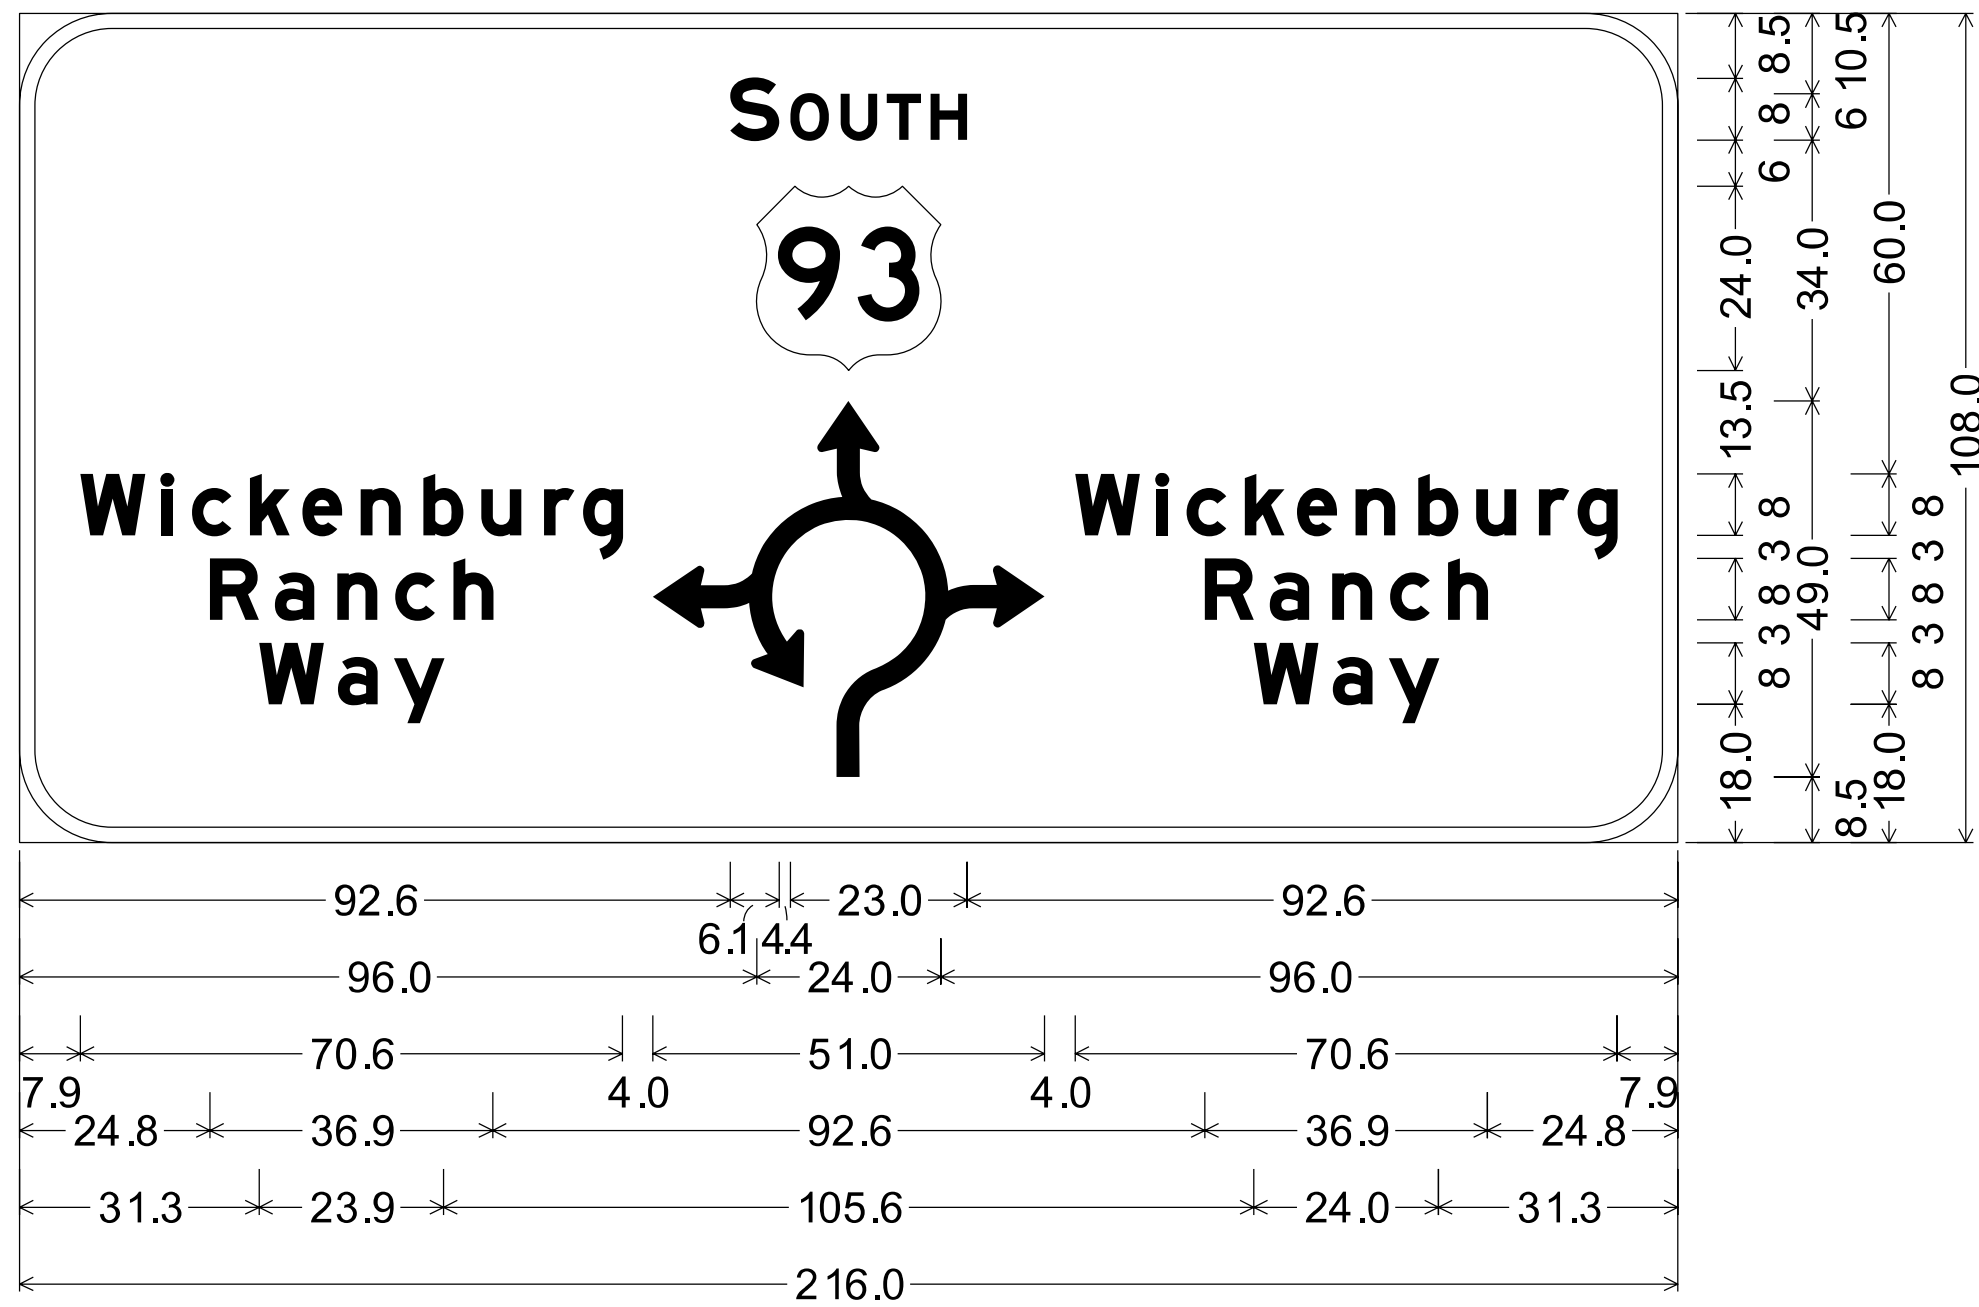


N194.47, S194.20
12.0" Radius, 2.0" Border, White on Green;
"SOUTH", E Mod; "Wickenburg", E Mod; "Ranch", E Mod; "Way", E Mod;
"Wickenburg", E Mod; "Ranch", E Mod; "Way", E Mod;

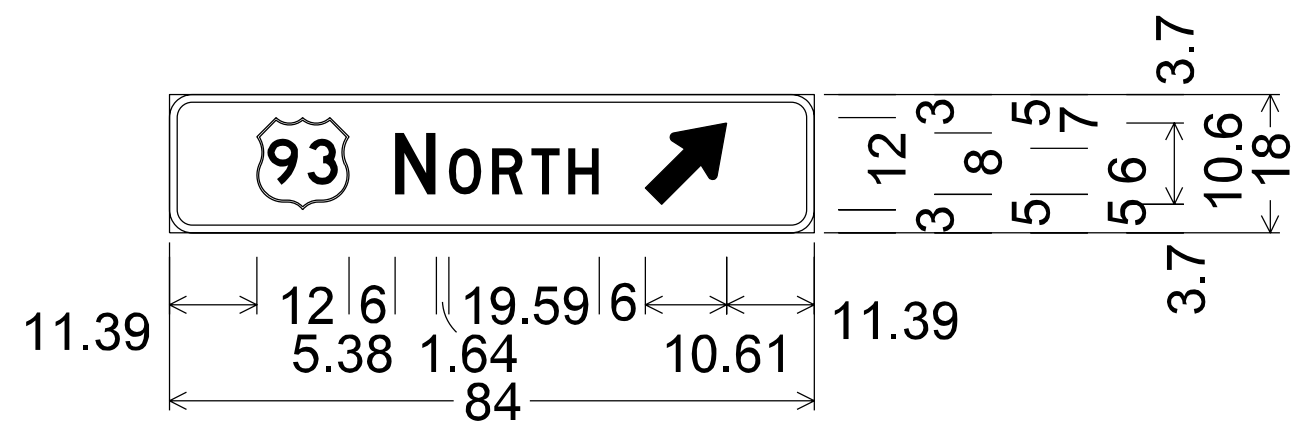


N193.43B
3.00" Radius, 1.00" Border, White on Green;
US 93 M1-4c;
[NORTH] D;
Arrow 6" Type D2 - 13.50" 45°;

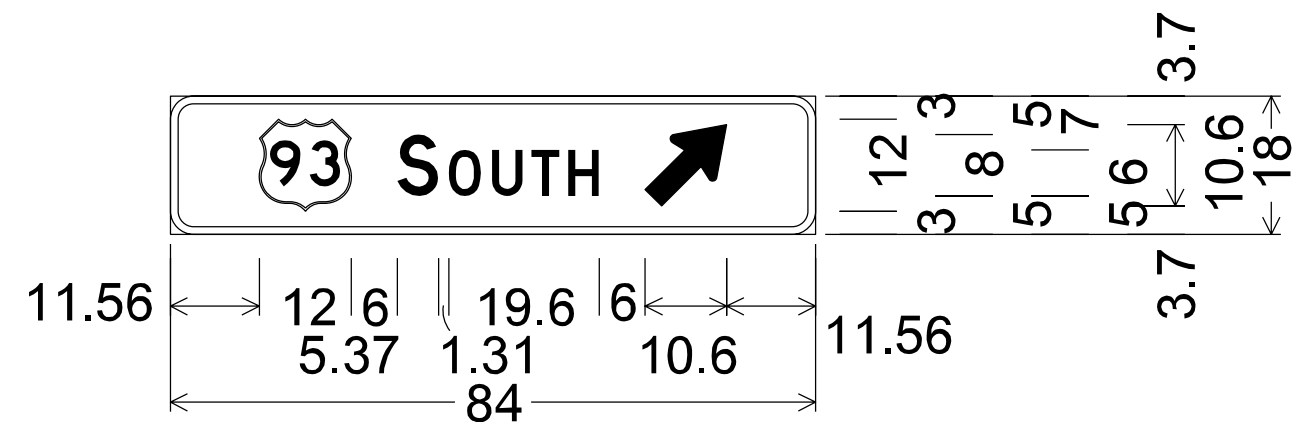

S193.47
3.00" Radius, 1.00" Border, White on Green;
US 93 M1-4c;
[SOUTH] D;
Arrow 6" Type D2 - 13.50" 45°;

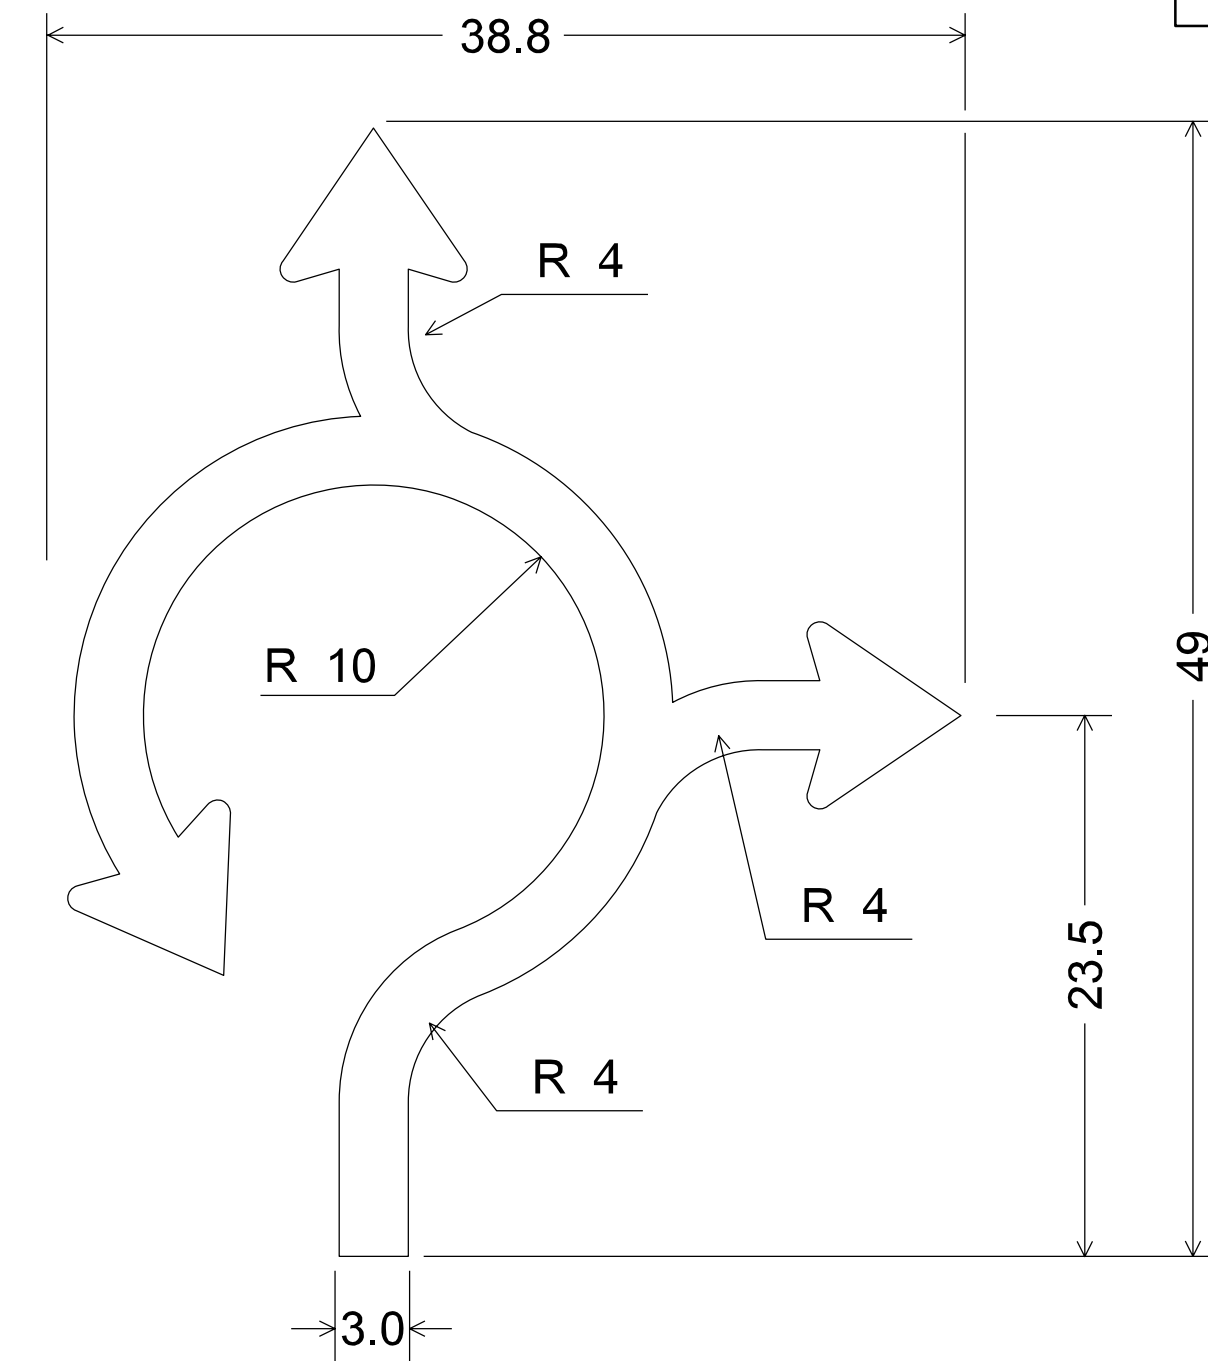


Roundabout Graphic 1
N193.54

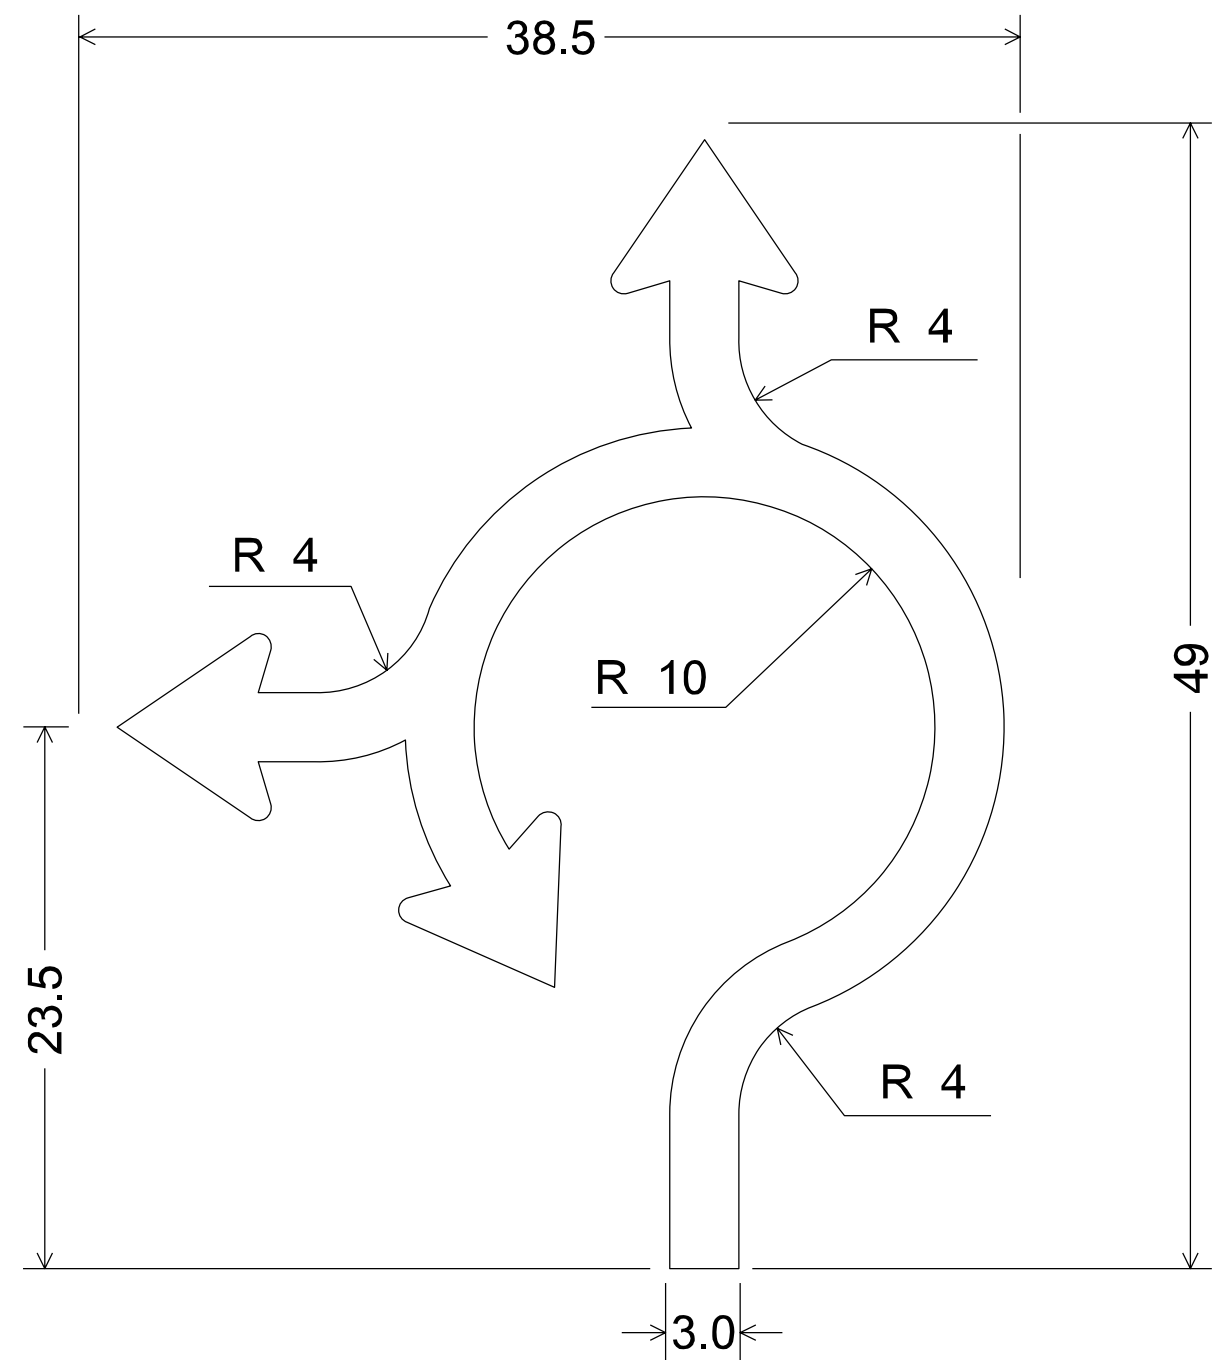


Roundabout Graphic 2
S193.32

F.H.W.A. REGION	STATE	PROJECT NO.	SHEET NO.	TOTAL SHEETS	RECORD DRAWING
9	ARIZ.	093-B(230)T	408	524	

093 YV 189

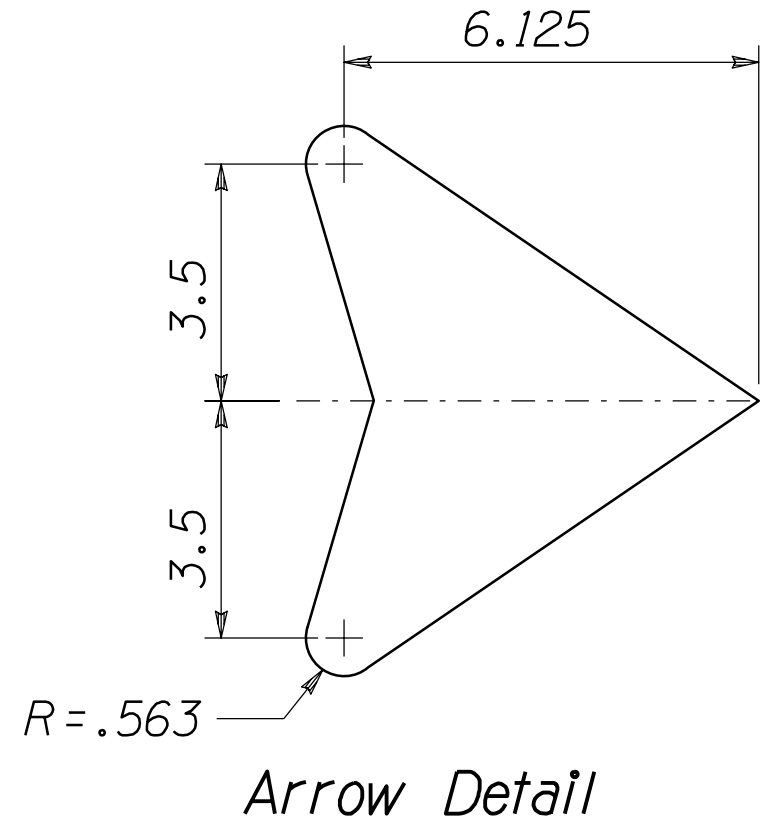


DESIGN	NAME	DATE	ARIZONA DEPARTMENT OF TRANSPORTATION PROJECT DELIVERY AND OPERATIONS DIVISION TRAFFIC DESIGN SERVICES	REGISTERED PROFESSIONAL ENGINEER 51481 BRIANNE MARIE TURPIN ARIZONA, U.S.A.
DRAWN	ME1	06/26	US 93 SIGN FORMATS	
CHECKED	SRH	06/26		
ROUTED	BMT	06/26		
ROUTE	LOCATION			
US 93	WICKENBURG RANCH WAY TO VISTA ROYALE			DWG NO. T-6.01
TRACS NO. F0738 OIC			093-B(230)T	OF

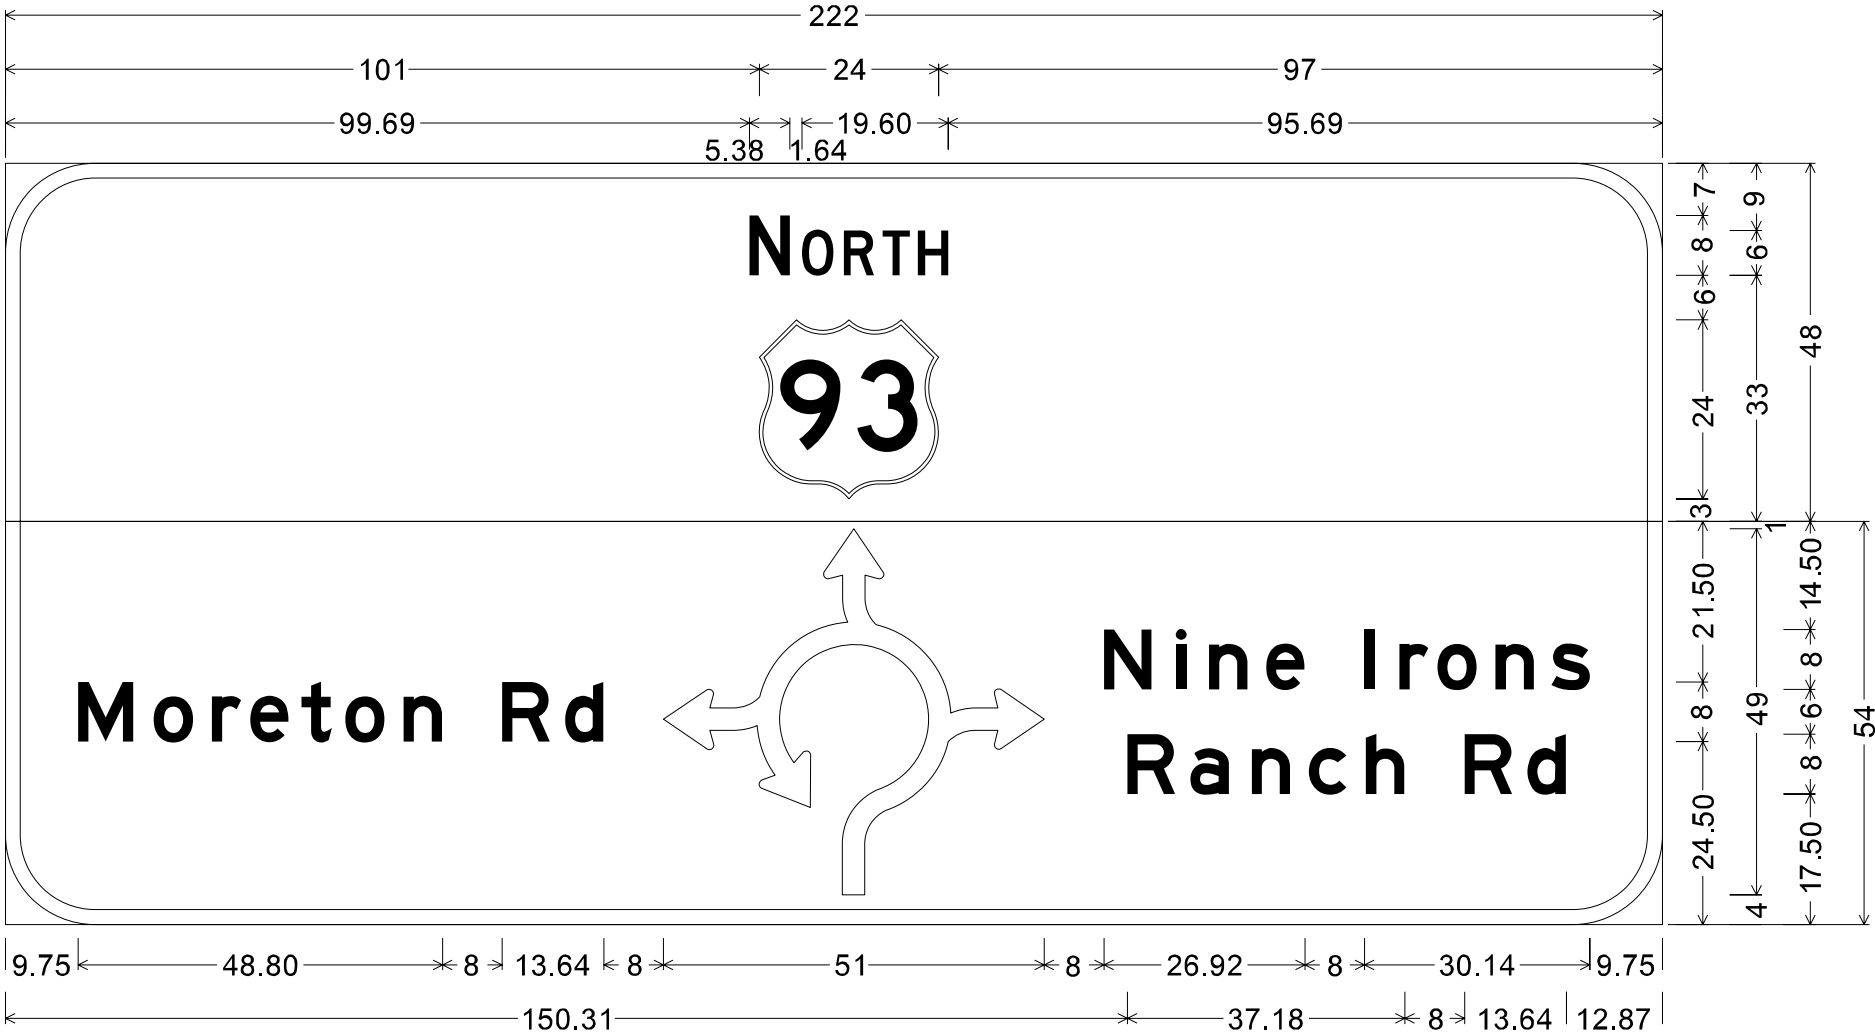


12.00" Radius, 2.00" Border, White on Green;
"NORTH", D; US 93 M1-4c;

12.00" Radius, 2.00" Border, White on Green;
"Moreton Rd", E; "Nine Irons", E; "Ranch Rd", E;

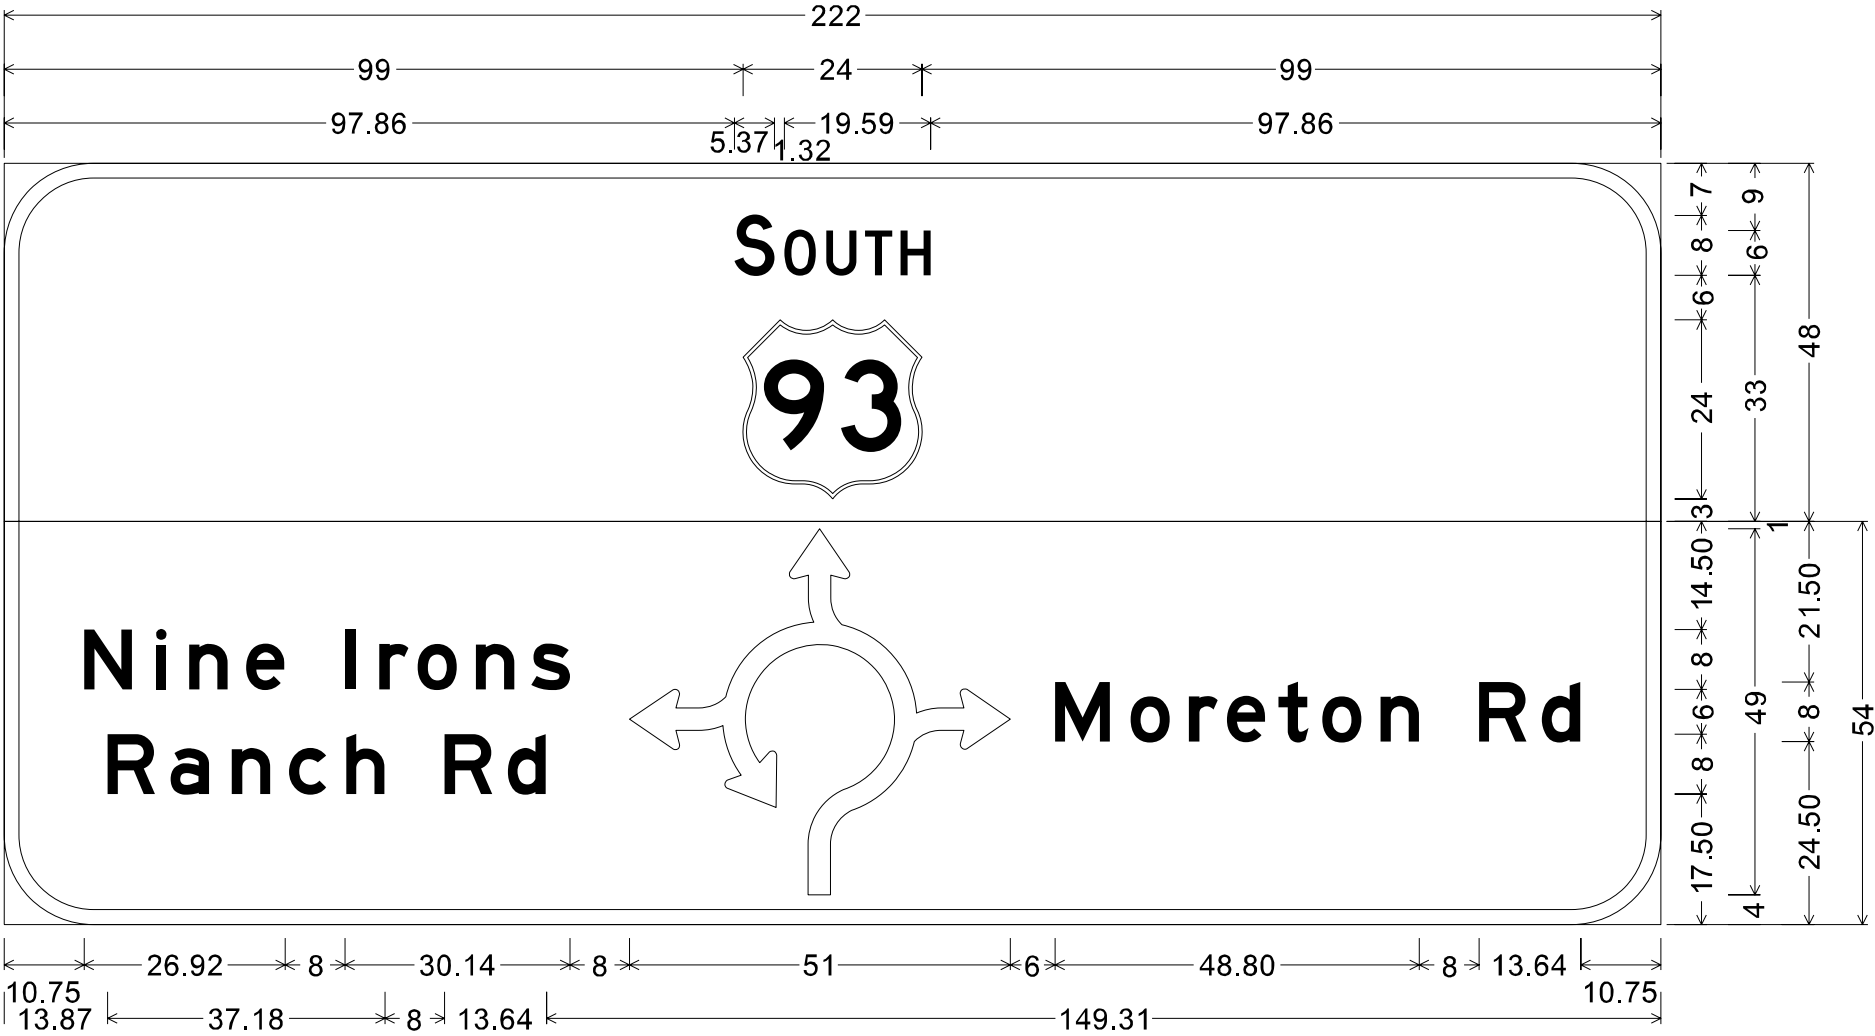


12.00" Radius, 2.00" Border, White on Green;
"SOUTH", D; US 93 M1-4c;


12.00" Radius, 2.00" Border, White on Green;
"Nine Irons", E; "Ranch Rd", E; "Moreton Rd", E;

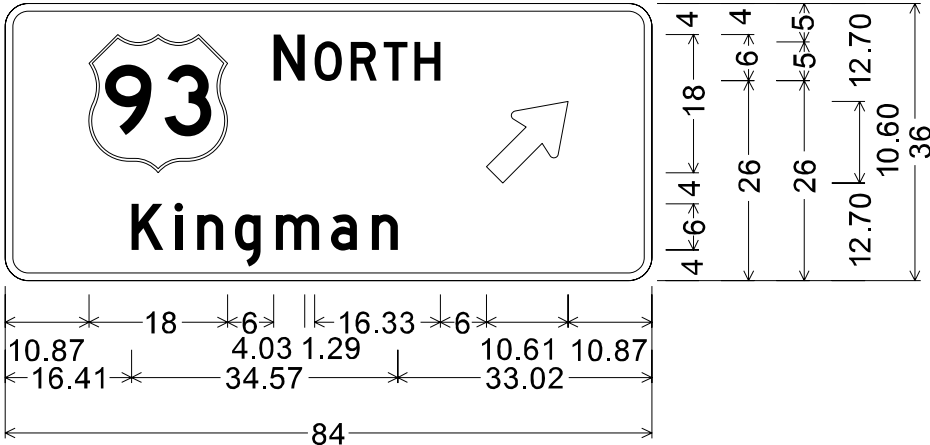

3.00" Radius, 1.00" Border, White on Green;
US 93 M1-4c; "NORTH", D;
"Kingman", D; Arrow 6" Type D2 - 45°;

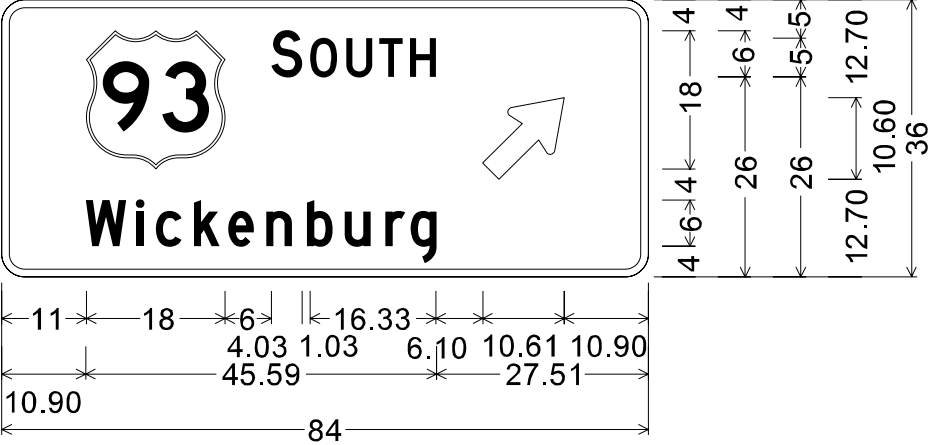


3.00" Radius, 1.00" Border, White on Green;
US 93 M1-4c; "SOUTH", D;
"Wickenburg", D;
Arrow 6" Type D2 - 45°;

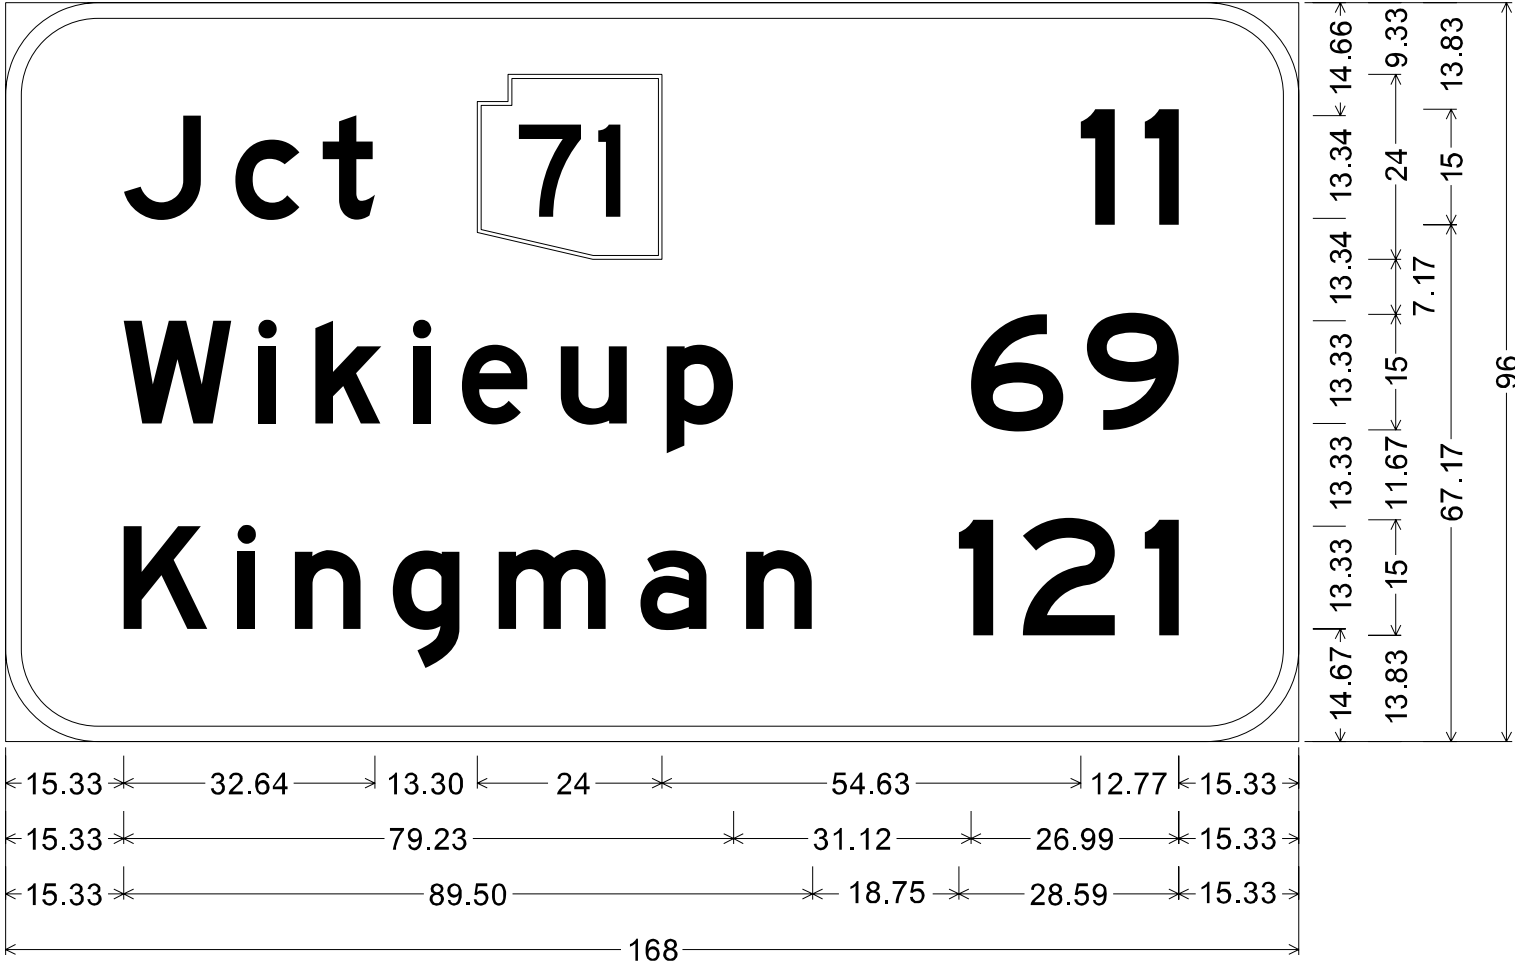


12.00" Radius, 2.00" Border, White on Green;
"Jct", E; State Highway 71 M1-5c; "11", E; "Wikieup", E; "69", E; "Kingman", E;
"121", E;




3.00" Radius, 1.00" Border, White on Green;
"Caballero Dr", D;

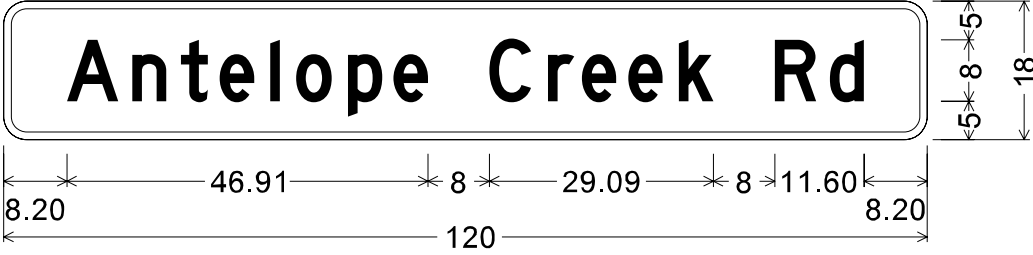


3.00" Radius, 1.00" Border, White on Green;
"Antelope Creek Rd", D;

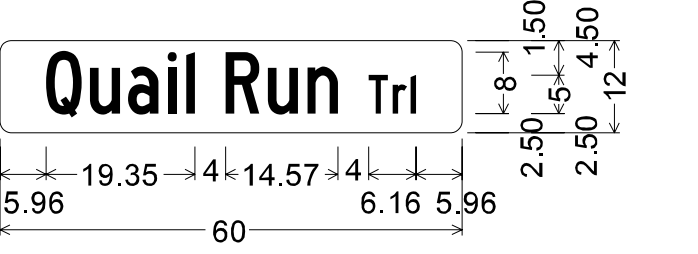


1.50" Radius, No border, White on Brown;
"Quail Run", C 50% spacing;
"Trl", C 50% spacing;

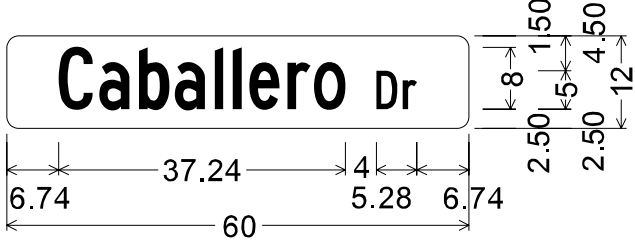


1.50" Radius, No border, White on Green;
"Caballero", C 50% spacing;
"Dr", C 50% spacing;

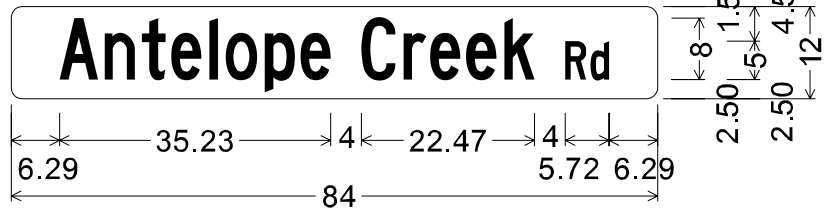


1.50" Radius, No border, White on Green;
"Antelope Creek", C 50% spacing;
"Rd", C 50% spacing;

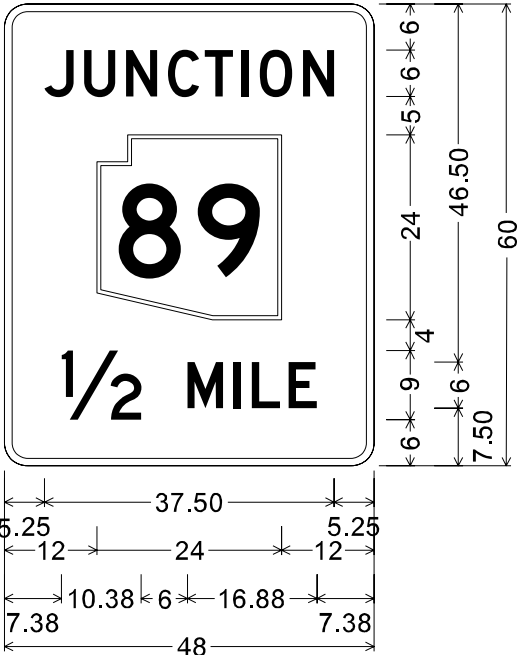


3.00" Radius, 1.00" Border, White on Green;
"JUNCTION", D;
State Highway 89 M1-5c;
"1/2", D; "MILE", D;

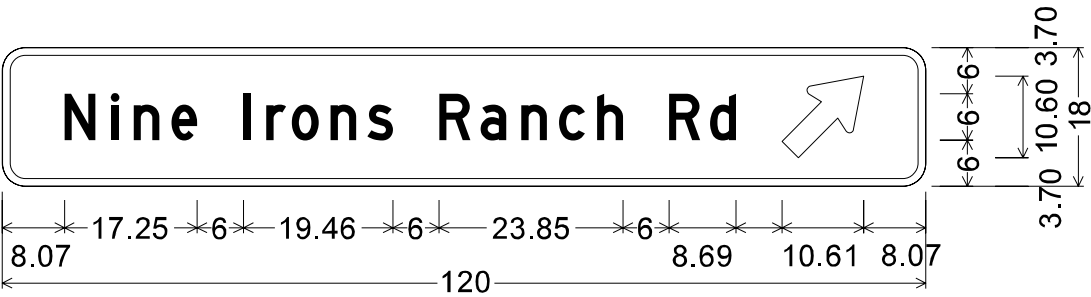

3.00" Radius, 1.00" Border, White on Green;
"Nine Irons Ranch Rd", D; Arrow 6" Type D2 - 45°;

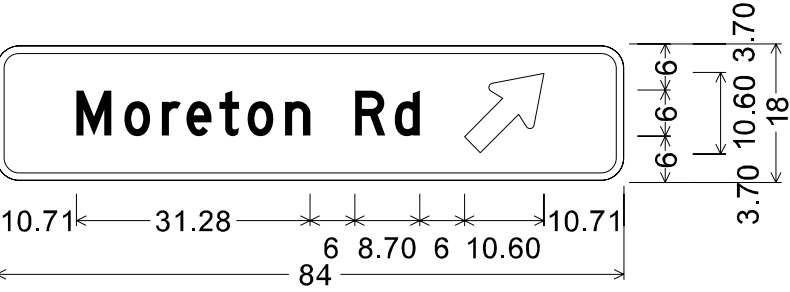


3.00" Radius, 1.00" Border, White on Green;
"Moreton Rd", D;
Arrow 6" Type D2 - 13.50" 45°;

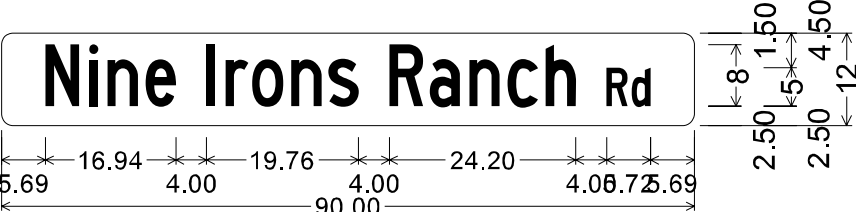


1.50" Radius, No border, White on Green;
"Nine Irons Ranch", C 50% spacing;
"Rd", C 50% spacing;


		NAME	DATE	ARIZONA DEPARTMENT OF TRANSPORTATION PROJECT DELIVERY AND OPERATIONS DIVISION TRAFFIC DESIGN SERVICES	ROUTE	F.H.W.A. Arizona Division	STATE	PROJECT NO.	FEDERAL ID NO.	SHEET NO.	TOTAL SHEETS	RECORD DRAWING	
	DESIGN	I ROBLES	06/26		US 93		ARIZ.	093 YV 190	093-B-NFA	409	524		
	DRAWN	C VALENCIA	06/26		MILEPOST	LOCATION							DWG No. T-6.02
	CHECKED	C RICKETTS	06/26	190.5									
		TRANSPORTATION	SIGN FORMATS			STRUCTURE NO.	TRACS NO. F0738 01C						
	AECOM TECHNICAL SERVICES, Inc. 7720 N. 16th St., Suite 100 Phoenix, Arizona 85020 T 602.371.1100	 www.aecom.com											

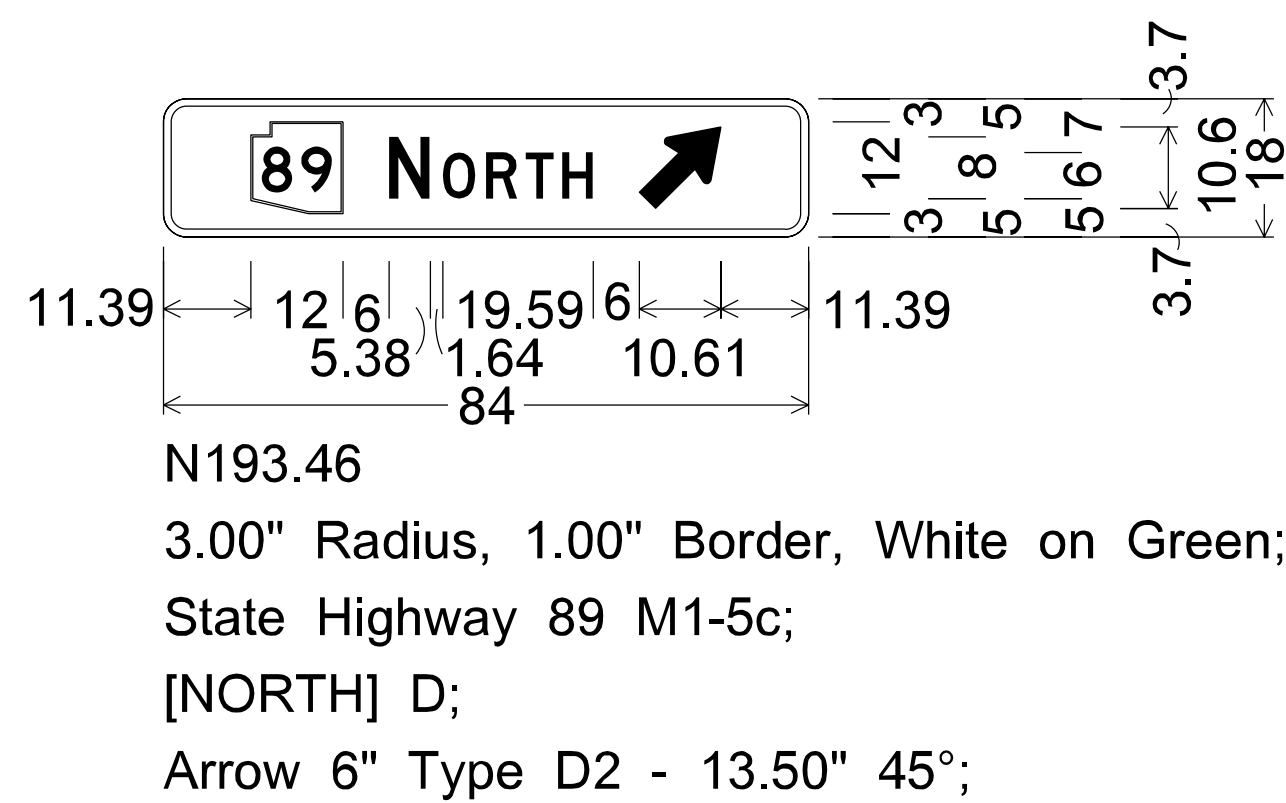


N193.46
3.00" Radius, 1.00" Border, White on Green;
State Highway 89 M1-5c;
[NORTH] D;
Arrow 6" Type D2 - 13.50" 45°;

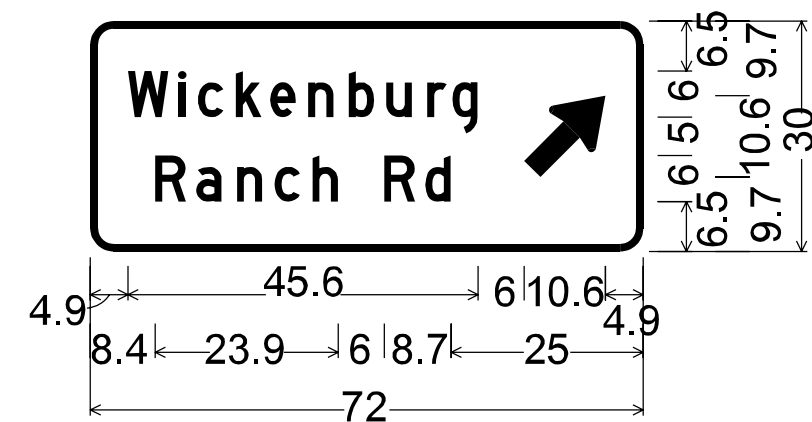


W-20B
D1-1a (conventional road - 2 line);
3.0" Radius, 1.0" Border, White on, Green;
"Wickenburg", D; "Ranch Rd", D;
Arrow 6" Type D2 - 13.5" 45°;

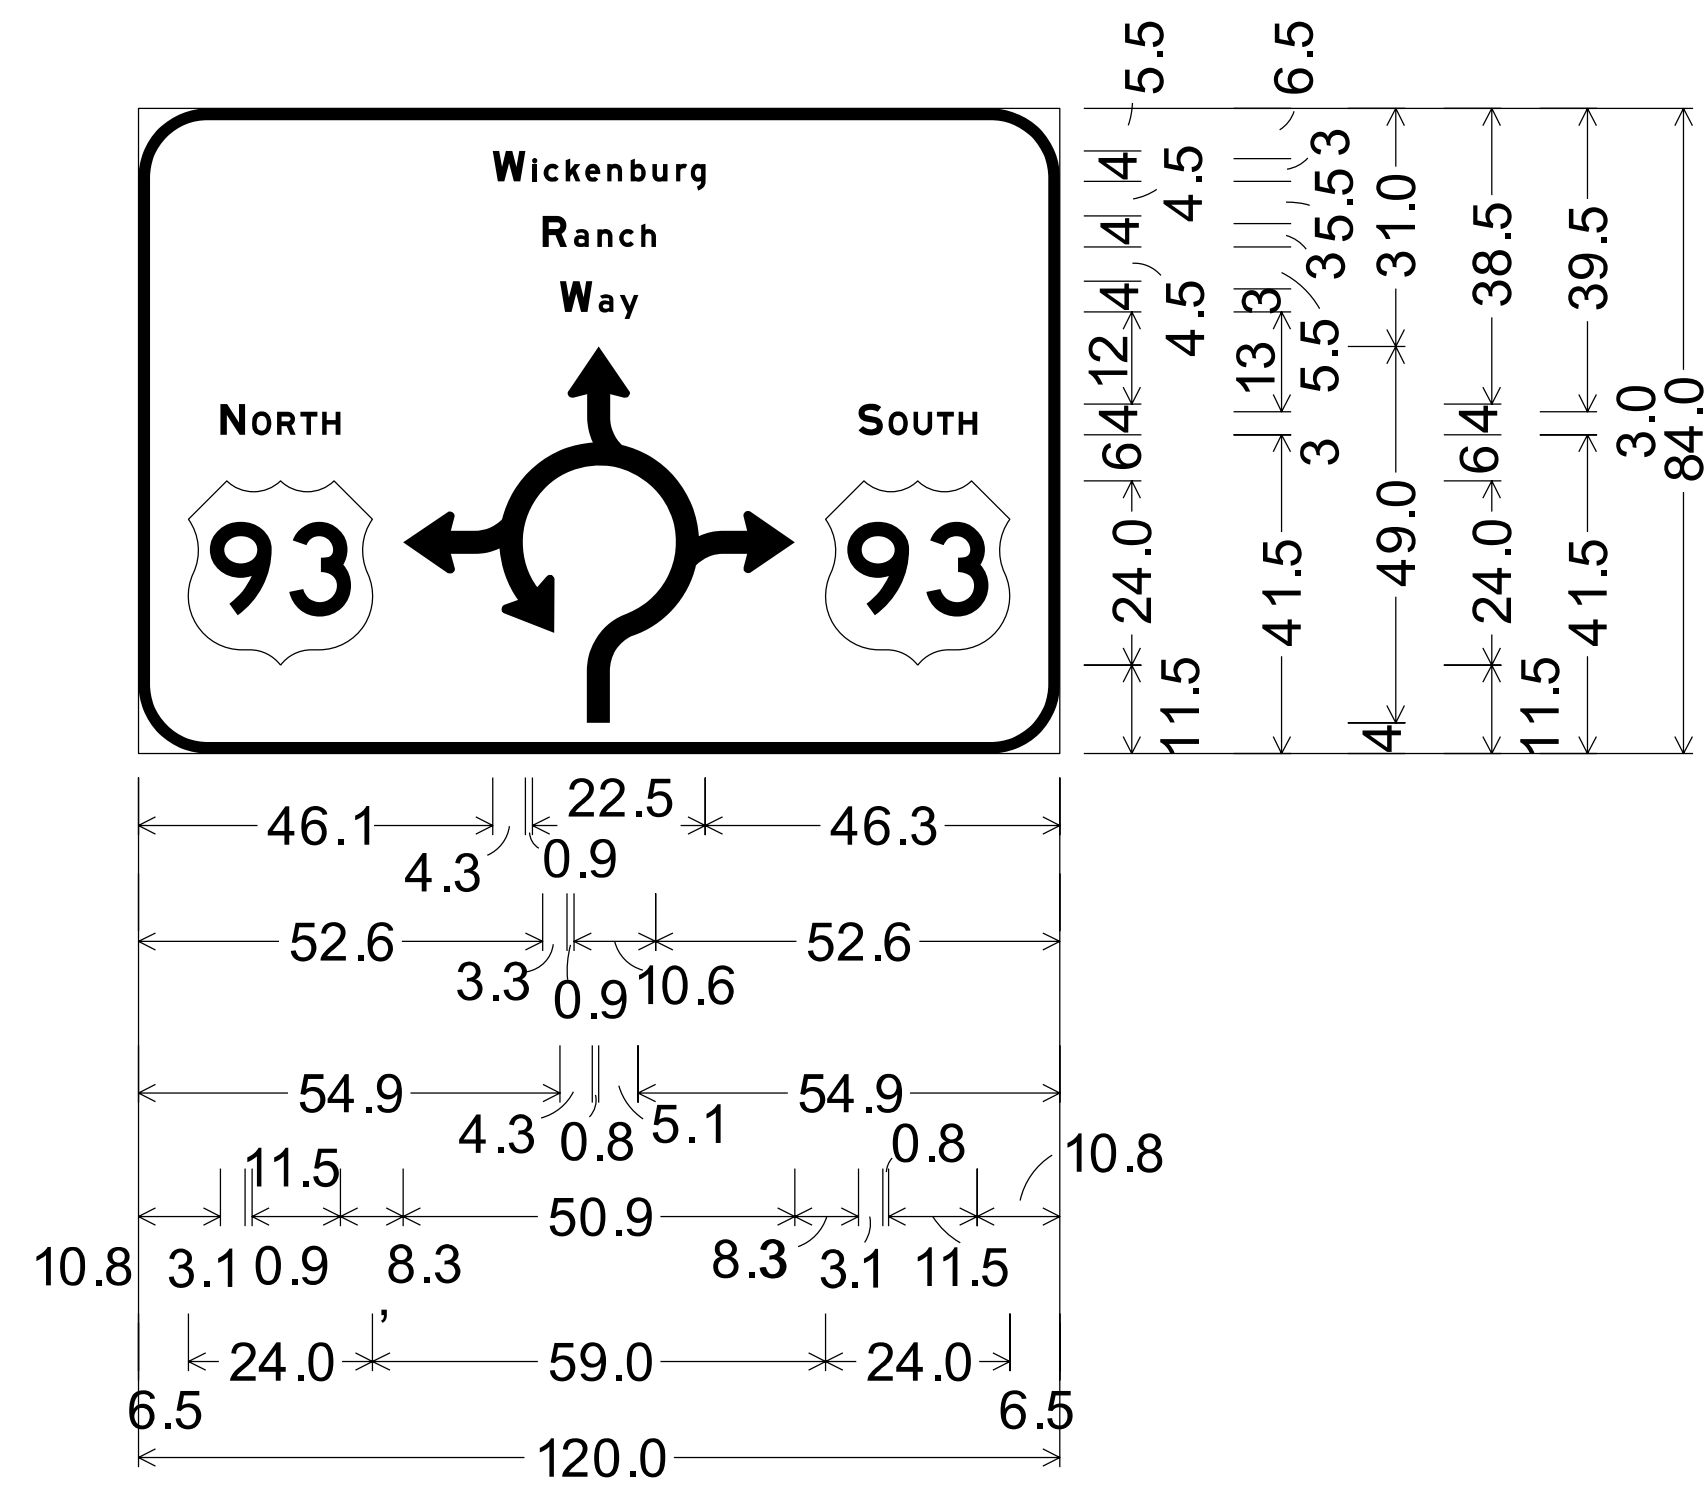


W-08
9.0" Radius, 1.5" Border, White on Green;
"Wickenburg", E Mod;
"Ranch", E Mod; "Way", E Mod;
"NORTH" E Mod;
"SOUTH", E Mod;

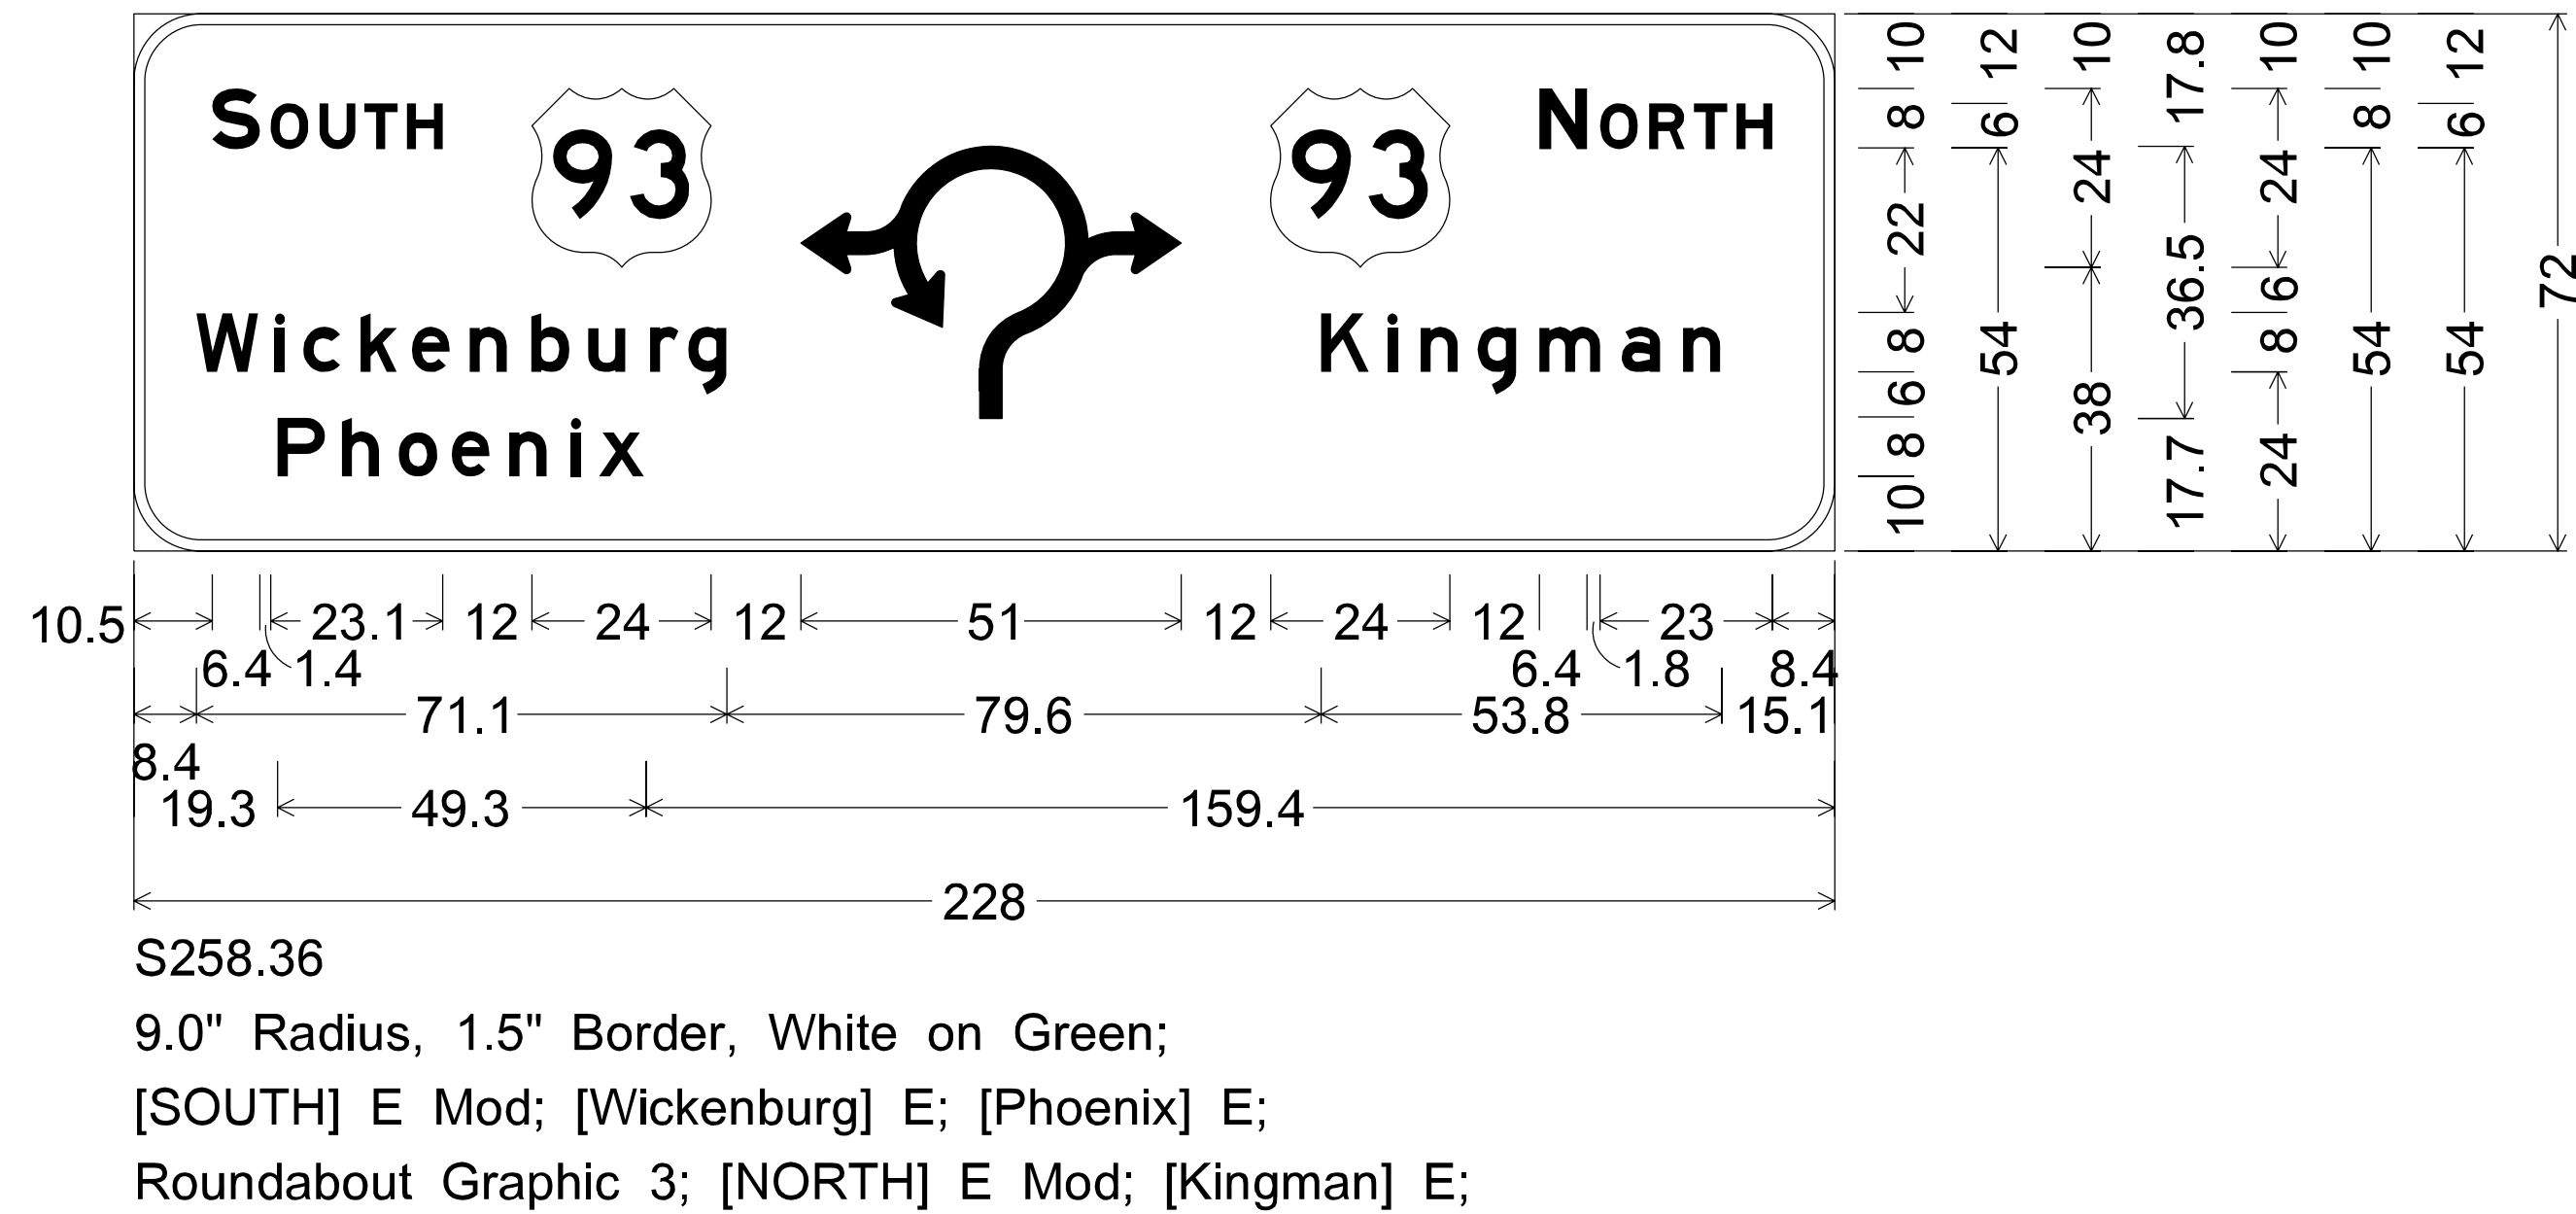

S258.36
9.0" Radius, 1.5" Border, White on Green;
[SOUTH] E Mod; [Wickenburg] E; [Phoenix] E;
Roundabout Graphic 3; [NORTH] E Mod; [Kingman] E;

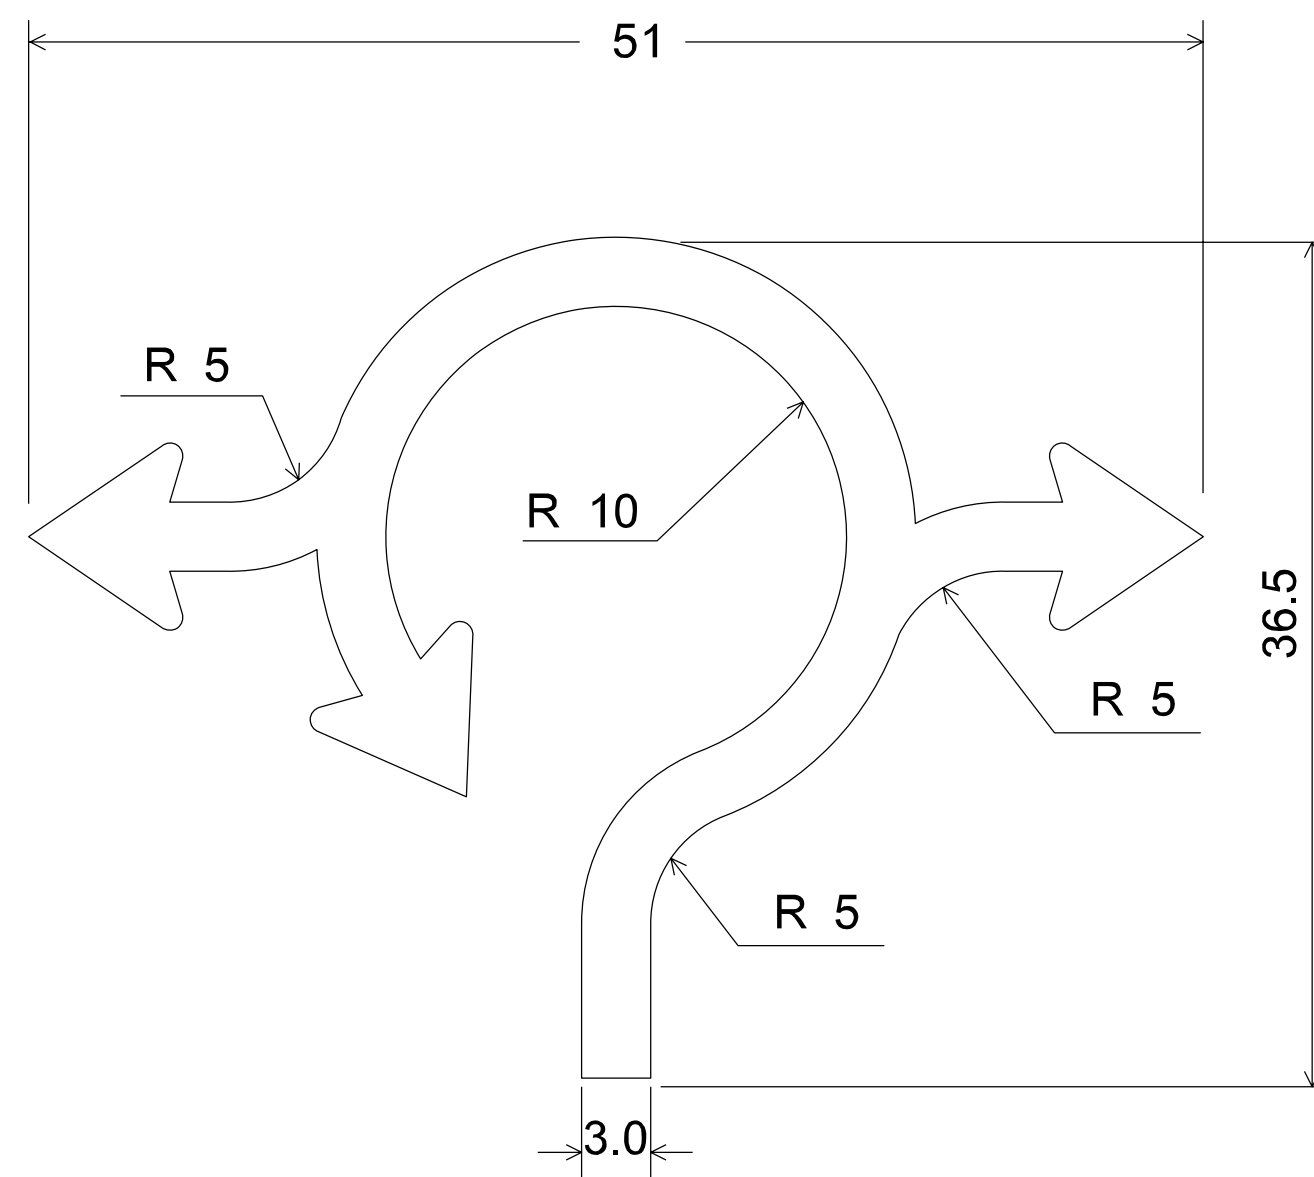

ROUNDABOUT GRAPHIC 3
S258.36

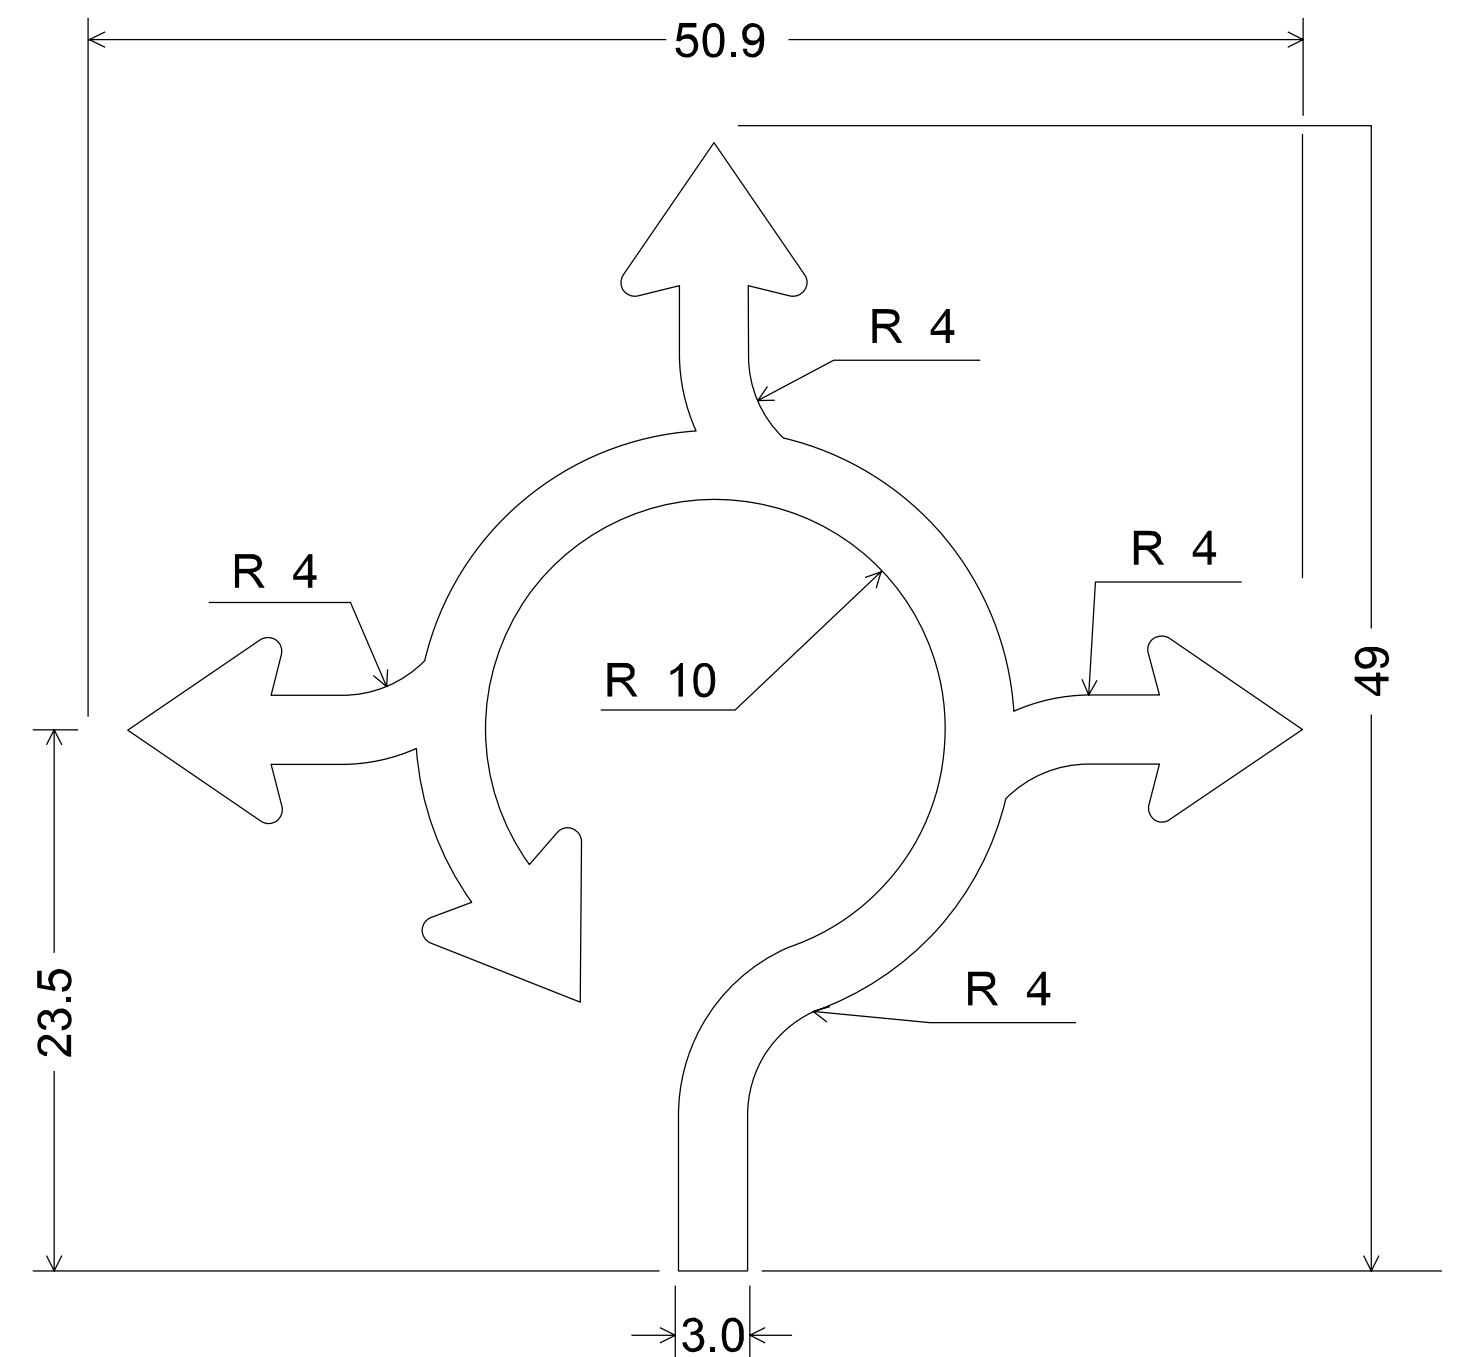


Roundabout Graphic 4
N194.47, S194.20, W-08

F.H.W.A. REGION	STATE	PROJECT NO.	SHEET NO.	TOTAL SHEETS	RECORD DRAWING
9	ARIZ.	093-B(230)T	410	524	
093 YV 189					

		NAME	DATE	ARIZONA DEPARTMENT OF TRANSPORTATION PROJECT DELIVERY AND OPERATIONS DIVISION TRAFFIC DESIGN SERVICES	
DESIGN		MEI	06/26		
DRAWN		SRH	06/26		
CHECKED		BMT	06/26		
 Stanley Consultants INC.				SR 89 CROSSROADS SIGN FORMATS	
3133 East Camelback Road, Suite 100 Phoenix, Arizona 85016 Phone: (602) 333-2200					
ROUTE		LOCATION			
US 93		WICKENBURG RANCH WAY TO VISTA ROYALE		DWG NO. T-6.03	
TRACS NO. F0738 OIC			093-B(230)T		
			OF		

F.H.W.A. REGION	STATE	PROJECT NO.	SHEET NO.	TOTAL SHEETS	RECORD DRAWING
9	ARIZ.	093-B(230)T	411	524	


093 YV 189

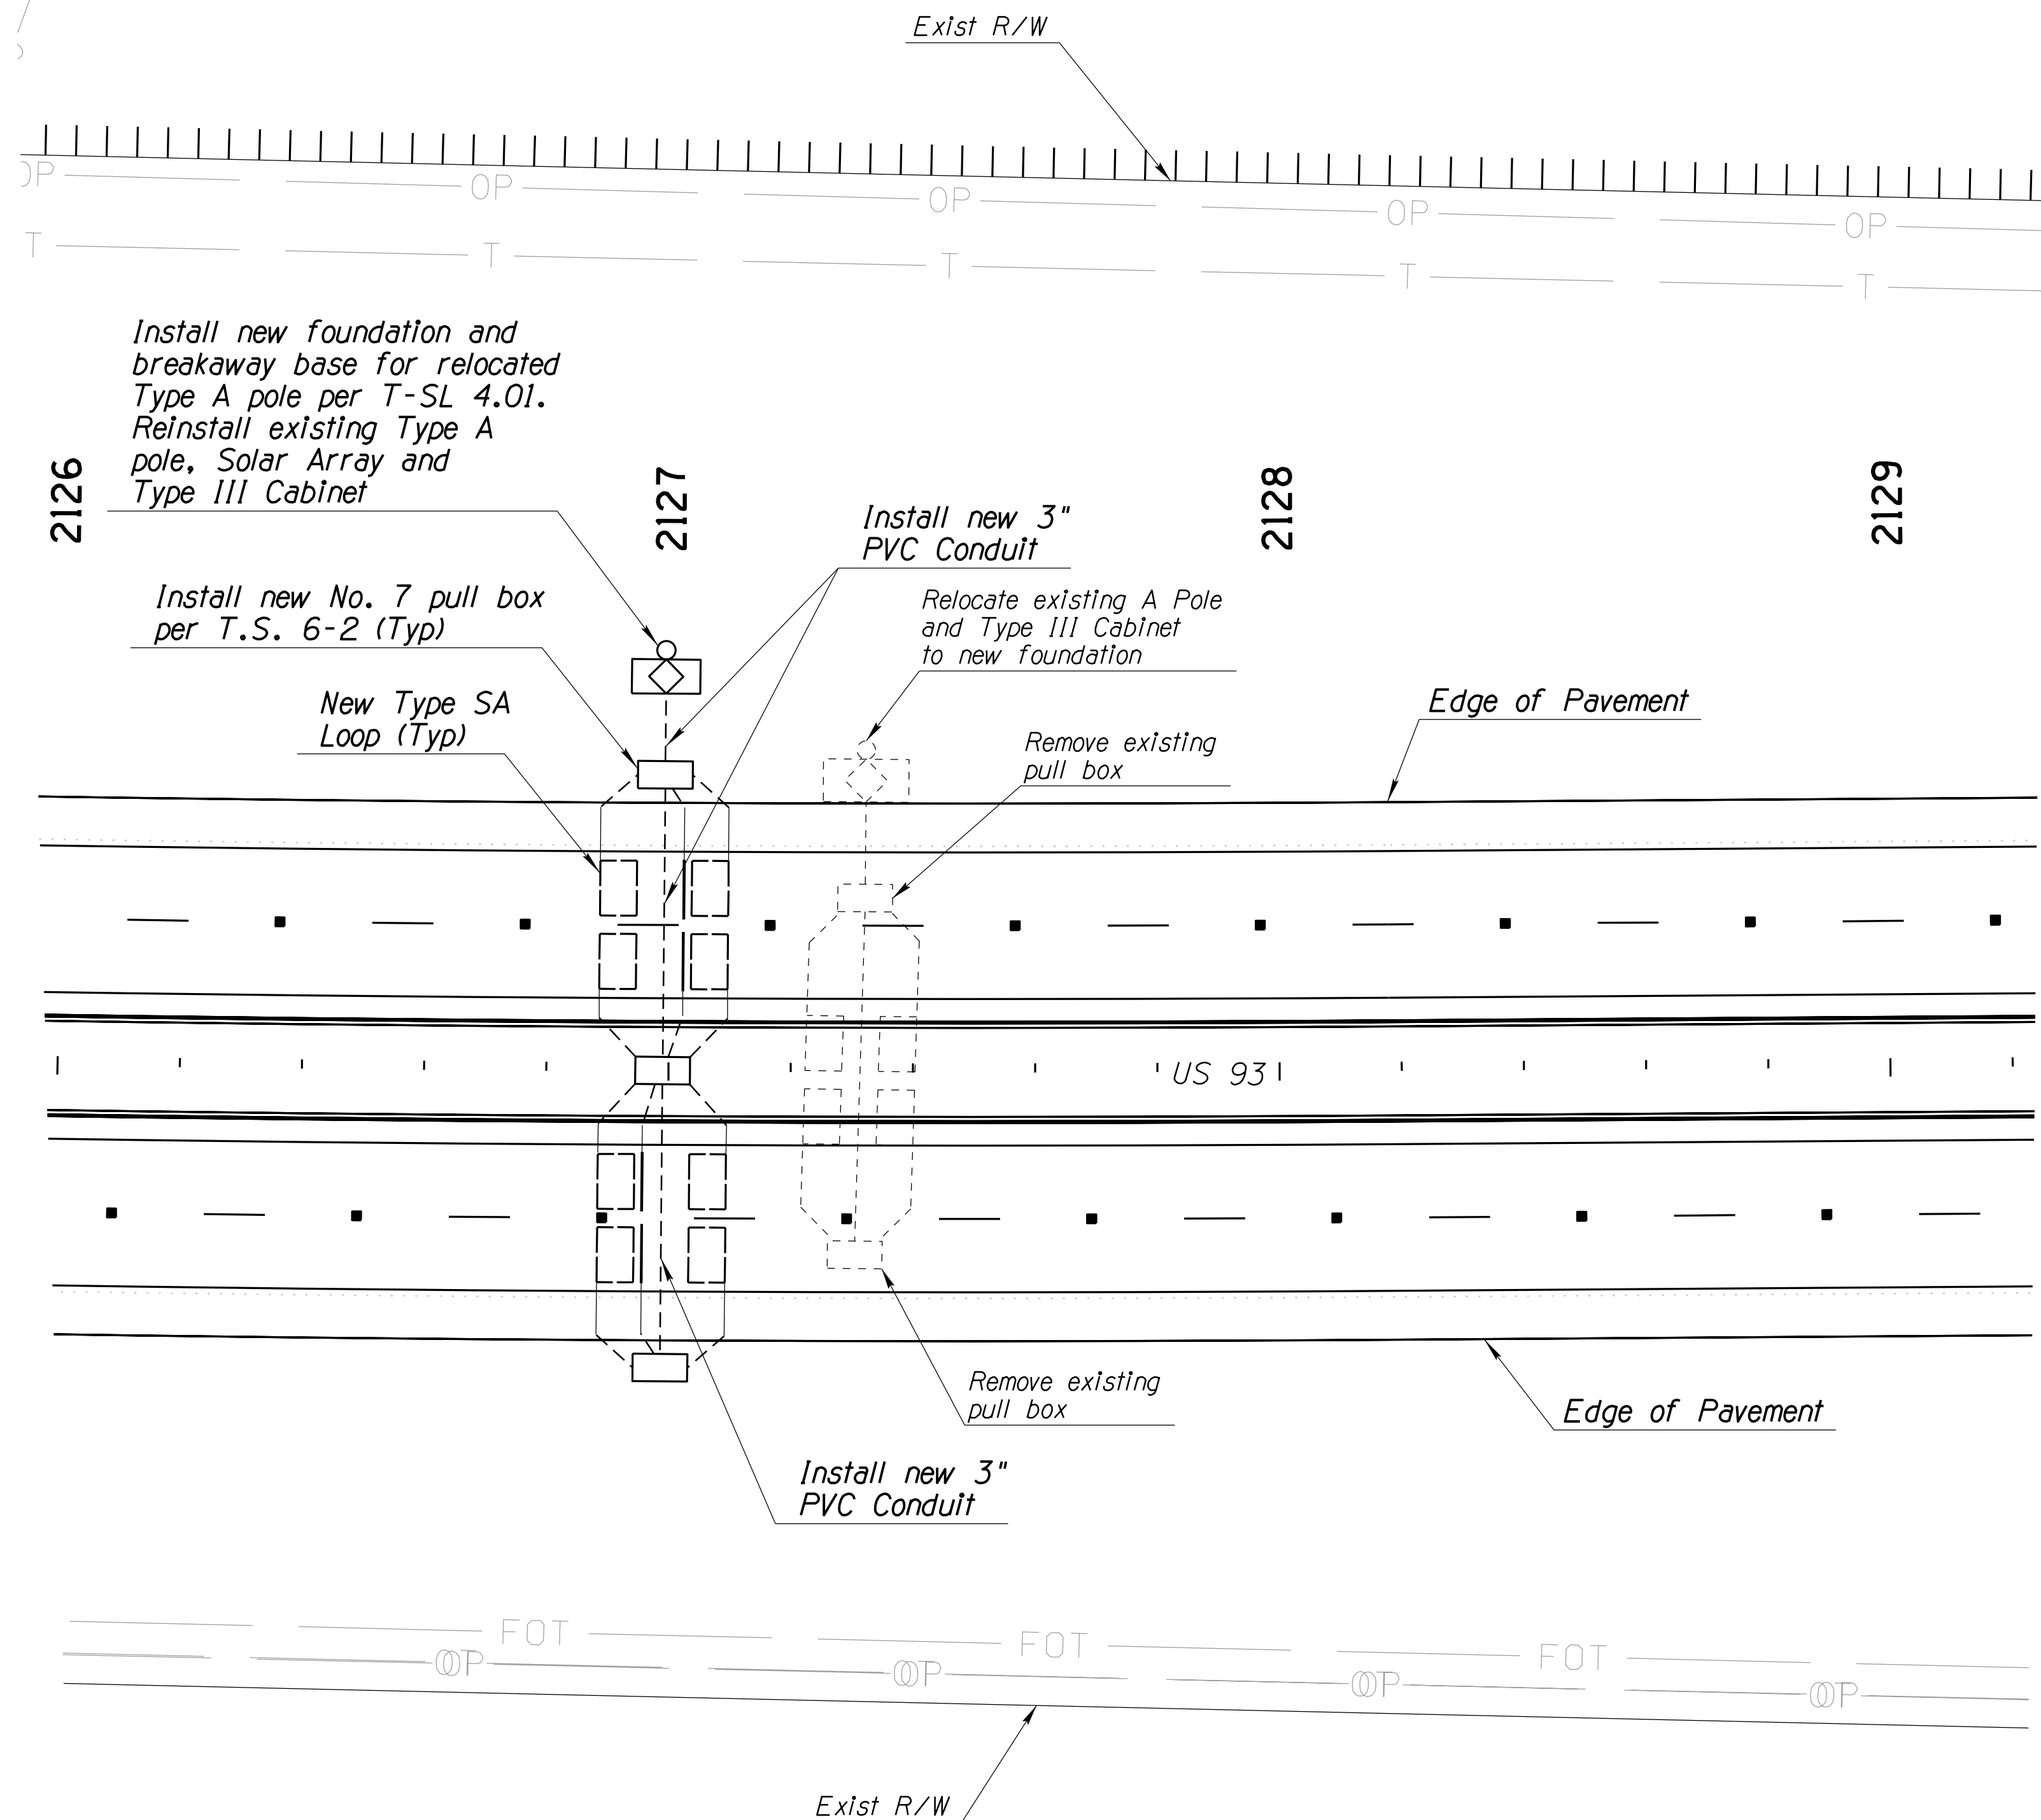

CONSTRUCTION NOTES:

1. Relocate existing Type A pole, with pole mounted Type III Cabinet and Solar Array to new Type A pole foundation and breakaway base. See Special Provisions Item 7350040 for materials and construction requirements.
2. Remove existing No. 7 Pull Boxes and Type A pole foundation. The contractor shall backfill and compact all voids in accordance with Subsection 202-3.01 of the specifications.
3. Contractor shall install new Type SA Speed/Vehicle Classification system per T.S. 6-2 and the specifications.

DESIGN	ME1	DATE	06/26	ARIZONA DEPARTMENT OF TRANSPORTATION PROJECT DELIVERY AND OPERATIONS DIVISION TRAFFIC DESIGN SERVICES	
DRAWN	SRH	DATE	06/26		
CHECKED	BMT	DATE	06/26		
Stanley Consultants inc. 3133 East Camelback Road, Suite 100 Phoenix, Arizona 85016 Phone: (602) 333-2200				US 93 RELOCATE TYPE SA SPEED/VEHICLE CLASSIFICATION SYSTEM	
ROUTE		LOCATION		DWG NO. T-7.01	
US 93		WICKENBURG RANCH WAY TO VISTA ROYALE			
TRACS NO. F0738 OIC				093-B(230)T	
				OF	

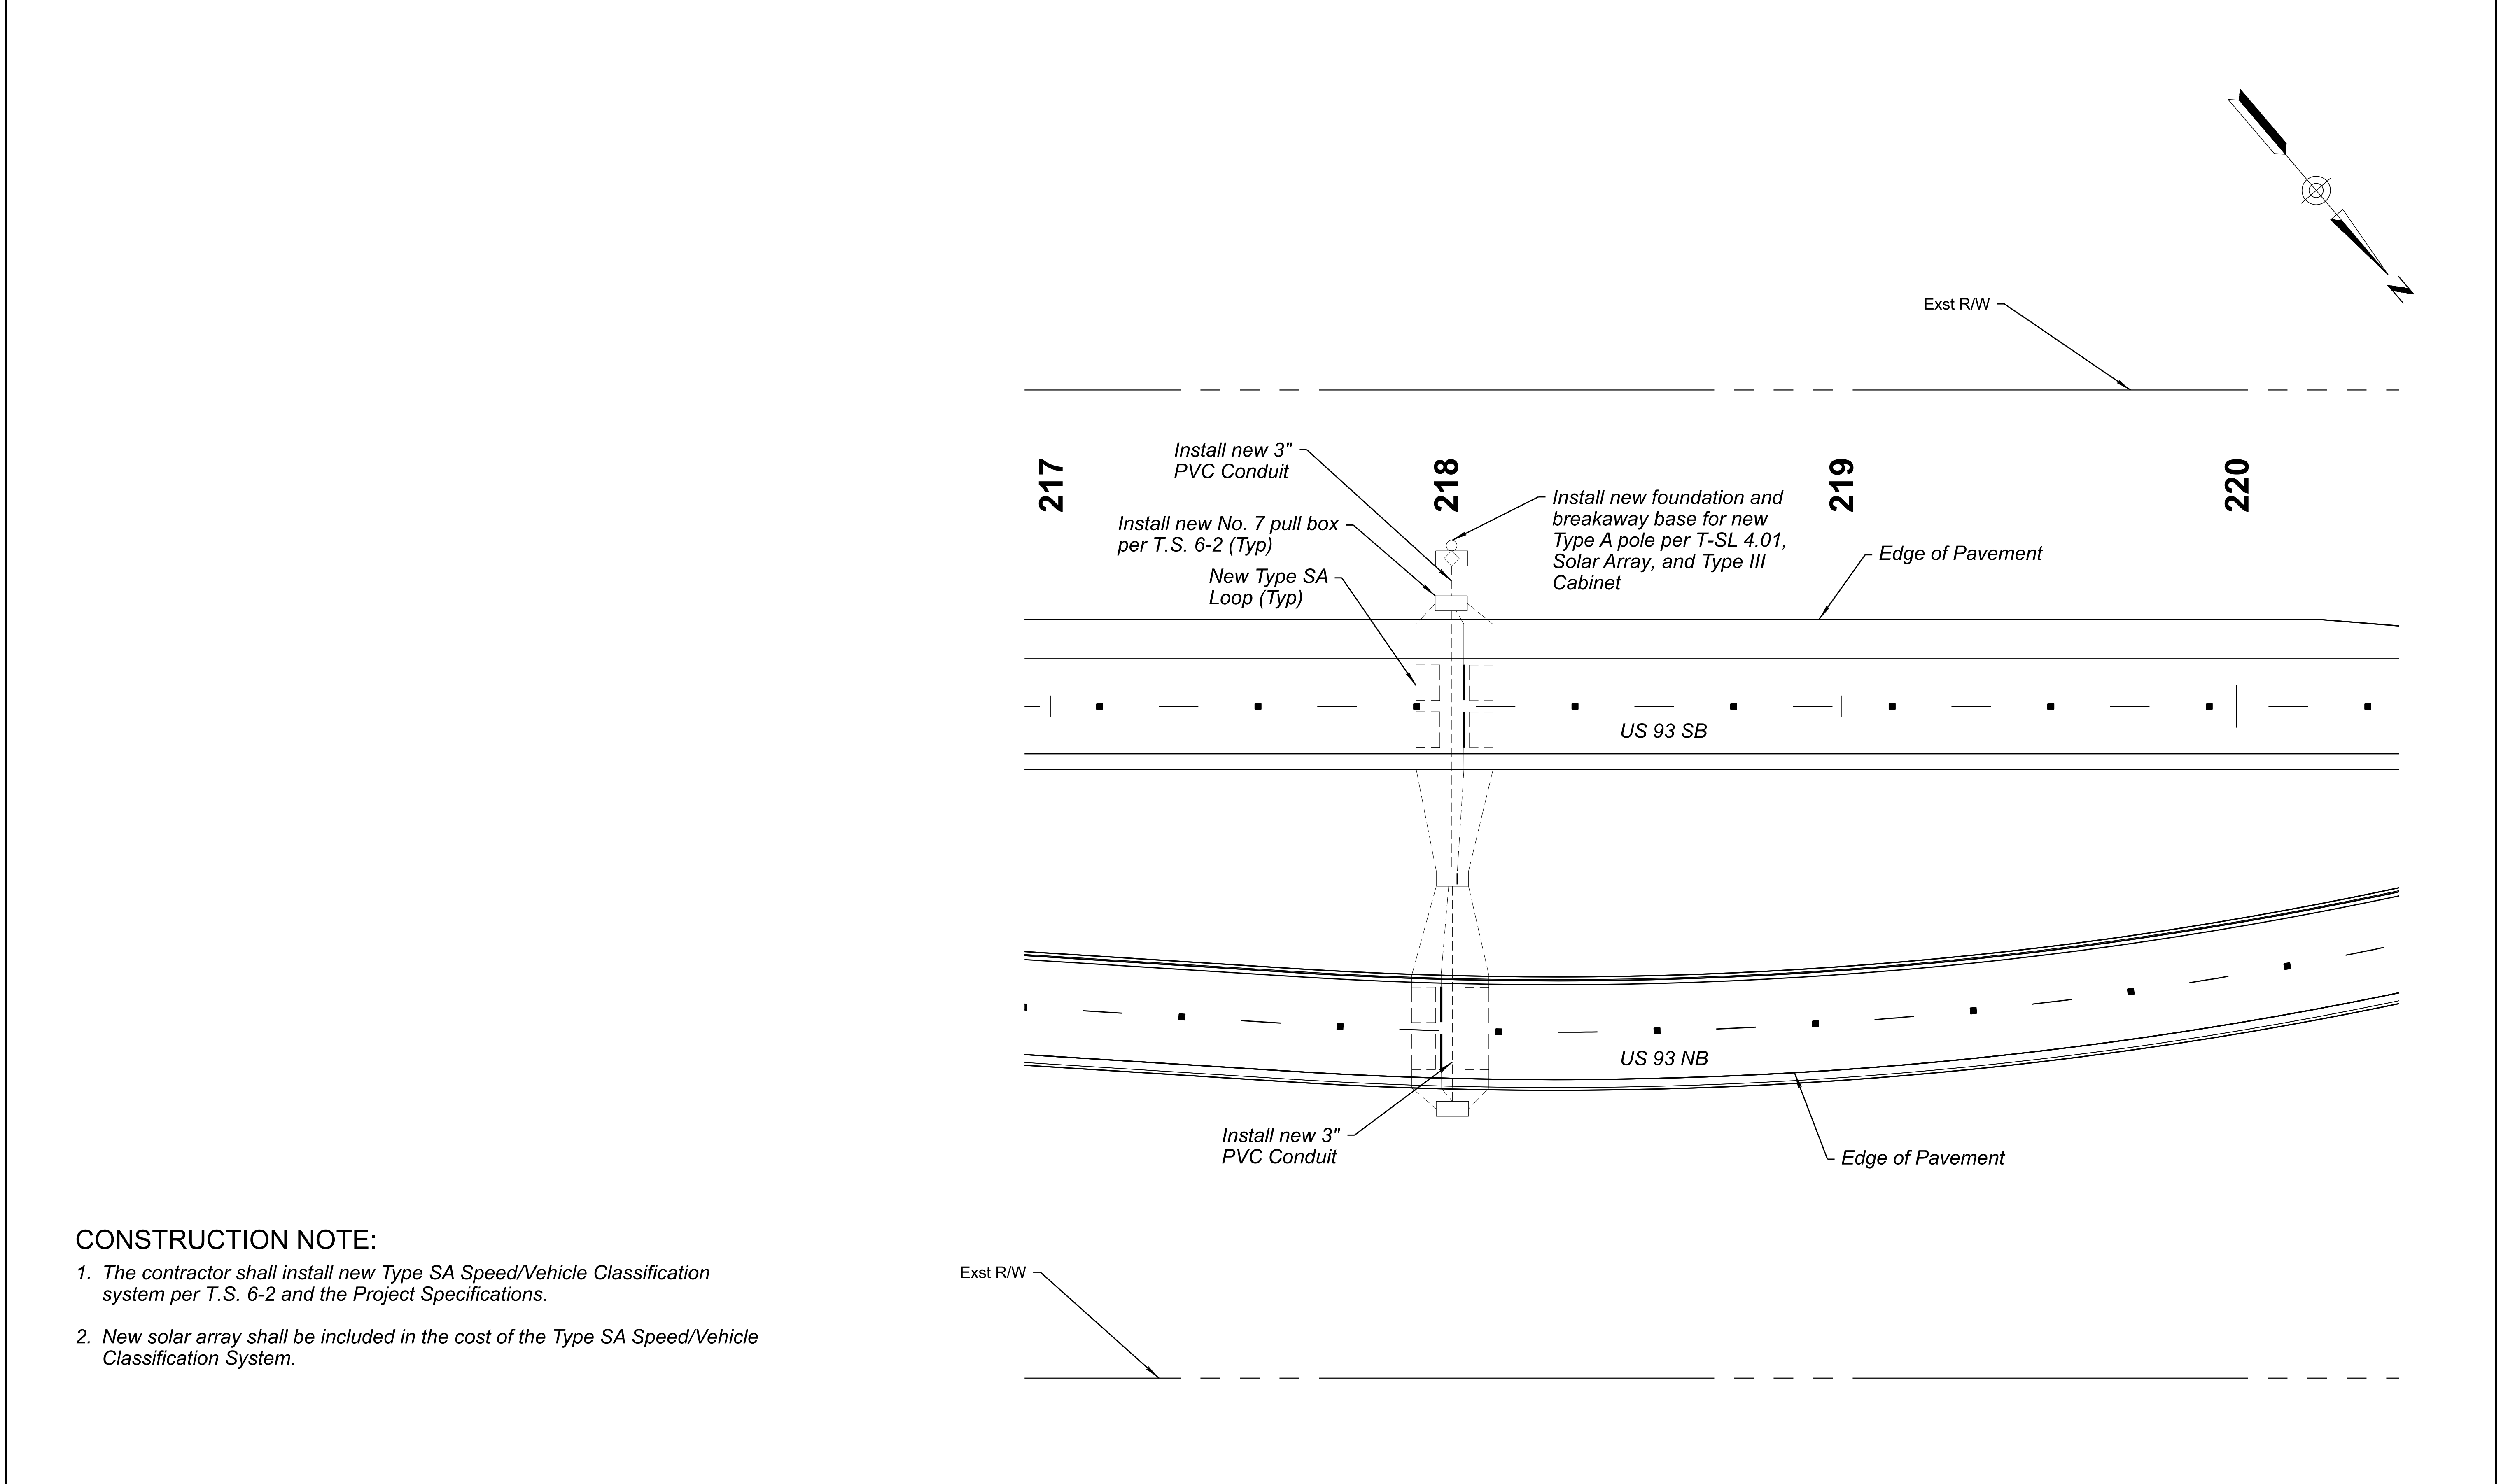

CONSTRUCTION NOTE:

1. The contractor shall install new Type SA Speed/Vehicle Classification system per T.S. 6-2 and the Project Specifications.
2. New solar array shall be included in the cost of the Type SA Speed/Vehicle Classification System.

	<table><tr><th></th><th>NAME</th><th>DATE</th></tr><tr><td>DESIGN</td><td>I ROBLES</td><td>06/26</td></tr><tr><td>DRAWN</td><td>C VALENCIA</td><td>06/26</td></tr><tr><td>CHECKED</td><td>C RICKETTS</td><td>06/26</td></tr></table>			NAME	DATE	DESIGN	I ROBLES	06/26	DRAWN	C VALENCIA	06/26	CHECKED	C RICKETTS	06/26	ARIZONA DEPARTMENT OF TRANSPORTATION PROJECT DELIVERY AND OPERATIONS DIVISION TRAFFIC DESIGN SERVICES		ROUTE US 93	F.H.W.A. Arizona Division	STATE ARIZ.	PROJECT NO.	FEDERAL ID NO.	SHEET NO.	TOTAL SHEETS	RECORD DRAWING
		NAME	DATE																					
	DESIGN	I ROBLES	06/26																					
	DRAWN	C VALENCIA	06/26																					
CHECKED	C RICKETTS	06/26																						
TRANSPORTATION AECOM TECHNICAL SERVICES, Inc. 7720 N. 16th St., Suite 100 Phoenix, Arizona 85020 T 602.371.1100 www.aecom.com		US 93 NEW TYPE SA SPEED/ VEHICLE CLASSIFICATION SYSTEM		MILEPOST 190.5	093 YV 190	093-B-NFA	412	524																
				STRUCTURE NO.	VISTA ROYALE						DWG No. T-7.02													
					TRACS NO. F0738 01C						___ OF ___													

DATE- LOCATION- REVISIONS- FINISHED PLANS- SURVEY NO. DATE- LOCATION- REVISIONS- FINISHED PLANS- SURVEY NO.

ROADWAY LIGHTING GENERAL NOTES:

1. For installation procedures, see ADOT's Traffic Signal and Lighting Standard Drawings and the Standard Specifications.
2. The location of utilities shown on the plans are approximate. All involved utilities may not be shown on the plans. The contractor shall be responsible per Sections 107.15 & 730-6 of the Standard Specifications, for contacting all utilities for the exact location prior to any construction activity. The contractor is responsible for maintaining proper clearances as required by the utility company.
3. All lighting units shall be installed with the mast arm perpendicular to the lane or ramp on which they are located.
4. For electrical service requirements, contact Ben Gowers APS Representative at 602-809-3611 per Section 107 of the Special Provisions.
5. All light poles and foundations shall be in accordance with ADOT Standard Drawings. Luminares shall be in accordance with the ADOT Approved Products List (APL).
6. Pole offsets shall be measured from the construction centerline indicated to the center line of pole as indicated on the pole schedule. Refer to lighting plan sheets for additional information.
7. Conduit runs are diagrammatic. Exact location of conduit runs and pull boxes shall be determined by the Engineer when a field question arises.
8. All conduits shall be installed per Section 732-3.01 of the Standard Specifications.
9. The contractor is responsible for contacting "AZ 811" for verification of underground utility locations.
10. All new pole foundations shall be inspected by ADOT Superintendent Trevor Eltringham at (928) 308-3361 prior to placement of concrete.
11. All horizontal mount luminares shall be marked with their lamp wattage "LED". These markings shall be placed on the luminaire housing and shall be clearly visible from the ground.
12. The contractor shall field verify all pole locations with the Engineer prior to any construction activity.
13. Each pole mounted luminaire shall be individually fused with in-line connectors in the nearest adjacent pull box.
14. The metered load center cabinet and foundation shall be installed per ADOT Standard Drawings. The contractor shall coordinate final placement and surrounding grading requirements at the metered load center cabinet with the Engineer.
15. The contractor shall install the service conduit from the meter pedestal cabinet to the point of electrical service in accordance with APS requirements. The service conduit shall be inspected by APS prior to backfilling the trench.
16. All lighting pull boxes shall be heavy duty with locking lids in accordance with ADOT Standard Drawing No. T.S. 1-12 and shall be gray color only.

F.H.W.A. REGION	STATE	PROJECT NO.	SHEET NO.	TOTAL SHEETS	RECORD DRAWING
9	ARIZ.	093-B(230)T	413	524	
093 YV 189					

APPROXIMATE LIGHTING QUANTITIES			
BID ITEM No.	ITEM DESCRIPTION	UNIT	QUANTITY
7310092	Pole (Type H) (Aluminum, Breakaway Base)	Each	43
7310201	Breakaway Base for Lighting Poles (Over 30')	Each	43
7310276	Pole Foundation (Type H) (Breakaway)	Each	43
7310650	Mast Arm (10') (Aluminum)	Each	43
7320040	Electrical Conduit (1 1/2") (PVC)	L. FT	120
7320050	Electrical Conduit (2") (PVC)	L. FT	7430
7320060	Electrical Conduit (2 1/2") (PVC)	L. FT	120
7320456	Pull Box (No. 4B) (ADOT Std. Dtl. T.S. 1-12)	Each	46
7320459	Pull Box (No. 6B) (ADOT Std. Dtl. T.S. 1-12)	Each	3
7320500	Conductor (No. 12)	L. FT	6470
7320510	Conductor (No. 10)	L. FT	2500
7320520	Conductor (No. 8)	L. FT	12830
7320530	Conductor (No. 6)	L. FT	3700
7320570	Conductor (No. 1)	L. FT	102
7320581	Conductor (Bare Bond) (No. 6)	L. FT	40
7320586	Conductor (Bare Bond) (No. 8)	L. FT	7280
7360105	Luminaire (Horizontal Mount) (25L) (LED)	Each	18
7360112	Luminaire (Horizontal Mount) (15L) (LED)	Each	25
7360235	Load Center Cabinet (Type II) (120/240V Metered)	Each	2
7360240	Load Center Cabinet Foundation	Each	2
7370452	Miscellaneous Electrical (Electrical Record Drawings)	L. Sum	1
9240020	Force Account Work (Electrical Service)	L. Sum	1


LIGHTING DESIGN CRITERIA:

- * Minimum average maintained horizontal illuminance 0.8fc
- * Average to minimum uniformity ratio 6:1

		NAME	DATE	ARIZONA DEPARTMENT OF TRANSPORTATION PROJECT DELIVERY AND OPERATIONS DIVISION TRAFFIC DESIGN SERVICES	
DESIGN		ME1	06/26		
DRAWN		SRH	06/26		
CHECKED		BMT	06/26	US 93 & SR 89 LIGHTING GENERAL NOTES AND LEGEND	
 3133 East Camelback Road, Suite 100 Phoenix, Arizona 85016 Phone: (602) 333-2200					
ROUTE		LOCATION			
US 93		WICKENBURG RANCH WAY TO VISTA ROYALE		DWG NO. T-8.01	
TRACS NO. F0738 OIC			093-B(230)T		___ OF ___

F.H.W.A. REGION	STATE	PROJECT NO.	SHEET NO.	TOTAL SHEETS	RECORD DRAWING
9	ARIZ.	093-B(230)T	414	524	

093 YV 189

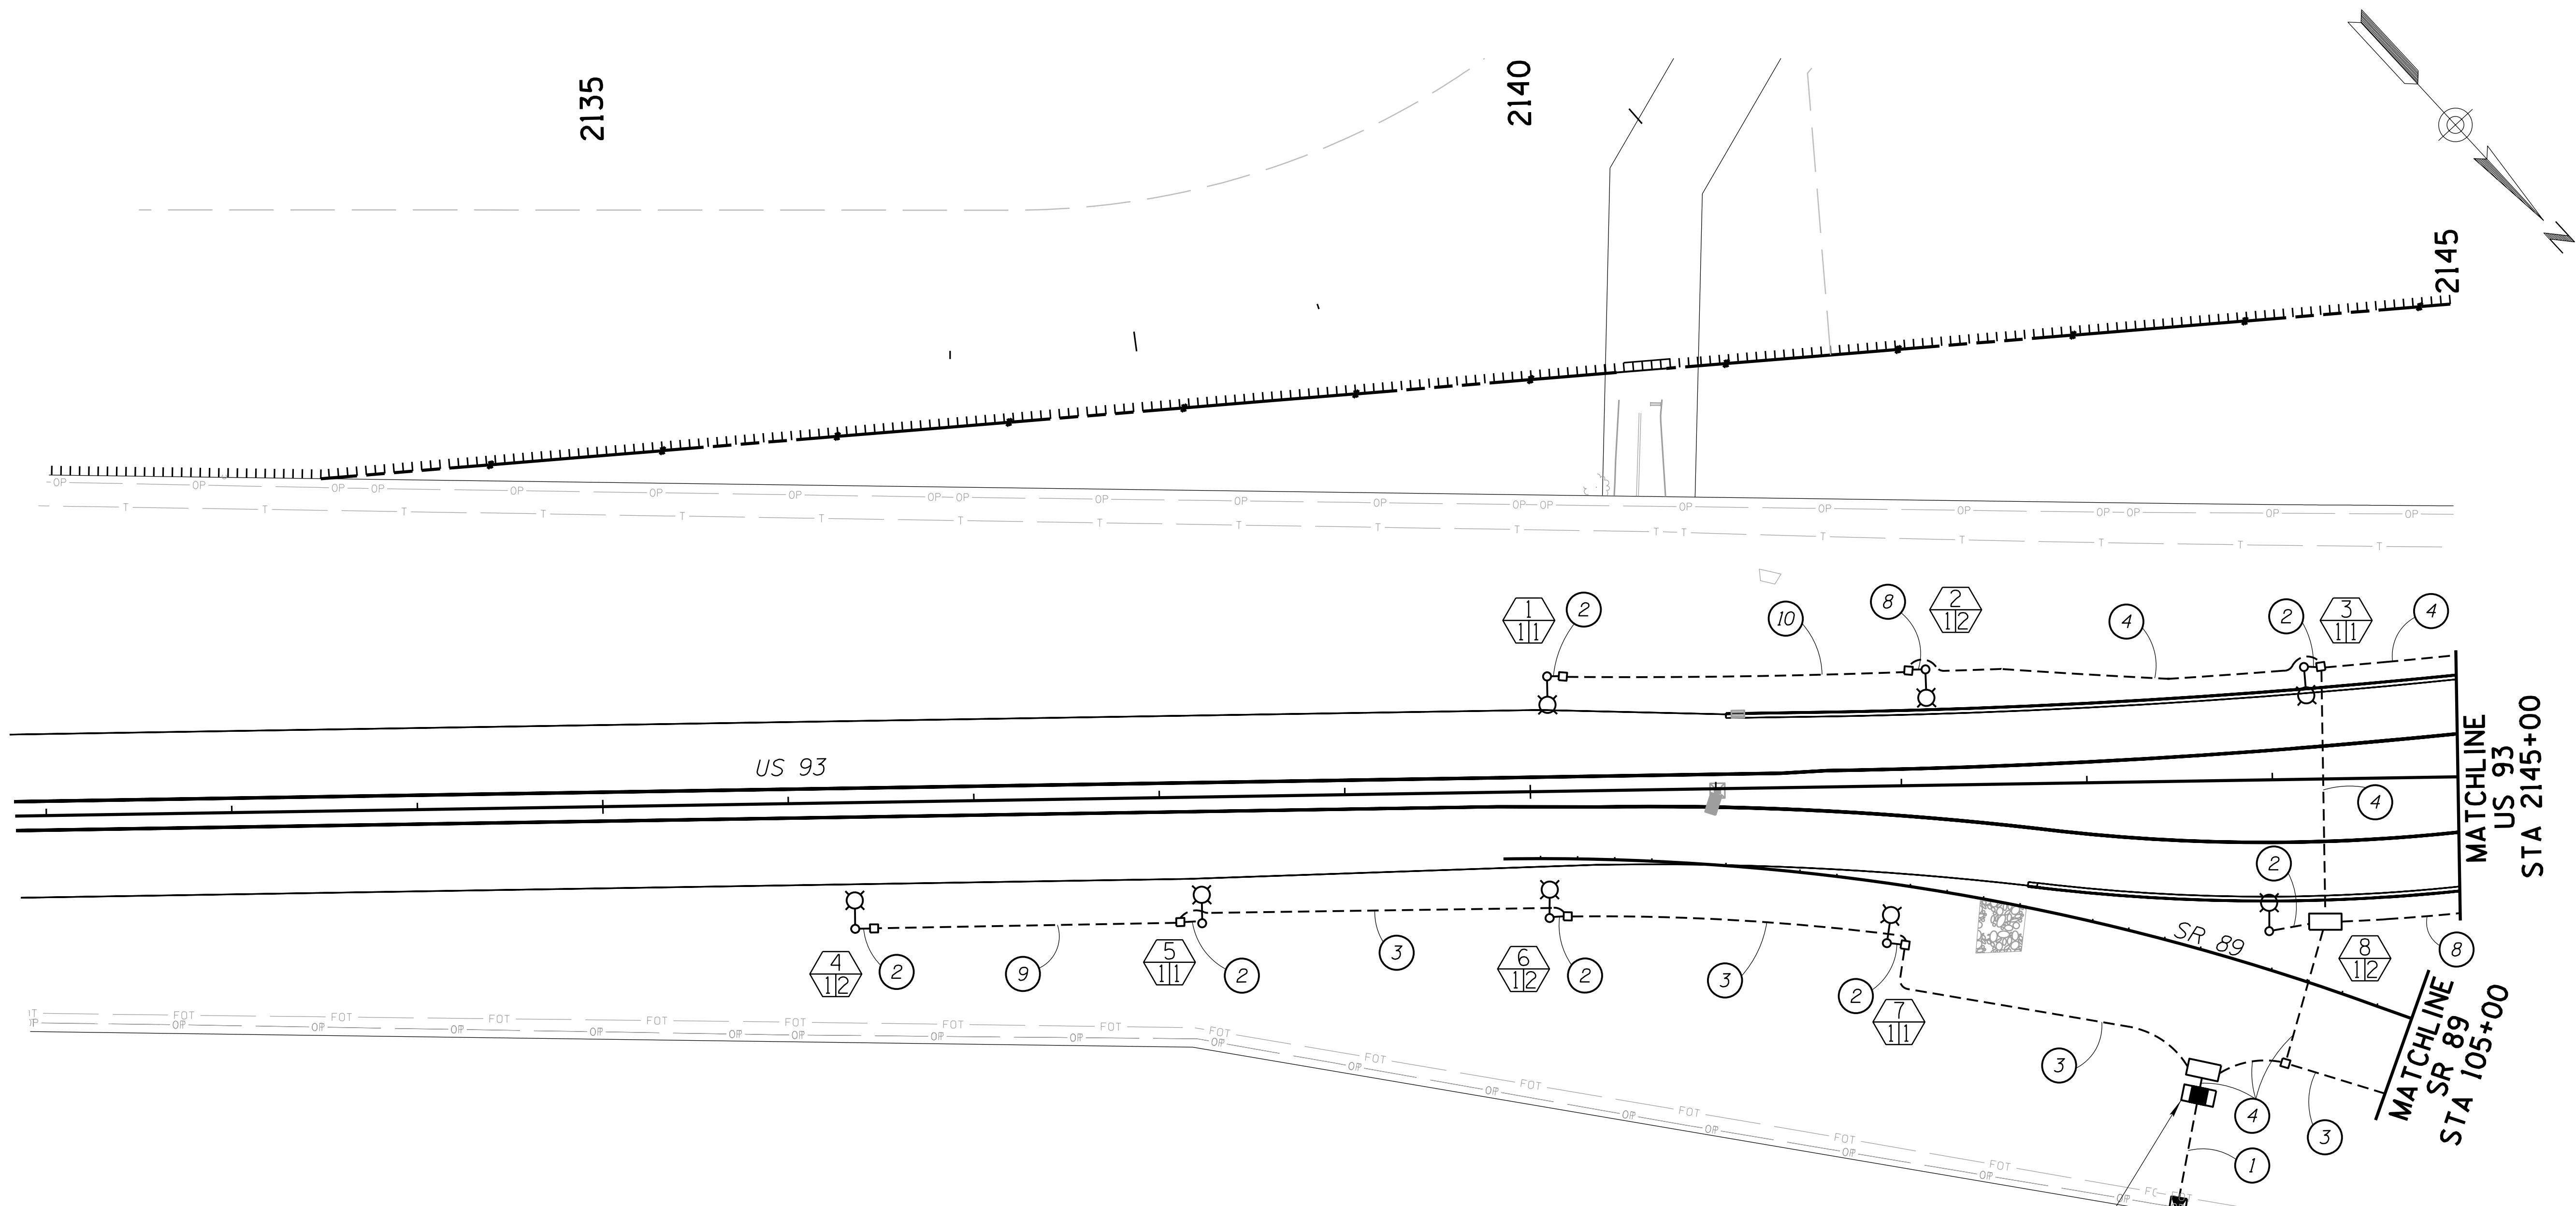

LEGEND	
	X-Pole Number Y-Load Center Number Y-Circuit Number
	Type "H" Aluminum Pole With LED Fixture (See Pole And Luminaire Schedule)
	Metered Load Center Cabinet and Foundation
	No. 4b Pull Box, See Note 16 Above
	No. 6b Pull Box, See Note 16 Above
	New Conduit
	X-New Conduit Run Number with New Conductors

Install Load Center Cabinet (LC-1)
120/240V Metered (3-20 AMP Breakers)
US 93 Sta 2143+58, 169.5' Rt
Electrical Service Address:
36315 S. US Highway 93


APS Ground
Mounted Transformer

APS Power Pole

		NAME	DATE	ARIZONA DEPARTMENT OF TRANSPORTATION PROJECT DELIVERY AND OPERATIONS DIVISION TRAFFIC DESIGN SERVICES US 93 & SR 89 LIGHTING PLAN BEGIN PROJECT TO STA 2145+00		
DESIGN	ME1	06/26				
DRAWN	SRH	06/26				
CHECKED	BMT	06/26				
 Stanley Consultants inc.		3133 East Camelback Road, Suite 100 Phoenix, Arizona 85016 Phone: (602) 333-2200		DWG NO. T-8.02 ____ OF ____		
ROUTE		LOCATION				
US 93		WICKENBURG RANCH WAY TO VISTA ROYALE				
TRACS NO. F0738 OIC			093-B(230)T			

F.H.W.A. REGION	STATE	PROJECT NO.	SHEET NO.	TOTAL SHEETS	RECORD DRAWING
9	ARIZ.	093-B(230)T	415	524	

093 YV 189

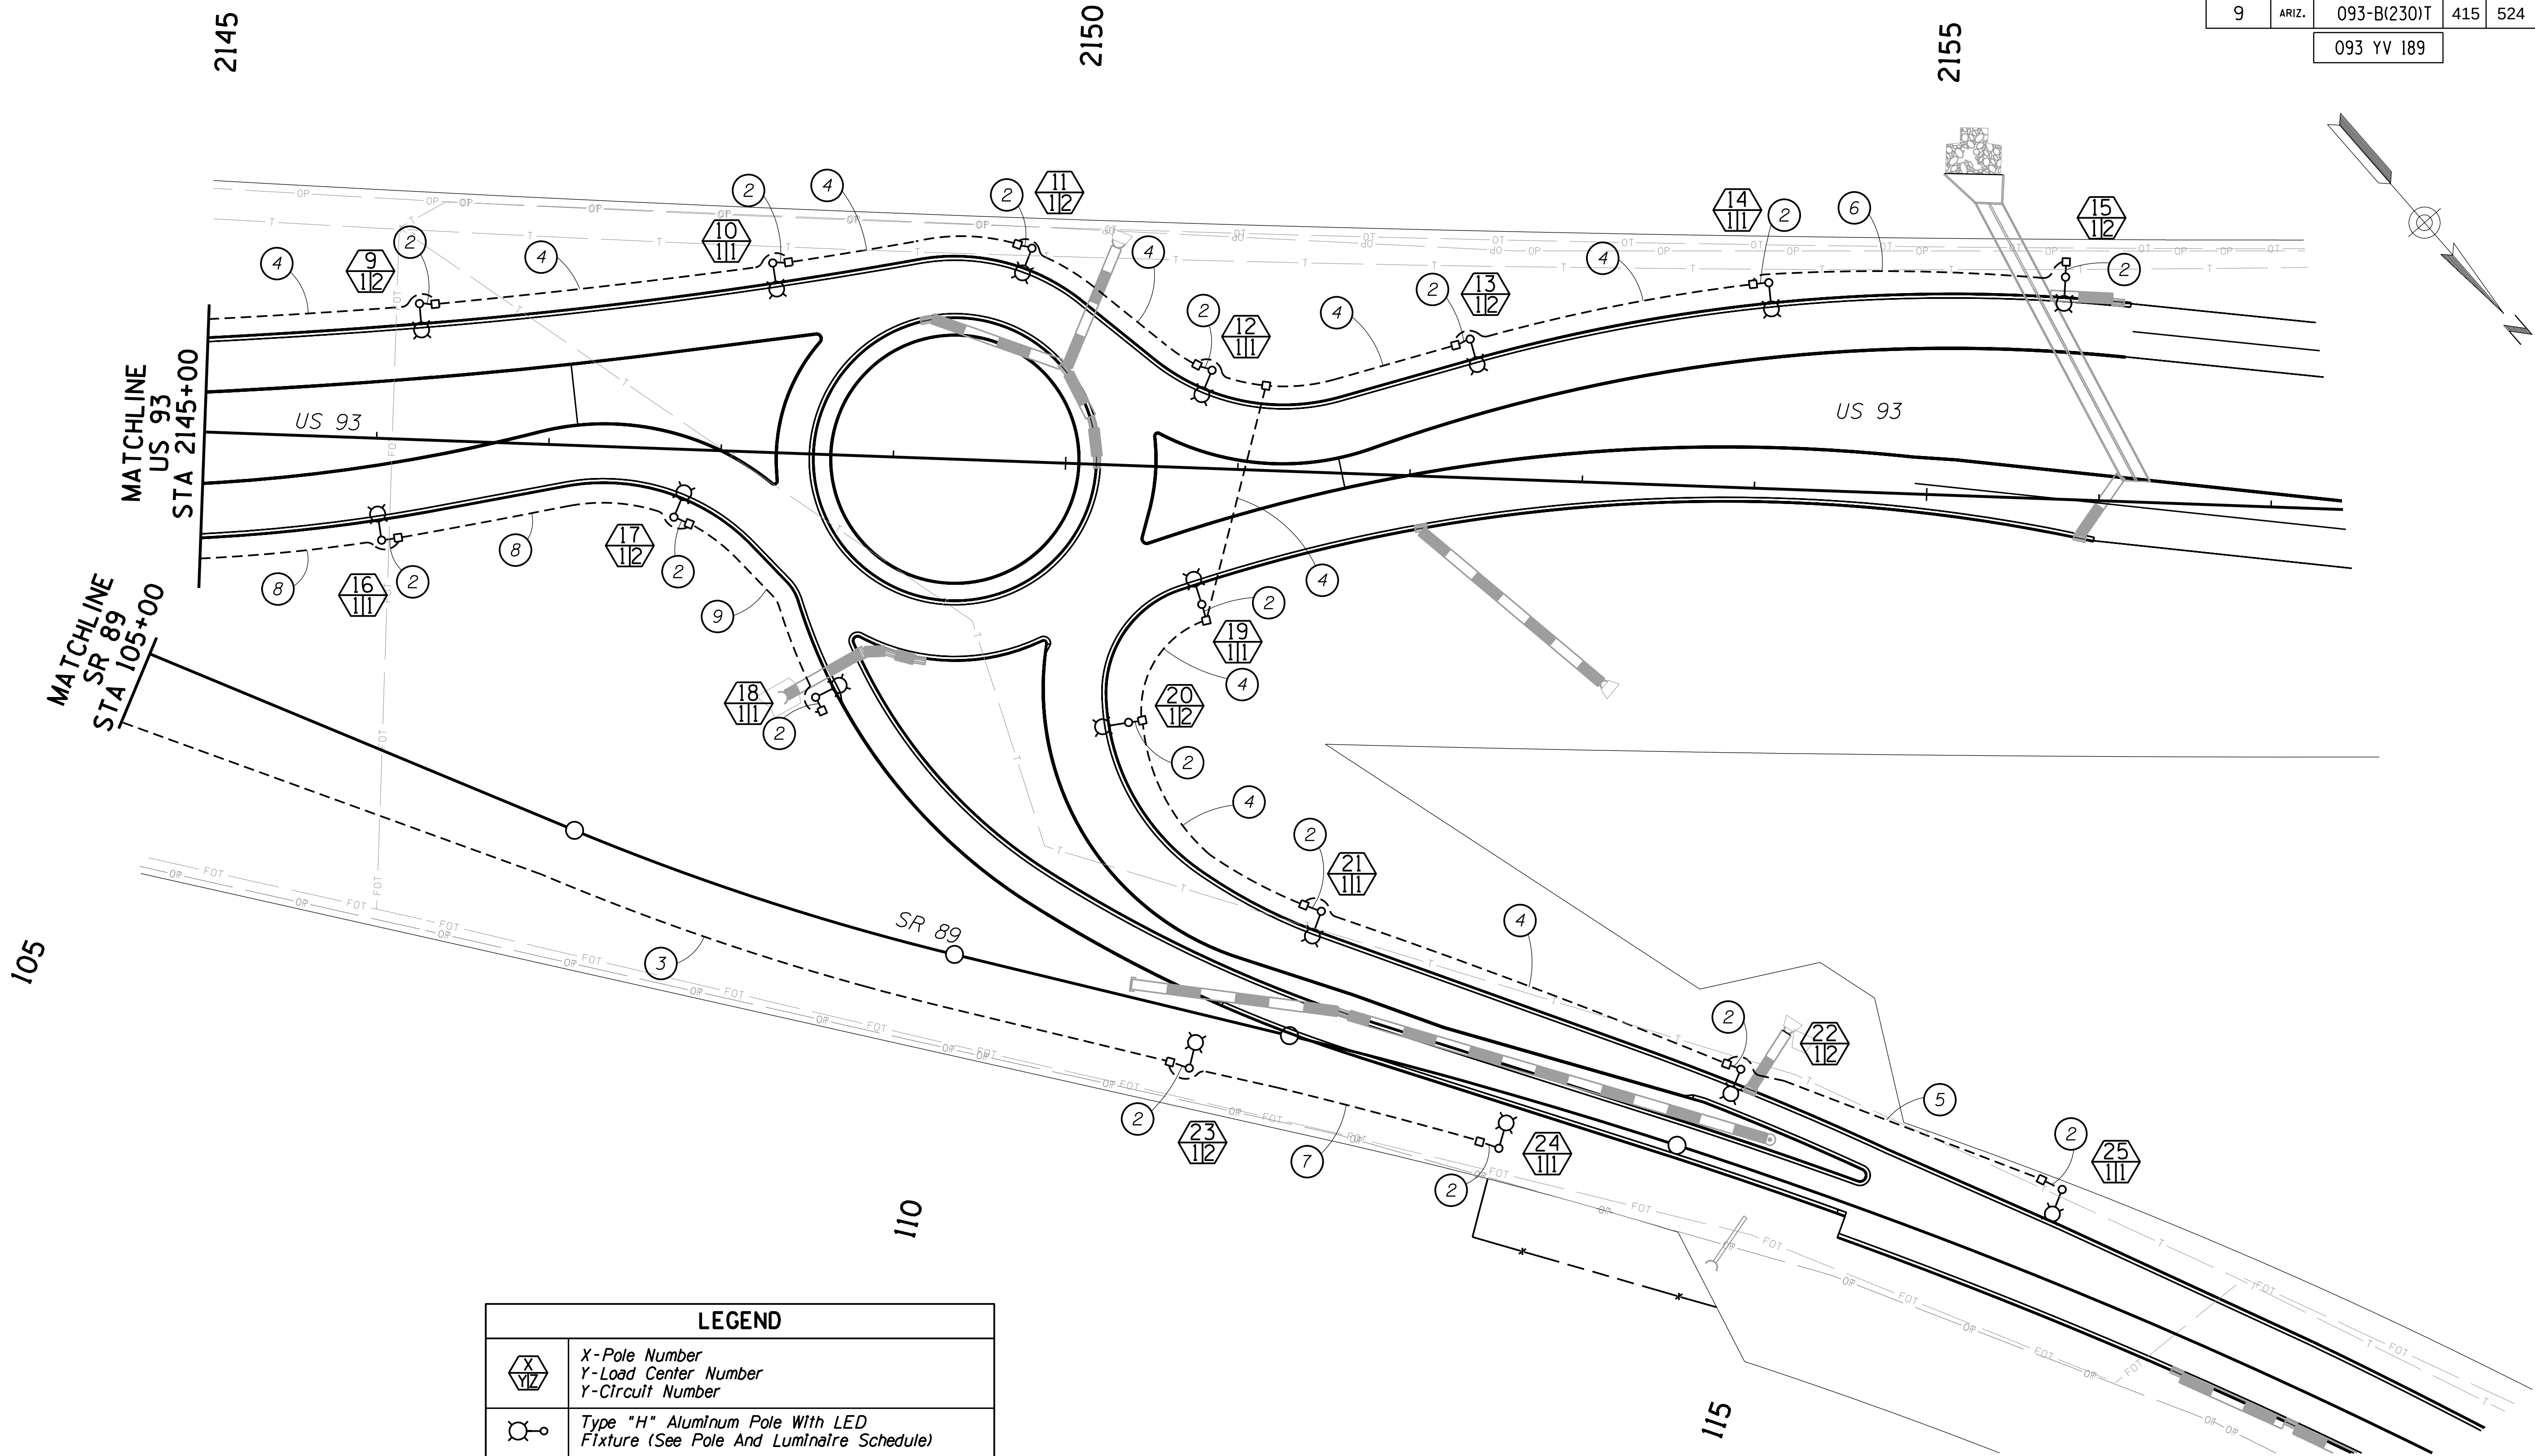

LEGEND	
	X-Pole Number Y-Load Center Number Z-Circuit Number
	Type "H" Aluminum Pole With LED Fixture (See Pole And Luminaire Schedule)
	Metered Load Center Cabinet and Foundation
	No. 4b Pull Box, See Note 16 Above
	No. 6b Pull Box, See Note 16 Above
	New Conduit
	X-New Conduit Run Number with New Conductors

NOTE:
Verify location of utilities prior to conduit and light pole installation.

		NAME	DATE	ARIZONA DEPARTMENT OF TRANSPORTATION PROJECT DELIVERY AND OPERATIONS DIVISION TRAFFIC DESIGN SERVICES	
DESIGN	ME1		06/26		
DRAWN	SRH		06/26		
CHECKED	BMT		06/26		
 Stanley Consultants inc.		3133 East Camelback Road, Suite 100 Phoenix, Arizona 85016 Phone: (602) 333-2200		US 93 & SR 89 LIGHTING PLAN STA 2145+00 TO END PROJECT	
ROUTE		LOCATION			
US 93		WICKENBURG RANCH WAY TO VISTA ROYALE		DWG NO. T-8.03	
TRACS NO. F0738 OIC			093-B(230)T		___ OF ___

DATE- LOCATION- REVISIONS- FINISHED PLANS- SURVEY NO. DATE- LOCATION- REVISIONS- FINISHED PLANS- SURVEY NO.

F.H.W.A. REGION	STATE	PROJECT NO.	SHEET NO.	TOTAL SHEETS	RECORD DRAWING
9	ARIZ.	093-B(230)T	416	524	
093 YV 189					

ROADWAY LIGHTING POLE AND LUMINAIRE SCHEDULE US 93 & SR 89												
POLE NO.	CENTERLINE	STATION	OFFSET	CIRCUIT	POLE		FOUNDATION		LUMINAIRE		REMARKS	MAINTENANCE UNIT NO.
					TYPE	MAST ARM LENGTH	TYPE	BASE	ADOT TYPE	NO		
1	US 93 Cst E	2140+10	62' Lt	1	H - 40'	10'	B/A	B/A-3	15L	1		
2	US 93 Cst E	2142+14	62.5' Lt	2	H - 40'	10'	B/A	B/A-3	15L	1		
3	US 93 Cst E	2144+18	60.5' Lt	1	H - 40'	10'	B/A	B/A-3	15L	1		
4	US 93 Cst E	2136+35	68' Rt	2	H - 40'	10'	B/A	B/A-3	15L	1		
5	US 93 Cst E	2138+22	68' Rt	1	H - 40'	10'	B/A	B/A-3	15L	1		
6	SR 89 Cst E	100+25	32' Rt	2	H - 40'	10'	B/A	B/A-3	15L	1		
7	SR 89 Cst E	102+12	32' Rt	1	H - 40'	10'	B/A	B/A-3	15L	1		
8	US 93 Cst E	2143+97	82' Rt	2	H - 40'	10'	B/A	B/A-3	15L	1		
9	US 93 Cst E	2146+22	79' Lt	2	H - 40'	10'	B/A	B/A-3	15L	1		
10	US 93 Cst E	2148+26	110' Lt	1	H - 40'	10'	B/A	B/A-3	15L	1		
11	US 93 Cst E	2149+76	124' Lt	2	H - 40'	10'	B/A	B/A-3	15L	1	Verify utility location	
12	US 93 Cst E	2150+83	57' Lt	1	H - 40'	10'	B/A	B/A-3	15L	1		
13	US 93 Cst E	2152+32	80.5' Lt	2	H - 40'	10'	B/A	B/A-3	15L	1		
14	US 93 Cst E	2154+04	119.5' Lt	1	H - 40'	10'	B/A	B/A-3	15L	1		
15	US 93 Cst E	2155+76	129' Lt	2	H - 40'	10'	B/A	B/A-3	15L	1	Verify utility location	
16	US 93 Cst E	2146+05	59' Rt	1	H - 40'	10'	B/A	B/A-3	15L	1	Verify utility location	
17	US 93 Cst E	2147+74	39.5' Rt	2	H - 40'	10'	B/A	B/A-3	15L	1		
18	US 93 Cst E	2148+60	141' Rt	1	H - 40'	10'	B/A	B/A-3	15L	1		
19	US 93 Cst E	2150+82	79' Rt	1	H - 40'	10'	B/A	B/A-3	15L	1		
20	US 93 Cst E	2150+42	149' Rt	2	H - 40'	10'	B/A	B/A-3	15L	1		
21	SR 89 Cst E	112+00	74.5' Lt	1	H - 40'	10'	B/A	B/A-3	15L	1		
22	SR 89 Cst E	114+55	53.5' Lt	2	H - 40'	10'	B/A	B/A-3	15L	1	Verify utility location	
23	SR 89 Cst E	111+47	32' Rt	2	H - 40'	10'	B/A	B/A-3	15L	1		
24	SR 89 Cst E	113+34	32' Rt	1	H - 40'	10'	B/A	B/A-3	15L	1		
25	SR 89 Cst E	116+50	52' Lt	1	H - 40'	10'	B/A	B/A-3	15L	1	Verify utility location	

POLE AND LUMINAIRE SCHEDULE NOTES:

1. Offset is referenced from the construction centerline in Pole Schedule to the center of the pole.
2. The contractor shall obtain maintenance unit numbers as described in Specifications Item 7370452 Miscellaneous Electrical (Electrical Record Drawings).
3. Contractor shall obtain approval from electrical Inspector prior to digging pole foundations. Contractor shall inform electrical Inspector of any potential conflicts prior to digging pole foundations.
4. All streetlight poles are to be installed a minimum of 12 feet behind the face of curb or as shown on the roadway lighting and pole luminaire schedule. Luminaire arms shall be oriented perpendicular to adjacent curb unless noted otherwise.
5. Except where behind guard rail, all poles are to be mounted on Type 3 Breakaway Bases per ADOT Std. Dwg. T.S. 5-0, T.S. 5-2 and T.S. 5-3. (B/A-3) See Pole and Luminaire Schedule.

LEGEND:

- H - Type H Pole Per ADOT Std. Dwg. T-SL 4.09
- B/A - Type H Pole Foundation with bolt circle to match Type 3 Breakaway base
- B/A-3 - Type 3 Breakaway Base Per ADOT Std. Dwg. T.S. 5-2
- 15L - Horizontal Mount LED Luminaire- Refer to ADOT Approved Products List and Specifications

		NAME	DATE	ARIZONA DEPARTMENT OF TRANSPORTATION PROJECT DELIVERY AND OPERATIONS DIVISION TRAFFIC DESIGN SERVICES		
DESIGN	ME1		06/26			
DRAWN	SRH		06/26			
CHECKED	BMT		06/26			
 3133 East Camelback Road, Suite 100 Phoenix, Arizona 85016 Phone: (602) 333-2200				US 93 & SR 89 LIGHT POLE SCHEDULE		
ROUTE		LOCATION				
US 93		WICKENBURG RANCH WAY TO VISTA ROYALE				
TRACS NO. F0738 OIC				093-B(230)T	___ OF ___	

DATE- LOCATION- REVISIONS- FINISHED PLANS- SURVEY NO. DATE- LOCATION- REVISIONS- FINISHED PLANS- SURVEY NO.

F.H.W.A. REGION	STATE	PROJECT NO.	SHEET NO.	TOTAL SHEETS	RECORD DRAWING
9	ARIZ.	093-B(230)T	417	524	
093 YV 189					

ROADWAY LIGHTING CONDUCTOR SCHEDULE US 93 & SR 89											
	CONDUIT RUN NUMBER	1	2	3	4	5	6	7	8	9	10
	CONDUIT SIZE IN INCHES	2.5	2	2	2	2	2	2	2	2	2
AWG	CIRCUIT PHASE	●									
#12	Lighting (Pole to pull box)		2								
#12	Lighting Circuit 1			2				2			
	Lighting Circuit 2			2						2	
#10	Lighting Circuit 1								2		2
	Lighting Circuit 2						2		2		
#8	Lighting Circuit 1				2	2					
	Lighting Circuit 2				2						
#8	Bare Bond		1	1	1	1	1	1	1	1	1

● = Conduit installed by contractor, conductors by APS

US93 Highway Lighting Service

Plan Designation	Interchange	New/Exst	Service Address	Maintenance Unit No.	Type
LC-1	US 93	NEW	36315 S. US Highway 93	XXXXX	120/240V

LC - Load center cabinet Type II per ADOT Std. Dwg. T.S. 3-1

LOAD CENTER TABLE


Load center No:	LC-1
Load center location:	US 93, STA 2143+58, 169.5' RT
Meter pedestal type:	TYPE II (120/240V)
Main circuit bkr:	100 A

Circuit	Status	Voltage	Voltage drop	% Drop	Breaker	Load AMPS
1	NEW	240	6.89	2.87	20	6.37
2	NEW	240	5.98	2.49	20	5.88
Service amps						12.25
Additional 25% demand						3.06
Total AMPS						16.31
Power (VA)						3675

		NAME	DATE	ARIZONA DEPARTMENT OF TRANSPORTATION PROJECT DELIVERY AND OPERATIONS DIVISION TRAFFIC DESIGN SERVICES US 93 & SR 89 CONDUCTOR SCHEDULE	
DESIGN		ME1	06/26		
DRAWN		SRH	06/26		
CHECKED		BMT	06/26		
 3133 East Camelback Road, Suite 100 Phoenix, Arizona 85016 Phone: (602) 333-2200					
ROUTE		LOCATION			
US 93		WICKENBURG RANCH WAY TO VISTA ROYALE			
TRACS NO. F0738 OIC			093-B(230)T		
			___ OF ___		

CONDUIT AND PULLBOX LEGEND	
NEW	
	Type II Load Center Cabinet with meter pedestal Per ADOT Std. Dtl. T.S. 3-1
	Heavy Duty No. 4B Pull Box w/ Security Lid, Per ADOT Std. Dtl. T.S. 1-12
	Heavy Duty No. 6B Pull Box w/ Security Lid, Per ADOT Std. Dtl. T.S. 1-12
	Conduit Sch 40 PVC
	Conduit Callouts (See Conductor Schedule)

POLE AND LUMINAIRE LEGEND	
	New Lighting Pole With New Luminaire
	X - Pole Number Y - Load Center number Z - Circuit

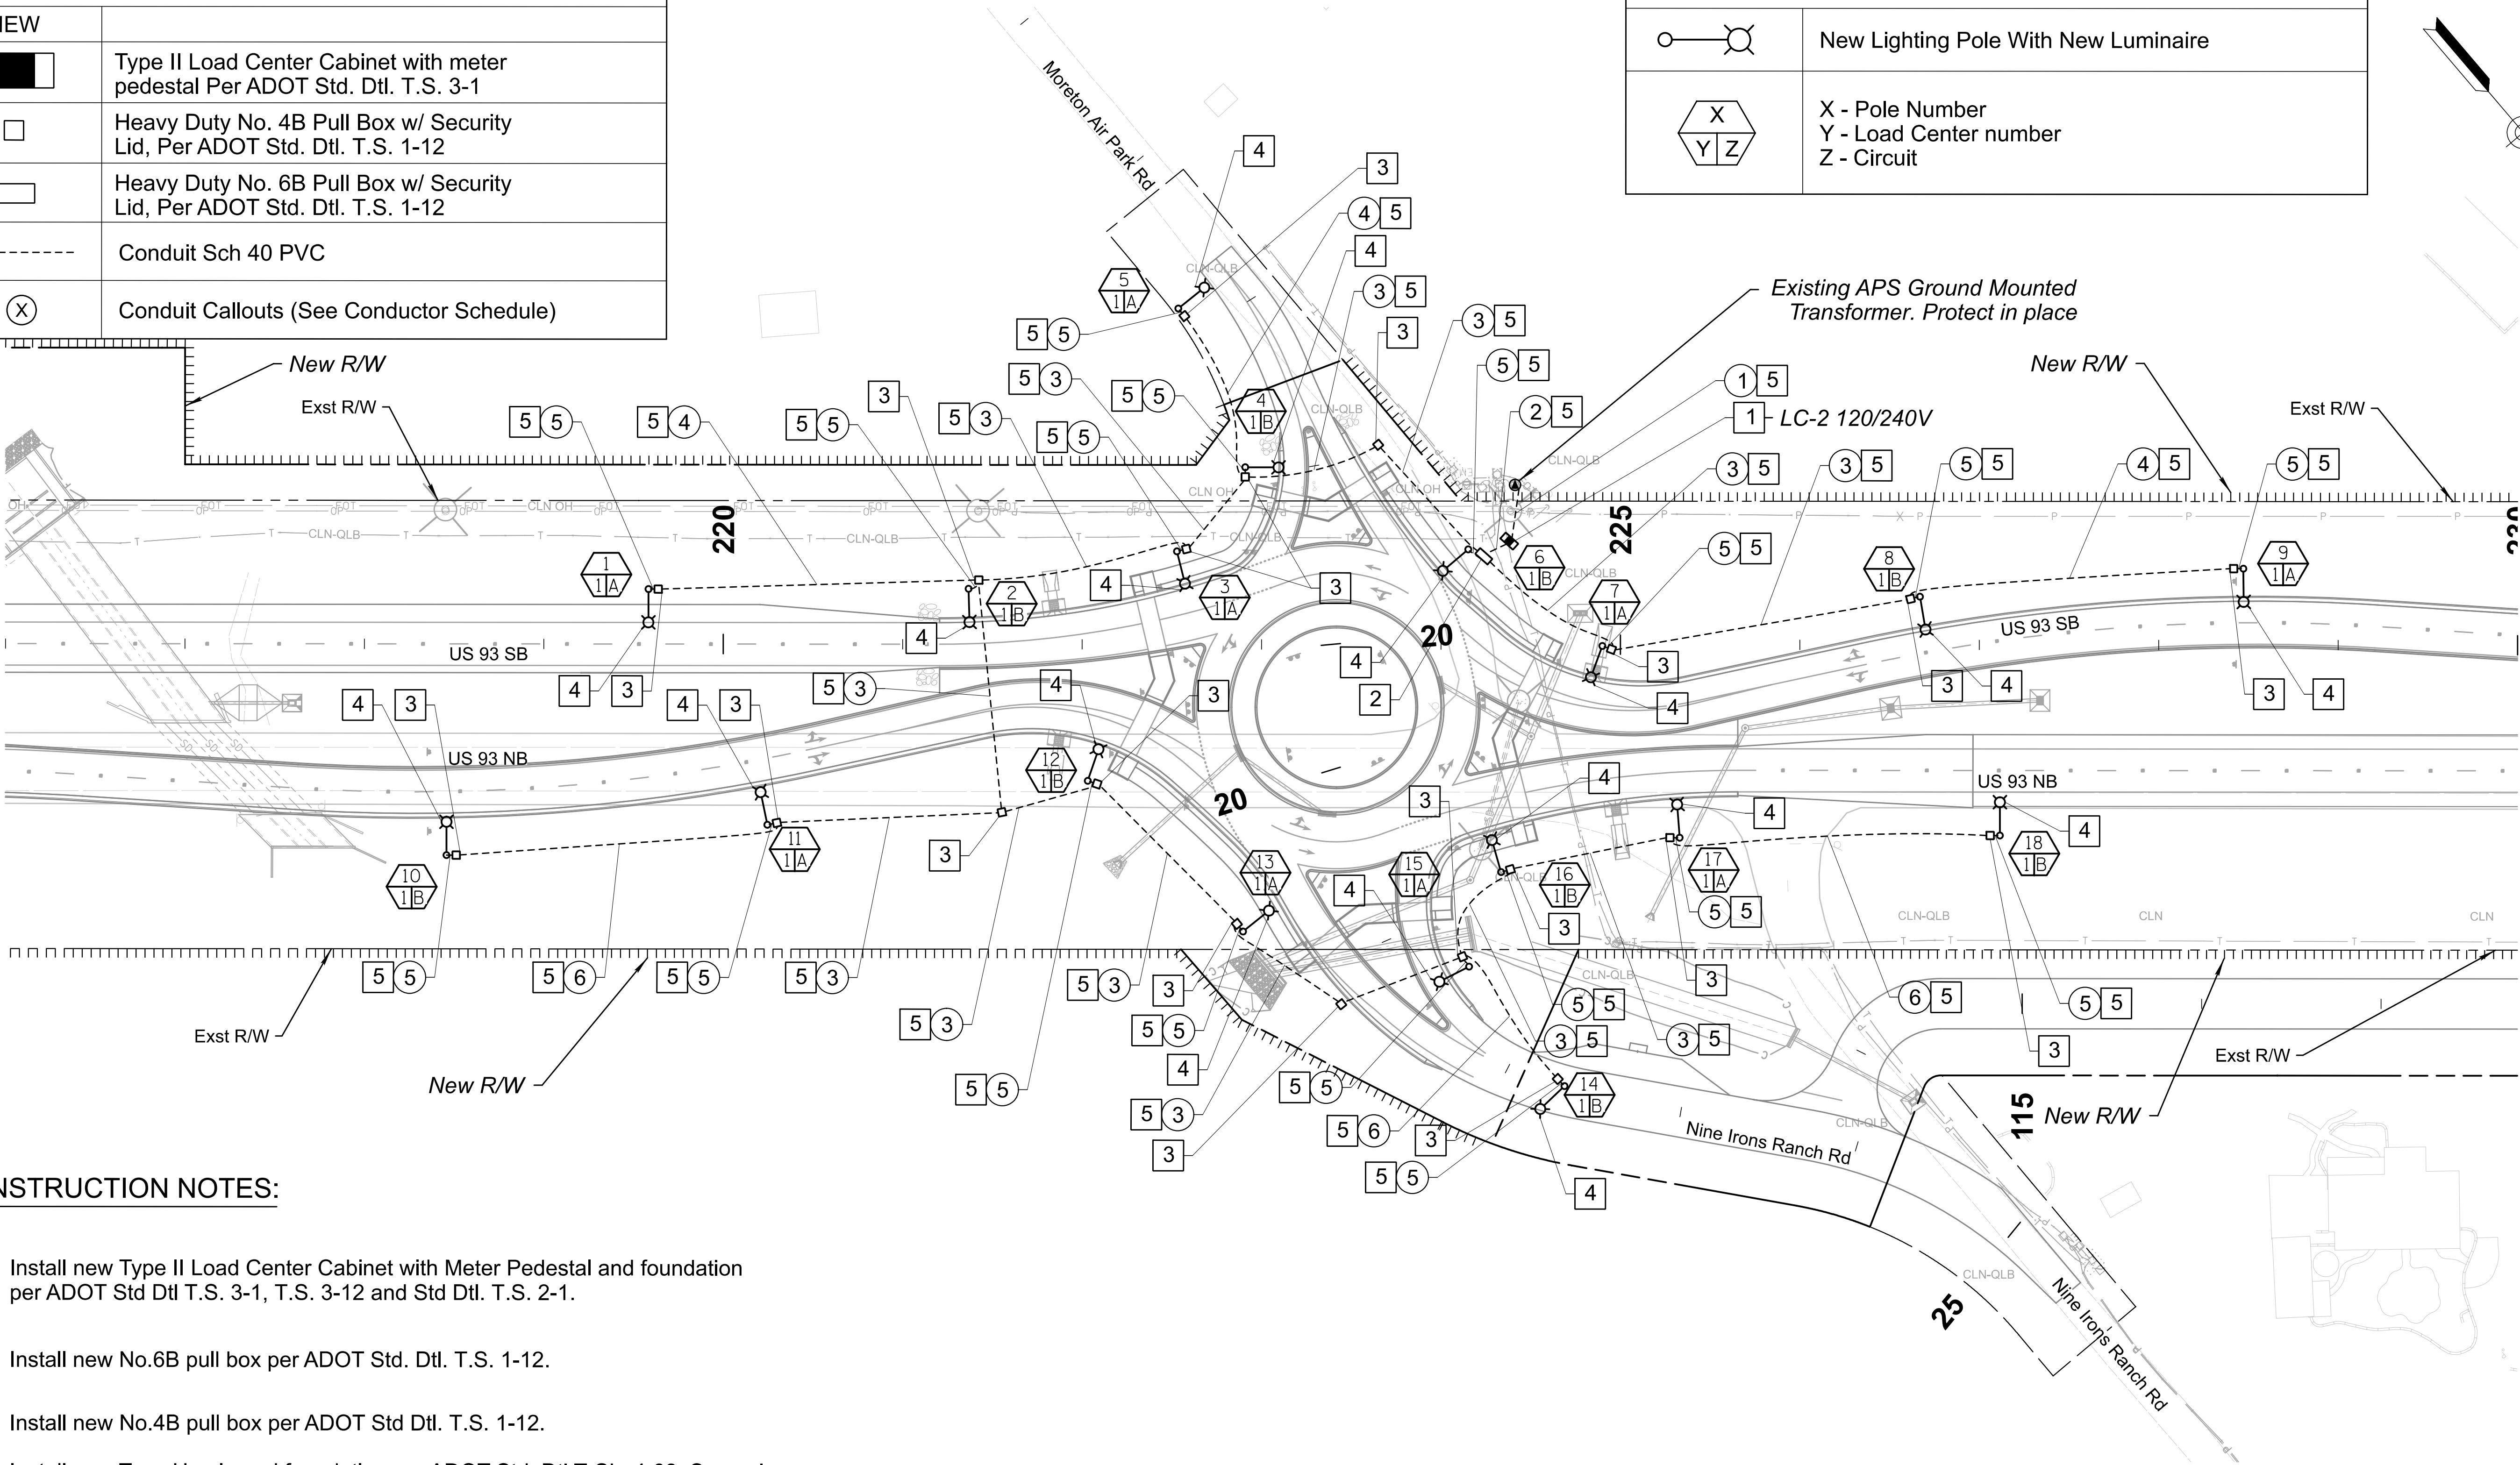

CONSTRUCTION NOTES:

- 1 Install new Type II Load Center Cabinet with Meter Pedestal and foundation per ADOT Std Dtl T.S. 3-1, T.S. 3-12 and Std Dtl. T.S. 2-1.
- 2 Install new No.6B pull box per ADOT Std. Dtl. T.S. 1-12.
- 3 Install new No.4B pull box per ADOT Std Dtl. T.S. 1-12.
- 4 Install new Type H pole and foundation per ADOT Std. Dtl T-SL. 4-09. See pole schedule for breakaway base and foundation.
- 5 Trench conduit per ADOT Std. Dtl. T.S. 1-5. See Plan and Schedule for more information



	NAME	DATE
DESIGN	G S RAI	06/26
DRAWN	G S RAI	06/26
CHECKED	I YORDANOV	06/26

TRANSPORTATION
AECOM TECHNICAL SERVICES, INC.
7720 N. 168th St., Suite 100
Phoenix, Arizona 85020
T 602.371.1100
www.aecom.com

ARIZONA DEPARTMENT OF TRANSPORTATION PROJECT DELIVERY AND OPERATIONS DIVISION TRAFFIC DESIGN SERVICES	ROUTE US 93 MILEPOST 190.5 STRUCTURE NO.
PLAN SHEET SB US 93 STA 216+00 TO STA 230+00	

F.H.W.A. Arizona Division	STATE ARIZ.	PROJECT NO. 093 YV 190	FEDERAL ID NO. 093-B-NFA	SHEET NO. 418	TOTAL SHEETS 524	RECORD DRAWING
LOCATION US 93, MORETON RD & NINE IRONS RANCH RD						DWG No. T-8.06
TRACS NO. F0738 01C						OF

US93 HIGHWAY LIGHTING SERVICE
US 93 AND MORETON RD

LIST OF LUMINAIRES		
TYPE	WATTAGE	IES DISTRIBUTION
25L	160 - 200	Type III MEDIUM

Plan Designation	Interchange	New/Exst	Service Address	Maintenance Unit No.	Type
LC-2	US 93	New	20999 S US Highway 93		120/240V

LC - Load center cabinet Type II per ADOT Std. Dwg. T.S. 3-1

CONDUCTOR SCHEDULE
US 93 AND MORETON RD

Conduit run numbers (X)		1	2	3	4	5	6		
Conduit size in inches		2 1/2	2 1/2	2	2	1 1/2	2		
AWG		Number of wires							
# 10	New					2			
# 8	Lighting Circuit A		2	2	2				
	New insulated green bond		1	1	1	1	1		
# 6	Lighting Circuit B		2	2			2		
	New insulated green bond	1							
# 1	New service 120/240V	3							

LOAD CENTER TABLE

Load center No:				LC-2		
Load center location				MORETON RD & US 93, STA 224+38, 58' LT		
Meter pedestal type:				TYPE II (120/240V)		
Main circuit bkr:				100 A		
Circuit	Status	Voltage	Voltage drop	% Drop	Breaker	Load AMPS
A	NEW	240	6.14	2.56	20	8.1
B	NEW	240	4.76	1.98	20	8.1
Service amps						16.2
Additional 25% demand						4.05
Total AMPS						20.25
Power (VA)						4860

POLE AND LUMINAIRE SCHEDULE - US 93 AND MORETON RD

POLE NO.	ROADWAY	STATION	OFFSET	LOAD CENTER CABINET	CIRCUIT	POLE		FOUNDATION		LUMINAIRE	REMARKS	MAINTENANCE UNIT NO.
						TYPE	MAST ARM LENGTH	TYPE	BASE			
1	US 93	219+58	31' LT	LC-1	A	H - 40'	10'	B/A	B/A - 3	25L		
2	US 93	221+37	31' LT	LC-1	B	H - 40'	10'	B/A	B/A - 3	25L		
3	US 93	222+54	52' LT	LC-1	A	H - 40'	10'	B/A	B/A - 3	25L		
4	US 93	222+91	99' LT	LC-1	B	H - 40'	10'	B/A	B/A - 3	25L		
5	MORETON RD	17+80	35' RT	LC-1	A	H - 40'	10'	B/A	B/A - 3	25L		
6	US 93	224+15	54' LT	LC-1	B	H - 40'	10'	B/A	B/A - 3	25L		
7	US 93	224+90	1' RT	LC-1	A	H - 40'	10'	B/A	B/A - 3	25L		
8	US 93	226+67	27' LT	LC-1	B	H - 40'	10'	B/A	B/A - 3	25L		
9	US 93	228+47	43' LT	LC-1	A	H - 40'	10'	B/A	B/A - 3	25L		
10	US 93	218+46	118' RT	LC-1	B	H - 40'	10'	B/A	B/A - 3	25L		
11	US 93	220+24	101' RT	LC-1	A	H - 40'	10'	B/A	B/A - 3	25L		
12	US 93	222+03	76' RT	LC-1	B	H - 40'	10'	B/A	B/A - 3	25L		
13	US 93	222+90	160' RT	LC-1	A	H - 40'	10'	B/A	B/A - 3	25L		
14	NINE IRONS RANCH RD	22+27	26' LT	LC-1	B	H - 40'	10'	B/A	B/A - 3	25L		
15	NINE IRONS RANCH RD	21+20	29' LT	LC-1	A	H - 40'	10'	B/A	B/A - 3	25L		
16	US 93	224+33	127' RT	LC-1	B	H - 40'	10'	B/A	B/A - 3	25L		
17	US 93	225+33	108' RT	LC-1	A	H - 40'	10'	B/A	B/A - 3	25L		
18	US 93	227+11	106' RT	LC-1	B	H - 40'	10'	B/A	B/A - 3	25L		

POLE AND LUMINAIRE LEGEND:

- H - Type H Pole per ADOT Std. Dwg. T-SL 4.09
- B/A - Type H Pole Foundation with bolt circle to match Type 3 Breakaway Base
- B/A-3 - Type 3 Breakaway Base per ADOT Std. Dwg. T.S. 5-2
- 25L - Horizontal Mount LED Luminaire - Refer to ADOT Approved Products List and Specifications



DESIGN	G S RAI	06/26
DRAWN	G S RAI	06/26
CHECKED	I YORDANOV	06/26

TRANSPORTATION
AECOM TECHNICAL SERVICES, Inc.
7720 N. 16th St., Suite 100
Phoenix, Arizona 85021
T 602.371.1100



ARIZONA DEPARTMENT OF TRANSPORTATION
PROJECT DELIVERY AND OPERATIONS DIVISION
TRAFFIC DESIGN SERVICES

LIGHTING LOAD CENTER TABLES
AND
CONDUCTOR AND LUMINAIRE SCHEDULE

ROUTE
US 93

MILEPOST
190.5

STRUCTURE NO.

F.H.W.A. Arizona Division

STATE
ARIZ.

PROJECT NO.
093 YV 190

FEDERAL ID NO.
093-B-NFA

SHEET NO.
419

TOTAL SHEETS
524


RECORD DRAWING

LOCATION
US 93, MORETON RD & NINE IRONS RANCH RD

TRACS NO. F0738 01C



DWG No. T-8.07
____ OF ____

KINGMAN-WICKENBURG HWY (US93)
SB BNSF OVERPASS
YAVAPAI COUNTY

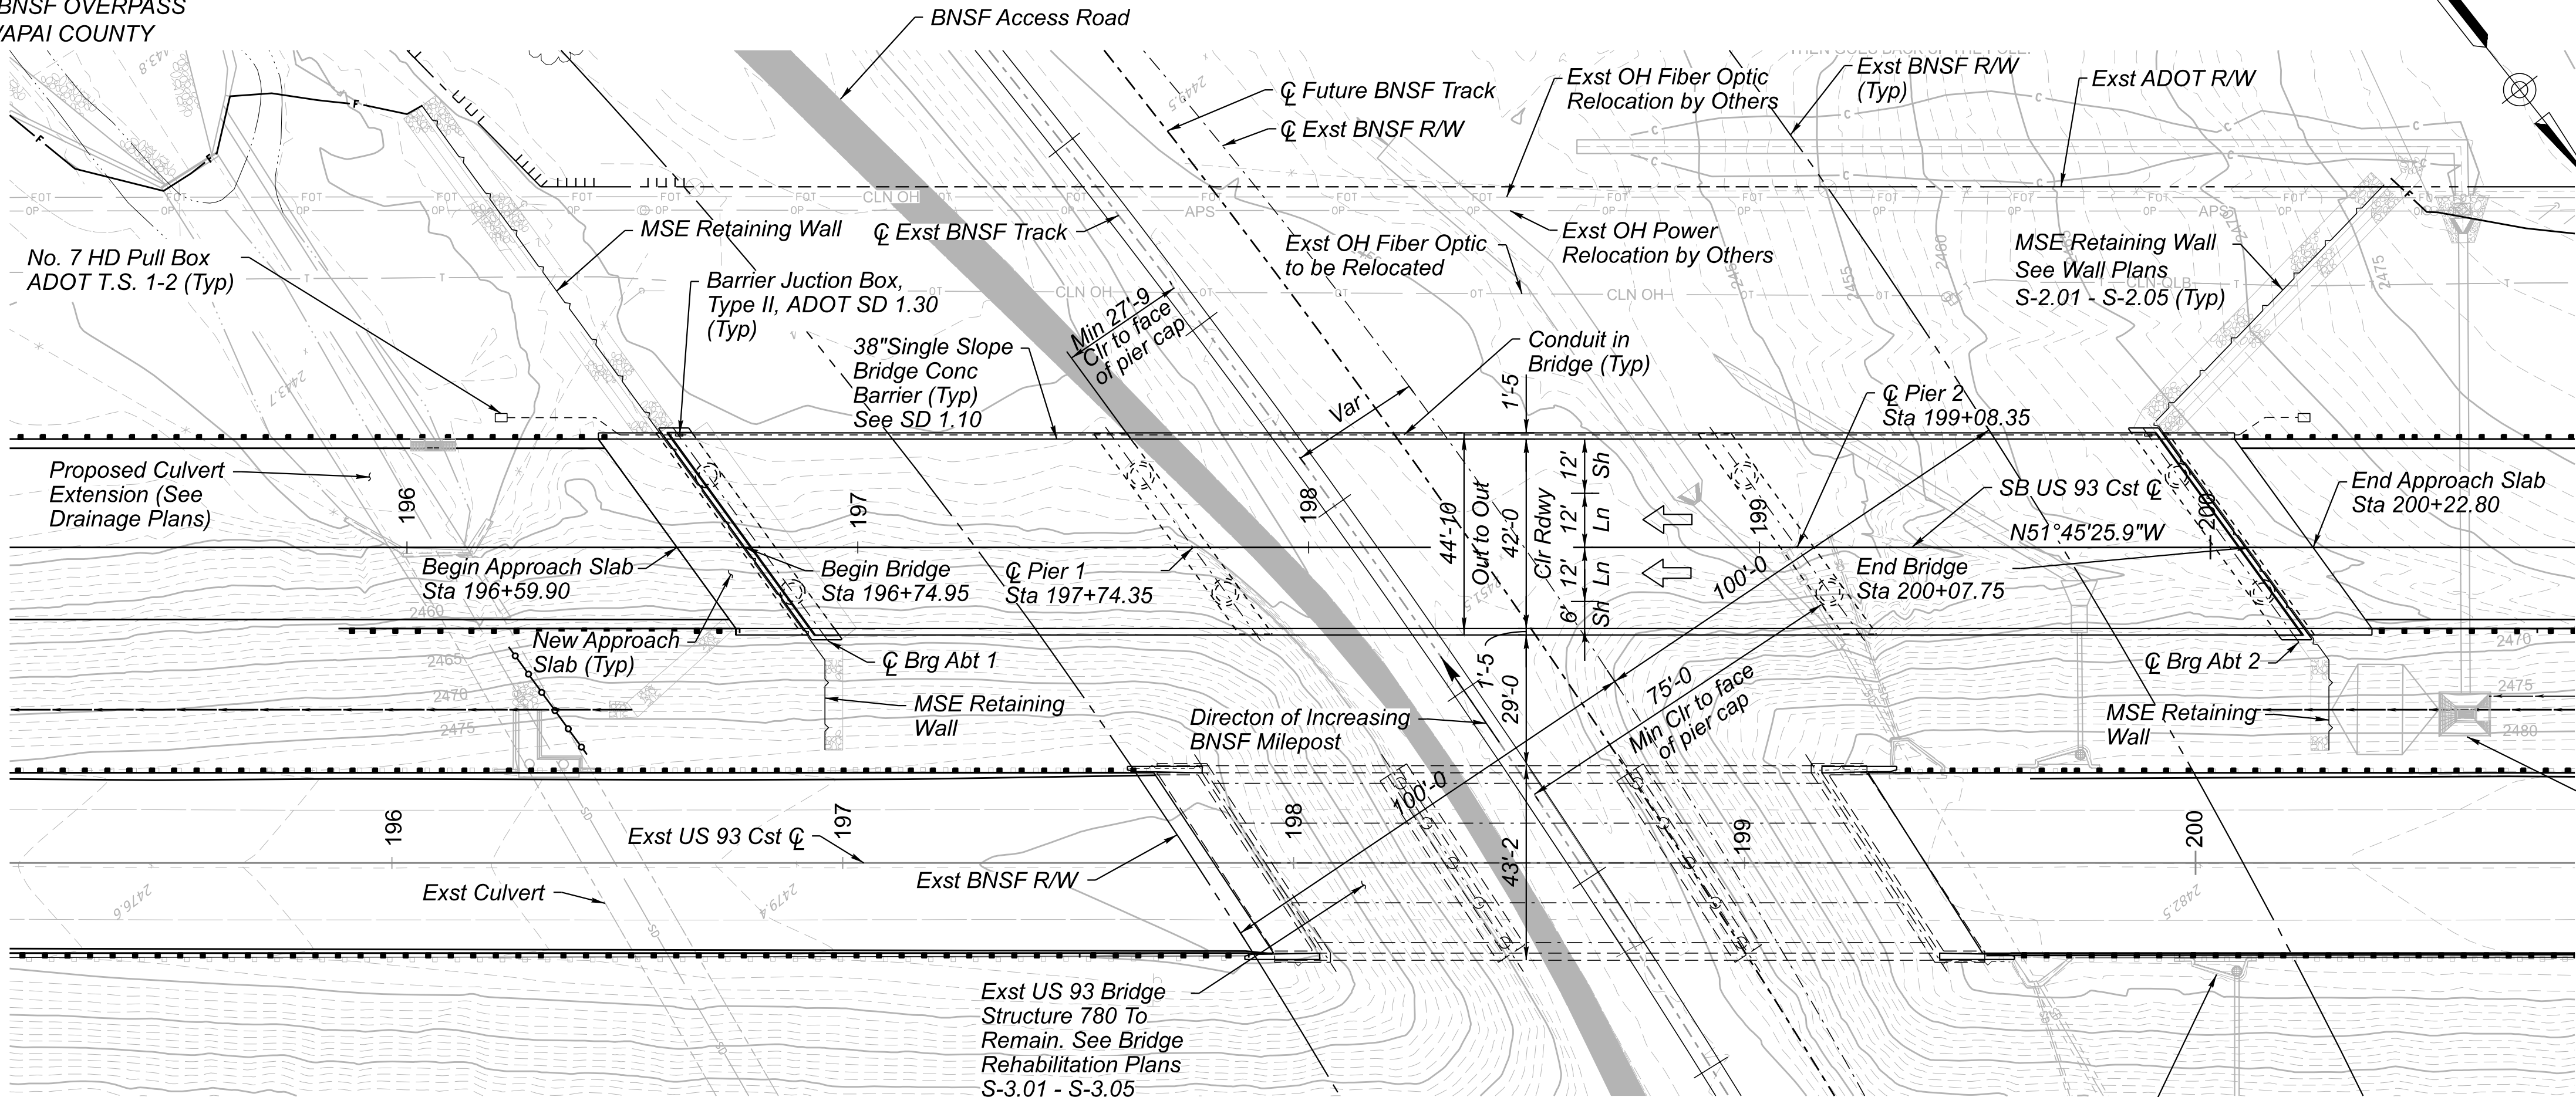

INDEX OF SHEETS

S-1.01	General Plan & Elevation
S-1.02	General Notes, Typical Section & Quantities
S-1.03	BNSF General Notes For Overhead Structures
S-1.04	Foundation Layout
S-1.05	Drilled Shaft Details
S-1.06	Abutment 1 Plan & Elevation
S-1.07	Abutment 2 Plan & Elevation
S-1.08	Abutment Details (1 of 2)
S-1.09	Abutment Details (2 of 2)
S-1.10	Pier Plan & Elevation
S-1.11	Pier Details
S-1.12	Restrainer & Bearing Pad Details
S-1.13	Girder Details (1 of 4)
S-1.14	Girder Details (2 of 4)
S-1.15	Girder Details (3 of 4)
S-1.16	Girder Details (4 of 4)
S-1.17	Framing Plan
S-1.18	Deck Details
S-1.19	Abutment Diaphragm Details
S-1.20	Pier Diaphragm Details
S-1.21	Intermediate Diaphragm Details
S-1.22	Fence Details
S-1.23	Miscellaneous Details
S-1.24	Screed Elevations

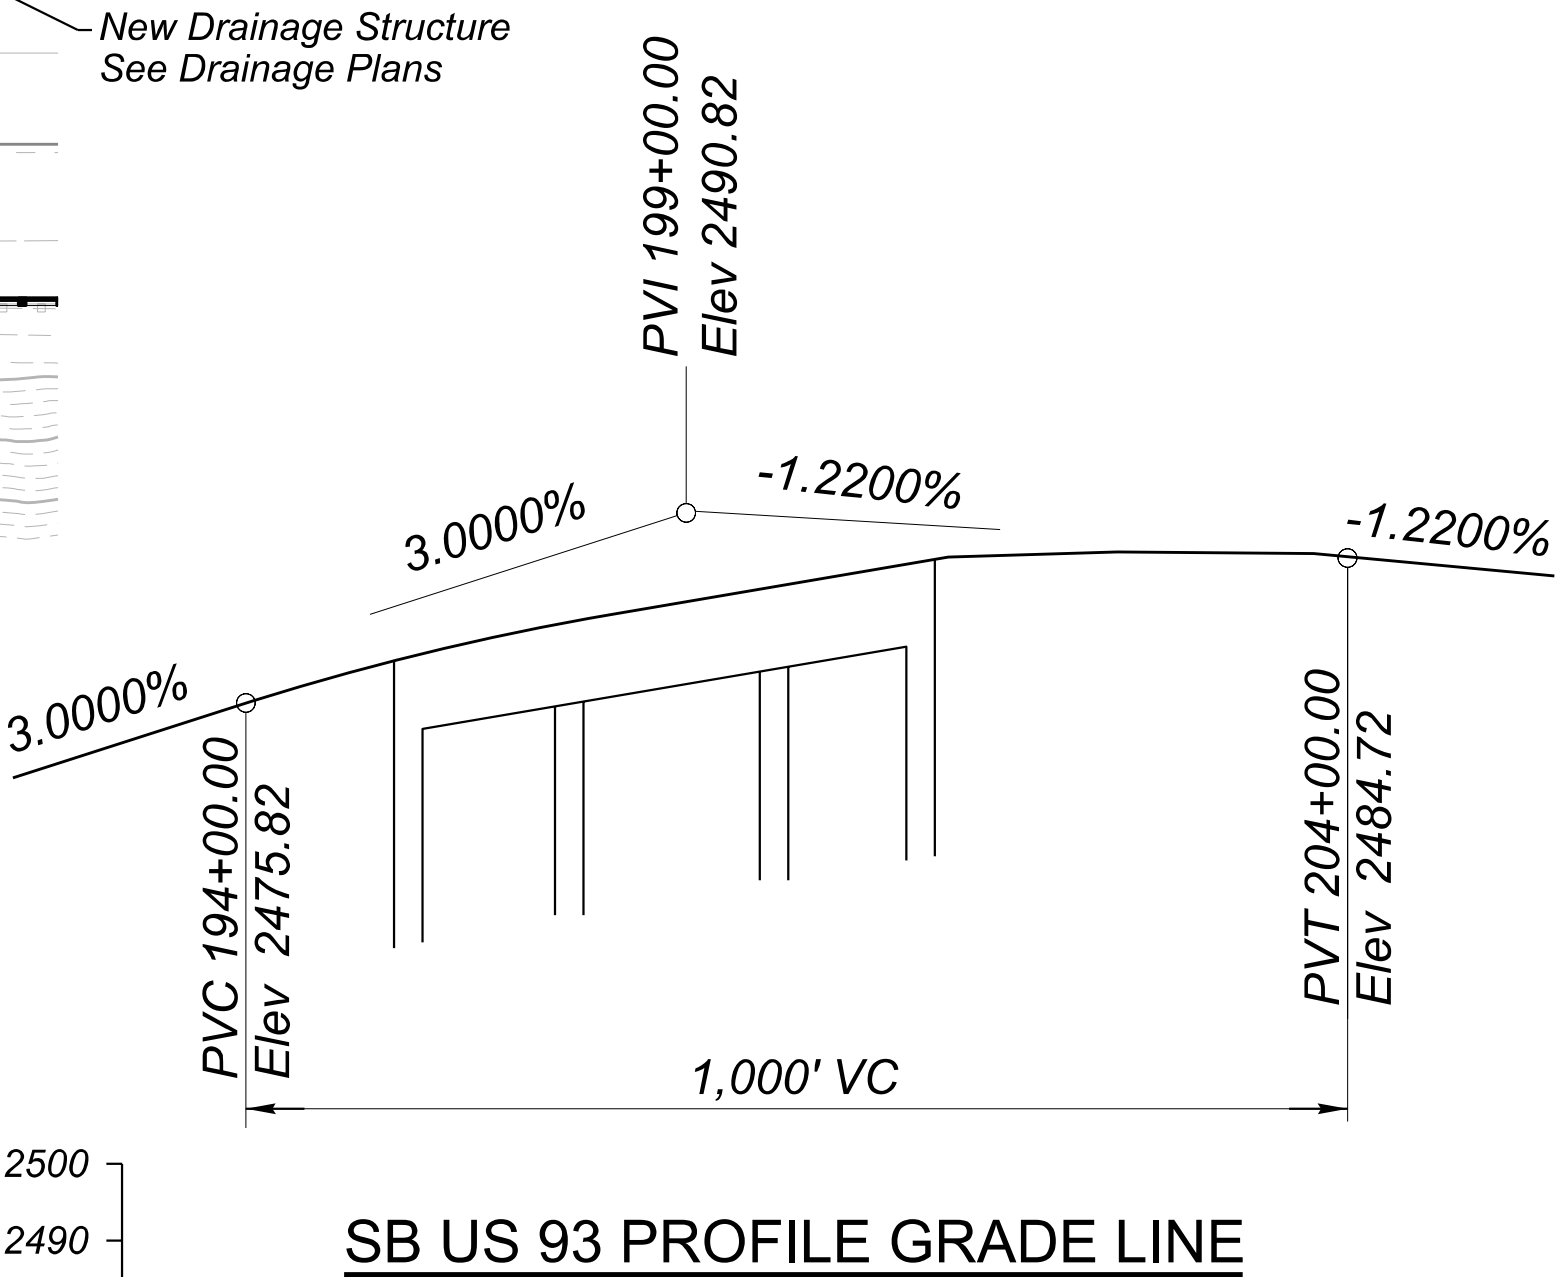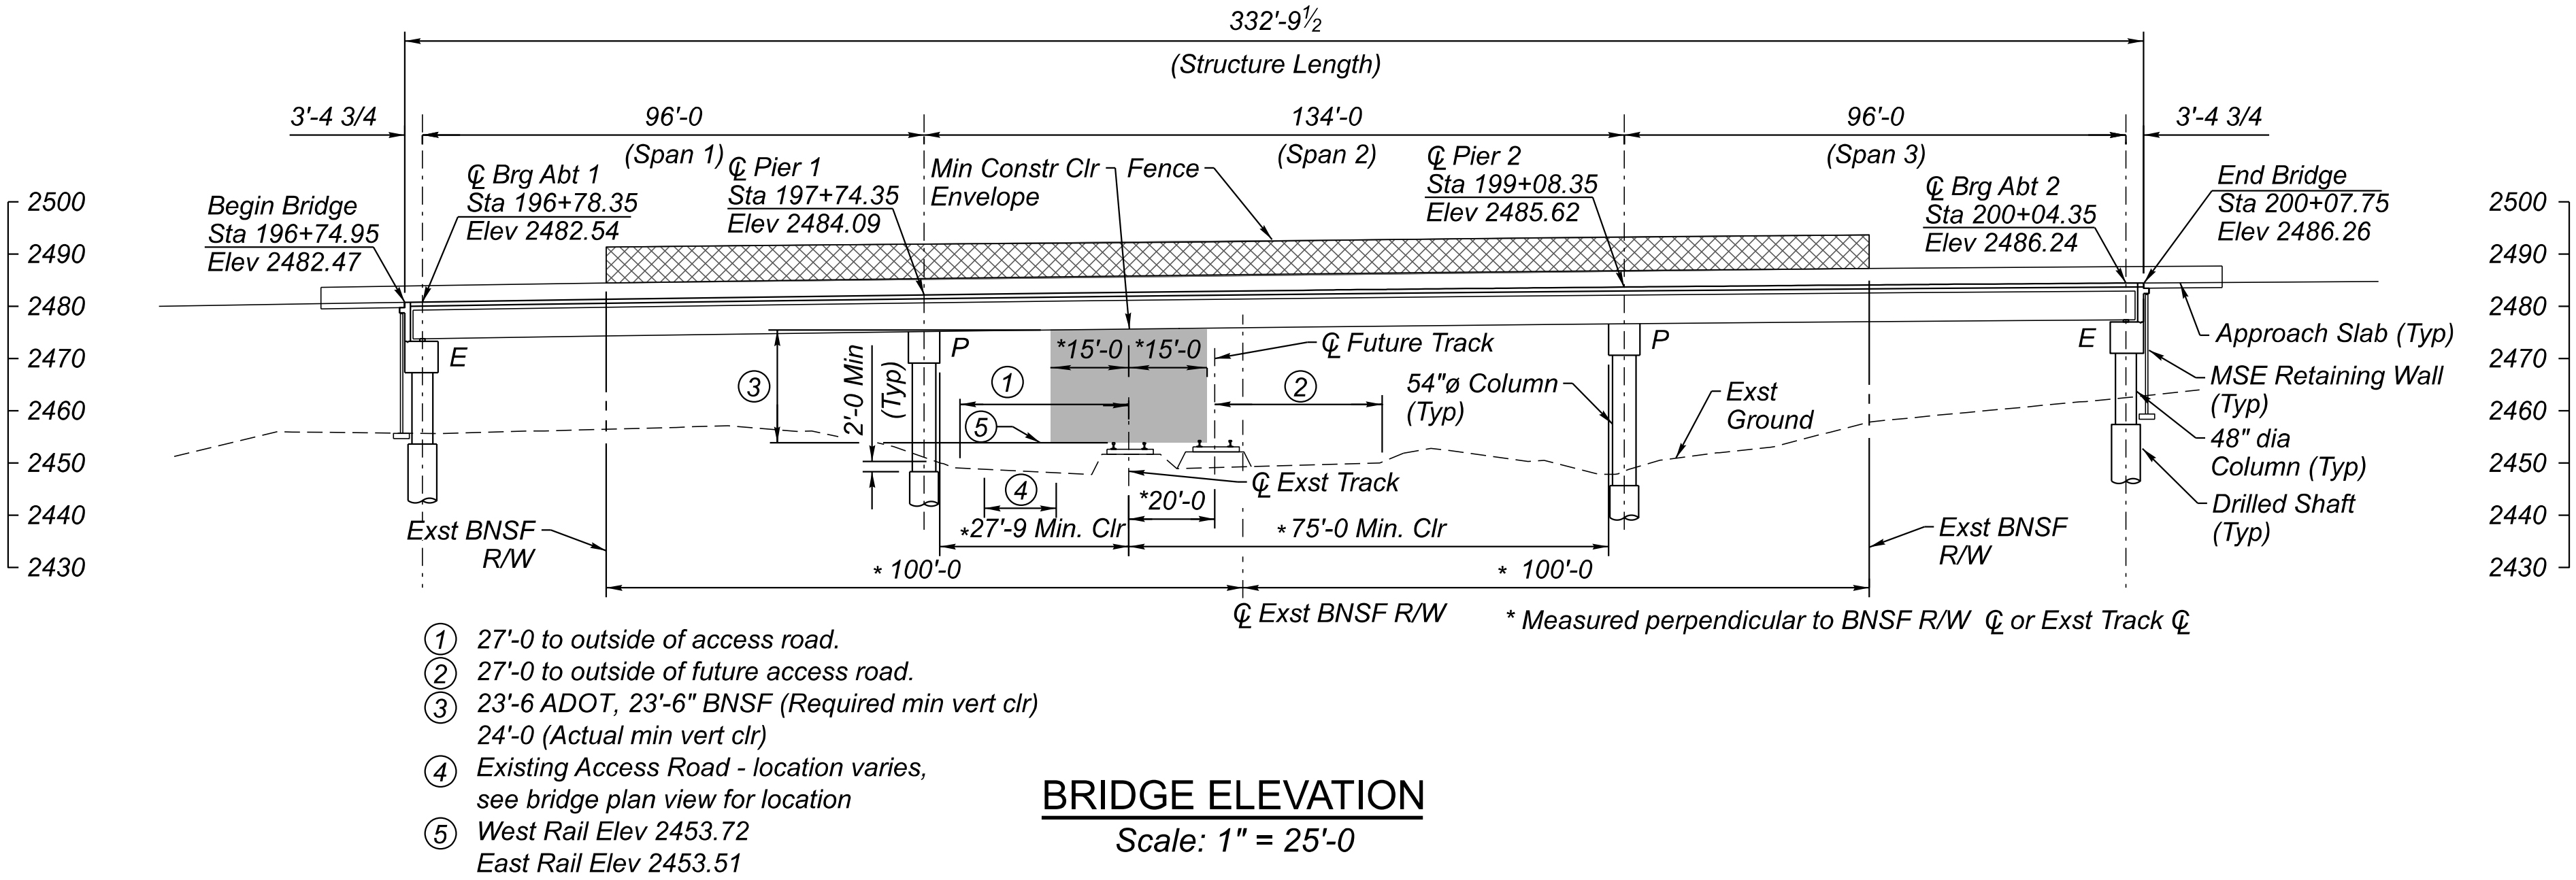

	NAME	DATE
DESIGN	M. Noche	06/26
DRAWN	G. Zenuch	06/26
CHECKED	B. Ansley	06/26

TRANSPORTATION
AECOM TECHNICAL SERVICES, Inc.
7720 N. 16th St., Suite 100
Phoenix, Arizona 85020
T 602.371.1100
www.aecom.com


AECOM

ARIZONA DEPARTMENT OF TRANSPORTATION INFRASTRUCTURE DELIVERY AND OPERATIONS DIVISION BRIDGE GROUP	ROUTE US 93 MILEPOST 192.90 STRUCTURE NO. 20313
US 93 SB BNSF OP BRIDGE GENERAL PLAN AND ELEVATION	

F.H.W.A. Arizona Division	STATE ARIZ.	PROJECT NO. 093 YV 189	FEDERAL ID NO. 093-B-(230)T	SHEET NO. 420	TOTAL SHEETS 524	RECORD DRAWING
LOCATION WICKENBURG RANCH WAY TO VISTA ROYALE						DWG No. S-1.01
TRACS NO. F0738 01C						OF


BNSF GENERAL NOTES FOR OVERHEAD STRUCTURES:

1. Refer to Subsection 104.07 of the Specifications and the Special Provisions for Bid Item 9240012 for additional requirements.

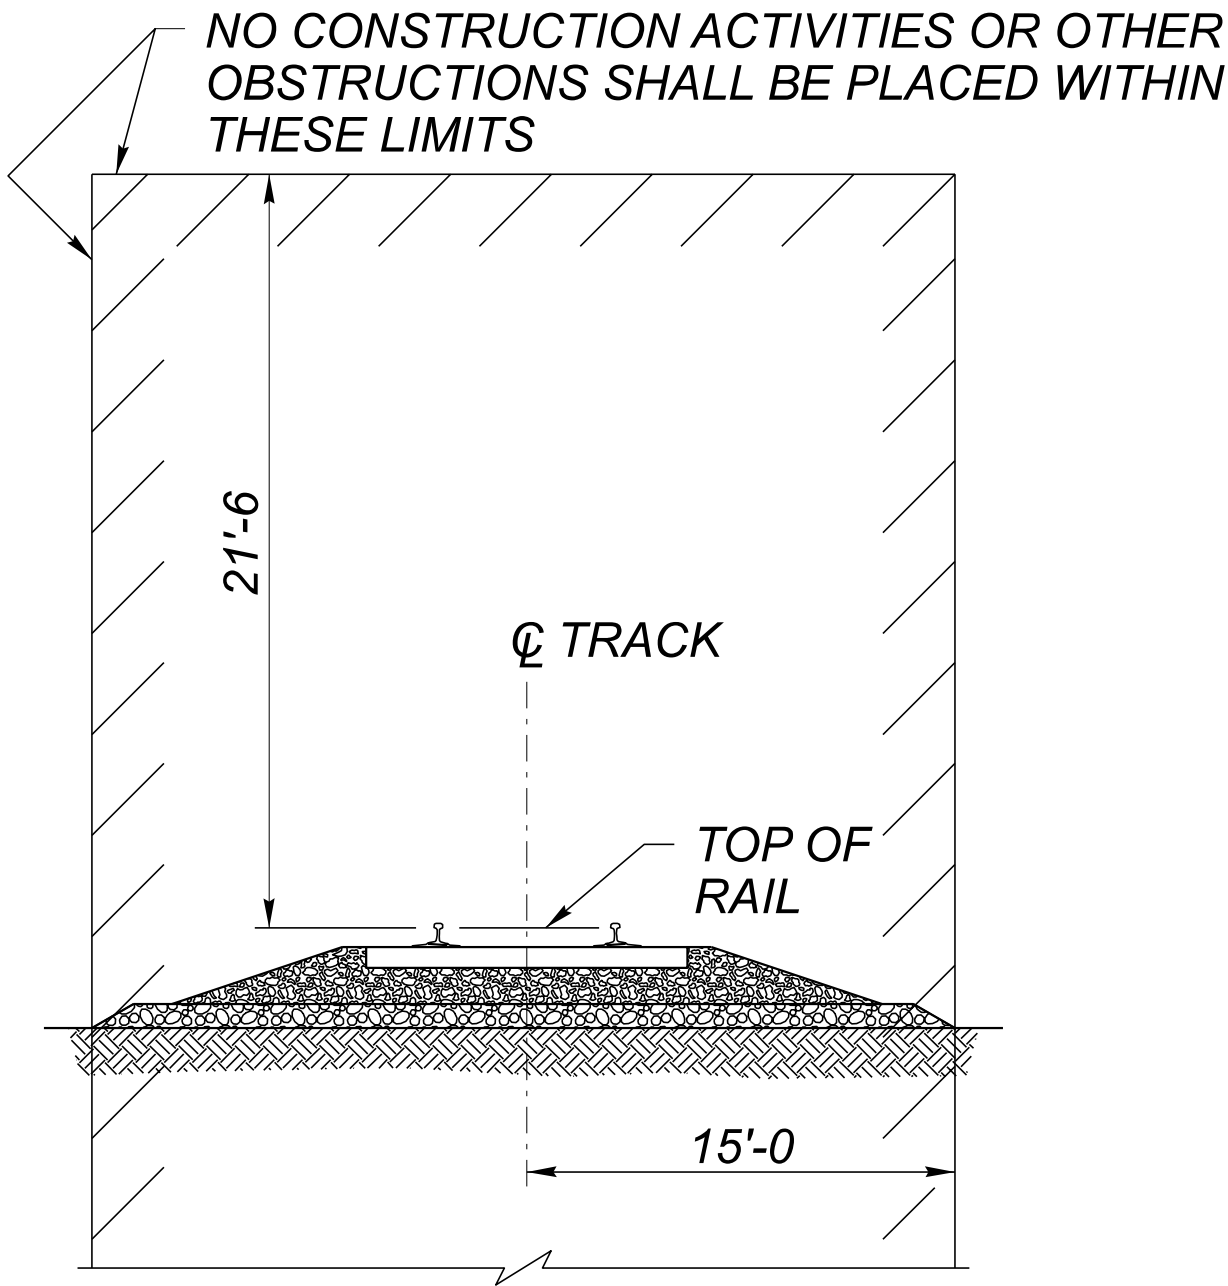

MINIMUM CONSTRUCTION CLEARANCE ENVELOPE
(NORMAL TO RAILROAD)

Professional Engineer 80073 MAXIME NOCHE DOMINGANG 06/26/2026 TRANSPORTATION AECOM TECHNICAL SERVICES, Inc. 7720 N. 16th St., Suite 100 Phoenix, Arizona 85020 T 602.371.1100 www.aecom.com AECOM www.aecom.com	DESIGN	M. Noche	06/26	ARIZONA DEPARTMENT OF TRANSPORTATION INFRASTRUCTURE DELIVERY AND OPERATIONS DIVISION BRIDGE GROUP US 93 SB BNSF OP BRIDGE BNSF GENERAL NOTES FOR OVERHEAD STRUCTURES	ROUTE	F.H.W.A. Arizona Division	STATE	PROJECT NO.	FEDERAL ID NO.	SHEET NO.	TOTAL SHEETS	RECORD DRAWING
	DRAWN	G. Zenuch	06/26		MILEPOST		093 YV 189	093-B-(230)T	422	524		
	CHECKED	B. Ansley	06/26		STRUCTURE NO.		WICKENBURG RANCH WAY TO VISTA ROYALE			DWG No. S-1.03		
					TRACS NO. F0738 01C		____ OF ____					

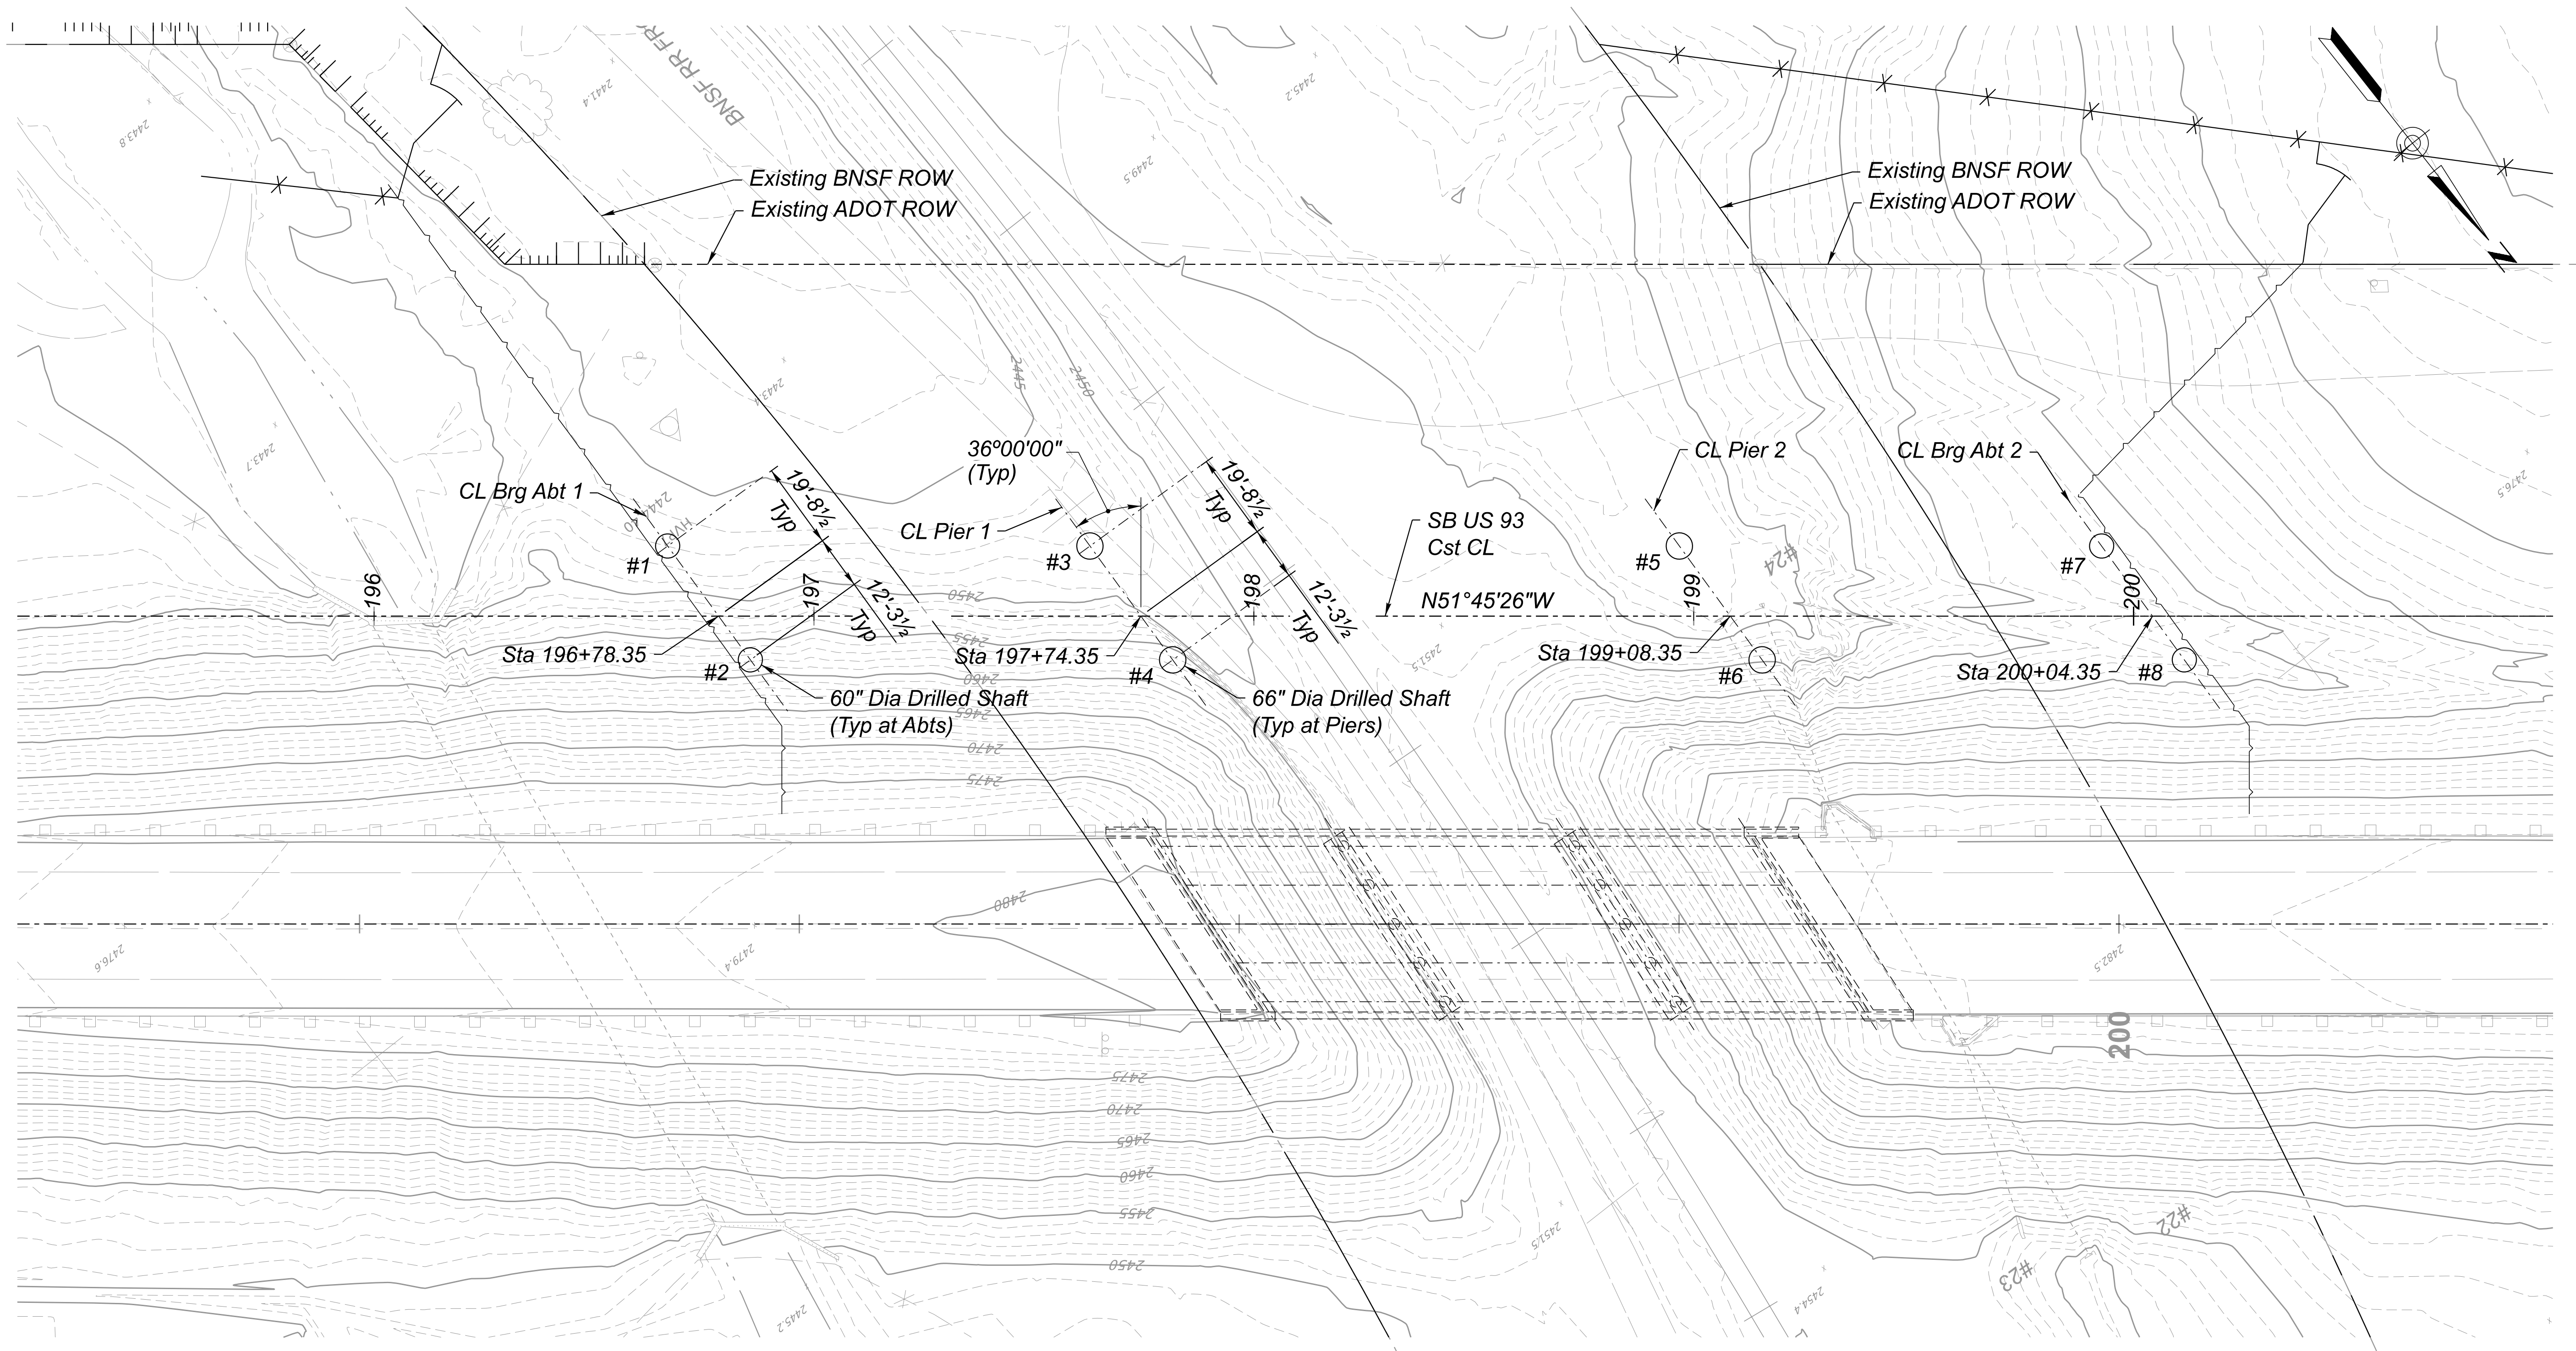

FOUNDATION NOTES:



- 1. Information pertaining to the soil & site conditions can be obtained from the Final Geotechnical Report (dated 12/17/2025) by ADOT Geotechnical Services. It is the responsibility of the contractor to review the Final Geotechnical Report.
- 2. Contour interval = 1 ft.
- 3. Contours are based on field survey by ADOT in August 2024.

FOUNDATION PLAN

Scale: 1" = 20'-0

THE LOCATION OF ALL UTILITIES IS APPROXIMATE ONLY. LOCATIONS SHOWN REFLECT THE FINDINGS OF THE LATEST AVAILABLE MAPPING.

	NAME		DATE	ARIZONA DEPARTMENT OF TRANSPORTATION INFRASTRUCTURE DELIVERY AND OPERATIONS DIVISION BRIDGE GROUP	ROUTE	F.H.W.A. Arizona Division	STATE ARIZ.	PROJECT NO.	FEDERAL ID NO.	SHEET NO.	TOTAL SHEETS	RECORD DRAWING
	DESIGN	M. Noche	06/26		US 93			093 YV 189	093-B-(230)T	423	524	
	DRAWN	G. Zenuch	06/26									
	CHECKED	B. Ansley	06/26									
	TRANSPORTATION AECOM TECHNICAL SERVICES, Inc. 7720 N. 16th St., Suite 100 Phoenix, Arizona 85020 T 602.371.1100			US 93 SB BNSF OP BRIDGE FOUNDATION LAYOUT	MILEPOST 192.90	LOCATION WICKENBURG RANCH WAY TO VISTA ROYALE						DWG No. S-1.04
	AECOM www.aecom.com				STRUCTURE NO. 20313	TRACS NO. F0738 01C						OF


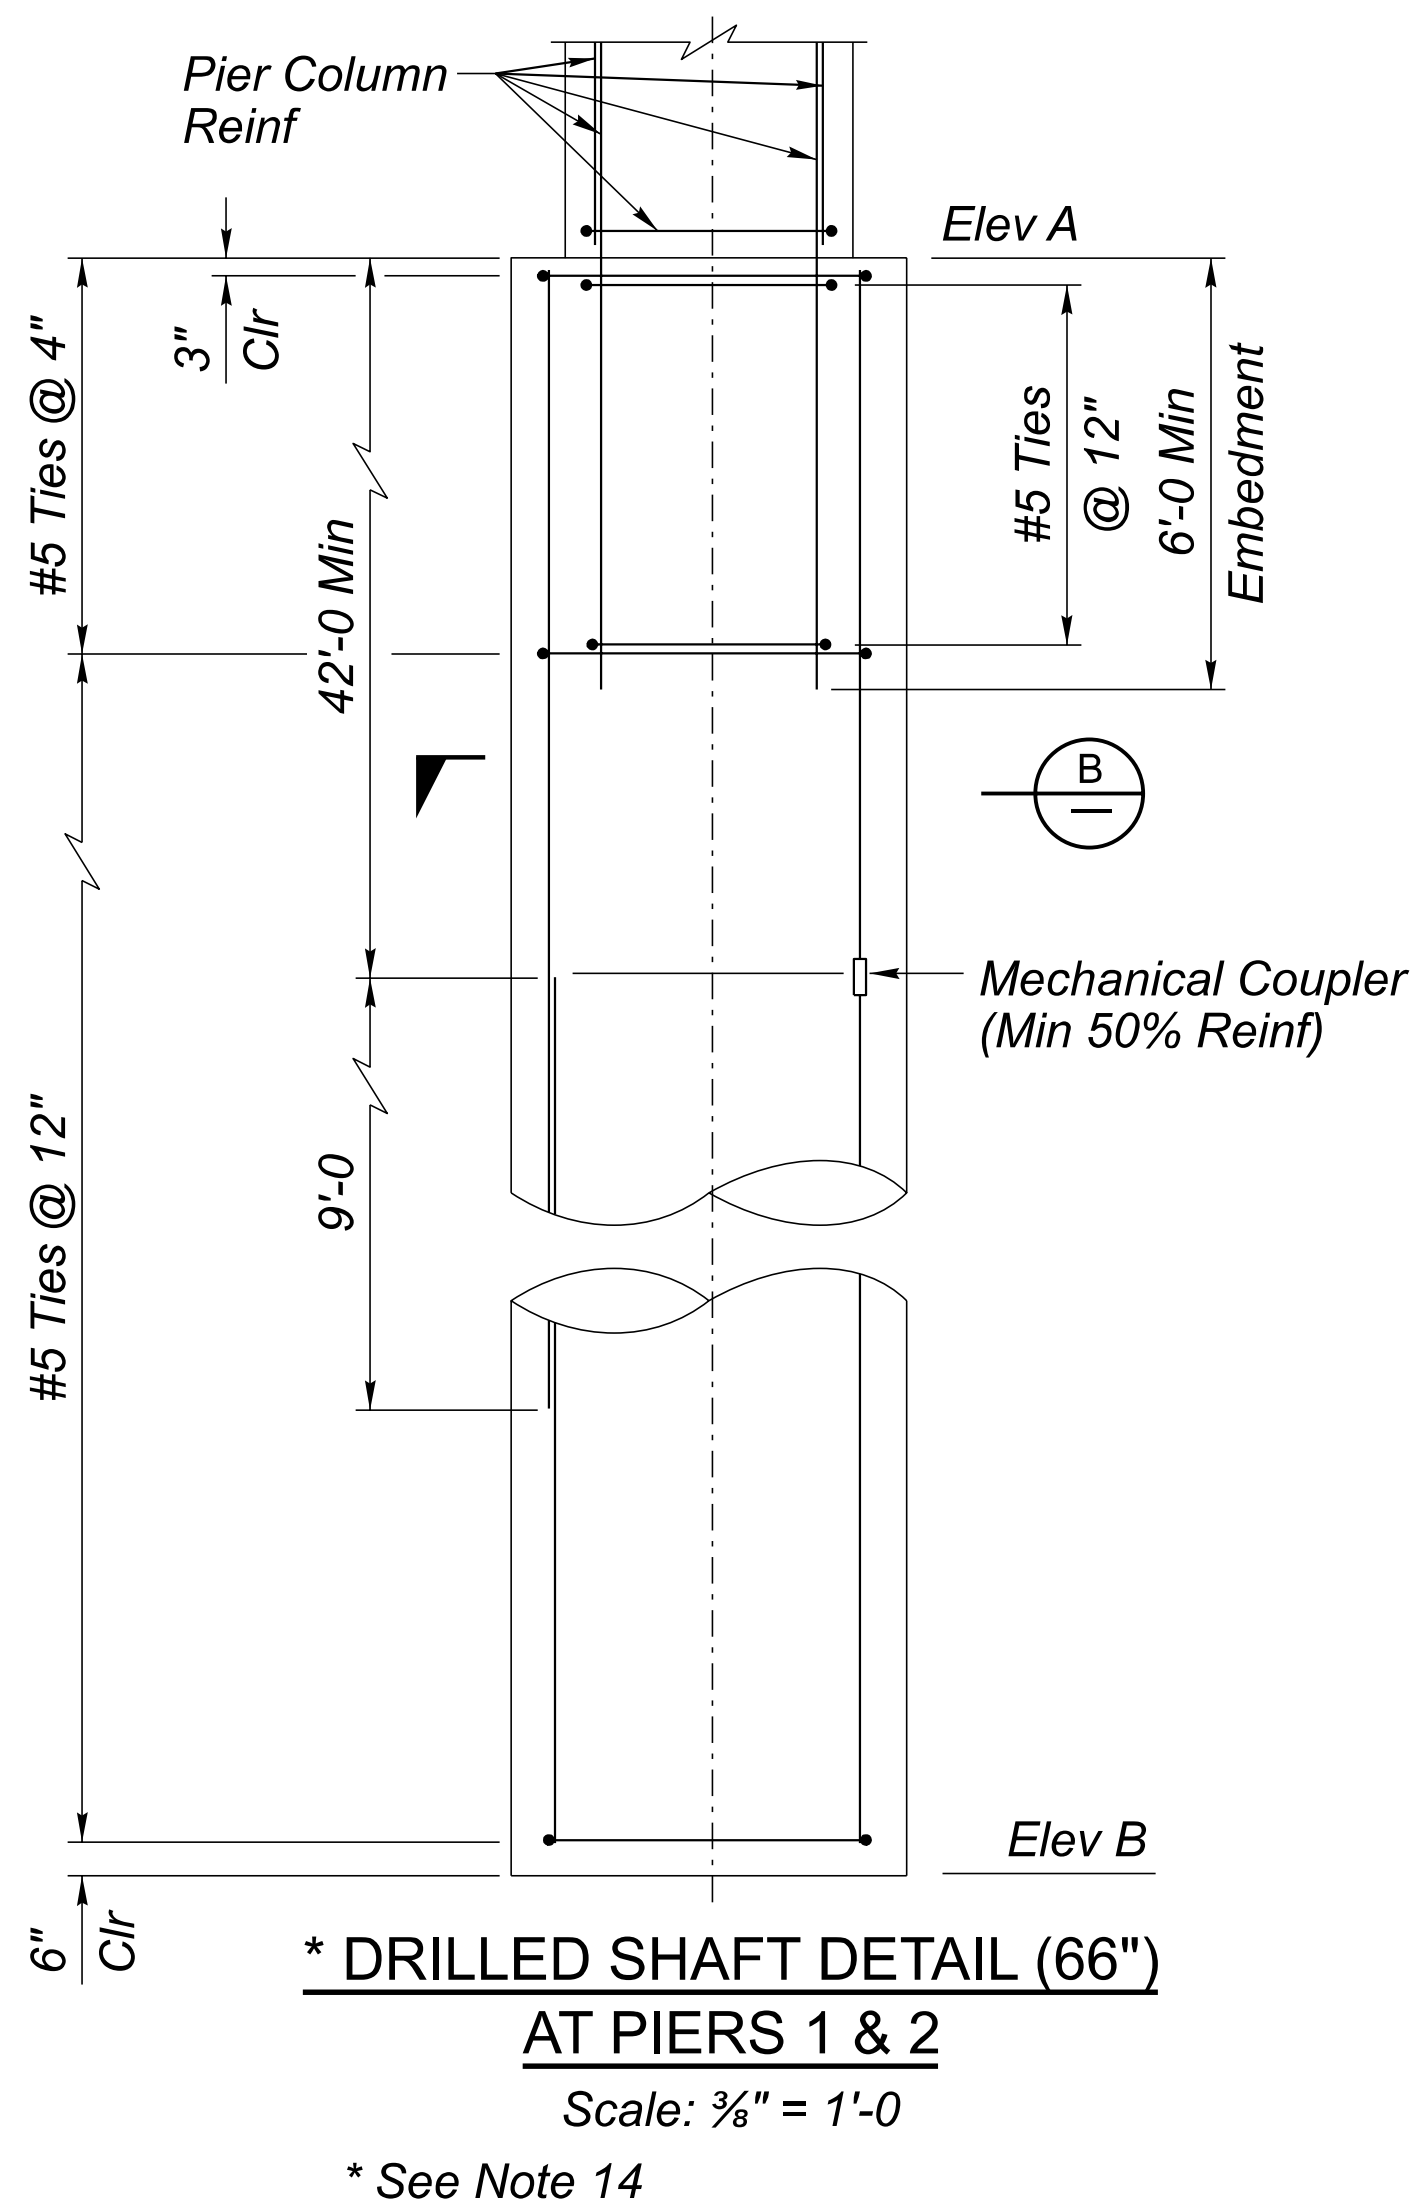
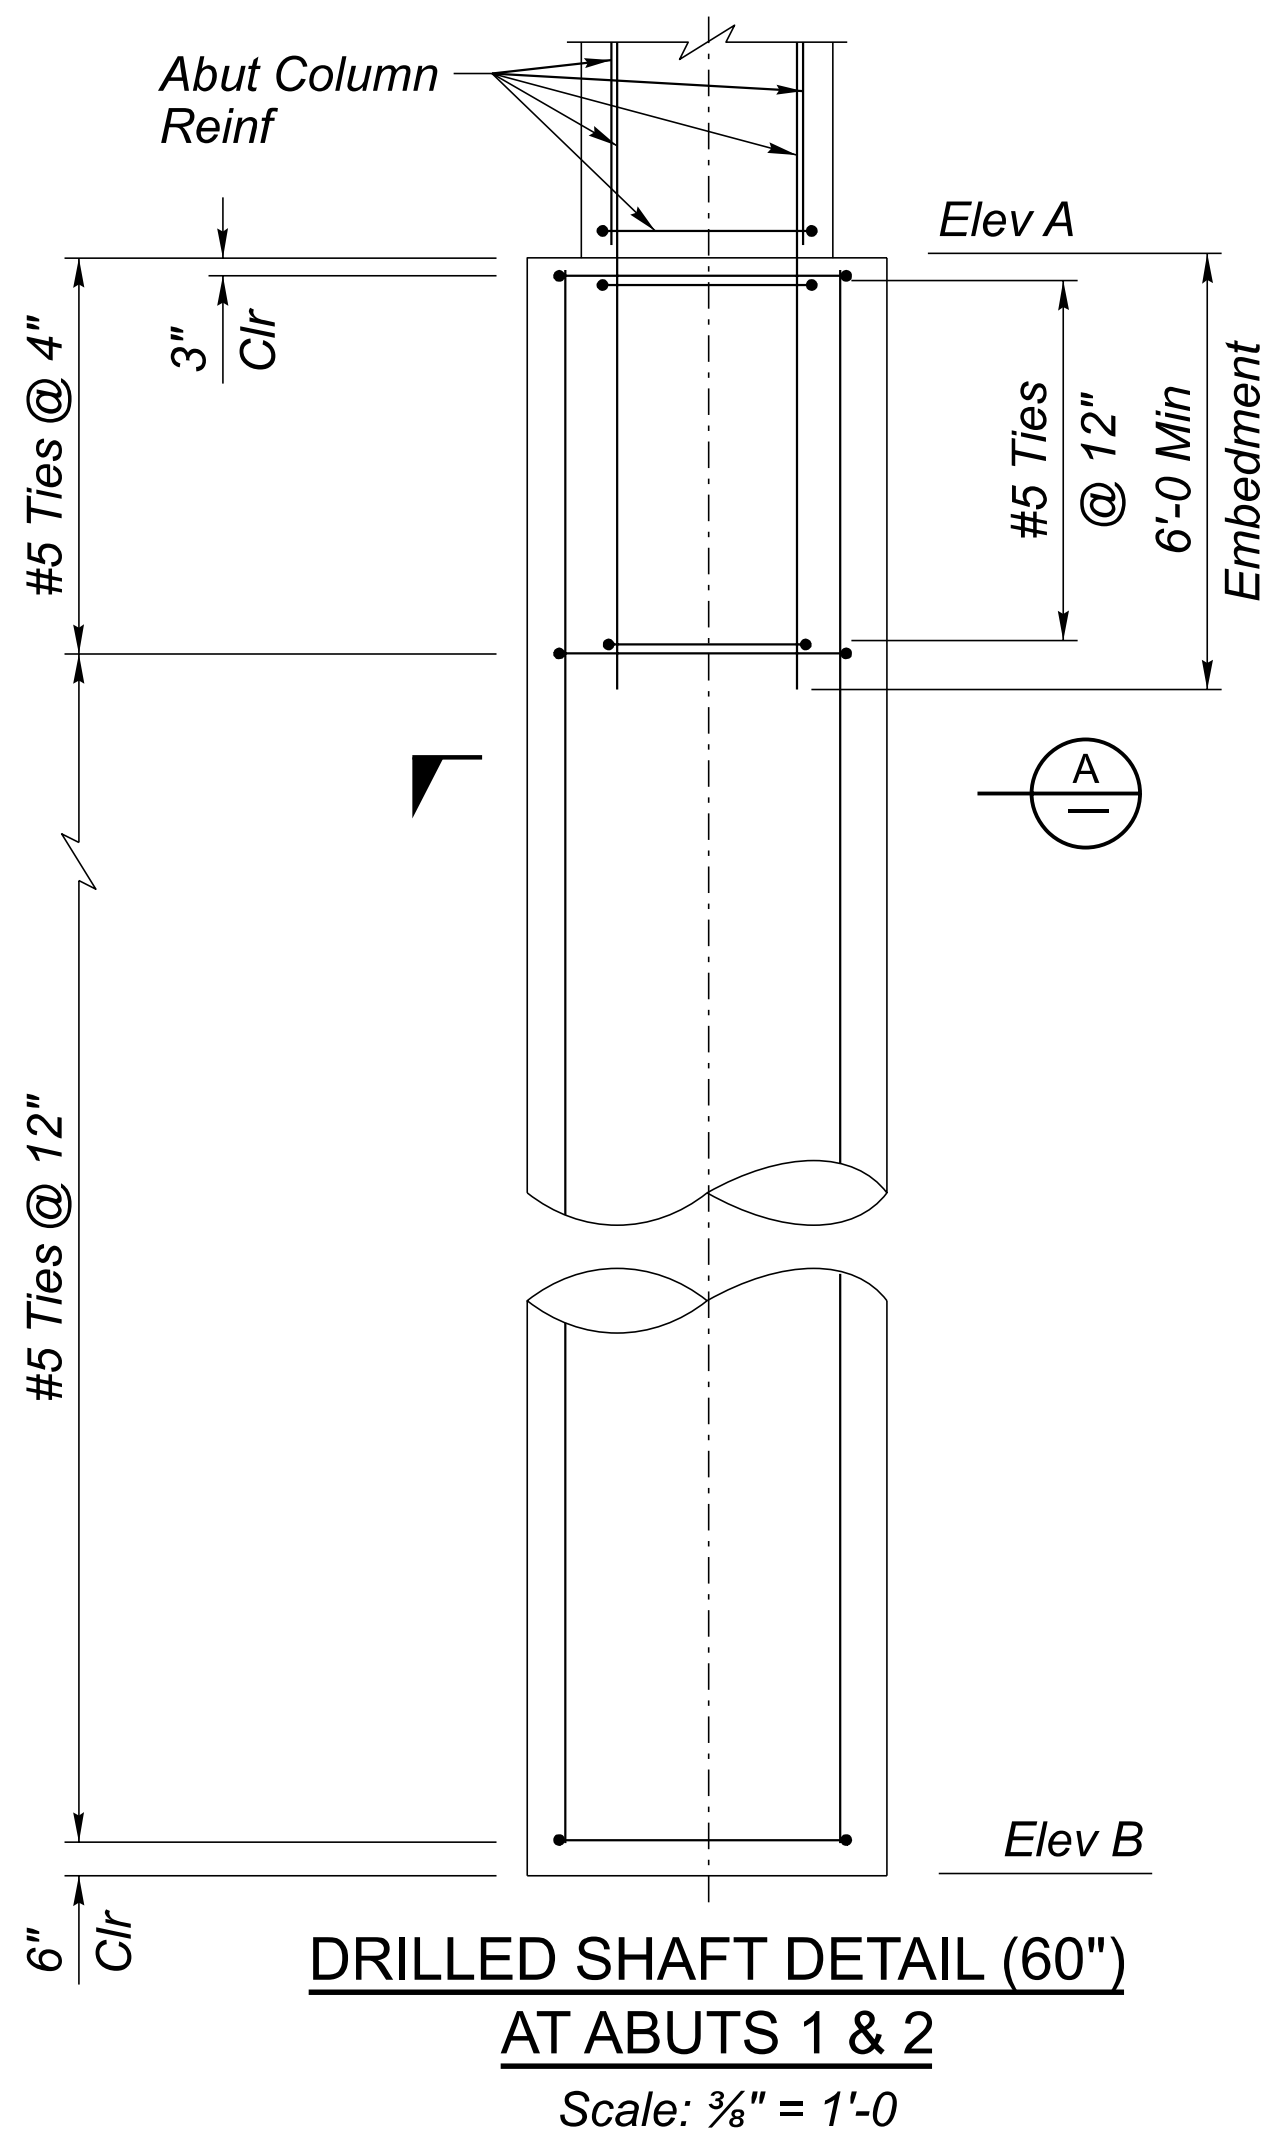


DRILLED SHAFT NOTES:

- The contractor shall select a confirmation shaft in accordance with the Standard Specifications & as approved by the Engineer.
- The contractor shall orient the drilled shaft reinforcing cage to minimize conflicts with the reinforcing in abutment & pier caps.
- Number of inspection tubes, inspection tube size, type & details shall be per the Specifications.
- Inspection tubes shall not be attached to the longitudinal reinforcing.
- Drilled shaft excavations may encounter caving conditions and/or groundwater. The Contractor may require temporary casing or other measures in the event such conditions exist. See Final Geotechnical Report for additional shaft construction considerations.
- Construction joints not shown on the plans shall require the approval of the Engineer prior to construction. Construction joints below the water line are not allowed.
- In the event of a weak layer (silt, clay, loose sand, etc.) at the recommended elevation of the shaft bottom, the shaft shall be extended to bear on firm soil as determined by the Engineer.
- Concrete shall be placed within 24 hours after the excavation has been completed & the reinforcing cage placed in its position.
- No excavation, except as required for drilled shaft construction, shall occur below the bottom of the abutment.
- Drilled shaft reinforcing shall not be spliced in the upper 1/3 of the shaft. Lap splices shall be staggered as far as possible below this region.
- All reinforcing in drilled shafts, including the steel projecting into the pier columns shall be included in the cost of the drilled shaft.
- See Special Provisions for additional drilled shaft requirements.
- See Pier Detail sheets for Column Details.
- Portions of the drilled shaft excavation at Piers 1 & 2 extend into the BNSF General Shoring Zone A shown in the BNSF Guidelines for Temporary Shoring. Prior to commencing any work, the contractor shall submit calculations & designs signed & sealed by an Engineer registered in the State of Arizona for shoring/casing or showing shoring/casing is not needed for drilled shaft excavation for approval by the Railroad per requirements in the current BNSF Guidelines for Temporary Shoring.

DRILLED SHAFTS TABLE						
Drilled Shaft Number	Elev A (Top of Drilled Shaft)	Elev B (Bottom of Shaft)	Drilled Shaft Length	Design Loads (kips)		Strength Axial Capacity (1) (kips)
				Service Limit State	Strength Limit State	
1	2440.00	2408.00	32'	907	1214	1214
2	2445.00	2408.00	37'			1214
3	2445.00	2394.00	51'	1470	1986	2000
4	2454.00	2394.00	60'			2000
5	2445.00	2394.00	51'			2000
6	2452.00	2394.00	58'	833	1125	2000
7	2457.00	2425.00	32'			1125
8	2457.00	2425.00	32'			1125

(1) Axial Capacity reduced by group factor = 1.00

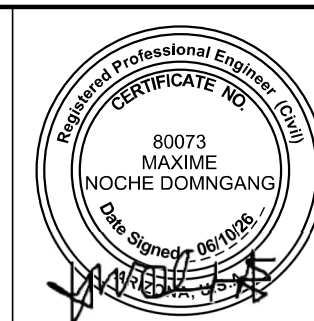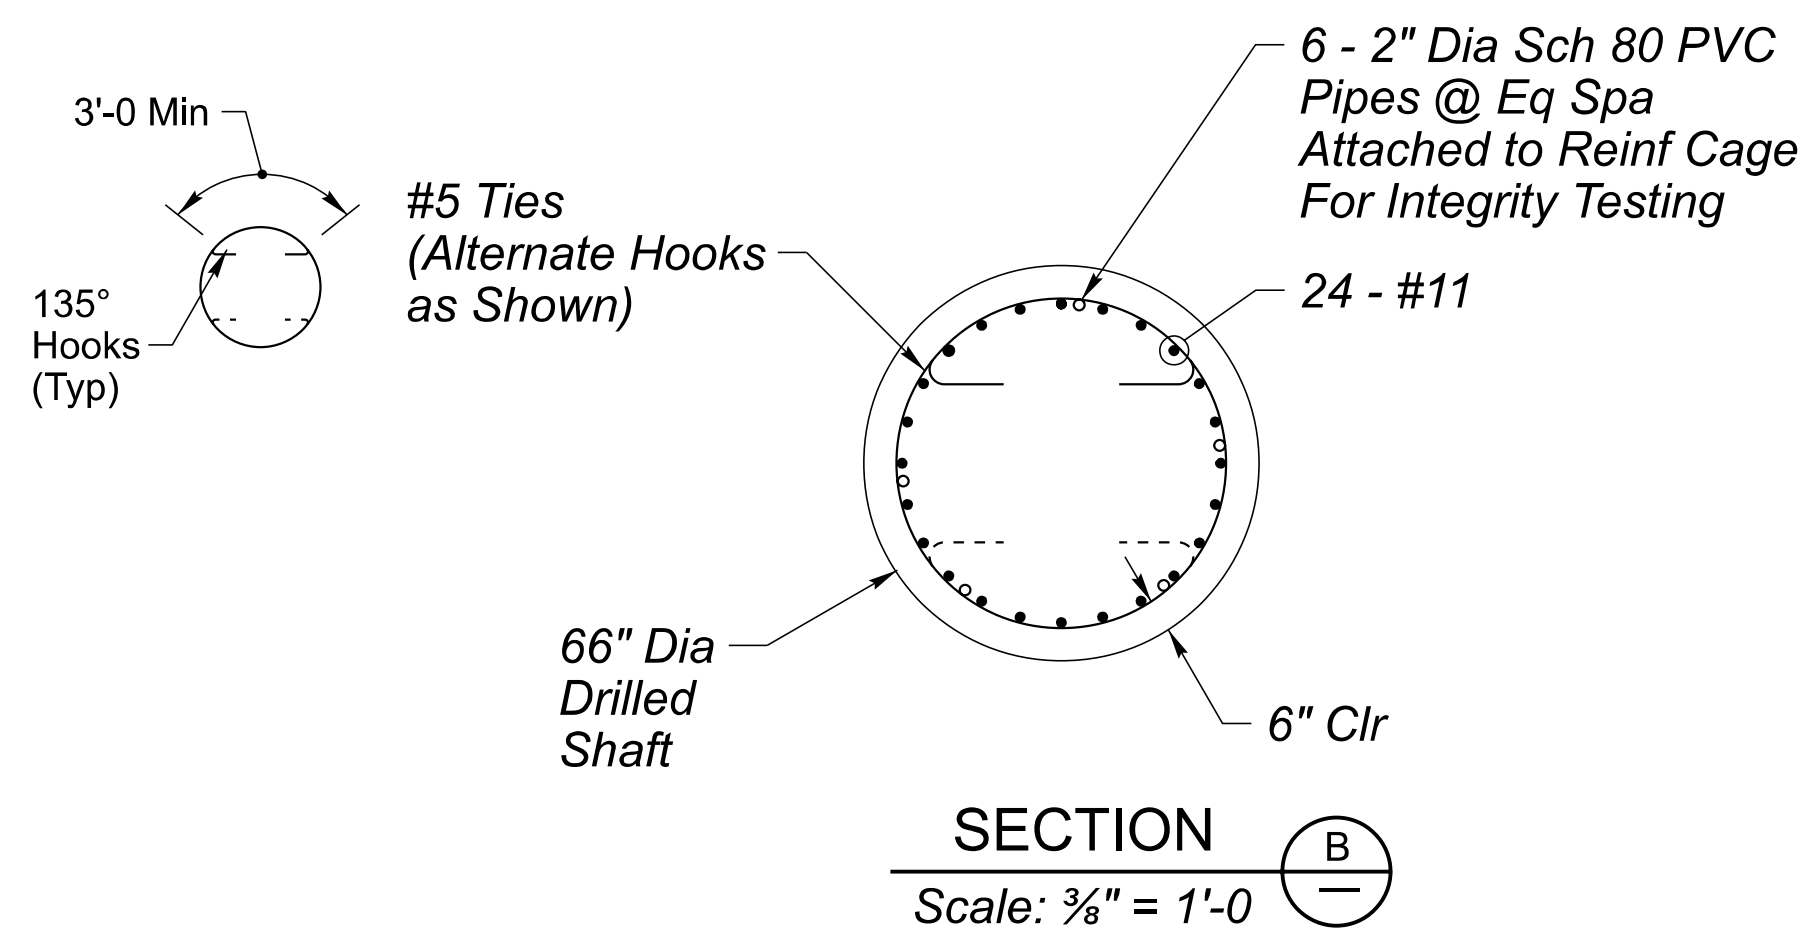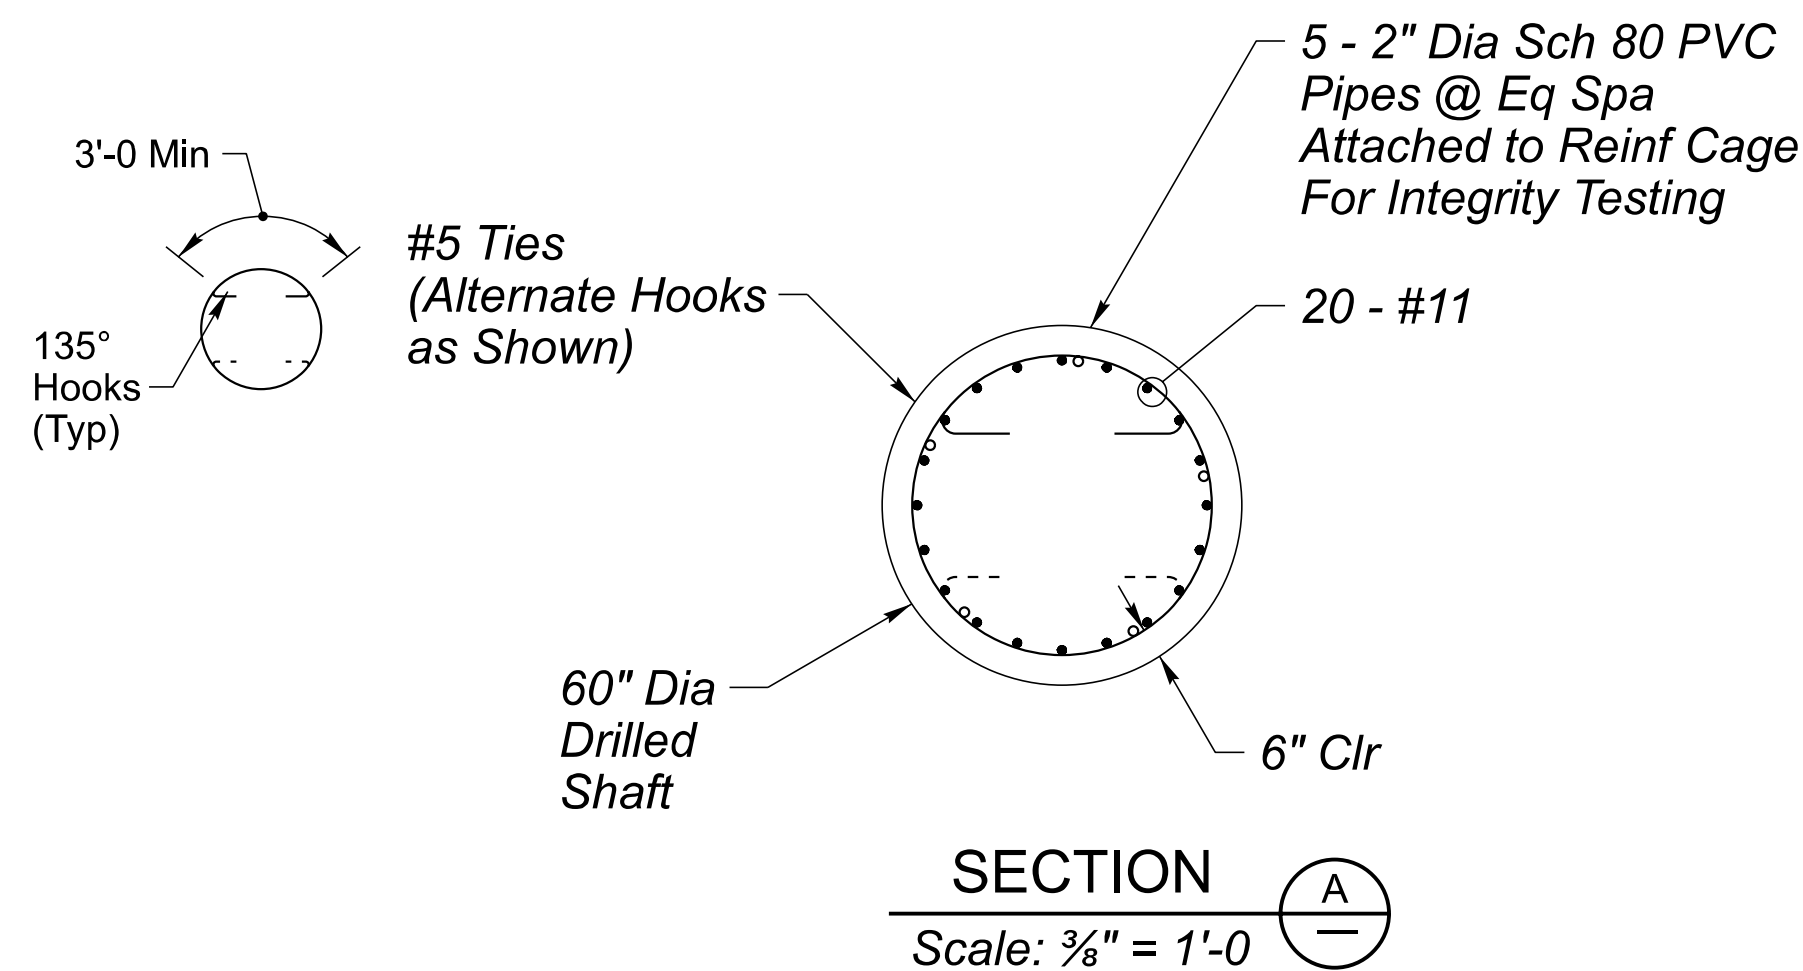


DESIGN	NAME	DATE
DRAWN	M. Noche	06/26
CHECKED	G. Zenuch	06/26
	B. Ansley	06/26

TRANSPORTATION
AECOM TECHNICAL SERVICES, Inc.
7720 N. 16th St., Suite 100
Phoenix, Arizona 85020
T 602.371.1100
www.aecom.com

ARIZONA DEPARTMENT OF TRANSPORTATION
INFRASTRUCTURE DELIVERY AND OPERATIONS DIVISION
BRIDGE GROUP


US 93 SB BNSF OP BRIDGE
DRILLED SHAFT DETAILS

ROUTE	STATE	PROJECT NO.	FEDERAL ID NO.	SHEET NO.	TOTAL SHEETS	RECORD DRAWING
US 93	ARIZ.	093 YV 189	093-B-(230)T	424	524	
MILEPOST 192.90	WICKENBURG RANCH WAY TO VISTA ROYALE					DWG No. S-1.05
STRUCTURE NO. 20313	TRACS NO. F0738 01C					OF

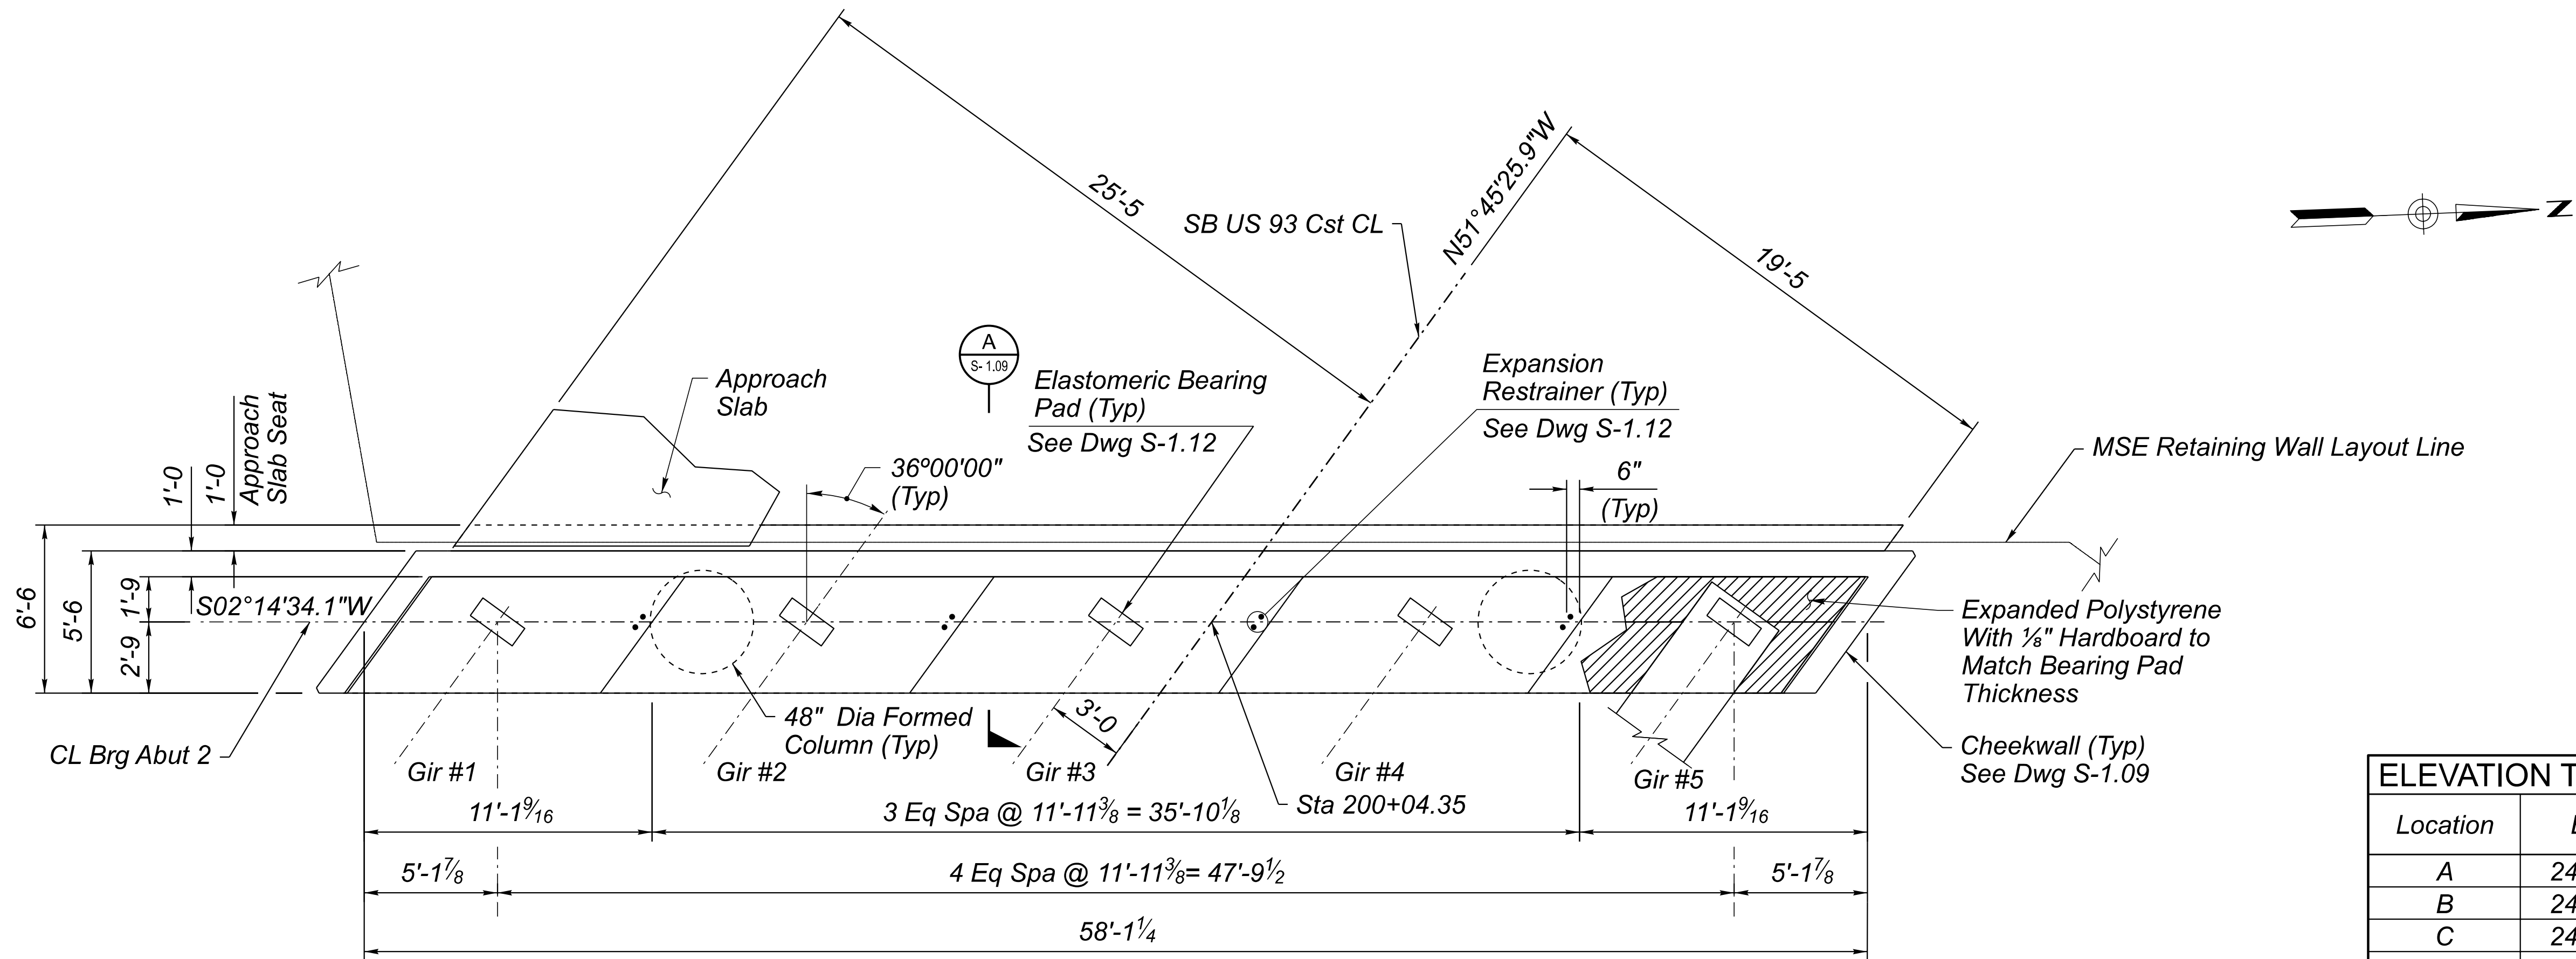

ABUTMENT 2 PLAN

Looking Ahead Station
Scale: 1/4" = 1'-0"

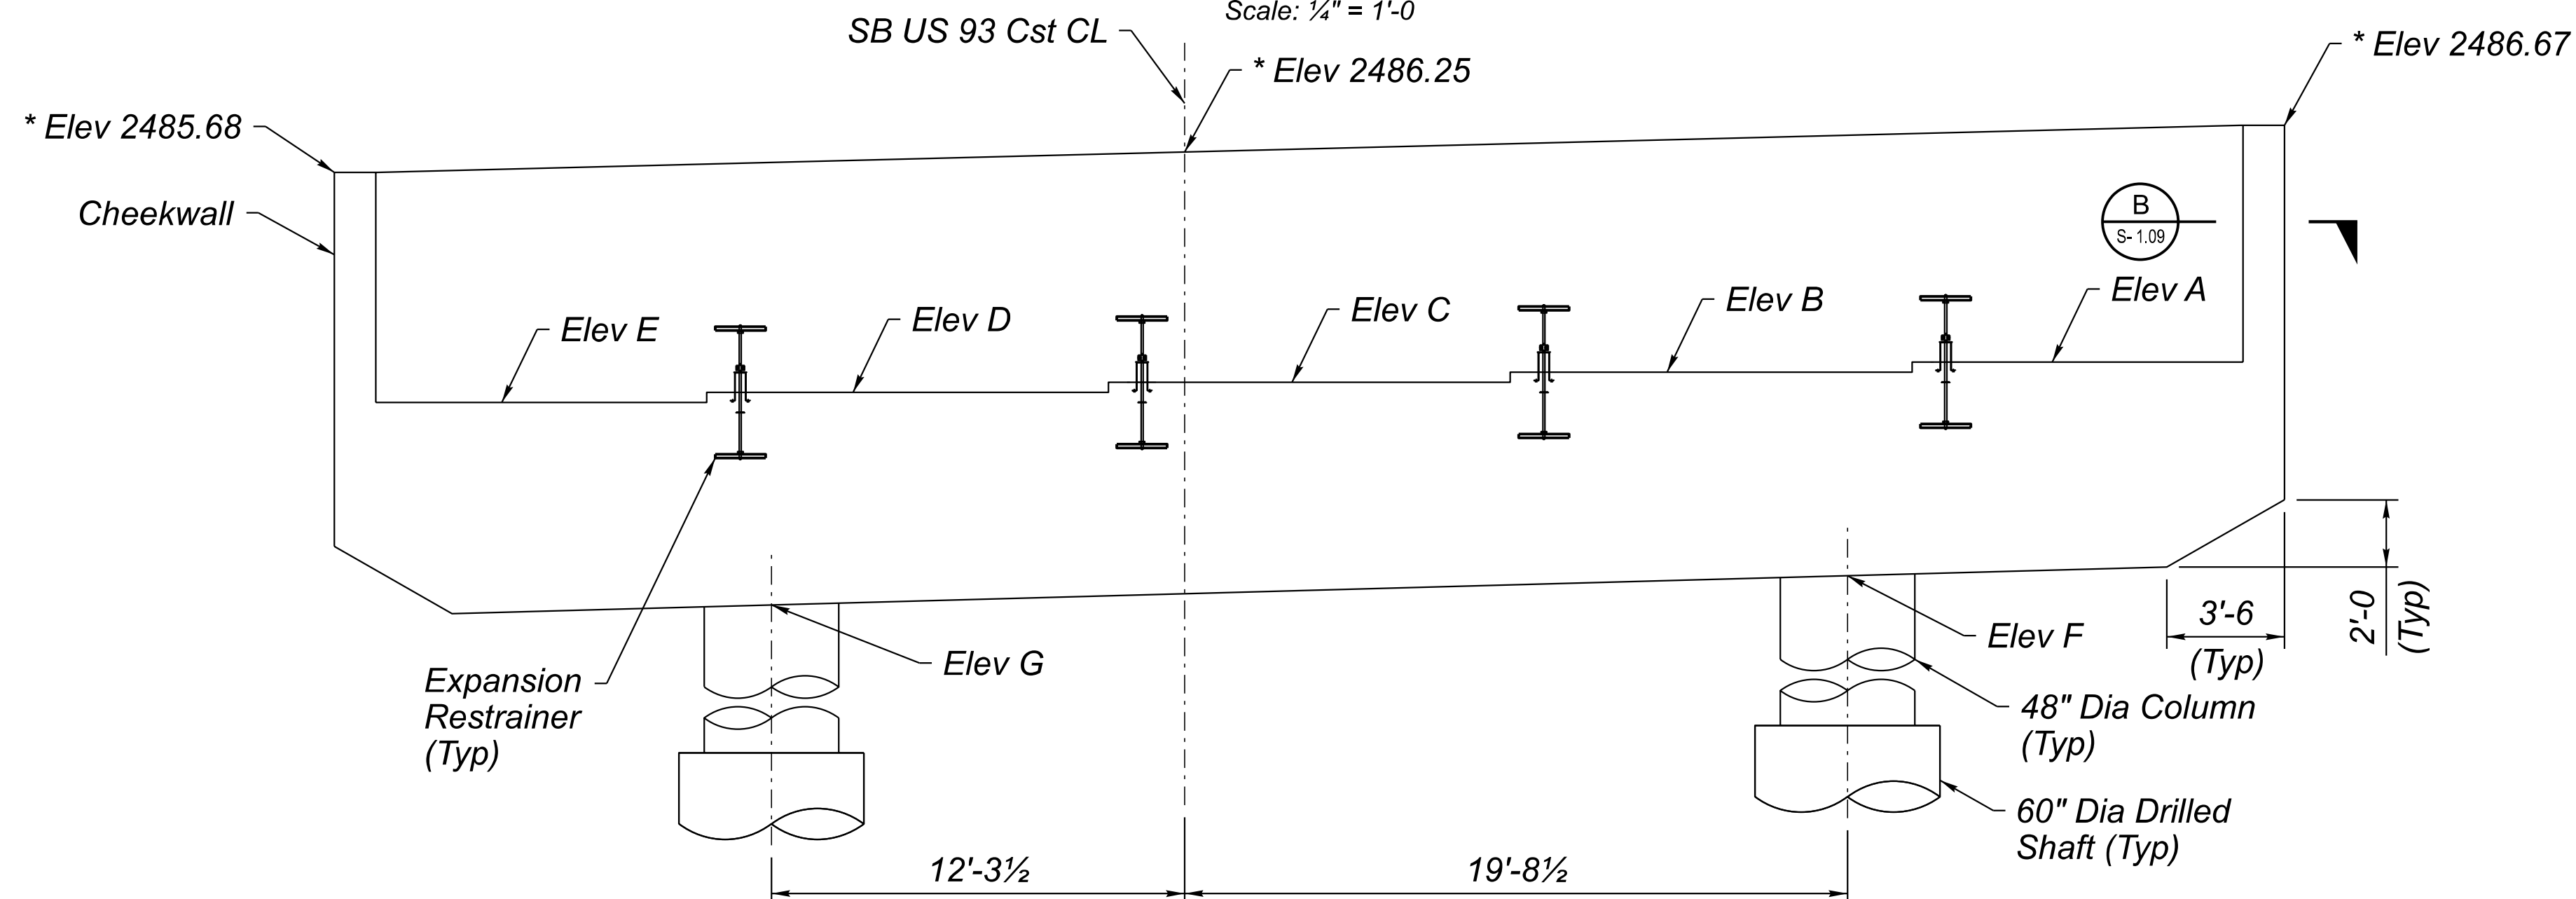

ABUTMENT 2 ELEVATION

Looking Ahead Station
Scale: 1/4" = 1'-0"

ELEVATION TABLE	
Location	Elev
A	2479.73
B	2479.50
C	2479.28
D	2479.05
E	2478.82
F	2473.47
G	2472.97

* Elevations shown at front face of backwall.



	NAME	DATE
DESIGN	M. Noche	06/26
DRAWN	G. Zenuch	06/26
CHECKED	B. Ansley	06/26


TRANSPORTATION
AECOM TECHNICAL SERVICES, Inc.
7720 N. 16th St., Suite 100
Phoenix, Arizona 85020
T 602.371.1100

AECOM
www.aecom.com



ARIZONA DEPARTMENT OF TRANSPORTATION
INFRASTRUCTURE DELIVERY AND OPERATIONS DIVISION
BRIDGE GROUP

US 93 SB BNSF OP BRIDGE
ABUTMENT 2 PLAN AND ELEVATION


ROUTE US 93	F.H.W.A. Arizona Division	STATE ARIZ.	PROJECT NO. 093 YV 189	FEDERAL ID NO. 093-B-(230)T	SHEET NO. 426	TOTAL SHEETS 524	RECORD DRAWING
MILEPOST 192.90	WICKENBURG RANCH WAY TO VISTA ROYALE						DWG No. S-1.07
STRUCTURE NO. 20313	TRACS NO. F0738 01C						___ OF ___

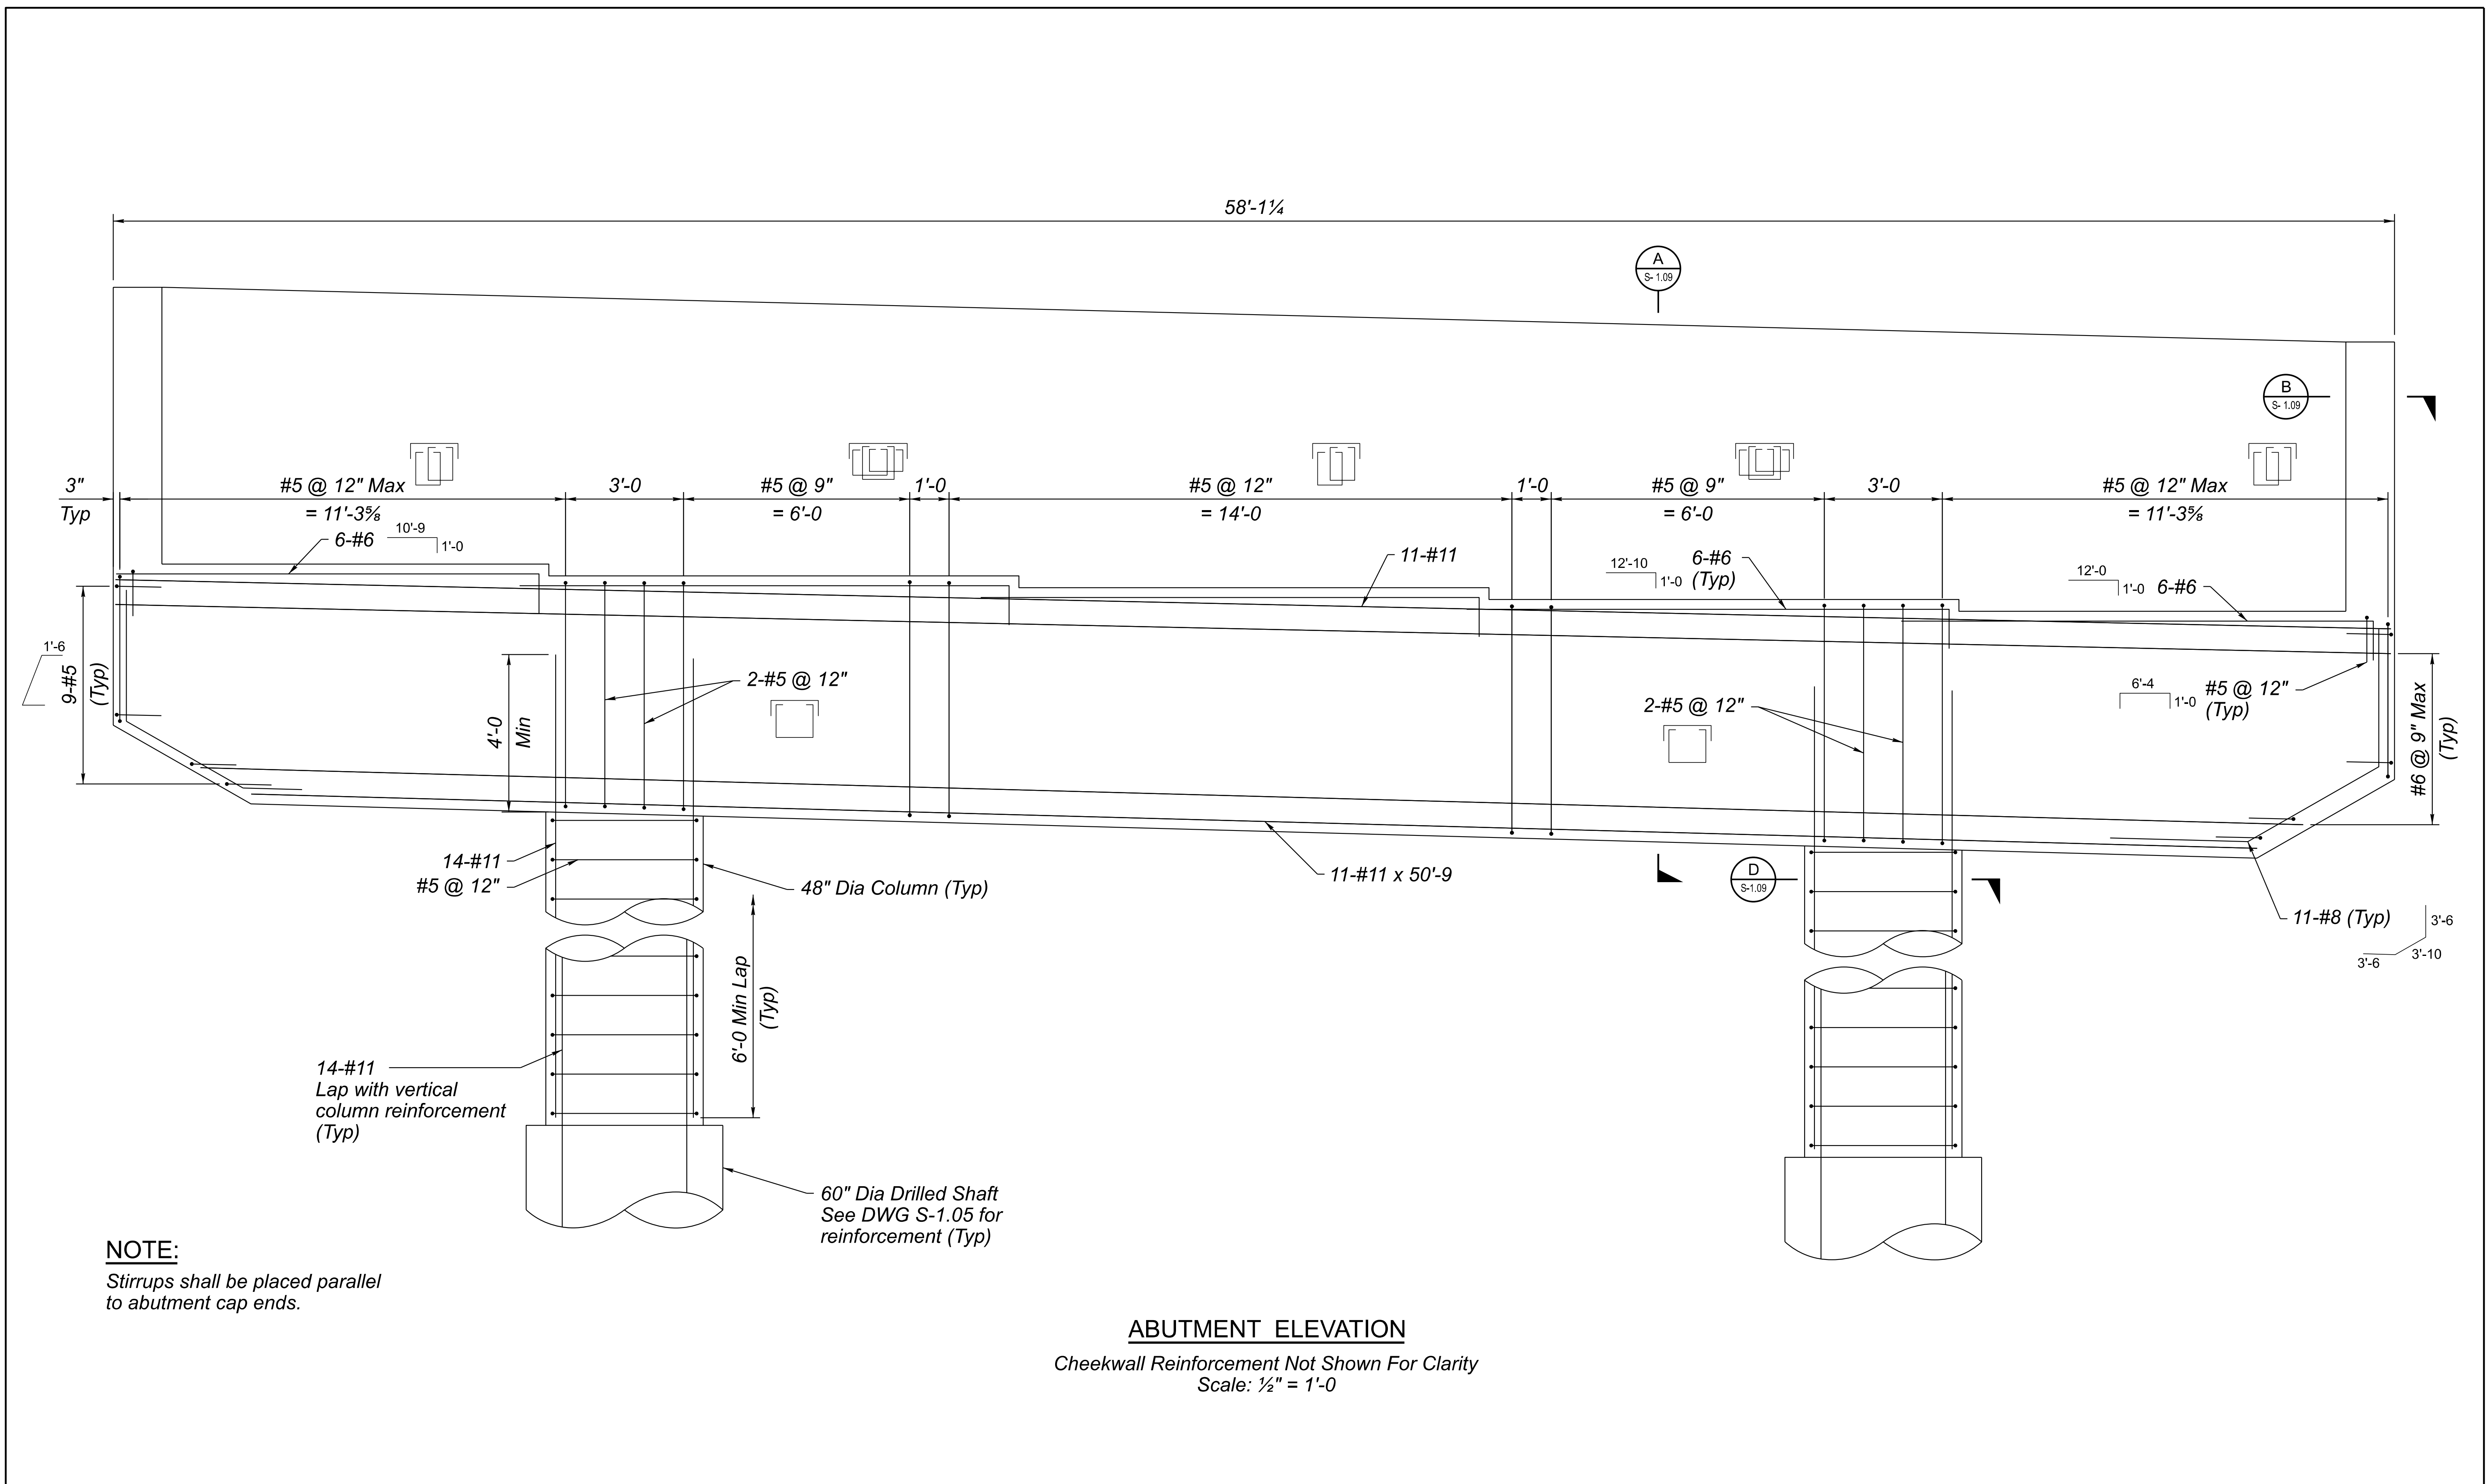


		NAME	DATE	ARIZONA DEPARTMENT OF TRANSPORTATION INFRASTRUCTURE DELIVERY AND OPERATIONS DIVISION BRIDGE GROUP	ROUTE	F.H.W.A. Arizona Division	STATE	PROJECT NO.	FEDERAL ID NO.	SHEET NO.	TOTAL SHEETS	RECORD DRAWING		
	DESIGN	M. Noche	06/26		US 93	ARIZ.	093 YV 189	093-B-(230)T	427	524				
	DRAWN	G. Zenuch	06/26		MILEPOST									
	CHECKED	B. Ansley	06/26	192.90	LOCATION	WICKENBURG RANCH WAY TO VISTA ROYALE					DWG No.	S-1.08		
TRANSPORTATION AECOM TECHNICAL SERVICES, Inc. 7720 N. 16th St., Suite 100 Phoenix, Arizona 85020 T 602.371.1100 www.aecom.com				US 93 SB BNSF OP BRIDGE ABUTMENT DETAILS (1 OF 2)	STRUCTURE NO.	TRACS NO.		F0738 01C					OF	
					20313									

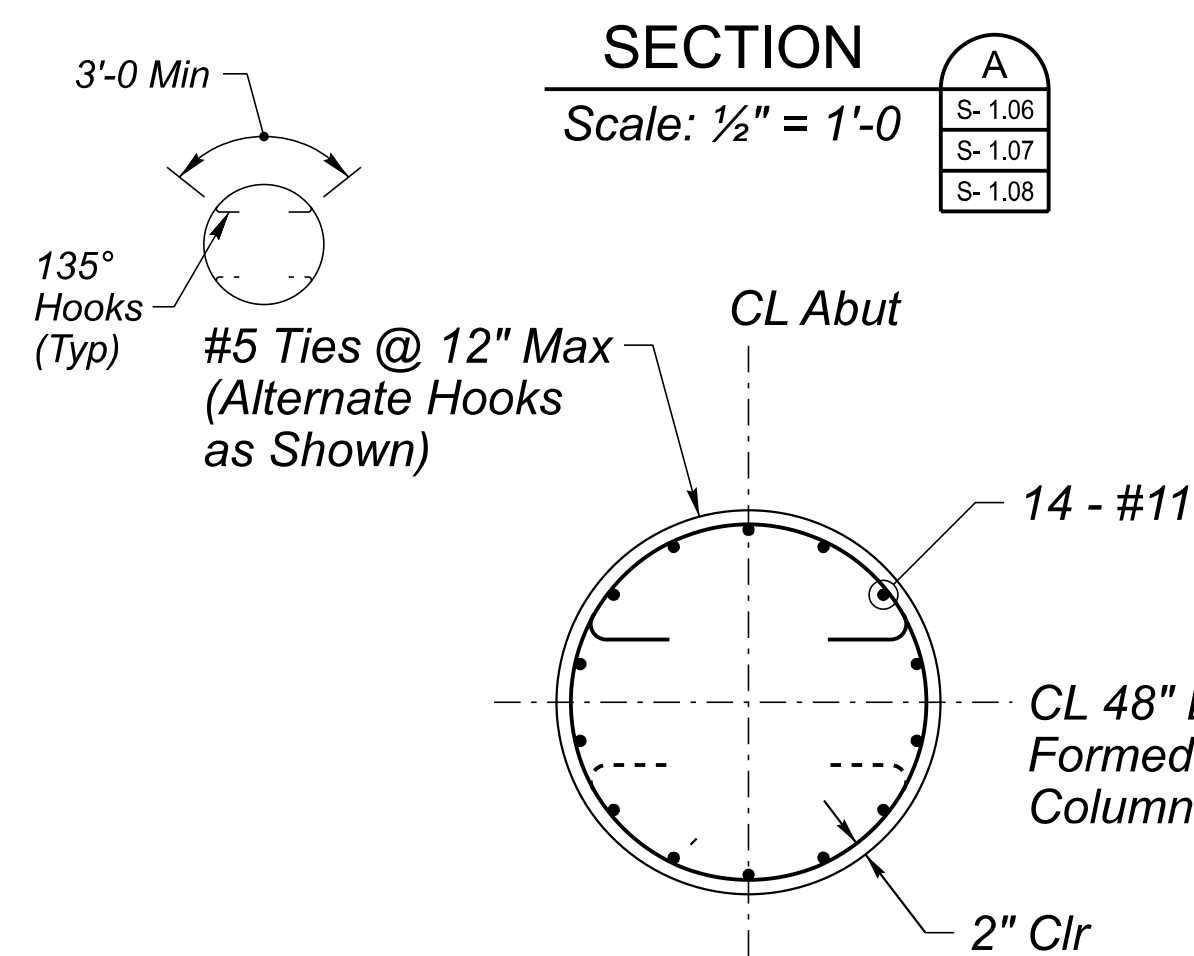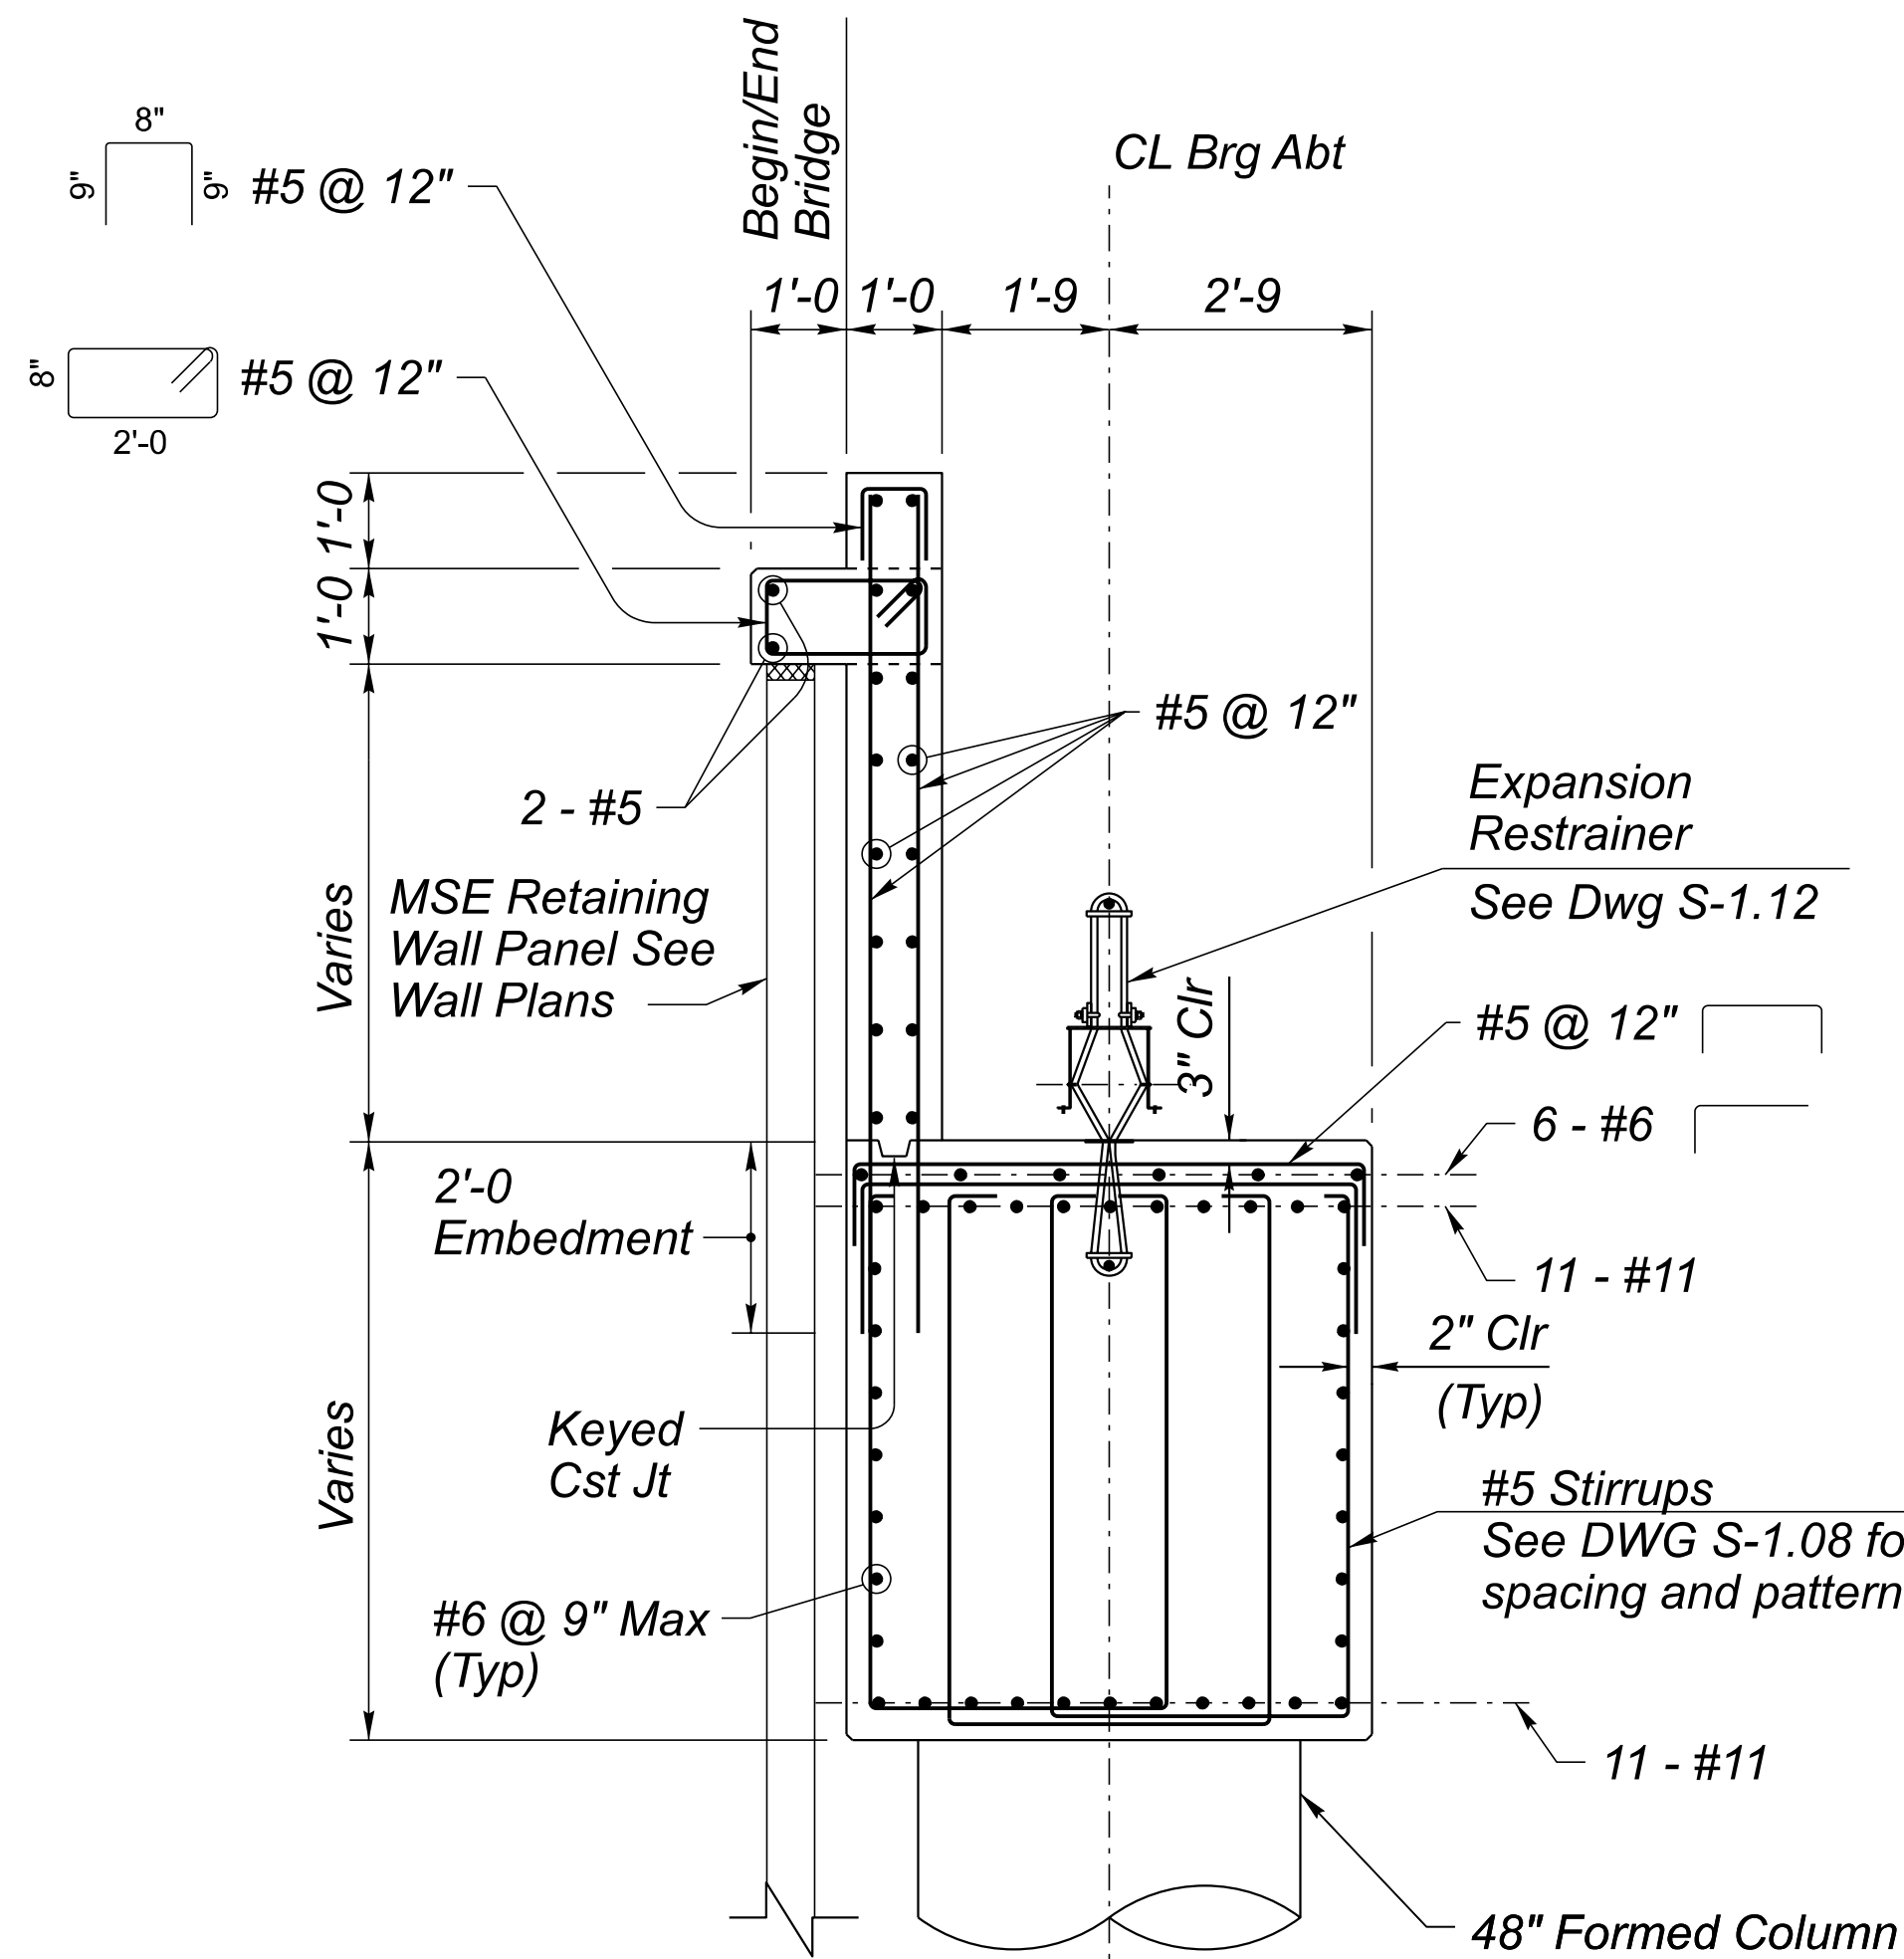


SECTION
Scale: 1/2" = 1'-0"

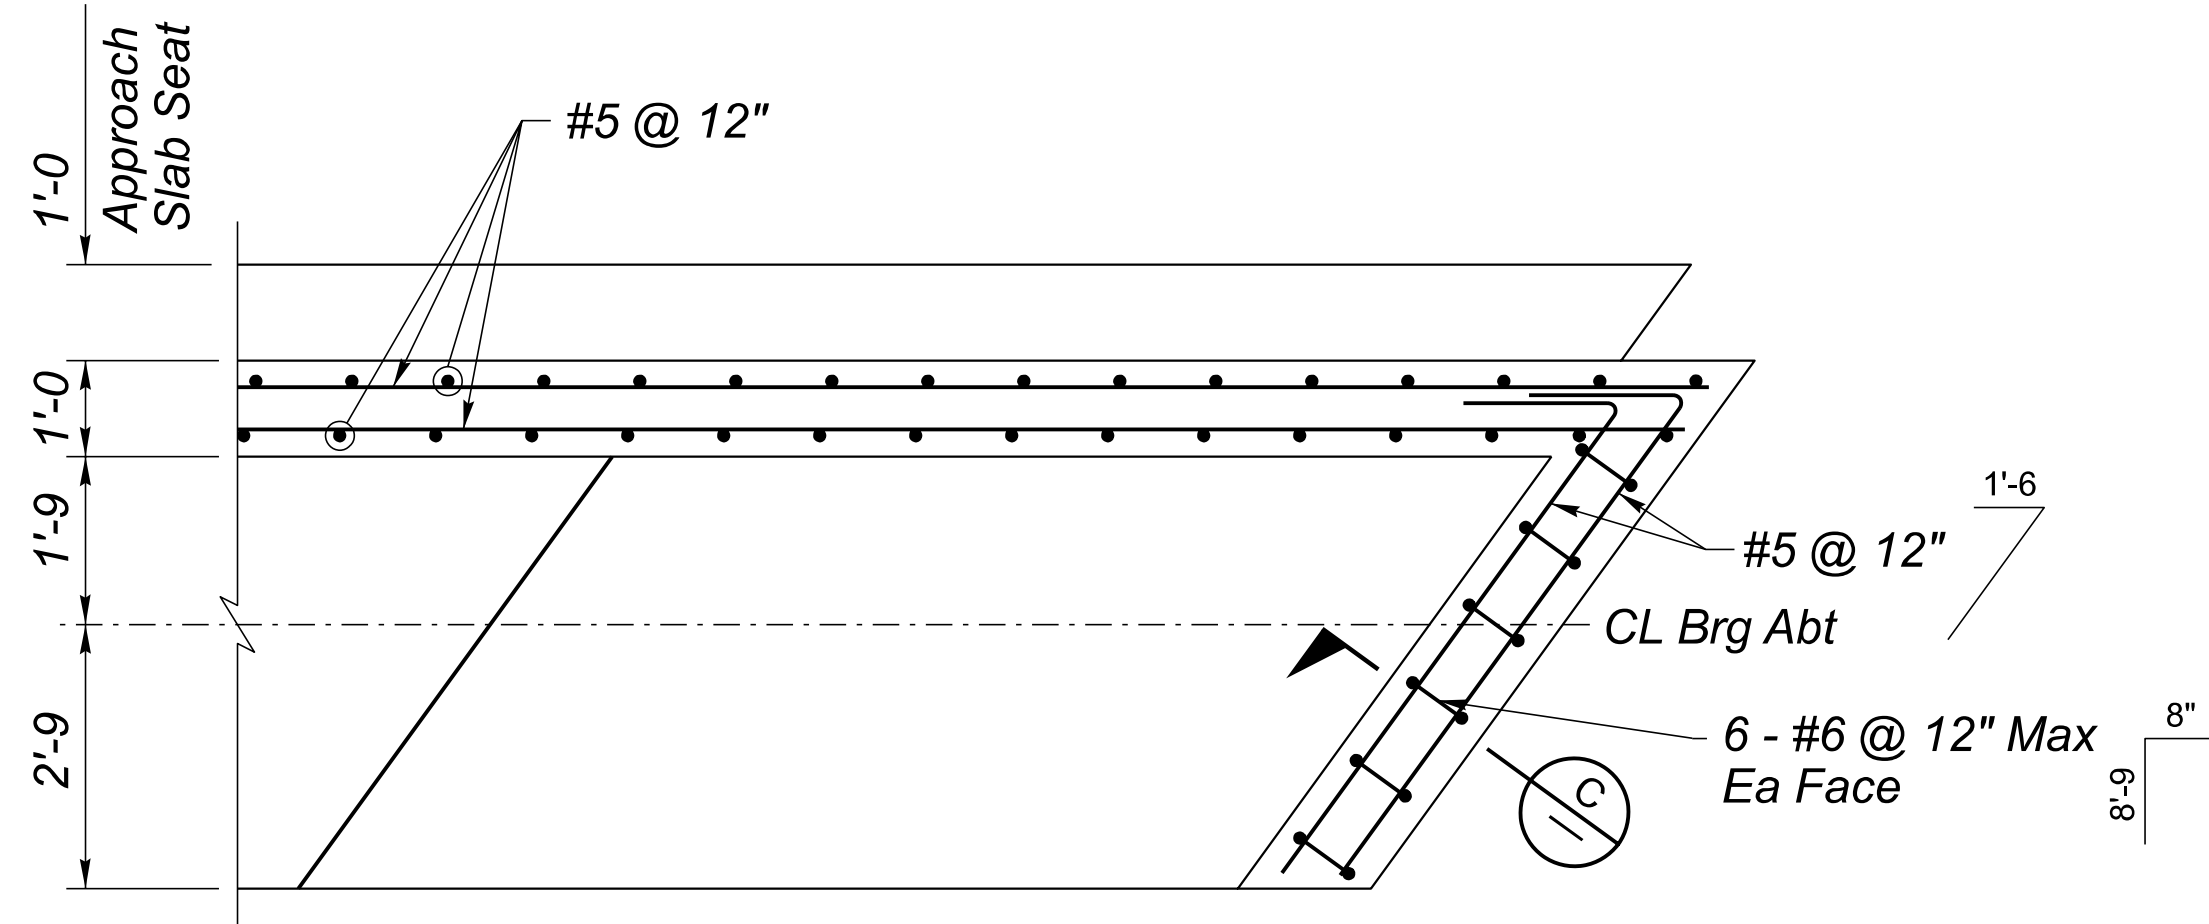


SECTION
Scale: 1/2" = 1'-0"

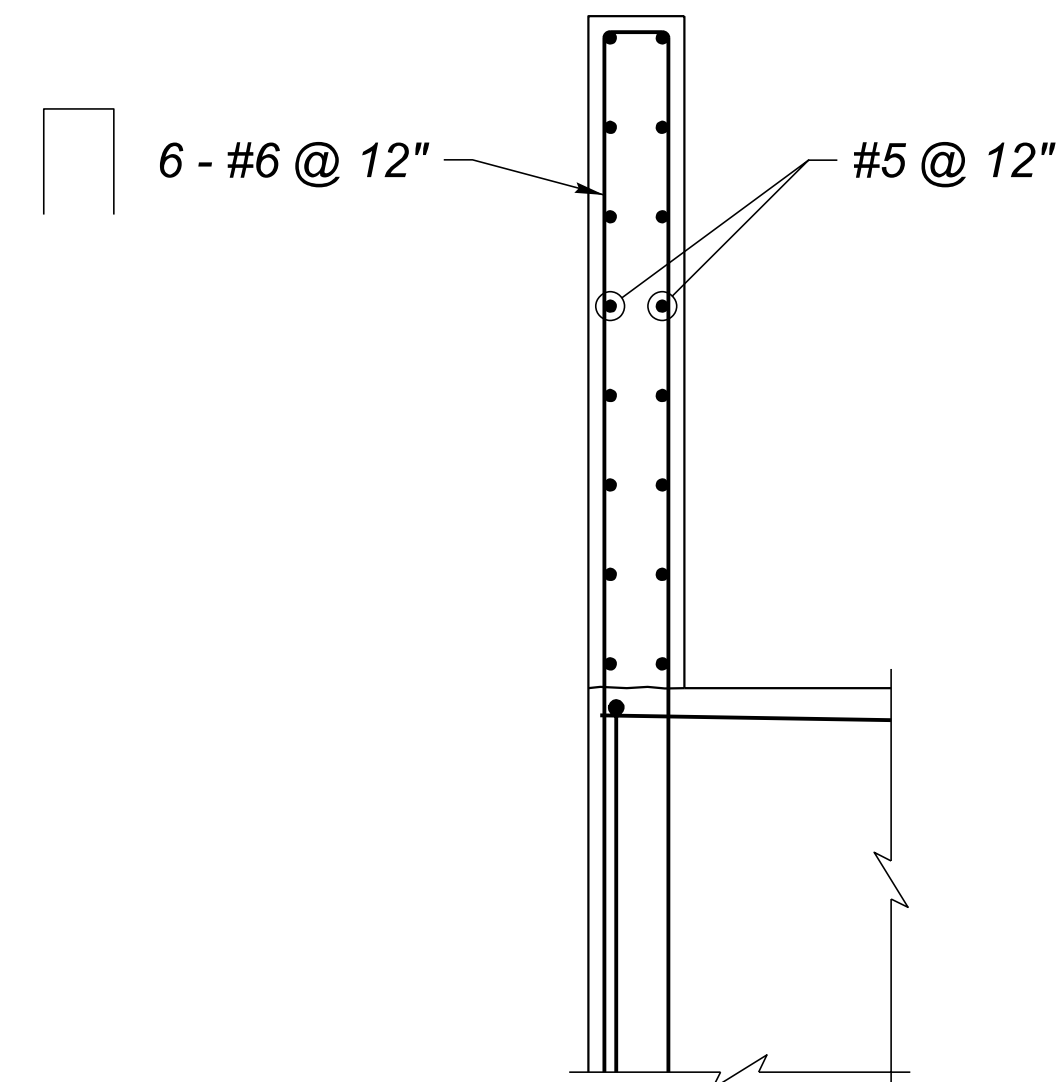

SECTION
Scale: 1/2" = 1'-0"

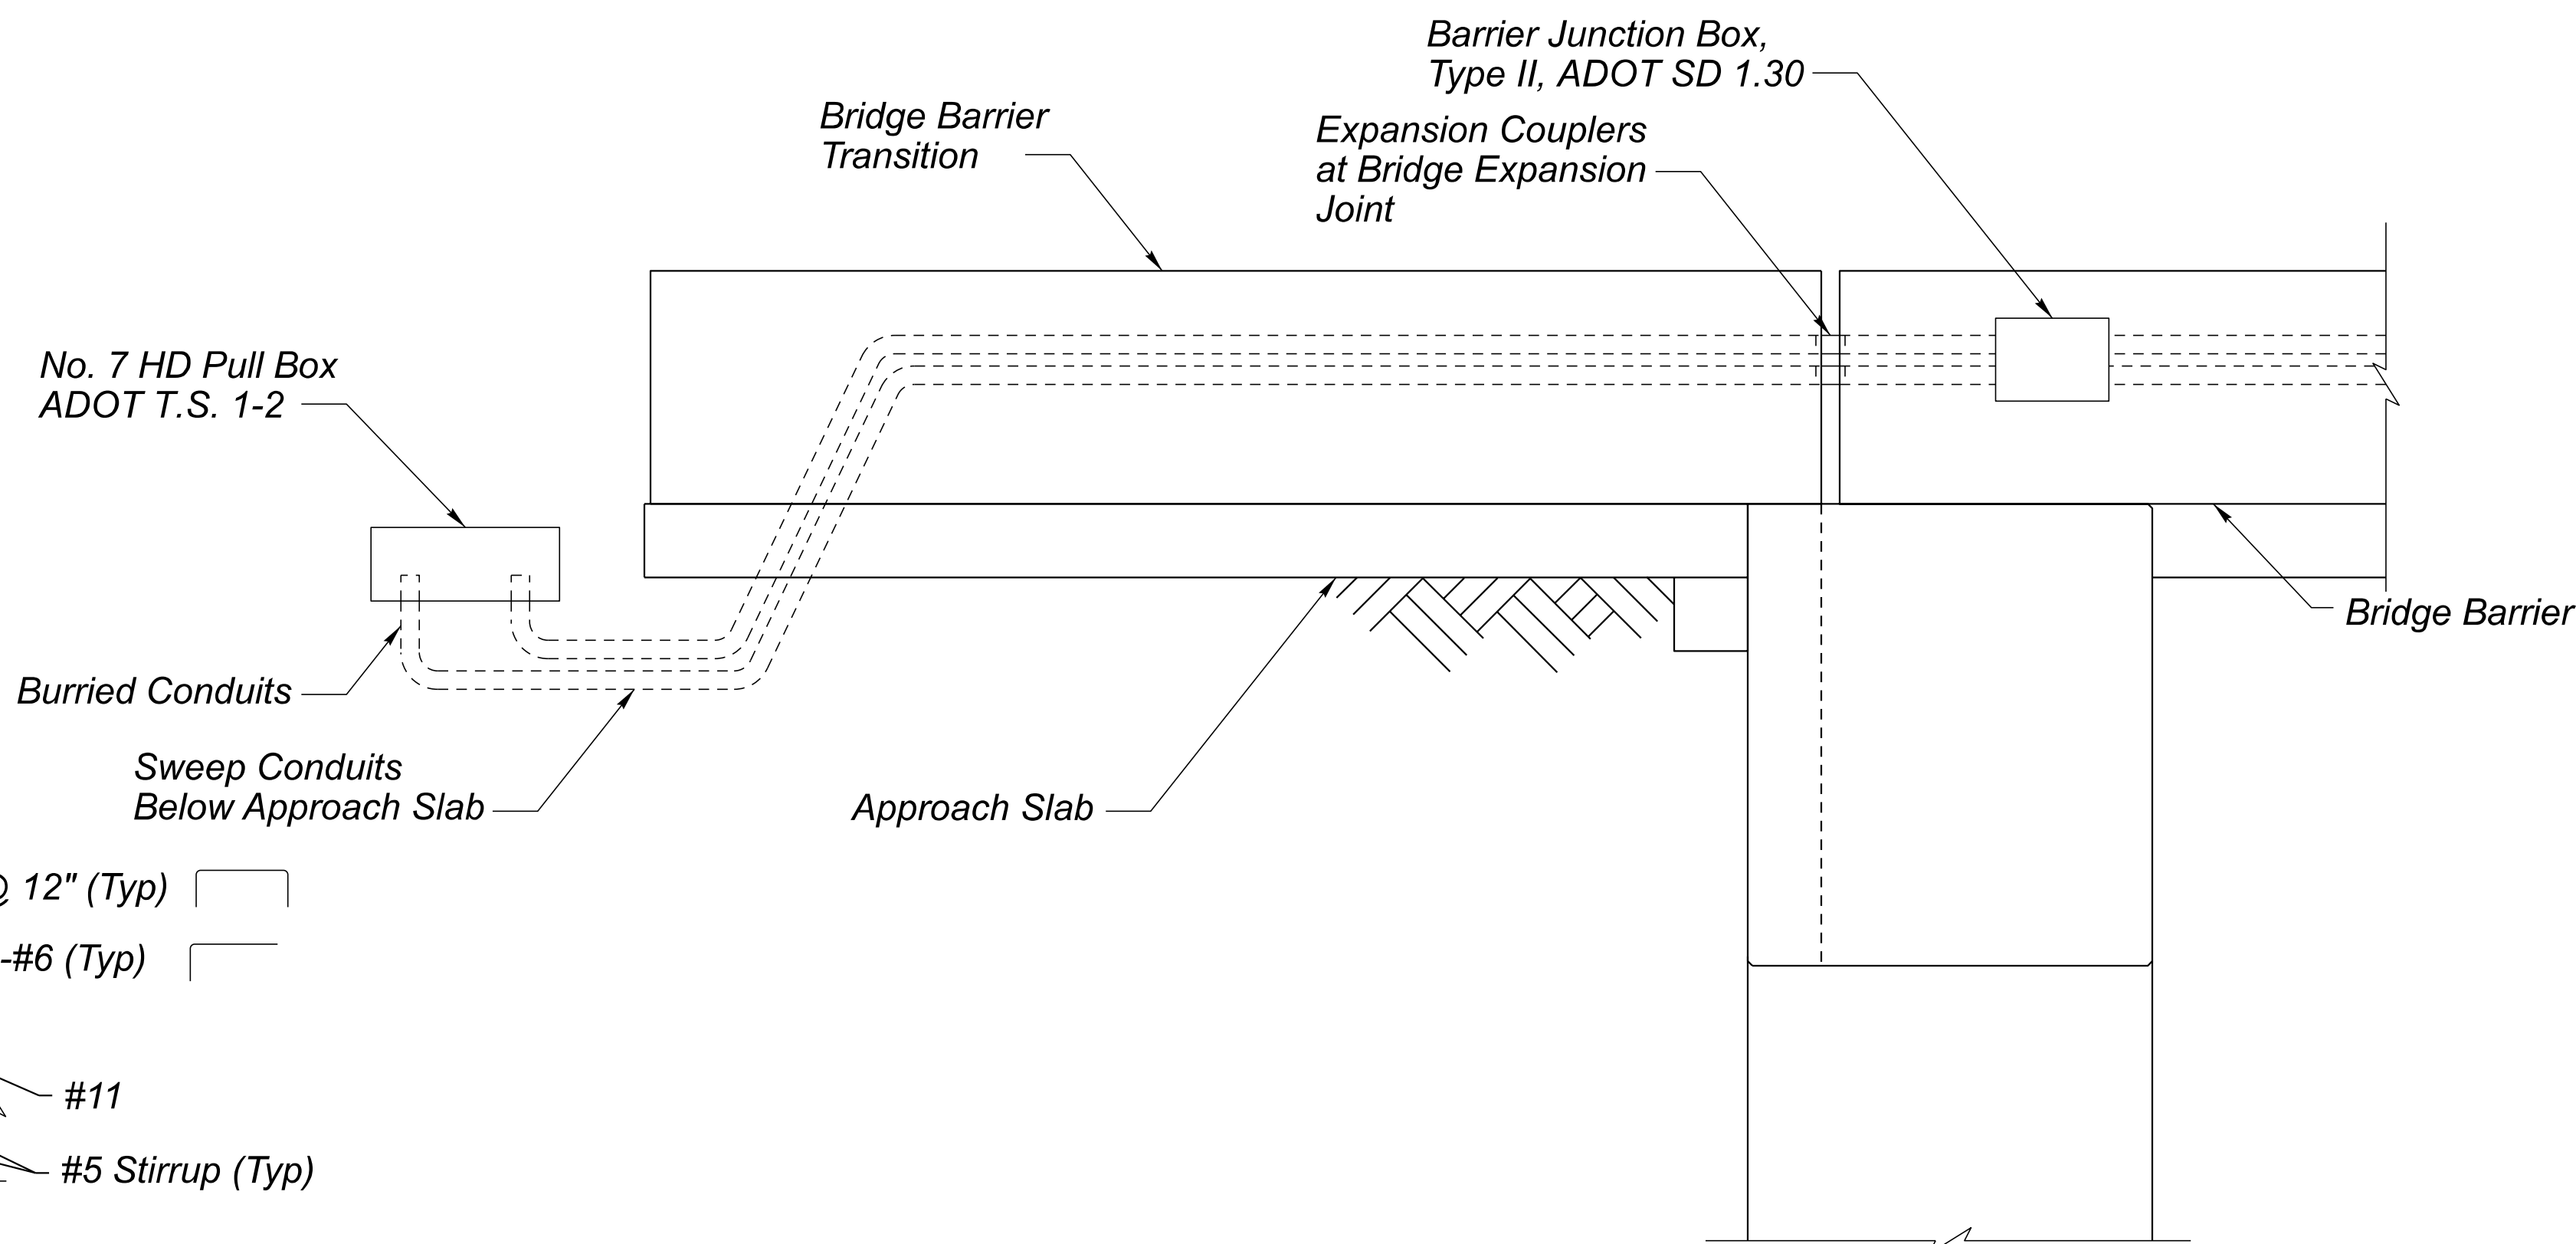

CONDUIT AT BRIDGE END DETAIL
Scale: 1/2" = 1'-0"

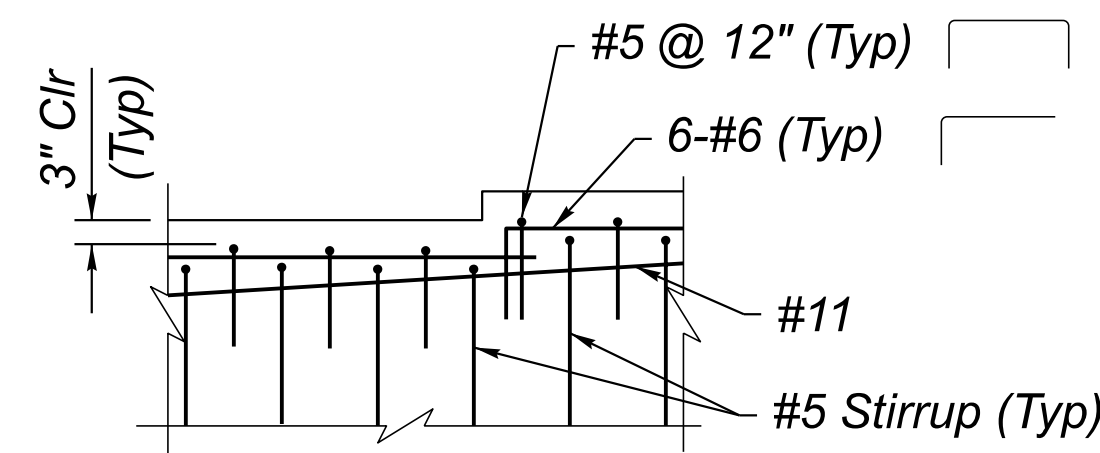

STEP DETAIL
Scale: 1/2" = 1'-0"



	NAME	DATE
DESIGN	M. Noche	06/26
DRAWN	G. Zenuch	06/26
CHECKED	B. Ansley	06/26


TRANSPORTATION
AECOM TECHNICAL SERVICES, Inc.
7720 N. 16th St., Suite 100
Phoenix, Arizona 85020
T 602.371.1100

AECOM
www.aecom.com

ARIZONA DEPARTMENT OF TRANSPORTATION
INFRASTRUCTURE DELIVERY AND OPERATIONS DIVISION
BRIDGE GROUP


**US 93 SB BNSF OP BRIDGE
ABUTMENT DETAILS (2 OF 2)**

ROUTE	STATE	PROJECT NO.	FEDERAL ID NO.	SHEET NO.	TOTAL SHEETS	RECORD DRAWING
US 93	ARIZ.	093 YV 189	093-B-(230)T	428	524	
MILEPOST 192.90	WICKENBURG RANCH WAY TO VISTA ROYALE					DWG No. S-1.09
STRUCTURE NO. 20313	TRACS NO. F0738 01C					OF

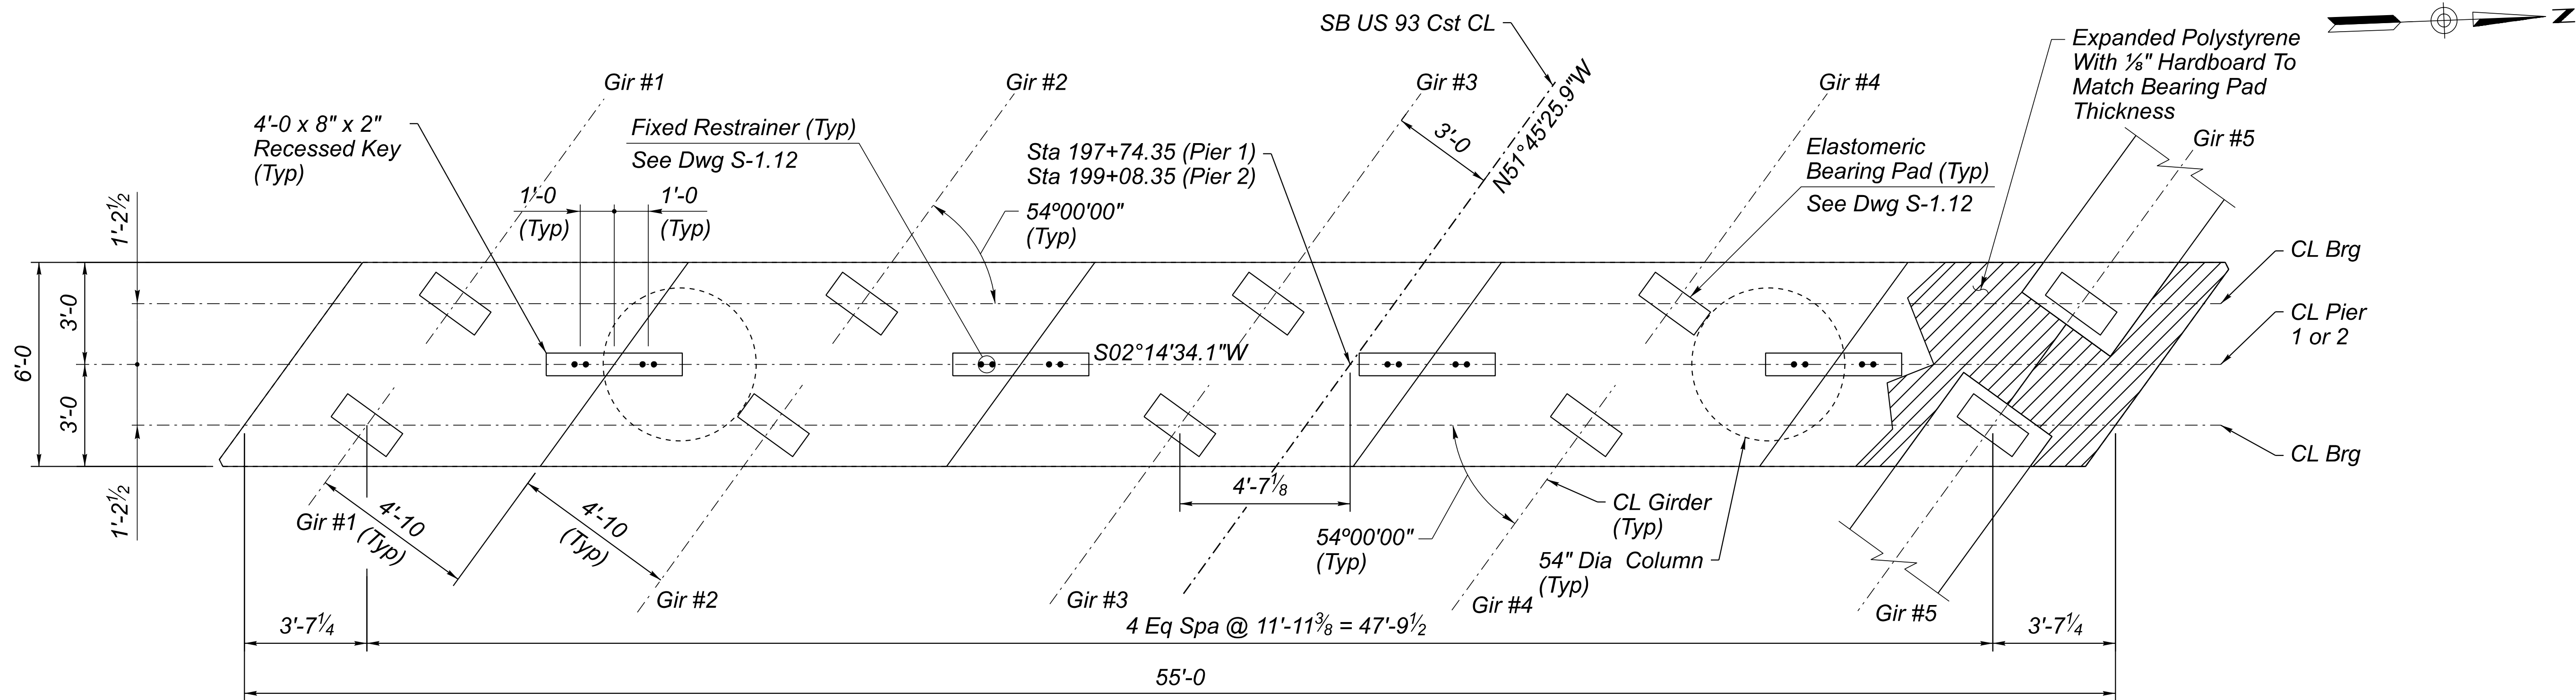

PIER 1 & 2 PLAN

Looking Ahead Station
Scale: 3/8" = 1'-0

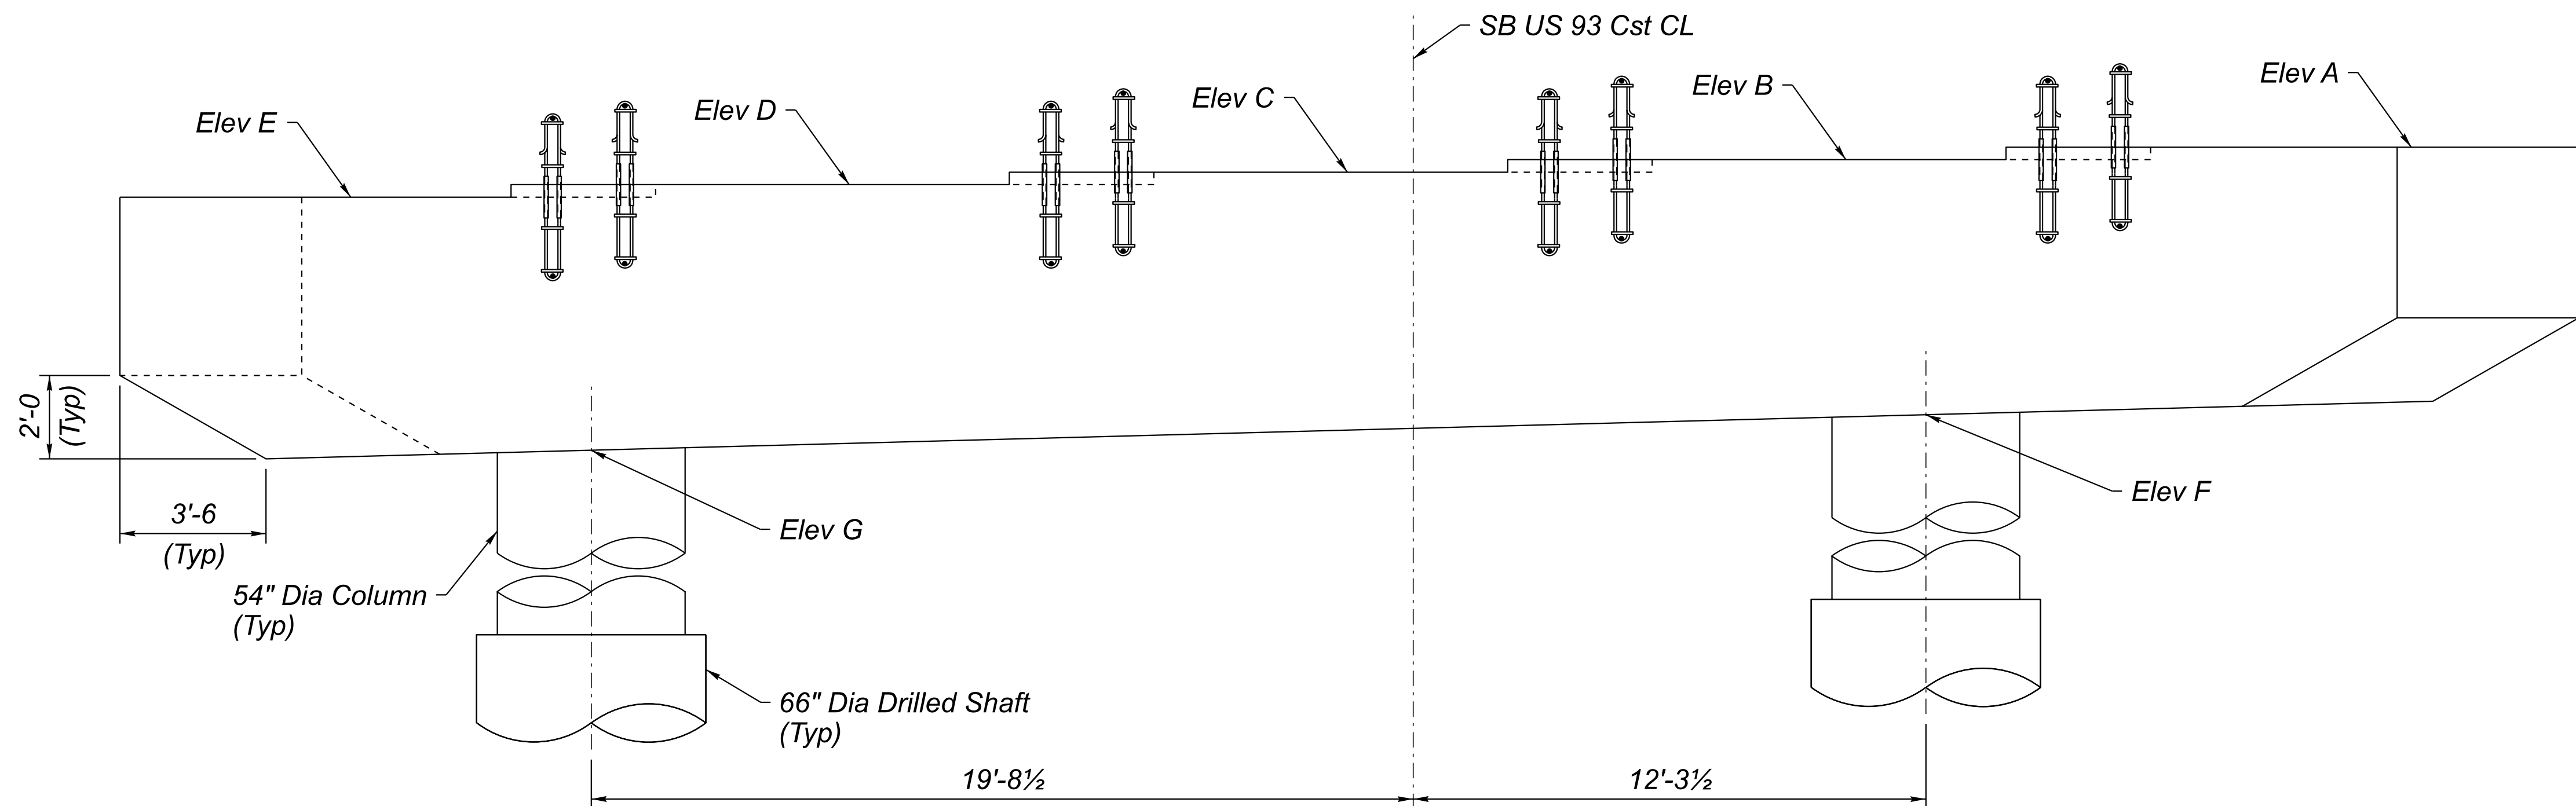

PIER 1 & 2 ELEVATION

Looking Ahead Station
Scale: 3/8" = 1'-0

ELEVATION TABLE		
Location	Pier 1 Elev	Pier 2 Elev
A	2477.70	2479.16
B	2477.41	2478.91
C	2477.12	2478.66
D	2476.82	2478.40
E	2476.53	2478.15
F	2471.38	2472.89
G	2470.70	2472.29




	NAME	DATE
DESIGN	M. Noche	06/26
DRAWN	G. Zenuch	06/26
CHECKED	B. Ansley	06/26

TRANSPORTATION
AECOM TECHNICAL SERVICES, Inc.
7720 N. 16th St., Suite 100
Phoenix, Arizona 85020
T 602.371.1100




AECOM
www.aecom.com

ARIZONA DEPARTMENT OF TRANSPORTATION INFRASTRUCTURE DELIVERY AND OPERATIONS DIVISION BRIDGE GROUP
US 93 SB BNSF OP BRIDGE PIER PLAN AND ELEVATION

ROUTE US 93	F.H.W.A. Arizona Division	STATE ARIZ.	PROJECT NO. 093 YV 189	FEDERAL ID NO. 093-B-(230)T	SHEET NO. 429	TOTAL SHEETS 524	RECORD DRAWING
MILEPOST 192.90	LOCATION WICKENBURG RANCH WAY TO VISTA ROYALE					DWG No. S-1.10	
STRUCTURE NO. 20313	TRACS NO. F0738 01C					OF	


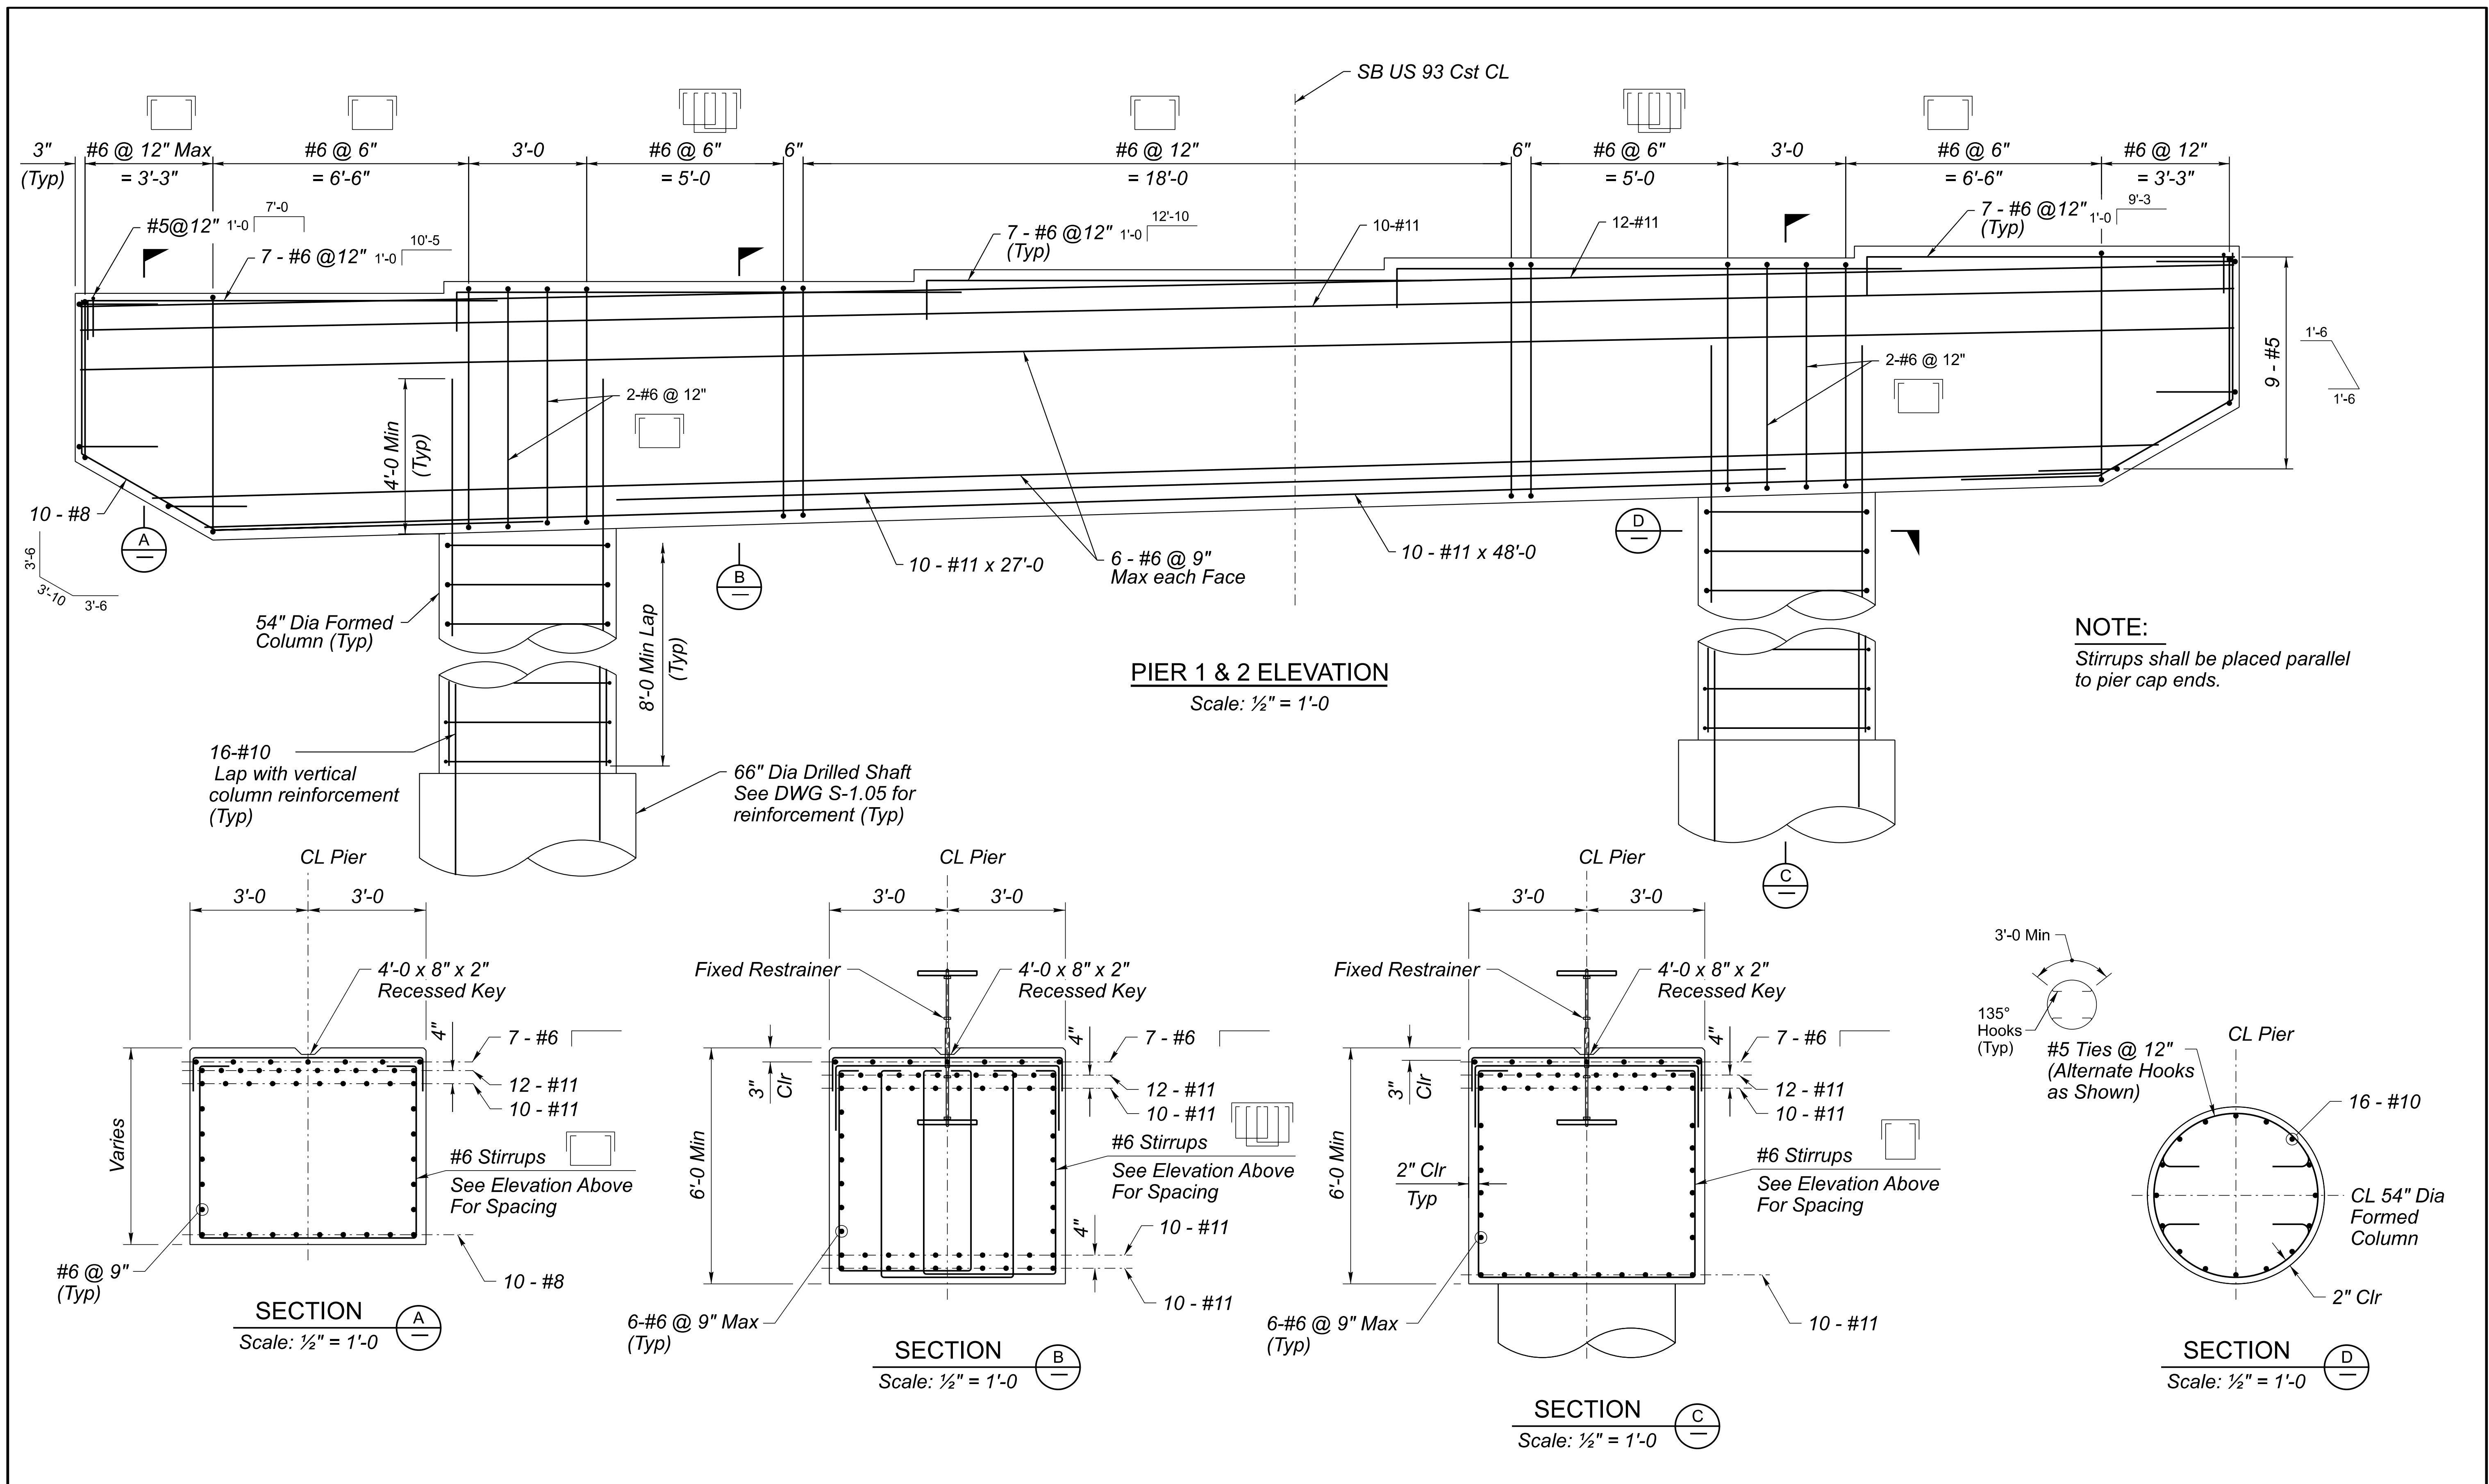


		NAME	DATE	ARIZONA DEPARTMENT OF TRANSPORTATION INFRASTRUCTURE DELIVERY AND OPERATIONS DIVISION BRIDGE GROUP	ROUTE	F.H.W.A. Arizona Division	STATE	PROJECT NO.	FEDERAL ID NO.	SHEET NO.	TOTAL SHEETS	RECORD DRAWING
	DESIGN	M. Noche	06/26		US 93		ARIZ.	093 YV 189	093-B-(230)T	430	524	
	DRAWN	G. Zenuch	06/26									
	CHECKED	B. Ansley	06/26			LOCATION WICKENBURG RANCH WAY TO VISTA ROYALE						DWG No. S-1.11
	TRANSPORTATION AECOM TECHNICAL SERVICES, Inc. 7720 N. 16th St., Suite 100 Phoenix, Arizona 85020 T 602.371.1100 AECOM www.aecom.com			US 93 SB BNSF OP BRIDGE PIER DETAILS	STRUCTURE NO. 20313	TRACS NO. F0738 01C						OF

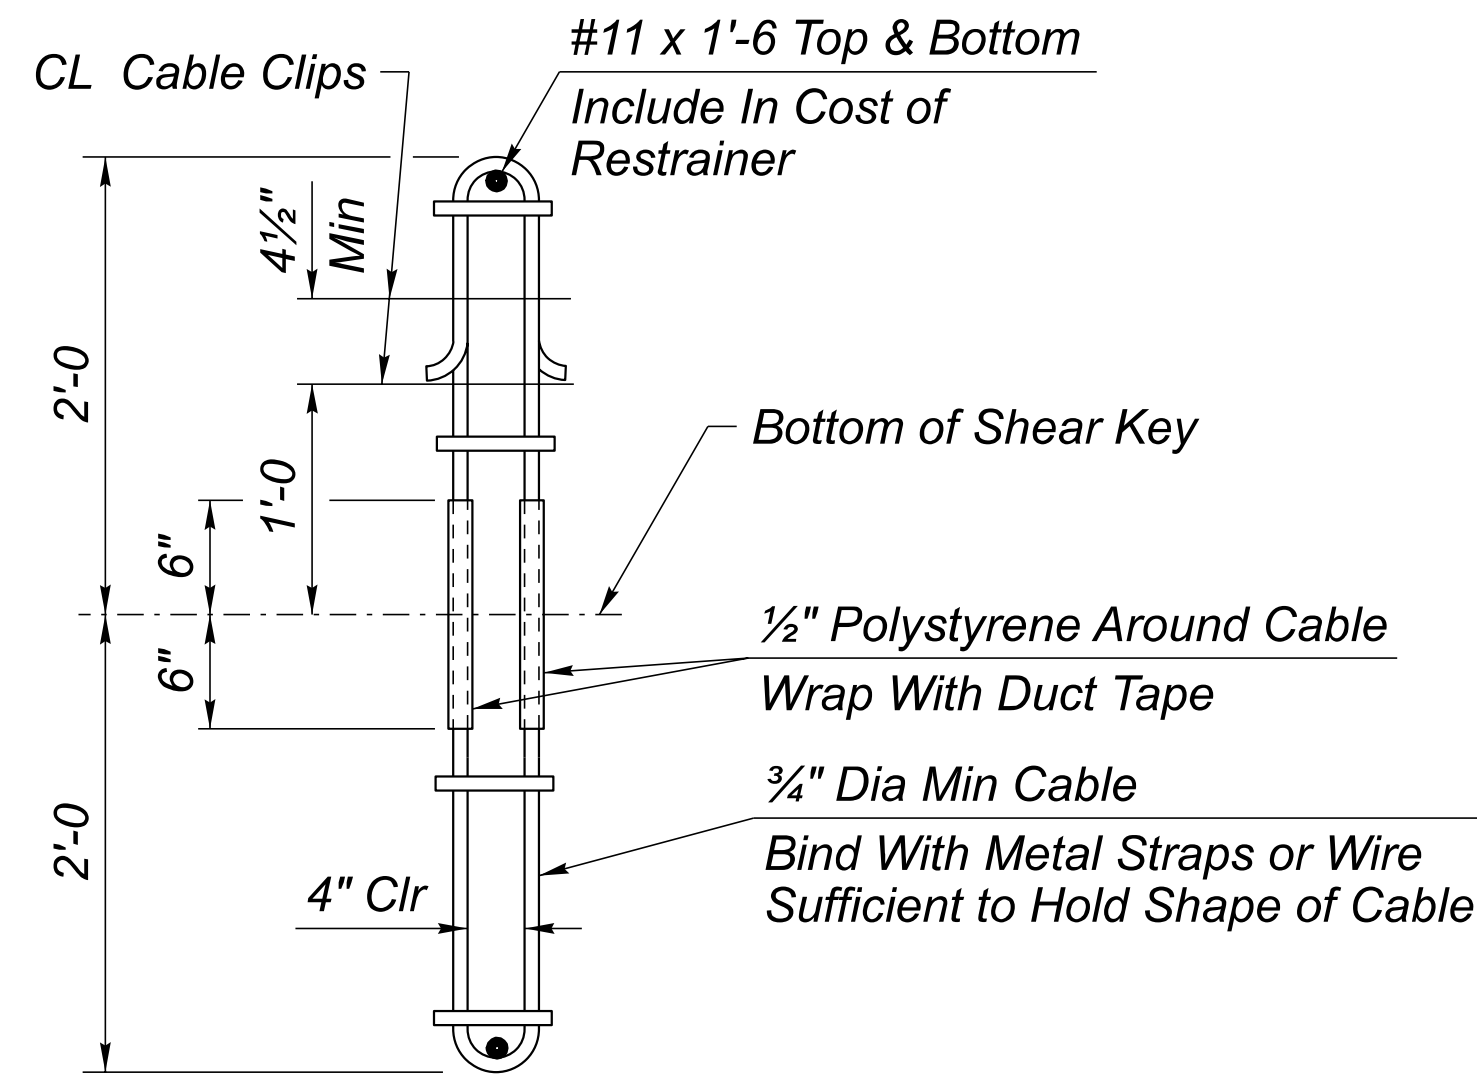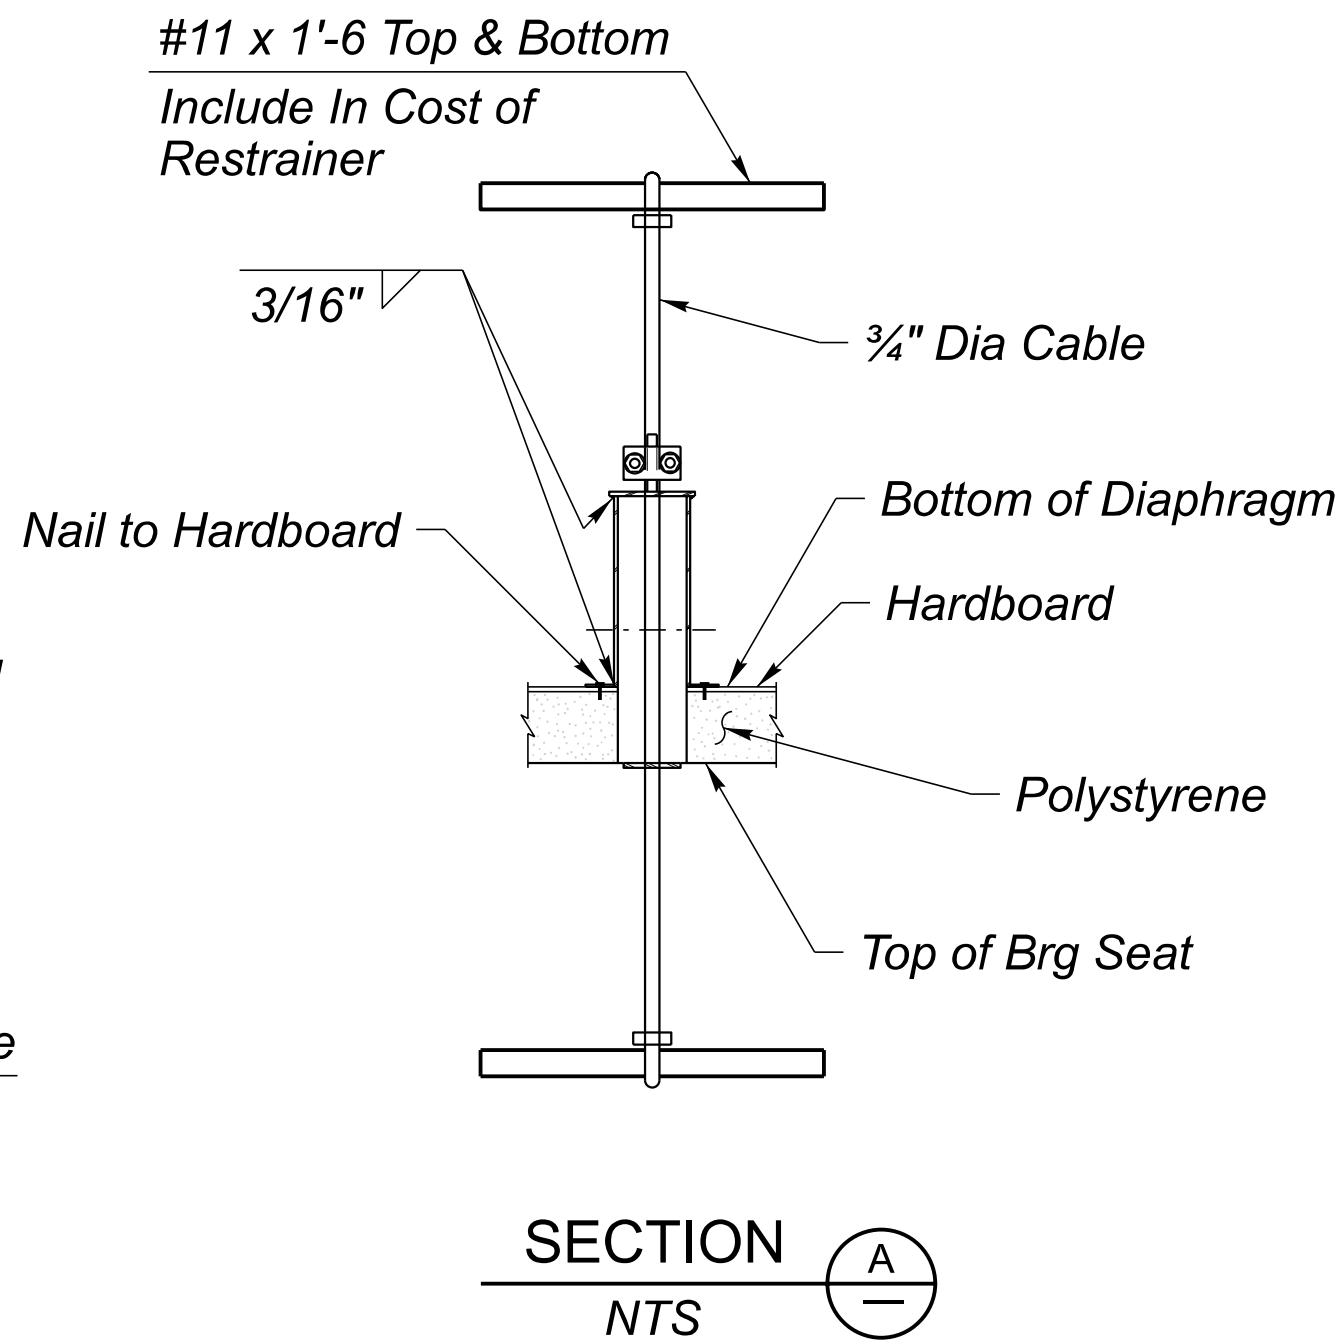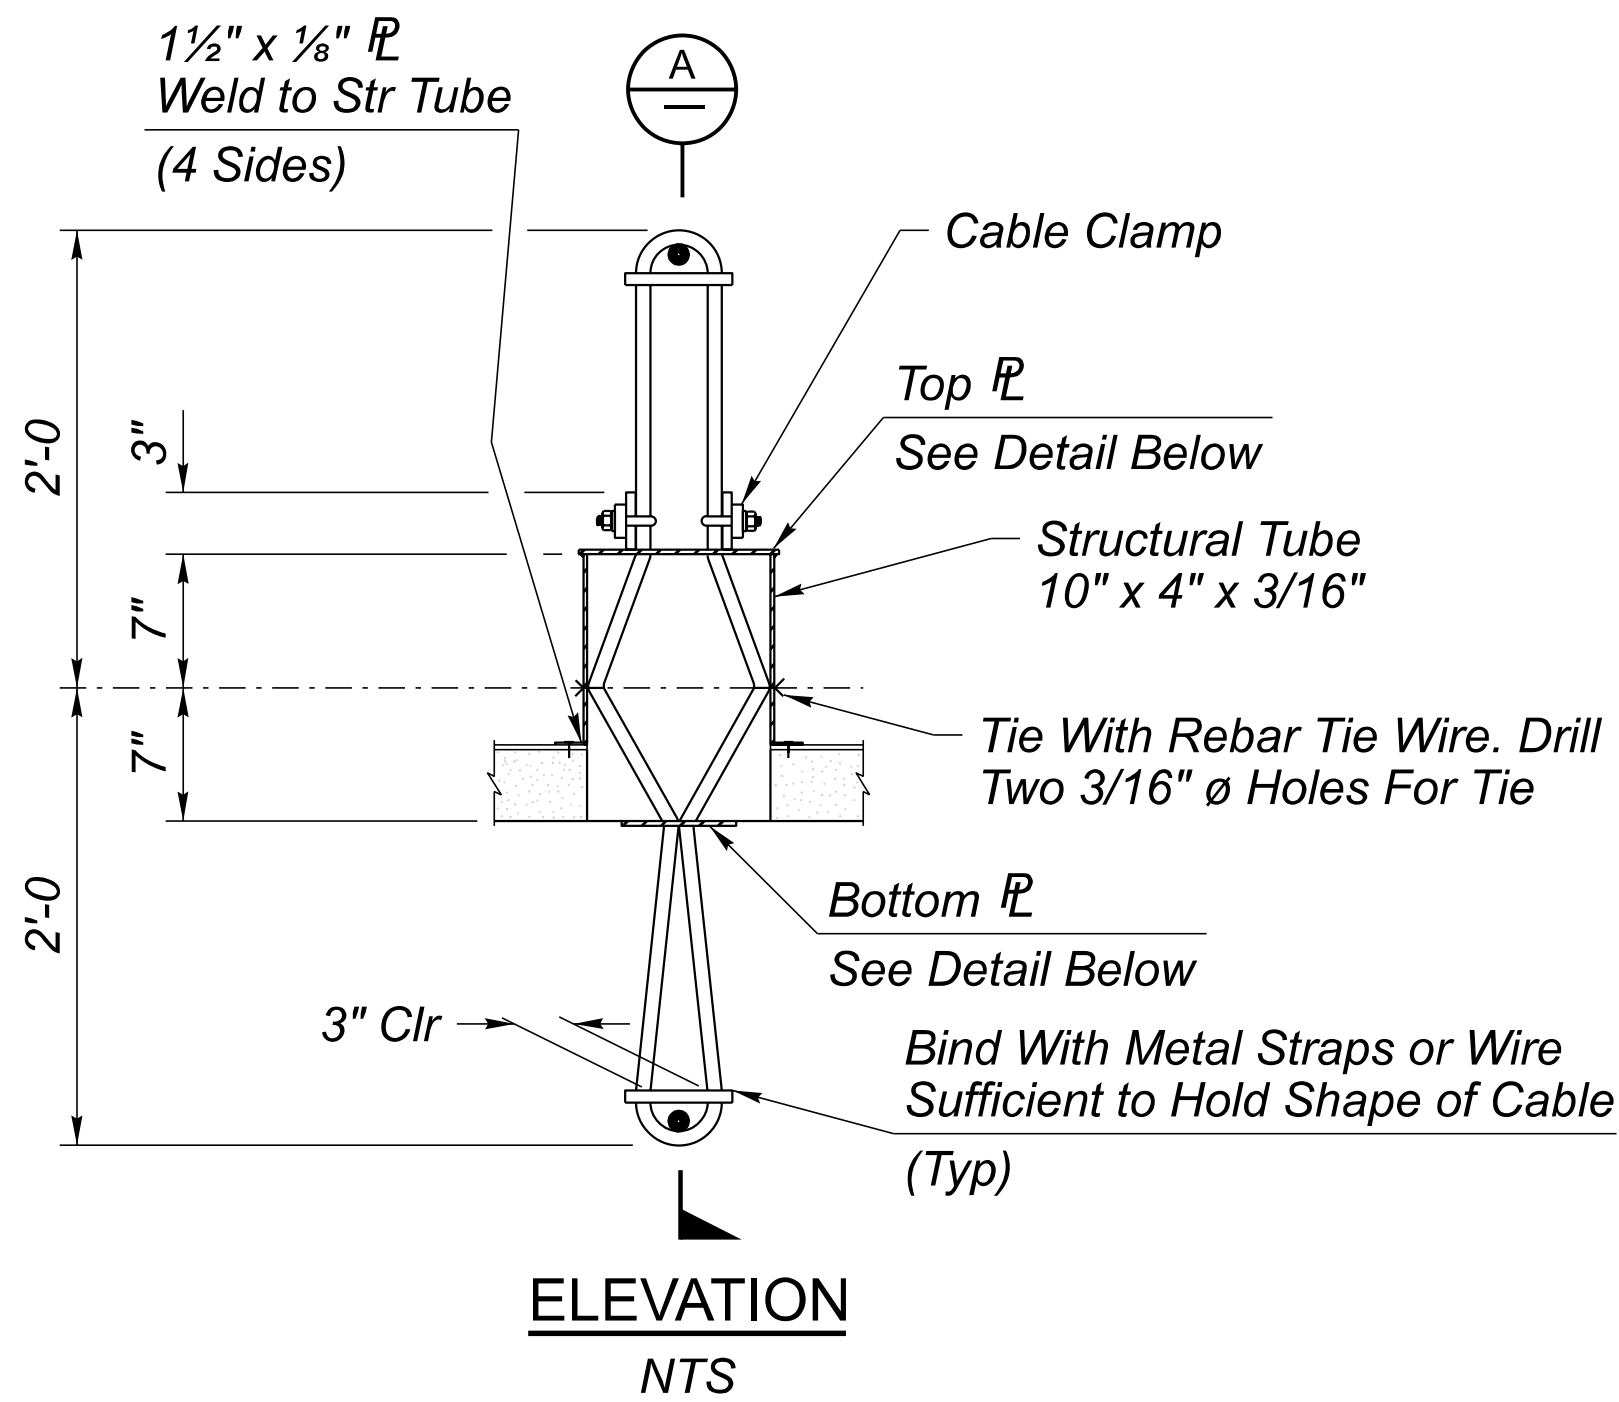


FIXED RESTRAINER DETAIL

Restrainer Cables shall be 3/4" Dia preformed 6x19 galvanized with a minimum breaking strength of 42 kips. One sample of cable 3 feet in length shall be furnished to the Engineer for testing.

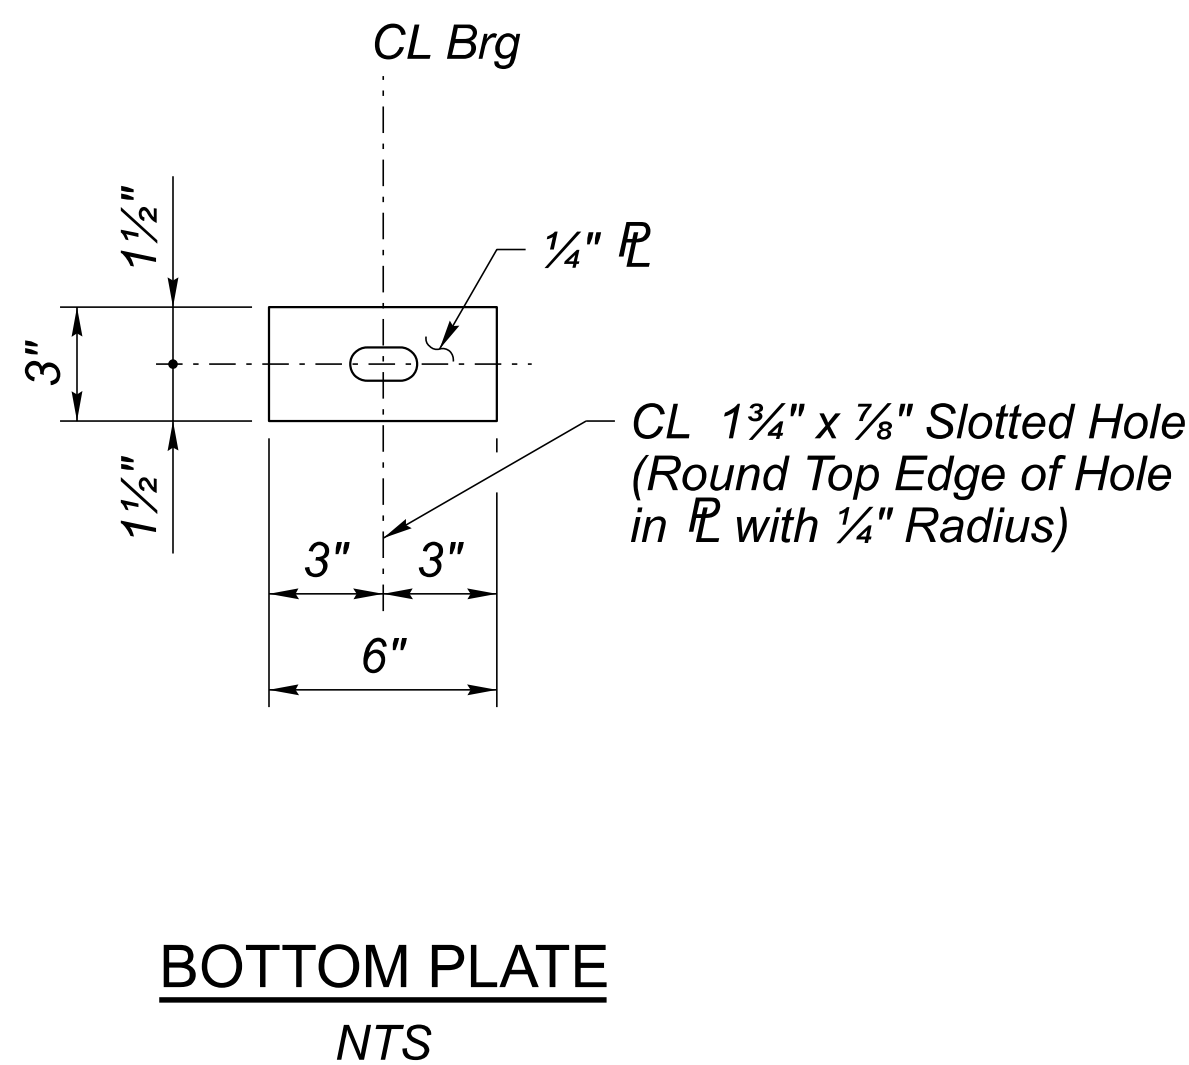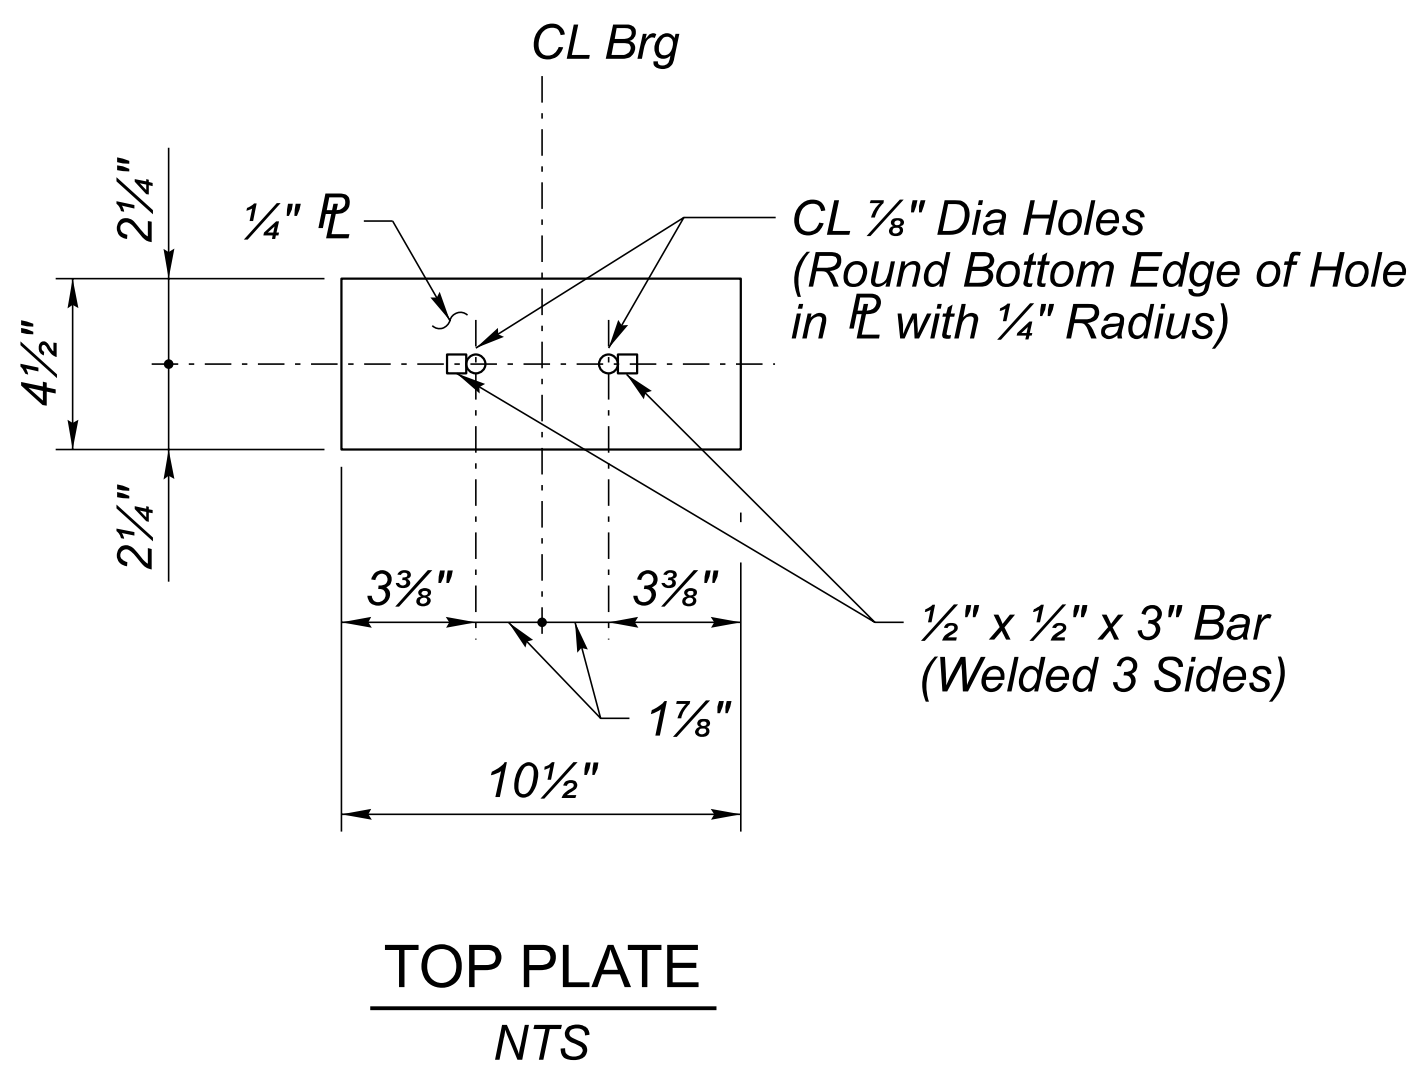

EXPANSION RESTRAINER DETAIL

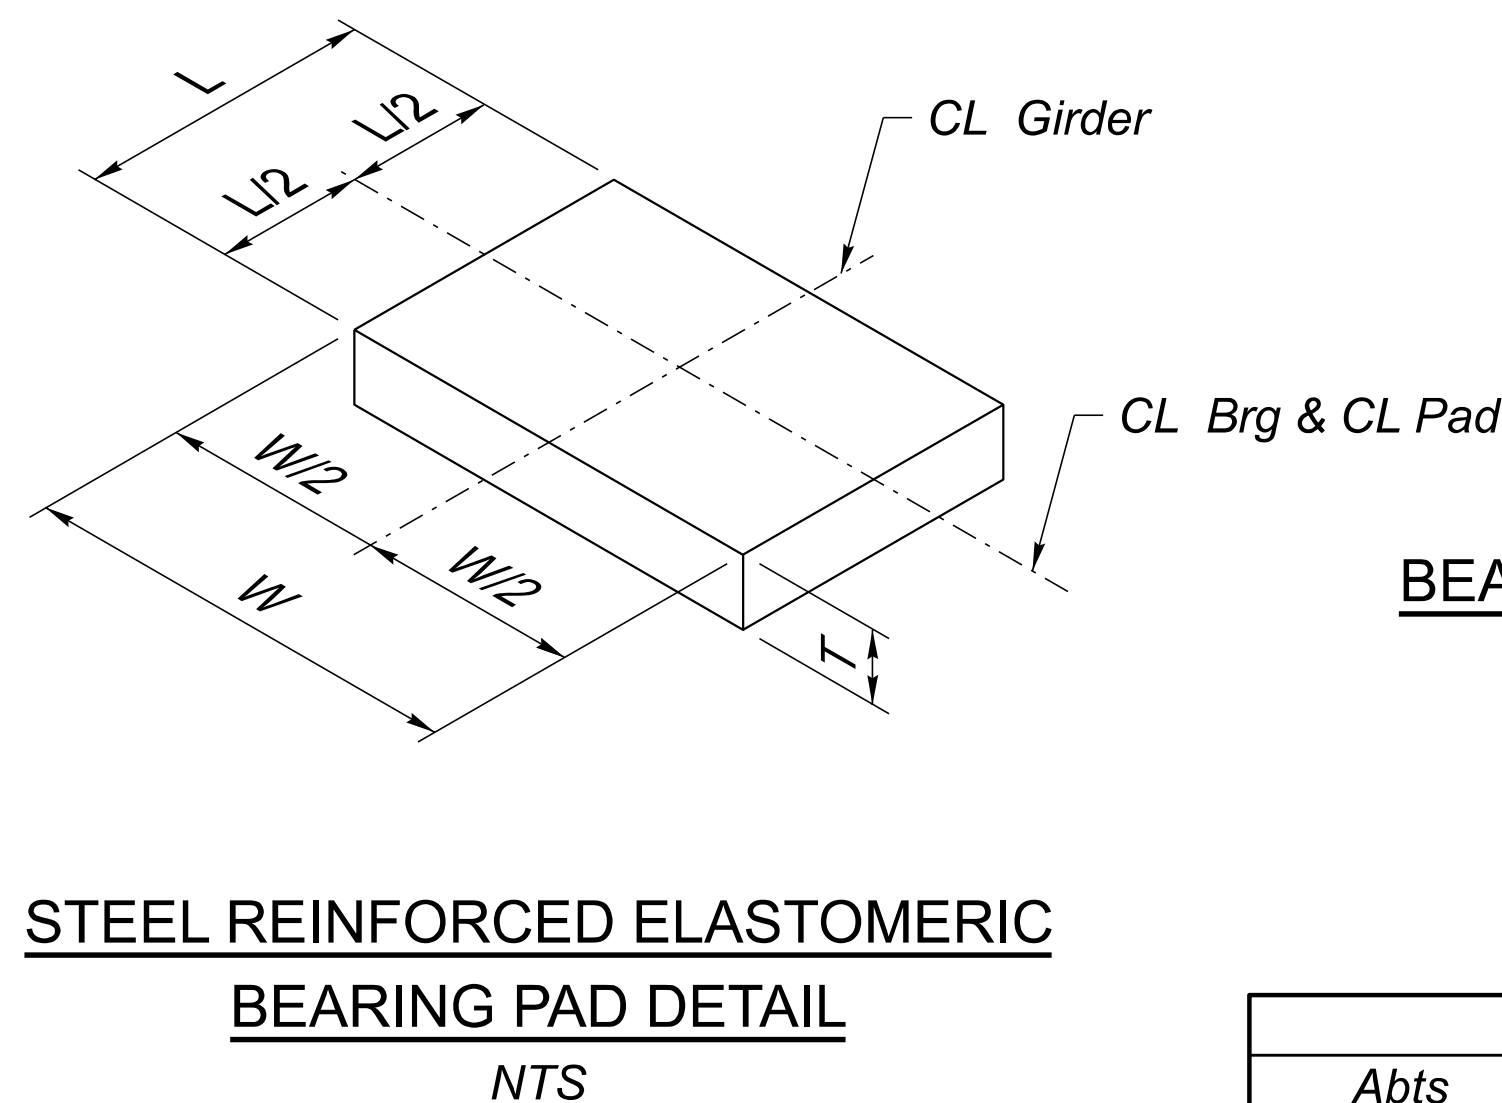

STEEL REINFORCED ELASTOMERIC BEARING PAD DETAIL

BEARING PAD DESIGN CRITERIA

Design Method A
Low Temperature Zone A
Elastomer Grade 0
130 psi Shear Modulus (Hardness 55)
Elastomeric Bearing Pads Shall Be
Steel Laminated Neoprene Pads

	T	L	W	Design Load
Abts	4"	12"	20"	212 kips
Piers	3"	10"	25"	267 kips

NOTES:

- Seal all openings in structural tube to prohibit concrete intrusion.
- Restrainer Cables shall be 3/4" dia preformed 6x19 galvanized with a minimum breaking strength of 42 kips. One sample of cable between 27 inches and 33 inches in length shall be furnished to the Engineer for testing.



	NAME	DATE
DESIGN	M. Noche	06/26
DRAWN	G. Zenuch	06/26
CHECKED	B. Ansley	06/26


TRANSPORTATION
AECOM TECHNICAL SERVICES, Inc.
7720 N. 16th St., Suite 100
Phoenix, Arizona 85020
T 602.371.1100

AECOM
www.aecom.com

ARIZONA DEPARTMENT OF TRANSPORTATION
INFRASTRUCTURE DELIVERY AND OPERATIONS DIVISION
BRIDGE GROUP


**US 93 SB BNSF OP BRIDGE
RESTRAINER & BEARING PAD DETAILS**

ROUTE US 93	F.H.W.A. Arizona Division	STATE ARIZ.	PROJECT NO. 093 YV 189	FEDERAL ID NO. 093-B-(230)T	SHEET NO. 431	TOTAL SHEETS 524	RECORD DRAWING
MILEPOST 192.90	LOCATION WICKENBURG RANCH WAY TO VISTA ROYALE					DWG No.	S-1.12
STRUCTURE NO. 20313	TRACS NO. F0738 01C					OF	

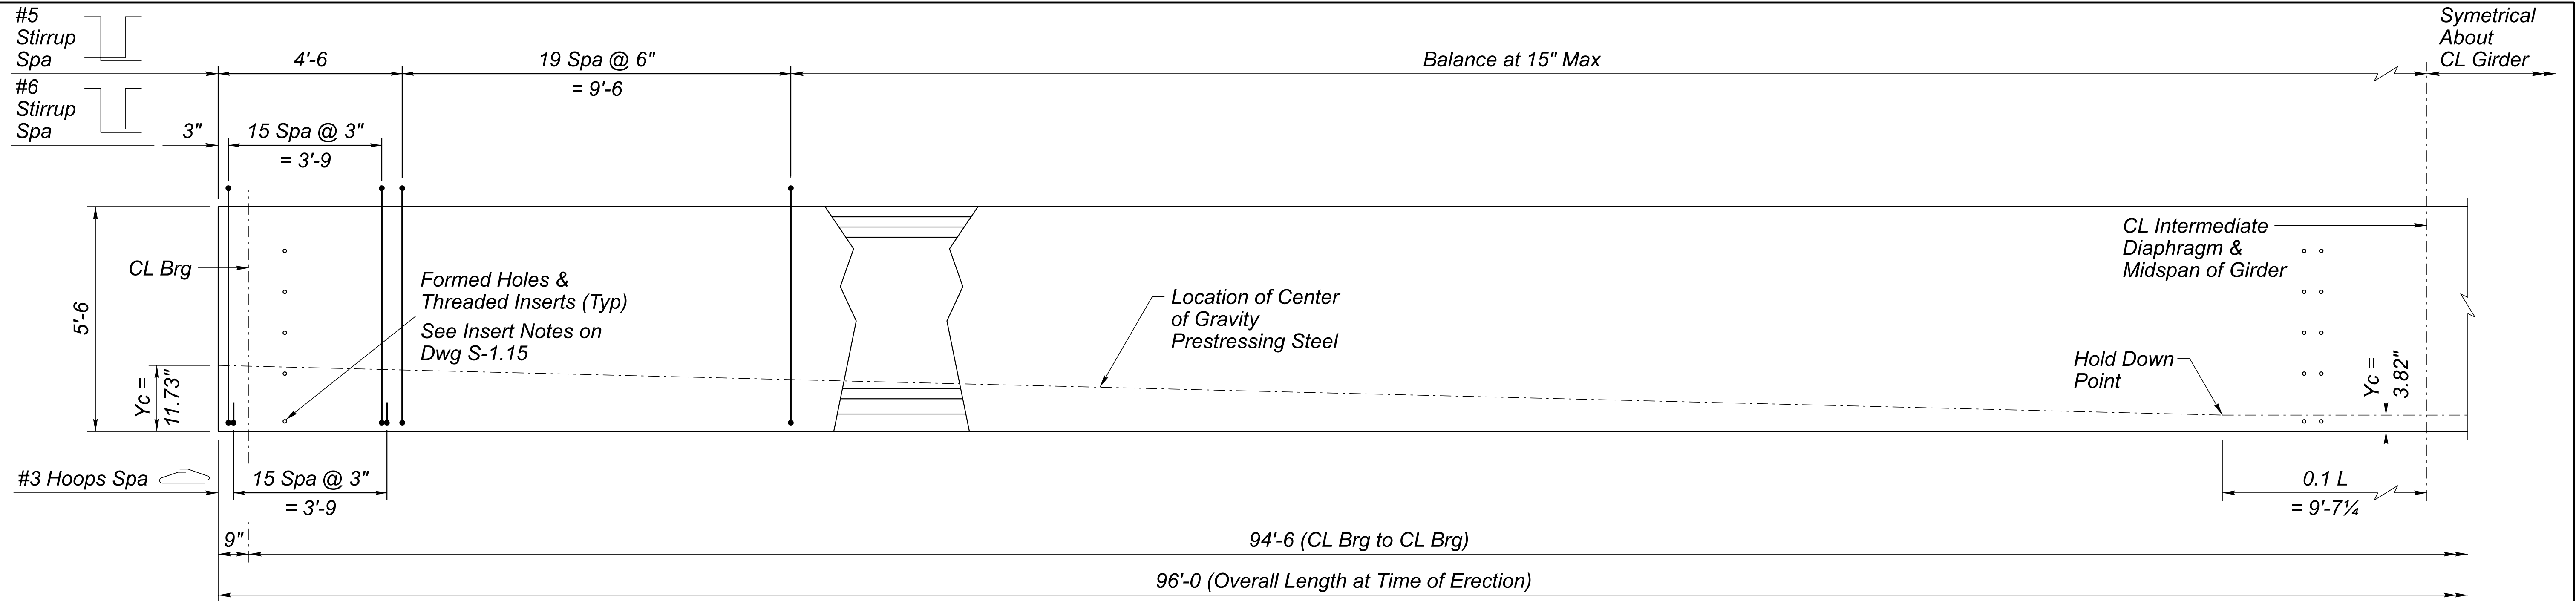


GIRDER ELEVATION AT SPAN 1 & 3

Scale: 1/2" = 1'-0

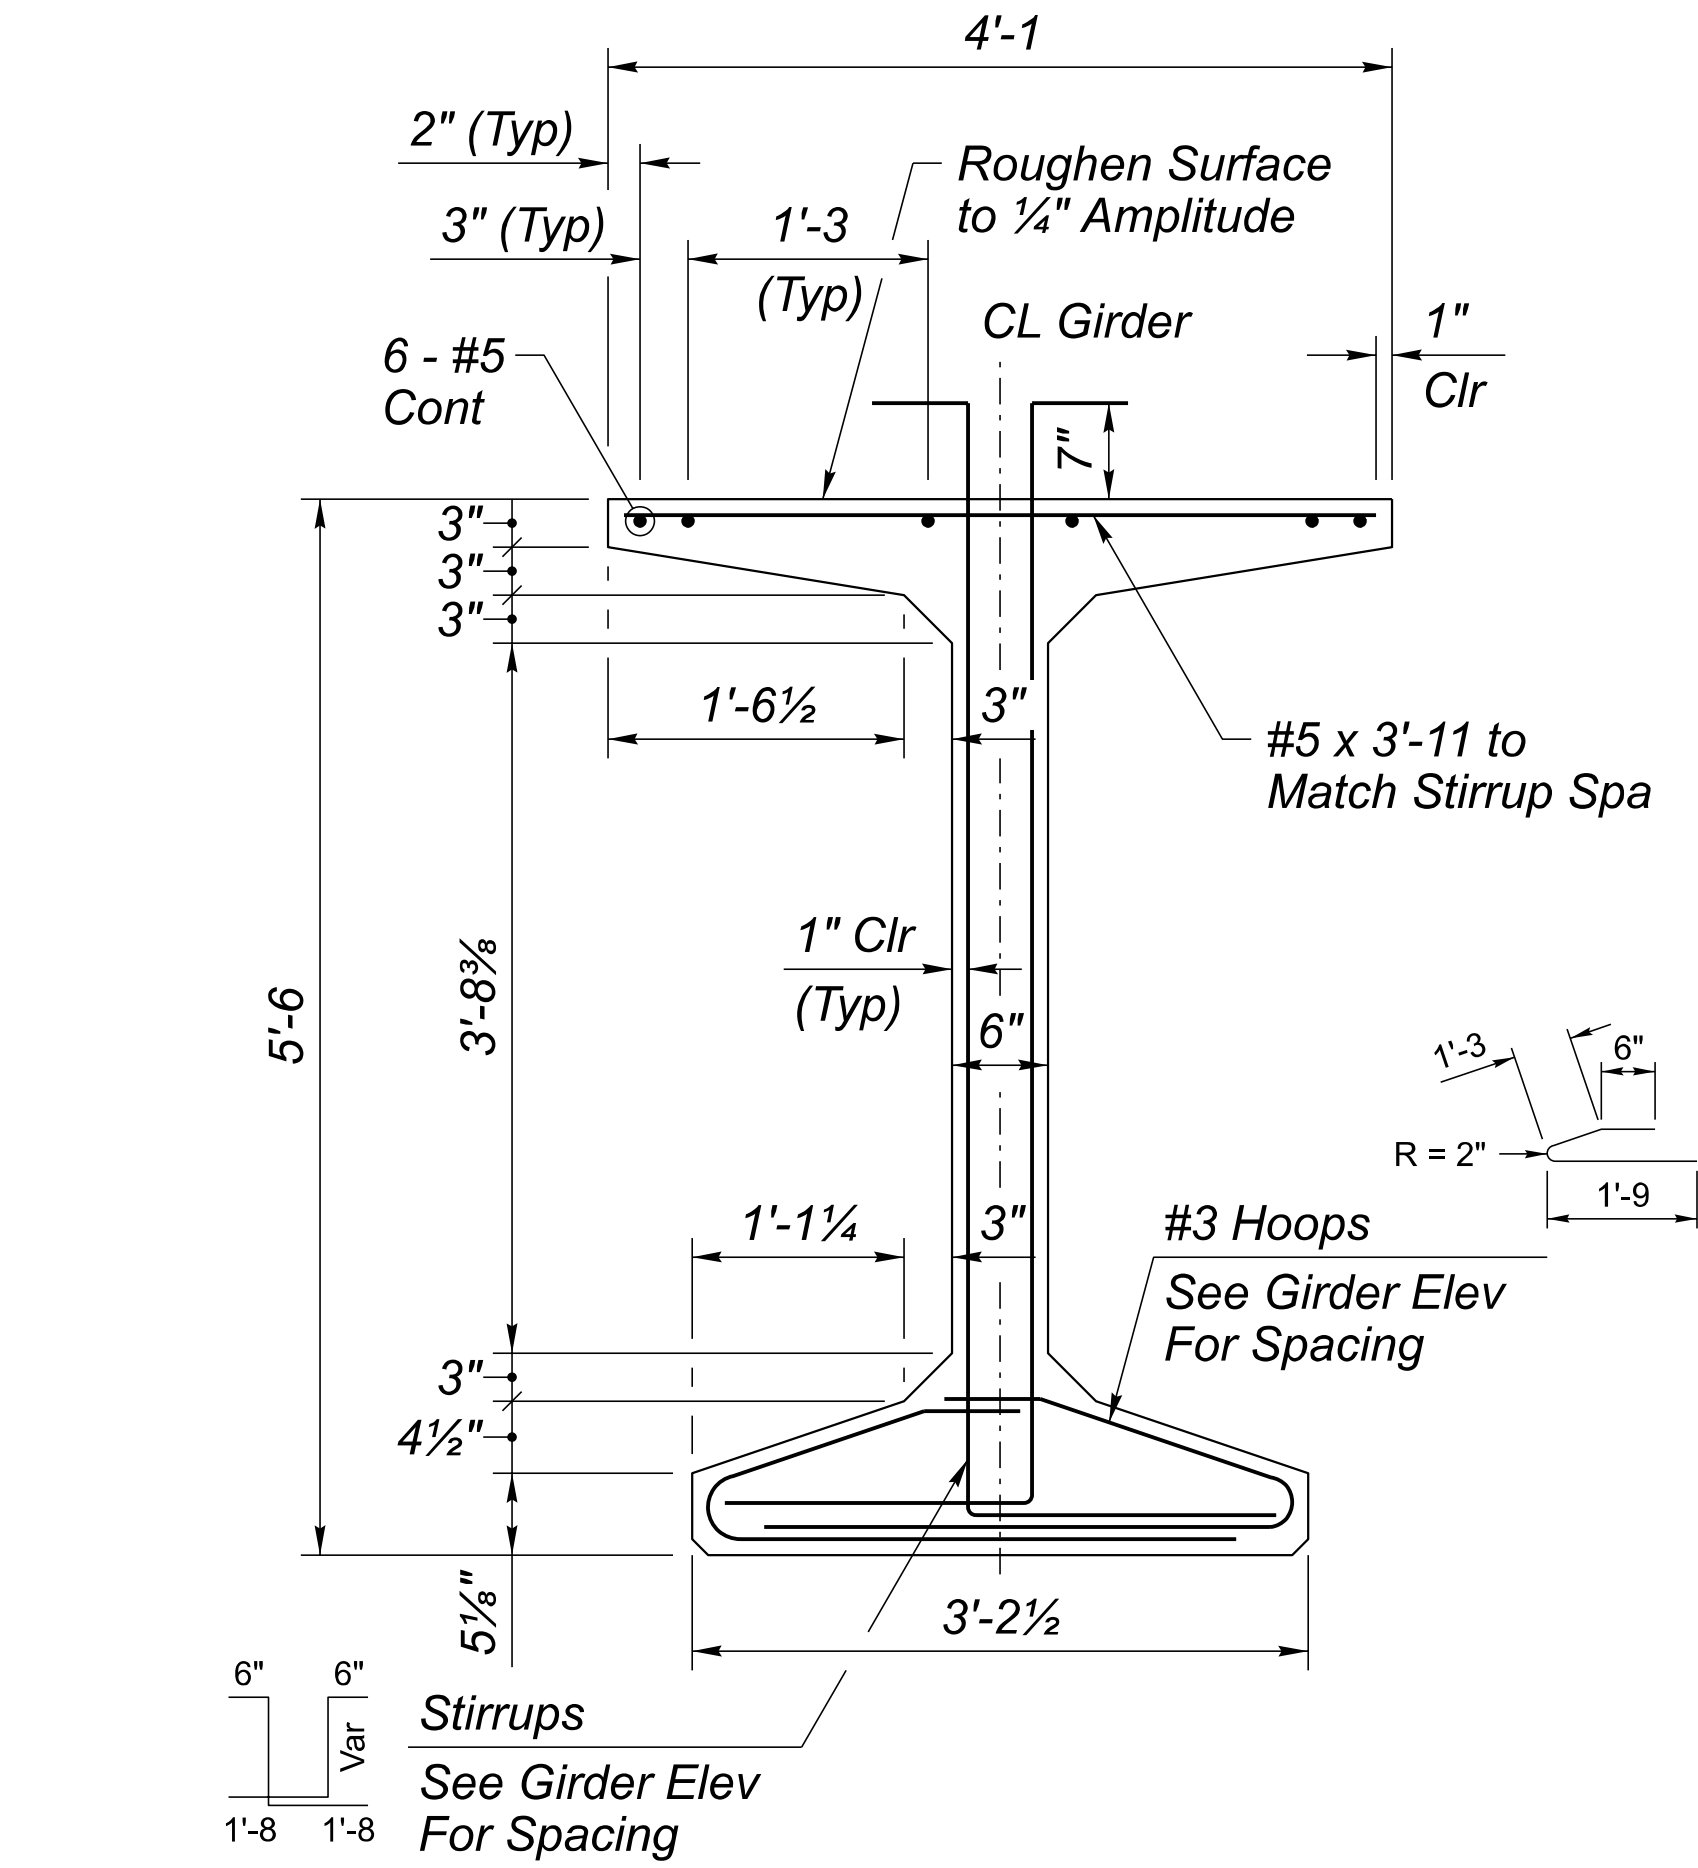

BT66 GIRDER

Scale: 1" = 1'-0

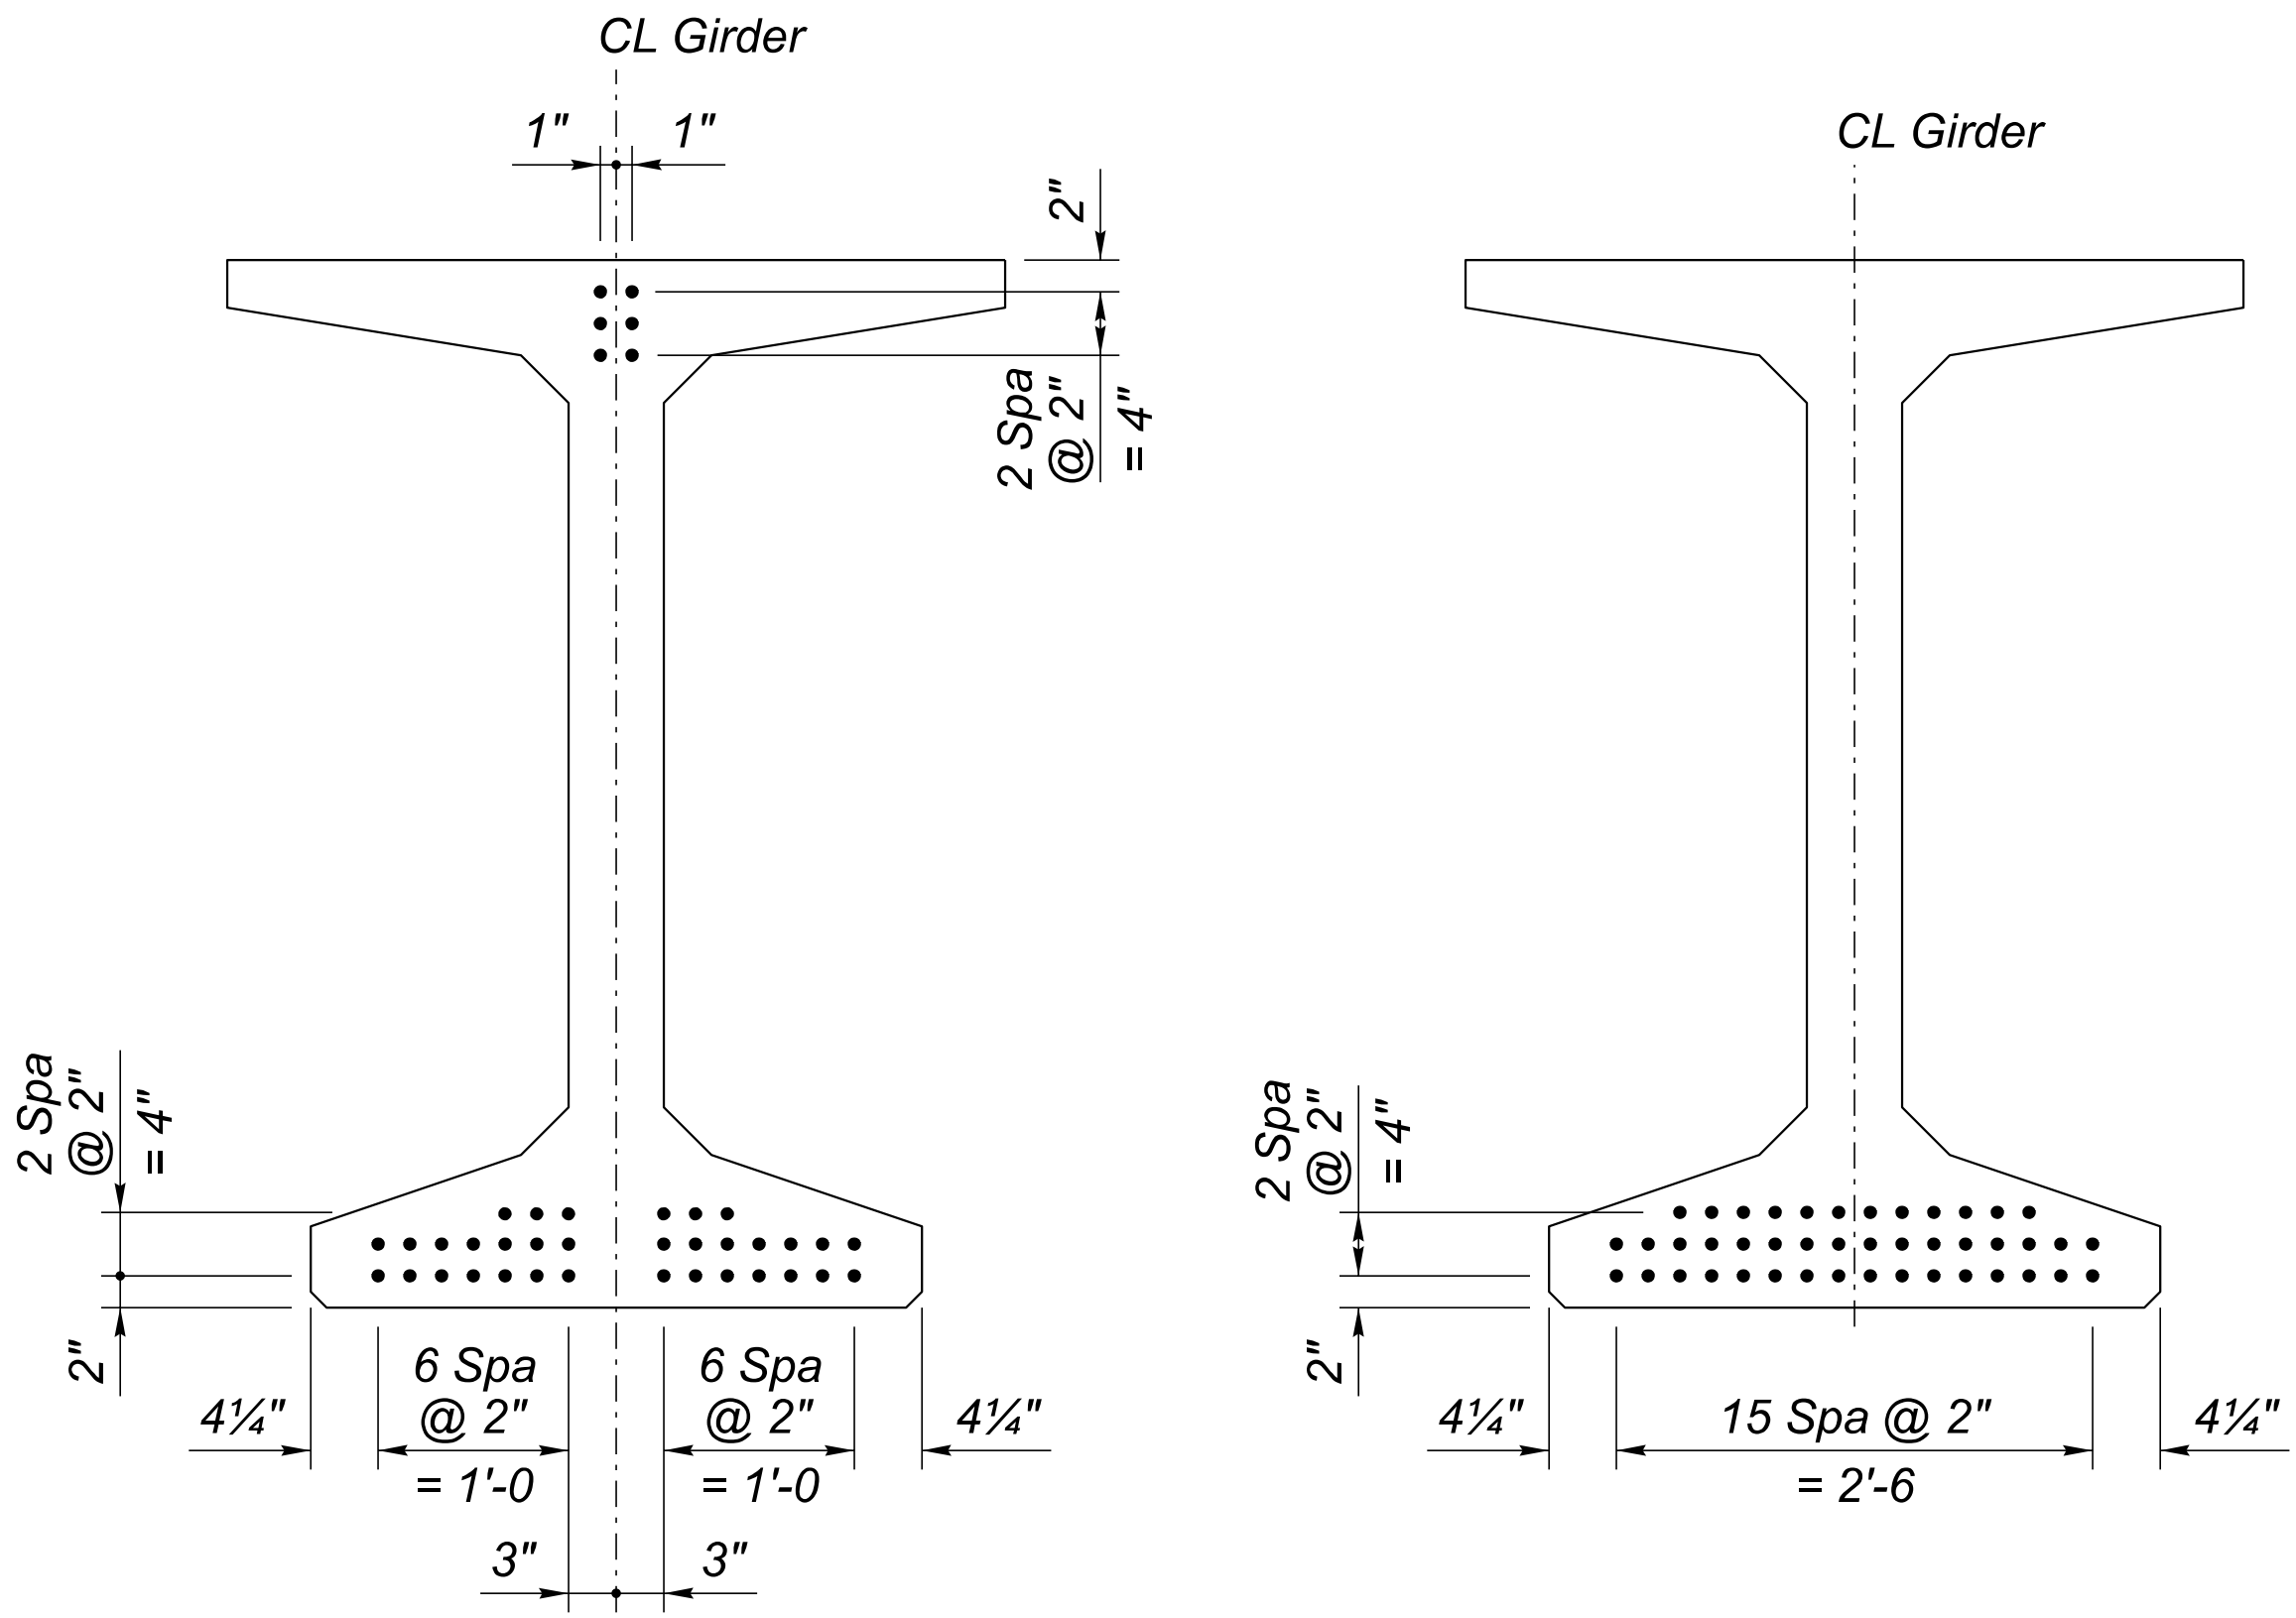

AT ENDS

STRAND PATTERN

AT MIDSPAN

Reinforcement Omitted For Clarity
Scale: 1" = 1'-0

SPAN 1 & 3 PRESTRESSING NOTES:

- 44 (6 harped & 38 straight) 0.6 inch dia 7-wire low-relaxation strands.
- See General Notes on Dwg S-1.02.
- Pi = 1933.47 kips. Initial tension before losses.
Pw = 1532.36 kips. Working force remaining after all losses.
fci = 7,000 psi minimum strength at transfer.
fc = 9,000 psi minimum strength at 28 days.
- All low-relaxation strands shall be stressed to 0.75 fpu.
- All girders shall be prestressed by the pretensioning method only.
- Use of masked strands will not be allowed.
- Yc = Distance to center of gravity of prestressing measured from bottom of girder.
- Cut strands flush with concrete at abutment ends & coat with an approved bituminous material.
- See Dwg S-1.16 for strand extensions at pier.
- For release & initial deflections, see Dwg S-1.16.
- Girder design utilizes transformed section properties of prestressing strands.
- Tops of girders shall be roughened transversely with a roughness amplitude of 1/4".
- See Insert Detail on Dwg S-1.15 for insert locations.




	NAME	DATE
DESIGN	M. Noche	06/26
DRAWN	G. Zenuch	06/26
CHECKED	B. Ansley	06/26

TRANSPORTATION
AECOM TECHNICAL SERVICES, Inc.
7720 N. 16th St., Suite 100
Phoenix, Arizona 85020
T 602.371.1100

AECOM
www.aecom.com


ARIZONA DEPARTMENT OF TRANSPORTATION INFRASTRUCTURE DELIVERY AND OPERATIONS DIVISION BRIDGE GROUP	ROUTE US 93 MILEPOST 192.90 STRUCTURE NO. 20313
US 93 SB BNSF OP BRIDGE GIRDER DETAILS (1 OF 4)	

F.H.W.A. Arizona Division	STATE ARIZ.	PROJECT NO. 093 YV 189	FEDERAL ID NO. 093-B-(230)T	SHEET NO. 432	TOTAL SHEETS 524	RECORD DRAWING
LOCATION WICKENBURG RANCH WAY TO VISTA ROYALE						DWG No. S-1.13
TRACS NO. F0738 01C						OF

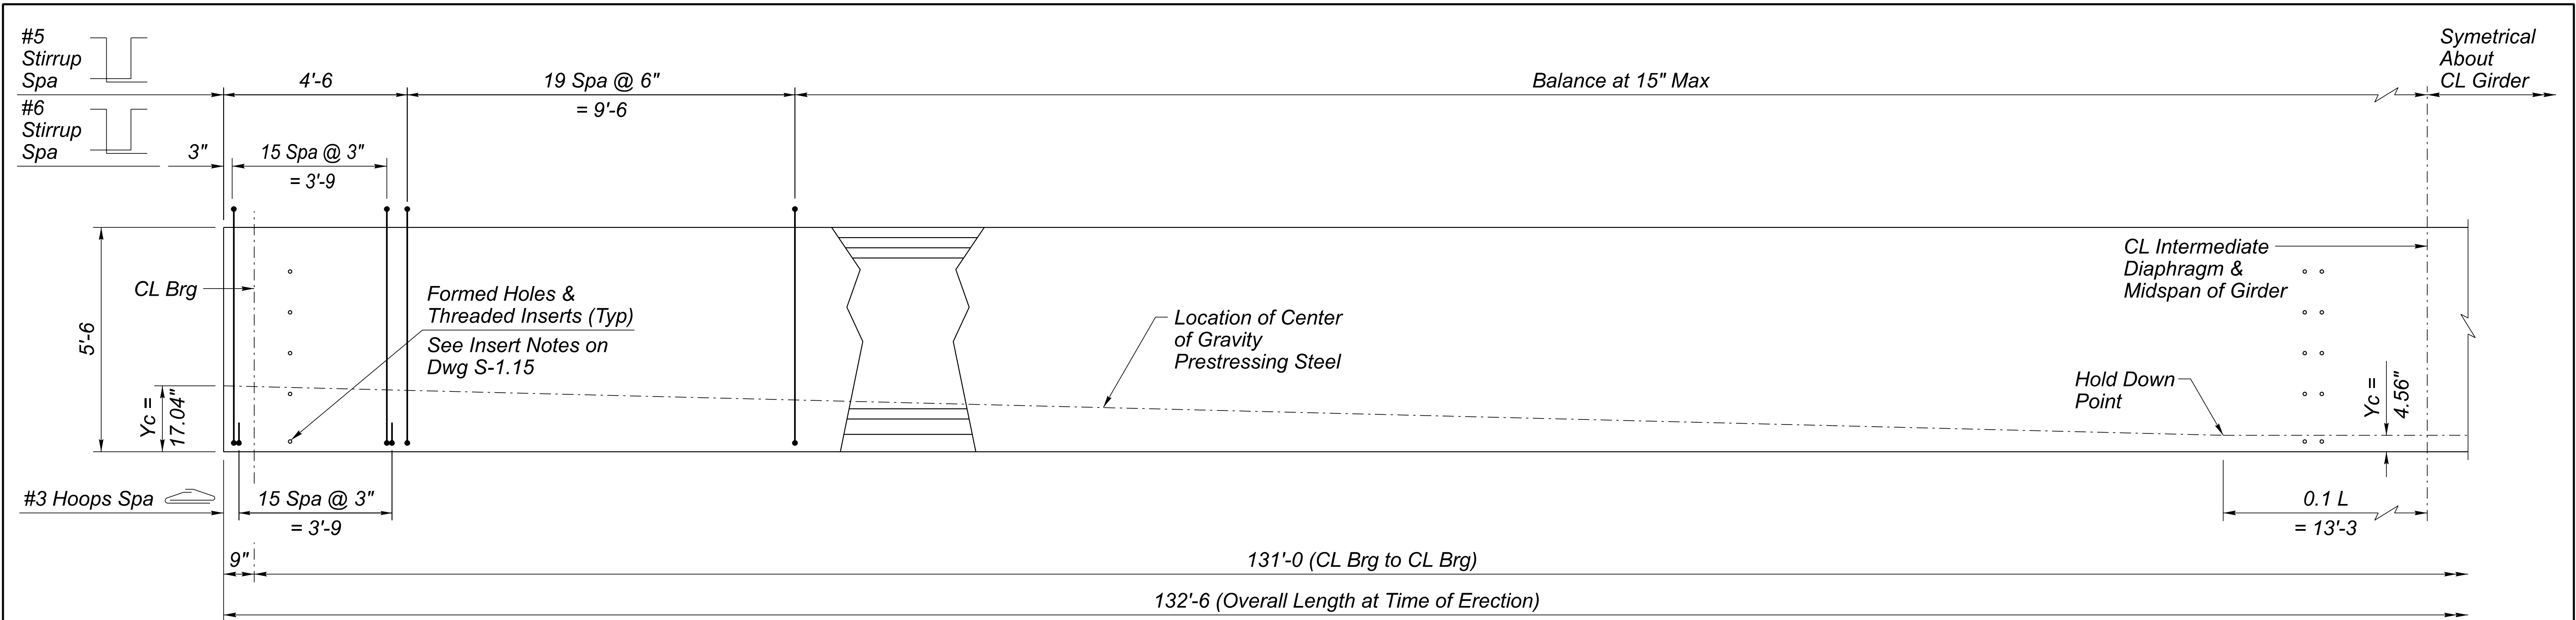


GIRDER ELEVATION AT SPAN 2

Scale: 1/2" = 1'-0

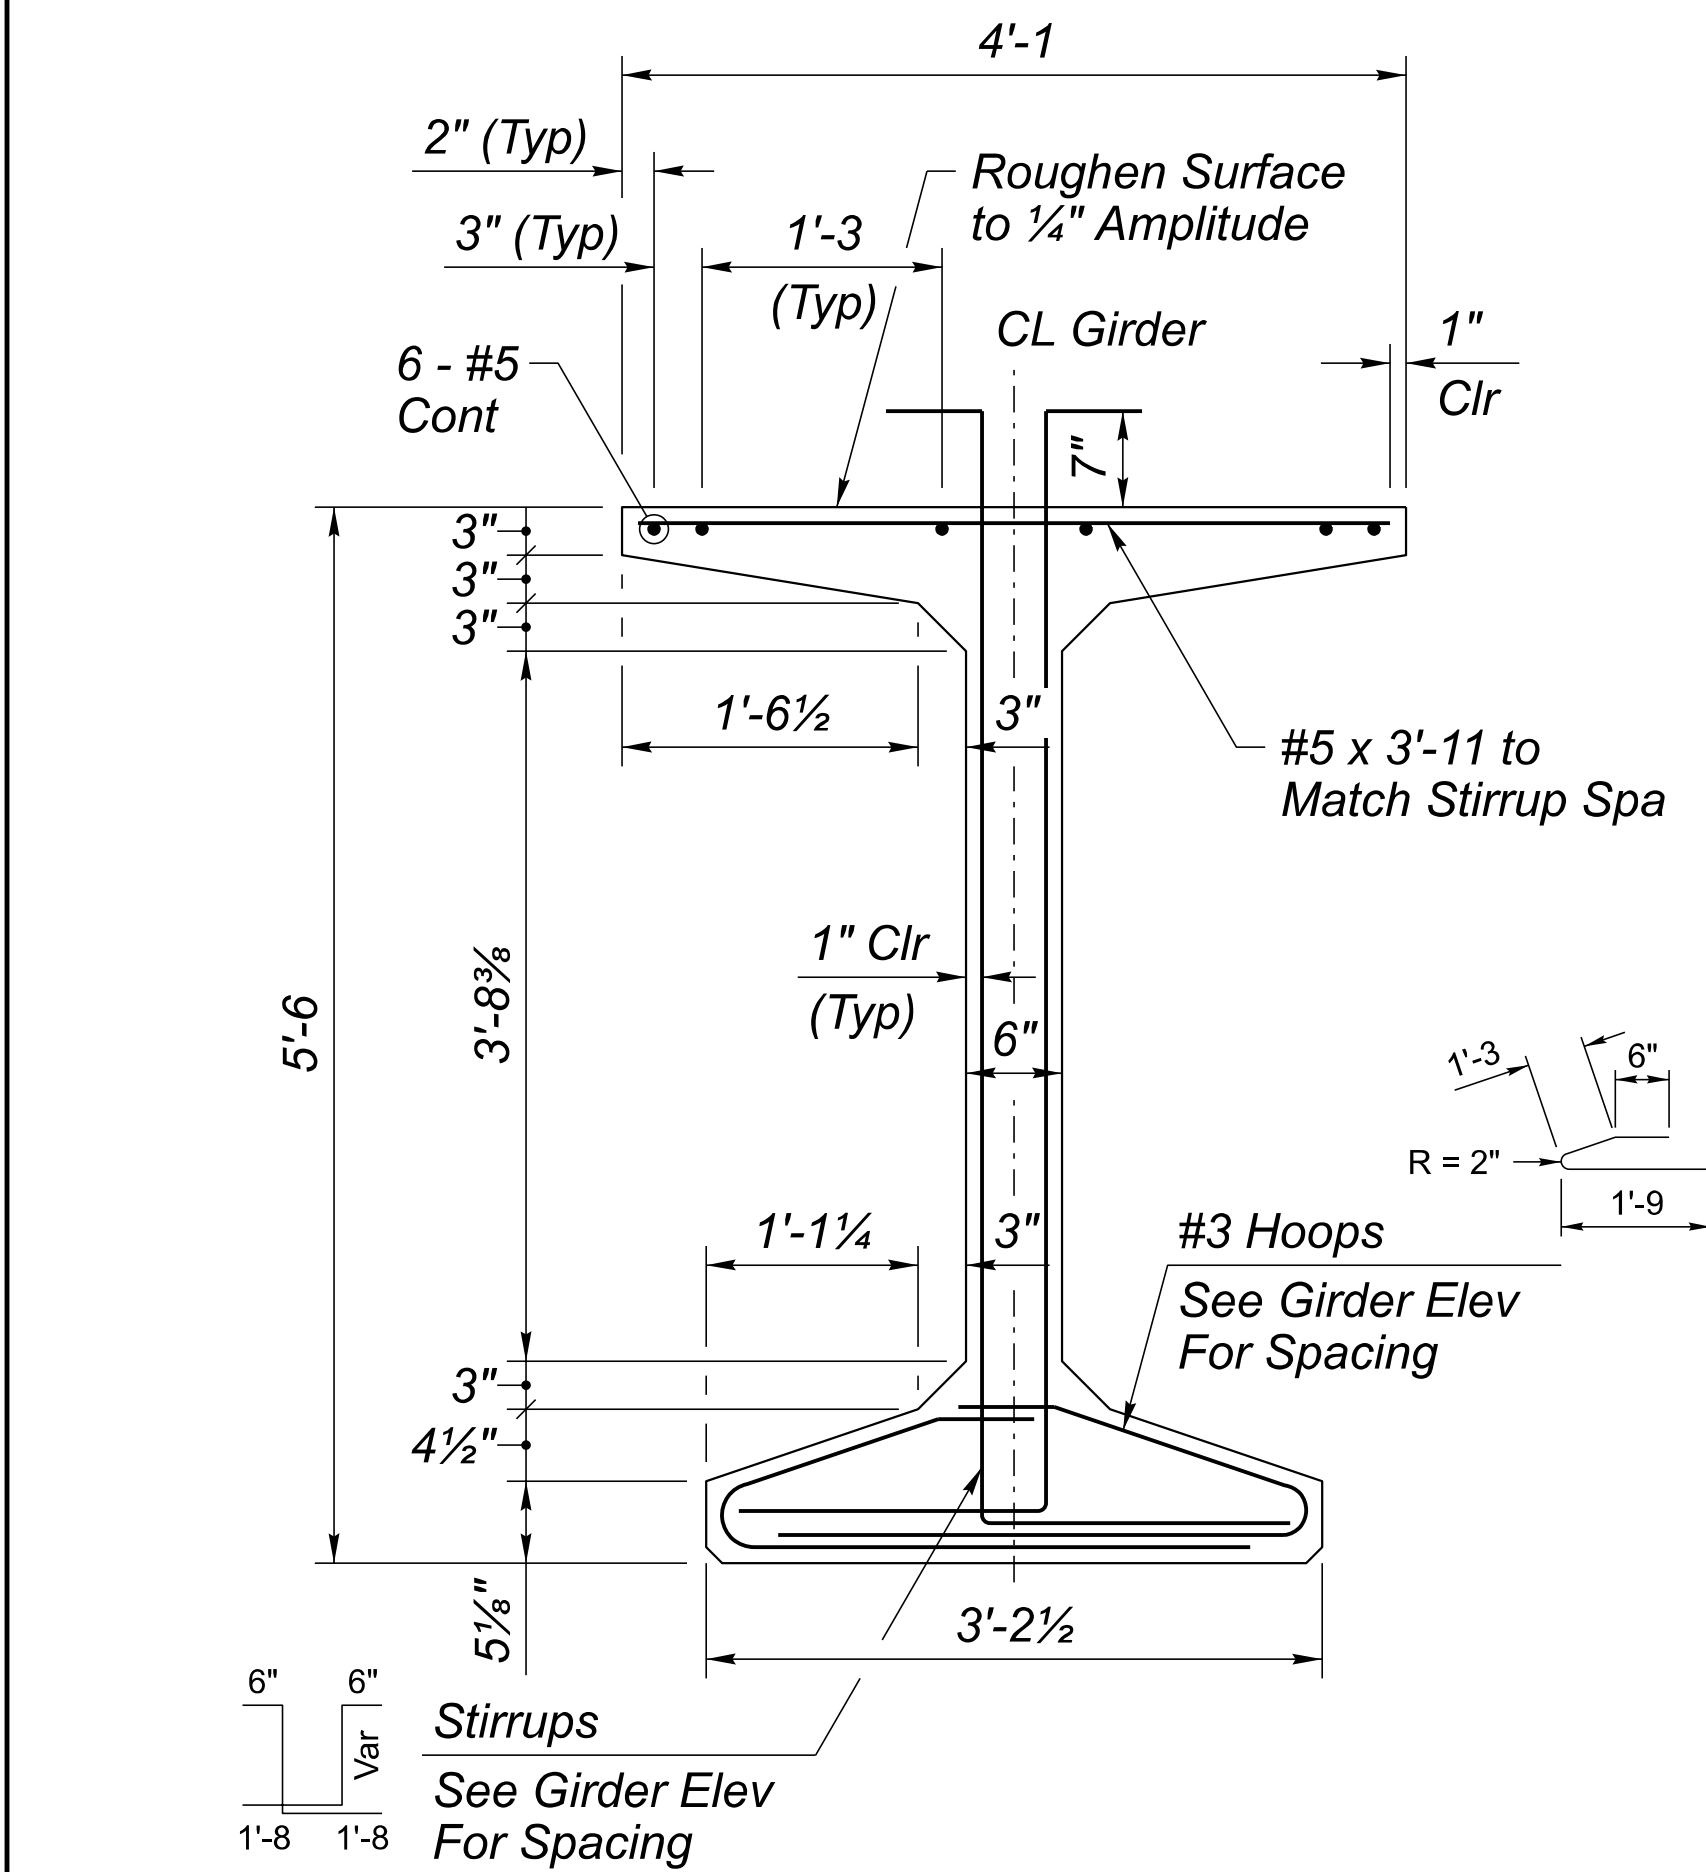

BT66 GIRDER

Scale: 1" = 1'-0

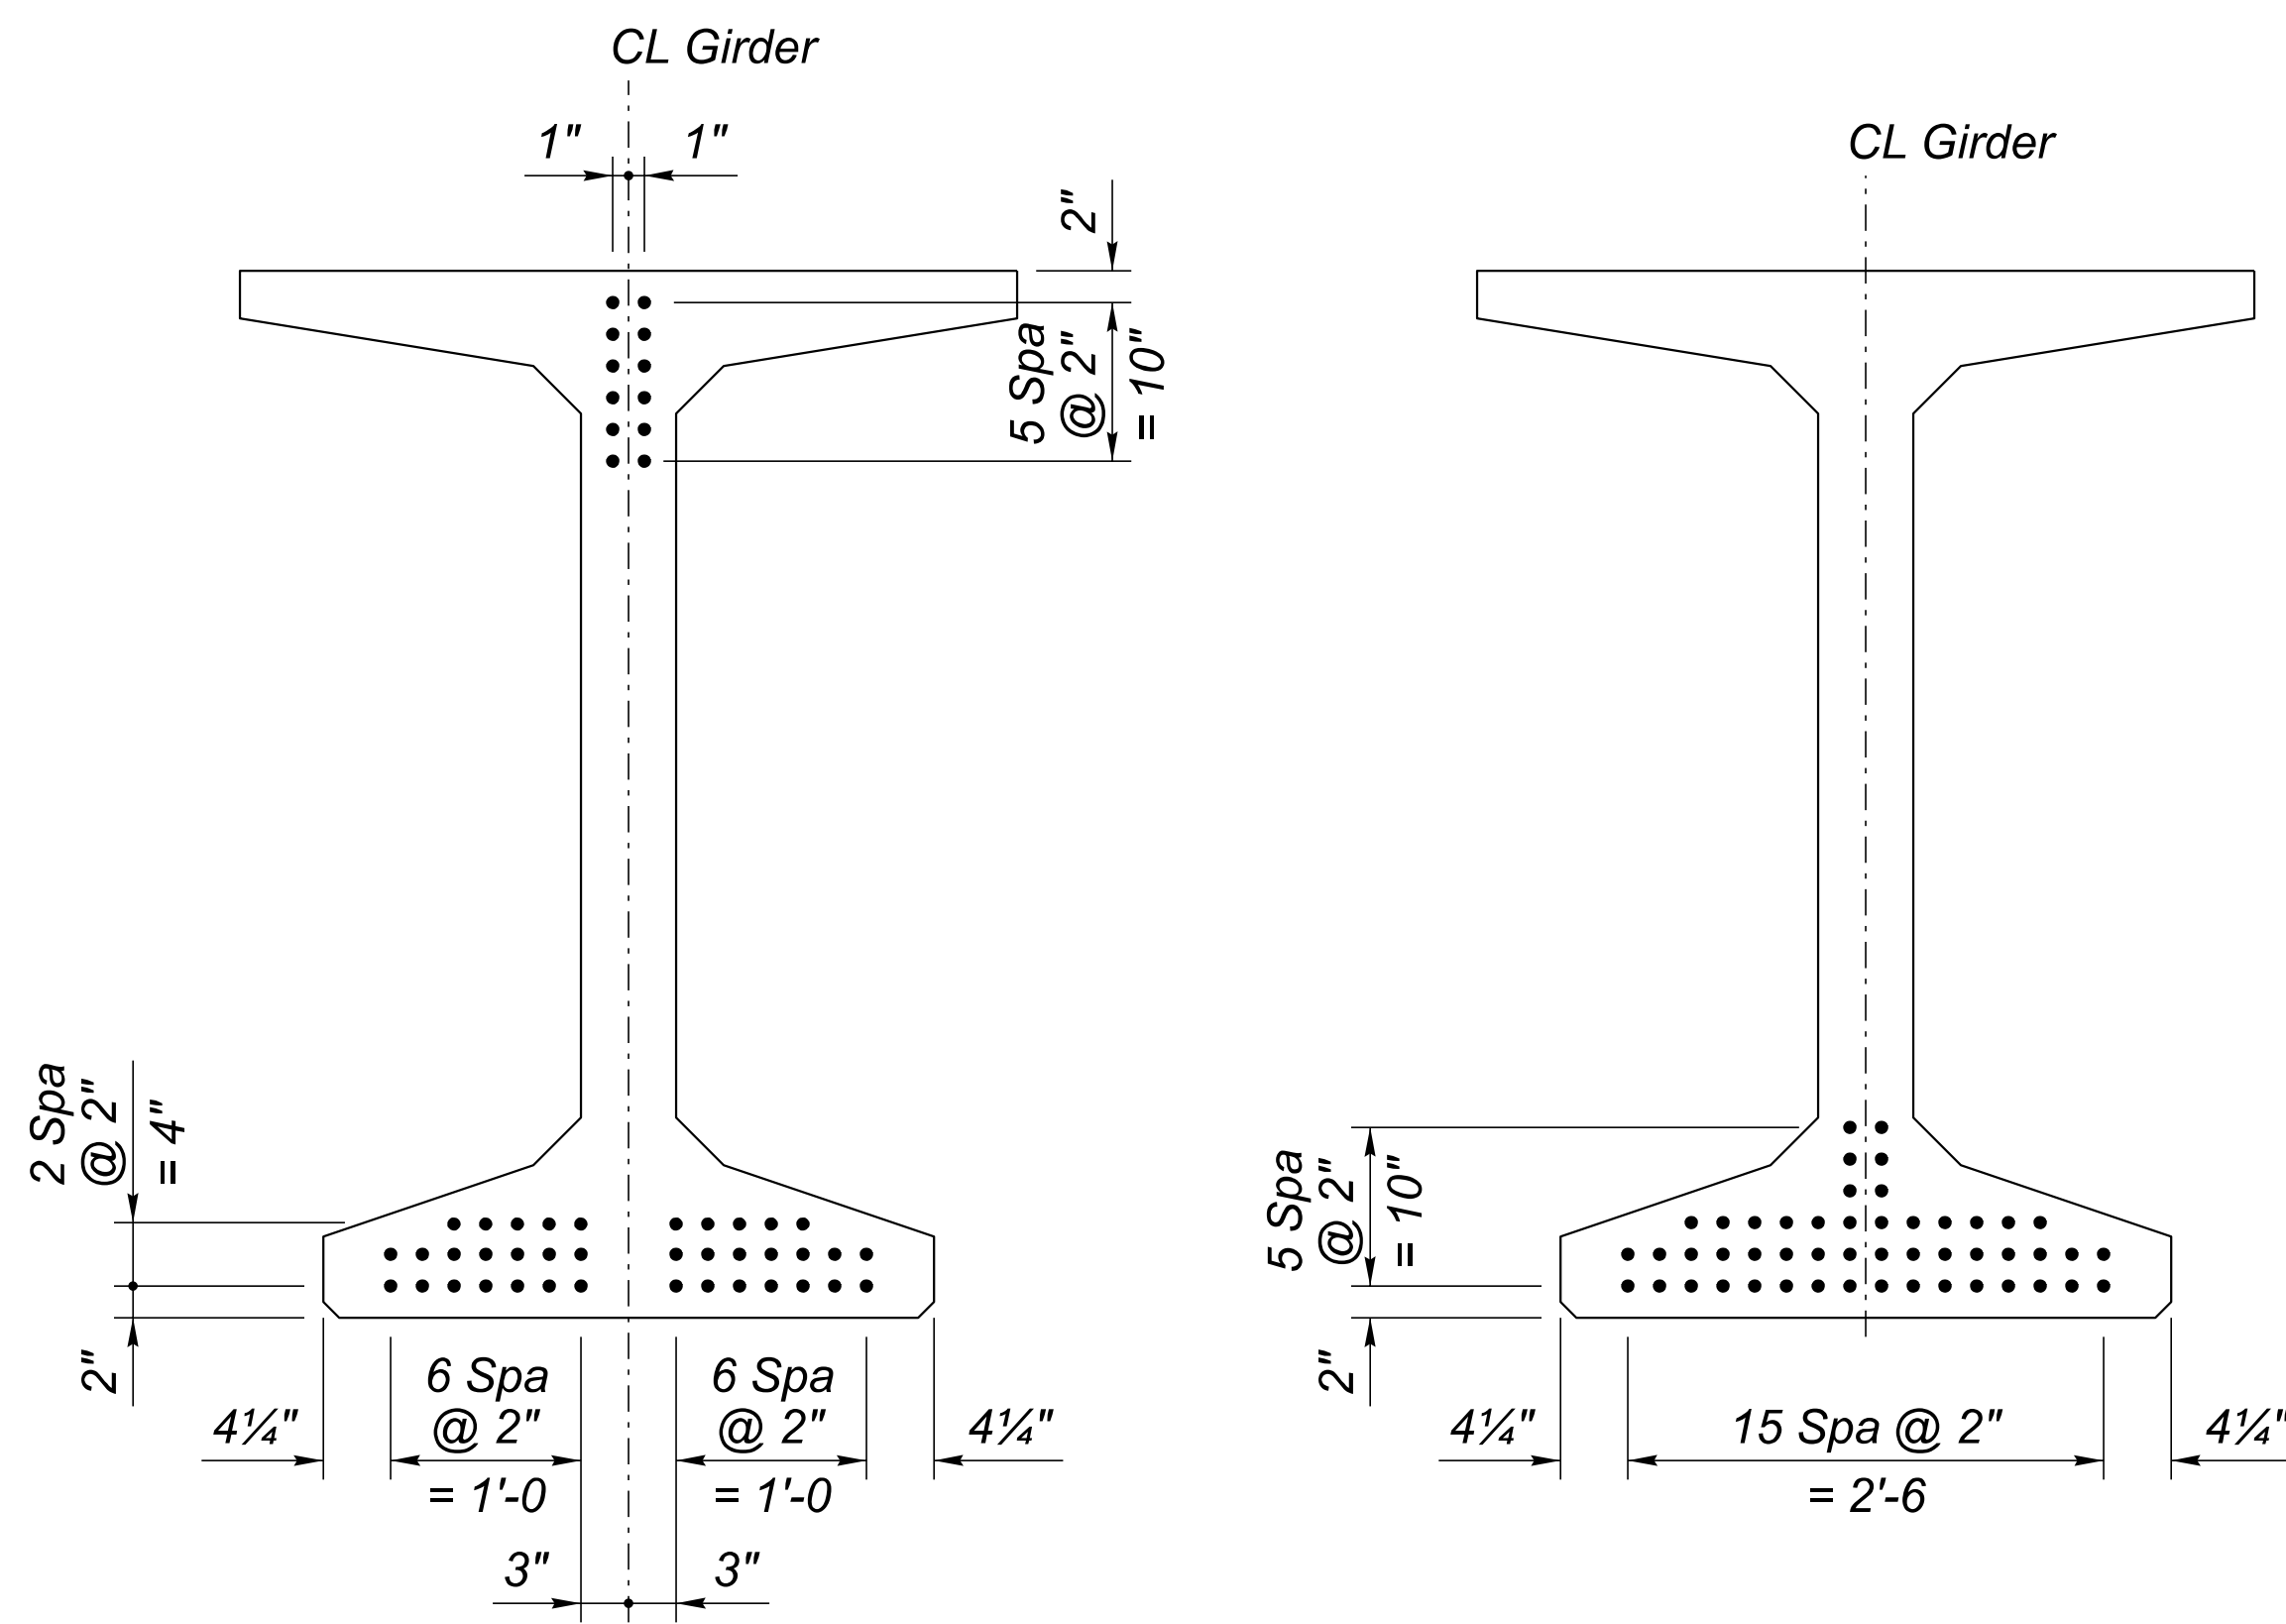

AT ENDS

STRAND PATTERN

Reinforcement Omitted For Clarity


Scale: 1" = 1'-0

AT MIDSPAN

SPAN 2 PRESTRESSING NOTES:

- 50 (12 harped & 38 straight) 0.6 inch dia 7-wire low-relaxation strands.
- See General Notes on Dwg S-1.02.
- Pi = 2197.13 kips. Initial tension before losses.
Pw = 1787.21 kips. Working force remaining after all losses.
fci = 7,000 psi minimum strength at transfer.
fc = 9,000 psi minimum strength at 28 days.
- All low-relaxation strands shall be stressed to 0.75 fpu.
- All girders shall be prestressed by the pretensioning method only.
- Use of masked strands will not be allowed.
- Yc = Distance to center of gravity of prestressing measured from bottom of girder.
- Cut strands flush with concrete at abutment ends & coat with an approved bituminous material.
- See Dwg S-1.16 for strand extensions at pier.
- For release & initial deflections, see Dwg S-1.16.
- Girder design utilizes transformed section properties of prestressing strands.
- Tops of girders shall be roughened transversely with a roughness amplitude of 1/4".
- See Insert Detail on Dwg S-1.15 for insert locations.


																																																																																																																																																																																																																																																																																																																																																																																																																																																																																																																																																																																																																																																																																																																																																																																																																																																																																																																																																																																																																																																																																																																																																																																																																																																																																																																																																																																																								</
--	--	----

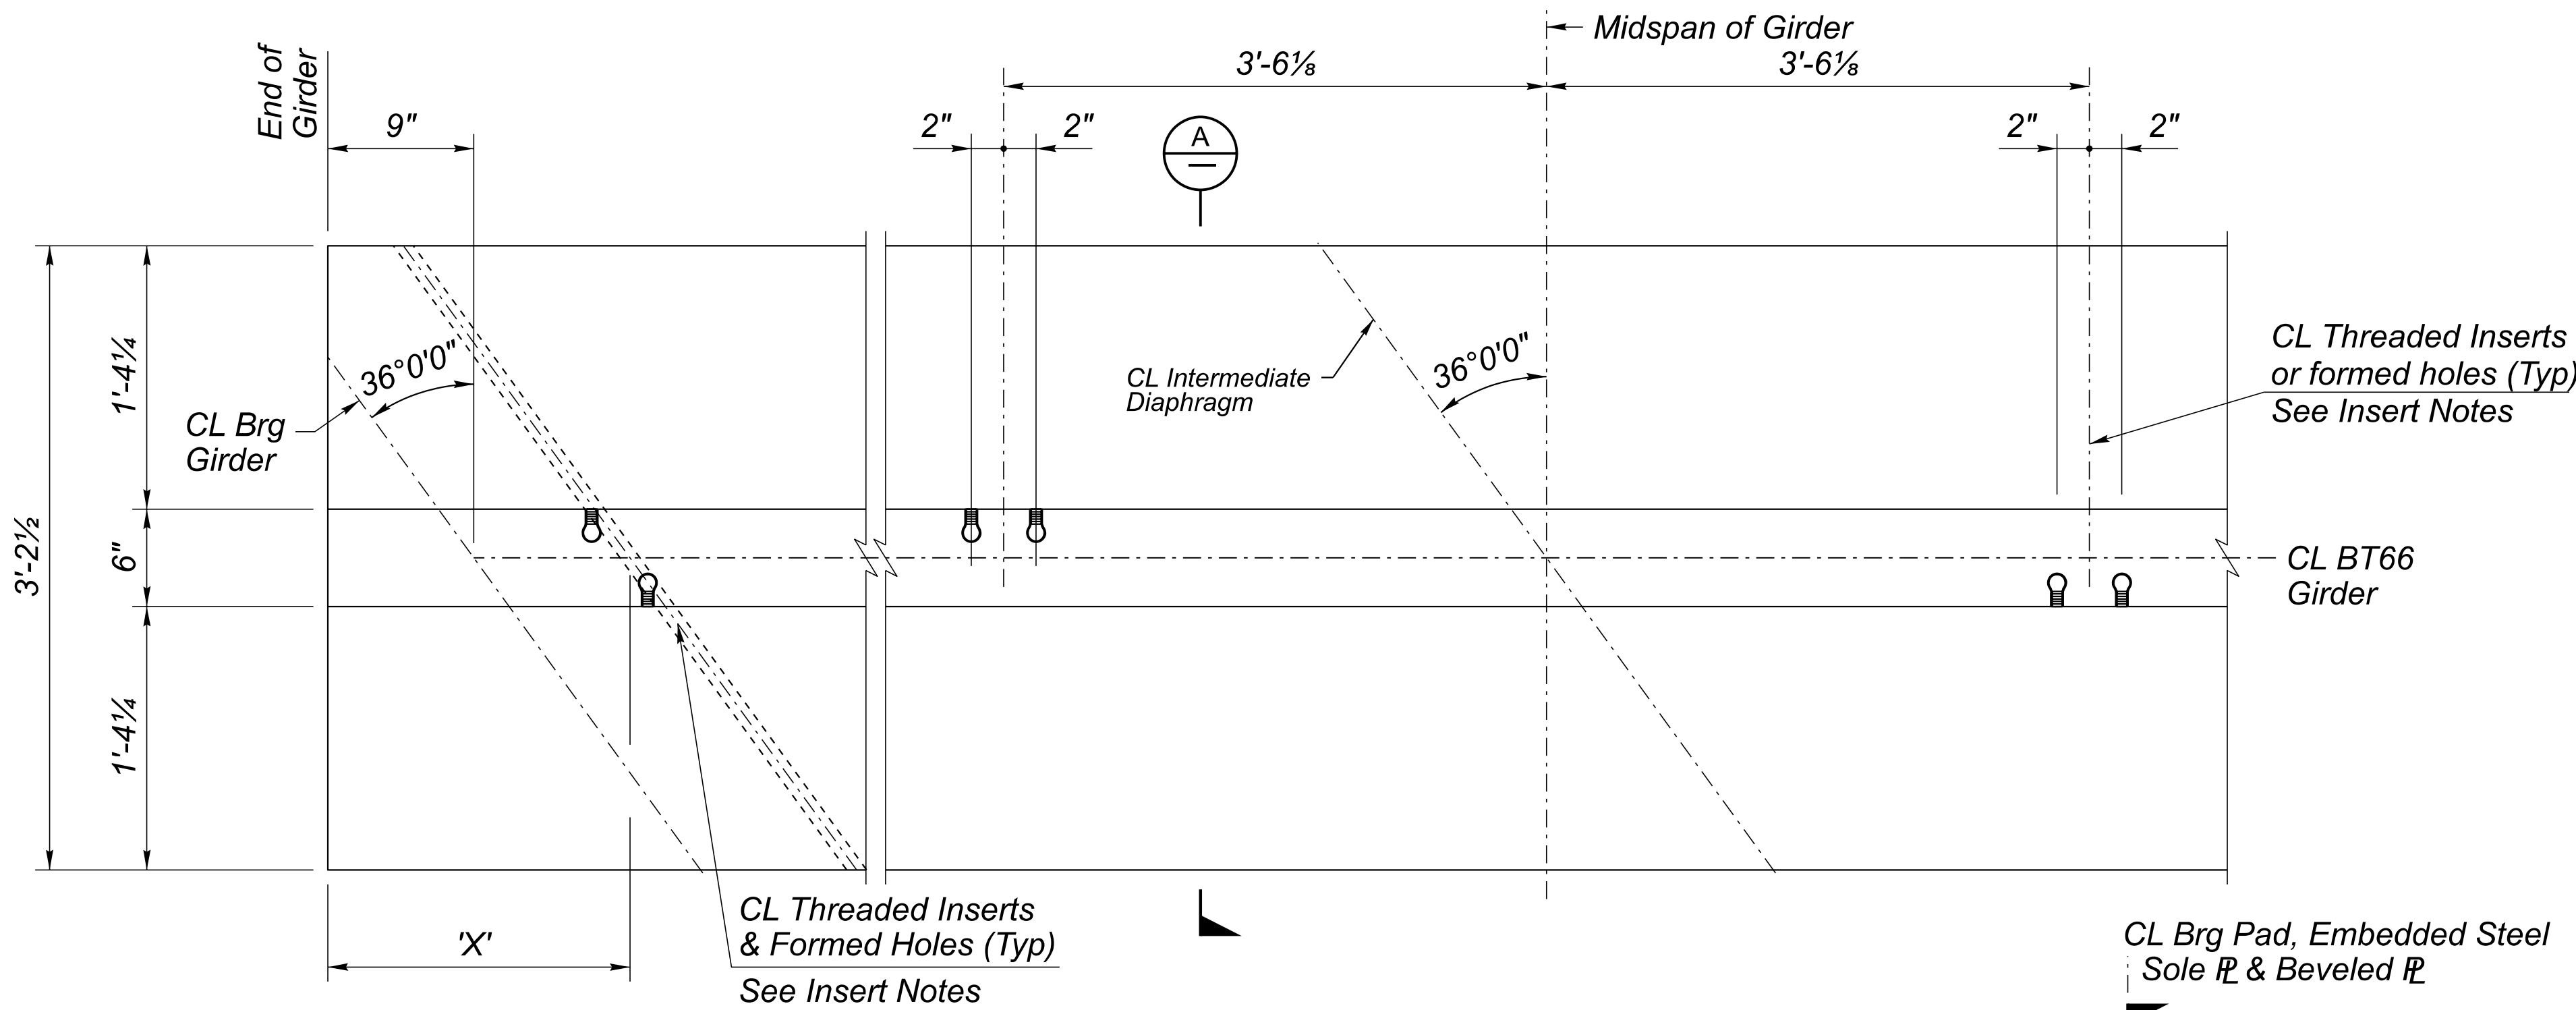


INSERT DETAIL
Scale: 1 $\frac{1}{2}$ " = 1'-0

INSERT & FORMED HOLE NOTES:


1. Threaded inserts are ferrule loop inserts for #5 reinforcing bars threaded on end. Inserts shall have a 10,800 lb ultimate pullout strength.
2. Threaded inserts shall be placed normal to girder surface.
3. Cost of threaded inserts & threaded bars shall be included in the bid item for prestressed girders.
4. Omit bottom flange formed holes at intermediate diaphragms.

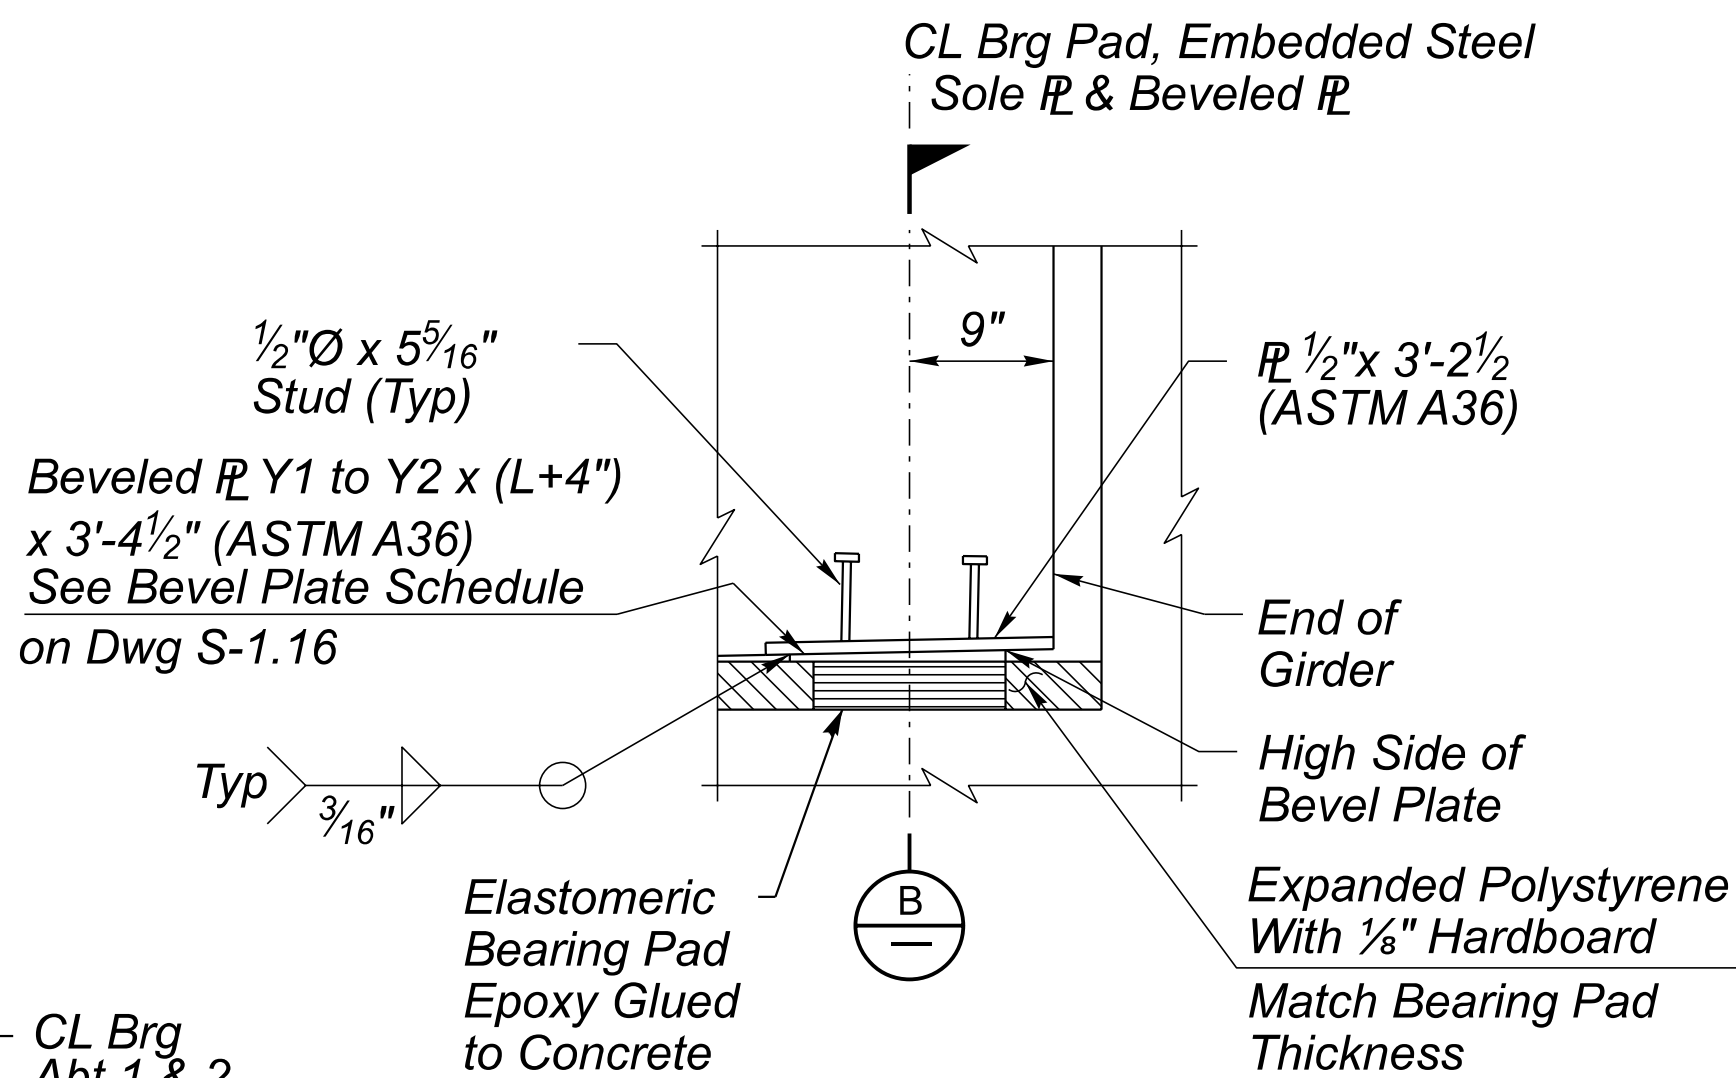


GIRDER SHIM DETAIL
NTS

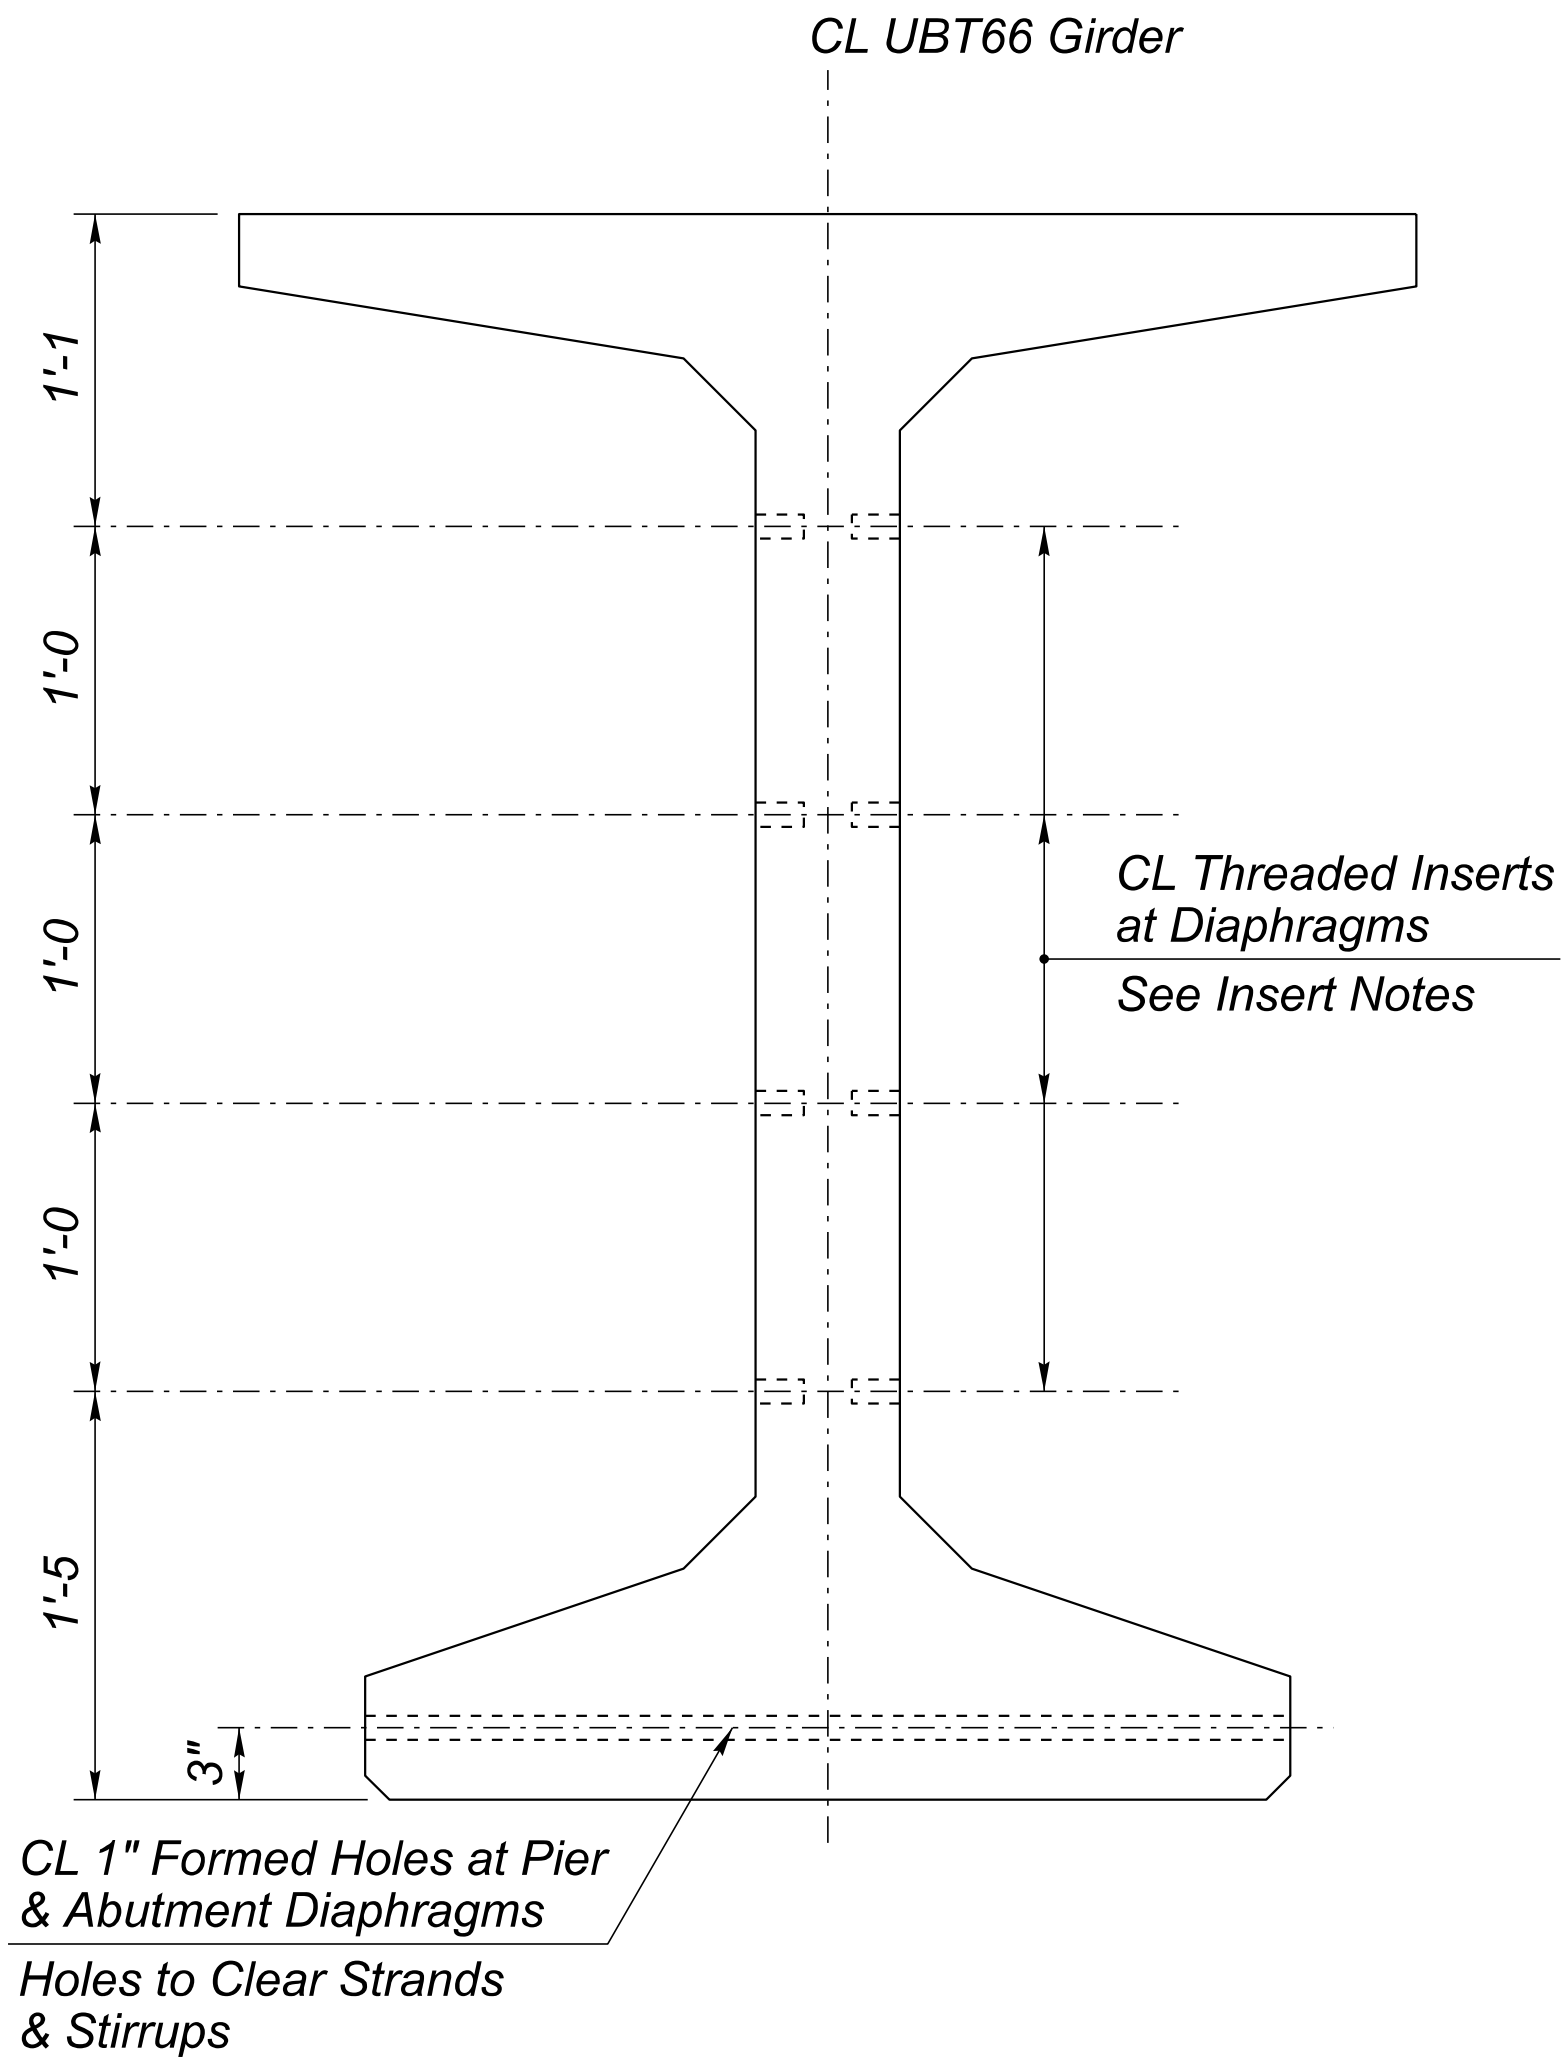


SECTION A
Scale: 1 $\frac{1}{2}$ " = 1'-0

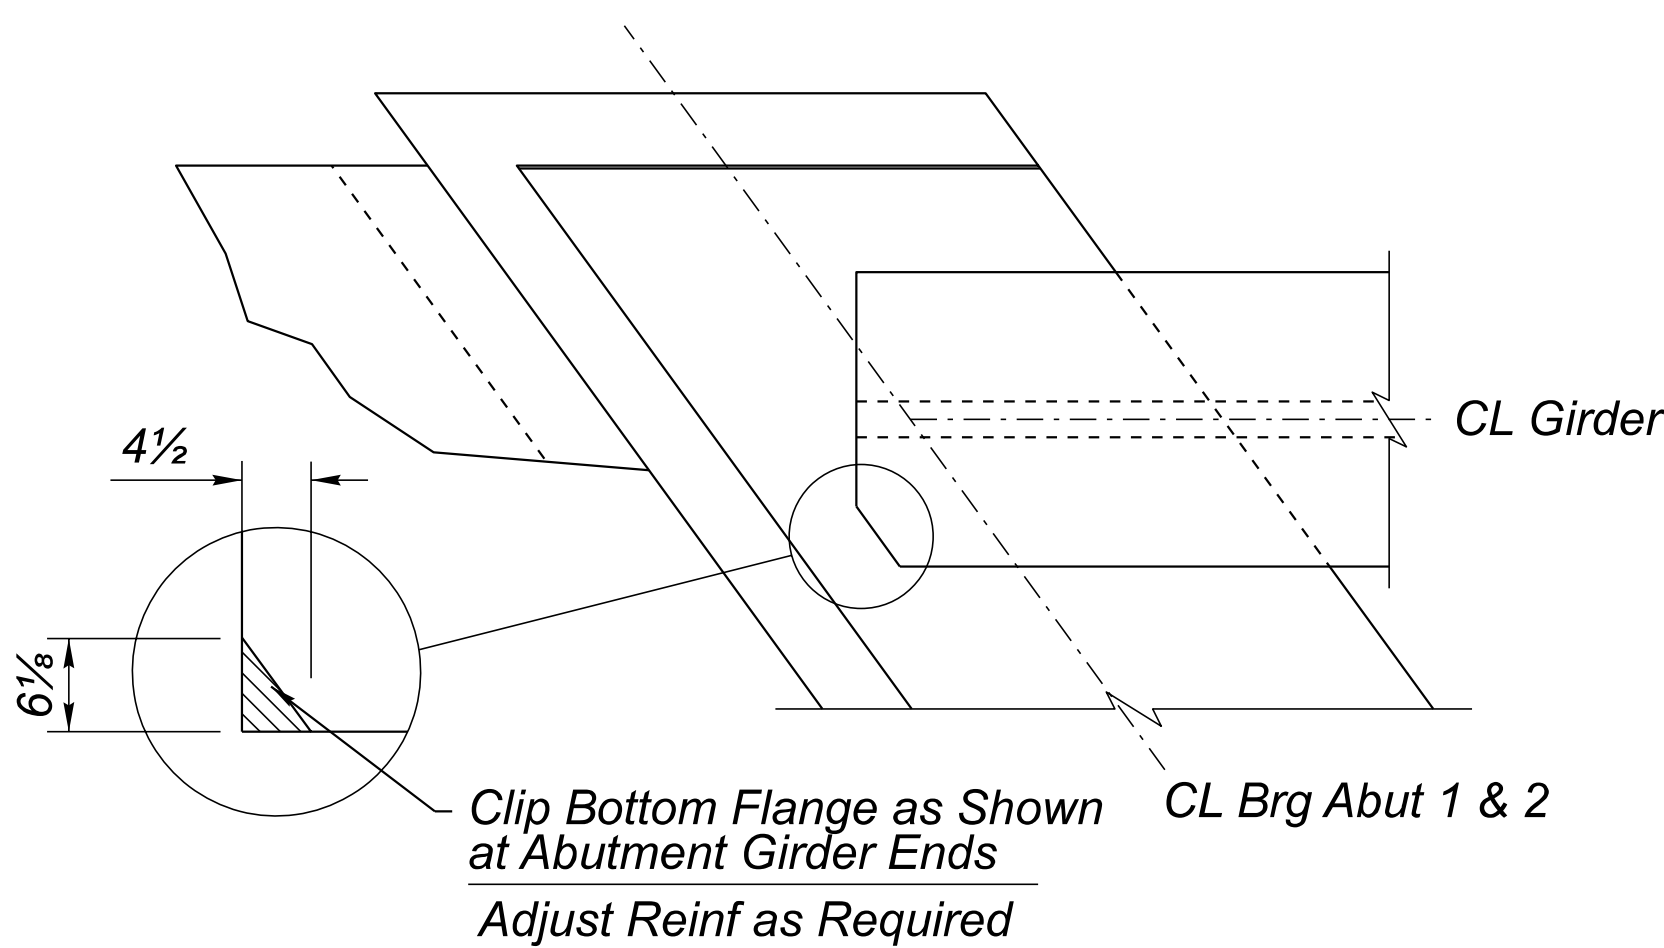

BOTTOM FLANGE CLIP DETAIL
Scale: 3 $\frac{3}{8}$ " = 1'-0

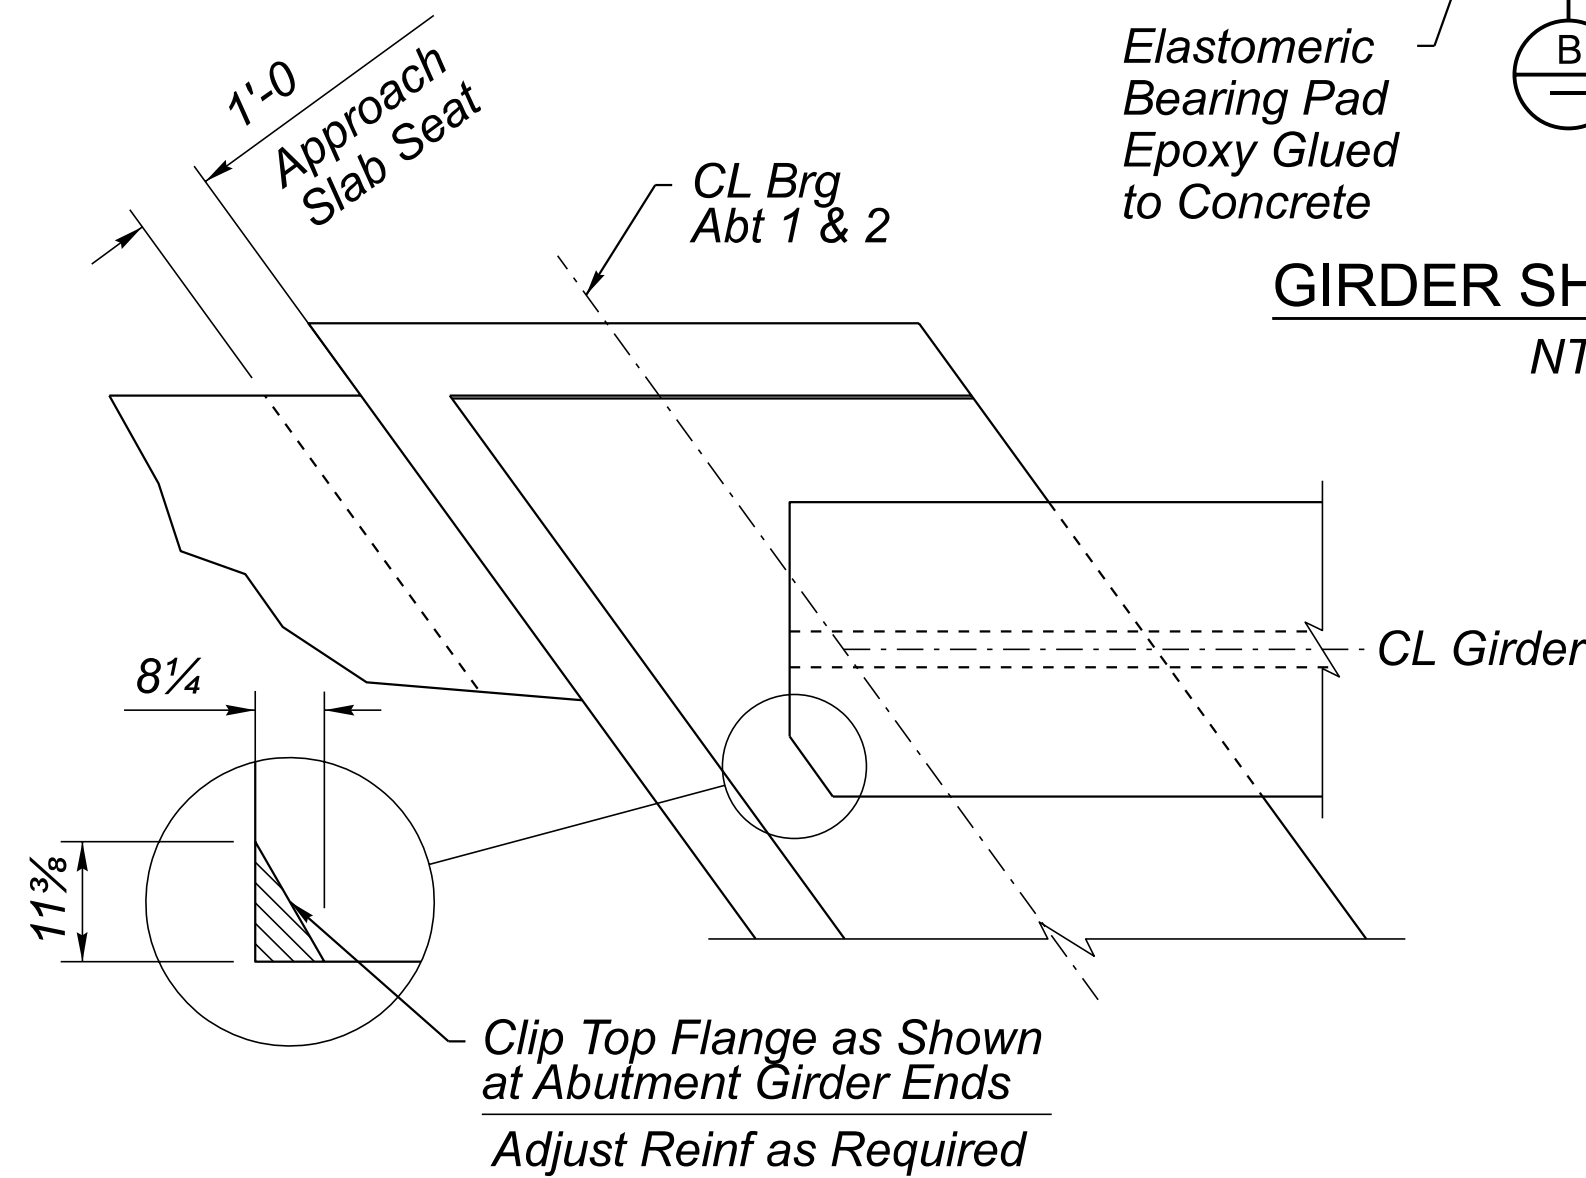

TOP FLANGE CLIP DETAIL
Scale: 3 $\frac{3}{8}$ " = 1'-0

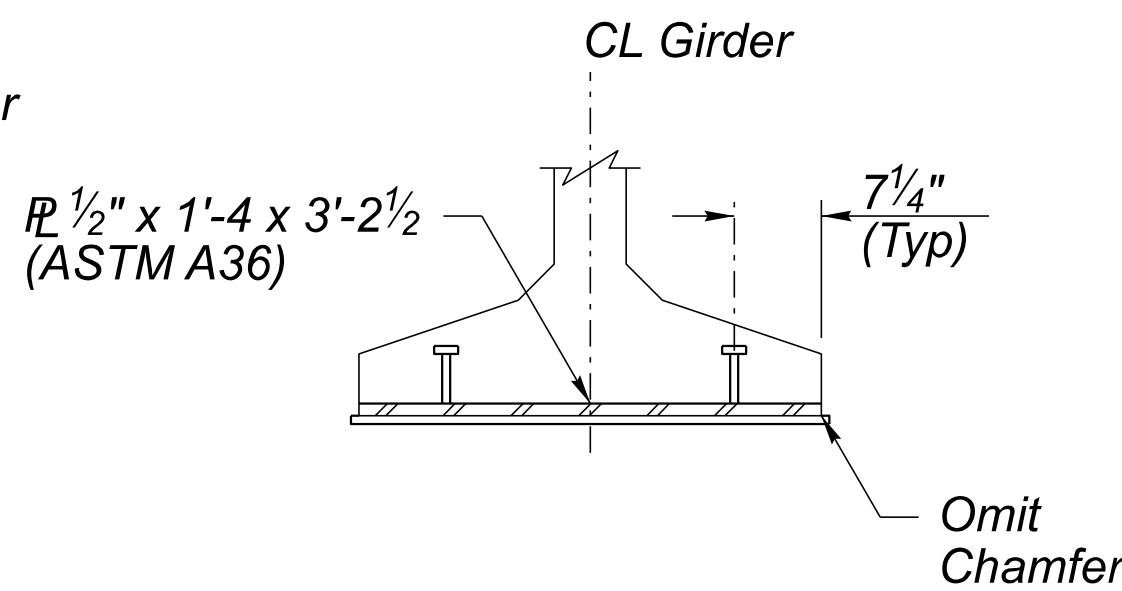

SECTION B
NTS

INSERT TABLE (ABT & PIER DIAPHRAGMS)	
Location	'X'
Abt 1	3'-3 $\frac{3}{8}$ "
Pier 1	2'-1 $\frac{1}{8}$ "
Pier 2	2'-1 $\frac{1}{8}$ "
Abt 2	3'-3 $\frac{3}{8}$ "

NOTE:

'X' is measured parallel to the girder CL.



	NAME	DATE
DESIGN	M. Noche	06/26
DRAWN	G. Zenuch	06/26
CHECKED	B. Ansley	06/26

TRANSPORTATION
AECOM TECHNICAL SERVICES, Inc.
7720 N. 16th St., Suite 100
Phoenix, Arizona 85020
T 602.371.1100


AECOM
www.aecom.com

ARIZONA DEPARTMENT OF TRANSPORTATION
INFRASTRUCTURE DELIVERY AND OPERATIONS DIVISION
BRIDGE GROUP

**US 93 SB BNSF OP BRIDGE
GIRDER DETAILS (3 OF 4)**


ROUTE US 93
MILEPOST 192.90
STRUCTURE NO. 20313

F.H.W.A. Arizona Division	STATE ARIZ.	PROJECT NO. 093 YV 189	FEDERAL ID NO. 093-B-(230)T	SHEET NO. 434	TOTAL SHEETS 524	RECORD DRAWING
LOCATION WICKENBURG RANCH WAY TO VISTA ROYALE						DWG No. S-1.15
TRACS NO. F0738 01C						____ OF ____

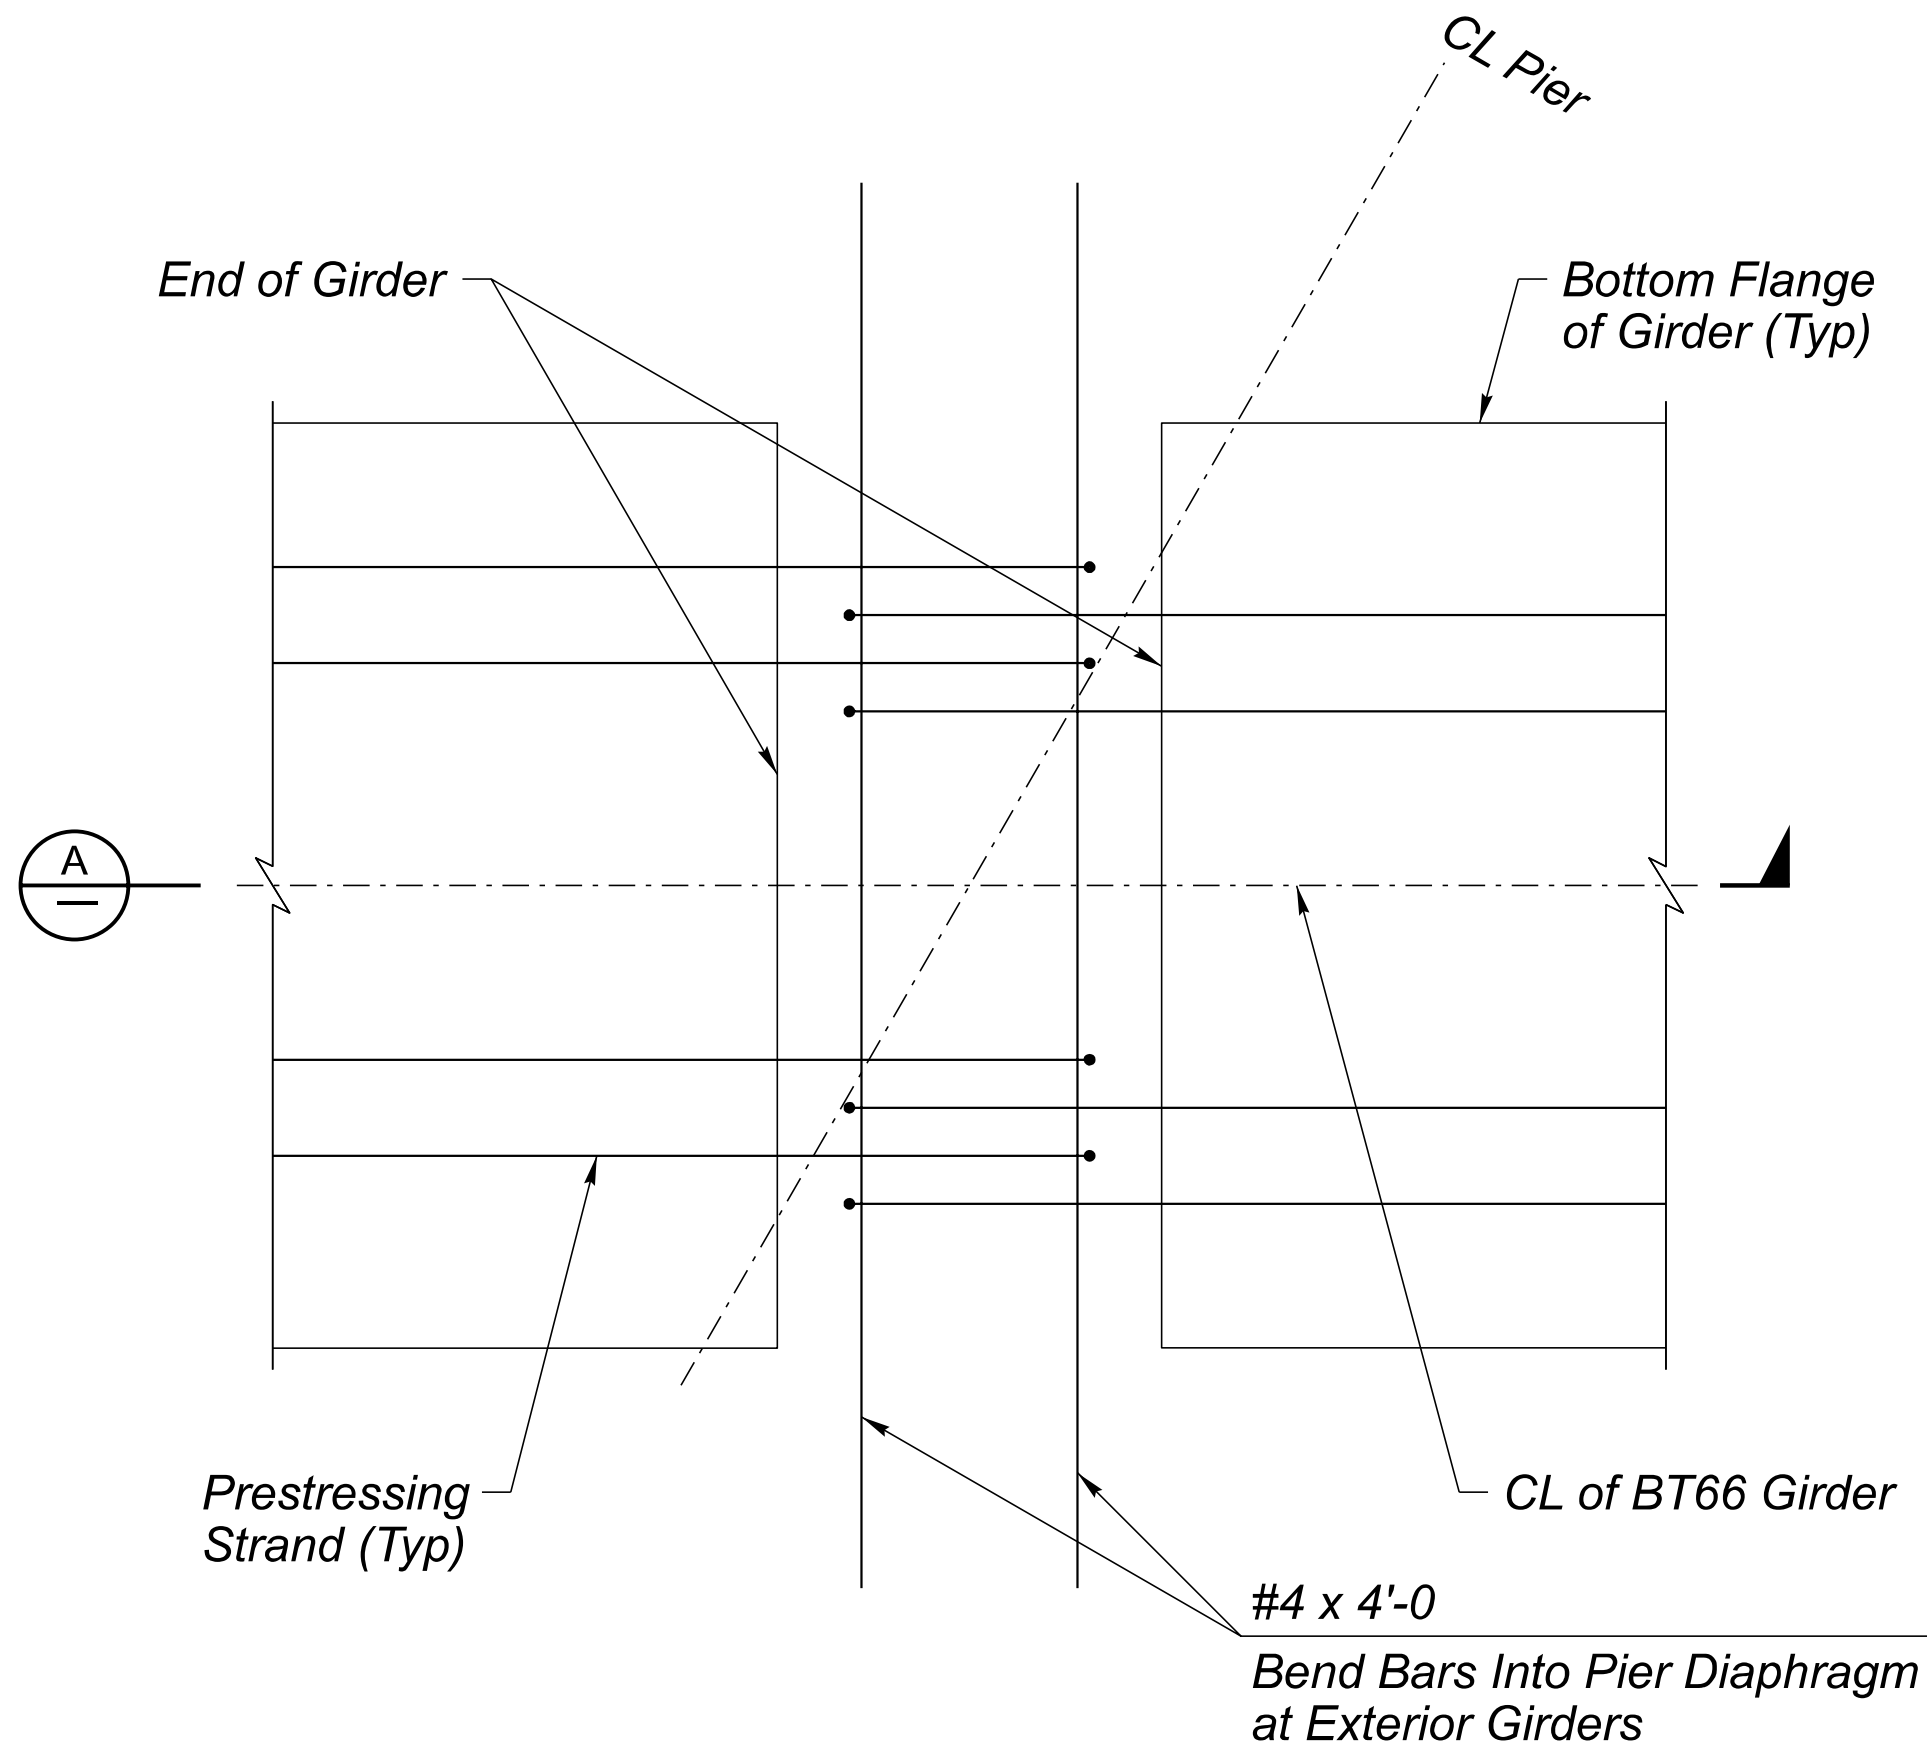


TYPICAL END OF GIRDER PLAN AT PIER

Scale: 1 1/2" = 1'-0

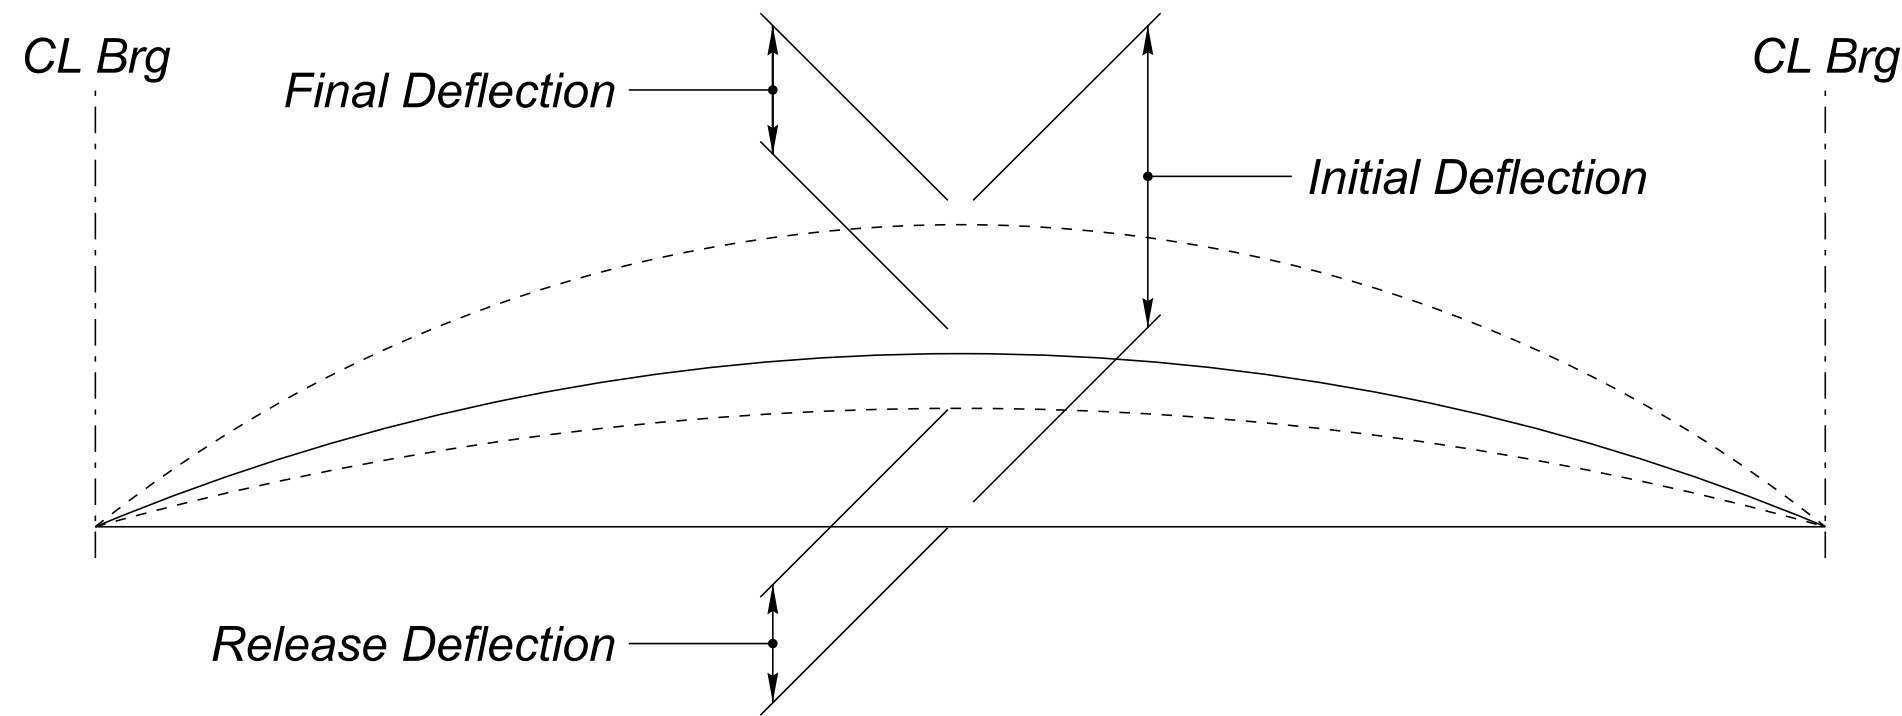


DEFLECTION DIAGRAM

NTS

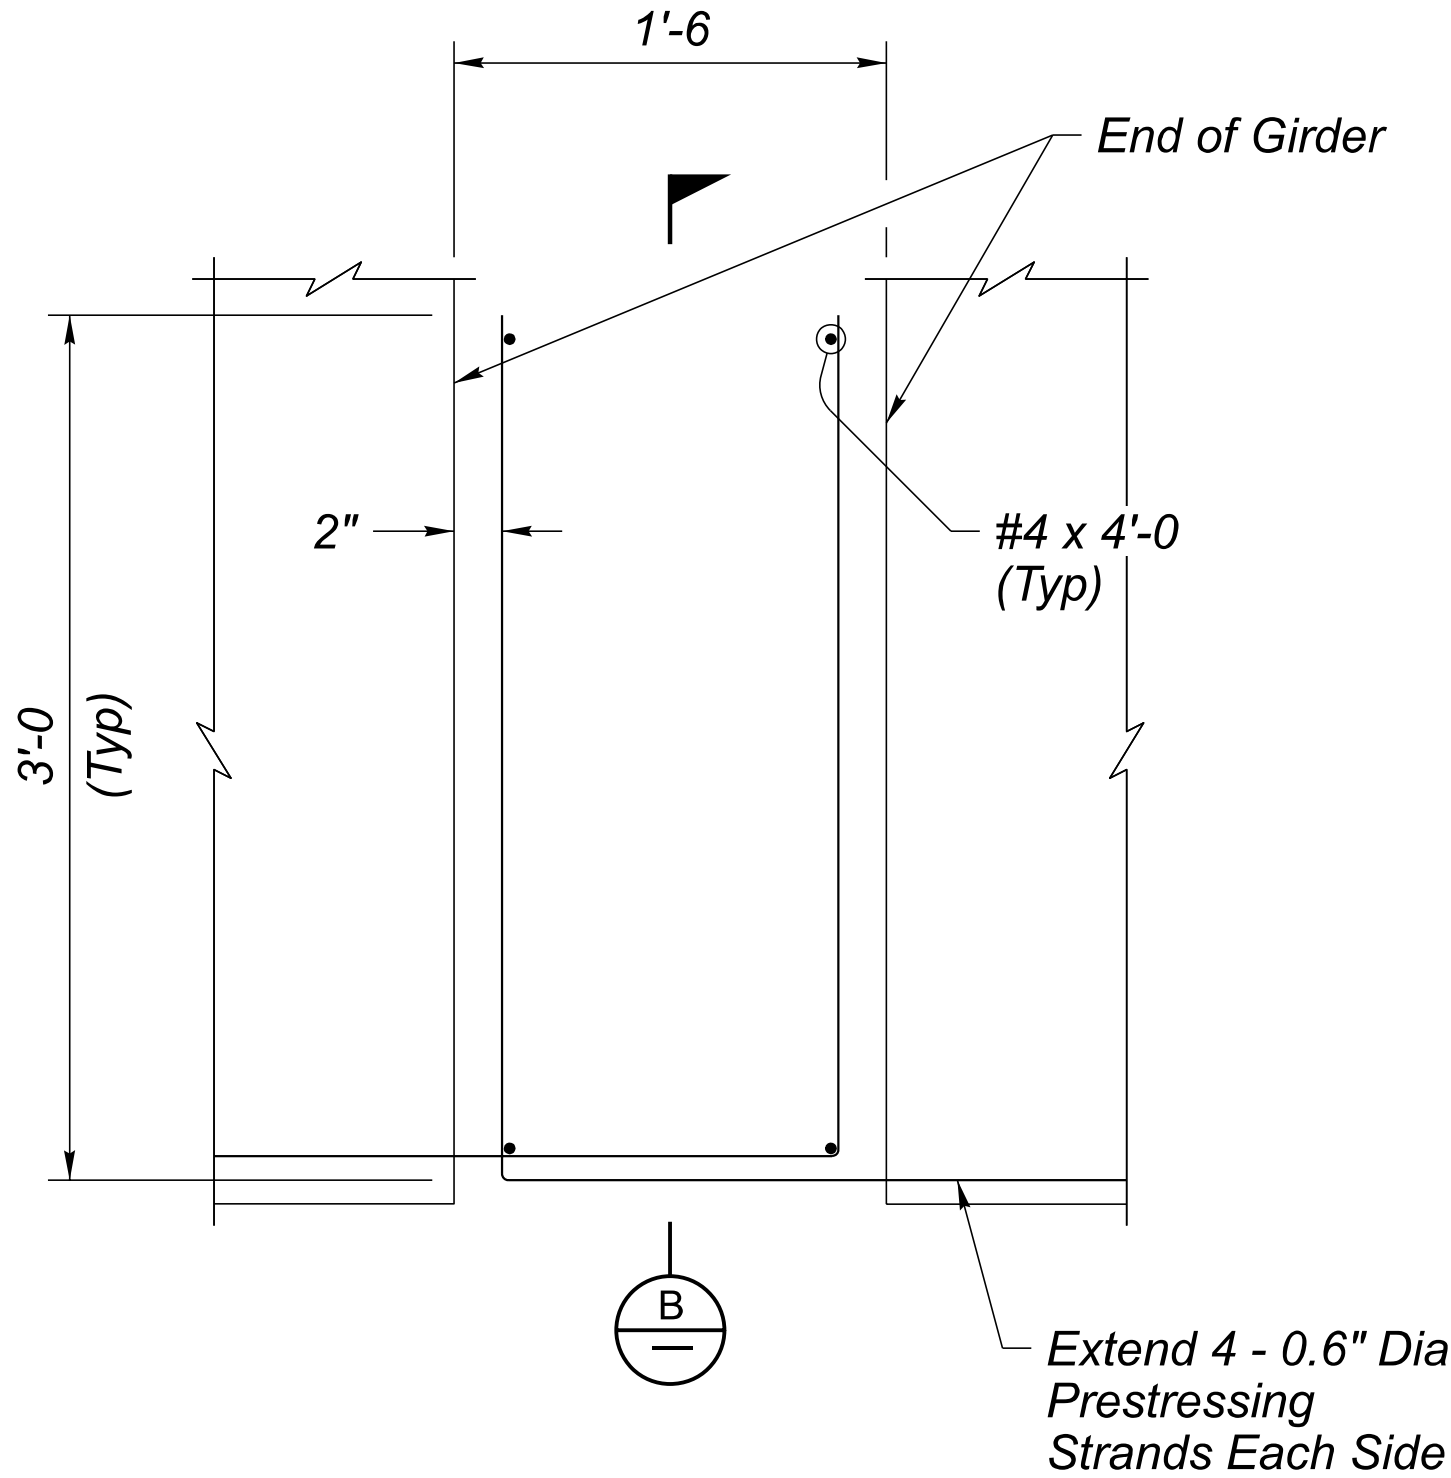

SECTION

Scale: 1 1/2" = 1'-0

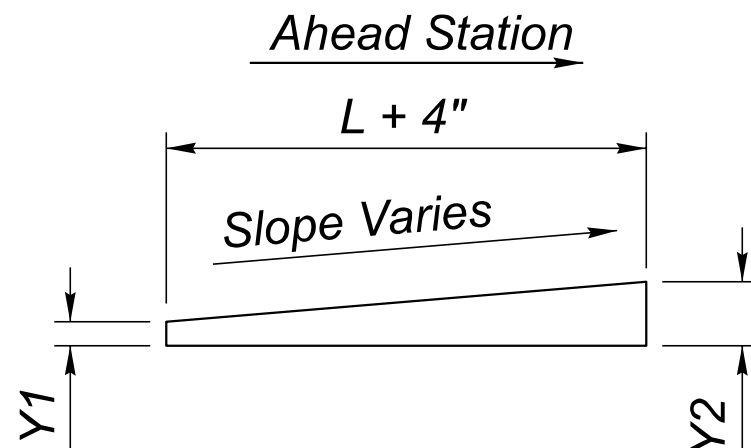


BEVELED PLATE DETAIL

NTS

BEVELED PLATE NOTES:

- Beveled plate shall be placed centered on the bearing & girder.
- See Dwg S-1.12 for "L" Dimension.

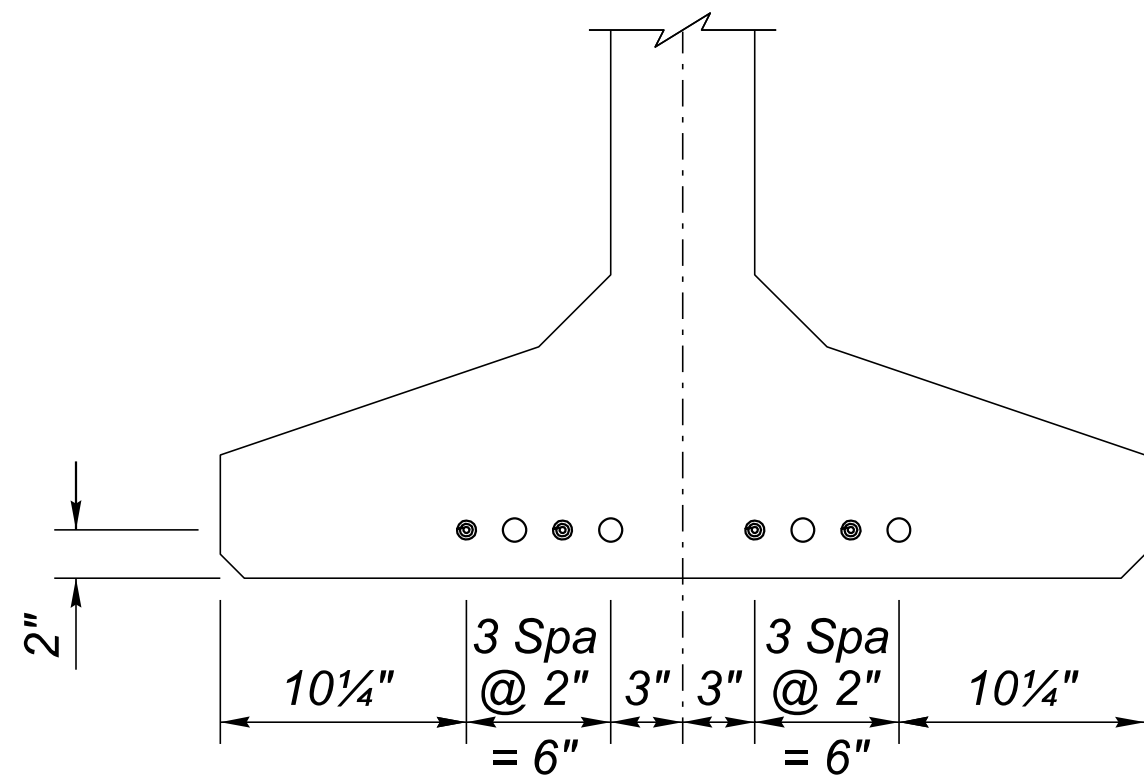

GIRDER STRAND EXTENSION LEGEND


- Extended Strands
- Extended Strands for Opposite Girder

NOTE:

Extend 4 - 0.6" diameter prestressing strands from end of girder at pier. Bend strands into pier diaphragm at exterior girders. Bend strands to line up between opposing strands of opposite girders. Extended strands at exterior girders shall be rotated to maintain concrete cover.

SECTION

Scale: 1 1/2" = 1'-0

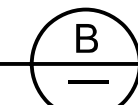

DEFLECTION NOTES:

- Release Deflection equals the deflection that the prestressed girder undergoes at the time of strand release. The Release Deflection Includes the dead load of the girder & the release prestressing force (including the effects of elastic shortening).
- See Screed Elevation Notes on Dwg S-1.24.
- Initial Deflection equals the deflection the prestressed girder undergoes at the time of erection prior to the diaphragm or deck pours. The Initial Deflection Includes the deflection due to the dead load of the girder, the initial prestressing & the effects of creep up to the time of erection. (Assumed at 60 days after release).
- Final Deflection equals the immediate downward deflection due to the dead load of the deck slab, diaphragms & barriers plus the effects of long-term creep on the composite girders.

DEFLECTIONS (ft)										
Location		0.1	02	0.3	0.4	0.5	0.6	0.7	0.8	0.9
Spans 1 & 3	Release (Up)	0.067	0.118	0.154	0.174	0.182	0.174	0.154	0.118	0.067
Span 2	Release (Up)	0.105	0.184	0.239	0.268	0.280	0.268	0.239	0.184	0.105
Spans 1 & 3	Initial (Up)	0.119	0.210	0.274	0.311	0.324	0.311	0.274	0.210	0.119
Span 2	Initial (Up)	0.186	0.326	0.422	0.474	0.495	0.474	0.422	0.326	0.186
Spans 1 & 3	Final (Down)	0.018	0.035	0.048	0.056	0.059	0.056	0.048	0.035	0.018
Span 2	Final (Down)	0.066	0.128	0.176	0.205	0.215	0.205	0.176	0.128	0.066

BEVELED PLATE SCHEDULE		
Location	Dim Y1	Dim Y2
Abut 1 - Span 1	3/4"	1 1/8"
Pier 1 - Span 1	15/16"	3/4"
Pier 1 - Span 2	3/4"	15/16"
Pier 2 - Span 2	7/8"	3/4"
Pier 2 - Span 3	3/4"	7/8"
Abut 2 - Span 3	-	-




DESIGN		
NAME	M. Noche	DATE
DESIGN	M. Noche	06/26
DRAWN	G. Zenuch	06/26
CHECKED	B. Ansley	06/26

ARIZONA DEPARTMENT OF TRANSPORTATION
INFRASTRUCTURE DELIVERY AND OPERATIONS DIVISION
BRIDGE GROUP

US 93 SB BNSF OP BRIDGE
GIRDER DETAILS (4 OF 4)


ROUTE	STATE	PROJECT NO.	FEDERAL ID NO.	SHEET NO.	TOTAL SHEETS	RECORD DRAWING
US 93	ARIZ.	093 YV 189	093-B-(230)T	435	524	
MILEPOST 192.90	WICKENBURG RANCH WAY TO VISTA ROYALE					DWG No. S-1.16
STRUCTURE NO. 20313	TRACS NO. F0738 01C					OF

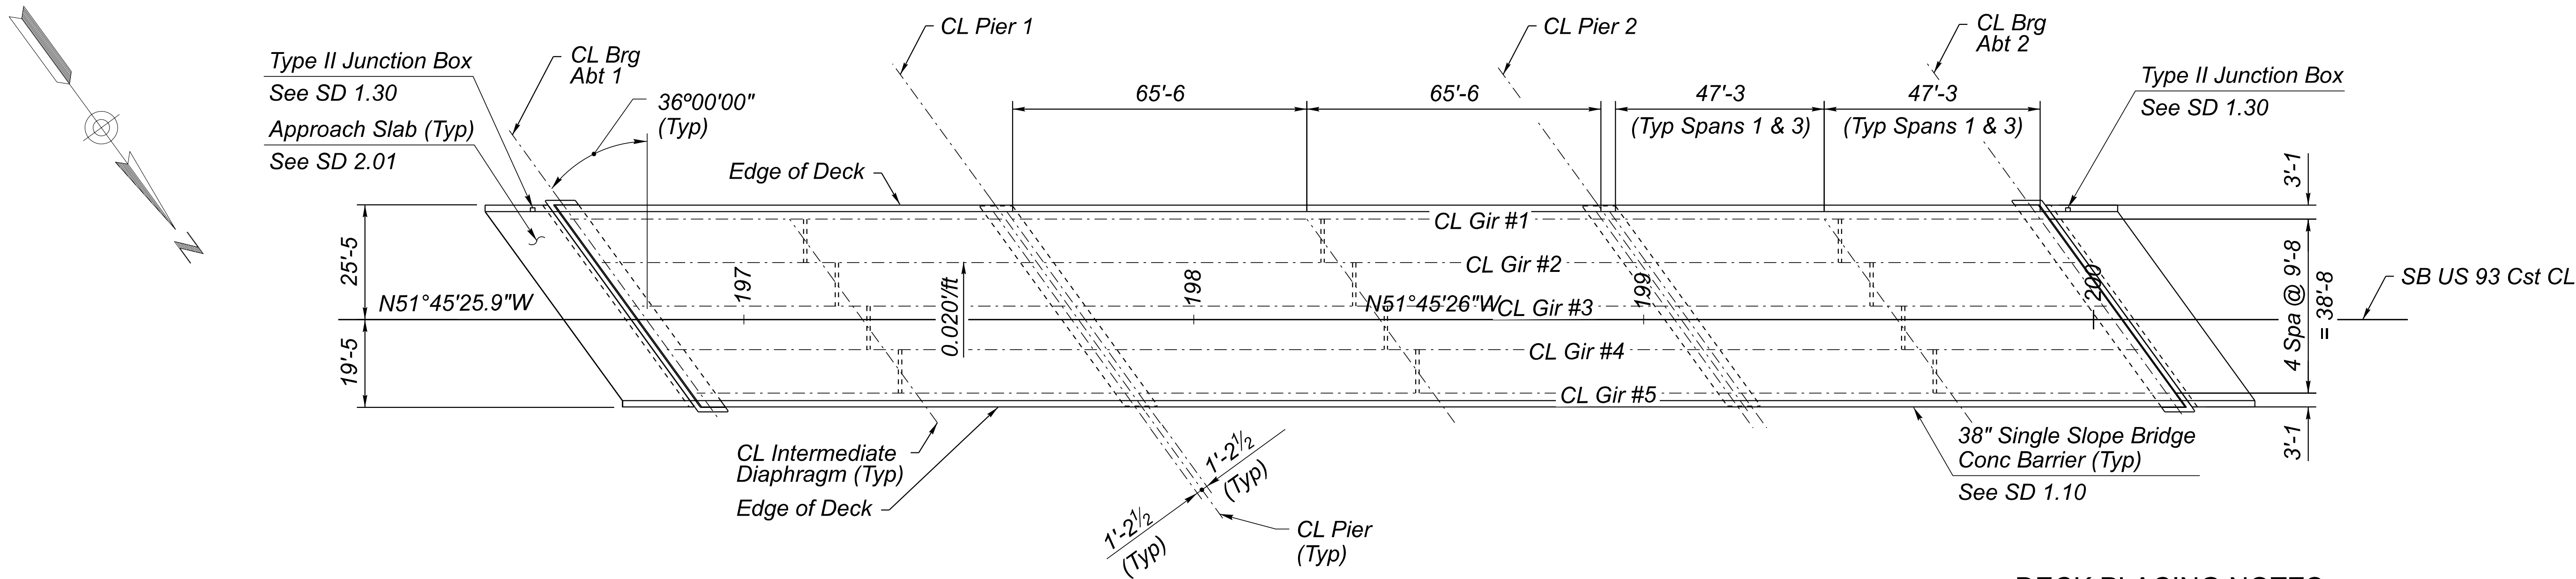


FRAMING PLAN
Scale: 1" = 30'-0

DECK PLACING NOTES:


- Intermediate diaphragms & abutment diaphragms shall be poured a minimum of 12 hours prior to the deck pour.
- Pier diaphragms shall be poured concurrent with the deck pour.
- Longitudinal construction joints shall not be permitted except as approved by the Engineer.
- Transverse construction joints shall be located in accordance with the "DECK POUR SEQUENCE PLAN".
- Reinforcing shall be continuous through construction joints.
- Construction joints shall be clean & free of laitance prior to placing adjacent concrete.
- Numbers ① & ② indicate the placing sequence of deck concrete. Place section ② a minimum of 12 hours after the adjacent sections ① have been placed.
- Sections ① & ② may be placed consecutively, but only in the direction from ① to ② & a minimum of 12 hours after the first section ① has been placed.
- The contractor shall submit a deck pour schedule to the Engineer for approval prior to placing concrete.
- Alternate pouring sequences require the Engineer's approval & shall be at no additional cost to the Department.

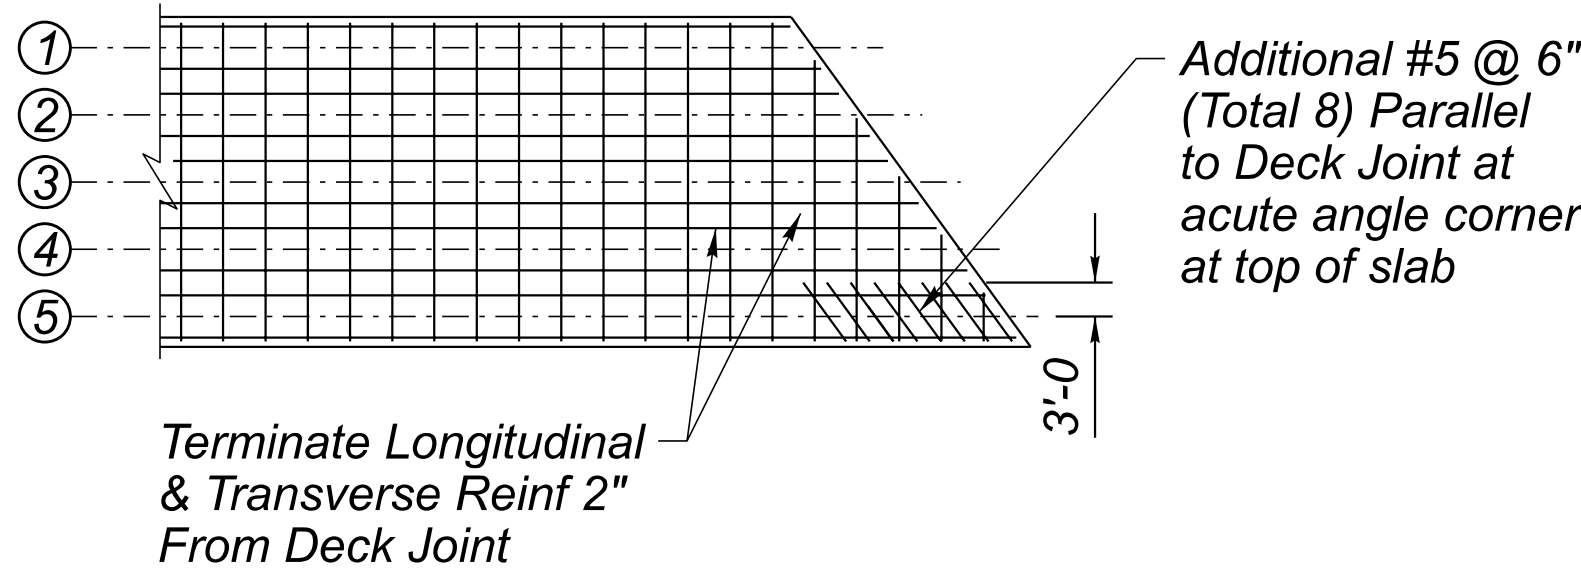

PLAN AT END OF DECK
NTS

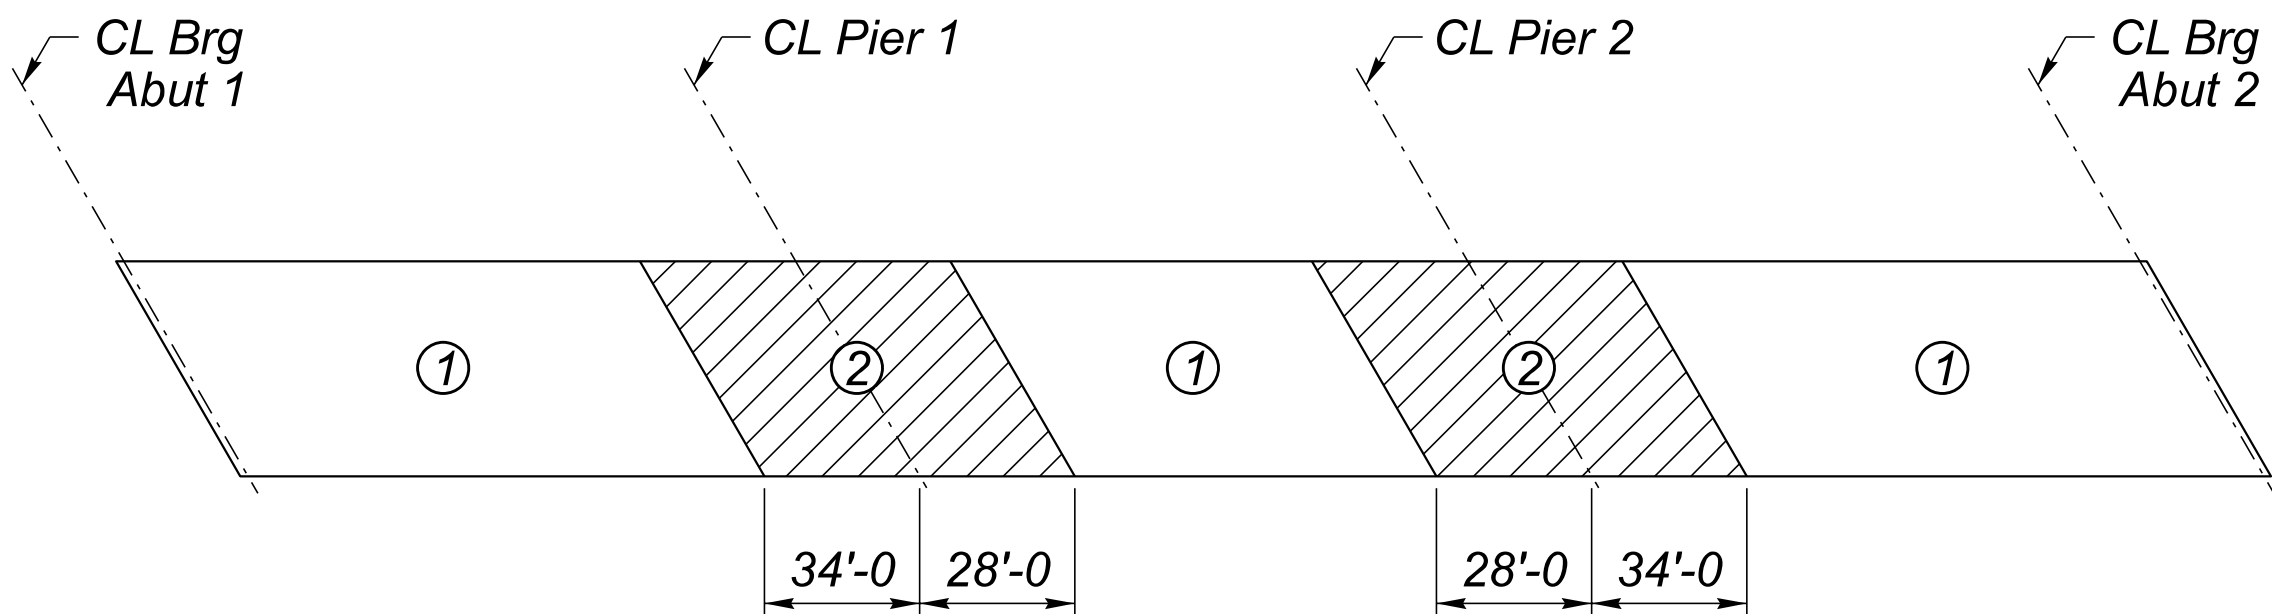

DECK POUR SEQUENCE PLAN
NTS

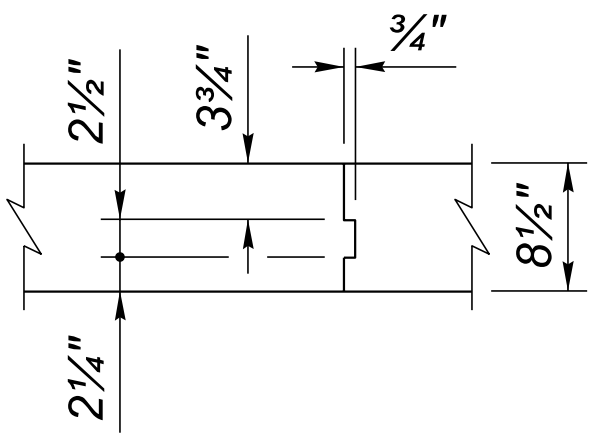

KEYED CONSTRUCTION JOINT DETAIL
NTS

GIRDER BRACING NOTE:

The contractor shall provide temporary bracing for the girders immediately after erection to ensure that they remain stable until the permanent intermediate diaphragms are constructed. The temporary bracing must remain in place until the intermediate diaphragms are poured & the concrete has reached the required 28 day strength. The cost of temporary bracing shall be incidental to the cost of the girders.




	NAME	DATE
DESIGN	M. Noche	06/26
DRAWN	G. Zenuch	06/26
CHECKED	B. Ansley	06/26

TRANSPORTATION
AECOM TECHNICAL SERVICES, Inc.
7720 N. 16th St., Suite 100
Phoenix, Arizona 85020
T 602.371.1100
www.aecom.com

AECOM


ARIZONA DEPARTMENT OF TRANSPORTATION INFRASTRUCTURE DELIVERY AND OPERATIONS DIVISION BRIDGE GROUP
US 93 SB BNSF OP BRIDGE FRAMING PLAN

ROUTE US 93	F.H.W.A. Arizona Division	STATE ARIZ.	PROJECT NO. 093 YV 189	FEDERAL ID NO. 093-B-(230)T	SHEET NO. 436	TOTAL SHEETS 524	RECORD DRAWING
MILEPOST 192.90	LOCATION WICKENBURG RANCH WAY TO VISTA ROYALE					DWG No. S-1.17	
STRUCTURE NO. 20313	TRACS NO. F0738 01C					OF	

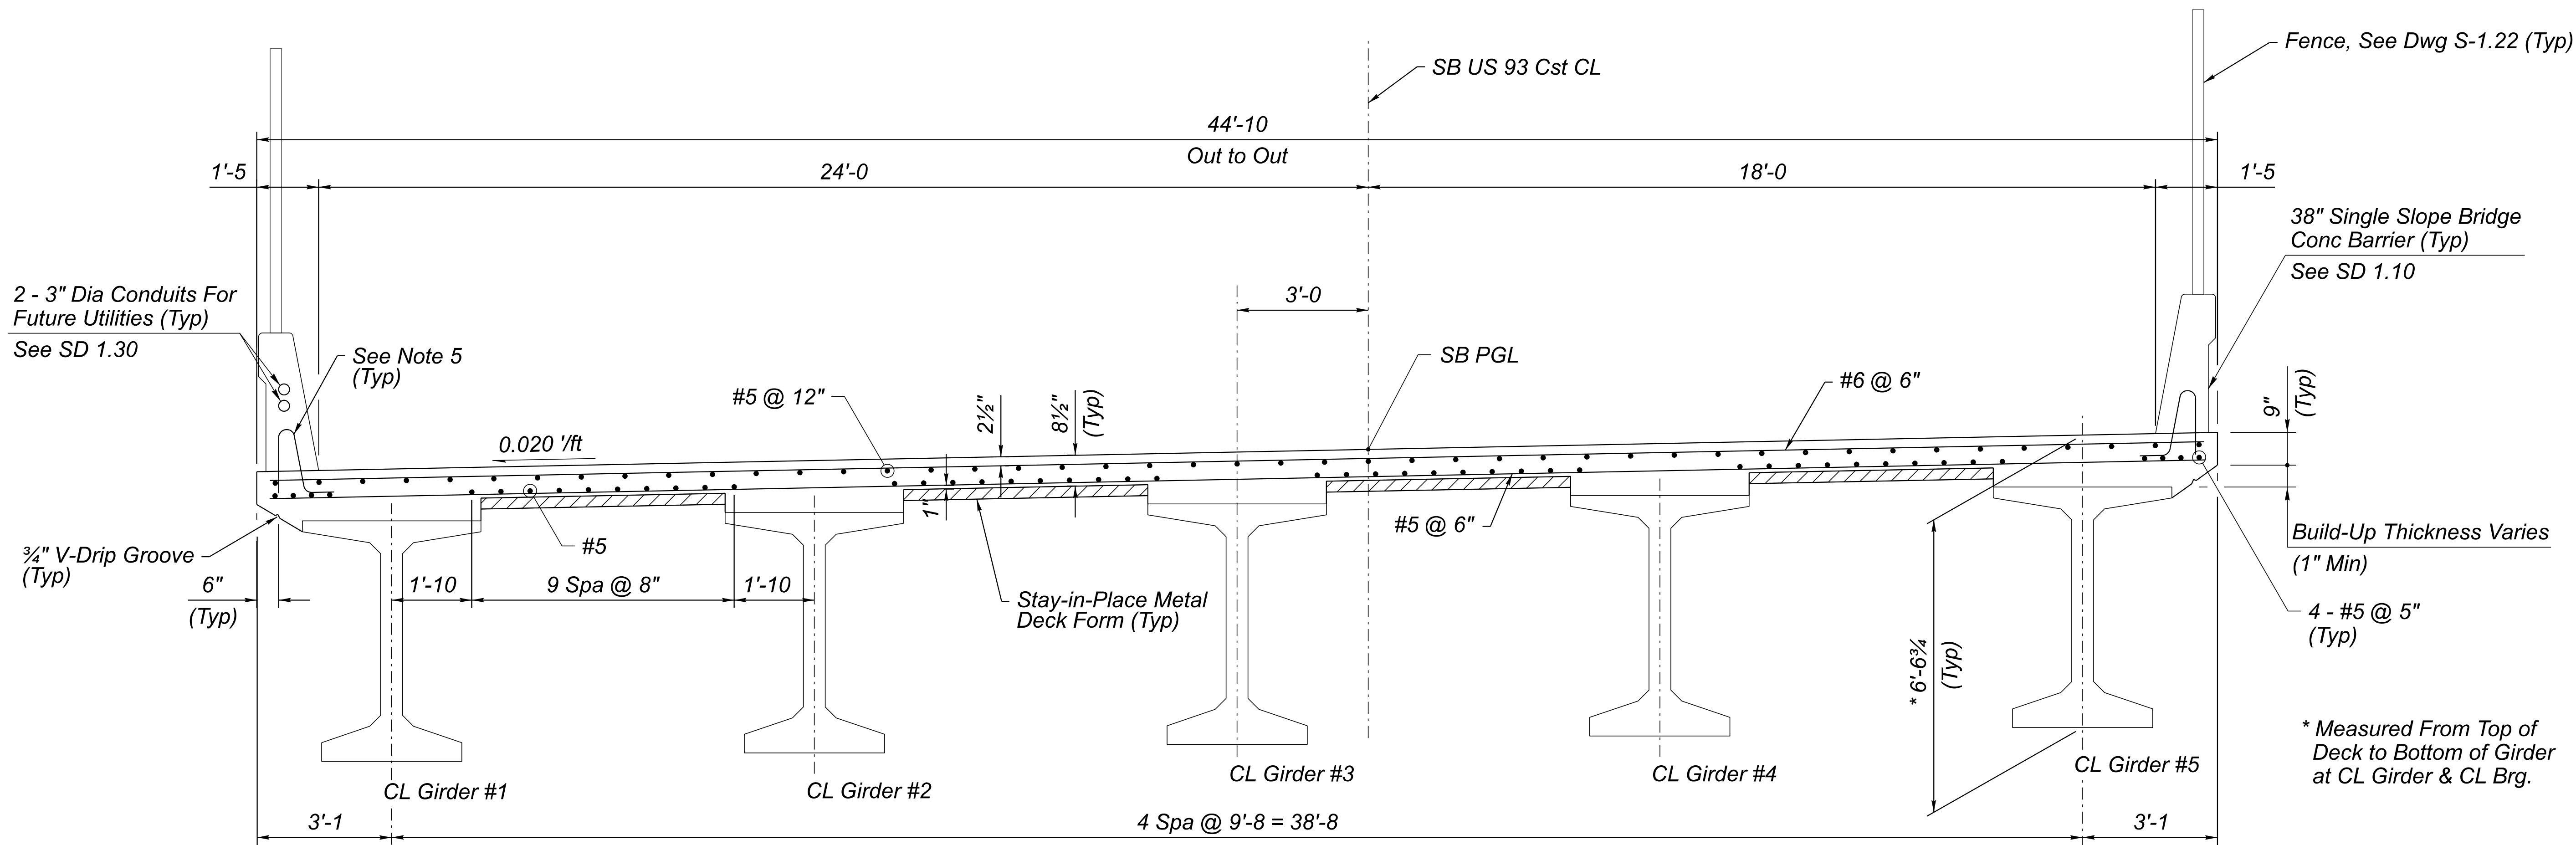

TYPICAL SECTION THRU DECK

Scale: 1/2" = 1'-0

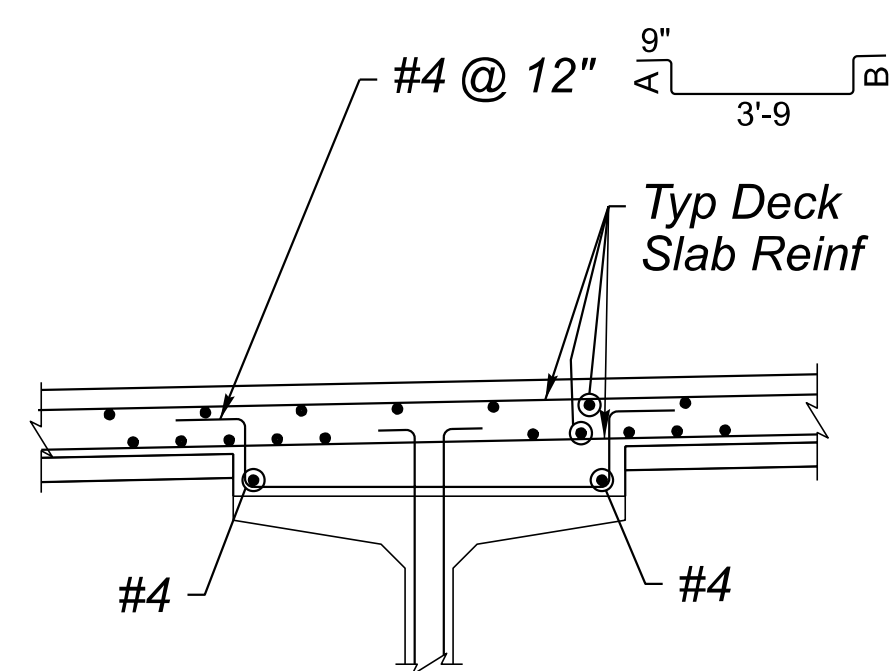


NOTES:

- Build-up reinforcing is required where the build-up exceeds 4" at Girder Centerline.
- A = High Side Build-up plus 2"
B = Low Side Build-up plus 2".

BUILT-UP REINFORCING DETAIL

Scale: 3/4" = 1'-0

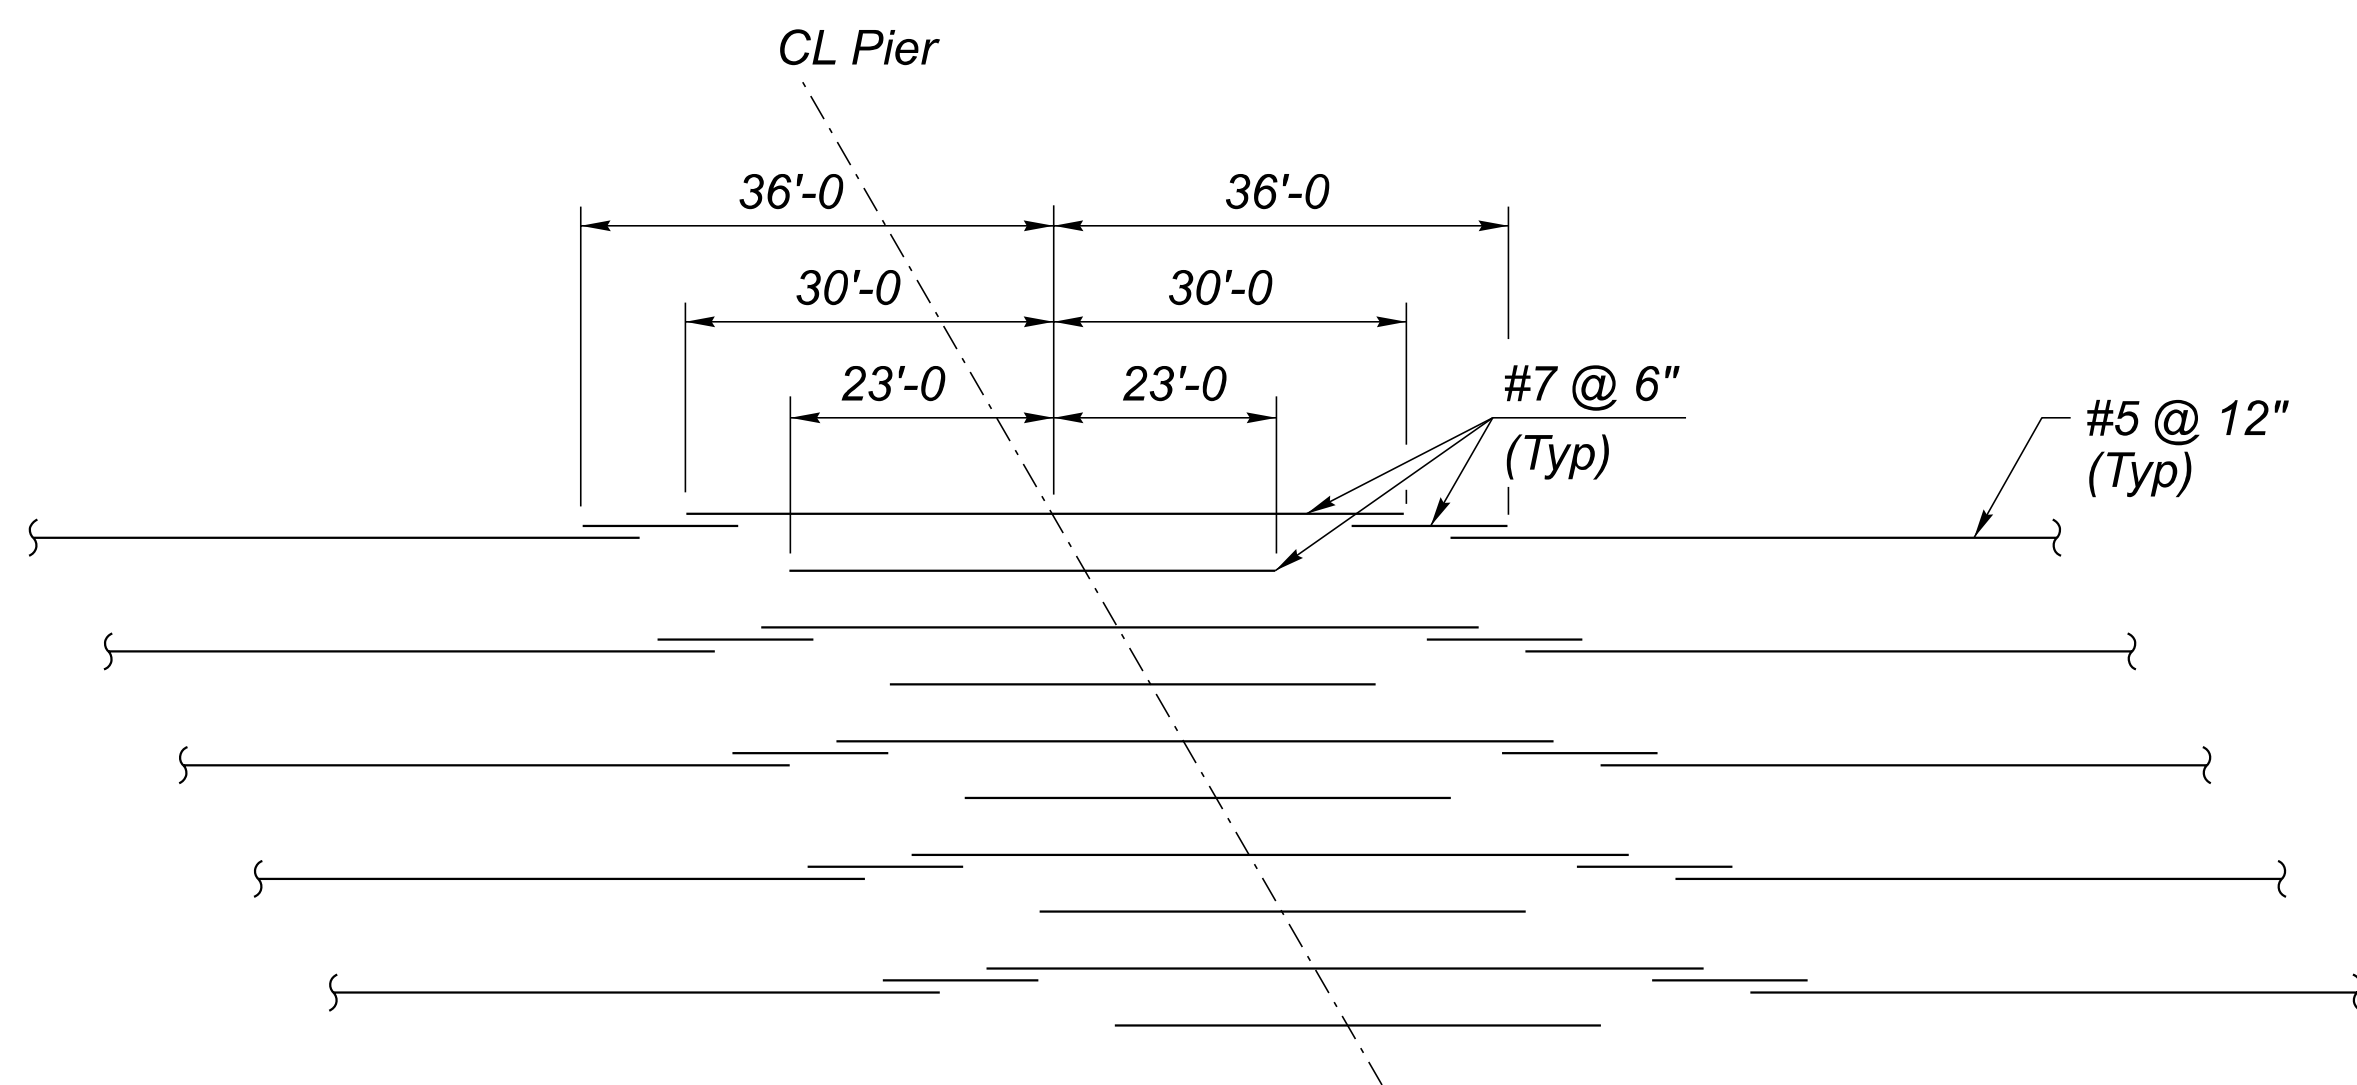

PARTIAL DECK TOP LONGITUDINAL REINFORCING PLAN

NTS

NOTES:

- All continuous horizontal bars in deck, diaphragms, single slope barrier, excluding transverse bars in the deck slab, may be spliced where required with minimum lap length as specified:

#4 bars 1'-9
#5 bars 2'-2
#6 bars 2'-7
#7 bars 3'-2
- Transverse deck reinforcing splices where required shall be:

Top Bars: 2'-0 minimum lap at centerline of interior bay.
Bottom Bars: 2'-0 minimum lap at centerline of girder.
- Bars shall not be spliced within the required lap length of the adjacent bars.
- Transverse deck reinforcing shall be placed perpendicular to the girder centerlines.
- See SD 1.10 for details. These bars are included in the linear foot cost of the 38" Single Slope Bridge Concrete Barrier.



	NAME	DATE
DESIGN	M. Noche	06/26
DRAWN	G. Zenuch	06/26
CHECKED	B. Ansley	06/26


TRANSPORTATION
AECOM TECHNICAL SERVICES, Inc.
7720 N. 16th St., Suite 100
Phoenix, Arizona 85020
T 602.371.1100

AECOM
www.aecom.com


ARIZONA DEPARTMENT OF TRANSPORTATION
INFRASTRUCTURE DELIVERY AND OPERATIONS DIVISION
BRIDGE GROUP

US 93 SB BNSF OP BRIDGE
DECK DETAILS


ROUTE US 93	F.H.W.A. Arizona Division	STATE ARIZ.	PROJECT NO. 093 YV 189	FEDERAL ID NO. 093-B-(230)T	SHEET NO. 437	TOTAL SHEETS 524	RECORD DRAWING
MILEPOST 192.90	LOCATION WICKENBURG RANCH WAY TO VISTA ROYALE						DWG No. S-1.18
STRUCTURE NO. 20313	TRACS NO. F0738 01C						OF

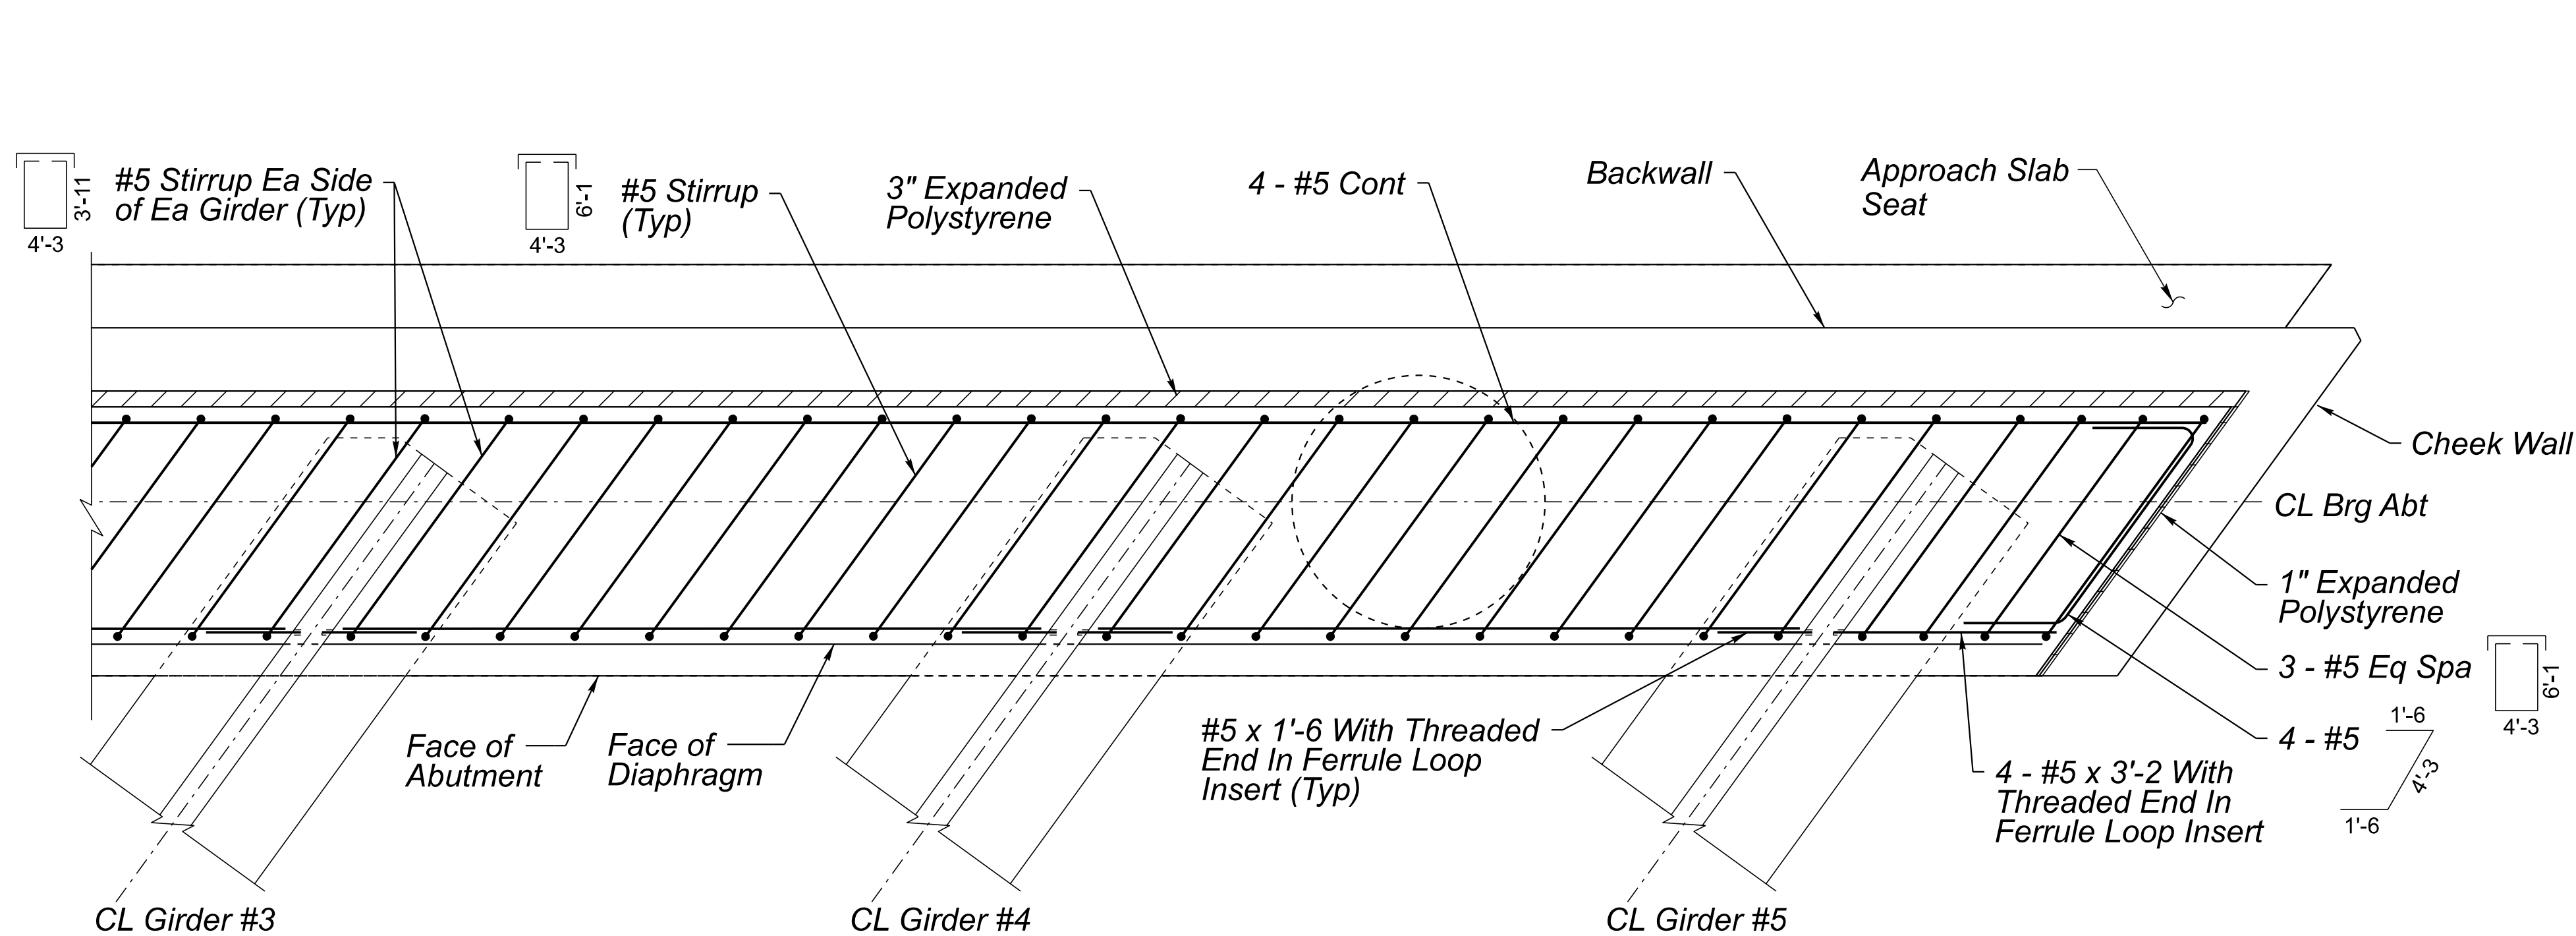

ABUTMENT DIAPHRAGM PLAN
 Abutment 2 Shown, Abutment 1 Similar
 Scale: 1/2" = 1'-0"

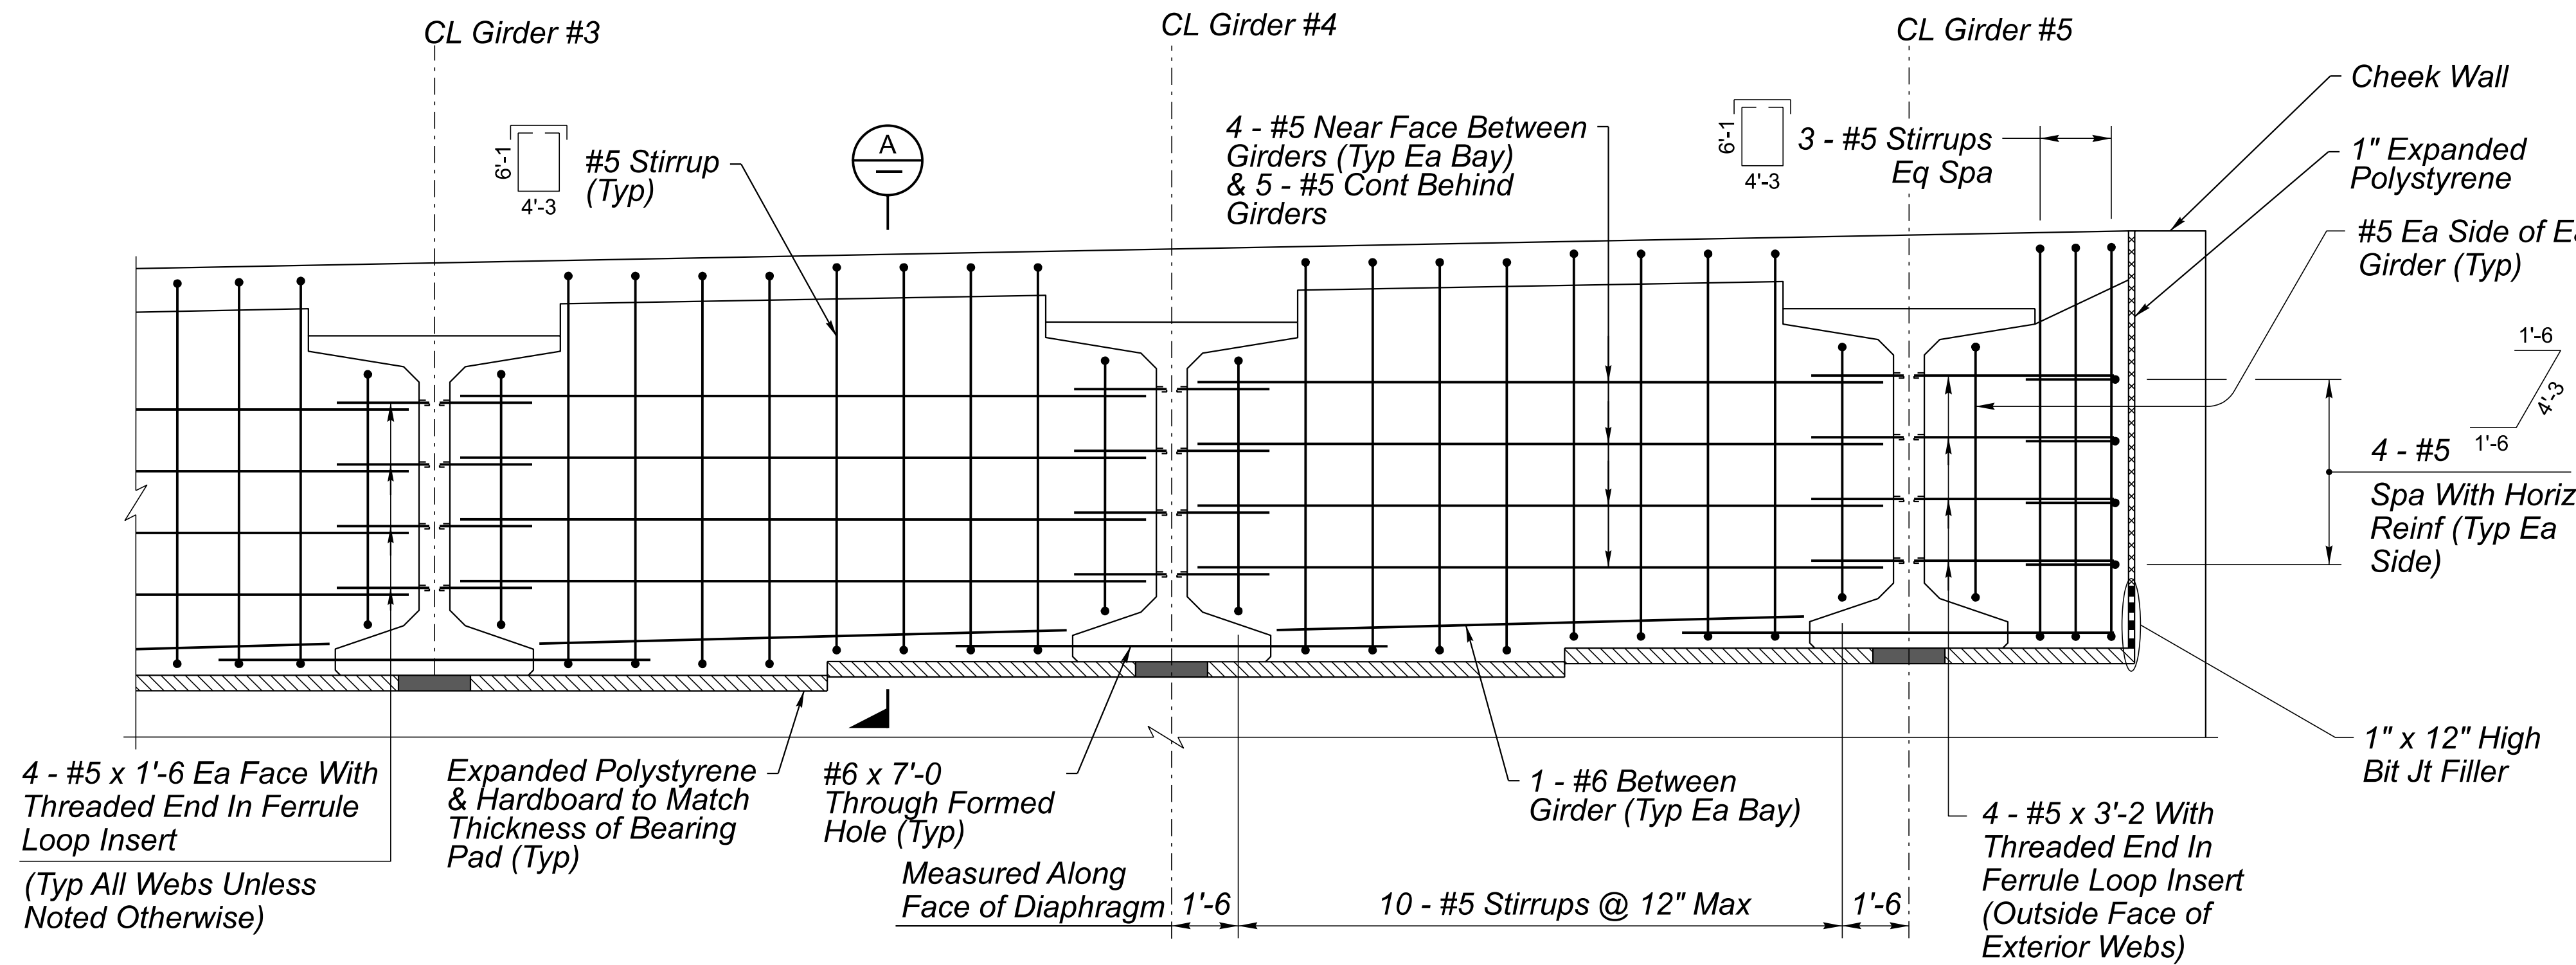


ABUTMENT DIAPHRAGM ELEVATION
 Abutment 2 Shown, Abutment 1 Similar
 Scale: 1/2" = 1'-0"

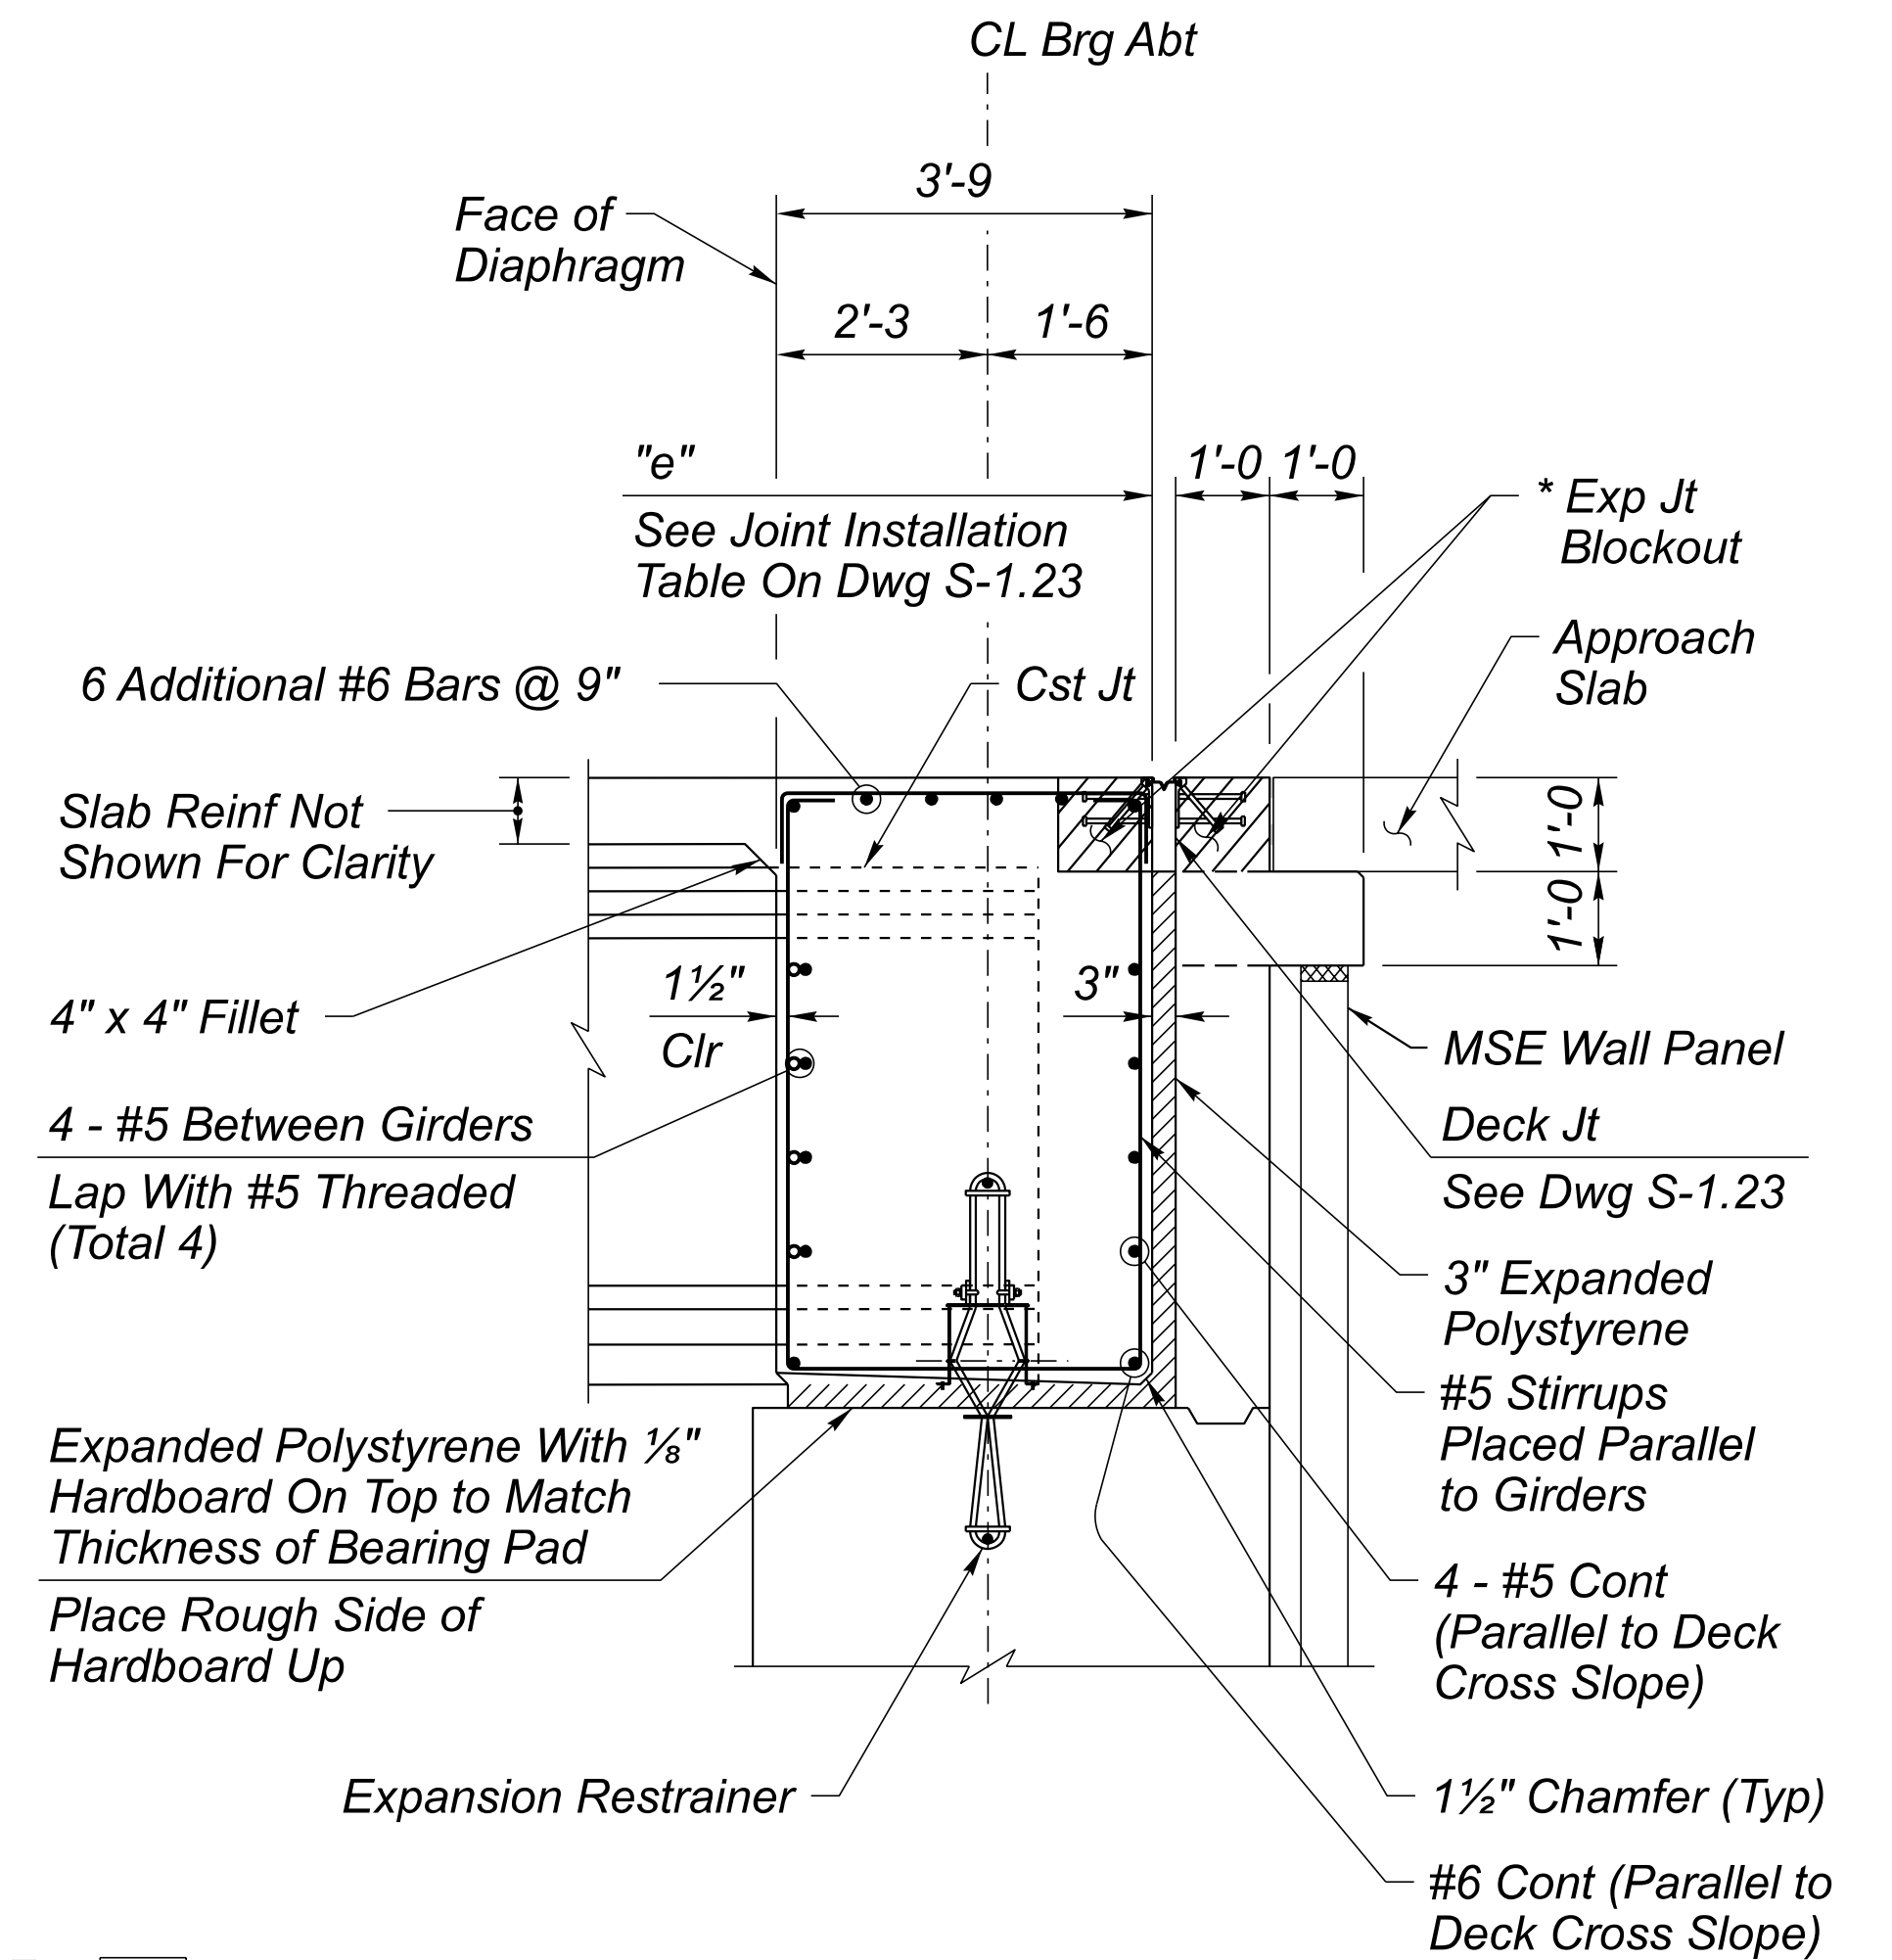

SECTION
 Scale: 1/2" = 1'-0"

* Use Only 4500 psi Concrete After Installation of Expansion Jt. (See Expansion Joint Notes on Dwg S-1.23)

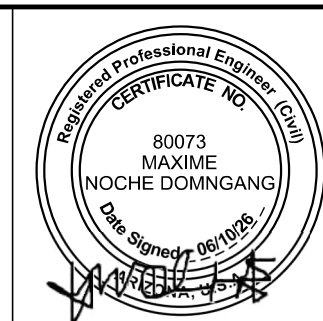

	NAME	DATE
DESIGN	M. Noche	06/26
DRAWN	G. Zenuch	06/26
CHECKED	B. Ansley	06/26


TRANSPORTATION
 AECOM TECHNICAL SERVICES, Inc.
 7720 N. 16th St., Suite 100
 Phoenix, Arizona 85020
 T 602.371.1100


AECOM
 www.aecom.com

ARIZONA DEPARTMENT OF TRANSPORTATION
 INFRASTRUCTURE DELIVERY AND OPERATIONS DIVISION
 BRIDGE GROUP

US 93 SB BNSF OP BRIDGE
 ABUTMENT DIAPHRAGM DETAILS

ROUTE US 93	F.H.W.A. Arizona Division	STATE ARIZ.	PROJECT NO. 093 YV 189	FEDERAL ID NO. 093-B-(230)T	SHEET NO. 438	TOTAL SHEETS 524	RECORD DRAWING
MILEPOST 192.90	LOCATION WICKENBURG RANCH WAY TO VISTA ROYALE					DWG No.	S-1.19
STRUCTURE NO. 20313	TRACS NO. F0738 01C					OF	

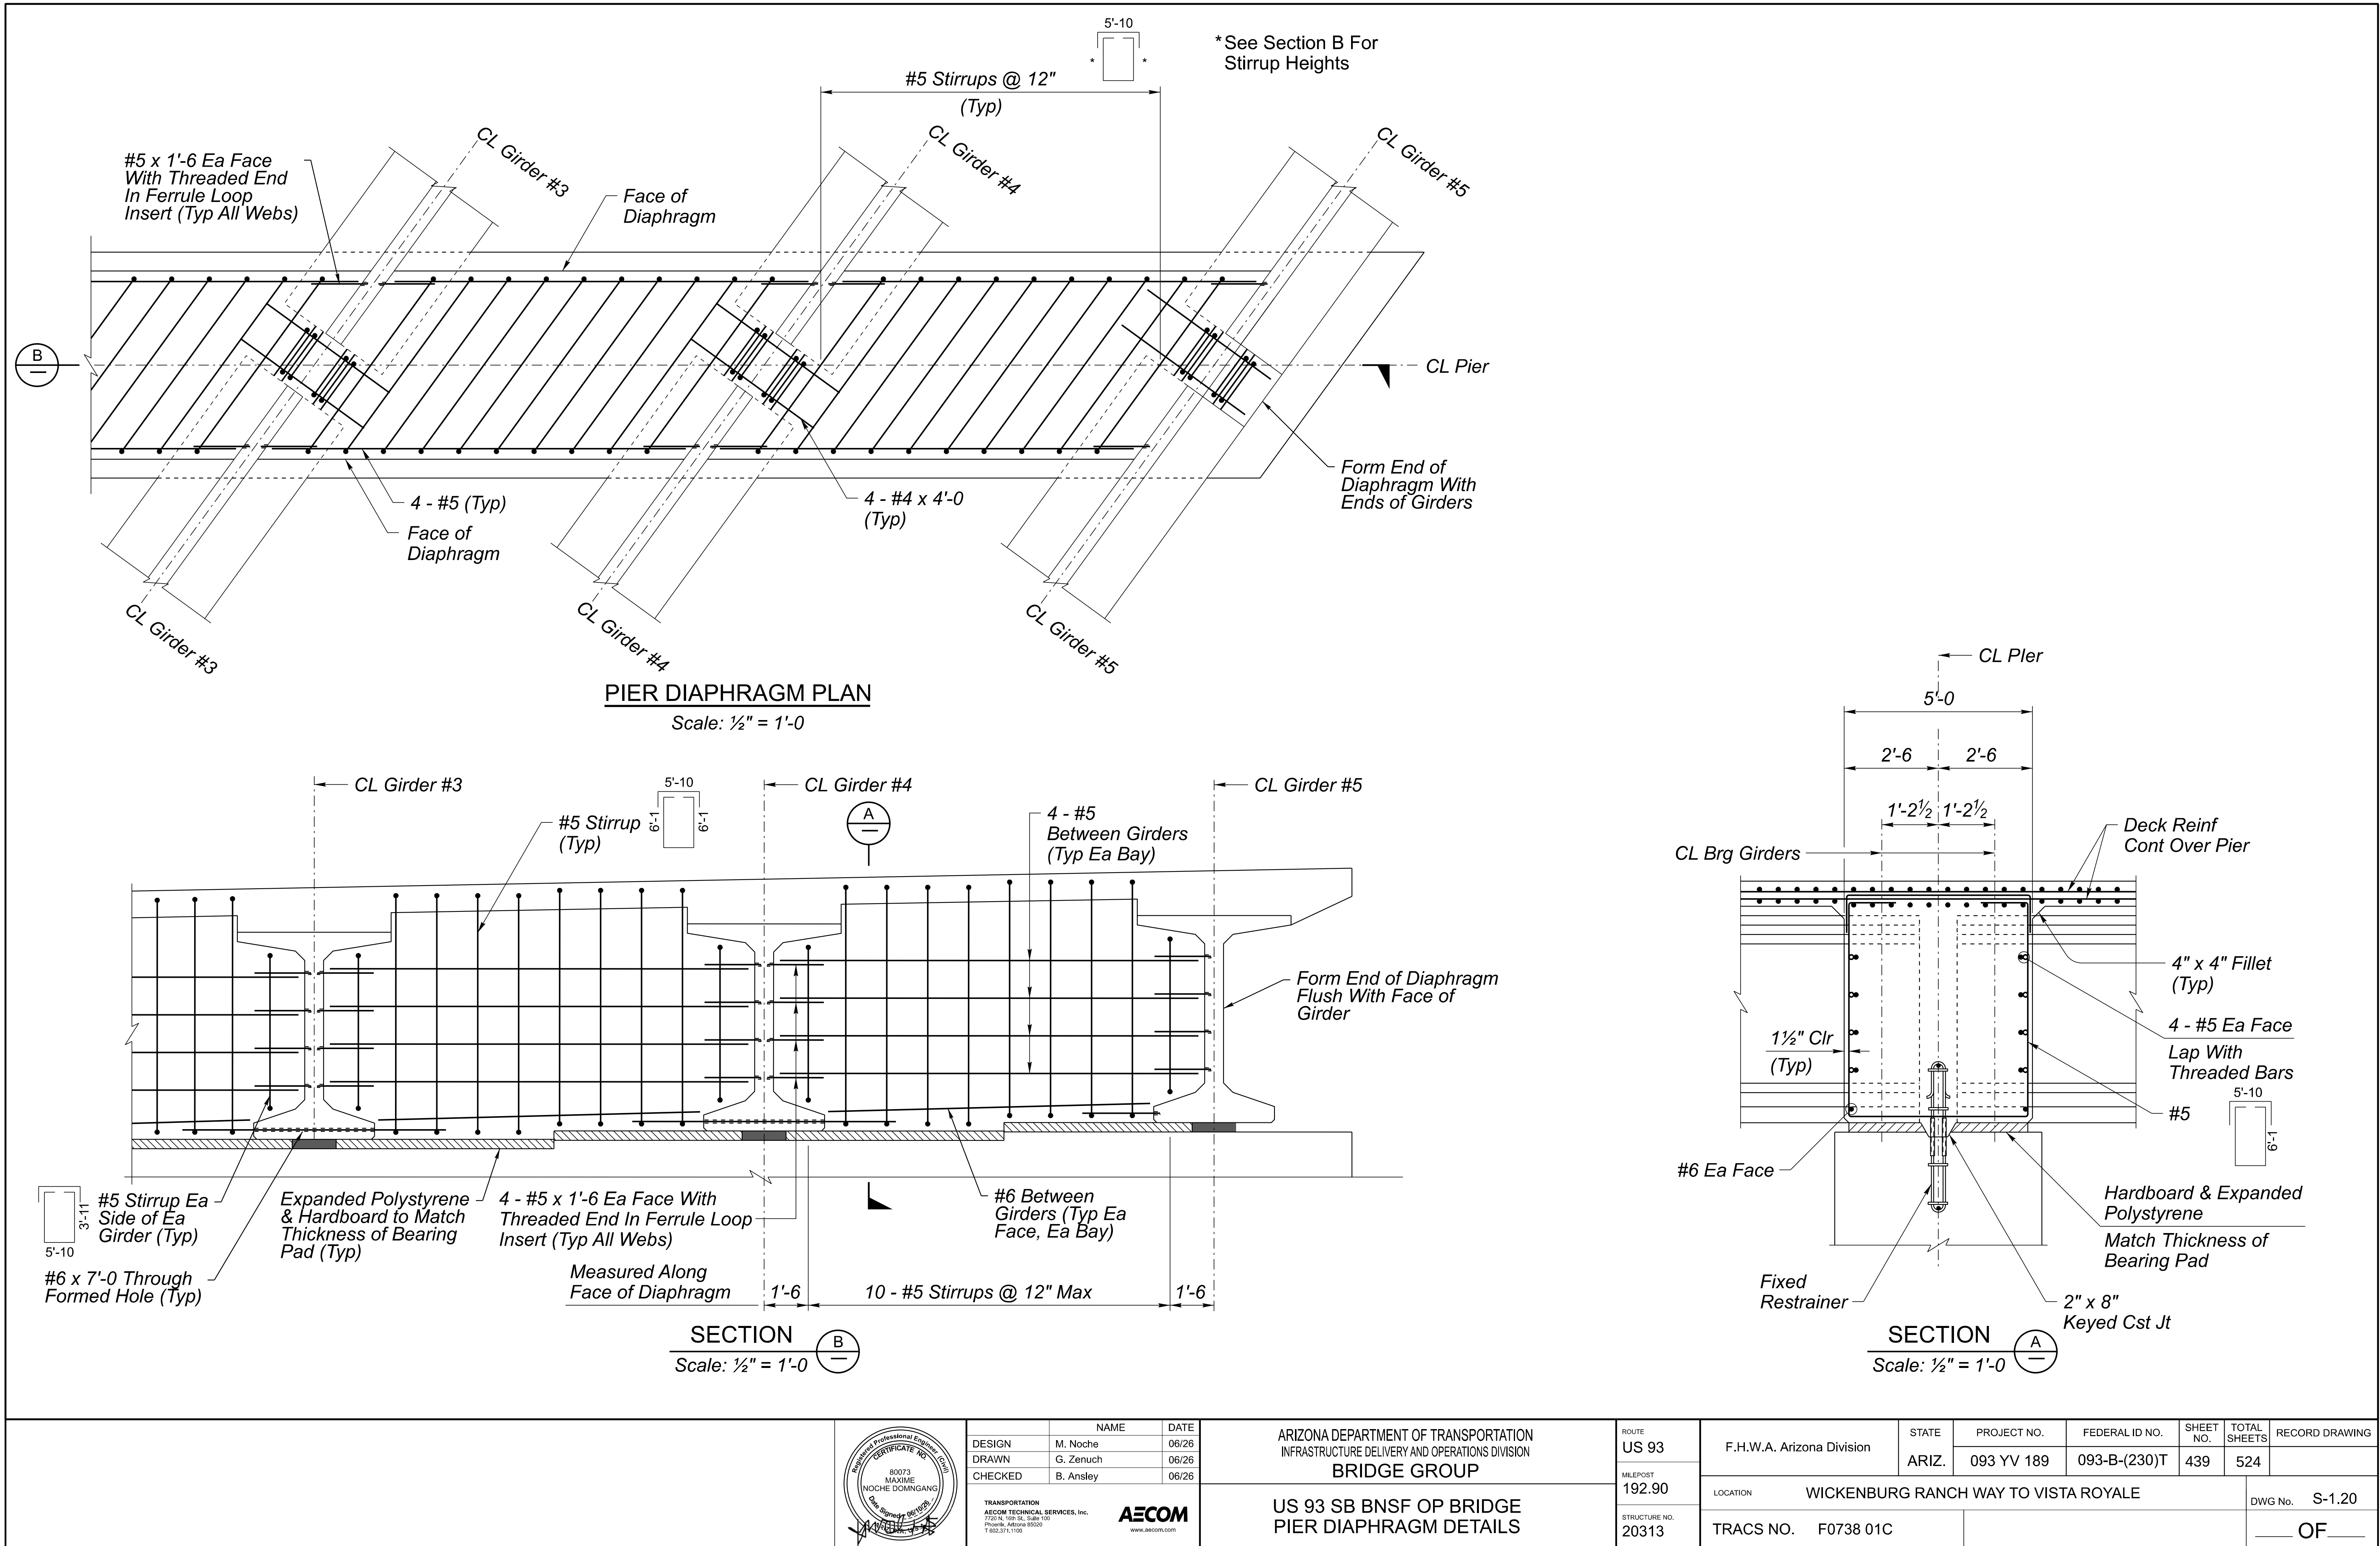

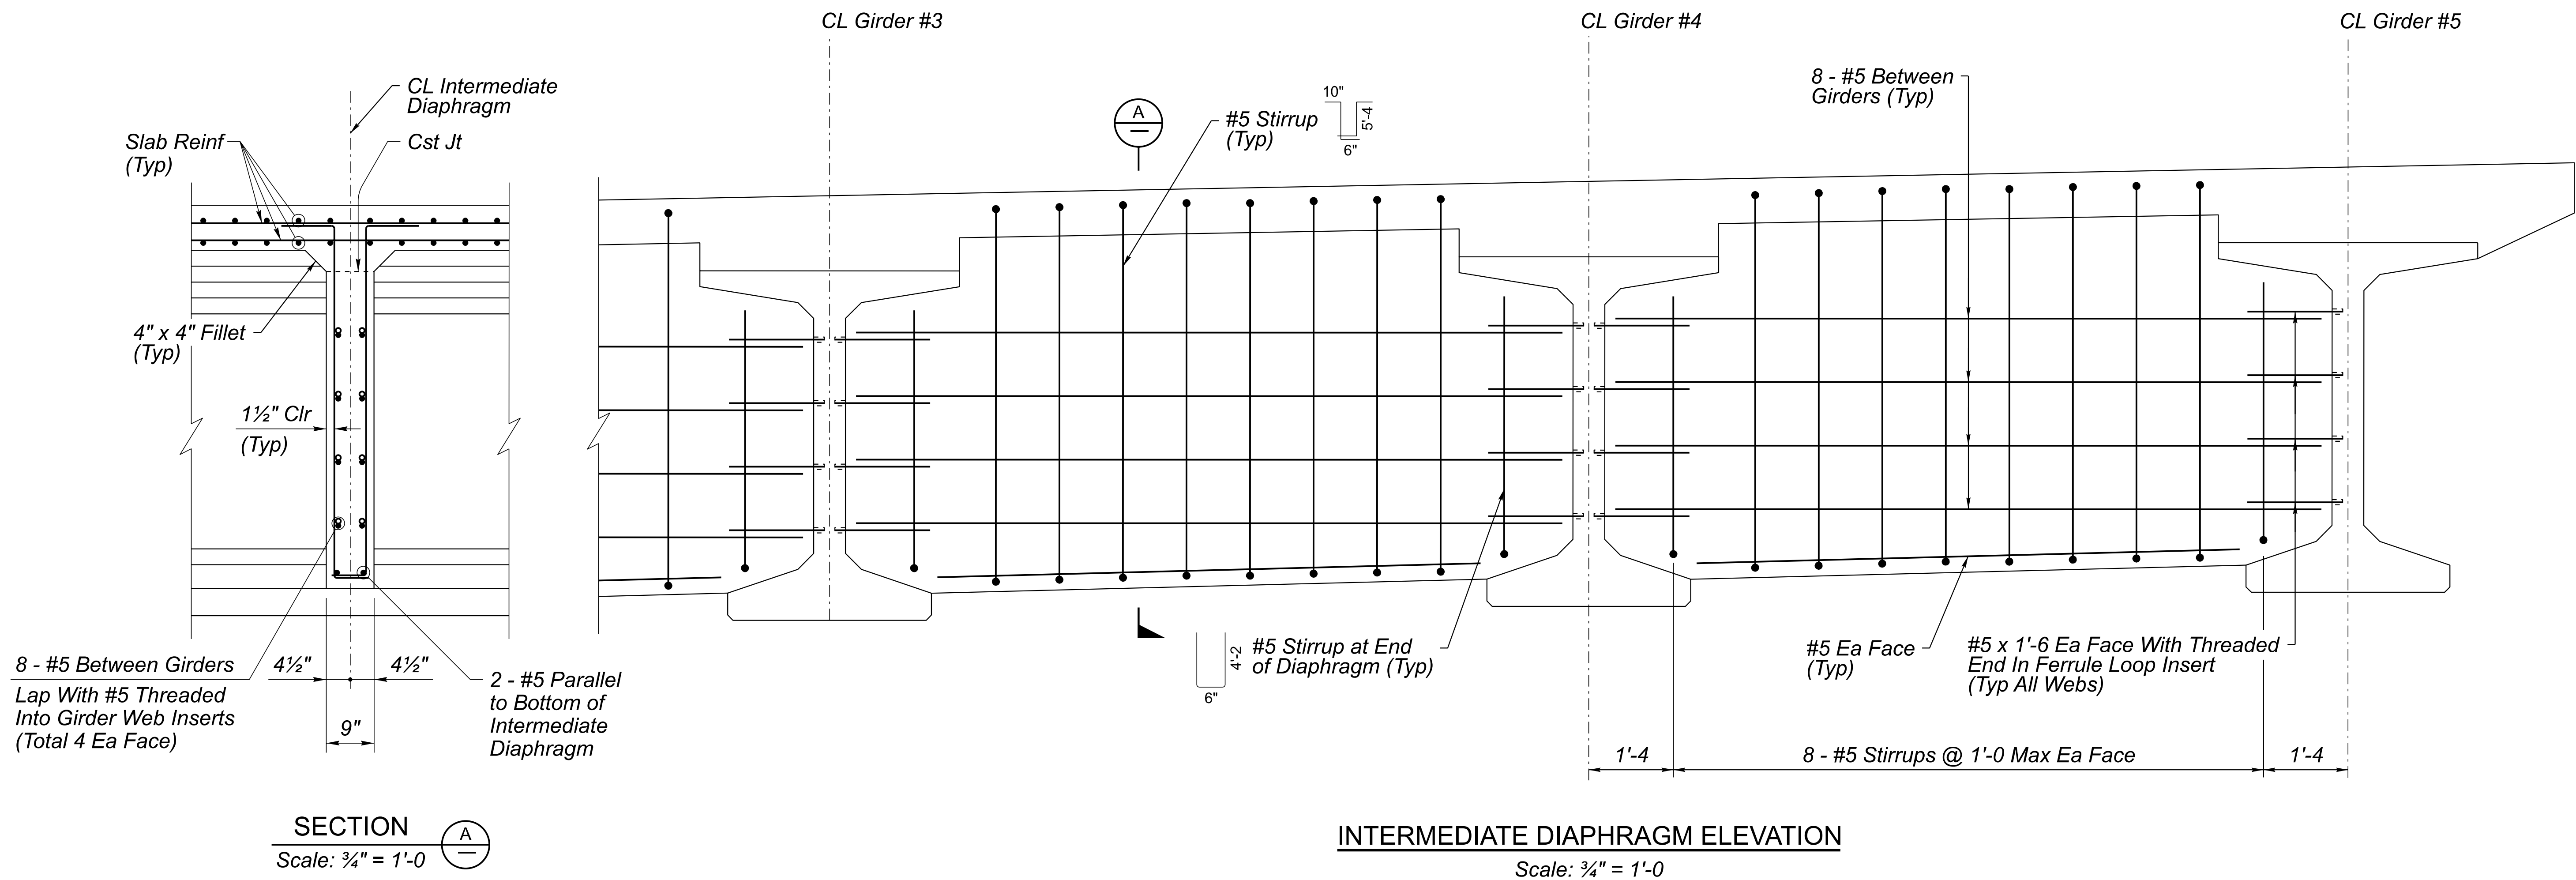


	NAME	DATE
DESIGN	M. Noche	06/26
DRAWN	G. Zenuch	06/26
CHECKED	B. Ansley	06/26

TRANSPORTATION
AECOM TECHNICAL SERVICES, Inc.
7720 N. 16th St., Suite 100
Phoenix, Arizona 85020
T 602.371.1100

AECOM
www.aecom.com


ARIZONA DEPARTMENT OF TRANSPORTATION INFRASTRUCTURE DELIVERY AND OPERATIONS DIVISION BRIDGE GROUP
US 93 SB BNSF OP BRIDGE INTERMEDIATE DIAPHRAGM DETAILS

ROUTE US 93	F.H.W.A. Arizona Division	STATE ARIZ.	PROJECT NO. 093 YV 189	FEDERAL ID NO. 093-B-(230)T	SHEET NO. 440	TOTAL SHEETS 524	RECORD DRAWING
MILEPOST 192.90	LOCATION WICKENBURG RANCH WAY TO VISTA ROYALE					DWG No. S-1.21	
STRUCTURE NO. 20313	TRACS NO. F0738 01C					OF	

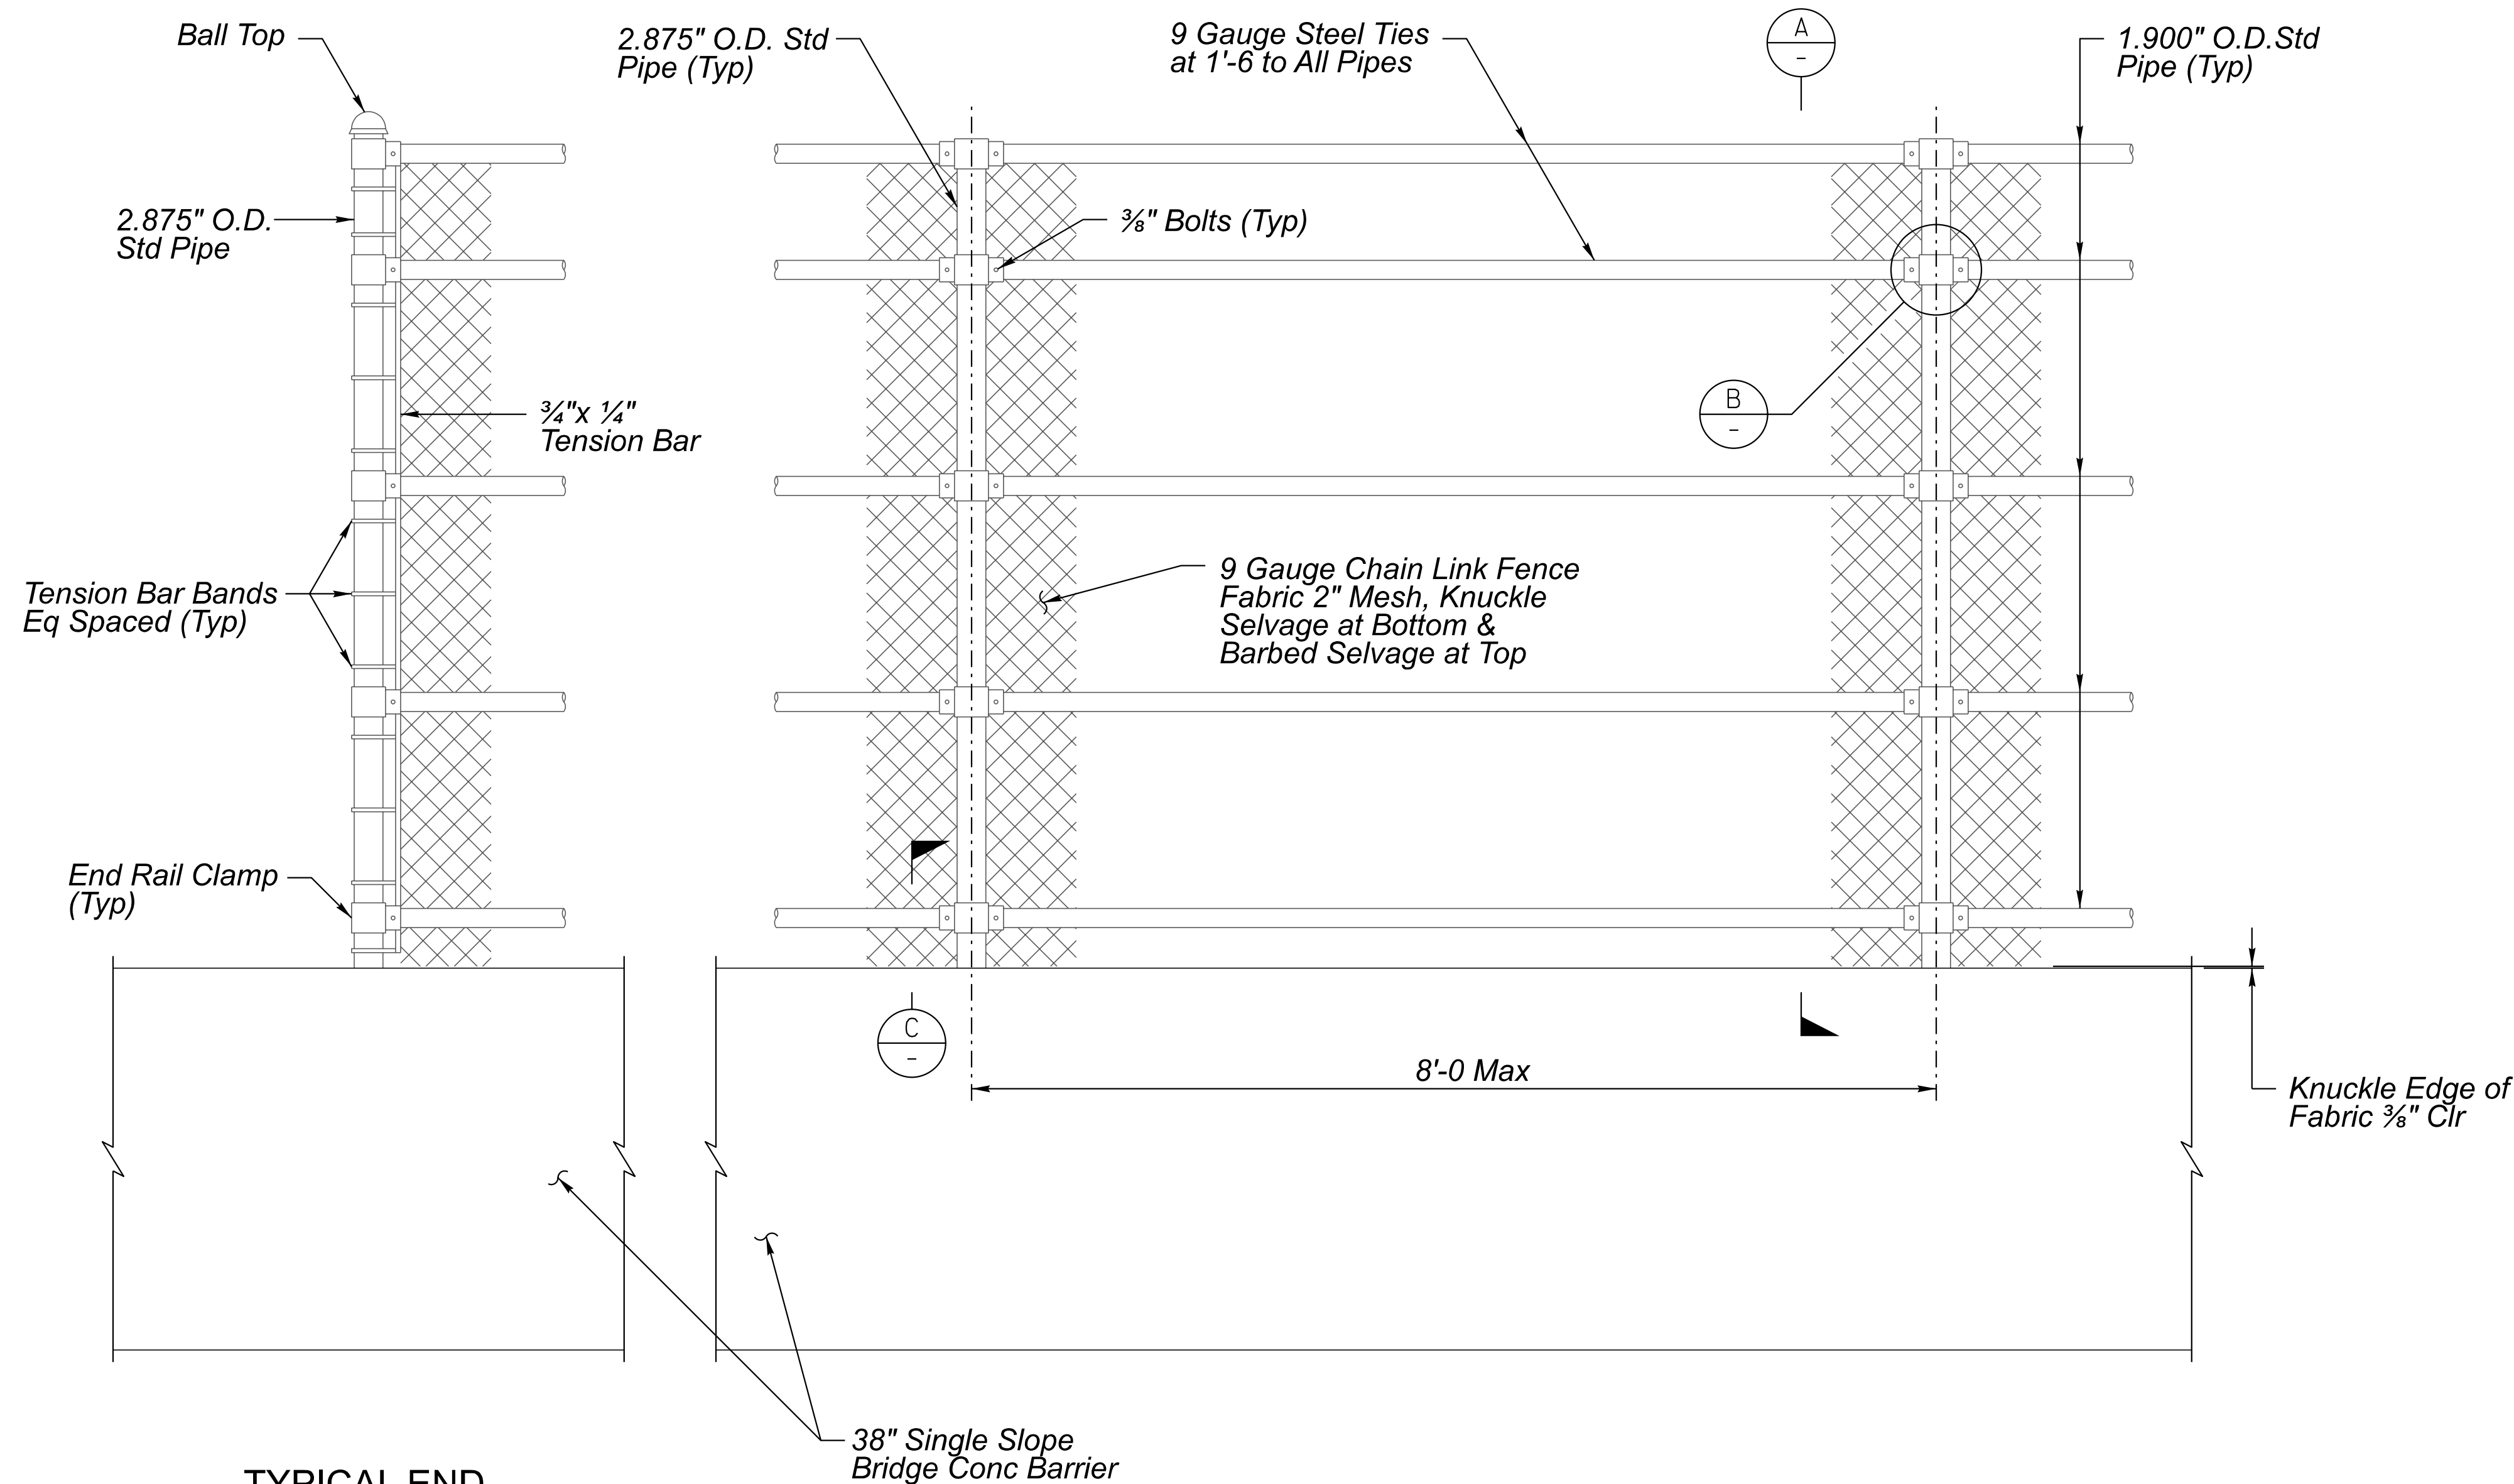


TYPICAL END POST ELEVATION
Scale: 1" = 1'-0


TYPICAL PANEL ELEVATION
Scale: 1" = 1'-0

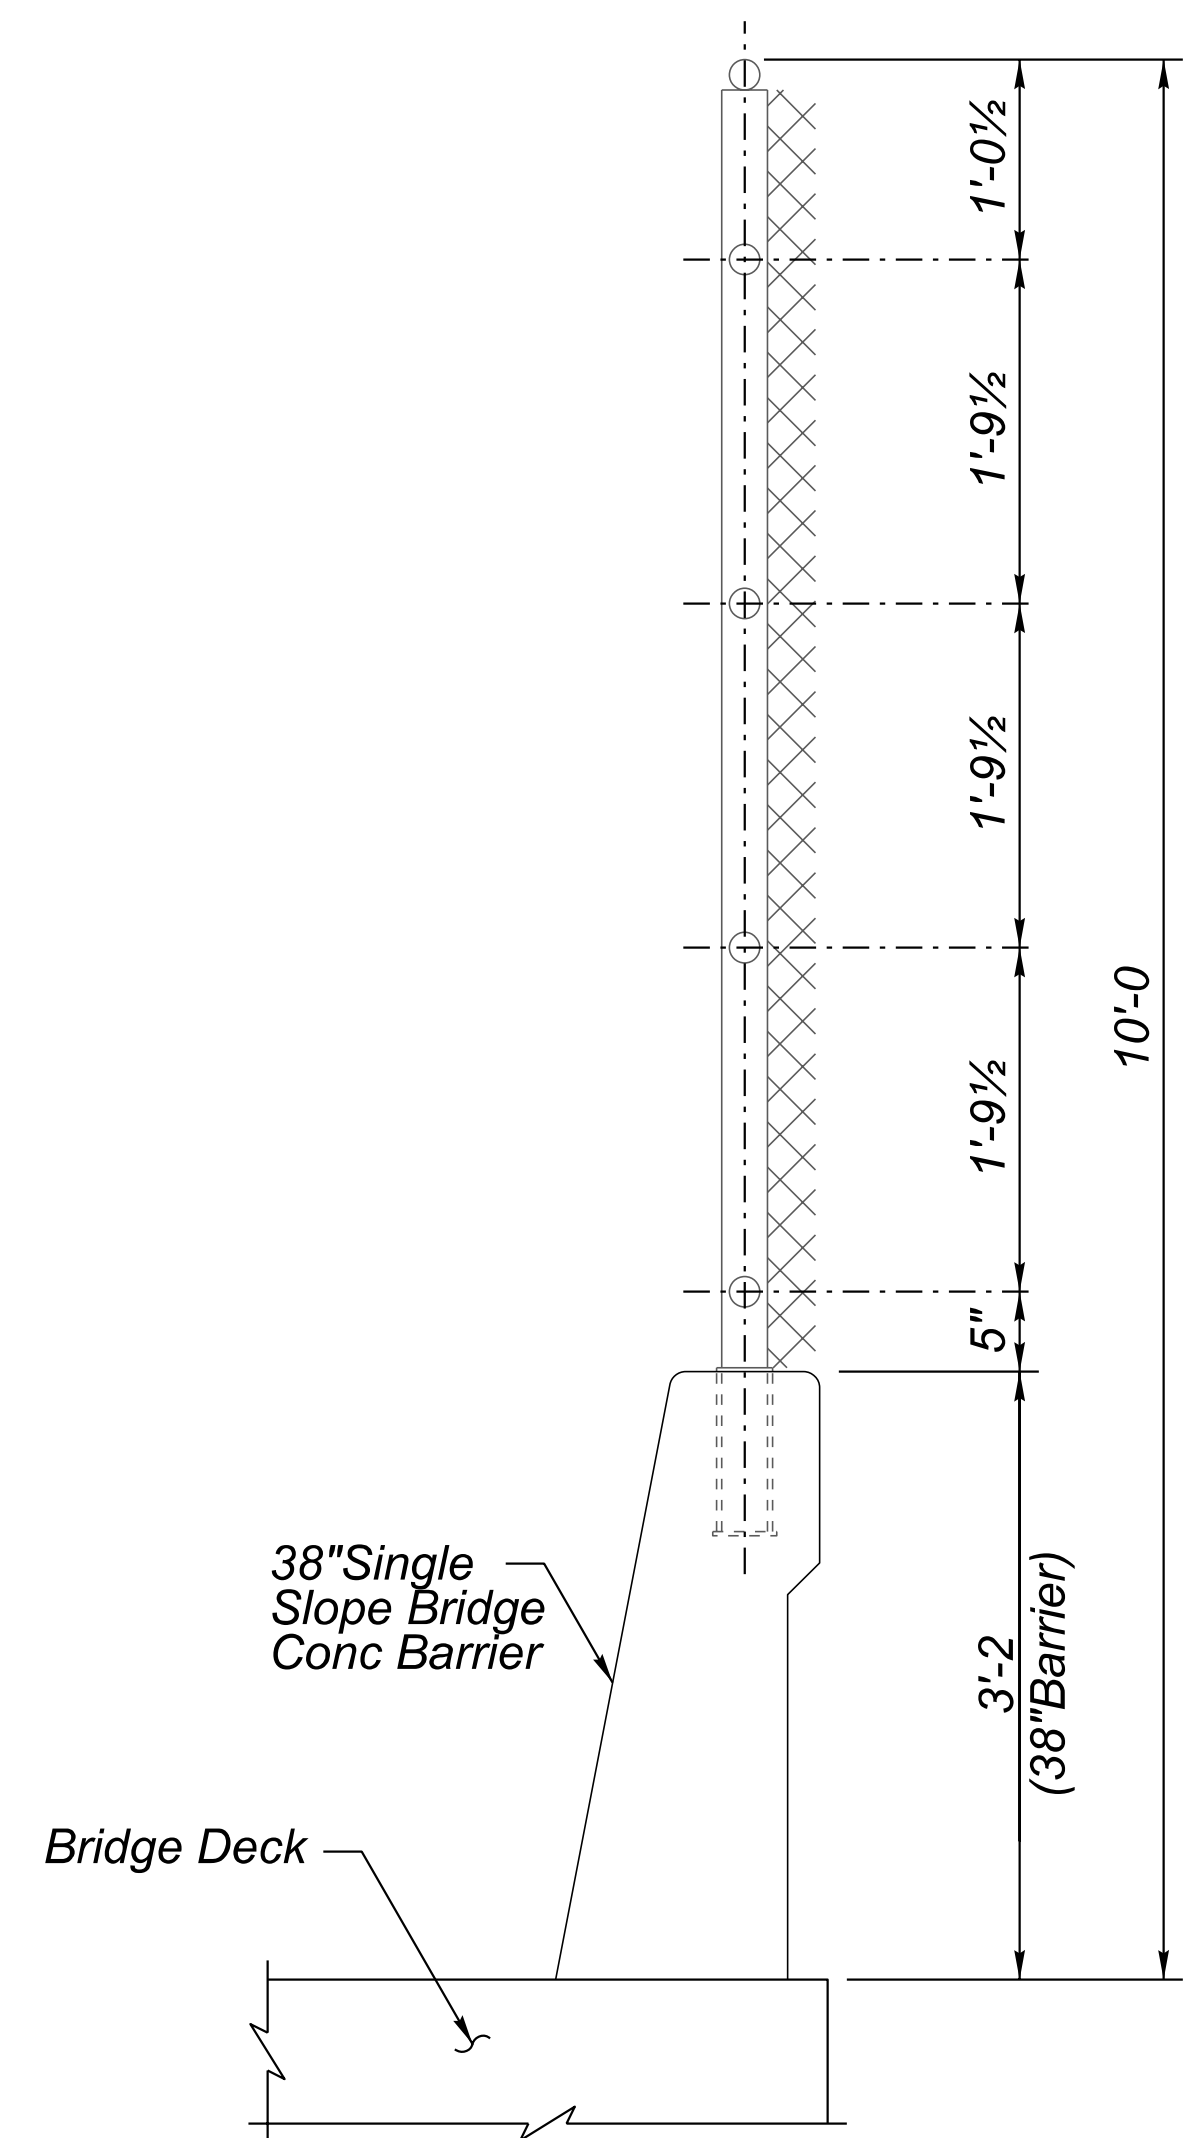

SECTION
Scale: 1" = 1'-0

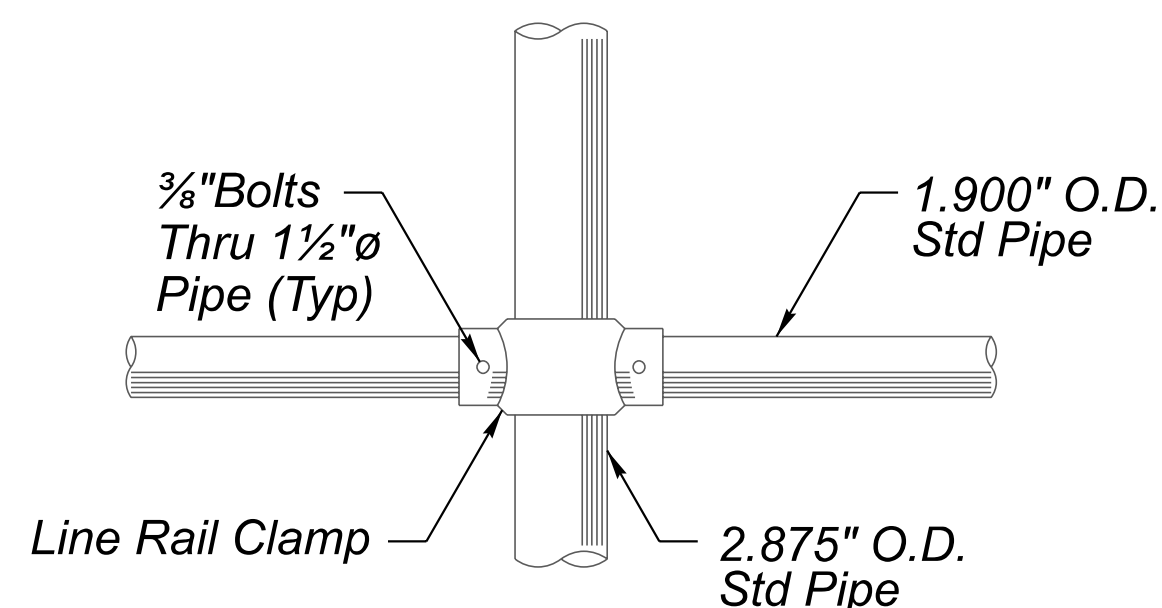

DETAIL
NTS

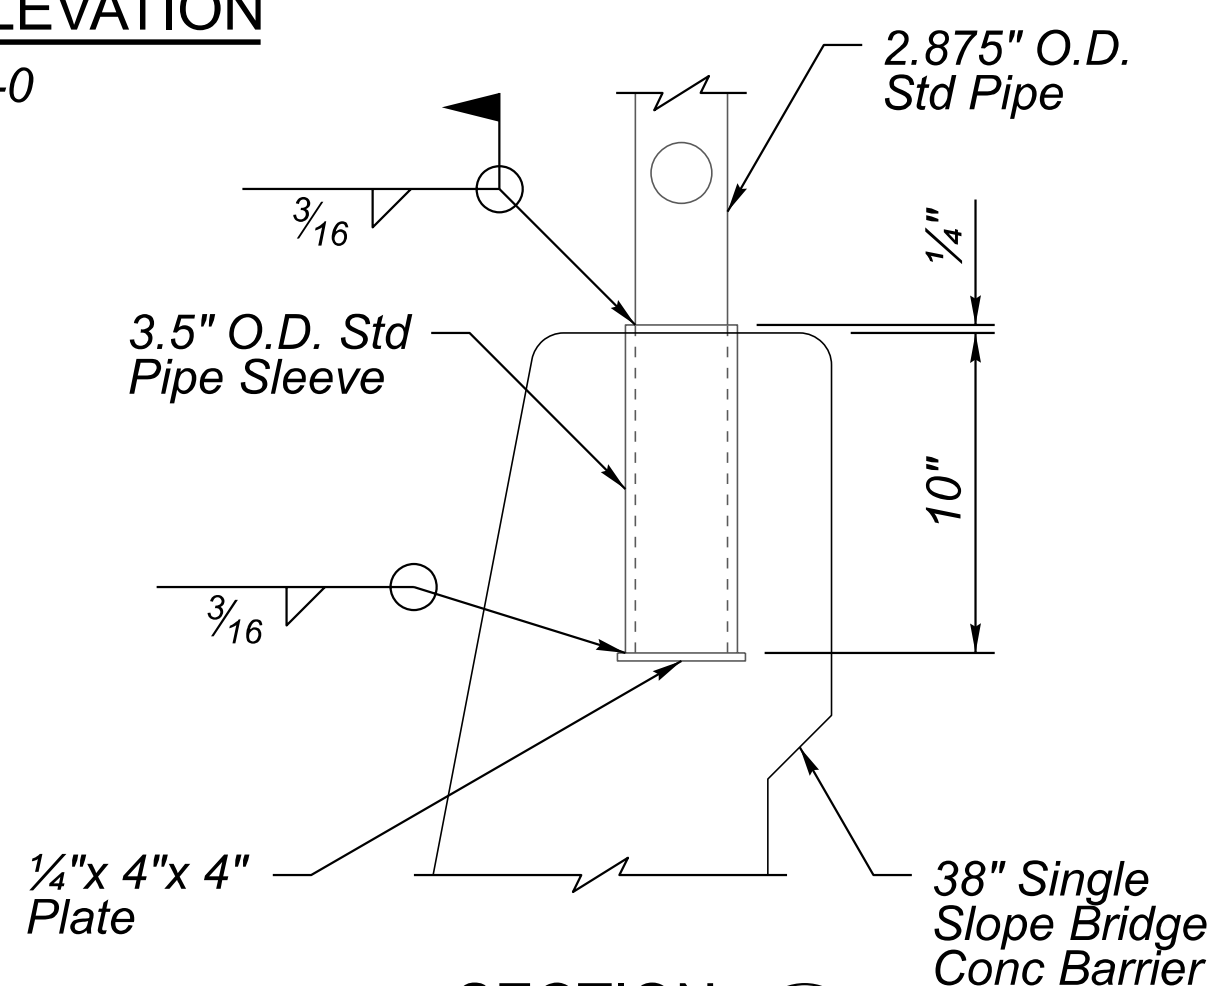

SECTION
NTS

NOTES:

- Chain link fence fabric, posts, fittings & hardware shall conform to AASHTO M181 - Grade I or Grade II. The zinc coated fabric shall be Class C or D.
- All galvanizing that has been damaged in handling, transporting or welding shall be repaired by the application of a paste compound of an approved zinc powder & flux.
- All exposed edges shall be ground smooth.
- All bolt heads shall be installed on the roadway side.
- Fence fabric shall be installed on the outside.
- All welding shall conform to the requirements of the American Welding Society, ANSI/AASHTO/AWS D1.5 Bridge Welding Code, latest edition.



	NAME	DATE
DESIGN	M. Noche	06/26
DRAWN	G. Zenuch	06/26
CHECKED	B. Ansley	06/26

TRANSPORTATION
AECOM TECHNICAL SERVICES, Inc.
7720 N. 16th St., Suite 100
Phoenix, Arizona 85020
T 602.371.1100

AECOM
www.aecom.com

ARIZONA DEPARTMENT OF TRANSPORTATION
INFRASTRUCTURE DELIVERY AND OPERATIONS DIVISION
BRIDGE GROUP

**US 93 SB BNSF OP BRIDGE
FENCE DETAILS**


ROUTE US 93	F.H.W.A. Arizona Division	STATE ARIZ.	PROJECT NO. 093 YV 189	FEDERAL ID NO. 093-B-(230)T	SHEET NO. 441	TOTAL SHEETS 524	RECORD DRAWING
MILEPOST 192.90	LOCATION WICKENBURG RANCH WAY TO VISTA ROYALE					DWG No.	S-1.22
STRUCTURE NO. 20313	TRACS NO. F0738 01C					OF	




SCREED ELEVATIONS - SB SPAN 1											
	CL Brg Abt 1	0.1	0.2	0.3	0.4	0.5	0.6	0.7	0.8	0.9	CL Brg Pier 1
Lt Edge of Deck	2481.68	2481.88	2482.07	2482.25	2482.43	2482.59	2482.75	2482.90	2483.04	2483.17	2483.29
Girder #1	2481.79	2481.98	2482.17	2482.36	2482.53	2482.69	2482.85	2483.00	2483.13	2483.26	2483.39
Girder #2	2482.11	2482.30	2482.49	2482.67	2482.84	2483.01	2483.16	2483.30	2483.44	2483.56	2483.69
Girder #3	2482.44	2482.63	2482.81	2482.99	2483.16	2483.31	2483.46	2483.60	2483.74	2483.86	2483.98
SB Cst CL & PGL	2482.54	2482.72	2482.91	2483.08	2483.25	2483.41	2483.56	2483.70	2483.83	2483.95	2484.07
Girder #4	2482.76	2482.94	2483.13	2483.30	2483.47	2483.62	2483.77	2483.91	2484.04	2484.16	2484.27
Girder #5	2483.08	2483.26	2483.44	2483.61	2483.77	2483.93	2484.07	2484.21	2484.33	2484.45	2484.57
Rt Edge of Deck	2483.18	2483.36	2483.54	2483.71	2483.87	2484.02	2484.17	2484.30	2484.43	2484.54	2484.66

SCREED ELEVATIONS - SB SPAN 2											
	CL Brg Pier 1	0.1	0.2	0.3	0.4	0.5	0.6	0.7	0.8	0.9	CL Brg Pier 2
Lt Edge of Deck	2483.34	2483.60	2483.84	2484.07	2484.27	2484.44	2484.59	2484.70	2484.80	2484.87	2484.93
Girder #1	2483.43	2483.69	2483.94	2484.16	2484.36	2484.53	2484.67	2484.79	2484.88	2484.95	2485.01
Girder #2	2483.73	2483.98	2484.22	2484.44	2484.64	2484.81	2484.95	2485.06	2485.15	2485.22	2485.27
Girder #3	2484.02	2484.27	2484.51	2484.73	2484.92	2485.08	2485.22	2485.33	2485.41	2485.47	2485.53
SB Cst CL & PGL	2484.11	2484.36	2484.60	2484.81	2485.00	2485.17	2485.30	2485.41	2485.49	2485.55	2485.60
Girder #4	2484.32	2484.56	2484.80	2485.01	2485.19	2485.35	2485.49	2485.59	2485.67	2485.73	2485.78
Girder #5	2484.61	2484.85	2485.08	2485.29	2485.47	2485.62	2485.75	2485.86	2485.93	2485.99	2486.03
Rt Edge of Deck	2484.70	2484.94	2485.17	2485.37	2485.56	2485.71	2485.84	2485.94	2486.01	2486.07	2486.11

SCREED ELEVATIONS - SB SPAN 3											
	CL Brg Pier 2	0.1	0.2	0.3	0.4	0.5	0.6	0.7	0.8	0.9	CL Brg Abt 2
Lt Edge of Deck	2484.96	2485.06	2485.16	2485.25	2485.33	2485.41	2485.47	2485.53	2485.57	2485.61	2485.65
Girder #1	2485.04	2485.14	2485.24	2485.33	2485.41	2485.49	2485.55	2485.60	2485.65	2485.69	2485.72
Girder #2	2485.30	2485.40	2485.49	2485.58	2485.66	2485.73	2485.79	2485.84	2485.88	2485.92	2485.95
Girder #3	2485.55	2485.65	2485.74	2485.83	2485.90	2485.97	2486.03	2486.08	2486.11	2486.15	2486.17
SB Cst CL & PGL	2485.63	2485.73	2485.82	2485.90	2485.98	2486.04	2486.10	2486.15	2486.19	2486.22	2486.24
Girder #4	2485.80	2485.90	2485.99	2486.07	2486.14	2486.21	2486.26	2486.31	2486.35	2486.37	2486.40
Girder #5	2486.05	2486.15	2486.23	2486.31	2486.38	2486.44	2486.50	2486.54	2486.57	2486.60	2486.62
Rt Edge of Deck	2486.13	2486.22	2486.31	2486.39	2486.46	2486.52	2486.57	2486.61	2486.65	2486.67	2486.69

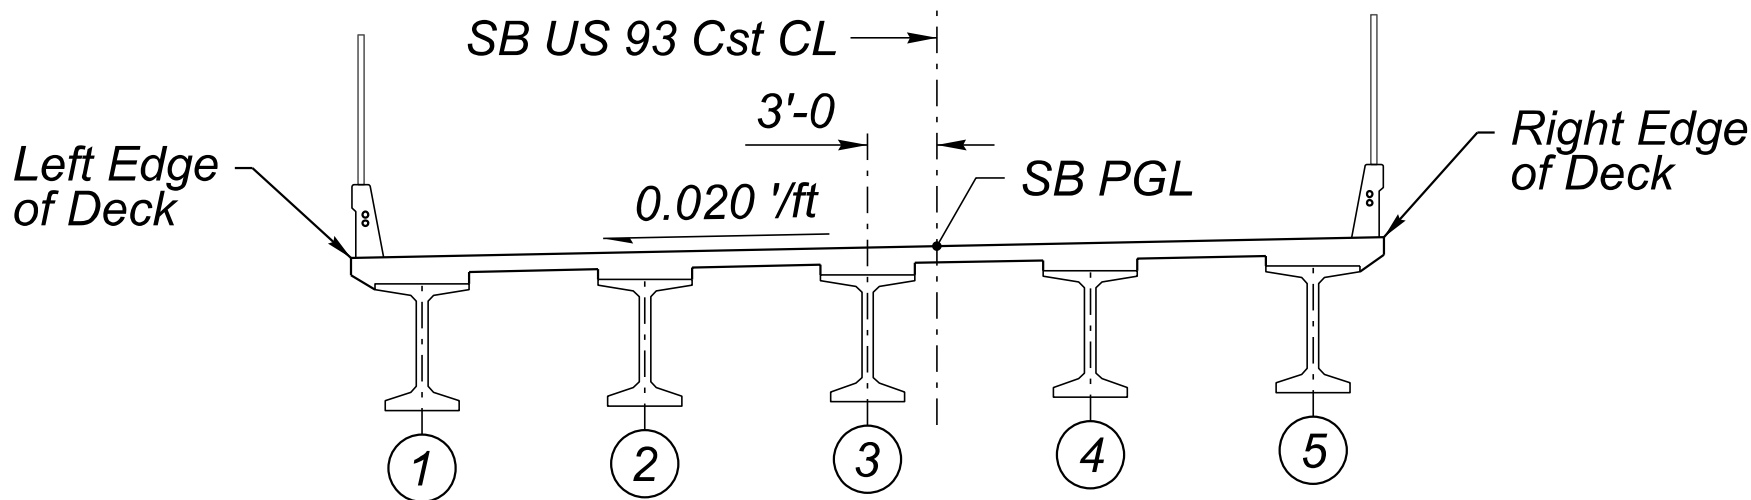


DECK SECTION
Scale: 1" = 10'-0

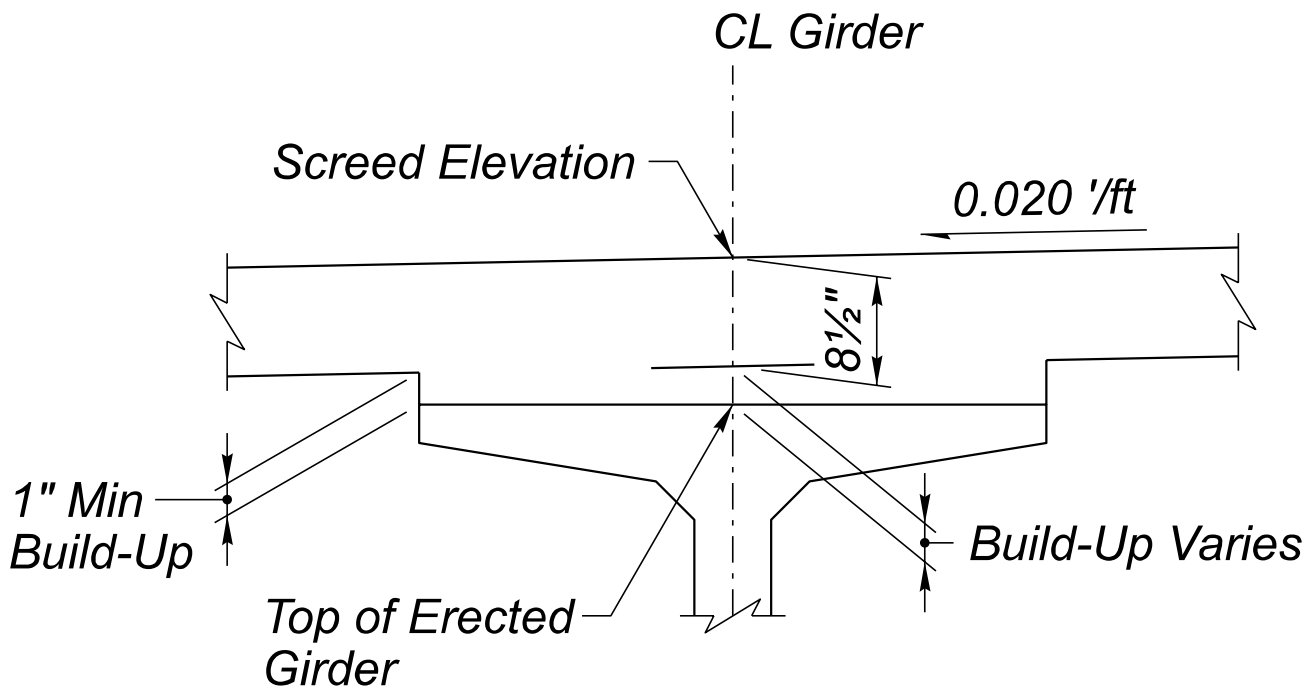

TYPICAL SECTION
NTS

SCREED ELEVATION NOTES:

- The top of Erected Girder Elevation shall be measured in the field at tenth points & submitted to the Engineer for evaluation of the build-up prior to setting deck forms.
- The Screed Elevation includes an allowance for the deflection due to the dead load of the concrete deck slab (including stay-in-place form dead load if applicable), diaphragms, barrier & the effect of long-term creep.
- Screed Elevations shall be used in setting screeds. Adjustments to the Screed Elevations, if necessary, will be determined by the Bridge Engineer after reviewing the top of erected girder elevations.
DO NOT USE FINISHED GRADE ELEVATIONS FOR SETTING SCREEDS.

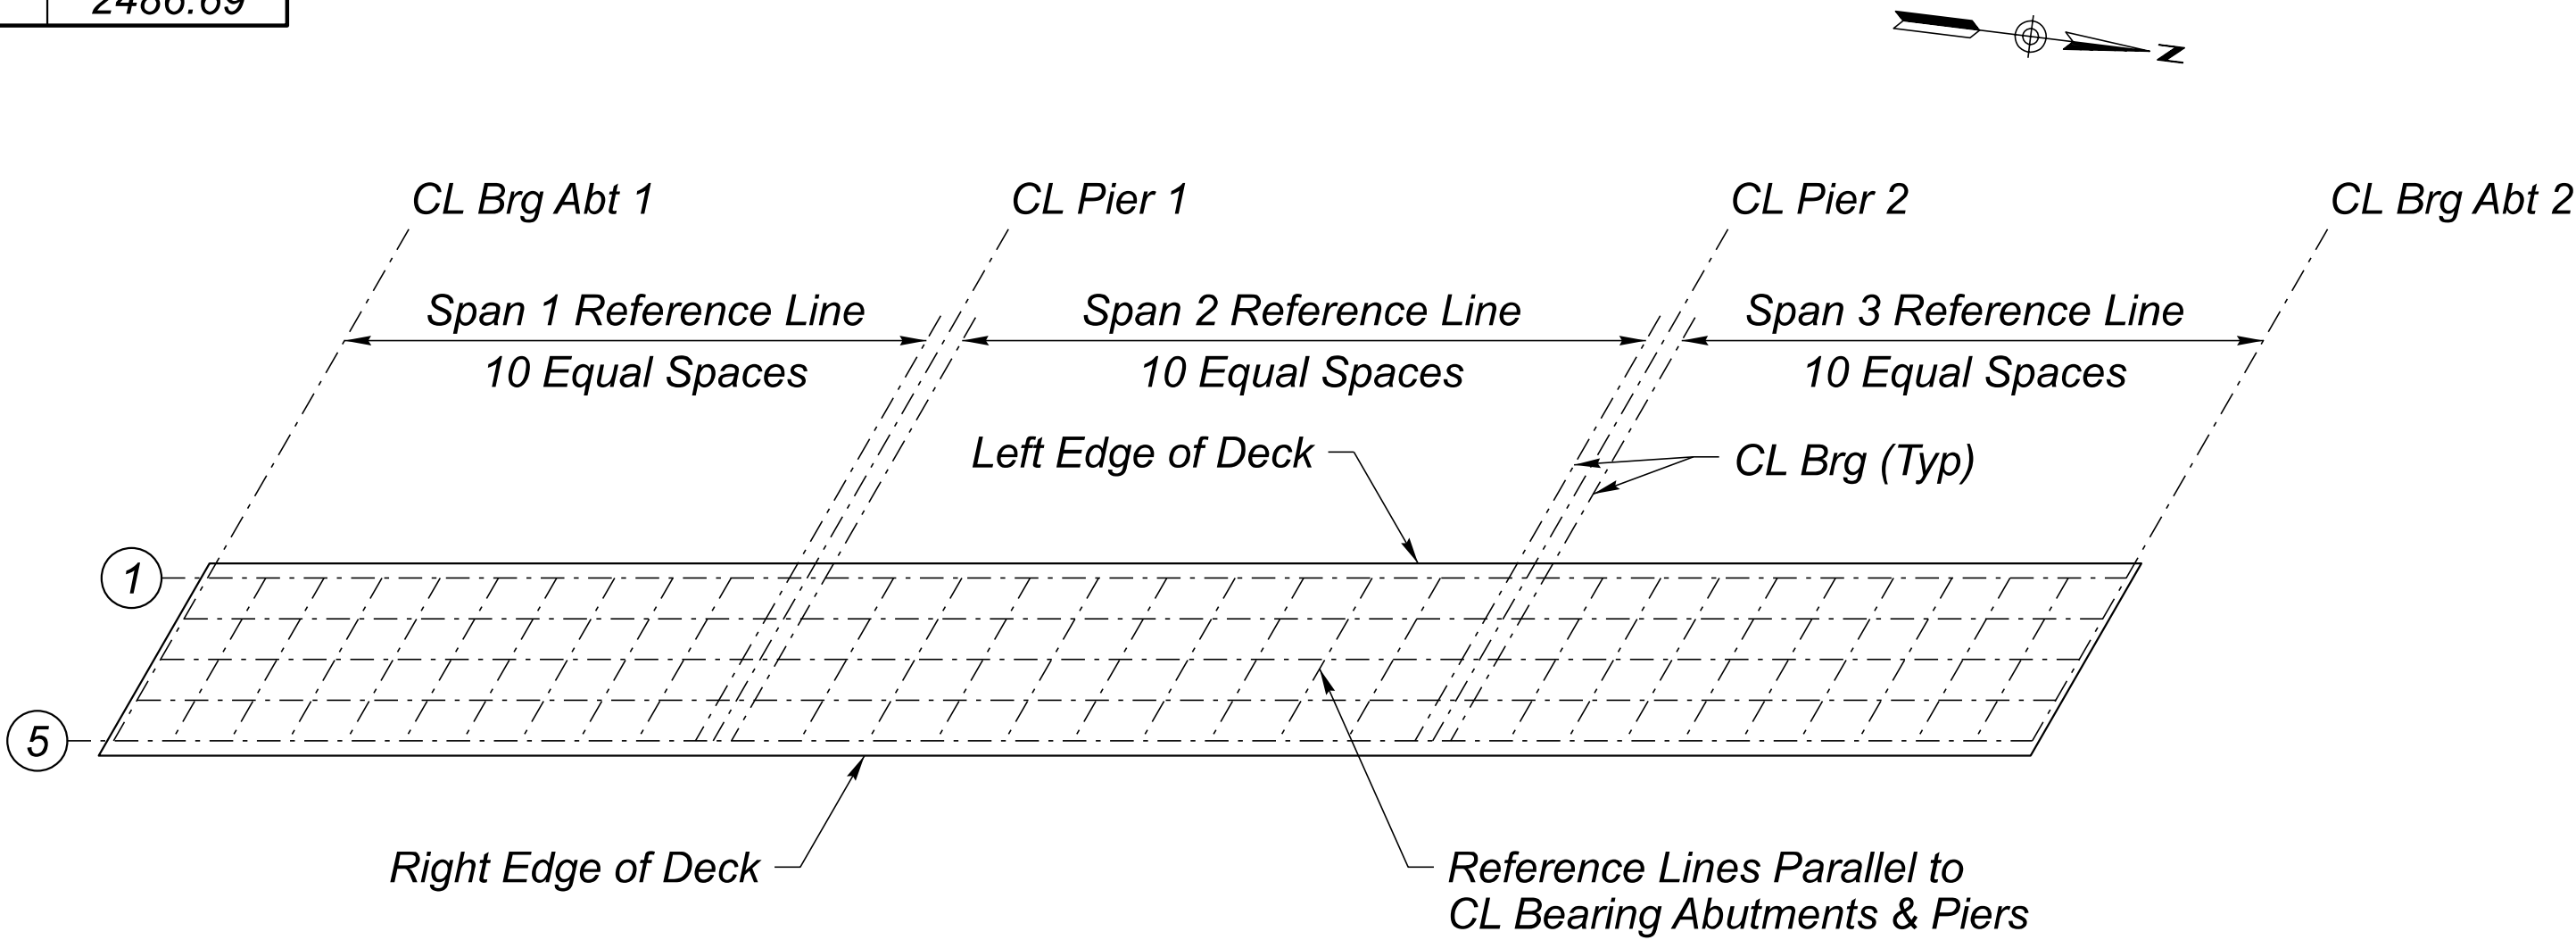

TYPICAL SCREED REFERENCE LINE PLAN
NTS



	NAME	DATE
DESIGN	M. Noche	06/26
DRAWN	G. Zenuch	06/26
CHECKED	B. Ansley	06/26

TRANSPORTATION
AECOM TECHNICAL SERVICES, Inc.
7720 N. 16th St., Suite 100
Phoenix, Arizona 85020
T 602.371.1100

AECOM
www.aecom.com

ARIZONA DEPARTMENT OF TRANSPORTATION INFRASTRUCTURE DELIVERY AND OPERATIONS DIVISION BRIDGE GROUP	ROUTE US 93	F.H.W.A. Arizona Division	STATE ARIZ.	PROJECT NO.	FEDERAL ID NO.	SHEET NO.	TOTAL SHEETS	RECORD DRAWING
	093 YV 189			093-B-(230)T	443	524		
	US 93 SB BNSF OP BRIDGE SCREED ELEVATIONS	MILEPOST 192.90	LOCATION WICKENBURG RANCH WAY TO VISTA ROYALE					
STRUCTURE NO. 20313		TRACS NO. F0738 01C						____ OF ____

MSE WALL GENERAL NOTES:

Construction Specifications - Arizona Department of Transportation Standard Specifications for Road & Bridge Construction, Edition of 2021.

Design Specifications:

- 1. AASHTO LRFD Bridge Design Specifications, 8th Edition, 2017, with current interims.
- 2. FHWA Geotechnical Engineer Circular No. 11 Design & Construction of Mechanically Stabilized Earth Walls & Reinforced Soil Slopes, NH1 Courses No. 132042 & 132043, Publication Nos. FHWA-NH1-10-024 & FHWA-NH1-10-025, Volumes 1 & 2, 2009.

Walls shall be constructed in accordance with the Standards and/or Special Details indicated, unless noted otherwise.

Dimensions shall not be scaled from drawings.

Seismic Performance - Seismic Zone 1, Site Class C, PGA = 0.057g, SDS = 0.155g, SD1 = 0.088g.

Stresses:

Grade 60 reinforcing steel (unless noted otherwise)..... fy = 60,000 psi

Temporary Shoring - Temporary shoring may be required for excavation & construction of walls to accomplish the work without adversely affecting existing facilities/utilities. The contractor shall be responsible for providing temporary shoring as required to maintain traffic, to protect utilities, for protection of workers or as otherwise needed to accomplish the work. The contractor shall submit a plan outlining construction procedures, shoring requirements & design to the Engineer for review & approval prior to proceeding with the work. For additional information, see Subsection 929-4.01 of the Specifications. No additional payment will be made for temporary shoring.

Retaining wall geometry refers to the exposed face of wall, unless noted otherwise.

Where retaining walls support roadways, the top of wall coping shall follow the profile of the adjacent roadway. The contractor shall verify the top of wall elevations shown on the Project Plans prior to fabricating any wall elements.

Where retaining walls do not support roadways, linear interpolation shall be used to calculate the top of wall where not shown on plans.

For soil boring logs & geotechnical information, refer to the Final Geotechnical Report (dated 12/17/2025) by ADOT Geotechnical Services. This report is available through the ADOT Contracts & Specifications website.

For MSE Wall Design parameters, see the Final Geotechnical Report (dated 12/17/2025) by ADOT Geotechnical Services. This report is available through the ADOT Contracts & Specifications website.

All utilities shown in the Project Plans are provided for the contractor's general information only. The locations are approximate. It shall be the contractor's responsibility to determine & coordinate the actual location of utilities in the vicinity of wall construction. Existing utility locations shown reflect the findings of the latest available mapping. Refer to existing condition plans for status of existing utilities.

Finished Grade Elevations along the front face (FF) of the walls are provided in the tables on the elevation sheets.

MSE WALL GENERAL NOTES (CONT):

Any variances to wall elevations shall incorporate minimum wall embedments below finished grade at the wall face per Table 2.2/Figure 2-16 of FHWA-NHI-10-024 & in accordance with information provided in the Final Geotechnical Exploration Report.

Mechanically Stabilized Earth (MSE) retaining walls are to be designed by the MSE wall manufacturer & constructed in accordance with the manufacturer's recommendations & the Project Specifications.


The top of leveling pad & finished grade elevations at the front face of wall shall be the minimum required for the MSE wall.

Painting shall be in accordance with Section 610 of the Specifications. Face of Wall & coping shall be painted. The paint color shall be ADOT Tan - (Federal Spec 30318) Flat Finish.

INDEX OF SHEETS:

- S-2.01 Wall General Notes & Quantities
- S-2.02 Abutment 1 Wall Plan & Elevation
- S-2.03 Abutment 2 Wall Plan & Elevation
- S-2.04 Wall Details
- S-2.05 MSE Wall Design Summary Sheet

LEGEND:

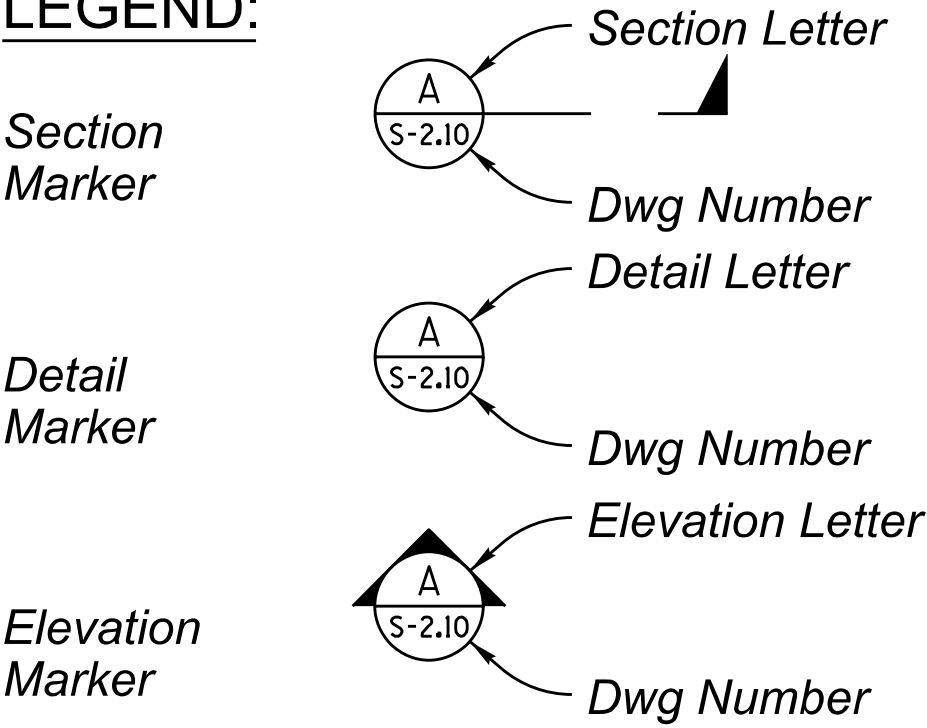


NOTE:

A line (—) in place of the Drawing Number indicates that the SECTION or DETAIL is located on the same drawing that the SECTION or DETAIL is cut.

Elev = Elevation
TOW = Top of Wall


WALL SUMMARY AND APPROXIMATE QUANTITIES		
Wall No.	MSE Retaining Wall (SF)	Metal Handrail (Detail DO) (LF)
Abut 1 Wall	4,352	123
Abut 2 Wall	3,068	102
Total	7,420	225
As Built		

	NAME		DATE	ARIZONA DEPARTMENT OF TRANSPORTATION INFRASTRUCTURE DELIVERY AND OPERATIONS DIVISION BRIDGE GROUP	ROUTE	F.H.W.A. Arizona Division	STATE ARIZ.	PROJECT NO.	FEDERAL ID NO.	SHEET NO.	TOTAL SHEETS	RECORD DRAWING
	DESIGN	M. Noche	06/26		US 93			093 YV 189	093-B-(230)T	444	524	
	DRAWN	G. Zenuch	06/26									
	CHECKED	B. Ansley	06/26									
	TRANSPORTATION AECOM TECHNICAL SERVICES, Inc. 7720 N. 16th St., Suite 100 Phoenix, Arizona 85021 T 602.371.1100			 www.aecom.com	RETAINING WALL WALL GENERAL NOTES & QUANTITIES	MILEPOST	LOCATION WICKENBURG RANCH WAY TO VISTA ROYALE DWG No. S-2.01					
					STRUCTURE NO.	TRACS NO. F0738 01C		___ OF ___				

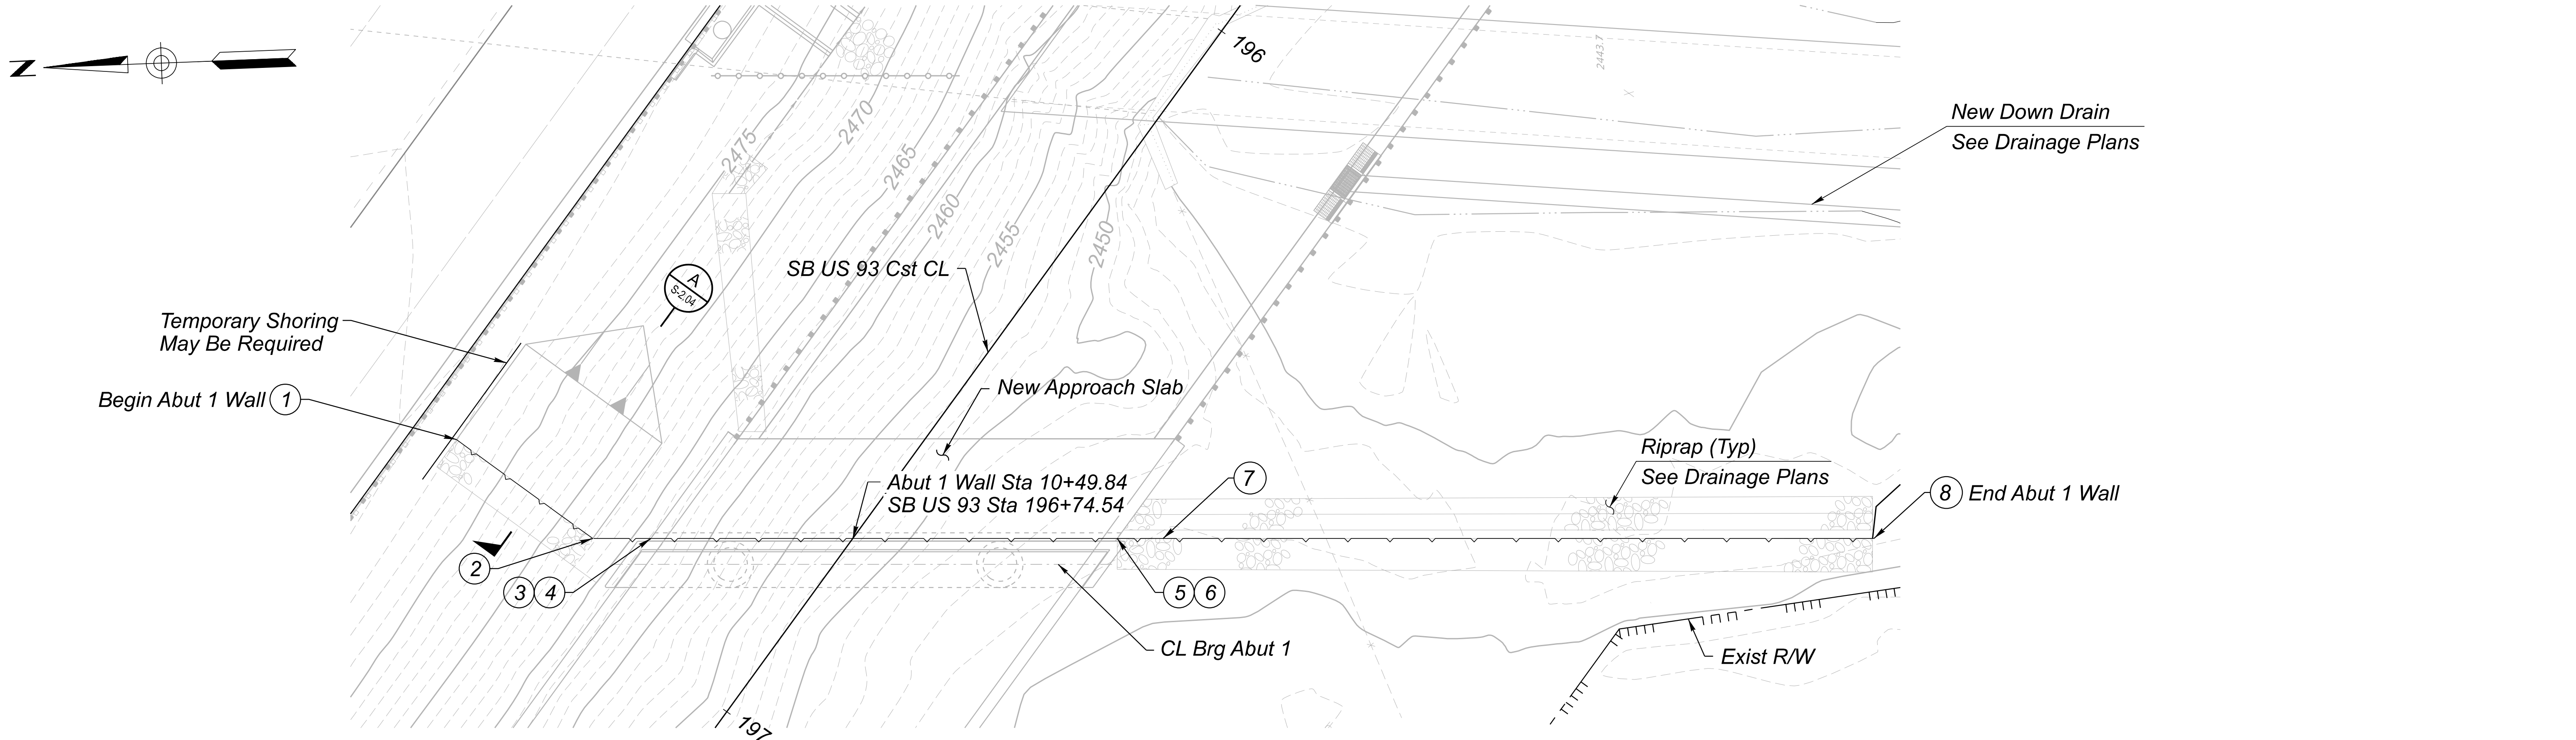

ABUTMENT 1 MSE WALL PLAN
Scale: 1" = 10'-0

ABUTMENT 1 WALL ELEVATION TABLE					
Mark	Wall Station	Roadway Station	Offset	Finished Grade Elev	TOW Elev
1	10+00.00	196+92.70	45.00' Rt	2477.22	2477.72
2	10+20.00	196+92.70	25.00' Rt	2482.22	2482.72
3	10+26.80	196+88.70	19.50' Rt	2483.07	2483.57
4	10+26.80	196+88.70	19.50' Rt	2480.90	2480.90
5	10+82.42	196+56.01	25.50' Lt	2479.46	2479.46
6	10+82.42	196+56.01	25.50' Lt	2481.63	2482.13
7	10+89.22	196+52.01	31.00' Lt	2480.63	2481.13
8	11+72.22	196+03.23	98.15' Lt	2446.06	2446.56

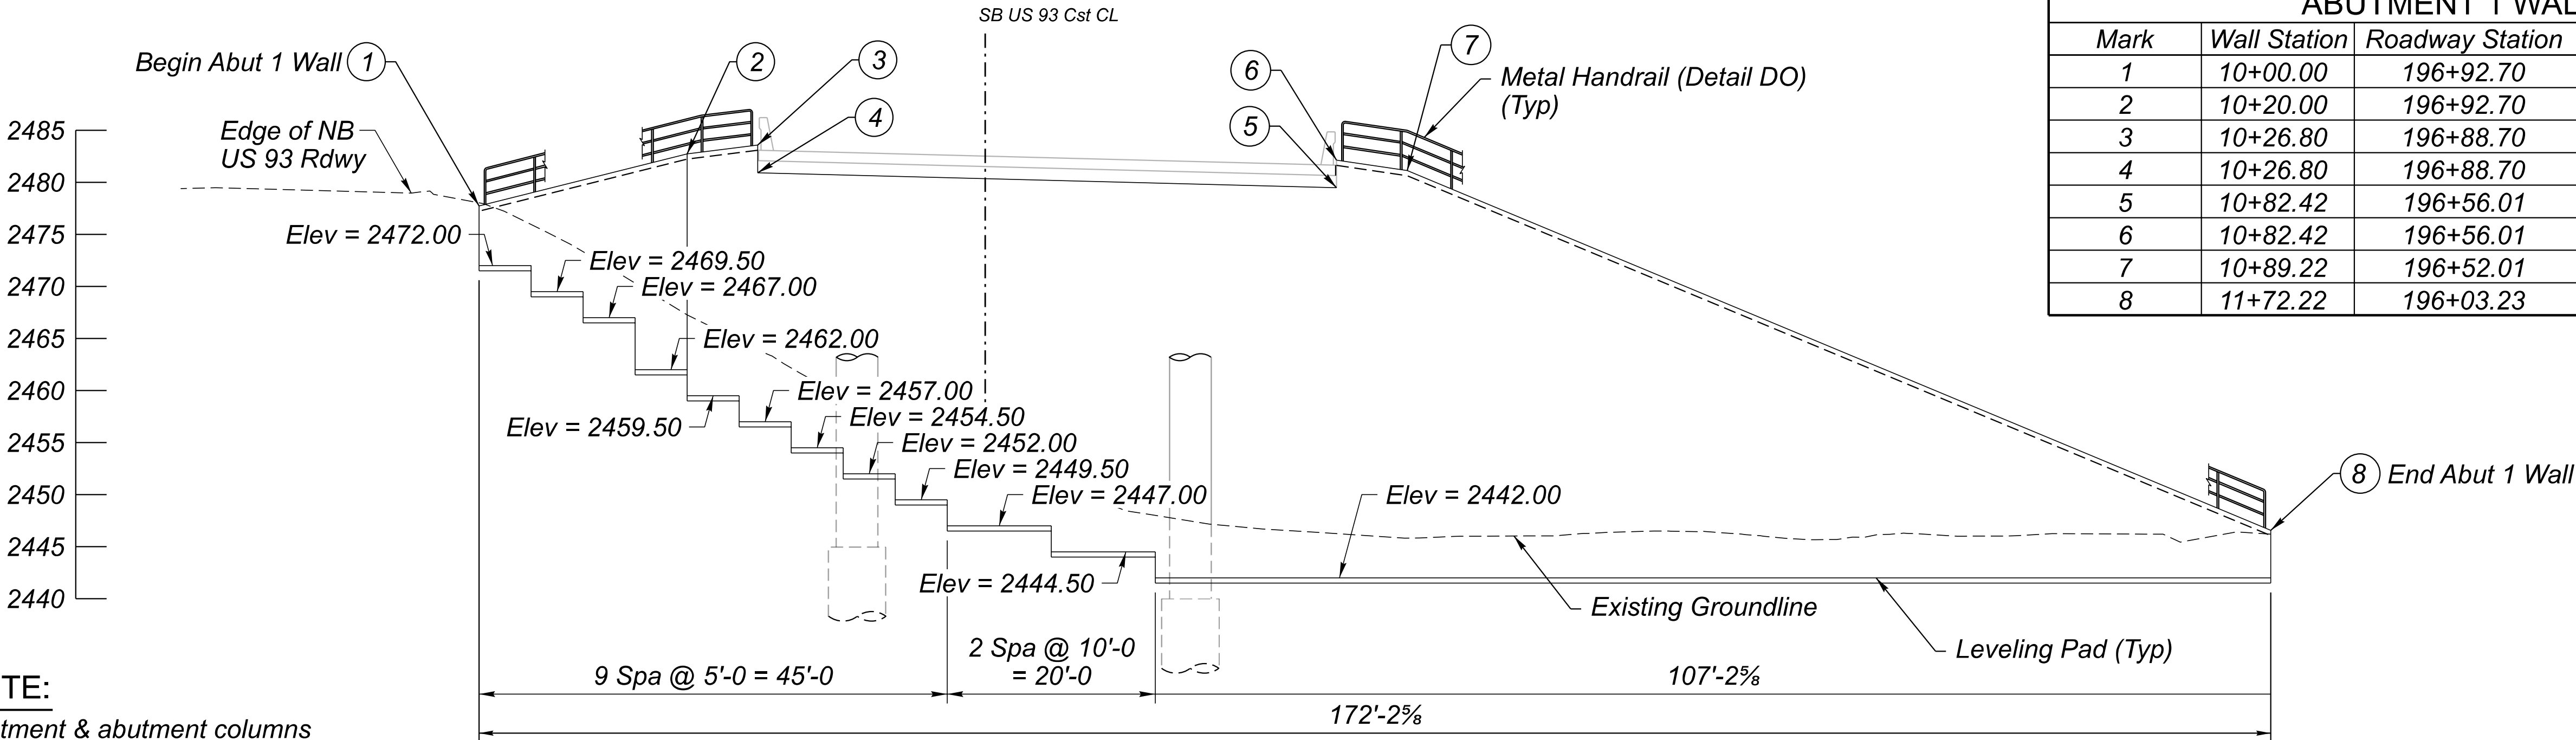

NOTE:
Abutment & abutment columns
not shown for clarity.

ABUTMENT 1 MSE WALL ELEVATION
Scale: 1" = 10'-0




	NAME	DATE
DESIGN	M. Noche	06/26
DRAWN	G. Zenuch	06/26
CHECKED	B. Ansley	06/26

TRANSPORTATION
AECOM TECHNICAL SERVICES, Inc.
7720 N. 16th St., Suite 100
Phoenix, Arizona 85020
T 602.371.1100


AECOM
www.aecom.com

ARIZONA DEPARTMENT OF TRANSPORTATION INFRASTRUCTURE DELIVERY AND OPERATIONS DIVISION BRIDGE GROUP		ROUTE US 93	F.H.W.A. Arizona Division		STATE ARIZ.	PROJECT NO. 093 YV 189	FEDERAL ID NO. 093-B-(230)T	SHEET NO. 445	TOTAL SHEETS 524	RECORD DRAWING
ABUTMENT 1 WALL PLAN AND ELEVATION		MILEPOST	LOCATION WICKENBURG RANCH WAY TO VISTA ROYALE							DWG No. S-2.02
		STRUCTURE NO.	TRACS NO. F0738 01C							OF

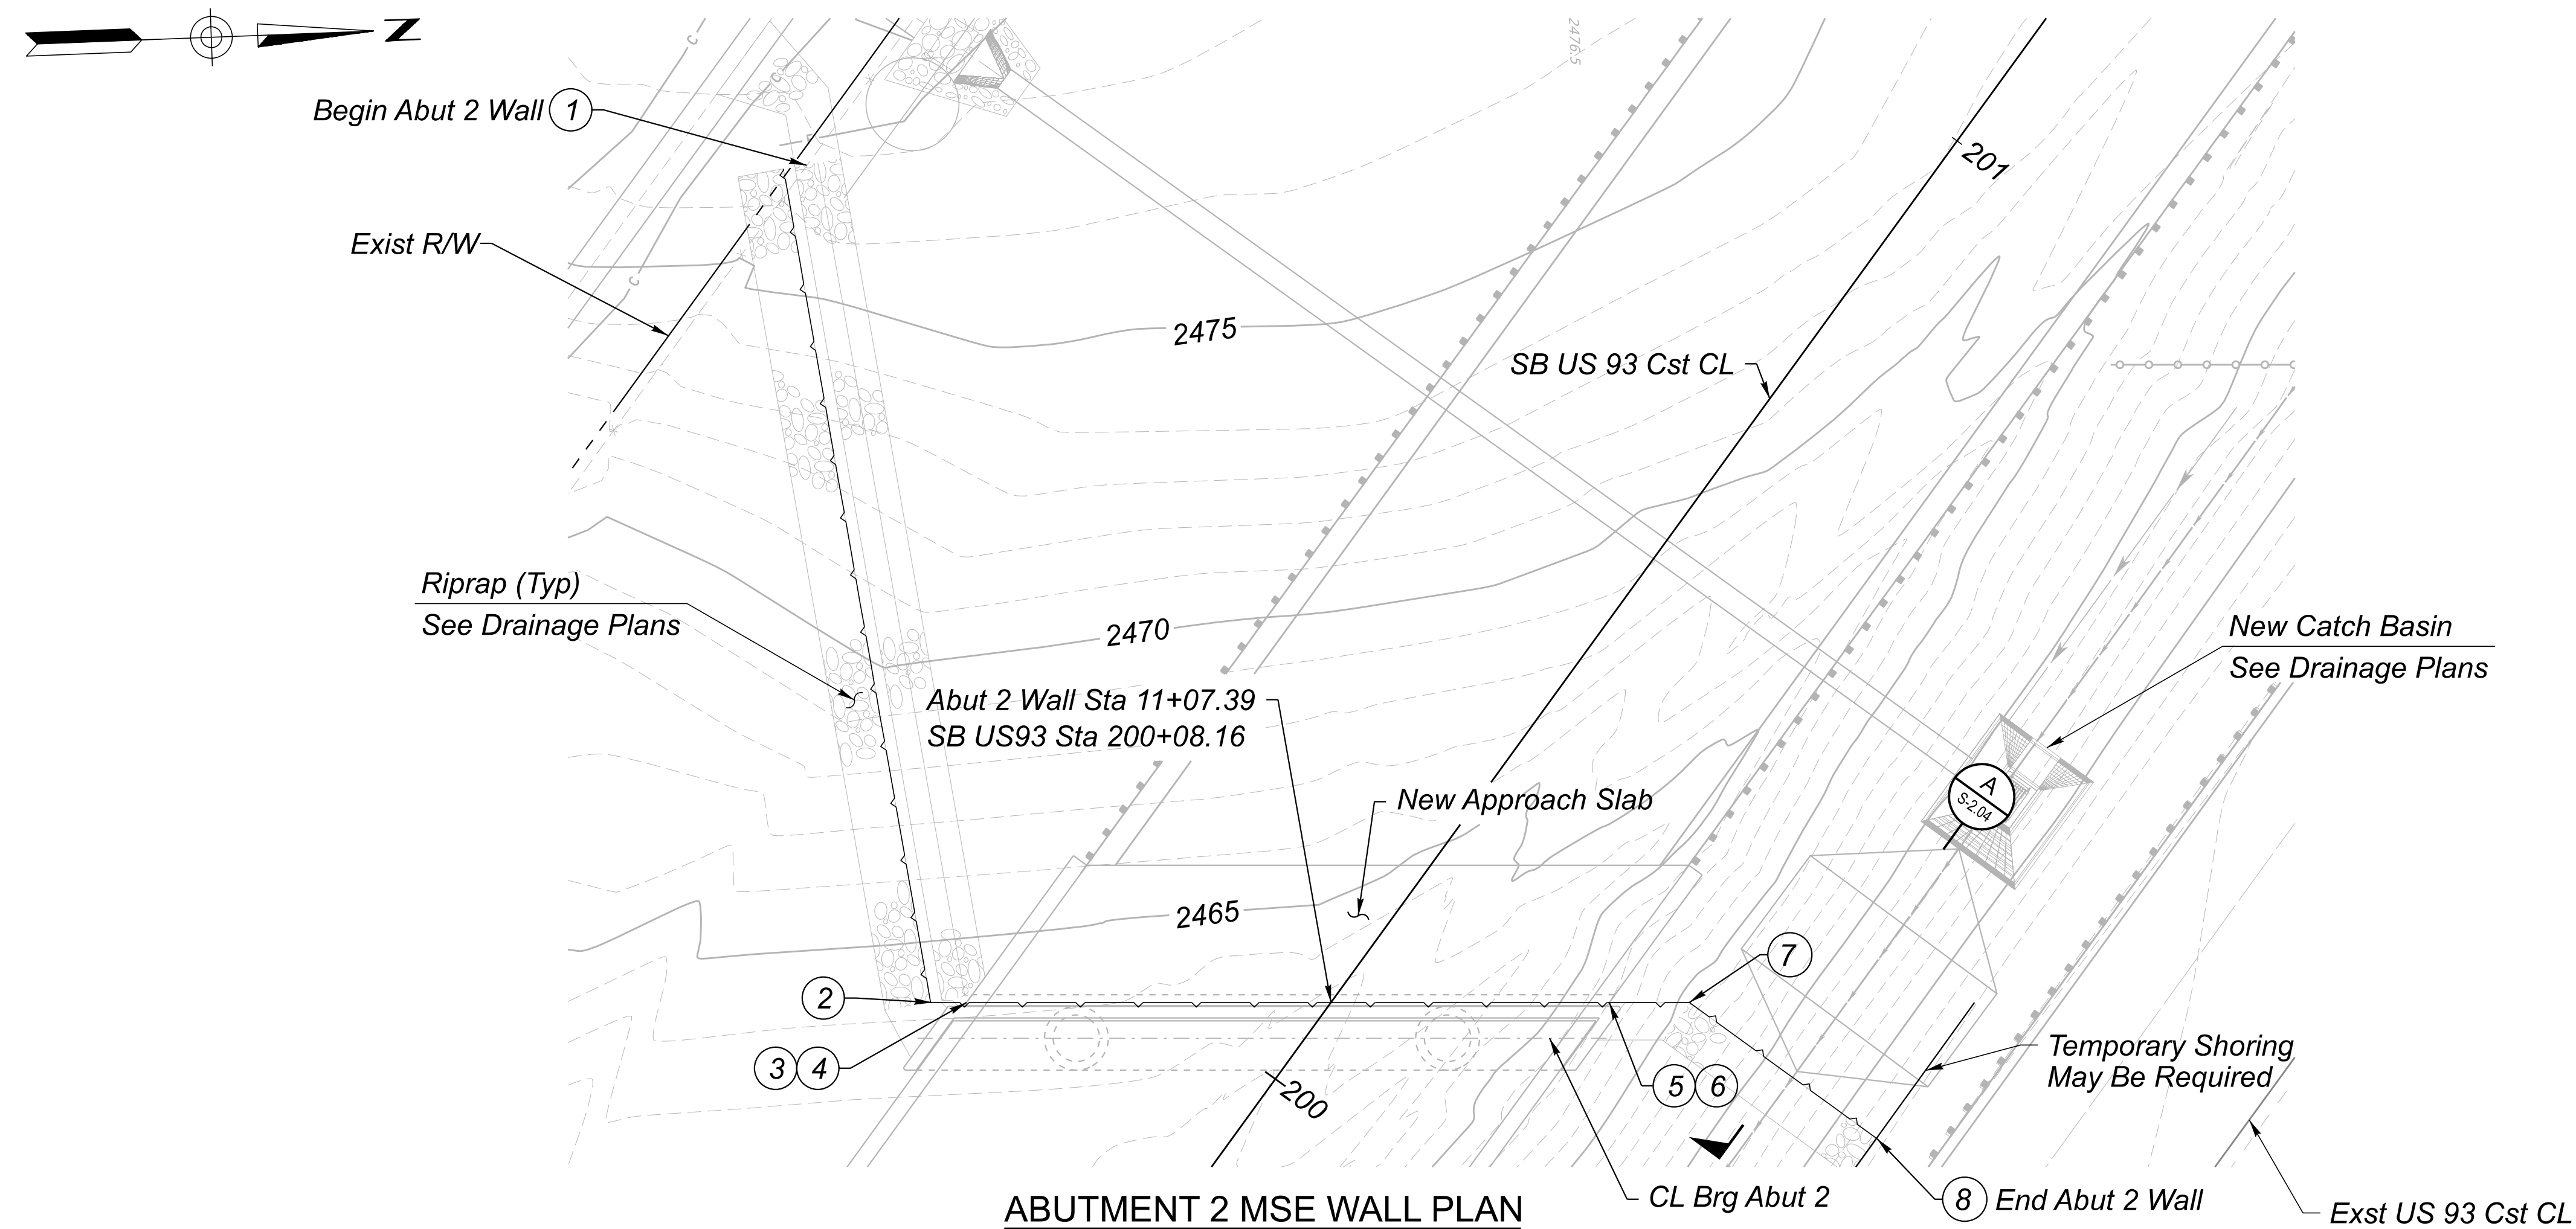

NOTE:

*Abutment & abutment columns
not shown for clarity.*

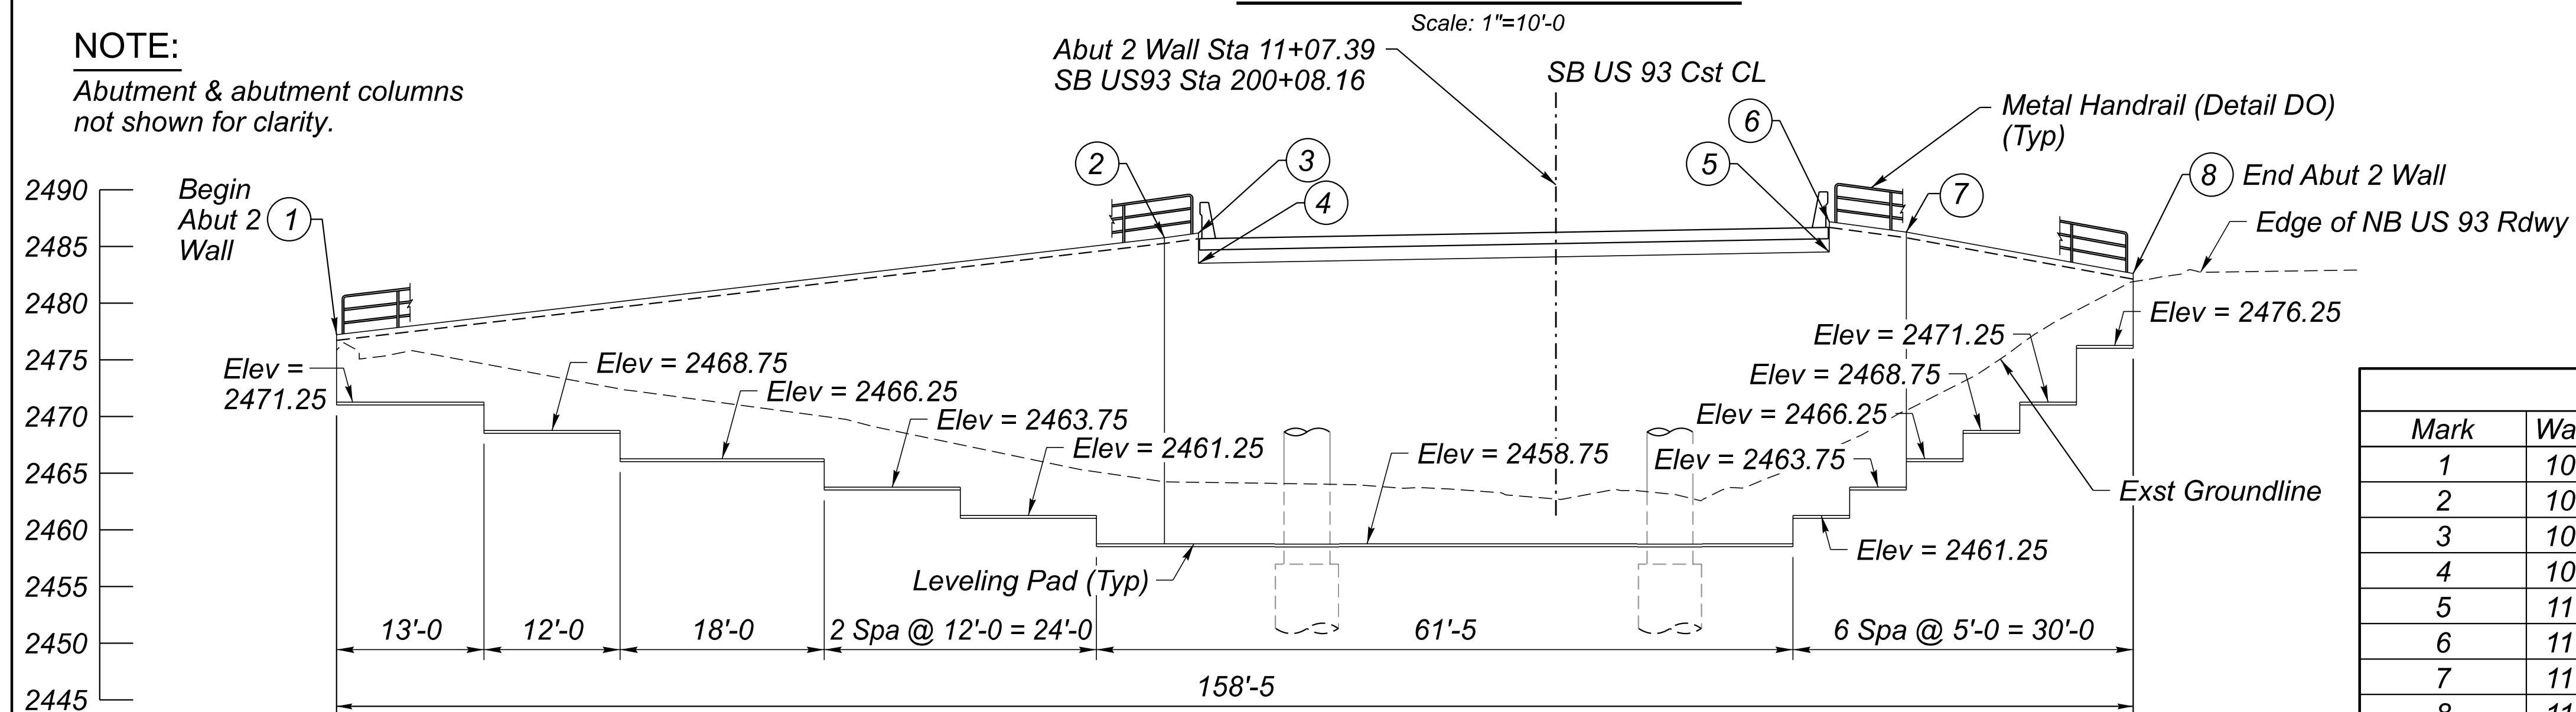

Mark	Wall Station	Roadway Station	Offset	Finished Grade Elev	TOW Elev
1	10+00.00	200+38.58	80.43' Lt	2476.72	2477.22
2	10+73.00	199+87.87	27.93' Lt	2485.26	2485.76
3	10+76.00	199+89.63	25.50' Lt	2485.68	2486.18
4	10+76.00	199+89.63	25.50' Lt	2483.51	2483.51
5	11+31.62	200+22.33	19.50' Rt	2484.50	2484.50
6	11+31.62	200+22.33	19.50' Rt	2486.67	2487.17
7	11+38.42	200+26.32	25.00' Rt	2485.76	2486.26
8	11+58.42	200+26.32	45.00' Rt	2480.76	2482.61



Registered Professional Engineer (Civil)
 CERTIFICATE NO
 80073
 MAXIME
 NOCHE DOMINGANG
 Date Signed 06/10/26
 JAVIER L. A.

	NAME	DATE
DESIGN	M. Noche	06/26
DRAWN	G. Zenuch	06/26
CHECKED	B. Ansley	06/26


TRANSPORTATION
AECOM TECHNICAL SERVICES, Inc.
 7720 N. 16th St., Suite 100
 Phoenix, Arizona 85020
 T 602.371.1100




ARIZONA DEPARTMENT OF TRANSPORTATION
INFRASTRUCTURE DELIVERY AND OPERATIONS DIVISION
BRIDGE GROUP

ABUTMENT 2 WALL
PLAN AND ELEVATION


ROUTE US 93	F.H.W.A. Arizona Division	STATE	PROJECT NO.	FEDERAL ID NO.	SHEET NO.	TOTAL SHEETS	RECORD DRAWING
MILEPOST		ARIZ.	093 YV 189	093-B-(230)T	446	524	
STRUCTURE NO.	LOCATION WICKENBURG RANCH WAY TO VISTA ROYALE						DWG NO. S-2.03
	TRACS NO. F0738 01C						OF

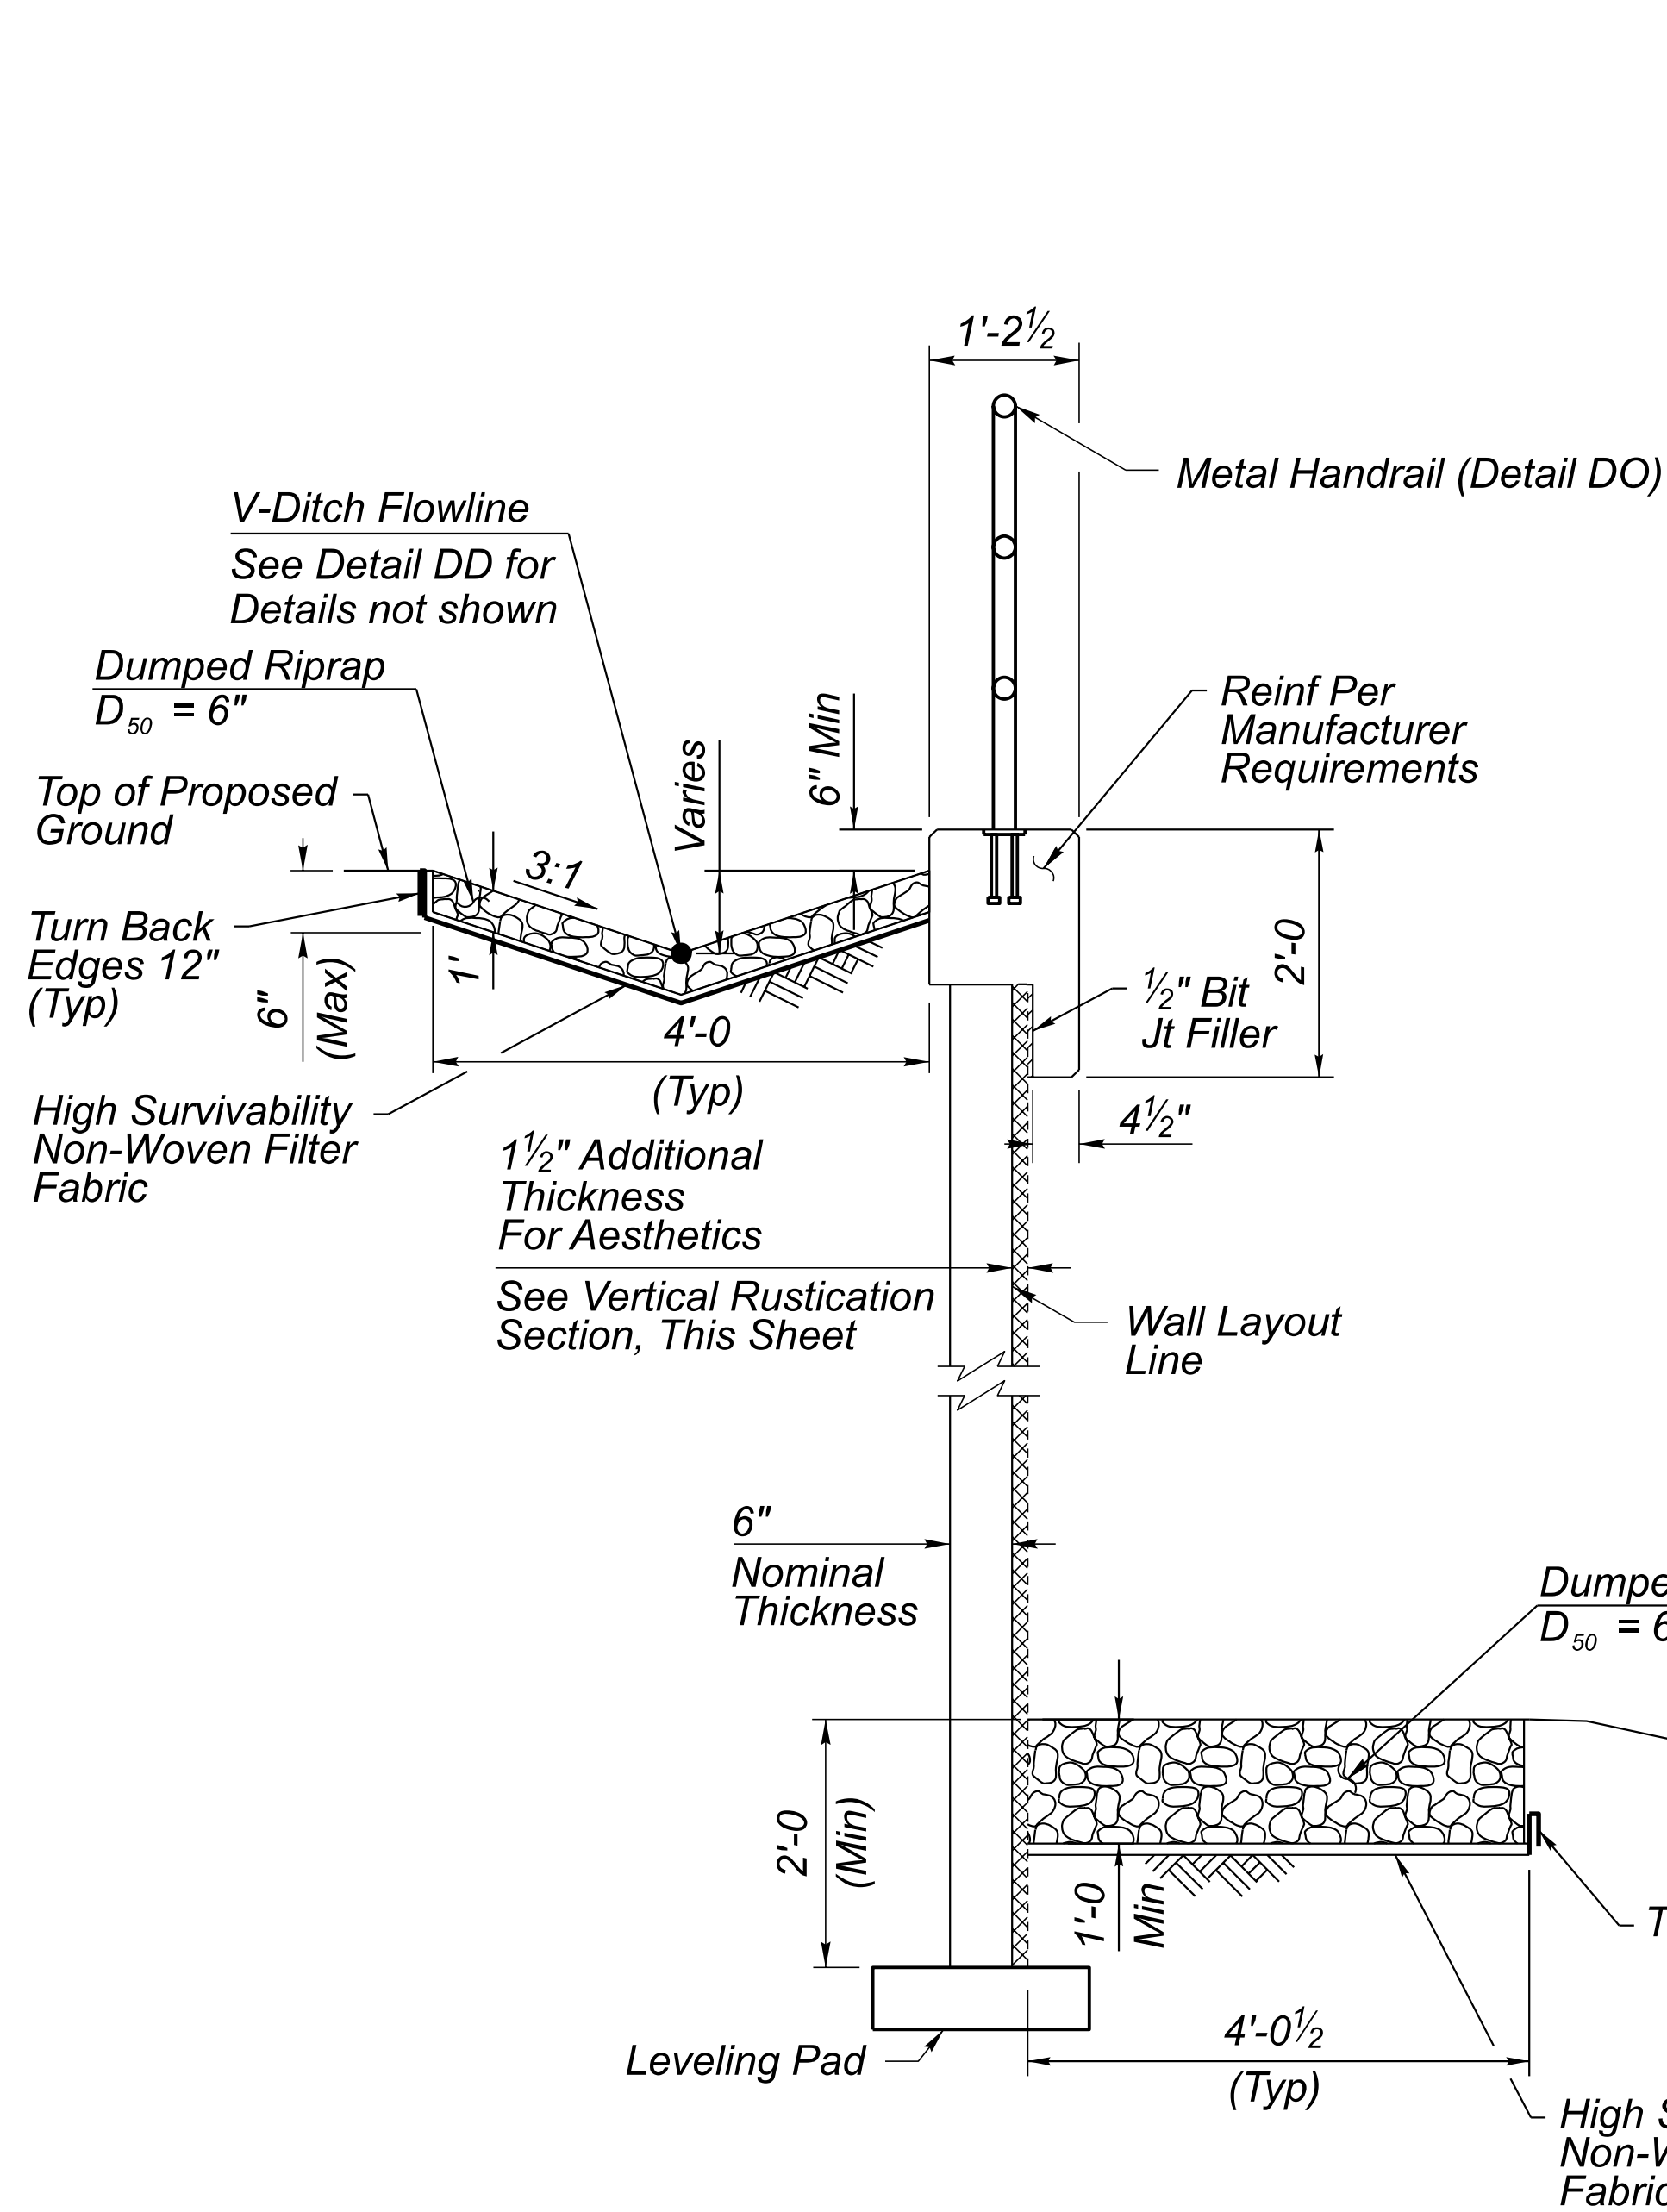


MSE WALL - TYPICAL SECTION
Scale: 3/4" = 1'-0

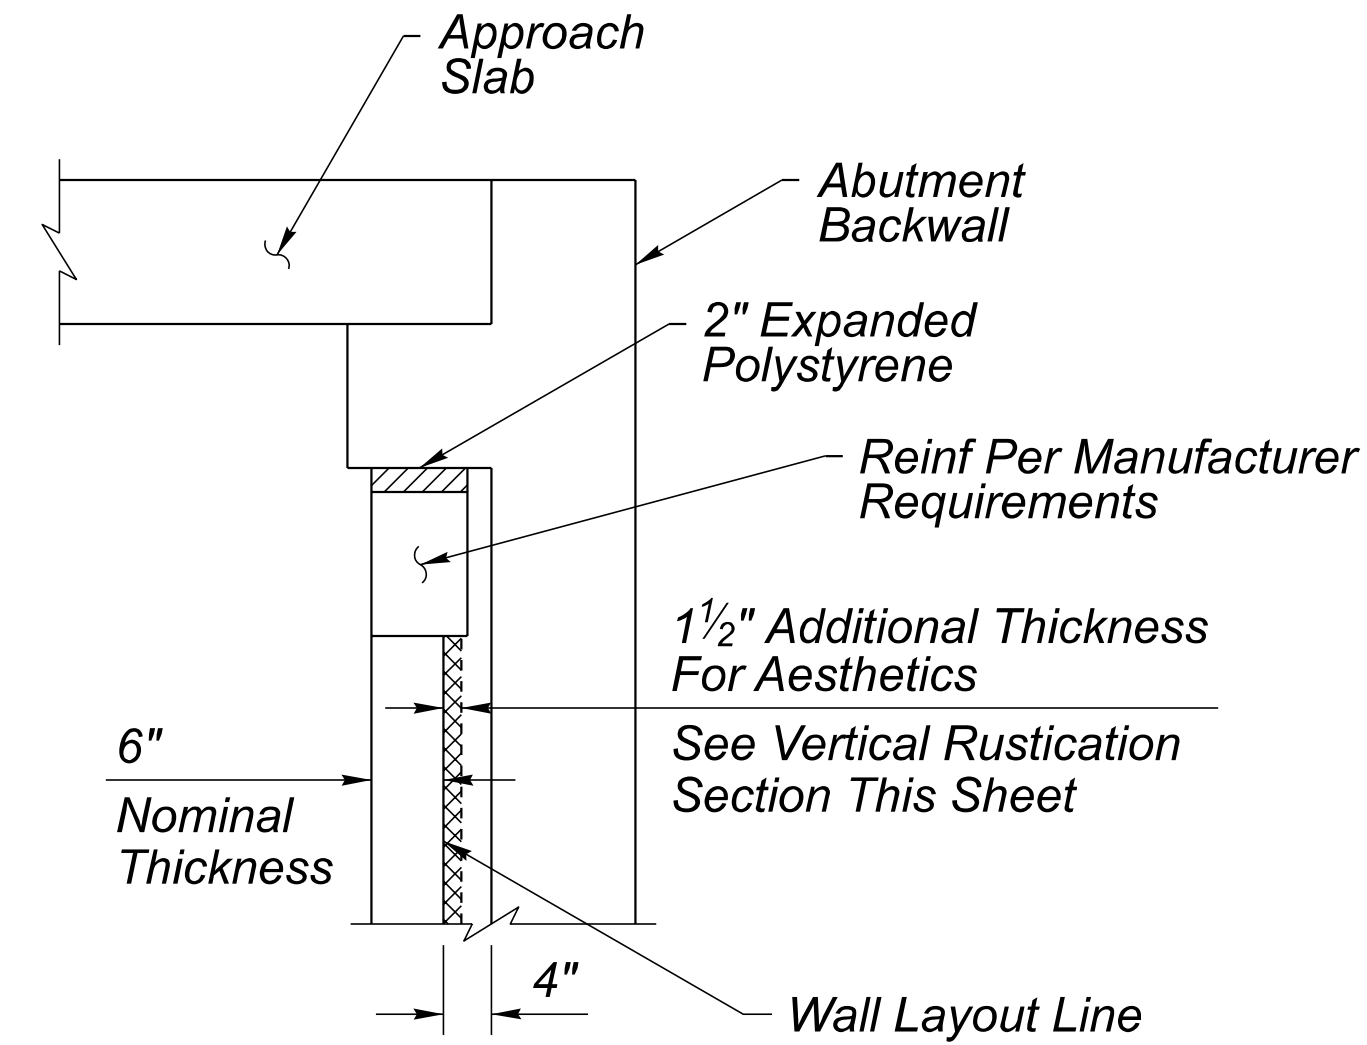

CIP COPING AT APPROACH SLAB
Scale: 3/4" = 1'-0

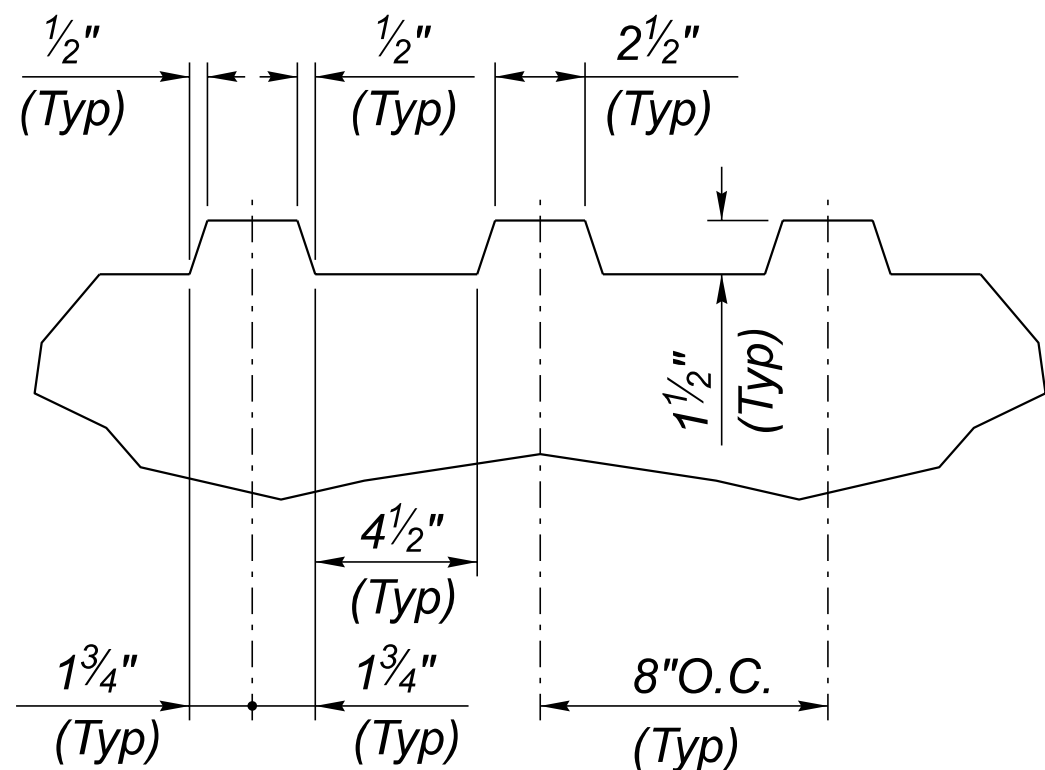

VERTICAL RUSTICATION SECTION
NTS

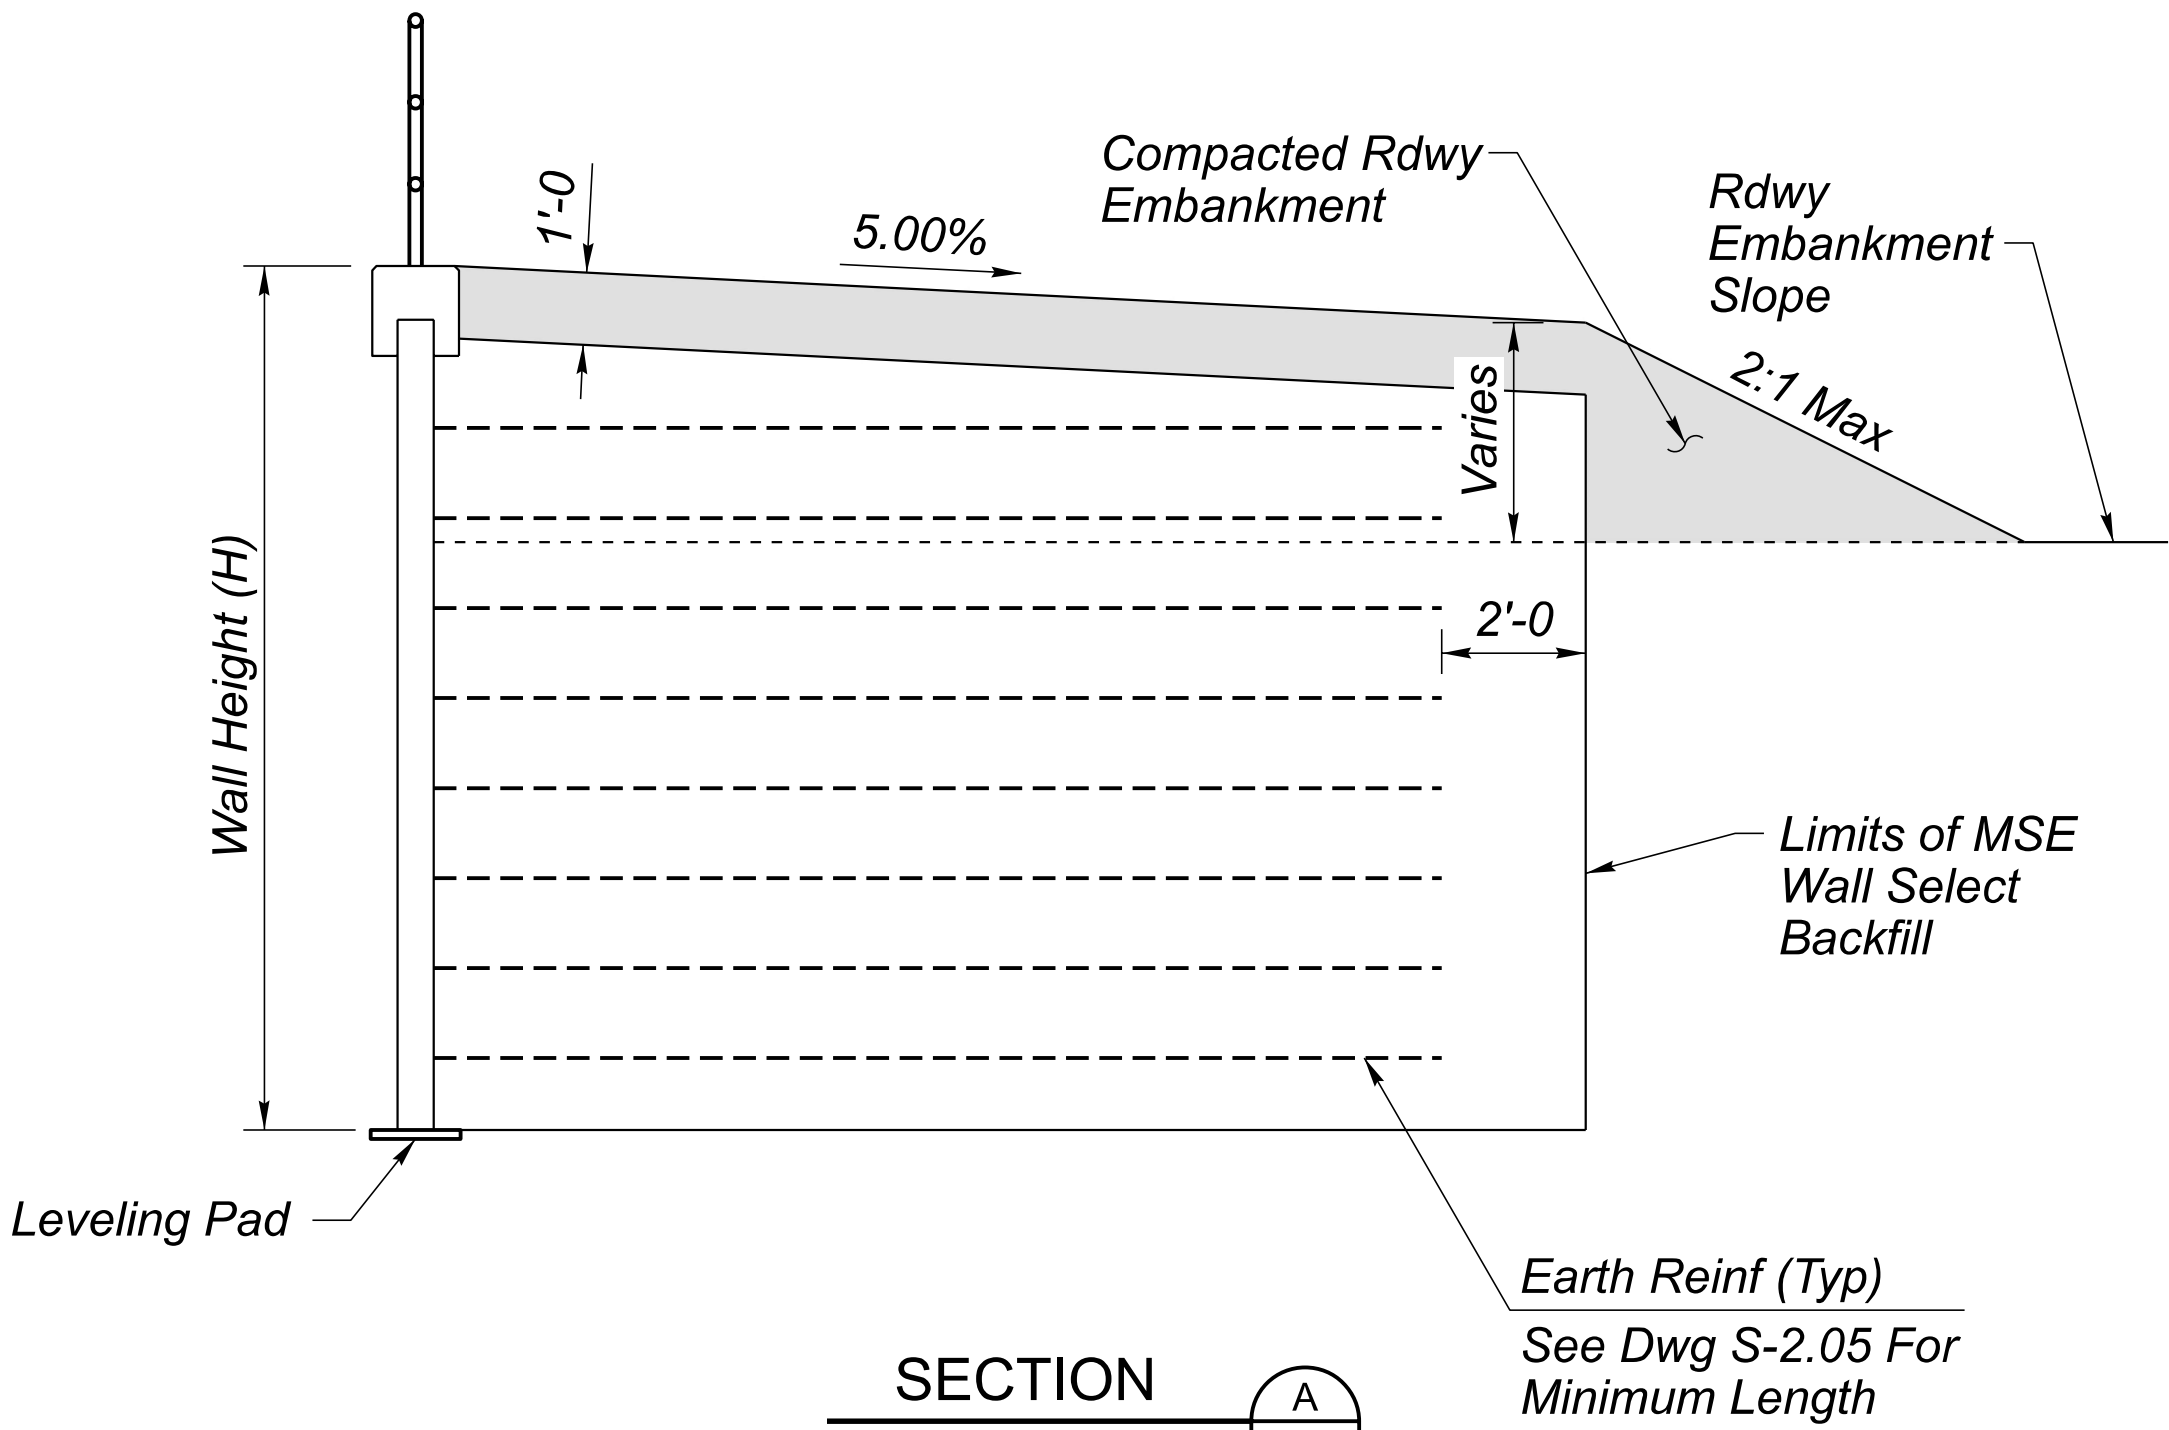

SECTION A
Scale: 1 1/2" = 1'-0

METAL HANDRAIL FOUNDATION NOTE:

- See Drainage Detail DO for metal handrail details not shown.



	NAME	DATE
DESIGN	M. Noche	06/26
DRAWN	G. Zenuch	06/26
CHECKED	B. Ansley	06/26

ARIZONA DEPARTMENT OF TRANSPORTATION INFRASTRUCTURE DELIVERY AND OPERATIONS DIVISION BRIDGE GROUP	ROUTE US 93
WALL DETAILS	MILEPOST
	STRUCTURE NO.

F.H.W.A. Arizona Division	STATE ARIZ.	PROJECT NO. 093 YV 189	FEDERAL ID NO. 093-B-(230)T	SHEET NO. 447	TOTAL SHEETS 524	RECORD DRAWING
LOCATION WICKENBURG RANCH WAY TO VISTA ROYALE						DWG No. S-2.04
TRACS NO. F0738 01C						OF


MSE Retaining Wall	Begin Station	End Station	Retained Soil Friction Angle ¹	Foundation Soil Friction Angle ²	Ground Improvement ³	Min Earth Reinforcement Length ⁴	Min Wall Embedment ⁵	Underdrain Required	Drawdown Analysis	Bench Width ⁶
Abutment 1	10+00.00	10+20.00	30	30	Yes, over-excavation	0.7H	2 feet or H/20	No	No	n/a, level
Abutment 1	10+20.00	10+35.00	30	30	Yes, over-excavation	1.2H	2 feet or H/10	No	No	4 feet
Abutment 1	10+35.00	10+65.00	30	30	Yes, over-excavation	0.8H	2 feet or H/10	No	No	4 feet
Abutment 1	10+65.00	11+72.22	30	32	Yes, over-excavation	0.7H	2 feet or H/20	No	No	n/a, level
Abutment 2	10+00.00	11+07.39	30	32	Yes, over-excavation	0.7H	2 feet or H/10	No	No	4 feet
Abutment 2	11+07.39	11+28.00	30	32	Yes, over-excavation	0.7H	2 feet or H/20	No	No	n/a, level
Abutment 2	11+28.00	11+58.42	30	30	Yes, over-excavation	0.7H	2 feet or H/20	No	No	n/a, level

H = height; psf = pounds per square foot

WALL SUMMARY

NOTES:

- Retained soil meeting the minimum strength values shall extend laterally a minimum of 0.5H plus 2 feet behind the end of earth reinforcement at all locations. Cohesion (c') of retained backfill = 0 psf.
- Cohesion (c') of foundation soil = 0 psf.
- Over-excavation and compaction of subgrade soils is required below the bottom of leveling pad elevation and shall extend across the entire footprint of the MSE walls and retained areas with fill heights greater than 5 feet. Refer to the Detail Sheets, Detail E for over-excavation depths.
- Minimum of 8 feet or length specified, whichever is greater. H = wall height from top of leveling pad.
- Minimum of 2 feet or ratio specified, whichever is greater. H = wall height from top of leveling pad.
- Perpendicular to wall face.
- Refer to Final Geotechnical Report (dated 05/04/2026) by ADOT Geotechnical Services for additional data.

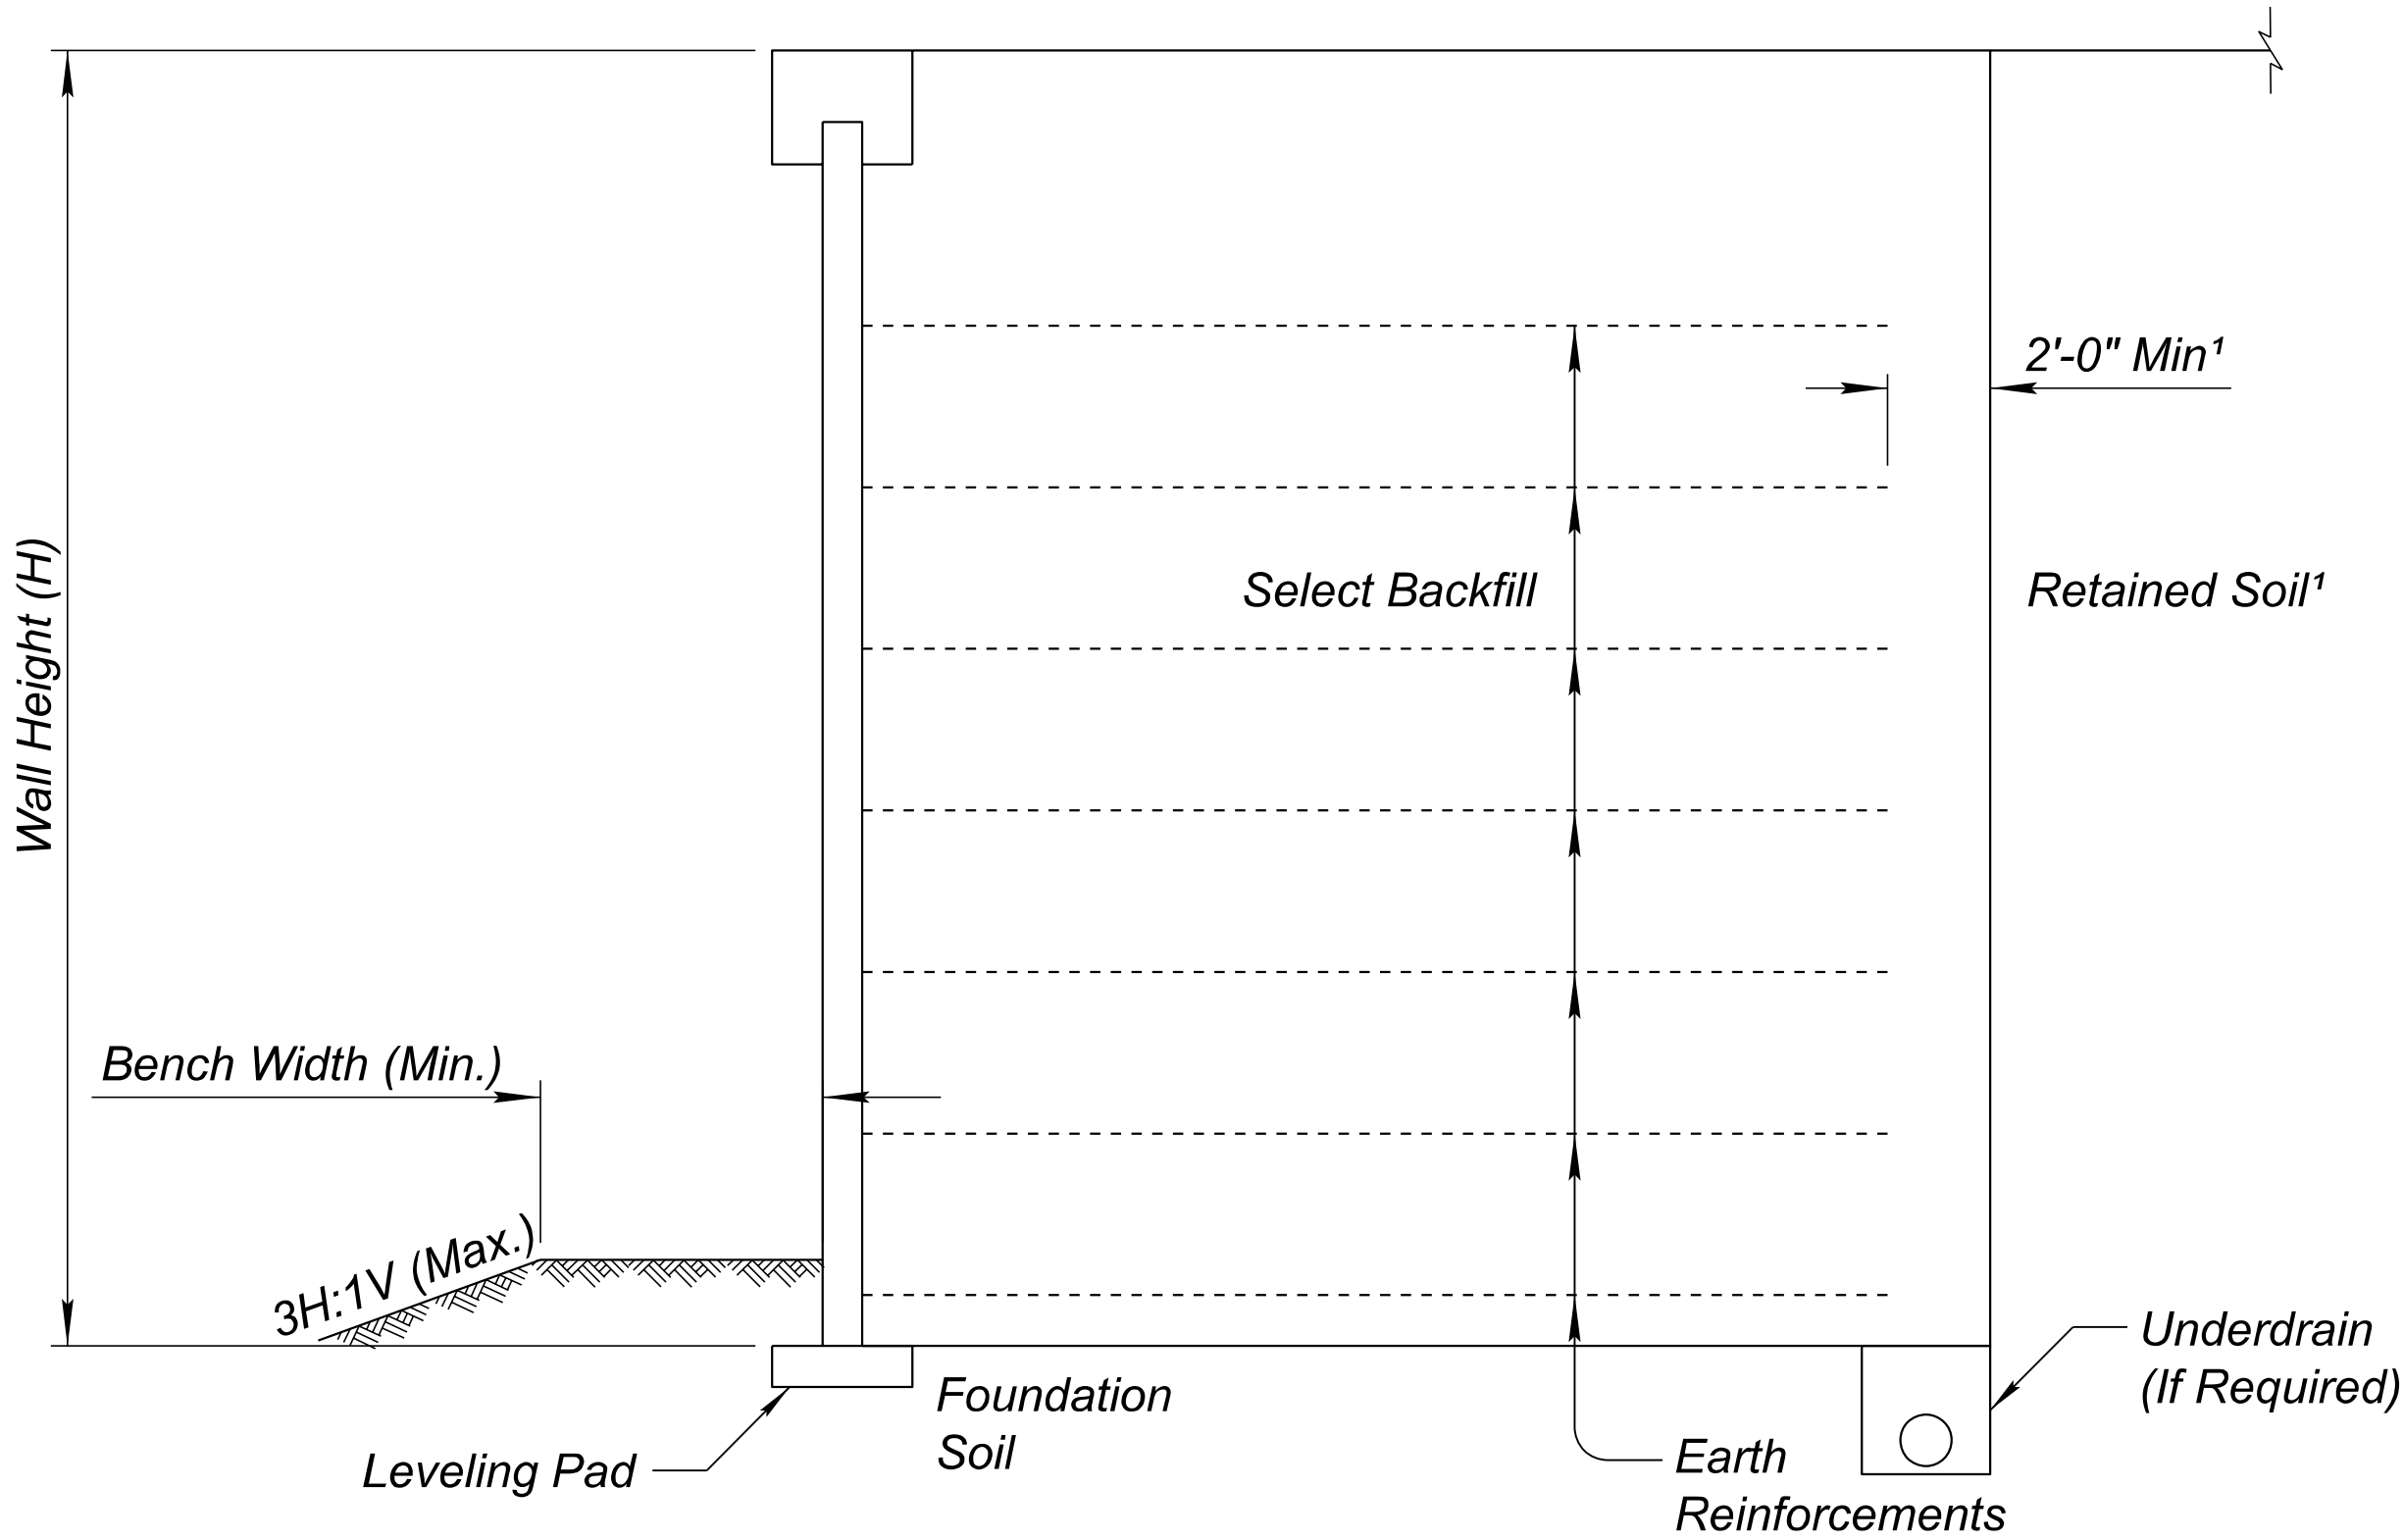

TYPICAL SECTION





	NAME	DATE
DESIGN	K. MACKAY	06/26
DRAWN	H. MORRIS	06/26
CHECKED	J. HUSTON	06/26

ethos
ENGINEERING, LLC.

9180 S Kyrene Rd
Suite #104
Tempe, AZ 85284

ARIZONA DEPARTMENT OF TRANSPORTATION INFRASTRUCTURE DELIVERY AND OPERATIONS DIVISION BRIDGE GROUP	ROUTE US 93
RETAINING WALL SHEETS MSE WALL DESIGN SUMMARY SHEET	MILEPOST
	STRUCTURE NO.

ROUTE US 93		F.H.W.A. Arizona Division		STATE ARIZ.	PROJECT NO. 093 YV 189	FEDERAL ID NO. 093-B-(230)T	SHEET NO. 448	TOTAL SHEETS 524	RECORD DRAWING
MILEPOST									
LOCATION		WICKENBURG RANCH WAY TO VISTA ROYALE							DWG No. S-2.05
STRUCTURE NO.		TRACS NO. F0738 01C							____ OF ____

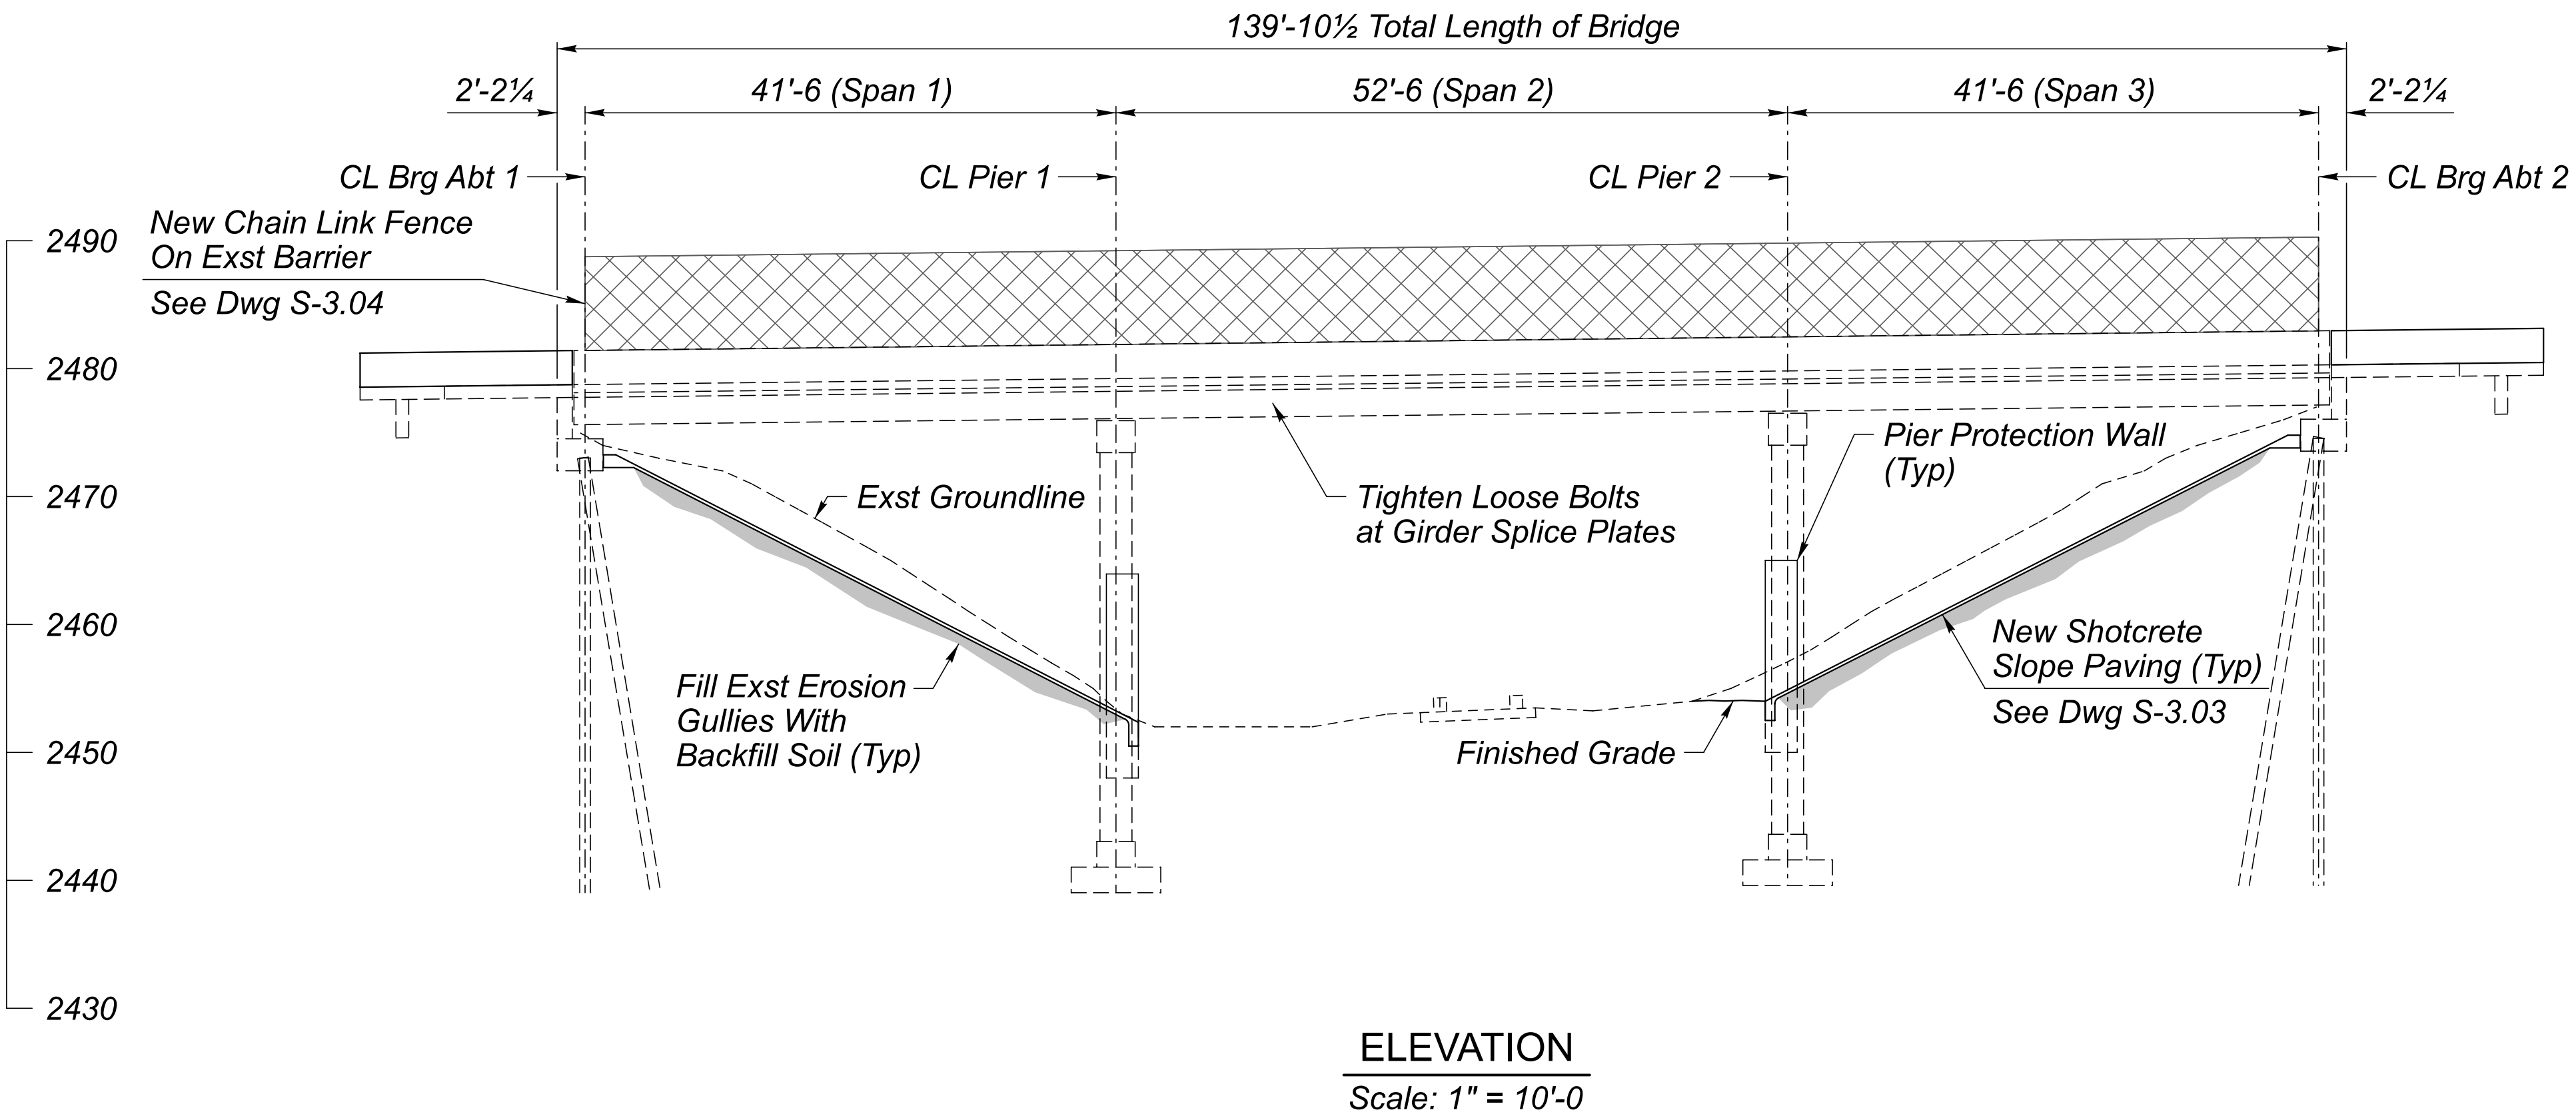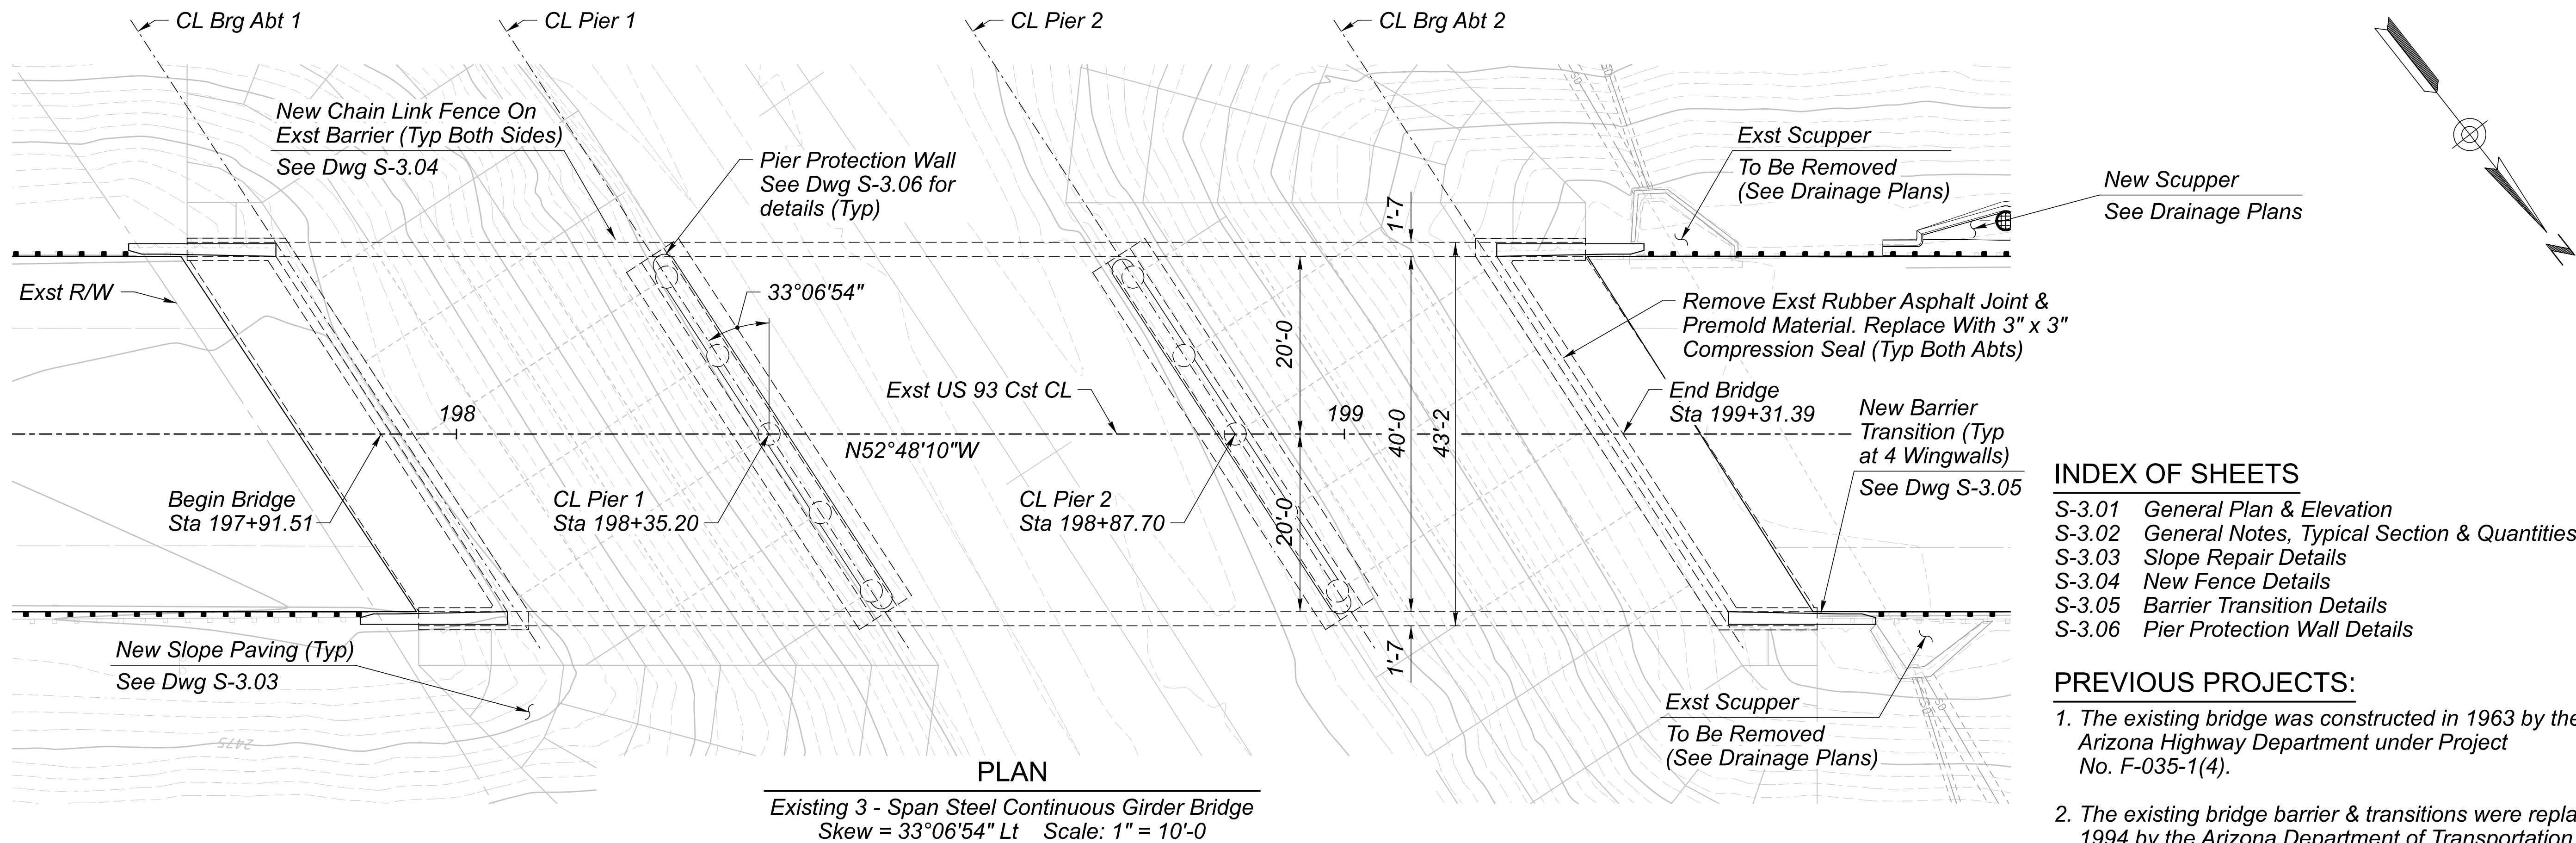

INDEX OF SHEETS


S-3.01	General Plan & Elevation
S-3.02	General Notes, Typical Section & Quantities
S-3.03	Slope Repair Details
S-3.04	New Fence Details
S-3.05	Barrier Transition Details
S-3.06	Pier Protection Wall Details

PREVIOUS PROJECTS:

1. The existing bridge was constructed in 1963 by the Arizona Highway Department under Project No. F-035-1(4).
2. The existing bridge barrier & transitions were replaced in 1994 by the Arizona Department of Transportation under Project No. STP-035-1(24)P.

SCOPE OF WORK:

1. Contractor shall check all 340 girder splice plate bolts for tightness. Any loose bolts shall be tightened to a minimum tension of 36 kips. This work is paid for under item No. 6010508 Bridge Repair (Tighten Splice Bolts).
2. At both abutment slopes, fill existing erosion gullies with backfill soil & construct new shotcrete slope paving. The work is paid for under item No. 9120002 Shotcrete (3" Slope Paving, Fiber Reinforced).
3. Remove four existing barrier transitions & construct four new barrier transitions. See Dwg S-3.05 for details. Removal is paid for under item No. 2020185 Remove (Bridge Barrier Transition). Construction of the new barrier transitions is paid for under item No. 9100053 Concrete Bridge Barrier Transition.
4. At both abutment expansion joints, remove the existing asphalt rubber seal & preform filler & replace with new 3" x 3" compression seal. See Dwg S-3.02 for details. This work is paid for under item No. 6011190 Replace Bridge Deck Joint Seal (3x3 Compression Seal) (SD 3.01).
5. At both edges of deck, construct new chain link fence on existing bridge barrier. See Dwg S-3.04 for details. This work is paid for under item No. 9020028 Chain Link Fence (On Existing Structure).
6. At both piers, construct pier protection walls. See Dwg S-3.06 for details. This work is paid for under item No. 9240118 Miscellaneous Work (Pier Protection Wall).

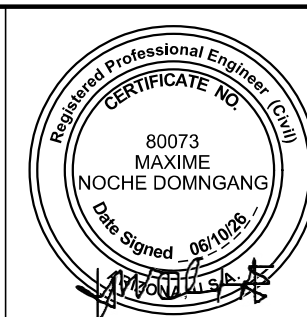

	NAME	DATE
DESIGN	M. Noche	06/26
DRAWN	T. Talbert	06/26
CHECKED	B. Ansley	06/26

TRANSPORTATION
AECOM TECHNICAL SERVICES, Inc.
7720 N. 18th St., Suite 100
Phoenix, Arizona 85021
T 602.371.1100

AECOM
www.aecom.com

ARIZONA DEPARTMENT OF TRANSPORTATION
INFRASTRUCTURE DELIVERY AND OPERATIONS DIVISION
BRIDGE GROUP

STA 198+
US 93 NB BNSF OP BRIDGE
GENERAL PLAN & ELEVATION

ROUTE
US 93

MILEPOST
192.88

STRUCTURE NO.
780

F.H.W.A. Arizona Division

STATE
ARIZ.

PROJECT NO.
093 YV 189

FEDERAL ID NO.
093-B-(230)T

SHEET NO.
449

TOTAL SHEETS
524


RECORD DRAWING

LOCATION
WICKENBURG RANCH WAY TO VISTA ROYALE

TRACS NO. **F0738 01C**


DWG No. **S-3.01**

OF

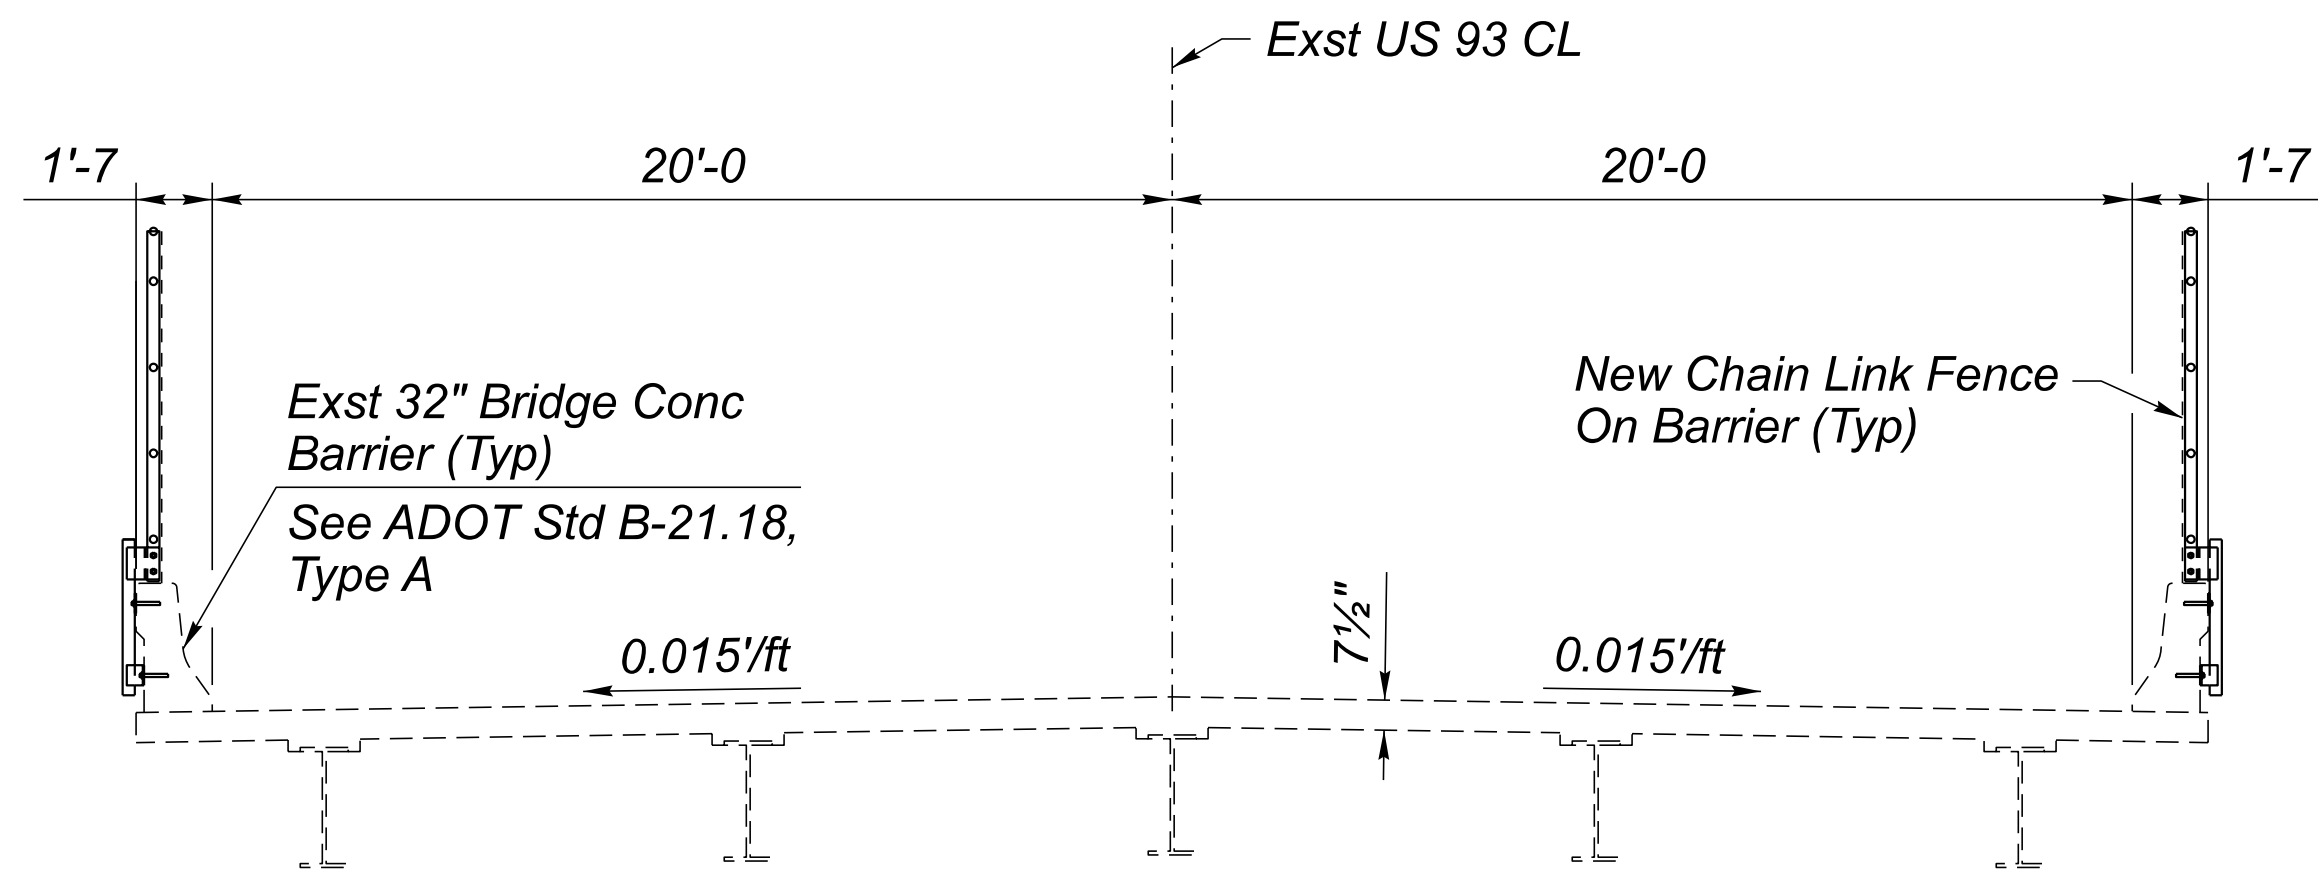


EXISTING BRIDGE TYPICAL SECTION

Scale: 1/4" = 1'-0

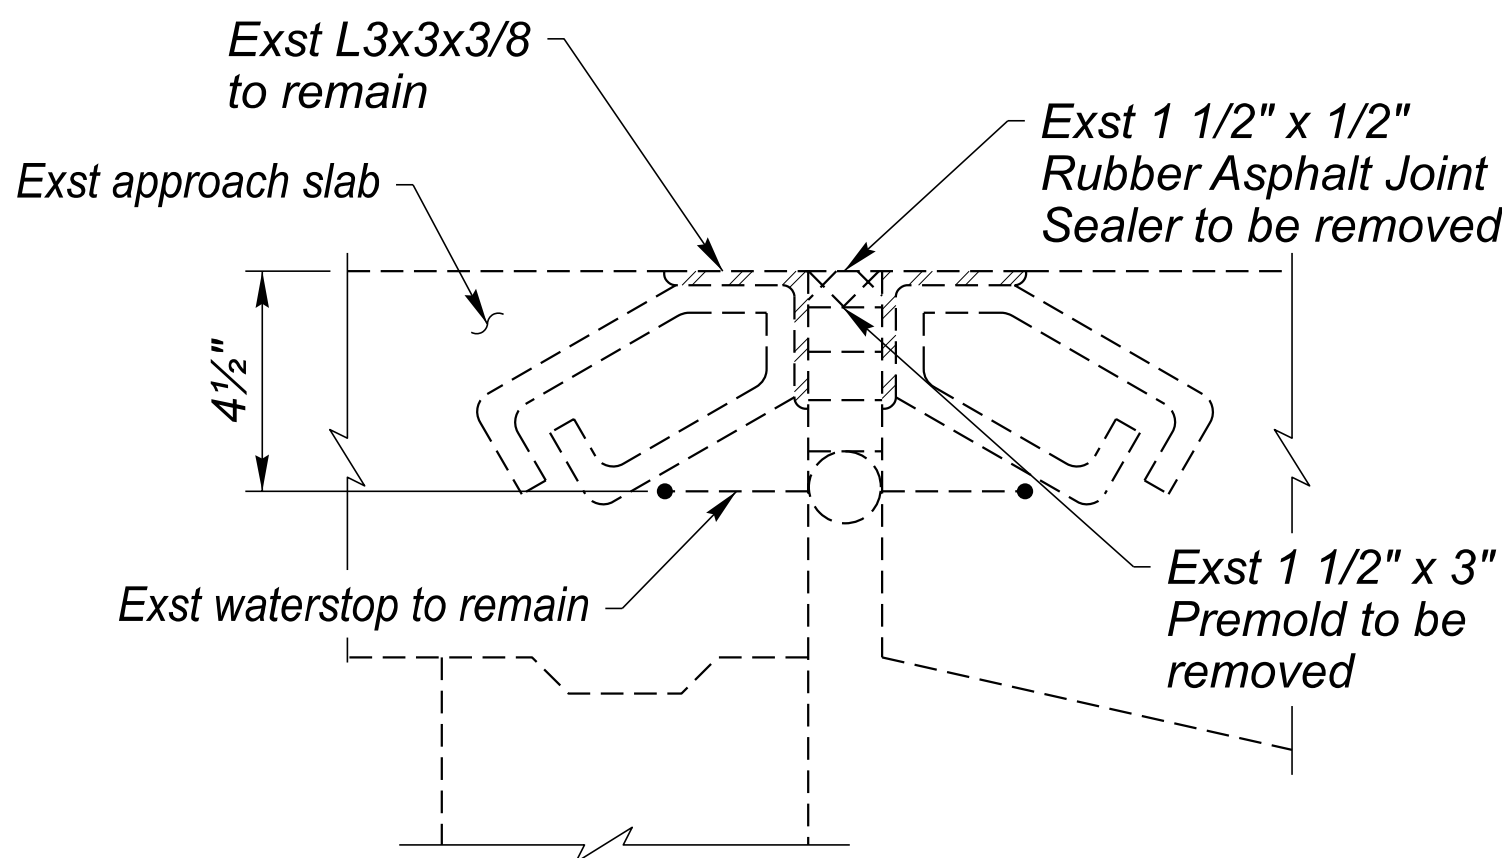

REMOVAL

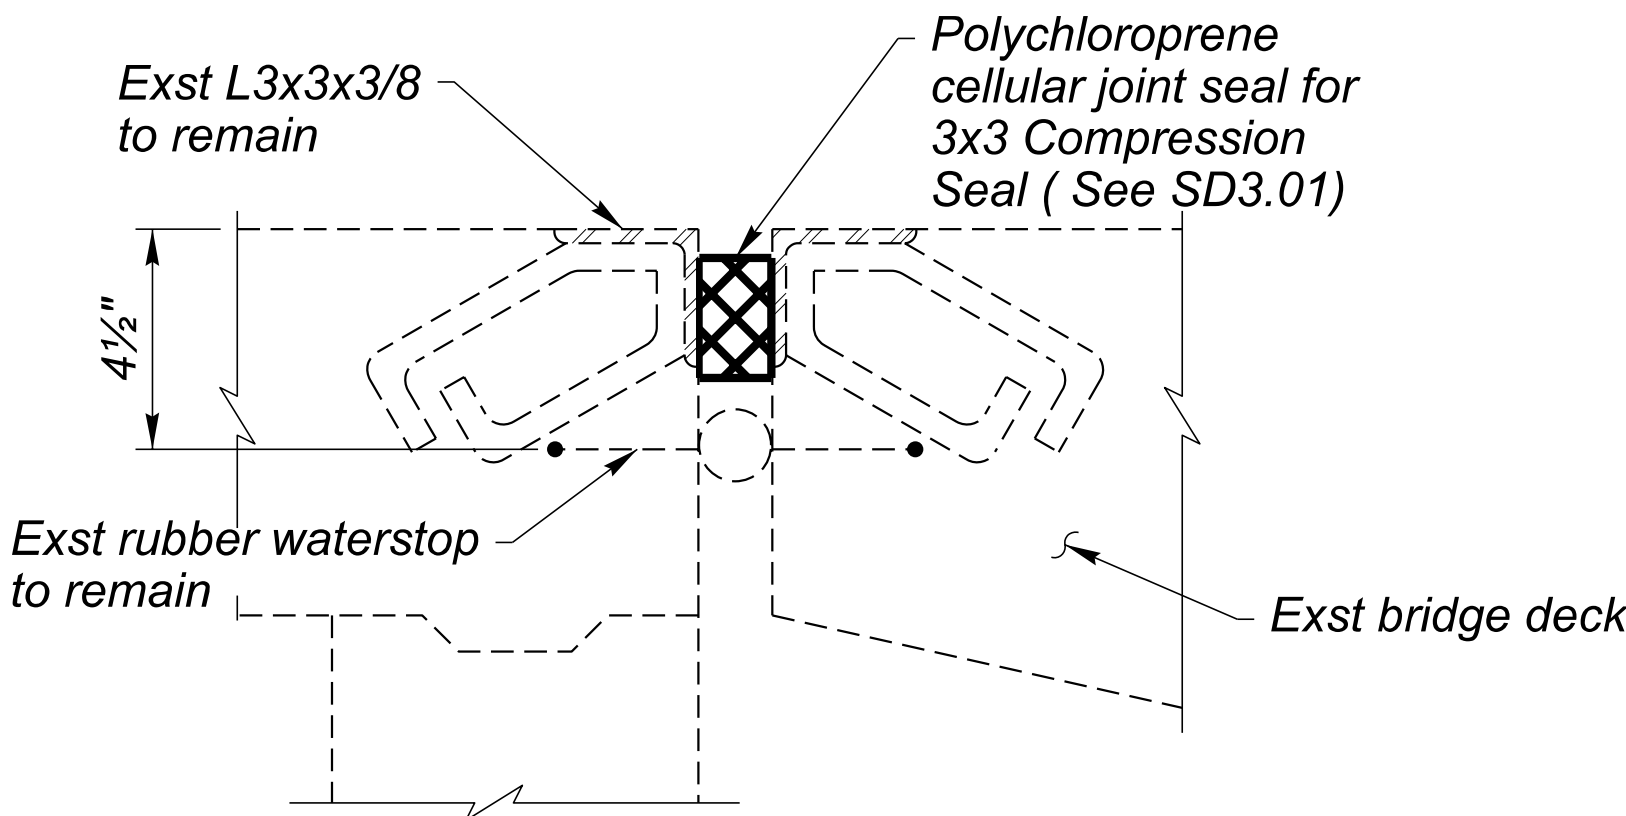

PROPOSED

DECK JOINT SECTION

Scale: 1" = 1'-0

GENERAL NOTES:

Construction Specifications - Arizona Department of Transportation Standard Specifications for Road & Bridge Construction, Edition of 2021.

Design Specifications - AASHTO LRFD Bridge Design Specifications, 9th Edition, 2020 with current interims.

All concrete shall be Class 'S' unless noted otherwise.

Reinforcing steel shall conform to ASTM Specification A615, Grade 60.

All bends & hooks shall meet the requirements of AASHTO Article 5.10. All bend dimensions for reinforcing steel shall be out-to-out of bars. All placement dimensions for reinforcing steel shall be to center of bars unless noted otherwise.

All reinforcing steel shall have 2 inch clear cover unless noted otherwise.

All mechanical splices shall conform to the requirements for mechanical connnections in Section 605-3.02 of the Standard Specifications.

Stresses: Pier Protection Wall f'c = 3,000 psi Barrier Transition f'c = 4,000 psi All other Grade 60 reinforcing fy = 60,000 psi

All welding shall conform to the requirments of the American Welding Society, ANSI/AASHTO/AWS D1.5 Bridge Welding Code (latest edition).

Dimensions shall not be scaled from drawings.

Construction joints not shown on the plans shall require the approval of the Engineer prior to construction.

Chamfer all exposed corners 3/4" unless noted otherwise.


ADOT STANDARD DRAWING LIST

SD 3.01, SD 5.01, SD 5.02

LEGEND:

DETAIL Marker

SECTION Marker

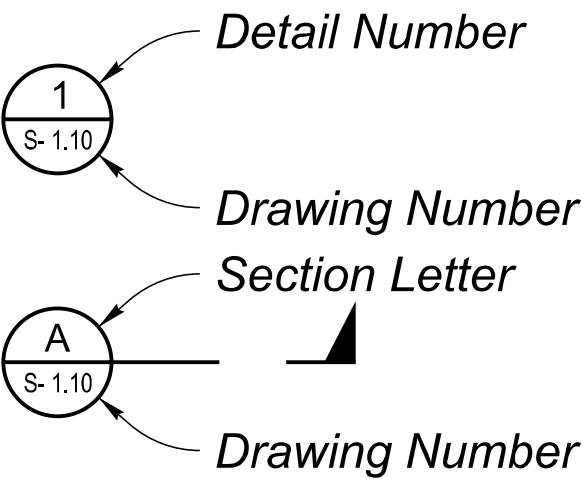

NOTE:

A line (—) in place of the Drawing Number indicates that the SECTION or DETAIL is located on the same drawing.

APPROXIMATE QUANTITIES:

Bridge Repair (Tighten Splice Bolts)	1 LS
Shotcrete (3" Slope Paving, Fiber Reinforced)	1,269 SY
Replace Bridge Deck Joint Seal (3x3 Compression Seal)(SD 3.01)	96 LF
Chain Link Fence (On Existing Structure)	271 LF
Concrete Bridge Barrier Transition	4 EA
Remove (Bridge Barrier Transition)	4 EA
Miscellaneous Work (Pier Protection Wall)	1,181 SF




	NAME	DATE
DESIGN	M. Noche	06/26
DRAWN	T. Talbert	06/26
CHECKED	B. Ansley	06/26

TRANSPORTATION
AECOM TECHNICAL SERVICES, Inc.
7720 N. 16th St., Suite 100
Phoenix, Arizona 85020
T 602.371.1100
www.aecom.com

ARIZONA DEPARTMENT OF TRANSPORTATION INFRASTRUCTURE DELIVERY AND OPERATIONS DIVISION BRIDGE GROUP	ROUTE US 93 MILEPOST 192.88 STRUCTURE NO. 780
STA 198+ US 93 NB BNSF OP BRIDGE GENERAL NOTES, TYPICAL SECTION & QUANTITIES	

F.H.W.A. Arizona Division	STATE ARIZ.	PROJECT NO. 093 YV 189	FEDERAL ID NO. 093-B-(230)T	SHEET NO. 450	TOTAL SHEETS 524	RECORD DRAWING
LOCATION WICKENBURG RANCH WAY TO VISTA ROYALE						DWG No. S-3.02
TRACS NO. F0738 01C						OF

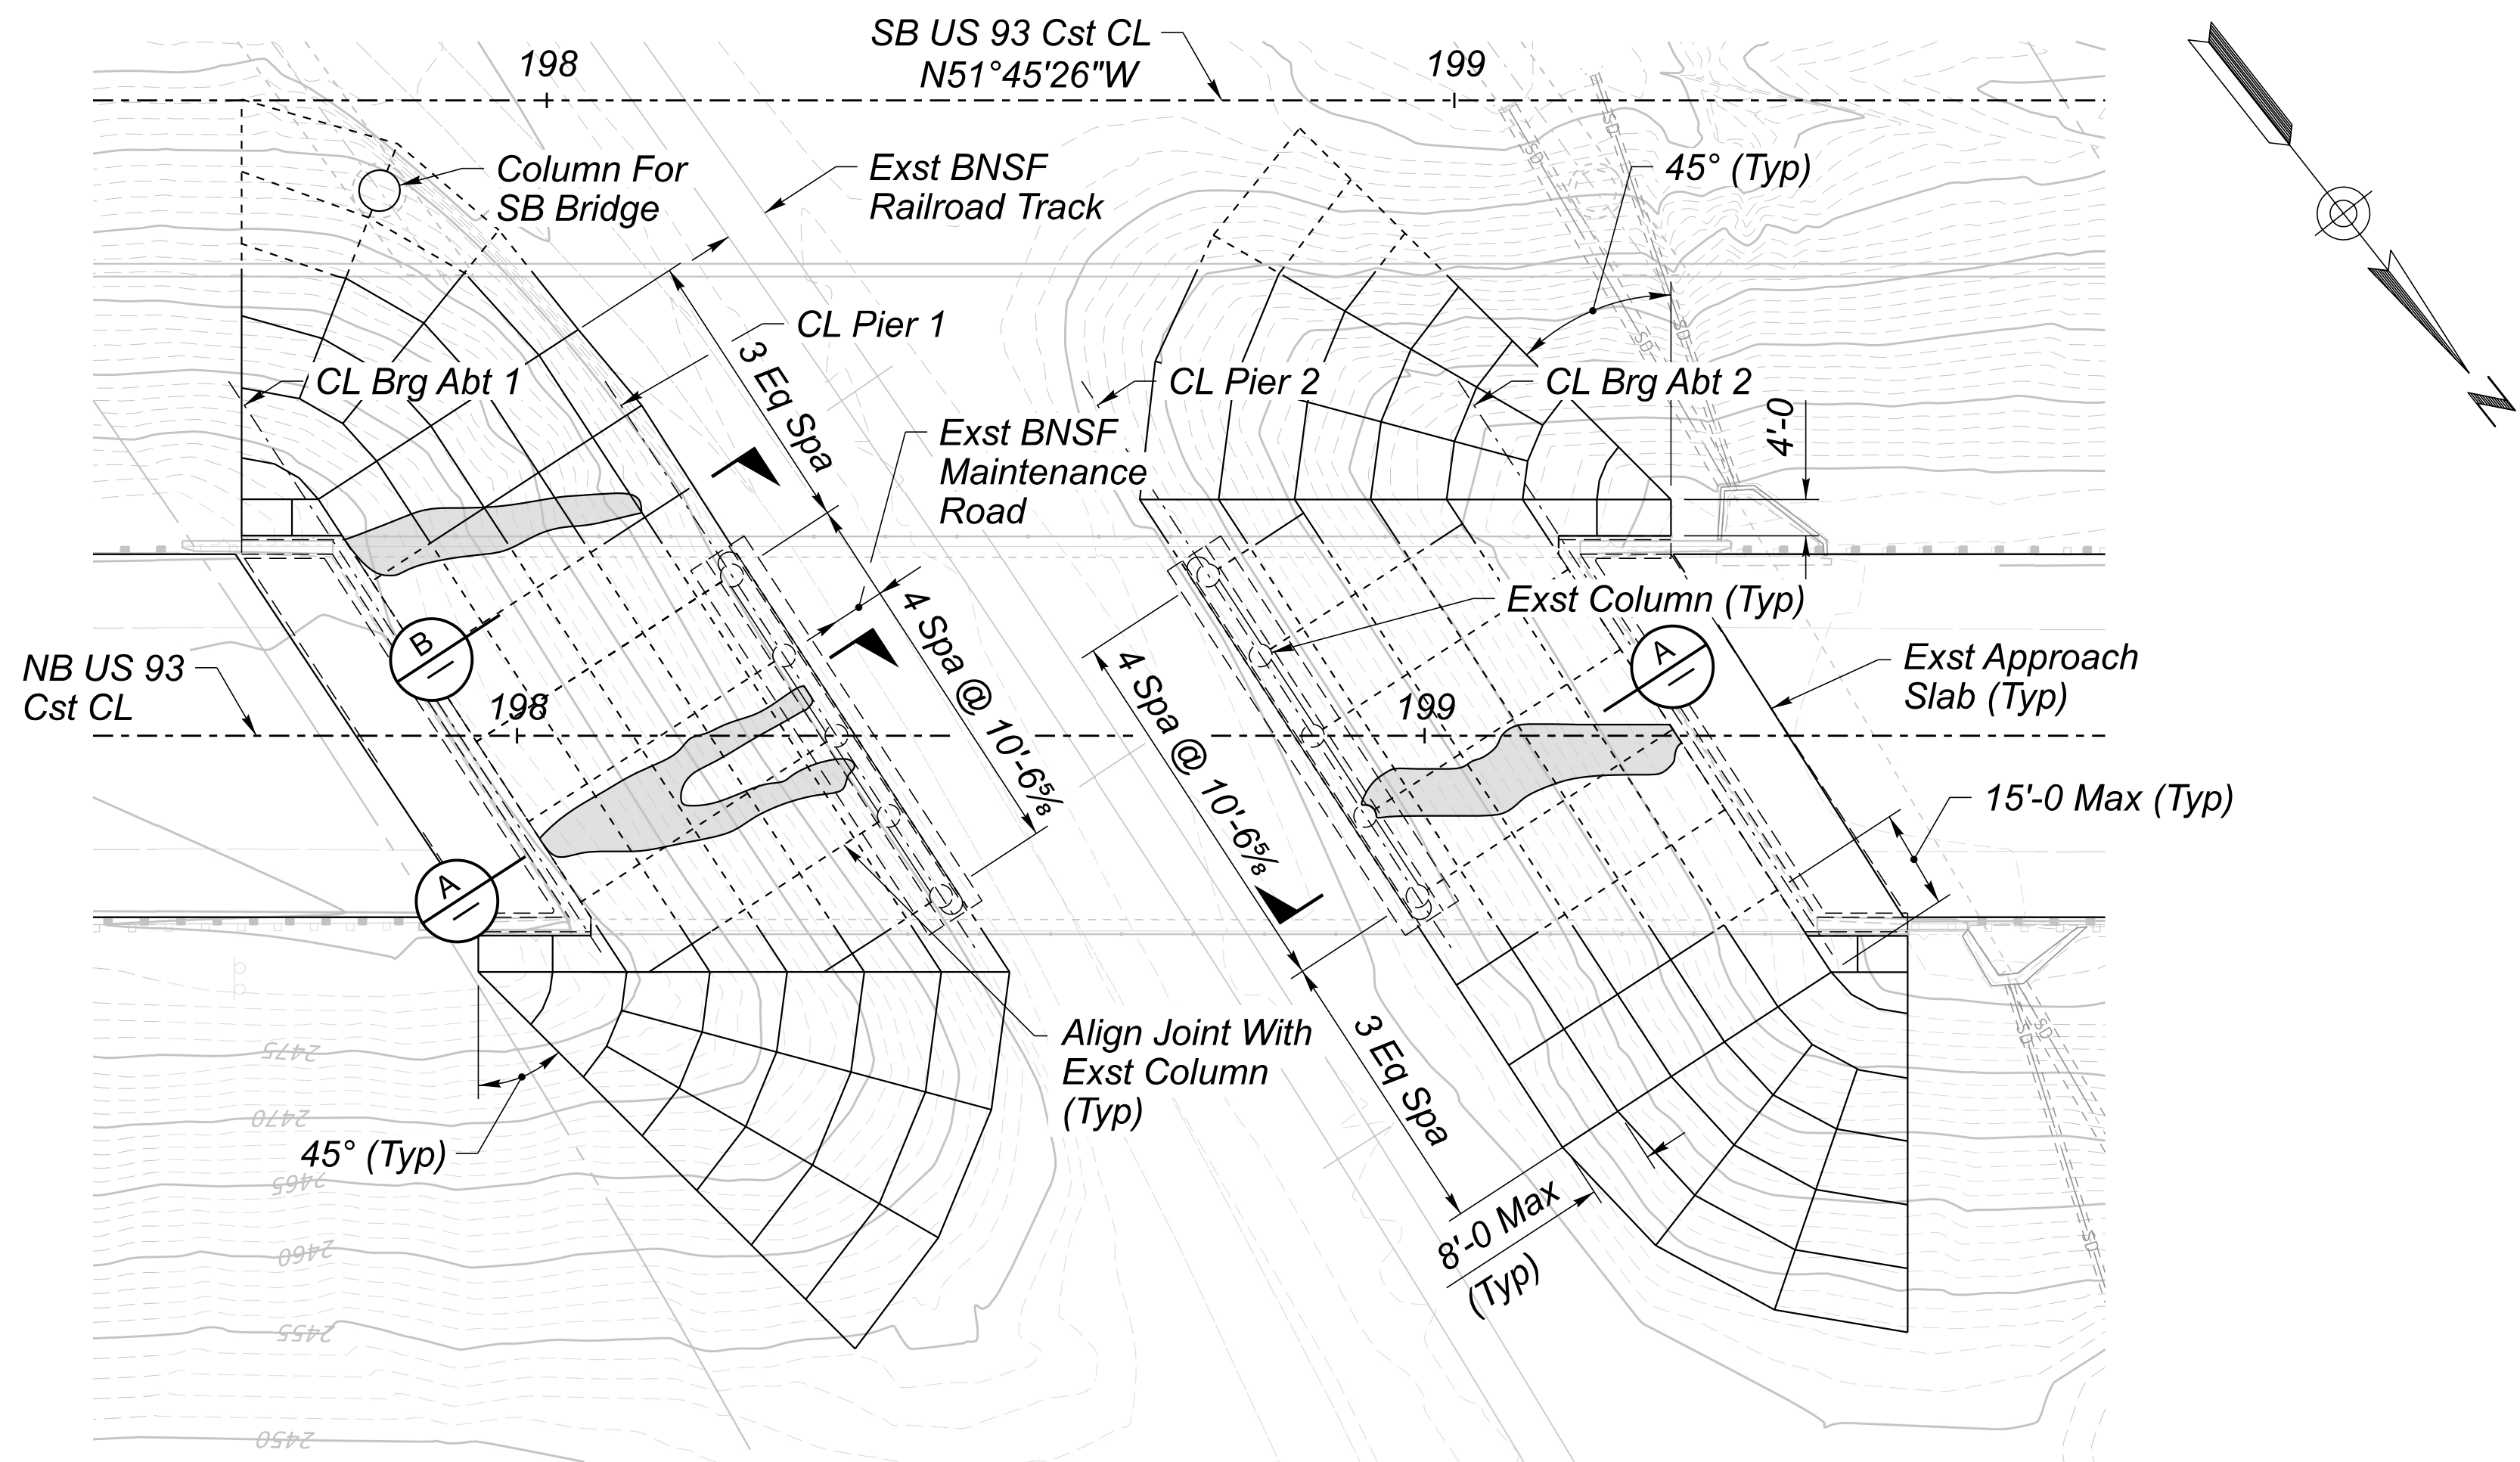


SHOTCRETE SLOPE PAVING PLAN

Scale: 1/16" = 1'-0


LEGEND:

Repair Exst Erosion Gullies With Backfill (See Note 1)

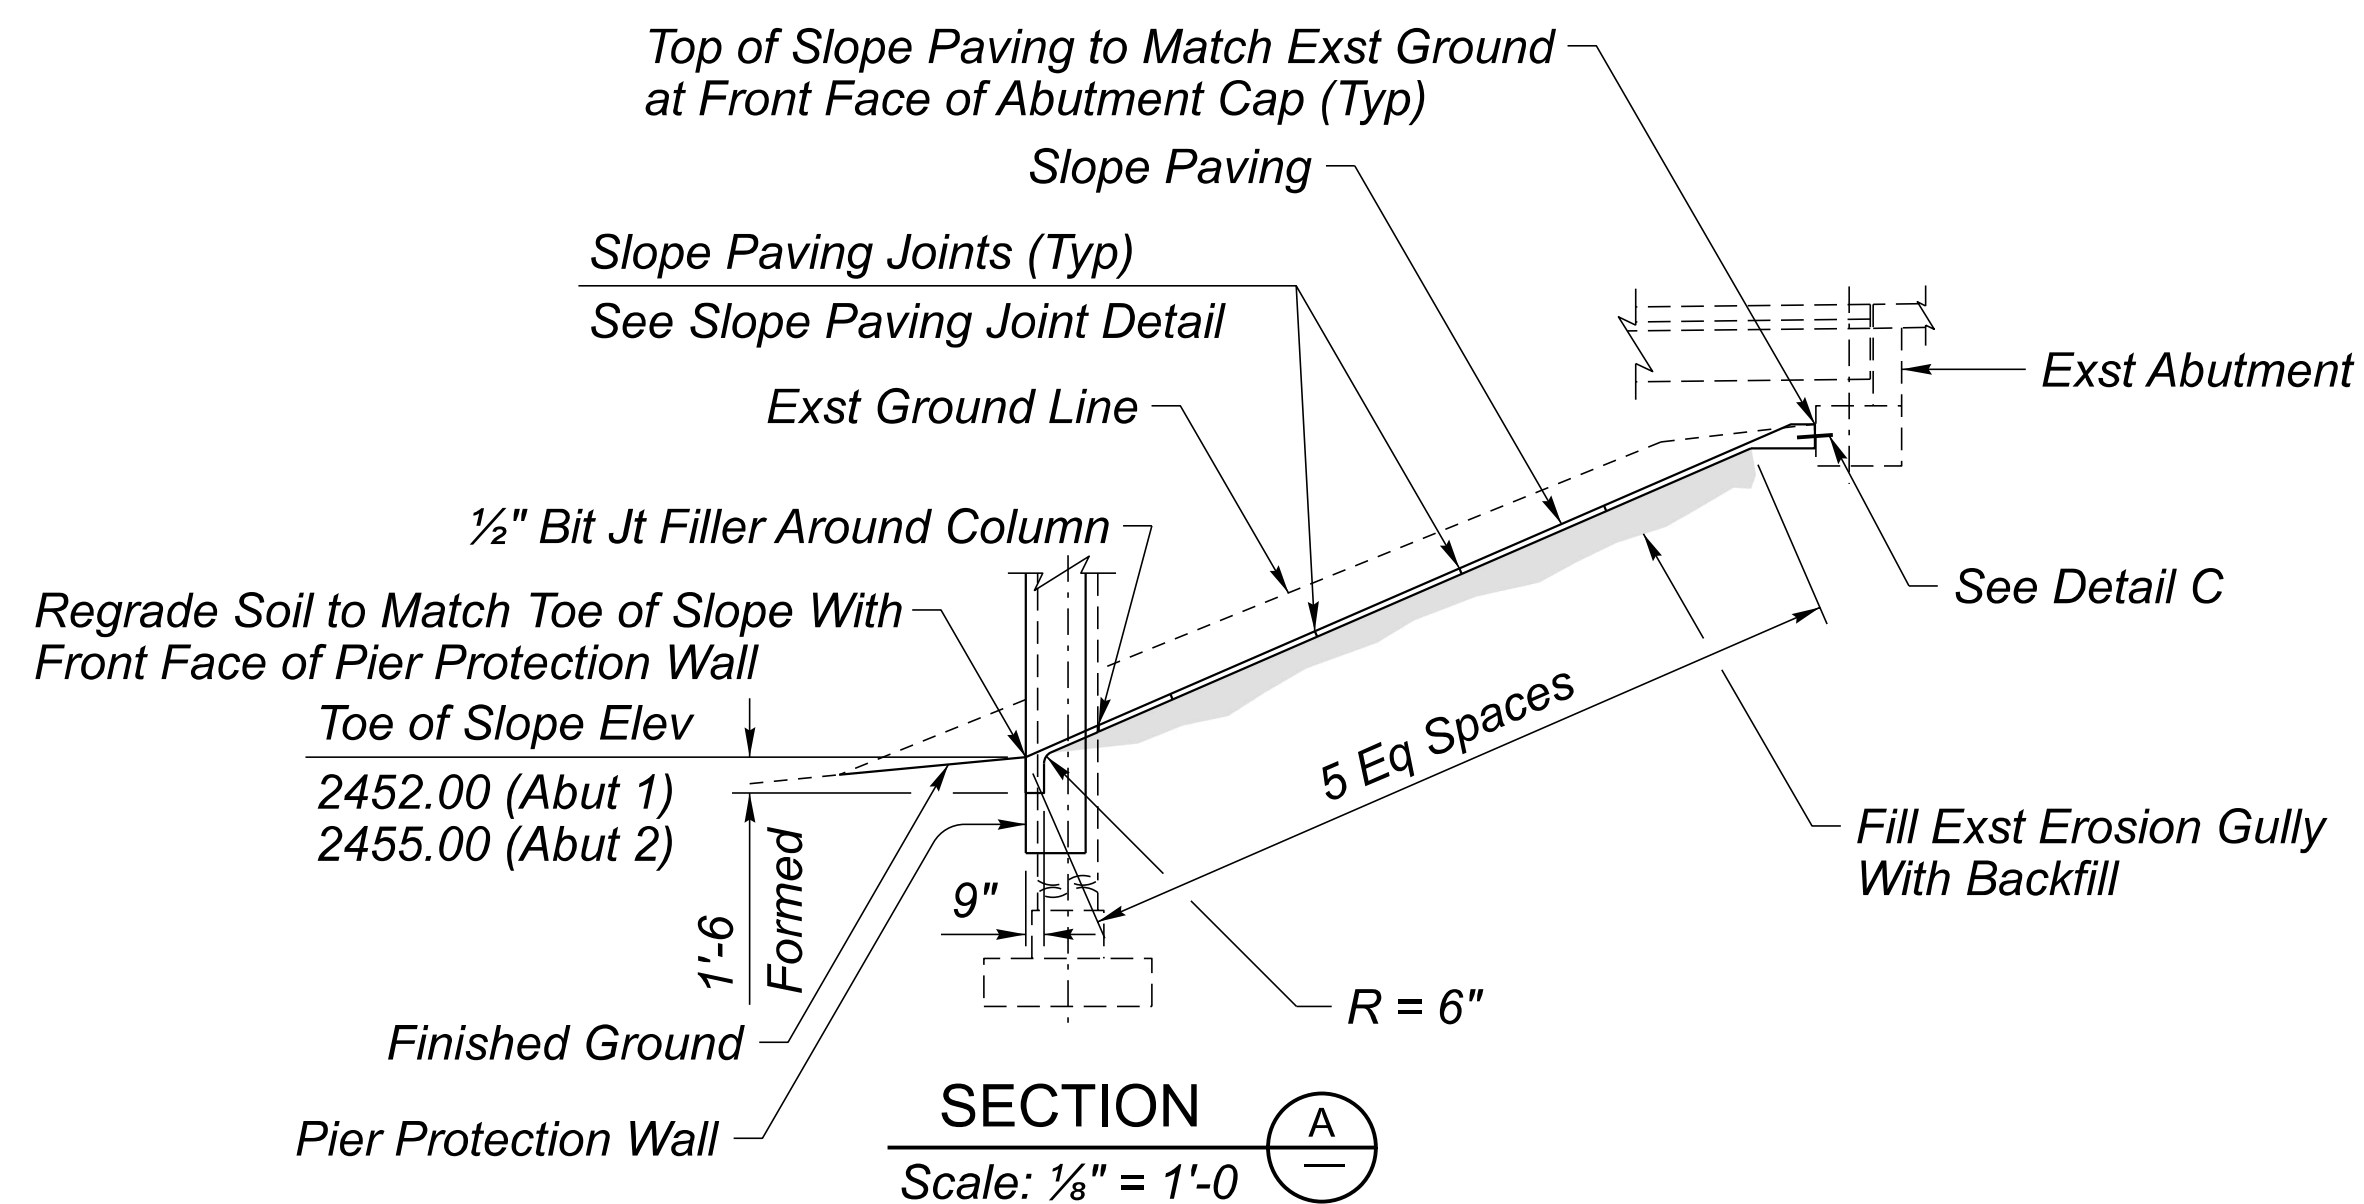


SECTION A
Scale: 1/8" = 1'-0

- SHOTCRETE SLOPE PAVING NOTES:**
- Shaded areas indicating existing erosion gullies are approximate. Place backfill in gullies to restore the embankment to a near original shape. Backfill needed to fill gullies is estimated as 80 CY. Gullies shall be filled and compacted prior to shotcrete placement.
 - The cost of shotcrete and gully backfilling is included in Item No. 9120002 Shotcrete (3" Slope Paving, Fiber Reinforced). See Section 912 of the Specifications.

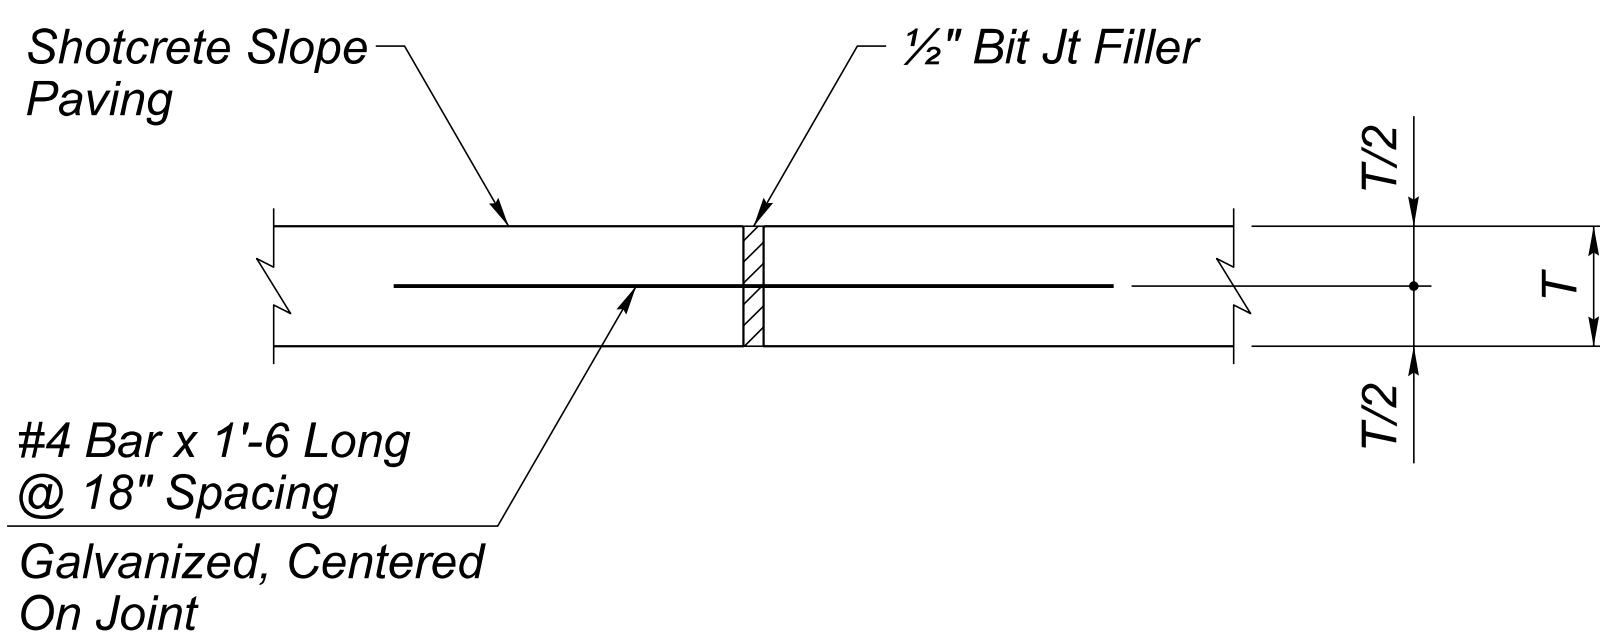

SLOPE PAVING JOINT DETAIL

NTS

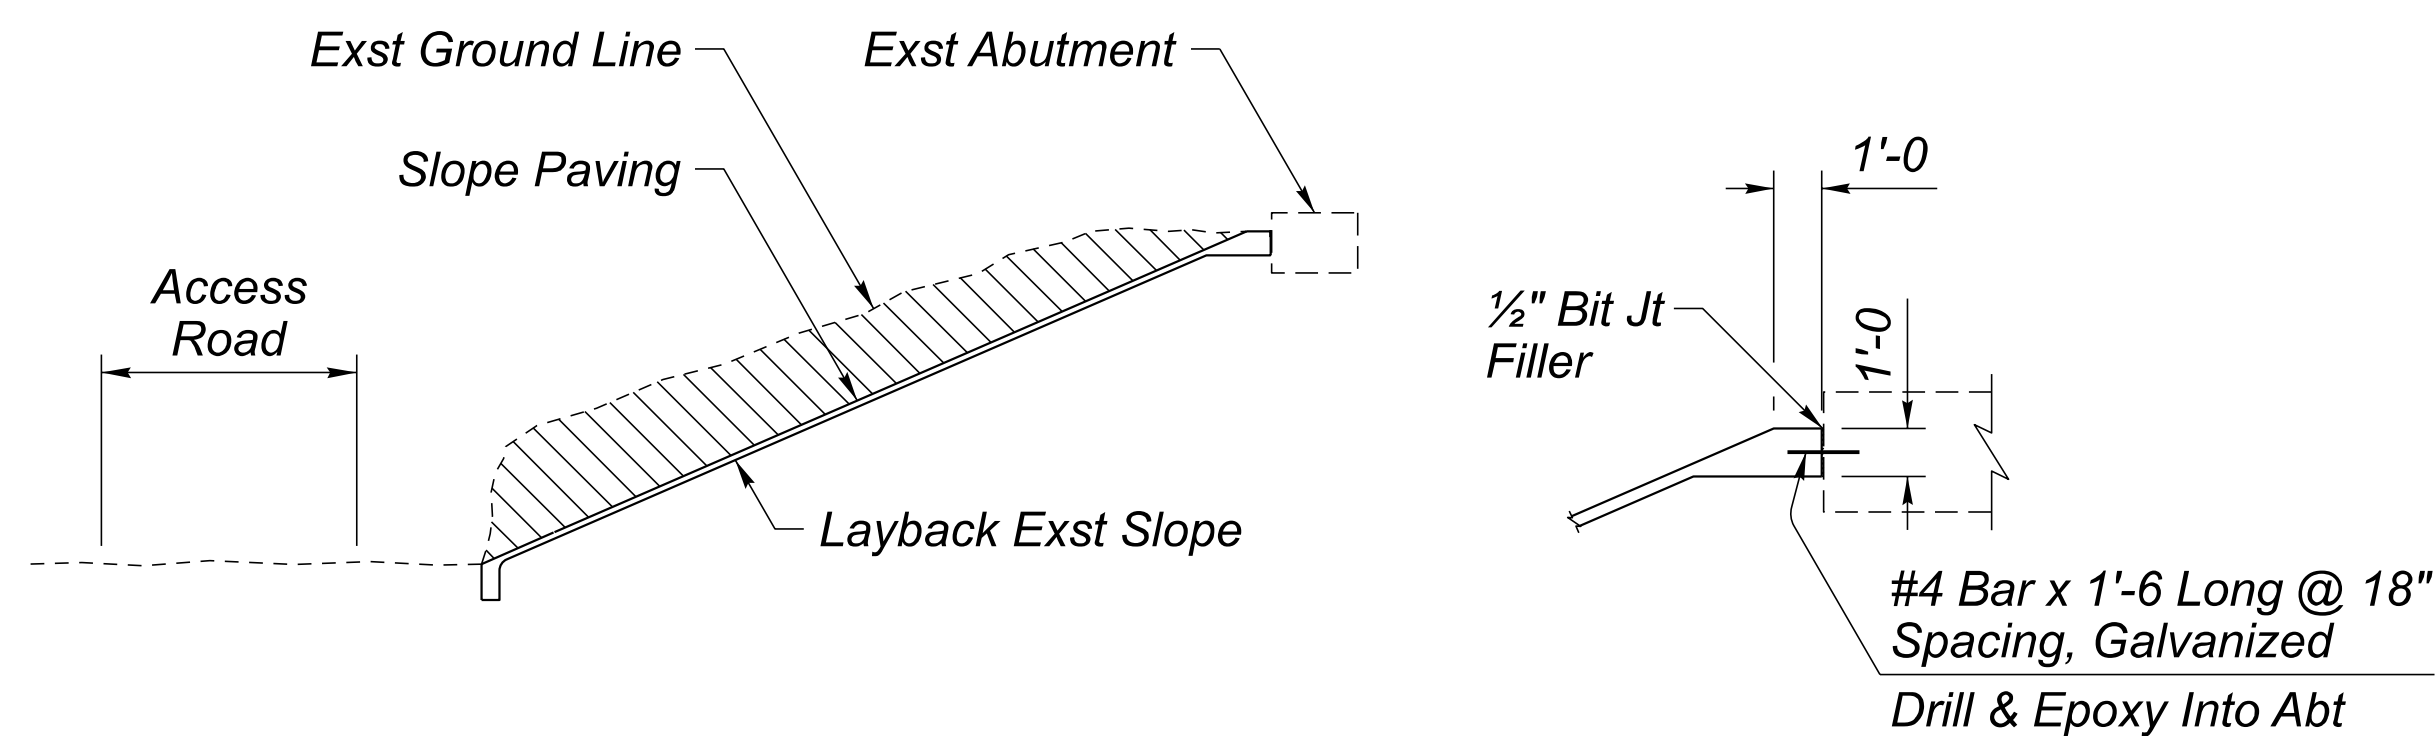

SECTION B
Scale: 1/8" = 1'-0

DETAIL C
Scale: 1/4" = 1'-0



	NAME	DATE
DESIGN	M. Noche	06/26
DRAWN	T. Talbert	06/26
CHECKED	B. Ansley	06/26

TRANSPORTATION
AECOM TECHNICAL SERVICES, Inc.
7720 N. 16th St., Suite 100
Phoenix, Arizona 85020
T 602.371.1100

AECOM
www.aecom.com

ARIZONA DEPARTMENT OF TRANSPORTATION
INFRASTRUCTURE DELIVERY AND OPERATIONS DIVISION
BRIDGE GROUP

STA 198+
US 93 NB BNSF OP BRIDGE
SLOPE REPAIR DETAILS

ROUTE
US 93

MILEPOST
192.88

STRUCTURE NO.
780

F.H.W.A. Arizona Division

STATE
ARIZ.

PROJECT NO.
093 YV 189

FEDERAL ID NO.
093-B-(230)T

SHEET
NO. 451

TOTAL
SHEETS 524



RECORD DRAWING

LOCATION WICKENBURG RANCH WAY TO VISTA ROYALE

TRACS NO. F0738 01C

DWG No. S-3.03


OF

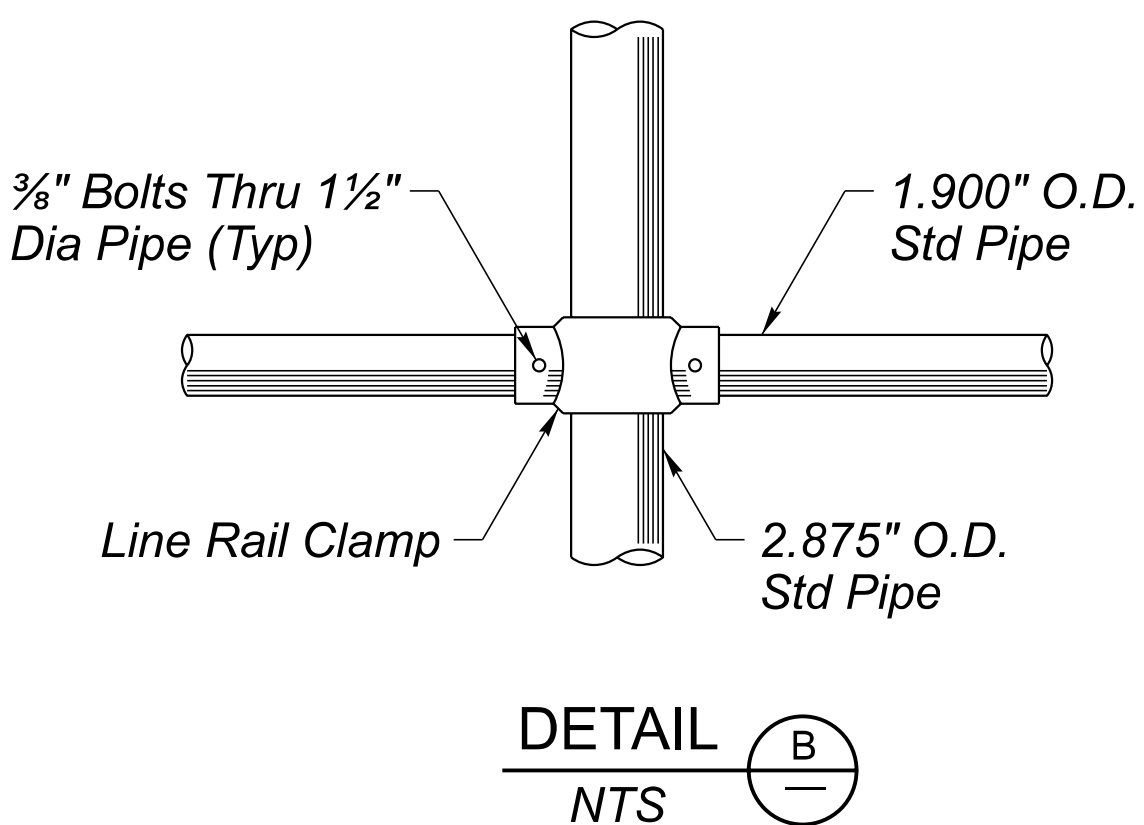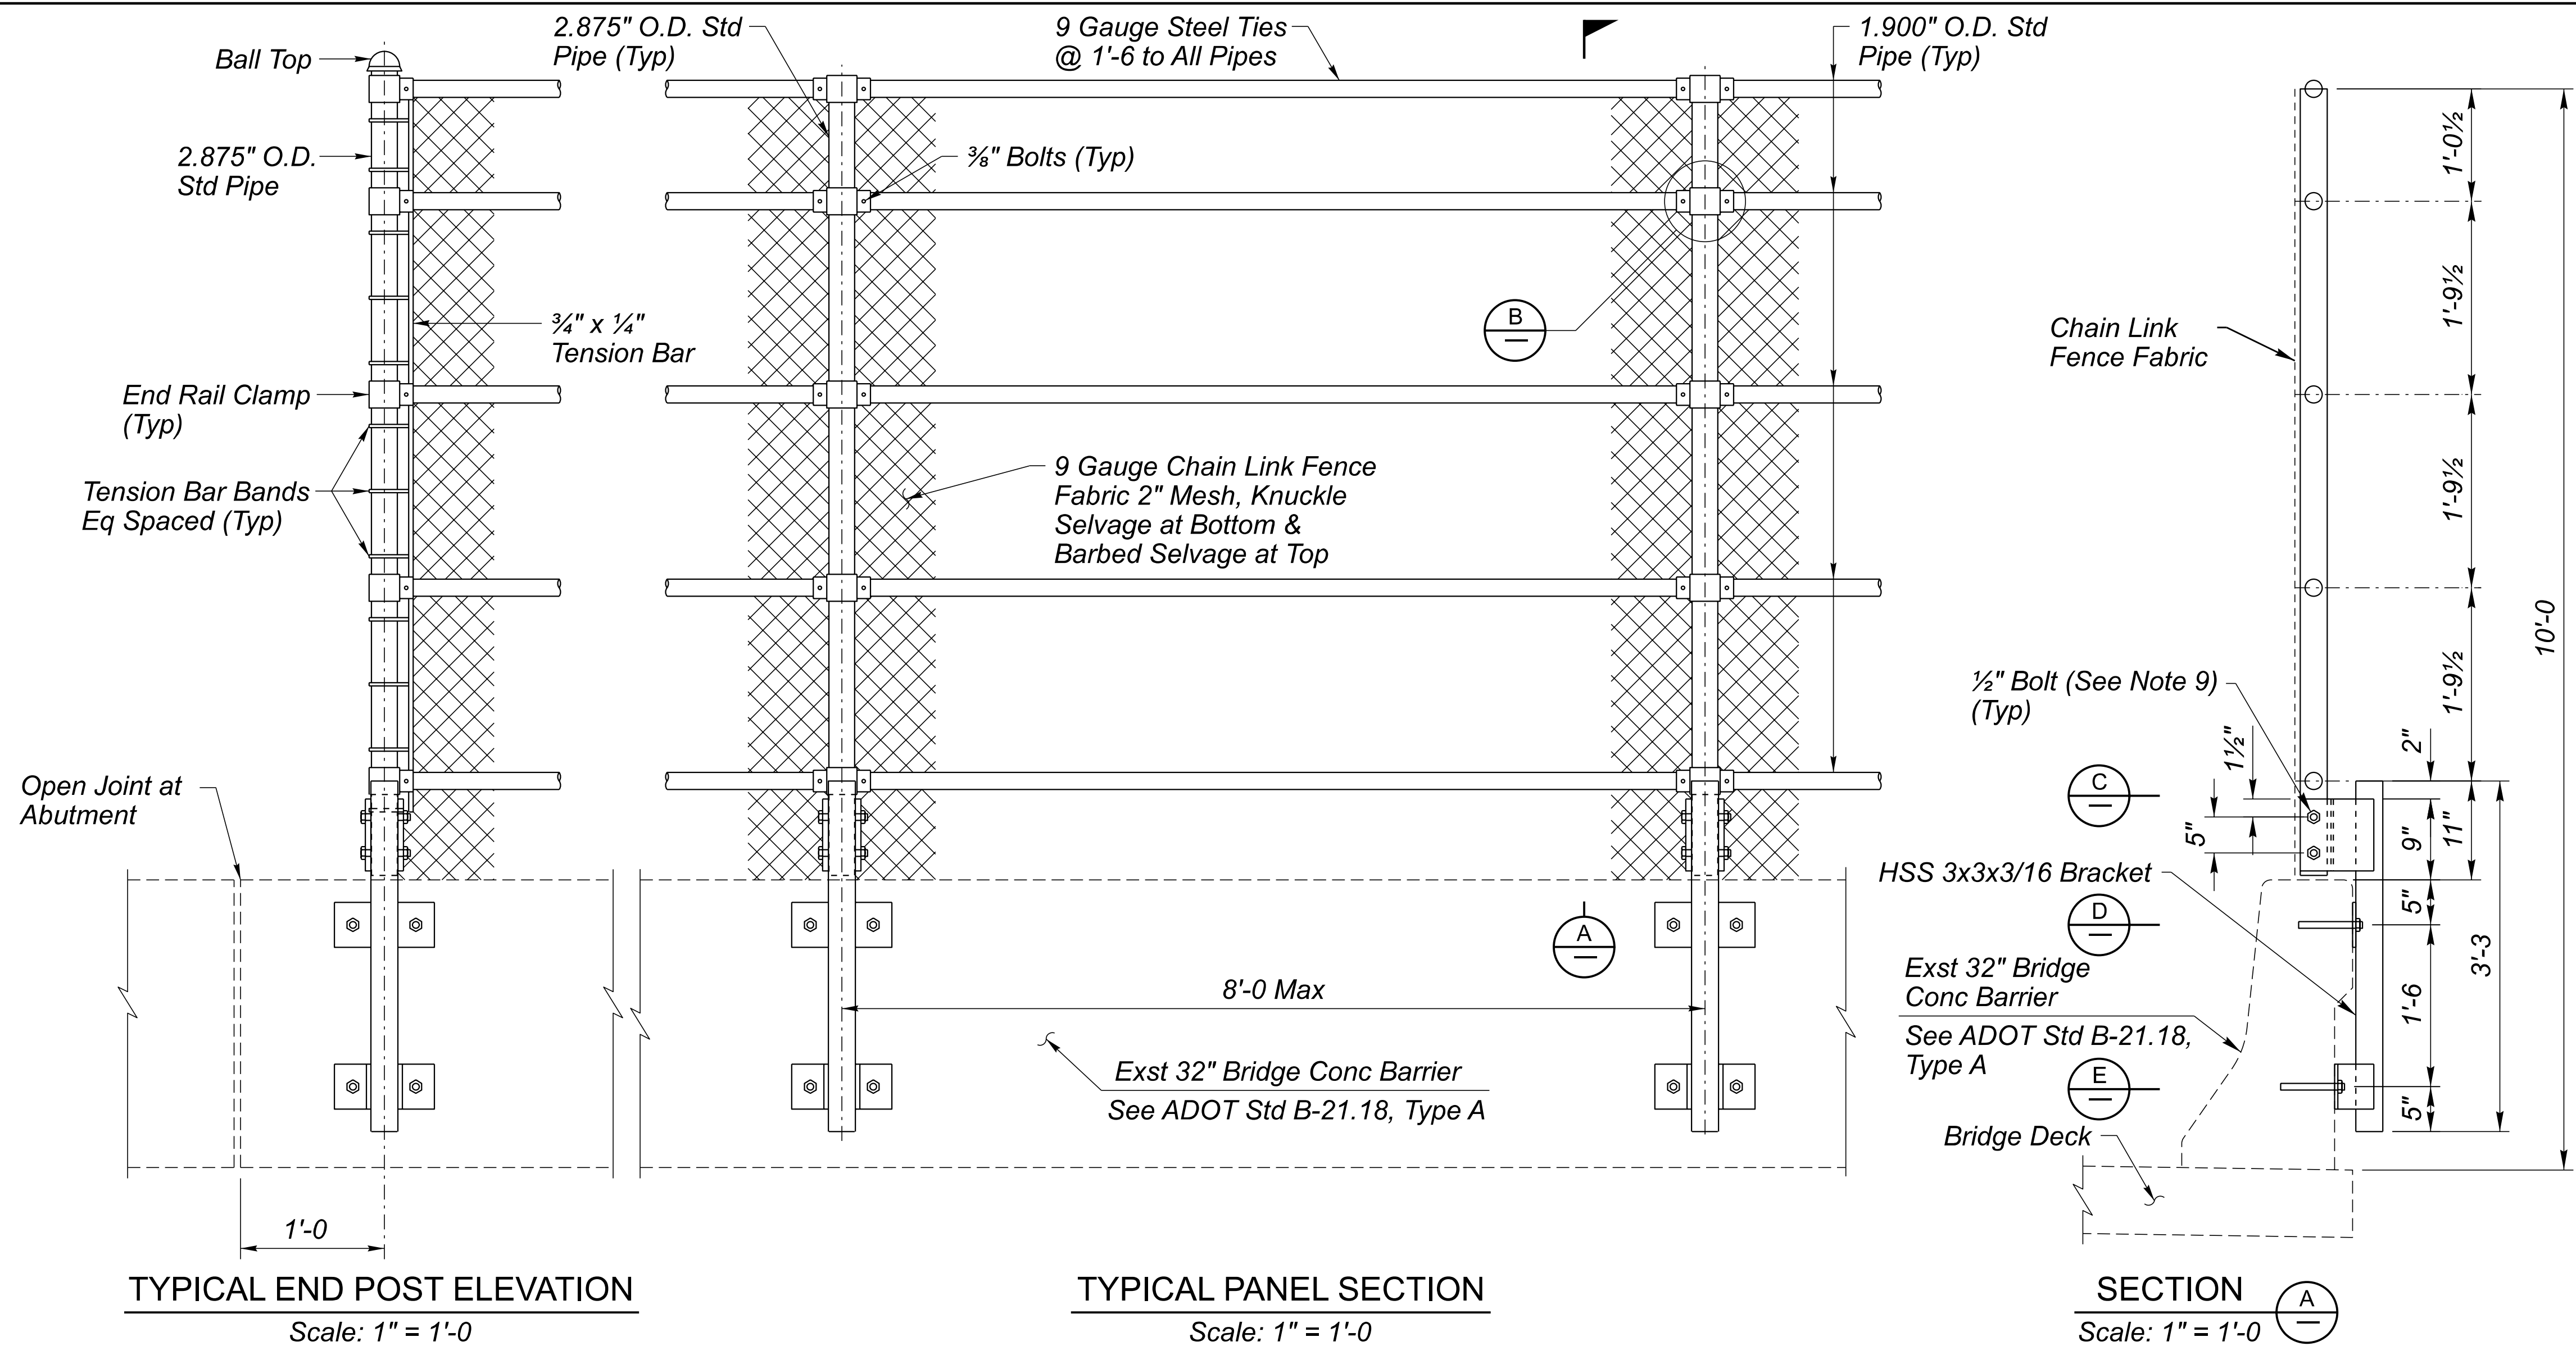


- NOTES:**
- Chain link fence fabric, posts, fittings & hardware shall conform to AASHTO M181 - Grade I or Grade II. The zinc coated fabric shall be Class C or D.
 - All galvanizing that has been damaged in handling, transporting or welding shall be repaired by the application of a paste compound of an approved zinc powder & flux.
 - All exposed edges shall be ground smooth.
 - All bolt heads shall be installed on the roadway side.
 - Fence fabric shall be installed on the inside.
 - All welding shall conform to the requirements of the American Welding Society, ANSI/AASHTO/AWS D1.5 Bridge Welding Code, latest edition.
 - Anchor bolts shall be furnished galvanized & in accordance with ASTM F 1554, Grade 55.
 - This work is paid for under item No. 9020028 Chain Link Fence (For Existing Structure).
 - Provide 1/2" Dia ASTM A307 Grade A hex bolt with one hex nut.
 - HSS shapes shall conform to ASTM A500 Grade B. Plates shall conform to ASTM A36. The bracket assembly shall be galvanized after fabrication in accordance with ASTM A123.
 - Contractor shall submit shop drawing of the Fence Post Bracket to the Engineer for review prior to fabrication.

DRILL & EPOXY NOTES:

Drill & epoxy grout with Hilti HIT-HY100 or approved equal from current ADOT approved product list per Manufacturer's recommendation.

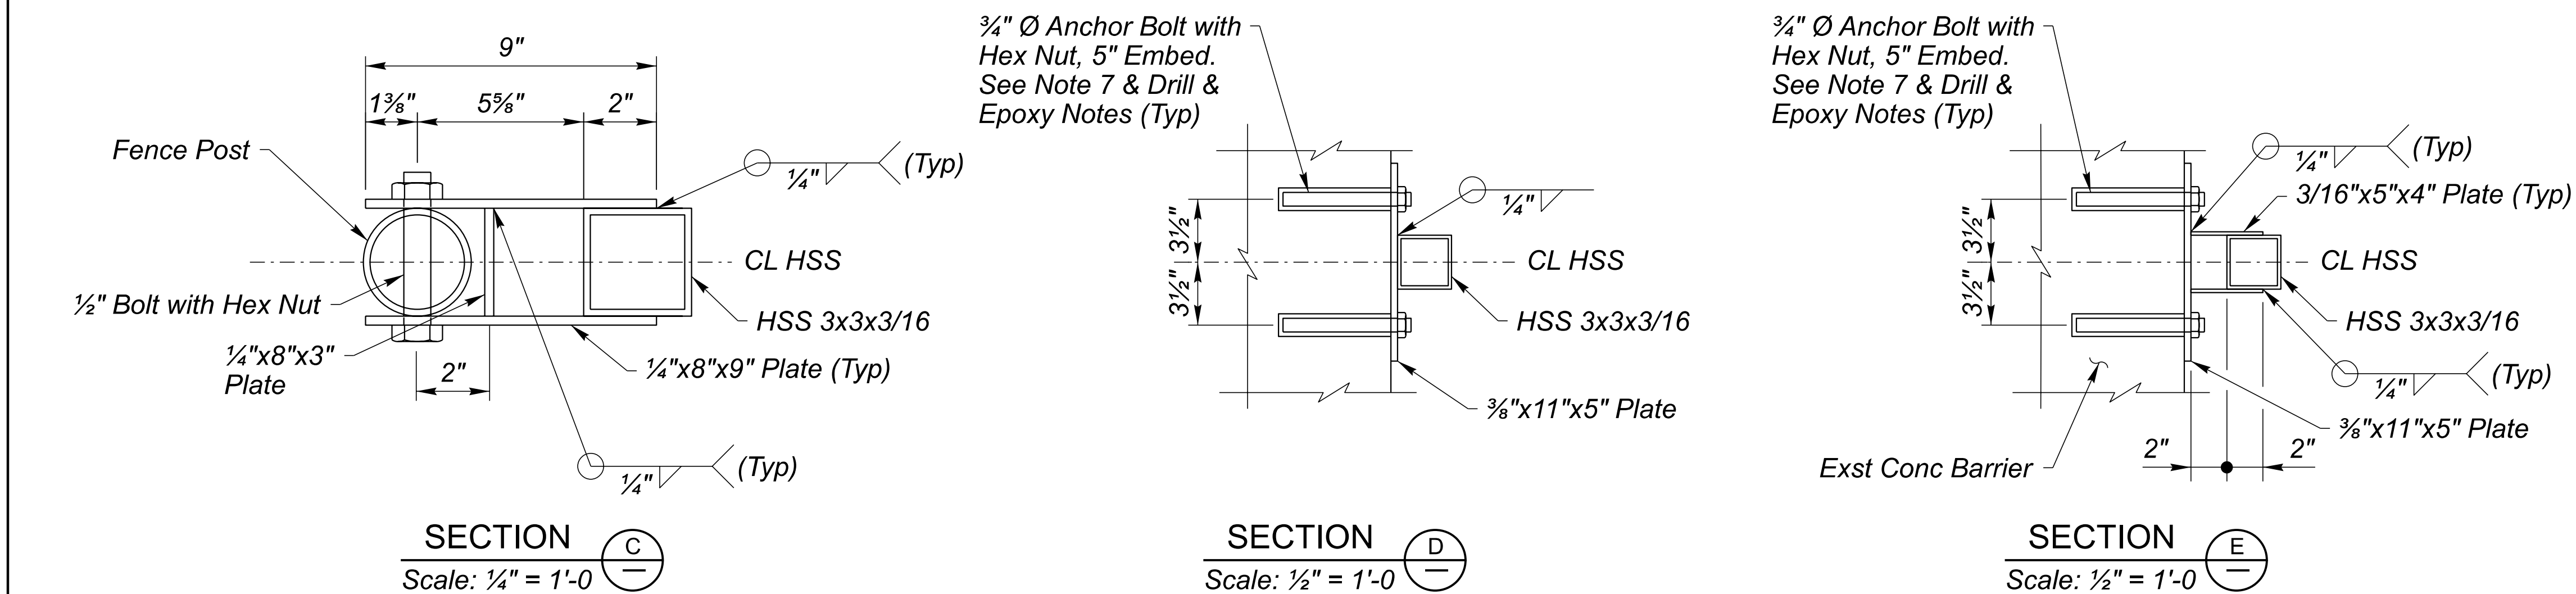


	NAME		DATE	ARIZONA DEPARTMENT OF TRANSPORTATION INFRASTRUCTURE DELIVERY AND OPERATIONS DIVISION BRIDGE GROUP	ROUTE	F.H.W.A. Arizona Division	STATE ARIZ.	PROJECT NO.	FEDERAL ID NO.	SHEET NO.	TOTAL SHEETS	RECORD DRAWING		
	DESIGN	M. Noche	06/26		US 93			093 YV 189	093-B-(230)T	452	524			
	DRAWN	T. Talbert	06/26		MILEPOST			LOCATION WICKENBURG RANCH WAY TO VISTA ROYALE						
	CHECKED	B. Ansley	06/26		192.88			DWG No. S-3.04						
	TRANSPORTATION AECOM TECHNICAL SERVICES, Inc. 7720 N. 16th St., Suite 100 Phoenix, Arizona 85020 T 602.371.1100 AECOM www.aecom.com				STRUCTURE NO.			TRACS NO. F0738 01C						
STA 198+ US 93 NB BNSF OP BRIDGE NEW FENCE DETAILS				780	OF									

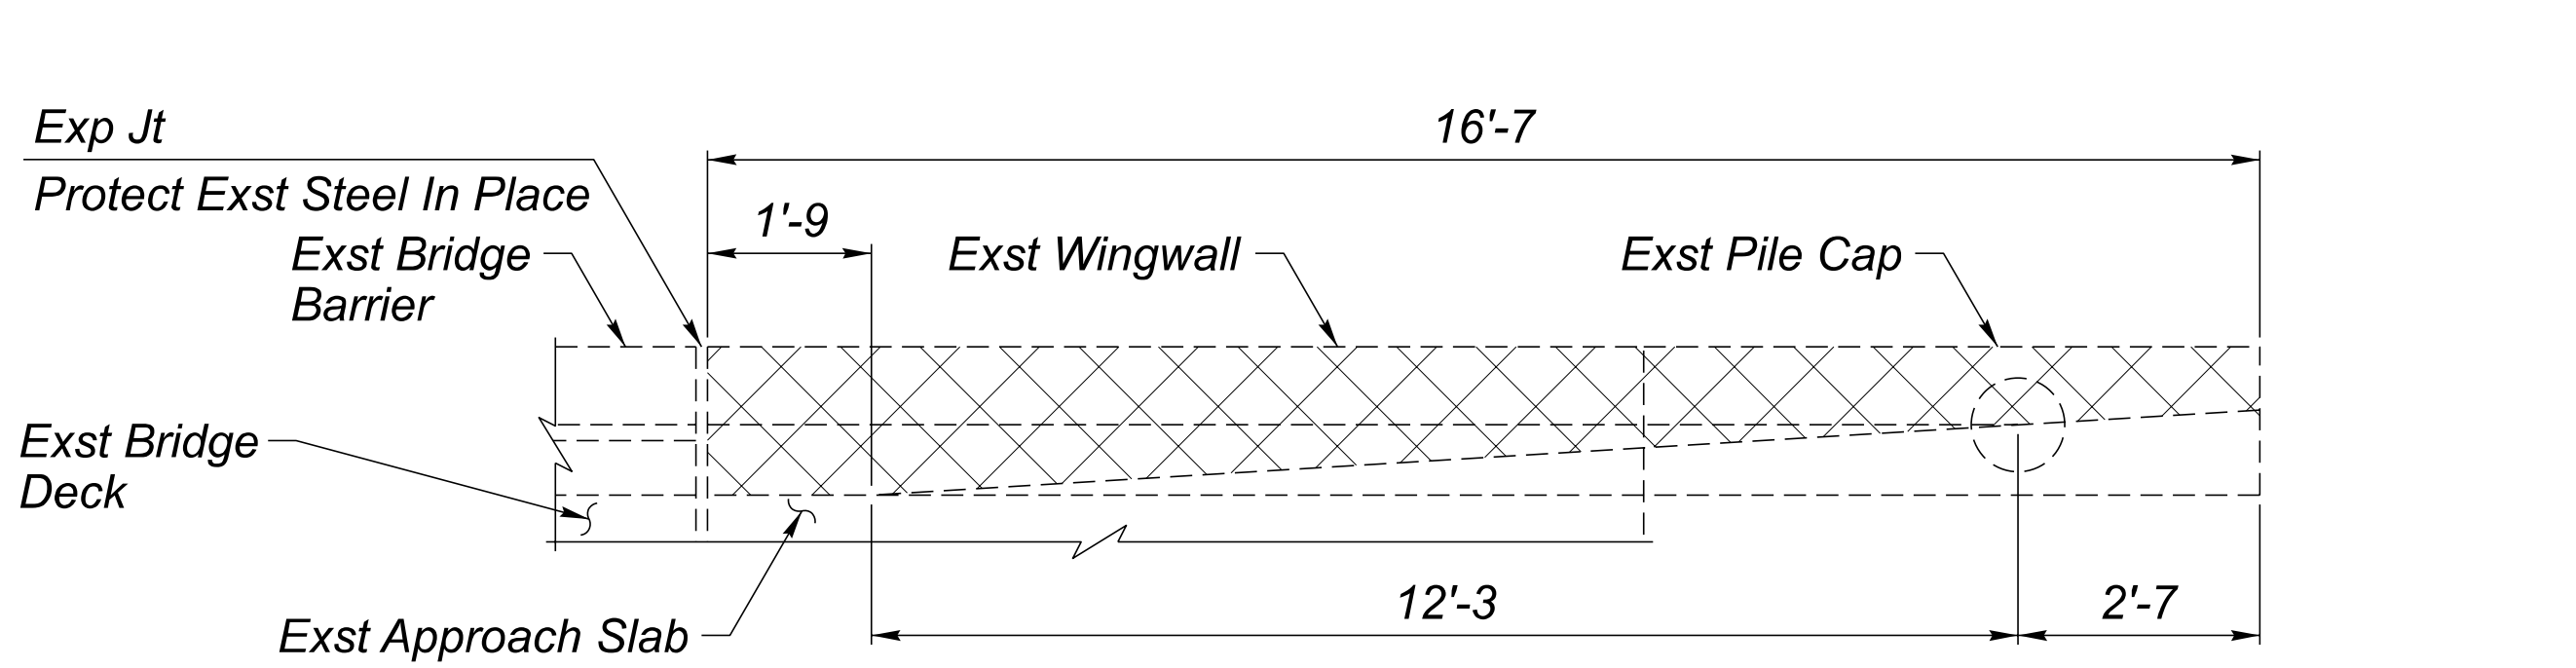


PLAN - REMOVALS

Scale: 1/2" = 1'-0

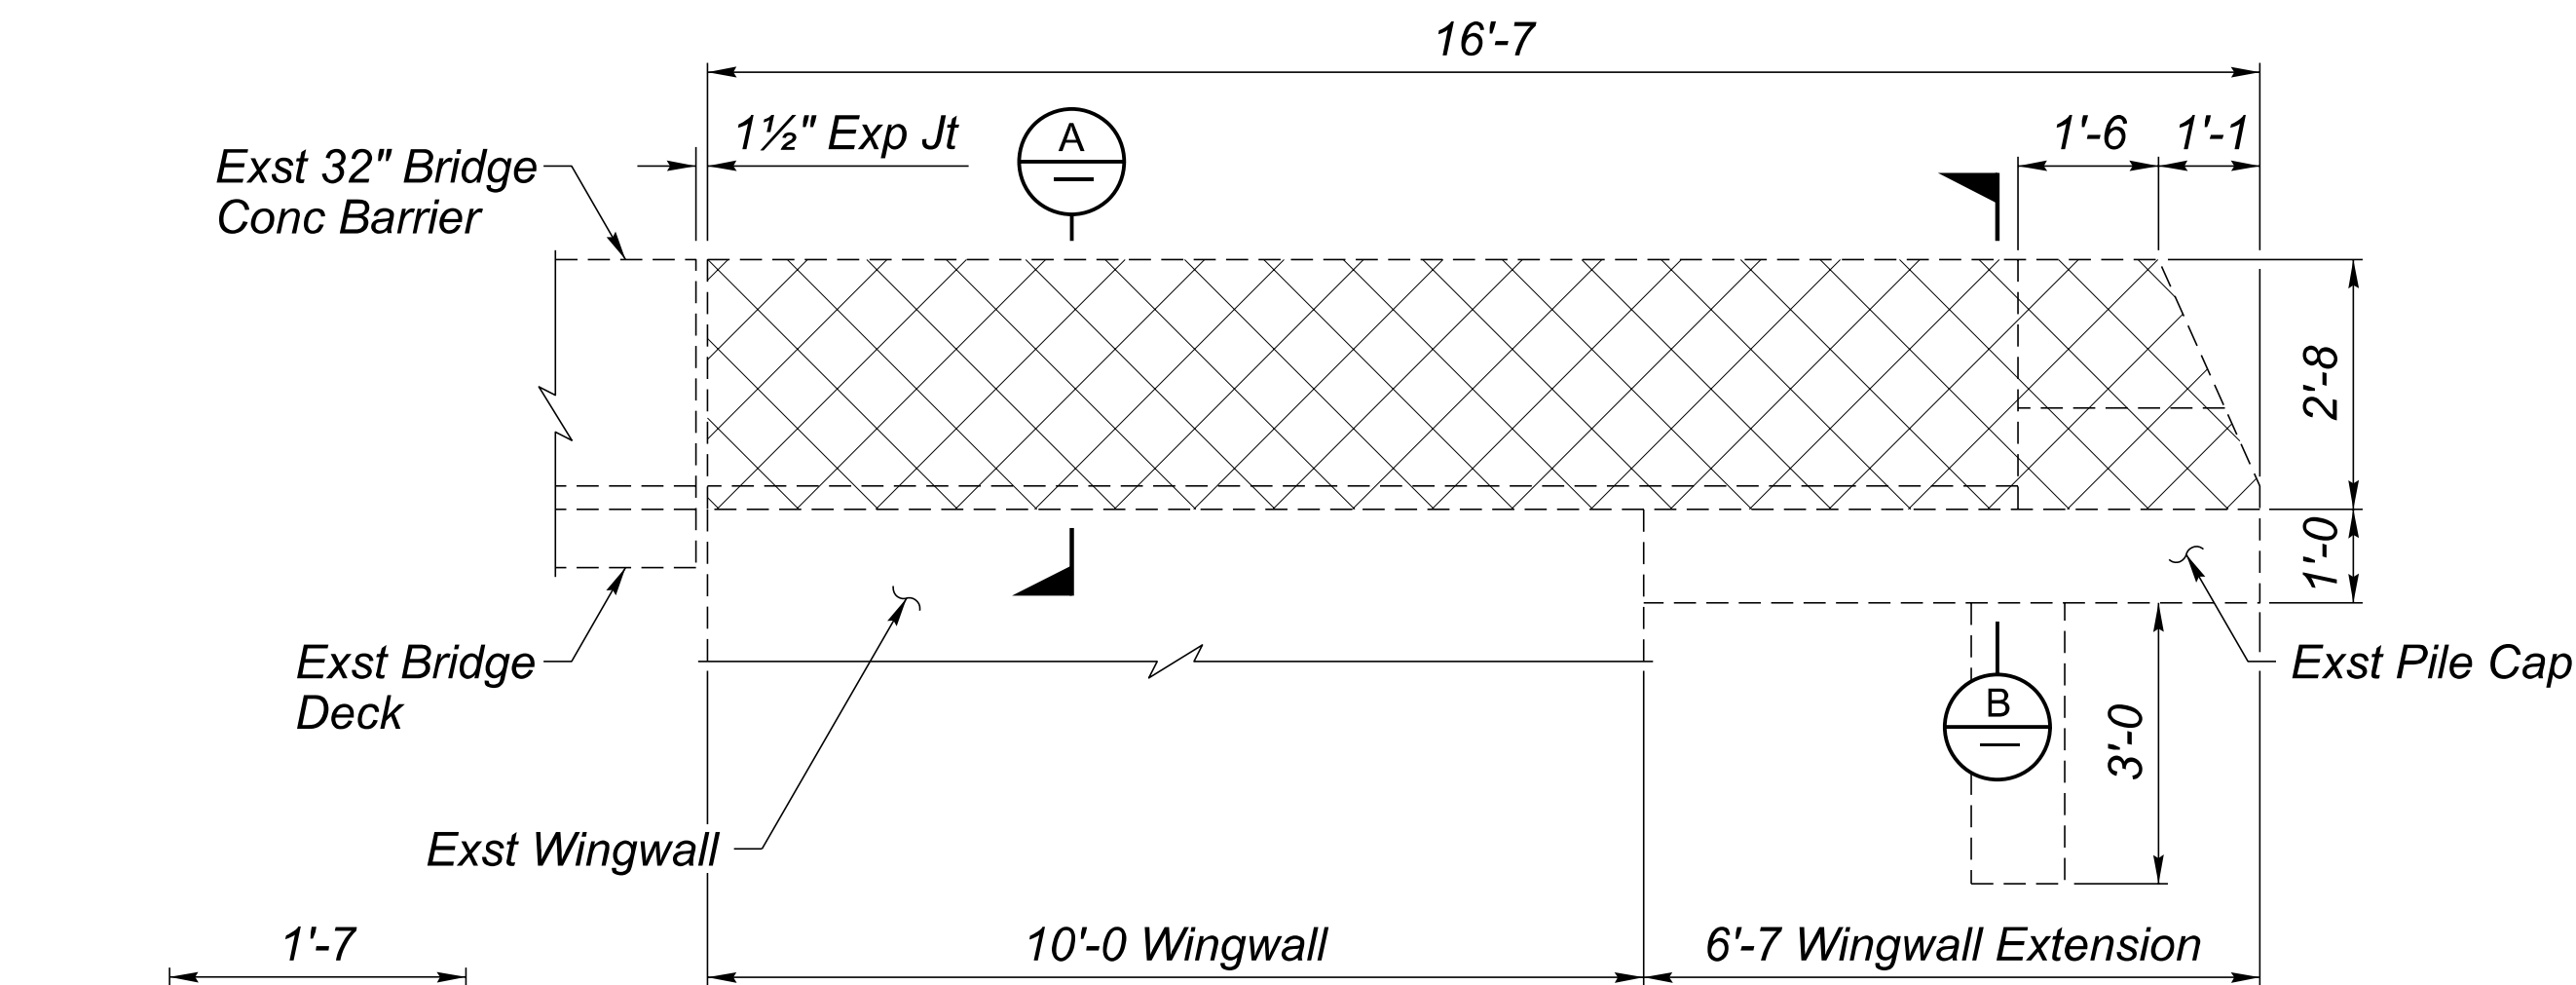

ELEVATION - REMOVALS

Scale: 1/2" = 1'-0

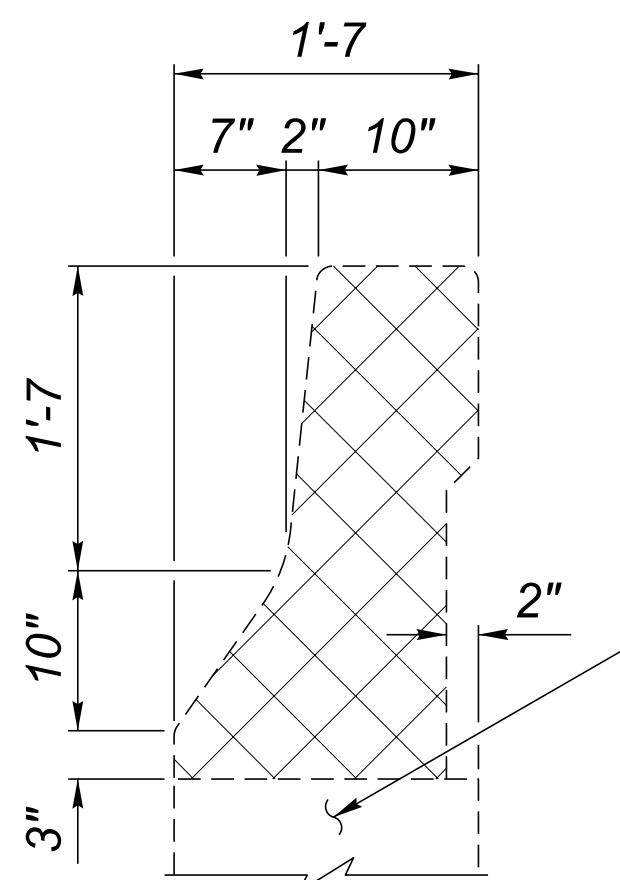

SECTION A


Scale: 1" = 1'-0

EPOXY NOTES:

Drill & epoxy grout with Hilti HIT-HY100 or approved equal from current ADOT approved product list per Manufacturer's recommendations.


BARRIER TRANSITION NOTE:

Existing barrier transition removal & new barrier transition construction shall be paid for under Bid Item No. 2020185 Remove (Bridge Barrier Transition) & Bid Item No. 9100053 Concrete Bridge Barrier Transition respectively.

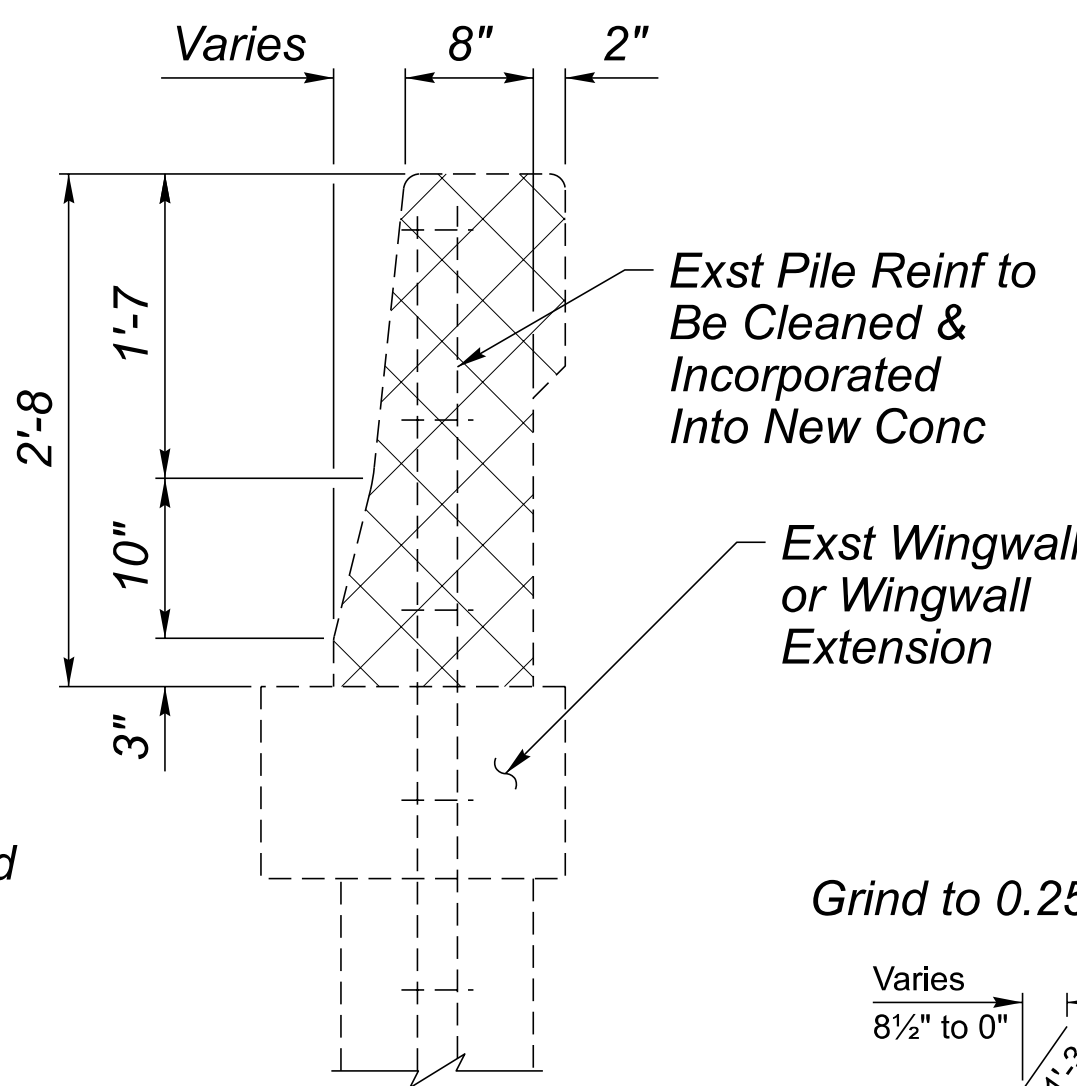


SECTION B

Scale: 1" = 1'-0

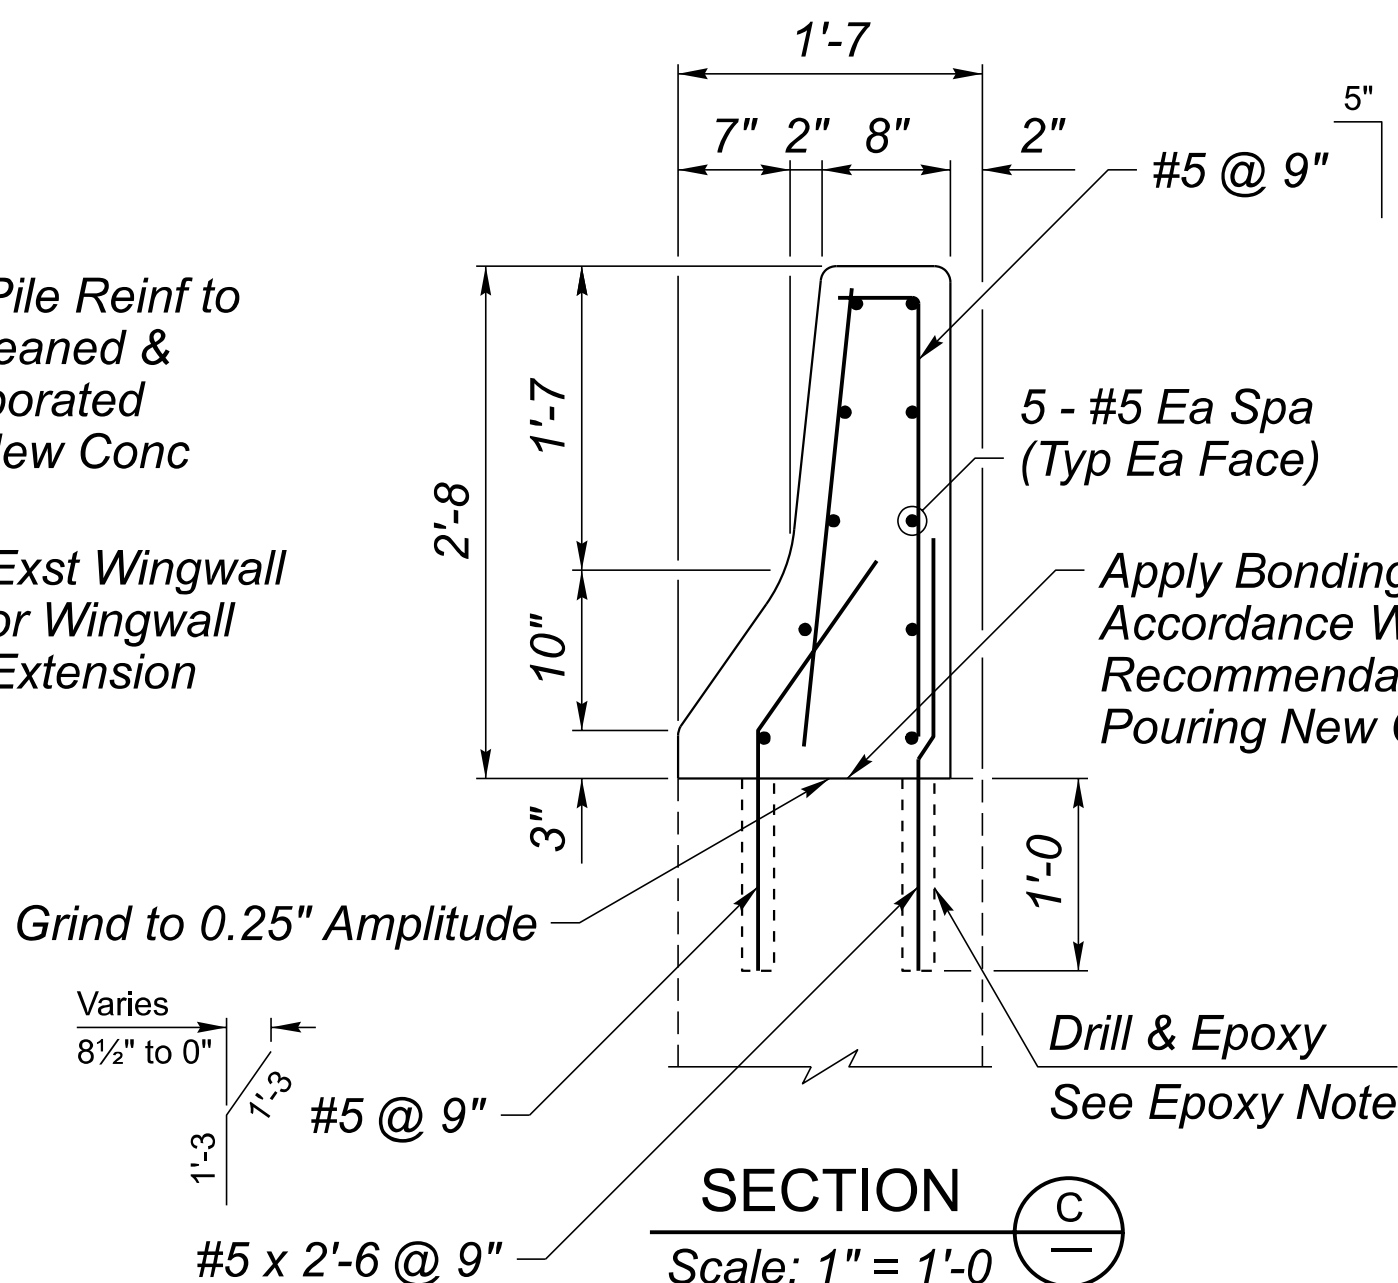


SECTION C

Scale: 1" = 1'-0

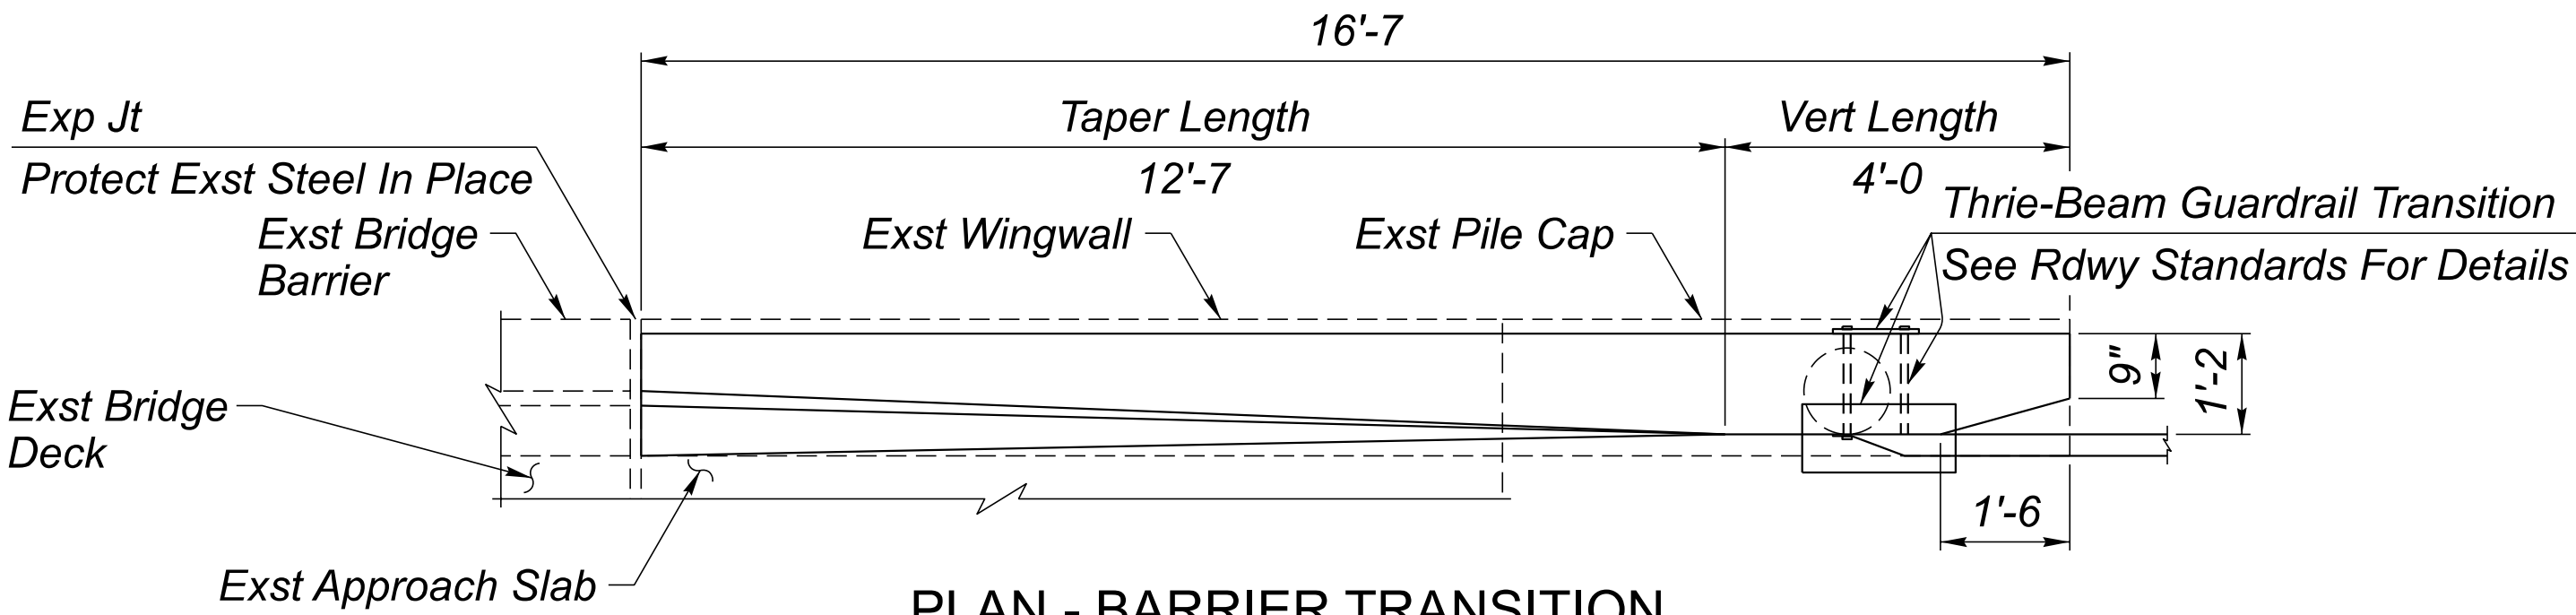


PLAN - BARRIER TRANSITION

Scale: 1/2" = 1'-0

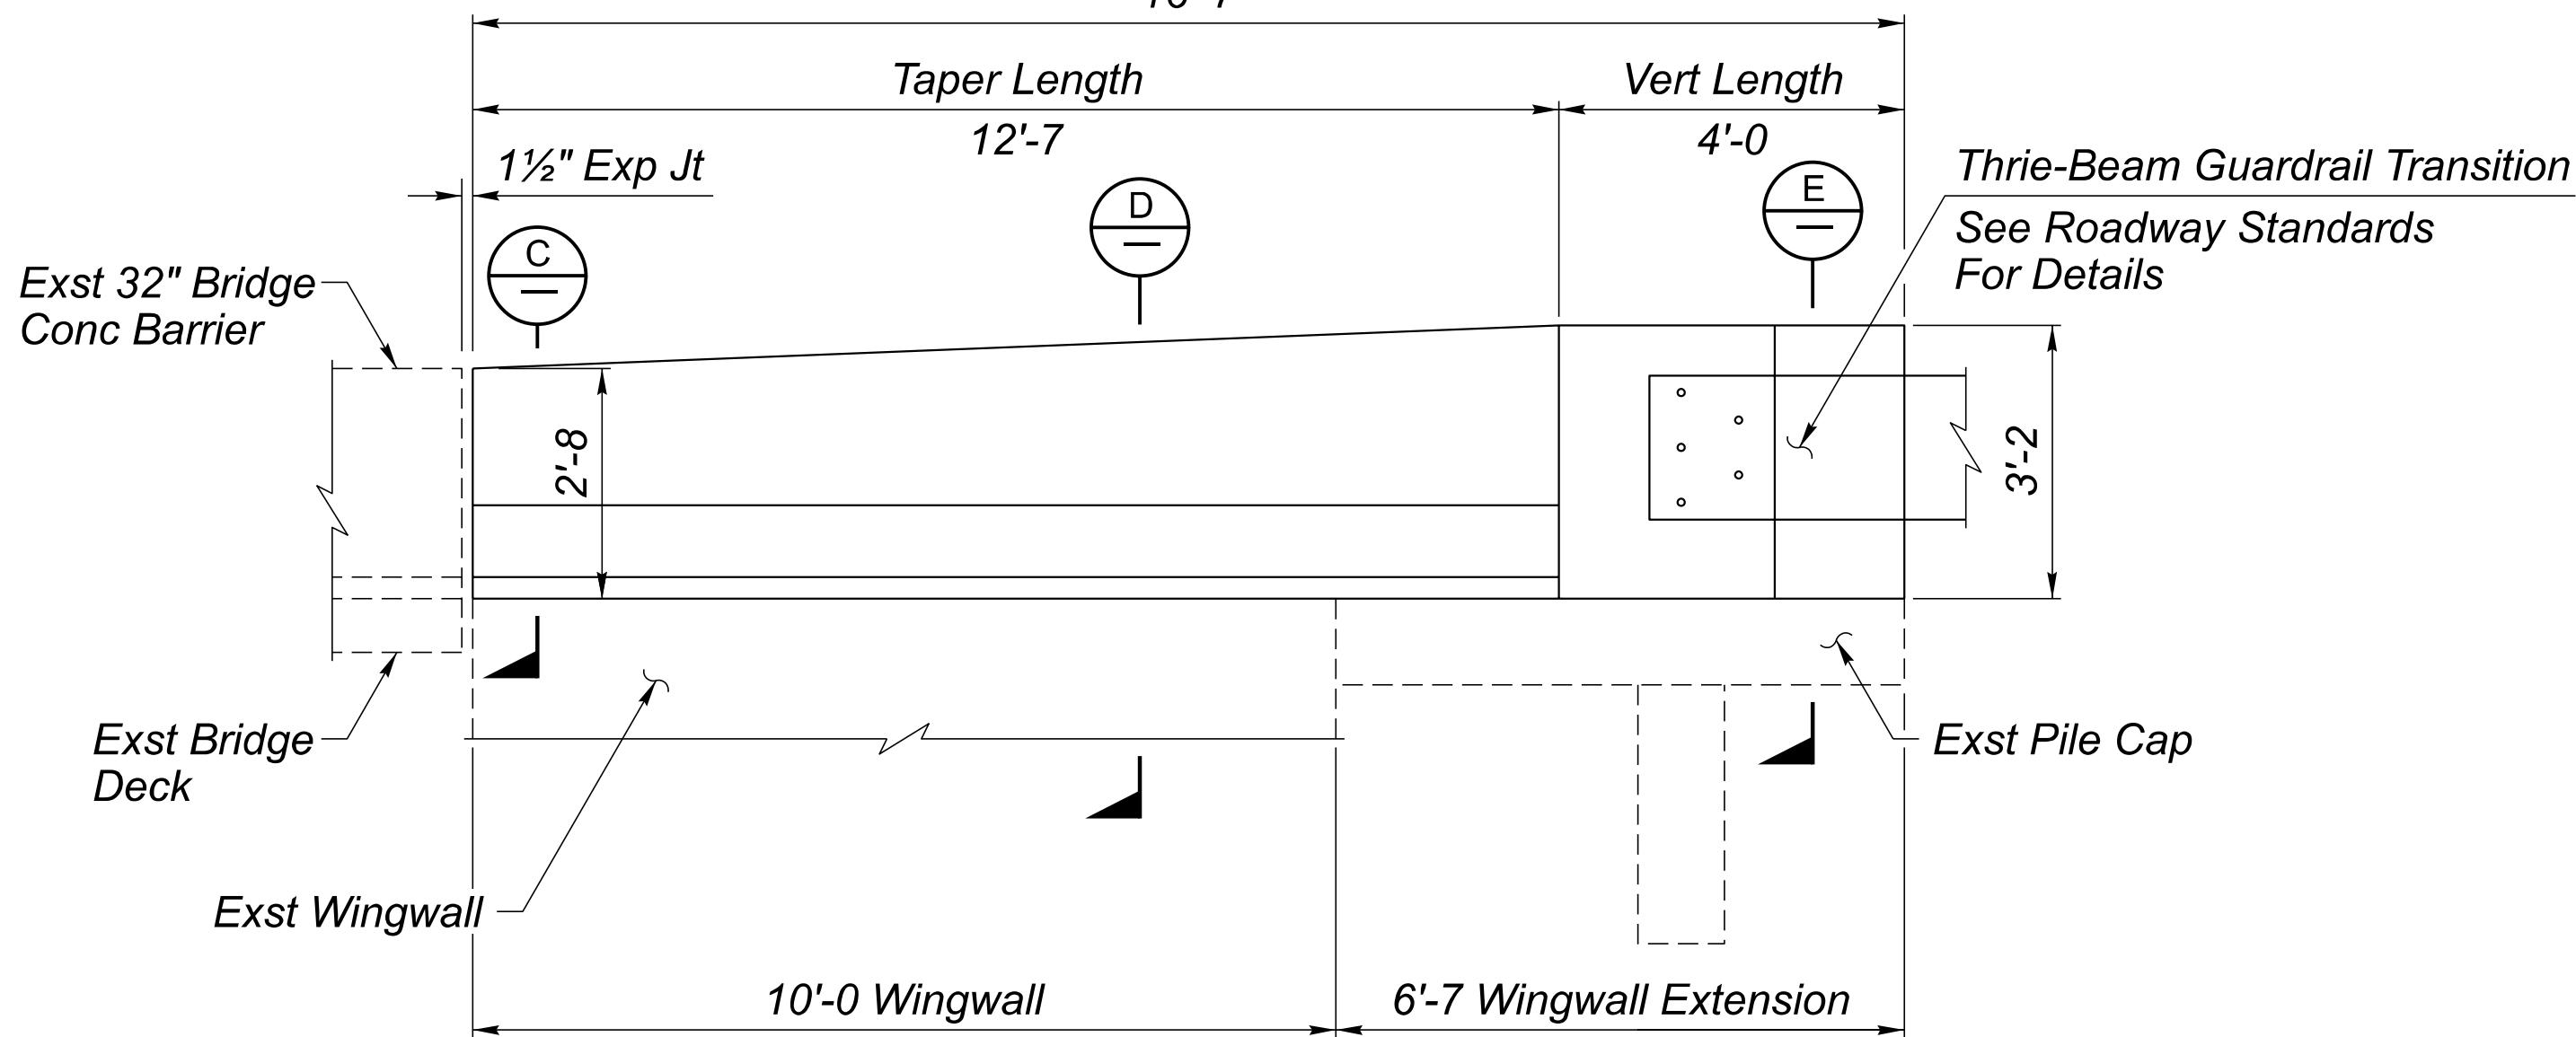


ELEVATION - BARRIER TRANSITION

Scale: 1/2" = 1'-0

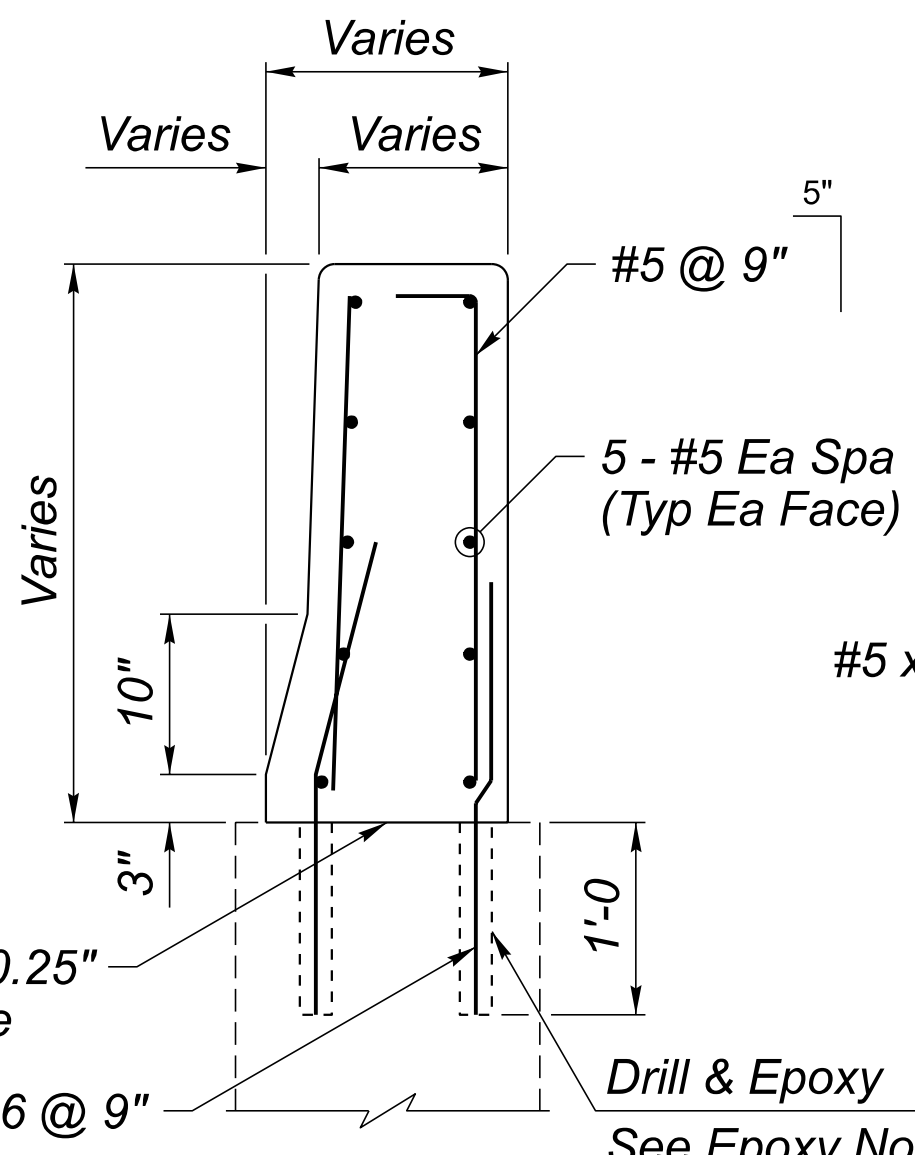

SECTION D

Scale: 1" = 1'-0

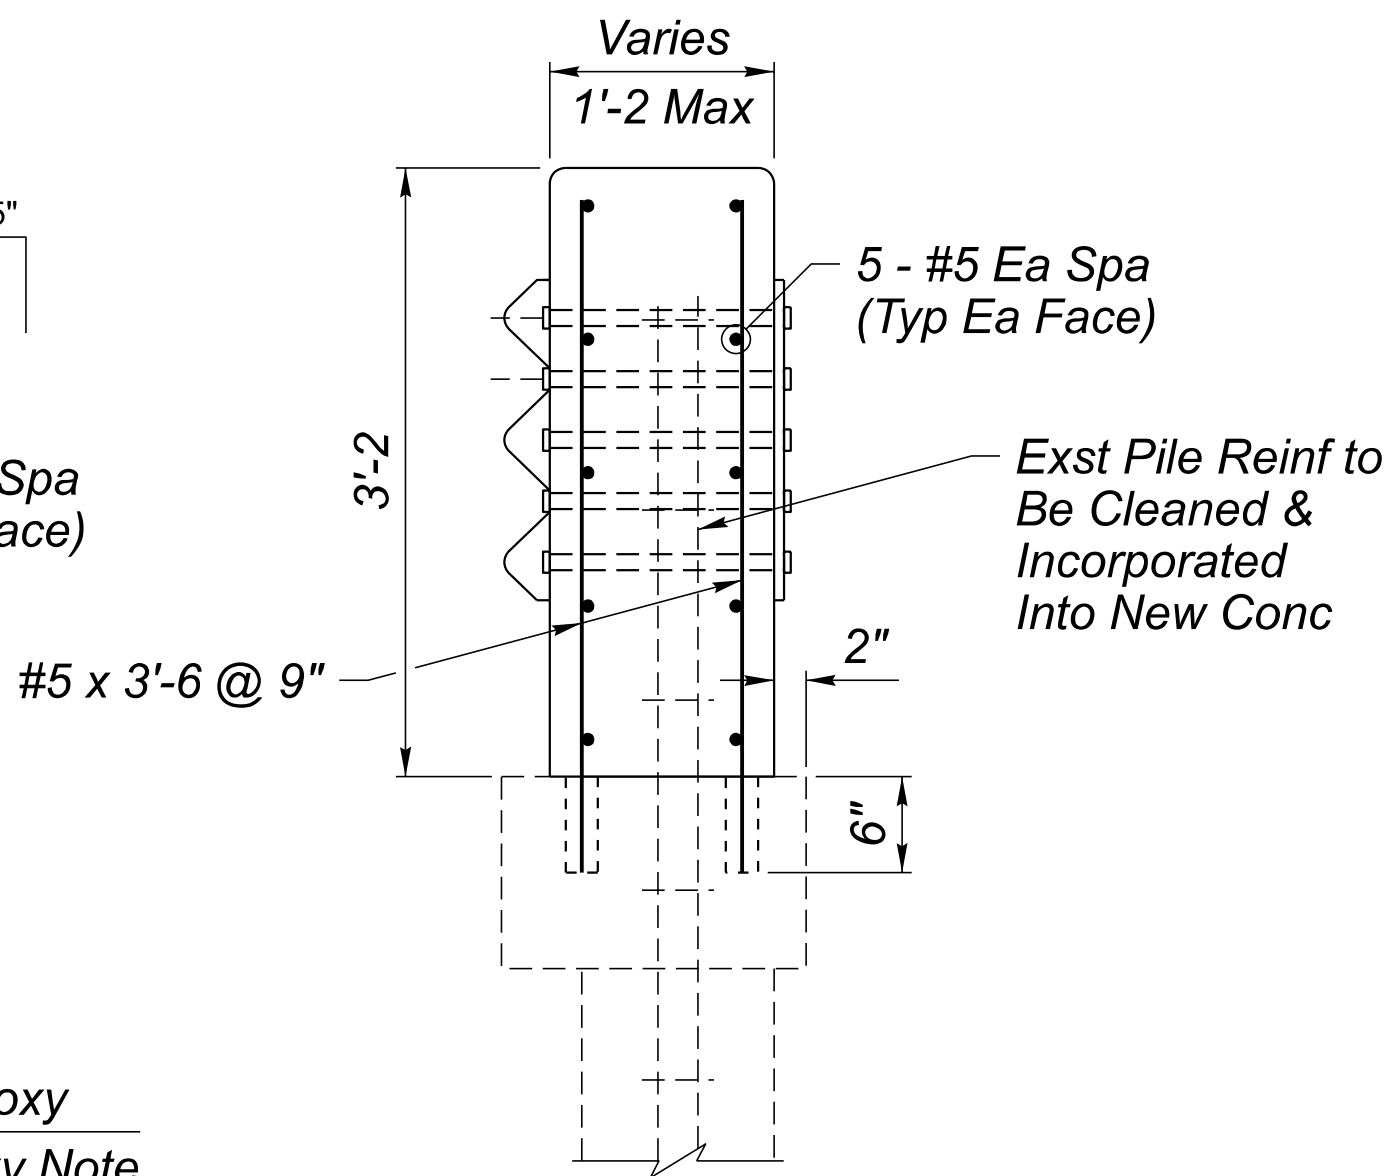

SECTION E

Scale: 1" = 1'-0



	NAME	DATE
DESIGN	M. Noche	06/26
DRAWN	T. Talbert	06/26
CHECKED	B. Ansley	06/26


TRANSPORTATION
AECOM TECHNICAL SERVICES, Inc.
7700 N. 190th St., Suite 100
Edmonds, WA 98020
206.271.1100
www.aecom.com

ARIZONA DEPARTMENT OF TRANSPORTATION
INFRASTRUCTURE DELIVERY AND OPERATIONS DIVISION
BRIDGE GROUP
STA 198+
US 93 NB BNSF OP BRIDGE
BARRIER TRANSITION DETAILS

ROUTE
US 93
MILEPOST
192.88
STRUCTURE NO.
780

F.H.W.A. Arizona Division
LOCATION
WICKENBURG RANCH WAY TO VISTA ROYALE
TRACS NO. F0738 01C


STATE	PROJECT NO.	FEDERAL ID NO.	SHEET NO.	TOTAL SHEETS	RECORD DRAWING
ARIZ.	093 YV 189	093-B-(230)T	453	524	
DWG No. S-3.05					OF

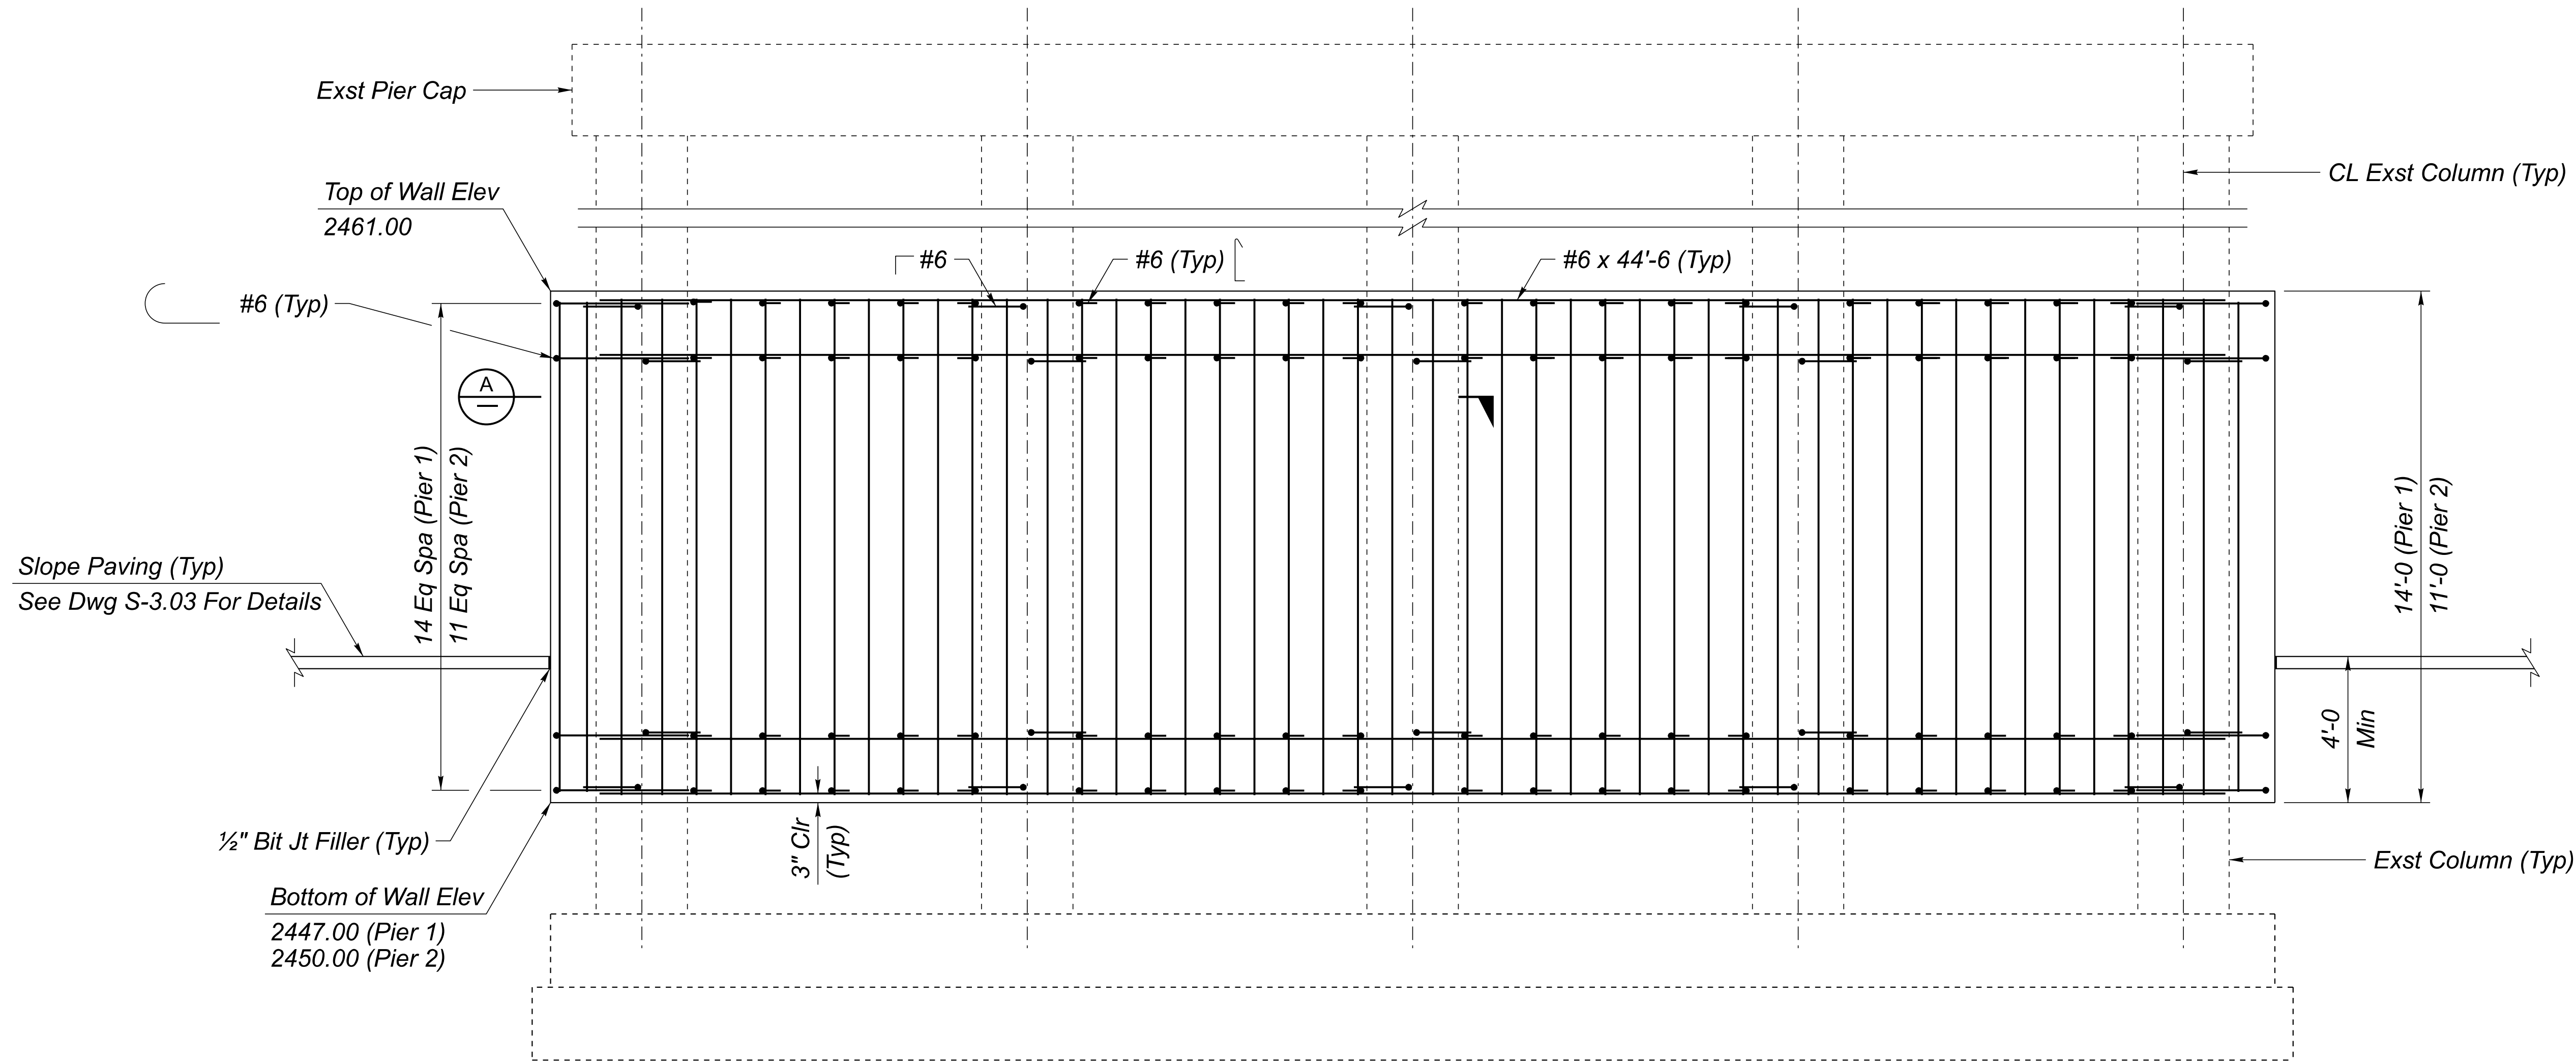

PIER PROTECTION WALL ELEVATION

Pier 1 Shown, Pier 2 Similar
Scale: 3/8" = 1-0

Drill & Epoxy (Typ)
See Epoxy Notes On Dwg S-3.05

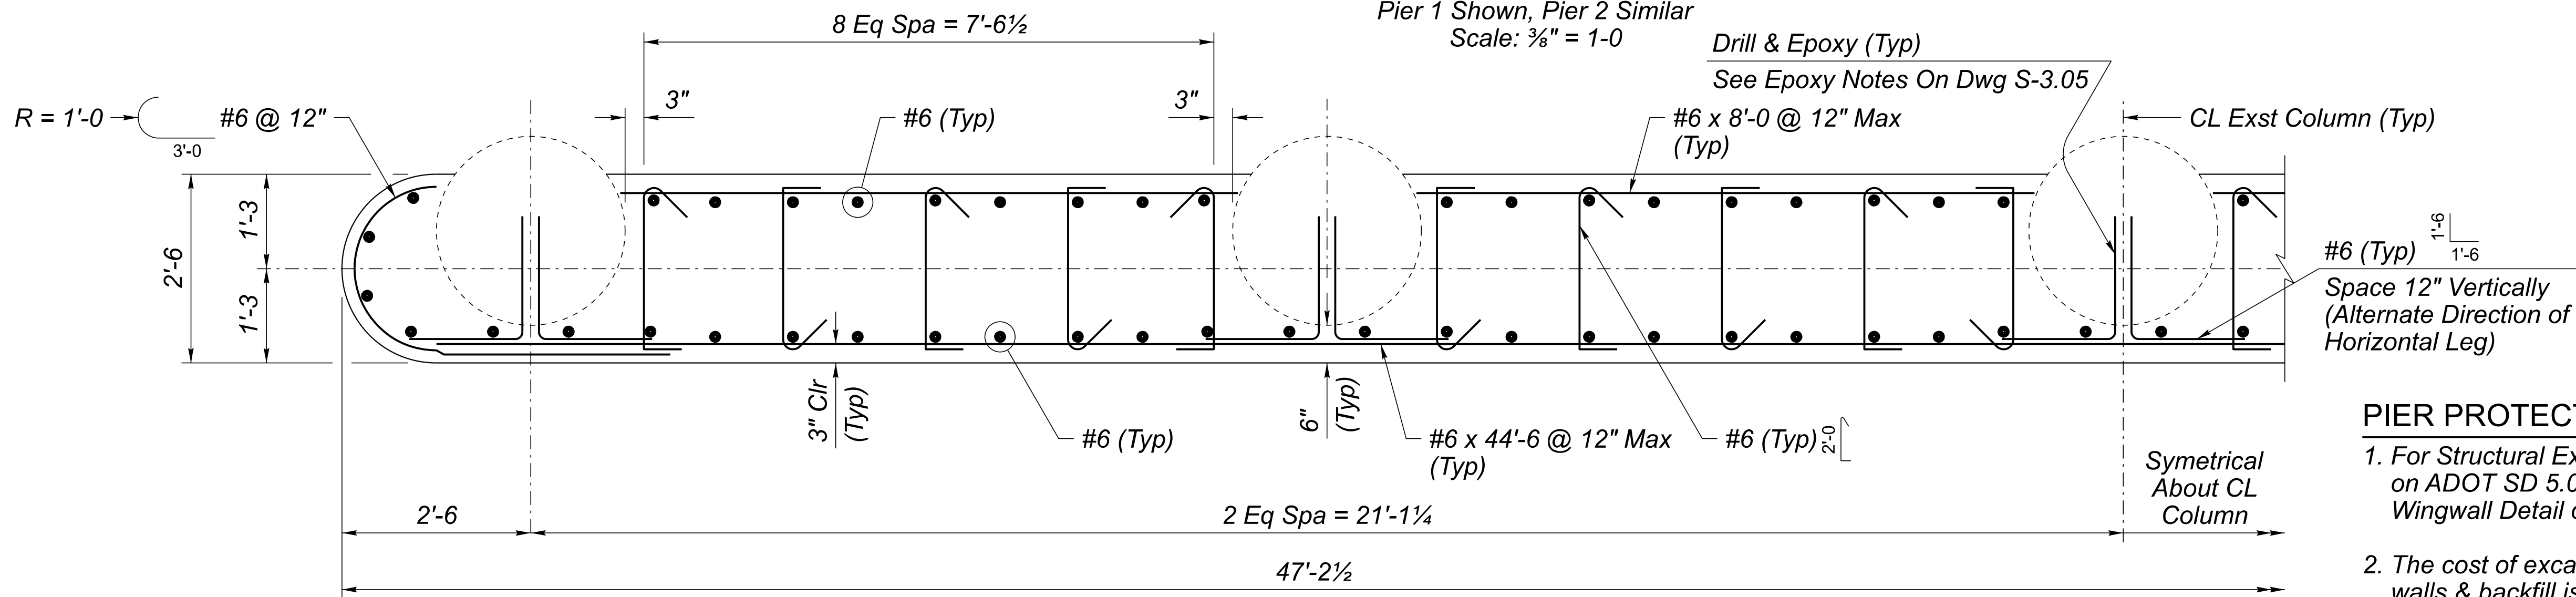

SECTION

Scale: 3/4" = 1-0

PIER PROTECTION WALL NOTES:

1. For Structural Excavation limits, see Wingwall Detail on ADOT SD 5.01. For Structure Backfill limits, see Wingwall Detail on ADOT SD 5.02.
2. The cost of excavation, construction of pier protection walls & backfill is included in Item No. 9240118 Miscellaneous Work (Pier Protection Wall). See Special Provisions for additional information.




	NAME	DATE
DESIGN	M. Noche	06/26
DRAWN	G. Zenuch	06/26
CHECKED	B. Ansley	06/26

TRANSPORTATION
AECOM TECHNICAL SERVICES, Inc.
7720 N. 19th St., Suite 100
Phoenix, Arizona 85020
T 602.371.1100
www.aecom.com

ARIZONA DEPARTMENT OF TRANSPORTATION
INFRASTRUCTURE DELIVERY AND OPERATIONS DIVISION
BRIDGE GROUP

STA 198+
US 93 NB BNSF OP BRIDGE
PIER PROTECTION WALL DETAILS


ROUTE US 93	F.H.W.A. Arizona Division	STATE ARIZ.	PROJECT NO. 093 YV 189	FEDERAL ID NO. 093-B-(230)T	SHEET NO. 454	TOTAL SHEETS 524	RECORD DRAWING
MILEPOST 192.88	LOCATION WICKENBURG RANCH WAY TO VISTA ROYALE						DWG No. S-3.06
STRUCTURE NO. 780	TRACS NO. F0738 01C		____ OF ____				

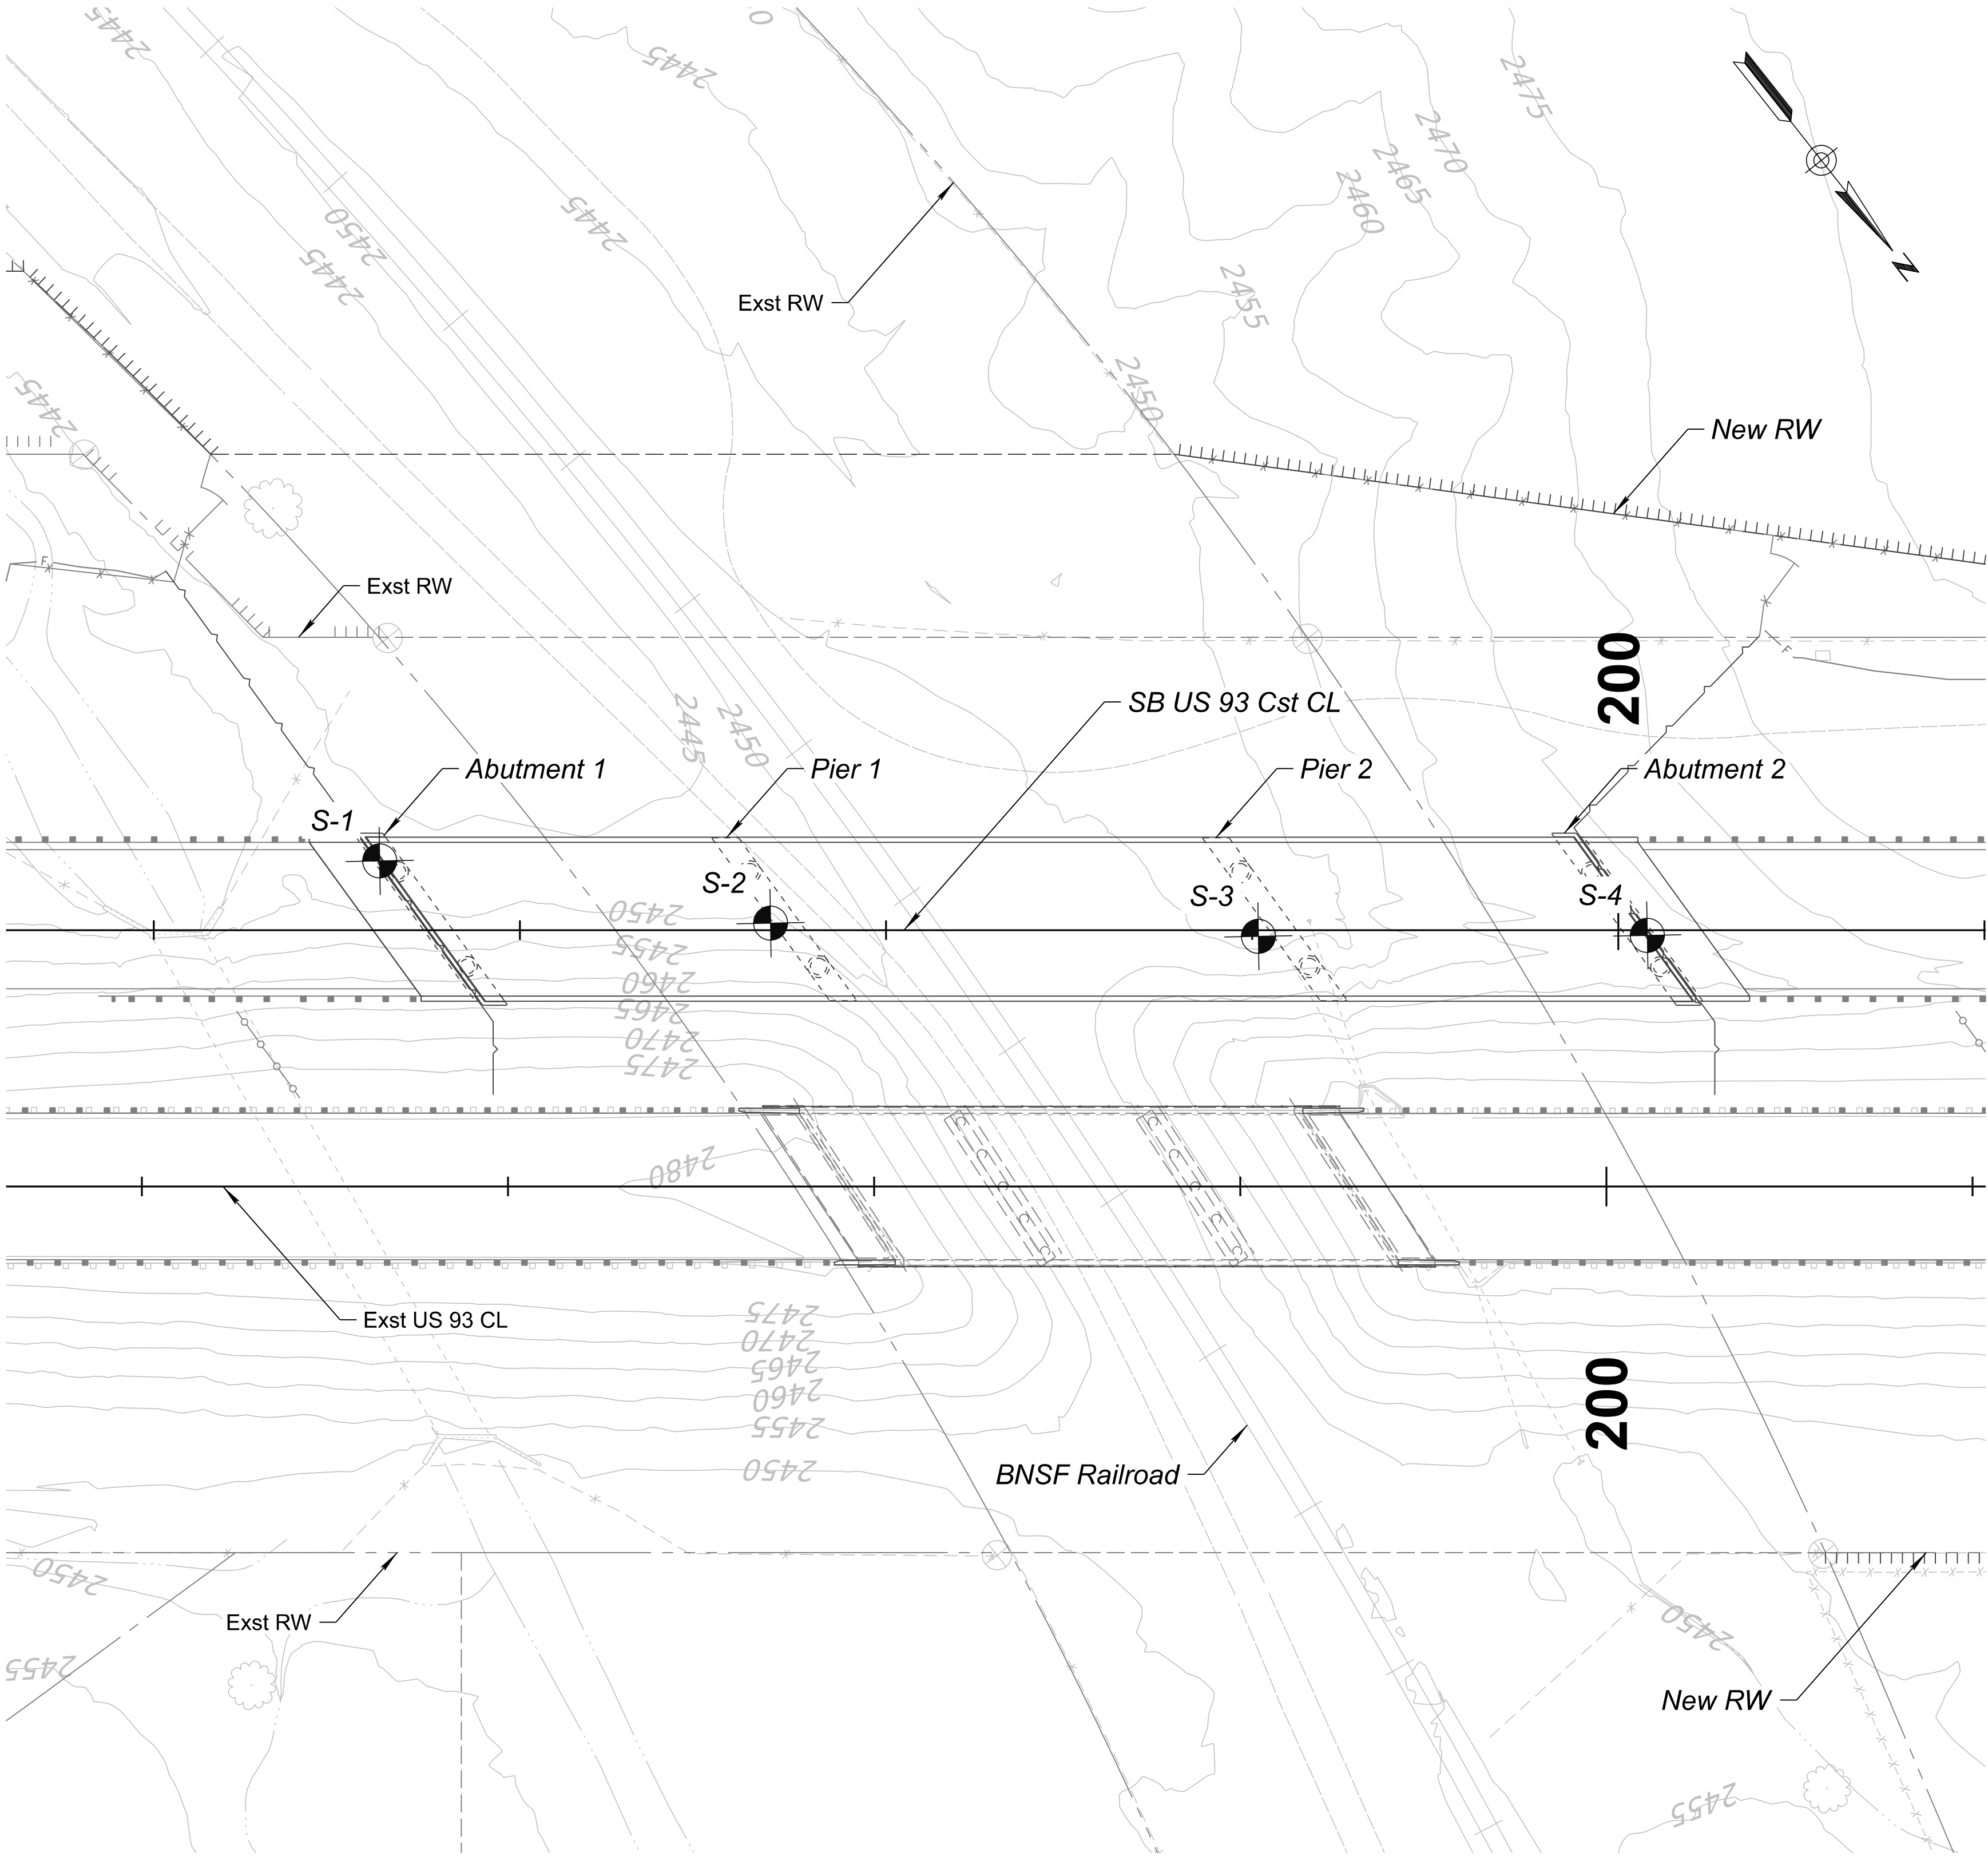

PLAN
Scale: 1" = 30'-0"

Boring	Approx. Depth	US 93 Cst @ Station	Offset
S-1	80 ft	196+65	90 ft L
S-2	100 ft	197+70	70 ft L
S-3	100 ft	199+05	70 ft L
S-4	80 ft	200+10	70 ft L


LEGEND:

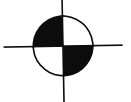 Boring Location & ID


NOTES:

- General soil descriptions and indicated boundaries are based on engineering interpretation of available subsurface information and associated laboratory testing by the geotechnical engineer and may not reflect actual variations in the subsurface conditions between borings and samples. The location of contacts between strata indicated on the logs is to be considered approximate, and changes between material types may be gradual rather than abrupt. Classification of soil materials is in general accordance with ASTM D 2488 and is based on field observation unless accompanied by laboratory test results presented in the Geotechnical Investigation Report.
- The observed water levels and/or subsurface water conditions indicated on the boring logs are as recorded at the time of the field exploration. These water levels and/or moisture conditions may vary significantly with time according to the prevailing climate, rainfall or other factors and are otherwise dependent upon the duration of and methods used in the exploration program.
- Sound engineering judgment was exercised in preparing the subsurface information presented on these sheets. This information was prepared and is intended for design and estimate purposes. Its presentation on the plans or elsewhere is for the purpose of providing intended users with access to the same information as the State and its designers. This subsurface information interpretation is presented in good faith and is not intended as a substitute for personal investigation, independent interpretations or judgment of the contractor or subcontractor.
- Excavations may encounter caving sands with cobbles and possible small boulders. The Contractor shall be prepared to deal with such conditions.
- A 140-lb hammer, 30-inch free-fall, was used to drive the 2-inch O.D. Standard Penetration Test (SPT) split-spoon sampler (ASTM D 1586) or a 3-inch O.D. Modified California Split Barrel sampler lined with 2.42-inch I.D. brass rings (ASTM D3550).
- For further subsurface information, refer to the Final Geotechnical Report (dated 12/17/2025) by ADOT Geotechnical Services for this project. This Report is available online at ADOT Contracts and Specifications.
- All Geotechnical reports prepared for this project shall be considered by the contractor in developing bid documents.


		NAME	DATE	ARIZONA DEPARTMENT OF TRANSPORTATION INFRASTRUCTURE DELIVERY AND OPERATIONS DIVISION BRIDGE GROUP	ROUTE	F.H.W.A. Arizona Division	STATE	PROJECT NO.	FEDERAL ID NO.	SHEET NO.	TOTAL SHEETS	RECORD DRAWING	
	DESIGN	H. MILLS	06/26		US 93	ARIZ.	093 YV 189	093-B-(230)T	455	524			
	DRAWN	H. MORRIS	06/26		MILEPOST							192.90	
	CHECKED	J. HUSTON	06/26		STRUCTURE NO.							20313	
		STA 196+ US 93 SB BNSF OP BRIDGE FOUNDATION DATA SHEET 1			LOCATION		WICKENBURG RANCH WAY TO VISTA ROYALE					DWG No.	SF-1.01
					TRACS NO.		F0738 01C					____ OF ____	

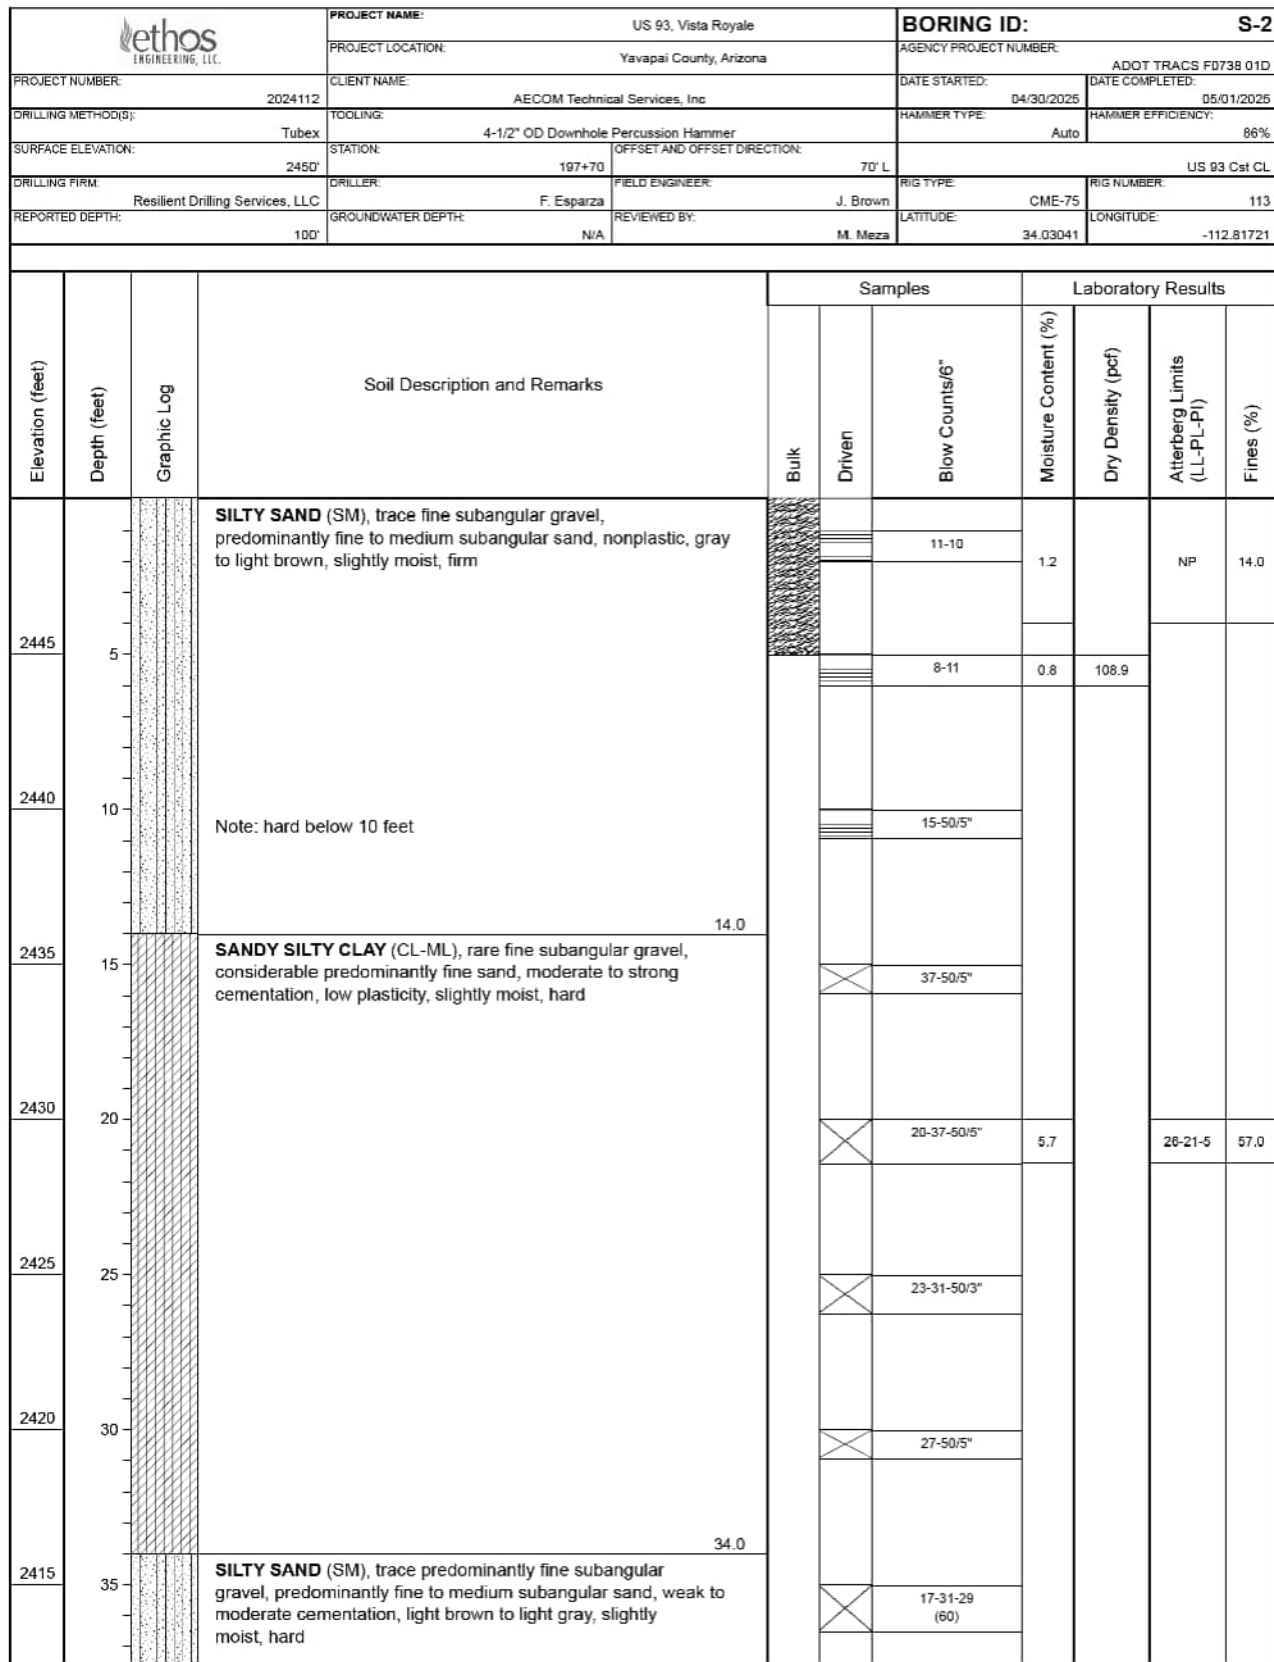


Page 1 of 3

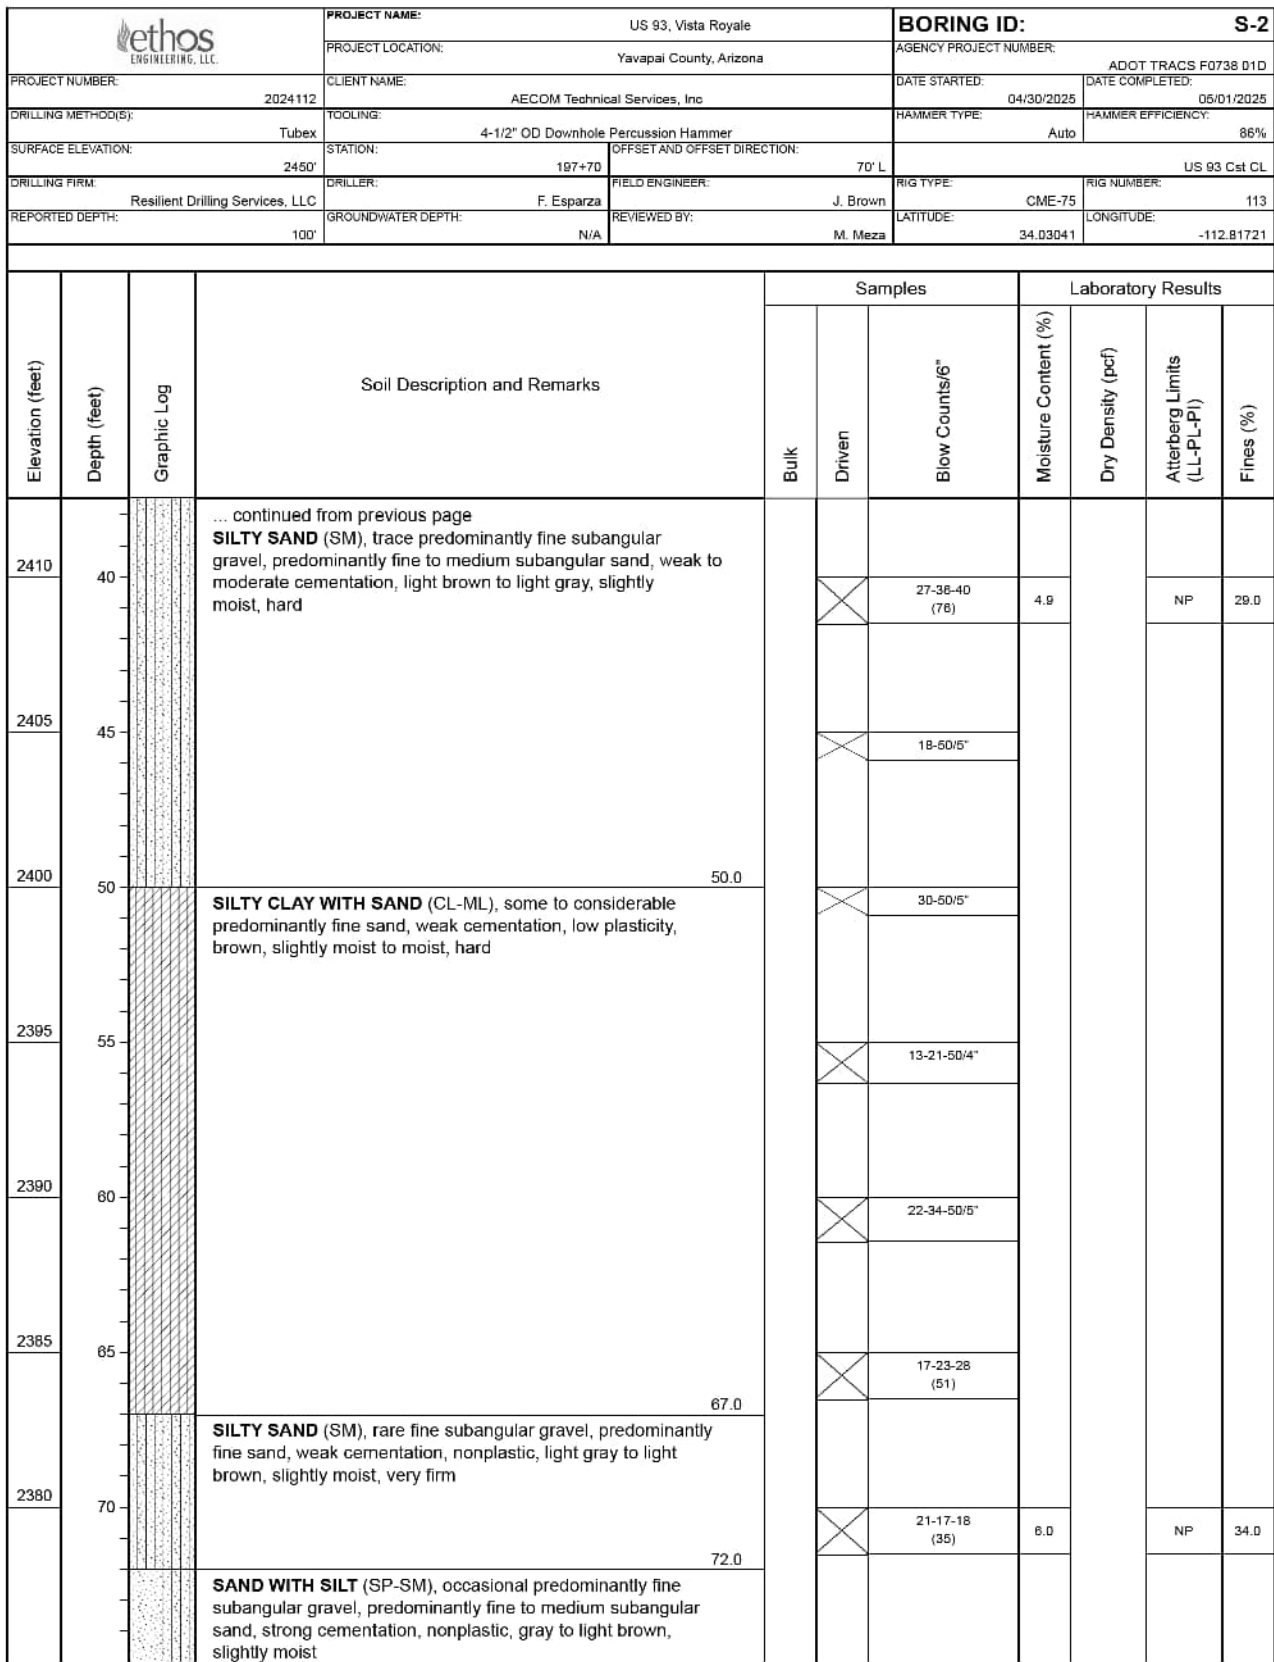

Page 2 of 3

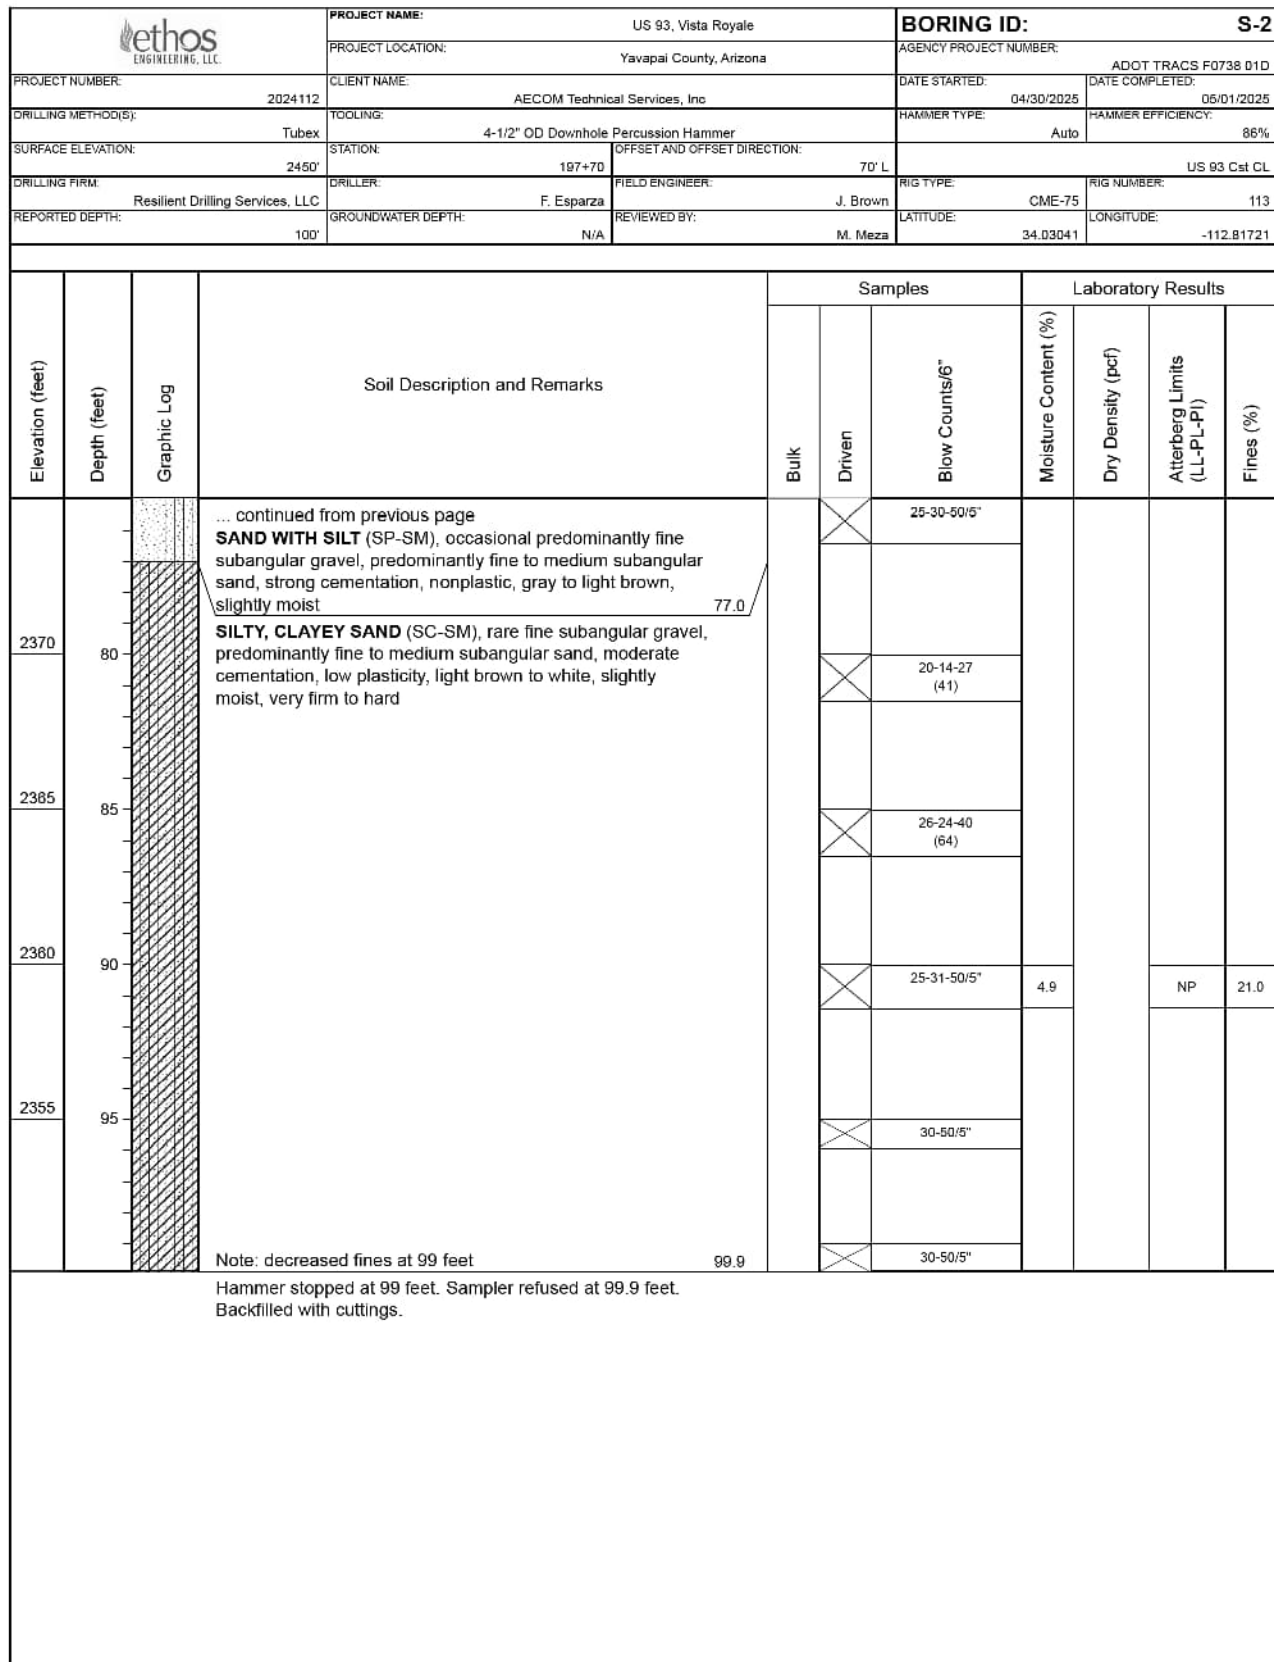

Page 3 of 3

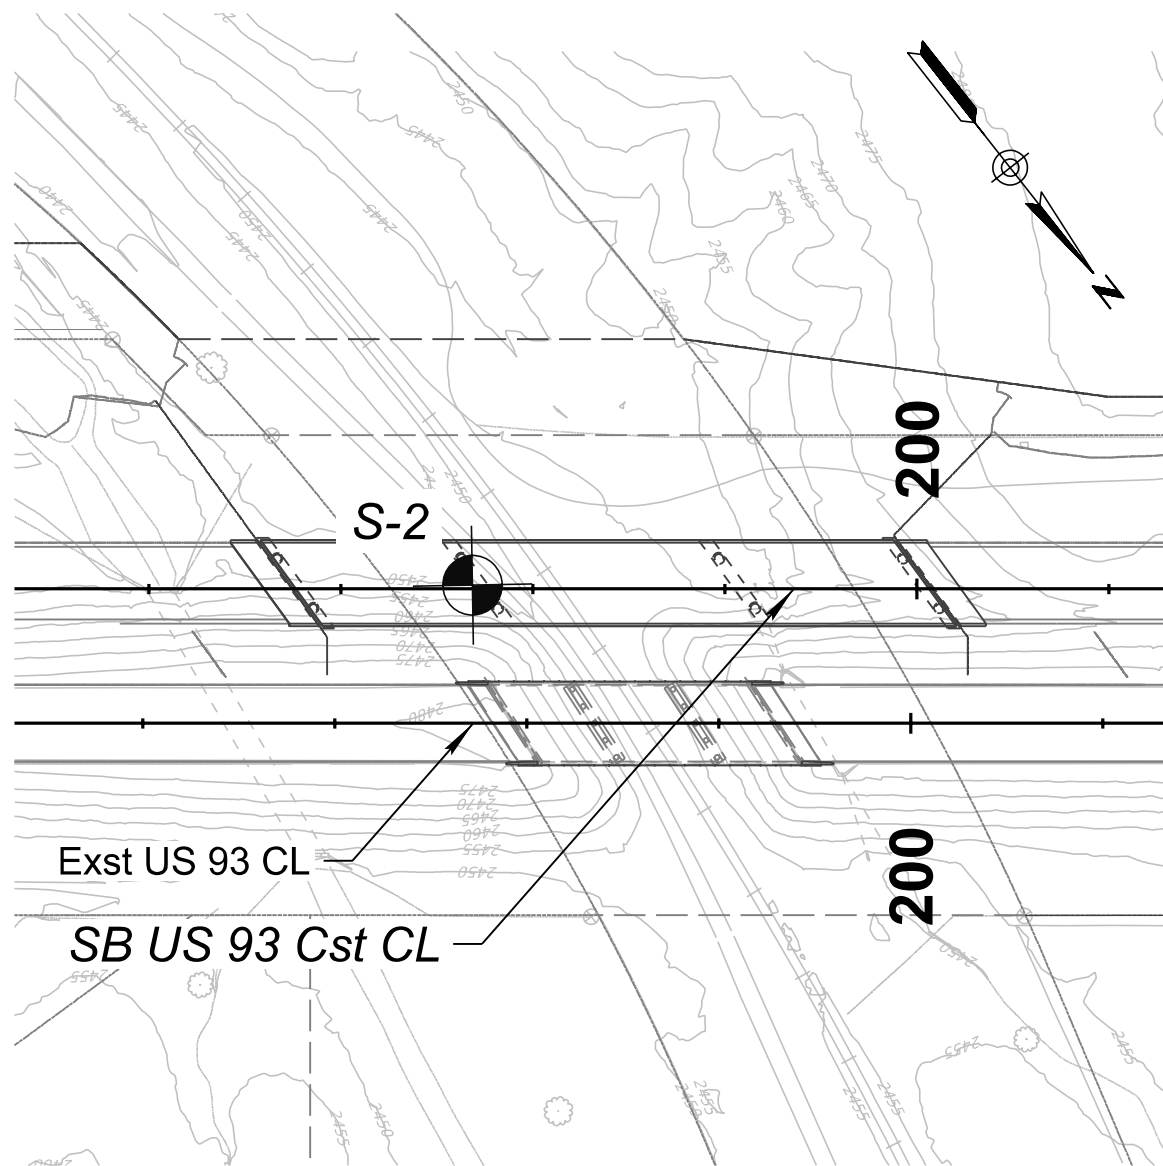

PLAN
Scale: 1" = 100'-0"

LEGEND:



Boring Location & ID



	NAME	DATE
DESIGN	H. MILLS	06/26
DRAWN	H. MORRIS	06/26
CHECKED	J. HUSTON	06/26

ethos ENGINEERING, LLC

9180 S Kyrene Rd
Suite #104
Tempe, AZ 85284

ARIZONA DEPARTMENT OF TRANSPORTATION
INFRASTRUCTURE DELIVERY AND OPERATIONS DIVISION
BRIDGE GROUP

STA 196+
US 93 SB BNSF OP BRIDGE
FOUNDATION DATA SHEET 3

ROUTE

US 93

MILEPOST

192.90

STRUCTURE NO.

20313

F.H.W.A. Arizona Division

STATE

ARIZ.

PROJECT NO.

093 YV 189

FEDERAL ID NO.

093-B-(230)T

SHEET NO.

457

TOTAL SHEETS

524

RECORD DRAWING


DWG No. SF-1.03

OF

		PROJECT NAME: US 93, Vista Royale		BORING ID: S-3	
		PROJECT LOCATION: Yavapai County, Arizona		AGENCY PROJECT NUMBER:	
PROJECT NUMBER: 2024112		CLIENT NAME: AECOM Technical Services, Inc.		DATE STARTED: 09/01/2024	
DRILLER (FIRM): Tubex		LOGGING: 4'-1/2" OD Downhole Penetration Hammer		DATE COMPLETED: 09/02/2024	
SURFACE ELEVATION: 2450'		STATION: 109+00		WATER EFFICIENCY: 80%	
DRILLER PERSON: Resident Drilling Services, LLC		FIELD ENGINEER: F. Espadas		LOG TYPE: Auto	
REPORTED DEPTH: 150'		GROUNDWATER DEPTH: N/A		WELL NUMBER: US 93 Cst CL	
		REVIEWED BY: J. Brown / L. Soder		DATE: 34.03/24	
		DATE: 14. March		CONVOLUTE: -112.87161	

Elevation (feet)	Depth (feet)	Graphic Log	Soil Description and Remarks	Bulk	Samples		Laboratory Results			
					Driven	Bow Corrupt	Moisture Content (%)	Dry Density (pcf)	Shrinkage Units (LL-PL, %)	Free (%)
2445	5		SAND WITH SILT (SP-SM) , trace fine subangular gravel, predominantly fine to medium subangular sand, nonplastic, light brown, slightly moist, medium dense to dense			4-13	1.1		NP	9.9
2440	10		12.0			15-28	1.1	111.1		
2435	15		SAND (SP) , trace fine to coarse subangular gravel, predominantly fine to medium subangular sand, nonplastic, light brown, slightly moist, dense to very dense			35-21				
2430	20		19.0			19-18-32 (50)	3.4		NP	4.6
2425	25		SILTY SAND (SM) , occasional fine to coarse subangular gravel, predominantly fine to medium subangular sand, weak to moderate cementation, nonplastic, light gray to light brown, slightly moist, very firm to hard			26-22-25 (47)				
2420	30					36-22-32 (44)				
2415	35					23-30-40 (70)	6.5		NP	39.0
						31-50/7				

Page 1 of 3

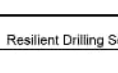
		PROJECT NAME: US 93, Vista Royale PROJECT LOCATION: Yavapai County, Arizona		BORING ID: US-93-010	
CLIENT NAME: AECOM Technical Services, Inc.		AGENCY PROJECT NUMBER:		ADOT TRACS F073B 010	
PROJECT NUMBER: 2224112		DATE STARTED: 06/01/2023		DATE COMPLETED: 06/02/2023	
DRILLAGE METHOD(S): Tubes		NUMBER TYPE: Auto		FOUNDER EFFICIENCY: 96%	
SURFACE ELEVATION: 2450		FIELD OBSERVER: J. Brown / L. Suben		LOG NUMBER: US 93 Col Card	
DRILLAGE FIRM: Resident Drilling Services, LLC		DATE: CME-25		DATE: 11/2	
REPORTED DEPTH: 330		REVIEWED BY: M. Mena		UNIQUE ID: 112-8176	
PROJECT NAME: US 93, Vista Royale PROJECT LOCATION: Yavapai County, Arizona BORING ID: US-93-010		AGENCY PROJECT NUMBER:		ADOT TRACS F073B 010	
CLIENT NAME: AECOM Technical Services, Inc.		DATE STARTED: 06/01/2023		DATE COMPLETED: 06/02/2023	
PROJECT NUMBER: 2224112		NUMBER TYPE: Auto		FOUNDER EFFICIENCY: 96%	
DRILLAGE METHOD(S): Tubes		FIELD OBSERVER: J. Brown / L. Suben		LOG NUMBER: US 93 Col Card	
SURFACE ELEVATION: 2450		DATE: CME-25		DATE: 11/2	
DRILLAGE FIRM: Resident Drilling Services, LLC		REVIEWED BY: M. Mena		UNIQUE ID: 112-8176	
REPORTED DEPTH: 330		UNIQUE ID: 112-8176			
PROJECT NAME: US 93, Vista Royale PROJECT LOCATION: Yavapai County, Arizona BORING ID: US-93-010		AGENCY PROJECT NUMBER:		ADOT TRACS F073B 010	
CLIENT NAME: AECOM Technical Services, Inc.		DATE STARTED: 06/01/2023		DATE COMPLETED: 06/02/202	

Page 2 of 2

		PROJECT NAME: US-93_Vista Royale		SURVEY NUMBER:	
		PROJECT LOCATION: Yavapai County, Arizona			
PROJECT NUMBER:	2024112	CLIENT NAME: AECOM Technical Services, Inc.		DATE STARTED:	05/01/2023
DRAWING METHOD:	Tubes	ROUTE: 4-1/2" OD Doublet Percussion Hammer	OFFSET AND OFFSET DIRECTION:	NUMBER TYPE: Asis	HAMMER EFFICIENCY: 98%
SURFACE ELEVATION:	2450	STATION: 109+00	FIELD BREAKS: J Brown / L Suben	PG NUMBER:	US-93 Cal CD
DRAWING FIRM:	Resident Drilling Services, LLC	DRAWER: F. Espada	REVIEWED BY:	MO TYPE: GME-TS	111
REPORTED DEPTH:	100	GROUNDWATER DEPTH: N/A	M. Huse	LATITUDE: 34.53274	LONGITUDE: -112.81726

		Soil Description and Remarks		Samples		Laboratory Results	
				Bulk	Driven	Bore Coursing	Moisture Content (%)
Elevation (feet)	Depth (feet)	continued from previous page SILTY SAND (SM), occasional fine subangular to subrounded gravel, predominantly fine to medium subangular sand, weak to moderate cementation, nonplastic, light brown to gray, slightly moist, hard Note: slightly moist to moist below 85 feet					
2370	80				92°		
				X	34-50°		
2385	85			X	26-50°		
				X	20-50°		
2350	90						
				X	26-33-50°	3.2	NP 13.0
2335	95				50°		


Hammer stopped at 99 feet. Sampler refused at 99.4 feet.
Backfilled with cuttings.

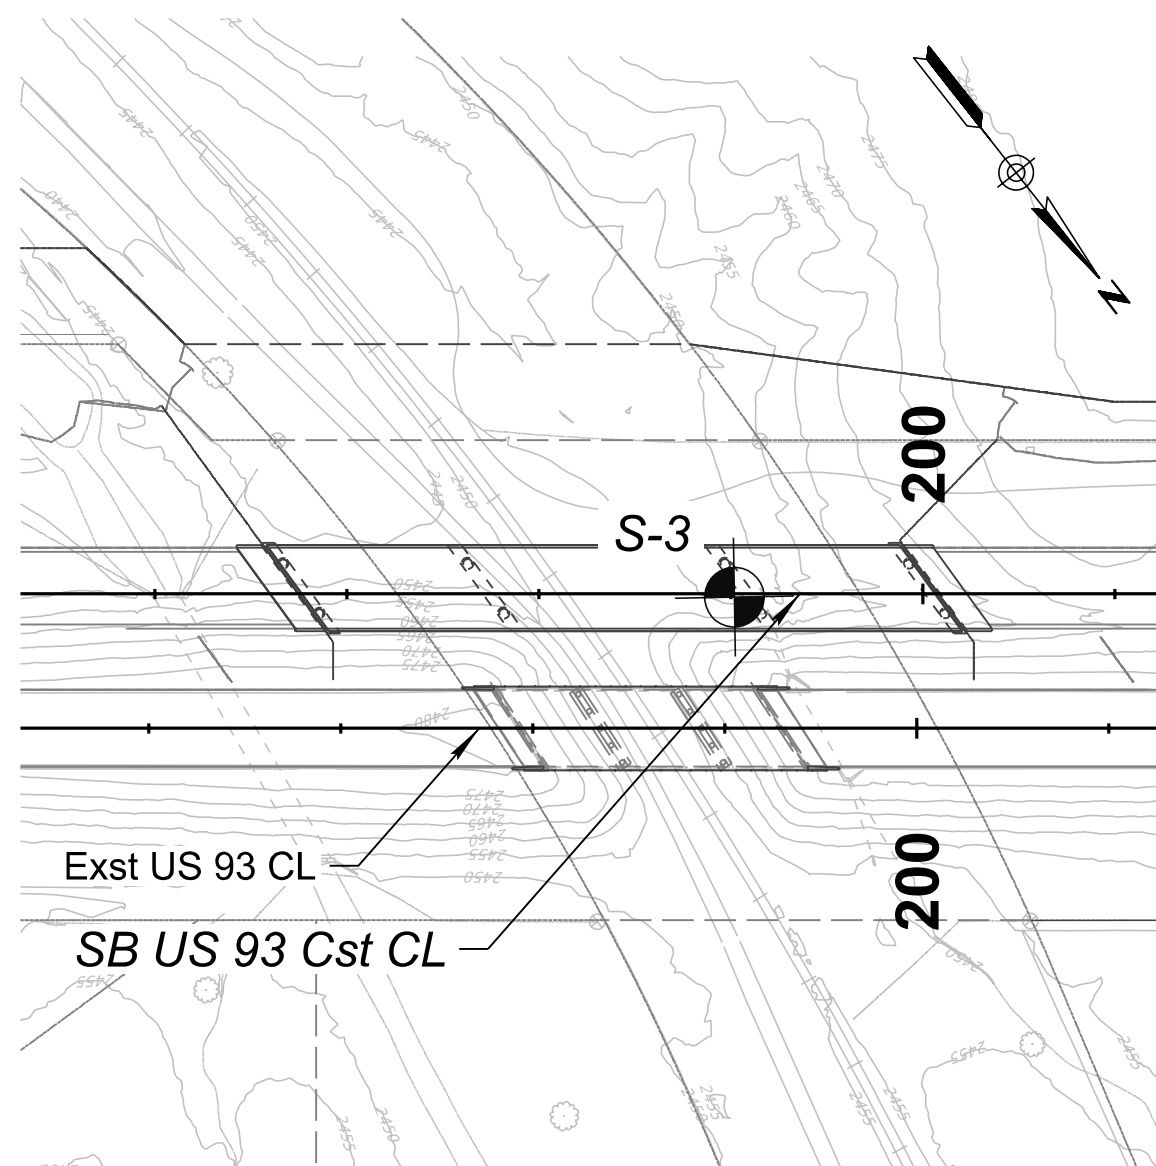Page 3 of 3

PLAN

Scale: 1" = 100'-0"

LEGEND:

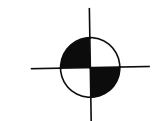

Boring Location & ID

	NAME	DATE
DESIGN	H. MILLS	06/26/2012
DRAWN	H. MORRIS	06/26/2012
CHECKED	J. HUSTON	06/26/2012



9180 S Kyrene Rd
Suite #104
Tempe, AZ 85284

ARIZONA DEPARTMENT OF TRANSPORTATION
INFRASTRUCTURE DELIVERY AND OPERATIONS DIVISION
BRIDGE GROUP

STA 196+
US 93 SB BNSF OP BRIDGE
FOUNDATION DATA SHEET 4

ROUTE	US 93
MILEPOST	192.90
STRUCTURE NUMBER	20313

F H W A Arizona Division

STATE
ARIZ

PROJECT NO.
093 YV 189

FEDERAL ID NO.
093-B-(230)T

SHEET
NO.
458

TOTAL SHEETS	
524	

RECORD


DRAWING


DWG No. SF-1.04

TRACS NO. F0738 01COF

ethos SOLUTION LLC		PROJECT NAME: US 93, Vista Royale		BORING ID: S-4				
PROJECT LOCATION: Yavapai County, Arizona		AGENCY PROJECT NUMBER:		ADOT TRACE# F0728 010				
CLIENT NAME: AECOM Technical Services, Inc.		DATE STARTED: 09/02/2020		DATE COMPLETED: 09/02/2020				
TUBES: 100mm		STATION: 4+152' @ Overhead Partitioning Hammer		NUMBER EFFORTS: 54%				
SURFACE ELEVATION: 2466		OFFSET AND OFFSET DIRECTION: TP L		BIS TYPE: CME-75				
DRILLER: RESIDENT		FIELD ENGINEER: S. Singh		SP NUMBER: 127				
GRACE/MSM: Resident Drilling Services, LLC		REVIEWED BY: M. Marra		CONTRACT: US 93 CL				
REPORTED DEPTH: 80'		GROUNDWATER DEPTH: N/A		CONTRACT#: 112 0789				
Elevation (feet)		Soil Description and Remarks		Laboratory Results				
Depth (feet)		Graphic Log		Samples				
				Driven				
				Bow Count*				
				Moisture Content (%)				
				Dry Density (pcf)				
				Shrinkage Limits (LL, PL, FL)				
				Free (%)				
2465	5	SILTY SAND (SM) , some cobbles, trace predominantly fine subangular to subrounded gravel, predominantly fine to medium subangular sand, weak cementation, nonplastic, light gray to brown, slightly moist to moist, hard			19-20-38 (58)	4.2	NP	28.0
2460	10				35-30-23 (55)			
2455	15	GRAVEL WITH SAND (GP) , predominantly fine subangular to subrounded gravel, considerable predominantly fine to medium subangular sand, nonplastic, grayish brown, slightly moist, very dense			7-24-28 (52)			
2450	20	SAND WITH SILT (SP-SM) , predominantly fine sand, nonplastic, brown, slightly moist, very dense			50%			
2445	25	SILTY, CLAYEY SAND (SC-SM) , trace predominantly fine subangular gravel, predominantly fine sand, moderate to strong cementation, low plasticity, brown, slightly moist, hard			34-50-57			
2440	30	SAND WITH SILT (SP-SM) , trace fine subangular to subrounded gravel, predominantly fine to medium subangular sand, nonplastic, grayish brown, slightly moist, very dense			21-22-39 (60)	1.1	NP	7.1
2435	35	SAND WITH SILT AND GRAVEL (SP-SM) , some fine subangular to subrounded gravel, predominantly fine to medium subangular sand, weak to moderate cementation, nonplastic, brown to light brown, slightly moist, very dense			22-37-35 (72)			
					25-23-38 (61)			

						BORING ID:							
			PROJECT NAME:	US 93, Vieta Royale			AGENCY PROJECT NUMBER:						
			PURCHASER LOCATION:	Yavapai County, Arizona			ADOPT TRACS FORTRAN DTD:						
PROJECT NUMBER:			0224-121			CLIENT NAME:			AECOM Technical Services, Inc.				
DRAWN METHOD(S) :			Tube(s)			TOTAL LOG:			4'-1/2' OD Downhole Penetration Hammer				
SURFACE ELEVATION:			2496'			EQUIPMENT AND OFFSET DIRECTON:			TV-L				
CORRELATION ITEM:			Resident Drilling Services, LLC			DRILLER:			S. Singhra				
REPORTED DEPTH:			87'			GROUNDSWATER DEPTH:			F. Nicks				
						REVIEWED BY:			M. Meera				
						LATITUDE:			34.0306°				
						LONGITUDE:			-112.8178°				
			Soil Description and Remarks			Samples			Laboratory Results				
Elevation (feet)	Depth (feet)	Graphic Log				Bulk	Driven	Bore Count ^a	Moisture Content (%)	Dry Density (pcf)	Atterberg Limits CL _L -P(%)	Fines (%)	
2425	40		continued from previous page SAND WITH SILT AND GRAVEL (SP-SM), some fine subangular to subrounded gravel, predominantly fine to medium subangular sand, weak to moderate cementation, nonplastic, brown to light brown, slightly moist, very dense				X	28-29-33 (SI)	2.8		NP	10.0	
	45			X	20-24-29 (SI)								
2420			Note: gravel lens between 47 to 49 feet										
			50.0										
2415	55		SILTY SAND (SM), trace to some fine subangular to subrounded gravel, predominantly fine to medium subangular sand, moderate to strong cementation, nonplastic, brown, slightly moist, hard					31-60 ^b *					
	60												
2410	65							80+*					
	70												
2405	75		GRAVELLY SAND (GP*), considerable fine to medium subangular sand, predominantly fine subangular to subrounded gravel, nonplastic, grayish brown, slightly moist, very dense										
	80												
2400	85						X	40-25-30 (SI)					
	90												
2395	95		SAND WITH SILT (SP-SM), occasional fine subangular to subrounded gravel, predominantly fine to medium subangular sand, weak lime cementation, nonplastic, grayish brown, slightly moist, very dense				X	30-60 ^c *	1.9		NP	8.8	
	100												

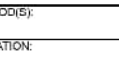
		PROJECT NAME: US 93, Villa Royale		S-4																																							
PROJECT LOCATION: Yavapai County, Arizona		AGENCY/PROJECT NUMBER: ADOT TRACS F0738 B15		DATE COMPLETED: 05/02/2024																																							
CLIENT NAME: ASCORA Technical Services, Inc.		DRAWN TYPE: Auto		HAMMER EFFICIENCY: 94%																																							
DRAWING IDENTIFIER: DRAWING ELEVATION: DRAWING TITLE: REPORTED DEPTH:	2024112 Tubes 246F Realist Drilling Services, LLC 80'	TOLERANCE: STATION: DRAWER: GROUNDWATER DEPTH:	0.004in 4-1/2" OD Double-flute Percussion Hammer 205-10 F. Espinoza N/A	TEST METHOD: FIELD TECHNIQUE: REMOVED BY:	TO L S. Singha M. Morris CME-35 34.6305D 112.8178N																																						
		<table border="1" style="width: 100%; border-collapse: collapse;"> <thead> <tr> <th colspan="3" style="text-align: center;">Samples</th> <th colspan="3" style="text-align: center;">Laboratory Results</th> </tr> <tr> <th rowspan="2" style="writing-mode: vertical-rl; transform: rotate(180deg);">Bulk</th> <th rowspan="2" style="writing-mode: vertical-rl; transform: rotate(180deg);">Driven</th> <th rowspan="2" style="writing-mode: vertical-rl; transform: rotate(180deg);">Bow Count(s)</th> <th colspan="4"></th> </tr> <tr> <th style="writing-mode: vertical-rl; transform: rotate(180deg);">Moisture Content (%)</th> <th style="writing-mode: vertical-rl; transform: rotate(180deg);">Dry Density (pcf)</th> <th style="writing-mode: vertical-rl; transform: rotate(180deg);">Standard Units (ASTM D1557)</th> <th style="writing-mode: vertical-rl; transform: rotate(180deg);">Free (%)</th> </tr> </thead> <tbody> <tr> <td></td> <td style="text-align: center;">☒</td> <td></td> <td style="text-align: center;">40-57-30 (67)</td> <td></td> <td></td> <td></td> </tr> <tr> <td></td> <td></td> <td></td> <td></td> <td></td> <td></td> <td></td> </tr> <tr> <td></td> <td style="text-align: center;">☒</td> <td></td> <td style="text-align: center;">21-35-50^a</td> <td></td> <td></td> <td></td> </tr> </tbody> </table>				Samples			Laboratory Results			Bulk	Driven	Bow Count(s)					Moisture Content (%)	Dry Density (pcf)	Standard Units (ASTM D1557)	Free (%)		☒		40-57-30 (67)												☒		21-35-50 ^a			
Samples			Laboratory Results																																								
Bulk	Driven	Bow Count(s)																																									
			Moisture Content (%)	Dry Density (pcf)	Standard Units (ASTM D1557)	Free (%)																																					
	☒		40-57-30 (67)																																								
	☒		21-35-50 ^a																																								
		<table border="1" style="width: 100%; border-collapse: collapse;"> <thead> <tr> <th colspan="2" style="text-align: center;">Soil Description and Remarks</th> </tr> </thead> <tbody> <tr> <td style="height: 150px; vertical-align: top;"> Elevation (feet) 2390 Depth (feet) 80' Graphic Log </td> <td style="vertical-align: top;"> SILTY SAND WITH GRAVEL (SM), some fine subangular to subrounded gravel, predominantly fine to medium subangular sand, nonplastic, grayish brown, slightly moist, hard Note: reddish brown at 75 feet 81.4 </td> </tr> </tbody> </table>				Soil Description and Remarks		Elevation (feet) 2390 Depth (feet) 80' Graphic Log	SILTY SAND WITH GRAVEL (SM), some fine subangular to subrounded gravel, predominantly fine to medium subangular sand, nonplastic, grayish brown, slightly moist, hard Note: reddish brown at 75 feet 81.4																																		
Soil Description and Remarks																																											
Elevation (feet) 2390 Depth (feet) 80' Graphic Log	SILTY SAND WITH GRAVEL (SM), some fine subangular to subrounded gravel, predominantly fine to medium subangular sand, nonplastic, grayish brown, slightly moist, hard Note: reddish brown at 75 feet 81.4																																										
		Hammer stopped at 80 feet. Sampler refused at 81.4 feet. Backfilled with cuttings.																																									

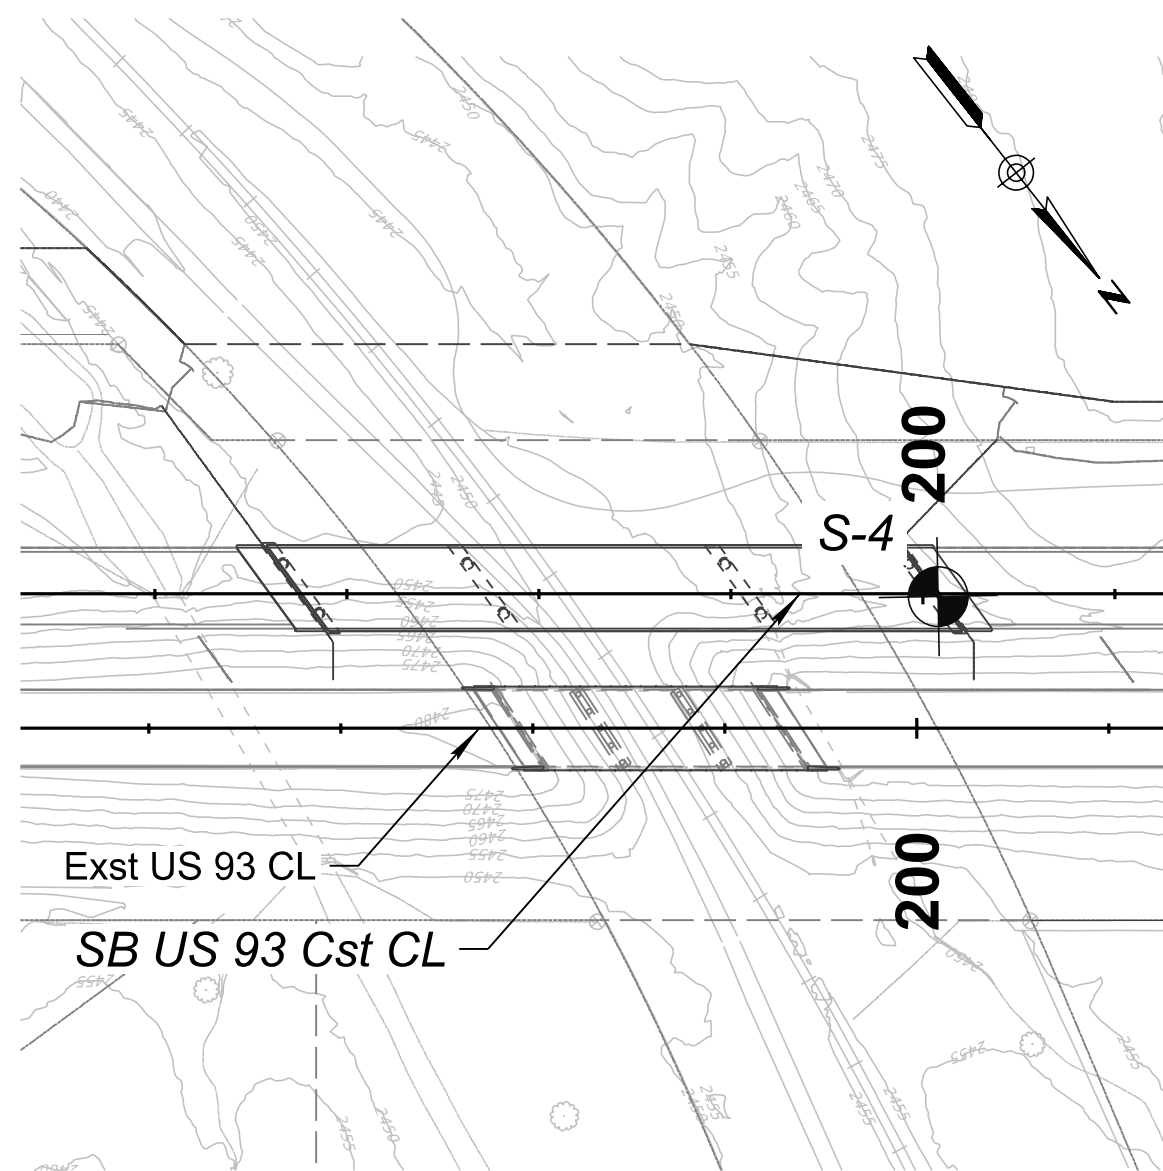

PLAN

Scale: 1" = 100'-0"

LEGEND:

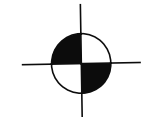

Boring Location & ID

REV. DATE: 4/21

NATIVE PLANT INVENTORY
Plants Tagged in Field - Station 190+00 To Station 354+10

ID #	Symbol	Botanical Name	Common Name	Height (ft)	Salvage Designation	Condition	Canes	Total per Species
105	ⓕⒸ	<i>Ferocactus cylindraceus</i>	Barrel Cactus	2	Salvage	Good		1
106	ⓕⓈ	<i>Fouquieria splendens</i>	Ocotillo	12	Salvage	Good	25	1
107	ⓅⒺ	<i>Peniocereus greggii</i>	Arizona Queen Of The Night	2	Salvage	Good		1
Bid Quantity Total (Per Species)								3

SMALL CACTUS TABULATION
(Plants Not Tagged) (Mile Post Limits Reflect Inventory Segments Not Sheet Cuts)

SCIENTIFIC NAME COMMON NAME	MP 193 to MP 192	MP 192 to MP 191	MP 191 to MP 190	Total per Species
<i>Cylindropuntia acanthocarpa</i> Buckhorn Cholla	9	5	63	77
<i>Cylindropuntia leptocaulis</i> Desert Christmas Cactus	0	3	1	4
<i>Mammillaria grahamii</i> Fishhook Pincushion	0	0	1	1
<i>Opuntia chorotica</i> Pancake Prickly Pear	0	4	5	9
<i>Opuntia engelmannii</i> Desert Prickly Pear	0	6	0	6
<i>Yucca baccata</i> Banana Yucca	1	0	1	2
<i>Yucca elata</i> Soaptree Yucca	0	1	12	13
Total per MP Section (small cactus species)	10	19	83	112

NOTES:

1. The plants noted for salvage in the Inventory Table shall be replanted as shown on the landscape revegetation sheets.
2. Refer to the Landscape Revegetation Summary Sheets for replanting requirements for small cactus.
3. The quantity of inventoried plants is for information purposes only and is not a basis for pay item quantities. The pay item quantities for plant salvage and replanting are shown on Dwg L-1.01.

NATIVE PLANT INVENTORY
Plants Tagged in Field - Station 110+00 TO Station 190+00

ID #	Symbol	Botanical Name	Common Name	Height (ft)	Salvage Designation	Condition	Canes	Total per Species
200	ⓕⒸ	<i>Ferocactus cylindraceus</i>	Barrel Cactus	1	Salvage	Good		1
201	ⓕⒸ	<i>Ferocactus cylindraceus</i>	Barrel Cactus	1	Remain In Place	Good		1
202	ⓕⒸ	<i>Ferocactus cylindraceus</i>	Barrel Cactus	1	Remain In Place	Good		1
203	ⓕⒸ	<i>Ferocactus cylindraceus</i>	Barrel Cactus	1	Salvage	Good		1
204	ⓕⒸ	<i>Ferocactus cylindraceus</i>	Barrel Cactus	1	Remain In Place	Good		1
205	ⓕⒸ	<i>Ferocactus cylindraceus</i>	Barrel Cactus	2	Salvage	Good		1
206	ⓕⒸ	<i>Ferocactus cylindraceus</i>	Barrel Cactus	2	Salvage	Good		1
207	ⓕⒸ	<i>Ferocactus cylindraceus</i>	Barrel Cactus	2	Salvage	Good		1
208	ⓕⒸ	<i>Ferocactus cylindraceus</i>	Barrel Cactus	1	Salvage	Good		1
209	ⓕⒸ	<i>Ferocactus cylindraceus</i>	Barrel Cactus	1	Salvage	Good		1
210	ⓕⒸ	<i>Ferocactus cylindraceus</i>	Barrel Cactus	1	Salvage	Good		1
211	ⓕⒸ	<i>Ferocactus cylindraceus</i>	Barrel Cactus	1	Salvage	Good		1
212	ⓕⒸ	<i>Ferocactus cylindraceus</i>	Barrel Cactus	1	Salvage	Good		1
213	ⓕⒸ	<i>Ferocactus cylindraceus</i>	Barrel Cactus	1	Salvage	Good		1
214	ⓕⒸ	<i>Ferocactus cylindraceus</i>	Barrel Cactus	1	Salvage	Good		1
215	ⓕⒸ	<i>Ferocactus cylindraceus</i>	Barrel Cactus	1	Salvage	Good		1
216	ⓕⒸ	<i>Ferocactus cylindraceus</i>	Barrel Cactus	1	Salvage	Good		1
217	ⓕⒸ	<i>Ferocactus cylindraceus</i>	Barrel Cactus	1	Salvage	Good		1
218	ⓕⒸ	<i>Ferocactus cylindraceus</i>	Barrel Cactus	1	Salvage	Good		1
219	ⓕⓈ	<i>Fouquieria splendens</i>	Ocotillo	1	Remain-In-Place	Good	25	1
220	ⓕⒸ	<i>Ferocactus cylindraceus</i>	Barrel Cactus	1	Remain-In-Place	Good		1
221	ⓕⒸ	<i>Ferocactus cylindraceus</i>	Barrel Cactus	1	Remain-In-Place	Good		1
222	ⓕⒸ	<i>Ferocactus cylindraceus</i>	Barrel Cactus	1	Remain-In-Place	Good		1
223	ⓕⒸ	<i>Ferocactus cylindraceus</i>	Barrel Cactus	1	Remain-In-Place	Good		1
224	ⓕⒸ	<i>Ferocactus cylindraceus</i>	Barrel Cactus	1	Remain-In-Place	Good		1
225	ⓕⒸ	<i>Ferocactus cylindraceus</i>	Barrel Cactus	1	Remain-In-Place	Good		1
226	ⓕⒸ	<i>Ferocactus cylindraceus</i>	Barrel Cactus	1	Remain-In-Place	Good		1
Bid Quantity Total (Per Species)								27

SMALL CACTUS TABULATION
(Plants Not Tagged) - Station 110+00 to Station 190+00

SCIENTIFIC NAME COMMON NAME	Total Per Species
<i>Cylindropuntia acanthocarpa</i> Buckhorn Cholla	12
<i>Yucca elata</i> Soaptree Yucca	41
	53

DESIGN

DRAWN

CHECKED

NAME

W HERRERA

STAFF

W COLEBANK

DATE

06/26

06/26

06/26

REGISTERED LANDSCAPE ARCHITECT
CERTIFICATE NO. 21401
M. WAYNE COLEBANK
Designed 06/11/2026
ARIZONA, U.S.A.
Expires 06/30/2029

LOGANSIMPSON

222 SOUTH WILLOW AVENUE, SUITE 202
TAMPA, FL 33607
P: (813) 967-1543

ARIZONA DEPARTMENT OF TRANSPORTATION
PROJECT DELIVERY AND OPERATIONS DIVISION
ROADWAY DESIGN SERVICES

PLANT INVENTORY SUMMARY SHEET

ROUTE
US 93

MILEPOST
189.92

STRUCTURE NO.

F.H.W.A. Arizona Division

STATE
ARIZ.

PROJECT NO.
093 YV 189

FEDERAL ID NO.
093-B(230)T

SHEET NO.
460

TOTAL SHEETS
524


RECORD DRAWING

LOCATION
WICKENBURG RANCH WAY TO VISTA ROYALE


TRACS NO. F0738 01C

DWG No. P-1.01
OF


c:\pwworking\usaz\dms09643\0738_p-1.01.dgn
6/11/2026 @10:56:29 AM WHerrera

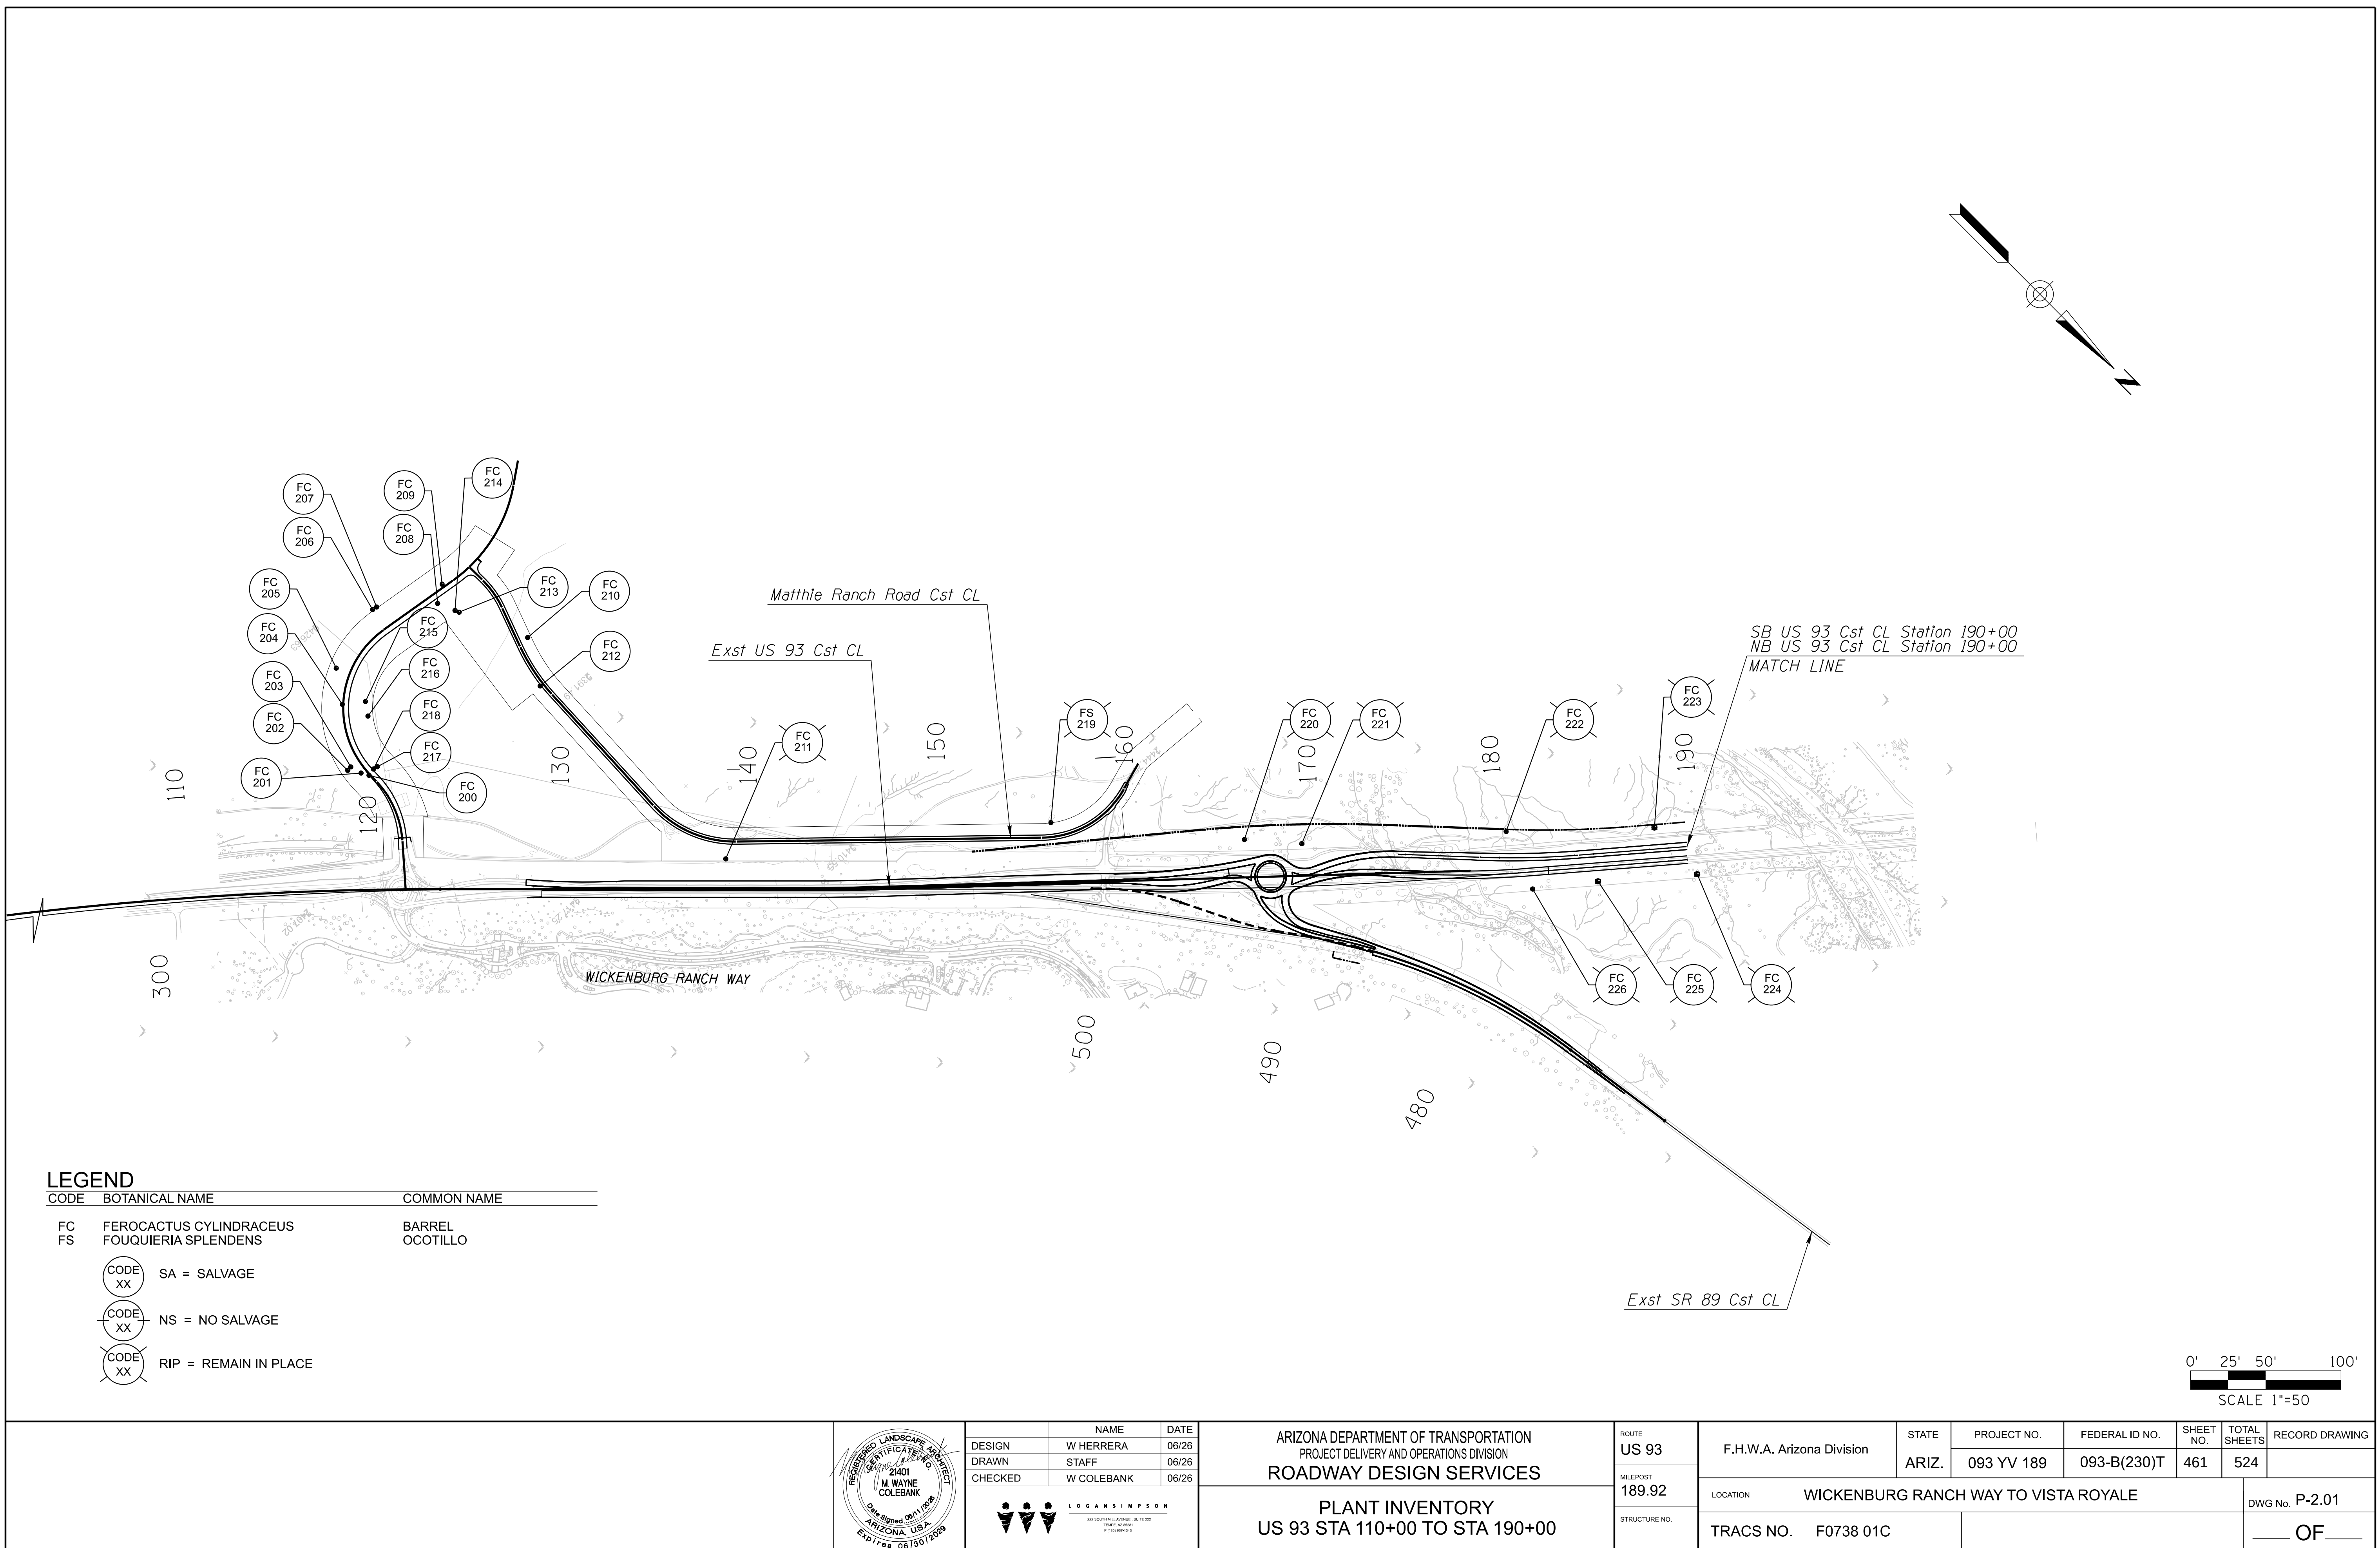

LEGEND		
CODE	BOTANICAL NAME	COMMON NAME
FC	FEROCACTUS CYLINDRACEUS	BARREL
FS	FOUQUIERIA SPLENDENS	OCOTILLO
CODE XX	SA = SALVAGE	
CODE XX	NS = NO SALVAGE	
CODE XX	RIP = REMAIN IN PLACE	

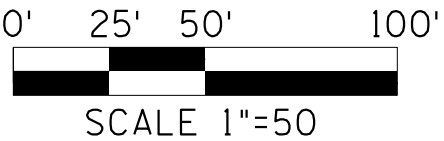

		NAME	DATE	ARIZONA DEPARTMENT OF TRANSPORTATION PROJECT DELIVERY AND OPERATIONS DIVISION ROADWAY DESIGN SERVICES		ROUTE	F.H.W.A. Arizona Division	STATE	PROJECT NO.	FEDERAL ID NO.	SHEET NO.	TOTAL SHEETS	RECORD DRAWING					
	DESIGN	W HERRERA	06/26			US 93	ARIZ.	093 YV 189	093-B(230)T	461	524							
	DRAWN	STAFF	06/26			MILEPOST												
	CHECKED	W COLEBANK	06/26			189.92												
				PLANT INVENTORY US 93 STA 110+00 TO STA 190+00		STRUCTURE NO.							WICKENBURG RANCH WAY TO VISTA ROYALE					
						TRACS NO. F0738 01C							___ OF ___					

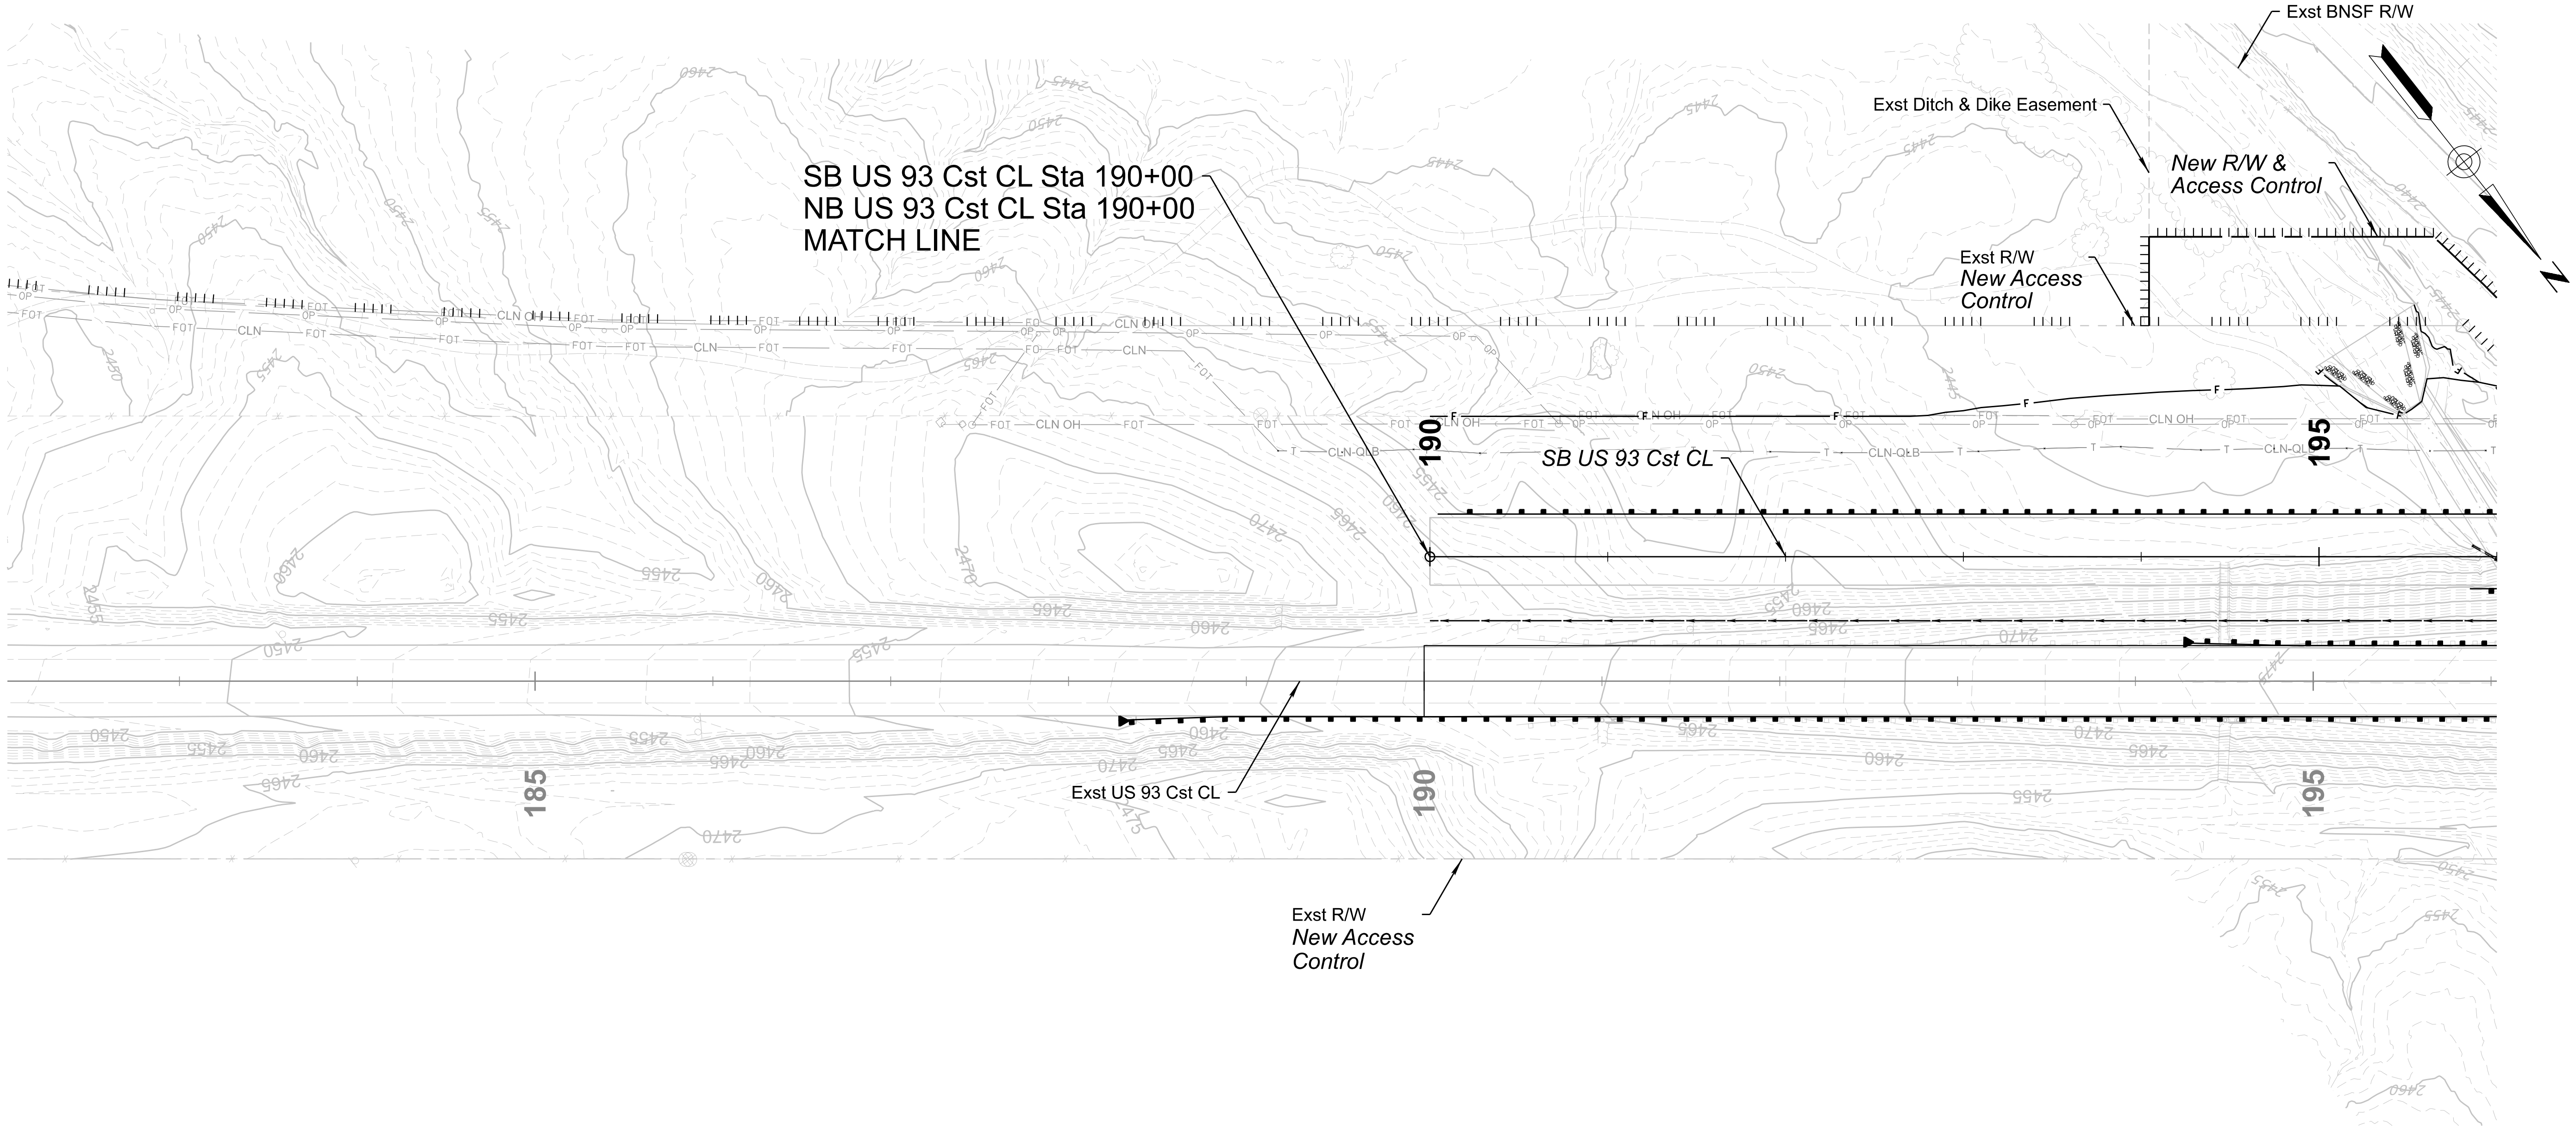

LEGEND


CODE	BOTANICAL NAME	COMMON NAME
FC	FEROCACTUS CYLINDRACEUS	BARREL
FS	FOUQUIERIA SPLENDENS	OCOTILLO
PG	PENIOCEREUS GREGGII	ARIZONA QUEEN OF THE NIGHT

- CODE
XX


SA = SALVAGE
- CODE
XX

NS = NO SALVAGE
- CODE
XX

RIP = REMAIN IN PLACE

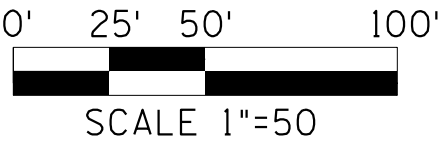

		NAME	DATE	ARIZONA DEPARTMENT OF TRANSPORTATION PROJECT DELIVERY AND OPERATIONS DIVISION ROADWAY DESIGN SERVICES	ROUTE	F.H.W.A. Arizona Division	STATE	PROJECT NO.	FEDERAL ID NO.	SHEET NO.	TOTAL SHEETS	RECORD DRAWING
	DESIGN	W HERRERA	06/26		US 93		ARIZ.	093 YV 189	093-B(230)T	462	524	
	DRAWN	STAFF	06/26		MILEPOST	189.92						
	CHECKED	W COLEBANK	06/26	STRUCTURE NO.		LOCATION WICKENBURG RANCH WAY TO VISTA ROYALE					DWG No. P-2.02	
		LOGANSIMPSON 222 SOUTHWEST AVE., SUITE 202 TUCSON, AZ 85701 P. (520) 582-1243			PLANT INVENTORY SB US 93 STA 190+00 TO STA 196+00		TRACS NO. F0738 01C		OF			

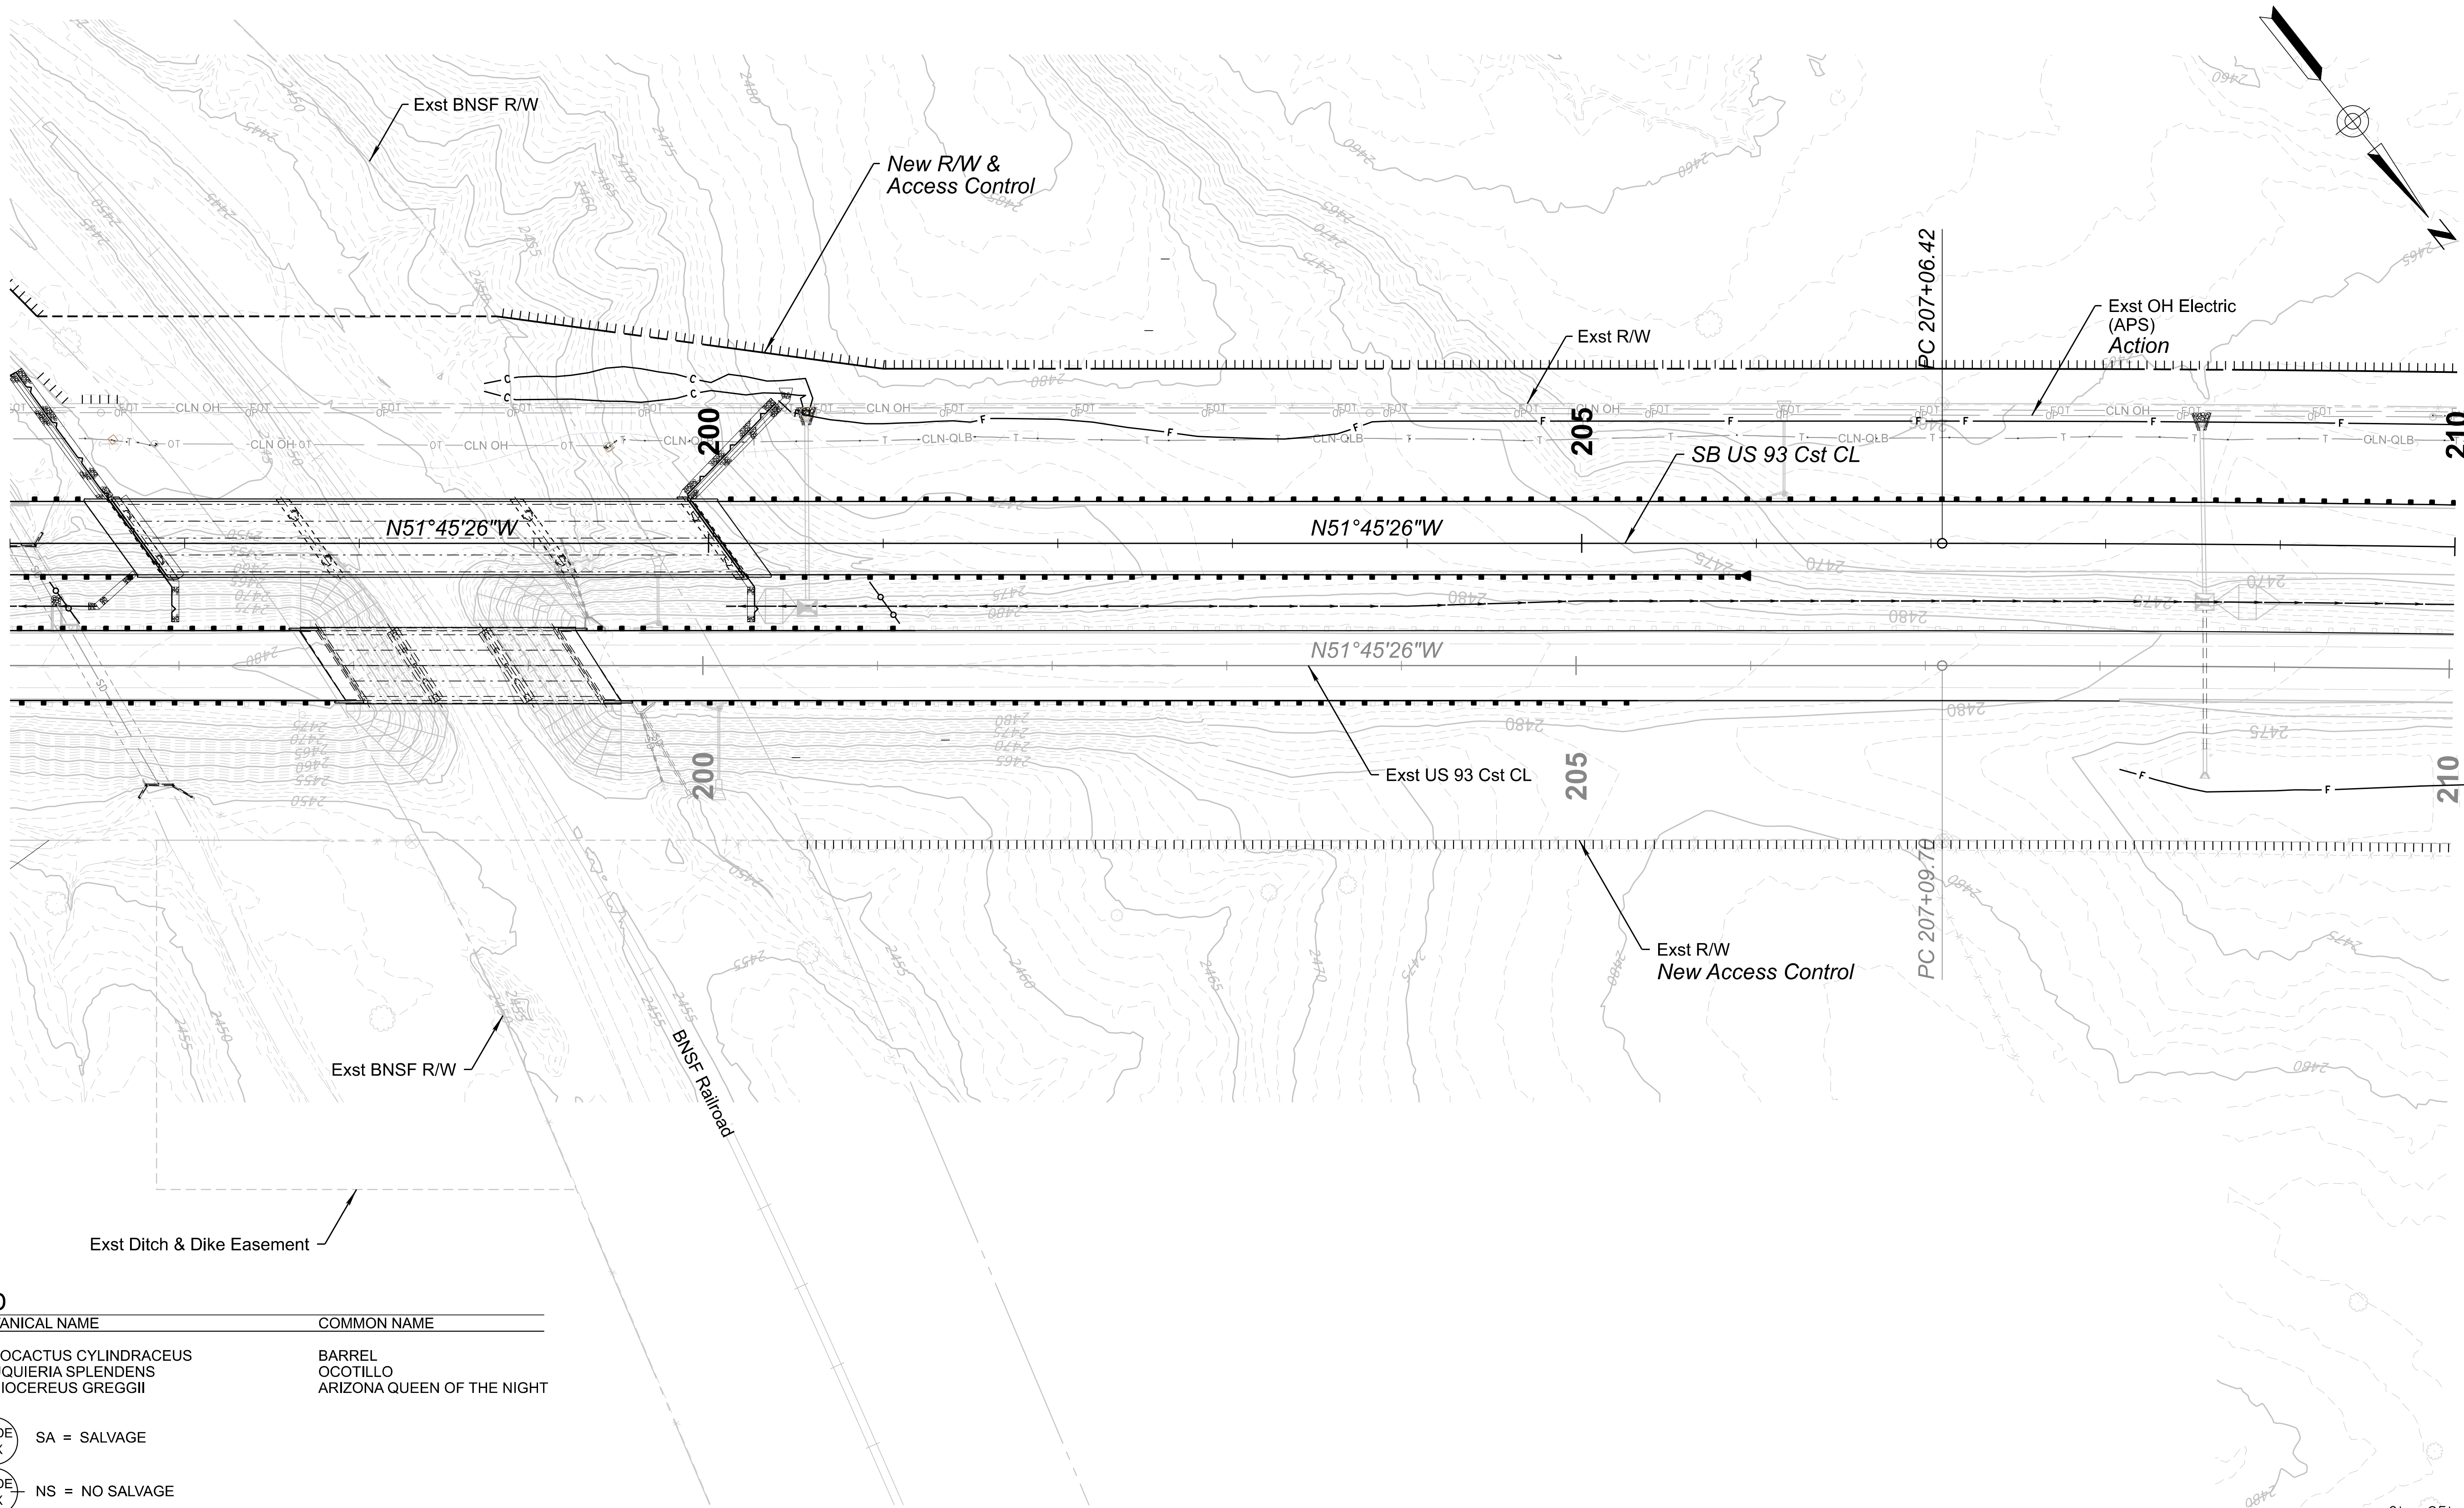

LEGEND		
CODE	BOTANICAL NAME	COMMON NAME
FC	FEROCACTUS CYLINDRACEUS	BARREL
FS	FOUQUIERIA SPLENDENS	OCOTILLO
PG	PENIOCEREUS GREGGII	ARIZONA QUEEN OF THE NIGHT



- CODE
XX

SA = SALVAGE
- CODE
XX

NS = NO SALVAGE
- CODE
XX

RIP = REMAIN IN PLACE

NO INVENTORIED PLANT MATERIAL THIS SHEET

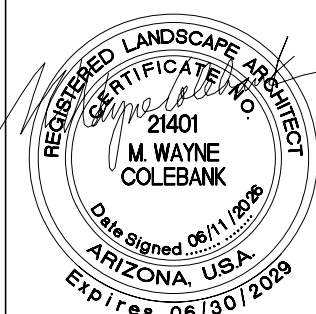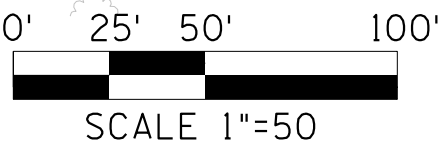



	NAME	DATE
DESIGN	W HERRERA	06/26
DRAWN	STAFF	06/26
CHECKED	W COLEBANK	06/26

LOGANSIMPSON
222 SOUTH FARM ROAD, SUITE 202
TAMPA, FL 33613
P: 813.887.1543

ARIZONA DEPARTMENT OF TRANSPORTATION PROJECT DELIVERY AND OPERATIONS DIVISION ROADWAY DESIGN SERVICES	ROUTE US 93
PLANT INVENTORY SB US 93 STA 196+00 TO STA 210+00	MILEPOST 189.92
	STRUCTURE NO.

F.H.W.A. Arizona Division	STATE ARIZ.	PROJECT NO. 093 YV 189	FEDERAL ID NO. 093-B(230)T	SHEET NO. 463	TOTAL SHEETS 524	RECORD DRAWING
LOCATION WICKENBURG RANCH WAY TO VISTA ROYALE						DWG No. P-2.03
TRACS NO. F0738 01C						OF

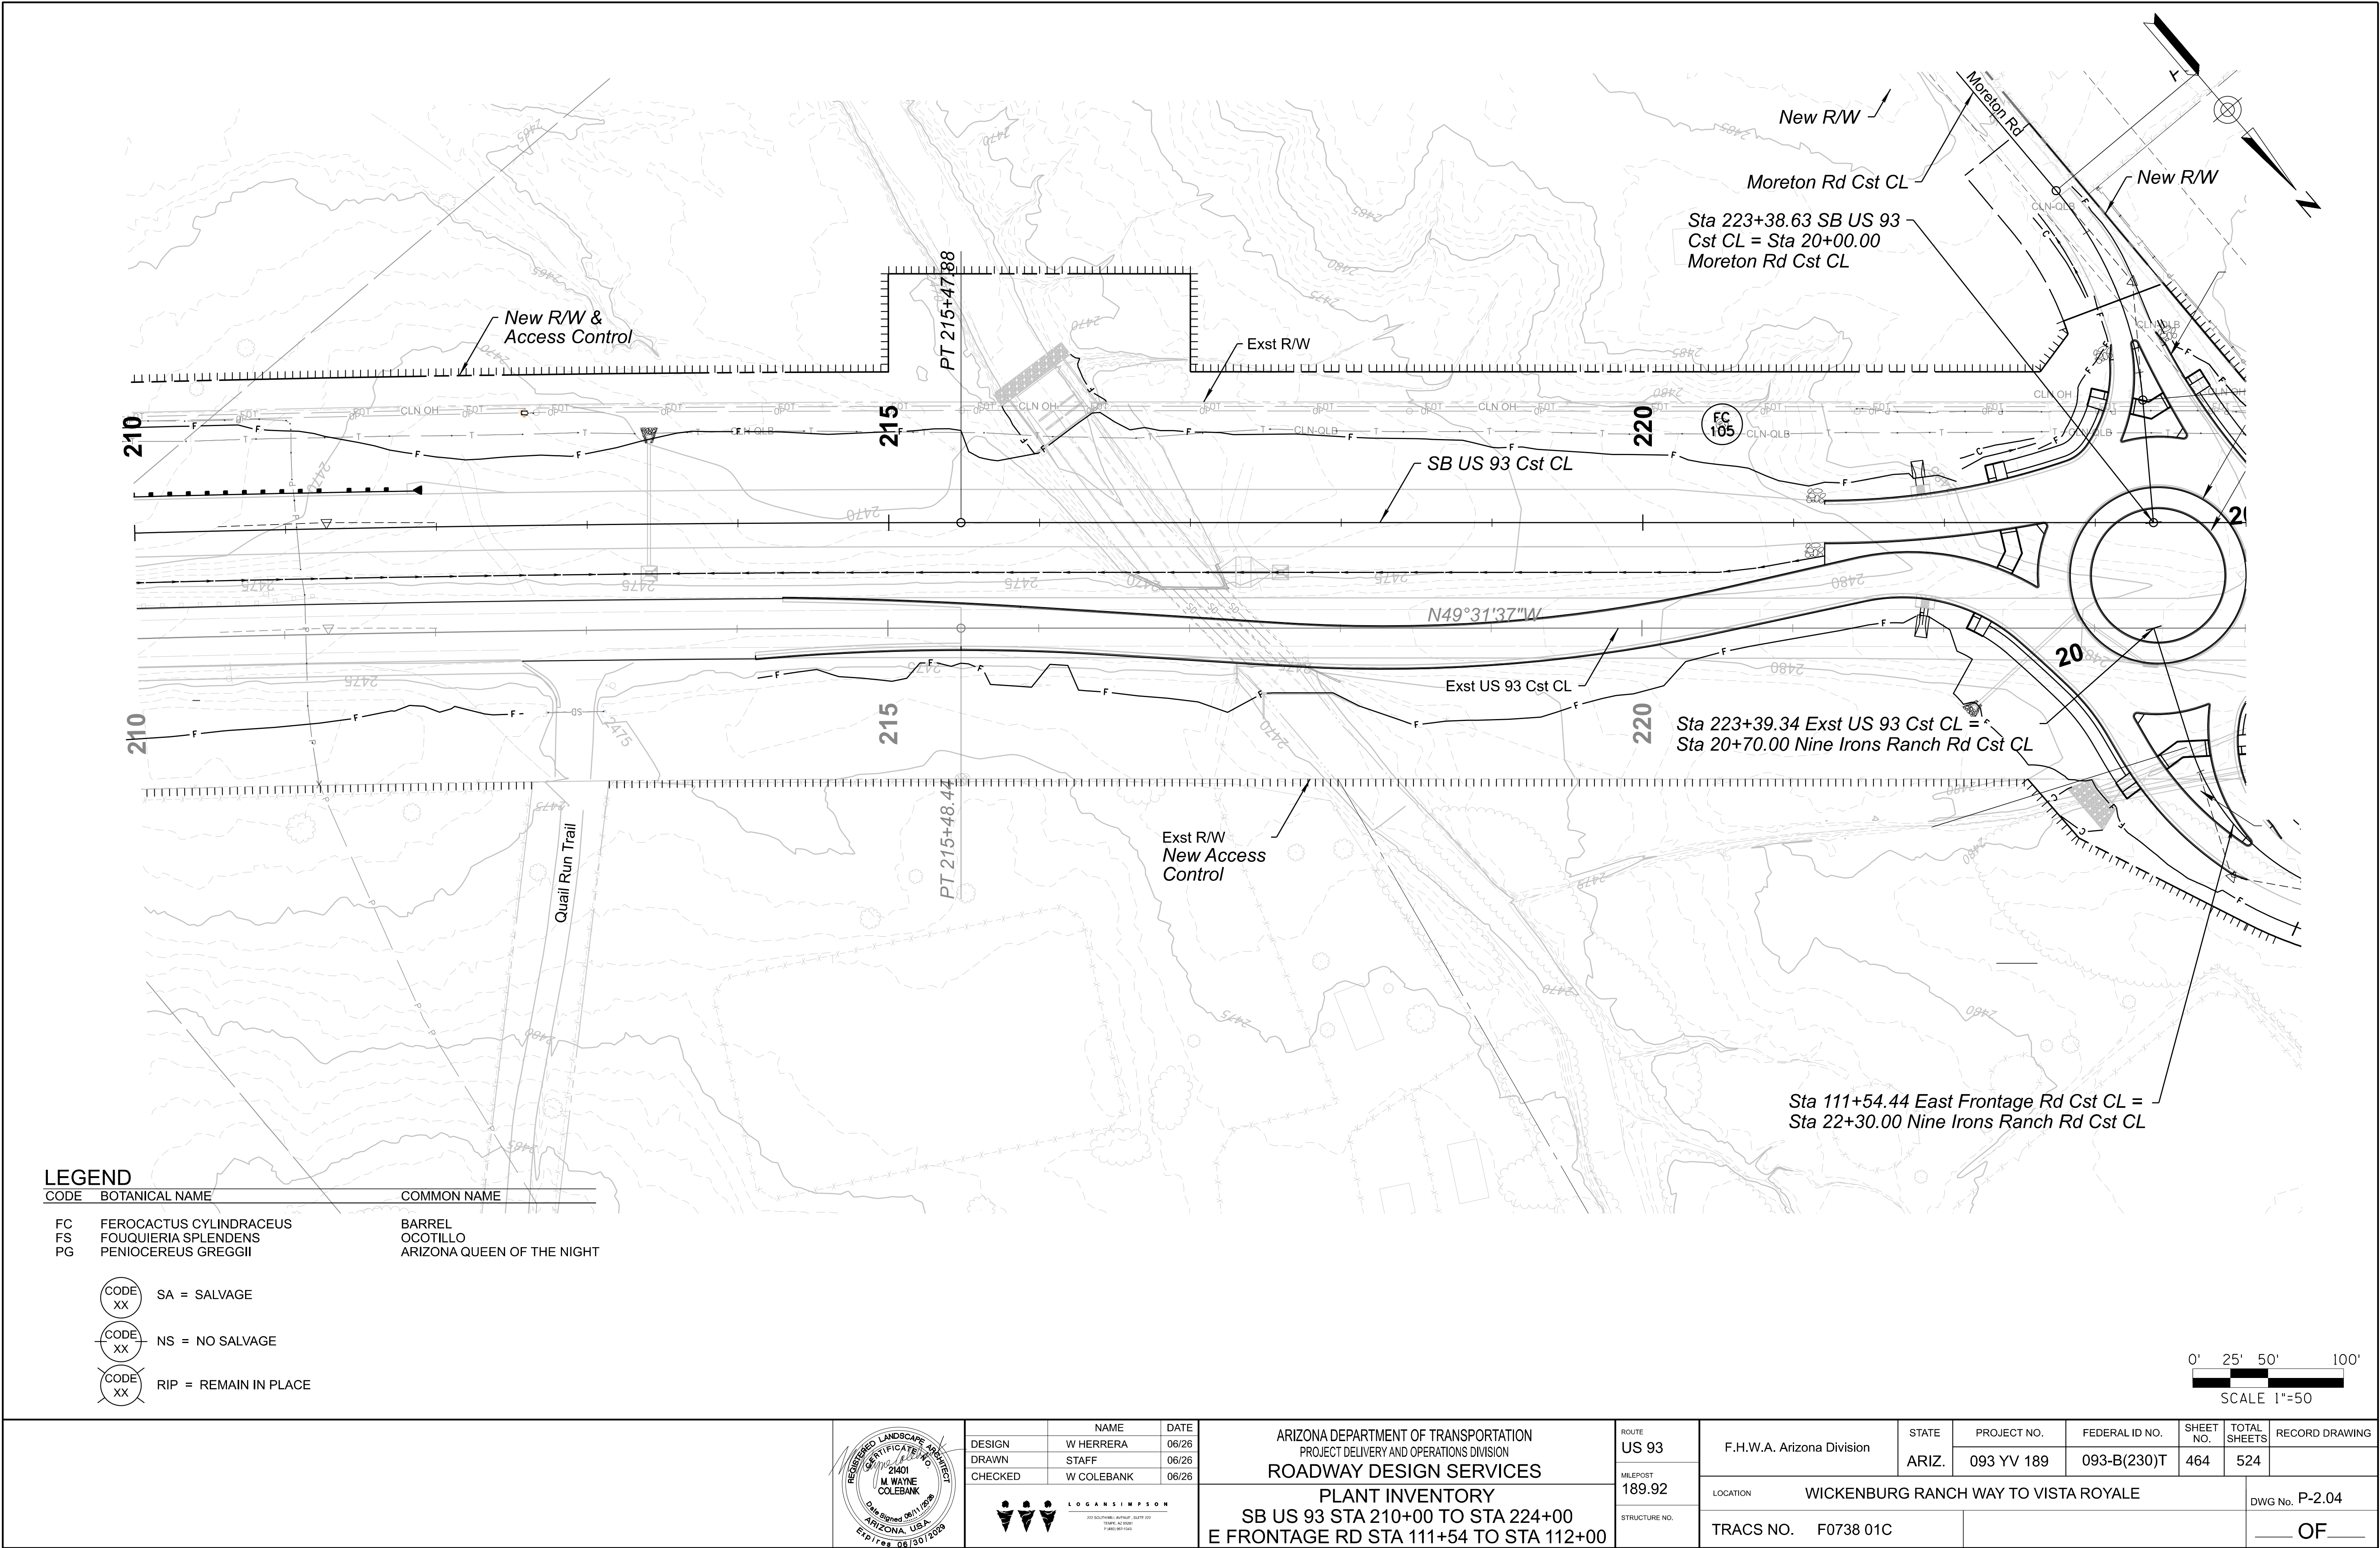

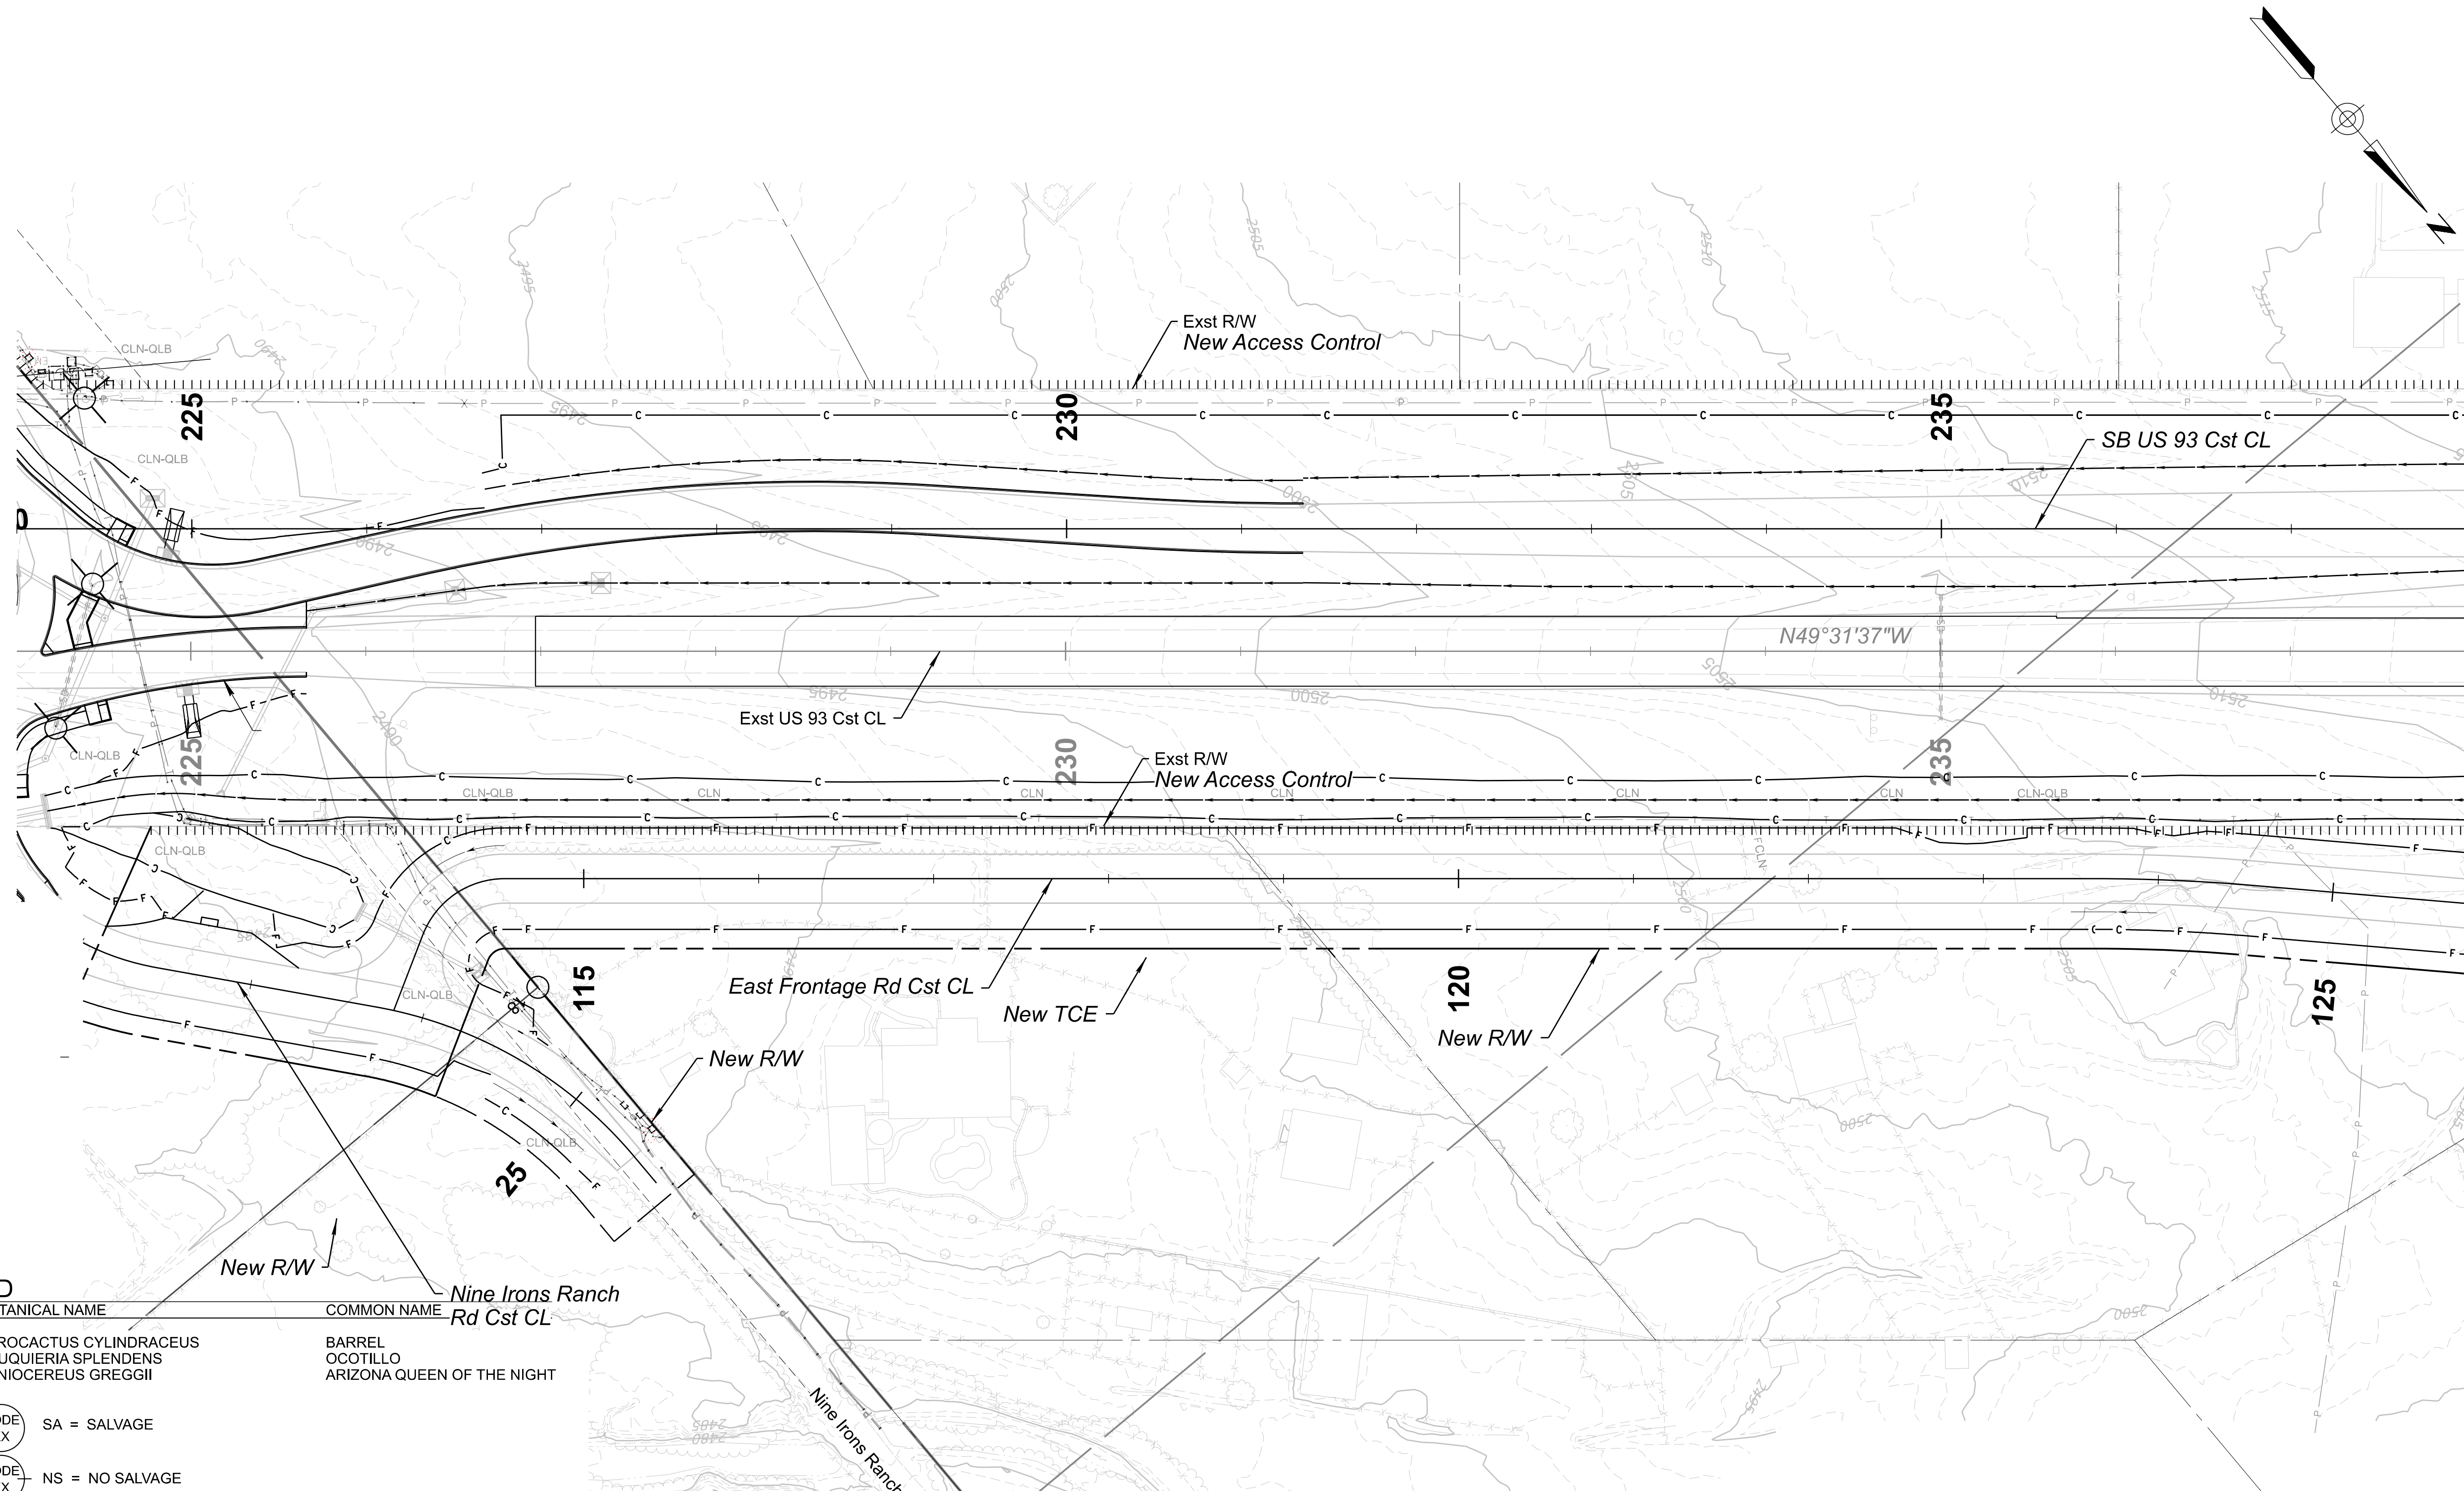

LEGEND		
CODE	BOTANICAL NAME	COMMON NAME
FC	FEROCACTUS CYLINDRACEUS	BARREL
FS	FOUQUIERIA SPLENDENS	OCOTILLO
PG	PENIOCEREUS GREGGII	ARIZONA QUEEN OF THE NIGHT


- CODE
XX


SA = SALVAGE
- CODE
XX

NS = NO SALVAGE
- CODE
XX

RIP = REMAIN IN PLACE

NO INVENTORIED PLANT MATERIAL THIS SHEET

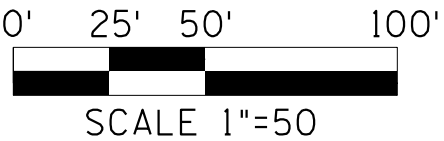

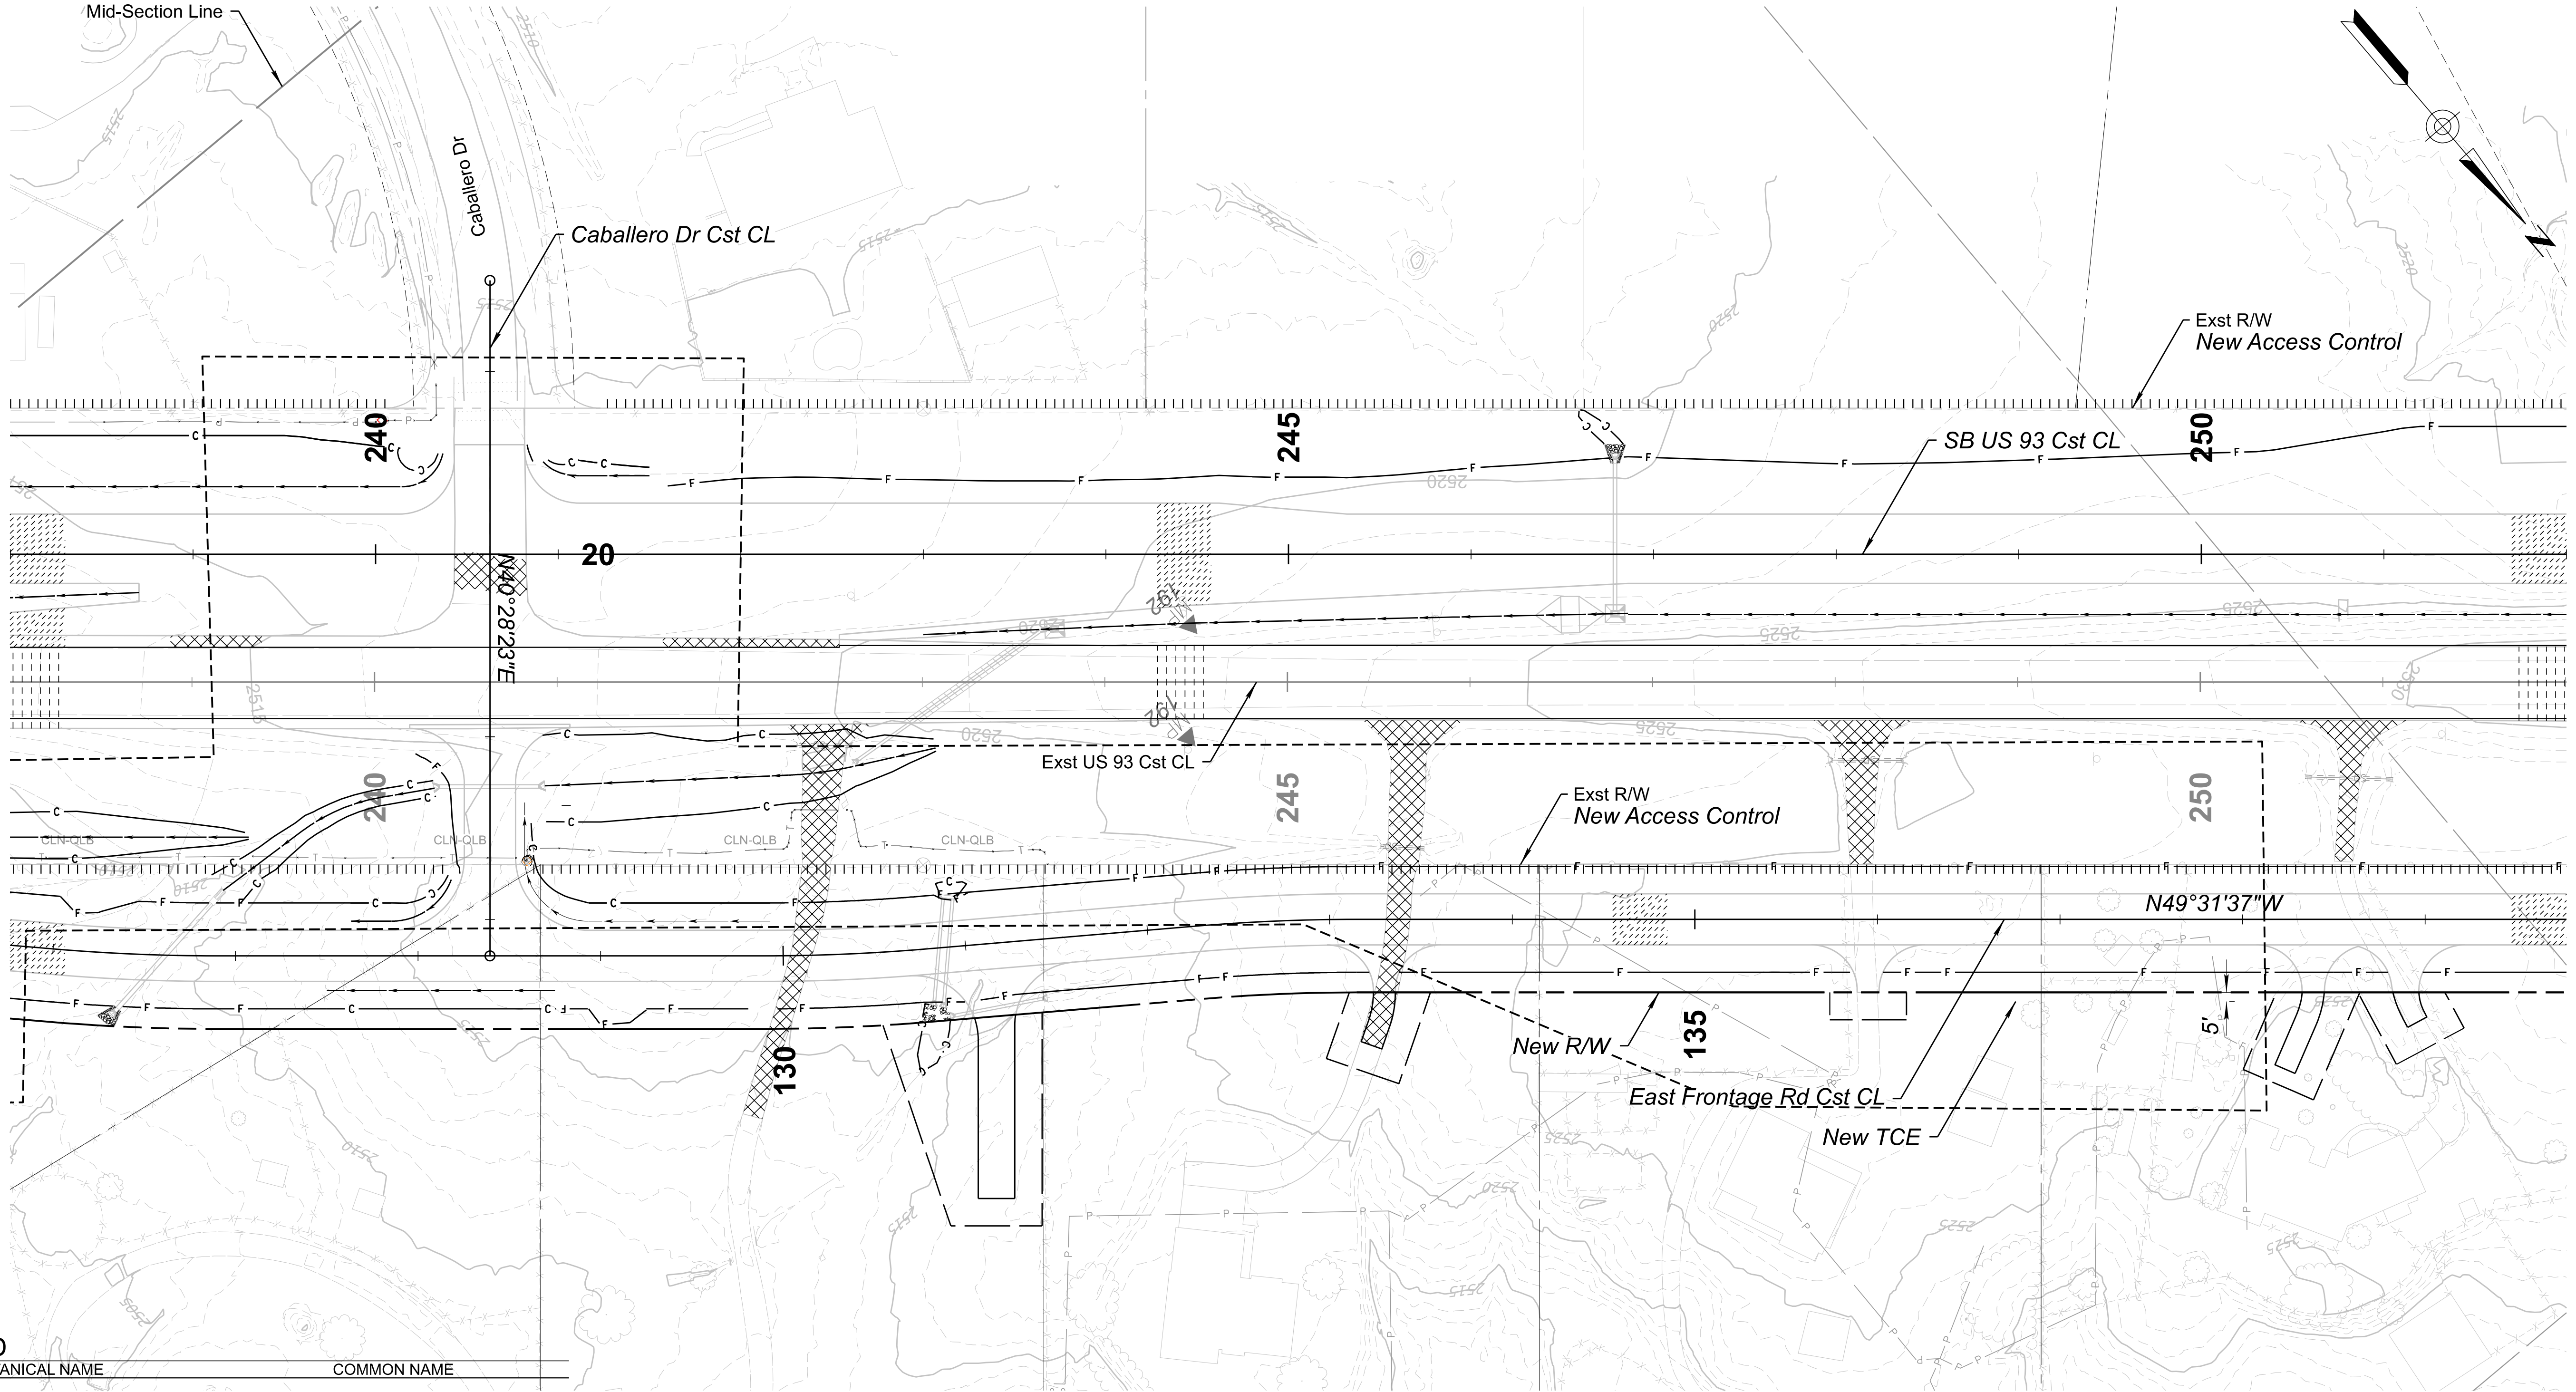

LEGEND		
CODE	BOTANICAL NAME	COMMON NAME
FC	FEROCACTUS CYLINDRACEUS	BARREL
FS	FOUQUIERIA SPLENDENS	OCOTILLO
PG	PENIOCEREUS GREGGII	ARIZONA QUEEN OF THE NIGHT



- CODE
XX

SA = SALVAGE
- CODE
XX

NS = NO SALVAGE
- CODE
XX

RIP = REMAIN IN PLACE

NO INVENTORIED PLANT MATERIAL THIS SHEET

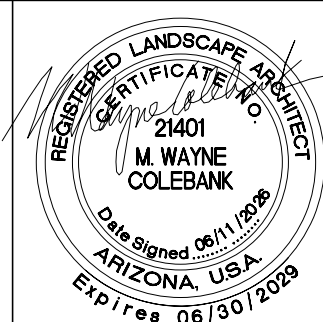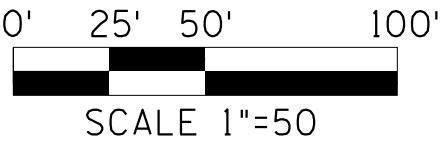


	NAME	DATE
DESIGN	W HERRERA	06/26
DRAWN	STAFF	06/26
CHECKED	W COLEBANK	06/26

LOGANSIMPSON
222 SOUTH HAVEN LANE, SUITE 202
TAMPA, FL 33601
P: (813) 987-1543

ARIZONA DEPARTMENT OF TRANSPORTATION PROJECT DELIVERY AND OPERATIONS DIVISION ROADWAY DESIGN SERVICES	
PLANT INVENTORY SB US 93 STA 238+00 TO STA 252+00 E FRONTAGE RD STA 126+00 TO STA 140+00	

ROUTE US 93	F.H.W.A. Arizona Division	STATE	PROJECT NO.	FEDERAL ID NO.	SHEET NO.	TOTAL SHEETS	RECORD DRAWING
MILEPOST 189.92		ARIZ.	093 YV 189	093-B(230)T	466	524	
STRUCTURE NO.	LOCATION WICKENBURG RANCH WAY TO VISTA ROYALE						DWG No. P-2.06
	TRACS NO. F0738 01C						____ OF ____

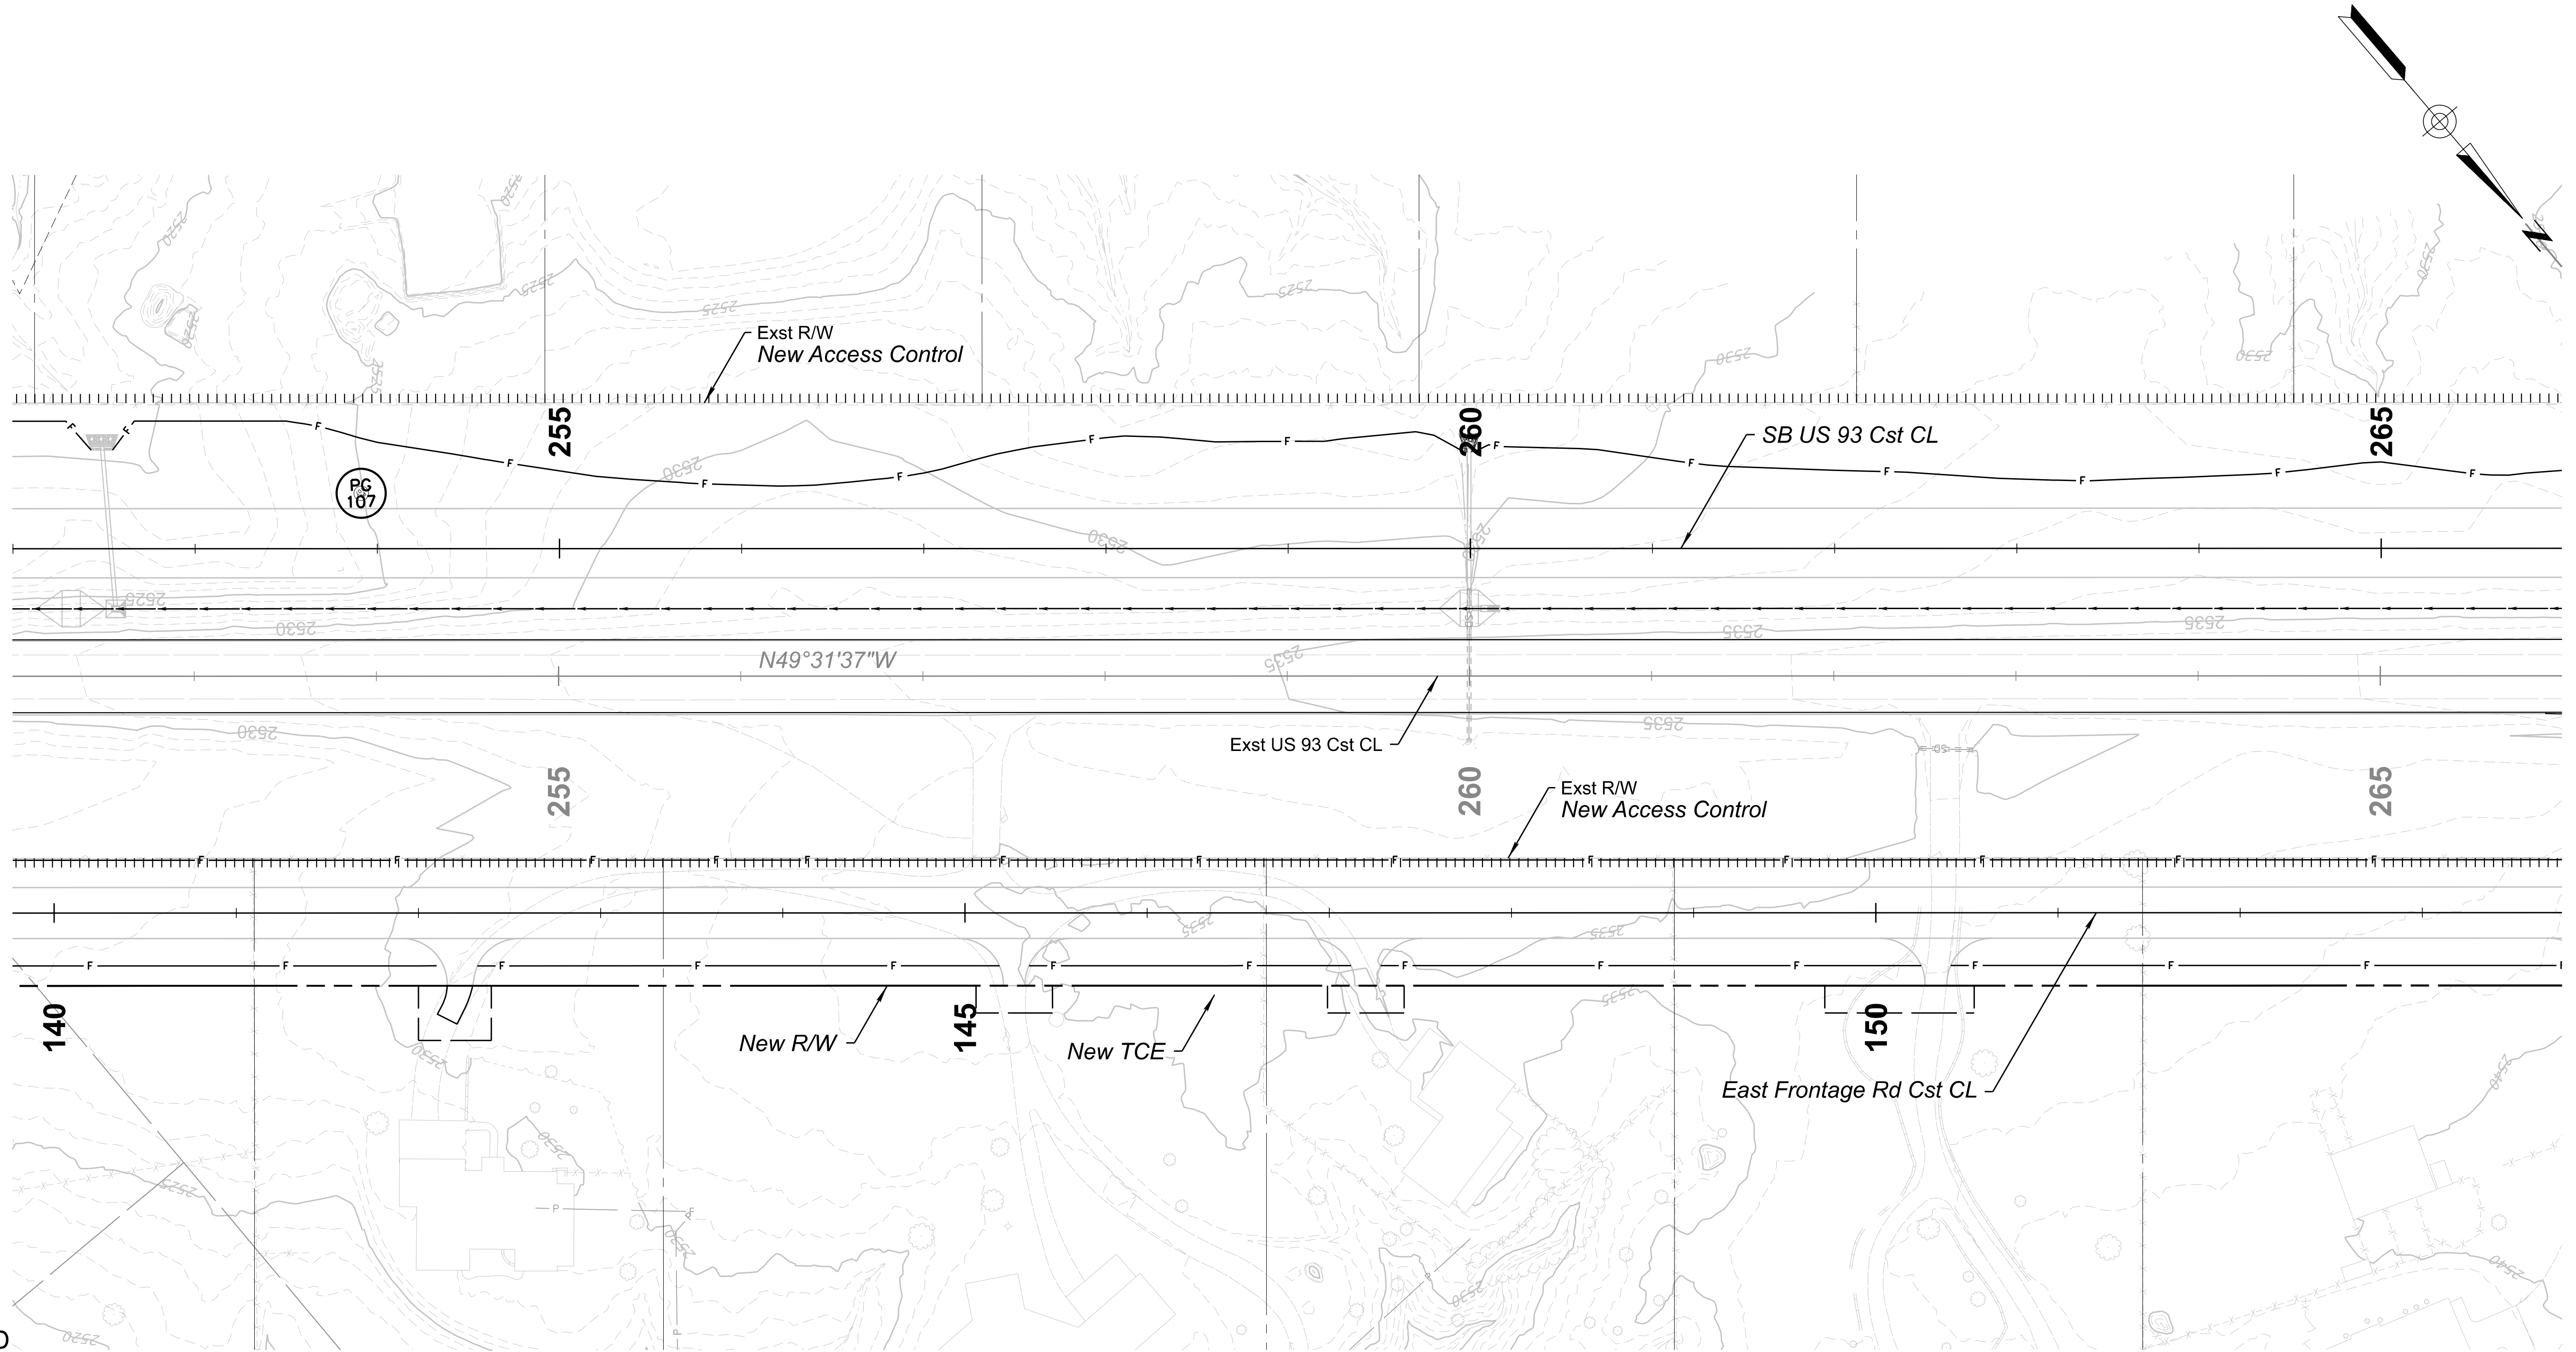

LEGEND


CODE	BOTANICAL NAME	COMMON NAME
FC	FEROCACTUS CYLINDRACEUS	BARREL
FS	FOUQUIERIA SPLENDENS	OCOTILLO
PG	PENIOCEREUS GREGGII	ARIZONA QUEEN OF THE NIGHT

- CODE
XX


SA = SALVAGE
- CODE
XX

NS = NO SALVAGE
- CODE
XX

RIP = REMAIN IN PLACE

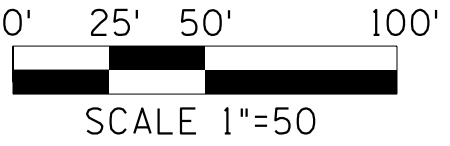

SCALE 1"=50'

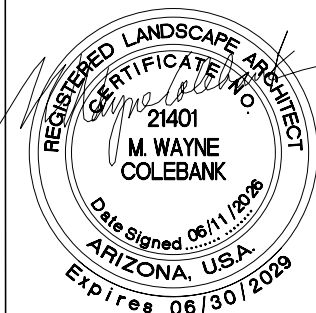

	NAME	DATE
DESIGN	W HERRERA	06/26
DRAWN	STAFF	06/26
CHECKED	W COLEBANK	06/26


LOGANSIMPSON
222 SOUTH MILL AVENUE, SUITE 202
TAMPA, FL 33601
P: (813) 997-1343

ARIZONA DEPARTMENT OF TRANSPORTATION
PROJECT DELIVERY AND OPERATIONS DIVISION
ROADWAY DESIGN SERVICES

PLANT INVENTORY
SB US 93 STA 252+00 TO STA 266+00
E FRONTAGE RD STA 140+00 TO STA 154+00

ROUTE	US 93
MILEPOST	189.92
STRUCTURE NO.	

F.H.W.A. Arizona Division	STATE	ARIZ.	PROJECT NO.	093 YV 189	FEDERAL ID NO.	093-B(230)T	SHEET NO.	467	TOTAL SHEETS	524	RECORD DRAWING
LOCATION		WICKENBURG RANCH WAY TO VISTA ROYALE								DWG No. P-2.07	
TRACS NO.		F0738 01C								___ OF ___	

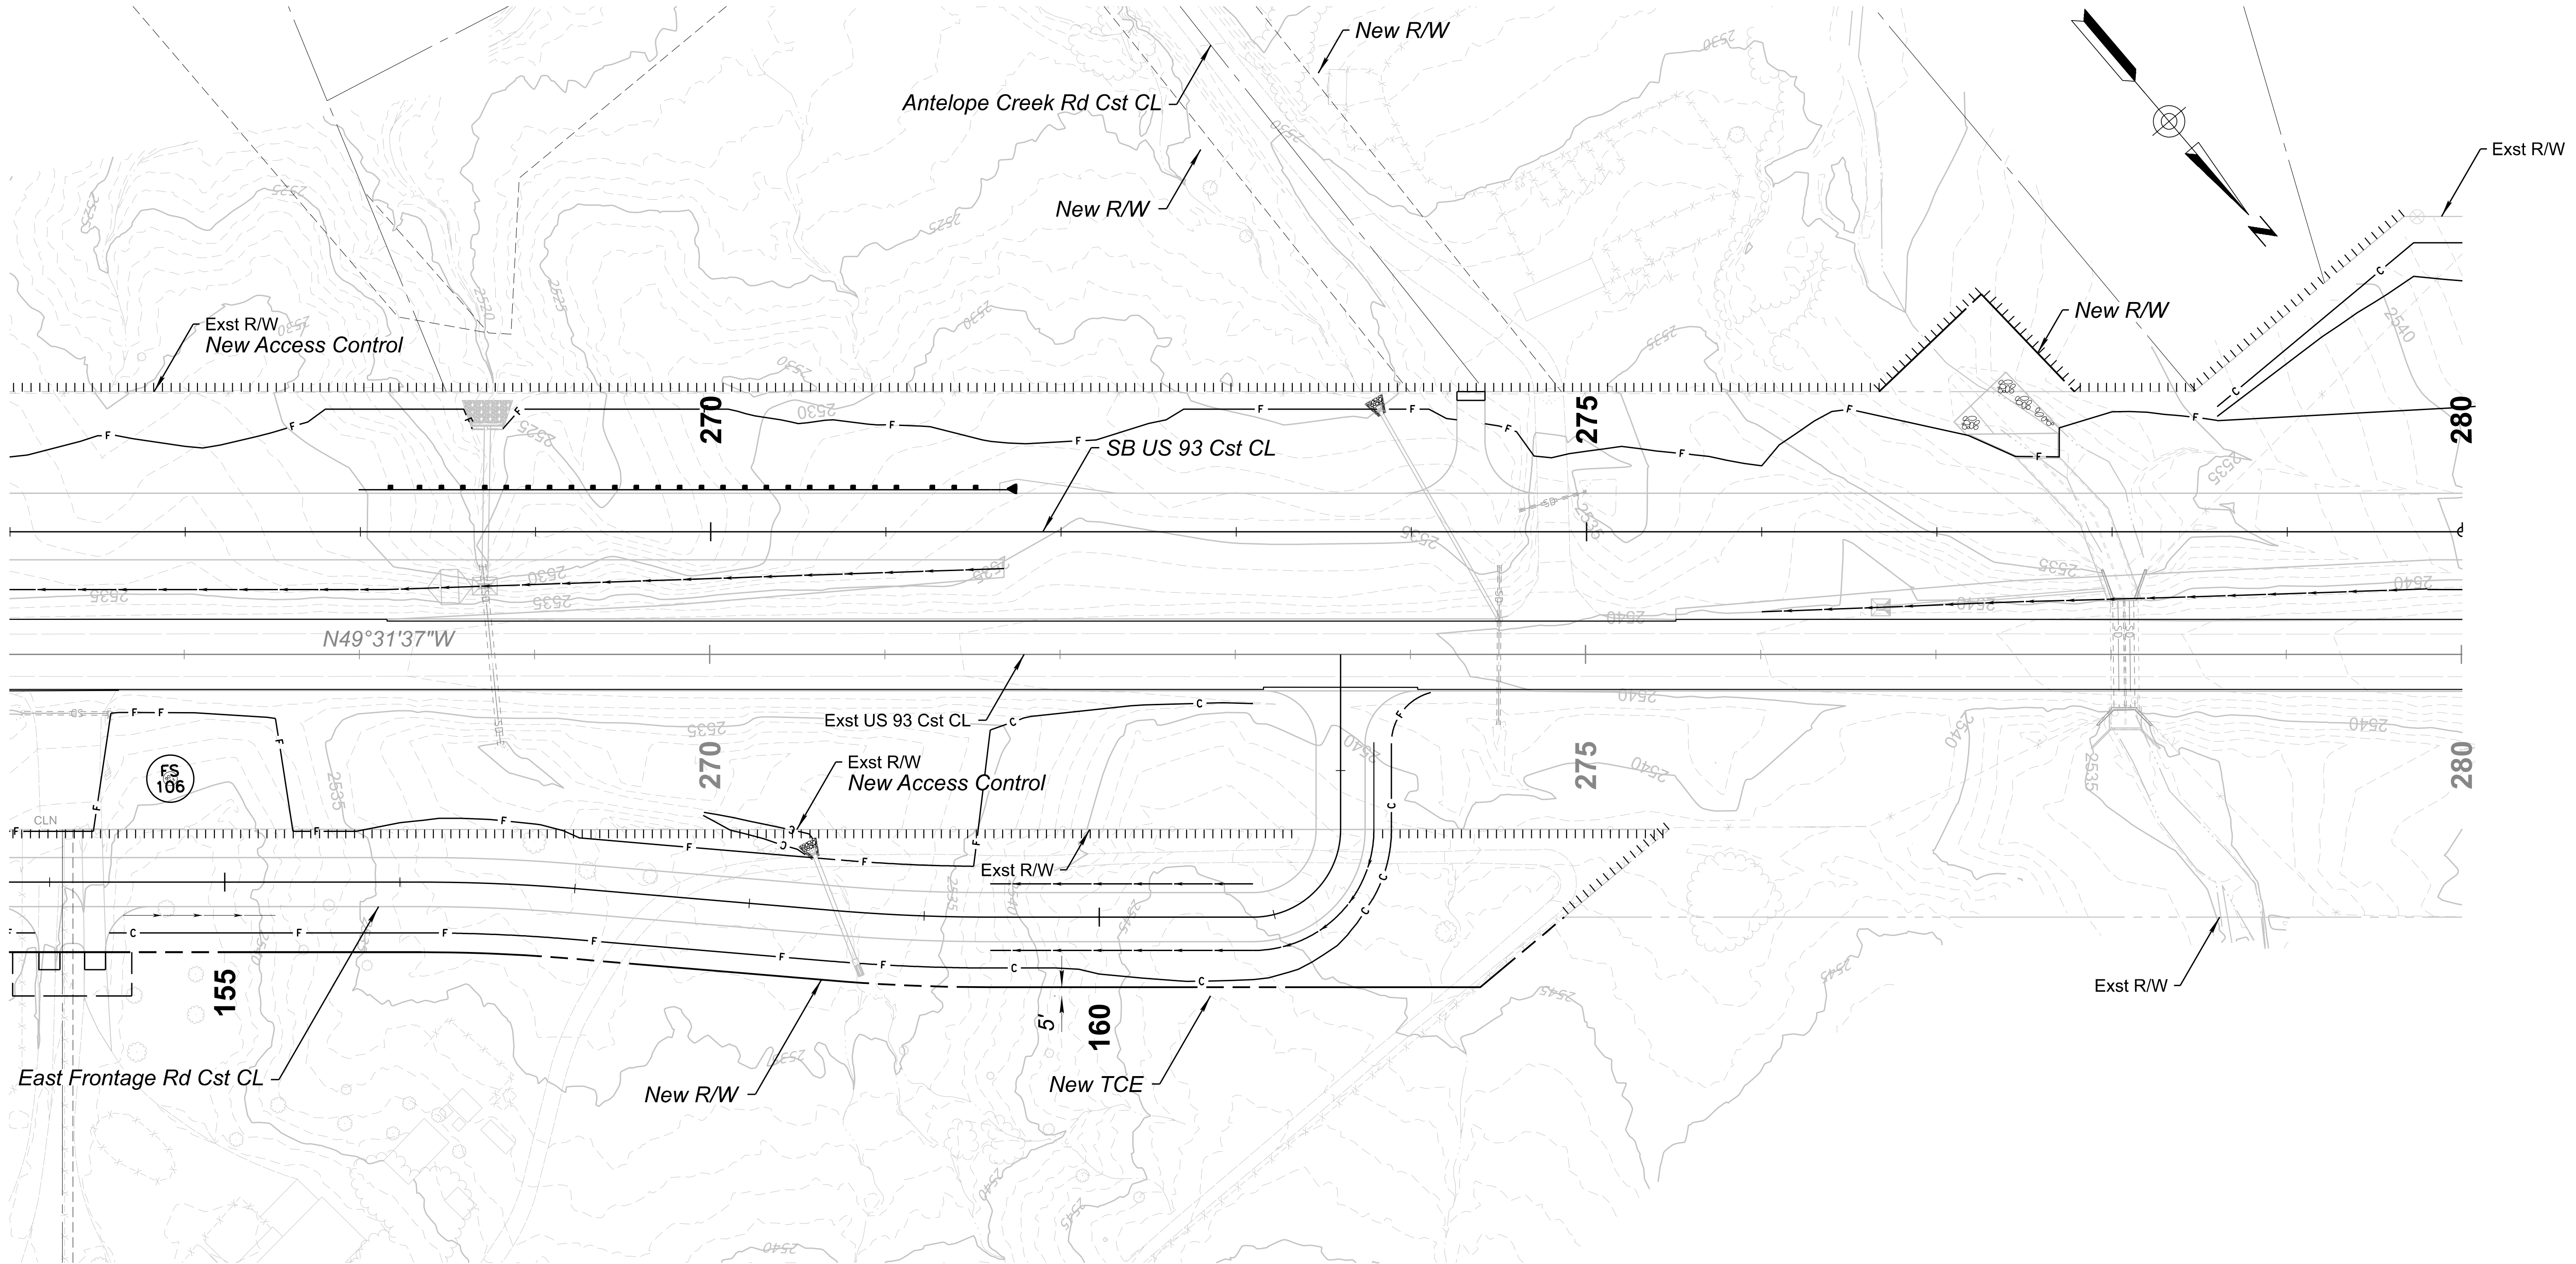

LEGEND


CODE	BOTANICAL NAME	COMMON NAME
FC	FEROCACTUS CYLINDRACEUS	BARREL
FS	FOUQUIERIA SPLENDENS	OCOTILLO
PG	PENIOCEREUS GREGGII	ARIZONA QUEEN OF THE NIGHT


- CODE
XX

SA = SALVAGE
- CODE
XX

NS = NO SALVAGE
- CODE
XX

RIP = REMAIN IN PLACE

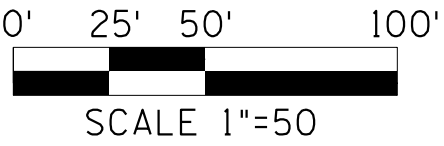

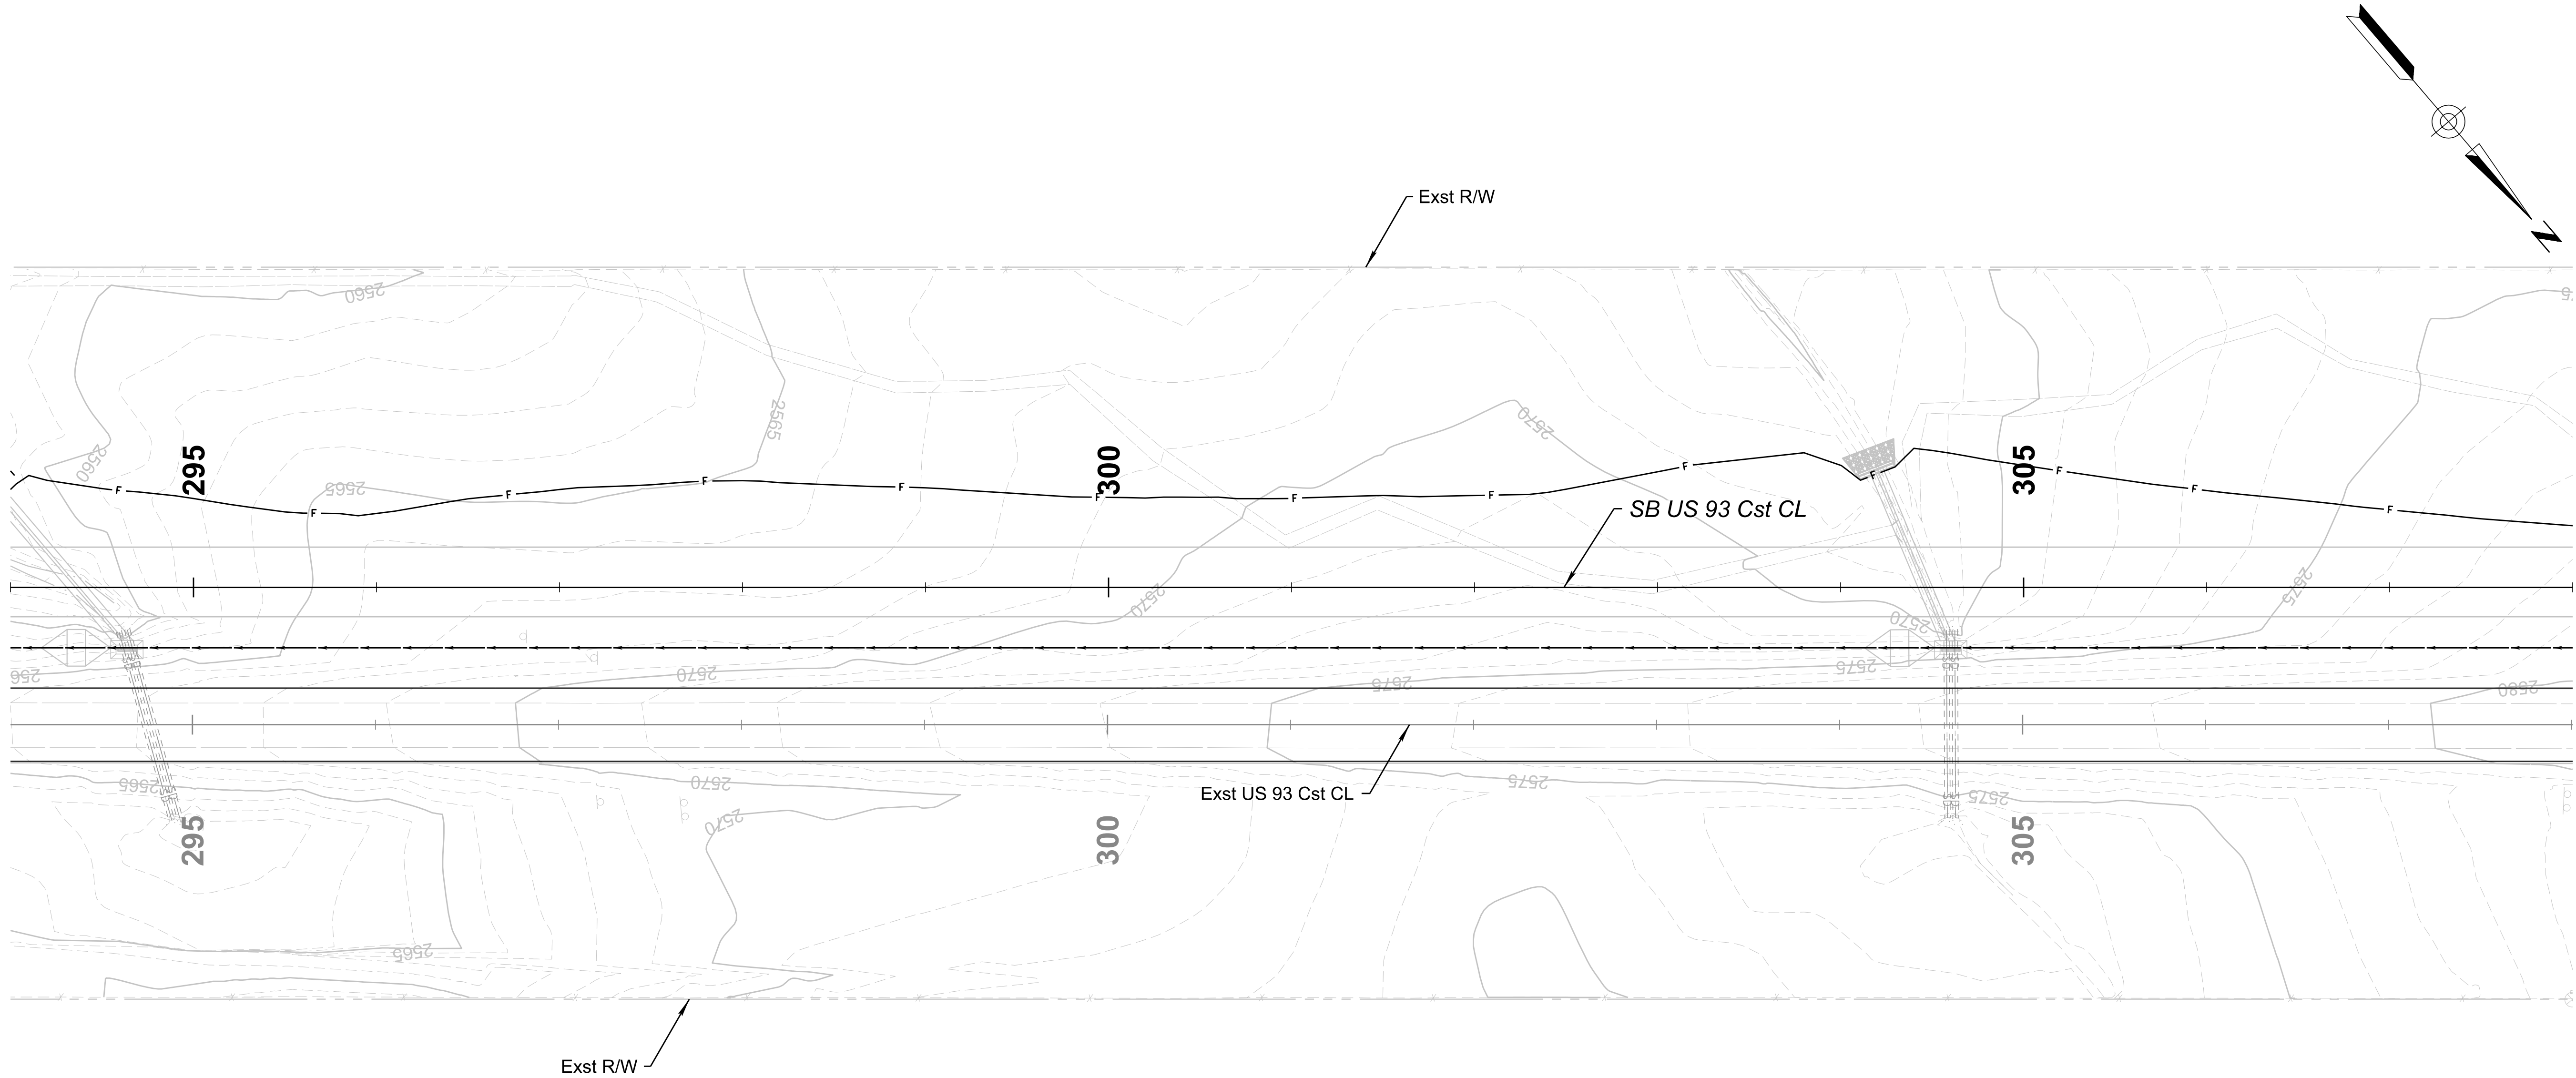

LEGEND

CODE	BOTANICAL NAME	COMMON NAME
FC	FEROCACTUS CYLINDRACEUS	BARREL
FS	FOUQUIERIA SPLENDENS	OCOTILLO
PG	PENIOCEREUS GREGGII	ARIZONA QUEEN OF THE NIGHT


- CODE
XX

SA = SALVAGE
- CODE
XX


NS = NO SALVAGE
- CODE
XX

RIP = REMAIN IN PLACE

NO INVENTORIED PLANT MATERIAL THIS SHEET

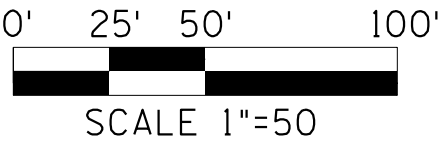

	DESIGN	NAME	DATE	ARIZONA DEPARTMENT OF TRANSPORTATION PROJECT DELIVERY AND OPERATIONS DIVISION ROADWAY DESIGN SERVICES	ROUTE	F.H.W.A. Arizona Division	STATE	PROJECT NO.	FEDERAL ID NO.	SHEET NO.	TOTAL SHEETS	RECORD DRAWING	
	DRAWN	STAFF	06/26		MILEPOST			093 YV 189	093-B(230)T	470	524		
	CHECKED	W COLEBANK	06/26		STRUCTURE NO.			WICKENBURG RANCH WAY TO VISTA ROYALE			DWG No. P-2.10		
					PLANT INVENTORY SB US 93 STA 294+00 TO STA 308+00			US 93			TRACS NO. F0738 01C		

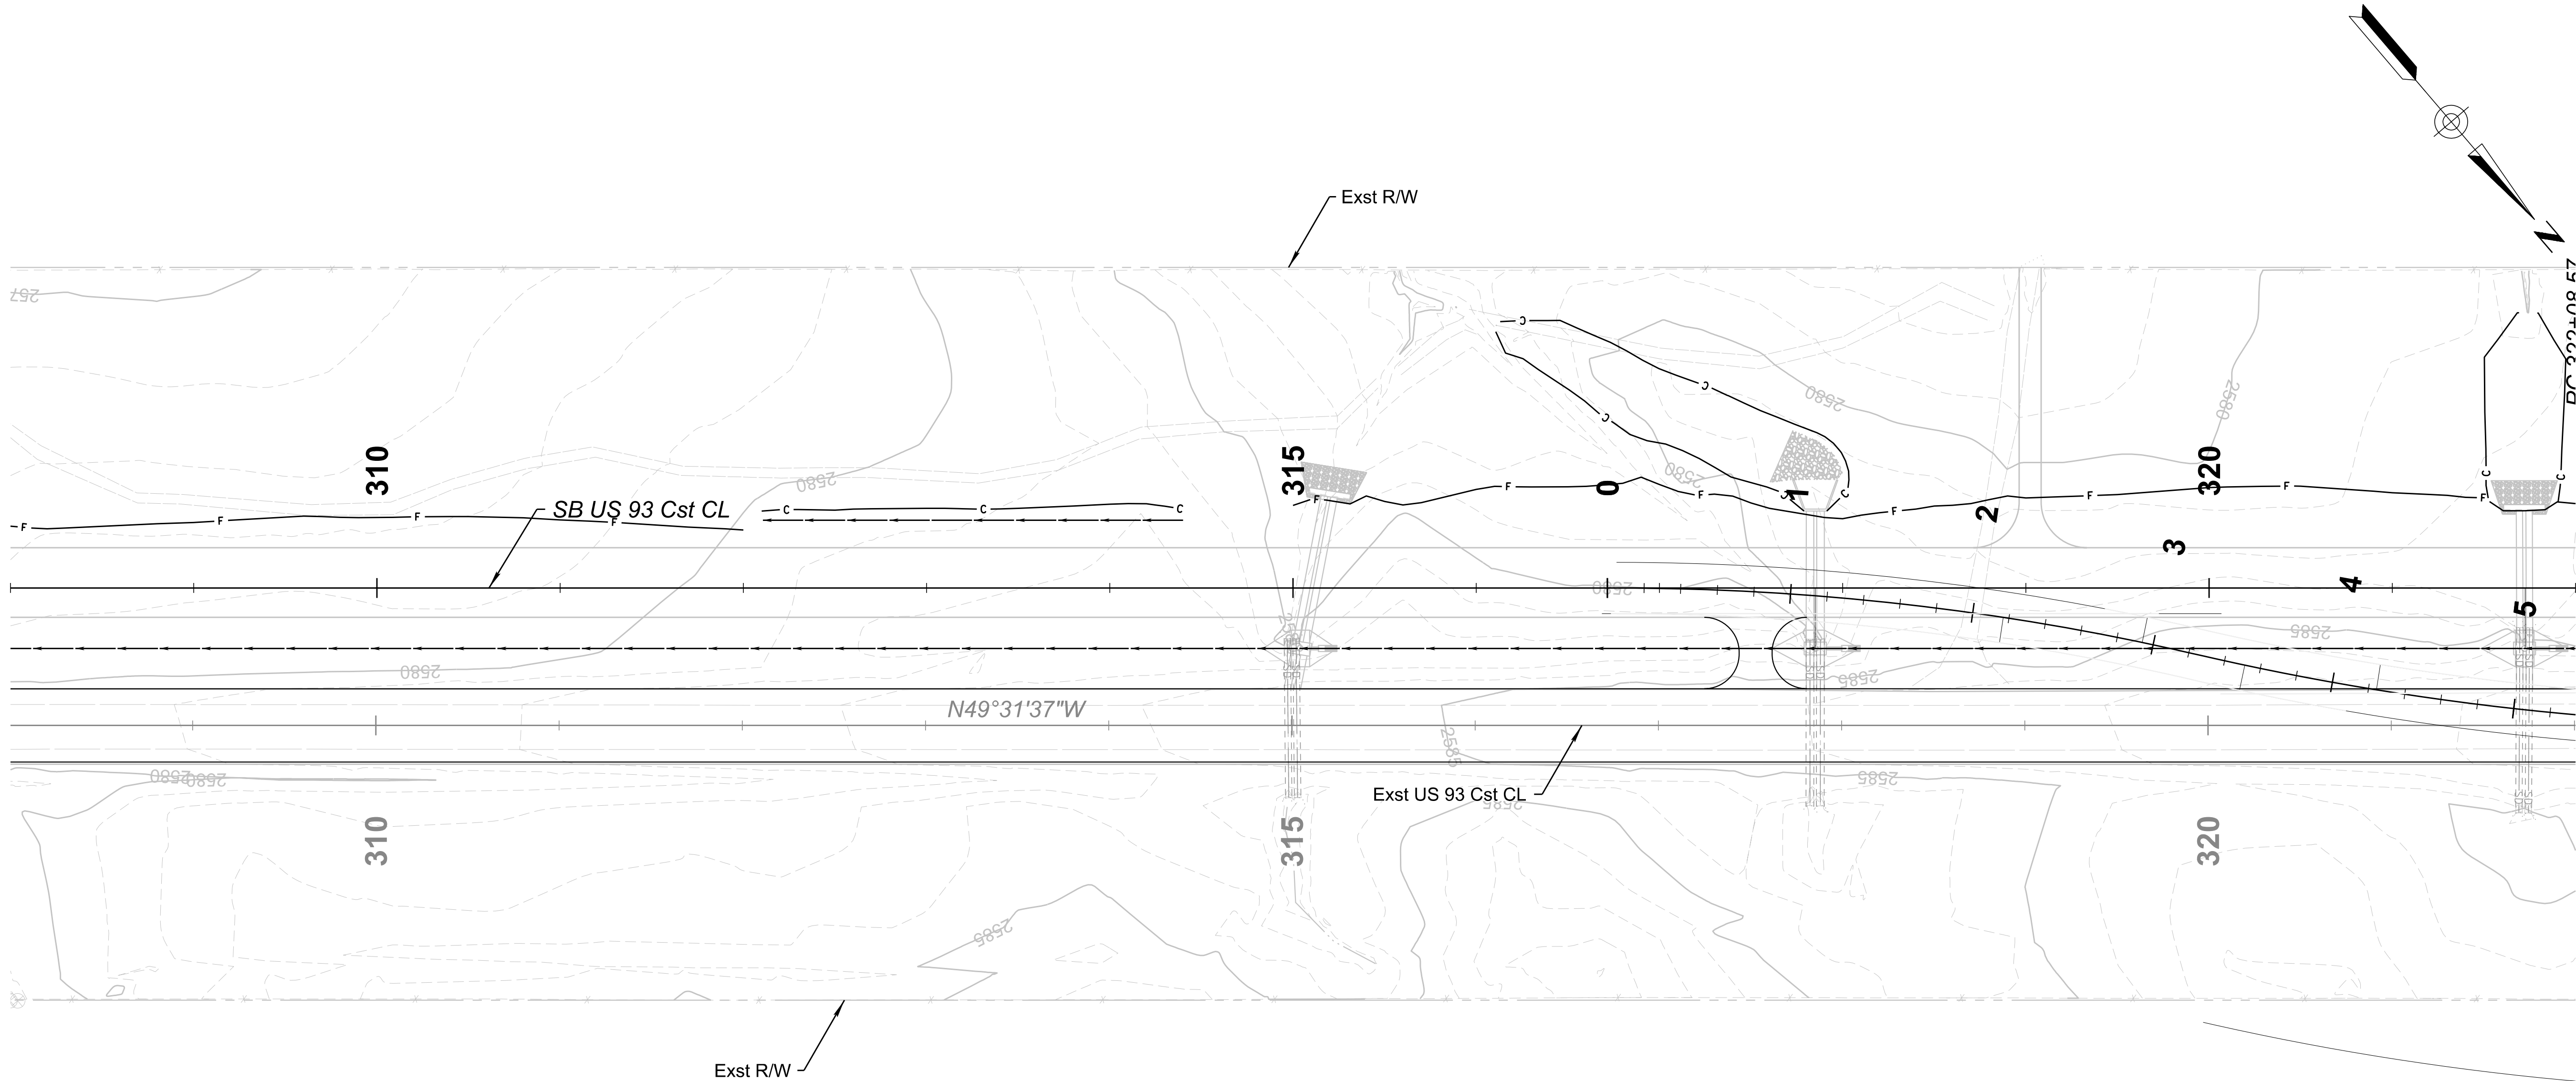


LEGEND		
CODE	BOTANICAL NAME	COMMON NAME
FC	FEROCACTUS CYLINDRACEUS	BARREL
FS	FOUQUIERIA SPLENDENS	OCOTILLO
PG	PENIOCEREUS GREGGII	ARIZONA QUEEN OF THE NIGHT

- CODE
XX

SA = SALVAGE
- CODE
XX


NS = NO SALVAGE
- CODE
XX

RIP = REMAIN IN PLACE

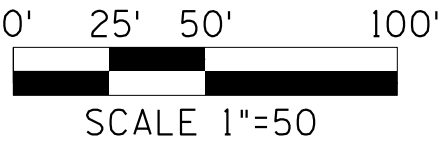

NO INVENTORIED PLANT MATERIAL THIS SHEET

	DESIGN	NAME	DATE	ARIZONA DEPARTMENT OF TRANSPORTATION PROJECT DELIVERY AND OPERATIONS DIVISION ROADWAY DESIGN SERVICES	ROUTE	F.H.W.A. Arizona Division	STATE ARIZ.	PROJECT NO.	FEDERAL ID NO.	SHEET NO.	TOTAL SHEETS	RECORD DRAWING
	DRAWN	STAFF	06/26		US 93			093 YV 189	093-B(230)T	471	524	
	CHECKED	W COLEBANK	06/26			MILEPOST 189.92	LOCATION WICKENBURG RANCH WAY TO VISTA ROYALE					
					PLANT INVENTORY SB US 93 STA 308+00 TO STA 322+00	STRUCTURE NO.	TRACS NO. F0738 01C		OF			

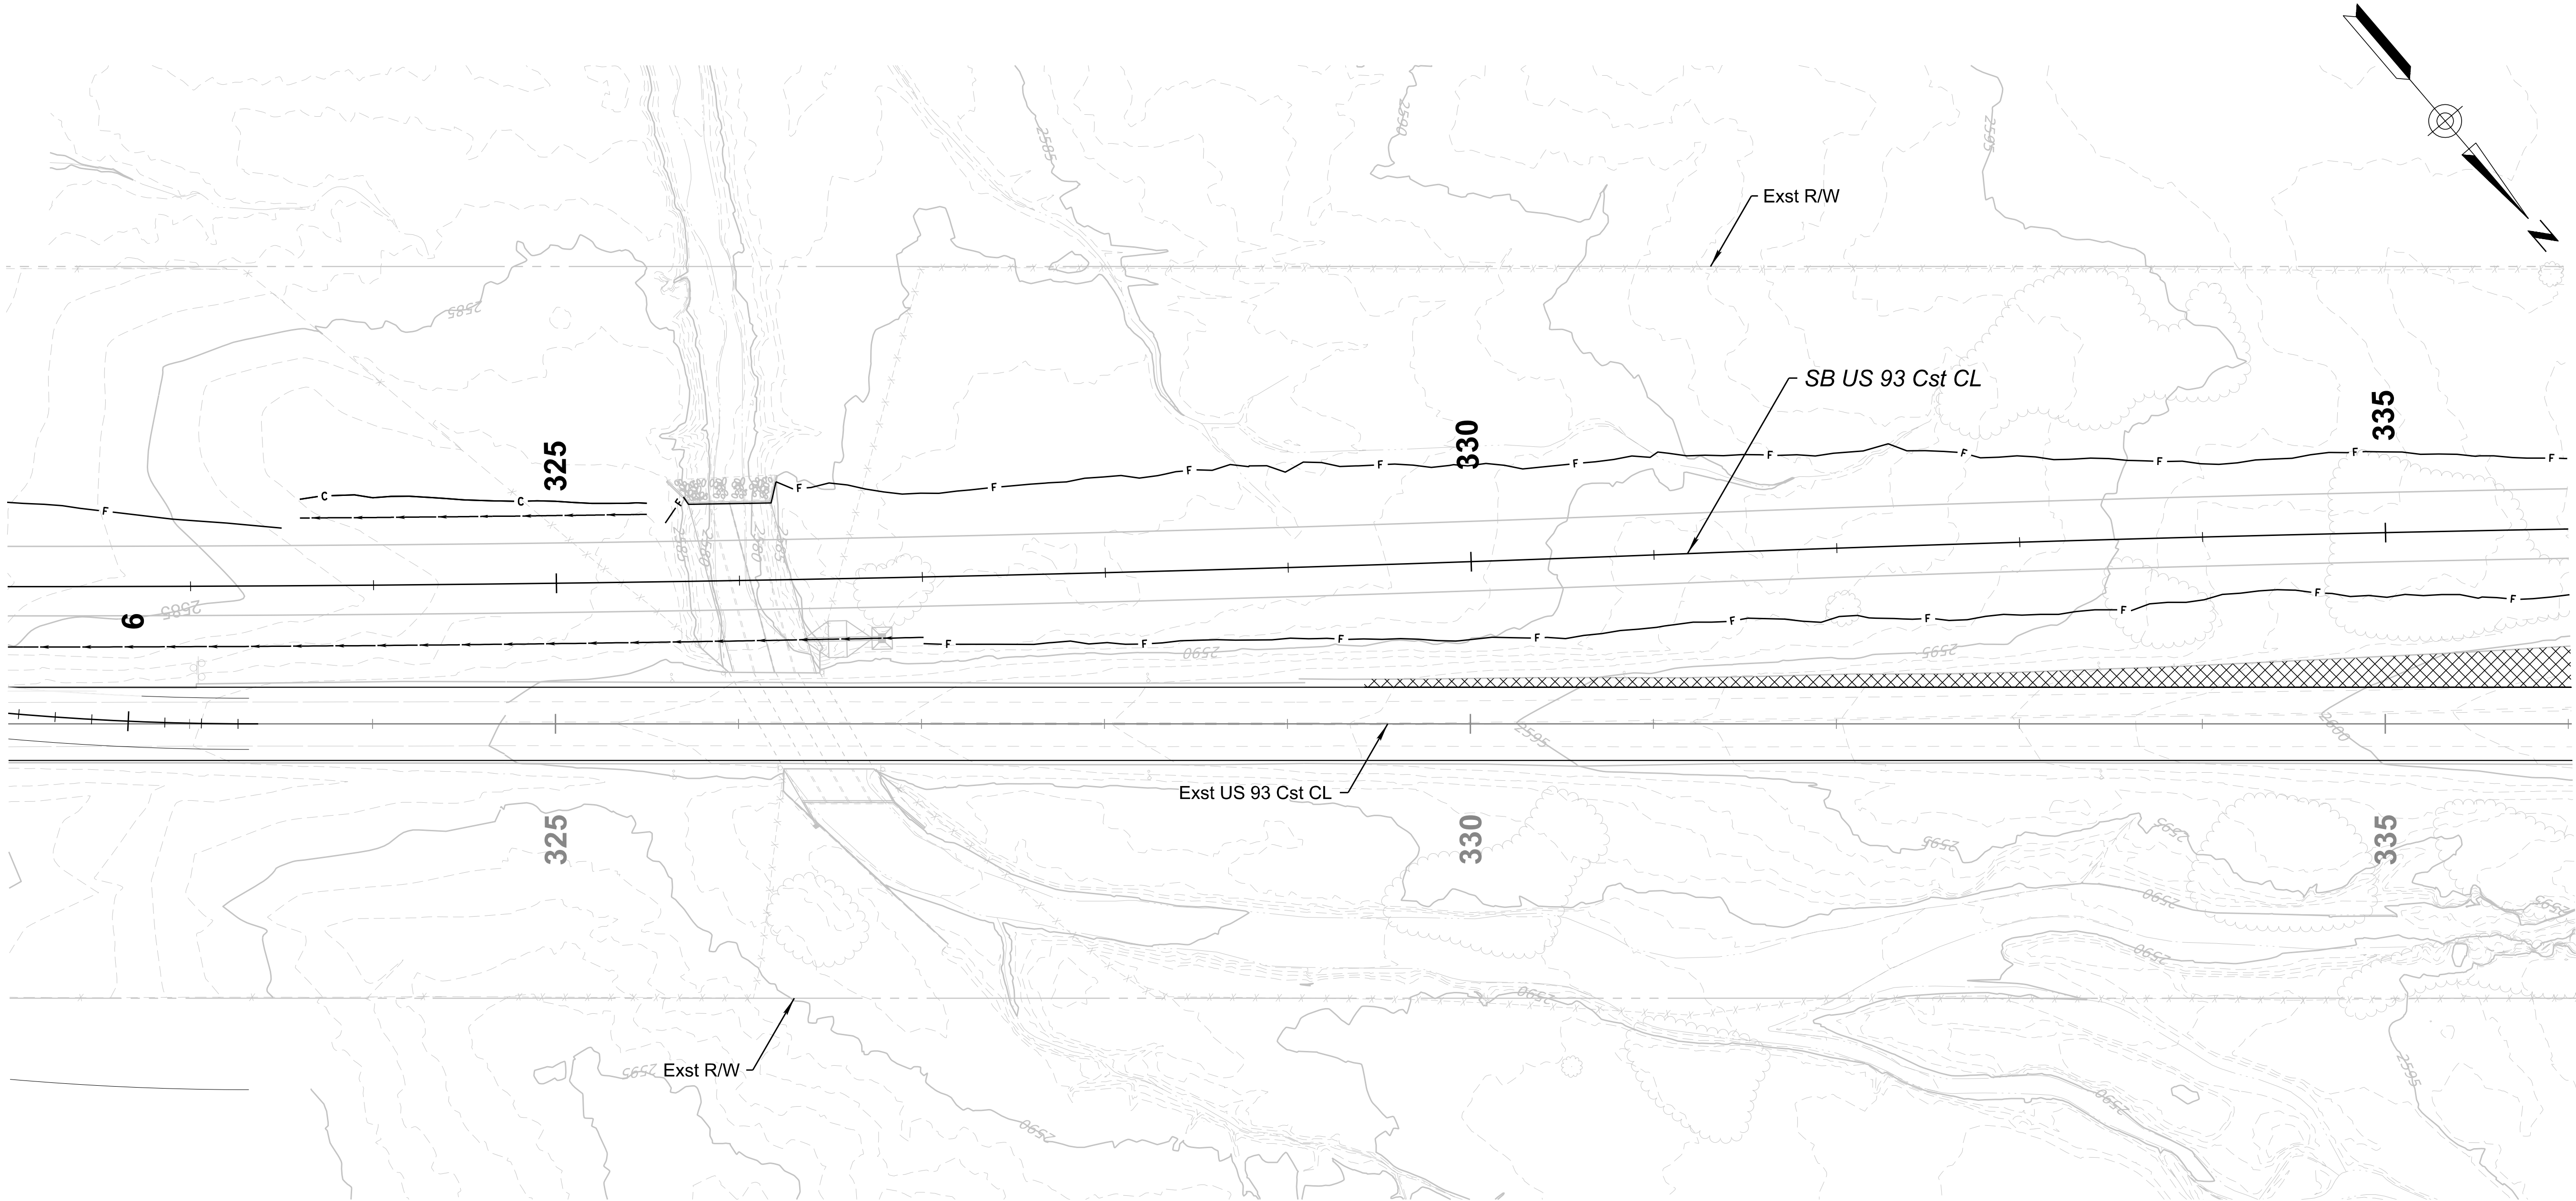

LEGEND

CODE	BOTANICAL NAME	COMMON NAME
FC	FEROCACTUS CYLINDRACEUS	BARREL
FS	FOUQUIERIA SPLENDENS	OCOTILLO
PG	PENIOCEREUS GREGGII	ARIZONA QUEEN OF THE NIGHT


- CODE
XX

SA = SALVAGE
- CODE
XX


NS = NO SALVAGE
- CODE
XX

RIP = REMAIN IN PLACE

NO INVENTORIED PLANT MATERIAL THIS SHEET

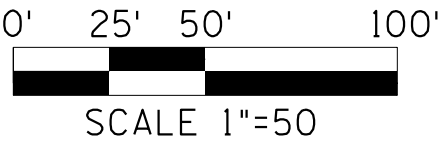

	DESIGN	NAME	DATE	ARIZONA DEPARTMENT OF TRANSPORTATION PROJECT DELIVERY AND OPERATIONS DIVISION ROADWAY DESIGN SERVICES	ROUTE	F.H.W.A. Arizona Division	STATE	PROJECT NO.	FEDERAL ID NO.	SHEET NO.	TOTAL SHEETS	RECORD DRAWING
	DRAWN	STAFF	06/26		MILEPOST		ARIZ.	093 YV 189	093-B(230)T	472	524	
	CHECKED	W COLEBANK	06/26		STRUCTURE NO.							
					PLANT INVENTORY SB US 93 STA 322+00 TO STA 336+00		LOCATION WICKENBURG RANCH WAY TO VISTA ROYALE DWG No. P-2.12					
						TRACS NO. F0738 01C		OF				

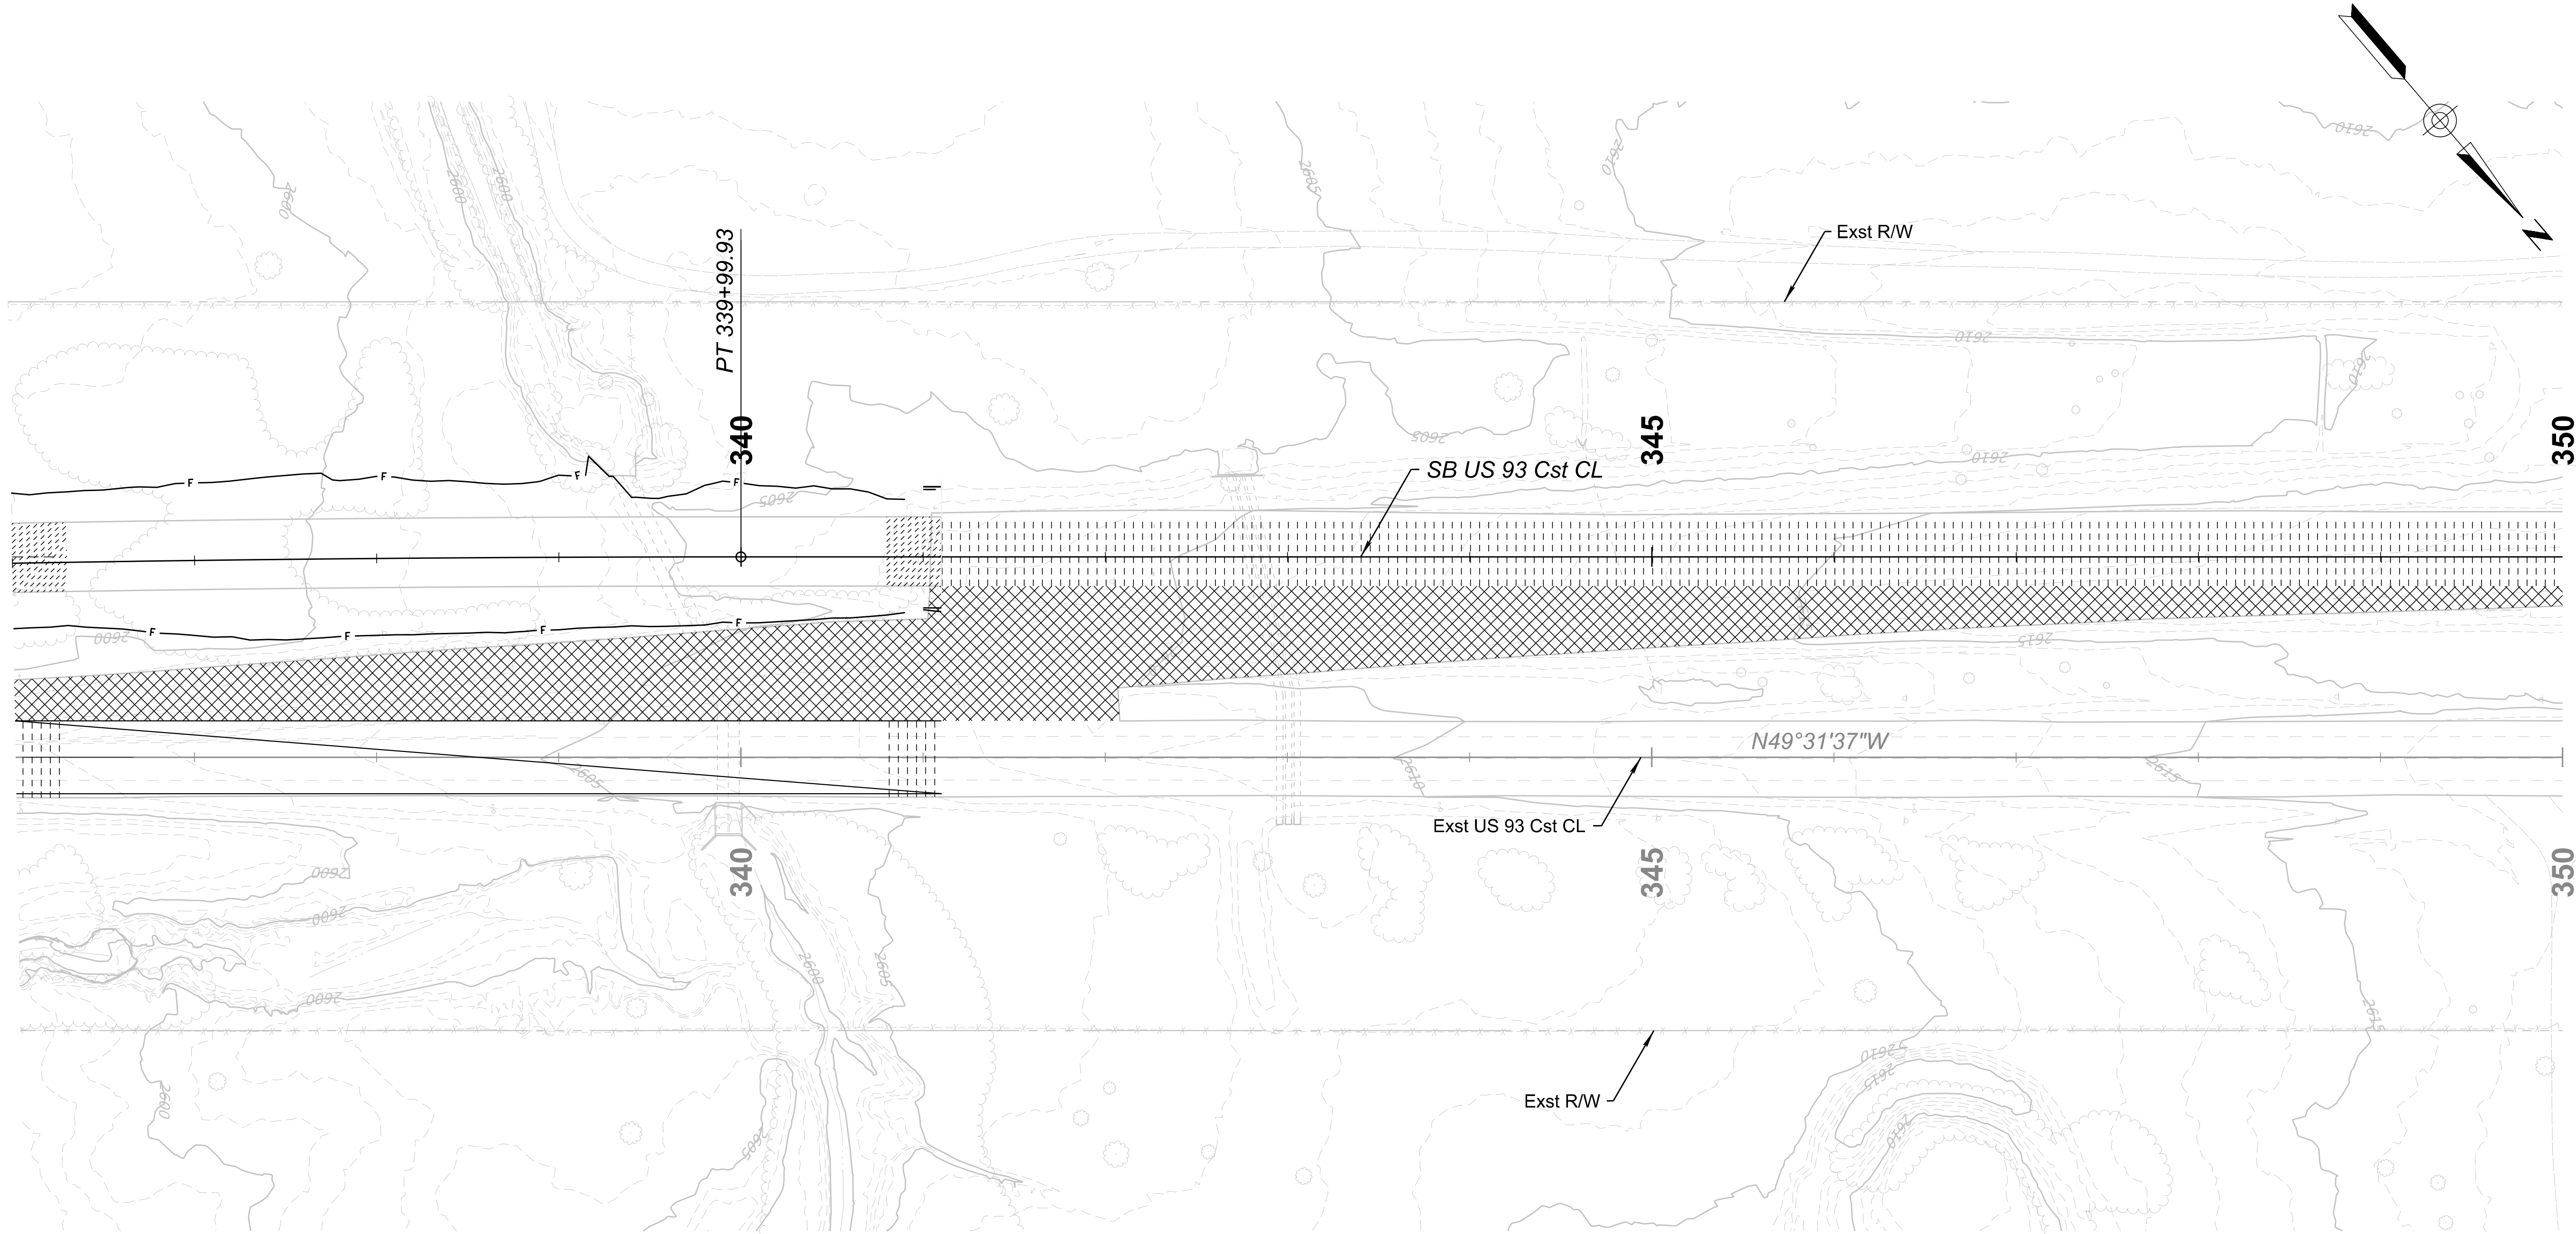

LEGEND

CODE	BOTANICAL NAME	COMMON NAME
FC	FEROCACTUS CYLINDRACEUS	BARREL
FS	FOUQUIERIA SPLENDENS	OCOTILLO
PG	PENIOCEREUS GREGGII	ARIZONA QUEEN OF THE NIGHT


- CODE
XX

SA = SALVAGE
- CODE
XX


NS = NO SALVAGE
- CODE
XX

RIP = REMAIN IN PLACE

NO INVENTORIED PLANT MATERIAL THIS SHEET

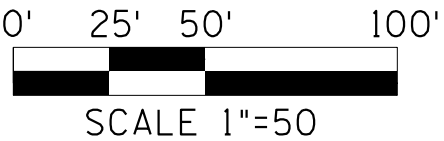

		NAME	DATE	ARIZONA DEPARTMENT OF TRANSPORTATION PROJECT DELIVERY AND OPERATIONS DIVISION ROADWAY DESIGN SERVICES	ROUTE	F.H.W.A. Arizona Division	STATE	PROJECT NO.	FEDERAL ID NO.	SHEET NO.	TOTAL SHEETS	RECORD DRAWING
	DESIGN	W HERRERA	06/26		US 93	ARIZ.	093 YV 189	093-B(230)T	473	524		
	DRAWN	STAFF	06/26		MILEPOST							
	CHECKED	W COLEBANK	06/26	189.92	LOCATION	WICKENBURG RANCH WAY TO VISTA ROYALE					DWG No. P-2.13	
					STRUCTURE NO.	TRACS NO. F0738 01C					____ OF ____	
PLANT INVENTORY SB US 93 STA 336+00 TO STA 350+00												

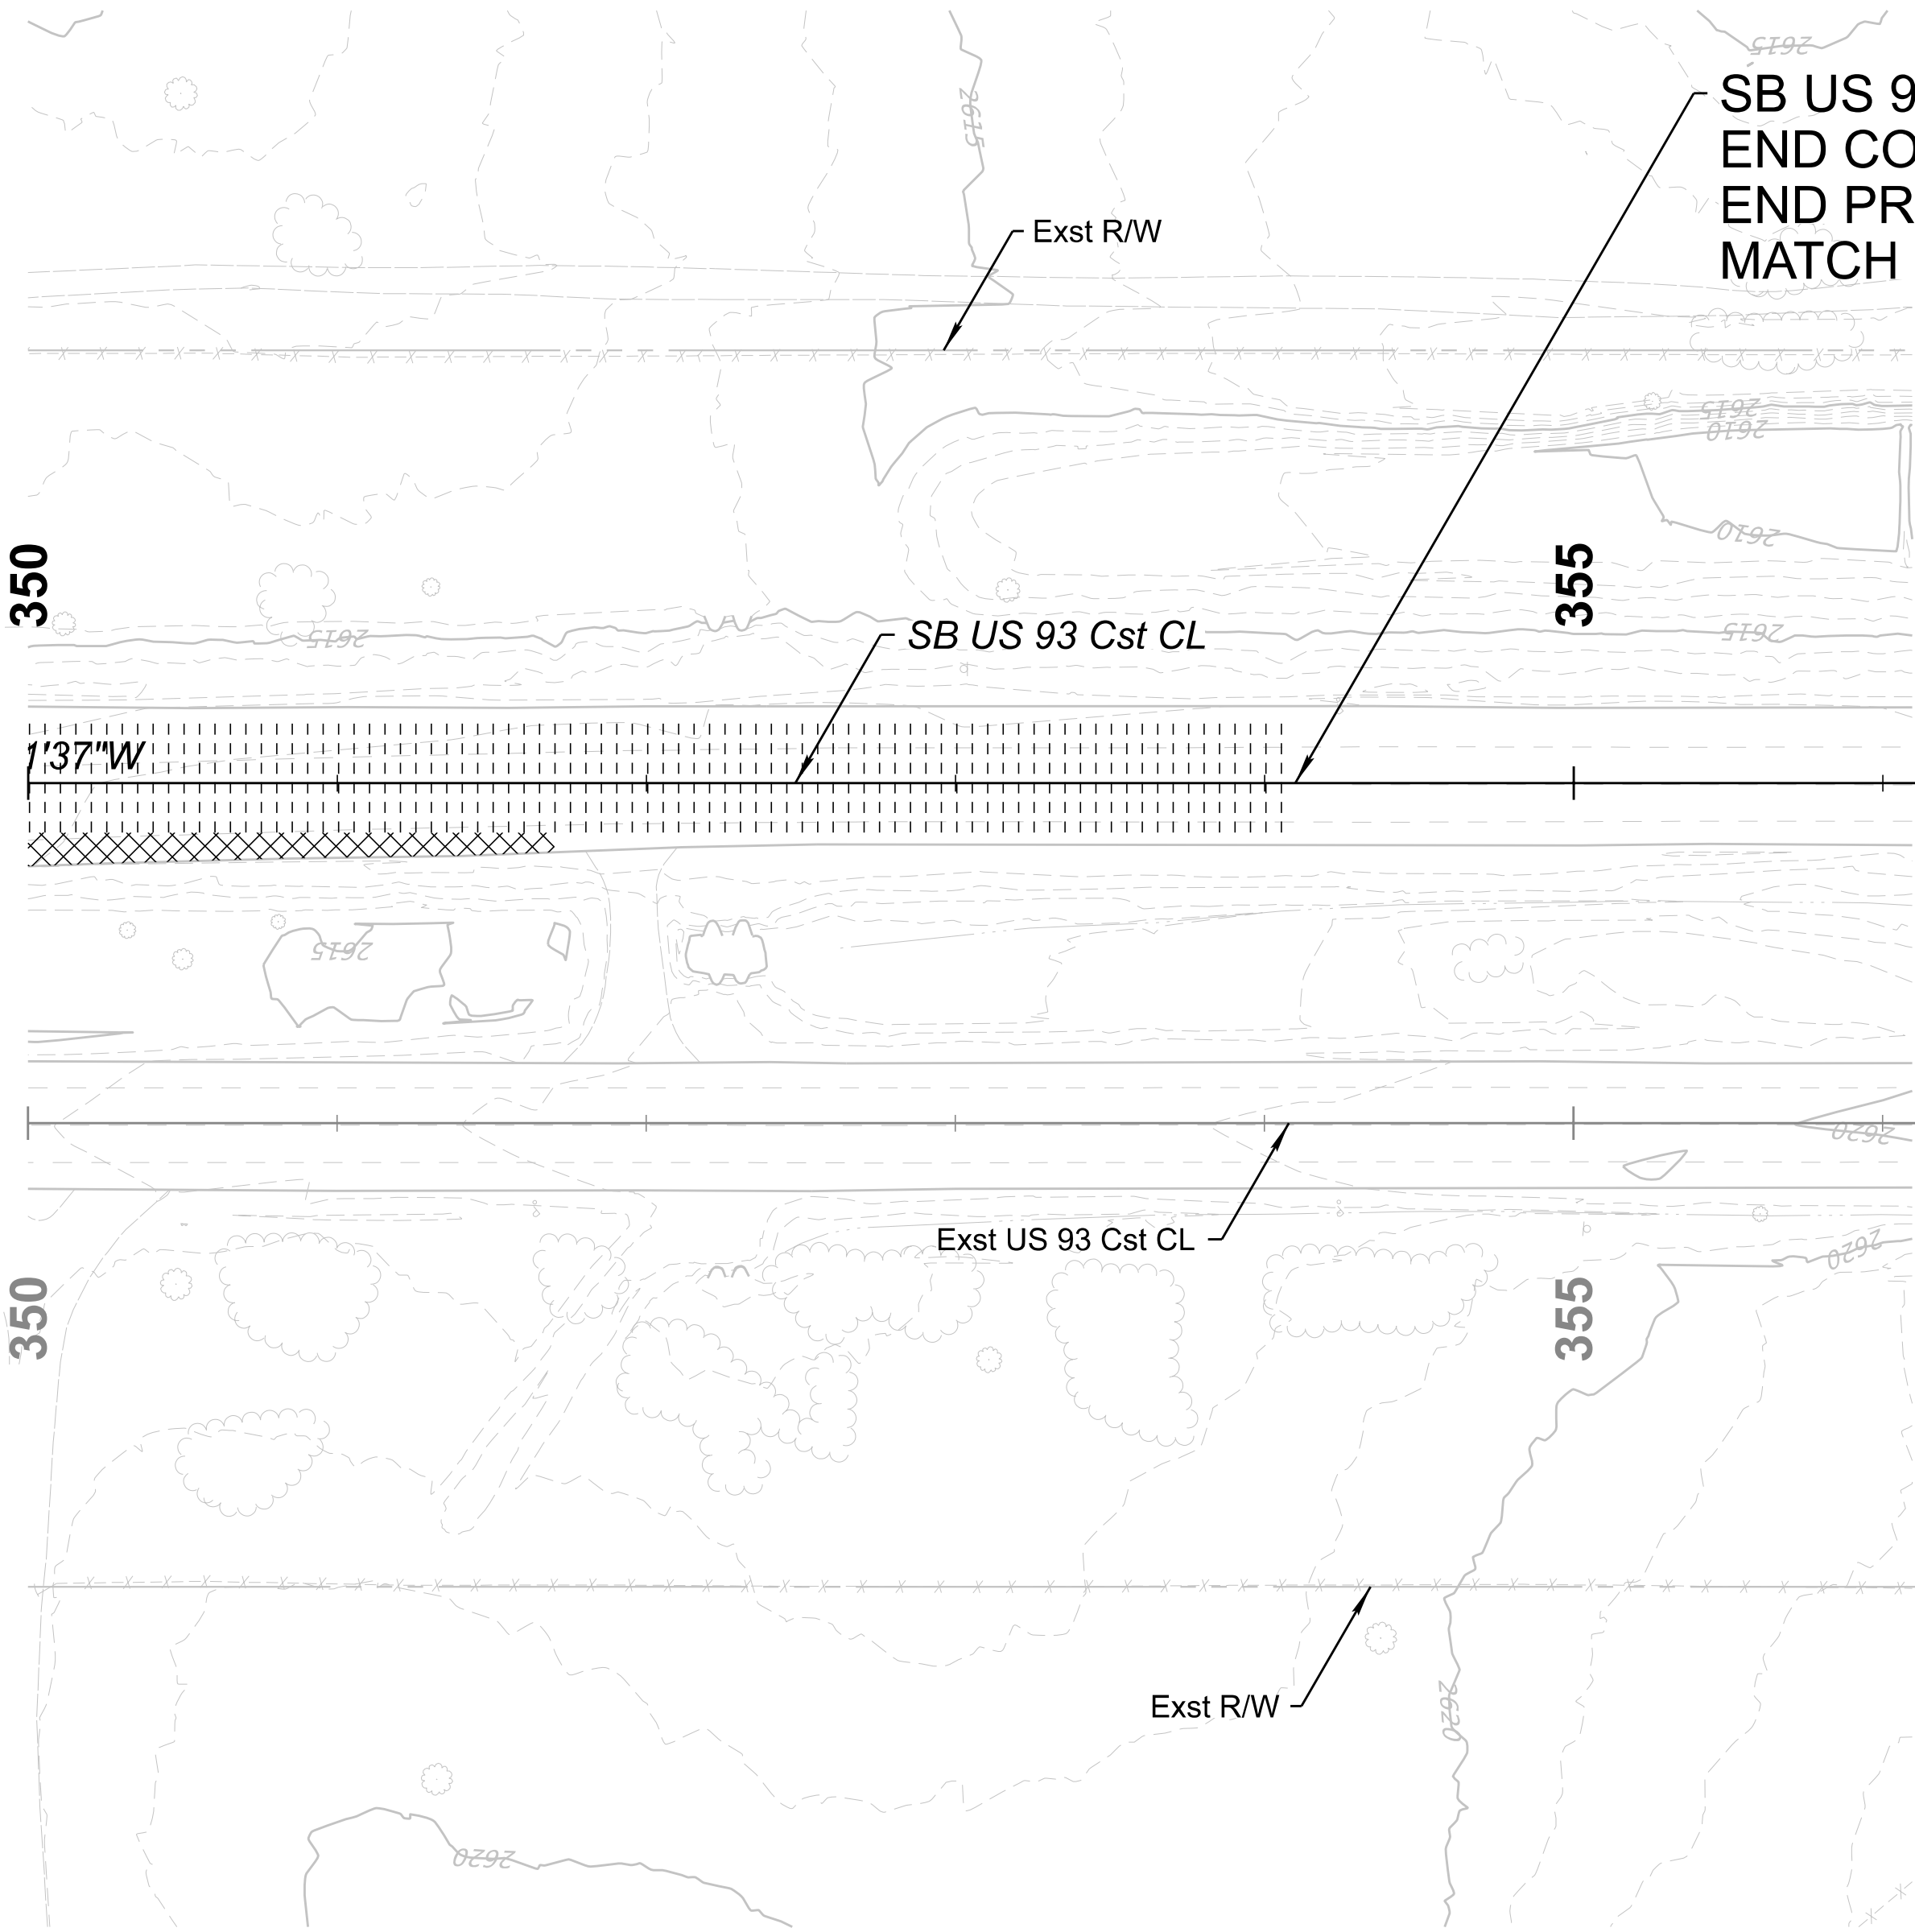

LEGEND

CODE	BOTANICAL NAME	COMMON NAME
FC	FEROCACTUS CYLINDRACEUS	BARREL
FS	FOUQUIERIA SPLENDENS	OCOTILLO
PG	PENIOCEREUS GREGGII	ARIZONA QUEEN OF THE NIGHT



- CODE
XX

SA = SALVAGE
- CODE
XX

NS = NO SALVAGE
- CODE
XX

RIP = REMAIN IN PLACE

NO INVENTORIED PLANT MATERIAL THIS SHEET

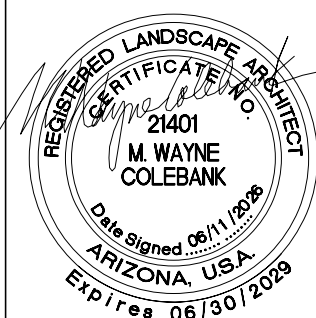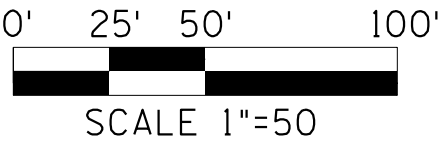

	NAME	DATE
DESIGN	W HERRERA	06/26
DRAWN	STAFF	06/26
CHECKED	W COLEBANK	06/26

LOGANSIMPSON
222 SOUTH PAVENHILL AVENUE, SUITE 202
TAMPA, FL 33601
P: (813) 987-1543

ARIZONA DEPARTMENT OF TRANSPORTATION PROJECT DELIVERY AND OPERATIONS DIVISION ROADWAY DESIGN SERVICES	ROUTE US 93
PLANT INVENTORY SB US 93 STA 350+00 TO STA 354+10	MILEPOST 189.92
	STRUCTURE NO.

F.H.W.A. Arizona Division	STATE ARIZ.	PROJECT NO. 093 YV 189	FEDERAL ID NO. 093-B(230)T	SHEET NO. 474	TOTAL SHEETS 524	RECORD DRAWING
LOCATION WICKENBURG RANCH WAY TO VISTA ROYALE						DWG No. P-2.14
TRACS NO. F0738 01C						___ OF ___

REV. DATE: 4/21

SALVAGED PLANTS REPLANTING
(NB STA 273+73 TO STA 340+110)

BOTANICAL NAME COMMON NAME	Total per Species
Ferocactus cylindraceus Barrel Cactus	2
Fouquieria splendens Ocotillo	1
Peniocereus greggii Arizona Queen Of The Night	1
Total per Section (all species)	4

SMALL CACTUS REPLANTING
(NB STA 273+73 TO STA 340+110)

BOTANICAL NAME COMMON NAME	Total per Species
Cylindropuntia acanthocarpa Buckhorn Cholla	77
Cylindropuntia leptocaulis Desert Christmas Cactus	4
Mammillaria grahamii Fishhook Pincushion Cactus	1
Opuntia chorotica Pancake Prickly Pear	9
Opuntia engelmannii Desert Prickly Pear	6
Yucca baccata Soaptree Yucca	2
Yucca elata Banana Yucca	13
Total per Section (all species)	112

SALVAGED PLANTS REPLANTING
(STA 136+00 TO STA 156+81)

BOTANICAL NAME COMMON NAME	Total per Species
Ferocactus cylindraceus Barrel Cactus	19

SMALL CACTUS REPLANTING
(STA 136+00 TO STA 156+81)


BOTANICAL NAME COMMON NAME	Total per Species
Cylindropuntia acanthocarpa Buckhorn Cholla	12
Yucca elata Banana Yucca	41
Total per Section (all species)	53

NOTES:


1. The intent is to move-once plant material with the quantities of small cacti listed above to the undisturbed areas shown in the Landscape Revegetation Sheets.
2. As part of the contractor's transplanting plan, the contractor shall identify the new planting locations for the small cacti to be replanted.
3. The tagged inventory plants are to be salvaged and replanted as shown in the Landscape Revegetation Sheets.

		NAME	DATE	ARIZONA DEPARTMENT OF TRANSPORTATION PROJECT DELIVERY AND OPERATIONS DIVISION ROADWAY DESIGN SERVICES	ROUTE	F.H.W.A. Arizona Division	STATE ARIZ.	PROJECT NO.	FEDERAL ID NO.	SHEET NO.	TOTAL SHEETS	RECORD DRAWING
	DESIGN	W HERRERA	06/26		US 93			093 YV 189	093-B(230)T	475	524	
	DRAWN	STAFF	06/26		LANDSCAPE REVEGETATION SUMMARY SHEET	MILEPOST 189.92	LOCATION WICKENBURG RANCH WAY TO VISTA ROYALE DWG No. L-1.01					
	CHECKED	W COLEBANK	06/26	STRUCTURE NO.		TRACS NO. F0738 01C ____ OF ____						


REV. DATE: 4/21

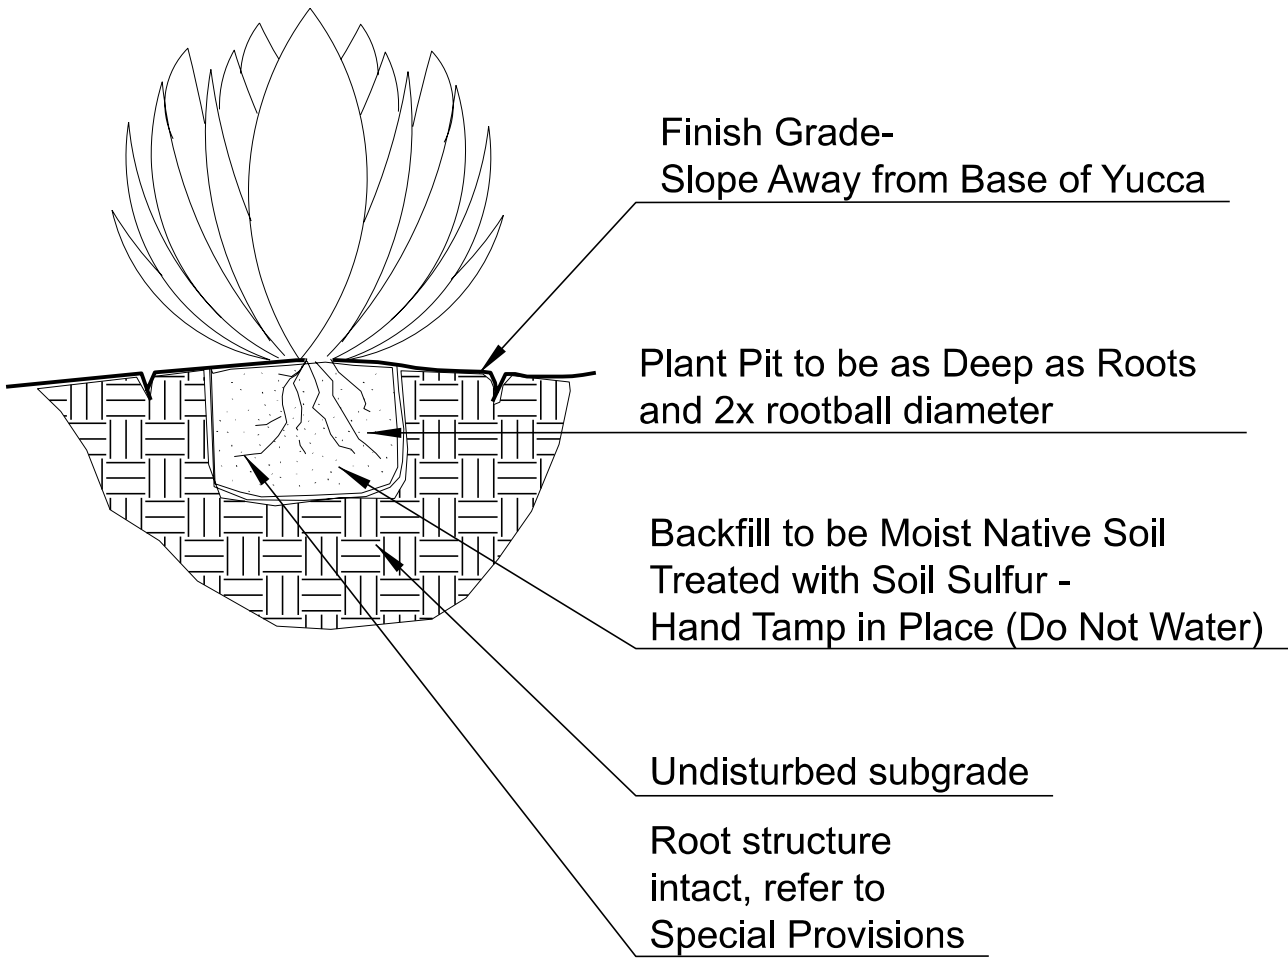


1 YUCCA PLANTING
NTS

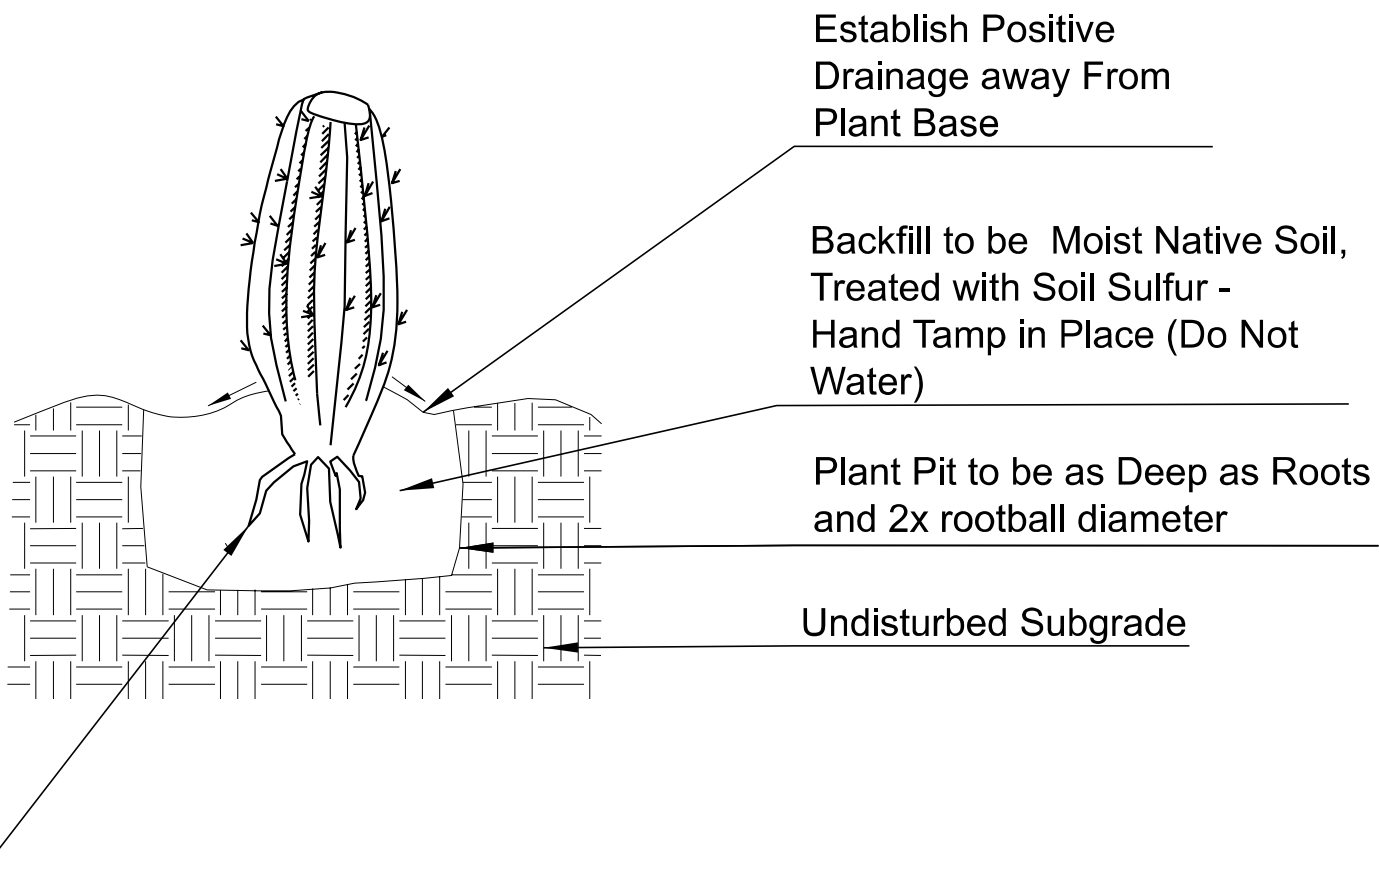


2 BARREL CACTUS PLANTING
NTS

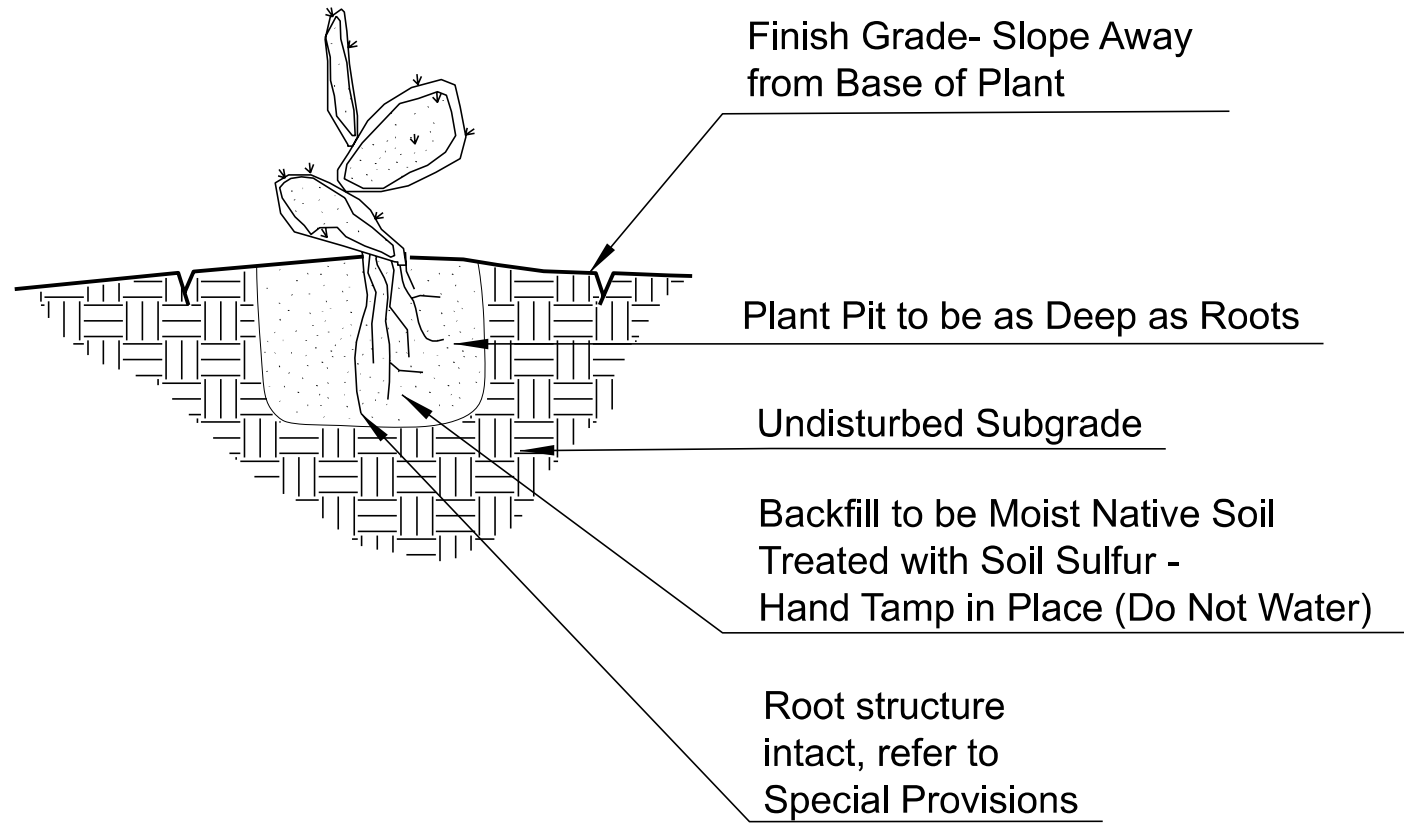

3 CHOLLA/PRICKLY PEAR PLANTING
NTS

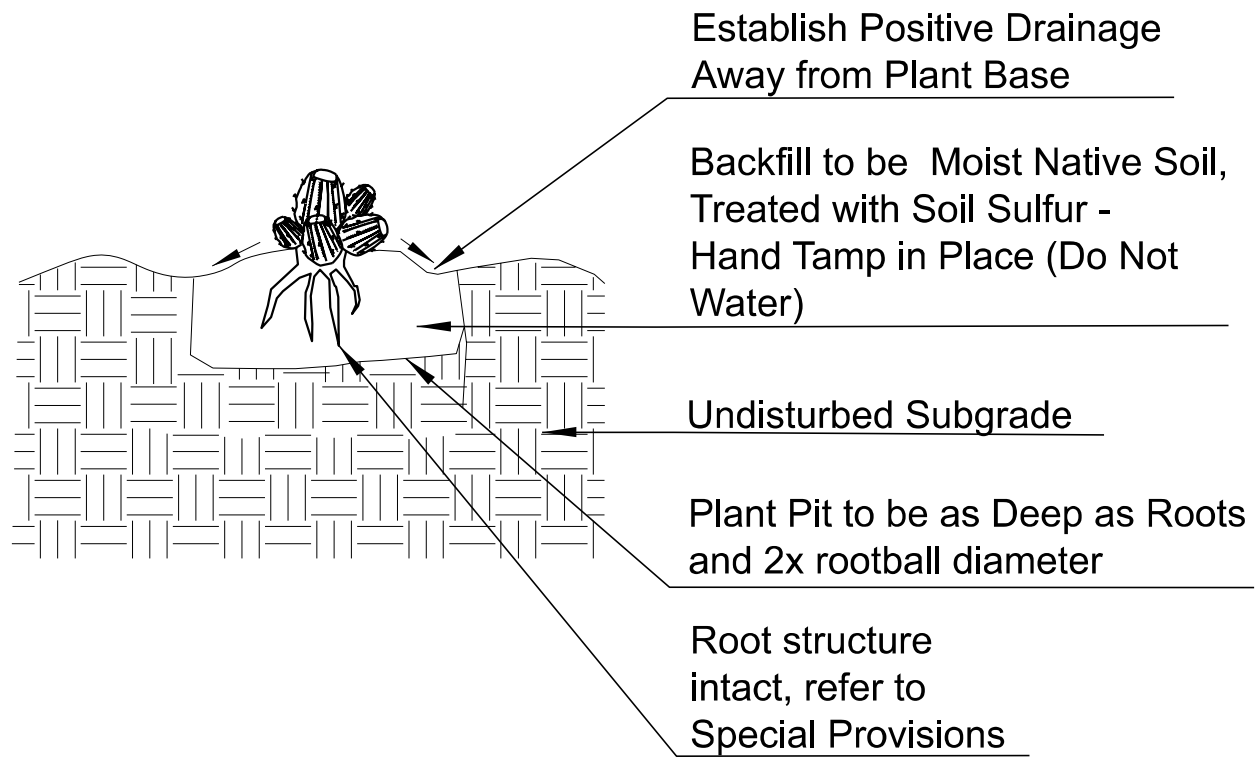


4 SMALL CACTUS PLANTING
NTS

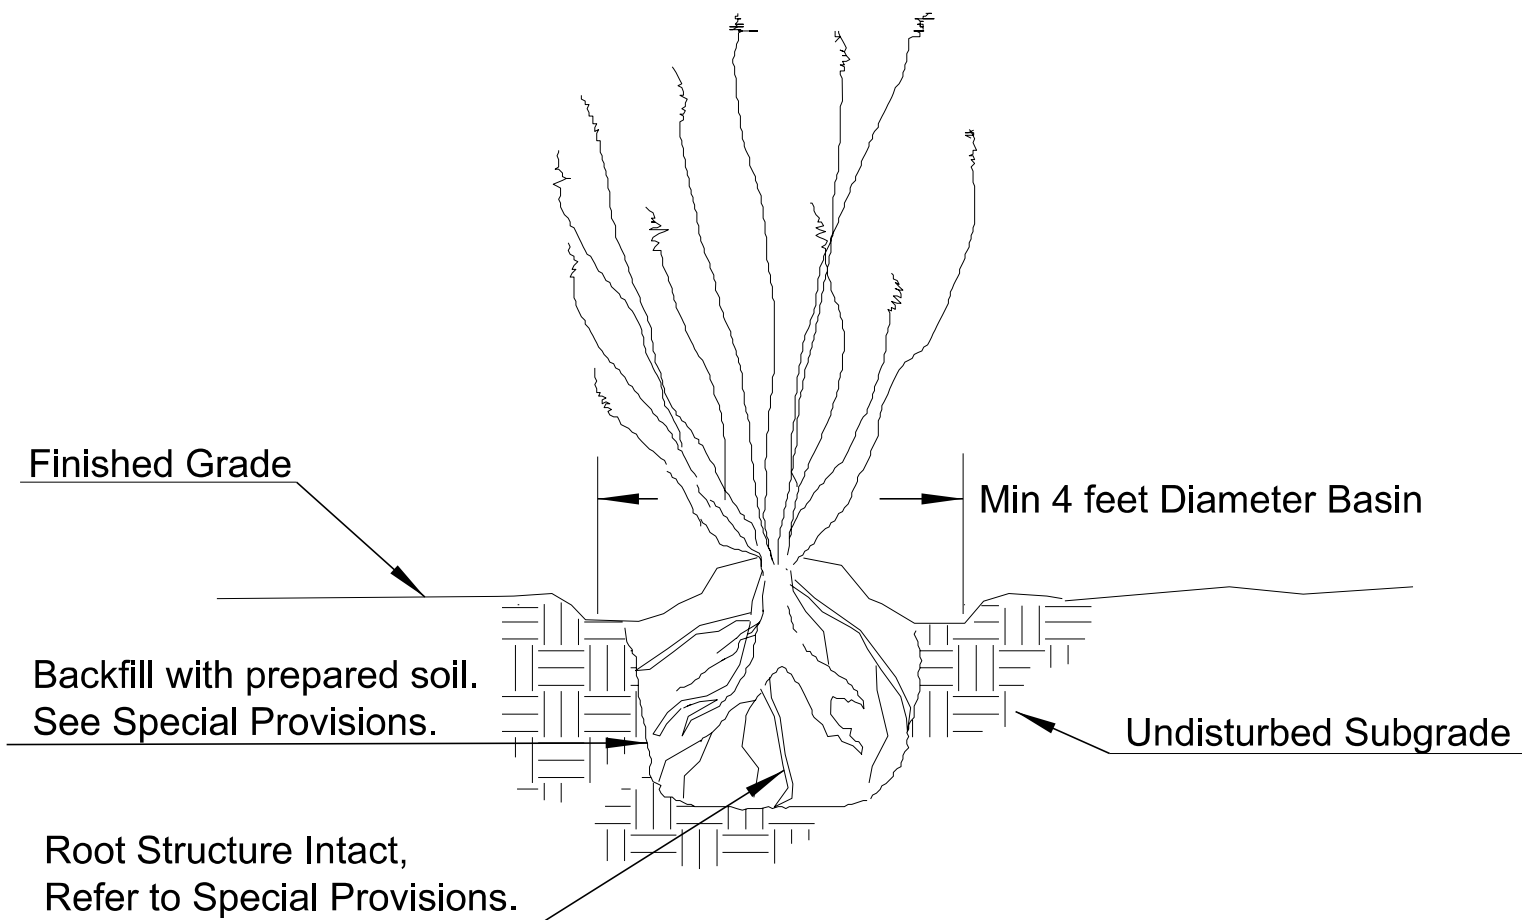

5 BARE ROOT OCOTILLO PLANTING
NTS

- GENERAL NOTES:
1. Root prune all shredded or damaged roots.
 2. Ensure all wounds to the root system are clean cut before planting, apply dusting sulfur to all areas below grade.
 3. For backfill see special provisions.
 4. Bare roots shall not be out of the ground for more than two (2) days before planting.
 5. Planting depth shall be depth at which plant was grown.
 6. Replant salvaged cacti in original north-south orientation as originally grown.
 7. Roughen sides of plant pit prior to planting.

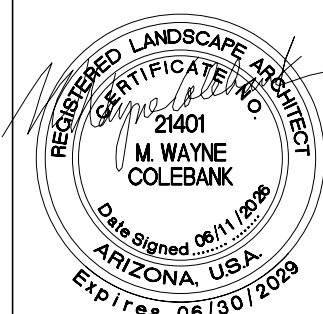


	NAME	DATE
DESIGN	W HERRERA	06/26
DRAWN	STAFF	06/26
CHECKED	W COLEBANK	06/26




LOGAN SIMPSON
222 SOUTH WILLOW AVENUE, SUITE 202
TAMPA, FL 33609
P: 813.967.1543

ARIZONA DEPARTMENT OF TRANSPORTATION PROJECT DELIVERY AND OPERATIONS DIVISION ROADWAY DESIGN SERVICES
LANDSCAPE REVEGETATION DETAIL SHEET


ROUTE US 93	F.H.W.A. Arizona Division	STATE ARIZ.	PROJECT NO. 093 YV 189	FEDERAL ID NO. 093-B(230)T	SHEET NO. 476	TOTAL SHEETS 524	RECORD DRAWING
MILEPOST 189.92	LOCATION WICKENBURG RANCH WAY TO VISTA ROYALE					DWG No. L-1.02	
STRUCTURE NO.	TRACS NO. F0738 01C					____ OF ____	

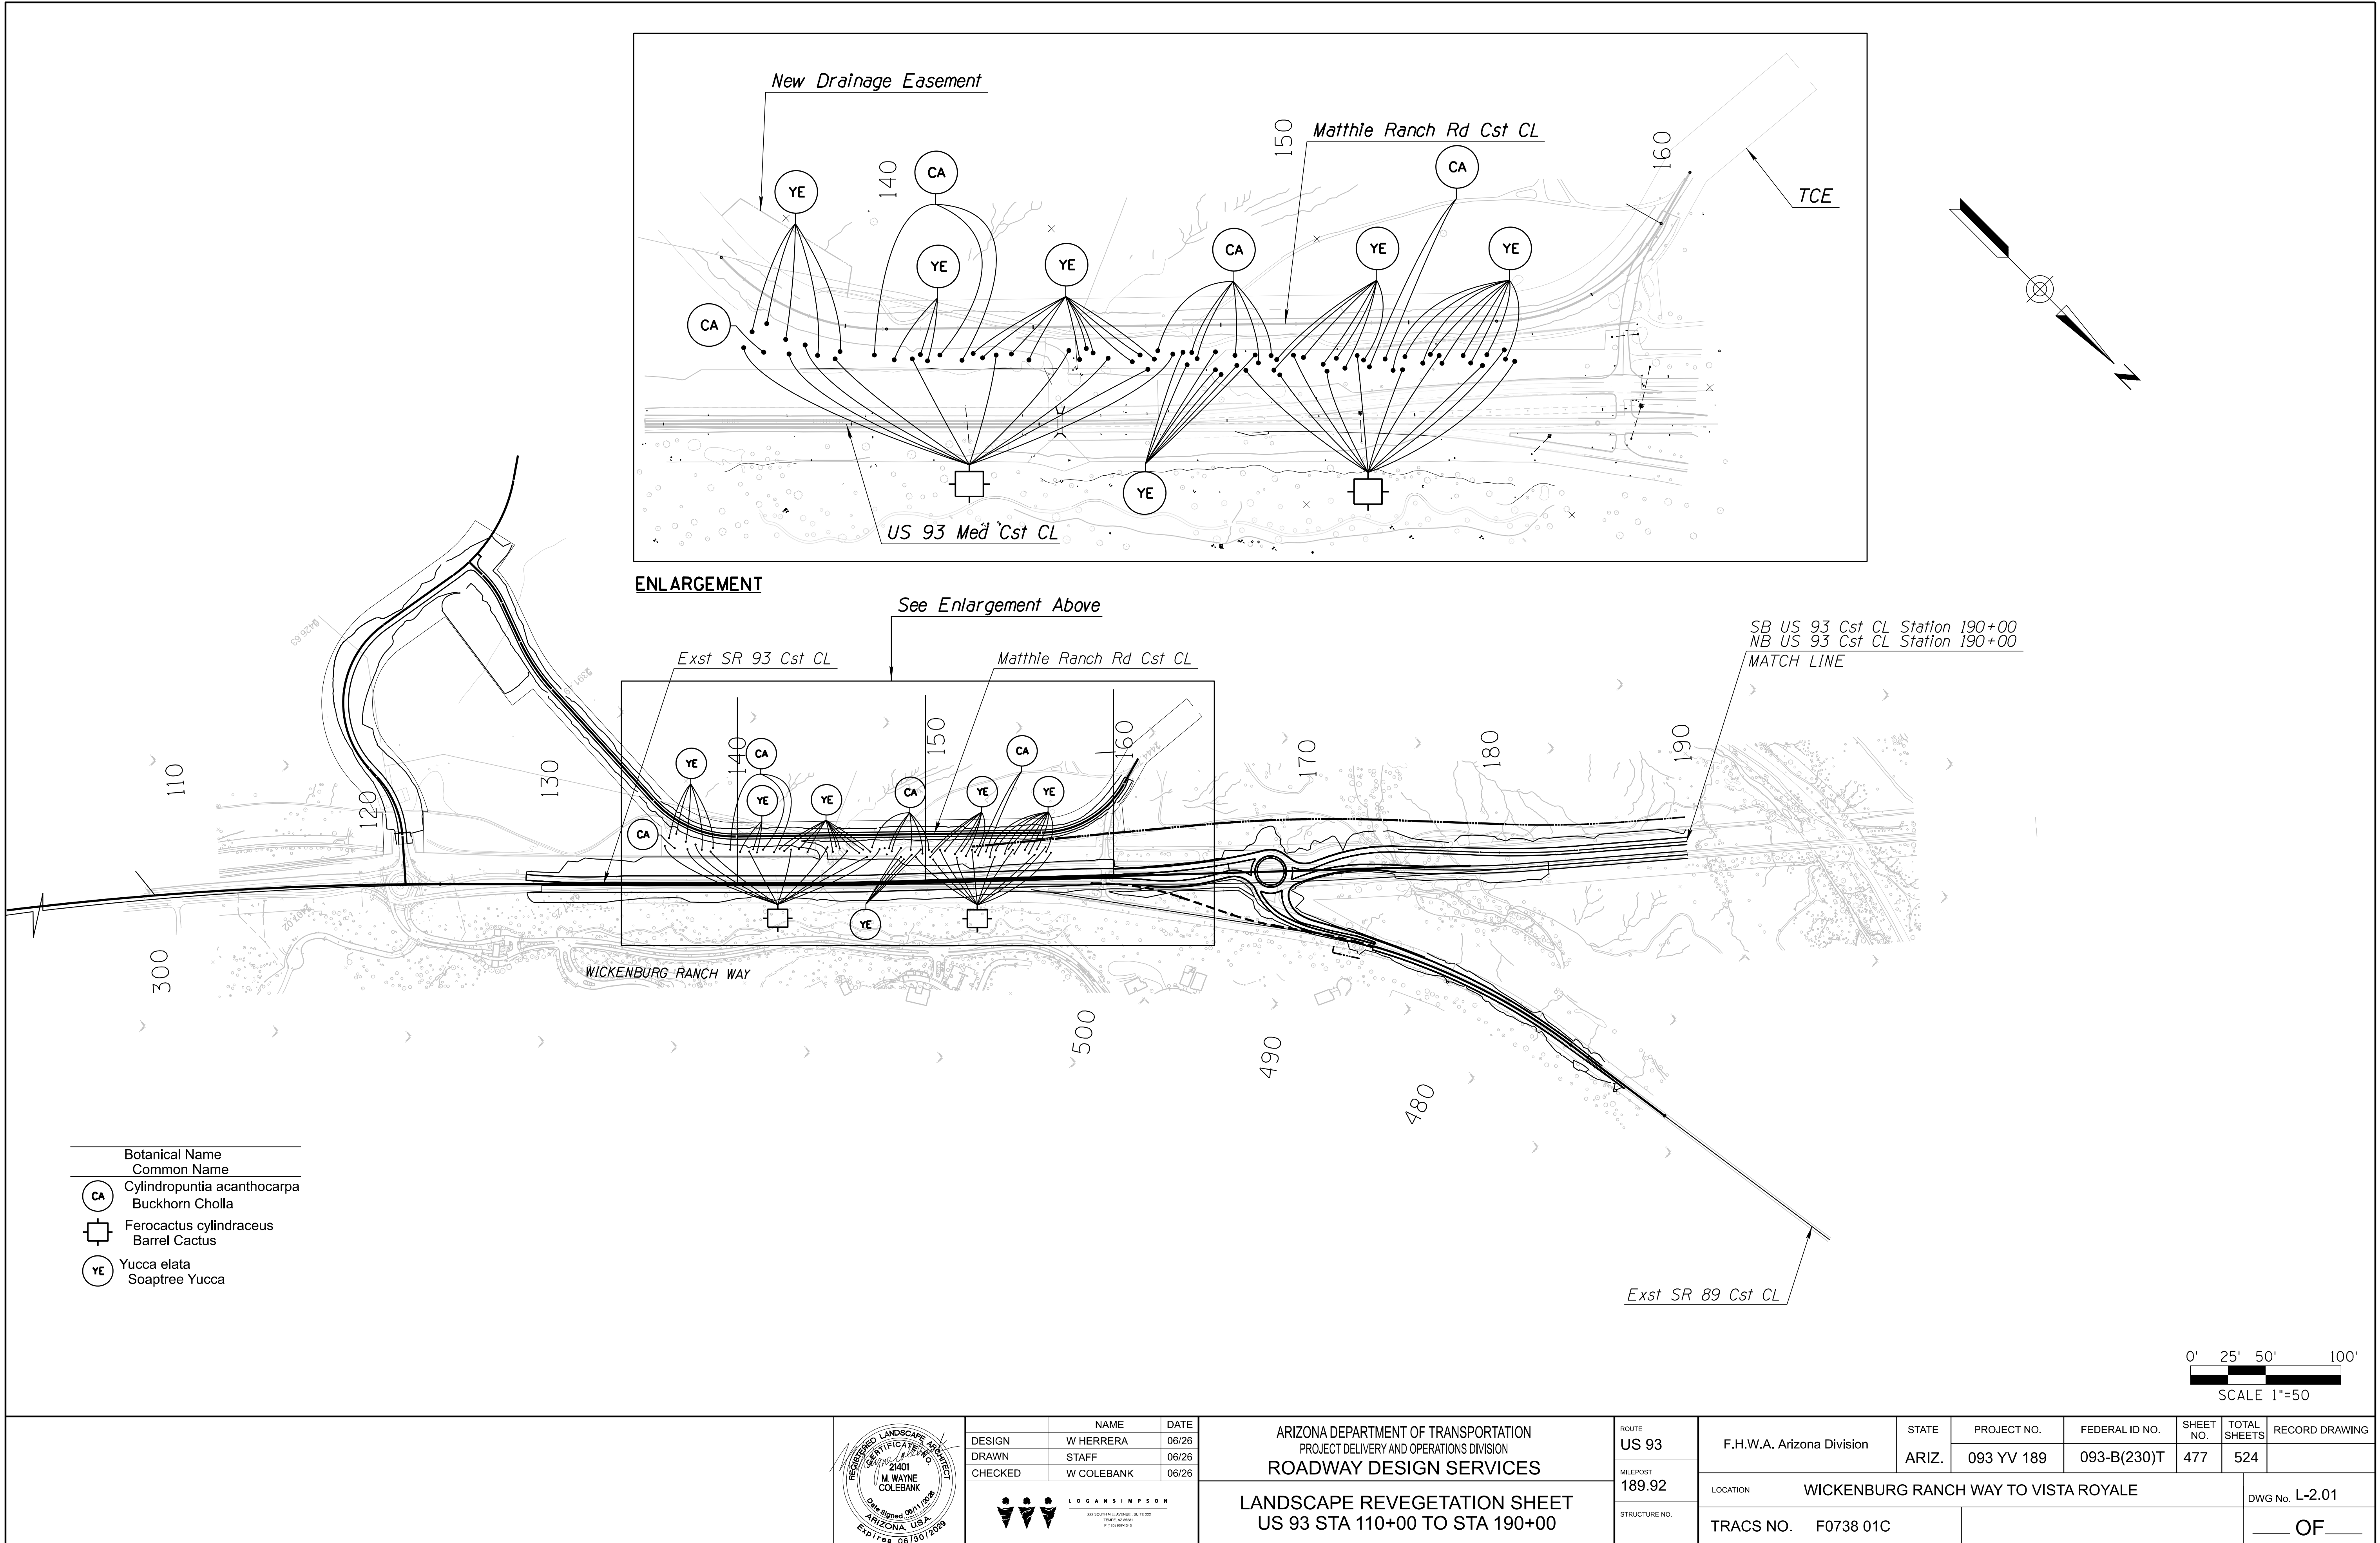

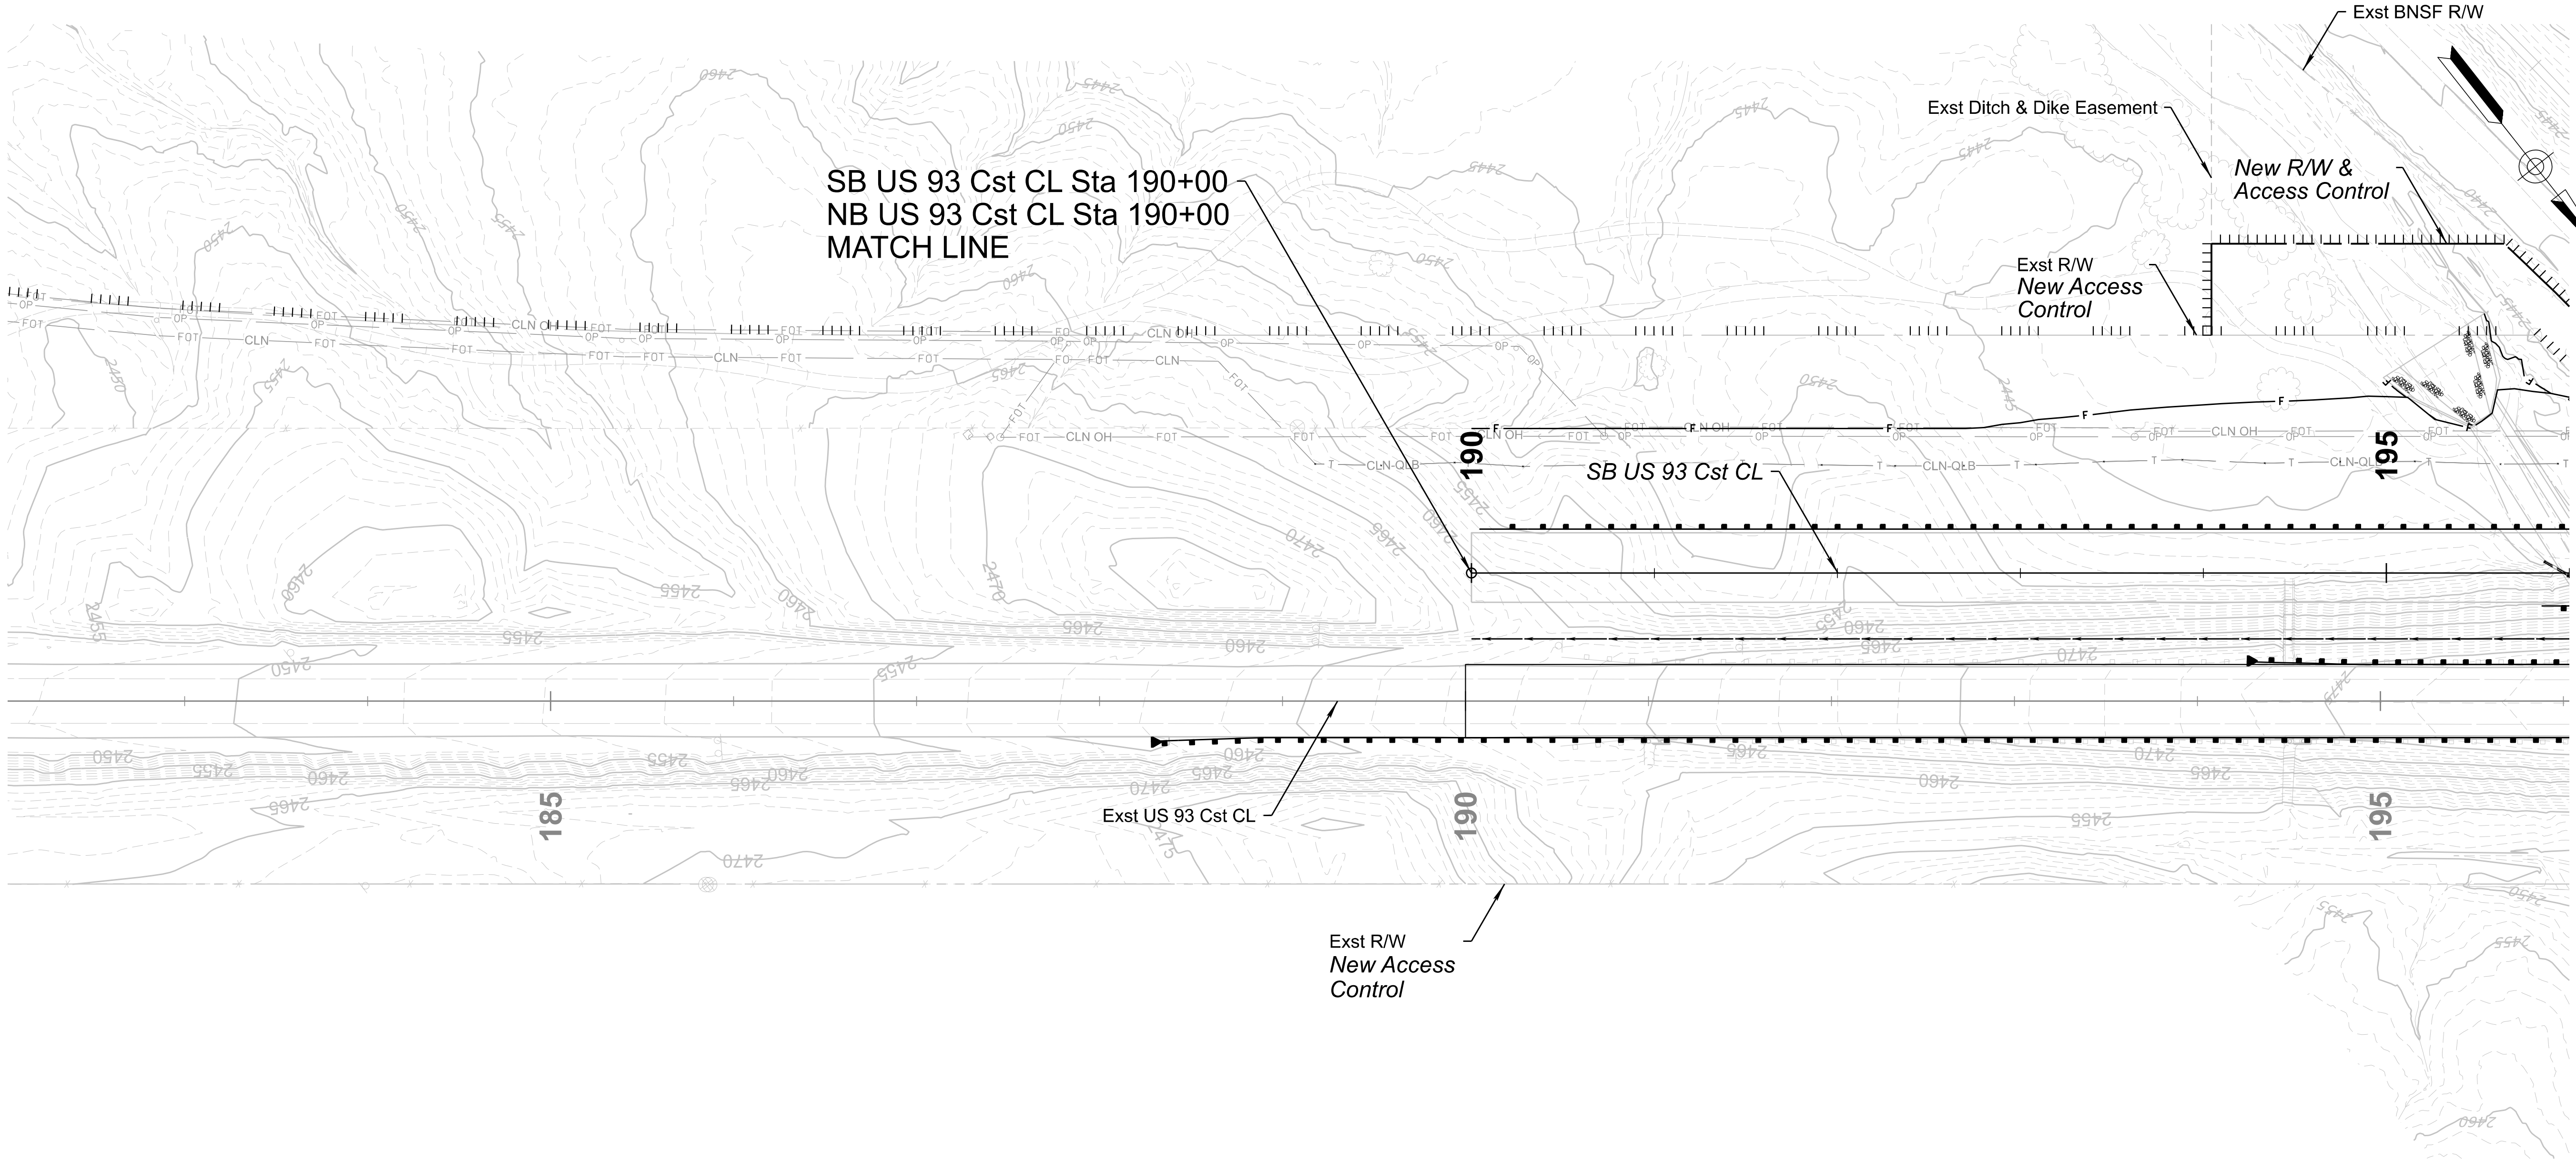


PLANT LEGEND

Botanical Name		Common Name	
CA	Cylindropuntia acanthocarpa	OC	Opuntia chorotica
	Buckhorn Cholla		Pancake Prickly Pear
CL	Cylindropuntia leptocaulis	OE	Opuntia engelmannii
	Desert Christmas Cactus		Desert Prickly Pear
*	Ferocactus cylindraceus	PG	Peniocereus greggii
	Barrel Cactus		Arizona Queen Of The Night
□	Fouquieria splendens	YB	Yucca baccata
	Ocotillo		Banana Yucca
MG	Mammillaria grahamii	YE	Yucca elata
	Fishhook Pincushion		Soaptree Yucca

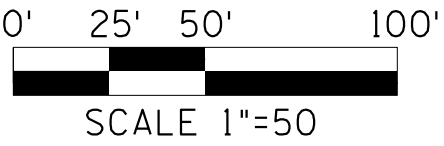

NO REVEGETATION PLANT MATERIAL THIS SHEET

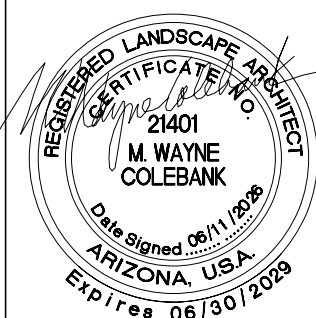


	NAME	DATE
DESIGN	W HERRERA	06/26
DRAWN	STAFF	06/26
CHECKED	W COLEBANK	06/26

LOGAN SIMPSON
222 SOUTH FARMER LANE SUITE 202
TAMPA, FL 33613
P: (813) 987-1243

ARIZONA DEPARTMENT OF TRANSPORTATION PROJECT DELIVERY AND OPERATIONS DIVISION ROADWAY DESIGN SERVICES	
LANDSCAPE REVEGETATION SHEET SB US 93 STA 190+00 TO STA 196+00	

ROUTE US 93
MILEPOST 189.92
STRUCTURE NO.

F.H.W.A. Arizona Division		STATE ARIZ.	PROJECT NO. 093 YV 189	FEDERAL ID NO. 093-B(230)T	SHEET NO. 478	TOTAL SHEETS 524	RECORD DRAWING
LOCATION WICKENBURG RANCH WAY TO VISTA ROYALE						DWG No. L-2.02	
TRACS NO. F0738 01C						___ OF ___	

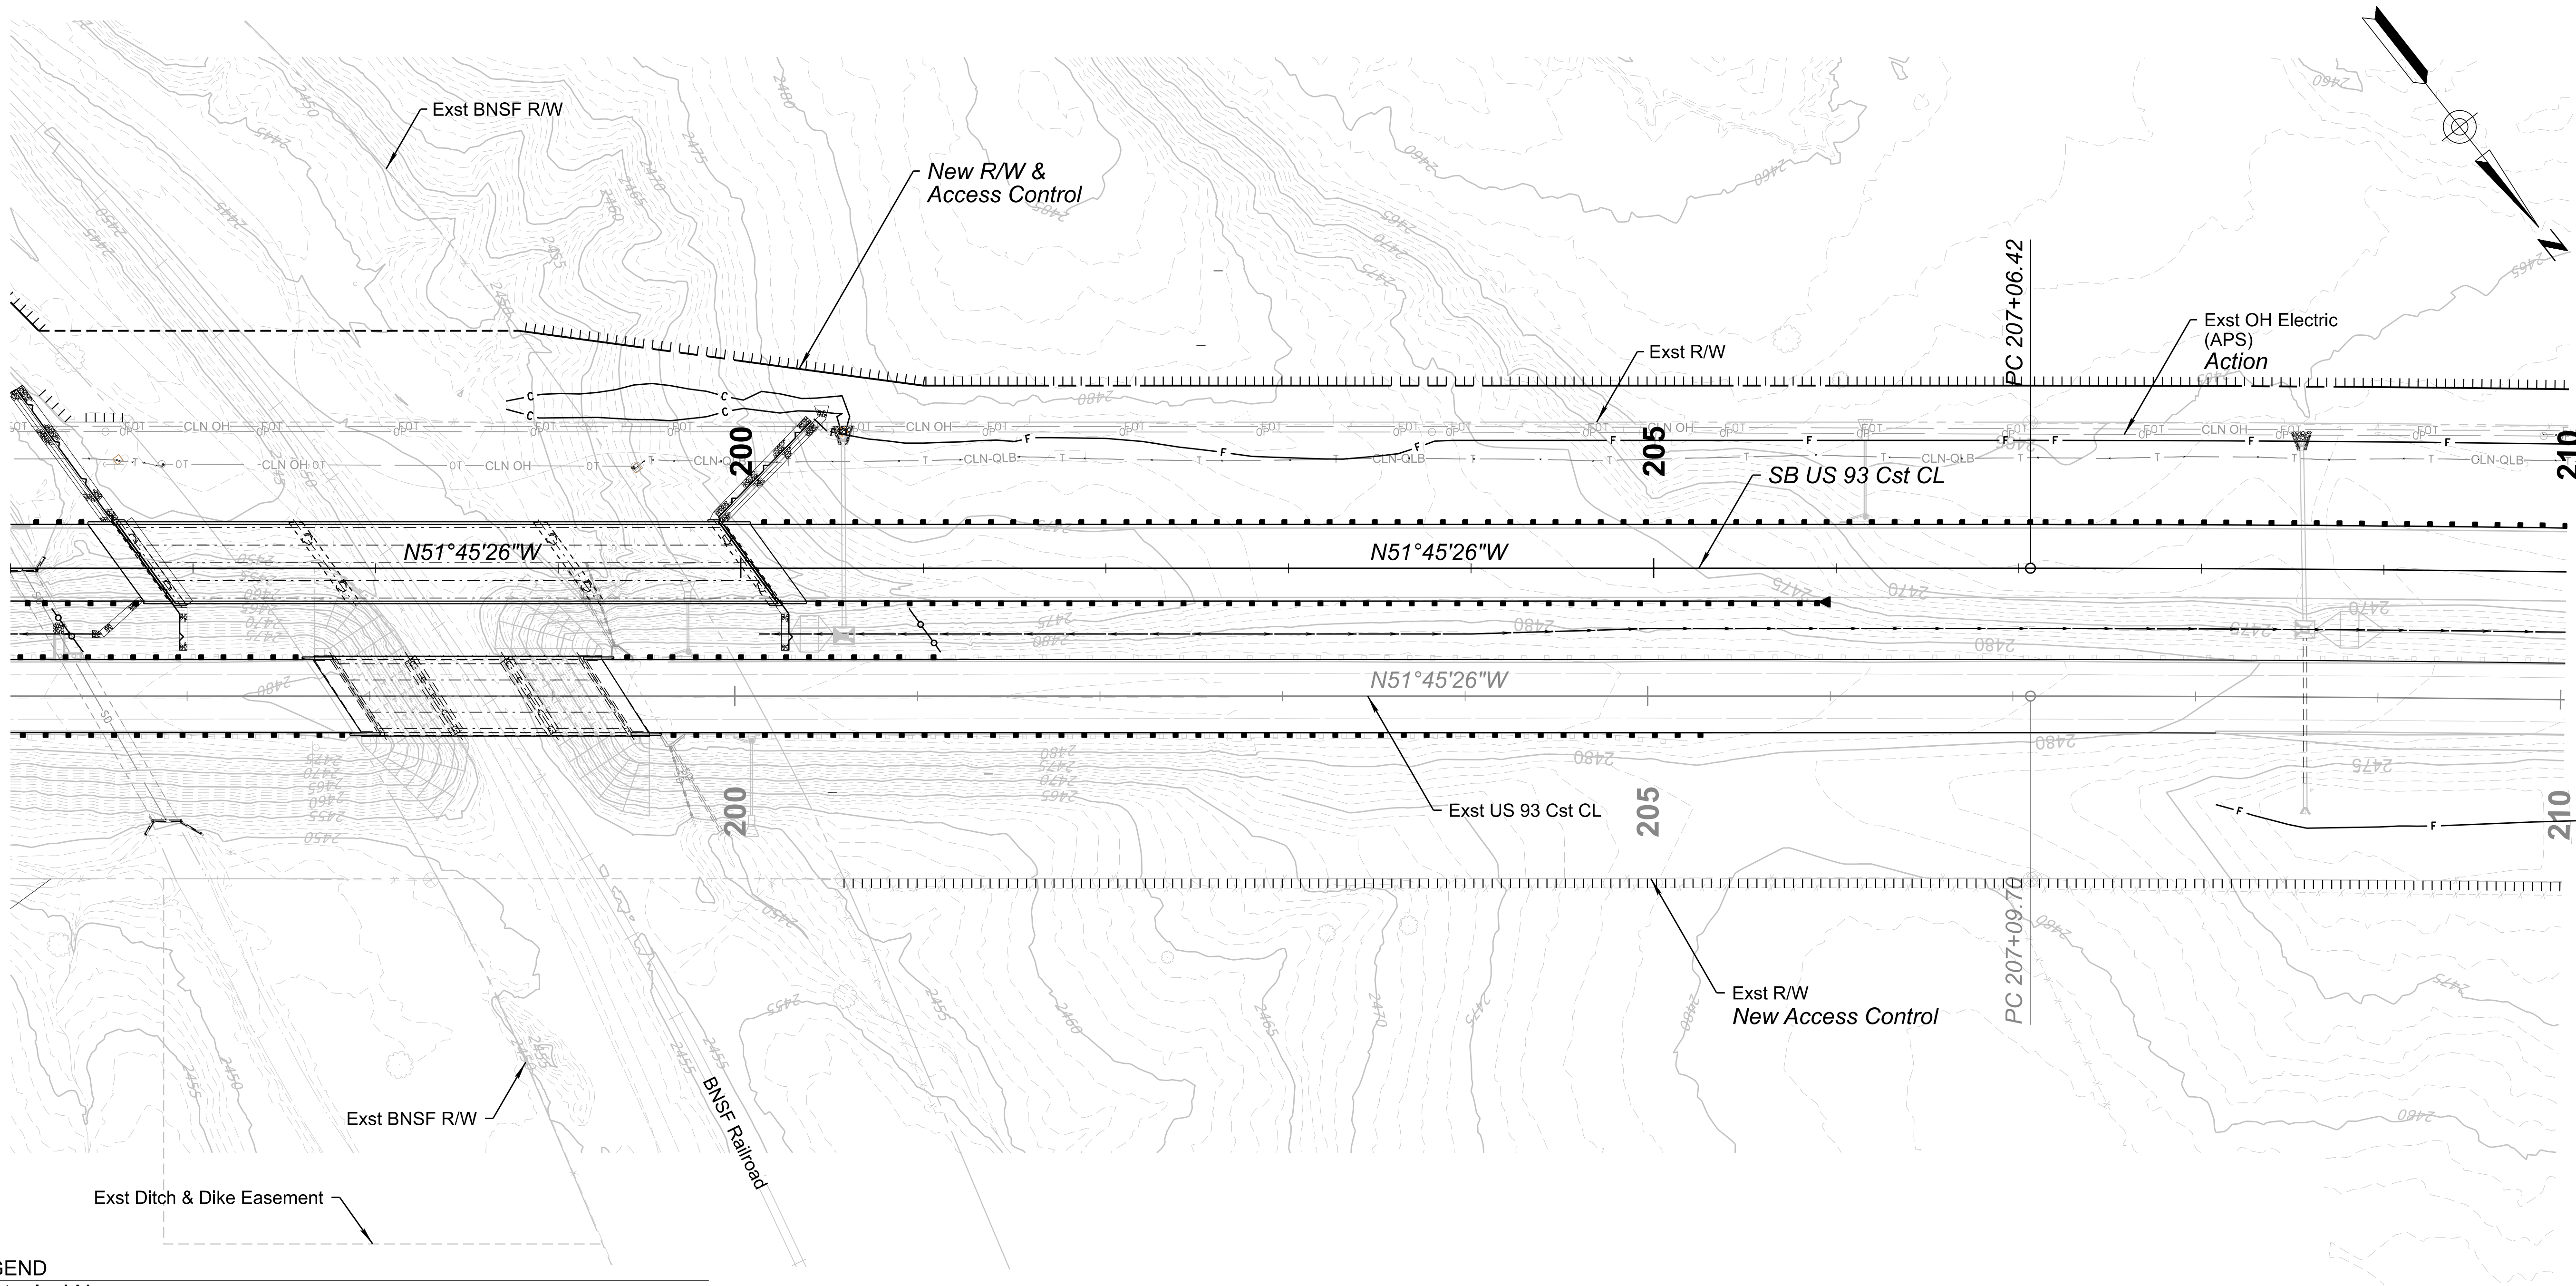


PLANT LEGEND


Botanical Name
Common Name

- | | | | |
|----|---|----|---|
| CA | Cylindropuntia acanthocarpa
Buckhorn Cholla | OC | Opuntia chorotica
Pancake Prickly Pear |
| CL | Cylindropuntia leptocaulis
Desert Christmas Cactus | OE | Opuntia engelmannii
Desert Prickly Pear |
| ✱ | Ferocactus cylindraceus
Barrel Cactus | PG | Peniocereus greggii
Arizona Queen Of The Night |
| □ | Fouquieria splendens
Ocotillo | YB | Yucca baccata
Banana Yucca |
| MG | Mammillaria grahamii
Fishhook Pincushion | YE | Yucca elata
Soaptree Yucca |

NO REVEGETATION PLANT MATERIAL THIS SHEET

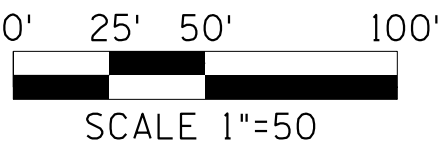


	DESIGN	NAME	DATE	ARIZONA DEPARTMENT OF TRANSPORTATION PROJECT DELIVERY AND OPERATIONS DIVISION ROADWAY DESIGN SERVICES	ROUTE	F.H.W.A. Arizona Division	STATE	PROJECT NO.	FEDERAL ID NO.	SHEET NO.	TOTAL SHEETS	RECORD DRAWING				
	DRAWN	STAFF	06/26		MILEPOST			ARIZ.	093 YV 189	093-B(230)T	479		524			
	CHECKED	W COLEBANK	06/26		STRUCTURE NO.											
					LANDSCAPE REVEGETATION SHEET SB US 93 STA 196+00 TO STA 210+00		WICKENBURG RANCH WAY TO VISTA ROYALE							DWG No. L-2.03		
							TRACS NO. F0738 01C								___ OF ___	

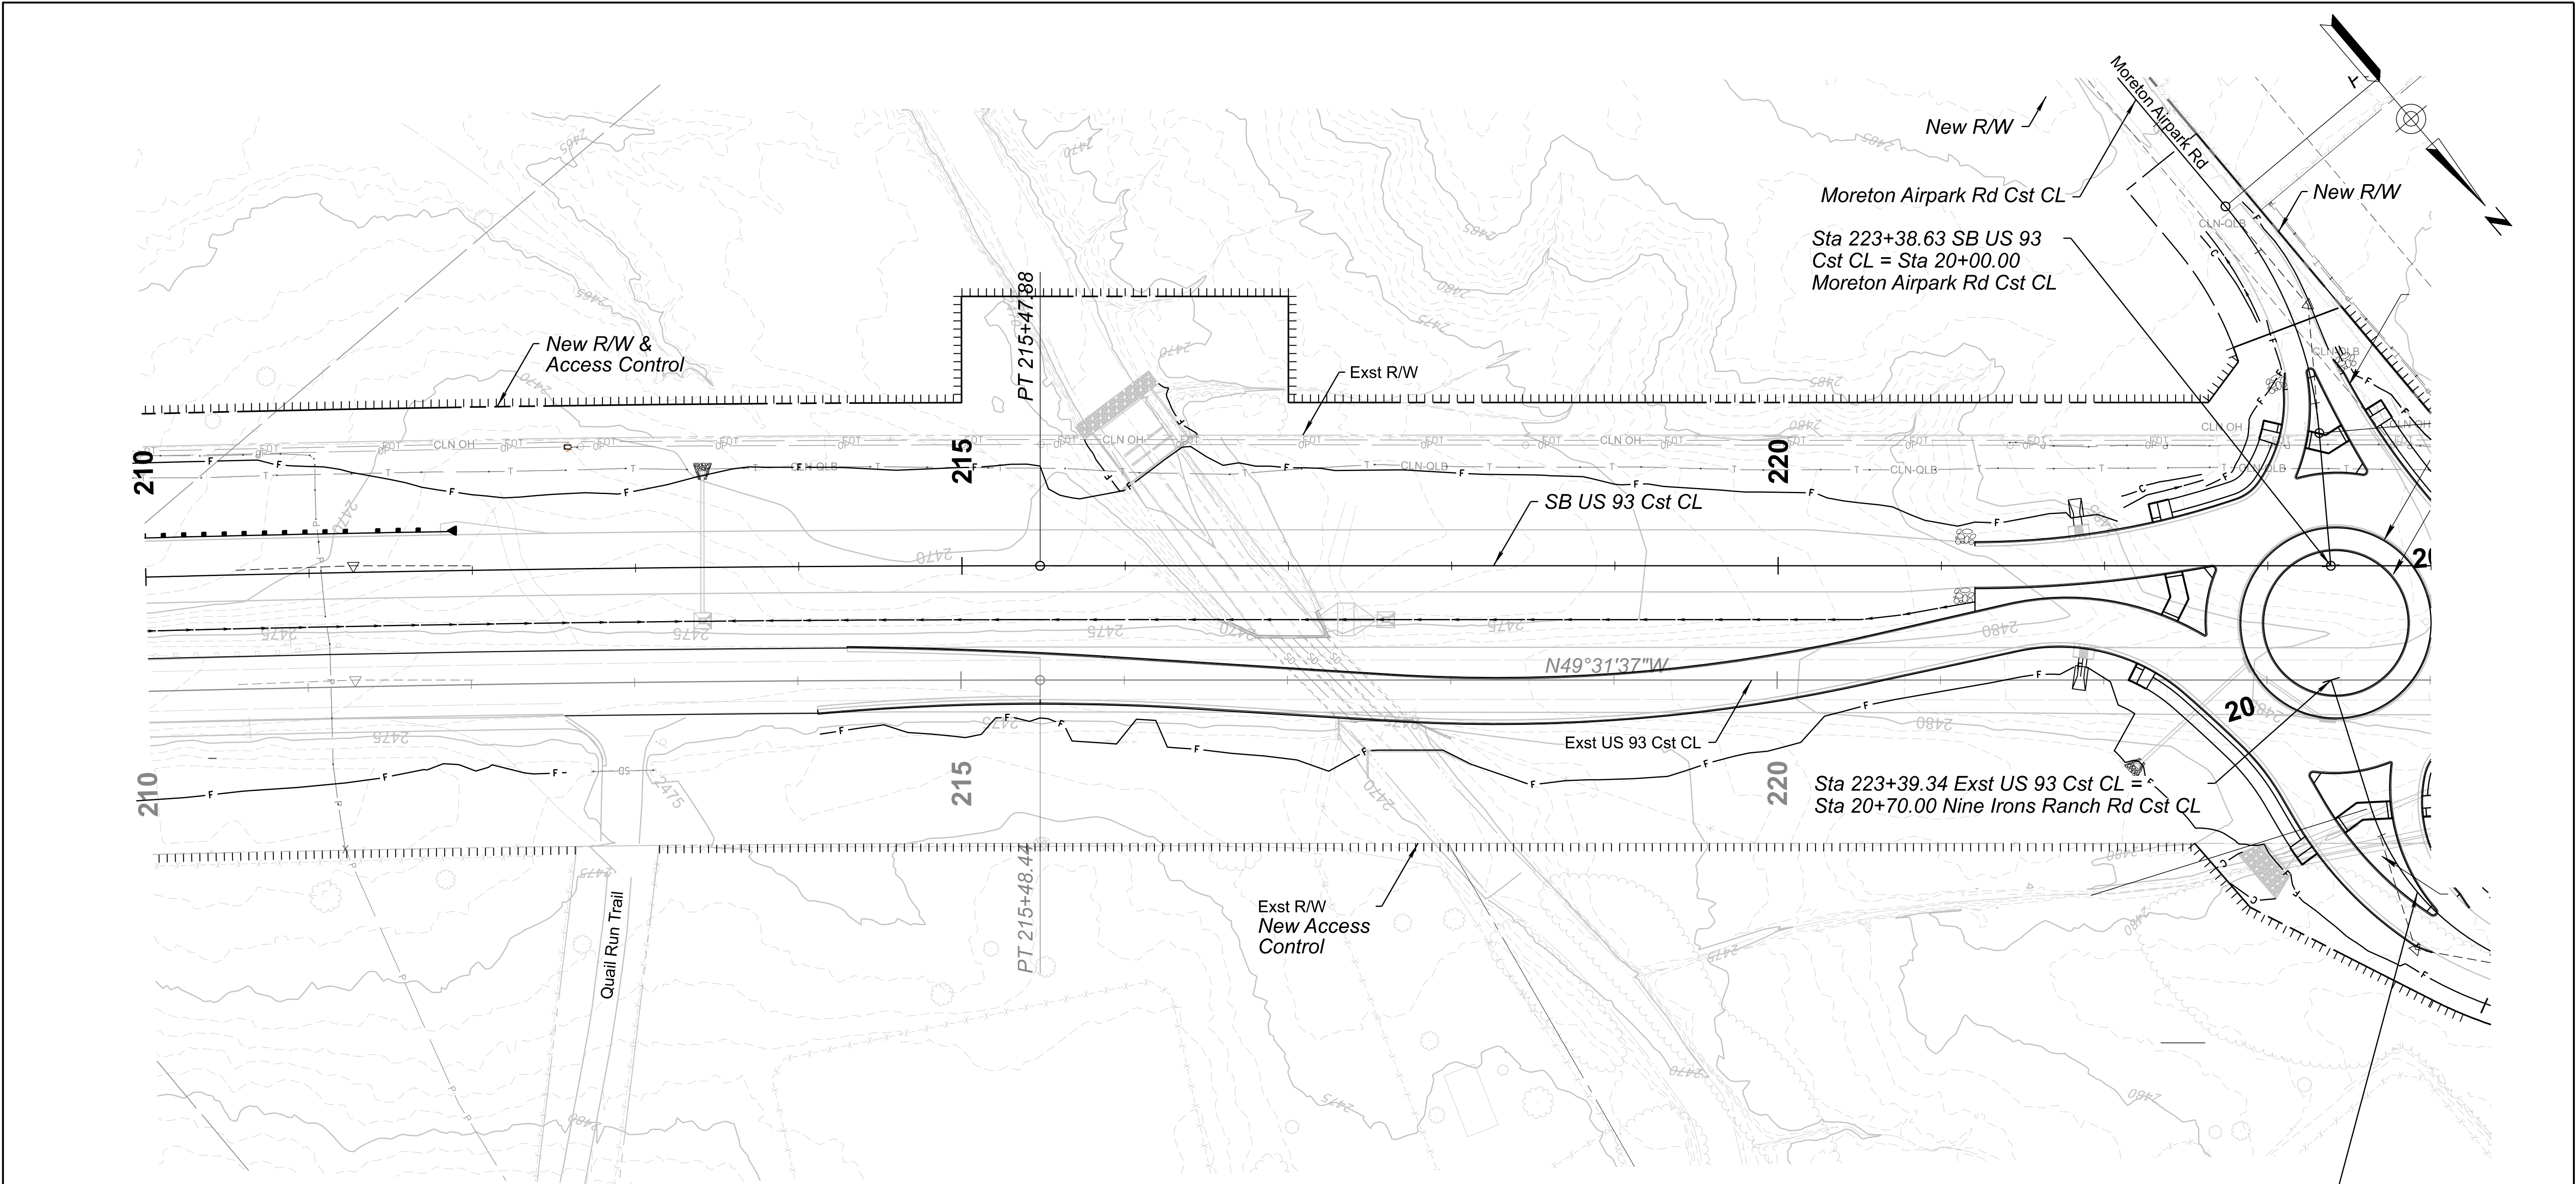


PLANT LEGEND

Botanical Name		Common Name	
CA	Cylindropuntia acanthocarpa	OC	Opuntia chorotica
	Buckhorn Cholla		Pancake Prickly Pear
CL	Cylindropuntia leptocaulis	OE	Opuntia engelmannii
	Desert Christmas Cactus		Desert Prickly Pear
*	Ferocactus cylindraceus	PG	Peniocereus greggii
	Barrel Cactus		Arizona Queen Of The Night
□	Fouquieria splendens	YB	Yucca baccata
	Ocotillo		Banana Yucca
MG	Mammillaria grahamii	YE	Yucca elata
	Fishhook Pincushion		Soaptree Yucca

NO REVEGETATION PLANT MATERIAL THIS SHEET

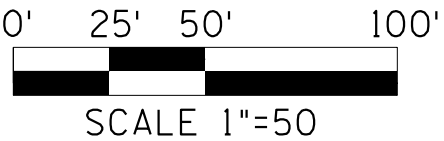



		NAME	DATE	ARIZONA DEPARTMENT OF TRANSPORTATION PROJECT DELIVERY AND OPERATIONS DIVISION ROADWAY DESIGN SERVICES	ROUTE	F.H.W.A. Arizona Division	STATE	PROJECT NO.	FEDERAL ID NO.	SHEET NO.	TOTAL SHEETS	RECORD DRAWING
	DESIGN	W HERRERA	06/26		US 93			093 YV 189	093-B(230)T	480	524	
	DRAWN	STAFF	06/26		MILEPOST			189.92				
	CHECKED	W COLEBANK	06/26	STRUCTURE NO.			LOCATION WICKENBURG RANCH WAY TO VISTA ROYALE				DWG No. L-2.04	
					LANDSCAPE REVEGETATION SHEET SB US 93 STA 210+00 TO STA 224+00 E FRONTAGE RD STA 111+54 TO STA 112+00		TRACS NO. F0738 01C		____ OF ____			

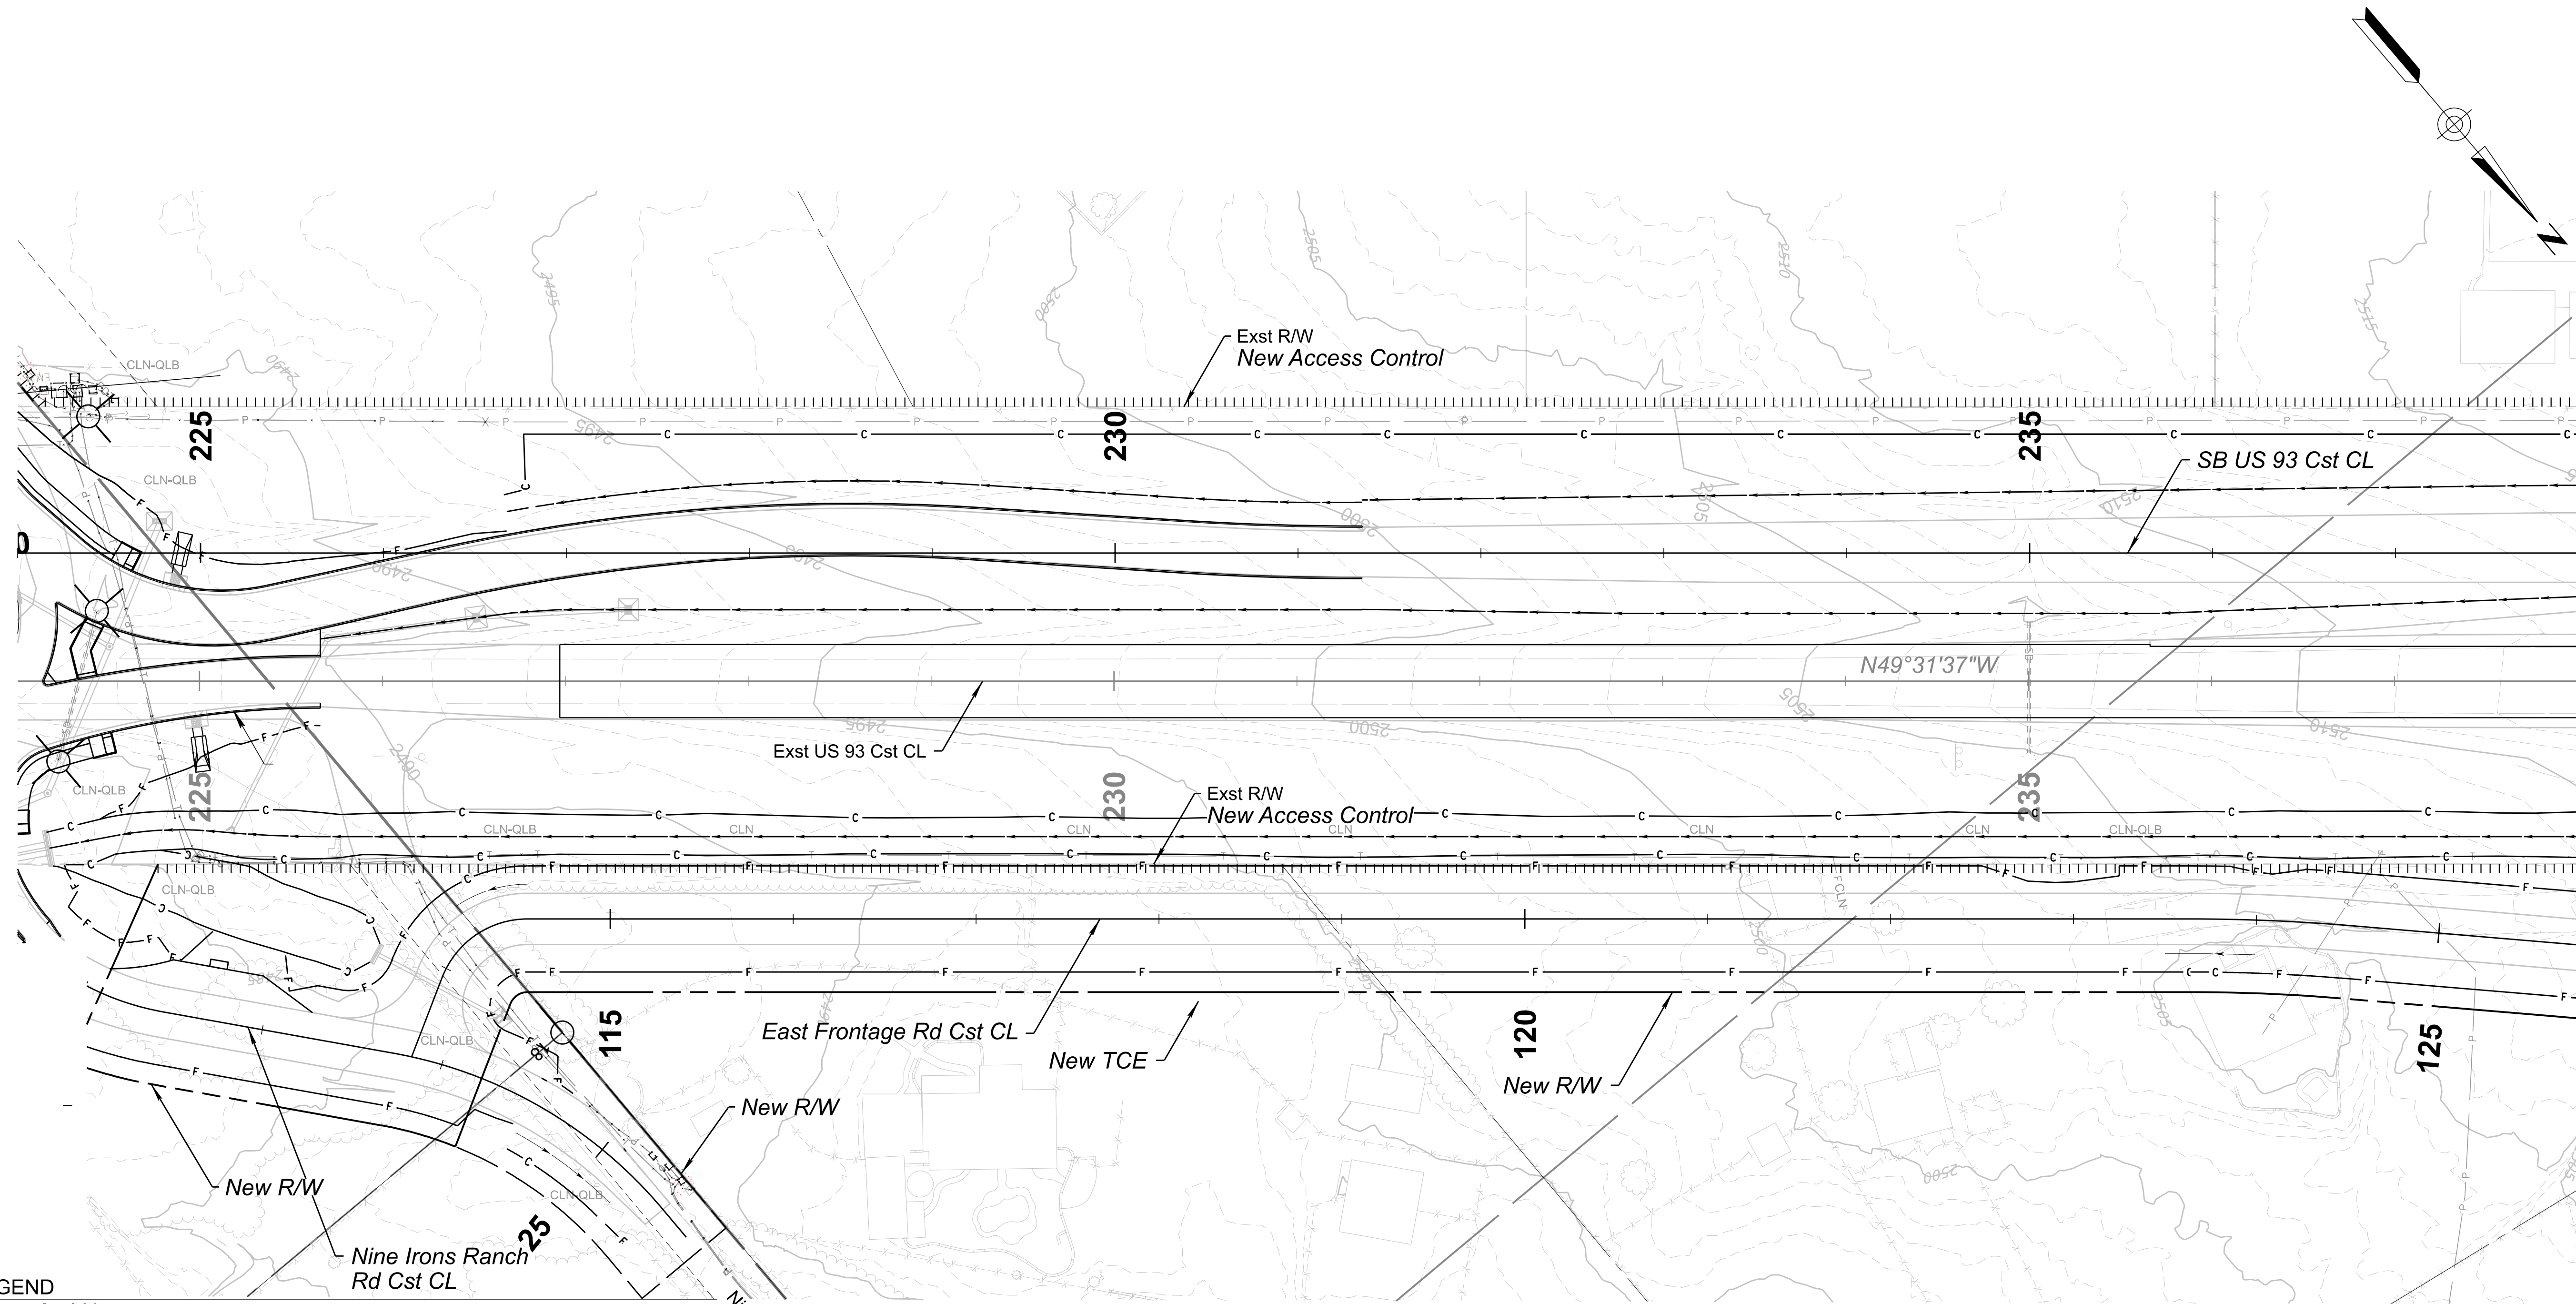

PLANT LEGEND

Botanical Name	Common Name
CA	Cylindropuntia acanthocarpa Buckhorn Cholla
CL	Cylindropuntia leptocaulis Desert Christmas Cactus
*	Ferocactus cylindraceus Barrel Cactus
□	Fouquieria splendens Ocotillo
MG	Mammillaria grahamii Fishhook Pincushion
OC	Opuntia chorotica Pancake Prickly Pear
OE	Opuntia engelmannii Desert Prickly Pear
PG	Peniocereus greggii Arizona Queen Of The Night
YB	Yucca baccata Banana Yucca
YE	Yucca elata Soaptree Yucca

NO REVEGETATION PLANT MATERIAL THIS SHEET

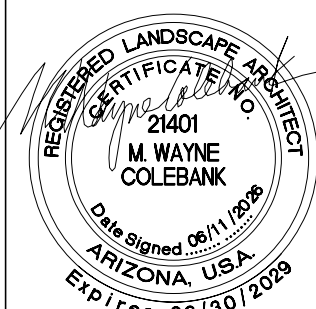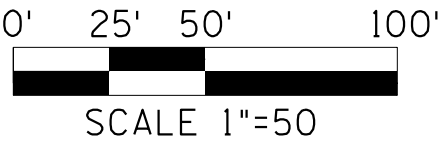


NAME	DATE
DESIGN W HERRERA	06/26
DRAWN STAFF	06/26
CHECKED W COLEBANK	06/26

LOGAN SIMPSON
222 SOUTH FERNBUSH AVENUE, SUITE 202
TAMPA, FL 33601
P: (813) 987-1543

ARIZONA DEPARTMENT OF TRANSPORTATION
PROJECT DELIVERY AND OPERATIONS DIVISION
ROADWAY DESIGN SERVICES
LANDSCAPE REVEGETATION SHEET
SB US 93 STA 224+00 TO STA 238+00
E FRONTAGE RD STA 112+00 TO STA 126+00

ROUTE US 93
MILEPOST 189.92
STRUCTURE NO.


F.H.W.A. Arizona Division	STATE ARIZ.	PROJECT NO. 093 YV 189	FEDERAL ID NO. 093-B(230)T	SHEET NO. 481	TOTAL SHEETS 524	RECORD DRAWING
LOCATION WICKENBURG RANCH WAY TO VISTA ROYALE						DWG No. L-2.05
TRACS NO. F0738 01C						OF

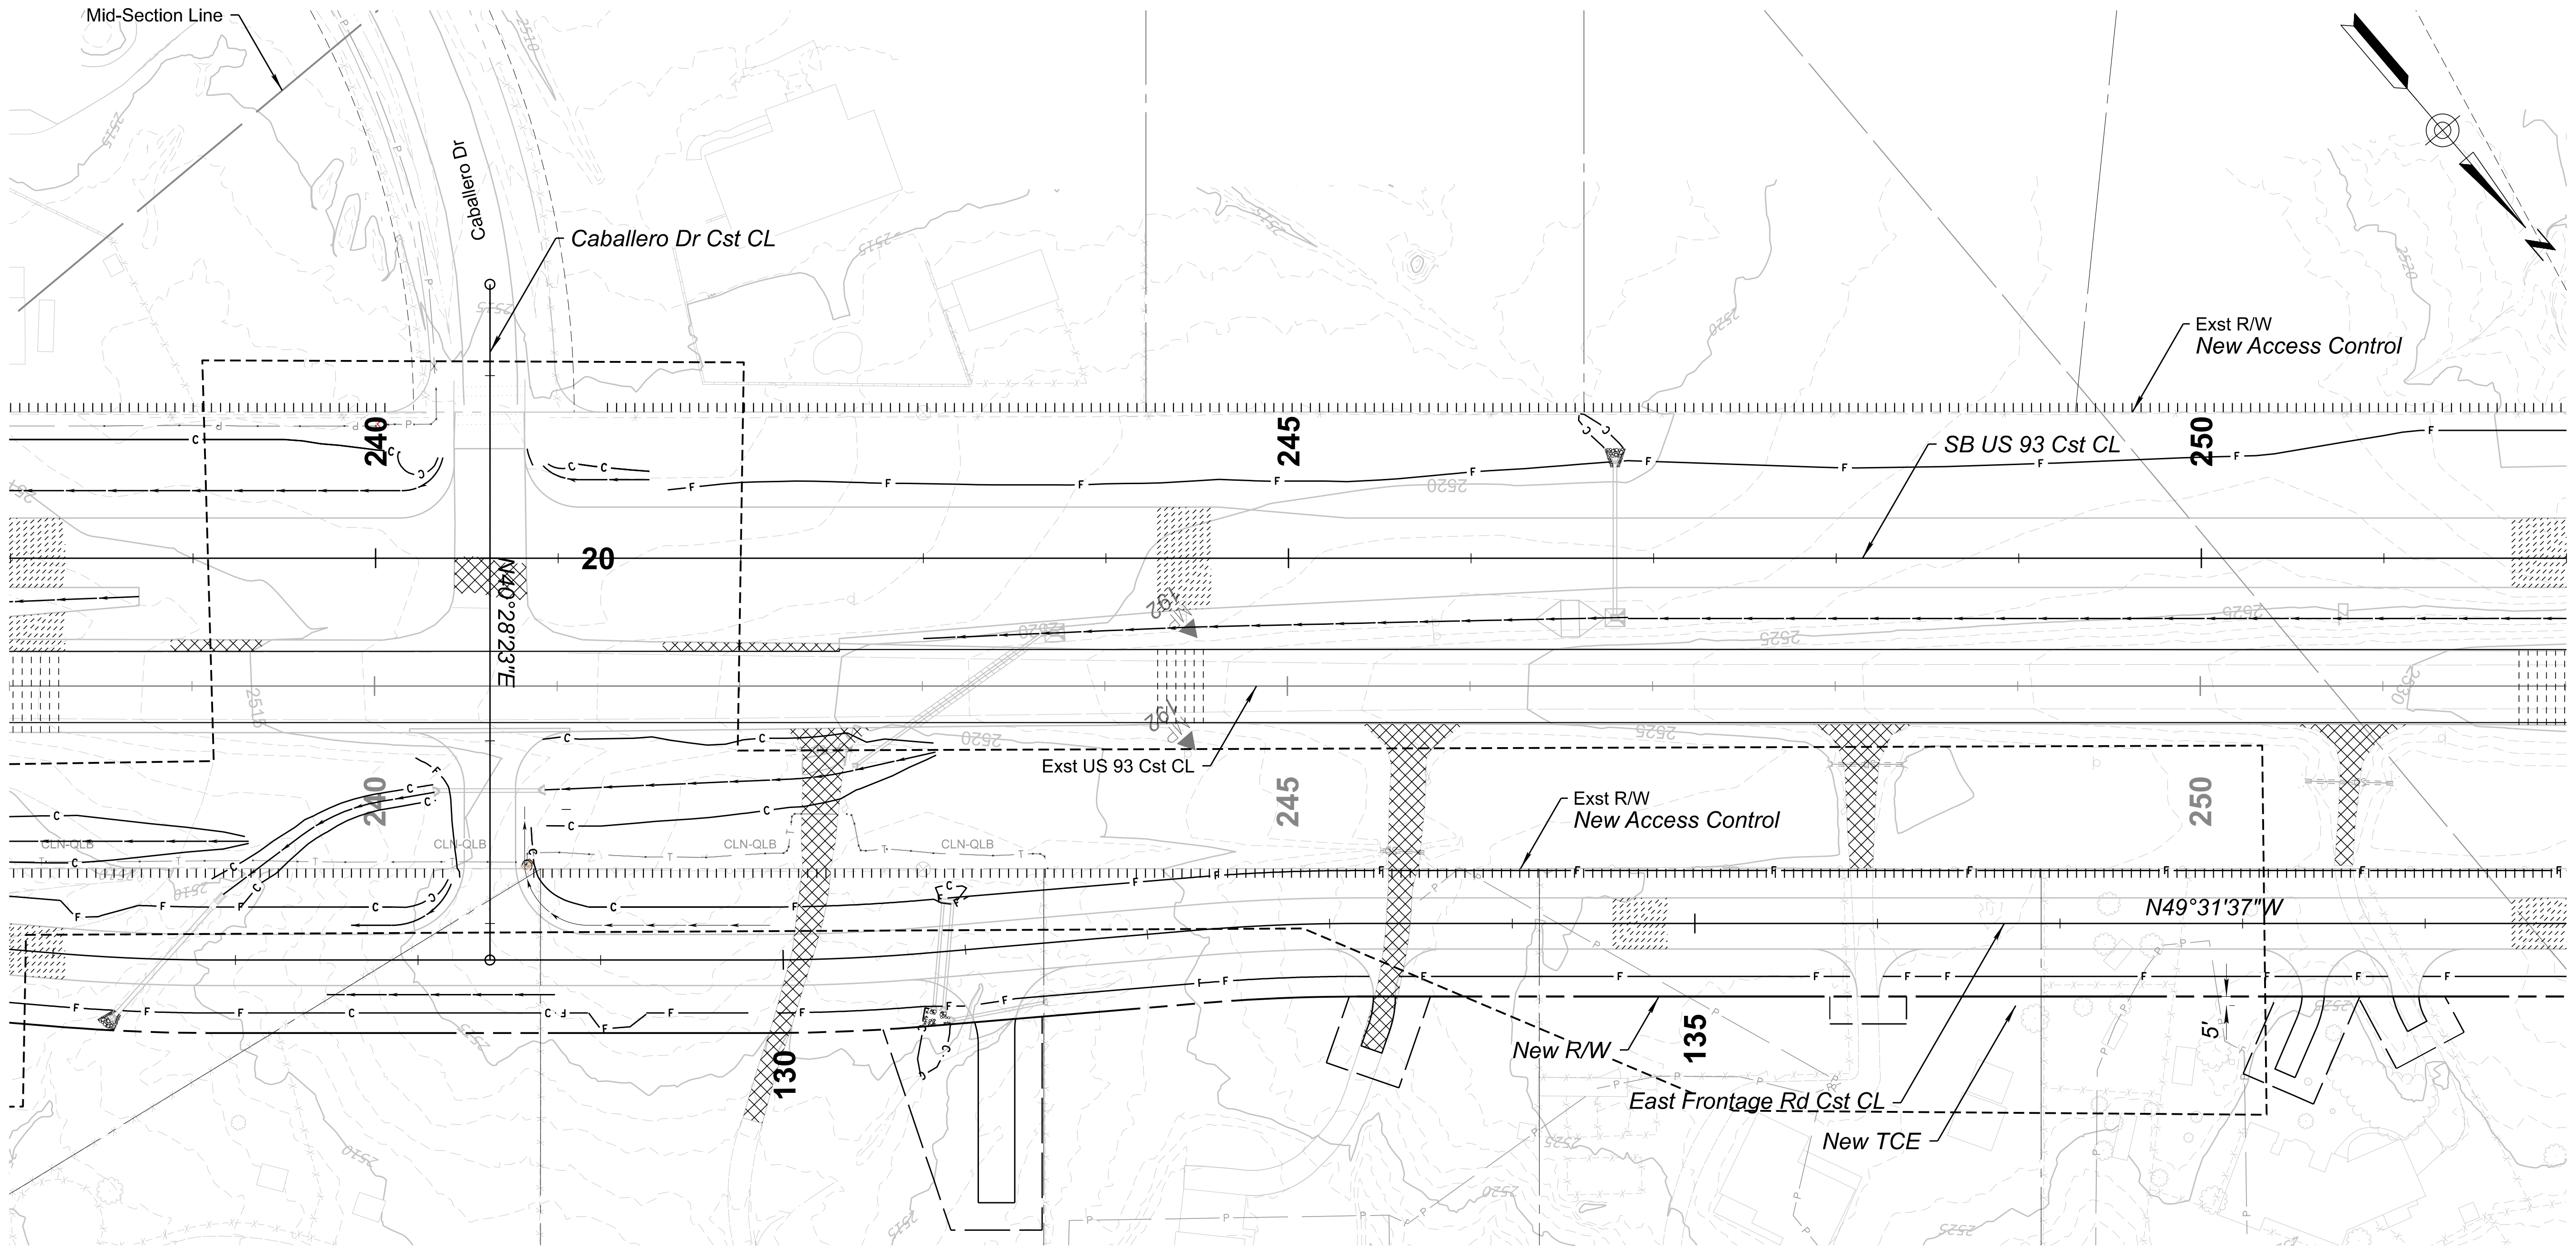


PLANT LEGEND

Botanical Name	Common Name
CA	Cylindropuntia acanthocarpa Buckhorn Cholla
CL	Cylindropuntia leptocaulis Desert Christmas Cactus
*	Ferocactus cylindraceus Barrel Cactus
□	Fouquieria splendens Ocotillo
MG	Mammillaria grahamii Fishhook Pincushion
OC	Opuntia chorotica Pancake Prickly Pear
OE	Opuntia engelmannii Desert Prickly Pear
PG	Peniocereus greggii Arizona Queen Of The Night
YB	Yucca baccata Banana Yucca
YE	Yucca elata Soaptree Yucca

NO REVEGETATION PLANT MATERIAL THIS SHEET

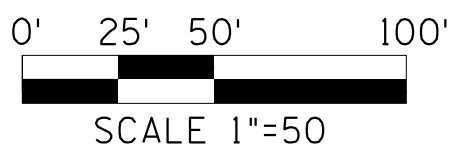



	DESIGN	NAME	DATE	ARIZONA DEPARTMENT OF TRANSPORTATION PROJECT DELIVERY AND OPERATIONS DIVISION ROADWAY DESIGN SERVICES LANDSCAPE REVEGETATION SHEET SB US 93 STA 238+00 TO STA 252+00 E FRONTAGE RD STA 126+00 TO STA 140+00	ROUTE	F.H.W.A. Arizona Division	STATE	PROJECT NO.	FEDERAL ID NO.	SHEET NO.	TOTAL SHEETS	RECORD DRAWING
	DRAWN	STAFF	06/26		US 93			093 YV 189	093-B(230)T	482	524	
	CHECKED	W COLEBANK	06/26		MILEPOST			LOCATION				
					189.92			WICKENBURG RANCH WAY TO VISTA ROYALE				
						STRUCTURE NO.	TRACS NO. F0738 01C				___ OF ___	

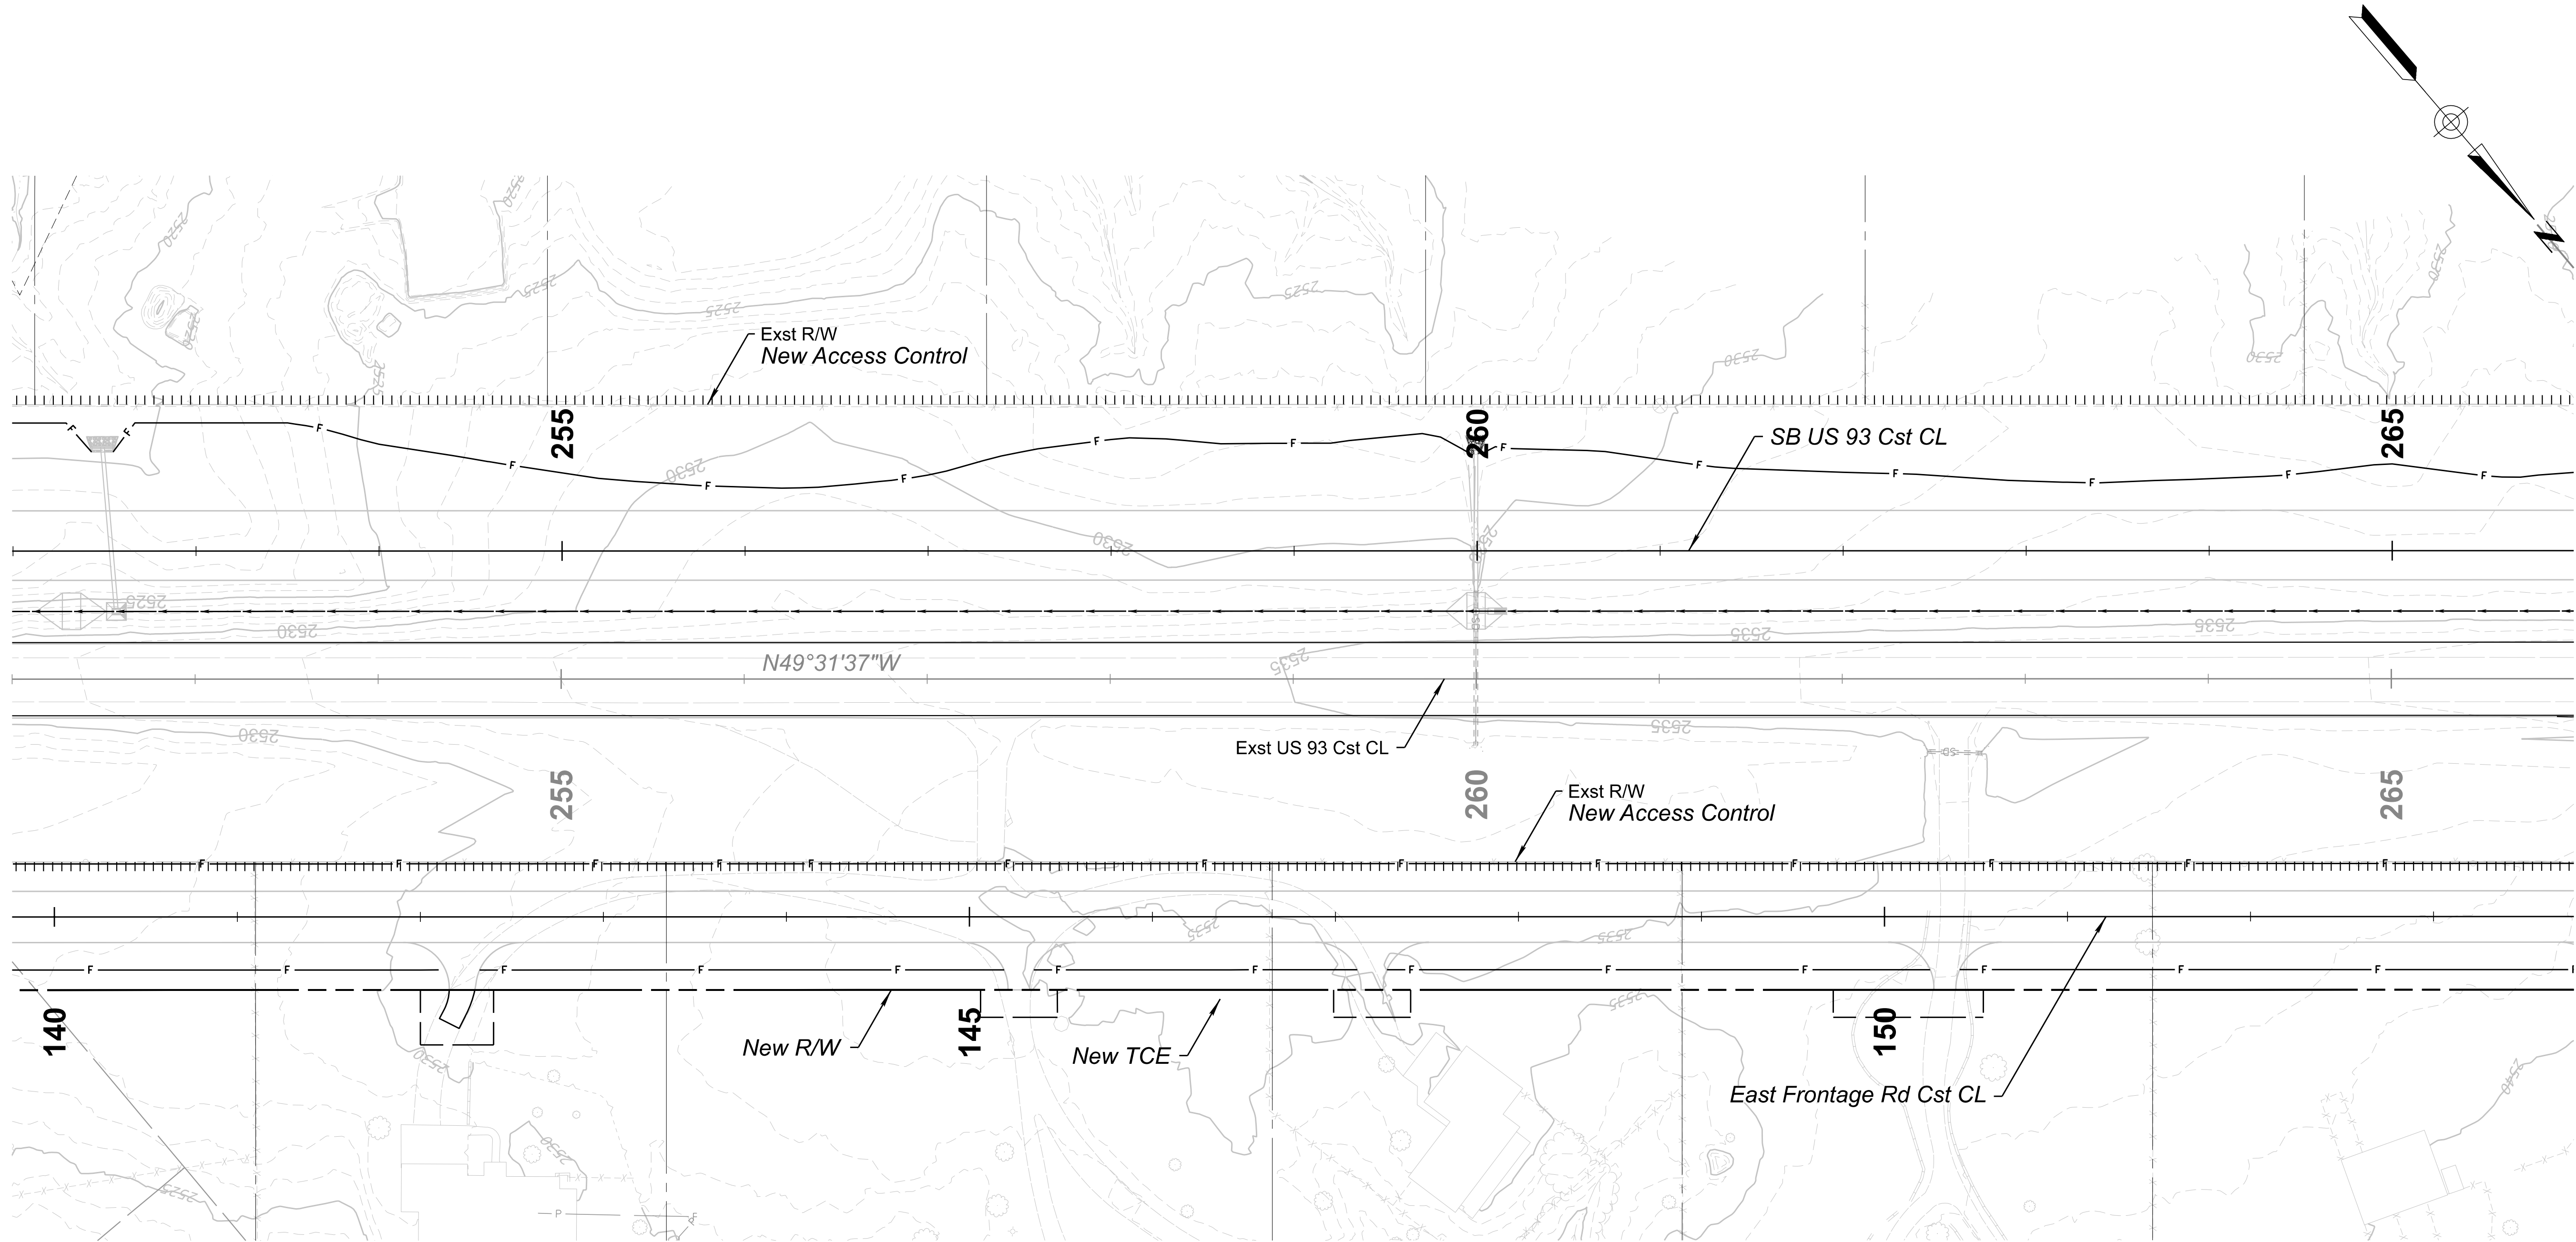

PLANT LEGEND

Botanical Name		Common Name	
CA	Cylindropuntia acanthocarpa	OC	Opuntia chorotica
	Buckhorn Cholla		Pancake Prickly Pear
CL	Cylindropuntia leptocaulis	OE	Opuntia engelmannii
	Desert Christmas Cactus		Desert Prickly Pear
*	Ferocactus cylindraceus	PG	Peniocereus greggii
	Barrel Cactus		Arizona Queen Of The Night
□	Fouquieria splendens	YB	Yucca baccata
	Ocotillo		Banana Yucca
MG	Mammillaria grahamii	YE	Yucca elata
	Fishhook Pincushion		Soaptree Yucca

NO REVEGETATION PLANT MATERIAL THIS SHEET

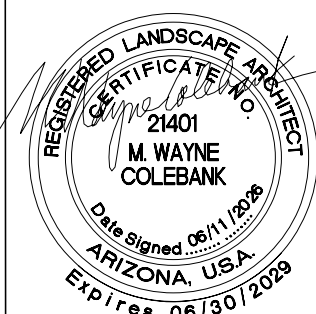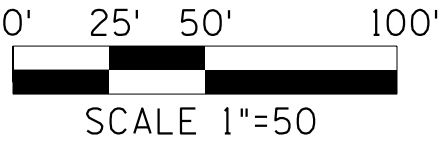

NAME		DATE
DESIGN	W HERRERA	06/26
DRAWN	STAFF	06/26
CHECKED	W COLEBANK	06/26




LOGANSIMPSON
200 SOUTH MILL AVENUE, SUITE 202
TAMPA, FL 33601
P: (813) 997-1247

ARIZONA DEPARTMENT OF TRANSPORTATION	
PROJECT DELIVERY AND OPERATIONS DIVISION	
ROADWAY DESIGN SERVICES	
LANDSCAPE REVEGETATION SHEET	
SB US 93 STA 252+00 TO STA 266+00	
E FRONTAGE RD STA 140+00 TO STA 154+00	


ROUTE	US 93
MILEPOST	189.92
STRUCTURE NO.	

F.H.W.A. Arizona Division	STATE	PROJECT NO.	FEDERAL ID NO.	SHEET NO.	TOTAL SHEETS	RECORD DRAWING	
	ARIZ.	093 YV 189	093-B(230)T	483	524		
LOCATION					WICKENBURG RANCH WAY TO VISTA ROYALE		DWG No. L-2.07
TRACS NO.		F0738 01C			_____ OF _____		

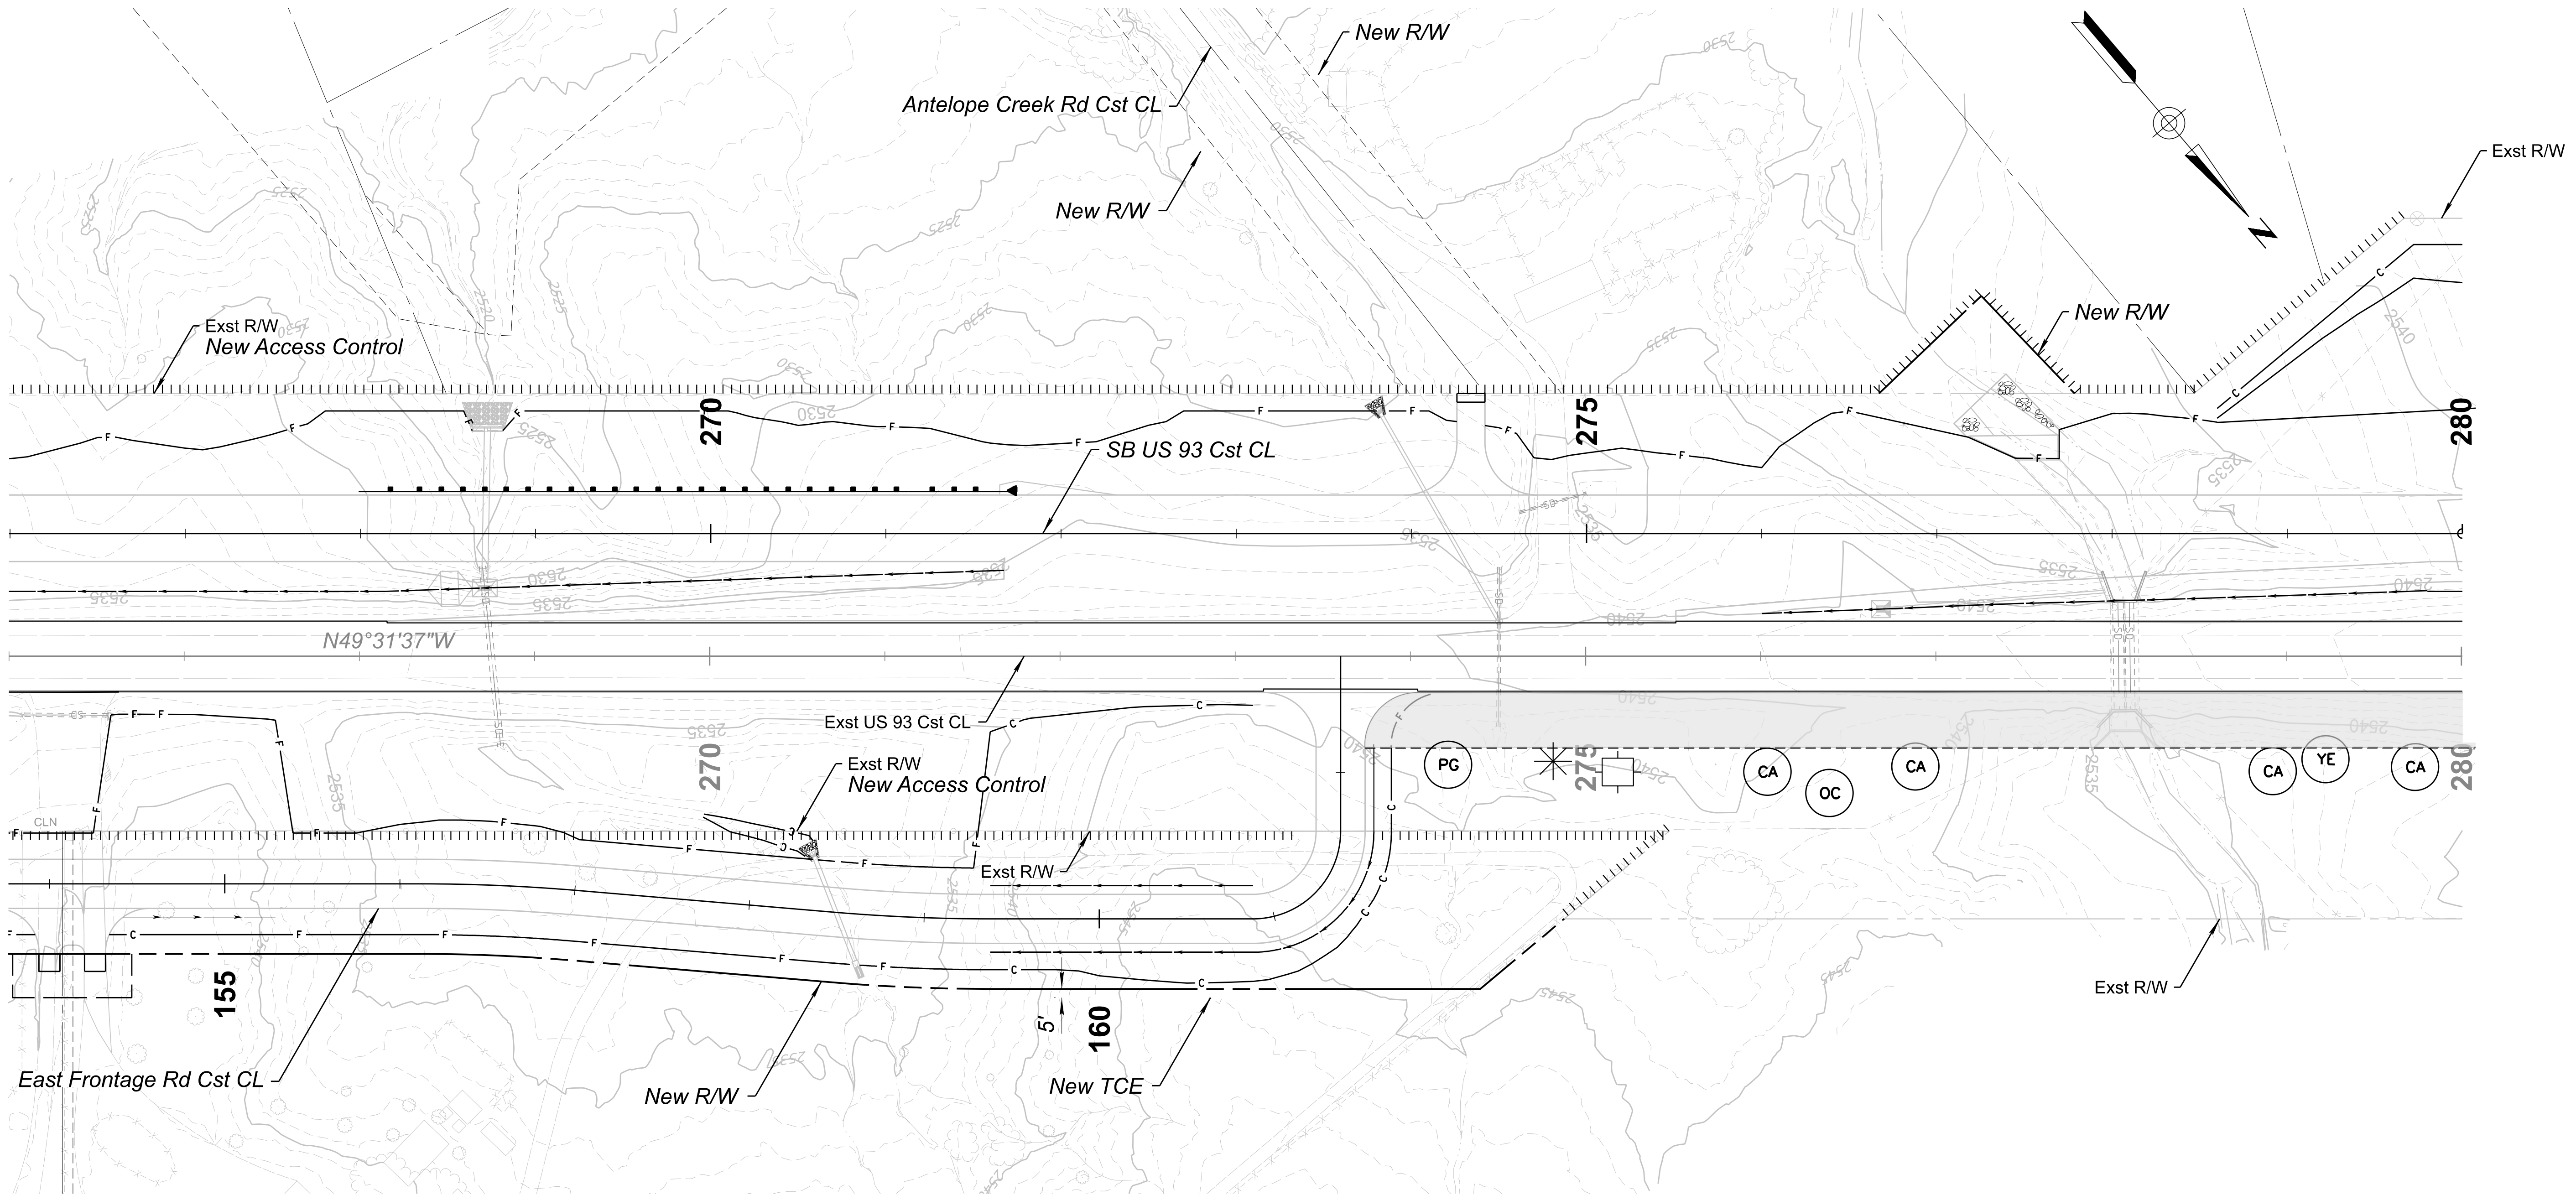

PLANT LEGEND

Botanical Name		Common Name	
CA	Cylindropuntia acanthocarpa	OC	Opuntia chorotica
	Buckhorn Cholla		Pancake Prickly Pear
CL	Cylindropuntia leptocaulis	OE	Opuntia engelmannii
	Desert Christmas Cactus		Desert Prickly Pear
*	Ferocactus cylindraceus	PG	Peniocereus greggii
	Barrel Cactus		Arizona Queen Of The Night
□	Fouquieria splendens	YB	Yucca baccata
	Ocotillo		Banana Yucca
MG	Mammillaria grahamii	YE	Yucca elata
	Fishhook Pincushion		Soaptree Yucca

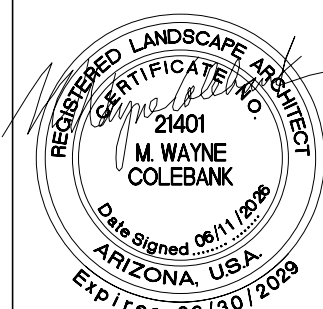


NAME		DATE
DESIGN	W HERRERA	06/26
DRAWN	STAFF	06/26
CHECKED	W COLEBANK	06/26

LOGAN SIMPSON
222 SOUTH FARMER AVENUE, SUITE 202
TAMPA, FL 33604
P: (813) 987-1543

ARIZONA DEPARTMENT OF TRANSPORTATION
PROJECT DELIVERY AND OPERATIONS DIVISION
ROADWAY DESIGN SERVICES
LANDSCAPE REVEGETATION SHEET
SB US 93 STA 266+00 TO STA 280+00
E FRONTAGE RD STA 154+00 TO STA 161+66


ROUTE	US 93
MILEPOST	189.92
STRUCTURE NO.	

F.H.W.A. Arizona Division		STATE	ARIZ.	PROJECT NO.	093 YV 189	FEDERAL ID NO.	093-B(230)T	SHEET NO.	484	TOTAL SHEETS	524	RECORD DRAWING
LOCATION										DWG No. L-2.08		
TRACS NO. F0738 01C										OF		

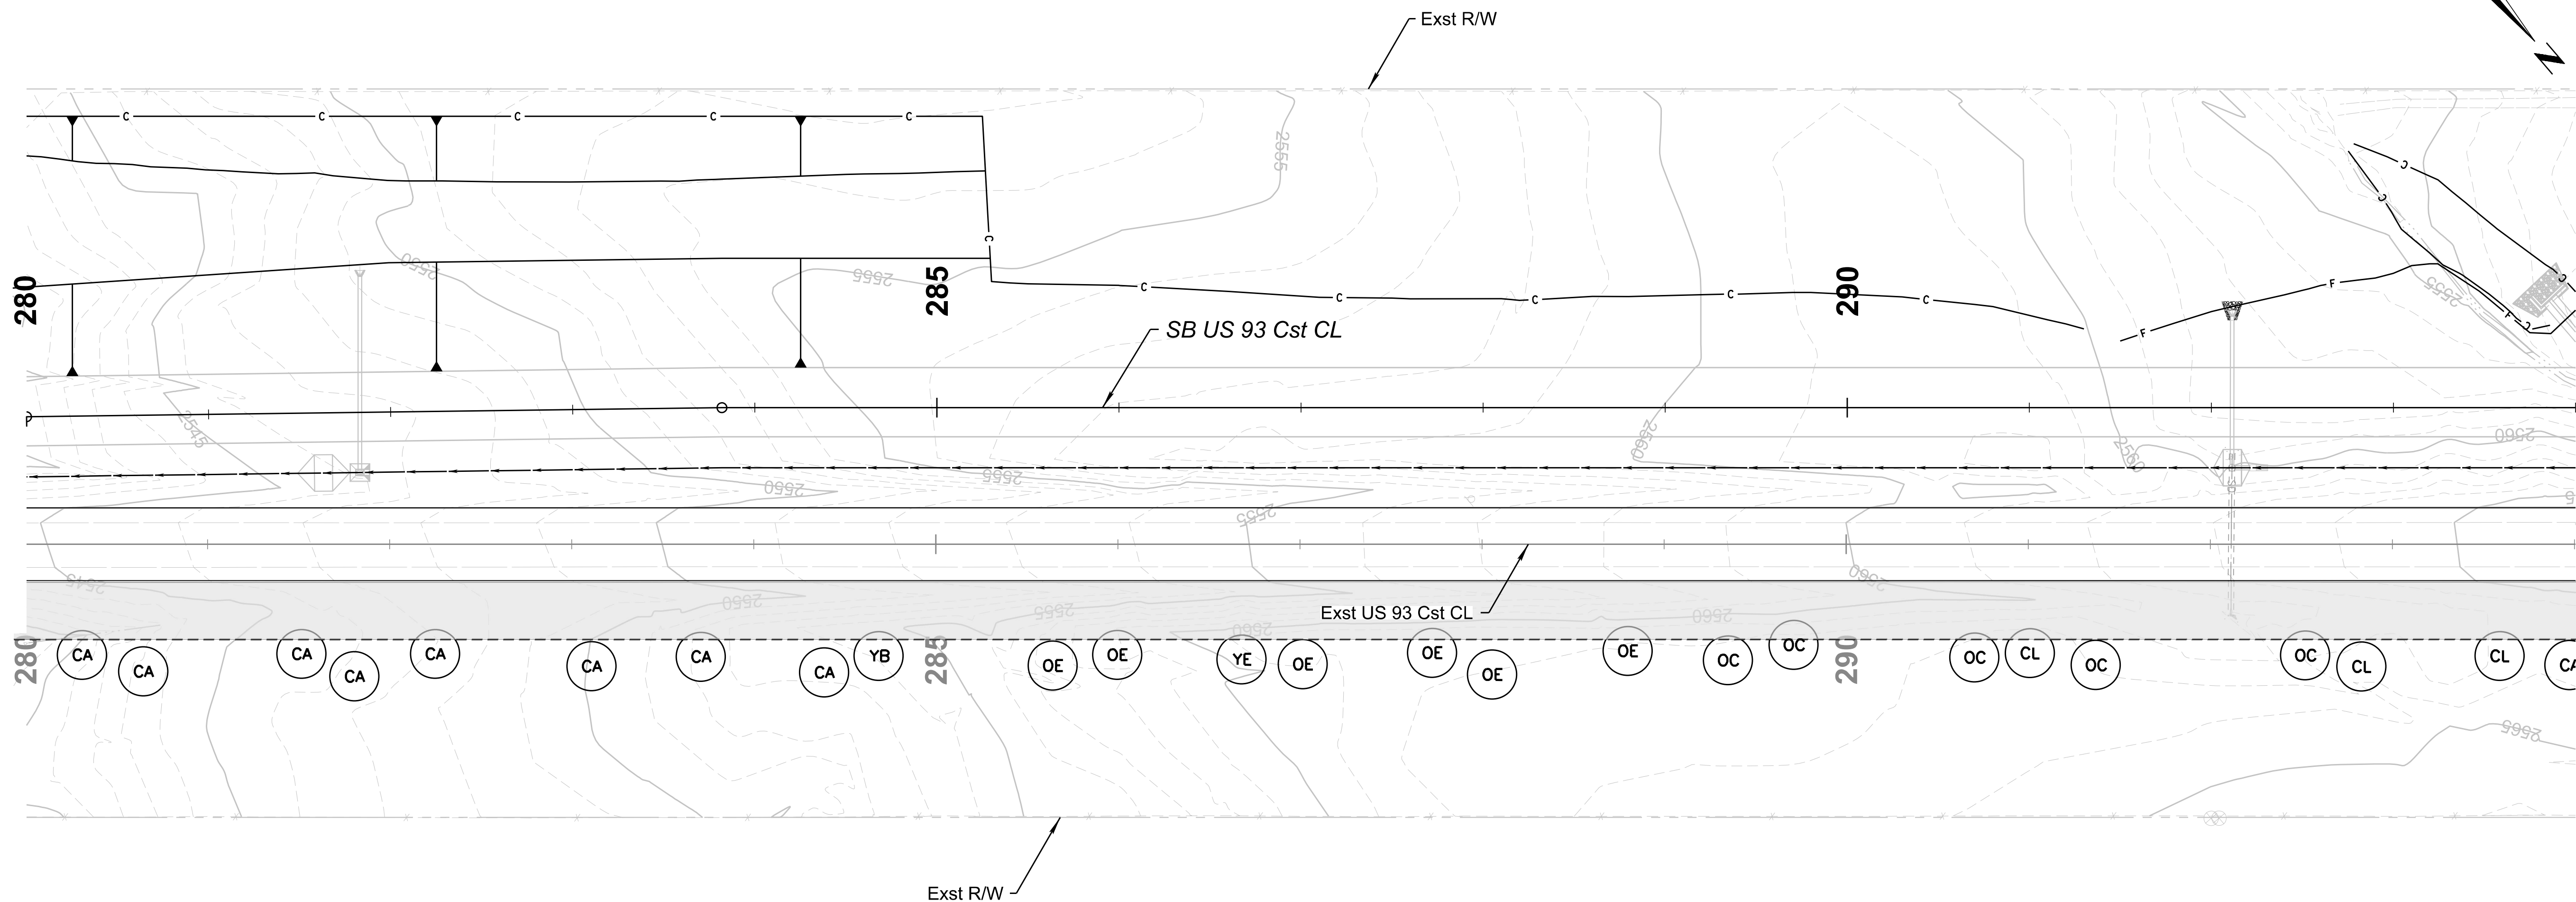


PLANT LEGEND

Botanical Name		Common Name	
CA	Cylindropuntia acanthocarpa	OC	Opuntia chorotica
	Buckhorn Cholla		Pancake Prickly Pear
CL	Cylindropuntia leptocaulis	OE	Opuntia engelmannii
	Desert Christmas Cactus		Desert Prickly Pear
*	Ferocactus cylindraceus	PG	Peniocereus greggii
	Barrel Cactus		Arizona Queen Of The Night
□	Fouquieria splendens	YB	Yucca baccata
	Ocotillo		Banana Yucca
MG	Mammillaria grahamii	YE	Yucca elata
	Fishhook Pincushion		Soaptree Yucca

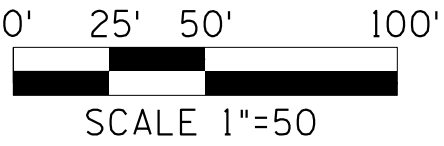


		NAME	DATE	ARIZONA DEPARTMENT OF TRANSPORTATION PROJECT DELIVERY AND OPERATIONS DIVISION ROADWAY DESIGN SERVICES	ROUTE	F.H.W.A. Arizona Division	STATE	PROJECT NO.	FEDERAL ID NO.	SHEET NO.	TOTAL SHEETS	RECORD DRAWING	
	DESIGN	W HERRERA	06/26		US 93								
	DRAWN	STAFF	06/26		MILEPOST 189.92	ARIZ.	093 YV 189	093-B(230)T	485	524			
	CHECKED	W COLEBANK	06/26										
		LANDSCAPE REVEGETATION SHEET SB US 93 STA 280+00 TO STA 294+00			STRUCTURE NO.	LOCATION					WICKENBURG RANCH WAY TO VISTA ROYALE		DWG No. L-2.09
						TRACS NO. F0738 01C							____ OF ____

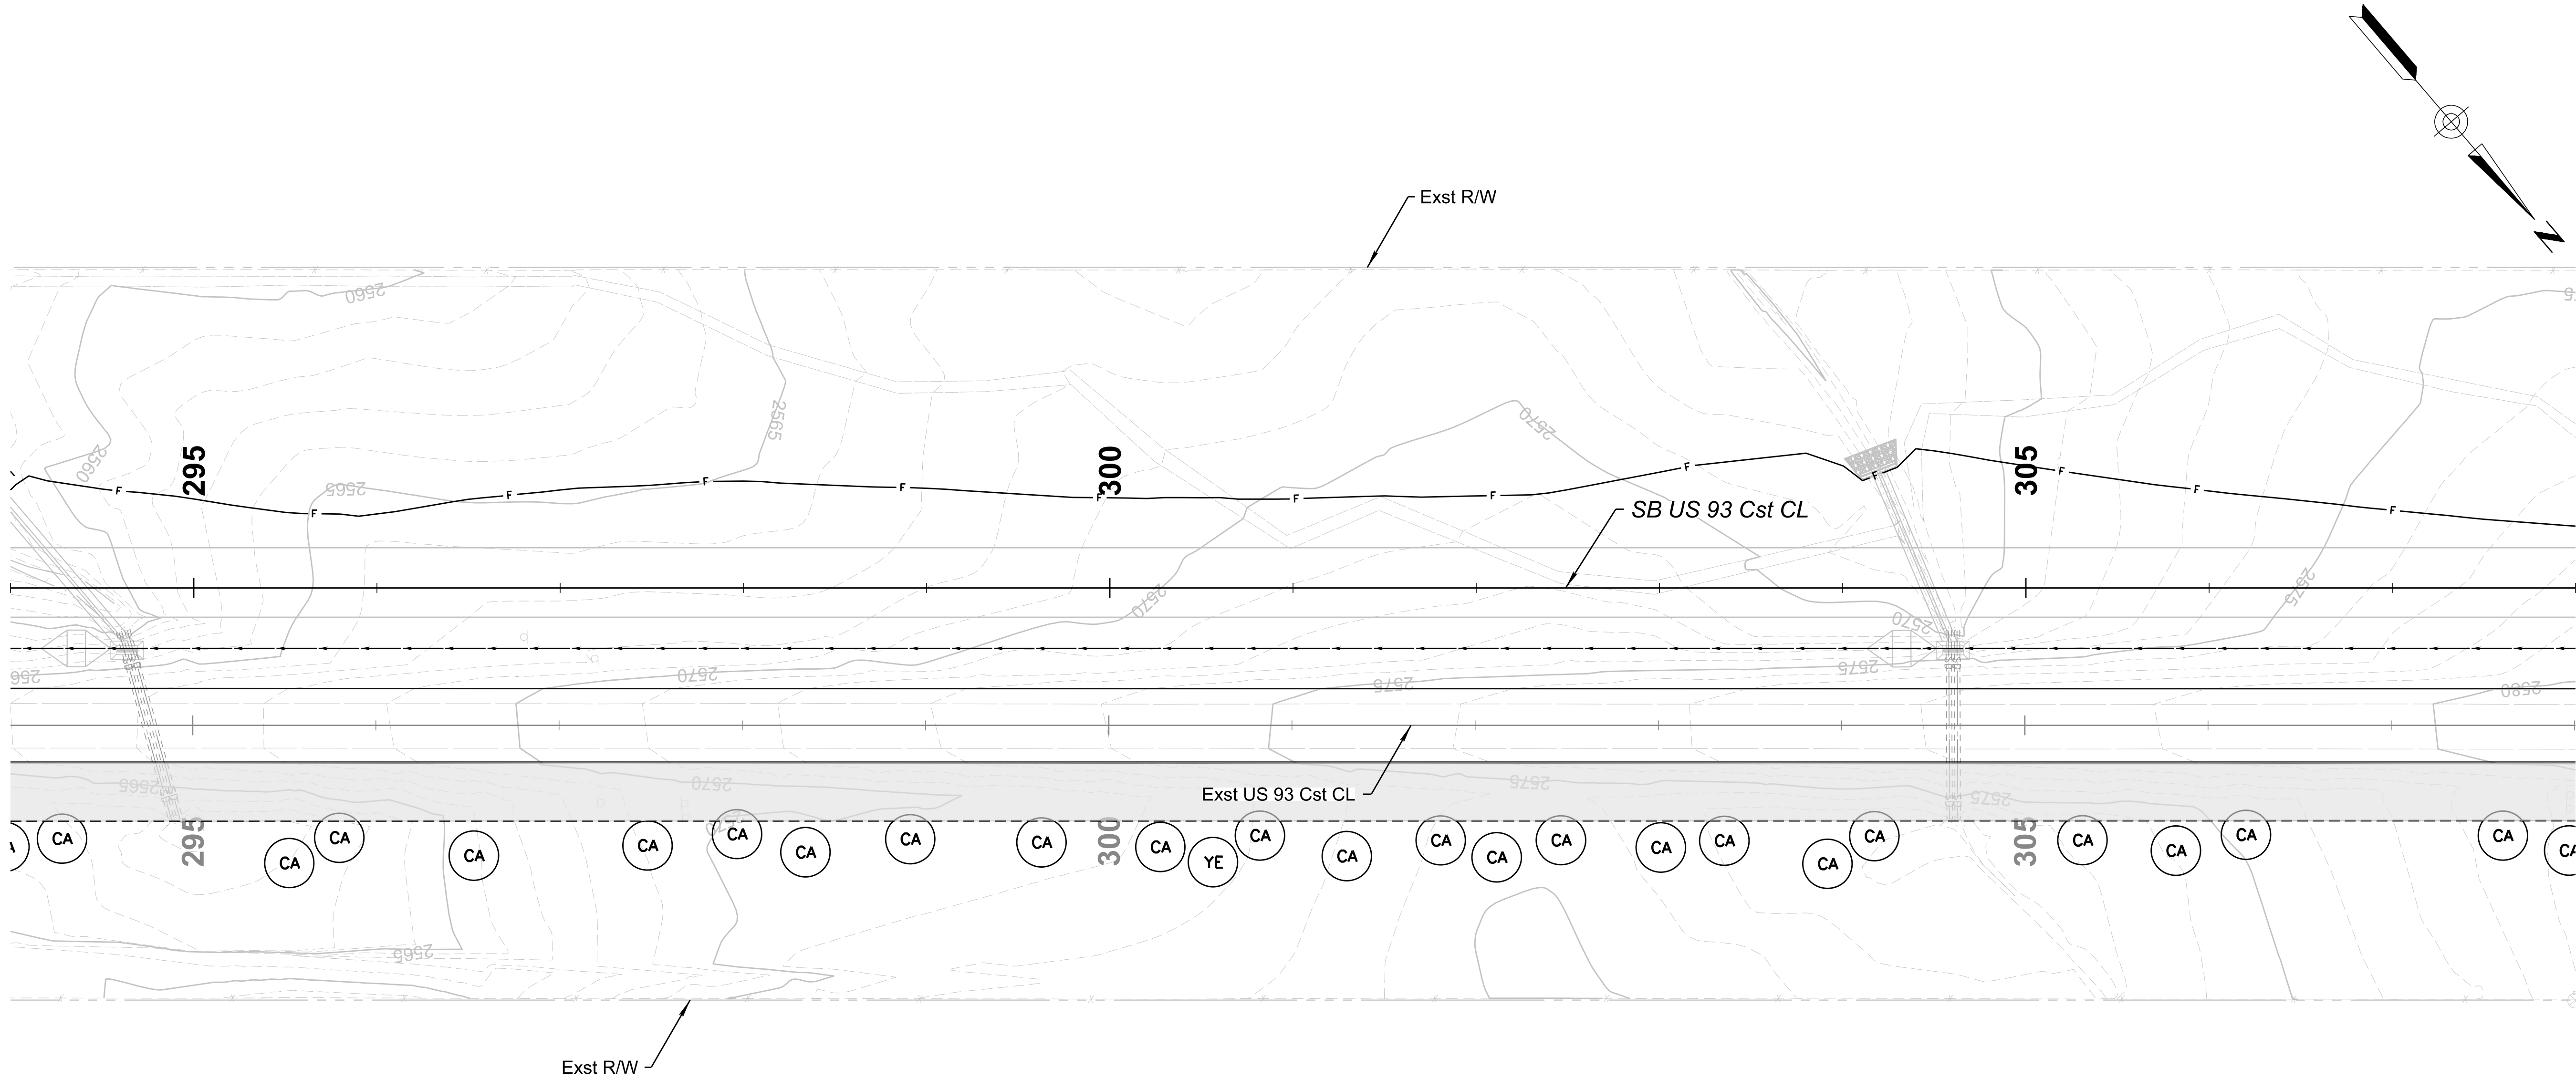


PLANT LEGEND

Botanical Name		Common Name	
CA	Cylindropuntia acanthocarpa	OC	Opuntia chorotica
	Buckhorn Cholla		Pancake Prickly Pear
CL	Cylindropuntia leptocaulis	OE	Opuntia engelmannii
	Desert Christmas Cactus		Desert Prickly Pear
*	Ferocactus cylindraceus	PG	Peniocereus greggii
	Barrel Cactus		Arizona Queen Of The Night
□	Fouquieria splendens	YB	Yucca baccata
	Ocotillo		Banana Yucca
MG	Mammillaria grahamii	YE	Yucca elata
	Fishhook Pincushion		Soaptree Yucca

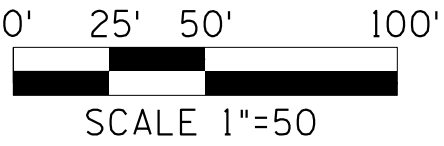

SCALE 1"=50'

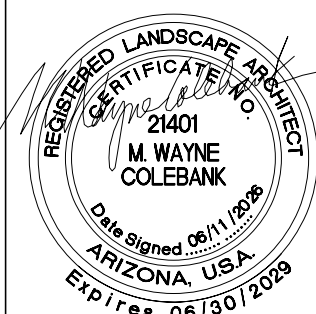


	NAME	DATE
DESIGN	W HERRERA	06/26
DRAWN	STAFF	06/26
CHECKED	W COLEBANK	06/26

LOGAN SIMPSON
200 SOUTH FARM LANE, SUITE 200
TAMPA, FL 33613
P: 813.887.1543

ARIZONA DEPARTMENT OF TRANSPORTATION PROJECT DELIVERY AND OPERATIONS DIVISION ROADWAY DESIGN SERVICES
LANDSCAPE REVEGETATION SHEET SB US 93 STA 294+00 TO STA 308+00


ROUTE US 93
MILEPOST 189.92
STRUCTURE NO.

F.H.W.A. Arizona Division	STATE ARIZ.	PROJECT NO. 093 YV 189	FEDERAL ID NO. 093-B(230)T	SHEET NO. 486	TOTAL SHEETS 524	RECORD DRAWING
LOCATION WICKENBURG RANCH WAY TO VISTA ROYALE						DWG No. L-2.10
TRACS NO. F0738 01C						___ OF ___

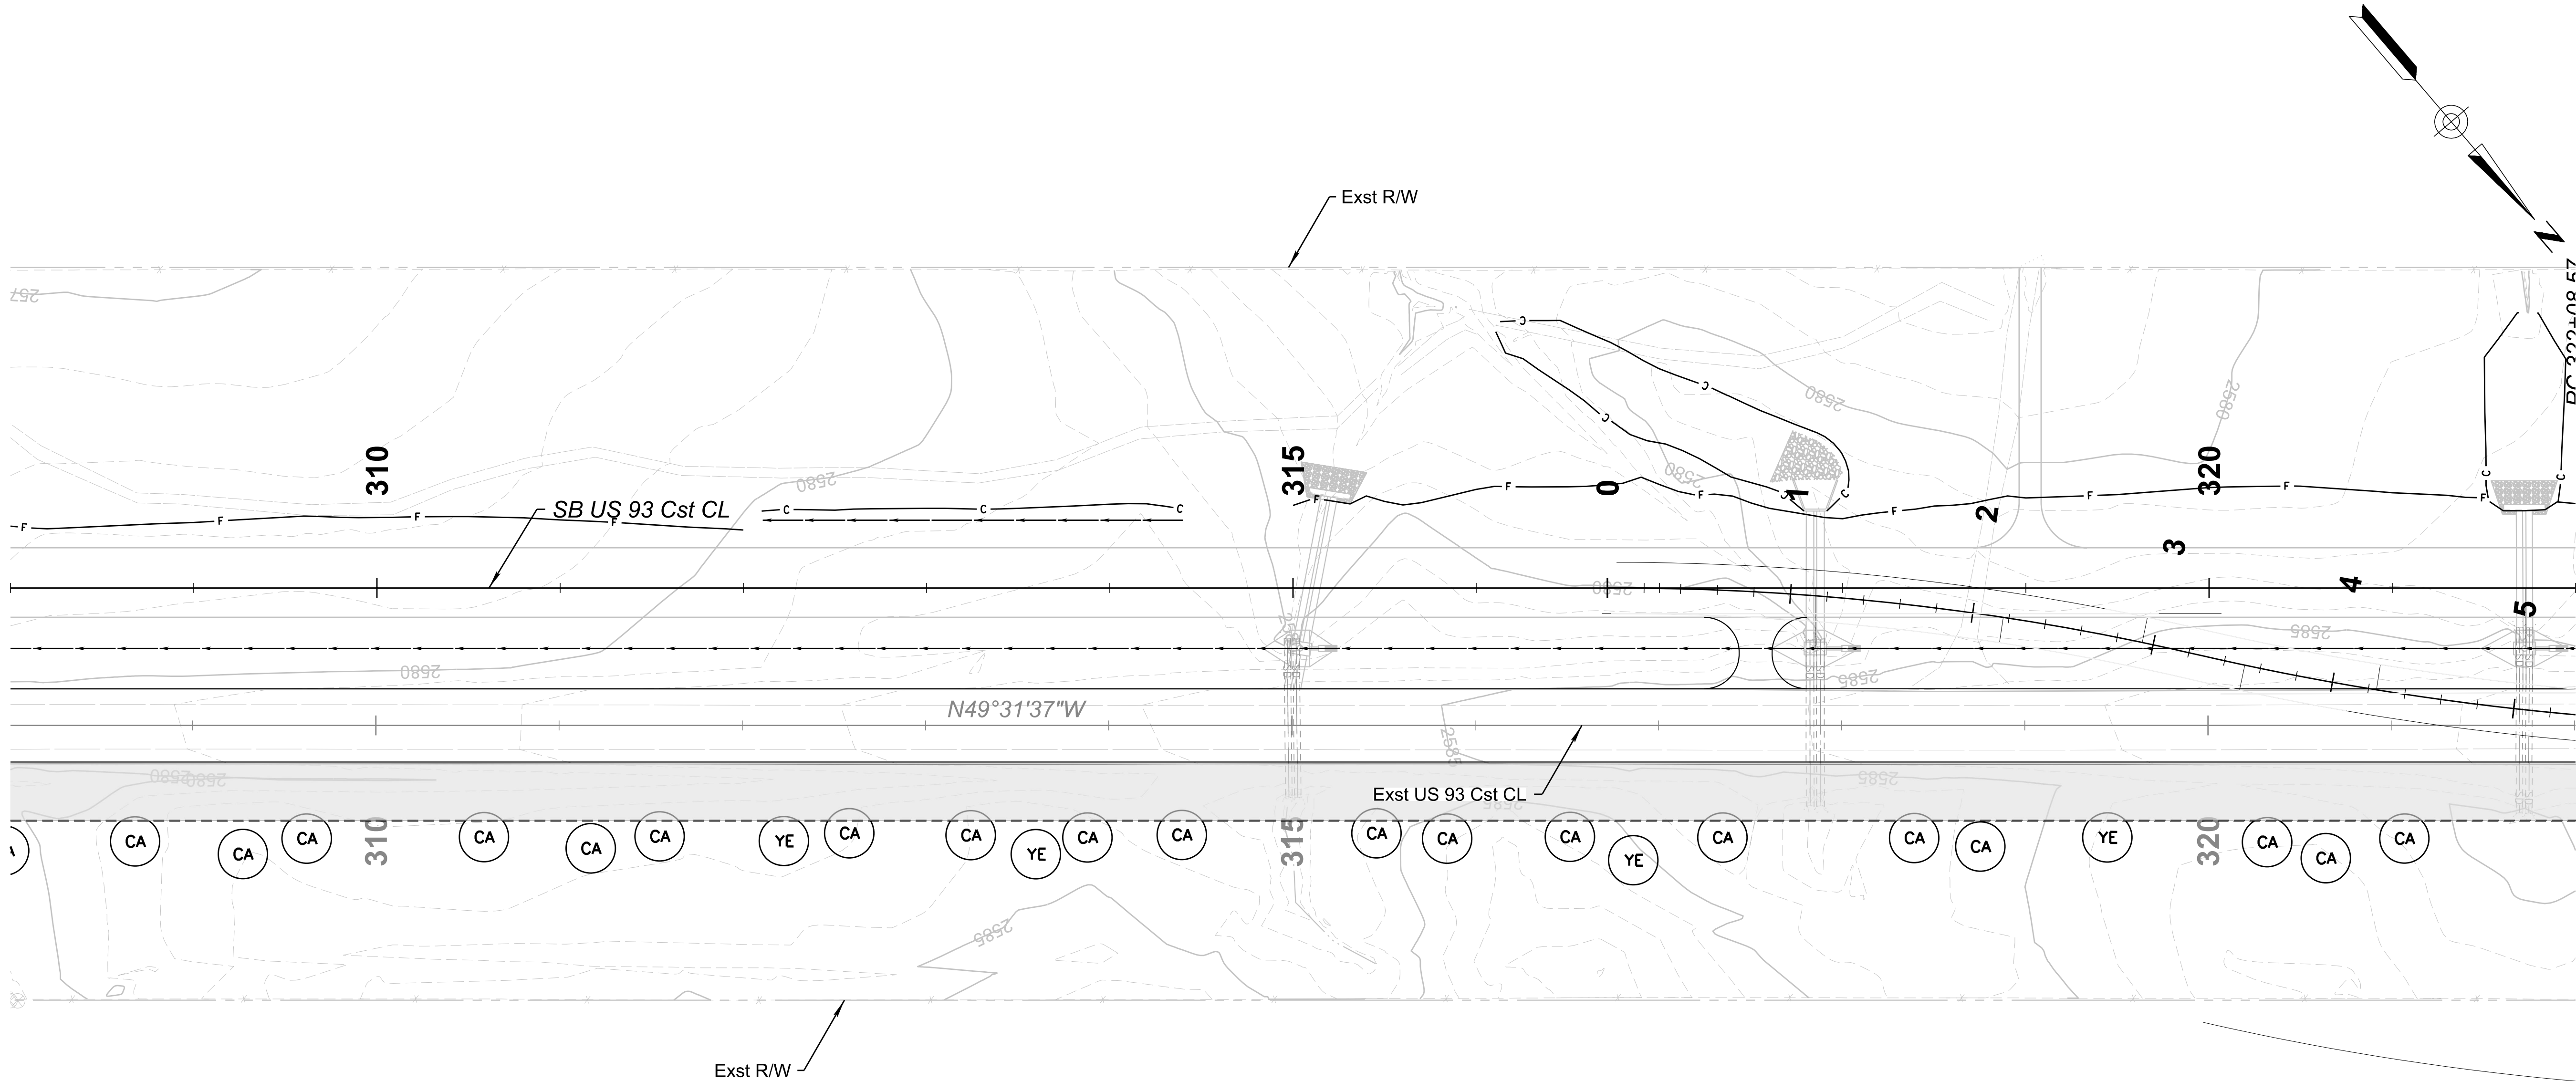


PLANT LEGEND

Botanical Name		Common Name	
CA	Cylindropuntia acanthocarpa	OC	Opuntia chorotica
	Buckhorn Cholla		Pancake Prickly Pear
CL	Cylindropuntia leptocaulis	OE	Opuntia engelmannii
	Desert Christmas Cactus		Desert Prickly Pear
*	Ferocactus cylindraceus	PG	Peniocereus greggii
	Barrel Cactus		Arizona Queen Of The Night
□	Fouquieria splendens	YB	Yucca baccata
	Ocotillo		Banana Yucca
MG	Mammillaria grahamii	YE	Yucca elata
	Fishhook Pincushion		Soaptree Yucca

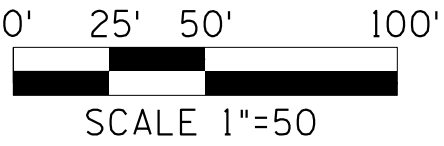


SCALE 1"=50'

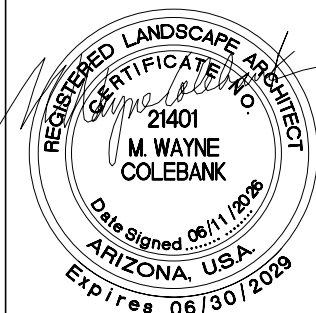

	NAME	DATE
DESIGN	W HERRERA	06/26
DRAWN	STAFF	06/26
CHECKED	W COLEBANK	06/26
 LOGANSIMPSON 222 SOUTH FARMER LANE SUITE 202 TAMPA, FL 33607 P: (813) 987-1243		


ARIZONA DEPARTMENT OF TRANSPORTATION PROJECT DELIVERY AND OPERATIONS DIVISION ROADWAY DESIGN SERVICES	ROUTE US 93
LANDSCAPE REVEGETATION SHEET SB US 93 STA 308+00 TO STA 322+00	MILEPOST 189.92
	STRUCTURE NO.

F.H.W.A. Arizona Division	STATE ARIZ.	PROJECT NO. 093 YV 189	FEDERAL ID NO. 093-B(230)T	SHEET NO. 487	TOTAL SHEETS 524	RECORD DRAWING
LOCATION WICKENBURG RANCH WAY TO VISTA ROYALE						DWG No. L-2.11
TRACS NO. F0738 01C						___ OF ___

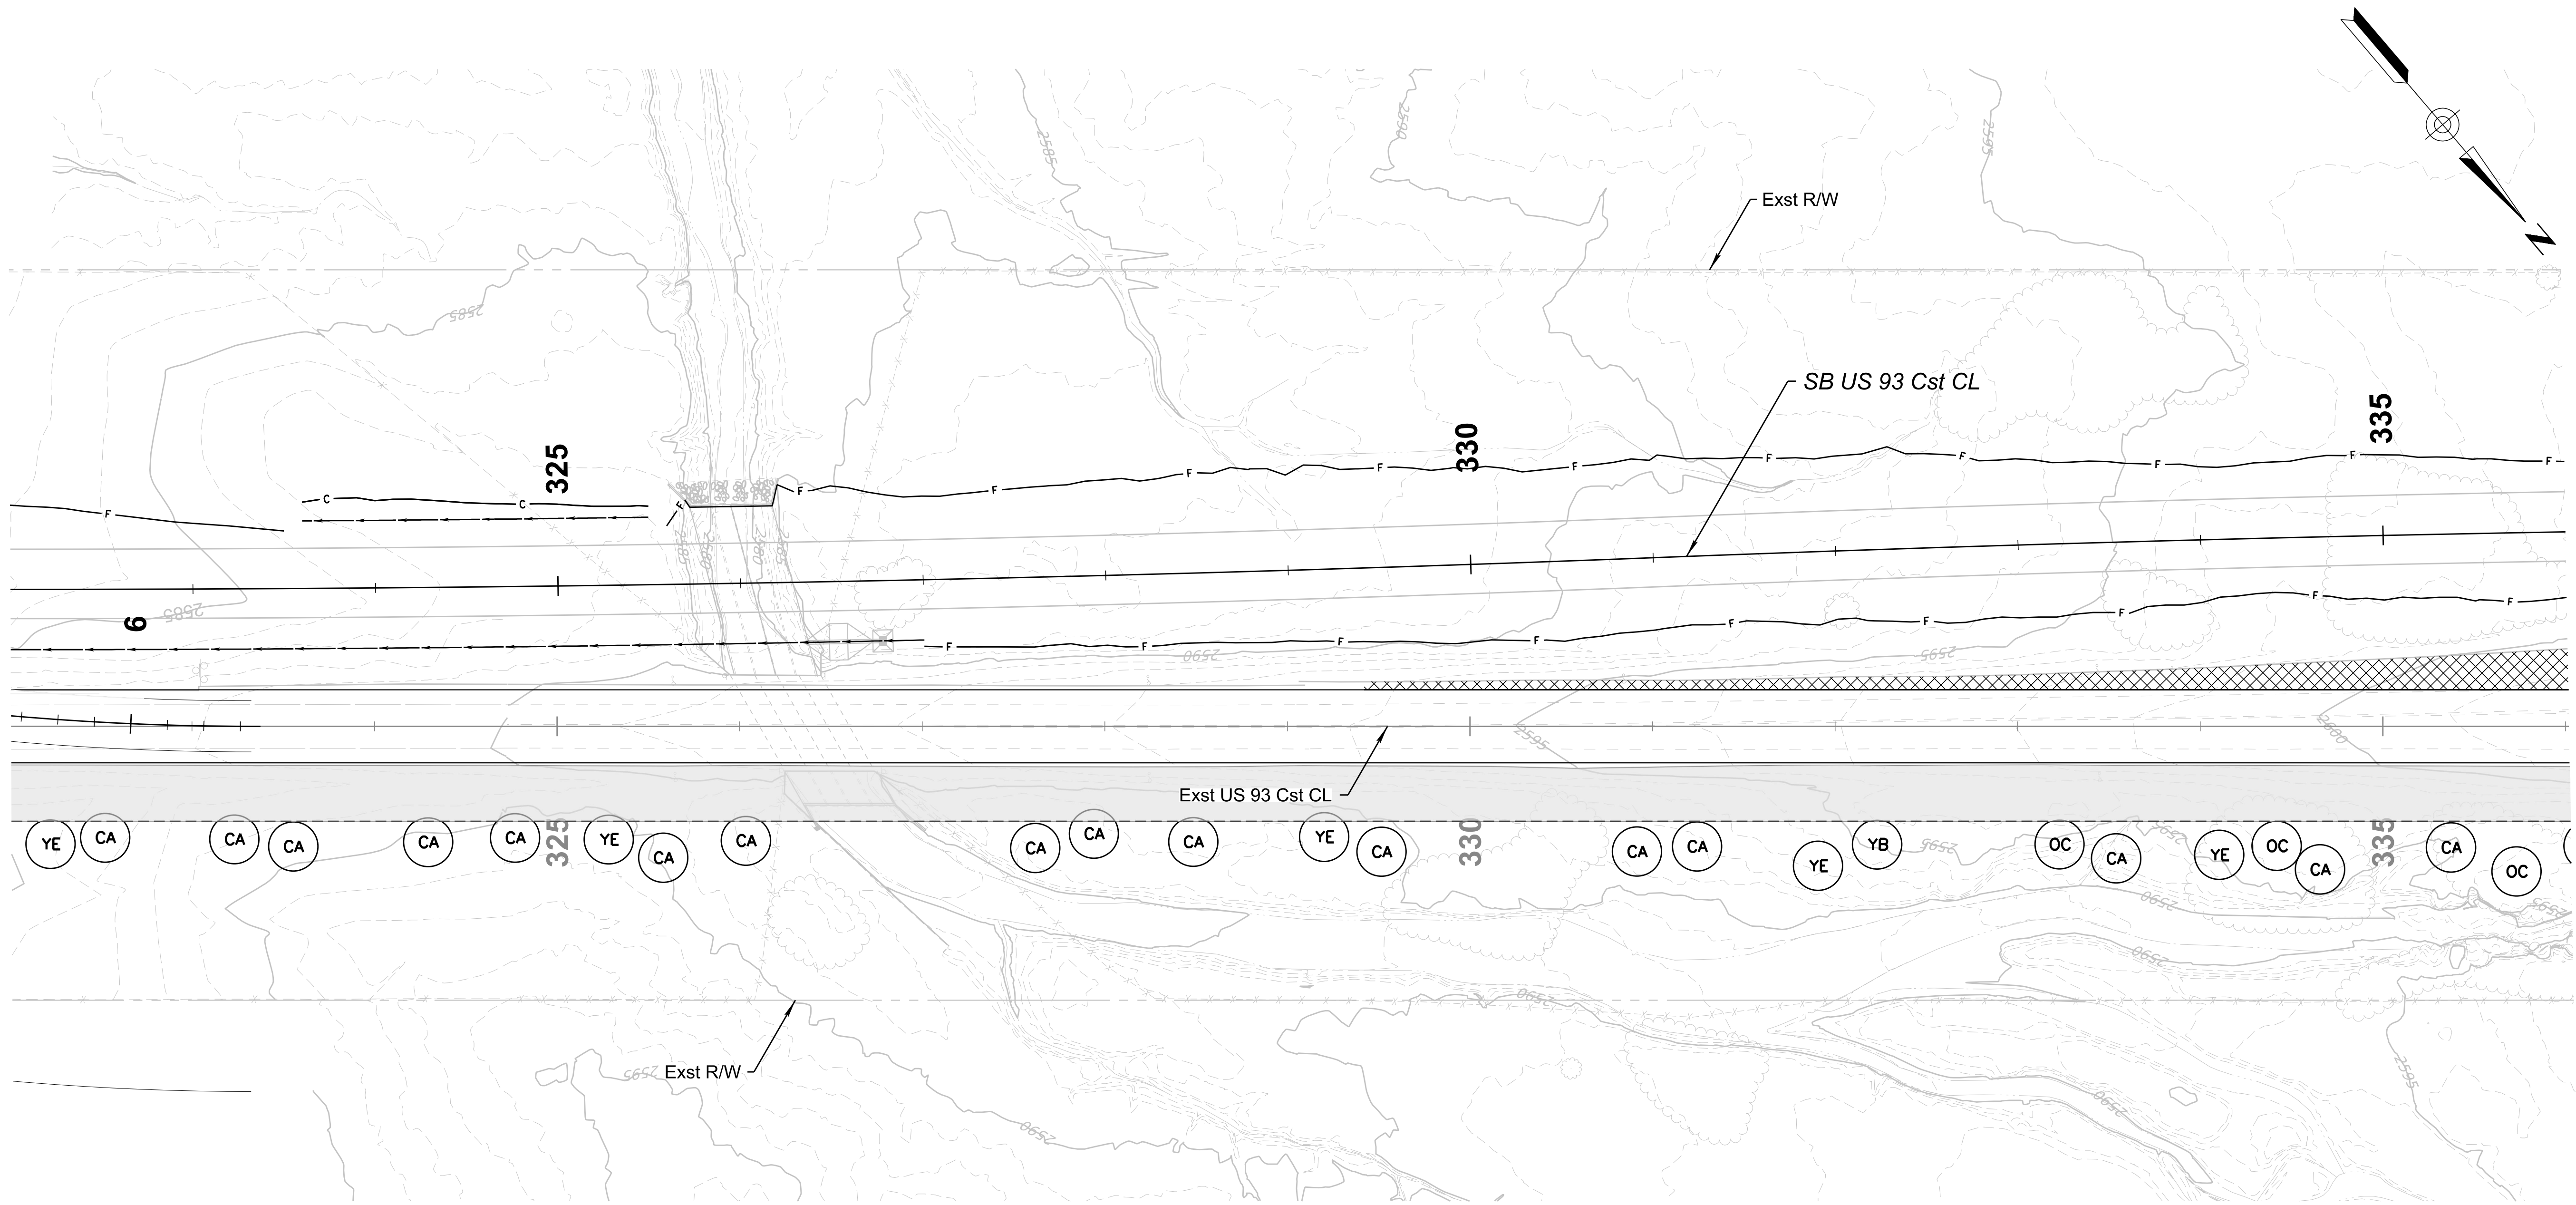


PLANT LEGEND

Botanical Name	Common Name
CA	Cylindropuntia acanthocarpa Buckhorn Cholla
CL	Cylindropuntia leptocaulis Desert Christmas Cactus
*	Ferocactus cylindraceus Barrel Cactus
□	Fouquieria splendens Ocotillo
MG	Mammillaria grahamii Fishhook Pincushion
OC	Opuntia chorotica Pancake Prickly Pear
OE	Opuntia engelmannii Desert Prickly Pear
PG	Peniocereus greggii Arizona Queen Of The Night
YB	Yucca baccata Banana Yucca
YE	Yucca elata Soaptree Yucca

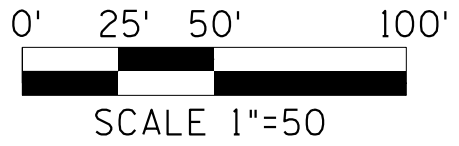



SCALE 1"=50'

		NAME	DATE	ARIZONA DEPARTMENT OF TRANSPORTATION PROJECT DELIVERY AND OPERATIONS DIVISION ROADWAY DESIGN SERVICES		ROUTE US 93	F.H.W.A. Arizona Division	STATE ARIZ.	PROJECT NO.	FEDERAL ID NO.	SHEET NO.	TOTAL SHEETS	RECORD DRAWING	
	DESIGN	W HERRERA	06/26			MILEPOST 189.92			093 YV 189	093-B(230)T	488	524		
	DRAWN	STAFF	06/26				LOCATION WICKENBURG RANCH WAY TO VISTA ROYALE							DWG No. L-2.12
	CHECKED	W COLEBANK	06/26	LANDSCAPE REVEGETATION SHEET SB US 93 STA 322+00 TO STA 336+00			TRACS NO. F0738 01C							
					LOGANSIMPSON 222 SOUTHMAN - AVENUE, SUITE 200 TAMPA, FL 33629 P 813.257.1243		STRUCTURE NO.							

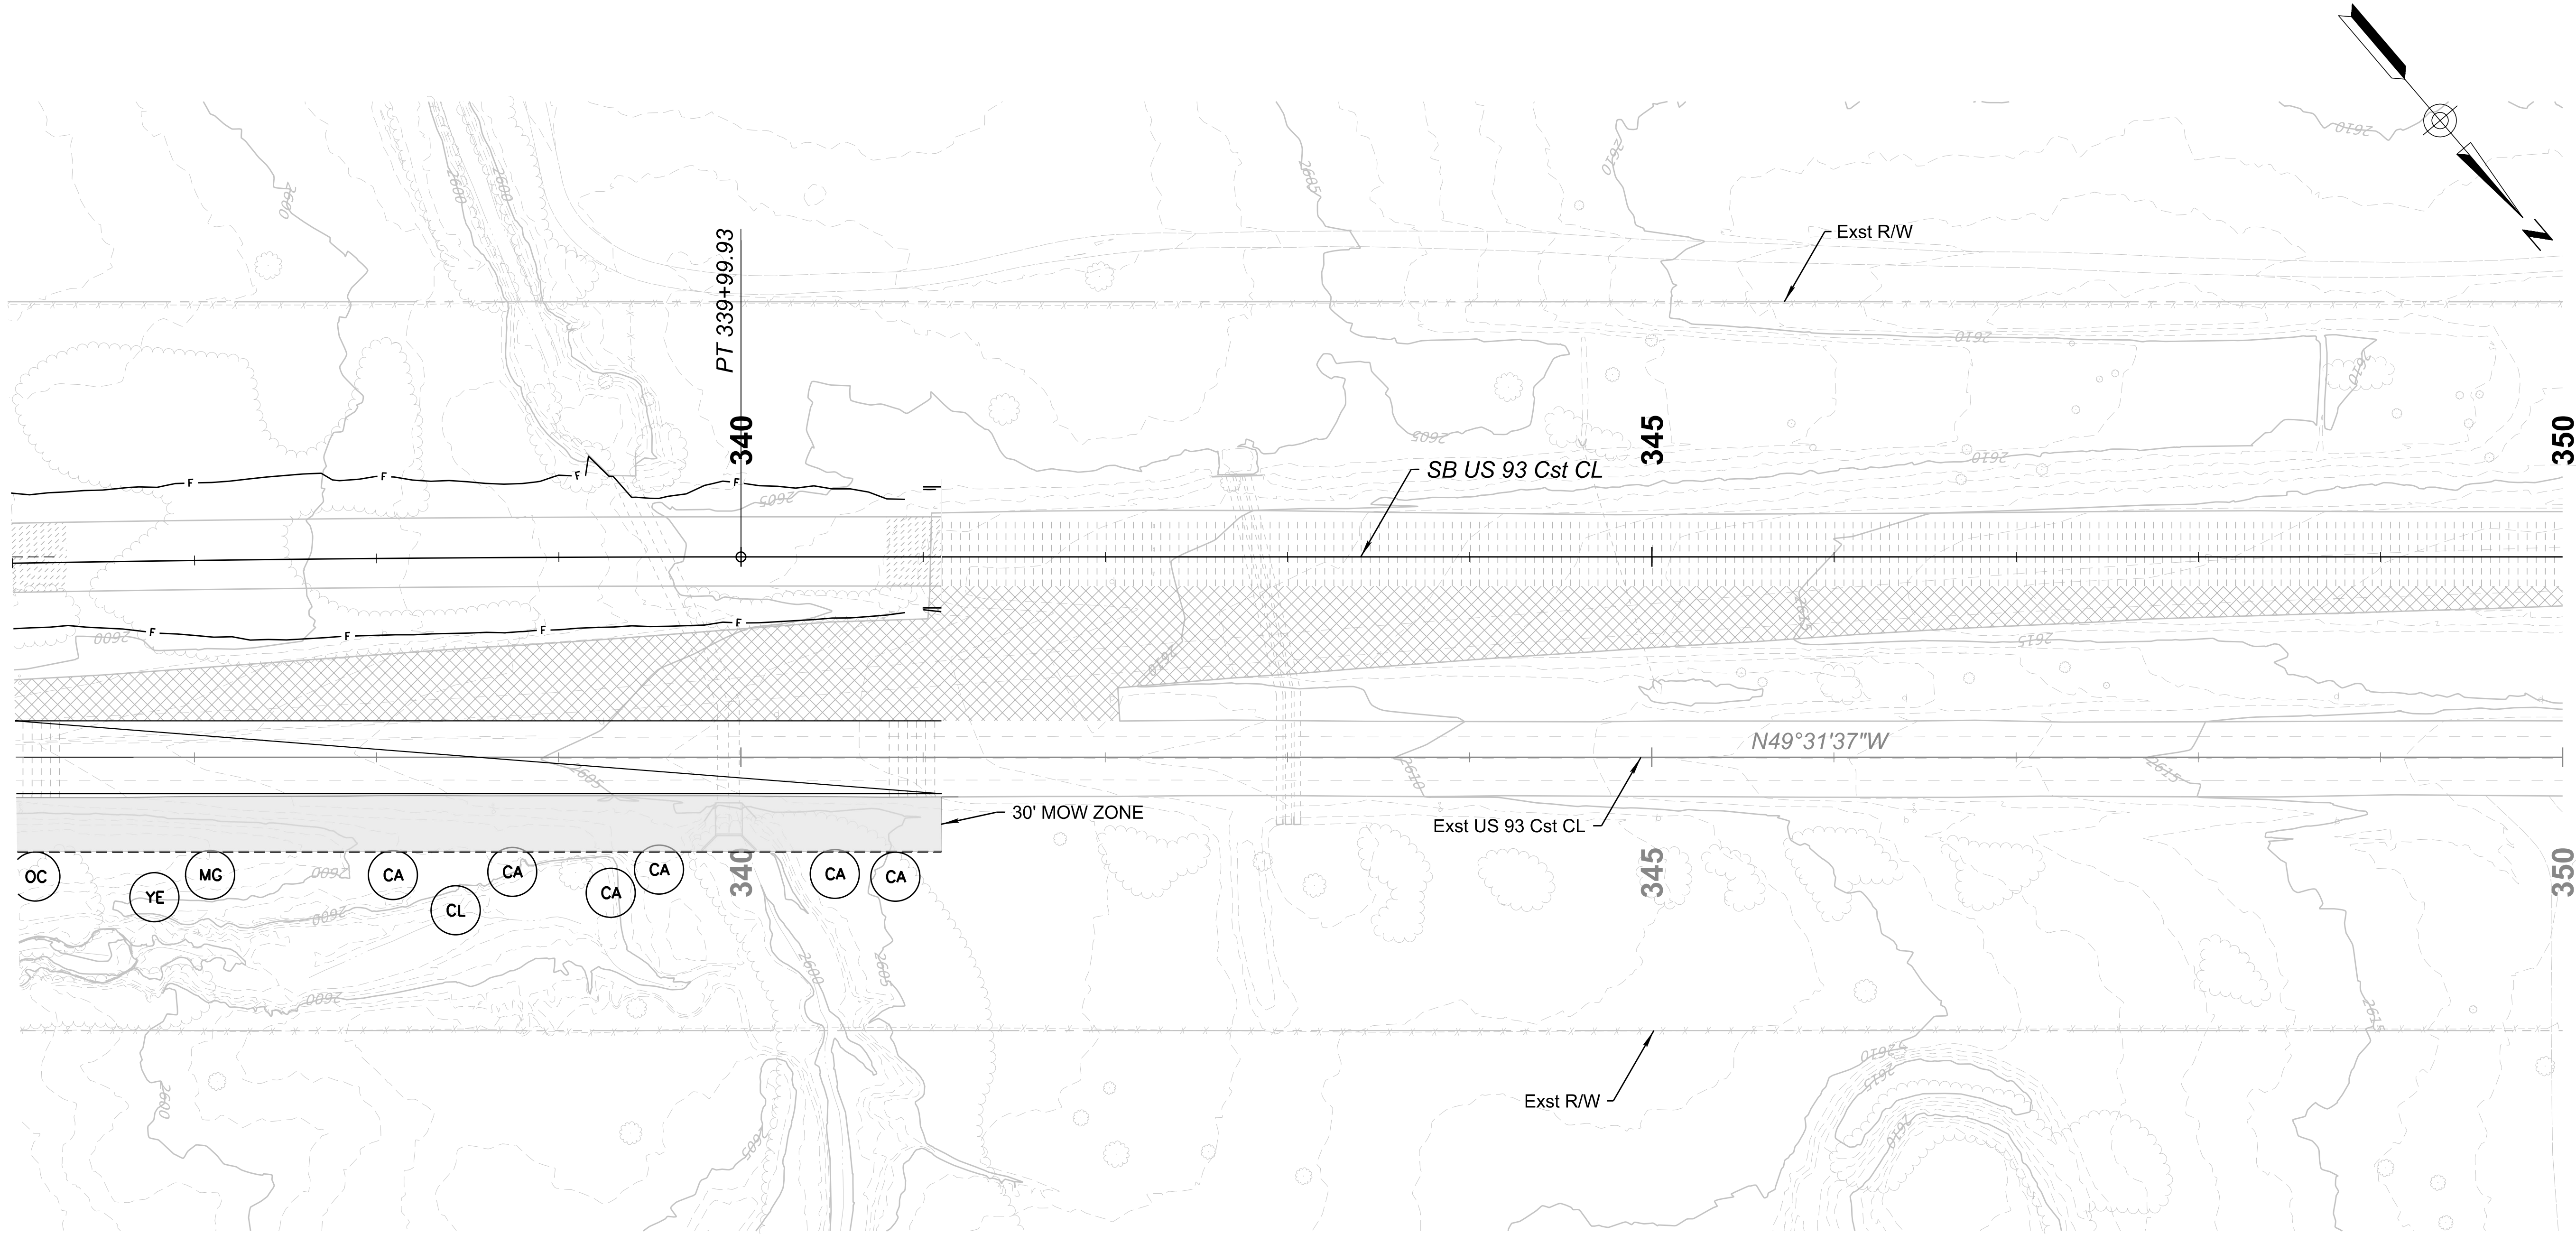

PLANT LEGEND

Botanical Name	Common Name
CA Cylindropuntia acanthocarpa	Buckhorn Cholla
CL Cylindropuntia leptocaulis	Desert Christmas Cactus
* Ferocactus cylindraceus	Barrel Cactus
□ Fouquieria splendens	Ocotillo
MG Mammillaria grahamii	Fishhook Pincushion
OC Opuntia chorotica	Pancake Prickly Pear
OE Opuntia engelmannii	Desert Prickly Pear
PG Peniocereus greggii	Arizona Queen Of The Night
YB Yucca baccata	Banana Yucca
YE Yucca elata	Soaptree Yucca

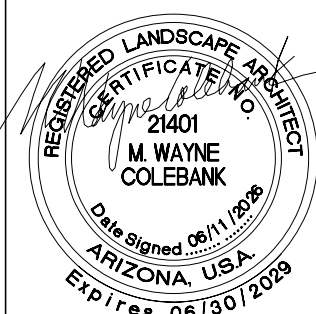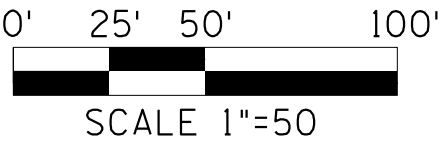


NAME	DATE
DESIGN W HERRERA	06/26
DRAWN STAFF	06/26
CHECKED W COLEBANK	06/26

LOGAN SIMPSON
200 SOUTH FARM LANE, SUITE 200
TAMPA, FL 33613
P: 813.887.1543


ARIZONA DEPARTMENT OF TRANSPORTATION PROJECT DELIVERY AND OPERATIONS DIVISION ROADWAY DESIGN SERVICES
LANDSCAPE REVEGETATION SHEET SB US 93 STA 336+00 TO STA 350+00

ROUTE US 93	F.H.W.A. Arizona Division	STATE	PROJECT NO.	FEDERAL ID NO.	SHEET NO.	TOTAL SHEETS	RECORD DRAWING
MILEPOST 189.92		ARIZ.	093 YV 189	093-B(230)T	489	524	
STRUCTURE NO.	LOCATION WICKENBURG RANCH WAY TO VISTA ROYALE						DWG No. L-2.13
	TRACS NO. F0738 01C						___ OF ___

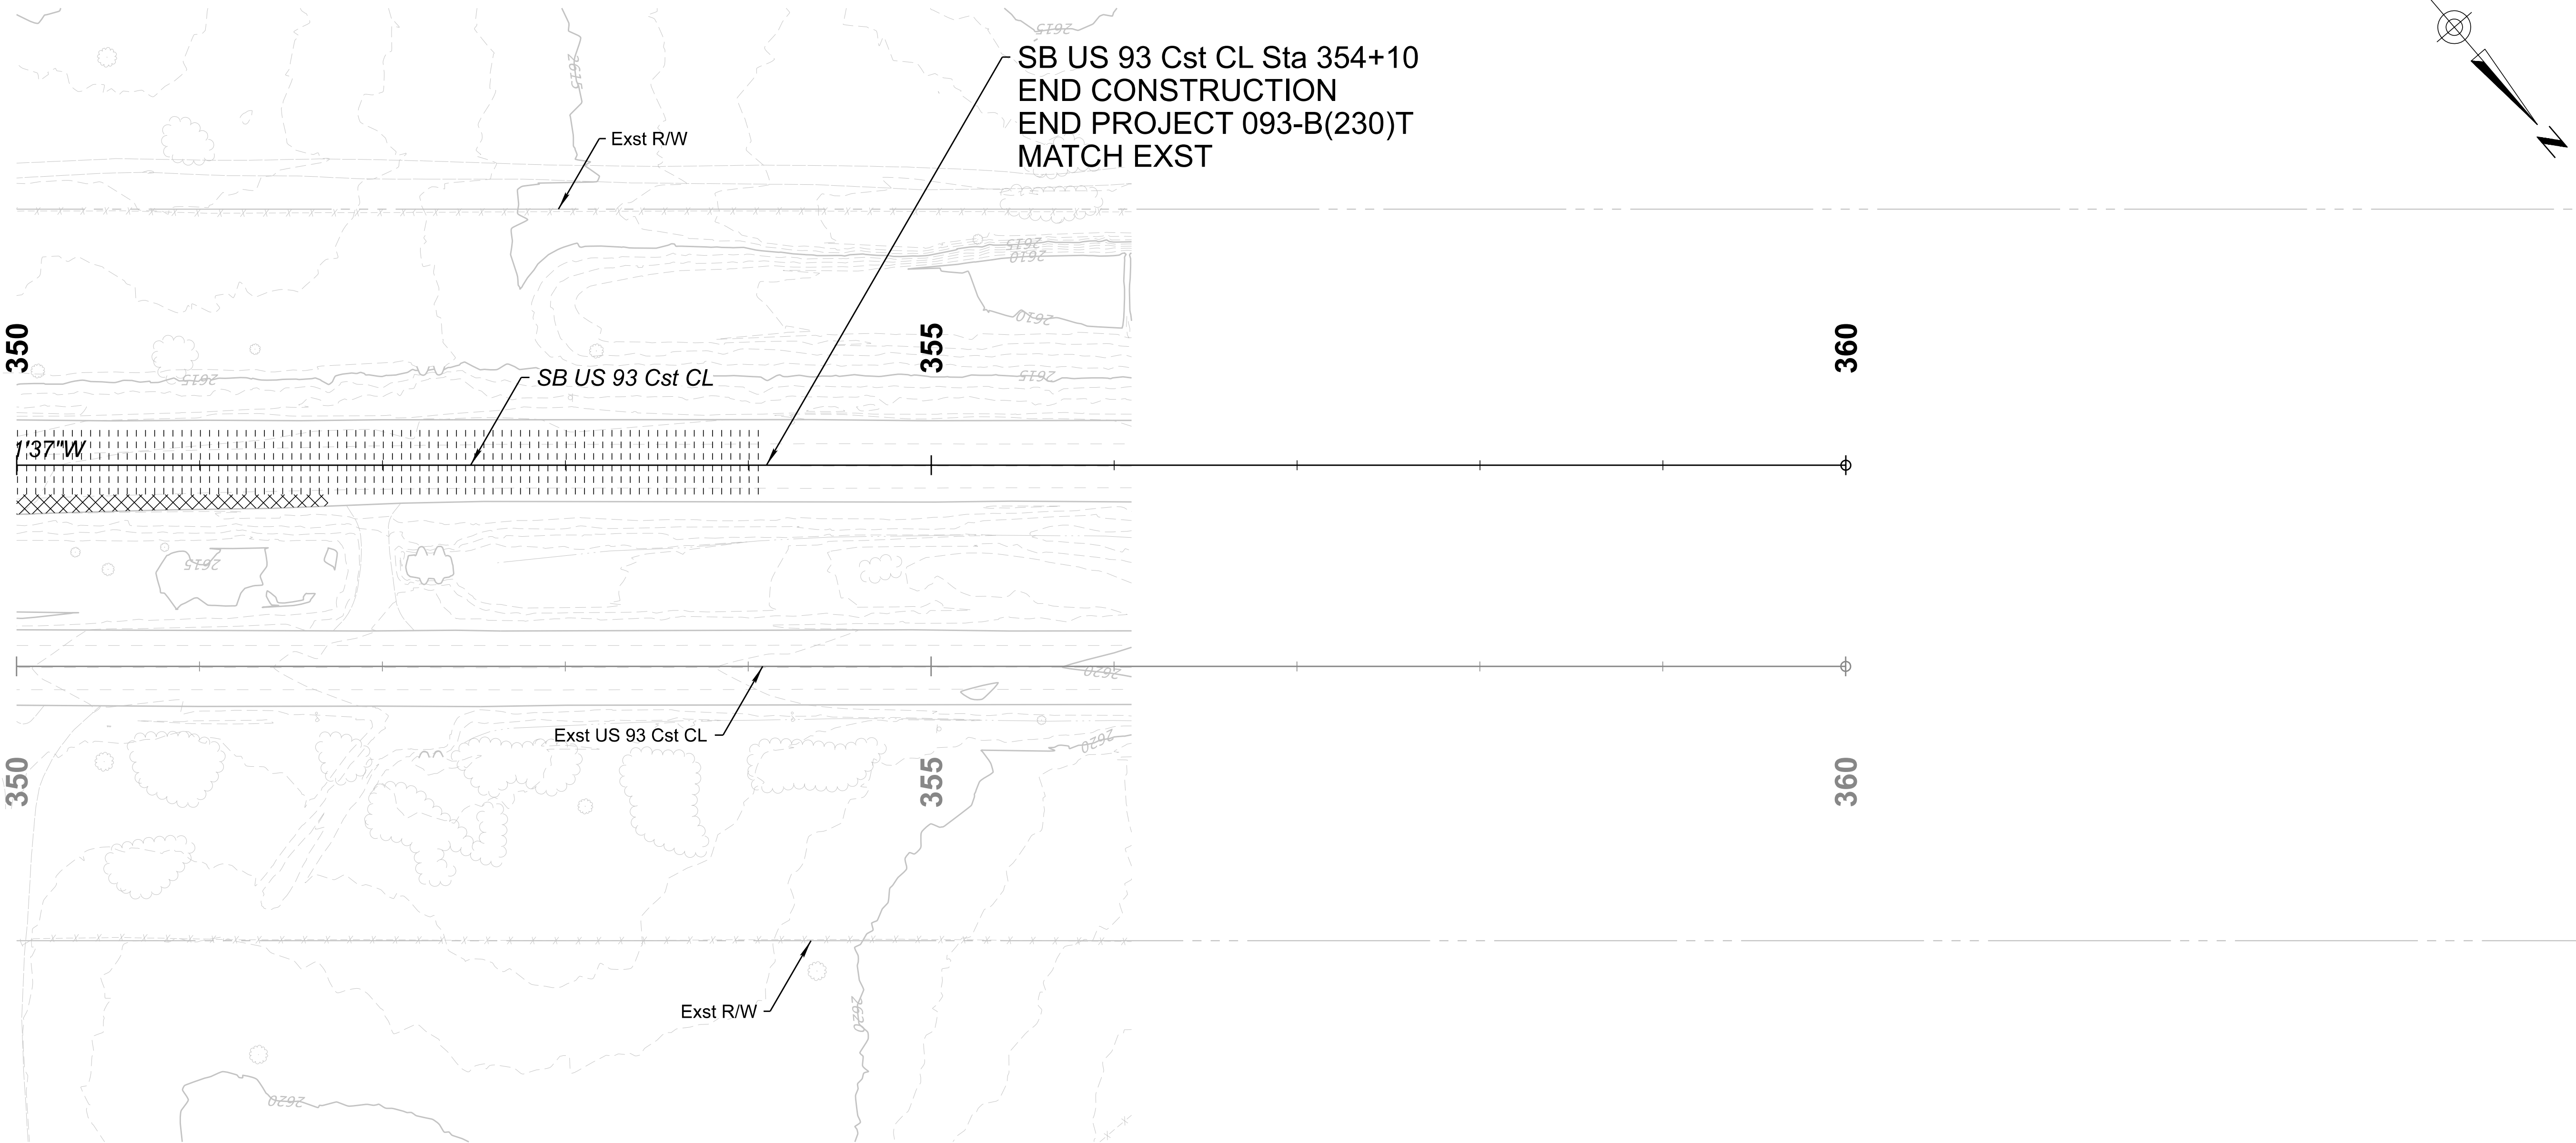

PLANT LEGEND

Botanical Name		Common Name		MP 190	
CA	Cylindropuntia acanthocarpa	OC	Opuntia chorotica		
	Buckhorn Cholla		Pancake Prickly Pear		
CL	Cylindropuntia leptocaulis	OE	Opuntia engelmannii		
	Desert Christmas Cactus		Desert Prickly Pear		
*	Ferocactus cylindraceus	PG	Peniocereus greggii		
	Barrel Cactus		Arizona Queen Of The Night		
□	Fouquieria splendens	YB	Yucca baccata		
	Ocotillo		Banana Yucca		
MG	Mammillaria grahamii	YE	Yucca elata		
	Fishhook Pincushion		Soaptree Yucca		

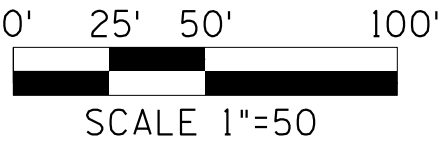

		NAME	DATE	ARIZONA DEPARTMENT OF TRANSPORTATION PROJECT DELIVERY AND OPERATIONS DIVISION ROADWAY DESIGN SERVICES	ROUTE	F.H.W.A. Arizona Division	STATE	PROJECT NO.	FEDERAL ID NO.	SHEET NO.	TOTAL SHEETS	RECORD DRAWING
	DESIGN	W HERRERA	06/26		US 93							
	DRAWN	STAFF	06/26									
	CHECKED	W COLEBANK	06/26									
		LOGANSIMPSON 222 SOUTHWEST AVENUE, SUITE 202 TUCSON, AZ 85701 P (520) 561-1243			LANDSCAPE REVEGETATION SHEET SB US 93 STA 350+00 TO STA 354+10	MILEPOST	WICKENBURG RANCH WAY TO VISTA ROYALE					
					189.92							
					STRUCTURE NO.	TRACS NO. F0738 01C						____ OF ____

REV. DATE: 4/21

CONTROL MEASURE INDEX SHEET (CMIS)

TO BE COMPLETED FOR PROJECTS WITH ONE (1) ACRE OR MORE OF SOIL/GROUND DISTURBANCE OUTSIDE OF JURISDICTIONAL WATERS OF THE U.S. (1 ACRE*)

* For projects that meet the definition of maintenance under AZPDES CGP, the permit threshold is five (≥5) acres. Consult with ADOT EP Water Resources Management to define Jurisdictional Waters of the U. S.

I. PROJECT DESCRIPTION

A. Owner Name and Address:

Arizona Department of Transportation
205 South 17th Avenue
Phoenix, Arizona 85007-3213

B. Project TRACS Number: F0738 01C

C. Project Name/Location (be consistent with the plan set cover sheet): Wickenburg Ranch Way to Vista Royale US 93

City: Wickenburg County: Maricopa/Yavapai

Beginning Latitude (NAD 83): 34°6'0" N

Beginning Longitude (NAD 83): 112°46'48" W

Ending Latitude (NAD 83): 34°3'25" N

Ending Longitude (NAD 83): 112°46'48" W

To obtain the project latitude/longitude data, refer to the Flash Earth web link below (Bing Maps with labels):

http://www.flashearth.com/

D. Project Description: Project expands US 93 from two lanes to four lanes, creating a divided roadway with center median and 8-foot shoulders,adds a two-way frontage road on the east side for local access between Nine Irons Ranch Road and Antelope Creek Road,buils a new southbound bridge over the BNSF railroad tracks to eliminate at-grade crossings, and installs a roundabout at Moreton Rd and Nine Irons Ranch Road. This project also includes Gap A limits which include Wickenburg Ranch Way and Matthie Ranch Road.

II. HYDROLOGIC INFORMATION

A. Percentage of the site that is impervious before and after construction:

Percentage before Construction:

Percentage after Construction:

B. Receiving Water(s), refer to the plan set cover sheet and the NHD Plus HR Availability Map Web Link below:

https://usgs.maps.arcgis.com/apps/MapTools/index.html?appid=41a5c2ca49bd4a83b239450e61022d53

(If unnamed, state as unnamed)

III. SOIL STABILIZATION MEASURES

- ☐ All disturbed soil, which will not be paved, riprapped or otherwise covered to prevent erosion, will be revegetated and/or landscaped in accordance with the project plans and specifications.

IV. MEASURES TO CONTROL STORMWATER AND AIR QUALITY

A. Temporary Stormwater and Air Quality Control Measures (CMs) / Best Management Practices (BMPs)

- ☐ Temporary Diversion Dikes
☐ Temporary Rock Check Dams
☒ Stabilized Construction Entrance/Exit Gravel Pad
☐ Soil Stabilizer for Wind Erosion and Dust Control
☒ Rock Inlet/Outlet Protection
☐ Sediment Control Berms
☐ Silt Fences
☒ Wattles (Excelsior/Straw/Compost)
☐ Excelsior Logs / Sediment Logs
☐ Erosion Control Mattings
☐ Seeding (Class II with final mulch cover)
☐ Gravelbag
☐ Catch Basin Temporary Fabric Filter
☐ Designated Washout Areas
☐ Protected Chemical and Material Storage Area
☐ Equipment Maintenance Procedures
☐ Others Describe:



B. Permanent and Post-construction Stormwater and Air Quality Control Measures (CMs) / Best ManagementPractices (BMPs):

- ☐ Crown Ditch/Dike
☒ Rock Protection
☐ Rock Riprap Channel Lining
☐ Sediment Basin
☐ Embankment Curb
☐ Spillways
☐ Downdrains
☐ Minibenching
☐ Solid Waste Management
☐ **Rock-filled Stormwater Infiltration CM/BMP as Infiltration Basin and/or Trench
☐ **Filtration Structures
☐ **Infiltration Basin and/or Trench
☐ **Retention and/or Detention Basins
☐ **Bioretention
☐ **Manufactured Treatment Devices
☒ Seeding established as a perennial vegetative cover with a density of 70% of the native background vegetative cover.

☐ Others Describe:

** Track and report to ADOT EP Water Resources Management:

ADOTWater@azdot.gov

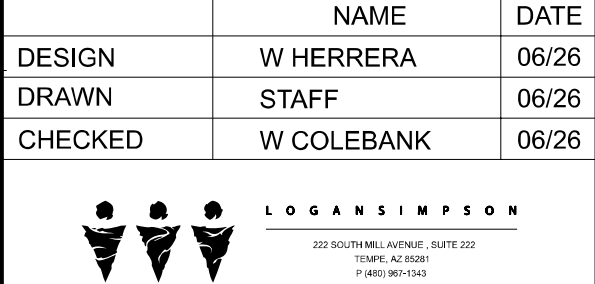
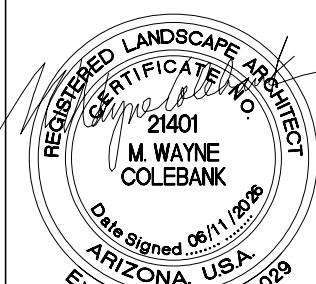


ROUTE US 93	F.H.W.A. Arizona Division	STATE	PROJECT NO.	FEDERAL ID NO.	SHEET NO.	TOTAL SHEETS	RECORD DRAWING
		ARIZ.	093 YV 189	093-B(230)T	491	524	
MILEPOST 189.92	LOCATION WICKENBURG RANCH WAY TO VISTA ROYALE						DWG No. E-1.01
STRUCTURE NO.	TRACS NO. F0738 01C						OF

EROSION CONTROL QUANTITIES								
SHEETS	Sediment Wattle - 9" (Lin Ft)	Sediment Wattle - 20" (Lin Ft)	Rock Mulch (Cu Yd)	Sediment Log (Lin Ft)	Check Dam (Cu Yd)	Stabilized Construction Entrance (Sq Yd) Detail ES 6	Granite Mulch (1 1/4" Minus) (Sq Yd) See Note 3	Seeding (Ac)
E-03.01	2074	0	0	0	18	0	1096	2.2
E-03.02	2162	1478	135	48	24	0	2269	4.5
E-03.03	0	1134	27	64	18	400	3246	3.9
E-03.04	1117	2101	49	0	9	0	5320	5.3
E-03.05	1363	0	75	24	33	0	0	3.8
E-03.06	1991	603	6.5	0	39	17	0	1.3
E-03.07	2583	1427	4	0	36	0	0	2.1
E-03.08	3483	1405	14	0	36	33	0	2.7
E-03.09	6003	4027	15.2	0	90	68	0	6.1
E-03.10	3140	4144	7.7	0	63	68	0	5.2
E-03.11	4734	3573	5.8	0	18	17	0	5.4
E-03.12	3491	3116	18.4	0	39	51	0	4.1
E-03.13	3806	2469	12.2	0	36	17	0	3.7
E-03.14	2083	1381	8.6	0	33	17	0	2.3
E-03.15	1610	1325	12.5	0	15	17	0	2.0
E-03.16	2300	2281	11	0	9	34	0	1.7
E-03.17	1020	1021	2	0	0	0	0	0.5
E-03.18	0	0	0	0	0	0	0	0
E-03.19	162	1271	20	0	0	0	176	1.5
E-03.20	184	87	13	0	6	0	0	0.4
E-03.21	2749	192	13	231	0	0	0	7.0
E-03.22	791	0	0	0	0	0	0	2.2
E-03.23	2260	0	12	195	0	0	0	2.6
E-03.24	2540	0	0	0	6	0	0	2.1
E-03.25	2342	0	0	0	0	0	0	1.4
G-03.07	0	0	0	0	0	0	685	0
Totals =	53,988	33,035	461.9	562	528	739	12,792	74.0

- NOTES:**
- 1.The quantities shown here are approximate and are subject to field adjustment.
- 2.Temporary BMP's are detailed only. The Contractor shall provide a temporary SWPPP Plan prior to construction for approval. Quantities for this work are estimated and shown in the bid schedule.
- 3.Granite Mulch in roundabout and median shall be placed to a thickness of 3-inches and will be measured and paid for under Item 8030092 - Granite Mulch (1 1/4" Minus).

DESIGN		JML	DATE	06-26	ARIZONA DEPARTMENT OF TRANSPORTATION PROJECT DELIVERY AND OPERATIONS DIVISION ROADSIDE DEVELOPMENT SECTION	
DRAWN		RM	DATE	06-26		
CHECKED		DBK	DATE	06-26		
 Stanley Consultants Inc.		3133 East Camelback Road, Suite 100 Phoenix, Arizona 85016 Phone: (602) 333-2200			EROSION CONTROL QUANTITIES	
ROUTE		LOCATION		DWG NO. E-1.02		
US 93		WICKENBURG RANCH WAY TO VISTA ROYALE				
TRACS NO. F0738 OIC				093-B(230)T		OF

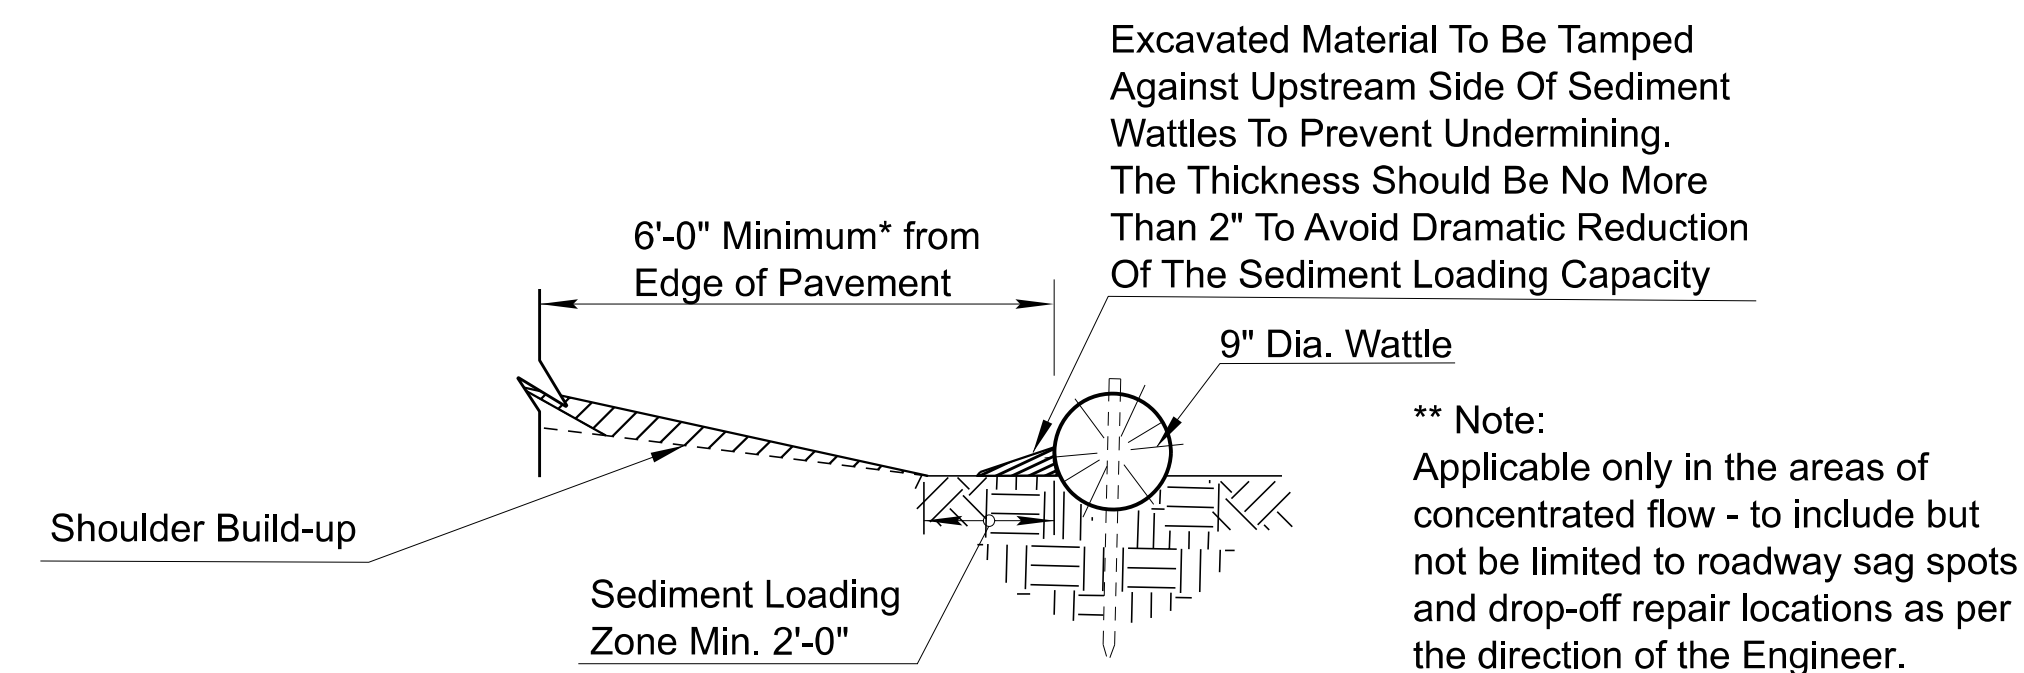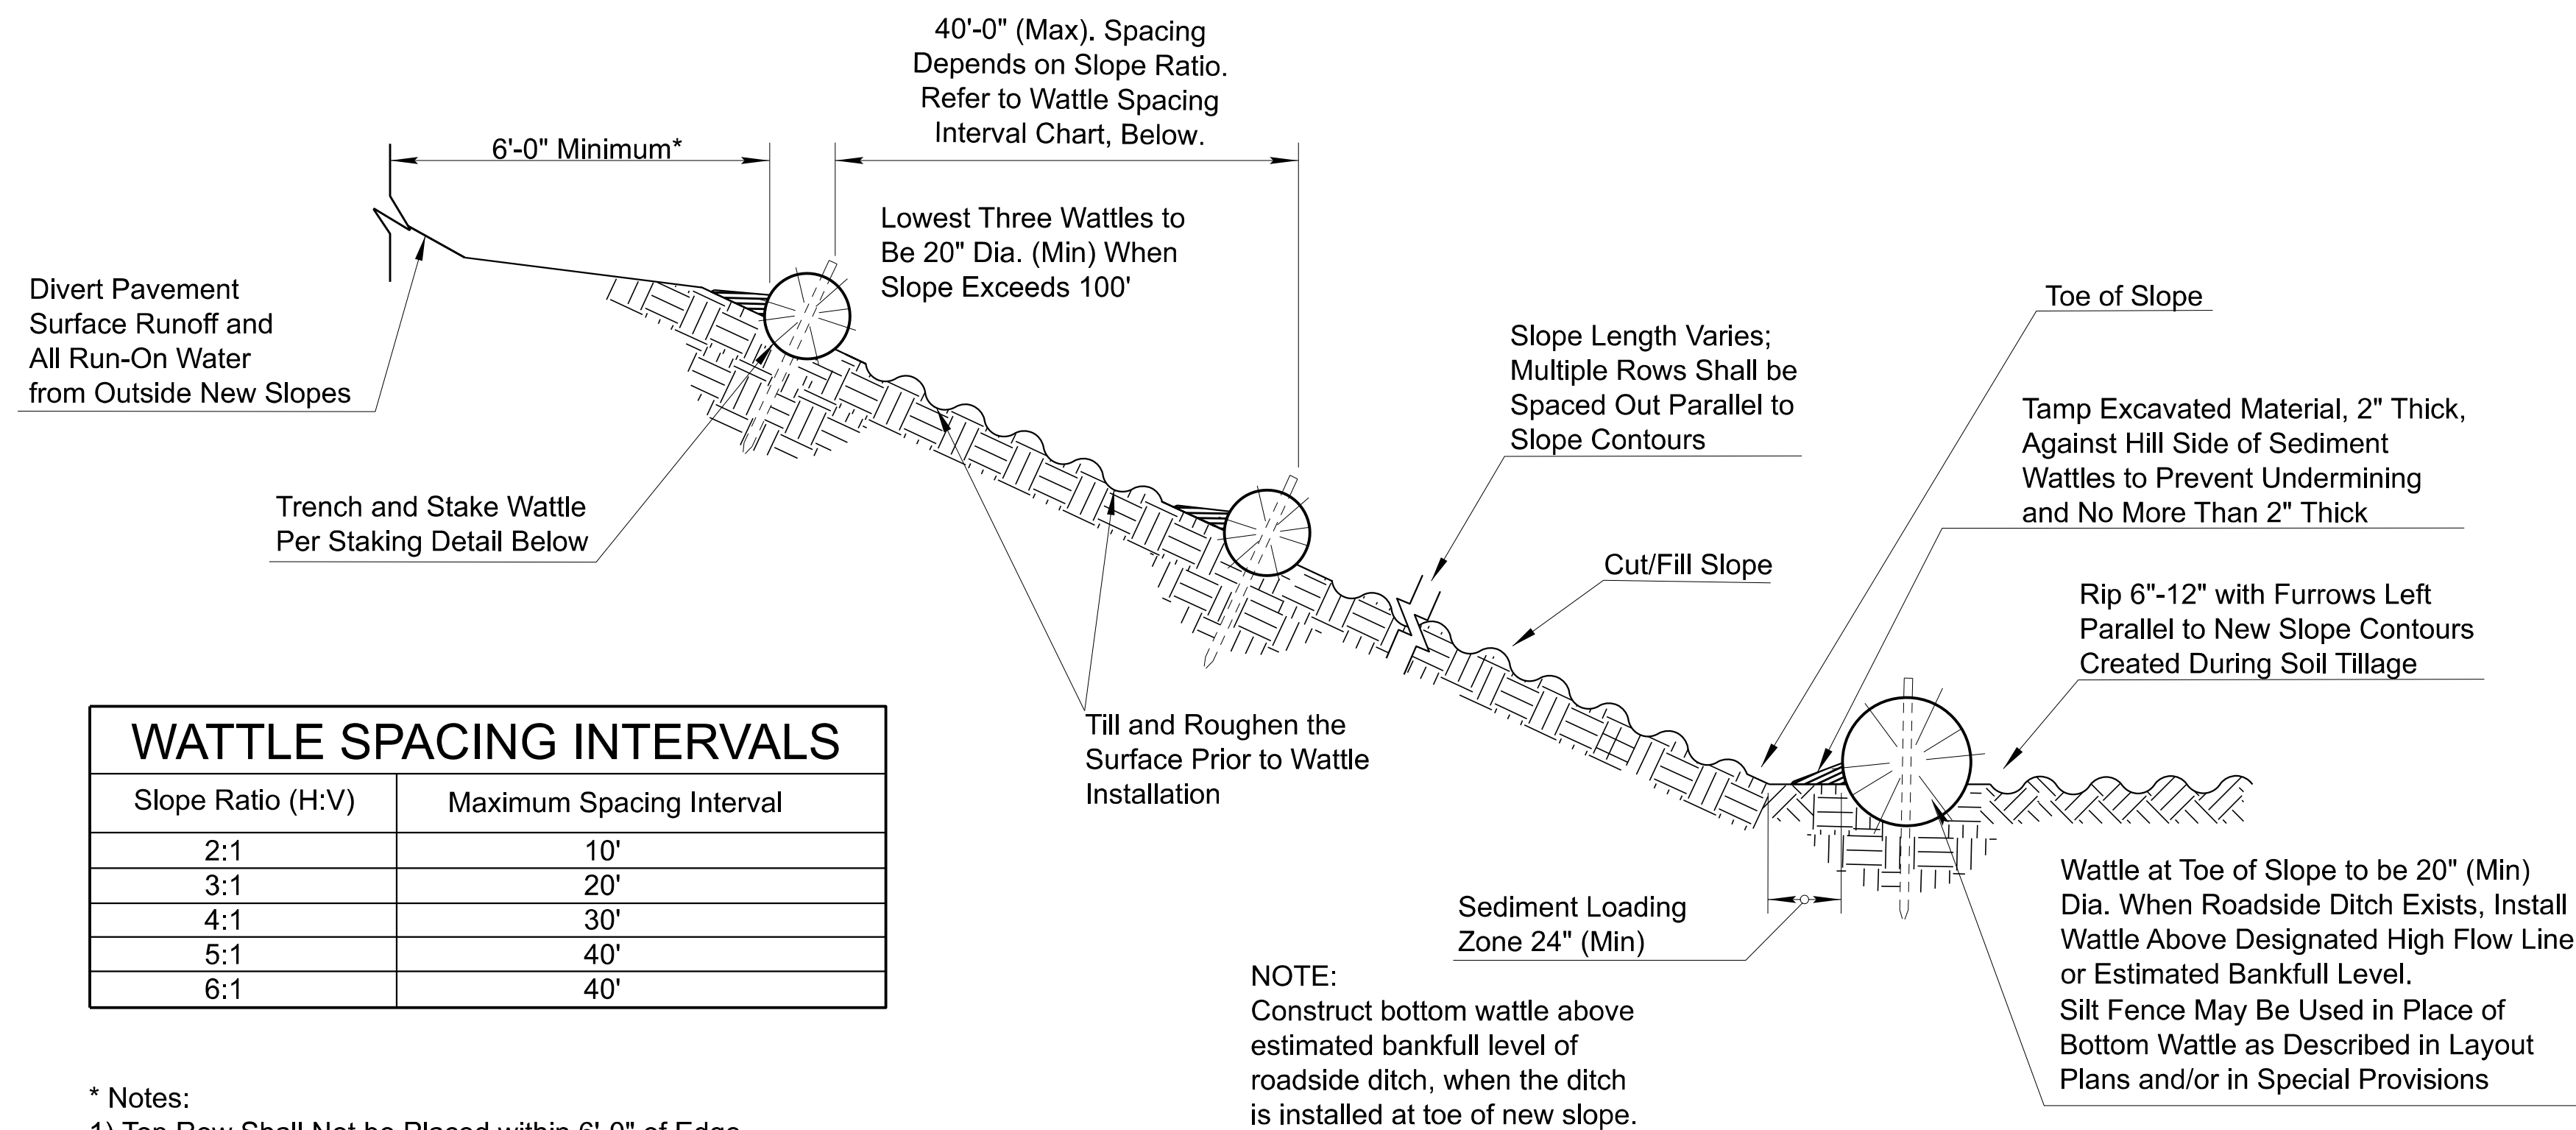


NEW SHOULDER BUILDUP **
PROTECTION SECTION (NTS)

NOTES:

1. Install Sediment Wattles as slopes are constructed to grade or as directed by the Engineer. Select, install and maintain in conformance with manufacturers' specifications to meet site conditions for slope protection and in accordance with good engineering practices. No Sediment Wattles shall be installed in urban freeway medians, nor where cable barrier systems are employed.
2. Sediment Wattles shall be in continuous contact with trench bottom and sides. Do not overlap wattle ends on top of each other. A 20" Dia. wattle may be made from 2-3 rolled excelsior or straw blankets.
3. Butt adjoining wattles tightly against each other. Drive the first end stake of the second wattle at an angle toward the first wattle to help abut them tightly.
4. Repair any rills or gullies promptly. Make field adjustments and corrections of Wattle CM/BMP immediately if it is causing flooding, erosion, and/or affecting roadway safety.
5. Construction of cut slopes 2:1 and steeper in soil and rock materials that can be ripped shall be constructed, whenever possible, by Minibenching. Refer to Slope Minibenching CM/BMP Detail.
6. Loosening surface soil is not required where Minibenchings are used. For seeded areas, tillage shall be performed to form minor ridges and furrows parallel to new slope contours and as specified in Section 805 of the Specifications and project special provisions.
7. Divert and direct run-on water from outside of the slopes to the spillways and/or rock riprap/rock mulch. Diversion dikes and/or ditches are necessary on natural undisturbed slopes beyond the top limits of new slopes to divert run-on water.
8. Installation and maintenance of Sediment Wattle CM's/BMP's shall not negatively impact traffic safety, nor the designed function of roadway or bridge drainage facilities.
9. Install and maintain Sediment Wattle CM's/BMP's to carry the stormwater of at least 2-year, 24-hour events.
10. The Sediment Wattle CM's/BMP's pay/bid item shall include all materials used for this CM/BMP: all ground preparation, furnishing, installing, maintenance, final removal, and disposal of this temporary CM/BMP, as well as returning the area to an acceptable condition as approved by the Engineer.
11. Refer to Specification Section 810-2.06(C) for Sediment Wattle material specifications.
12. Make field adjustments and corrections to ensure NO sensitive biological resources (native species / habitats) will be adversely impacted.


SECTION (NTS)

Stake Length:
24" for 9" Dia. Wattle
33" for 20" Dia. Wattle

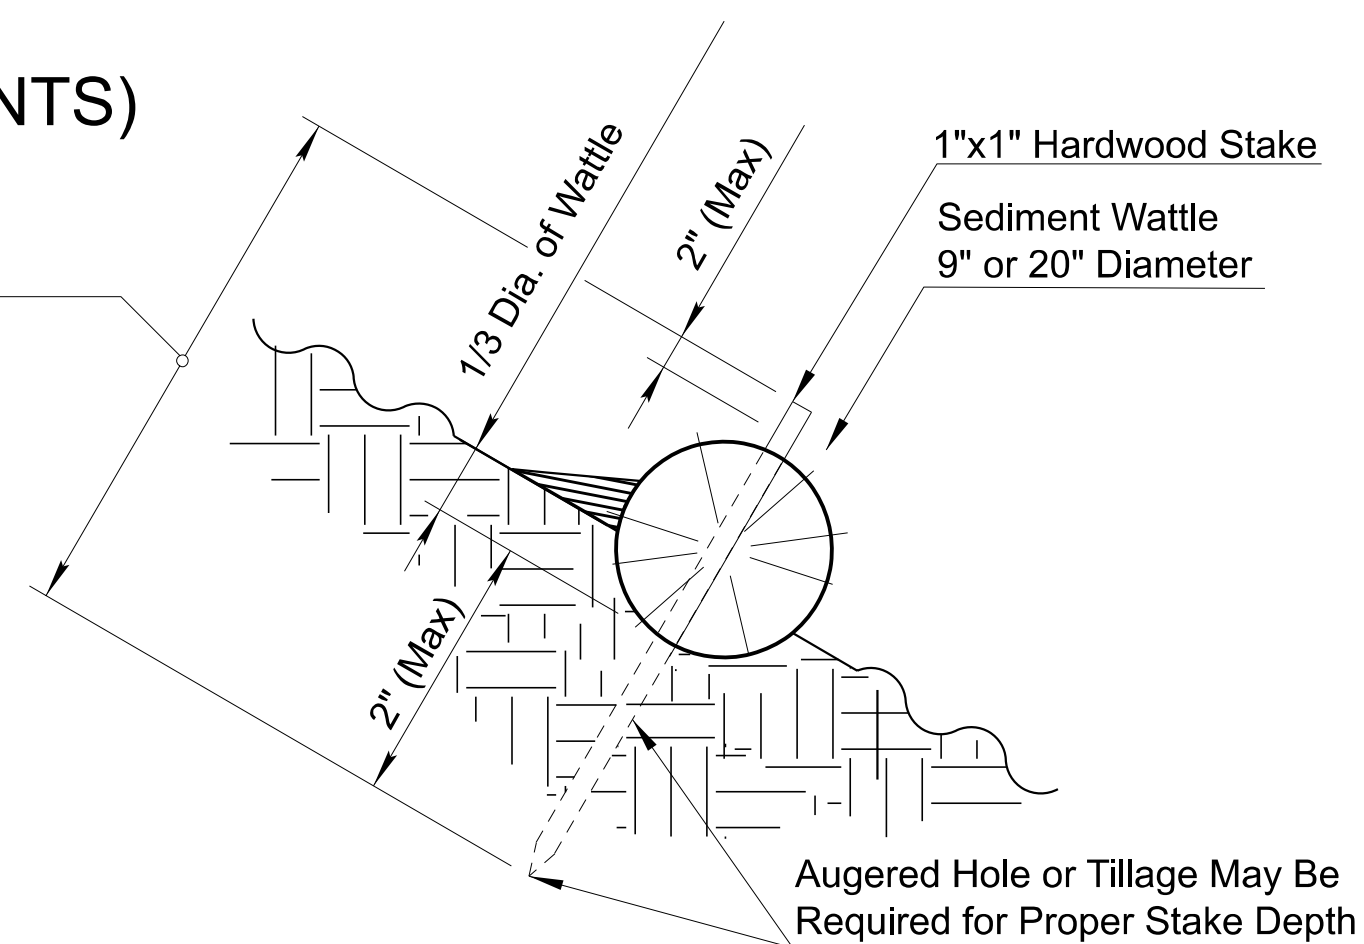


SEDIMENT WATTLE STAKING DETAIL (NTS)

Abut Wattle Ends Tight.
No Gaps. Wood Stake to
Penetrate Netting Only

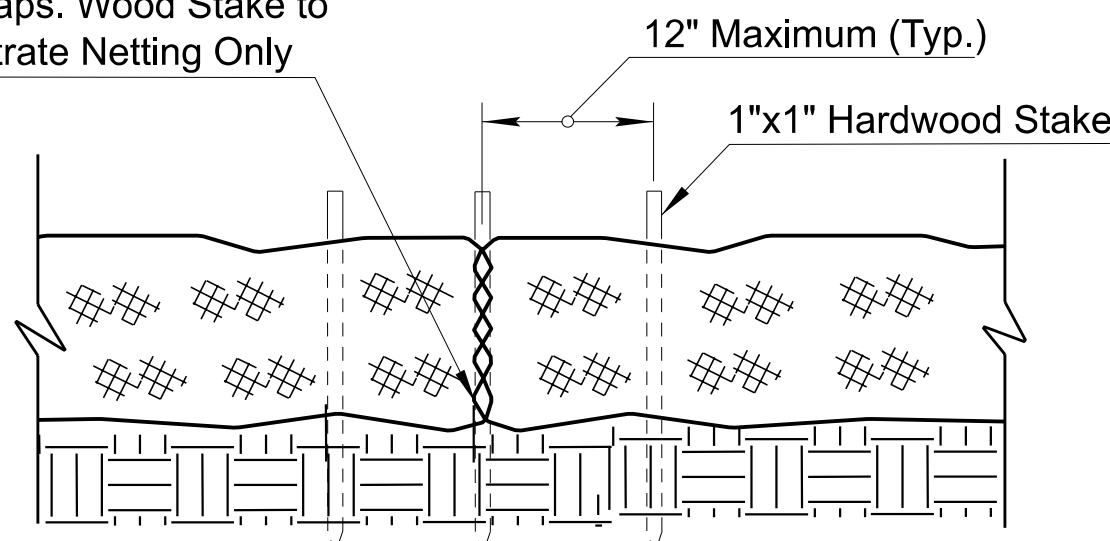

SEDIMENT WATTLE
OVERLAP (NTS)

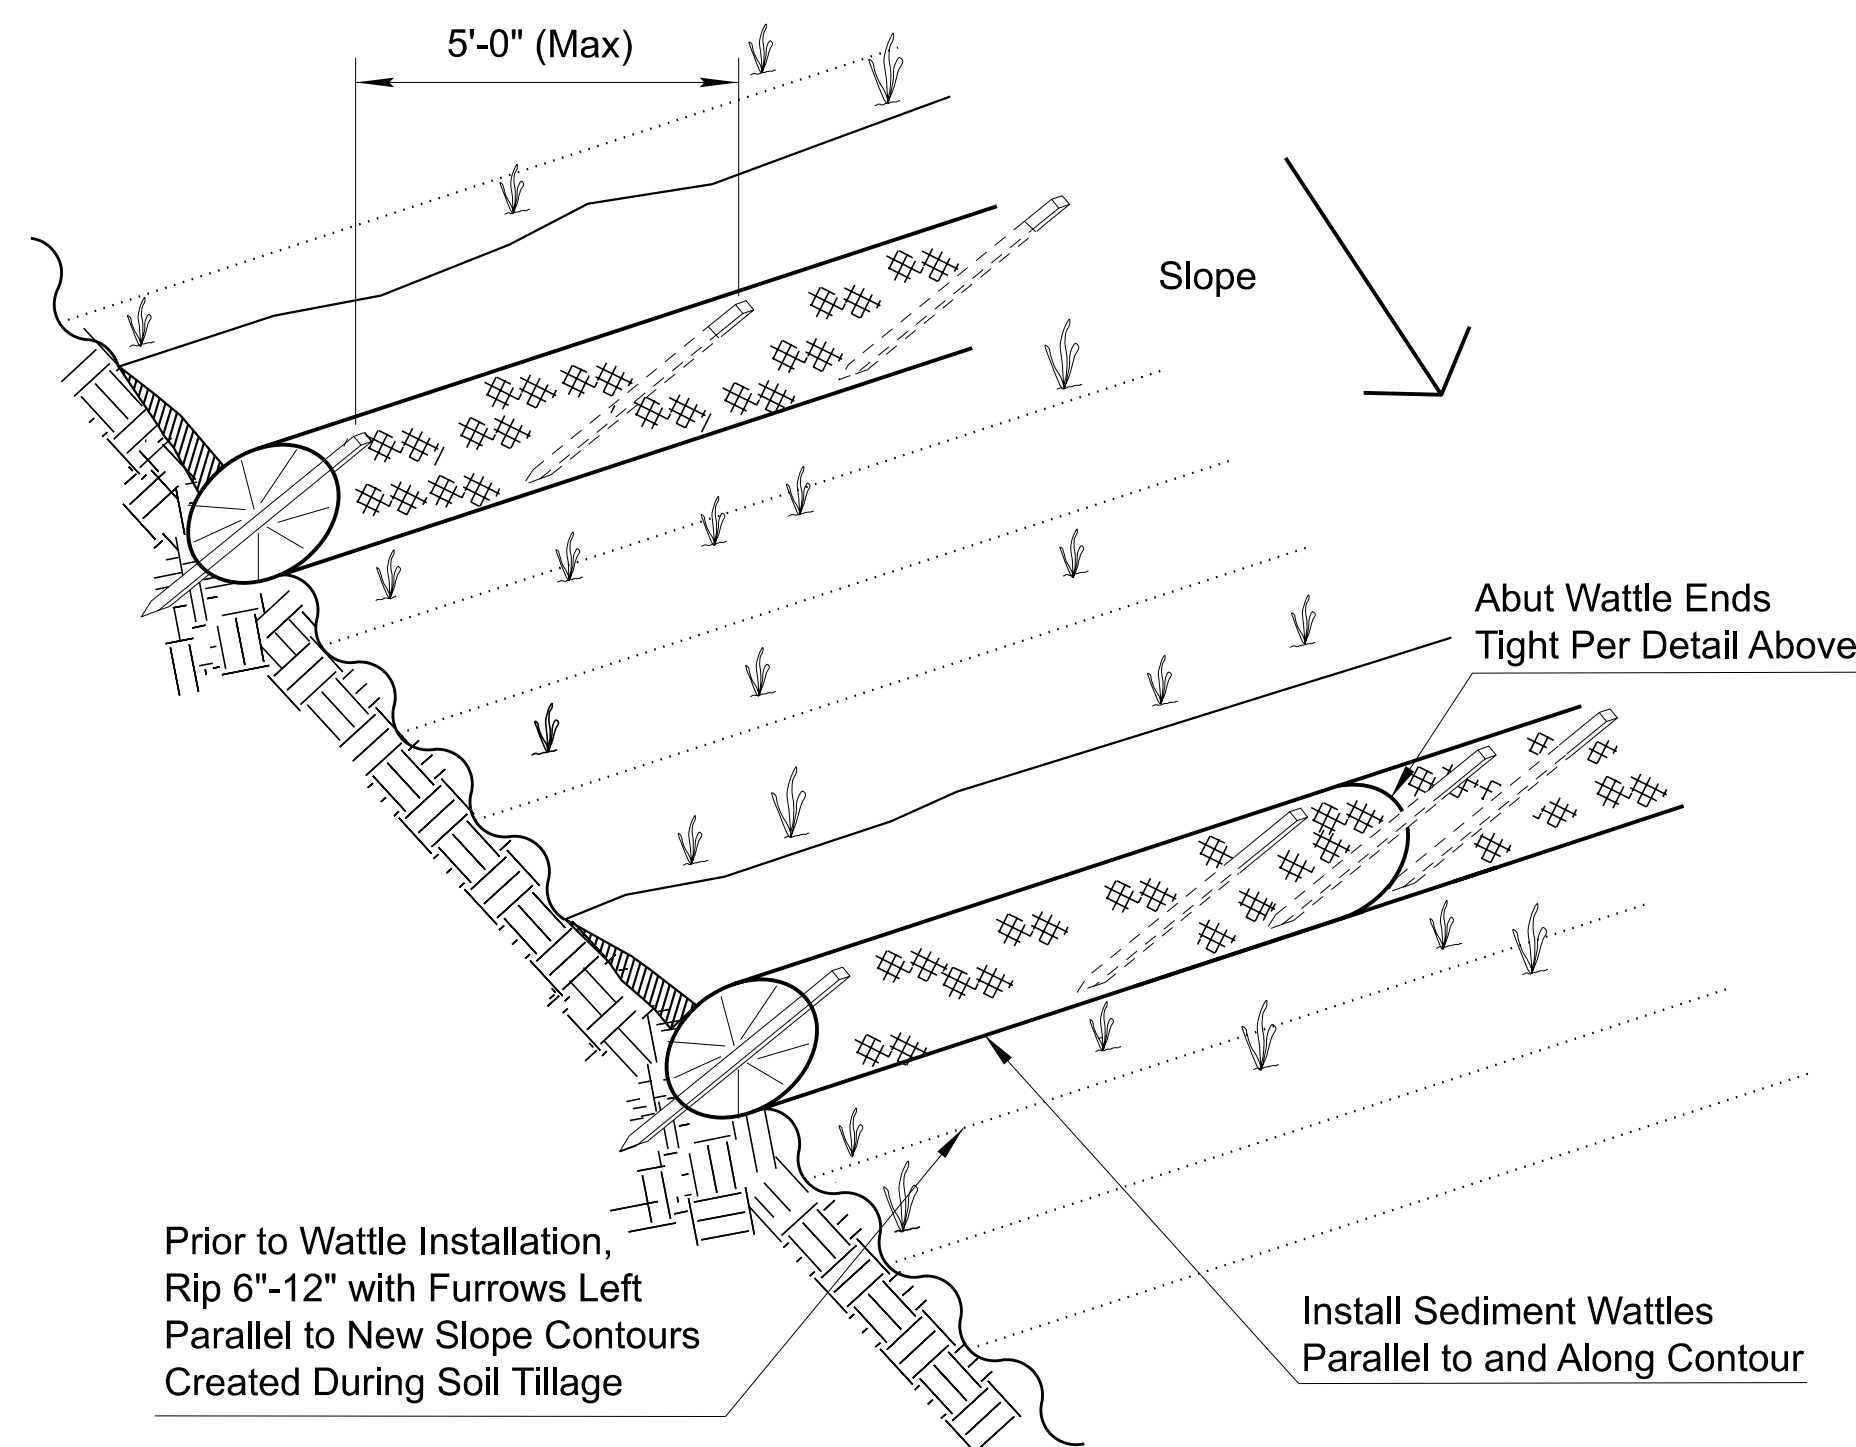

SEDIMENT WATTLE LAYOUT (NTS)

WATTLE SPACING INTERVALS	
Slope Ratio (H:V)	Maximum Spacing Interval
2:1	10'
3:1	20'
4:1	30'
5:1	40'
6:1	40'

* Notes:

- 1) Top Row Shall Not be Placed within 6'-0" of Edge of Pavement and 9'-0" from Outside Surface of Barrier.
- 2) For erosive soils, place rows of wattles closer together.
- 3) For soils with low erosive potential, place rows of wattles further apart.

	NAME	DATE
DESIGN	W HERRERA	06/26/2017
DRAWN	STAFF	06/26/2017
CHECKED	W COLEBANK	06/26/2017



LOGANSIMPSON

202 SCOUTS HILL AVENUE, SUITE 202
 TOMBALL, TX 77455
 P: 281-360-1943

ARIZONA DEPARTMENT OF TRANSPORTATION
PROJECT DELIVERY AND OPERATIONS DIVISION
ROADWAY DESIGN SERVICES




EROSION DETAIL SHEET

ROUTE US 93	F.H.W.A. Arizona Division	STATE ARIZ.	PROJECT NO. 093 YV 189	FEDERAL ID NO. 093-B(230)T	SHEET NO. 493	TOTAL SHEETS 524	RECORD DRAWING
MILEPOST 189.92		LOCATION WICKENBURG RANCH WAY TO VISTA ROYALE					
STRUCTURE NO.	TRACS NO. F0738 01C						___ OF ___



DETAIL ES1

SEDIMENT WATTLE

REV. DATE: 4/21

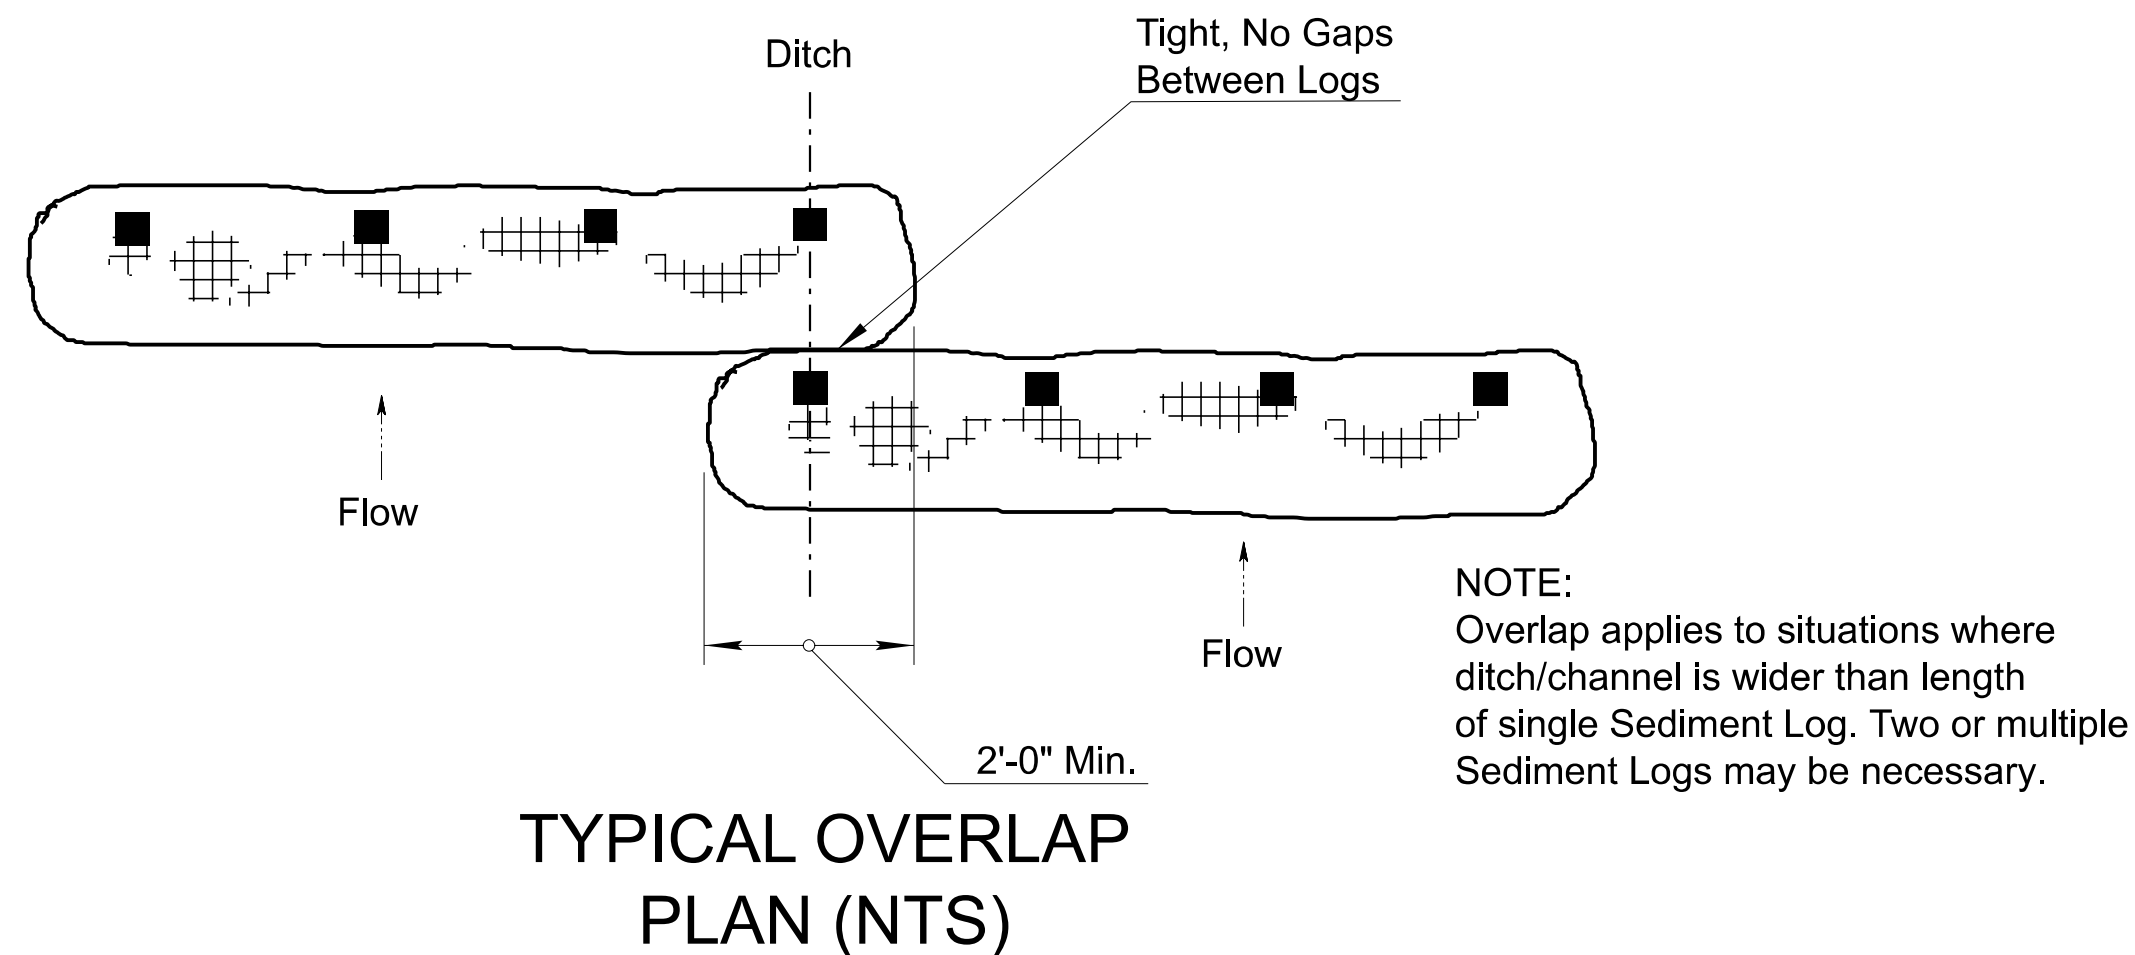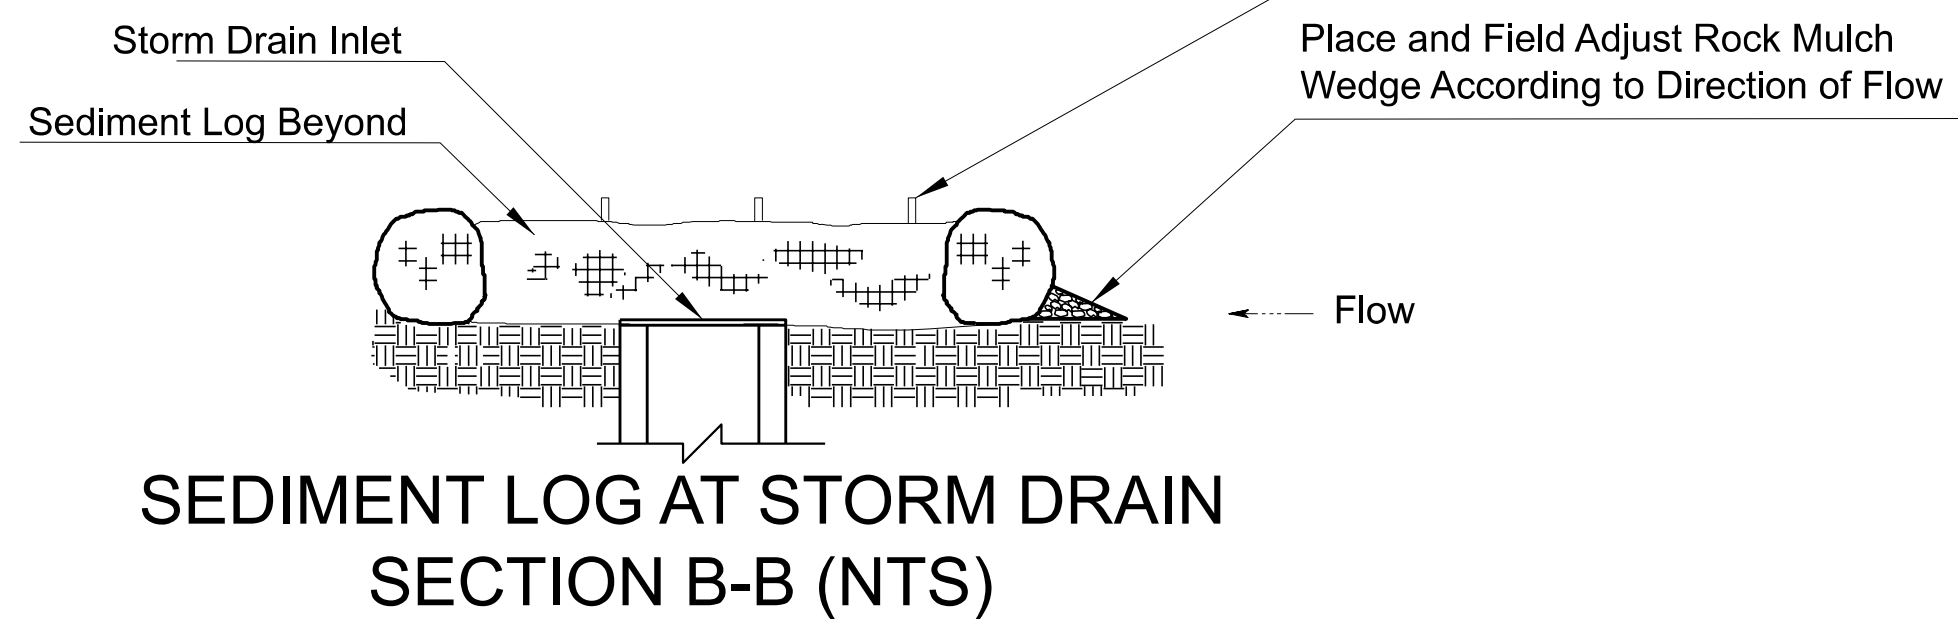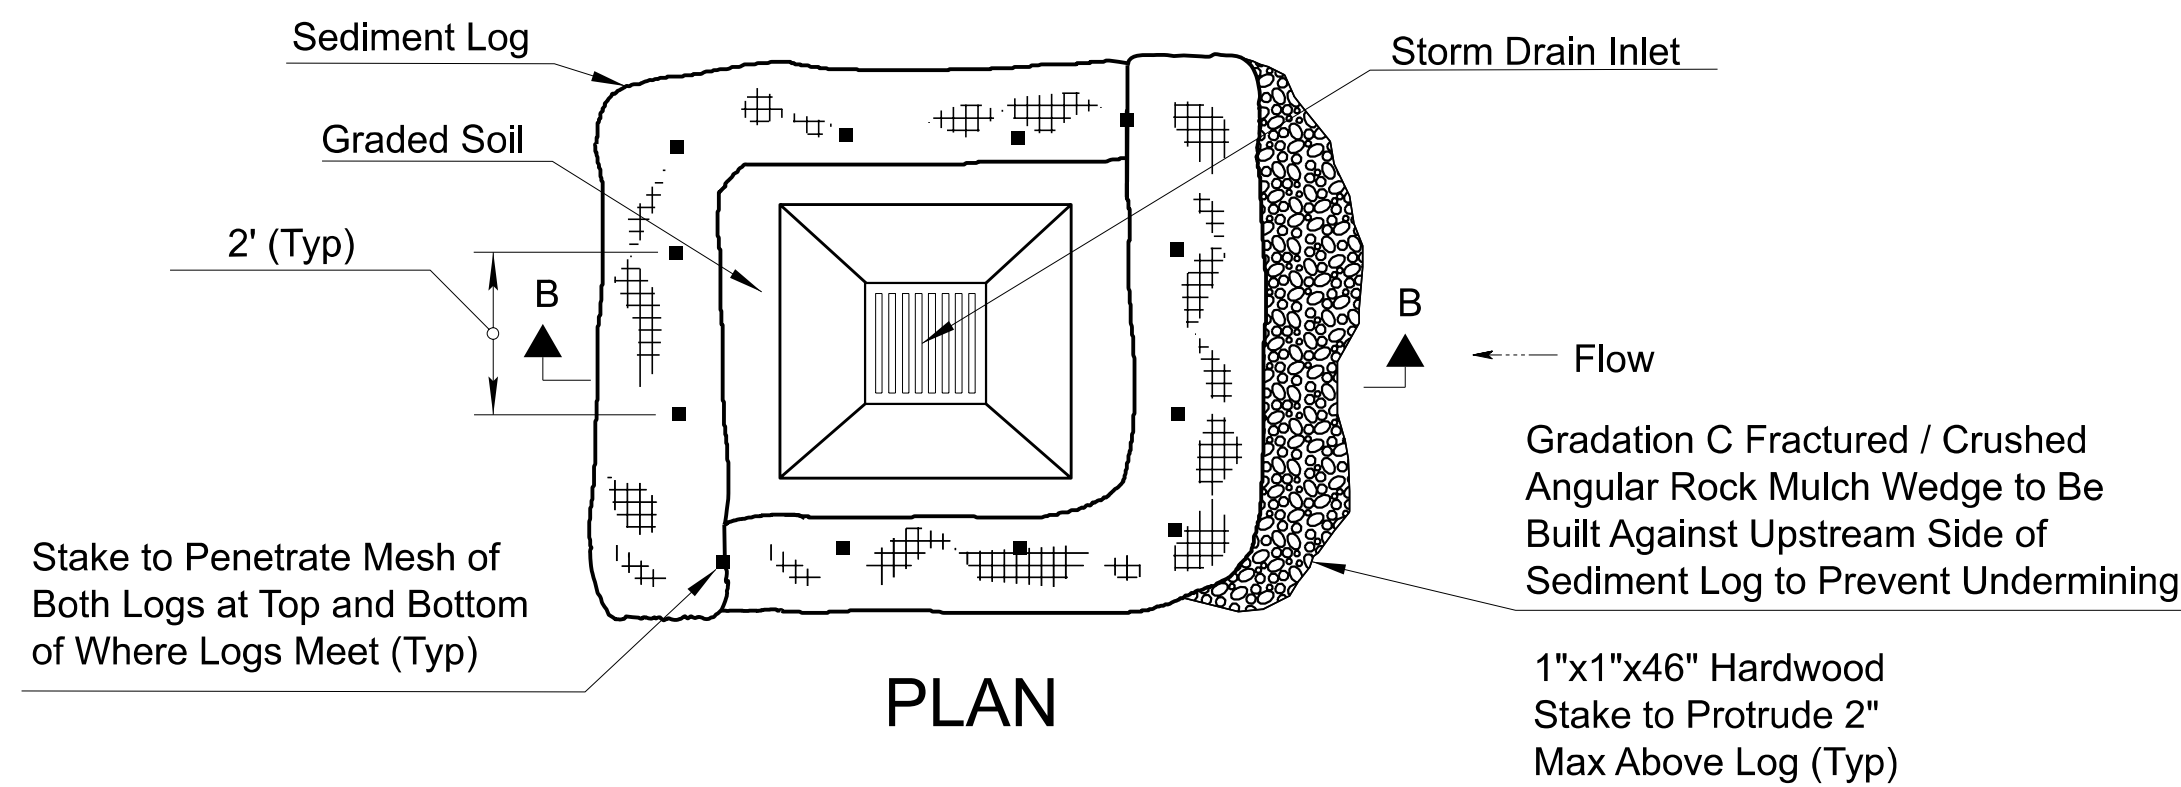

- NOTES:
1. Sediment Logs shall not be installed in the urban freeway medians, nor where cable barrier systems are employed.
 2. Locate Sediment Logs as indicated in plans, SWPPP or as directed by the Engineer.
 3. Select, install and maintain Sediment Logs per manufacturers' specifications and good engineering practices.
 4. Lay Sediment Log across prepared roadside ditch or channel. Trenching or burial of Sediment Logs is not required. The close, continuous contact between the bottom of the Log and the ground is mandatory. The Logs shall be installed in the roadside ditch, swale or channel bottom perpendicular to the flow of water as shown on detail this sheet.
 5. Stake Log as shown. Stakes shall be placed through downstream side only as shown.
 6. DO NOT drive stakes through center of the Log. Stakes must be driven into the ground as shown.
 7. Ensure that no gaps exist between soil and bottom of Sediment Log. Repair any rills or undercuts promptly.
 8. Placement of Sediment Logs shall be evaluated by the Engineer in rocky soil conditions.
 9. Remove Sediment Log CM's/BMP's within the ditches/channels and around the storm drain inlets as per the direction of the Engineer or as soon as practicable upon stabilization of the construction disturbed area.
 10. Dispose of Sediment Logs and trapped sediment material and fill trench created by Sediment Log.
 11. The installation and maintenance of Sediment Log CM's/BMP's shall not negatively impact traffic safety, nor the designed function of roadway or bridge drainage facilities. Sediment Logs shall be installed and maintained to carry the stormwater of at least 2-year, 24-hour events.
 12. Make field adjustments and corrections of Sediment Log CM's/BMP's immediately if it is causing flooding, erosion, and/or affecting roadway safety.
 13. Rock mulch/riprap may be required for channel/ditch lining or rock check dams for longitudinal ditch slopes that exceed 5% and/or for soil conditions not suitable for Log installation.
 14. The Sediment Log CM's/BMP's pay/bid item shall include all materials used for this CM's/BMP's: all ground preparation, furnishing, installing, maintenance, final removal, and disposal, as well as returning the area to an acceptable condition as approved by the Engineer.
 15. Refer to Specification Section 810-2.06(B) for Sediment Log material specifications.
 16. Make field adjustments and corrections to ensure NO sensitive biological resources (native species / habitats) will be adversely impacted.
 17. Construct Rock Wedge with angular-shaped Gradation C Rock Mulch as defined in Section 810-2.03 of the Specifications and project special provisions. Natural river-run materials such as rounded river rocks/cobblestones and pebbles are NOT acceptable.

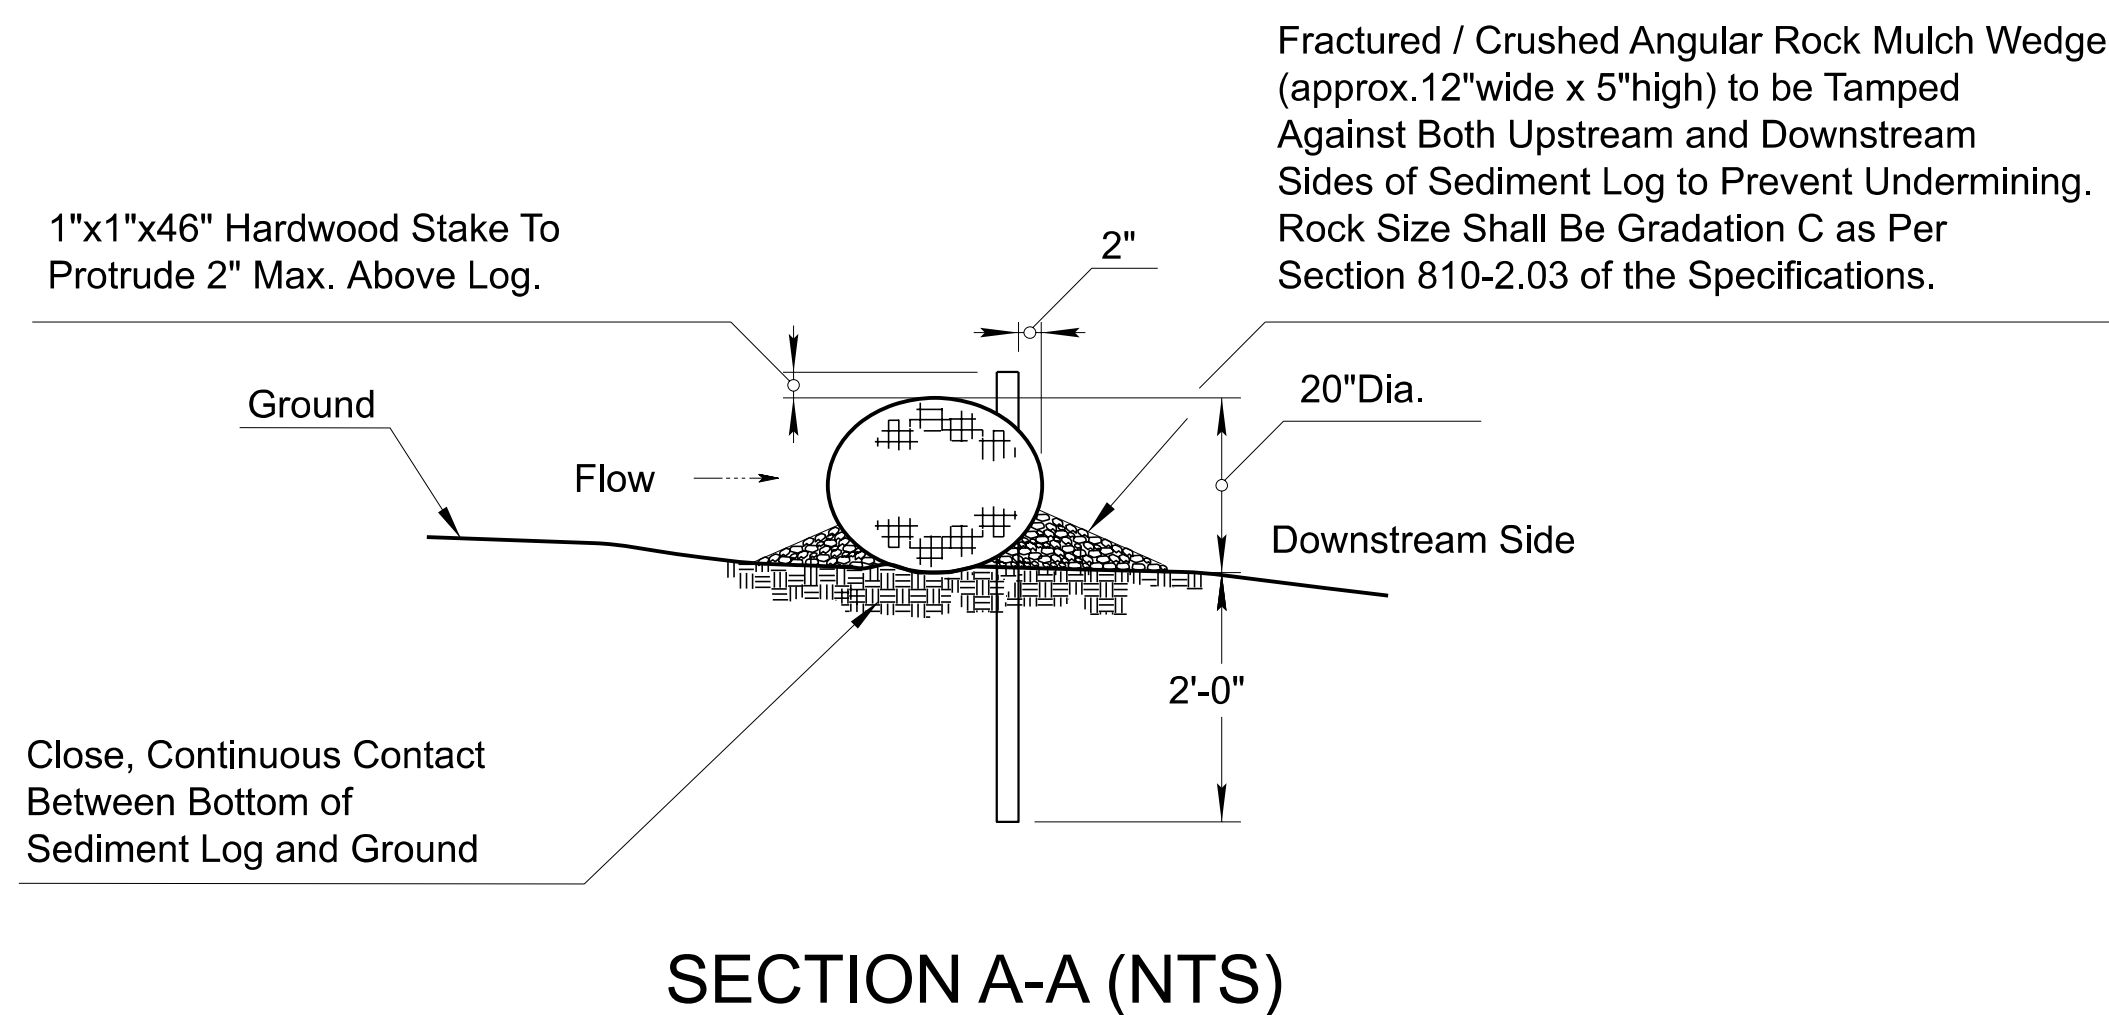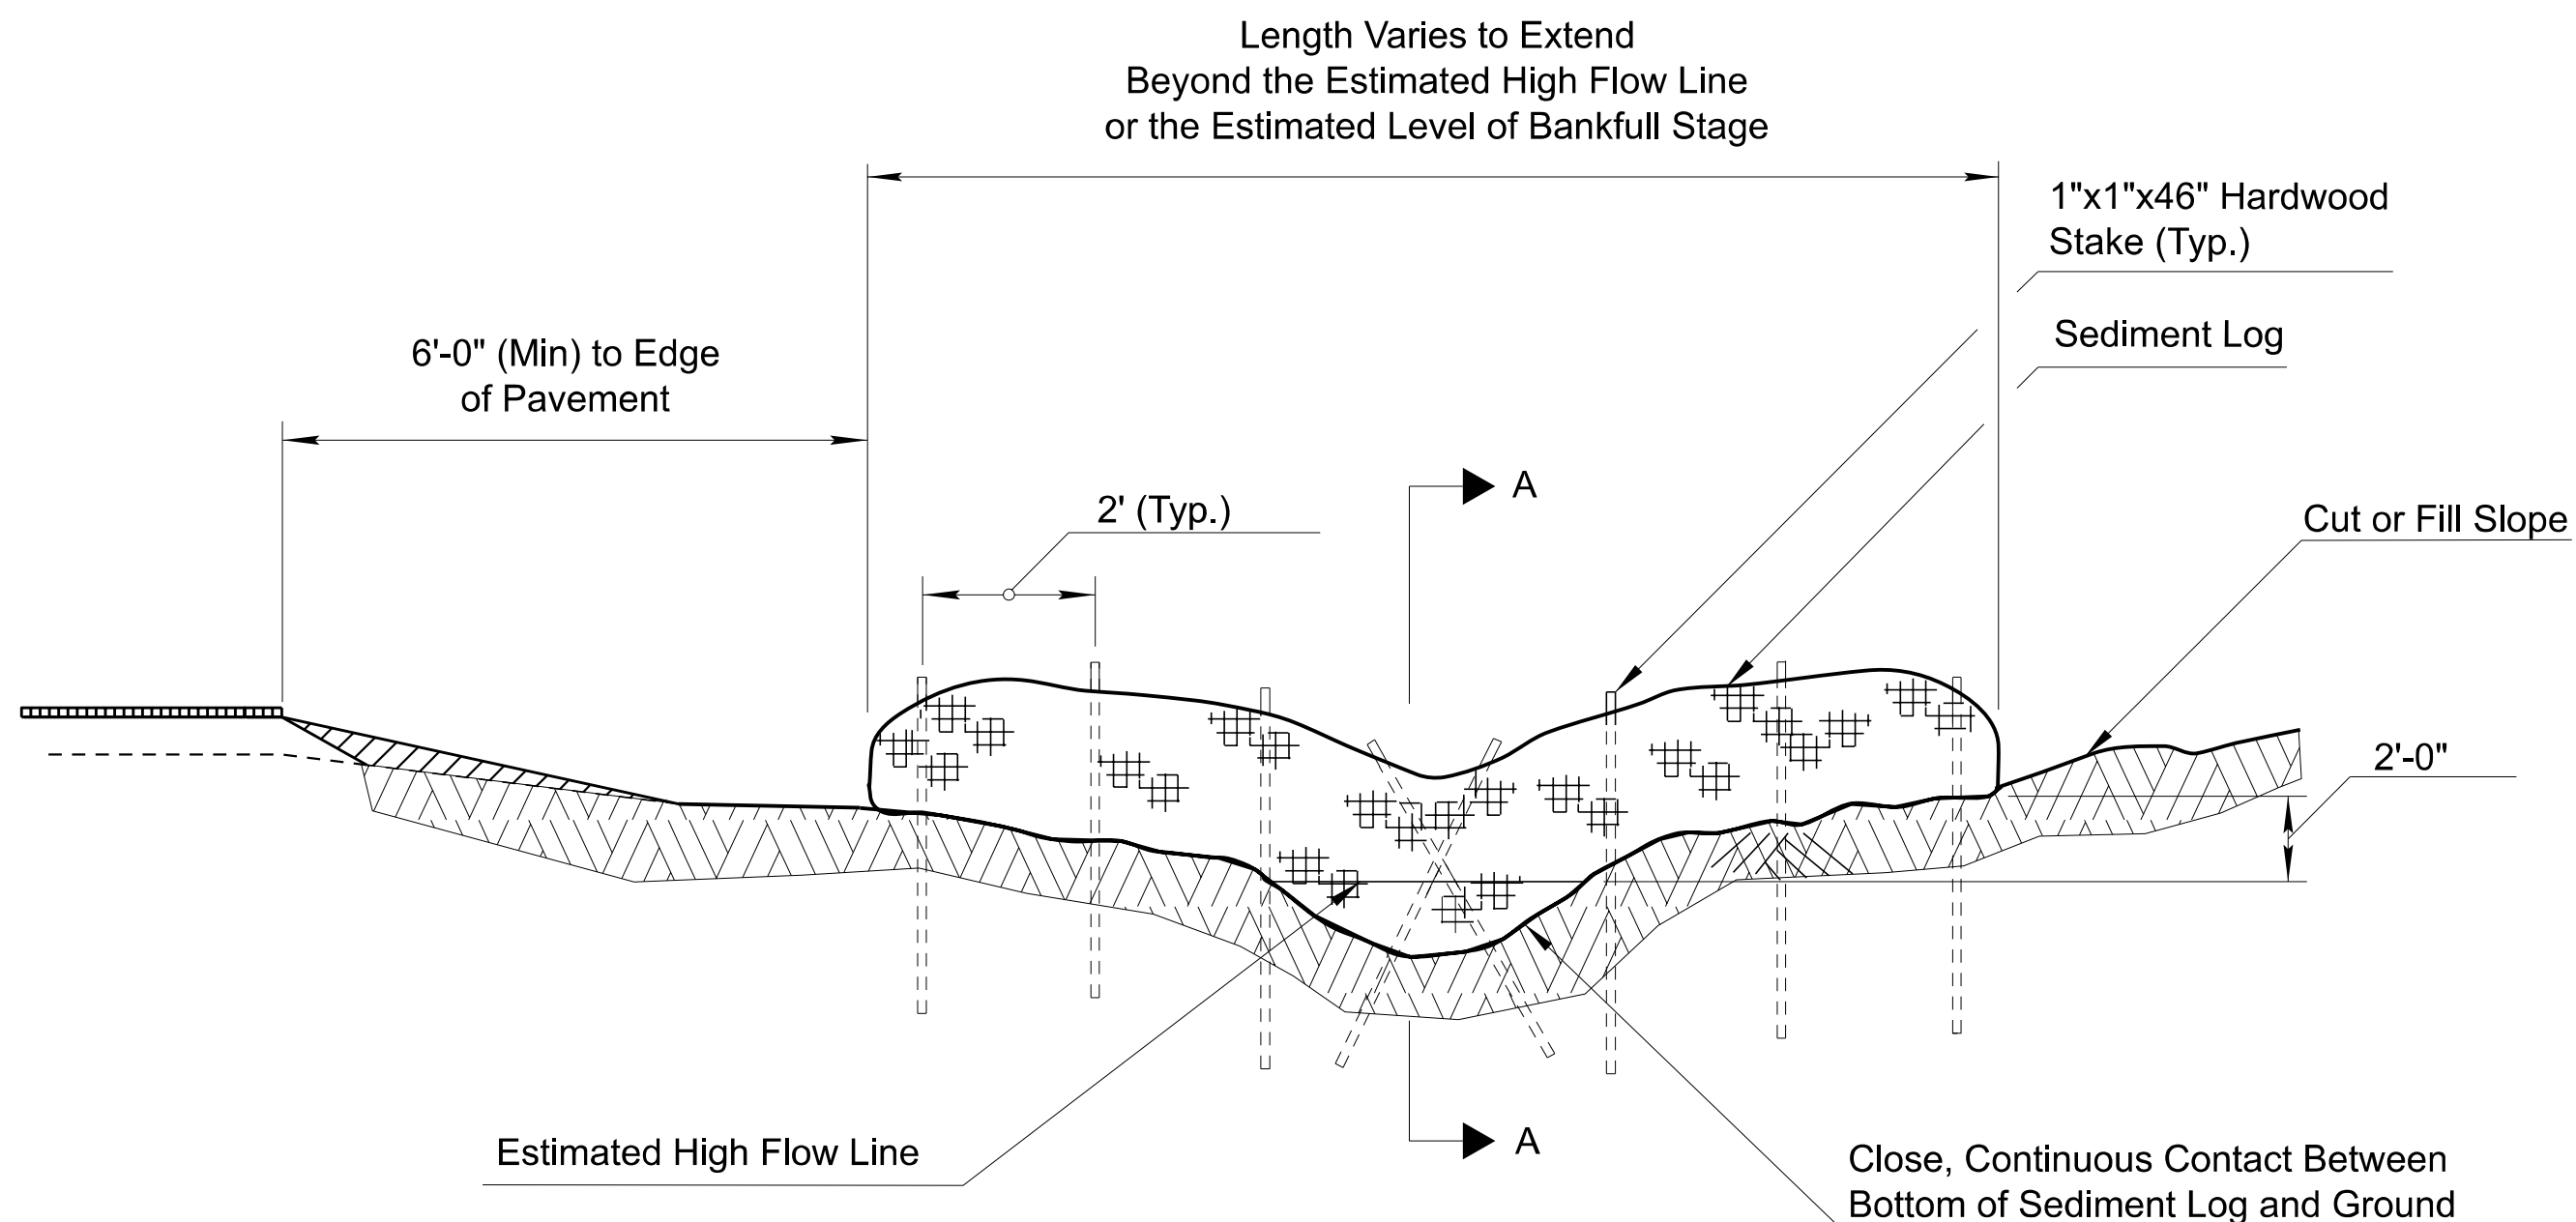


DETAIL ES2

SEDIMENT LOG

		NAME	DATE	ARIZONA DEPARTMENT OF TRANSPORTATION PROJECT DELIVERY AND OPERATIONS DIVISION ROADWAY DESIGN SERVICES		ROUTE	F.H.W.A. Arizona Division	STATE	PROJECT NO.	FEDERAL ID NO.	SHEET NO.	TOTAL SHEETS	RECORD DRAWING
	DESIGN	W HERRERA	06/26			US 93		ARIZ.	093 YV 189	093-B(230)T	494	524	
	DRAWN	STAFF	06/26			MILEPOST							
	CHECKED	W COLEBANK	06/26	189.92	LOCATION WICKENBURG RANCH WAY TO VISTA ROYALE					DWG No. E-2.02			
	 LOGANSIMPSON 222 SOUTH HARRIS AVENUE, SUITE 202 TAMPA, FL 33606 P: 813-940-0044			EROSION CONTROL DETAIL SHEET		STRUCTURE NO.	TRACS NO. F0738 01C					___ OF ___	

REV. DATE: 4/21

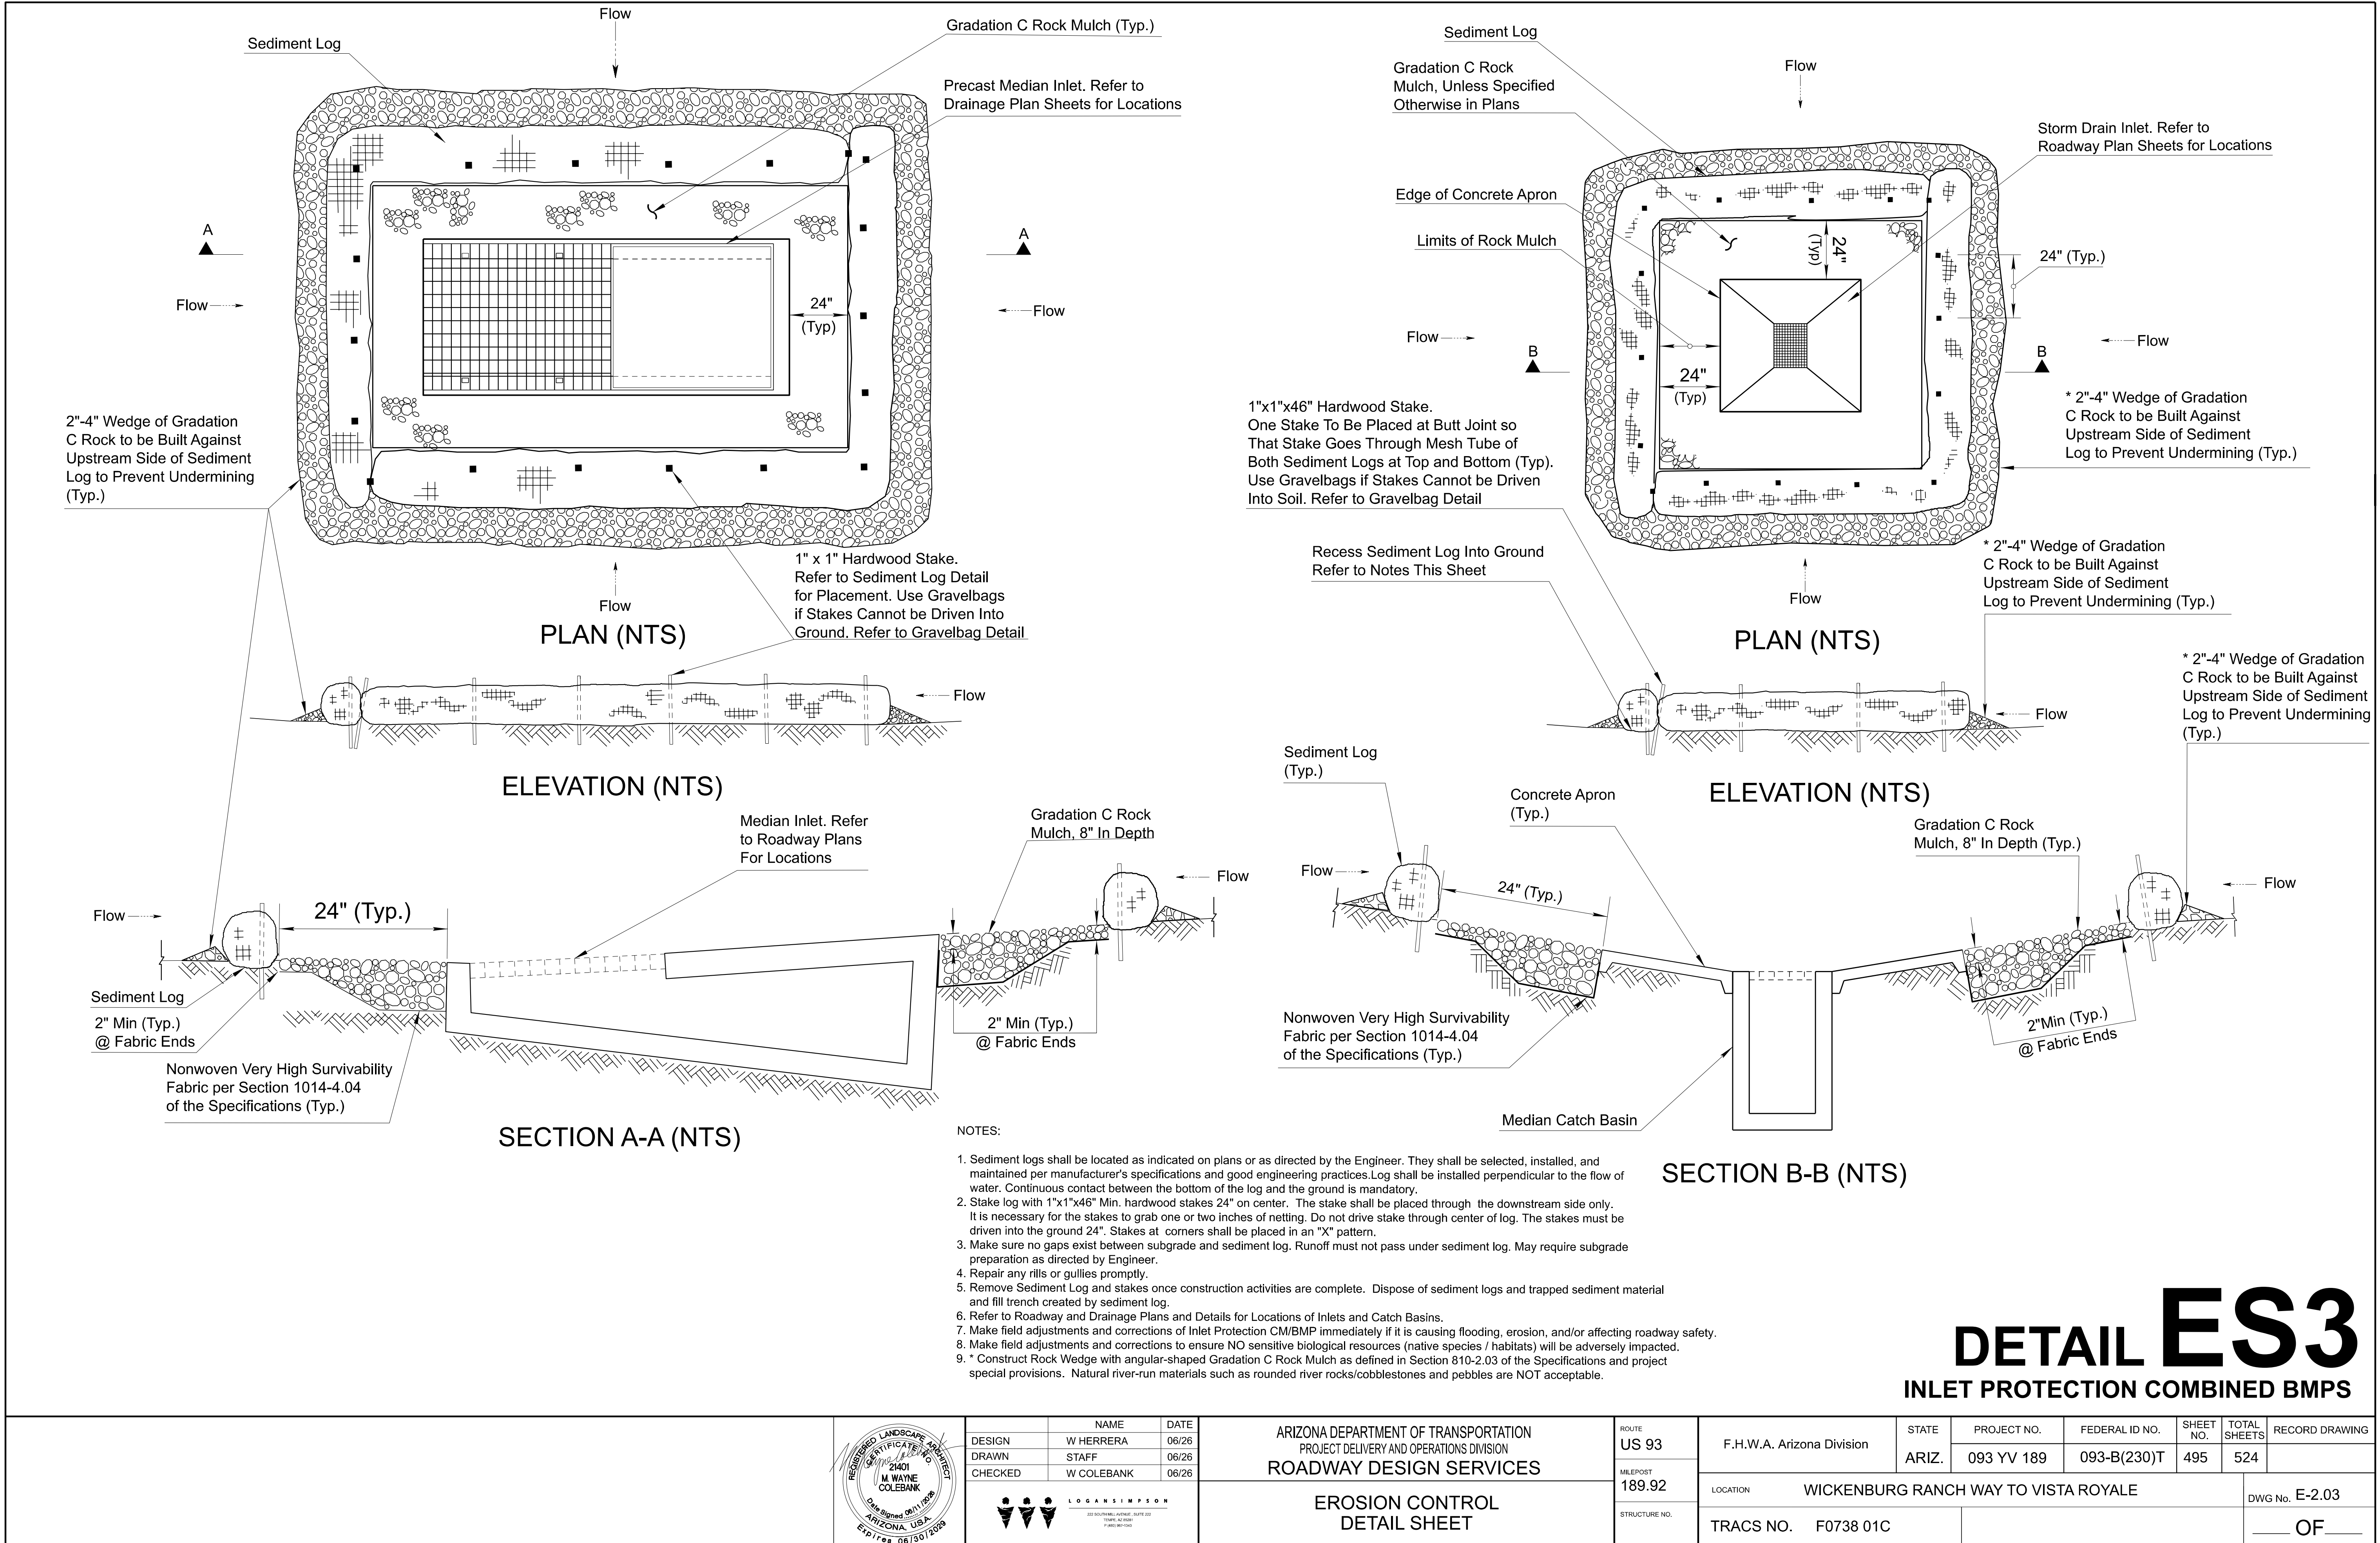


DETAIL ES3


INLET PROTECTION COMBINED BMPs

	<table><tr><th>DESIGN</th><th>NAME</th><th>DATE</th></tr><tr><td>DRAWN</td><td>W HERRERA</td><td>06/26</td></tr><tr><td>CHECKED</td><td>W COLEBANK</td><td>06/26</td></tr></table>		DESIGN	NAME	DATE	DRAWN	W HERRERA	06/26	CHECKED	W COLEBANK	06/26	ARIZONA DEPARTMENT OF TRANSPORTATION PROJECT DELIVERY AND OPERATIONS DIVISION ROADWAY DESIGN SERVICES		ROUTE US 93	F.H.W.A. Arizona Division	STATE ARIZ.	PROJECT NO.	FEDERAL ID NO.	SHEET NO.	TOTAL SHEETS	RECORD DRAWING
	DESIGN	NAME	DATE																		
	DRAWN	W HERRERA	06/26																		
	CHECKED	W COLEBANK	06/26																		
				MILEPOST 189.92	093 YV 189	093-B(230)T	495	524													
		EROSION CONTROL DETAIL SHEET				LOCATION WICKENBURG RANCH WAY TO VISTA ROYALE						DWG No. E-2.03									
						TRACS NO. F0738 01C				OF											


REV. DATE: 4/21

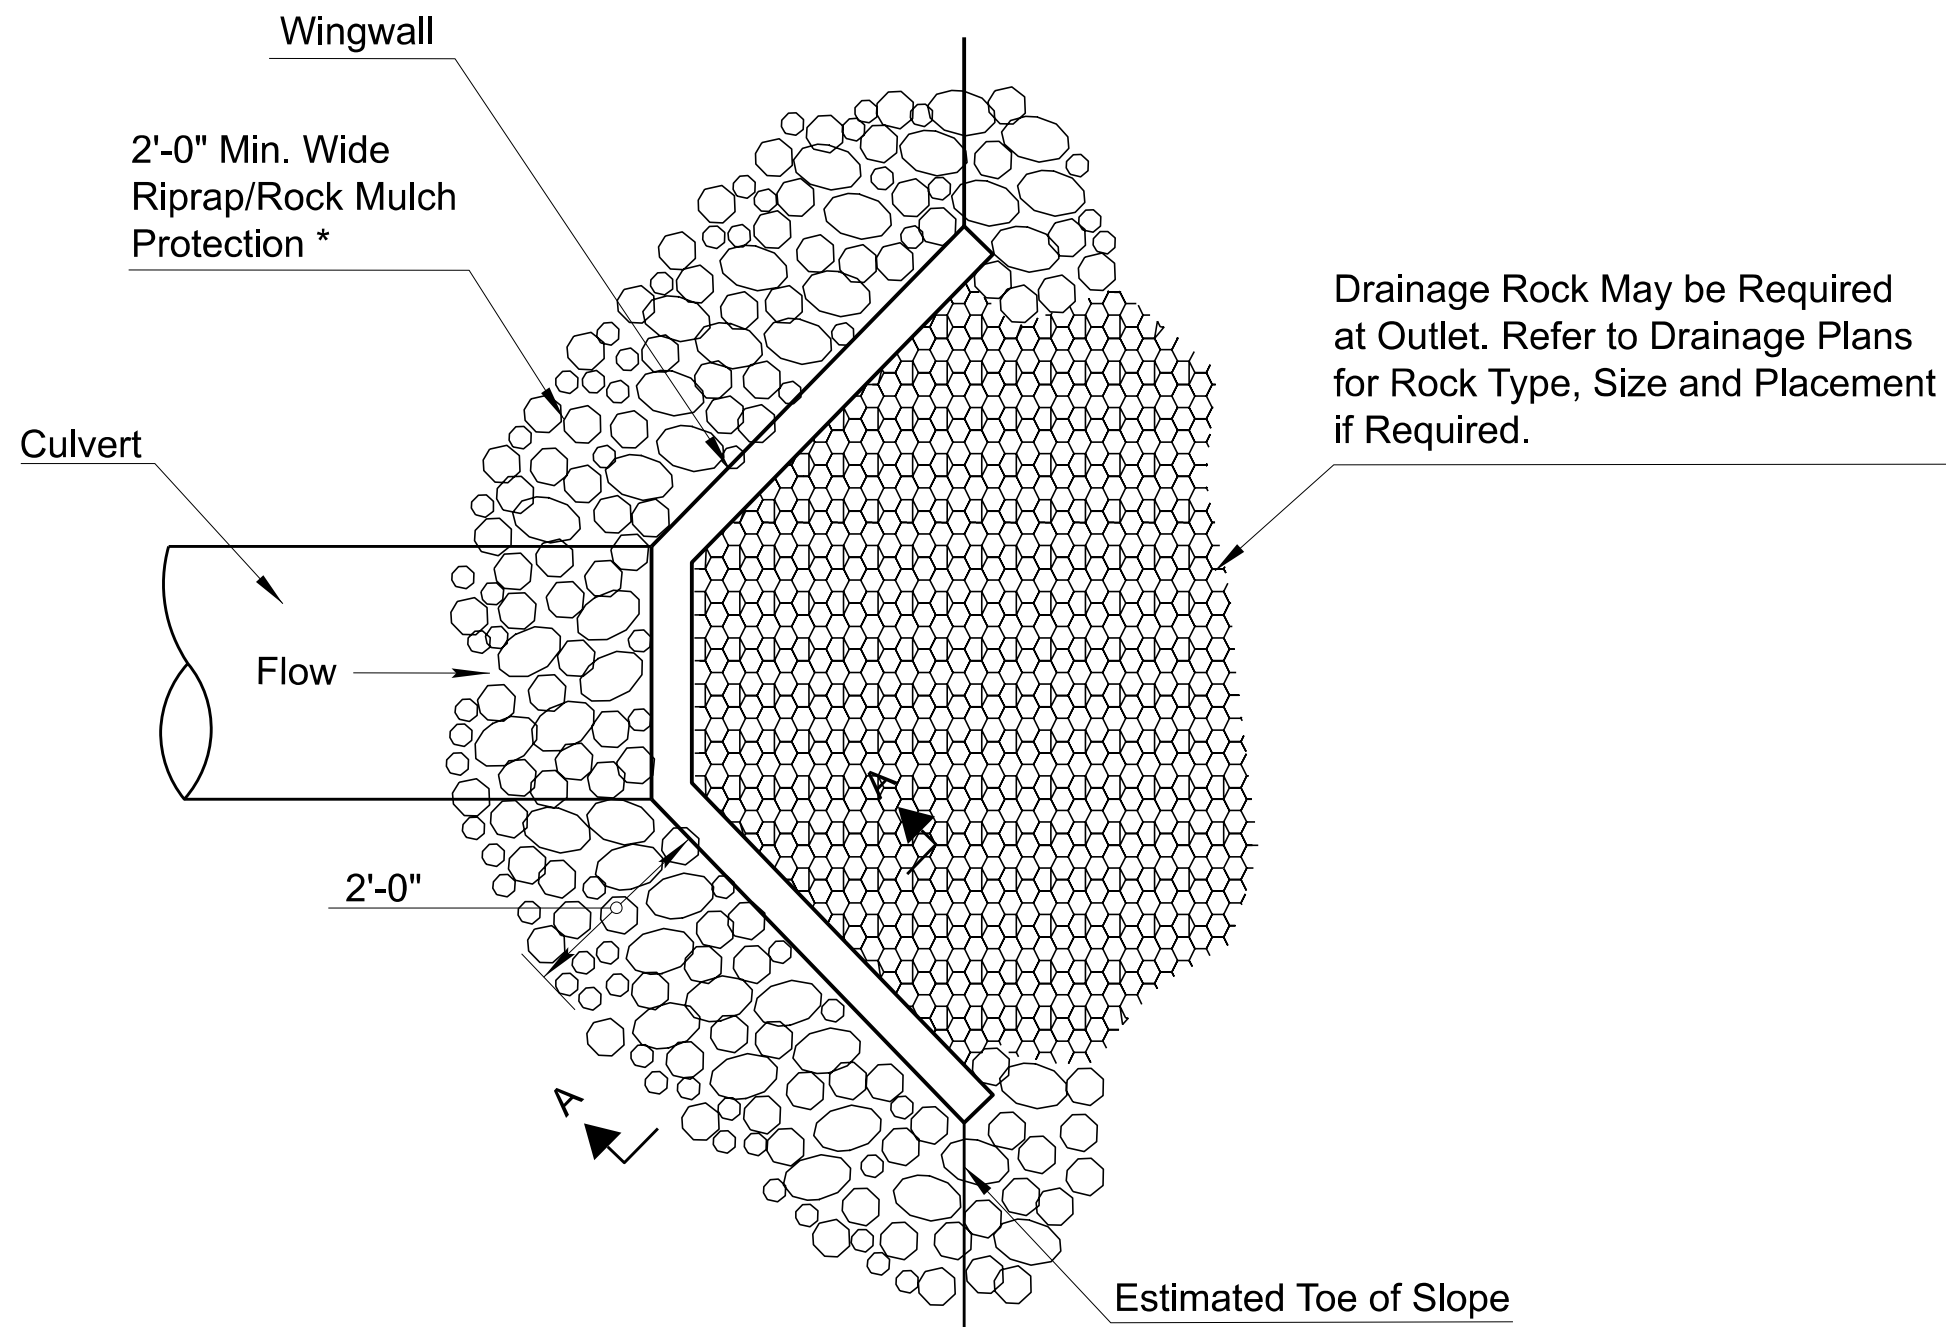


ANGLED HEADWALL
PLAN VIEW (NTS)

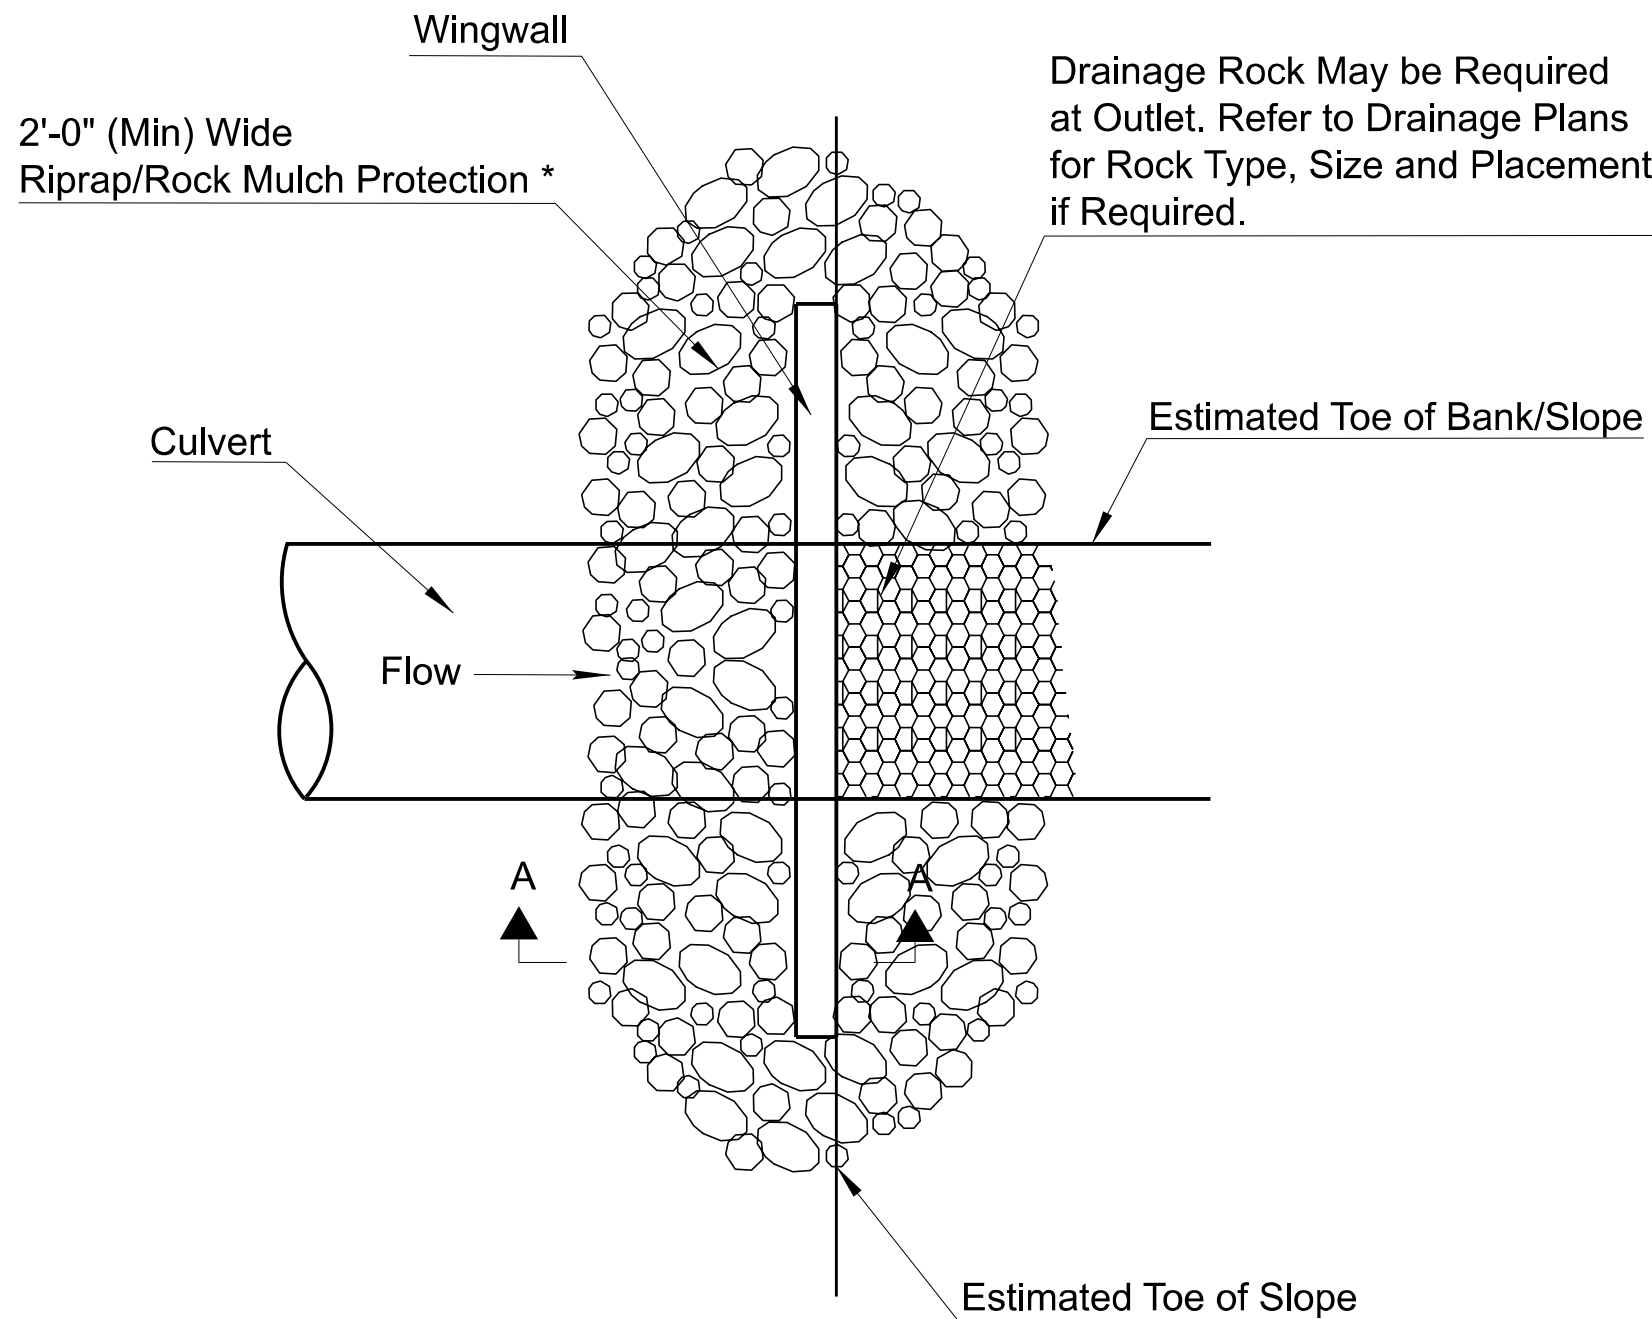


FLUSH HEADWALL
PLAN VIEW (NTS)

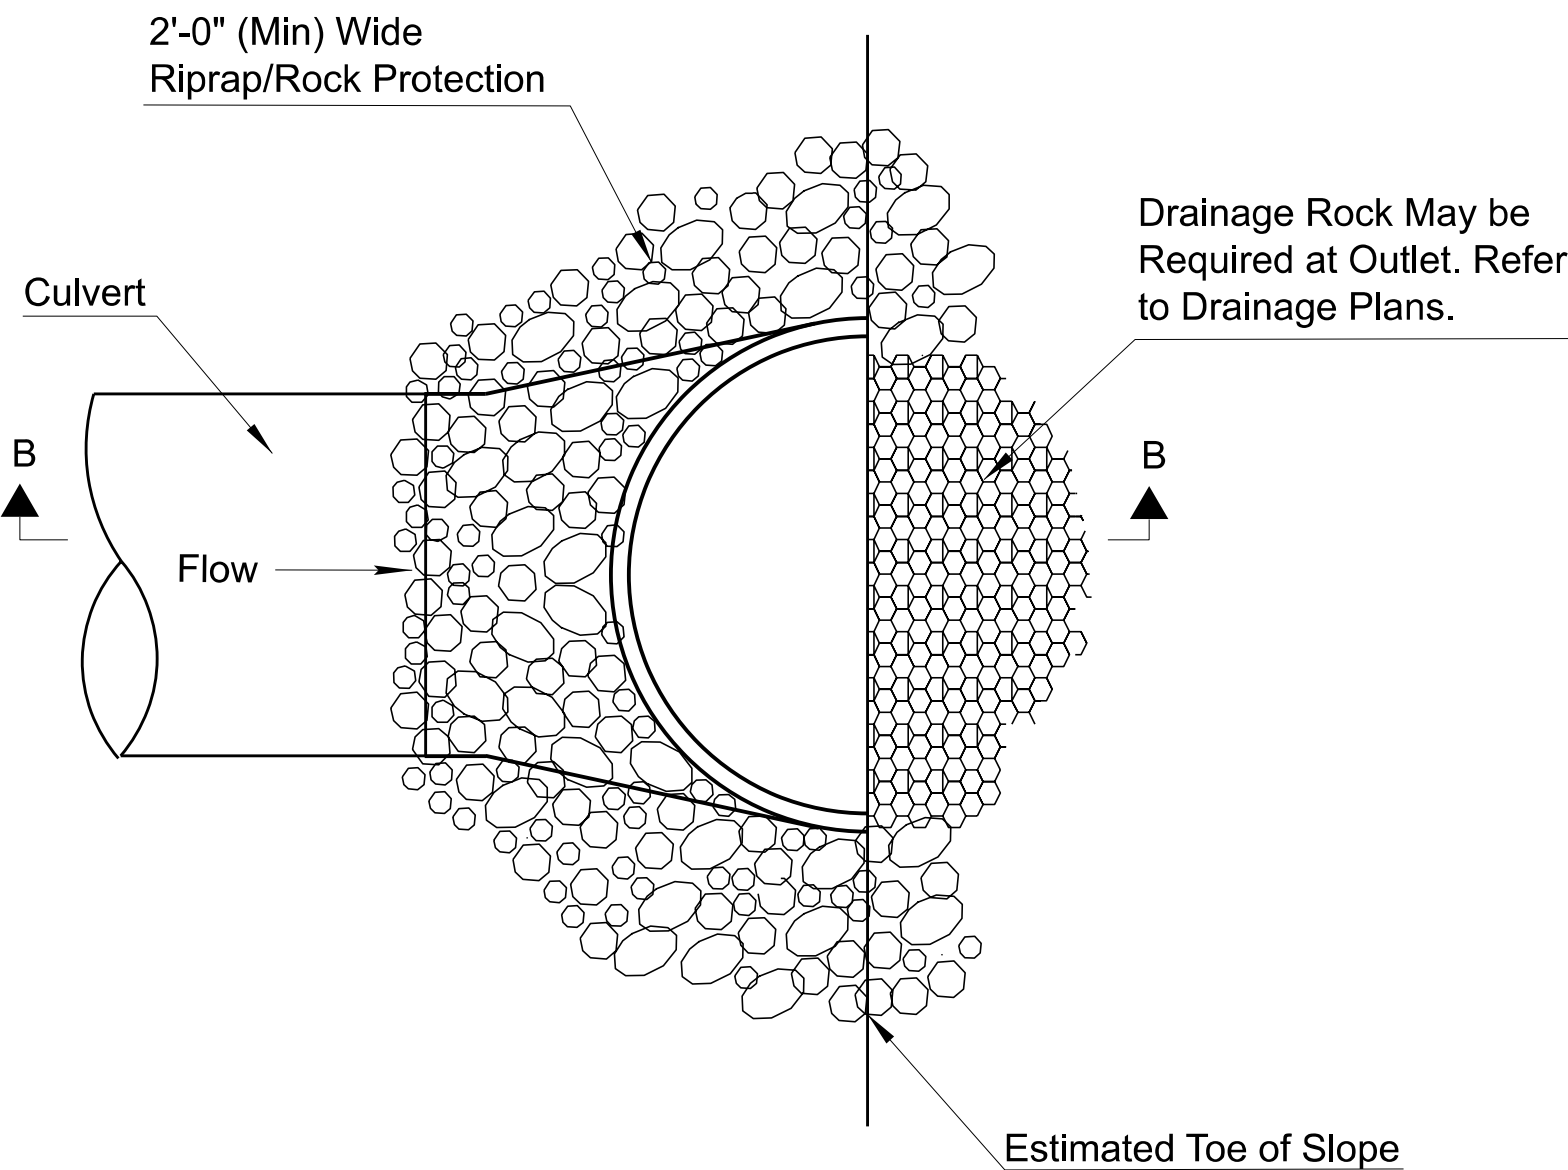

FLARED END
PLAN VIEW (NTS)

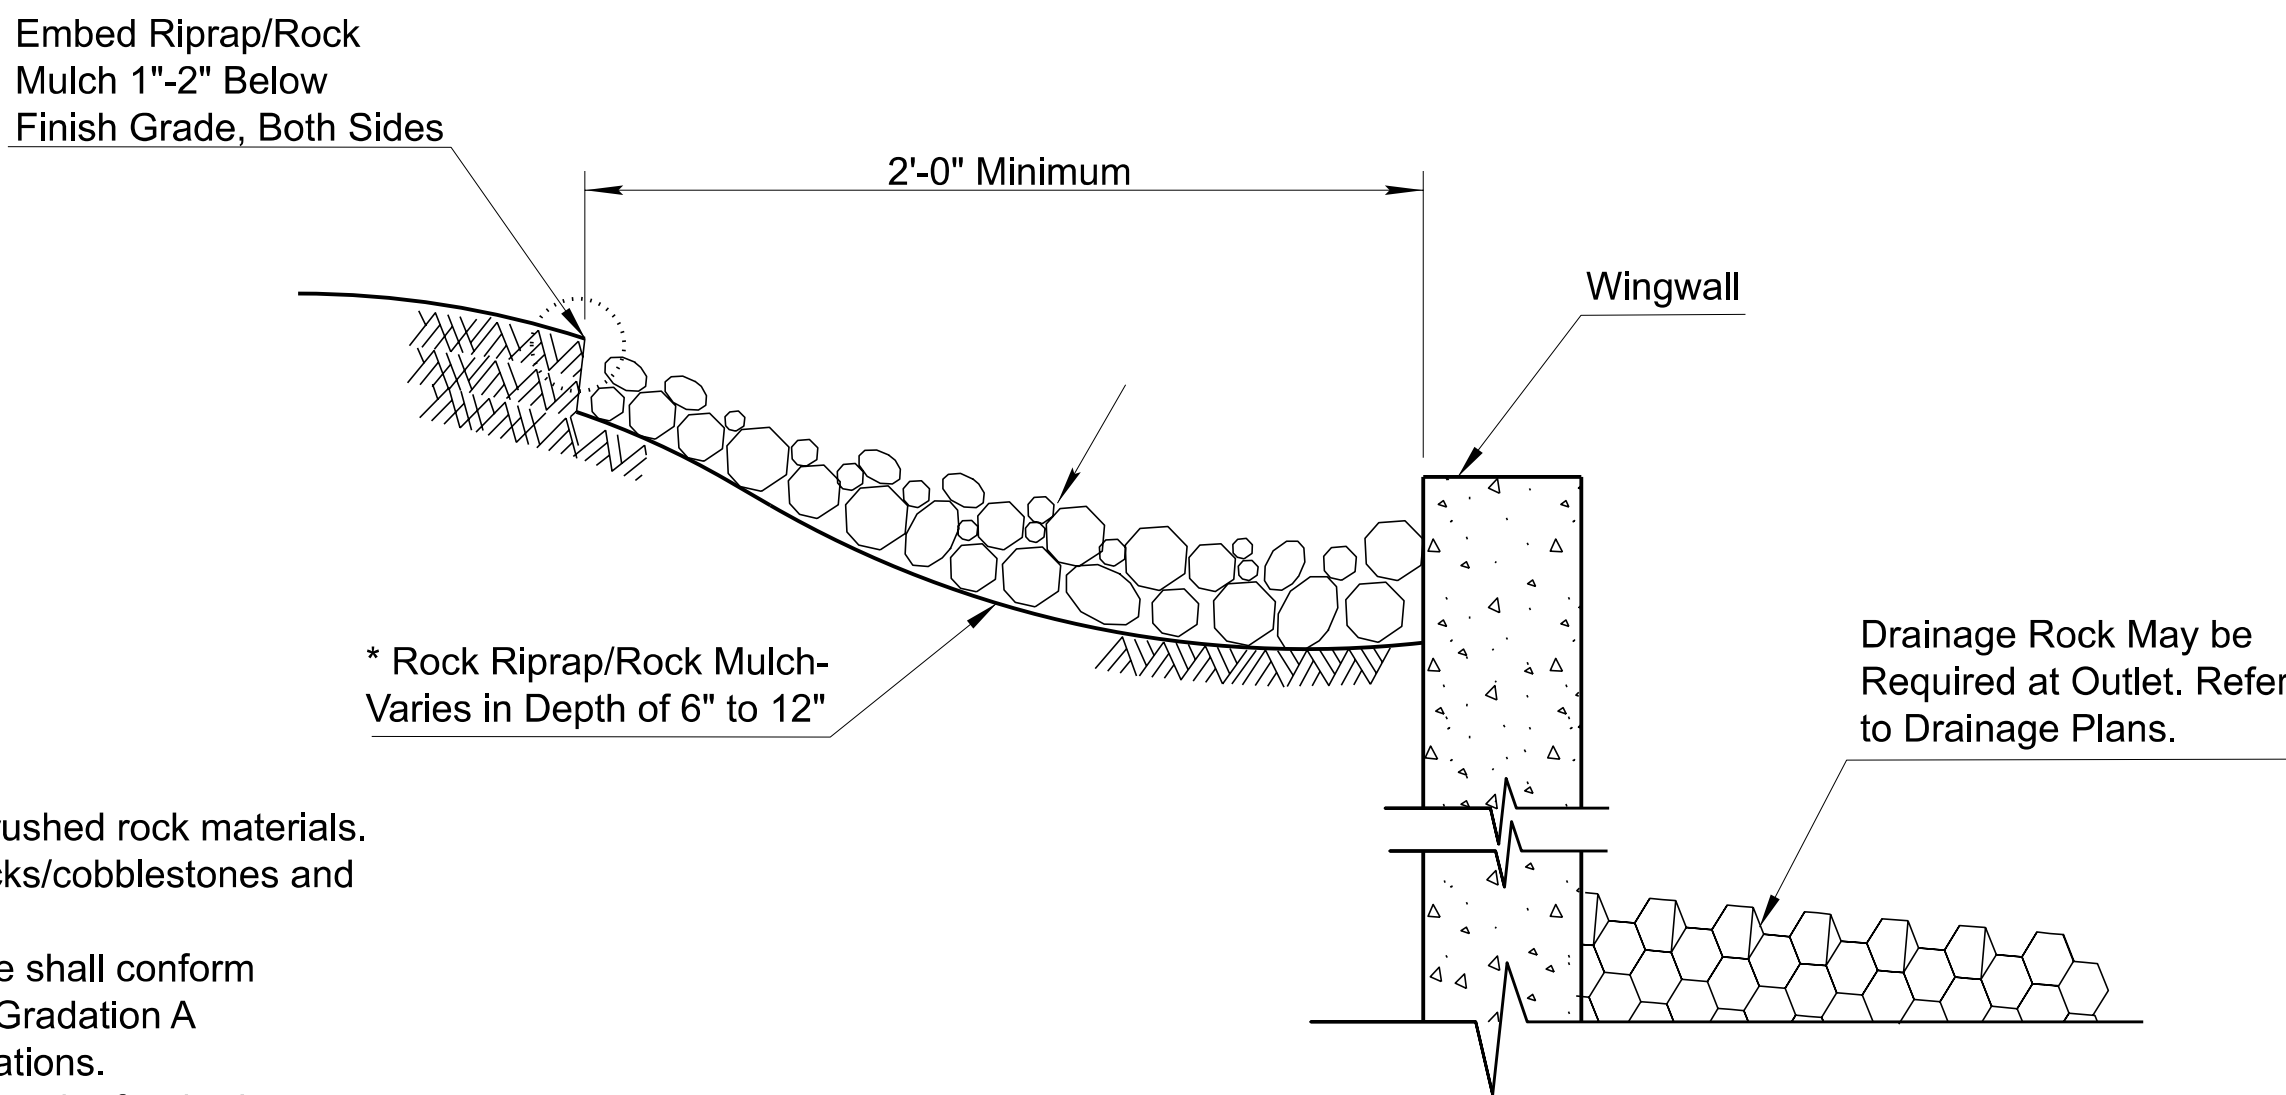

WINGWALL
SECTION A-A (NTS)

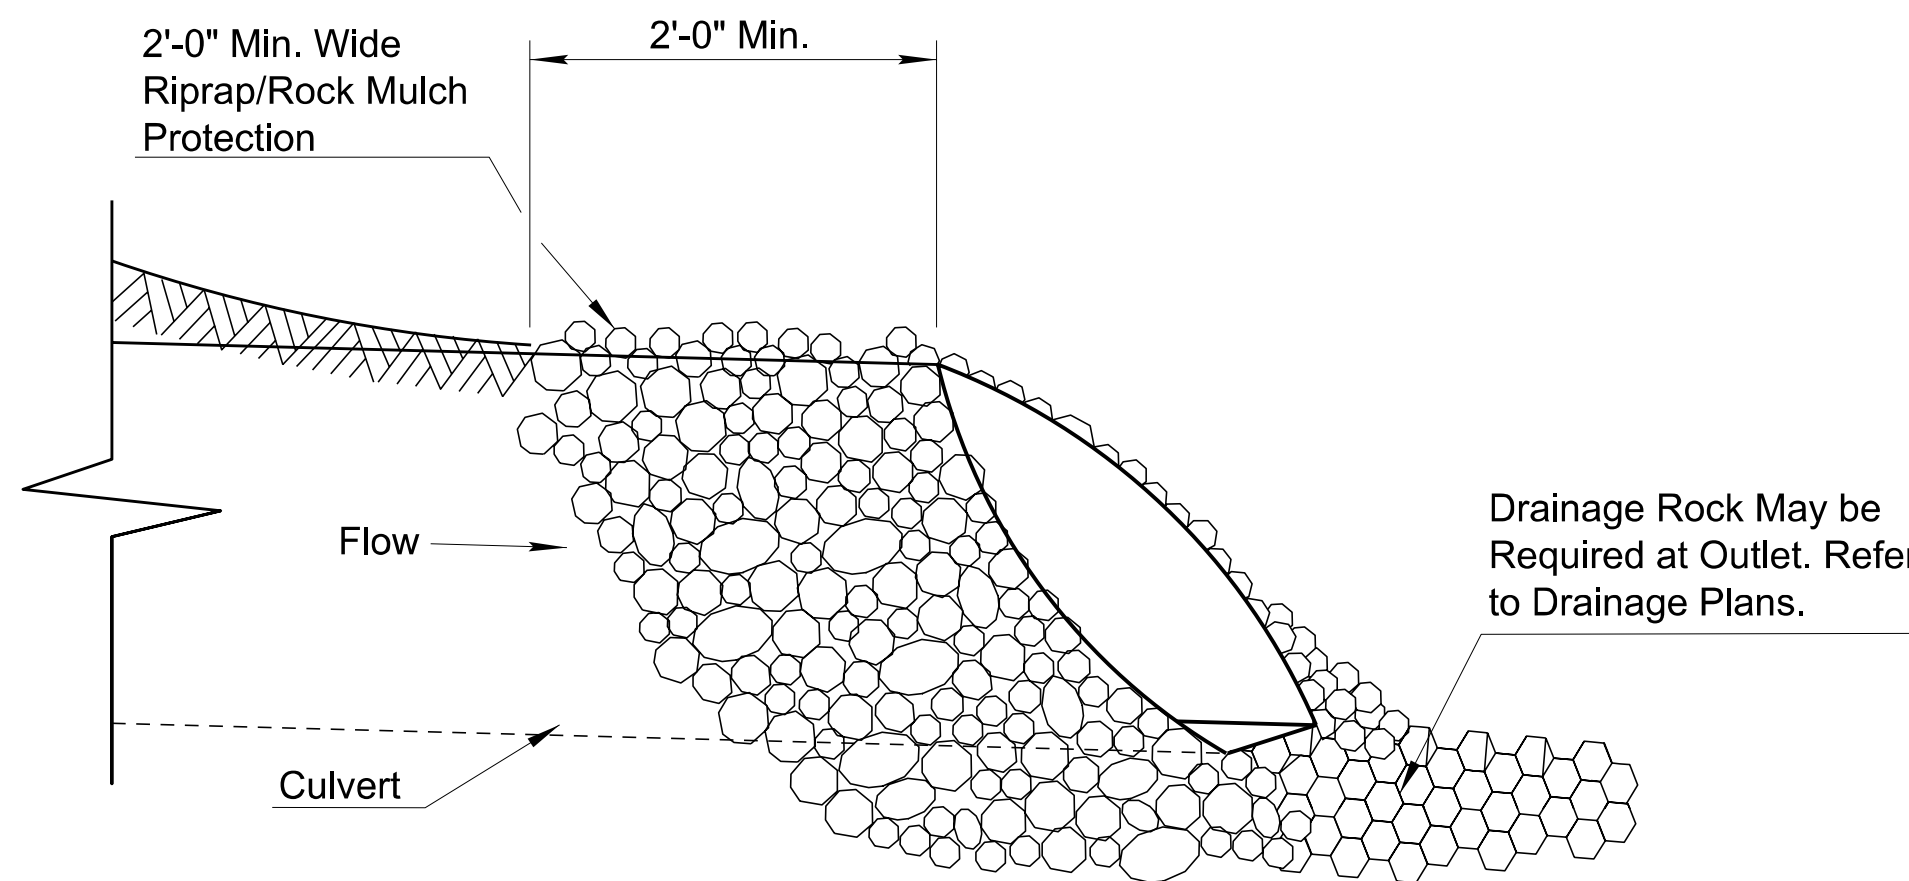

FLARED END
SECTION B-B (NTS)


NOTES:

1. Rock Riprap/Rock Much shall be angular shaped, crushed rock materials. Natural river-run materials such as rounded river rocks/cobblestones and pebbles are NOT acceptable.
2. Rock Riprap/Rock Mulch within the traffic Clear Zone shall conform to the requirements of Section 810-2.03 Sieve Size Gradation A and/or Gradation C, and Section 913 of the Specifications.
3. Embed rock within traffic recovery area/clear zone into the finished grade so that any portion of the rock above the grade will be less than 4" in height.
4. The installation and maintenance of Rock Protection CMs/BMPs shall not negatively impact traffic safety, nor the designed function of roadway or bridge drainage facilities. Rock Protection CMs/BMPs shall be installed and maintained to carry the stormwater of at least 2-year, 24-hour events.
5. Make field adjustments and corrections of Rock Protection CM/BMP immediately if it is causing flooding, erosion, and/or affecting roadway safety.
6. The Rock Protection CM/BMP's pay/bid item shall include all materials used for this CM/BMP: all ground preparation, furnishing, installing, maintaining as well as returning the area to an acceptable condition as approved by the Engineer.
7. Make field adjustments and corrections to ensure NO sensitive biological resources (native species / habitats) will be adversely impacted.

* Rock protection shall be installed behind applicable box culvert headwall/wingwall where called out in the plans and approved by the Engineer.

DETAIL ES4

ROCK PROTECTION FOR INLETS,
OUTLETS AND HEADWALL TRANSITION

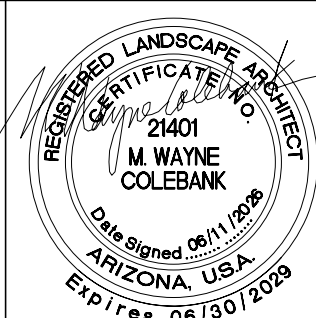


	NAME	DATE
DESIGN	W HERRERA	06/26
DRAWN	STAFF	06/26
CHECKED	W COLEBANK	06/26

LOGAN SIMPSON
222 SOUTH WILLOW AVENUE, SUITE 202
TAMPA, FL 33607
P: 813.967.1543


ARIZONA DEPARTMENT OF TRANSPORTATION PROJECT DELIVERY AND OPERATIONS DIVISION ROADWAY DESIGN SERVICES
EROSION CONTROL DETAIL SHEET

ROUTE	F.H.W.A. Arizona Division	STATE	PROJECT NO.	FEDERAL ID NO.	SHEET NO.	TOTAL SHEETS	RECORD DRAWING
US 93		ARIZ.	093 YV 189	093-B(230)T	496	524	
MILEPOST 189.92	LOCATION WICKENBURG RANCH WAY TO VISTA ROYALE						DWG No. E-2.04
STRUCTURE NO.	TRACS NO. F0738 01C			____ OF ____			


REV. DATE: 4/21

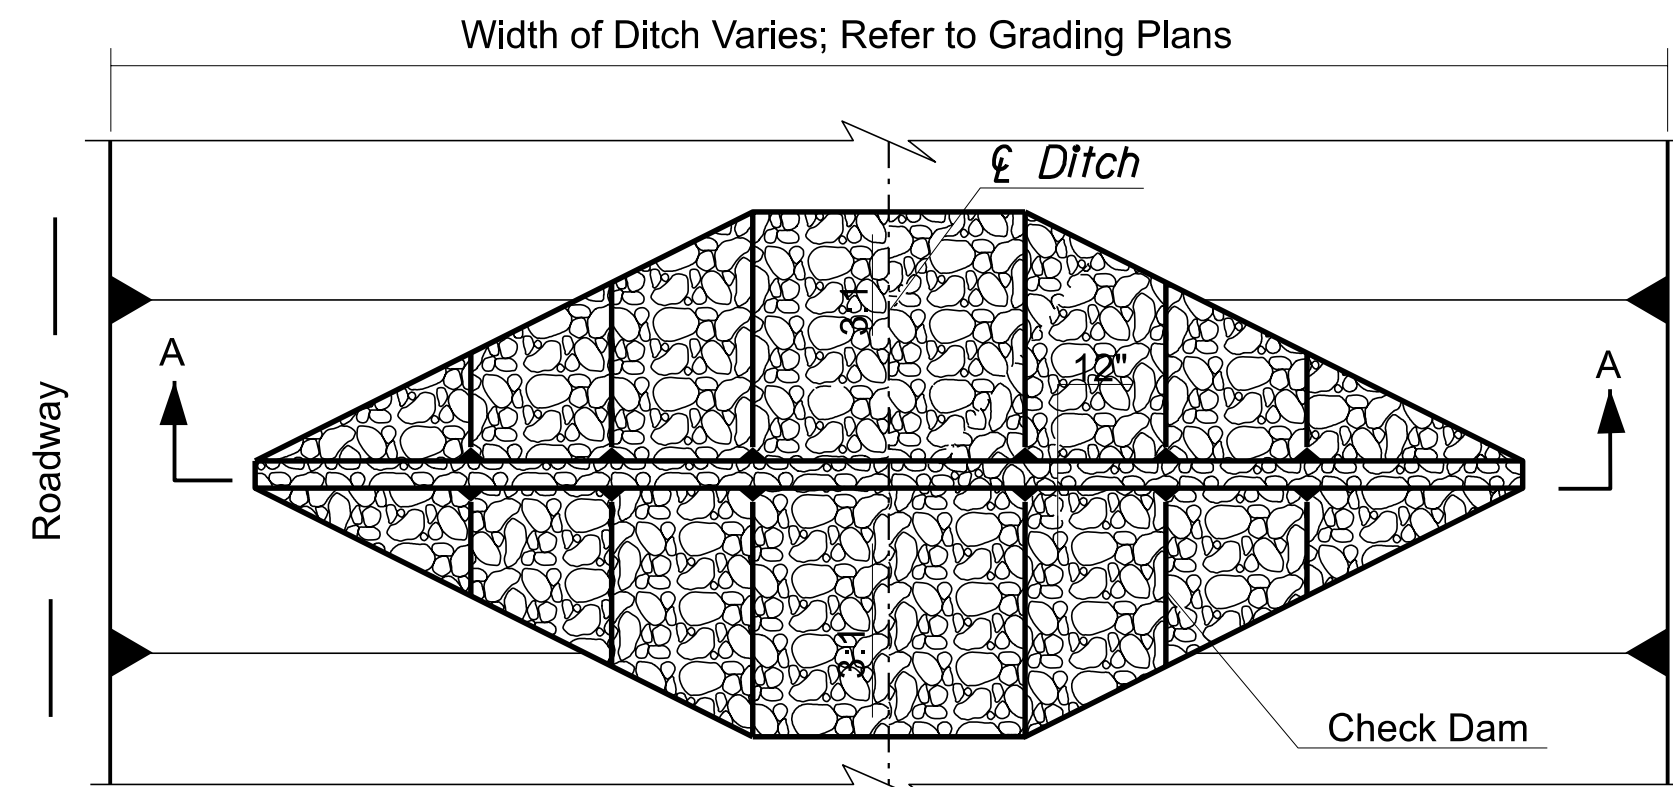


TRAPEZOIDAL DITCH PLAN (NTS)

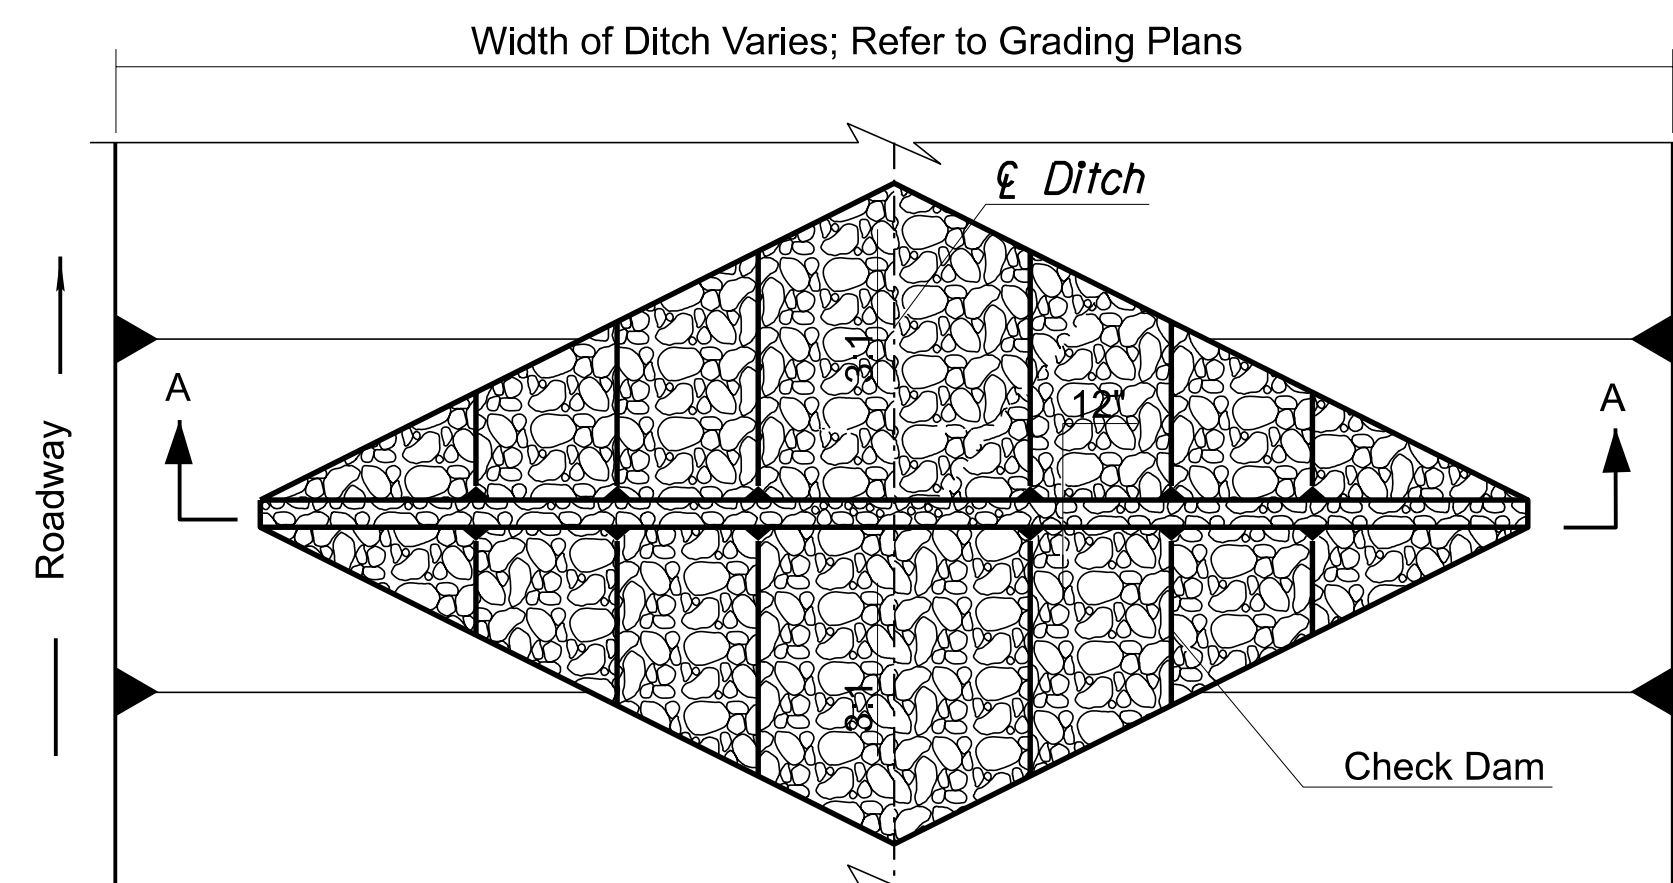

V-DITCH PLAN (NTS)

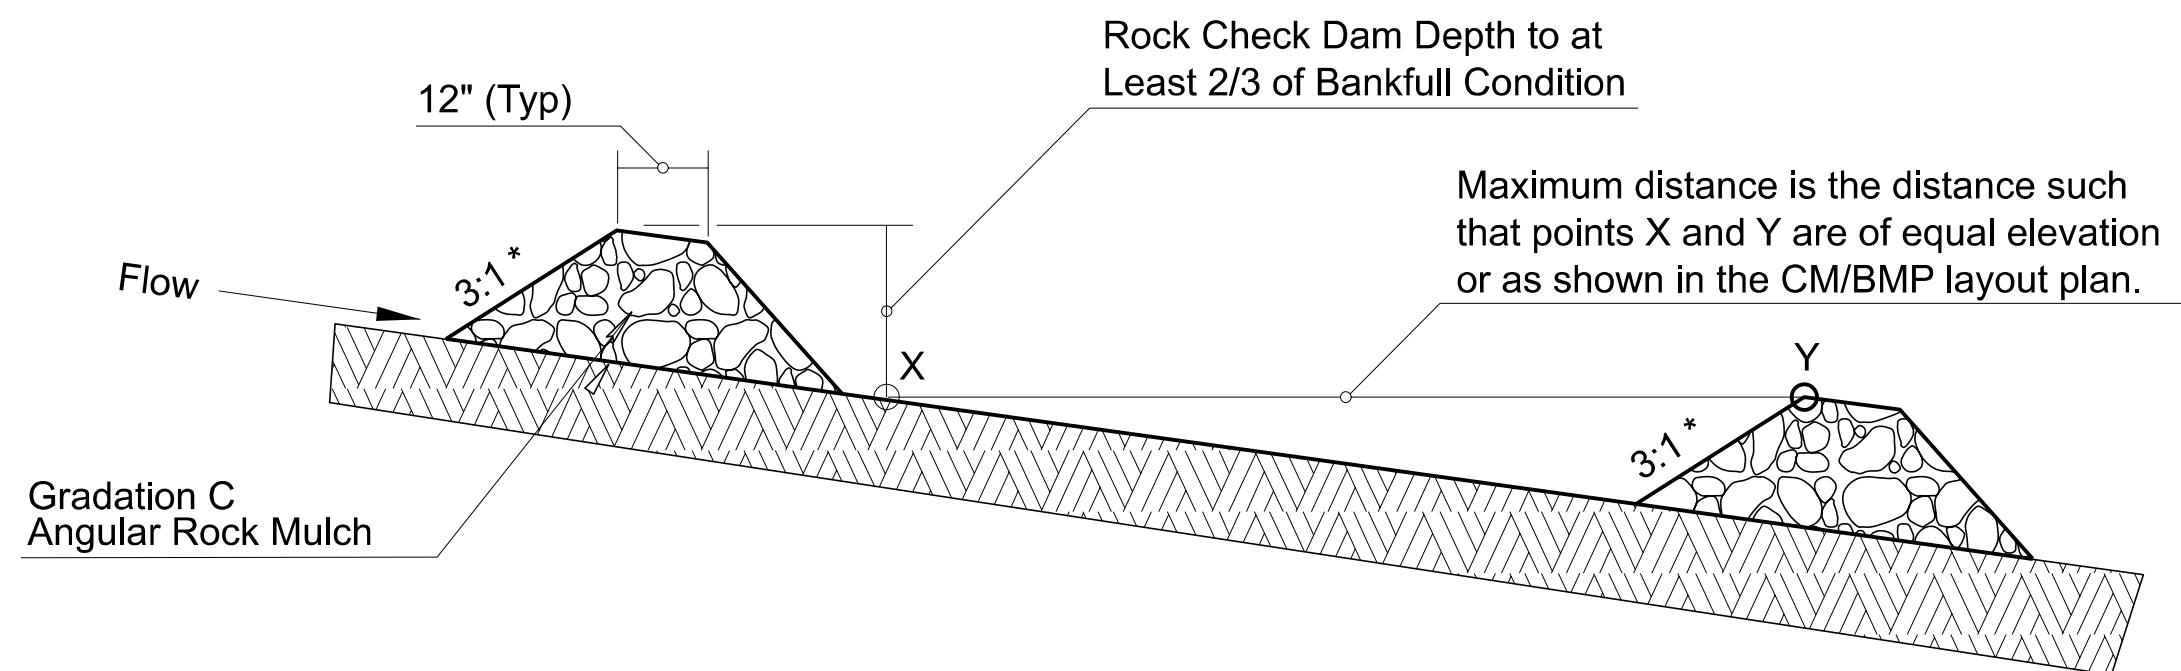

ELEVATION ALONG DITCH SLOPE (NTS)

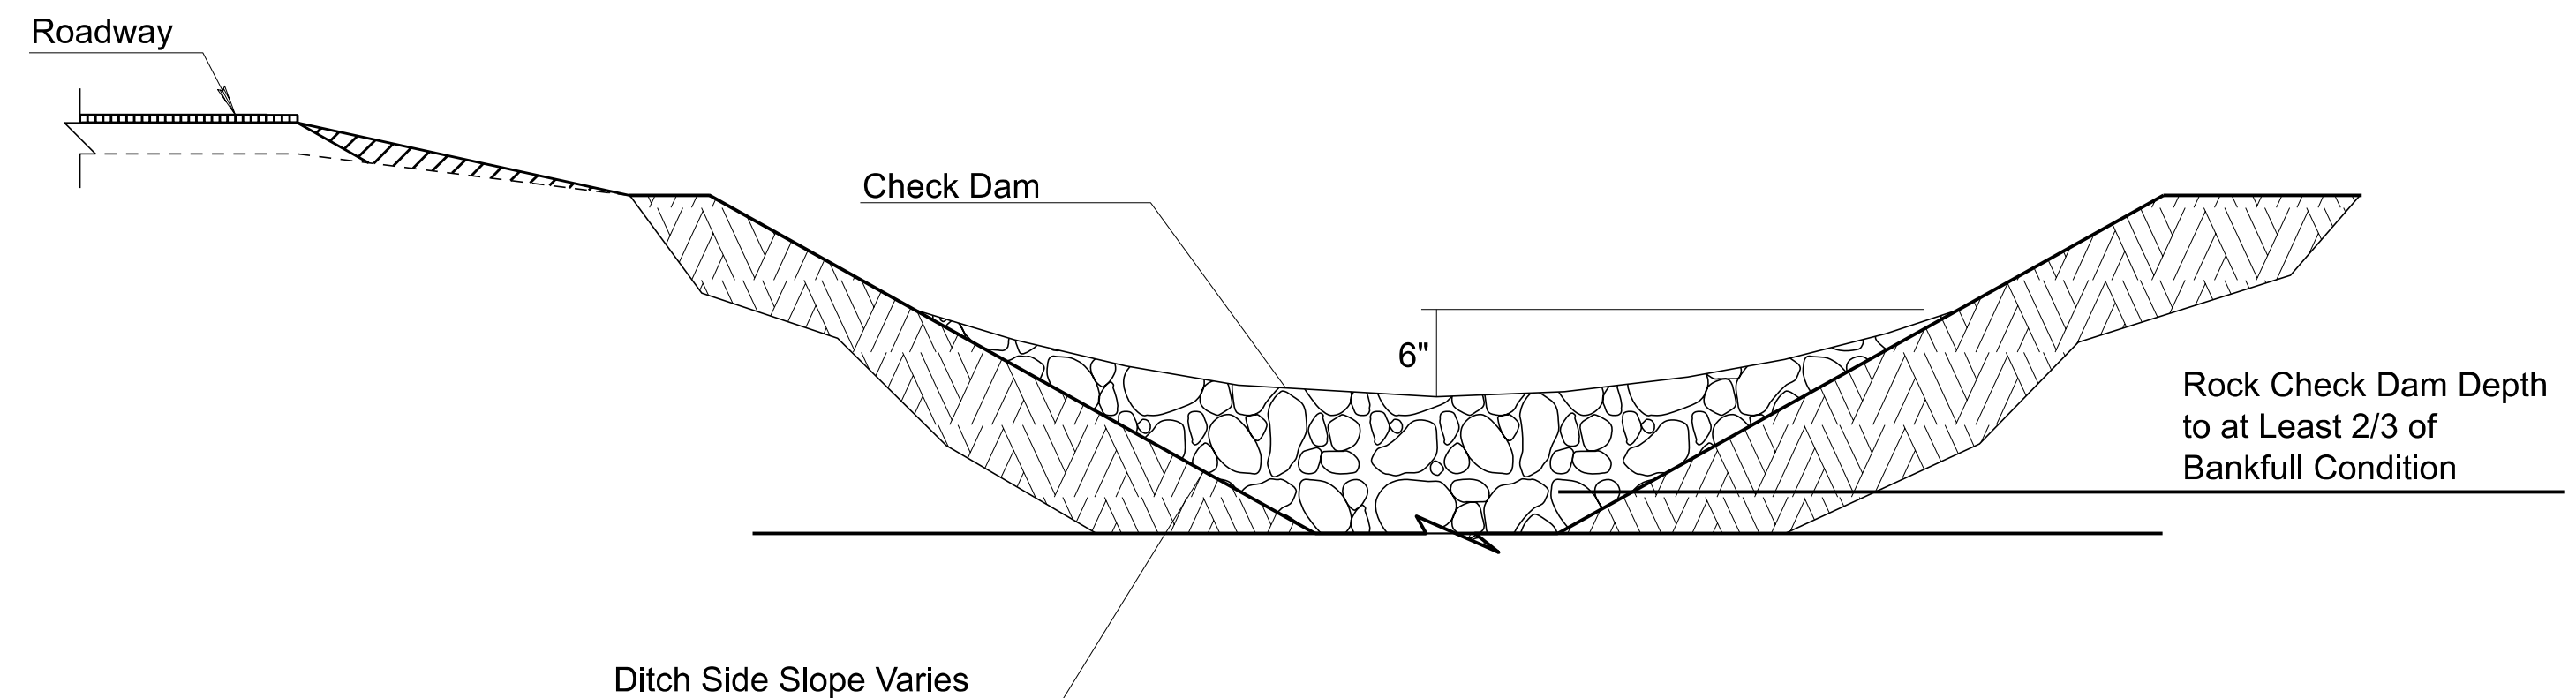

SECTION A-A
TRAPEZOIDAL- OR V-DITCH
(NTS)


NOTES:

1. Construct Rock Check Dams with angular-shaped Gradation C Rock Mulch as defined in Section 810-2.03 of the Specifications and project special provisions. Natural river-run materials such as rounded river rocks/cobblestones and pebbles are NOT acceptable.
- 2.*Slope shall be 1(V) : 6(H) or flatter if Check Dam is within the traffic clear zone/recovery areas as defined in ADOT Roadway Design Guidelines (303.2 to 303.3 Roadside Recovery Area).
3. Make field adjustments of sizing and spacing of Rock Check Dams as necessary for traffic safety as well as proper functioning of the drainage facilities.
4. Flatten and re-grade Rock Check Dams to the finished grade, level within the ditch, as soon as practicable for Final Stabilization.
5. Make field adjustments and corrections of Rock Check Dam CM/BMP immediately if it is causing flooding, erosion, and/or affecting roadway safety.
6. Make field adjustments to ensure the top of the Rock Check Dam is approximately 2/3 height of the estimated ditch bankfull level.
7. When paid separately, the Rock Check Dam CM/BMP pay/bid item shall include all materials used for this CM/BMP: all ground preparation, furnishing, installing, maintenance, flattening/grading back to the finished grade, as well as returning the area to an acceptable condition as approved by the Engineer.
8. Make field adjustments and corrections to ensure NO sensitive biological resources (native species / habitats) will be adversely impacted.

DETAIL **ES5**
ROCK CHECK DAM


		NAME	DATE	ARIZONA DEPARTMENT OF TRANSPORTATION PROJECT DELIVERY AND OPERATIONS DIVISION ROADWAY DESIGN SERVICES		ROUTE US 93	F.H.W.A. Arizona Division	STATE ARIZ.	PROJECT NO. 093 YV 189	FEDERAL ID NO. 093-B(230)T	SHEET NO. 497	TOTAL SHEETS 524	RECORD DRAWING
	DESIGN	W HERRERA	06/26		EROSION CONTROL DETAIL SHEET	MILEPOST 189.92	LOCATION WICKENBURG RANCH WAY TO VISTA ROYALE DWG No. E-2.05						
	DRAWN	STAFF	06/26										
	CHECKED	W COLEBANK	06/26			STRUCTURE NO.	TRACS NO. F0738 01C ____ OF ____						

REV. DATE: 4/21

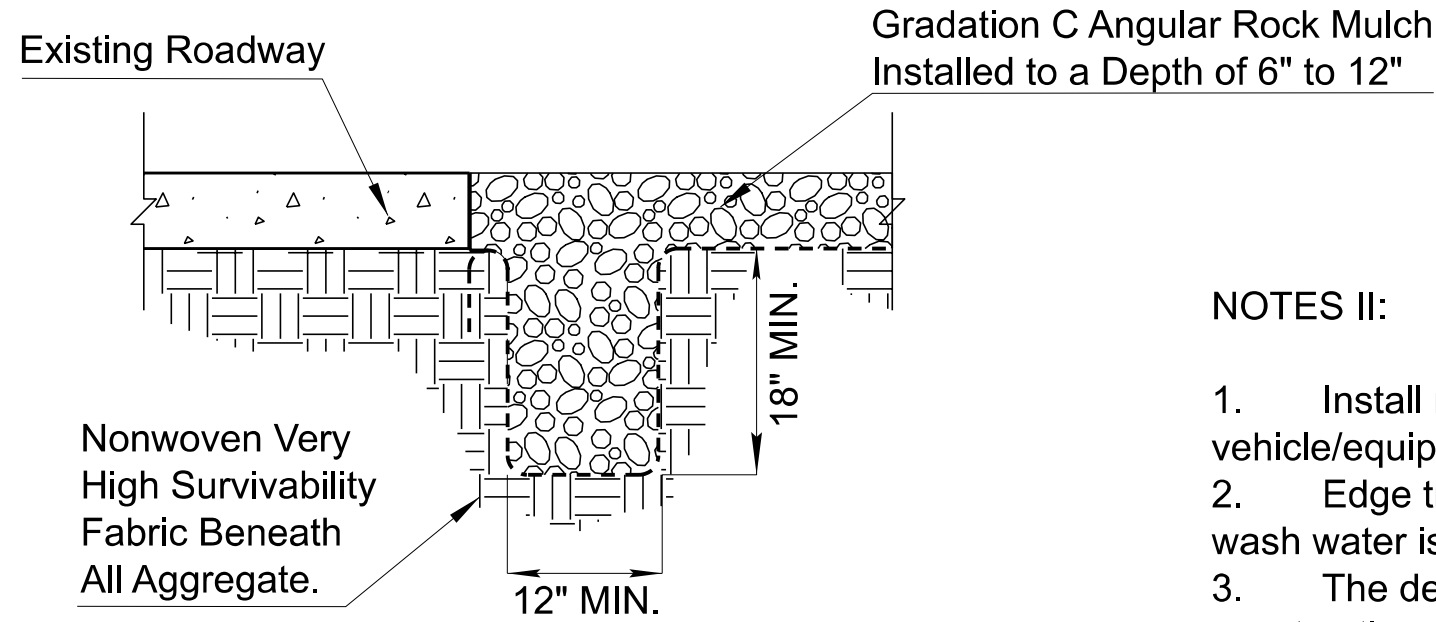

EDGE TREATMENT TRENCHING
TYPICAL SECTION (NTS)

- NOTES II:
1. Install nonwoven fabric when water is applied for construction vehicle/equipment cleaning on Gravel Pad.
 2. Edge treatment trenching and nonwoven fabric shall not be required if NO wash water is used for vehicle/equipment cleaning.
 3. The depth of Gravel Pad varies from 6" to 12" based on the necessities of construction vehicle/equipment as per the approval of the Engineer.

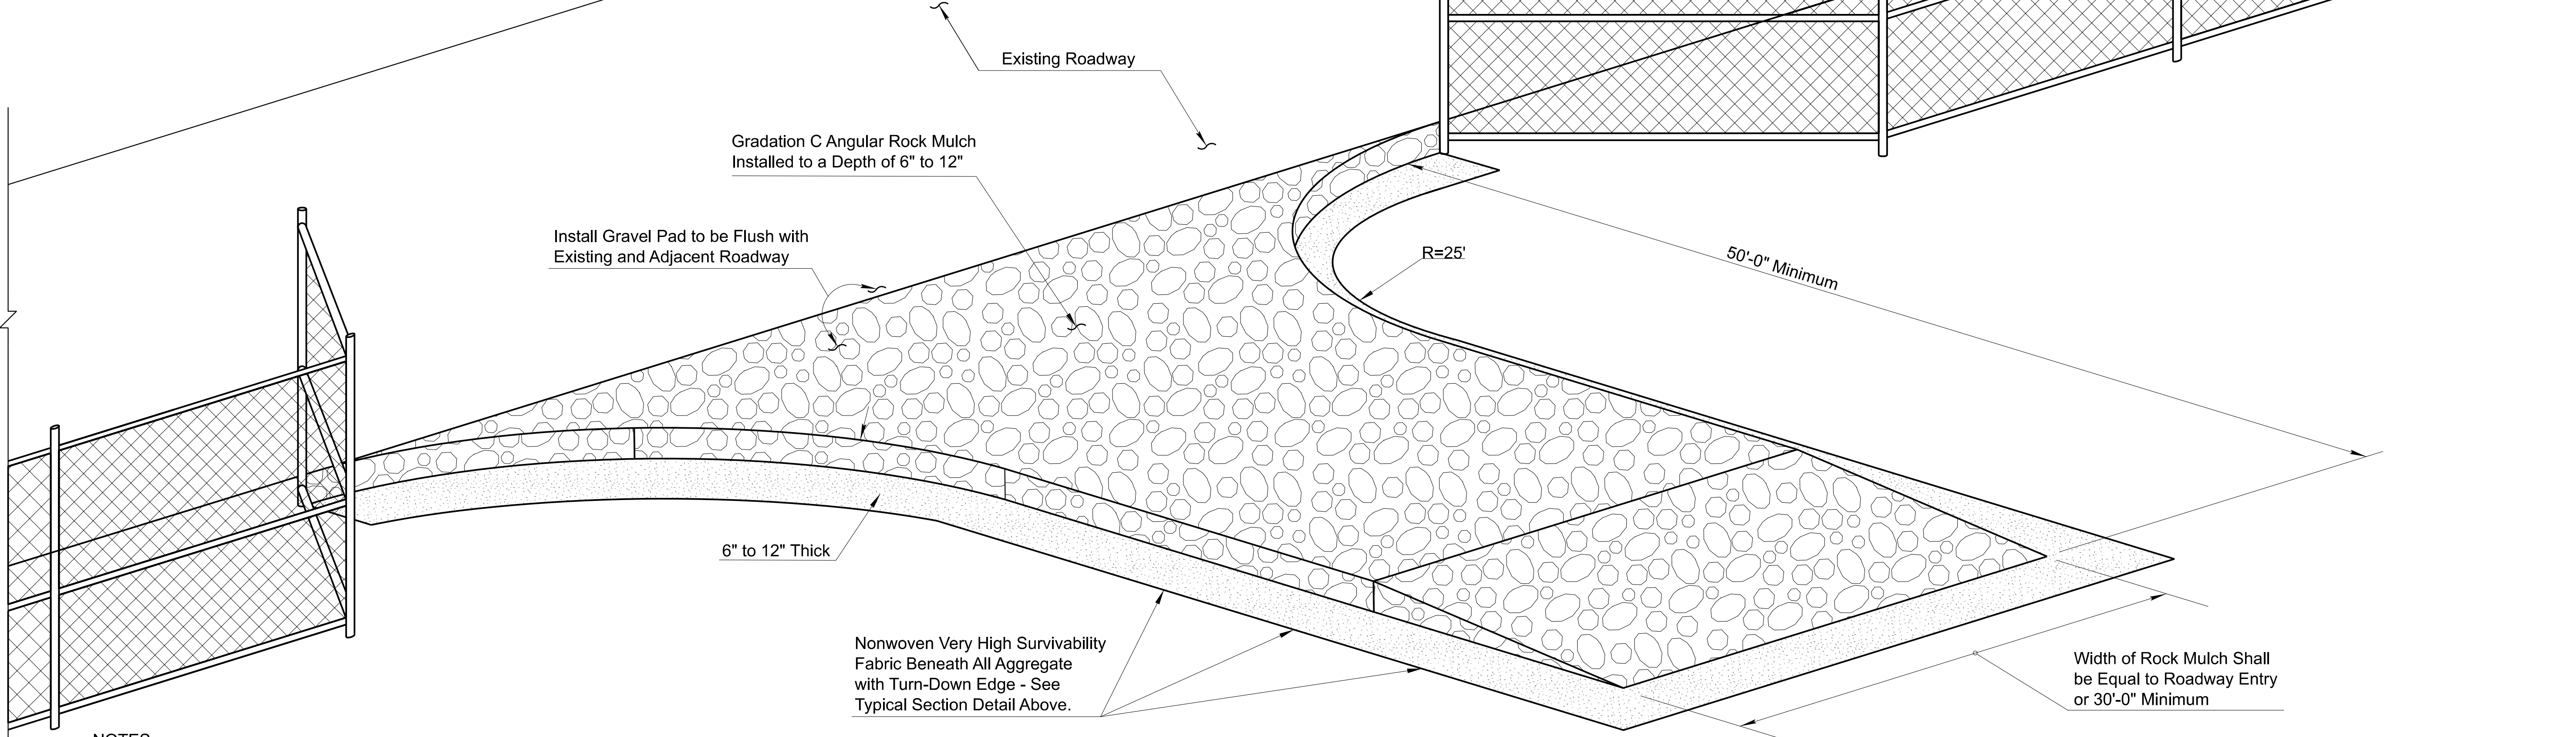

BIRD'S EYE VIEW (NTS)

- NOTES :
1. Install Stabilized Construction Entrance/Exit Gravel Pad CM/BMP for traffic entering or exiting a construction site where sedimentation, clay, silt or other pollutants can be tracked onto public roads and/or adjacent water bodies, as approved by the Engineer. It may also be applied for construction entrance/exit wind erosion/dust control, as approved by the Engineer.
 2. Locate new Construction Entrance(s)/Exit(s) at appropriate project entrance/exit points as determined in field with the approval of the Engineer. Relocate Stabilized Construction Entrance/Exit Gravel Pad CM/BMP as needed as project progresses. Replace Rock Mulch materials in drive paths when dirt or mud accumulates.
 3. Nonwoven Very High Survivability Fabric shall conform to the standards of Sub-section 1014-4.04 of the Specifications.
 4. Rock Mulch materials shall be fractured/crushed rocks in angular shape and as defined in the Sub-section 810-2.03 of the Specifications. Natural river-run materials, especially rounded natural river rocks are not acceptable.
 5. Make field adjustments and corrections of Construction Entrance/Exit Gravel Pad CM/BMP immediately if it is causing flooding and/or affecting roadway safety.
 6. When paid separately, the Stabilized Construction Entrance/Exit Gravel Pad CM/BMP's pay/bid item shall include all materials used for this CM/BMP: all ground preparation, furnishing, installing, final removal, and disposal of this temporary CM/BMP, as well as returning the area to an acceptable condition as approved by the Engineer.
 7. * Fence/barricade pay/bid item shall not be included as a component of the Stabilized Construction Entrance/Exit Gravel Pad CM/BMP pay/bid item.
 8. Make field adjustments and corrections to ensure NO sensitive biological resources (native species / habitats) will be adversely impacted.


DETAIL ES6

STABILIZED CONSTRUCTION
ENTRANCE/EXIT GRAVEL PAD


	DESIGN	NAME	DATE	ARIZONA DEPARTMENT OF TRANSPORTATION PROJECT DELIVERY AND OPERATIONS DIVISION ROADWAY DESIGN SERVICES	ROUTE	F.H.W.A. Arizona Division	STATE ARIZ.	PROJECT NO.	FEDERAL ID NO.	SHEET NO.	TOTAL SHEETS	RECORD DRAWING		
	DRAWN	W HERRERA	06/26		MILEPOST			093 YV 189	093-B(230)T	498	524			
	CHECKED	W COLEBANK	06/26		STRUCTURE NO.									
					EROSION CONTROL MEASURE INDEX SHEET	LOCATION WICKENBURG RANCH WAY TO VISTA ROYALE								DWG No. E-2.06
						TRACS NO. F0738 01C								___ OF ___

F.H.W.A. REGION	STATE	PROJECT NO.	SHEET NO.	TOTAL SHEETS	RECORD DRAWING
9	ARIZ.	093-B(230)T	499	524	

093 YV 189

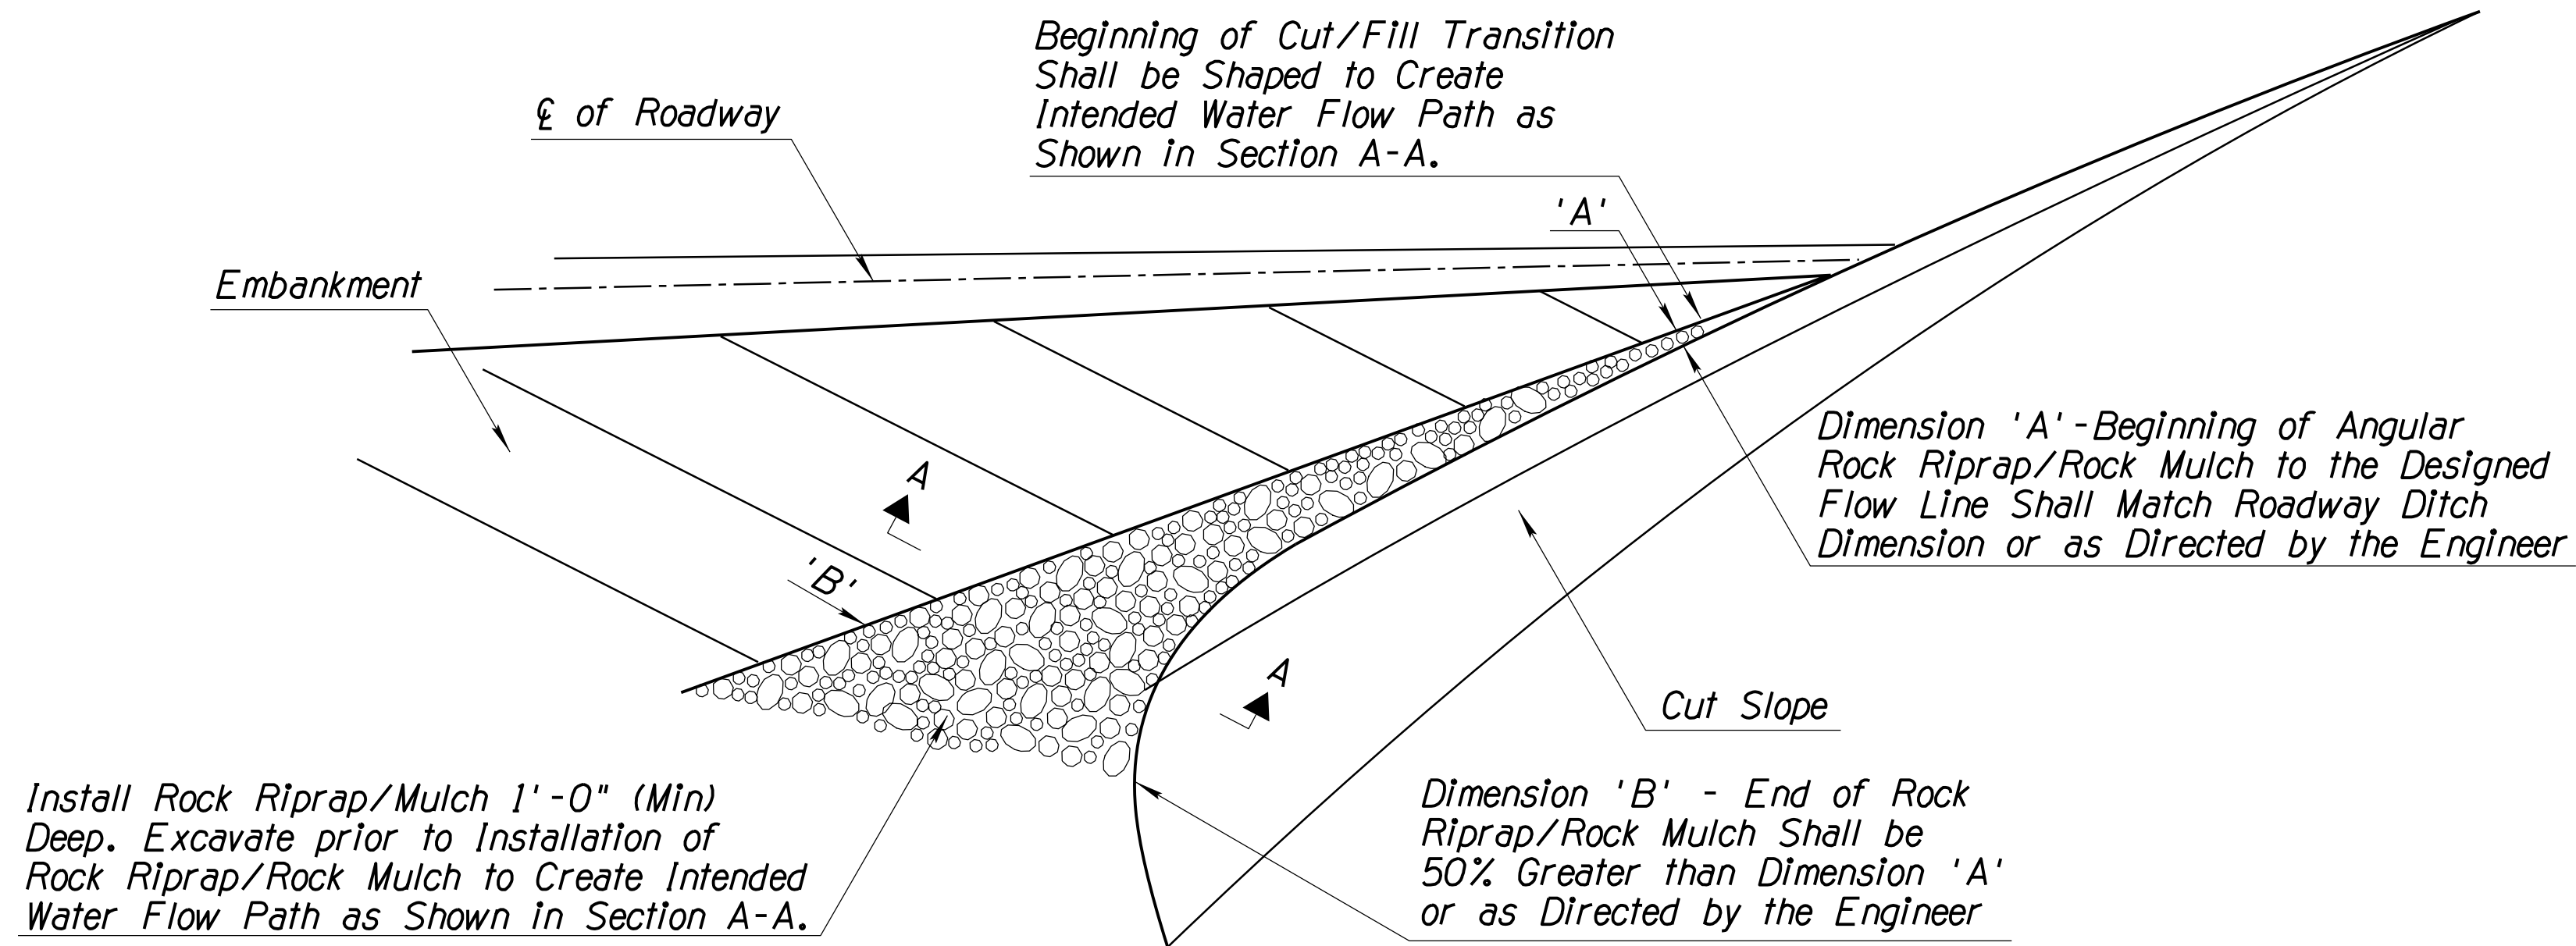


ROCK RIPRAP/ROCK MULCH FLOW PATH PERSPECTIVE (NTS)

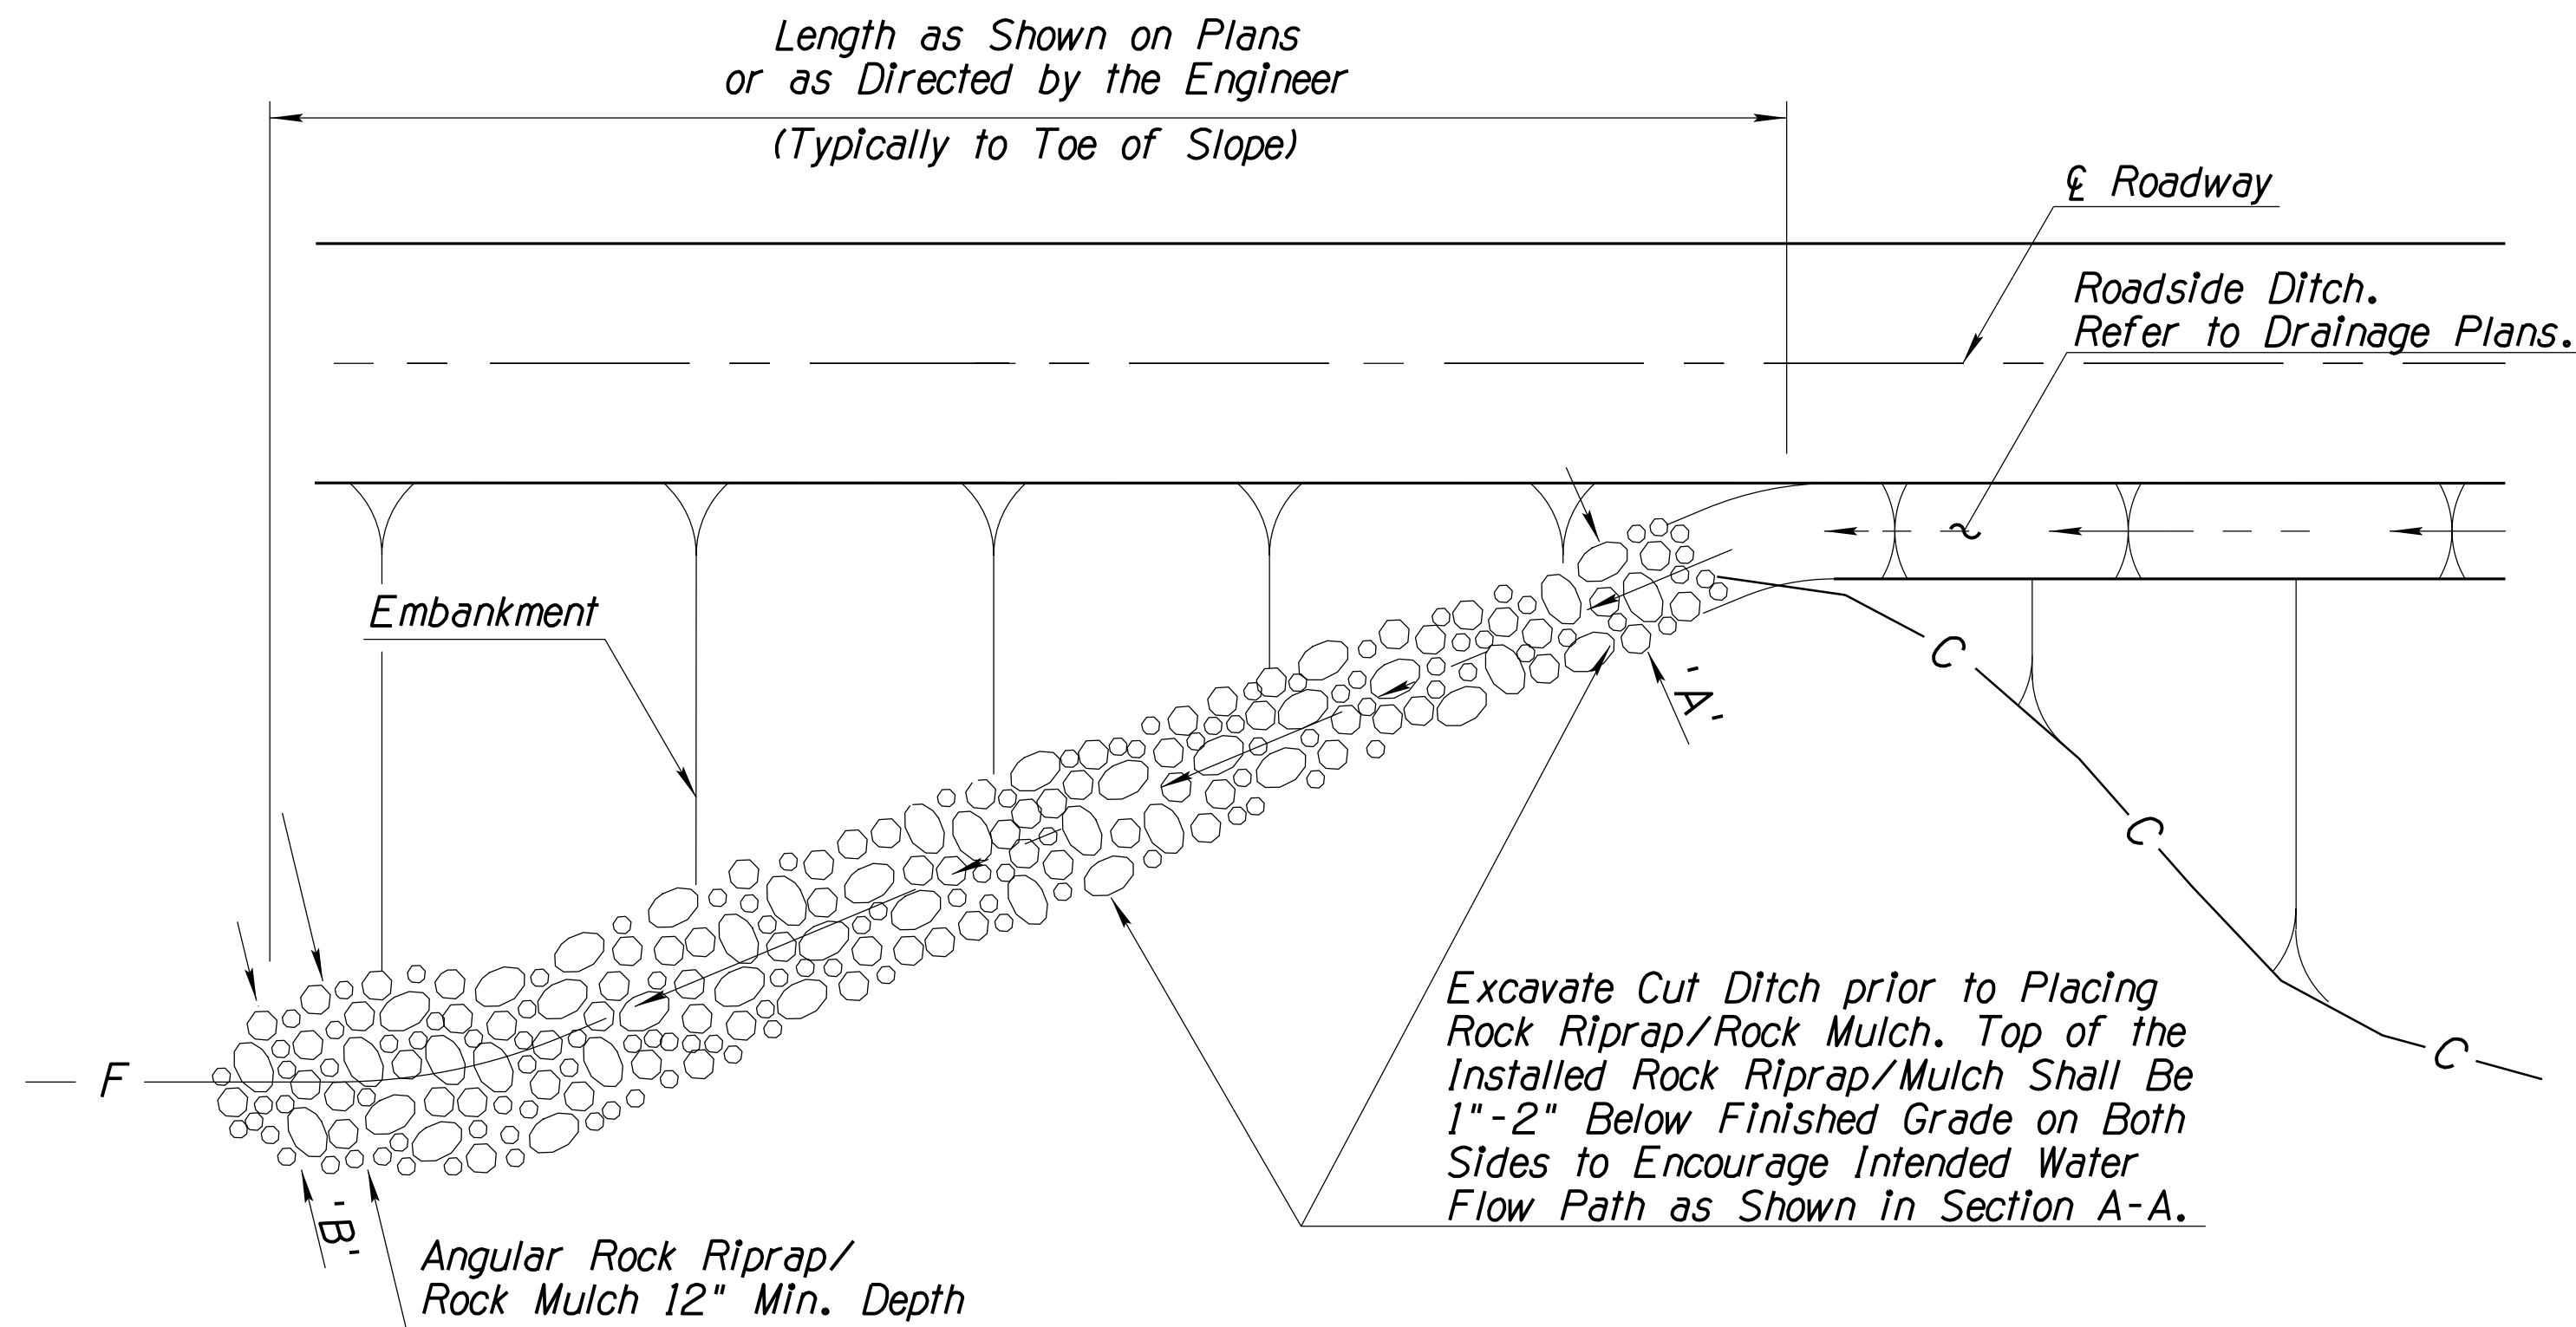

ROCK RIPRAP/ROCK MULCH FLOW PATH PLAN VIEW (NTS)

NOTE:

Cut and fill transition shall be placed as shown on plans or where the length of the roadside ditch is 50 feet or greater. Field adjust per direction of Engineer.

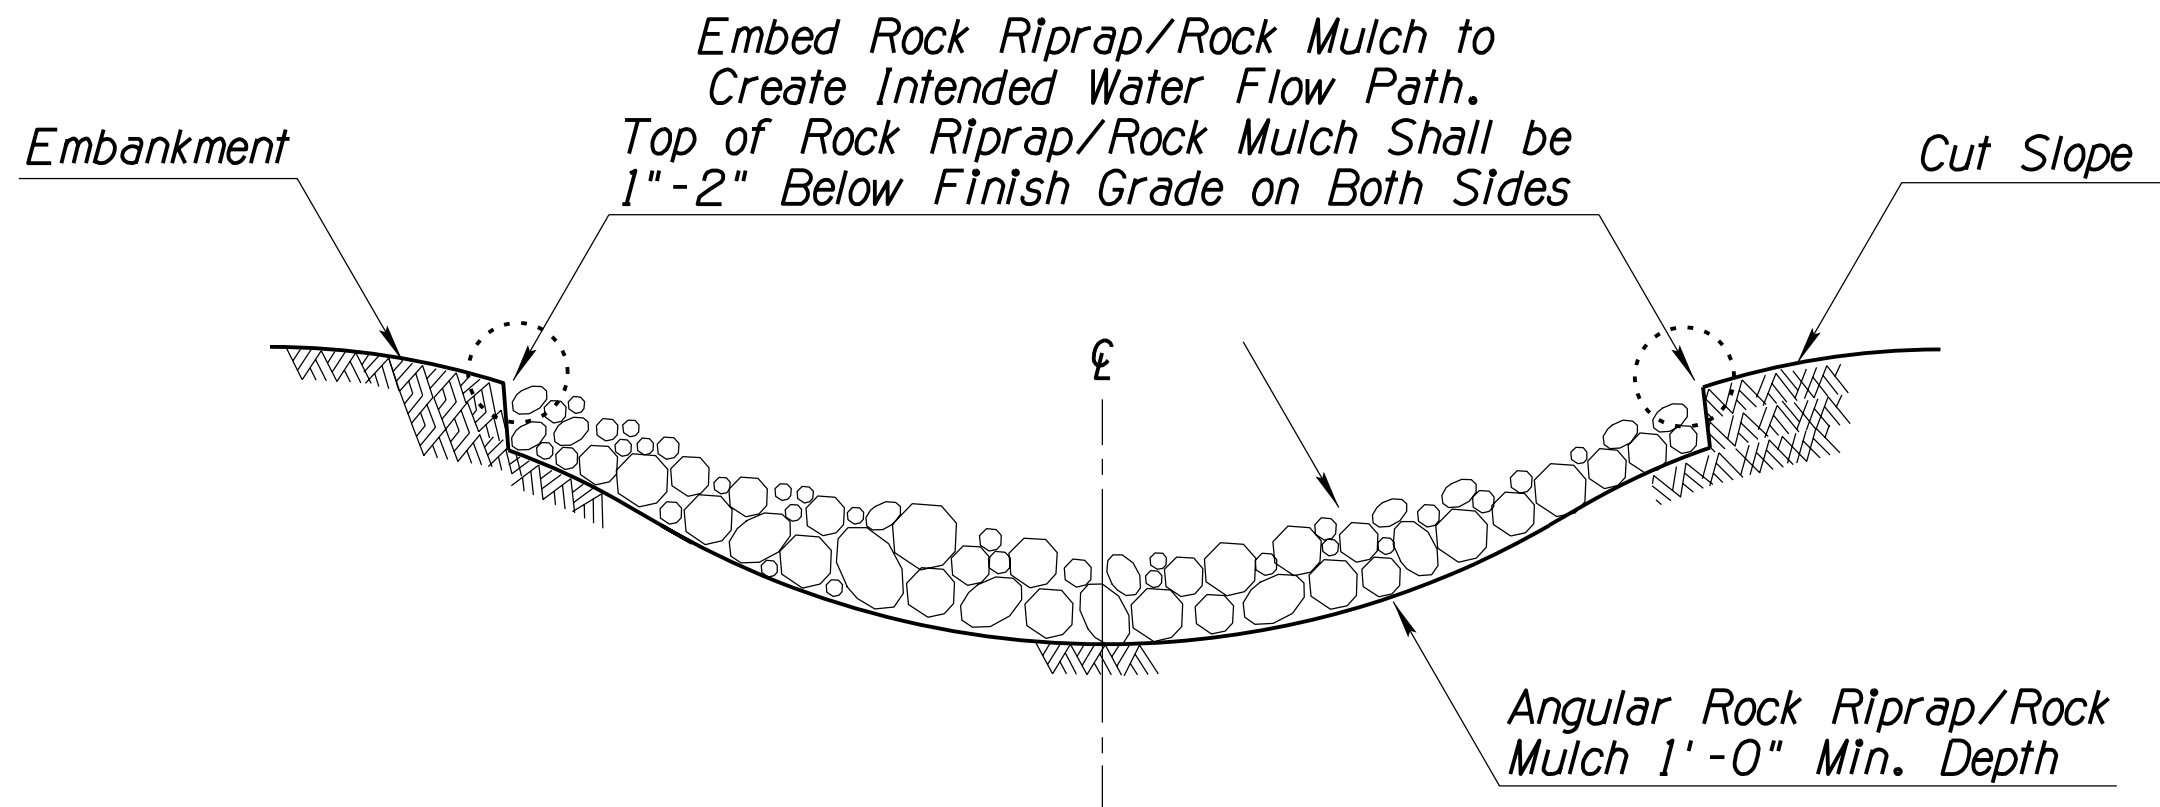

ROCK RIPRAP/ROCK MULCH FLOW PATH EMBEDMENT SECTION A-A (NTS)

NOTES:

1. Rock Riprap/Rock Mulch shall be angular shaped, crushed rock materials. Natural river-run materials such as rounded river rocks/cobblestones and pebbles are NOT acceptable.
2. Rock Riprap/Rock Mulch within the traffic Clear Zone/Recovery Area shall conform to the requirements of Section 810-2.03 Sieve Size Gradation A and/or Gradation C, and Section 913 of the Specifications and project special provisions.
3. Install Rock Riprap/Rock Mulch to a minimum depth of 12" for Channel Lining and Cut/Fill Transition. Excavate ground surface to a depth that the top of Rock is 1"-2" below the grade of the ditch to encourage Intended Flow Path as shown in Section A-A.
4. Embed any rock into the finished grade so that any portion of the Rock is less than 4" above grade, within traffic recovery area/clear zone.
5. The installation and maintenance of Rock Protection CMs/BMPs shall not negatively impact traffic safety, nor the designed function of roadway or bridge drainage facilities. Rock Protection CMs/BMPs shall be installed and maintained to carry the stormwater of at least 2-year, 24-hour events.
6. Make field adjustments and corrections of Rock Protection CM/BMP immediately if it is causing flooding, erosion, and/or affecting roadway safety.
7. Make field adjustments to ensure the top surface of Rock Riprap/Rock Mulch is graded lower than the surrounding finished grade to collect surface stormwater runoff and concentrated flow.
8. The Rock Protection CM/BMP's pay/bid item shall include all materials used for this CM/BMP; all ground preparation, furnishing, installing, maintaining, as well as returning the area to an acceptable condition as approved by the Engineer.
9. Make field adjustments and corrections to ensure NO sensitive biological resources (native species/habitats) will be adversely impacted.


DETAIL ES7

ROCK PROTECTION FOR CUT & FILL TRANSITION AND CHANNEL LINING

DESIGN	NAME	DATE	ARIZONA DEPARTMENT OF TRANSPORTATION PROJECT DELIVERY AND OPERATIONS DIVISION ROADSIDE DEVELOPMENT SECTION	
DRAWN	JML	06-26	STORMWATER QUALITY PROTECTION & EROSION/SEDIMENT CONTROL DETAILS	
CHECKED	RM	06-26		
	DBK	06-26		
ROUTE 93			LOCATION WICKENBURG RANCH WAY TO VISTA ROYALE	DWG NO. E-2.07
TRACS NO. F0738 OIC			093-B(230)T	OF

F.H.W.A. REGION	STATE	PROJECT NO.	SHEET NO.	TOTAL SHEETS	RECORD DRAWING
9	ARIZ.	093-B(230)T	500	524	

093 YV 189

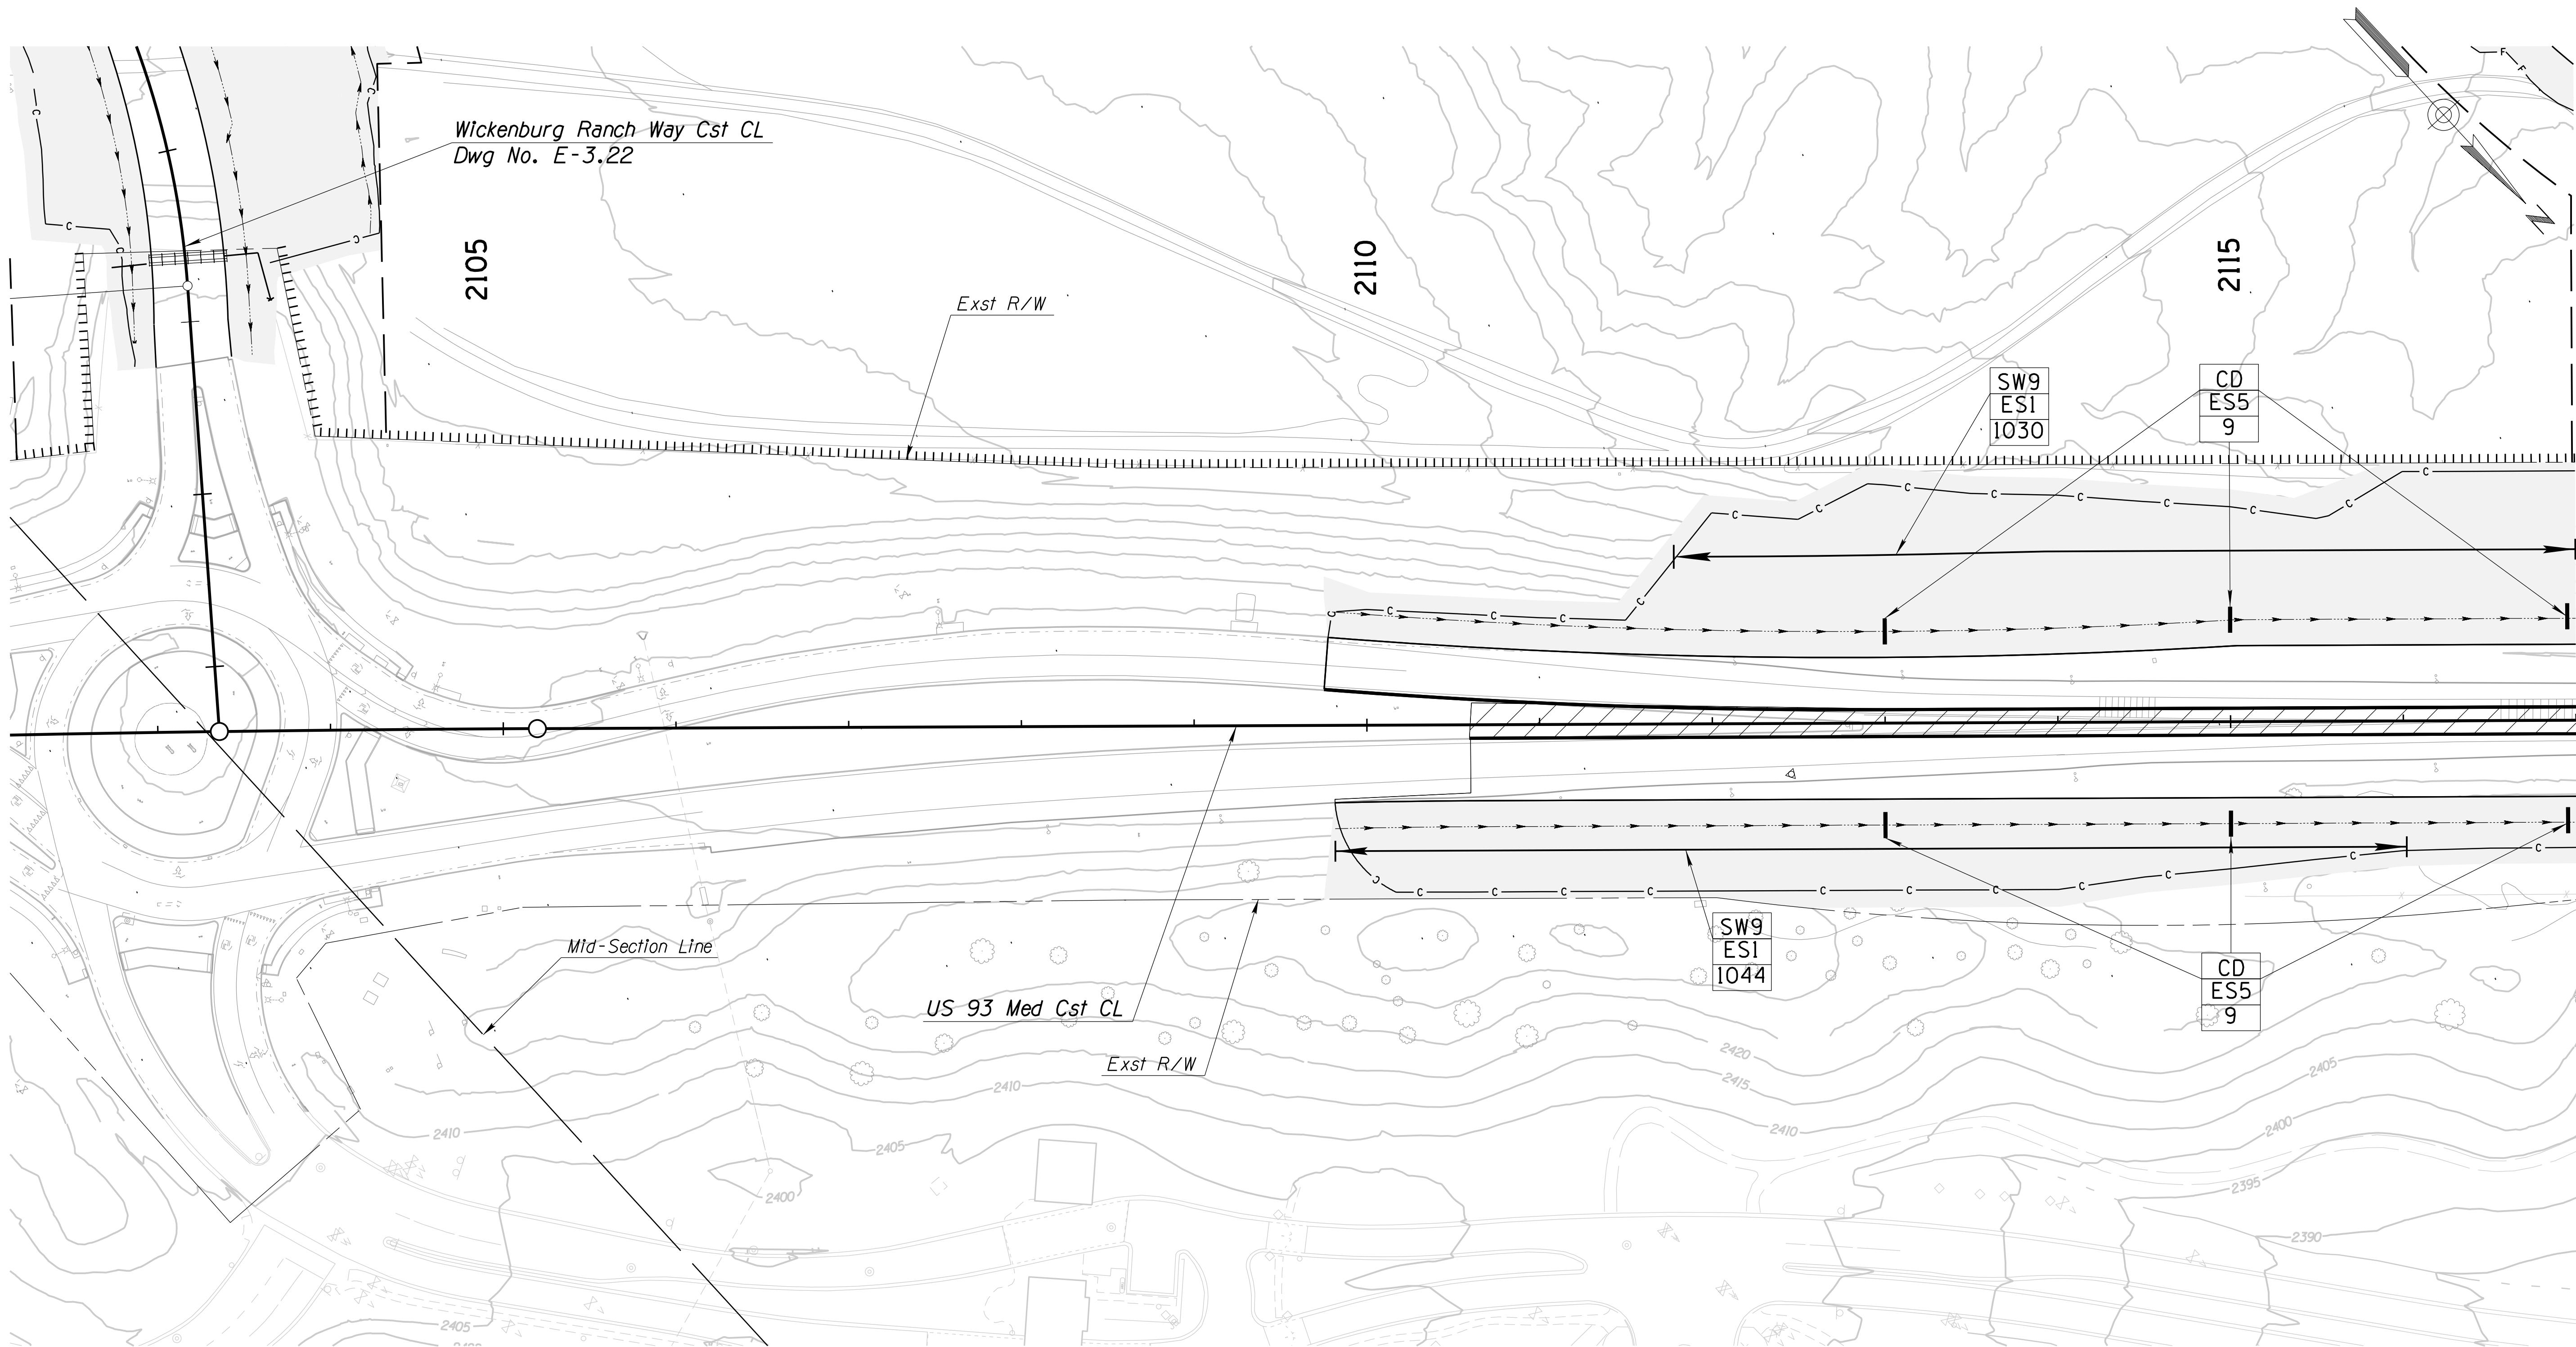

SYMBOL	DESCRIPTION	QUANTITY
	SEEDING	2.2 Ac
	GRANITE MULCH (See Note 1)	1096 Sq Yd

NOTE:
1. Granite Mulch in roundabout and median shall be placed to a thickness of 3-inches and will be measured and paid for under Item 8030092-Granite Mulch (1 1/4" Minus).


Erosion Control Method	
	SW20 = Sediment Wattles - 20"
	SW9 = Sediment Wattles - 9"
	CD = Check Dam
	RP = Rock Protection
	IP = Inlet Protection
	SL = Sediment Log
	CE = Construction Entrance
Detail Number Reference	
	Quantity

		NAME	DATE	ARIZONA DEPARTMENT OF TRANSPORTATION PROJECT DELIVERY AND OPERATIONS DIVISION ROADSIDE DEVELOPMENT SECTION US 93 EROSION CONTROL PLAN STA 2105+24.94 TO STA 2117+00		
DESIGN	JML		06-26			
DRAWN	JML		06-26			
CHECKED	JPM		06-26			
 3133 East Camelback Road, Suite 100 Phoenix, Arizona 85016 Phone: (602) 333-2200						
ROUTE		LOCATION			DWG NO. E-3.01	
US 93		WICKENBURG RANCH WAY TO VISTA ROYALE				
TRACS NO. F0738 OIC			093-B(230)T			___ OF ___

F.H.W.A. REGION	STATE	PROJECT NO.	SHEET NO.	TOTAL SHEETS	RECORD DRAWING
9	ARIZ.	093-B(230)T	501	524	

093 YV 189

See Dwg No. E-3.24 for
for Quantities outside of
US 93 Exst R/W

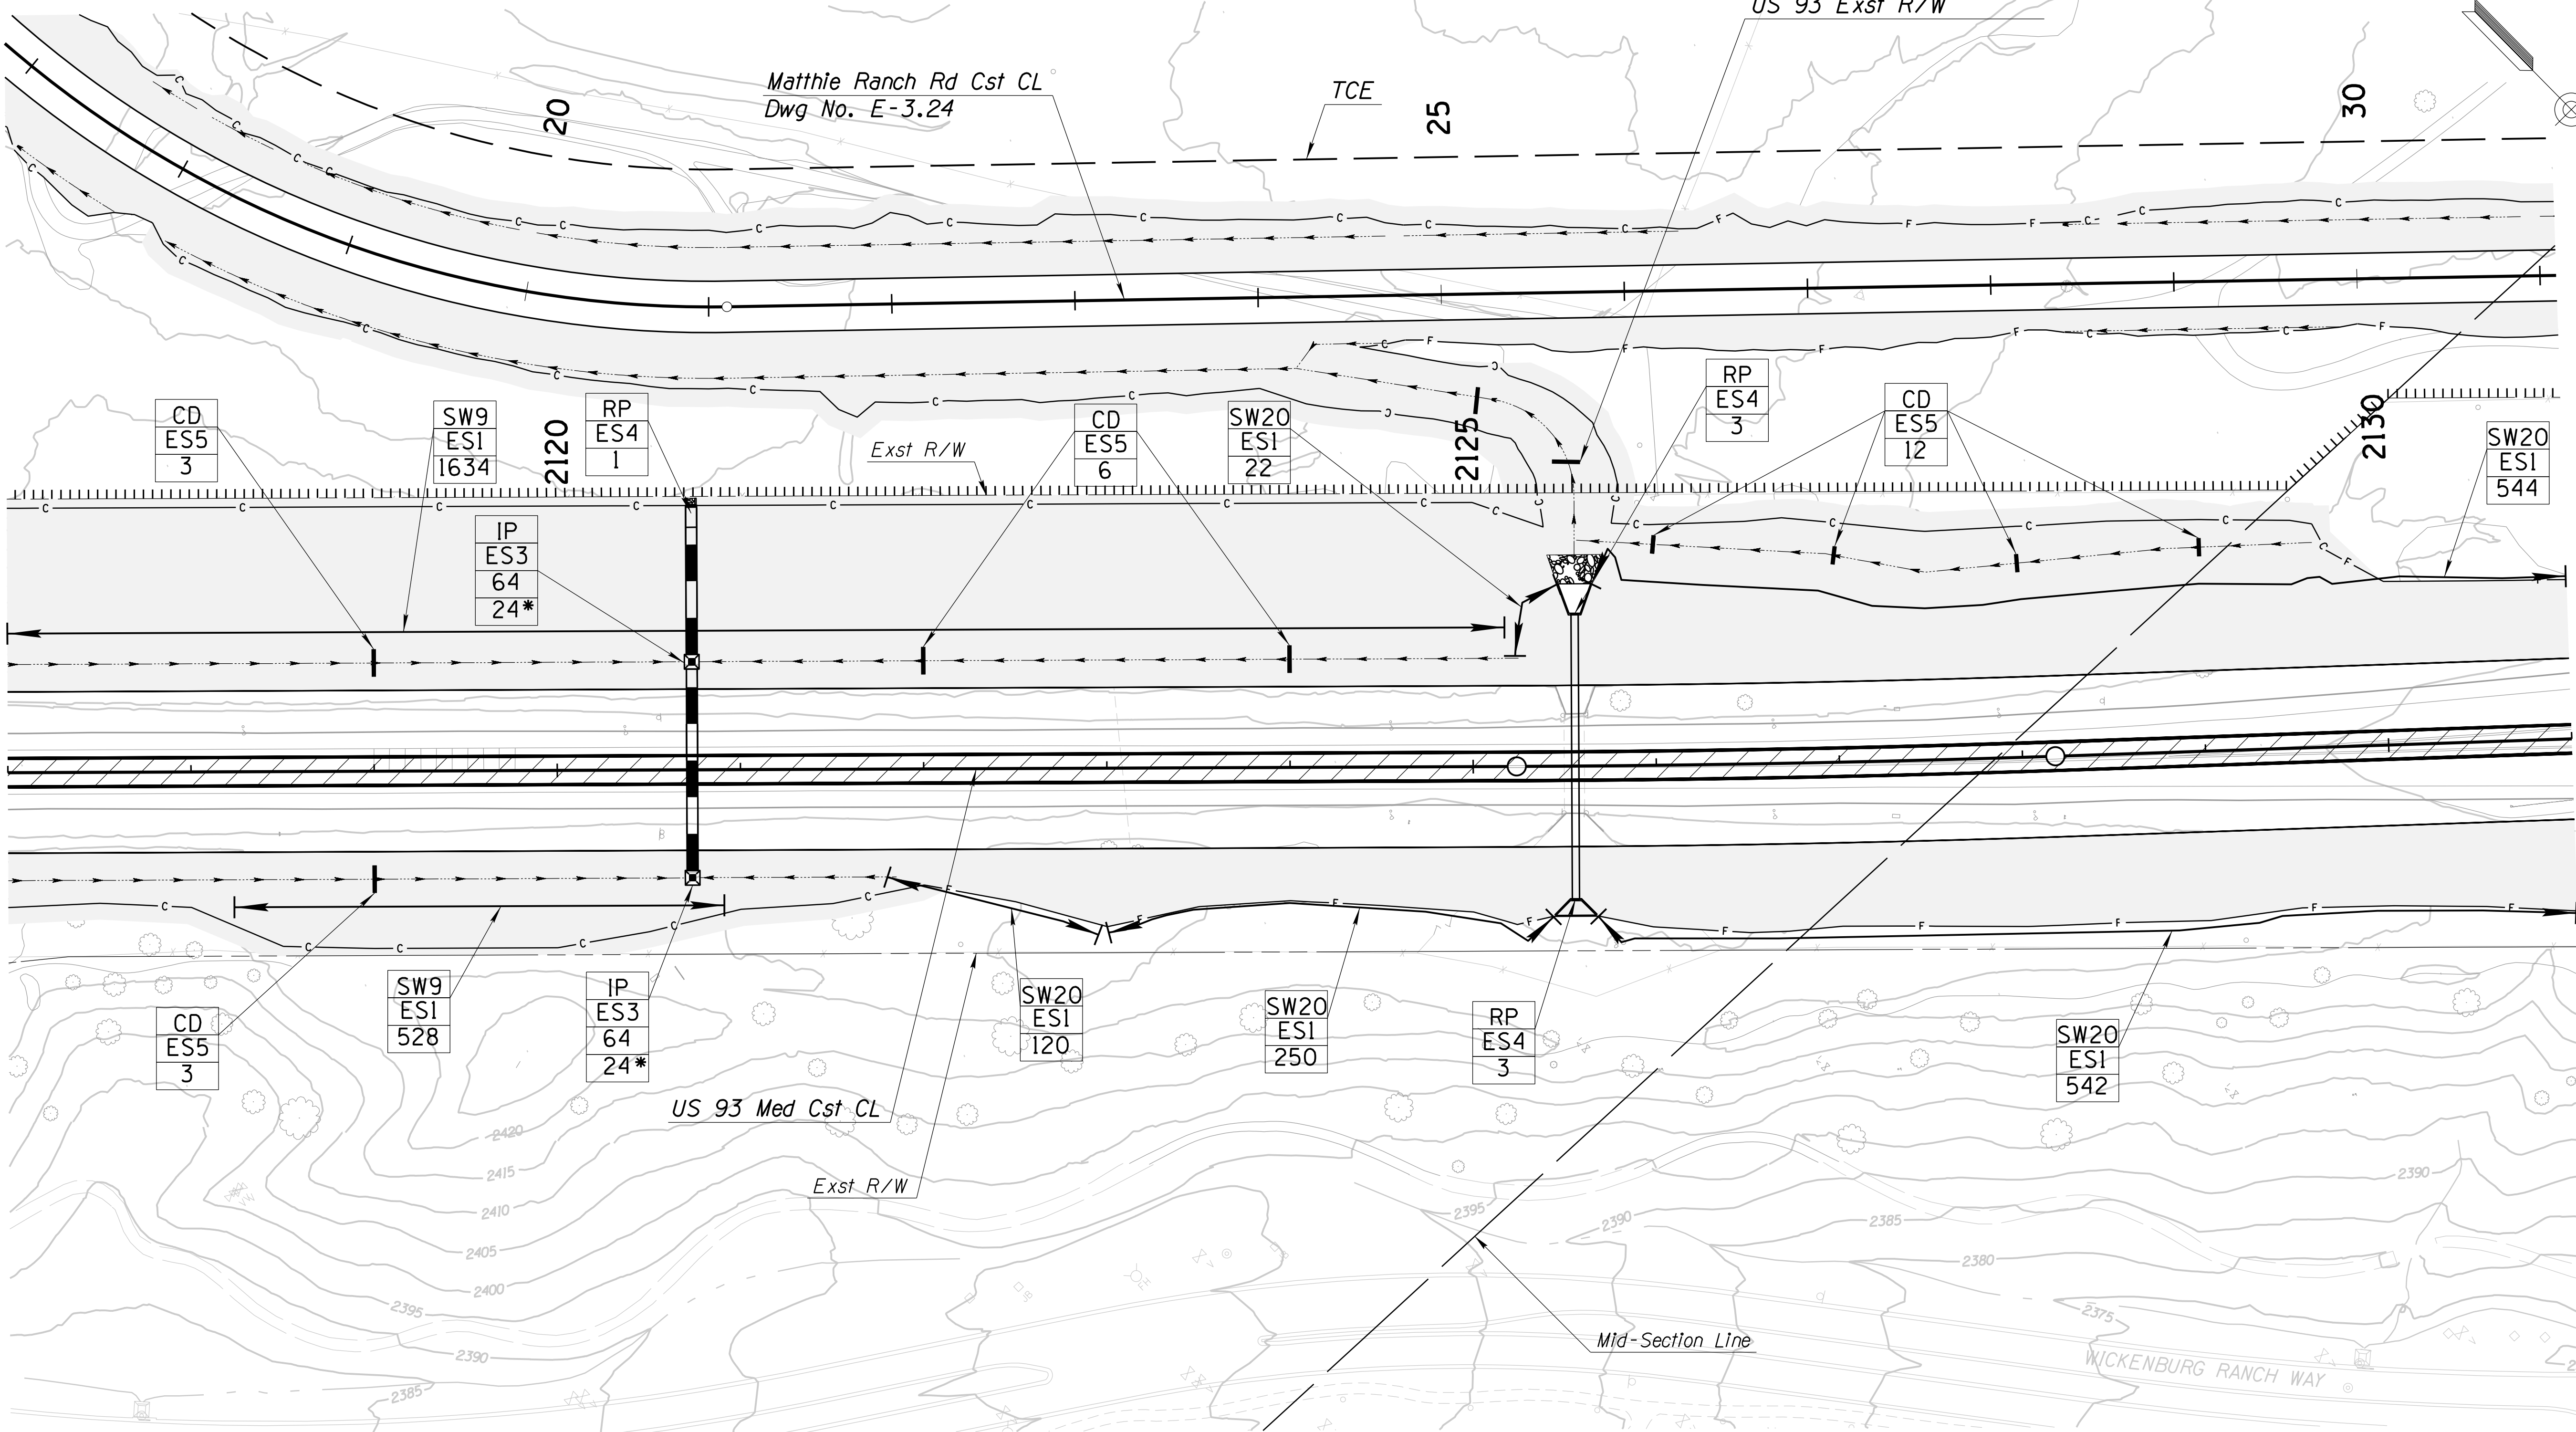

SYMBOL	DESCRIPTION	QUANTITY
	SEEDING	4.5 Ac
	GRANITE MULCH (See Note 1)	2269 Sq Yd

NOTE:
1. Granite Mulch in roundabout and median shall be placed to a thickness of 3-inches and will be measured and paid for under Item 8030092-Granite Mulch (1 1/4" Minus).

Erosion Control Method


- SW20 = Sediment Wattles - 20"
- SW9 = Sediment Wattles - 9"
- CD = Check Dam
- RP = Rock Protection
- IP = Inlet Protection
- SL = Sediment Log
- CE = Construction Entrance

Detail Number Reference

Quantity *Quantity of sediment log (Lin Ft+).

DESIGN	JML	DATE	06-26	ARIZONA DEPARTMENT OF TRANSPORTATION PROJECT DELIVERY AND OPERATIONS DIVISION ROADSIDE DEVELOPMENT SECTION US 93/SR 89 EROSION CONTROL PLAN STA 2117+00 TO STA 2131+00	
DRAWN	JML	DATE	06-26		
CHECKED	JPM	DATE	06-26		
				3133 East Camelback Road, Suite 100 Phoenix, Arizona 85016 Phone: (602) 333-2200	
ROUTE	US 93			LOCATION	WICKENBURG RANCH WAY TO VISTA ROYALE
TRACS NO. F0738 OIC				093-B(230)T	
				DWG NO. E-3.02	
				OF	

F.H.W.A. REGION	STATE	PROJECT NO.	SHEET NO.	TOTAL SHEETS	RECORD DRAWING
9	ARIZ.	093-B(230)T	502	524	
093 YV 189					

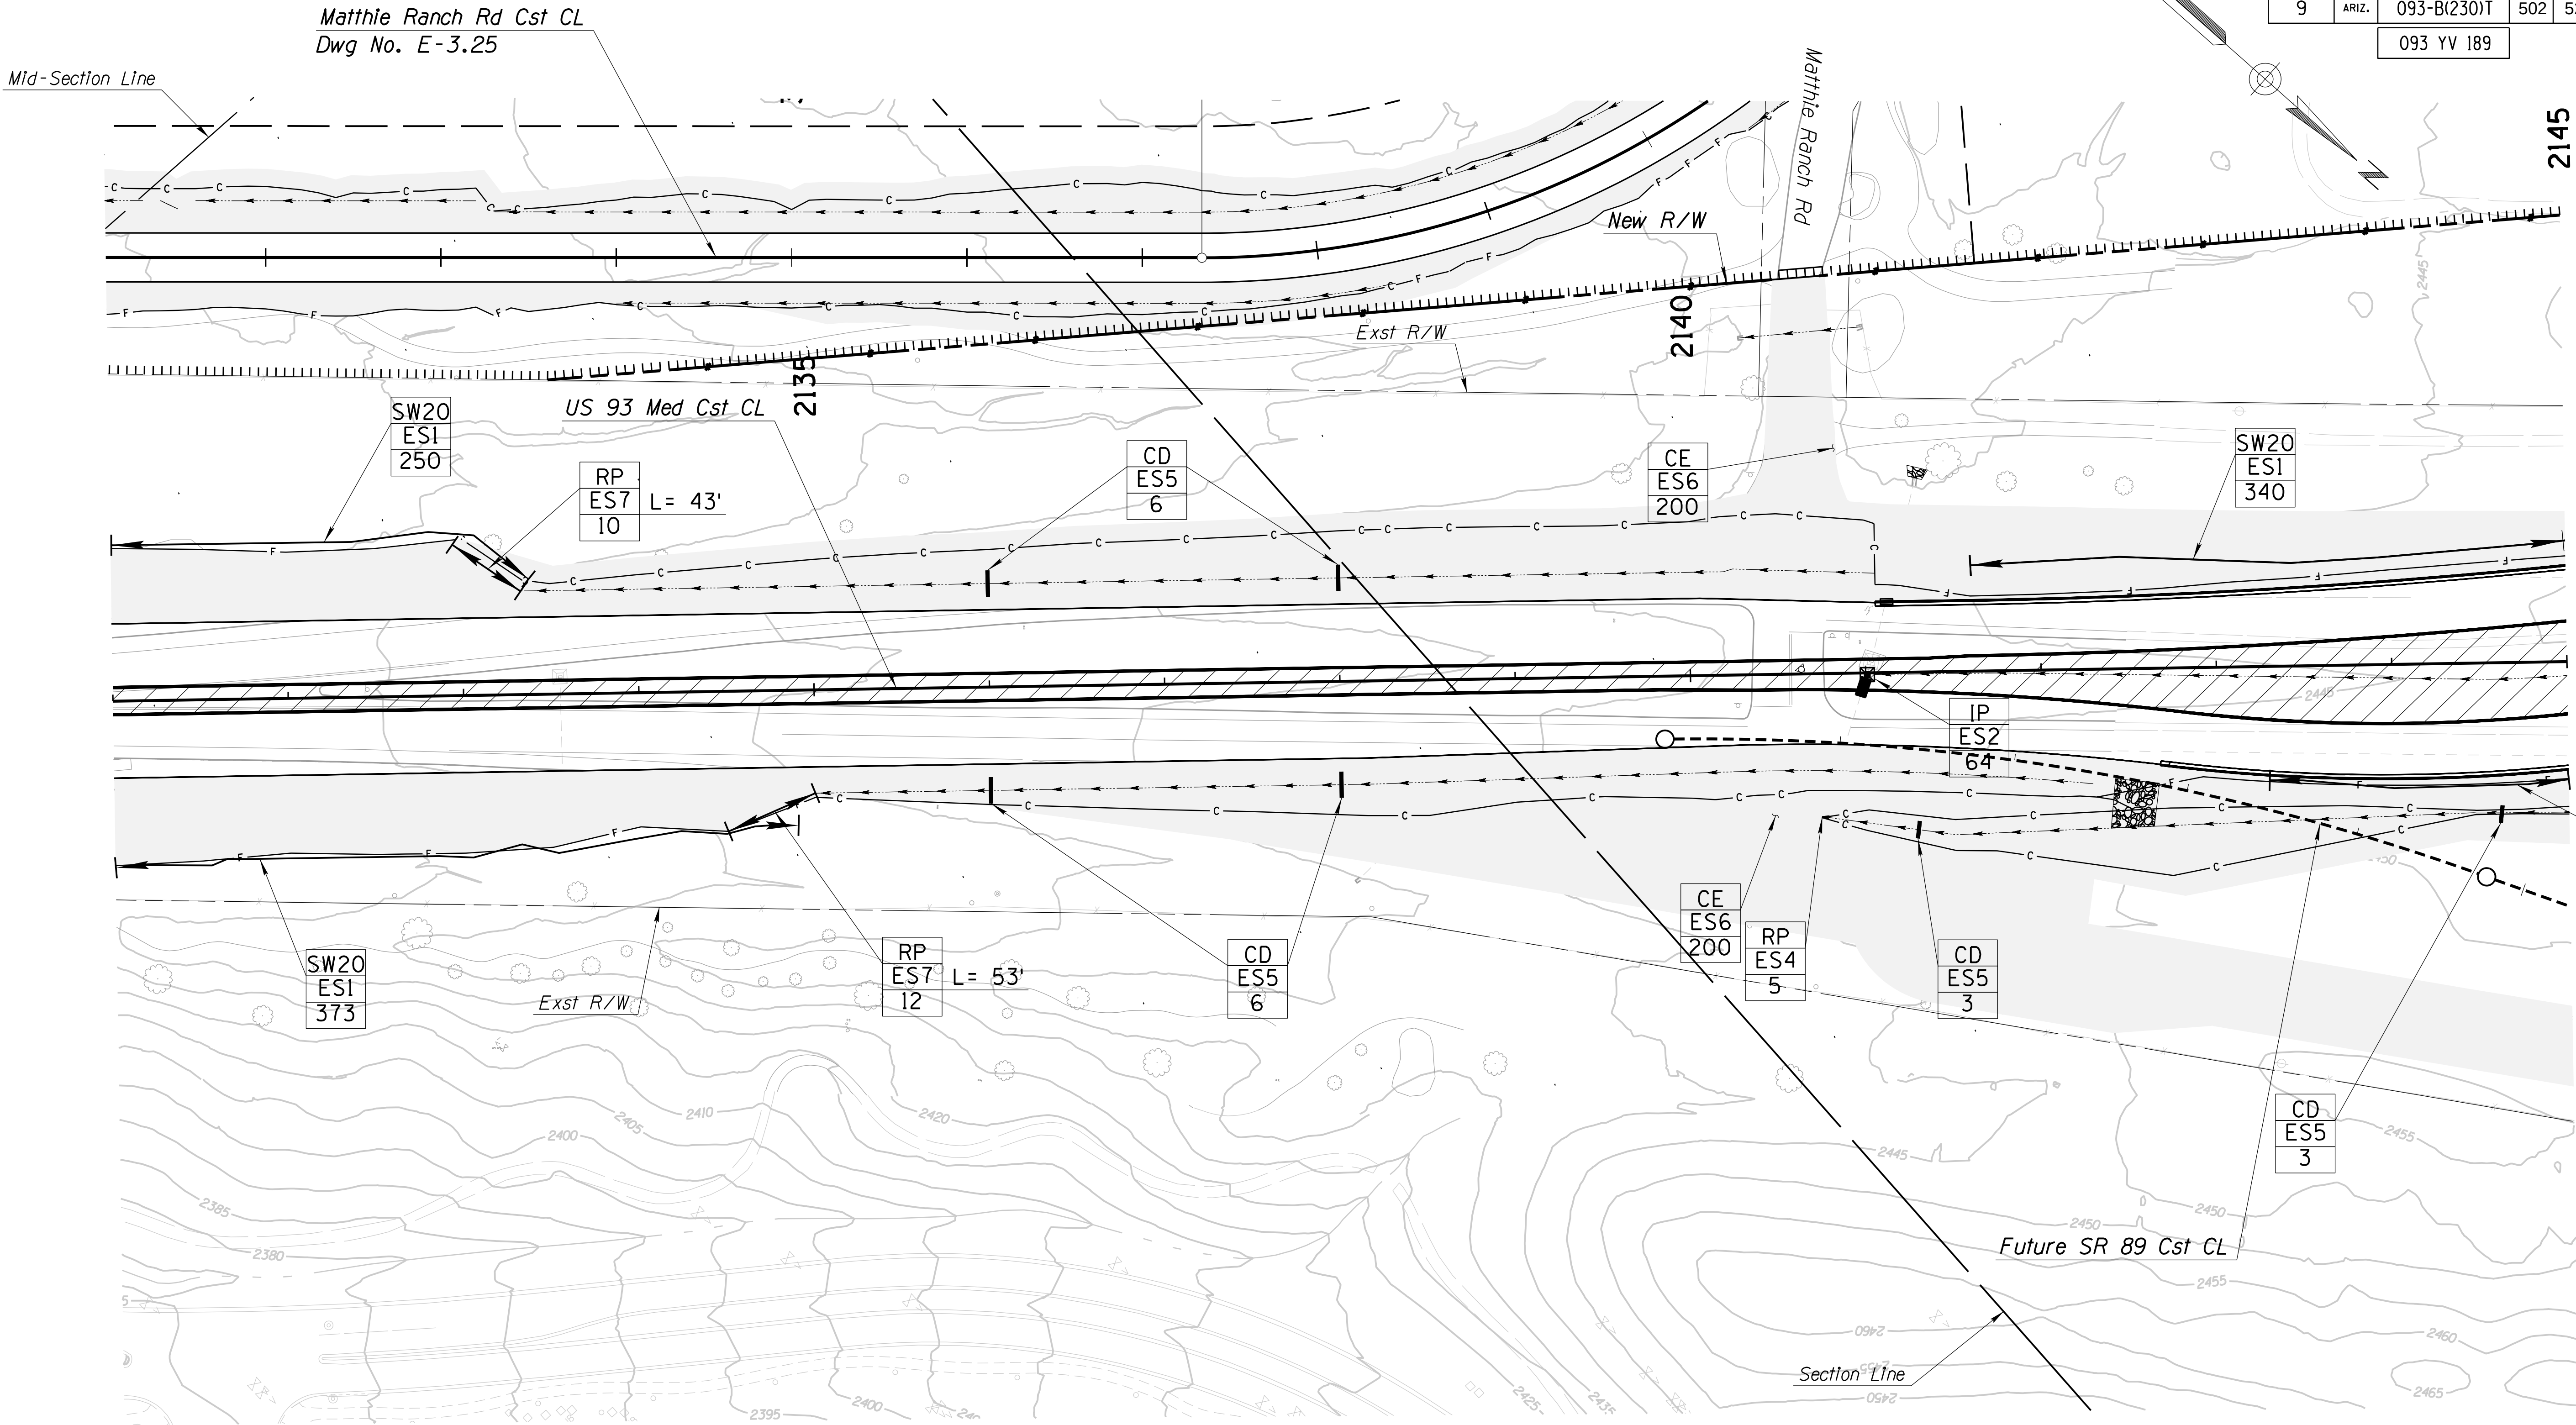

SYMBOL	DESCRIPTION	QUANTITY
	SEEDING	3.9 Ac
	GRANITE MULCH (See Note 1)	3246 Sq Yd

NOTE:


1. Granite Mulch in roundabout and median shall be placed to a thickness of 3-inches and will be measured and paid for under Item 8030092-Granite Mulch (1 1/4" Minus).

Erosion Control Method	
	SW20 = Sediment Wattles - 20"
	SW9 = Sediment Wattles - 9"
	CD = Check Dam
	RP = Rock Protection
	IP = Inlet Protection
	SL = Sediment Log
	CE = Construction Entrance
Detail Number Reference	
	Quantity

DESIGN	NAME	DATE	ARIZONA DEPARTMENT OF TRANSPORTATION PROJECT DELIVERY AND OPERATIONS DIVISION ROADSIDE DEVELOPMENT SECTION US 93/SR 89 EROSION CONTROL PLAN STA 2131+00 TO STA 2145+00	
DRAWN	JML	06-26		
CHECKED	JPM	06-26		
 3133 East Camelback Road, Suite 100 Phoenix, Arizona 85016 Phone: (602) 333-2200			ROUTE US 93	LOCATION WICKENBURG RANCH WAY TO VISTA ROYALE
TRACS NO. F0738 OIC			093-B(230)T	
			DWG NO. E-3.03	
			OF	

F.H.W.A. REGION	STATE	PROJECT NO.	SHEET NO.	TOTAL SHEETS	RECORD DRAWING
9	ARIZ.	093-B(230)T	503	524	

093 YV 189

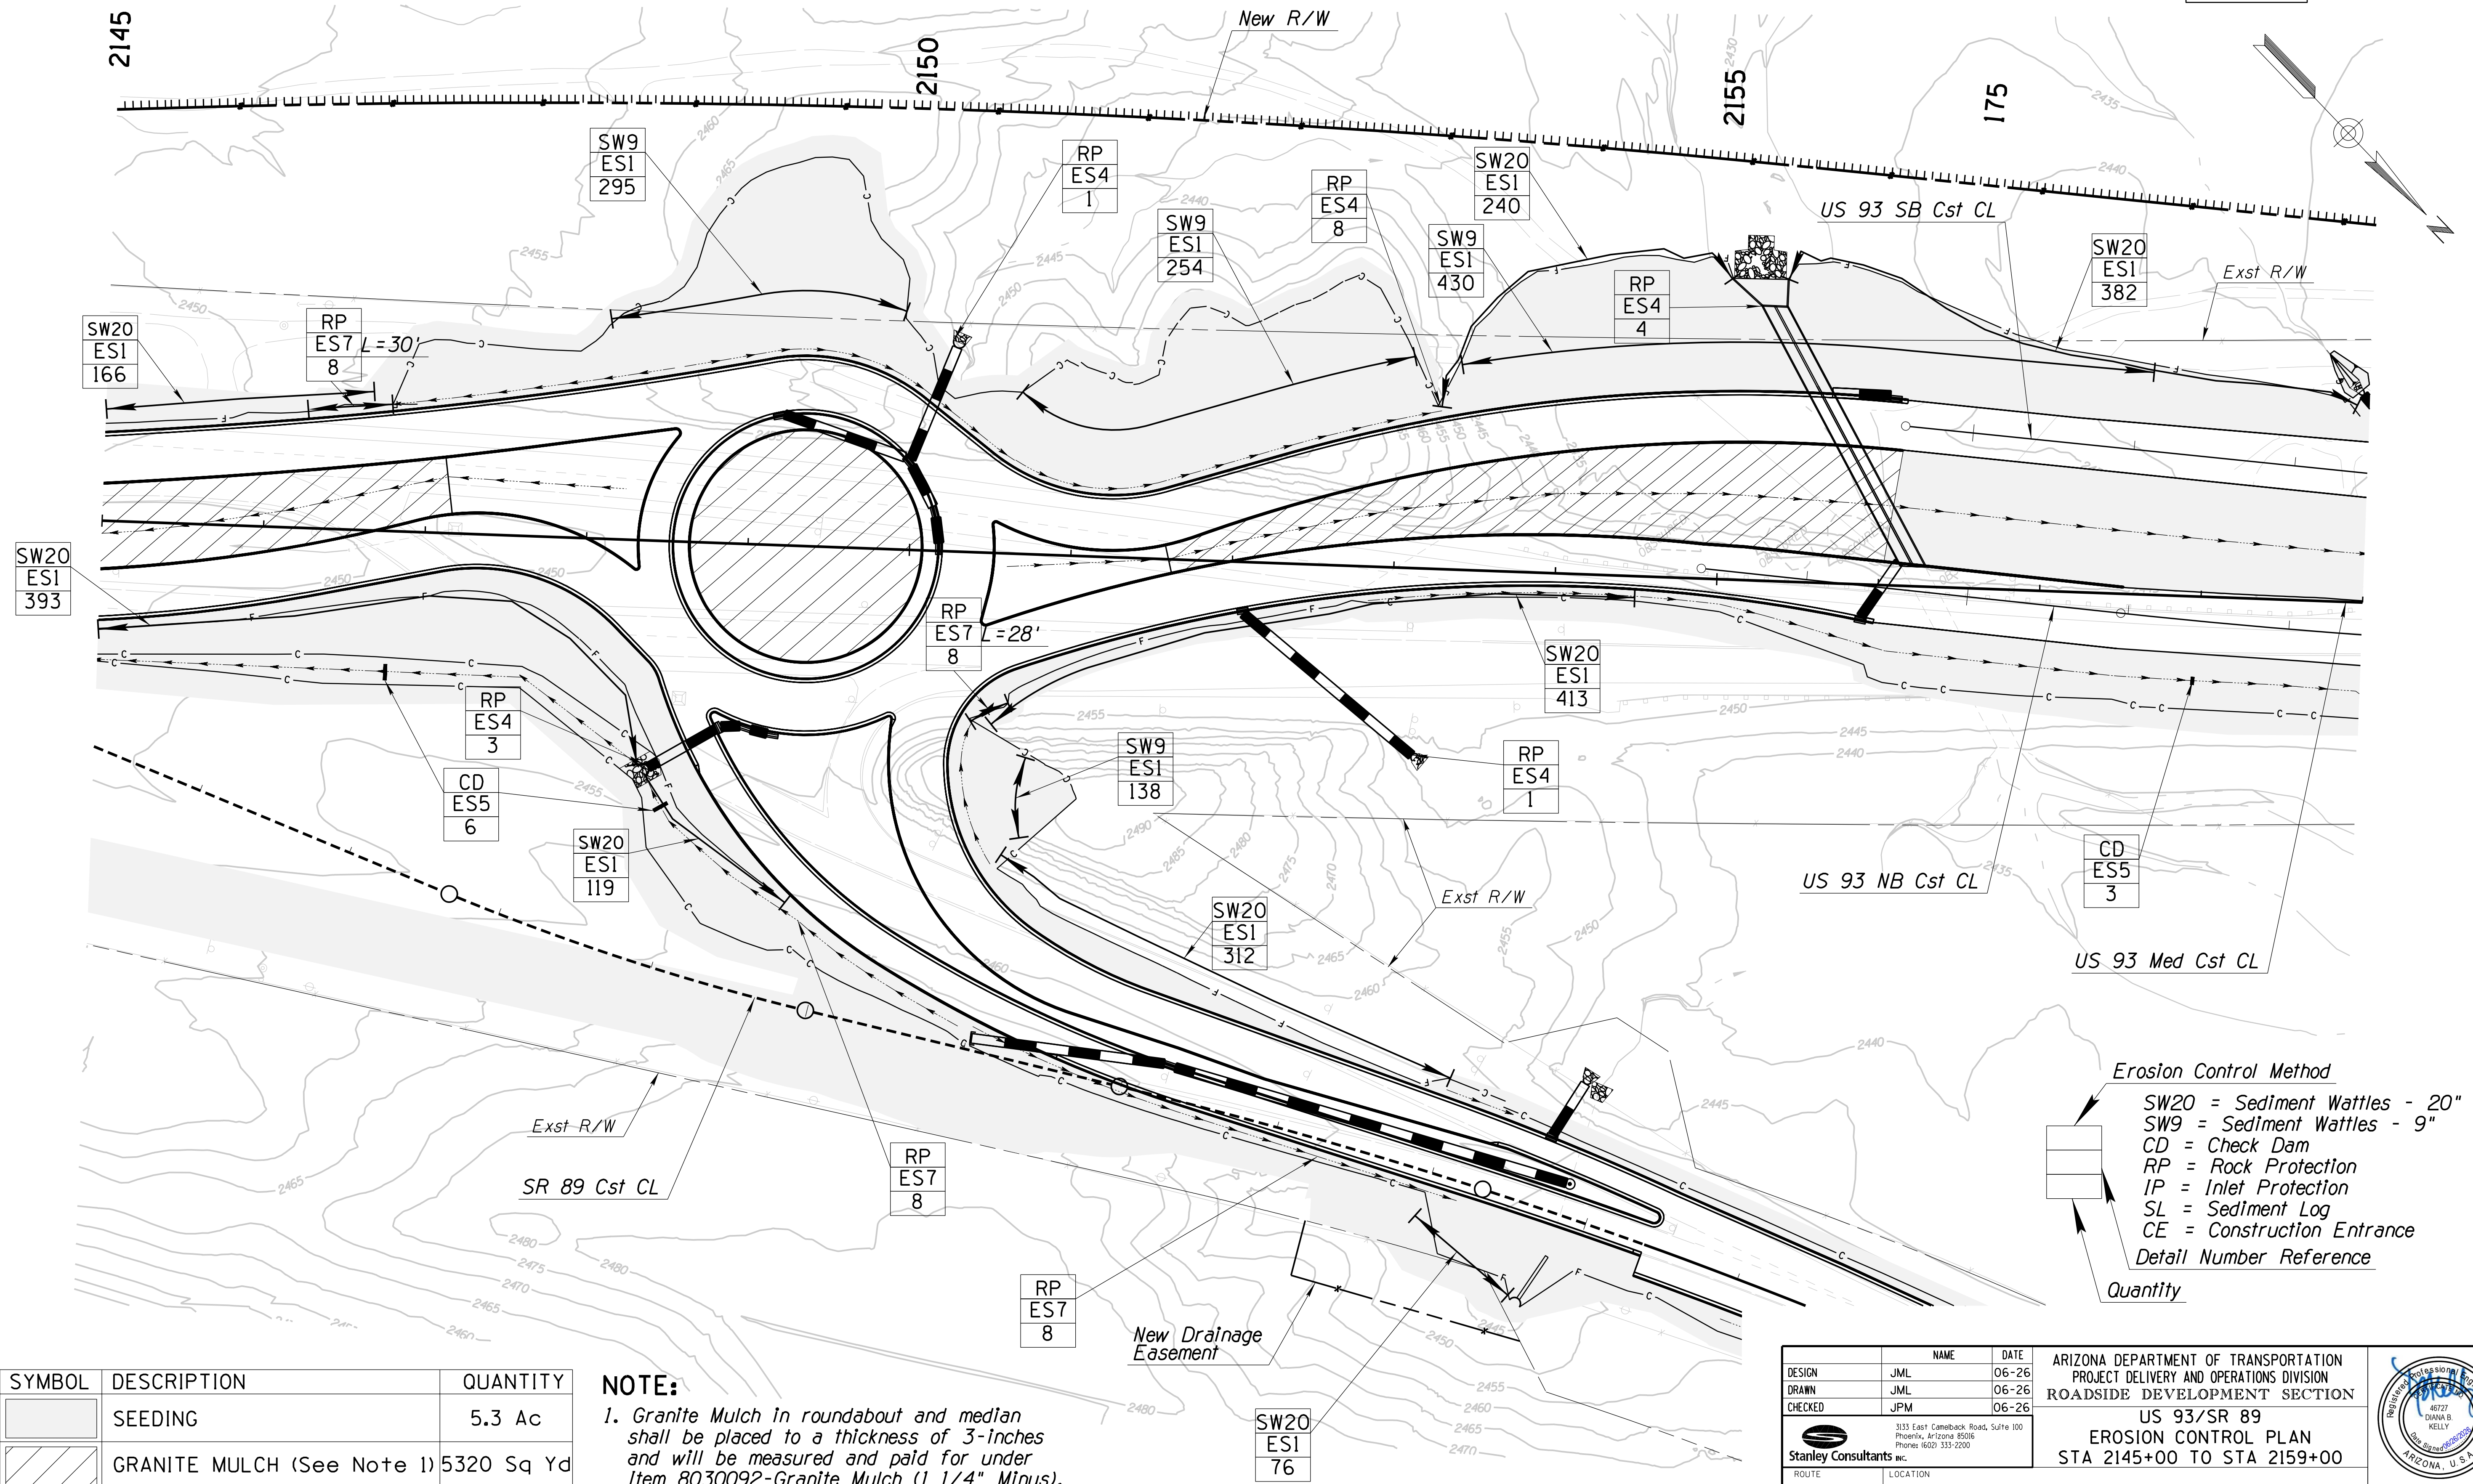

- Erosion Control Method**
- SW20 = Sediment Wattles - 20"
 - SW9 = Sediment Wattles - 9"
 - CD = Check Dam
 - RP = Rock Protection
 - IP = Inlet Protection
 - SL = Sediment Log
 - CE = Construction Entrance
- Quantity**

SYMBOL	DESCRIPTION	QUANTITY
	SEEDING	5.3 Ac
	GRANITE MULCH (See Note 1)	5320 Sq Yd

NOTE:

1. Granite Mulch in roundabout and median shall be placed to a thickness of 3-inches and will be measured and paid for under Item 8030092-Granite Mulch (1 1/4" Minus).

DESIGN	JML	DATE	06-26
DRAWN	JML	DATE	06-26
CHECKED	JPM	DATE	06-26

3133 East Camelback Road, Suite 100
Phoenix, Arizona 85016
Phone: (602) 333-2200

Stanley Consultants inc.

ROUTE: US 93 LOCATION: WICKENBURG RANCH WAY TO VISTA ROYALE


ARIZONA DEPARTMENT OF TRANSPORTATION
PROJECT DELIVERY AND OPERATIONS DIVISION
ROADSIDE DEVELOPMENT SECTION

US 93/SR 89
EROSION CONTROL PLAN
STA 2145+00 TO STA 2159+00

DWG NO. E-3.04

093-B(230)T

OF

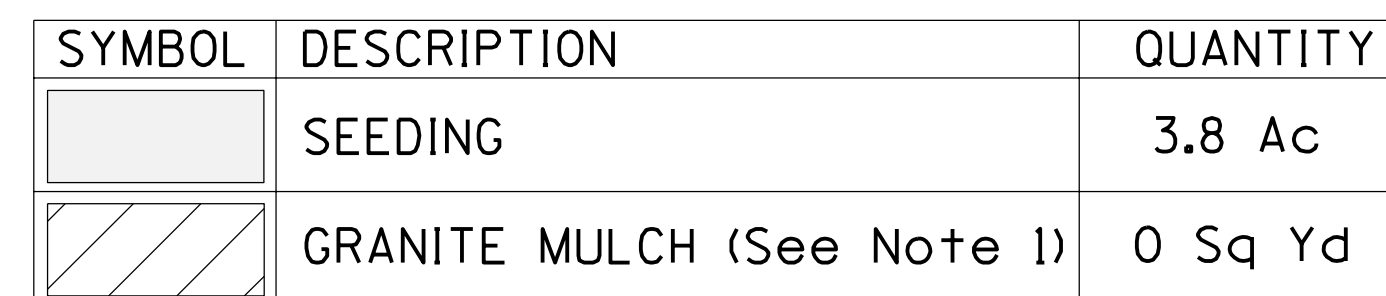
093 YV 189

1. Granite Mulch in roundabout and median shall be placed to a thickness of 3-inches and will be measured and paid for under Item 8030092-Granite Mulch (1 1/4" Minus).

CD = Check Dam
RP = Rock Protection
IP = Inlet Protection
SL = Sediment Log
CE = Construction Entrance
Detail Number Reference


*Quantity of sediment log (Lin Ft).

		NAME	DATE	ARIZONA DEPARTMENT OF TRANSPORTATION PROJECT DELIVERY AND OPERATIONS DIVISION ROADSIDE DEVELOPMENT SECTION US 93/SR 89 EROSION CONTROL PLAN STA 2159+00 TO STA 2173+50		
DESIGN	JML	06-26				
DRAWN	JML	06-26				
CHECKED	JPM	06-26				
		3133 East Camelback Road, Suite 100 Phoenix, Arizona 85016 Phone: (602) 333-2200 Stanley Consultants inc.				
ROUTE		LOCATION				
US 93		WICKENBURG RANCH WAY TO VISTA ROYALE				DWG NO. E-3.05
TRACS NO. F0738 OIC				093-B(230)T		___ OF ___

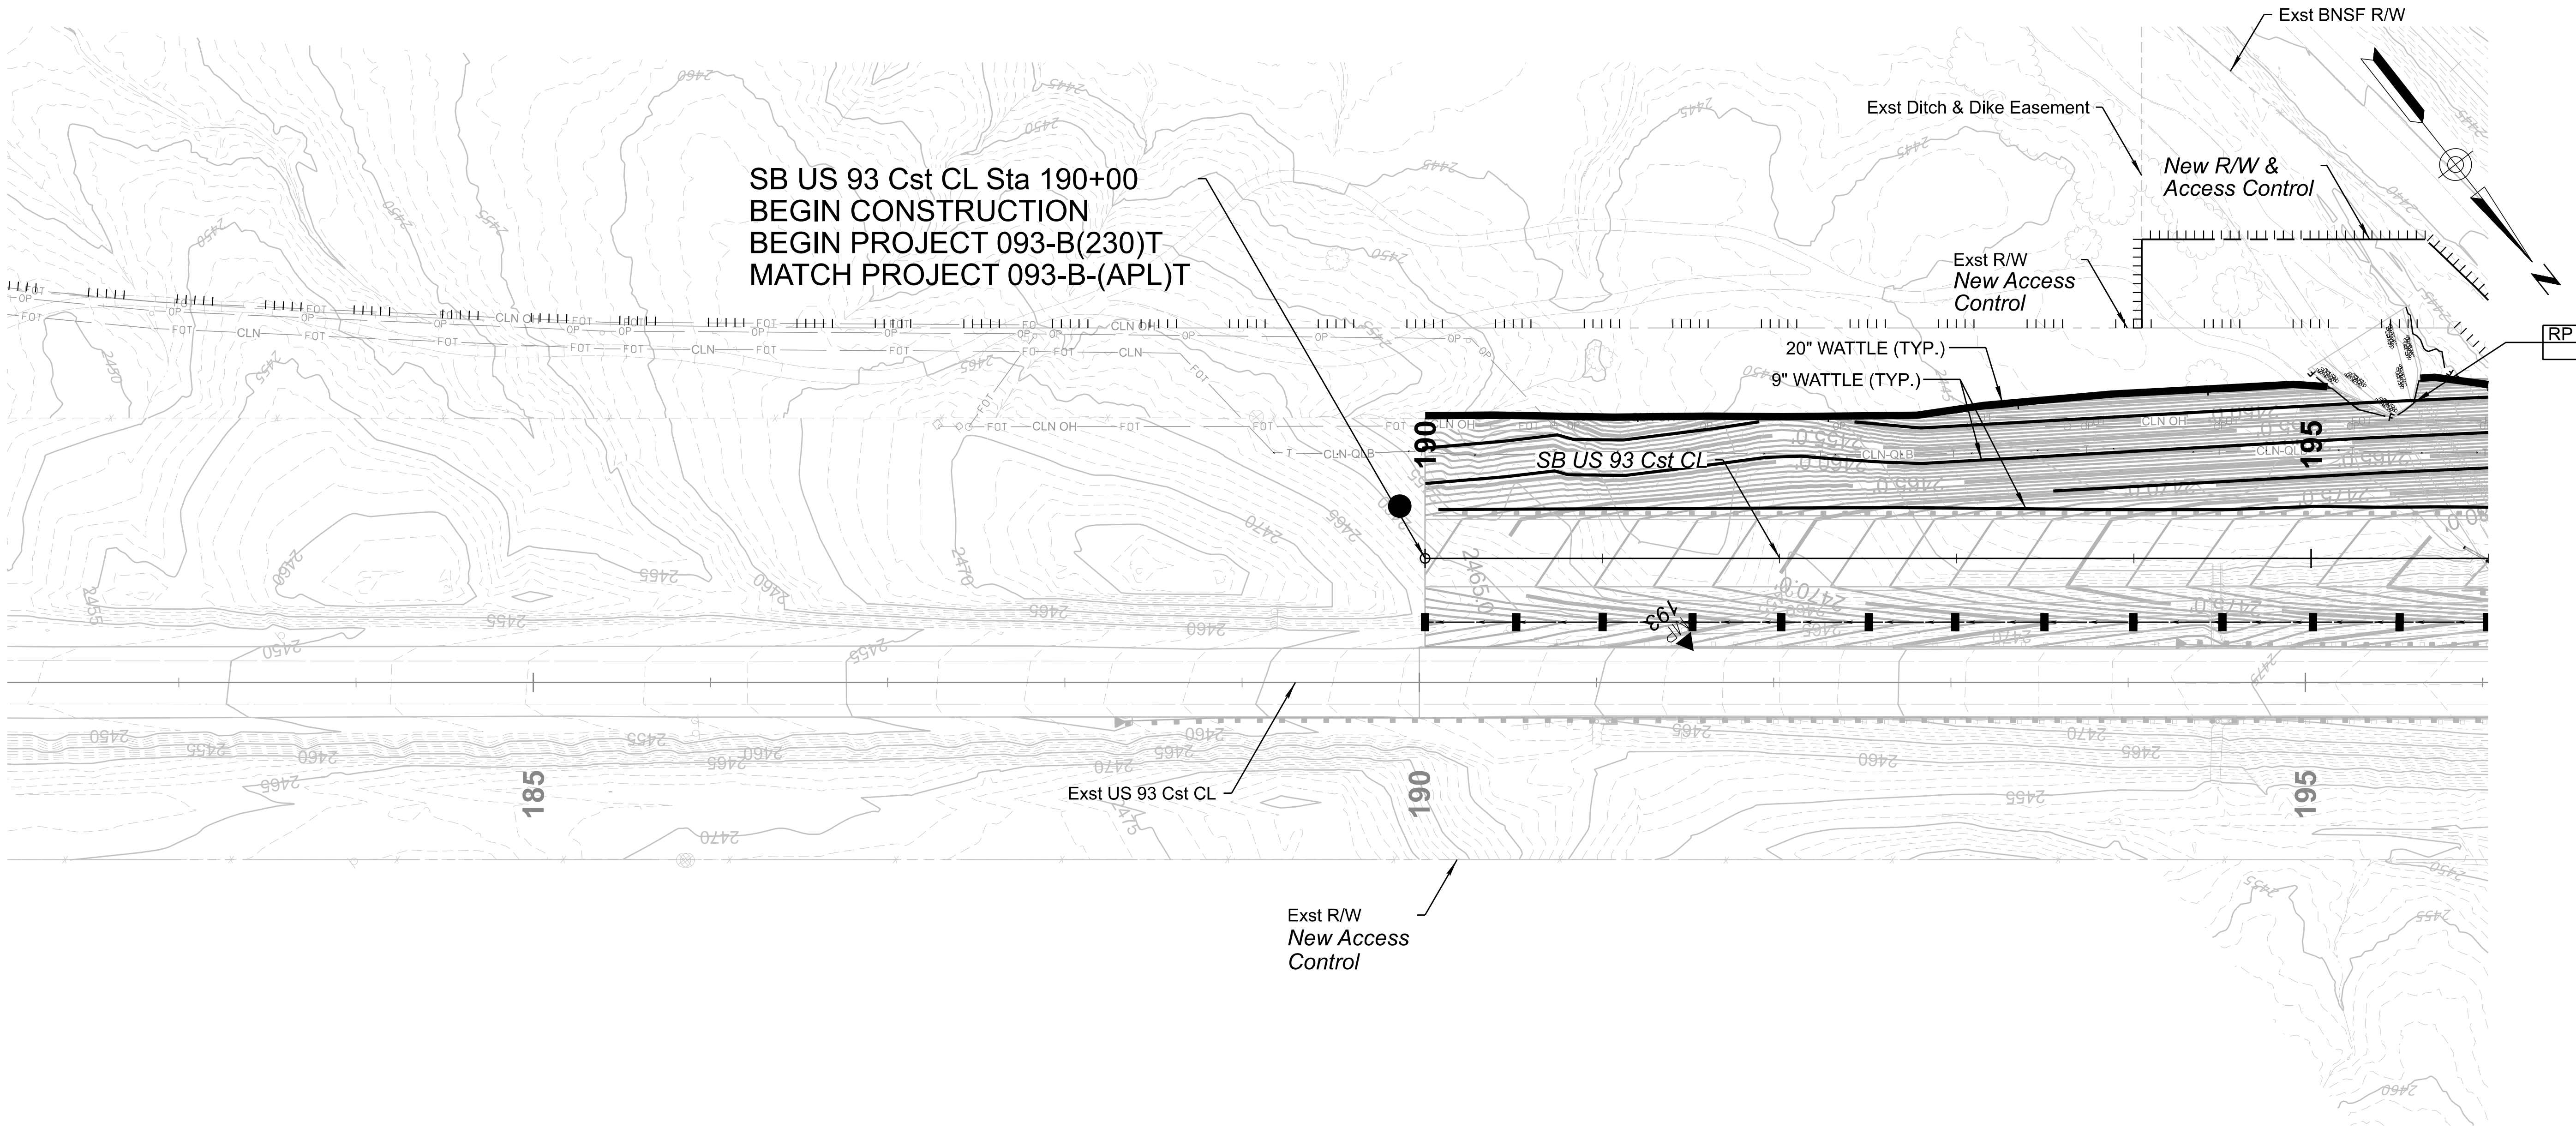


LEGEND

SYMBOL	DESCRIPTION
	9" WATTLE - SEE SHEET E-1.02, DETAIL 1
	20" WATTLE - SEE SHEET E-1.02, DETAIL 1
	INLET PROTECTION - SEE SHEET E-1.04, DETAIL 3
	ROCK PROTECTION - SEE SHEET E-1.05, DETAIL 4
	ROCK CHECK DAM - SEE SHEET E-1.06, DETAIL 5
	STABILIZED CONSTRUCTION ENTRANCE - SEE SHEET E-1.07, DETAIL 7

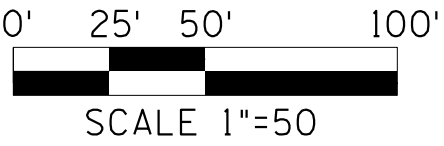

SCALE 1"=50'

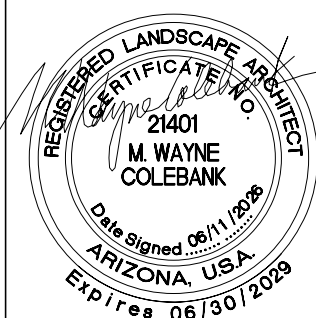


	NAME	DATE
DESIGN	W HERRERA	06/26
DRAWN	STAFF	06/26
CHECKED	W COLEBANK	06/26

ARIZONA DEPARTMENT OF TRANSPORTATION
PROJECT DELIVERY AND OPERATIONS DIVISION
ROADWAY DESIGN SERVICES



EROSION CONTROL SHEET
SB US 93 STA 190+00 TO STA 196+00

ROUTE	US 93
MILEPOST	189.92
STRUCTURE NO.	

F.H.W.A. Arizona Division	STATE	ARIZ.	PROJECT NO.	093 YV 189	FEDERAL ID NO.	093-B(230)T	SHEET NO.	505	TOTAL SHEETS	524	RECORD DRAWING
LOCATION										DWG No. E-3.06	
TRACS NO. F0738 01C										___ OF ___	

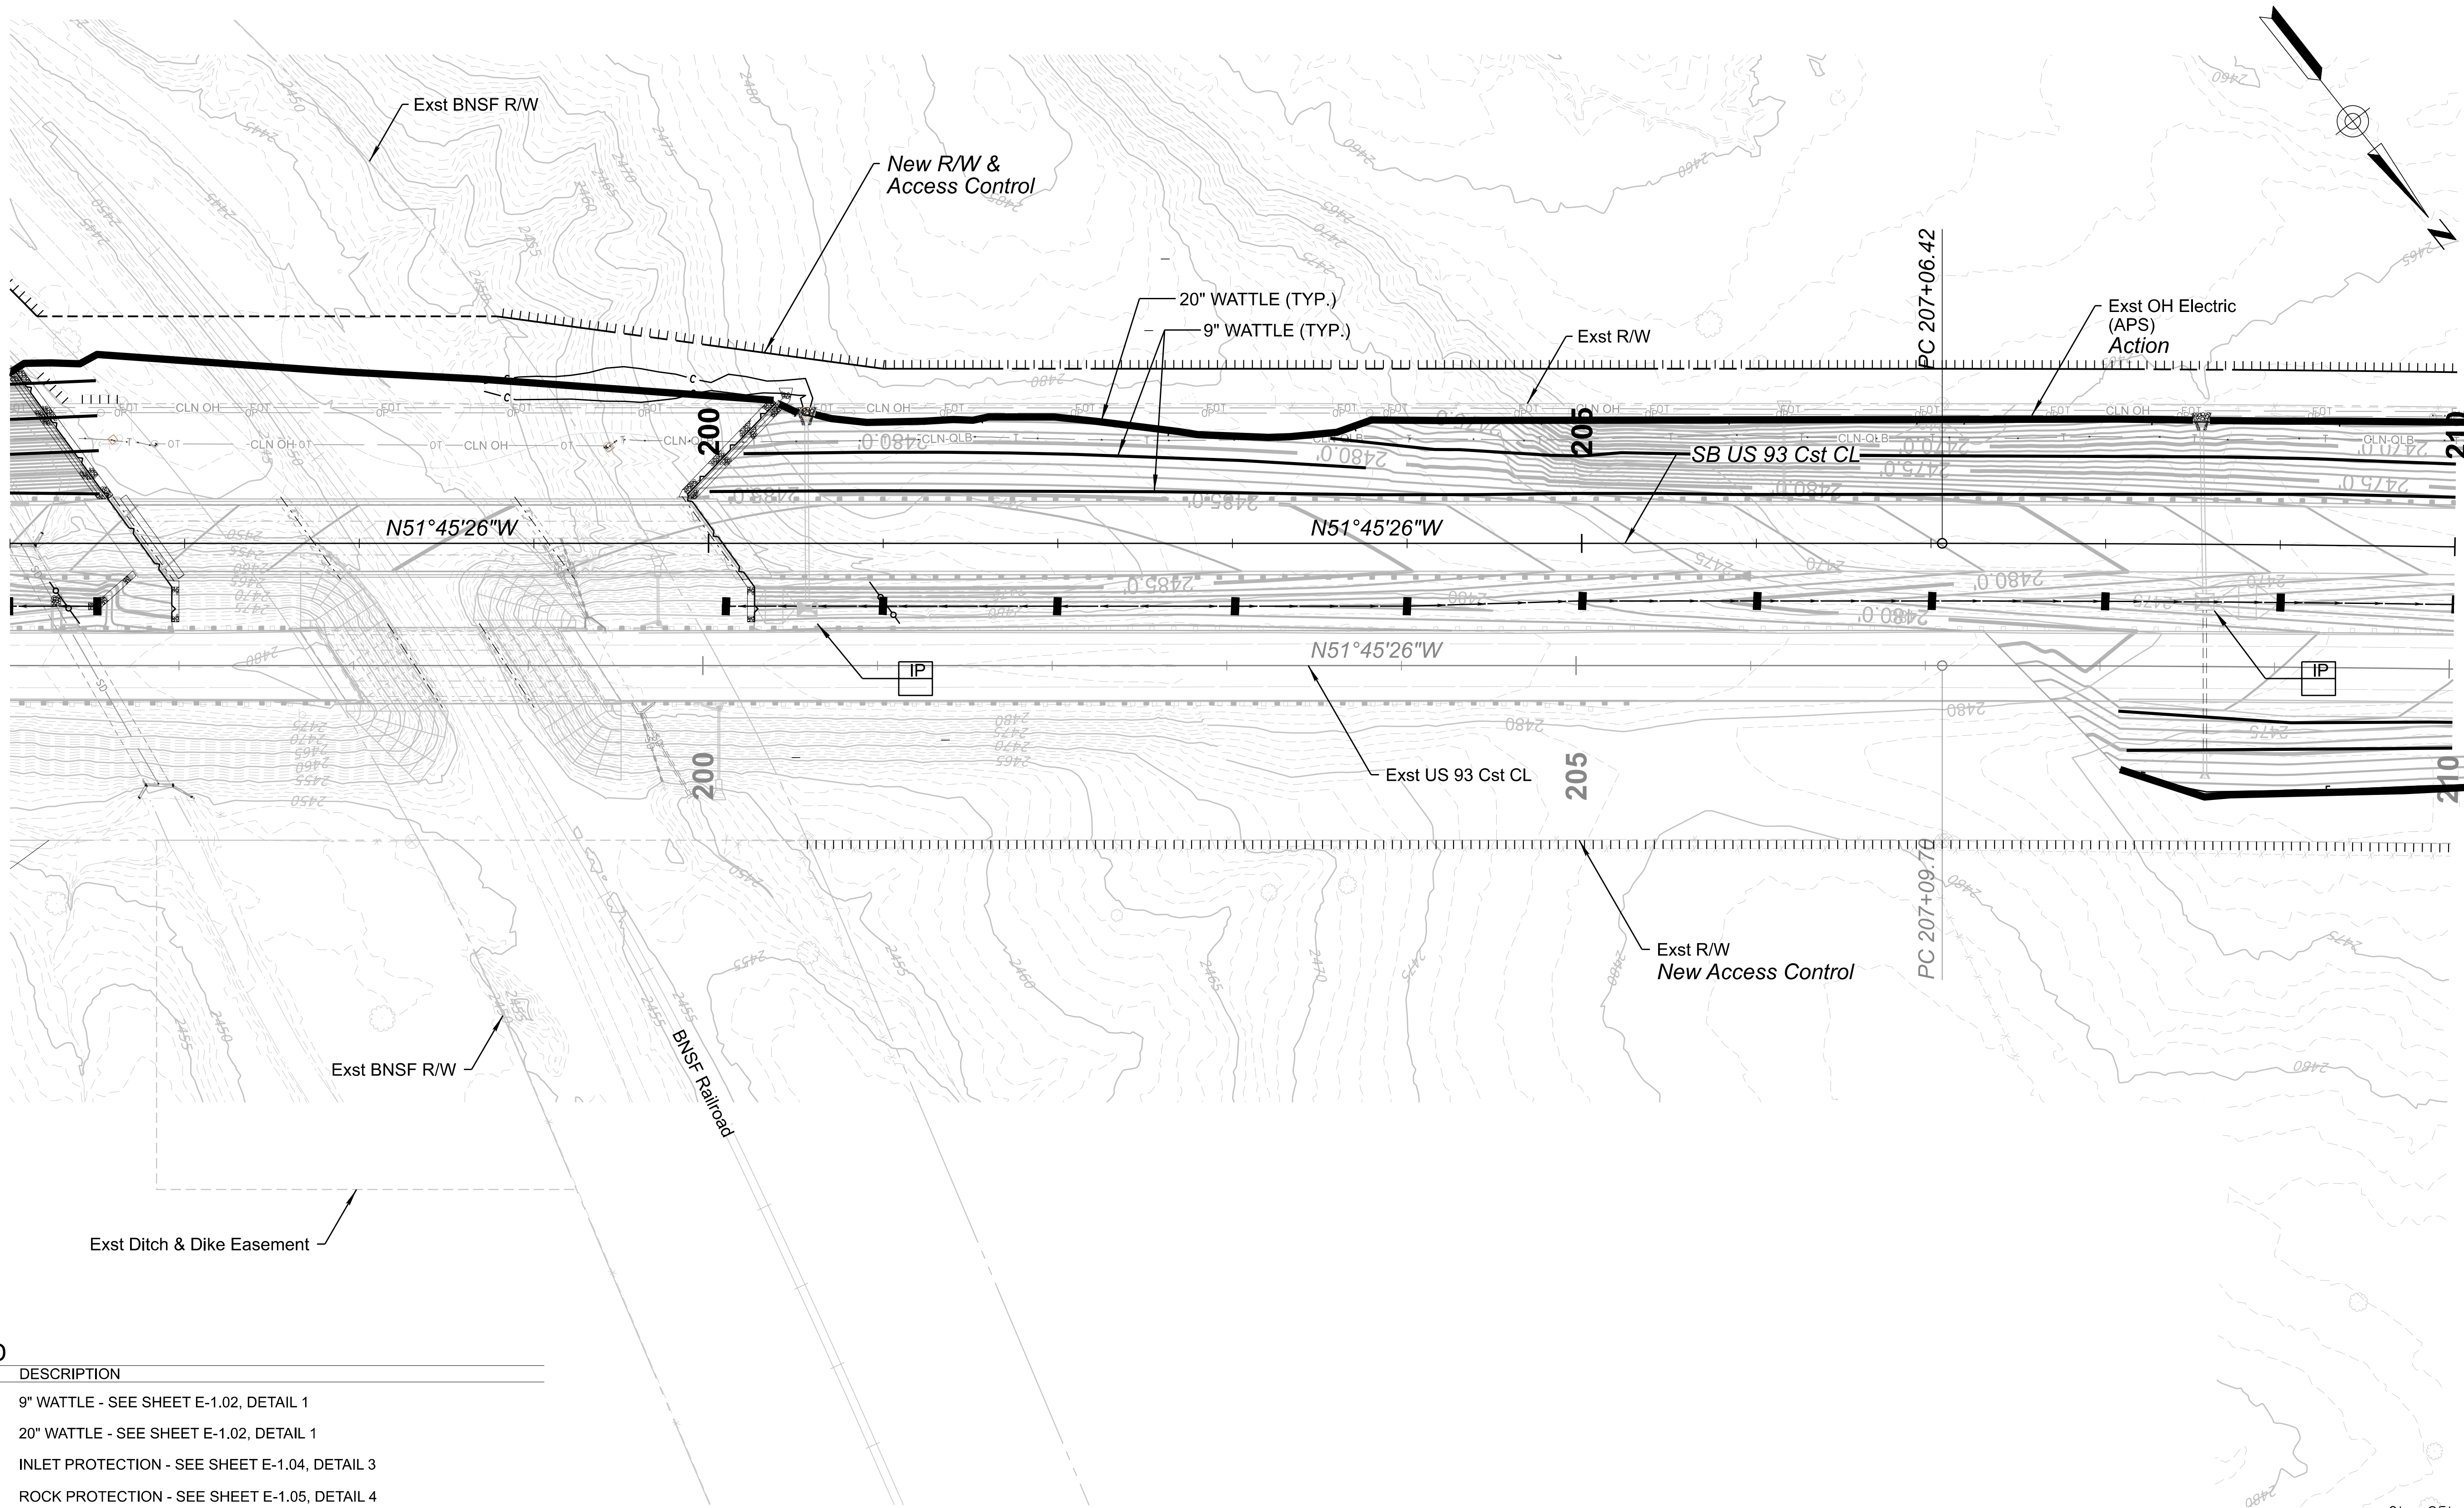


LEGEND	
SYMBOL	DESCRIPTION
	9" WATTLE - SEE SHEET E-1.02, DETAIL 1
	20" WATTLE - SEE SHEET E-1.02, DETAIL 1
	INLET PROTECTION - SEE SHEET E-1.04, DETAIL 3
	ROCK PROTECTION - SEE SHEET E-1.05, DETAIL 4
	ROCK CHECK DAM - SEE SHEET E-1.06, DETAIL 5
	STABILIZED CONSTRUCTION ENTRANCE - SEE SHEET E-1.07, DETAIL 7

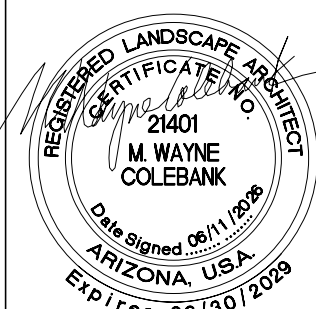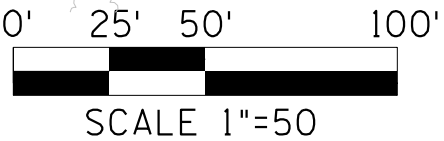


	NAME	DATE
DESIGN	W HERRERA	06/26
DRAWN	STAFF	06/26
CHECKED	W COLEBANK	06/26



ARIZONA DEPARTMENT OF TRANSPORTATION PROJECT DELIVERY AND OPERATIONS DIVISION ROADWAY DESIGN SERVICES	
EROSION CONTROL SHEET SB US 93 STA 196+00 TO STA 210+00	

ROUTE US 93	F.H.W.A. Arizona Division	STATE ARIZ.	PROJECT NO. 093 YV 189	FEDERAL ID NO. 093-B(230)T	SHEET NO. 506	TOTAL SHEETS 524	RECORD DRAWING
MILEPOST 189.92		LOCATION WICKENBURG RANCH WAY TO VISTA ROYALE					
STRUCTURE NO.	TRACS NO. F0738 01C						___ OF ___

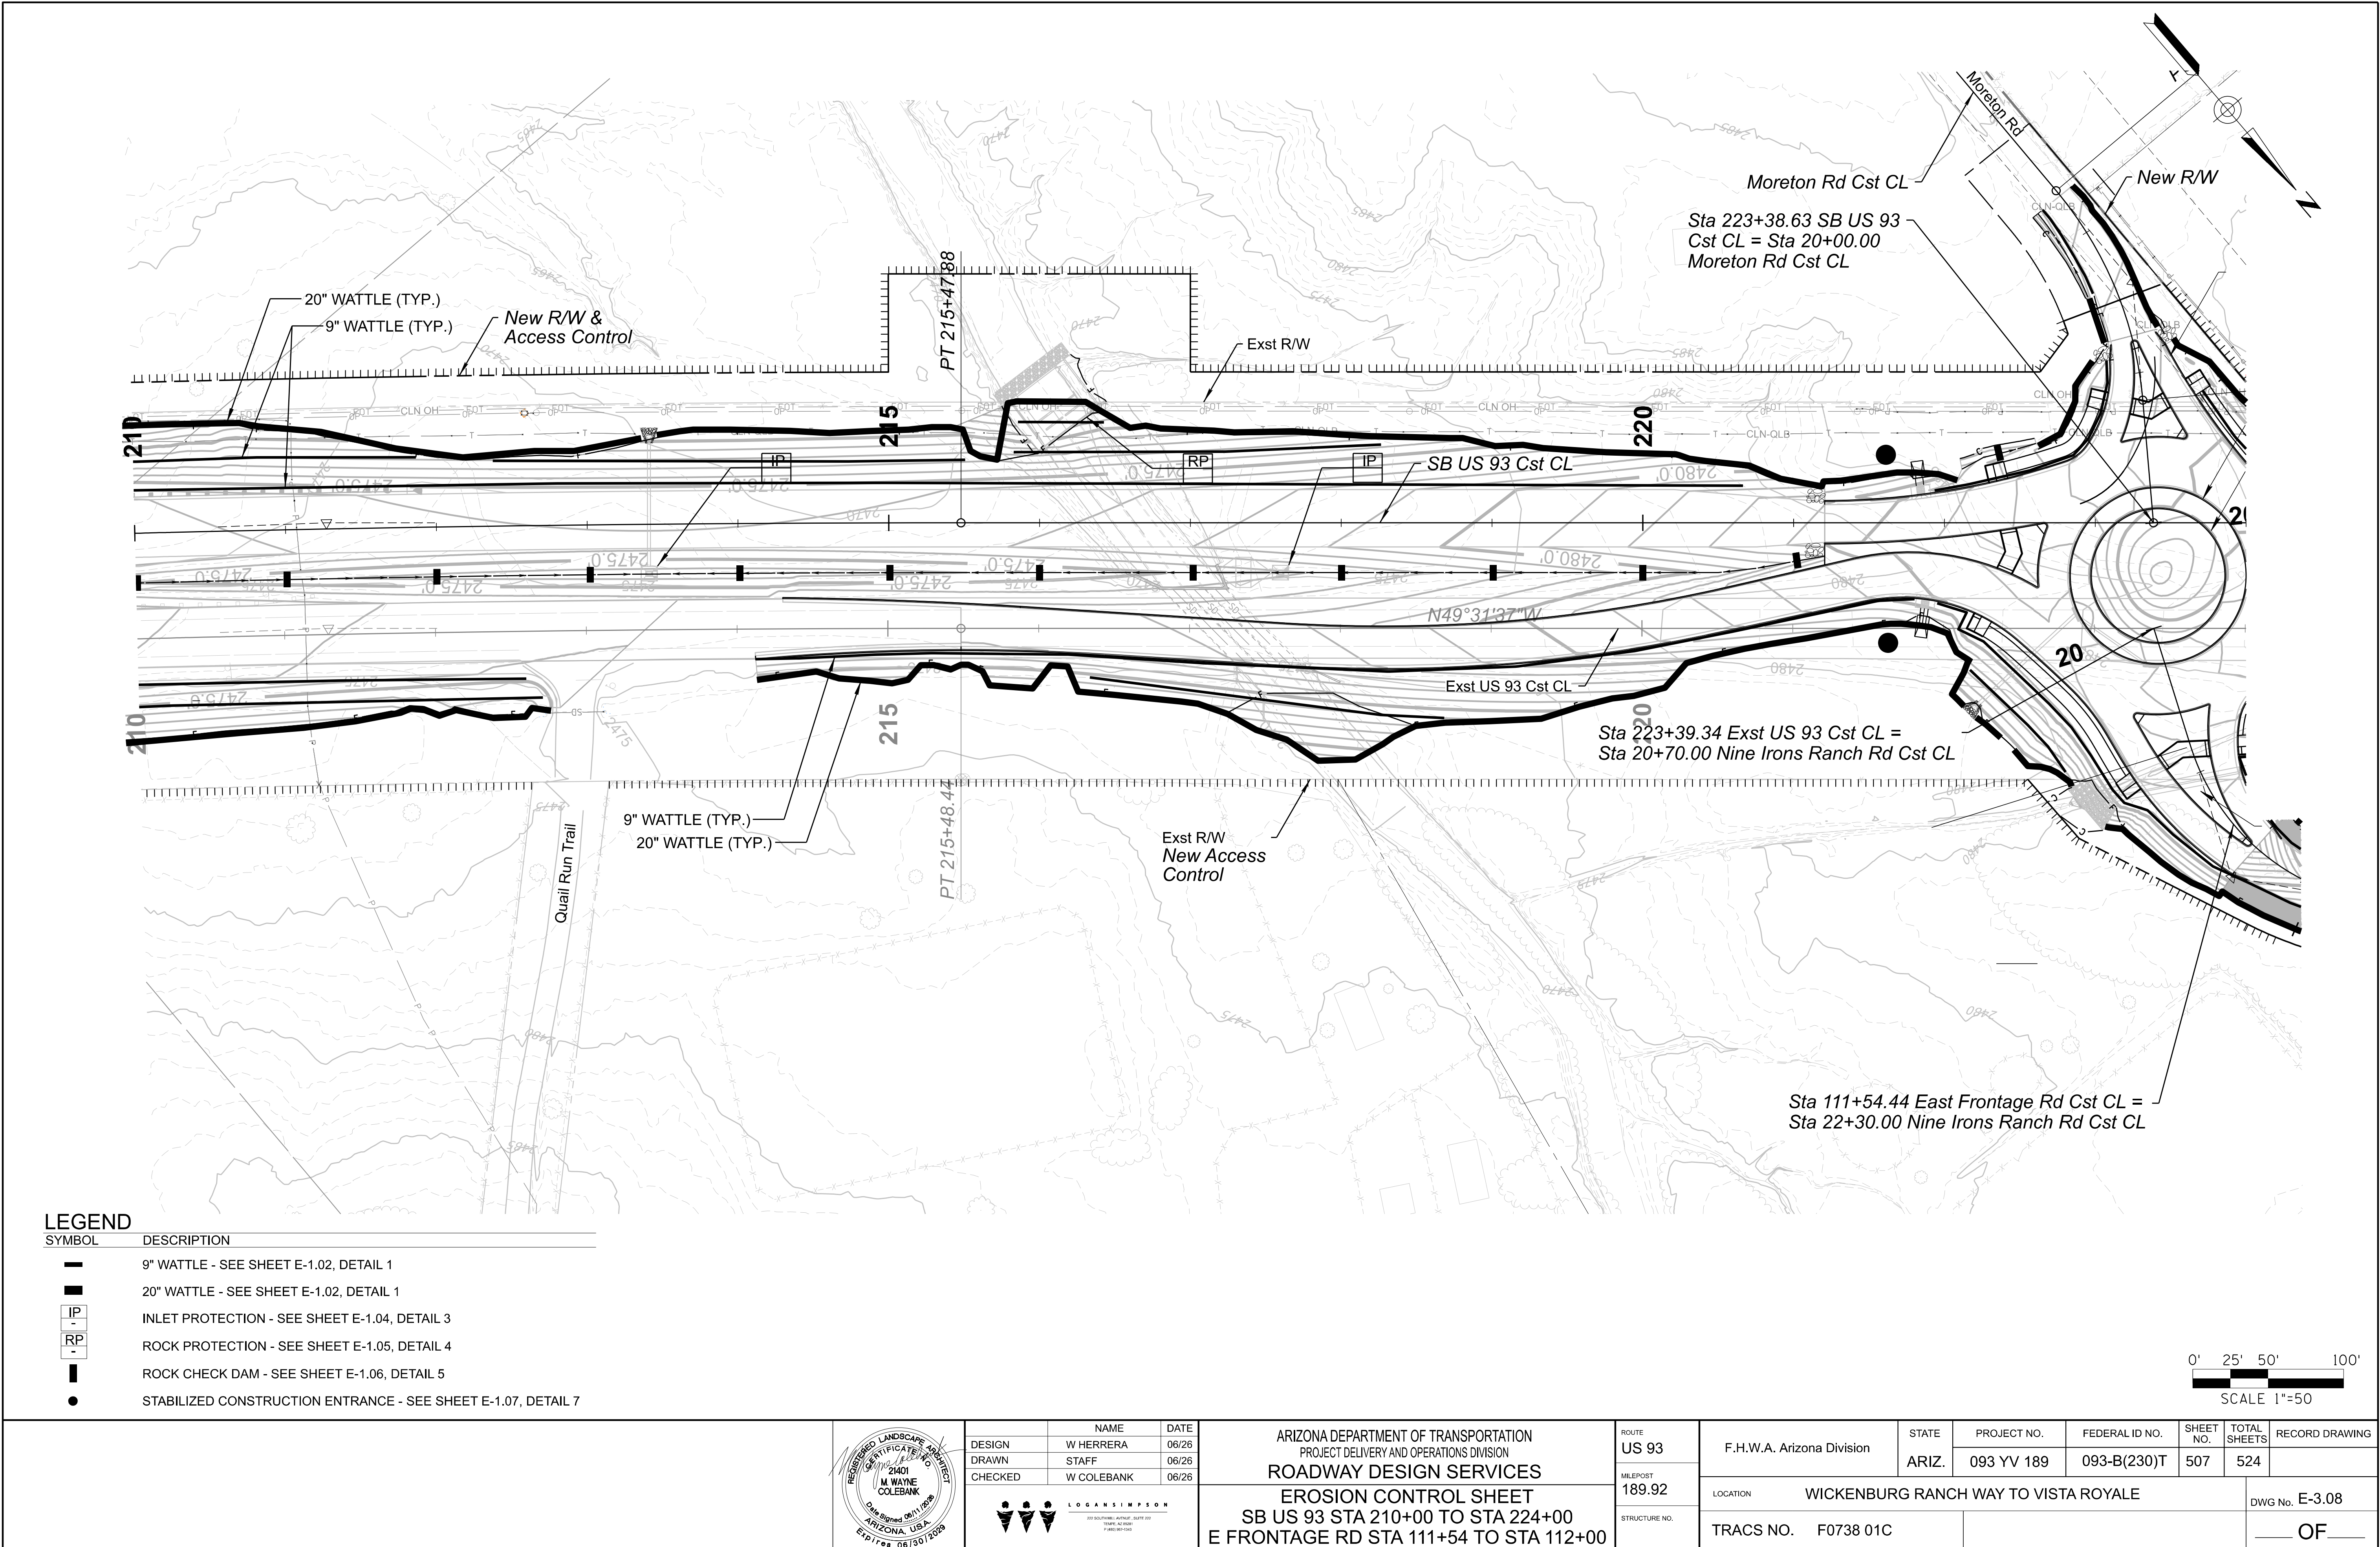

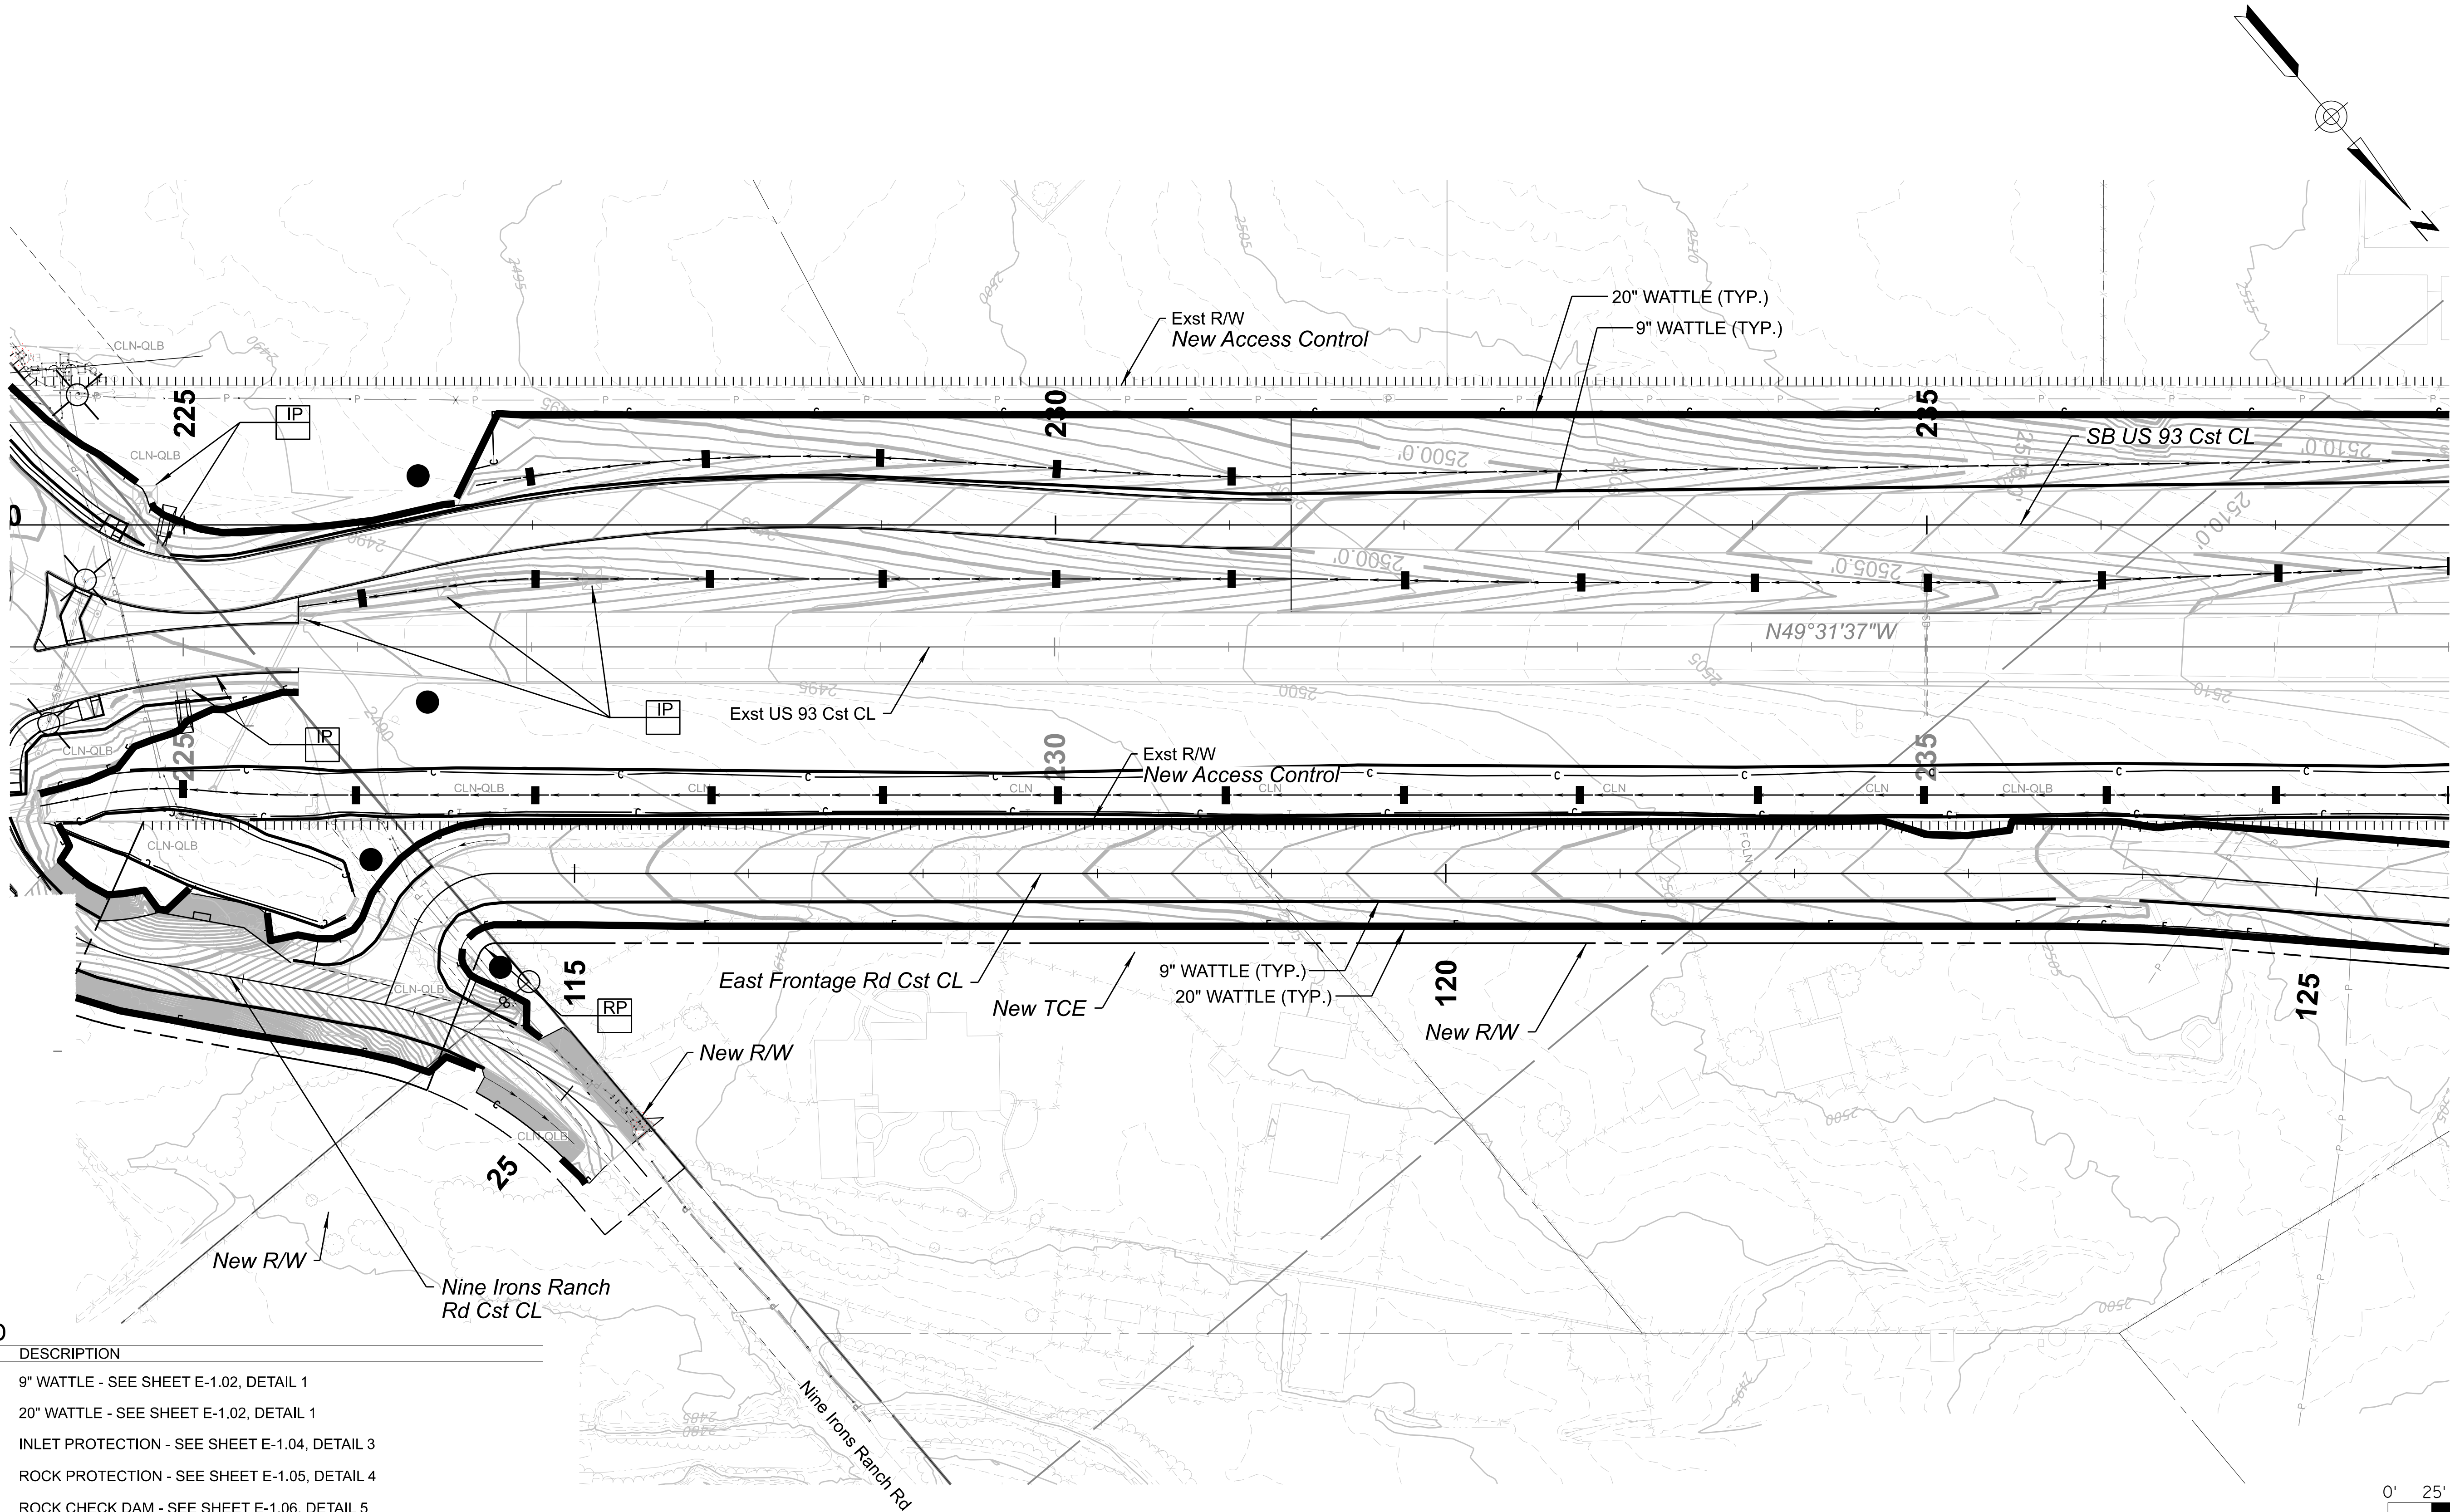

LEGEND	
SYMBOL	DESCRIPTION
	9" WATTLE - SEE SHEET E-1.02, DETAIL 1
	20" WATTLE - SEE SHEET E-1.02, DETAIL 1
	INLET PROTECTION - SEE SHEET E-1.04, DETAIL 3
	ROCK PROTECTION - SEE SHEET E-1.05, DETAIL 4
	ROCK CHECK DAM - SEE SHEET E-1.06, DETAIL 5
	STABILIZED CONSTRUCTION ENTRANCE - SEE SHEET E-1.07, DETAIL 7

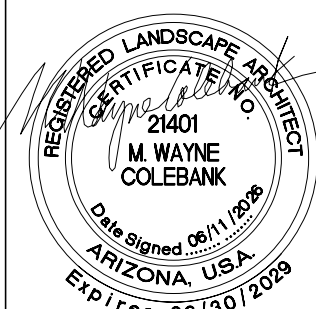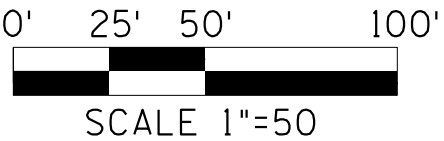


	NAME	DATE
DESIGN	W HERRERA	06/26
DRAWN	STAFF	06/26
CHECKED	W COLEBANK	06/26

LOGANSIMPSON
222 SOUTH HAVEN AVENUE, SUITE 202
TAMPA, FL 33601
P: (813) 987-1543



ARIZONA DEPARTMENT OF TRANSPORTATION
PROJECT DELIVERY AND OPERATIONS DIVISION
ROADWAY DESIGN SERVICES
EROSION CONTROL SHEET
SB US 93 STA 224+00 TO STA 238+00
E FRONTAGE RD STA 112+00 TO STA 126+00

ROUTE	US 93
MILEPOST	189.92
STRUCTURE NO.	

F.H.W.A. Arizona Division	STATE	PROJECT NO.	FEDERAL ID NO.	SHEET NO.	TOTAL SHEETS	RECORD DRAWING
	ARIZ.	093 YV 189	093-B(230)T	508	524	
LOCATION WICKENBURG RANCH WAY TO VISTA ROYALE						DWG No. E-3.09
TRACS NO. F0738 01C						OF

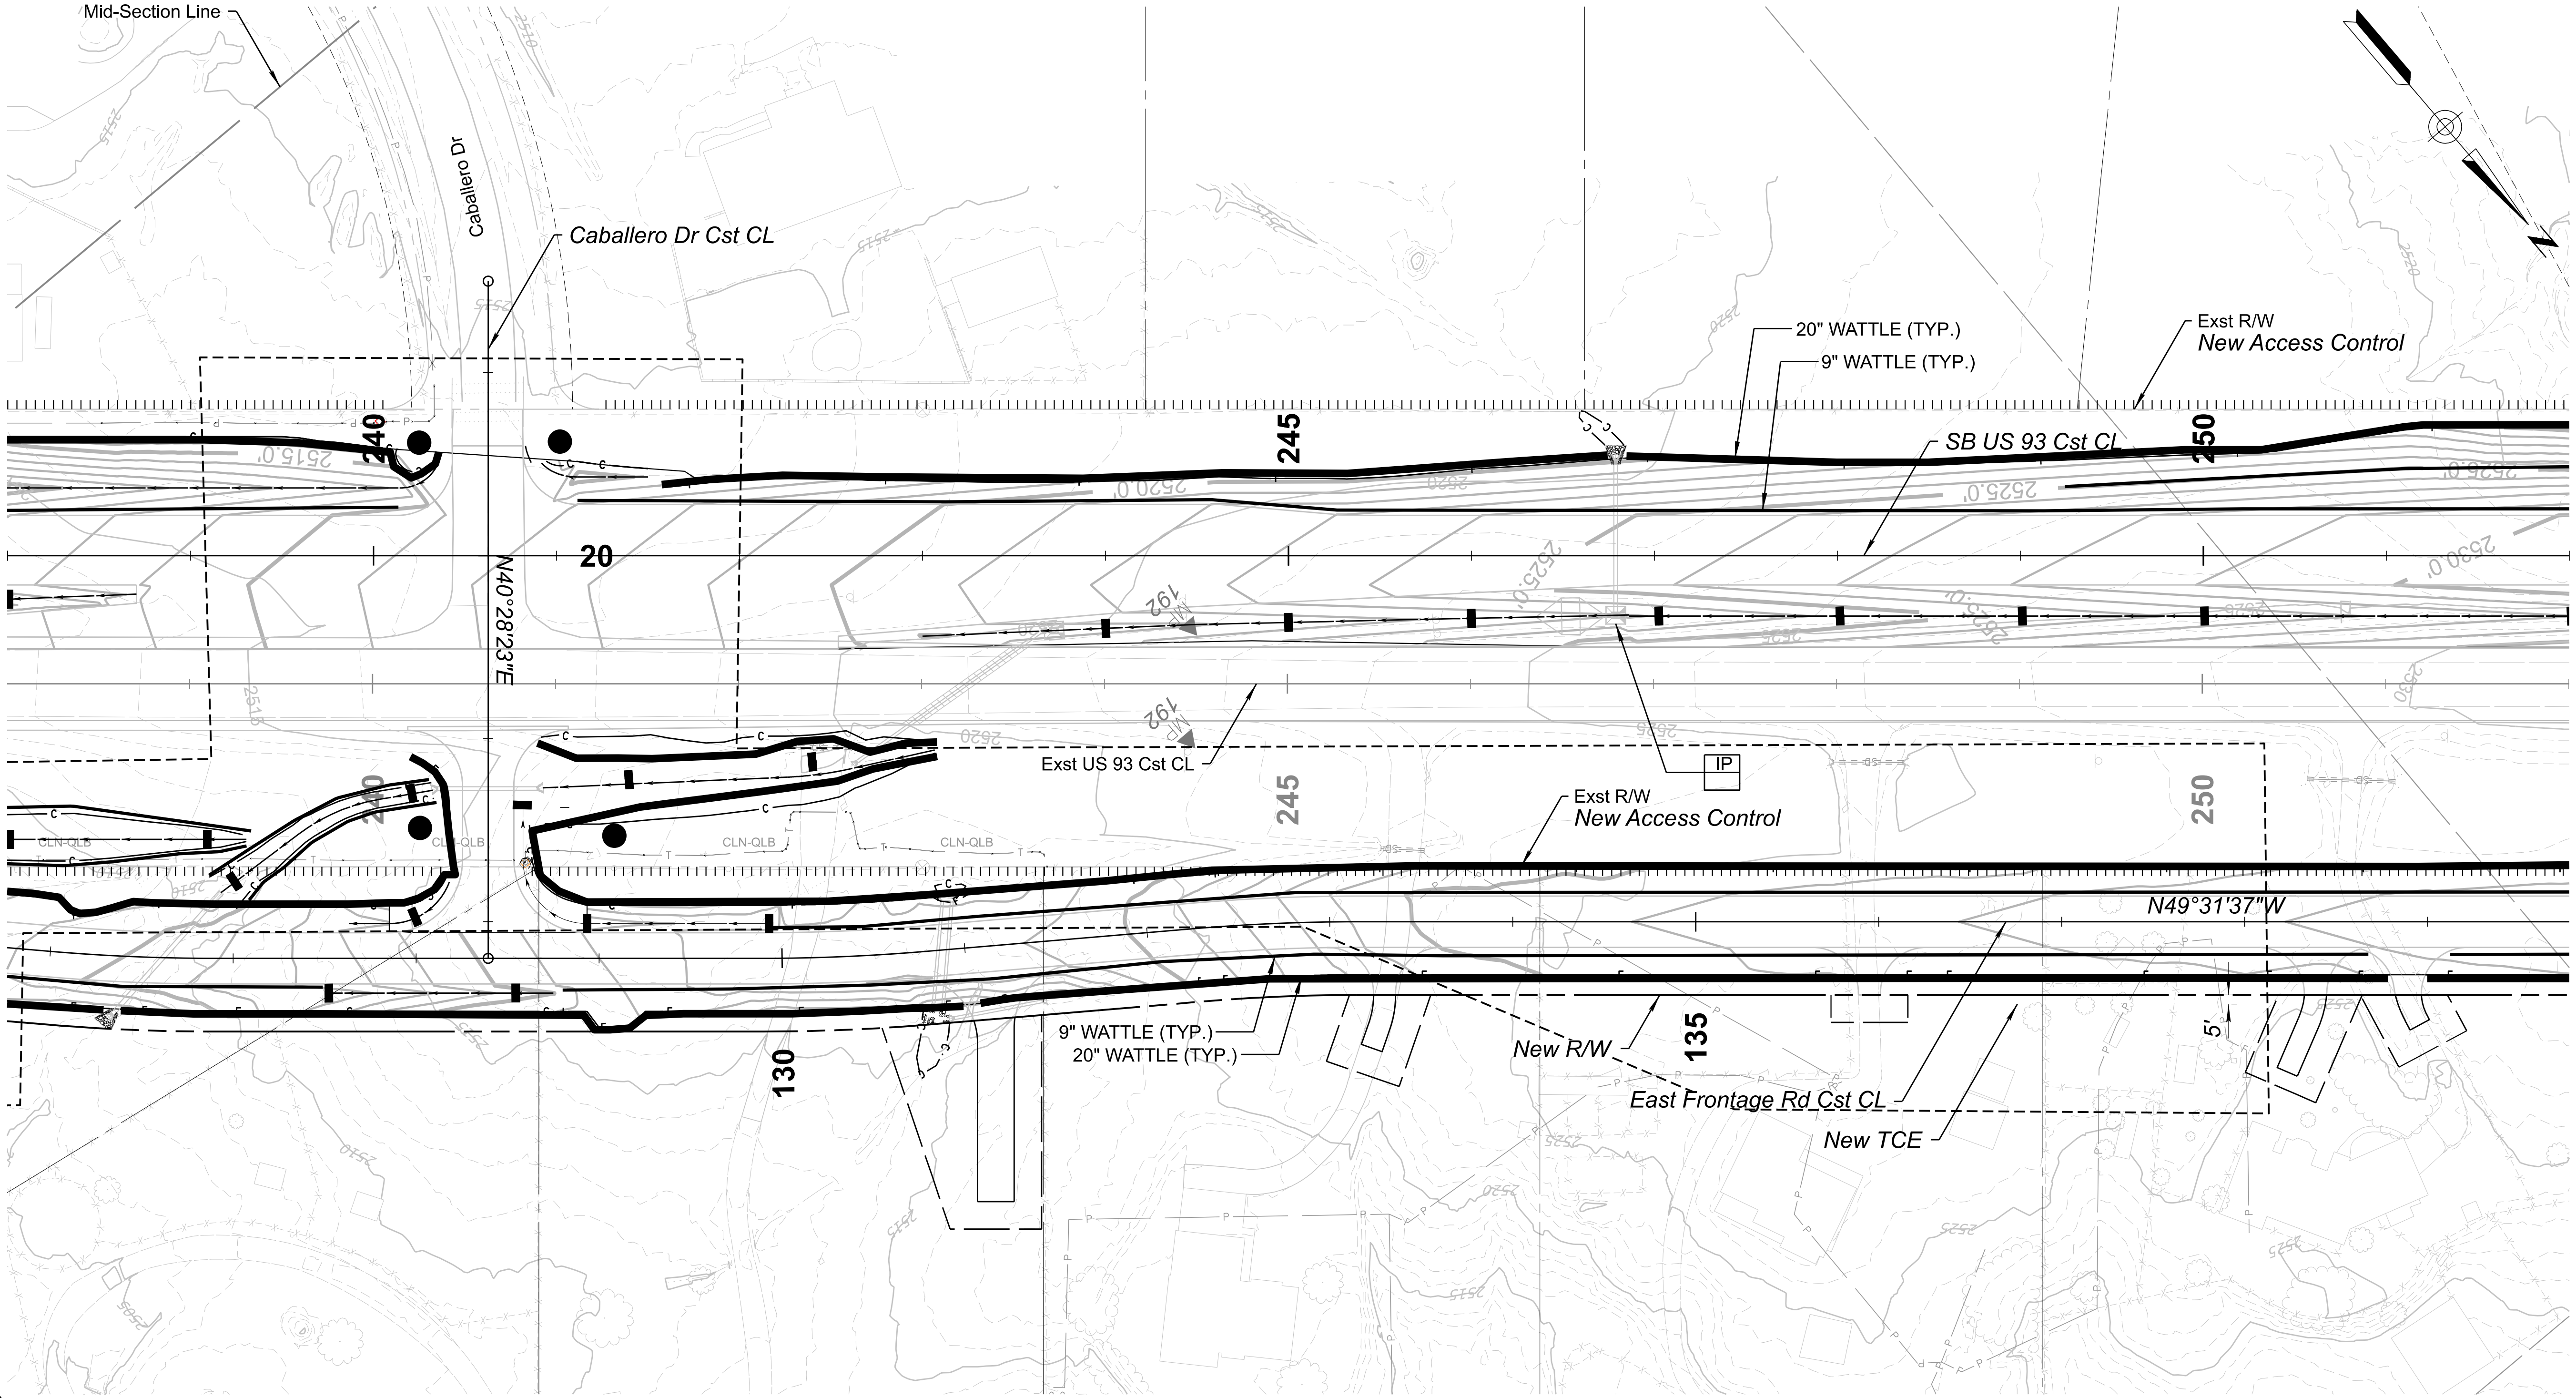

LEGEND	
SYMBOL	DESCRIPTION
	9" WATTLE - SEE SHEET E-1.02, DETAIL 1
	20" WATTLE - SEE SHEET E-1.02, DETAIL 1
	INLET PROTECTION - SEE SHEET E-1.04, DETAIL 3
	ROCK PROTECTION - SEE SHEET E-1.05, DETAIL 4
	ROCK CHECK DAM - SEE SHEET E-1.06, DETAIL 5
	STABILIZED CONSTRUCTION ENTRANCE - SEE SHEET E-1.07, DETAIL 7

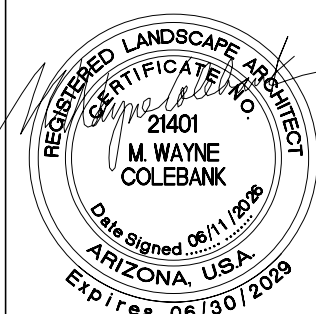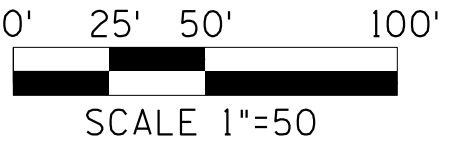


	NAME	DATE
DESIGN	W HERRERA	06/26
DRAWN	STAFF	06/26
CHECKED	W COLEBANK	06/26
		LOGANSIMPSON



ARIZONA DEPARTMENT OF TRANSPORTATION
PROJECT DELIVERY AND OPERATIONS DIVISION
ROADWAY DESIGN SERVICES
EROSION CONTROL SHEET
SB US 93 STA 238+00 TO STA 252+00
E FRONTAGE RD STA 126+00 TO STA 140+00

ROUTE	US 93
MILEPOST	189.92
STRUCTURE NO.	

F.H.W.A. Arizona Division	STATE	PROJECT NO.	FEDERAL ID NO.	SHEET NO.	TOTAL SHEETS	RECORD DRAWING
	ARIZ.	093 YV 189	093-B(230)T	509	524	
LOCATION WICKENBURG RANCH WAY TO VISTA ROYALE						DWG No. E-3.10
TRACS NO. F0738 01C						___ OF ___

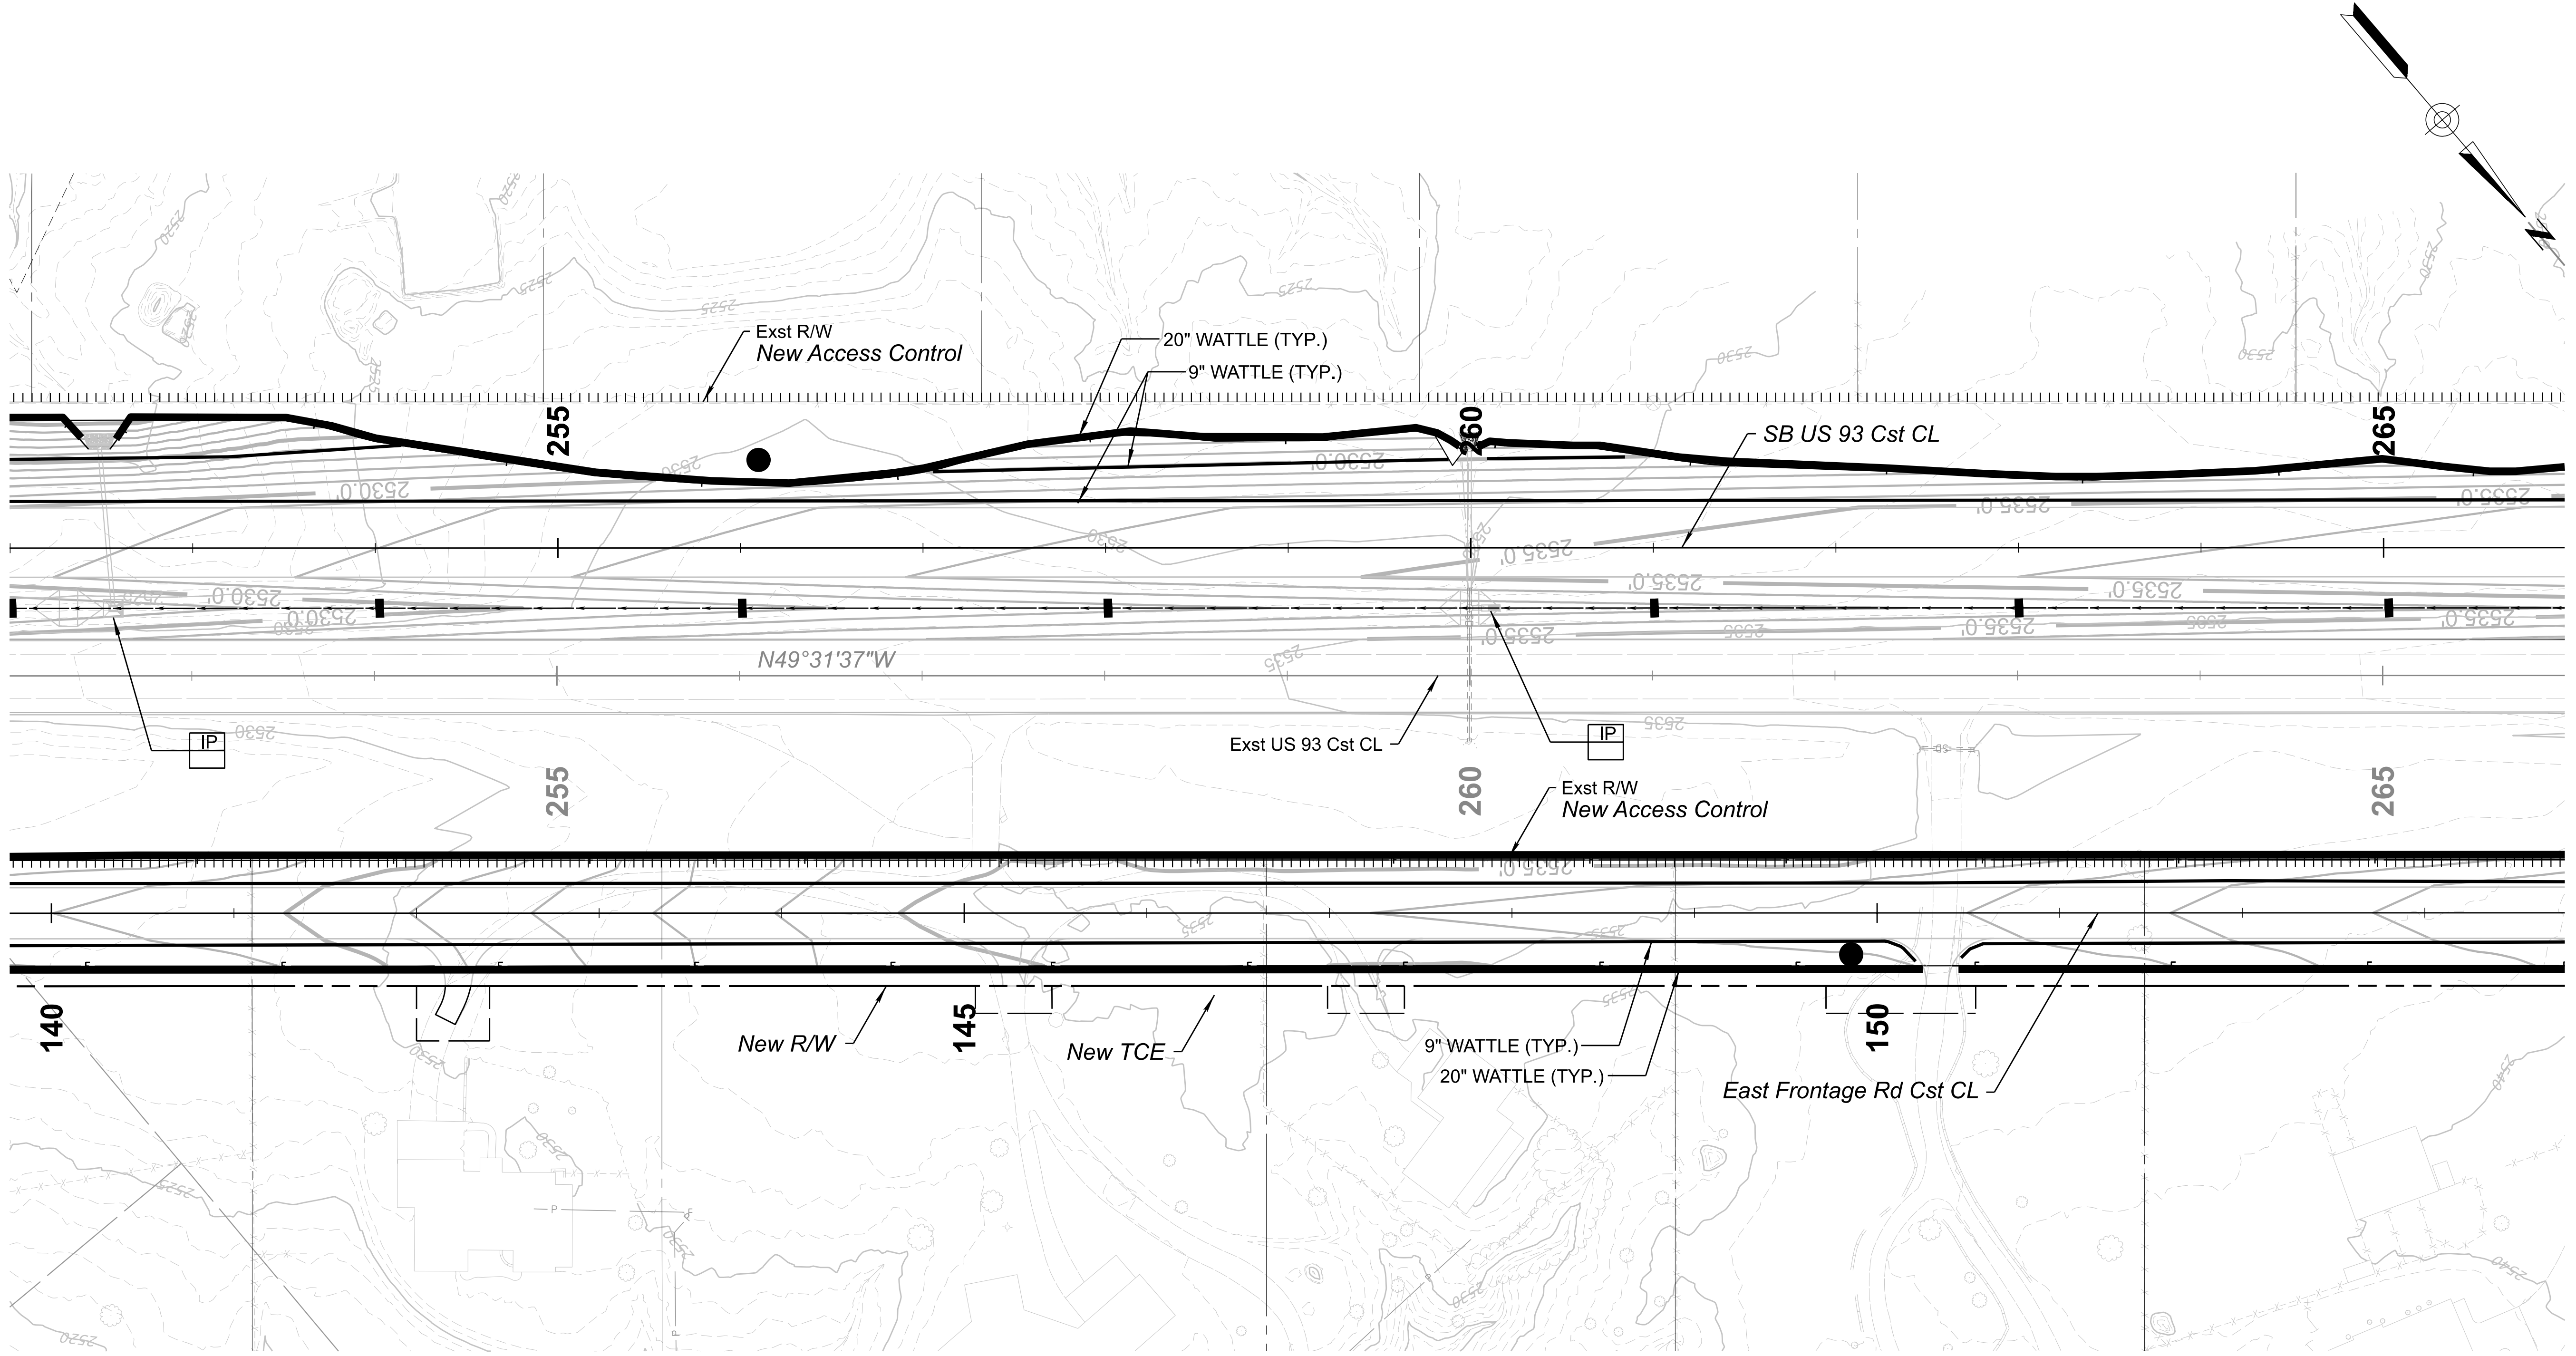

LEGEND	
SYMBOL	DESCRIPTION
	9" WATTLE - SEE SHEET E-1.02, DETAIL 1
	20" WATTLE - SEE SHEET E-1.02, DETAIL 1
	INLET PROTECTION - SEE SHEET E-1.04, DETAIL 3
	ROCK PROTECTION - SEE SHEET E-1.05, DETAIL 4
	ROCK CHECK DAM - SEE SHEET E-1.06, DETAIL 5
	STABILIZED CONSTRUCTION ENTRANCE - SEE SHEET E-1.07, DETAIL 7

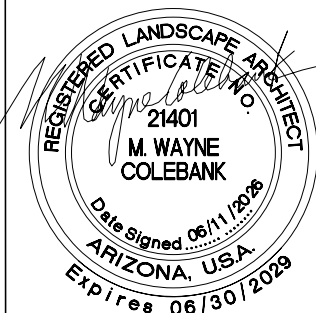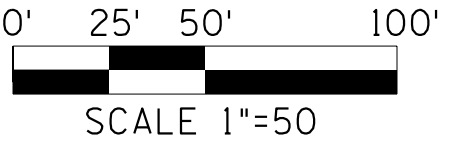


	NAME	DATE
DESIGN	W HERRERA	06/26
DRAWN	STAFF	06/26
CHECKED	W COLEBANK	06/26



ARIZONA DEPARTMENT OF TRANSPORTATION
PROJECT DELIVERY AND OPERATIONS DIVISION
ROADWAY DESIGN SERVICES
EROSION CONTROL SHEET
SB US 93 STA 252+00 TO STA 266+00
E FRONTAGE RD STA 140+00 TO STA 154+00

ROUTE	US 93
MILEPOST	189.92
STRUCTURE NO.	

F.H.W.A. Arizona Division		STATE	ARIZ.	PROJECT NO.	093 YV 189	FEDERAL ID NO.	093-B(230)T	SHEET NO.	510	TOTAL SHEETS	524	RECORD DRAWING
LOCATION										DWG No. E-3.11		
TRACS NO. F0738 01C										____ OF ____		

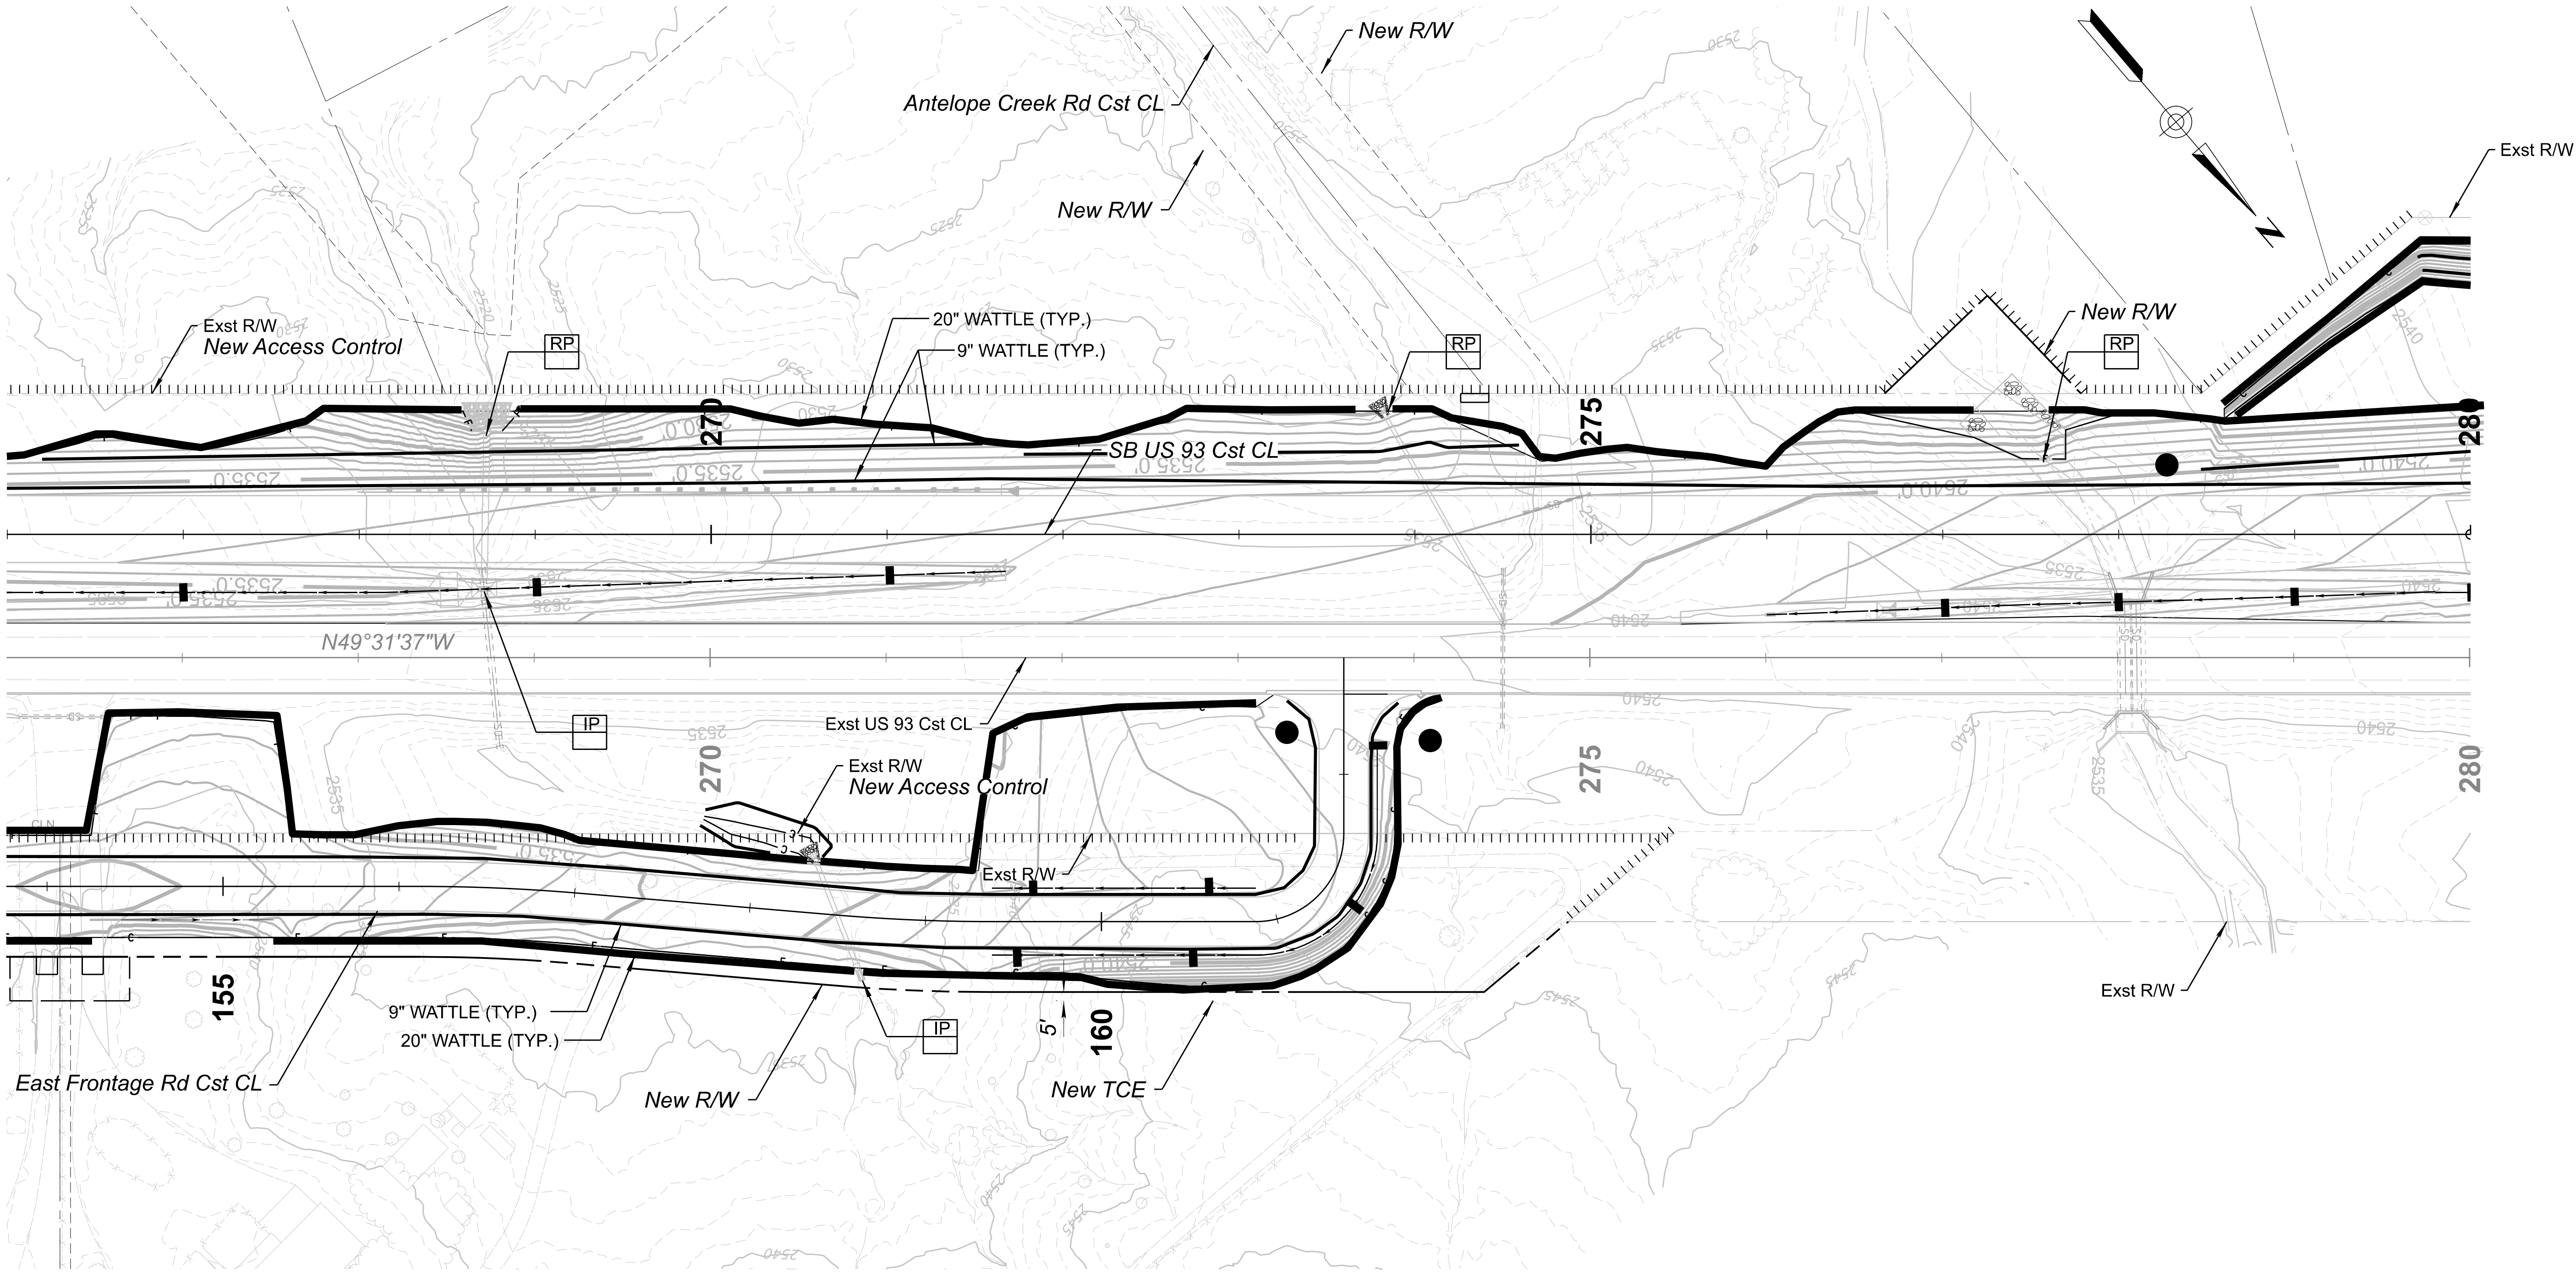

LEGEND	
SYMBOL	DESCRIPTION
	9" WATTLE - SEE SHEET E-1.02, DETAIL 1
	20" WATTLE - SEE SHEET E-1.02, DETAIL 1
	INLET PROTECTION - SEE SHEET E-1.04, DETAIL 3
	ROCK PROTECTION - SEE SHEET E-1.05, DETAIL 4
	ROCK CHECK DAM - SEE SHEET E-1.06, DETAIL 5
	STABILIZED CONSTRUCTION ENTRANCE - SEE SHEET E-1.07, DETAIL 7

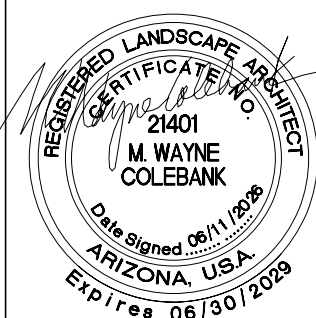
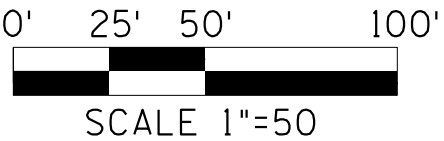


	NAME	DATE
DESIGN	W HERRERA	06/26
DRAWN	STAFF	06/26
CHECKED	W COLEBANK	06/26

ARIZONA DEPARTMENT OF TRANSPORTATION
PROJECT DELIVERY AND OPERATIONS DIVISION
ROADWAY DESIGN SERVICES
EROSION CONTROL SHEET
SB US 93 STA 266+00 TO STA 280+00
E FRONTAGE RD STA 154+00 TO STA 161+66


ROUTE	US 93
MILEPOST	189.92
STRUCTURE NO.	

F.H.W.A. Arizona Division	STATE	PROJECT NO.	FEDERAL ID NO.	SHEET NO.	TOTAL SHEETS	RECORD DRAWING
	ARIZ.	093 YV 189	093-B(230)T	511	524	
LOCATION WICKENBURG RANCH WAY TO VISTA ROYALE						DWG No. E-3.12
TRACS NO. F0738 01C						OF

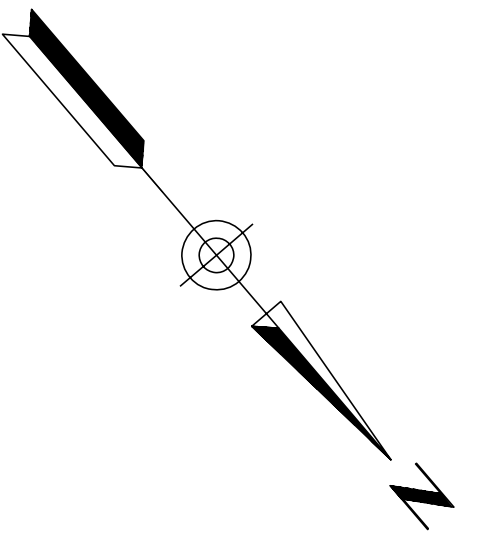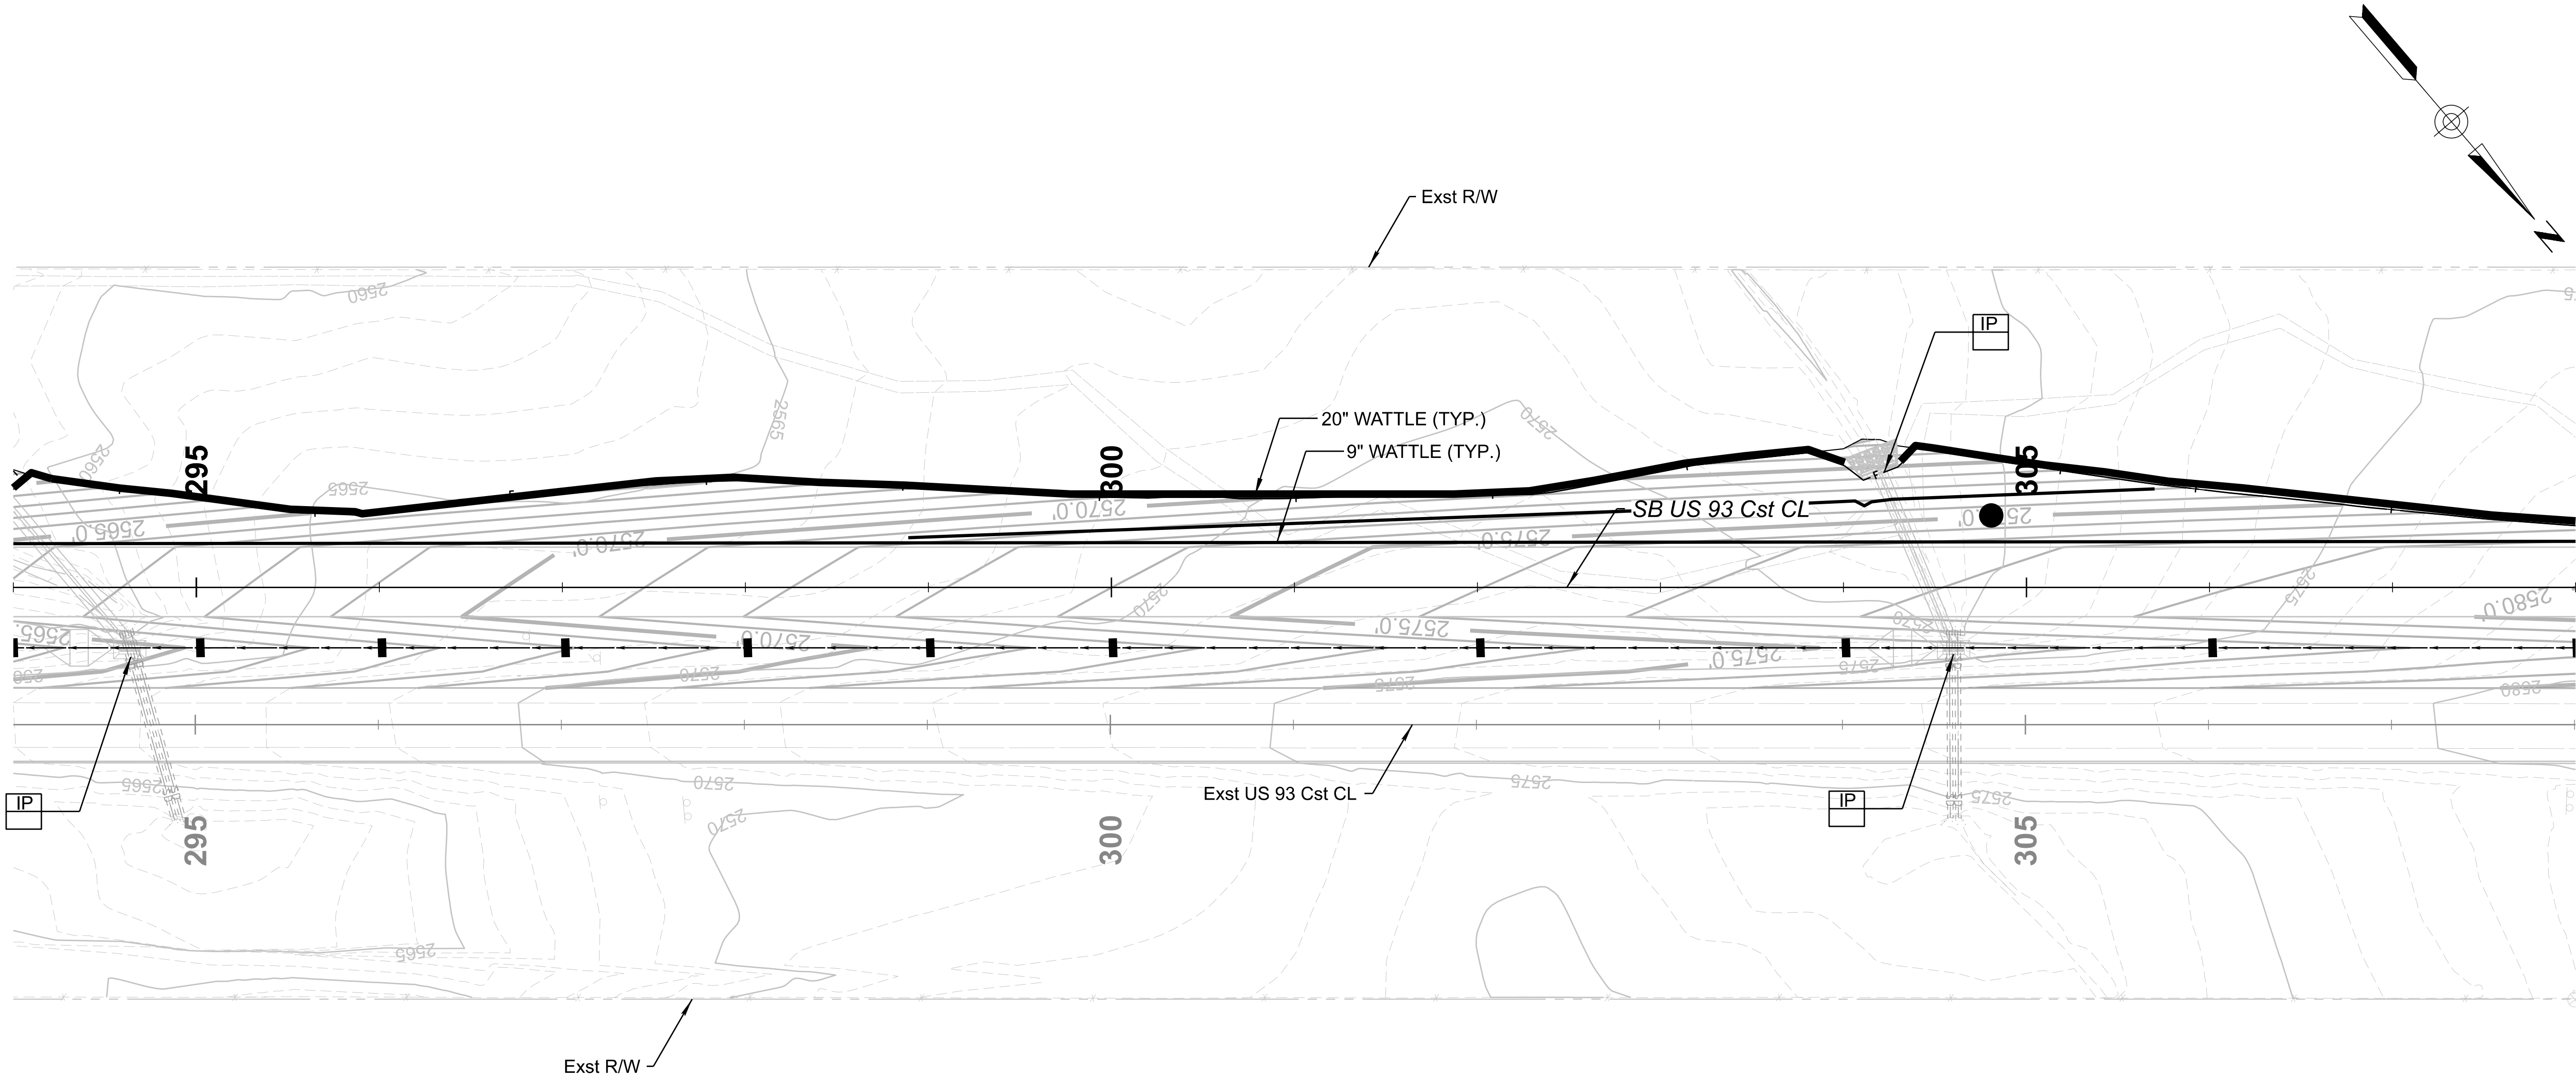


LEGEND

SYMBOL	DESCRIPTION
	9" WATTLE - SEE SHEET E-1.02, DETAIL 1
	20" WATTLE - SEE SHEET E-1.02, DETAIL 1
	INLET PROTECTION - SEE SHEET E-1.04, DETAIL 3
	ROCK PROTECTION - SEE SHEET E-1.05, DETAIL 4
	ROCK CHECK DAM - SEE SHEET E-1.06, DETAIL 5
	STABILIZED CONSTRUCTION ENTRANCE - SEE SHEET E-1.07, DETAIL 7

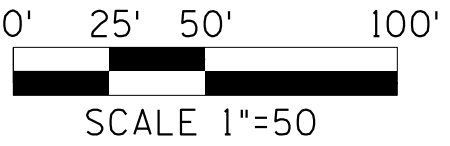



SCALE 1"=50'

		NAME	DATE	ARIZONA DEPARTMENT OF TRANSPORTATION PROJECT DELIVERY AND OPERATIONS DIVISION ROADWAY DESIGN SERVICES	ROUTE	F.H.W.A. Arizona Division	STATE	PROJECT NO.	FEDERAL ID NO.	SHEET NO.	TOTAL SHEETS	RECORD DRAWING	
	DESIGN	W HERRERA	06/26		US 93								
	DRAWN	STAFF	06/26										
	CHECKED	W COLEBANK	06/26										
		LOGANSIMPSON 222 SOUTHWEST AVENUE, SUITE 202 TUCSON, AZ 85701 P (520) 561-1243			EROSION CONTROL SHEET SB US 93 STA 294+00 TO STA 308+00	MILEPOST 189.92	LOCATION WICKENBURG RANCH WAY TO VISTA ROYALE						DWG No. E-3.14
					STRUCTURE NO.	TRACS NO. F0738 01C						___ OF ___	

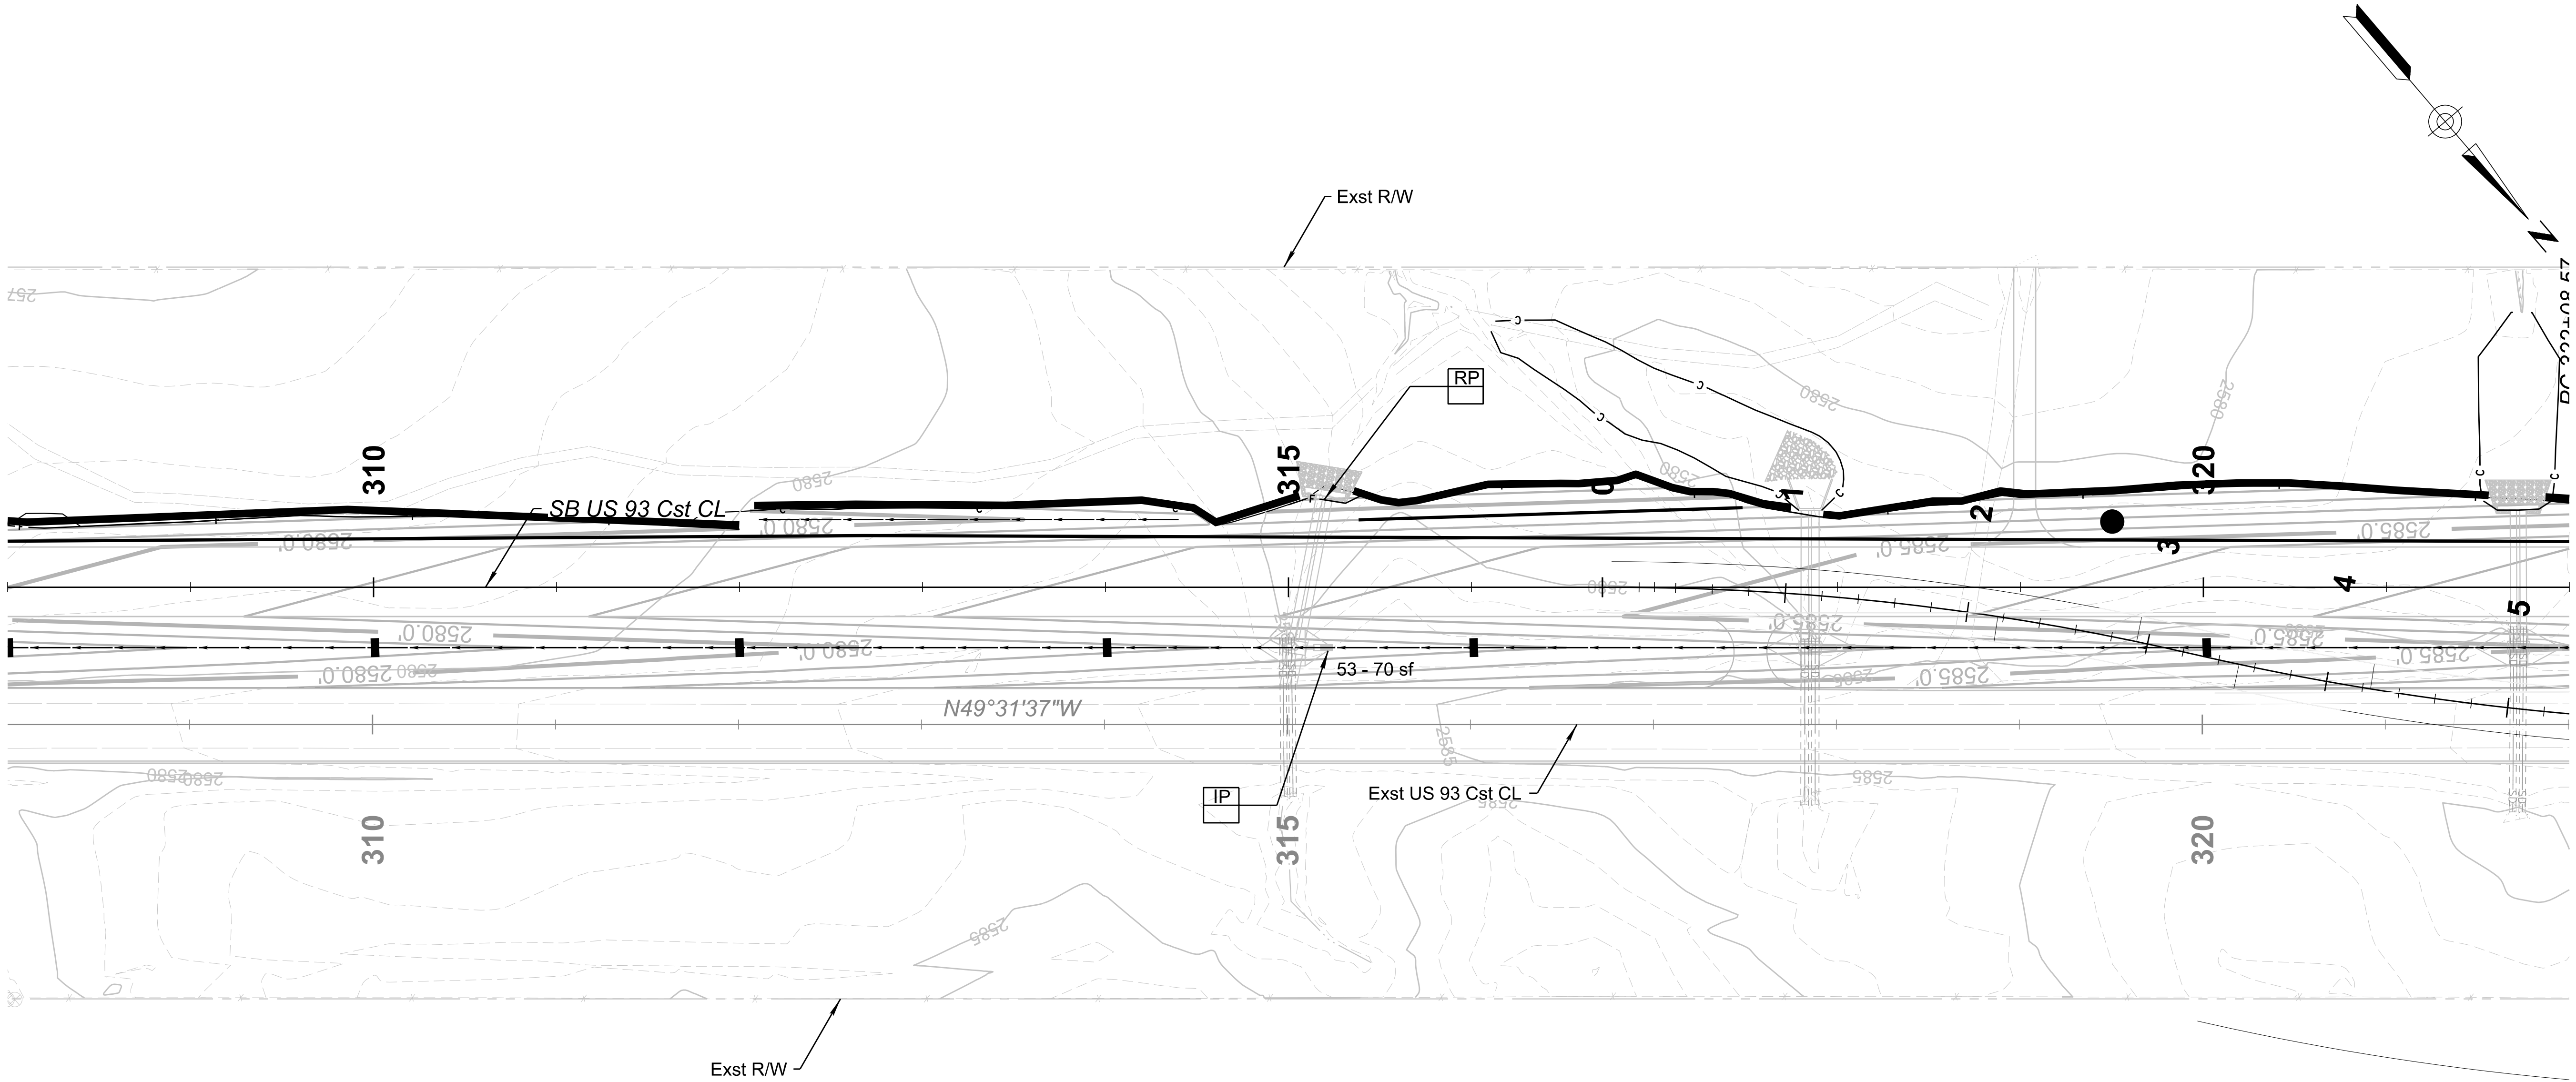

LEGEND

SYMBOL	DESCRIPTION
	9" WATTLE - SEE SHEET E-1.02, DETAIL 1
	20" WATTLE - SEE SHEET E-1.02, DETAIL 1
	INLET PROTECTION - SEE SHEET E-1.04, DETAIL 3
	ROCK PROTECTION - SEE SHEET E-1.05, DETAIL 4
	ROCK CHECK DAM - SEE SHEET E-1.06, DETAIL 5
	STABILIZED CONSTRUCTION ENTRANCE - SEE SHEET E-1.07, DETAIL 7

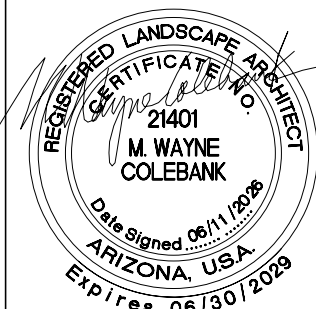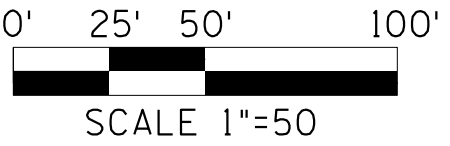


	NAME	DATE
DESIGN	W HERRERA	06/26
DRAWN	STAFF	06/26
CHECKED	W COLEBANK	06/26

ARIZONA DEPARTMENT OF TRANSPORTATION
PROJECT DELIVERY AND OPERATIONS DIVISION
ROADWAY DESIGN SERVICES

EROSION CONTROL SHEET
SB US 93 STA 308+00 TO STA 322+00


ROUTE	US 93
MILEPOST	189.92
STRUCTURE NO.	

F.H.W.A. Arizona Division	STATE	PROJECT NO.	FEDERAL ID NO.	SHEET NO.	TOTAL SHEETS	RECORD DRAWING
	ARIZ.	093 YV 189	093-B(230)T	514	524	
LOCATION					DWG No. E-3.15	
TRACS NO. F0738 01C					___ OF ___	

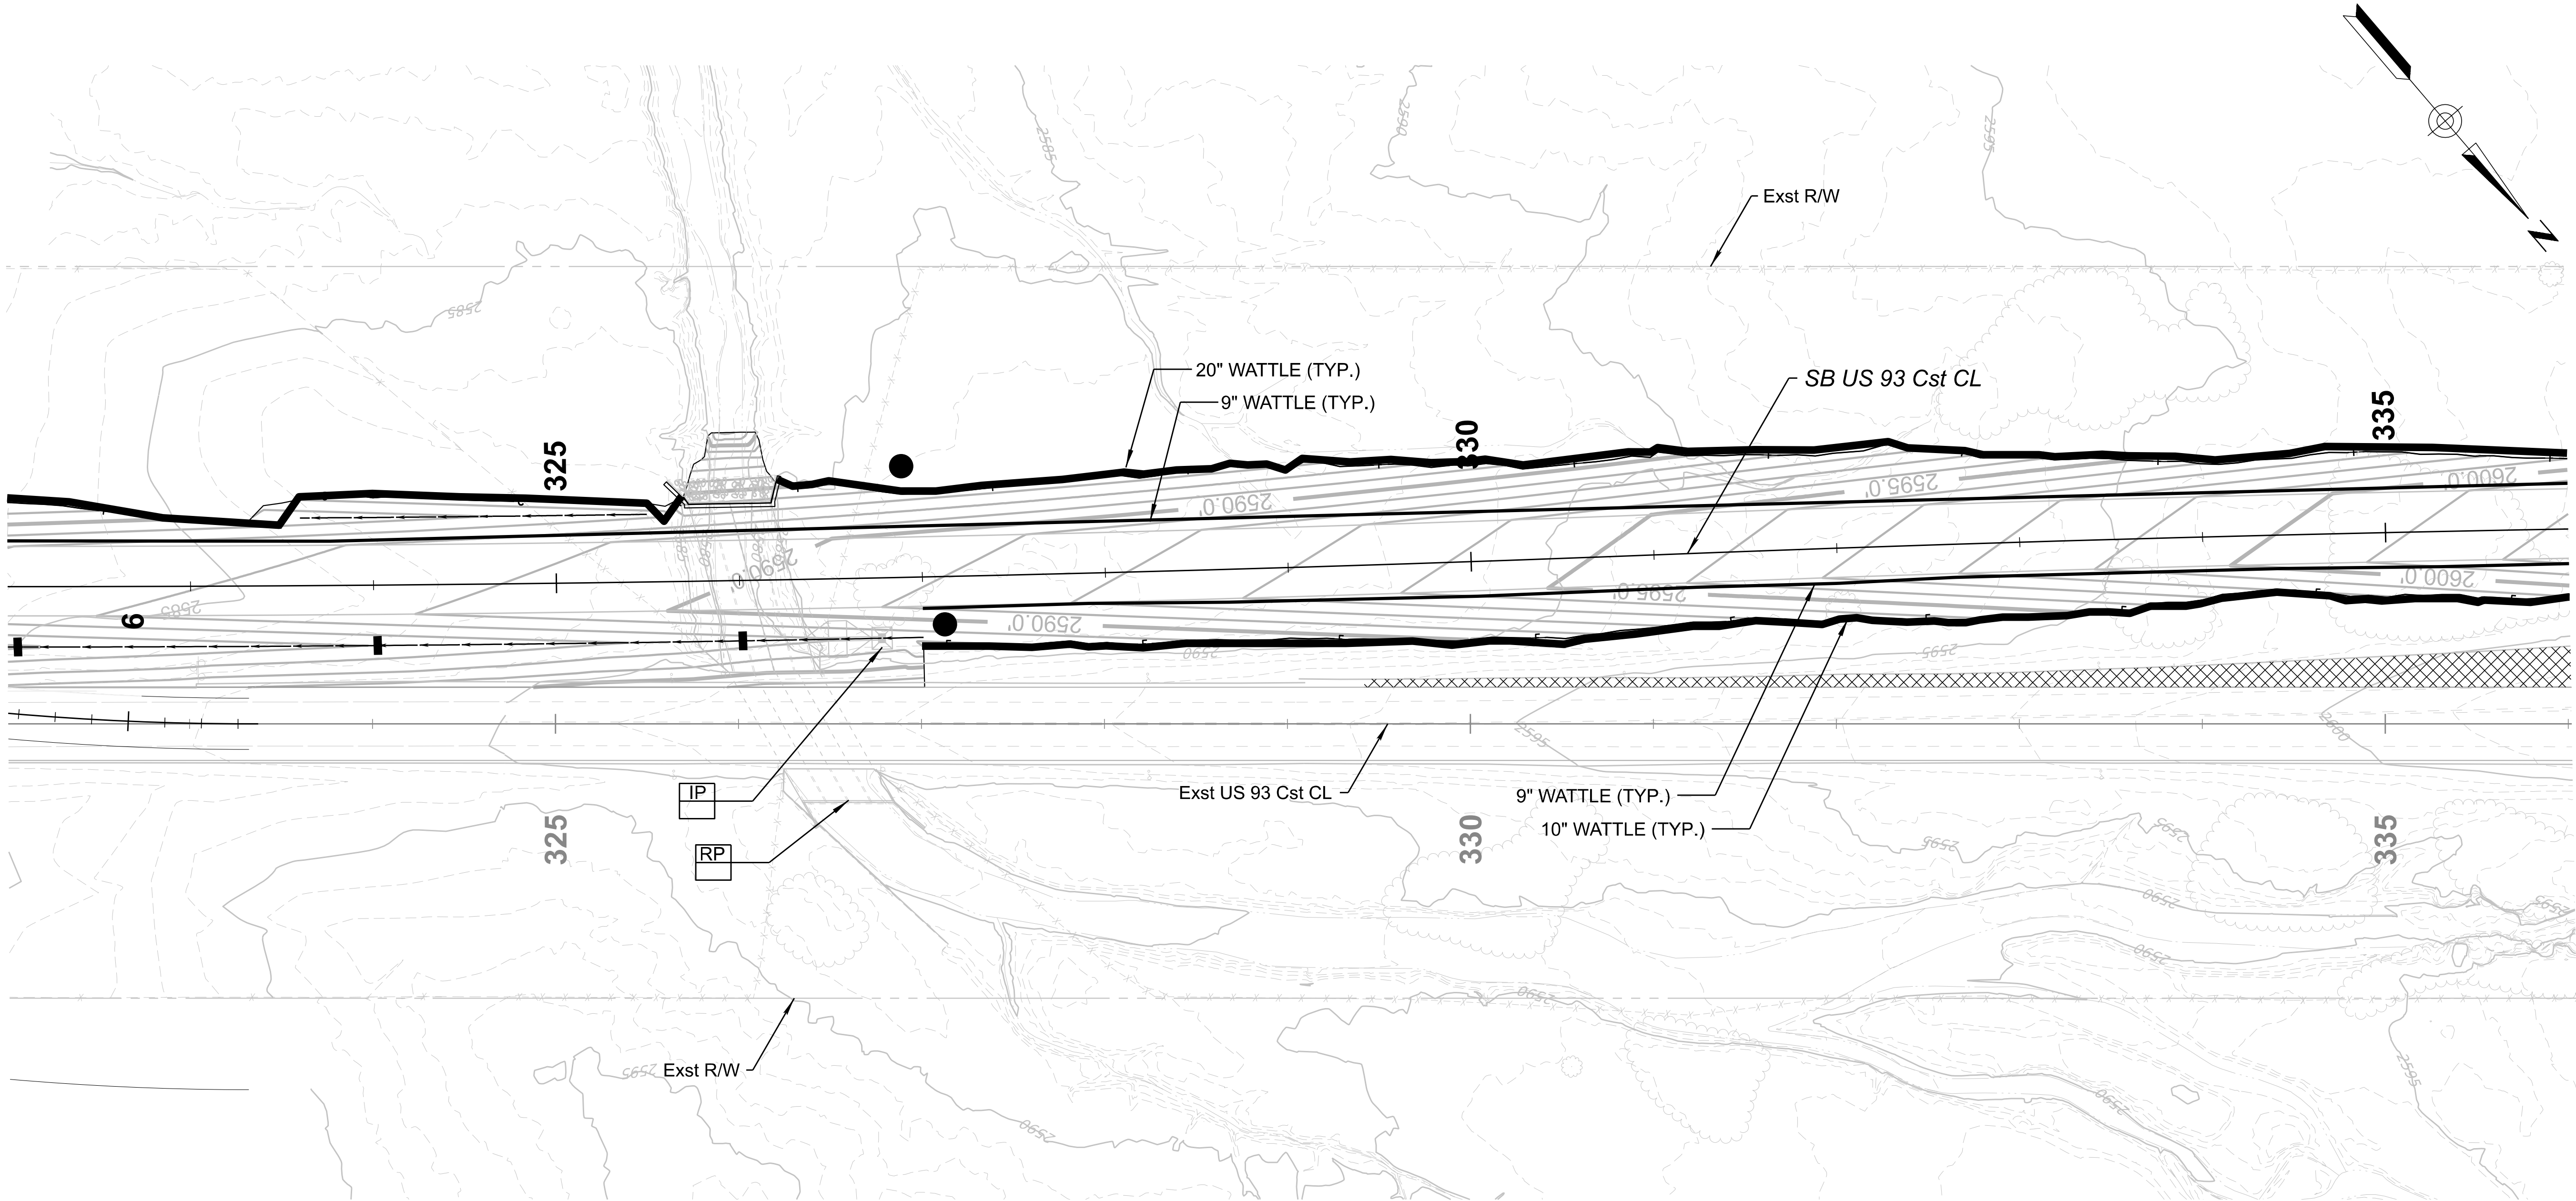


LEGEND

SYMBOL	DESCRIPTION
	9" WATTLE - SEE SHEET E-1.02, DETAIL 1
	20" WATTLE - SEE SHEET E-1.02, DETAIL 1
IP	INLET PROTECTION - SEE SHEET E-1.04, DETAIL 3
RP	ROCK PROTECTION - SEE SHEET E-1.05, DETAIL 4
	ROCK CHECK DAM - SEE SHEET E-1.06, DETAIL 5
	STABILIZED CONSTRUCTION ENTRANCE - SEE SHEET E-1.07, DETAIL 7

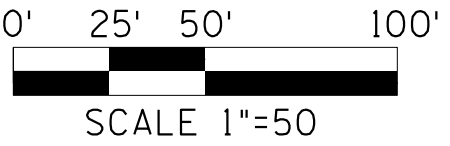

SCALE 1"=50'


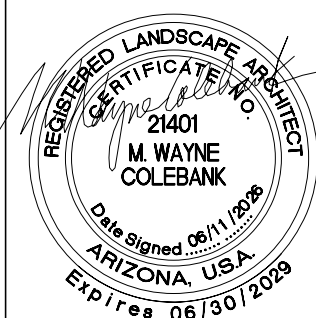


	NAME	DATE
DESIGN	W HERRERA	06/26
DRAWN	STAFF	06/26
CHECKED	W COLEBANK	06/26
 LOGANSIMPSON 222 SOUTH FARMER LANE, SUITE 202 TAMPA, FL 33613 P: (813) 987-1543		

ARIZONA DEPARTMENT OF TRANSPORTATION PROJECT DELIVERY AND OPERATIONS DIVISION ROADWAY DESIGN SERVICES	
EROSION CONTROL SHEET SB US 93 STA 322+00 TO STA 336+00	


ROUTE US 93
MILEPOST 189.92
STRUCTURE NO.

F.H.W.A. Arizona Division	STATE ARIZ.	PROJECT NO. 093 YV 189	FEDERAL ID NO. 093-B(230)T	SHEET NO. 515	TOTAL SHEETS 524	RECORD DRAWING
LOCATION WICKENBURG RANCH WAY TO VISTA ROYALE						DWG No. E-3.16
TRACS NO. F0738 01C						___ OF ___

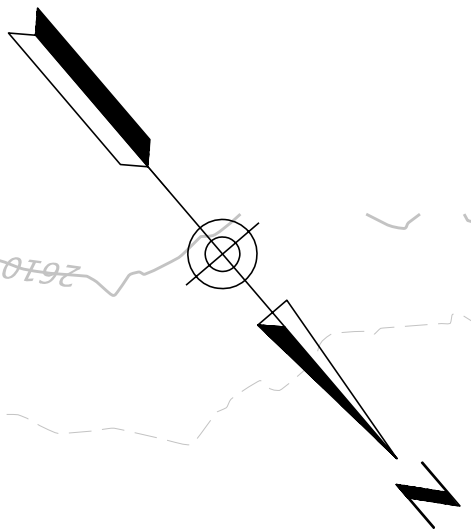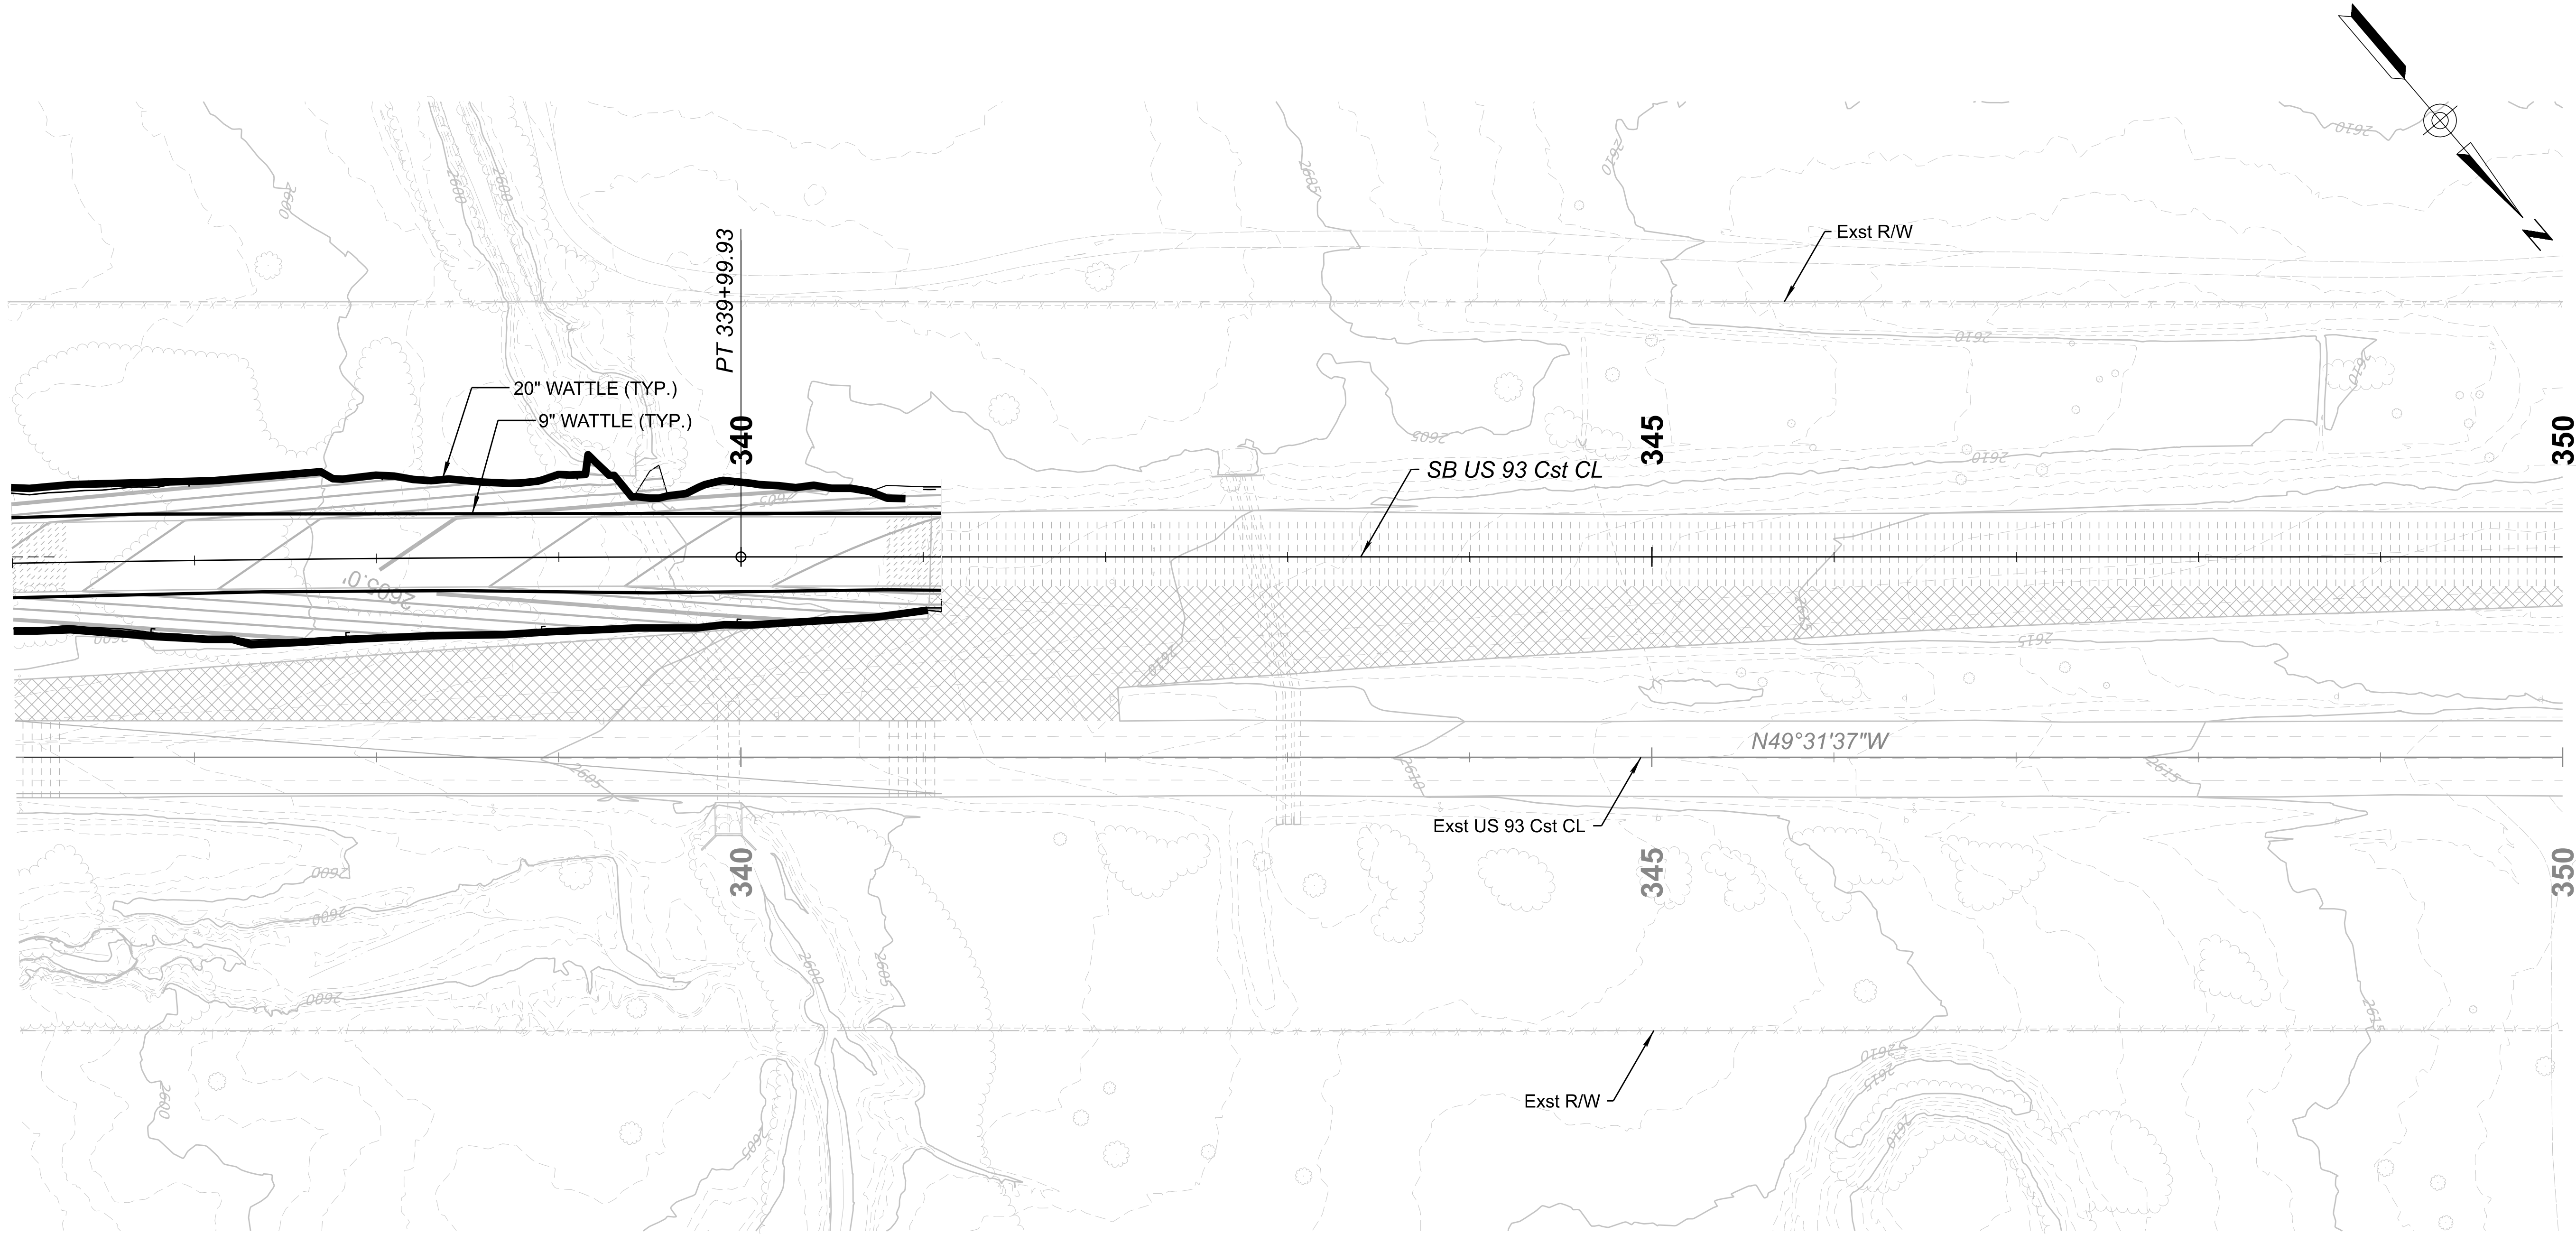


LEGEND

SYMBOL	DESCRIPTION
	9" WATTLE - SEE SHEET E-1.02, DETAIL 1
	20" WATTLE - SEE SHEET E-1.02, DETAIL 1
	INLET PROTECTION - SEE SHEET E-1.04, DETAIL 3
	ROCK PROTECTION - SEE SHEET E-1.05, DETAIL 4
	ROCK CHECK DAM - SEE SHEET E-1.06, DETAIL 5
	STABILIZED CONSTRUCTION ENTRANCE - SEE SHEET E-1.07, DETAIL 7

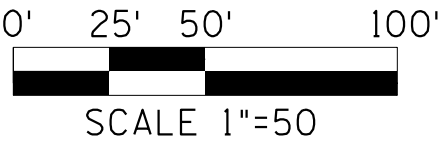

SCALE 1"=50'

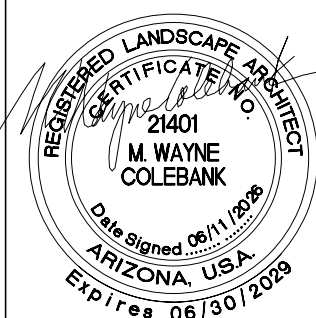


	NAME	DATE
DESIGN	W HERRERA	06/26
DRAWN	STAFF	06/26
CHECKED	W COLEBANK	06/26

ARIZONA DEPARTMENT OF TRANSPORTATION
PROJECT DELIVERY AND OPERATIONS DIVISION
ROADWAY DESIGN SERVICES


EROSION CONTROL SHEET
SB US 93 STA 336+00 TO STA 350+00

ROUTE	US 93
MILEPOST	189.92
STRUCTURE NO.	

F.H.W.A. Arizona Division	STATE	PROJECT NO.	FEDERAL ID NO.	SHEET NO.	TOTAL SHEETS	RECORD DRAWING	
	ARIZ.	093 YV 189	093-B(230)T	516	524		
LOCATION					WICKENBURG RANCH WAY TO VISTA ROYALE		DWG No. E-3.17
TRACS NO.		F0738 01C					
				___ OF ___			

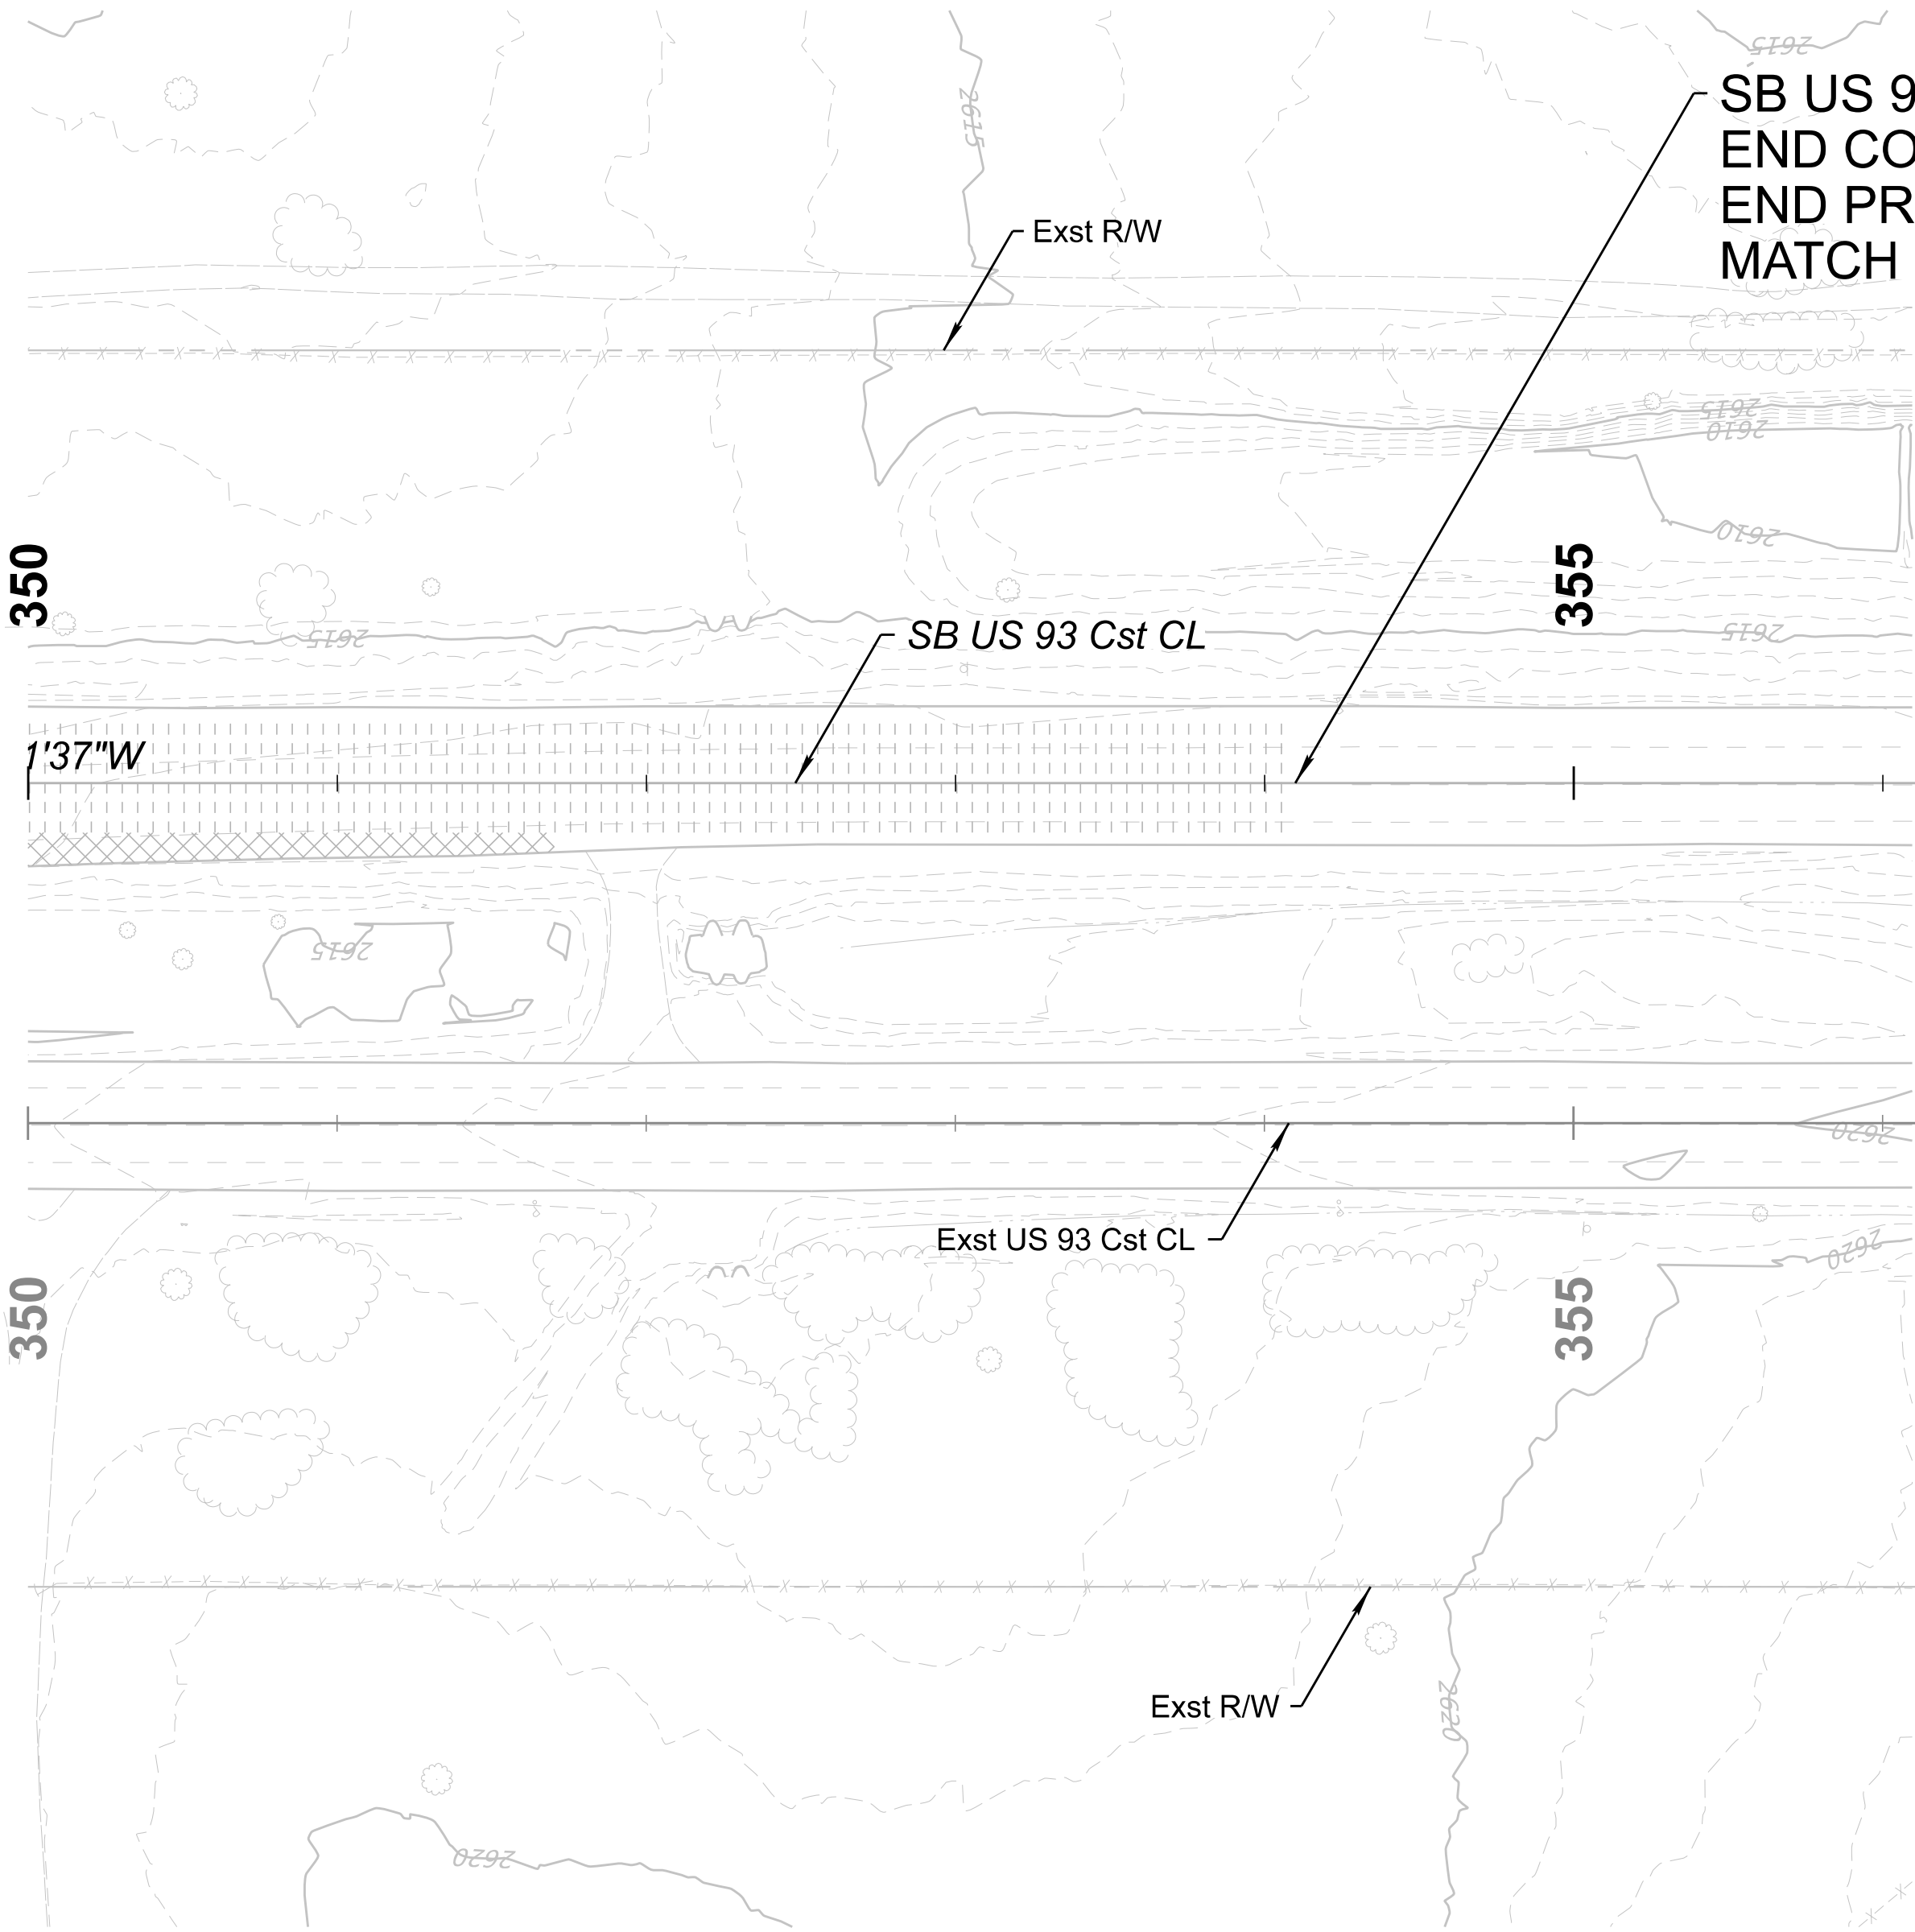


SB US 93 Cst CL Sta 354+10
END CONSTRUCTION
END PROJECT 093-B(230)T
MATCH EXST

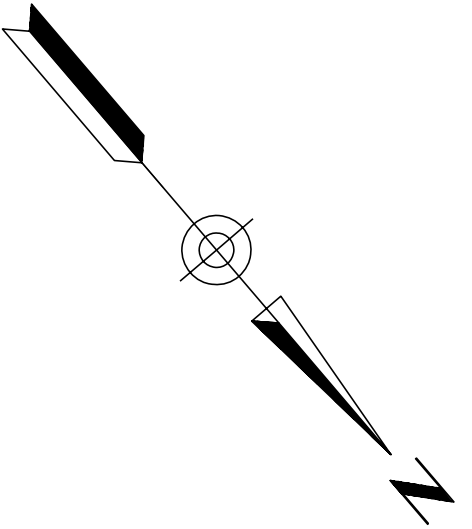


LEGEND

SYMBOL	DESCRIPTION
	9" WATTLE - SEE SHEET E-1.02, DETAIL 1
	20" WATTLE - SEE SHEET E-1.02, DETAIL 1
	INLET PROTECTION - SEE SHEET E-1.04, DETAIL 3
	ROCK PROTECTION - SEE SHEET E-1.05, DETAIL 4
	ROCK CHECK DAM - SEE SHEET E-1.06, DETAIL 5
	STABILIZED CONSTRUCTION ENTRANCE - SEE SHEET E-1.07, DETAIL 7

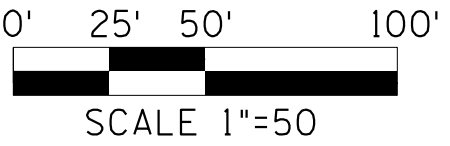

SCALE 1"=50'

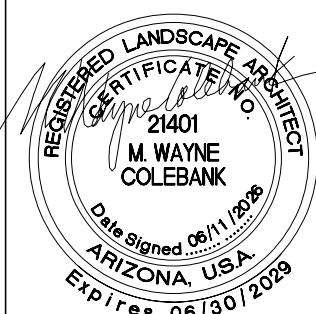



	NAME	DATE
DESIGN	W HERRERA	06/26
DRAWN	STAFF	06/26
CHECKED	W COLEBANK	06/26

ARIZONA DEPARTMENT OF TRANSPORTATION PROJECT DELIVERY AND OPERATIONS DIVISION ROADWAY DESIGN SERVICES	ROUTE US 93
EROSION CONTROL SHEET SB US 93 STA 350+00 TO STA 354+10	MILEPOST 189.92
	STRUCTURE NO.

F.H.W.A. Arizona Division	STATE ARIZ.	PROJECT NO. 093 YV 189	FEDERAL ID NO. 093-B(230)T	SHEET NO. 517	TOTAL SHEETS 524	RECORD DRAWING
LOCATION WICKENBURG RANCH WAY TO VISTA ROYALE						DWG No. E-3.18
TRACS NO. F0738 01C						___ OF ___

F.H.W.A. REGION	STATE	PROJECT NO.	SHEET NO.	TOTAL SHEETS	RECORD DRAWING
9	ARIZ.	093-B(230)T	519	524	

093 YV 189

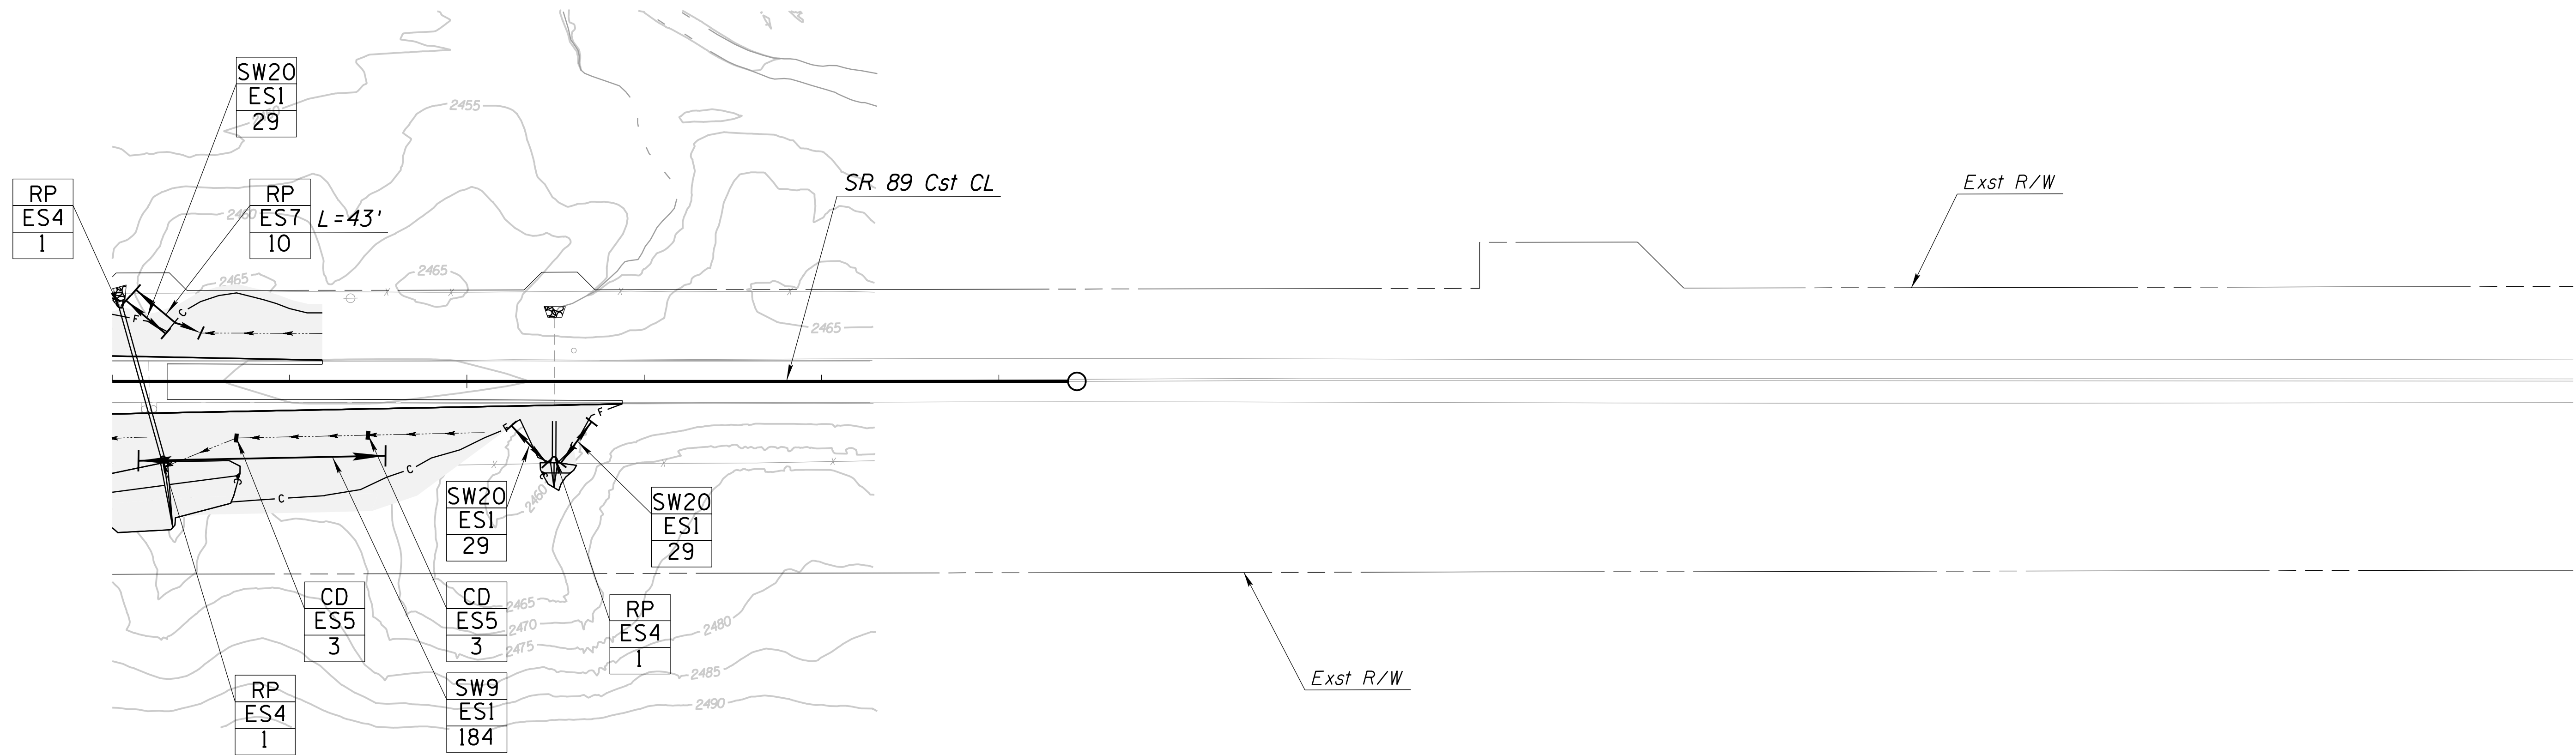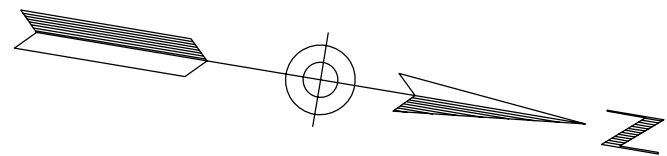

130

SYMBOL	DESCRIPTION	QUANTITY
	SEEDING	0.4 Ac
	GRANITE MULCH (See Note 1)	0 Sq Yd

NOTE:



1. Granite Mulch in roundabout and median shall be placed to a thickness of 3-inches and will be measured and paid for under Item 8030092-Granite Mulch (1 1/4" Minus).

Erosion Control Method
SW20 = Sediment Wattles - 20"
SW9 = Sediment Wattles - 9"
CD = Check Dam
RP = Rock Protection
IP = Inlet Protection
SL = Sediment Log
CE = Construction Entrance
Detail Number Reference
Quantity

DESIGN	NAME	DATE	ARIZONA DEPARTMENT OF TRANSPORTATION PROJECT DELIVERY AND OPERATIONS DIVISION ROADSIDE DEVELOPMENT SECTION	
DRAWN	JML	06-26	US 93/SR 89 EROSION CONTROL PLAN STA 128+00 TO STA 133+44.07	
CHECKED	JPM	06-26	Stanley Consultants Inc. 3133 East Camelback Road, Suite 100 Phoenix, Arizona 85016 Phone: (602) 333-2200	DWG NO. E-3.20
ROUTE	LOCATION		US 93 WICKENBURG RANCH WAY TO VISTA ROYALE	
TRACS NO.	F0738 OIC		093-B(230)T	OF

F.H.W.A. REGION	STATE	PROJECT NO.	SHEET NO.	TOTAL SHEETS	RECORD DRAWING
9	ARIZ.	093-B(230)T	520	524	

093 YV 189

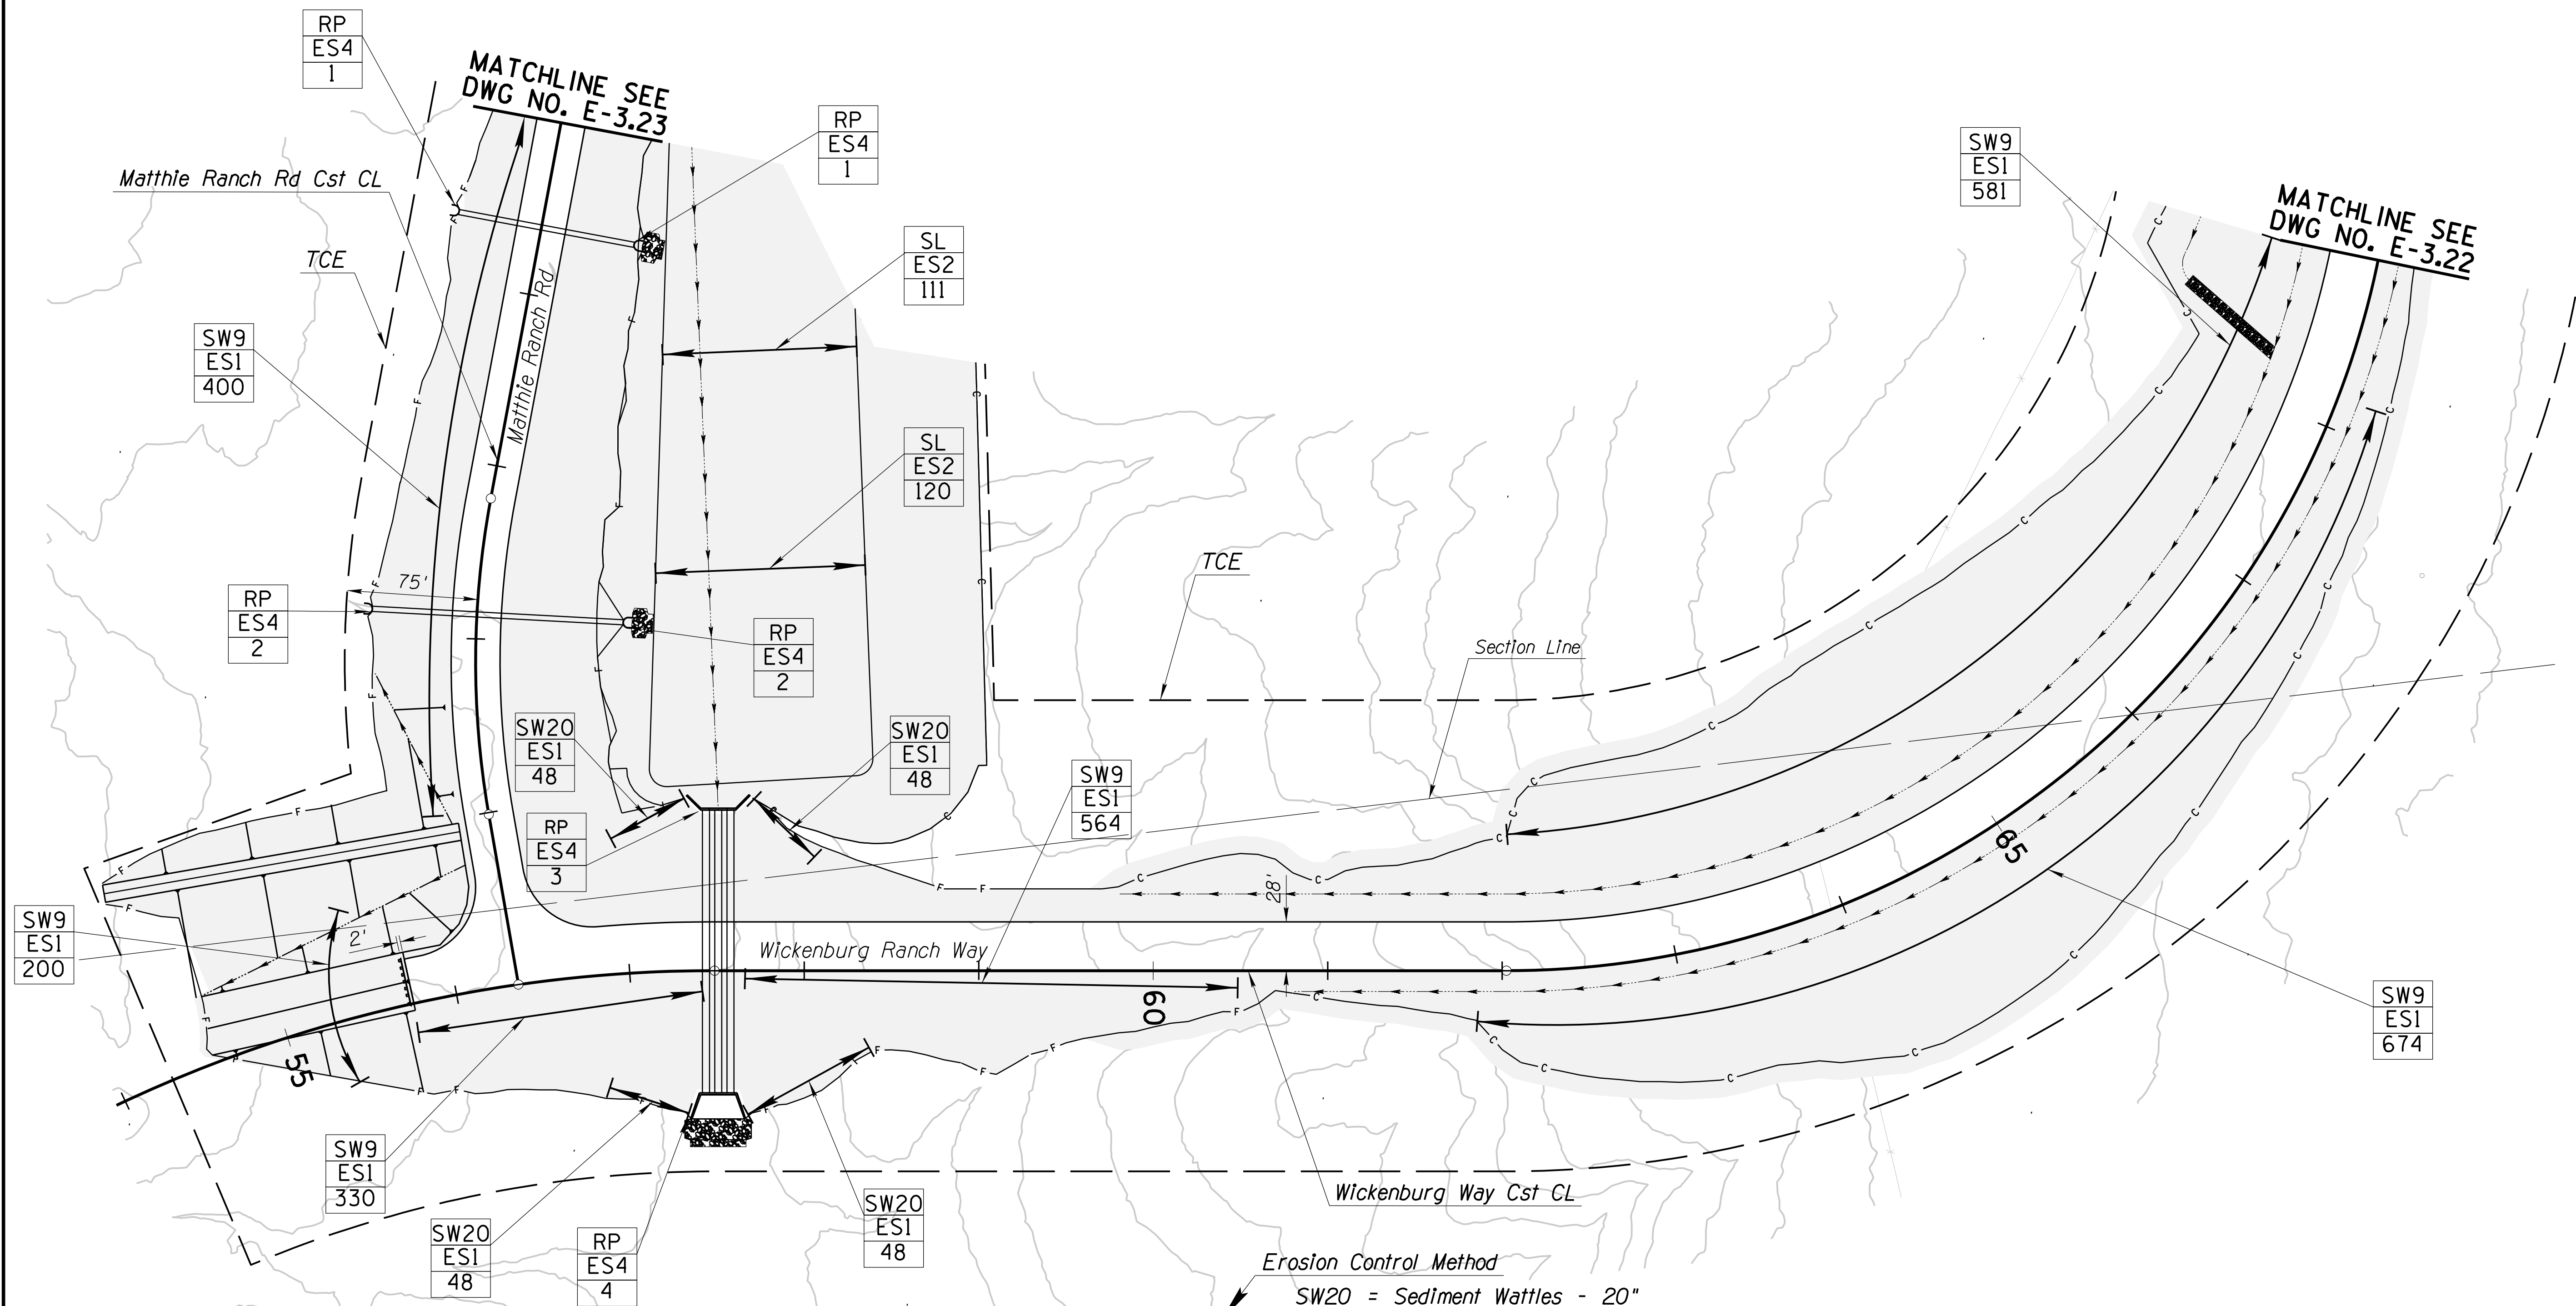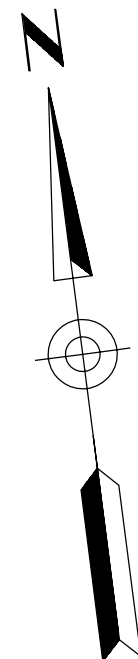

SYMBOL	DESCRIPTION	QUANTITY
	SEEDING	7.0 Ac
	GRANITE MULCH (See Note 1)	0 Sq Yd

NOTE:
1. Granite Mulch in roundabout and median shall be placed to a thickness of 3-inches and will be measured and paid for under Item 8030092-Granite Mulch (1 1/4" Minus).

Erosion Control Method

SW20 = Sediment Wattles - 20"
SW9 = Sediment Wattles - 9"
CD = Check Dam
RP = Rock Protection
IP = Inlet Protection
SL = Sediment Log
CE = Construction Entrance



Detail Number Reference

Quantity

DESIGN	JML	DATE	06-26	ARIZONA DEPARTMENT OF TRANSPORTATION PROJECT DELIVERY AND OPERATIONS DIVISION ROADSIDE DEVELOPMENT SECTION WICKENBURG RANCH WAY EROSION CONTROL PLAN STA 55+00 TO STA 69+00	
DRAWN	JML	DATE	06-26		
CHECKED	JPM	DATE	06-26		
				3133 East Camelback Road, Suite 100 Phoenix, Arizona 85016 Phone: (602) 333-2200	
ROUTE	US 93			LOCATION	WICKENBURG RANCH WAY TO VISTA ROYALE
TRACS NO. F0738 OIC				093-B(230)T	DWG NO. E-3.21 OF

F.H.W.A. REGION	STATE	PROJECT NO.	SHEET NO.	TOTAL SHEETS	RECORD DRAWING
9	ARIZ.	093-B(230)T	521	524	

093 YV 189

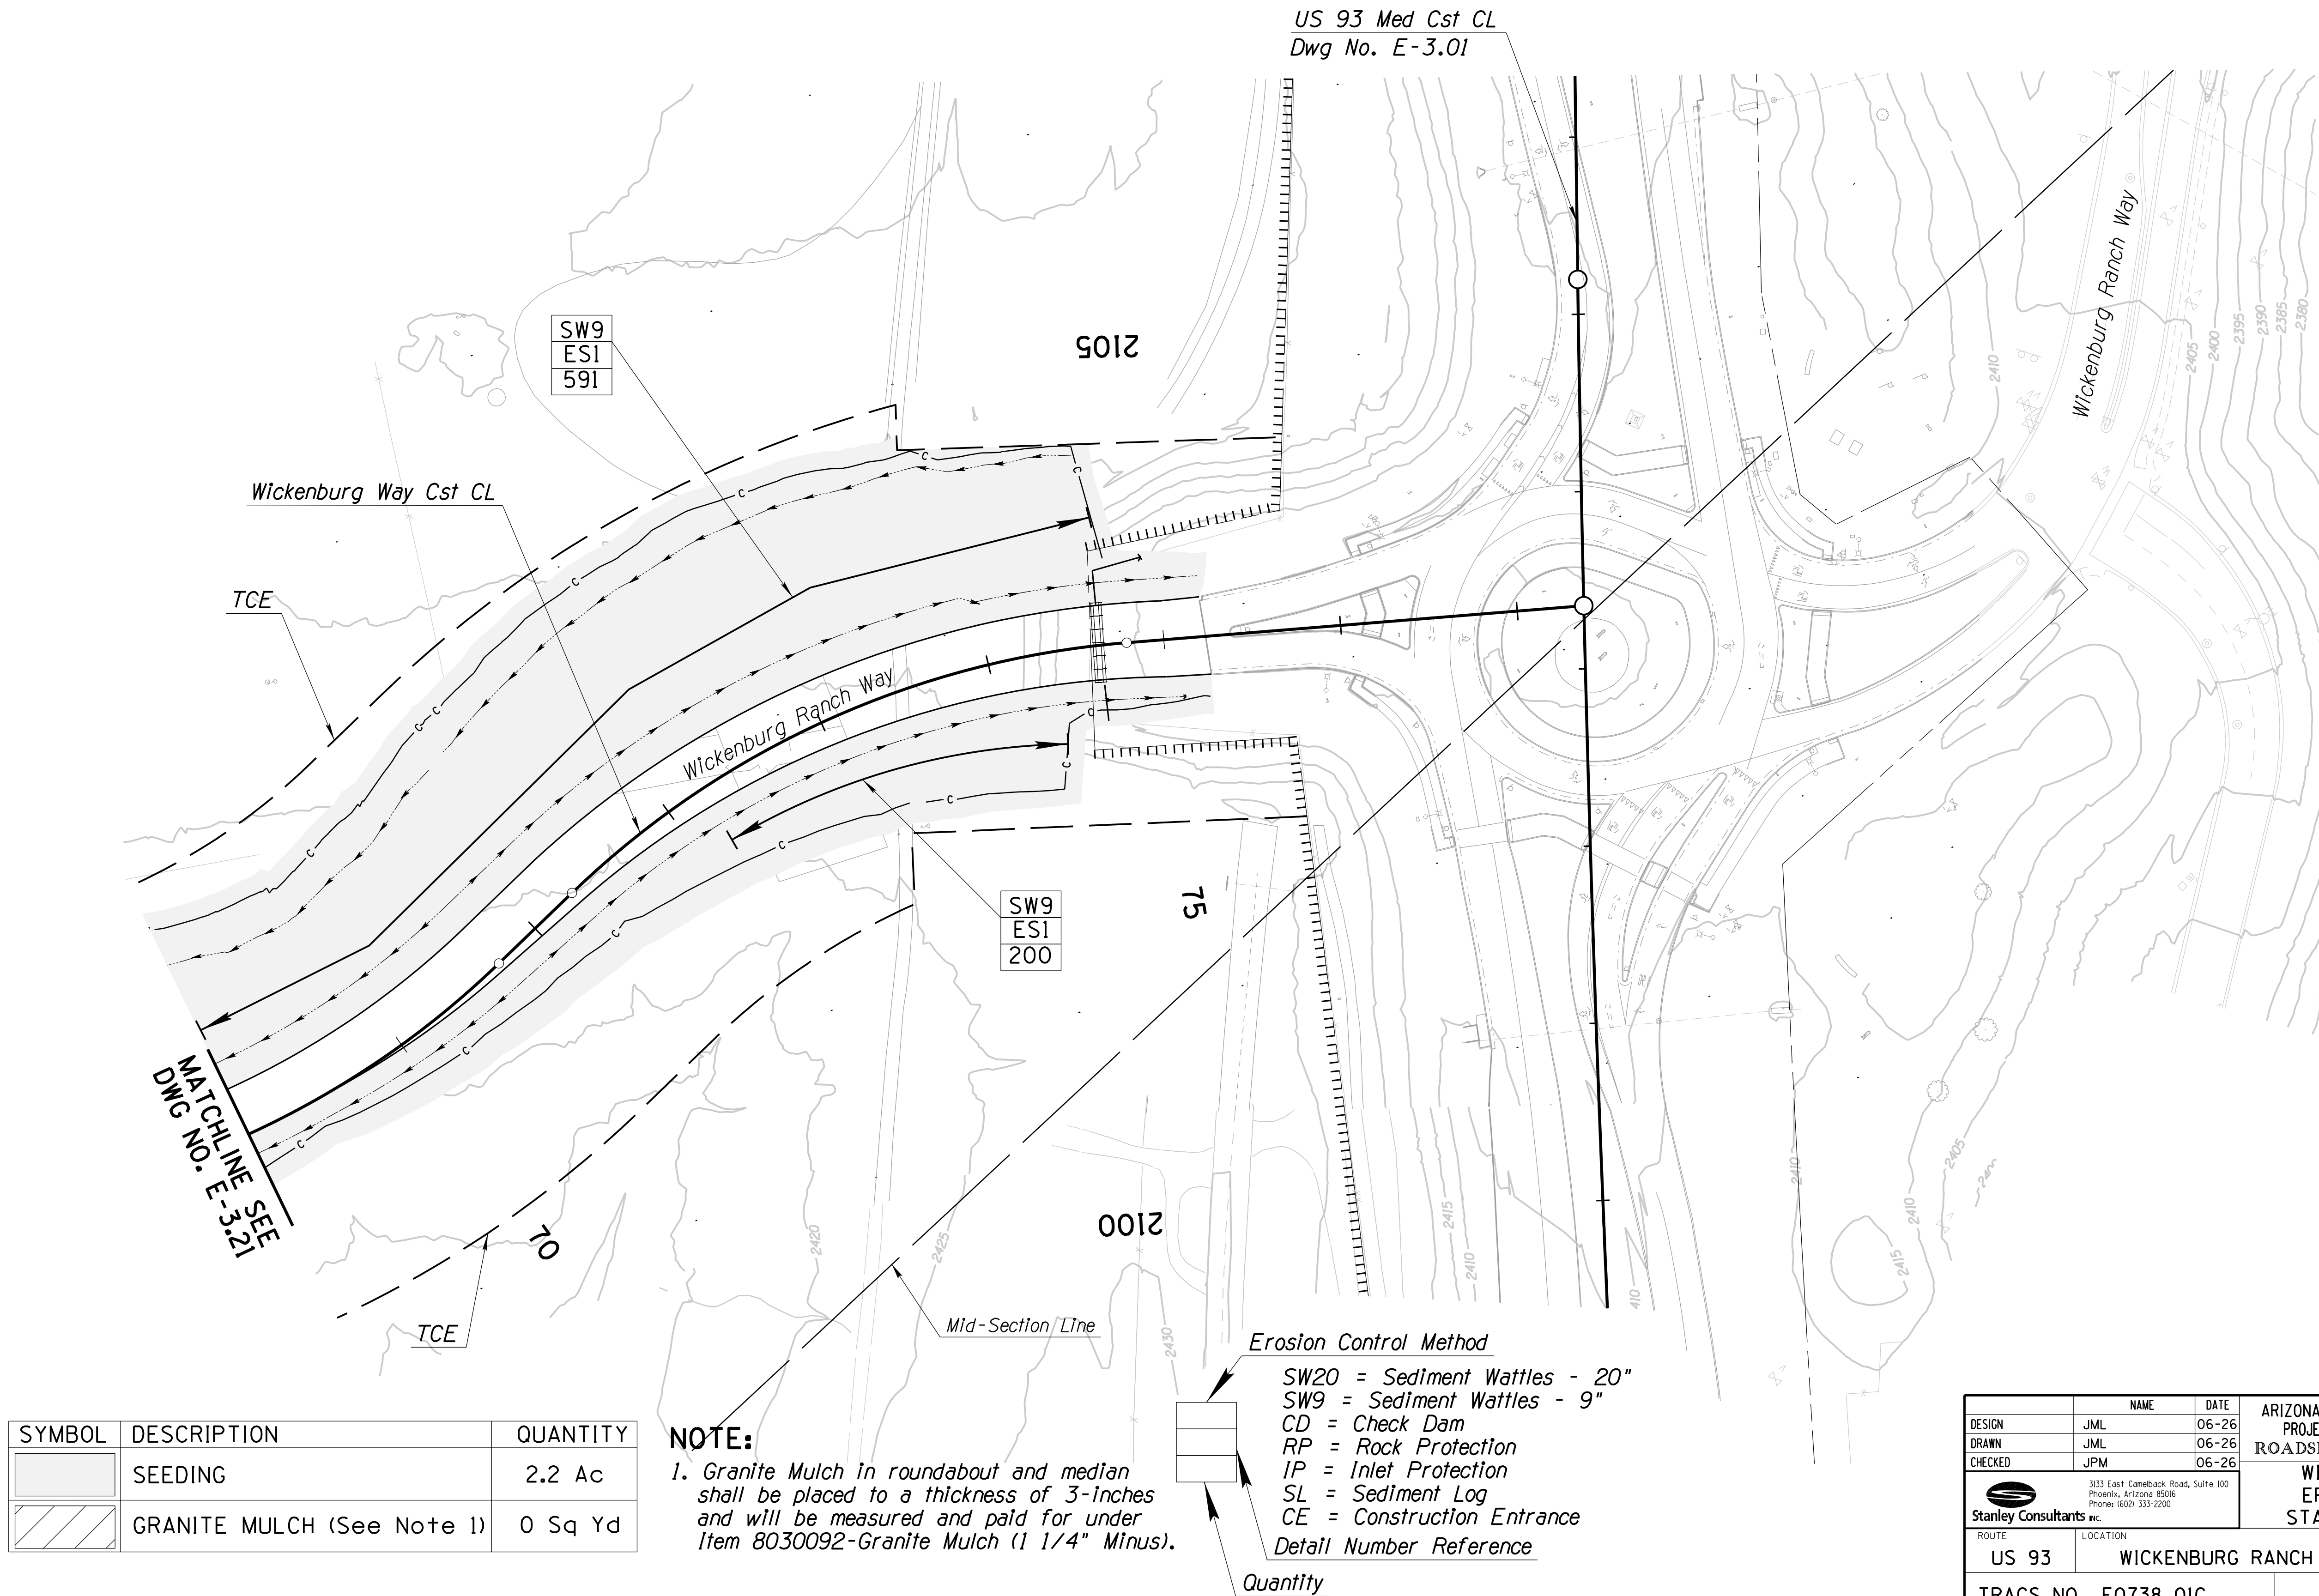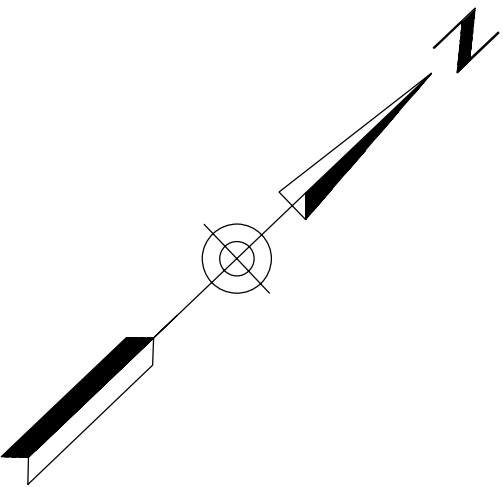

SYMBOL	DESCRIPTION	QUANTITY
	SEEDING	2.2 Ac
	GRANITE MULCH (See Note 1)	0 Sq Yd


NOTE:
1. Granite Mulch in roundabout and median shall be placed to a thickness of 3-inches and will be measured and paid for under Item 8030092-Granite Mulch (1 1/4" Minus).

Erosion Control Method	
SW20	= Sediment Wattles - 20"
SW9	= Sediment Wattles - 9"
CD	= Check Dam
RP	= Rock Protection
IP	= Inlet Protection
SL	= Sediment Log
CE	= Construction Entrance
Detail Number Reference	
	Quantity

		NAME	DATE	ARIZONA DEPARTMENT OF TRANSPORTATION PROJECT DELIVERY AND OPERATIONS DIVISION ROADSIDE DEVELOPMENT SECTION WICKENBURG RANCH WAY EROSION CONTROL PLAN STA 69+00 TO STA 76+00	
DESIGN		JML	06-26		
DRAWN		JML	06-26		
CHECKED		JPM	06-26		
		3133 East Camelback Road, Suite 100 Phoenix, Arizona 85016 Phone: (602) 333-2200			
ROUTE		LOCATION			
US 93		WICKENBURG RANCH WAY TO VISTA ROYALE			DWG NO. E-3.22
TRACS NO. F0738 OIC			093-B(230)T		___ OF ___

F.H.W.A. REGION	STATE	PROJECT NO.	SHEET NO.	TOTAL SHEETS	RECORD DRAWING
9	ARIZ.	093-B(230)T	522	524	

093 YV 189

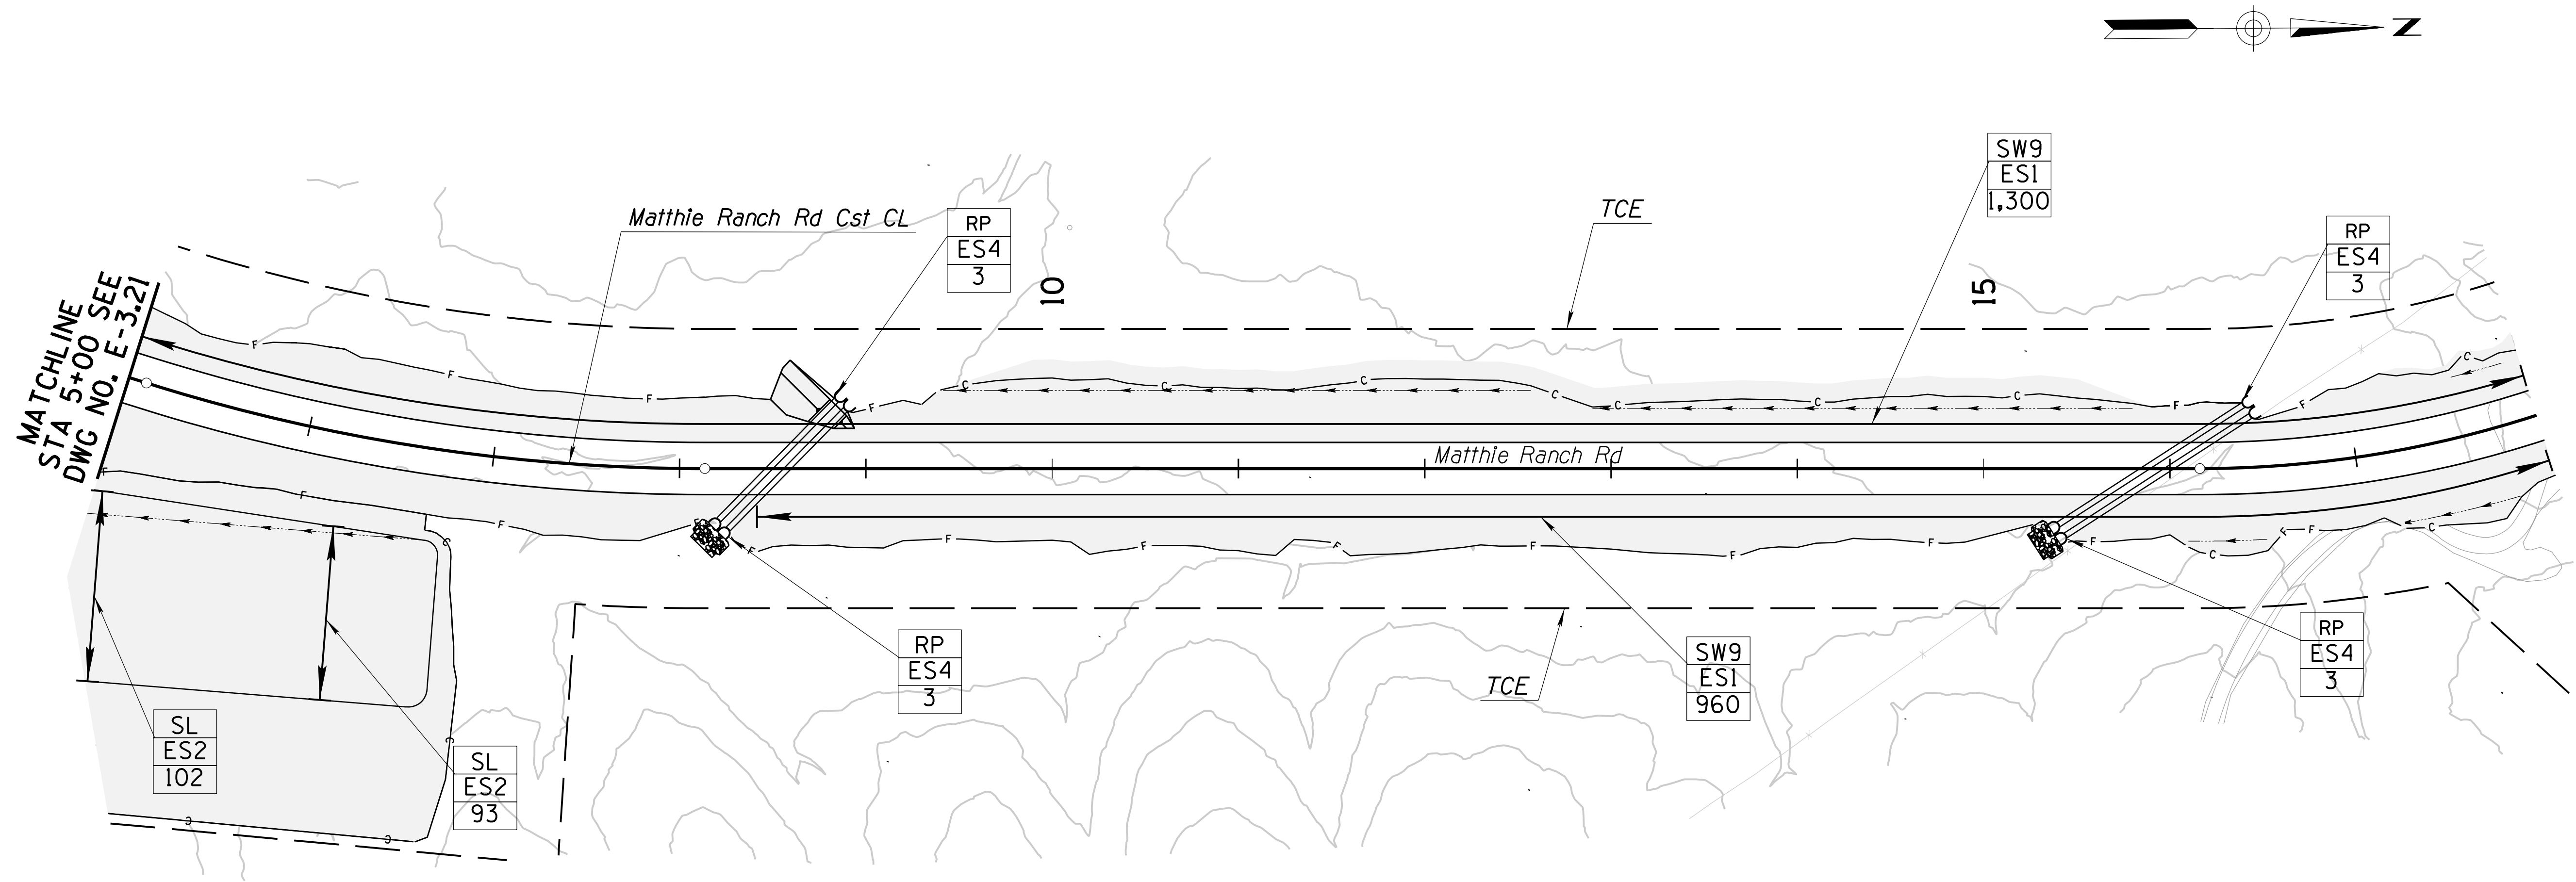

SYMBOL	DESCRIPTION	QUANTITY
	SEEDING	2.6 Ac
	GRANITE MULCH (See Note 1)	0 Sq Yd


NOTE:
1. Granite Mulch in roundabout and median shall be placed to a thickness of 3-inches and will be measured and paid for under Item 8030092-Granite Mulch (1 1/4" Minus).

Erosion Control Method
SW20 = Sediment Wattles - 20"
SW9 = Sediment Wattles - 9"
CD = Check Dam
RP = Rock Protection
IP = Inlet Protection
SL = Sediment Log
CE = Construction Entrance
Detail Number Reference
Quantity

DESIGN	NAME	DATE	ARIZONA DEPARTMENT OF TRANSPORTATION PROJECT DELIVERY AND OPERATIONS DIVISION ROADSIDE DEVELOPMENT SECTION	
DRAWN	JML	06-26	MATTHE RANCH ROAD EROSION CONTROL PLAN STA 5+00 TO STA 18+00	
CHECKED	JPM	06-26	US 93 WICKENBURG RANCH WAY TO VISTA ROYALE	DWG NO. E-3.23
Stanley Consultants Inc.			093-B(230)T	OF

F.H.W.A. REGION	STATE	PROJECT NO.	SHEET NO.	TOTAL SHEETS	RECORD DRAWING
9	ARIZ.	093-B(230)T	523	524	

093 YV 189

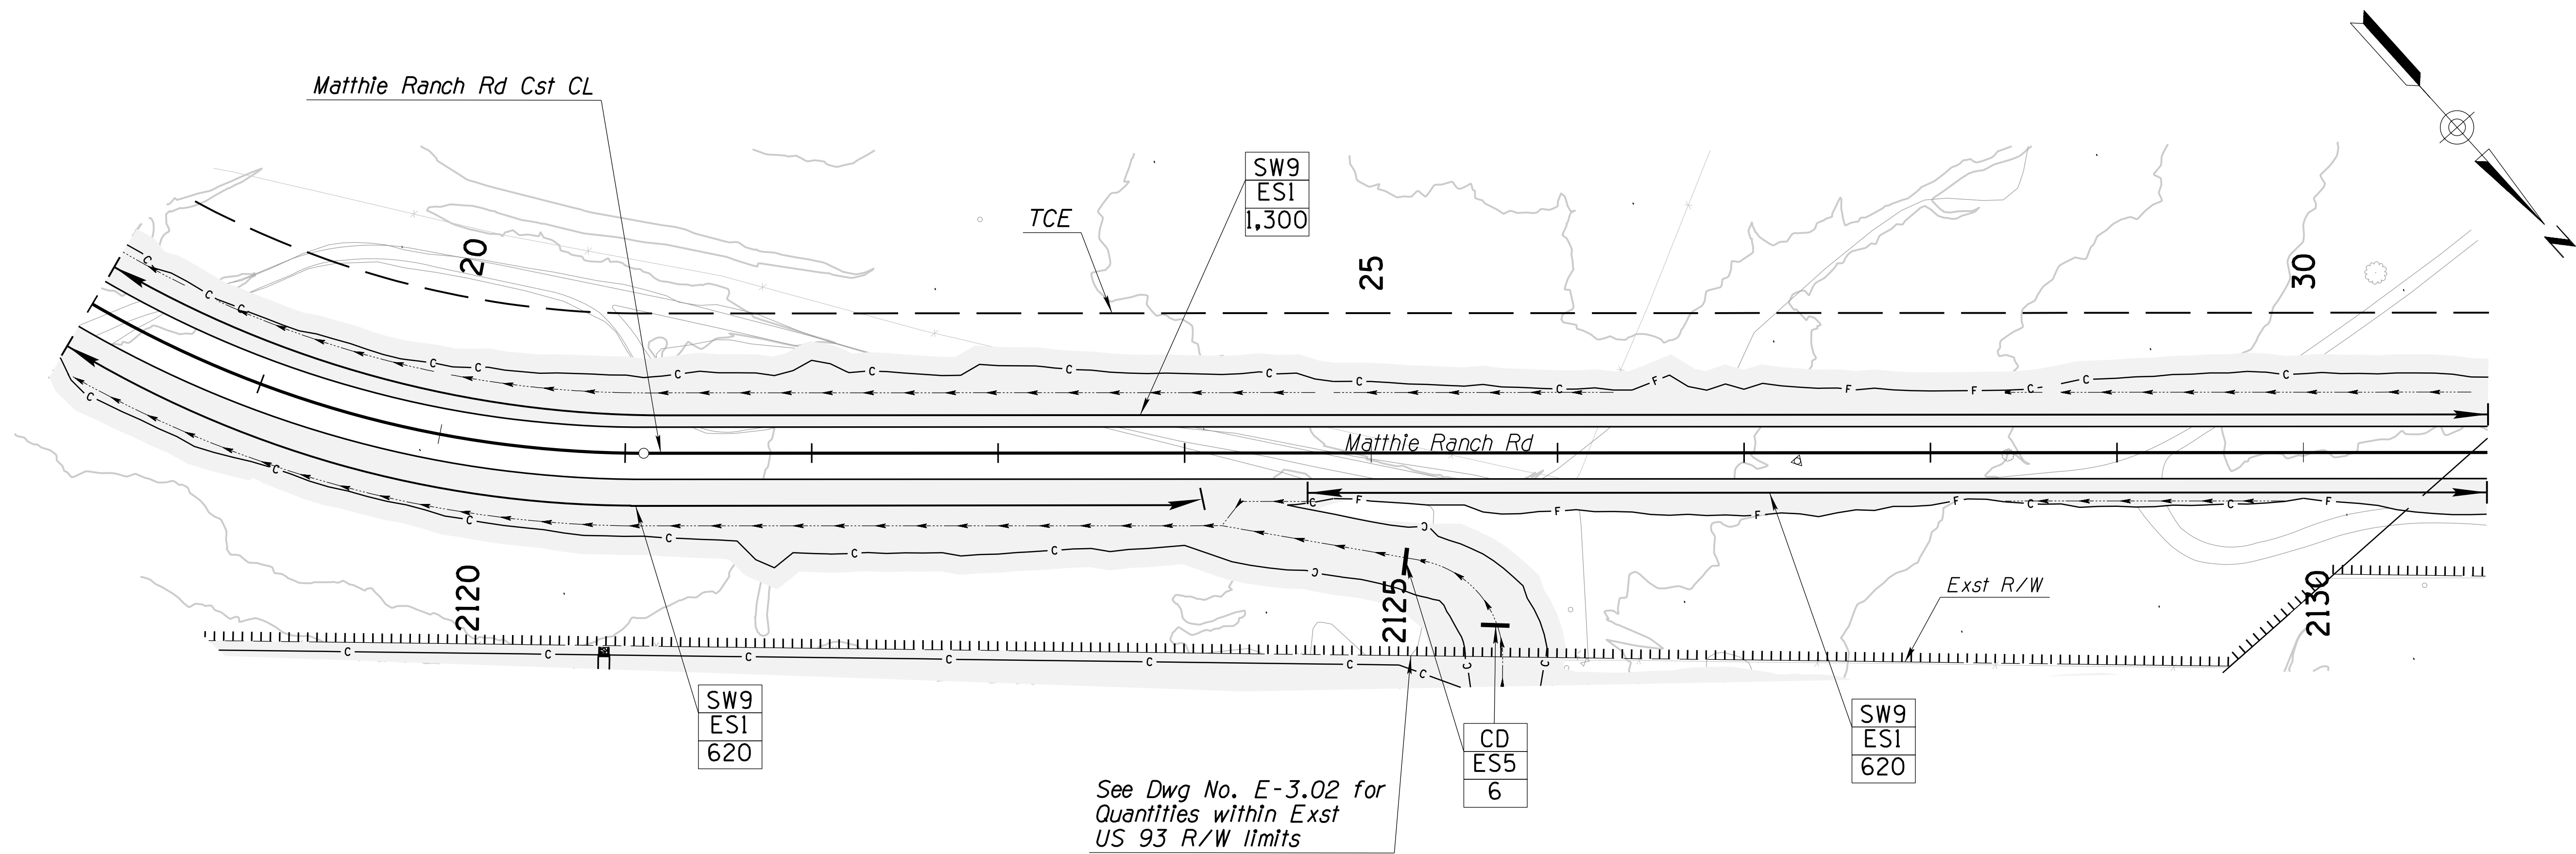

See Dwg No. E-3.02 for
Quantities within Exst
US 93 R/W limits

SYMBOL	DESCRIPTION	QUANTITY
	SEEDING	2.1 Ac
	GRANITE MULCH (See Note 1)	0 Sq Yd

NOTE:
1. Granite Mulch in roundabout and median shall be placed to a thickness of 3-inches and will be measured and paid for under Item 8030092-Granite Mulch (1 1/4" Minus).

Erosion Control Method

- SW20 = Sediment Wattles - 20"
- SW9 = Sediment Wattles - 9"
- CD = Check Dam
- RP = Rock Protection
- IP = Inlet Protection
- SL = Sediment Log
- CE = Construction Entrance


Detail Number Reference

Quantity

DESIGN	JML	DATE	06-26	ARIZONA DEPARTMENT OF TRANSPORTATION PROJECT DELIVERY AND OPERATIONS DIVISION ROADSIDE DEVELOPMENT SECTION MATTHIE RANCH ROAD EROSION CONTROL PLAN STA 18+00 TO STA 31+00	
DRAWN	JML	DATE	06-26		
CHECKED	JPM	DATE	06-26		
 3133 East Camelback Road, Suite 100 Phoenix, Arizona 85016 Phone: (602) 333-2200					
ROUTE	US 93			LOCATION	WICKENBURG RANCH WAY TO VISTA ROYALE
TRACS NO. F0738 OIC				093-B(230)T	DWG NO. E-3.24 OF

F.H.W.A. REGION	STATE	PROJECT NO.	SHEET NO.	TOTAL SHEETS	RECORD DRAWING
9	ARIZ.	093-B(230)T	524	524	

093 YV 189

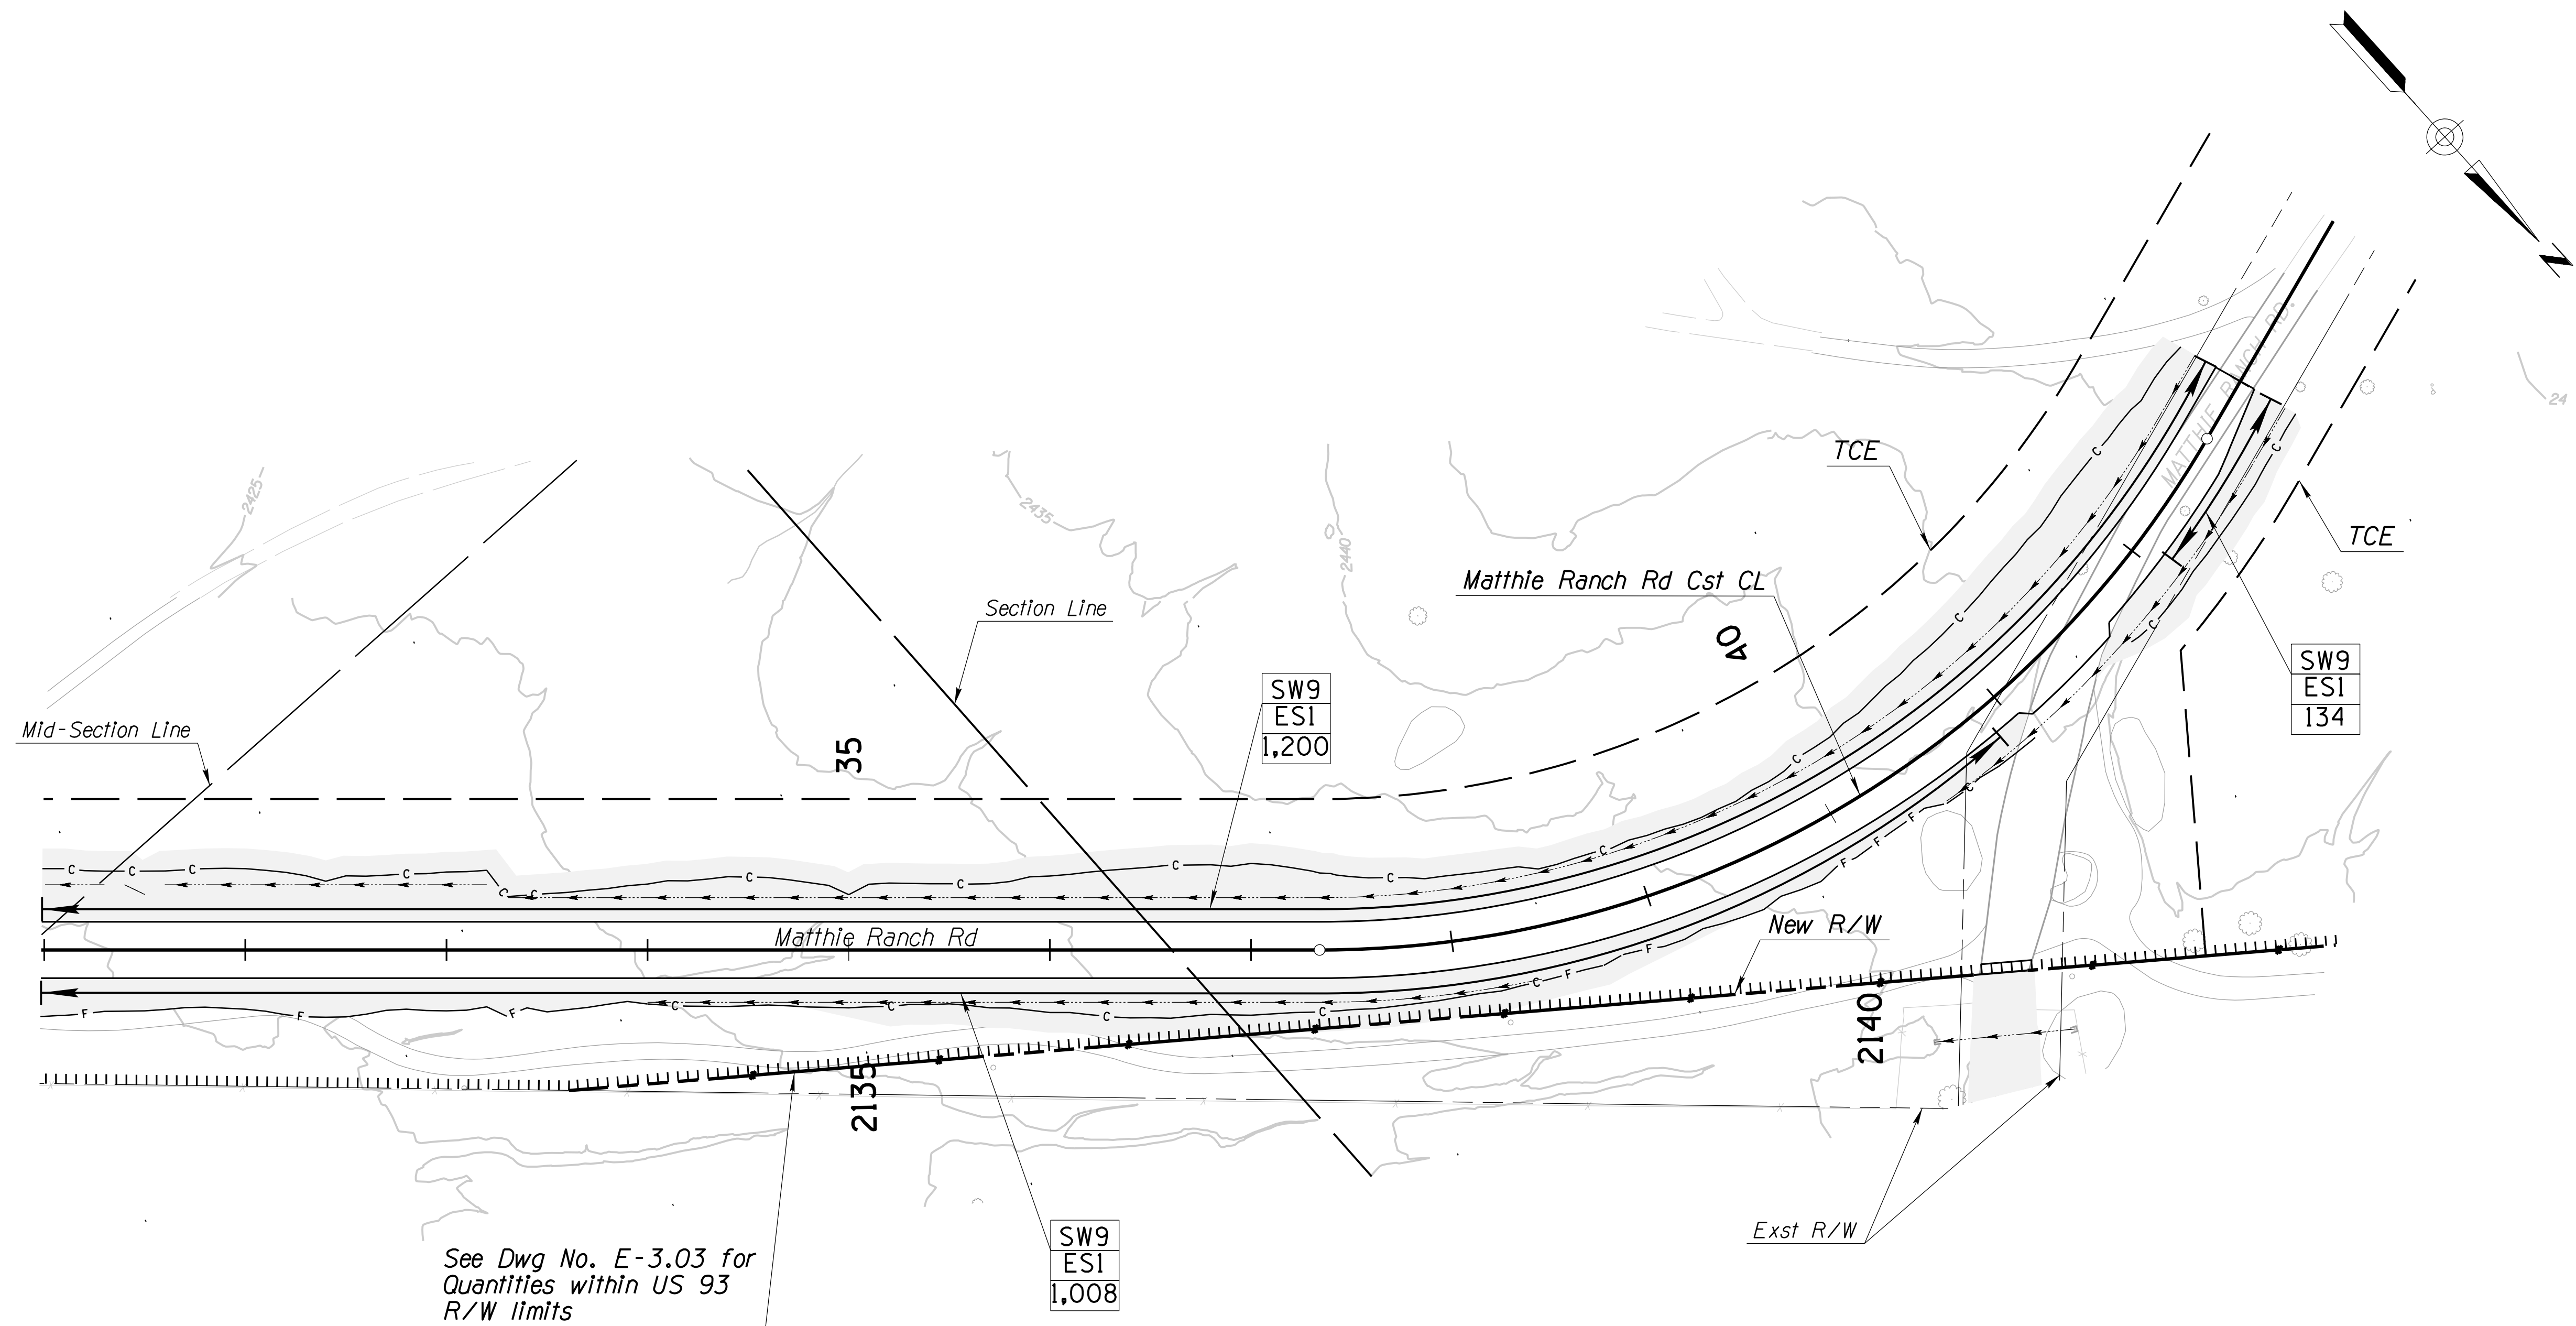

SYMBOL	DESCRIPTION	QUANTITY
	SEEDING	1.4 Ac
	GRANITE MULCH (See Note 1)	0 Sq Yd

NOTE:

1. Granite Mulch in roundabout and median shall be placed to a thickness of 3-inches and will be measured and paid for under Item 8030092-Granite Mulch (1 1/4" Minus).

Erosion Control Method

SW20 = Sediment Wattles - 20"
SW9 = Sediment Wattles - 9"
CD = Check Dam
RP = Rock Protection
IP = Inlet Protection
SL = Sediment Log
CE = Construction Entrance

Detail Number Reference

Quantity

DESIGN	NAME	DATE	ARIZONA DEPARTMENT OF TRANSPORTATION PROJECT DELIVERY AND OPERATIONS DIVISION ROADSIDE DEVELOPMENT SECTION	
DRAWN	JML	06-26	MATTHIE RANCH ROAD EROSION CONTROL PLAN STA 31+00 TO STA 43+00	
CHECKED	JPM	06-26		
Stanley Consultants Inc. 3133 East Camelback Road, Suite 100 Phoenix, Arizona 85016 Phone: (602) 333-2200				
ROUTE	LOCATION		DWG NO. E-3.25	
US 93	WICKENBURG RANCH WAY TO VISTA ROYALE			
TRACS NO. F0738 OIC			093-B(230)T	OF