




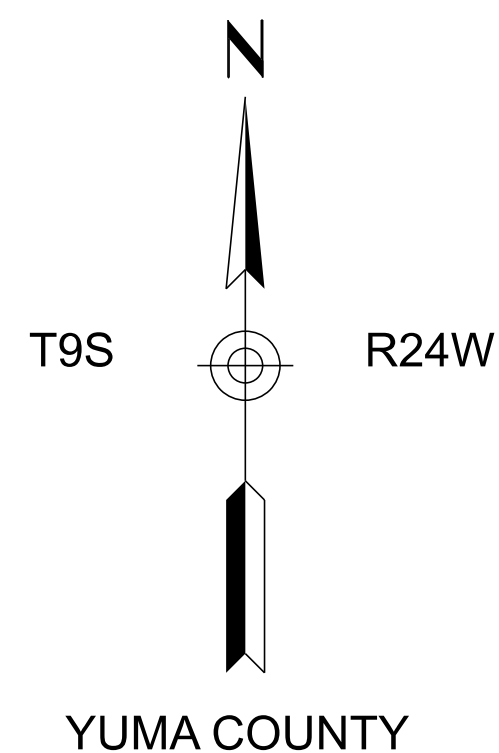

STATE OF ARIZONA
DEPARTMENT OF TRANSPORTATION
PROJECT DELIVERY AND OPERATIONS DIVISION

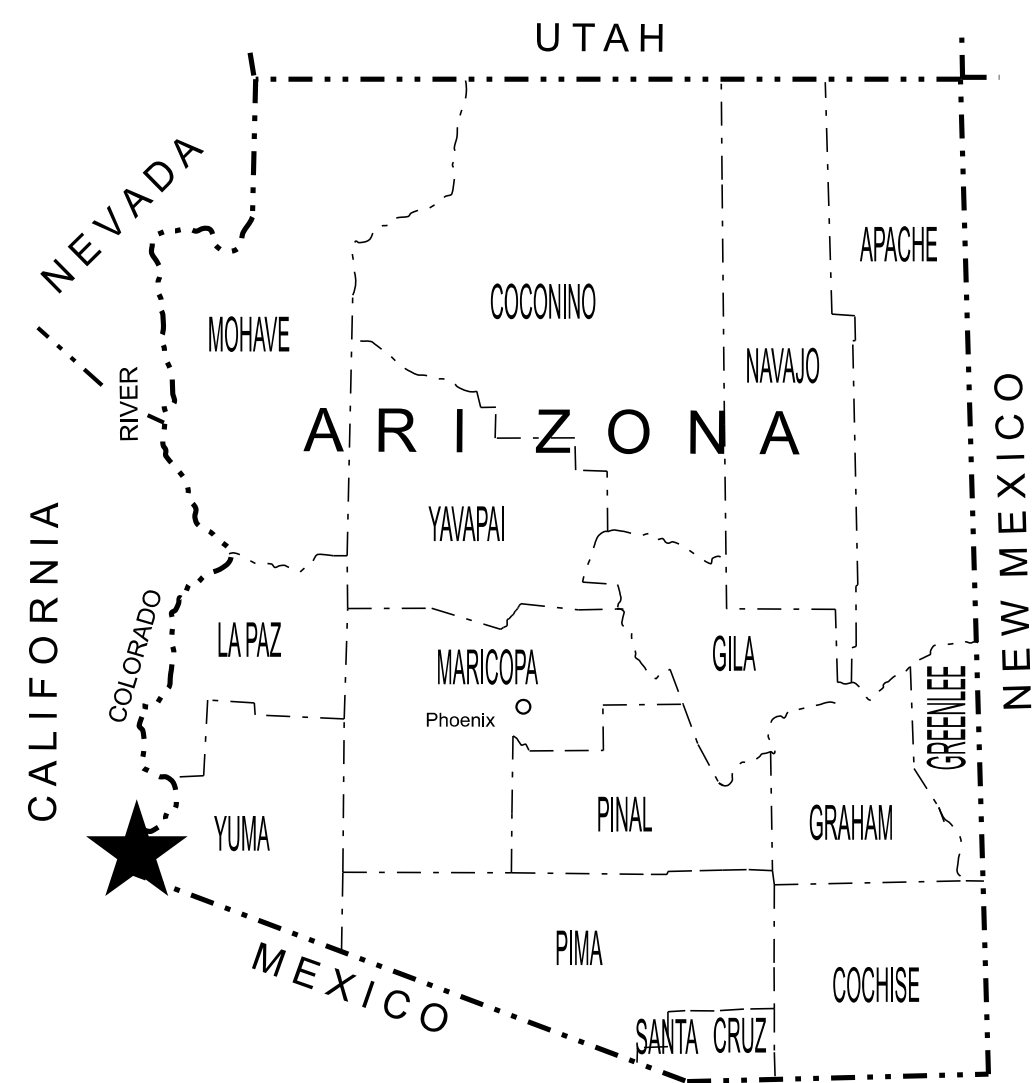

PROJECT PLANS
RURAL AREA
YUMA COUNTY

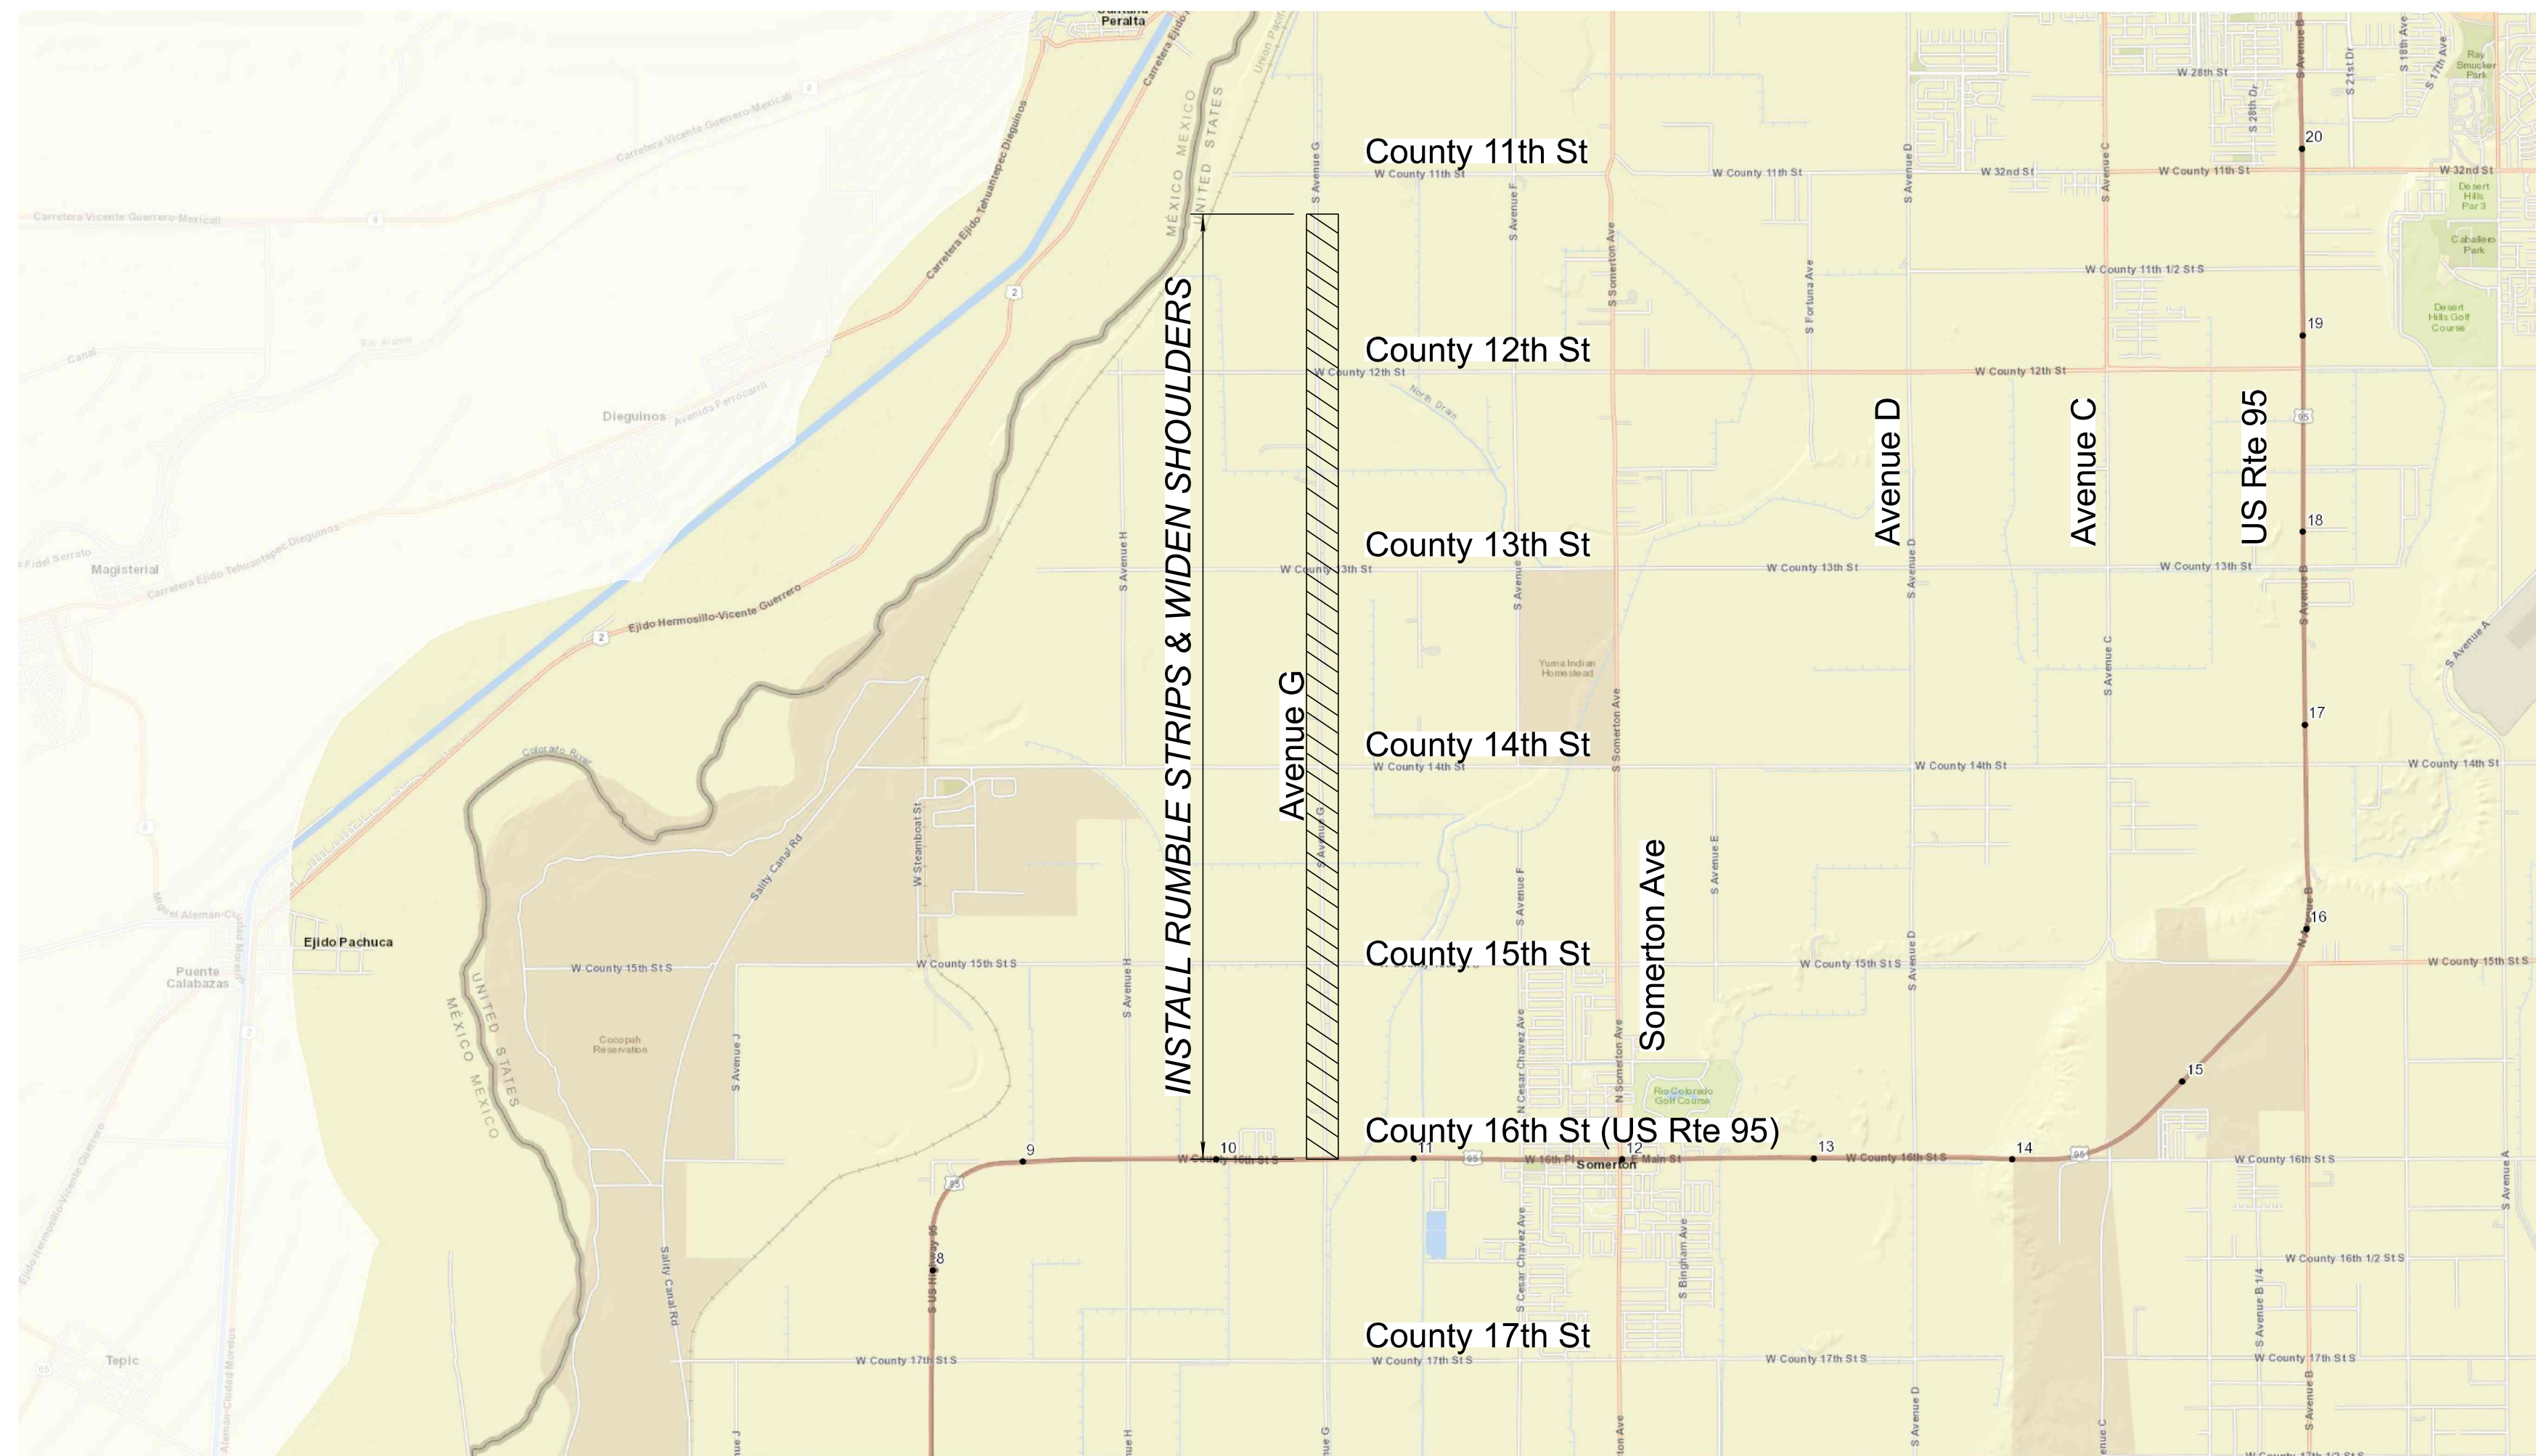

Constructed by:

Construction Company

Completion Date

Red-Lines by:

Construction Administrator Name & Company

Completion Date

Record Drawings by:

Record Drawings Designer Name & Company

Completion Date

AVENUE G, COUNTY 11TH ST - COUNTY 16TH ST
PROJECT NO.: 0000 YU YYU T0437 01C
FEDERAL AID NO.: YYU-0(225)T

ARIZONA DEPARTMENT OF TRANSPORTATION
PROJECT DELIVERY AND OPERATIONS DIVISION
AUDRA MERRICK, P.E., STATE ENGINEER

REC. DWGS. DATA	REC. DWG. DATE	OF
--------------------	----------------	----

ADOT STANDARD DRAWINGS

CONSTRUCTION STANDARDS
EFFECTIVE MARCH 2025

DATE	STANDARD	SUBJECT TITLE
5/12	C-01.10 SH 1	SYMBOL LEGEND
5/12	C-01.10 SH 2	SYMBOL LEGEND
5/12	C-01.10 SH 3	SYMBOL LEGEND
5/12	C-01.10 SH 4	SYMBOL LEGEND
12/17	C-01.30 SH 1	GENERAL ABBREVIATIONS
5/12	C-01.30 SH 2	GENERAL ABBREVIATIONS
5/12	C-01.30 SH 3	GENERAL ABBREVIATIONS
5/12	C-02.10	SLOPES, RURAL DIVIDED HIGHWAYS
5/12	C-02.20	SLOPES, RURAL UNDIVIDED AND FRINGE-URBAN HIGHWAYS
5/12	C-02.30	SLOPES, MISCELLANEOUS ROADWAYS
5/12	C-03.10 SH 1	DITCHES, CHANNELS, DIKES AND BERMS, DITCHES AND CHANNELS
5/12	C-03.10 SH 2	DITCHES, CHANNELS, DIKES AND BERMS, DIKES
5/12	C-03.10 SH 3	DITCHES, CHANNELS, DIKES AND BERMS, DITCH DIKE
5/12	C-03.10 SH 4	DITCHES, CHANNELS, DIKES AND BERMS, PIPE BERMS
5/12	C-03.10 SH 5	DITCHES, CHANNELS, DIKES AND BERMS, HEADWALL BERMS
12/17	C-04.10 SH 1	SPILLWAY, EMBANKMENT SINGLE INLET
12/17	C-04.10 SH 2	SPILLWAY, EMBANKMENT DOUBLE INLET
12/17	C-04.20 SH 1	DOWNDRAIN, EMBANKMENT SINGLE INLET
12/17	C-04.20 SH 2	DOWNDRAIN, EMBANKMENT DOUBLE INLET
12/17	C-04.30	SPILLWAY LENGTH TABLE
12/17	C-04.40	DOWNDRAIN LENGTH TABLE
5/12	C-04.50	DOWNDRAIN ENERGY DISSIPATOR
5/12	C-05.10	CURB & GUTTER, CURB, GUTTER
5/12	C-05.12 SH 1	CURB & GUTTER TRANSITIONS
5/12	C-05.12 SH 2	CURB & GUTTER TRANSITIONS
5/12	C-05.12 SH 3	CURB AND GUTTER TRANSITIONS
5/12	C-05.20 SH 1	CONCRETE DRIVEWAYS & SIDEWALKS, DRIVEWAYS
5/12	C-05.20 SH 2	CONCRETE DRIVEWAYS & SIDEWALKS, SIDEWALKS
5/12	C-05.30 SH 1	SIDEWALK RAMP, TYPE A
5/12	C-05.30 SH 2	SIDEWALK RAMP, TYPE B
5/12	C-05.30 SH 3	SIDEWALK RAMP, TYPE C
5/12	C-05.30 SH 4	SIDEWALK RAMP, TYPE D
5/12	C-05.30 SH 5	SIDEWALK RAMP, TYPE E
5/12	C-05.30 SH 6	SIDEWALK RAMP, TYPE F
5/12	C-05.30 SH 7	SIDEWALK RAMP, DETECTABLE WARNING STRIP
5/12	C-05.40	MEDIAN PAVING AND NOSE TAPER
5/12	C-05.50	CONCRETE BUS BAY
5/12	C-06.10 SH 1	DRIVEWAY & TURNOUT LAYOUTS
5/12	C-06.10 SH 2	DRIVEWAY & TURNOUT LAYOUTS
5/12	C-07.01 SH 1	PCCP JOINTS
5/12	C-07.01 SH 2	PCCP JOINTS
5/12	C-07.02	LOAD TRANSFER DOWEL ASSEMBLY
5/12	C-07.03 SH 1	PCCP JOINT LOCATIONS, MAINLINE SKEWED JOINTS
5/12	C-07.03 SH 2	PCCP JOINT LOCATIONS, MAINLINE SKEWED JOINTS
5/12	C-07.03 SH 3	PCCP JOINT LOCATIONS, MAINLINE SKEWED JOINTS
5/12	C-07.03 SH 4	PCCP JOINT LOCATIONS, MAINLINE SKEWED JOINTS
5/12	C-07.03 SH 5	PCCP JOINT LOCATIONS, MAINLINE NON-SKEWED JOINTS
5/12	C-07.03 SH 6	PCCP JOINT LOCATIONS, MAINLINE NON-SKEWED JOINTS
5/12	C-07.03 SH 7	PCCP JOINT LOCATIONS, MAINLINE NON-SKEWED JOINTS
5/12	C-07.03 SH 8	PCCP JOINT LOCATIONS, MAINLINE NON-SKEWED JOINTS
5/12	C-07.04 SH 1	PCCP JOINT LOCATIONS, PARALLEL-TYPE ENTRANCE RAMP WITH AUXILIARY LANE
5/12	C-07.04 SH 2	PCCP JOINT LOCATIONS, PARALLEL-TYPE EXIT RAMP WITH AUXILIARY LANE
5/12	C-07.04 SH 3	PCCP JOINT LOCATIONS, TAPER-TYPE ENTRANCE RAMP
5/12	C-07.04 SH 4	PCCP JOINT LOCATIONS, TAPER-TYPE EXIT RAMP
5/12	C-07.04 SH 5	PCCP JOINT LOCATIONS, CROSSROAD AND RAMP TERMINI
8/21	C-07.06	TRENCH BACKFILL AND PAVEMENT REPLACEMENT
5/12	C-08.20	PAVED GORE AREA
12/17	C-10.00	GUARDRAIL MEASUREMENT LIMITS
12/17	C-10.01	GUARDRAIL INSTALLATION
12/17	C-10.03	W-BEAM GUARDRAIL, MGS BLOCKED-OUT TIMBER POST
12/17	C-10.04	W-BEAM GUARDRAIL, MGS BLOCKED-OUT STEEL POST
12/17	C-10.05 SH 1	W-BEAM GUARDRAIL (MODIFIED) WITH FREEWAY CURB AND GUTTER
12/17	C-10.05 SH 2	W-BEAM GUARDRAIL (MODIFIED) WITH FREEWAY CURB AND GUTTER
12/17	C-10.06	W-BEAM GUARDRAIL LONG-SPAN
12/17	C-10.07 SH 1	W-BEAM GUARDRAIL, BOX CULVERT GUARDRAIL POST
12/17	C-10.07 SH 2	W-BEAM GUARDRAIL, BOX CULVERT GUARDRAIL POST
12/17	C-10.08 SH 1	W-BEAM GUARDRAIL, END ANCHOR
12/17	C-10.08 SH 2	W-BEAM GUARDRAIL, END ANCHOR
12/17	C-10.09	GUARDRAIL POST ROCK INSTALLATION
4/19	C-10.20 SH 1	GUARDRAIL END TERMINAL PAD LAYOUT FOR SOFTSTOP
4/19	C-10.20 SH 2	GUARDRAIL END TERMINAL PAD LAYOUT FOR SOFTSTOP
4/19	C-10.21 SH 1	GUARDRAIL END TERMINAL PAD LAYOUT FOR MSKT
4/19	C-10.21 SH 2	GUARDRAIL END TERMINAL PAD LAYOUT FOR MSKT
4/19	C-10.22 SH 1	GUARDRAIL END TERMINAL PAD LAYOUT FOR MAX-TENSION
4/19	C-10.22 SH 2	GUARDRAIL END TERMINAL PAD LAYOUT FOR MAX-TENSION
4/21	C-10.23 SH 1	GUARDRAIL END TERMINAL PAD LAYOUT FOR SGET
4/21	C-10.23 SH 2	GUARDRAIL END TERMINAL PAD LAYOUT FOR SGET
3/25	C-10.24 SH 1	GUARDRAIL END TERMINAL PAD LAYOUT FOR NGT
3/25	C-10.24 SH 2	GUARDRAIL END TERMINAL PAD LAYOUT FOR NGT
11/19	C-10.26 SH 1	GUARDRAIL END TERMINAL PAD LAYOUT FOR MFLEAT
11/19	C-10.26 SH 2	GUARDRAIL END TERMINAL PAD LAYOUT FOR MFLEAT
12/17	C-10.30 SH 1	GUARDRAIL TRANSITION TO CONCRETE BARRIER, TIMBER POST
12/17	C-10.30 SH 2	GUARDRAIL TRANSITION TO CONCRETE BARRIER, TIMBER POST
12/17	C-10.31 SH 1	GUARDRAIL TRANSITION TO CONCRETE BARRIER, STEEL POST
12/17	C-10.31 SH 2	GUARDRAIL TRANSITION TO CONCRETE BARRIER, STEEL POST
12/17	C-10.38 SH 1	GUARDRAIL TAPER G4 TO MGS W-BEAM WITH STAGGERED POST
12/17	C-10.38 SH 2	GUARDRAIL TAPER G4 TO MGS W-BEAM WITH OFFSET RAIL
12/17	C-10.40	CONCRETE MEDIAN BARRIER, 32" TYPE 'F', CAST-IN-PLACE
12/17	C-10.41	CONCRETE MEDIAN BARRIER, 42" TYPE 'F', CAST-IN-PLACE
12/17	C-10.44 SH 1	CONCRETE MEDIAN BARRIER, 42" TYPE 'F'WITH VARIABLE HEIGHT SIDES, H=0"TO 26"
12/17	C-10.44 SH 2	CONCRETE MEDIAN BARRIER, 42" TYPE 'F'WITH VARIABLE HEIGHT SIDES, H=0"TO 26"
12/17	C-10.45 SH 1	CONCRETE MEDIAN BARRIER, 42" TYPE 'F'WITH VARIABLE HEIGHT SIDES, H=26"TO 60"
12/17	C-10.45 SH 2	CONCRETE MEDIAN BARRIER, 42" TYPE 'F'WITH VARIABLE HEIGHT SIDES, H=26"TO 60"
12/17	C-10.50 SH 1	CONCRETE HALF BARRIER, 32" TYPE 'F', CAST-IN-PLACE
12/17	C-10.50 SH 2	CONCRETE HALF BARRIER, 32" TYPE 'F', PRECAST
12/17	C-10.51	CONCRETE HALF BARRIER, 32" TYPE 'F' WITH SIDEWALK

DATE	STANDARD	SUBJECT TITLE
12/17	C-10.52	CONCRETE HALF BARRIER, 32" TYPE 'F' WITH GUTTER
12/17	C-10.53	CONCRETE HALF BARRIER, 42" TYPE 'F' WITH GUTTER
12/17	C-10.54 SH 1	CONCRETE HALF BARRIER, 32" TYPE 'F' AT PIERS, CAST-IN-PLACE
12/17	C-10.54 SH 2	CONCRETE HALF BARRIER, 32" TYPE 'F' AT PIERS, PRECAST
12/17	C-10.54 SH 3	CONCRETE HALF BARRIER, 32" TYPE 'F' AT PIERS, LAYOUT
12/17	C-10.55 SH 1	CONCRETE HALF BARRIER, 42" TYPE 'F' AT PIERS, CAST-IN-PLACE
12/17	C-10.55 SH 2	CONCRETE HALF BARRIER, 42" TYPE 'F' AT PIERS, PRECAST
12/17	C-10.55 SH 3	CONCRETE HALF BARRIER, 42" TYPE 'F' AT PIERS, LAYOUT
12/17	C-10.70 SH 1	CONCRETE HALF-BARRIER TRANSITION TO VERTICAL, 32" TYPE 'F' WITH CAISSONS
12/17	C-10.70 SH 2	CONCRETE HALF-BARRIER TRANSITION TO VERTICAL, 32" TYPE 'F' WITH CAISSONS
12/17	C-10.70 SH 3	CONCRETE HALF-BARRIER TRANSITION TO VERTICAL, 32" TYPE 'F' WITH CAISSONS
12/17	C-10.71 SH 1	CONCRETE HALF-BARRIER TRANSITION TO VERTICAL, 32" TYPE 'F' WITH CURB & GUTTER
12/17	C-10.71 SH 2	CONCRETE HALF-BARRIER TRANSITION TO VERTICAL, 32" TYPE 'F' WITH CURB & GUTTER
12/17	C-10.72 SH 1	CONCRETE HALF-BARRIER TRANSITION TO VERTICAL, 42" TO 32" TYPE 'F' WITH CAISSONS
12/17	C-10.72 SH 2	CONCRETE HALF-BARRIER TRANSITION TO VERTICAL, 42" TO 32" TYPE 'F' WITH CAISSONS
12/17	C-10.72 SH 3	CONCRETE HALF-BARRIER TRANSITION TO VERTICAL, 42" TO 32" TYPE 'F' WITH CAISSONS
12/17	C-10.73 SH 1	CONCRETE HALF-BARRIER TRANSITION TO VERTICAL, 42" TO 32" TYPE 'F' WITH GUTTER
12/17	C-10.73 SH 2	CONCRETE HALF-BARRIER TRANSITION TO VERTICAL, 42" TO 32" TYPE 'F' WITH GUTTER
12/17	C-10.74	CONCRETE HALF-BARRIER TRANSITION, 42" TO 32" TYPE 'F'
12/17	C-10.75 SH 1	CONCRETE HALF-BARRIER TRANSITION, TYPE 'F' TANGENT DEPARTURE TYPE 1
12/17	C-10.75 SH 2	CONCRETE HALF-BARRIER TRANSITION, TYPE 'F' TANGENT DEPARTURE TYPE 2
12/17	C-10.76	CONCRETE HALF-BARRIER TRANSITION, TYPE 'F' AT RADIUS, 32" TO 0"
4/19	C-10.77	CONCRETE BARRIER TRANSITION TO GUARDRAIL END TERMINAL LAYOUT WITH CURB
12/17	C-10.78	CONCRETE HALF-BARRIER TRANSITION, 32" TYPE 'F' LOW SPEED APPROACH
12/17	C-10.79	CONCRETE HALF-BARRIER TRANSITION, 42" TYPE 'F' TANGENT DEPARTURE
5/12	C-11.10 SH 1	ROADWAY CATTLE GUARD
5/12	C-11.10 SH 2	ROADWAY CATTLE GUARD
5/12	C-11.10 SH 3	ROADWAY CATTLE GUARD
5/12	C-11.10 SH 4	ROADWAY CATTLE GUARD
5/12	C-11.20	CATTLE GUARD, DRAINAGE
5/12	C-12.10 SH 1	FENCE, WOVEN WIRE
5/12	C-12.10 SH 2	FENCE, BARBED WIRE
5/12	C-12.10 SH 3	FENCE, TYPE 1 AND 2 GATES, FLOOD GATE
5/12	C-12.10 SH 4	FENCE, FLOOD GATE INSTALLATION
5/12	C-12.10 SH 5	FENCE, MISCELLANEOUS DETAILS
5/12	C-12.20 SH 1	FENCE, CHAIN LINK, TYPE 1
5/12	C-12.20 SH 2	FENCE, CHAIN LINK, TYPE 2
5/12	C-12.20 SH 3	FENCE, CHAIN LINK, GATES
5/12	C-12.30 SH 1	FENCE, CHAIN LINK CABLE BARRIER
5/12	C-12.30 SH 2	FENCE, CHAIN LINK CABLE BARRIER
5/12	C-12.30 SH 3	FENCE, CHAIN LINK CABLE BARRIER
5/12	C-13.10 SH 1	PIPE CULVERT INSTALLATION
5/12	C-13.10 SH 2	PIPE CULVERT INSTALLATION
8/23	C-13.15	TYPICAL PIPE INSTALLATION
5/12	C-13.20	PIPE, REINFORCED CONCRETE END SECTION
5/12	C-13.25	PIPE, CORRUGATED METAL END SECTION
5/12	C-13.30	PIPE AND PIPE ARCH, CORRUGATED METAL, CONCRETE INVERT PAVING
5/12	C-13.55	PIPE, CATTLE-VEHICLE PASS, MITERED END TREATMENT
5/12	C-13.60	SLOTTED DRAIN DETAILS
5/12	C-13.65	SLOTTED DRAIN INSTALLATION DETAILS
5/12	C-13.70	STORM DRAIN CONNECTION DETAILS
5/12	C-13.75	STORM DRAIN OUTLET BARRIER GATE
5/12	C-13.76	STORM DRAIN OUTLET AND STORM DRAIN PLUG
5/12	C-13.80	PIPE COLLAR DETAILS
5/12	C-15.10	CATCH BASIN, TYPE 1
5/12	C-15.20 SH 1	CATCH BASIN, TYPE 3
5/12	C-15.20 SH 2	CATCH BASIN, TYPE 3
5/12	C-15.20 SH 3	CATCH BASIN, ACCESS FRAME AND COVER DETAILS
5/12	C-15.30	CATCH BASIN, TYPE 4
5/12	C-15.40 SH 1	CATCH BASIN, TYPE 5
5/12	C-15.40 SH 2	CATCH BASIN, TYPE 5
5/12	C-15.50	CATCH BASIN, FRAME AND GRATE
5/12	C-15.70 SH 1	CATCH BASIN, MISCELLANEOUS DETAILS
5/12	C-15.70 SH 2	CATCH BASIN, MISCELLANEOUS DETAILS
5/12	C-15.75	CATCH BASIN, DROP INLET
5/12	C-15.80	CATCH BASIN, FLUSH
5/12	C-15.81	CATCH BASIN, SIDE SLOPE
5/12	C-15.90	CATCH BASIN, MEDIAN DIKE, PRECAST
5/12	C-15.91 SH 1	FREEWAY CATCH BASIN DETAILS
5/12	C-15.91 SH 2	FREEWAY CATCH BASIN DETAILS
5/12	C-15.92 SH 1	CATCH BASIN WITH TYPE 'F' CONCRETE HALF BARRIER
5/12	C-15.92 SH 2	CATCH BASIN WITH TYPE 'F' CONCRETE HALF BARRIER
5/12	C-16.40	IRRIGATION SLEEVES
5/12	C-17.10	RAIL BANK PROTECTION FOR DRAINAGEWAYS, TYPES 1, 2 & 3
5/12	C-17.15	RAIL BANK PROTECTION AT ABUTMENTS, TYPES 4, 5 & 6
5/12	C-17.20	RAIL BANK PROTECTION FOR DRAINAGEWAYS, TYPES 7, 8 & 9
5/12	C-18.10 SH 1	MANHOLE, RISER DETAILS
5/12	C-18.10 SH 2	MANHOLE, BASE DETAILS, NORMAL INSTALLATION
5/12	C-18.10 SH 3	MANHOLE, FRAME AND COVER DETAILS
5/12	C-19.10 SH 1	FORD, CONCRETE WALLS
5/12	C-19.10 SH 2	FORD, TYPES 1 AND 2
5/12	C-21.10	SURVEY MONUMENT FRAME AND COVER
5/12	C-21.20	SURVEY MARKER

ADOT STANDARD DRAWINGS REVISION DATES and STANDARD NO.'s REVIEW			
CONSTRUCTION STANDARDS		NAME	DATE
PROJECT NO.		Michael Schoen	07/26
0000 YU YYU T0437 01C		1A	OF 37
RECORD DRAWING DATA	FEDERAL ID NO. YYU-0(225)T	REC. DWG. DATE	OF

ADOT STANDARD DRAWINGS

TRAFFIC SIGNING & MARKING STANDARDS

(SHEET 1 OF 2)

EFFECTIVE MAY 2025

REVISION DATE	STANDARD NUMBER	SUBJECT : SIGNING AND MARKING DETAILS
6/14	M-1	CURB MARKINGS FOR RAISED MEDIAN AND ISLANDS
1/20	M-2 SHT 1	INTERSECTION STRIPING
5/15	M-2 SHT 2	INTERSECTION STRIPING (TWO-LANE RURAL)
6/14	M-2 SHT 3	CENTERLINE AND REVERSE CURVE DETAILS
6/14	M-3	STRIPING AND DELINEATION FOR FREEWAY TERMINALS
6/14	M-4	PASSING LANE STRIPING DETAILS
6/14	M-5	RAILROAD PAVEMENT MARKINGS
6/14	M-6	WORD MARKINGS
6/14	M-7	PAVEMENT LETTERS
6/14	M-8	PAVEMENT LETTERS
6/14	M-9	PAVEMENT NUMBERS
6/14	M-10 SHT 1	PAVEMENT MARKING SYMBOLS
6/14	M-10 SHT 2	PAVEMENT MARKING SYMBOLS
5/25	M-10 SHT 3	PAVEMENT MARKING SYMBOLS
6/14	M-11	TURN LANE PAVEMENT MARKINGS
6/14	M-12	WRONG-WAY ARROWS
1/19	M-13	PREFERENTIAL LANE PAVEMENT MARKINGS
6/14	M-14	STRIPING AND DELINEATION FOR TRUCK ESCAPE RAMPS
8/20	M-15 SHT 1	PAVEMENT MARKING FOR FREEWAY ENTRANCE RAMP - TAPERED ACCELERATION LANE
8/20	M-15 SHT 2	PAVEMENT MARKING FOR FREEWAY ENTRANCE RAMP - PARALLEL ACCELERATION LANE
8/20	M-15 SHT 3	PAVEMENT MARKING FOR FREEWAY ENTRANCE RAMP - PARALLEL ACCELERATION LANE WITH HOV BYPASS
6/14	M-15 SHT 4	PAVEMENT MARKING FOR FREEWAY PARALLEL - ACCELERATION LANE
8/20	M-16 SHT 1	PAVEMENT MARKING FOR FREEWAY EXIT RAMPS - TAPERED DECELERATION LANE
8/20	M-16 SHT 2	PAVEMENT MARKING FOR FREEWAY EXIT RAMP - PARALLEL DECELERATION LANE
8/20	M-17	FREEWAY LANE DROP PAVEMENT MARKINGS
11/24	M-19 SHT 1	RAISED PAVEMENT MARKER PLAN LEGEND
6/14	M-19 SHT 2	NON-REFLECTIVE RAISED PAVEMENT MARKER DETAILS
11/24	M-19 SHT 3	RETROREFLECTIVE RAISED PAVEMENT MARKER DETAILS
11/24	M-19 SHT 4	RETROREFLECTIVE RAISED PAVEMENT MARKER DETAILS
5/15	M-19 SHT 5	PAVEMENT MARKING DETAILS FOR UNDIVIDED HIGHWAYS
6/14	M-19 SHT 6	RETROREFLECTIVE RAISED PAVEMENT MARKERS (RPM) FOR UNDIVIDED HIGHWAYS
8/20	M-19 SHT 7	FREEWAY AND DIVIDED HIGHWAY EDGE LINE AND LANE STRIPING
5/15	M-19 SHT 8	LANE DROP MARKING AND RAMP OR INTERSECTION GUIDE STRIPING
8/20	M-19 SHT 9	PAVEMENT MARKING CROSS-SECTION DETAILS FOR HIGHWAYS AND FREEWAYS
6/24	M-19 SHT 10	CONTRAST LANE LINE FOR FREEWAY AND DIVIDED HIGHWAY
10/23	M-19 SHT 11	LEAD-LAG CONTRAST PAVEMENT MARKINGS FOR CONCRETE PAVEMENT

REVISION DATE	STANDARD NUMBER	SUBJECT : SIGNING AND MARKING DETAILS
6/14	M-20 SHT 1	CHIP SEAL MARKER USAGE FOR TEMPORARY MARKERS
6/14	M-20 SHT 2	CHIP SEAL MARKER USAGE FOR TEMPORARY MARKERS
6/14	M-21	TRANSVERSE RUMBLE STRIP DETAILS
9/21	M-22 SHT 1	LONGITUDINAL RUMBLE STRIP GROOVE, PATTERN - AND LOCATION DETAILS
9/21	M-22 SHT 2	LONGITUDINAL RUMBLE STRIP EXCEPTION DETAILS
9/21	M-22 SHT 3	ENTRANCE AND EXIT RAMPS RUMBLE STRIP INSTALLATION DETAILS
3/22	M-22 SHT 4	CENTERLINE RUMBLE STRIP GROOVE, PATTERN - AND LOCATION DETAILS
6/14	M-23	OBJECT MARKER DETAILS
6/14	M-24	OBJECT MARKER PLACEMENT DETAILS
2/21	M-26 SHT 1	DELINEATOR PLACEMENT AND SPACING
2/21	M-26 SHT 2	DELINEATOR PLACEMENT AND SPACING
2/21	M-26 SHT 3	FLEXIBLE DELINEATOR ASSEMBLIES
2/21	M-26 SHT 4	SQUARE STEEL POST DELINEATOR
2/21	M-26 SHT 5	DELINEATOR FOUNDATION DETAILS
2/21	M-27 SHT 1	DELINEATION DETAILS FOR MEDIAN CROSSTRAVERS
2/21	M-27 SHT 2	DELINEATION DETAILS FOR MEDIAN CROSSTRAVERS
6/14	M-29	OFF- MAINLINE REFERENCE MARKER LOCATION DETAIL
6/14	M-30	OFF- MAINLINE REFERENCE MARKER DETAILS
6/14	M-32	BRIDGE AND BARRIER MARKER DETAILS
6/14	M-33	BRIDGE AND BARRIER MARKER PLACEMENT AND INSTALLATION DETAILS
6/14	M-34	GUARDRAIL END TERMINAL DELINEATION DETAILS
6/14	M-35	OBJECT MARKER FOR SAND BARREL CRASH CUSHION

ADOT STANDARD DRAWINGS REVISION DATES and STANDARD NO.'s REVIEW			
SIGNING & MARKING STANDARDS		NAME Michael Schoen	DATE 07/26
PROJECT NO. 0000 YU YYU T0437 01C		1B-1	OF 37
RECORD DRAWING DATA	FEDERAL ID NO. YYU-0(225)T	REC. DWG. DATE	OF

ADOT STANDARD DRAWINGS
TRAFFIC SIGNING & MARKING STANDARDS
(SHEET 2 OF 2)
EFFECTIVE MAY 2025

REVISION DATE	STANDARD NUMBER	SUBJECT : SIGNING AND MARKING DETAILS
4/19	S-1 SHT 1	GENERAL SIGNING NOTES
6/14	S-2 SHT 1	S & W BREAKAWAY POST SELECTION CHART
6/14	S-2 SHT 2	S & W BREAKAWAY POST INSTALLATION DETAILS
6/14	S-3 SHT 1	FLAT SHEET SIGNS SQUARE TUBE POST GENERAL NOTES
6/14	S-3 SHT 2	SINGLE POST FLAT SHEET RECTANGULAR SIGN ASSEMBLY - 12, 18 AND 24 INCH WIDTHS
6/14	S-3 SHT 3	SINGLE POST FLAT SHEET RECTANGULAR SIGN ASSEMBLY - 30, 36, 42 AND 54 INCH WIDTHS
6/14	S-3 SHT 4	TWO POST FLAT SHEET RECTANGULAR SIGN ASSEMBLY - 36, 42 AND 48 INCH WIDTHS
6/14	S-3 SHT 5	TWO POST FLAT SHEET RECTANGULAR SIGN ASSEMBLY - 54, 60 AND 72 INCH WIDTHS
6/14	S-3 SHT 6	TWO POST FLAT SHEET RECTANGULAR SIGN ASSEMBLY - 84 - 144 INCH WIDTHS
6/14	S-3 SHT 7	THREE POST FLAT SHEET RECTANGULAR SIGN ASSEMBLY - 48, 60 AND 72 INCH WIDTHS
6/14	S-3 SHT 8	THREE POST FLAT SHEET RECTANGULAR SIGN ASSEMBLY - 84 - 144 INCH WIDTHS
6/14	S-3 SHT 9	WARNING SIGN ASSEMBLY - SINGLE POST
6/14	S-3 SHT 10	WARNING SIGN ASSEMBLY - TWO POST
6/14	S-3 SHT 11	WARNING SIGN ASSEMBLY - THREE POST
6/14	S-3 SHT 12	MULTIPLE ROUTE MARKER ASSEMBLIES
6/14	S-3 SHT 13	SPECIAL SIGN ASSEMBLIES
6/14	S-3 SHT 14	STRINGER DETAILS FOR SQUARE TUBE POSTS
6/14	S-3 SHT 15	SQUARE TUBE SIGN POST FOUNDATION
6/14	S-3 SHT 16	SQUARE TUBE POST SLIP BASE DETAILS
6/14	S-4	W SHAPE BREAKAWAY POST FUSE PLATE AND HINGE DETAILS
6/22	S-5	W SHAPE BREAKAWAY POST DETAILS
6/22	S-6	S4x7.7 BREAKAWAY POST DETAILS
6/14	S-7 SHT 1	ALUMINUM EXTRUSION SIGN PANEL DETAILS
6/14	S-7 SHT 2	ALUMINUM EXTRUSION AUXILIARY SIGN INSTALLATION DETAILS
5/15	S-7 SHT 3	ALUMINUM EXTRUSION EXIT PANEL INSTALLATION DETAIL
6/14	S-8 SHT 1	FLAT SHEET ALUMINUM PANEL ON BREAKAWAY POSTS INSTALLATION DETAIL
6/14	S-8 SHT 2	ALUMINUM EXTRUSION SIGN TO PERFORATED POSTS INSTALLATION DETAIL
8/22	S-9 SHT 1	SIGN INSTALLATION ON POLE
8/22	S-9 SHT 2	SIGNS (BACK TO BACK) INSTALLATION ON POLE
8/22	S-9 SHT 3	SIGN INSTALLATION ON SIGNAL POLE
8/22	S-9 SHT 4	SIGN INSTALLATION ON POLE BAND-TYPE CLAMP
6/14	S-10	MILEPOST AND REFERENCE LOCATION SIGNS
11/22	S-11 SHT 1	TAPERED TUBE SIGN STRUCTURE SINGLE BEAM
4/19	S-11 SHT 2	TAPERED TUBE SIGN STRUCTURE SINGLE BEAM POST AND BEAM DETAILS

REVISION DATE	STANDARD NUMBER	SUBJECT : SIGNING AND MARKING DETAILS
6/14	S-12 SHT 1	TYPE A, B, AND DOWN ARROWS
6/14	S-12 SHT 2	TYPE C AND D ARROWS
6/14	S-12 SHT 3	C2 ARROW DETAIL
6/14	S-13	SIGN IDENTIFICATION DETAILS
6/14	S-14 SHT 1	ROTATING OPEN/CLOSED SIGN
6/14	S-14 SHT 2	ROTATING OPEN/CLOSED SIGN DETAILS
6/14	S-14 SHT 3	ROTATING OPEN/CLOSED SIGN MOUNTING DETAILS
6/14	S-15 SHT 1	FOLDING RECTANGULAR SIGN ASSEMBLY
6/14	S-15 SHT 2	FOLDING RECTANGULAR SIGN OPERATION
6/14	S-15 SHT 3	FOLDING DIAMOND SIGN ASSEMBLY
4/19	S-16 SHT 1	TEMPORARY WOOD POSTS
4/19	S-16 SHT 2	TEMPORARY WOOD POSTS SELECTION CHART
6/14	S-17	END OF ROAD BARRICADE
7/19	S-18 SHT 1	ALUMINUM GRAFFITI SHIELD EXIT AND GUIDE SIGN ASSEMBLY
7/19	S-18 SHT 2	ALUMINUM GRAFFITI SHIELD RIGHT RIDER SIDE PANEL
7/19	S-18 SHT 3	ALUMINUM GRAFFITI SHIELD LEFT RIDER SIDE PANEL
7/19	S-18 SHT 4	ALUMINUM GRAFFITI SHIELD CORNER
7/19	S-18 SHT 5	ALUMINUM GRAFFITI SHIELD SPLICE PLATE
7/19	S-18 SHT 6	ALUMINUM GRAFFITI SHIELD FIN
7/19	S-18 SHT 7	ALUMINUM GRAFFITI SHIELD TOP PANEL
7/19	S-18 SHT 8	ALUMINUM GRAFFITI SHIELD SIDE PANEL
7/19	S-18 SHT 9	ALUMINUM GRAFFITI SHIELD RIGHT TRANSITION FROM RIDER
7/19	S-18 SHT 10	ALUMINUM GRAFFITI SHIELD LEFT TRANSITION FROM RIDER
7/19	S-18 SHT 11	ALUMINUM GRAFFITI SHIELD SPLICE PLATE FOR FIN
12/18	C-1	SAND BARREL CRASH CUSHION
12/18	C-2	SAND BARREL CRASH CUSHION TYPICAL INSTALLATION
6/14	C-3 SHT 1	PRECAST CONCRETE BARRIER STRUCTURAL DETAILS
6/14	C-3 SHT 2	PRECAST CONCRETE BARRIER PIN AND LOOP ASSEMBLY
6/14	C-4 SHT 1	MEDIAN CROSSOVER
6/14	C-4 SHT 2	TYPICAL END TREATMENTS FOR DETOURS USING TEMPORARY CONCRETE BARRIER (TCB)
6/14	C-5 SHT 1	APPROACH PLATE AND TRANSITION SECTION FOR TEMPORARY CONCRETE BARRIER
6/14	C-5 SHT 2	APPROACH PLATE AND TRANSITION SECTION FOR TEMPORARY CONCRETE BARRIER

ADOT STANDARD DRAWINGS REVISION DATES and STANDARD NO.'s REVIEW			
SIGNING & MARKING STANDARDS		NAME Michael Schoen	DATE 07/26
PROJECT NO. 0000 YU YYU T0437 01C		1B-2	OF 37
RECORD DRAWING DATA	FEDERAL ID NO. YYU-0(225)T	REC. DWG. DATE	OF

1. **SPILL PREVENTION, CONTROL, AND COUNTERMEASURES – CWA SECTION 311**

If total above-ground storage capacity, including mobile re-fuelers stationed on-site, is greater than 1,320 gallons of oil (oils, greases, fuel, asphalt, and asphalt derivatives), where a spill has the potential to reach Waters of the US, the Contractor shall prepare a SPCC plan per contract specifications in Section 104.16 (C) of the Standard Specifications.

2. **SURFACE WATER POLLUTION PREVENTION – CWA SECTION 402**

☒ Arizona Pollutant Discharge Elimination System (AZPDES) CGP coverage applies (104SWDEQ needed)

3. **WORK IN WATERS OF THE UNITED STATES – CWA SECTION 404/401**

☒ No Permit Required; Refer to Section 104.16 (D) of the Standard Specifications for General Requirements

4. **BIOLOGY PROGRAM – ESA SECTION 7; MBTA, ARIZONA REVISED STATUTES TITLE 17**

BIO-1: Environmental Awareness, Monitoring and Avoidance ☒ N/A

BIO-2: Migratory Bird Treaty Act (MBTA) ☒ N/A

BIO-2D: MBTA – Active Cliff Swallow Nests ☒ N/A

BIO-3: Burrowing Owls ☐ N/A

BIO-3A and BIO-3C: Burrowing Owl Awareness Flyer and Burrowing Owl Relocations; see Section 104.16 BIO-3A and Section 104.16 BIO-3C of the specifications for direction.

BIO-4: Bats ☒ N/A

BIO-5: Sonoran Desert Tortoise ☒ No ☐ Yes

5. **VEGETATION PROTECTION PROGRAM – CWA SECTION 402, EO 13122**

General (applies to all projects); The contractor shall comply with the requirements specified in Section 104.16 (F) of the Special Provisions and Section 104.16 (B) of the Standard Specifications.

☒ No Vegetation Protection Program Action Required; See Std. Spec. 107.11 for General Requirements

6. **CULTURAL RESOURCES PROGRAM**

☒ No Cultural Resources Program Action Required; See Std. Spec. 107.05 and 107.06 for General Requirements

7. **HAZARDOUS MATERIALS PROGRAM**

General (applies to all projects); See Std. Spec. 107.07 for General Requirements.

☒ No Hazardous Materials Program Action Required

8. **NOISE PROGRAM**

☒ No Noise Program Specific Project Action Required; See Std. Spec. 104.08 for General Requirements

9. **AIR QUALITY PROGRAM**

☒ No Air Quality Program Action Required; See Std. Spec. 104.08 for General Requirements

10. **OTHER ENVIRONMENTAL ISSUES**

Project Specific Environmental Commitments: ☐ N/A

- If any burrowing owls or active burrows are identified the contractor shall notify the Engineer immediately. No construction activities shall take place within 100 feet of any active burrow.

Arizona Department of Transportation Environmental Planning Standard Template			
Environmental, Permits, Issues, And Commitments (EPIC) Sheet			
Environmental Planner Name	Dena Whitaker	R.E. Name	
Environmental Planning Date of Completion	7/2/2026	R.E. Signature With the above signature, the R.E. attests that all EPIC work for this project has been satisfactorily completed.	
FEDERAL ID NO.	YYU-Q(225)T		
PROJECT NO.	0000 YU YYU T0437 01C		
REC DWG DATE:		1F OF 37	Sheet 1F

MIDPOINT OF PROJECT

West Zone
State Plane Coordinates
X=396459.741
Y=596033.920

DESIGN DATA

2023 AADT = 6189
Design Speed = 50 MPH

LENGTH OF PROJECT

Sta 17+32.11 to 265+40.35 = 24,808.24'
Gross and Net Length = 24,808.24' - 4.70 Miles

EARTHWORK QUANTITIES

Roadway Excavation	8,381 CY
Excavation Shrink	1,425 CY
Embankment	319 CY
Excess Material Waste	6,637 CY

Note: Roadway excavation does not include AC removal quantitiy

Pay Item

EARTHWORK FACTORS

Location	Shrink	Ground Compaction
Within Project Limits	17.0%	0.10'

INDEX OF SHEETS

Sheet No.	DWG No.	Sheet Type
1	1	Face Sheet
1A, 1B-1, 1B-2	1A, 1B-1, 1B-2	ADOT Standard Drawing Sheets
1F	1F	Epic Sheet
2	DS01	Design Sheet
3	DS02	Typical Section Sheet
4	DS03	Detail Sheet
5	SUM01	Barrier Summary Sheet
6-9	GEO1-GEO4	Geometric Control Sheets
10-24	P01-P15	Plan Sheets
25-29	MOT01-MOT05	Maintenance of Traffic Sheets
30-31	PM00-PM01	Pavement Marking Sheet and Signing Notes Sheet
32-33	SGN01-SGN02	Sign Summary Sheets
34-35	RS01-RS02	Rumble Strip Sheets
36-37	EC01-EC02	Erosion Control Sheets

LEGEND

AP	Angle Point
EOS	Edge of Shoulder
ESMT	Easement
PROP	Proposed
R/W	Right-of-Way
SHLDR	Shoulder
DWY	Driveway

GENERAL NOTES

Roadway plans have been designed utilizing the Construction Standard Drawings (C-Series) and current revisions. Refer to the 1A sheet for a listing of current revision dates.

The project roadway shall be striped by the contractor in accordance with the current edition of the Signing and Marking Standard Drawings (M and S-Series) and the pavement marking plans.

Pavement lift thickness is nominal.


Where only the horizontal location of an existing utility is shown, the location is approximate. Where both the horizontal and vertical location of an existing utility is shown, the location has been verified by field survey methods. The contractor shall comply with all current Arizona 811 laws and Section 107.15 of the specifications.

The average project elevation is 115' .

The pavement shoulders shall be treated with a rumble strip: see detail sheet.

New R/W and/or easements are not required.

There will be no separate payment for safety edge work. Payment for this work is to be included in the payment for asphalt paving.

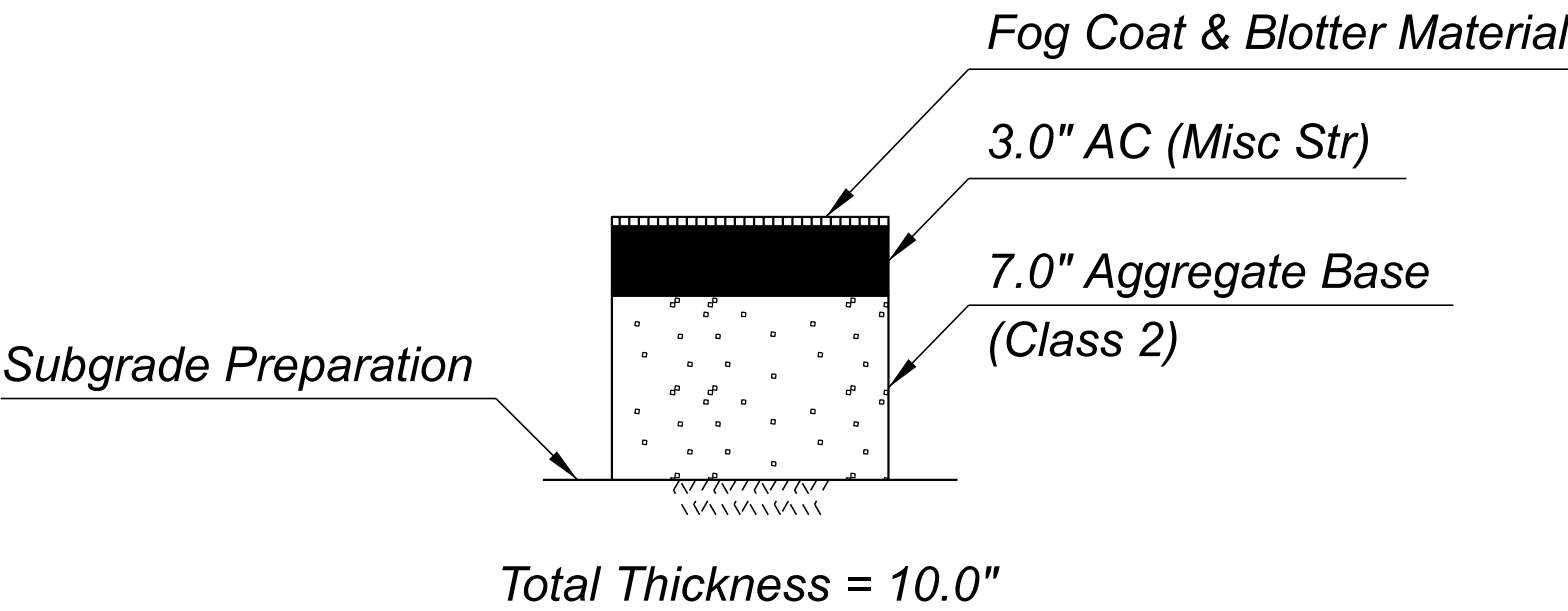


PAVEMENT STRUCTURAL NO.1

Roadway Width Limits**
20.7± - 16.00 19+08.87 - 21.93.34

Sawcut Limits***

12.50'-8.00'	19+08.87 - 21+93.28
8.00'	21+93.28 - 97+17.81
9.00'	97+17.81 - 108+88.11
9.50'	122+46.43 - 125+81.62
10.00'	125+81.62 - 159+72.65
9.50'	159+72.65 - 180+70.46
10.50'	180+70.46 - 265+40.35

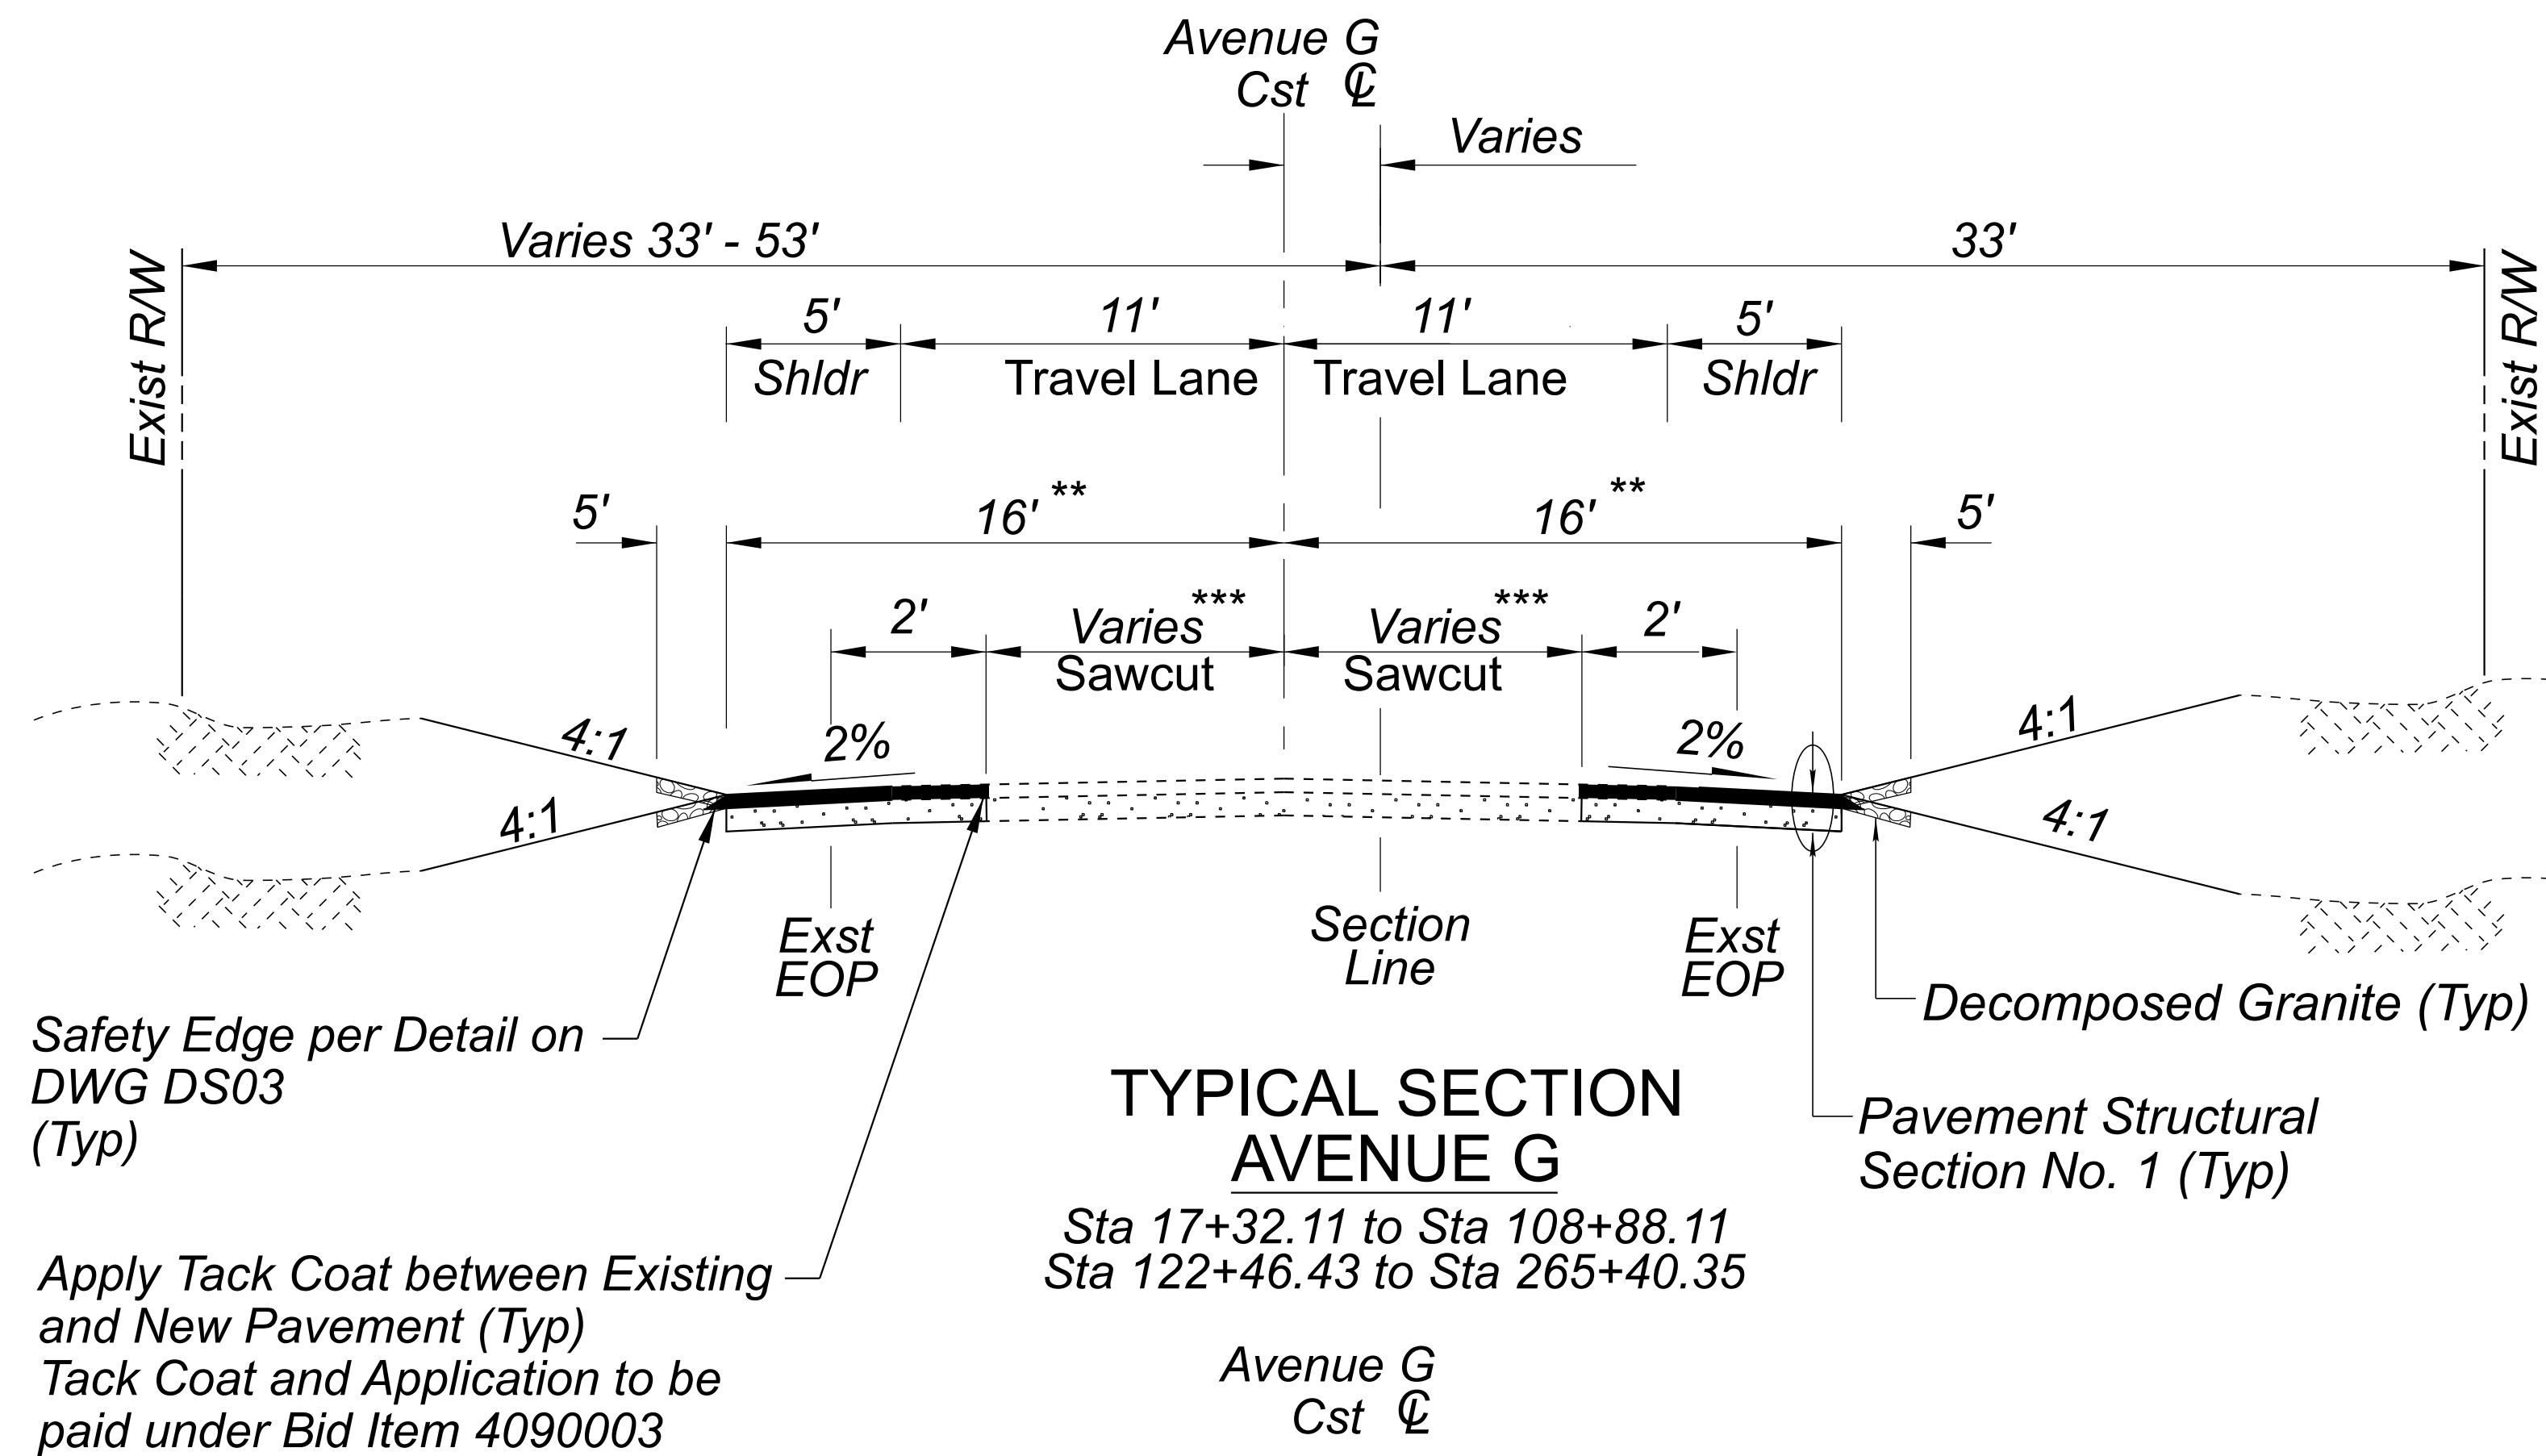

Roadway Width Limits**
19.9± - 16.00 17+32.11 - 18+92.99


Sawcut Limits***

12.87' - 9.00'	17+32.11 - 18+92.91
9.00'	18+92.91 - 53+99.94
9.50'	53+99.94 - 108+88.11
10.00'	122+46.43 - 177+99.83
9.50'	177+99.83 - 190+22.79
10.50'	190+22.79 - 265+40.35

Roadway Width Limits**
16.00'-24.00' 108+88.11 - 113+28.87
24.00'-16.00' 117+50.88 - 122+46.43

Sawcut Limits***

9.00' - 17.00'	108+88.11 - 113+28.87
17.00'	113+28.87 - 114+67.47
17.00'	116+32.86 - 117+50.87
17.00' - 9.50'	117+50.87 - 122+46.43

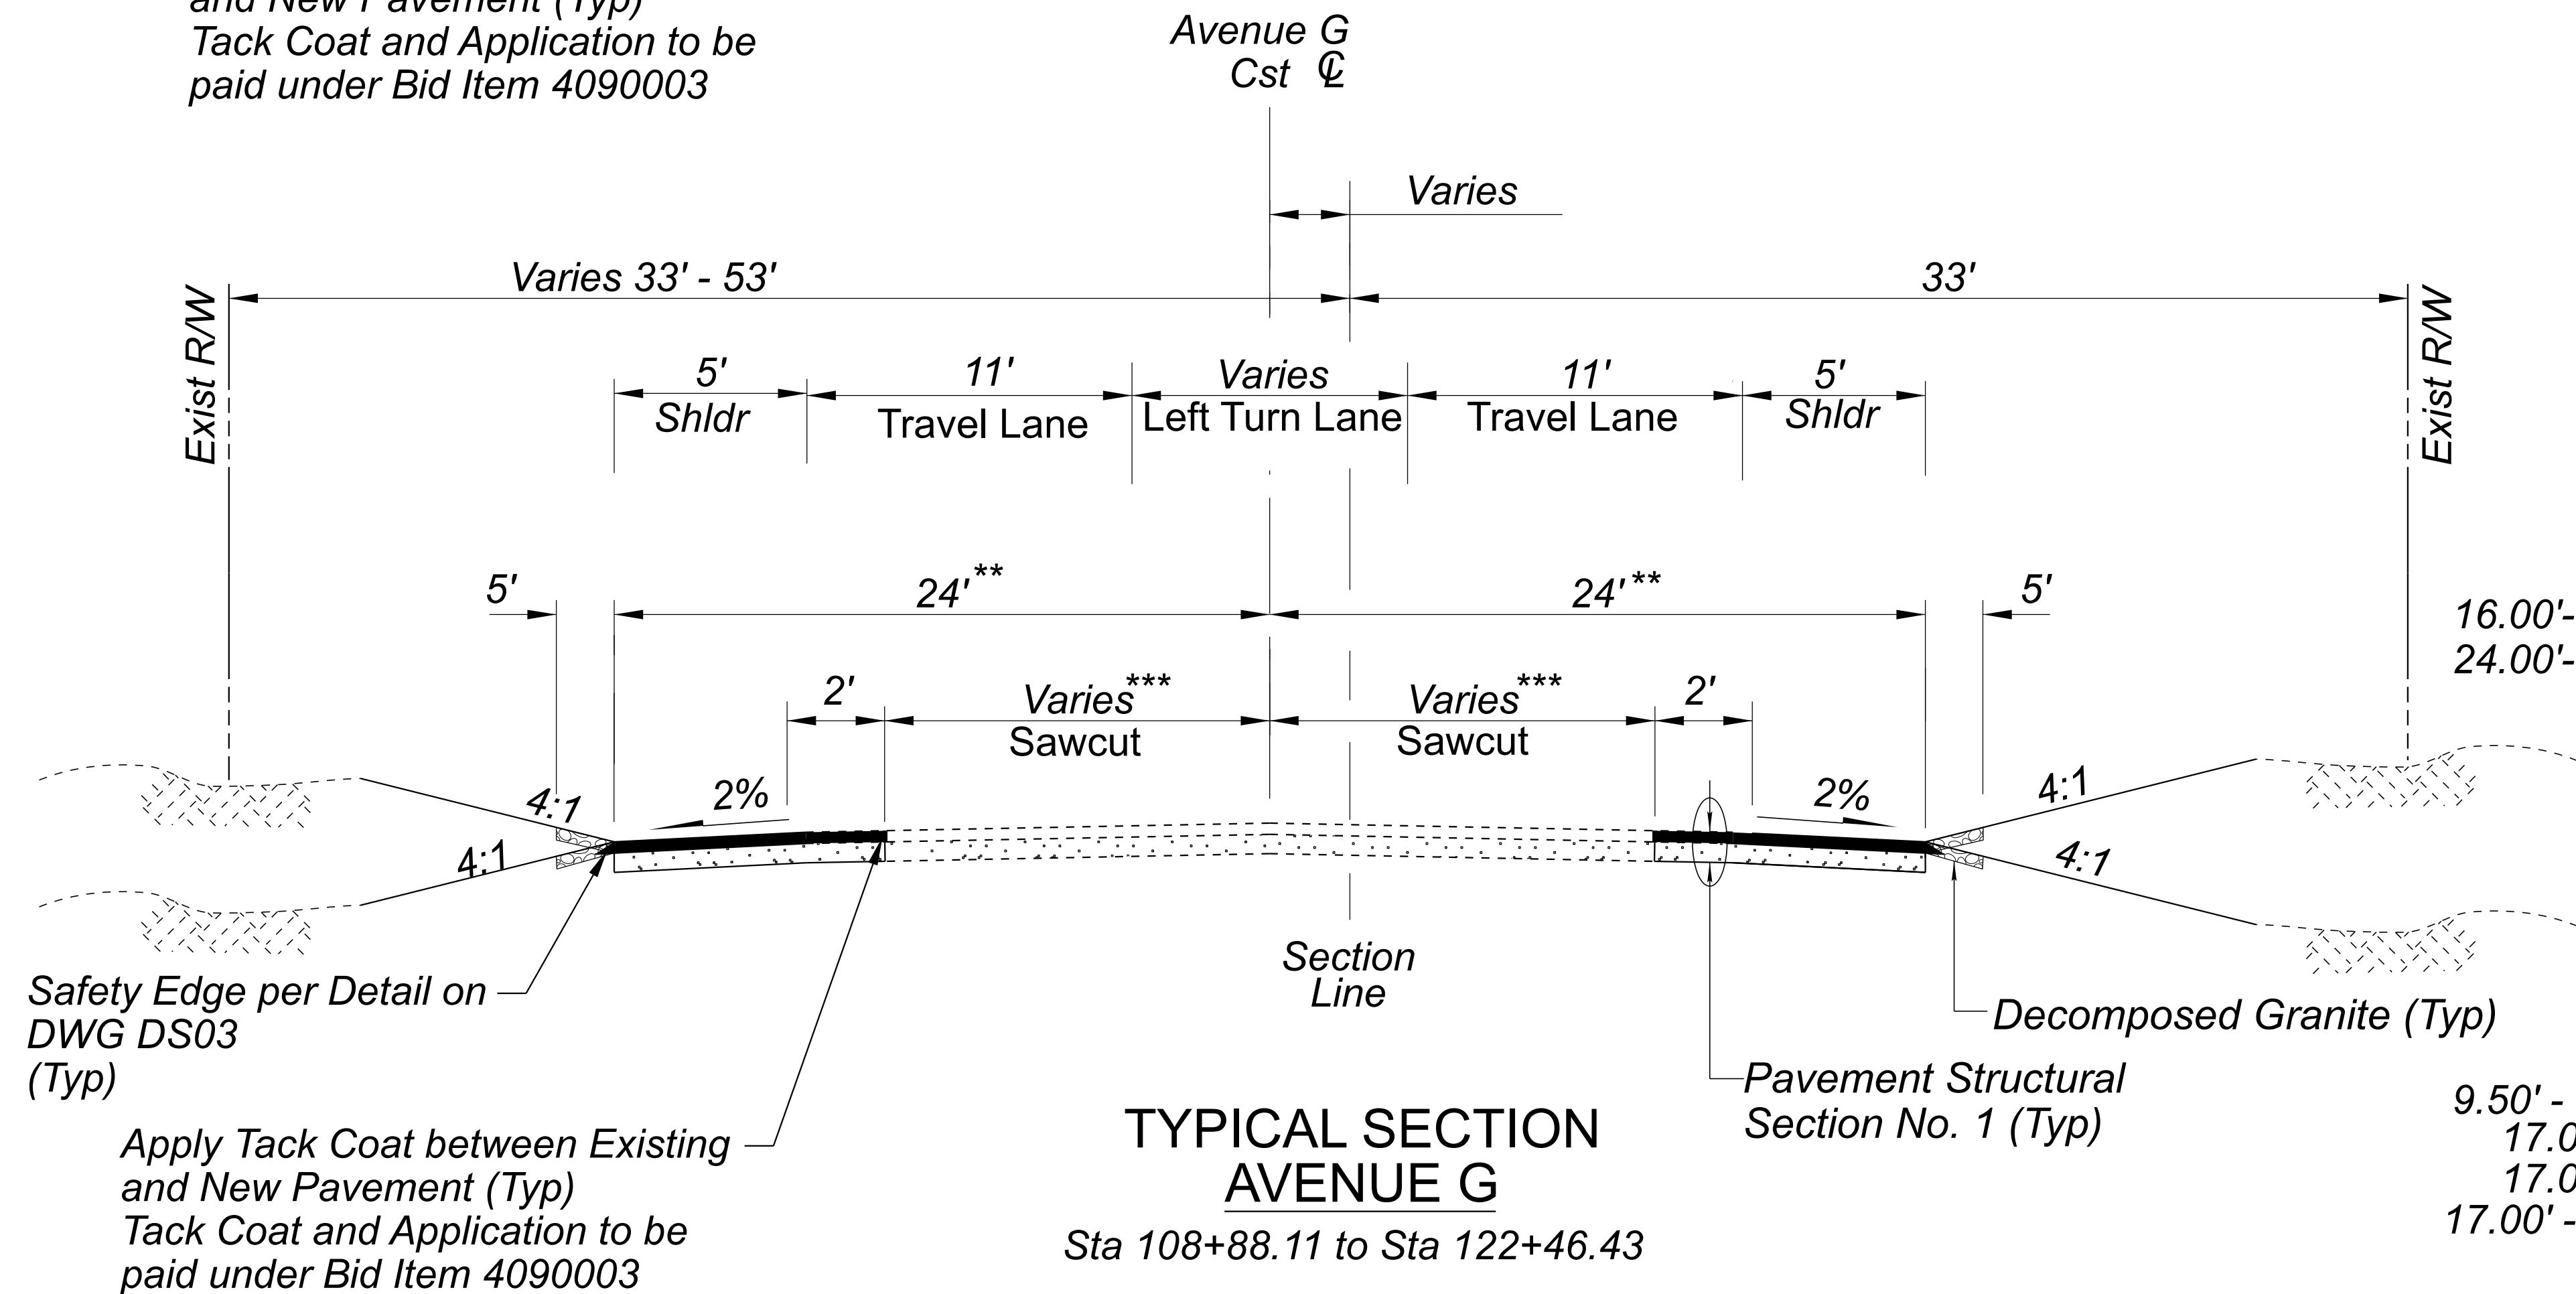

Roadway Width Limits**
16.00'-24.00' 108+88.11 - 113+28.87
24.00'-16.00' 117+50.88 - 122+46.43


Sawcut Limits***

9.50' - 17.00'	108+88.11 - 113+28.87
17.00'	113+28.87 - 114+80.17
17.00'	116+45.47 - 118+14.26
17.00' - 9.50'	118+14.26 - 122+46.43

	DESIGN	M. SCHOEN	DATE	07/26	ARIZONA DEPARTMENT OF TRANSPORTATION PROJECT DELIVERY AND OPERATIONS DIVISION ROADWAY DESIGN SECTION	ROUTE	F.H.W.A. Arizona Division	STATE	ARIZ.	PROJECT NO.	0000 YU YYU	FEDERAL ID NO.	YYU-0(225)T	SHEET NO.	3	TOTAL SHEETS	37	RECORD DRAWING
	DRAWN	N. EKI BWANGOY	DATE	07/26		LOCATION	AVENUE G, COUNTY 11TH ST - COUNTY 16TH ST											
	CHECKED	H. RIOS	DATE	07/26		STRUCTURE NO.	TRACS NO. T0437 01C											
	TYPICAL SECTION SHEET																	


WSP USA Inc.
1230 West Washington Street, Suite 600
Tempe, AZ 85288

DWG DS02
OF

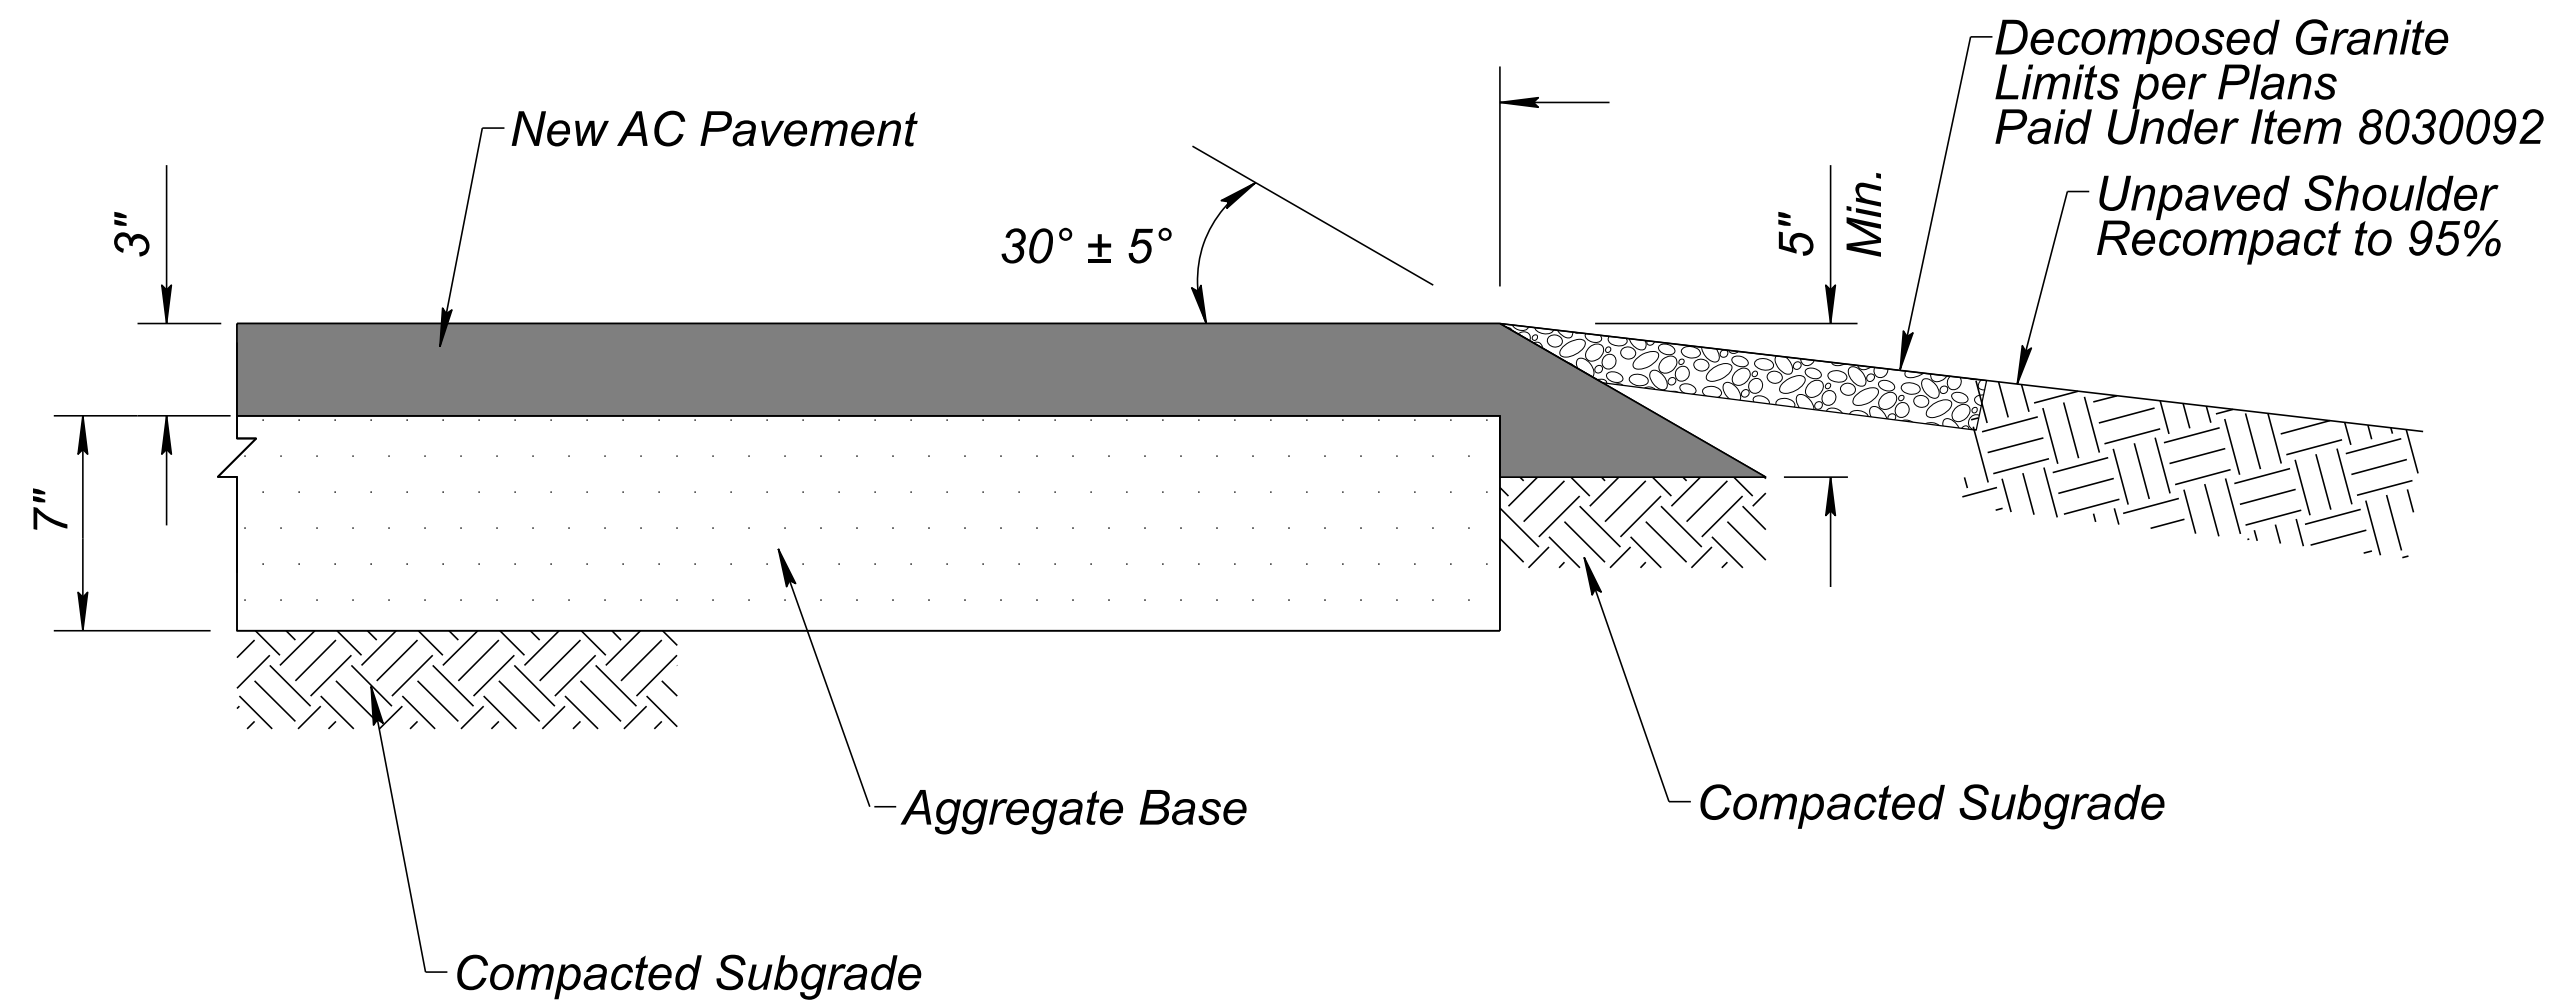

Safety Edge is to be paid under Bid Item 4090003

SAFETY EDGE

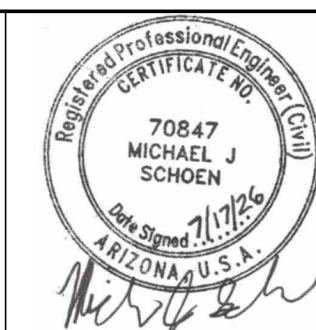

	NAME	DATE
DESIGN	M. SCHOEN	07/26
DRAWN	N. EKI BWANGOY	07/26
CHECKED	H. RIOS	07/26






WSP USA Inc.
1200 West Washington Street, Suite 600
Tempe, AZ 85281

ARIZONA DEPARTMENT OF TRANSPORTATION
PROJECT DELIVERY AND OPERATIONS DIVISION
ROADWAY DESIGN SECTION

DETAIL SHEET

ROUTE	STATE	PROJECT NO.	FEDERAL ID NO.	SHEET NO.	TOTAL SHEETS	RECORD DRAWING
F.H.W.A. Arizona Division	ARIZ.	0000 YU YYU	YYU-0(225)T	4	37	
LOCATION	AVENUE G, COUNTY 11TH ST - COUNTY 16TH ST					DWG DS03
STRUCTURE NO.	TRACS NO. T0437 01C					____ OF ____

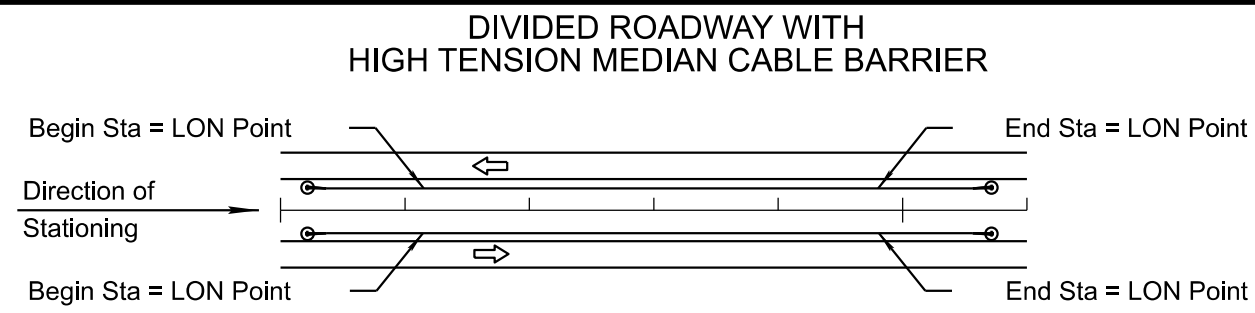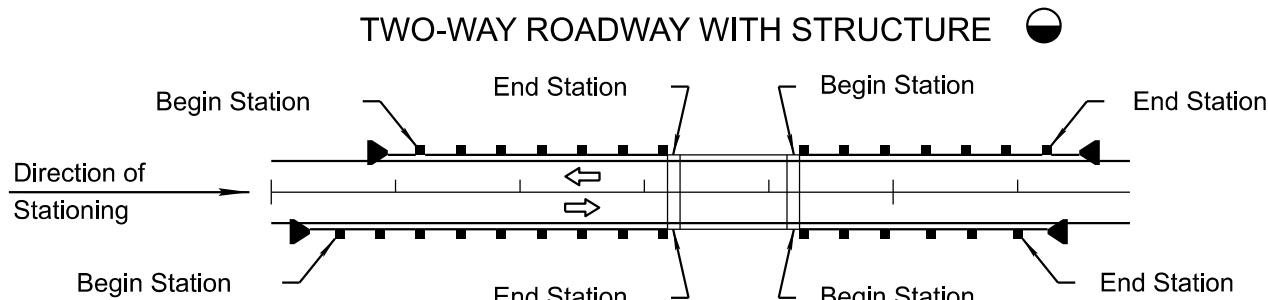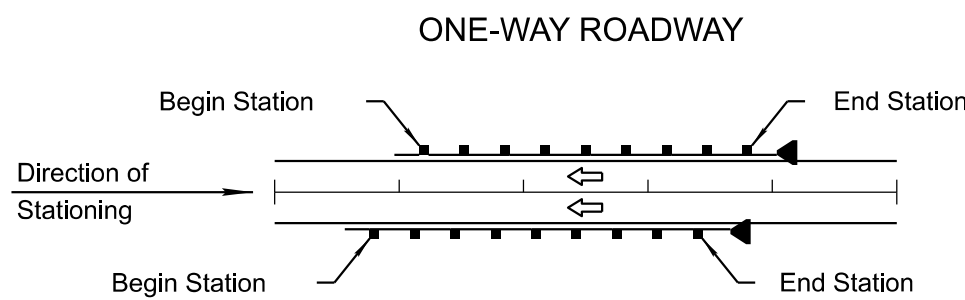

Begin End		Station (Approximate) (0)	LOCATION		NEW GUARDRAIL	BARRIER										TRANSITION		END TREATMENT																																																																																																																																																																																																																																																																																																																																																																																																																																																																																																																																																																																																																																																																																																																																																																								
			Plan Reference Number	C-10.01 Guardrail Installation Detail		Length (Linear Feet) (0.0)	C-10.06 Long Span	Shop Curved Guardrail Length (Linear Feet) (0.0)	Reconstruct-Extst Post, Block Length (Linear Feet) (0.0)	Reconstruct-New Post, Block Length (Linear Feet) (0.0)	Remove and Salvage Length (Linear Feet) (0.0)	Construct from Salvage Length (Linear Feet) (0.0)	Remove Length (Linear Feet) (0.0)	Length (Linear Feet) (0.0)	C-10.40 (32" Median)	C-10.41 (42" Median)	C-10.30 (32" Median)	C-10.54 (32" Half)	C-10.55 (42" Half at Piers)	Detail	Remove Existing Length (Linear Feet) (0.0)	High-Tension Cable Barrier Length (Linear Feet) (0)	C-12.30 Chain-Link Cable Barrier Length (Linear Feet) (0)	Begin = Treatment at Beginning	End = Treatment at End	C-10.30 (Wood Post)	C-10.31 (Steel Post)	C-10.70 32" or C-10.72 42" Detail	Tangent C-10.20 thru C-10.23	Flared C-10.26	End Anchor C-10.08 or Detail	High-Tension Cable Terminal	Sand Barrels C-1 or Detail	Attenuator Detail	Reconstruct (See Special Ptv)	Remove and Salvage	Construct from Salvage	Tangent	Flared	End Anchor C-10.08 or Detail	High-Tension Cable Terminal	Sand Barrels C-1 or Detail	Attenuator Detail	BCT (L=12.5')	REMARKS																																																																																																																																																																																																																																																																																																																																																																																																																																																																																																																																																																																																																																																																																																																																													
																																														RAIL	CONC BARRIER	Each	Each	Each	Action	Each																																																																																																																																																																																																																																																																																																																																																																																																																																																																																																																																																																																																																																																																																																																																						
Each	Each	
THE ZEROS IN PARENTHESES (0.0) INDICATE THE DIMENSIONAL PRECISION FOR THAT COLUMN.

● LENGTH IS FROM LENGTH OF NEED (LON) POINT TO LON POINT. ACTUAL SEGMENT LENGTH VARIES DEPENDING ON TERMINAL TYPE. SEE SPECIAL PROVISIONS.

NOTE: FOR RECORD DRAWING PREPARATION - CIRCLE END TREATMENT INSTALLED.

● SEE BRIDGE SHEETS FOR BRIDGE BARRIER DETAILS AND QUANTITIES.

☒ ALLOWABLE END TREATMENT OPTIONS ARE INDICATED WITH THE NUMBER '1' IN THE SPACE. BLANK SPACES ARE NOT VIABLE ALTERNATIVES.

■ ARRAY TYPE AND ANGLE IS NOTED UNDER 'REMARKS'.

Registered Professional Engineer (Civil)
 CERTIFICATE NO.
 70847
 MICHAEL J
 SCHOEN
 Date Signed 7/17/26
 ARIZONA, U.S.A.

	NAME	DATE
DESIGN	M. SCHOEN	07/26
DRAWN	N. EKI BWANGOY	07/26
CHECKED	H. RIOS	07/26




WSP USA Inc.
 1230 West Washington Street, Suite 600
 Tempe, AZ 85288

ARIZONA DEPARTMENT OF TRANSPORTATION
PROJECT DELIVERY AND OPERATIONS DIVISION
ROADWAY DESIGN SECTION

BARRIER SUMMARY SHEET

ROUTE	F.H.W.A. Arizona Division	STATE	PROJECT NO.	FEDERAL ID NO.	SHEET NO.	TOTAL SHEETS	RECORD DRAWING
MILEPOST		ARIZ.	0000 YU YYU	YYU-0(225)T	5	37	
STRUCTURE NO.	LOCATION AVENUE G, COUNTY 11TH ST - COUNTY 16TH ST						DWG SUM01
	TRACS NO. T0437 01C						___ OF ___

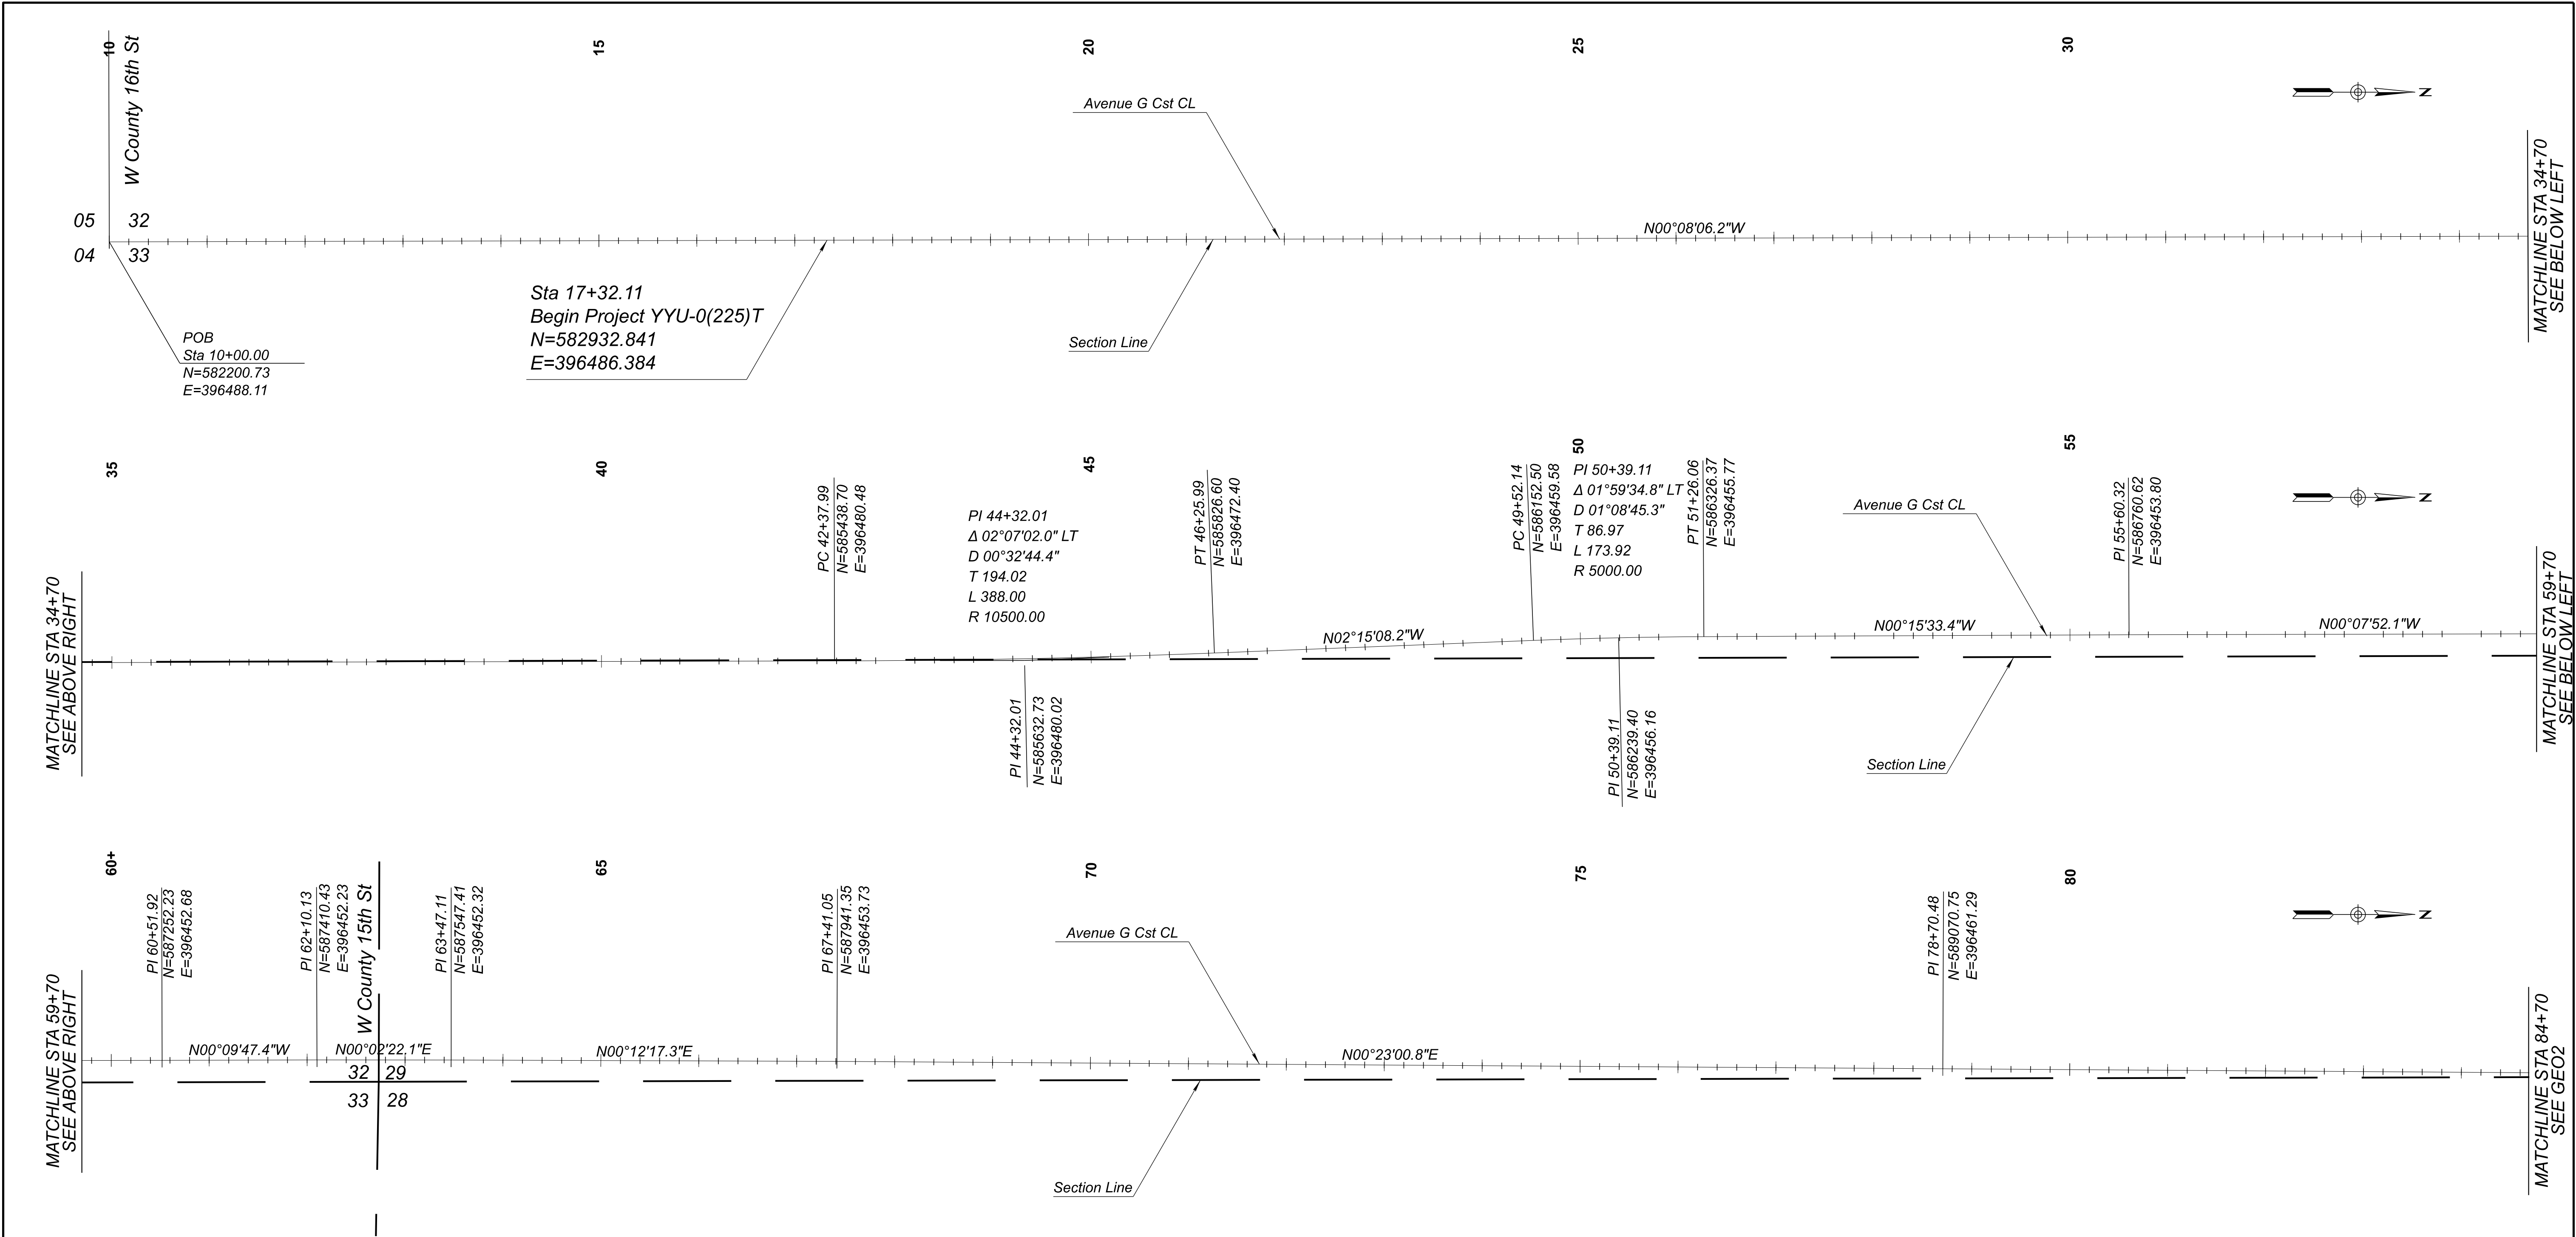


SURVEY CONTROL

HORIZONTAL DATUM:
NAD 83 Arizona State Plane - West Zone, International Feet
Scaled from grid to ground coordinates at N:0000.00, E: 0000.00,
using a scale factor of 1.000023

PRIMARY BENCHMARK:
Trace Point #102, a rebar with orange cap located near the North edge of headwall
at the Southeast corner of Avenue G and County 13th Street, Elev. = 113.19 (NAVD88)


SECONDARY BENCHMARK:
Trace Point #103 a rebar with orange cap located near the West edge of headwall
at the Southeast corner of Avenue G and County 11th Street, Elev. = 116.78 (NAVD88)

70847 MICHAEL J SCHOEN Arizona Professional Engineer No. 70847 7/17/26 Arizona U.S.A. WSP WSP USA Inc. 1230 West Washington Street, Suite 600 Tempe, AZ 85288	DESIGN	M. SCHOEN	07/26	ARIZONA DEPARTMENT OF TRANSPORTATION PROJECT DELIVERY AND OPERATIONS DIVISION ROADWAY DESIGN SECTION	ROUTE	F.H.W.A. Arizona Division	STATE	PROJECT NO.	FEDERAL ID NO.	SHEET NO.	TOTAL SHEETS	RECORD DRAWING		
	DRAWN	N. EKI BWANGOY	07/26		MILEPOST		ARIZ.	0000 YU YYU	YYU-0(225)T	6	37			
	CHECKED	H. RIOS	07/26		STRUCTURE NO.									
	GEOMETRIC CONTROL SHEETS				AVENUE G, COUNTY 11TH ST - COUNTY 16TH ST								DWG	GEO1
					TRACS NO. T0437 01C								___ OF ___	

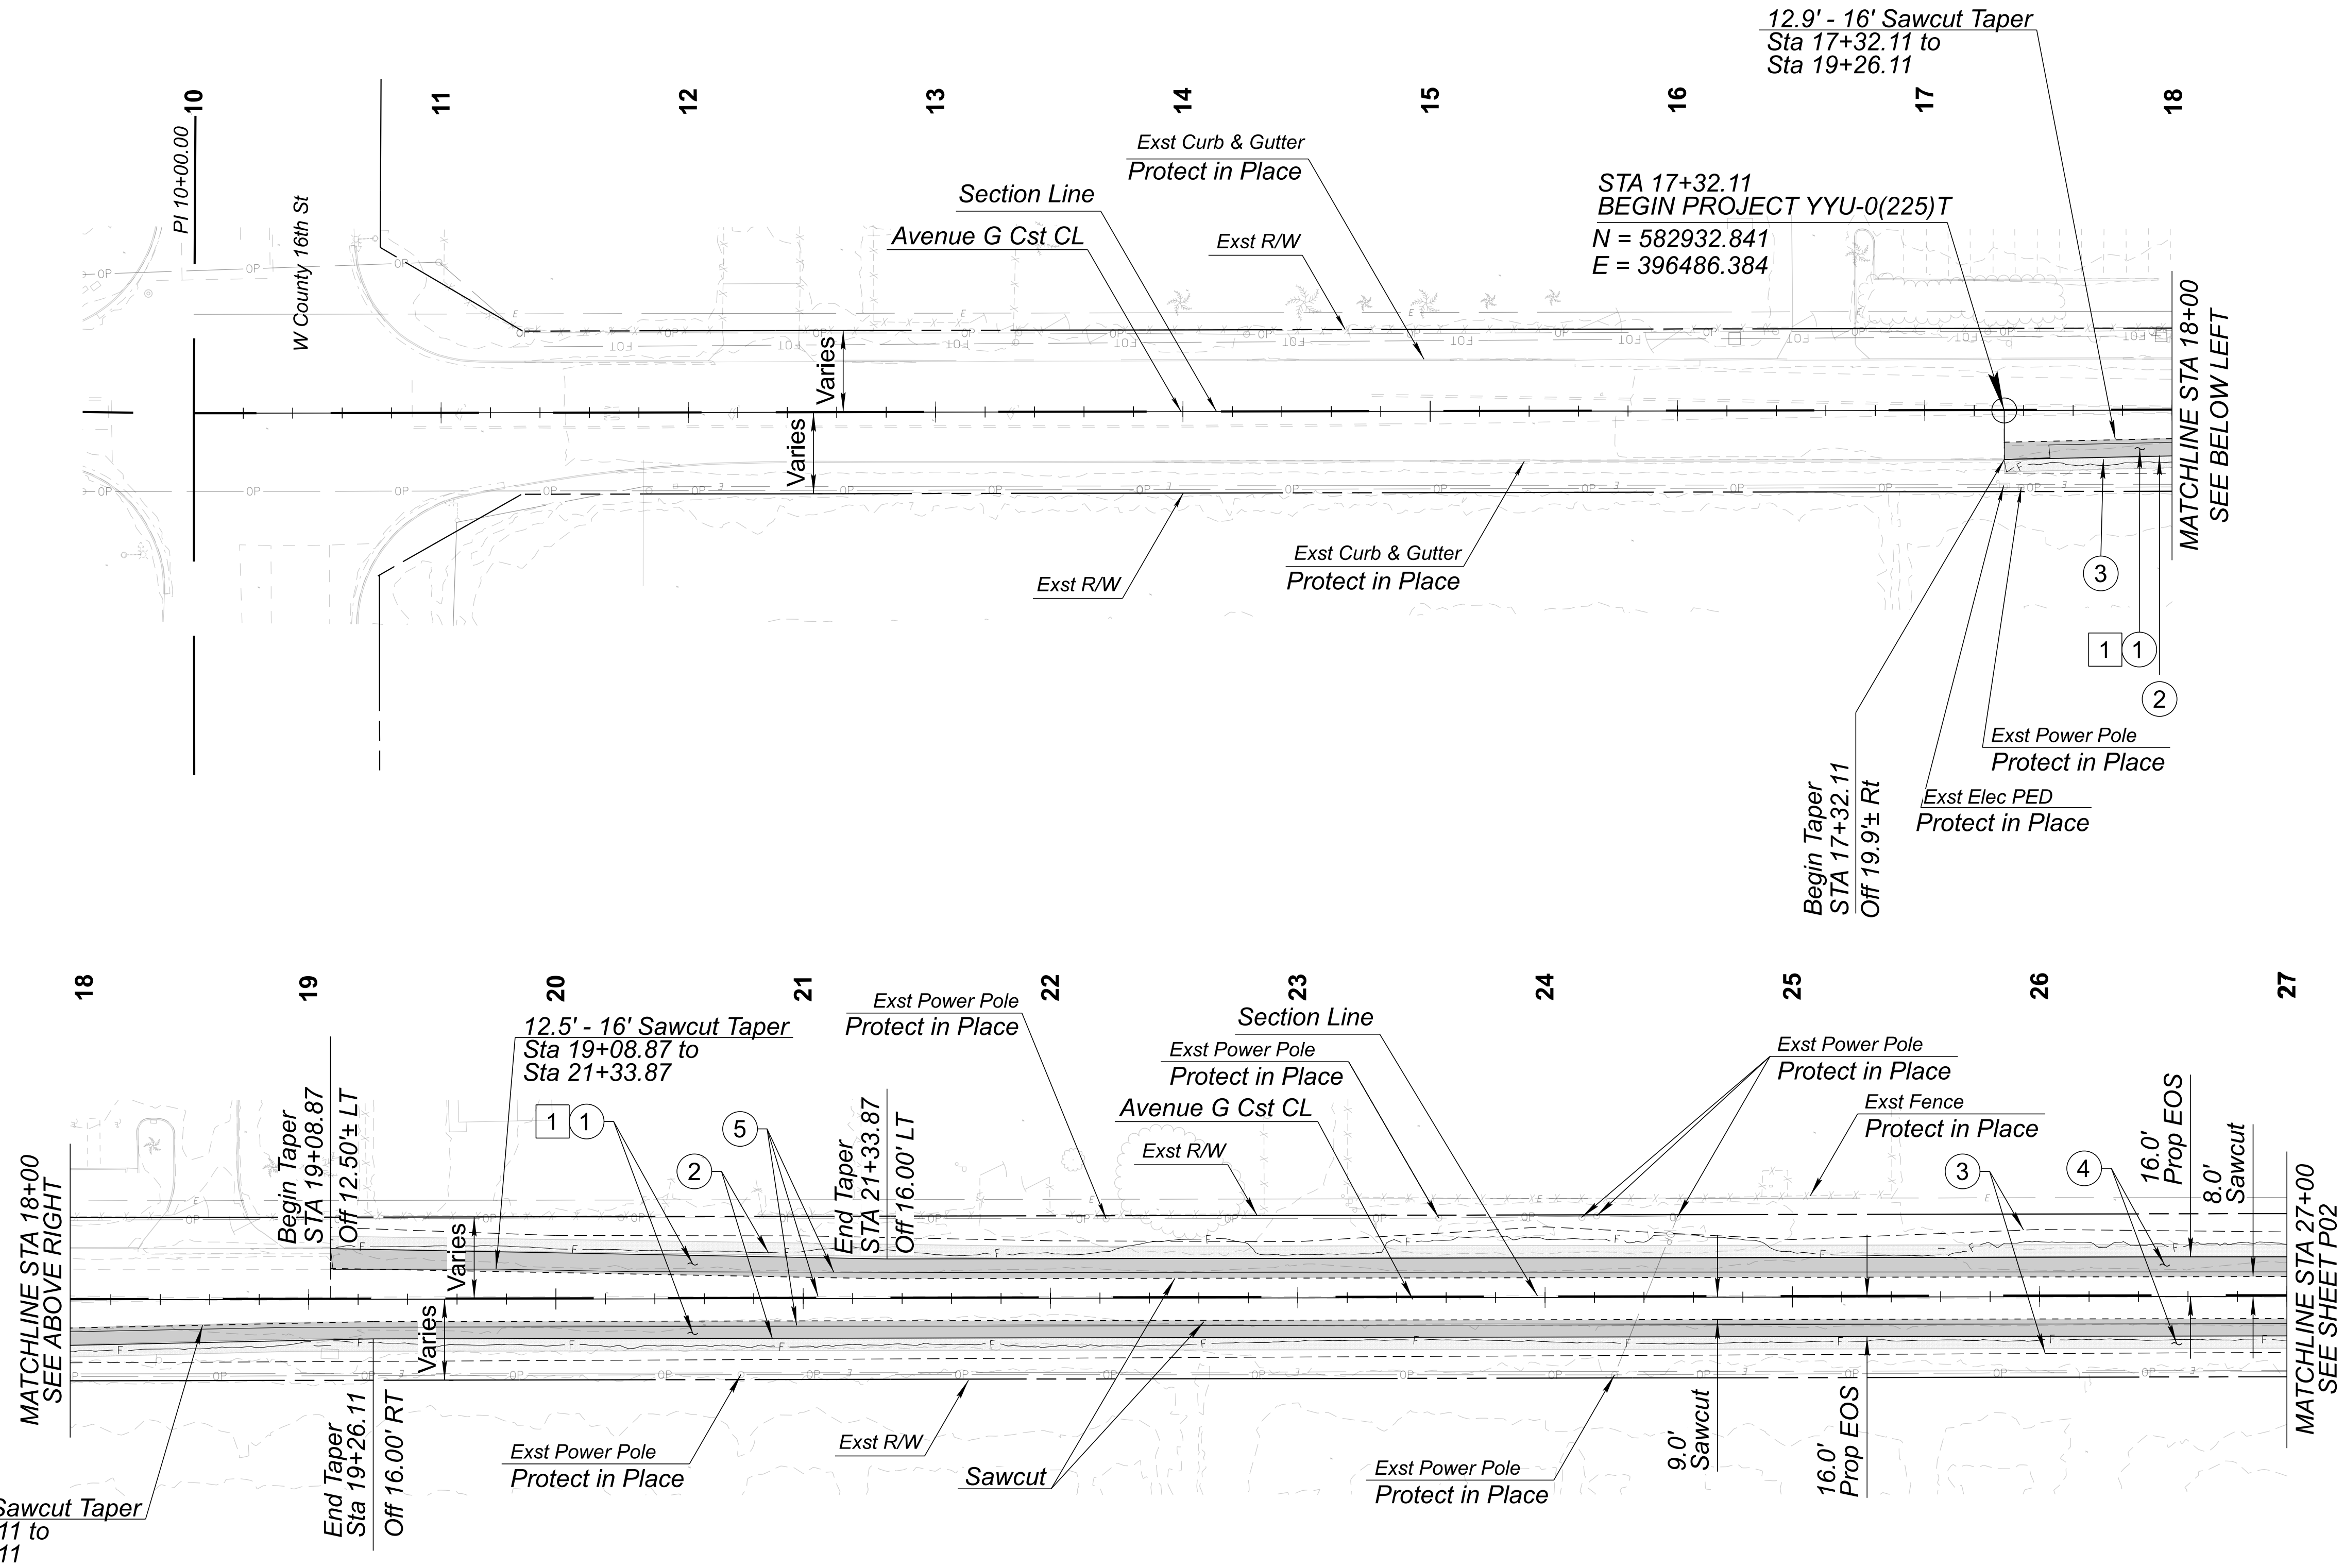


REMOVAL NOTES	
NO.	DESCRIPTION
1	Sawcut and Remove Exst Asphalt Pavement
CONSTRUCTION NOTES	
NO.	DESCRIPTION
1	Construct Asphalt Pavement Per PSS1 on DWG DS01
2	Install Safety Edge Per DTL on DWG DS03
3	Install 9-inch Sediment Wattle Per Dtl EC02
4	Install Granite Mulch (1-1/4 Inch Minus) from Edge of Shoulder extending 5 ft offset along Improvements Limits
5	Install Fog Coat on Obliterated Centerline Striping and New Shoulder per DWG RS01

		NAME	DATE	ARIZONA DEPARTMENT OF TRANSPORTATION PROJECT DELIVERY AND OPERATIONS DIVISION ROADWAY DESIGN SECTION	ROUTE	F.H.W.A. Arizona Division	STATE	PROJECT NO.	FEDERAL ID NO.	SHEET NO.	TOTAL SHEETS	RECORD DRAWING		
	DESIGN	M. SCHOEN	07/26		MILEPOST		ARIZ.	0000 YU YYU	YYU-0(225)T	10	37			
	DRAWN	N. EKI BWANGOY	07/26		 WSP USA Inc. 1200 West Washington Street, Suite 600 Tempe, AZ 85288	STRUCTURE NO.	LOCATION AVENUE G, COUNTY 11TH ST - COUNTY 16TH ST						DWG	P01
	CHECKED	H. RIOS	07/26				TRACS NO. T0437 01C						___ OF ___	
					PLAN SHEET BEGIN TO 27+00									

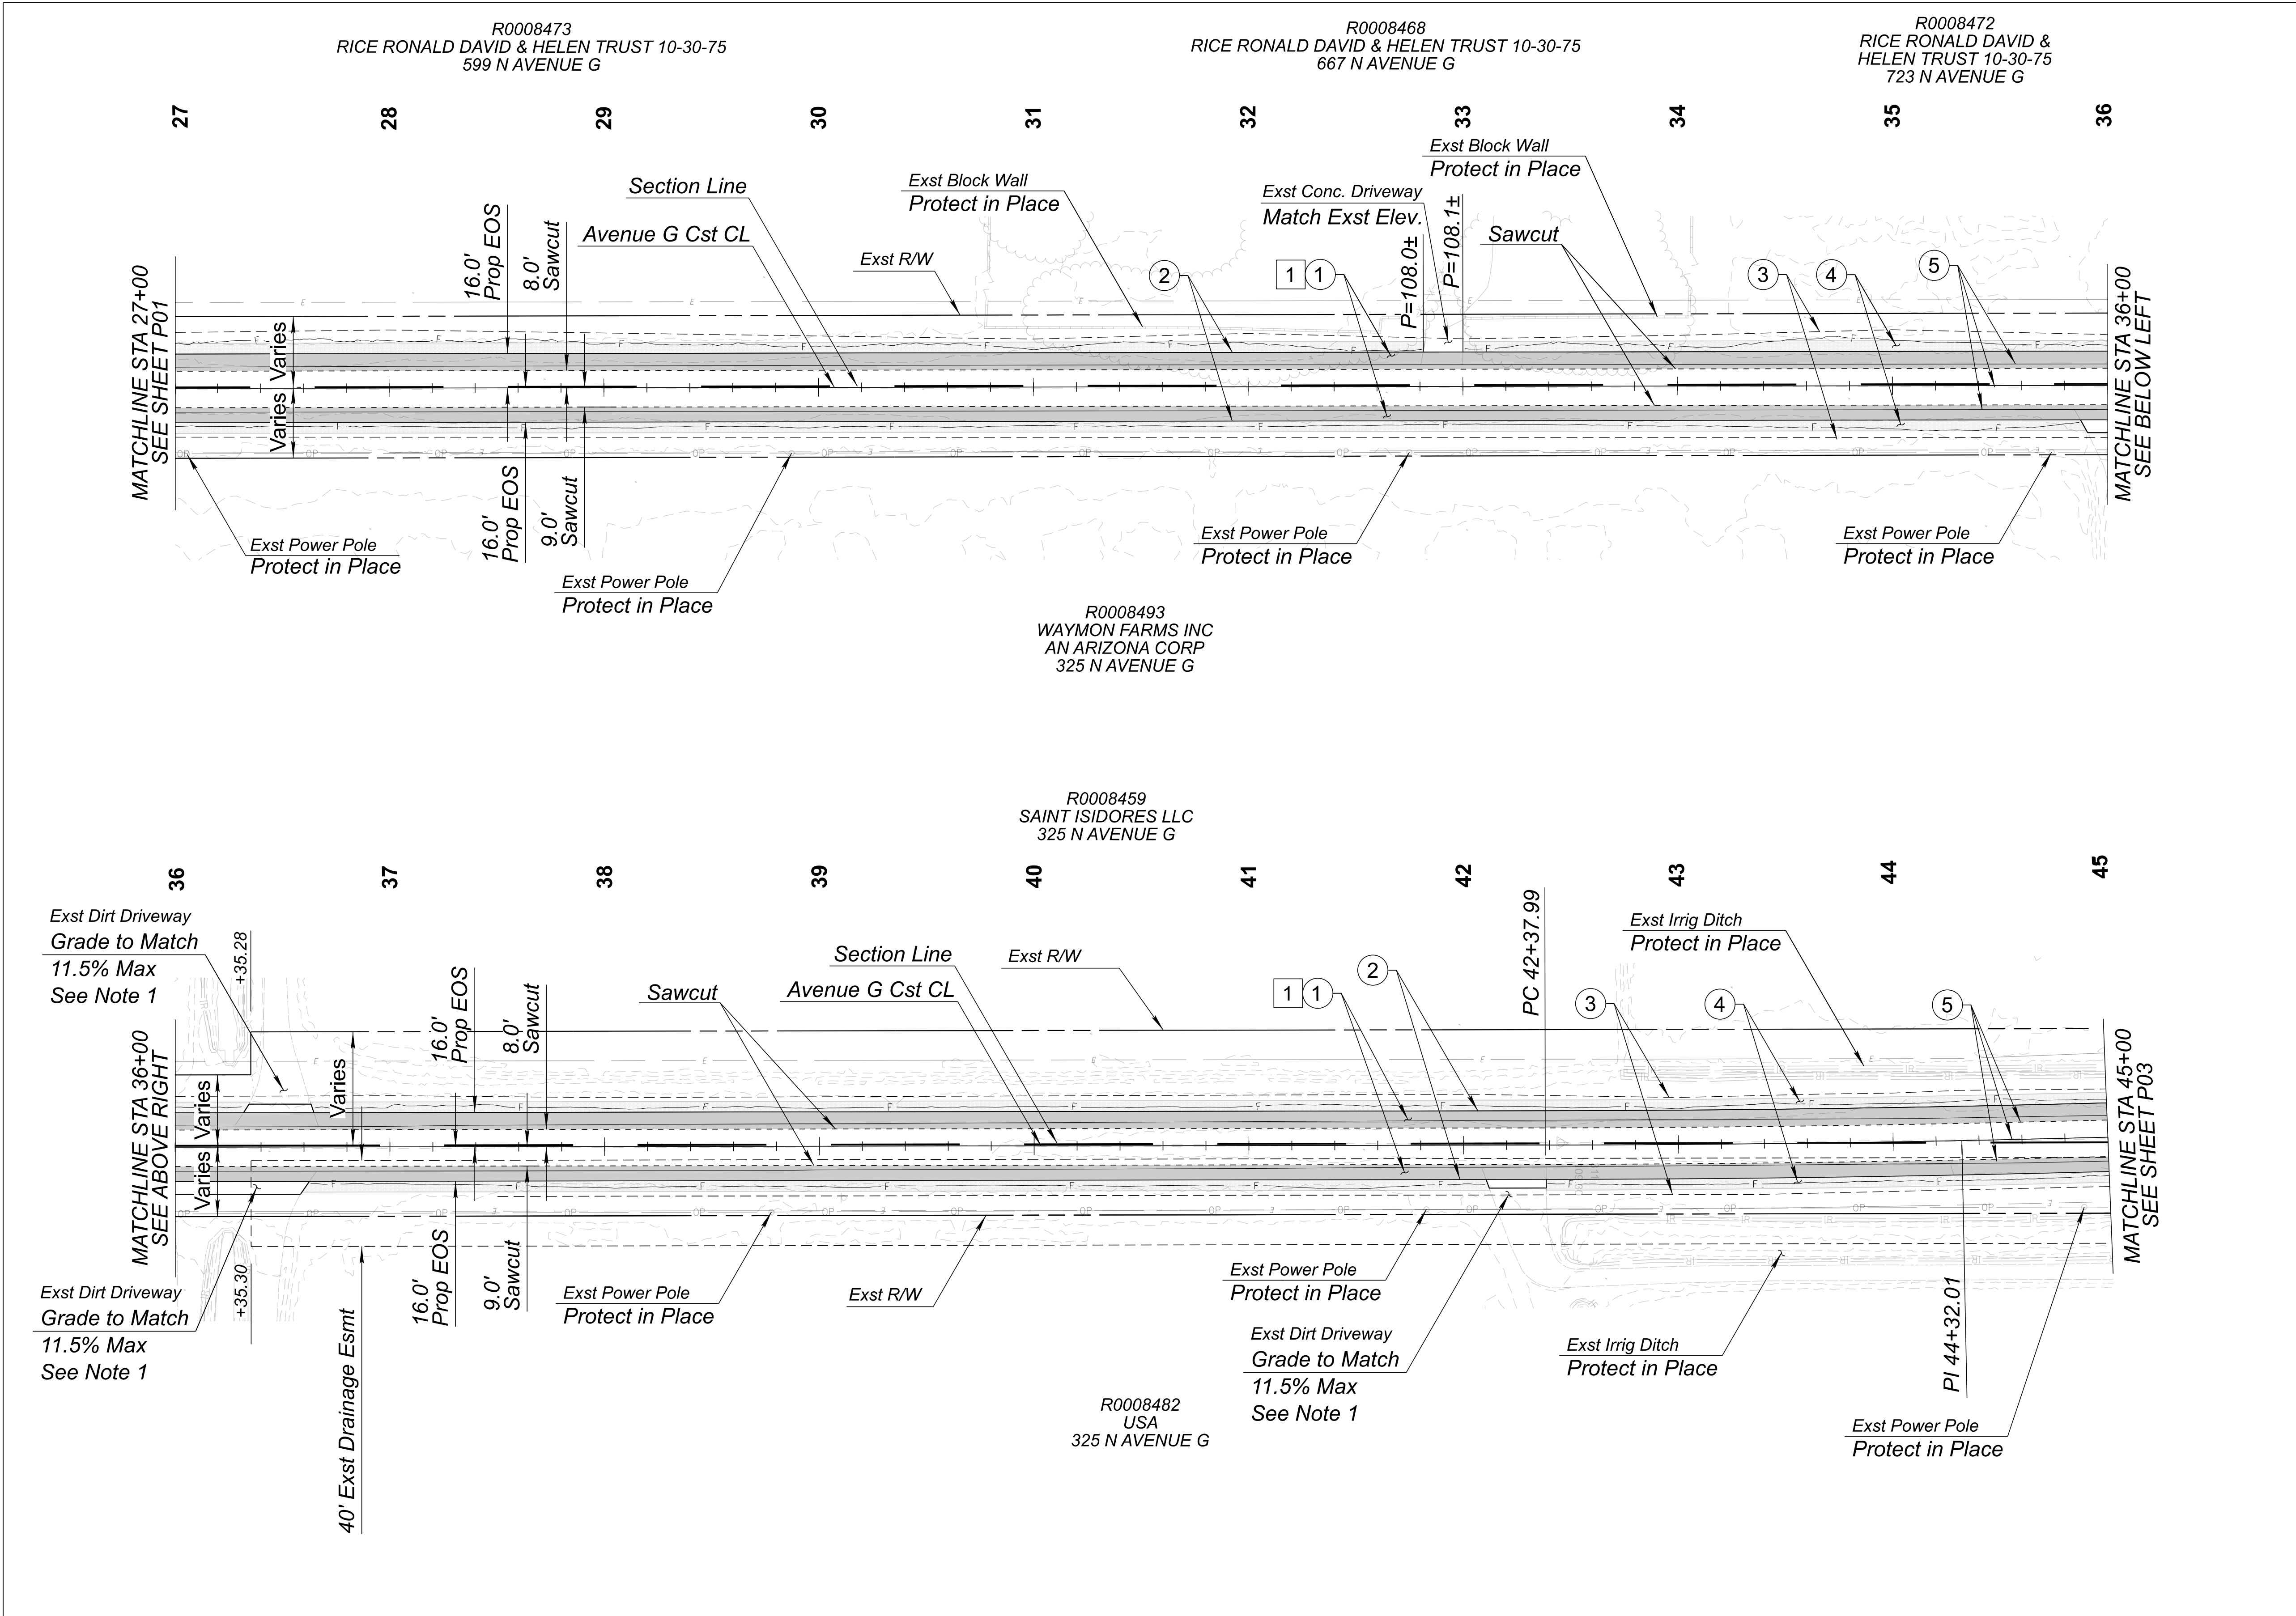


REMOVAL NOTES	
NO.	DESCRIPTION
1	Sawcut and Remove Exst Asphalt Pavement
CONSTRUCTION NOTES	
NO.	DESCRIPTION
1	Construct Asphalt Pavement Per PSS1 on DWG DS01
2	Install Safety Edge Per DTL on DWG DS03
3	Install 9-inch Sediment Wattle Per Dtl EC02
4	Install Granite Mulch (1-1/4 Inch Minus) from Edge of Shoulder extending 5 ft offset along Improvements Limits
5	Install Fog Coat on Obliterated Centerline Striping and New Shoulder per DWG RS01
Notes:	
1. Grading to be paid under Item 2030301	

	WSP USA Inc. 1230 West Washington Street, Suite 600 Tempe, AZ 85285	ARIZONA DEPARTMENT OF TRANSPORTATION PROJECT DELIVERY AND OPERATIONS DIVISION ROADWAY DESIGN SECTION PLAN SHEET STA 27+00 TO 45+00	ROUTE	F.H.W.A. Arizona Division	STATE	PROJECT NO.	FEDERAL ID NO.	SHEET NO.	TOTAL SHEETS	RECORD DRAWING		
			MILEPOST		ARIZ.	0000 YU YYU	YYU-0(225)T	11	37			
			STRUCTURE NO.	LOCATION AVENUE G, COUNTY 11TH ST - COUNTY 16TH ST							DWG P02	
			TRACS NO. T0437 01C					___ OF ___				

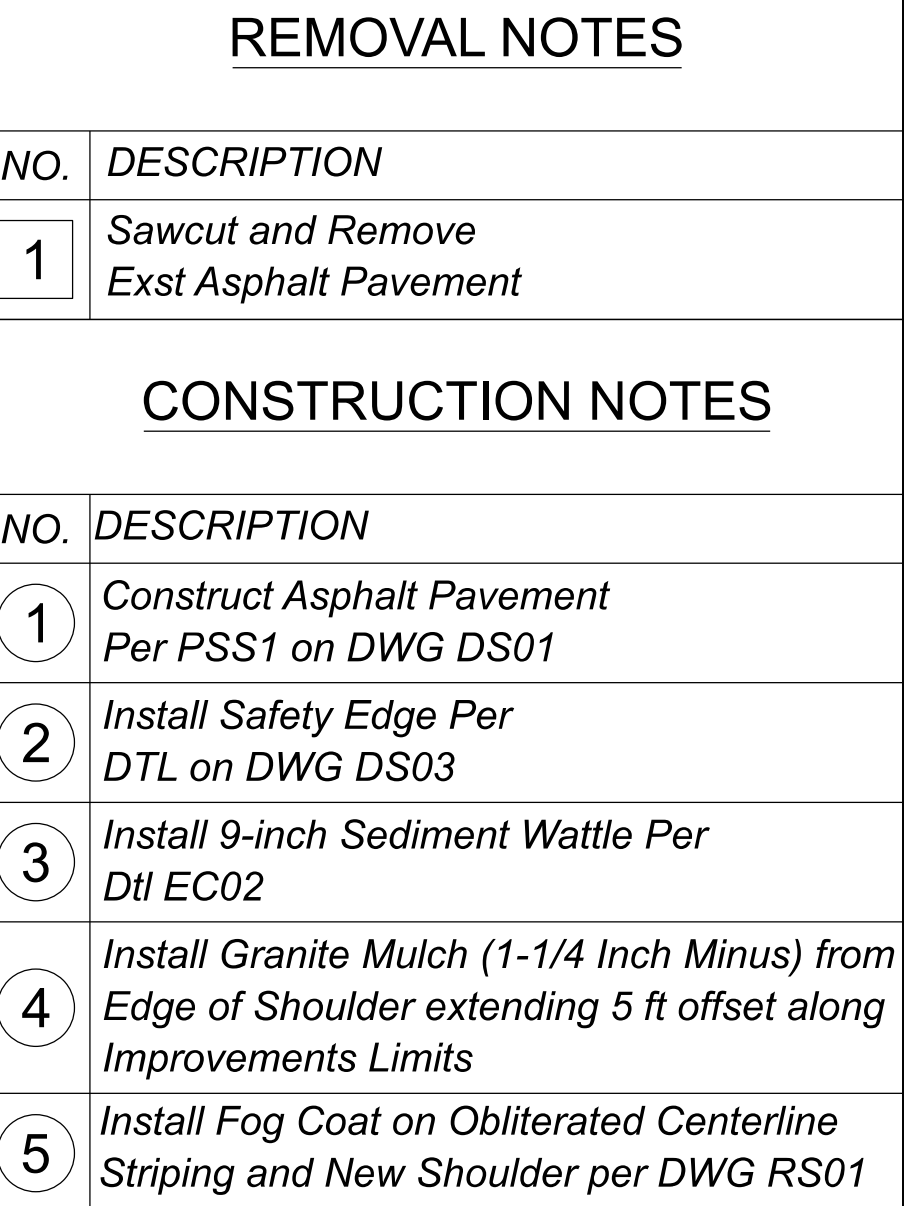


	<table border="1"> <thead> <tr> <th></th> <th>NAME</th> <th>DATE</th> </tr> </thead> <tbody> <tr> <td>DESIGN</td> <td>M. SCHOEN</td> <td>07/26</td> </tr> <tr> <td>DRAWN</td> <td>N. EKI BWANGOY</td> <td>07/26</td> </tr> <tr> <td>CHECKED</td> <td>H. RIOS</td> <td>07/26</td> </tr> </tbody> </table>		NAME	DATE	DESIGN	M. SCHOEN	07/26	DRAWN	N. EKI BWANGOY	07/26	CHECKED	H. RIOS	07/26	ARIZONA DEPARTMENT OF TRANSPORTATION PROJECT DELIVERY AND OPERATIONS DIVISION ROADWAY DESIGN SECTION	ROUTE MILEPOST STRUCTURE NO.	F.H.W.A. Arizona Division ARIZ.	STATE ARIZ.	PROJECT NO. 0000 YU YU	FEDERAL ID NO. YU-0(225)T	SHEET NO. 12	TOTAL SHEETS 37	RECORD DRAWING
		NAME	DATE																			
	DESIGN	M. SCHOEN	07/26																			
	DRAWN	N. EKI BWANGOY	07/26																			
CHECKED	H. RIOS	07/26																				
 WSP USA Inc. 1200 West Washington Street, Suite 600 Tempe, AZ 85288	PLAN SHEET STA 45+00 TO 63+00	LOCATION AVENUE G, COUNTY 11TH ST - COUNTY 16TH ST	DWG P03																			
		TRACS NO. T0437 01C	OF																			

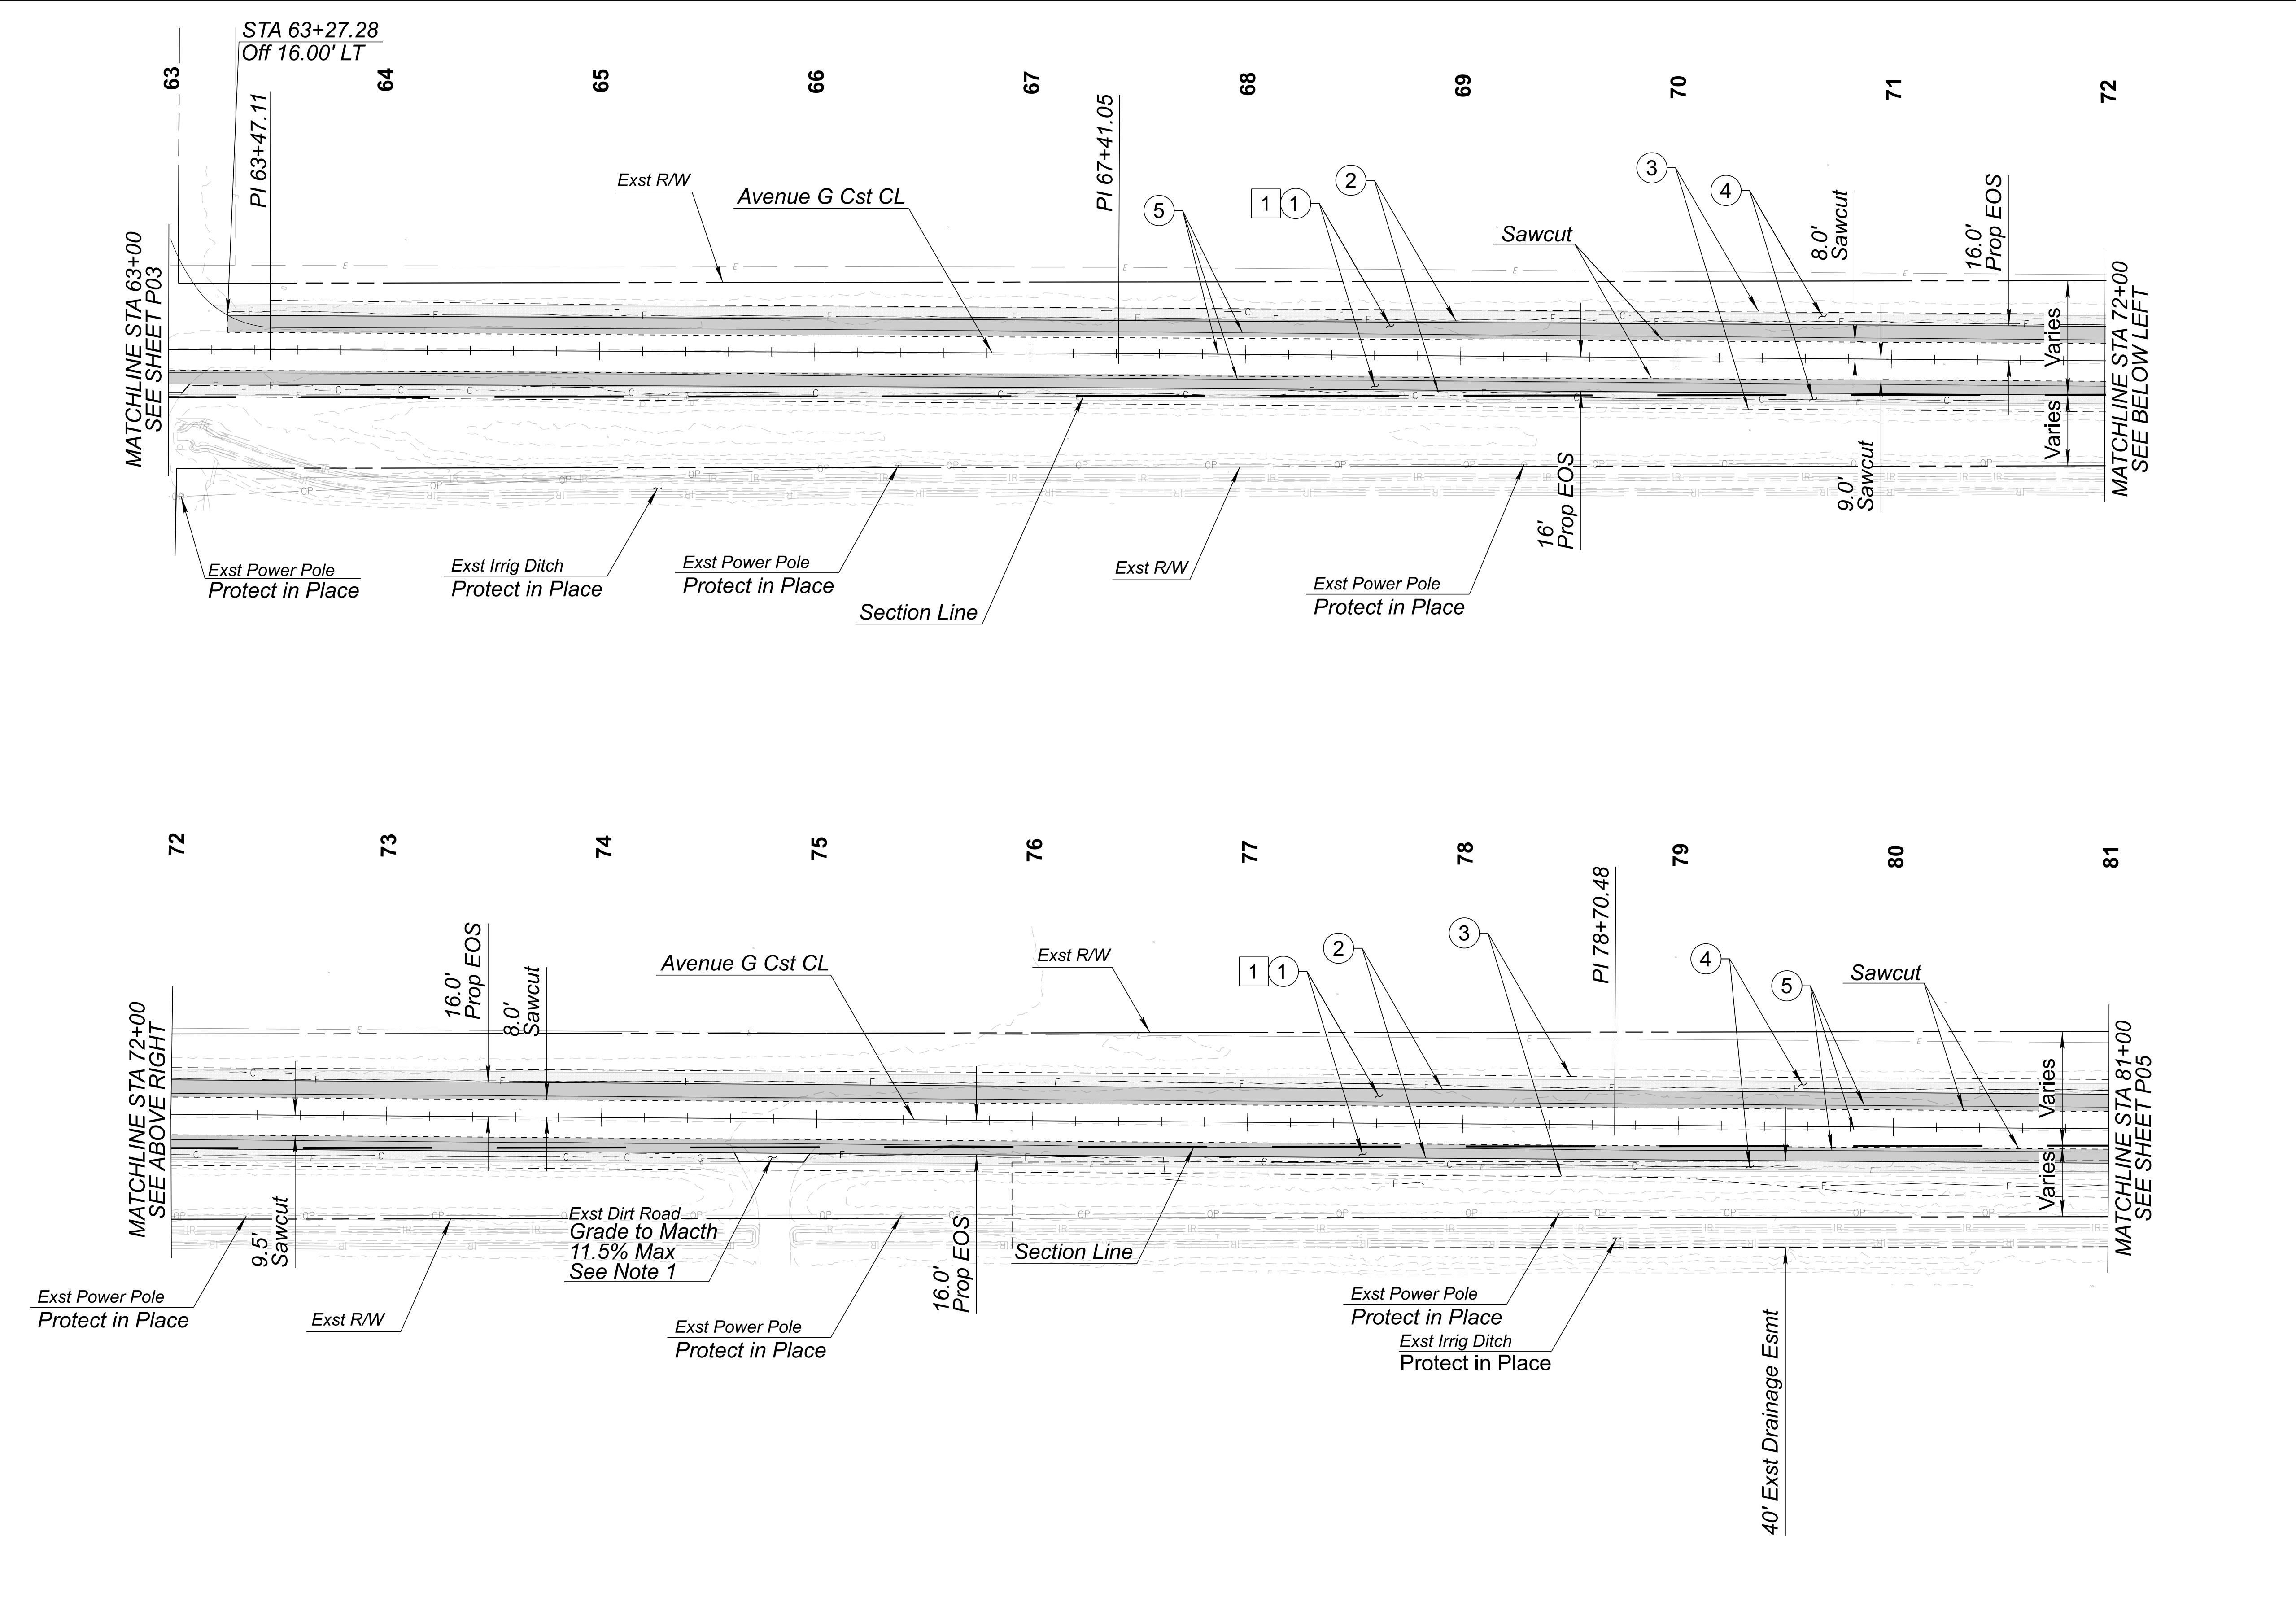


REMOVAL NOTES	
NO.	DESCRIPTION
1	Sawcut and Remove Exst Asphalt Pavement
CONSTRUCTION NOTES	
NO.	DESCRIPTION
1	Construct Asphalt Pavement Per PSS1 on DWG DS01
2	Install Safety Edge Per DTL on DWG DS03
3	Install 9-inch Sediment Wattle Per Dtl EC02
4	Install Granite Mulch (1-1/4 Inch Minus) from Edge of Shoulder extending 5 ft offset along Improvements Limits
5	Install Fog Coat on Obliterated Centerline Striping and New Shoulder per DWG RS01
Notes:	
1. Grading to be paid under Item 2030301	

	<table><tr><th>DESIGN</th><th>NAME</th><th>DATE</th></tr><tr><td>M. SCHOEN</td><td>M. SCHOEN</td><td>07/26</td></tr><tr><td>DRAWN</td><td>N. EKI BWANGOY</td><td>07/26</td></tr><tr><td>CHECKED</td><td>H. RIOS</td><td>07/26</td></tr></table>	DESIGN	NAME	DATE	M. SCHOEN	M. SCHOEN	07/26	DRAWN	N. EKI BWANGOY	07/26	CHECKED	H. RIOS	07/26	<table><tr><td colspan="2">ARIZONA DEPARTMENT OF TRANSPORTATION</td></tr><tr><td colspan="2">PROJECT DELIVERY AND OPERATIONS DIVISION</td></tr><tr><td colspan="2">ROADWAY DESIGN SECTION</td></tr><tr><td colspan="2">PLAN SHEET</td></tr><tr><td colspan="2">63+00 to 81+00</td></tr></table>	ARIZONA DEPARTMENT OF TRANSPORTATION		PROJECT DELIVERY AND OPERATIONS DIVISION		ROADWAY DESIGN SECTION		PLAN SHEET		63+00 to 81+00		<table><tr><td>ROUTE</td><td>F.H.W.A. Arizona Division</td><td>STATE</td><td>ARIZ.</td><td>PROJECT NO.</td><td>0000 YU YYU</td><td>FEDERAL ID NO.</td><td>YYU-0(225)T</td><td>SHEET NO.</td><td>13</td><td>TOTAL SHEETS</td><td>37</td><td>RECORD DRAWING</td></tr><tr><td>MILEPOST</td><td colspan="10">LOCATION AVENUE G, COUNTY 11TH ST - COUNTY 16TH ST</td><td>DWG</td><td>P04</td></tr><tr><td>STRUCTURE NO.</td><td colspan="10">TRACS NO. T0437 01C</td><td colspan="2">___ OF ___</td></tr></table>	ROUTE	F.H.W.A. Arizona Division	STATE	ARIZ.	PROJECT NO.	0000 YU YYU	FEDERAL ID NO.	YYU-0(225)T	SHEET NO.	13	TOTAL SHEETS	37	RECORD DRAWING	MILEPOST	LOCATION AVENUE G, COUNTY 11TH ST - COUNTY 16TH ST										DWG	P04	STRUCTURE NO.	TRACS NO. T0437 01C										___ OF ___	
	DESIGN	NAME	DATE																																																													
	M. SCHOEN	M. SCHOEN	07/26																																																													
	DRAWN	N. EKI BWANGOY	07/26																																																													
	CHECKED	H. RIOS	07/26																																																													
ARIZONA DEPARTMENT OF TRANSPORTATION																																																																
PROJECT DELIVERY AND OPERATIONS DIVISION																																																																
ROADWAY DESIGN SECTION																																																																
PLAN SHEET																																																																
63+00 to 81+00																																																																
ROUTE	F.H.W.A. Arizona Division	STATE	ARIZ.	PROJECT NO.	0000 YU YYU	FEDERAL ID NO.	YYU-0(225)T	SHEET NO.	13	TOTAL SHEETS	37	RECORD DRAWING																																																				
MILEPOST	LOCATION AVENUE G, COUNTY 11TH ST - COUNTY 16TH ST										DWG	P04																																																				
STRUCTURE NO.	TRACS NO. T0437 01C										___ OF ___																																																					

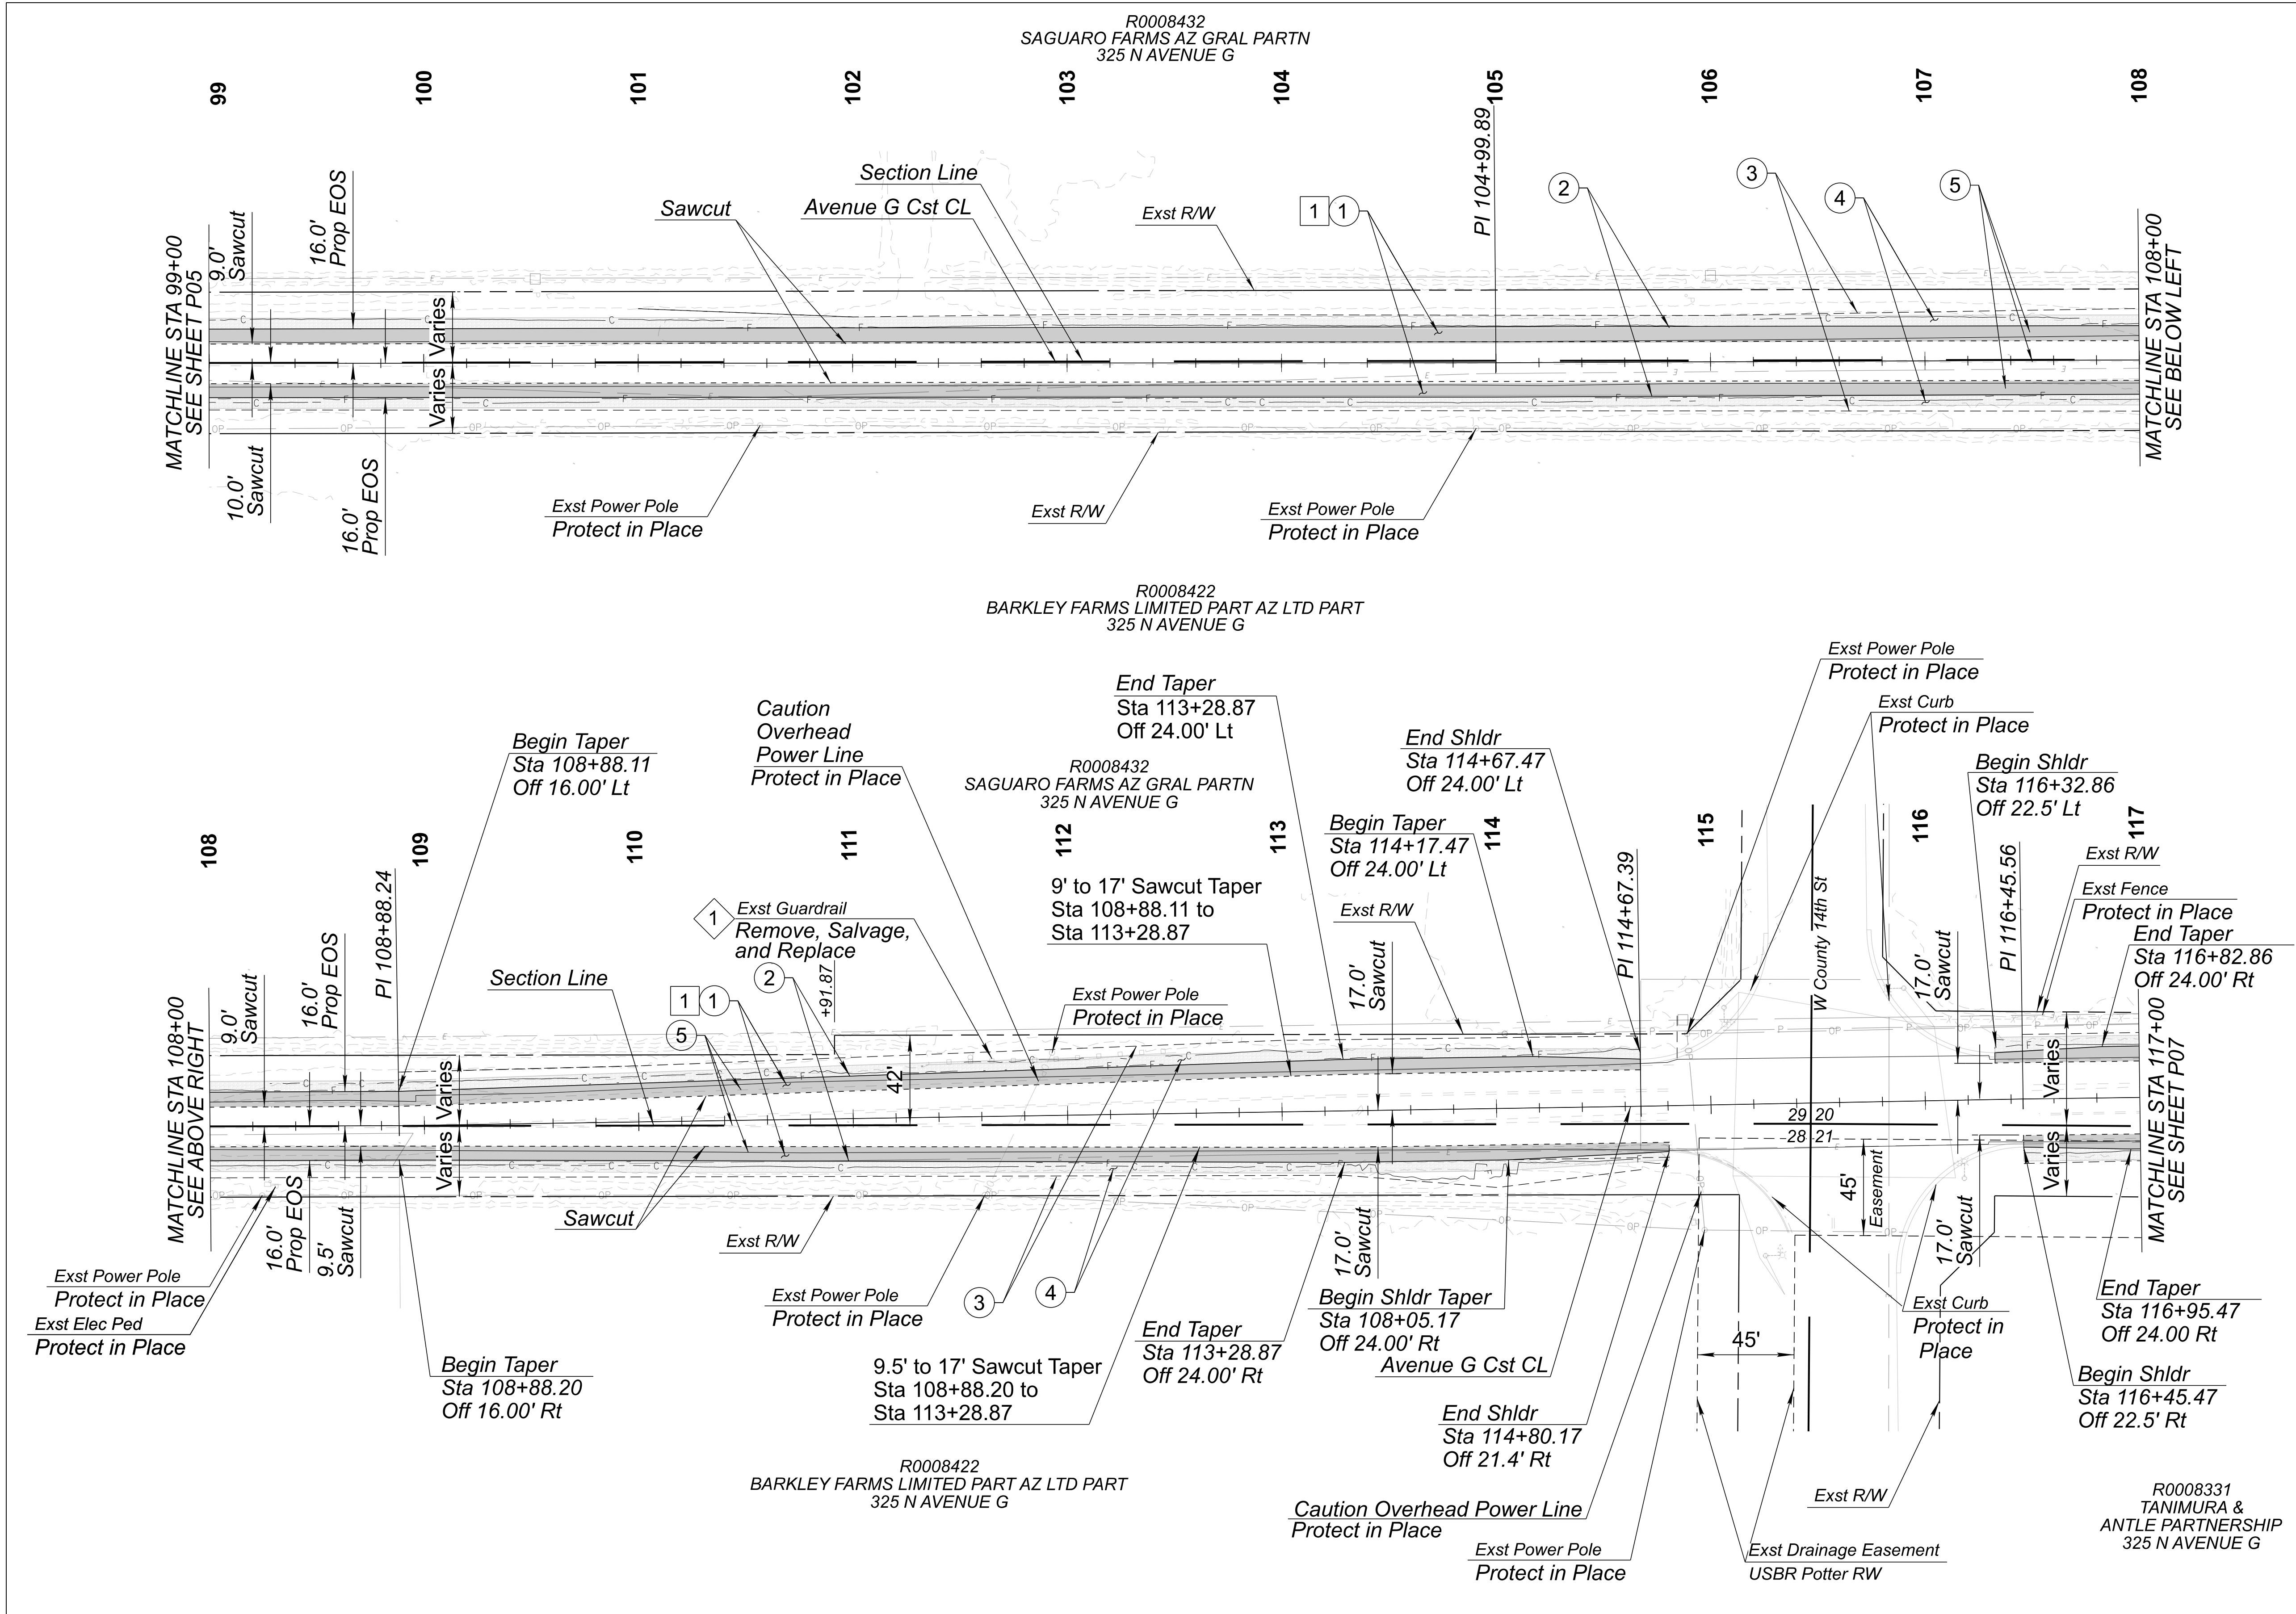

REMOVAL NOTES	
NO.	DESCRIPTION
1	Sawcut and Remove Exst Asphalt Pavement
CONSTRUCTION NOTES	
NO.	DESCRIPTION
1	Construct Asphalt Pavement Per PSS1 on DWG DS01
2	Install Safety Edge Per DTL on DWG DS03
3	Install 9-inch Sediment Wattle Per Dtl EC02
4	Install Granite Mulch (1-1/4 Inch Minus) from Edge of Shoulder extending 5 ft offset along Improvements Limits
5	Install Fog Coat on Obliterated Centerline Striping and New Shoulder per DWG RS01
Notes:	
1.	Deliver Salvaged Guardrail to: Yuma County Public Works Department 4343 S Avenue 6 1/2E, Yuma, Az 85365

		NAME M. SCHOEN DATE 07/26 DRAWN N. EKI BWANGOY 07/26 CHECKED H. RIOS 07/26	ARIZONA DEPARTMENT OF TRANSPORTATION PROJECT DELIVERY AND OPERATIONS DIVISION ROADWAY DESIGN SECTION PLAN SHEET STA 99+00 TO 117+00	ROUTE MILEPOST STRUCTURE NO.	F.H.W.A. Arizona Division LOCATION AVENUE G, COUNTY 11TH ST - COUNTY 16TH ST	STATE ARIZ.	PROJECT NO. 0000 YU YYU	FEDERAL ID NO. YYU-0(225)T	SHEET NO. 15	TOTAL SHEETS 37	RECORD DRAWING	DWG P06 OF

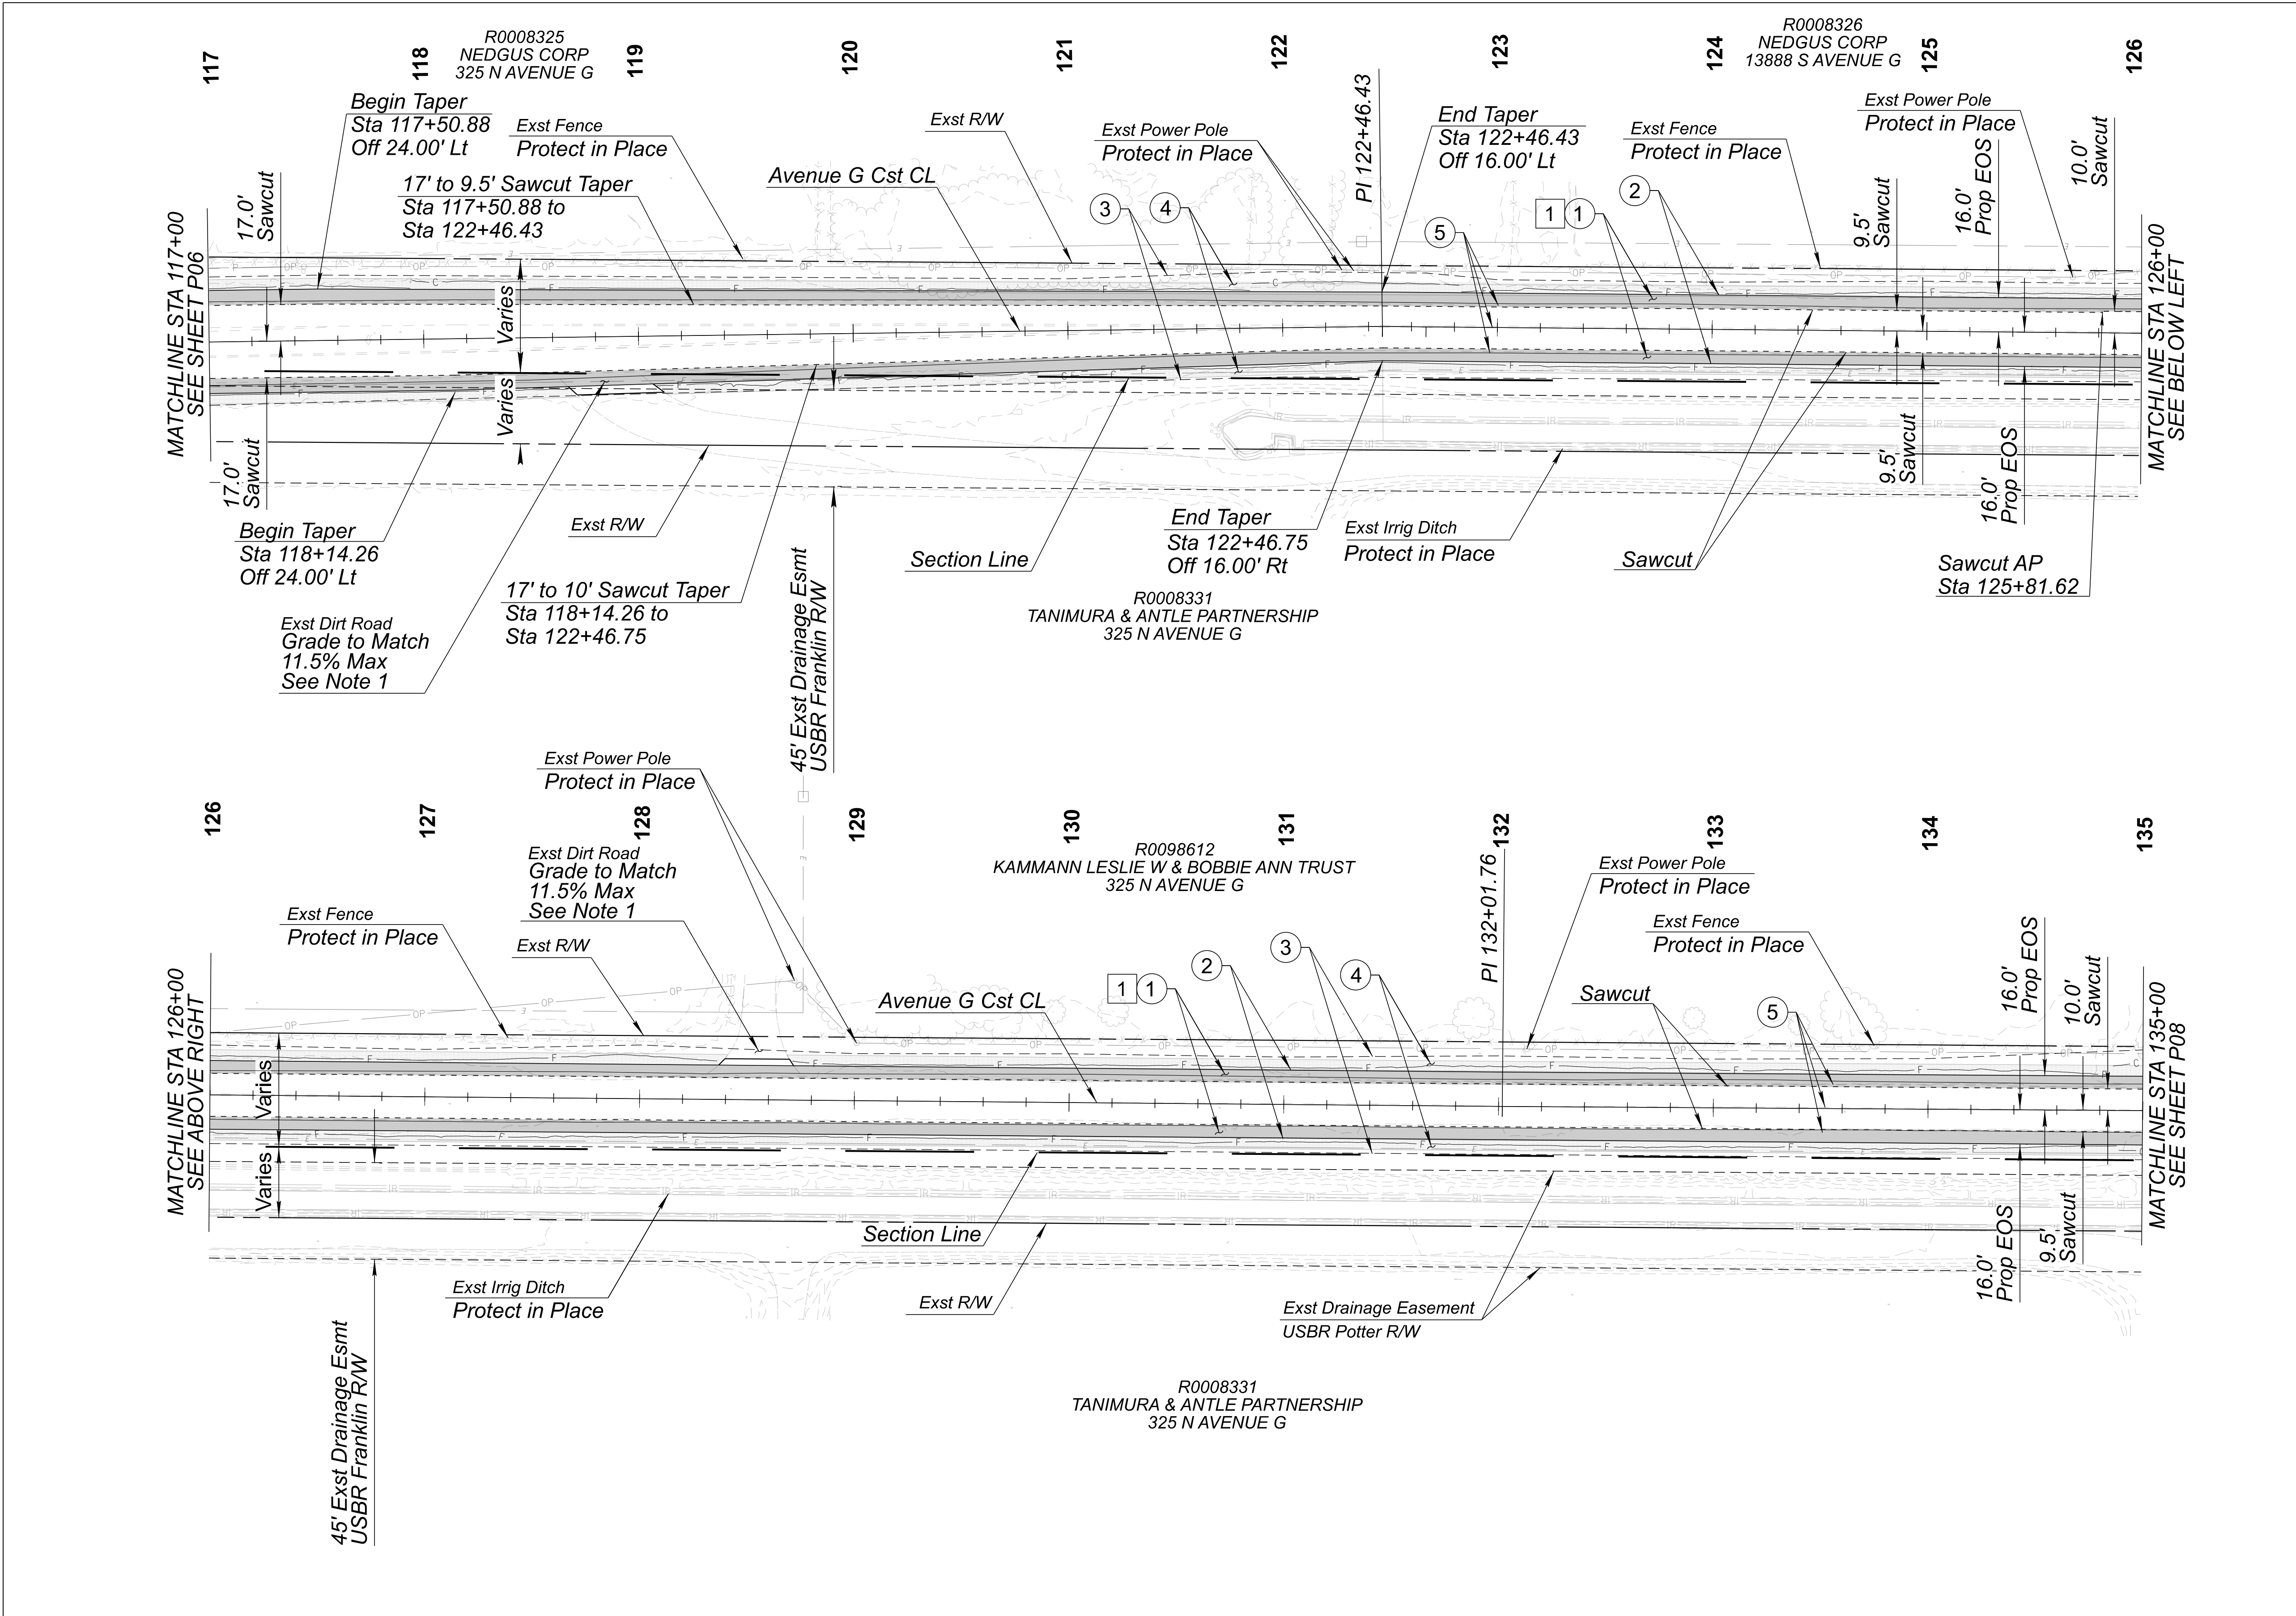

REMOVAL NOTES


NO.	DESCRIPTION
1	Sawcut and Remove Exst Asphalt Pavement

CONSTRUCTION NOTES

NO.	DESCRIPTION
1	Construct Asphalt Pavement Per PSS1 on DWG DS01
2	Install Safety Edge Per DTL on DWG DS03
3	Install 9-inch Sediment Wattle Per Dtl EC02
4	Install Granite Mulch (1-1/4 Inch Minus) from Edge of Shoulder extending 5 ft offset along Improvements Limits
5	Install Fog Coat on Obliterated Centerline Striping and New Shoulder per DWG RS01


Notes:
1. Grading to be paid under Item 2030301

	WSP USA Inc. 1230 West Washington Street, Suite 600 Tempe, AZ 85285	ARIZONA DEPARTMENT OF TRANSPORTATION PROJECT DELIVERY AND OPERATIONS DIVISION ROADWAY DESIGN SECTION PLAN SHEET STA 117+00 to 135+00	ROUTE	F.H.W.A. Arizona Division	STATE	PROJECT NO.	FEDERAL ID NO.	SHEET NO.	TOTAL SHEETS	RECORD DRAWING		
			MILEPOST		ARIZ.	0000 YU YYU	YYU-0(225)T	16	37			
			STRUCTURE NO.	LOCATION AVENUE G, COUNTY 11TH ST - COUNTY 16TH ST								DWG P07
			TRACS NO. T0437 01C								___ OF ___	

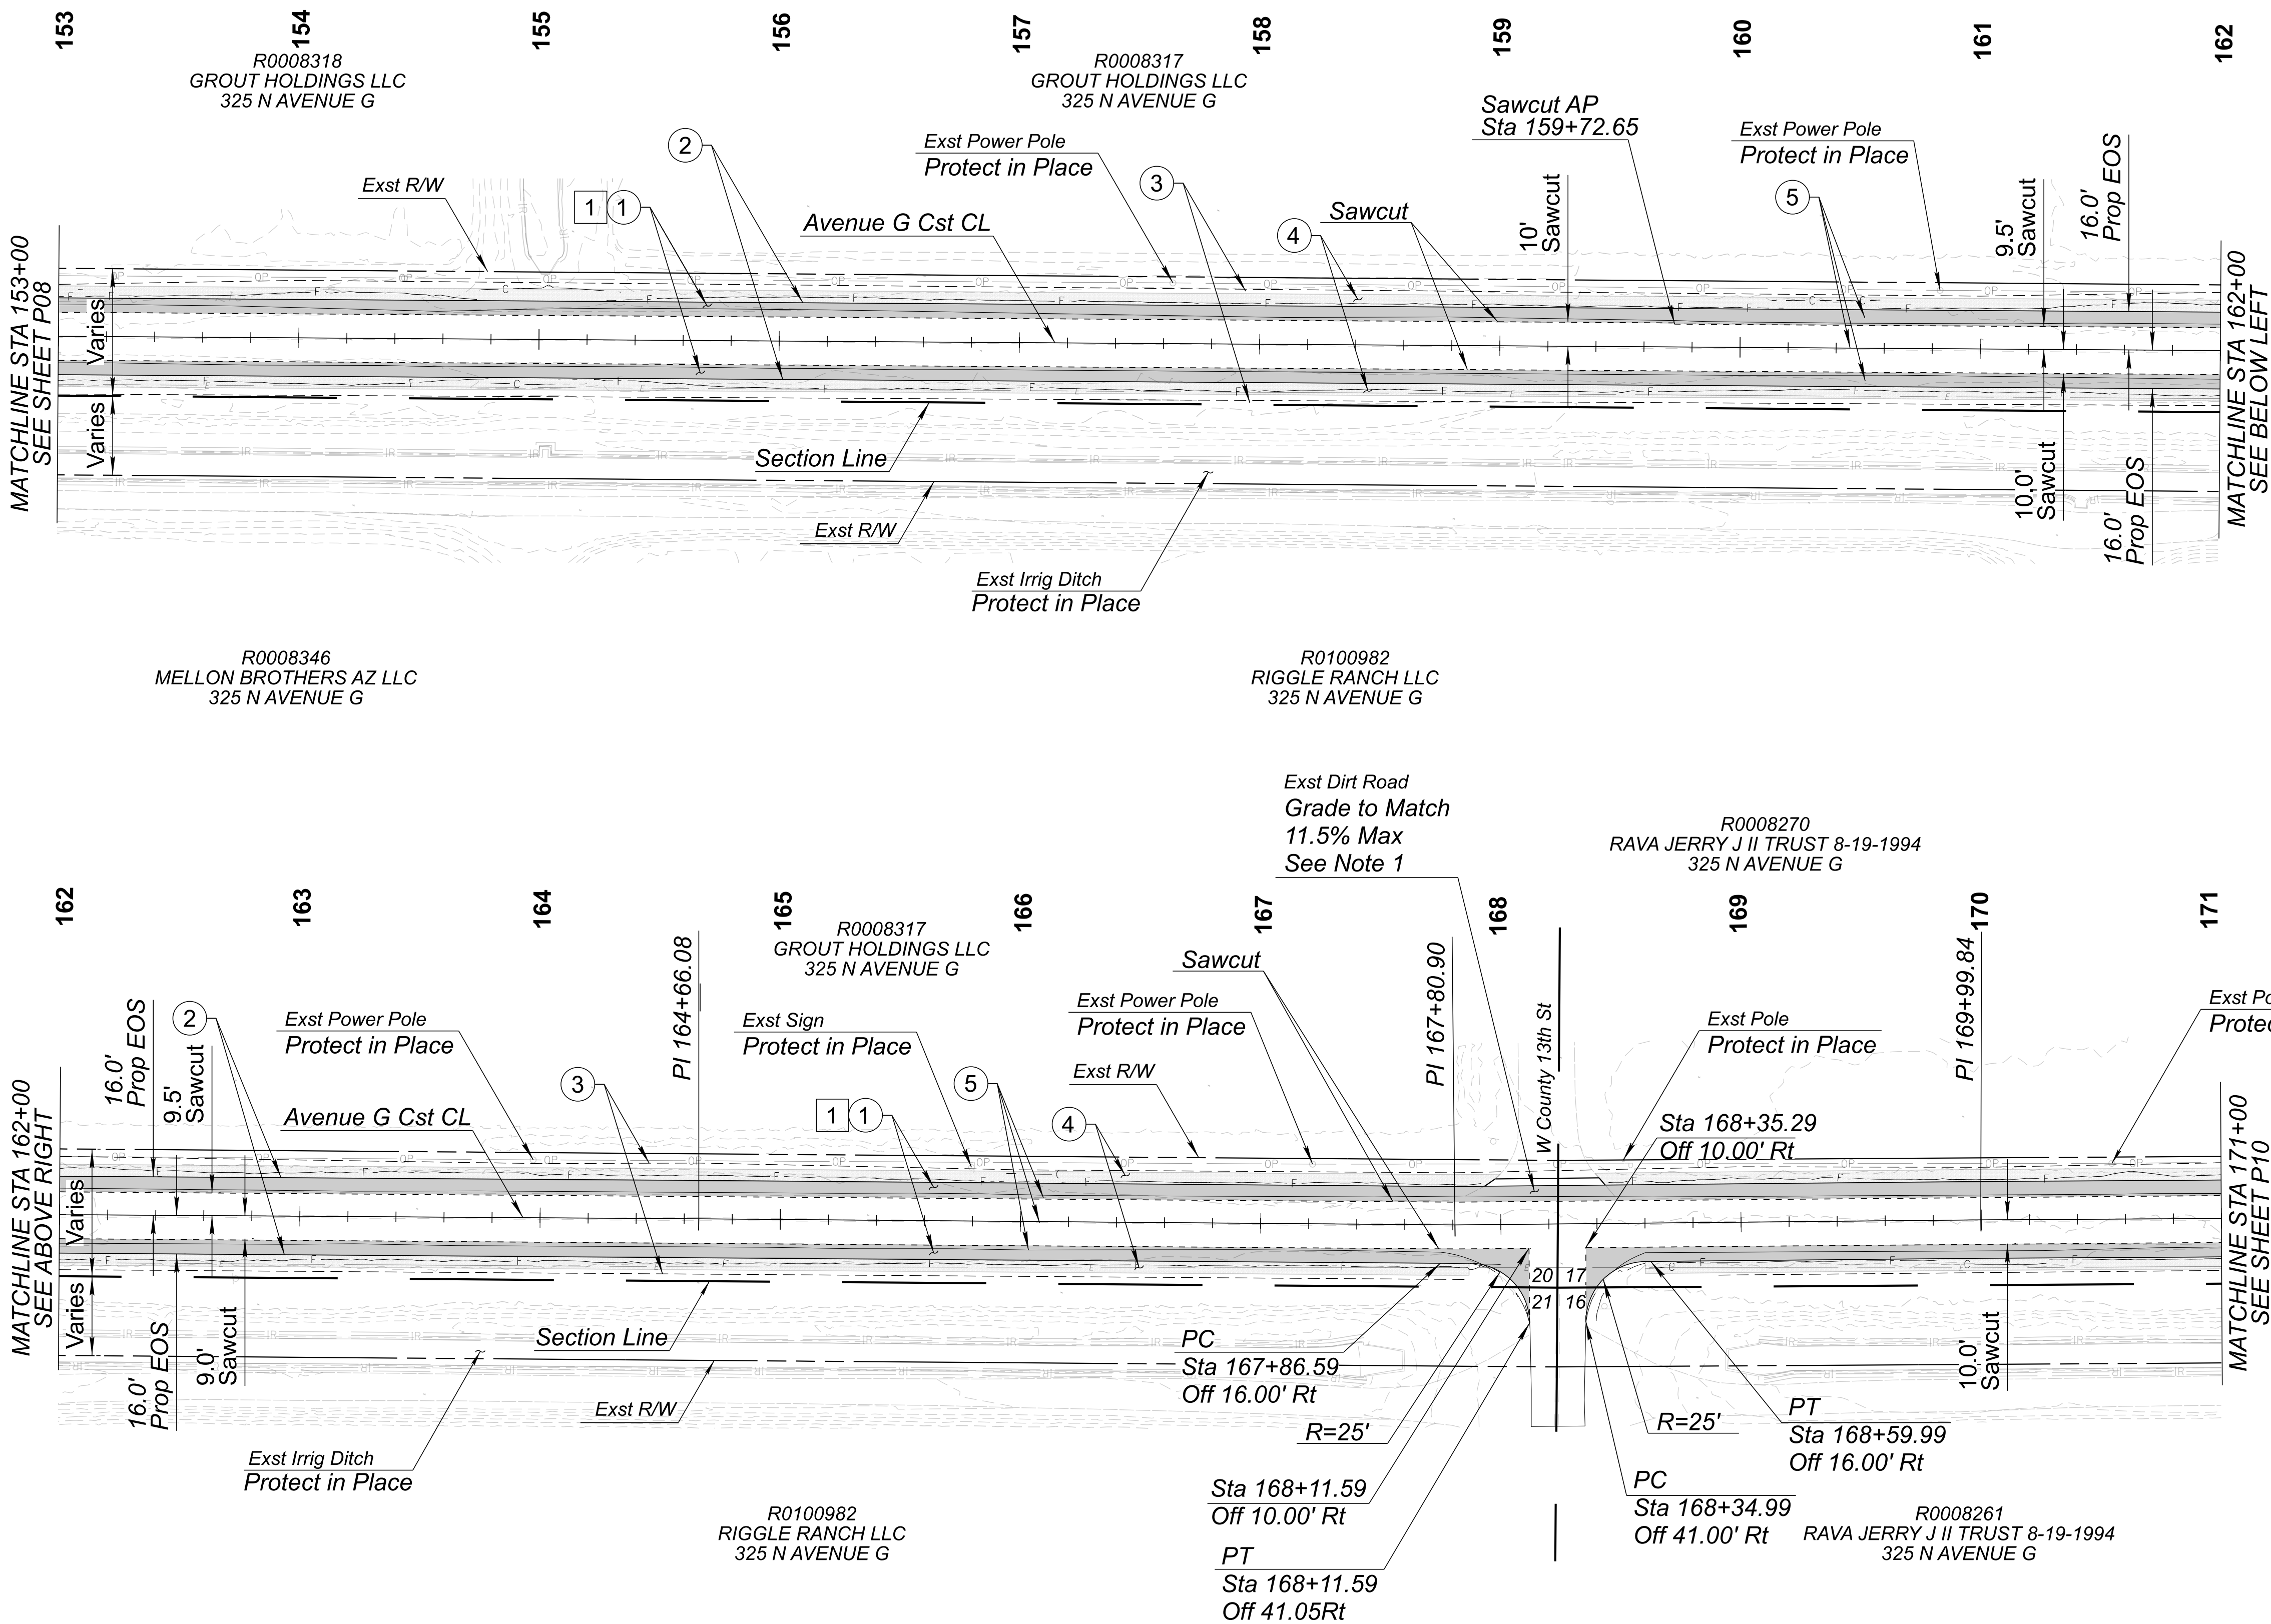


REMOVAL NOTES	
NO.	DESCRIPTION
1	Sawcut and Remove Exst Asphalt Pavement
CONSTRUCTION NOTES	
NO.	DESCRIPTION
1	Construct Asphalt Pavement Per PSS1 on DWG DS01
2	Install Safety Edge Per DTL on DWG DS03
3	Install 9-inch Sediment Wattle Per Dtl EC02
4	Install Granite Mulch (1-1/4 Inch Minus) from Edge of Shoulder extending 5 ft offset along Improvements Limits
5	Install Fog Coat on Obliterated Centerline Striping and New Shoulder per DWG RS01


- Notes:
- Grading to be paid under Item 2030301

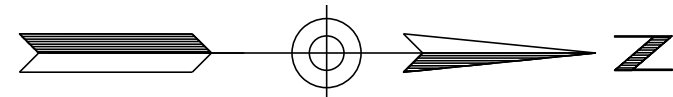

	DESIGN	NAME	DATE	ARIZONA DEPARTMENT OF TRANSPORTATION PROJECT DELIVERY AND OPERATIONS DIVISION ROADWAY DESIGN SECTION	ROUTE	F.H.W.A. Arizona Division	STATE	PROJECT NO.	FEDERAL ID NO.	SHEET NO.	TOTAL SHEETS	RECORD DRAWING	
	DRAWN	N. EKI BWANGOY	07/26		MILEPOST		ARIZ.	0000 YU YYU	YYU-0(225)T	18	37		
	CHECKED	H. RIOS	07/26		STRUCTURE NO.								
	WSP USA Inc. 1230 West Washington Street, Suite 600 Tempe, AZ 85288			PLAN SHEET STA 153+00 TO 171+00	LOCATION AVENUE G, COUNTY 11TH ST - COUNTY 16TH ST								DWG P09
TRACS NO. T0437 01C								___ OF ___					

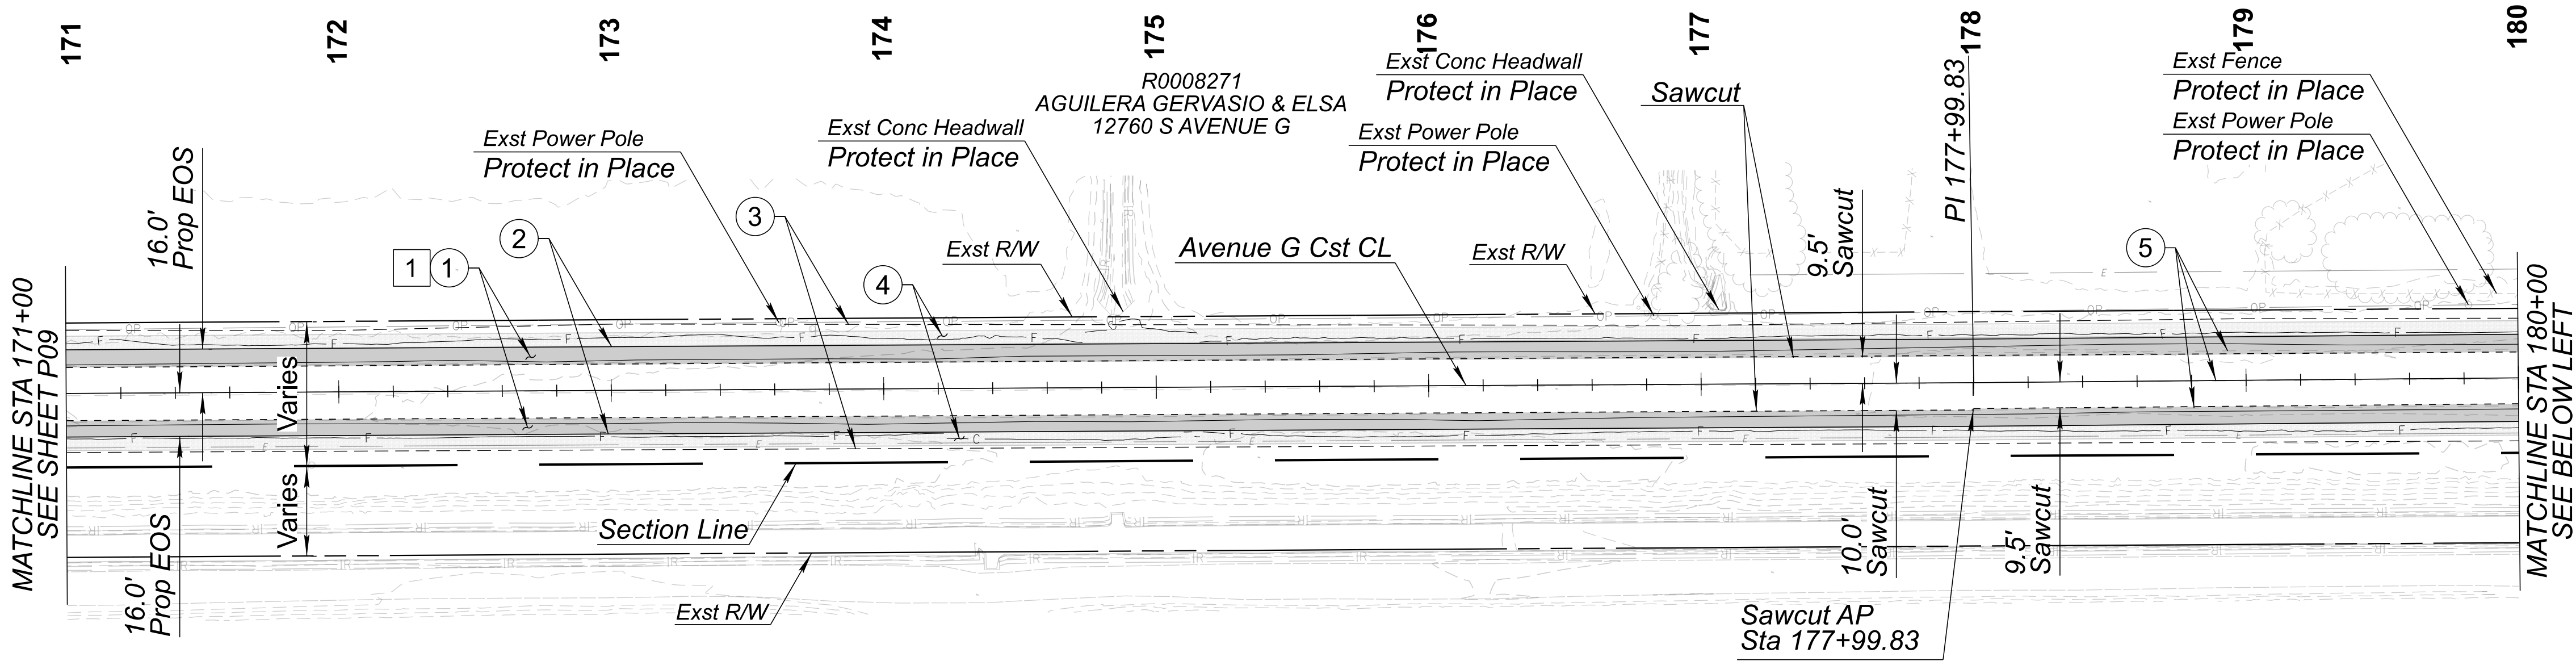

R0008261
RAVA JERRY J II TRUST 8-19-1994
325 N AVENUE G

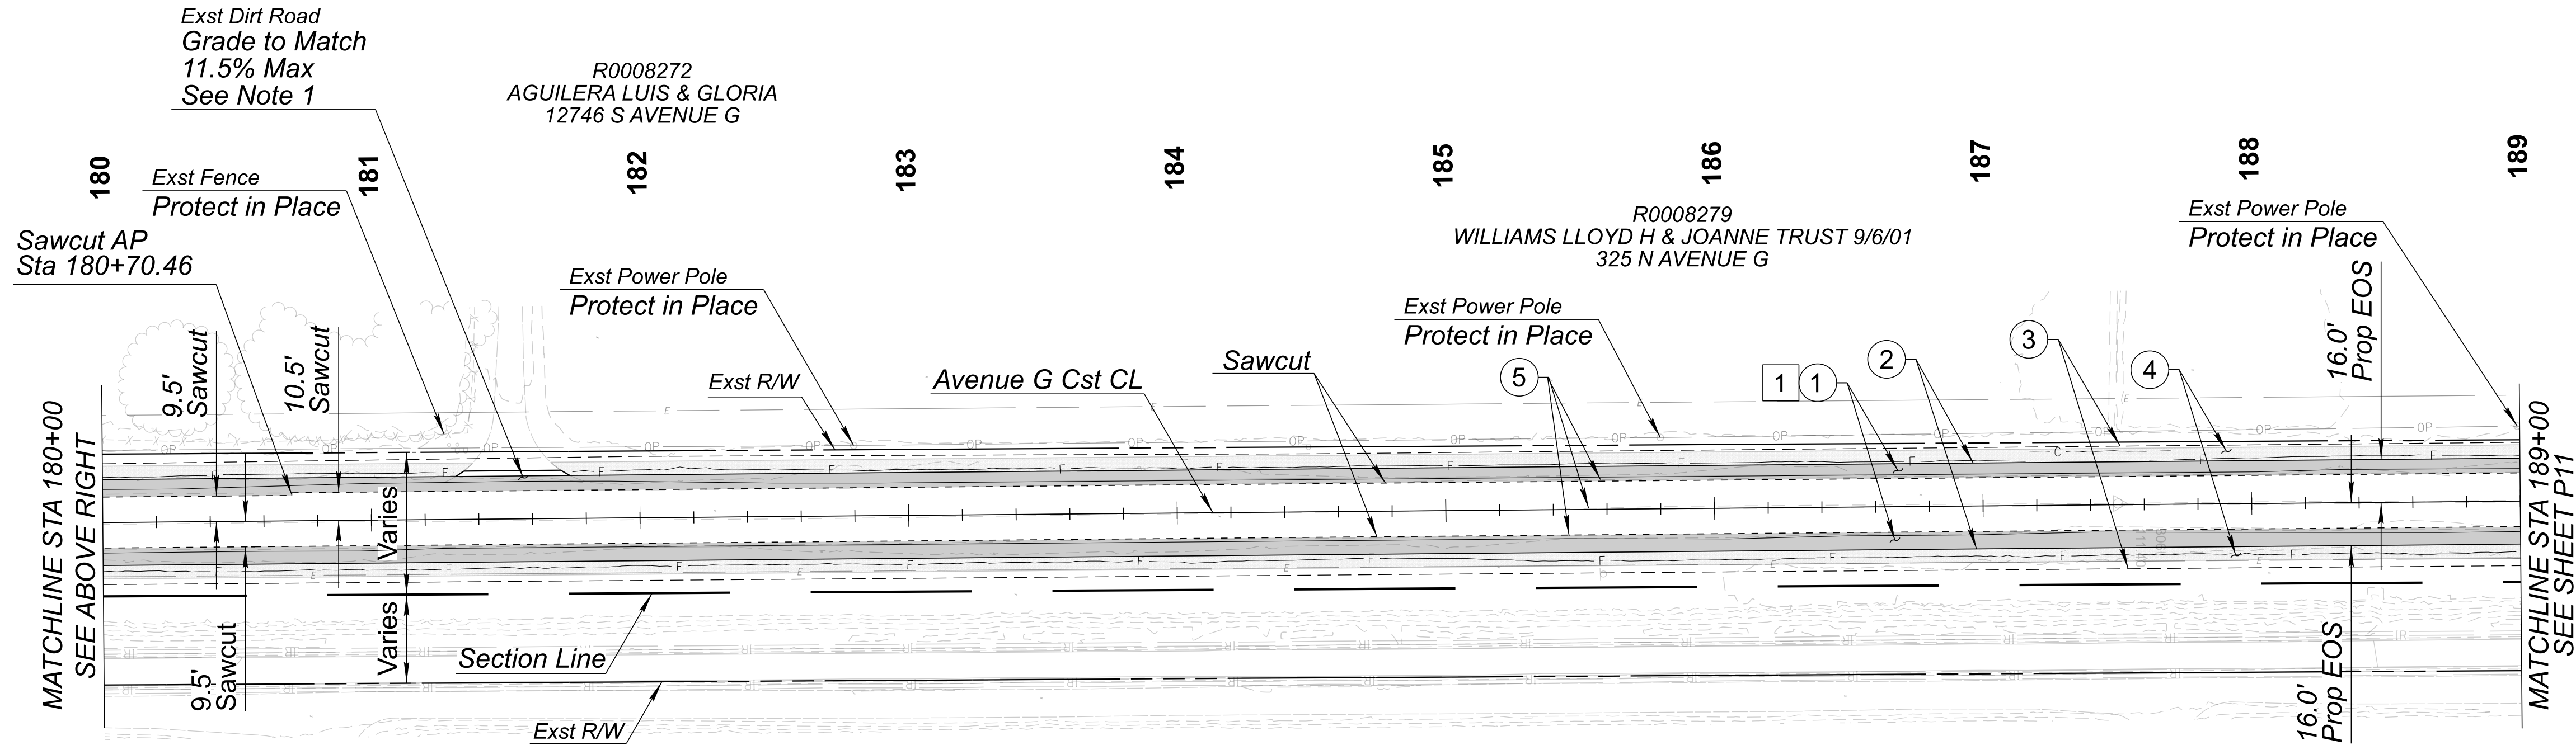

R0008261
RAVA JERRY J II TRUST 8-19-1994
325 N AVENUE G


REMOVAL NOTES

NO.	DESCRIPTION
1	Sawcut and Remove Exst Asphalt Pavement



CONSTRUCTION NOTES

NO.	DESCRIPTION
1	Construct Asphalt Pavement Per PSS1 on DWG DS01
2	Install Safety Edge Per DTL on DWG DS03
3	Install 9-inch Sediment Wattle Per Dtl EC02
4	Install Granite Mulch (1-1/4 Inch Minus) from Edge of Shoulder extending 5 ft offset along Improvements Limits
5	Install Fog Coat on Obliterated Centerline Striping and New Shoulder per DWG RS01

Notes:
1. Grading to be paid under Item 2030301

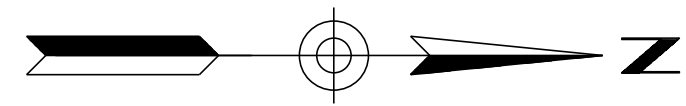

	DESIGN	NAME	DATE	ARIZONA DEPARTMENT OF TRANSPORTATION PROJECT DELIVERY AND OPERATIONS DIVISION ROADWAY DESIGN SECTION PLAN SHEET STA 171+00 TO 189+00	ROUTE	F.H.W.A. Arizona Division	STATE	PROJECT NO.	FEDERAL ID NO.	SHEET NO.	TOTAL SHEETS	RECORD DRAWING
	DRAWN	M. EKI BWANGOY	07/26		MILEPOST		ARIZ.	0000 YU YYU	YYU-0(225)T	19	37	
	CHECKED	H. RIOS	07/26		STRUCTURE NO.		LOCATION	AVENUE G, COUNTY 11TH ST - COUNTY 16TH ST				
	wsp				DWG P10							
				TRACS NO. T0437 01C				OF				

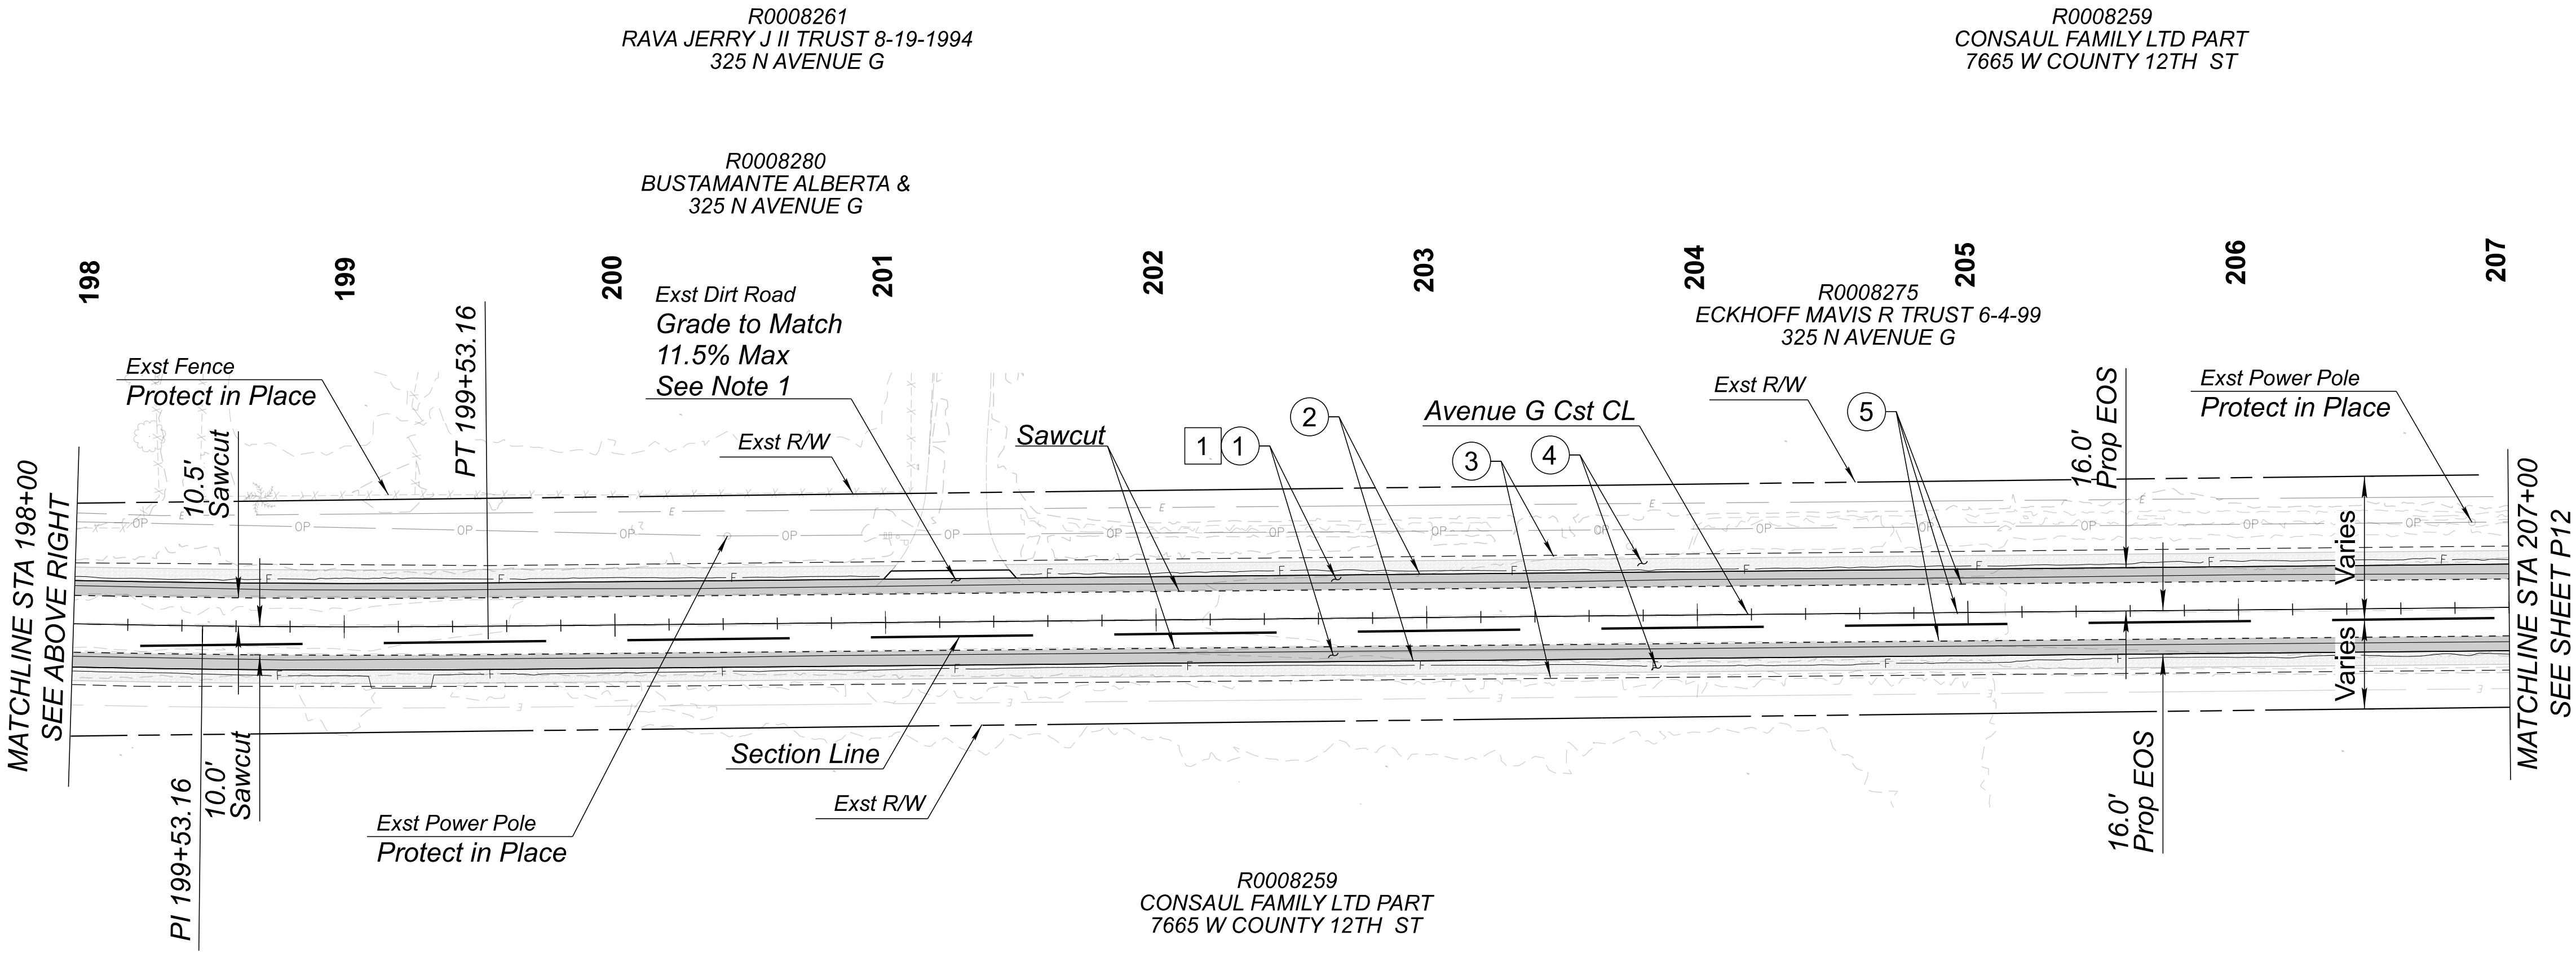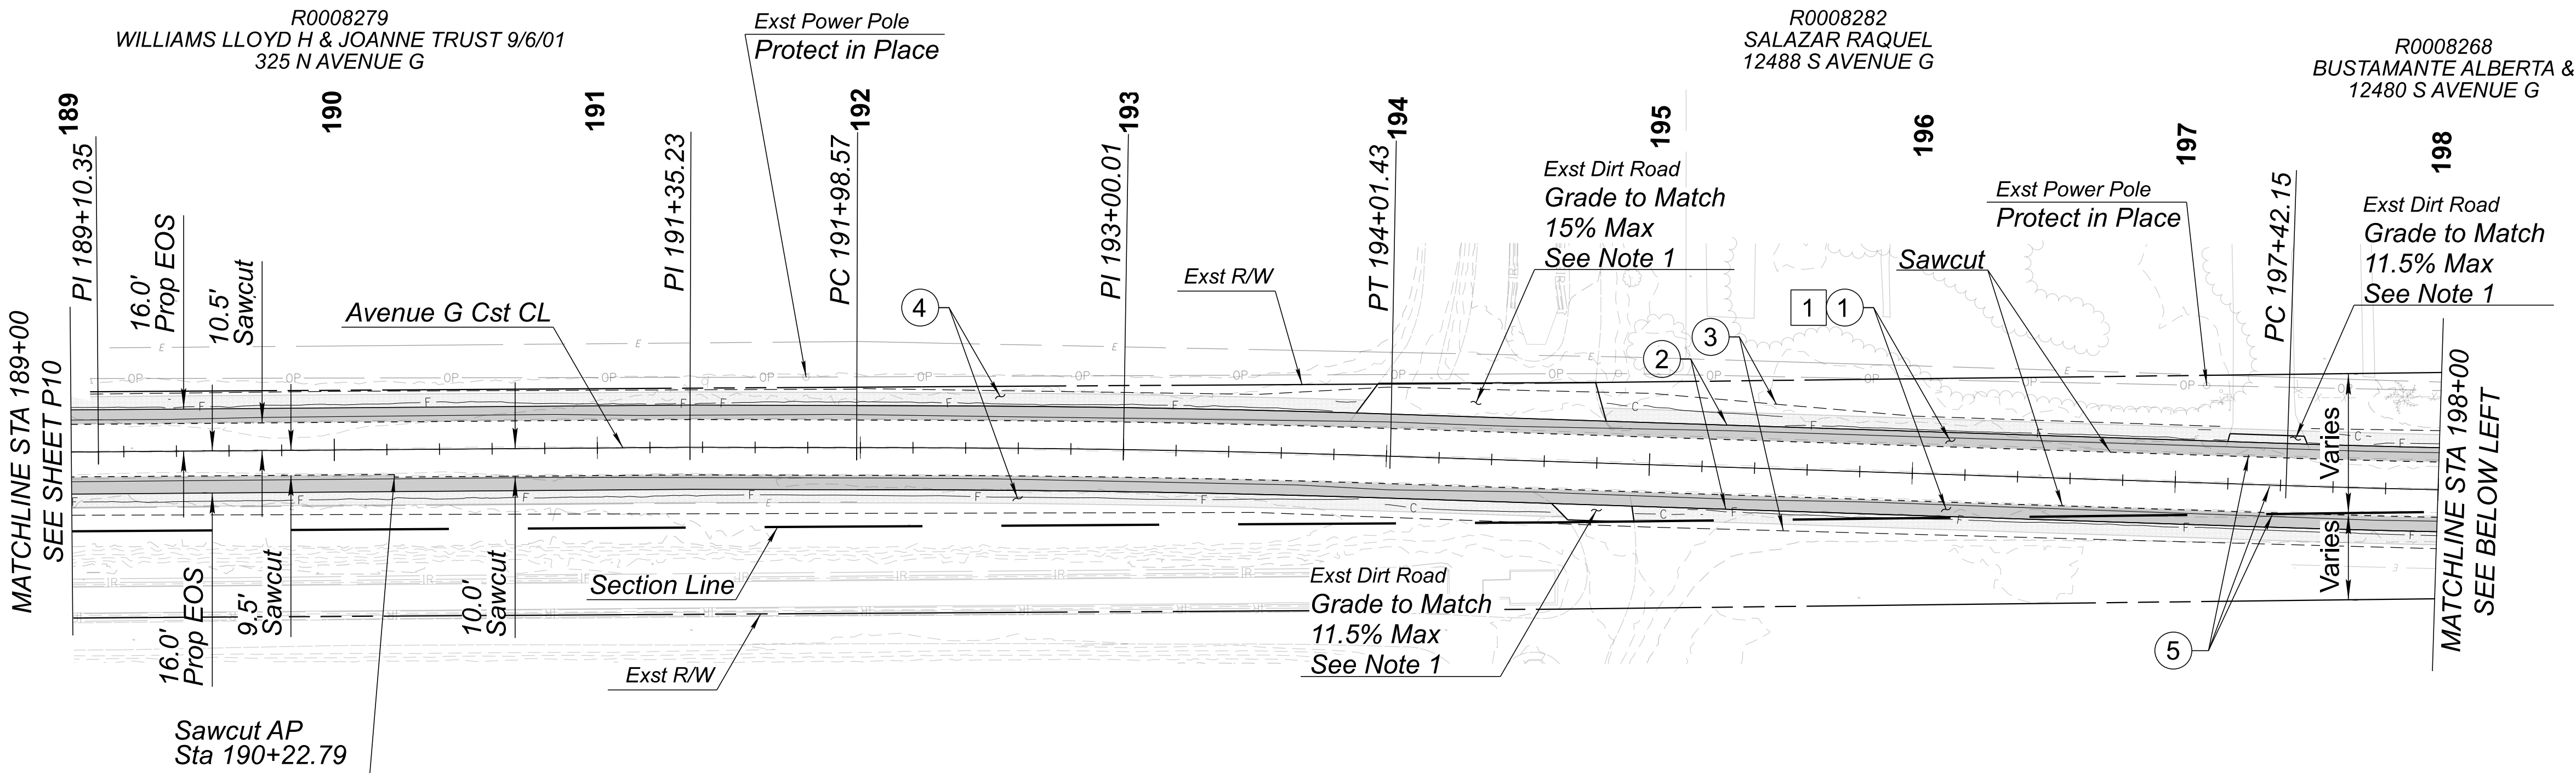


REMOVAL NOTES	
NO.	DESCRIPTION
1	Sawcut and Remove Exst Asphalt Pavement

CONSTRUCTION NOTES	
NO.	DESCRIPTION
1	Construct Asphalt Pavement Per PSS1 on DWG DS01
2	Install Safety Edge Per DTL on DWG DS03
3	Install 9-inch Sediment Wattle Per Dtl EC02
4	Install Granite Mulch (1-1/4 Inch Minus) from Edge of Shoulder extending 5 ft offset along Improvements Limits
5	Install Fog Coat on Obliterated Centerline Striping and New Shoulder per DWG RS01


Notes:

1. Grading to be paid under Item 2030301

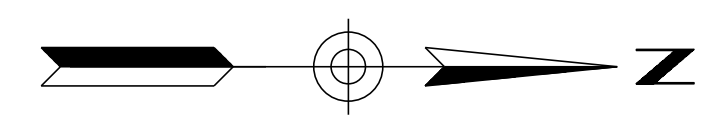




	DESIGN	M. SCHOEN	07/26	ARIZONA DEPARTMENT OF TRANSPORTATION PROJECT DELIVERY AND OPERATIONS DIVISION ROADWAY DESIGN SECTION	ROUTE	F.H.W.A. Arizona Division	STATE	PROJECT NO.	FEDERAL ID NO.	SHEET NO.	TOTAL SHEETS	RECORD DRAWING
	DRAWN	N. EKI BWANGOY	07/26		ARIZ.		0000 YU YYU	YYU-0(225)T	20	37		
	CHECKED	H. RIOS	07/26		LOCATION		AVENUE G, COUNTY 11TH ST - COUNTY 16TH ST				DWG	P11
	STRUCTURE NO.				TRACS NO. T0437 01C				OF			

PLAN SHEET STA 189+00 TO 207+00	
------------------------------------	--

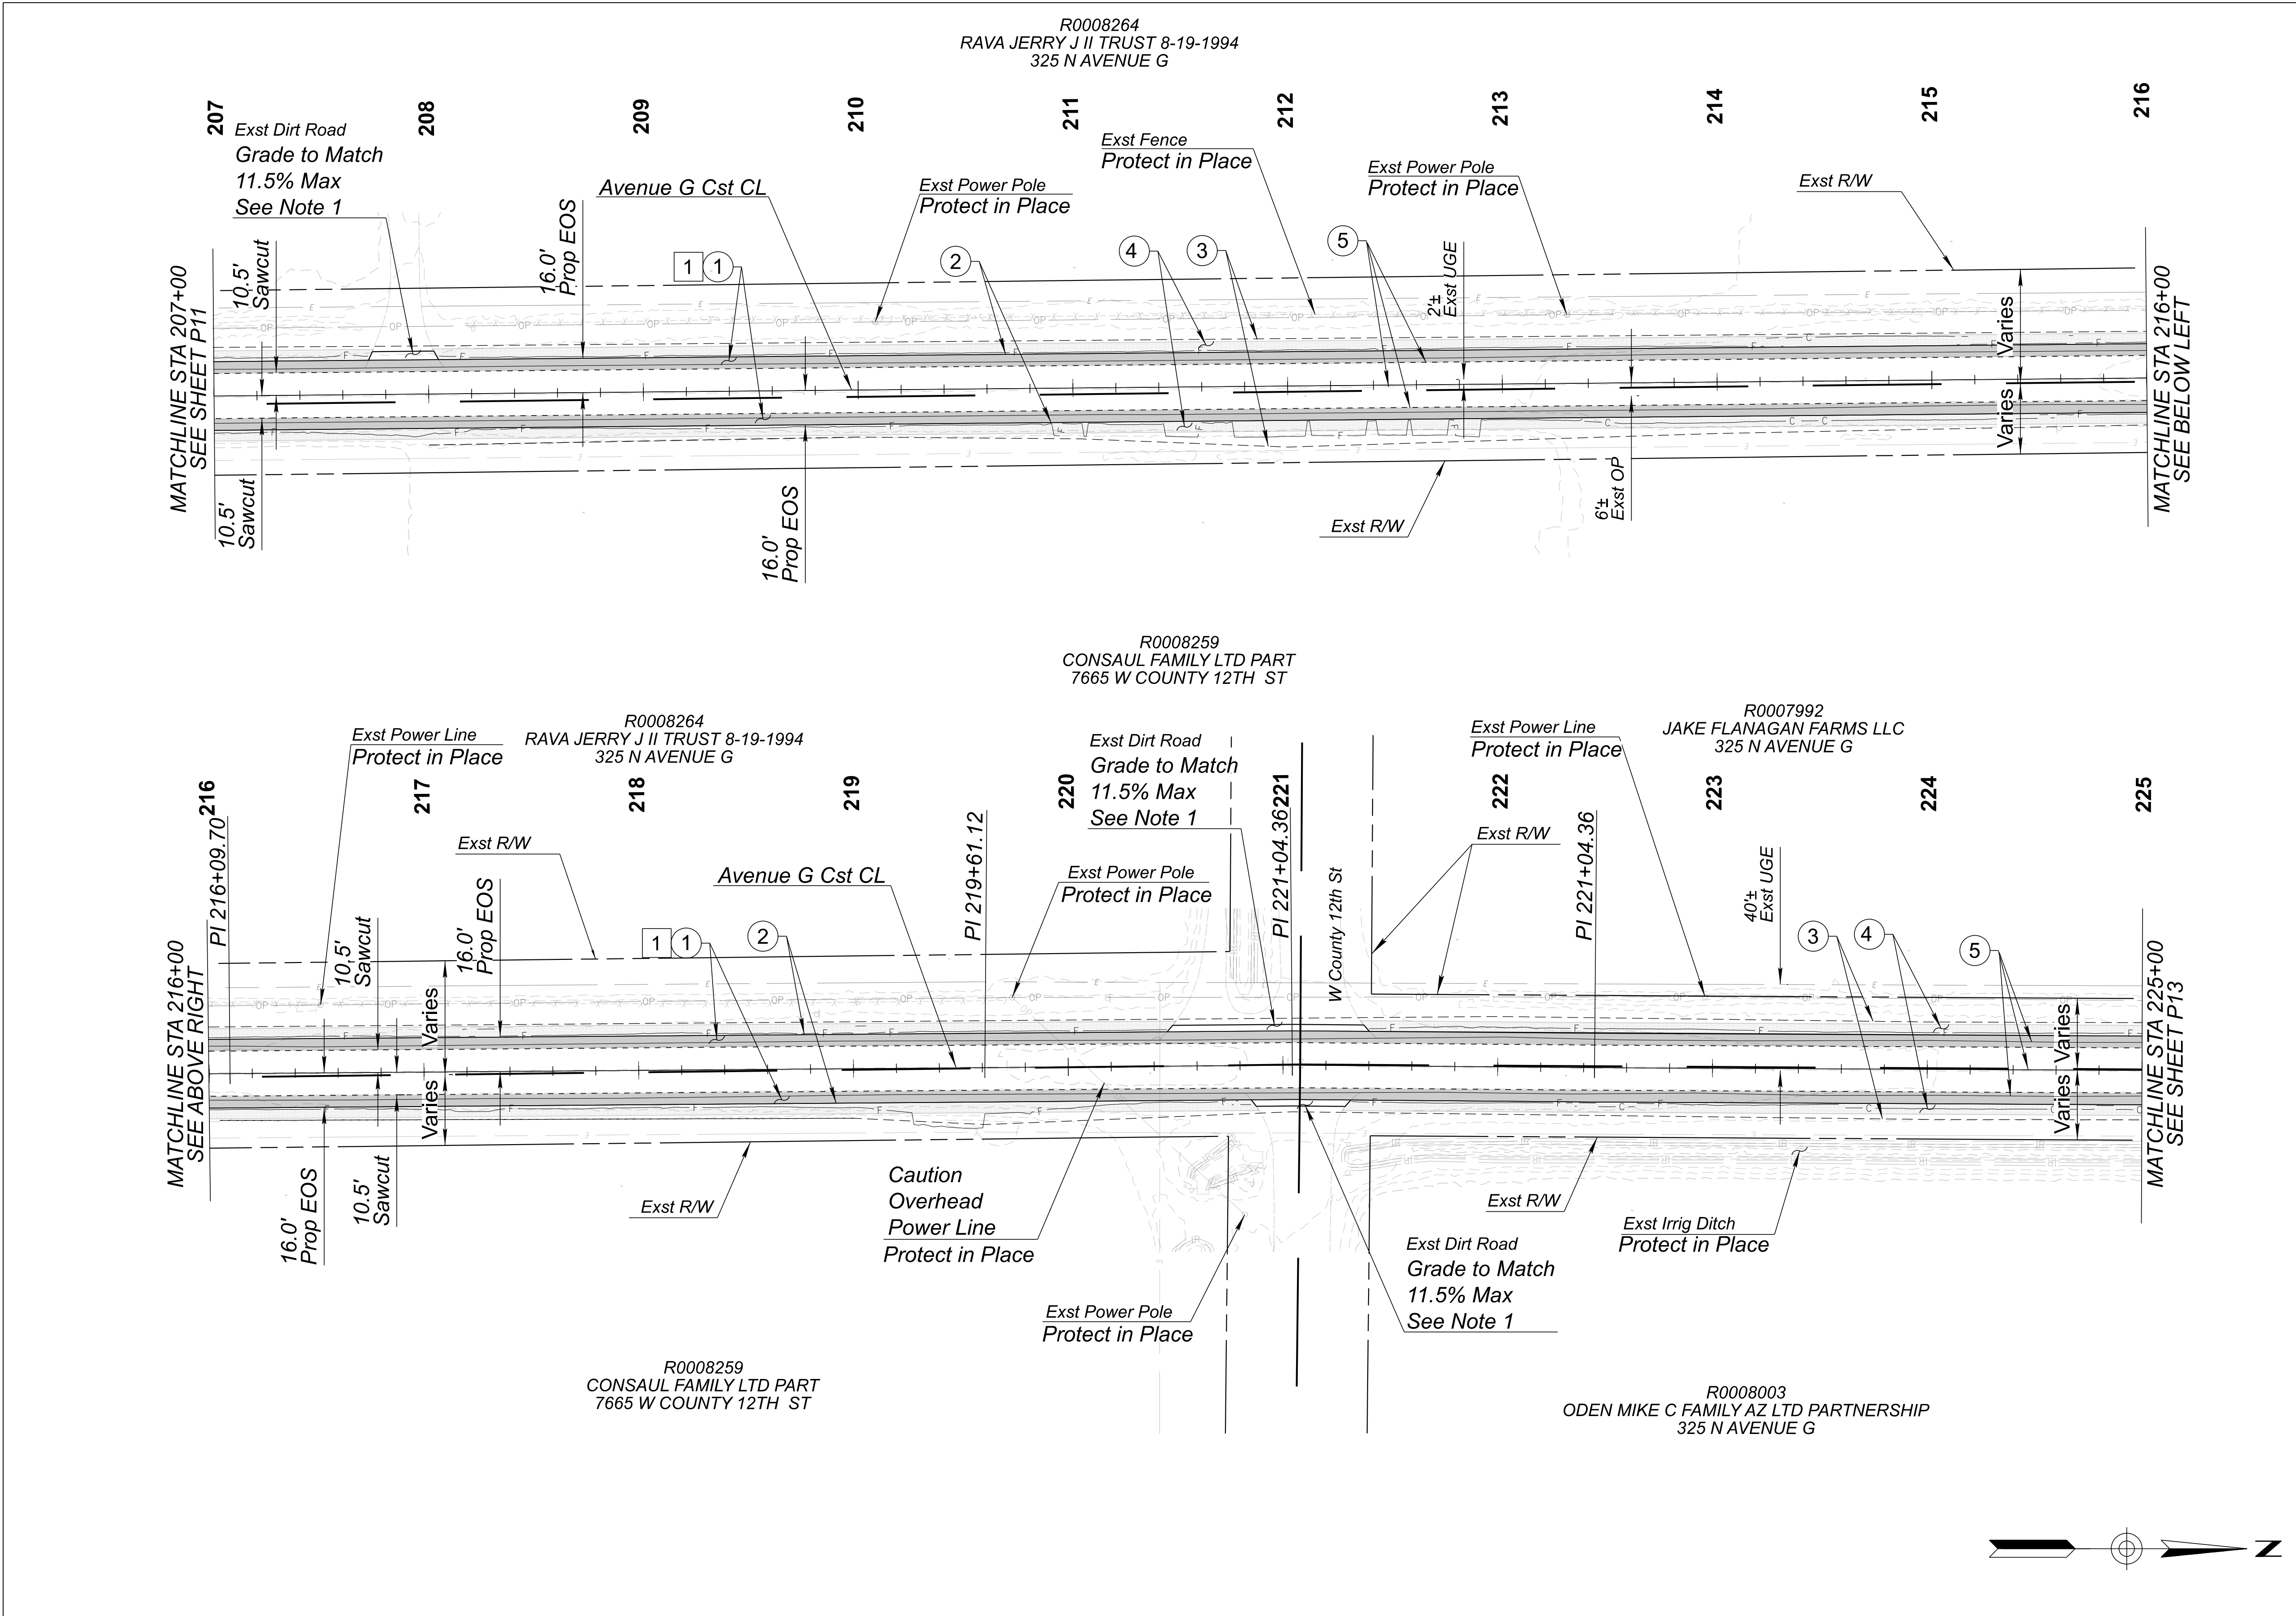

REMOVAL NOTES	
NO.	DESCRIPTION
1	Sawcut and Remove Exst Asphalt Pavement
CONSTRUCTION NOTES	
NO.	DESCRIPTION
1	Construct Asphalt Pavement Per PSS1 on DWG DS01
2	Install Safety Edge Per DTL on DWG DS03
3	Install 9-inch Sediment Wattle Per Dtl EC02
4	Install Granite Mulch (1-1/4 Inch Minus) from Edge of Shoulder extending 5 ft offset along Improvements Limits
5	Install Fog Coat on Obliterated Centerline Striping and New Shoulder per DWG RS01
Notes:	
1.	Grading to be paid under Item 2030301

	NAME		DATE	ARIZONA DEPARTMENT OF TRANSPORTATION PROJECT DELIVERY AND OPERATIONS DIVISION ROADWAY DESIGN SECTION	ROUTE	F.H.W.A. Arizona Division	STATE	PROJECT NO.	FEDERAL ID NO.	SHEET NO.	TOTAL SHEETS	RECORD DRAWING	
	DESIGN	M. SCHOEN	07/26		MILEPOST		ARIZ.	0000 YU YYU	YYU-0(225)T	21	37		
	DRAWN	N. EKI BWANGOY	07/26		 WSP USA Inc. 1230 West Washington Street, Suite 600 Tempe, AZ 85288	STRUCTURE NO.	LOCATION AVENUE G, COUNTY 11TH ST - COUNTY 16TH ST						DWG P12
	CHECKED	H. RIOS	07/26				TRACS NO. T0437 01C						___ OF ___
	PLAN SHEET STA 207+00 to 225+00												

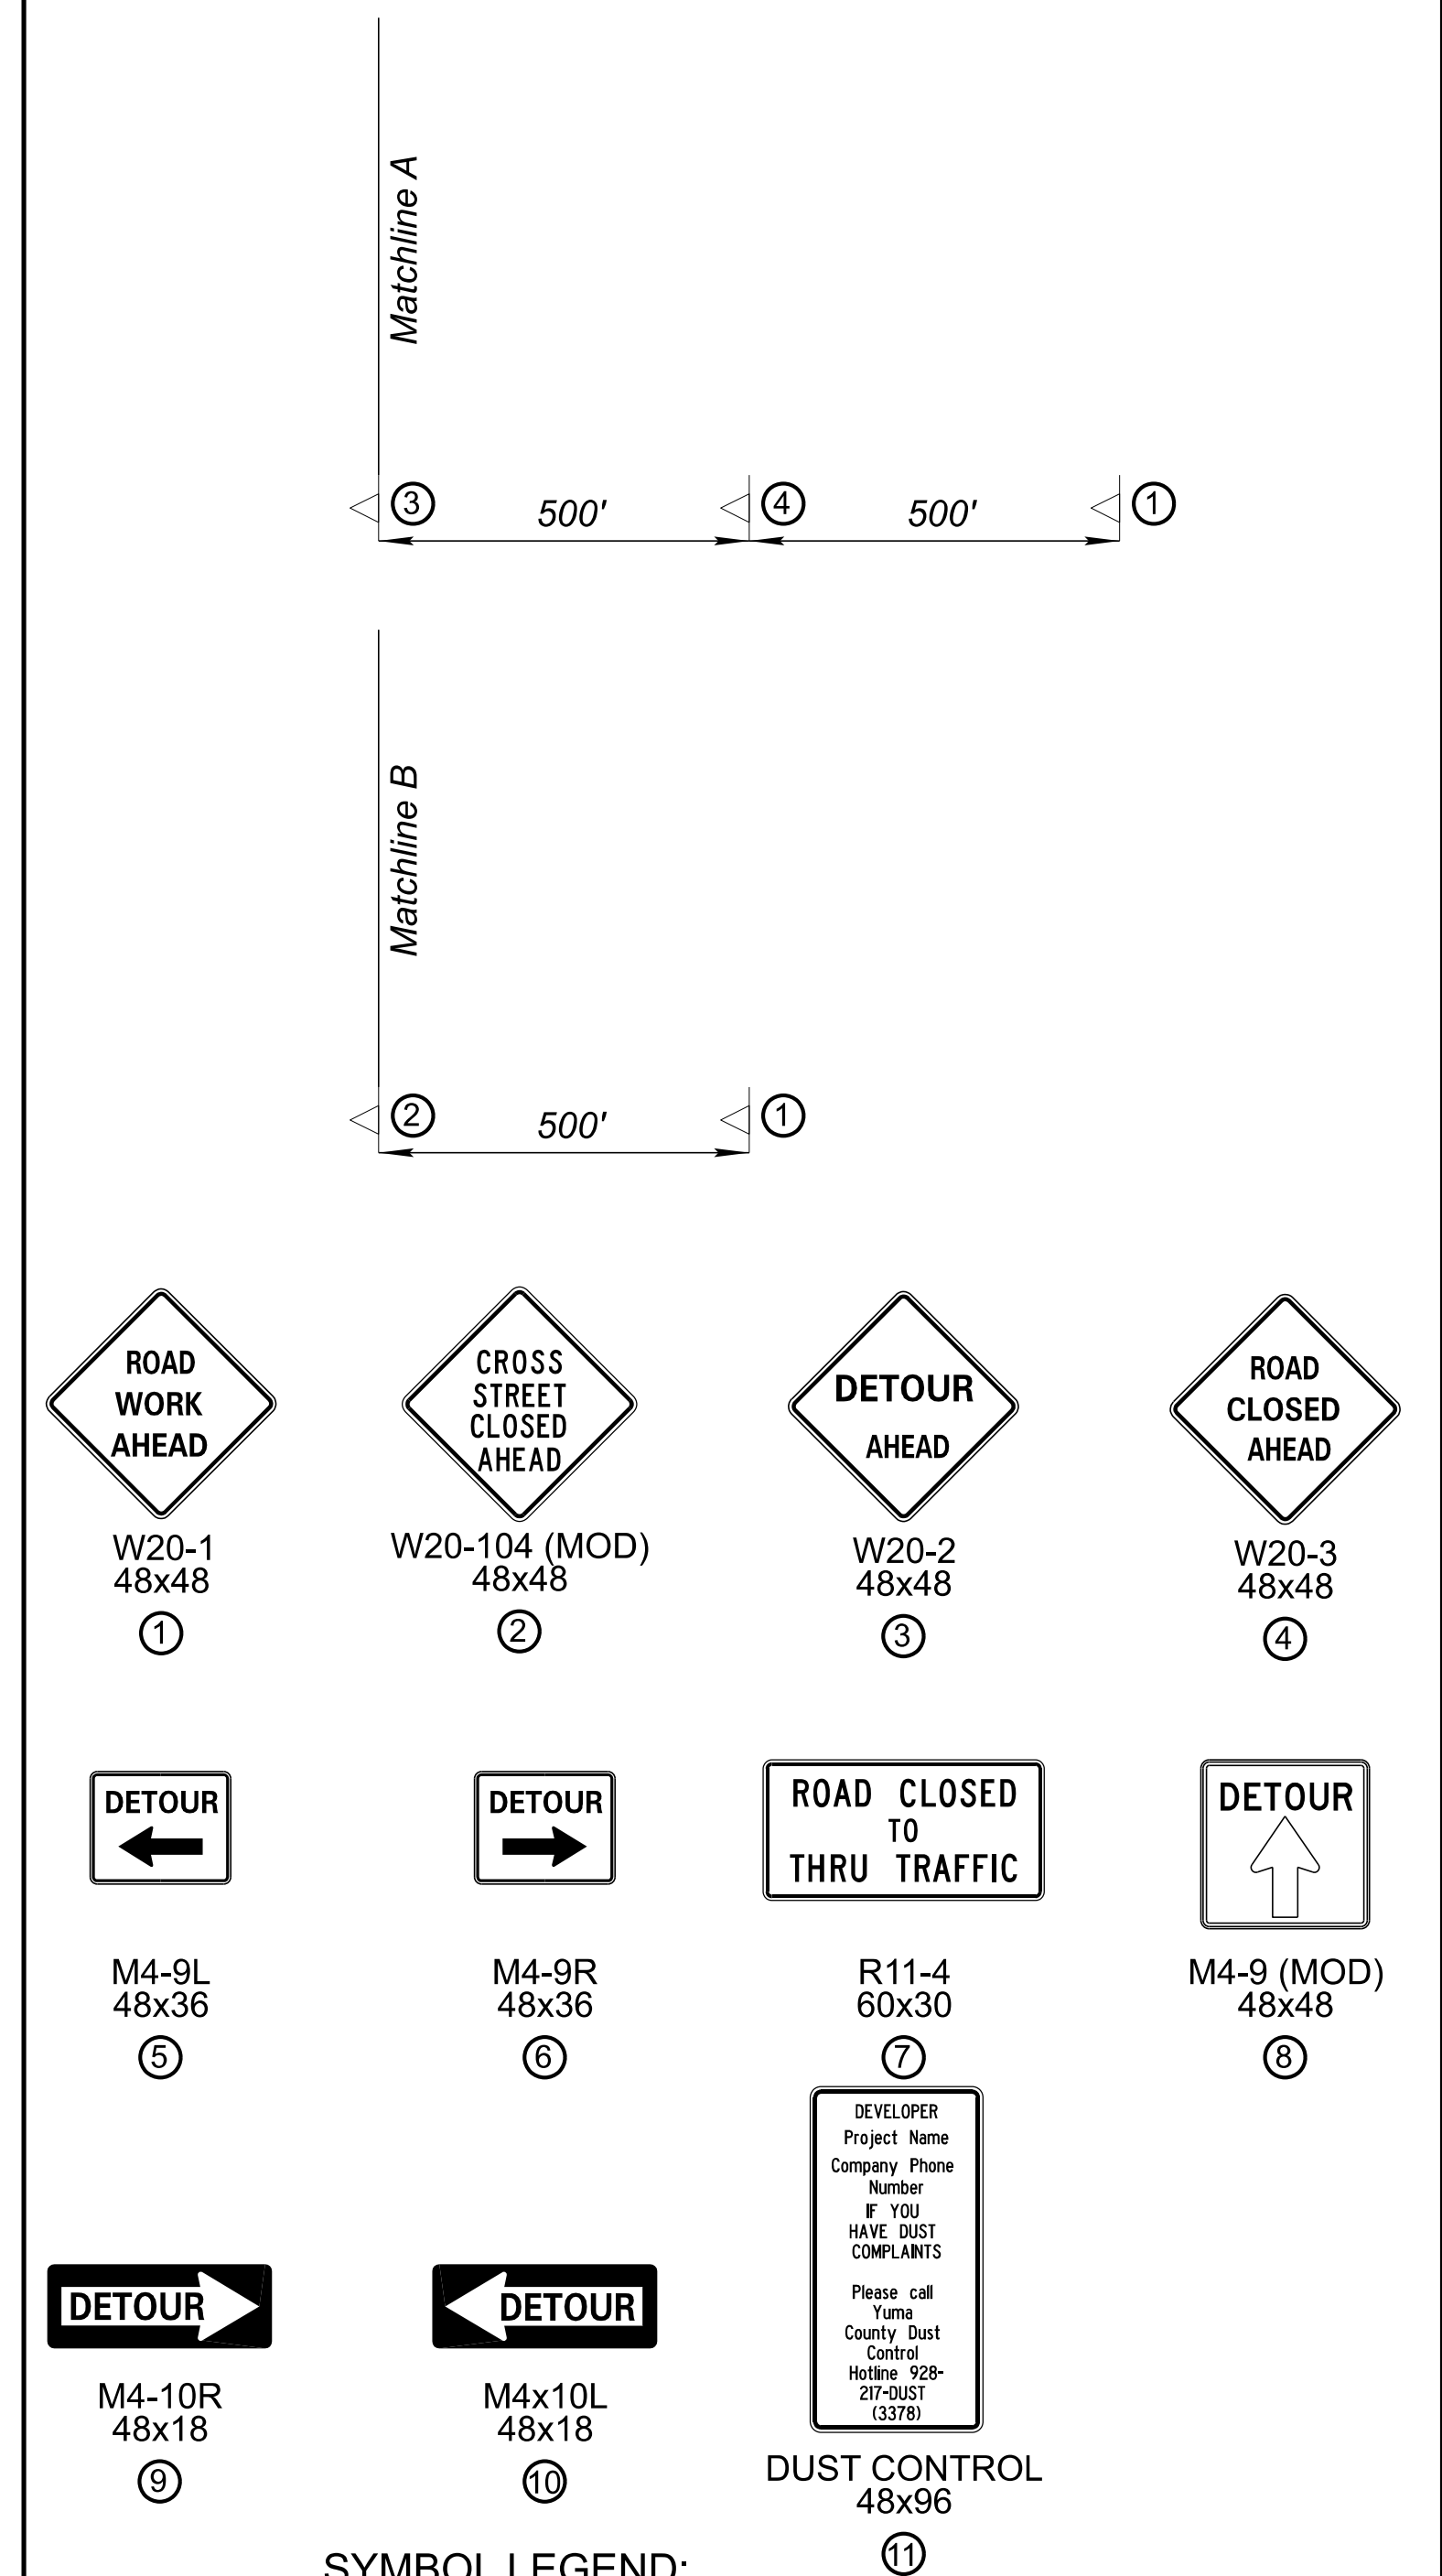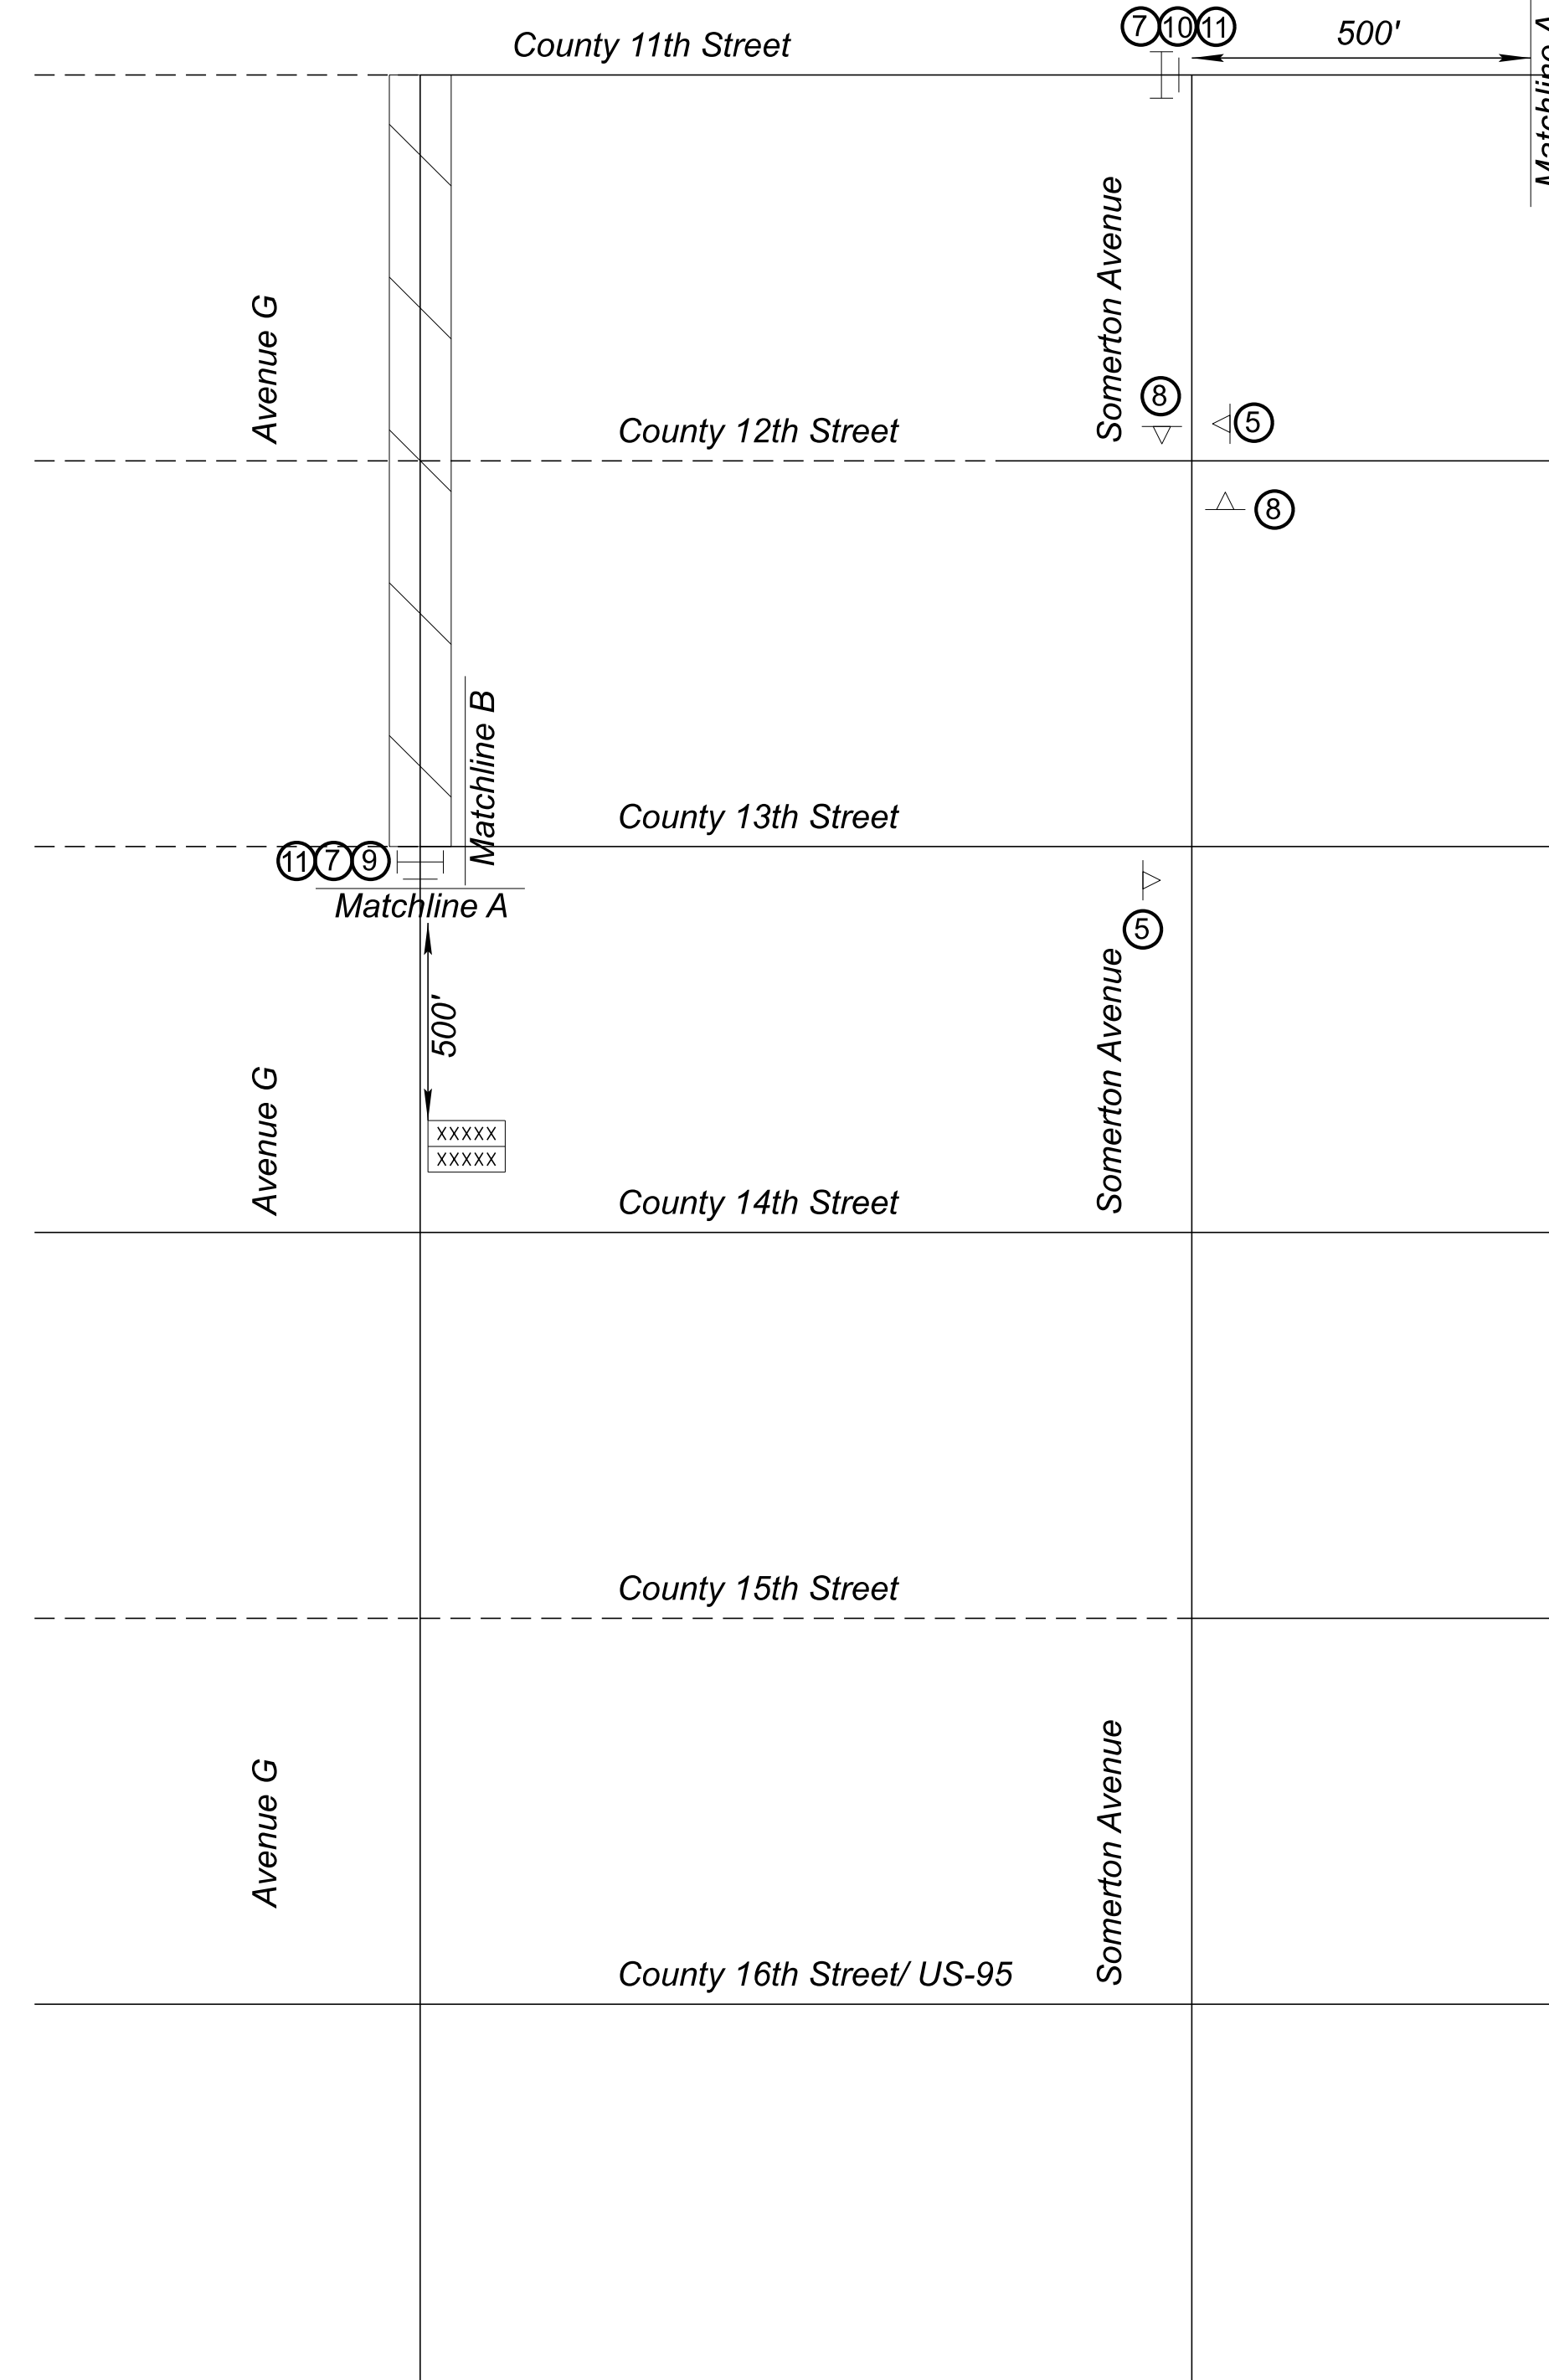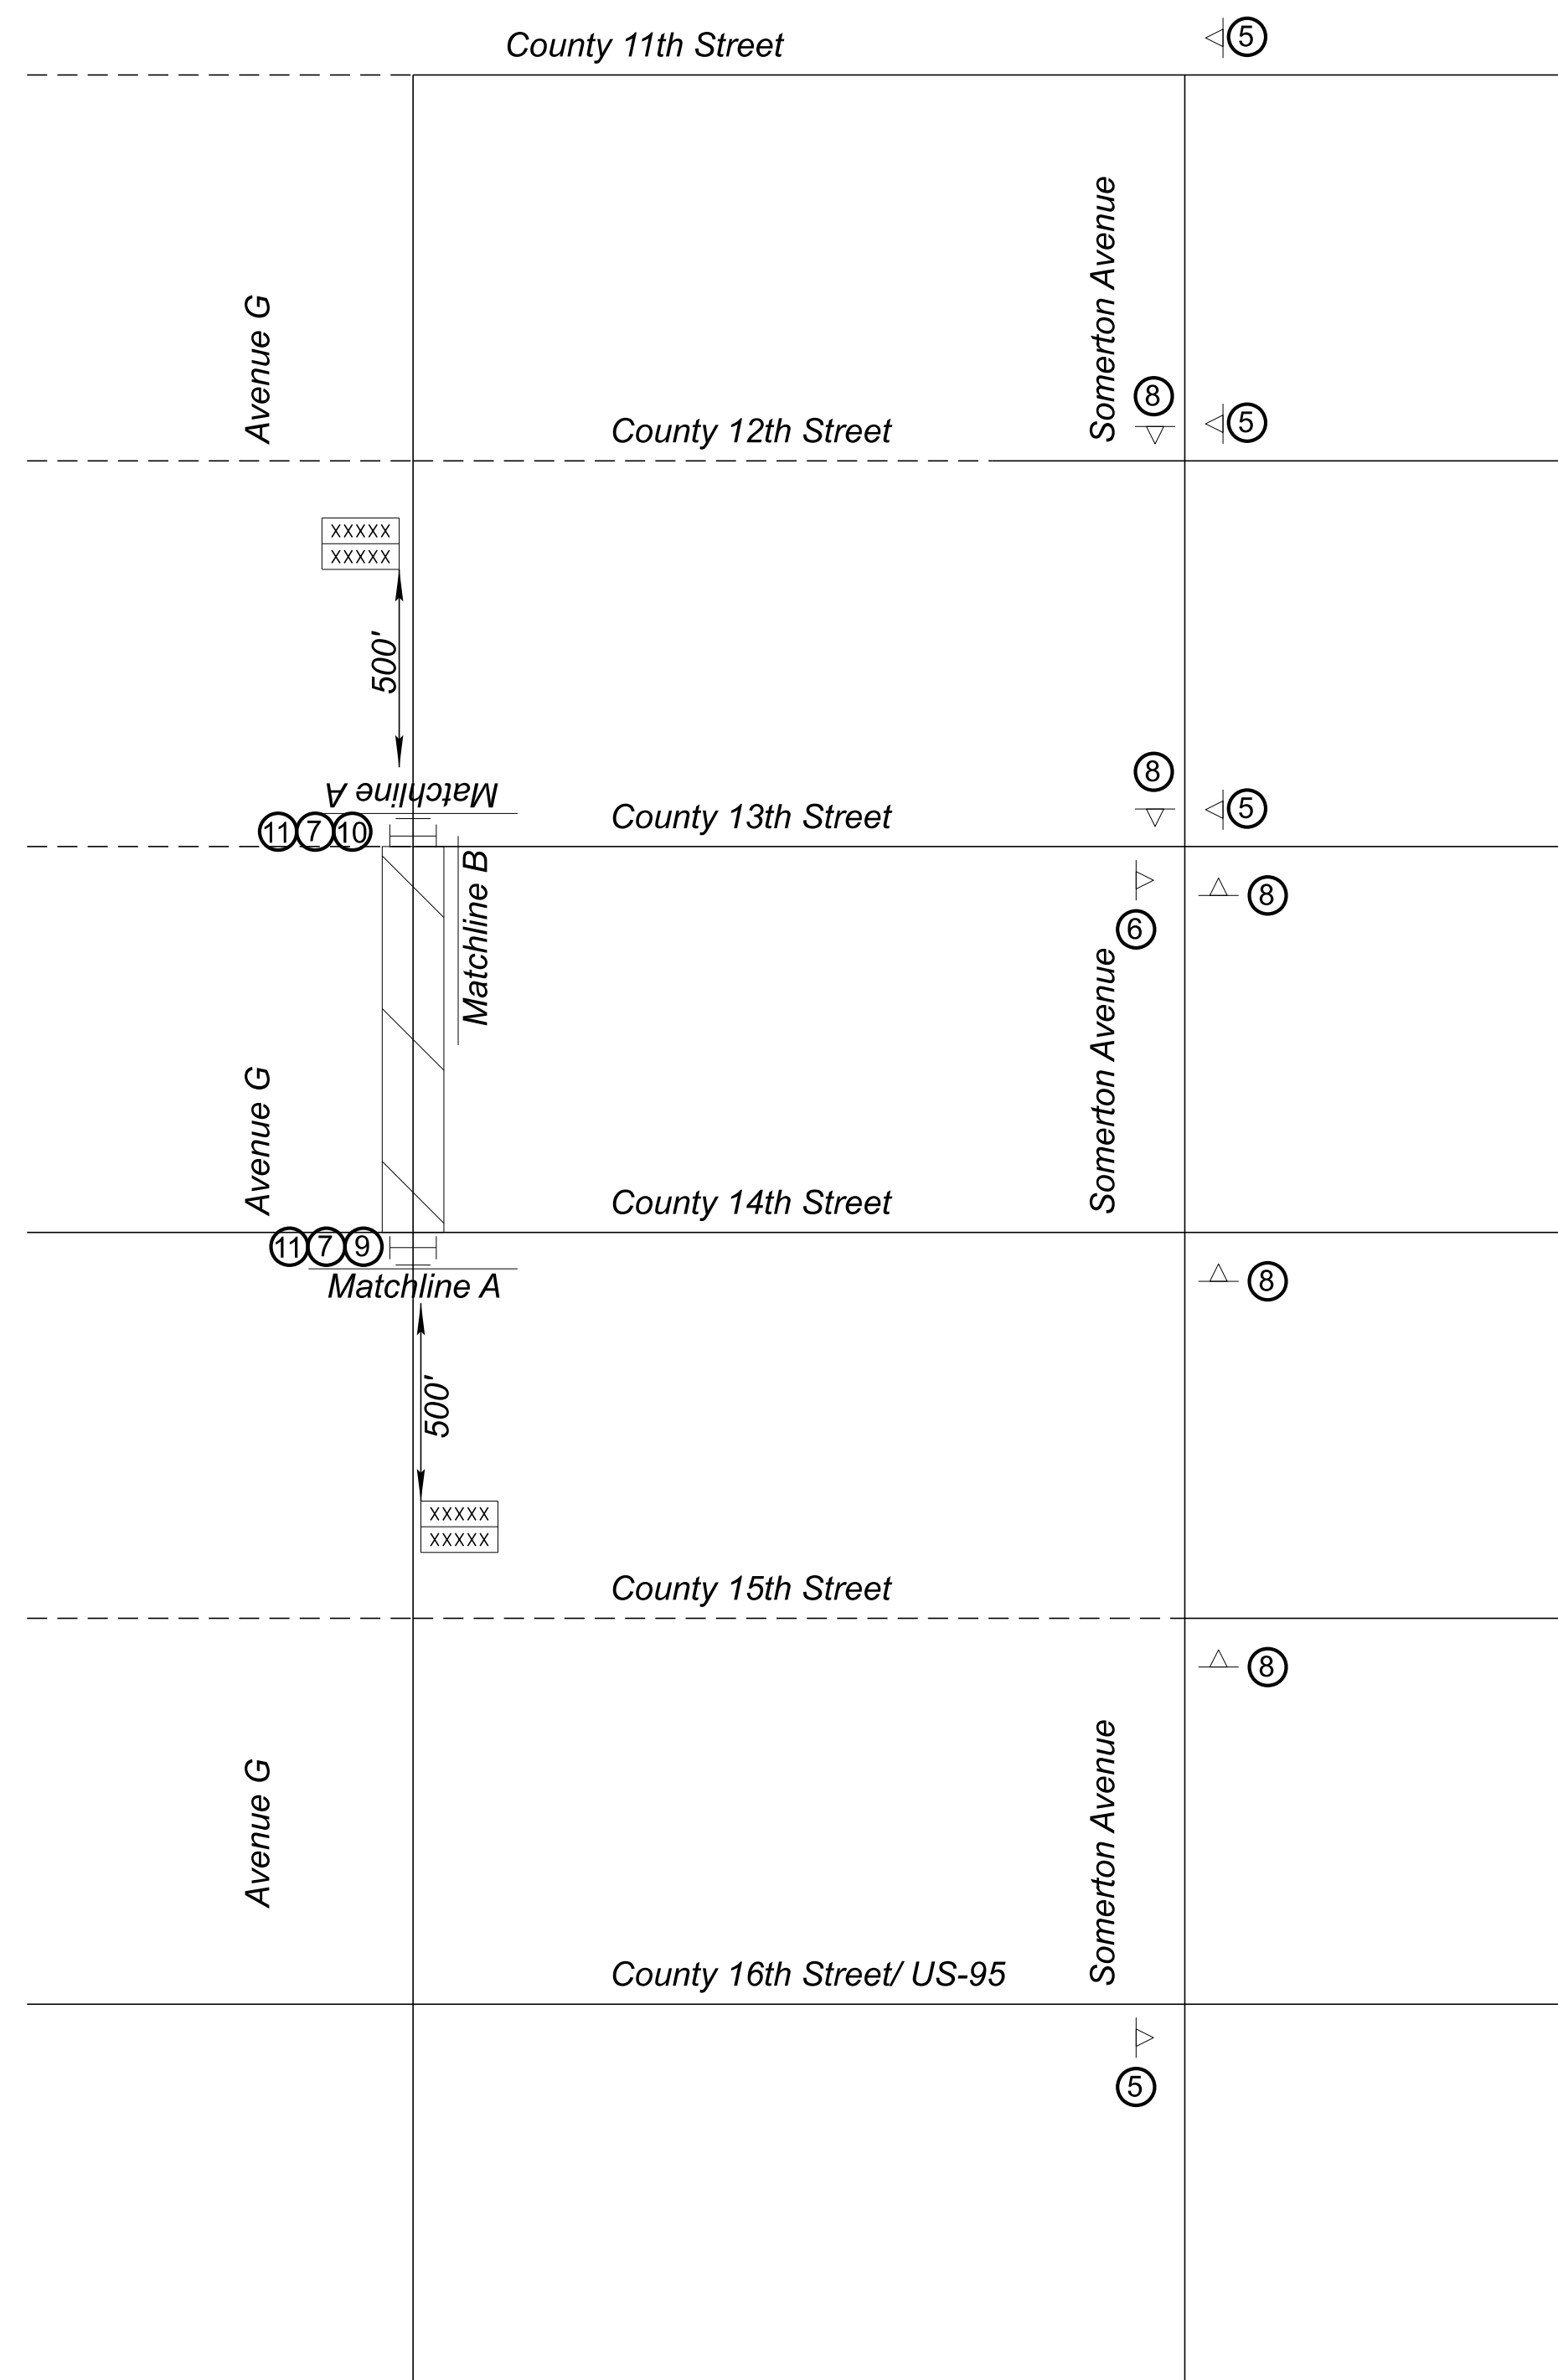



	NAME	DATE
DESIGN	W. GIL	07/26
DRAWN	W. GIL	07/26
CHECKED	H. RIOS	07/26

WSP | WSP USA Inc.
1230 West Washington Street, Suite 600
Tempe, AZ 85285

ARIZONA DEPARTMENT OF TRANSPORTATION
PROJECT DELIVERY AND OPERATIONS DIVISION
TRAFFIC DESIGN SECTION

MAINTENANCE OF TRAFFIC

ROUTE	F.H.W.A. Arizona Division	STATE	PROJECT NO.	FEDERAL ID NO.	SHEET NO.	TOTAL SHEETS	RECORD DRAWING
MILEPOST		ARIZ.	0000 YU YYU	YYU-0(225)T	27	37	
	LOCATION AVENUE G, COUNTY 11TH ST - COUNTY 16TH ST					DWG MOT03	
STRUCTURE NO.	TRACS NO. T0437 01C					___ OF ___	

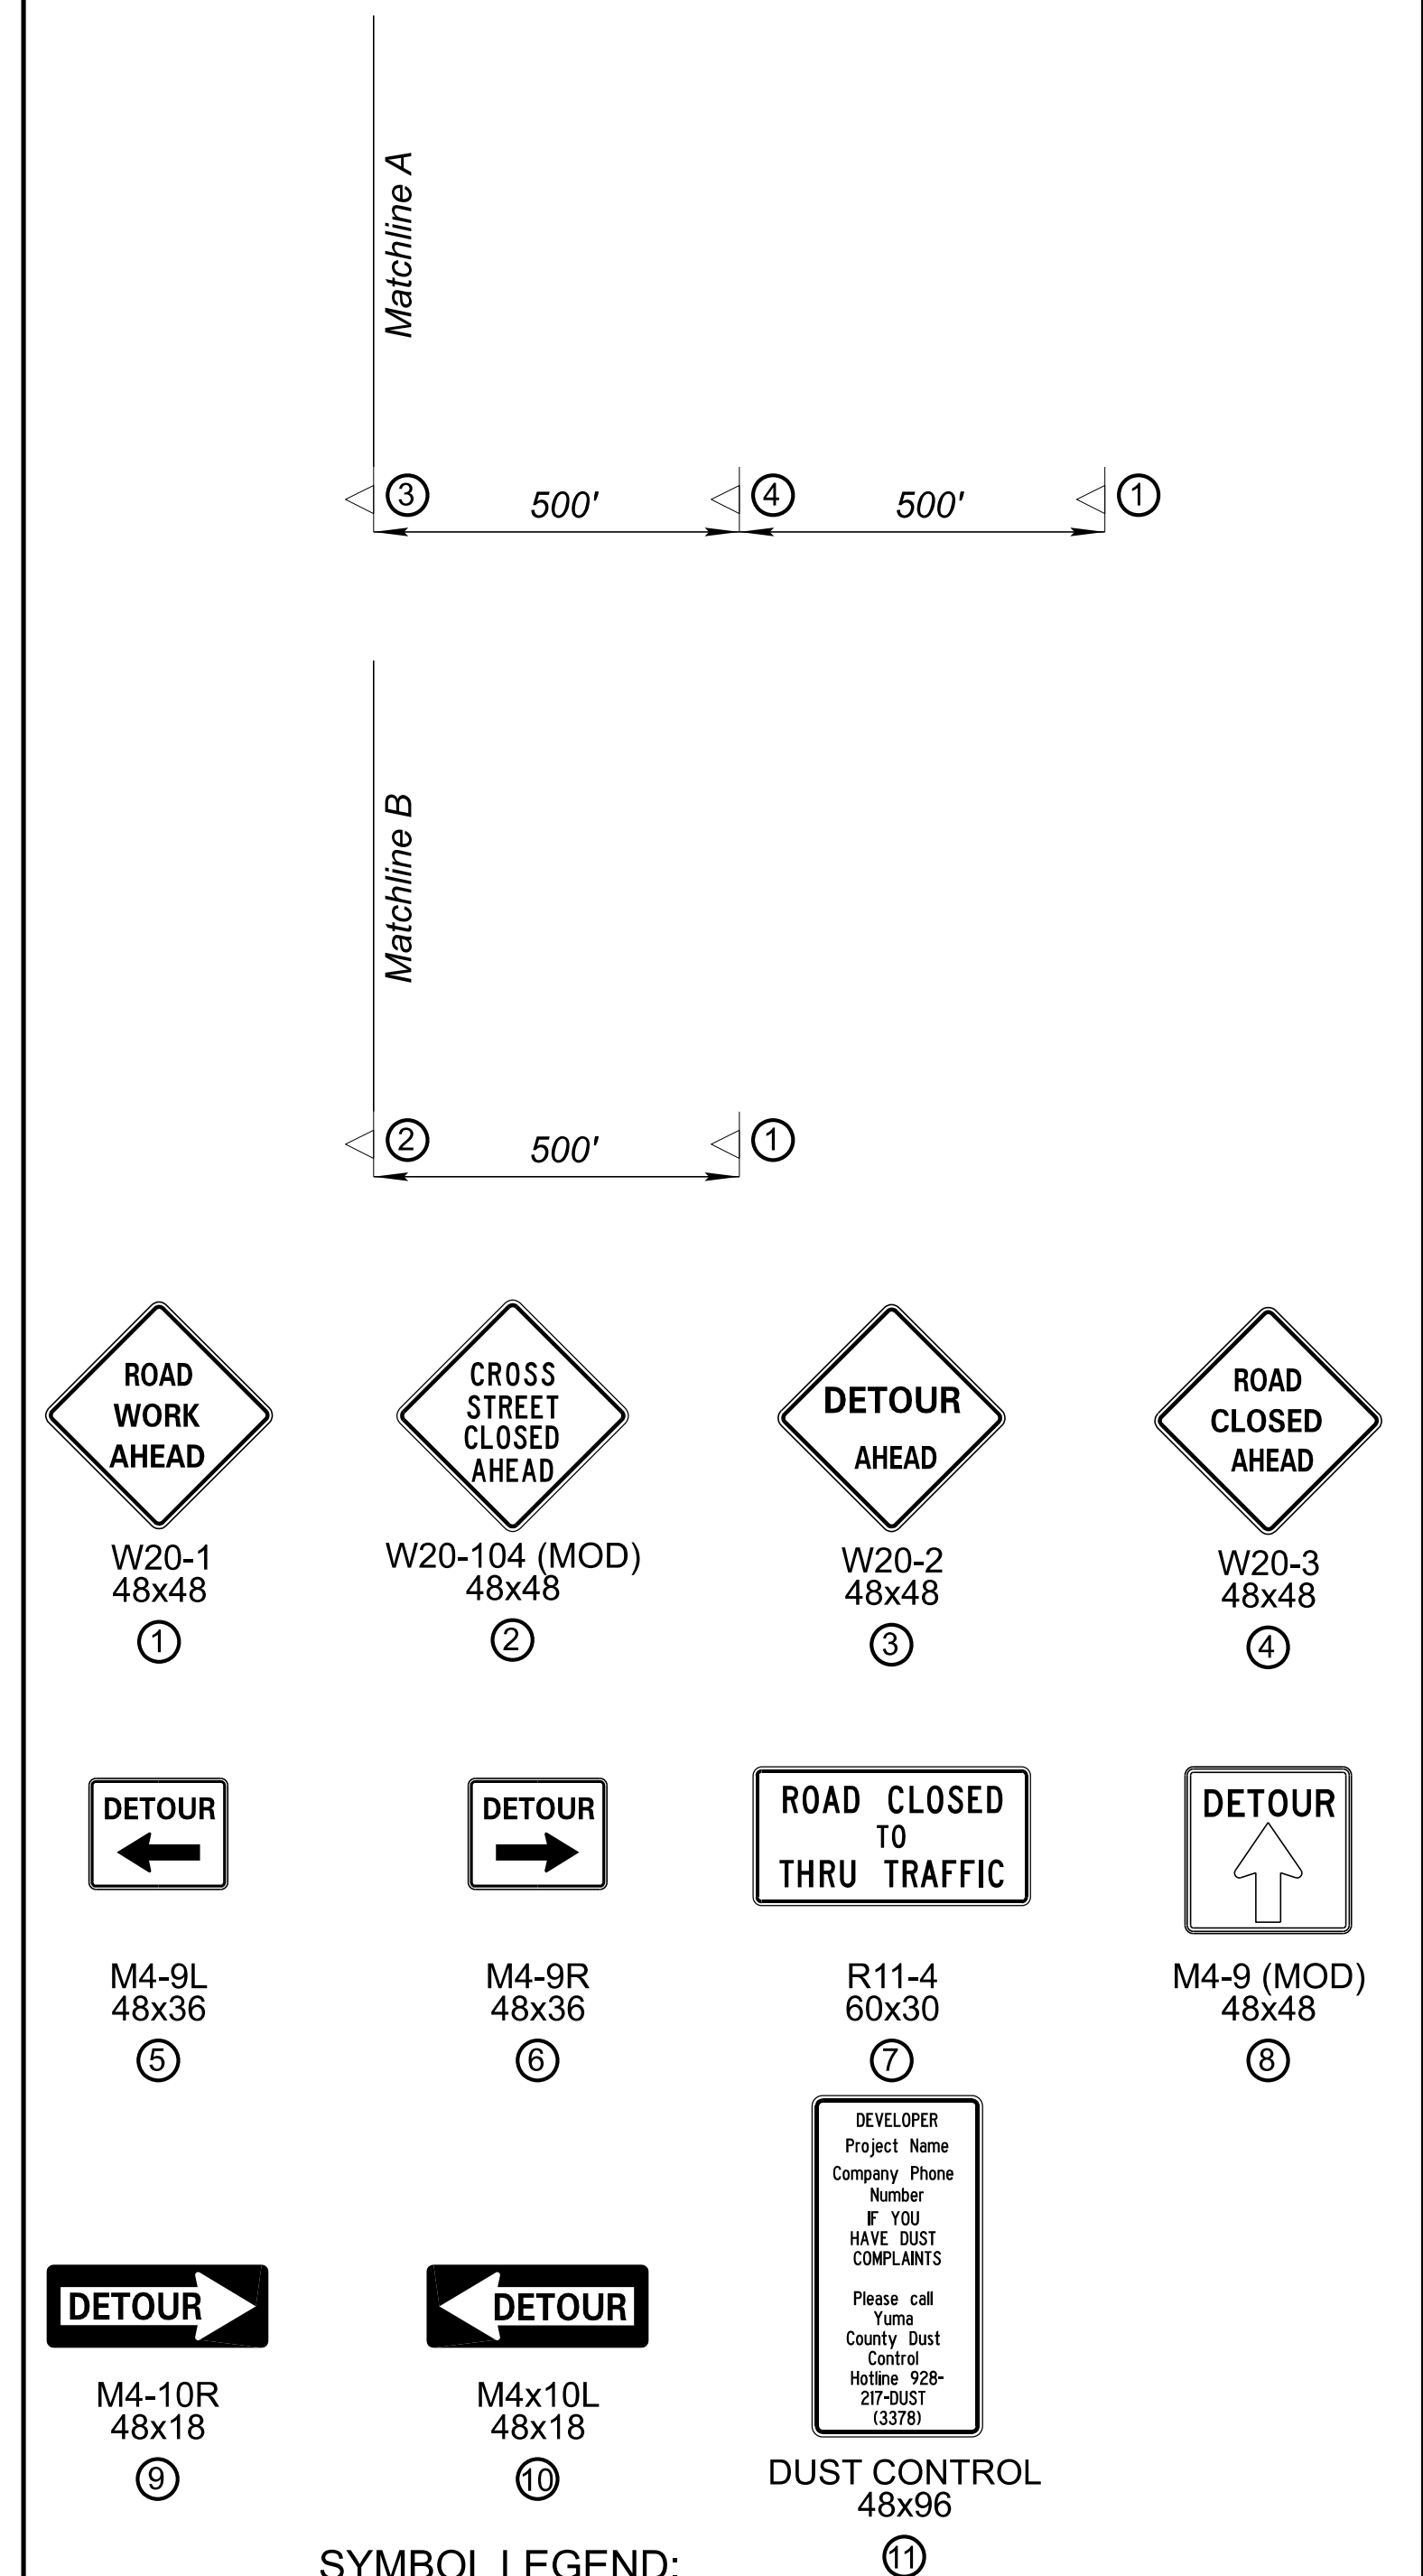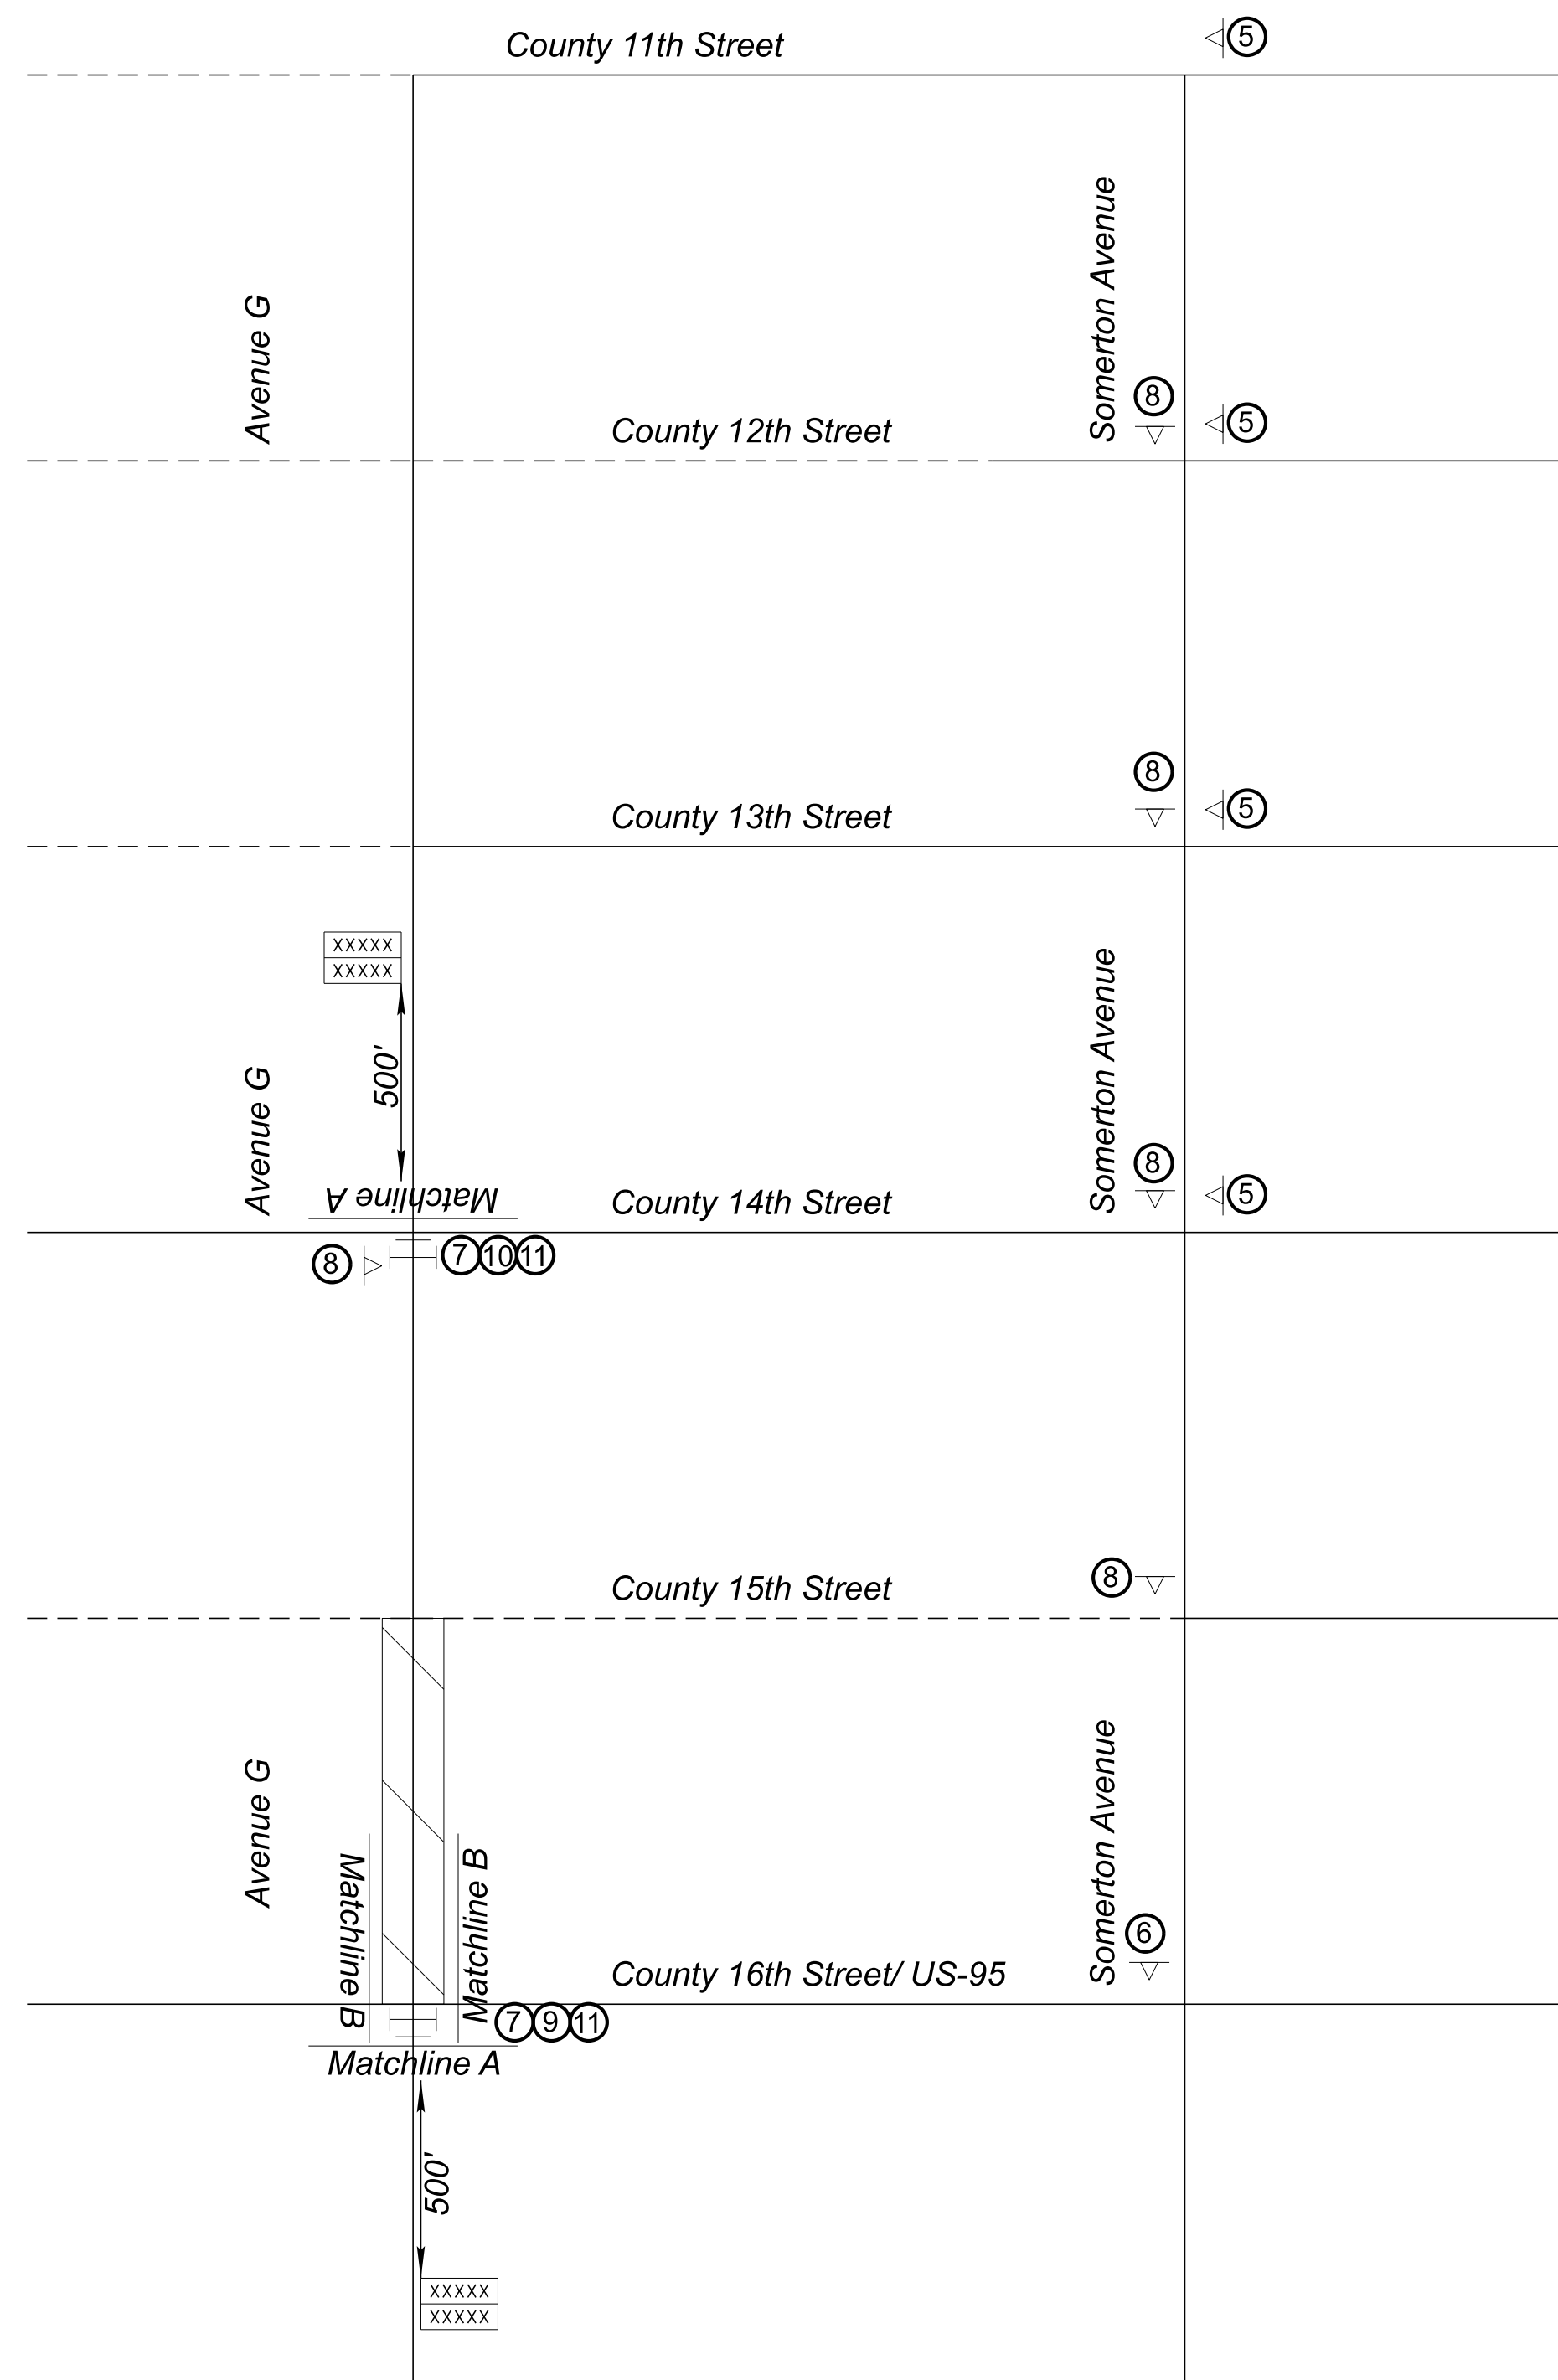



	NAME	DATE
DESIGN	W. GIL	07/26
DRAWN	W. GIL	07/26
CHECKED	H. RIOS	07/26

WSP | WSP USA Inc.
1230 West Washington Street, Suite 600
Tempe, AZ 85288


ARIZONA DEPARTMENT OF TRANSPORTATION
PROJECT DELIVERY AND OPERATIONS DIVISION
TRAFFIC DESIGN SECTION

MAINTENANCE OF TRAFFIC

ROUTE	F.H.W.A. Arizona Division	STATE ARIZ.	PROJECT NO. 0000 YU YUU	FEDERAL ID NO. YUU-0(225)T	SHEET NO. 28	TOTAL SHEETS 37	RECORD DRAWING
MILEPOST	LOCATION AVENUE G, COUNTY 11TH ST - COUNTY 16TH ST						DWG MOT04
STRUCTURE NO.	TRACS NO. T0437 01C					___ OF ___	

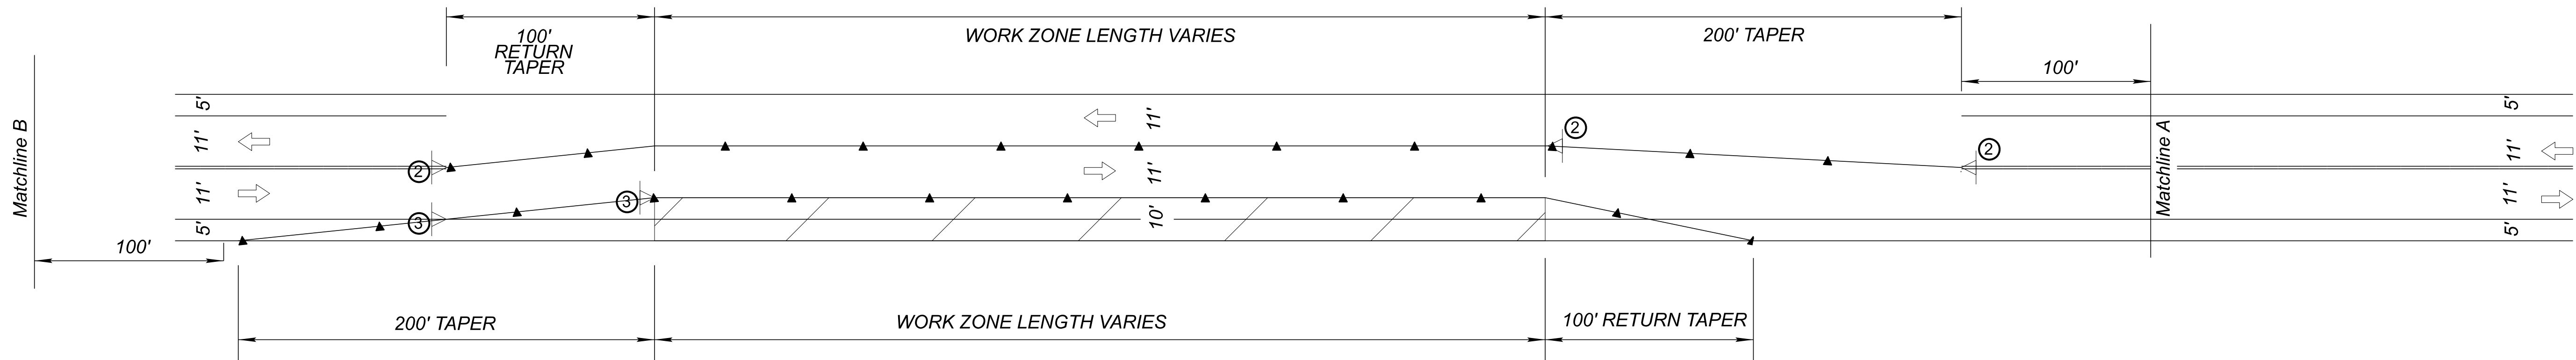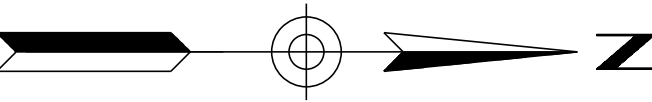

DETAIL B: RUMBLE STRIP
INSTALLATION LANE SHIFTS
(NORTHBOUND/SOUTHBOUND)

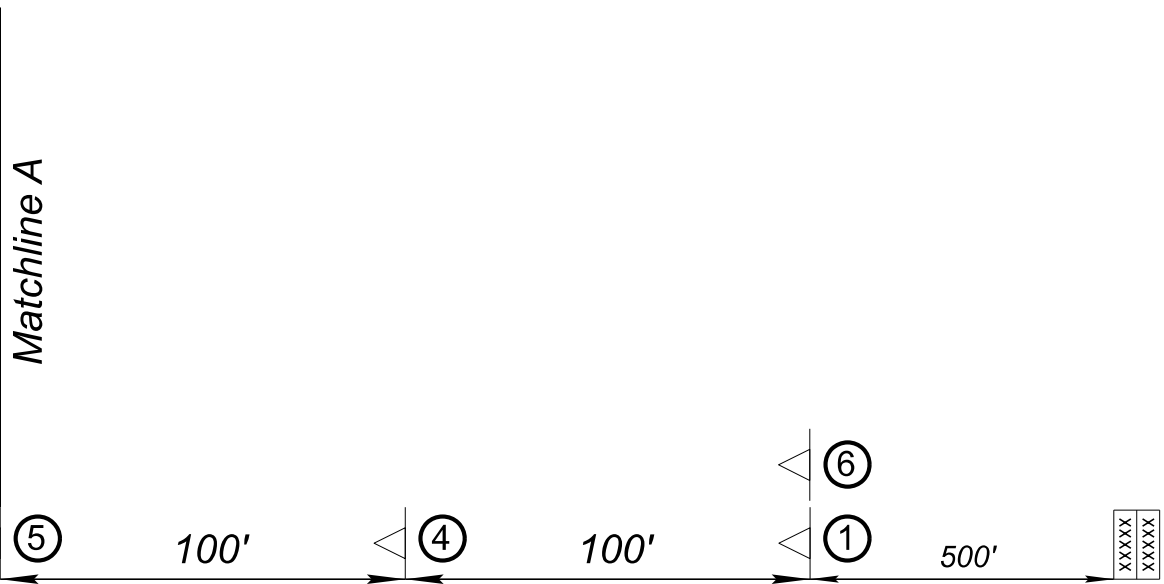

SYMBOL LEGEND:

	Sign on Spring Stand
	Vertical Panel (Plan/Elevation)
	Direction of Travel
	Work Area



①



②



③



④




⑤



⑥

NOTES

- Contractor shall maintain 11' minimum lanes at all times
- Panels shall be spaced at 40' on center on tapers, 80' on tangents

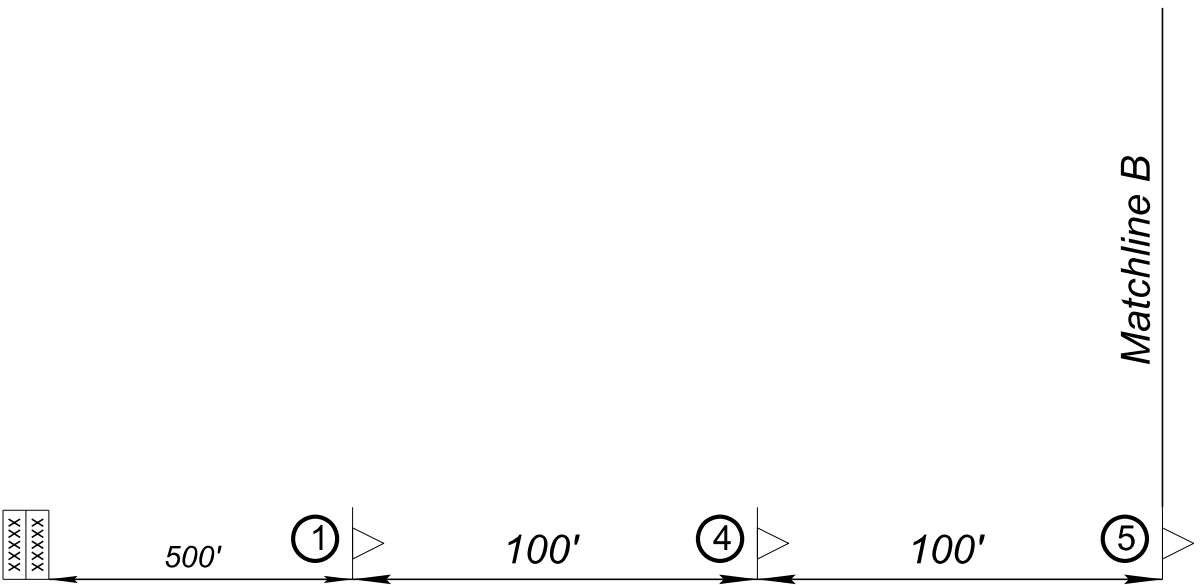

	NAME	DATE
DESIGN	W. GIL	07/26
DRAWN	W. GIL	07/26
CHECKED	H. RIOS	07/26

wsp | WSP USA Inc.
1200 West Washington Street, Suite 600
Tempe, AZ 85281

ARIZONA DEPARTMENT OF TRANSPORTATION PROJECT DELIVERY AND OPERATIONS DIVISION TRAFFIC DESIGN SECTION	ROUTE
MAINTENANCE OF TRAFFIC	MILEPOST
	STRUCTURE NO.

F.H.W.A. Arizona Division	STATE	PROJECT NO.	FEDERAL ID NO.	SHEET NO.	TOTAL SHEETS	RECORD DRAWING
	ARIZ.	0000 YU YYU	YYU-0(225)T	29	37	
LOCATION AVENUE G, COUNTY 11TH ST - COUNTY 16TH ST						DWG MOT05
TRACS NO. T0437 01C						____ OF ____

PAVEMENT MARKING NOTES

1. Final striping shall be 90 mil (0.090 inches) thick alkyl extruded thermoplastic reflectorized striping placed over the existing striping, placed at a minimum of 30 calendar days after the initial striping. All other markings shall be applied at the same time.
2. The contractor shall clean the roadway surface to the satisfaction of the Engineer, by sweeping and air-jet blowing, immediately prior to the placement of all pavement markings. The roadway surface shall be dry and the air and pavement temperatures shall be a minimum of 55 degree F and rising for the placement of thermoplastic striping.
3. It is the contractor’s responsibility to ensure that the final surface course is placed so that the striping is offset one foot clear of any construction joint, unless otherwise directed by the Engineer.
4. The contractor shall be responsible for the layout and installation of permanent pavement markings on the final surface course following control points that have been set no more than 50 feet apart along the lines to be striped.
5. The contractor shall break edge lines adjacent to turnouts across any intersections with dedicated roadways or as otherwise directed by the Engineer. In addition, the contractor shall not place any center lines within 10 feet of the nearest edge of pavement of the intersecting roadway.


6. There will be no pavement marking plans for this project. The replacement of all the existing pavement markings shall be the responsibility of the contractor. The contractor shall prepare and develop an "As-built Drawings" pavement marking plans for the existing pavement markings on the roadway within the project limits. "As-built" Plans shall be based on field survey which has measured the locations of all existing center lines and edge lines. The developed "As-built" plans shall provide adequate information and detail so that the new pavement markings can be installed per the applicable existing conditions and any modifications required by the current ADOT Signing and Marking Standard Drawings. The contractor shall follow these "As-built" plans when placing pavement markings on the final pavement surface. The "As-built" plans shall be submitted electronically in PDF format to the Engineer no less than 14 days prior to the start of construction activities for his review and approval. Full compensation for developing the existing pavement marking "As-built Drawings" pavement marking plans will be considered as include in the price of the contract bid item 9250001.
7. When stripe obliteration is necessary, it shall be accomplished by an approved method. Painting over striping, removal of pavement, and overlaying pavement do not constitute stripe obliteration.

ITEM	DESCRIPTION	UNIT	QUANTITY
6070038	SLIP BASE	EACH	28
6070054	SIGN POST (PERFORATED)(2S)	L.FT.	11
6070055	SIGN POST (PERFORATED) (2 1/2 S)	L.FT.	252
6070057	SIGN POST (PERFORATED) (2 1/2 T)	L.FT.	74
6070060	FOUNDATION FOR SIGN POST (CONCRETE)	EA	28
6080110	REMOVE AND REINSTALL SIGN	EACH	35
7015052	OBLITERATE PAVEMENT MARKING (STRIPE)	L.FT.	67,959
7040005	PAVEMENT MARKING (WHITE EXTRUDED THERMOPLASTIC) (0.090")	L.FT.	72,554
7080201	WATERBORNE-TYPE I PAVEMENT MARKING (PAINTED) (WHITE)	L.FT.	48,369
7080202	WATERBORNE-TYPE I PAVEMENT MARKING (PAINTED) (YELLOW)	L.FT.	45,306
9280034	GROUND IN RUMBLE-STRIP (6 INCH)	L.FT.	22,677
9280036	GROUND IN RUMBLE-STRIP (8 INCH)	L.FT.	35,504

*Quantities shown are 4-inch equivalents

SIGNING NOTES

1. All signs shall be in compliance with the Manual on Uniform Traffic Control Devices (MUTCD Signing and Marking Standard Drawings, and the ADOT Traffic Engineering Manual of Approved Signs.
2. The sign locations and the post lengths are approximate. The contractor shall verify the sign locations and actual post lengths with the Engineer prior to installing signs.
3. The bottom of each sign shall be at least 7 feet above the nearest edge of pavement and at least 7 feet above the ground under the sign.
4. Offsets for all signs shall be measured from the edge of the roadway to the nearest edge of the sign.
5. All new signs shall be fabricated of flat sheet aluminum as indicated in Section 608 of the specifications.
6. The retroreflective sheeting on all new signs shall meet ADOT Standard Specifications
7. The retroreflective sheeting on all new signs shall meet criteria established in Section 1007 of the Standard Specifications and in Section 380 of ADOT's Traffic Policies, Guideline and Procedures
8. All new signs shall be installed on new square tube posts with foundations as indicated in ADOT Standard Drawings
9. The Engineer may modify the signing plans.
10. Shop drawings will be required.
11. The contractor shall remove existing signing where indicated in the sign summary.
12. The contractor shall inventory all signs to be removed or covered and note damaged signs to the Engineer at the time of covering or removal. All signs damaged by covering or removal shall be replaced by the contractor at the contractors expense.
13. The contractor shall preserve all roadway signs, sign supports, object markers, and milepost markers. The contractor shall replace any signs, sign supports or markers damaged as a result of the construction at the contractor's expense.

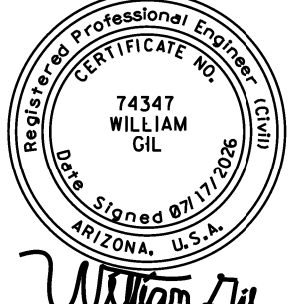
	<table><tr><td></td><td>NAME</td><td>DATE</td></tr><tr><td>DESIGN</td><td>W. GIL</td><td>07/26</td></tr><tr><td>DRAWN</td><td>W. GIL</td><td>07/26</td></tr><tr><td>CHECKED</td><td>H. RIOS</td><td>07/26</td></tr></table>		NAME	DATE	DESIGN	W. GIL	07/26	DRAWN	W. GIL	07/26	CHECKED	H. RIOS	07/26	<table><tr><td colspan="2">ARIZONA DEPARTMENT OF TRANSPORTATION PROJECT DELIVERY AND OPERATIONS DIVISION TRAFFIC DESIGN SECTION</td></tr><tr><td colspan="2">PAVEMENT MARKING AND SIGNING GENERAL NOTES</td></tr></table>	ARIZONA DEPARTMENT OF TRANSPORTATION PROJECT DELIVERY AND OPERATIONS DIVISION TRAFFIC DESIGN SECTION		PAVEMENT MARKING AND SIGNING GENERAL NOTES		ROUTE	F.H.W.A. Arizona Division	STATE ARIZ.	PROJECT NO. 0000 YU YYU	FEDERAL ID NO. YYU-0(225)T	SHEET NO. 30	TOTAL SHEETS 37	RECORD DRAWING
			NAME	DATE																						
		DESIGN	W. GIL	07/26																						
		DRAWN	W. GIL	07/26																						
CHECKED	H. RIOS	07/26																								
ARIZONA DEPARTMENT OF TRANSPORTATION PROJECT DELIVERY AND OPERATIONS DIVISION TRAFFIC DESIGN SECTION																										
PAVEMENT MARKING AND SIGNING GENERAL NOTES																										
MILEPOST																										
STRUCTURE NO.																										
		LOCATION		AVENUE G, COUNTY 11TH ST - COUNTY 16TH ST				DWG		PM00																
		TRACS NO.		T0437 01C				____ OF ____																		

Pavement Marking Locations NB Edge Line				
Avenue G				
Description	Begin Sta	End Sta	Length (LF)	4" Equiv
Solid Stripe (6" White)	17+32	261+40	24,408	36612
Exceptions	114+80	116+29	149	223.5

Pavement Marking Locations SB Edge Line				
Avenue G				
Description	Begin Sta	End Sta	Length (LF)	4" Equiv
Solid Stripe (6" White)	17+32	261+40	24,408	36612
Exceptions	114+80	116+29	149	223.5
	62+00	63+50	150	225


Pavement Marking Locations Centerline				
Avenue G				
Description	Begin Sta	End Sta	Length (LF)	4" Equiv
Double Yellow (4")*	19+36.3	61+99.1	4,263	8526
	63+48.5	108+11.6	4,463	8926
	122+46.5	167+75.0	4,529	9057
	168+77.3	219+84.4	5,107	10214
	222+48.7	265+40.3	4,292	8583
Obliteration (6")	19+36.3	61+99.1	4,263	12788
	63+48.5	108+11.6	4,463	13389
	122+46.5	167+75.0	4,529	13586
	168+77.3	219+84.4	5,107	15321
	222+48.7	265+40.3	4,292	12875
*Waterborne Only, County to install Yellow Thermoplastic at a later time				

	 WSP USA Inc. 1200 West Washington Street, Suite 600 Tempe, AZ 85288	NAME	DATE	ARIZONA DEPARTMENT OF TRANSPORTATION PROJECT DELIVERY AND OPERATIONS DIVISION TRAFFIC DESIGN SECTION	ROUTE	F.H.W.A. Arizona Division	STATE	PROJECT NO.	FEDERAL ID NO.	SHEET NO.	TOTAL SHEETS	RECORD DRAWING	
		DESIGN	W. GIL		07/26		MILEPOST	ARIZ.	0000 YU YYU	YYU-0(225)T	31	37	
		DRAWN	W. GIL		07/26								
		CHECKED	H. RIOS	07/26	STRUCTURE NO.	LOCATION	AVENUE G, COUNTY 11TH ST - COUNTY 16TH ST	DWG	PM01				
					TRACS NO.	T0437 01C				____ OF ____			

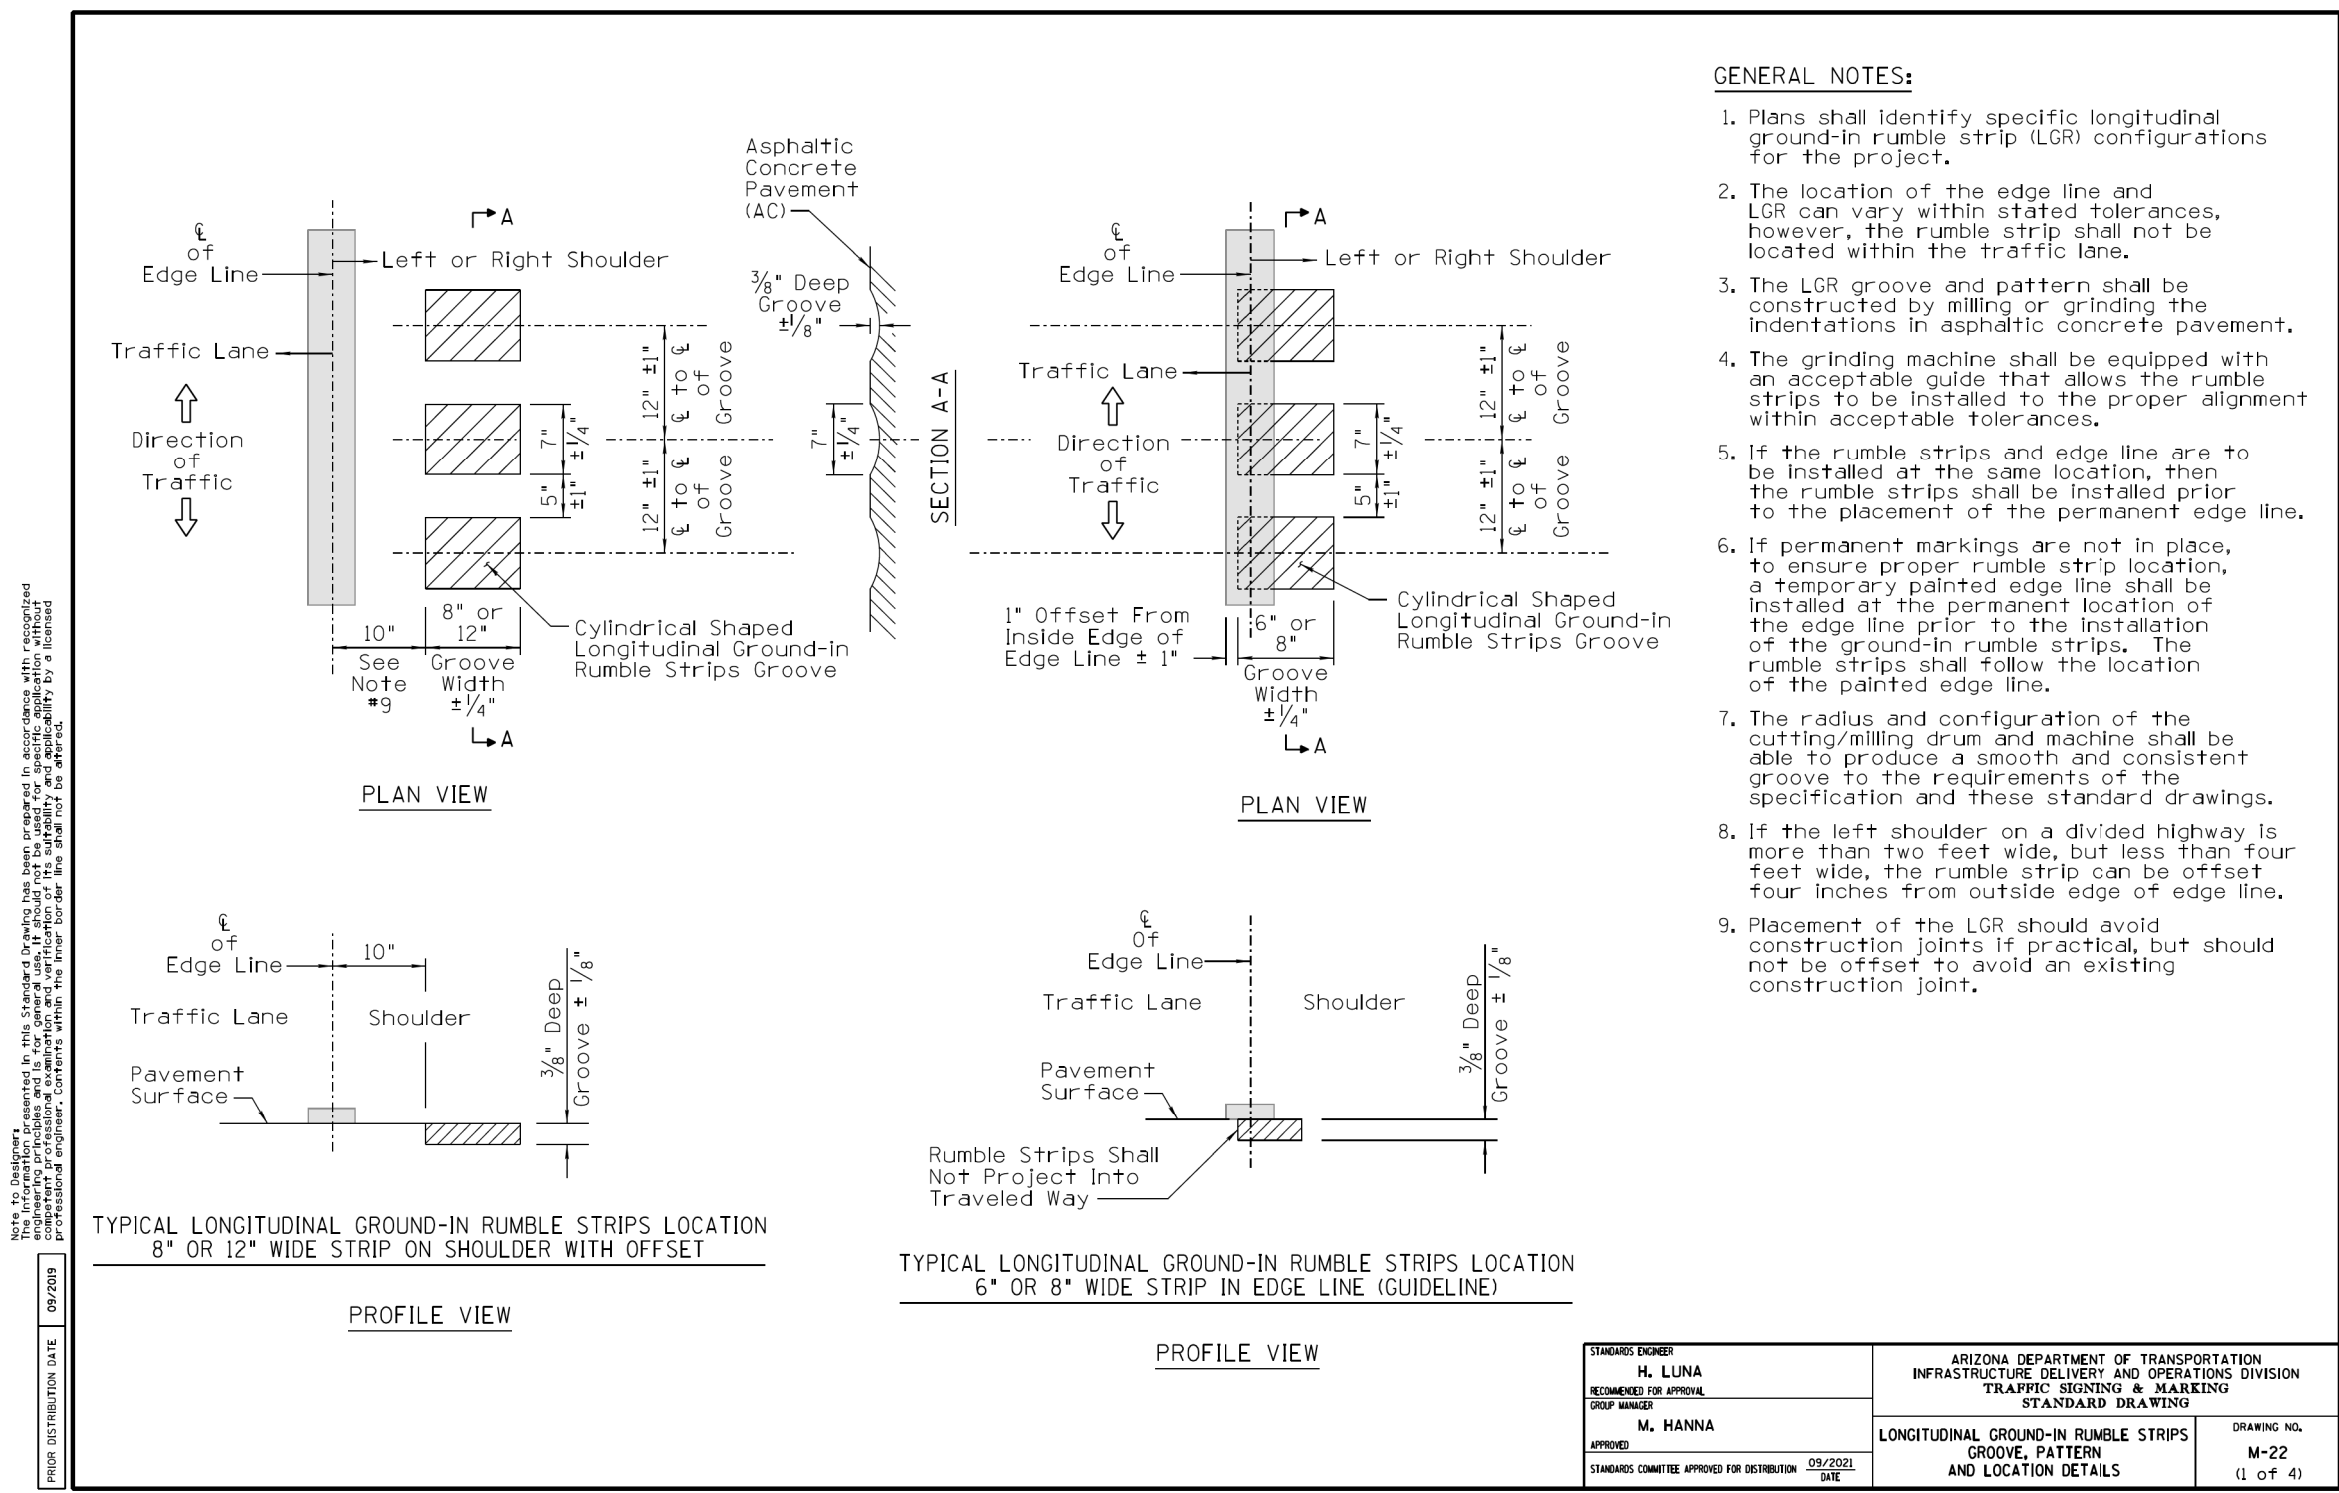


DETAIL A

ADOT STD DWG M-22
LONGITUDINAL GROUND IN RUMBLE STRIPS

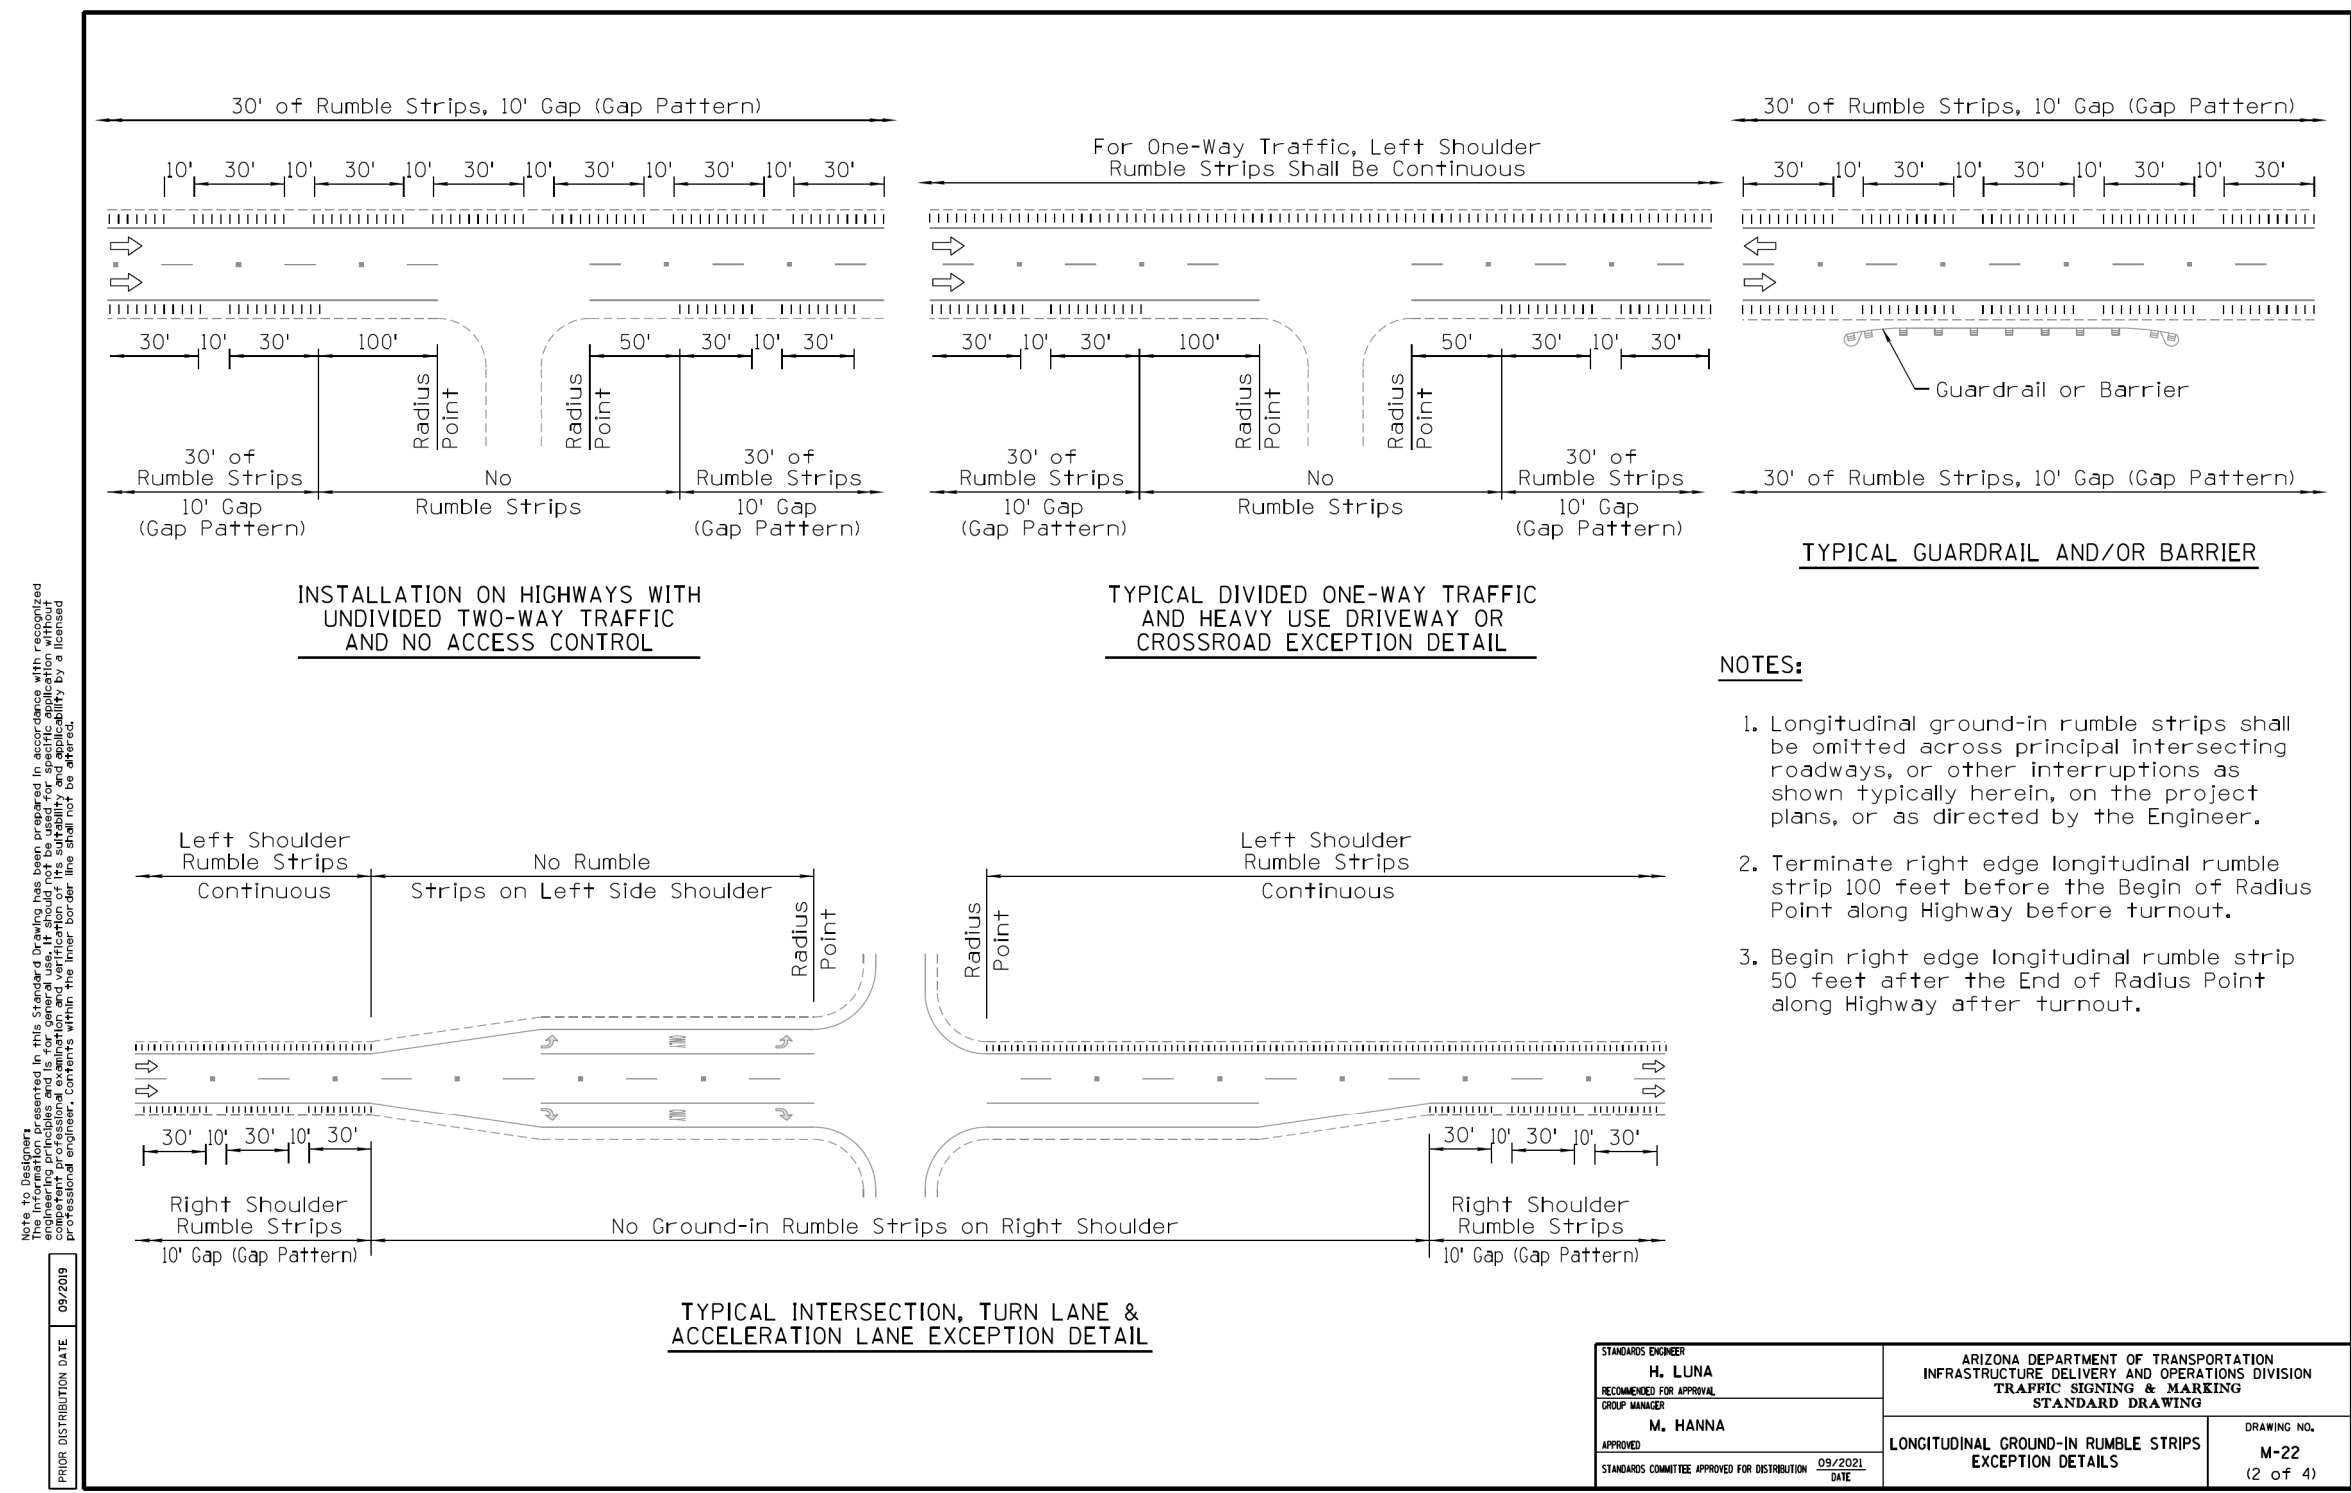

DETAIL B

ADOT STD DWG M-22
LONGITUDINAL GROUND IN RUMBLE STRIPS EXCEPTION DETAIL

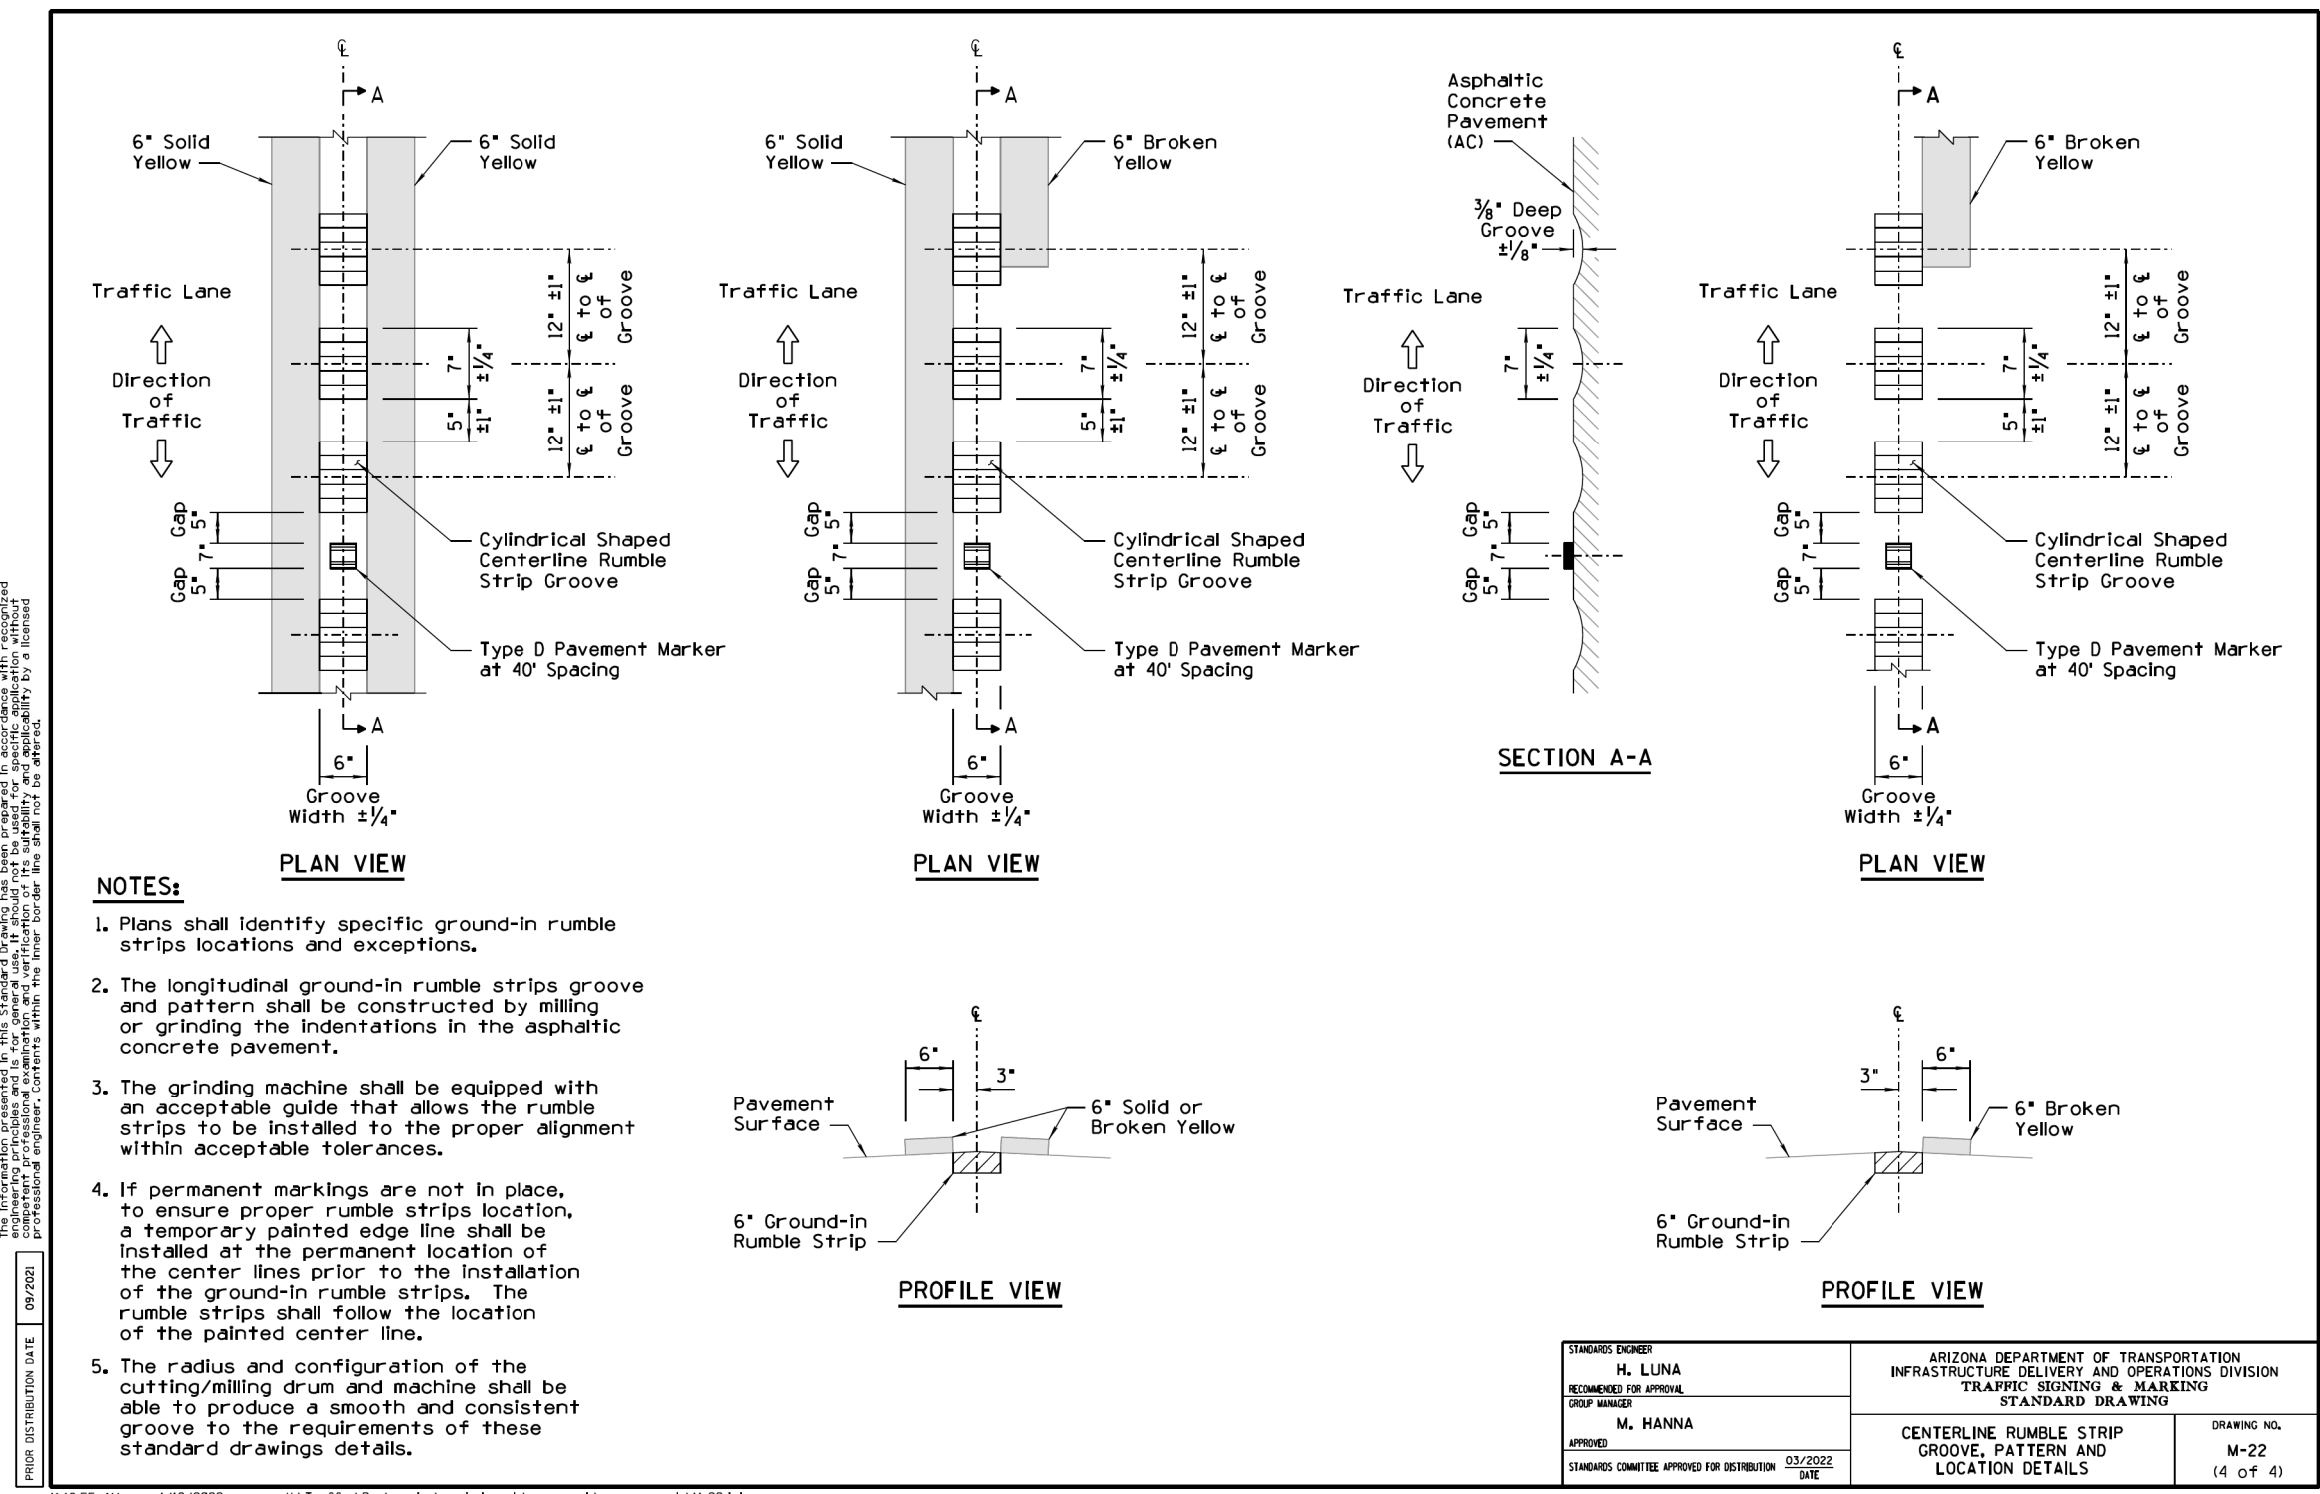

DETAIL C

ADOT STD DWG M-22
CENTERLINE RUMBLE STRIP GROOVE, PATTERN AND LOCATION DETAILS

  WSP USA Inc. 1230 West Washington Street, Suite 600 Tempe, AZ 85283				ARIZONA DEPARTMENT OF TRANSPORTATION INFRASTRUCTURE DELIVERY AND OPERATIONS DIVISION TRAFFIC DESIGN SECTION		ROUTE	F.H.W.A. Arizona Division	STATE ARIZ.	PROJECT NO.	FEDERAL ID NO.	SHEET NO.	TOTAL SHEETS	RECORD DRAWING
	DESIGN	W. GIL	07/26	DETAIL SHEET	MILEPOST	0000 YU YYU			YYU-0(225)T	35	37		
	DRAWN	W. GIL	07/26			LOCATION	AVENUE G, COUNTY 11TH ST TO COUNTY 16TH ST			DWG	RS02		
	CHECKED	H. RIOS	07/26			STRUCTURE NO.	TRACS NO. T0437 01C			____ OF ____			

CONTROL MEASURE INDEX SHEET (CMIS)

TO BE COMPLETED FOR PROJECTS WITH ONE (1) ACRE OR MORE OF SOIL/GROUND DISTURBANCE OUTSIDE OF JURISDICTIONAL WATERS OF THE U.S. (≥1 ACRE*)
* For projects that meet the definition of maintenance under AZPDES CGP, the permit threshold is five (≥ 5) acres. Consult with ADOT EP Water Resources Management to define Jurisdictional Waters of the U. S.

I. PROJECT DESCRIPTION

A. Owner Name and Address:

Arizona Department of Transportation
205 South 17th Avenue
Phoenix, Arizona 85007-3213

B. Project TRACS Number: T0437 01C

C. Project Name/location (be consistent with the plan set cover sheet): AVENUE G, COUNTY 11TH ST TO COUNTY 16TH ST

City: Yuma County: Yuma County

Beginning Latitude (NAD 83): 582200.726

Beginning Longitude (NAD 83): 396488.110

Ending Latitude (NAD 83): 608829.322

Ending Longitude (NAD 83): 396474.687

To obtain the project latitude/longitude data, refer to the Flash Earth web link below (Bing Maps with labels):

http://www.flashearth.com/

D. Project Description: Widening shoulder to 5' width, installing edge line rumble strips, and installing pavement markings.

II. HYDROLOGIC INFORMATION

A. Percentage of the site that is impervious before and after construction:

Percent before Construction:

Percent after Construction:

3. Receiving Water(s), refer to the plan set cover sheet and the NHD Plus HR Availability Map Web Link below:

https://usgs.maps.arcgis.com/apps/MapTools/index.html?appid=41a5c2ca49bda83b239450e61022d53

(if unnamed, state as unnamed)

III. SOIL STABILIZATION MEASURES

- ☐ All disturbed soil, which will not be paved, riprapped or otherwise covered to prevent erosion, will be revegetate and/or landscaped in accordance with the project plans and specifications.

IV. MEASURES TO CONTROL STORMWATER AND AIR QUALITY

A. Temporary Stormwater and Air Quality Control Measures (CMs) / Best Management Practices (BMPs)

- ☐ Temporary Diversion Dikes
☐ Temporary Rock Check Dams
☐ Stabilized Construction Entrance/Exit Gravel Pad
☐ Soil Stabilizer for Wind Erosion and Dust Control
☐ Rock Inlet/Outlet Protection
☐ Sediment Control Berms
☐ Silt Fences
☒ Wattles (Excelsior/Straw/Compost)
☐ Excelsior Logs / Sediments Logs
☐ Erosion Control Mattings
☐ Seeding (Class II with final mulch cover)
☐ Gravelbag
☐ Catch Basin Temporary Fabric Filter
☐ Designated Washout Areas
☐ Protected Chemical and Material Storage Area
☐ Equipment Maintenance Procedures
☐ Others Describe:


3. Permanent and Post-construction Stormwater and Air Quality Control Measures (CMs) / Best Management Practices (BMPs):

- ☐ Crown Ditch/Dike
☐ Rock Protection
☐ Rock Riprap Channel Lining
☐ Sediment Basin
☐ Embankment Curb
☐ Spillways
☐ Downdrains
☐ Minibenching
☐ Solid Waste Management
☐ **Rock-filled Stormwater Infiltration CM/BMP as Infiltration basin and/or Trench
☐ **Filtration Structures
☐ **Infiltration Basin and/or Trench
☐ **Retention and/or Detention Basins
☐ **Bioretention
☐ **Manufactured Treatment Devices
☐ Seeding established as a perennial vegegative cover with a density of 70% of the native background vegetative cover.
☒ Others Describe: Granite Mulch

** Track and report ADOT EP Water Resources Management:


ADOTWater@azdot.gov

	DESIGN	NAME	DATE	ARIZONA DEPARTMENT OF TRANSPORTATION PROJECT DELIVERY AND OPERATIONS DIVISION ROADSIDE DEVELOPMENT SECTION STORMWATER & AIR QUALITY CONTROL MEASURE INDEX SHEET (CMIS)	ROUTE	F.H.W.A. Arizona Division	STATE	PROJECT NO.	FEDERAL ID NO.	SHEET NO.	TOTAL SHEETS	RECORD DRAWING	
	DRAWN	N. EKI BWANGOY	07/26										
	CHECKED	H. RIOS	07/26										
	wsp WSP USA Inc. 1230 West Washington Street, Suite 600 Tempe, AZ 85288												
					MILEPOST	LOCATION AVENUE G, COUNTY 11TH ST - COUNTY 16TH ST							
					STRUCTURE NO.	TRACS NO. T0437 01C							
												DWG	EC01
												OF	

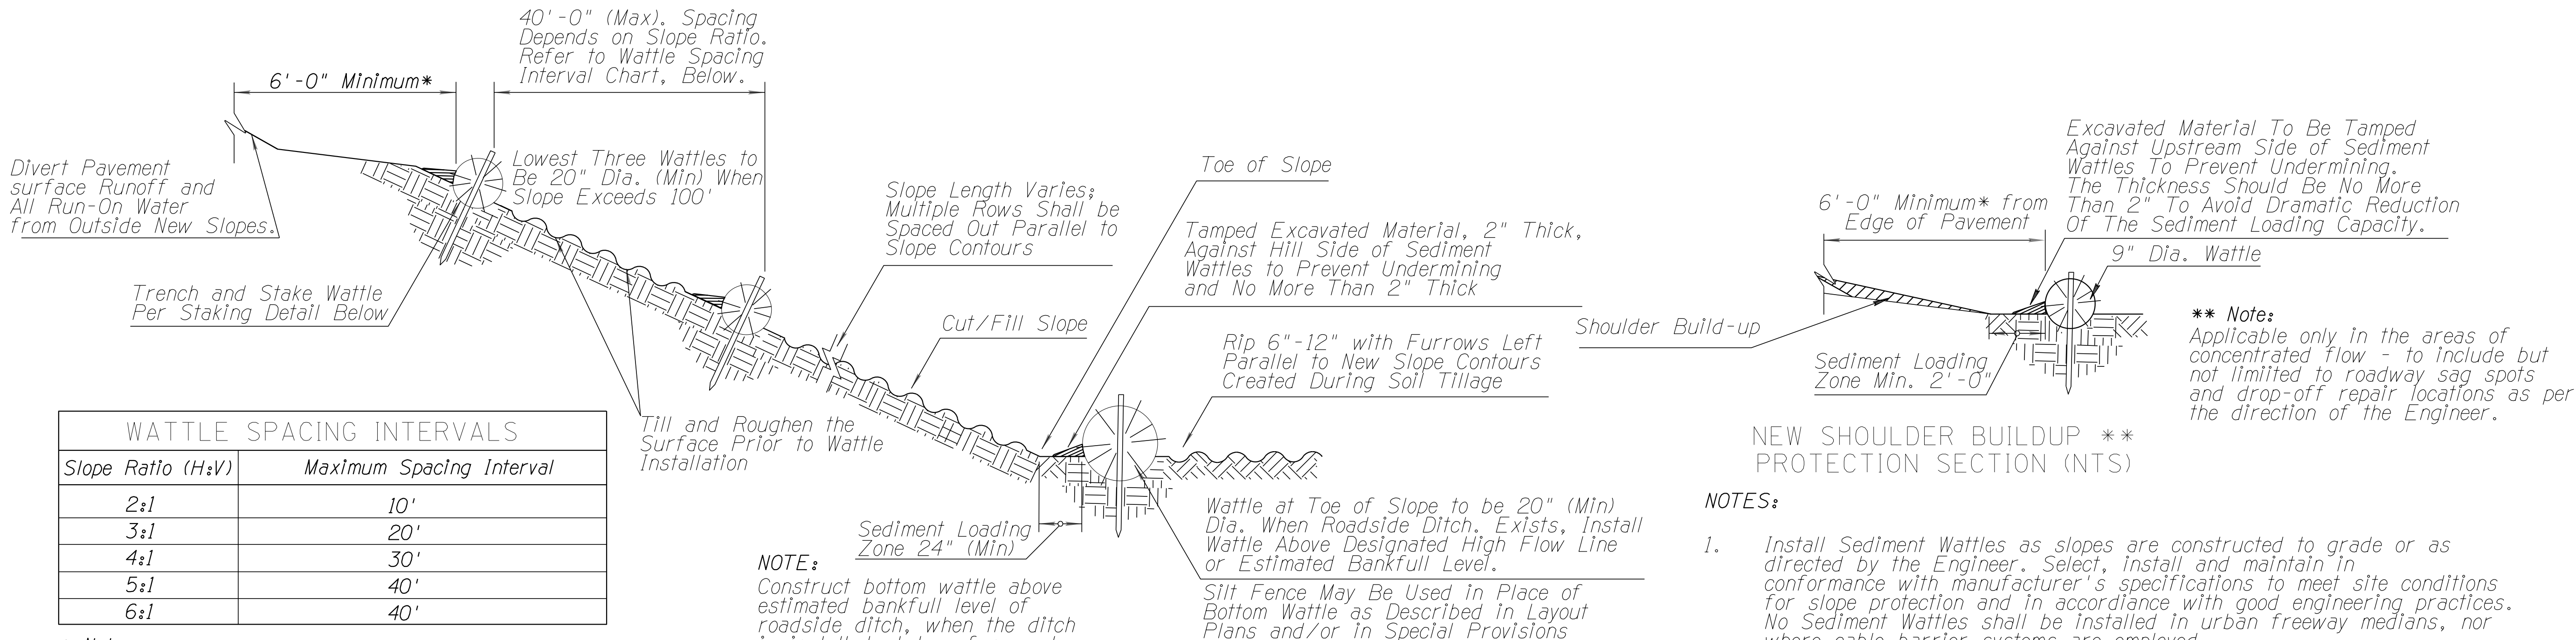


WATTLE SPACING INTERVALS	
Slope Ratio (H:V)	Maximum Spacing Interval
2:1	10'
3:1	20'
4:1	30'
5:1	40'
6:1	40'


- * Notes:
- 1) Top Row Shall be Placed within 6'-0" of Edge of Pavement and 9'-0" from Outside Surface of Barrier.
 - 2) For erosive soils, place rows of wattles closer together.
 - 3) For soils with low erosive potential, place rows of wattles further apart.

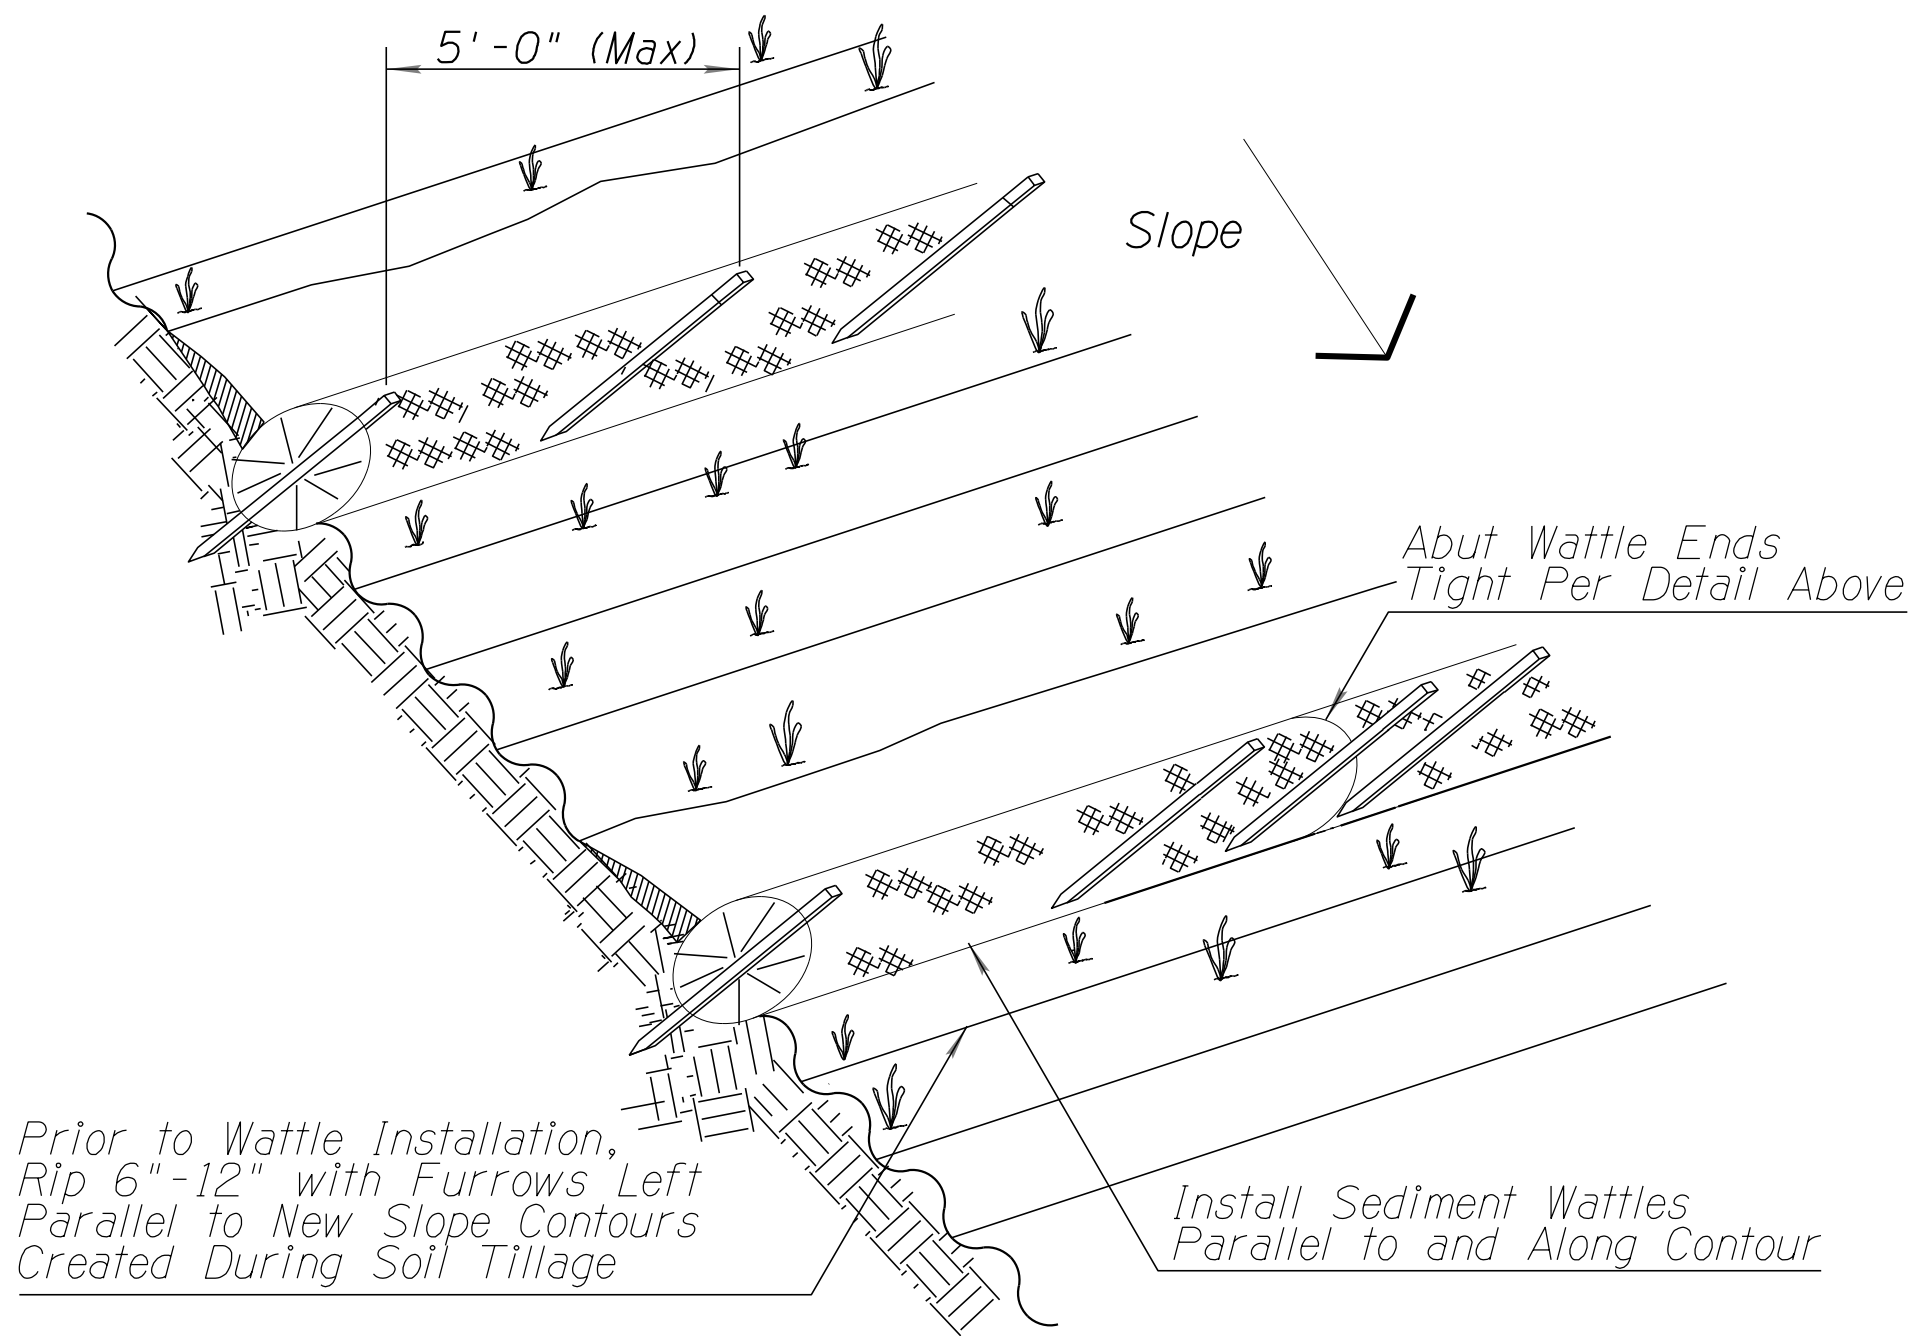

SEDIMENT WATTLE LAYOUT (NTS)

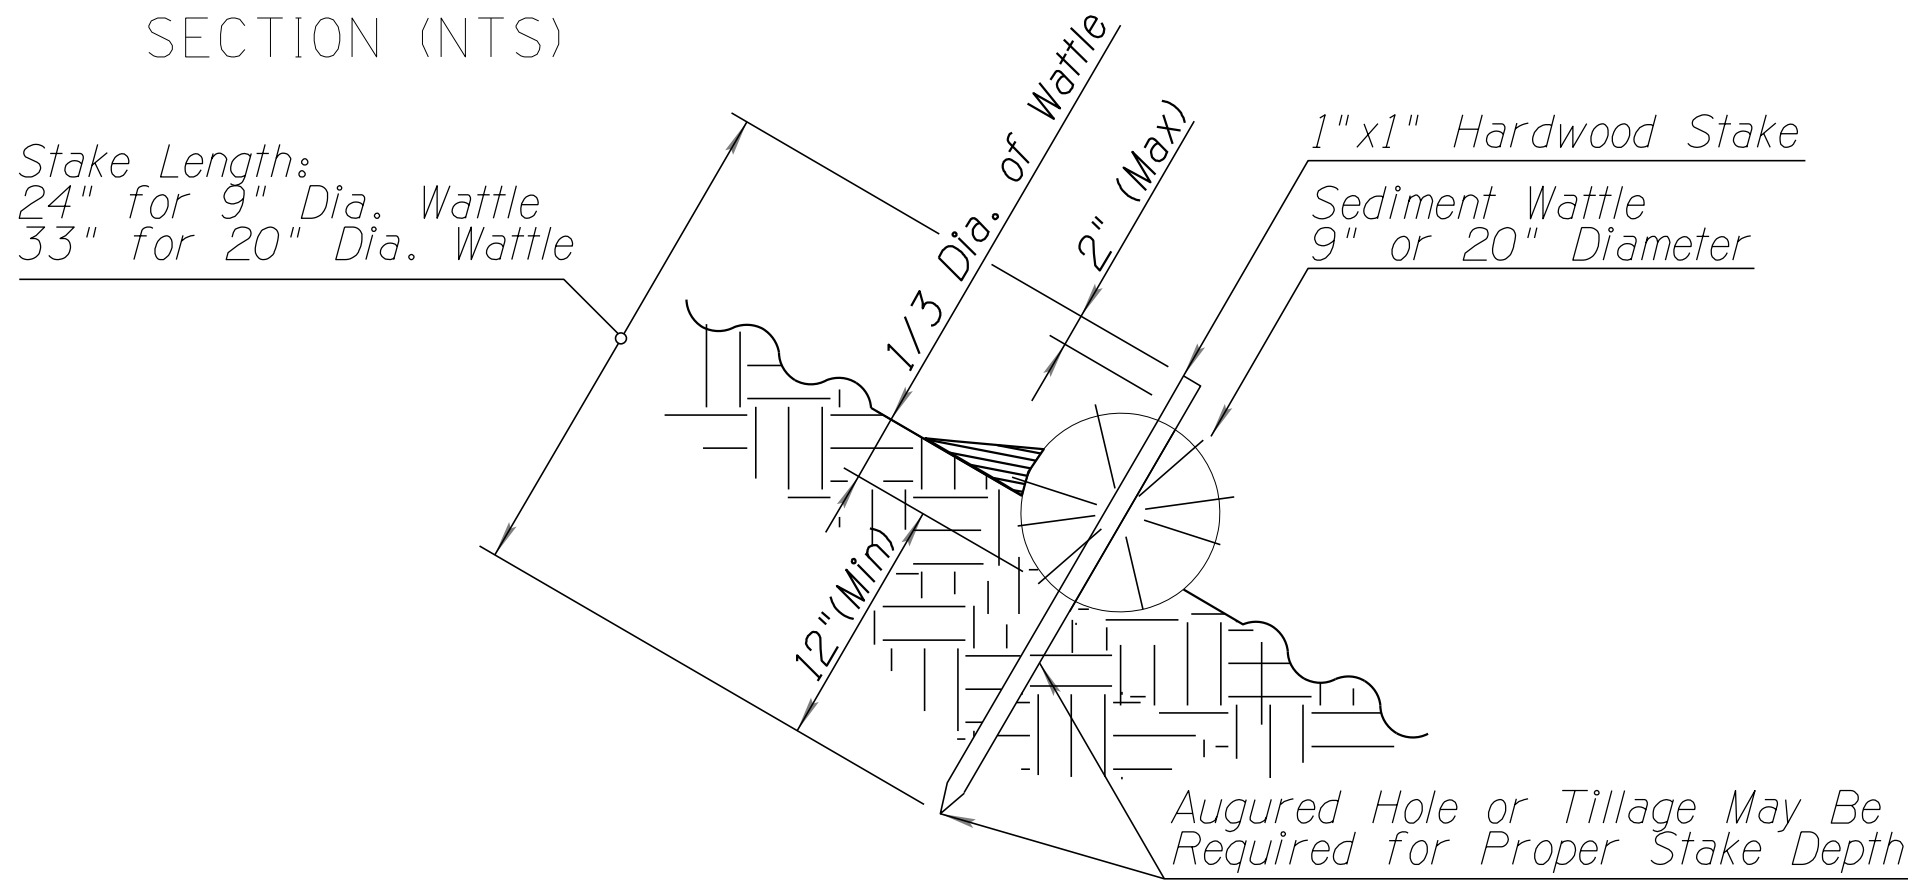

SEDIMENT WATTLE STAKING DETAIL (NTS)

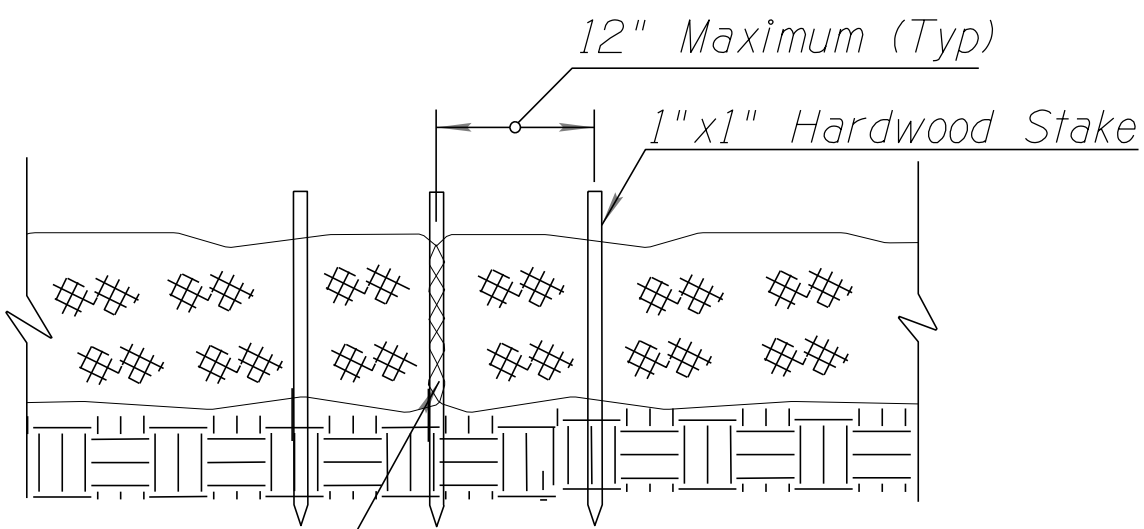

SEDIMENT WATTLE OVERLAP (NTS)

NEW SHOULDER BUILDUP ** PROTECTION SECTION (NTS)

NOTES:

1. Install Sediment Wattles as slopes are constructed to grade or as directed by the Engineer. Select, install, and maintain in conformance with manufacturer's specifications to meet site conditions for slope protection and in accordance with good engineering practices. No Sediment Wattles shall be installed in urban freeway medians, nor where cable barrier systems are employed.
2. Sediment Wattles shall be in continuous contact with trench bottom and sides. Do not overlap wattle ends on top of each other. A 20" Dia. wattle may be made from 2-3 rolled excelsior or straw blankets.
3. Butt adjoining wattles tightly against each other. Drive the first end stake of the second wattle at an angle toward the first wattle to help abut them tightly.
4. Repair any rills or gullies promptly. Make field adjustments and corrections of Wattle CM/BMP immediately if it is causing flooding, erosion, and/or affecting roadway safety.
5. Construction of cut slopes 2:1 and steeper in soil and rock materials that can be ripped shall be constructed, whenever possible, by Minibenching. refer to Slope Minibenching CM/BMP Detail.
6. Loosening surface soil is not required where Minibenches are used. For seeded areas, tillage shall be performed to form minor ridges and furrows parallel to new slope contours and as specified in Section 805 of the Specifications and project special provisions.
7. Divert and direct run-on water from outside of the slopes to the spillways and/or rock riprap/rock mulch. Diversion dikes and/or ditches are necessary on natural undisturbed slopes beyond the top limits of new slopes to divert run-on water.
8. Installation and maintenance of Sediment Wattle CMs/BMPs shall not negatively impact traffic safety, not the designed function of roadway or bridge drainage facilities.
9. Install and maintain Sediment Wattle CMs/BMPs to carry the stormwater of at least 2-year, 24-hour events.
10. The Sediment Wattle CM/BMP's pay/bid item shall include all materials used for this CM/BMP: all ground preparation, furnishing, installing, maintenance, final removal, and disposal of this temporary CM/BMP, as well as returning the area to an acceptable condition as approve by the Engineer.
11. Refer to Specification Section 810-2.06(C) for Sediment Wattle material specifications.
12. Make field adjustments and corrections to ensure NO sensitive biological resources (native / habitats) will be adversely impacted.

DETAIL ES1

SEDIMENT WATTLE

	<table><tr><th></th><th>NAME</th><th>DATE</th></tr><tr><td>DESIGN</td><td>M. SCHOEN</td><td>07/26</td></tr><tr><td>DRAWN</td><td>N. EKI BWANGOY</td><td>07/26</td></tr><tr><td>CHECKED</td><td>H. RIOS</td><td>07/26</td></tr></table>  WSP USA Inc. 1230 West Washington Street, Suite 600 Tempe, AZ 85285		NAME	DATE	DESIGN	M. SCHOEN	07/26	DRAWN	N. EKI BWANGOY	07/26	CHECKED	H. RIOS	07/26	ARIZONA DEPARTMENT OF TRANSPORTATION PROJECT DELIVERY AND OPERATIONS DIVISION ROADSIDE DEVELOPMENT SECTION		ROUTE		F.H.W.A. Arizona Division	STATE	PROJECT NO.	FEDERAL ID NO.	SHEET NO.	TOTAL SHEETS	RECORD DRAWING
			NAME	DATE																				
		DESIGN	M. SCHOEN	07/26																				
		DRAWN	N. EKI BWANGOY	07/26																				
		CHECKED	H. RIOS	07/26																				
MILEPOST		ARIZ.	0000 YU YYU	YYU-0(225)T	37	37																		
STRUCTURE NO.		LOCATION						AVENUE G, COUNTY 11TH ST - COUNTY 16TH ST		DWG	EC02													
		TRACS NO.						T0437 01C		____ OF ____														