





STATE OF ARIZONA
DEPARTMENT OF TRANSPORTATION
PROJECT DELIVERY AND OPERATIONS DIVISION
PROJECT PLANS

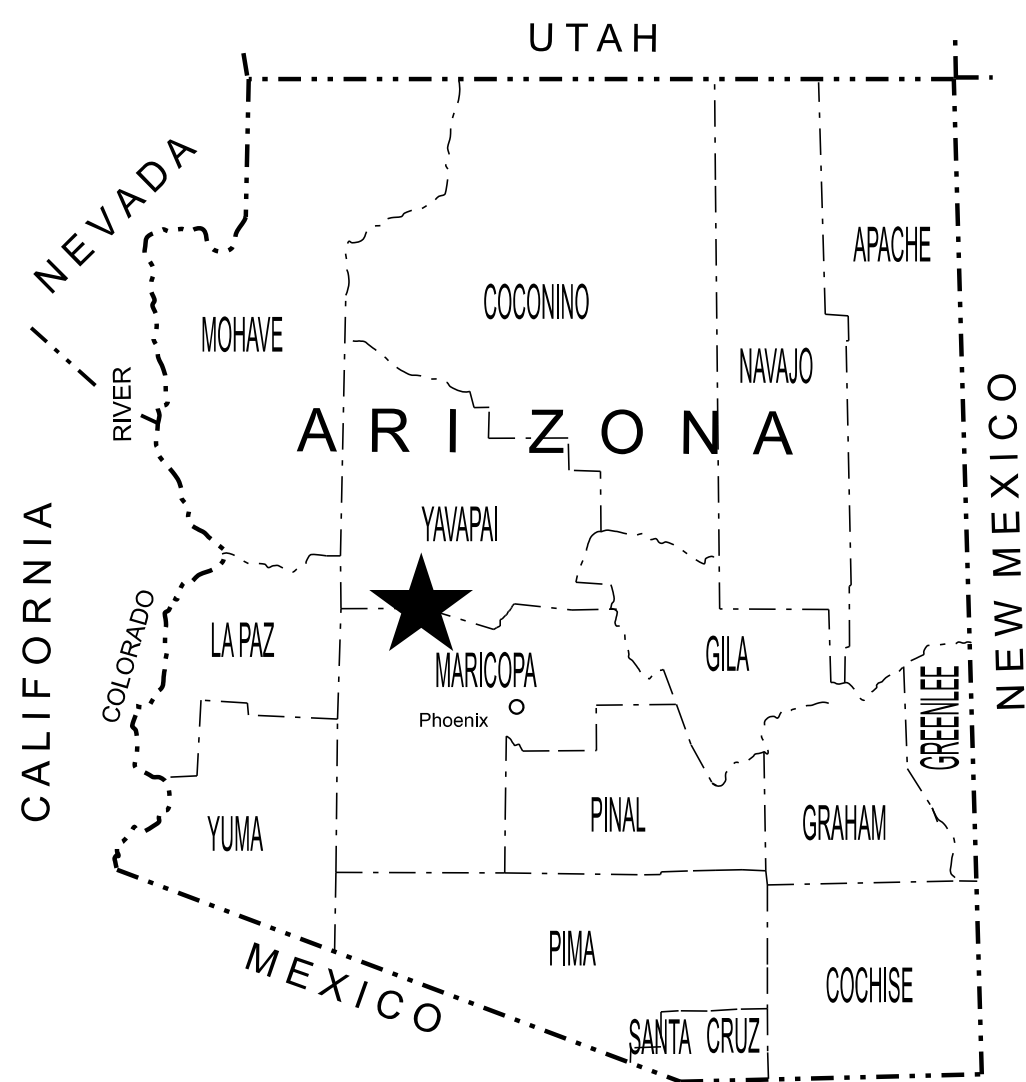

STATE HIGHWAY
KINGMAN-WICKENBURG HIGHWAY
US 93

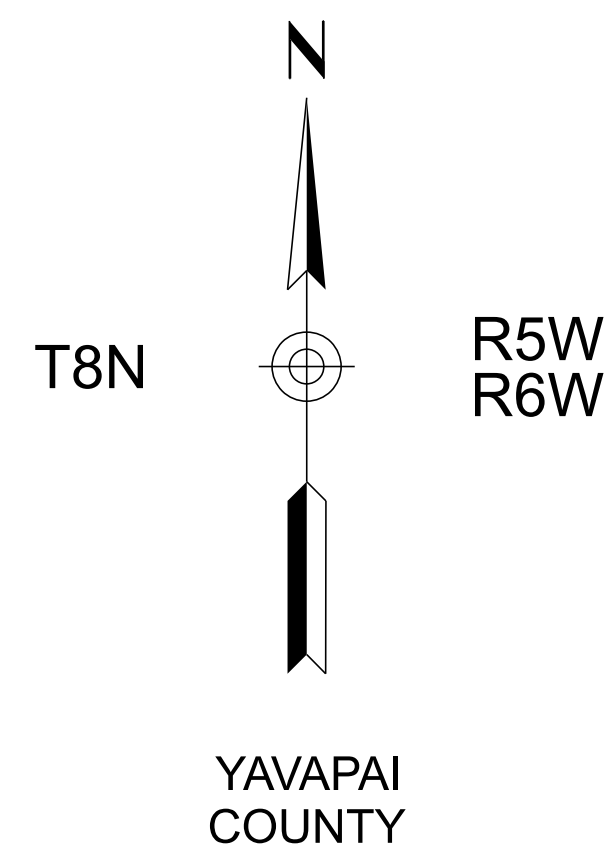

CROSS SECTIONS




WICKENBURG RANCH WAY TO VISTA ROYALE

PROJECT NO. 093 YV 189 F0738 01C
FEDERAL AID NO. 093-B(230)T

ARIZONA DEPARTMENT OF TRANSPORTATION
PROJECT DELIVERY AND OPERATIONS DIVISION
GREGORY BYRES, P.E., STATE ENGINEER




REC. DWGS. DATA	REC. DWG. DATE	OF
--------------------	----------------	----

F.H.W.A. REGION	STATE	PROJECT NO.	SHEET NO.	TOTAL SHEETS	RECORD DRAWING
9	ARIZ.	093-B(230)T	2	116	
093 YV 189					

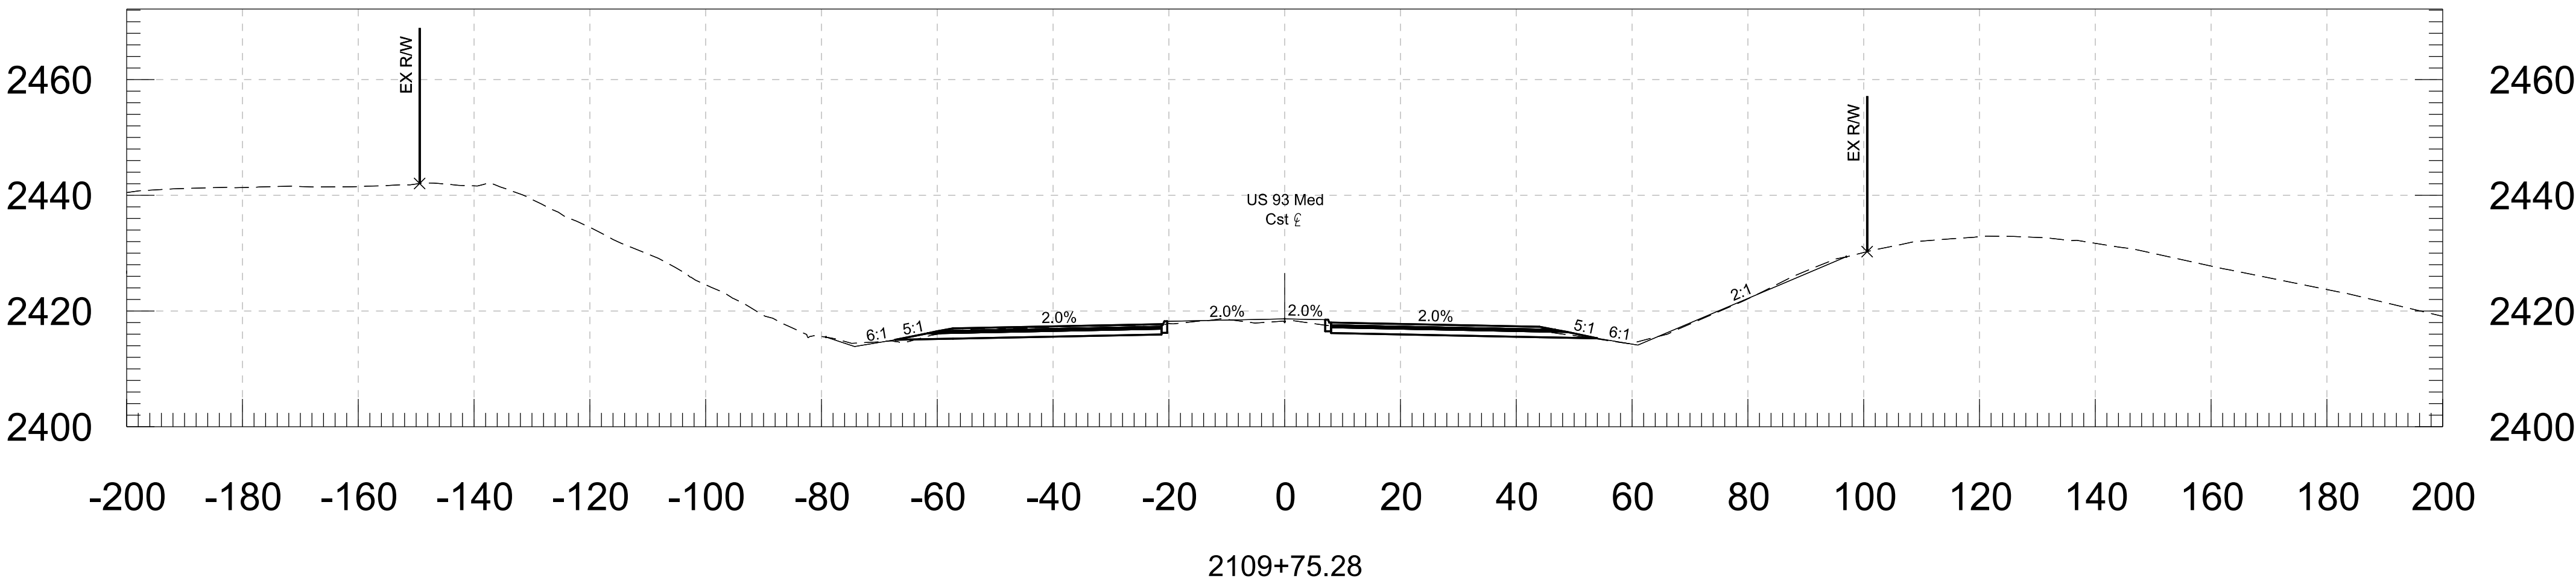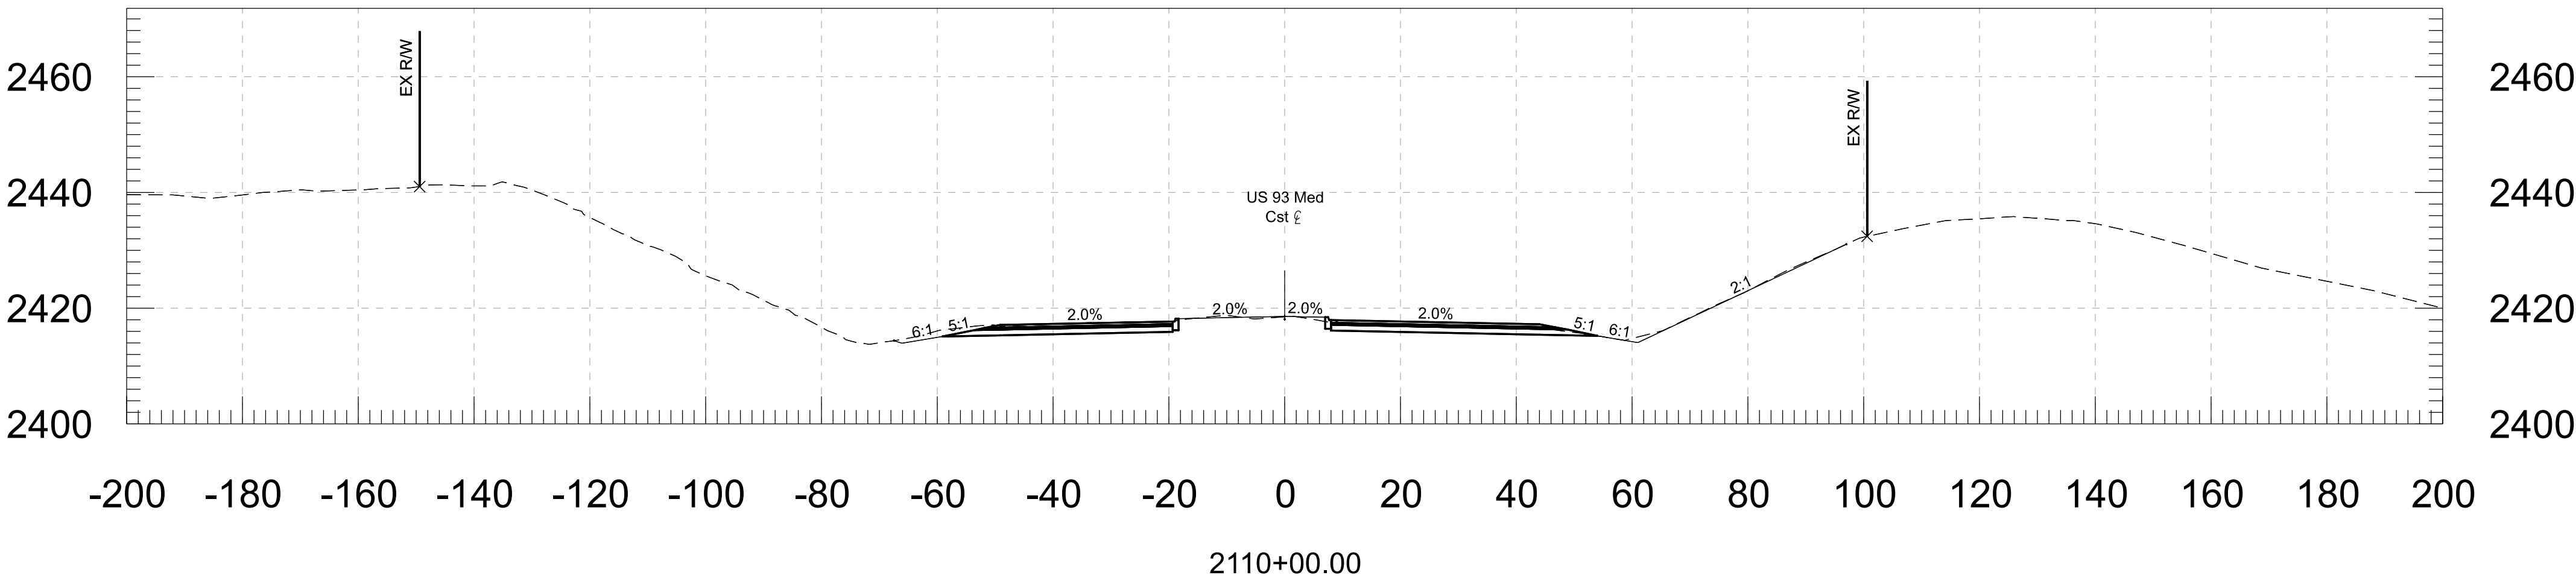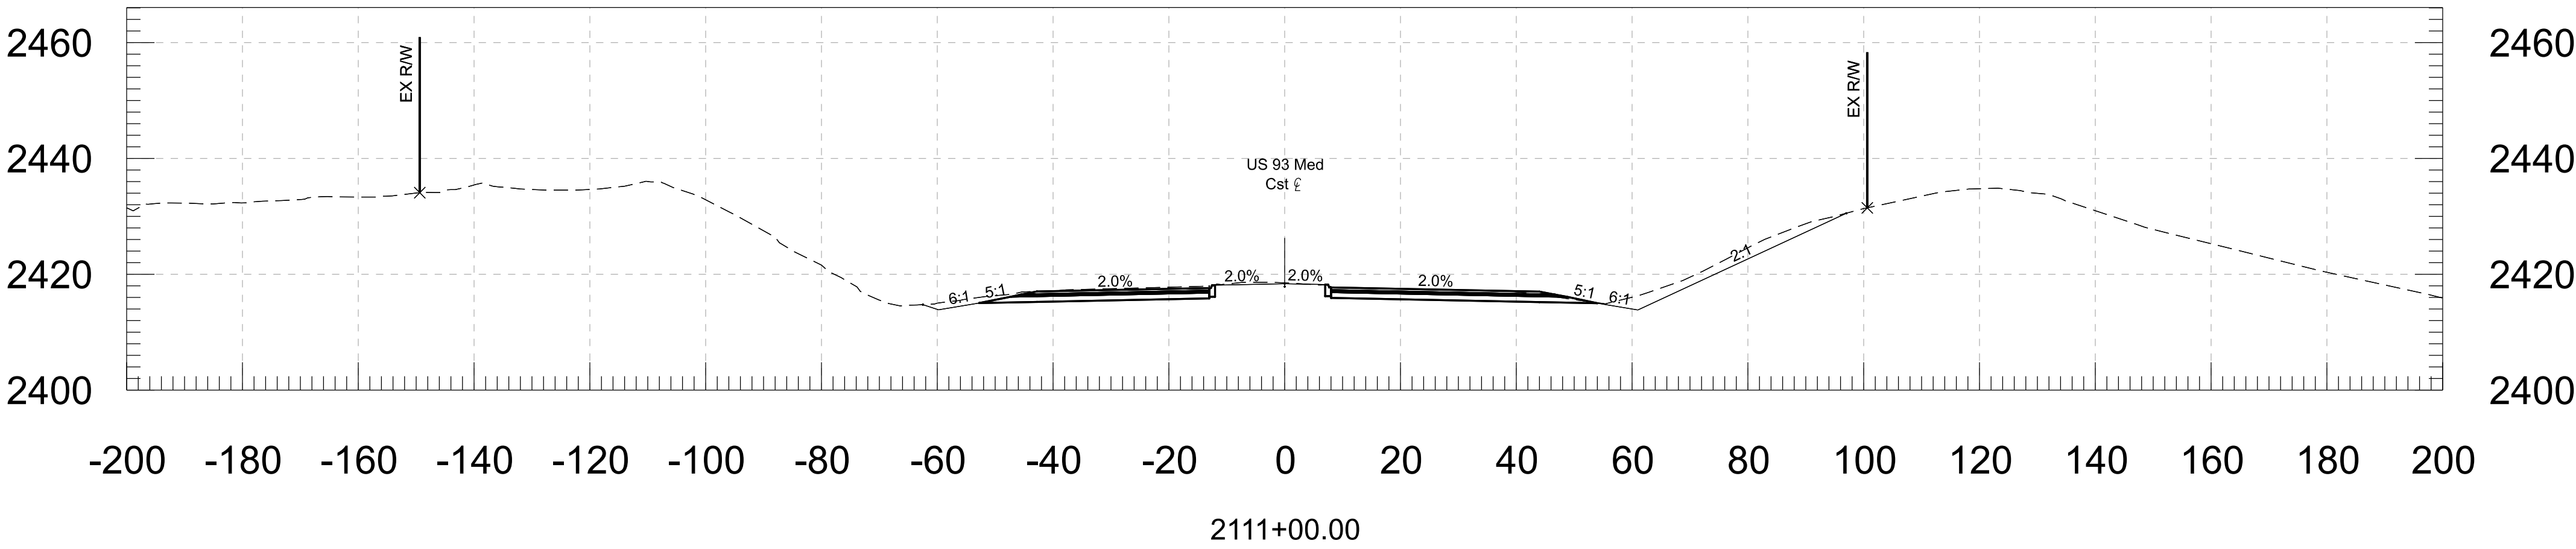



		NAME	DATE	ARIZONA DEPARTMENT OF TRANSPORTATION PROJECT DELIVERY AND OPERATIONS DIVISION ROADWAY DESIGN SERVICES	
DESIGN	ZSZ		06-26		
DRAWN	RM		06-26		
CHECKED	DBK		06-26	CROSS SECTIONS	
ROUTE		LOCATION			DWG NO. 1
US 93		WICKENBURG RANCH WAY TO VISTA ROYALE			
TRACS NO. F0738 OIC				093-B(230)T	OF

F.H.W.A. REGION	STATE	PROJECT NO.	SHEET NO.	TOTAL SHEETS	RECORD DRAWING
9	ARIZ.	093-B(230)T	3	116	
093 YV 189					

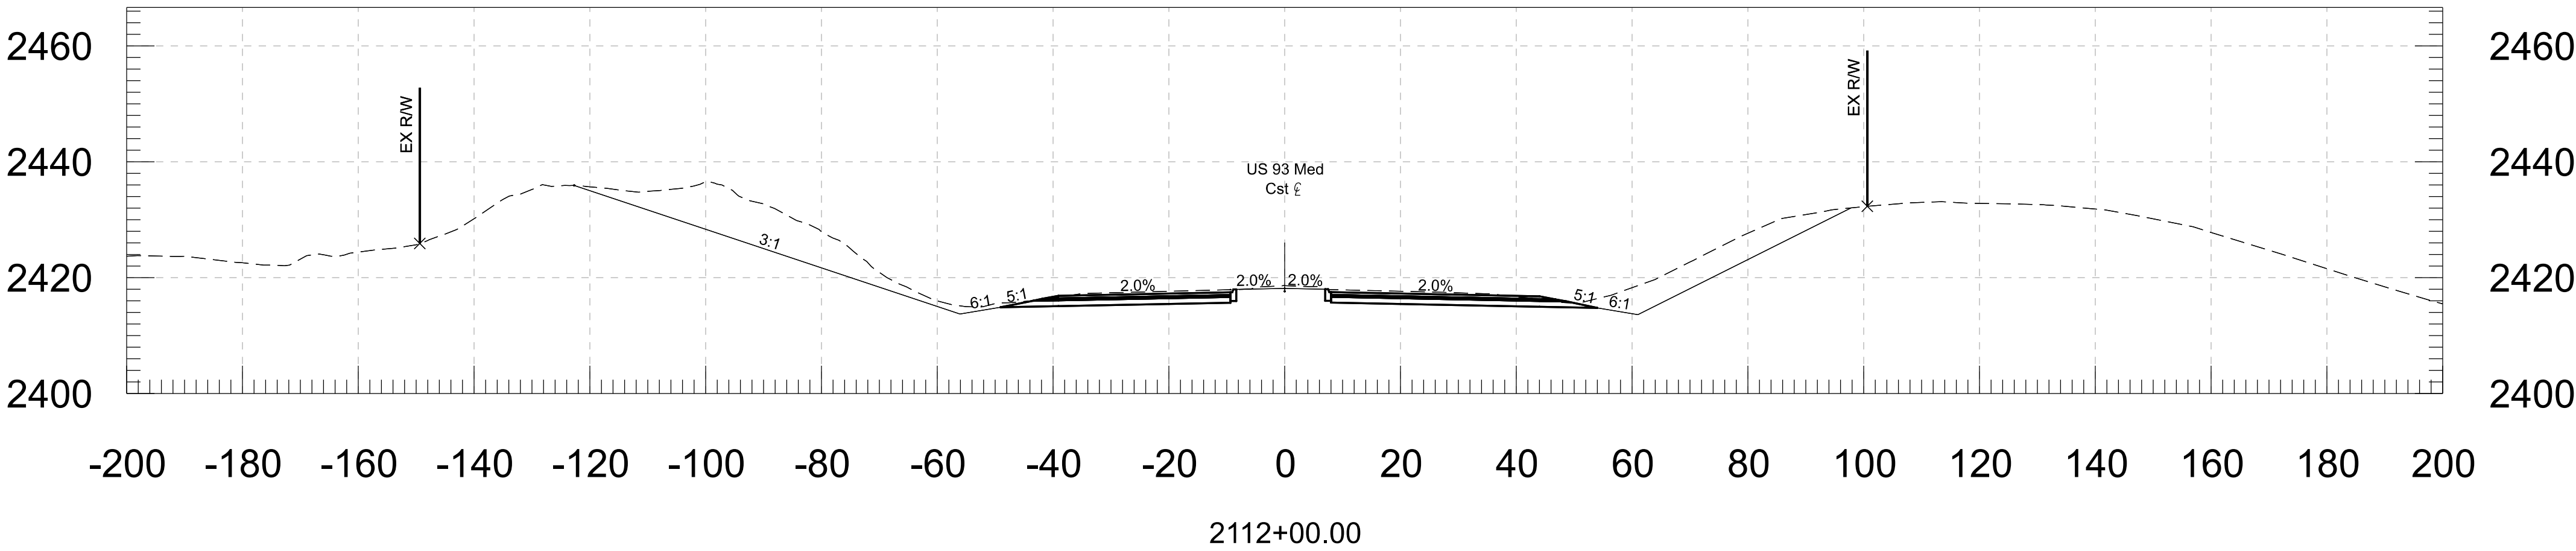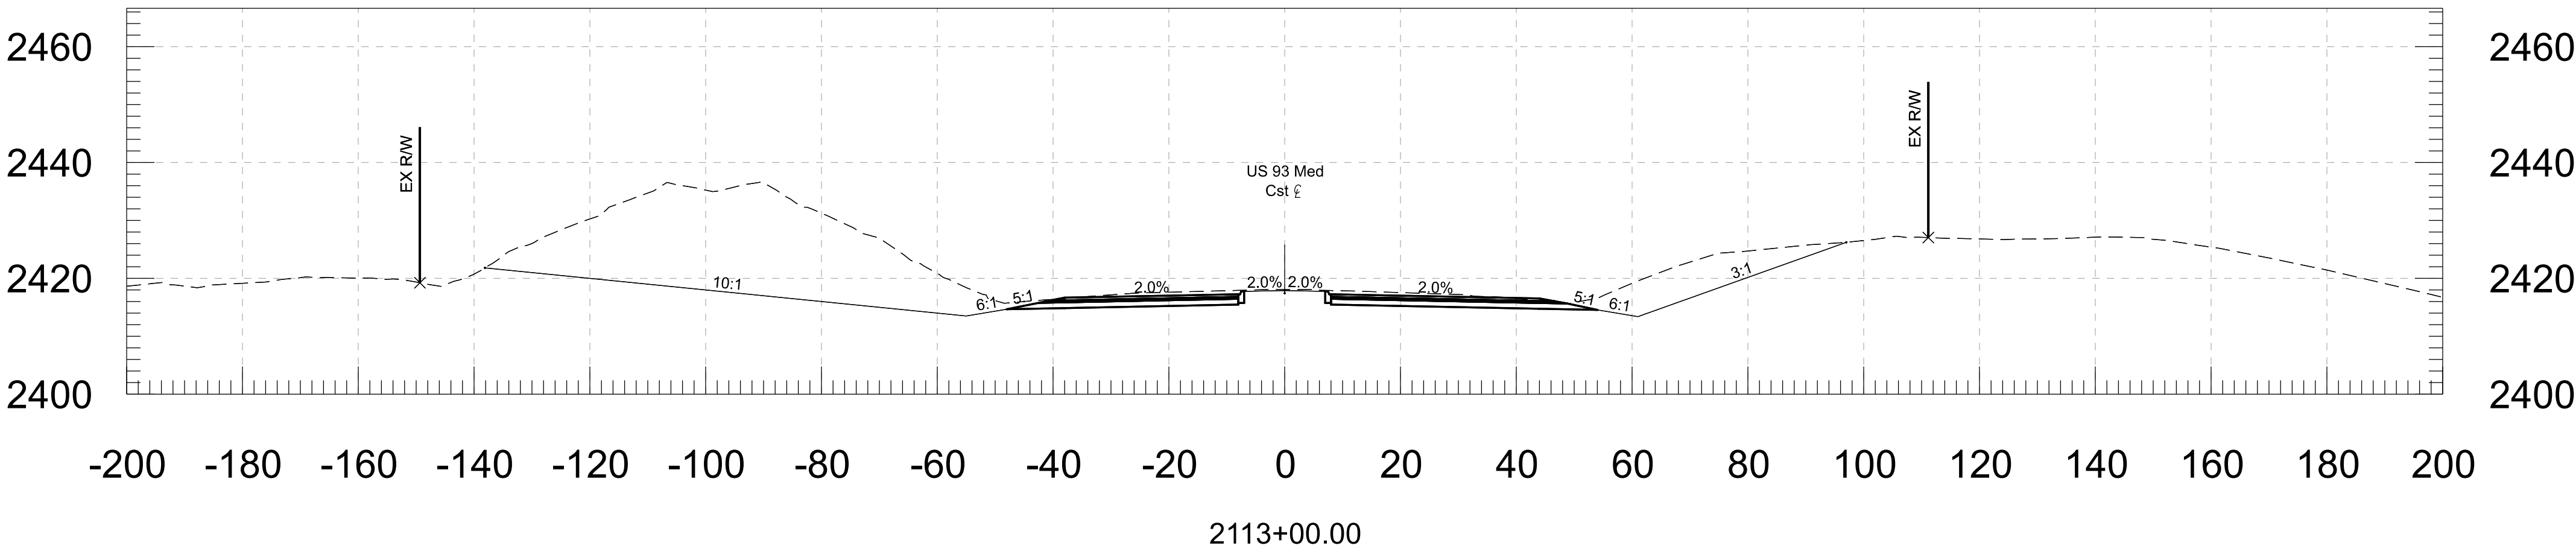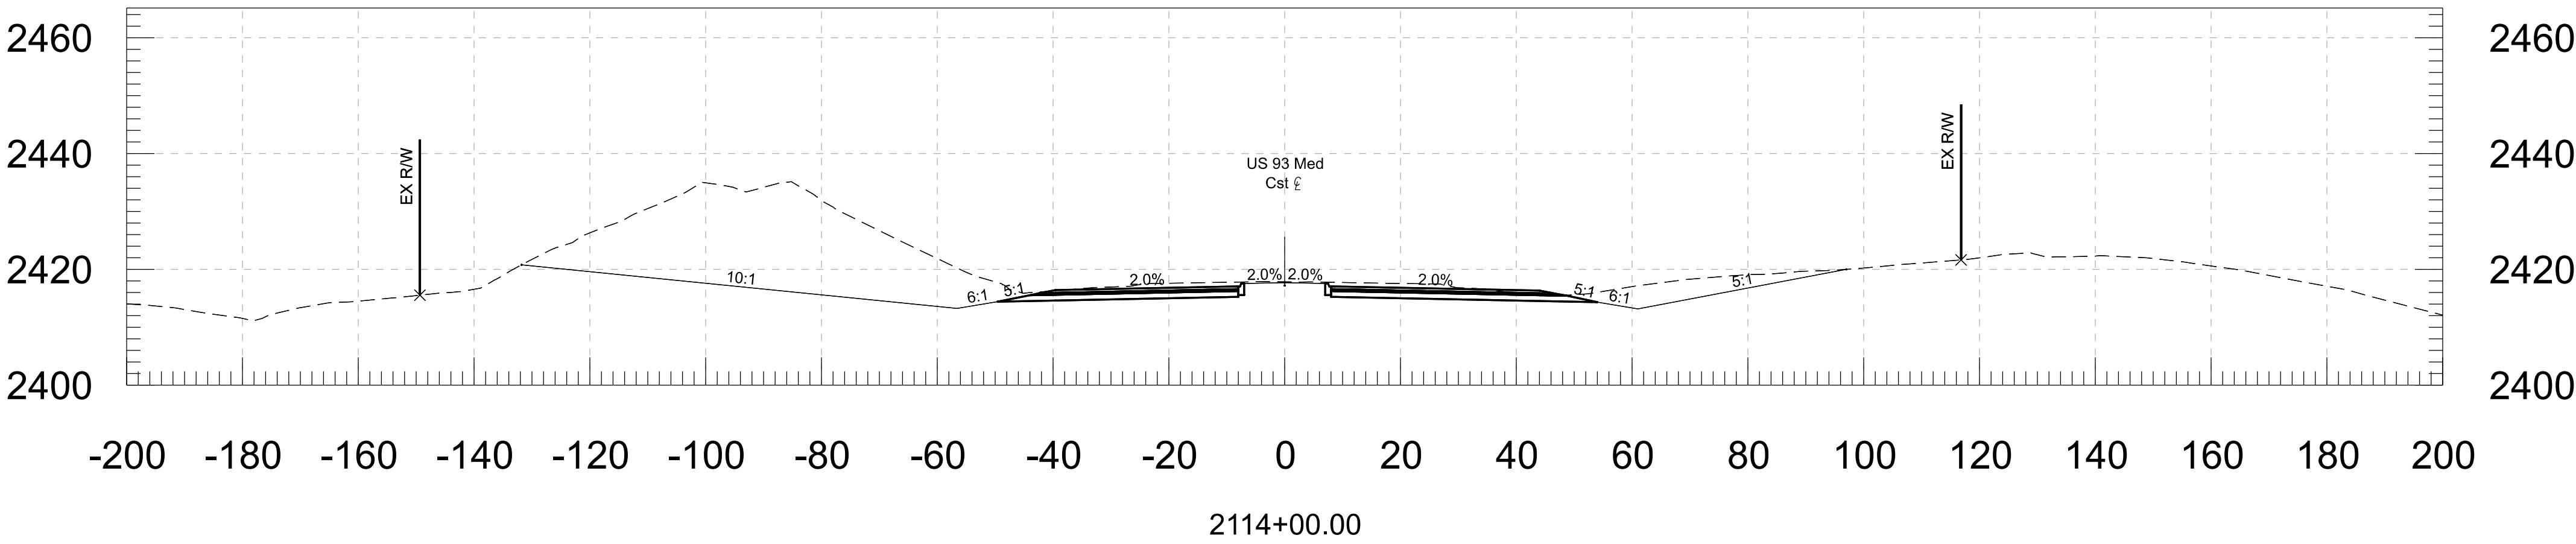



DESIGN	ZSZ	DATE	06-26	ARIZONA DEPARTMENT OF TRANSPORTATION PROJECT DELIVERY AND OPERATIONS DIVISION ROADWAY DESIGN SERVICES
DRAWN	RM	DATE	06-26	
CHECKED	DBK	DATE	06-26	
 Stanley Consultants inc. 333 East Camelback Road, Suite 100 Phoenix, Arizona 85016 Phone: 1602 333-2200				CROSS SECTIONS
ROUTE		LOCATION		DWG NO. 2
US 93		WICKENBURG RANCH WAY TO VISTA ROYALE		
TRACS NO. F0738 OIC		093-B(230)T		OF

F.H.W.A. REGION	STATE	PROJECT NO.	SHEET NO.	TOTAL SHEETS	RECORD DRAWING
9	ARIZ.	093-B(230)T	4	116	
093 YV 189					

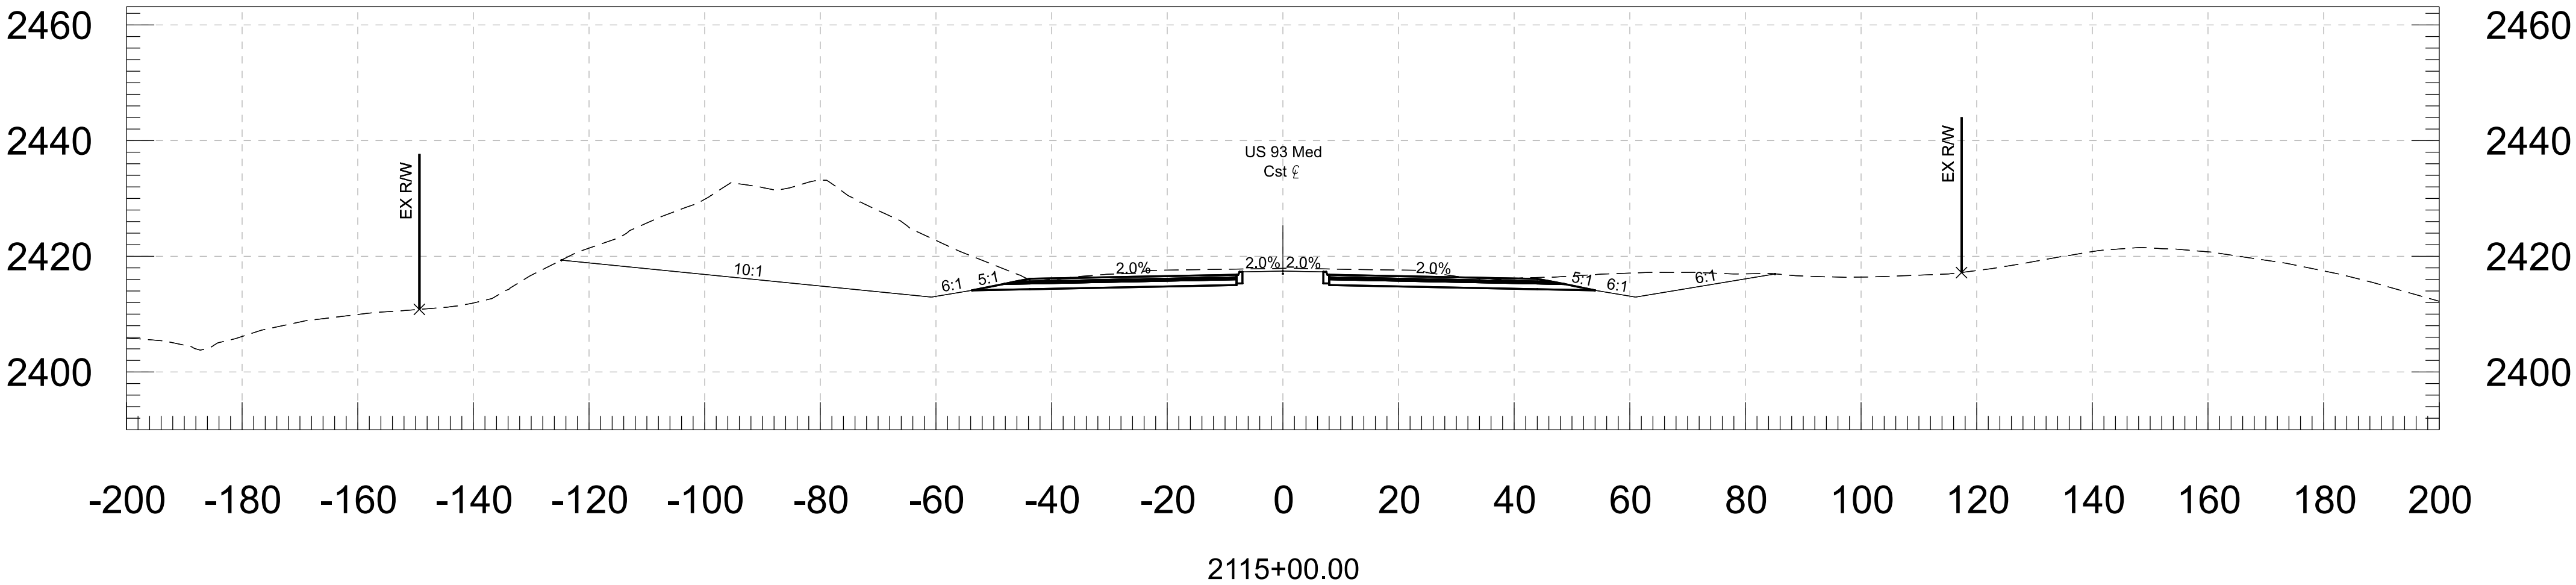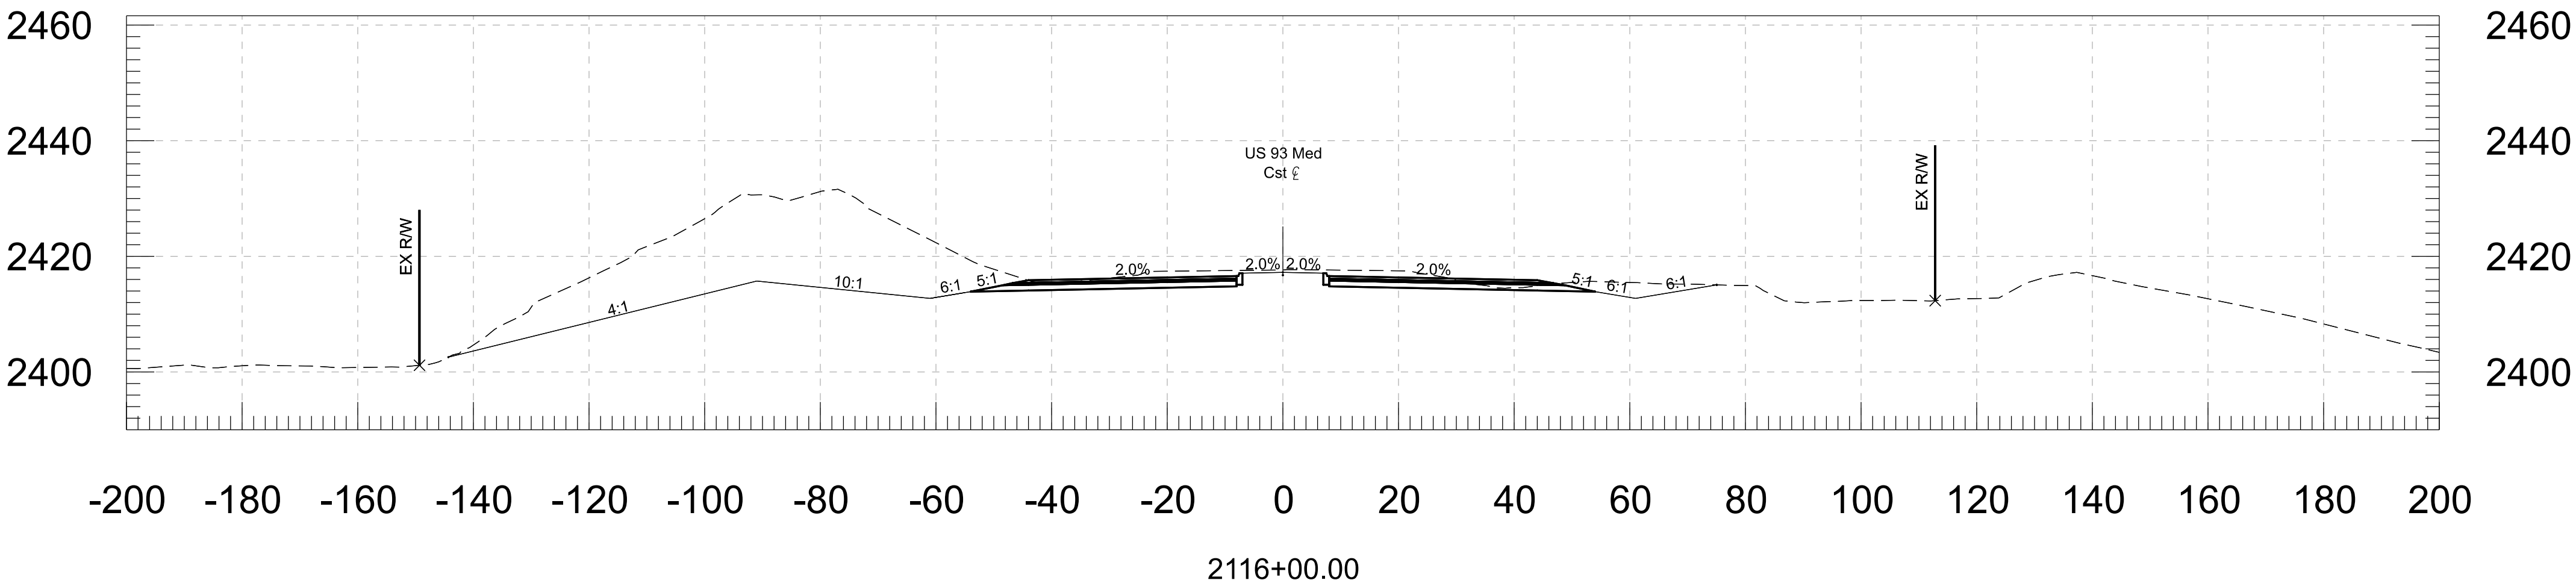



		NAME	DATE	ARIZONA DEPARTMENT OF TRANSPORTATION PROJECT DELIVERY AND OPERATIONS DIVISION ROADWAY DESIGN SERVICES	
DESIGN	ZSZ		06-26		
DRAWN	RM		06-26		
CHECKED	DBK		06-26		
		3133 East Camelback Road, Suite 100 Phoenix, Arizona 85016 Phone: 1602 333-2200		CROSS SECTIONS	
Stanley Consultants INC.					
ROUTE		LOCATION		DWG NO. 3	
US 93		WICKENBURG RANCH WAY TO VISTA ROYALE			
TRACS NO. F0738 OIC			093-B(230)T		___ OF ___

F.H.W.A. REGION	STATE	PROJECT NO.	SHEET NO.	TOTAL SHEETS	RECORD DRAWING
9	ARIZ.	093-B(230)T	5	116	
093 YV 189					

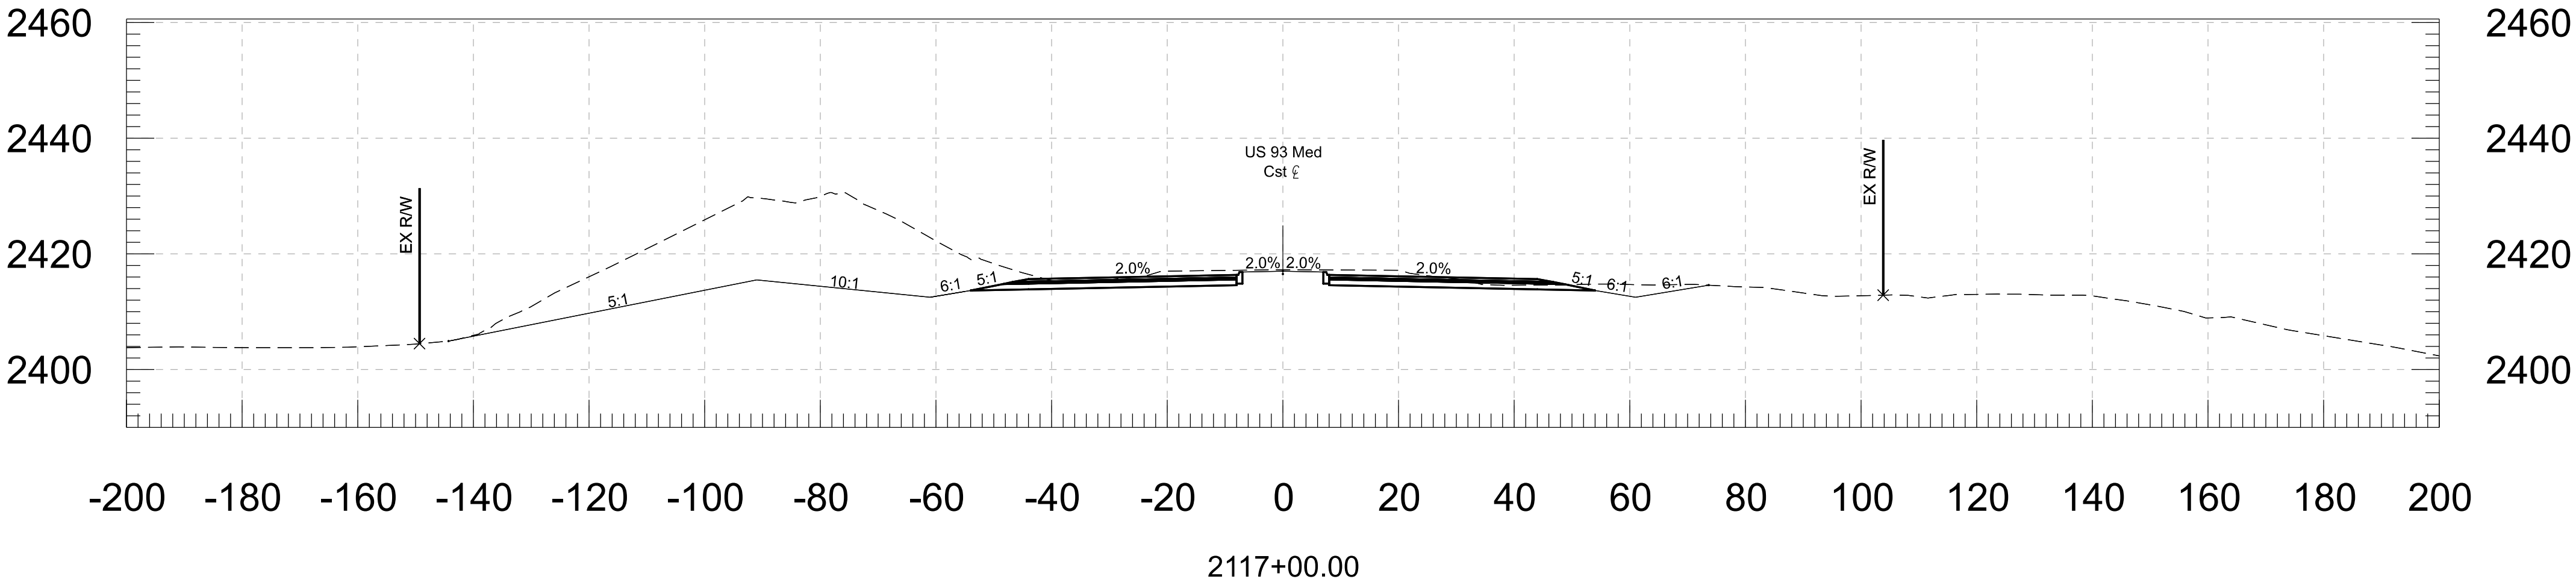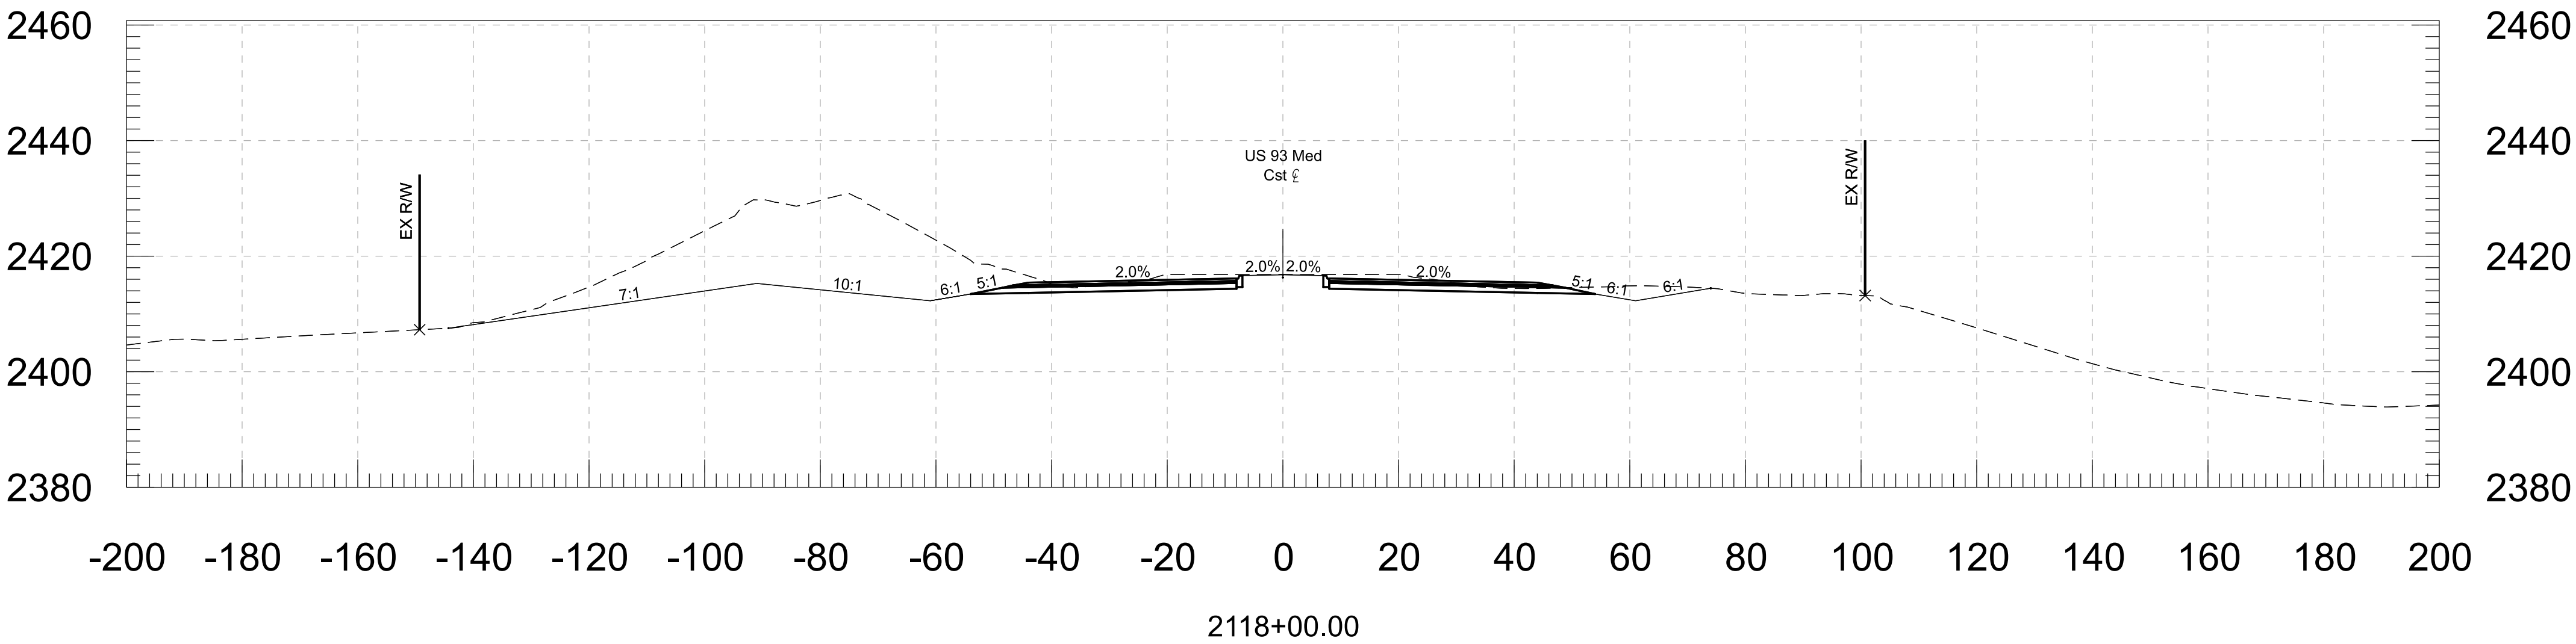



DESIGN	ZSZ	DATE	06-26	ARIZONA DEPARTMENT OF TRANSPORTATION PROJECT DELIVERY AND OPERATIONS DIVISION ROADWAY DESIGN SERVICES
DRAWN	RM	DATE	06-26	
CHECKED	DBK	DATE	06-26	
 3133 East Camelback Road, Suite 100 Phoenix, Arizona 85016 Phone: 1602/333-2200				CROSS SECTIONS
ROUTE		LOCATION		DWG NO.
US 93		WICKENBURG RANCH WAY TO VISTA ROYALE		4
TRACS NO. F0738 OIC			093-B(230)T	___ OF ___

F.H.W.A. REGION	STATE	PROJECT NO.	SHEET NO.	TOTAL SHEETS	RECORD DRAWING
9	ARIZ.	093-B(230)T	6	116	
093 YV 189					

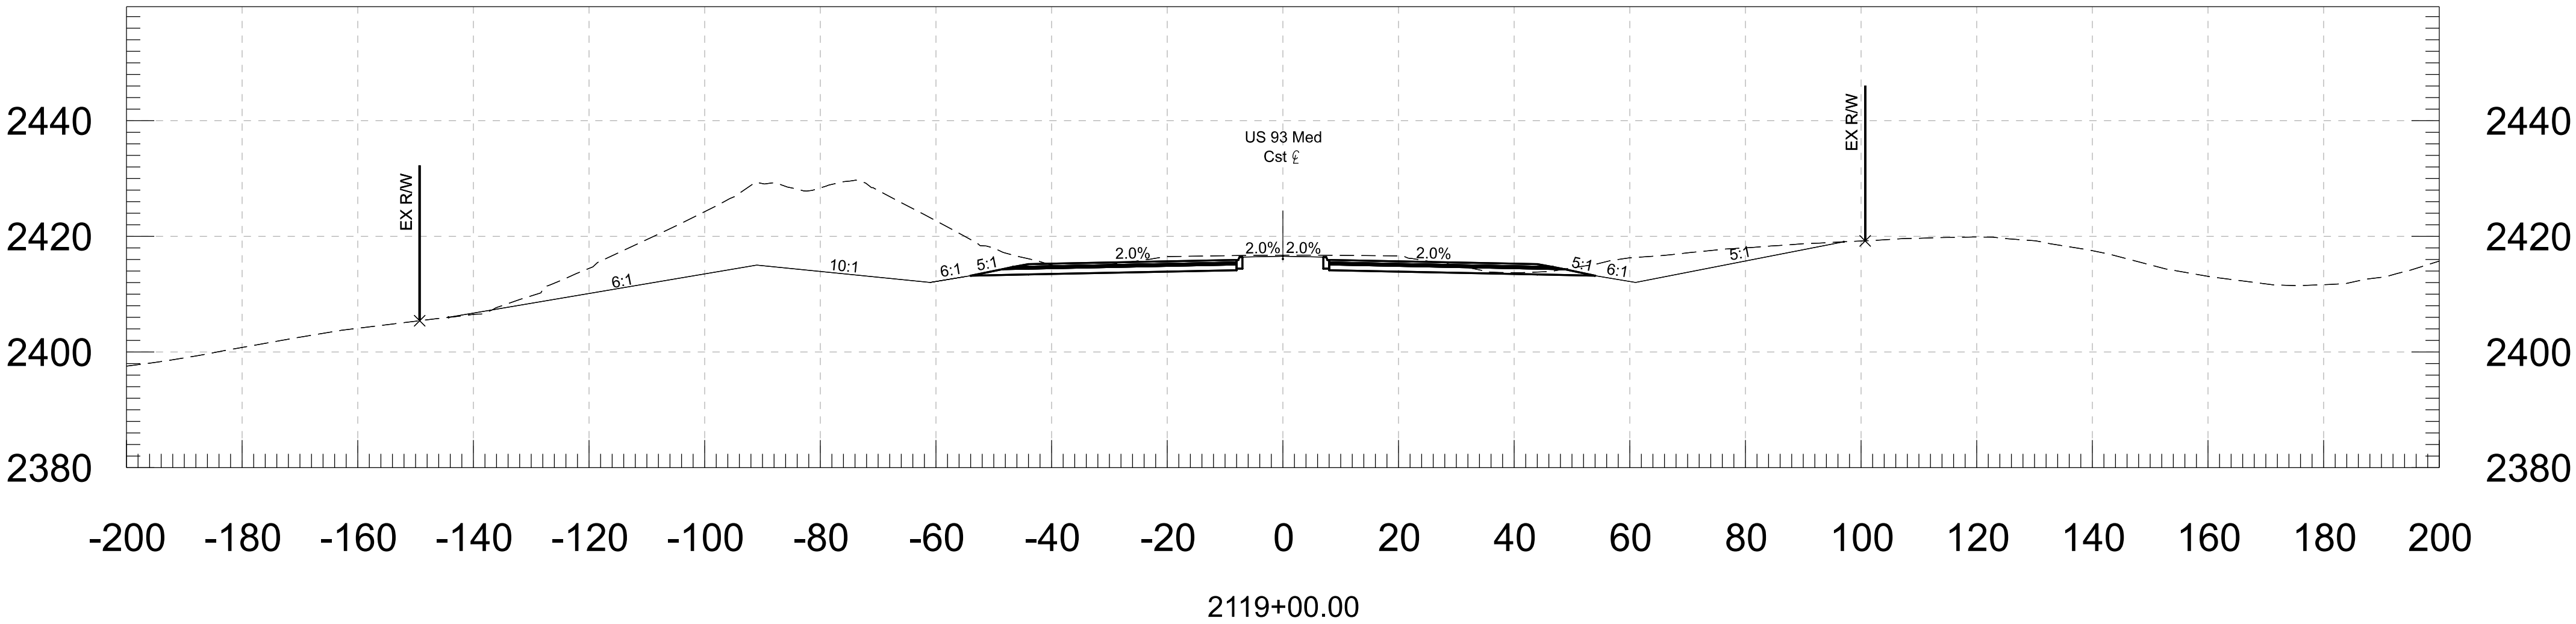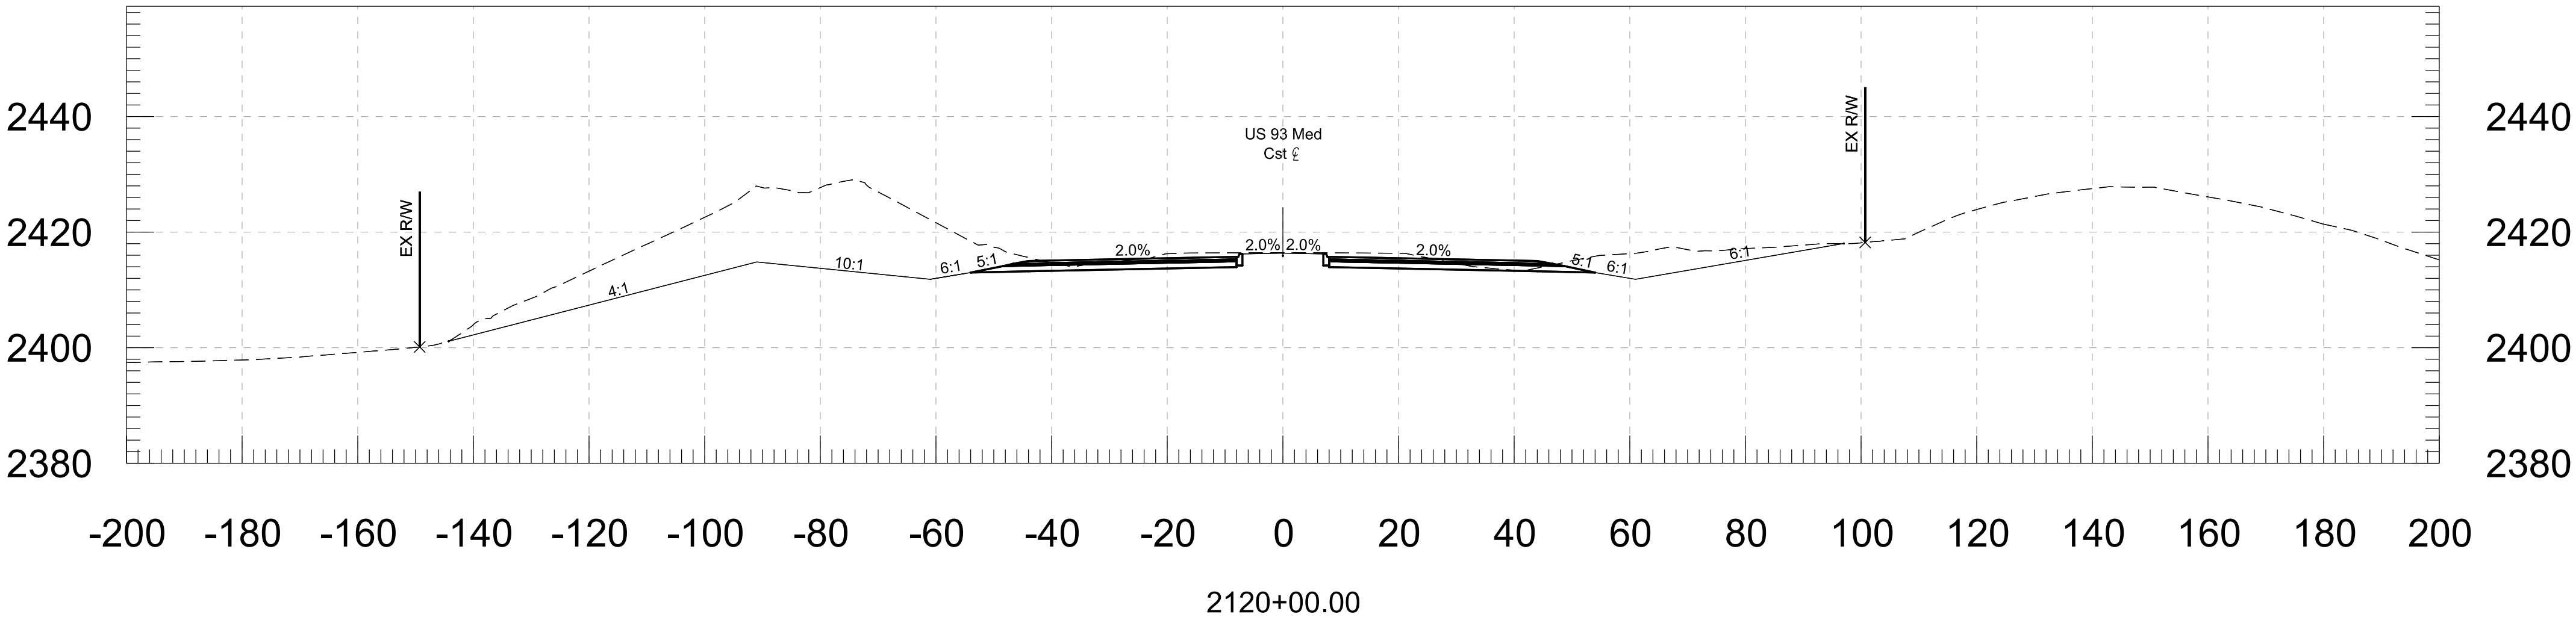



DESIGN	ZSZ	NAME	DATE	ARIZONA DEPARTMENT OF TRANSPORTATION PROJECT DELIVERY AND OPERATIONS DIVISION ROADWAY DESIGN SERVICES	
DRAWN	RM		06-26		
CHECKED	DBK		06-26		
Stanley Consultants 3333 East Camelback Road, Suite 100 Phoenix, Arizona 85018 Phone: 1602 333-2200				CROSS SECTIONS	
ROUTE		LOCATION			DWG NO.
US 93		WICKENBURG RANCH WAY TO VISTA ROYALE			5
TRACS NO. F0738 OIC			093-B(230)T		OF

F.H.W.A. REGION	STATE	PROJECT NO.	SHEET NO.	TOTAL SHEETS	RECORD DRAWING
9	ARIZ.	093-B(230)T	7	116	
093 YV 189					

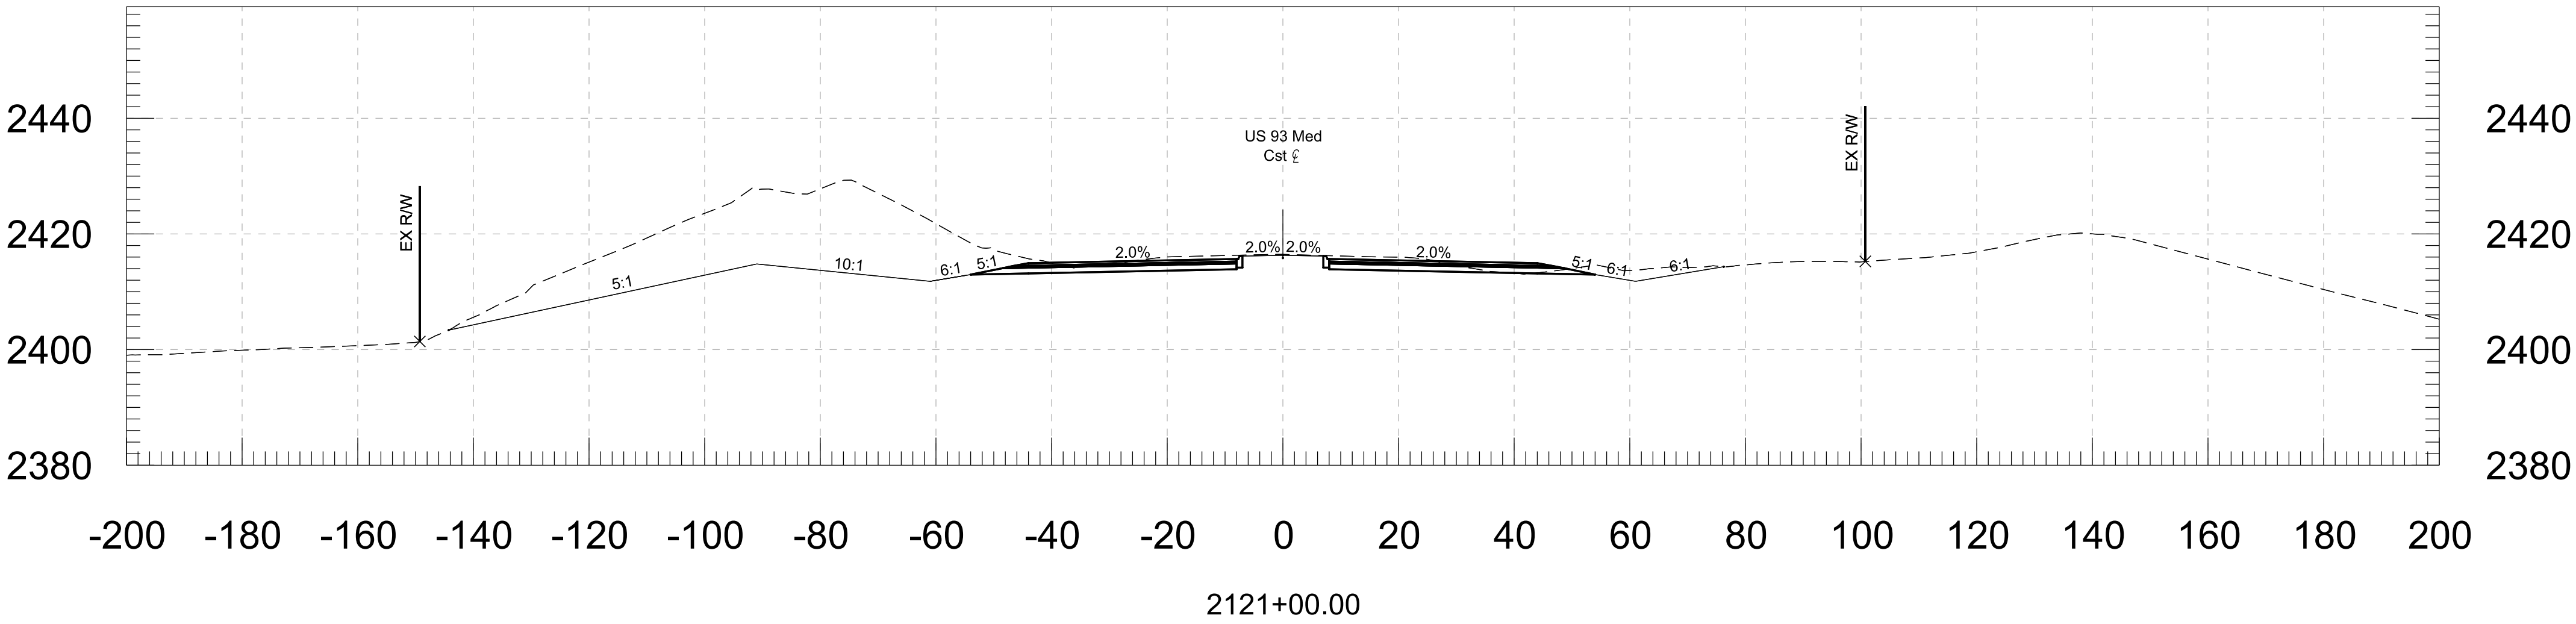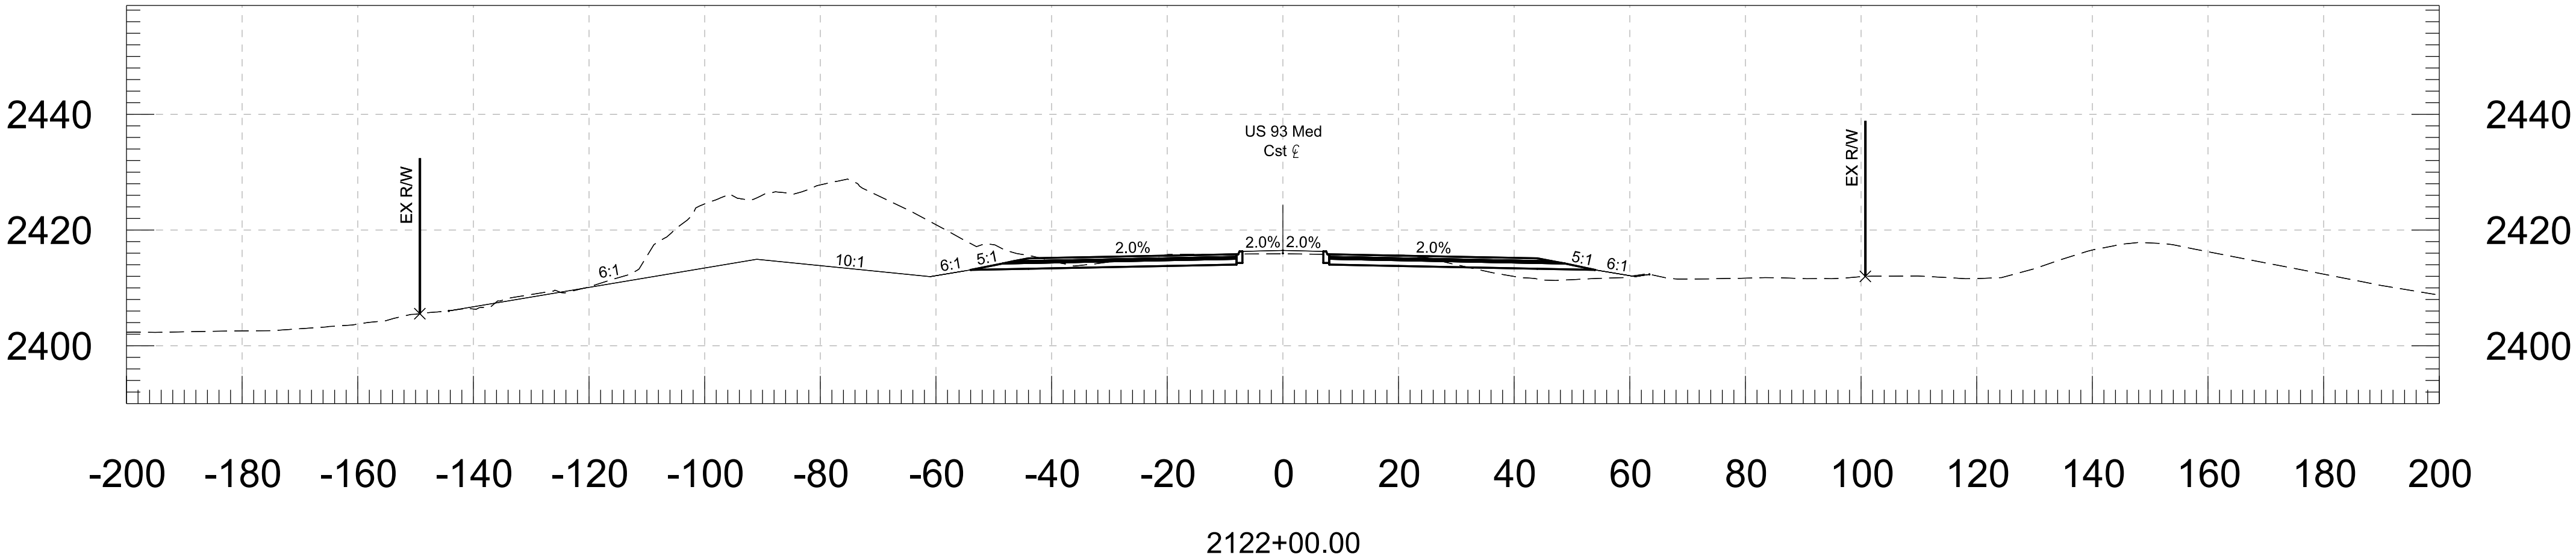



DESIGN	ZSZ	NAME	DATE	ARIZONA DEPARTMENT OF TRANSPORTATION PROJECT DELIVERY AND OPERATIONS DIVISION ROADWAY DESIGN SERVICES	
DRAWN	RM		06-26		
CHECKED	DBK		06-26		
 3133 East Camelback Road, Suite 100 Phoenix, Arizona 85016 Phone: 1602 333-2200				CROSS SECTIONS	
ROUTE		LOCATION			DWG NO. 6
US 93		WICKENBURG RANCH WAY TO VISTA ROYALE			
TRACS NO. F0738 OIC			093-B(230)T		___ OF ___

F.H.W.A. REGION	STATE	PROJECT NO.	SHEET NO.	TOTAL SHEETS	RECORD DRAWING
9	ARIZ.	093-B(230)T	8	116	
093 YV 189					

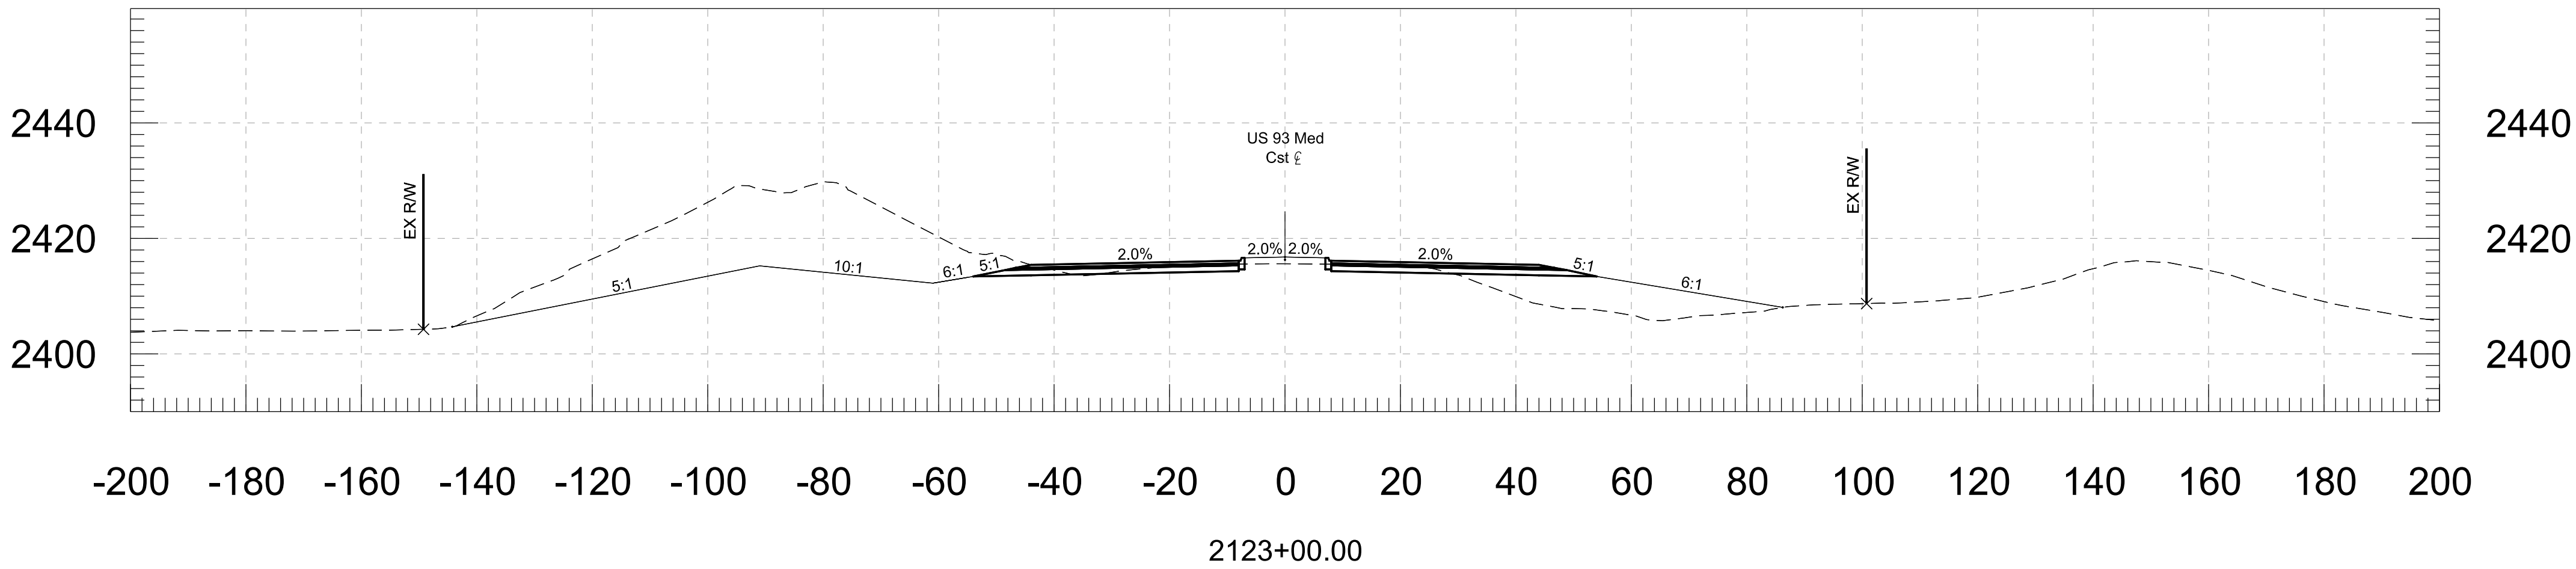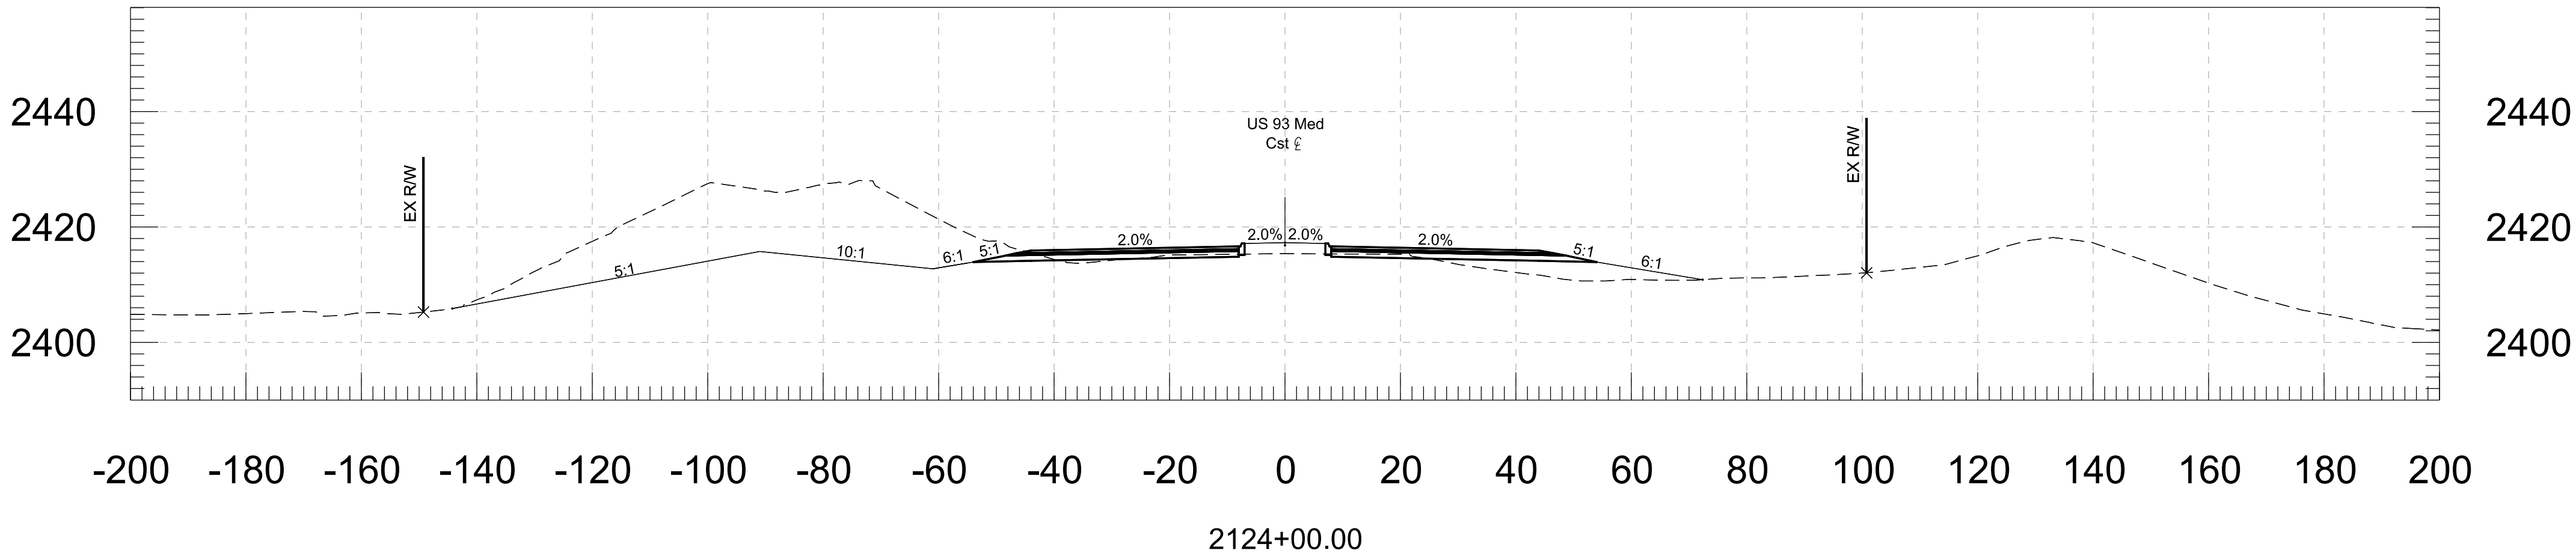




		NAME	DATE	ARIZONA DEPARTMENT OF TRANSPORTATION PROJECT DELIVERY AND OPERATIONS DIVISION ROADWAY DESIGN SERVICES		
DESIGN	ZSZ		06-26			
DRAWN	RM		06-26			
CHECKED	DBK		06-26	CROSS SECTIONS		
 3133 East Camelback Road, Suite 100 Phoenix, Arizona 85016 Phone: 1602-333-2200						
ROUTE		LOCATION		DWG NO. 7		
US 93		WICKENBURG RANCH WAY TO VISTA ROYALE				
TRACS NO. F0738 OIC			093-B(230)T			___ OF ___

F.H.W.A. REGION	STATE	PROJECT NO.	SHEET NO.	TOTAL SHEETS	RECORD DRAWING
9	ARIZ.	093-B(230)T	9	116	
093 YV 189					

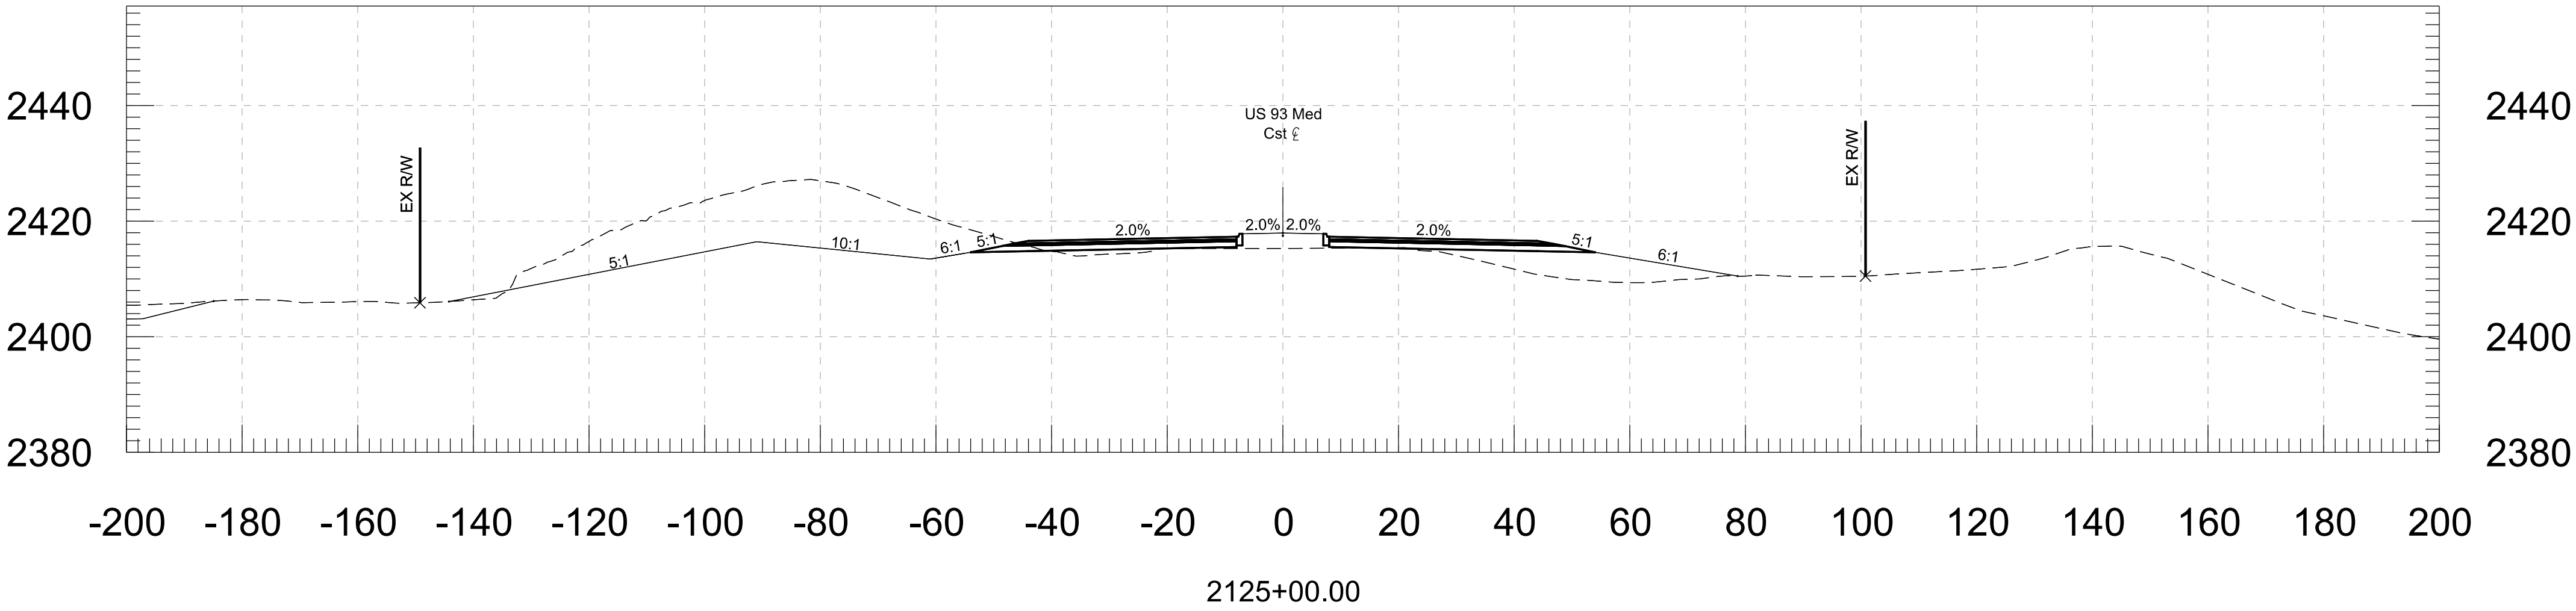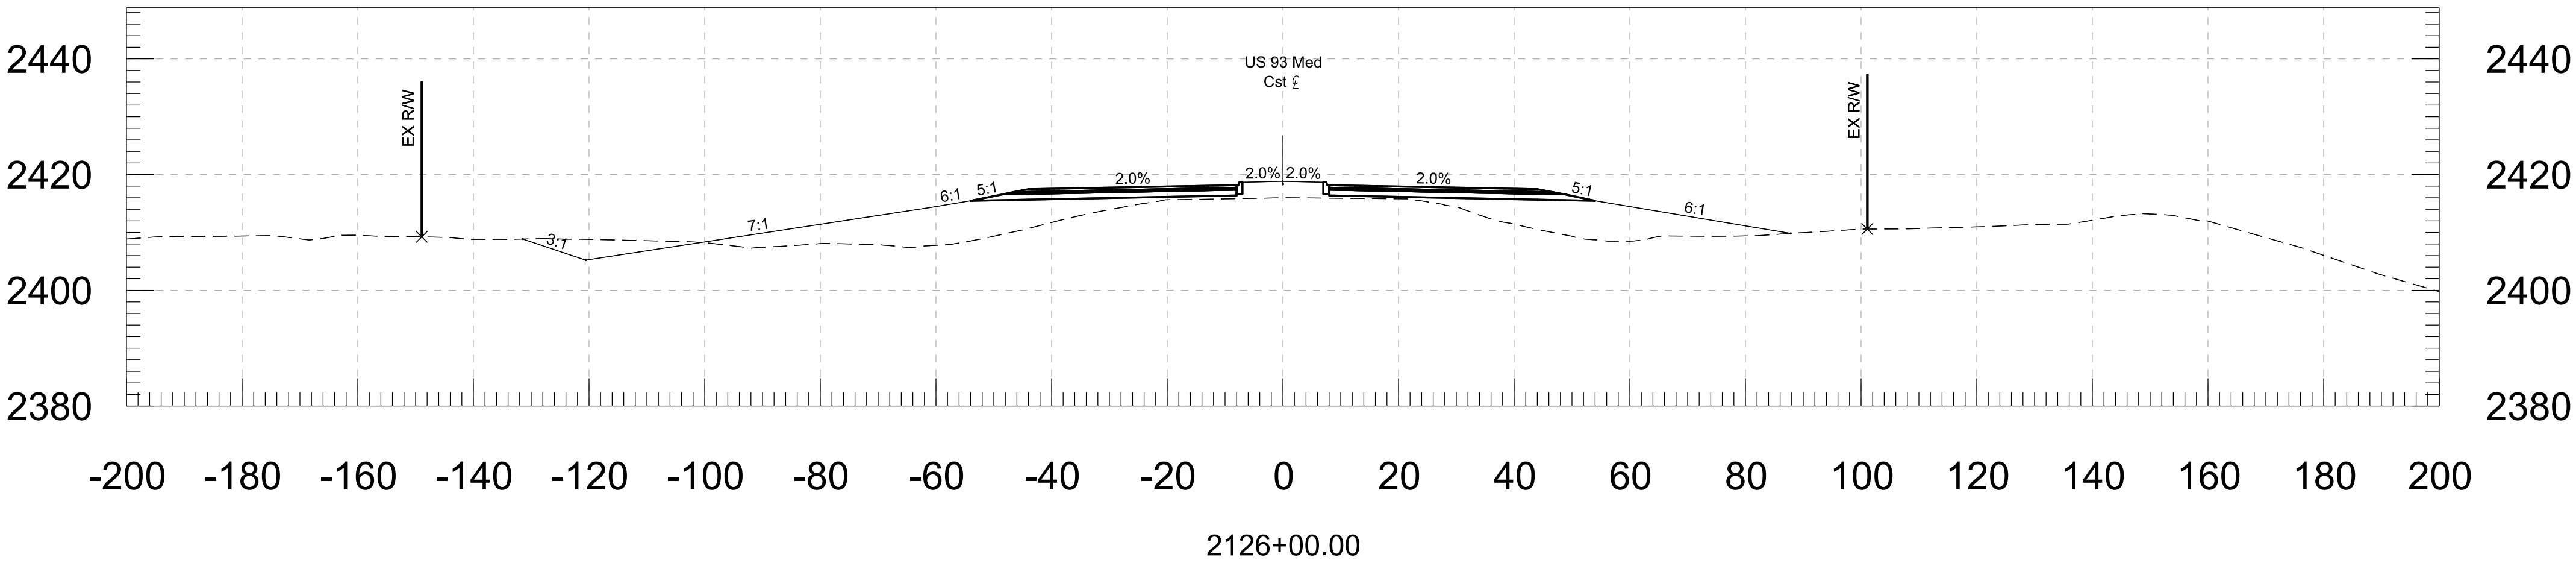



DESIGN	ZSZ	DATE	06-26	ARIZONA DEPARTMENT OF TRANSPORTATION PROJECT DELIVERY AND OPERATIONS DIVISION ROADWAY DESIGN SERVICES
DRAWN	RM	DATE	06-26	
CHECKED	DBK	DATE	06-26	
 3133 East Camelback Road, Suite 100 Phoenix, Arizona 85016 Phone: 1602 333-2200				CROSS SECTIONS
ROUTE	LOCATION			DWG NO. 8
US 93	WICKENBURG RANCH WAY TO VISTA ROYALE			
TRACS NO. F0738 OIC		093-B(230)T		OF

F.H.W.A. REGION	STATE	PROJECT NO.	SHEET NO.	TOTAL SHEETS	RECORD DRAWING
9	ARIZ.	093-B(230)T	10	116	
093 YV 189					

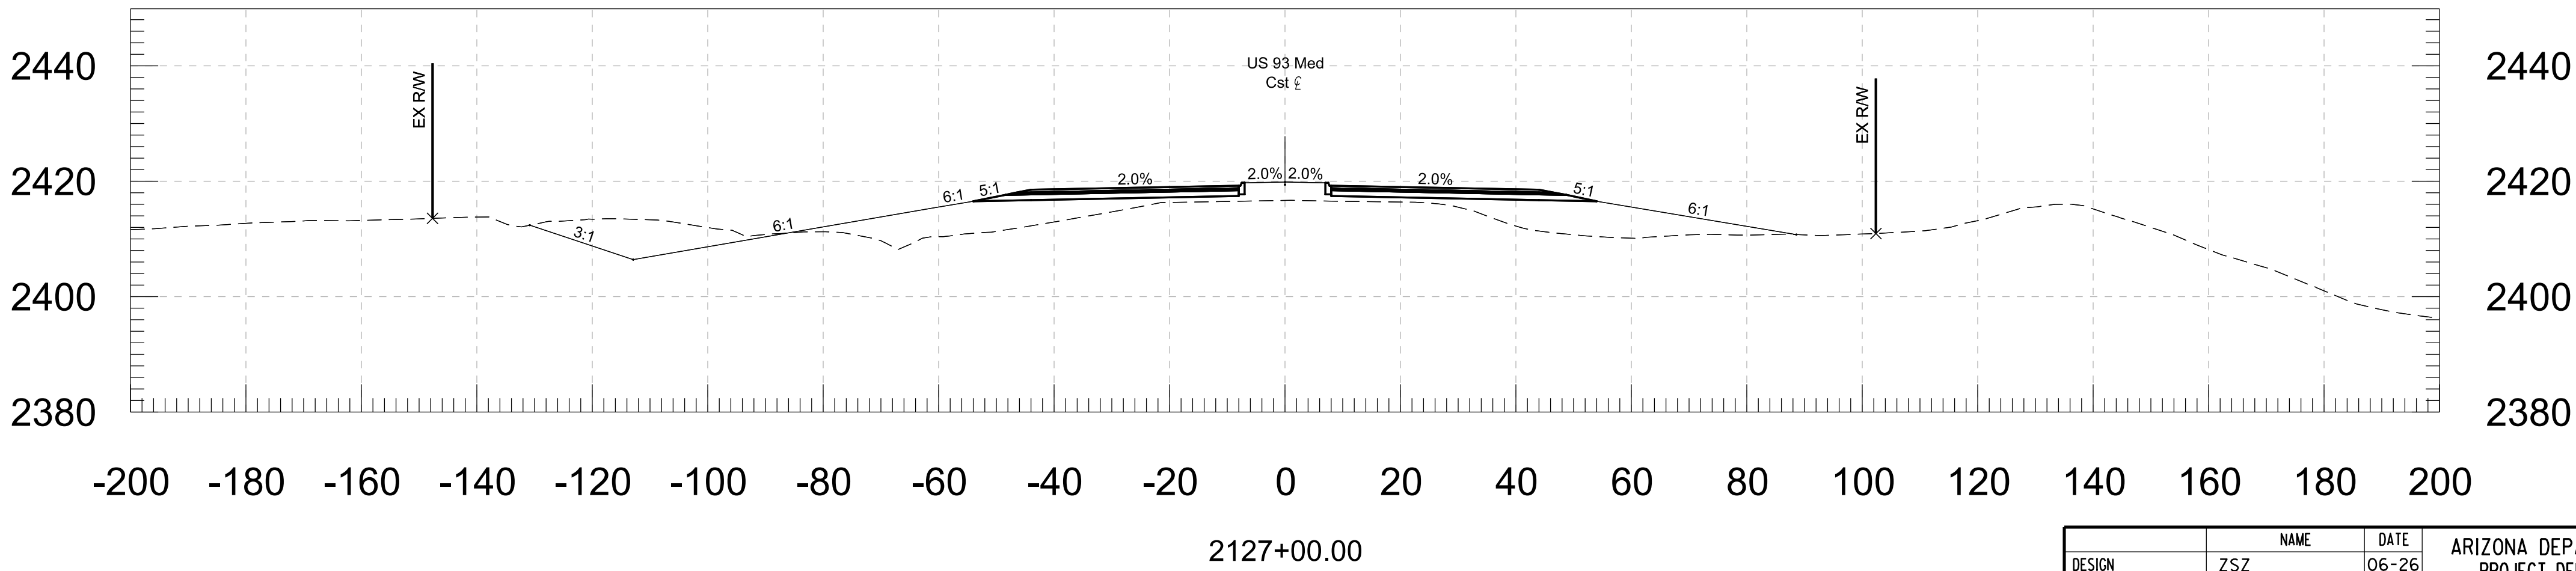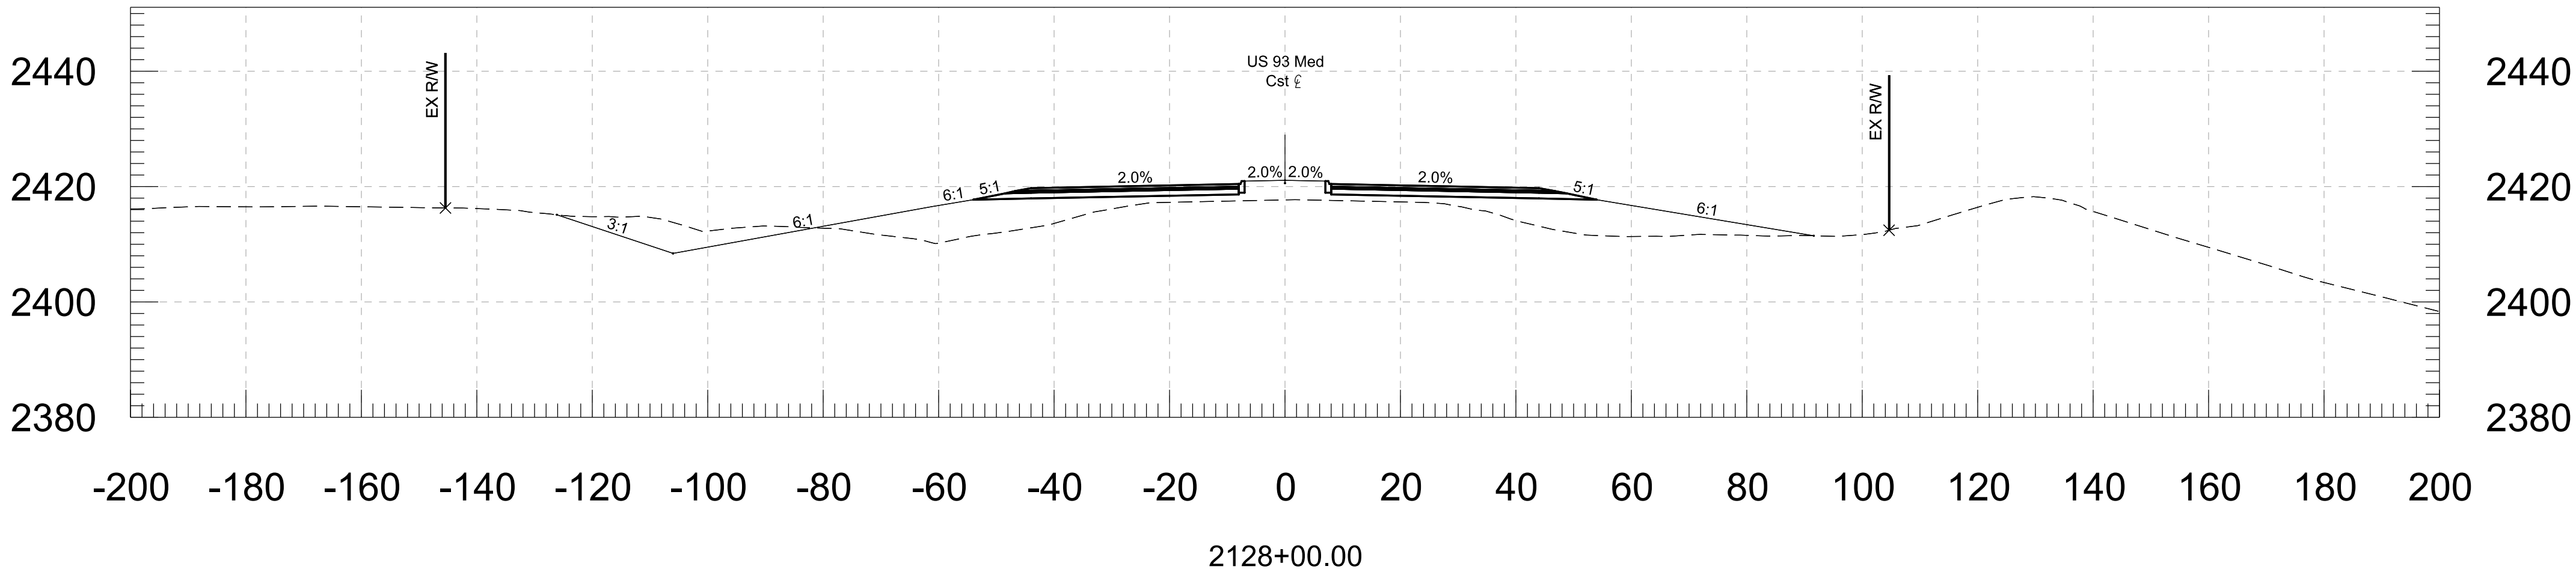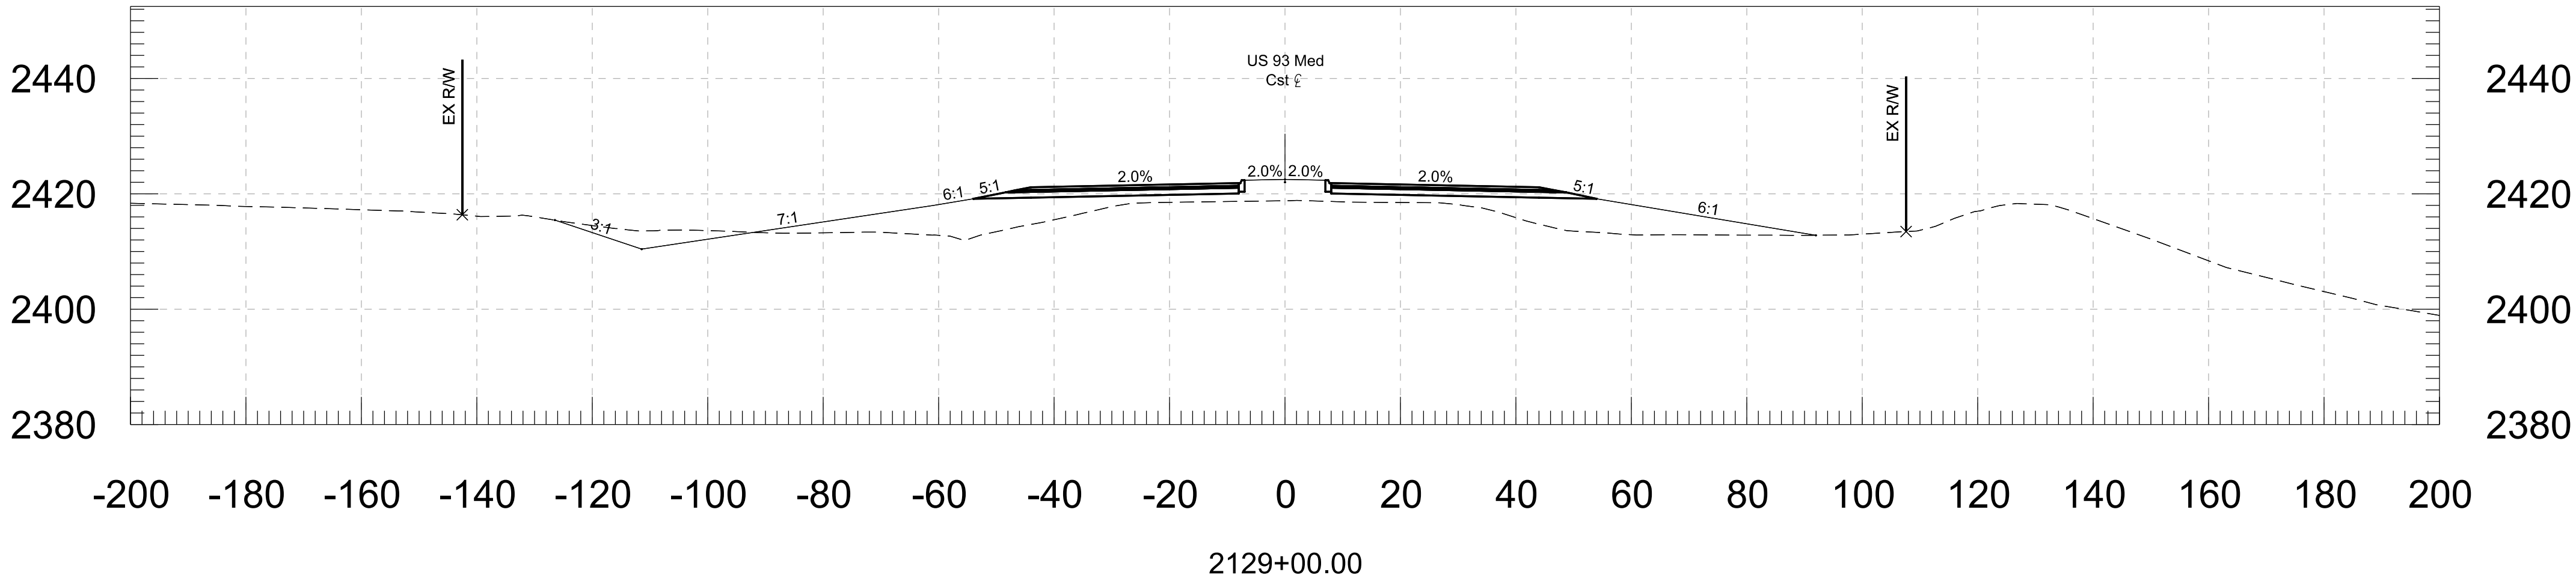




		NAME	DATE	ARIZONA DEPARTMENT OF TRANSPORTATION PROJECT DELIVERY AND OPERATIONS DIVISION ROADWAY DESIGN SERVICES		
DESIGN	ZSZ	06-26				
DRAWN	RM	06-26				
CHECKED	DBK	06-26				
 Stanley Consultants inc.		3133 East Camelback Road, Suite 100 Phoenix, Arizona 85016 Phone: 1602/333-2200		CROSS SECTIONS		
ROUTE		LOCATION				
US 93		WICKENBURG RANCH WAY TO VISTA ROYALE				DWG NO. 9
TRACS NO. F0738 OIC			093-B(230)T			___ OF ___

F.H.W.A. REGION	STATE	PROJECT NO.	SHEET NO.	TOTAL SHEETS	RECORD DRAWING
9	ARIZ.	093-B(230)T	11	116	
093 YV 189					

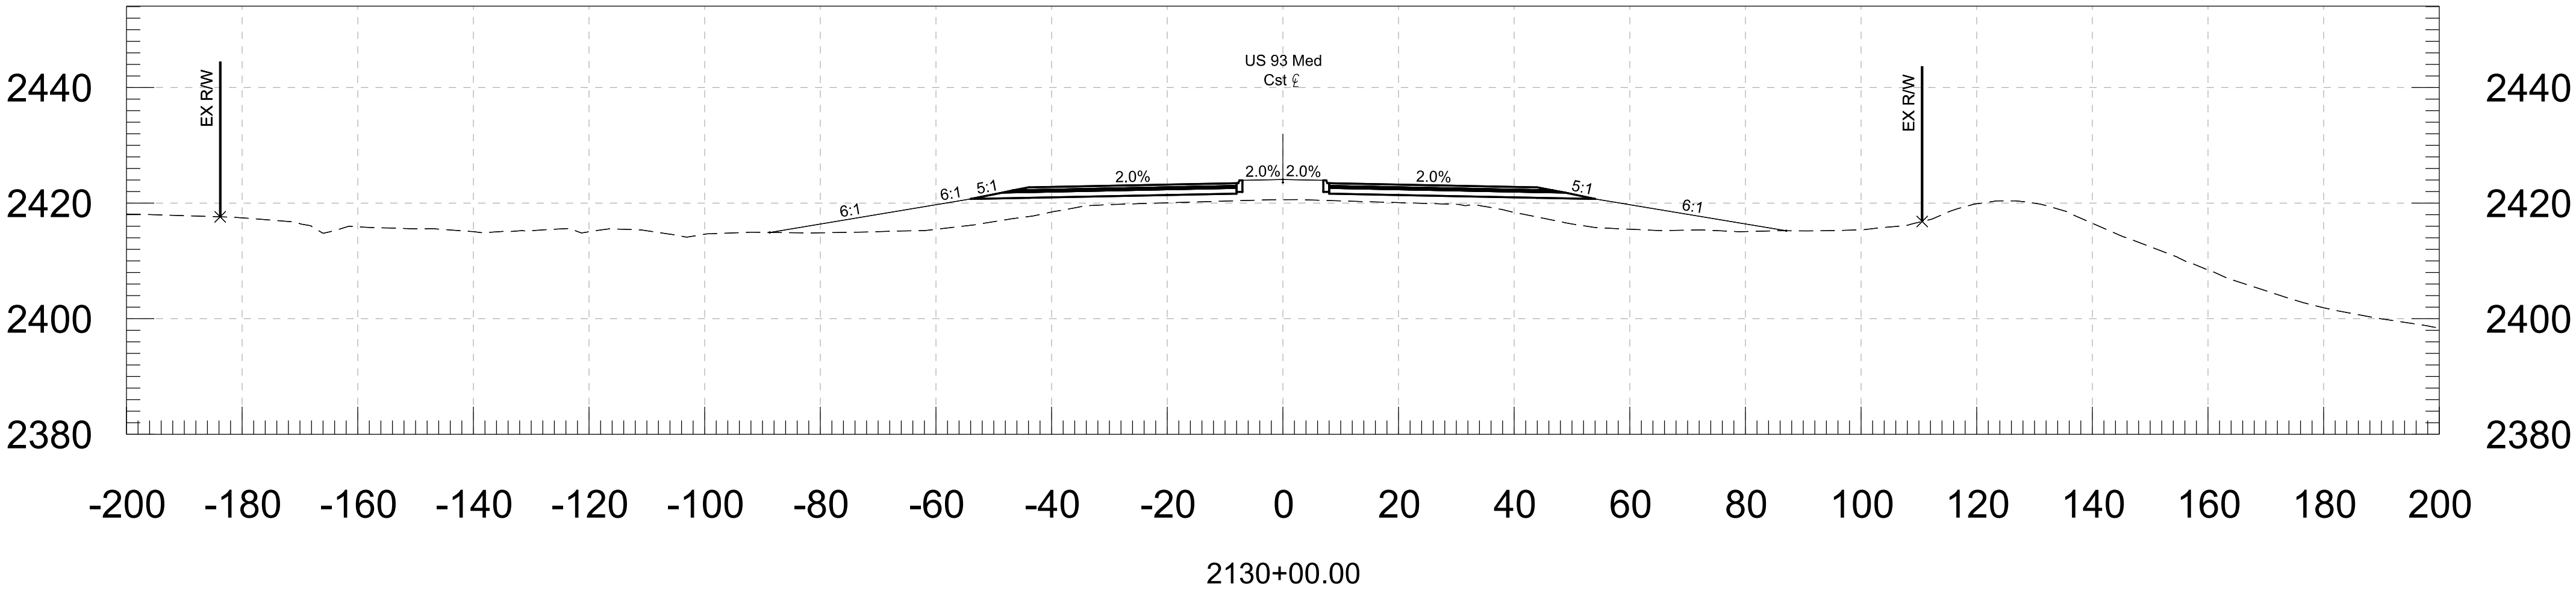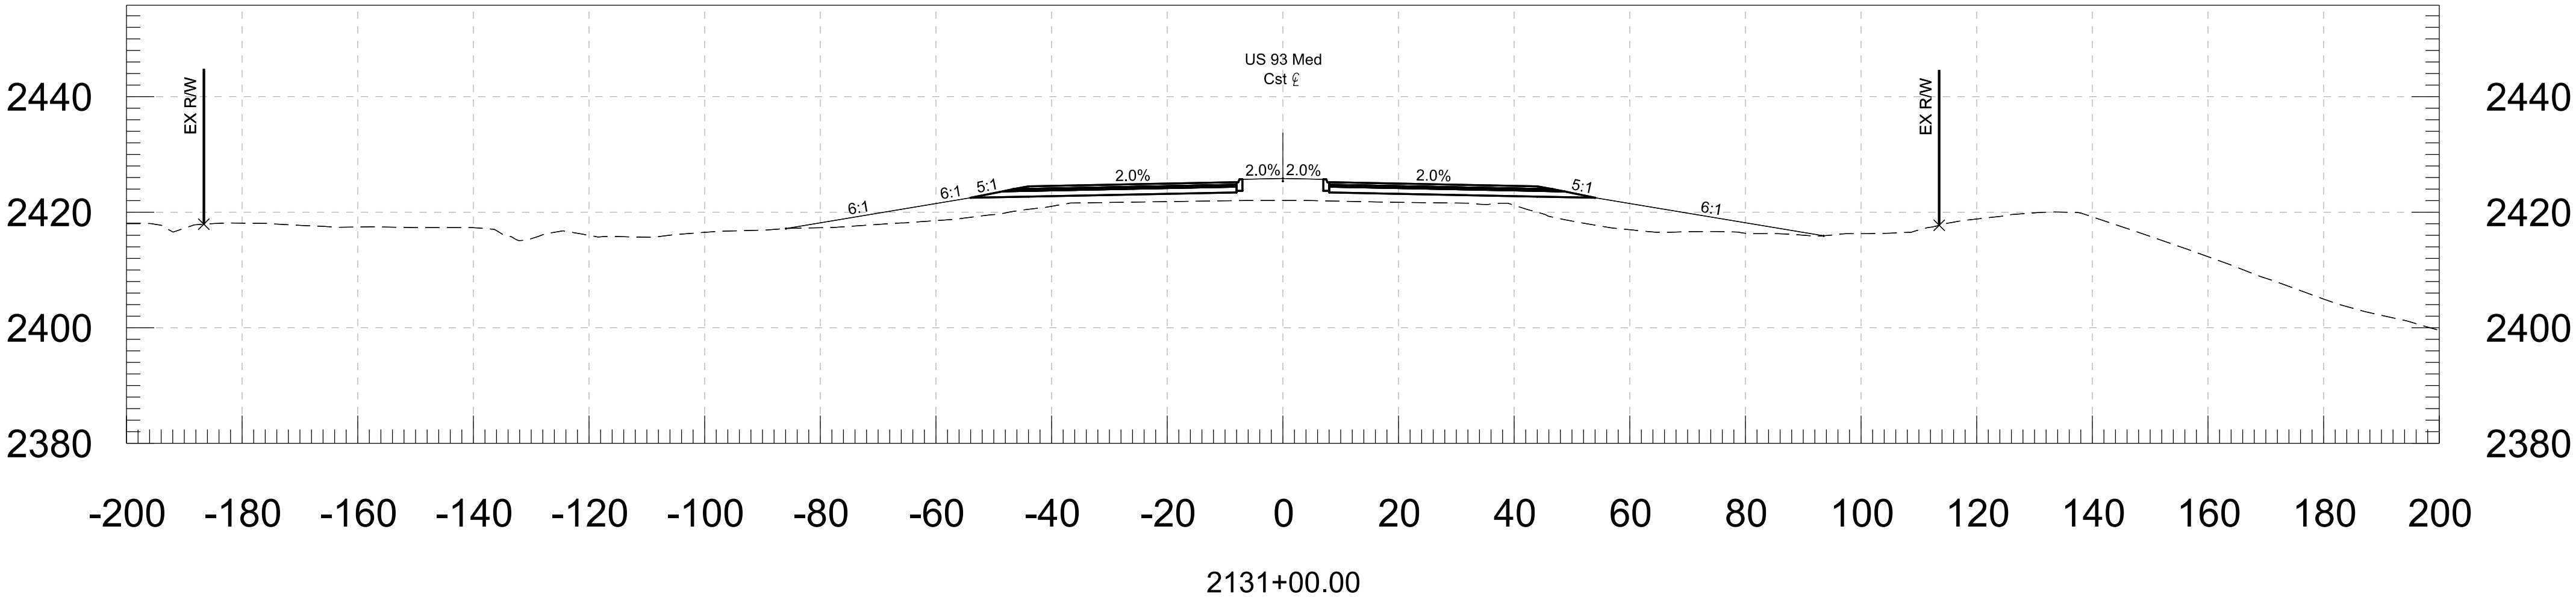

		NAME	DATE	ARIZONA DEPARTMENT OF TRANSPORTATION PROJECT DELIVERY AND OPERATIONS DIVISION ROADWAY DESIGN SERVICES	CROSS SECTIONS
DESIGN	ZSZ		06-26		
DRAWN	RM		06-26		
CHECKED	DBK		06-26		
 Stanley Consultants Inc.		3133 East Camelback Road, Suite 100 Phoenix, Arizona 85016 Phone: (602) 353-2200			
ROUTE		LOCATION			
US 93		WICKENBURG RANCH WAY TO VISTA ROYALE			DWG NO. 10
TRACS NO. F0738 OIC			093-B(230)T		___ OF ___

F.H.W.A. REGION	STATE	PROJECT NO.	SHEET NO.	TOTAL SHEETS	RECORD DRAWING
9	ARIZ.	093-B(230)T	12	116	
093 YV 189					

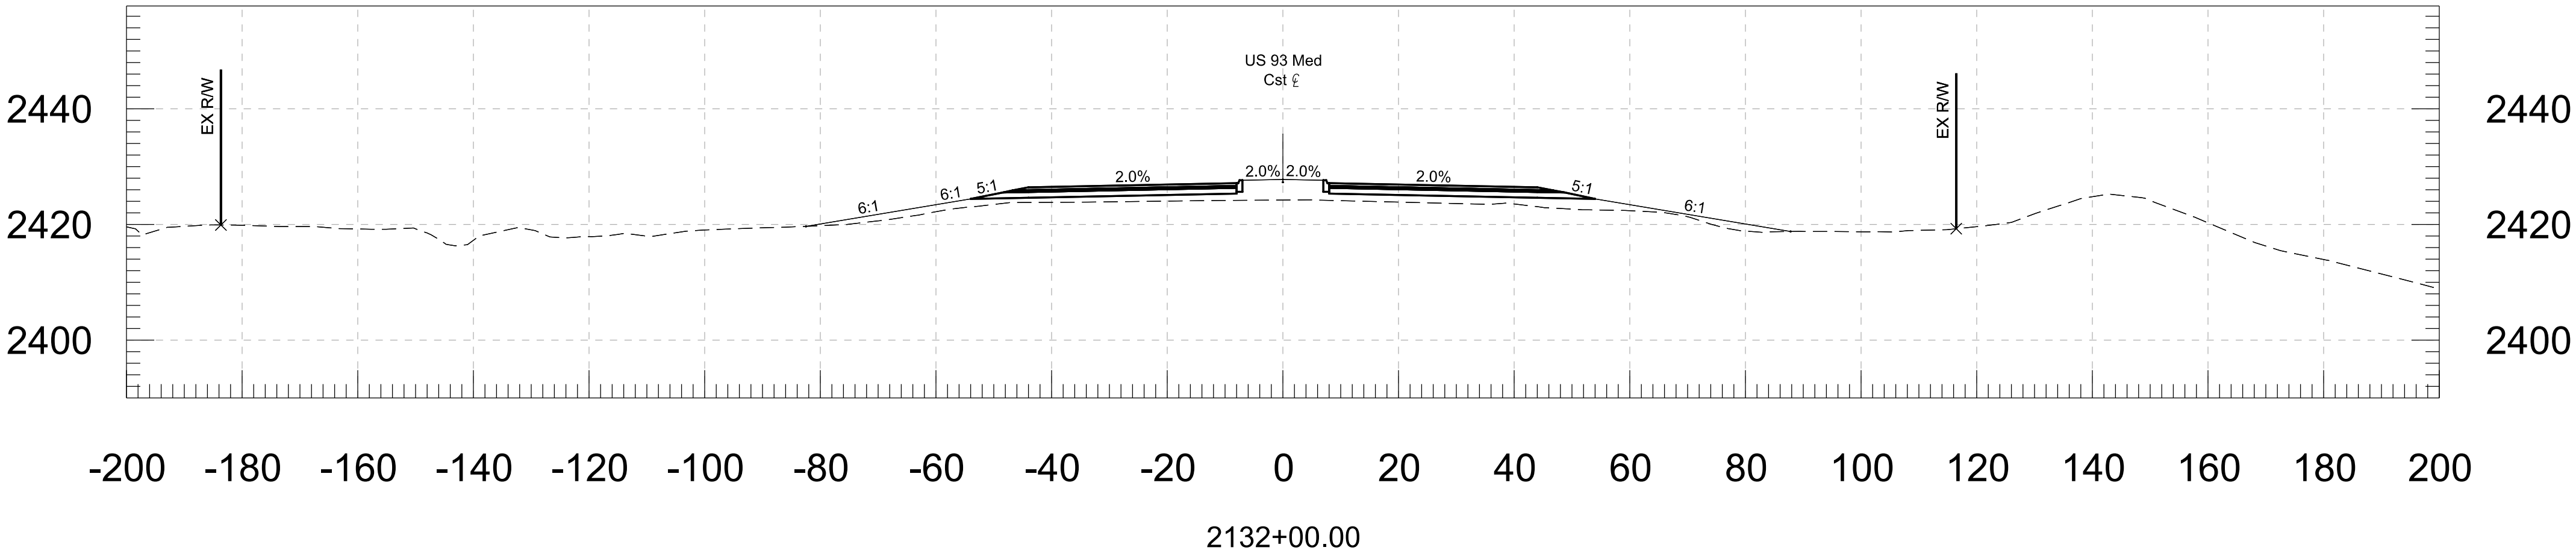
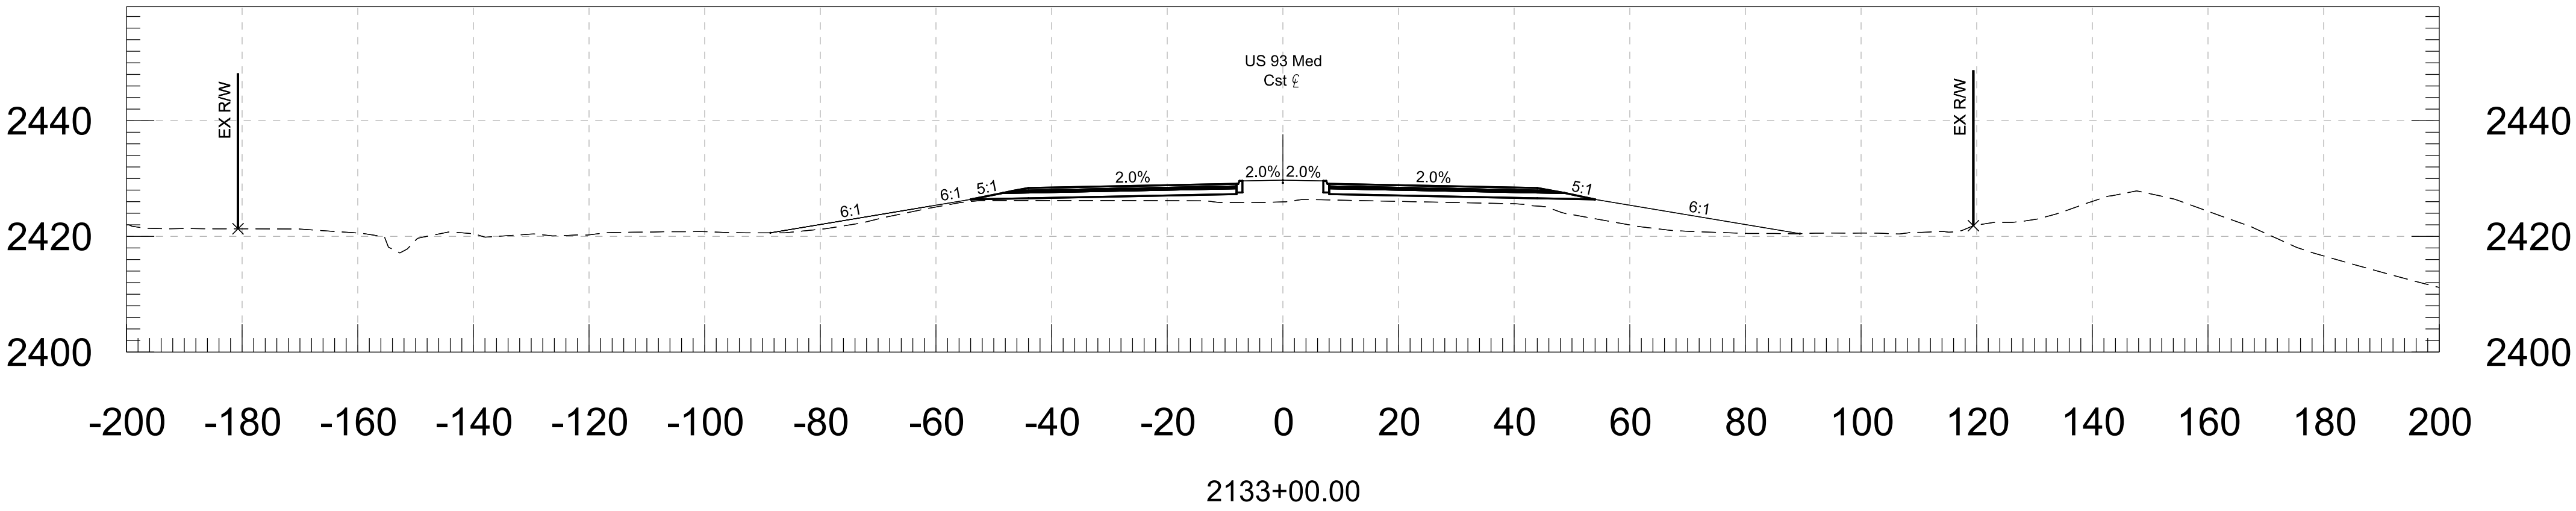
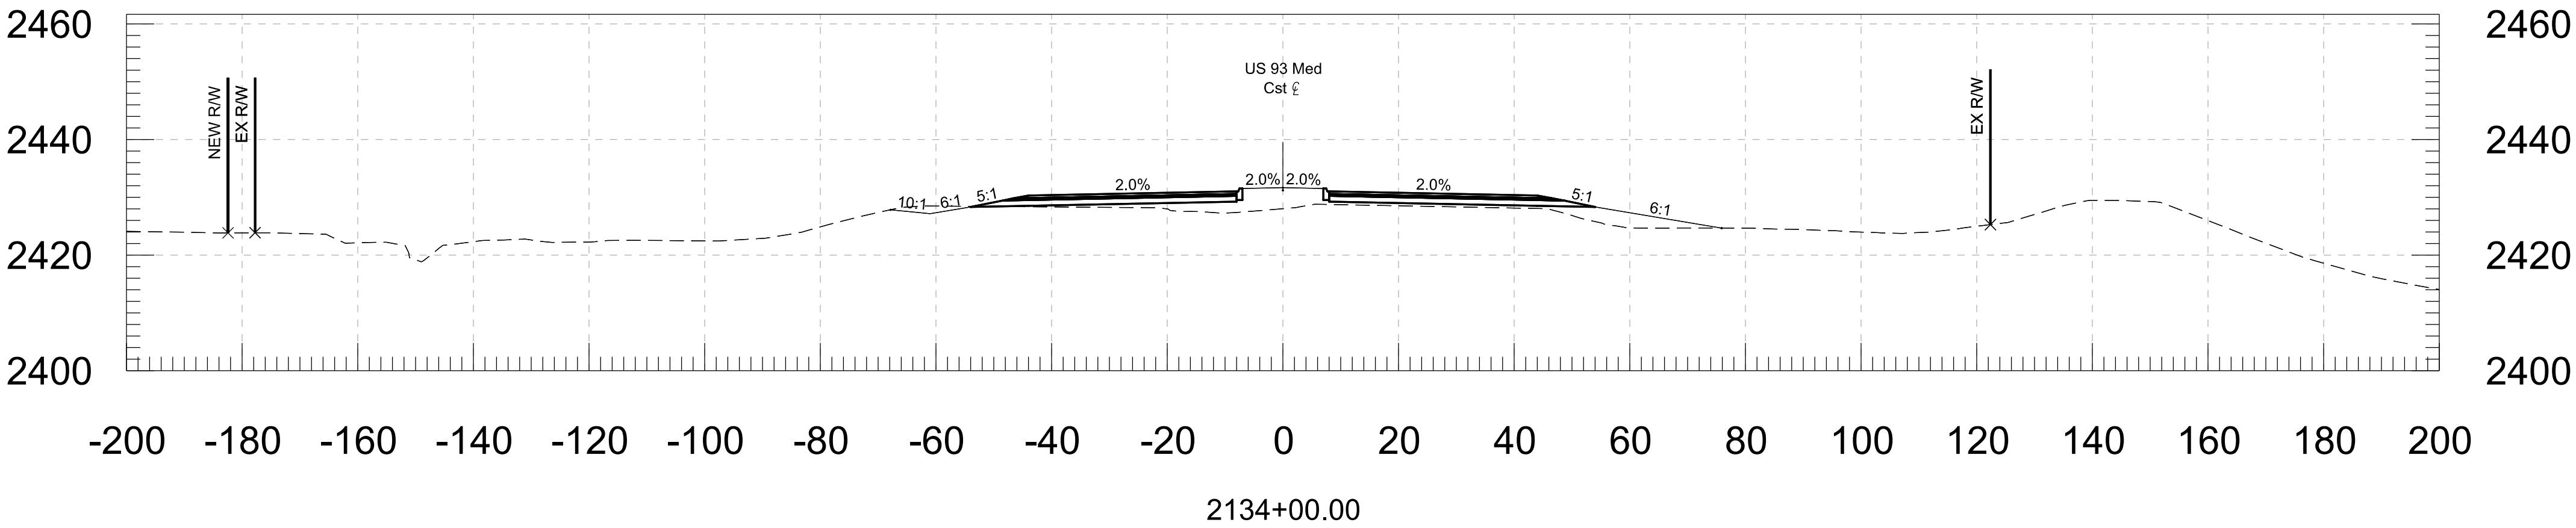


		NAME	DATE	ARIZONA DEPARTMENT OF TRANSPORTATION PROJECT DELIVERY AND OPERATIONS DIVISION ROADWAY DESIGN SERVICES		CROSS SECTIONS	
DESIGN		ZSZ	06-26				
DRAWN		RM	06-26				
CHECKED		DBK	06-26				
		3133 East Camelback Road, Suite 100 Phoenix, Arizona 85016 Phone: 602-355-2200					
Stanley Consultants INC.							
ROUTE		LOCATION					
US 93		WICKENBURG RANCH WAY TO VISTA ROYALE				DWG NO. 11	
TRACS NO. F0738 OIC			093-B(230)T			___ OF ___	

DATE- LOCATION- REVISIONS- FINISHED PLANS- SURVEY NO. DATE- LOCATION- REVISIONS- FINISHED PLANS- SURVEY NO.




F.H.W.A. REGION	STATE	PROJECT NO.	SHEET NO.	TOTAL SHEETS	RECORD DRAWING
9	ARIZ.	093-B(230)T	13	116	

093 YV 189

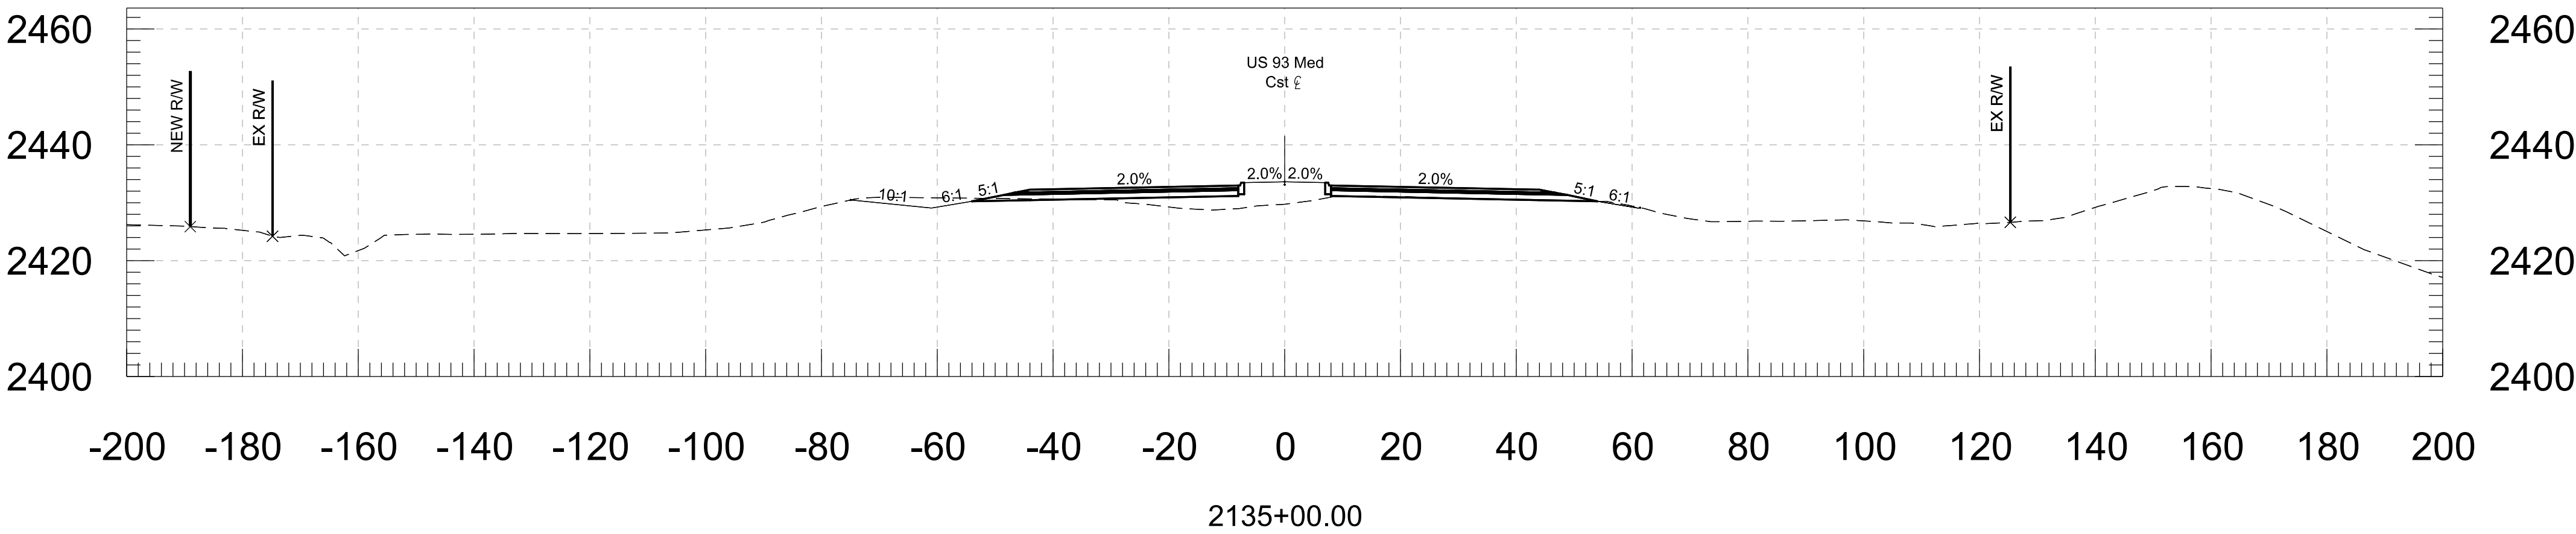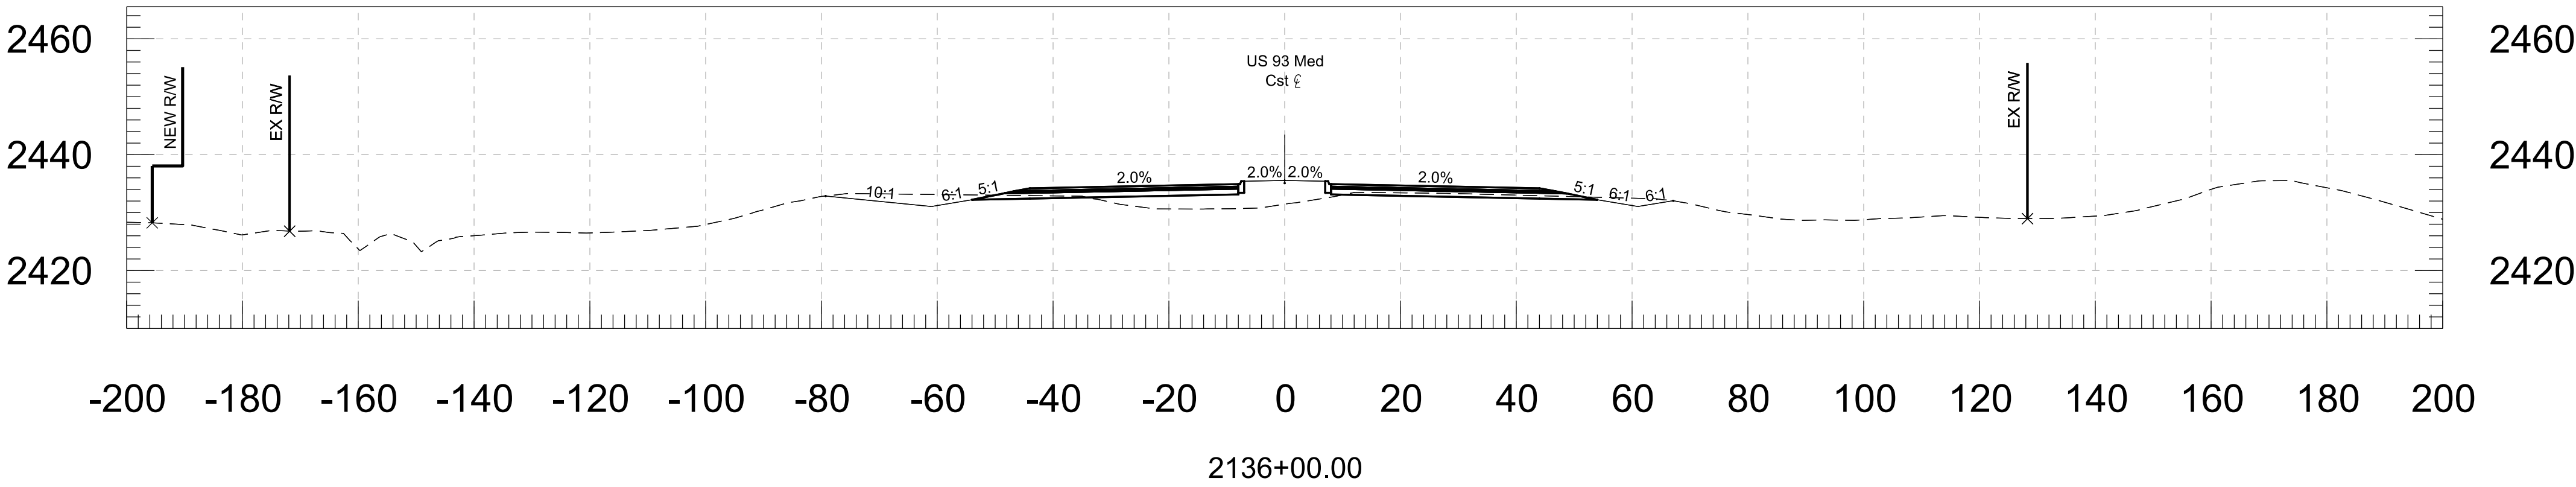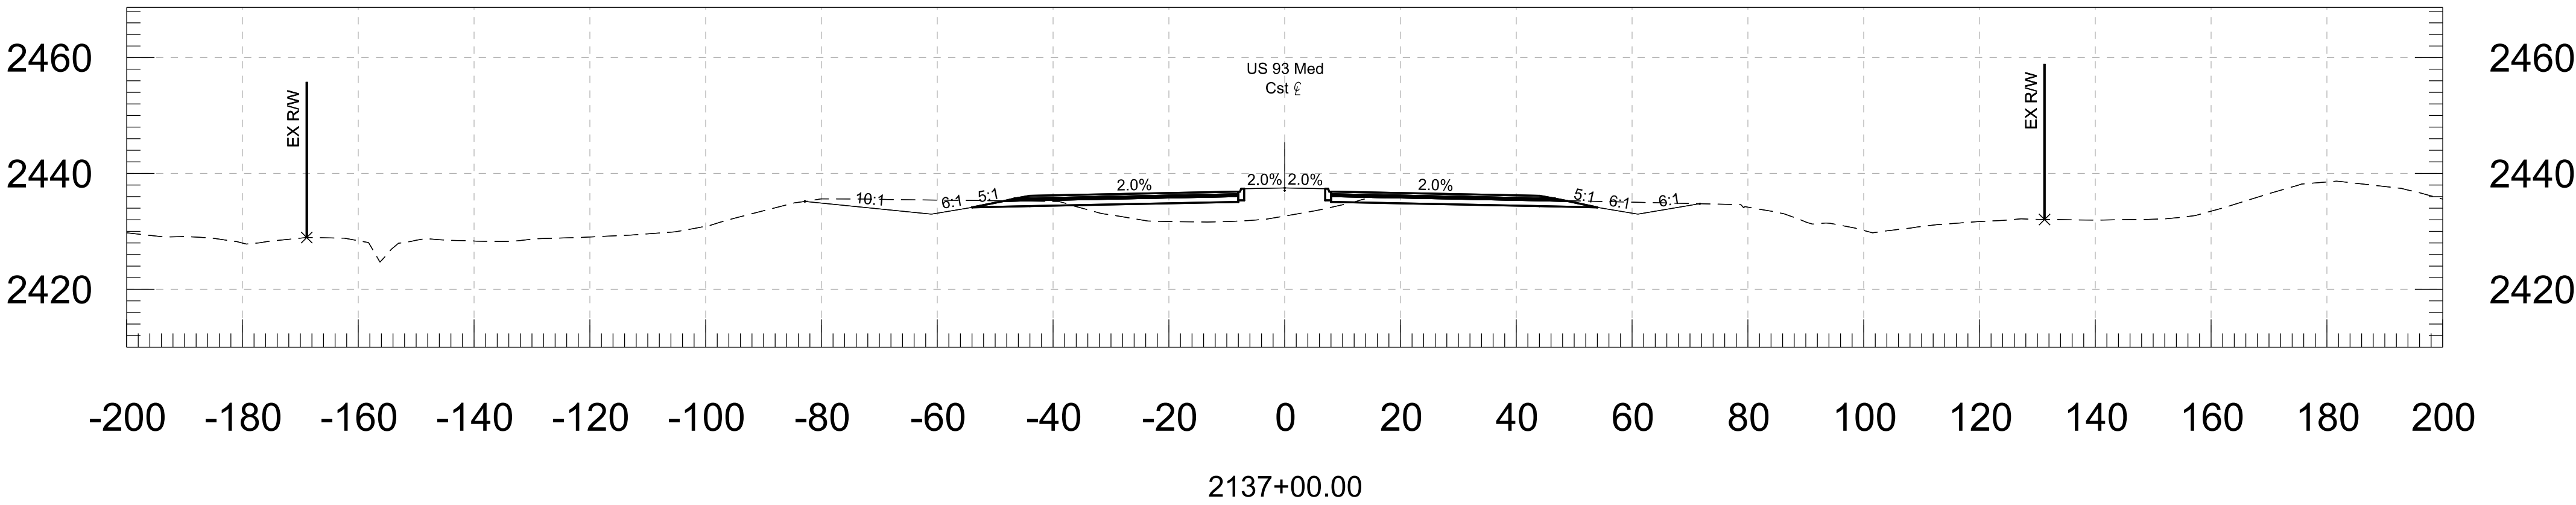




		NAME	DATE	ARIZONA DEPARTMENT OF TRANSPORTATION PROJECT DELIVERY AND OPERATIONS DIVISION ROADWAY DESIGN SERVICES		
DESIGN		ZSZ	06-26			
DRAWN		RM	06-26			
CHECKED		DBK	06-26			
		3133 East Camelback Road, Suite 100 Phoenix, Arizona 85016 Phone: 602-355-2200		CROSS SECTIONS		
Stanley Consultants inc.						
ROUTE		LOCATION			DWG NO. 12	
US 93		WICKENBURG RANCH WAY TO VISTA ROYALE				
TRACS NO. F0738 OIC			093-B(230)T		___ OF ___	

F.H.W.A. REGION	STATE	PROJECT NO.	SHEET NO.	TOTAL SHEETS	RECORD DRAWING
9	ARIZ.	093-B(230)T	14	116	
093 YV 189					

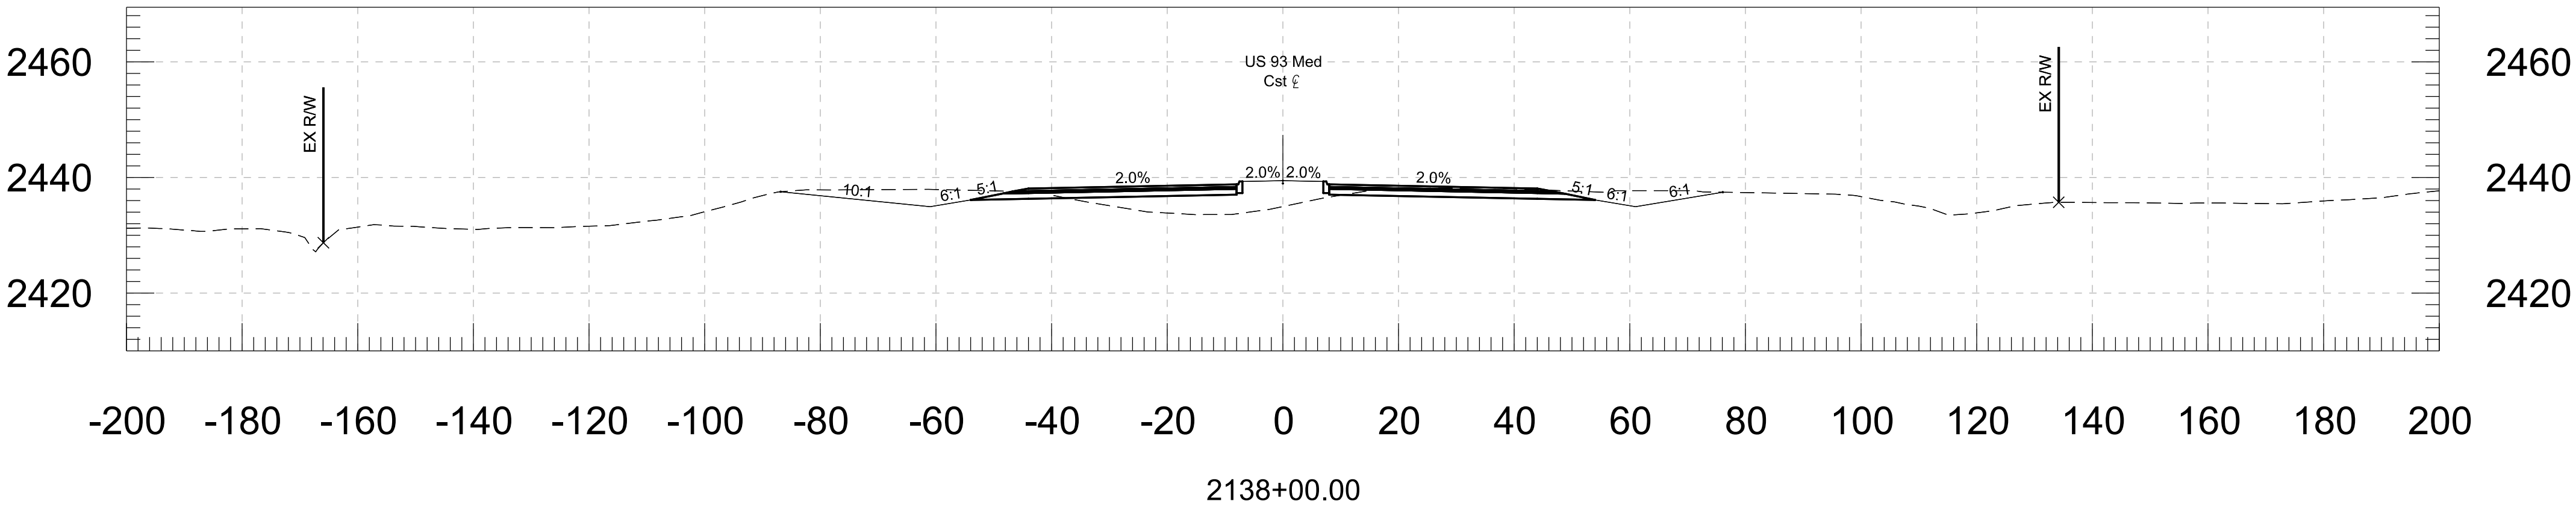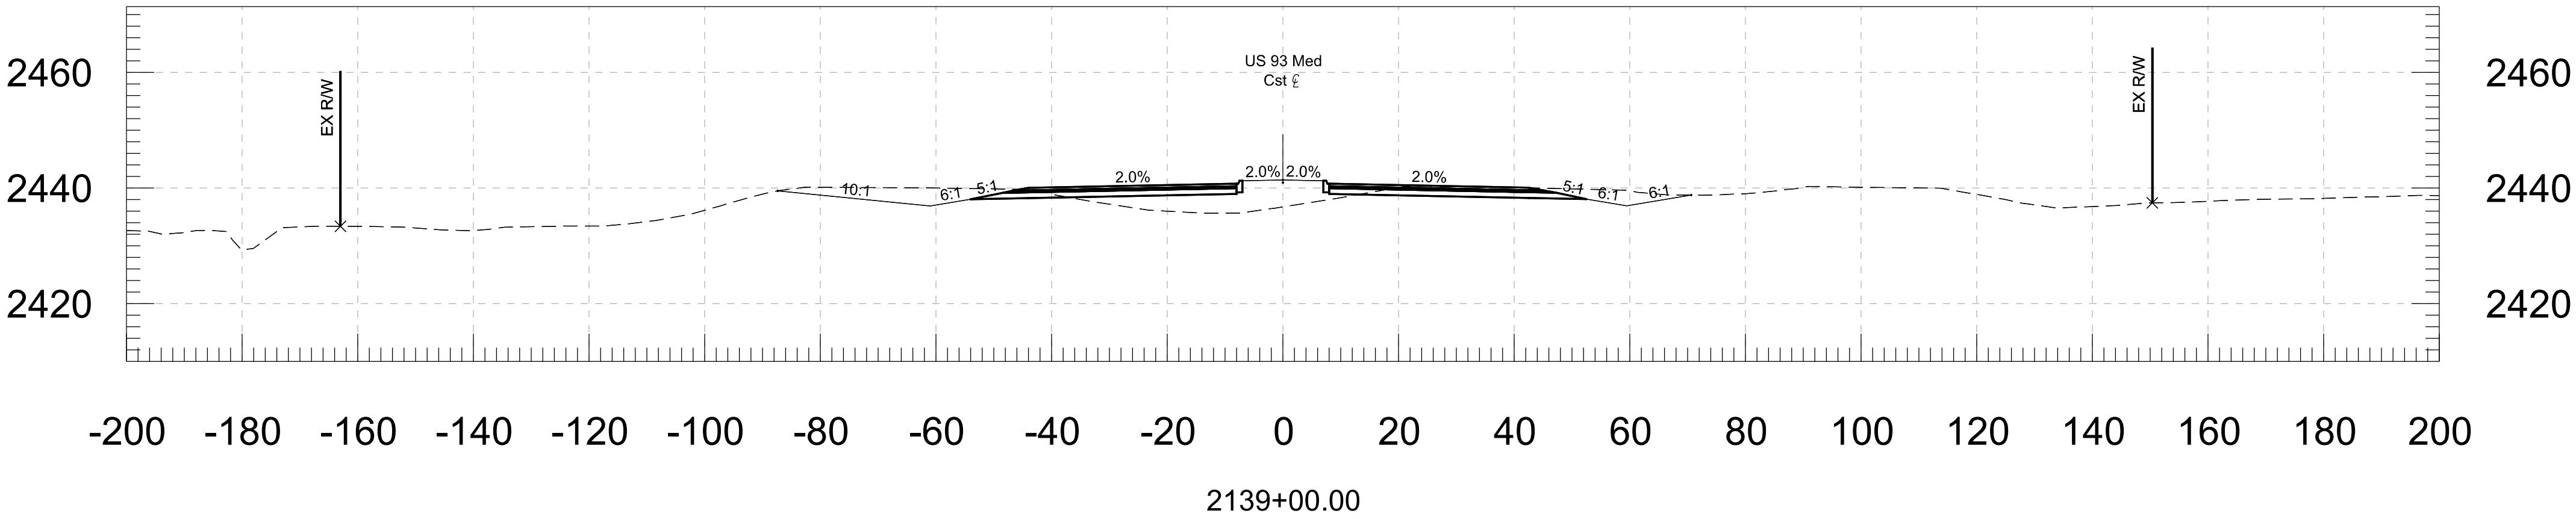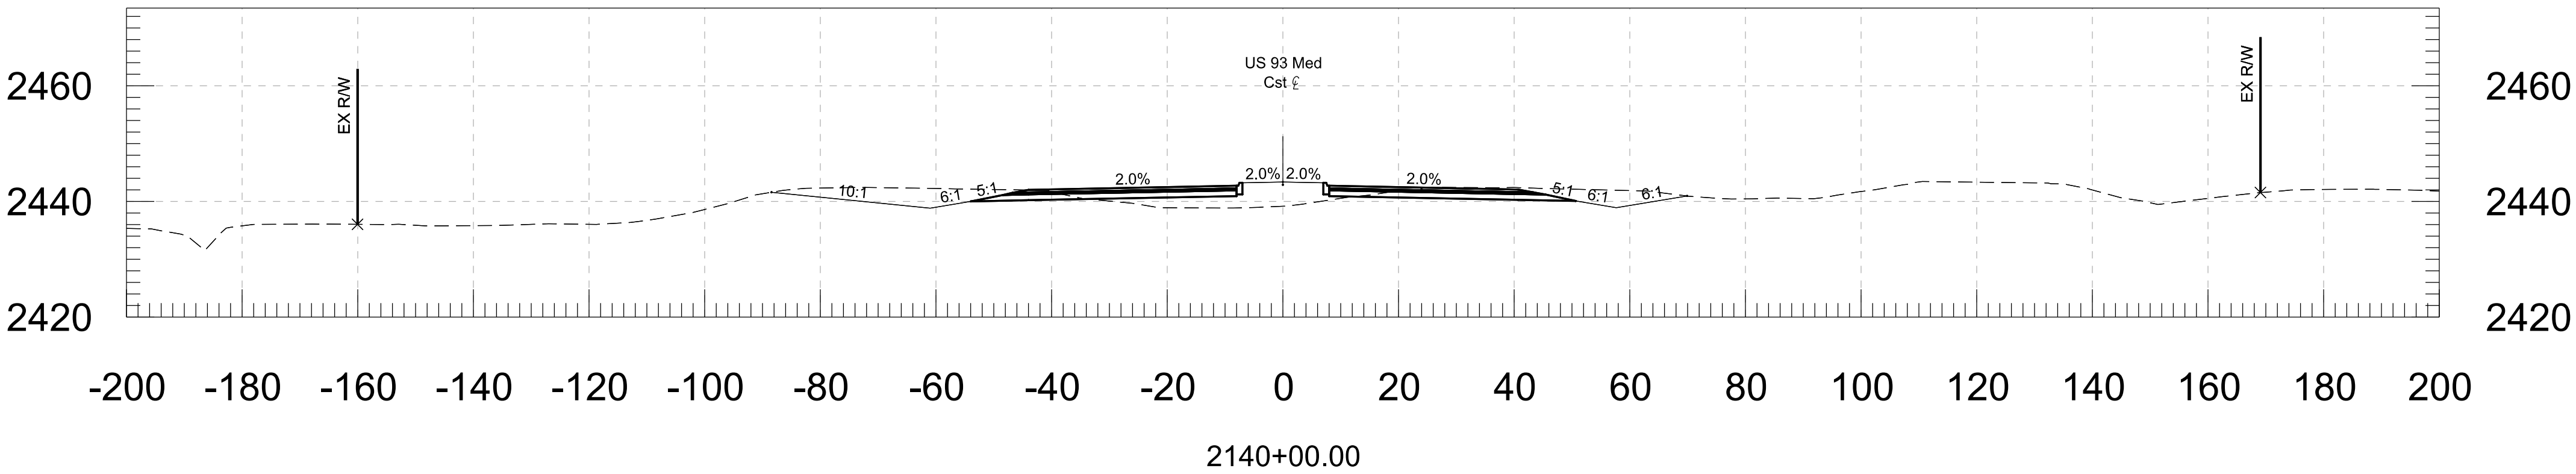

		NAME	DATE	ARIZONA DEPARTMENT OF TRANSPORTATION PROJECT DELIVERY AND OPERATIONS DIVISION ROADWAY DESIGN SERVICES	CROSS SECTIONS
DESIGN		ZSZ	06-26		
DRAWN		RM	06-26		
CHECKED		DBK	06-26		
 Stanley Consultants inc. 3133 East Camelback Road, Suite 100 Phoenix, Arizona 85016 Phone: (602) 333-2200					
ROUTE		LOCATION			
US 93		WICKENBURG RANCH WAY TO VISTA ROYALE		DWG NO. 13	
TRACS NO. F0738 OIC			093-B(230)T	___ OF ___	




F.H.W.A. REGION	STATE	PROJECT NO.	SHEET NO.	TOTAL SHEETS	RECORD DRAWING
9	ARIZ.	093-B(230)T	15	116	
093 YV 189					

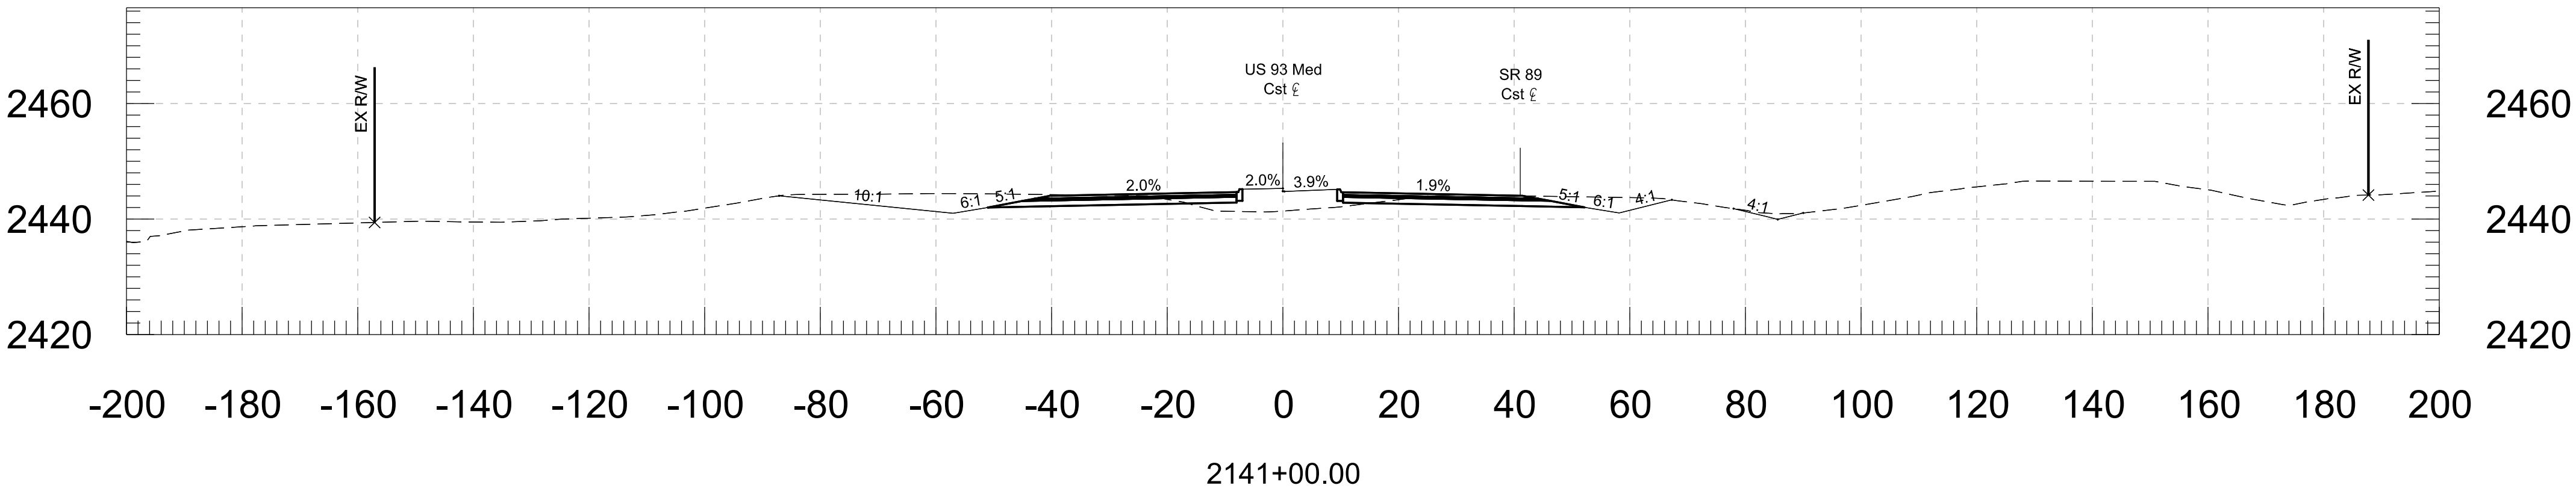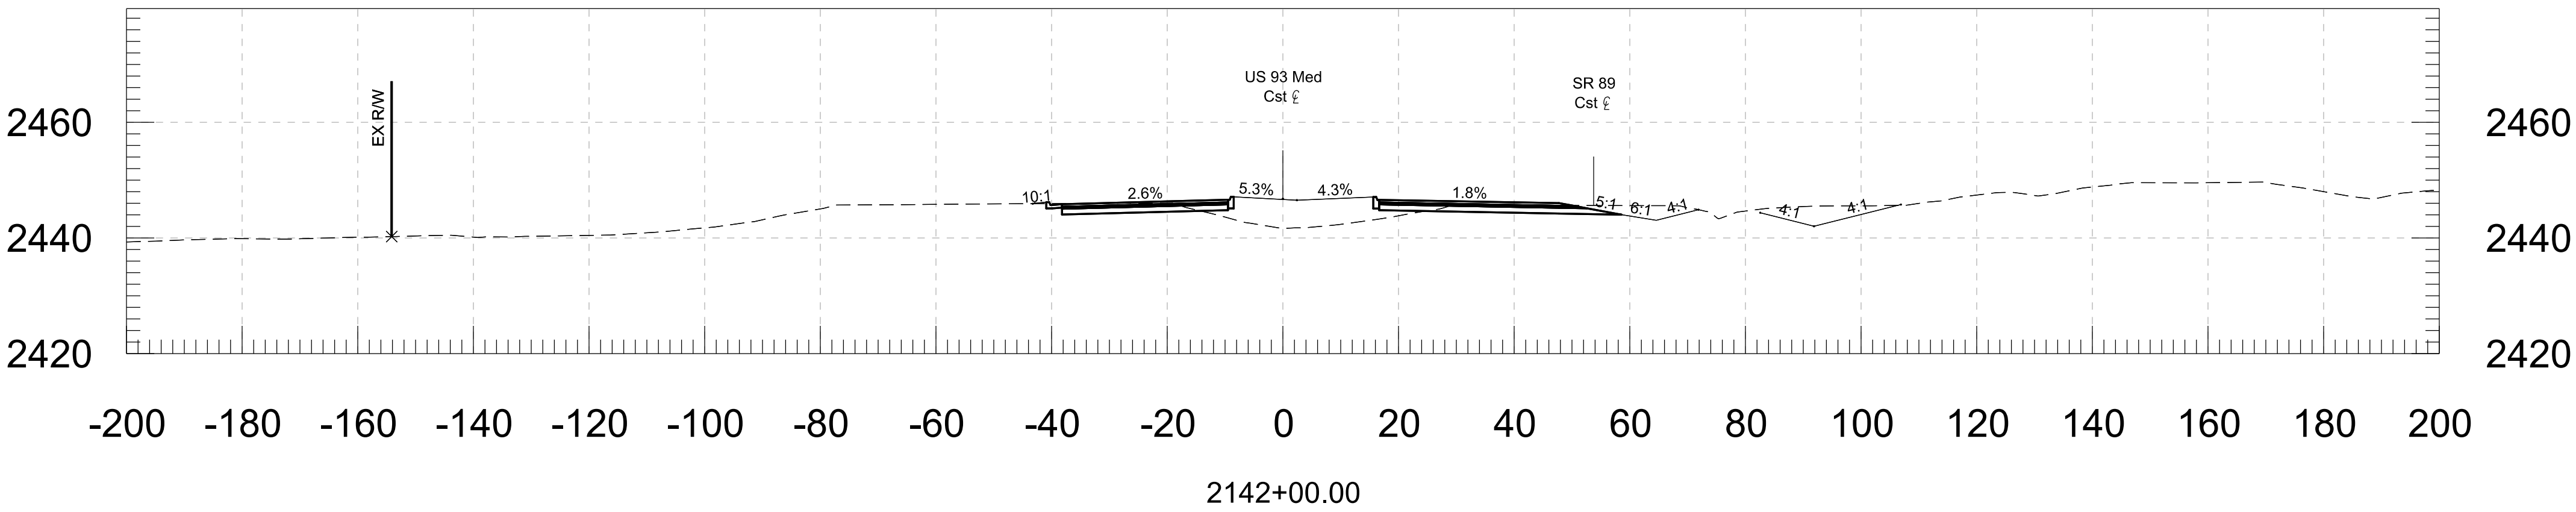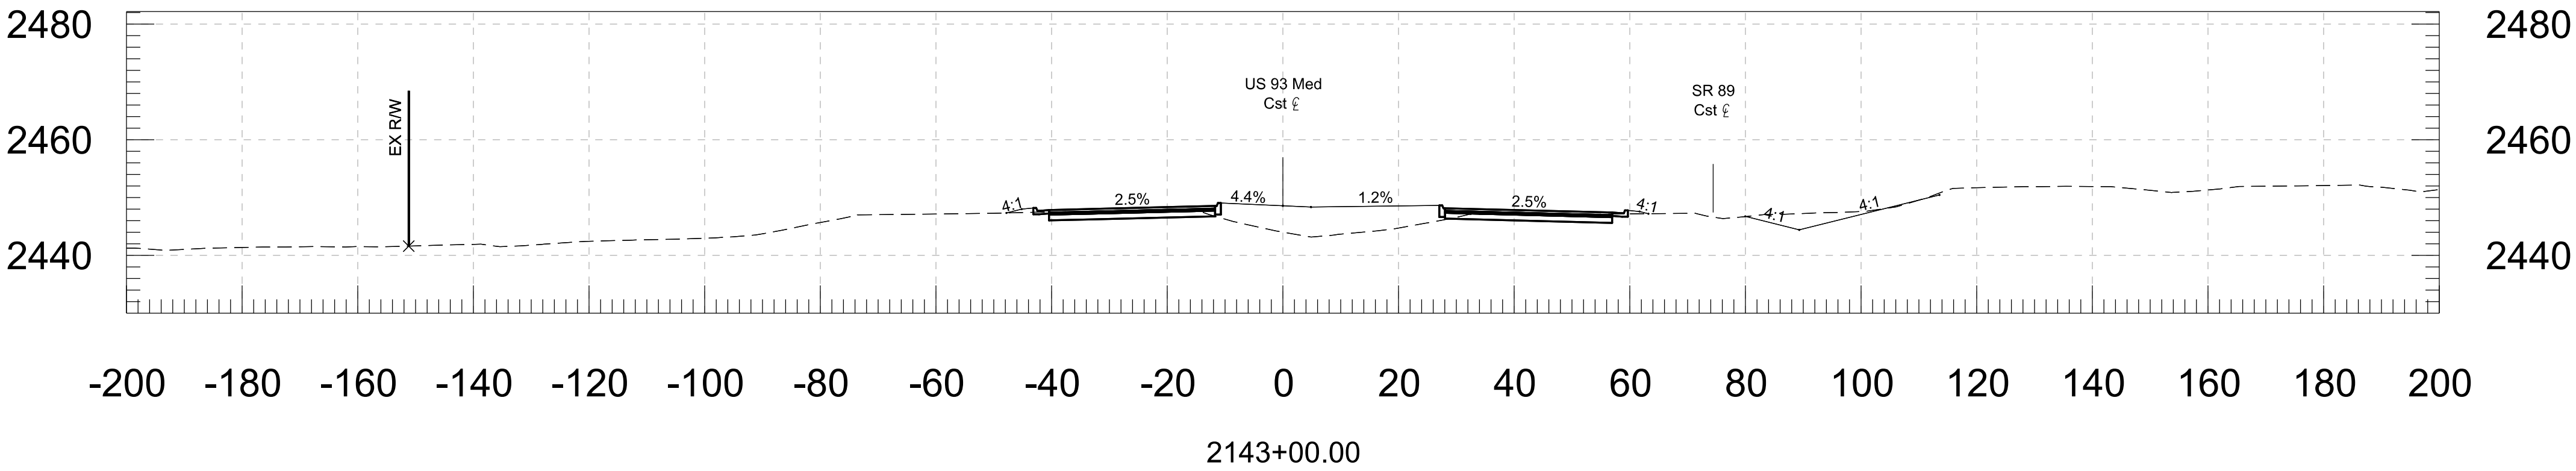

		NAME	DATE	ARIZONA DEPARTMENT OF TRANSPORTATION PROJECT DELIVERY AND OPERATIONS DIVISION ROADWAY DESIGN SERVICES	
DESIGN		ZSZ	06-26		
DRAWN		RM	06-26		
CHECKED		DBK	06-26		
 Stanley Consultants Inc.		3133 East Camelback Road, Suite 100 Phoenix, Arizona 85016 Phone: (602) 353-2200		CROSS SECTIONS	
ROUTE		LOCATION			
US 93		WICKENBURG RANCH WAY TO VISTA ROYALE			
		DWG NO. 14			
TRACS NO. F0738 OIC				093-B(230)T	
				___ OF ___	



F.H.W.A. REGION	STATE	PROJECT NO.	SHEET NO.	TOTAL SHEETS	RECORD DRAWING
9	ARIZ.	093-B(230)T	16	116	

093 YV 189

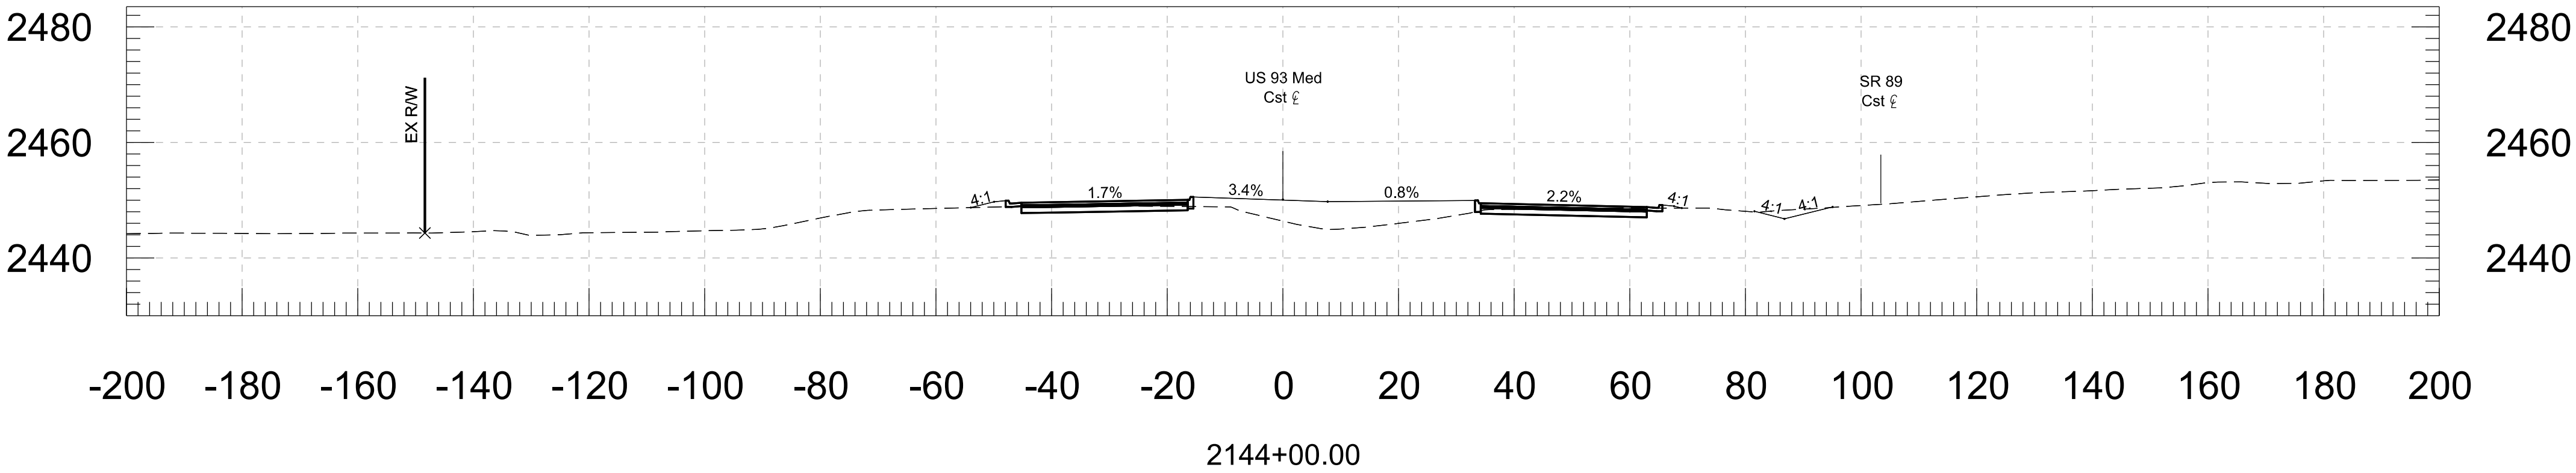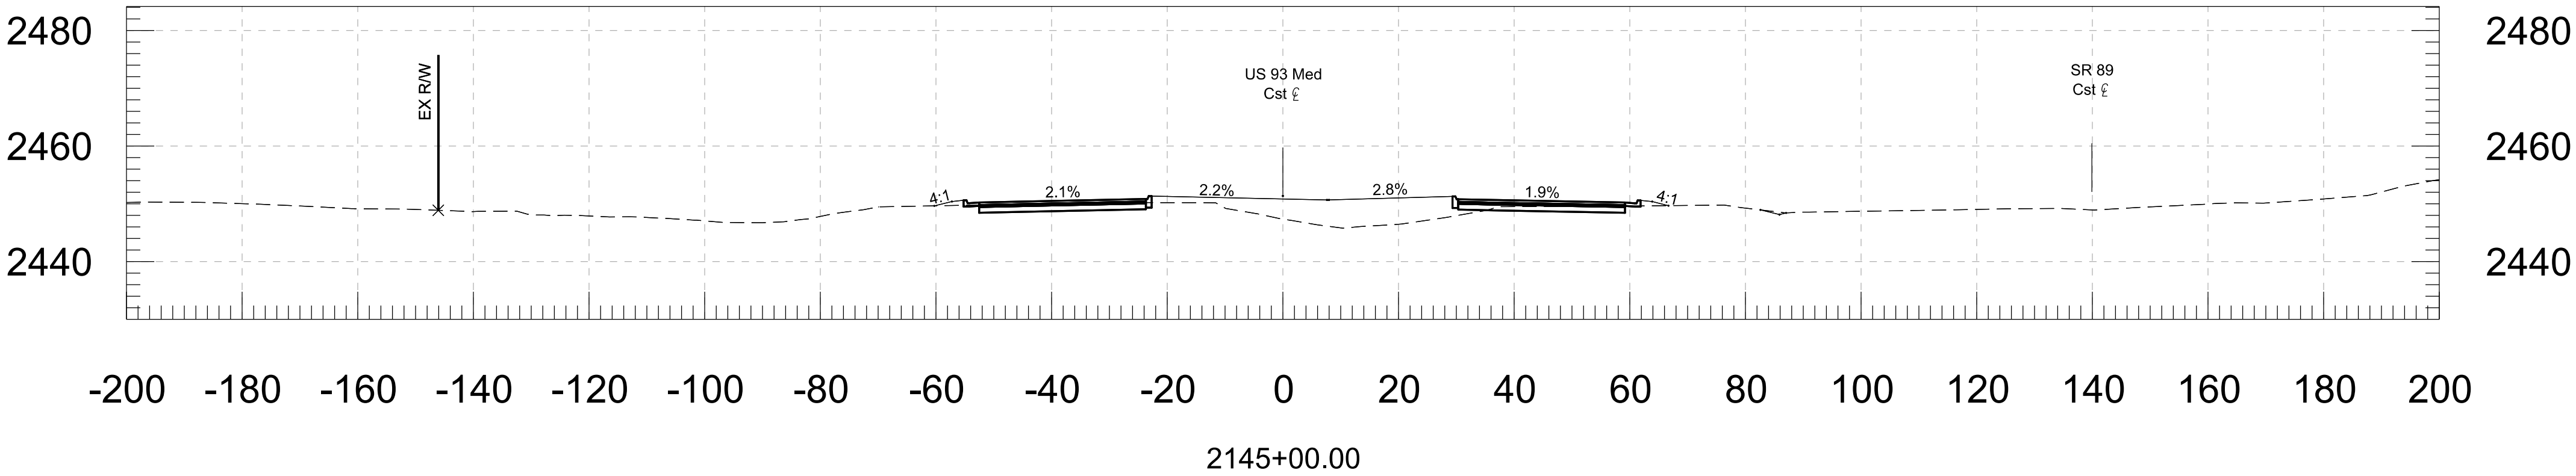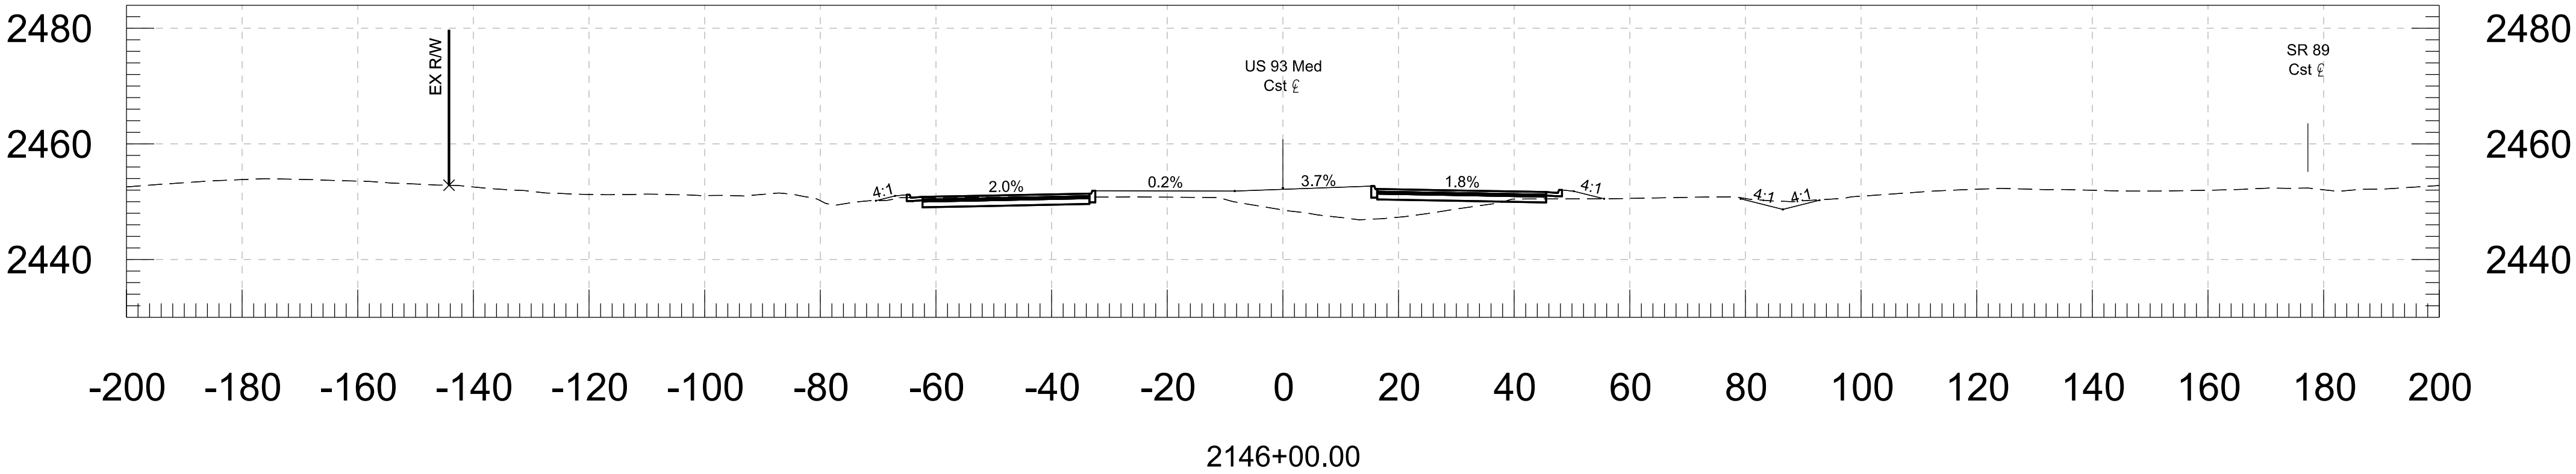



DESIGN	ZSZ	DATE	06-26	ARIZONA DEPARTMENT OF TRANSPORTATION PROJECT DELIVERY AND OPERATIONS DIVISION ROADWAY DESIGN SERVICES
DRAWN	RM	DATE	06-26	
CHECKED	DBK	DATE	06-26	
 3133 East Camelback Road, Suite 100 Phoenix, Arizona 85016 Phone: 1602 333-2200				CROSS SECTIONS
ROUTE		LOCATION		
US 93		WICKENBURG RANCH WAY TO VISTA ROYALE		DWG NO. 15
TRACS NO. F0738 OIC			093-B(230)T	OF

F.H.W.A. REGION	STATE	PROJECT NO.	SHEET NO.	TOTAL SHEETS	RECORD DRAWING
9	ARIZ.	093-B(230)T	17	116	
093 YV 189					

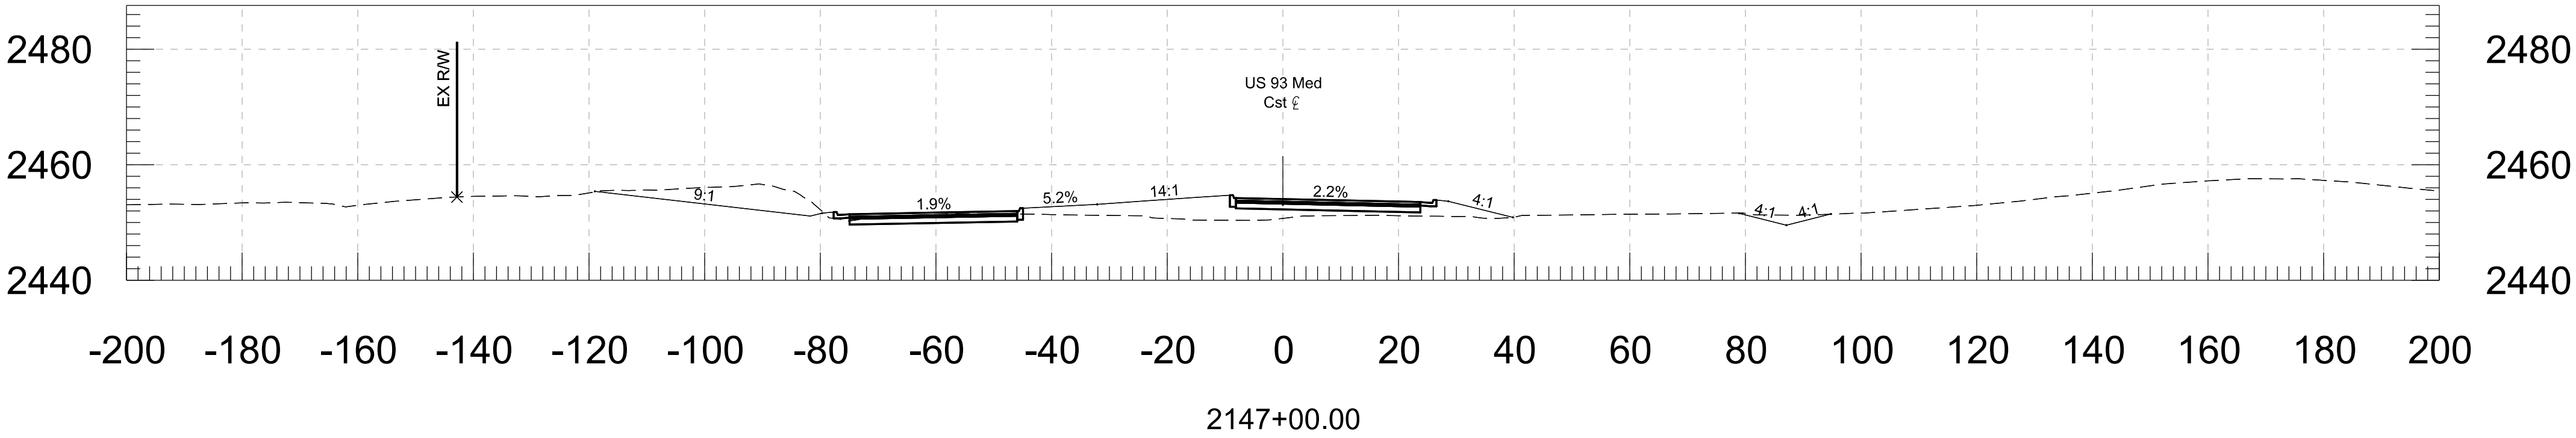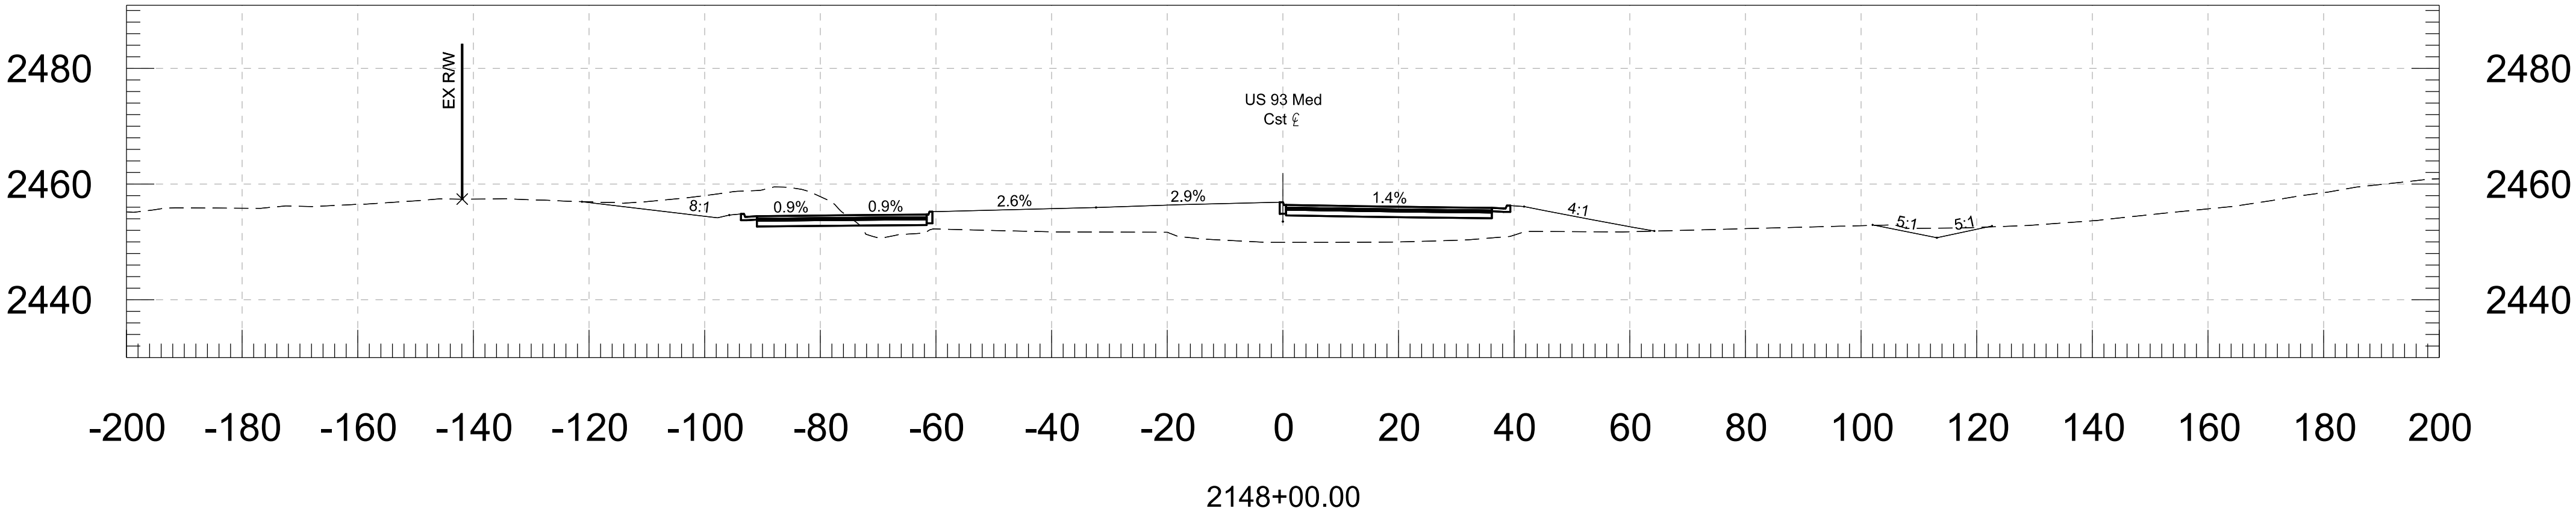

		NAME	DATE	ARIZONA DEPARTMENT OF TRANSPORTATION PROJECT DELIVERY AND OPERATIONS DIVISION ROADWAY DESIGN SERVICES	
DESIGN	ZSZ		06-26		
DRAWN	RM		06-26		
CHECKED	DBK		06-26		
 Stanley Consultants inc. 3133 East Camelback Road, Suite 100 Phoenix, Arizona 85016 Phone: (602) 333-2200				CROSS SECTIONS	
ROUTE		LOCATION			DWG NO. 16
US 93		WICKENBURG RANCH WAY TO VISTA ROYALE			
TRACS NO. F0738 OIC			093-B(230)T		___ OF ___



F.H.W.A. REGION	STATE	PROJECT NO.	SHEET NO.	TOTAL SHEETS	RECORD DRAWING
9	ARIZ.	093-B(230)T	18	116	
093 YV 189					

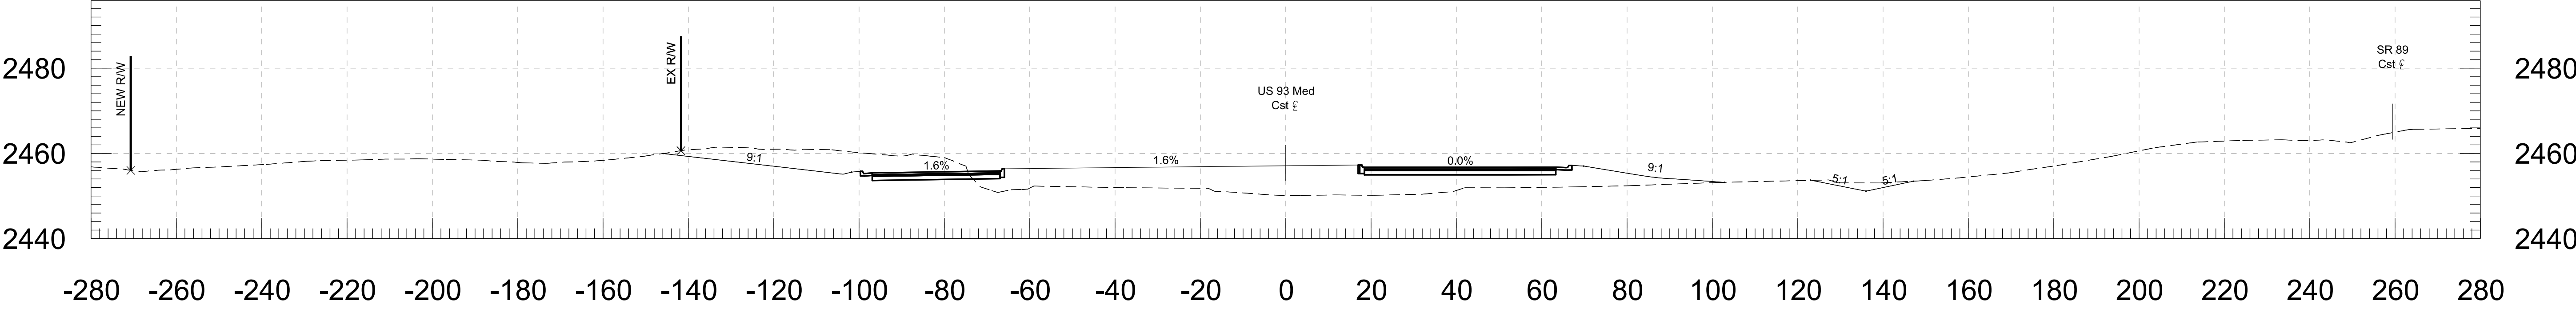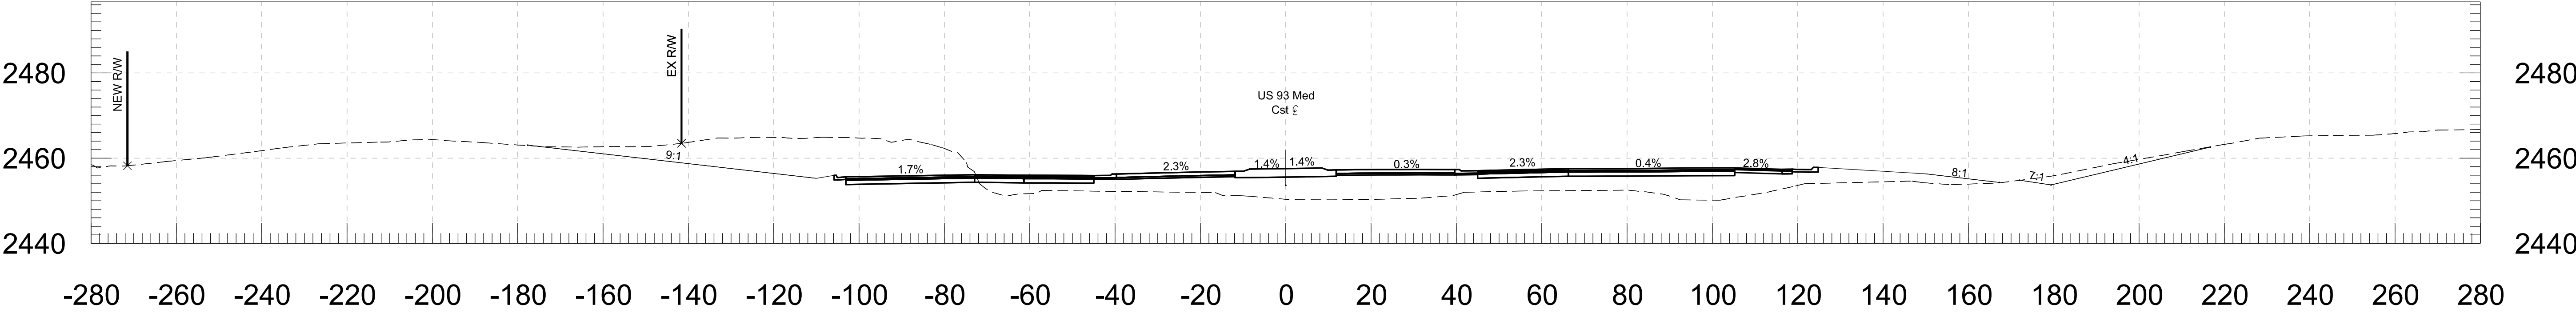

DESIGN	ZSZ	DATE	06-26	ARIZONA DEPARTMENT OF TRANSPORTATION PROJECT DELIVERY AND OPERATIONS DIVISION ROADWAY DESIGN SERVICES
DRAWN	RM	DATE	06-26	
CHECKED	DBK	DATE	06-26	
 Stanley Consultants inc. 3333 East Camelback Road, Suite 100 Phoenix, Arizona 85018 Phone: 1602 333-2200				CROSS SECTIONS
ROUTE	LOCATION			DWG NO.
US 93	WICKENBURG RANCH WAY TO VISTA ROYALE			17
TRACS NO. F0738 OIC		093-B(230)T		OF



F.H.W.A. REGION	STATE	PROJECT NO.	SHEET NO.	TOTAL SHEETS	RECORD DRAWING
9	ARIZ.	093-B(230)T	19	116	

093 YV 189

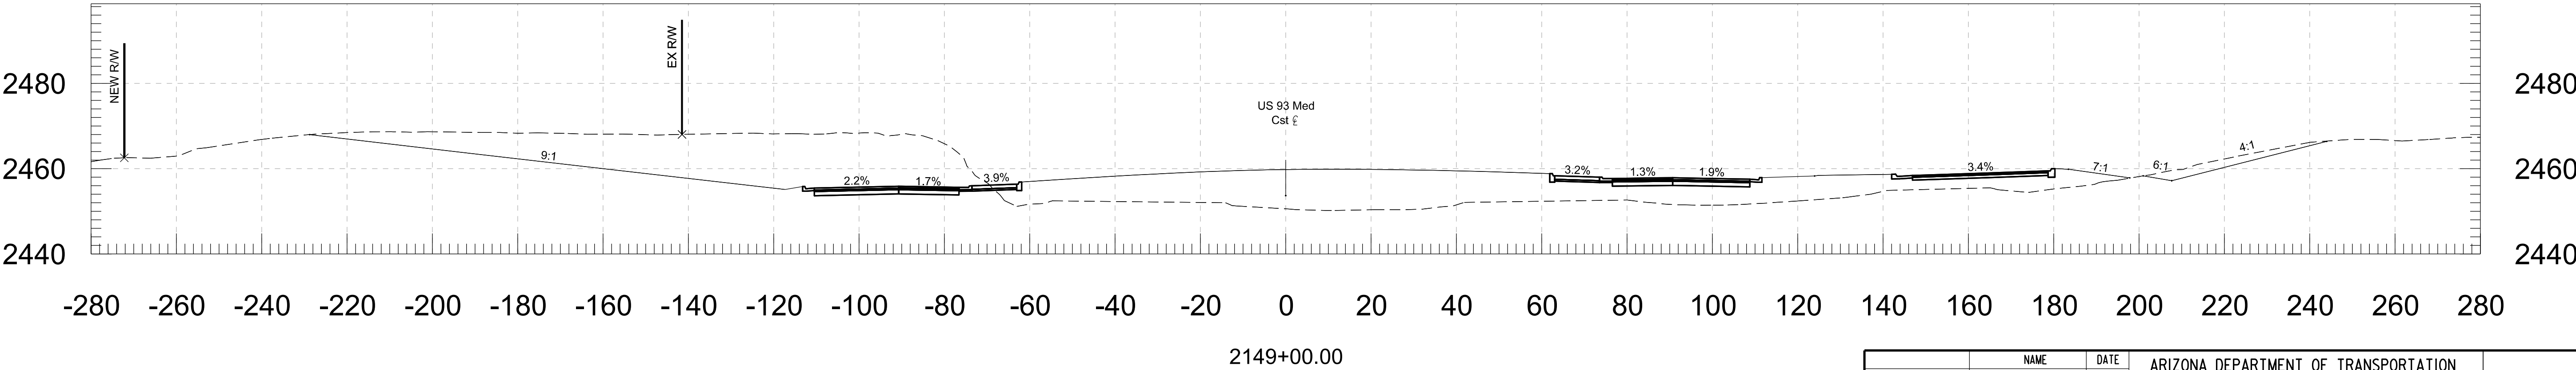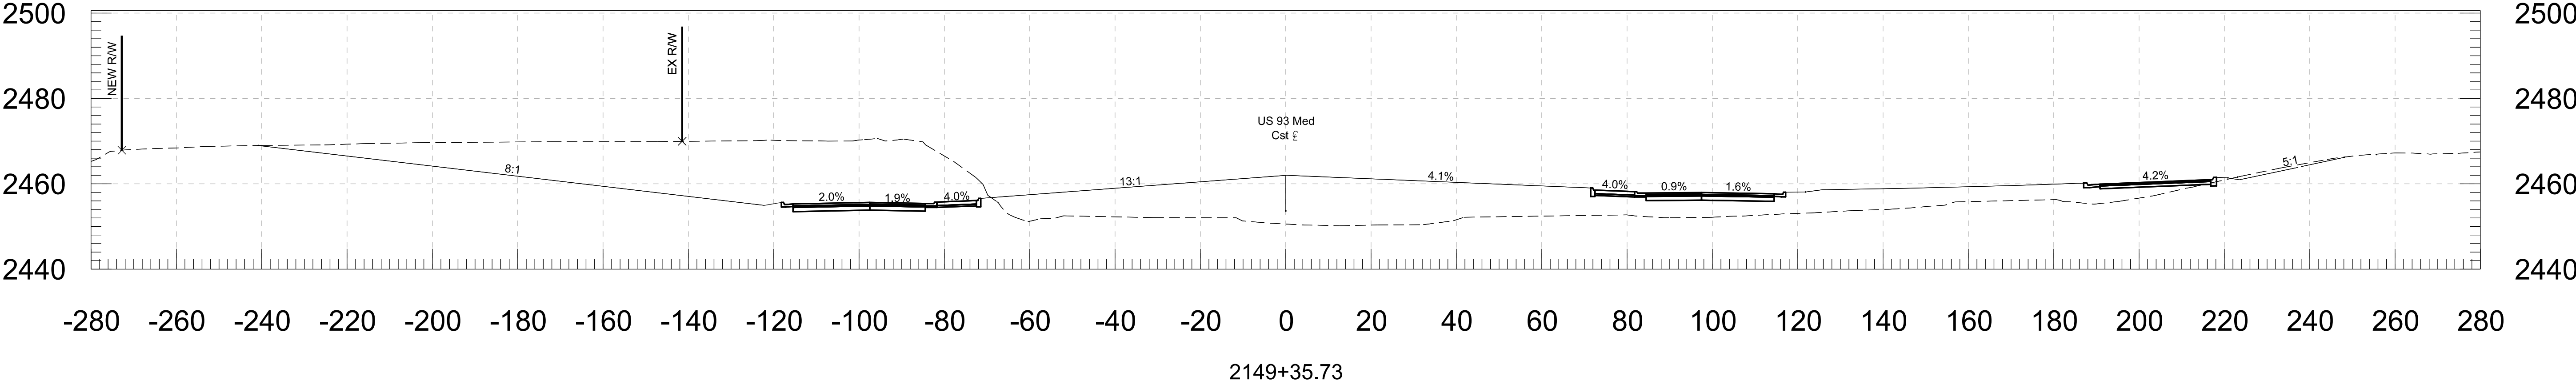

DESIGN	ZSZ	DATE	06-26	ARIZONA DEPARTMENT OF TRANSPORTATION PROJECT DELIVERY AND OPERATIONS DIVISION ROADWAY DESIGN SERVICES
DRAWN	RM	DATE	06-26	
CHECKED	DBK	DATE	06-26	
 333 East Camelback Road, Suite 100 Phoenix, Arizona 85016 Phone: 1602 333-2200				CROSS SECTIONS
ROUTE		LOCATION		DWG NO.
US 93		WICKENBURG RANCH WAY TO VISTA ROYALE		18
TRACS NO. F0738 OIC			093-B(230)T	OF


F.H.W.A. REGION	STATE	PROJECT NO.	SHEET NO.	TOTAL SHEETS	RECORD DRAWING
9	ARIZ.	093-B(230)T	20	116	
093 YV 189					

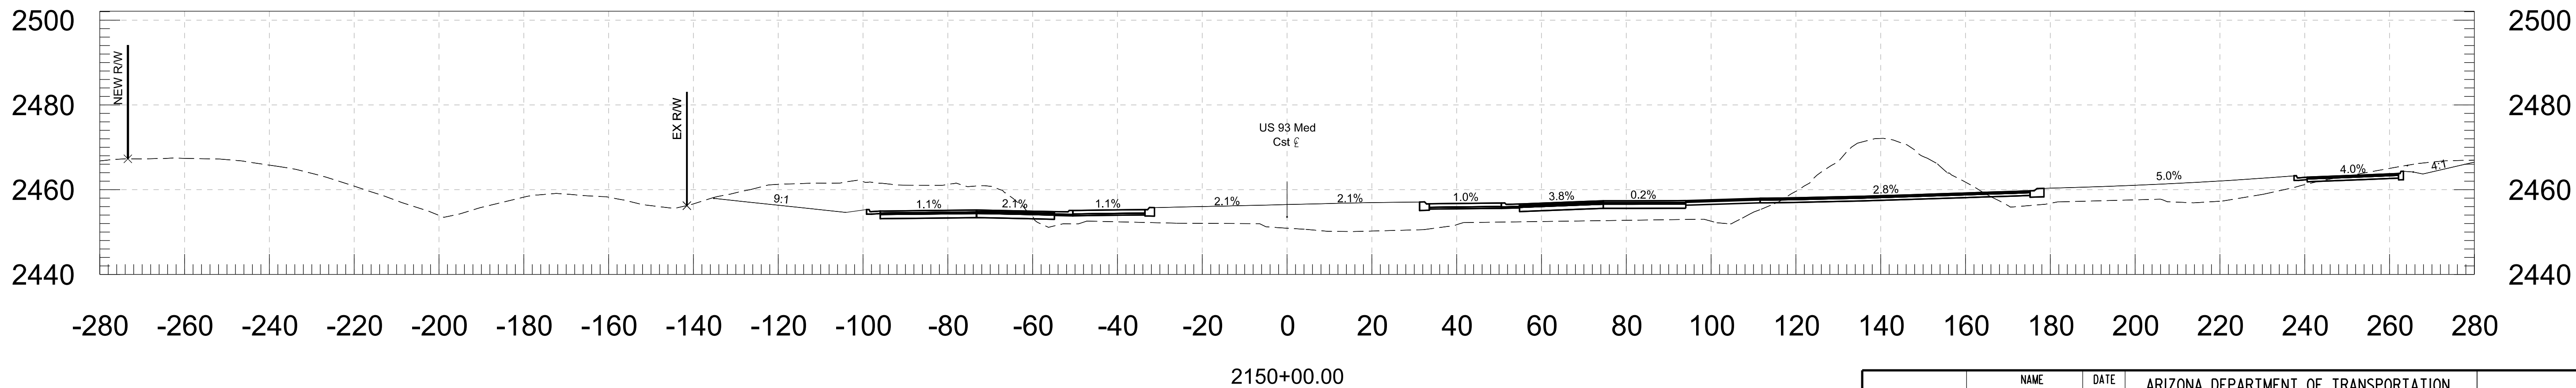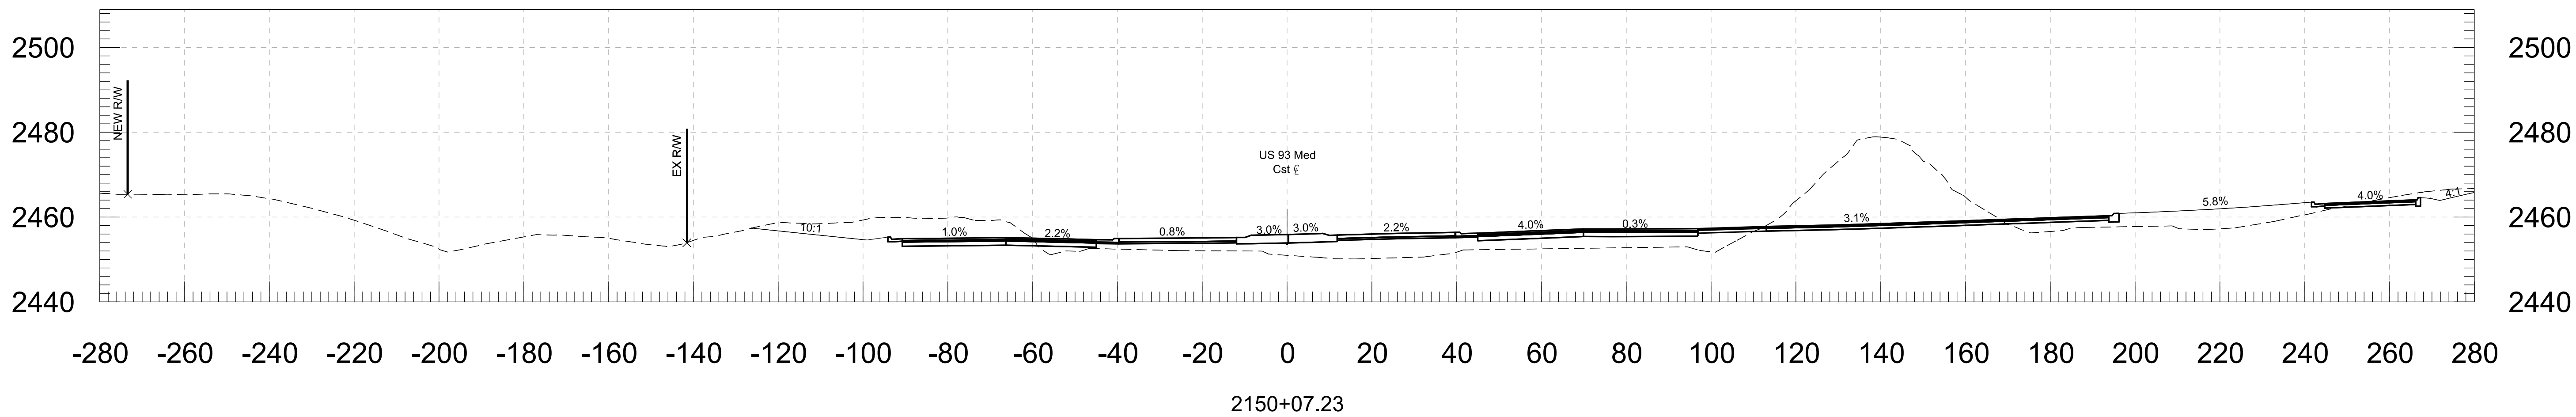

		NAME	DATE	ARIZONA DEPARTMENT OF TRANSPORTATION PROJECT DELIVERY AND OPERATIONS DIVISION ROADWAY DESIGN SERVICES		
DESIGN	ZSZ	06-26				
DRAWN	RM	06-26				
CHECKED	DBK	06-26				
 Stanley Consultants inc.		3133 East Camelback Road, Suite 100 Phoenix, Arizona 85016 Phone: 1602 333-2200		CROSS SECTIONS		
ROUTE		LOCATION				
US 93		WICKENBURG RANCH WAY TO VISTA ROYALE				DWG NO. 19
TRACS NO. F0738 OIC			093-B(230)T			___ OF ___



F.H.W.A. REGION	STATE	PROJECT NO.	SHEET NO.	TOTAL SHEETS	RECORD DRAWING
9	ARIZ.	093-B(230)T	21	116	

093 YV 189

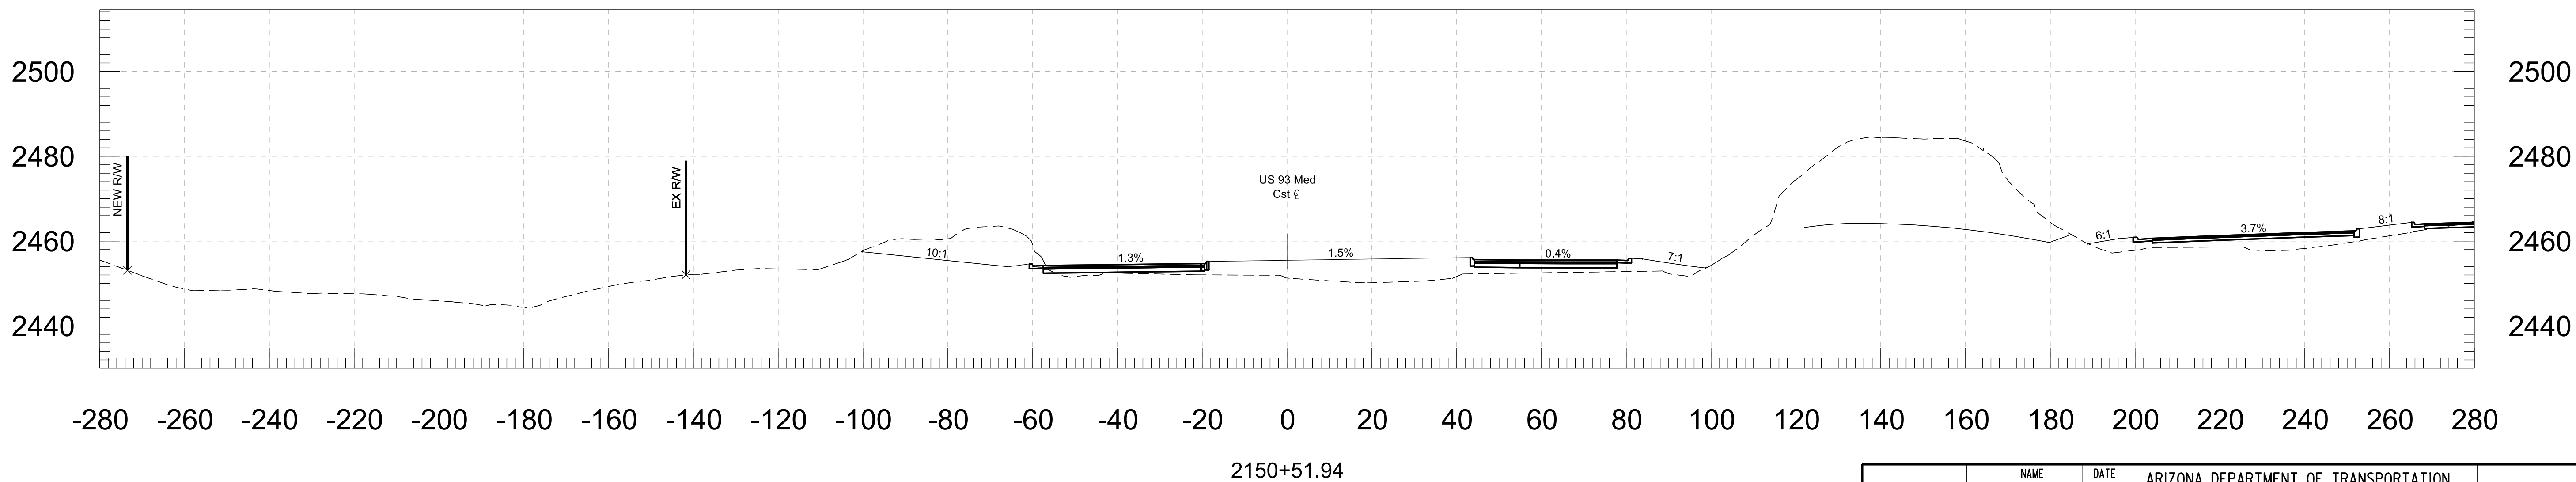

	NAME	DATE	ARIZONA DEPARTMENT OF TRANSPORTATION PROJECT DELIVERY AND OPERATIONS DIVISION ROADWAY DESIGN SERVICES
DESIGN	ZSZ	06-26	
DRAWN	RM	06-26	
CHECKED	DBK	06-26	
 Stanley Consultants inc. 3133 East Camelback Road, Suite 100 Phoenix, Arizona 85016 Phone: 1602 333-2200			CROSS SECTIONS
ROUTE	LOCATION		
US 93	WICKENBURG RANCH WAY TO VISTA ROYALE		
TRACS NO. F0738 OIC			093-B(230)T

F.H.W.A. REGION	STATE	PROJECT NO.	SHEET NO.	TOTAL SHEETS	RECORD DRAWING
9	ARIZ.	093-B(230)T	22	116	
093 YV 189					


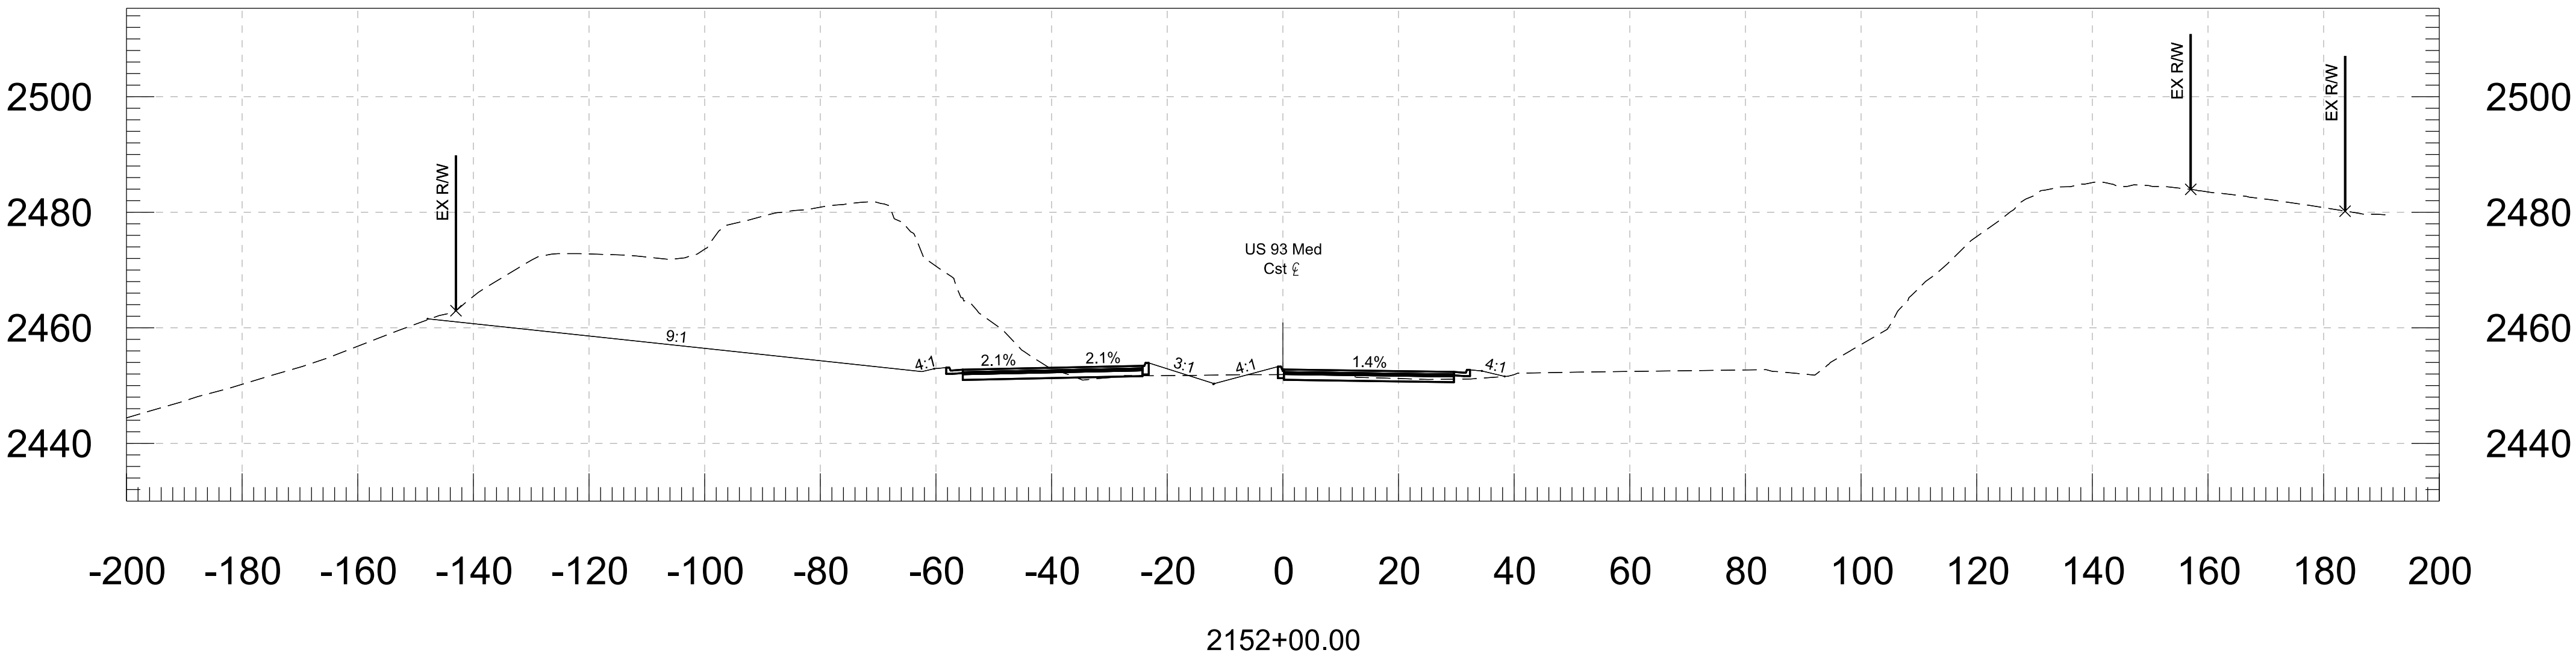
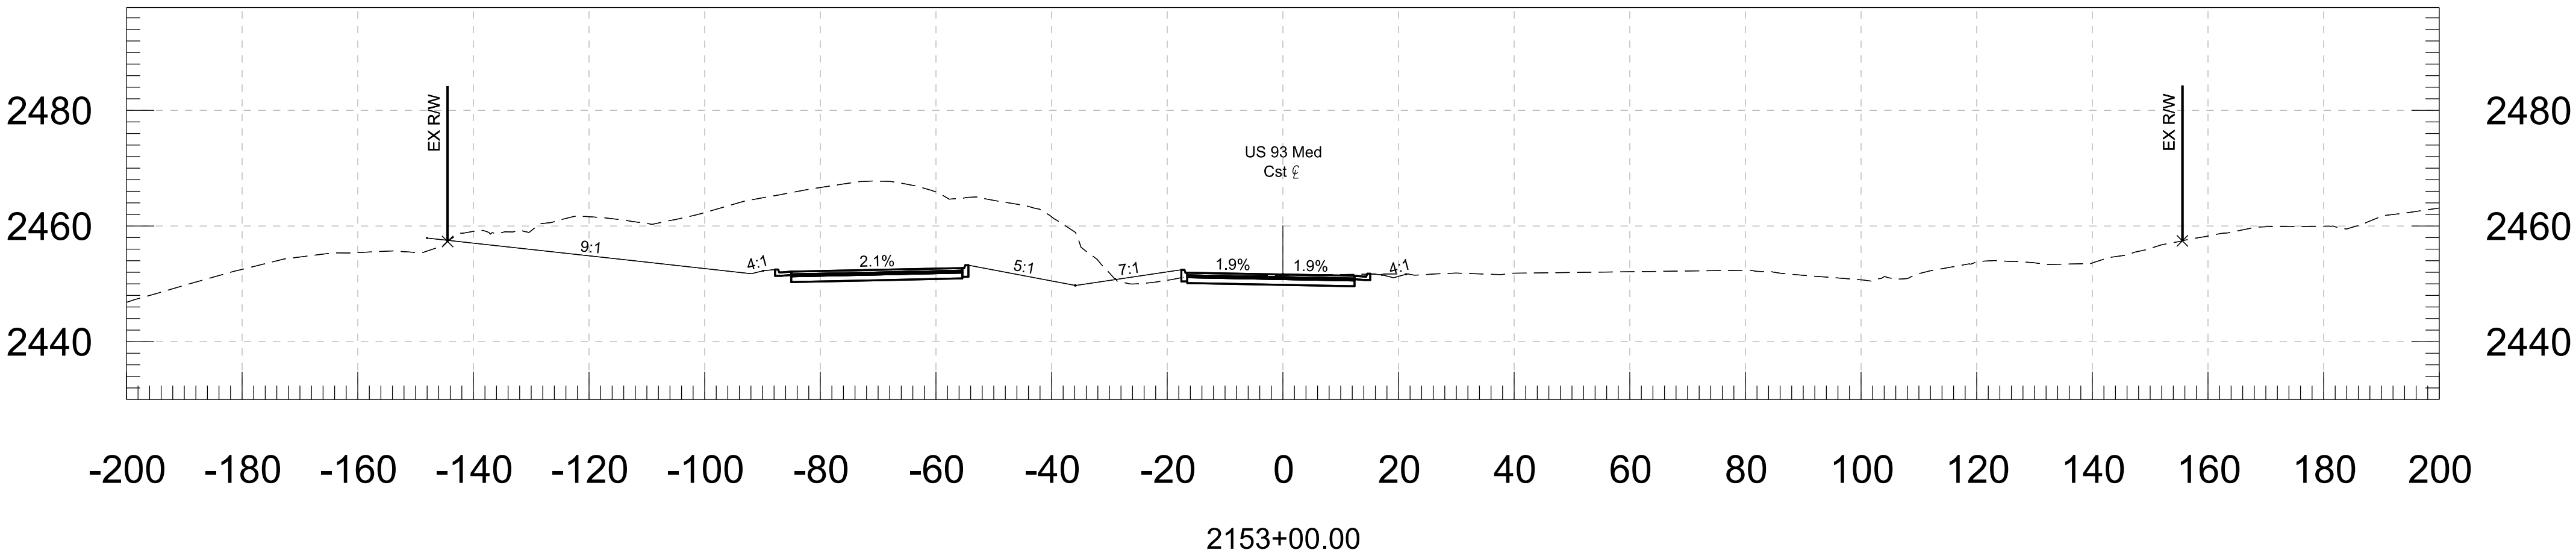


DESIGN	ZSZ	DATE	06-26	ARIZONA DEPARTMENT OF TRANSPORTATION PROJECT DELIVERY AND OPERATIONS DIVISION ROADWAY DESIGN SERVICES
DRAWN	RM	DATE	06-26	
CHECKED	DBK	DATE	06-26	
 Stanley Consultants inc. 3333 East Camelback Road, Suite 100 Phoenix, Arizona 85018 Phone: 1602 333-2200				CROSS SECTIONS
ROUTE	LOCATION			DWG NO. 21
US 93	WICKENBURG RANCH WAY TO VISTA ROYALE			
TRACS NO. F0738 OIC		093-B(230)T		___ OF ___

DATE- LOCATION- REVISIONS- FINISHED PLANS- SURVEY NO. DATE- LOCATION- REVISIONS- FINISHED PLANS- SURVEY NO.




F.H.W.A. REGION	STATE	PROJECT NO.	SHEET NO.	TOTAL SHEETS	RECORD DRAWING
9	ARIZ.	093-B(230)T	23	116	

093 YV 189

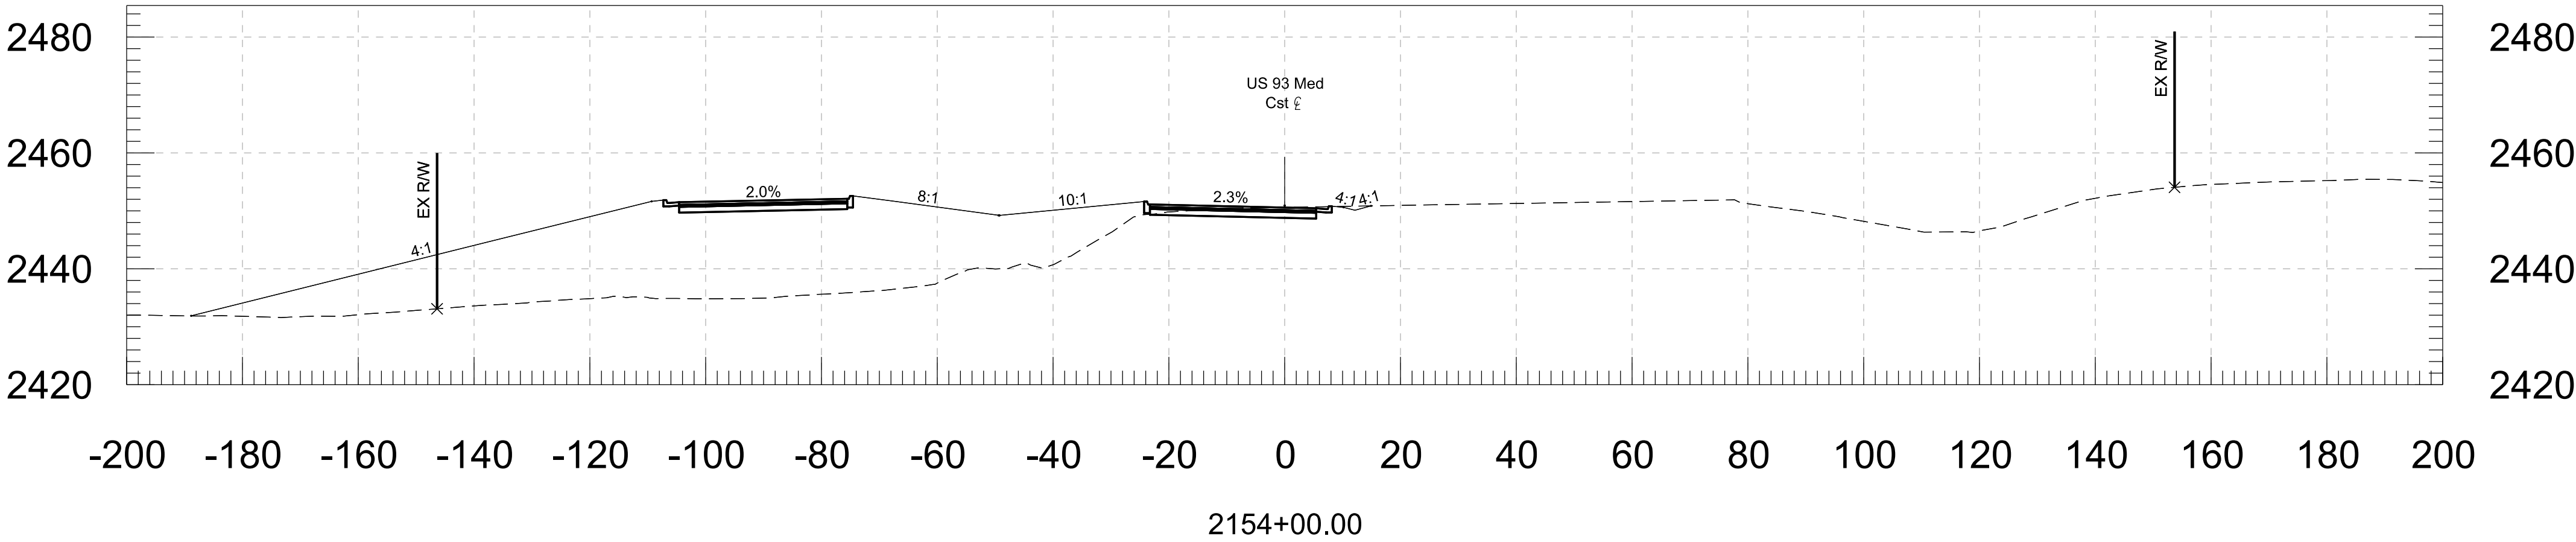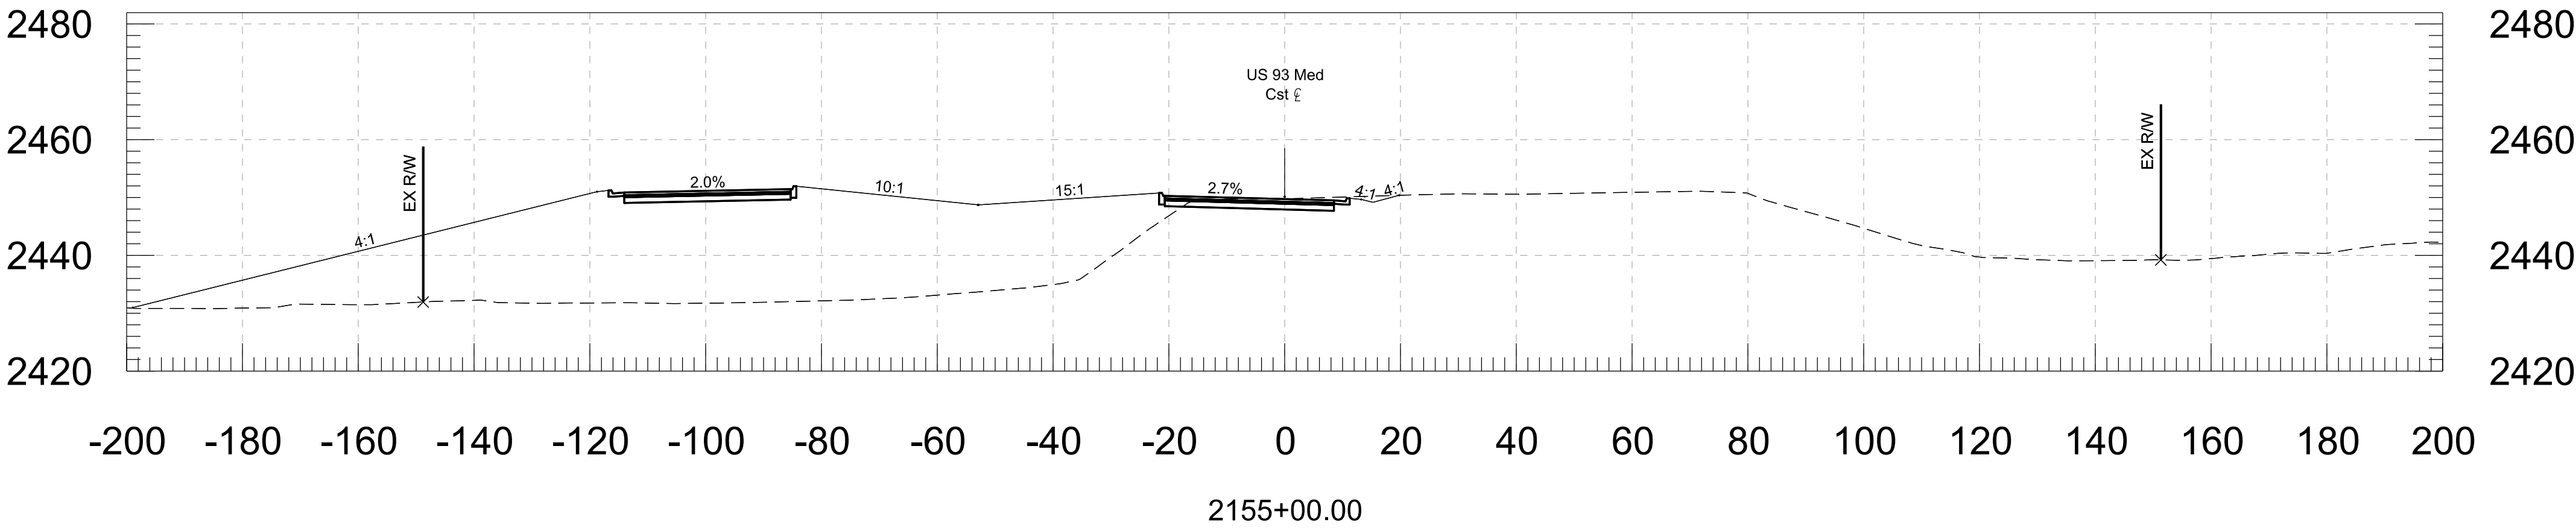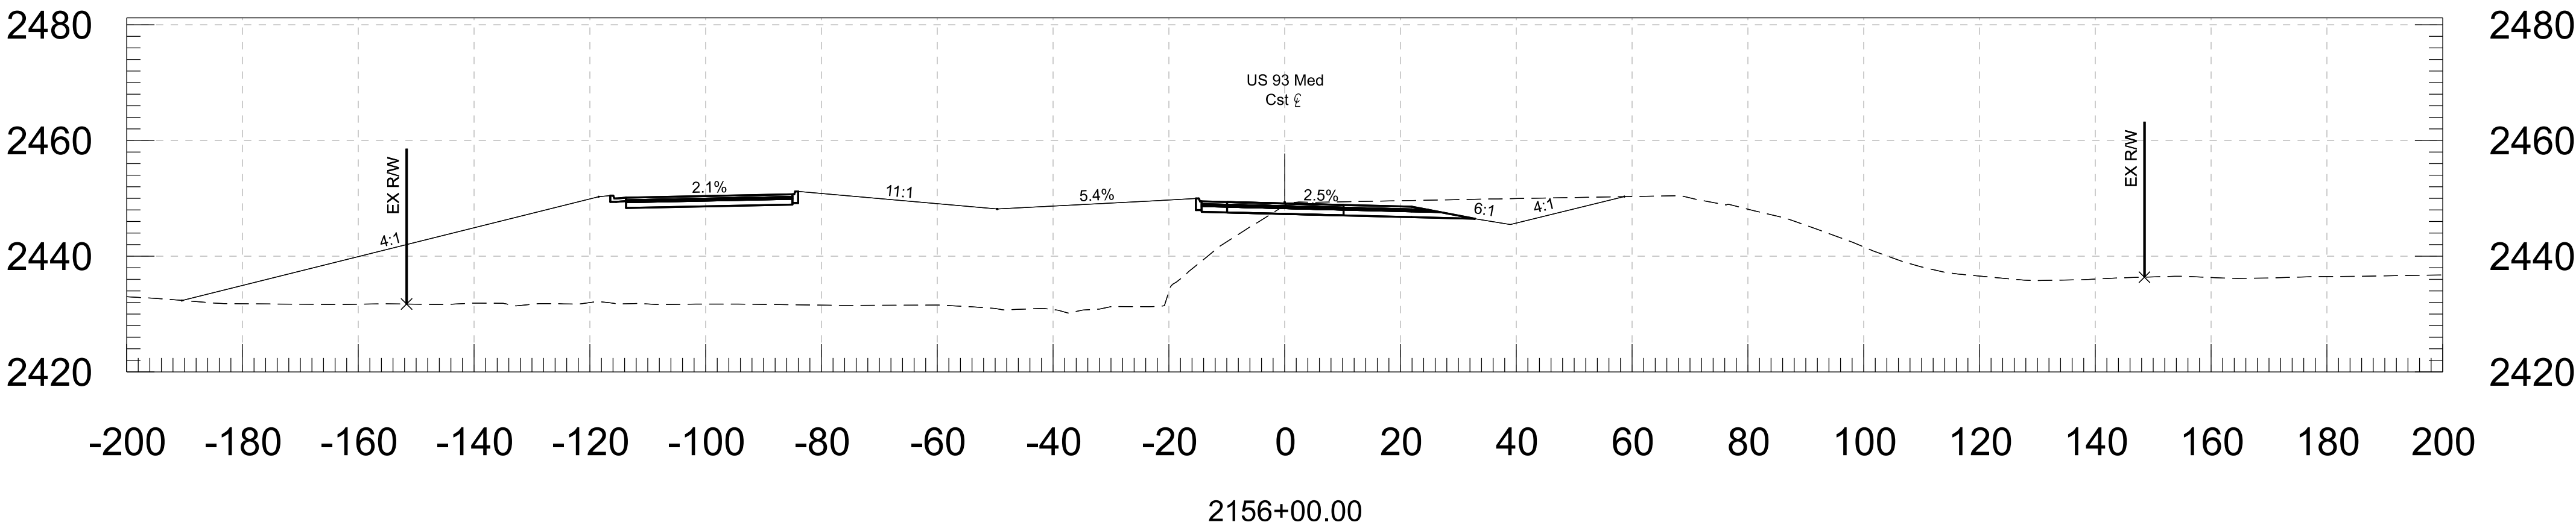


DESIGN	ZSZ	DATE	06-26	ARIZONA DEPARTMENT OF TRANSPORTATION PROJECT DELIVERY AND OPERATIONS DIVISION ROADWAY DESIGN SERVICES
DRAWN	RM	DATE	06-26	
CHECKED	DBK	DATE	06-26	
 Stanley Consultants inc. 333 East Camelback Road, Suite 100 Phoenix, Arizona 85016 Phone: 1602 333-2200				CROSS SECTIONS
ROUTE	US 93	LOCATION	WICKENBURG RANCH WAY TO VISTA ROYALE	DWG NO. 22
TRACS NO. F0738 OIC		093-B(230)T		OF

F.H.W.A. REGION	STATE	PROJECT NO.	SHEET NO.	TOTAL SHEETS	RECORD DRAWING
9	ARIZ.	093-B(230)T	24	116	
093 YV 189					

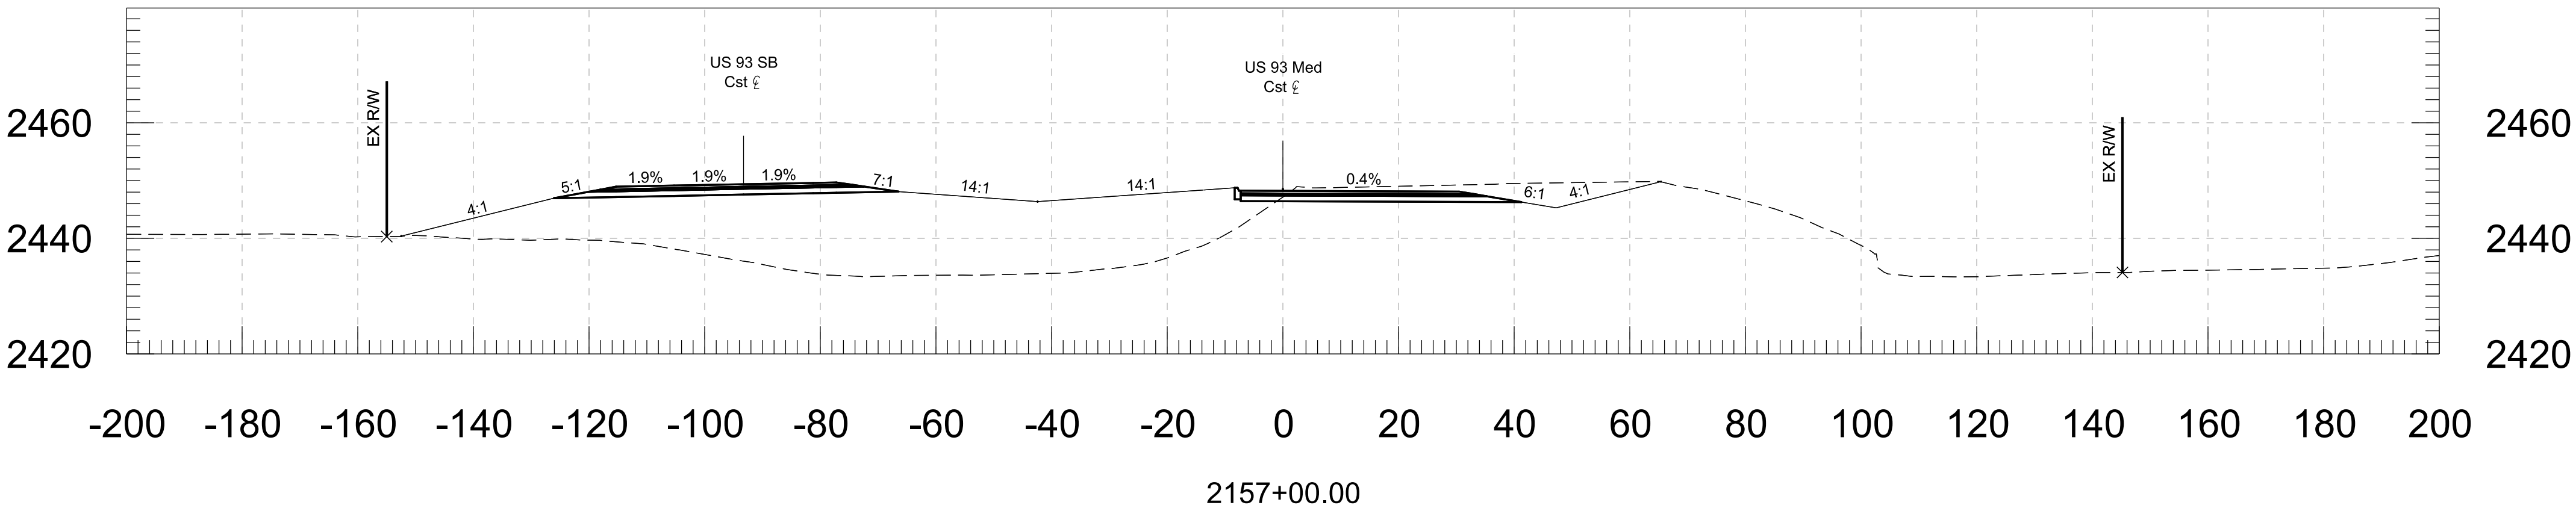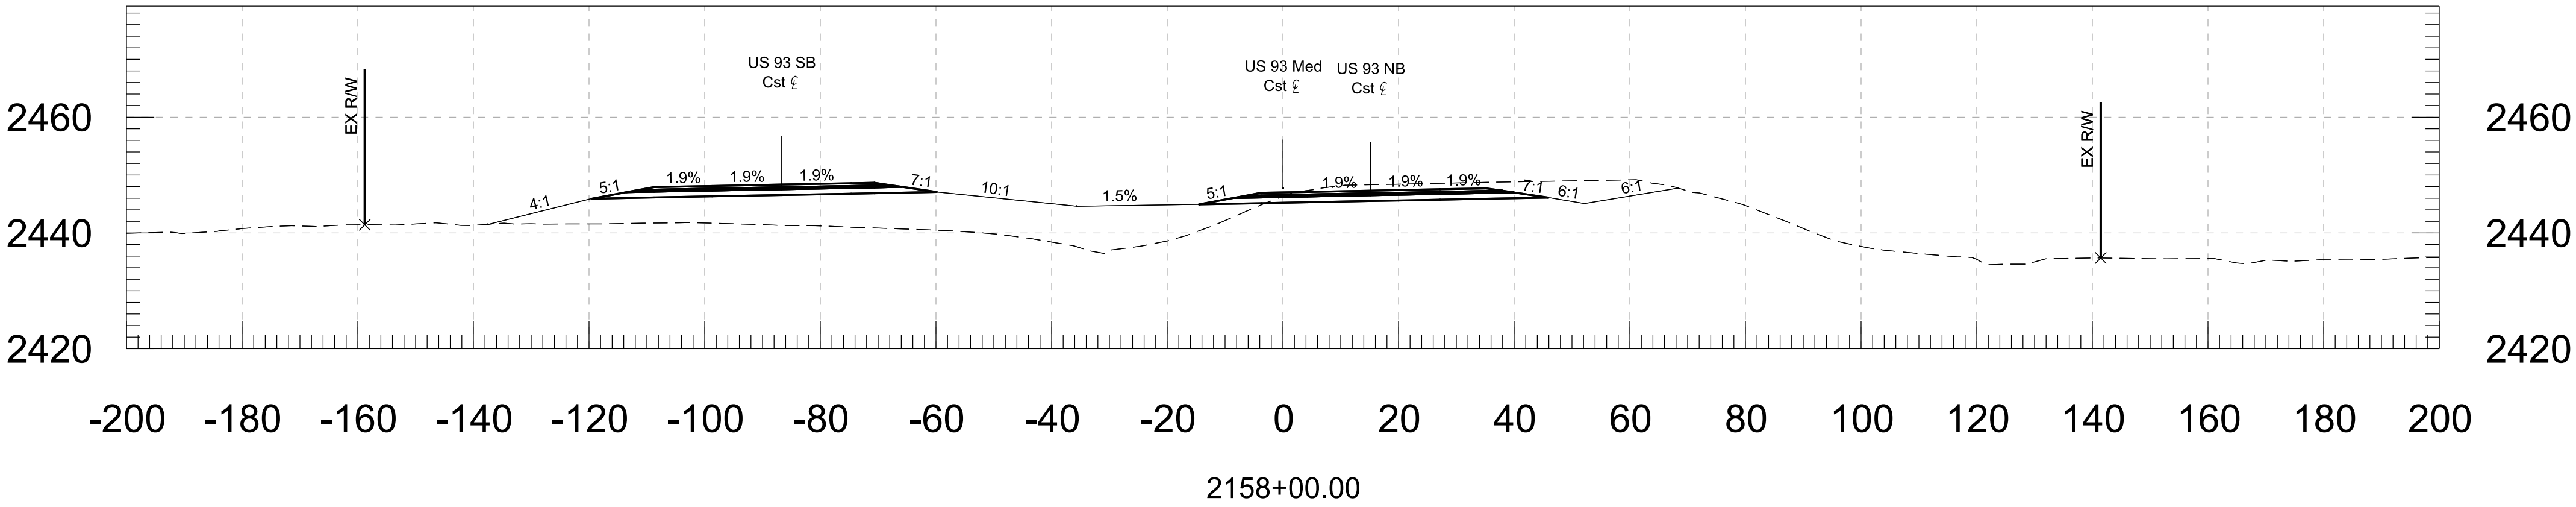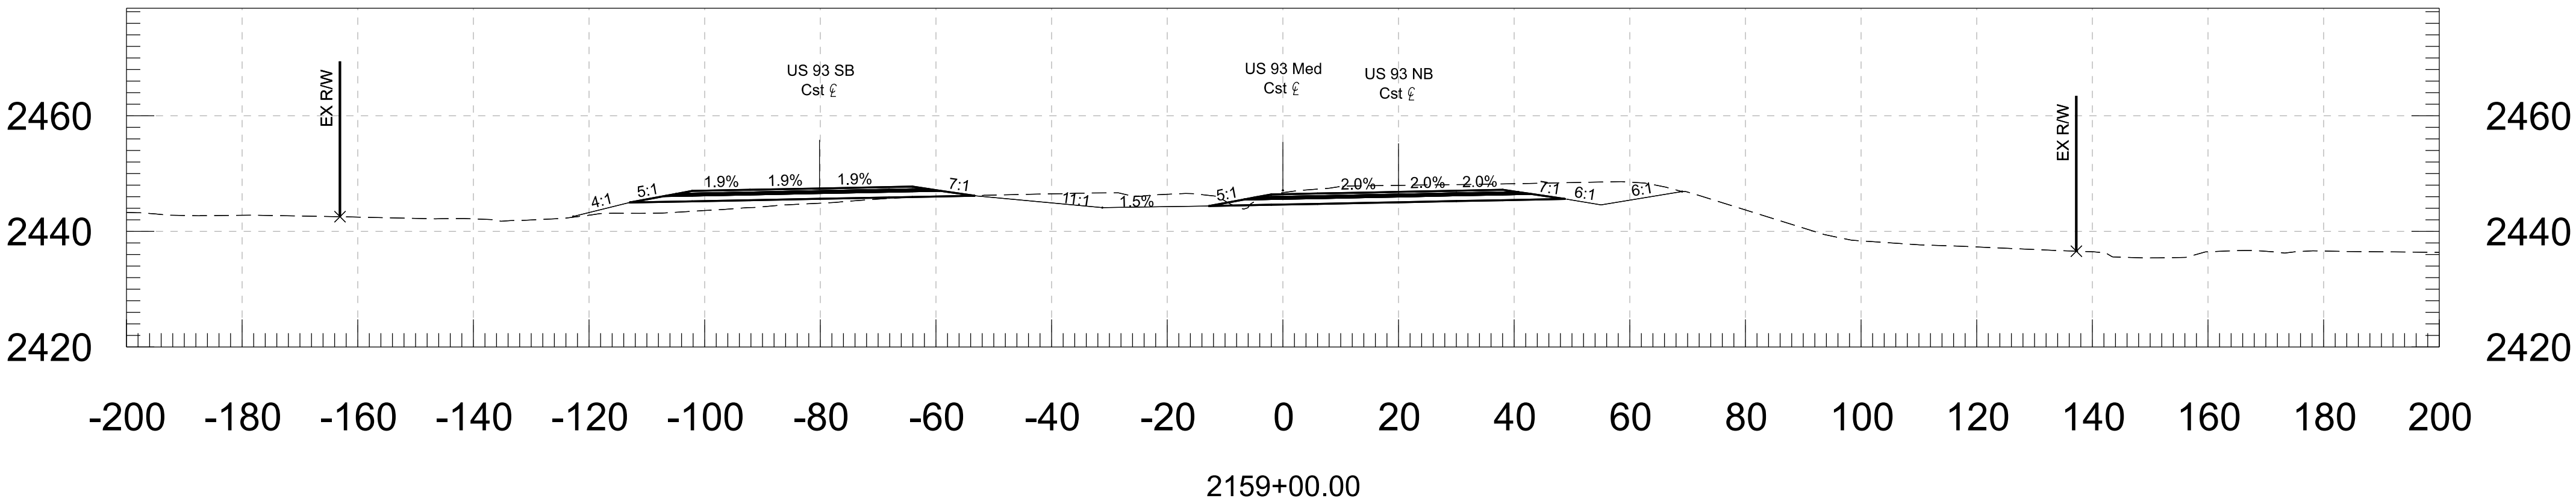




		NAME	DATE	ARIZONA DEPARTMENT OF TRANSPORTATION PROJECT DELIVERY AND OPERATIONS DIVISION ROADWAY DESIGN SERVICES	
DESIGN		ZSZ	06-26		
DRAWN		RM	06-26		
CHECKED		DBK	06-26		
 Stanley Consultants Inc.		3133 East Camelback Road, Suite 100 Phoenix, Arizona 85016 Phone: (602) 353-2200		CROSS SECTIONS	
ROUTE		LOCATION			
US 93		WICKENBURG RANCH WAY TO VISTA ROYALE			
		DWG NO. 23			
TRACS NO. F0738 OIC				093-B(230)T	
				___ OF ___	

F.H.W.A. REGION	STATE	PROJECT NO.	SHEET NO.	TOTAL SHEETS	RECORD DRAWING
9	ARIZ.	093-B(230)T	25	116	
093 YV 189					

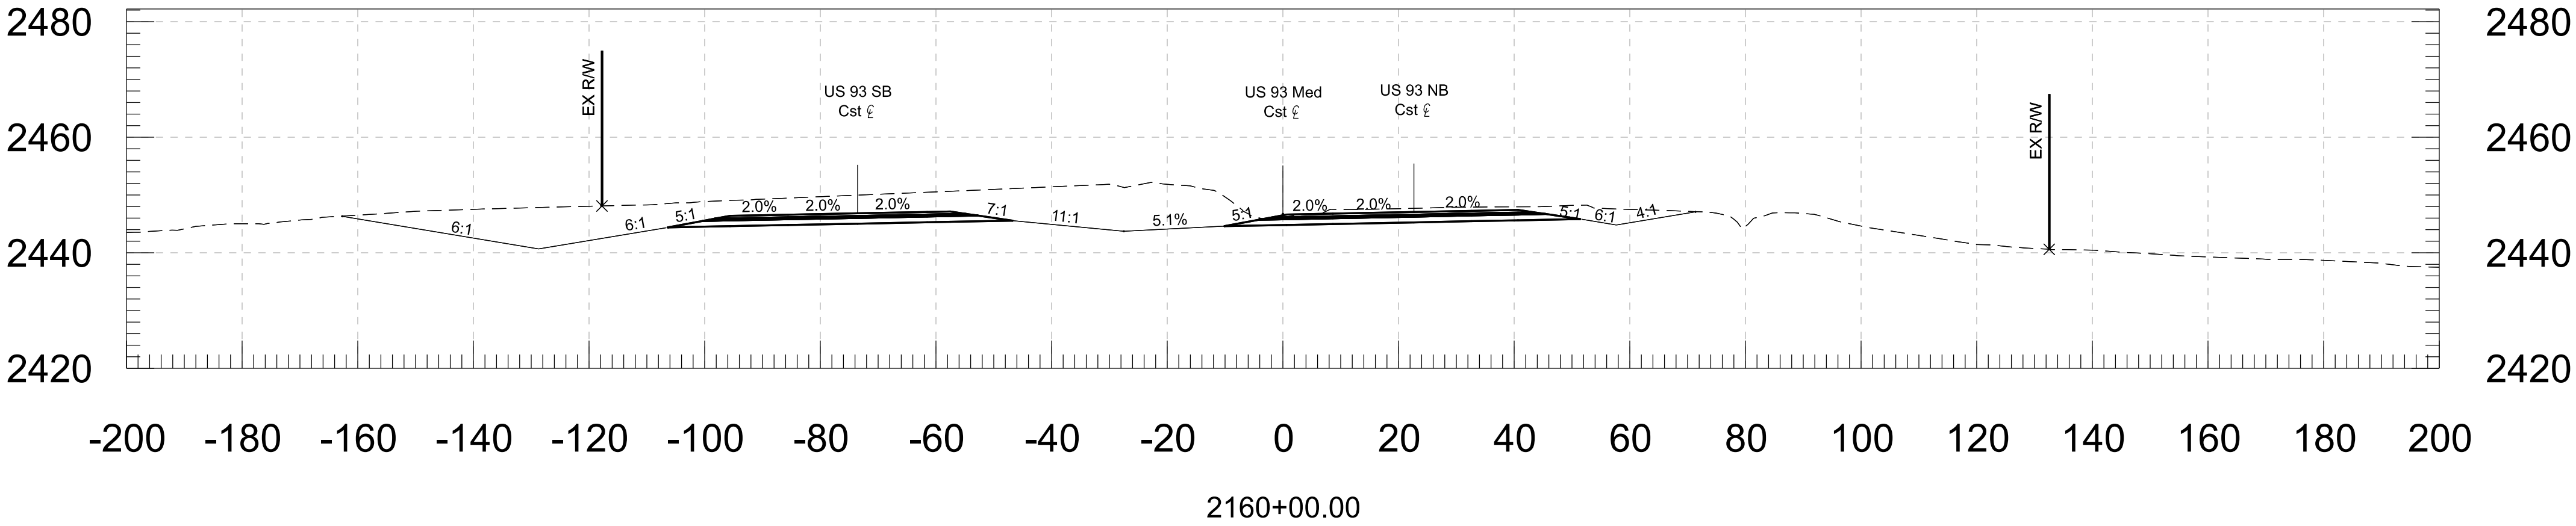

		NAME	DATE	ARIZONA DEPARTMENT OF TRANSPORTATION PROJECT DELIVERY AND OPERATIONS DIVISION ROADWAY DESIGN SERVICES	
DESIGN	ZSZ		06-26		
DRAWN	RM		06-26		
CHECKED	DBK		06-26	CROSS SECTIONS	
Stanley Consultants 333 East Camelback Road, Suite 100 Phoenix, Arizona 85016 Phone: 1602/333-2200					
ROUTE		LOCATION			DWG NO.
US 93		WICKENBURG RANCH WAY TO VISTA ROYALE			24
TRACS NO. F0738 OIC			093-B(230)T		___ OF ___




F.H.W.A. REGION	STATE	PROJECT NO.	SHEET NO.	TOTAL SHEETS	RECORD DRAWING
9	ARIZ.	093-B(230)T	26	116	
093 YV 189					

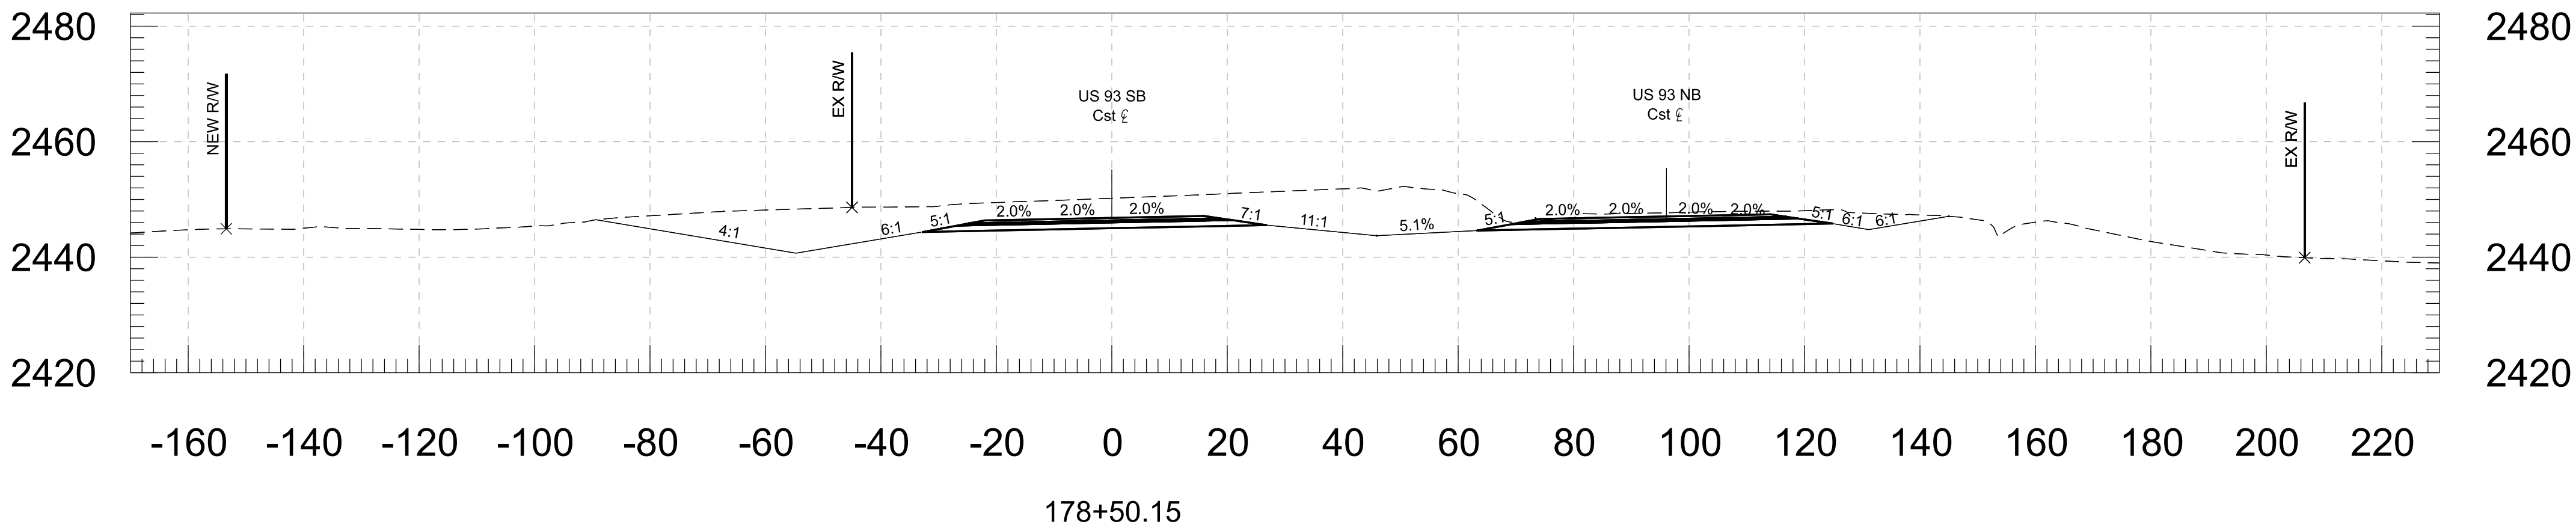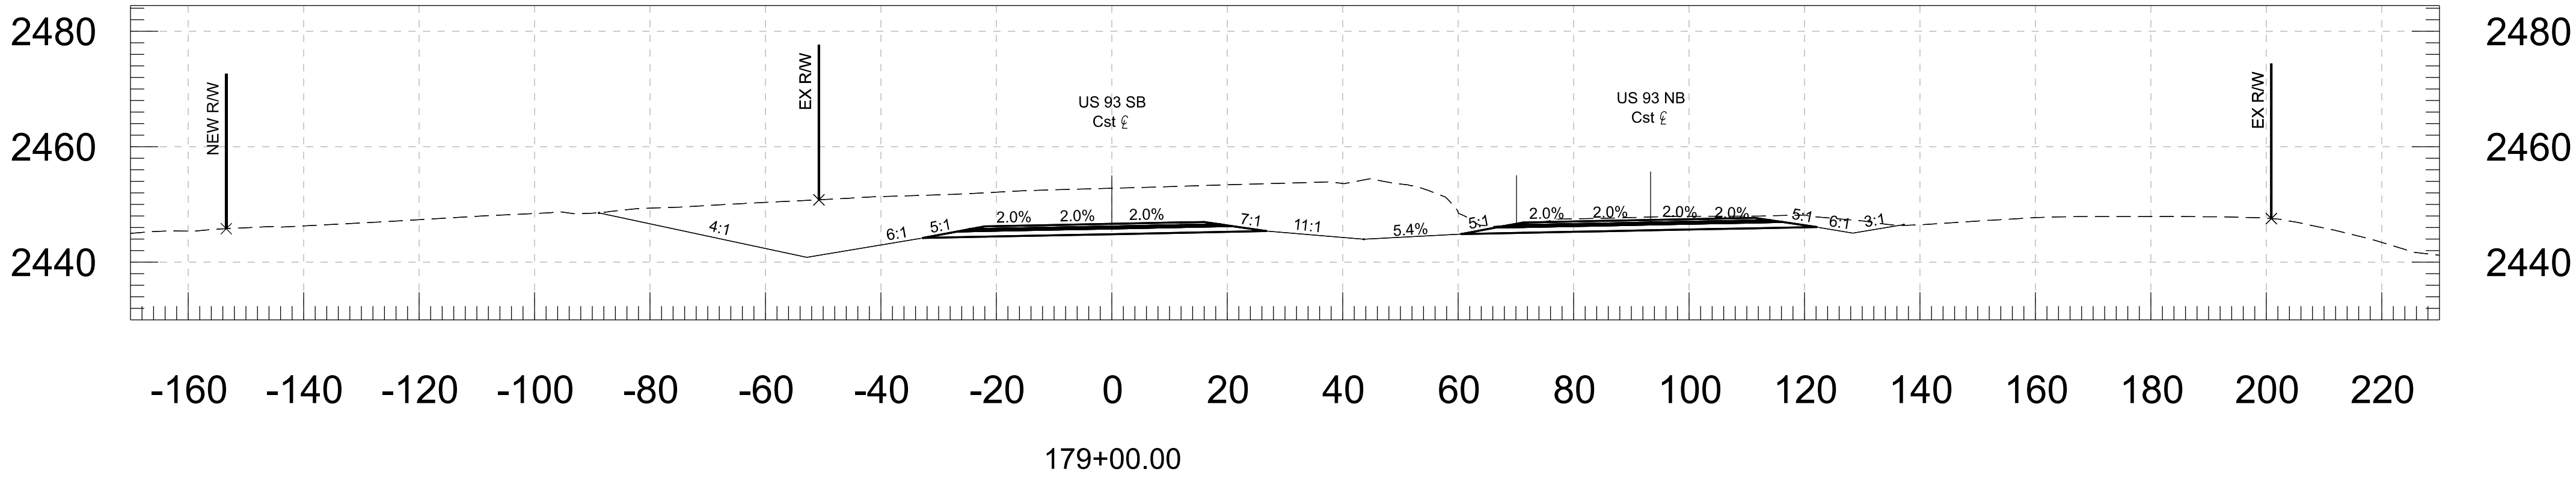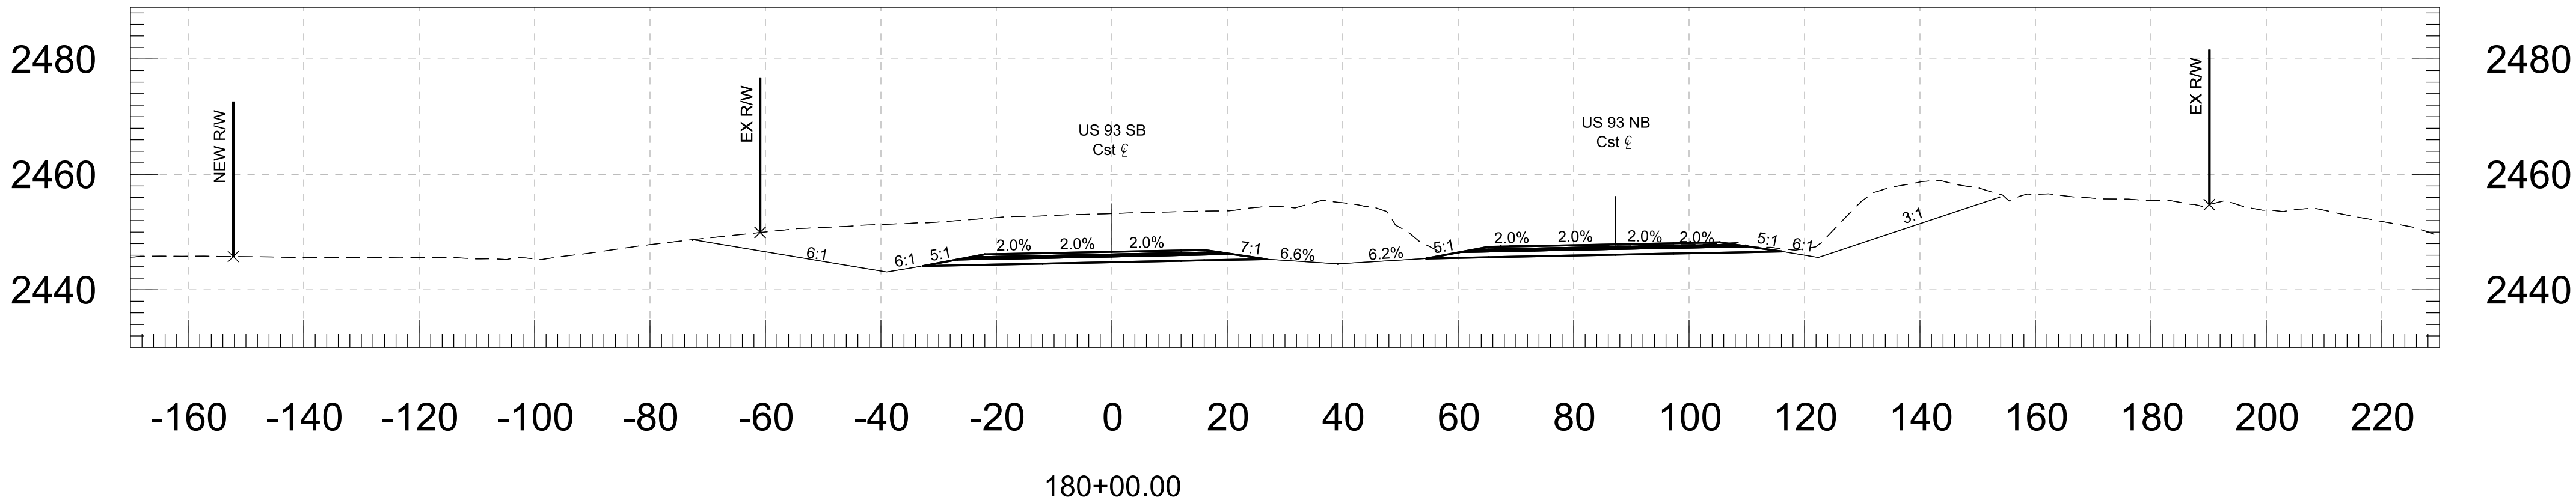

		NAME	DATE	ARIZONA DEPARTMENT OF TRANSPORTATION PROJECT DELIVERY AND OPERATIONS DIVISION ROADWAY DESIGN SERVICES		
DESIGN		ZSZ	06-26			
DRAWN		RM	06-26			
CHECKED		DBK	06-26			
		3133 East Camelback Road, Suite 100 Phoenix, Arizona 85016 Phone: 602/ 353-2200		CROSS SECTIONS		
Stanley Consultants INC.						
ROUTE		LOCATION				
US 93		WICKENBURG RANCH WAY TO VISTA ROYALE			DWG NO. 25	
TRACS NO. F0738 OIC			093-B(230)T		___ OF ___	

F.H.W.A. REGION	STATE	PROJECT NO.	SHEET NO.	TOTAL SHEETS	RECORD DRAWING
9	ARIZ.	093-B(230)T	27	116	




093 YV 189

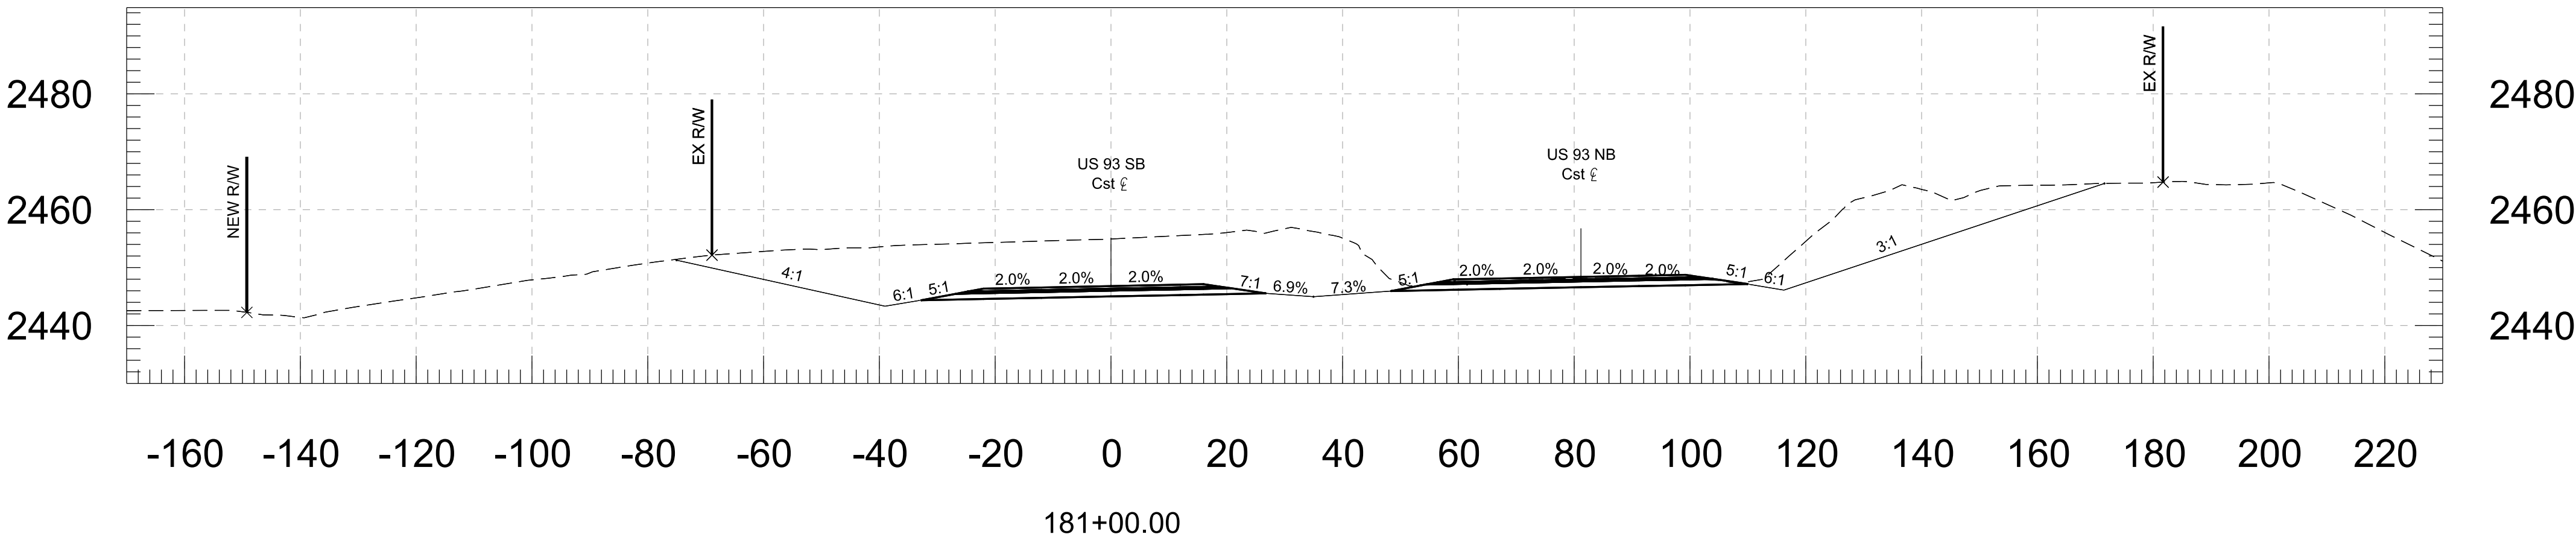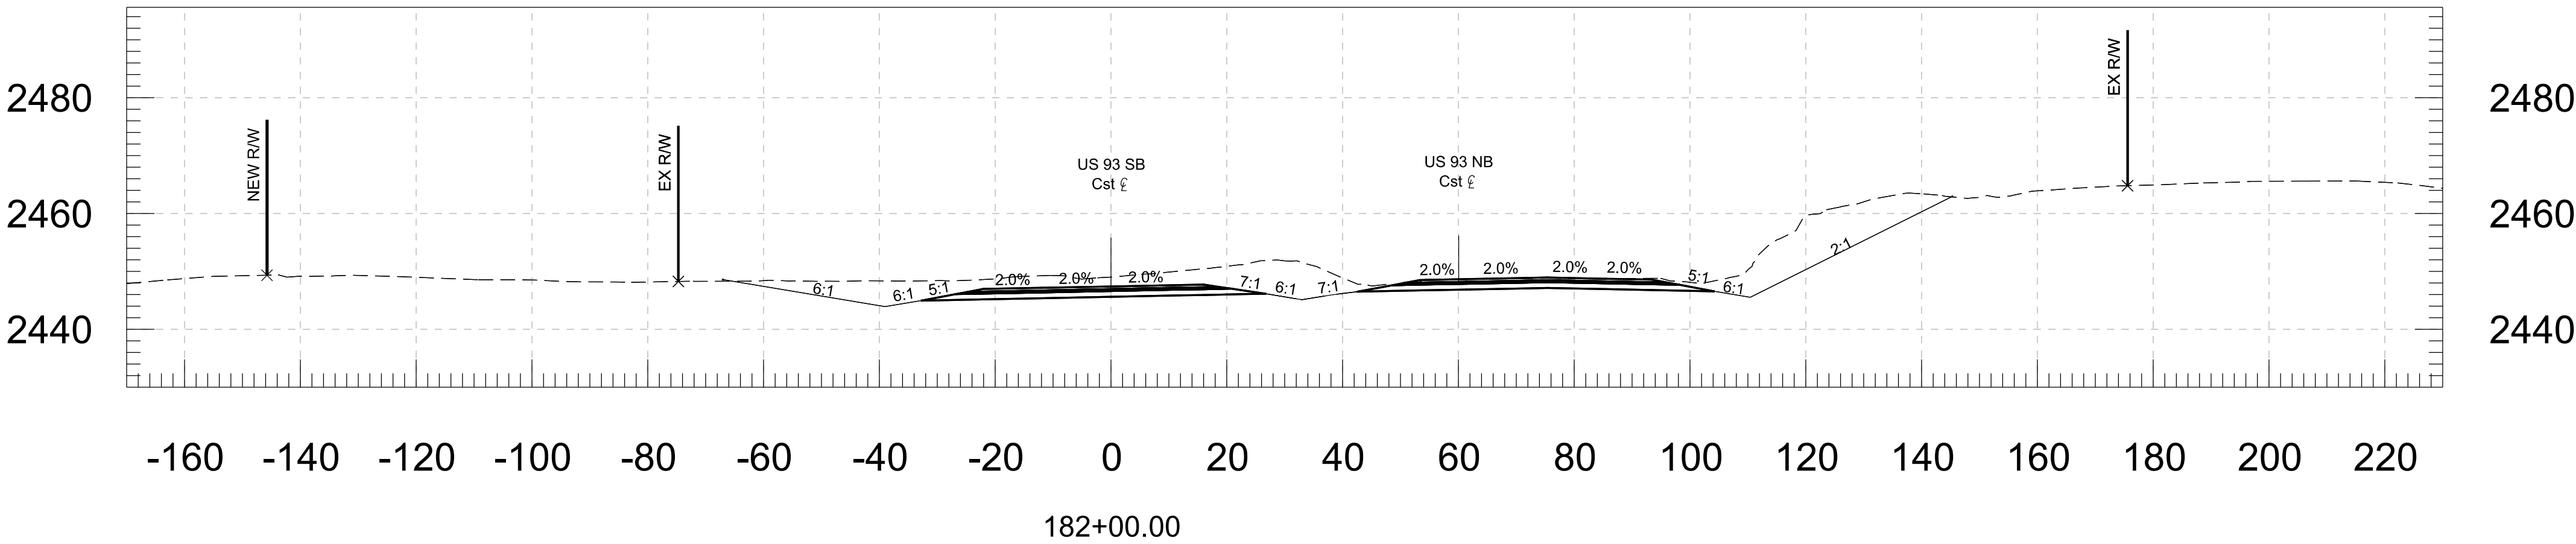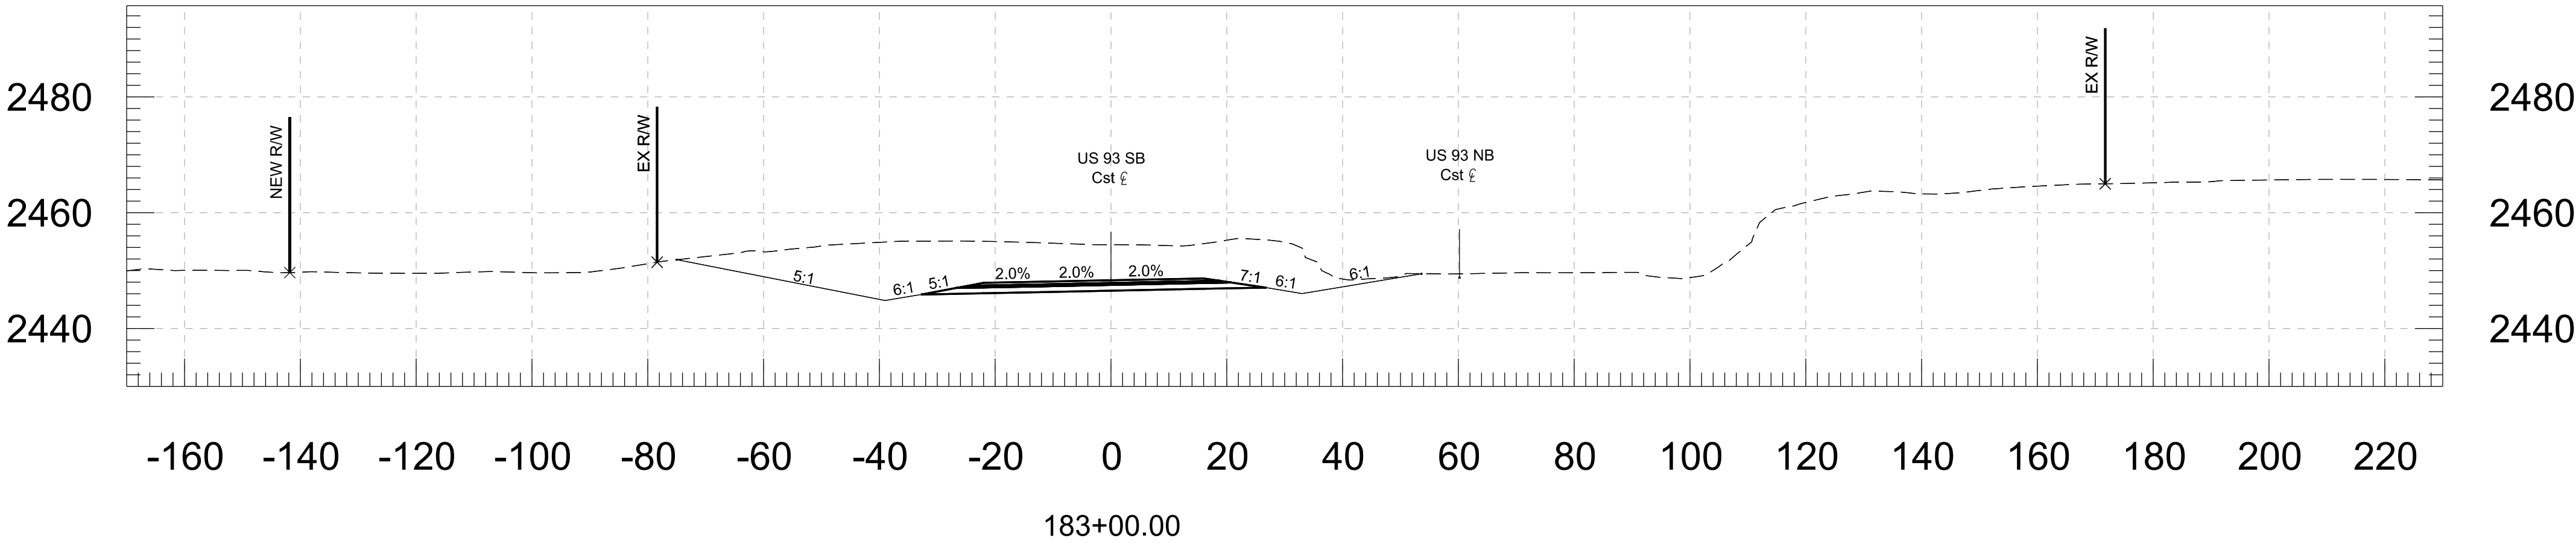

DESIGN	ZSZ	DATE	06-26	ARIZONA DEPARTMENT OF TRANSPORTATION PROJECT DELIVERY AND OPERATIONS DIVISION ROADWAY DESIGN SERVICES
DRAWN	RM	DATE	06-26	
CHECKED	DBK	DATE	06-26	
 Stanley Consultants inc. 3333 East Camelback Road, Suite 100 Phoenix, Arizona 85018 Phone: 1602 333-2200				CROSS SECTIONS
ROUTE	US 93	LOCATION	WICKENBURG RANCH WAY TO VISTA ROYALE	
TRACS NO.	F0738 OIC		093-B(230)T	DWG NO. 26 OF




F.H.W.A. REGION	STATE	PROJECT NO.	SHEET NO.	TOTAL SHEETS	RECORD DRAWING
9	ARIZ.	093-B(230)T	28	116	

093 YV 189

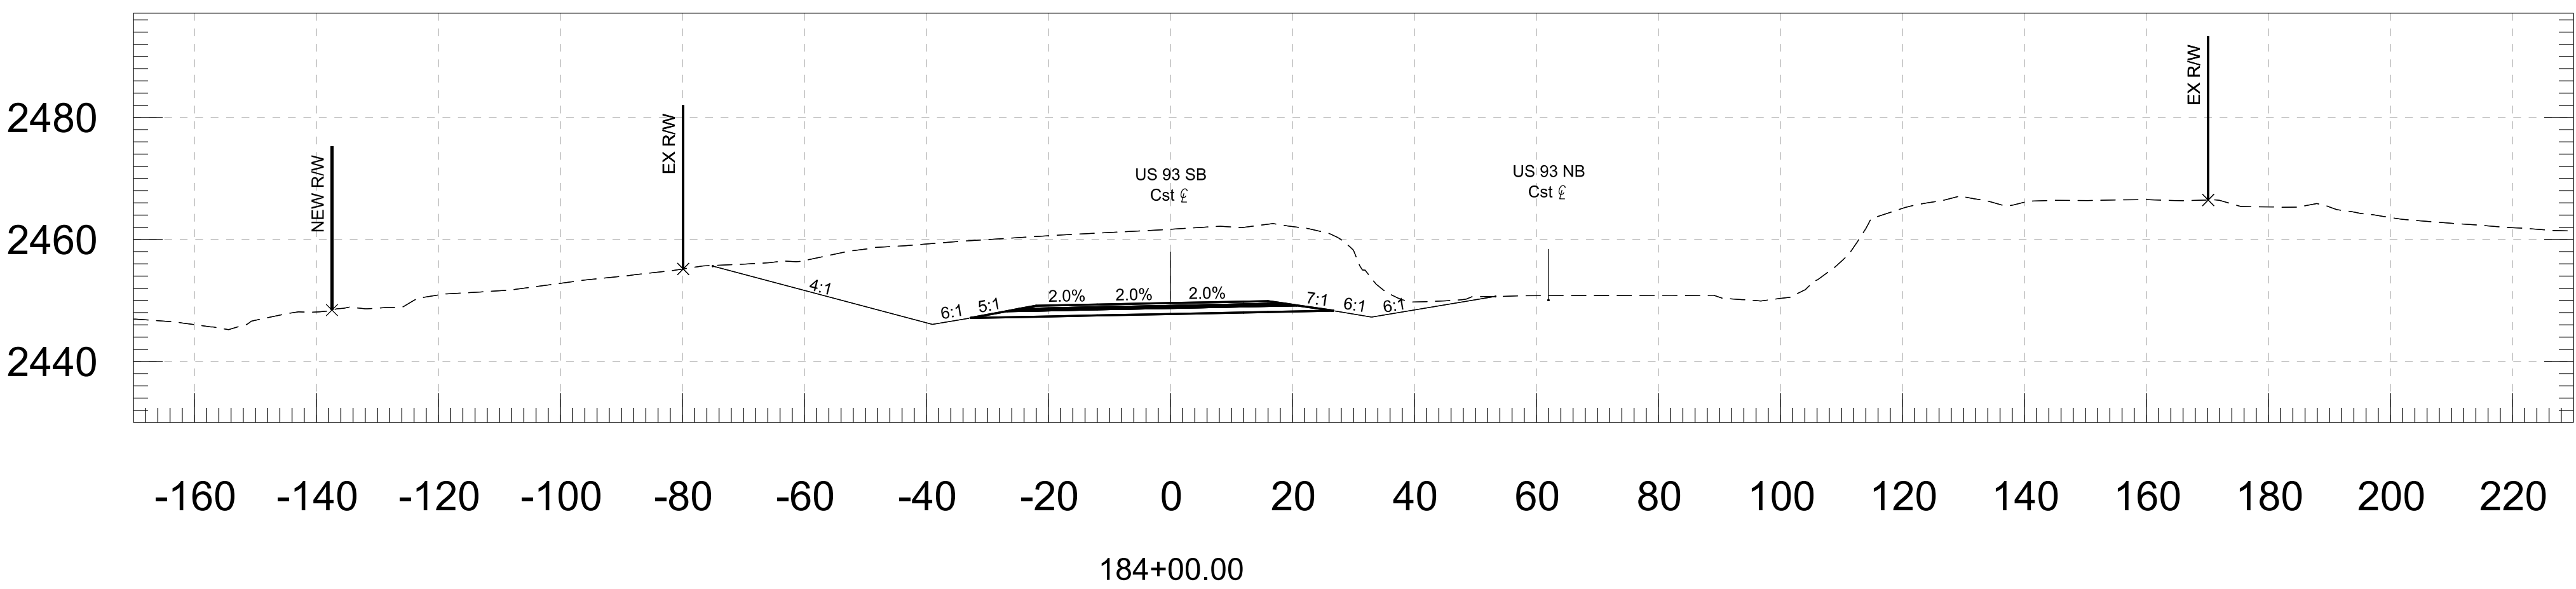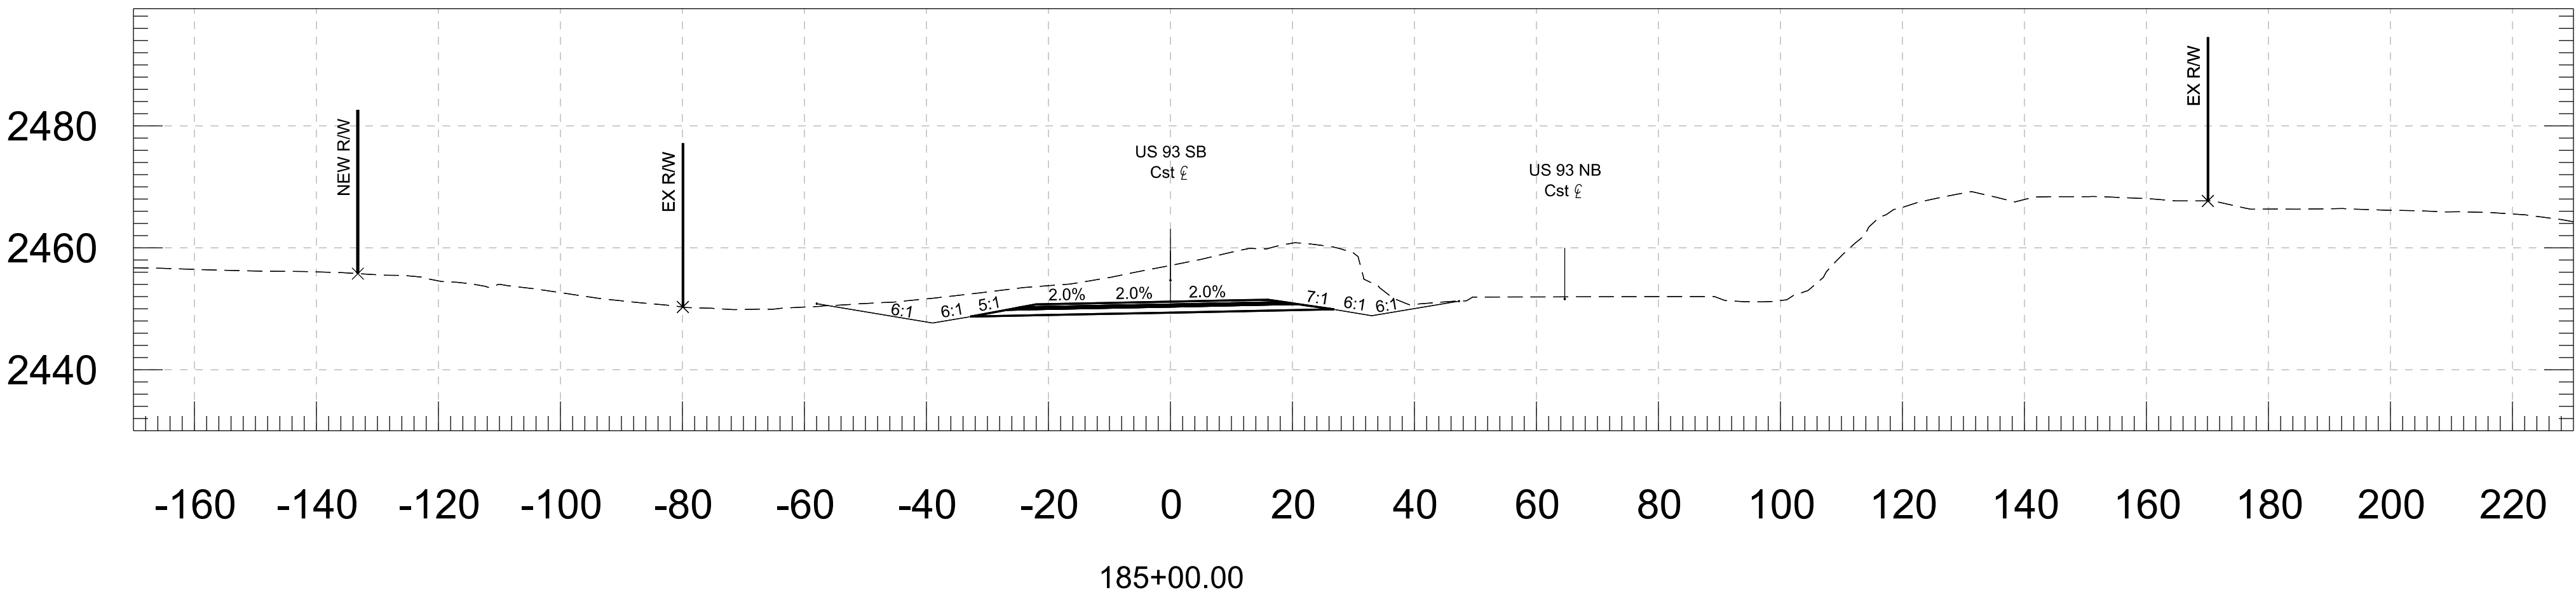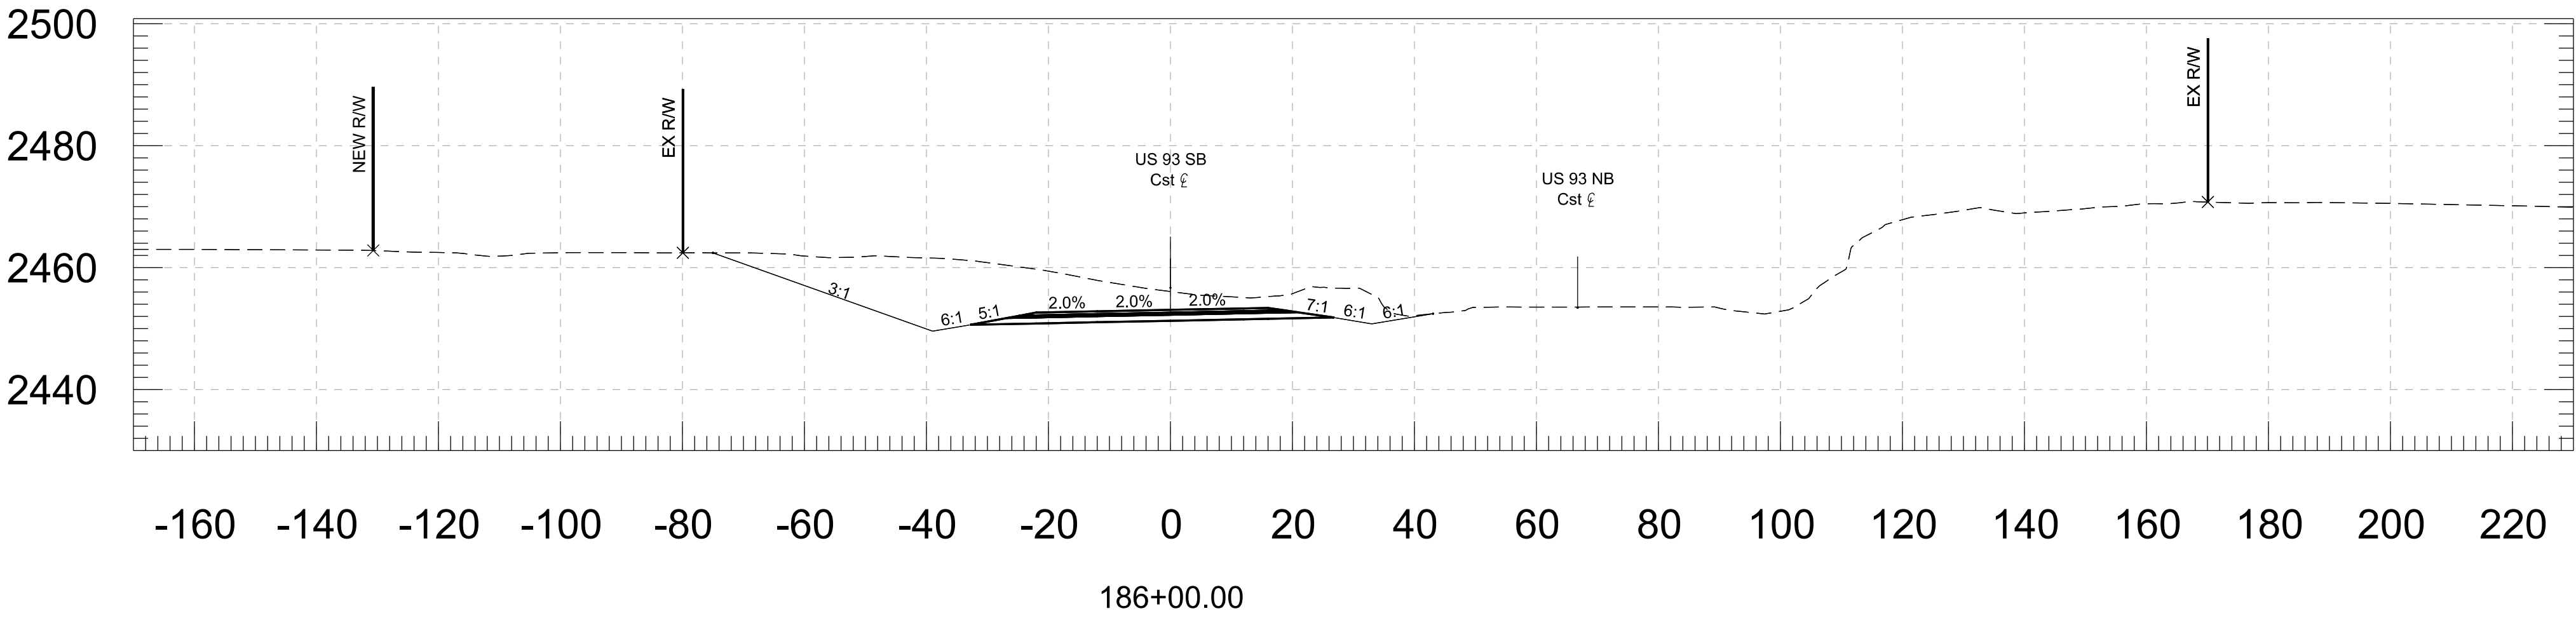

	NAME	DATE	ARIZONA DEPARTMENT OF TRANSPORTATION PROJECT DELIVERY AND OPERATIONS DIVISION ROADWAY DESIGN SERVICES	
DESIGN	ZSZ	06-26		
DRAWN	RM	06-26		
CHECKED	DBK	06-26	CROSS SECTIONS	
 Stanley Consultants inc. 3333 East Camelback Road, Suite 100 Phoenix, Arizona 85018 Phone: 1602/333-2200				
ROUTE	LOCATION			
US 93	WICKENBURG RANCH WAY TO VISTA ROYALE		DWG NO. 27	
TRACS NO. F0738 OIC		093-B(230)T		OF


F.H.W.A. REGION	STATE	PROJECT NO.	SHEET NO.	TOTAL SHEETS	RECORD DRAWING
9	ARIZ.	093-B(230)T	29	116	
093 YV 189					

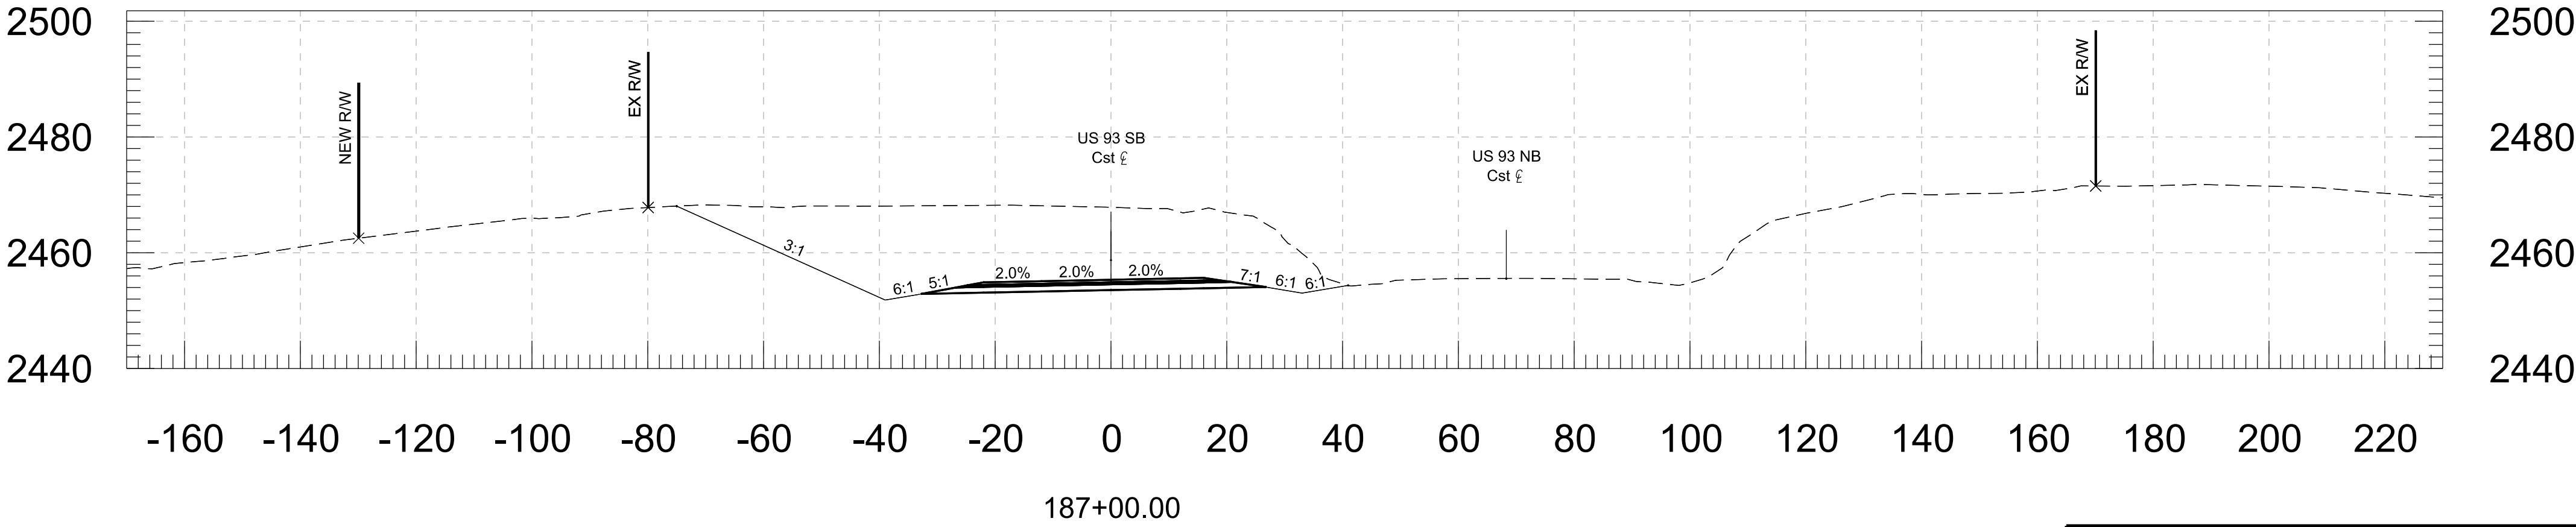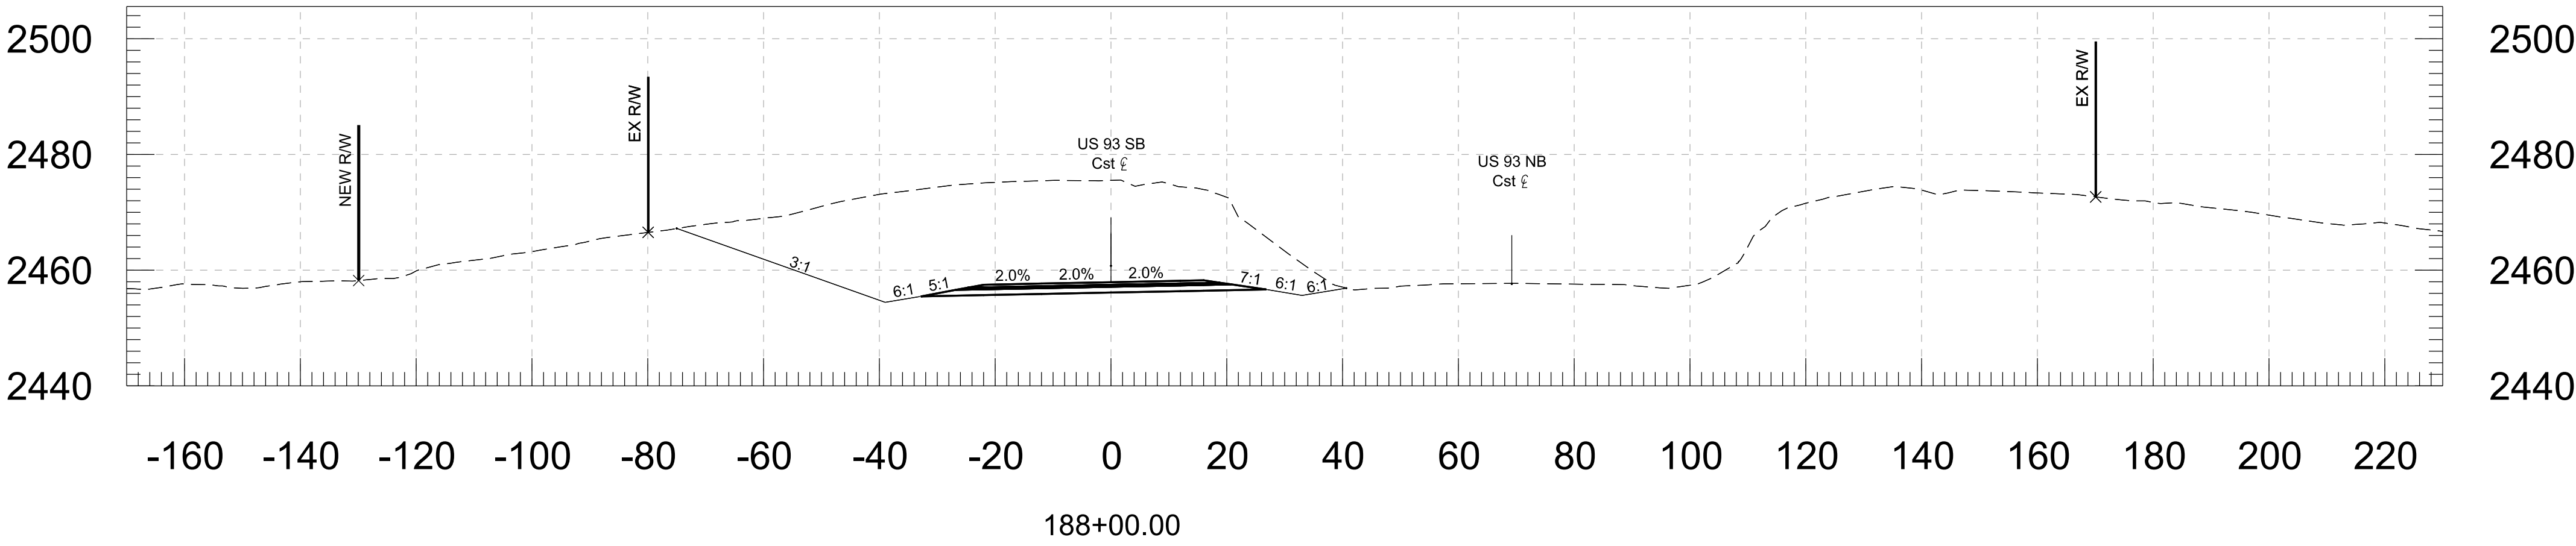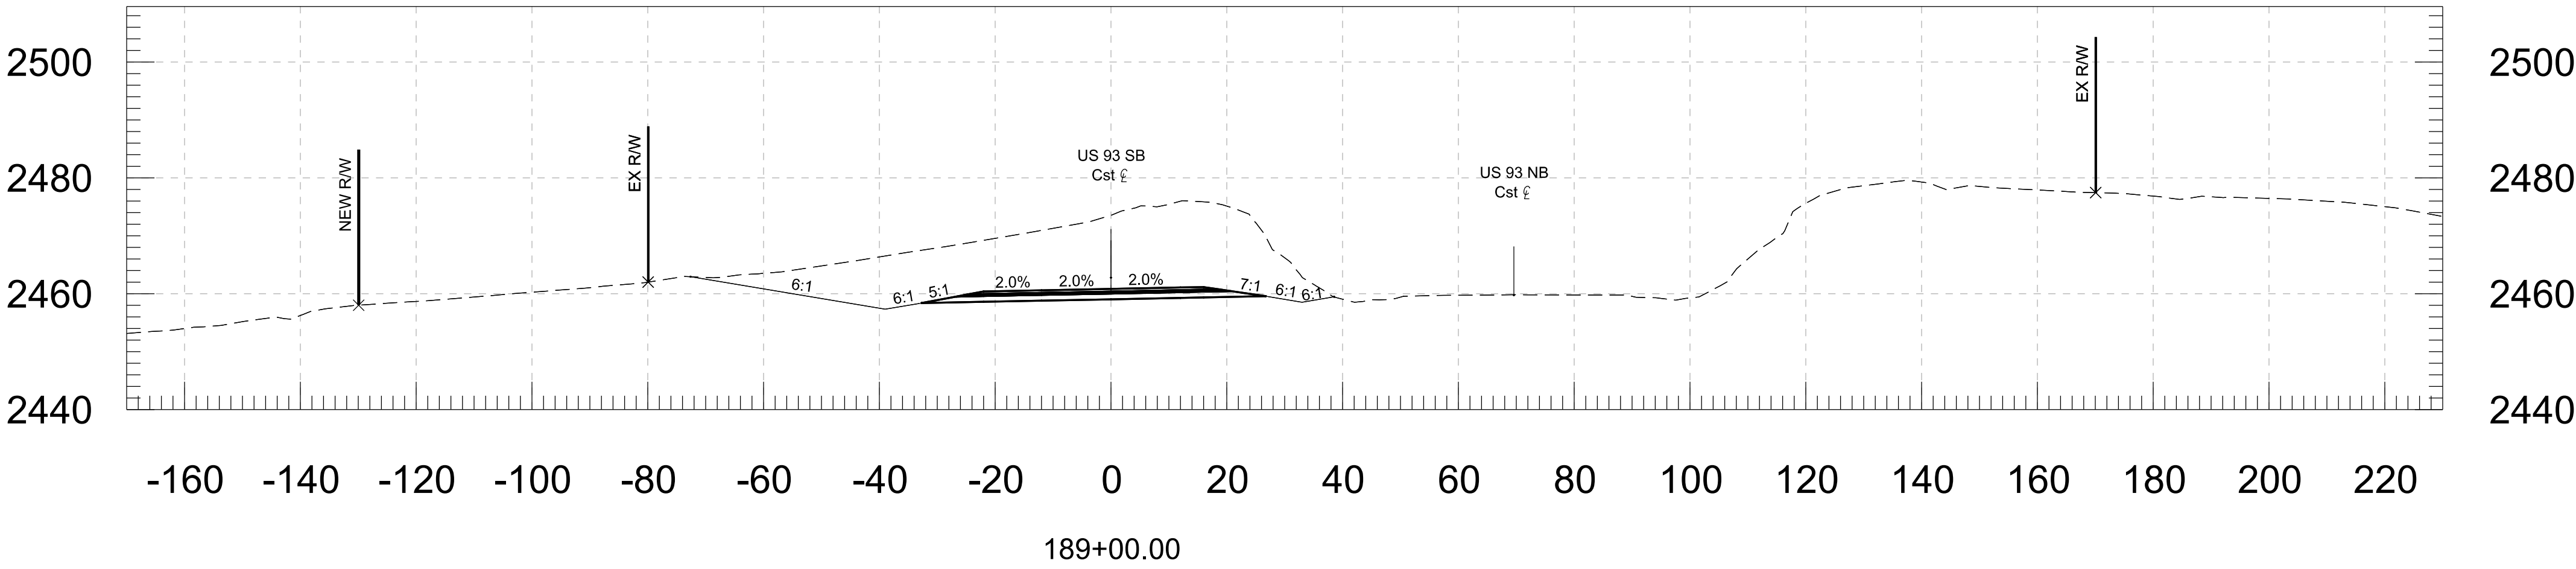


DESIGN	ZSZ	DATE	06-26
DRAWN	RM	DATE	06-26
CHECKED	DBK	DATE	06-26
ARIZONA DEPARTMENT OF TRANSPORTATION PROJECT DELIVERY AND OPERATIONS DIVISION ROADWAY DESIGN SERVICES			
CROSS SECTIONS			
ROUTE	US 93	LOCATION	WICKENBURG RANCH WAY TO VISTA ROYALE
TRACS NO. F0738 OIC			DWG NO. 28
093-B(230)T			OF

F.H.W.A. REGION	STATE	PROJECT NO.	SHEET NO.	TOTAL SHEETS	RECORD DRAWING
9	ARIZ.	093-B(230)T	30	116	


093 YV 189

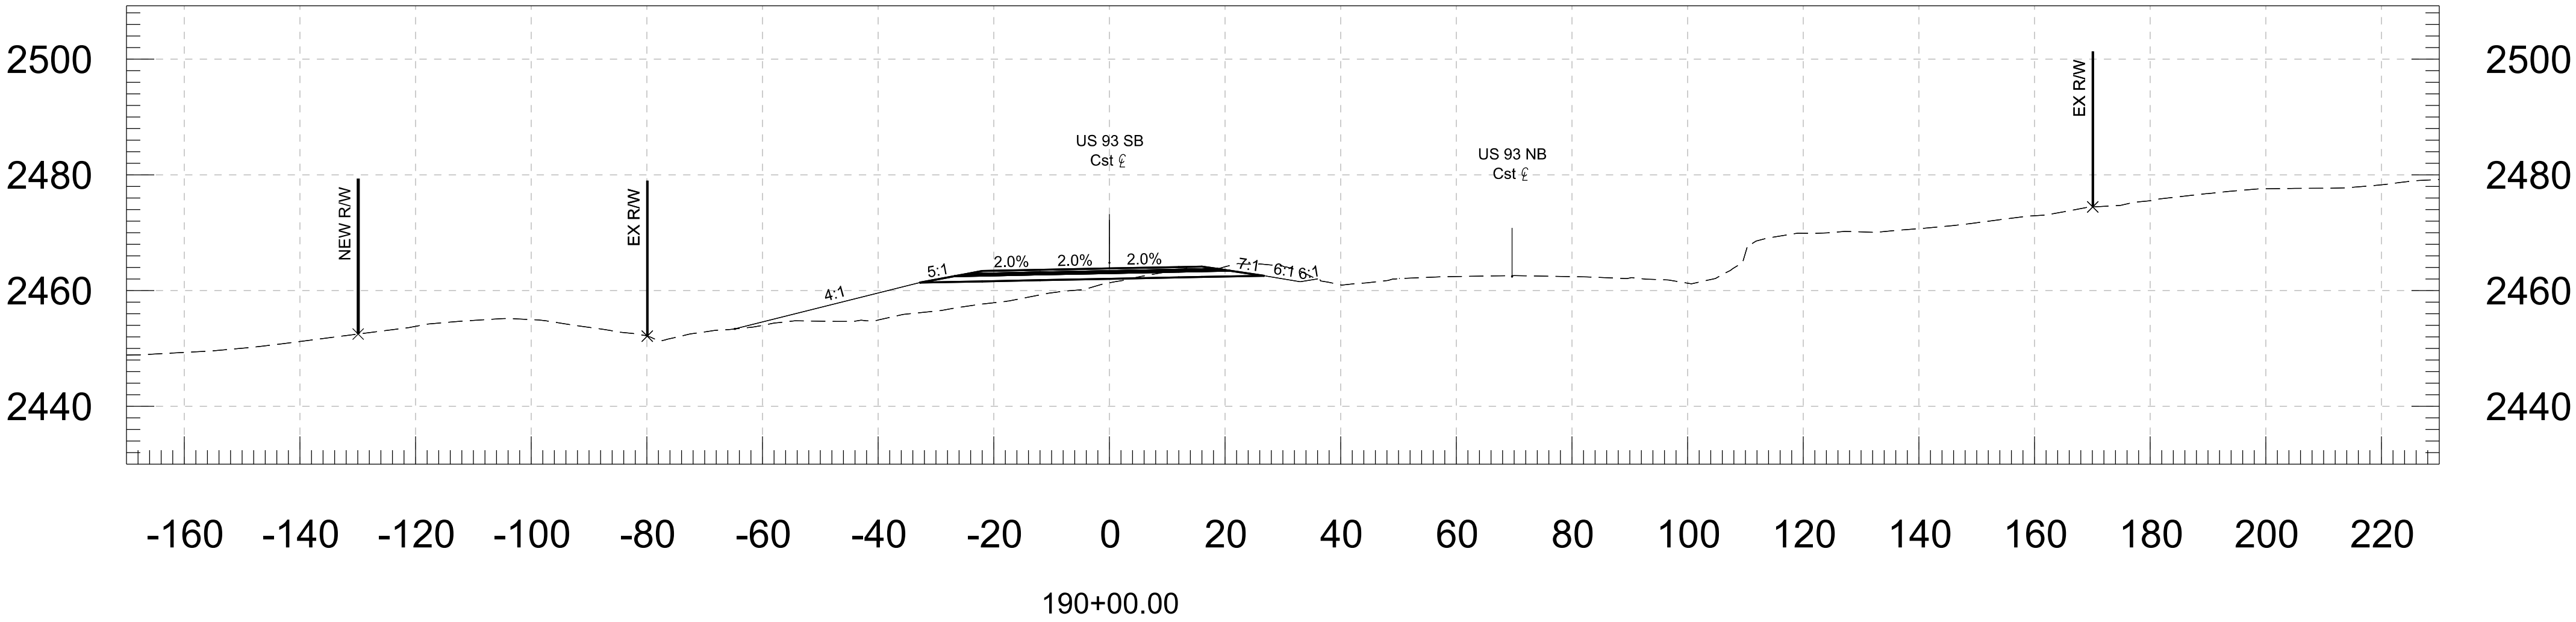


DESIGN	ZSZ	NAME	DATE	ARIZONA DEPARTMENT OF TRANSPORTATION PROJECT DELIVERY AND OPERATIONS DIVISION ROADWAY DESIGN SERVICES
DRAWN	RM		06-26	
CHECKED	DBK		06-26	
 3133 East Camelback Road, Suite 100 Phoenix, Arizona 85016 Phone: 1602 333-2200				CROSS SECTIONS
ROUTE	US 93	LOCATION	WICKENBURG RANCH WAY TO VISTA ROYALE	
TRACS NO.	F0738 OIC		093-B(230)T	DWG NO. 29 OF

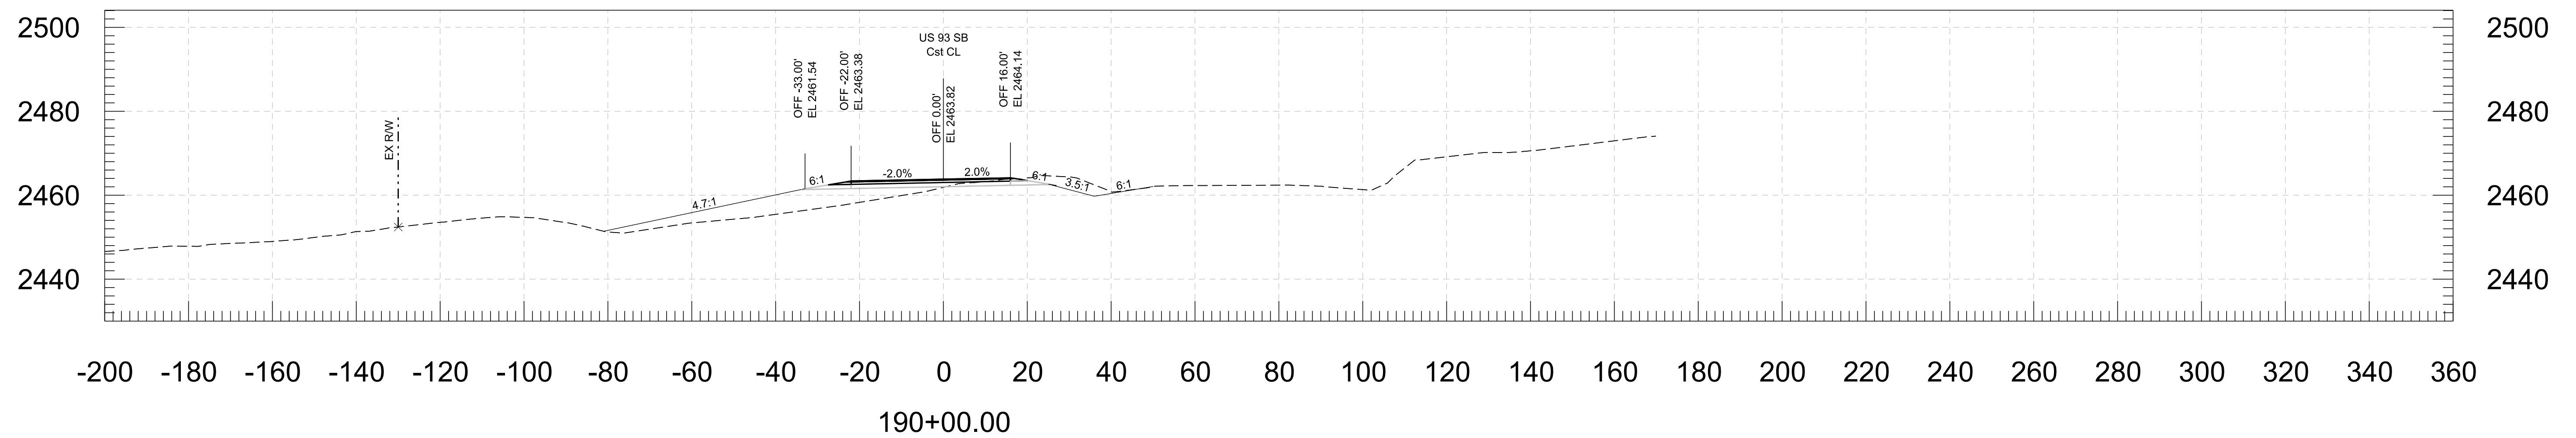



FOR INFORMATION ONLY		NAME	DATE	ARIZONA DEPARTMENT OF TRANSPORTATION PROJECT DELIVERY AND OPERATIONS DIVISION ROADWAY DESIGN SERVICES	ROUTE	F.H.W.A. Arizona Division	STATE ARIZ.	PROJECT NO.	FEDERAL ID NO.	SHEET NO.	TOTAL SHEETS	RECORD DRAWING
	DESIGN	J GILLIS	06/26		US 93			093 YV 189	093-B(230)T	31	116	
	DRAWN	J BEMELEN	06/26		MILEPOST							
	CHECKED	D WIGGINS	06/26	189.9								
		TRANSPORTATION AECOM TECHNICAL SERVICES, Inc. 7720 N. 119th St., Suite 100 Phoenix, Arizona 85050 T 602.371.1100 			CROSS SECTIONS	STRUCTURE NO.	WICKENBURG RANCH WAY TO VISTA ROYALE					DWG No. 30
					TRACS NO. F0738 01C							OF

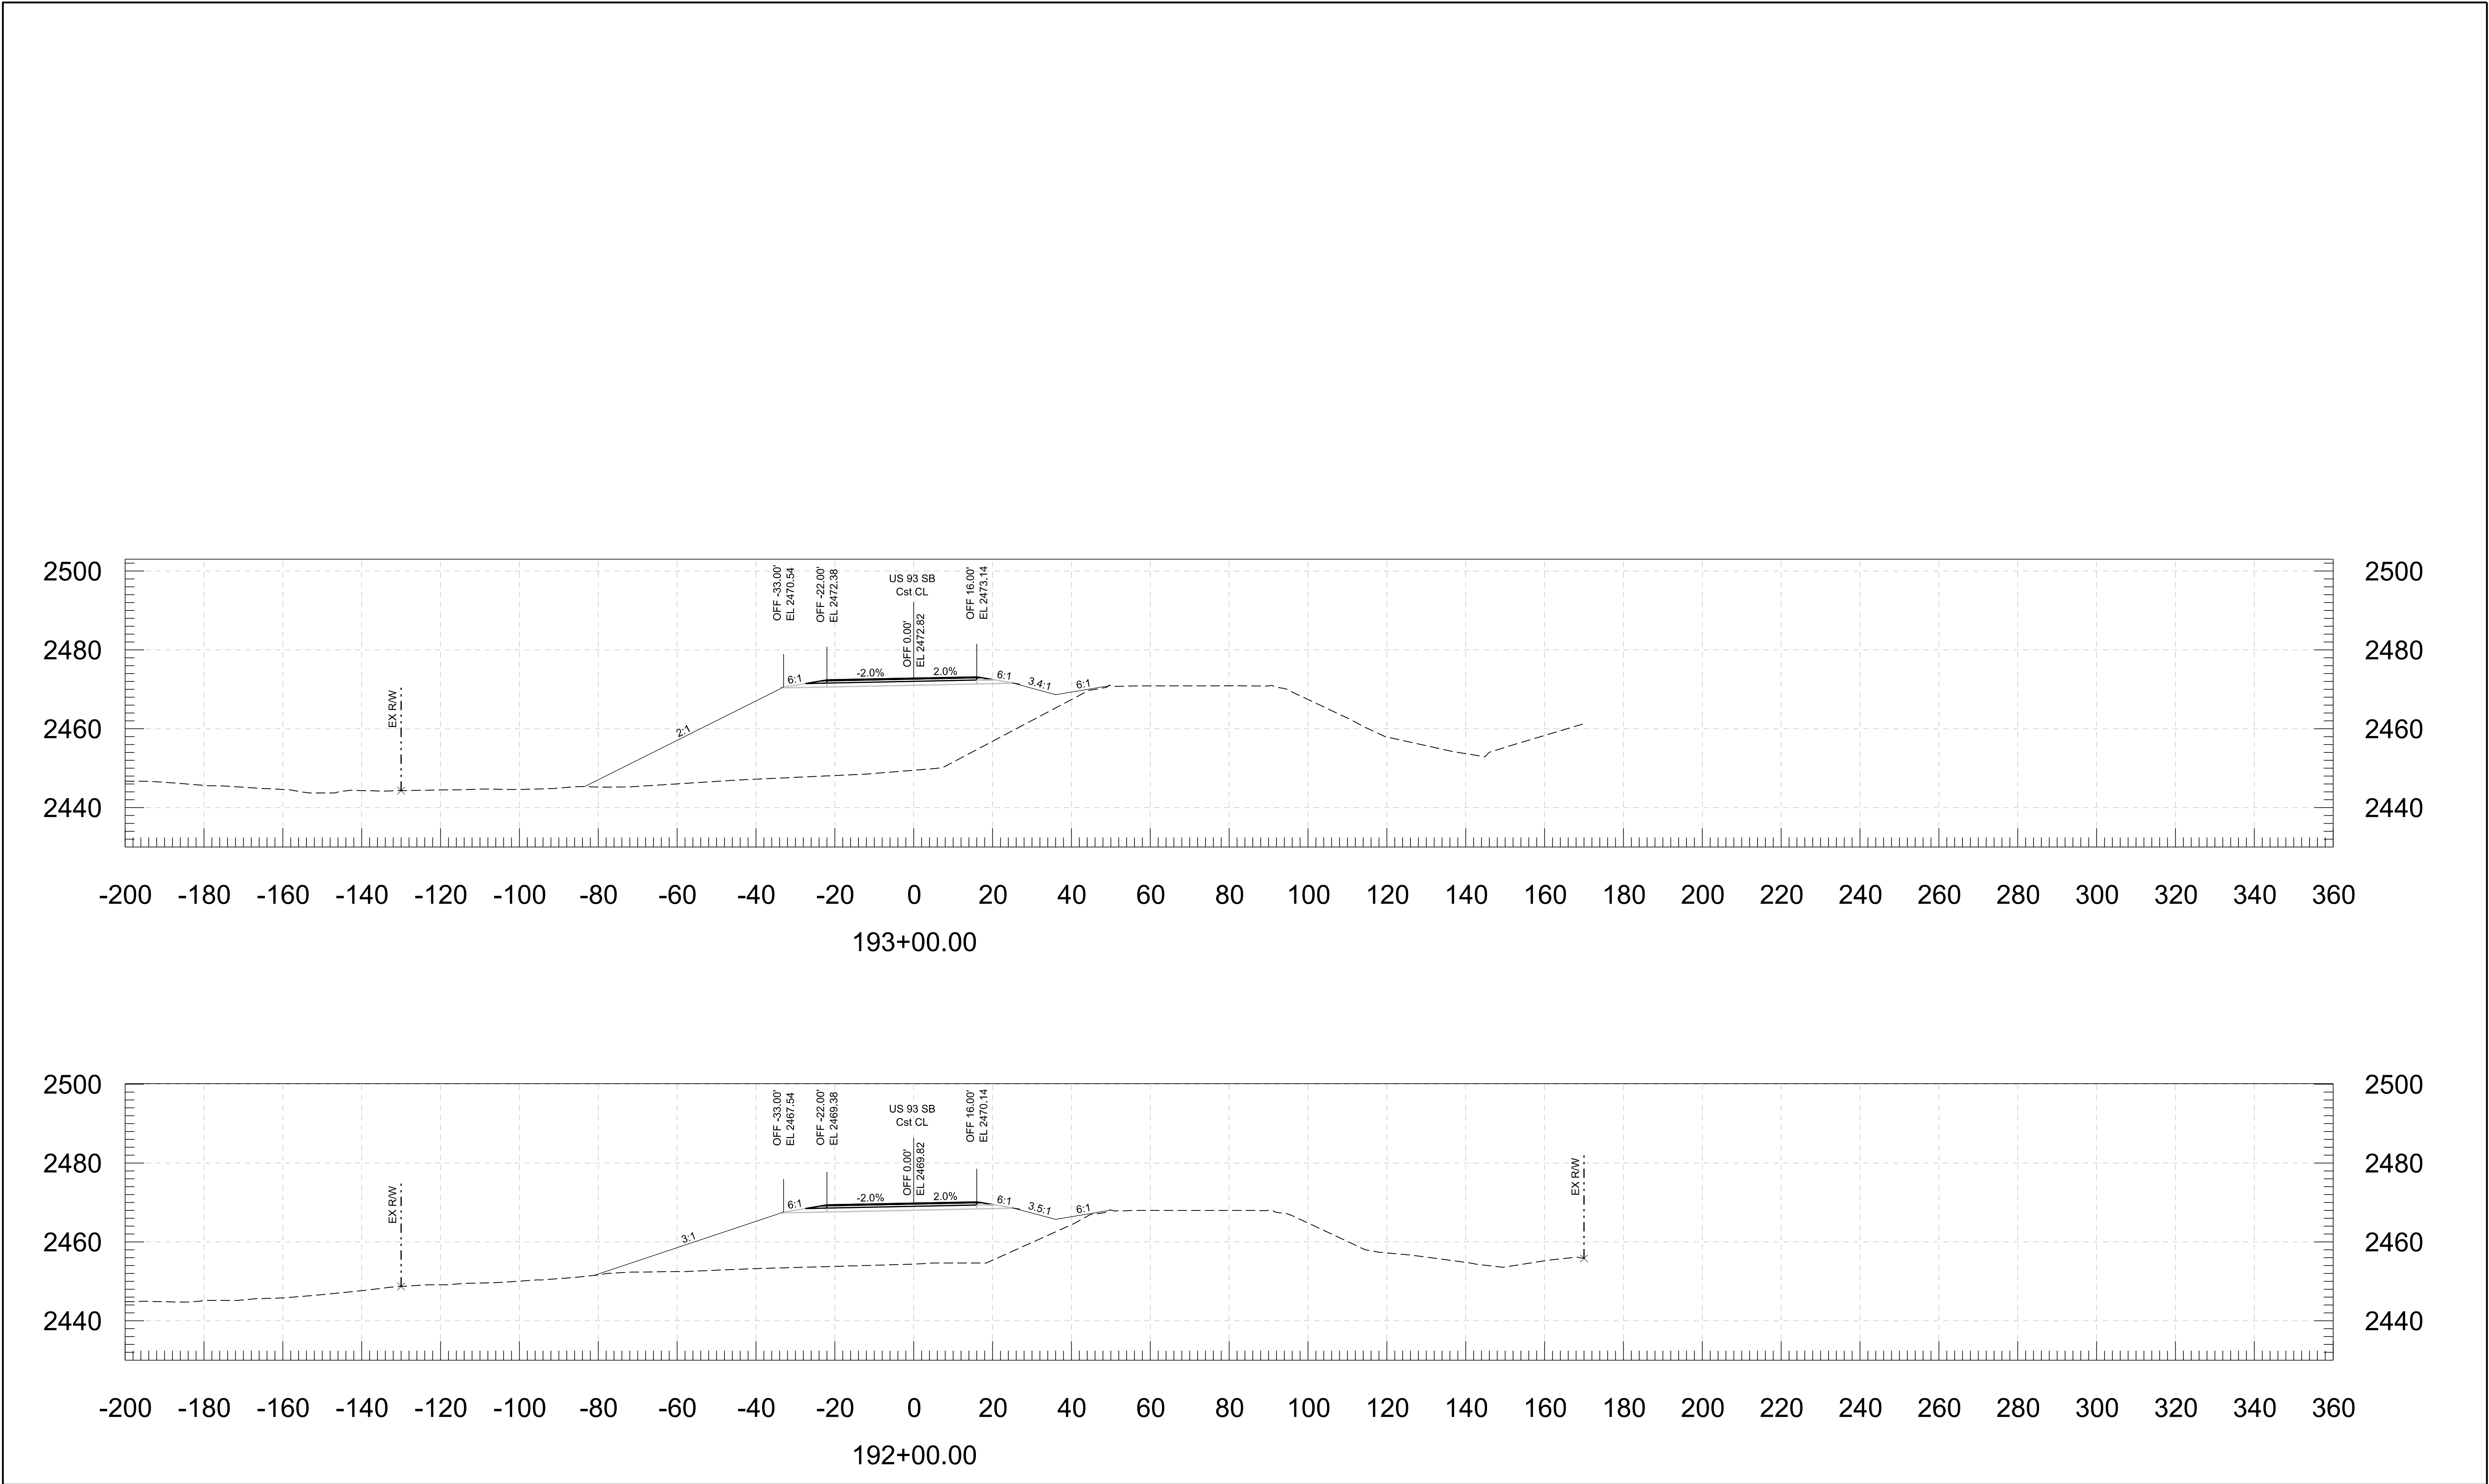



FOR INFORMATION ONLY	DESIGN	J GILLIS	06/26	ARIZONA DEPARTMENT OF TRANSPORTATION PROJECT DELIVERY AND OPERATIONS DIVISION ROADWAY DESIGN SERVICES	ROUTE	F.H.W.A. Arizona Division	STATE	PROJECT NO.	FEDERAL ID NO.	SHEET NO.	TOTAL SHEETS	RECORD DRAWING
	DRAWN	J BEMELLEN	06/26		US 93			093 YV 189	093-B(230)T	32	116	
	CHECKED	D WIGGINS	06/26		MILEPOST	189.9	LOCATION WICKENBURG RANCH WAY TO VISTA ROYALE					
	TRANSPORTATION AECOM TECHNICAL SERVICES, Inc. 7720 N. 16th St., Suite 100 Phoenix, Arizona 85020 T 602.371.1100 www.aecom.com			CROSS SECTIONS	STRUCTURE NO.	TRACS NO. F0738 01C						___ OF ___
	AECOM											



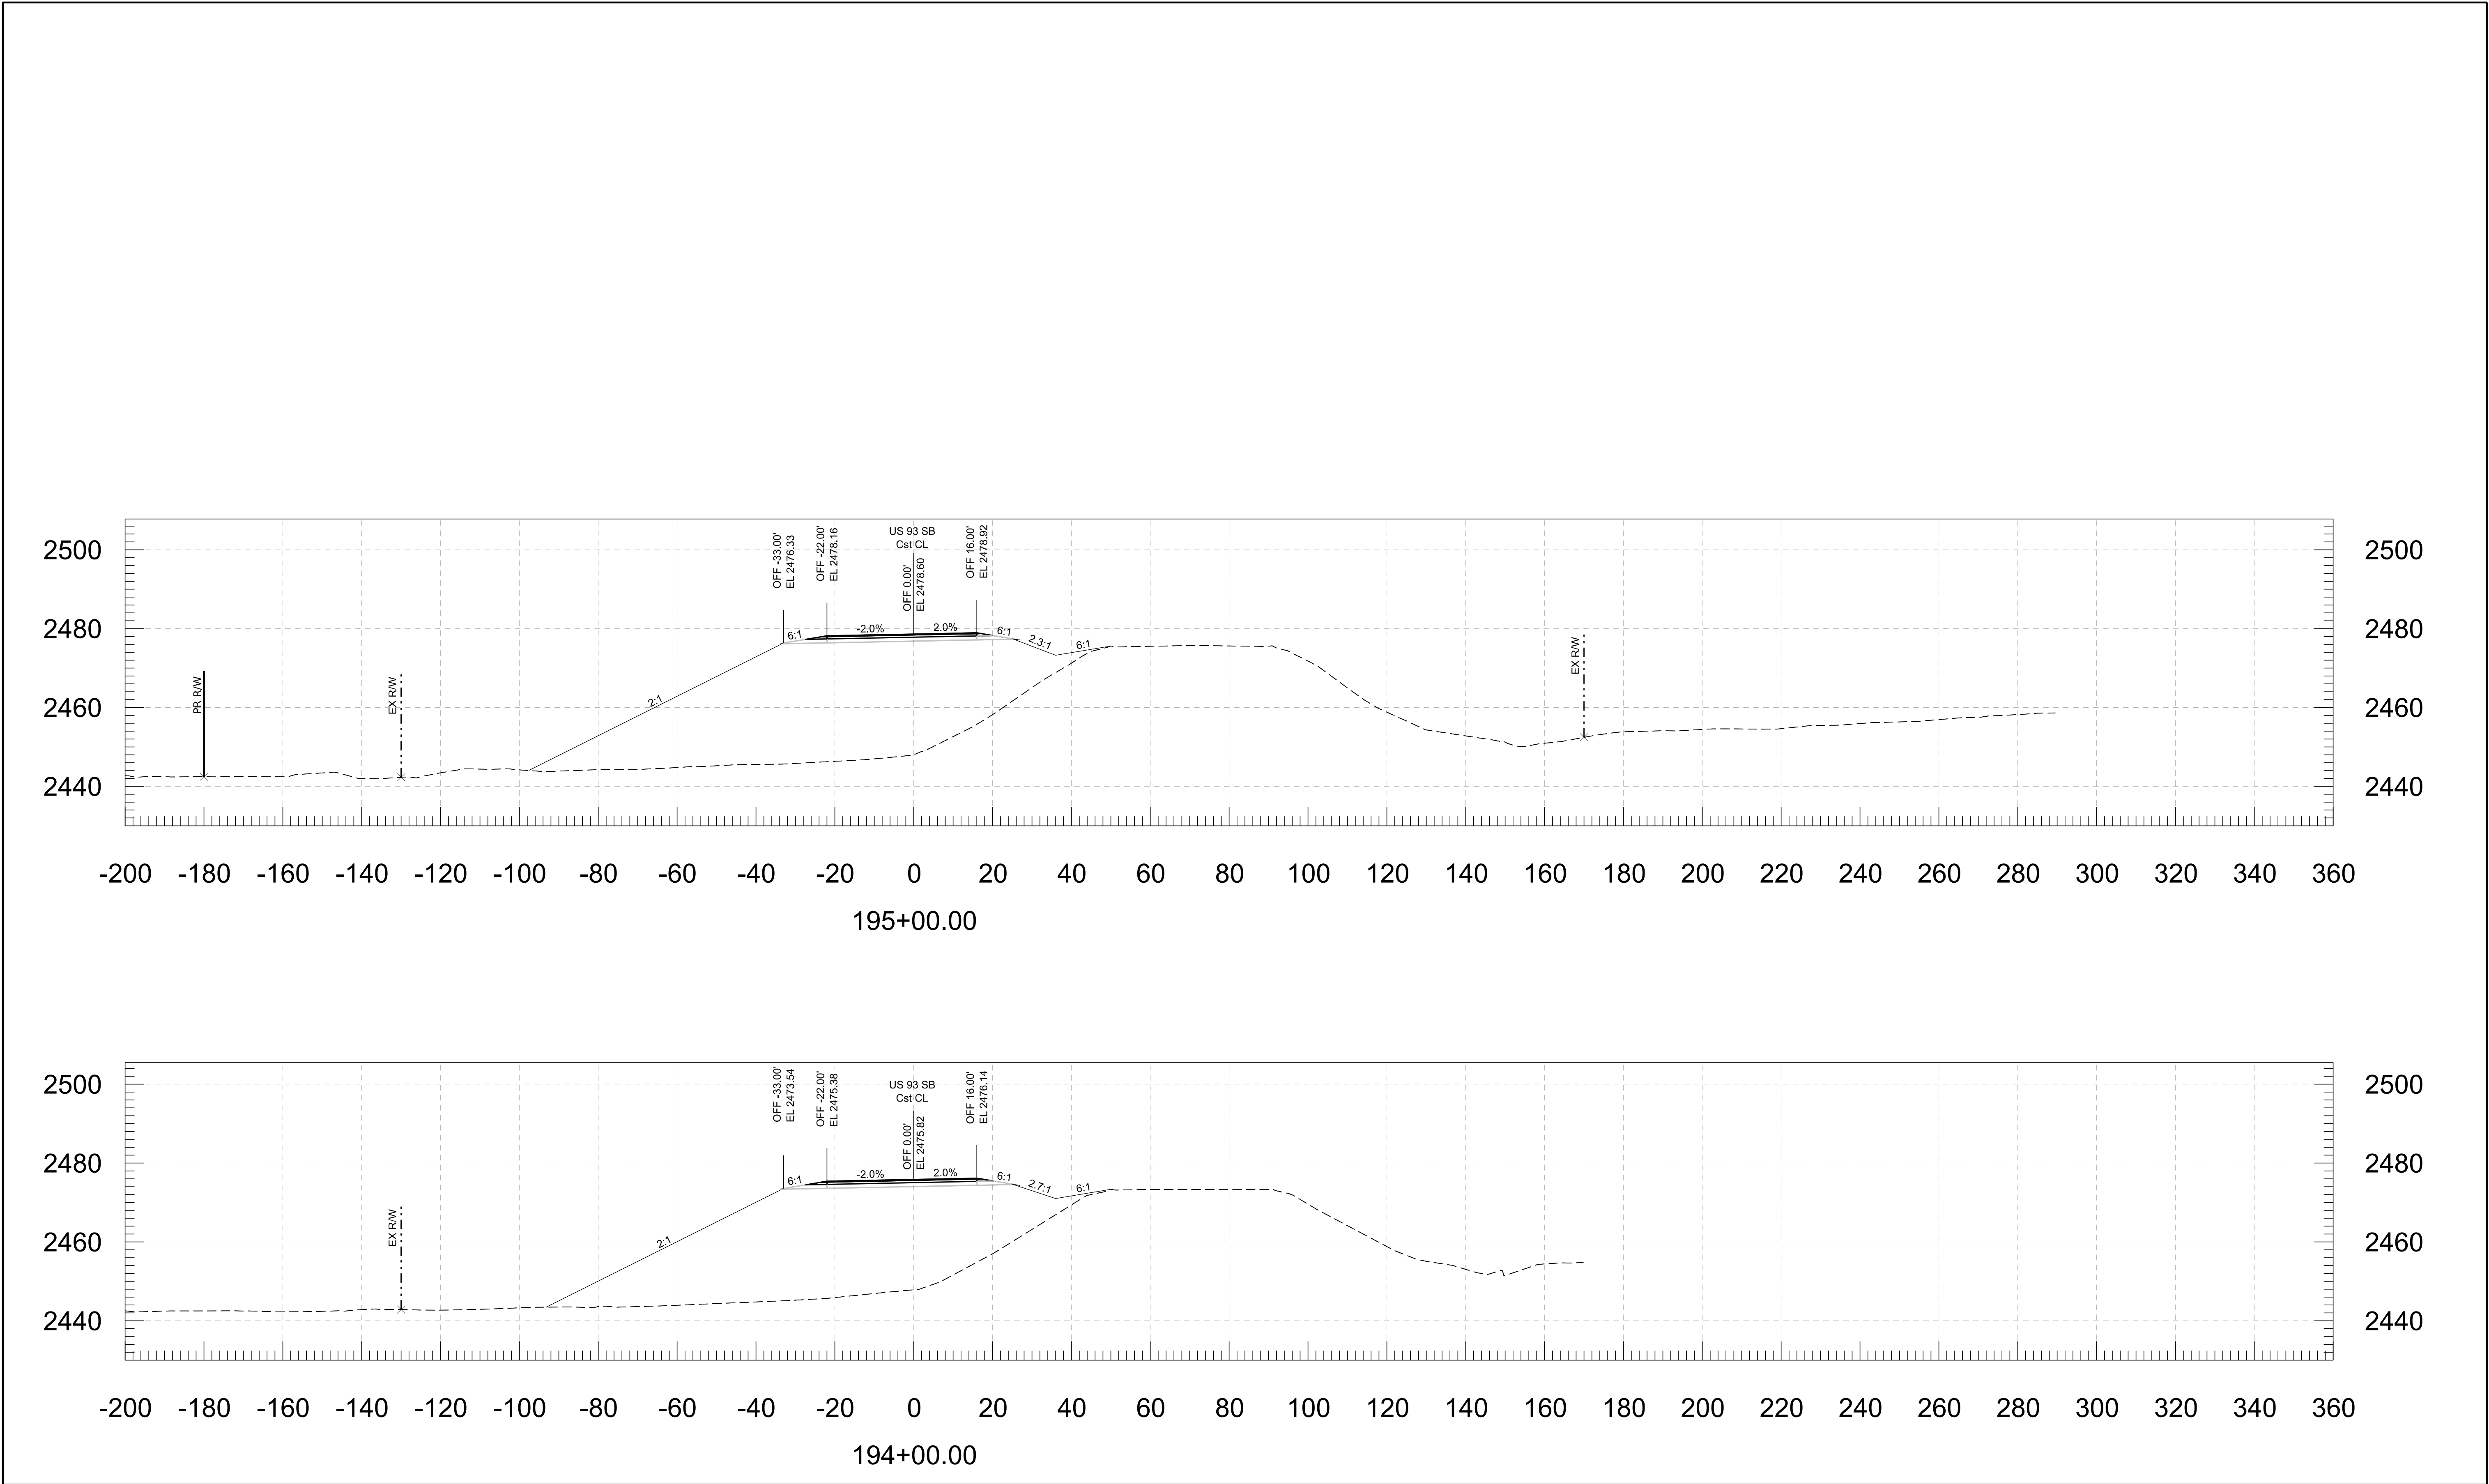


FOR INFORMATION ONLY	DESIGN	J GILLIS	06/26	ARIZONA DEPARTMENT OF TRANSPORTATION PROJECT DELIVERY AND OPERATIONS DIVISION ROADWAY DESIGN SERVICES	ROUTE	US 93	F.H.W.A. Arizona Division	STATE ARIZ.	PROJECT NO.	FEDERAL ID NO.	SHEET NO.	TOTAL SHEETS	RECORD DRAWING
	DRAWN	J BEMELEN	06/26		093 YV 189	093-B(230)T			33	116			
	CHECKED	D WIGGINS	06/26		CROSS SECTIONS	MILEPOST	189.9	LOCATION WICKENBURG RANCH WAY TO VISTA ROYALE					DWG No. 32
	TRANSPORTATION AECOM TECHNICAL SERVICES, Inc. 7720 N. 18th St., Suite 100 Phoenix, Arizona 85020 T 602.371.1100 www.aecom.com			STRUCTURE NO.		TRACS NO. F0738 01C					OF		
													


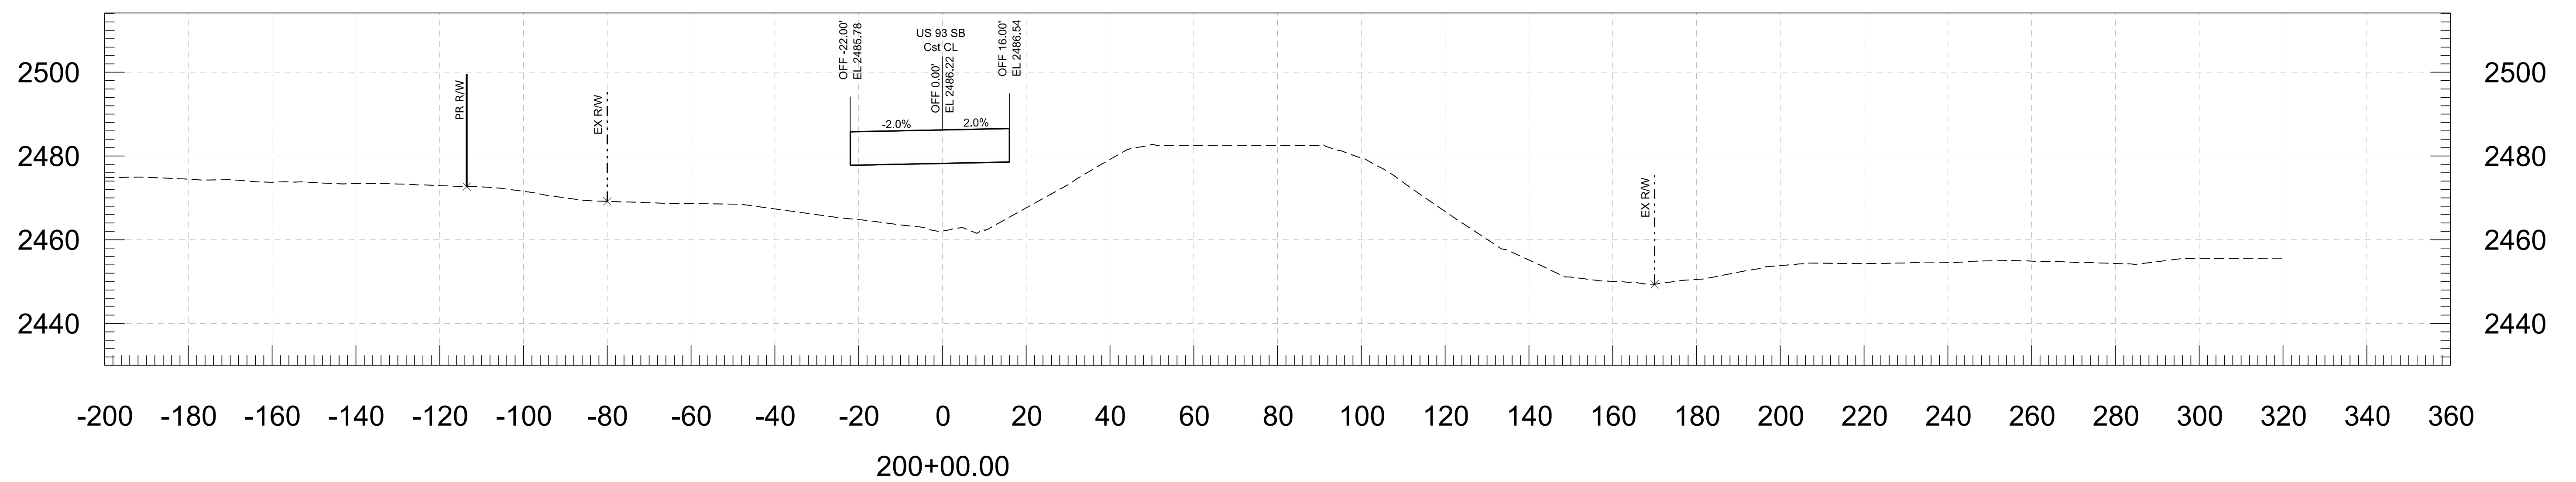
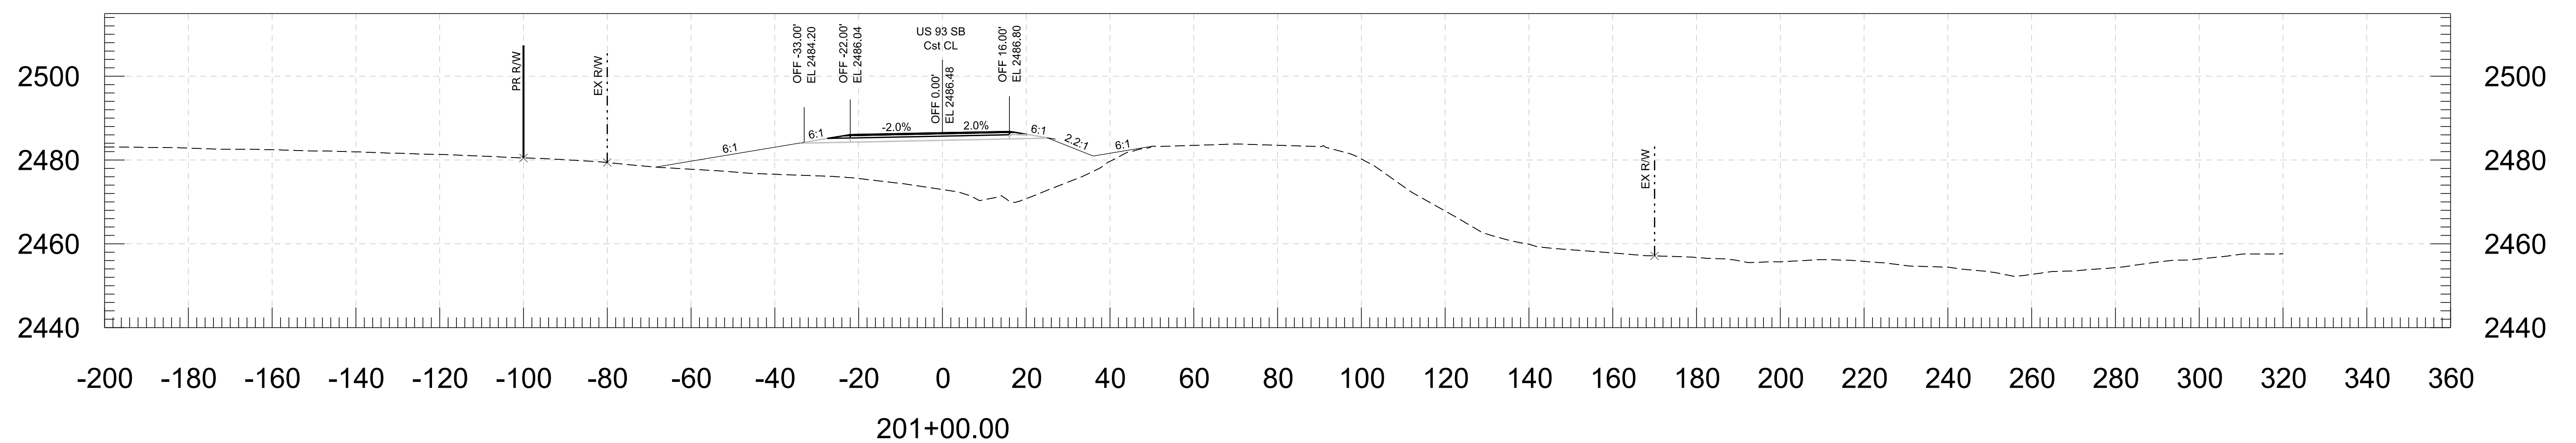


FOR INFORMATION ONLY																																																																																																																																																																																																																																																																																																																																																																																																																																																																																																																																																																																																																																																																																																																																																																																																																																																																																																																																																																																																																																																																																																																																																																																																																																																																																																																																																																																																																
----------------------------	--	--	
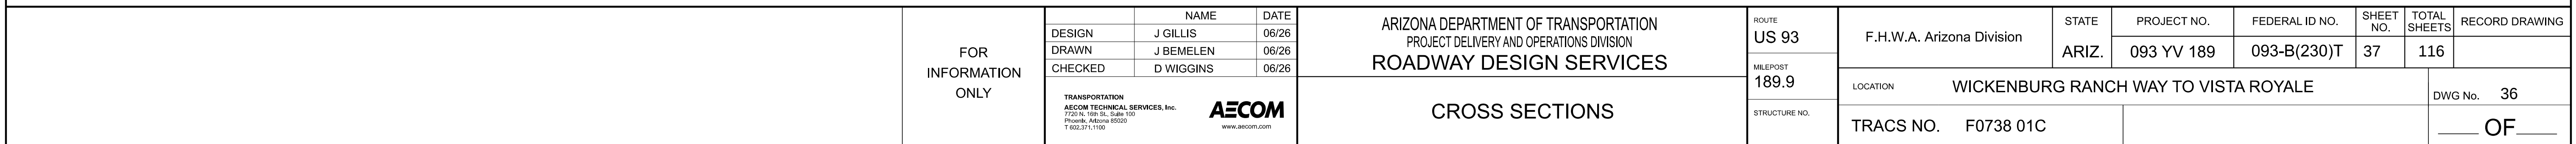
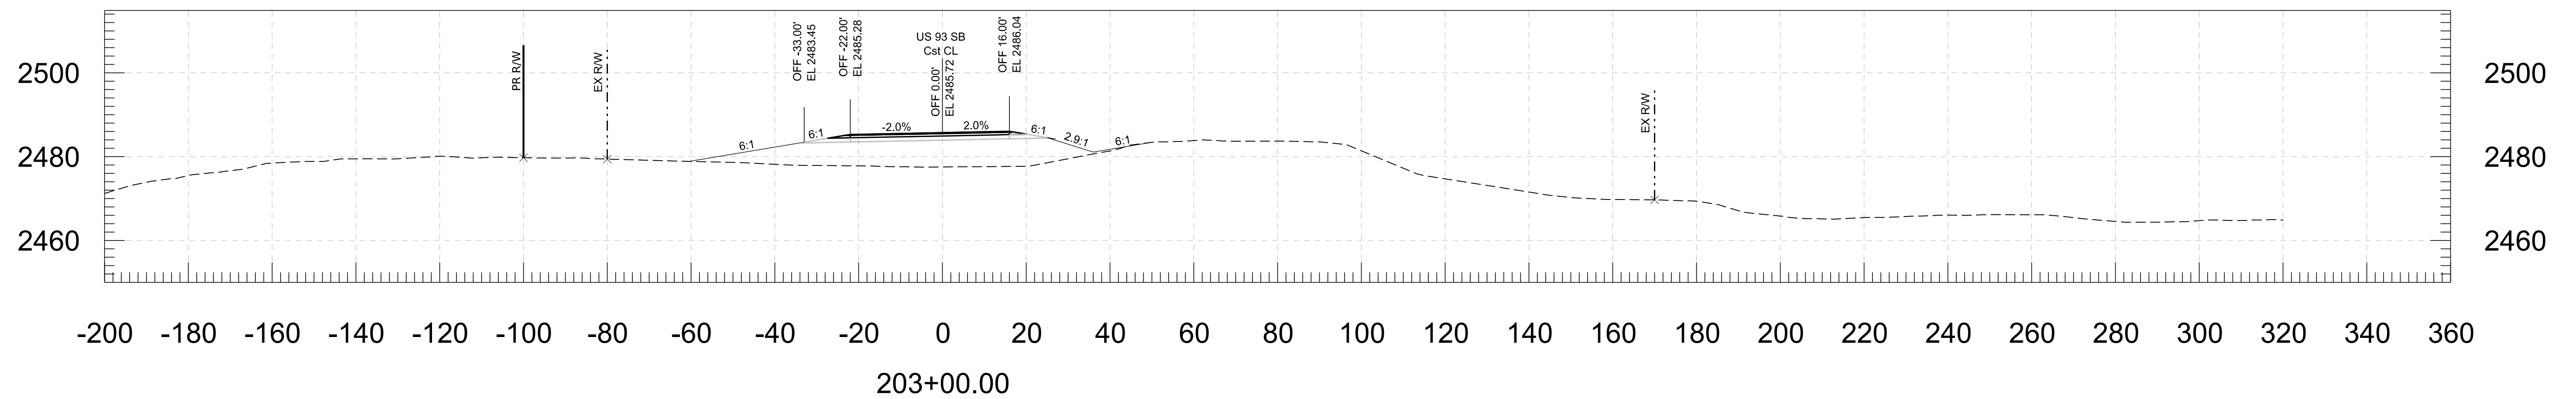


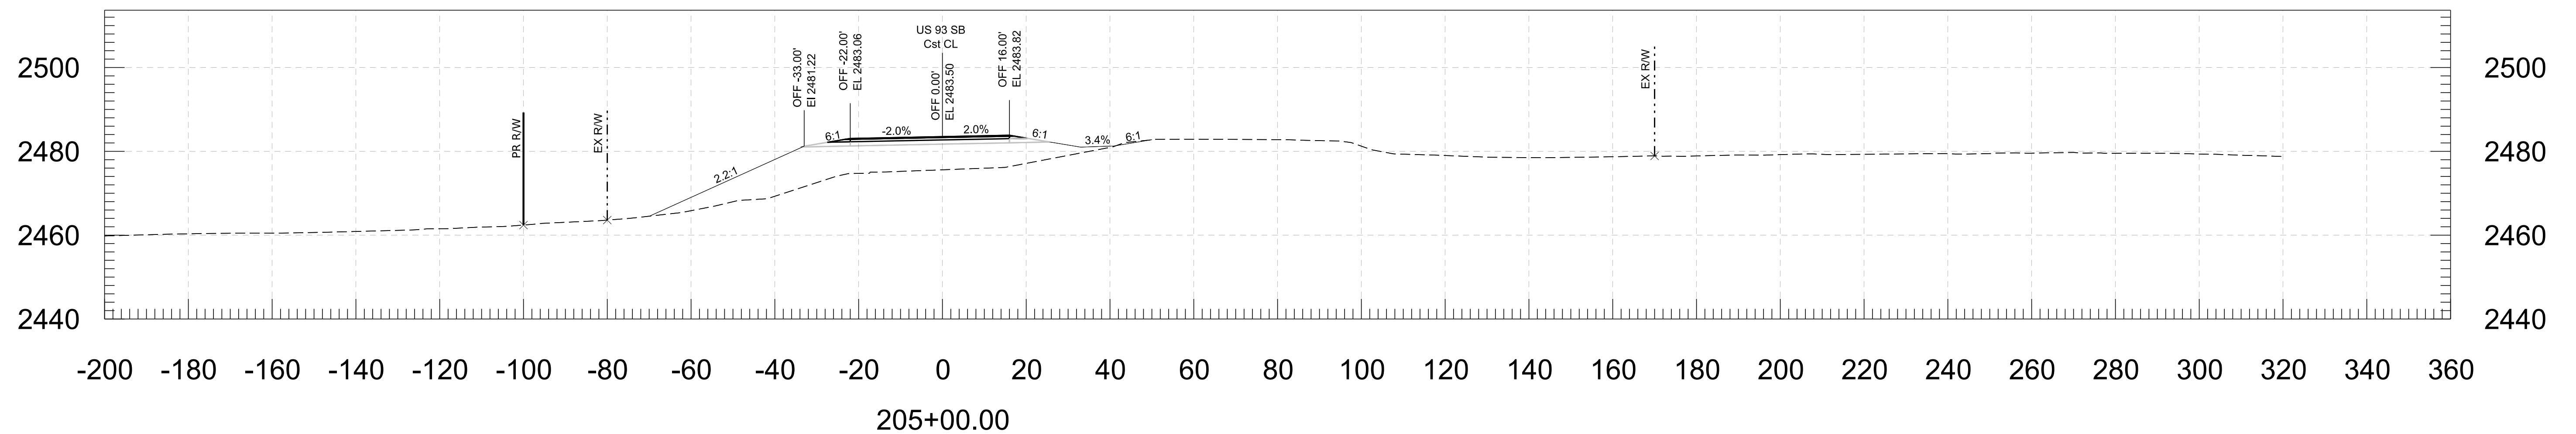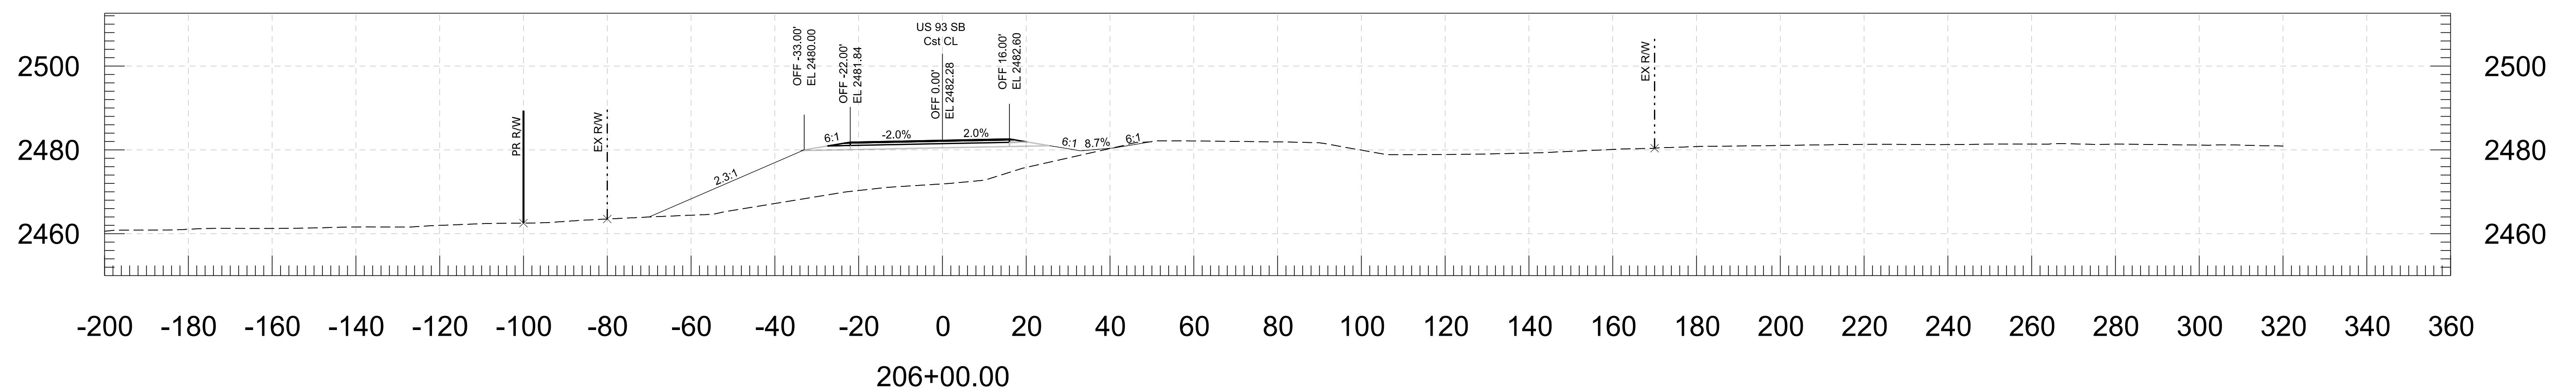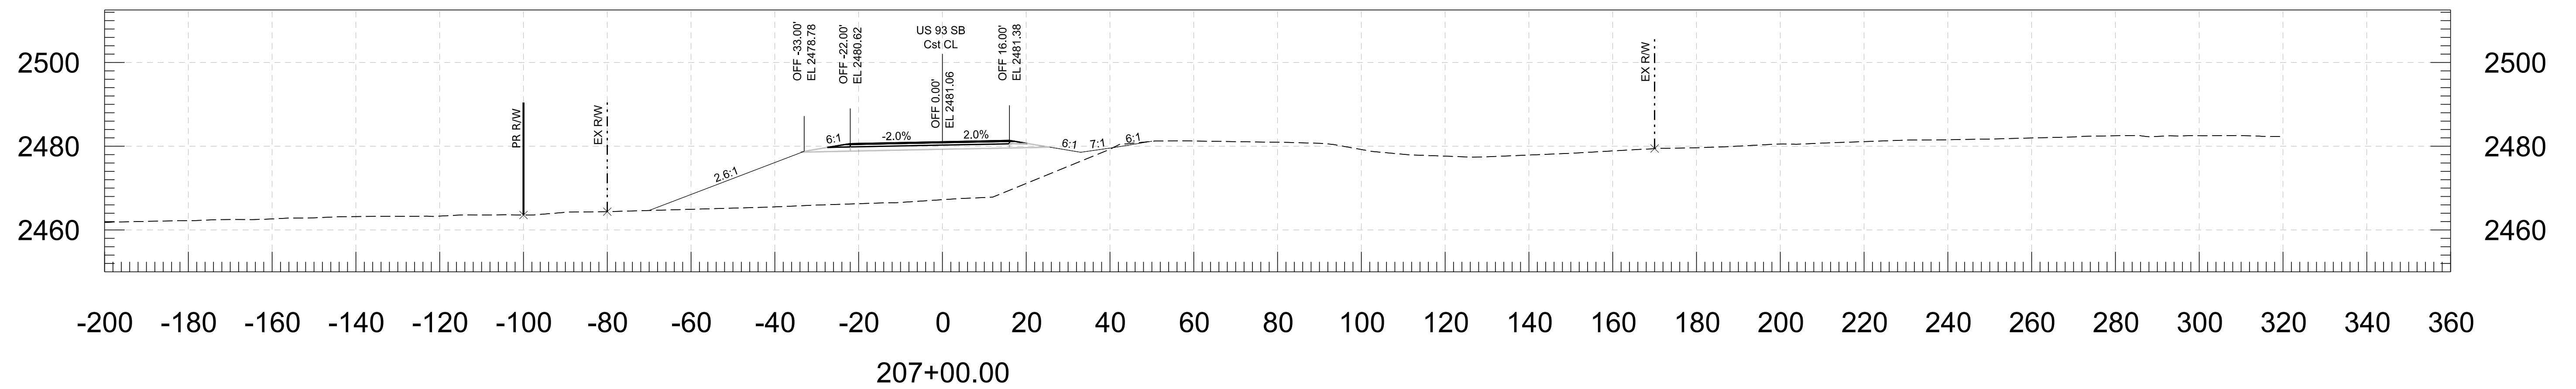




	FOR INFORMATION ONLY		NAME	DATE	ARIZONA DEPARTMENT OF TRANSPORTATION PROJECT DELIVERY AND OPERATIONS DIVISION ROADWAY DESIGN SERVICES	ROUTE	F.H.W.A. Arizona Division	STATE	PROJECT NO.	FEDERAL ID NO.	SHEET NO.	TOTAL SHEETS	RECORD DRAWING	
		DESIGN	J GILLIS	06/26		US 93			ARIZ.	093 YV 189	093-B(230)T	38	116	
		DRAWN	J BEMELEN	06/26		MILEPOST								
		CHECKED	D WIGGINS	06/26	189.9	LOCATION	WICKENBURG RANCH WAY TO VISTA ROYALE							DWG No. 37
		TRANSPORTATION AECOM TECHNICAL SERVICES, Inc. 7720 N. 16th St., Suite 100 Phoenix, Arizona 85020 T 602.371.1100  www.aecom.com			CROSS SECTIONS		STRUCTURE NO.	TRACS NO. F0738 01C		OF				

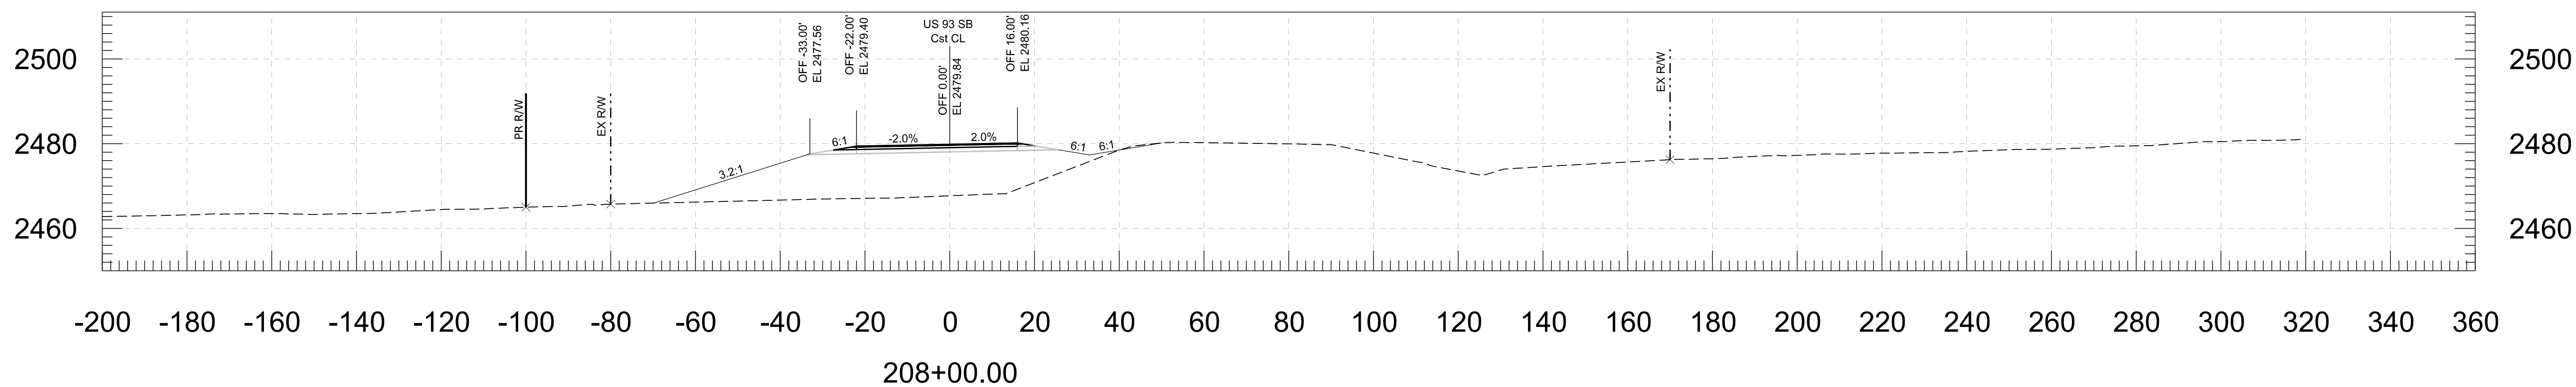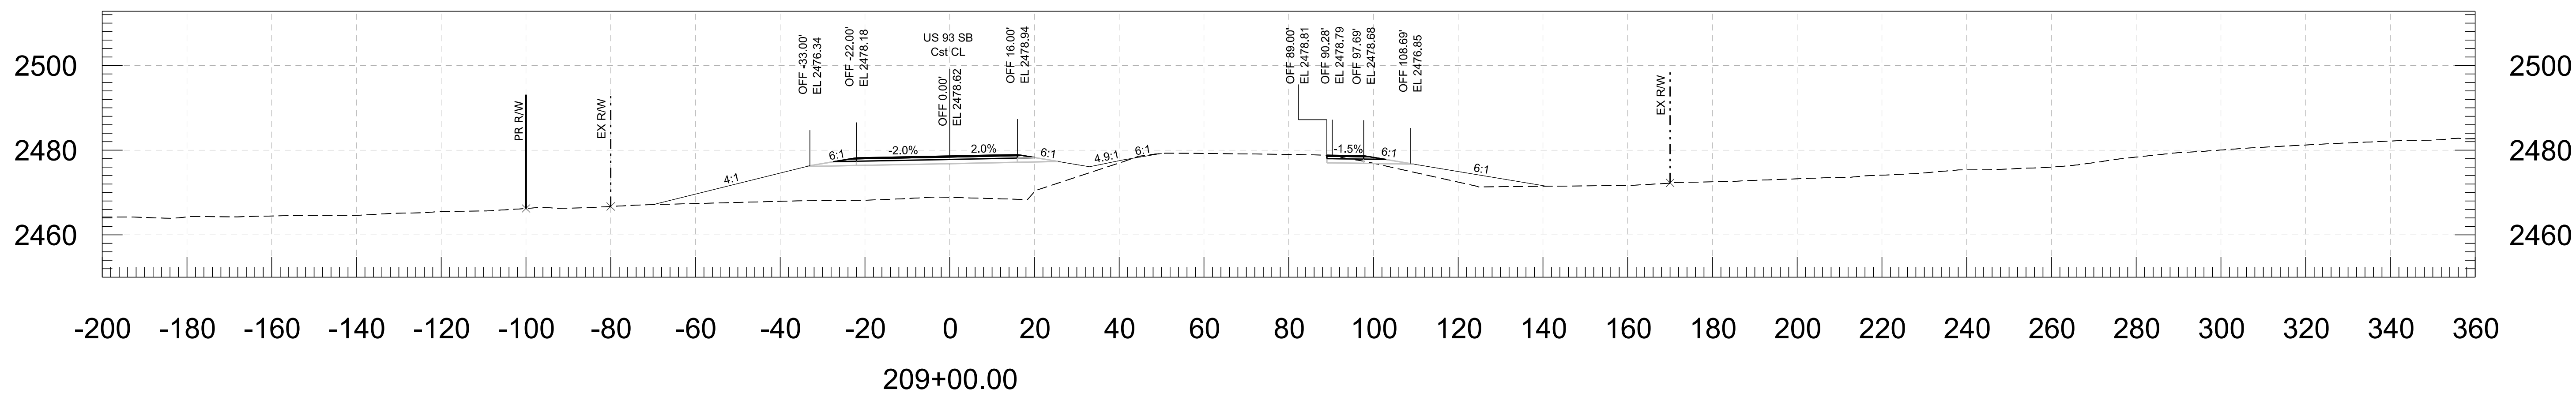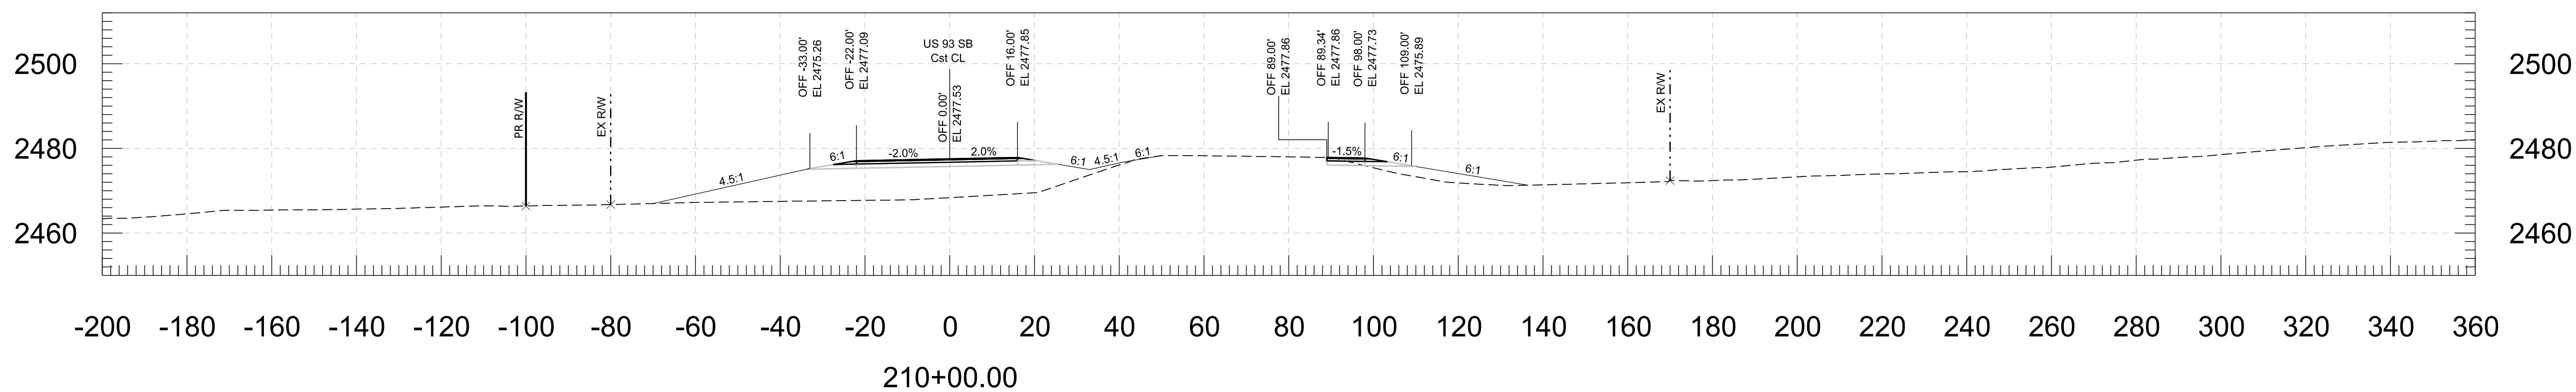




FOR INFORMATION ONLY		NAME	DATE	ARIZONA DEPARTMENT OF TRANSPORTATION PROJECT DELIVERY AND OPERATIONS DIVISION ROADWAY DESIGN SERVICES	ROUTE	F.H.W.A. Arizona Division	STATE ARIZ.	PROJECT NO.	FEDERAL ID NO.	SHEET NO.	TOTAL SHEETS	RECORD DRAWING
	DESIGN	J GILLIS	06/26		US 93			093 YV 189	093-B(230)T	39	116	
	DRAWN	J BEMELEN	06/26		MILEPOST	WICKENBURG RANCH WAY TO VISTA ROYALE DWG No. 38 OF						
	CHECKED	D WIGGINS	06/26		189.9							
	TRANSPORTATION AECOM TECHNICAL SERVICES, Inc. 7720 N. 119th St., Suite 100 Phoenix, Arizona 85050 T 602.371.1100 			CROSS SECTIONS	STRUCTURE NO.	TRACS NO. F0738 01C						

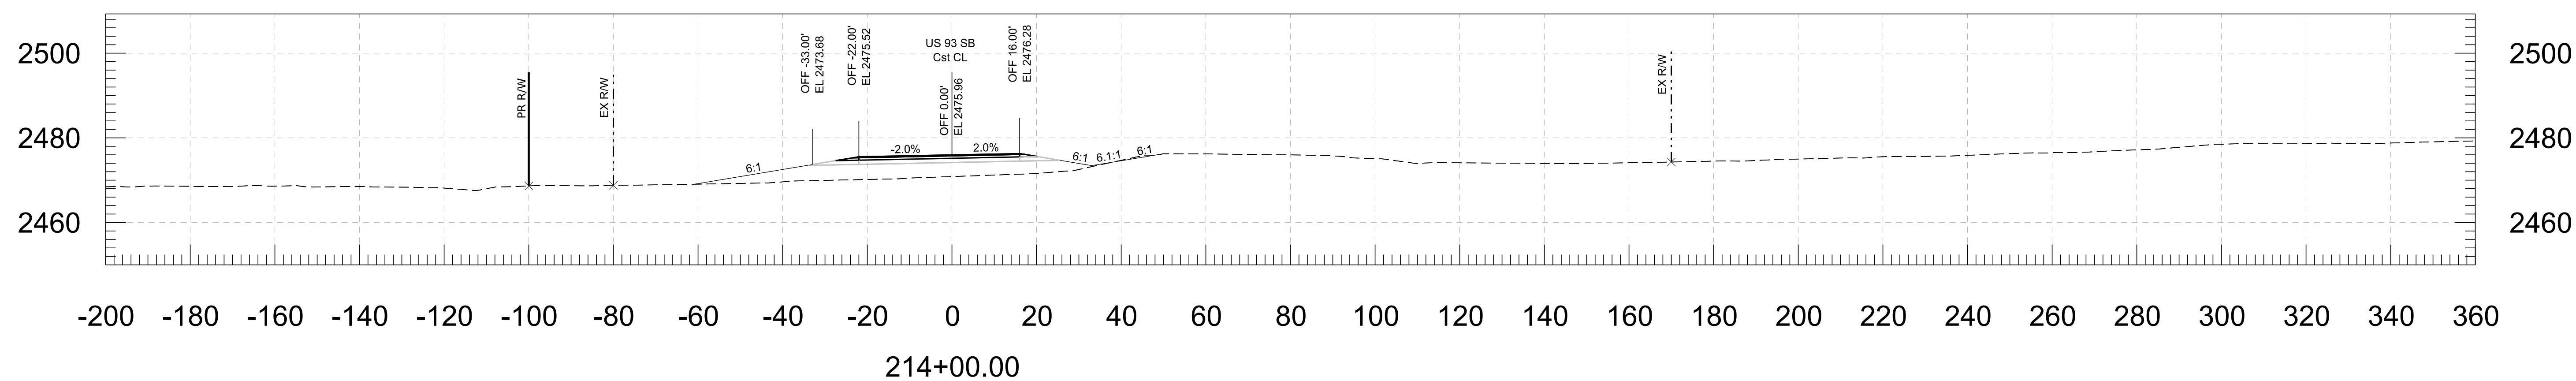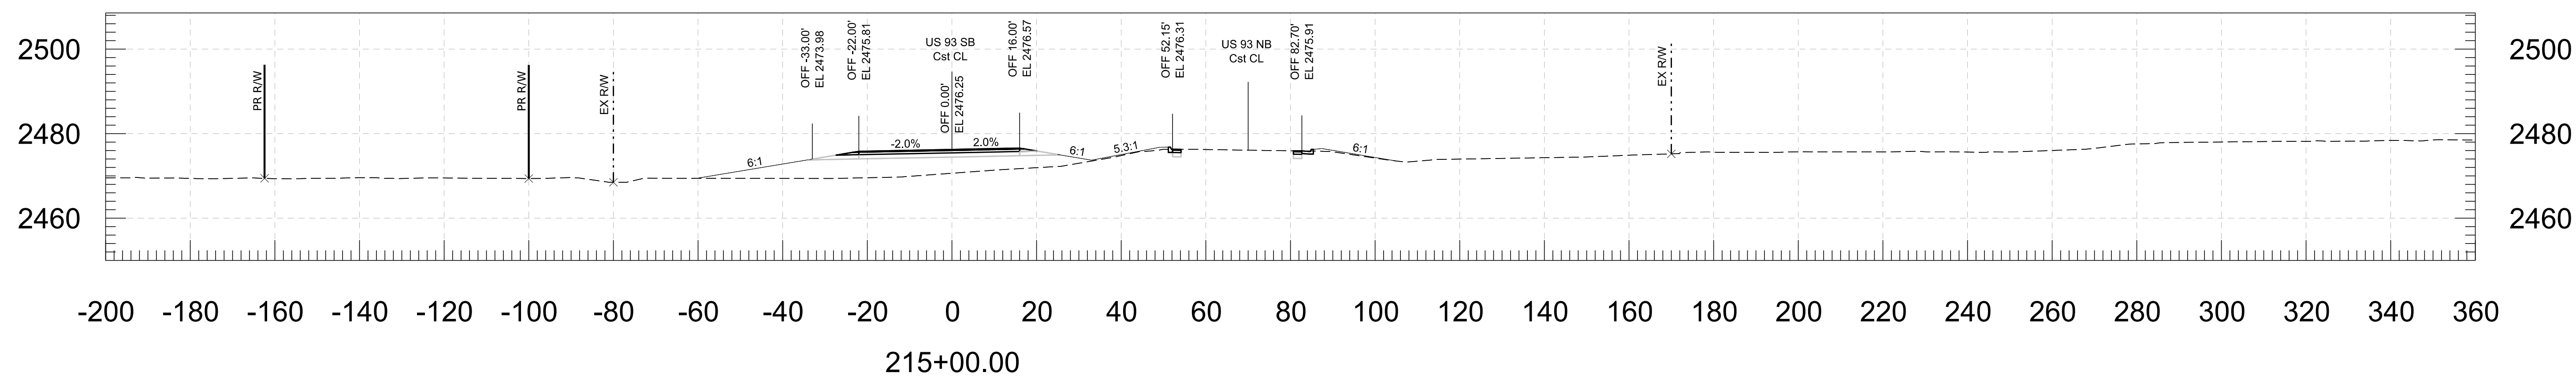




FOR INFORMATION ONLY		NAME	DATE	ARIZONA DEPARTMENT OF TRANSPORTATION PROJECT DELIVERY AND OPERATIONS DIVISION ROADWAY DESIGN SERVICES	ROUTE	F.H.W.A. Arizona Division	STATE	PROJECT NO.	FEDERAL ID NO.	SHEET NO.	TOTAL SHEETS	RECORD DRAWING
	DESIGN	J GILLIS	06/26		US 93		ARIZ.	093 YV 189	093-B(230)T	41	116	
	DRAWN	J BEMELLEN	06/26									
	CHECKED	D WIGGINS	06/26									
		TRANSPORTATION AECOM TECHNICAL SERVICES, Inc. 7720 N. 19th St., Suite 100 Phoenix, Arizona 85020 T 602.371.1100			CROSS SECTIONS		LOCATION			WICKENBURG RANCH WAY TO VISTA ROYALE		
						TRACS NO. F0738 01C						OF

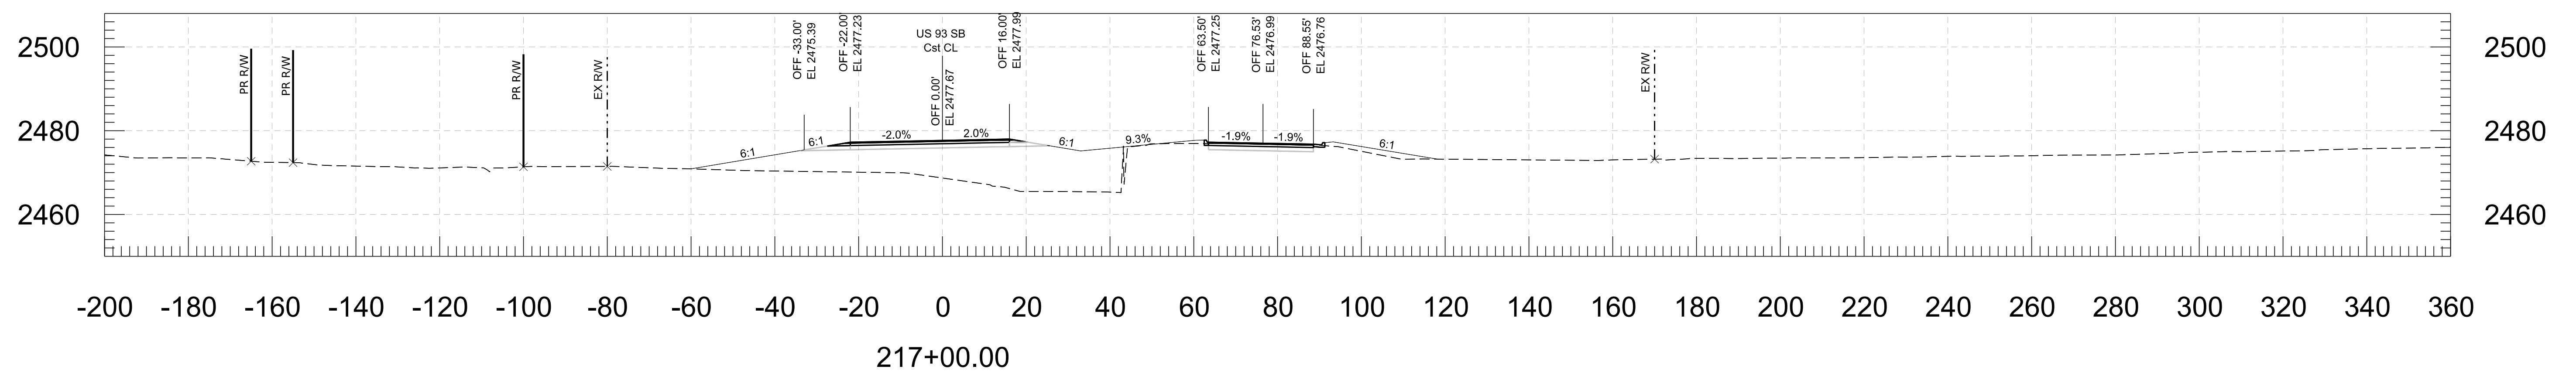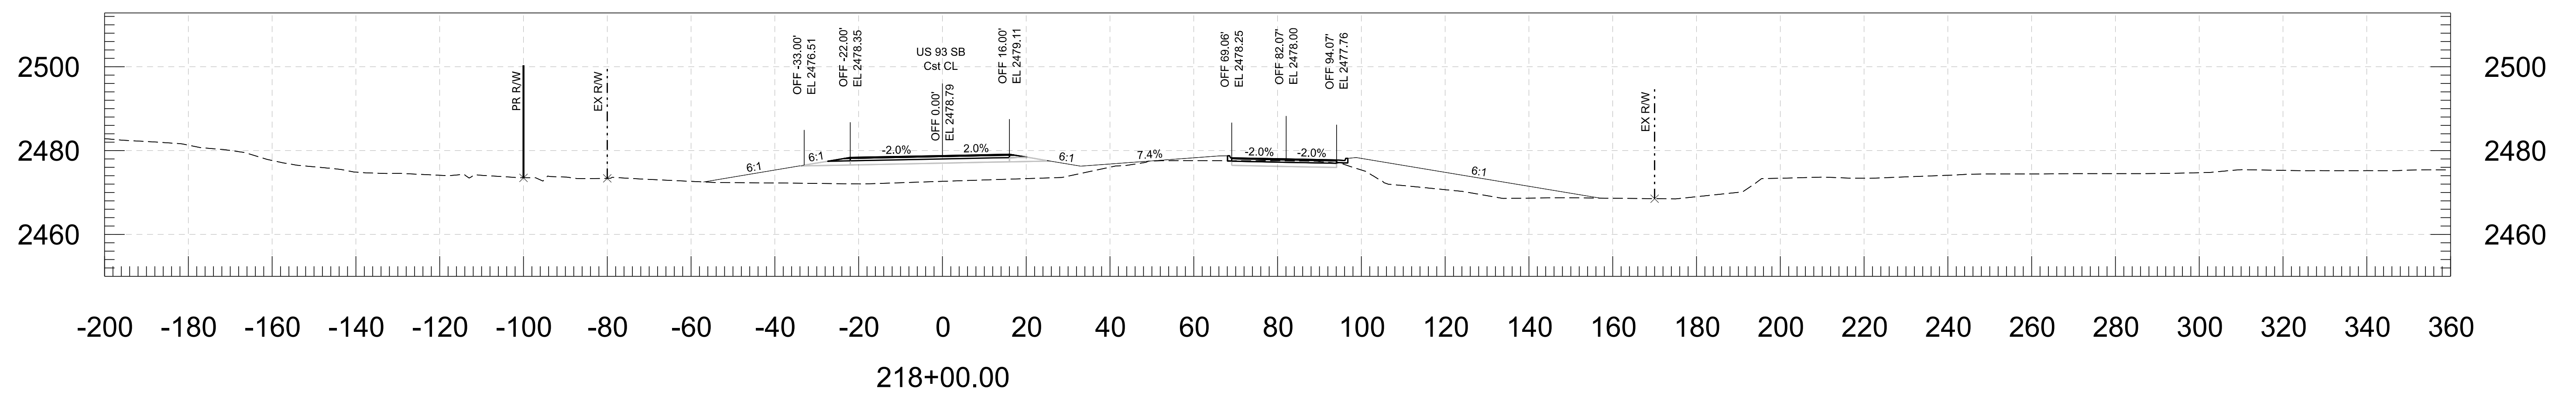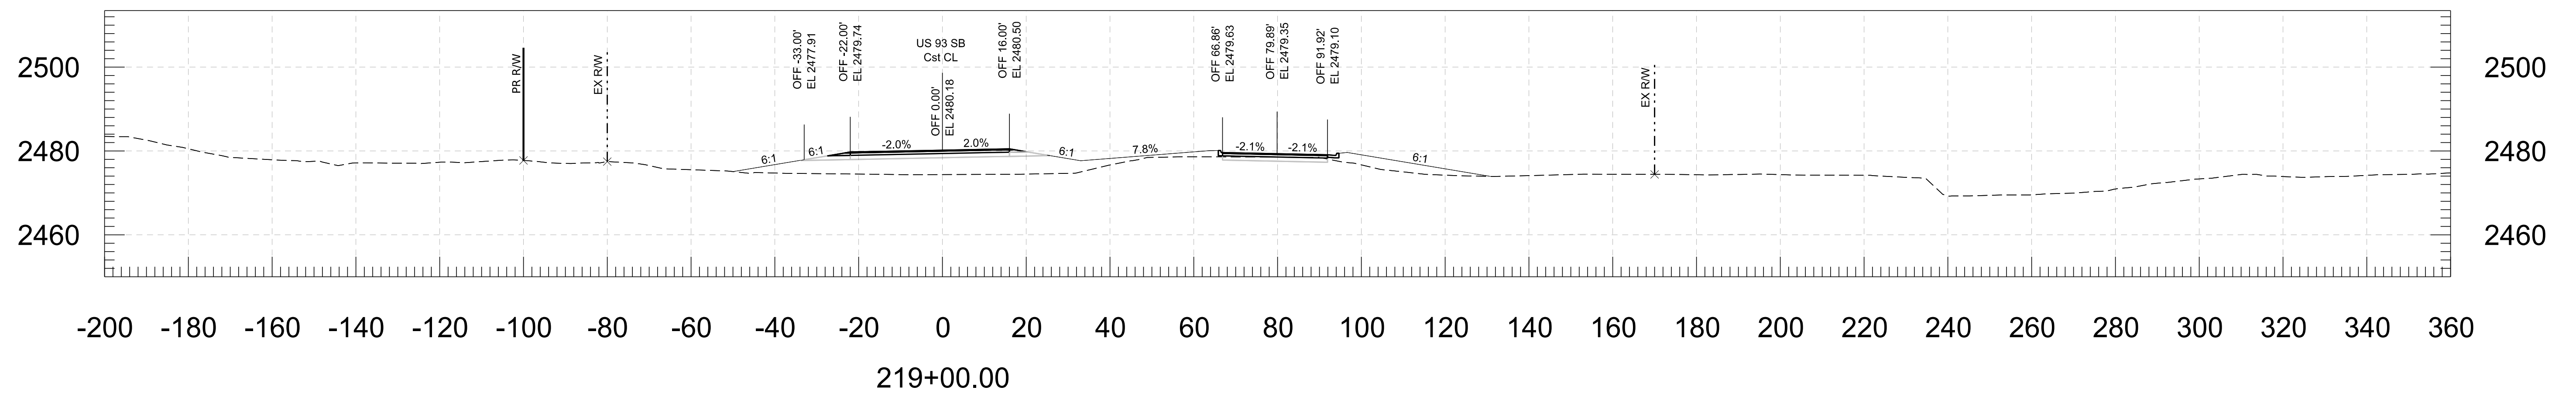


FOR INFORMATION ONLY																																																																																																																																																																																																																																																																																																																																																																																																																																																																																																																																																																																																																																																																																																																																																																																																																																																																																																																																																																																																																																																																																																																																																																																																																																																																																																																																																																																																																
----------------------------	--	--	
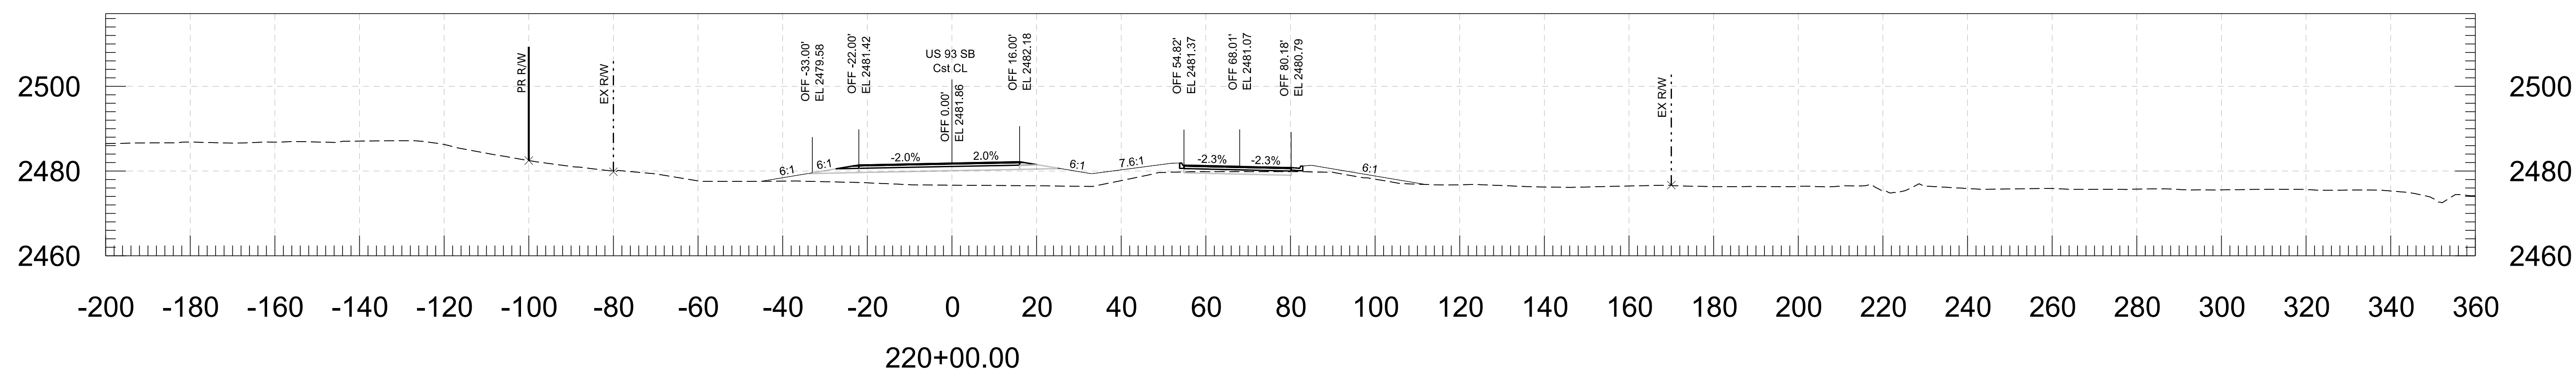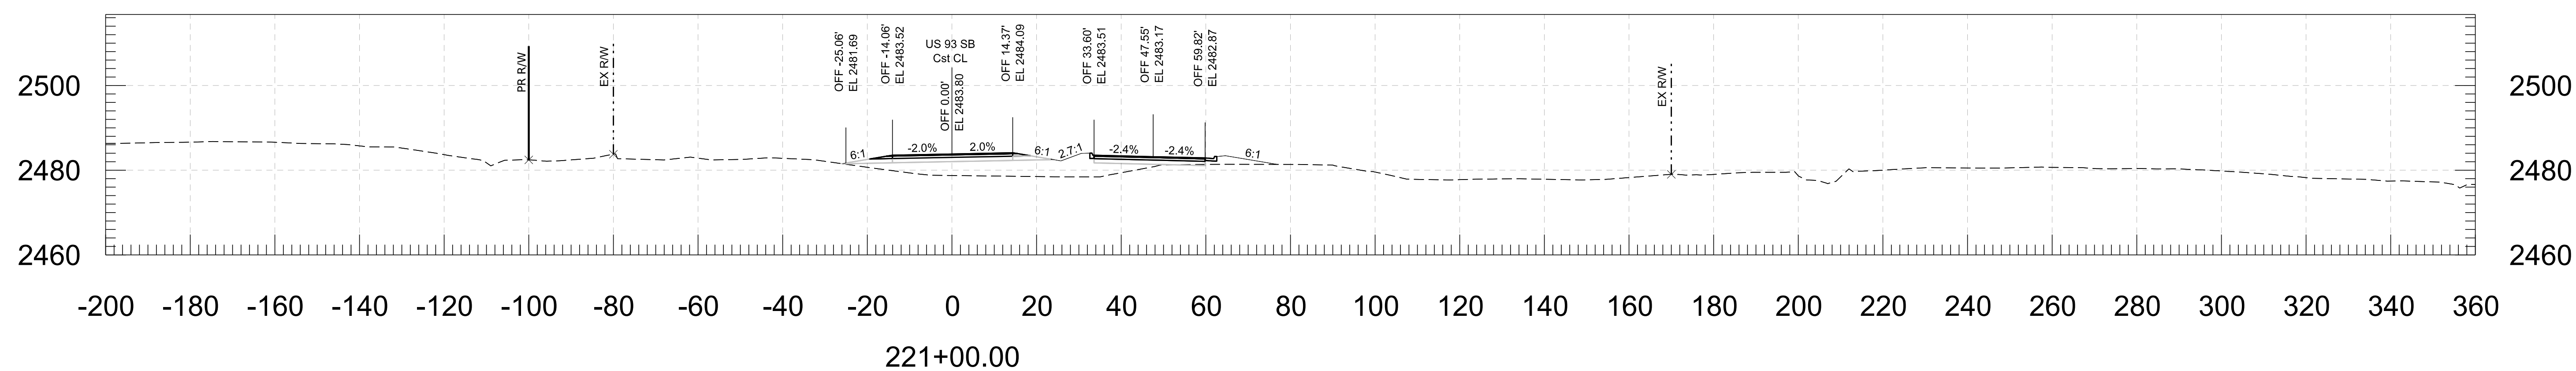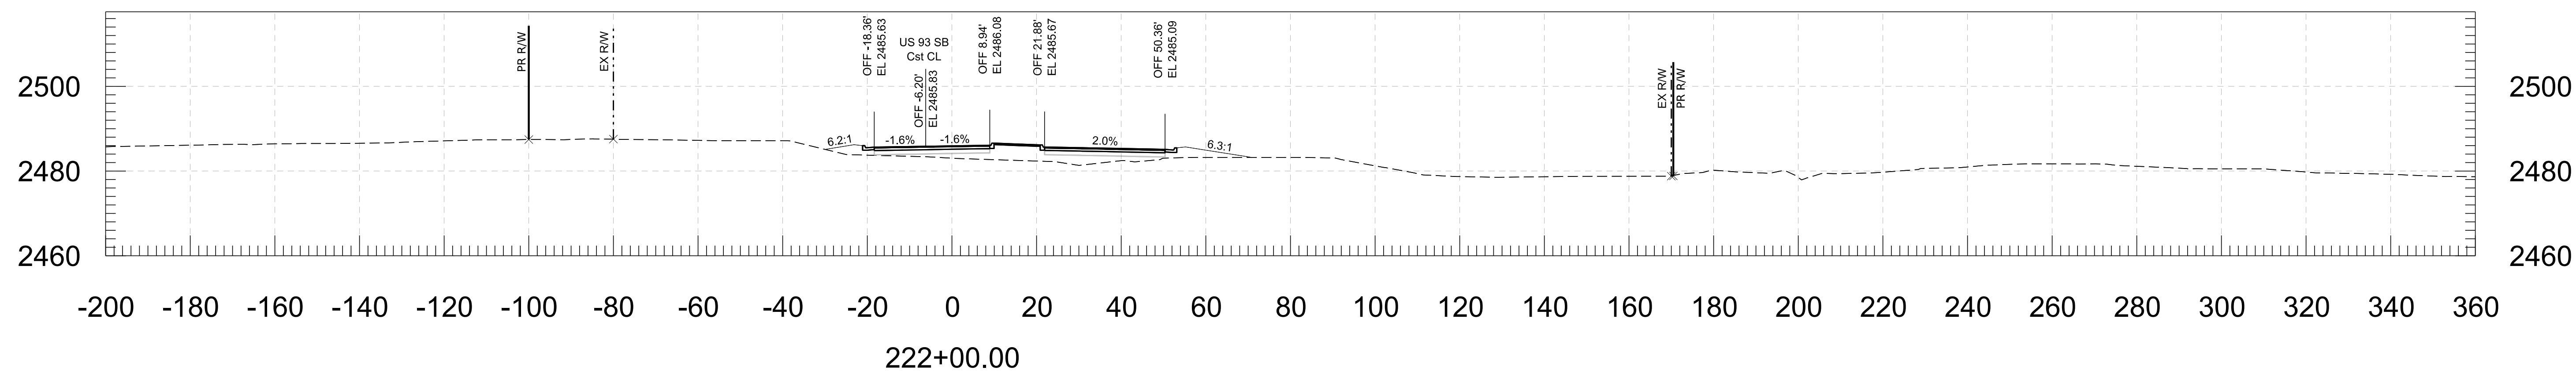


	FOR INFORMATION ONLY	<table><tr><td></td><td>NAME</td><td>DATE</td></tr><tr><td>DESIGN</td><td>J GILLIS</td><td>06/26</td></tr><tr><td>DRAWN</td><td>J BEMELEN</td><td>06/26</td></tr><tr><td>CHECKED</td><td>D WIGGINS</td><td>06/26</td></tr></table>		NAME	DATE	DESIGN	J GILLIS	06/26	DRAWN	J BEMELEN	06/26	CHECKED	D WIGGINS	06/26	ARIZONA DEPARTMENT OF TRANSPORTATION PROJECT DELIVERY AND OPERATIONS DIVISION ROADWAY DESIGN SERVICES	<table><tr><td>ROUTE</td><td>F.H.W.A. Arizona Division</td><td>STATE</td><td>PROJECT NO.</td><td>FEDERAL ID NO.</td><td>SHEET NO.</td><td>TOTAL SHEETS</td><td>RECORD DRAWING</td></tr><tr><td>US 93</td><td></td><td>ARIZ.</td><td>093 YV 189</td><td>093-B(230)T</td><td>43</td><td>116</td><td></td></tr></table>	ROUTE	F.H.W.A. Arizona Division	STATE	PROJECT NO.	FEDERAL ID NO.	SHEET NO.	TOTAL SHEETS	RECORD DRAWING	US 93		ARIZ.	093 YV 189	093-B(230)T	43	116	
			NAME	DATE																												
		DESIGN	J GILLIS	06/26																												
		DRAWN	J BEMELEN	06/26																												
CHECKED	D WIGGINS	06/26																														
ROUTE	F.H.W.A. Arizona Division	STATE	PROJECT NO.	FEDERAL ID NO.	SHEET NO.	TOTAL SHEETS	RECORD DRAWING																									
US 93		ARIZ.	093 YV 189	093-B(230)T	43	116																										
<table><tr><td>TRANSPORTATION AECOM TECHNICAL SERVICES, Inc. 2720 N. 105th St., Suite 100 Phoenix, Arizona 85020 T 602.371.1100</td><td></td></tr></table>	TRANSPORTATION AECOM TECHNICAL SERVICES, Inc. 2720 N. 105th St., Suite 100 Phoenix, Arizona 85020 T 602.371.1100		CROSS SECTIONS	<table><tr><td>MILEPOST</td><td colspan="5">LOCATION</td><td>DWG No.</td></tr><tr><td>189.9</td><td colspan="5">WICKENBURG RANCH WAY TO VISTA ROYALE</td><td>42</td></tr></table>	MILEPOST	LOCATION					DWG No.	189.9	WICKENBURG RANCH WAY TO VISTA ROYALE					42														
TRANSPORTATION AECOM TECHNICAL SERVICES, Inc. 2720 N. 105th St., Suite 100 Phoenix, Arizona 85020 T 602.371.1100																																
MILEPOST	LOCATION					DWG No.																										
189.9	WICKENBURG RANCH WAY TO VISTA ROYALE					42																										
		<table><tr><td>STRUCTURE NO.</td><td>TRACS NO.</td><td></td><td></td><td></td><td></td><td></td><td></td></tr><tr><td></td><td>F0738 01C</td><td></td><td></td><td></td><td></td><td></td><td>OF</td></tr></table>	STRUCTURE NO.	TRACS NO.								F0738 01C						OF														
STRUCTURE NO.	TRACS NO.																															
	F0738 01C						OF																									

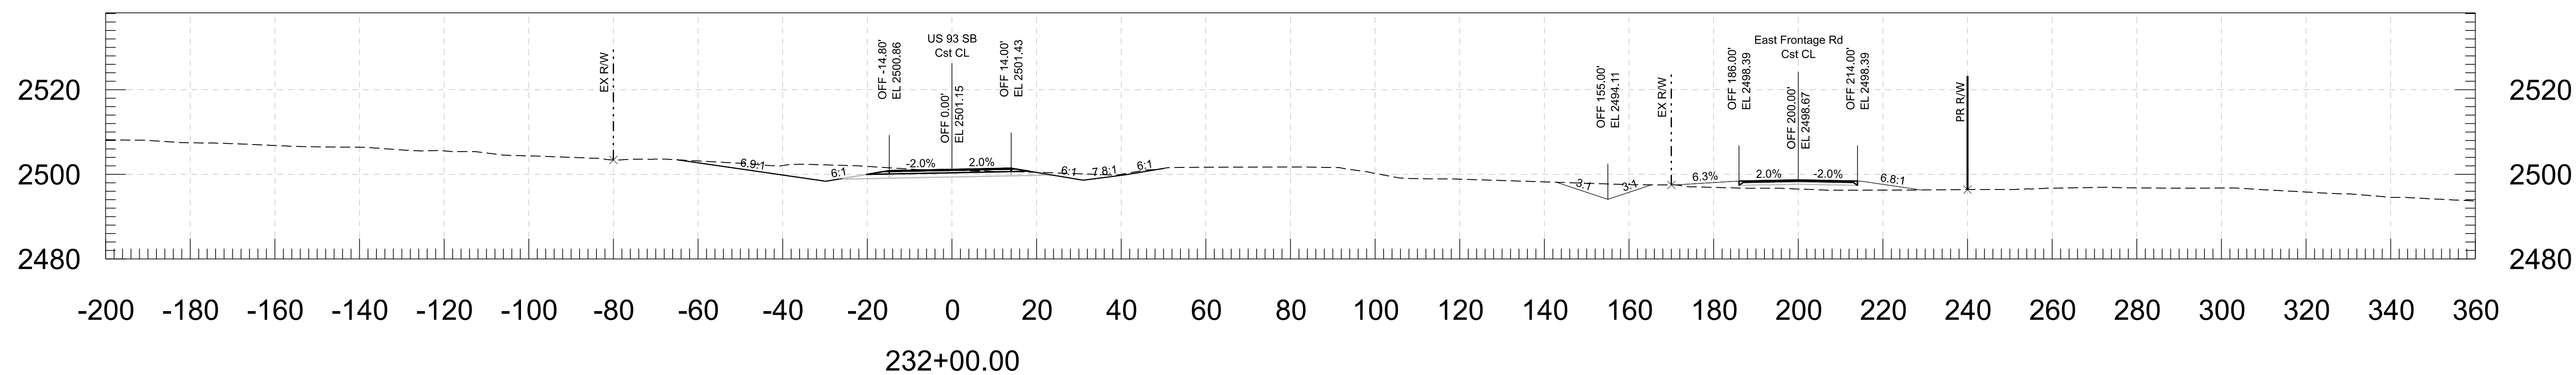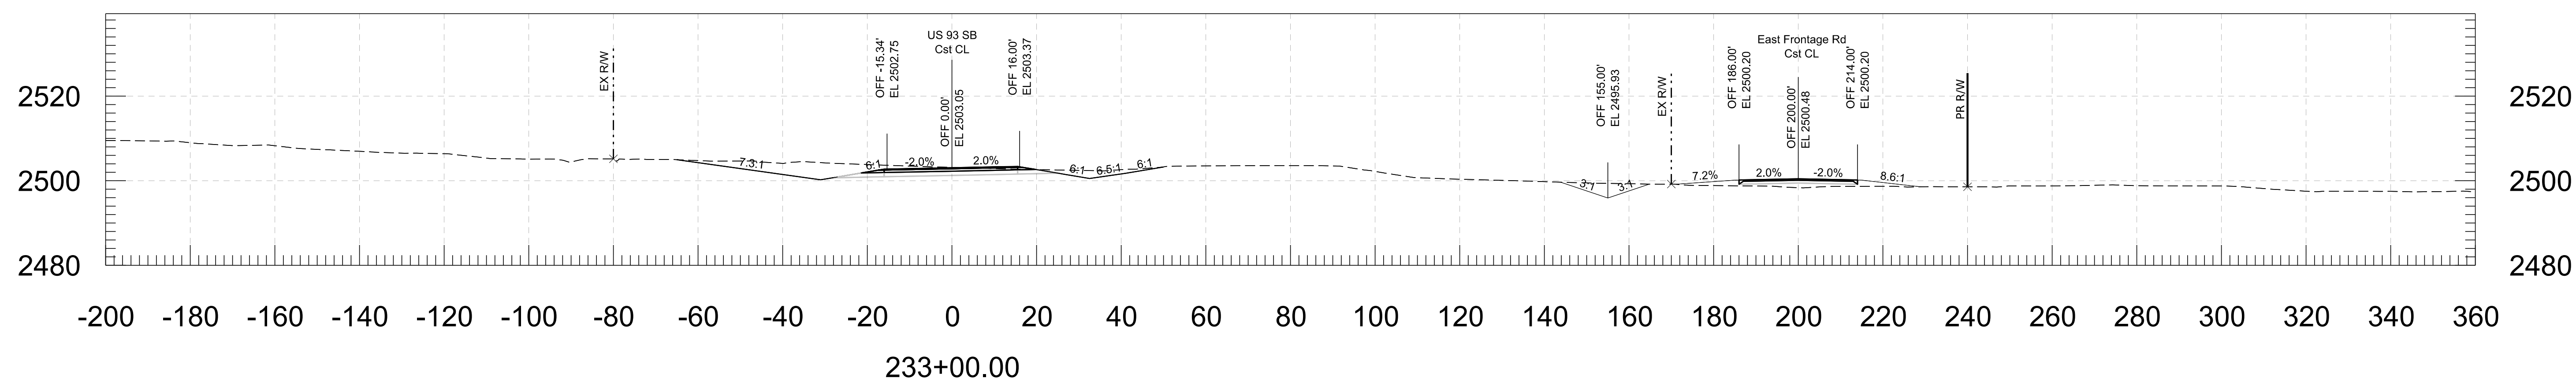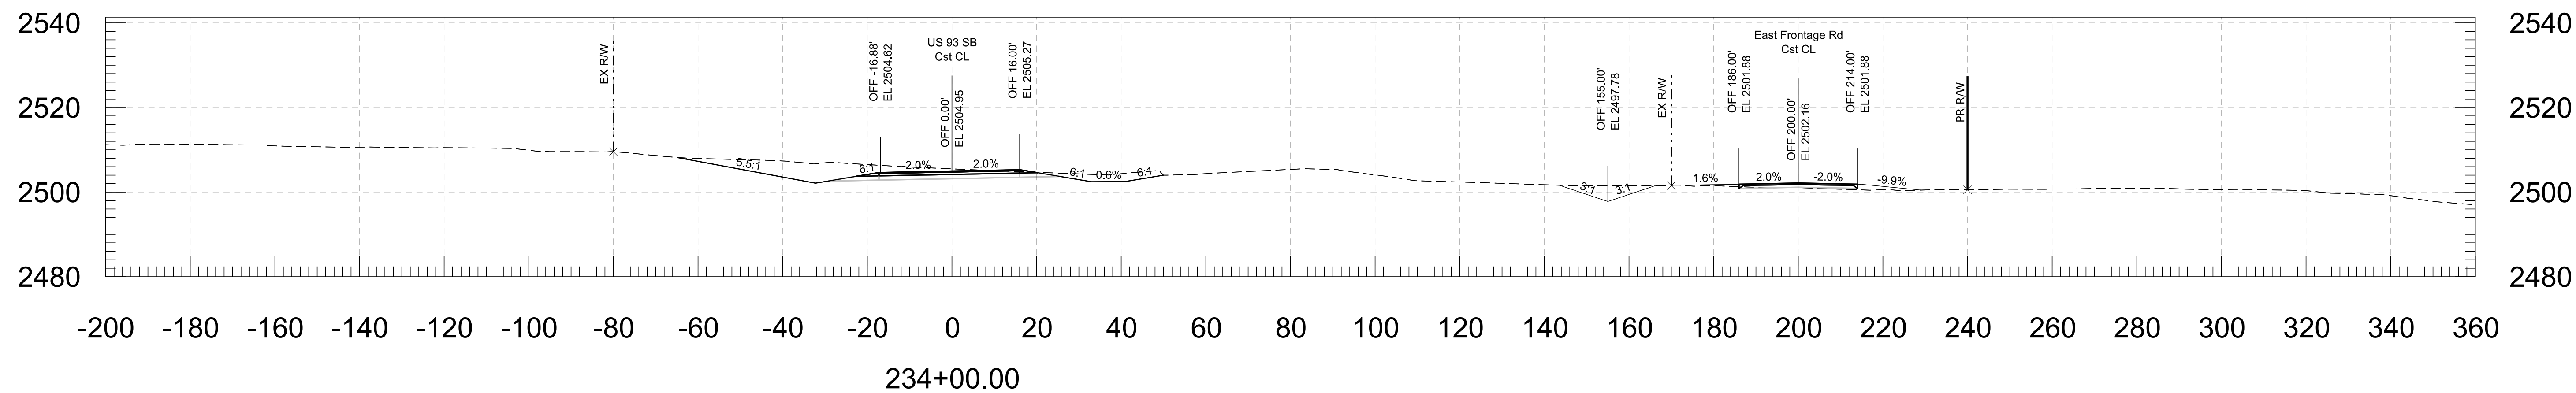


FOR INFORMATION ONLY		NAME	DATE	ARIZONA DEPARTMENT OF TRANSPORTATION PROJECT DELIVERY AND OPERATIONS DIVISION ROADWAY DESIGN SERVICES	ROUTE	F.H.W.A. Arizona Division	STATE	PROJECT NO.	FEDERAL ID NO.	SHEET NO.	TOTAL SHEETS	RECORD DRAWING
	DESIGN	J GILLIS	06/26		US 93			ARIZ.	093 YV 189	093-B(230)T	47	116
	DRAWN	J BEMELLEN	06/26		MILEPOST	LOCATION WICKENBURG RANCH WAY TO VISTA ROYALE						
	CHECKED	D WIGGINS	06/26	189.9	TRACS NO. F0738 01C					OF		
	TRANSPORTATION AECOM TECHNICAL SERVICES, Inc. 7725 N. 18th St., Suite 100 Phoenix, Arizona 85020 T 602.371.1100  www.aecom.com				CROSS SECTIONS							

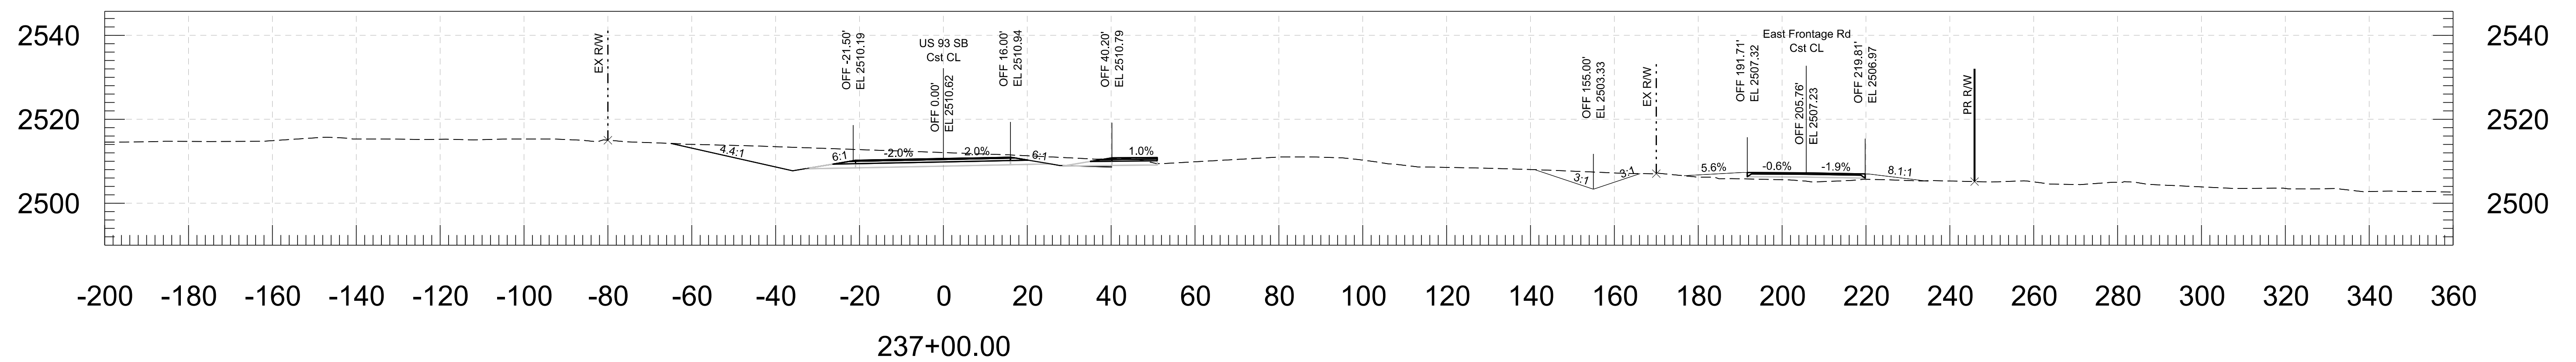


FOR INFORMATION ONLY																																																																																																																																																																																																																																																																																																																																																																																																																																																																																																																																																																																																																																																																																																																																																																																																																																																																																																																																																																																																																																																																																																																																																																																																																																																																																																																																																																																																																	
----------------------------	--	--	
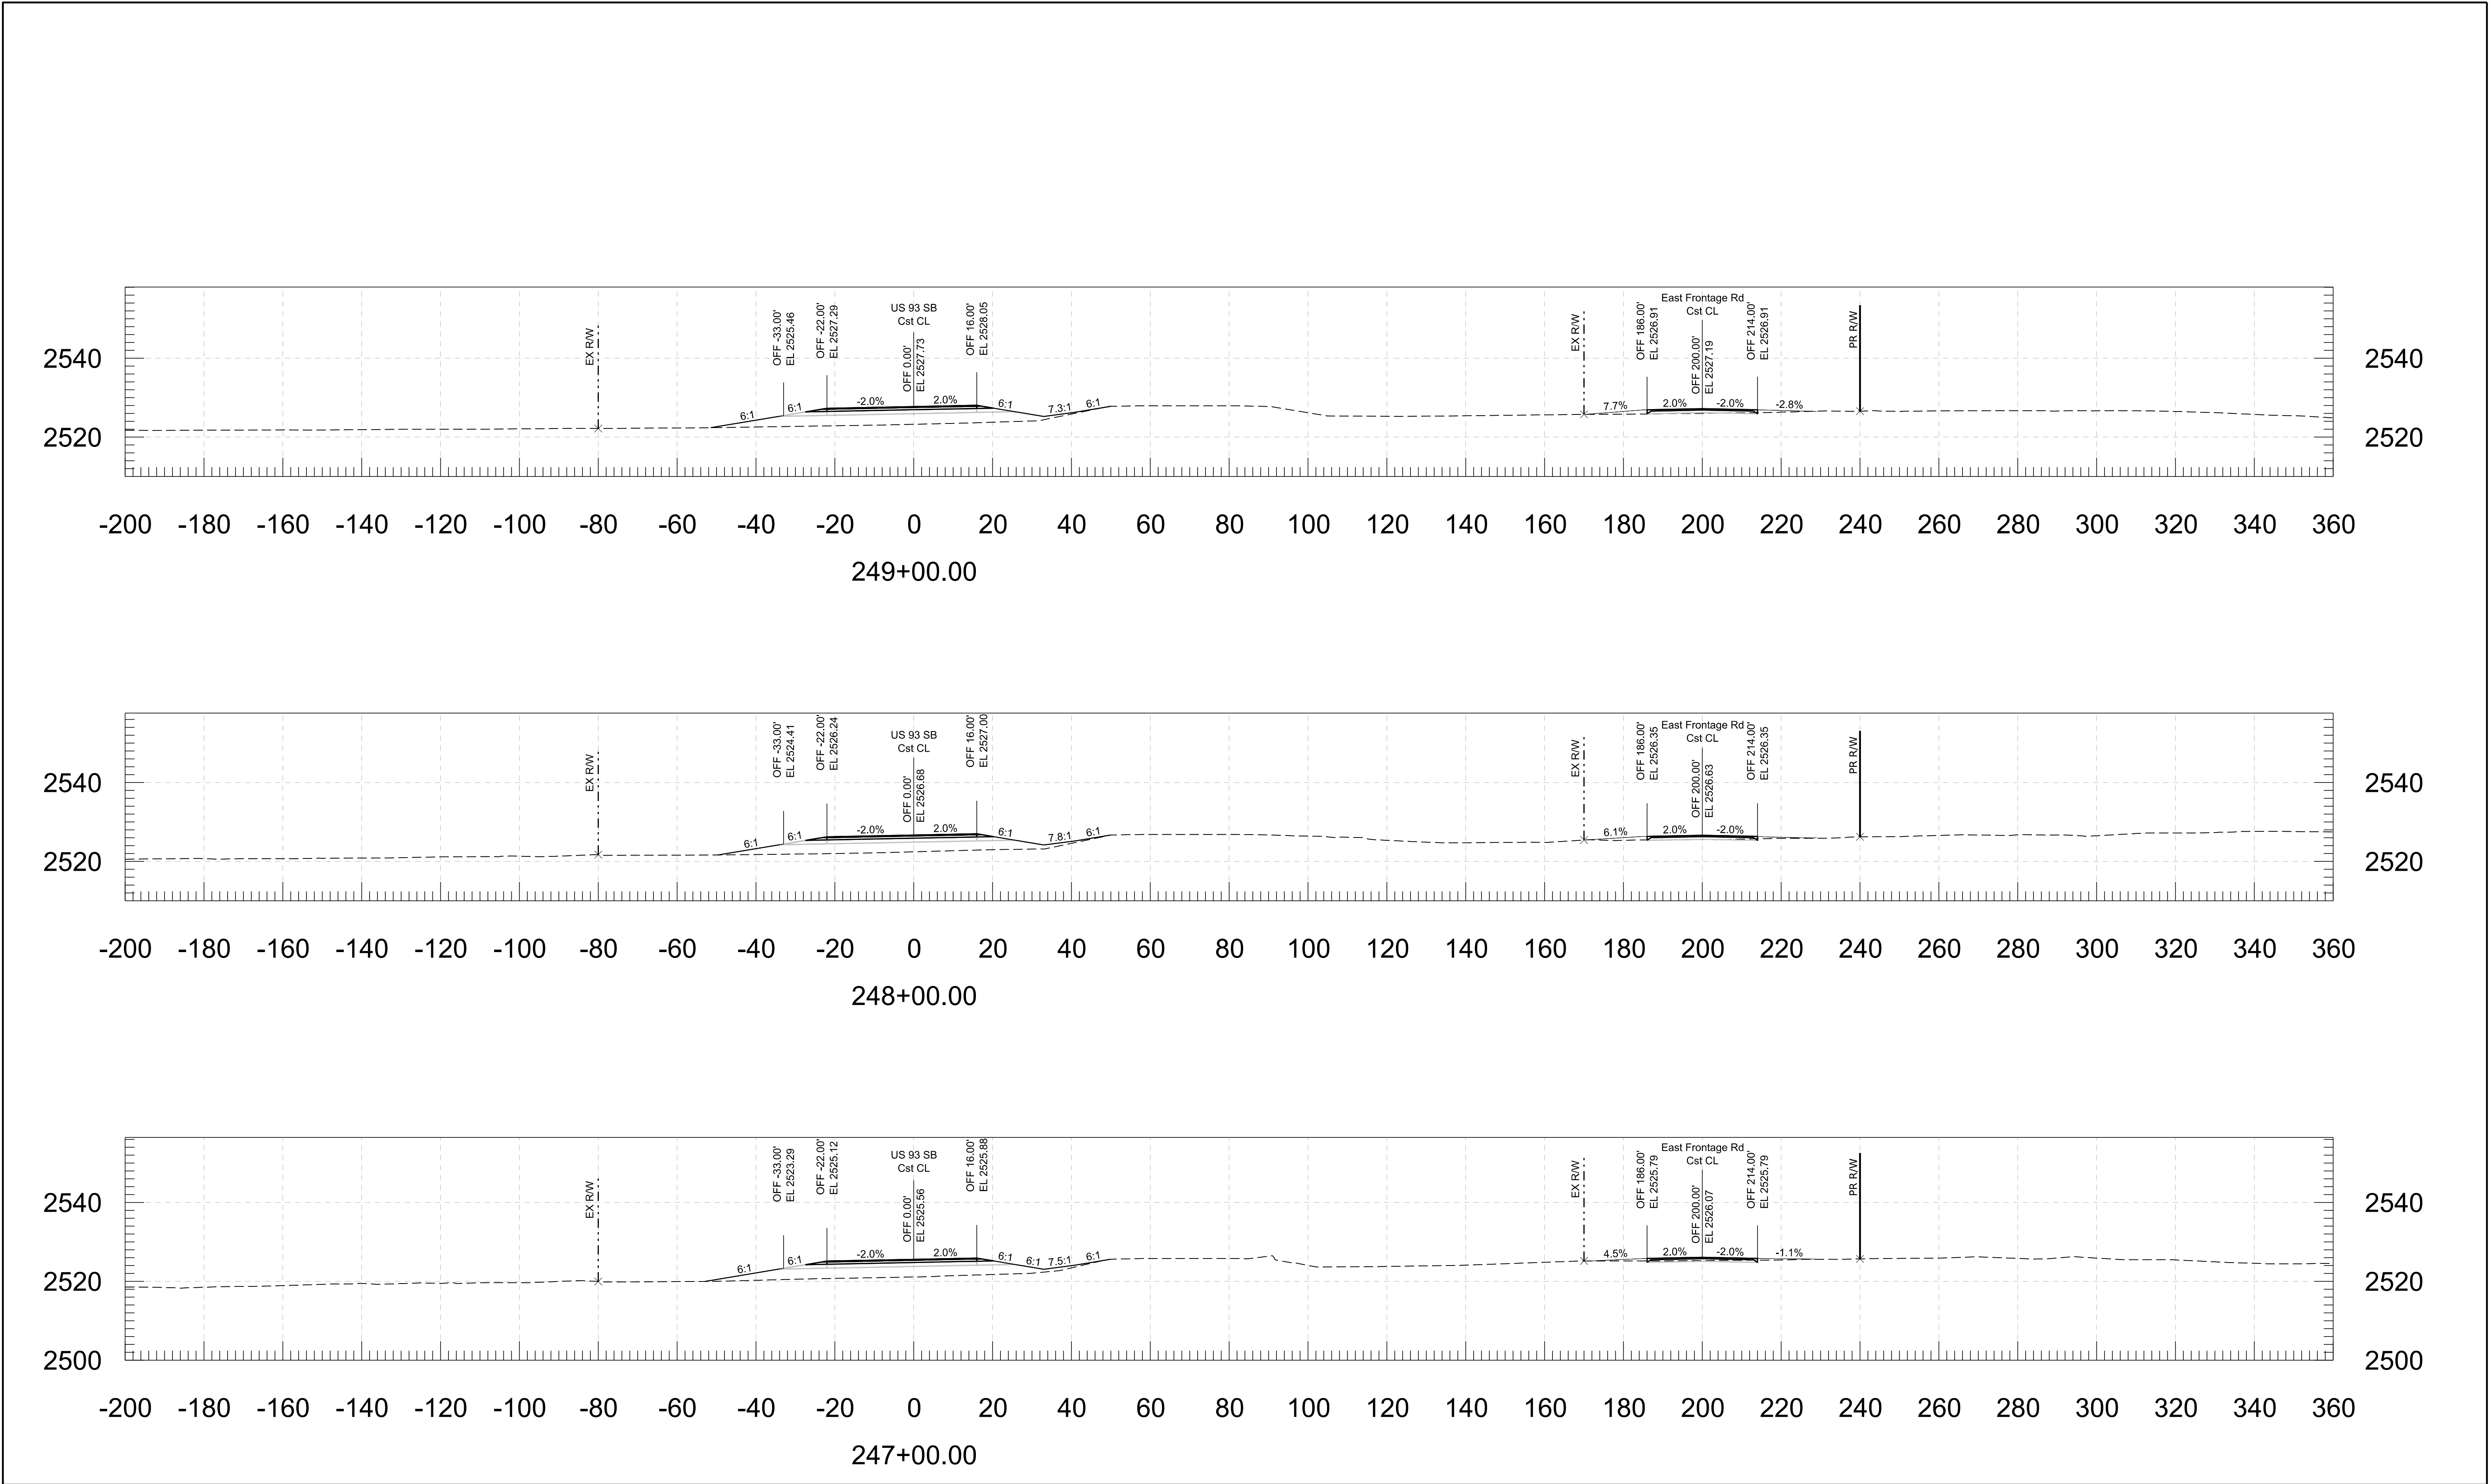


FOR INFORMATION ONLY			DESIGN	NAME	DATE	ARIZONA DEPARTMENT OF TRANSPORTATION PROJECT DELIVERY AND OPERATIONS DIVISION ROADWAY DESIGN SERVICES		ROUTE	F.H.W.A. Arizona Division	STATE	PROJECT NO.	FEDERAL ID NO.	SHEET NO.	TOTAL SHEETS	RECORD DRAWING
			DRAWN	J GILLIS	06/26			US 93			093 YV 189	093-B(230)T	52	116	
			CHECKED	D WIGGINS	06/26			MILEPOST 189.9			LOCATION WICKENBURG RANCH WAY TO VISTA ROYALE				DWG No. 51
			TRANSPORTATION AECOM TECHNICAL SERVICES, Inc. 7720 N. 18th St., Suite 100 Phoenix, Arizona 85020 T 602.371.1100 www.aecom.com				CROSS SECTIONS		STRUCTURE NO.		TRACS NO. F0738 01C				____ OF ____

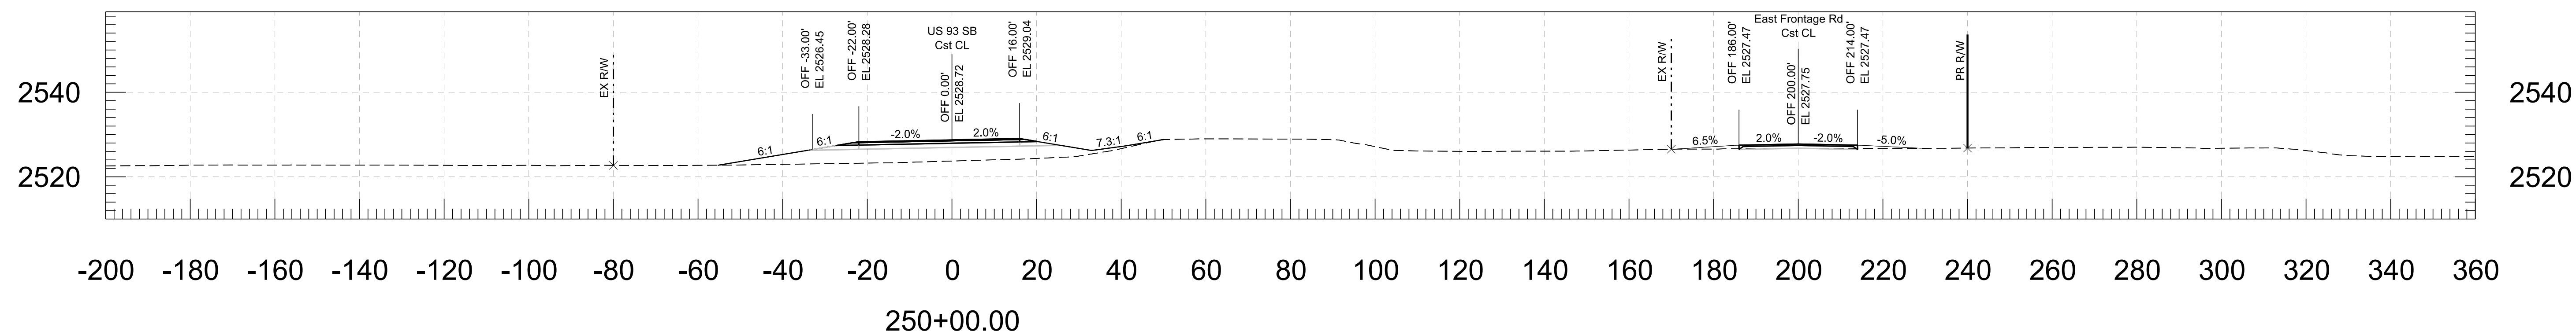



FOR INFORMATION ONLY		NAME	DATE	ARIZONA DEPARTMENT OF TRANSPORTATION PROJECT DELIVERY AND OPERATIONS DIVISION ROADWAY DESIGN SERVICES	ROUTE	F.H.W.A. Arizona Division	STATE	PROJECT NO.	FEDERAL ID NO.	SHEET NO.	TOTAL SHEETS	RECORD DRAWING
	DESIGN	J GILLIS	06/26		US 93		ARIZ.	093 YV 189	093-B(230)T	53	116	
	DRAWN	J BEMELEN	06/26		CROSS SECTIONS	MILEPOST	LOCATION WICKENBURG RANCH WAY TO VISTA ROYALE DWG No. 52					
	CHECKED	D WIGGINS	06/26			189.9						
	TRANSPORTATION AECOM TECHNICAL SERVICES, Inc. 7720 N. 19th St., Suite 100 Phoenix, Arizona 85020 T 602.371.1100 				STRUCTURE NO.	TRACS NO. F0738 01C		OF				

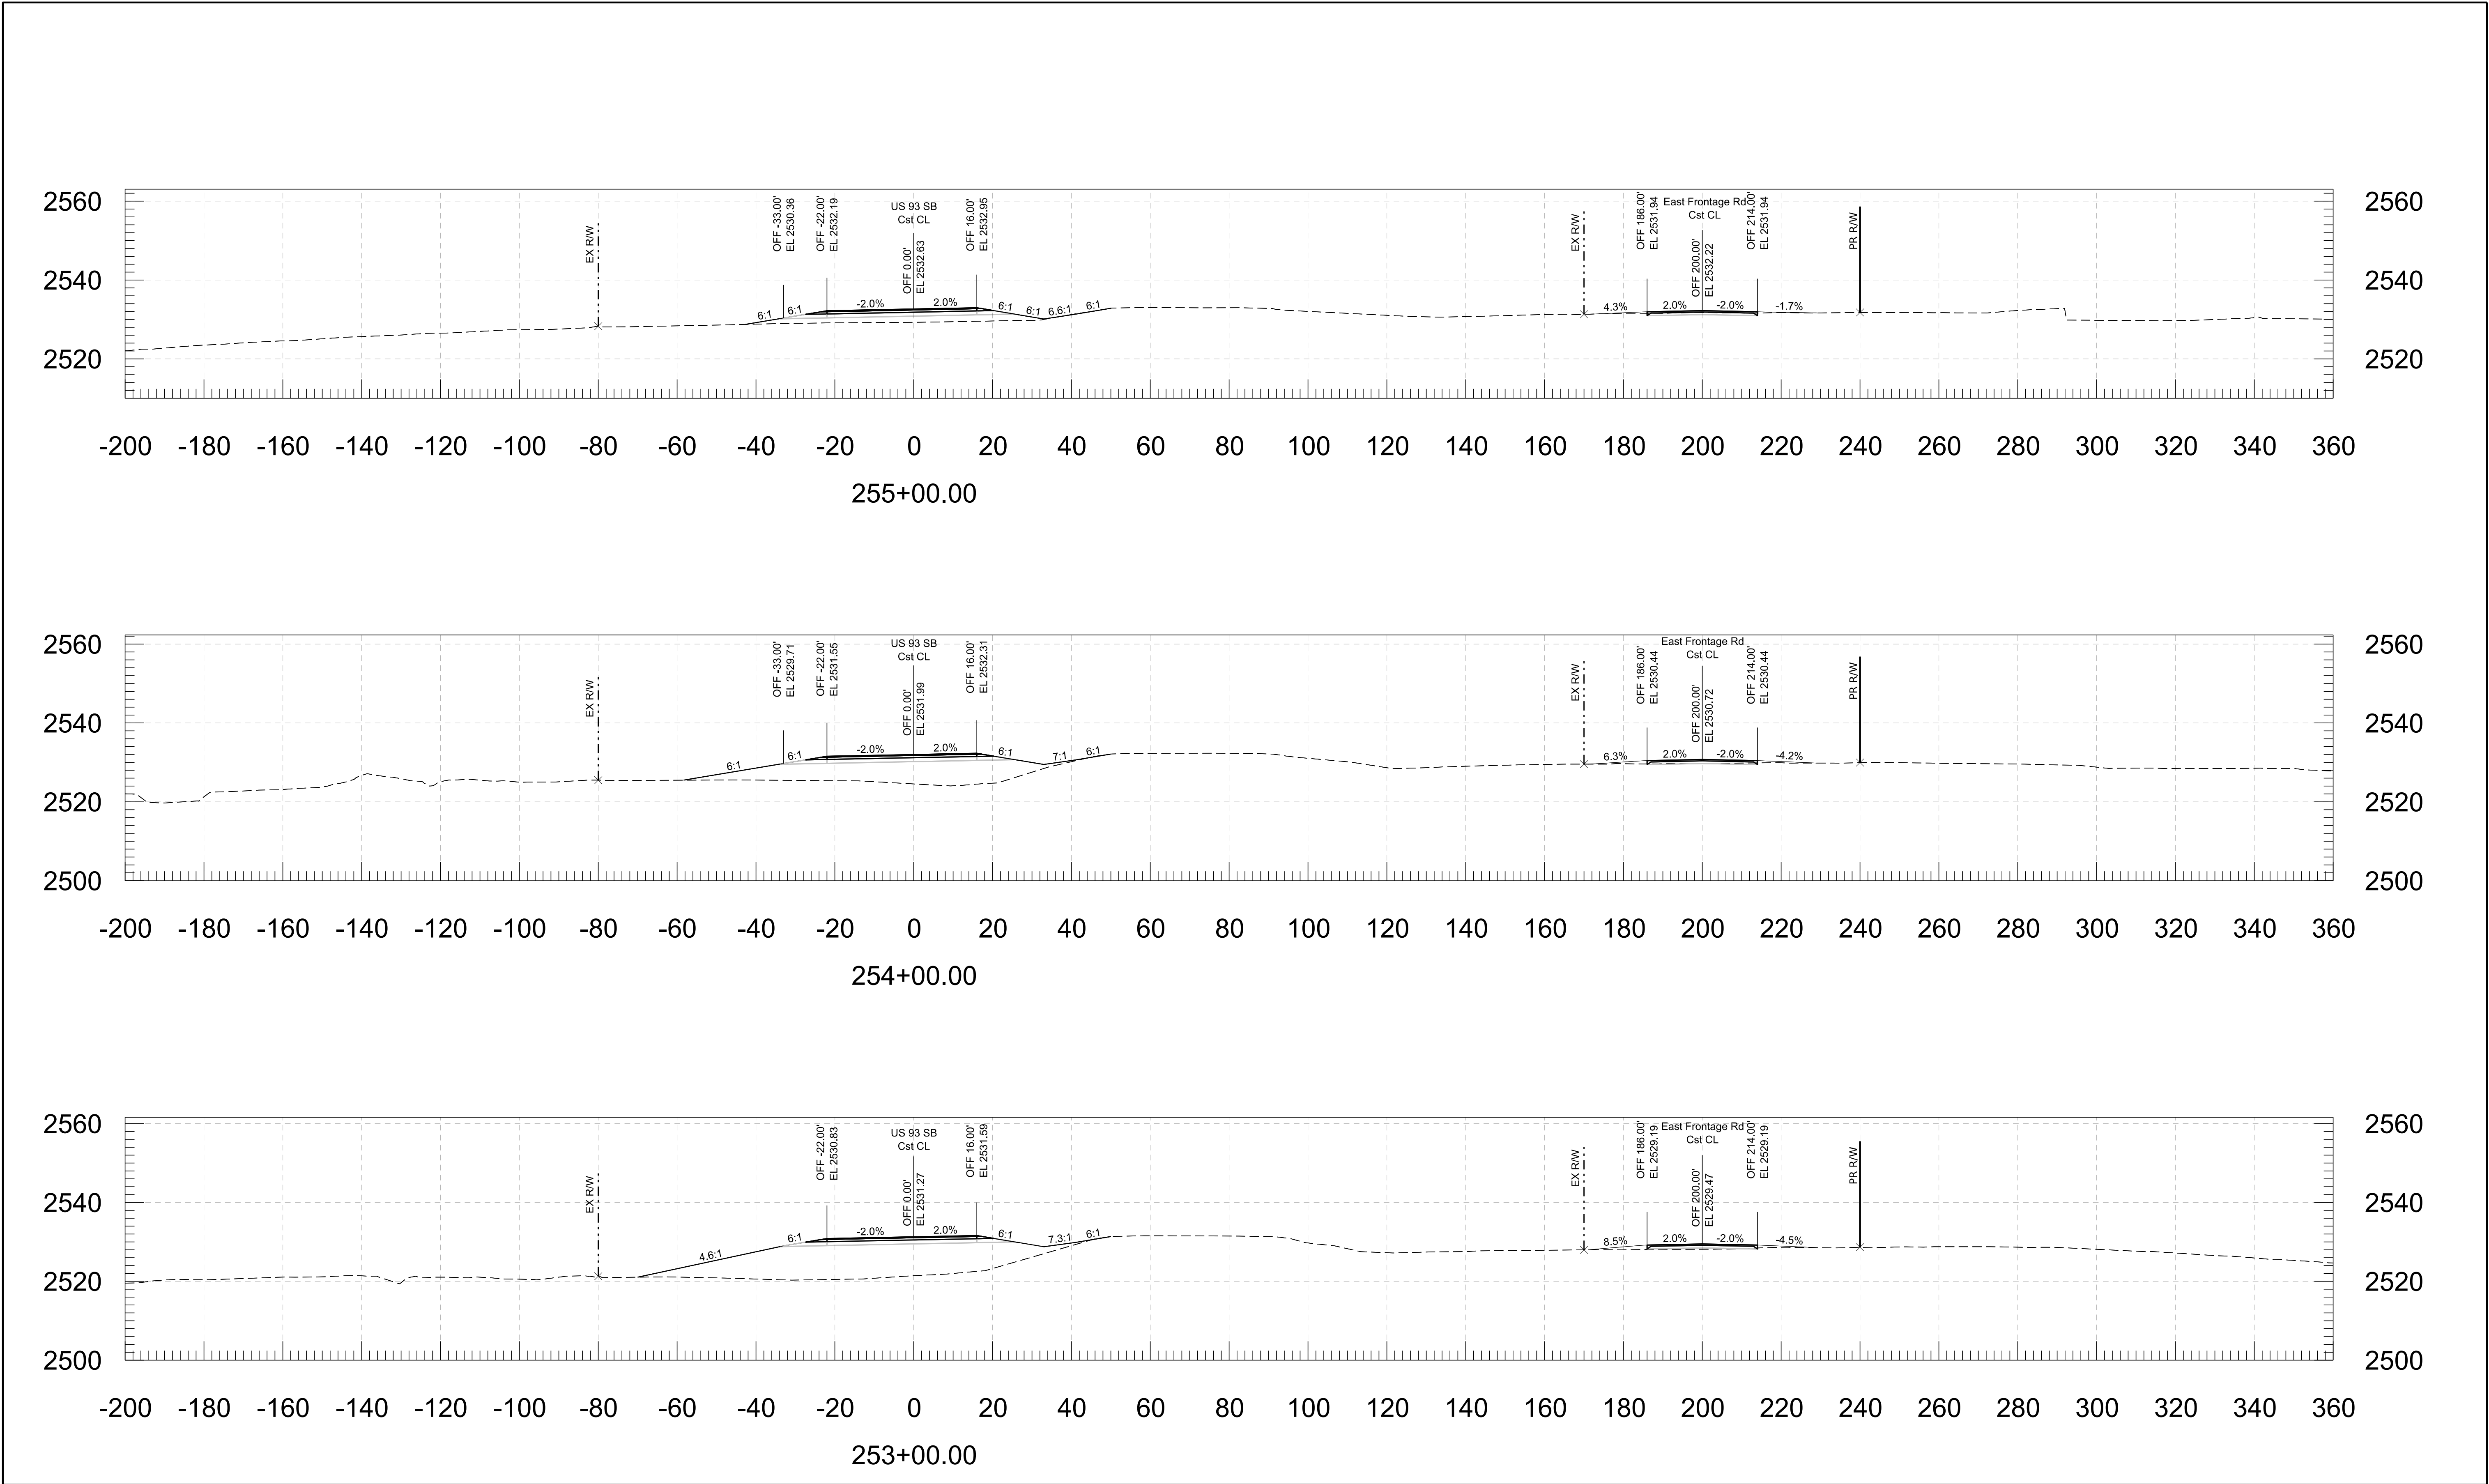


FOR INFORMATION ONLY	DESIGN	J GILLIS	06/26	ARIZONA DEPARTMENT OF TRANSPORTATION PROJECT DELIVERY AND OPERATIONS DIVISION ROADWAY DESIGN SERVICES	ROUTE	F.H.W.A. Arizona Division	STATE ARIZ.	PROJECT NO.	FEDERAL ID NO.	SHEET NO.	TOTAL SHEETS	RECORD DRAWING
	DRAWN	J BEMELLEN	06/26		US 93			093 YV 189	093-B(230)T	54	116	
	CHECKED	D WIGGINS	06/26		MILEPOST 189.9			LOCATION WICKENBURG RANCH WAY TO VISTA ROYALE				
	TRANSPORTATION AECOM TECHNICAL SERVICES, Inc. 7720 N. 16th St., Suite 100 Phoenix, Arizona 85020 T 602.371.1100			CROSS SECTIONS		STRUCTURE NO.	TRACS NO. F0738 01C		OF			
												


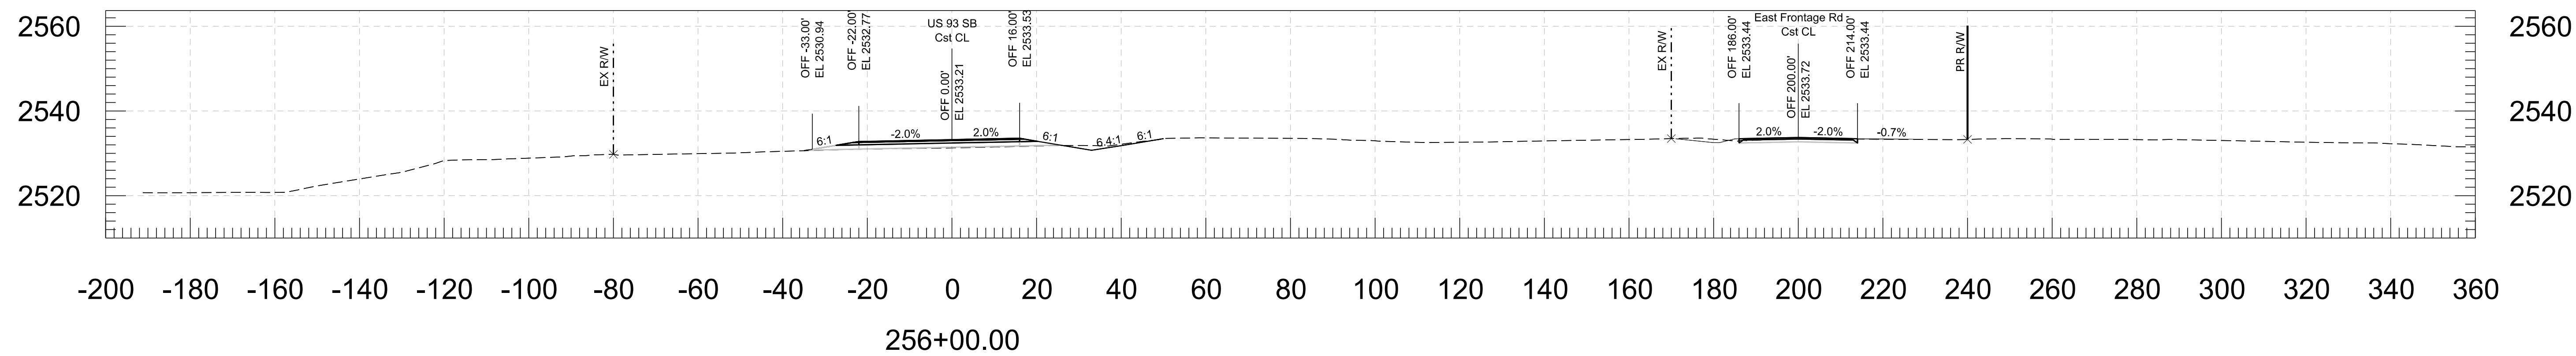


FOR INFORMATION ONLY		NAME	DATE	ARIZONA DEPARTMENT OF TRANSPORTATION PROJECT DELIVERY AND OPERATIONS DIVISION ROADWAY DESIGN SERVICES	ROUTE	F.H.W.A. Arizona Division	STATE ARIZ.	PROJECT NO.	FEDERAL ID NO.	SHEET NO.	TOTAL SHEETS	RECORD DRAWING
	DESIGN	J GILLIS	06/26		US 93			093 YV 189	093-B(230)T	55	116	
	DRAWN	J BEMELEN	06/26		MILEPOST							
	CHECKED	D WIGGINS	06/26		189.9							
	TRANSPORTATION AECOM TECHNICAL SERVICES, Inc. 7720 N. 19th St., Suite 100 Phoenix, Arizona 85020 T 602.371.1100 			CROSS SECTIONS	STRUCTURE NO.	LOCATION WICKENBURG RANCH WAY TO VISTA ROYALE TRACS NO. F0738 01C					DWG No. 54	OF


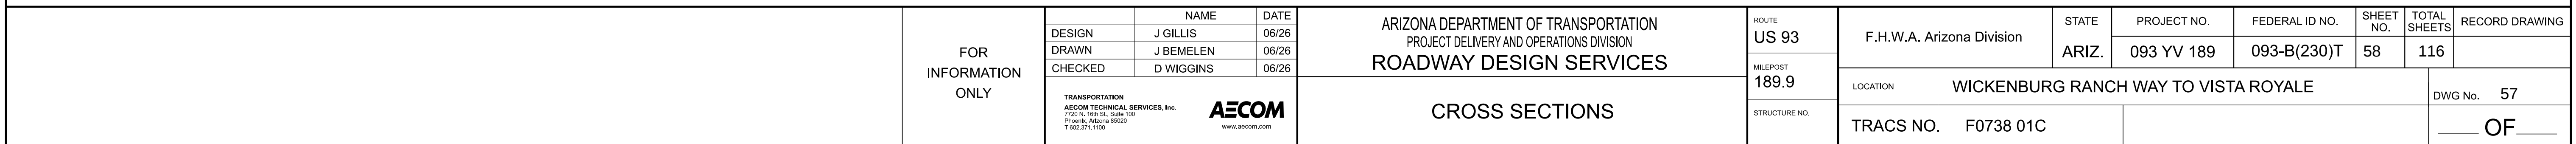
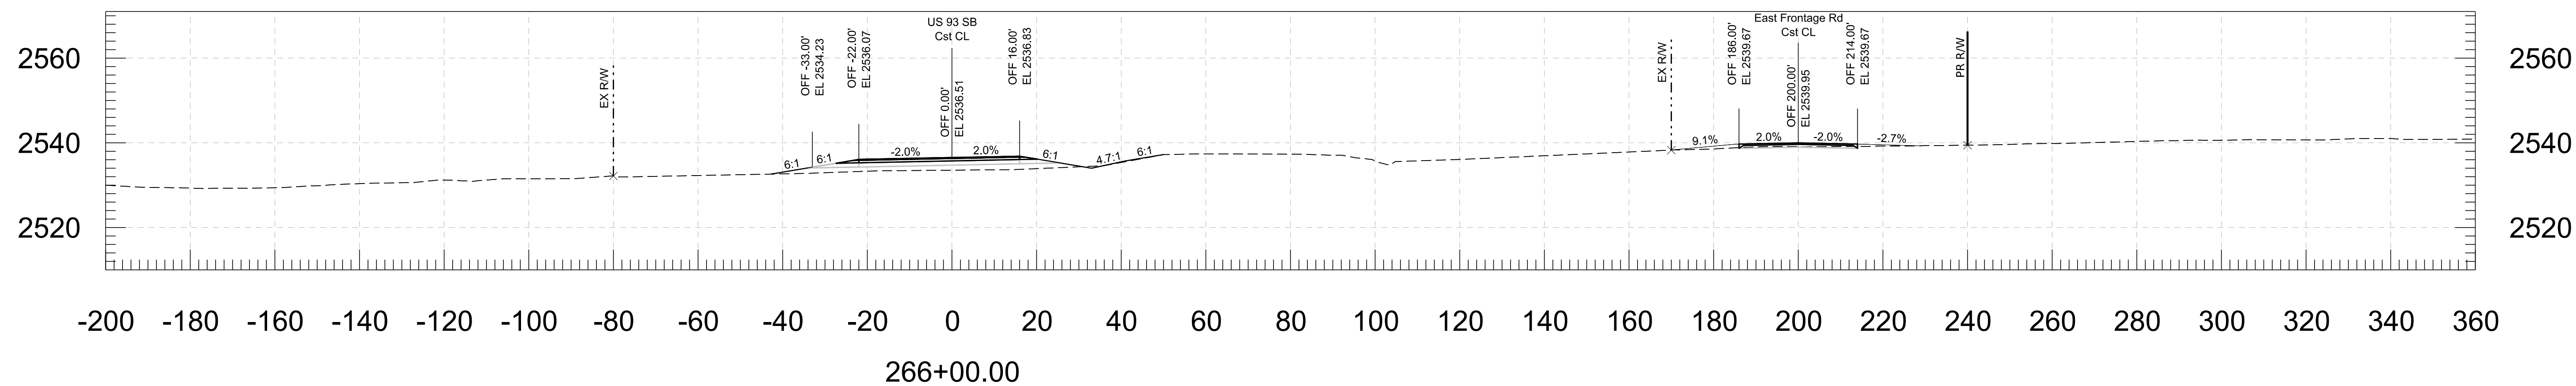


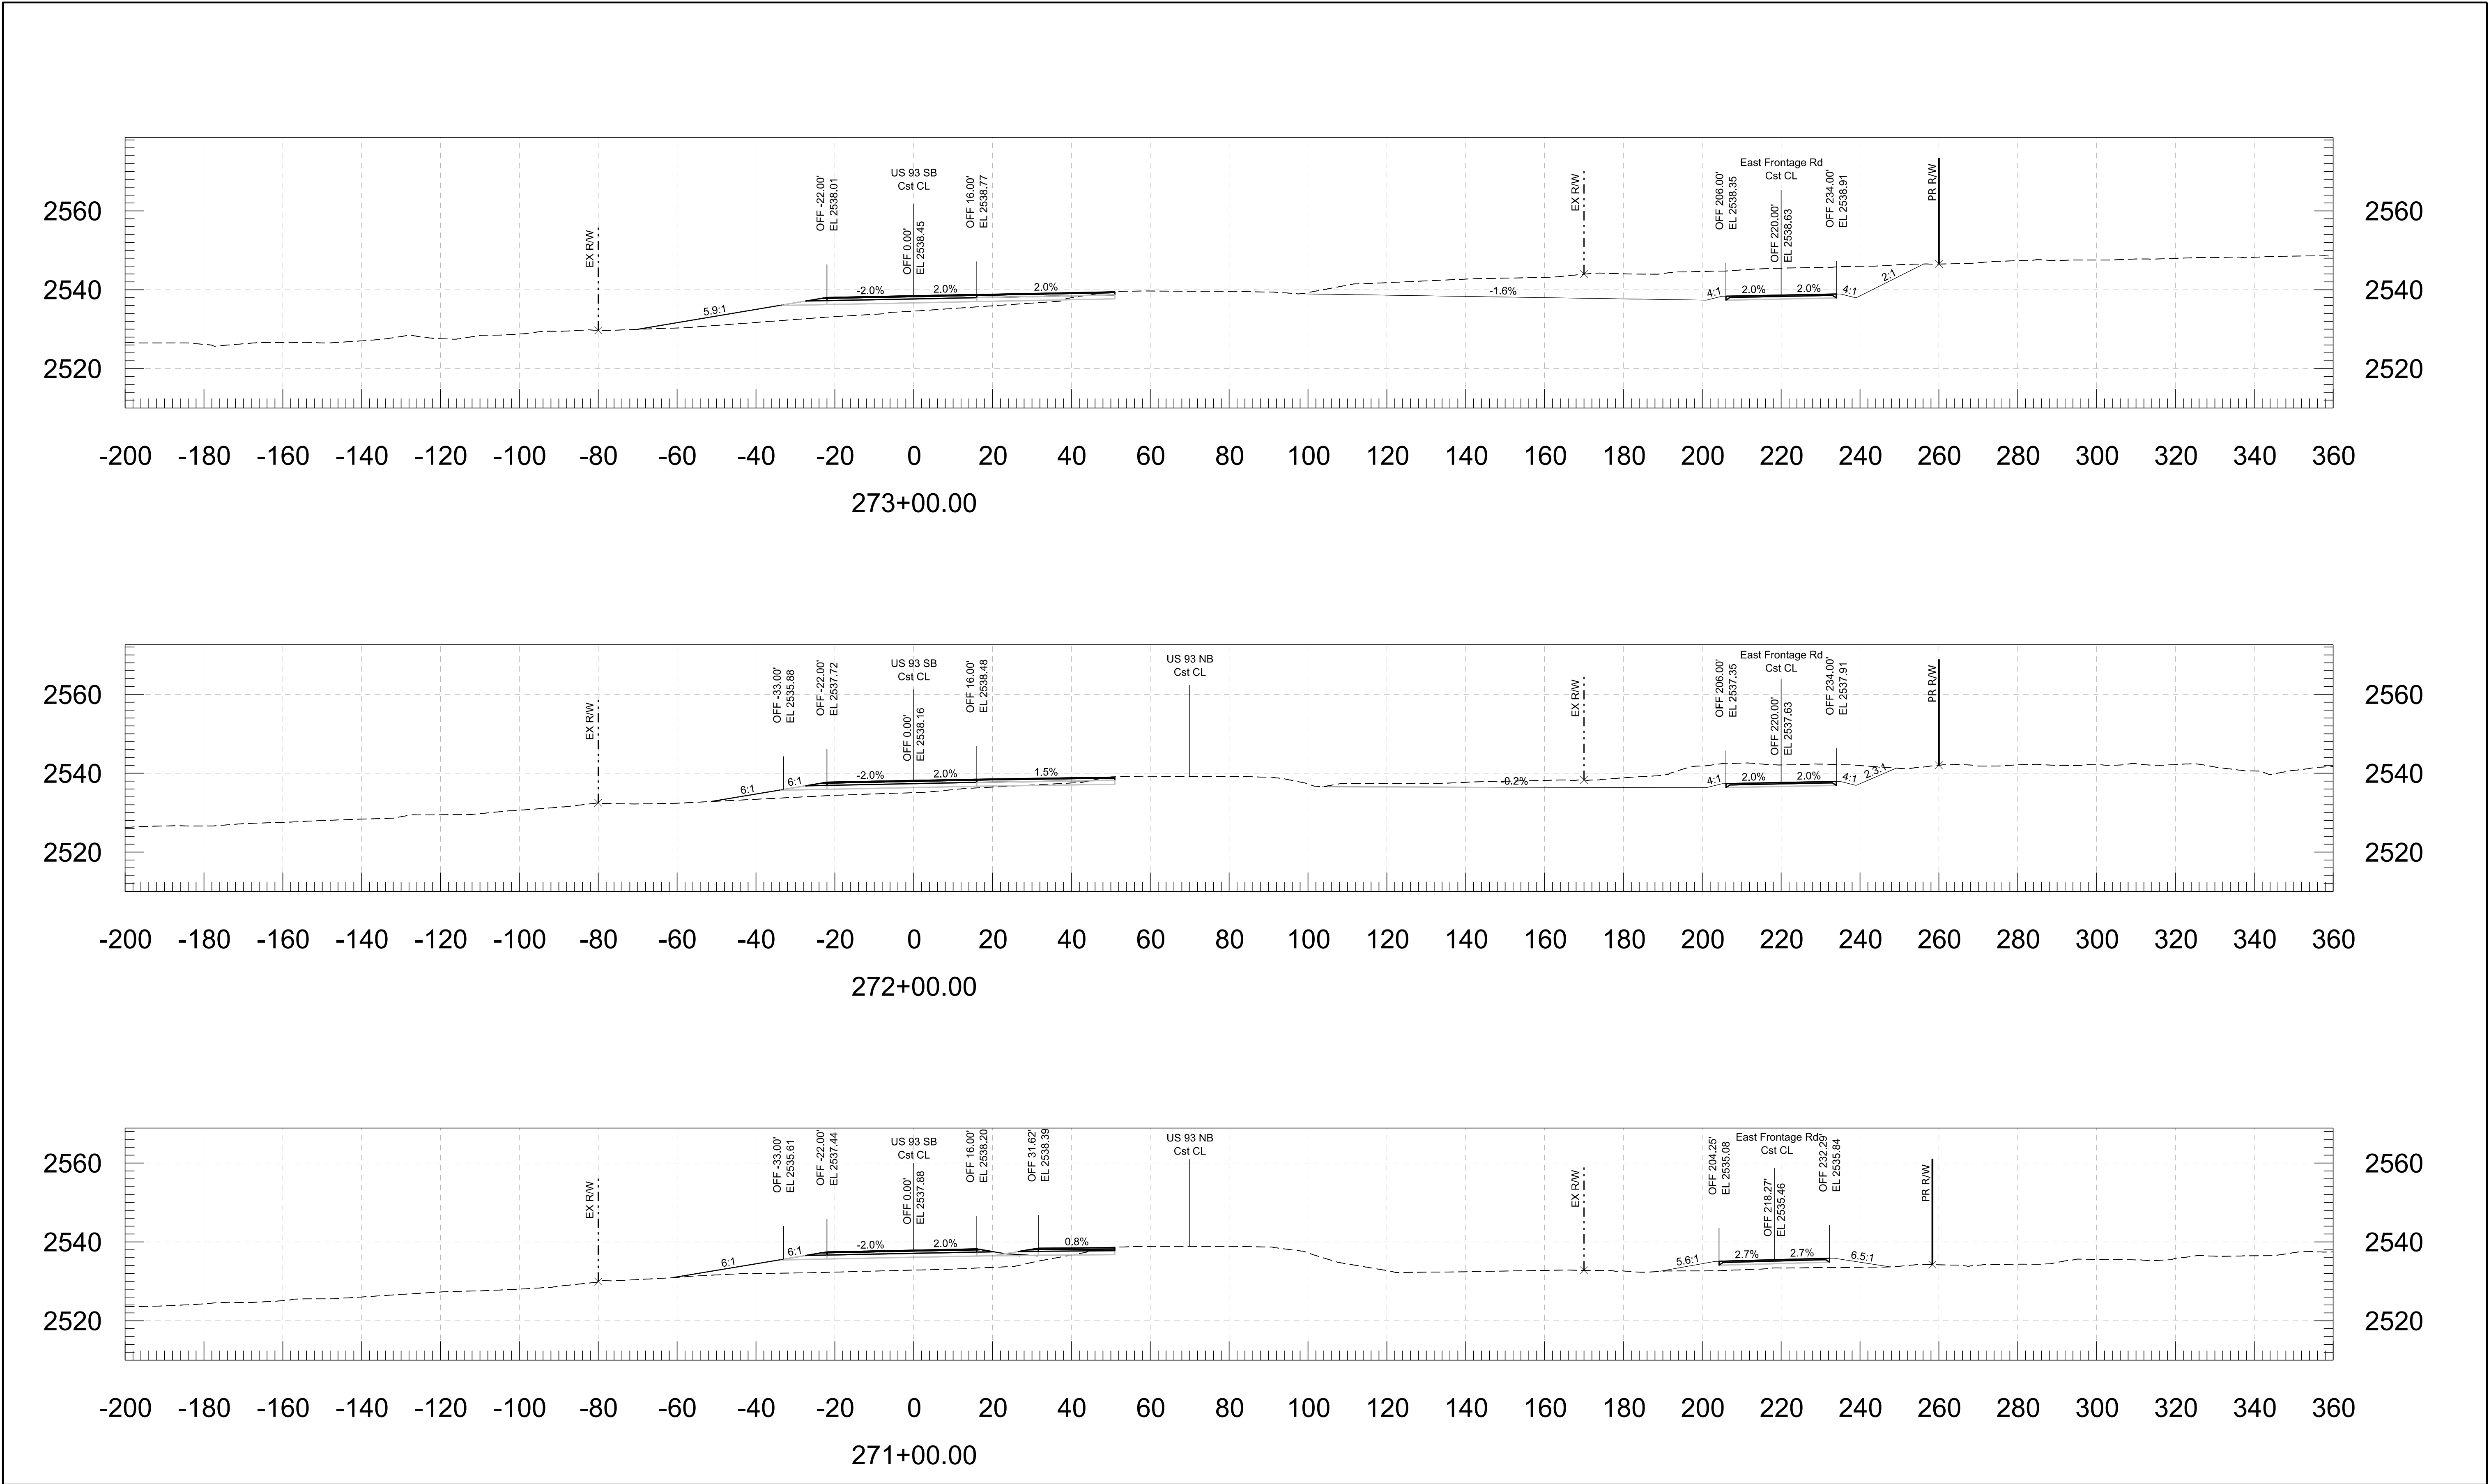




FOR INFORMATION ONLY	DESIGN	J GILLIS	06/26	ARIZONA DEPARTMENT OF TRANSPORTATION PROJECT DELIVERY AND OPERATIONS DIVISION ROADWAY DESIGN SERVICES	ROUTE	F.H.W.A. Arizona Division	STATE ARIZ.	PROJECT NO.	FEDERAL ID NO.	SHEET NO.	TOTAL SHEETS	RECORD DRAWING
	DRAWN	J BEMELLEN	06/26		US 93			093 YV 189	093-B(230)T	60	116	
	CHECKED	D WIGGINS	06/26		MILEPOST 189.9			LOCATION WICKENBURG RANCH WAY TO VISTA ROYALE				
	TRANSPORTATION AECOM TECHNICAL SERVICES, Inc. 7720 N. 16th St., Suite 100 Phoenix, Arizona 85020 T 602.371.1100 www.aecom.com			CROSS SECTIONS	STRUCTURE NO.	TRACS NO. F0738 01C		____ OF ____				

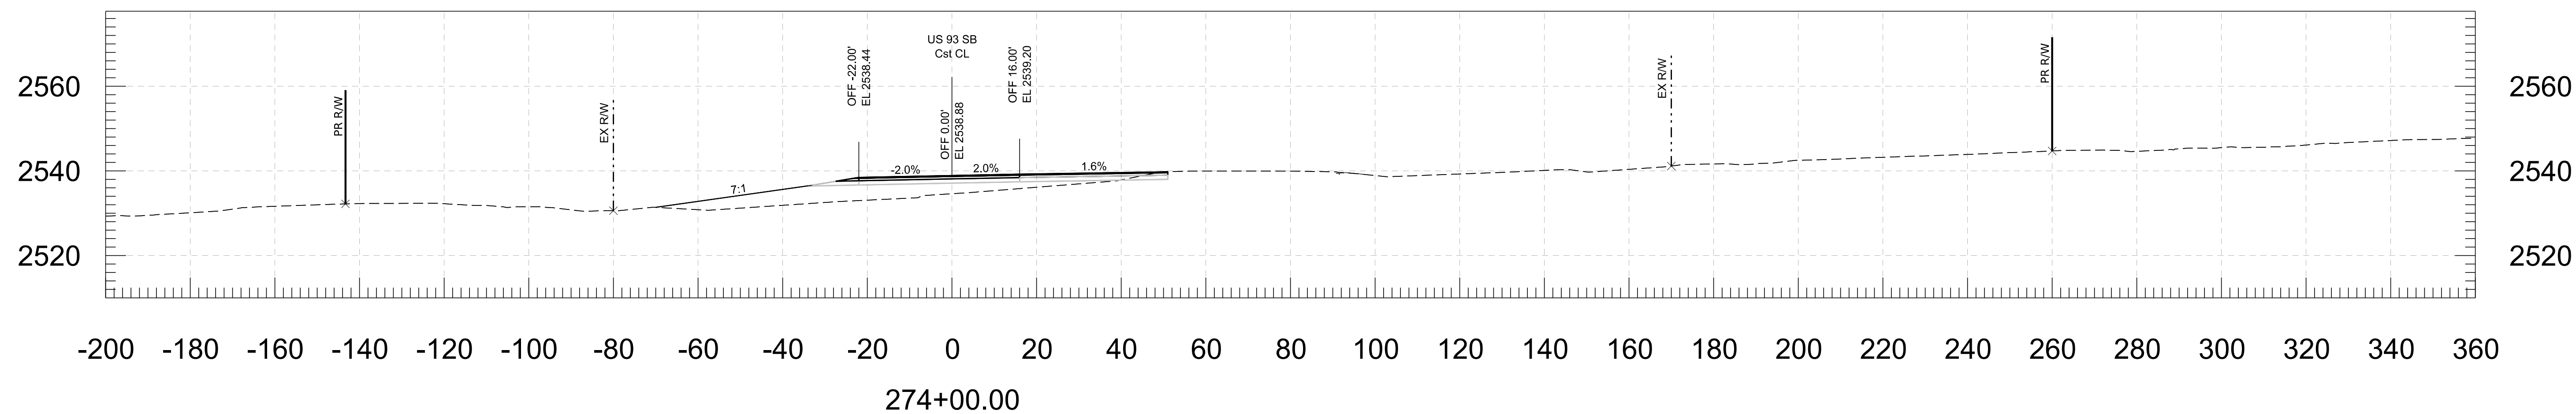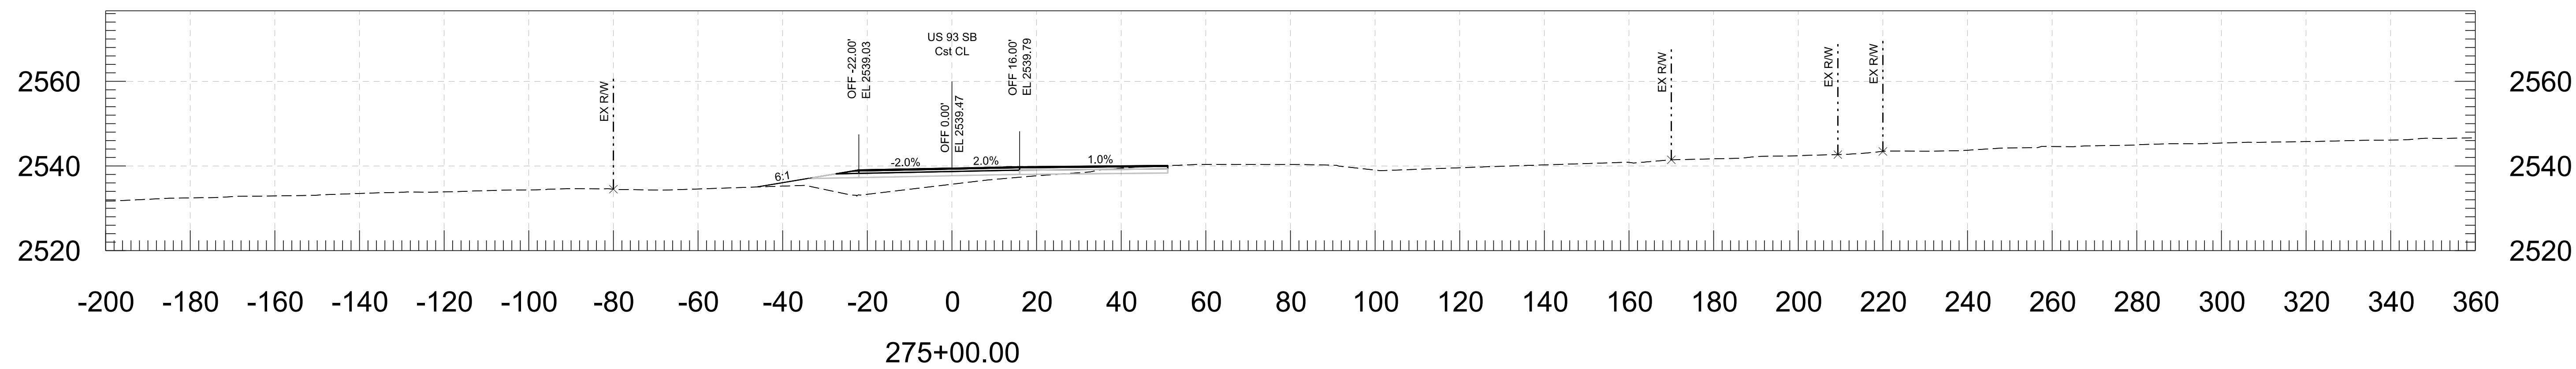




FOR INFORMATION ONLY		NAME	DATE	ARIZONA DEPARTMENT OF TRANSPORTATION PROJECT DELIVERY AND OPERATIONS DIVISION ROADWAY DESIGN SERVICES	ROUTE	F.H.W.A. Arizona Division	STATE	PROJECT NO.	FEDERAL ID NO.	SHEET NO.	TOTAL SHEETS	RECORD DRAWING
	DESIGN	J GILLIS	06/26		US 93		ARIZ.	093 YV 189	093-B(230)T	61	116	
	DRAWN	J BEMELLEN	06/26		CROSS SECTIONS	MILEPOST	WICKENBURG RANCH WAY TO VISTA ROYALE DWG No. 60					
	CHECKED	D WIGGINS	06/26			189.9						
	TRANSPORTATION AECOM TECHNICAL SERVICES, Inc. 7720 N. 19th St., Suite 100 Phoenix, Arizona 85020 T 602.371.1100						STRUCTURE NO.		TRACS NO. F0738 01C		OF	

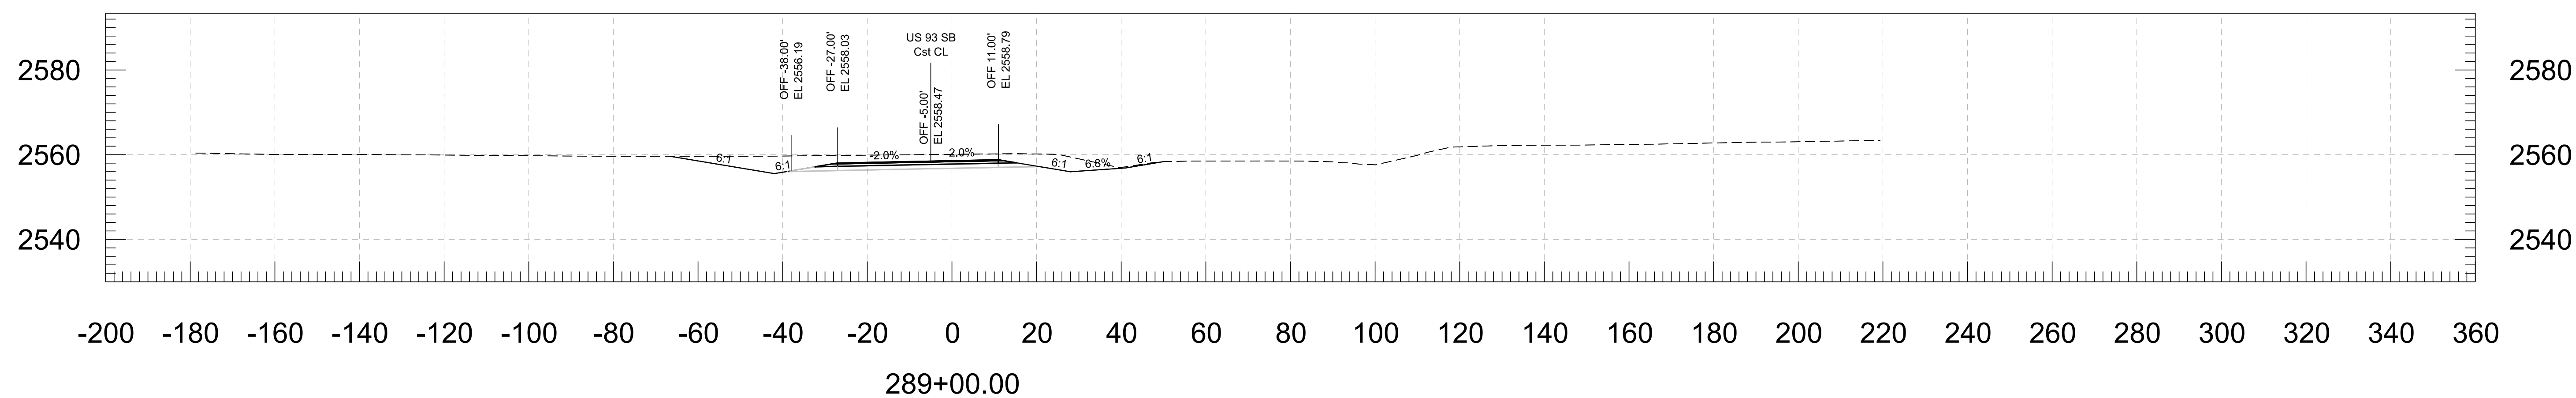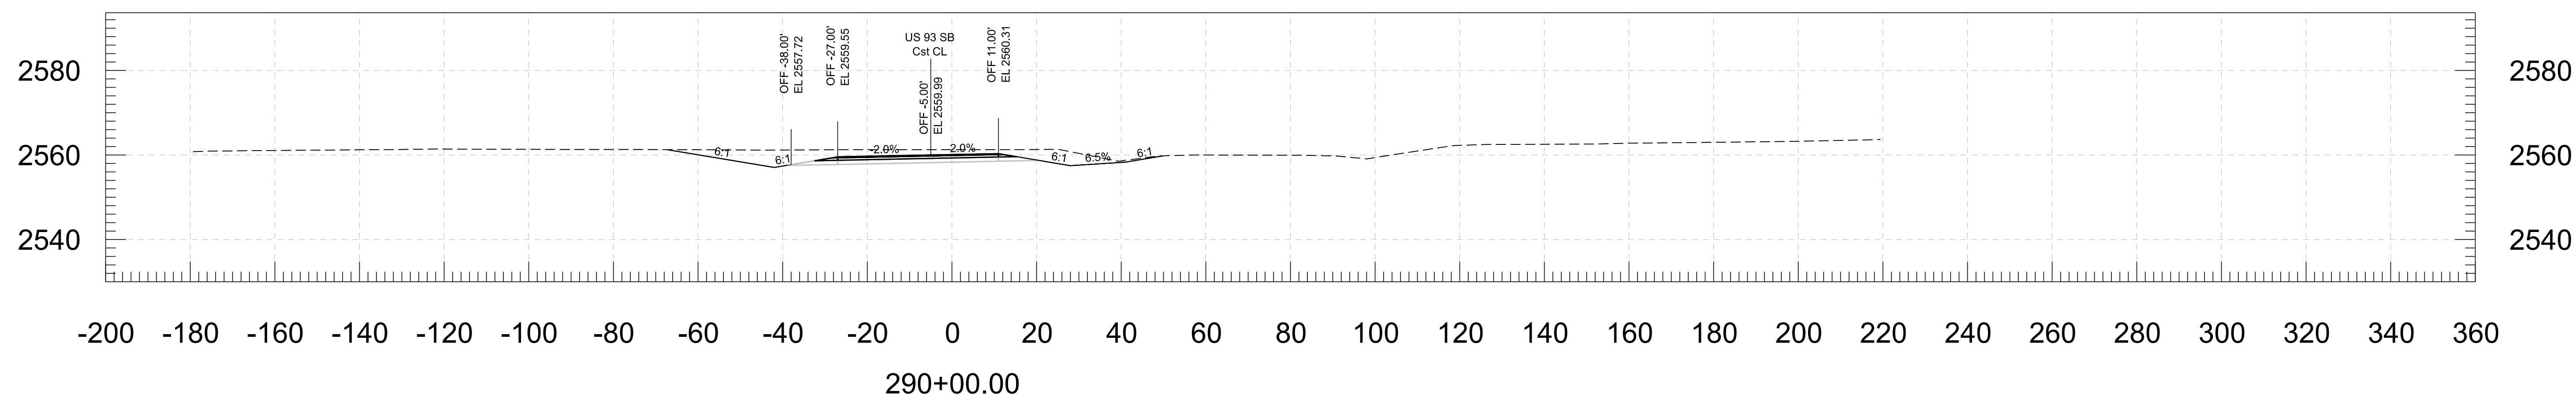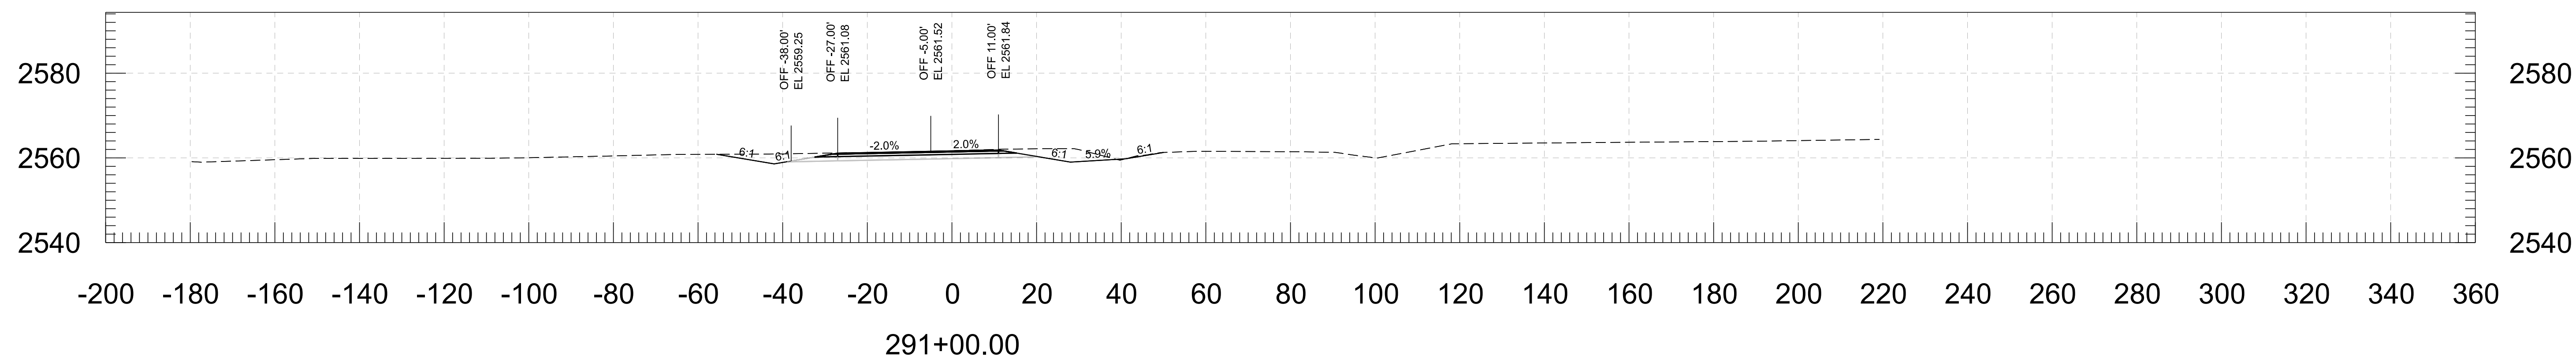



FOR INFORMATION ONLY		NAME	DATE	ARIZONA DEPARTMENT OF TRANSPORTATION PROJECT DELIVERY AND OPERATIONS DIVISION ROADWAY DESIGN SERVICES	ROUTE	F.H.W.A. Arizona Division	STATE	PROJECT NO.	FEDERAL ID NO.	SHEET NO.	TOTAL SHEETS	RECORD DRAWING
	DESIGN	J GILLIS	06/26		US 93		ARIZ.	093 YV 189	093-B(230)T	66	116	
	DRAWN	J BEMELEN	06/26		CROSS SECTIONS	MILEPOST	WICKENBURG RANCH WAY TO VISTA ROYALE DWG No. 65					
	CHECKED	D WIGGINS	06/26			189.9						
	TRANSPORTATION AECOM TECHNICAL SERVICES, Inc. 7720 N. 19th St., Suite 100 Phoenix, Arizona 85020 T 602.371.1100						STRUCTURE NO.		TRACS NO. F0738 01C		OF	

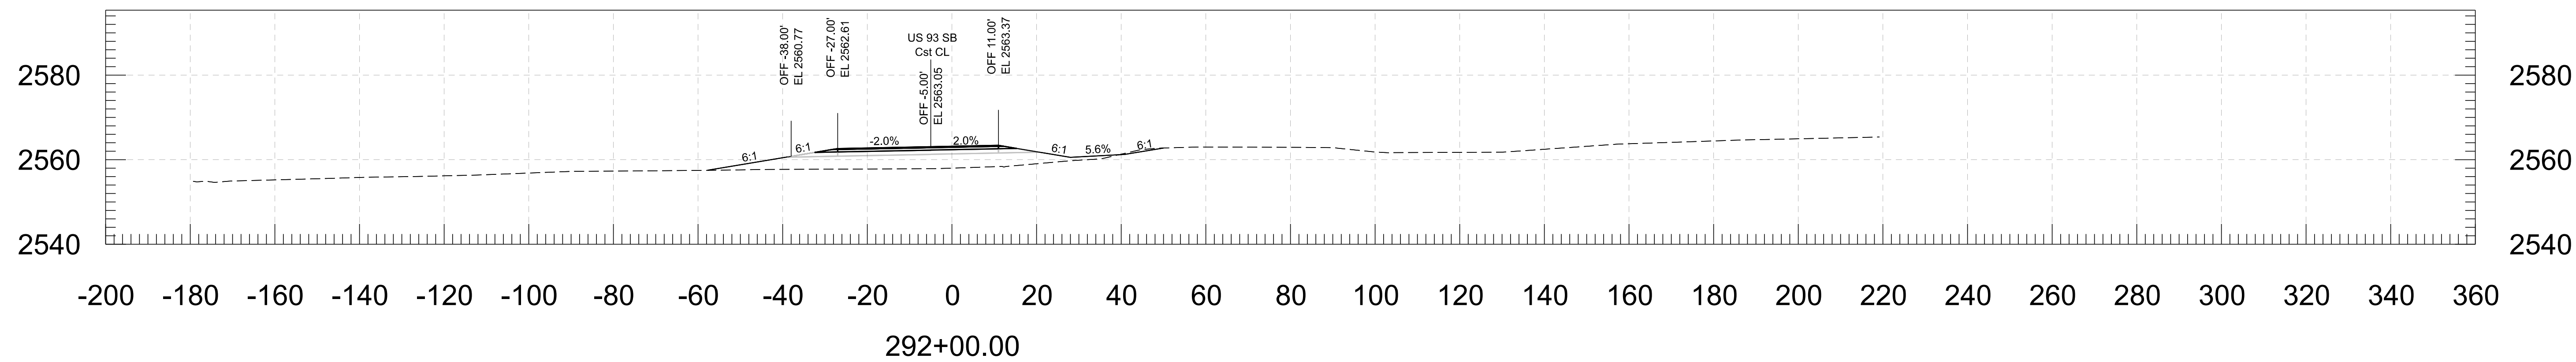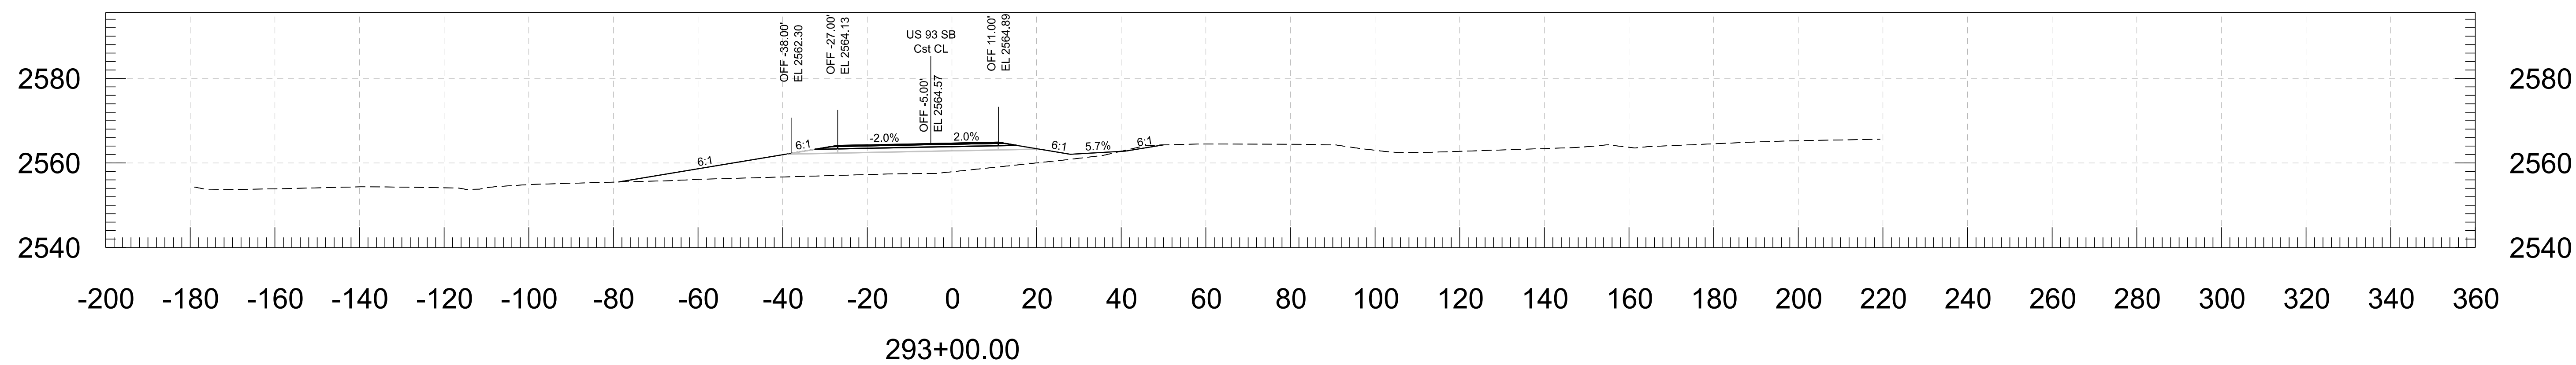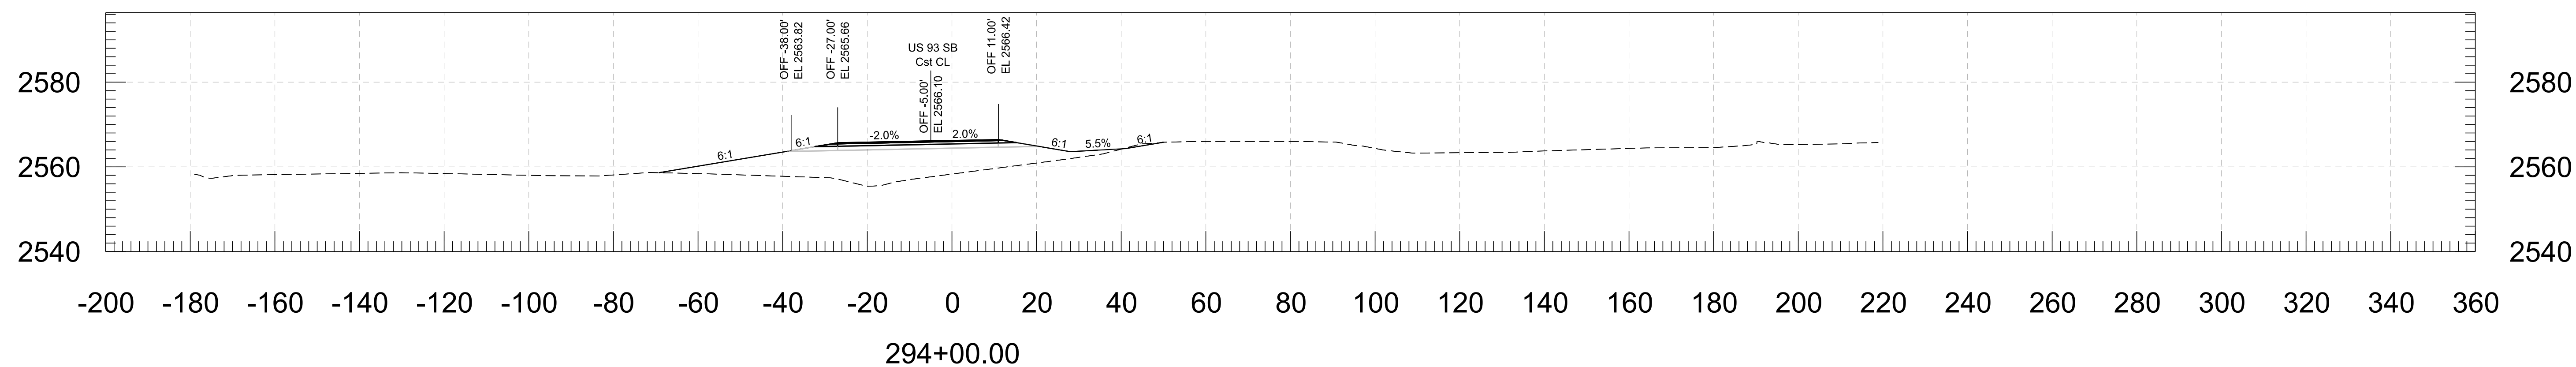




FOR INFORMATION ONLY		NAME	DATE	ARIZONA DEPARTMENT OF TRANSPORTATION PROJECT DELIVERY AND OPERATIONS DIVISION ROADWAY DESIGN SERVICES	ROUTE	F.H.W.A. Arizona Division	STATE ARIZ.	PROJECT NO.	FEDERAL ID NO.	SHEET NO.	TOTAL SHEETS	RECORD DRAWING
	DESIGN	J GILLIS	06/26		US 93			093 YV 189	093-B(230)T	67	116	
	DRAWN	J BEMELEN	06/26		MILEPOST							
	CHECKED	D WIGGINS	06/26	189.9								
		TRANSPORTATION AECOM TECHNICAL SERVICES, Inc. 7720 N. 19th St., Suite 100 Phoenix, Arizona 85020 T 602.371.1100 			CROSS SECTIONS	STRUCTURE NO.	WICKENBURG RANCH WAY TO VISTA ROYALE				DWG No. 66	
					TRACS NO. F0738 01C						OF	

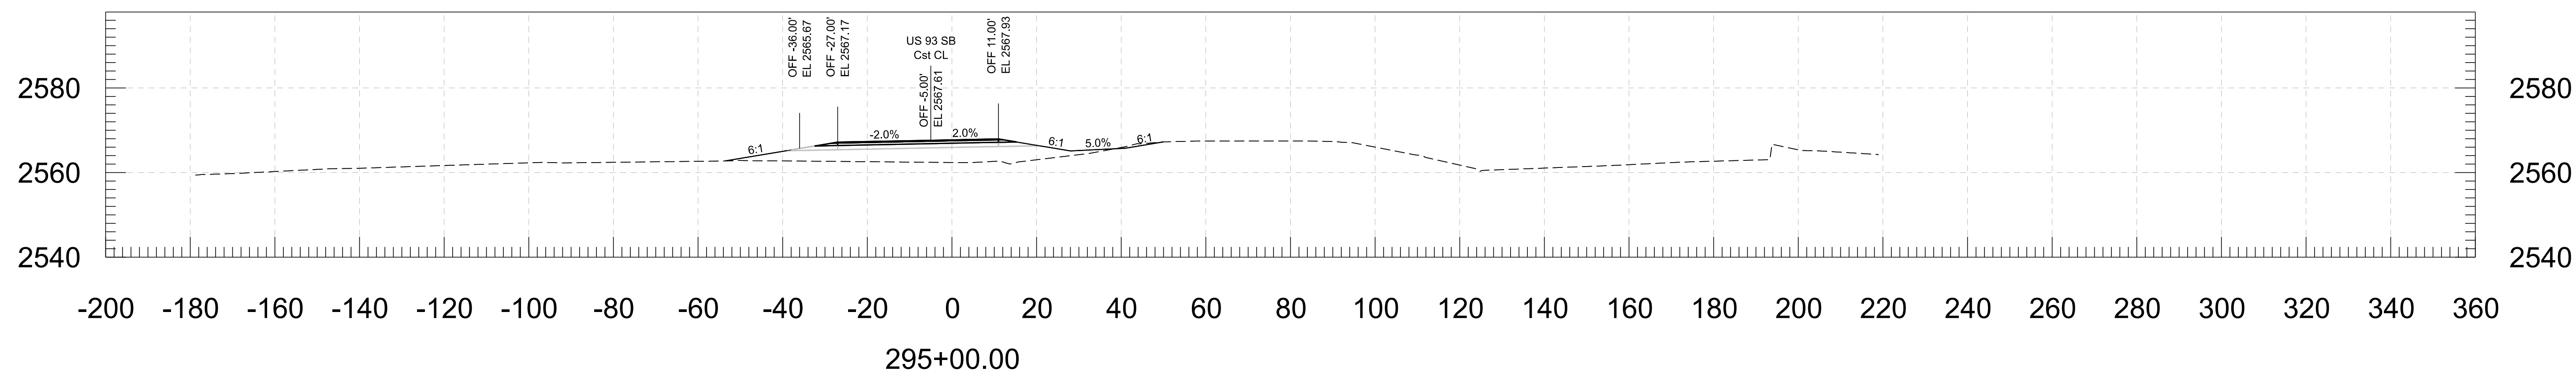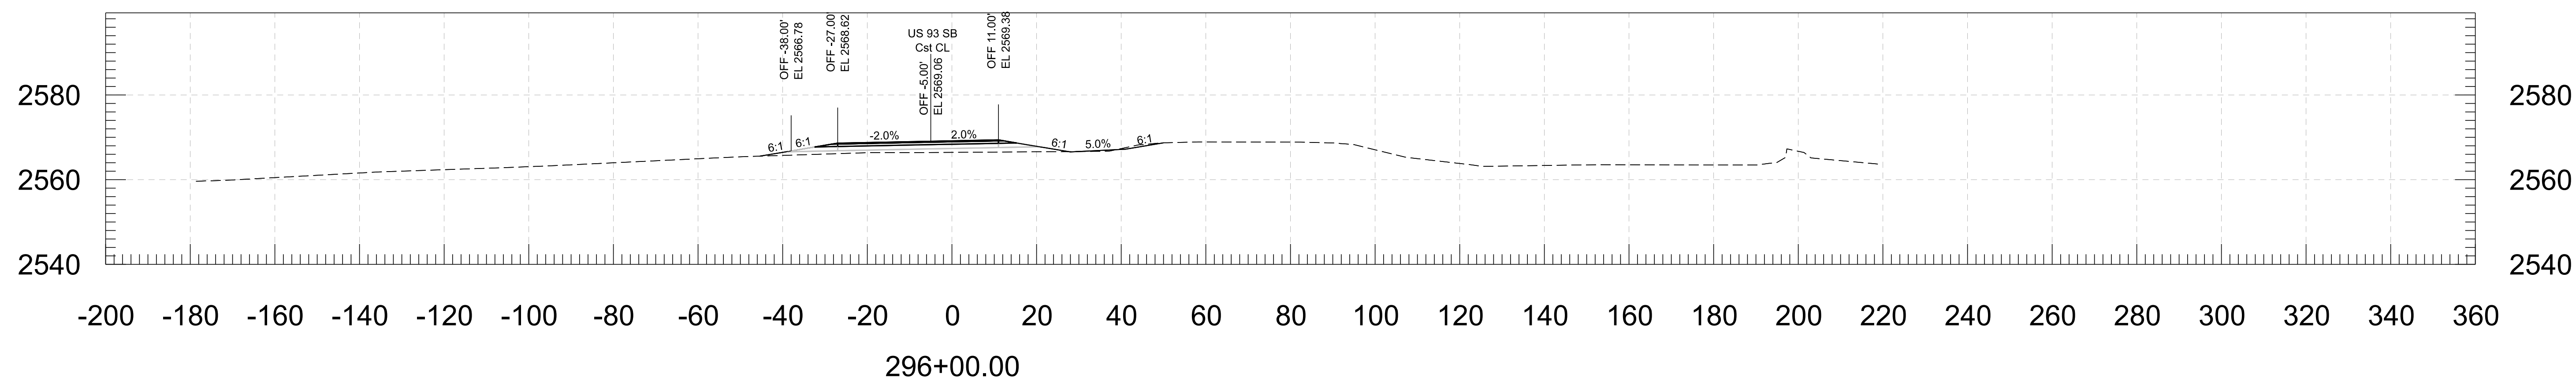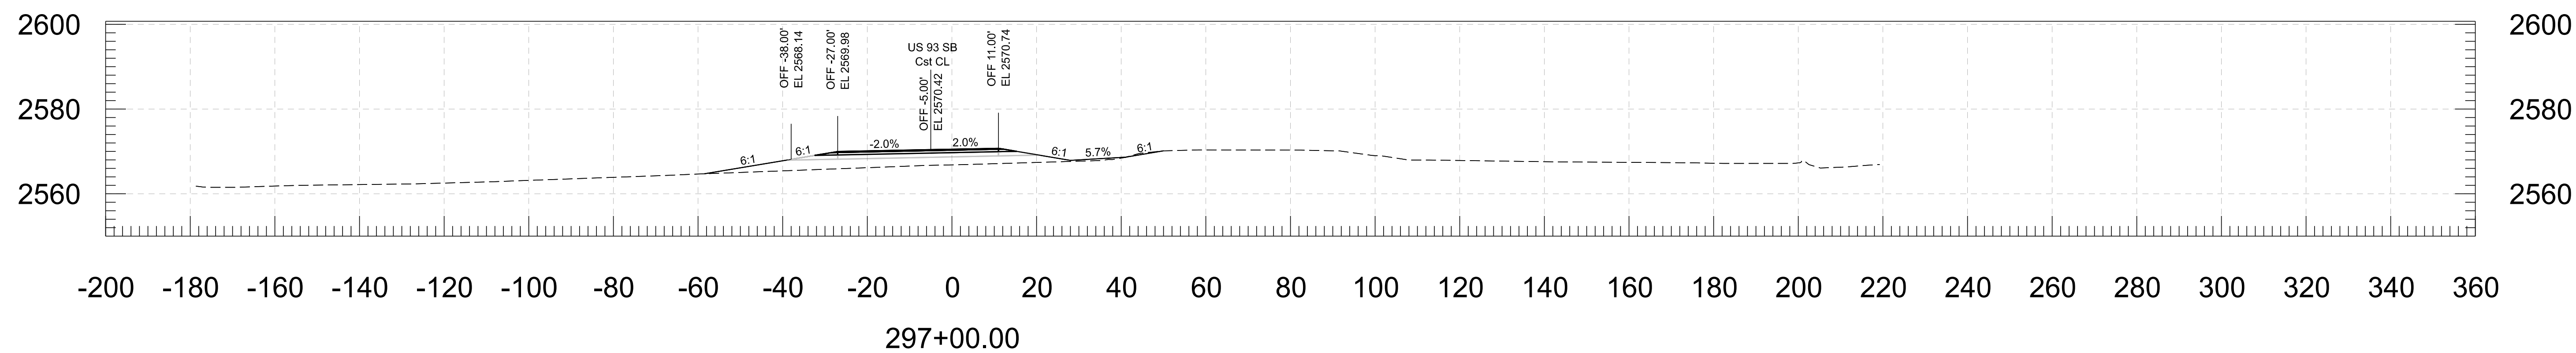


FOR INFORMATION ONLY		NAME	DATE	ARIZONA DEPARTMENT OF TRANSPORTATION PROJECT DELIVERY AND OPERATIONS DIVISION ROADWAY DESIGN SERVICES	ROUTE	F.H.W.A. Arizona Division	STATE ARIZ.	PROJECT NO.	FEDERAL ID NO.	SHEET NO.	TOTAL SHEETS	RECORD DRAWING
	DESIGN	J GILLIS	06/26		US 93			093 YV 189	093-B(230)T	68	116	
	DRAWN	J BEMELEN	06/26		MILEPOST	WICKENBURG RANCH WAY TO VISTA ROYALE DWG No. 67 OF						
	CHECKED	D WIGGINS	06/26		189.9							
	TRANSPORTATION AECOM TECHNICAL SERVICES, Inc. 7720 N. 119th St., Suite 100 Phoenix, Arizona 85050 T 602.371.1100 			CROSS SECTIONS	STRUCTURE NO.	TRACS NO. F0738 01C						

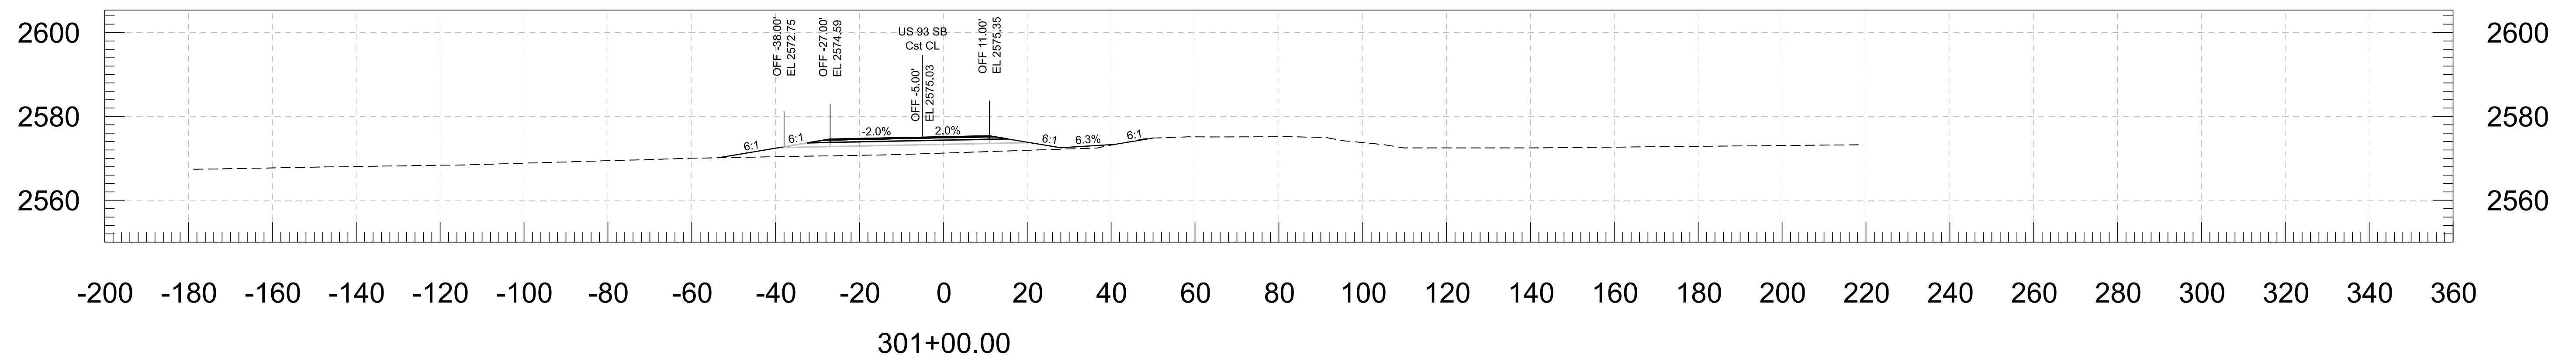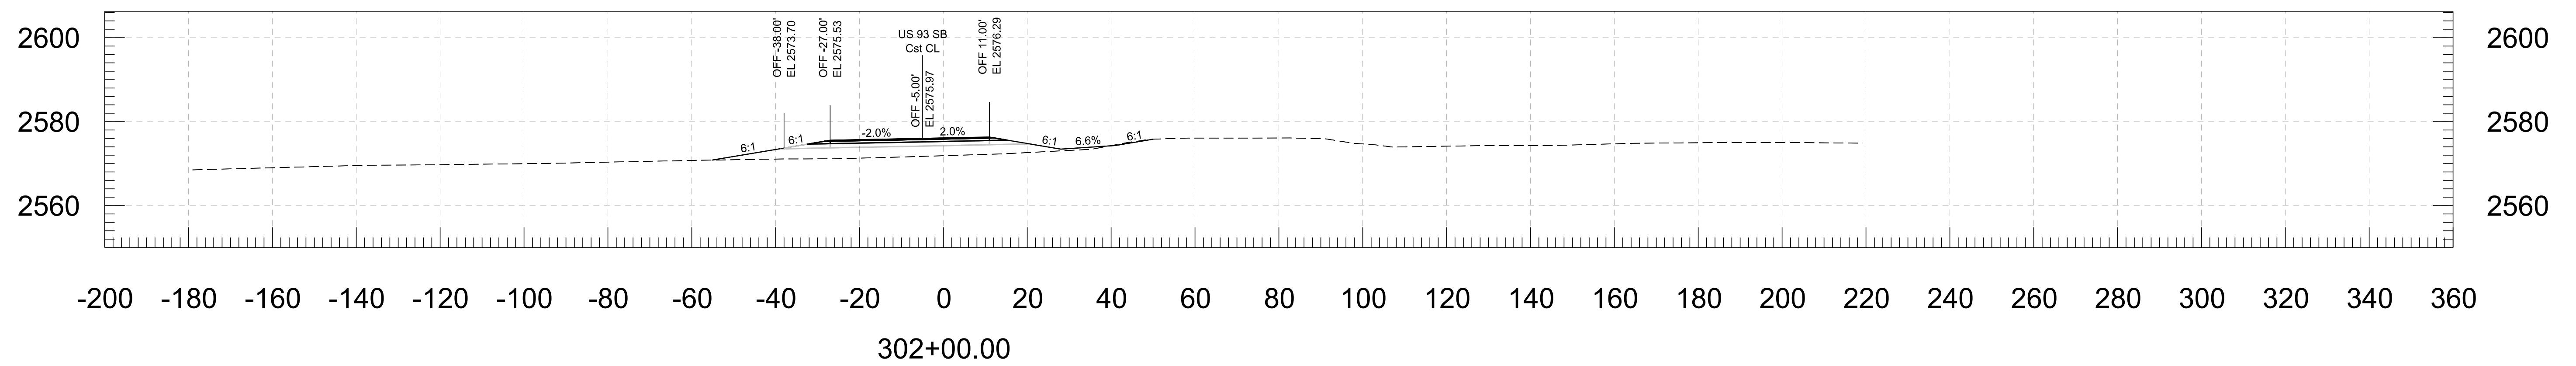


FOR INFORMATION ONLY																																																																																																																																																																																																																																																																																																																																																																																																																																																																																																																																																																																																																																																																																																																																																																																																																																																																																																																																																																																																																																																																																																																																																																																																																																																																																																																																																																																																																	
----------------------------	--	--	
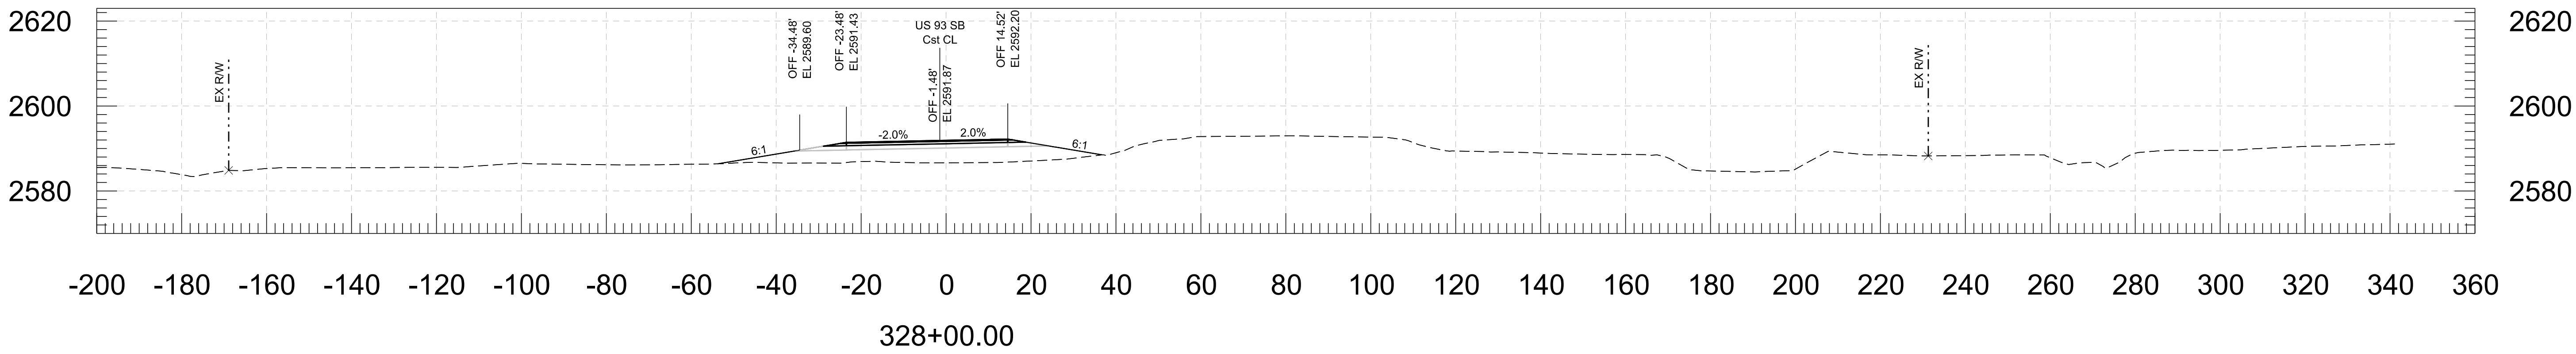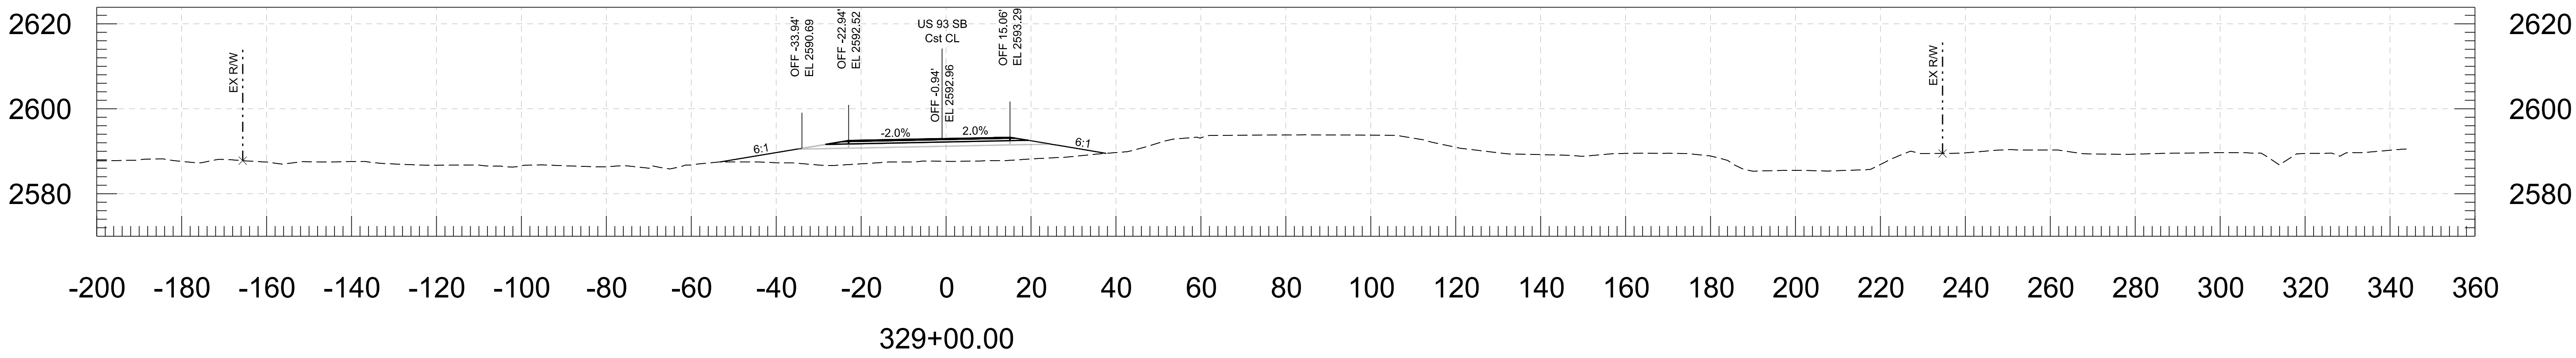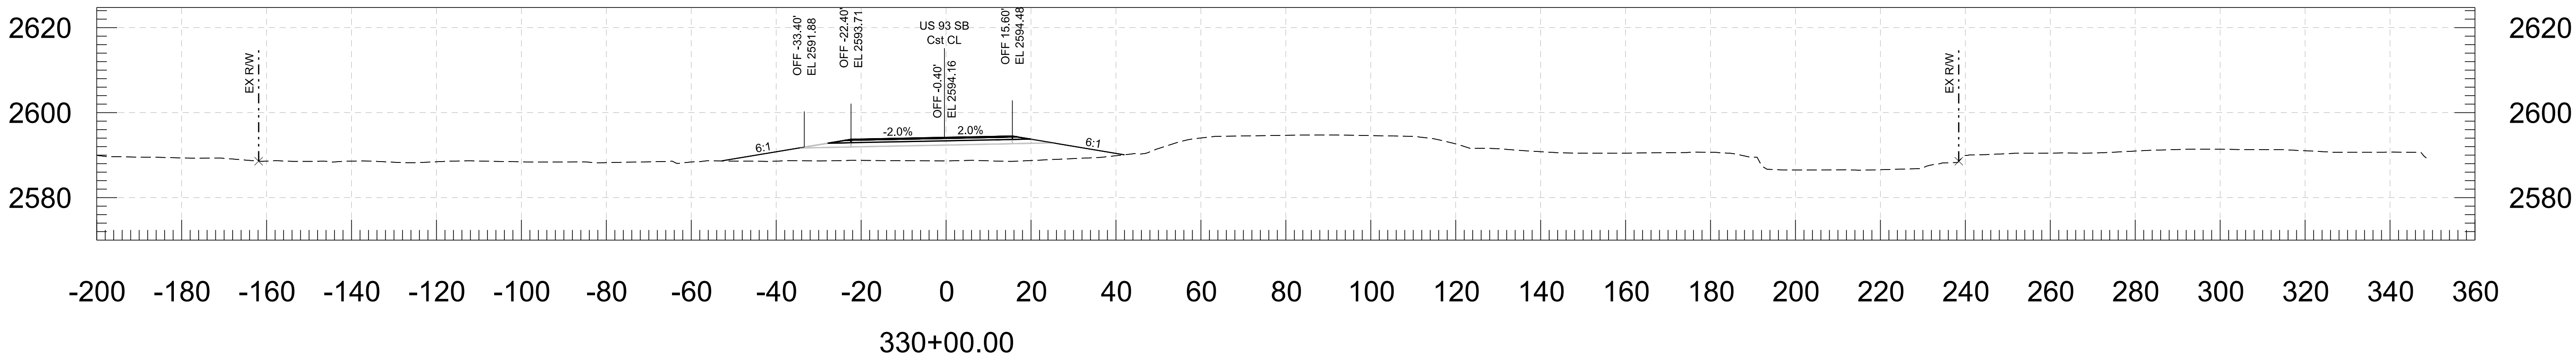

FOR INFORMATION ONLY	DESIGN	J GILLIS	06/26	ARIZONA DEPARTMENT OF TRANSPORTATION PROJECT DELIVERY AND OPERATIONS DIVISION ROADWAY DESIGN SERVICES	ROUTE	F.H.W.A. Arizona Division	STATE ARIZ.	PROJECT NO.	FEDERAL ID NO.	SHEET NO.	TOTAL SHEETS	RECORD DRAWING
	DRAWN	J BEMELEN	06/26		US 93			093 YV 189	093-B(230)T	79	116	
	CHECKED	D WIGGINS	06/26		MILEPOST 189.9	LOCATION WICKENBURG RANCH WAY TO VISTA ROYALE						DWG No. 78
	TRANSPORTATION AECOM TECHNICAL SERVICES, Inc. 7720 N. 18th St., Suite 100 Phoenix, Arizona 85020 T 602.371.1100			CROSS SECTIONS	STRUCTURE NO.	TRACS NO. F0738 01C		OF				
	 www.aecom.com											


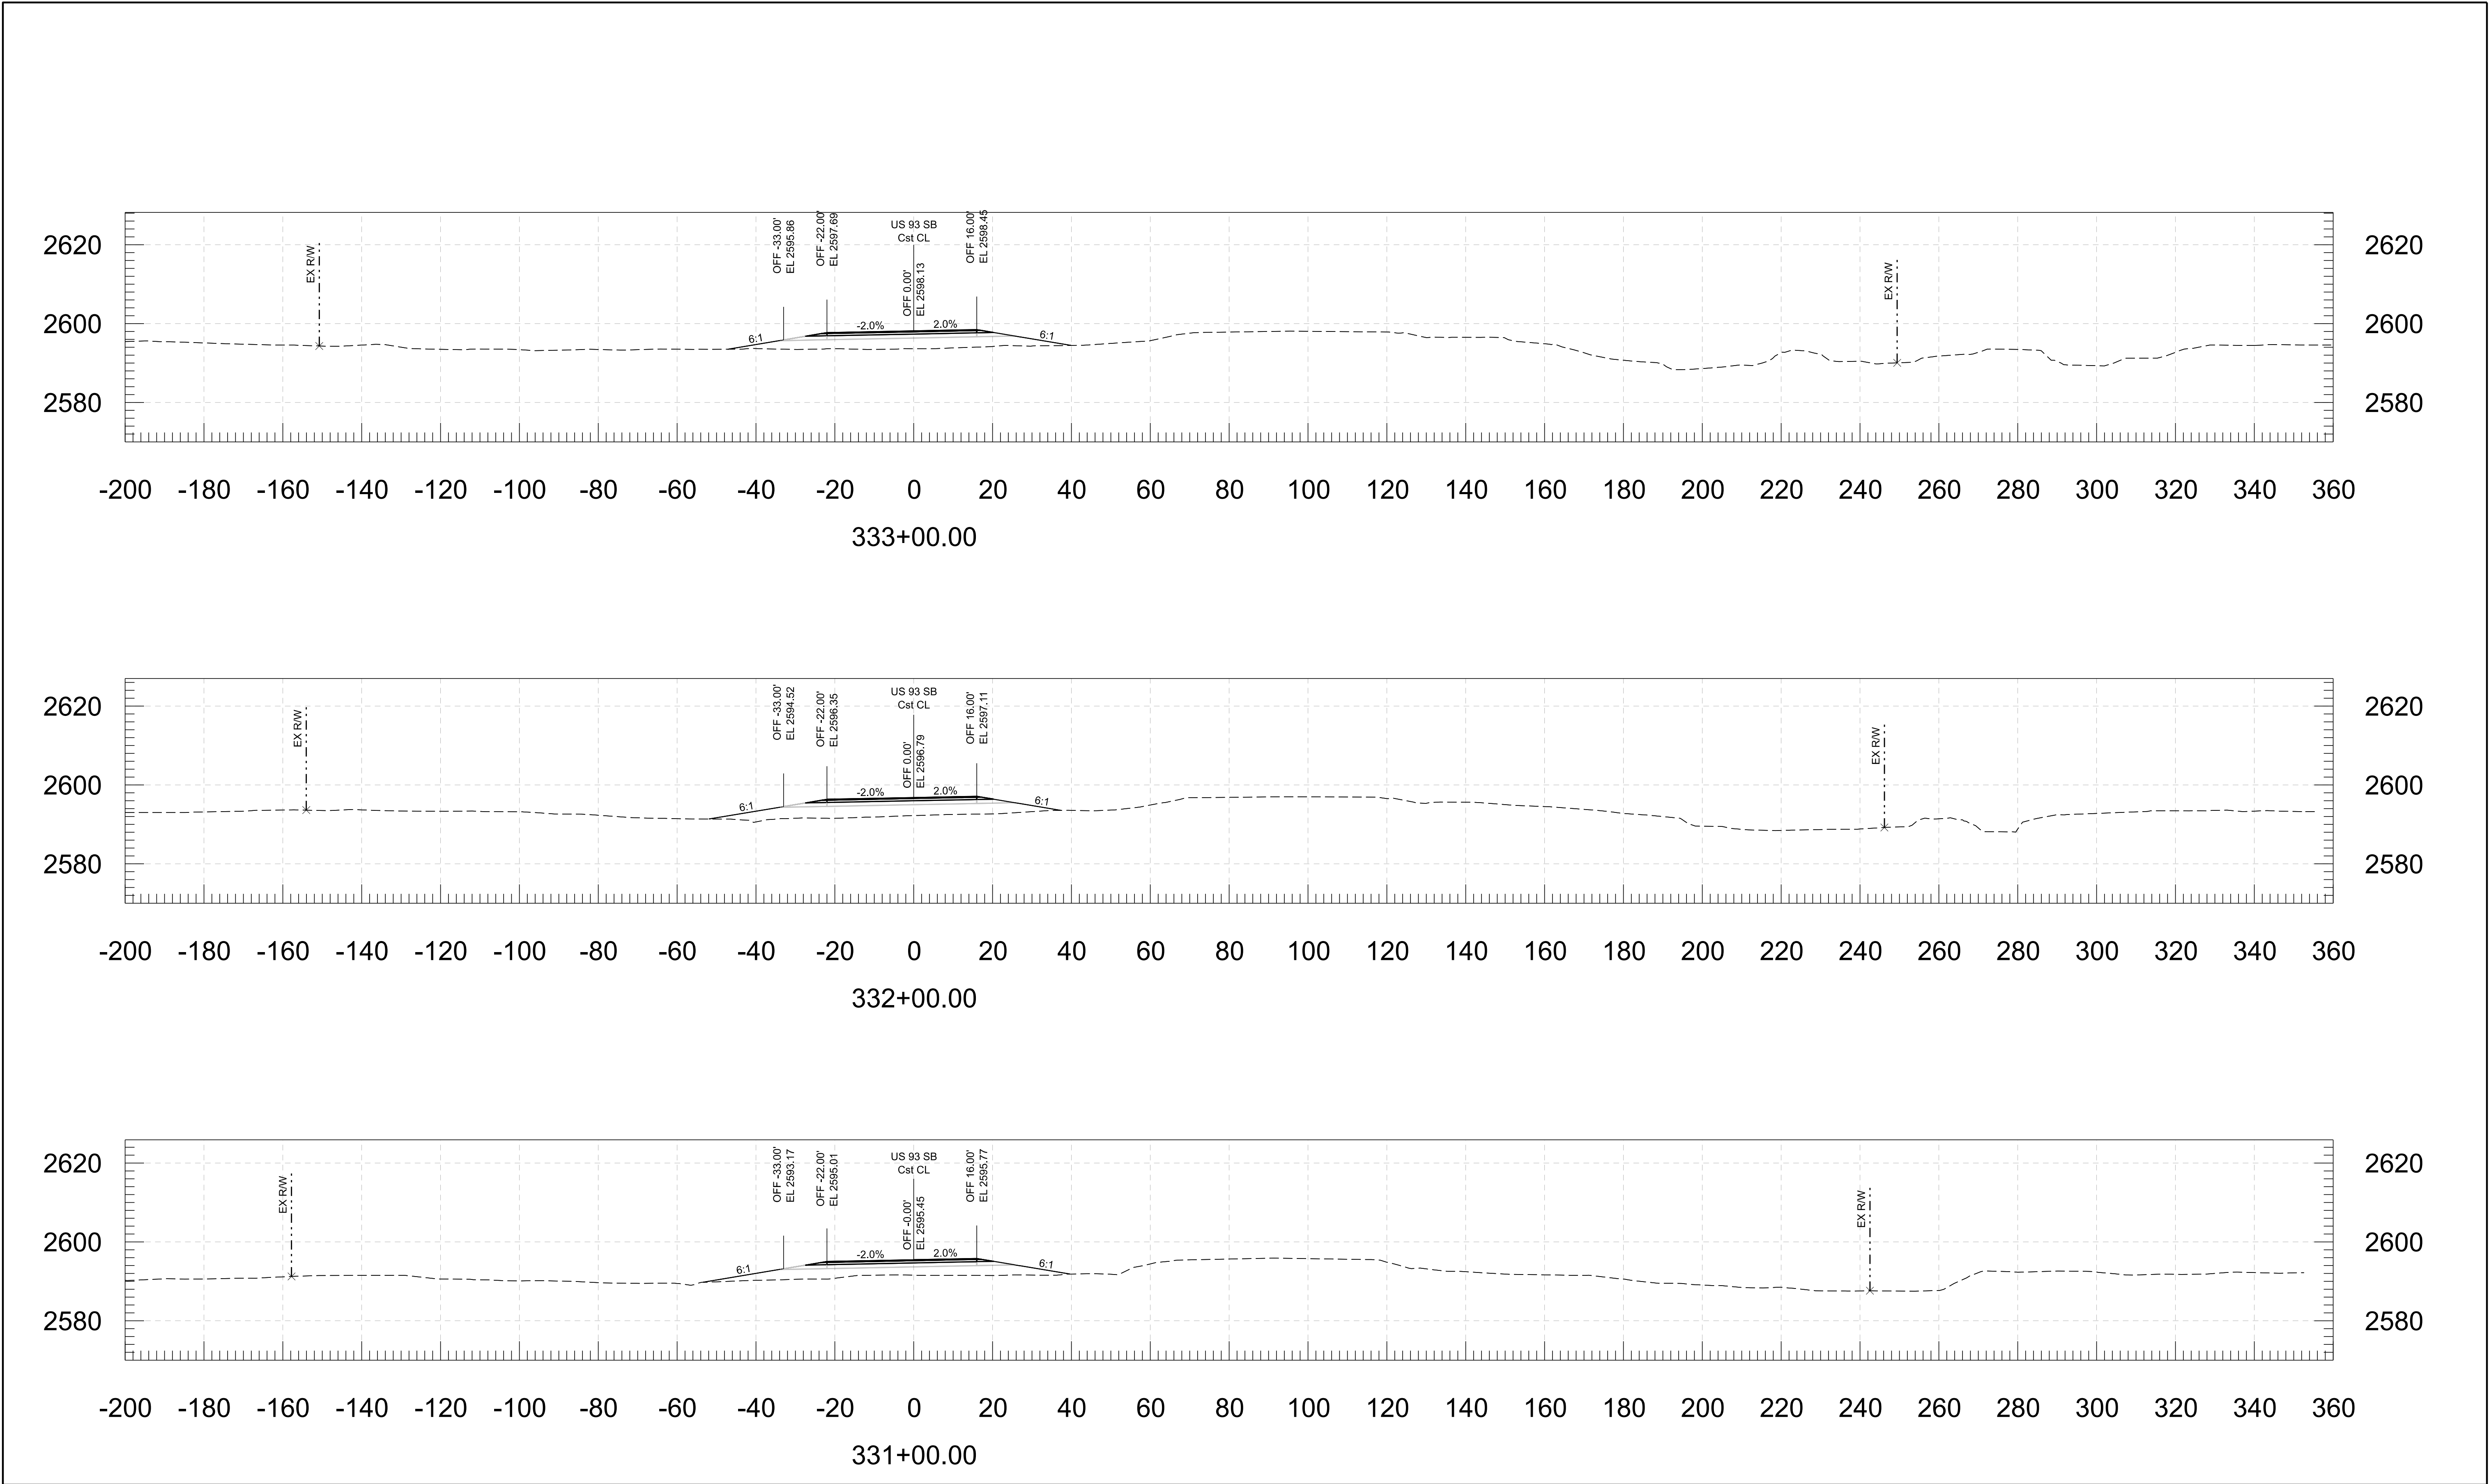


FOR INFORMATION ONLY	DESIGN	J GILLIS	06/26	ARIZONA DEPARTMENT OF TRANSPORTATION PROJECT DELIVERY AND OPERATIONS DIVISION ROADWAY DESIGN SERVICES	ROUTE	F.H.W.A. Arizona Division	STATE	PROJECT NO.	FEDERAL ID NO.	SHEET NO.	TOTAL SHEETS	RECORD DRAWING
	DRAWN	J BEMELEN	06/26		US 93			093 YV 189	093-B(230)T	80	116	
	CHECKED	D WIGGINS	06/26		MILEPOST	LOCATION WICKENBURG RANCH WAY TO VISTA ROYALE						
	TRANSPORTATION AECOM TECHNICAL SERVICES, Inc. 7720 N. 16th St., Suite 100 Phoenix, Arizona 85020 T 602.371.1100			CROSS SECTIONS	STRUCTURE NO.	TRACS NO. F0738 01C		OF				
	AECOM www.aecom.com											

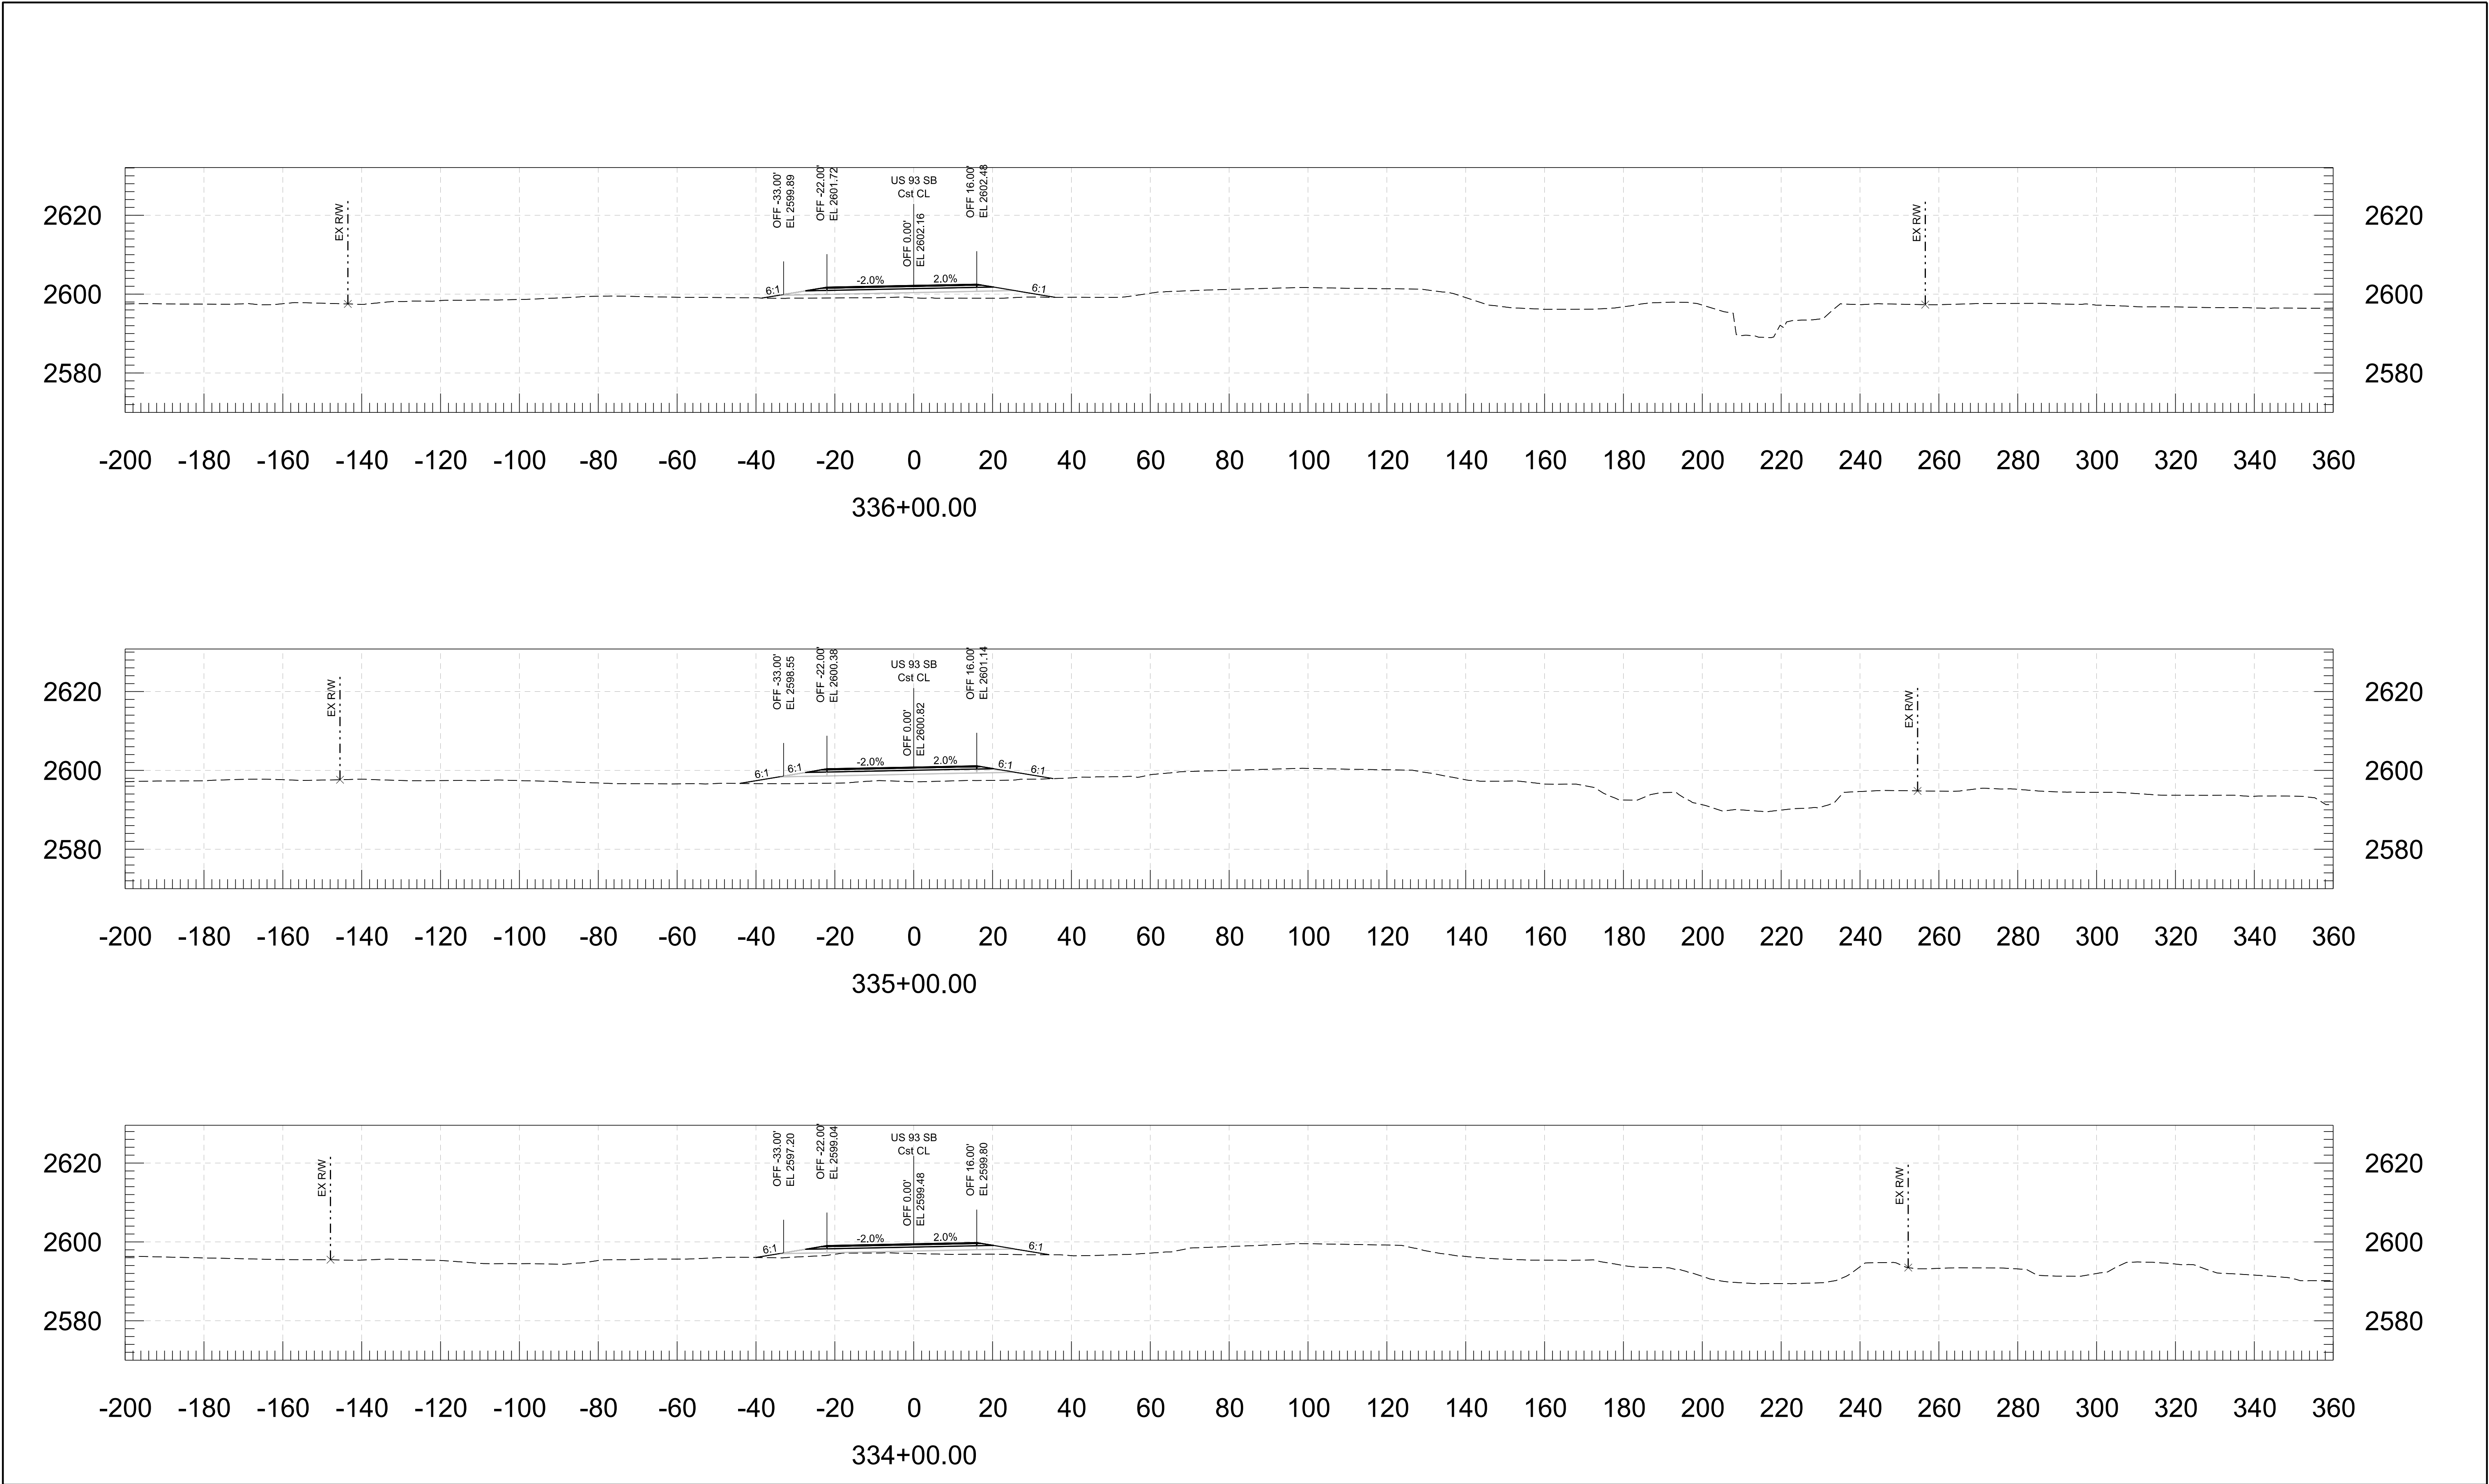



FOR INFORMATION ONLY			NAME		DATE	ARIZONA DEPARTMENT OF TRANSPORTATION PROJECT DELIVERY AND OPERATIONS DIVISION ROADWAY DESIGN SERVICES			ROUTE	F.H.W.A. Arizona Division	STATE	PROJECT NO.	FEDERAL ID NO.	SHEET NO.	TOTAL SHEETS	RECORD DRAWING
			DESIGN	J GILLIS	06/26				US 93		ARIZ.	093 YV 189	093-B(230)T	81	116	
			DRAWN	J BEMELEN	06/26				MILEPOST 189.9	LOCATION WICKENBURG RANCH WAY TO VISTA ROYALE						
			CHECKED	D WIGGINS	06/26	TRANSPORTATION AECOM TECHNICAL SERVICES, Inc. 7720 N. 16th St., Suite 100 Phoenix, Arizona 85020 T 602.371.1100 www.aecom.com			STRUCTURE NO.	TRACS NO. F0738 01C		DWG No. 80 ____ OF ____				

F.H.W.A. REGION	STATE	PROJECT NO.	SHEET NO.	TOTAL SHEETS	RECORD DRAWING
9	ARIZ.	093-B(230)T	84	116	
093 YV 189					

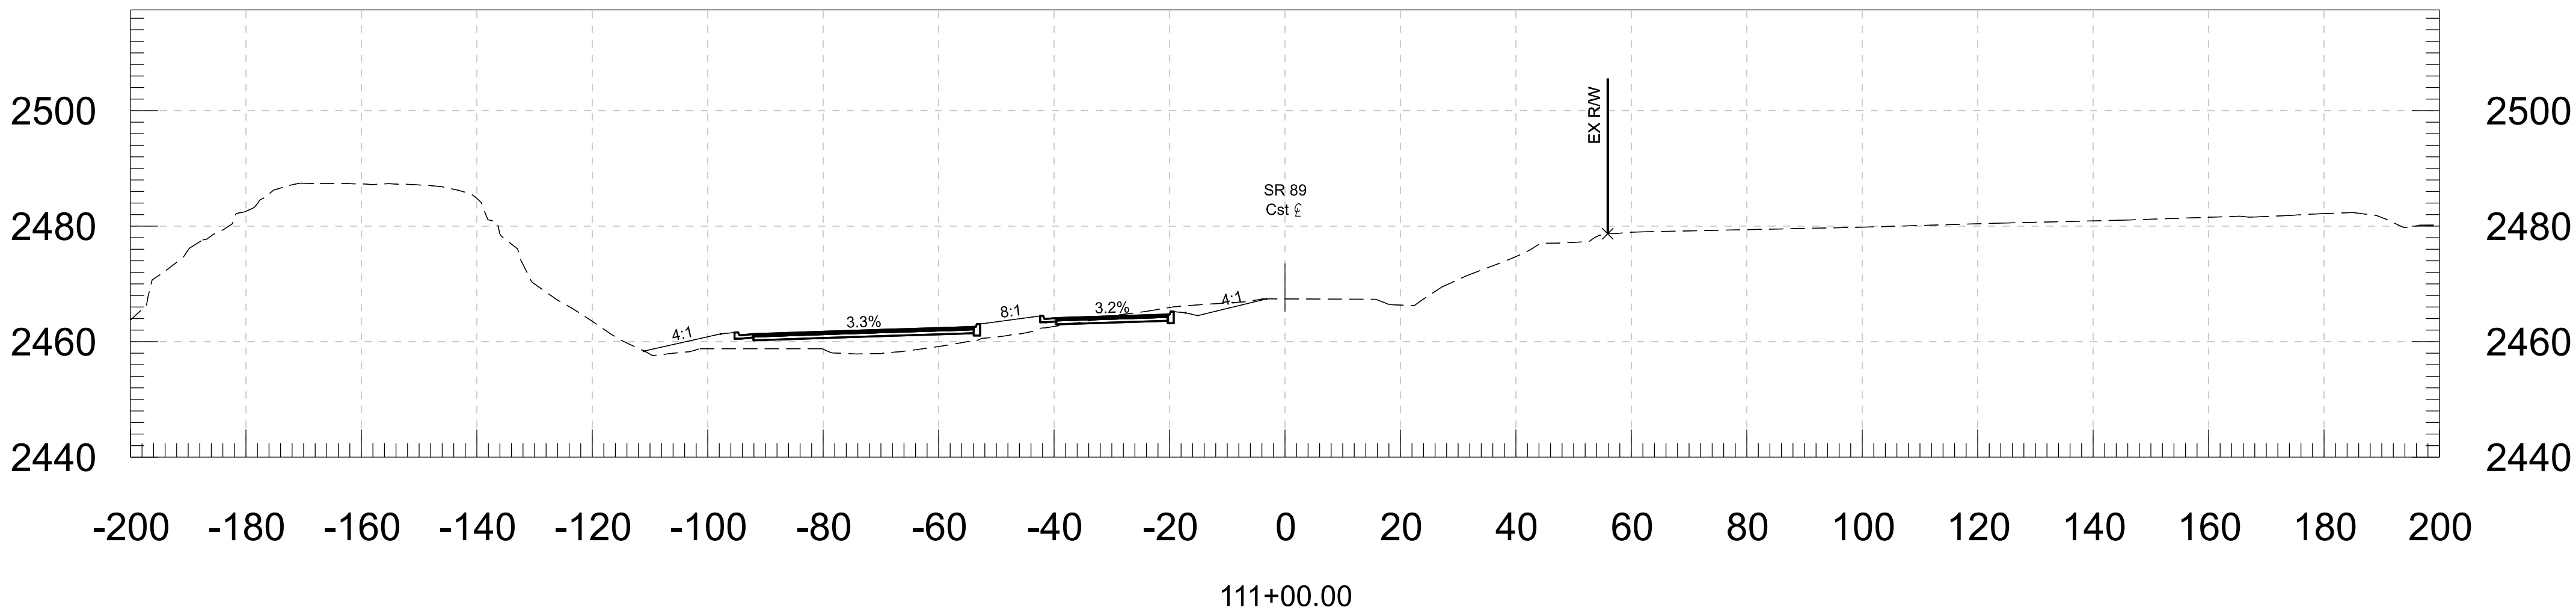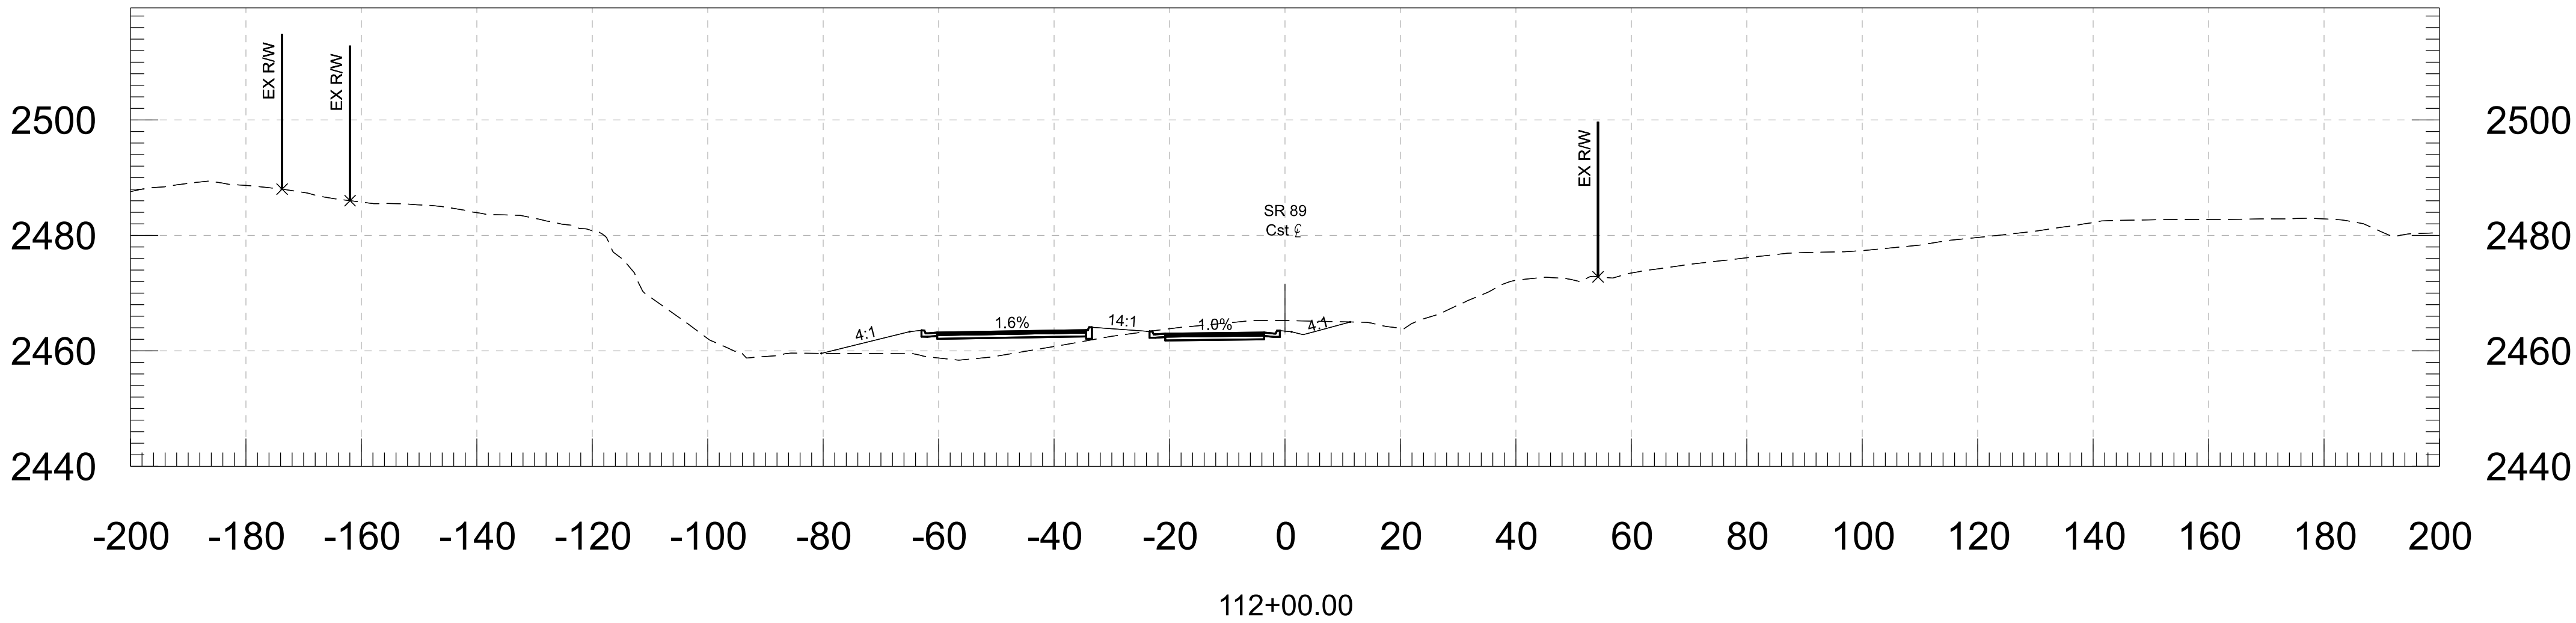



		NAME	DATE	ARIZONA DEPARTMENT OF TRANSPORTATION PROJECT DELIVERY AND OPERATIONS DIVISION ROADWAY DESIGN SERVICES	
DESIGN	ZSZ		06-26		
DRAWN	RM		06-26		
CHECKED	DBK		06-26	CROSS SECTIONS	
ROUTE		LOCATION			DWG NO. 83
US 93		WICKENBURG RANCH WAY TO VISTA ROYALE			
TRACS NO. F0738 OIC				093-B(230)T	___ OF ___

F.H.W.A. REGION	STATE	PROJECT NO.	SHEET NO.	TOTAL SHEETS	RECORD DRAWING
9	ARIZ.	093-B(230)T	85	116	
093 YV 189					

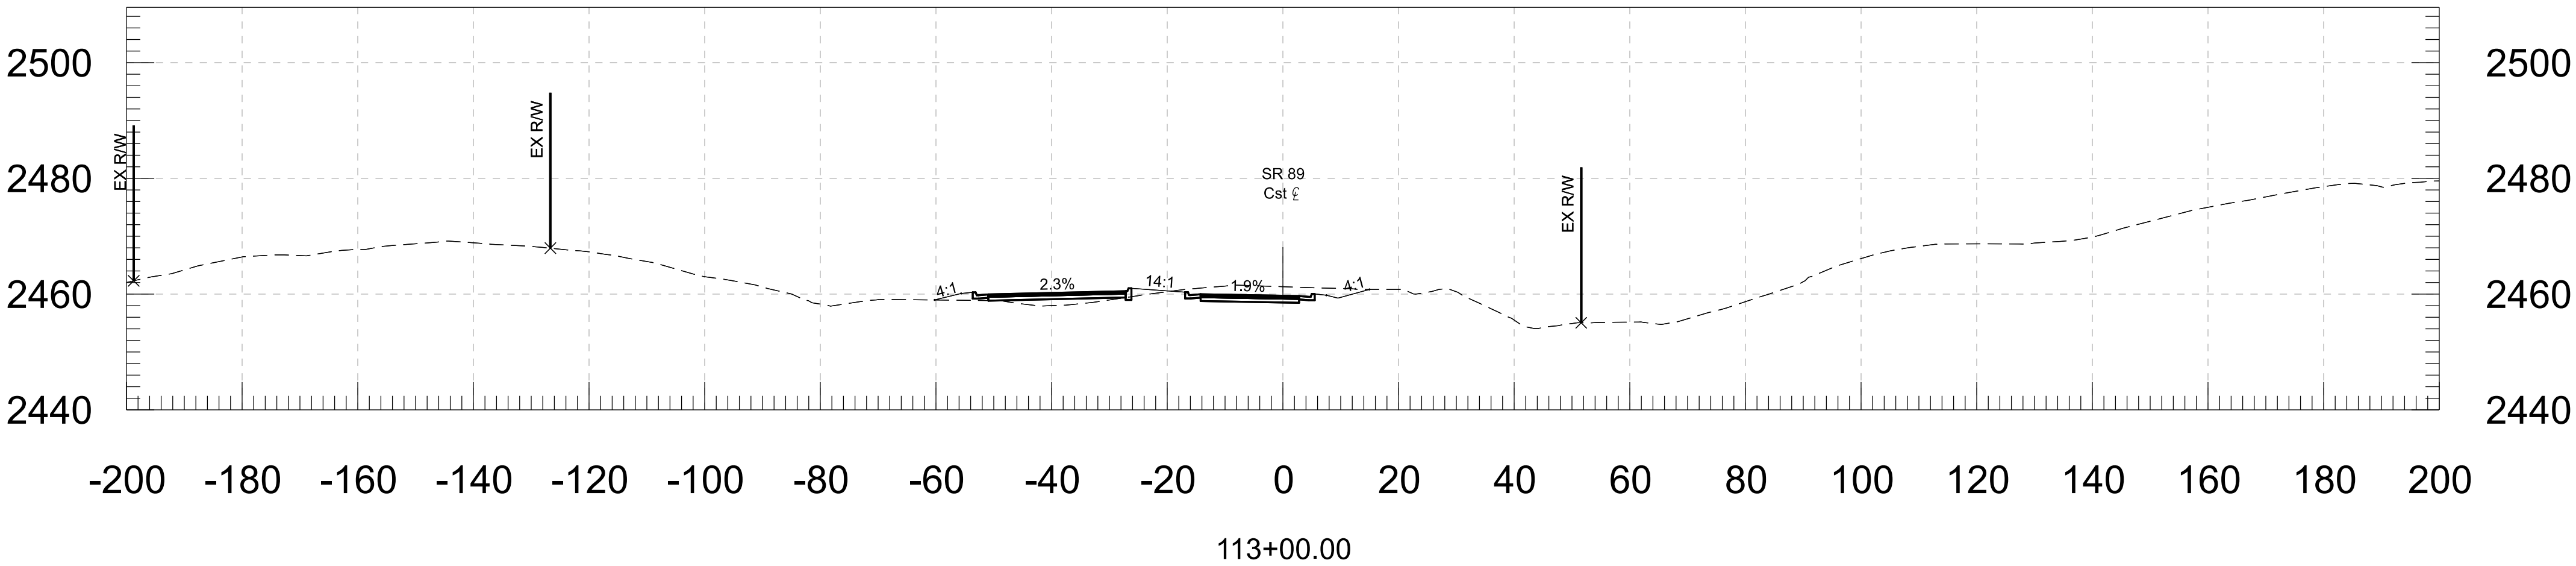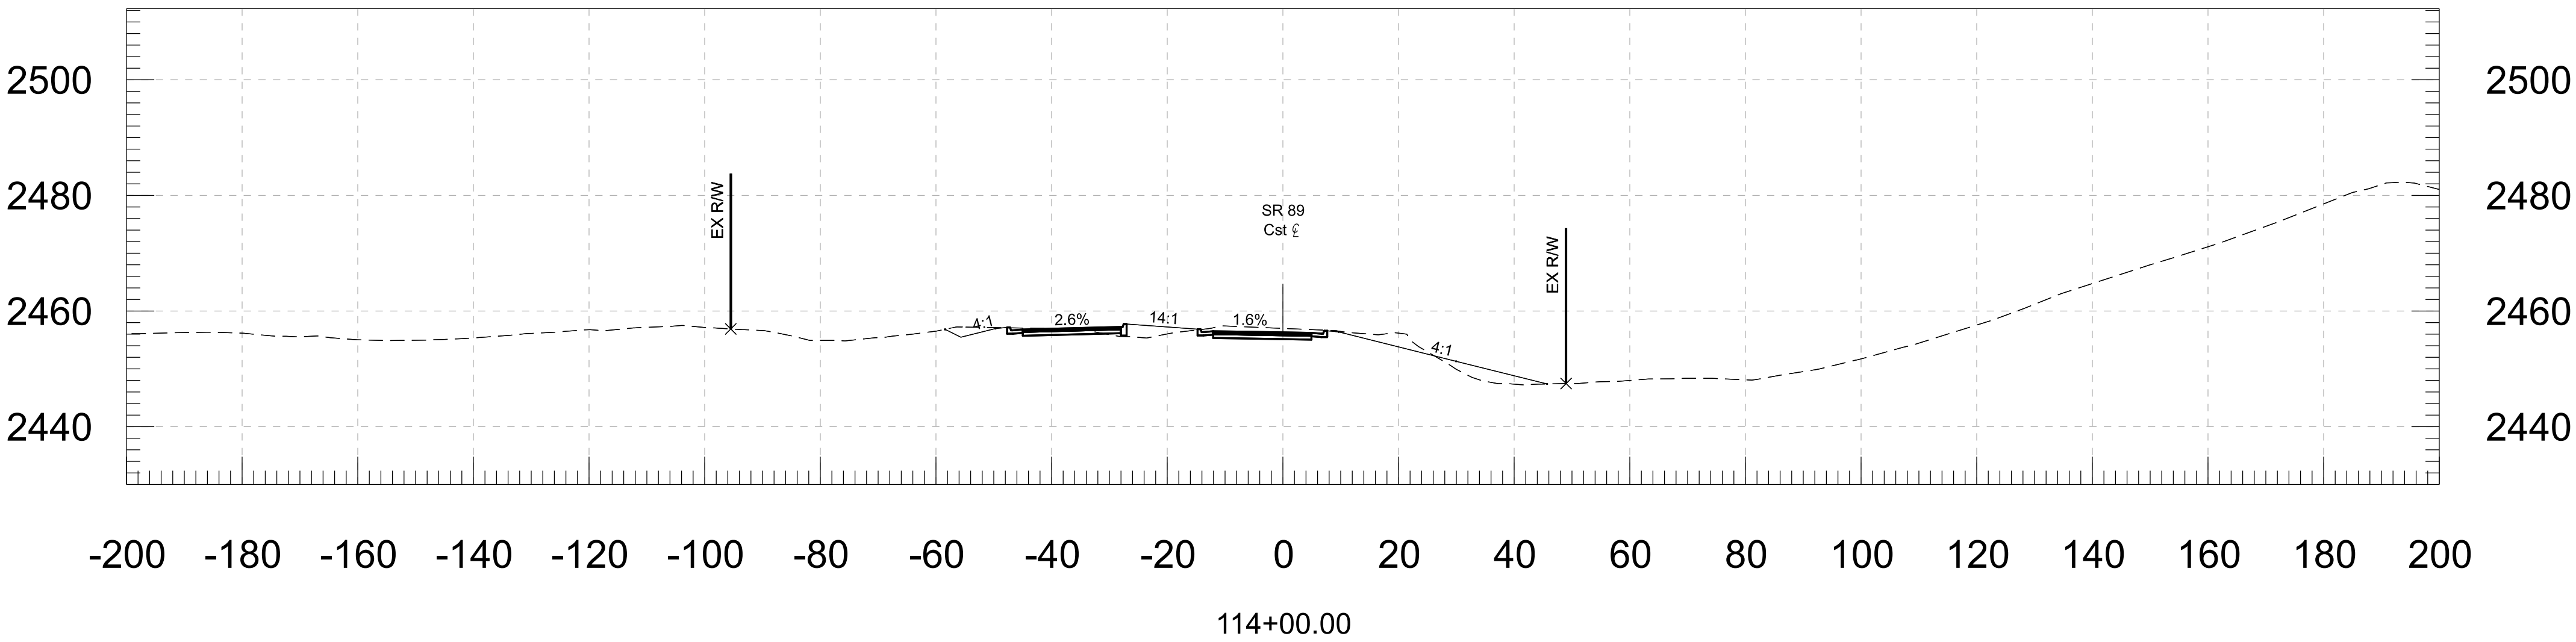



		NAME	DATE	ARIZONA DEPARTMENT OF TRANSPORTATION PROJECT DELIVERY AND OPERATIONS DIVISION ROADWAY DESIGN SERVICES		
DESIGN	ZSZ		06-26			
DRAWN	RM		06-26			
CHECKED	DBK		06-26	CROSS SECTIONS		
 Stanley Consultants INC.		3133 East Camelback Road, Suite 100 Phoenix, Arizona 85016 Phone: 602/ 353-2200				
ROUTE		LOCATION		DWG NO. 84		
US 93		WICKENBURG RANCH WAY TO VISTA ROYALE				
TRACS NO. F0738 OIC				093-B(230)T	___ OF ___	

F.H.W.A. REGION	STATE	PROJECT NO.	SHEET NO.	TOTAL SHEETS	RECORD DRAWING
9	ARIZ.	093-B(230)T	86	116	
093 YV 189					

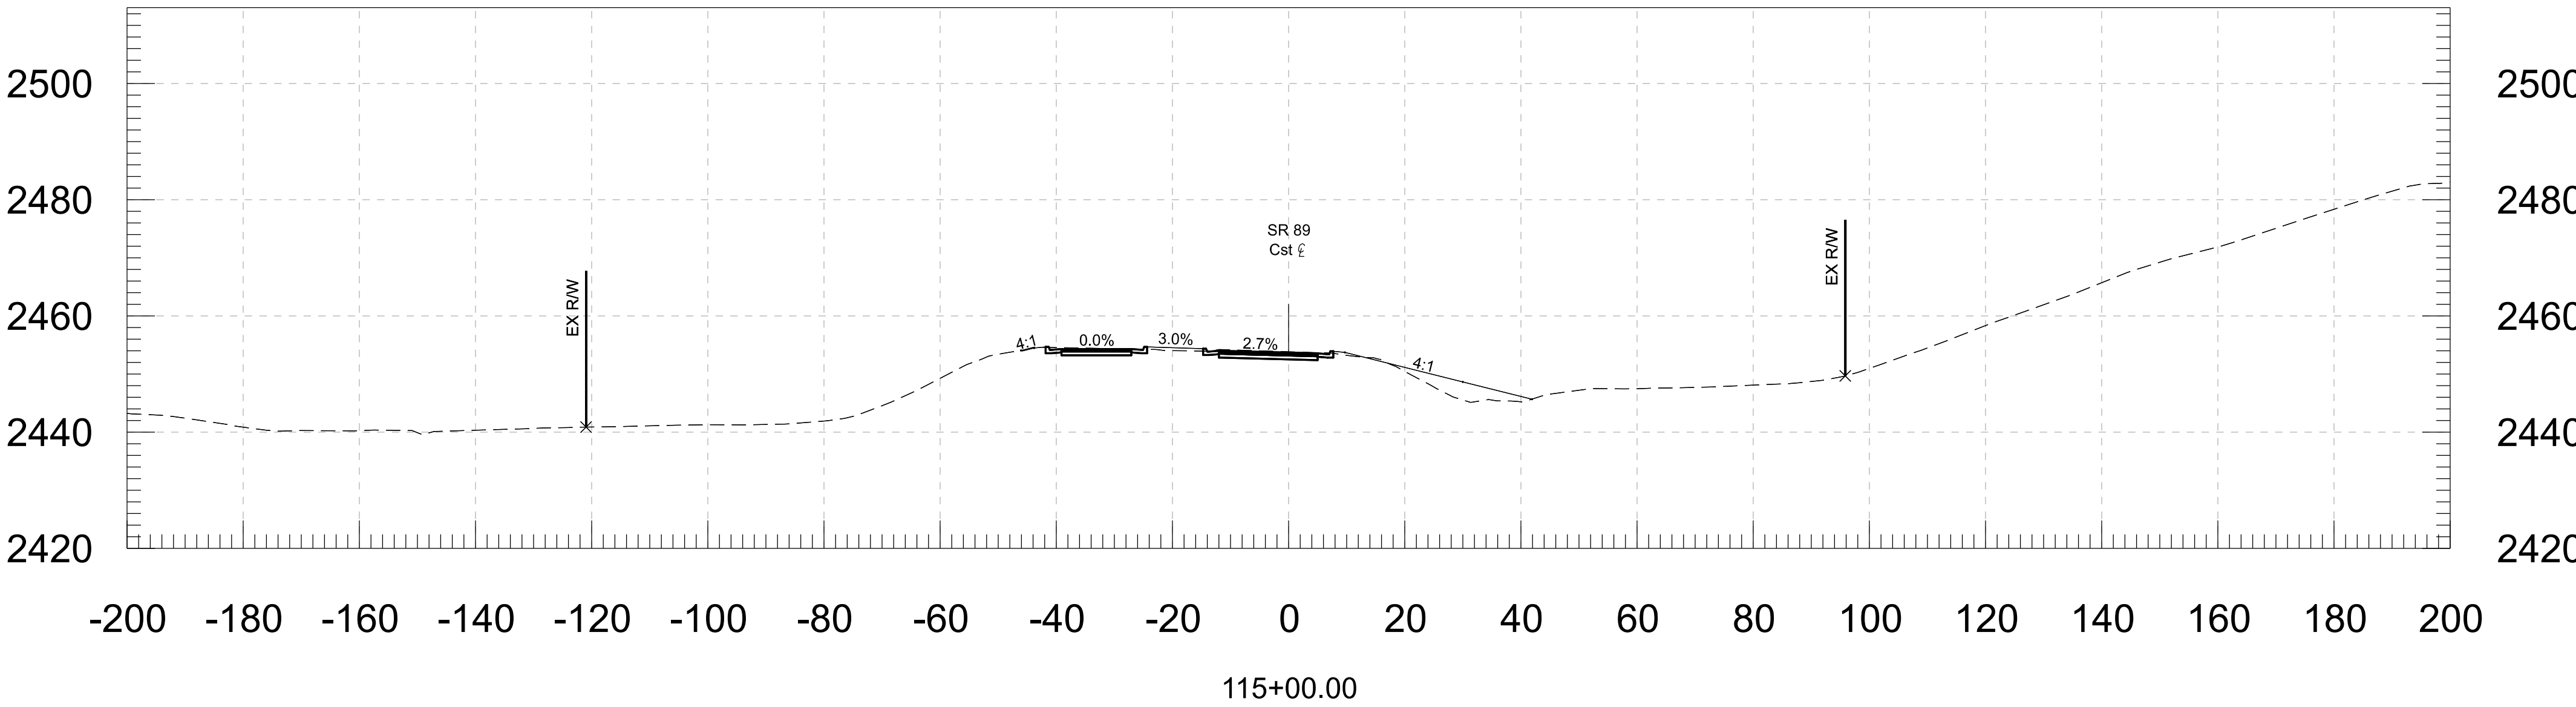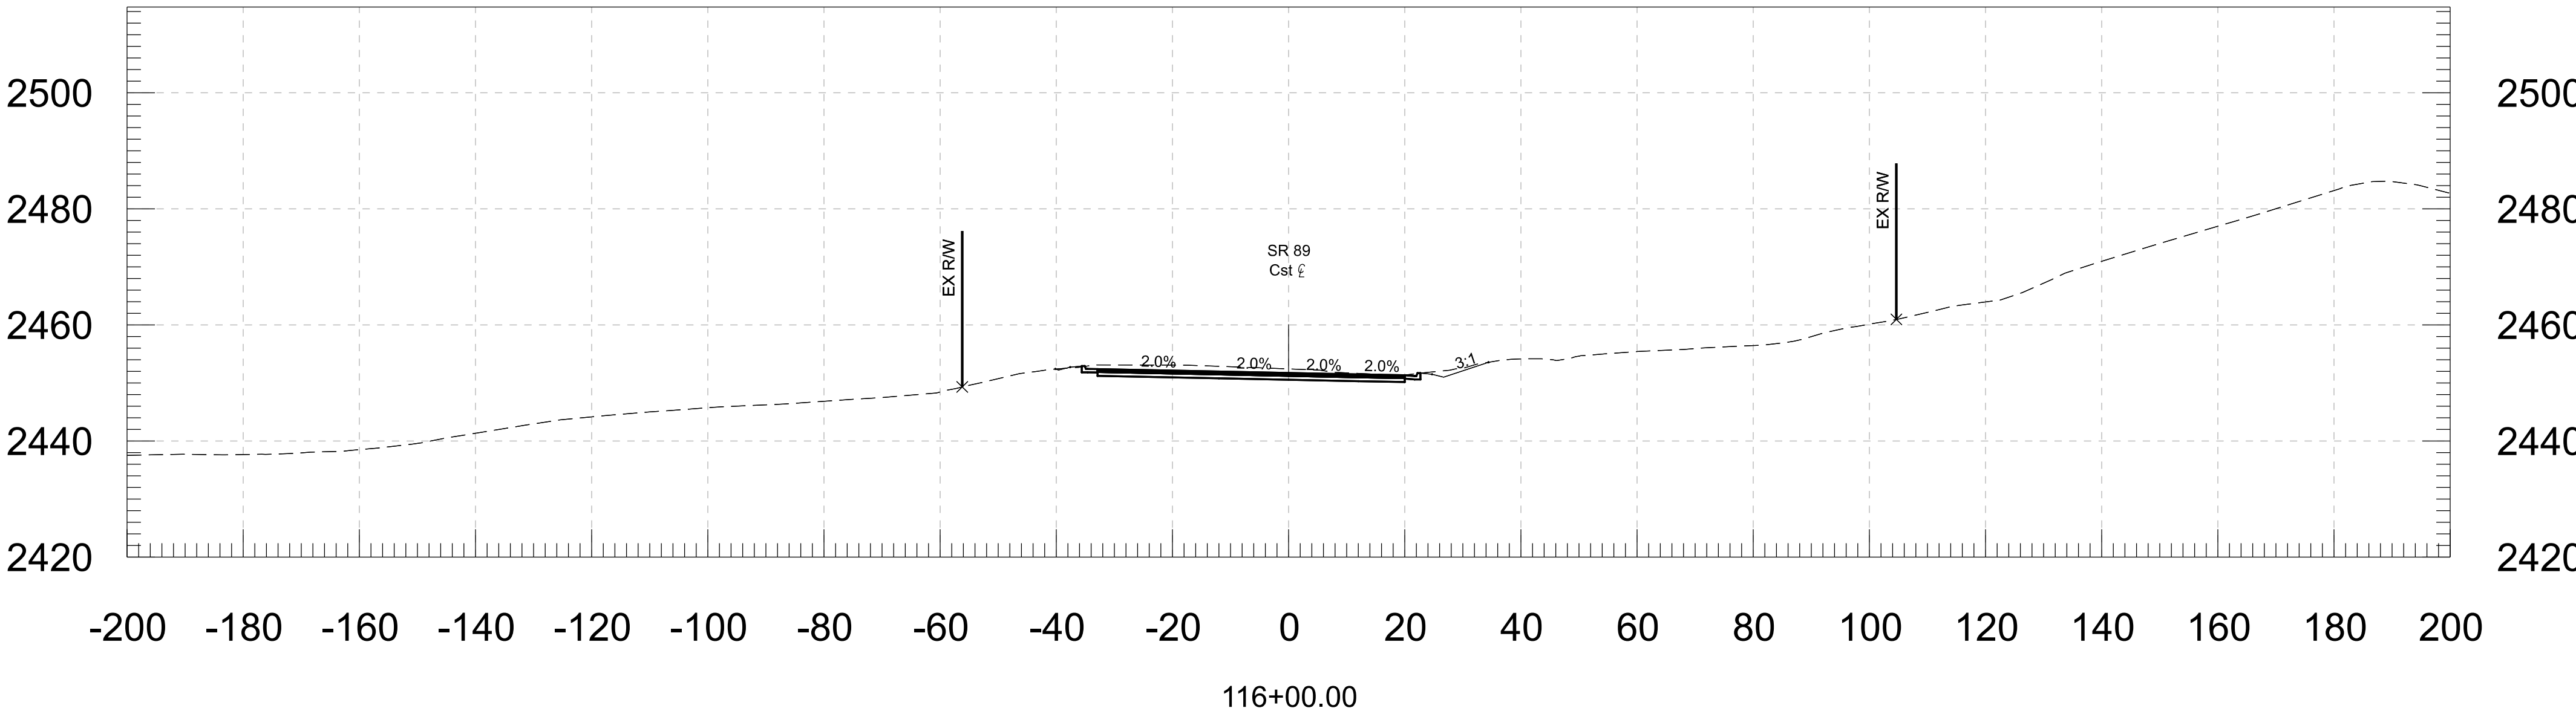



		NAME	DATE	ARIZONA DEPARTMENT OF TRANSPORTATION PROJECT DELIVERY AND OPERATIONS DIVISION ROADWAY DESIGN SERVICES	
DESIGN	ZSZ		06-26		
DRAWN	RM		06-26		
CHECKED	DBK		06-26	CROSS SECTIONS	
ROUTE		LOCATION			DWG NO. 85
US 93		WICKENBURG RANCH WAY TO VISTA ROYALE			
TRACS NO. F0738 OIC				093-B(230)T	___ OF ___

F.H.W.A. REGION	STATE	PROJECT NO.	SHEET NO.	TOTAL SHEETS	RECORD DRAWING
9	ARIZ.	093-B(230)T	87	116	
093 YV 189					

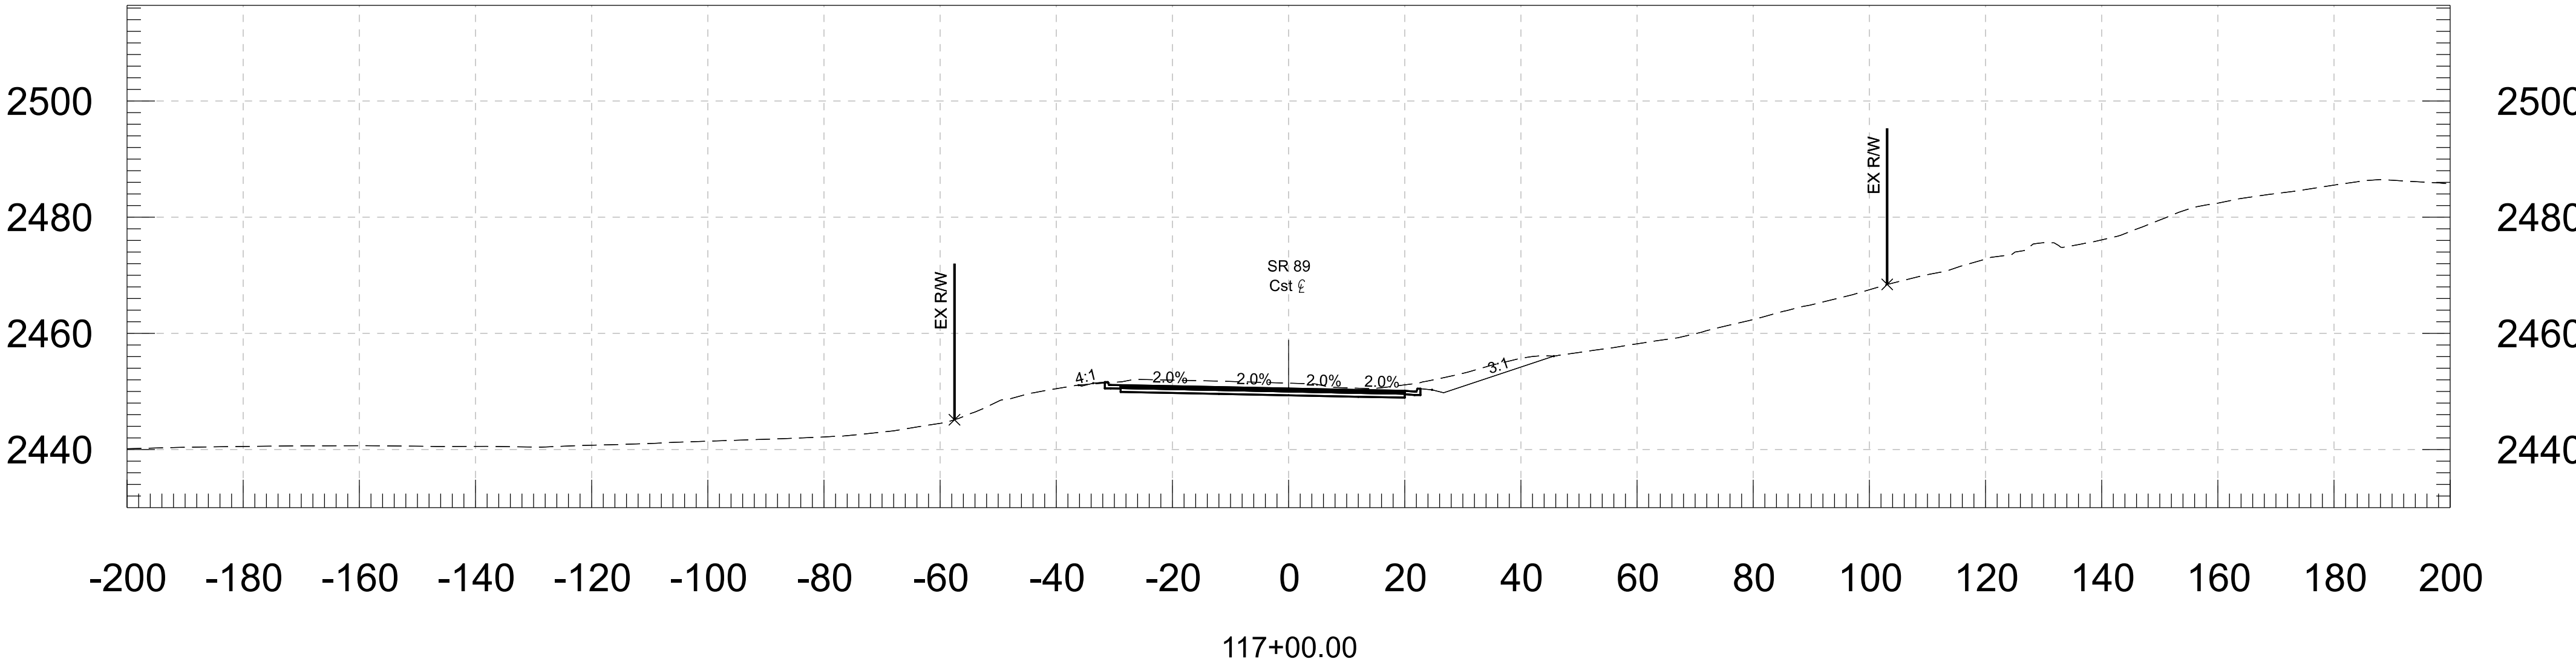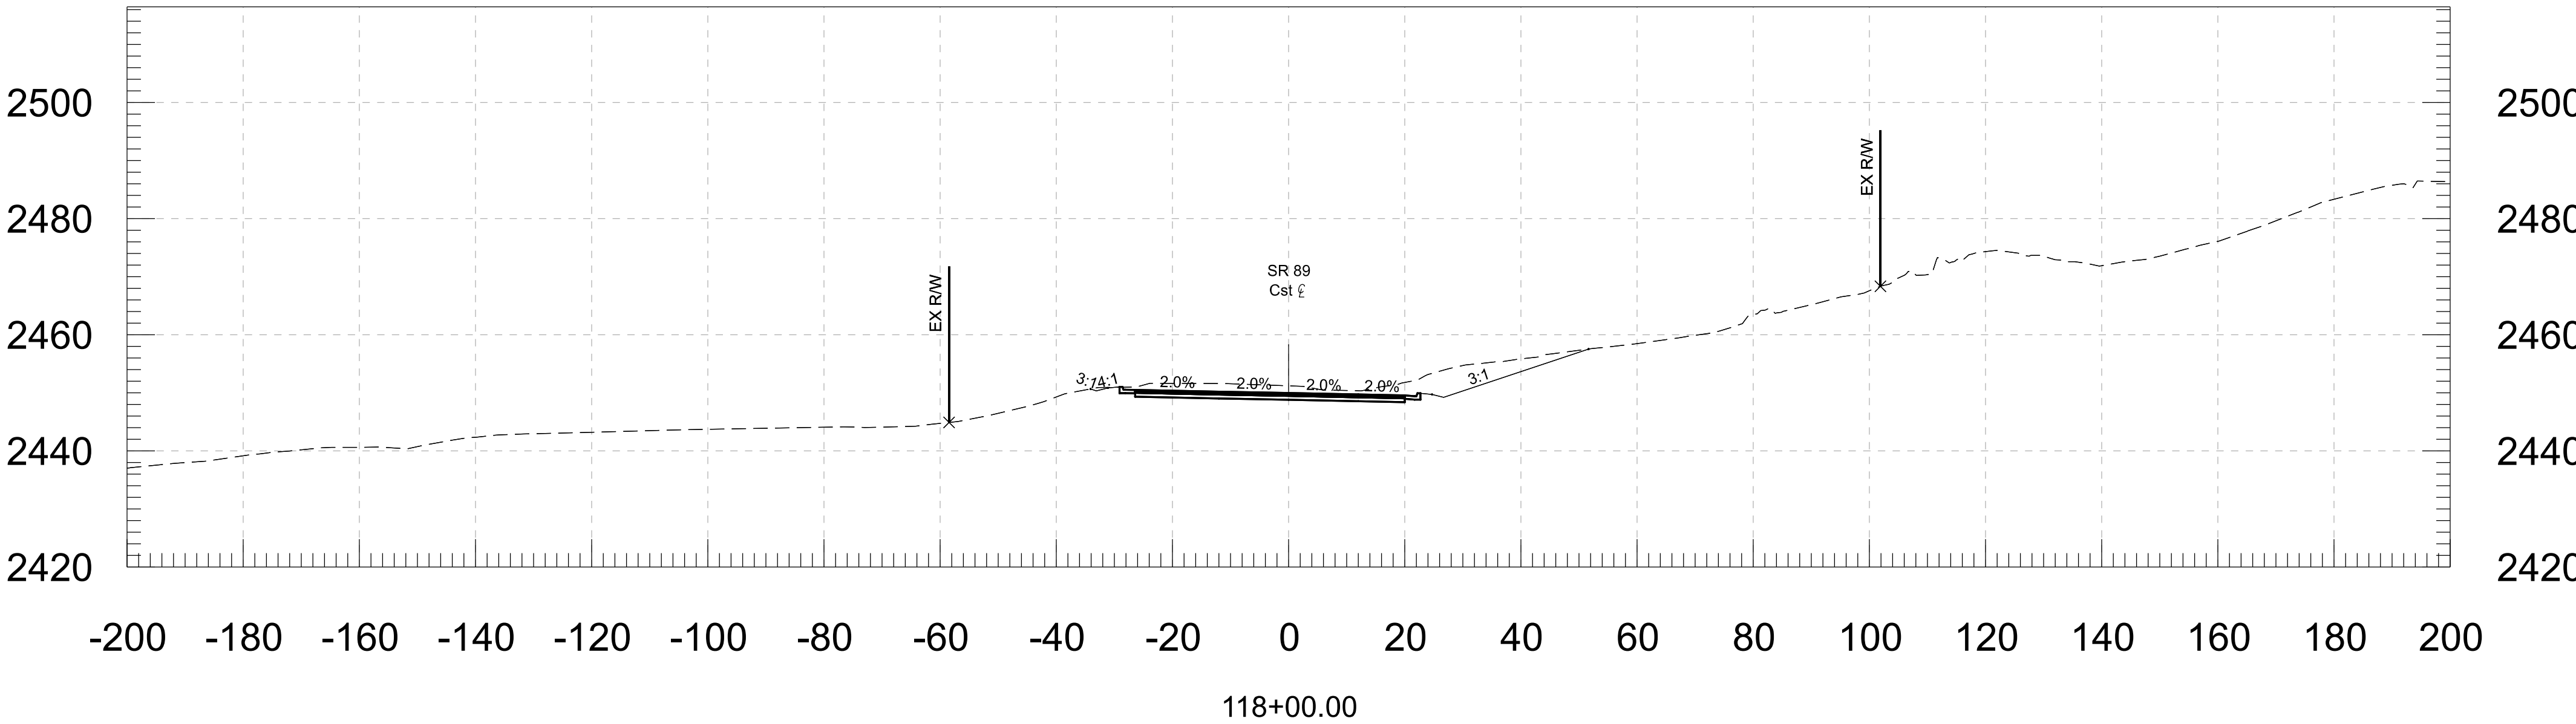



		NAME	DATE	ARIZONA DEPARTMENT OF TRANSPORTATION PROJECT DELIVERY AND OPERATIONS DIVISION ROADWAY DESIGN SERVICES	
DESIGN	ZSZ		06-26		
DRAWN	RM		06-26		
CHECKED	DBK		06-26	CROSS SECTIONS	
ROUTE		LOCATION			DWG NO. 86
US 93		WICKENBURG RANCH WAY TO VISTA ROYALE			
TRACS NO. F0738 OIC				093-B(230)T	___ OF ___

F.H.W.A. REGION	STATE	PROJECT NO.	SHEET NO.	TOTAL SHEETS	RECORD DRAWING
9	ARIZ.	093-B(230)T	88	116	
093 YV 189					

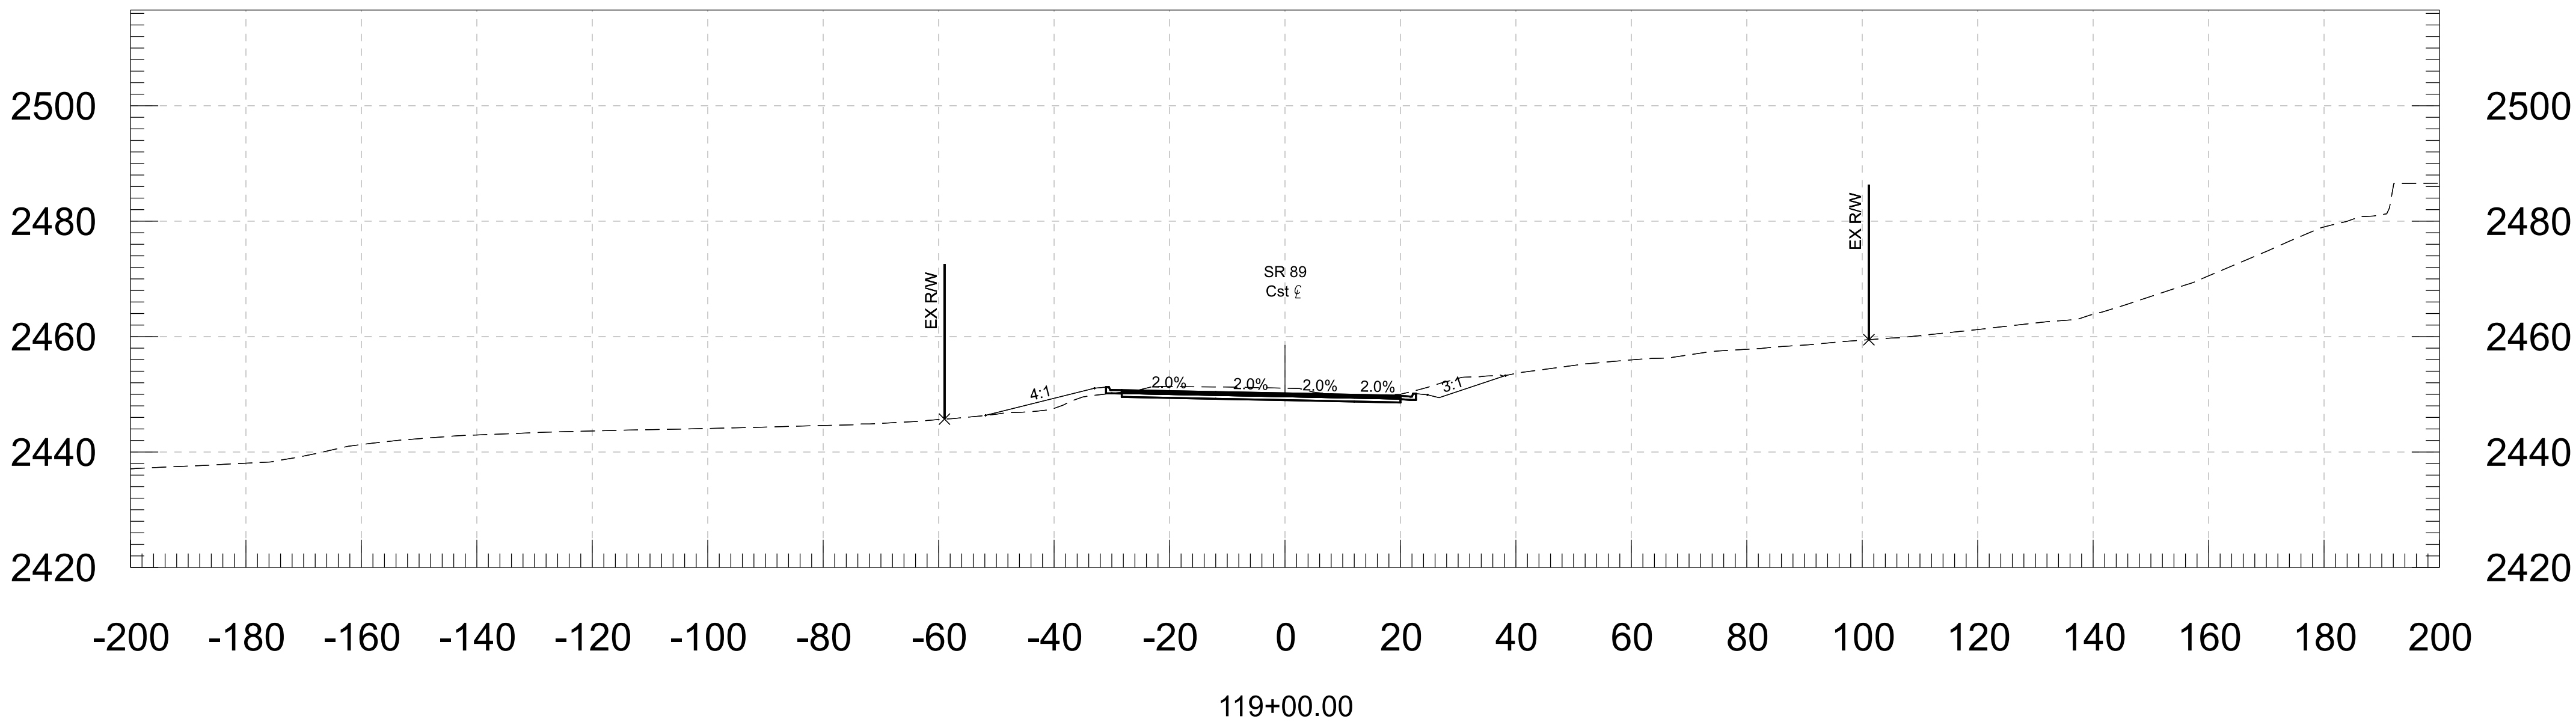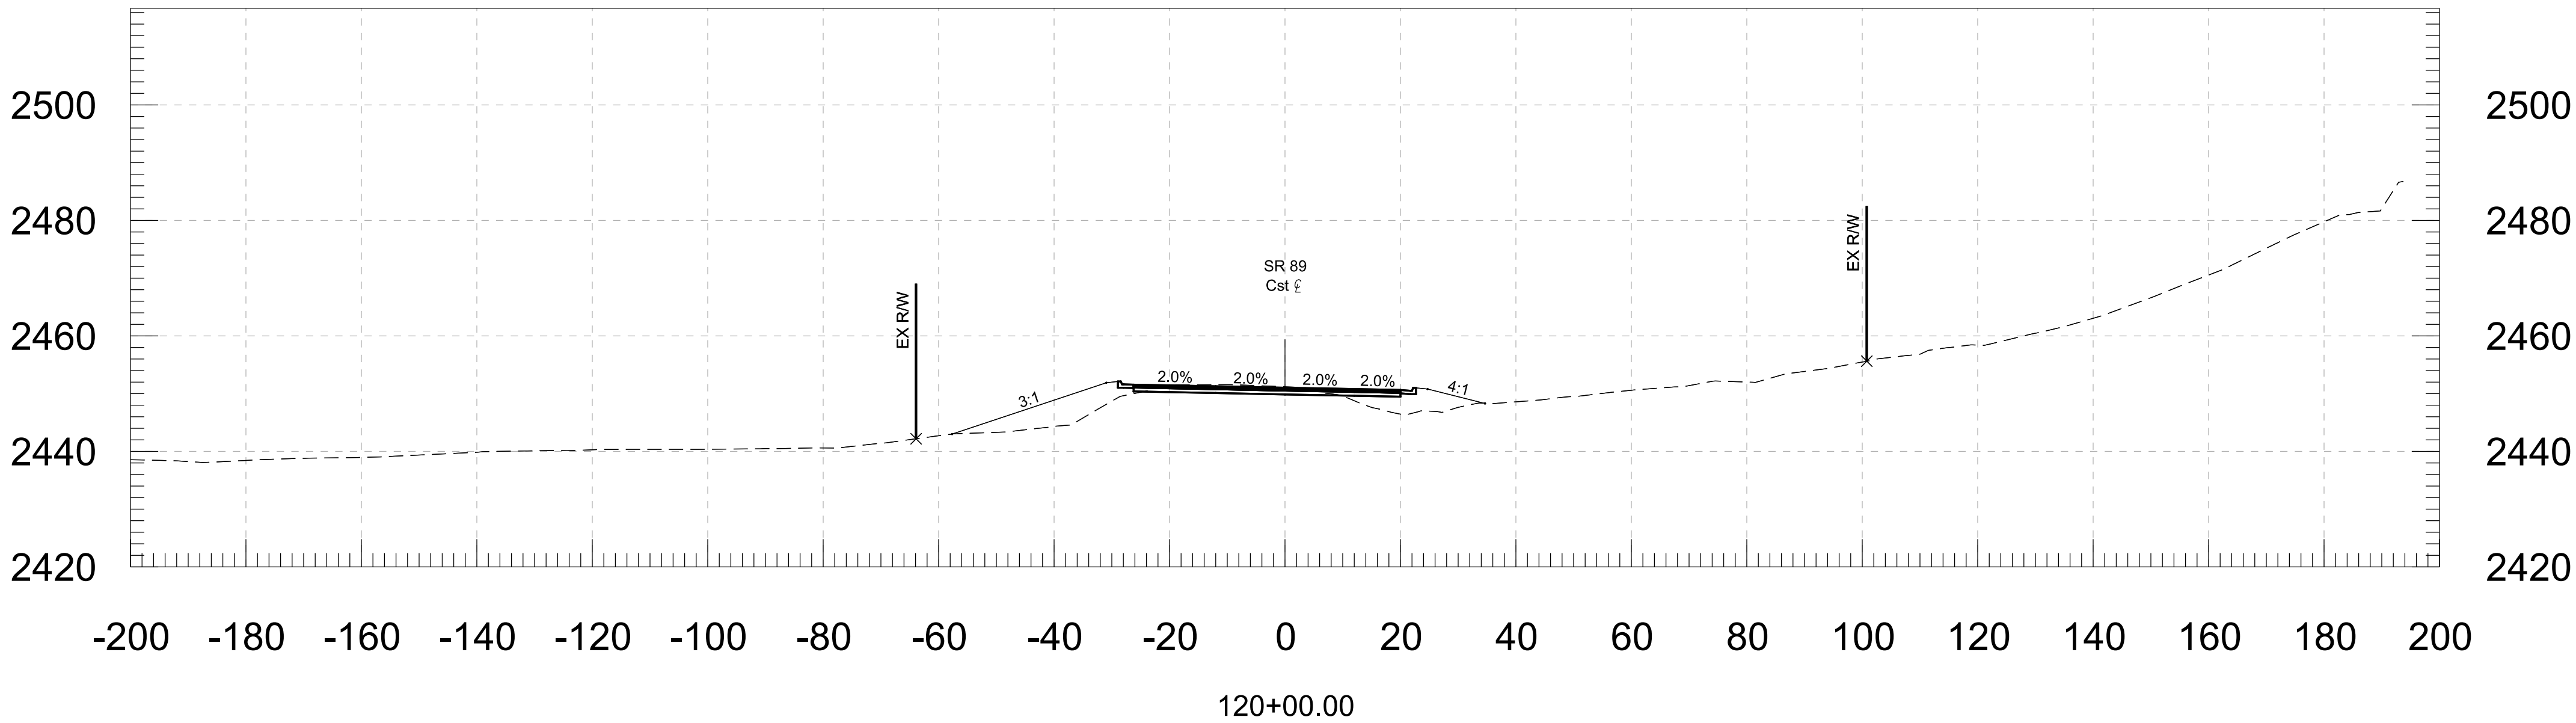



		NAME	DATE	ARIZONA DEPARTMENT OF TRANSPORTATION PROJECT DELIVERY AND OPERATIONS DIVISION ROADWAY DESIGN SERVICES	
DESIGN	ZSZ		06-26		
DRAWN	RM		06-26		
CHECKED	DBK		06-26	CROSS SECTIONS	
ROUTE		LOCATION			DWG NO. 87
US 93		WICKENBURG RANCH WAY TO VISTA ROYALE			
TRACS NO. F0738 OIC				093-B(230)T	___ OF ___

F.H.W.A. REGION	STATE	PROJECT NO.	SHEET NO.	TOTAL SHEETS	RECORD DRAWING
9	ARIZ.	093-B(230)T	89	116	
093 YV 189					

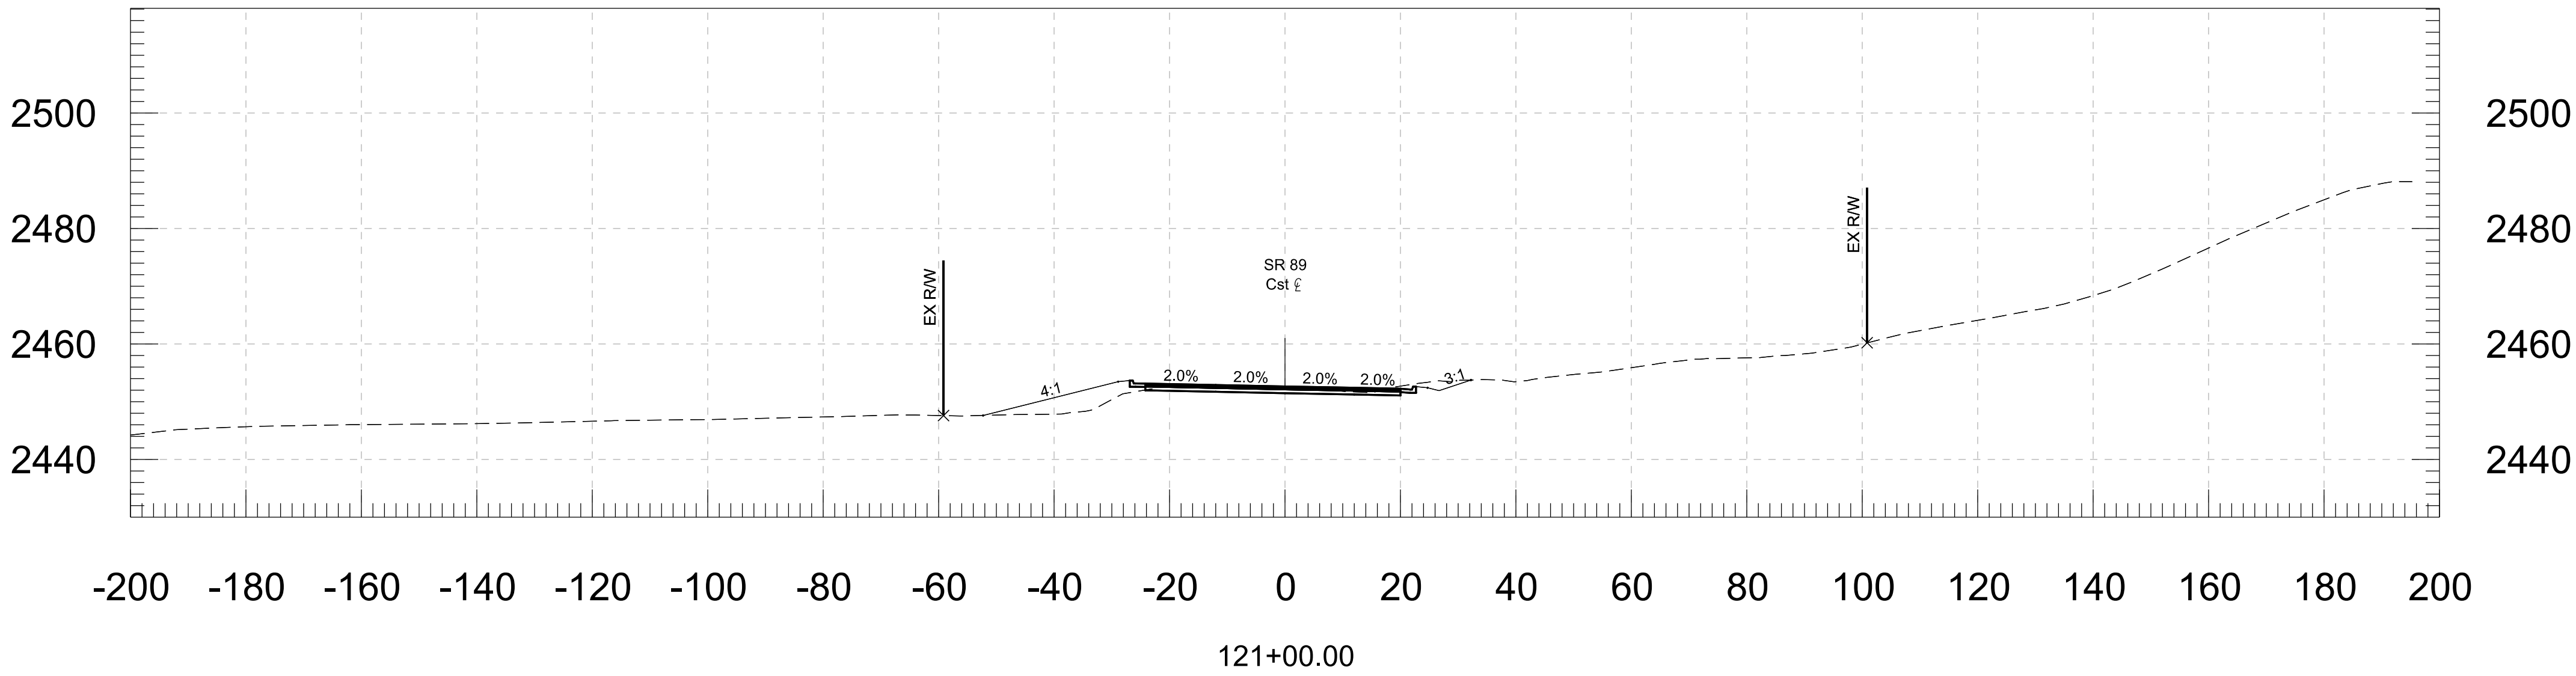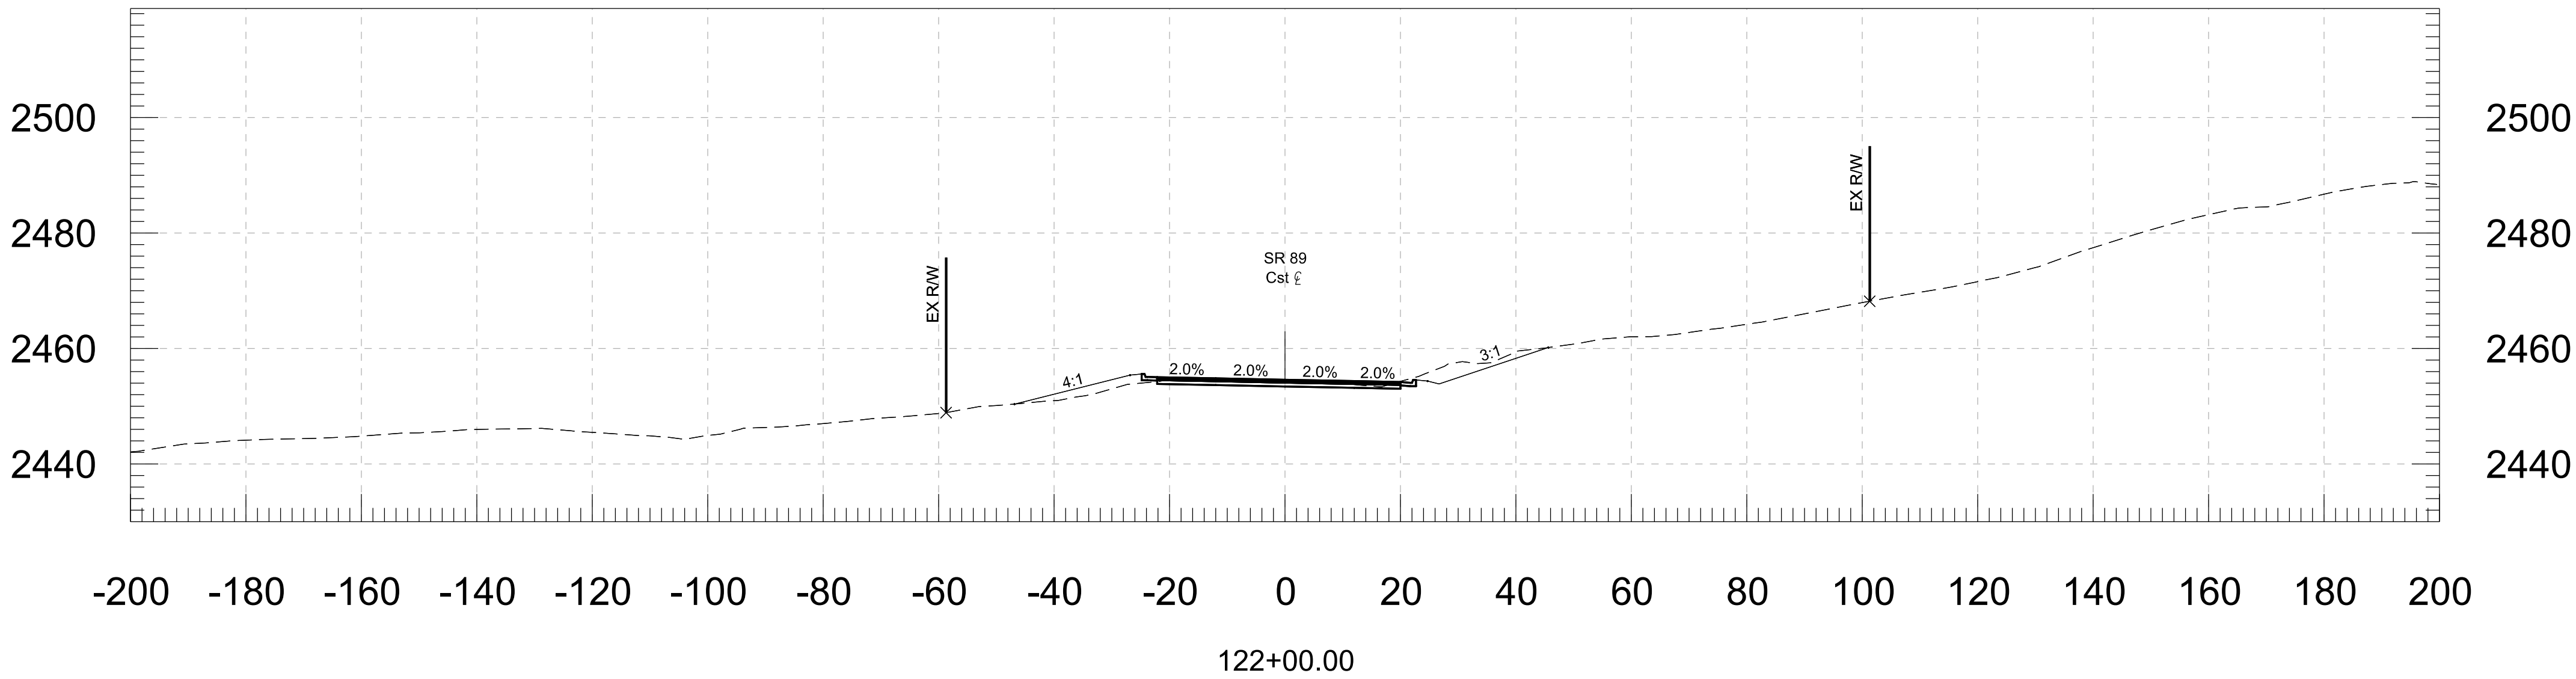



		NAME	DATE	ARIZONA DEPARTMENT OF TRANSPORTATION PROJECT DELIVERY AND OPERATIONS DIVISION ROADWAY DESIGN SERVICES	
DESIGN	ZSZ		06-26		
DRAWN	RM		06-26		
CHECKED	DBK		06-26	CROSS SECTIONS	
ROUTE		LOCATION			DWG NO. 88
US 93		WICKENBURG RANCH WAY TO VISTA ROYALE			
TRACS NO. F0738 OIC				093-B(230)T	___ OF ___

F.H.W.A. REGION	STATE	PROJECT NO.	SHEET NO.	TOTAL SHEETS	RECORD DRAWING
9	ARIZ.	093-B(230)T	90	116	
093 YV 189					

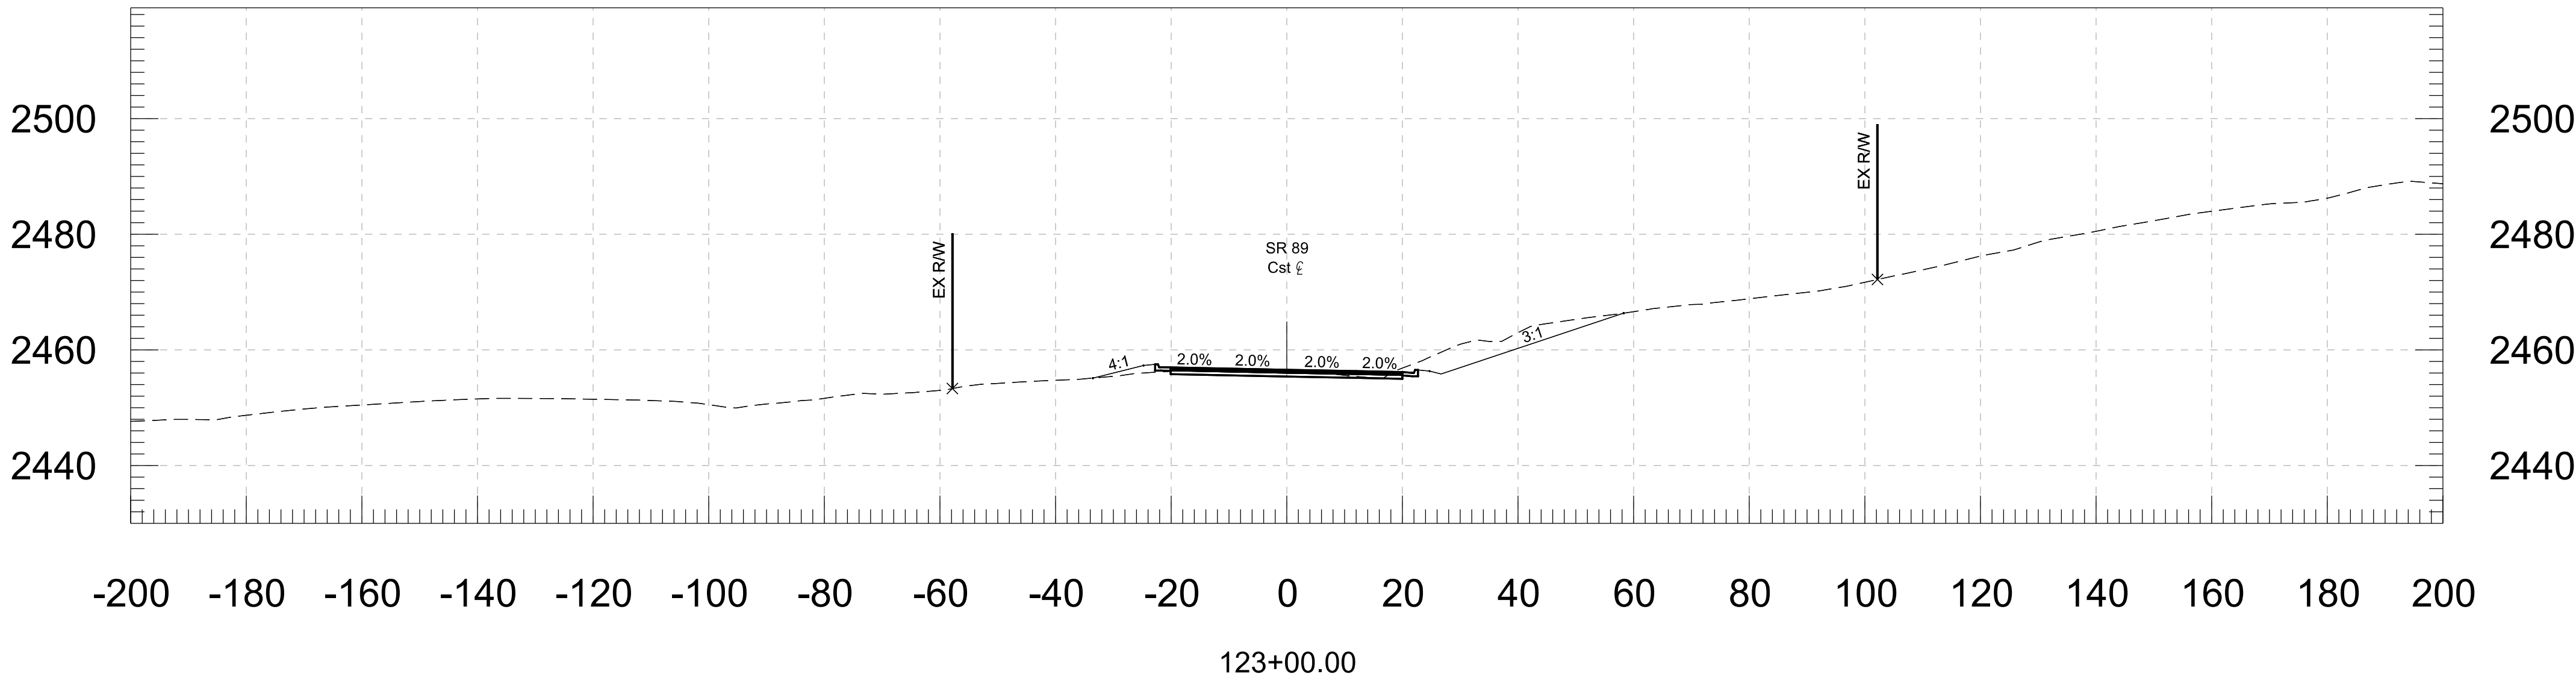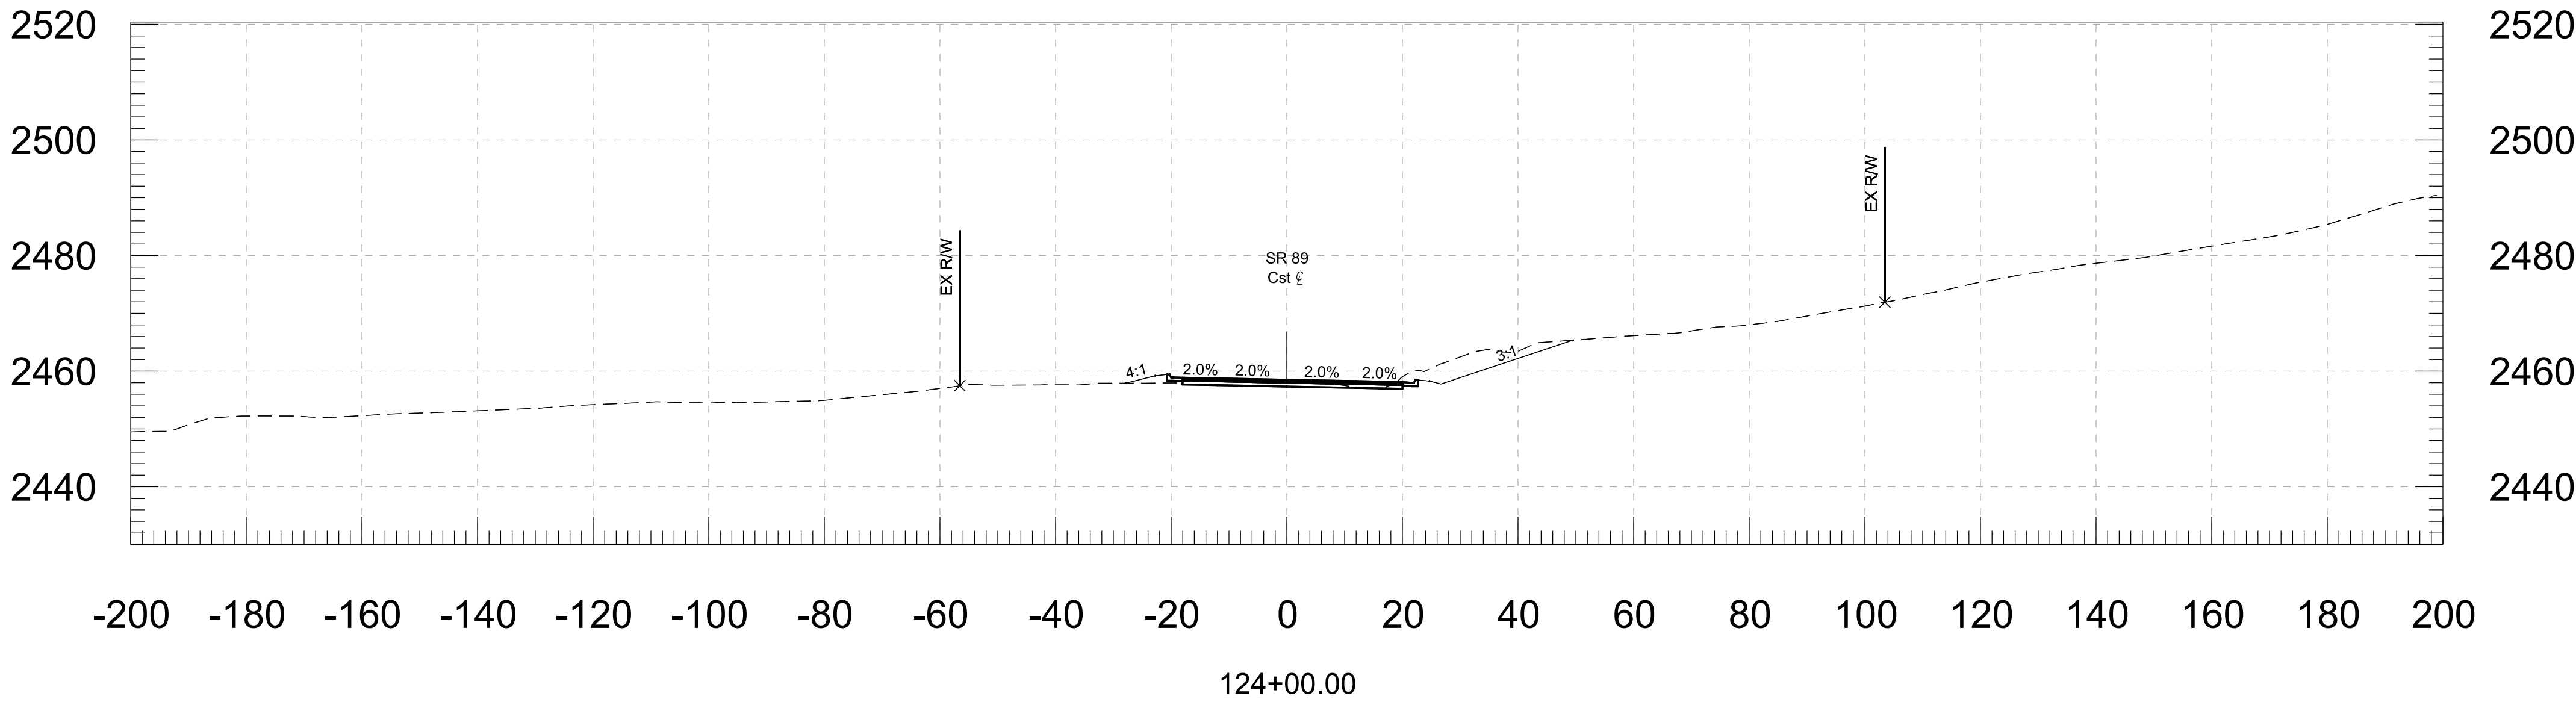

		NAME	DATE	ARIZONA DEPARTMENT OF TRANSPORTATION PROJECT DELIVERY AND OPERATIONS DIVISION ROADWAY DESIGN SERVICES	
DESIGN	ZSZ		06-26		
DRAWN	RM		06-26		
CHECKED	DBK		06-26	CROSS SECTIONS	
ROUTE		LOCATION			DWG NO. 89
US 93		WICKENBURG RANCH WAY TO VISTA ROYALE			
TRACS NO. F0738 OIC		093-B(230)T		___ OF ___	

F.H.W.A. REGION	STATE	PROJECT NO.	SHEET NO.	TOTAL SHEETS	RECORD DRAWING
9	ARIZ.	093-B(230)T	91	116	
093 YV 189					

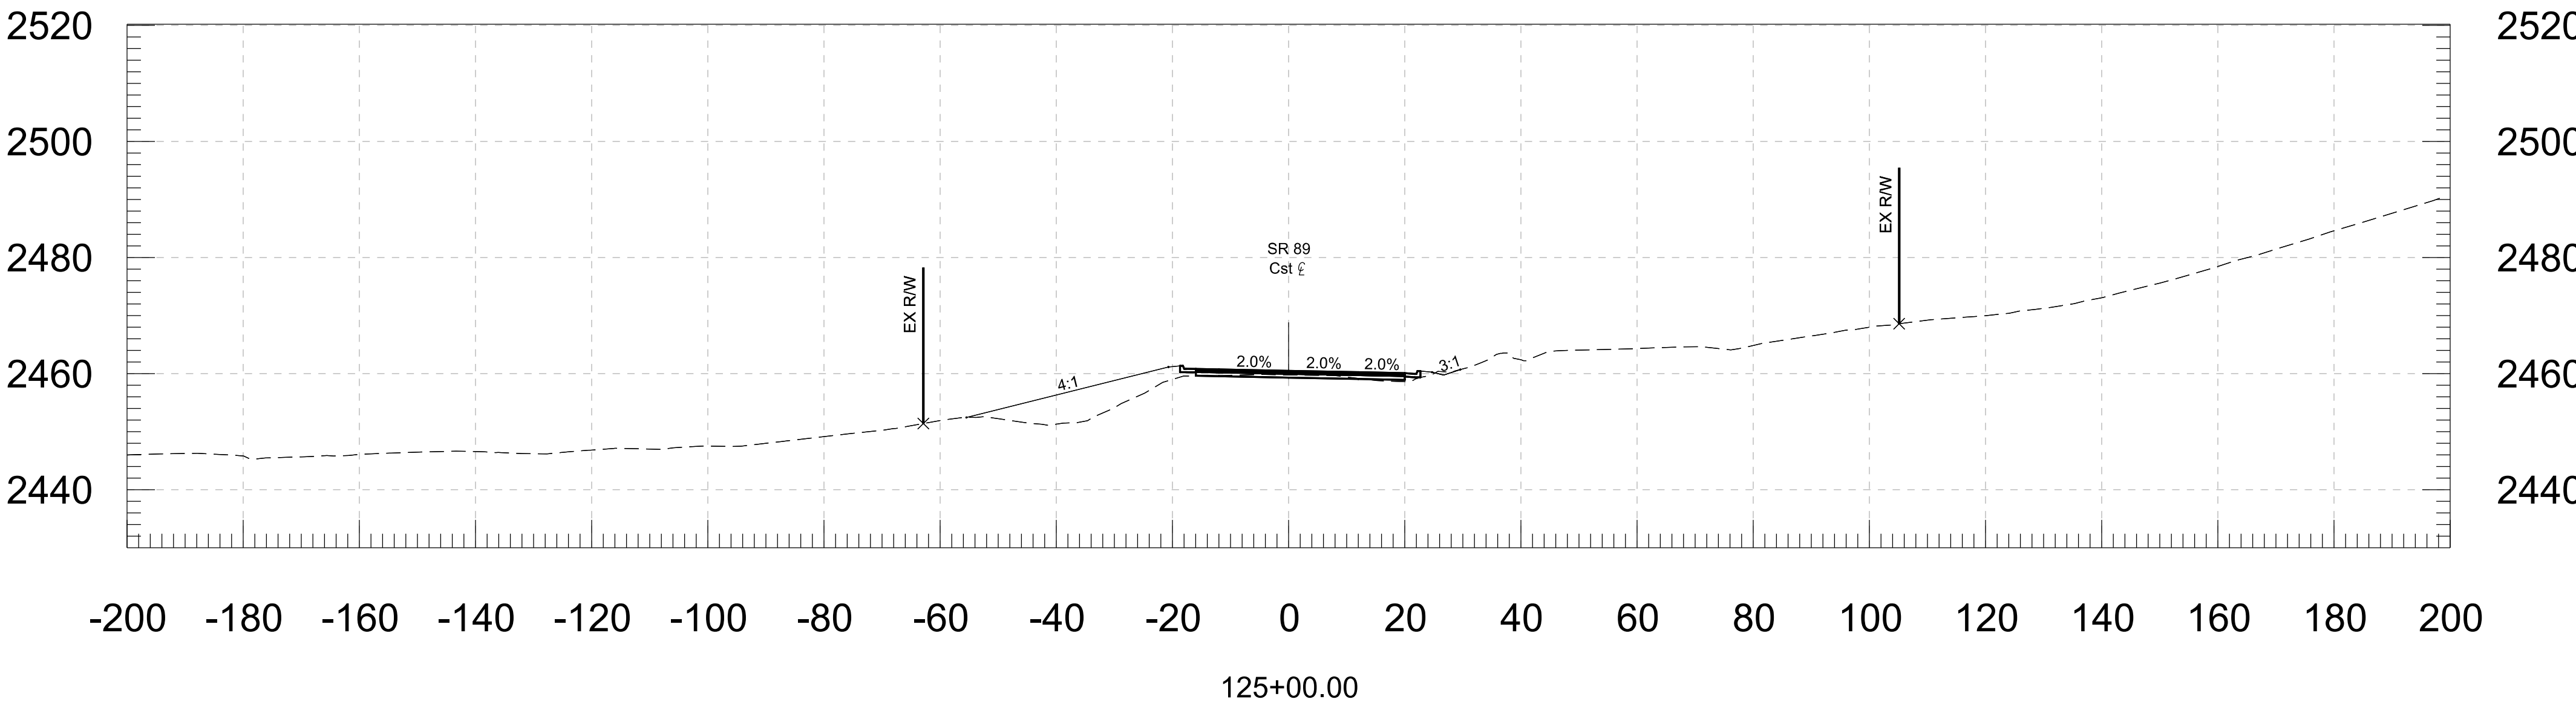
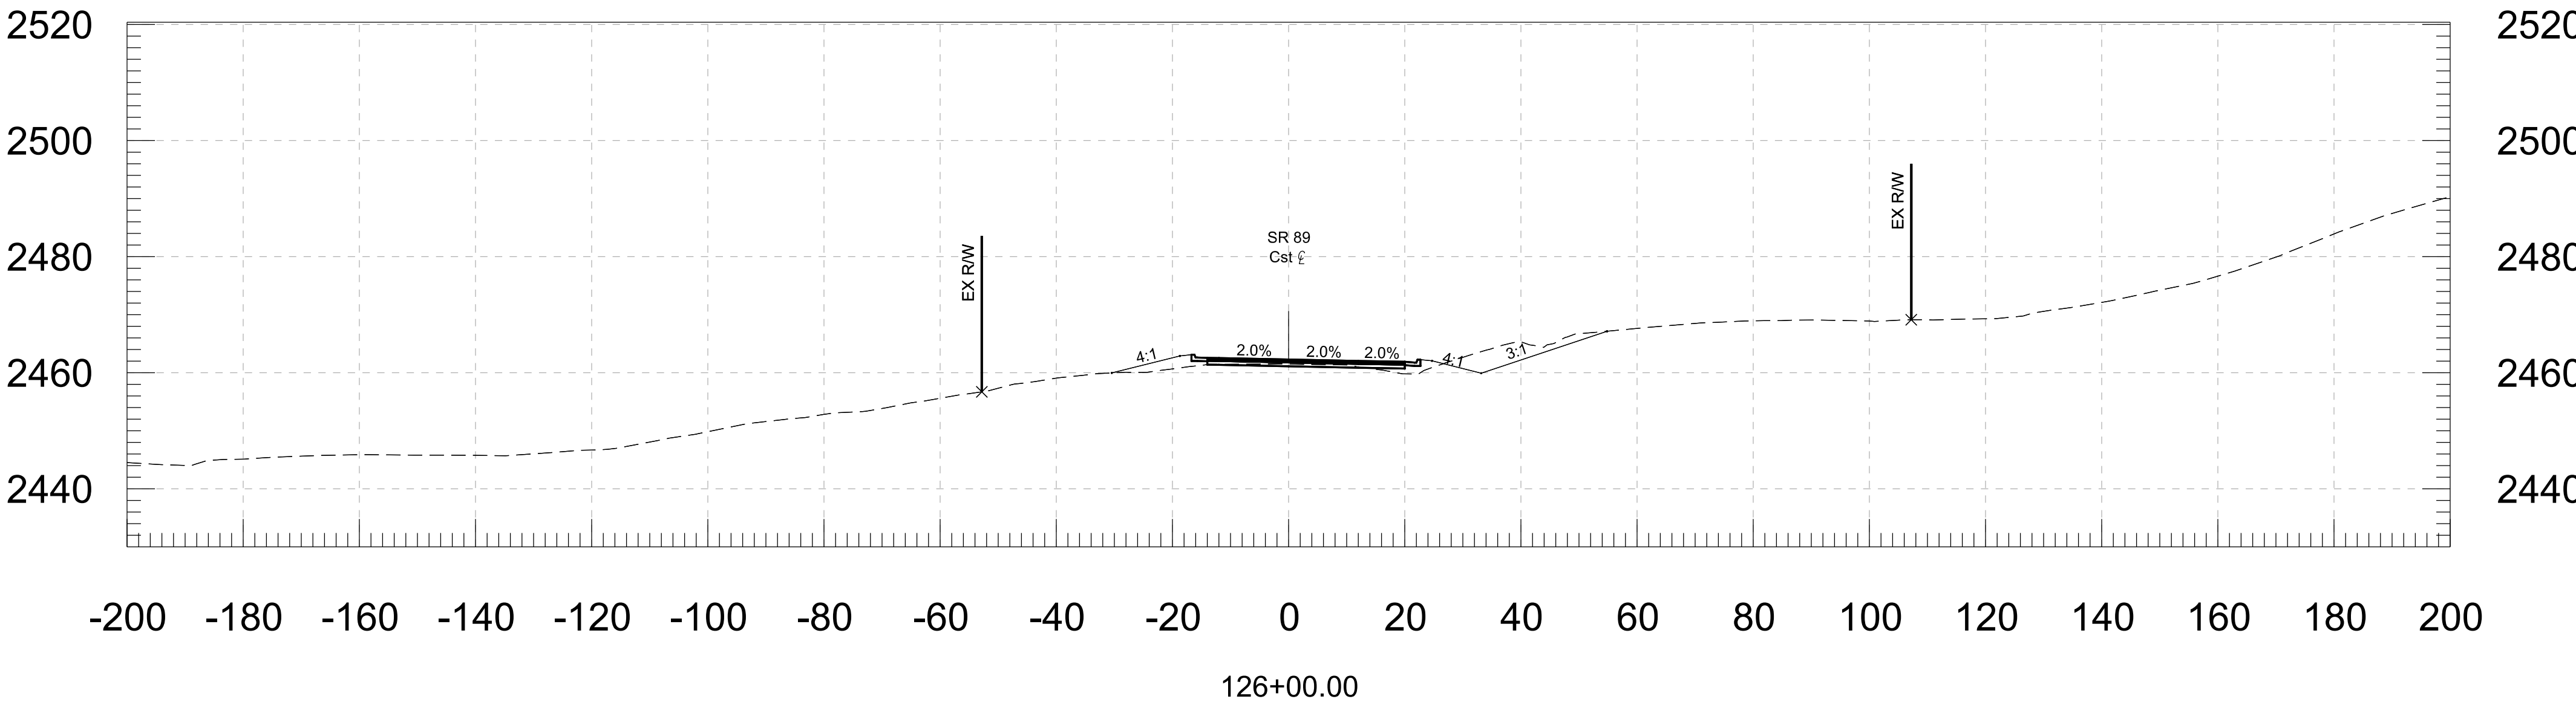


		NAME	DATE	ARIZONA DEPARTMENT OF TRANSPORTATION PROJECT DELIVERY AND OPERATIONS DIVISION ROADWAY DESIGN SERVICES	
DESIGN	ZSZ		06-26		
DRAWN	RM		06-26		
CHECKED	DBK		06-26	CROSS SECTIONS	
ROUTE		LOCATION			DWG NO. 90
US 93		WICKENBURG RANCH WAY TO VISTA ROYALE			
TRACS NO. F0738 OIC		093-B(230)T		___ OF ___	

DATE- LOCATION- REVISIONS- FINISHED PLANS- SURVEY NO. DATE- LOCATION- REVISIONS- FINISHED PLANS- SURVEY NO.

F.H.W.A. REGION	STATE	PROJECT NO.	SHEET NO.	TOTAL SHEETS	RECORD DRAWING
9	ARIZ.	093-B(230)T	92	116	



093 YV 189

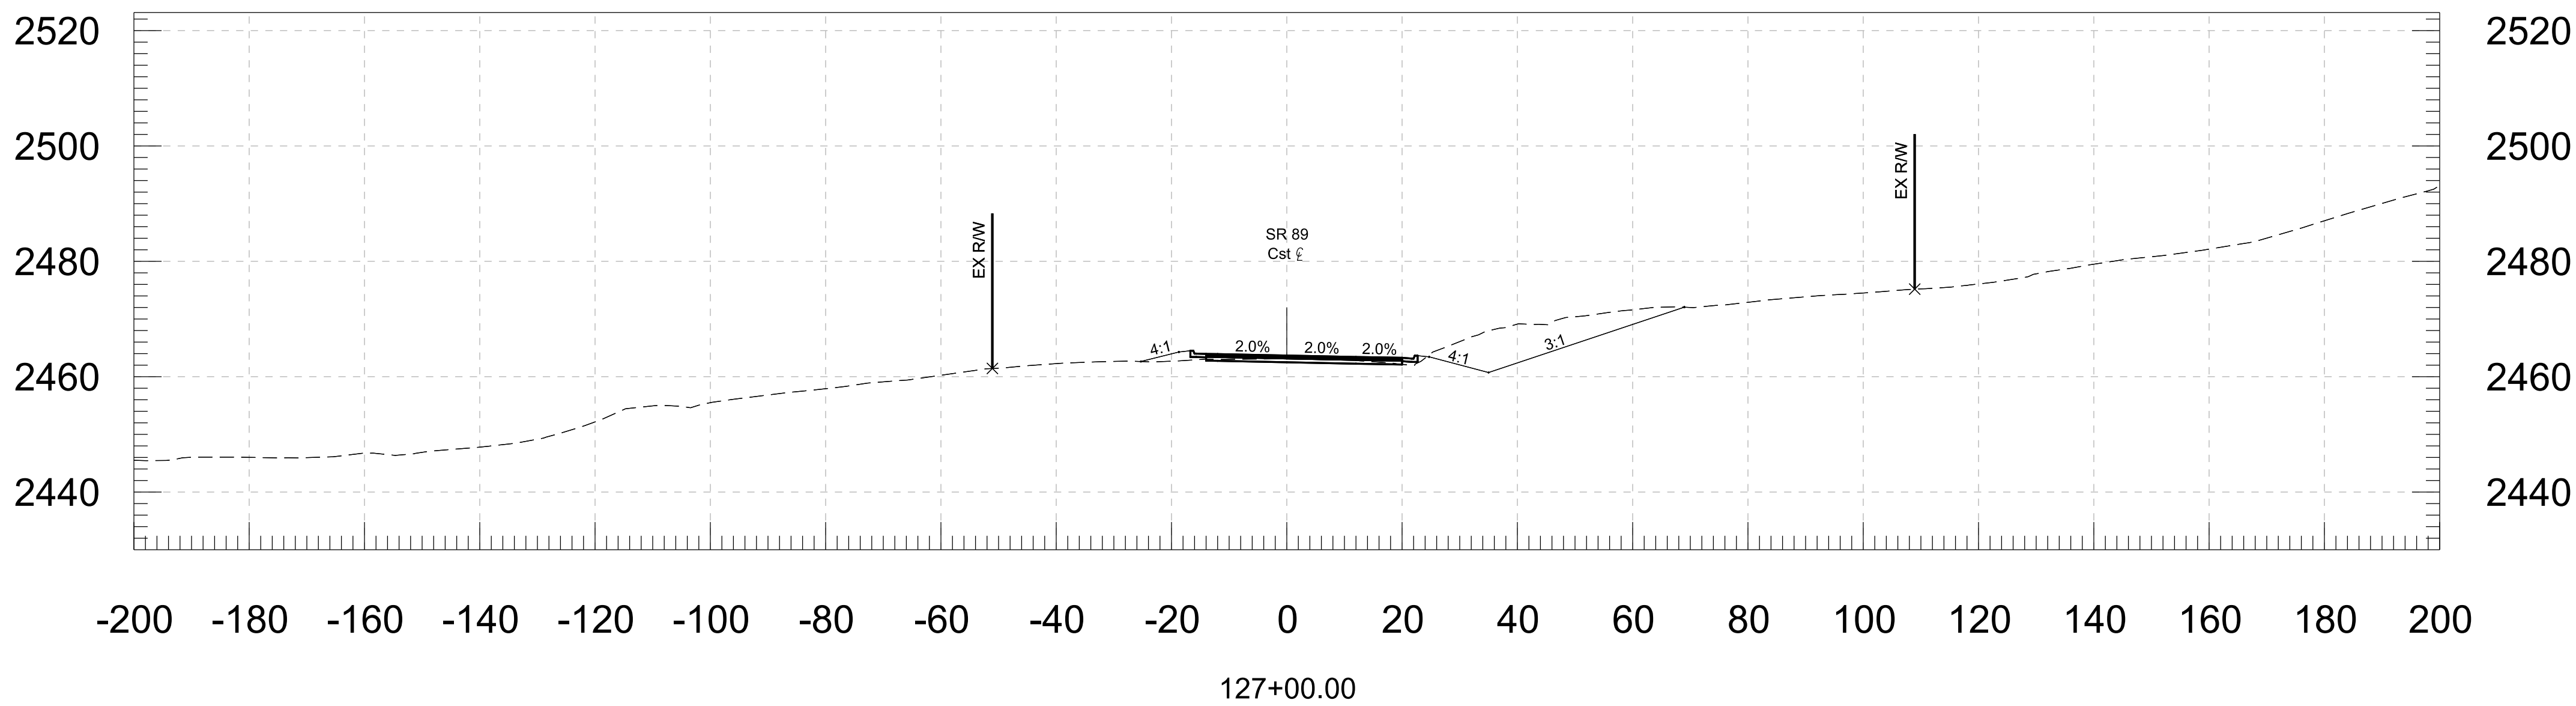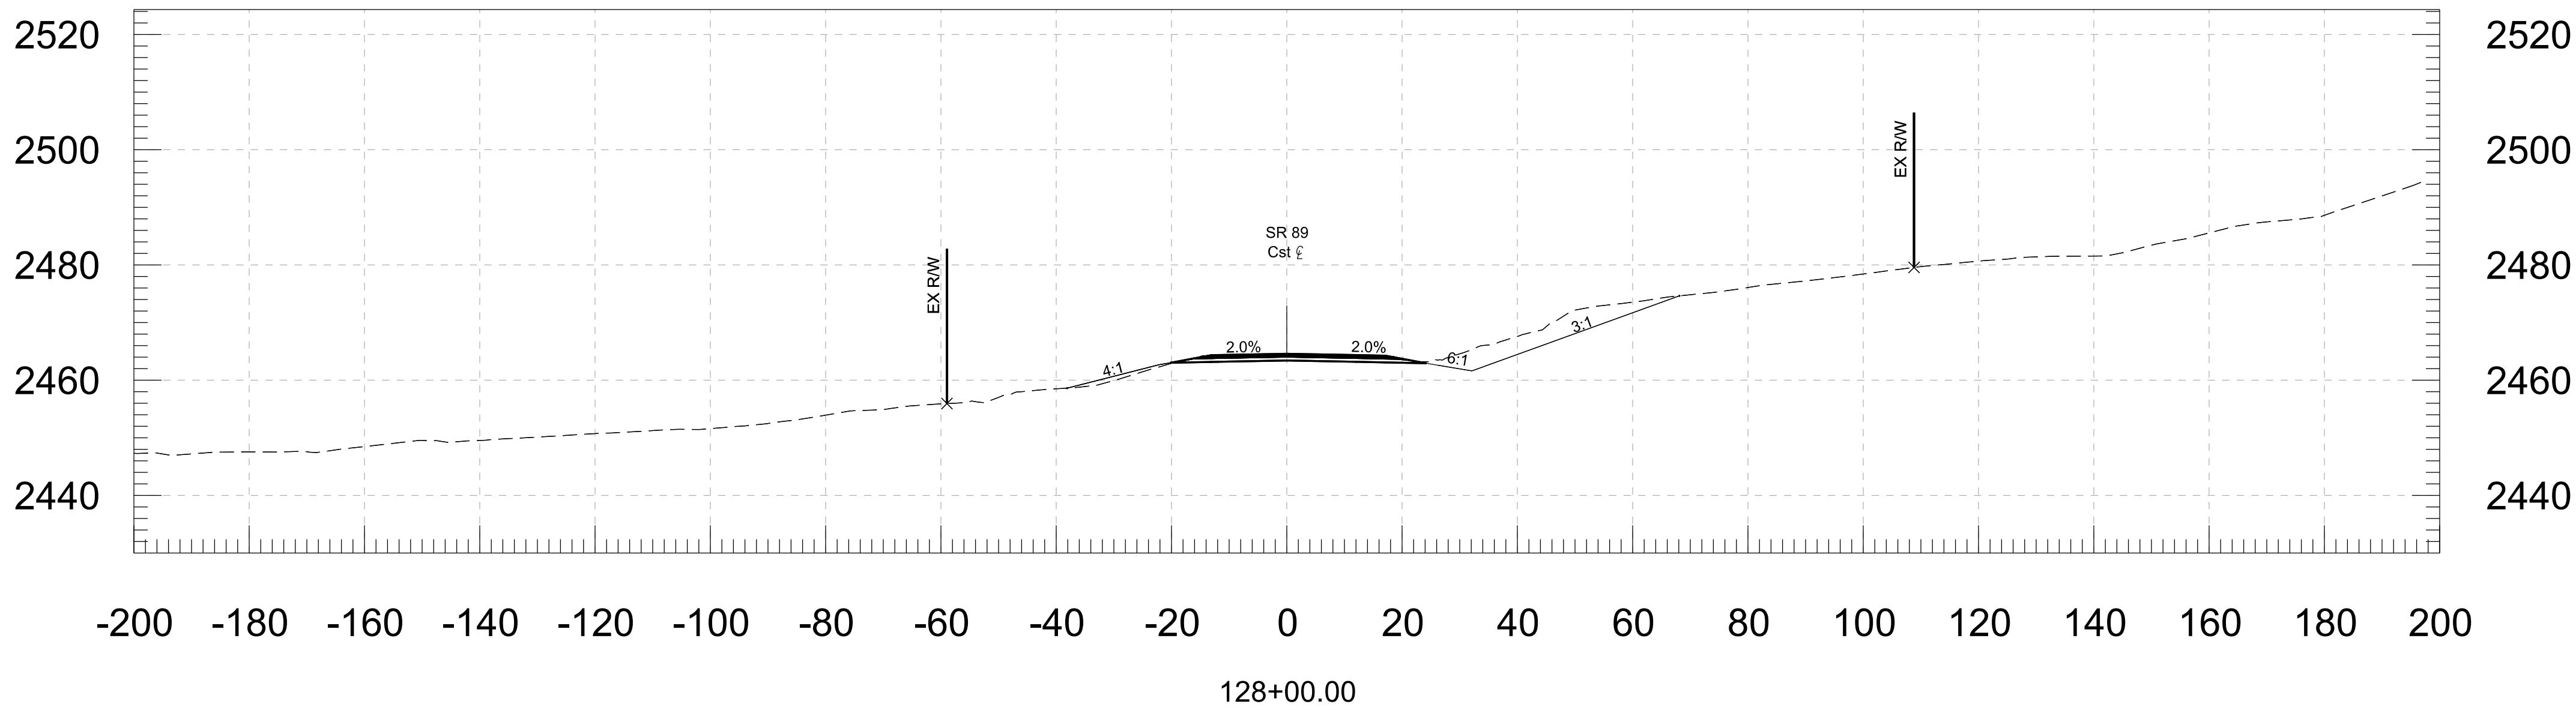

	NAME	DATE	ARIZONA DEPARTMENT OF TRANSPORTATION PROJECT DELIVERY AND OPERATIONS DIVISION ROADWAY DESIGN SERVICES		
DESIGN	ZSZ	06-26			
DRAWN	RM	06-26			
CHECKED	DBK	06-26	CROSS SECTIONS		
 3133 East Camelback Road, Suite 100 Phoenix, Arizona 85016 Phone: 1602/333-2200					
ROUTE	LOCATION		US 93 WICKENBURG RANCH WAY TO VISTA ROYALE		DWG NO. 91
TRACS NO. F0738 OIC			093-B(230)T		___ OF ___


F.H.W.A. REGION	STATE	PROJECT NO.	SHEET NO.	TOTAL SHEETS	RECORD DRAWING
9	ARIZ.	093-B(230)T	93	116	

093 YV 189

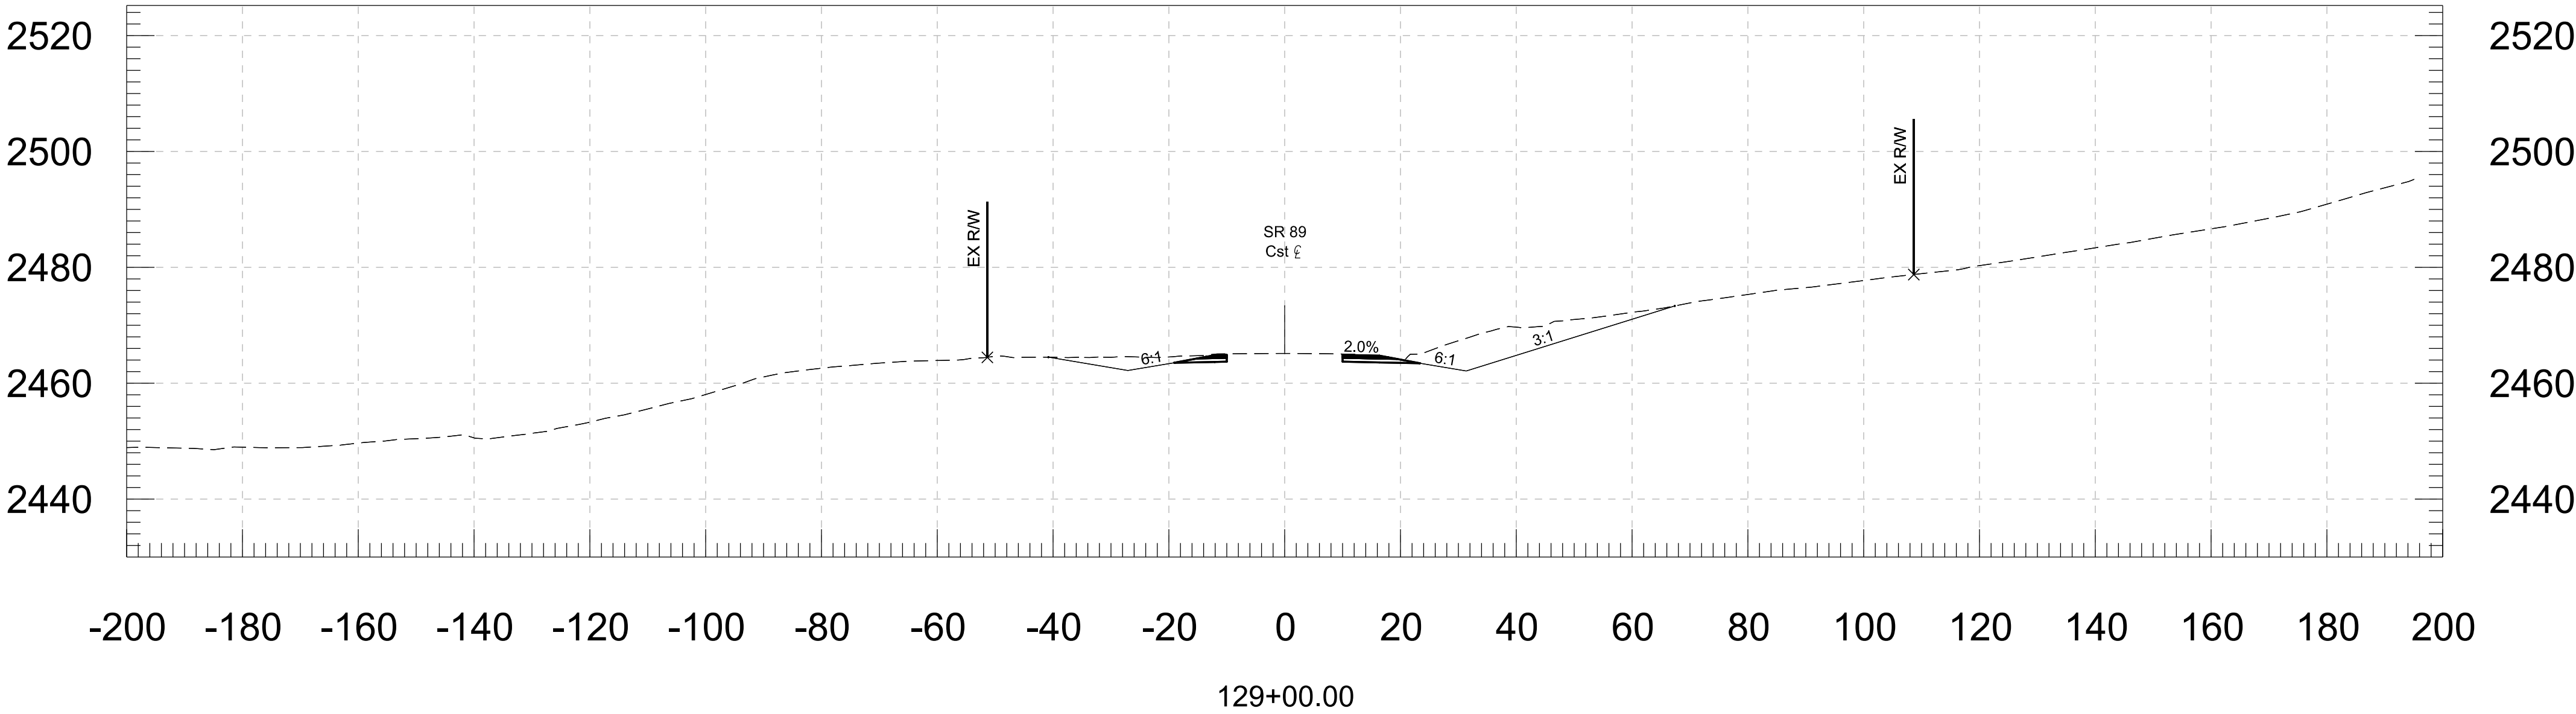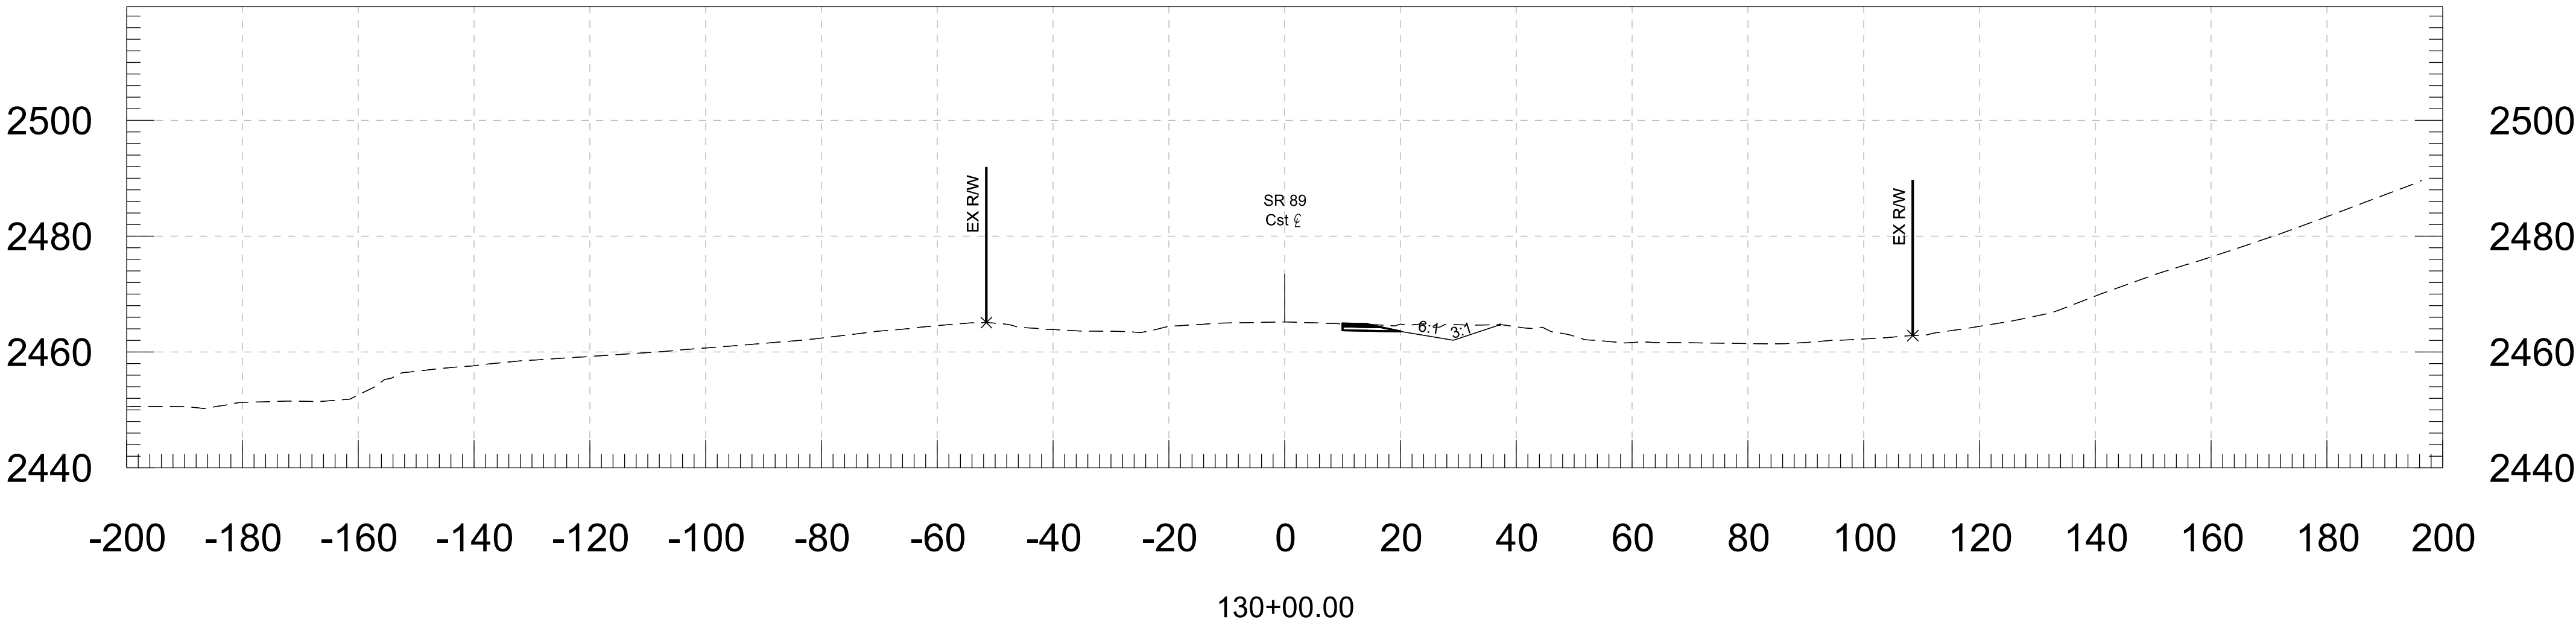

		NAME	DATE	ARIZONA DEPARTMENT OF TRANSPORTATION PROJECT DELIVERY AND OPERATIONS DIVISION ROADWAY DESIGN SERVICES
DESIGN		ZSZ	06-26	
DRAWN		RM	06-26	
CHECKED		DBK	06-26	
 Stanley Consultants inc.		3133 East Camelback Road, Suite 100 Phoenix, Arizona 85016 Phone: (602) 333-2200		CROSS SECTIONS
ROUTE		LOCATION		
US 93		WICKENBURG RANCH WAY TO VISTA ROYALE		
TRACS NO. F0738 OIC		093-B(230)T		DWG NO. 92
				___ OF ___

F.H.W.A. REGION	STATE	PROJECT NO.	SHEET NO.	TOTAL SHEETS	RECORD DRAWING
9	ARIZ.	093-B(230)T	94	116	
093 YV 189					






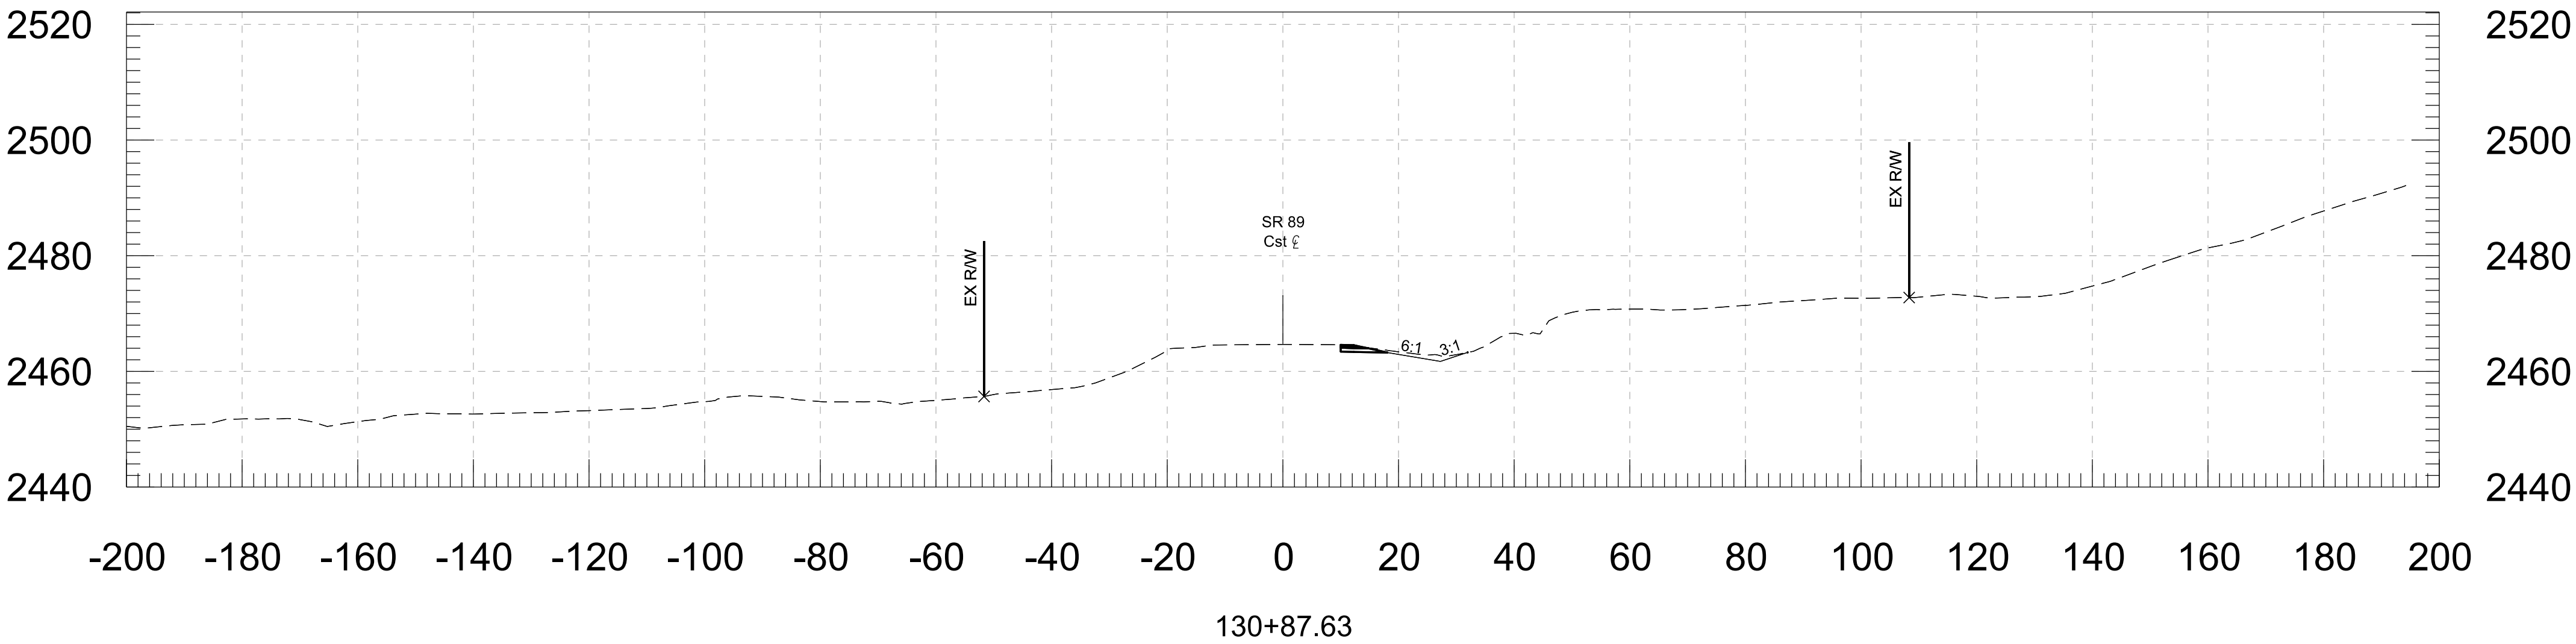


			ARIZONA DEPARTMENT OF TRANSPORTATION PROJECT DELIVERY AND OPERATIONS DIVISION ROADWAY DESIGN SERVICES		
DESIGN	ZSZ	06-26	Stanley Consultants 333 East Camelback Road, Suite 100 Phoenix, Arizona 85016 Phone: 1602-333-2200		
DRAWN	RM	06-26			
CHECKED	DBK	06-26			
ROUTE			CROSS SECTIONS		
US 93			WICKENBURG RANCH WAY TO VISTA ROYALE		
TRACS NO. F0738 OIC			093-B(230)T		
			DWG NO. 93		
			____ OF ____		

DATE- LOCATION- REVISIONS- FINISHED PLANS- SURVEY NO. DATE- LOCATION- REVISIONS- FINISHED PLANS- SURVEY NO.

F.H.W.A. REGION	STATE	PROJECT NO.	SHEET NO.	TOTAL SHEETS	RECORD DRAWING
9	ARIZ.	093-B(230)T	95	116	







093 YV 189

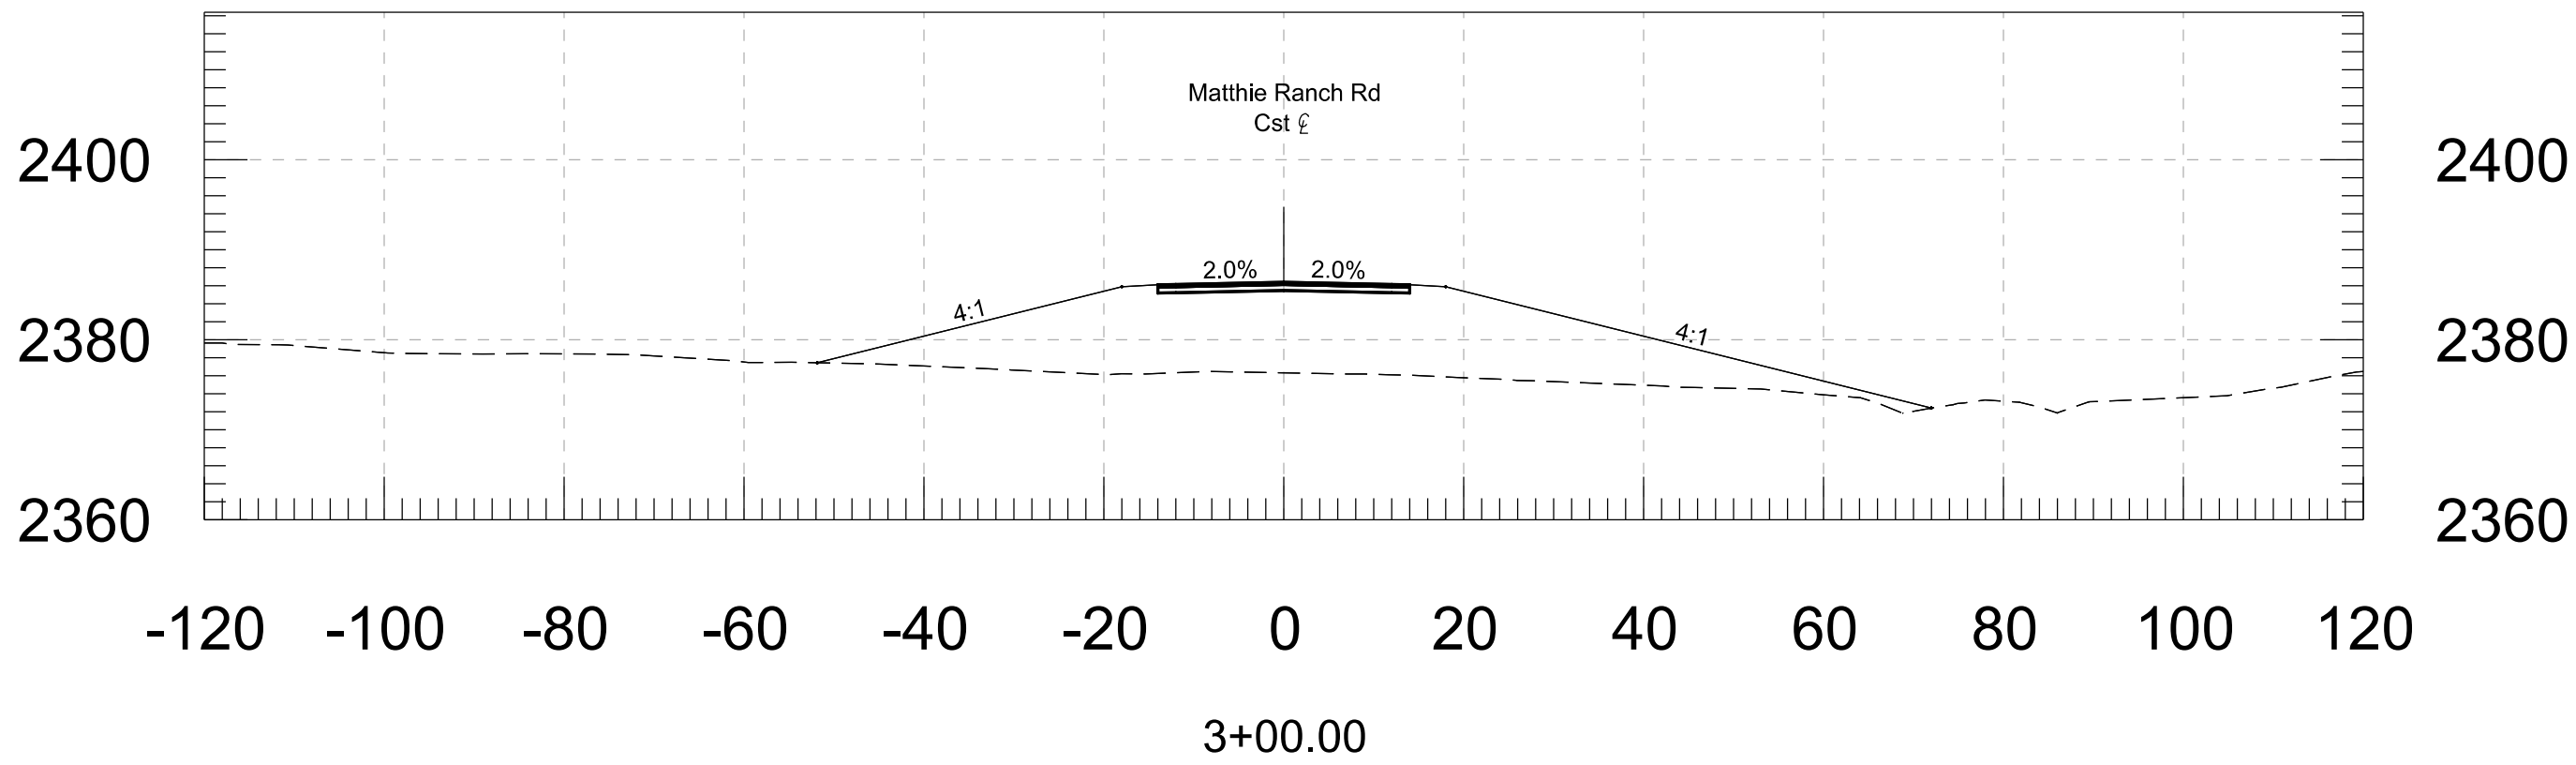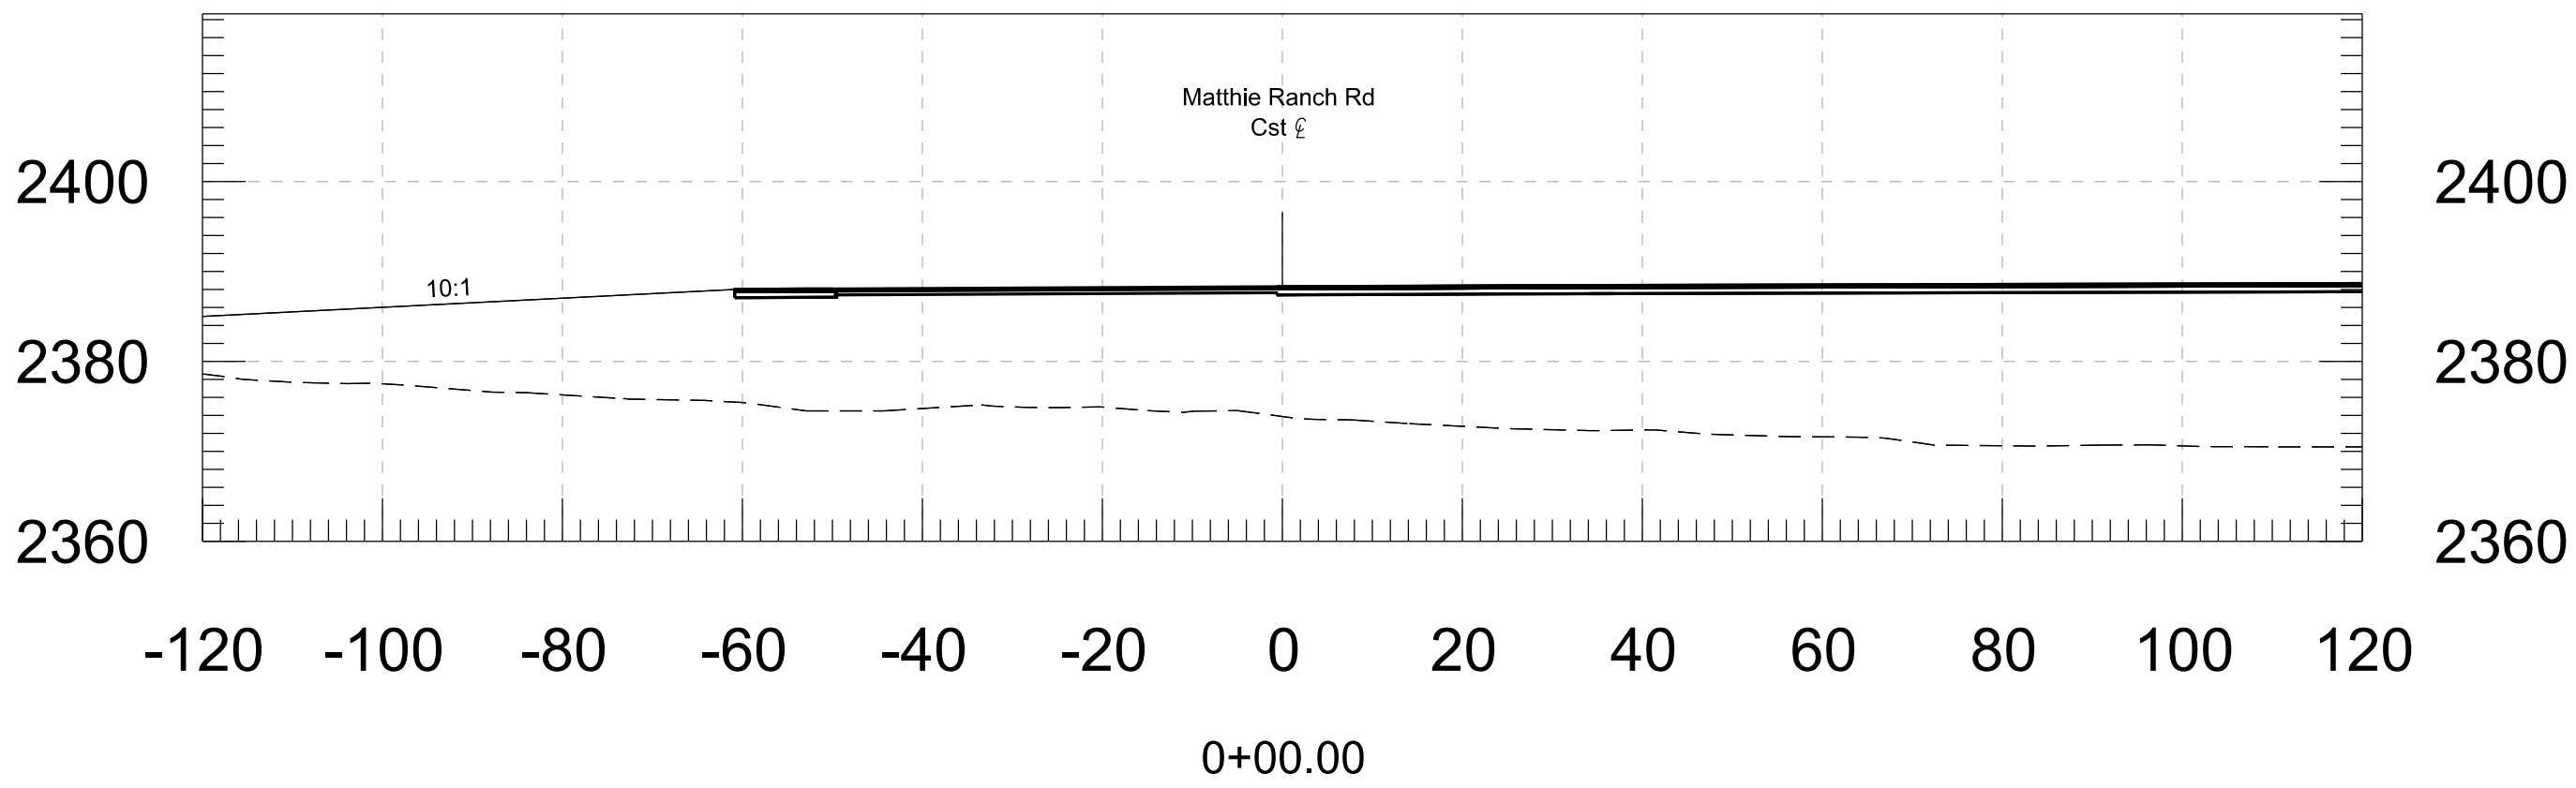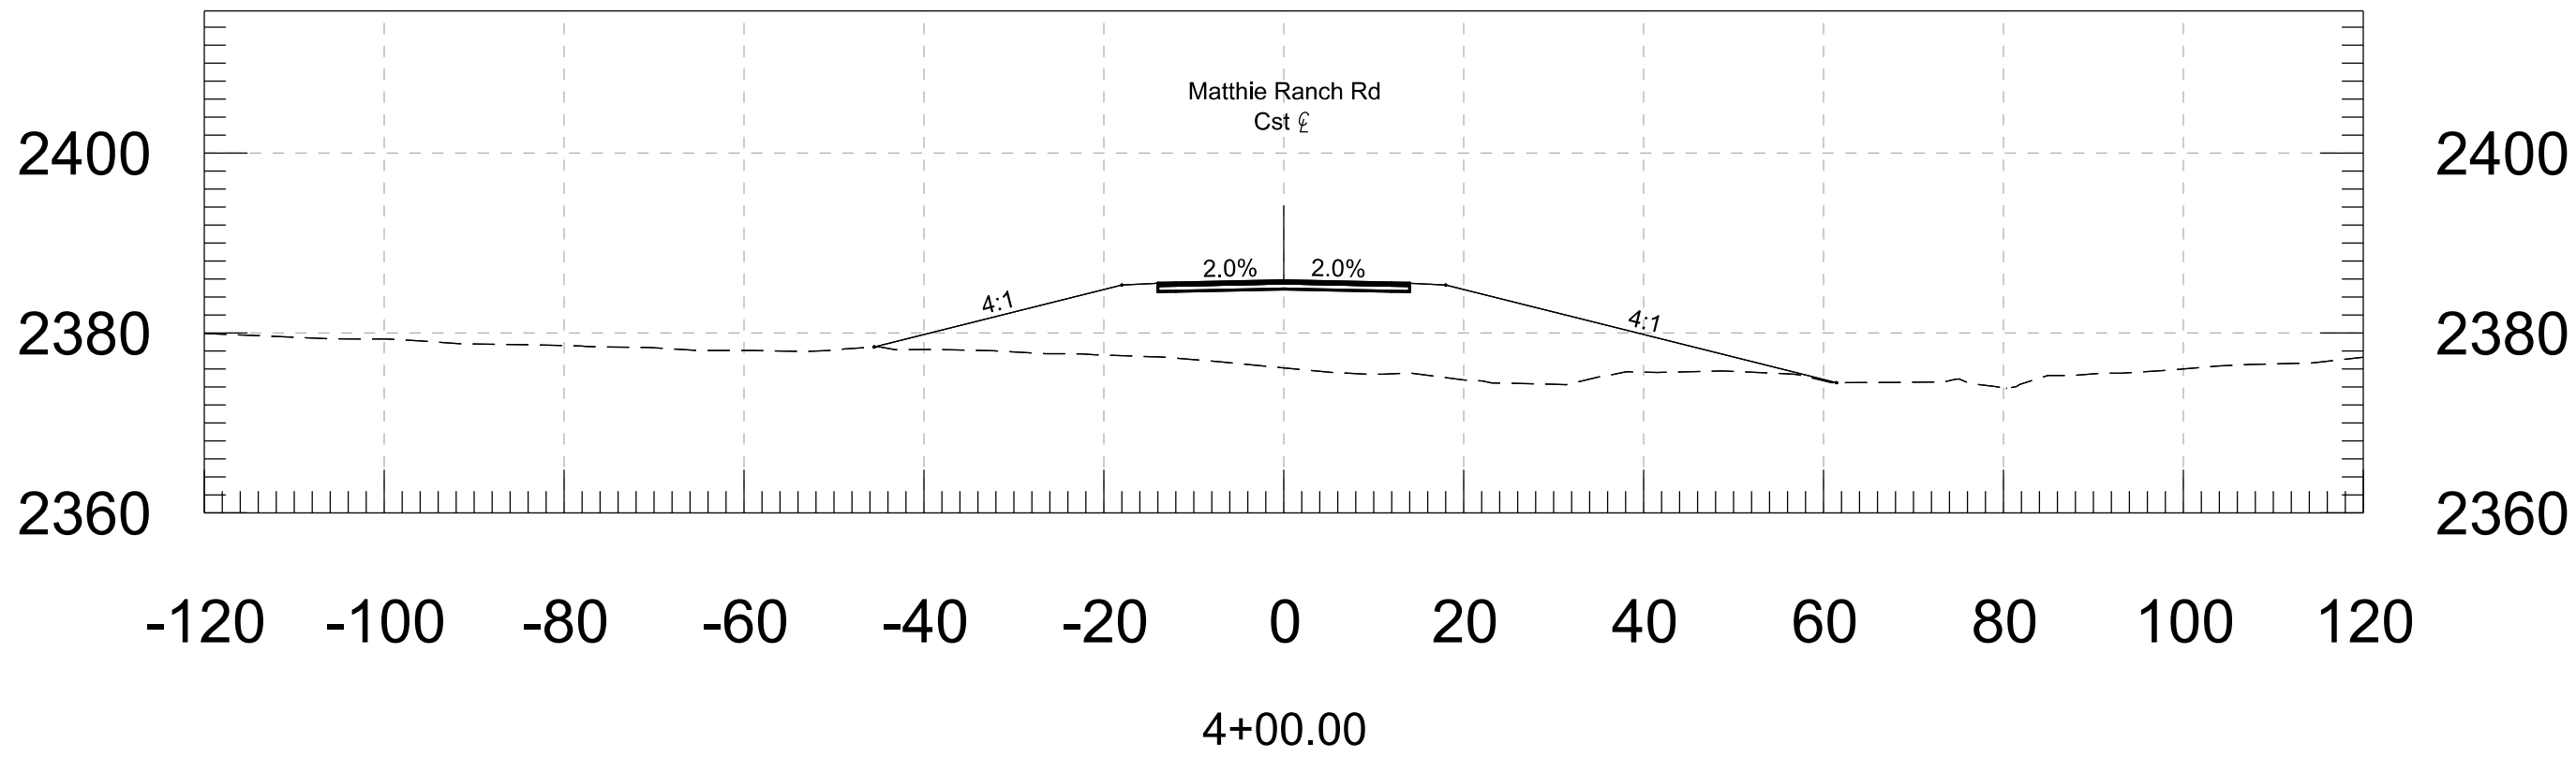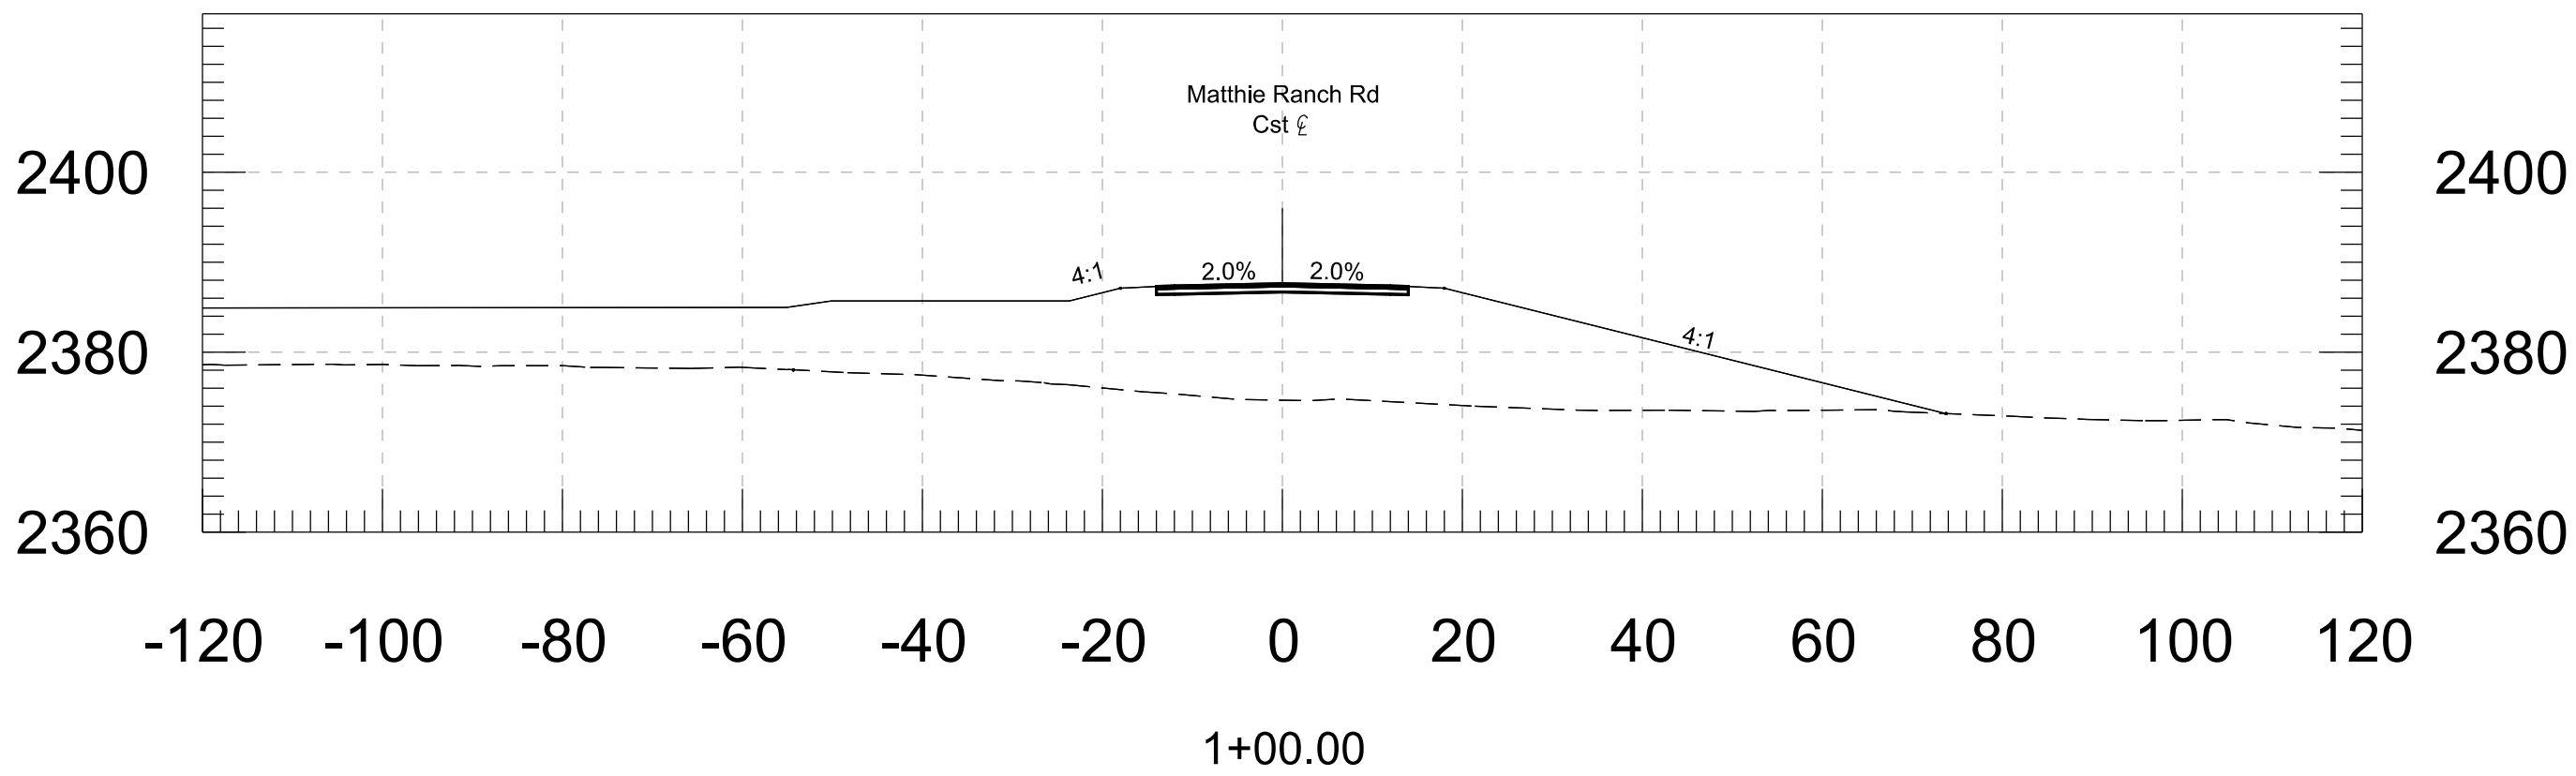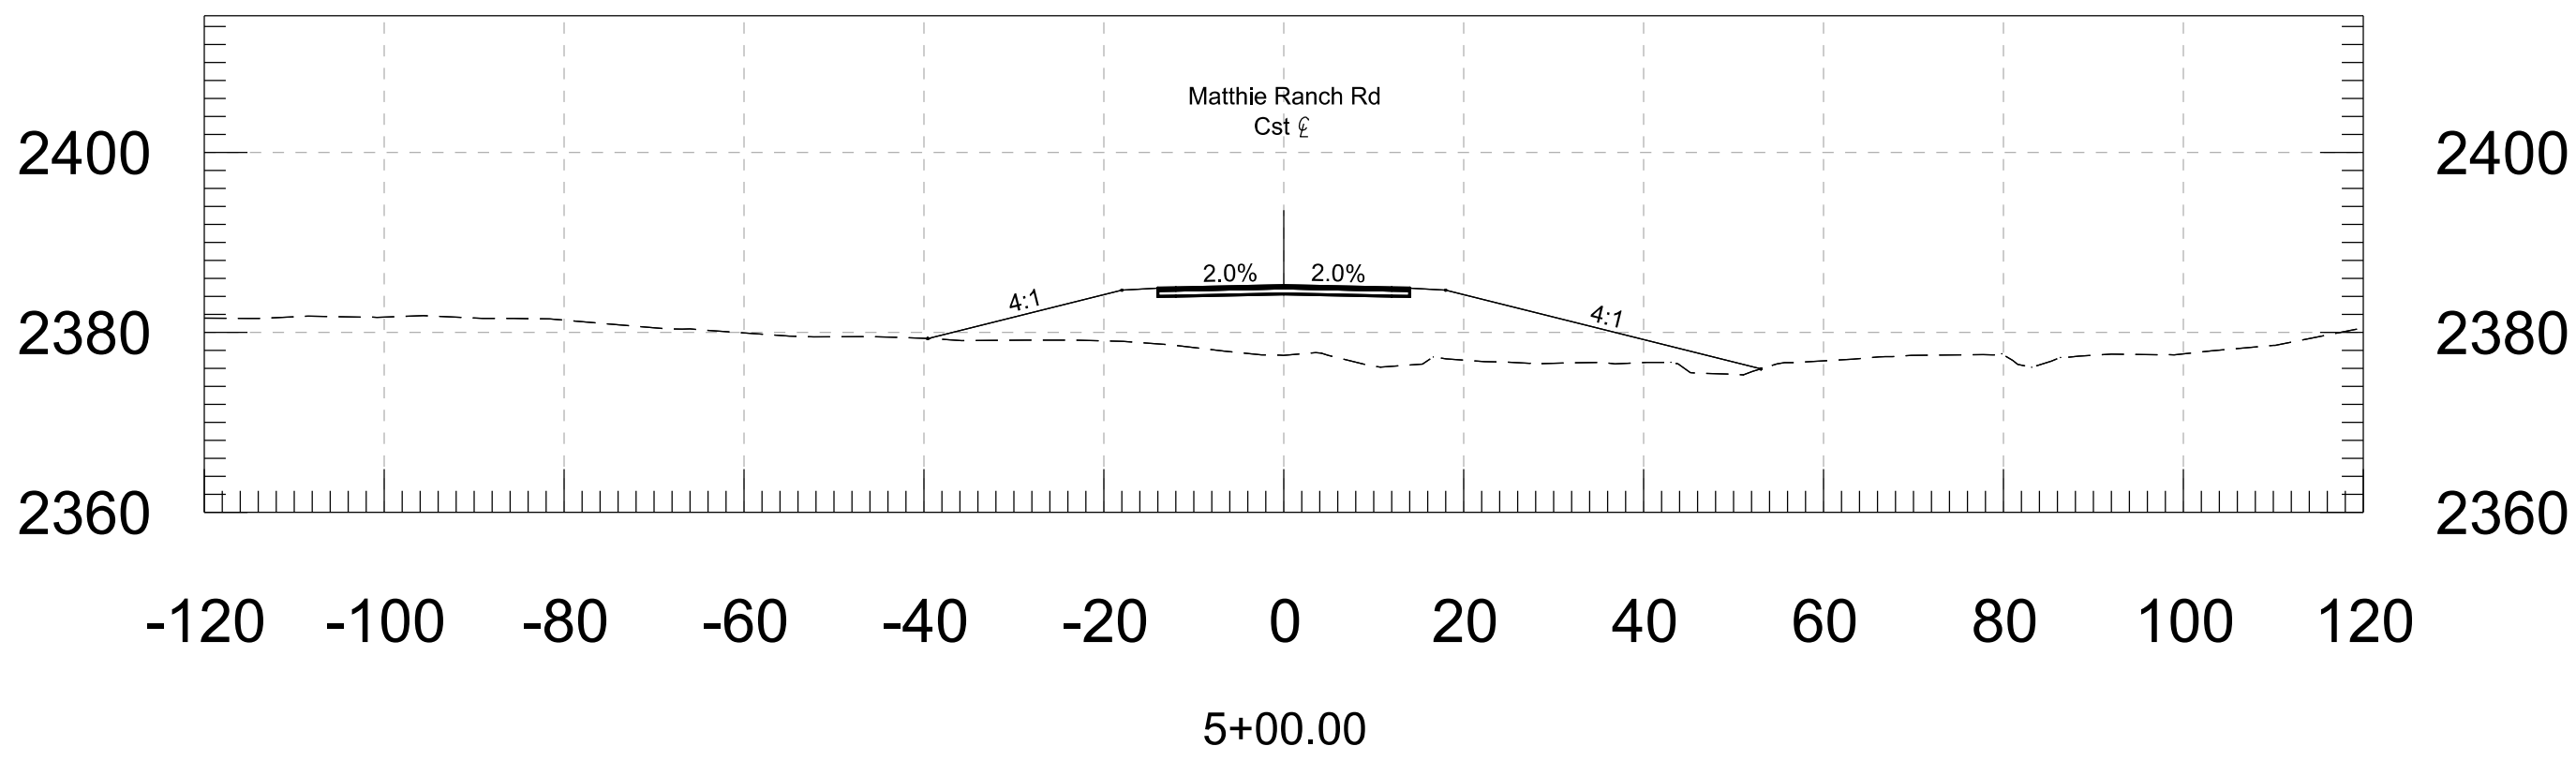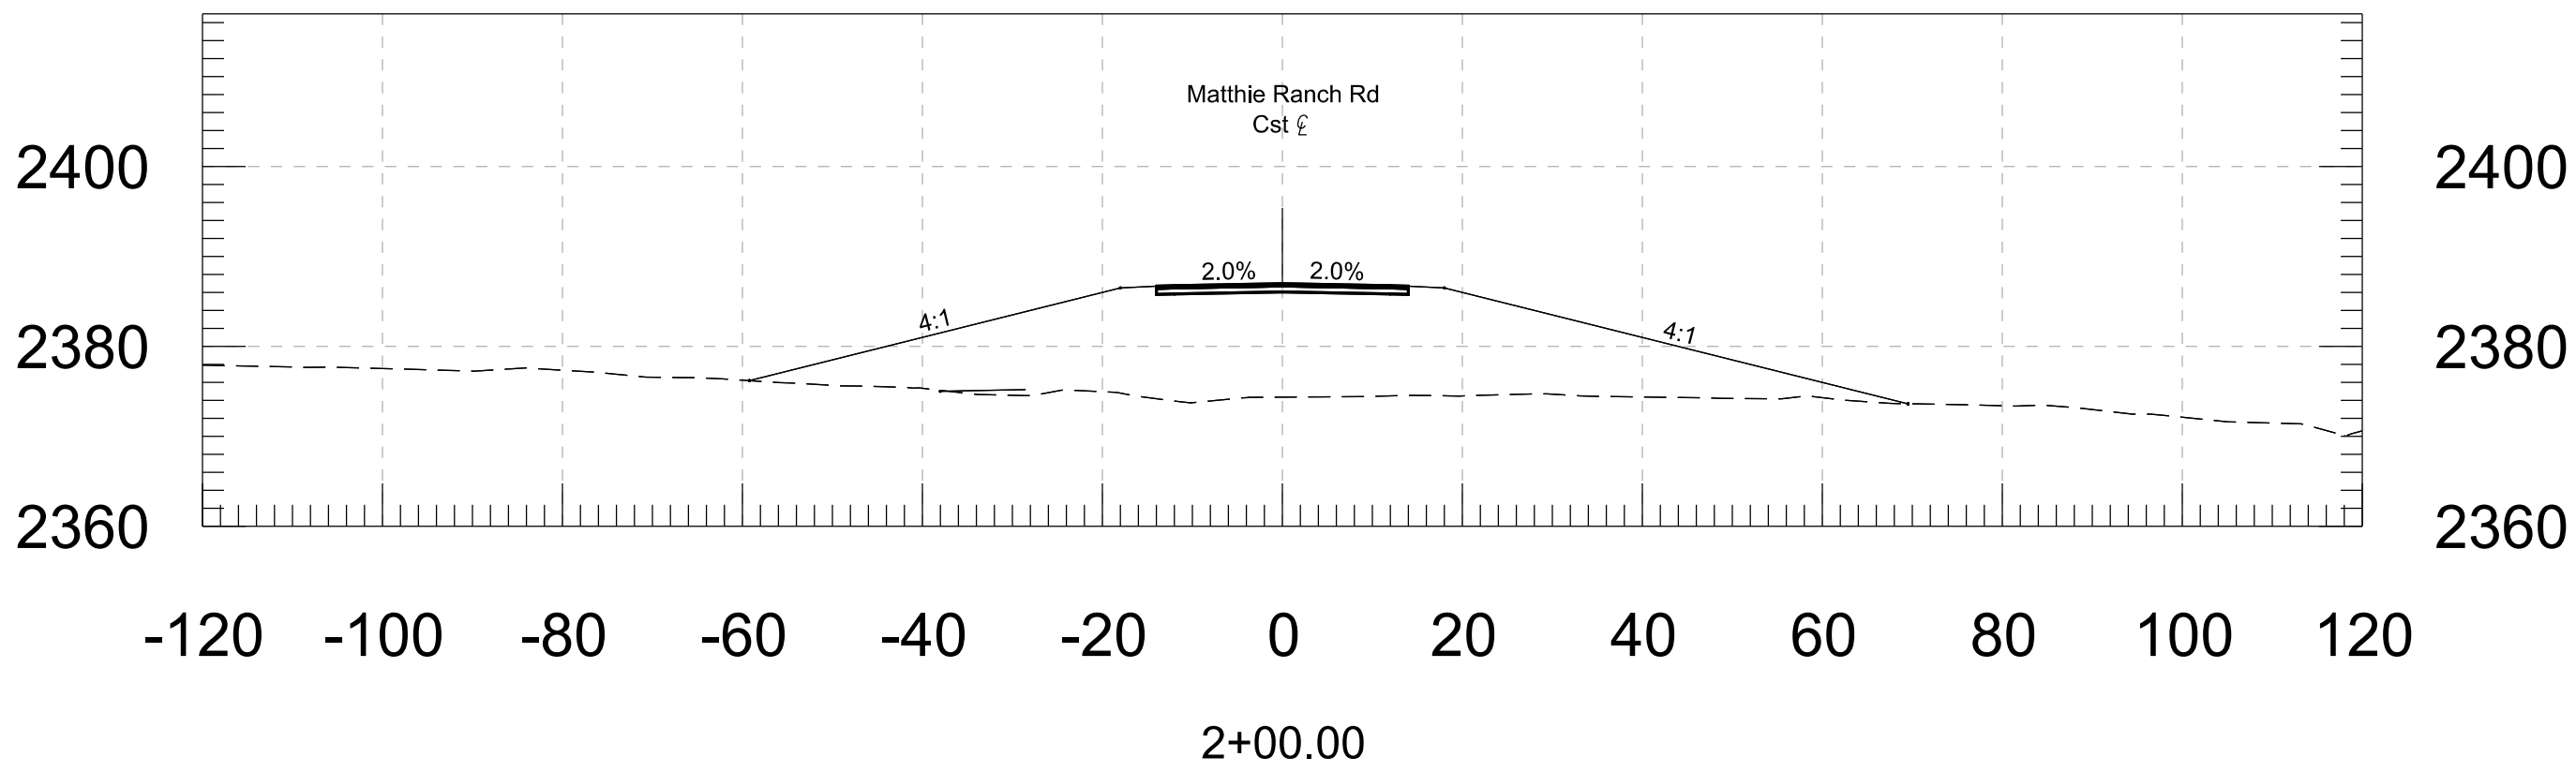

		NAME	DATE	ARIZONA DEPARTMENT OF TRANSPORTATION PROJECT DELIVERY AND OPERATIONS DIVISION ROADWAY DESIGN SERVICES		CROSS SECTIONS	
DESIGN	ZSZ	06-26					
DRAWN	RM	06-26					
CHECKED	DBK	06-26					
 Stanley Consultants inc. 3133 East Camelback Road, Suite 100 Phoenix, Arizona 85016 Phone: 1602 333-2200							
ROUTE		LOCATION					
US 93		WICKENBURG RANCH WAY TO VISTA ROYALE			DWG NO. 94		
TRACS NO. F0738 OIC			093-B(230)T		___ OF ___		







F.H.W.A. REGION	STATE	PROJECT NO.	SHEET NO.	TOTAL SHEETS	RECORD DRAWING
9	ARIZ.	093-B(230)T	96	116	

093 YV 189

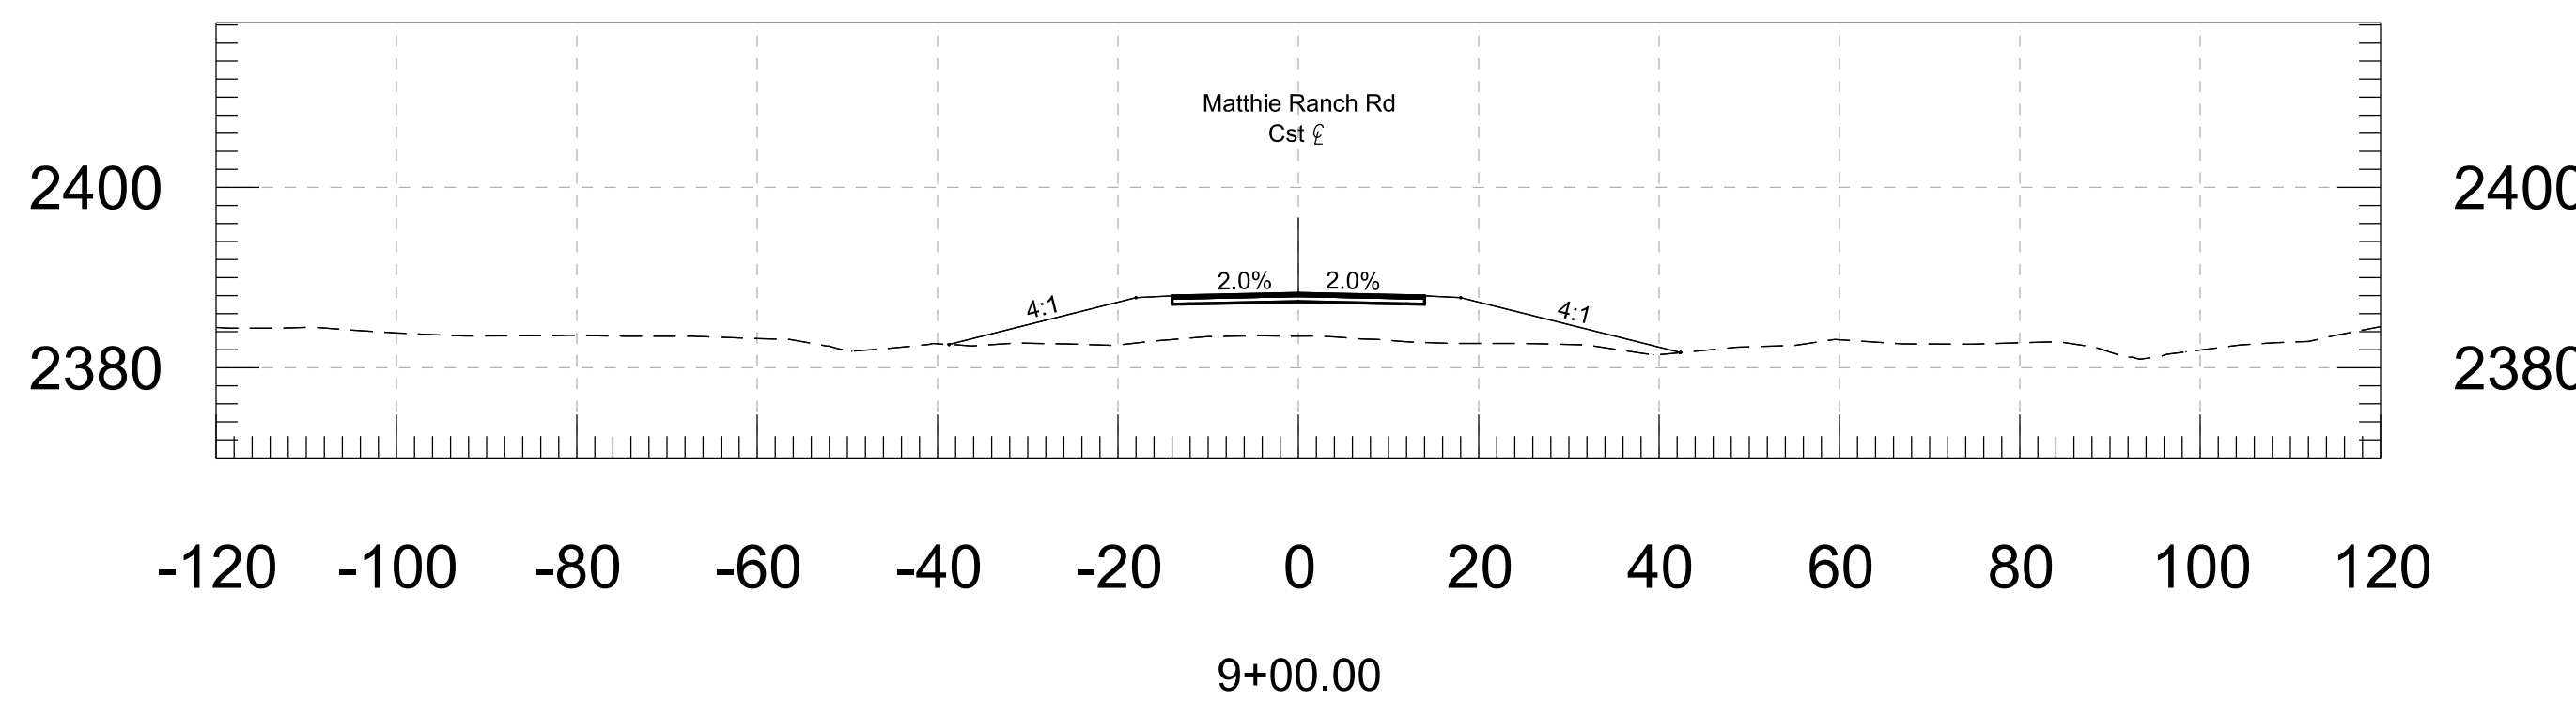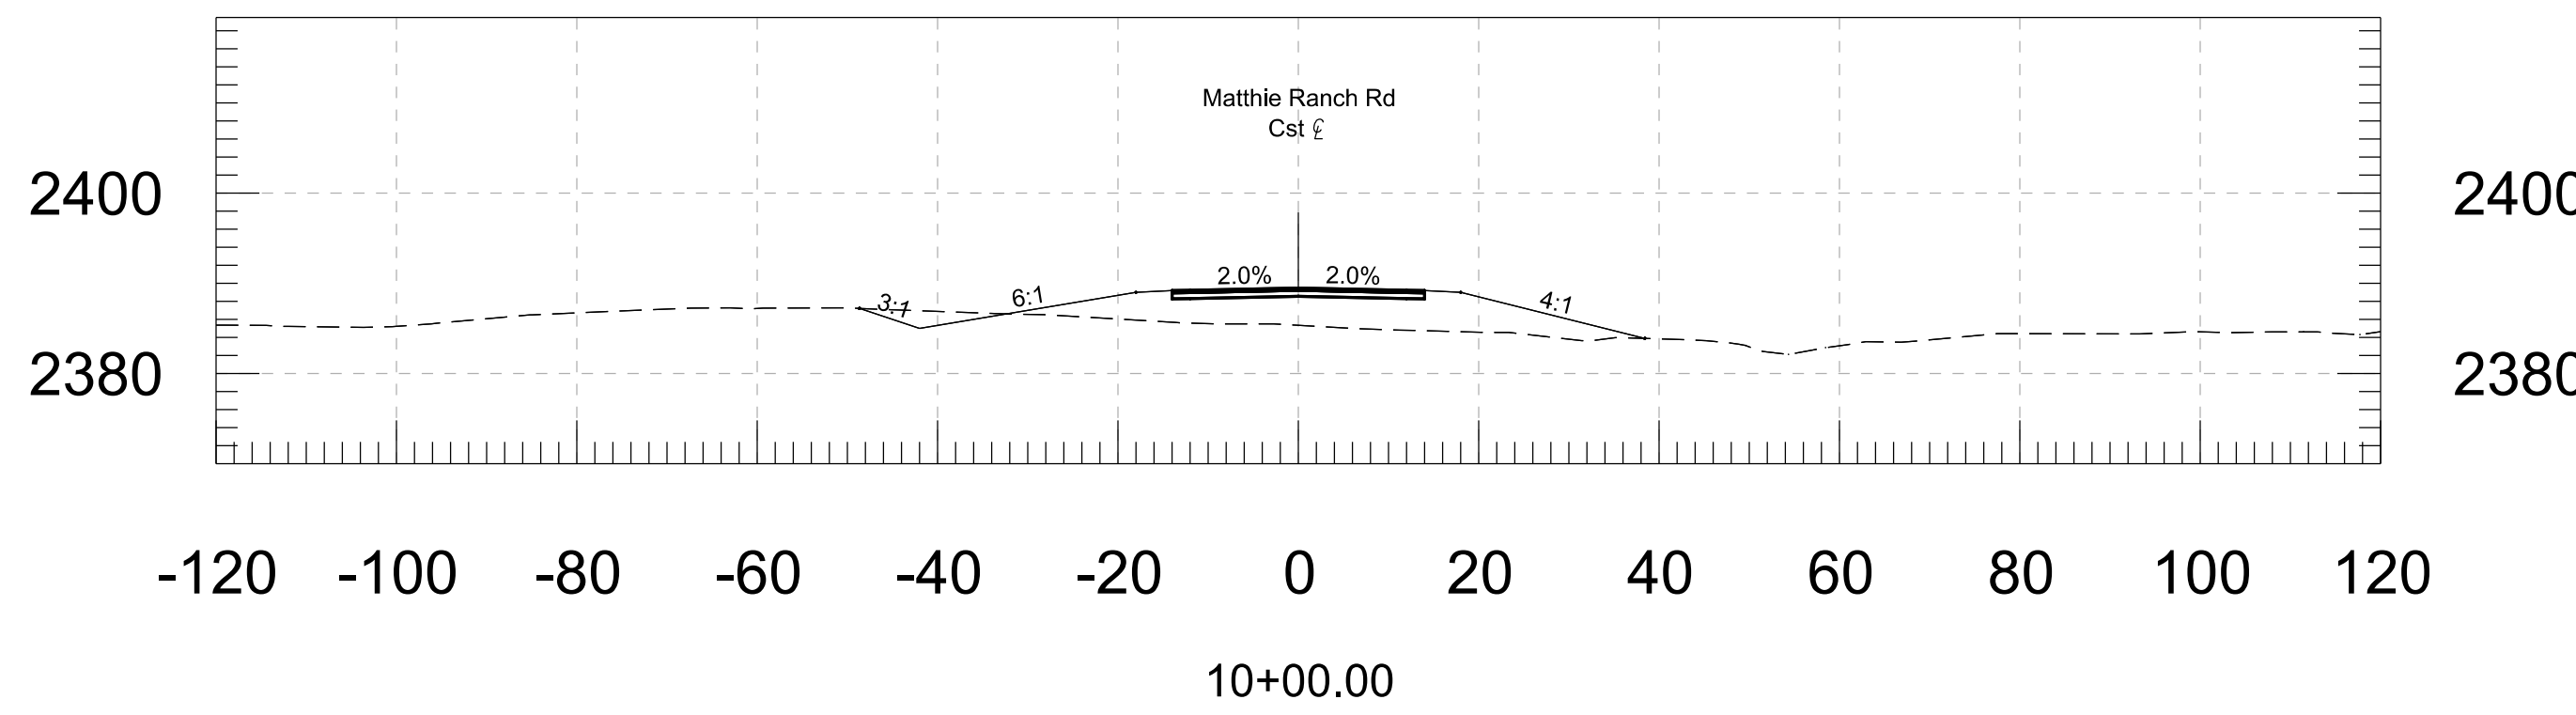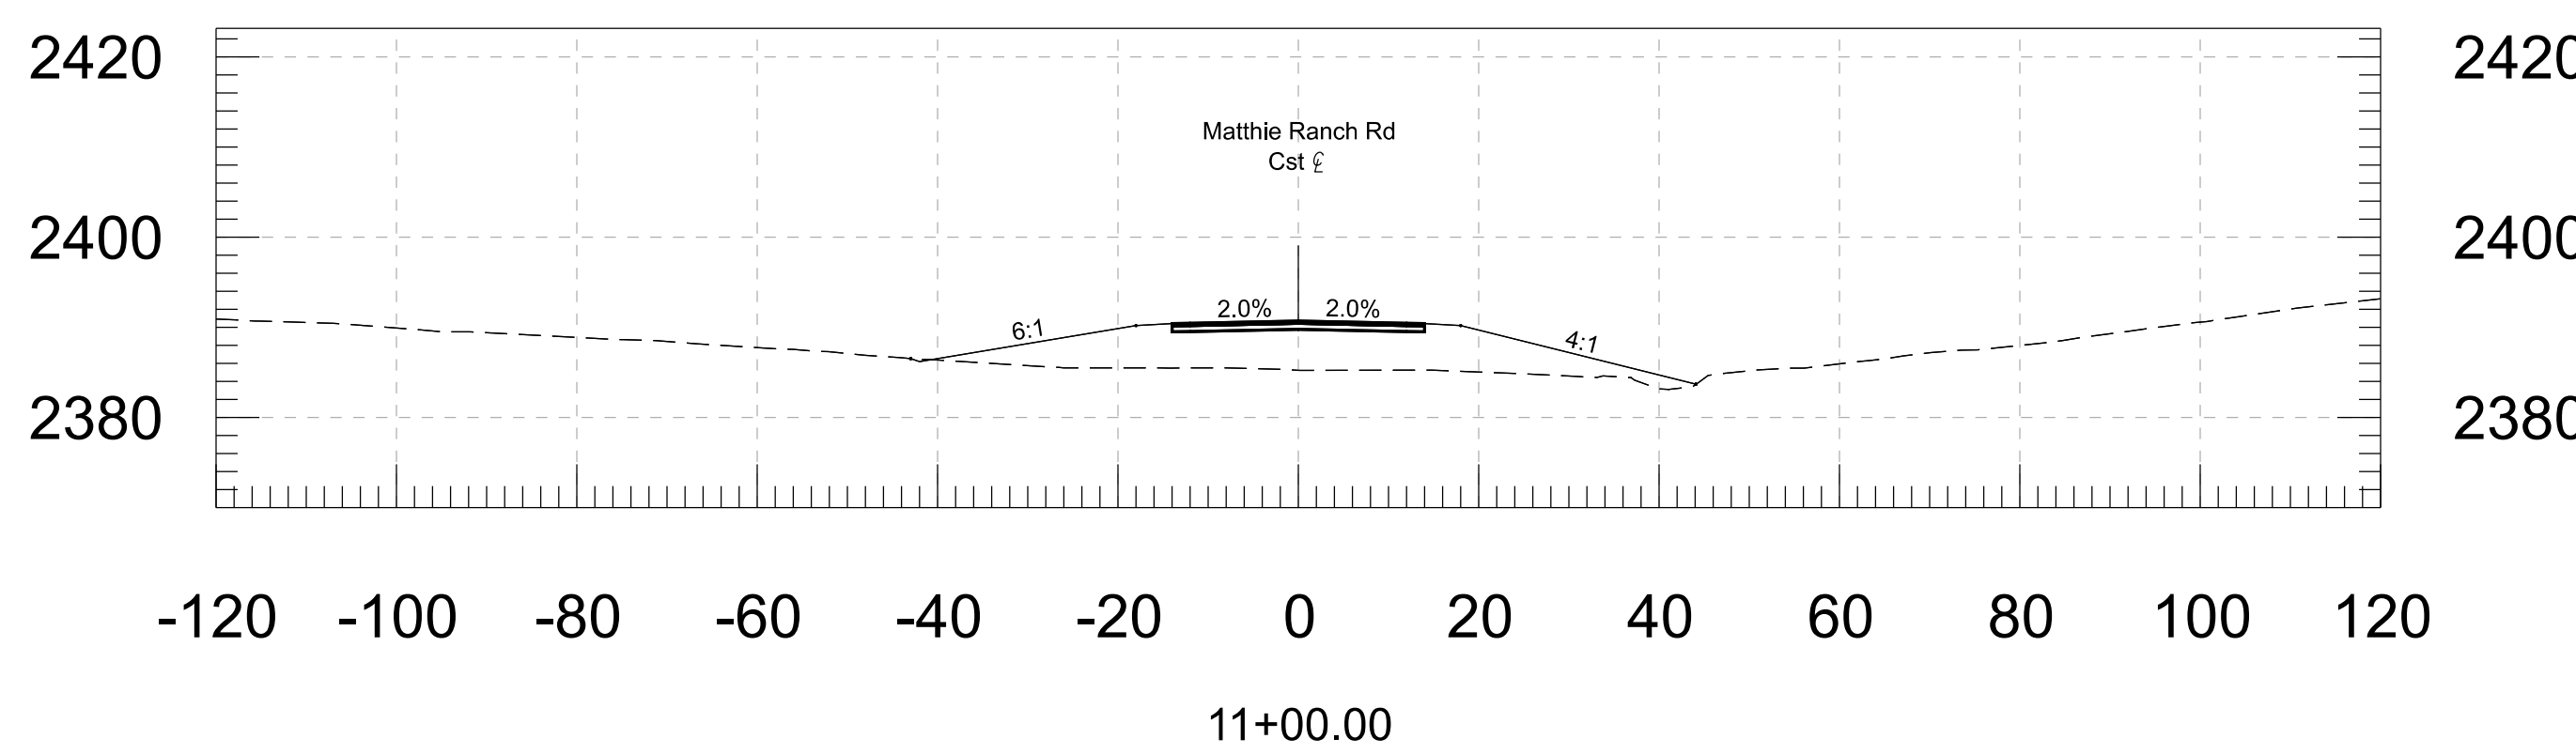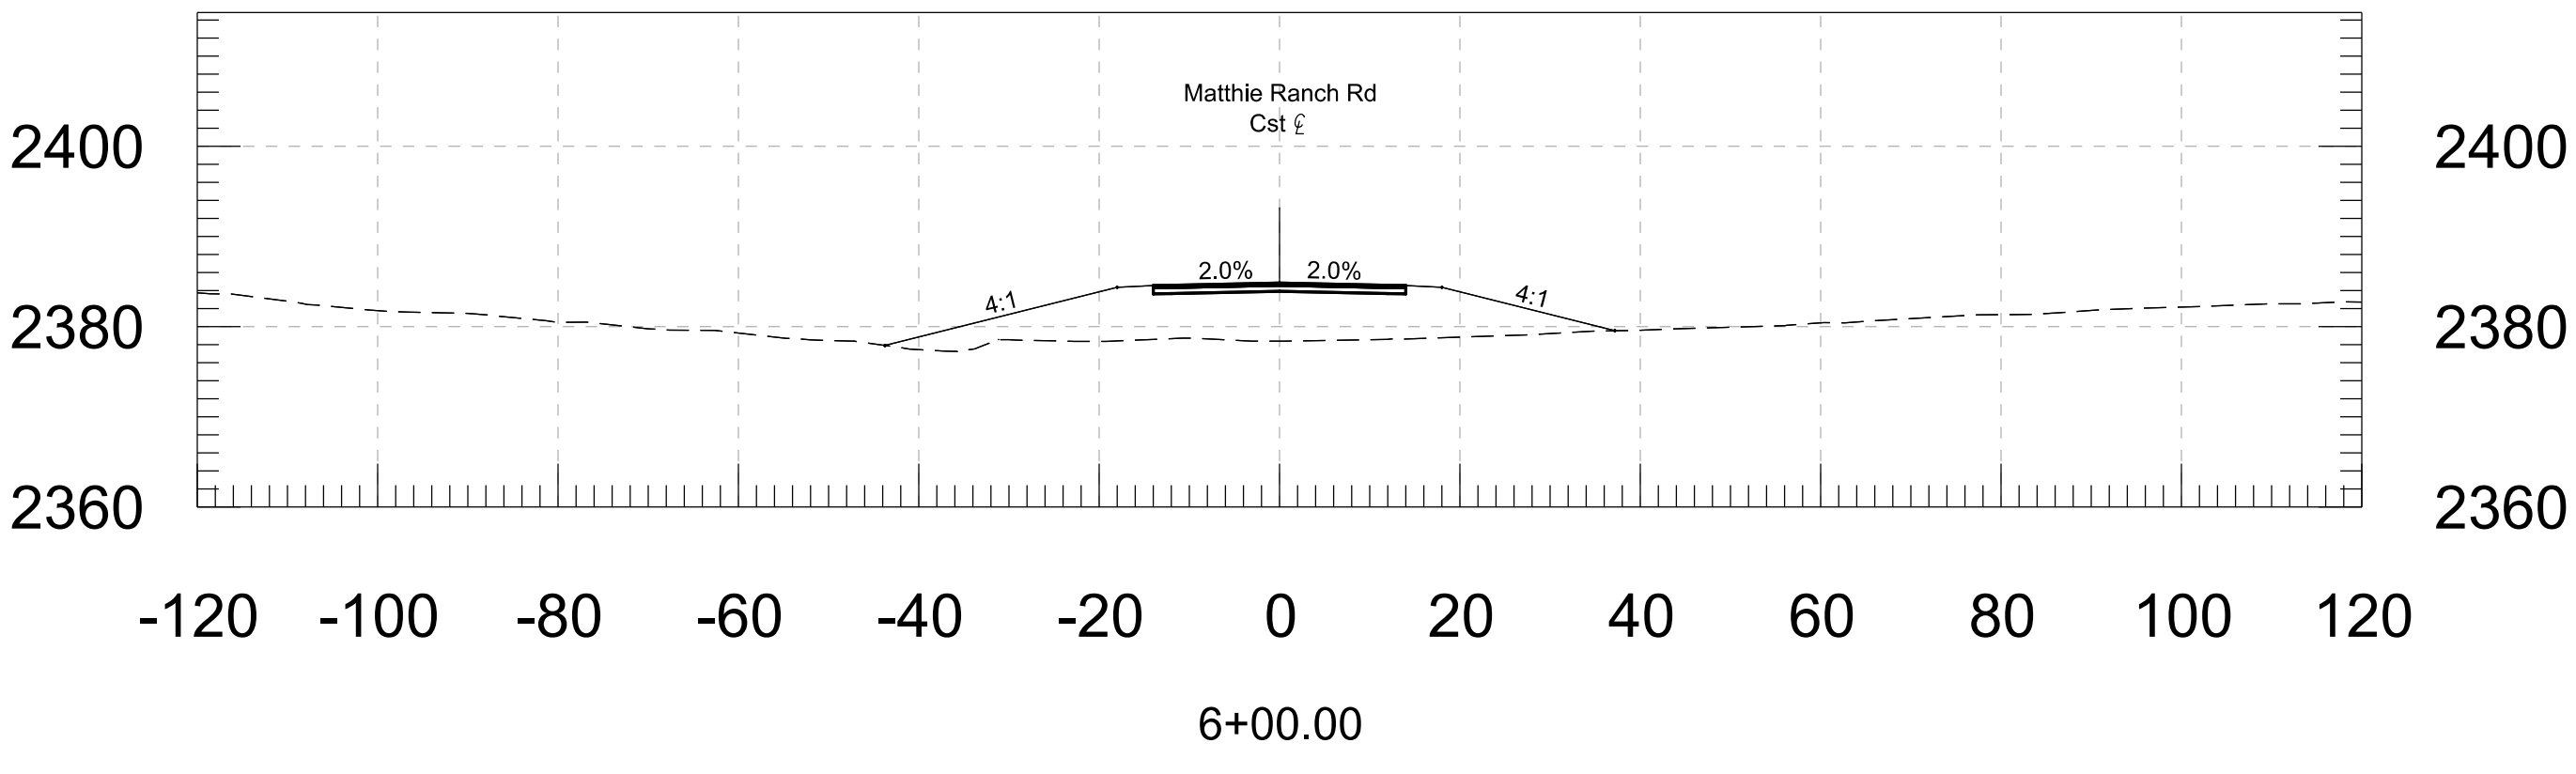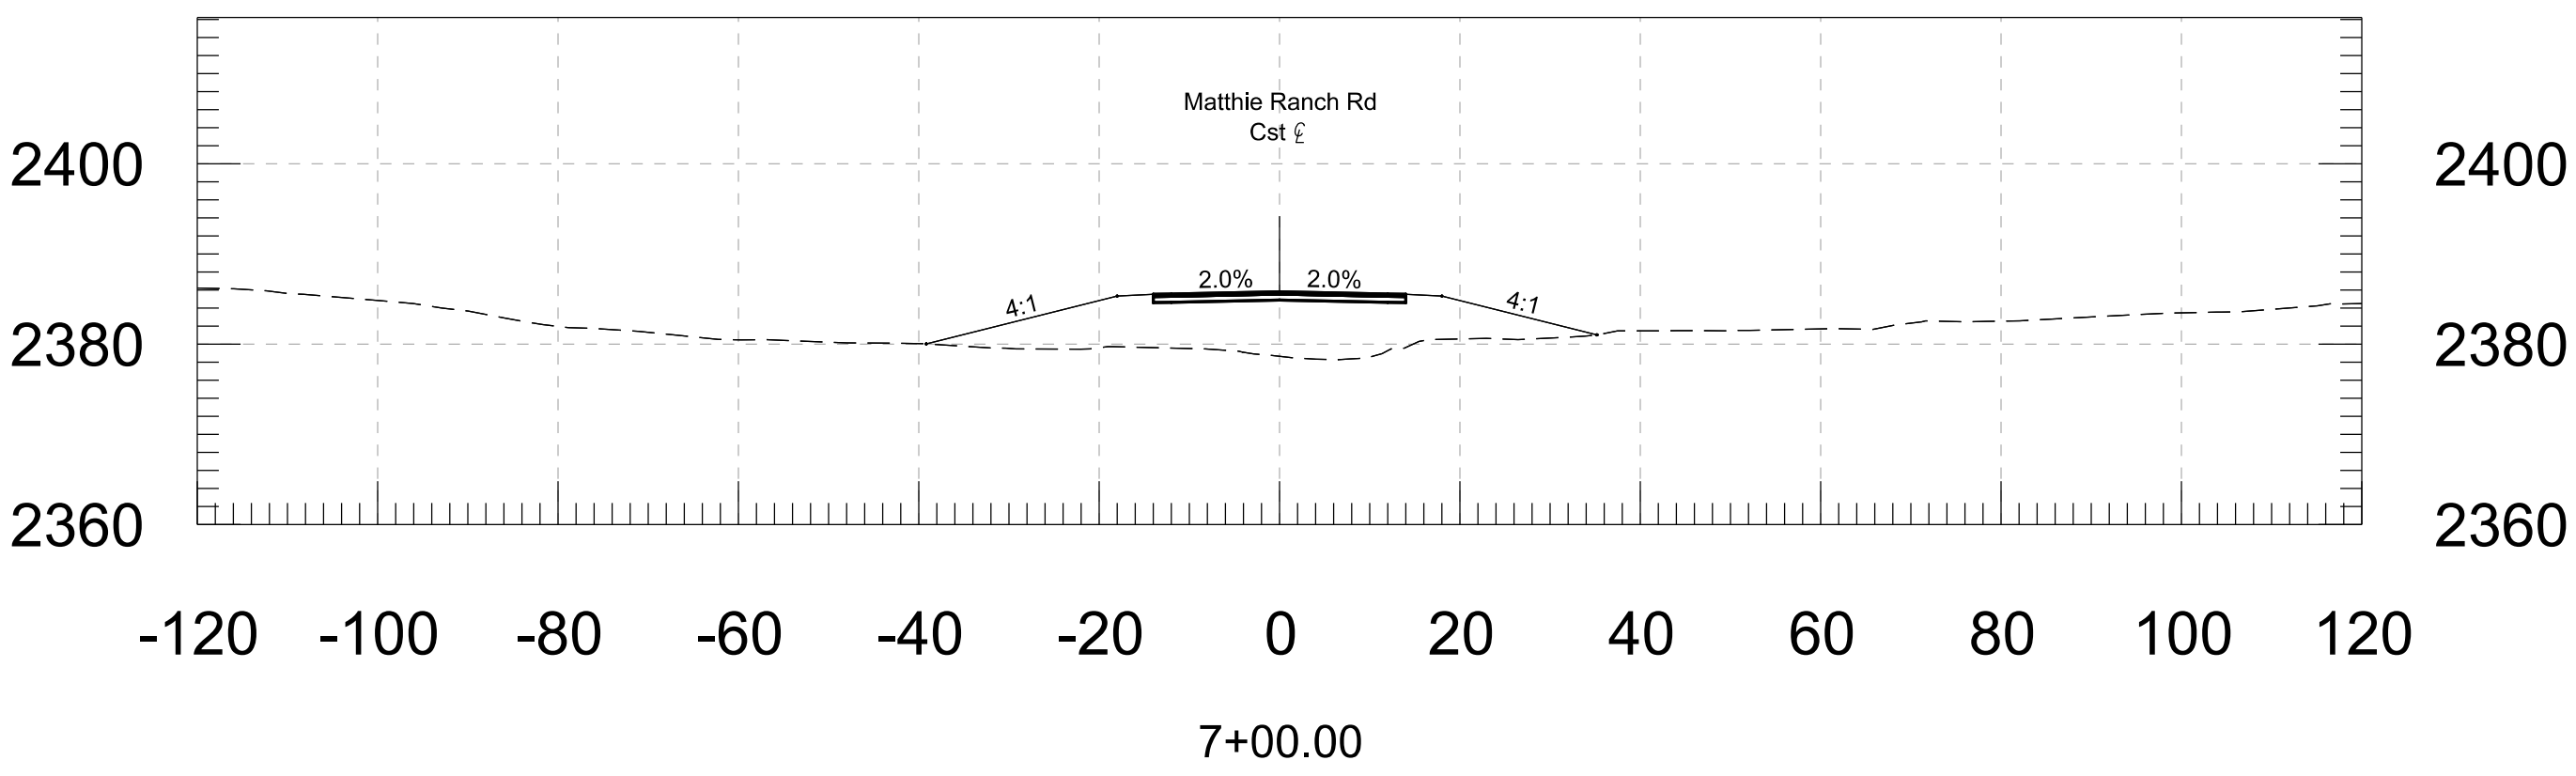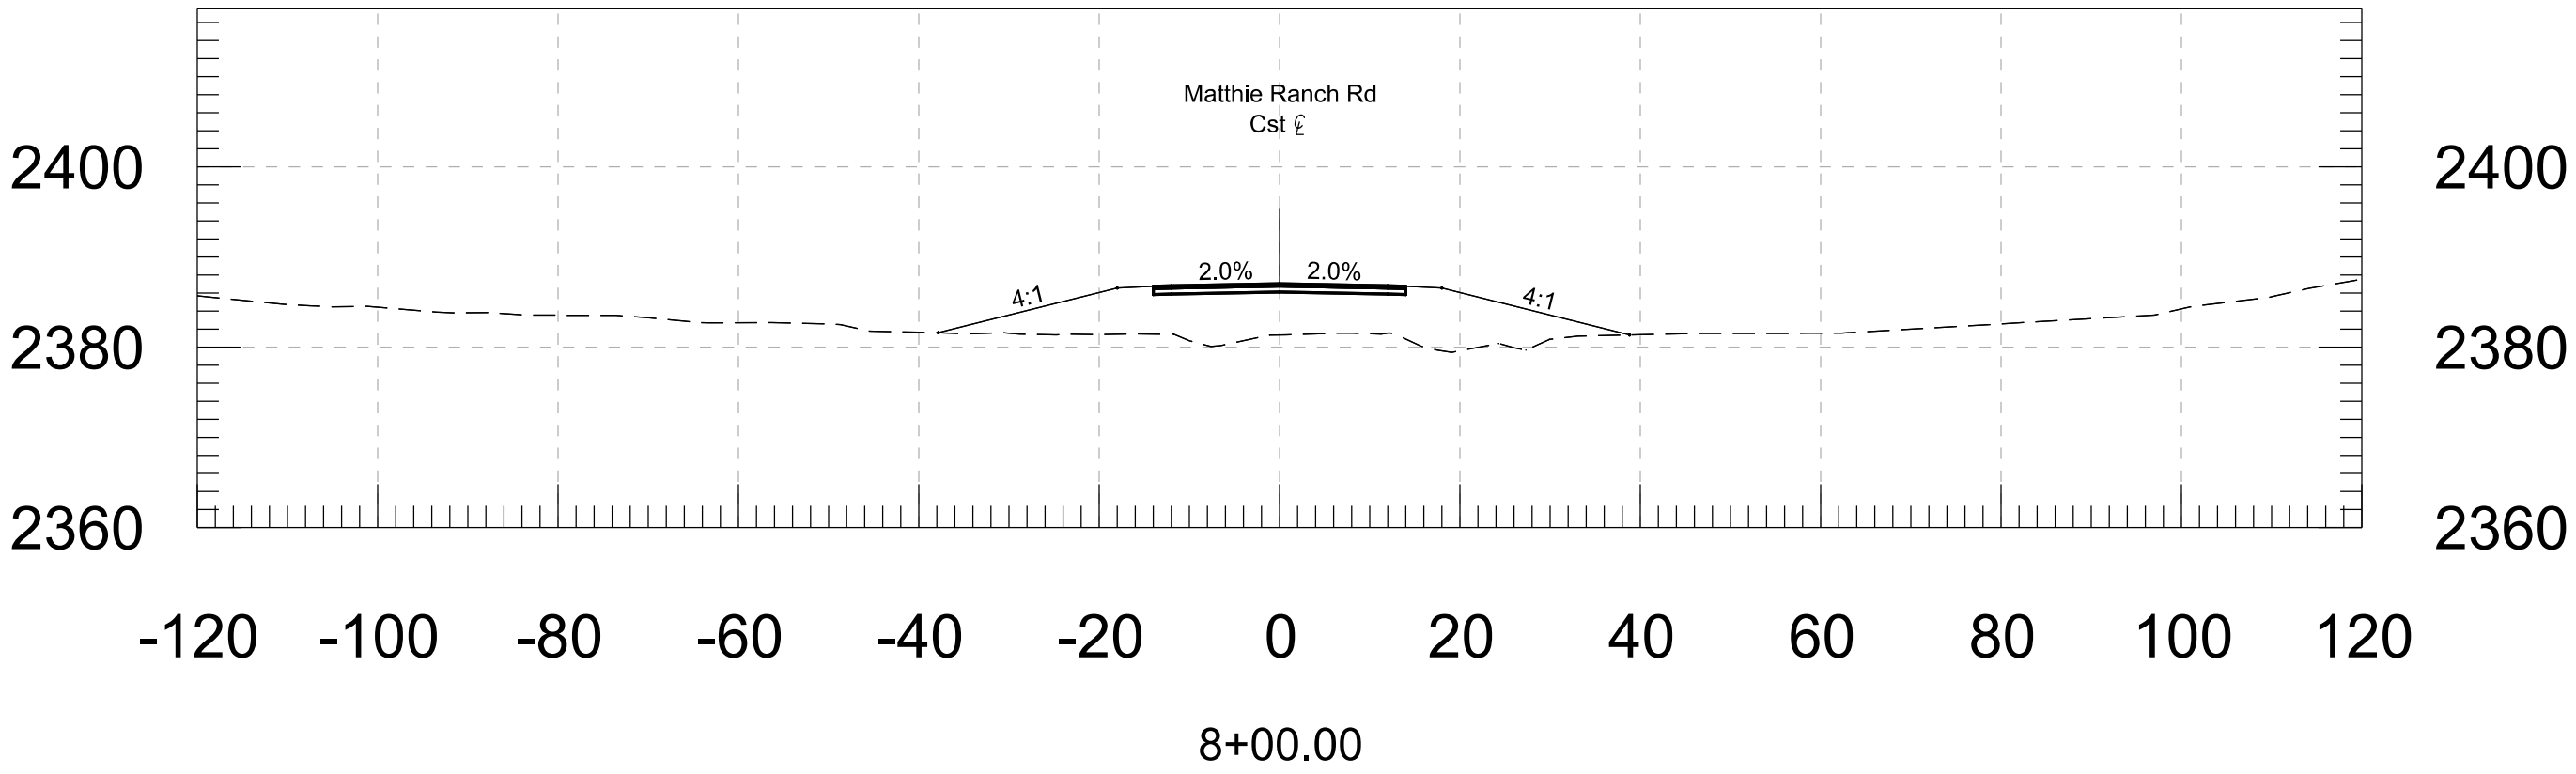

		NAME	DATE	ARIZONA DEPARTMENT OF TRANSPORTATION PROJECT DELIVERY AND OPERATIONS DIVISION ROADWAY DESIGN SERVICES		
DESIGN		ZSZ	06-26			
DRAWN		RM	06-26			
CHECKED		DBK	06-26			
		3133 East Camelback Road, Suite 100 Phoenix, Arizona 85016 Phone: 1602 333-2200		CROSS SECTIONS		
ROUTE		LOCATION		WICKENBURG RANCH WAY TO VISTA ROYALE		DWG NO. 95
US 93						
TRACS NO. F0738 OIC				093-B(230)T		___ OF ___







F.H.W.A. REGION	STATE	PROJECT NO.	SHEET NO.	TOTAL SHEETS	RECORD DRAWING
9	ARIZ.	093-B(230)T	97	116	
093 YV 189					

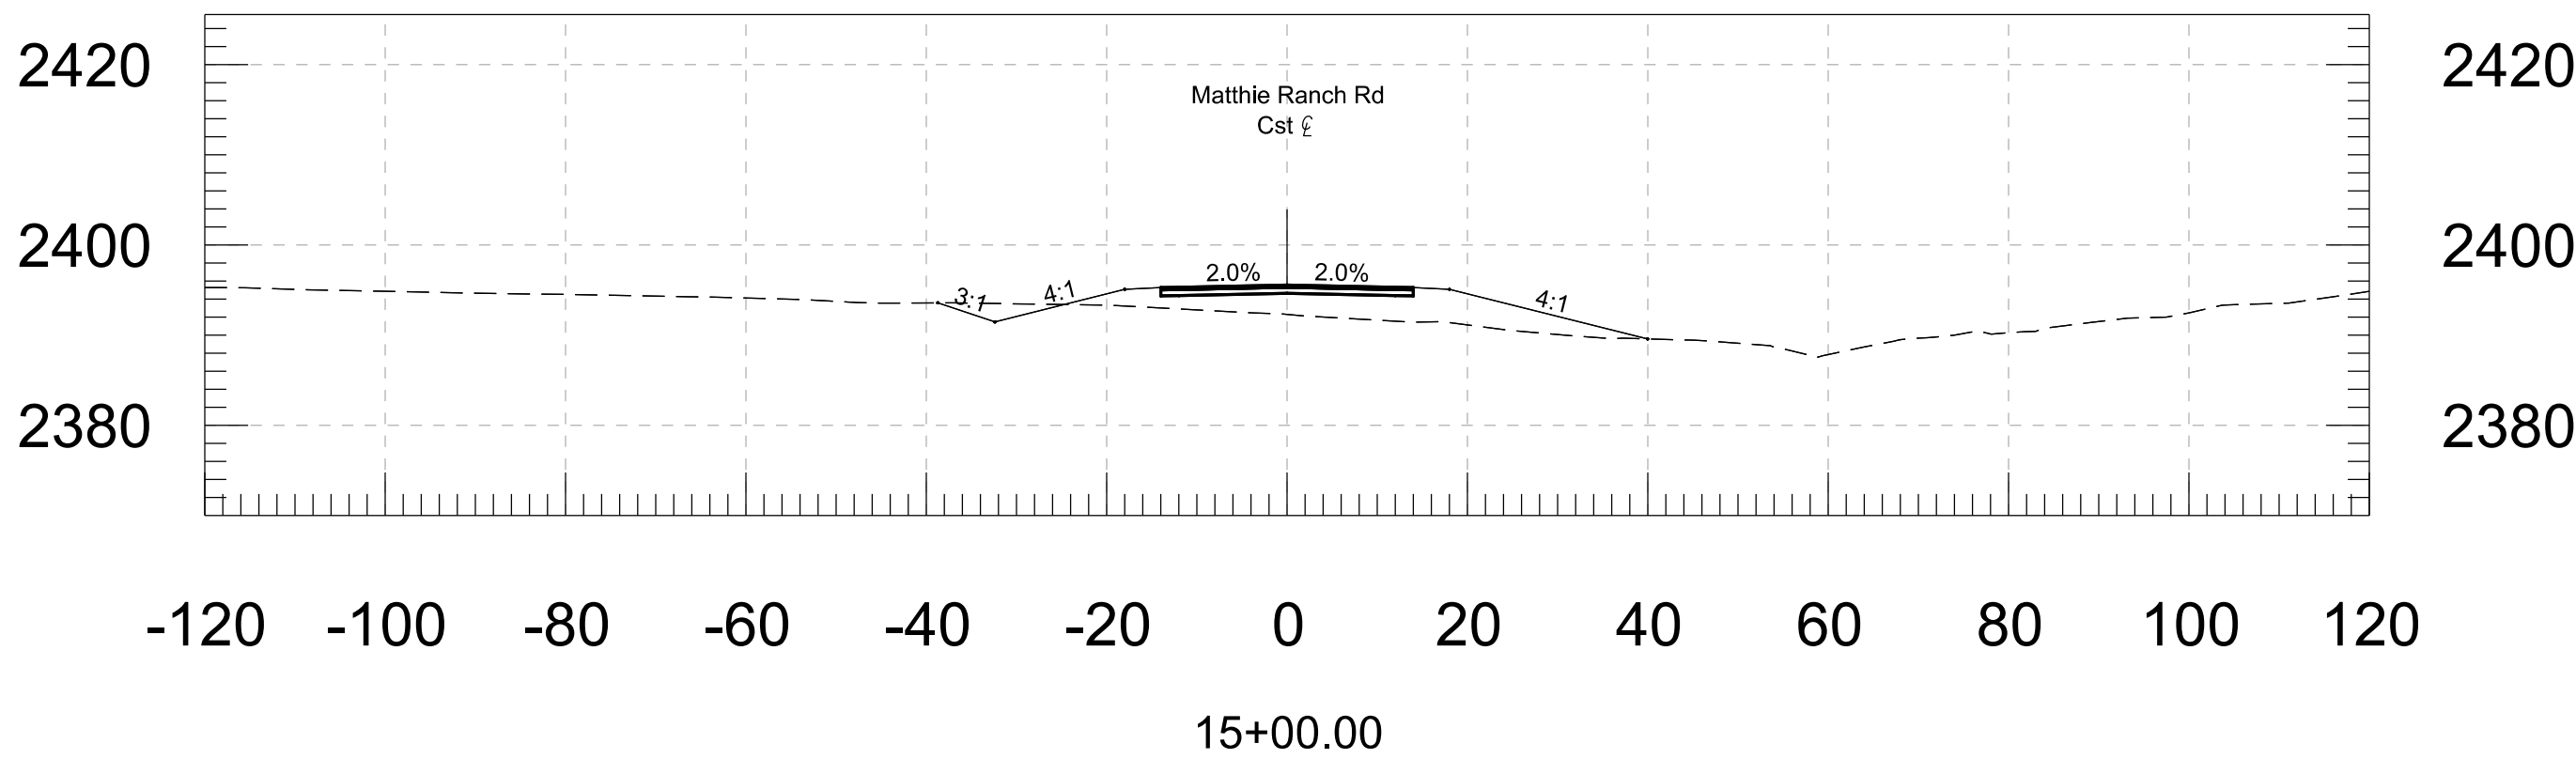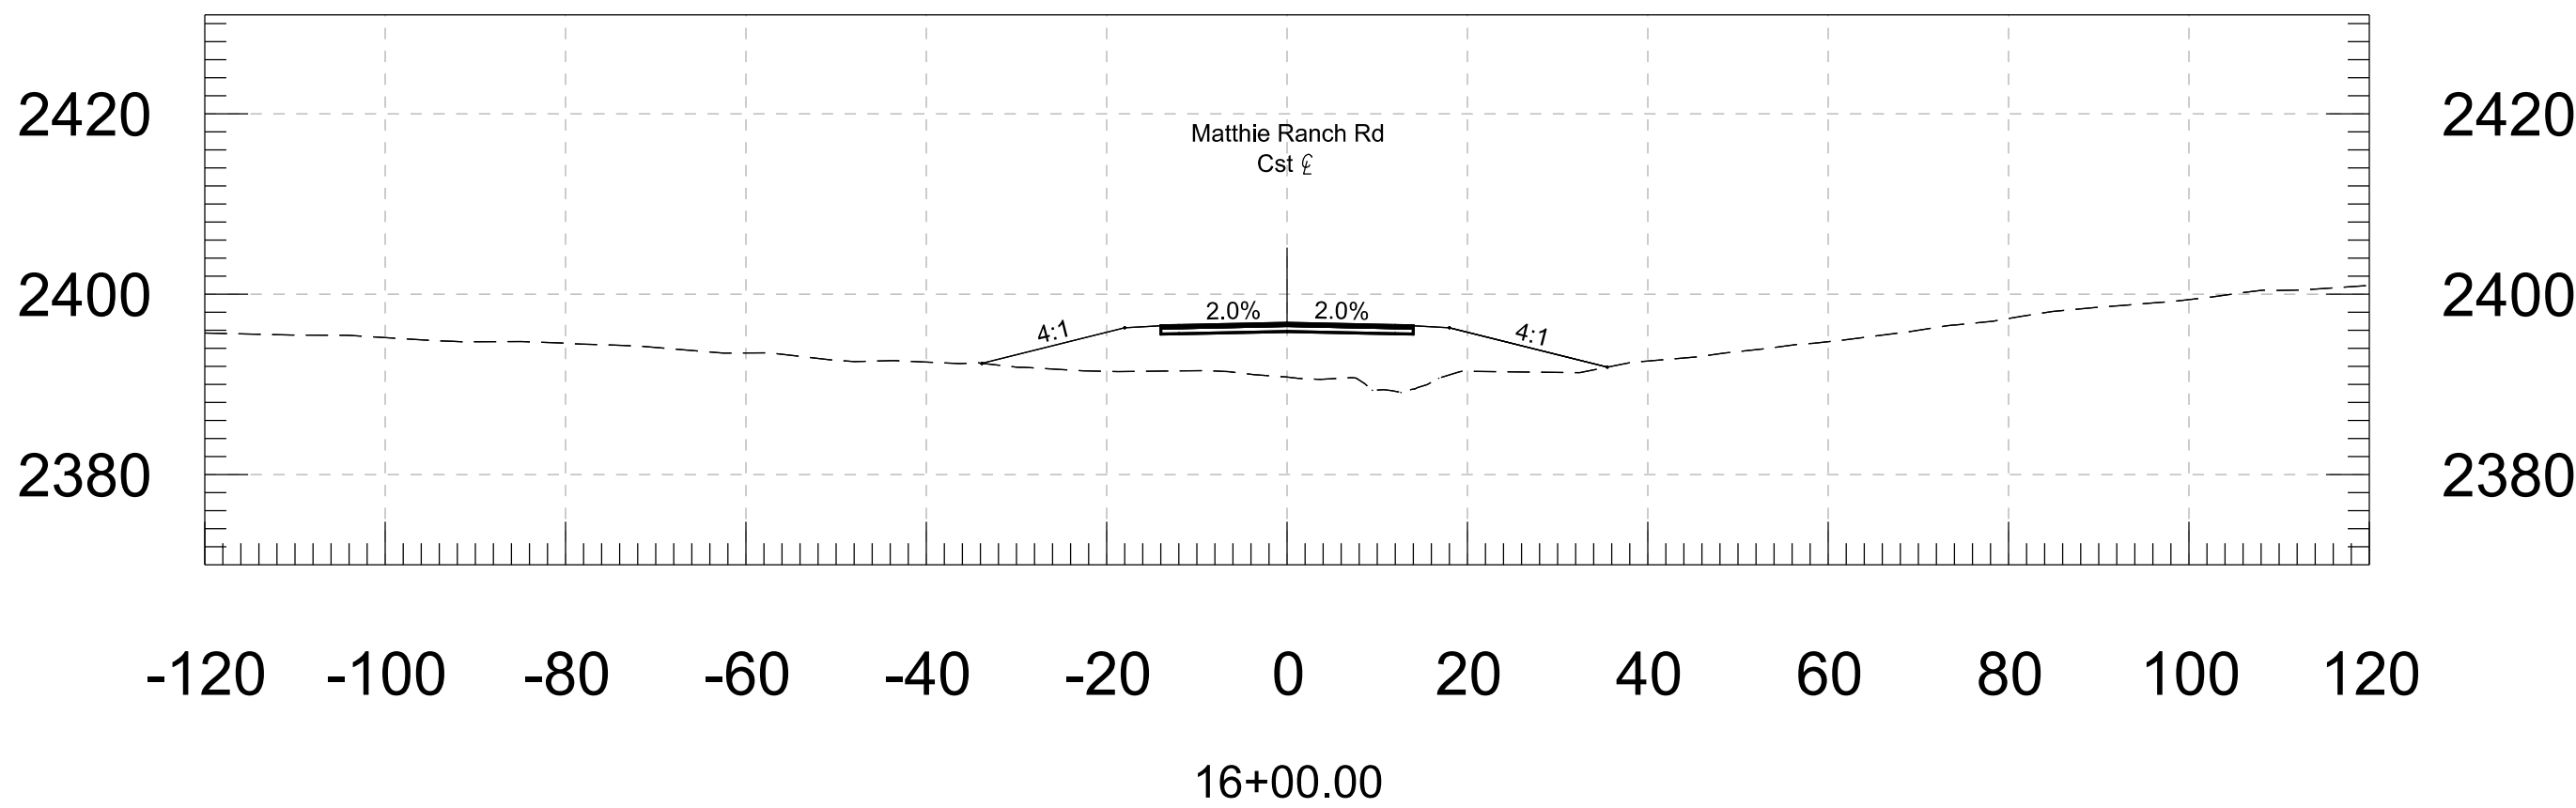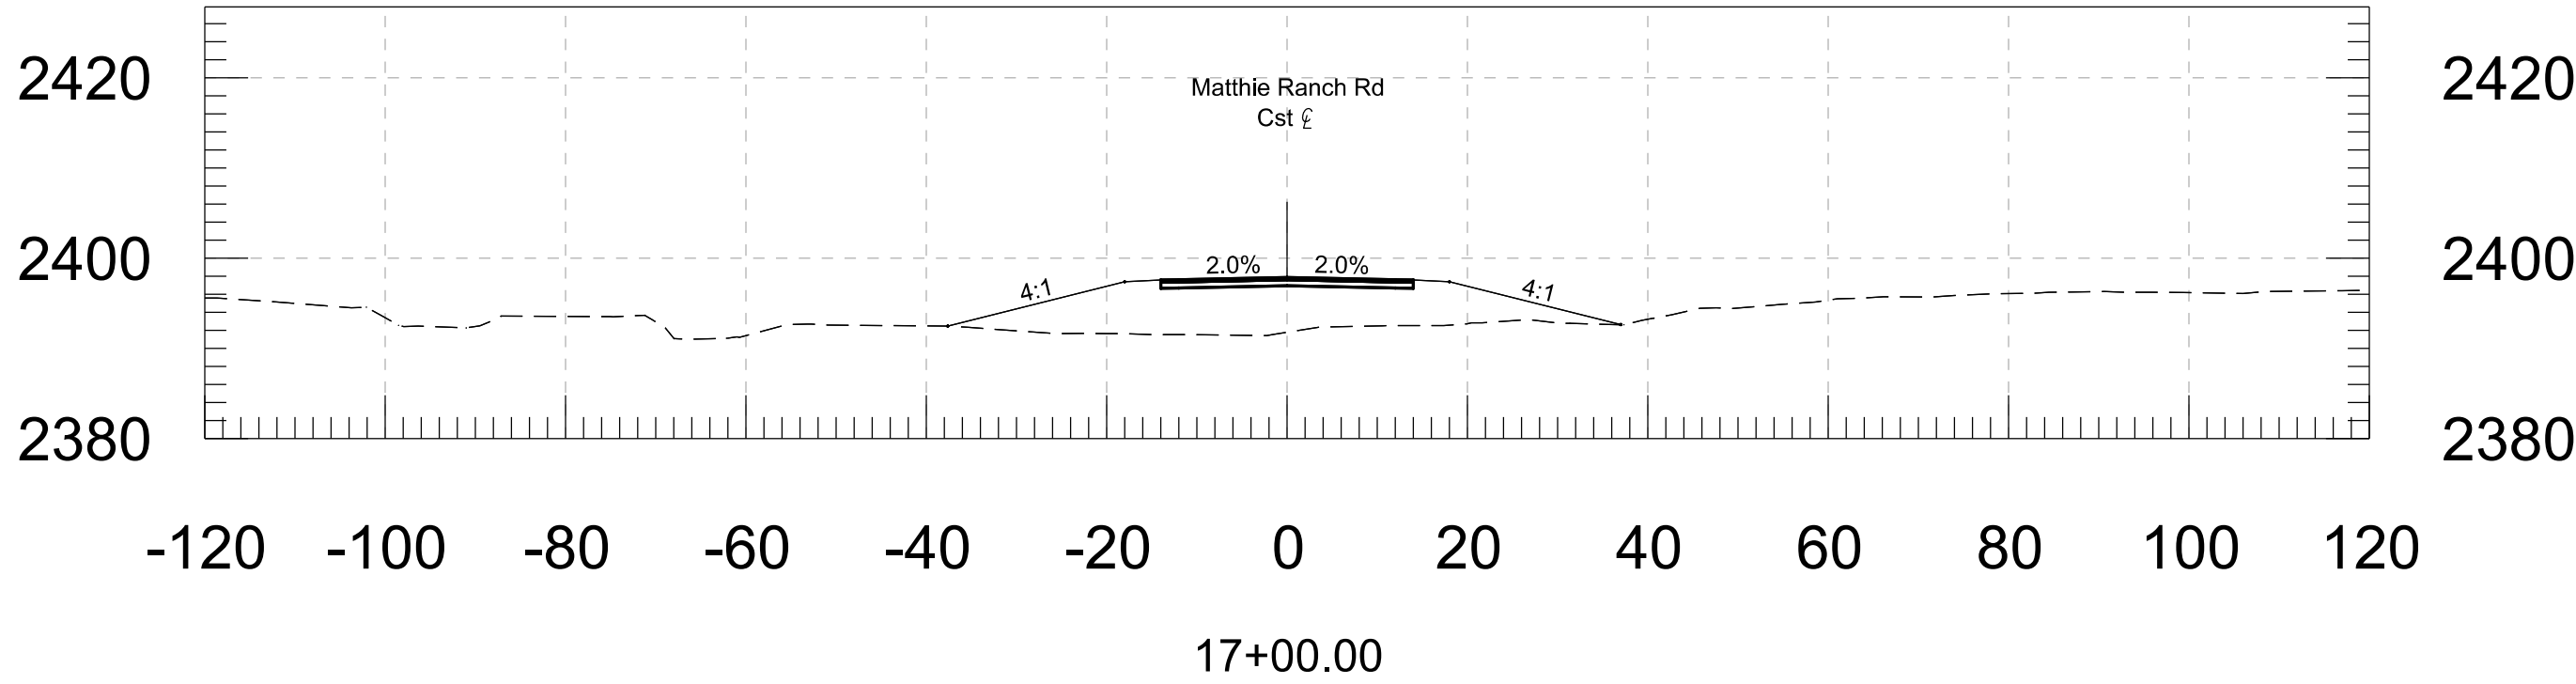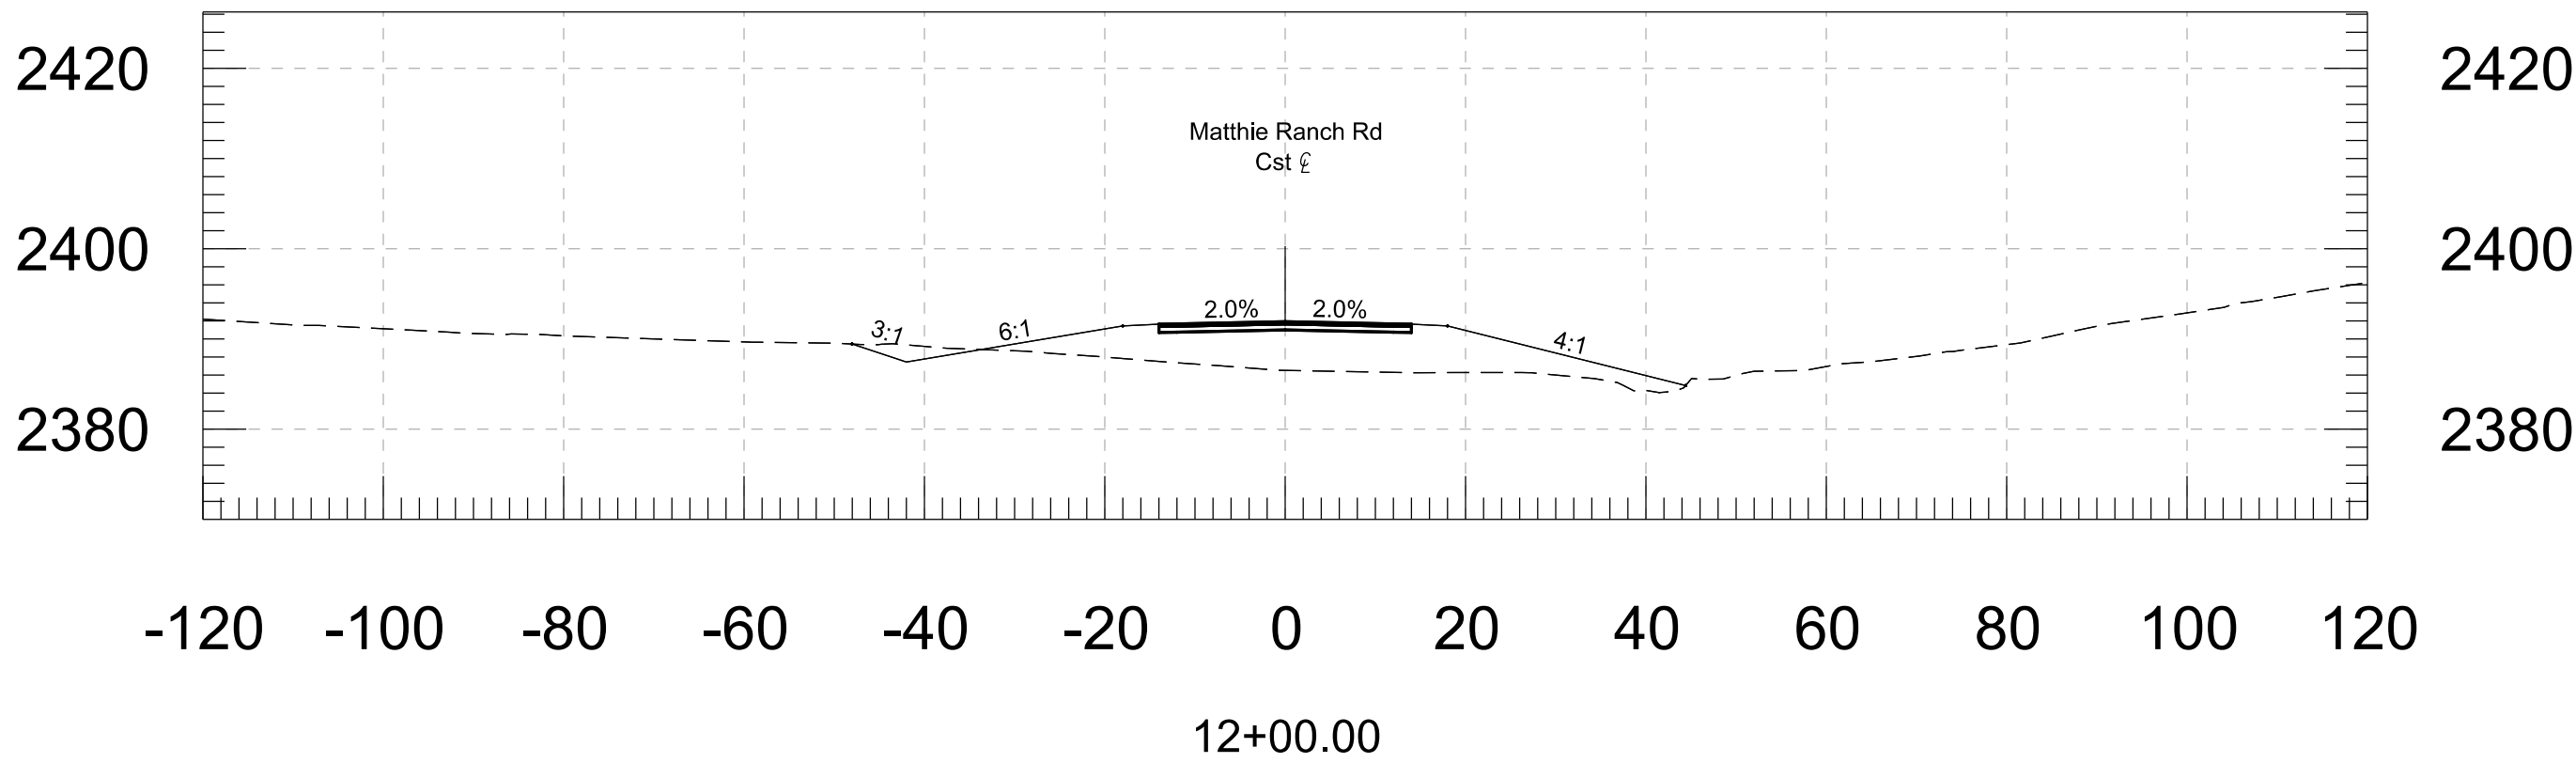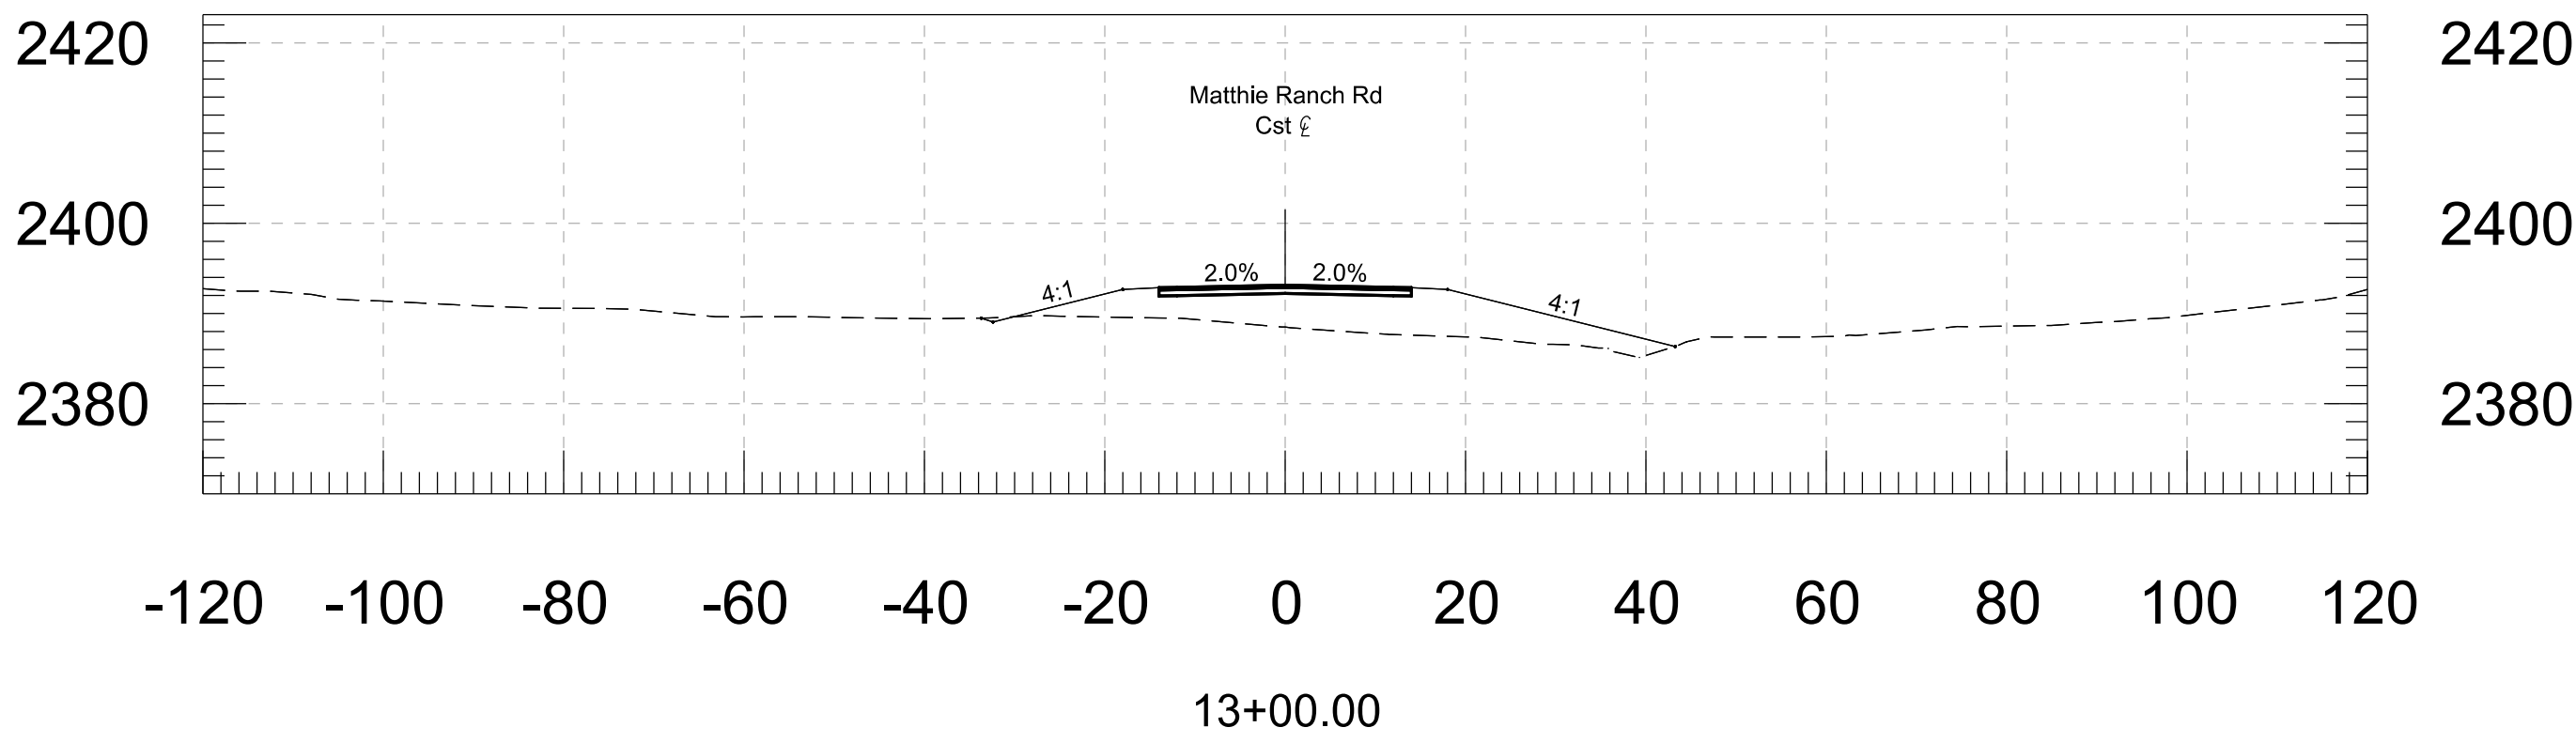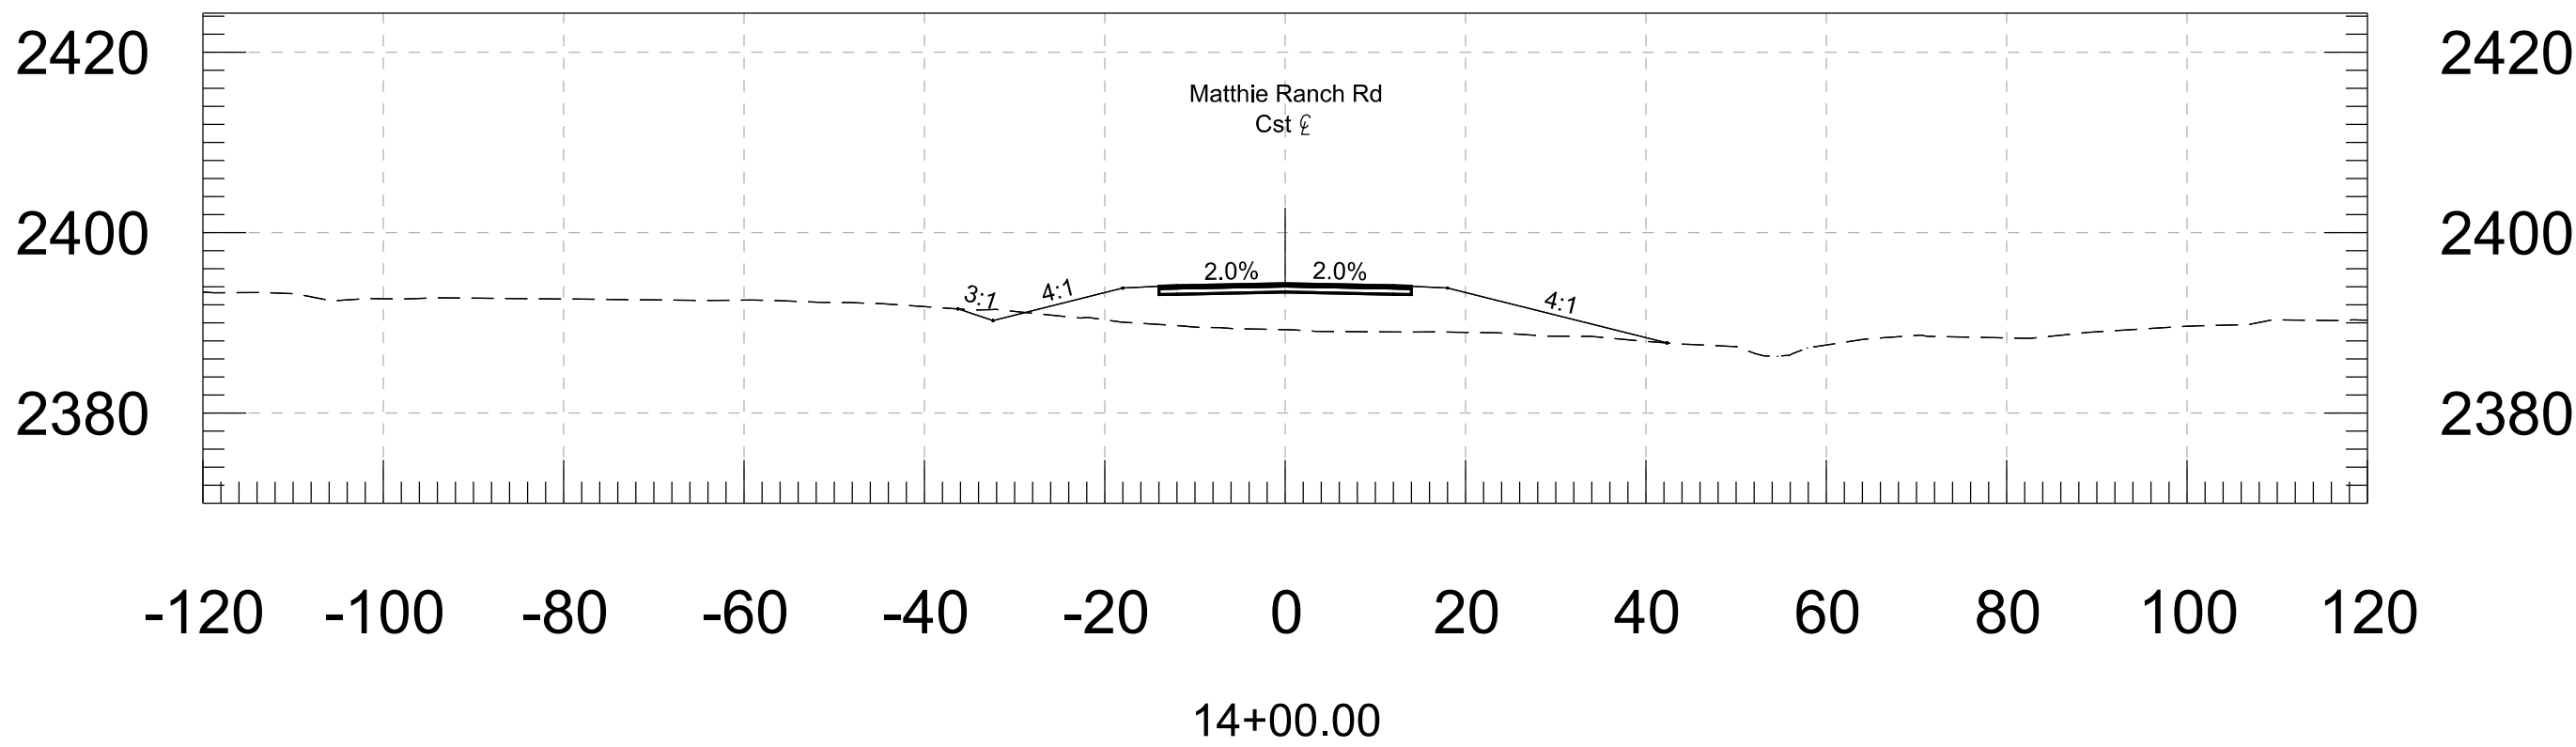

		NAME	DATE	ARIZONA DEPARTMENT OF TRANSPORTATION PROJECT DELIVERY AND OPERATIONS DIVISION ROADWAY DESIGN SERVICES		CROSS SECTIONS	
DESIGN	ZSZ	06-26					
DRAWN	RM	06-26					
CHECKED	DBK	06-26					
 Stanley Consultants inc.		3133 East Camelback Road, Suite 100 Phoenix, Arizona 85016 Phone: 1602/ 333-2200					
ROUTE		LOCATION					
US 93		WICKENBURG RANCH WAY TO VISTA ROYALE				DWG NO. 96	
TRACS NO. F0738 OIC			093-B(230)T			___ OF ___	







F.H.W.A. REGION	STATE	PROJECT NO.	SHEET NO.	TOTAL SHEETS	RECORD DRAWING
9	ARIZ.	093-B(230)T	98	116	

093 YV 189

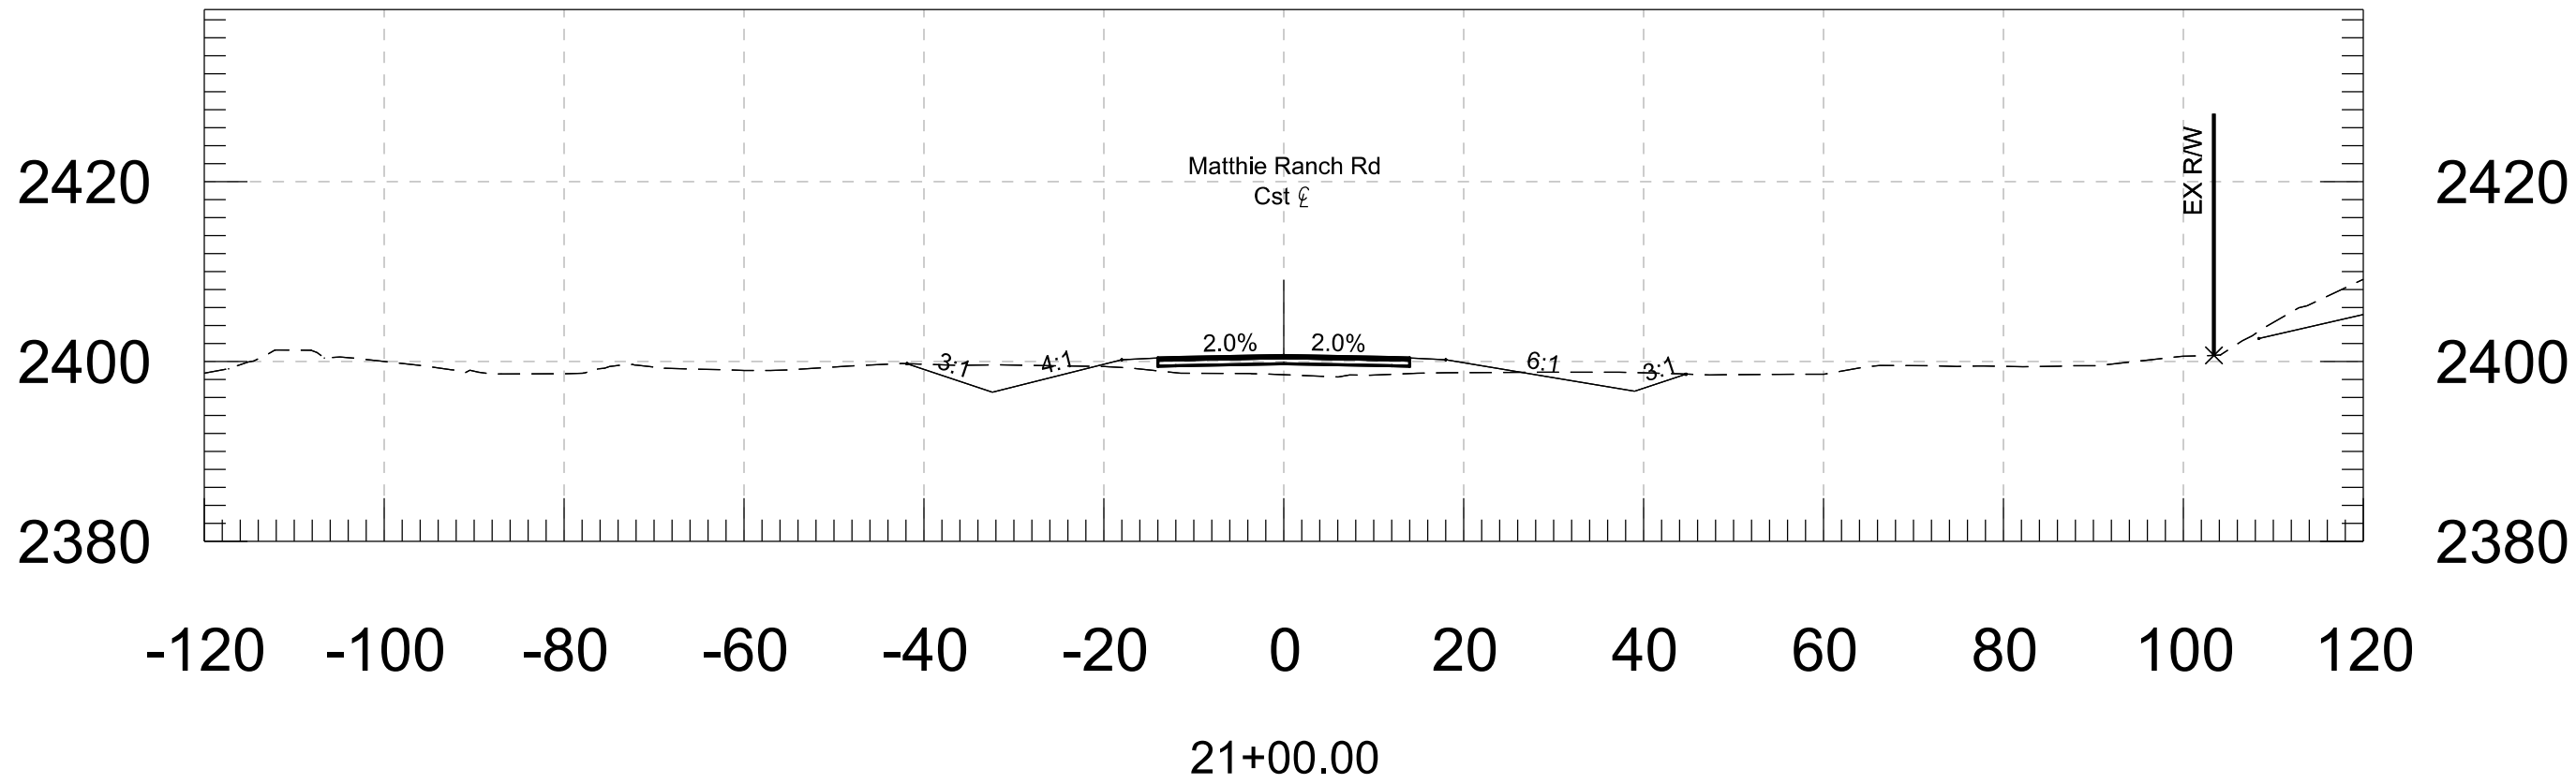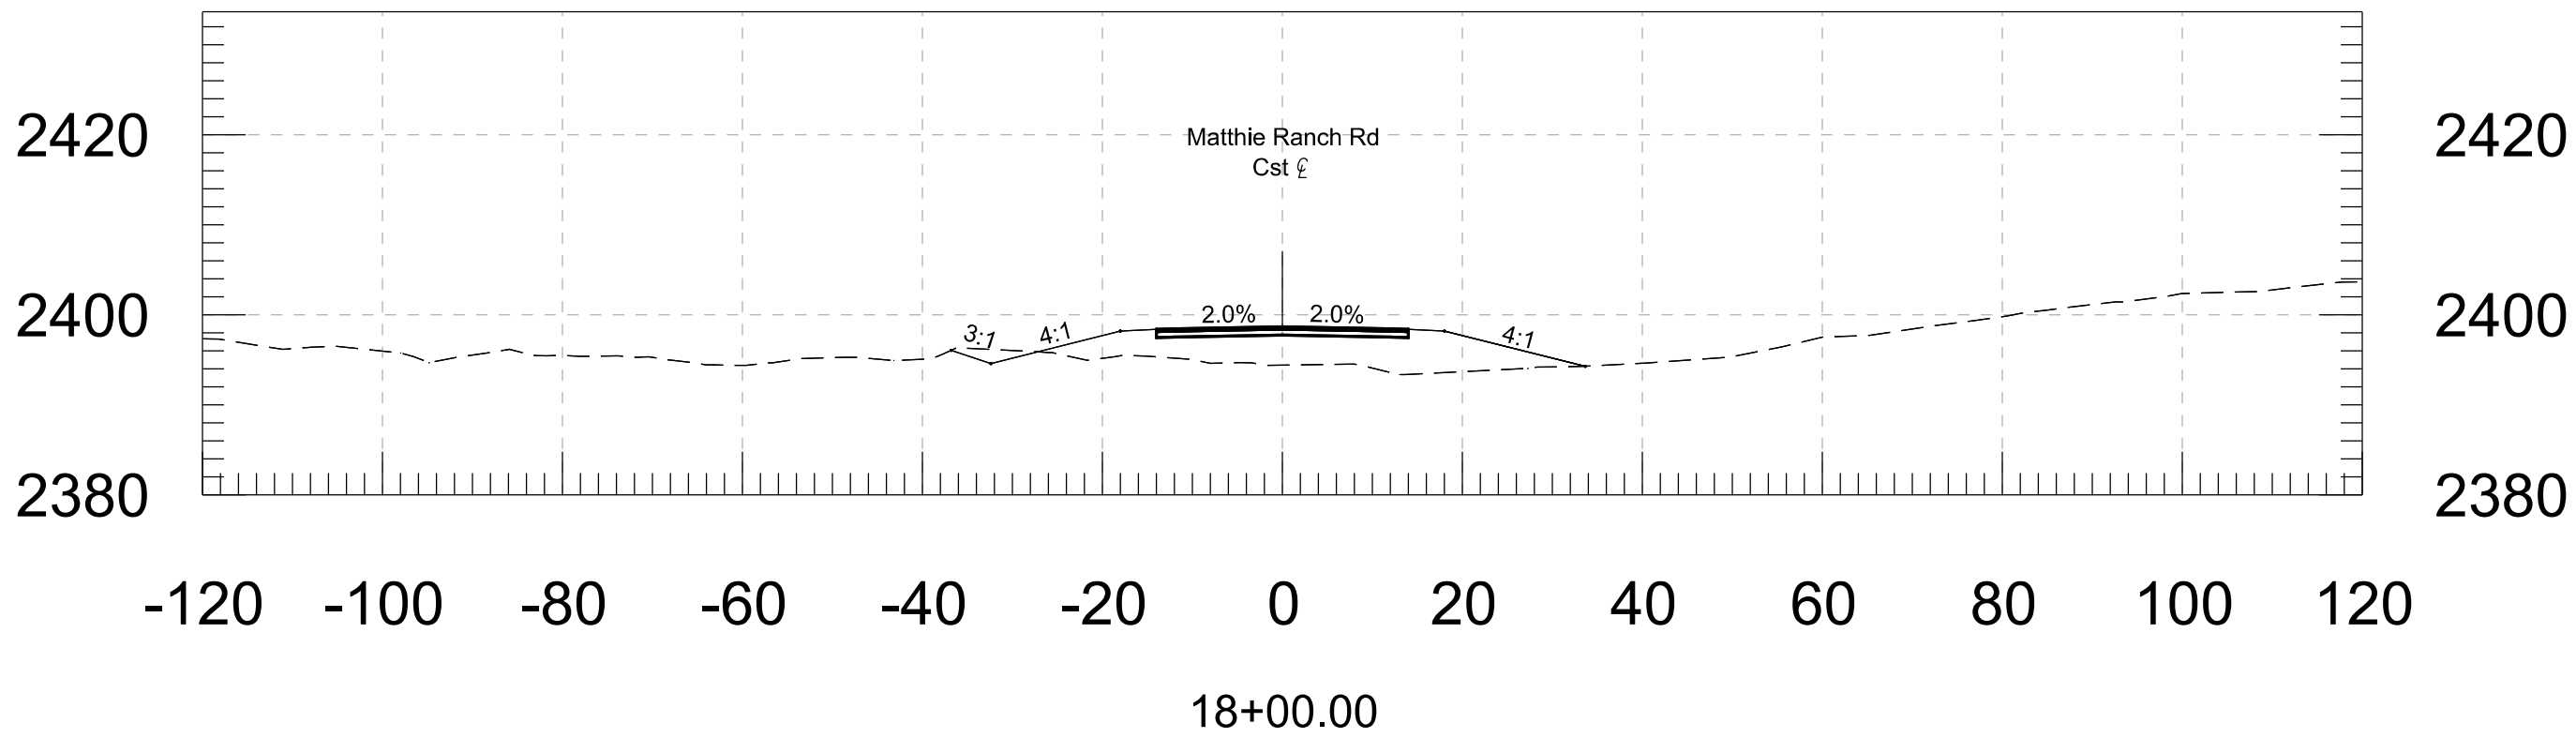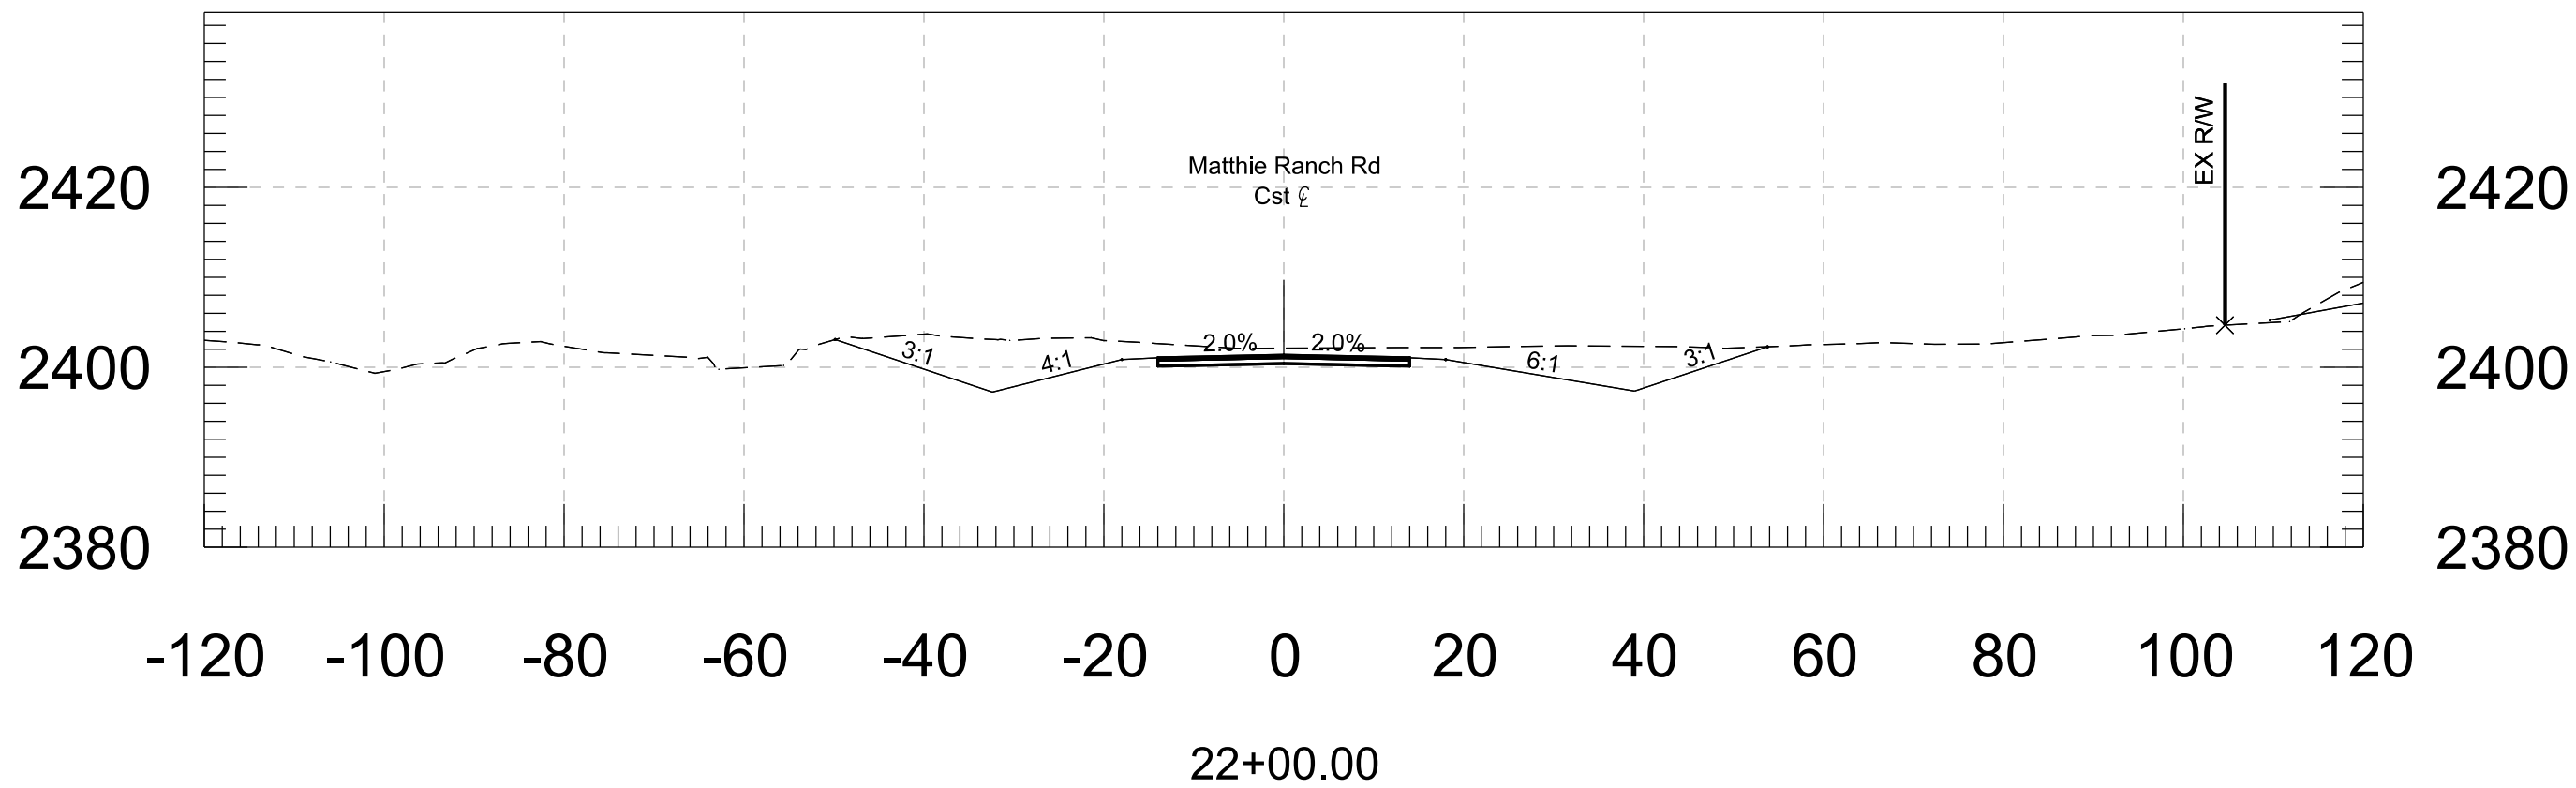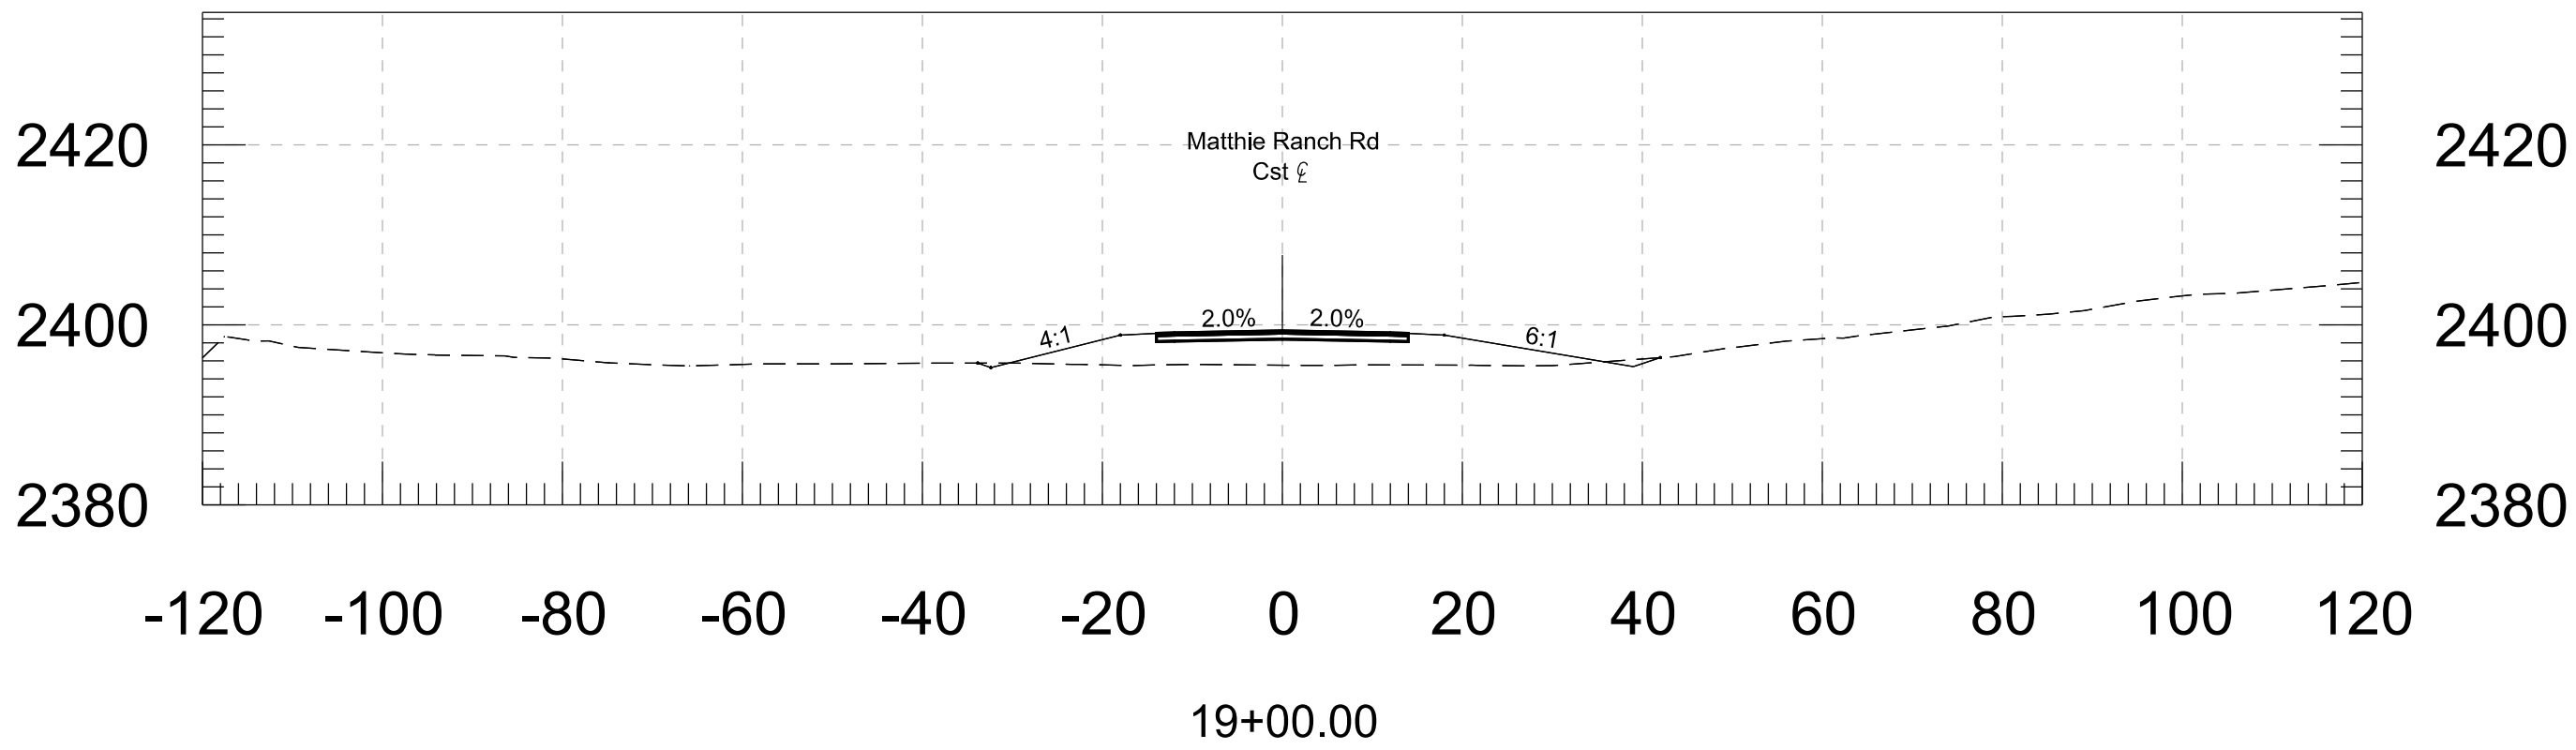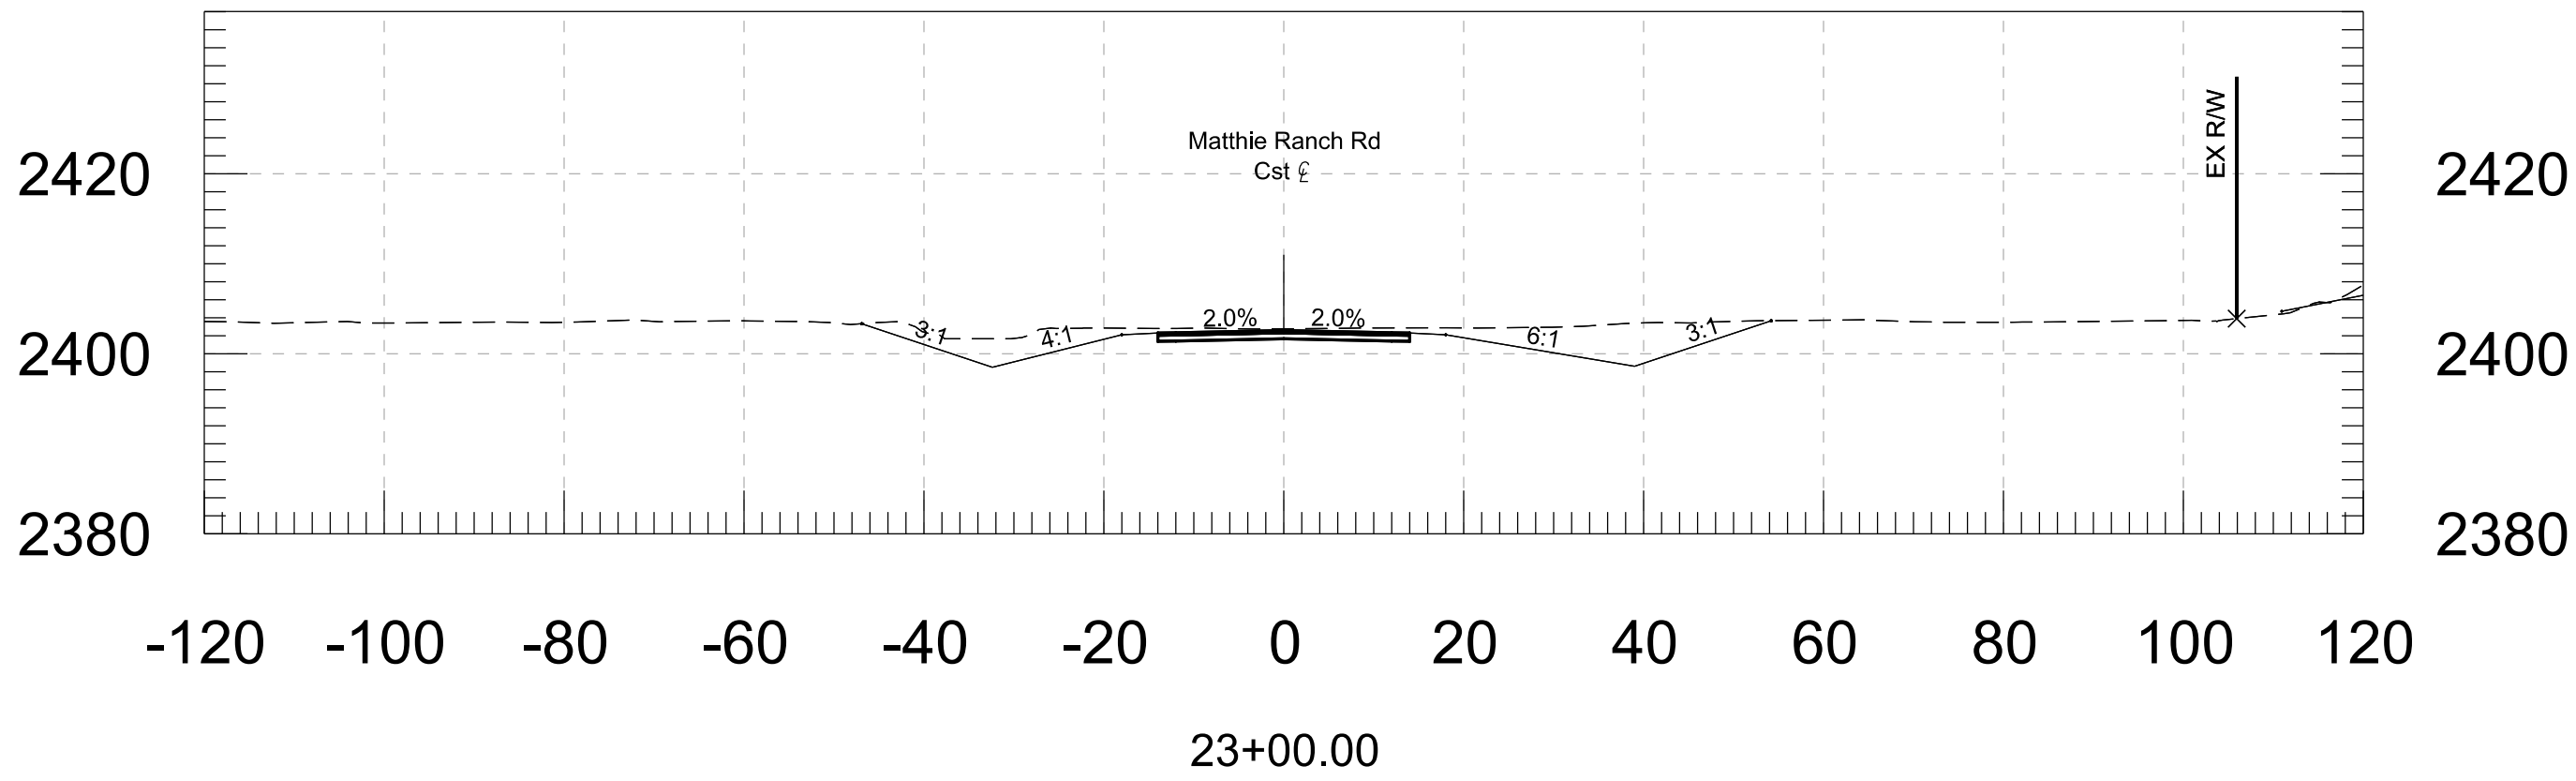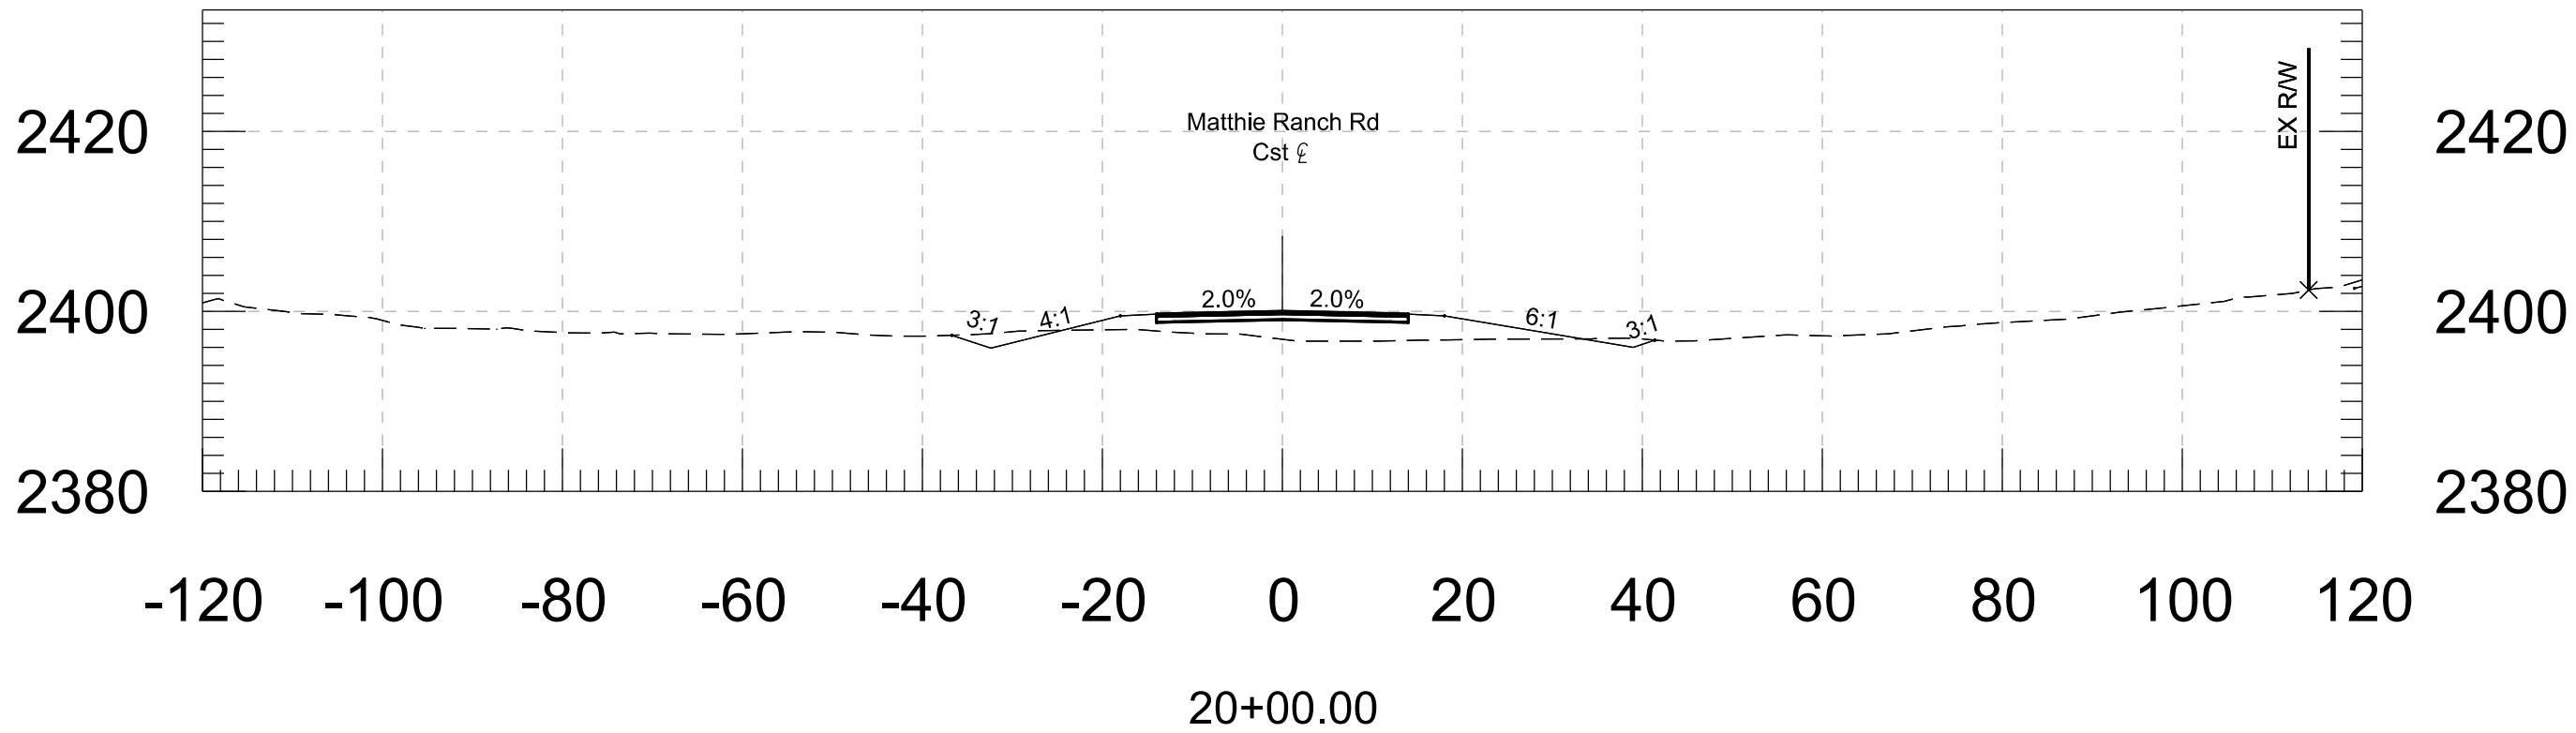







		NAME	DATE	ARIZONA DEPARTMENT OF TRANSPORTATION PROJECT DELIVERY AND OPERATIONS DIVISION ROADWAY DESIGN SERVICES		CROSS SECTIONS	DWG NO. 97
DESIGN	ZSZ	06-26					
DRAWN	RM	06-26					
CHECKED	DBK	06-26					
 Stanley Consultants inc. 3133 East Camelback Road, Suite 100 Phoenix, Arizona 85016 Phone: (602) 333-2200							
ROUTE		LOCATION					
US 93		WICKENBURG RANCH WAY TO VISTA ROYALE					
TRACS NO. F0738 OIC				093-B(230)T		___ OF ___	

F.H.W.A. REGION	STATE	PROJECT NO.	SHEET NO.	TOTAL SHEETS	RECORD DRAWING
9	ARIZ.	093-B(230)T	99	116	
093 YV 189					

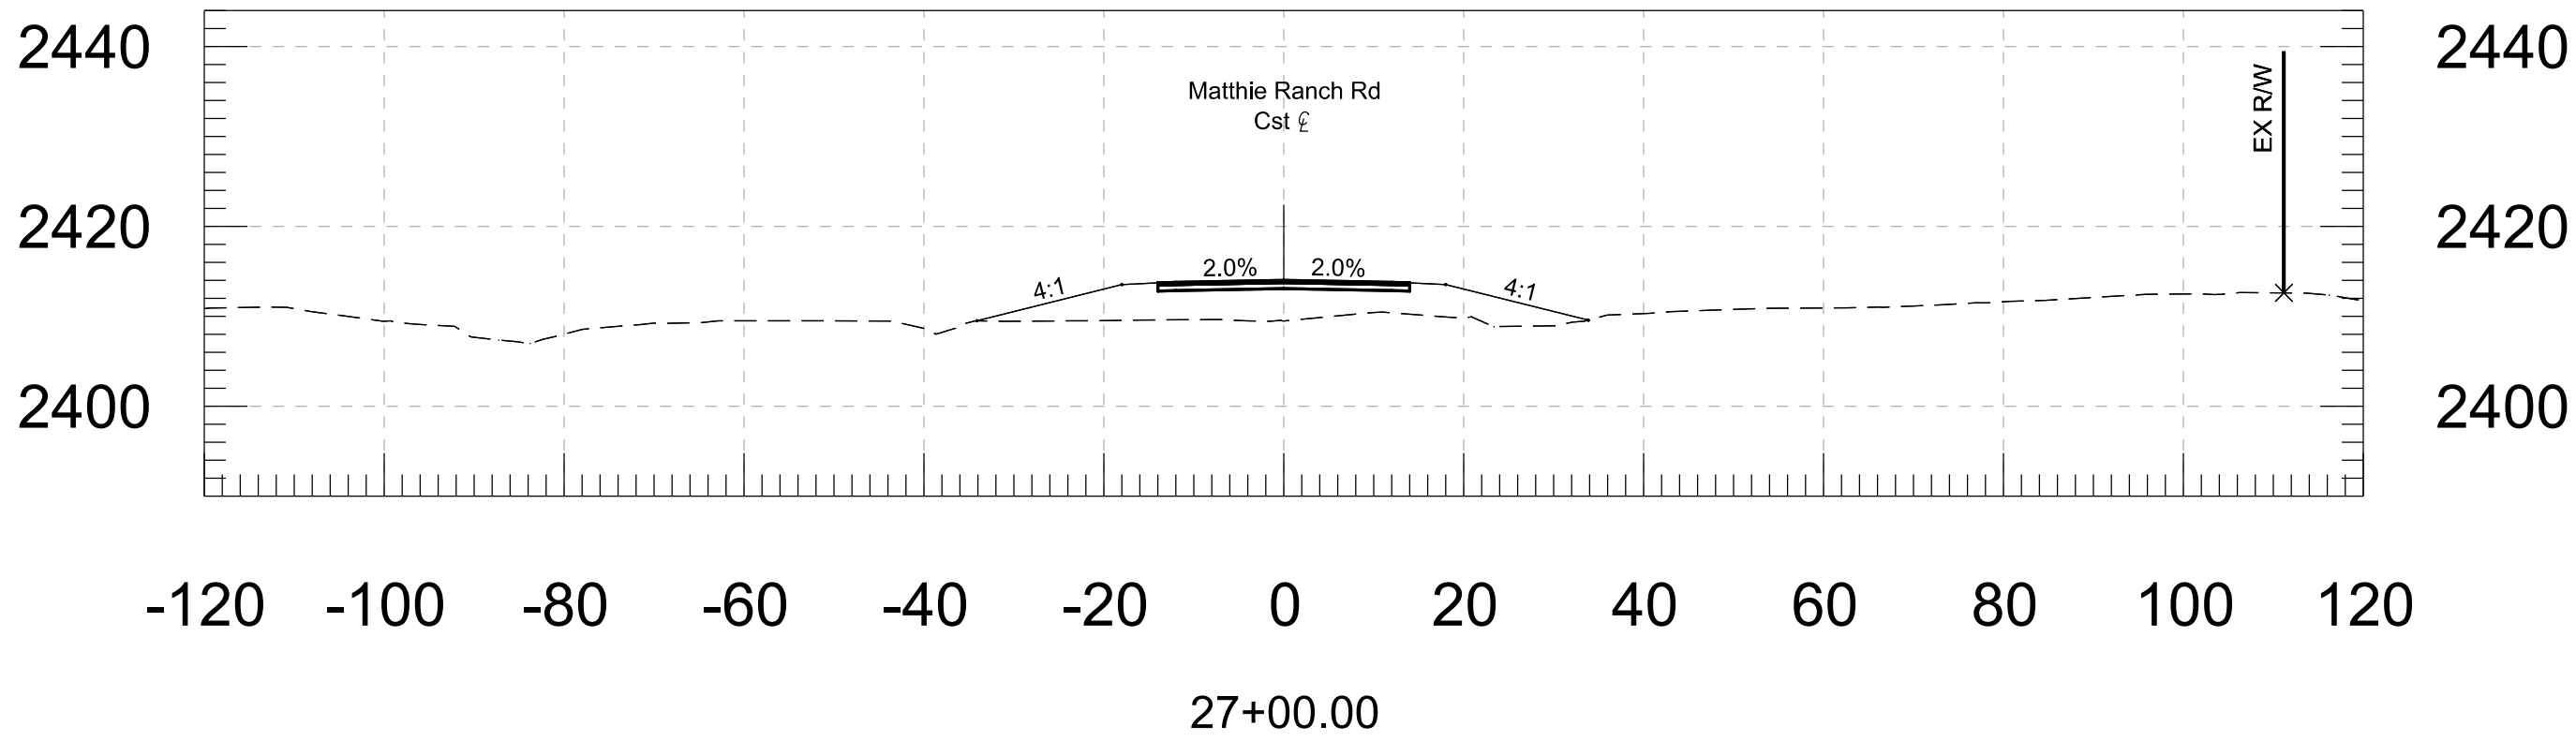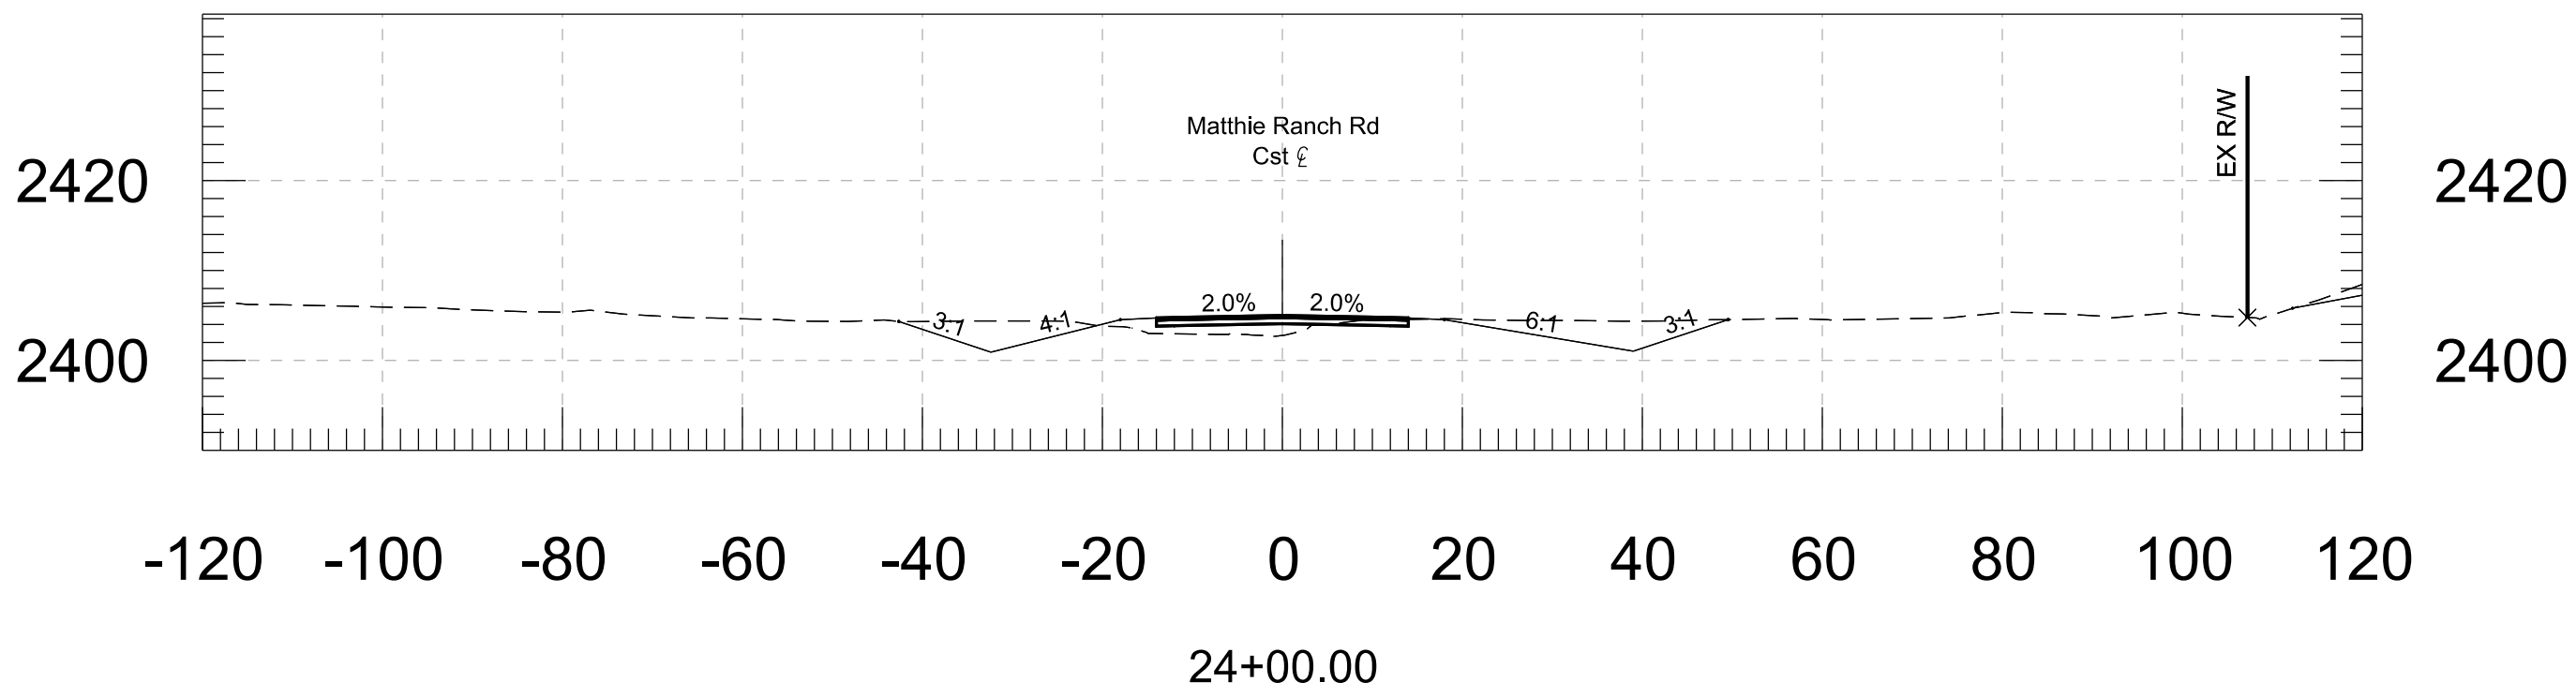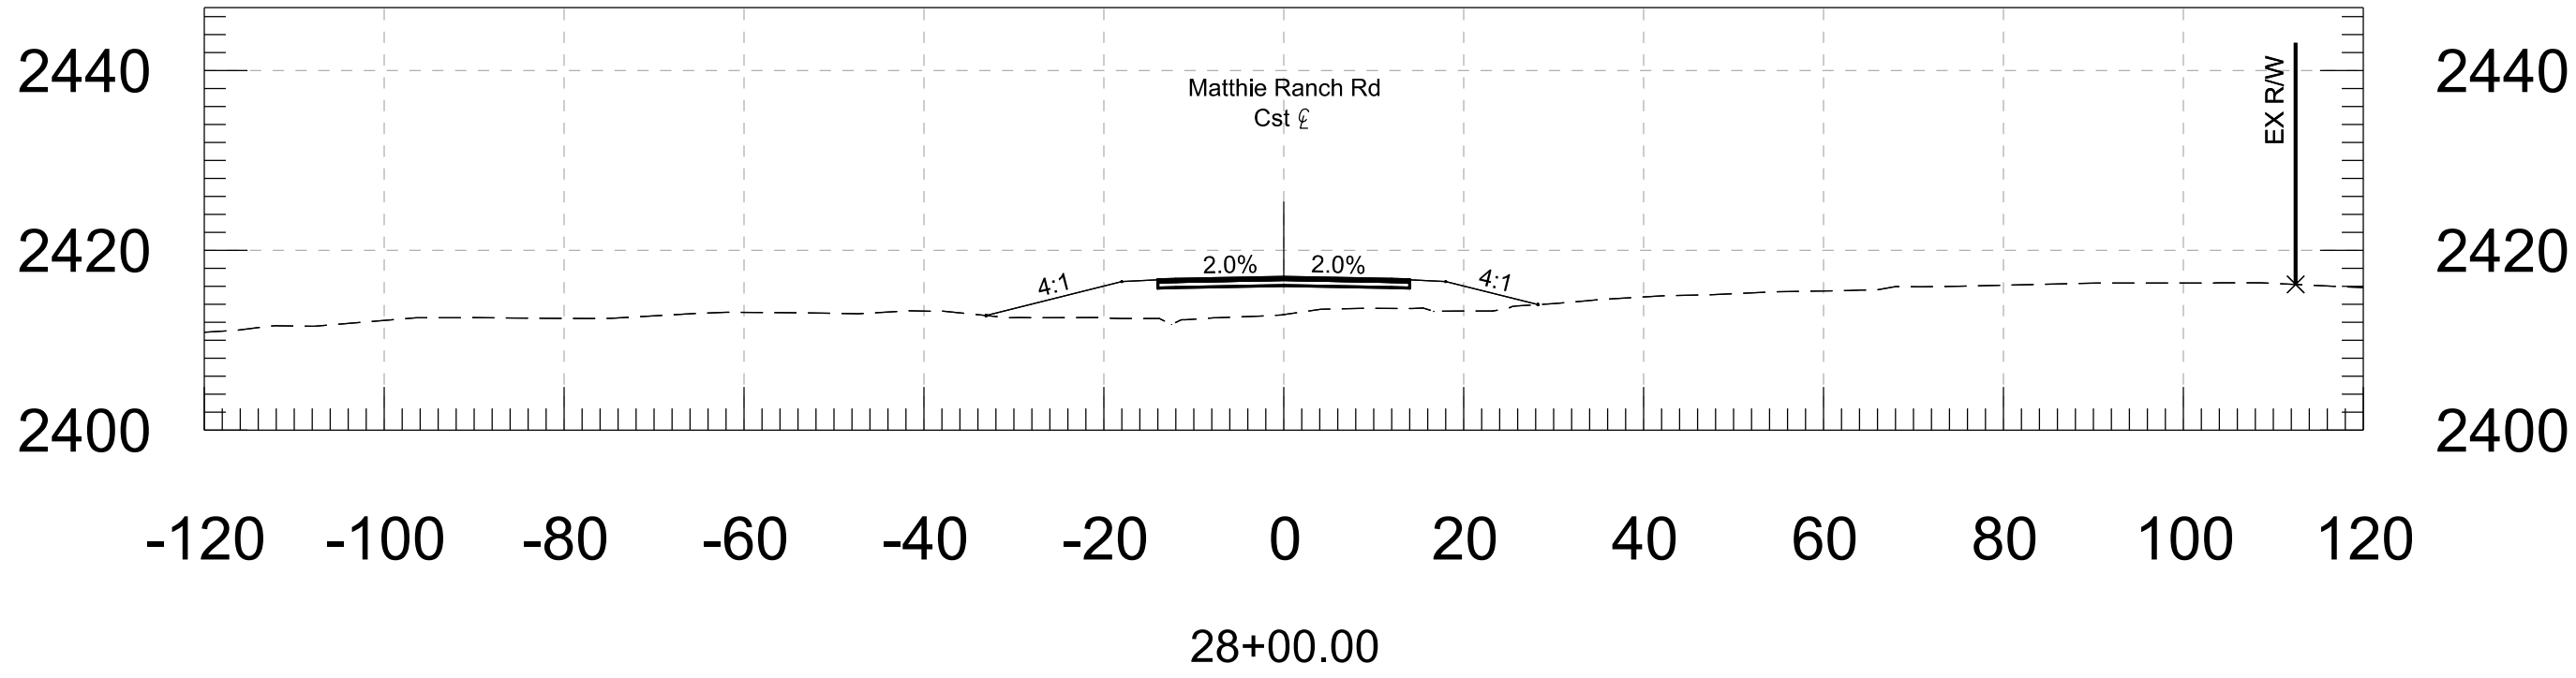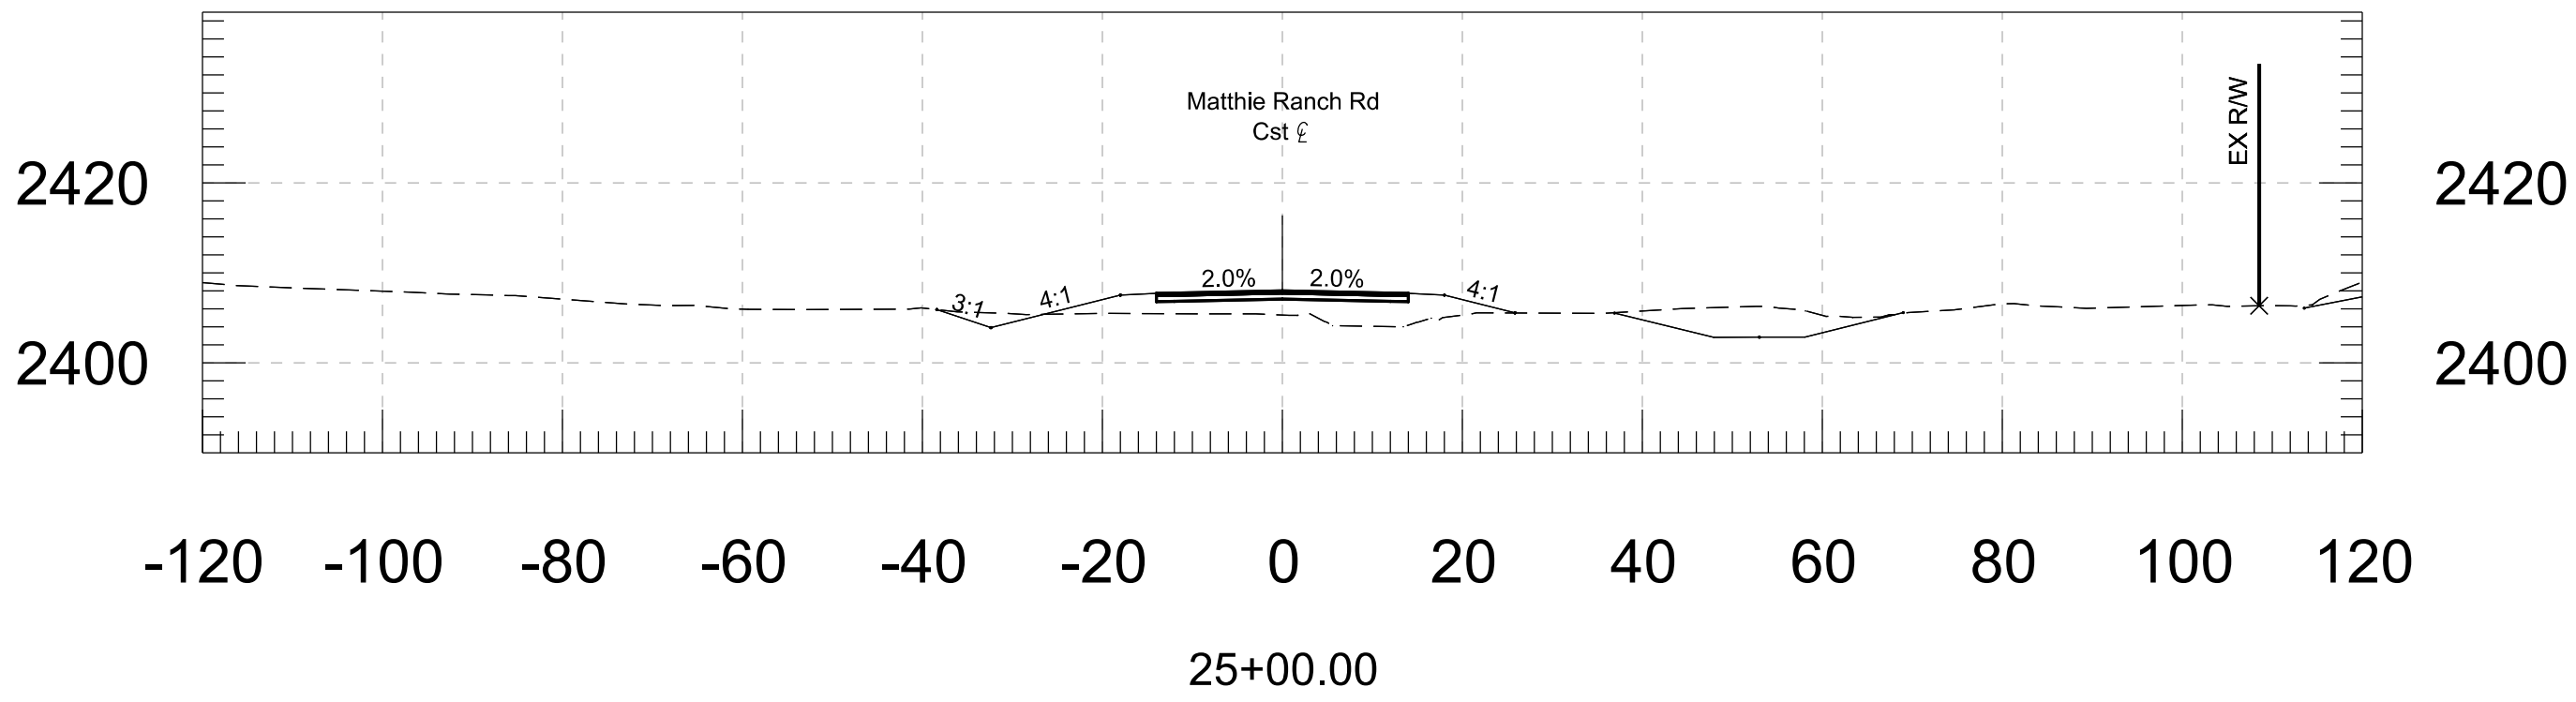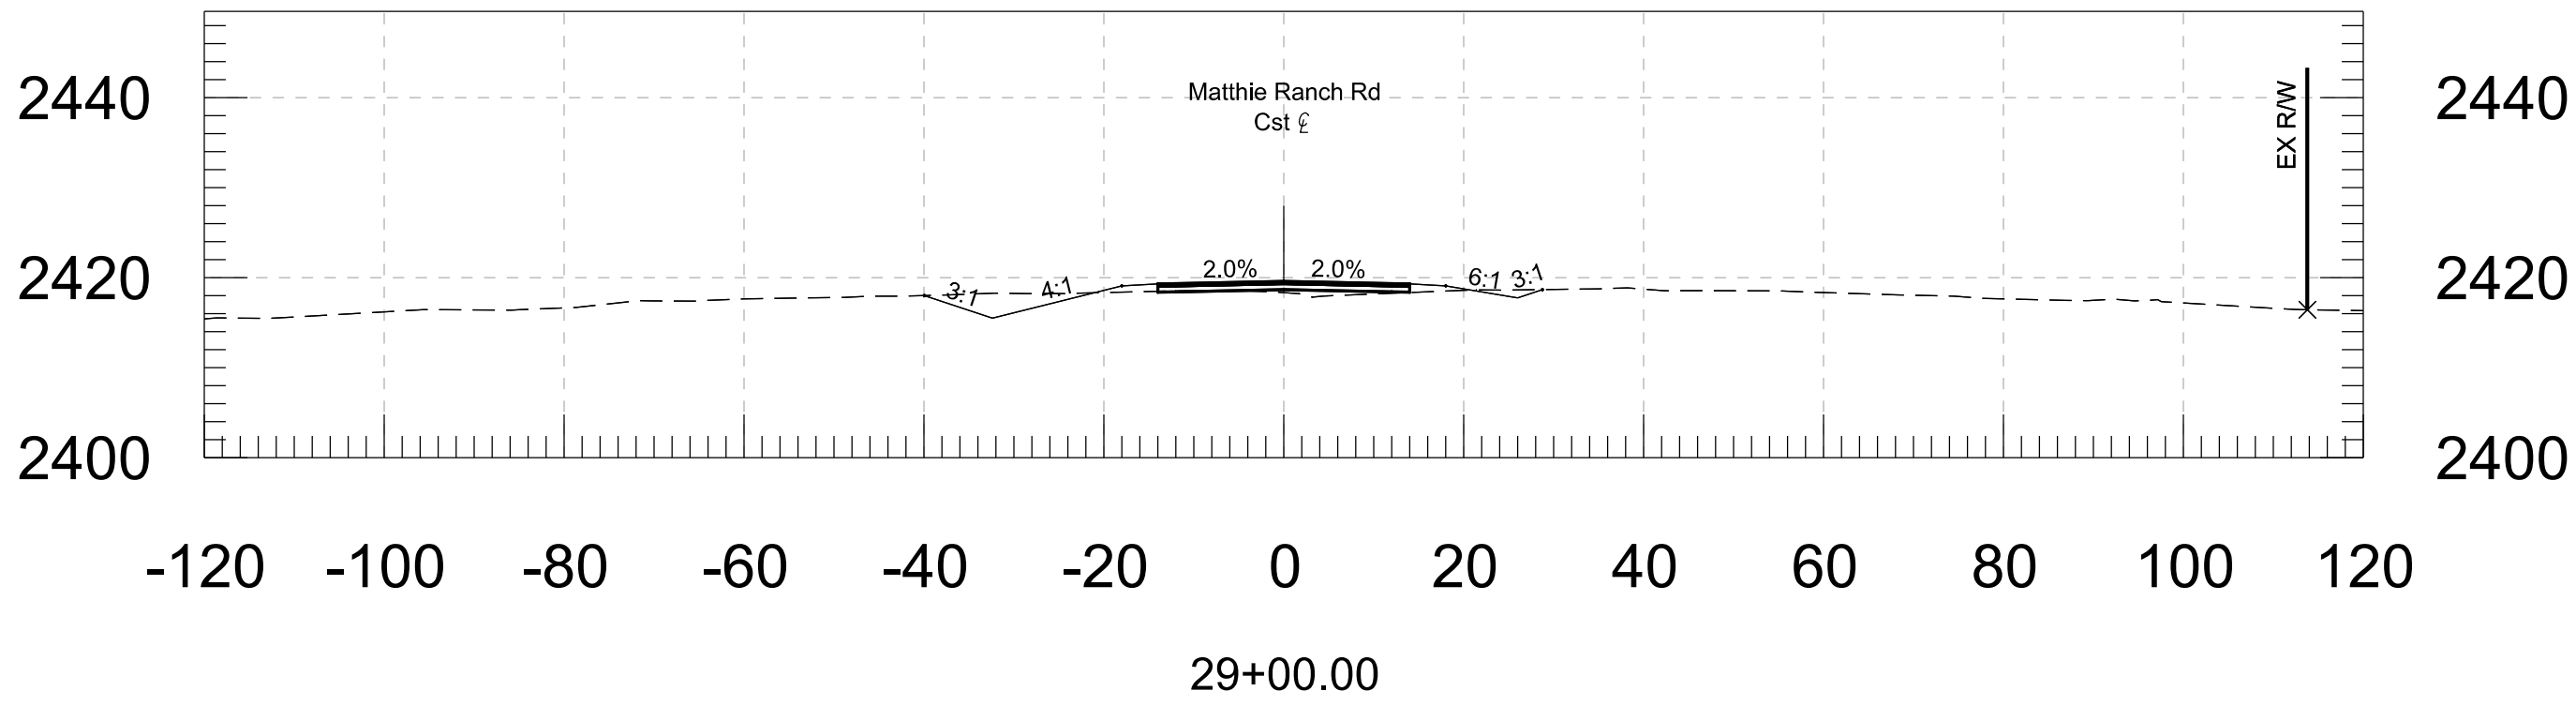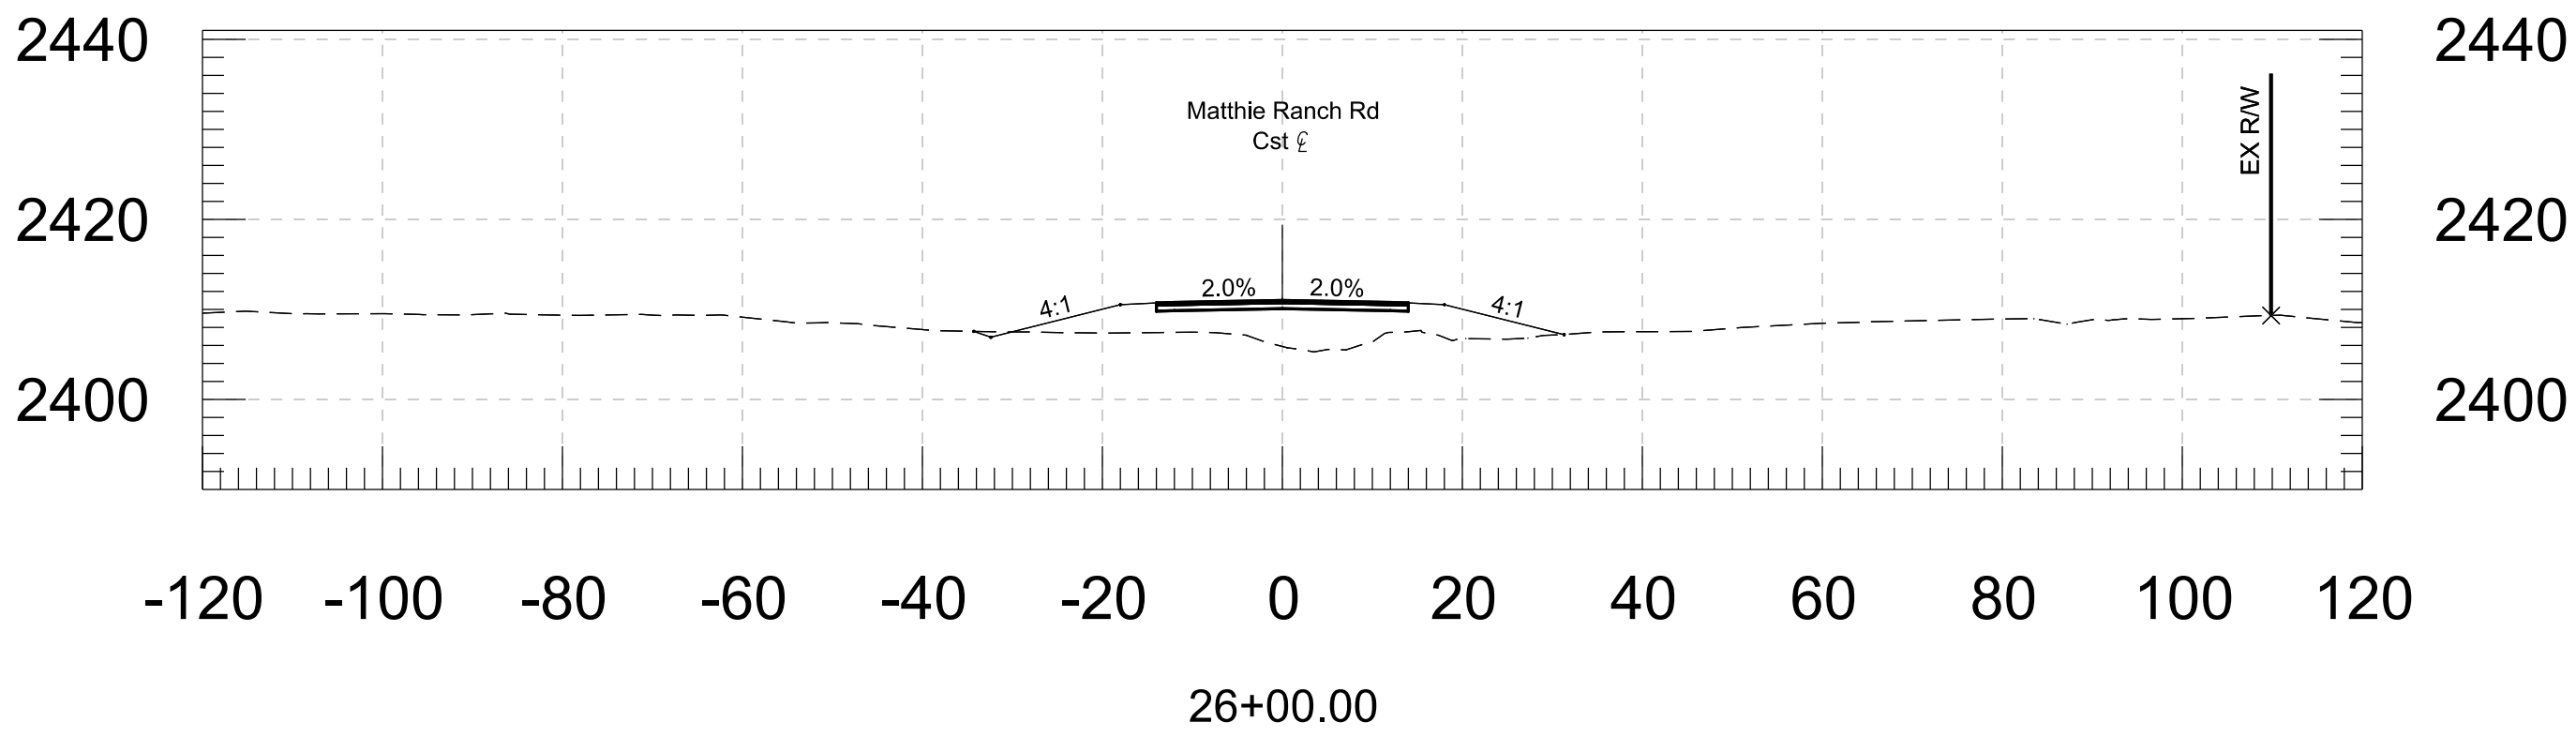

		NAME	DATE	ARIZONA DEPARTMENT OF TRANSPORTATION PROJECT DELIVERY AND OPERATIONS DIVISION ROADWAY DESIGN SERVICES		CROSS SECTIONS	
DESIGN	ZSZ	06-26					
DRAWN	RM	06-26					
CHECKED	DBK	06-26					
 Stanley Consultants inc.		3133 East Camelback Road, Suite 100 Phoenix, Arizona 85016 Phone: 1602/333-2200					
ROUTE		LOCATION					
US 93		WICKENBURG RANCH WAY TO VISTA ROYALE				DWG NO. 98	
TRACS NO. F0738 OIC			093-B(230)T			___ OF ___	







F.H.W.A. REGION	STATE	PROJECT NO.	SHEET NO.	TOTAL SHEETS	RECORD DRAWING
9	ARIZ.	093-B(230)T	100	116	
093 YV 189					

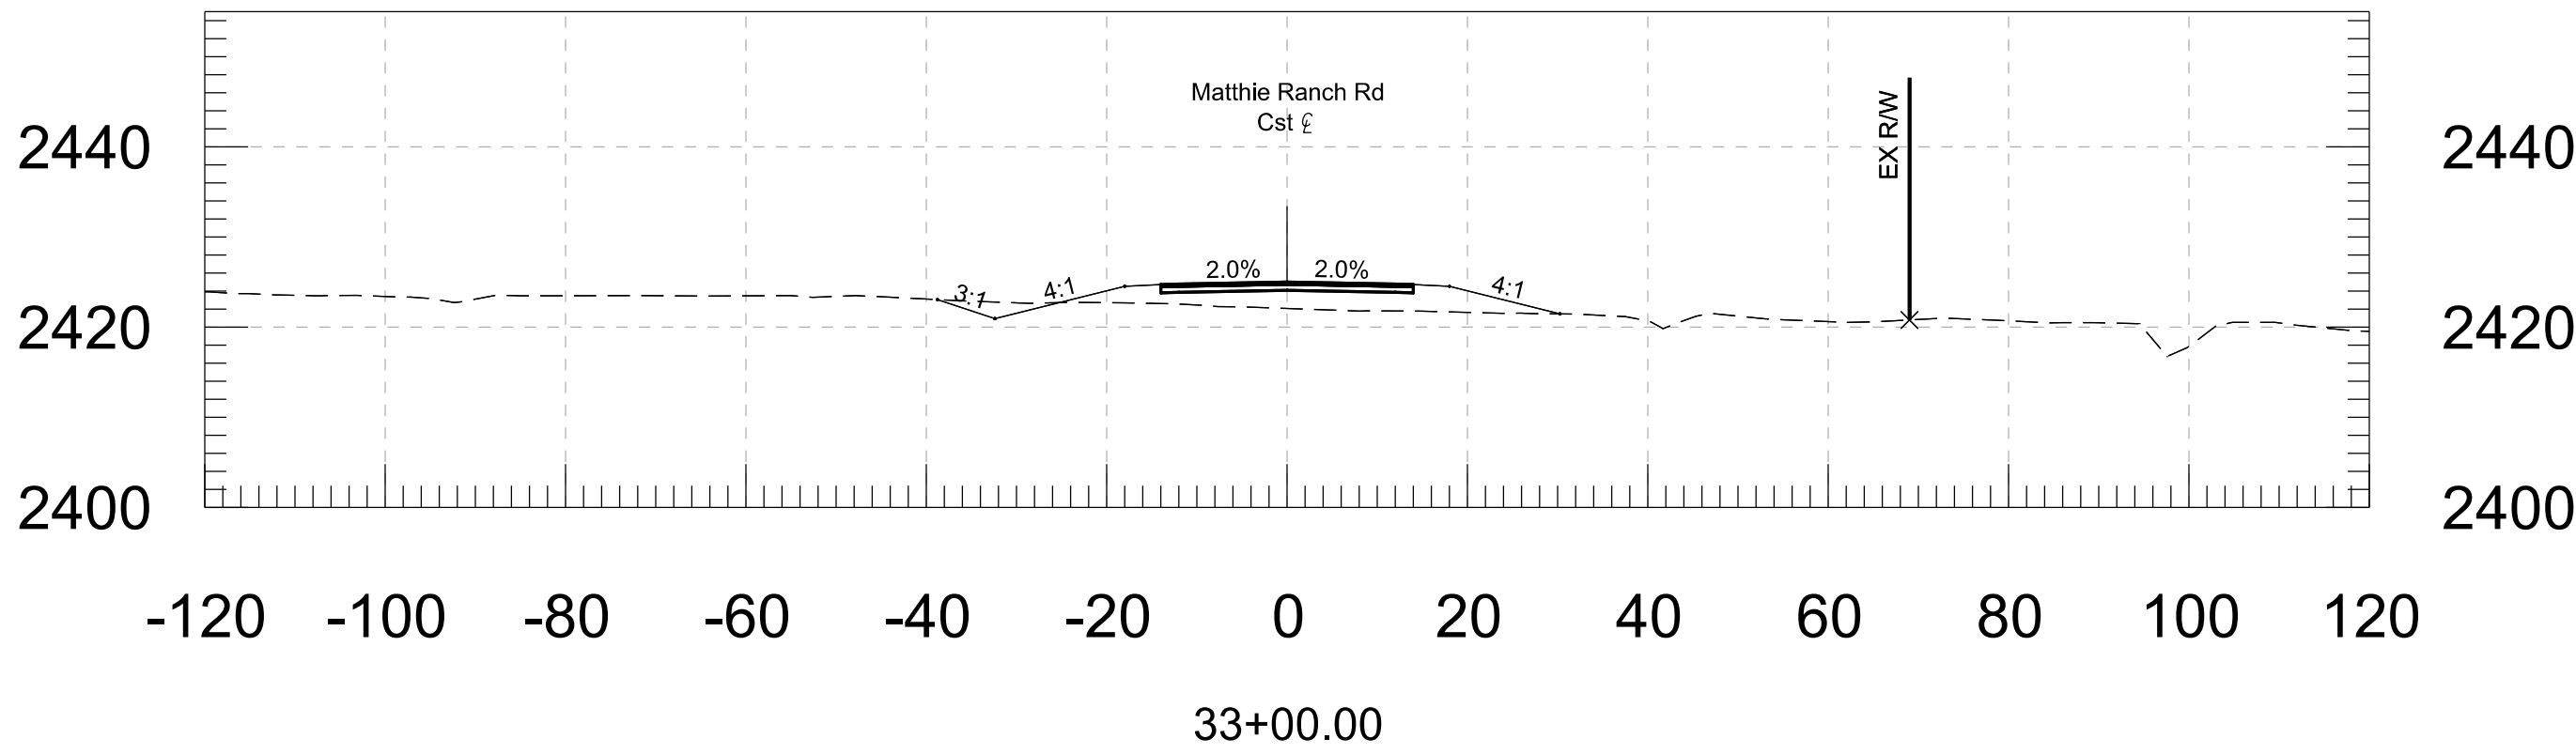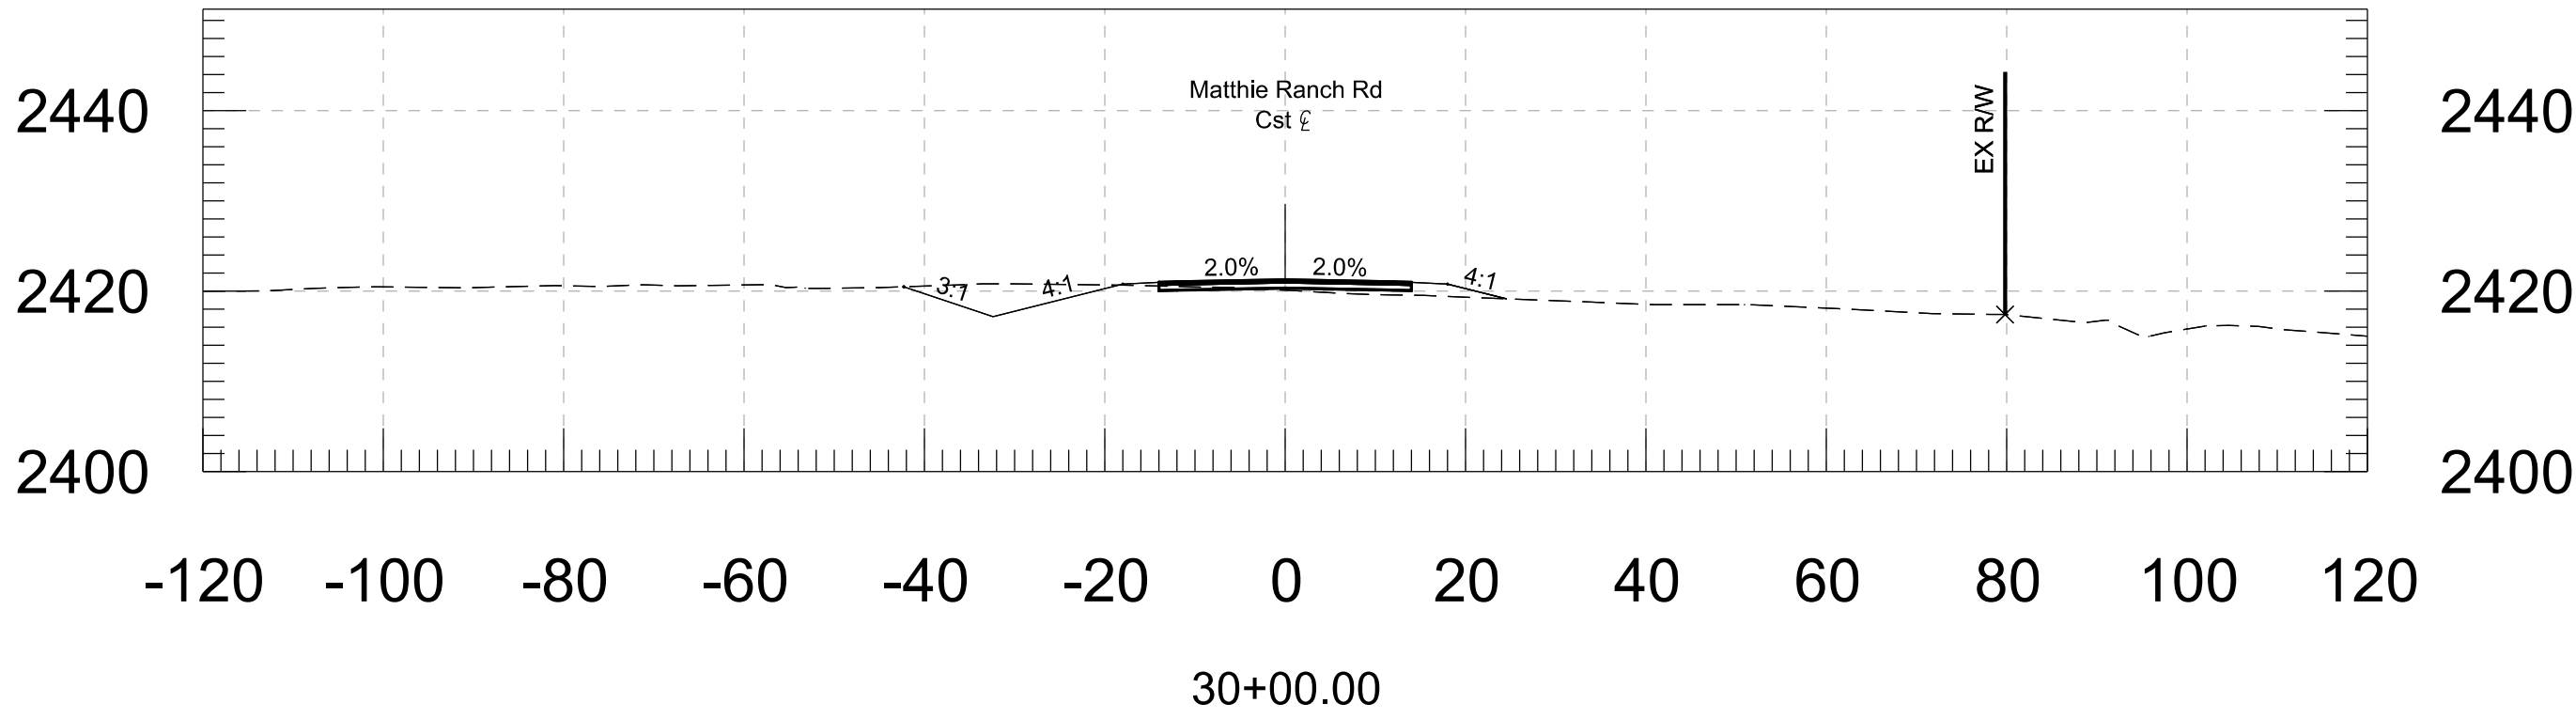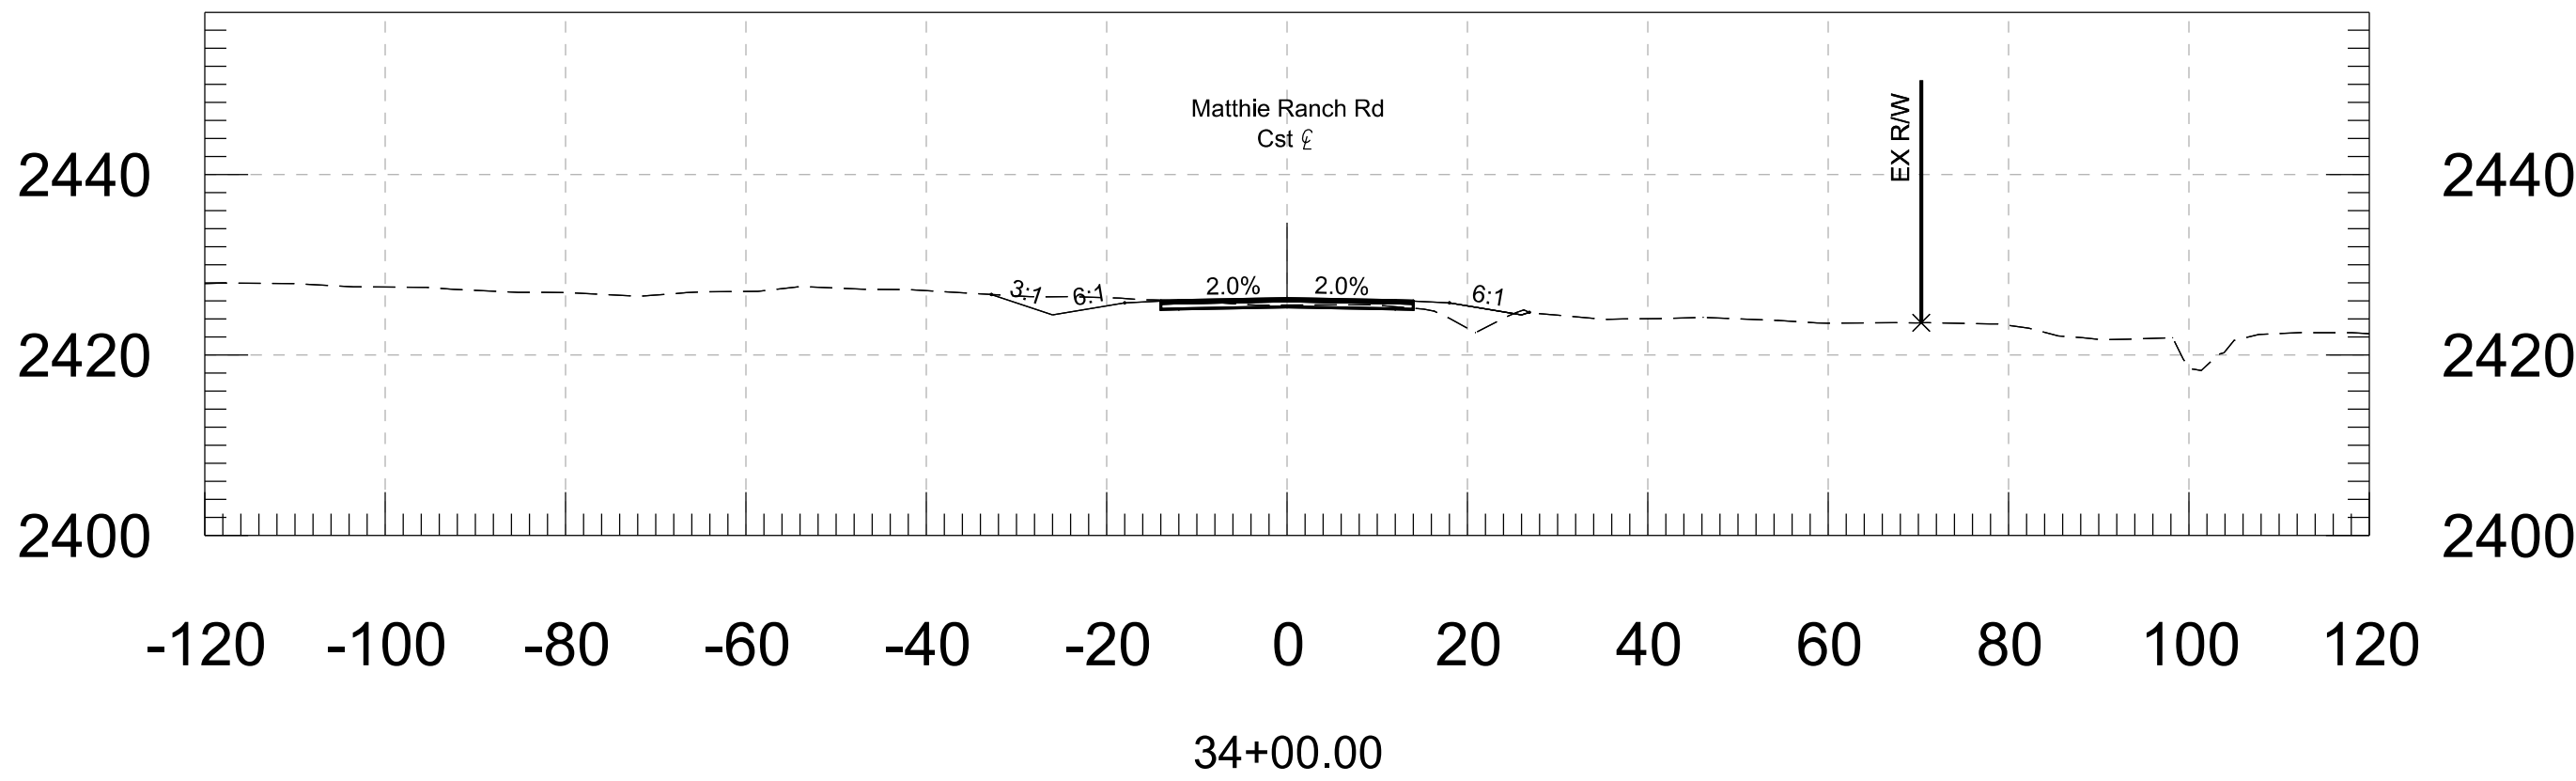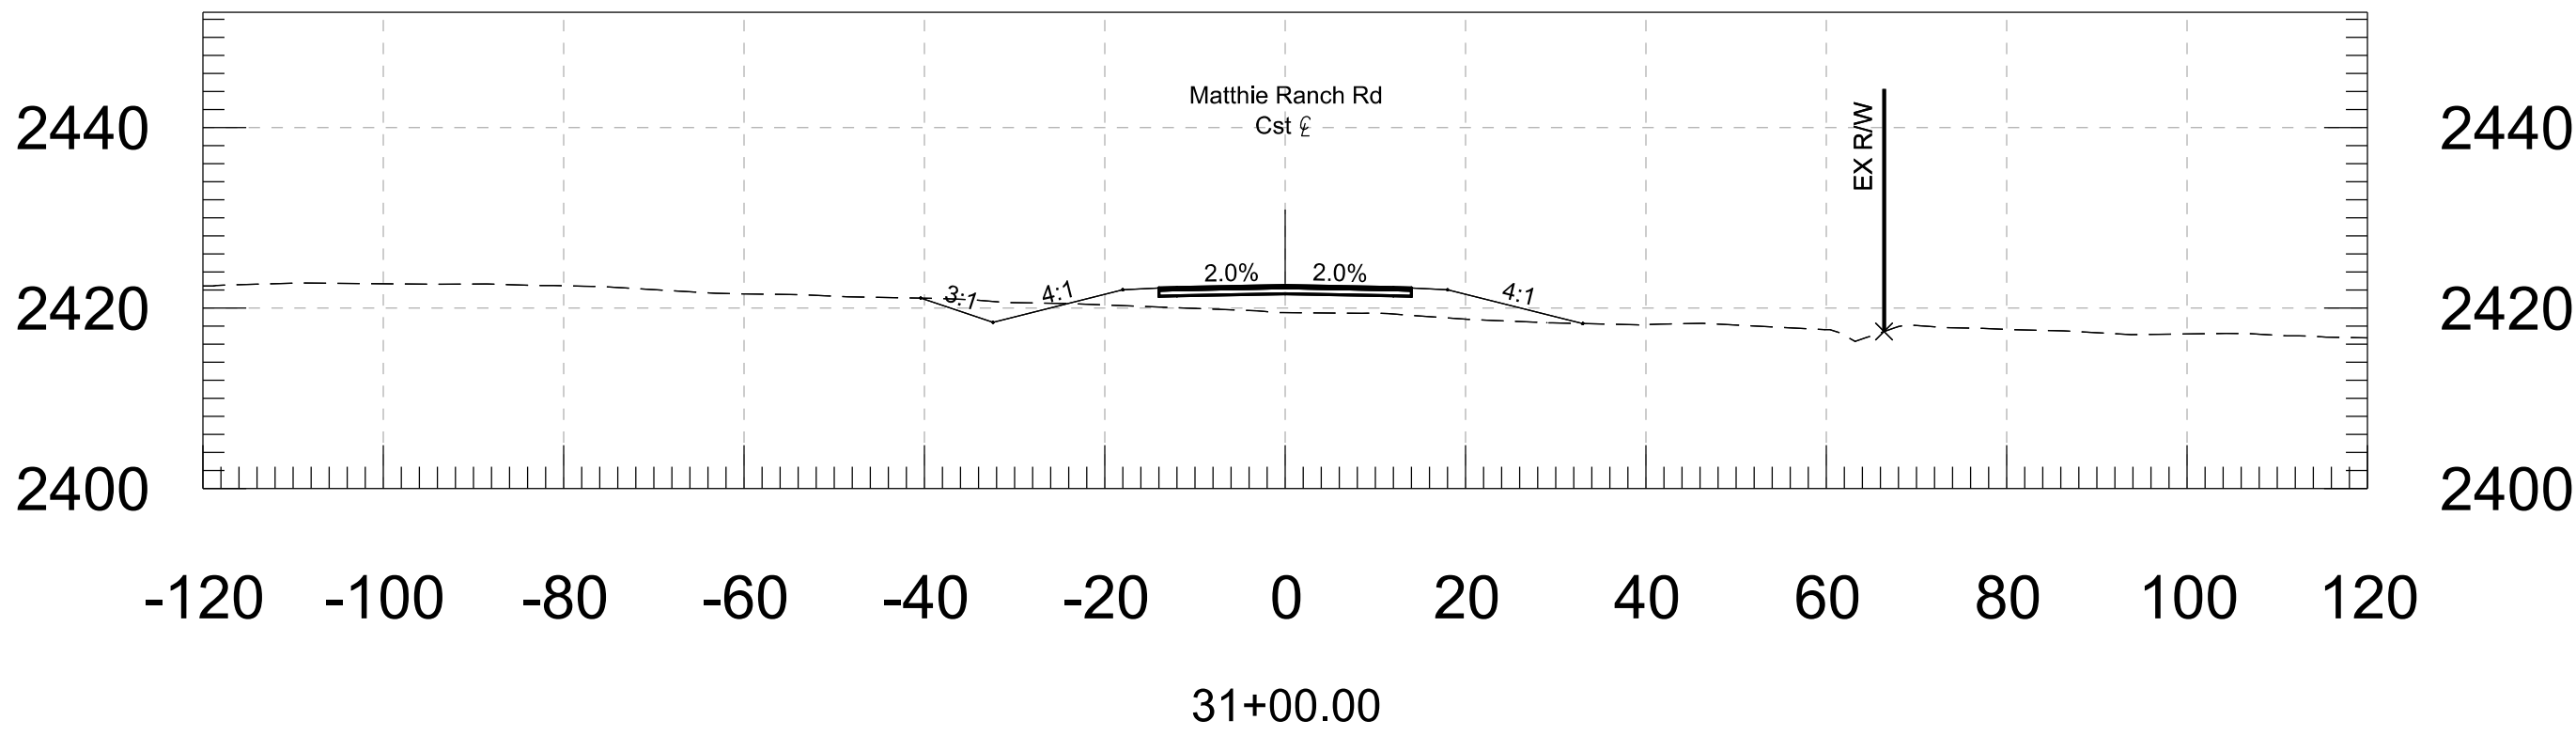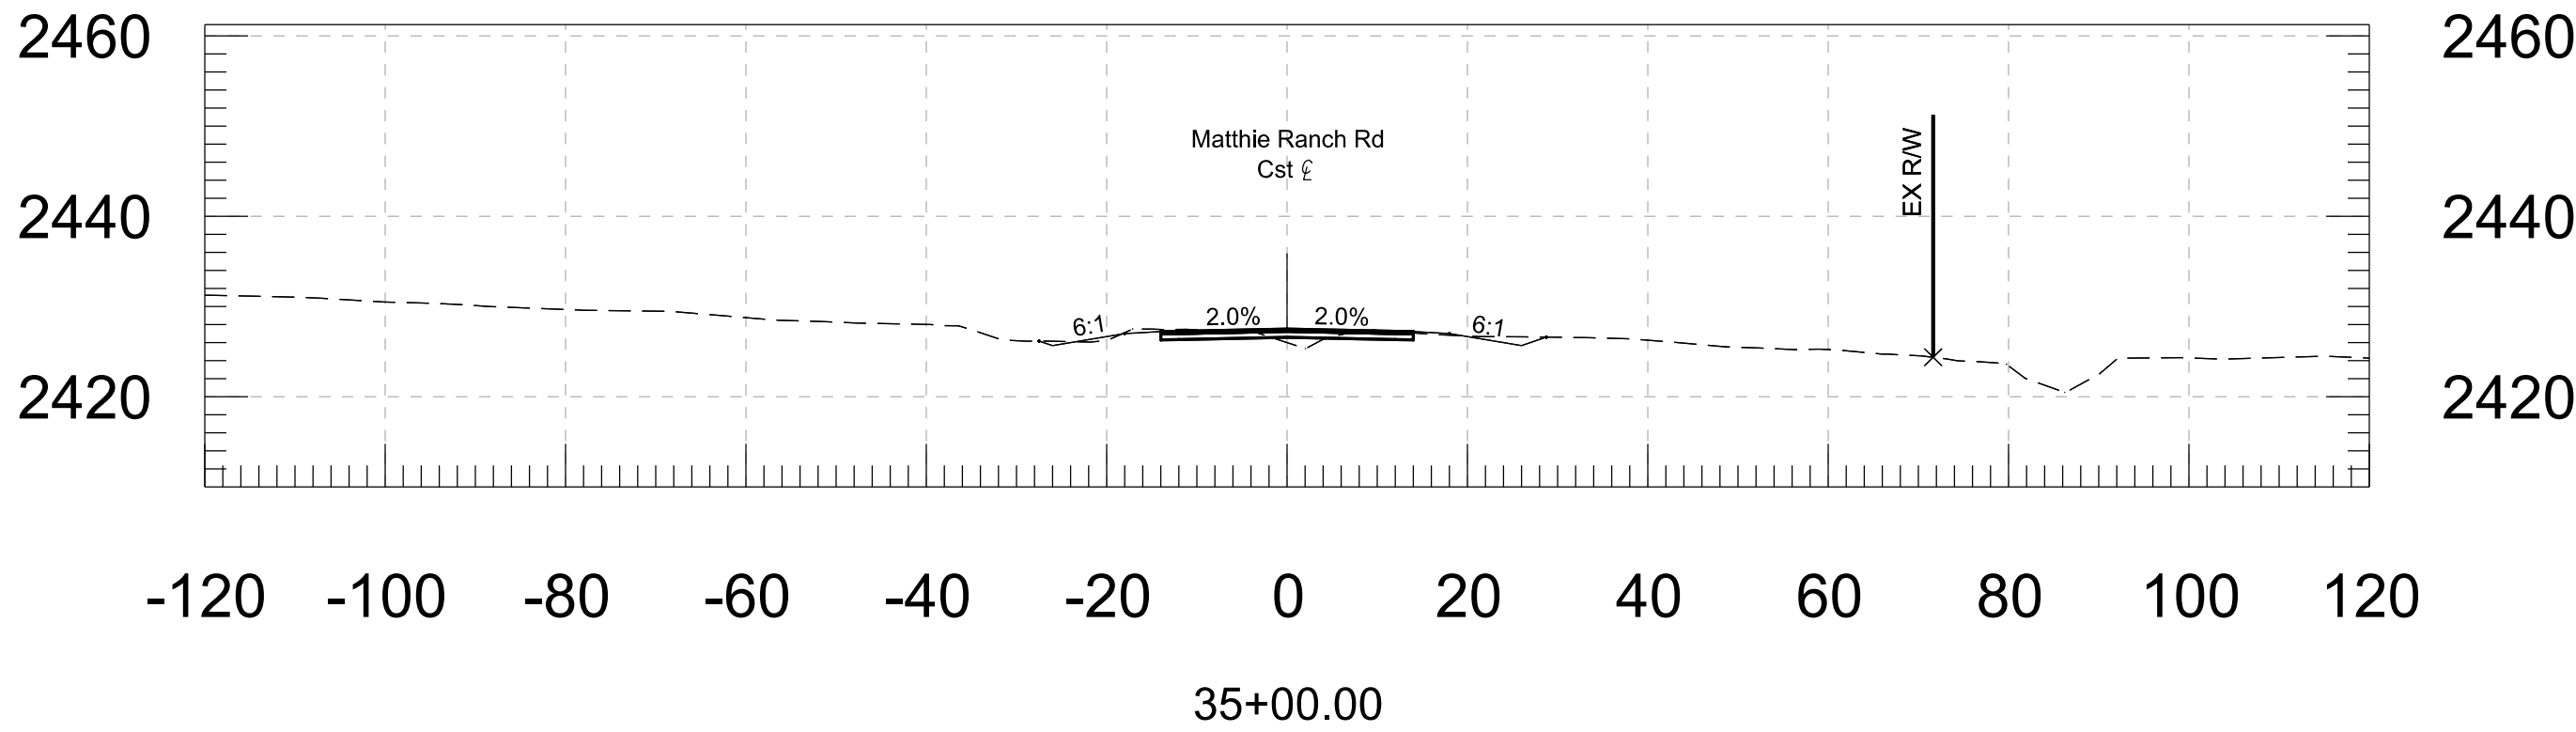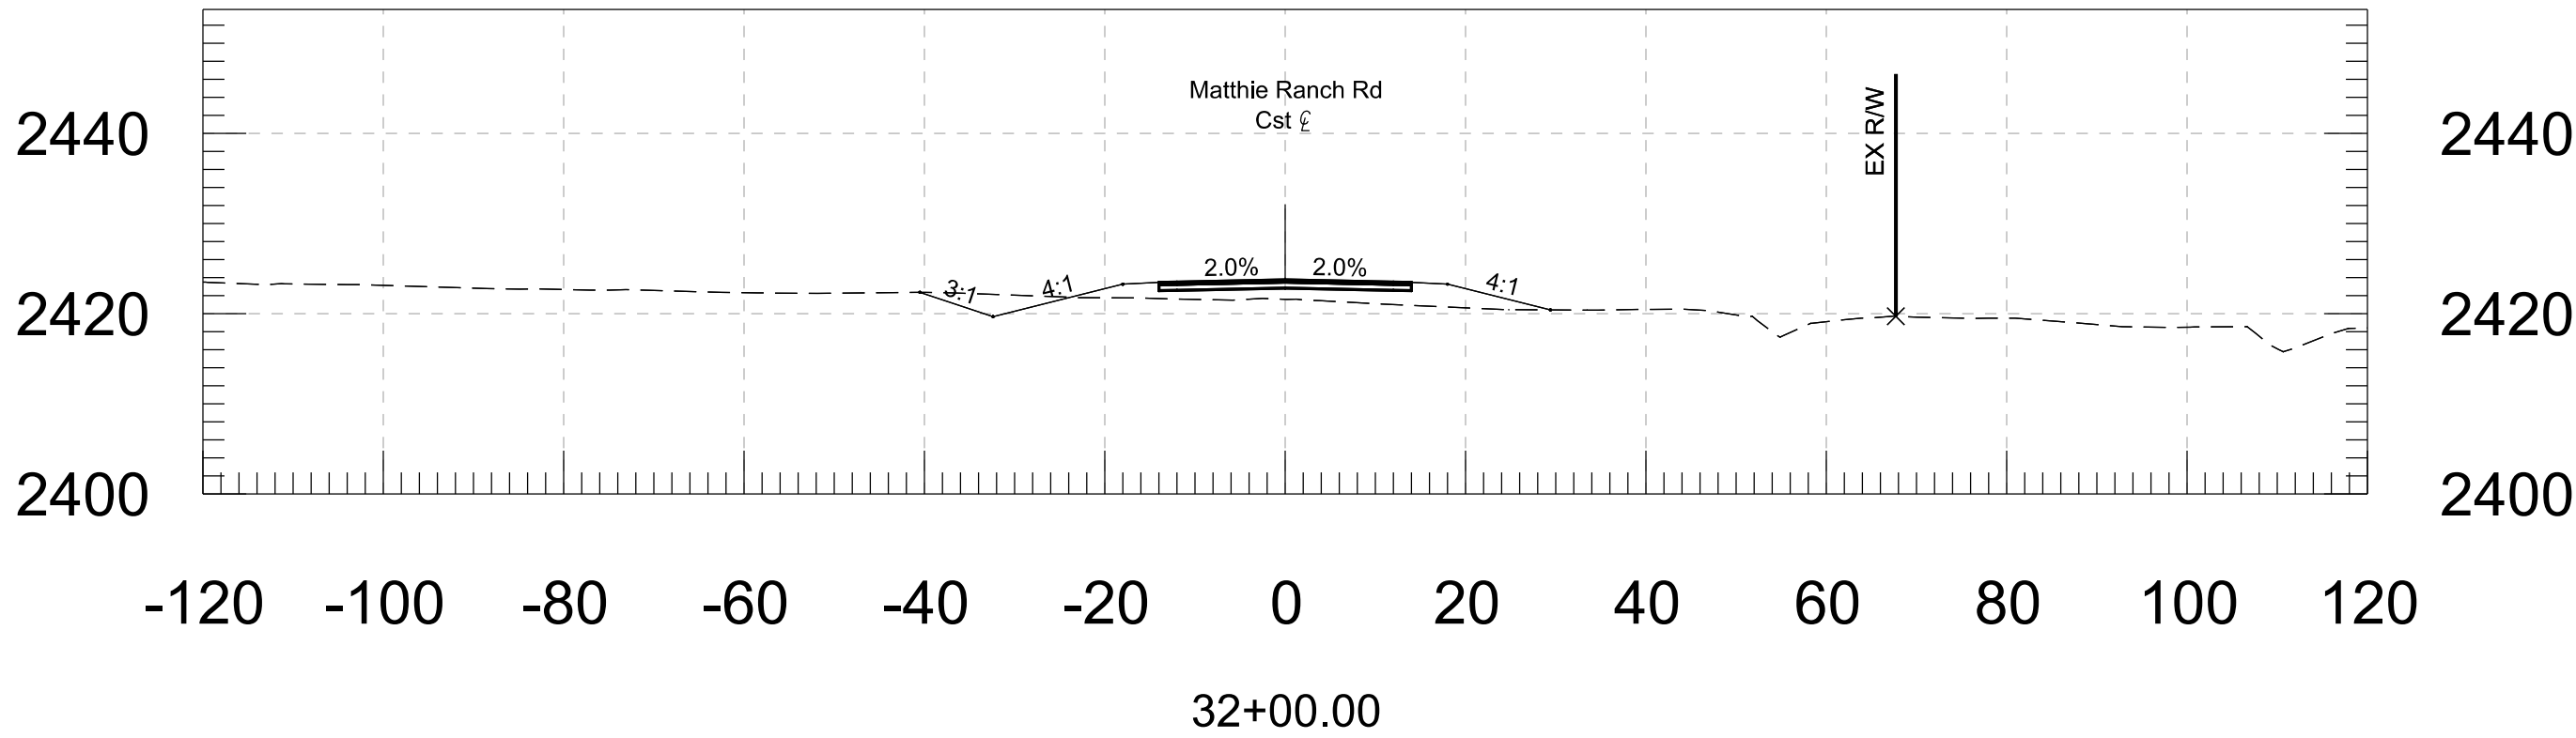

		NAME	DATE	ARIZONA DEPARTMENT OF TRANSPORTATION PROJECT DELIVERY AND OPERATIONS DIVISION ROADWAY DESIGN SERVICES		
DESIGN		ZSZ	06-26			
DRAWN		RM	06-26			
CHECKED		DBK	06-26			
 Stanley Consultants inc.		3133 East Camelback Road, Suite 100 Phoenix, Arizona 85016 Phone: 602-355-2200		CROSS SECTIONS		
ROUTE		LOCATION				
US 93		WICKENBURG RANCH WAY TO VISTA ROYALE				DWG NO. 99
TRACS NO. F0738 OIC			093-B(230)T			___ OF ___



F.H.W.A. REGION	STATE	PROJECT NO.	SHEET NO.	TOTAL SHEETS	RECORD DRAWING
9	ARIZ.	093-B(230)T	101	116	

093 YV 189

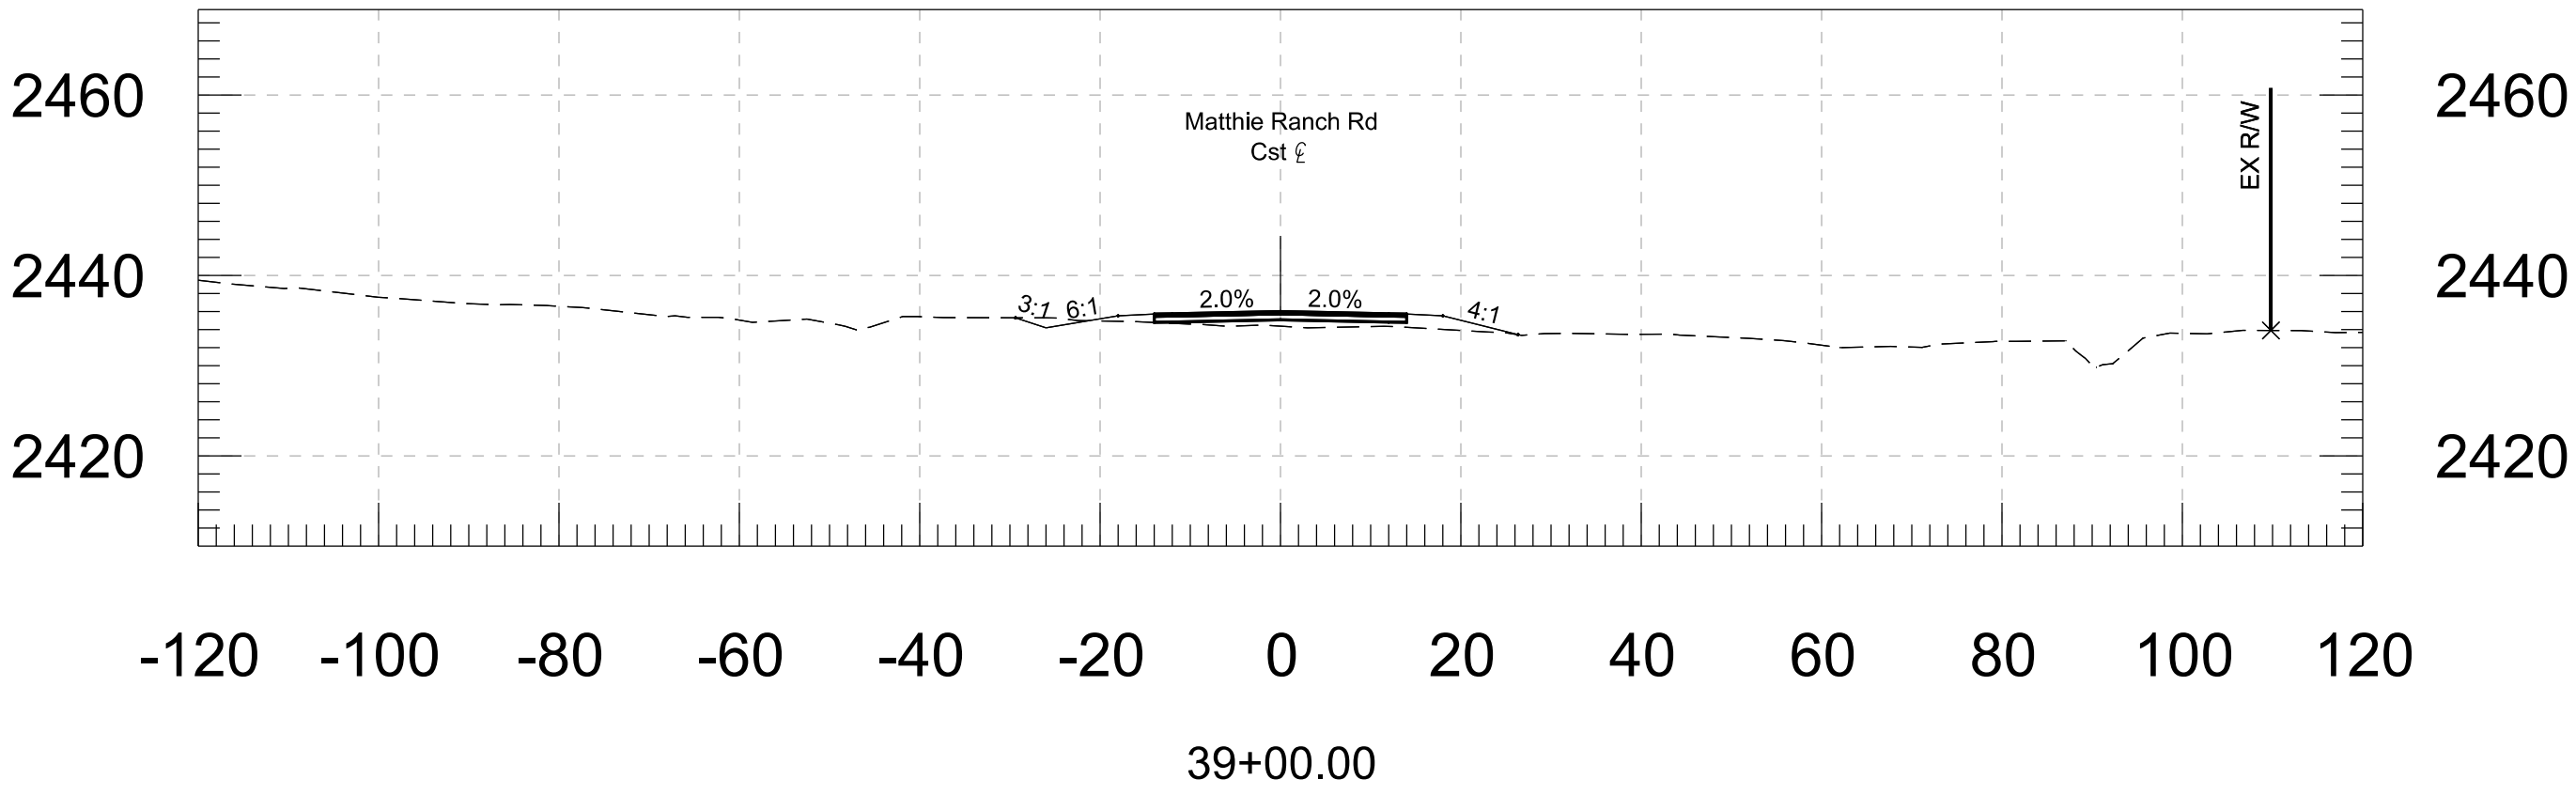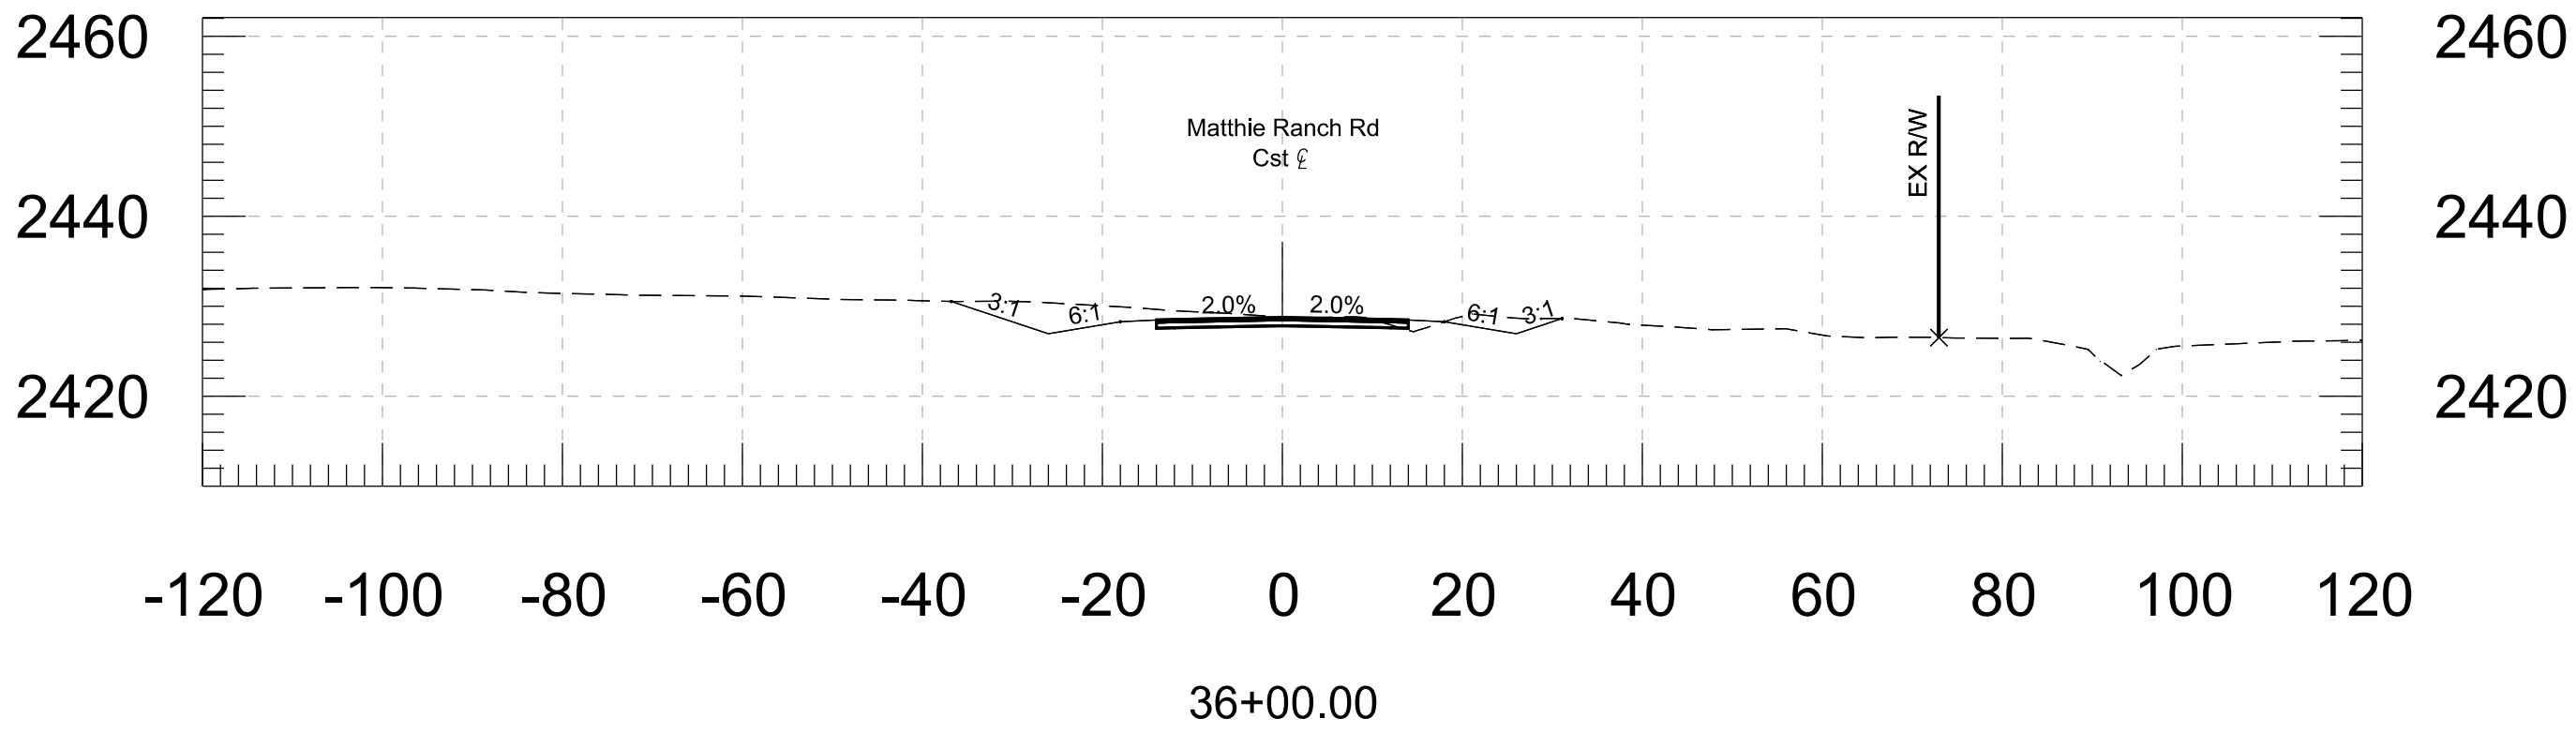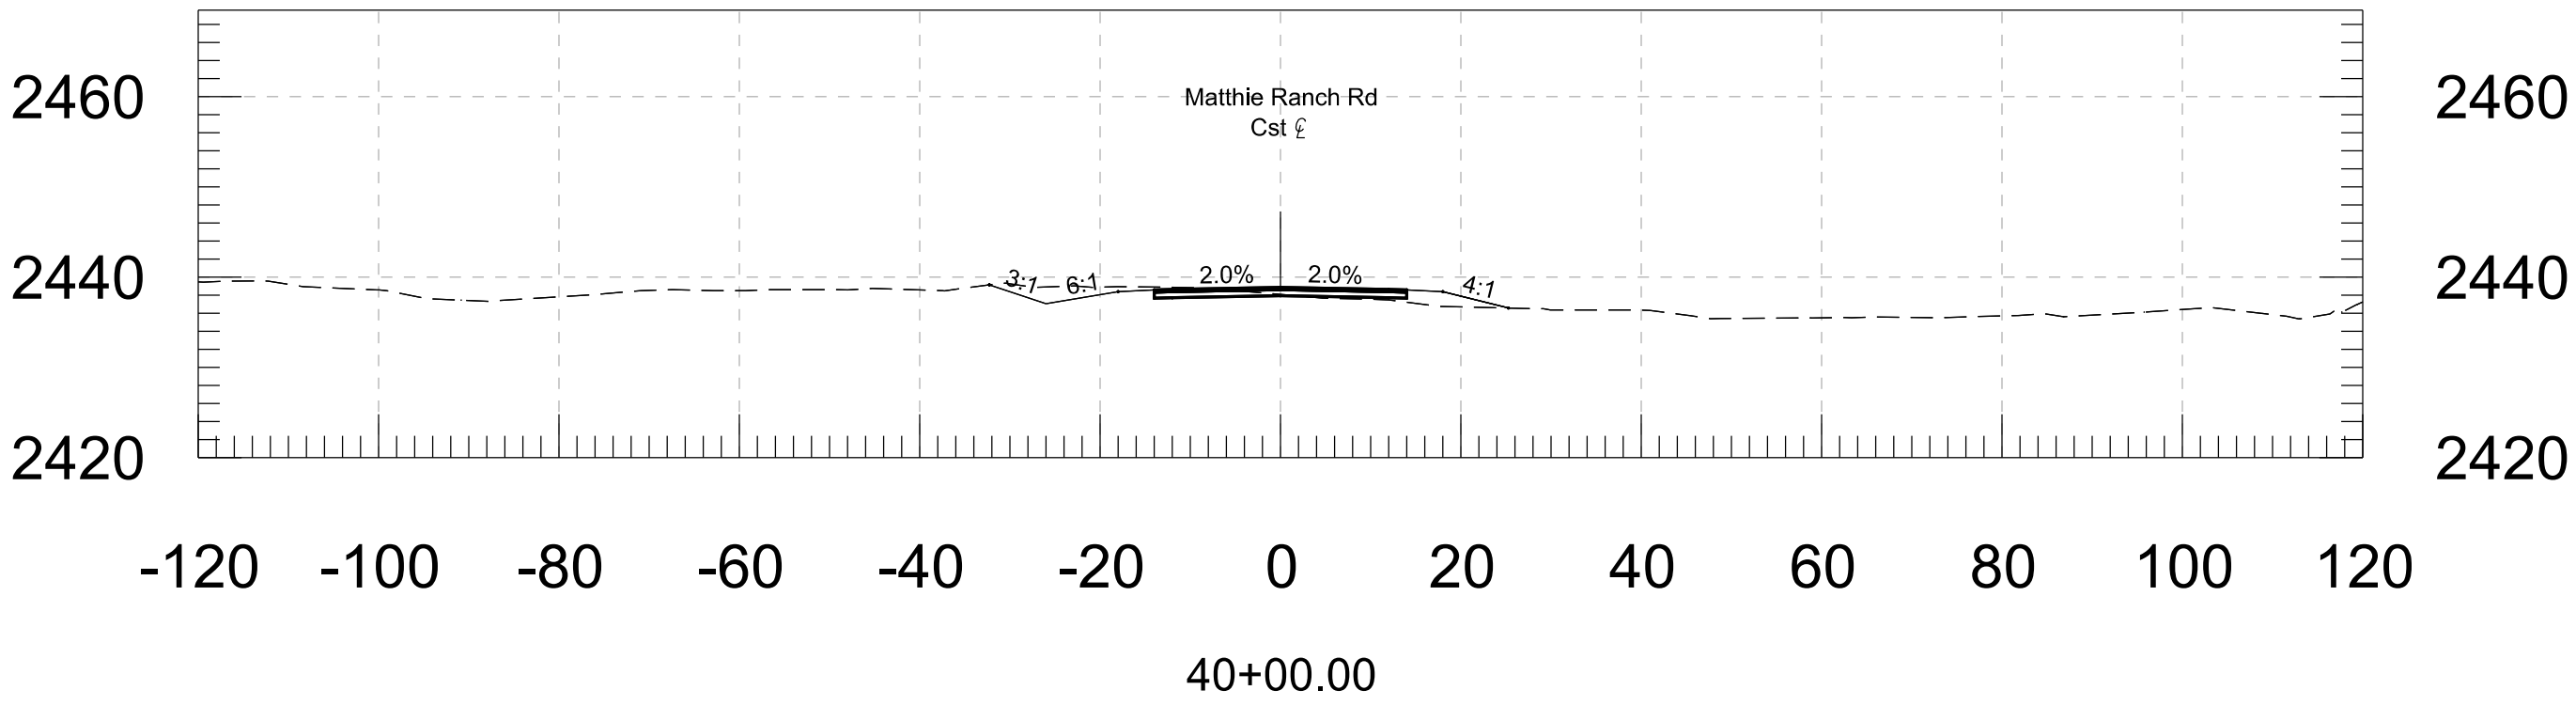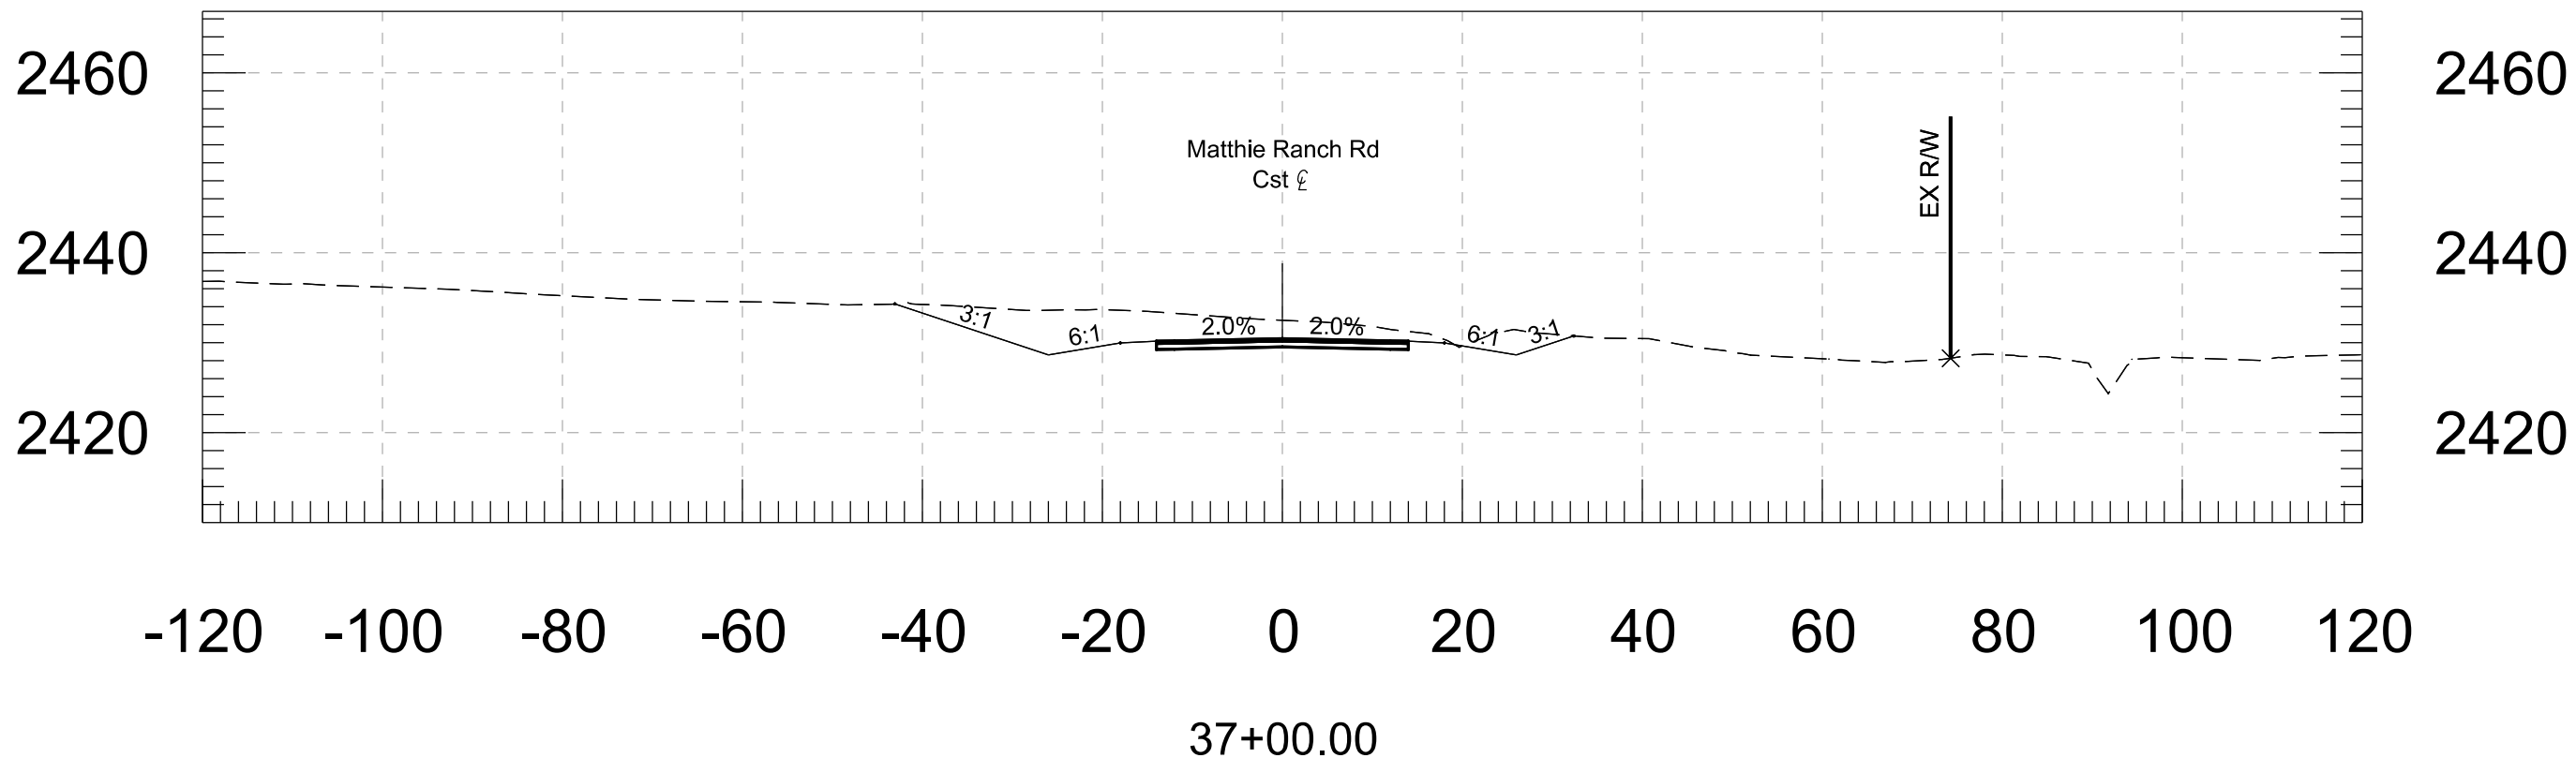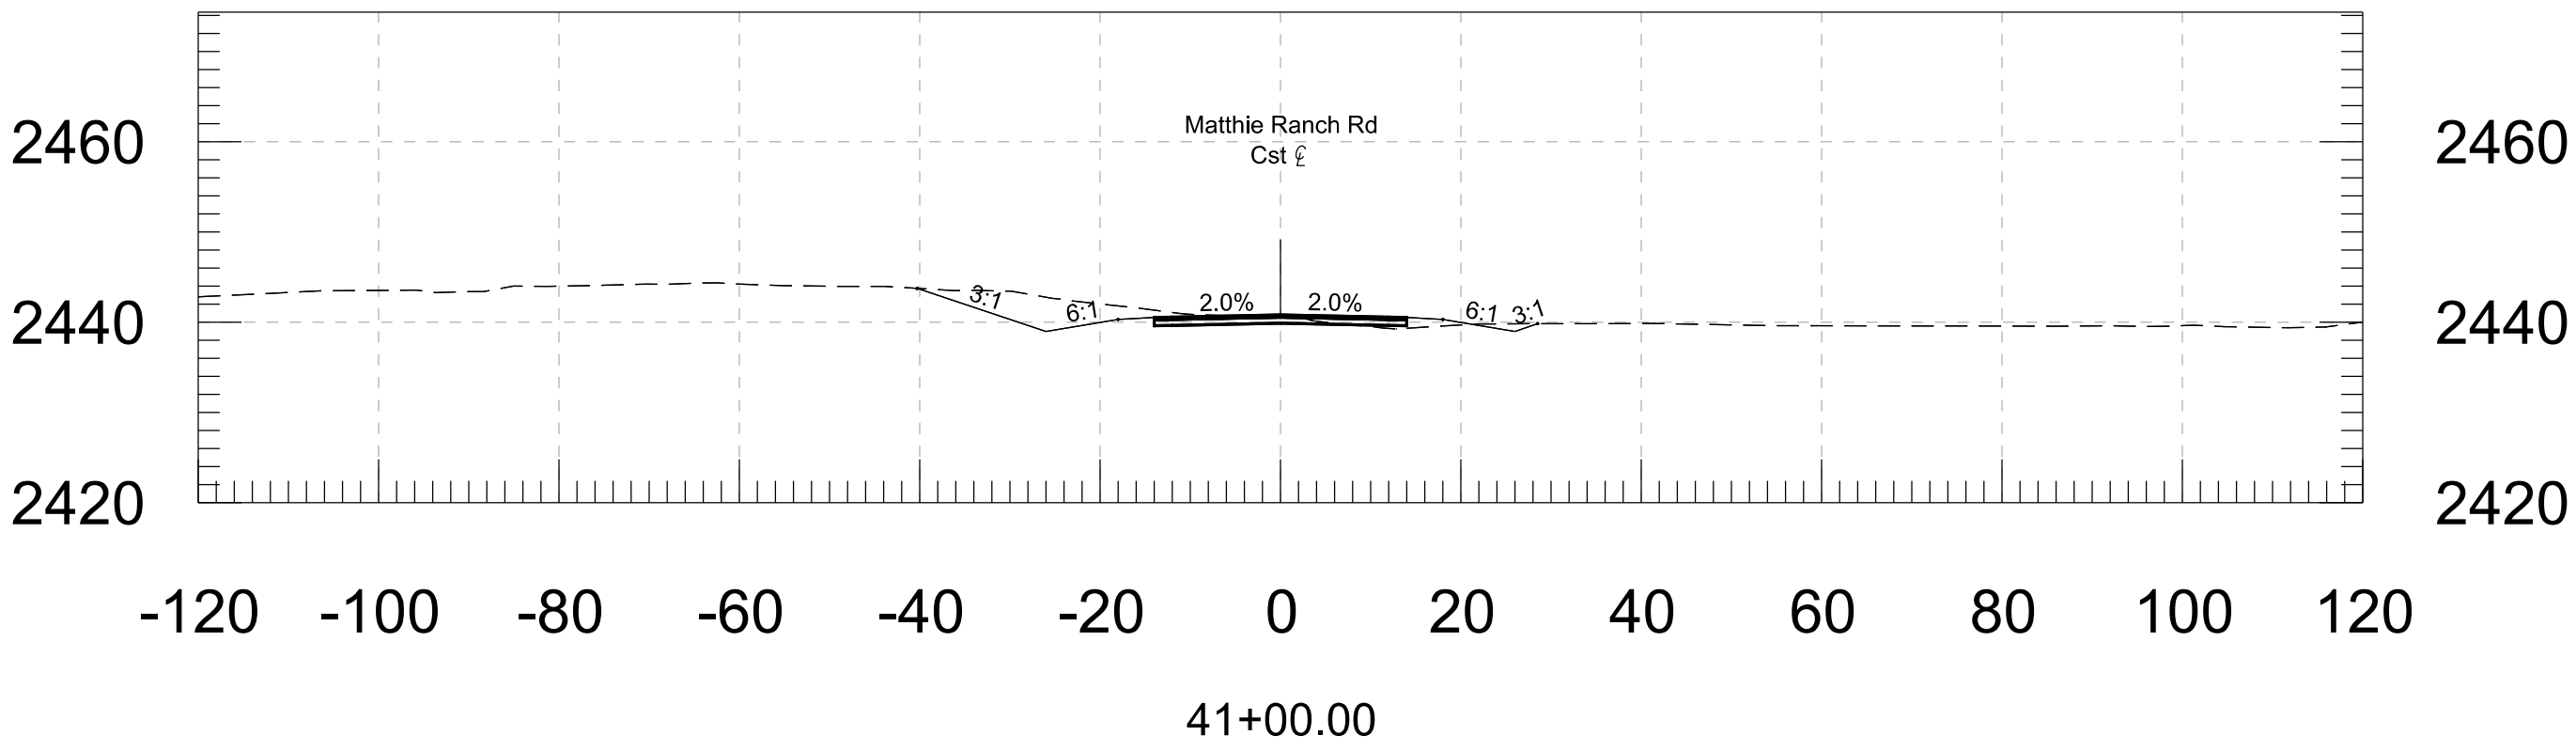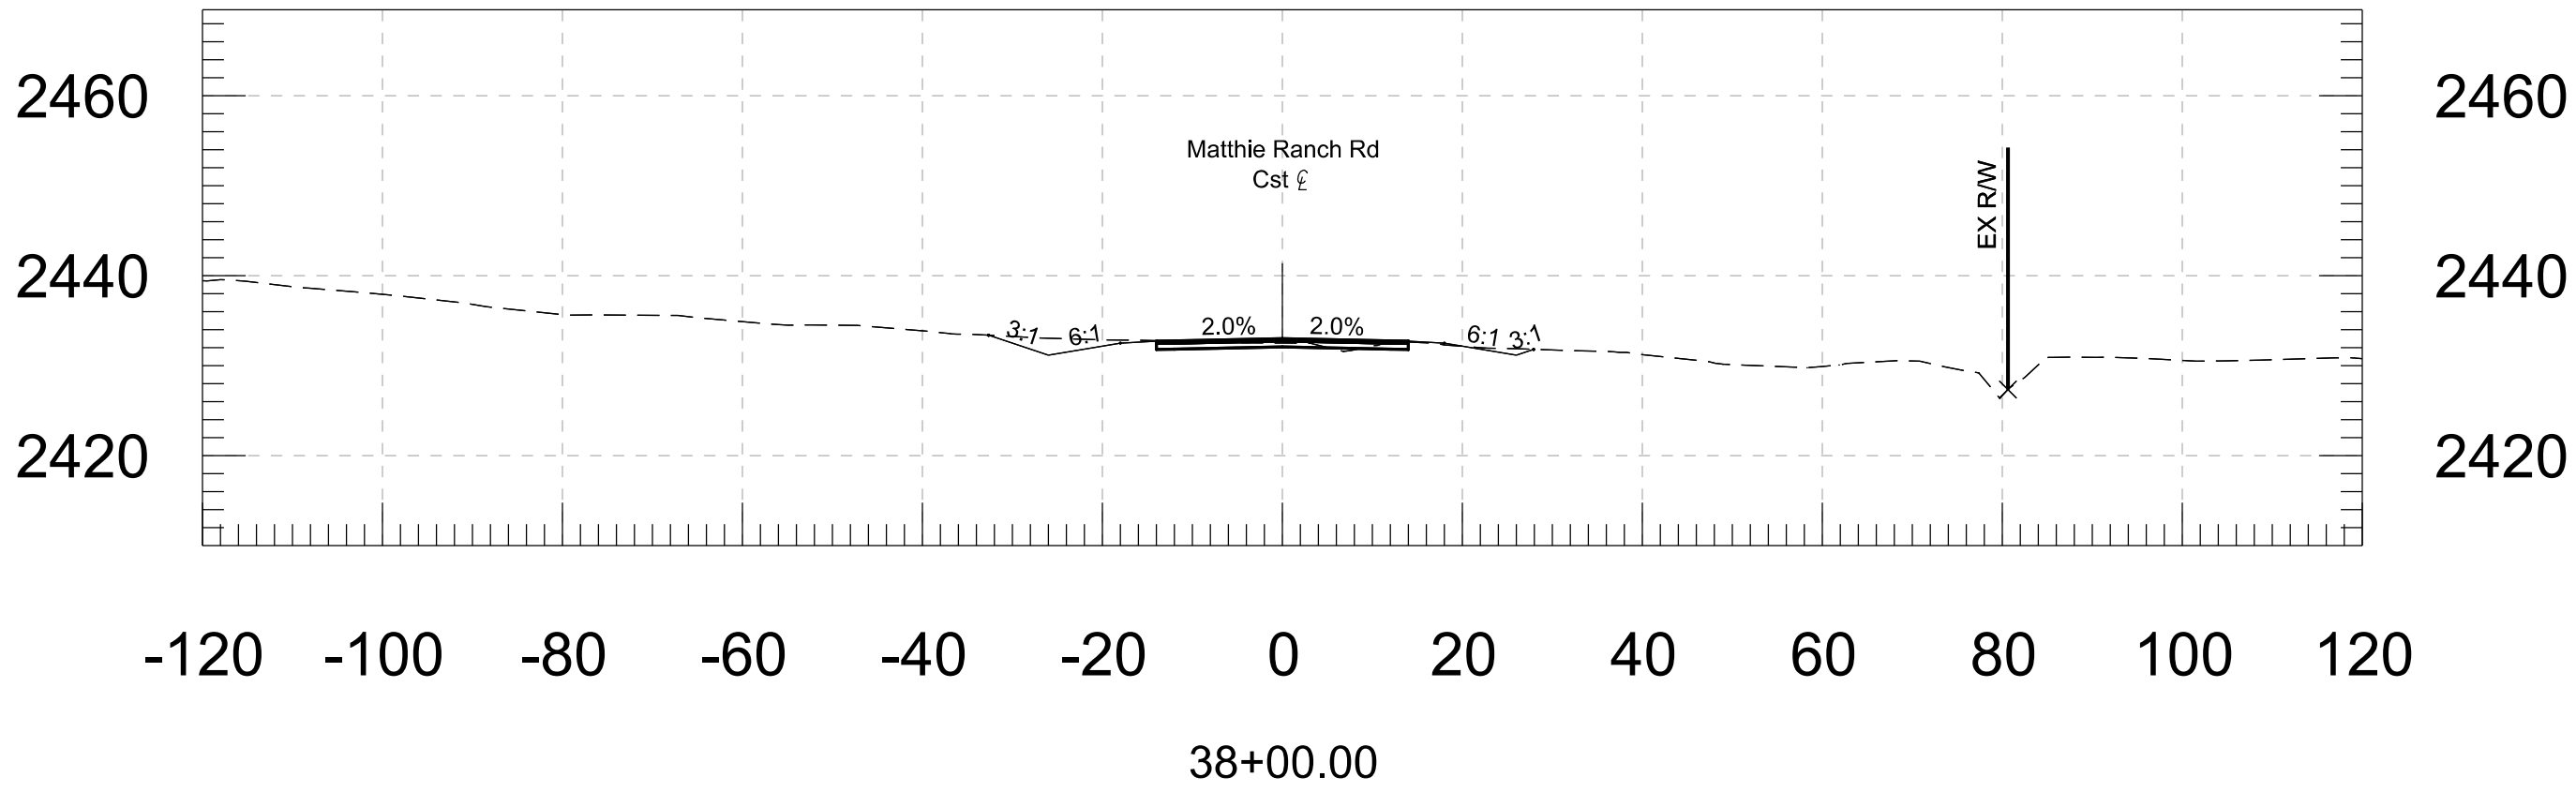

		NAME	DATE	ARIZONA DEPARTMENT OF TRANSPORTATION PROJECT DELIVERY AND OPERATIONS DIVISION ROADWAY DESIGN SERVICES		CROSS SECTIONS
DESIGN	ZSZ		06-26			
DRAWN	RM		06-26			
CHECKED	DBK		06-26			
 3133 East Camelback Road, Suite 100 Phoenix, Arizona 85016 Phone: 602/333-2200 Stanley Consultants inc.						
ROUTE		LOCATION				
US 93		WICKENBURG RANCH WAY TO VISTA ROYALE				
TRACS NO. F0738 OIC				093-B(230)T		___ OF ___




F.H.W.A. REGION	STATE	PROJECT NO.	SHEET NO.	TOTAL SHEETS	RECORD DRAWING
9	ARIZ.	093-B(230)T	102	116	
093 YV 189					

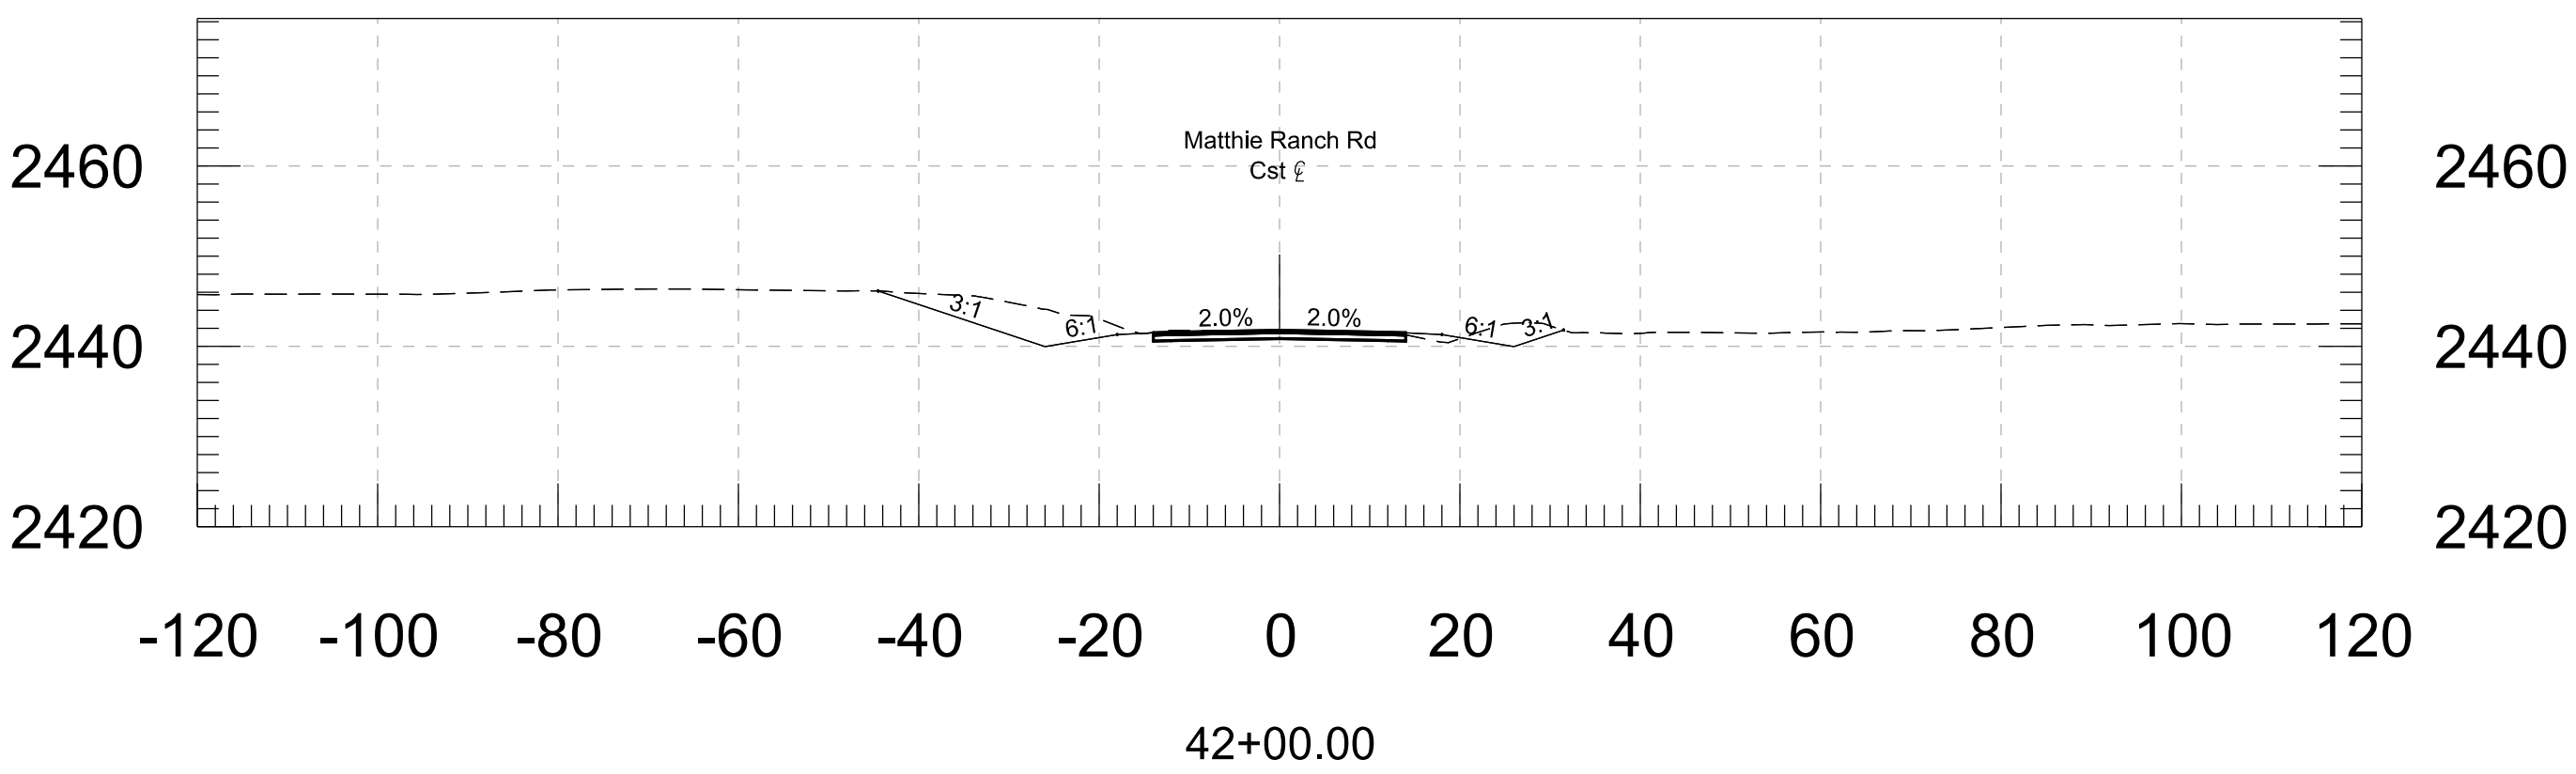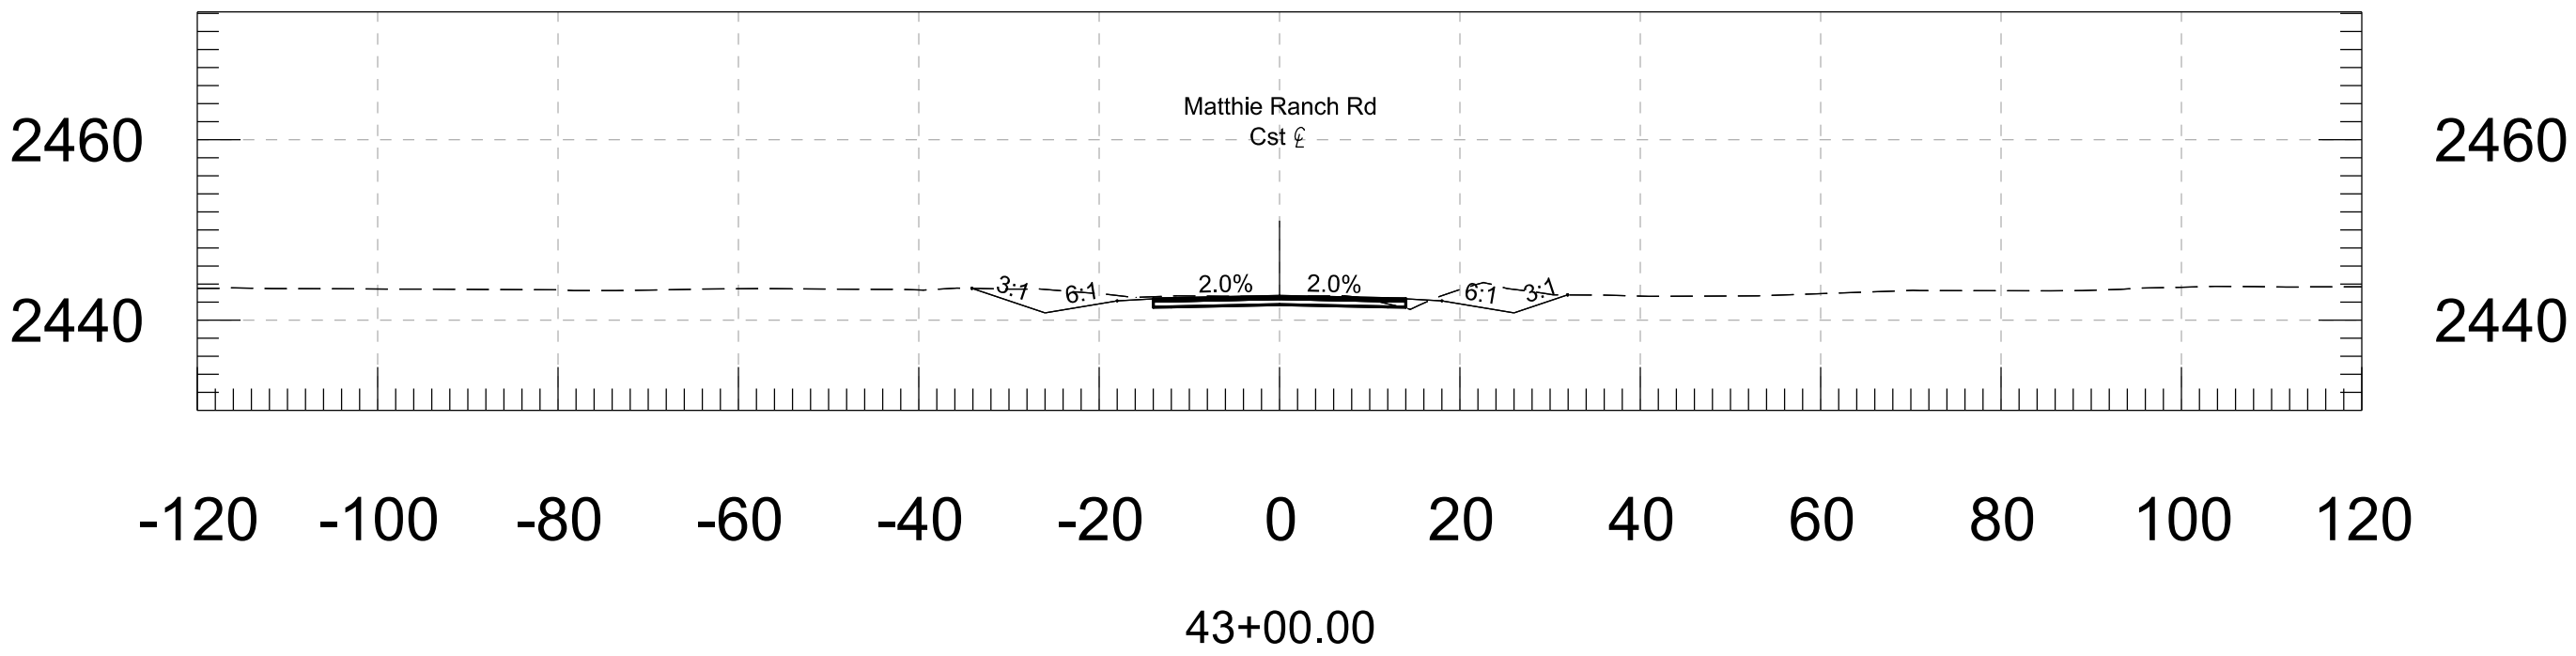

		NAME	DATE	ARIZONA DEPARTMENT OF TRANSPORTATION PROJECT DELIVERY AND OPERATIONS DIVISION ROADWAY DESIGN SERVICES	
DESIGN		ZSZ	06-26		
DRAWN		RM	06-26		
CHECKED		DBK	06-26		
 Stanley Consultants Inc.		3133 East Camelback Road, Suite 100 Phoenix, Arizona 85016 Phone: (602) 353-2200		CROSS SECTIONS	
ROUTE		LOCATION			
US 93		WICKENBURG RANCH WAY TO VISTA ROYALE			
		DWG NO. 101			
TRACS NO. F0738 OIC				093-B(230)T	
				___ OF ___	




F.H.W.A. REGION	STATE	PROJECT NO.	SHEET NO.	TOTAL SHEETS	RECORD DRAWING
9	ARIZ.	093-B(230)T	103	116	

093 YV 189

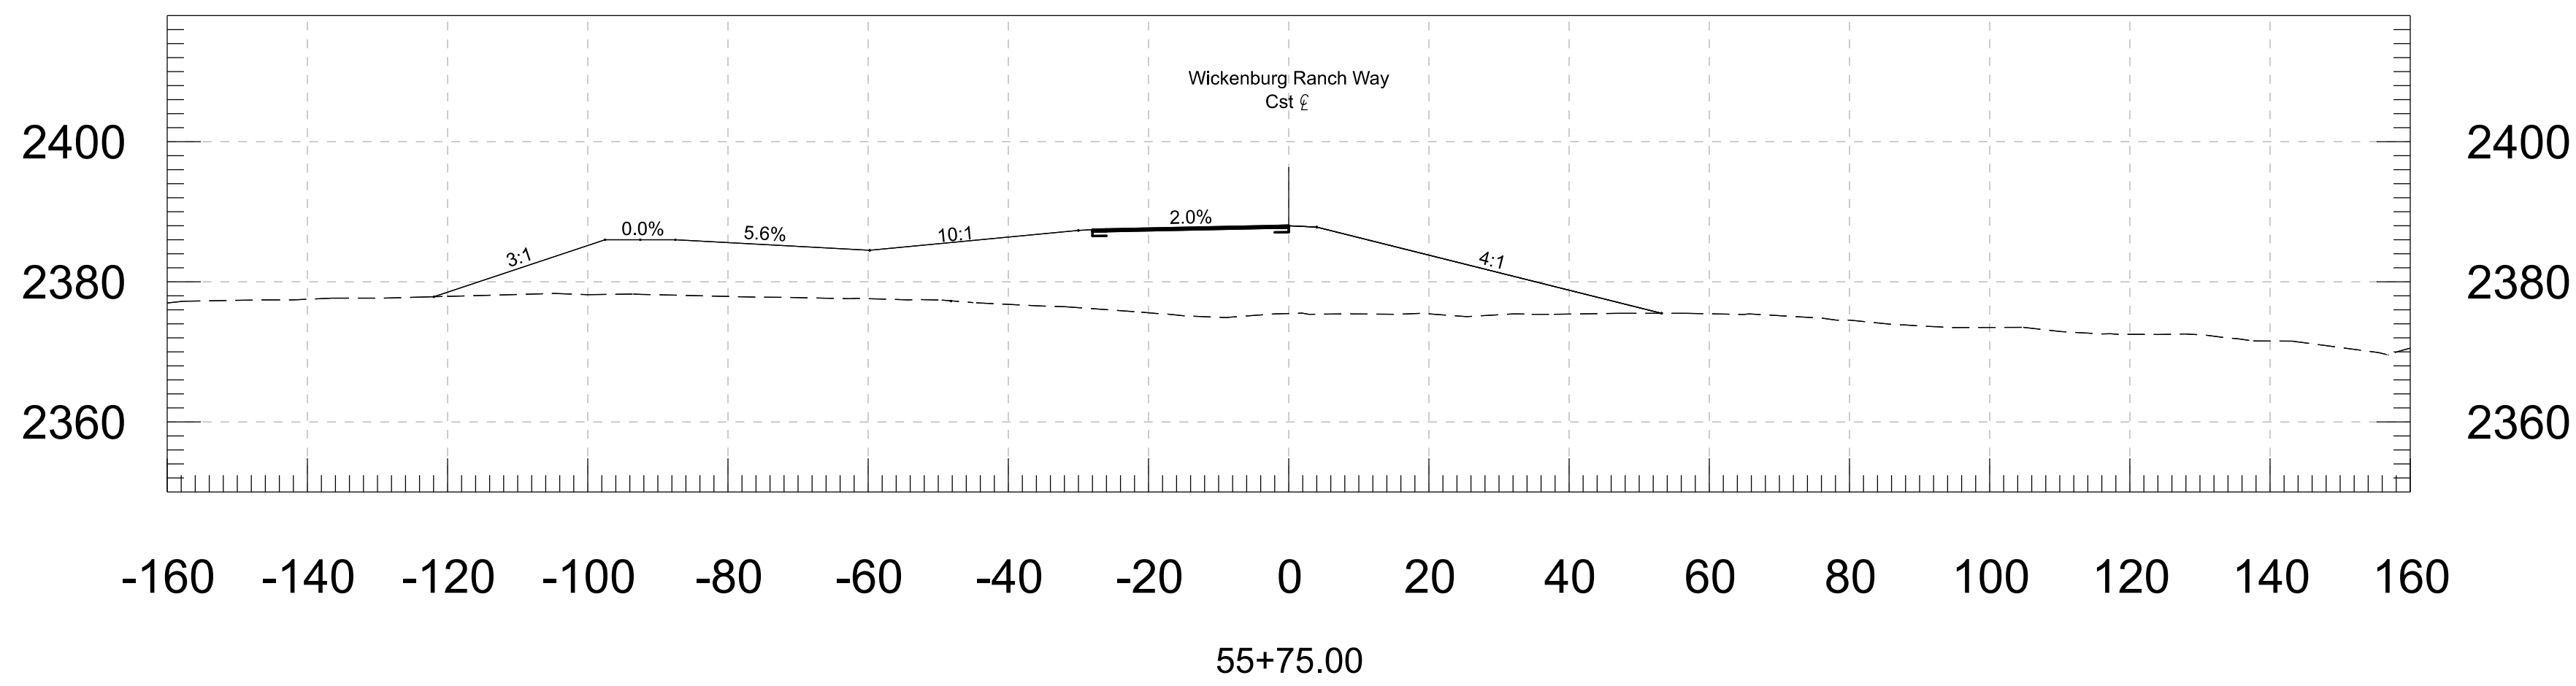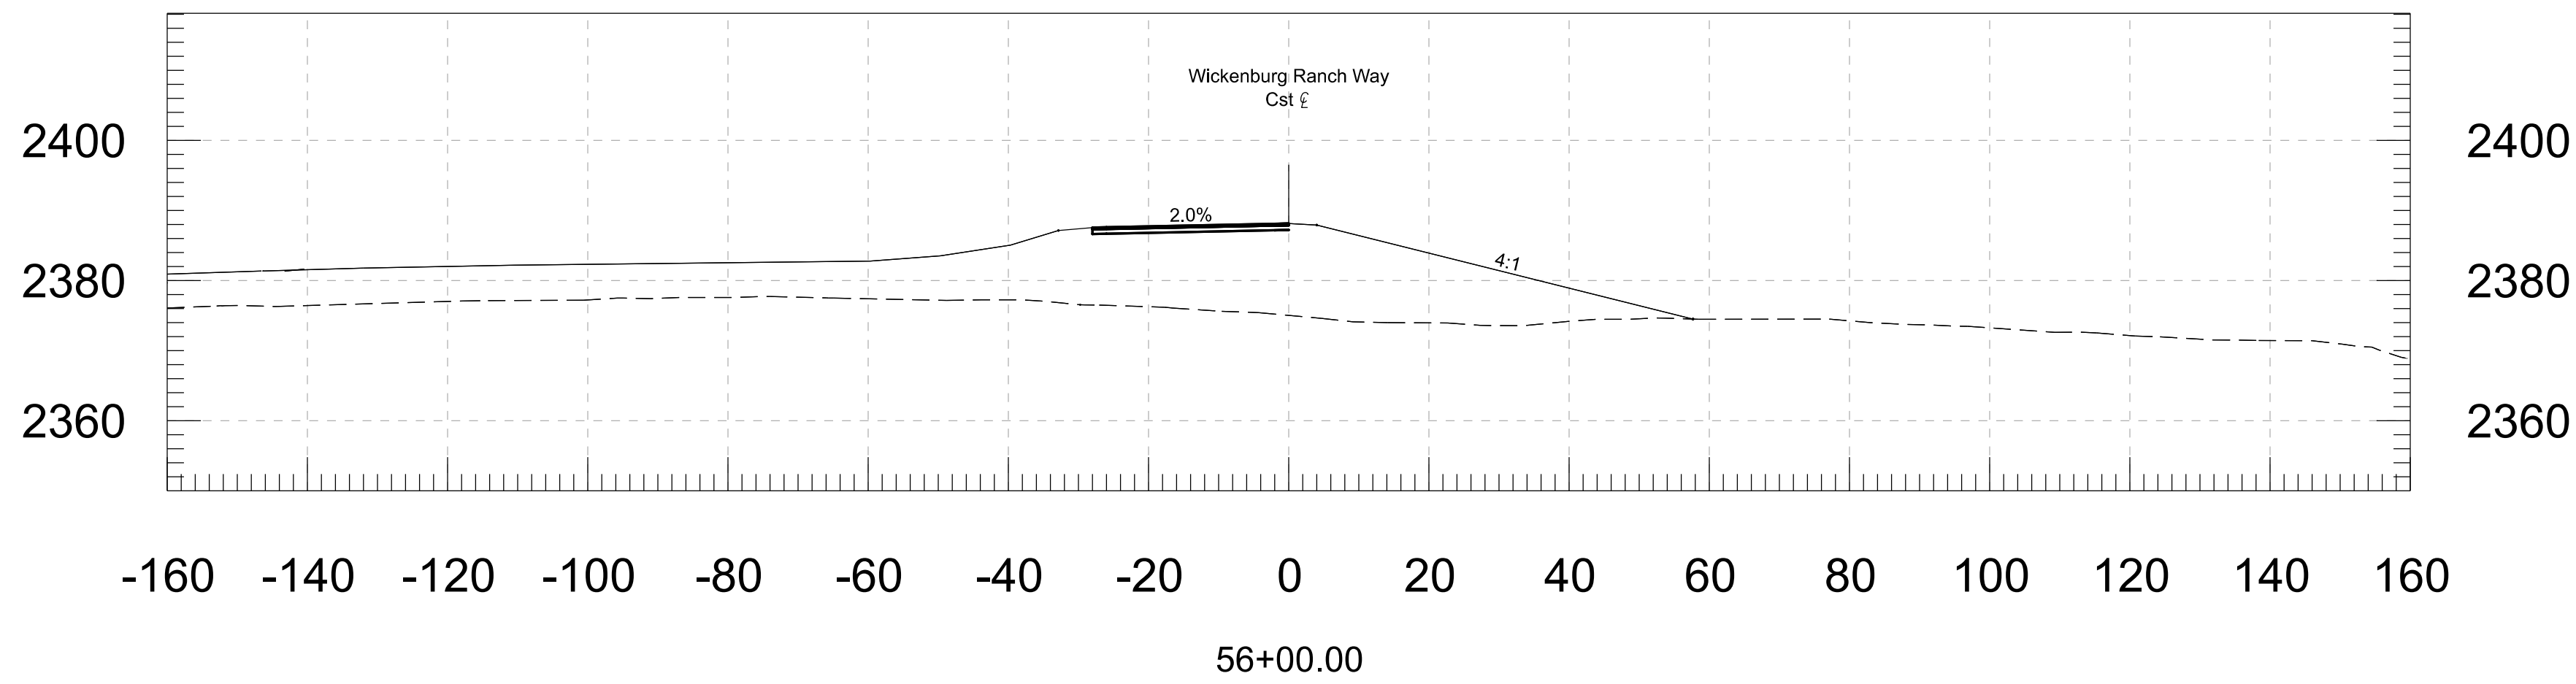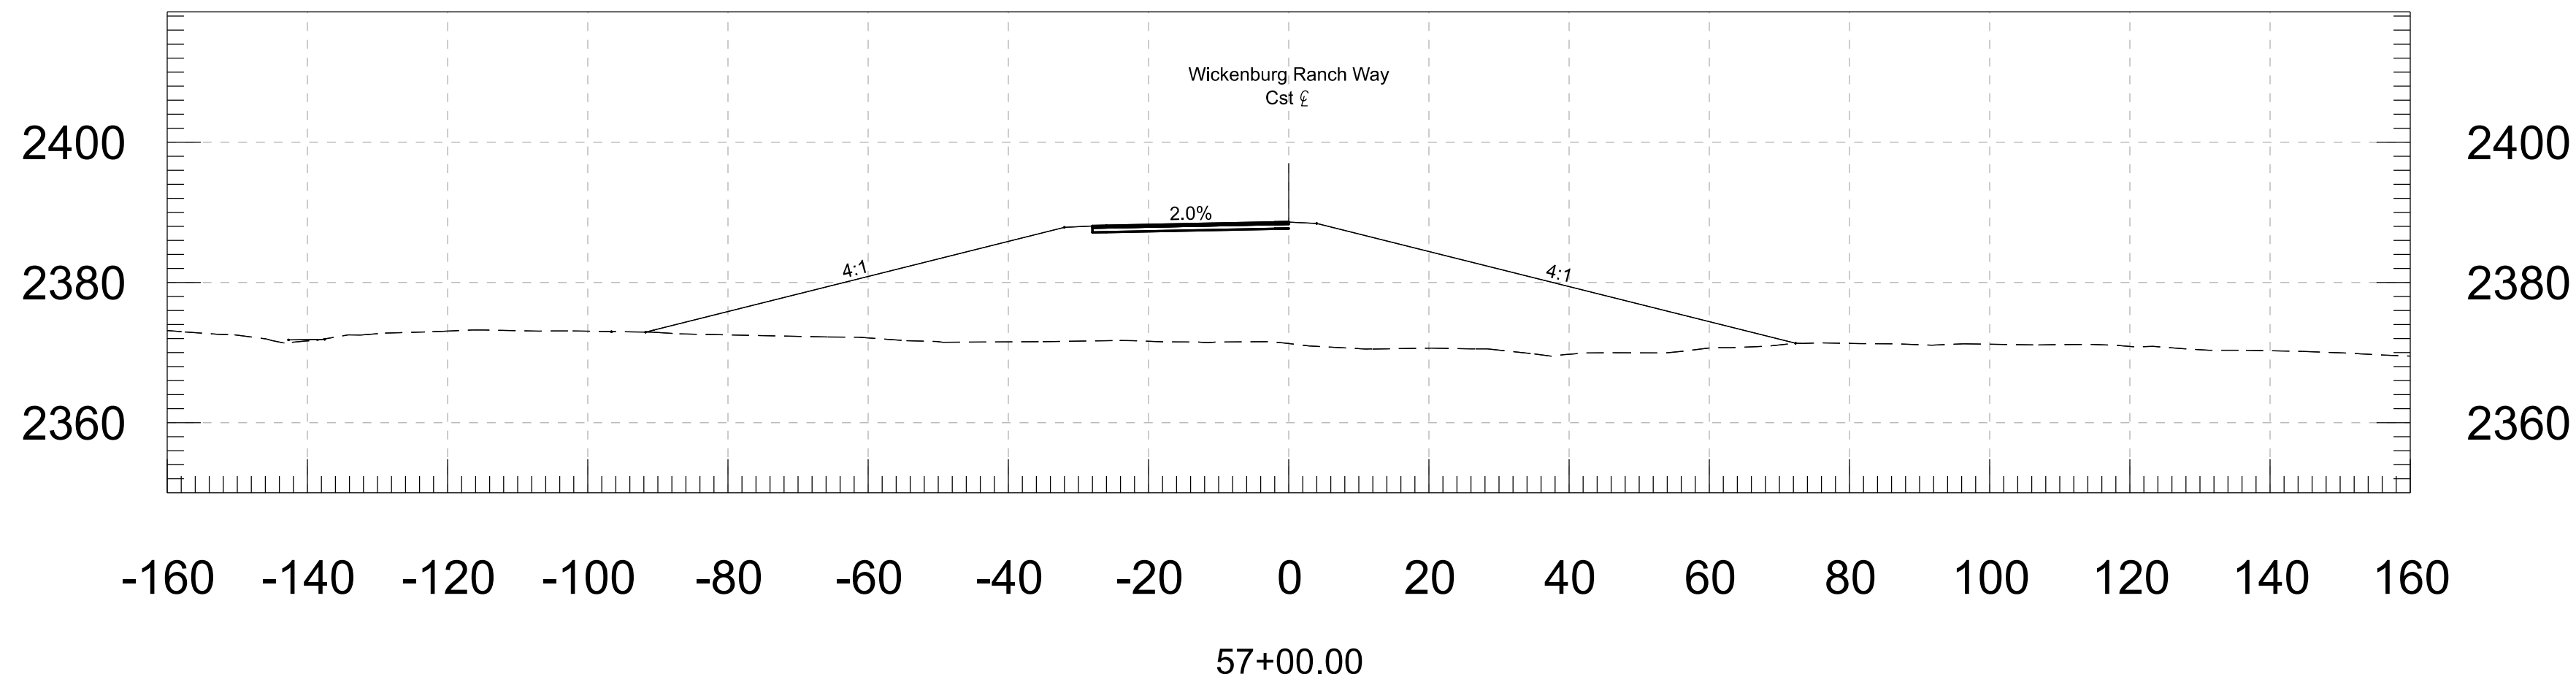




		NAME	DATE	ARIZONA DEPARTMENT OF TRANSPORTATION PROJECT DELIVERY AND OPERATIONS DIVISION ROADWAY DESIGN SERVICES		CROSS SECTIONS	
DESIGN	ZSZ		06-26				
DRAWN	RM		06-26				
CHECKED	DBK		06-26				
		3133 East Camelback Road, Suite 100 Phoenix, Arizona 85016 Phone: 602-335-2200					
Stanley Consultants inc.							
ROUTE		LOCATION		US 93 WICKENBURG RANCH WAY TO VISTA ROYALE		DWG NO. 102	
US 93							
TRACS NO. F0738 OIC				093-B(230)T	___ OF ___		

F.H.W.A. REGION	STATE	PROJECT NO.	SHEET NO.	TOTAL SHEETS	RECORD DRAWING
9	ARIZ.	093-B(230)T	104	116	
093 YV 189					

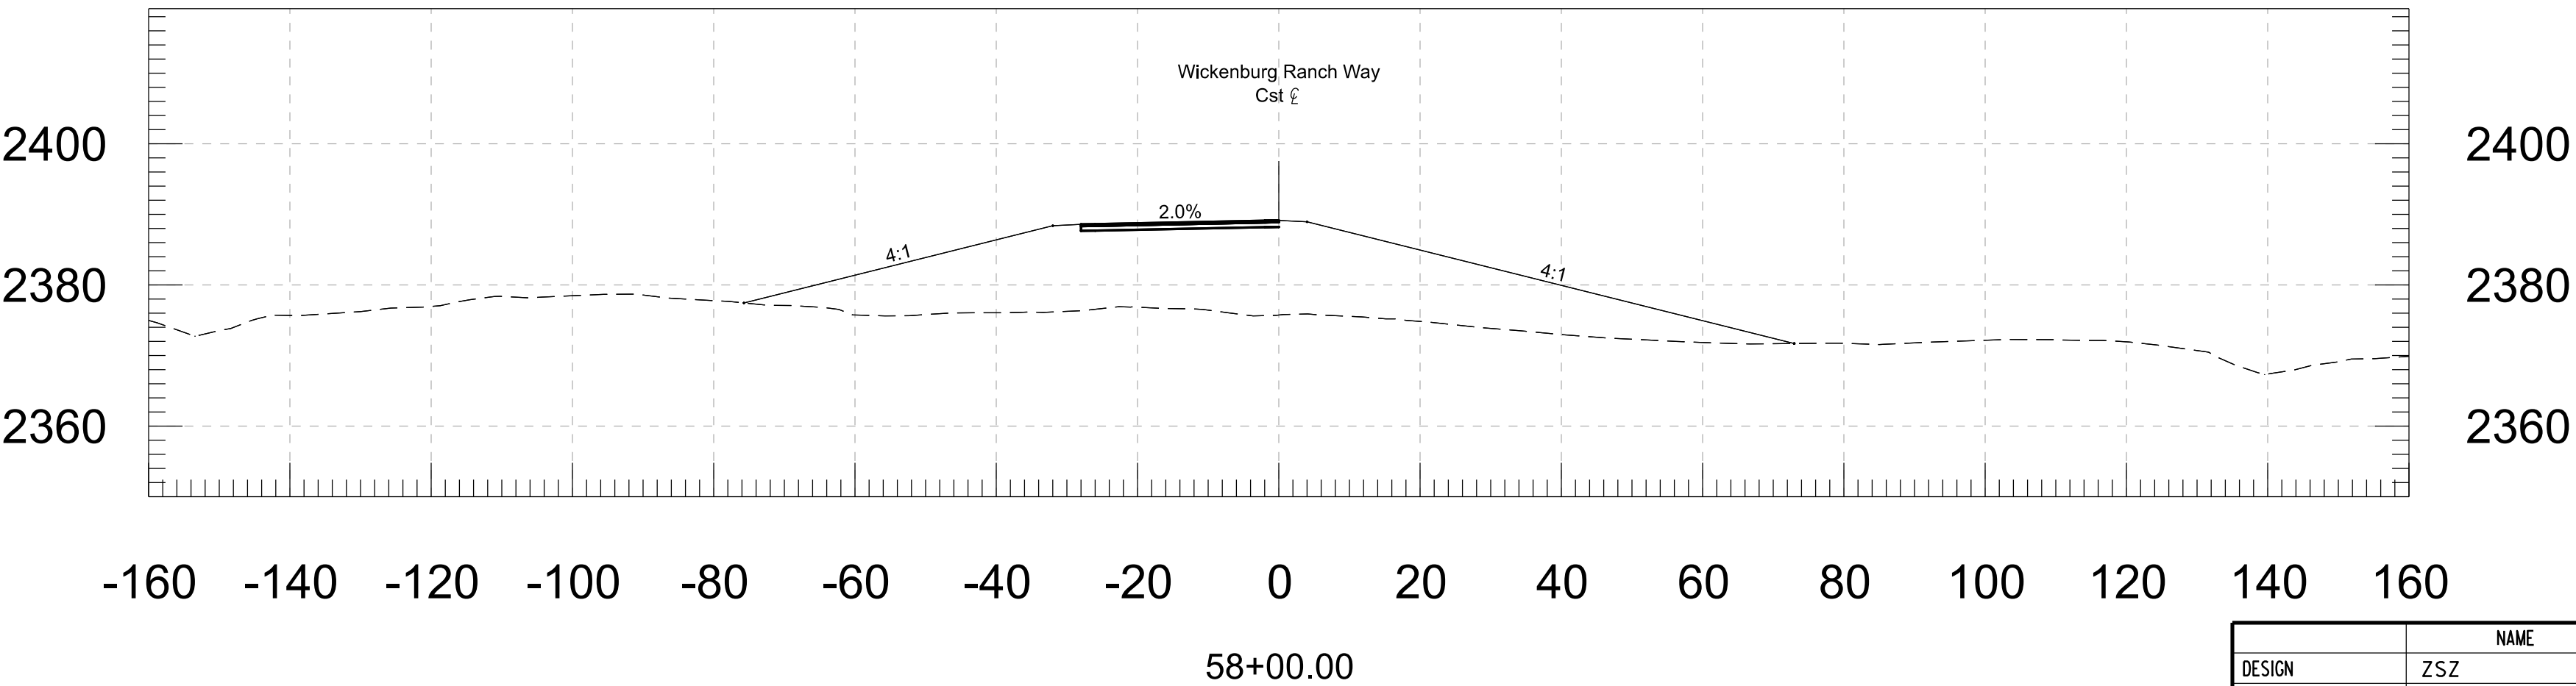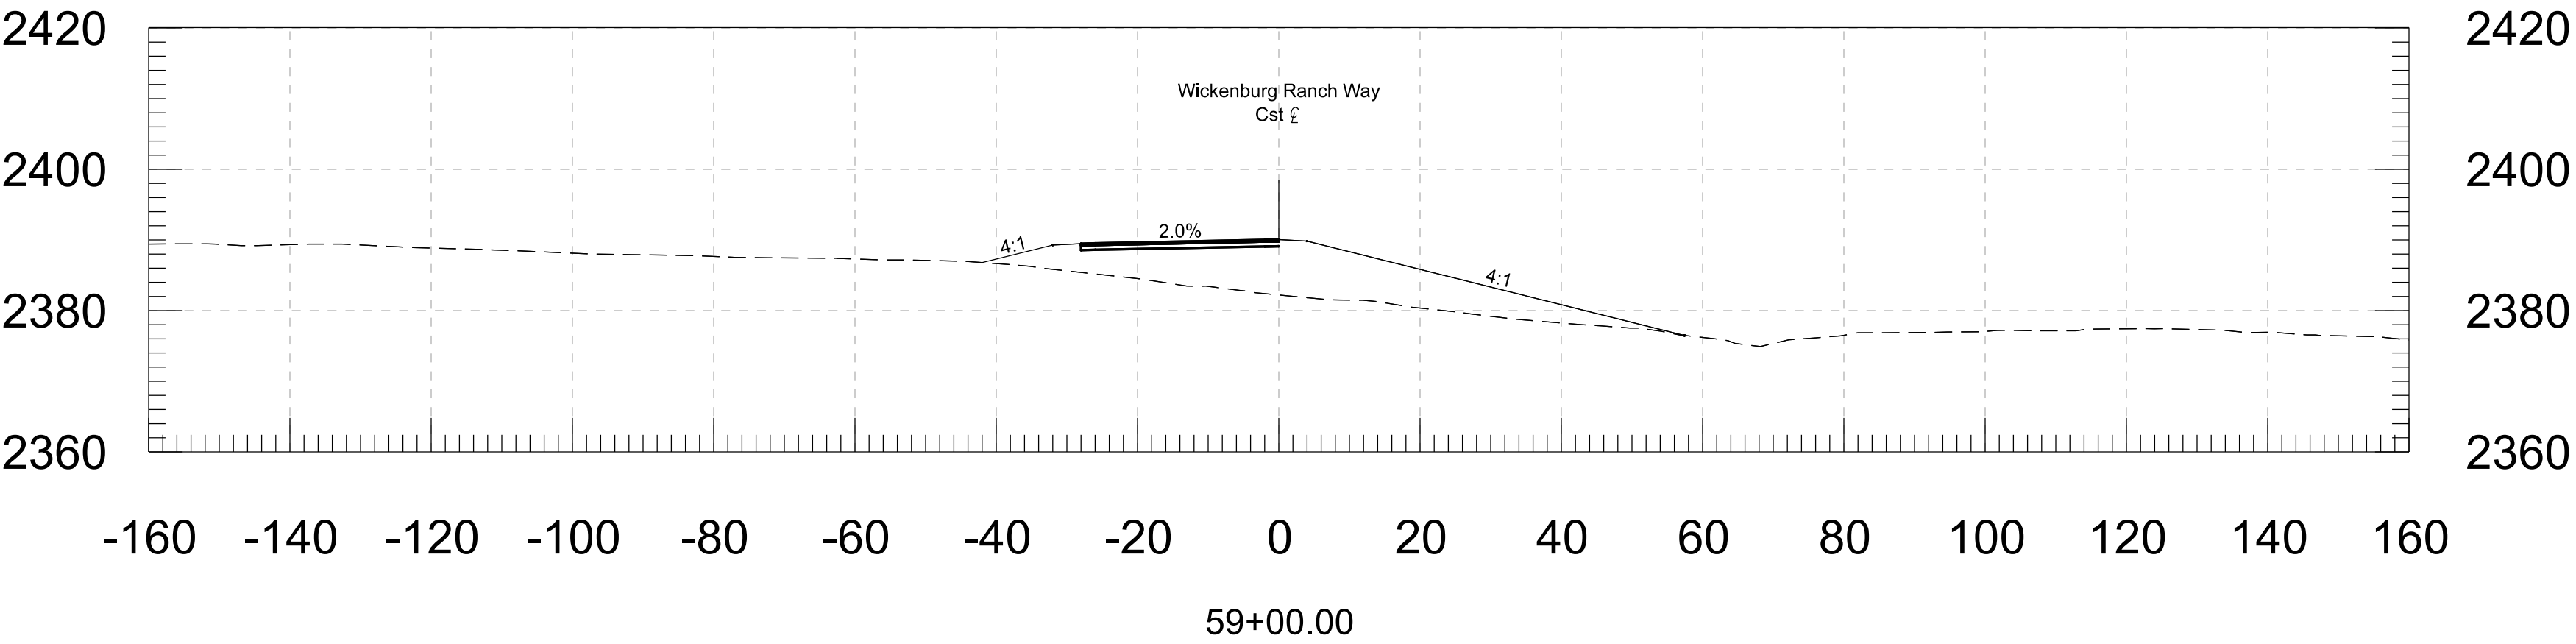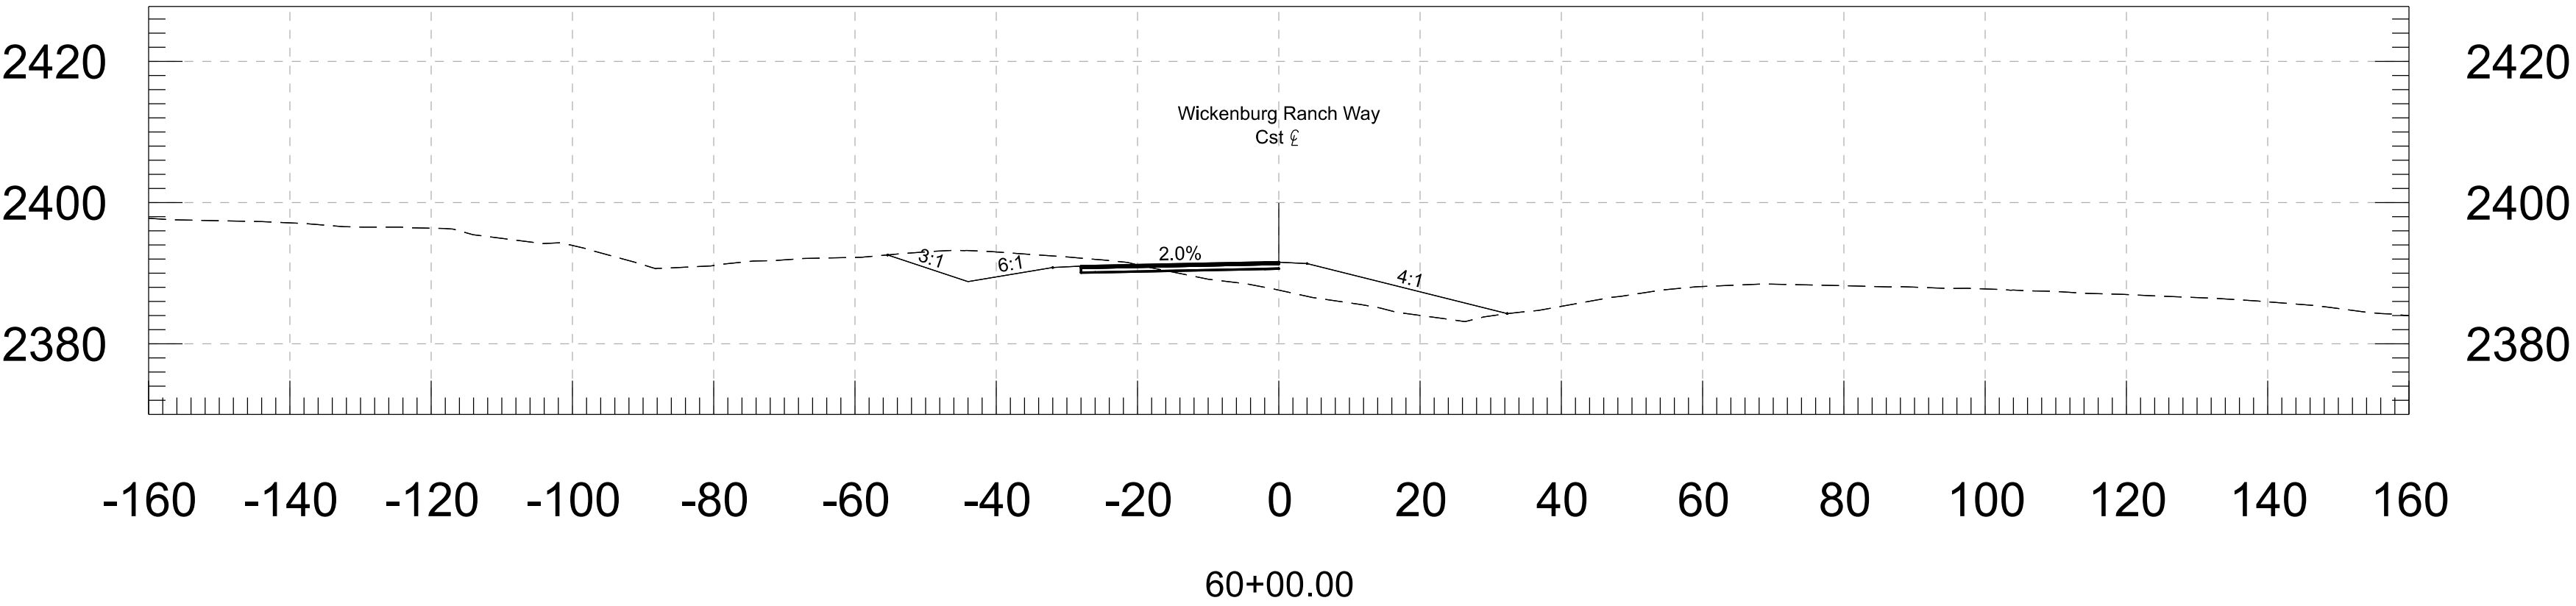



		NAME	DATE	ARIZONA DEPARTMENT OF TRANSPORTATION PROJECT DELIVERY AND OPERATIONS DIVISION ROADWAY DESIGN SERVICES	
DESIGN	ZSZ		06-26		
DRAWN	RM		06-26		
CHECKED	DBK		06-26		
 Stanley Consultants inc. 3133 East Camelback Road, Suite 100 Phoenix, Arizona 85016 Phone: (602) 353-2200				CROSS SECTIONS	
ROUTE		LOCATION		DWG NO. 103	
US 93		WICKENBURG RANCH WAY TO VISTA ROYALE			
TRACS NO. F0738 OIC				093-B(230)T	___ OF ___

F.H.W.A. REGION	STATE	PROJECT NO.	SHEET NO.	TOTAL SHEETS	RECORD DRAWING
9	ARIZ.	093-B(230)T	105	116	
093 YV 189					

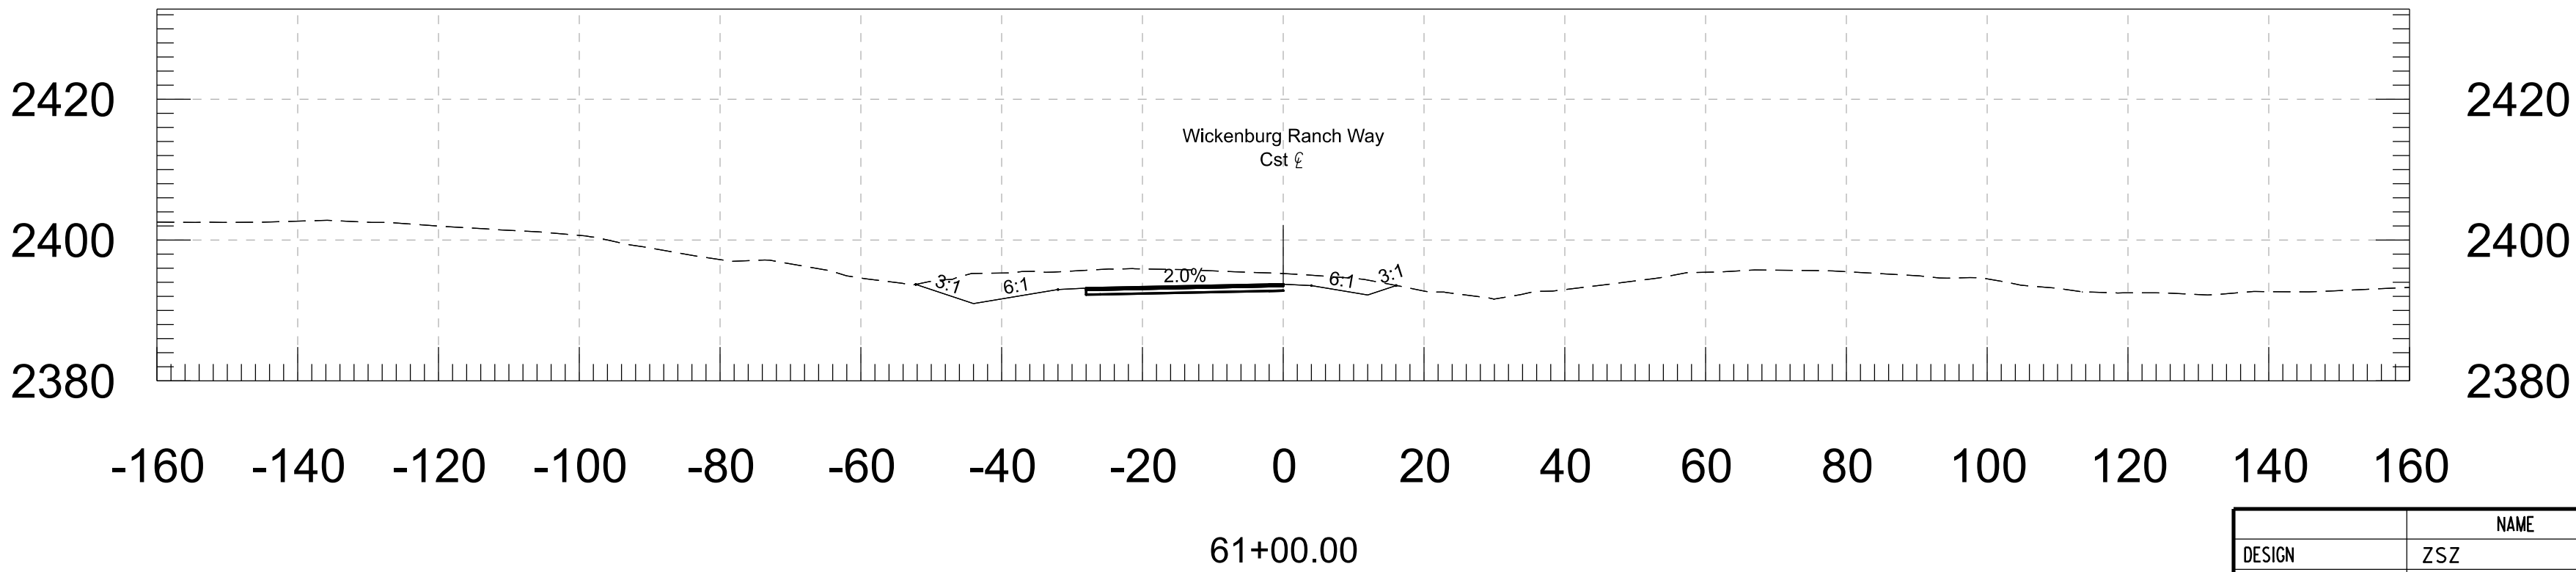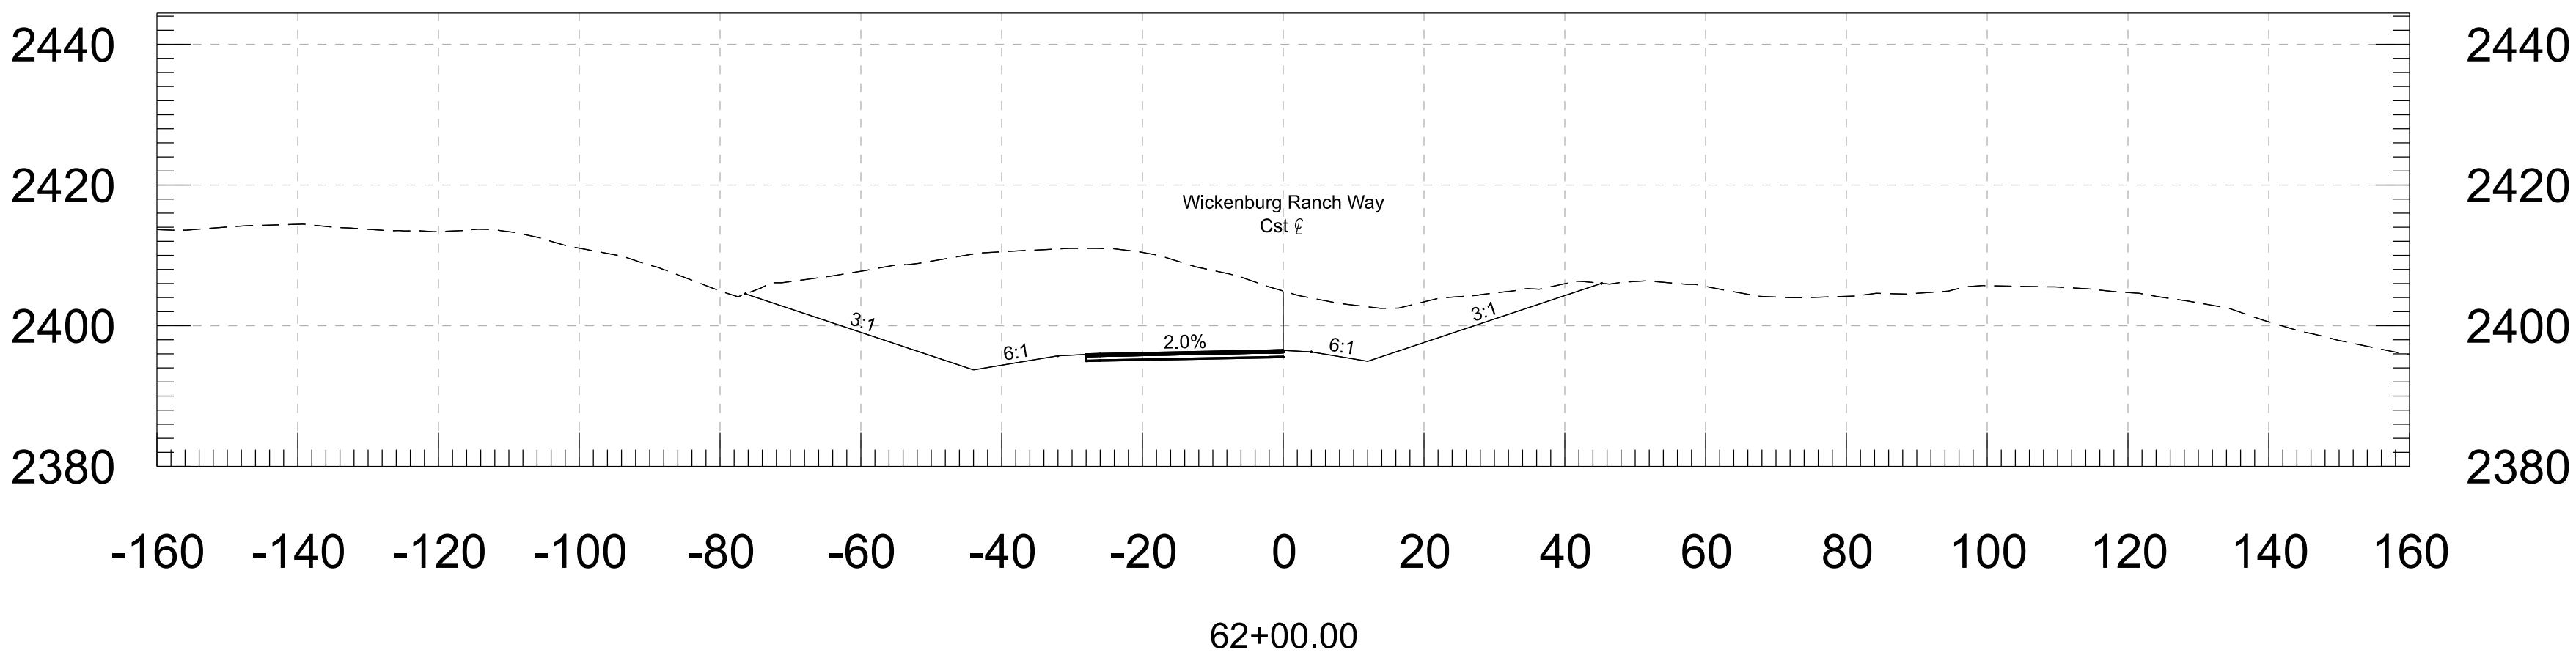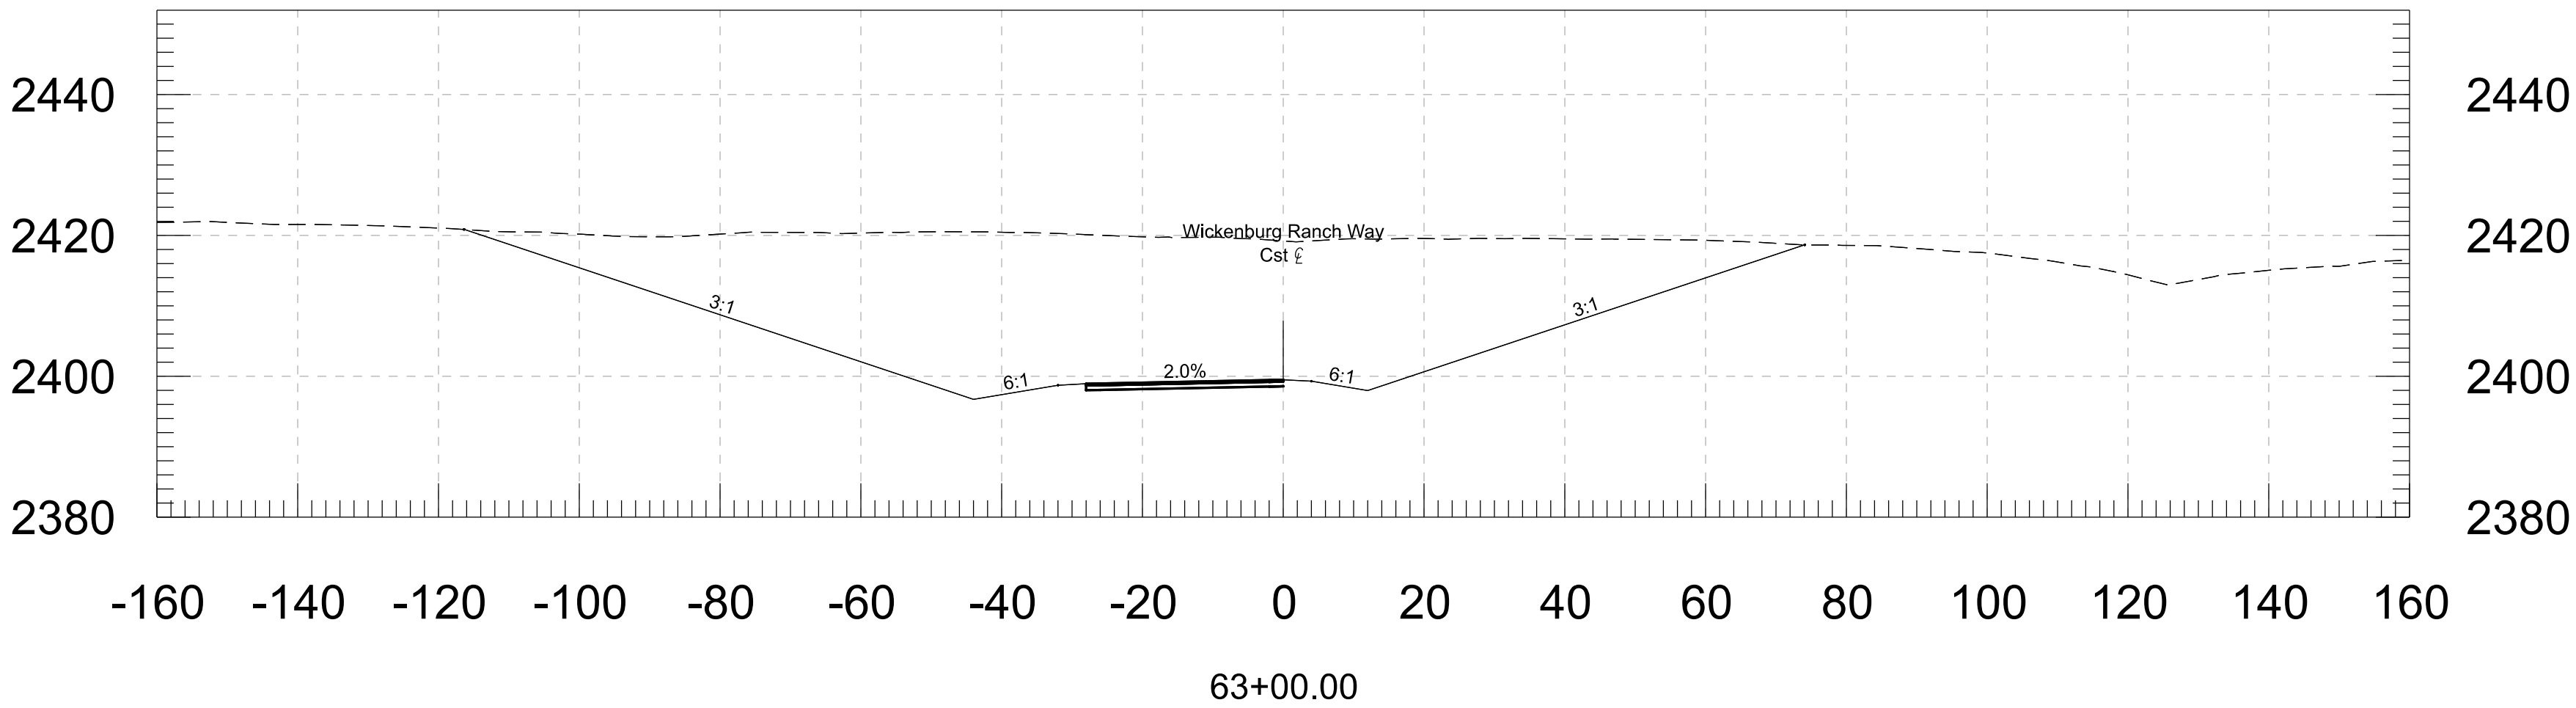




	NAME	DATE	ARIZONA DEPARTMENT OF TRANSPORTATION PROJECT DELIVERY AND OPERATIONS DIVISION ROADWAY DESIGN SERVICES		CROSS SECTIONS	
DESIGN	ZSZ	06-26				
DRAWN	RM	06-26				
CHECKED	DBK	06-26	3133 East Camelback Road, Suite 100 Phoenix, Arizona 85016 Phone: 602-335-2200			
 Stanley Consultants inc.						
ROUTE		LOCATION		DWG NO. 104		
US 93		WICKENBURG RANCH WAY TO VISTA ROYALE				
TRACS NO. F0738 OIC			093-B(230)T		___ OF ___	

F.H.W.A. REGION	STATE	PROJECT NO.	SHEET NO.	TOTAL SHEETS	RECORD DRAWING
9	ARIZ.	093-B(230)T	106	116	
093 YV 189					

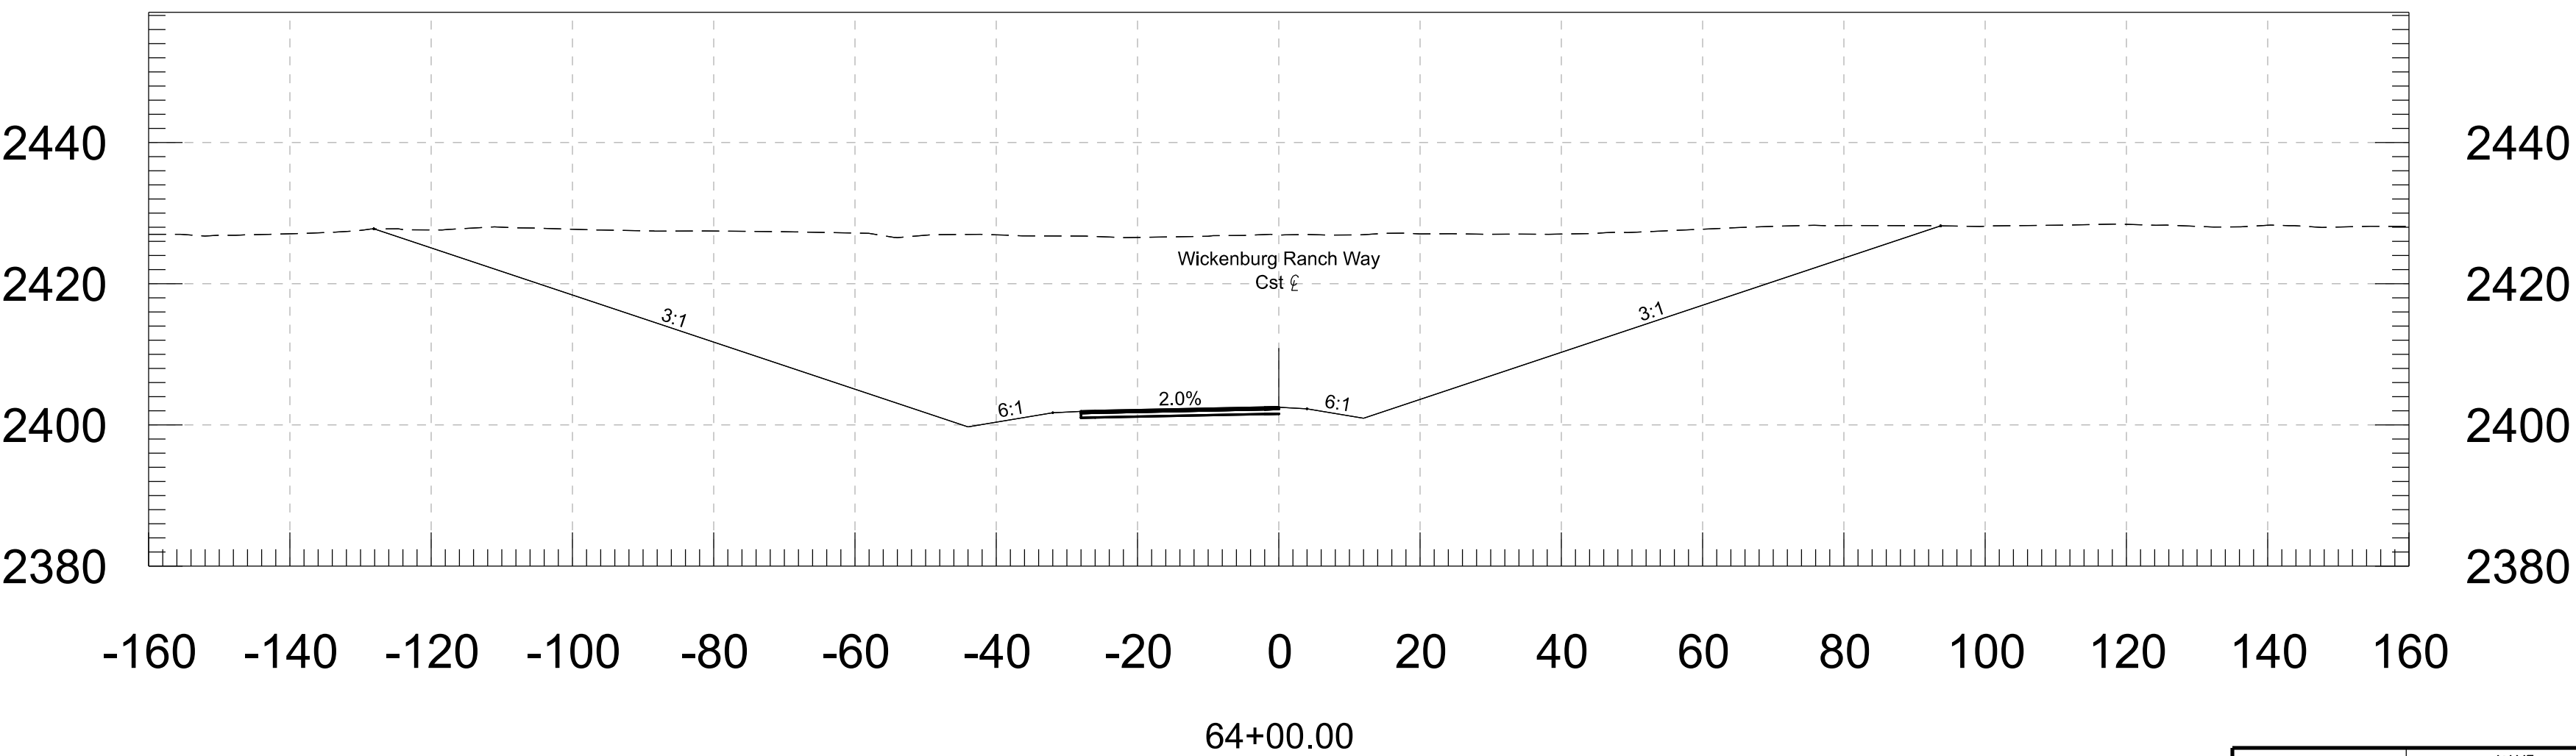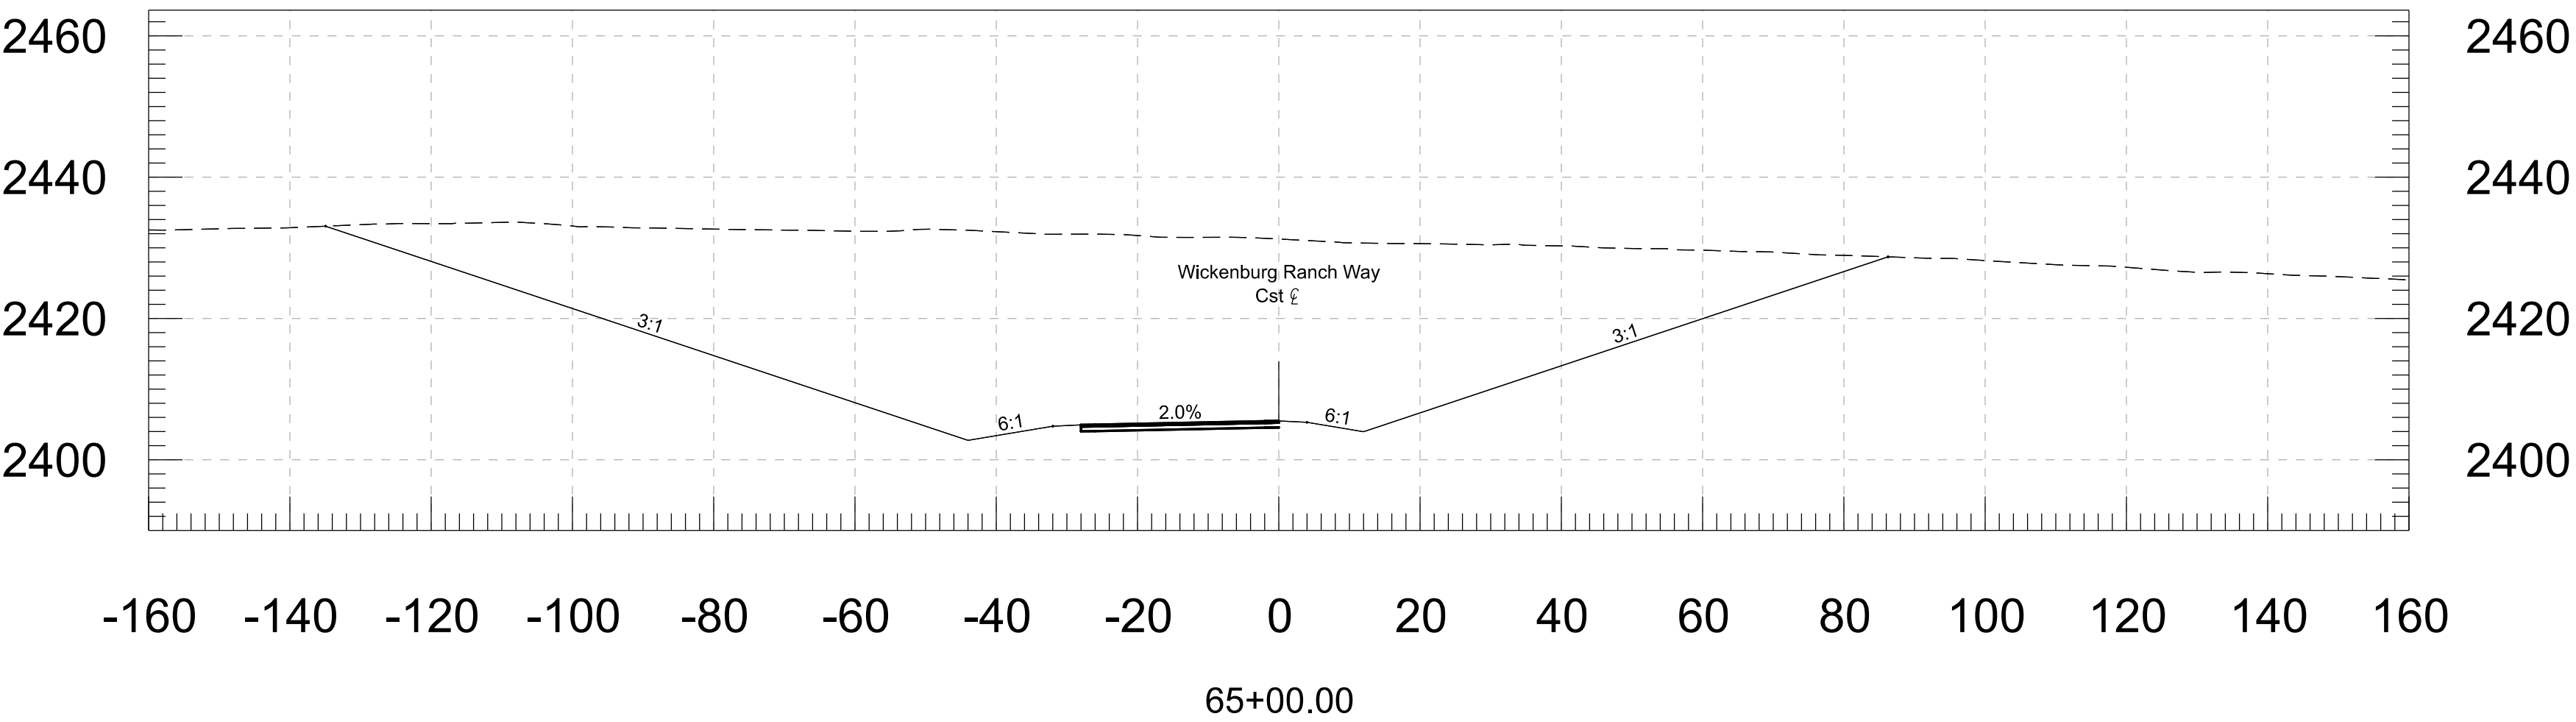

DESIGN	ZSZ	DATE	06-26	ARIZONA DEPARTMENT OF TRANSPORTATION PROJECT DELIVERY AND OPERATIONS DIVISION ROADWAY DESIGN SERVICES	
DRAWN	RM	DATE	06-26		
CHECKED	DBK	DATE	06-26		
Stanley Consultants 333 East Camelback Road, Suite 100 Phoenix, Arizona 85016 Phone: 1602 333-2200				CROSS SECTIONS	
ROUTE		LOCATION			DWG NO. 105
US 93		WICKENBURG RANCH WAY TO VISTA ROYALE			
TRACS NO. F0738 OIC			093-B(230)T		___ OF ___

F.H.W.A. REGION	STATE	PROJECT NO.	SHEET NO.	TOTAL SHEETS	RECORD DRAWING
9	ARIZ.	093-B(230)T	107	116	
093 YV 189					

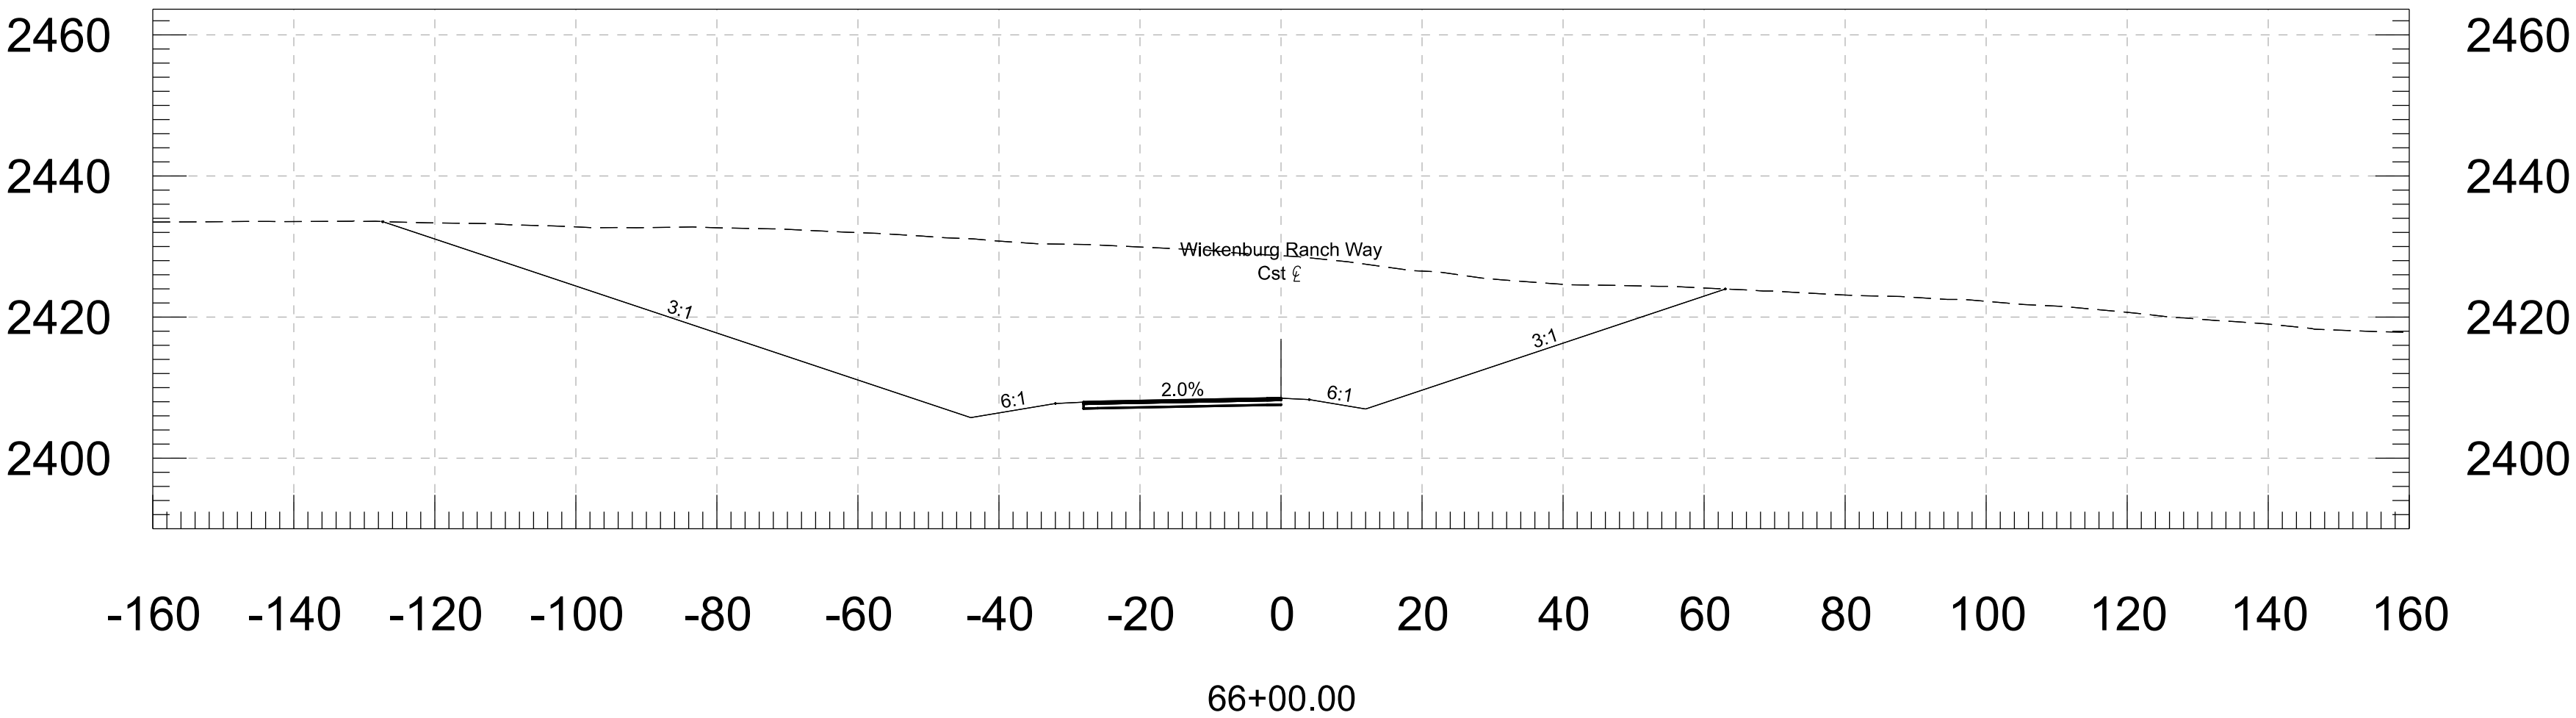
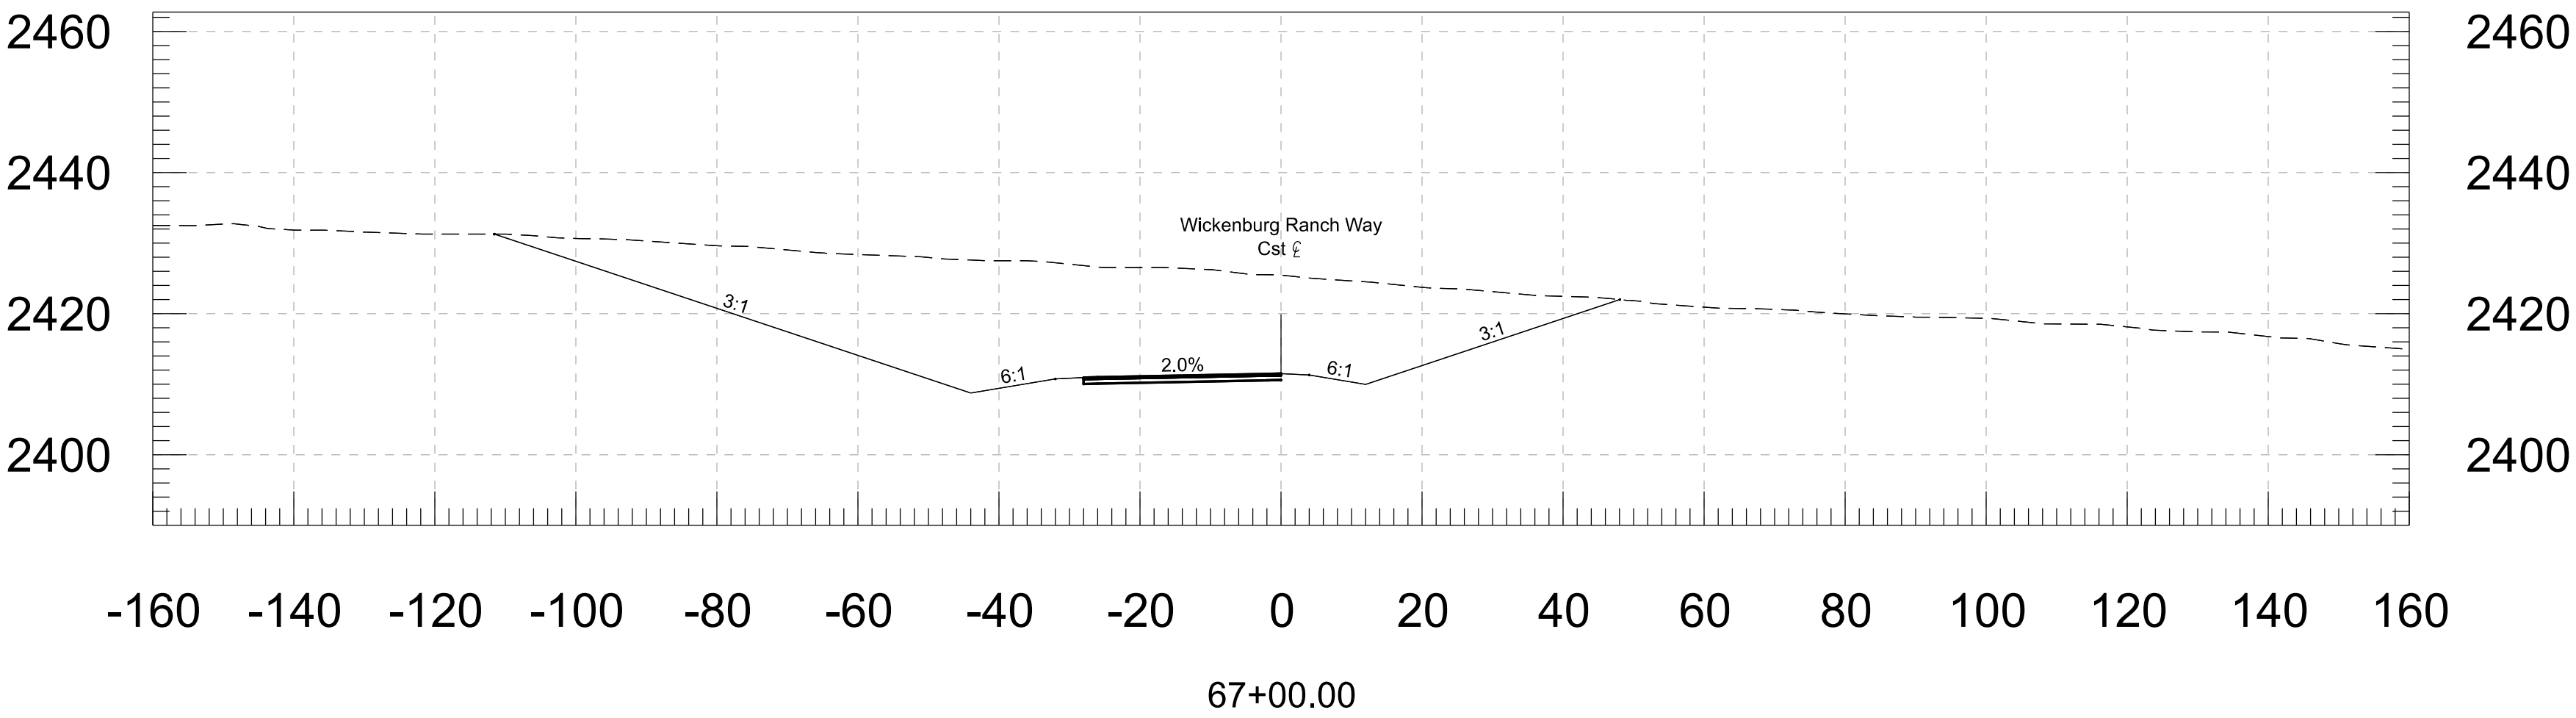
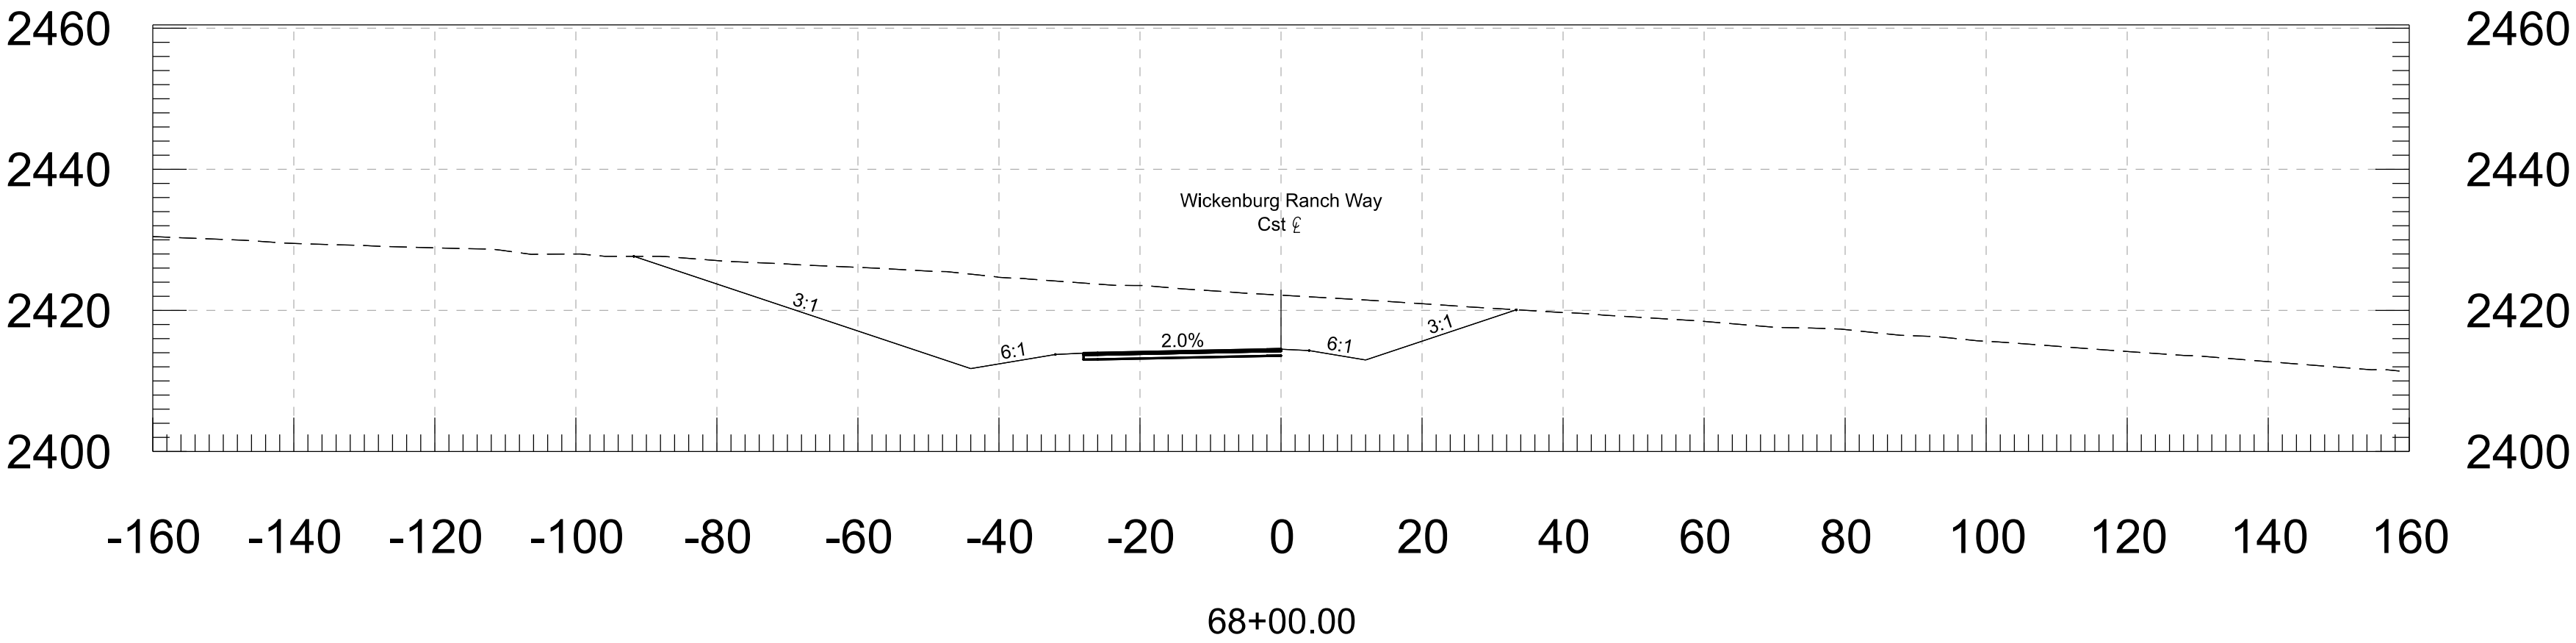


		NAME	DATE	ARIZONA DEPARTMENT OF TRANSPORTATION PROJECT DELIVERY AND OPERATIONS DIVISION ROADWAY DESIGN SERVICES		
DESIGN	ZSZ		06-26			
DRAWN	RM		06-26			
CHECKED	DBK		06-26	CROSS SECTIONS		
 3133 East Camelback Road, Suite 100 Phoenix, Arizona 85016 Phone: 1602/333-2200						
ROUTE		LOCATION			DWG NO. 106	
US 93		WICKENBURG RANCH WAY TO VISTA ROYALE				
TRACS NO. F0738 OIC			093-B(230)T			___ OF ___

DATE- LOCATION- REVISIONS- FINISHED PLANS- SURVEY NO. DATE- LOCATION- REVISIONS- FINISHED PLANS- SURVEY NO.

F.H.W.A. REGION	STATE	PROJECT NO.	SHEET NO.	TOTAL SHEETS	RECORD DRAWING
9	ARIZ.	093-B(230)T	108	116	




093 YV 189

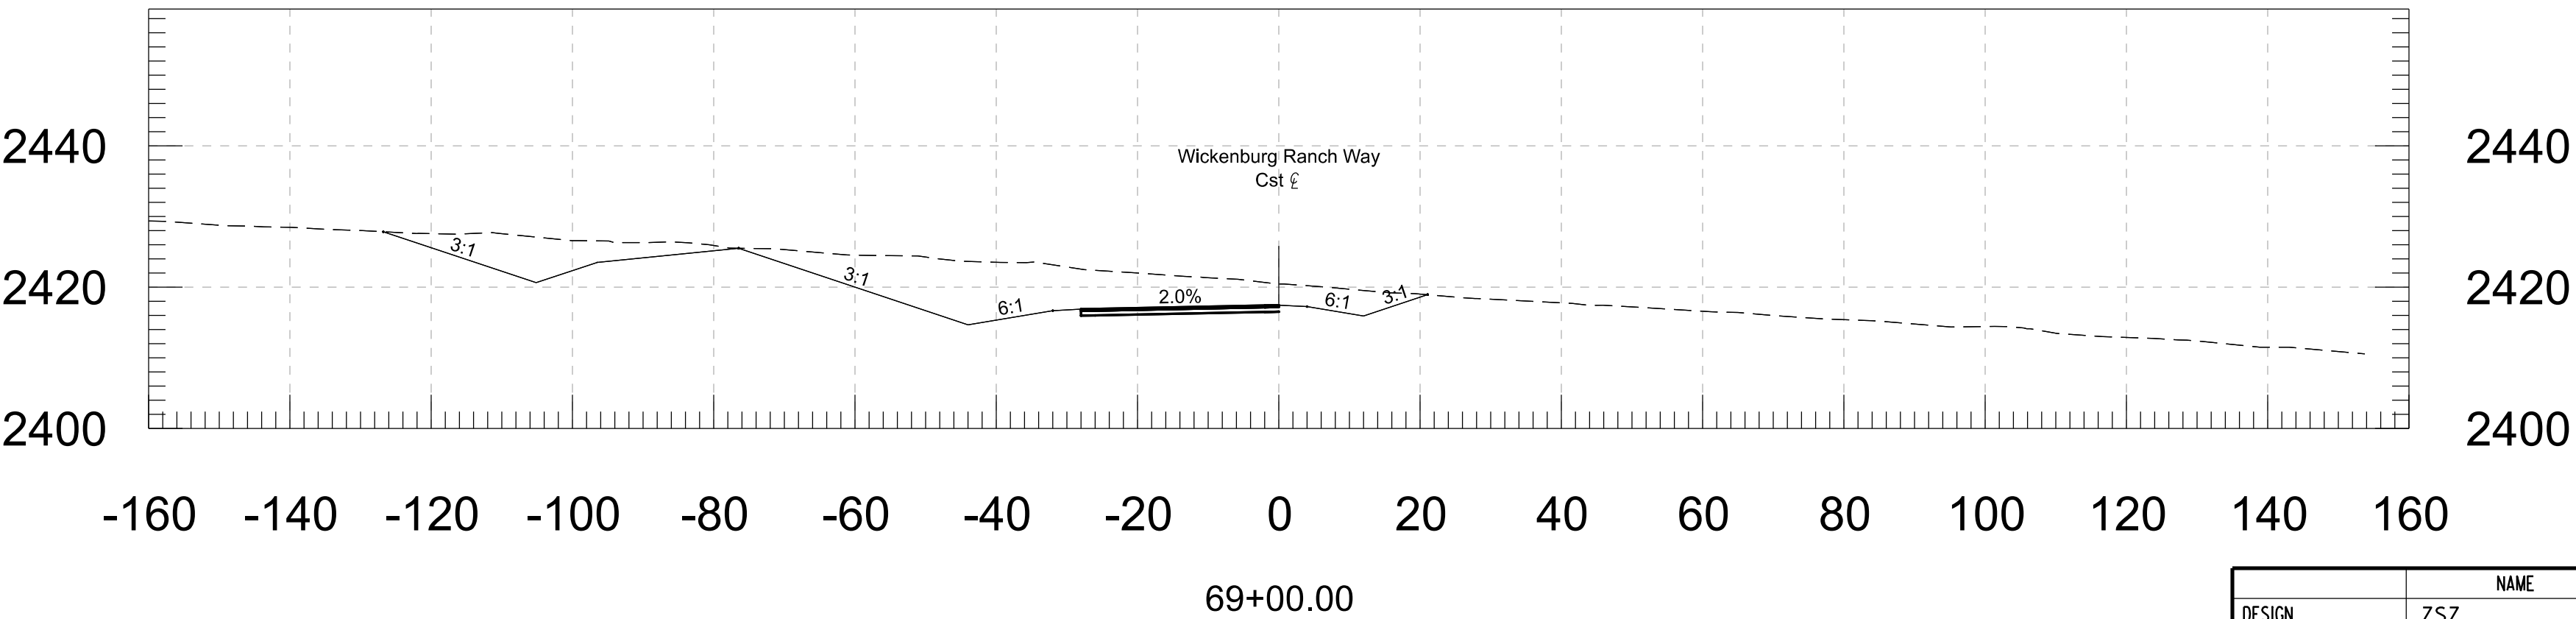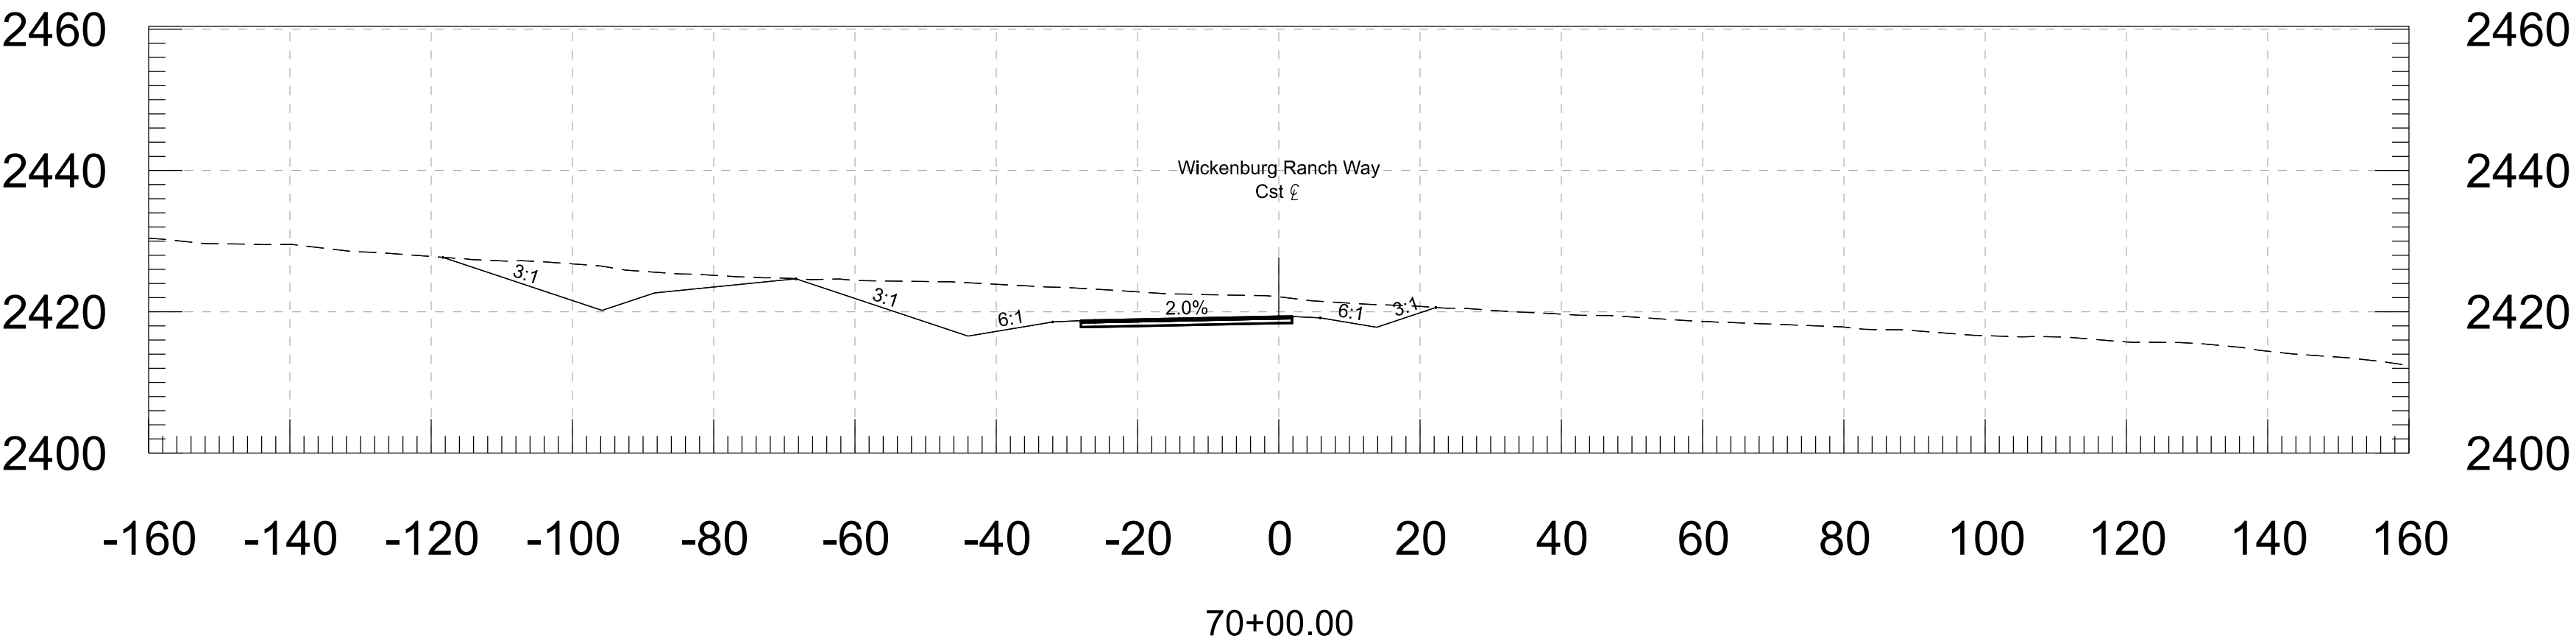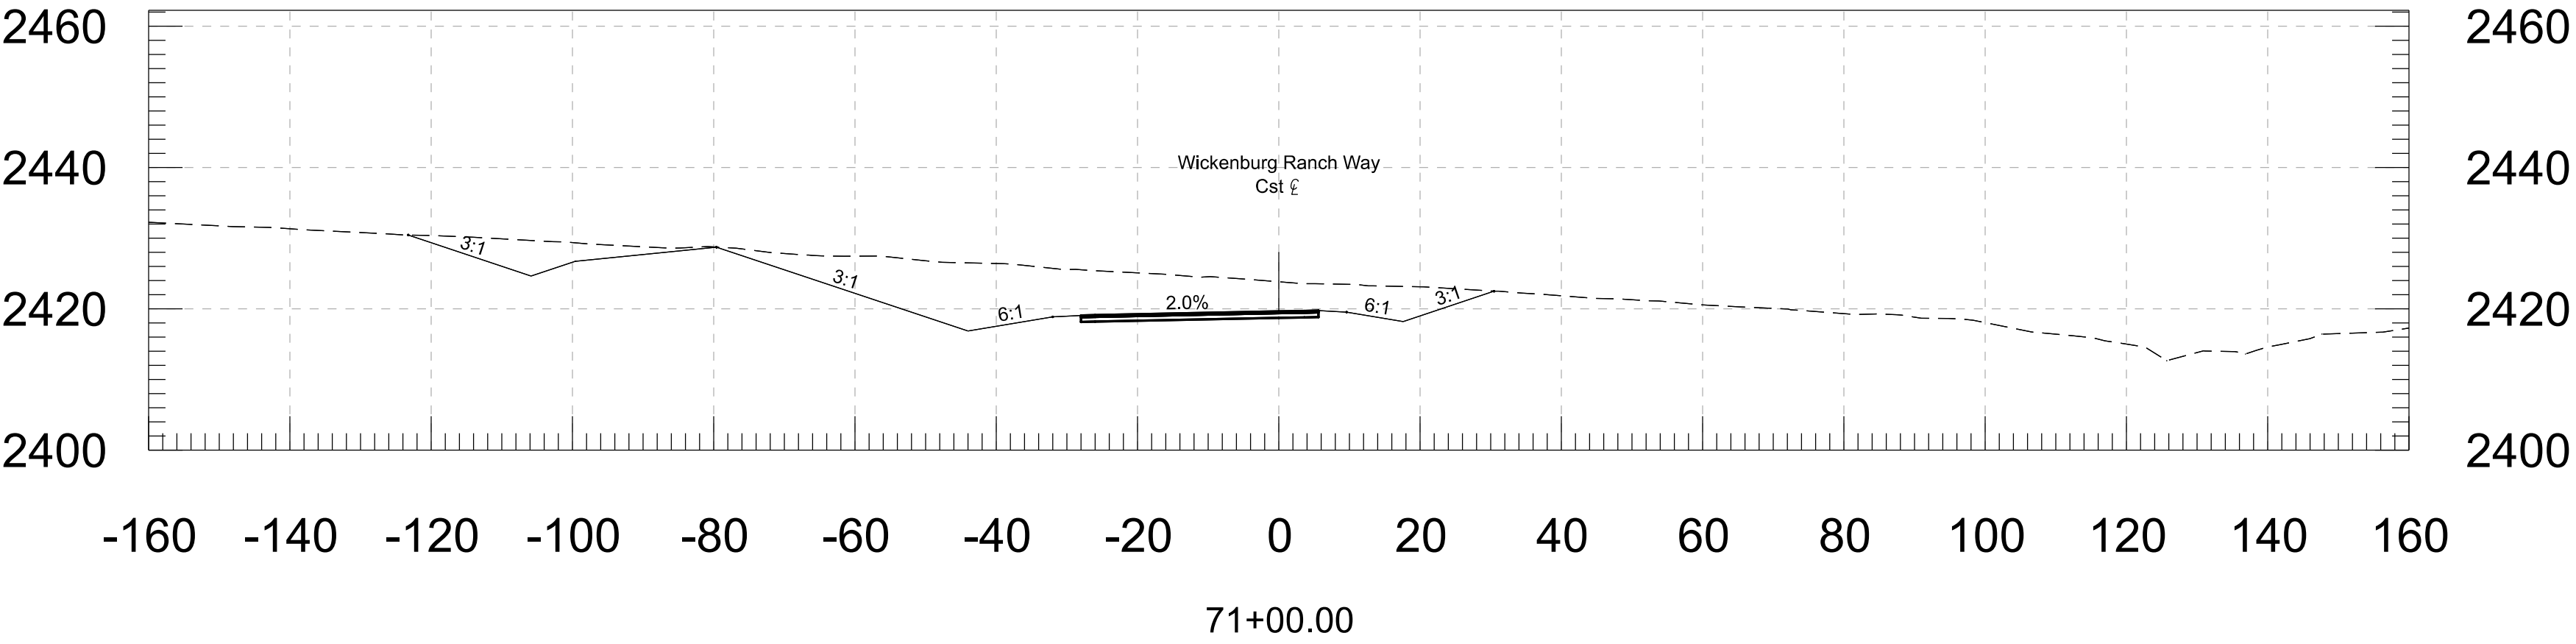

DESIGN	ZSZ	NAME	DATE	ARIZONA DEPARTMENT OF TRANSPORTATION PROJECT DELIVERY AND OPERATIONS DIVISION ROADWAY DESIGN SERVICES	
DRAWN	RM		06-26		
CHECKED	DBK		06-26		
 3133 East Camelback Road, Suite 100 Phoenix, Arizona 85016 Phone: 1602/333-2200				CROSS SECTIONS	
ROUTE		LOCATION			DWG NO. 107
US 93		WICKENBURG RANCH WAY TO VISTA ROYALE			
TRACS NO. F0738 OIC		093-B(230)T		___ OF ___	



F.H.W.A. REGION	STATE	PROJECT NO.	SHEET NO.	TOTAL SHEETS	RECORD DRAWING
9	ARIZ.	093-B(230)T	109	116	

093 YV 189

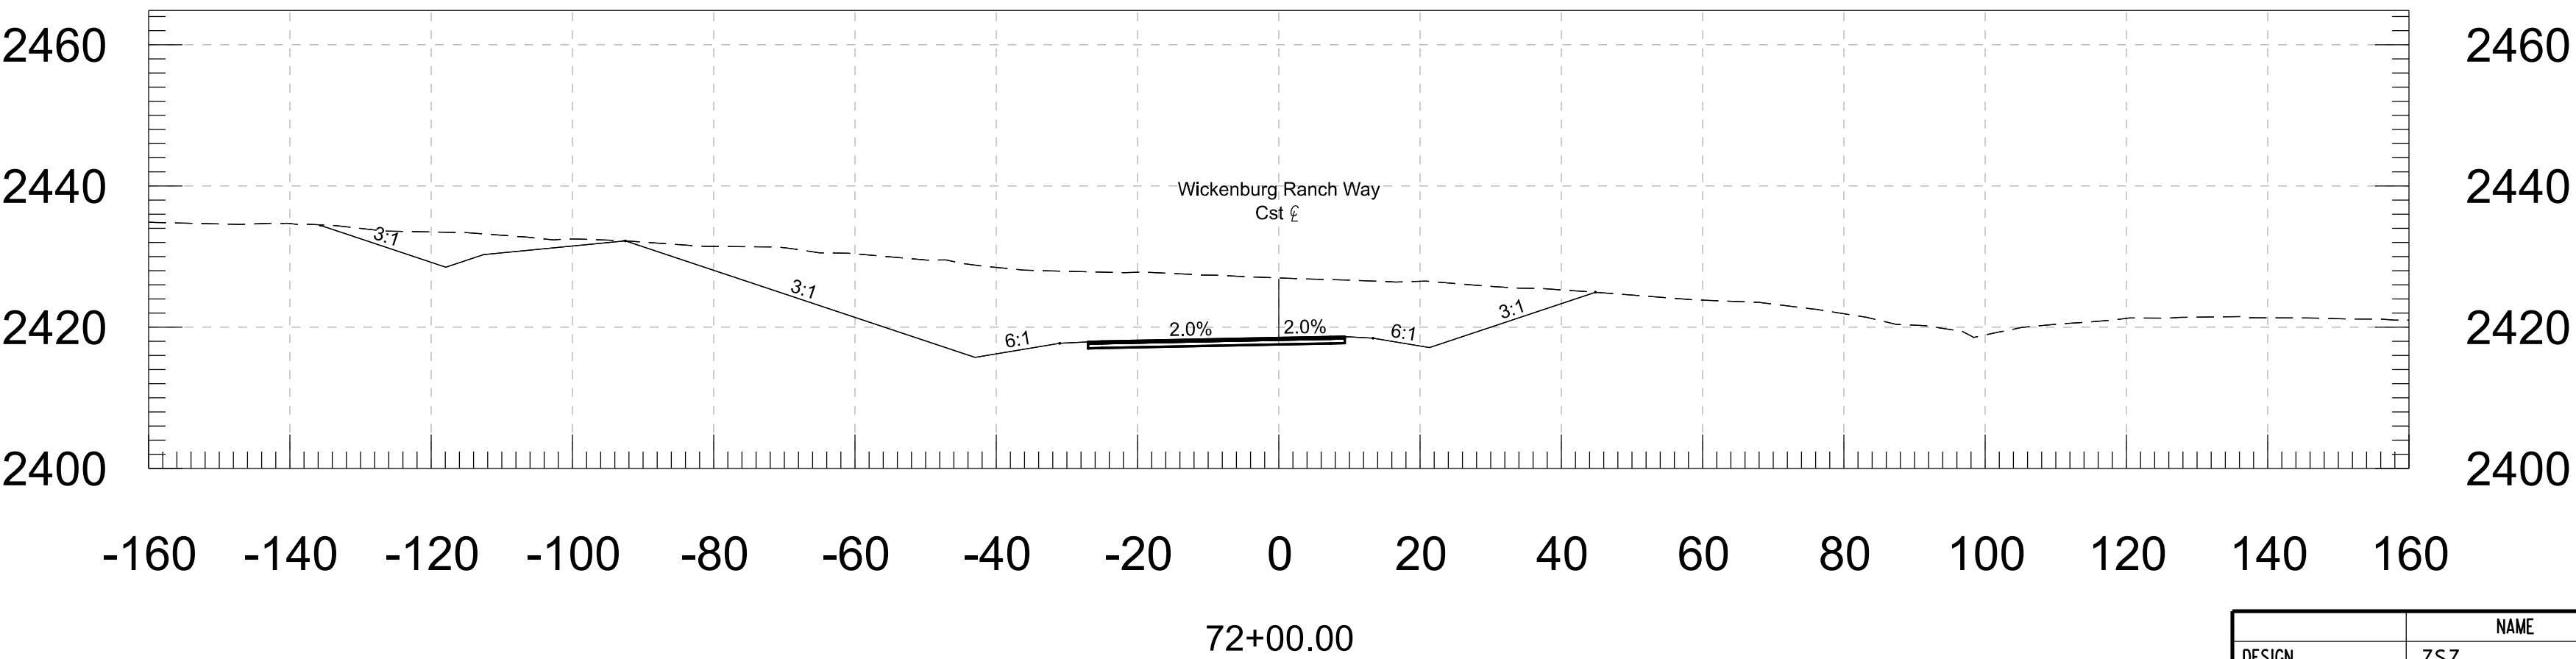
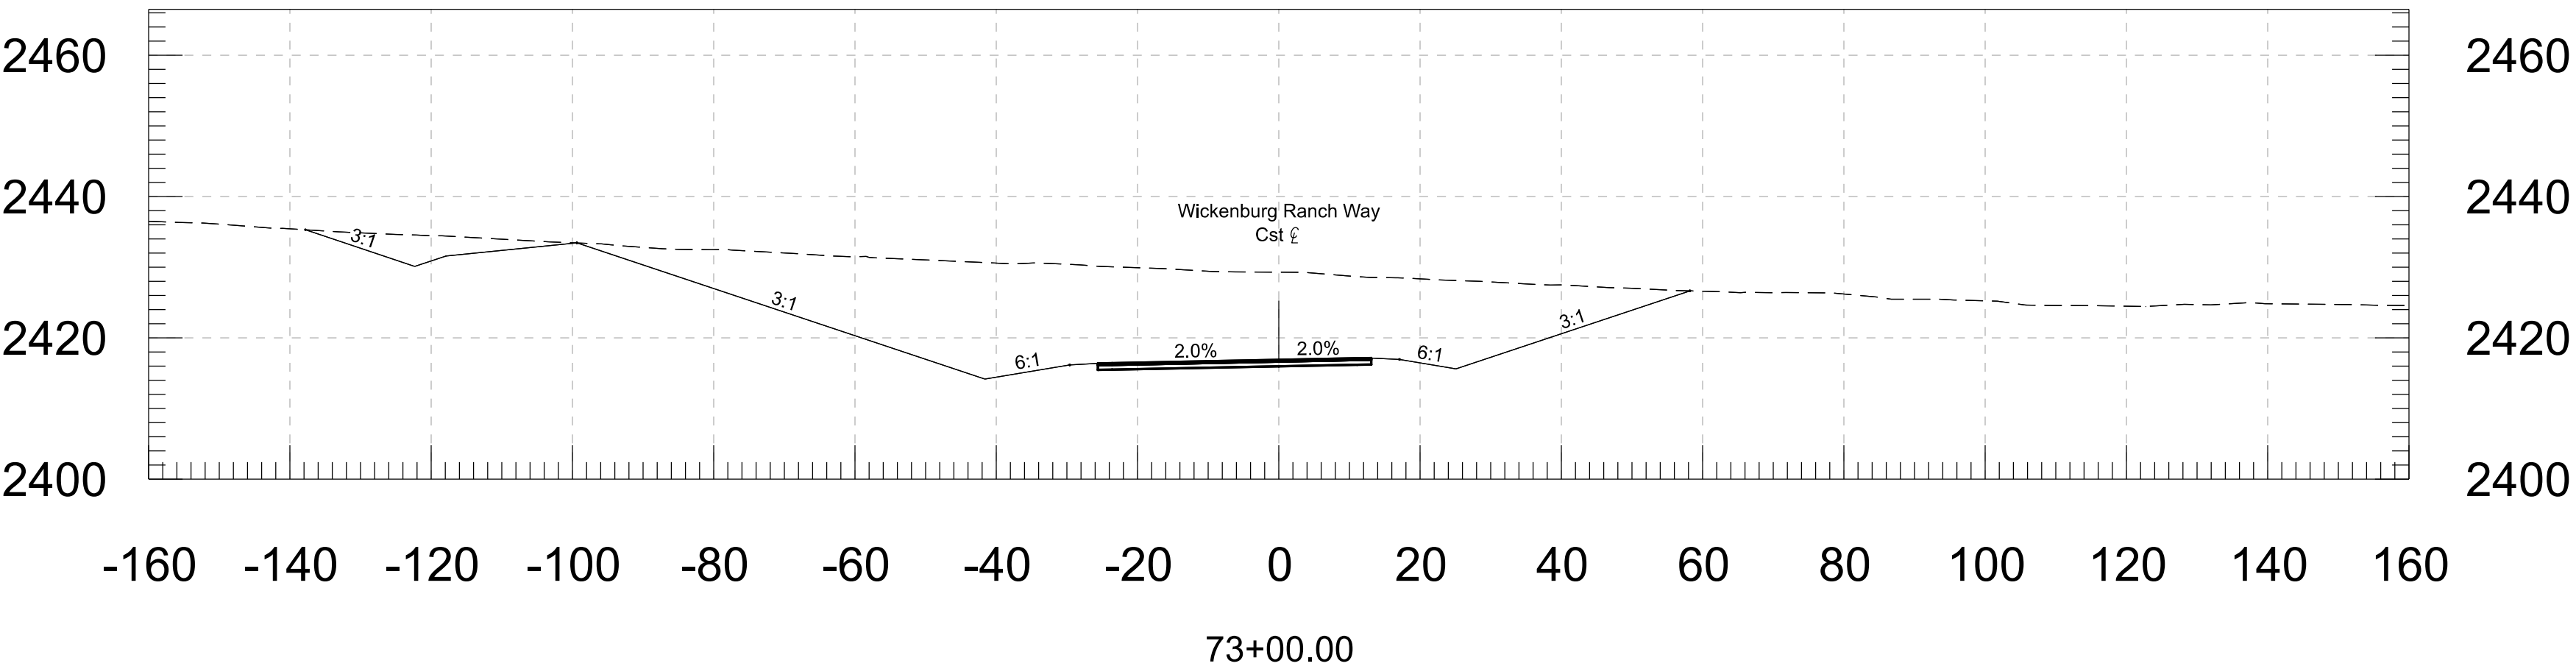
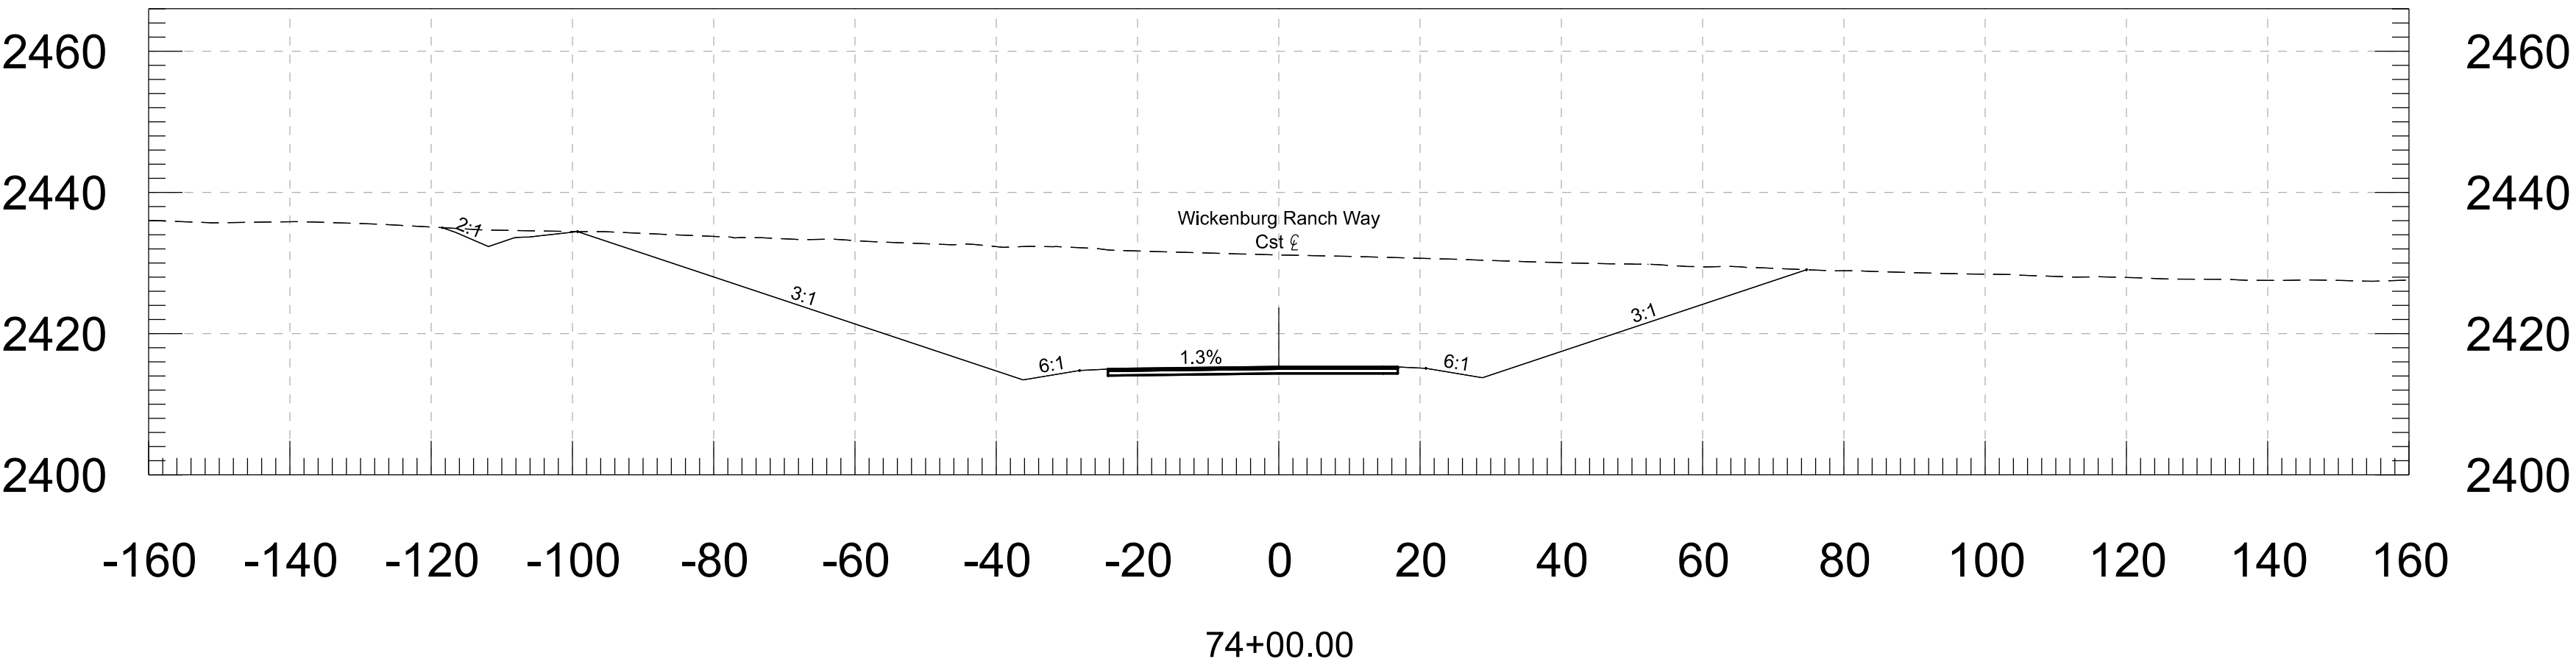


		NAME	DATE	ARIZONA DEPARTMENT OF TRANSPORTATION PROJECT DELIVERY AND OPERATIONS DIVISION ROADWAY DESIGN SERVICES	
DESIGN	ZSZ		06-26		
DRAWN	RM		06-26		
CHECKED	DBK		06-26		
 Stanley Consultants inc. 3133 East Camelback Road, Suite 100 Phoenix, Arizona 85016 Phone: (602) 333-2200				CROSS SECTIONS	
ROUTE		LOCATION			DWG NO. 108
US 93		WICKENBURG RANCH WAY TO VISTA ROYALE			
TRACS NO. F0738 OIC			093-B(230)T		___ OF ___



F.H.W.A. REGION	STATE	PROJECT NO.	SHEET NO.	TOTAL SHEETS	RECORD DRAWING
9	ARIZ.	093-B(230)T	110	116	
093 YV 189					

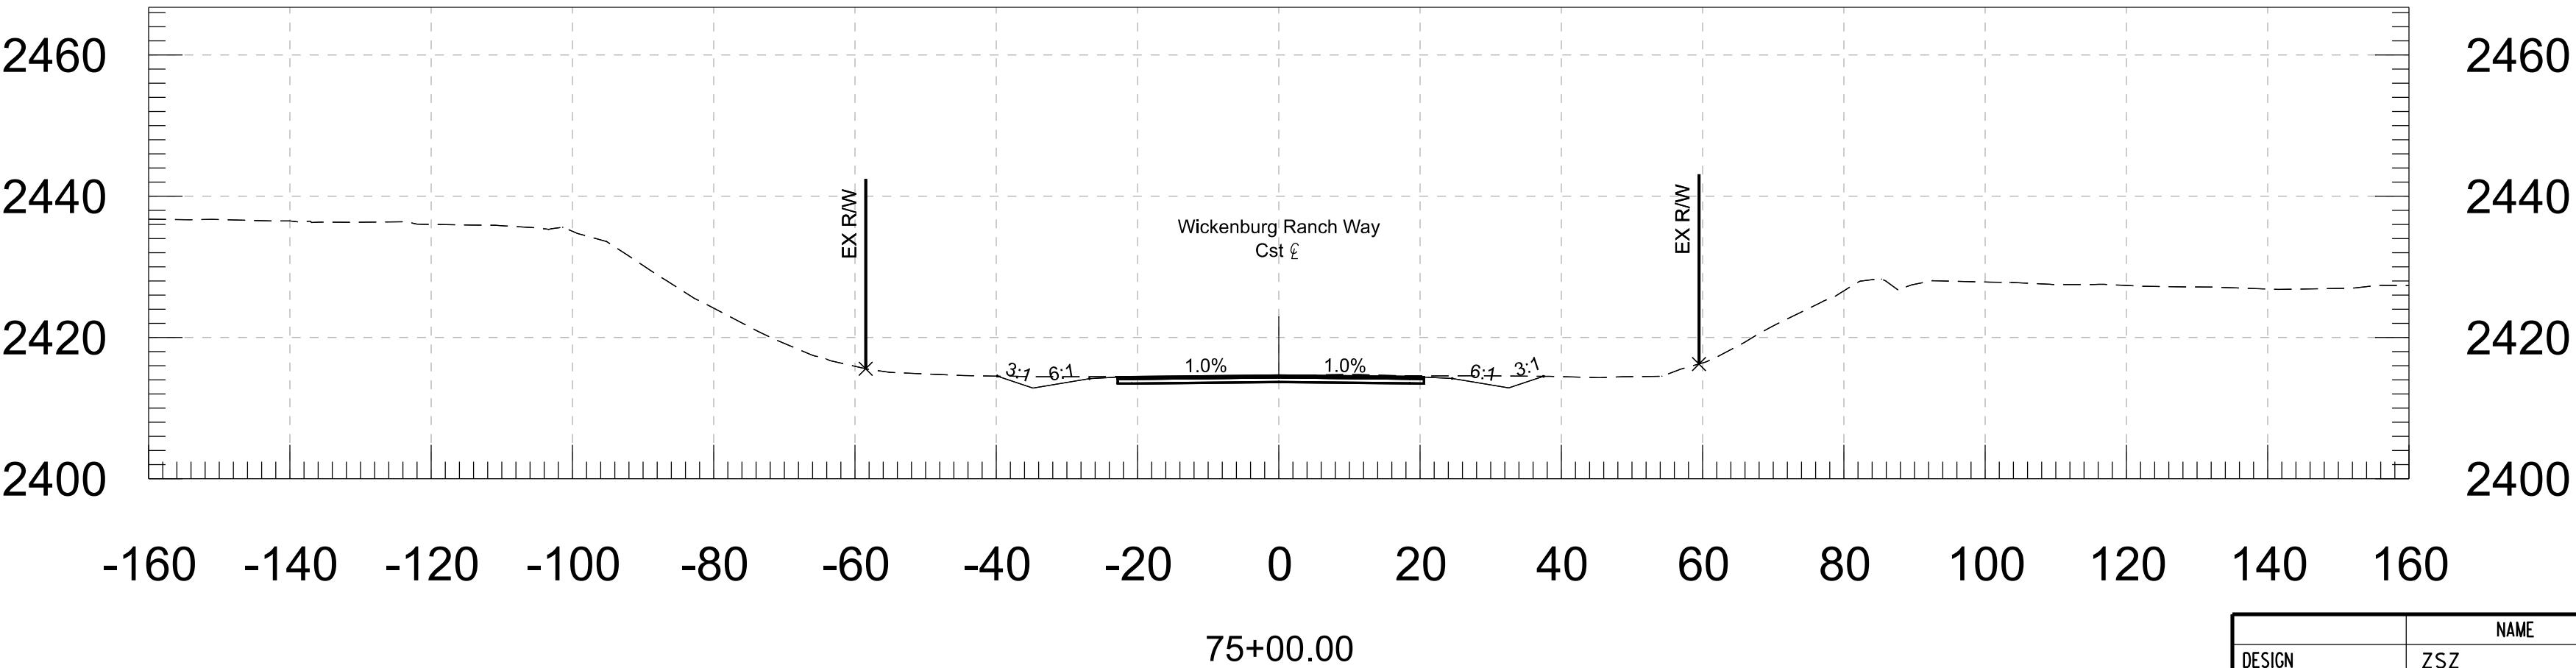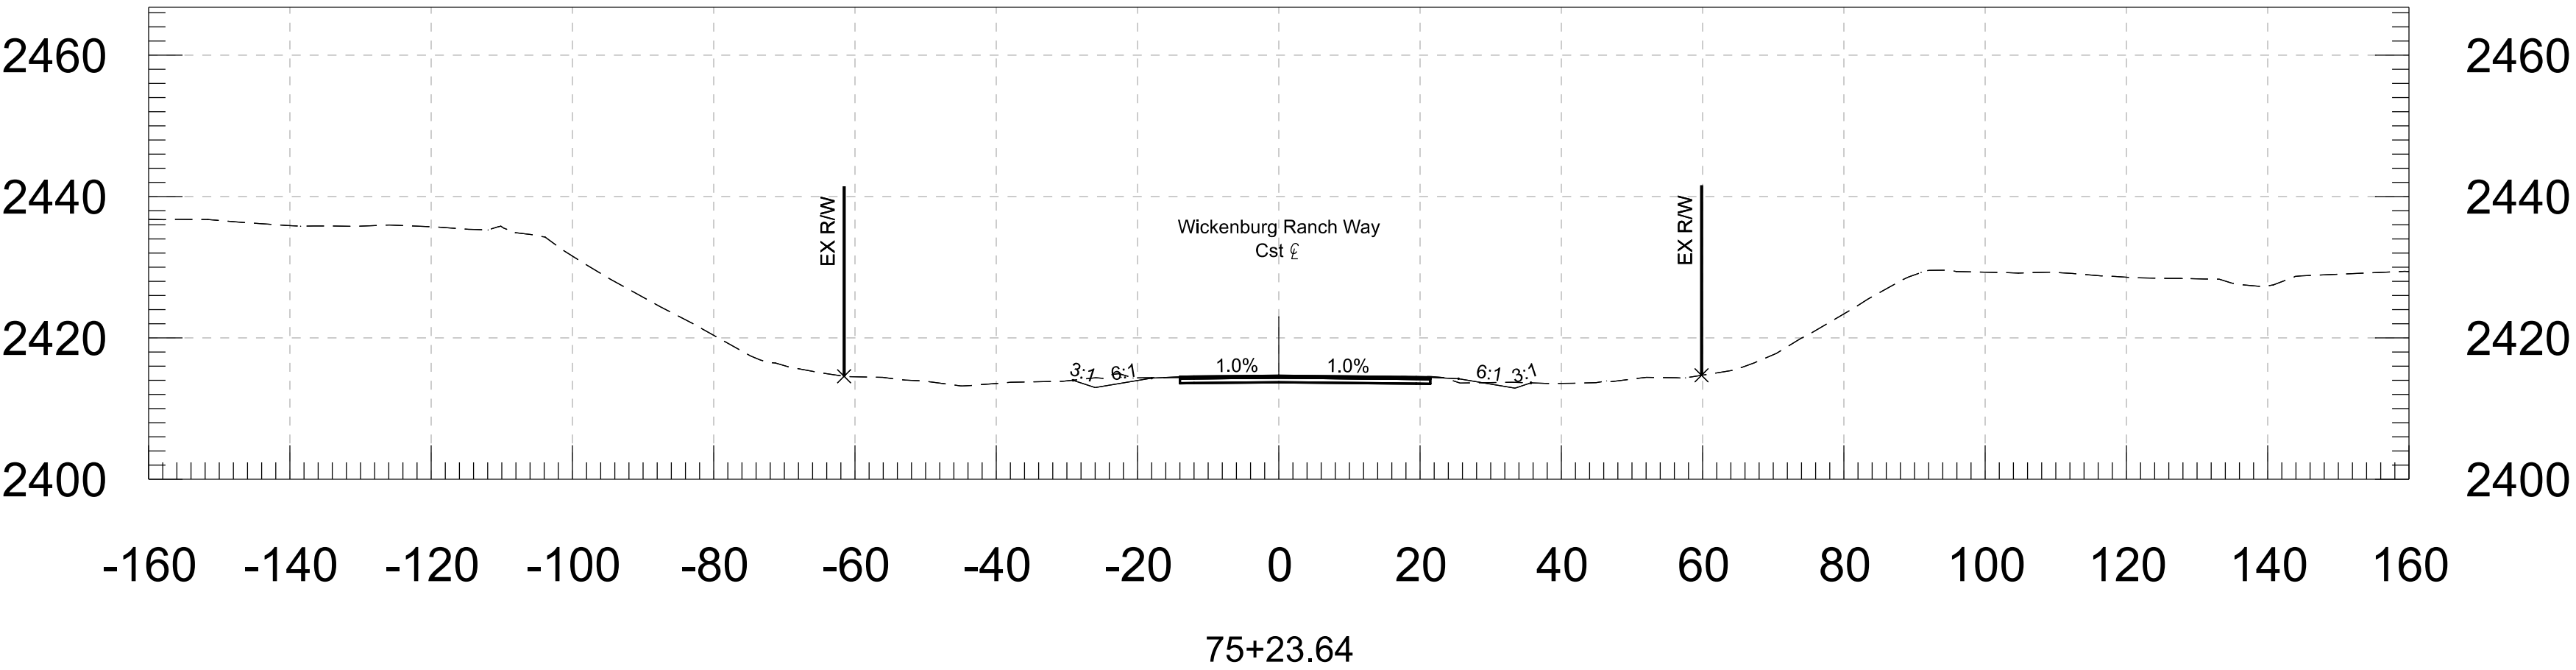




		NAME	DATE	ARIZONA DEPARTMENT OF TRANSPORTATION PROJECT DELIVERY AND OPERATIONS DIVISION ROADWAY DESIGN SERVICES	
DESIGN	ZSZ		06-26		
DRAWN	RM		06-26		
CHECKED	DBK		06-26		
 Stanley Consultants inc. 3133 East Camelback Road, Suite 100 Phoenix, Arizona 85016 Phone: (602) 333-2200				CROSS SECTIONS	
ROUTE		LOCATION			DWG NO. 109
US 93		WICKENBURG RANCH WAY TO VISTA ROYALE			
TRACS NO. F0738 OIC			093-B(230)T		___ OF ___

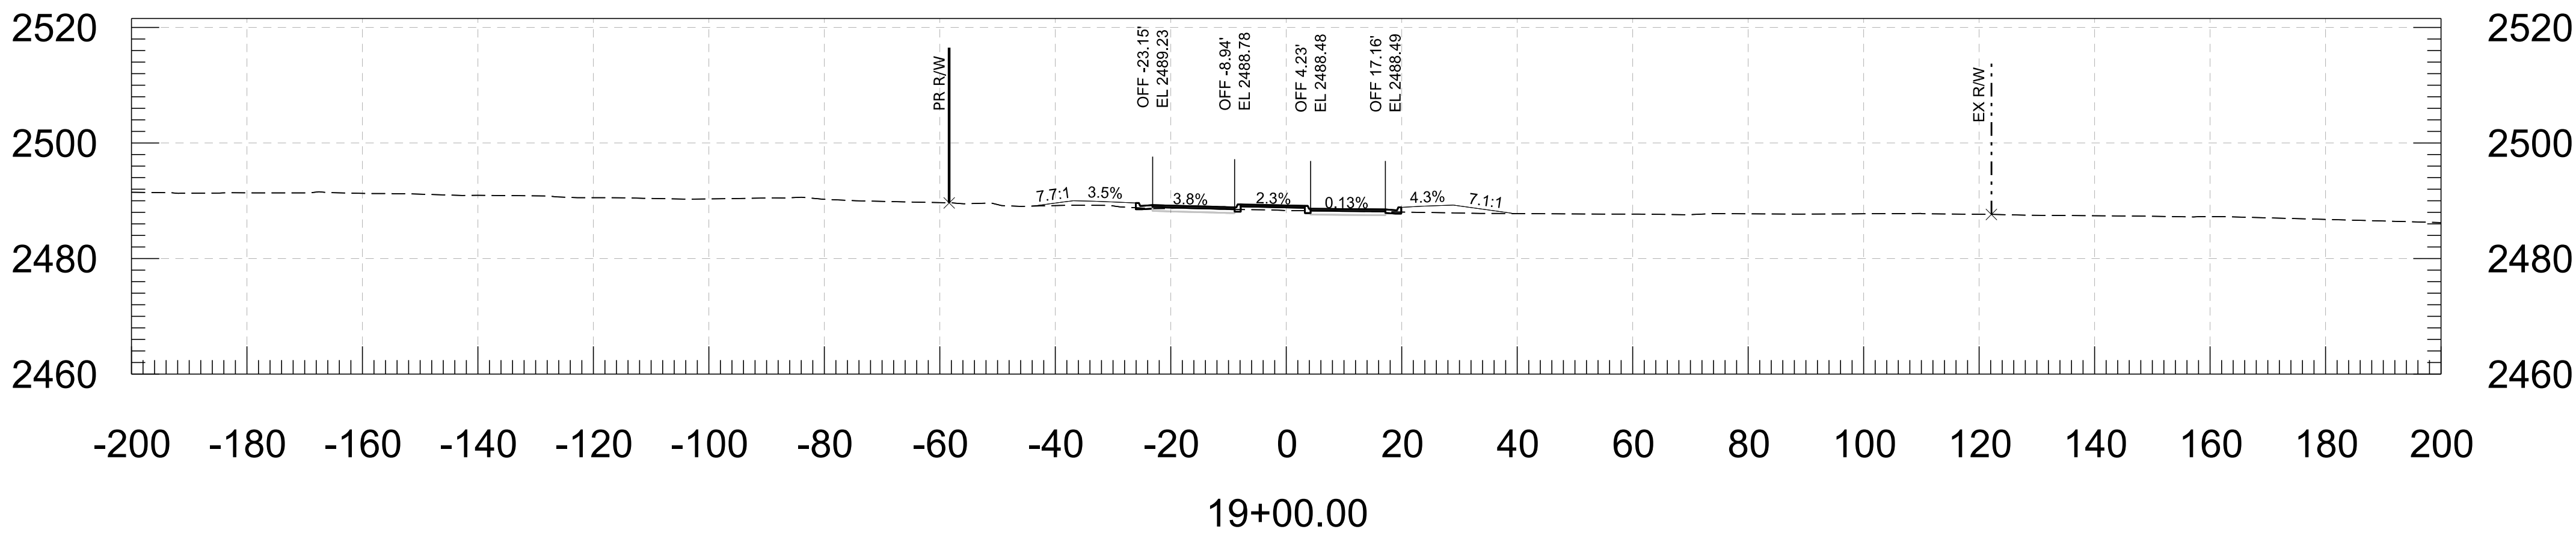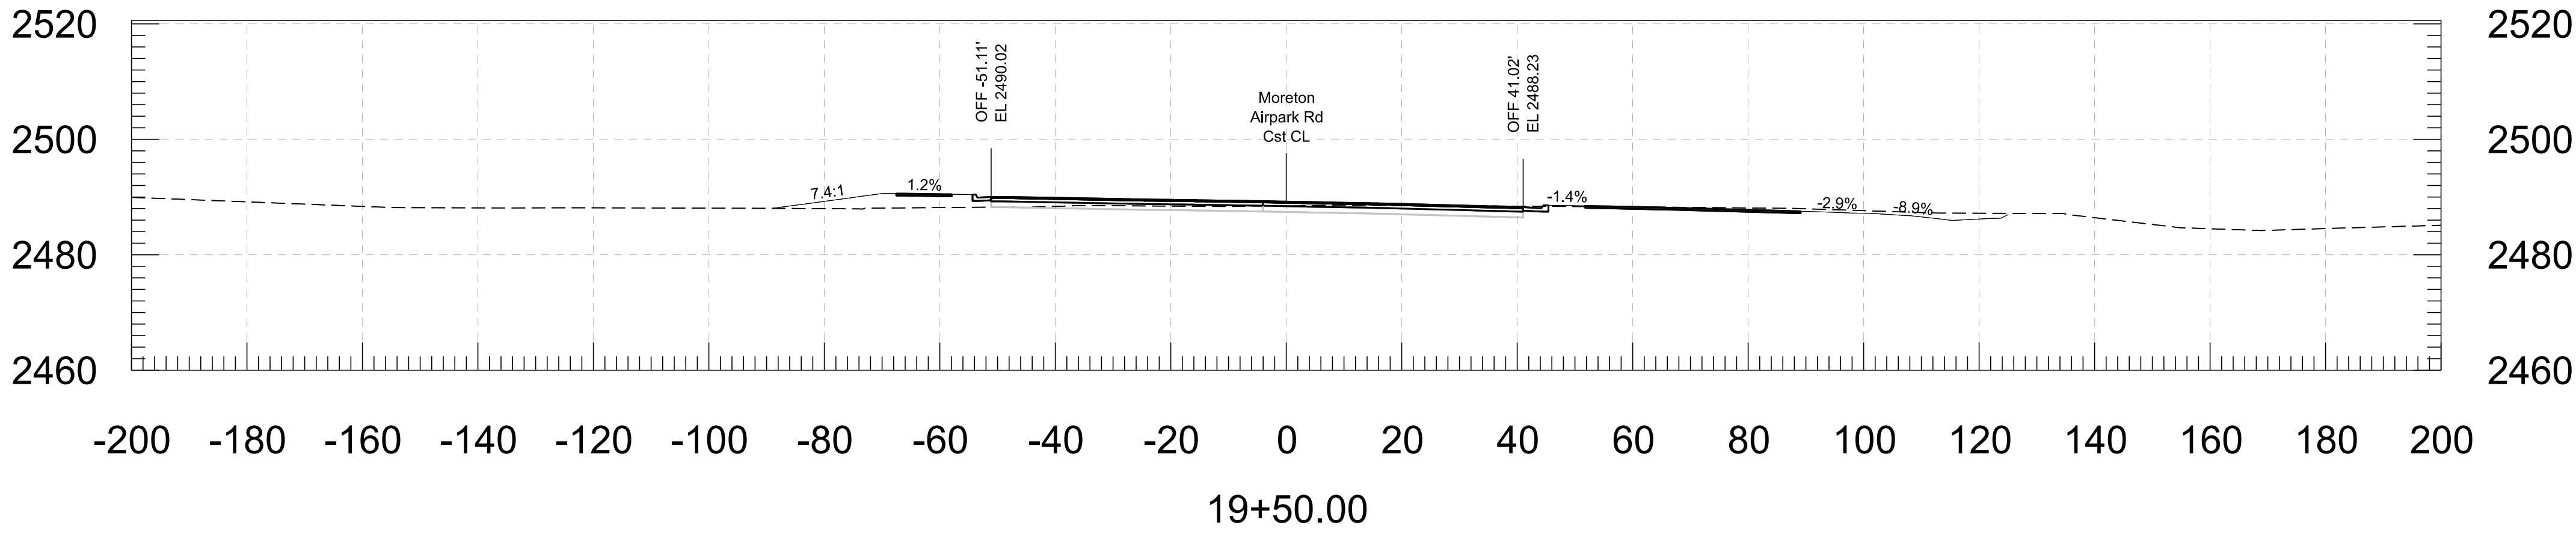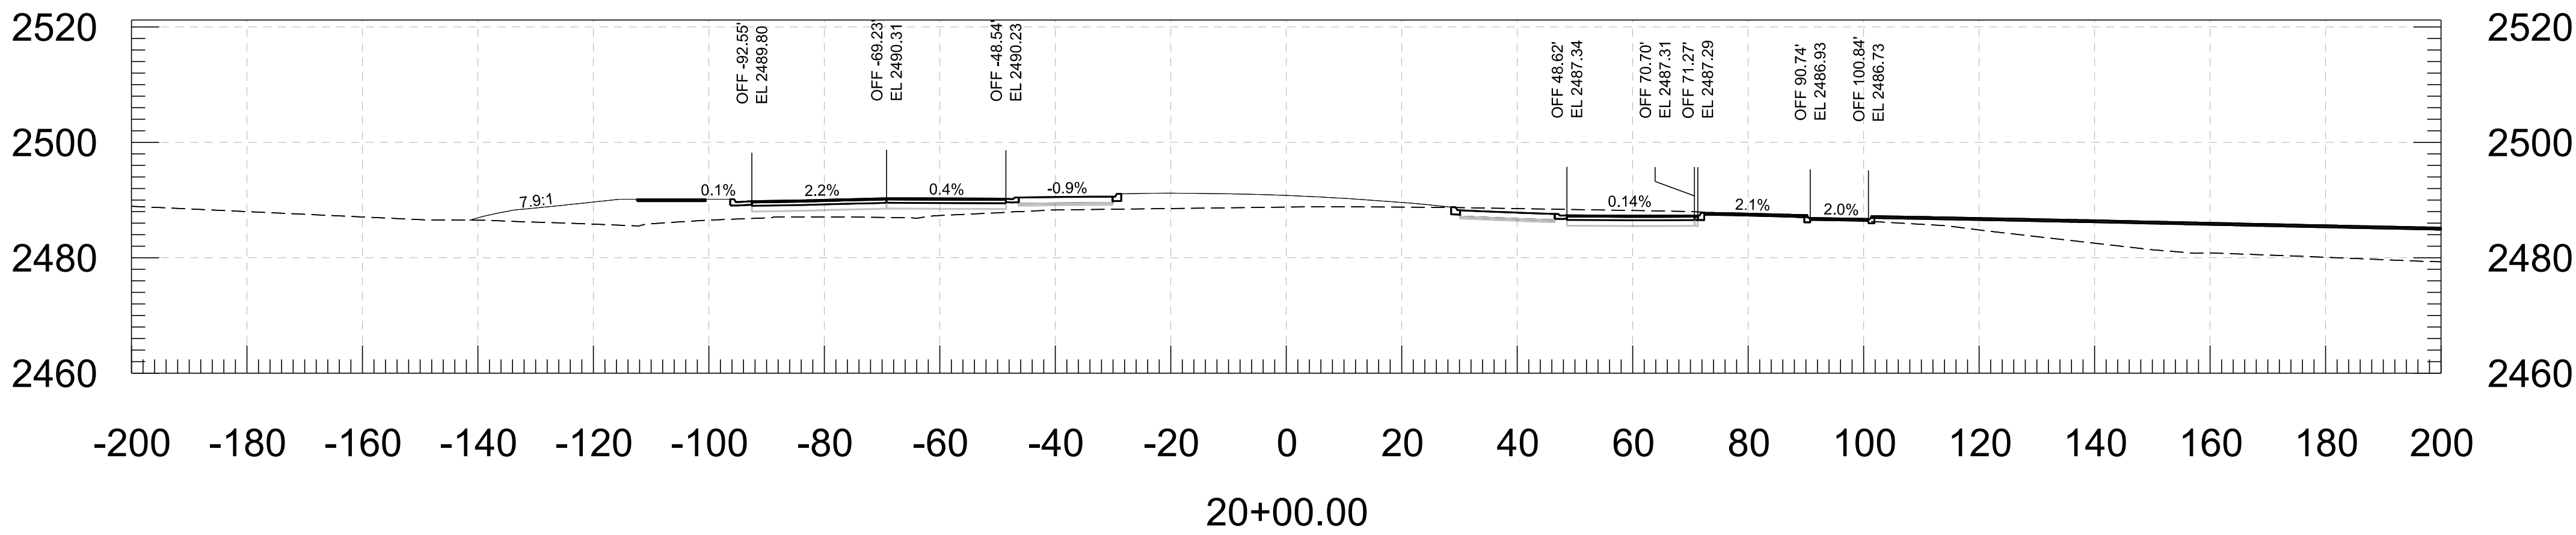




FOR INFORMATION ONLY	DESIGN	J GILLIS	06/26	ARIZONA DEPARTMENT OF TRANSPORTATION PROJECT DELIVERY AND OPERATIONS DIVISION ROADWAY DESIGN SERVICES	ROUTE	F.H.W.A. Arizona Division	STATE	PROJECT NO.	FEDERAL ID NO.	SHEET NO.	TOTAL SHEETS	RECORD DRAWING
	DRAWN	J BEMELLEN	06/26		US 93			093 YV 189	093-B(230)T	111	116	
	CHECKED	D WIGGINS	06/26		MILEPOST	LOCATION WICKENBURG RANCH WAY TO VISTA ROYALE						
	TRANSPORTATION AECOM TECHNICAL SERVICES, Inc. 7720 N. 16th St., Suite 100 Phoenix, Arizona 85020 T 602.371.1100 www.aecom.com			CROSS SECTIONS MORETON AIRPARK RD	STRUCTURE NO.	TRACS NO. F0738 01C		DWG No. 110 OF				

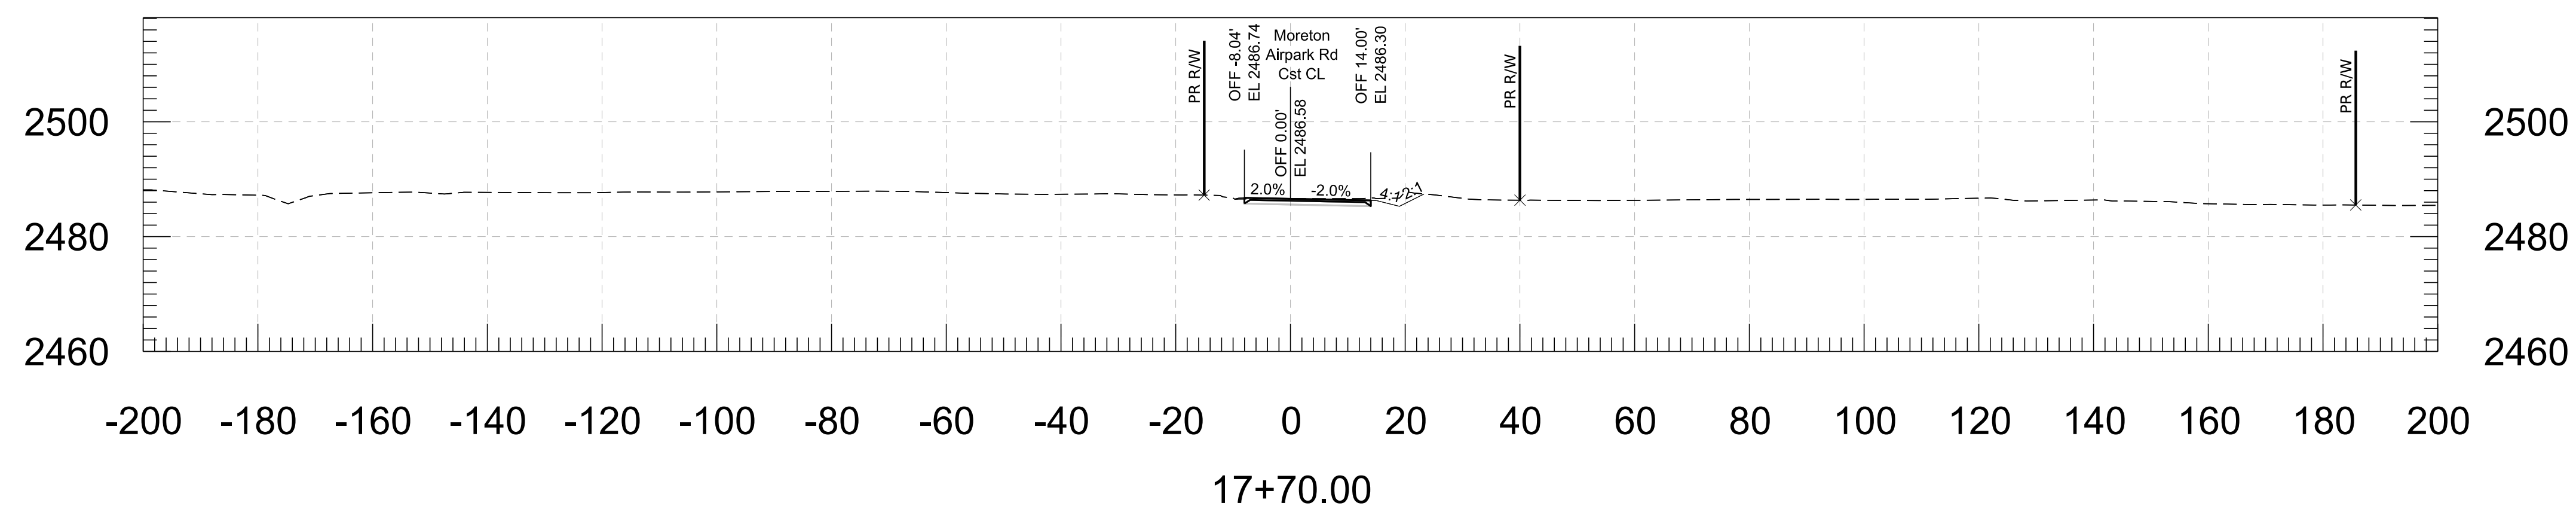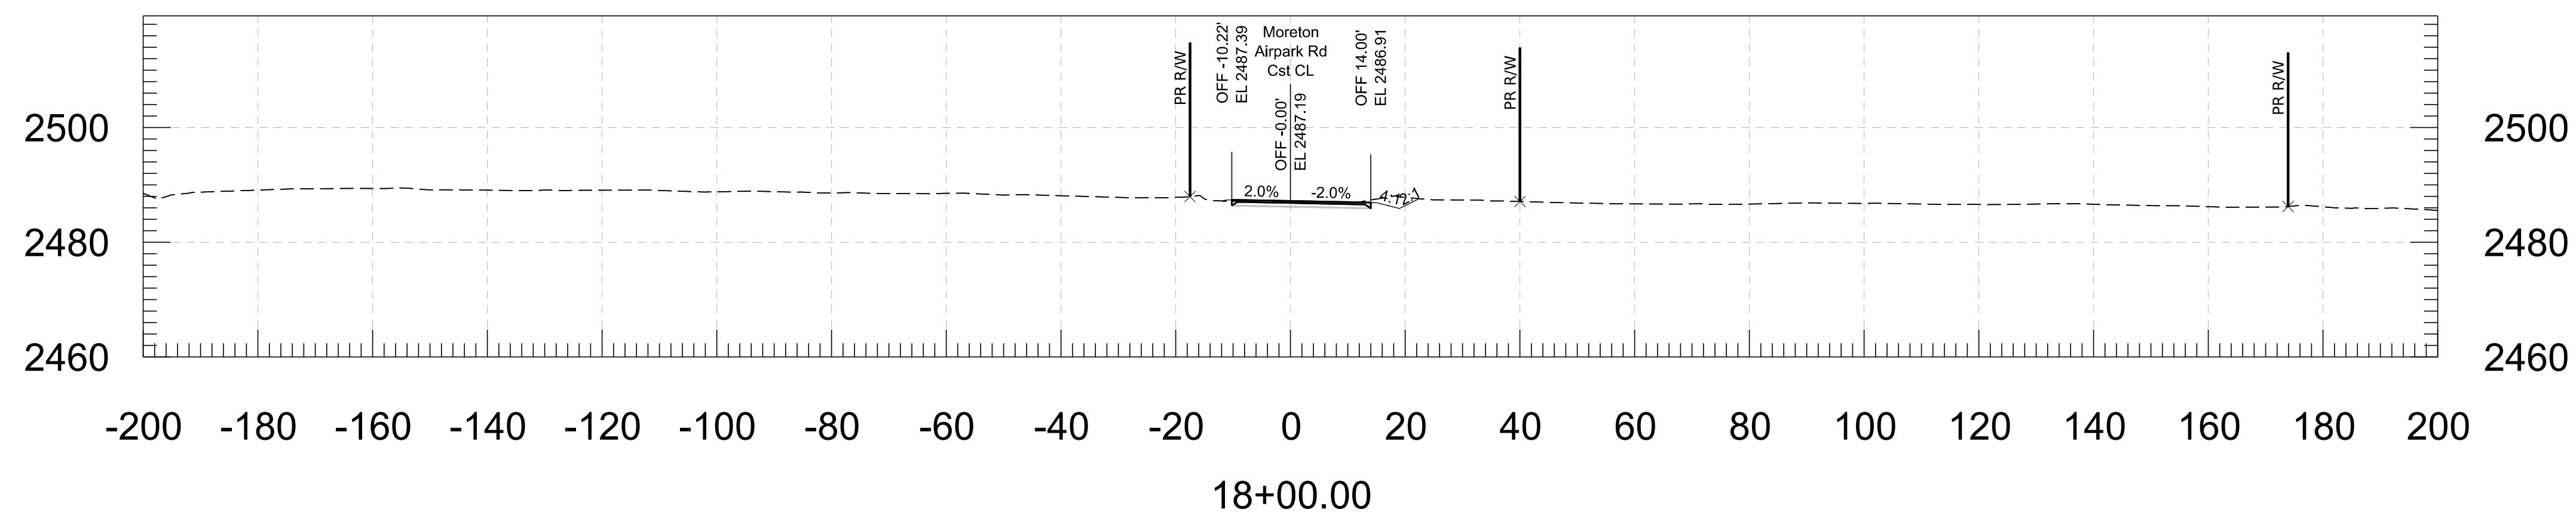


	FOR INFORMATION ONLY	<table><tr><td></td><td>NAME</td><td>DATE</td></tr><tr><td>DESIGN</td><td>J GILLIS</td><td>06/26</td></tr><tr><td>DRAWN</td><td>J BEMELEN</td><td>06/26</td></tr><tr><td>CHECKED</td><td>D WIGGINS</td><td>06/26</td></tr></table>		NAME	DATE	DESIGN	J GILLIS	06/26	DRAWN	J BEMELEN	06/26	CHECKED	D WIGGINS	06/26	<table><tr><td>ARIZONA DEPARTMENT OF TRANSPORTATION PROJECT DELIVERY AND OPERATIONS DIVISION ROADWAY DESIGN SERVICES</td></tr></table>	ARIZONA DEPARTMENT OF TRANSPORTATION PROJECT DELIVERY AND OPERATIONS DIVISION ROADWAY DESIGN SERVICES	<table><tr><td>ROUTE US 93</td></tr><tr><td>MILEPOST 189.9</td></tr><tr><td>STRUCTURE NO.</td></tr></table>	ROUTE US 93	MILEPOST 189.9	STRUCTURE NO.	<table><tr><td>F.H.W.A. Arizona Division</td><td>STATE ARIZ.</td><td>PROJECT NO. 093 YV 189</td><td>FEDERAL ID NO. 093-B(230)T</td><td>SHEET NO. 112</td><td>TOTAL SHEETS 116</td><td>RECORD DRAWING</td></tr></table>	F.H.W.A. Arizona Division	STATE ARIZ.	PROJECT NO. 093 YV 189	FEDERAL ID NO. 093-B(230)T	SHEET NO. 112	TOTAL SHEETS 116	RECORD DRAWING
			NAME	DATE																								
		DESIGN	J GILLIS	06/26																								
		DRAWN	J BEMELEN	06/26																								
		CHECKED	D WIGGINS	06/26																								
ARIZONA DEPARTMENT OF TRANSPORTATION PROJECT DELIVERY AND OPERATIONS DIVISION ROADWAY DESIGN SERVICES																												
ROUTE US 93																												
MILEPOST 189.9																												
STRUCTURE NO.																												
F.H.W.A. Arizona Division	STATE ARIZ.	PROJECT NO. 093 YV 189	FEDERAL ID NO. 093-B(230)T	SHEET NO. 112	TOTAL SHEETS 116	RECORD DRAWING																						
<table><tr><td>TRANSPORTATION AECOM TECHNICAL SERVICES, Inc. 7720 N. 16th St., Suite 100 Phoenix, Arizona 85020 T 602.371.1100</td><td> www.aecom.com</td></tr></table>	TRANSPORTATION AECOM TECHNICAL SERVICES, Inc. 7720 N. 16th St., Suite 100 Phoenix, Arizona 85020 T 602.371.1100	 www.aecom.com	<table><tr><td>CROSS SECTIONS</td></tr></table>	CROSS SECTIONS	<table><tr><td colspan="5">LOCATION WICKENBURG RANCH WAY TO VISTA ROYALE</td><td colspan="2">DWG No. 111</td></tr><tr><td colspan="2">TRACS NO. F0738 01C</td><td colspan="4">OF</td></tr></table>	LOCATION WICKENBURG RANCH WAY TO VISTA ROYALE					DWG No. 111		TRACS NO. F0738 01C		OF													
TRANSPORTATION AECOM TECHNICAL SERVICES, Inc. 7720 N. 16th St., Suite 100 Phoenix, Arizona 85020 T 602.371.1100	 www.aecom.com																											
CROSS SECTIONS																												
LOCATION WICKENBURG RANCH WAY TO VISTA ROYALE					DWG No. 111																							
TRACS NO. F0738 01C		OF																										

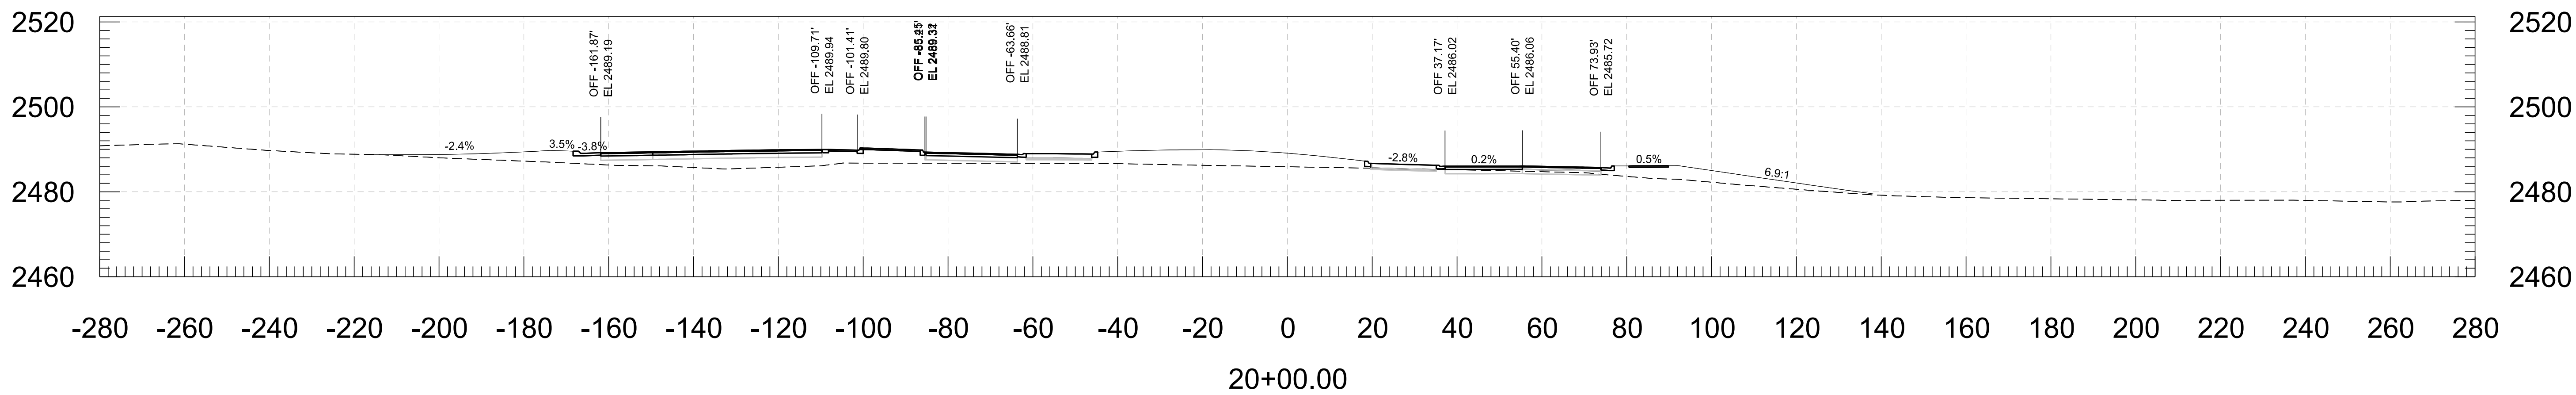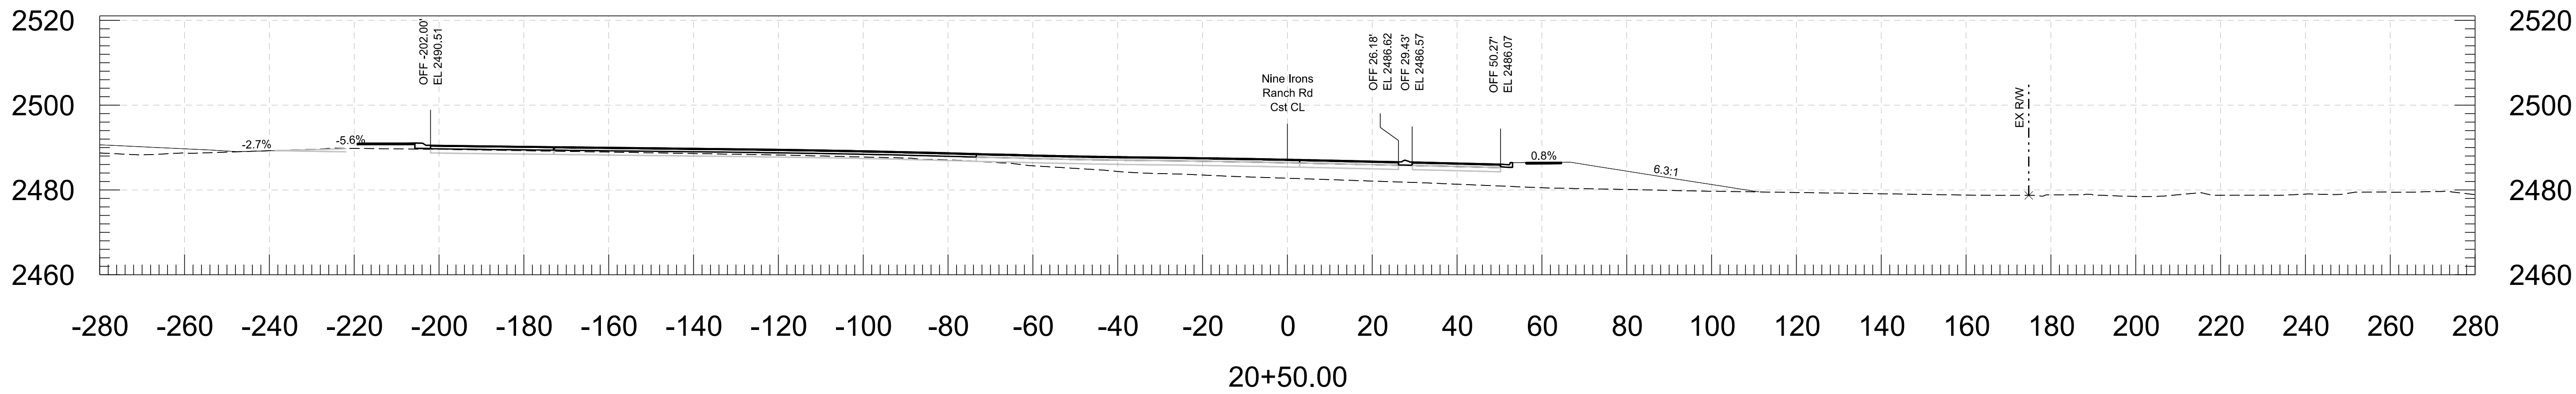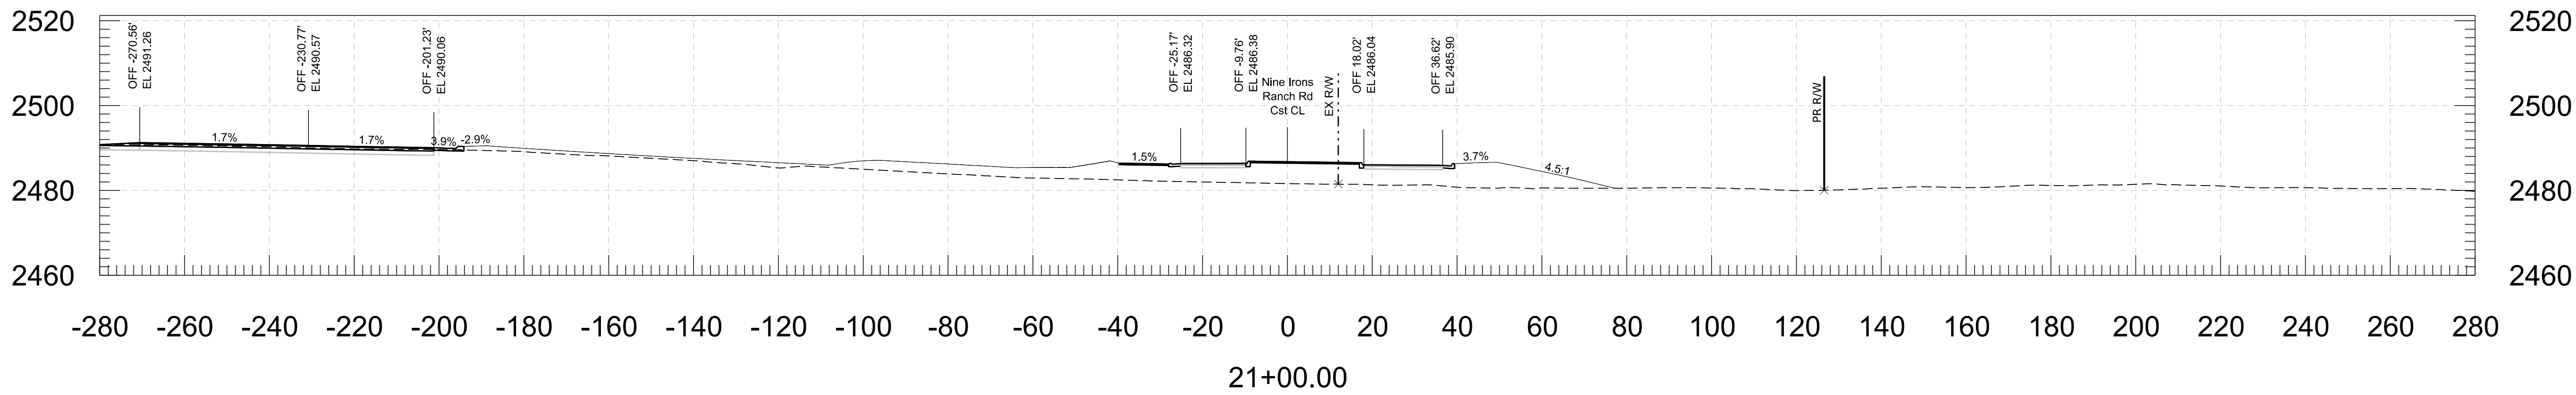

FOR INFORMATION ONLY	DESIGN	J GILLIS	06/26	ARIZONA DEPARTMENT OF TRANSPORTATION PROJECT DELIVERY AND OPERATIONS DIVISION ROADWAY DESIGN SERVICES	ROUTE	F.H.W.A. Arizona Division	STATE	PROJECT NO.	FEDERAL ID NO.	SHEET NO.	TOTAL SHEETS	RECORD DRAWING
	DRAWN	J BEMELLEN	06/26		US 93			093 YV 189	093-B(230)T	113	116	
	CHECKED	D WIGGINS	06/26		MILEPOST							
	TRANSPORTATION AECOM TECHNICAL SERVICES, Inc. 7720 N. 16th St., Suite 100 Phoenix, Arizona 85020 T 602.371.1100			CROSS SECTIONS NINE IRONS RANCH RD	STRUCTURE NO.	LOCATION WICKENBURG RANCH WAY TO VISTA ROYALE						
	AECOM www.aecom.com		DWG No. 112									
					TRACS NO. F0738 01C		OF					

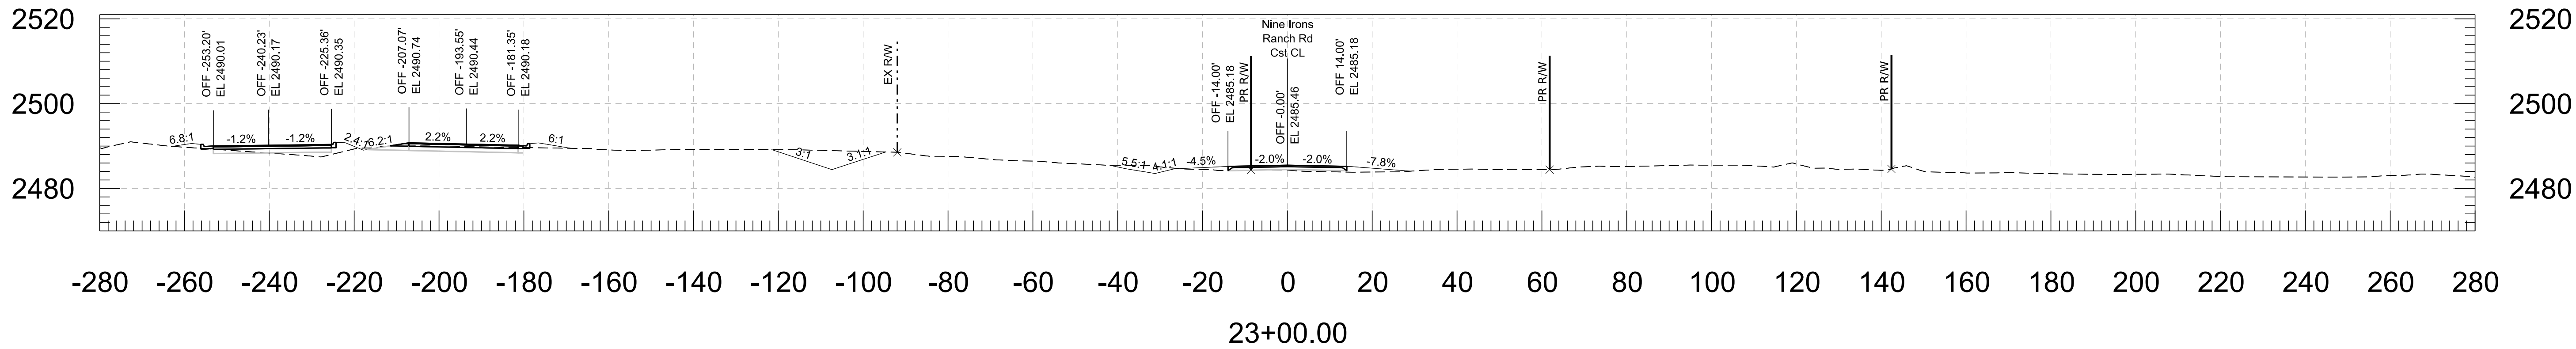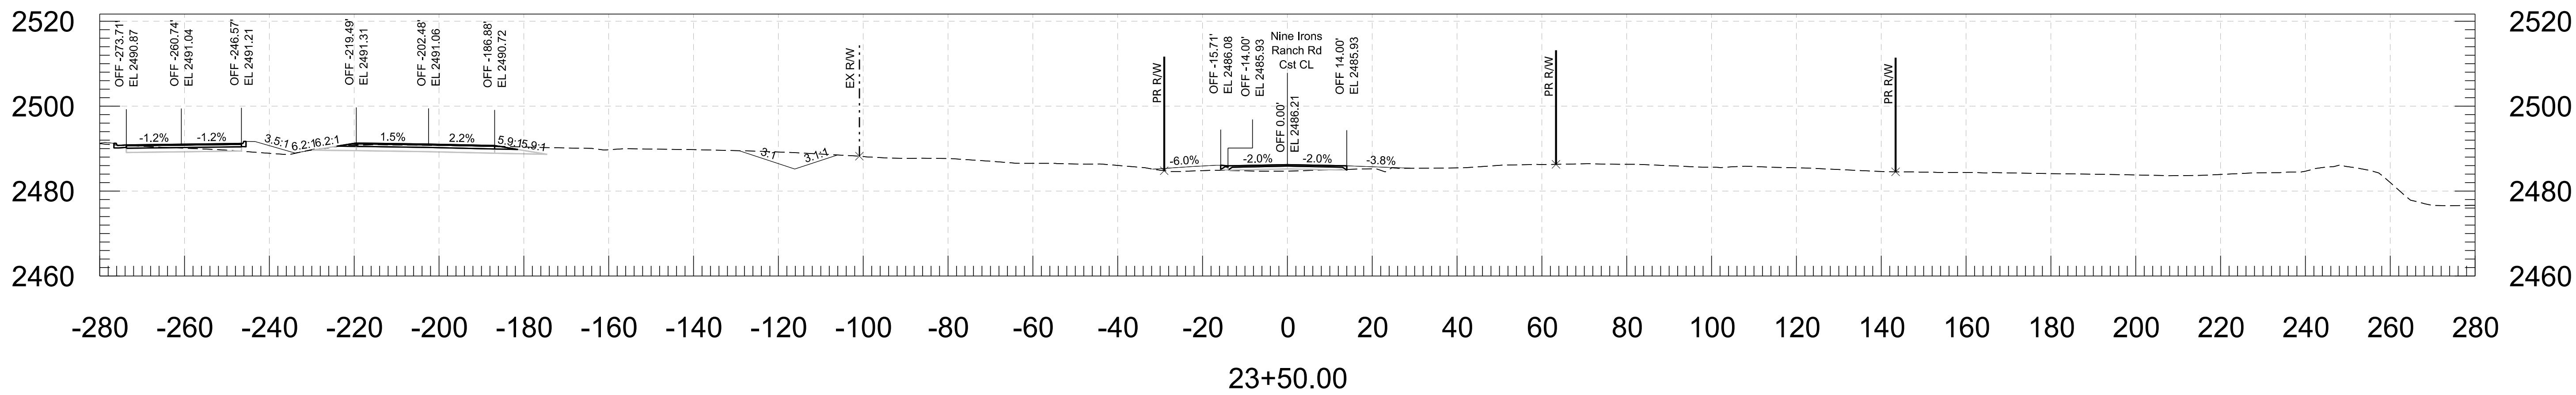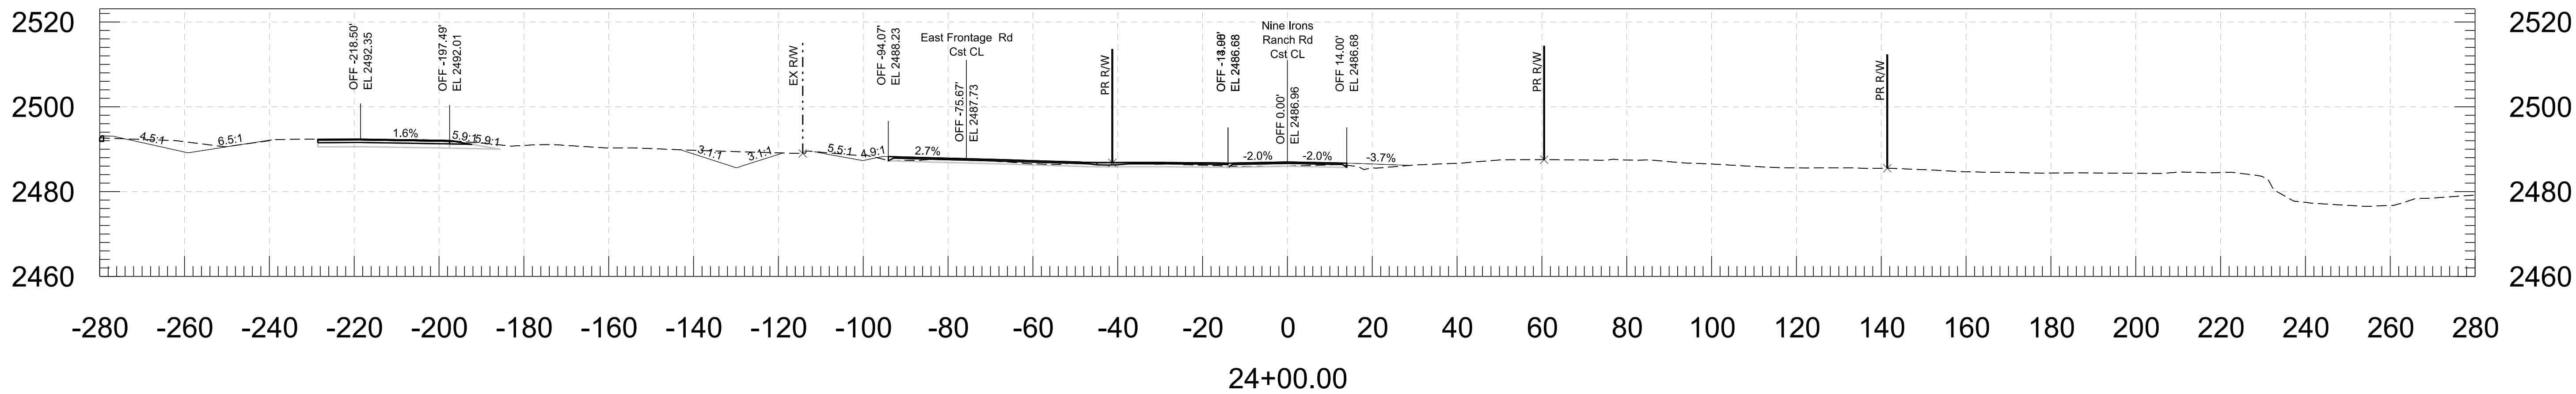

FOR INFORMATION ONLY		NAME	DATE	ARIZONA DEPARTMENT OF TRANSPORTATION PROJECT DELIVERY AND OPERATIONS DIVISION ROADWAY DESIGN SERVICES	ROUTE	F.H.W.A. Arizona Division	STATE	PROJECT NO.	FEDERAL ID NO.	SHEET NO.	TOTAL SHEETS	RECORD DRAWING	
	DESIGN	J GILLIS	06/26		US 93			093 YV 189	093-B(230)T	115	116		
	DRAWN	J BEMELEN	06/26		MILEPOST 189.9	LOCATION WICKENBURG RANCH WAY TO VISTA ROYALE							DWG No. 114
	CHECKED	D WIGGINS	06/26			TRACS NO. F0738 01C							
	TRANSPORTATION AECOM TECHNICAL SERVICES, Inc. 7720 N. 16th St., Suite 100 Phoenix, Arizona 85020 T 602.371.1100			CROSS SECTIONS NINE IRONS RANCH RD		STRUCTURE NO.							

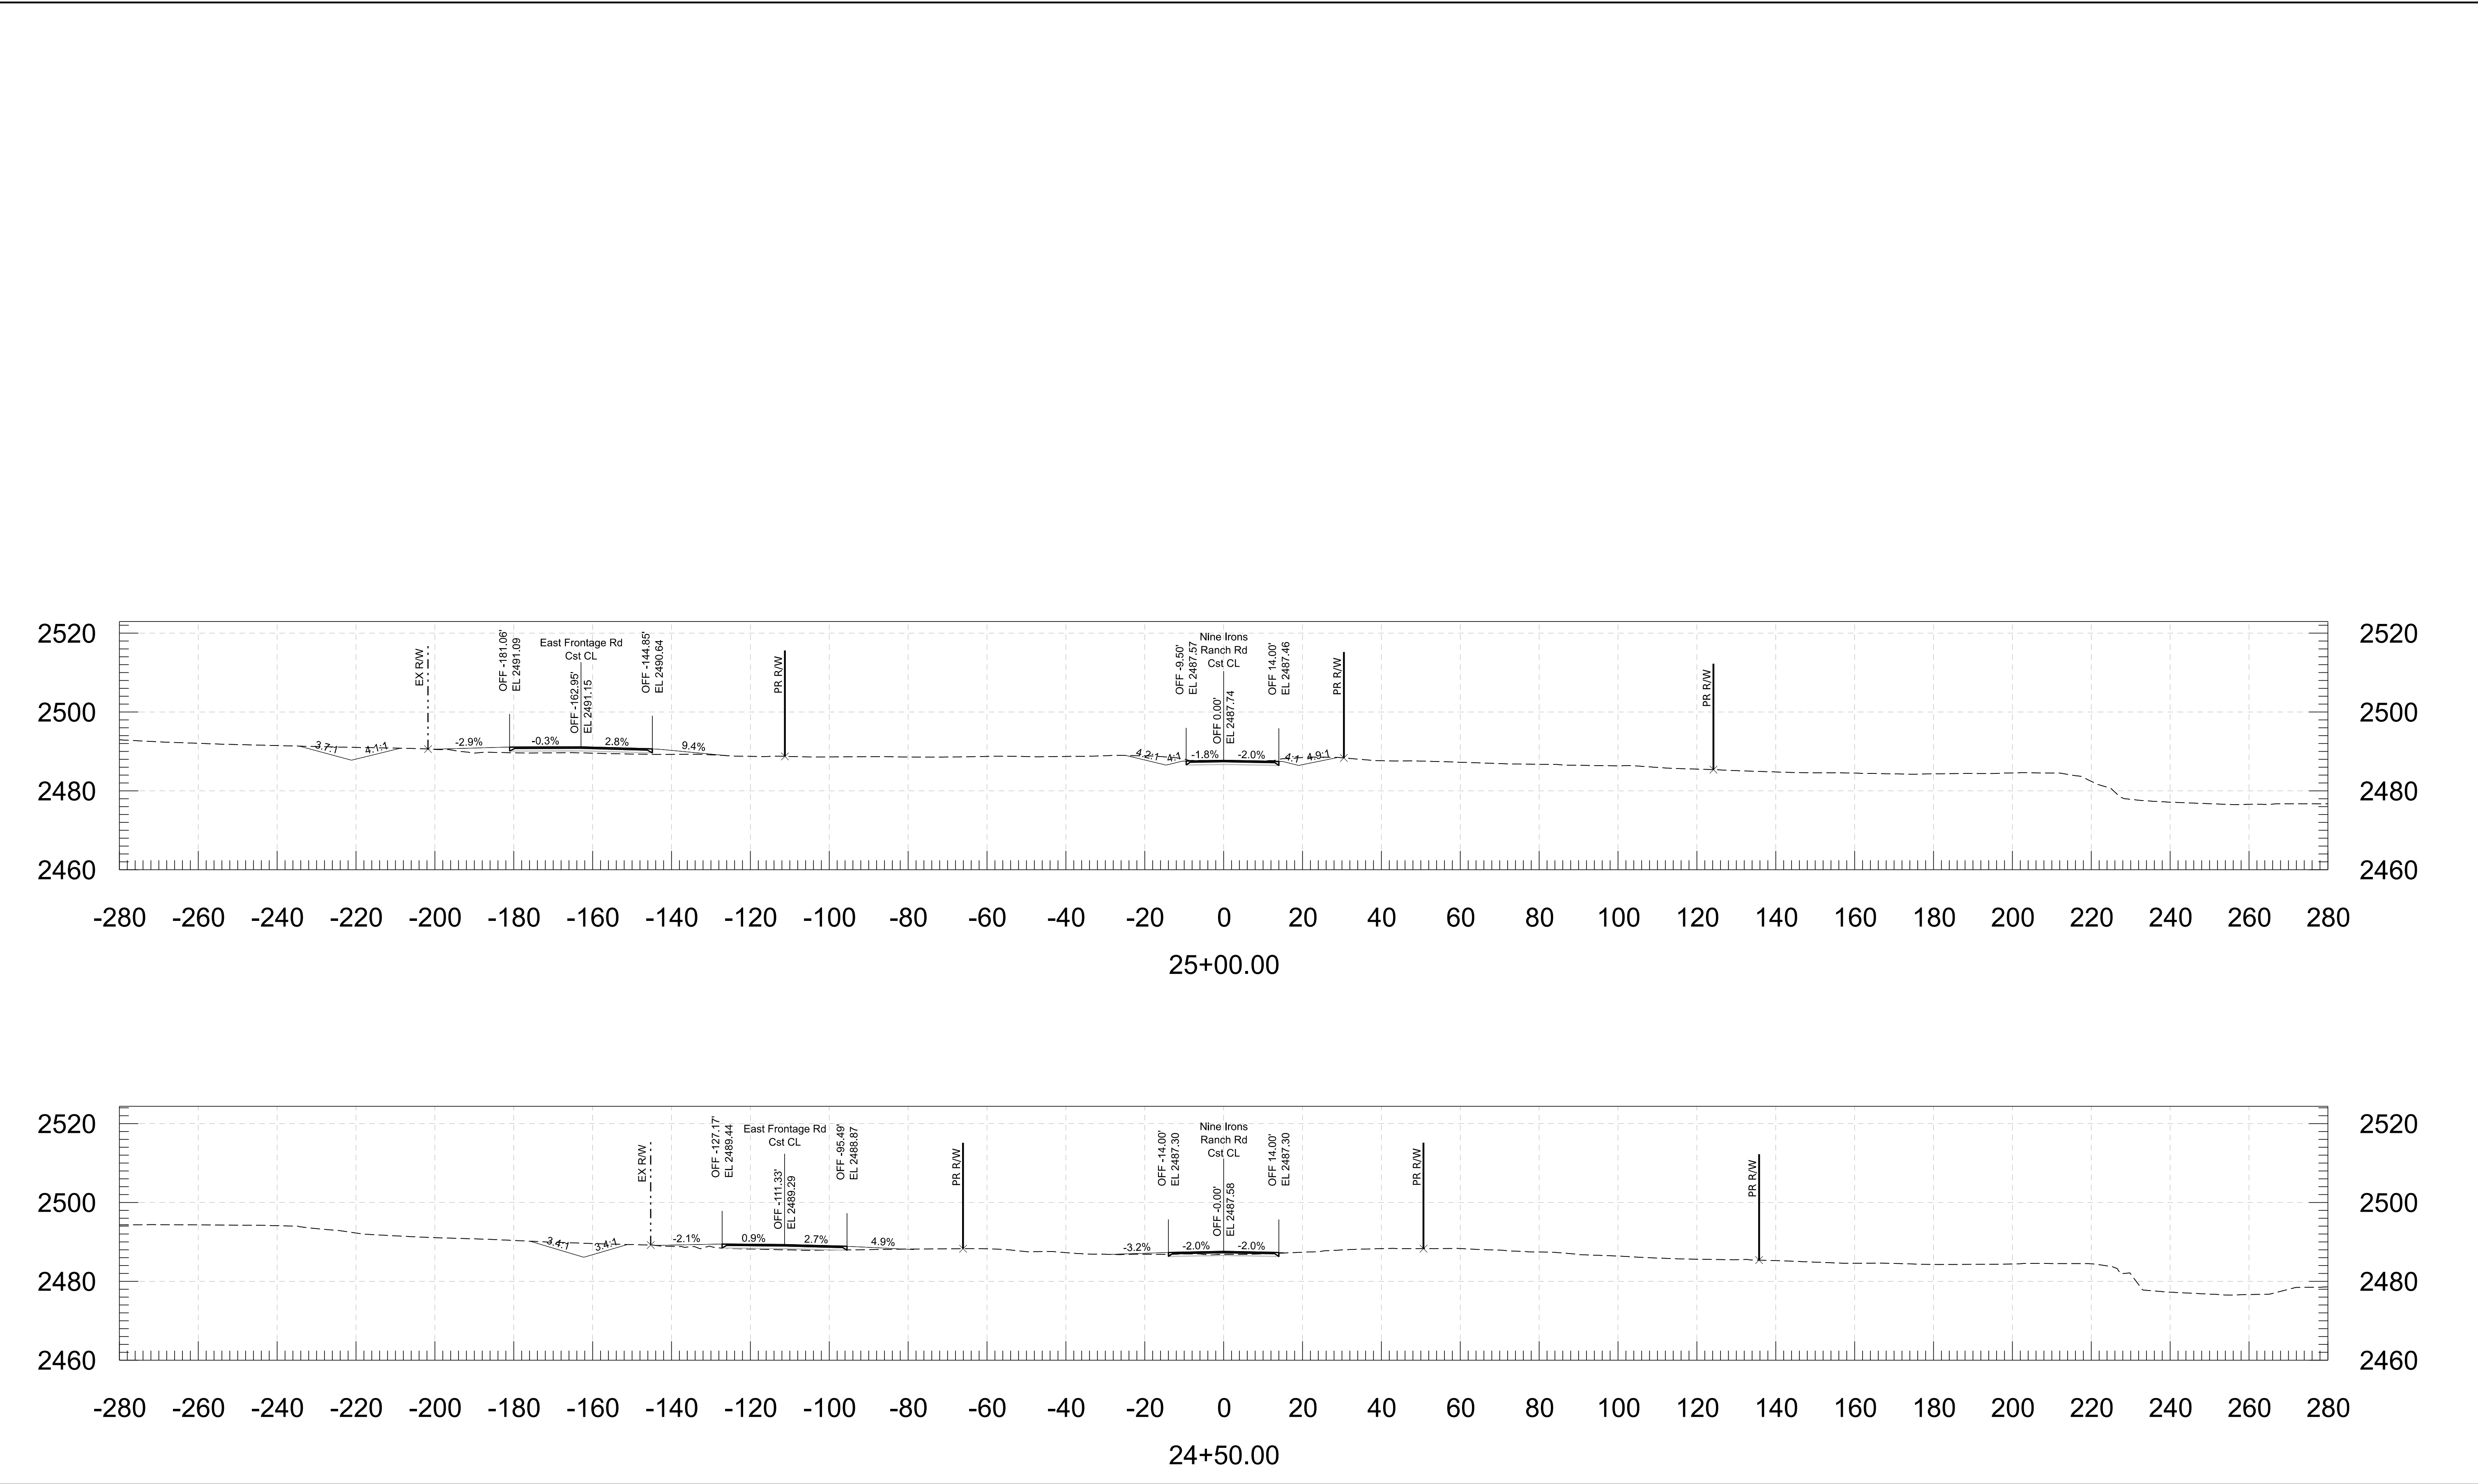

FOR INFORMATION ONLY		NAME	DATE	ARIZONA DEPARTMENT OF TRANSPORTATION PROJECT DELIVERY AND OPERATIONS DIVISION ROADWAY DESIGN SERVICES	ROUTE	F.H.W.A. Arizona Division	STATE ARIZ.	PROJECT NO.	FEDERAL ID NO.	SHEET NO.	TOTAL SHEETS	RECORD DRAWING
	DESIGN	J GILLIS	06/26		US 93			093 YV 189	093-B(230)T	116	116	
	DRAWN	J BEMELEN	06/26		MILEPOST 189.9	LOCATION WICKENBURG RANCH WAY TO VISTA ROYALE						DWG No. 115
	CHECKED	D WIGGINS	06/26									
	TRANSPORTATION AECOM TECHNICAL SERVICES, Inc. 7720 N. 16th St., Suite 100 Phoenix, Arizona 85020 T 602.371.1100			CROSS SECTIONS NINE IRONS RANCH RD			STRUCTURE NO.		TRACS NO. F0738 01C		____ OF ____	
AECOM www.aecom.com												