





STATE OF ARIZONA
DEPARTMENT OF TRANSPORTATION
PROJECT DELIVERY AND OPERATIONS DIVISION

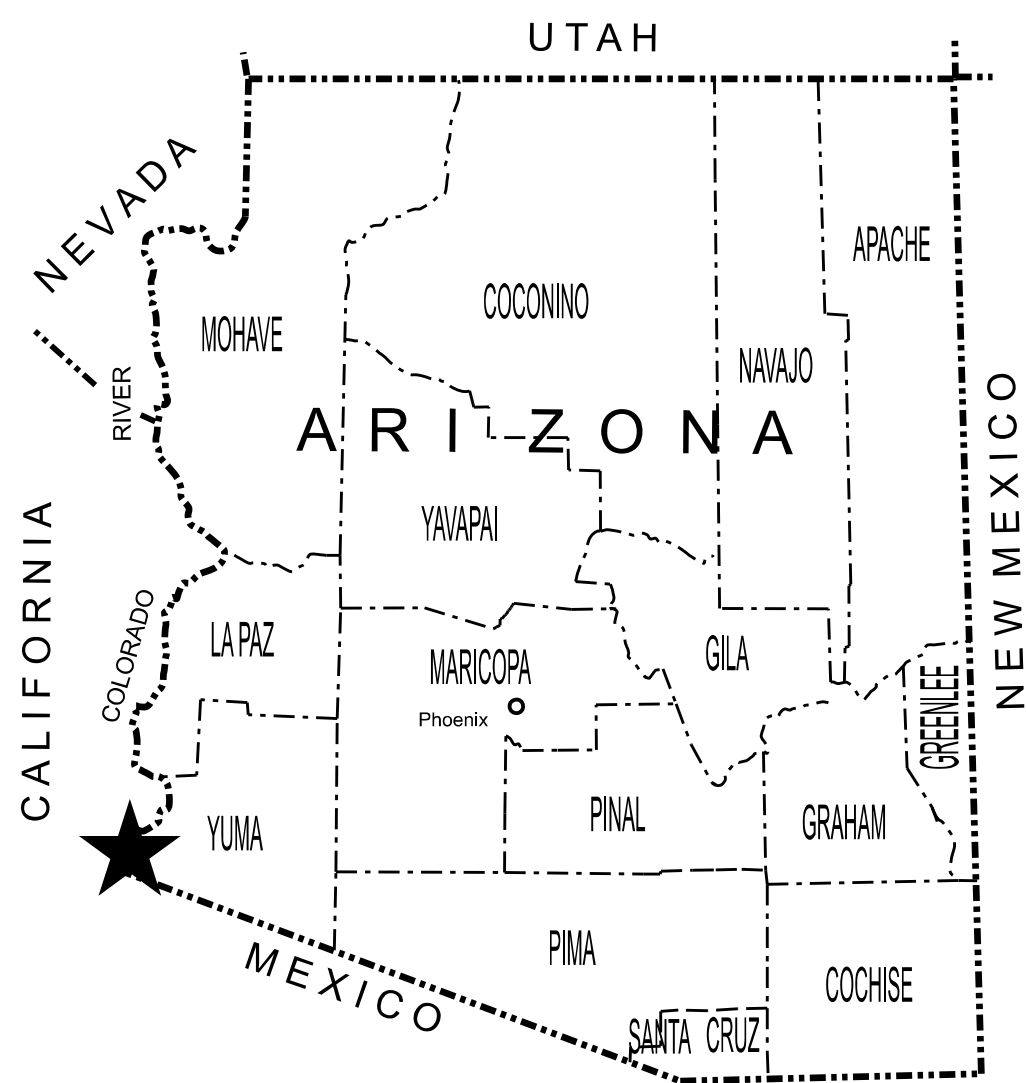

PROJECT PLANS
YUMA COUNTY

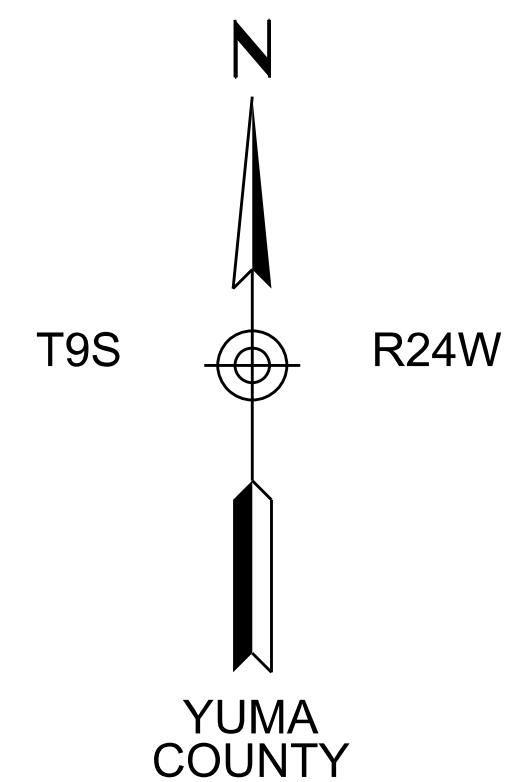

AVENUE G, COUNTY 11TH ST - COUNTY 16TH ST

0000 YU YYU T0437 01C

ROADWAY CROSS SECTIONS


FEDERAL AID NO. YYU-0(225)T

JULY 2026


ARIZONA DEPARTMENT OF TRANSPORTATION
INFRASTRUCTURE DELIVERY AND OPERATIONS DIVISION
AUDRA MERRICK, P.E., STATE ENGINEER

REC. DWGS. DATA	REC. DWG. DATE	OF
--------------------	----------------	----


Cut Area	11.12 SF	Fill Area	0.67 SF
Cut Vol.	16.01 CY	Fill Vol.	0.62 CY
Cut Adj. Vol.	16.01 CY	Fill Adj. Vol.	0.62 CY

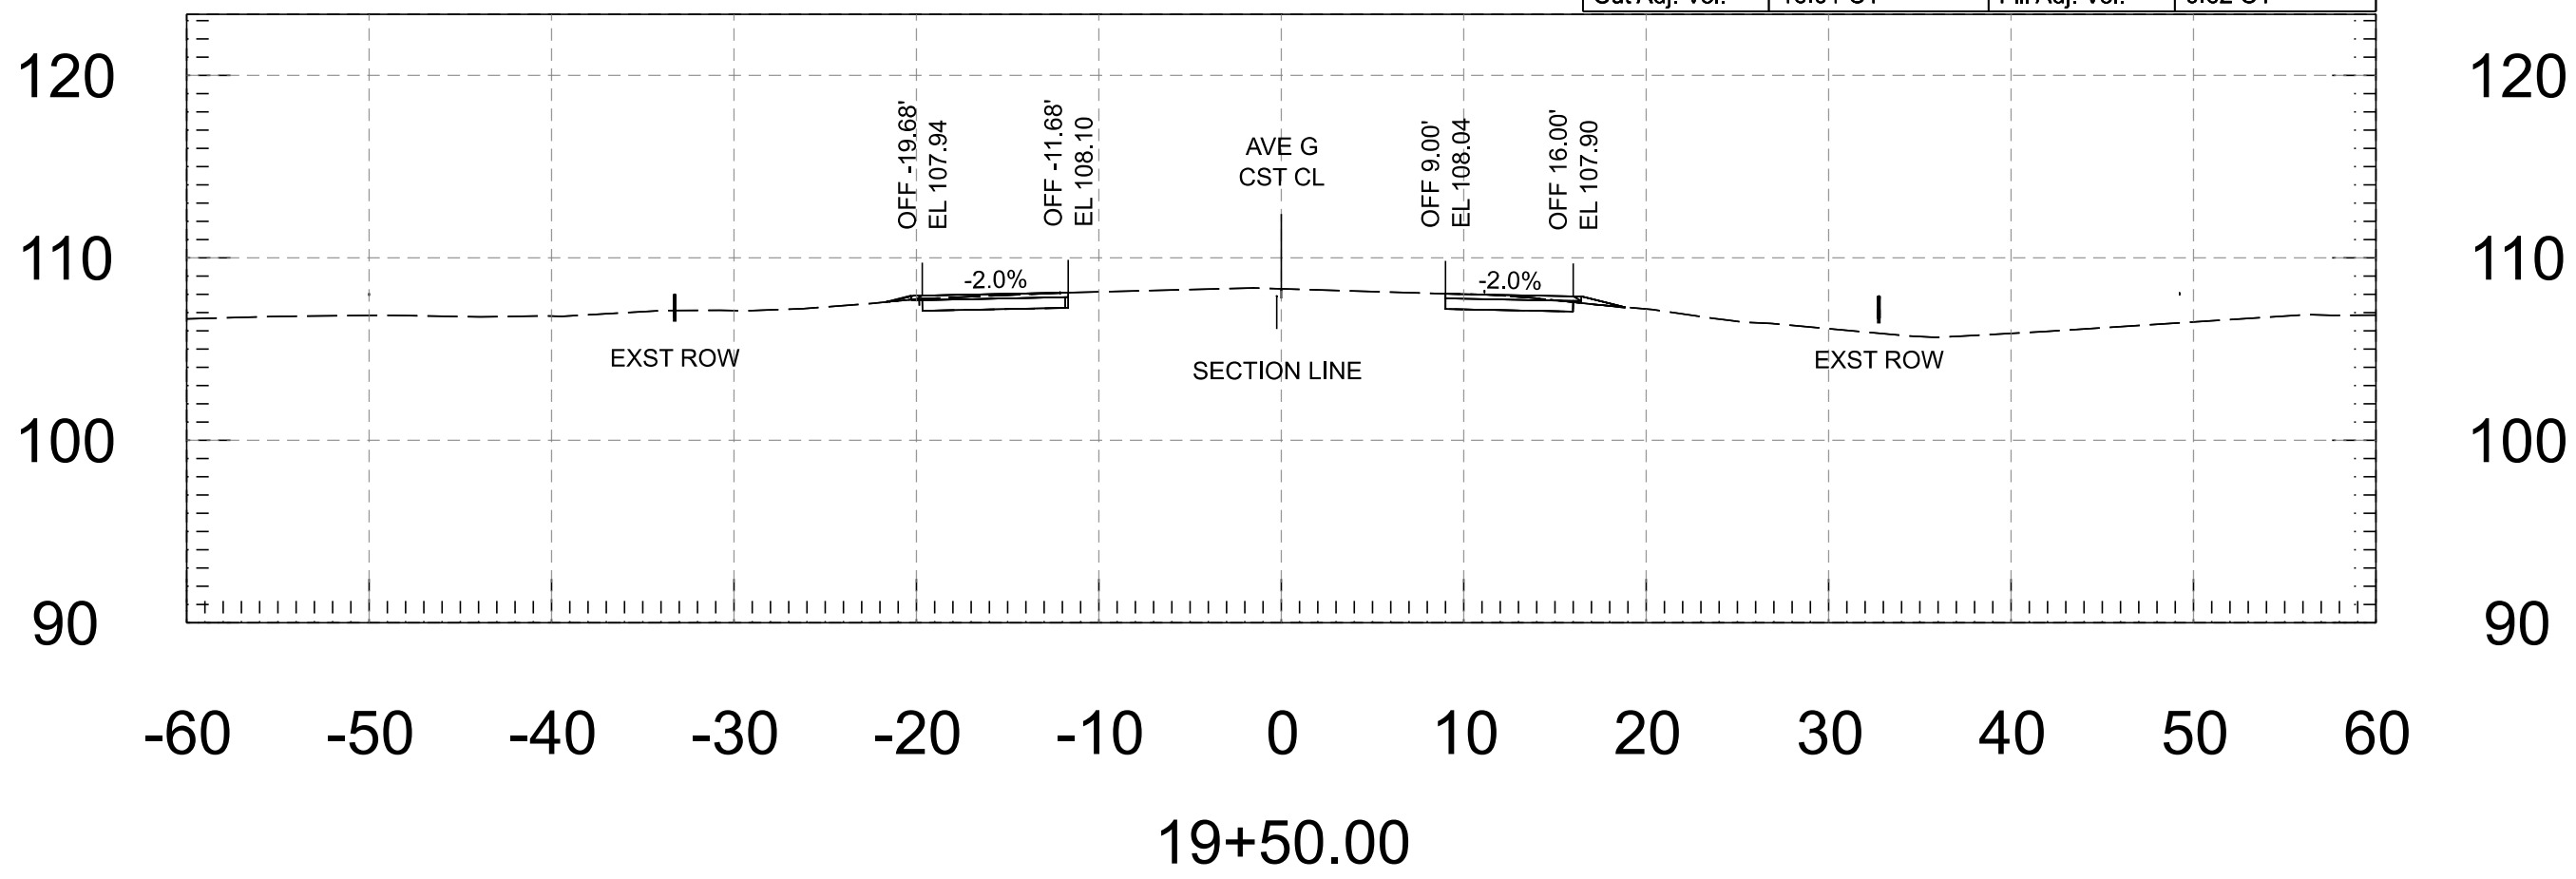


Cut Area	10.54 SF	Fill Area	0.60 SF
Cut Vol.	20.18 CY	Fill Vol.	1.02 CY
Cut Adj. Vol.	20.18 CY	Fill Adj. Vol.	1.02 CY

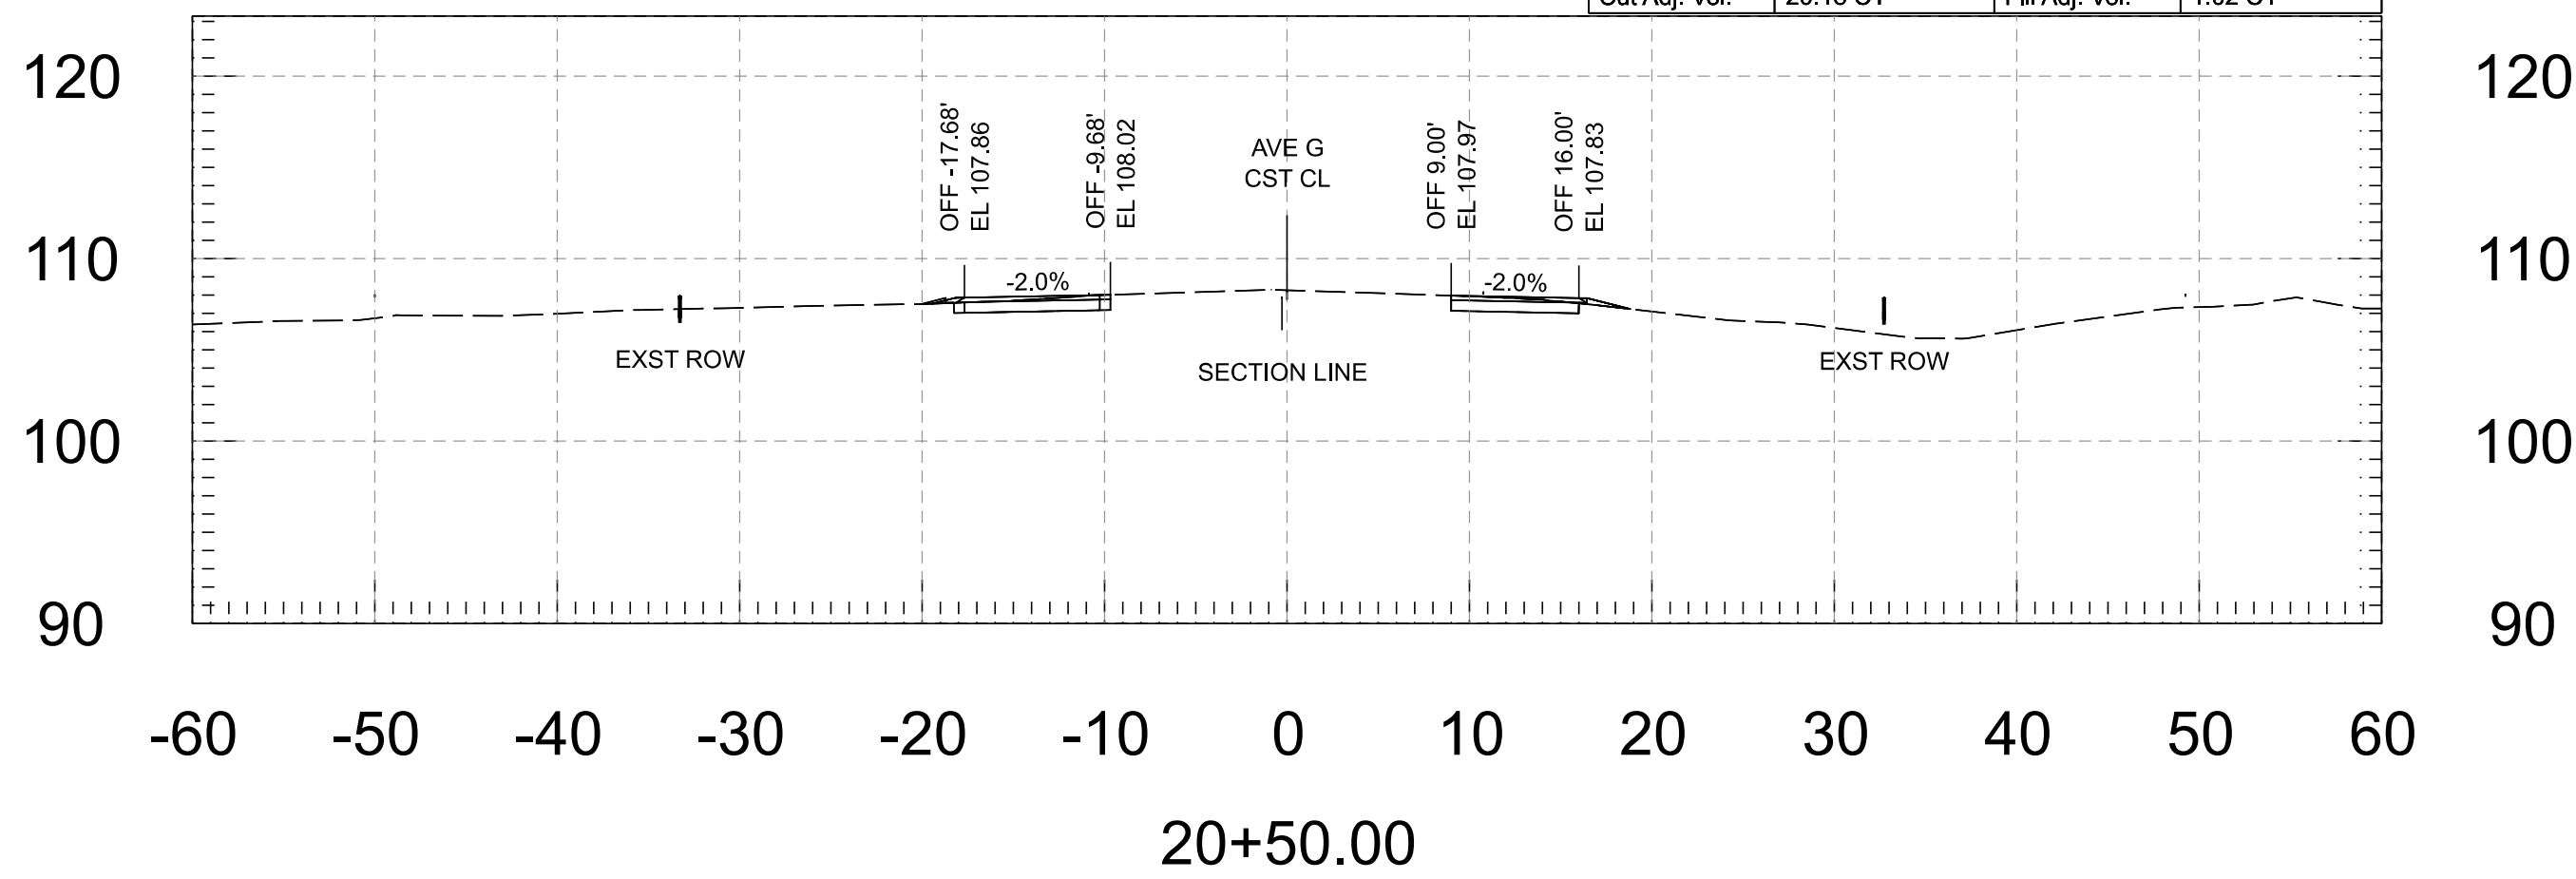



Cut Area	6.17 SF	Fill Area	0.00 SF
Cut Vol.	10.63 CY	Fill Vol.	0.20 CY
Cut Adj. Vol.	10.63 CY	Fill Adj. Vol.	0.20 CY

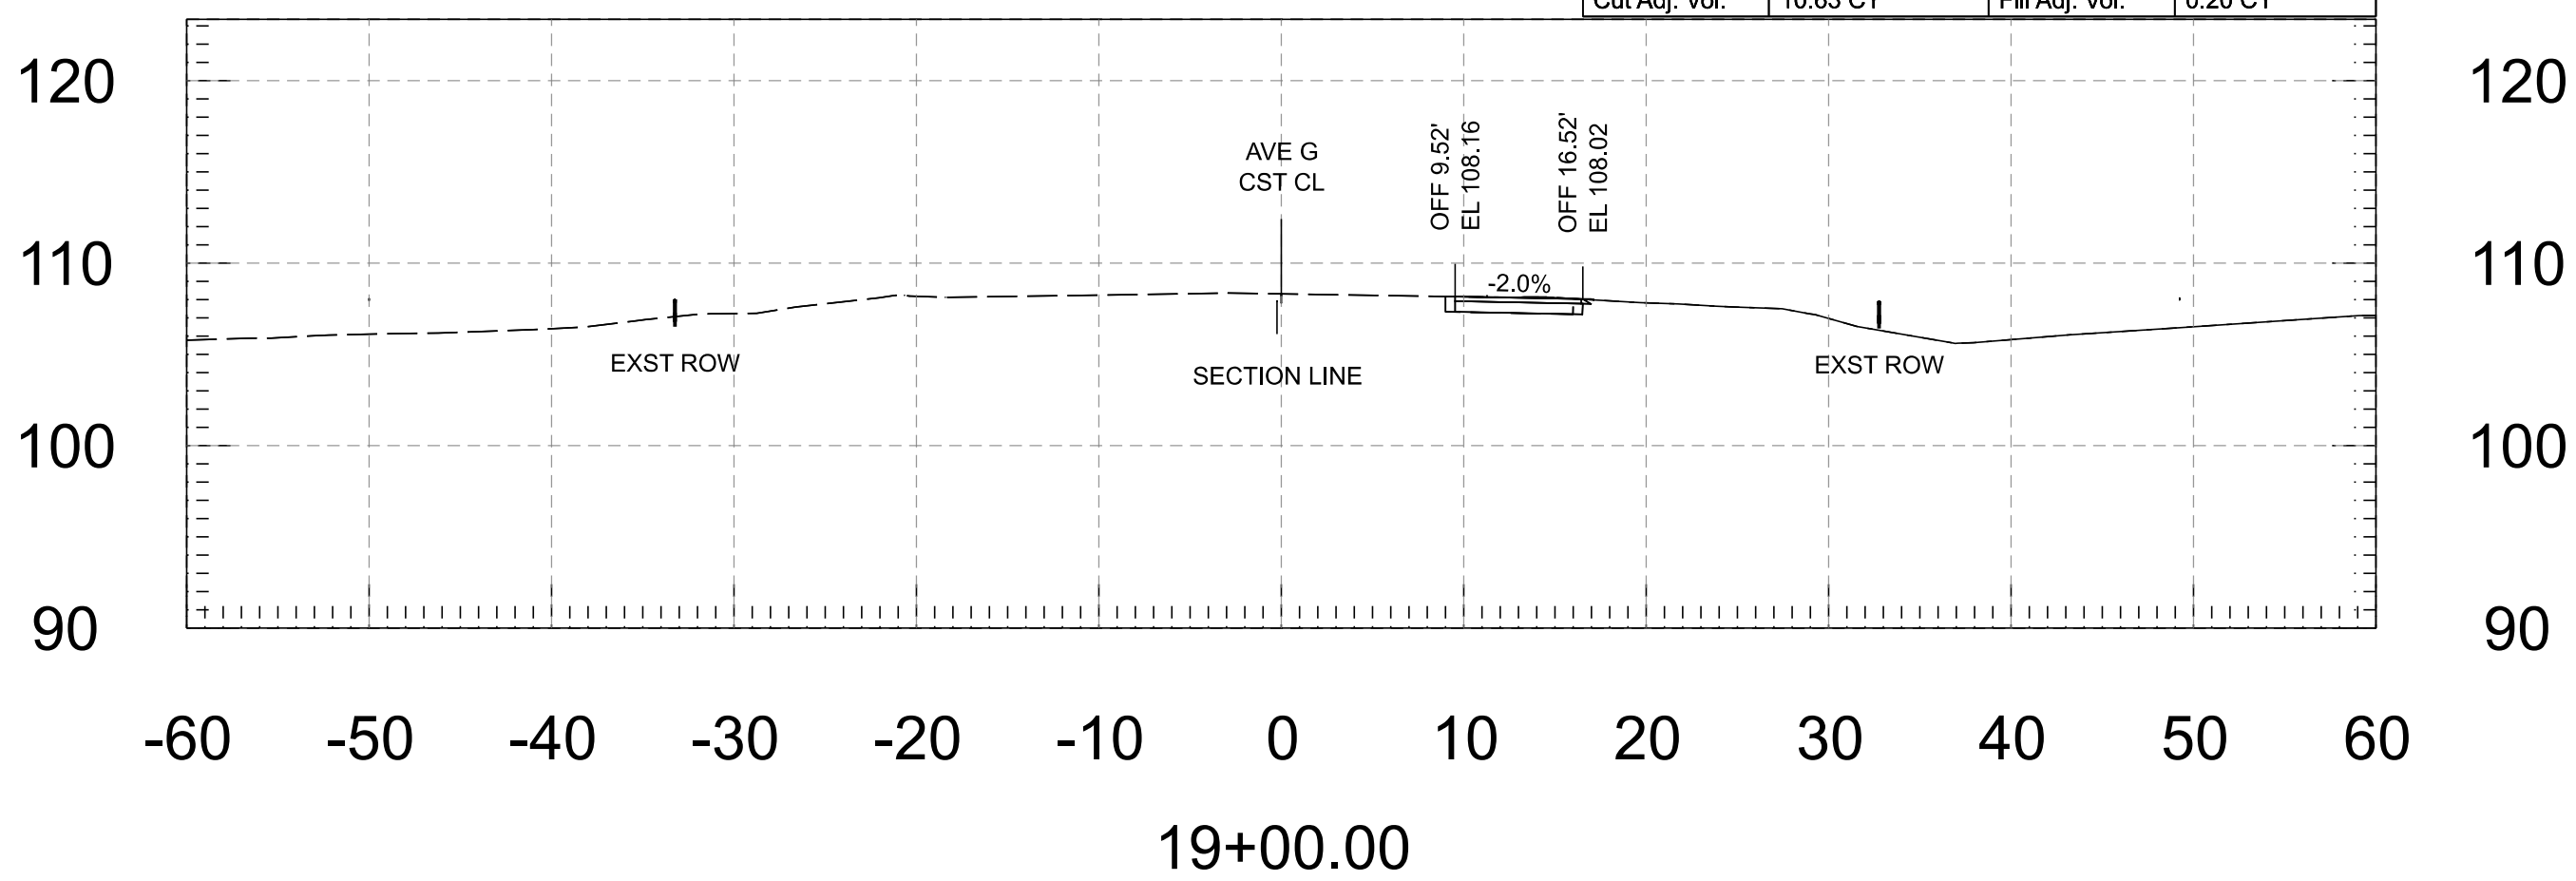

Cut Area	11.26 SF	Fill Area	0.50 SF
Cut Vol.	20.72 CY	Fill Vol.	1.08 CY
Cut Adj. Vol.	20.72 CY	Fill Adj. Vol.	1.08 CY

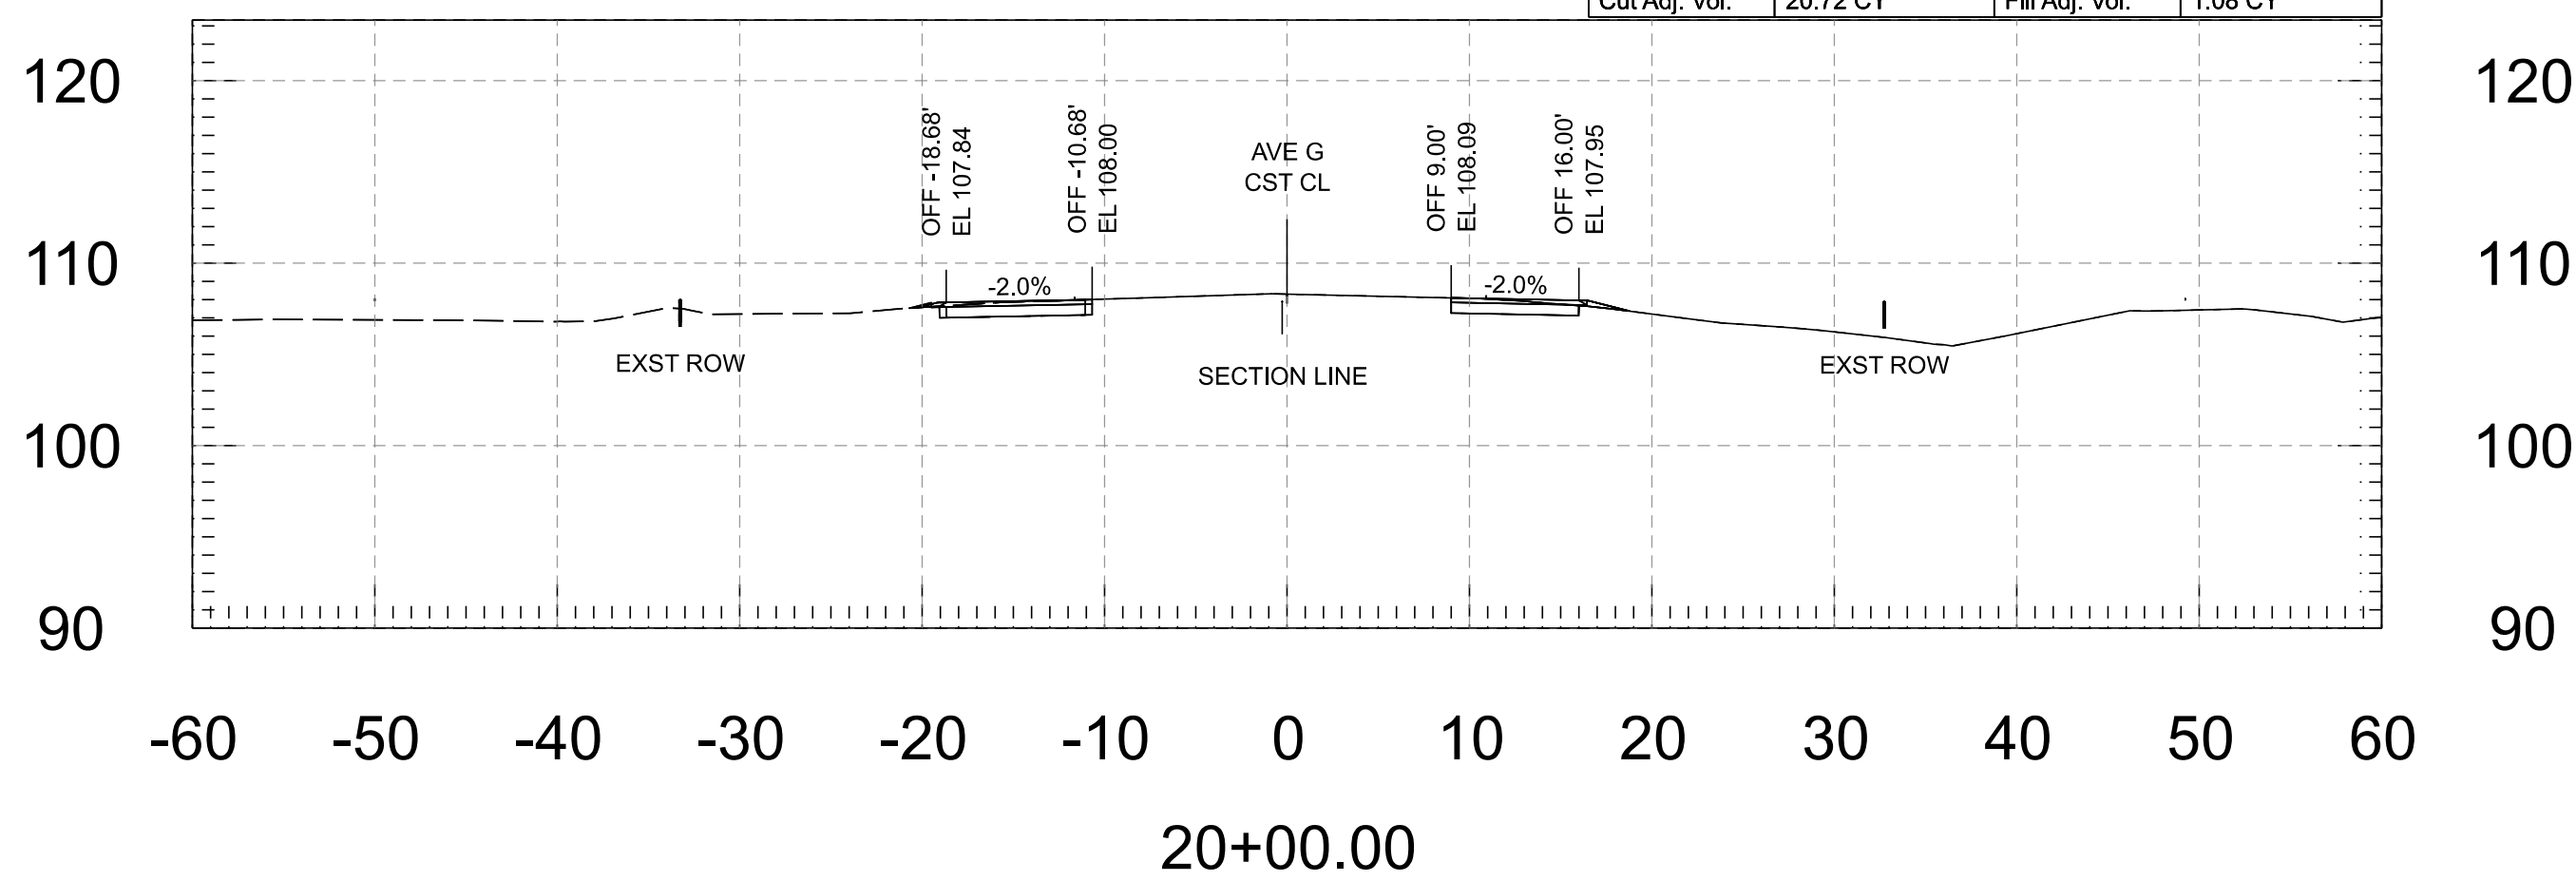


	FOR INFORMATION ONLY		NAME	DATE	ARIZONA DEPARTMENT OF TRANSPORTATION PROJECT DELIVERY AND OPERATIONS DIVISION ROADWAY DESIGN SERVICES	ROUTE	F.H.W.A. Arizona Division	STATE ARIZ.	PROJECT NO.	FEDERAL ID NO.	SHEET NO.	TOTAL SHEETS	RECORD DRAWING			
		DESIGN	M. SCHOEN	07/26		MILEPOST			0000 YU YYU	YYU-0(225)T	3	118				
		DRAWN	M. SCHOEN	07/26					LOCATION				AVENUE G, COUNTY 11TH ST - COUNTY 16TH ST			DWG
		CHECKED	H. RIOS	07/26					TRACS NO.				T0437 01C			
					WSP USA Inc. 1230 West Washington Street, Suite 405 Tempe, AZ 85288			AVENUE G - CROSS SECTIONS			____ OF ____					

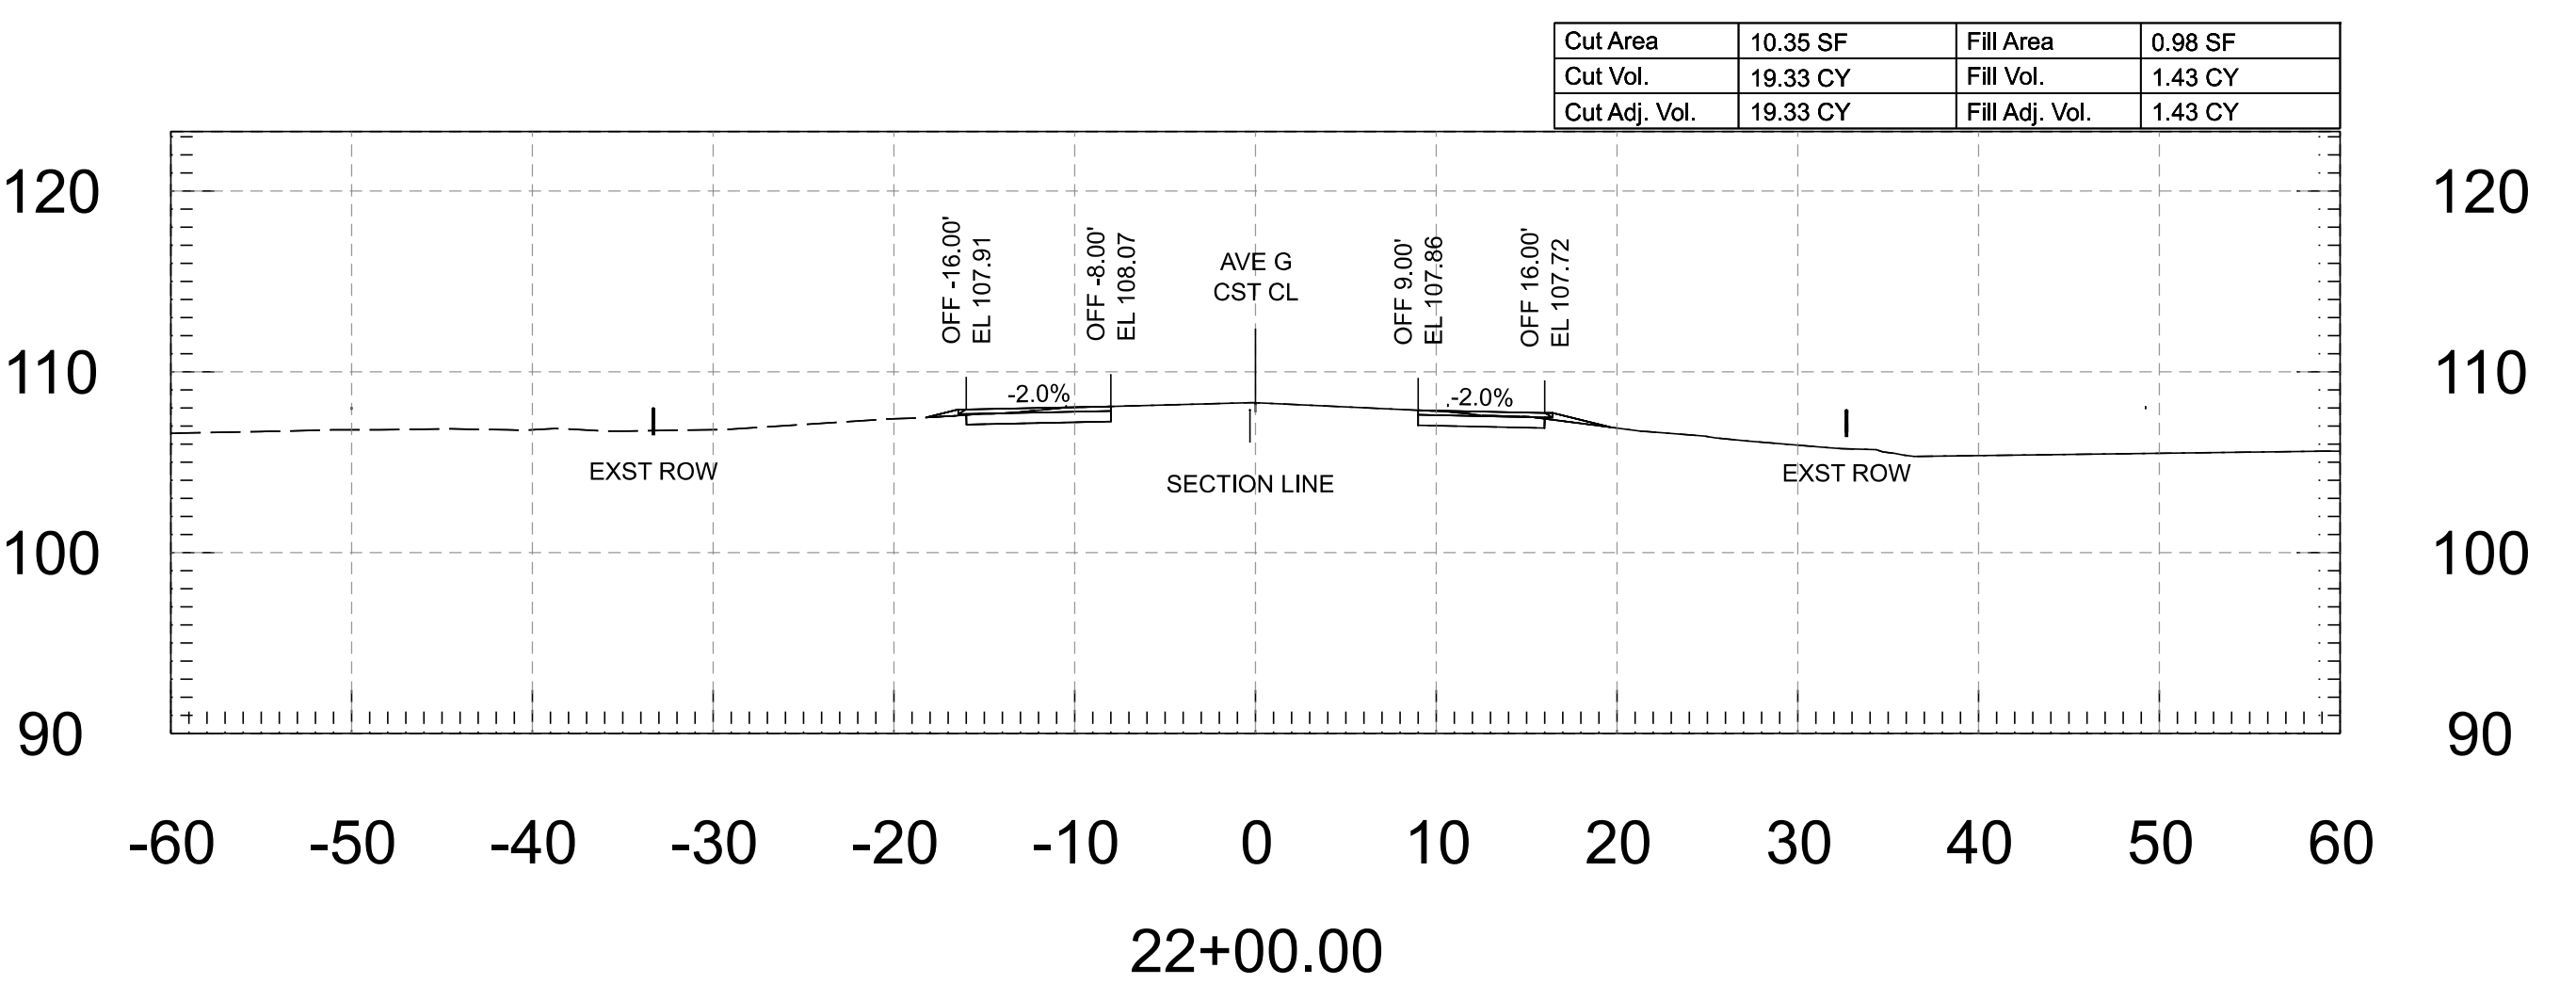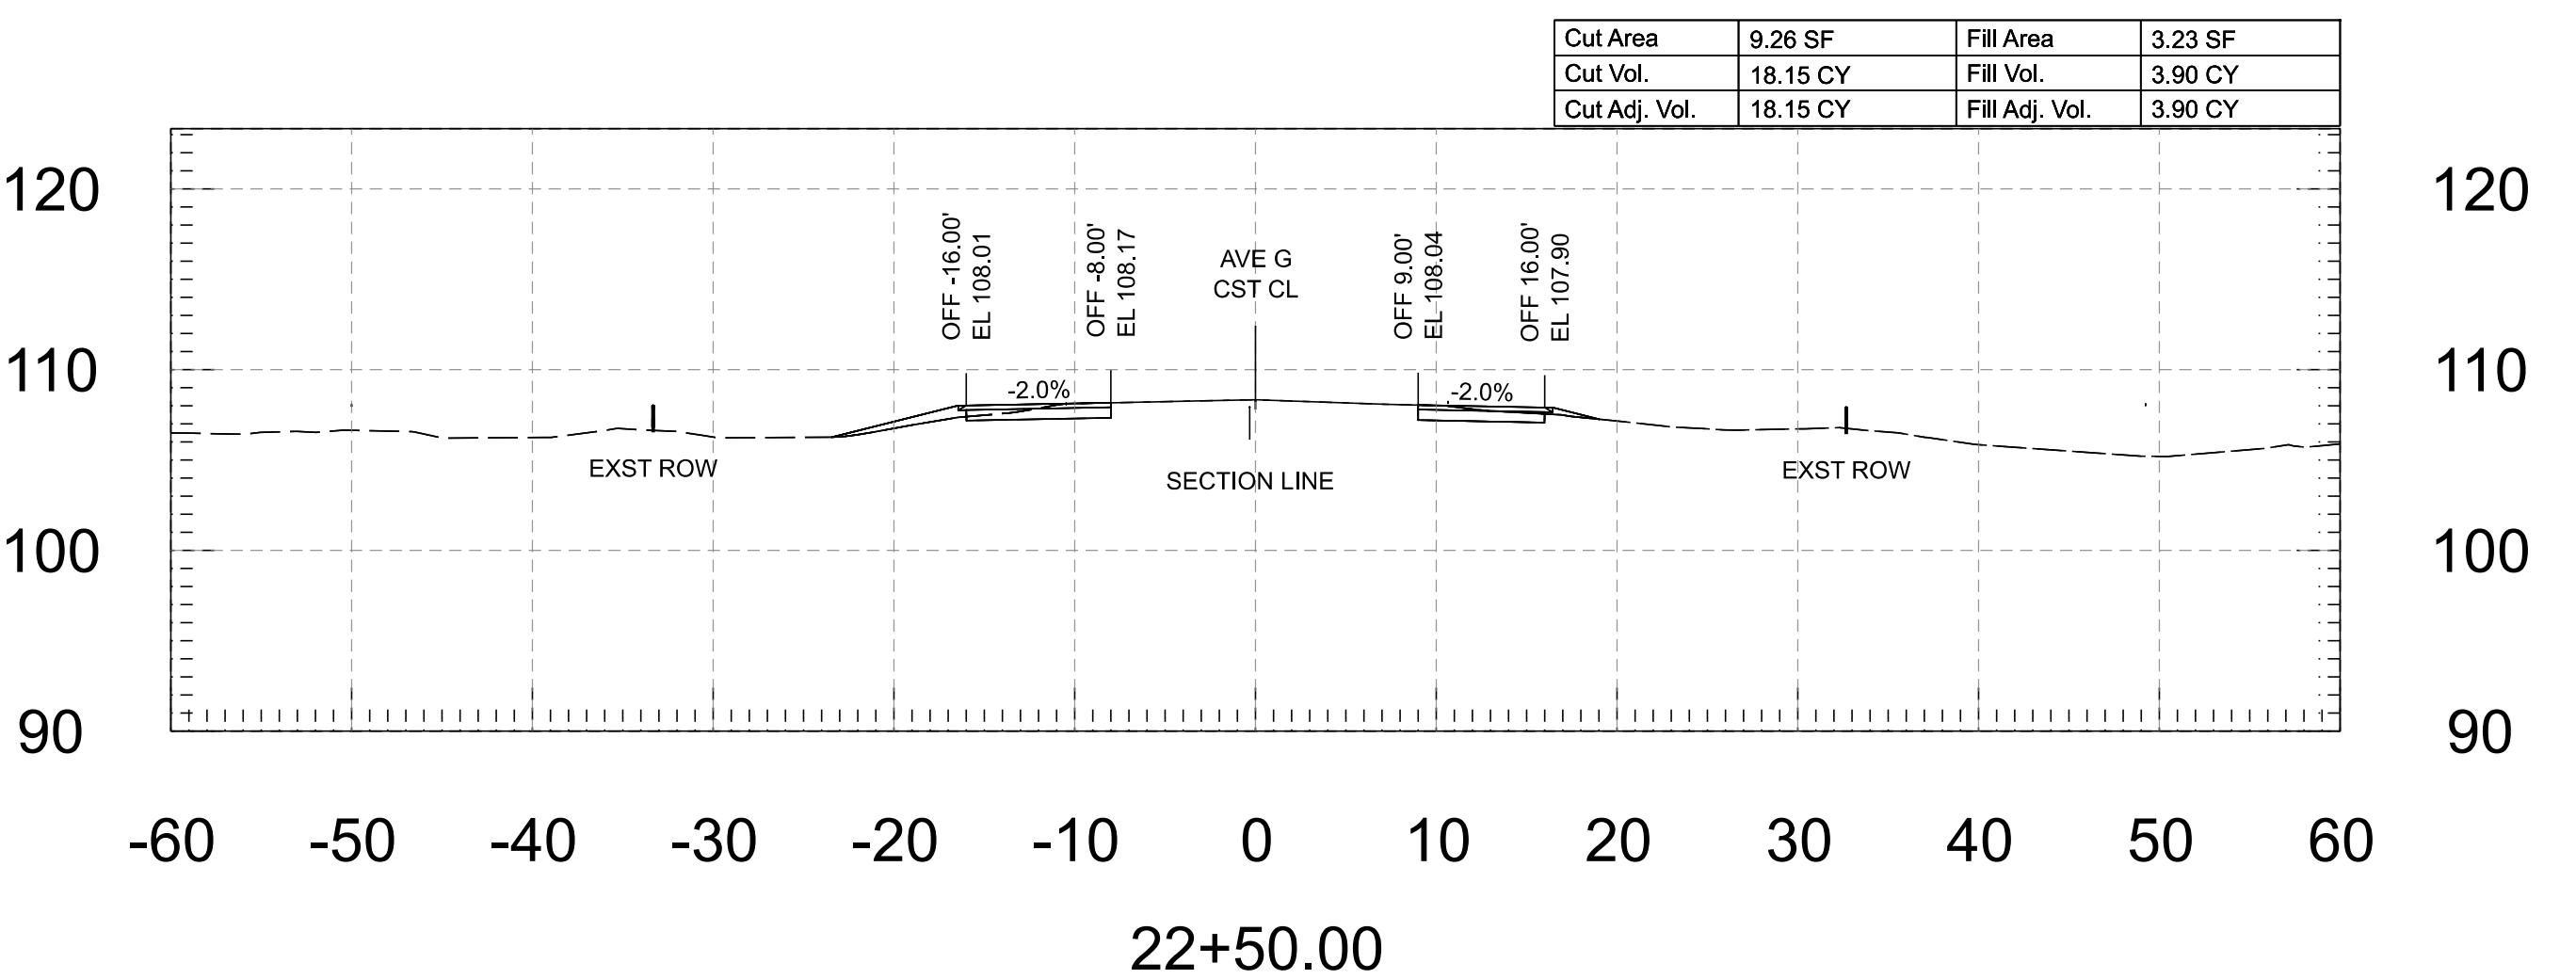


FOR INFORMATION ONLY		NAME	DATE	ARIZONA DEPARTMENT OF TRANSPORTATION PROJECT DELIVERY AND OPERATIONS DIVISION ROADWAY DESIGN SERVICES	ROUTE	F.H.W.A. Arizona Division	STATE ARIZ.	PROJECT NO.	FEDERAL ID NO.	SHEET NO.	TOTAL SHEETS	RECORD DRAWING
	DESIGN	M. SCHOEN	07/26		MILEPOST			0000 YU YU	YU-0(225)T	4	118	
	CHECKED	H. RIOS	07/26		STRUCTURE NO.							
	wsp WSP USA, Inc. 1238 West Washington Street, Suite 405 Tempe, AZ 85288	AVENUE G - CROSS SECTIONS			LOCATION AVENUE G, COUNTY 11TH ST - COUNTY 16TH ST DWG TRACS NO. T0437 01C OF							


Cut Area	9.79 SF	Fill Area	3.36 SF
Cut Vol.	19.11 CY	Fill Vol.	3.39 CY
Cut Adj. Vol.	19.11 CY	Fill Adj. Vol.	3.39 CY

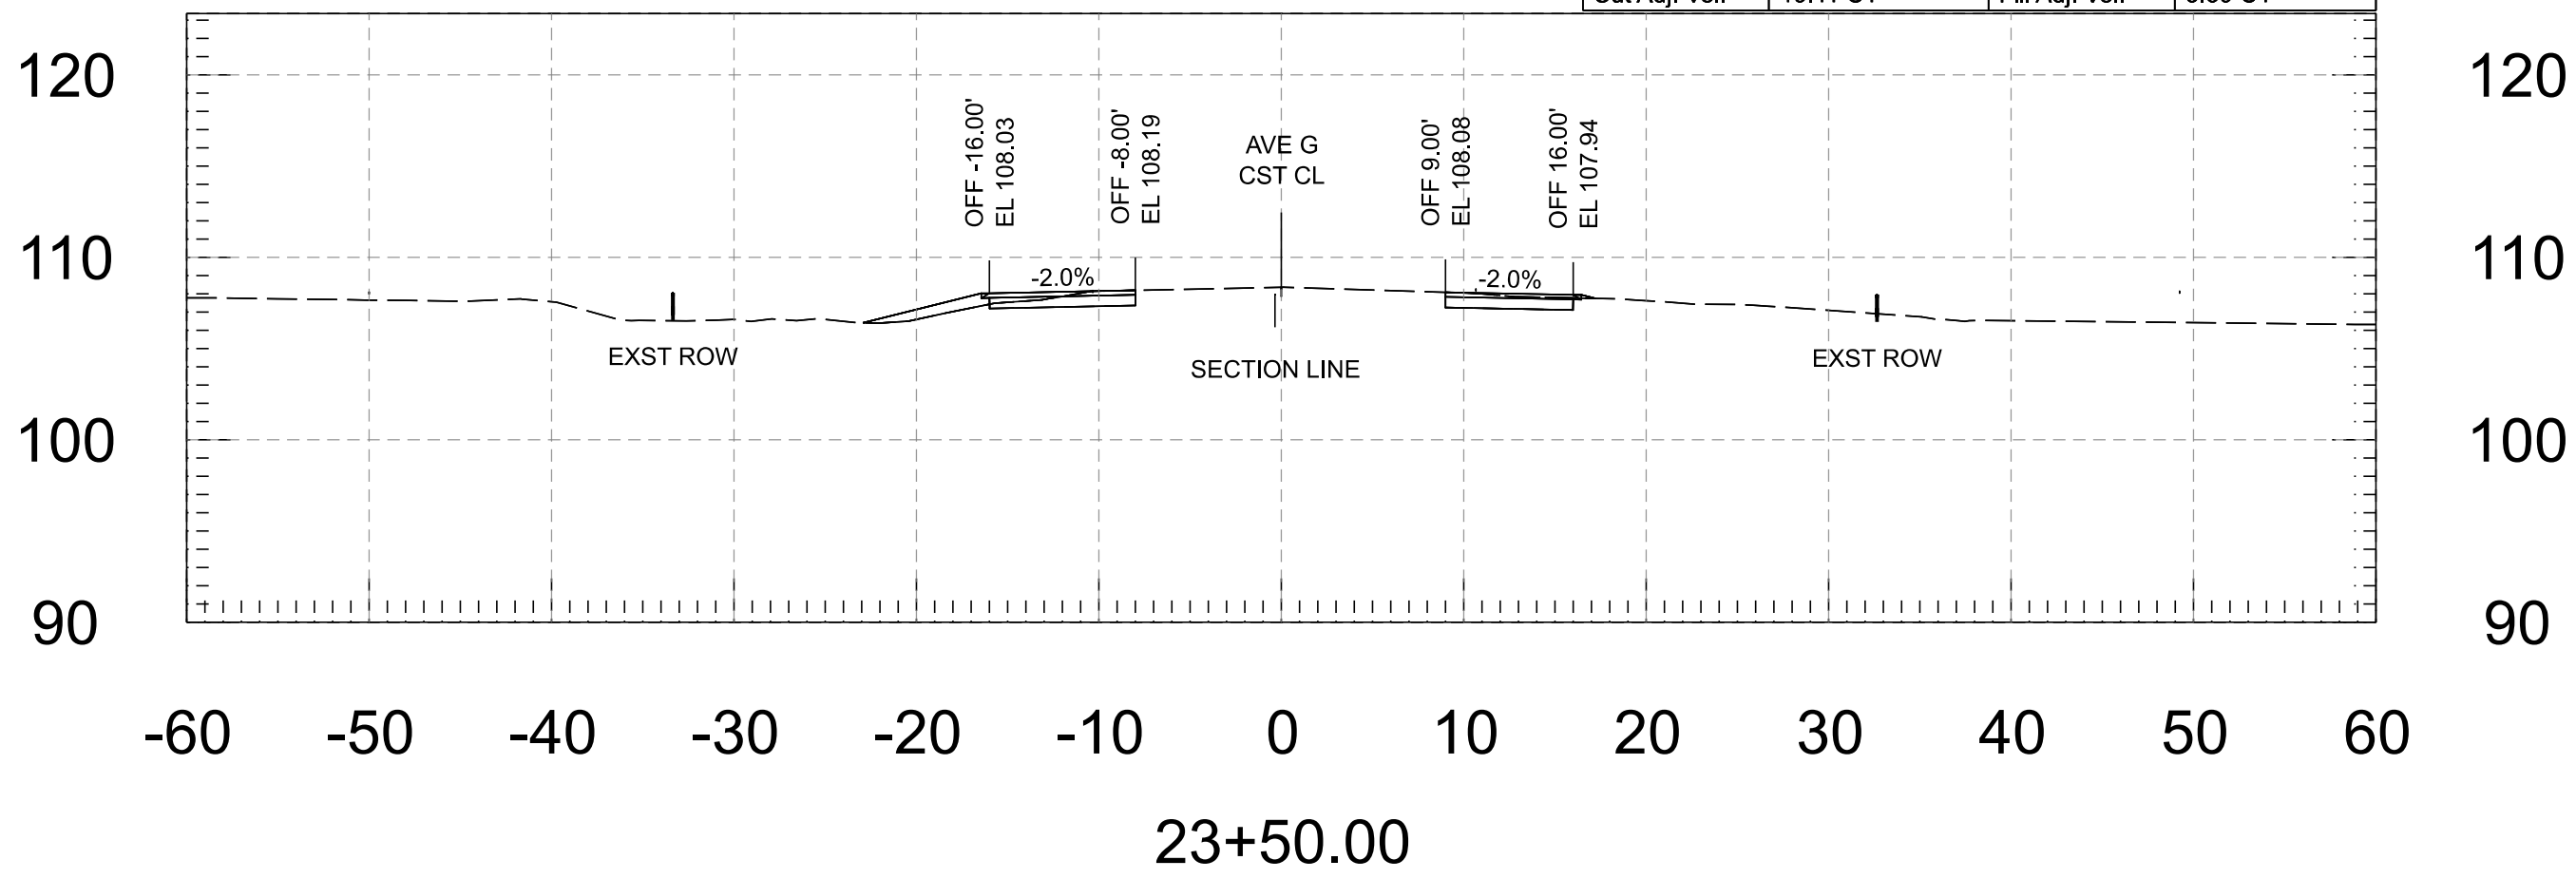


Cut Area	9.14 SF	Fill Area	5.14 SF
Cut Vol.	18.03 CY	Fill Vol.	7.83 CY
Cut Adj. Vol.	18.03 CY	Fill Adj. Vol.	7.83 CY

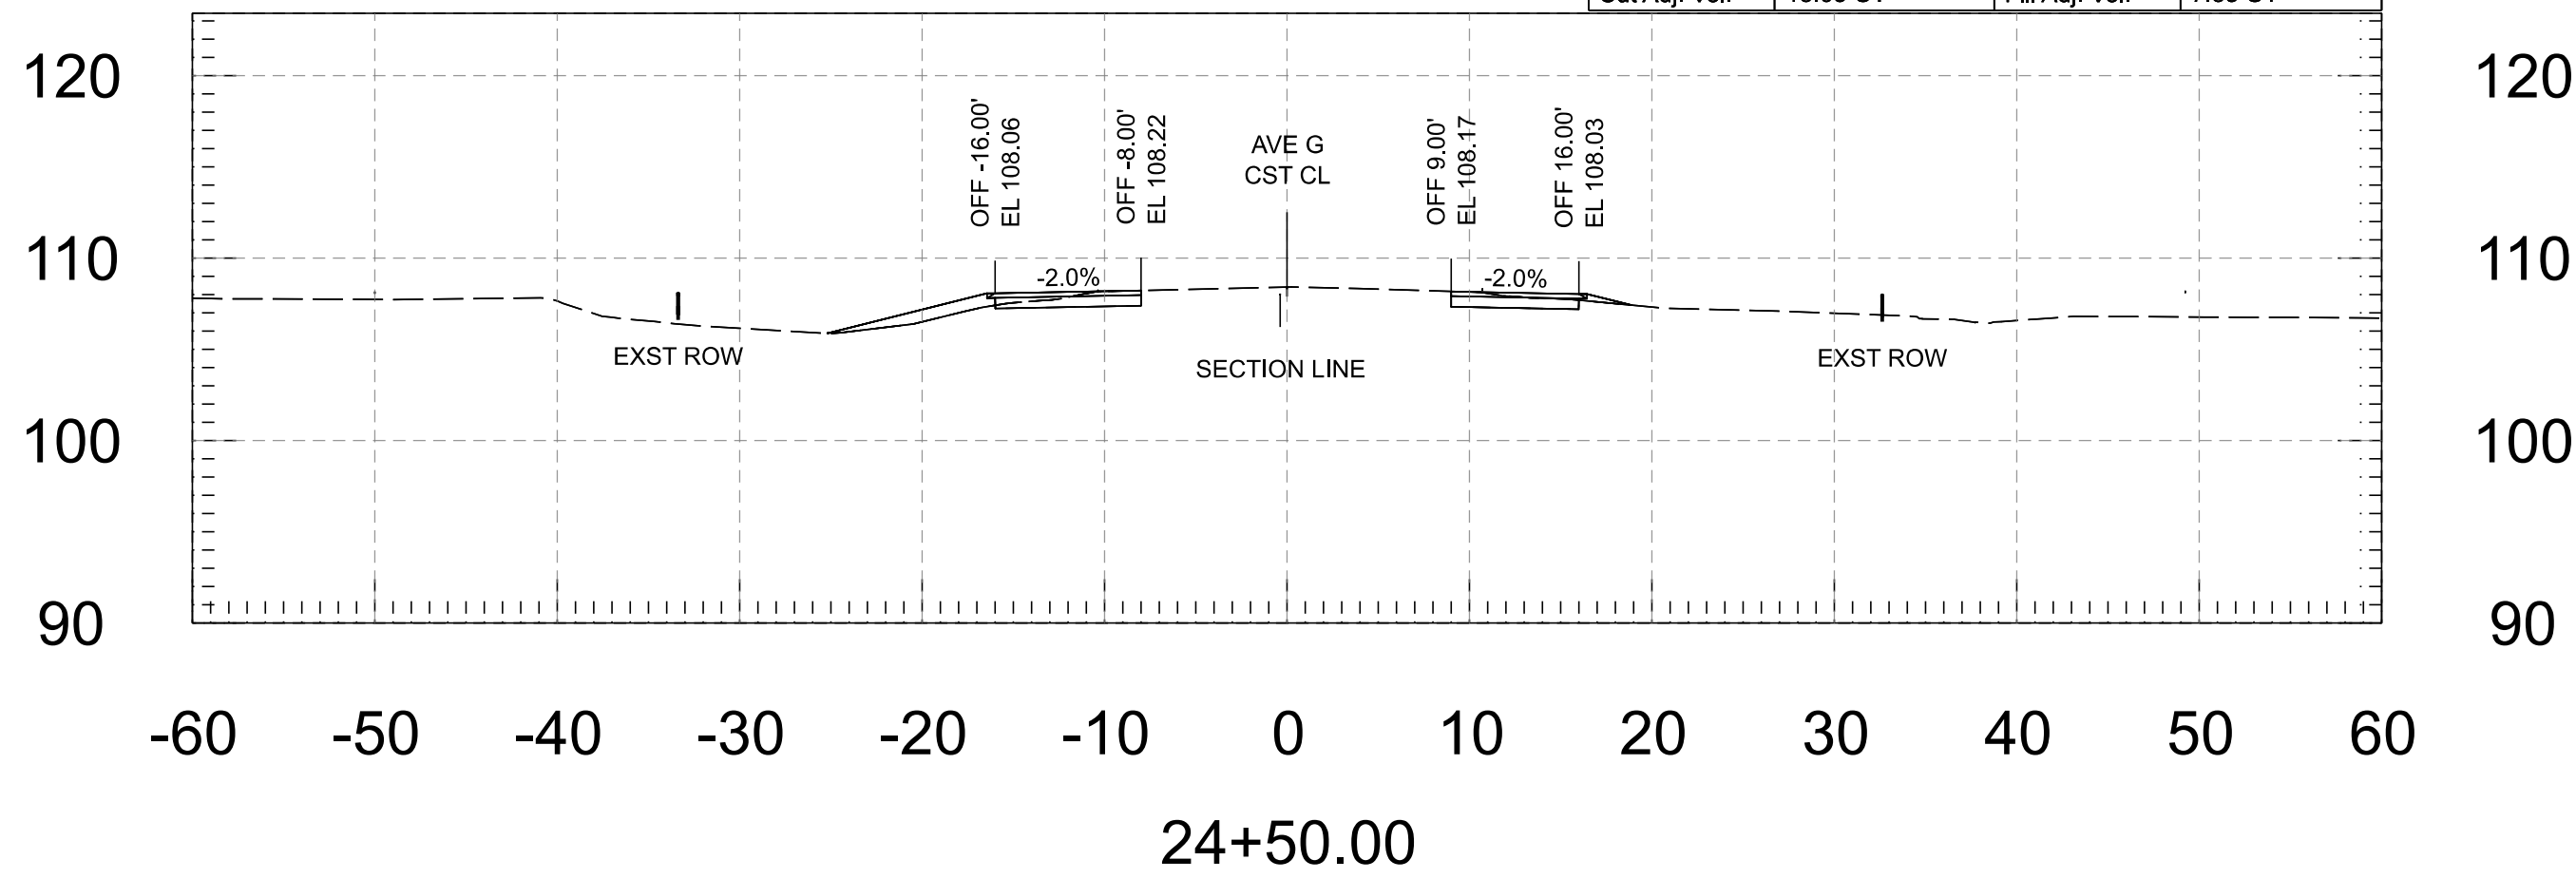





Cut Area	10.84 SF	Fill Area	0.31 SF
Cut Vol.	18.61 CY	Fill Vol.	3.28 CY
Cut Adj. Vol.	18.61 CY	Fill Adj. Vol.	3.28 CY


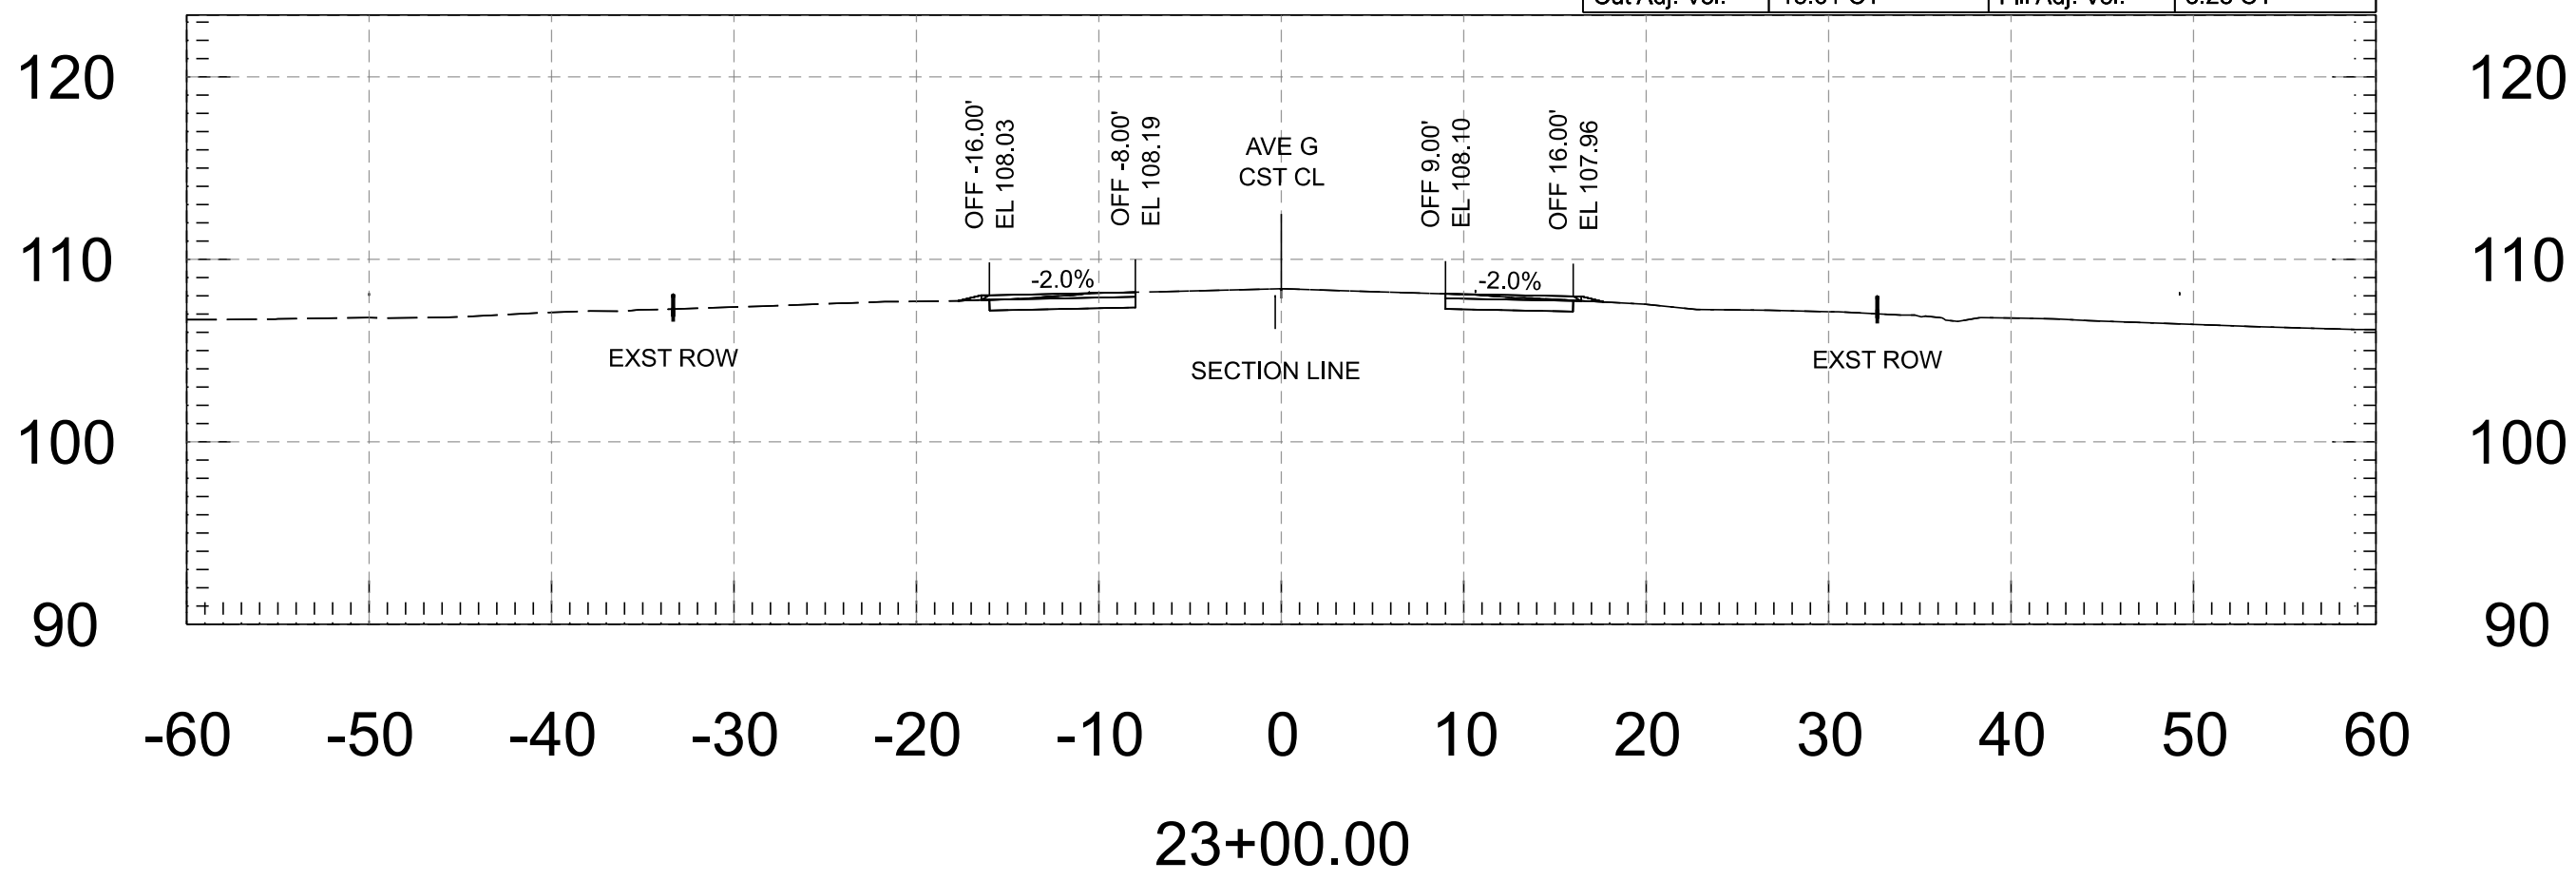


Cut Area	10.33 SF	Fill Area	3.32 SF
Cut Vol.	18.63 CY	Fill Vol.	6.18 CY
Cut Adj. Vol.	18.63 CY	Fill Adj. Vol.	6.18 CY


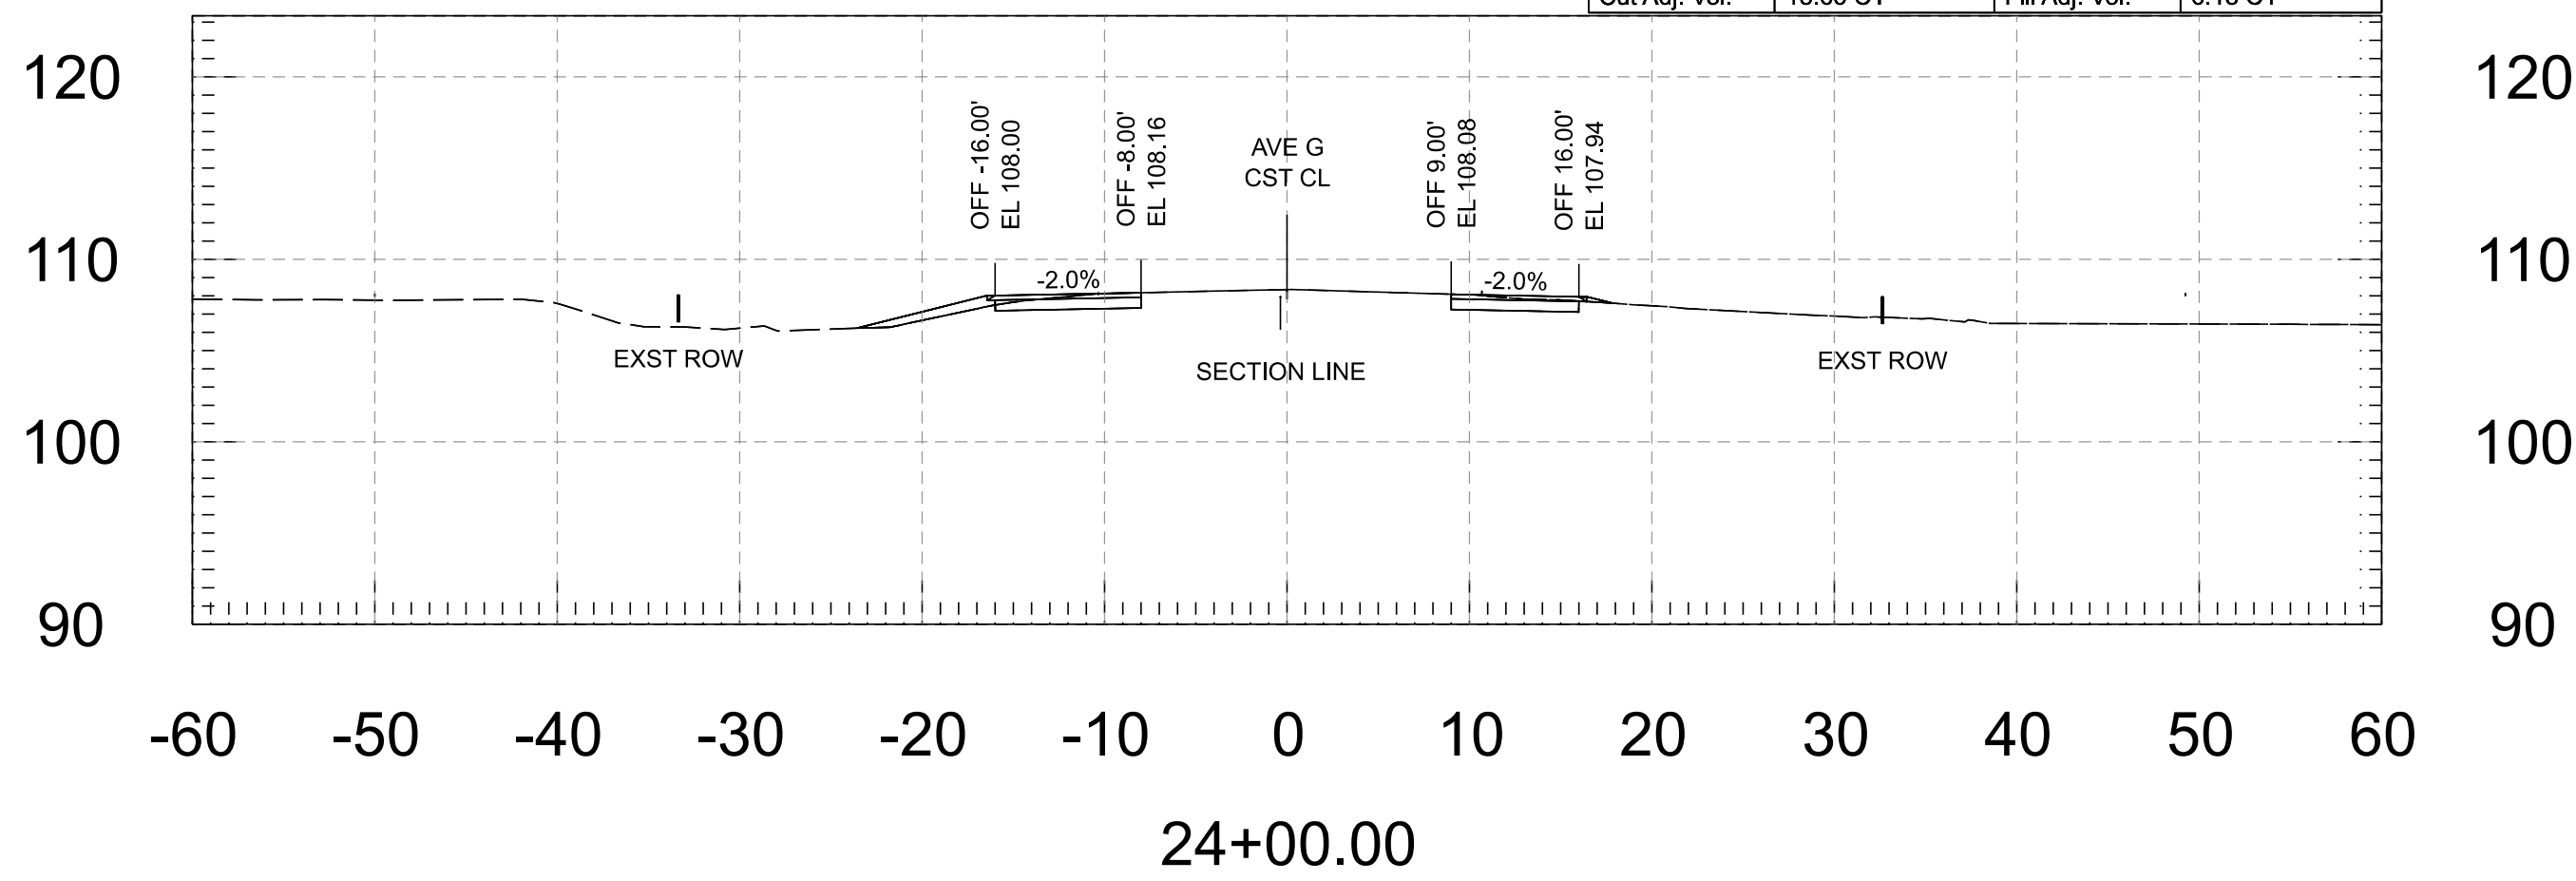


FOR INFORMATION ONLY		NAME	DATE	ARIZONA DEPARTMENT OF TRANSPORTATION PROJECT DELIVERY AND OPERATIONS DIVISION ROADWAY DESIGN SERVICES	ROUTE	F.H.W.A. Arizona Division	STATE ARIZ.	PROJECT NO.	FEDERAL ID NO.	SHEET NO.	TOTAL SHEETS	RECORD DRAWING
	DESIGN	M. SCHOEN	07/26		MILEPOST			0000 YU YYU	YYU-0(225)T	5	118	
	DRAWN	M. SCHOEN	07/26					LOCATION AVENUE G, COUNTY 11TH ST - COUNTY 16TH ST				
	CHECKED	H. RIOS	07/26	TRACS NO. T0437 01C								
	 WSP USA Inc. 1230 West Washington Street, Suite 405 Tempe, AZ 85288										AVENUE G - CROSS SECTIONS	

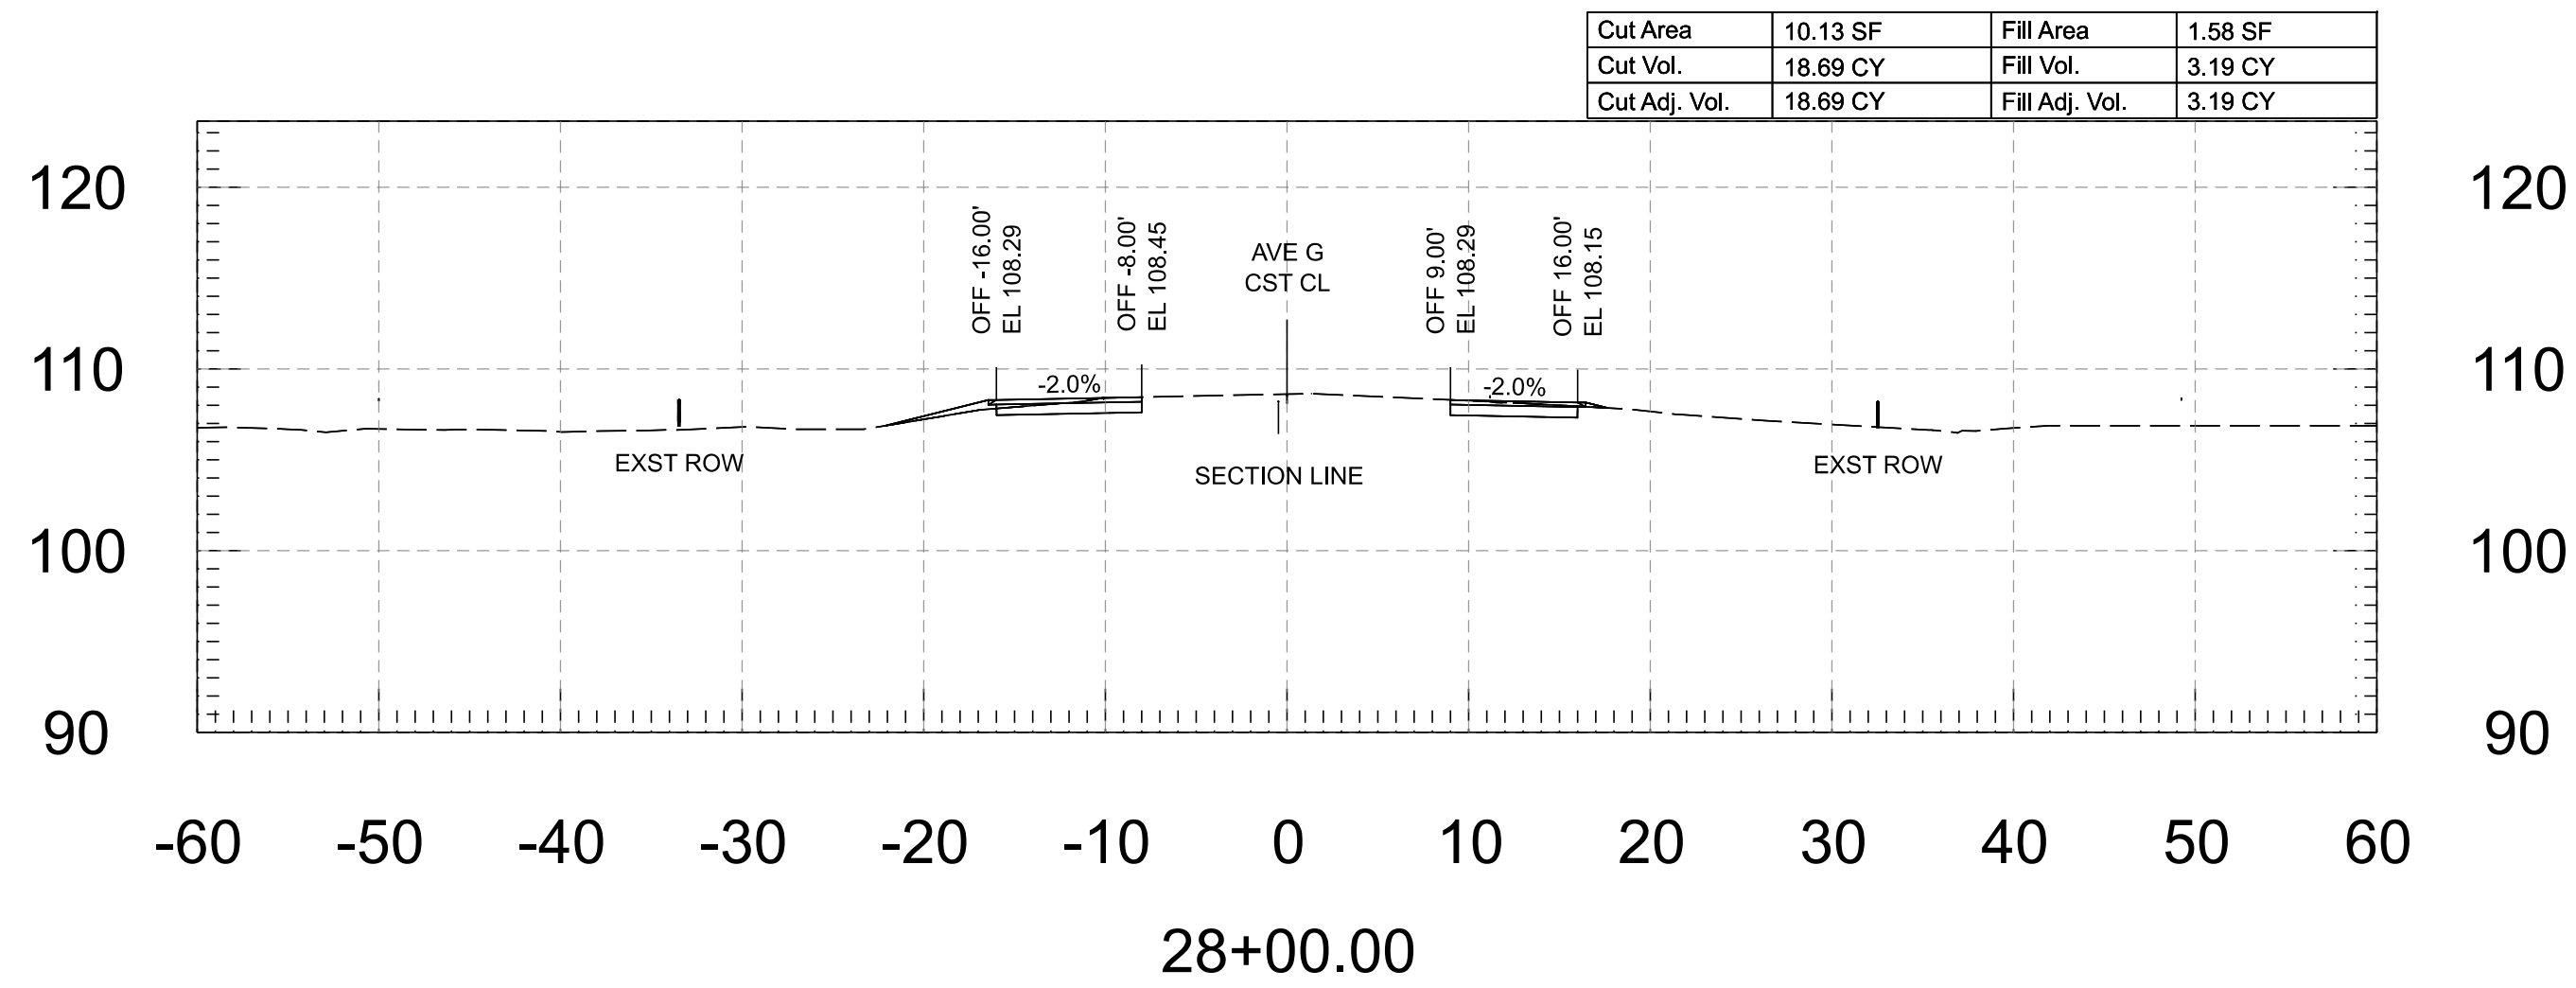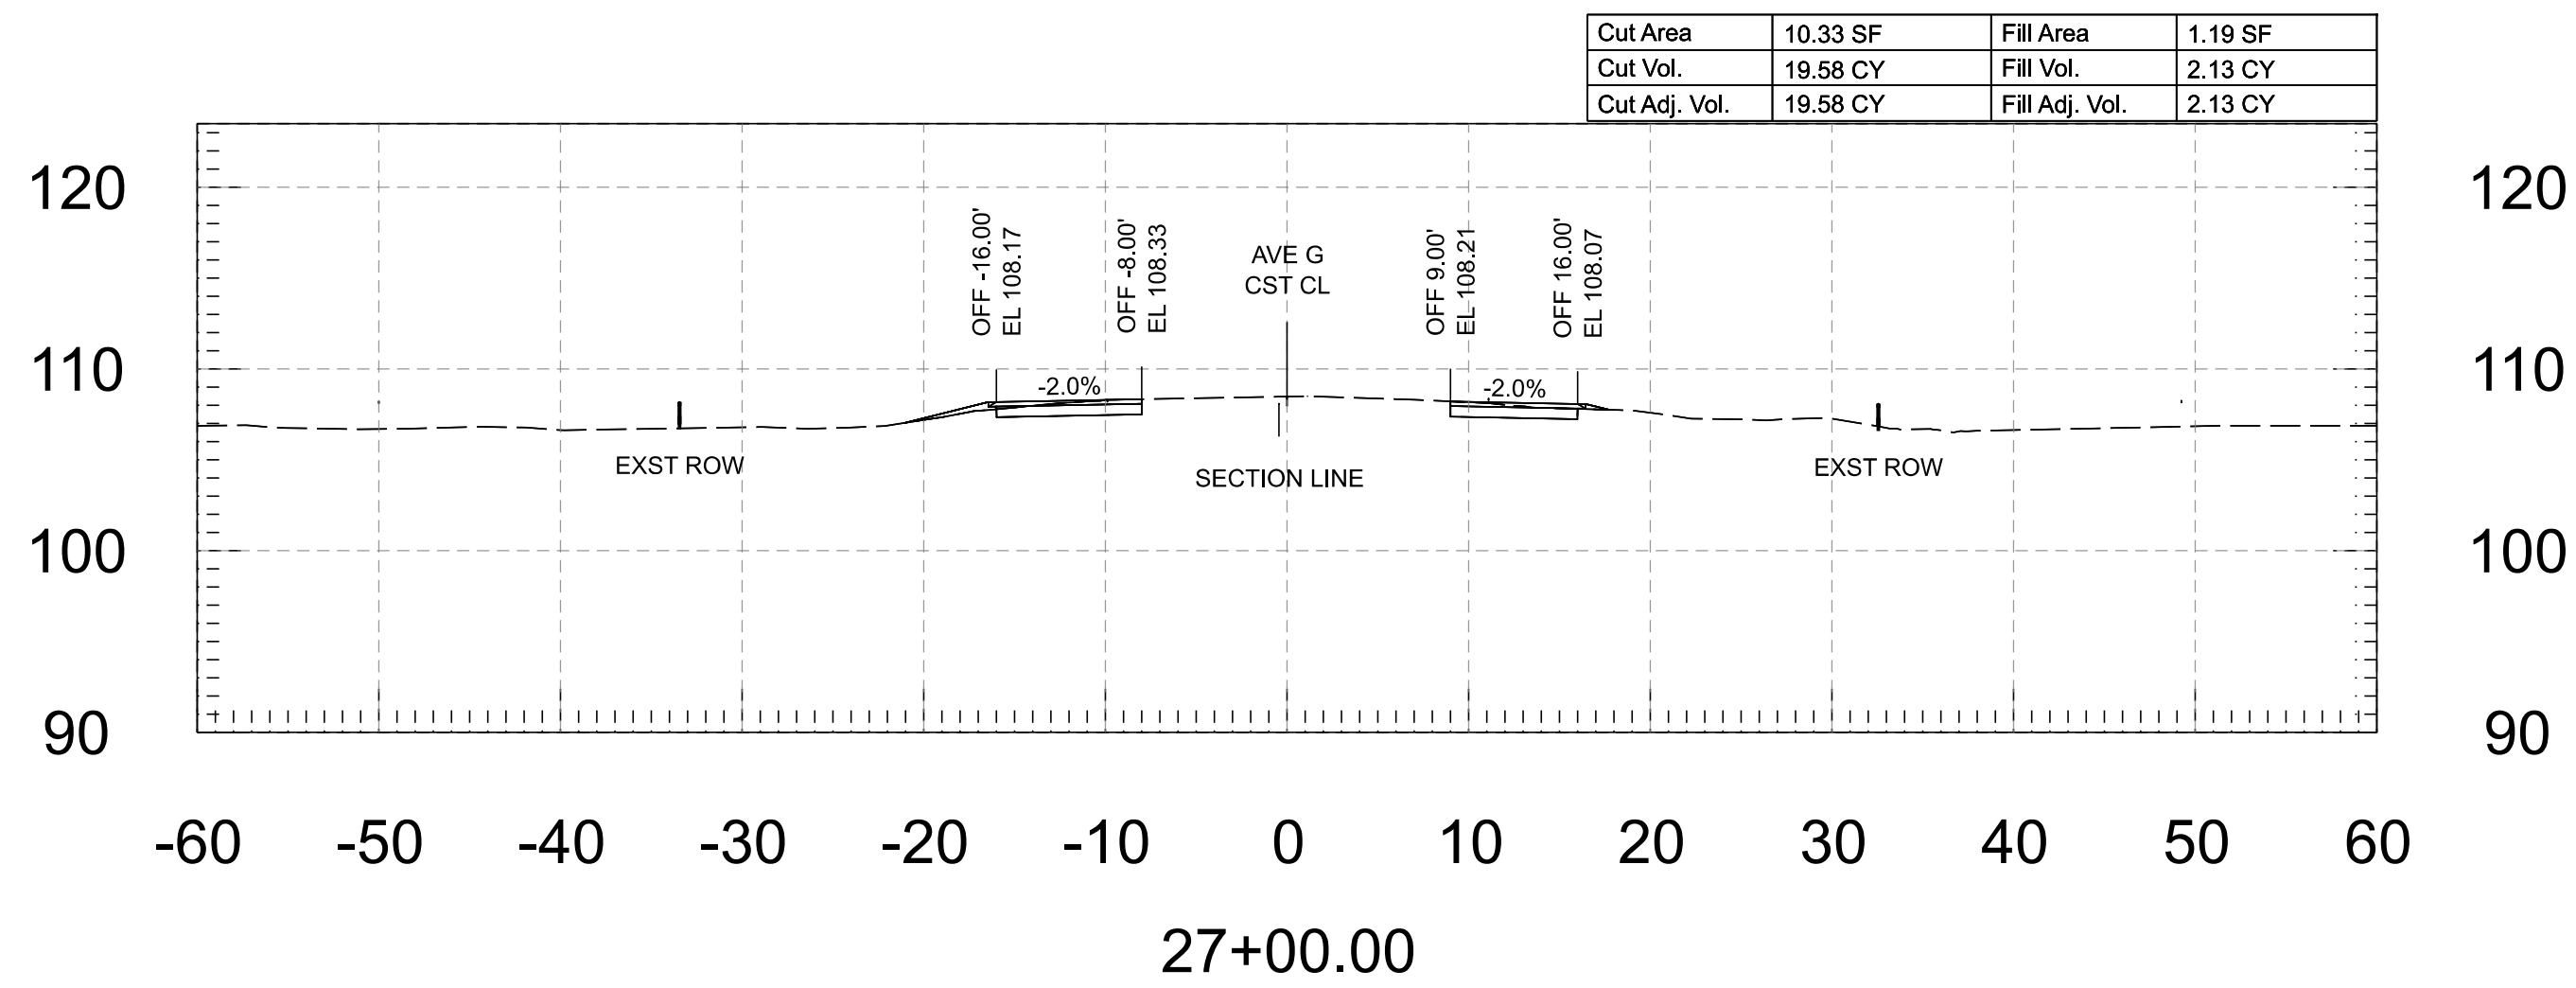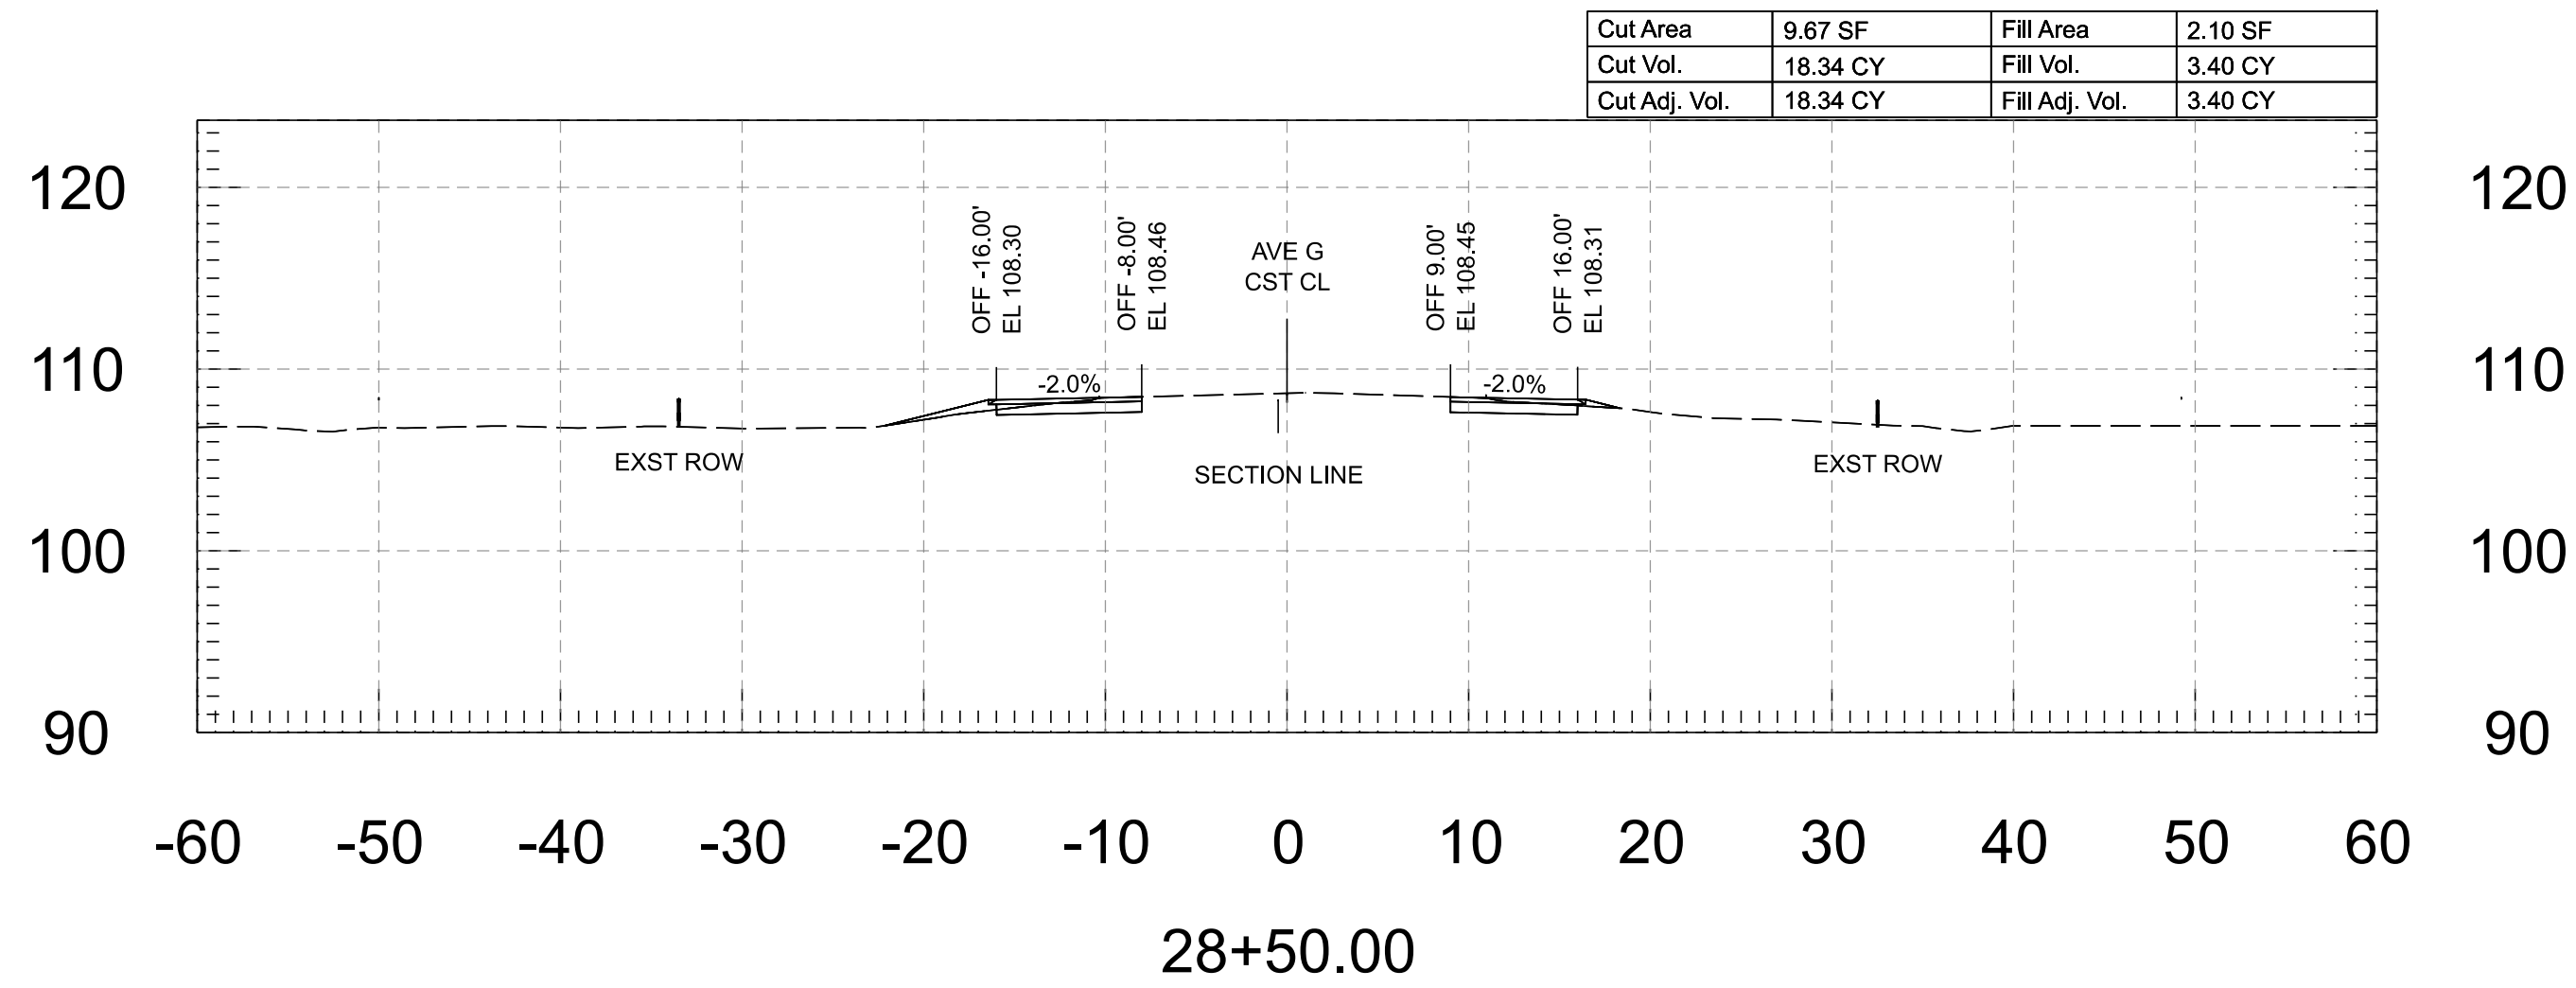
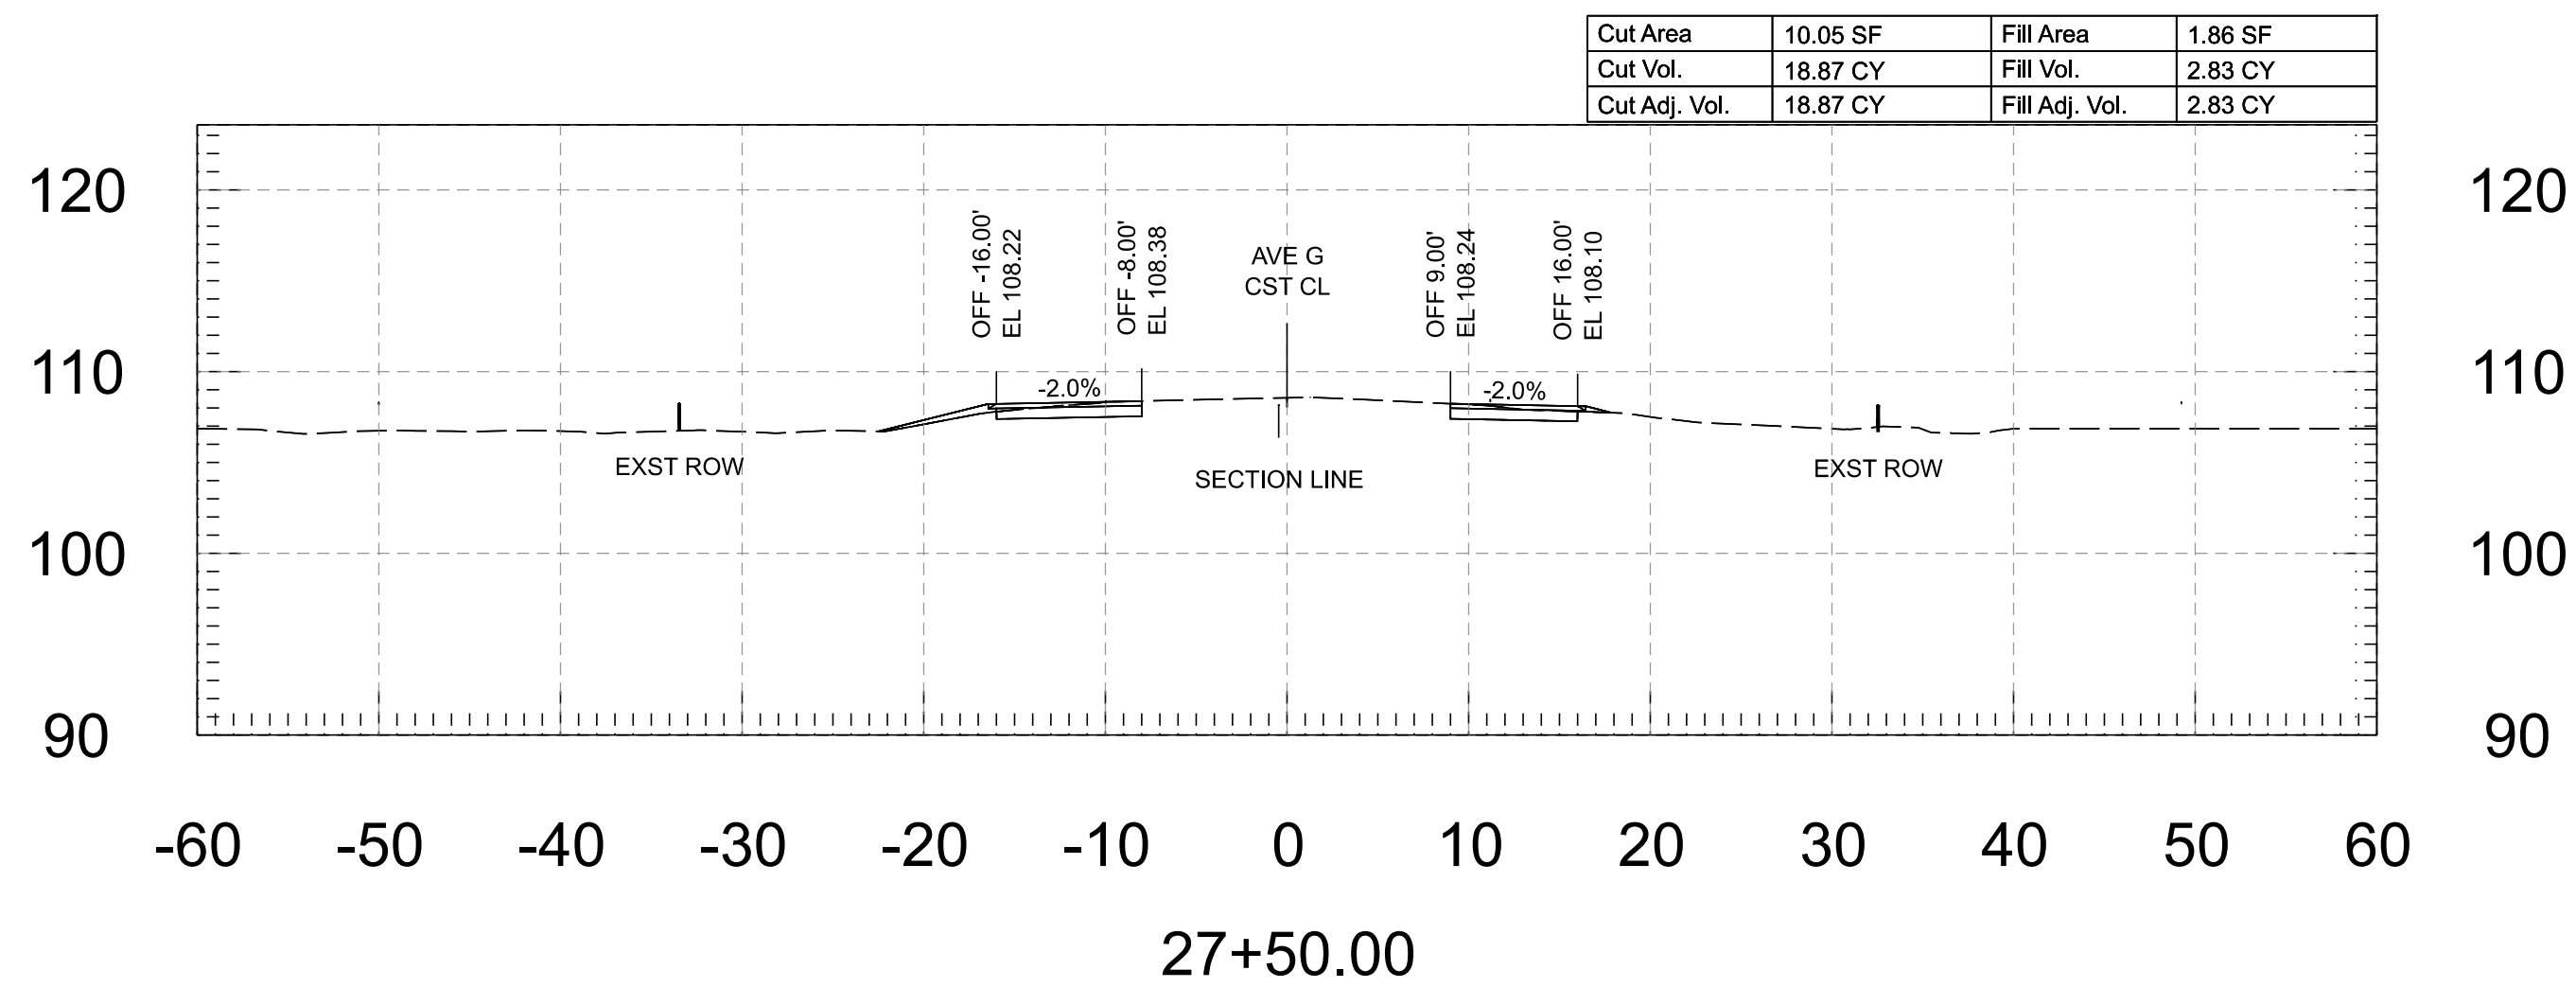


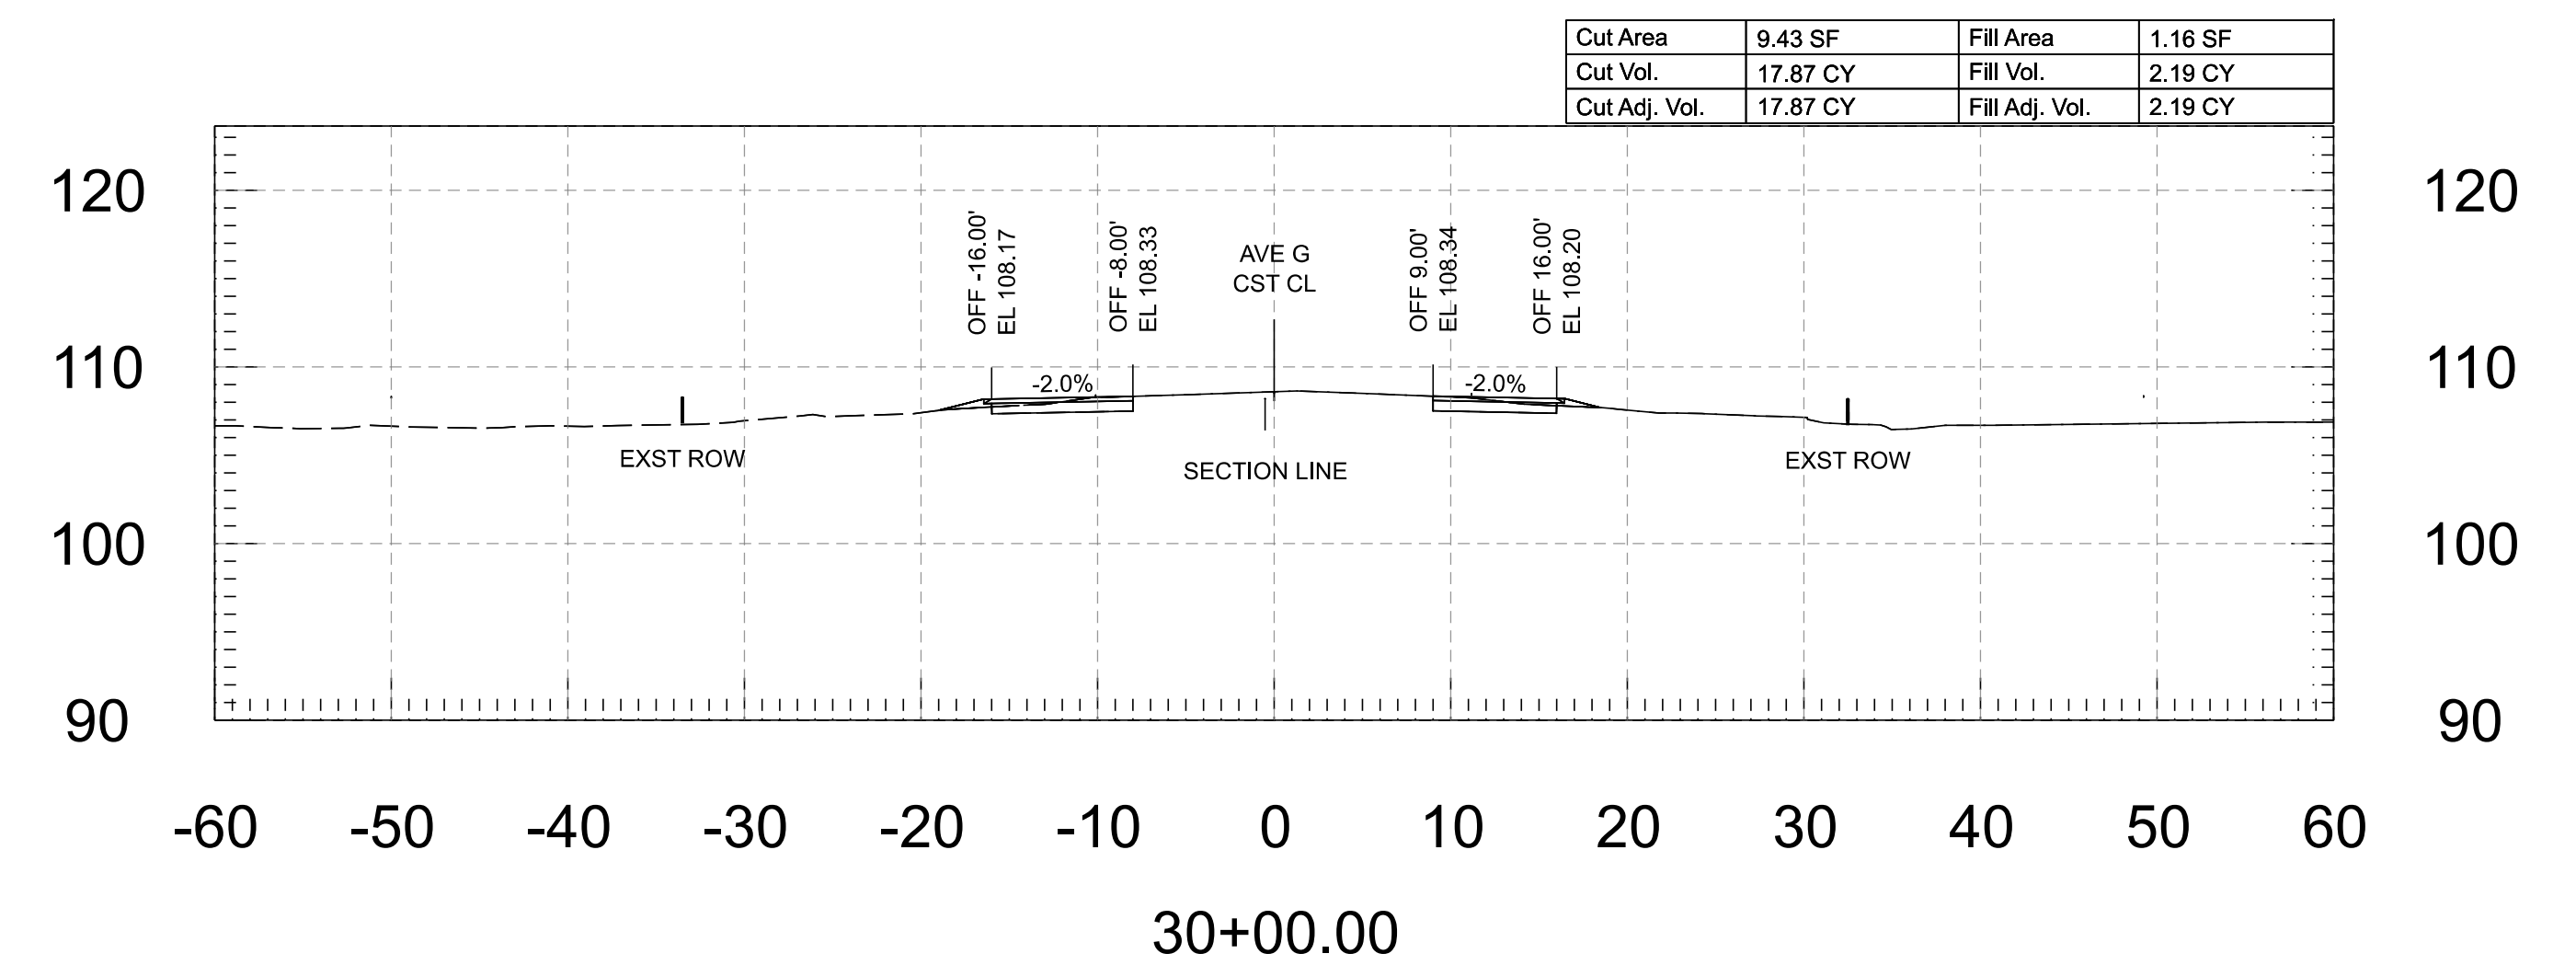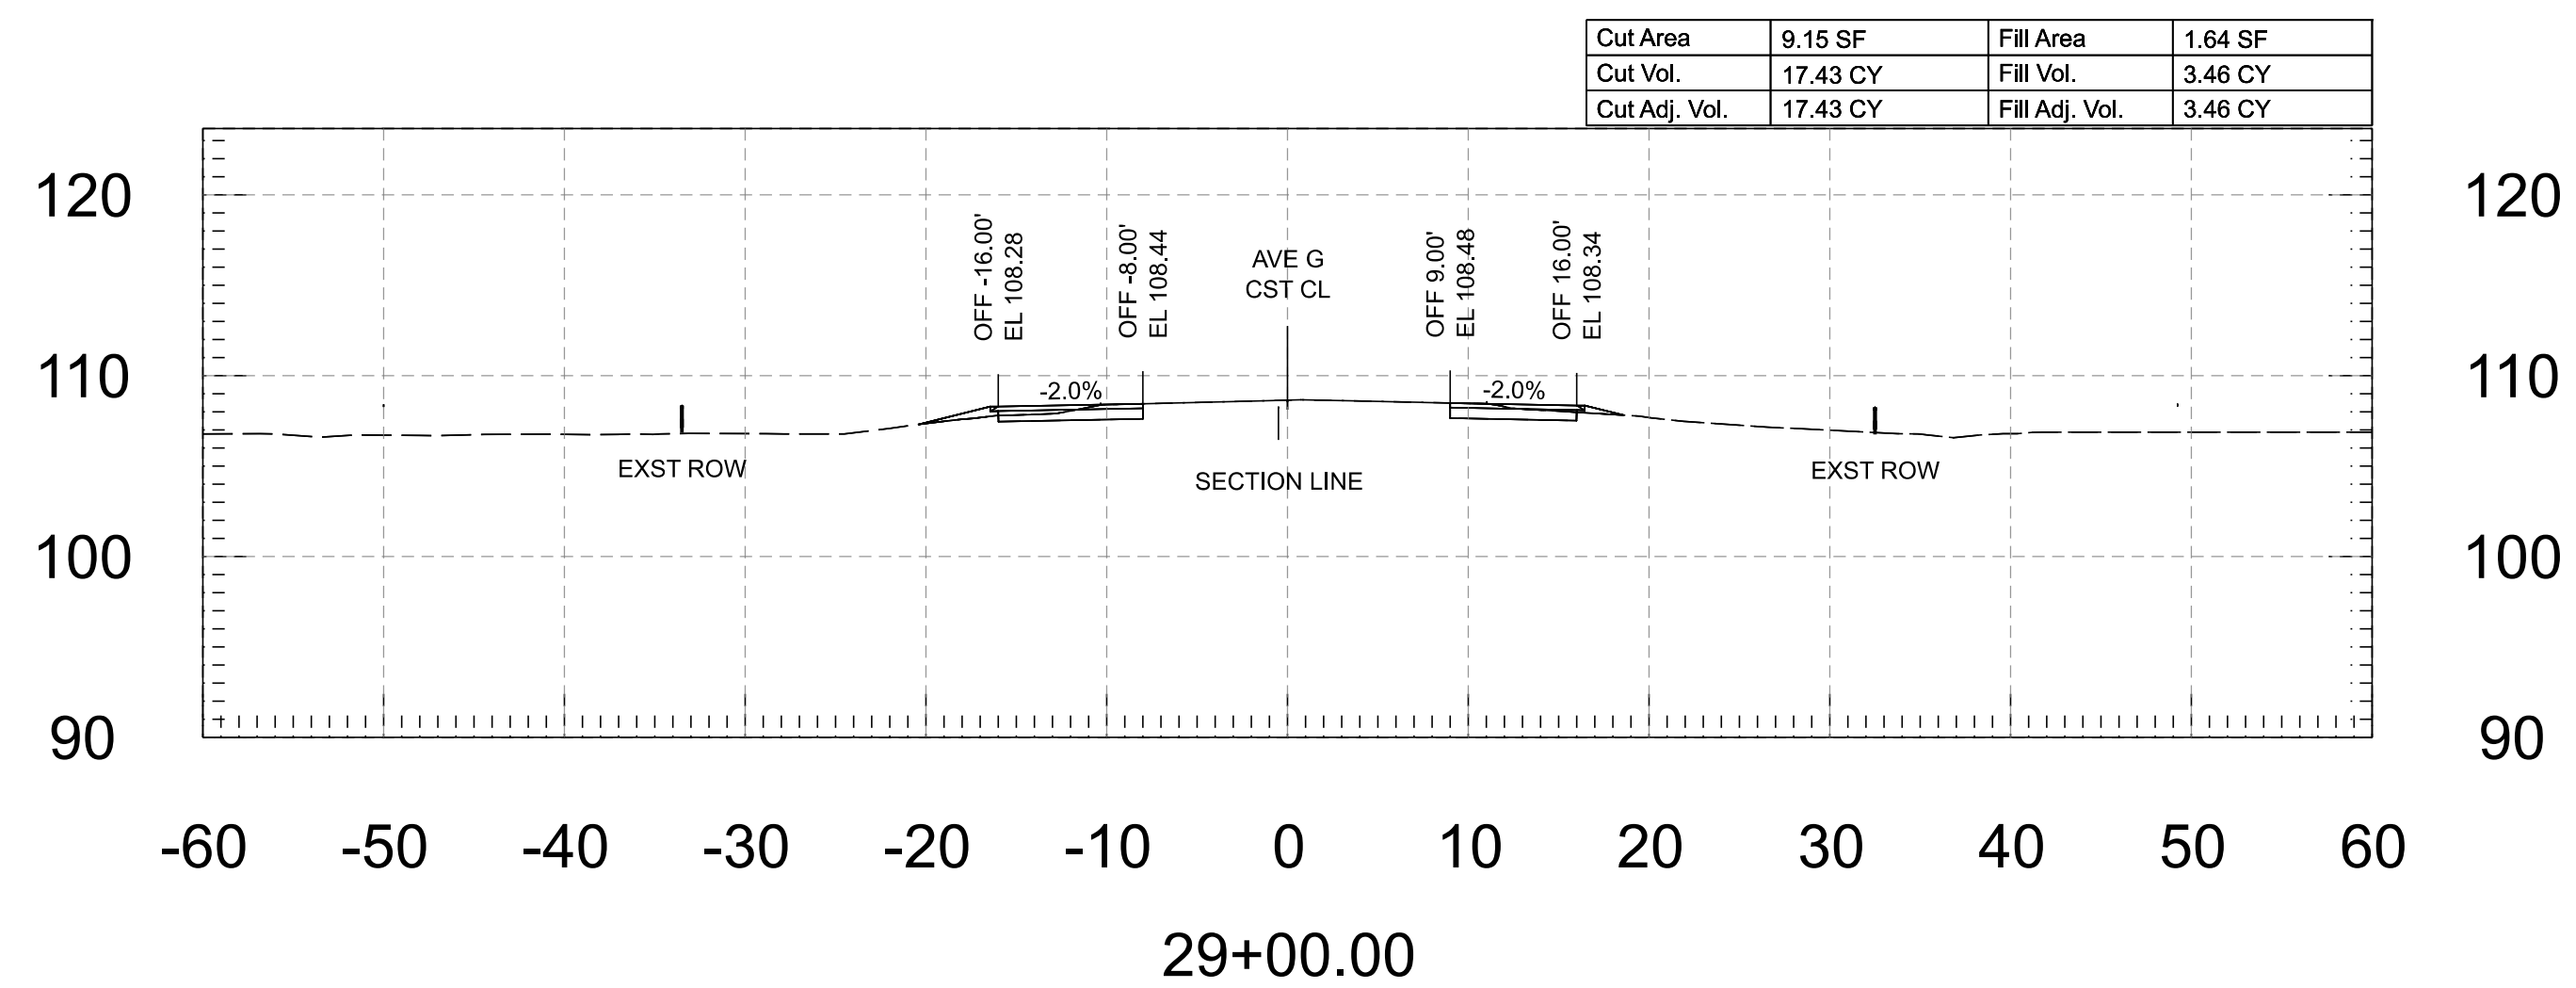

FOR INFORMATION ONLY		NAME	DATE	ARIZONA DEPARTMENT OF TRANSPORTATION PROJECT DELIVERY AND OPERATIONS DIVISION ROADWAY DESIGN SERVICES	ROUTE	F.H.W.A. Arizona Division	STATE ARIZ.	PROJECT NO.	FEDERAL ID NO.	SHEET NO.	TOTAL SHEETS	RECORD DRAWING
	DESIGN	M. SCHOEN	07/26		MILEPOST			0000 YU YYU	YYU-0(225)T	8	118	
	DRAWN	M. SCHOEN	07/26		wsp WSP USA Inc. 1200 West Washington Street, Suite 405 Tempe, AZ 85288	AVENUE G - CROSS SECTIONS	LOCATION		AVENUE G, COUNTY 11TH ST - COUNTY 16TH ST		DWG	
	CHECKED	H. RIOS	07/26				STRUCTURE NO.		TRACS NO. T0437 01C		___ OF ___	

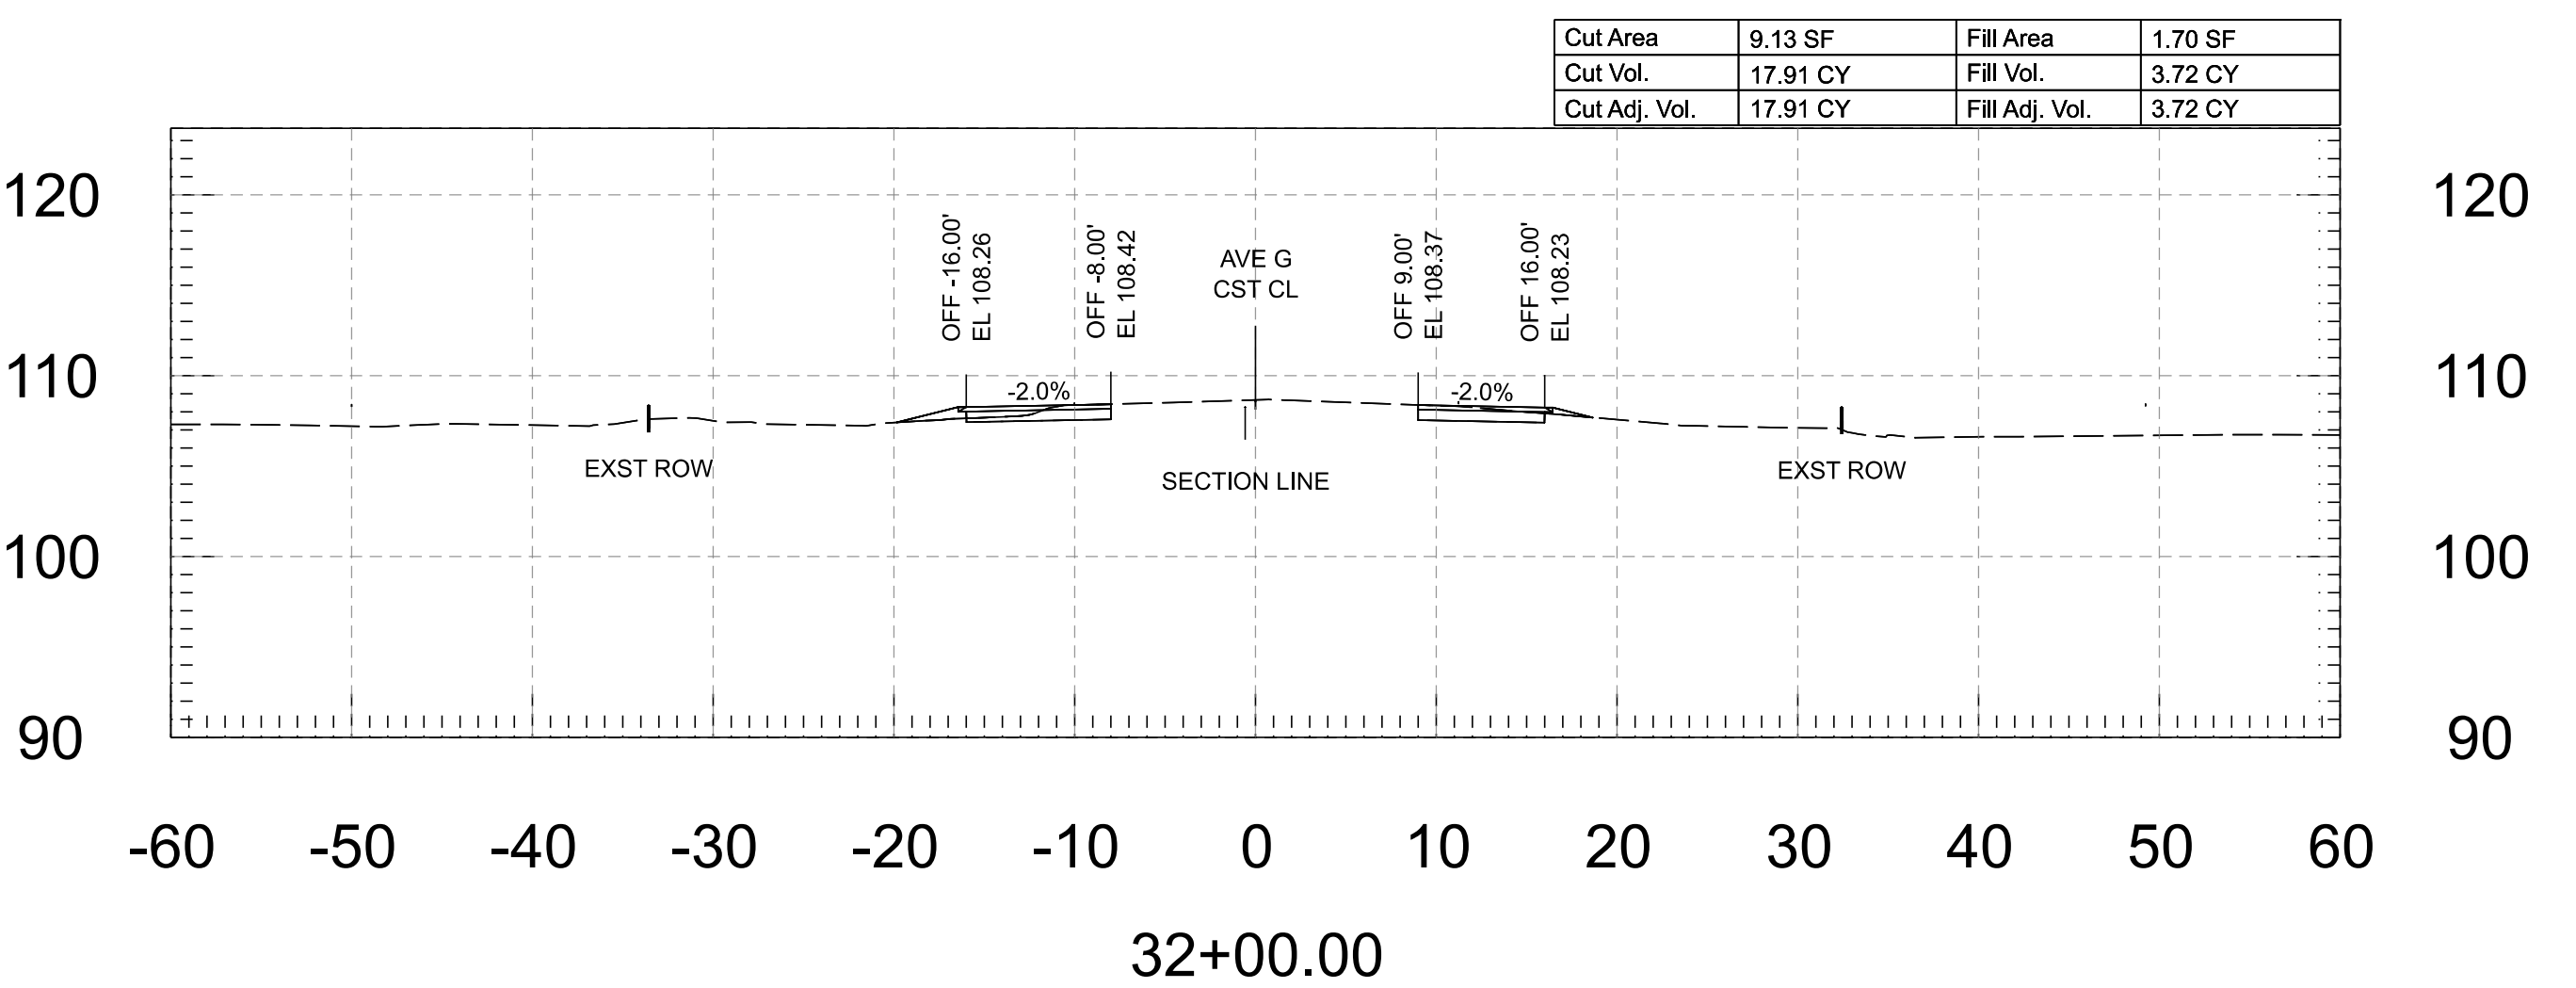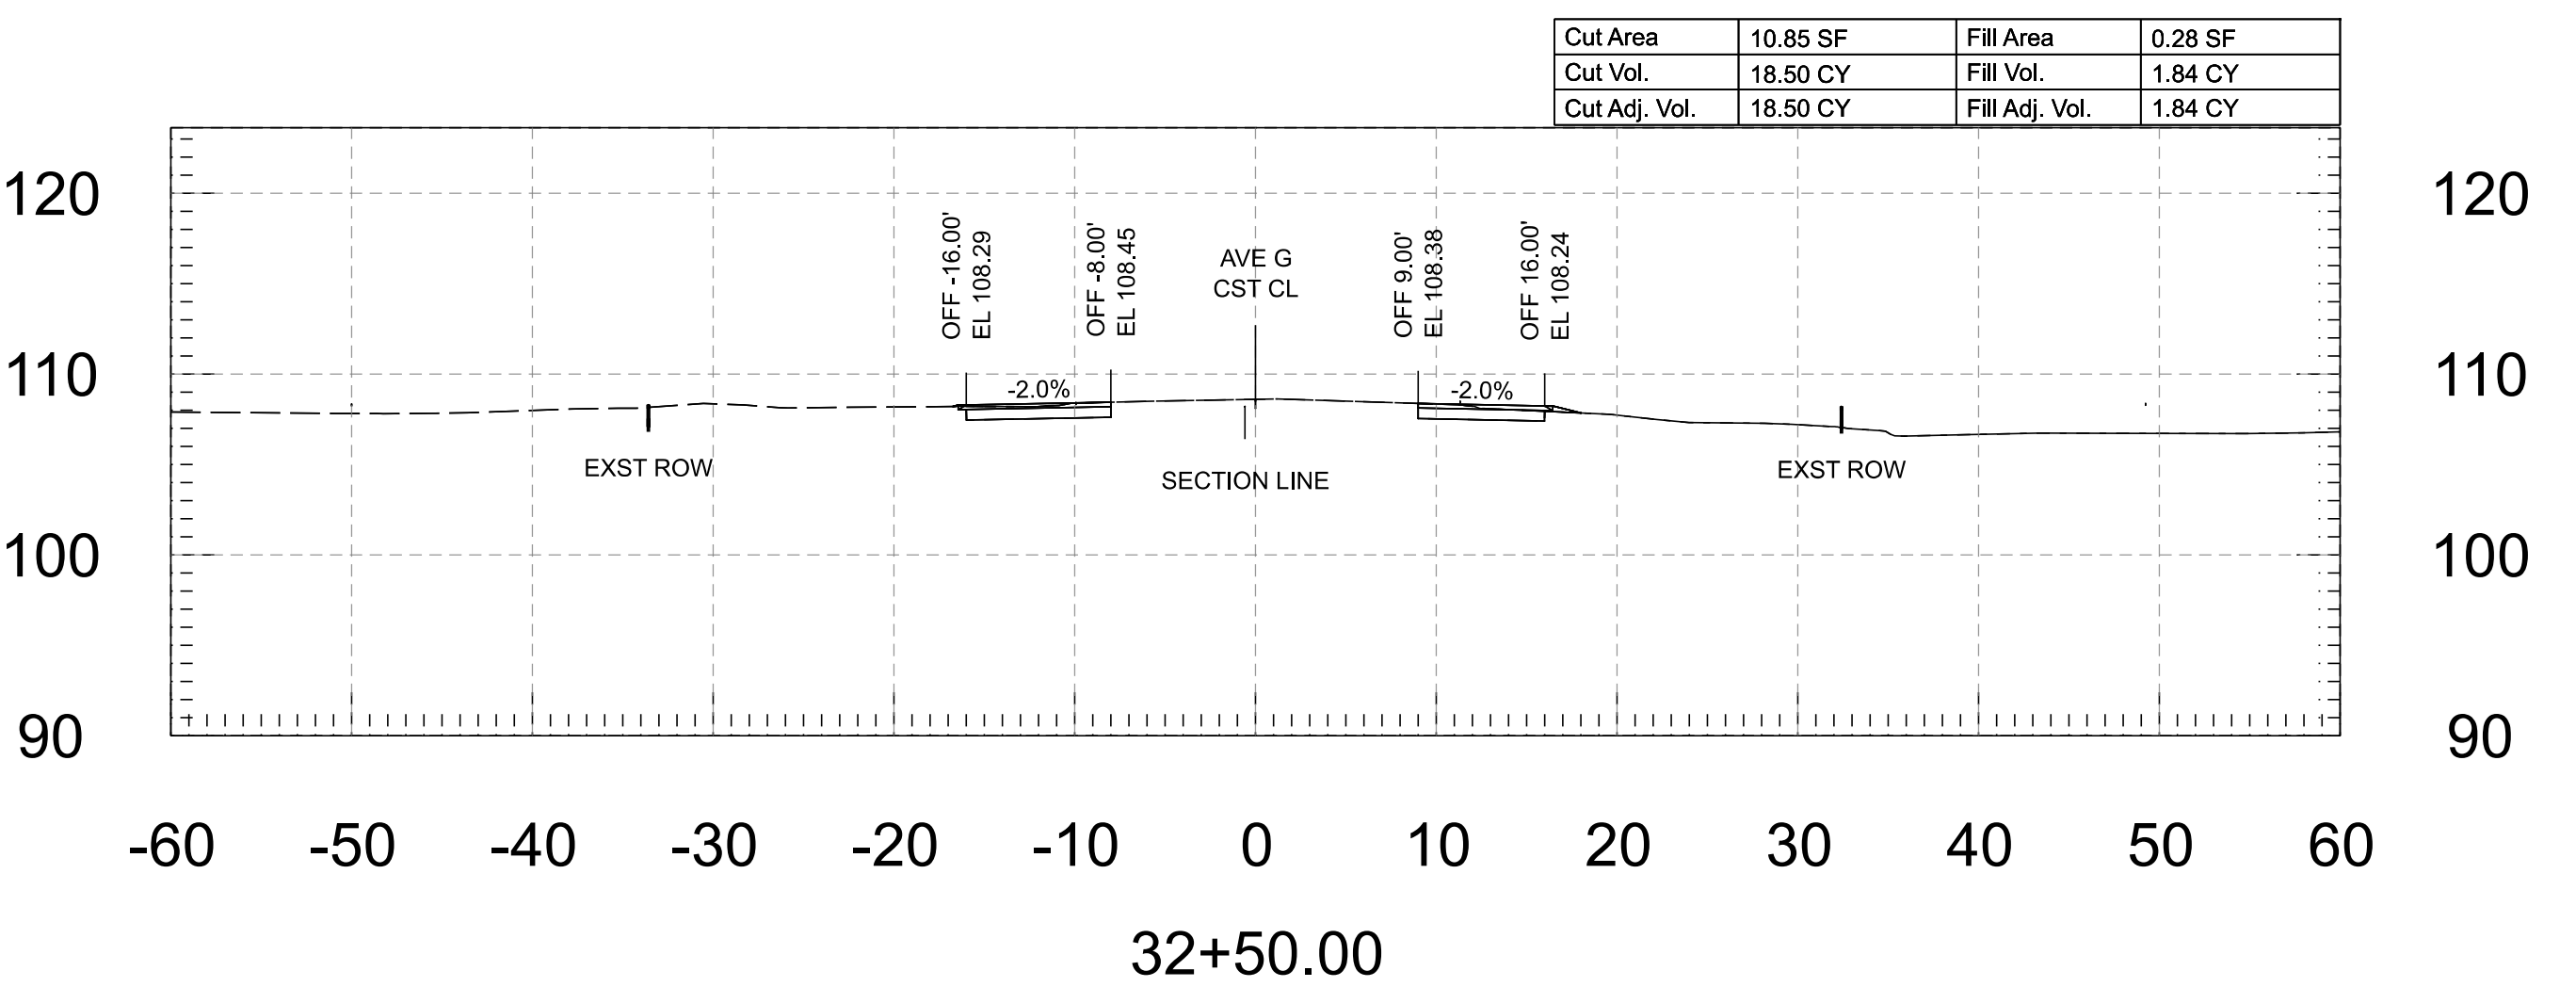


FOR INFORMATION ONLY		NAME	DATE	ARIZONA DEPARTMENT OF TRANSPORTATION PROJECT DELIVERY AND OPERATIONS DIVISION ROADWAY DESIGN SERVICES	ROUTE	F.H.W.A. Arizona Division	STATE ARIZ.	PROJECT NO.	FEDERAL ID NO.	SHEET NO.	TOTAL SHEETS	RECORD DRAWING
	DESIGN	M. SCHOEN	07/26		MILEPOST			0000 YU YUU	YUU-0(225)T	9	118	
	DRAWN	M. SCHOEN	07/26			STRUCTURE NO.	LOCATION AVENUE G, COUNTY 11TH ST - COUNTY 16TH ST					
	CHECKED	H. RIOS	07/26	wsp WSP USA Inc. 1250 West Washington Street, Suite 405 Tempe, AZ 85288			AVENUE G - CROSS SECTIONS		TRACS NO. T0437 01C		____ OF ____	

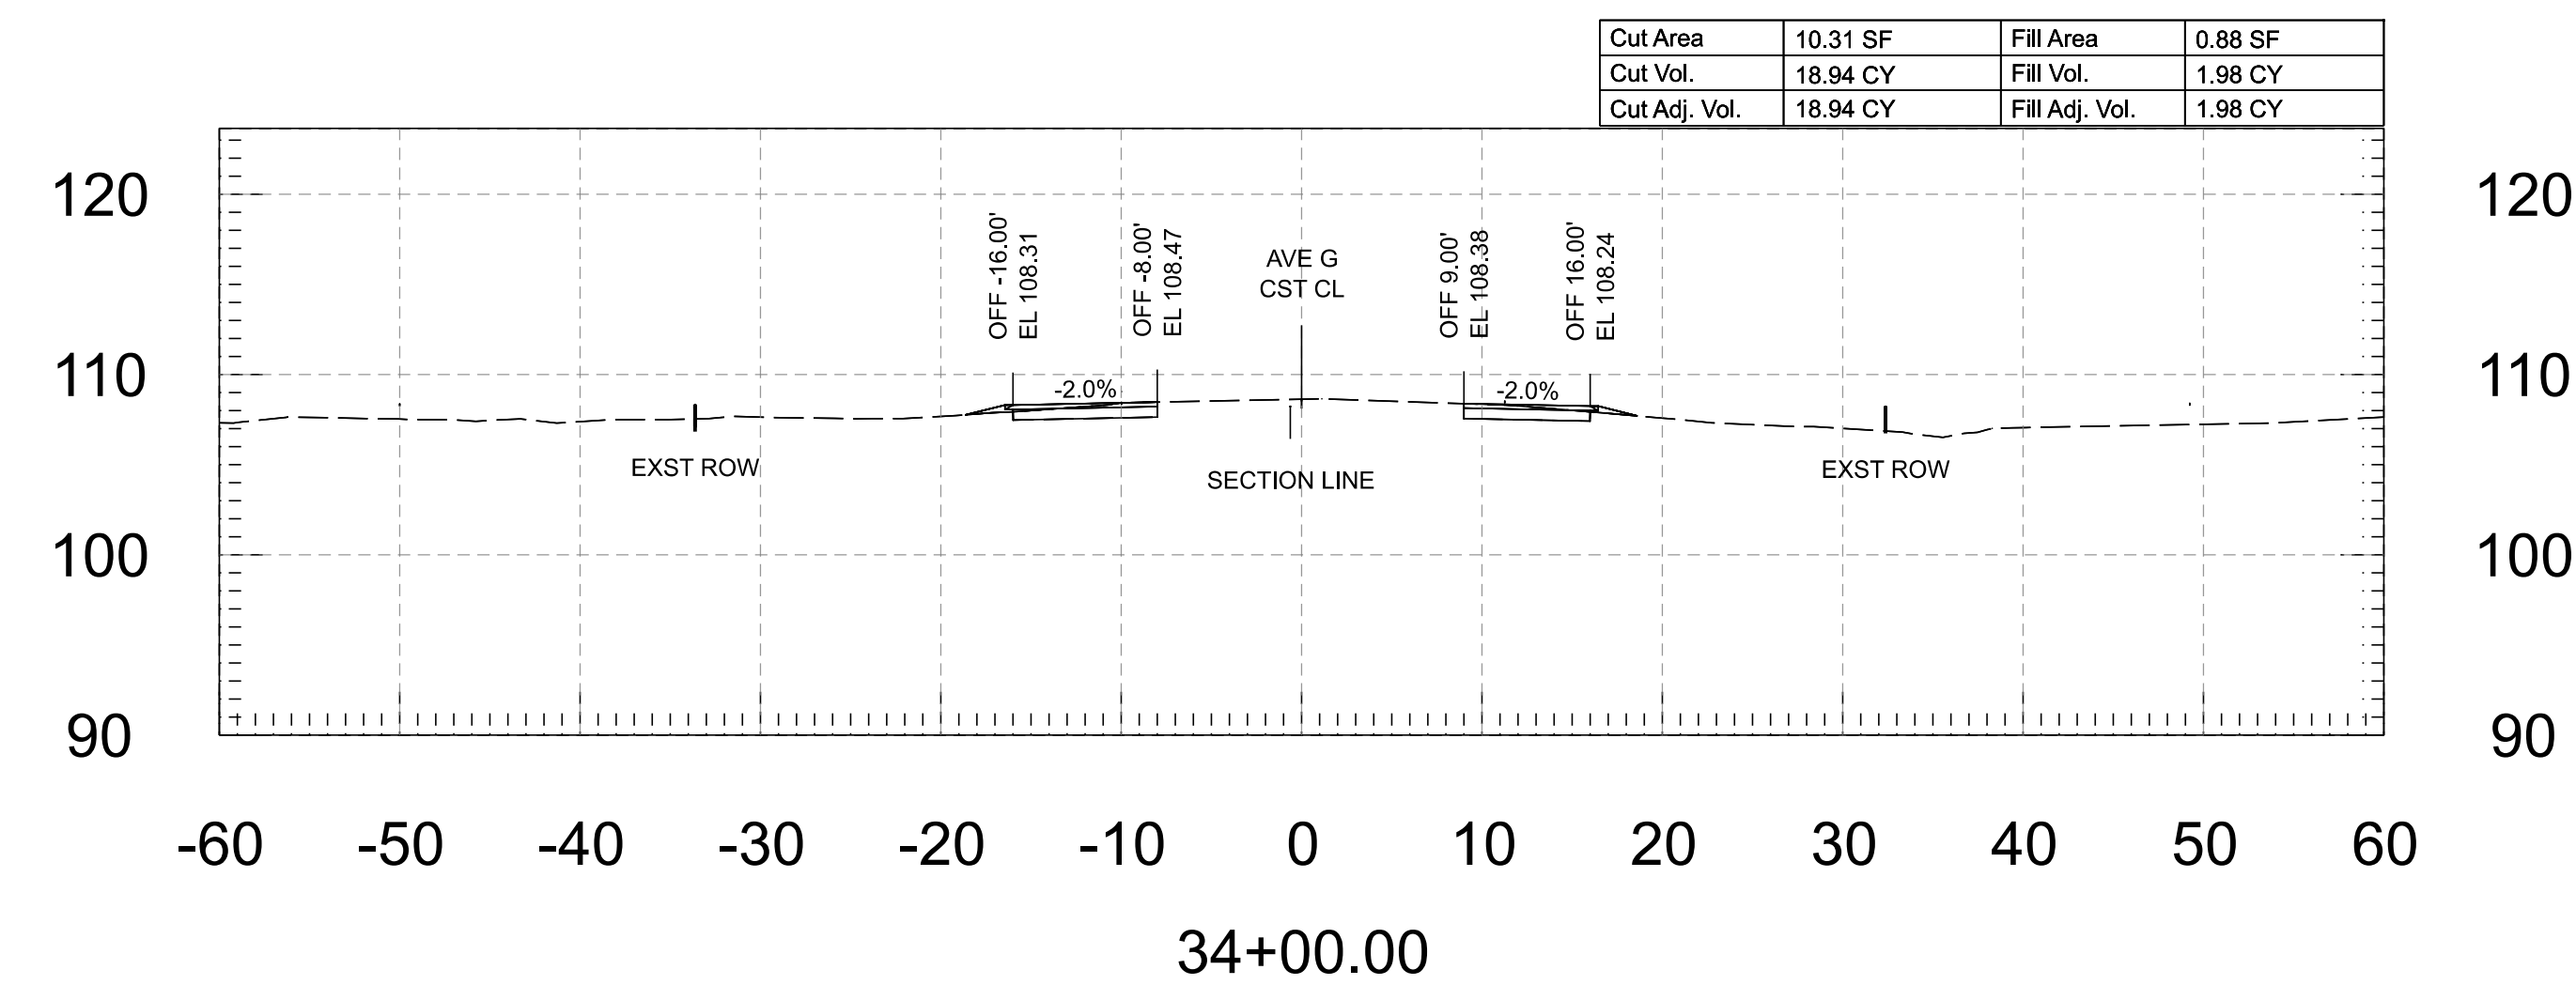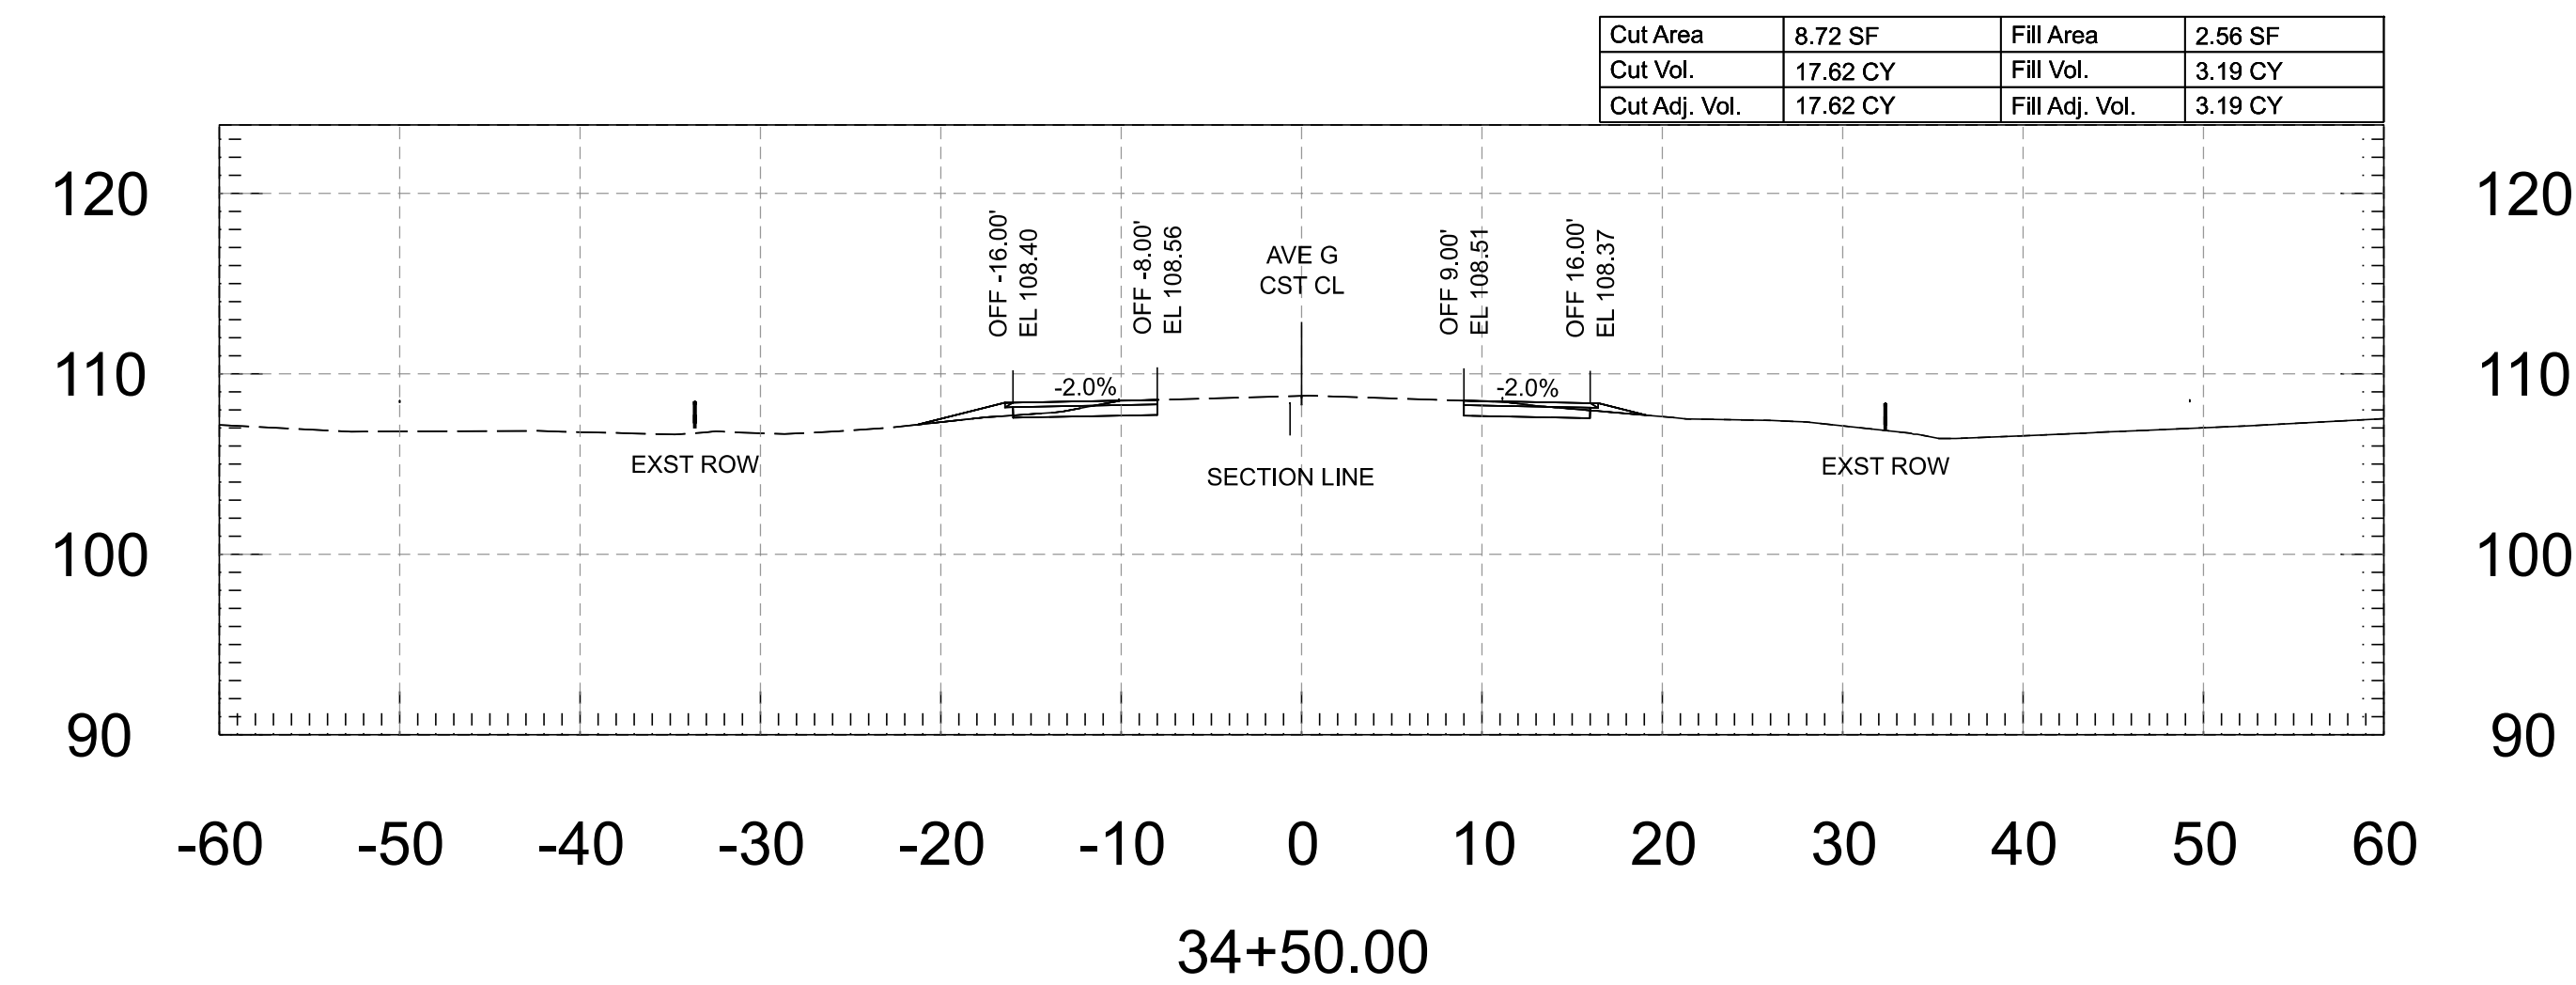


FOR INFORMATION ONLY		NAME	DATE	ARIZONA DEPARTMENT OF TRANSPORTATION PROJECT DELIVERY AND OPERATIONS DIVISION ROADWAY DESIGN SERVICES	ROUTE	F.H.W.A. Arizona Division	STATE ARIZ.	PROJECT NO.	FEDERAL ID NO.	SHEET NO.	TOTAL SHEETS	RECORD DRAWING
	DESIGN	M. SCHOEN	07/26						10	118		
	DRAWN	M. SCHOEN	07/26									
	CHECKED	H. RIOS	07/26									
		wsp WSP USA Inc. 1230 West Washington Street, Suite 405 Tempe, AZ 85288			AVENUE G - CROSS SECTIONS	MILEPOST	LOCATION AVENUE G, COUNTY 11TH ST - COUNTY 16TH ST					
					STRUCTURE NO.	TRACS NO. T0437 01C					___ OF ___	


Cut Area	9.36 SF	Fill Area	1.76 SF
Cut Vol.	16.91 CY	Fill Vol.	4.13 CY
Cut Adj. Vol.	16.91 CY	Fill Adj. Vol.	4.13 CY

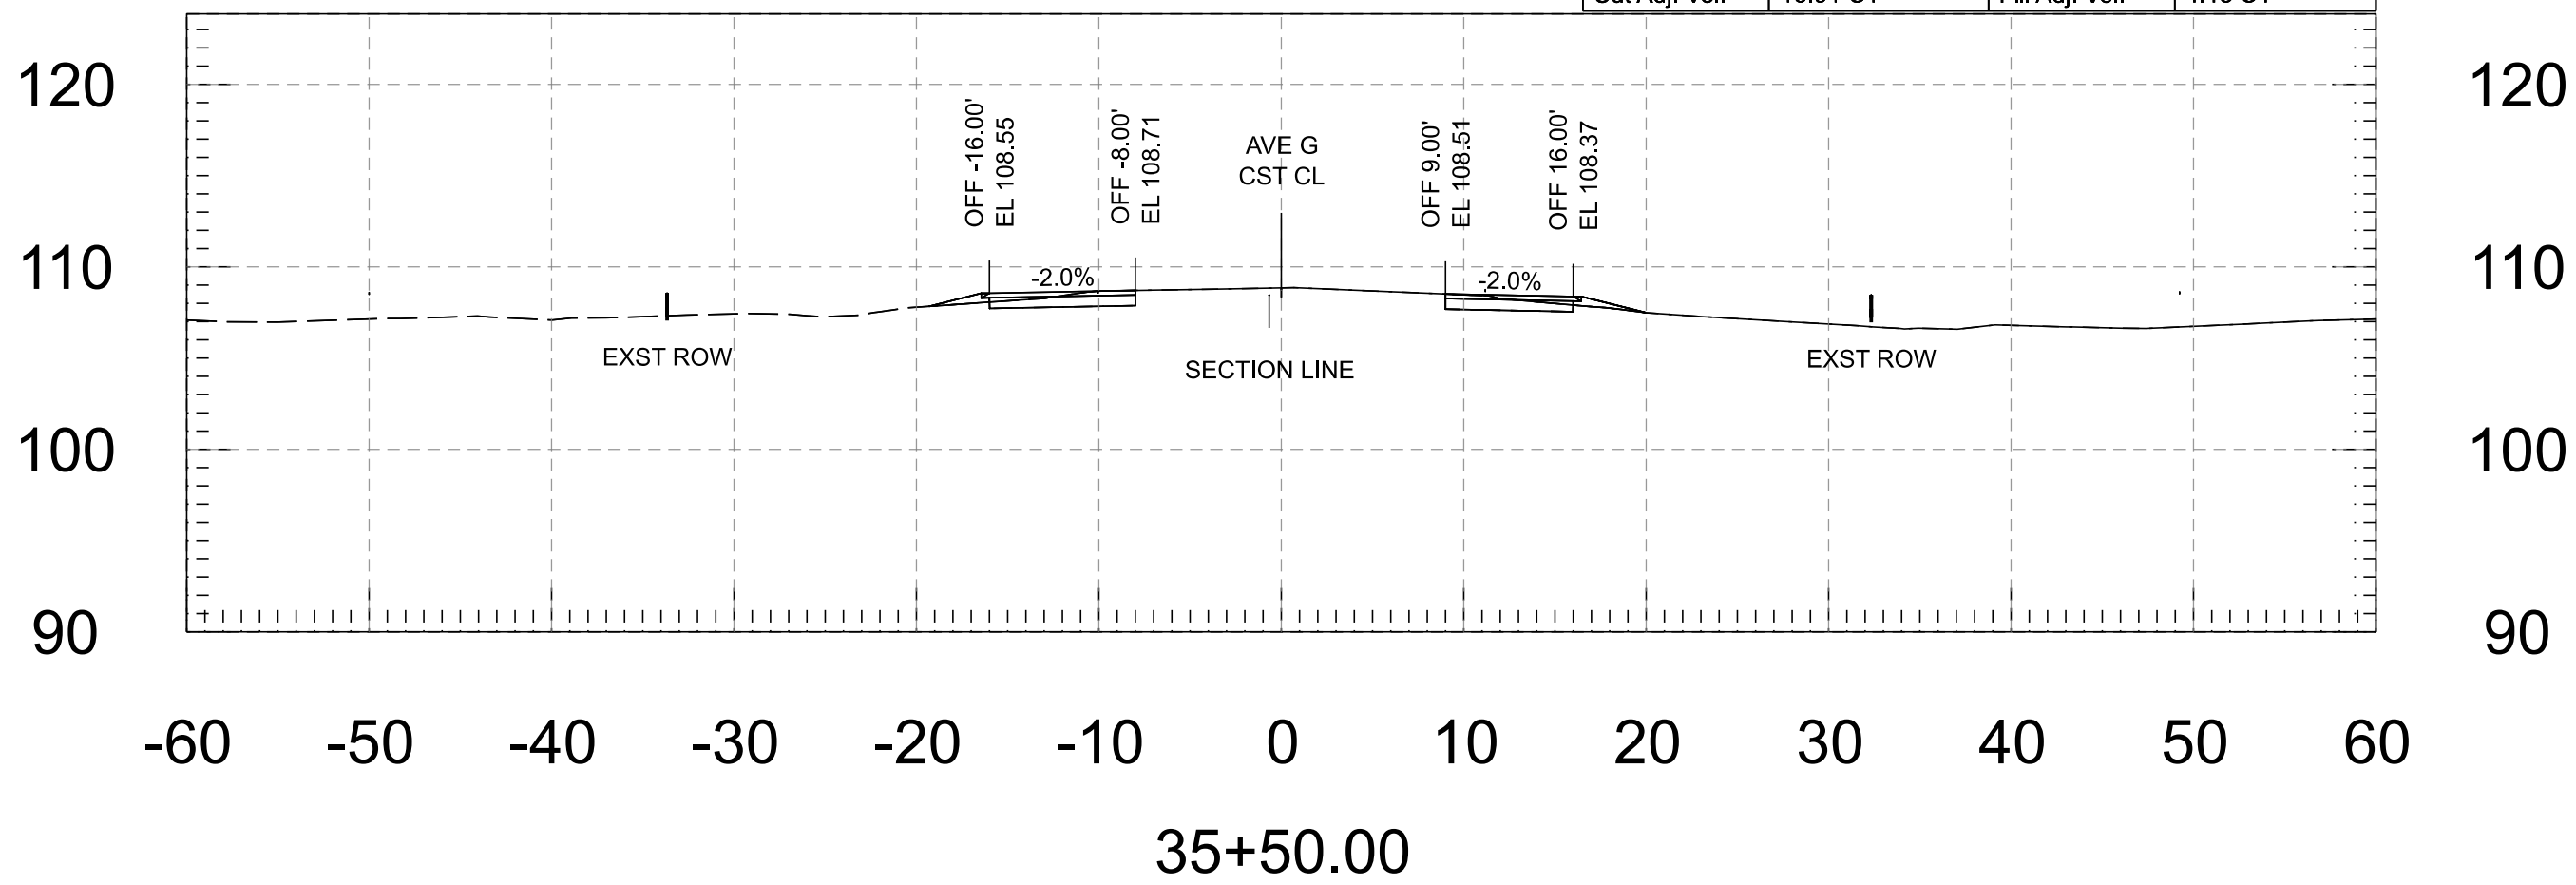


Cut Area	11.81 SF	Fill Area	0.10 SF
Cut Vol.	21.09 CY	Fill Vol.	0.67 CY
Cut Adj. Vol.	21.09 CY	Fill Adj. Vol.	0.67 CY

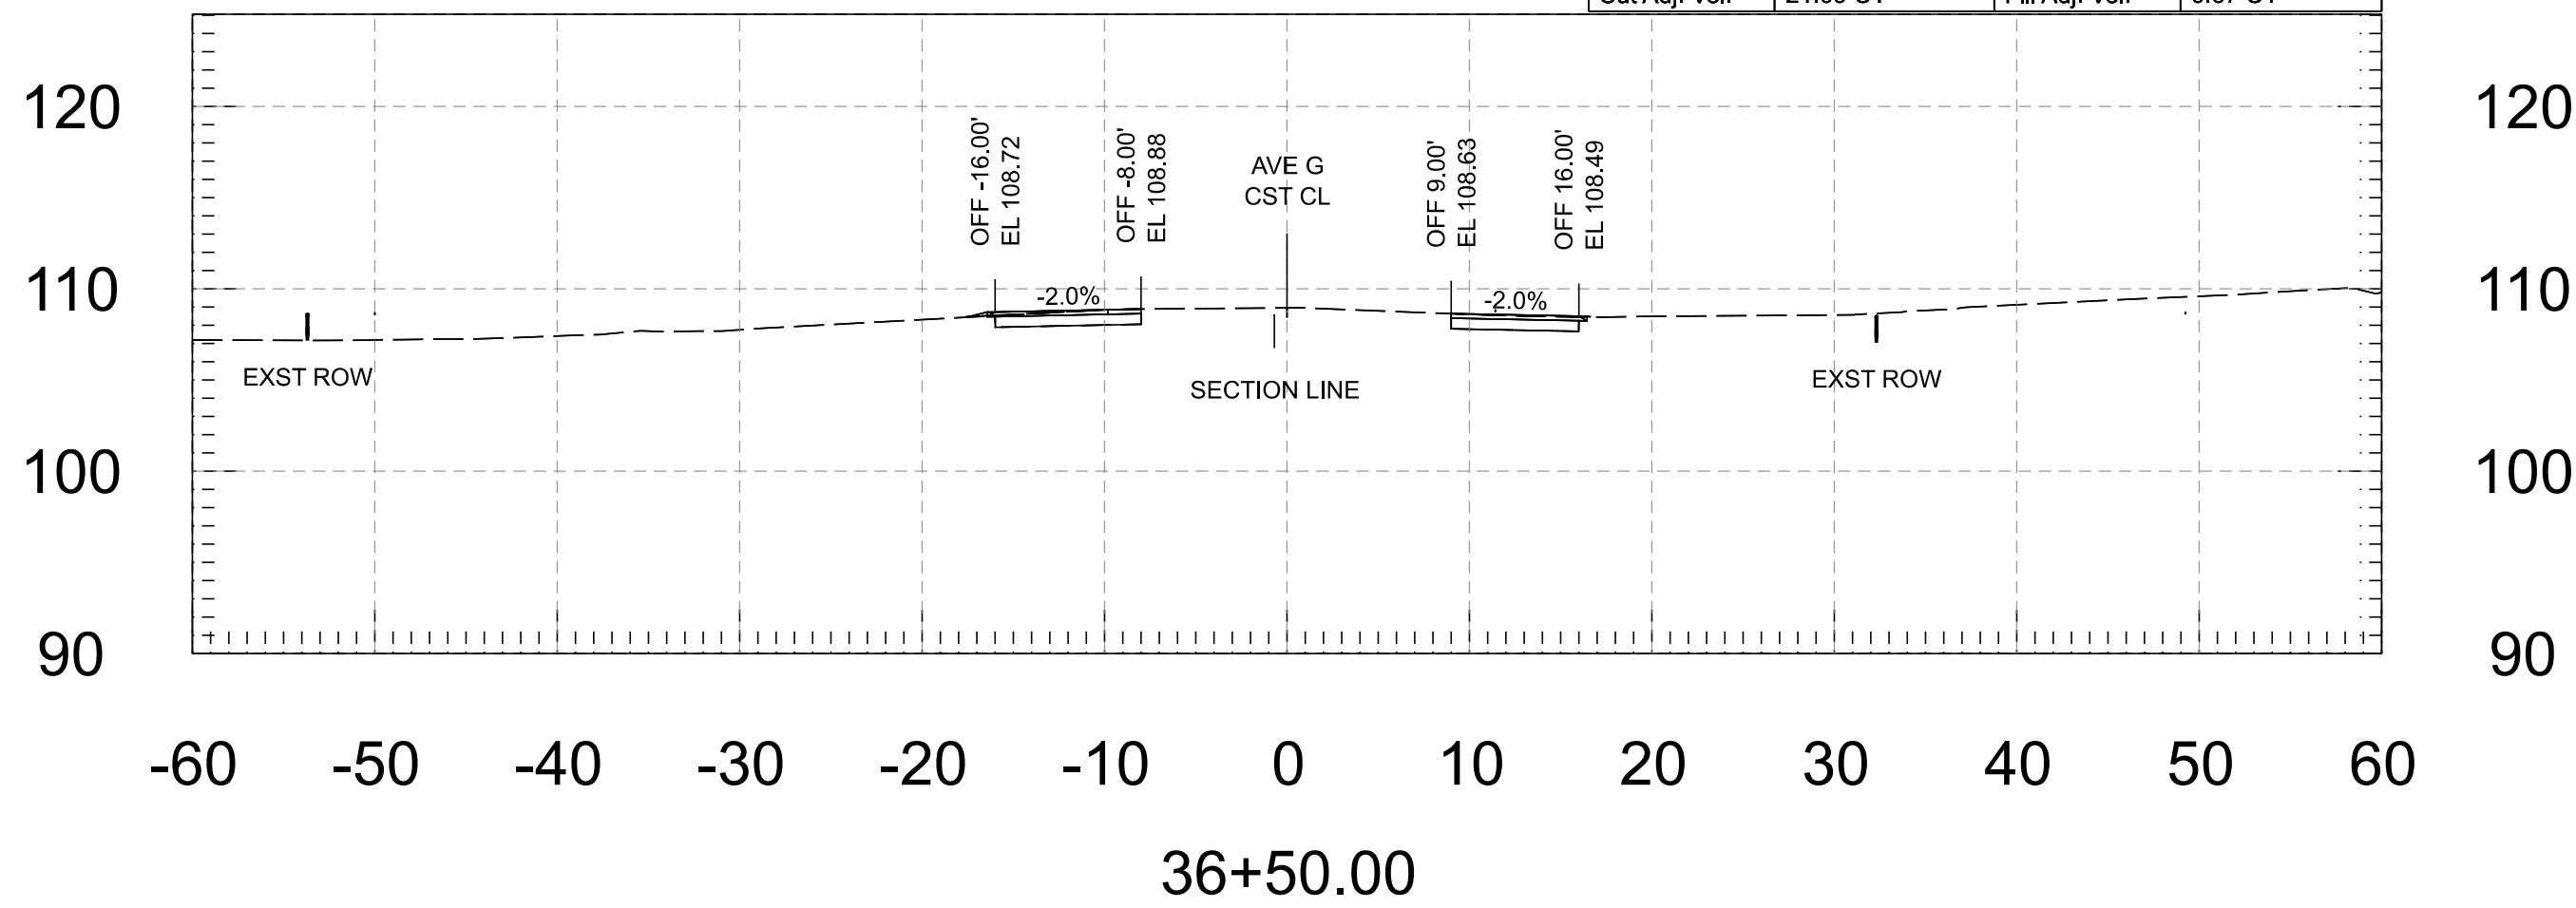



Cut Area	8.89 SF	Fill Area	2.70 SF
Cut Vol.	16.31 CY	Fill Vol.	4.87 CY
Cut Adj. Vol.	16.31 CY	Fill Adj. Vol.	4.87 CY

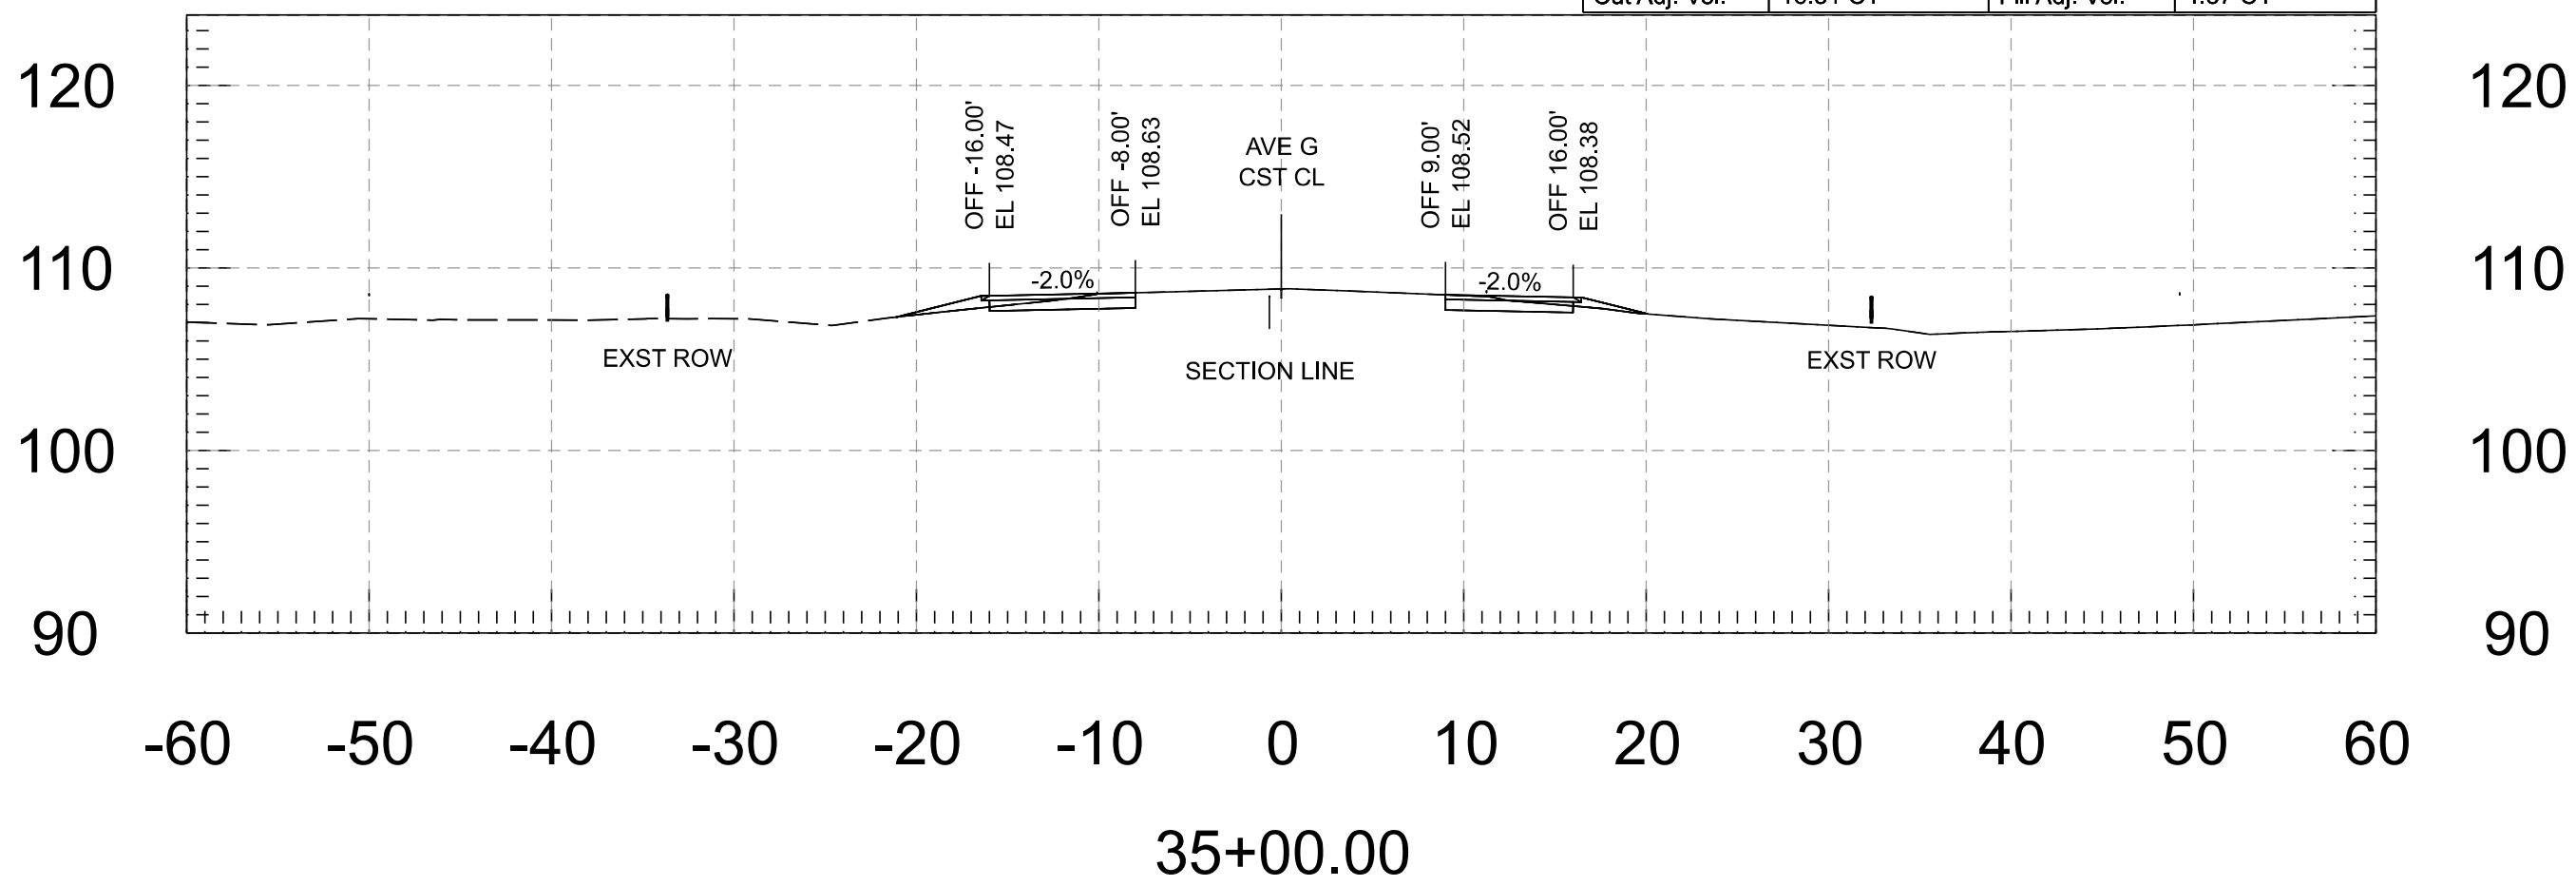





Cut Area	10.97 SF	Fill Area	0.62 SF
Cut Vol.	18.83 CY	Fill Vol.	2.20 CY
Cut Adj. Vol.	18.83 CY	Fill Adj. Vol.	2.20 CY

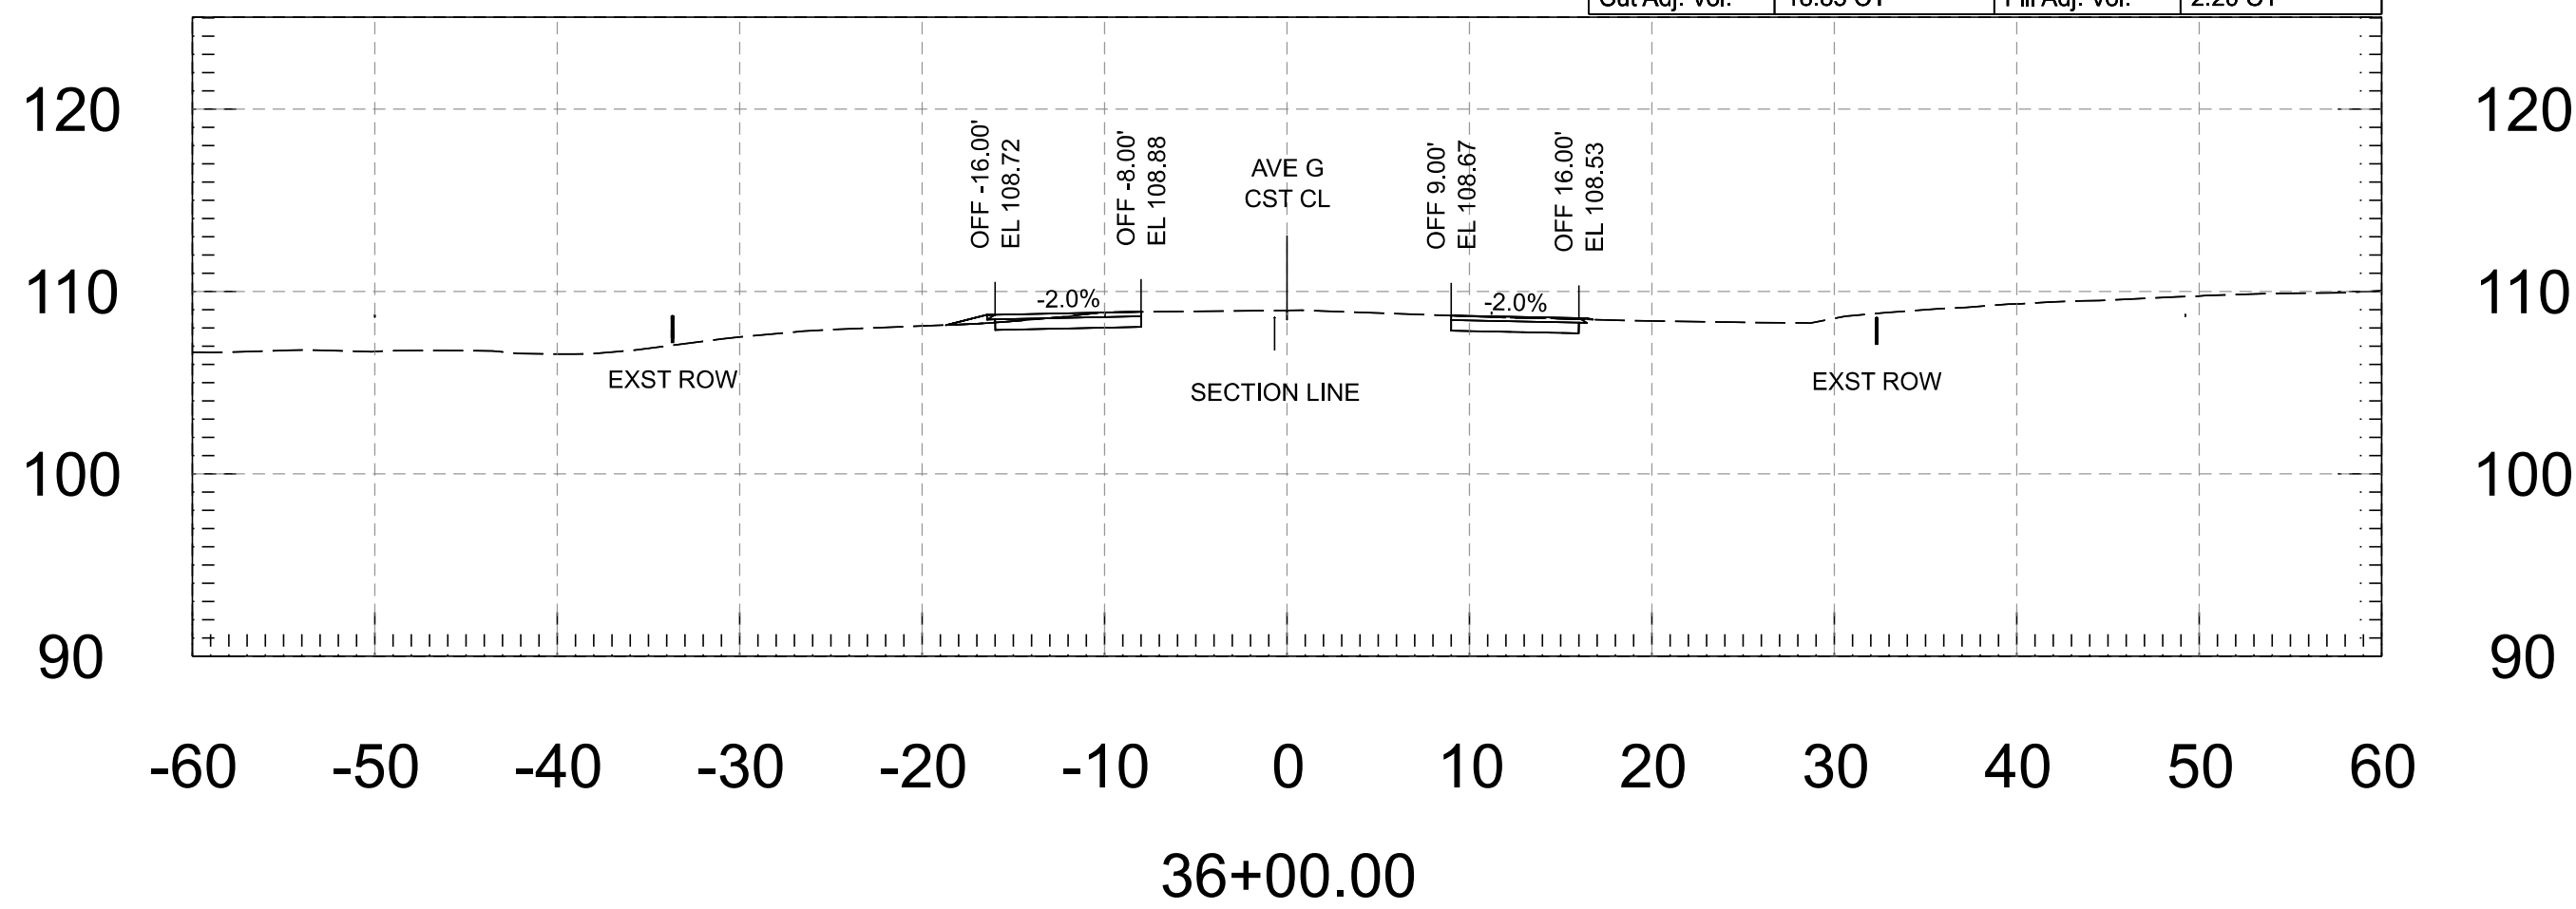



FOR INFORMATION ONLY		NAME	DATE	ARIZONA DEPARTMENT OF TRANSPORTATION PROJECT DELIVERY AND OPERATIONS DIVISION ROADWAY DESIGN SERVICES	ROUTE	F.H.W.A. Arizona Division	STATE ARIZ.	PROJECT NO.	FEDERAL ID NO.	SHEET NO.	TOTAL SHEETS	RECORD DRAWING
	DESIGN	M. SCHOEN	07/26					0000 YU YYU	YYU-0(225)T	11	118	
	DRAWN	M. SCHOEN	07/26									
	CHECKED	H. RIOS	07/26									
			WSP USA Inc. 1230 West Washington Street, Suite 405 Tempe, AZ 85288		AVENUE G - CROSS SECTIONS	STRUCTURE NO.	LOCATION AVENUE G, COUNTY 11TH ST - COUNTY 16TH ST					
						TRACS NO. T0437 01C					___ OF ___	

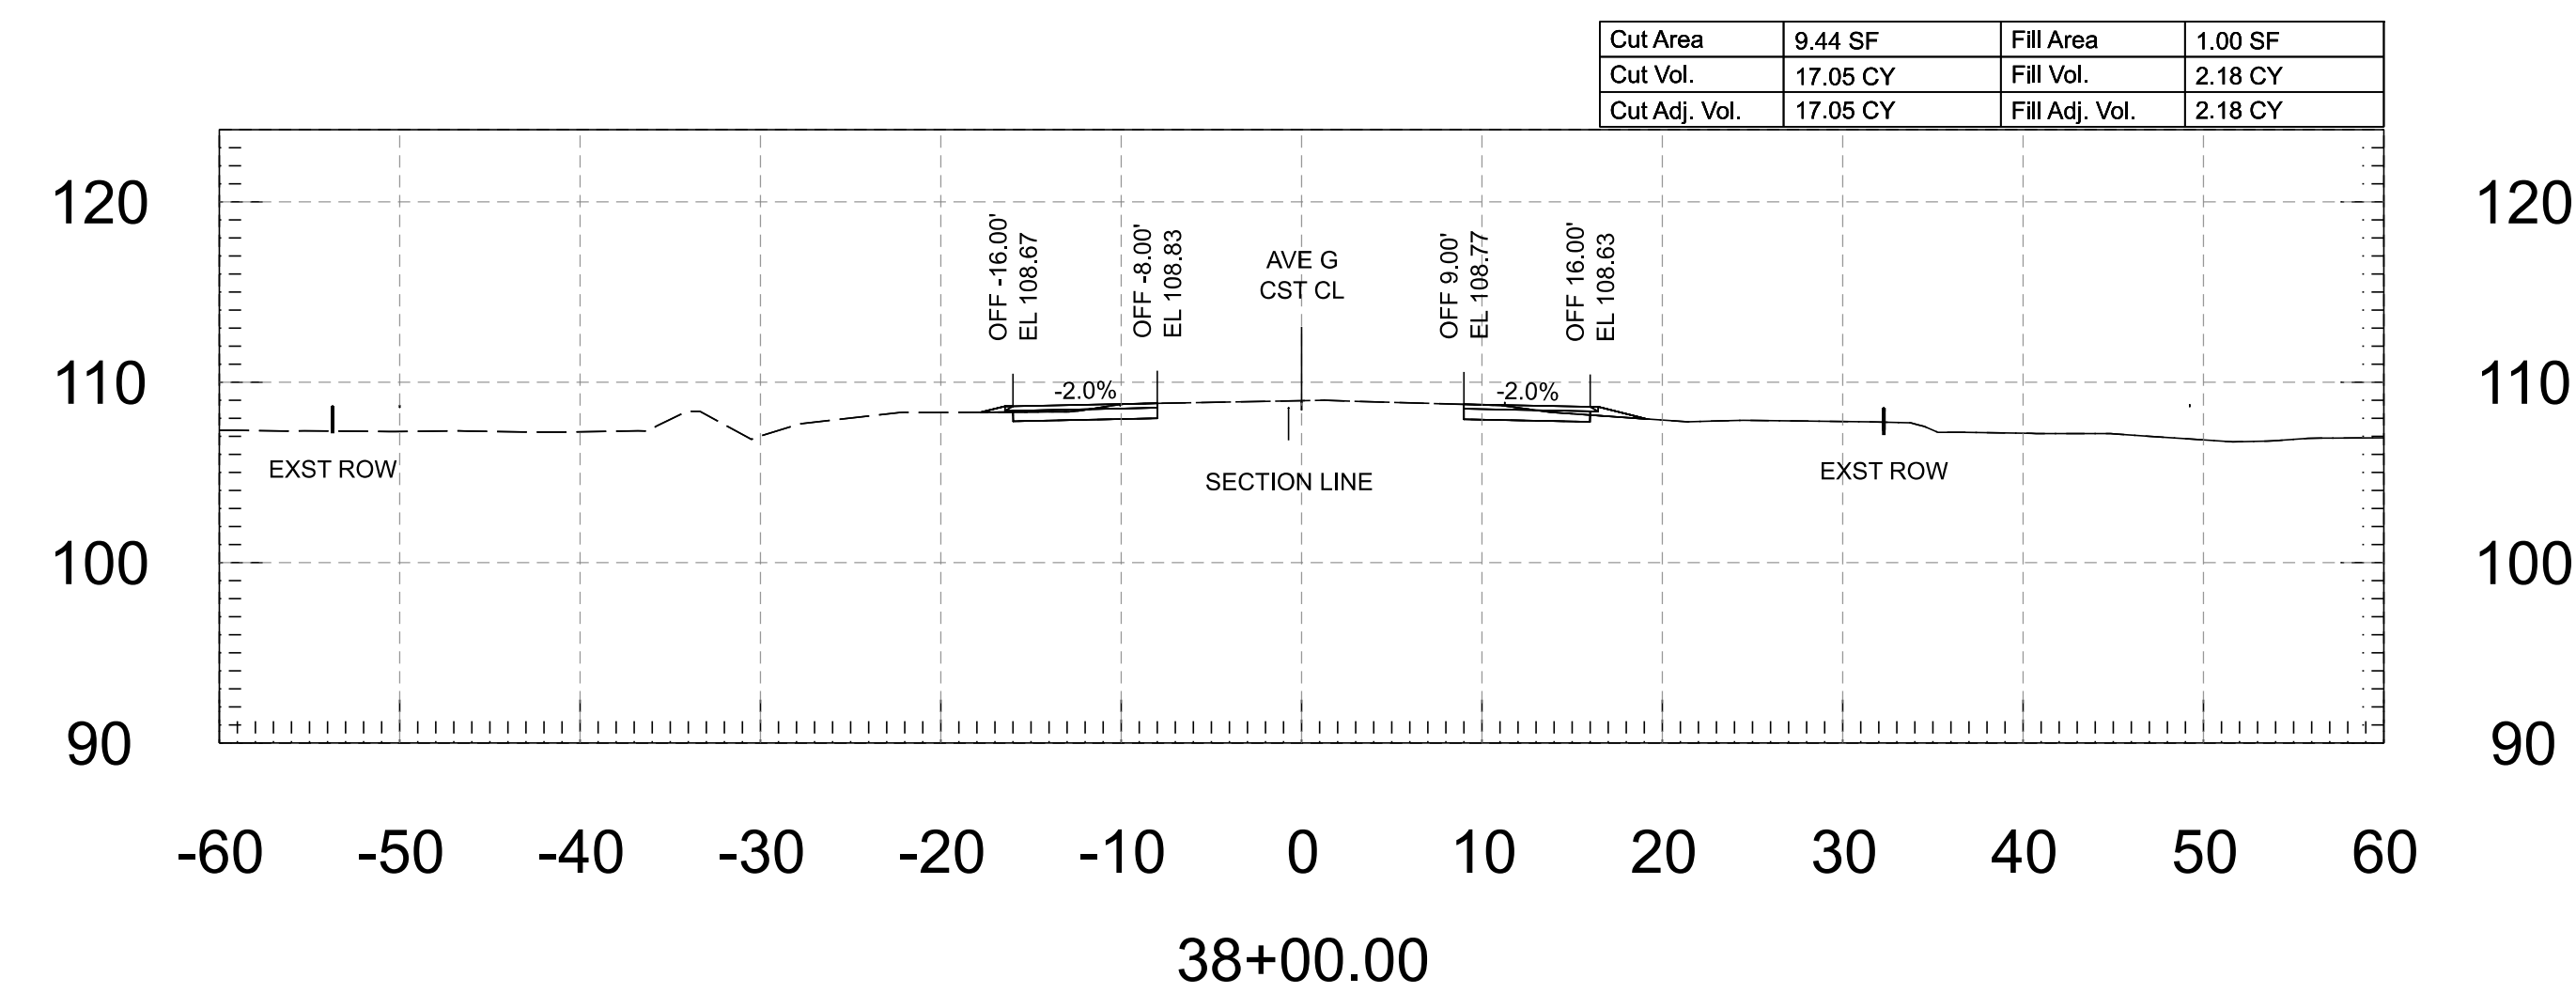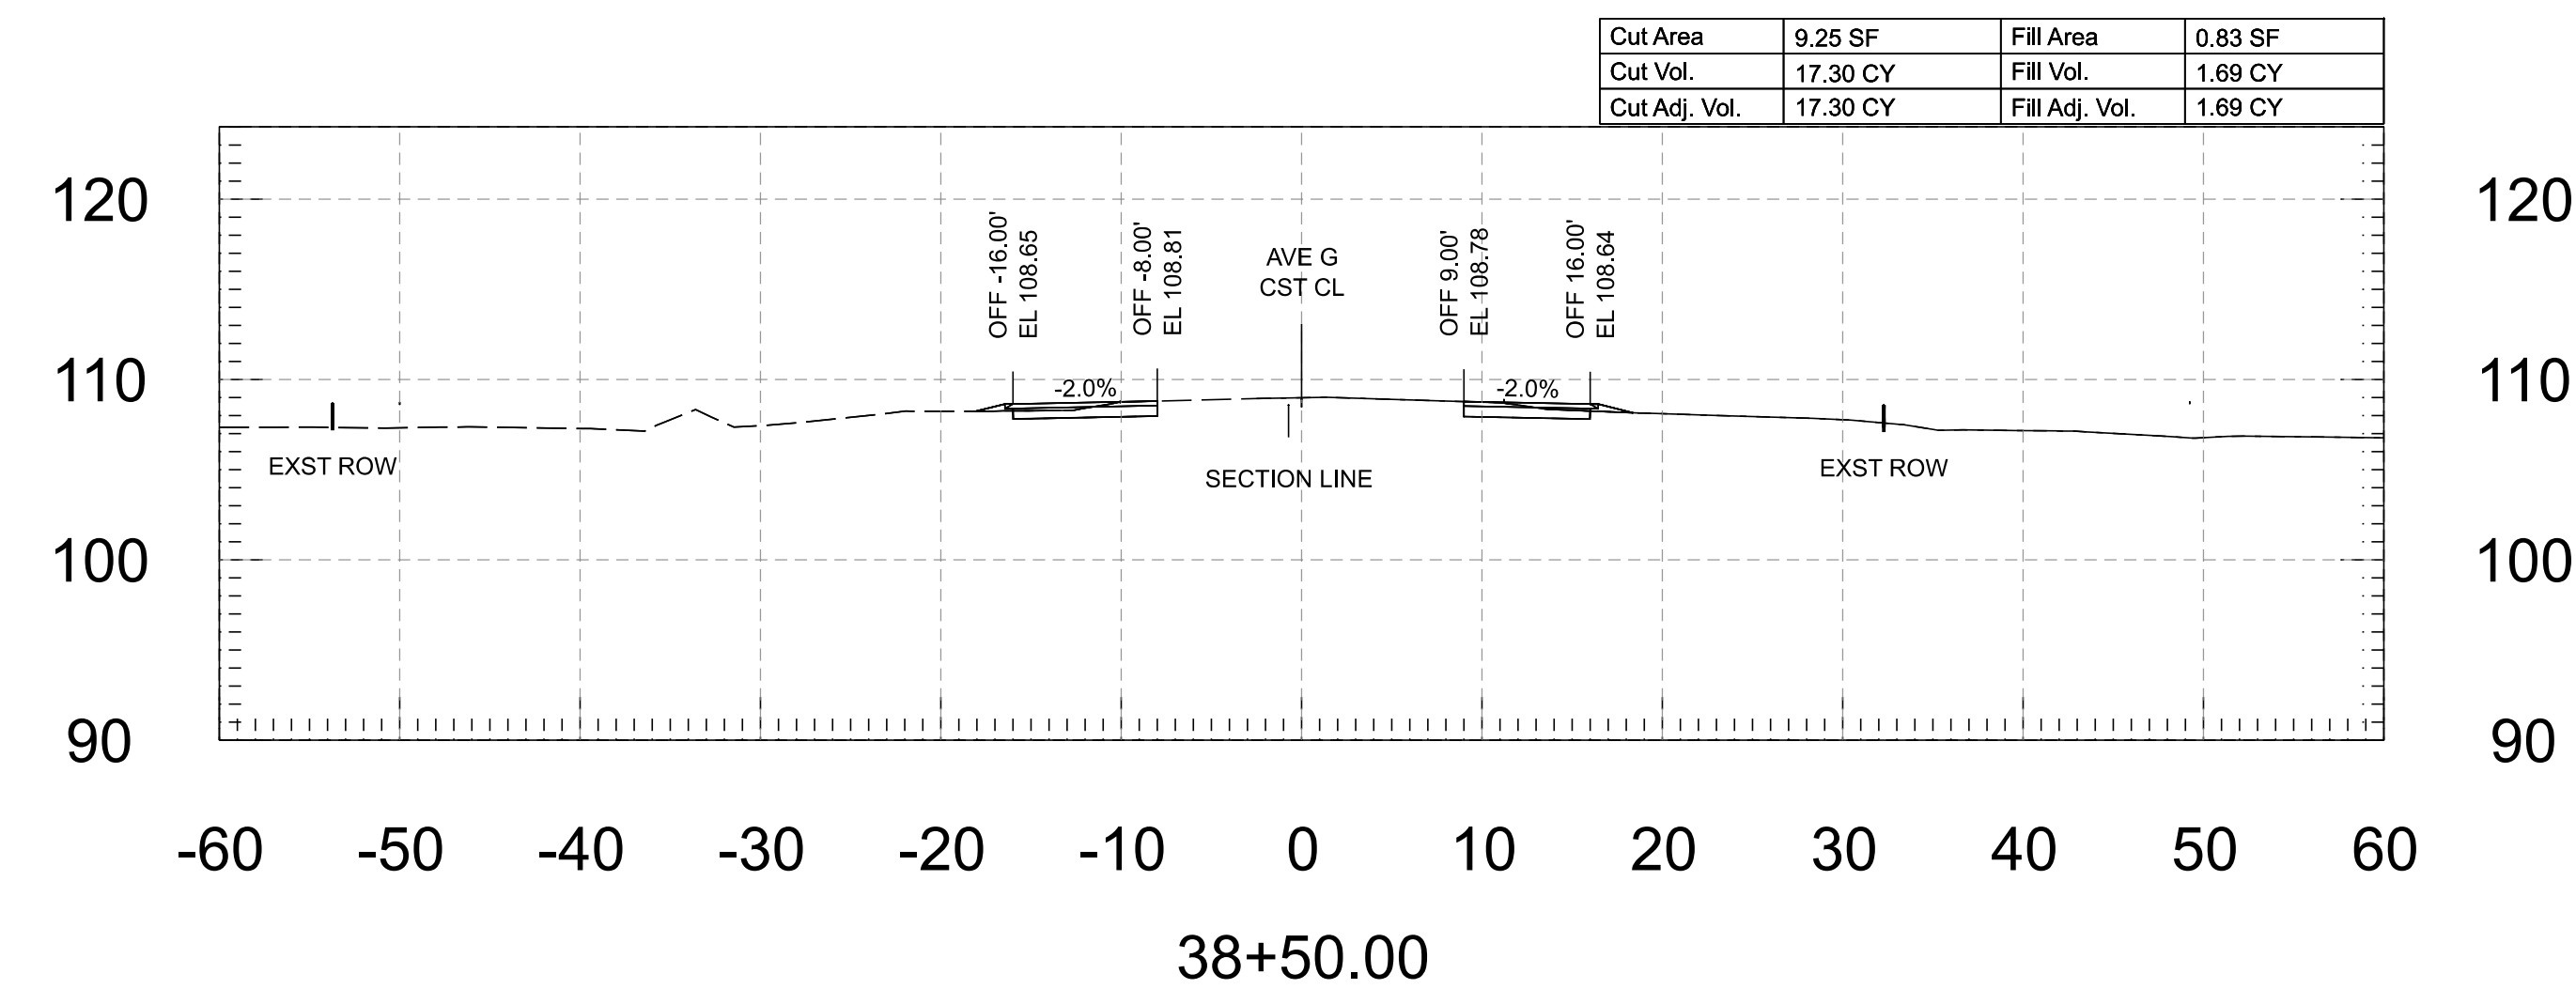


FOR INFORMATION ONLY		NAME	DATE	ARIZONA DEPARTMENT OF TRANSPORTATION PROJECT DELIVERY AND OPERATIONS DIVISION ROADWAY DESIGN SERVICES	ROUTE	F.H.W.A. Arizona Division	STATE ARIZ.	PROJECT NO.	FEDERAL ID NO.	SHEET NO.	TOTAL SHEETS	RECORD DRAWING
	DESIGN	M. SCHOEN	07/26						12			
	DRAWN	M. SCHOEN	07/26									
	CHECKED	H. RIOS	07/26									
		wsp WSP USA Inc. 1230 West Washington Street, Suite 405 Tempe, AZ 85288			AVENUE G - CROSS SECTIONS	MILEPOST	LOCATION AVENUE G, COUNTY 11TH ST - COUNTY 16TH ST					
					STRUCTURE NO.	TRACS NO. T0437 01C					___ OF ___	

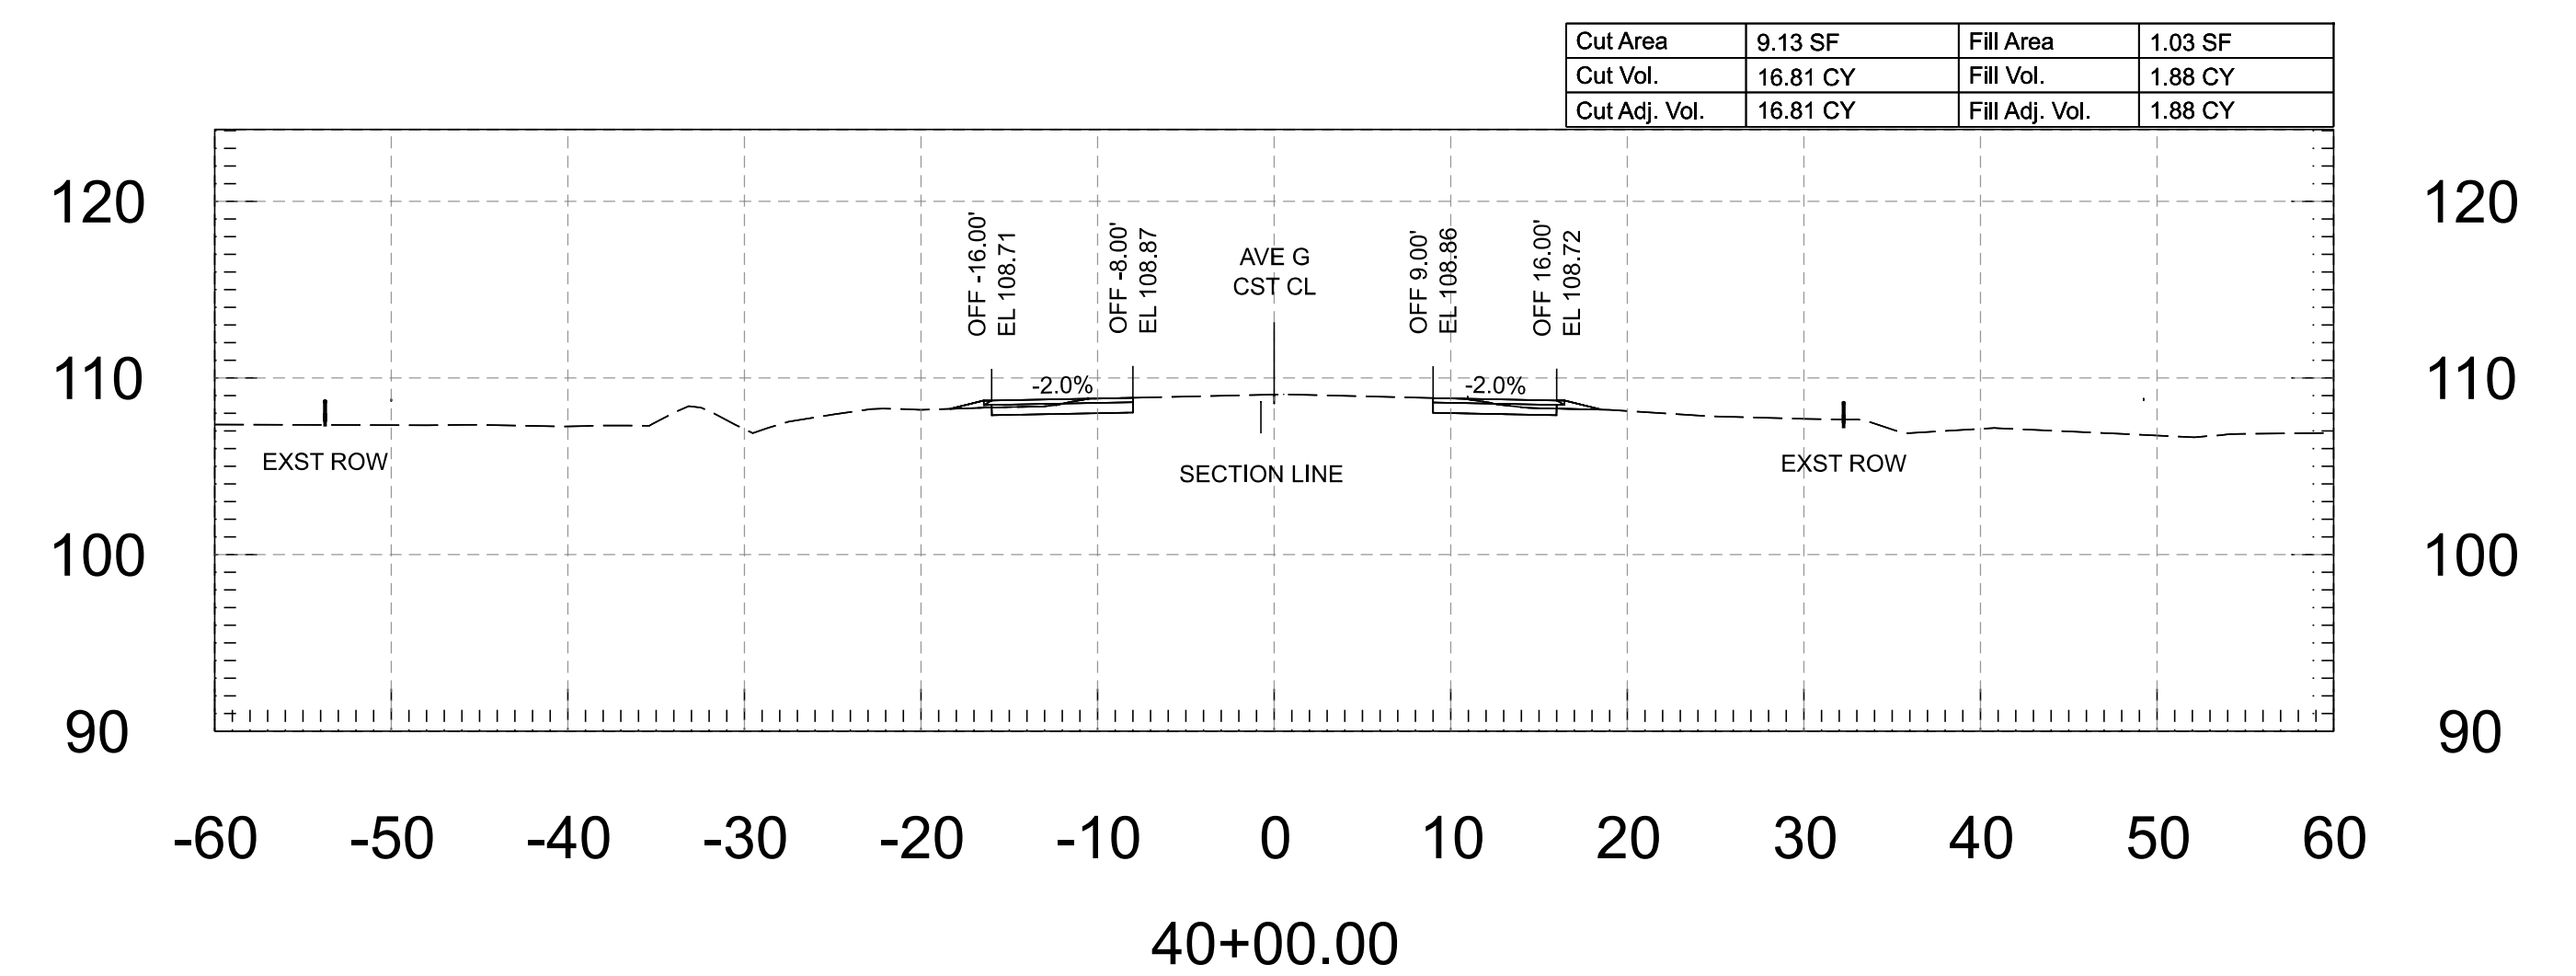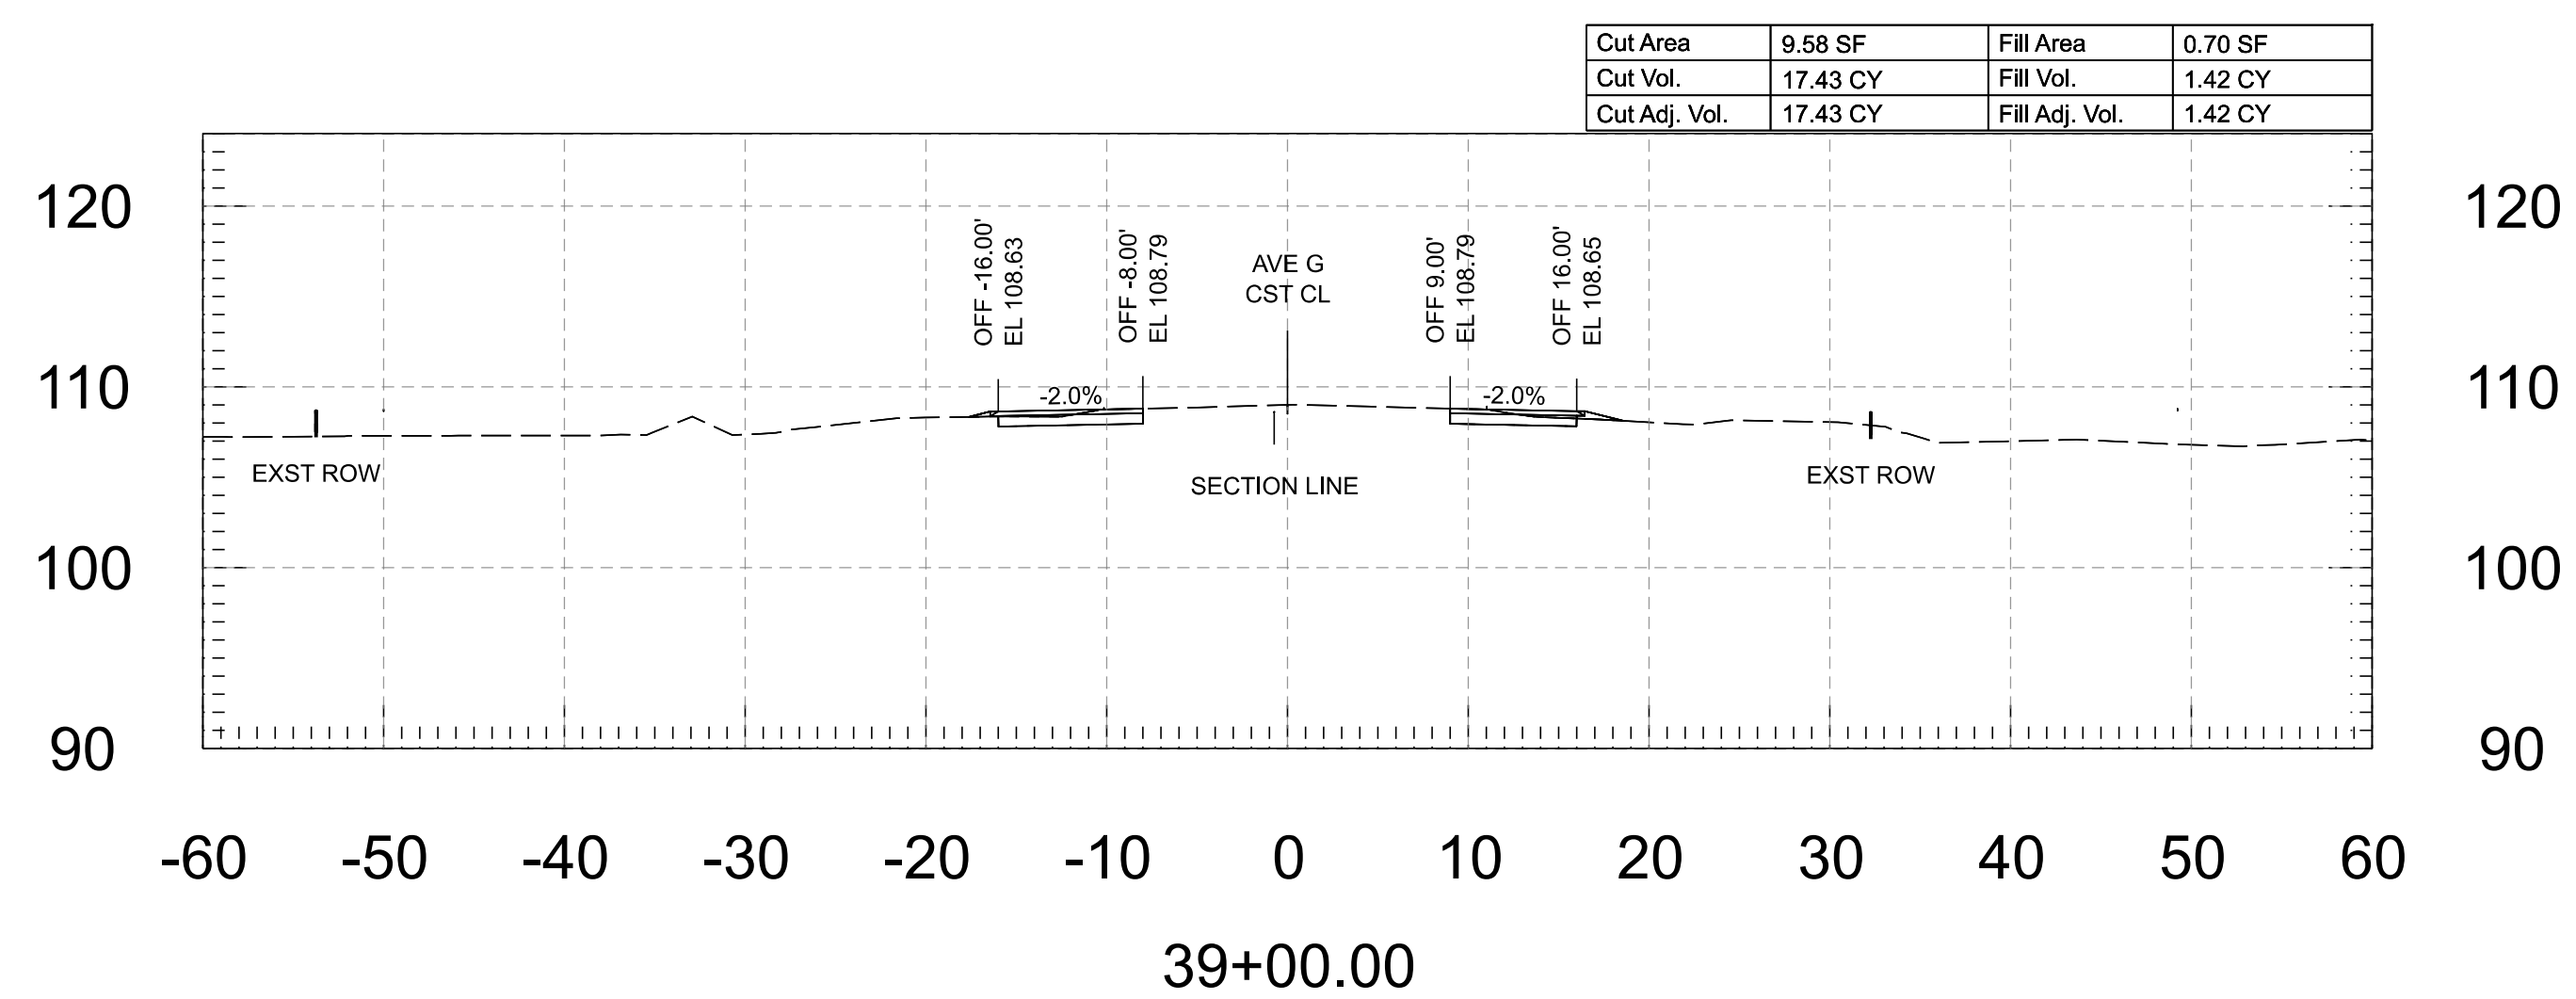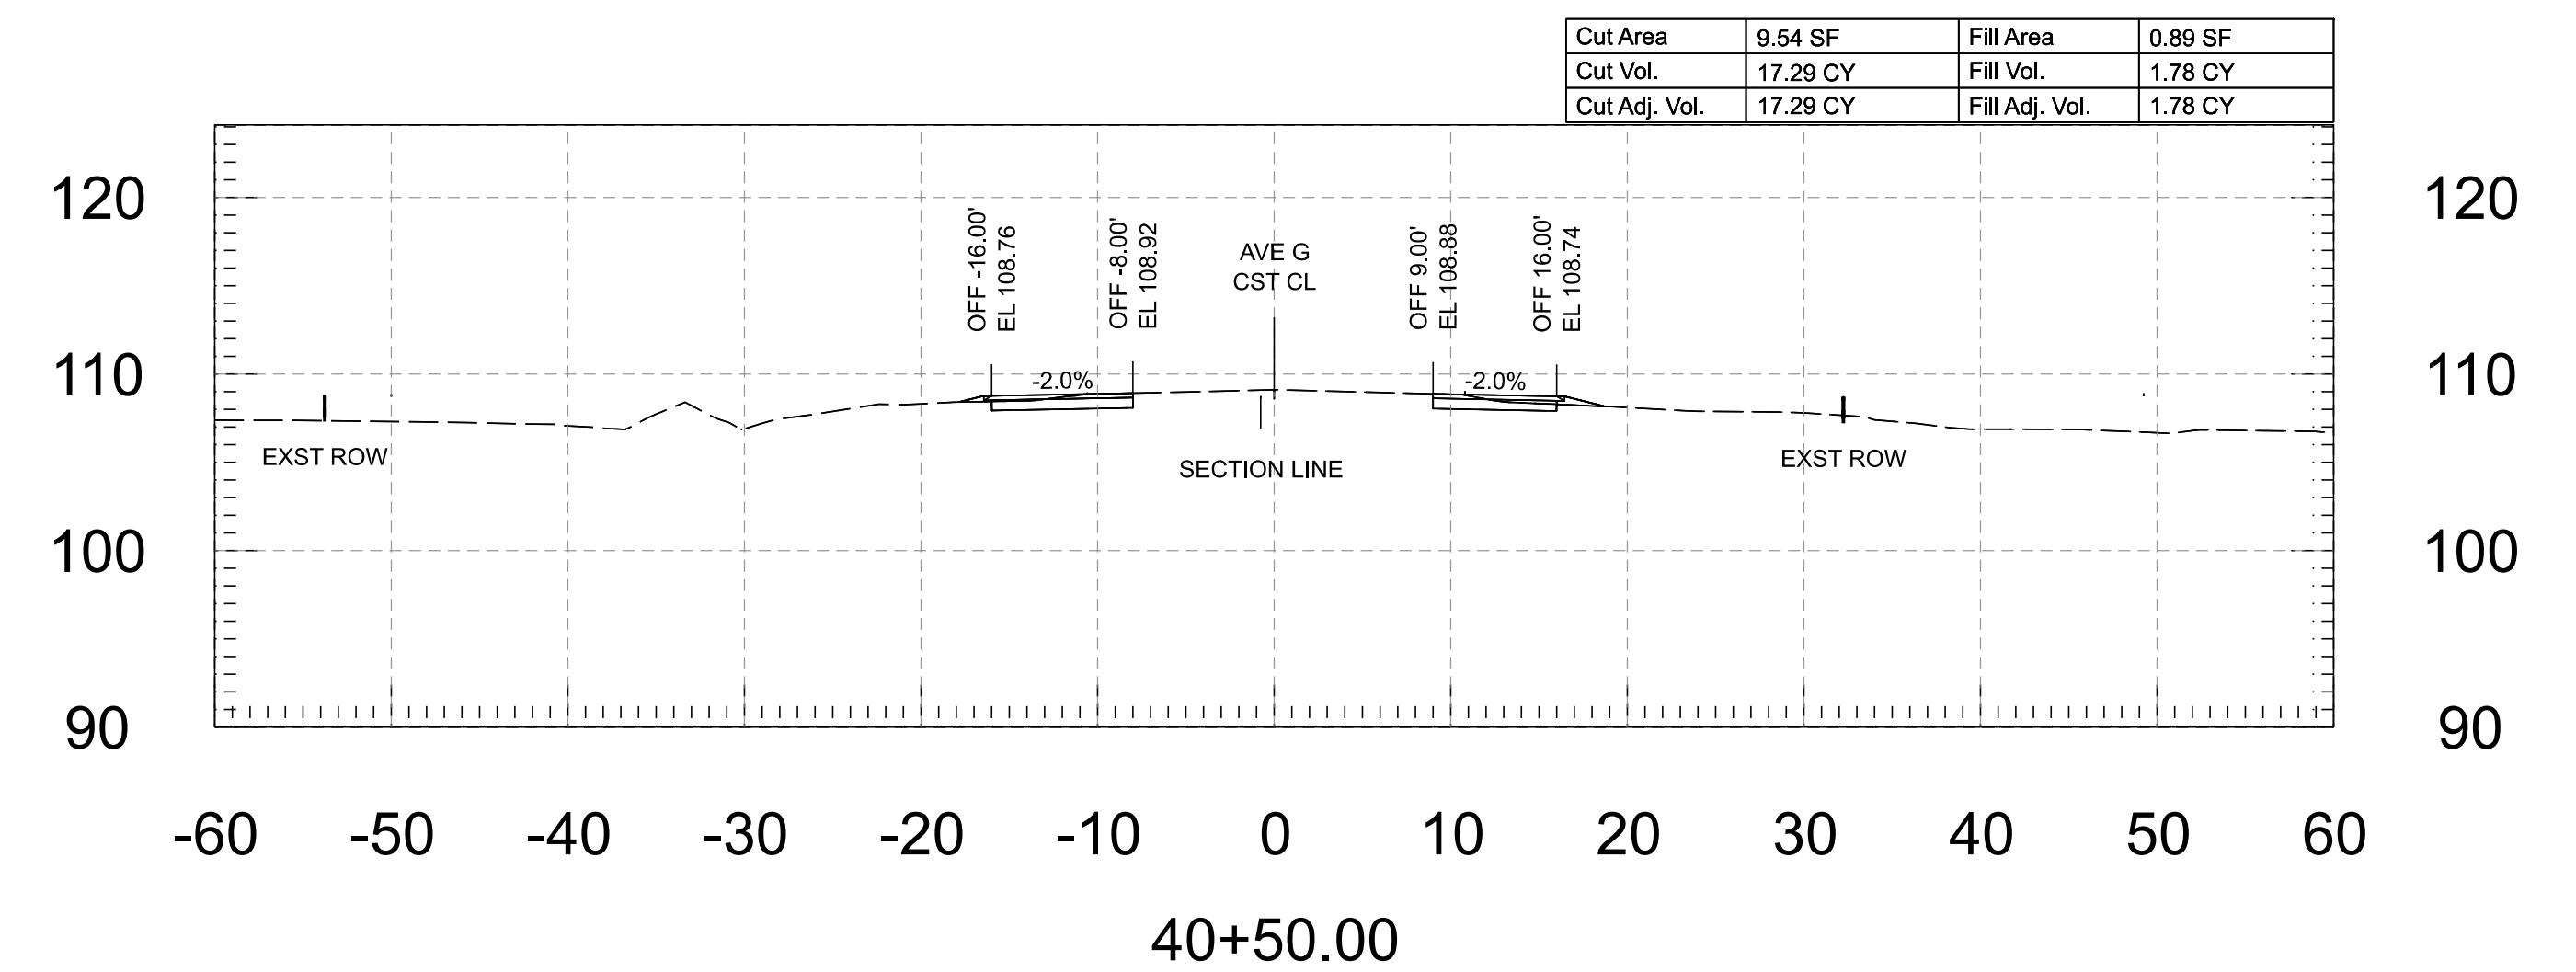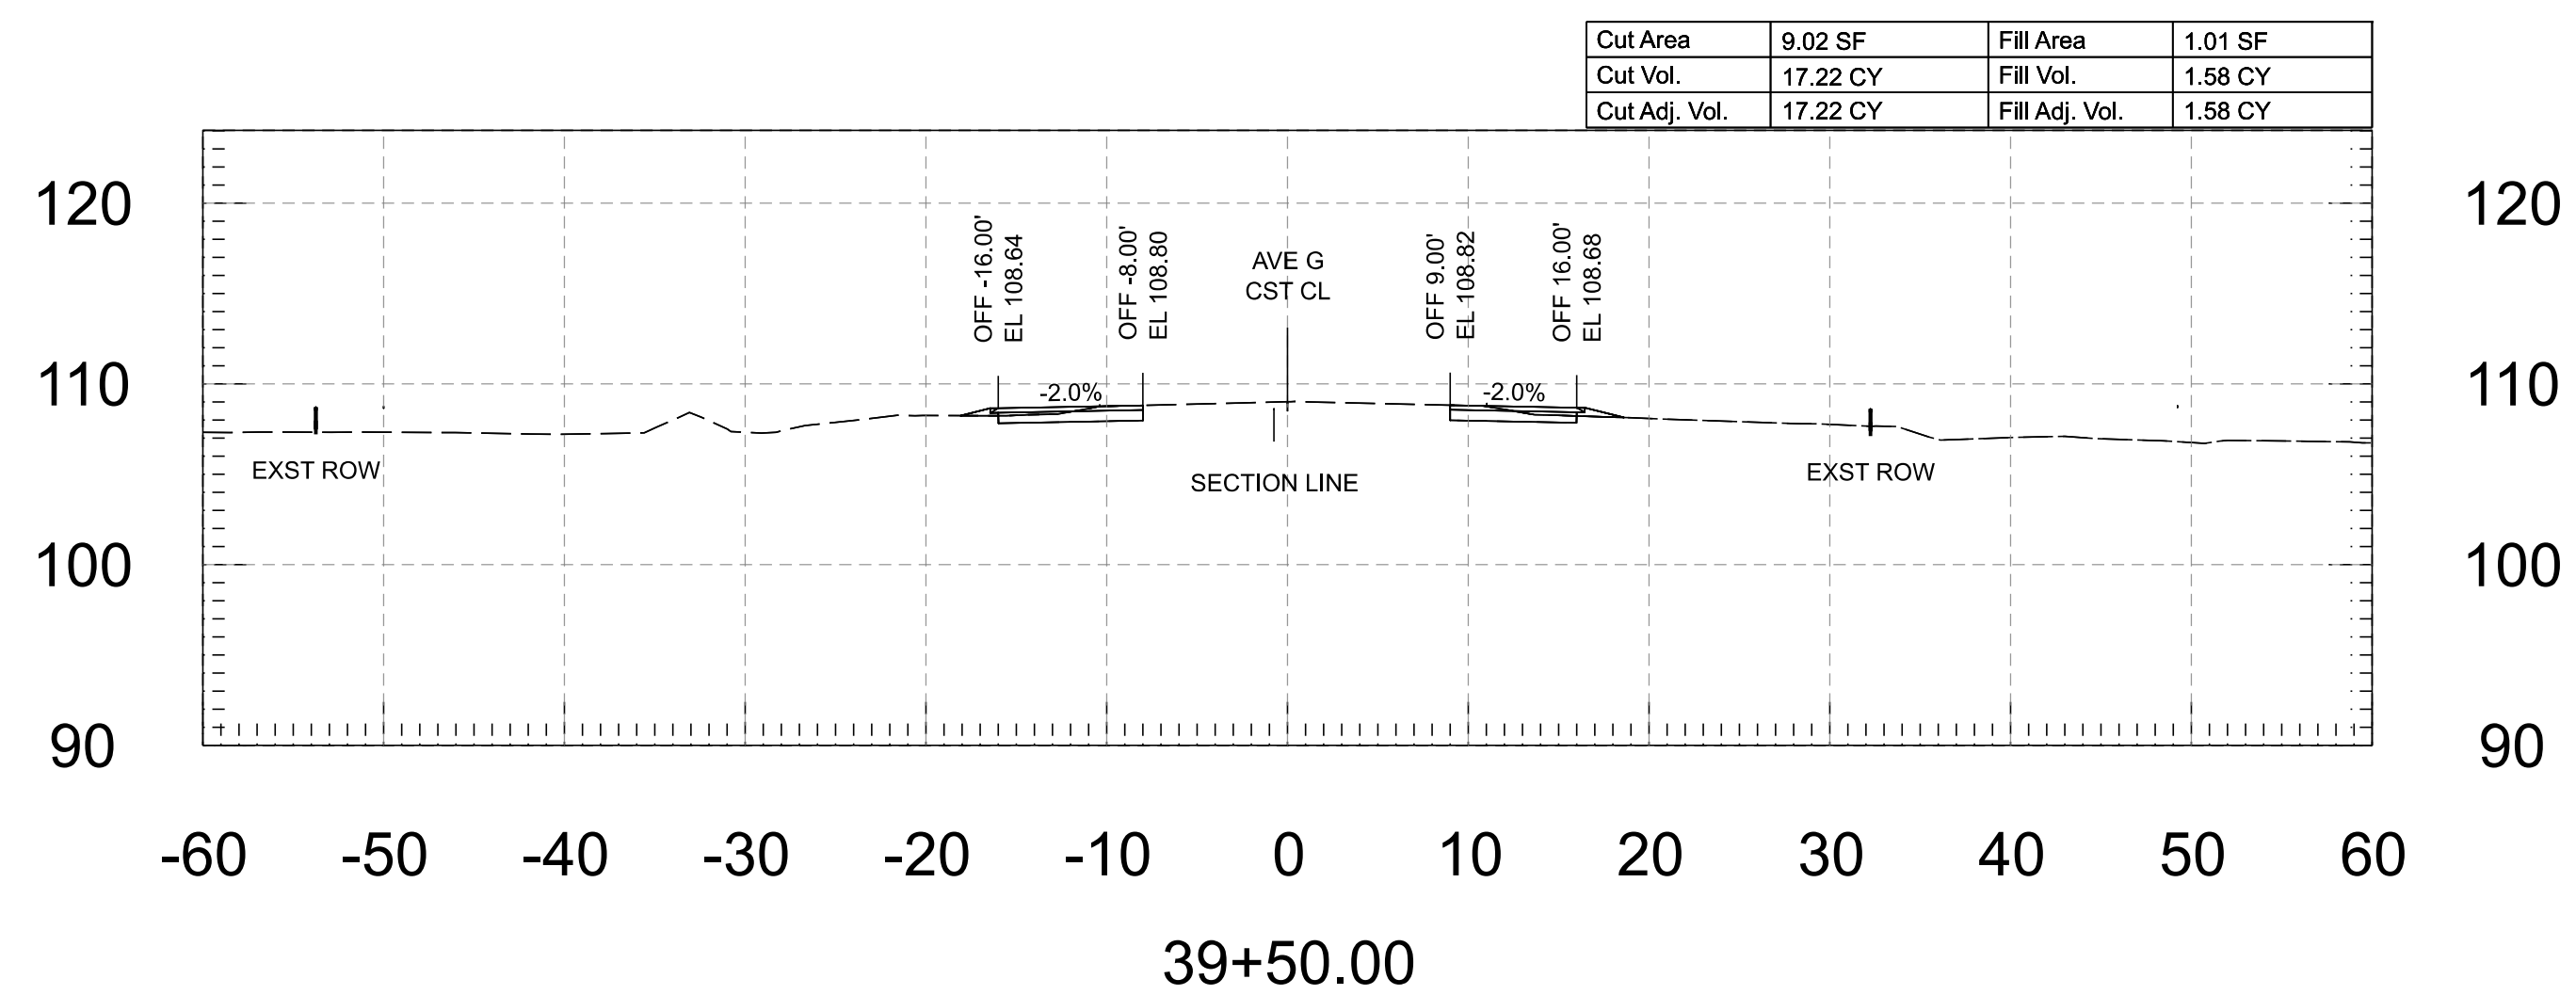

	FOR INFORMATION ONLY		NAME	DATE	ARIZONA DEPARTMENT OF TRANSPORTATION PROJECT DELIVERY AND OPERATIONS DIVISION ROADWAY DESIGN SERVICES	ROUTE	F.H.W.A. Arizona Division	STATE ARIZ.	PROJECT NO.	FEDERAL ID NO.	SHEET NO.	TOTAL SHEETS	RECORD DRAWING		
		DESIGN	M. SCHOEN	07/26		0000 YU YYU			YYU-0(225)T	13	118				
		DRAWN	M. SCHOEN	07/26											
		CHECKED	H. RIOS	07/26											
		 WSP USA Inc. 1200 West Washington Street, Suite 405 Tempe, AZ 85280				AVENUE G - CROSS SECTIONS			LOCATION AVENUE G, COUNTY 11TH ST - COUNTY 16TH ST DWG						
									TRACS NO. T0437 01C OF						

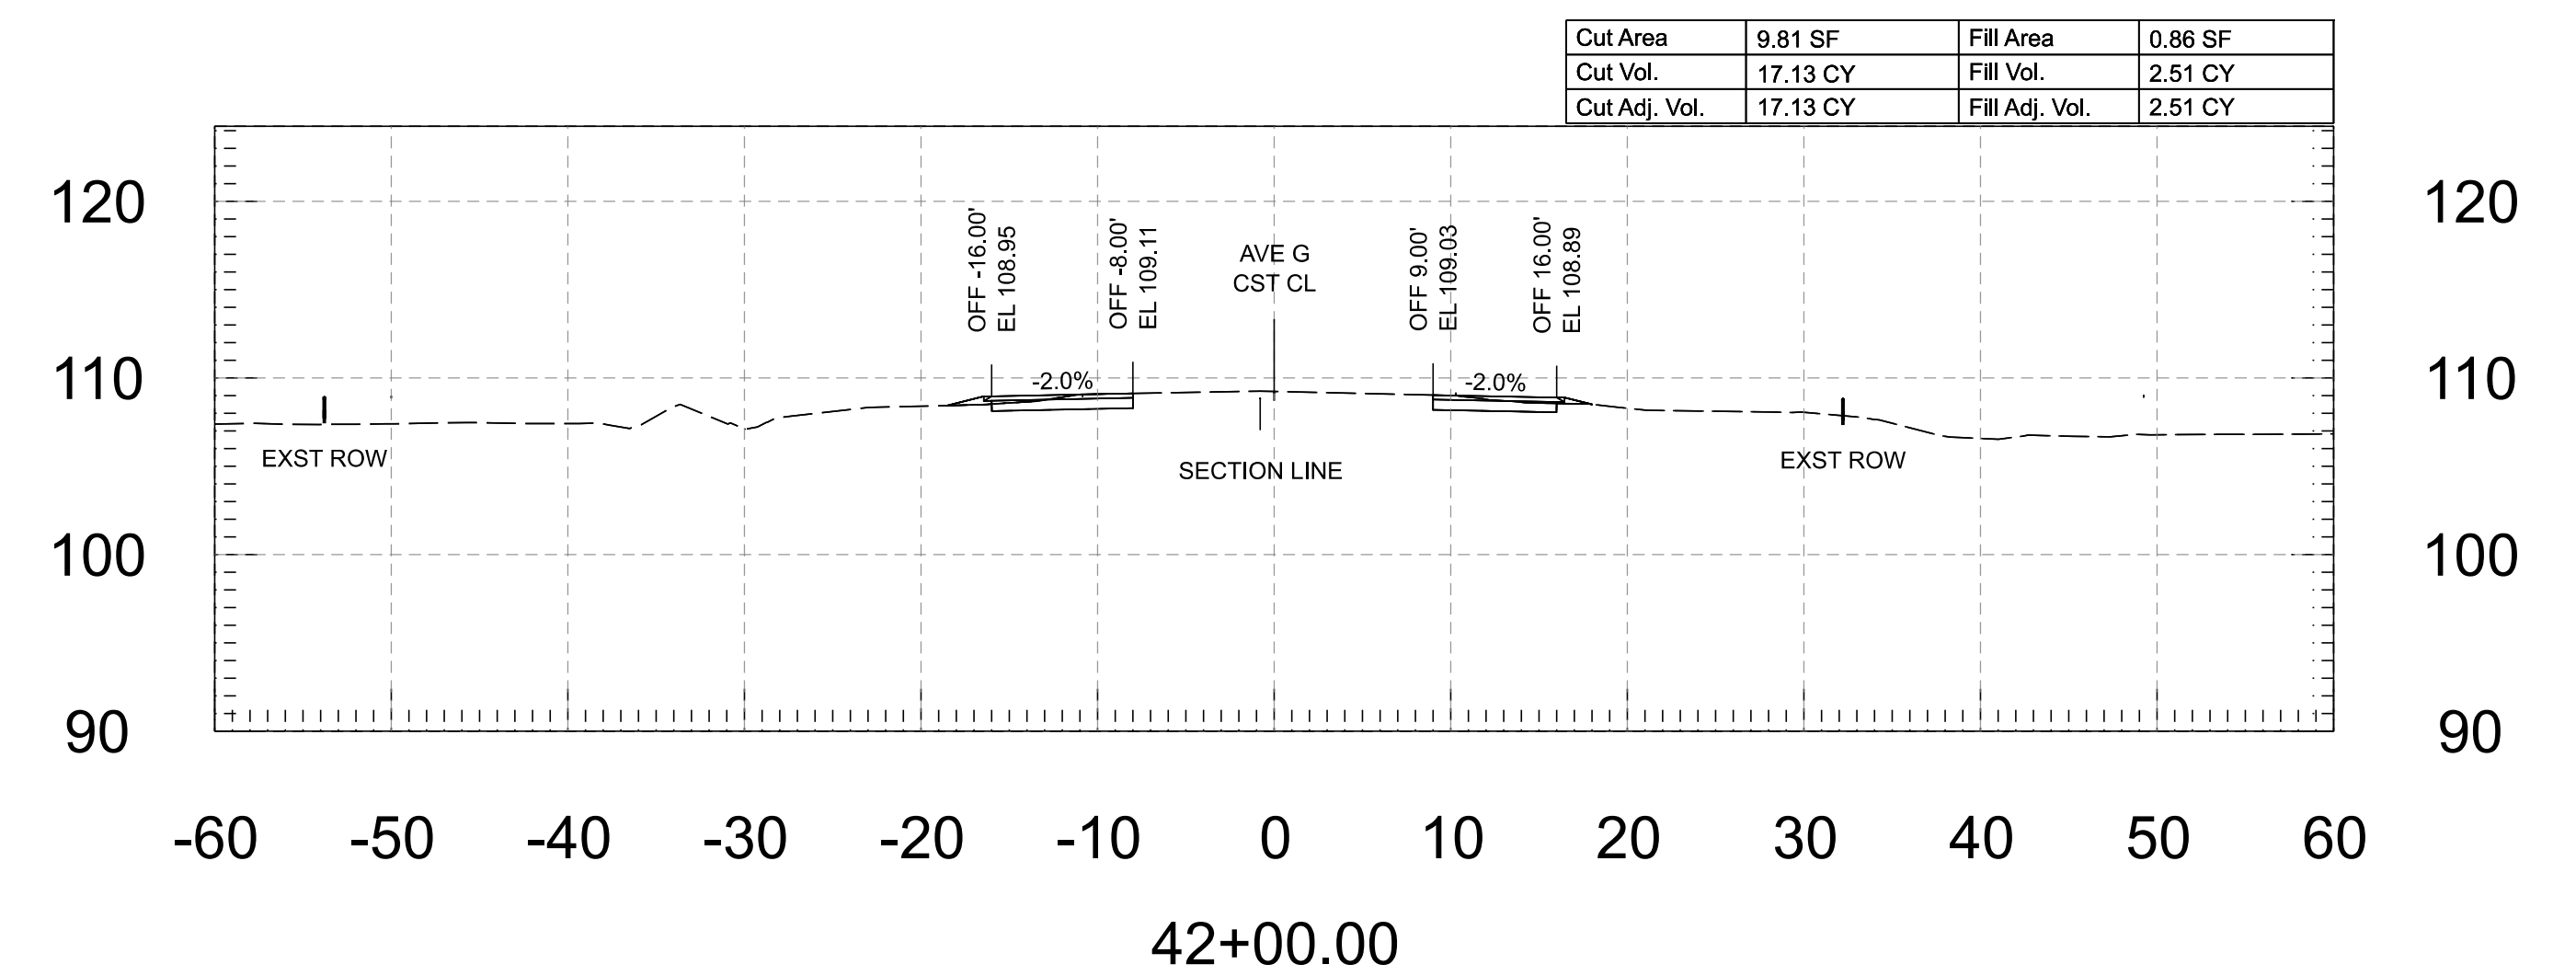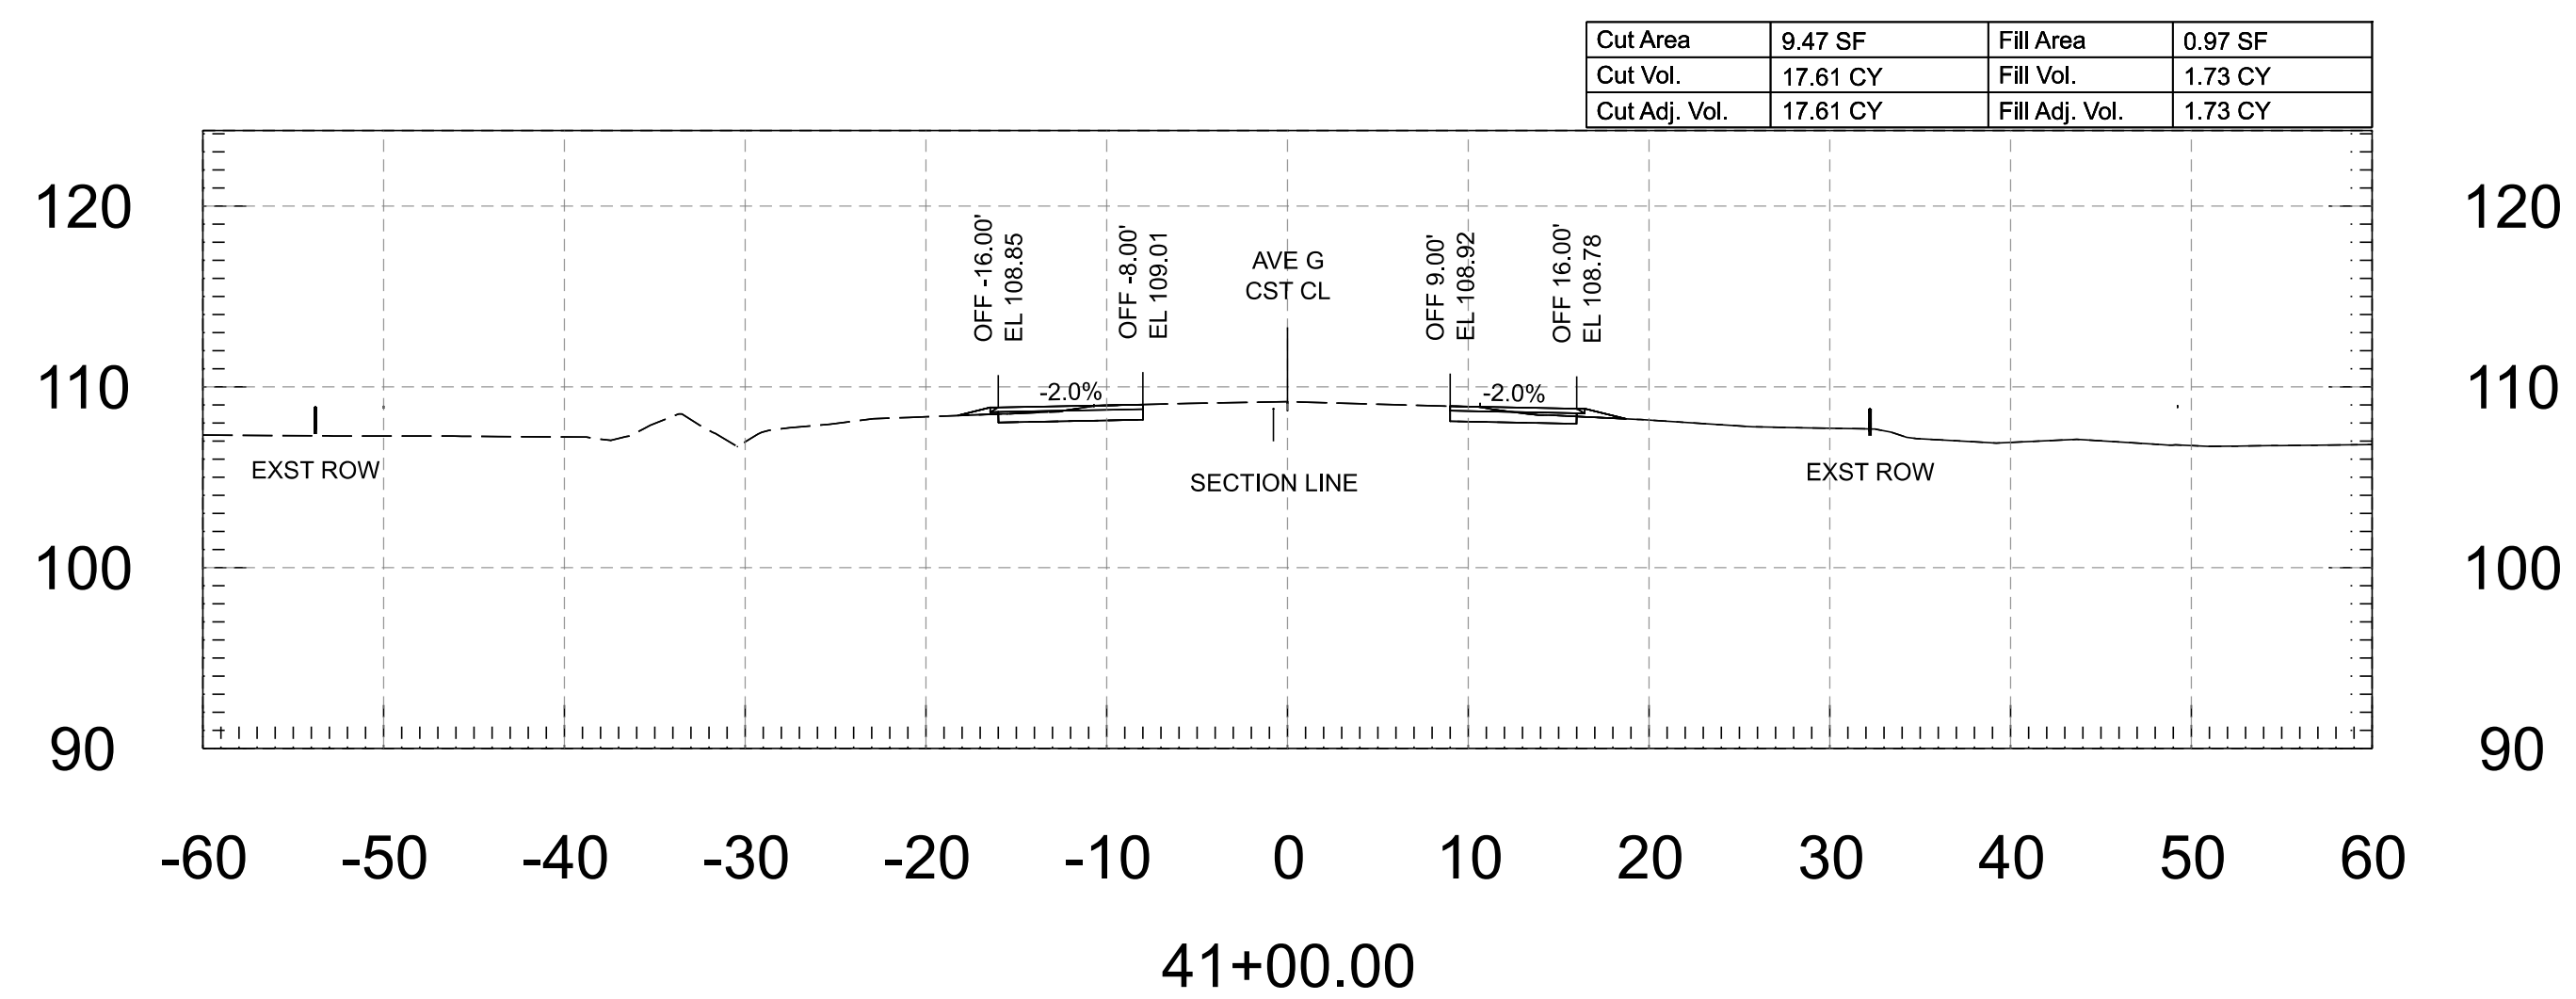

FOR INFORMATION ONLY		NAME	DATE	ARIZONA DEPARTMENT OF TRANSPORTATION PROJECT DELIVERY AND OPERATIONS DIVISION ROADWAY DESIGN SERVICES	ROUTE	F.H.W.A. Arizona Division	STATE	PROJECT NO.	FEDERAL ID NO.	SHEET NO.	TOTAL SHEETS	RECORD DRAWING	
	DESIGN	M. SCHOEN	07/26		MILEPOST		ARIZ.	0000 YU YYU	YYU-0(225)T	14	118		
	DRAWN	M. SCHOEN	07/26		wsp WSP USA Inc. 1200 West Washington Street, Suite 405 Tempe, AZ 85288	AVENUE G - CROSS SECTIONS	STRUCTURE NO.	LOCATION AVENUE G, COUNTY 11TH ST - COUNTY 16TH ST					DWG
	CHECKED	H. RIOS	07/26					TRACS NO. T0437 01C					___ OF ___

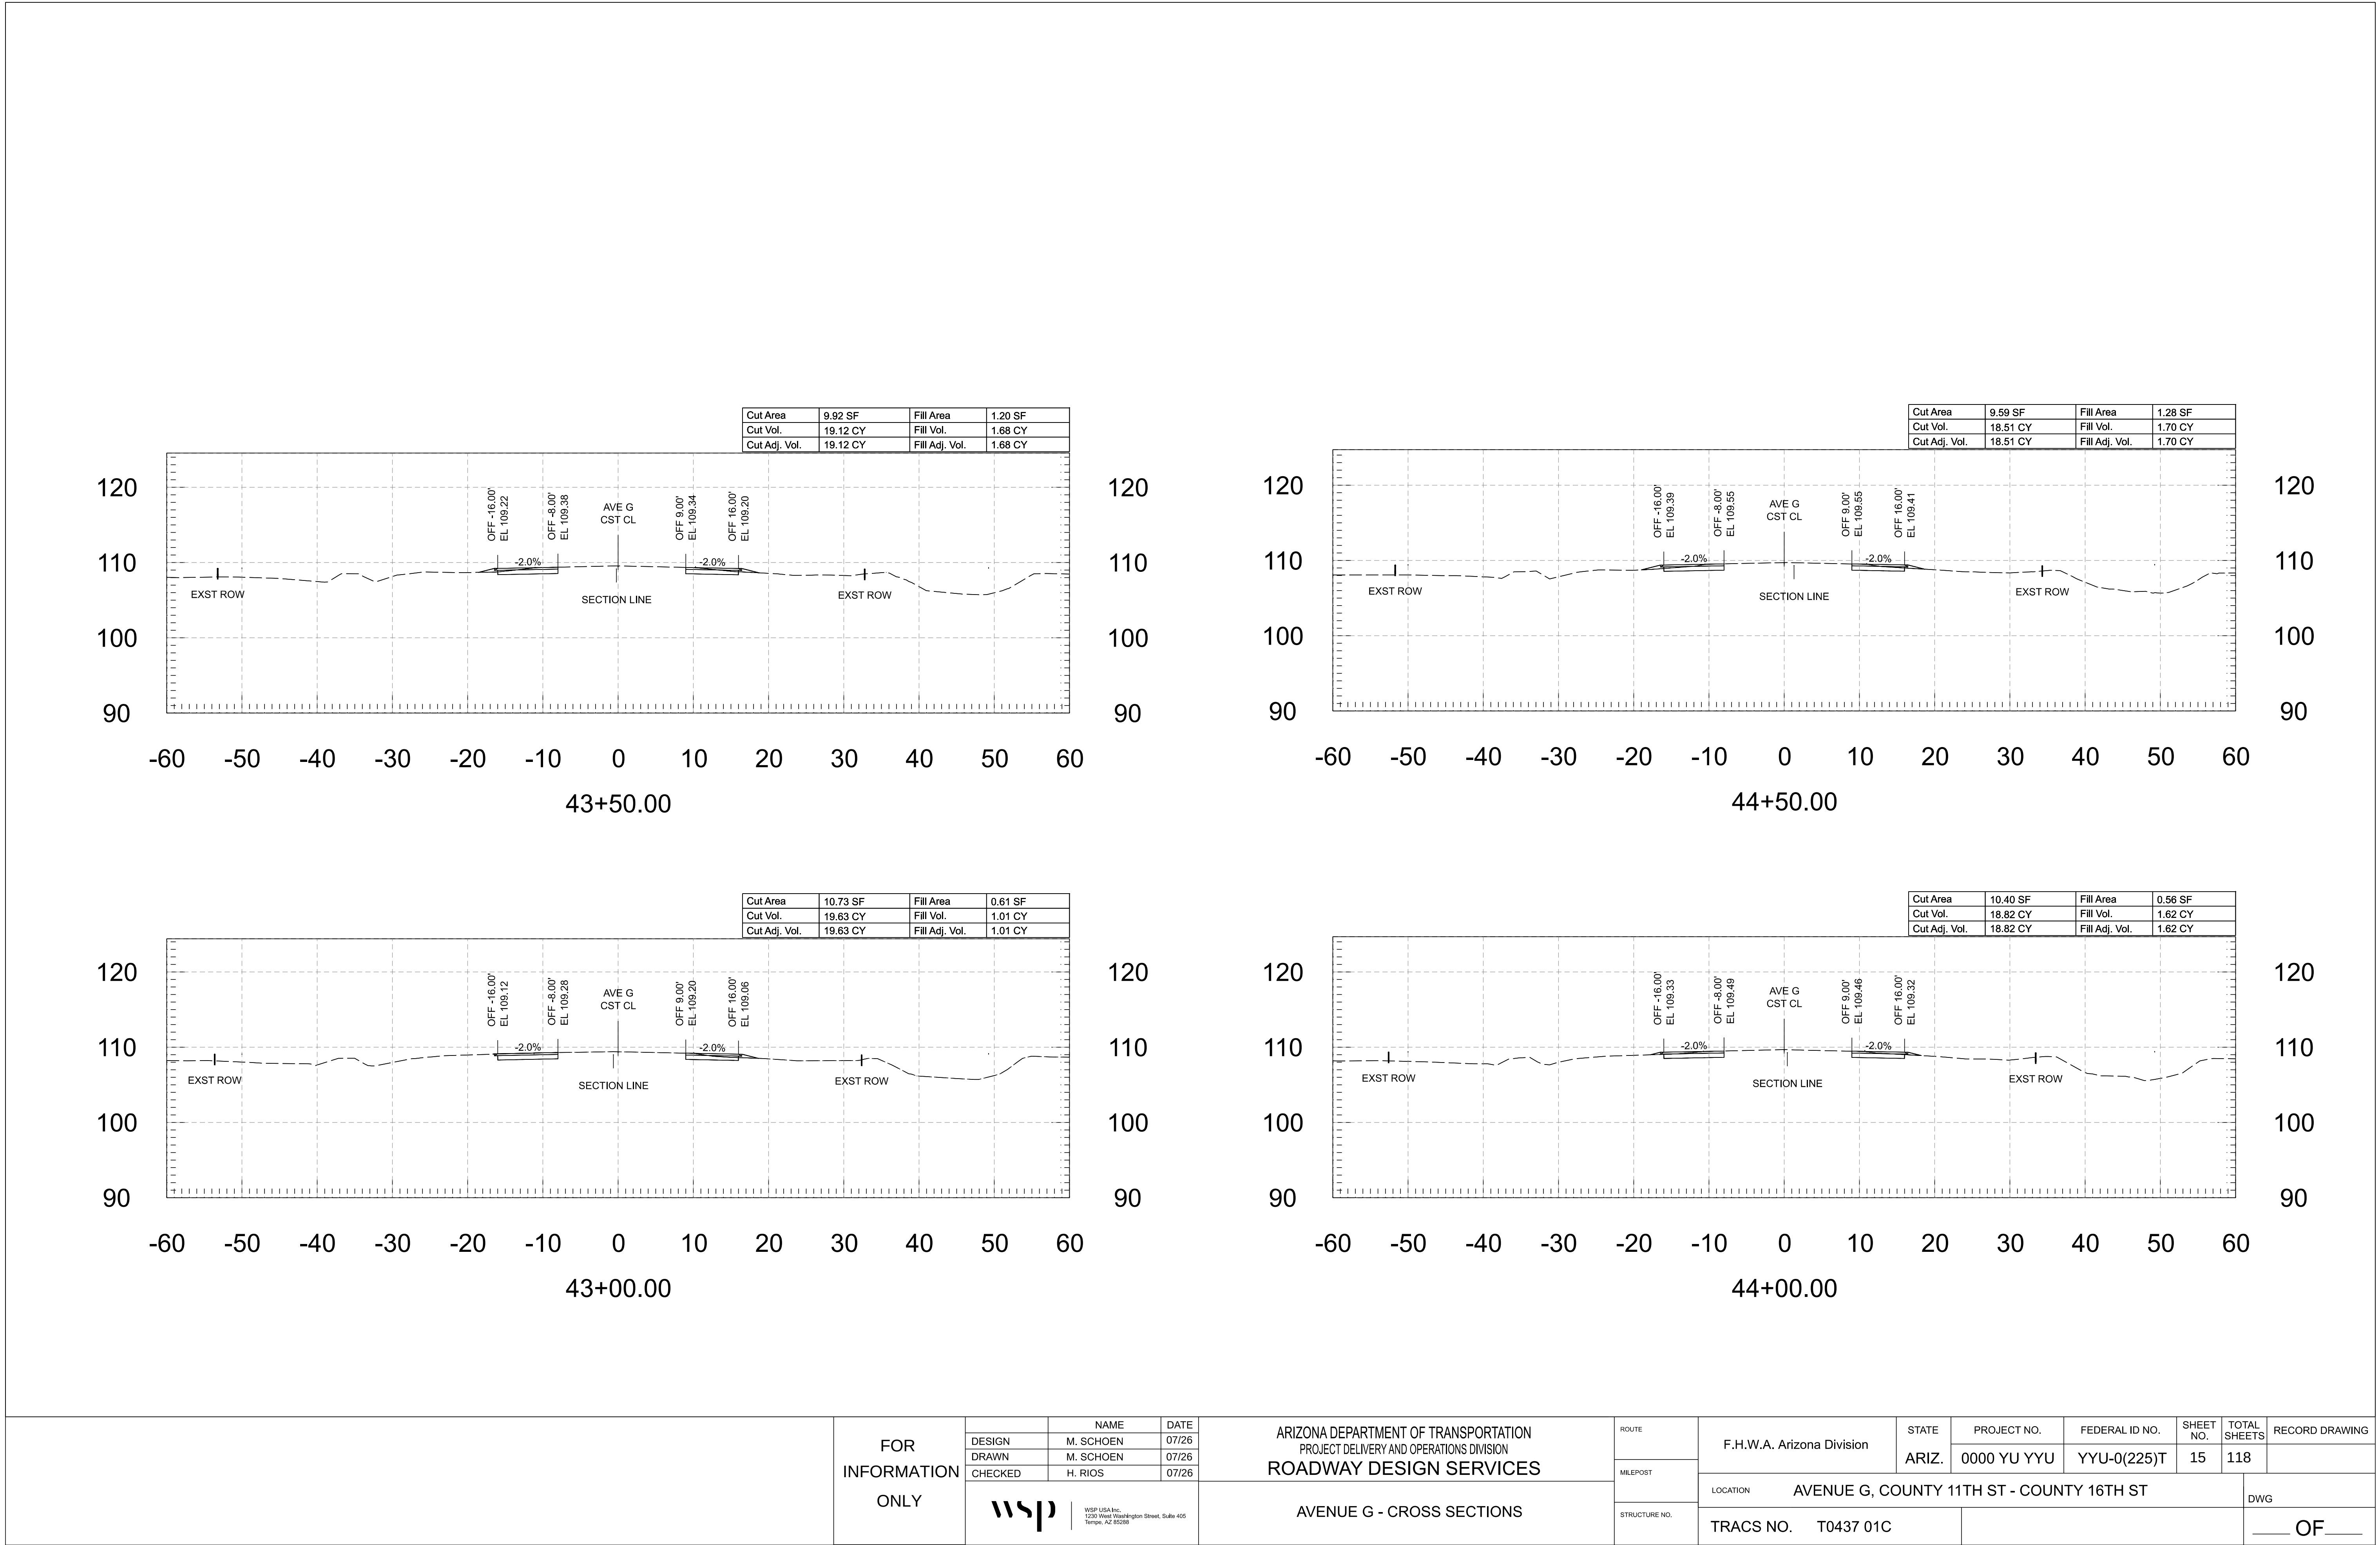

FOR INFORMATION ONLY

	NAME	DATE
DESIGN	M. SCHOEN	07/26
DRAWN	M. SCHOEN	07/26
CHECKED	H. RIOS	07/26



wsp

WSP USA Inc.
1200 West Washington Street, Suite 405
Tempe, AZ 85286





ARIZONA DEPARTMENT OF TRANSPORTATION
PROJECT DELIVERY AND OPERATIONS DIVISION
ROADWAY DESIGN SERVICES

AVENUE G - CROSS SECTIONS





ROUTE	F.H.W.A. Arizona Division	STATE	PROJECT NO.	FEDERAL ID NO.	SHEET NO.	TOTAL SHEETS	RECORD DRAWING
MILEPOST							
STRUCTURE NO.	LOCATION AVENUE G, COUNTY 11TH ST - COUNTY 16TH ST						DWG
TRACS NO. T0437 01C							

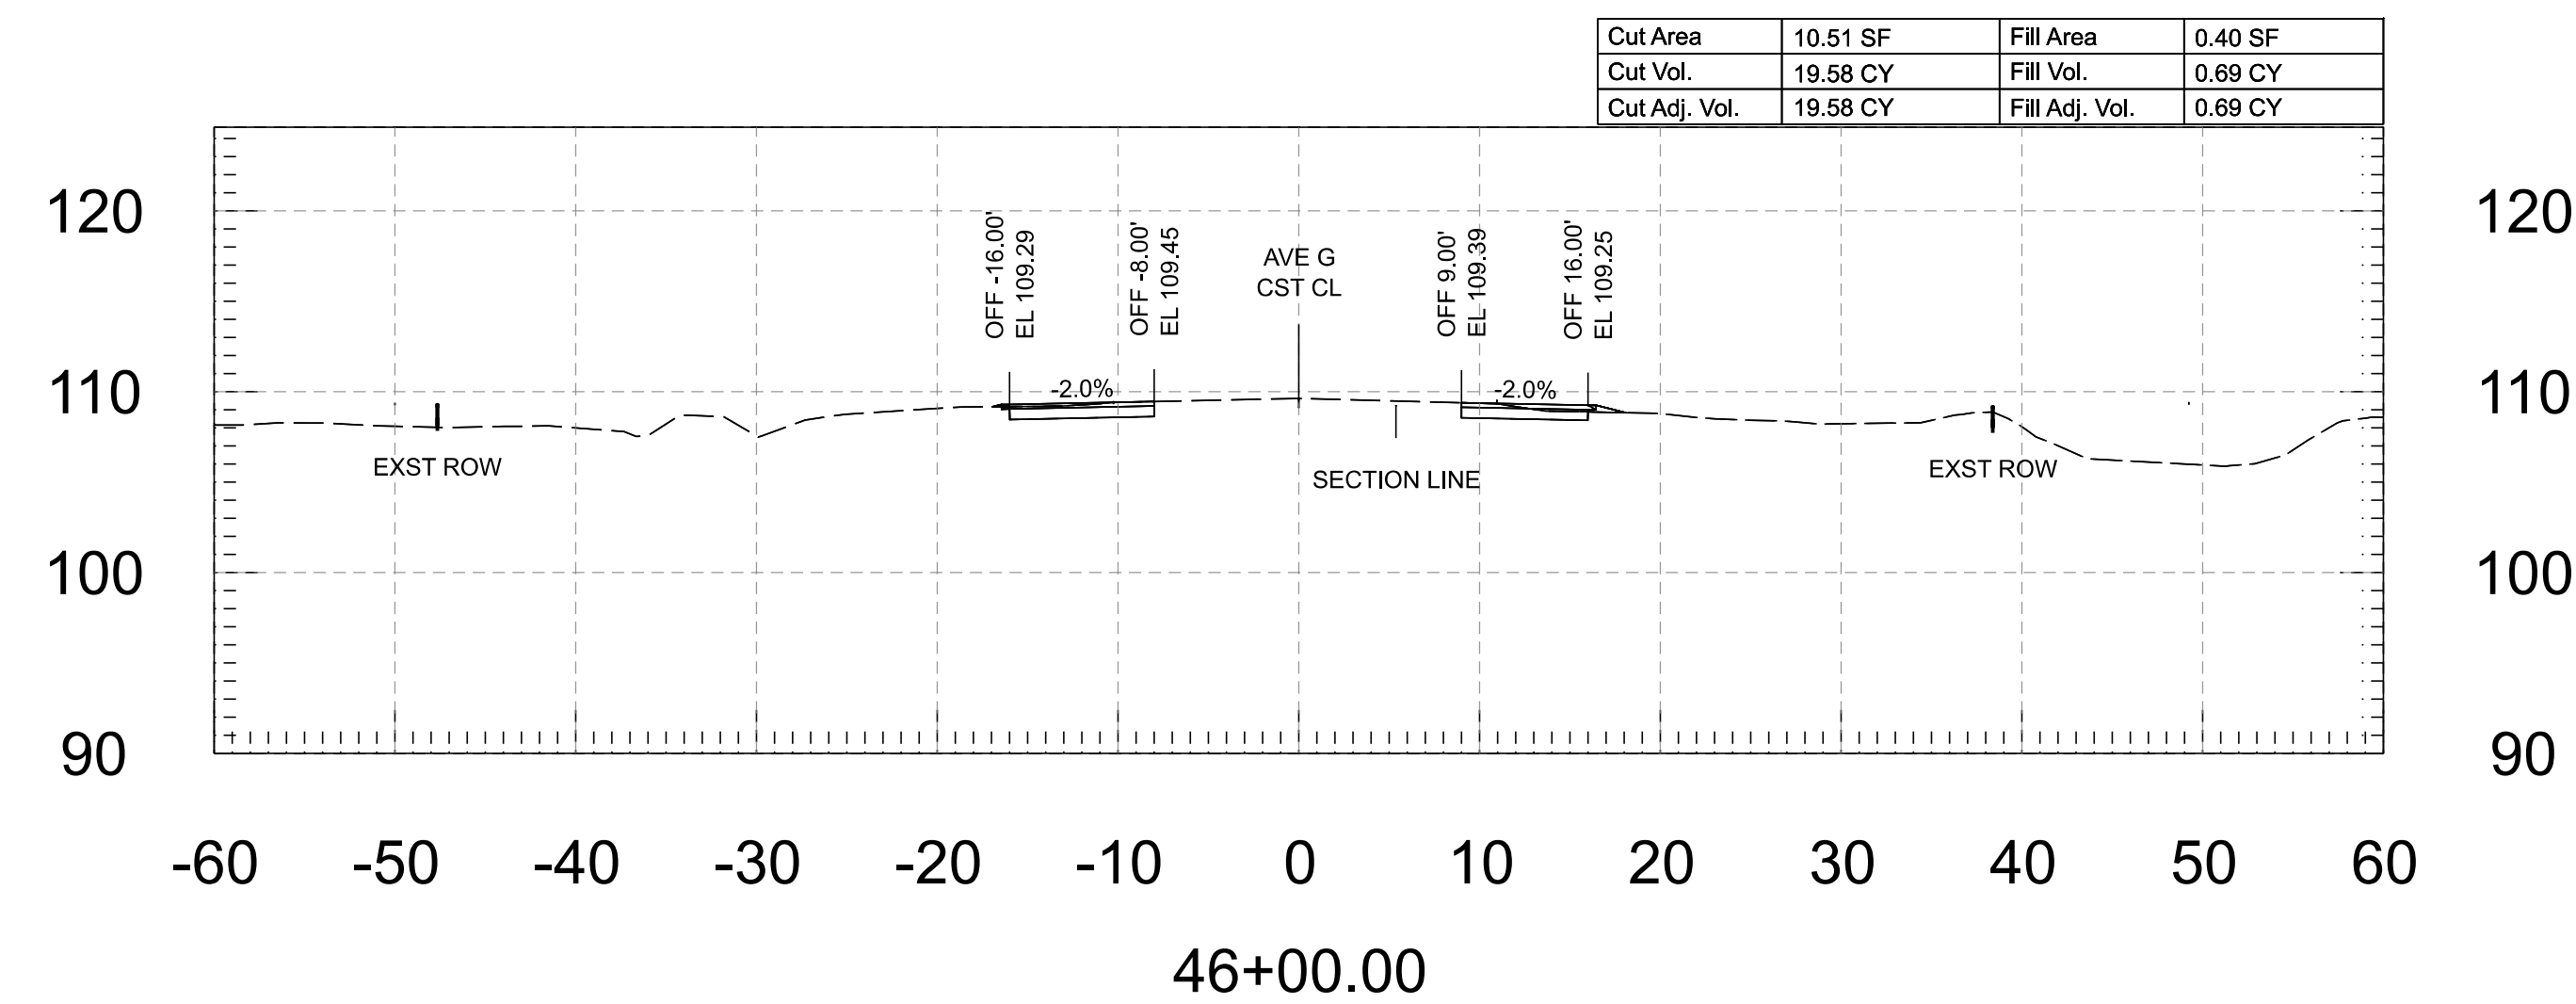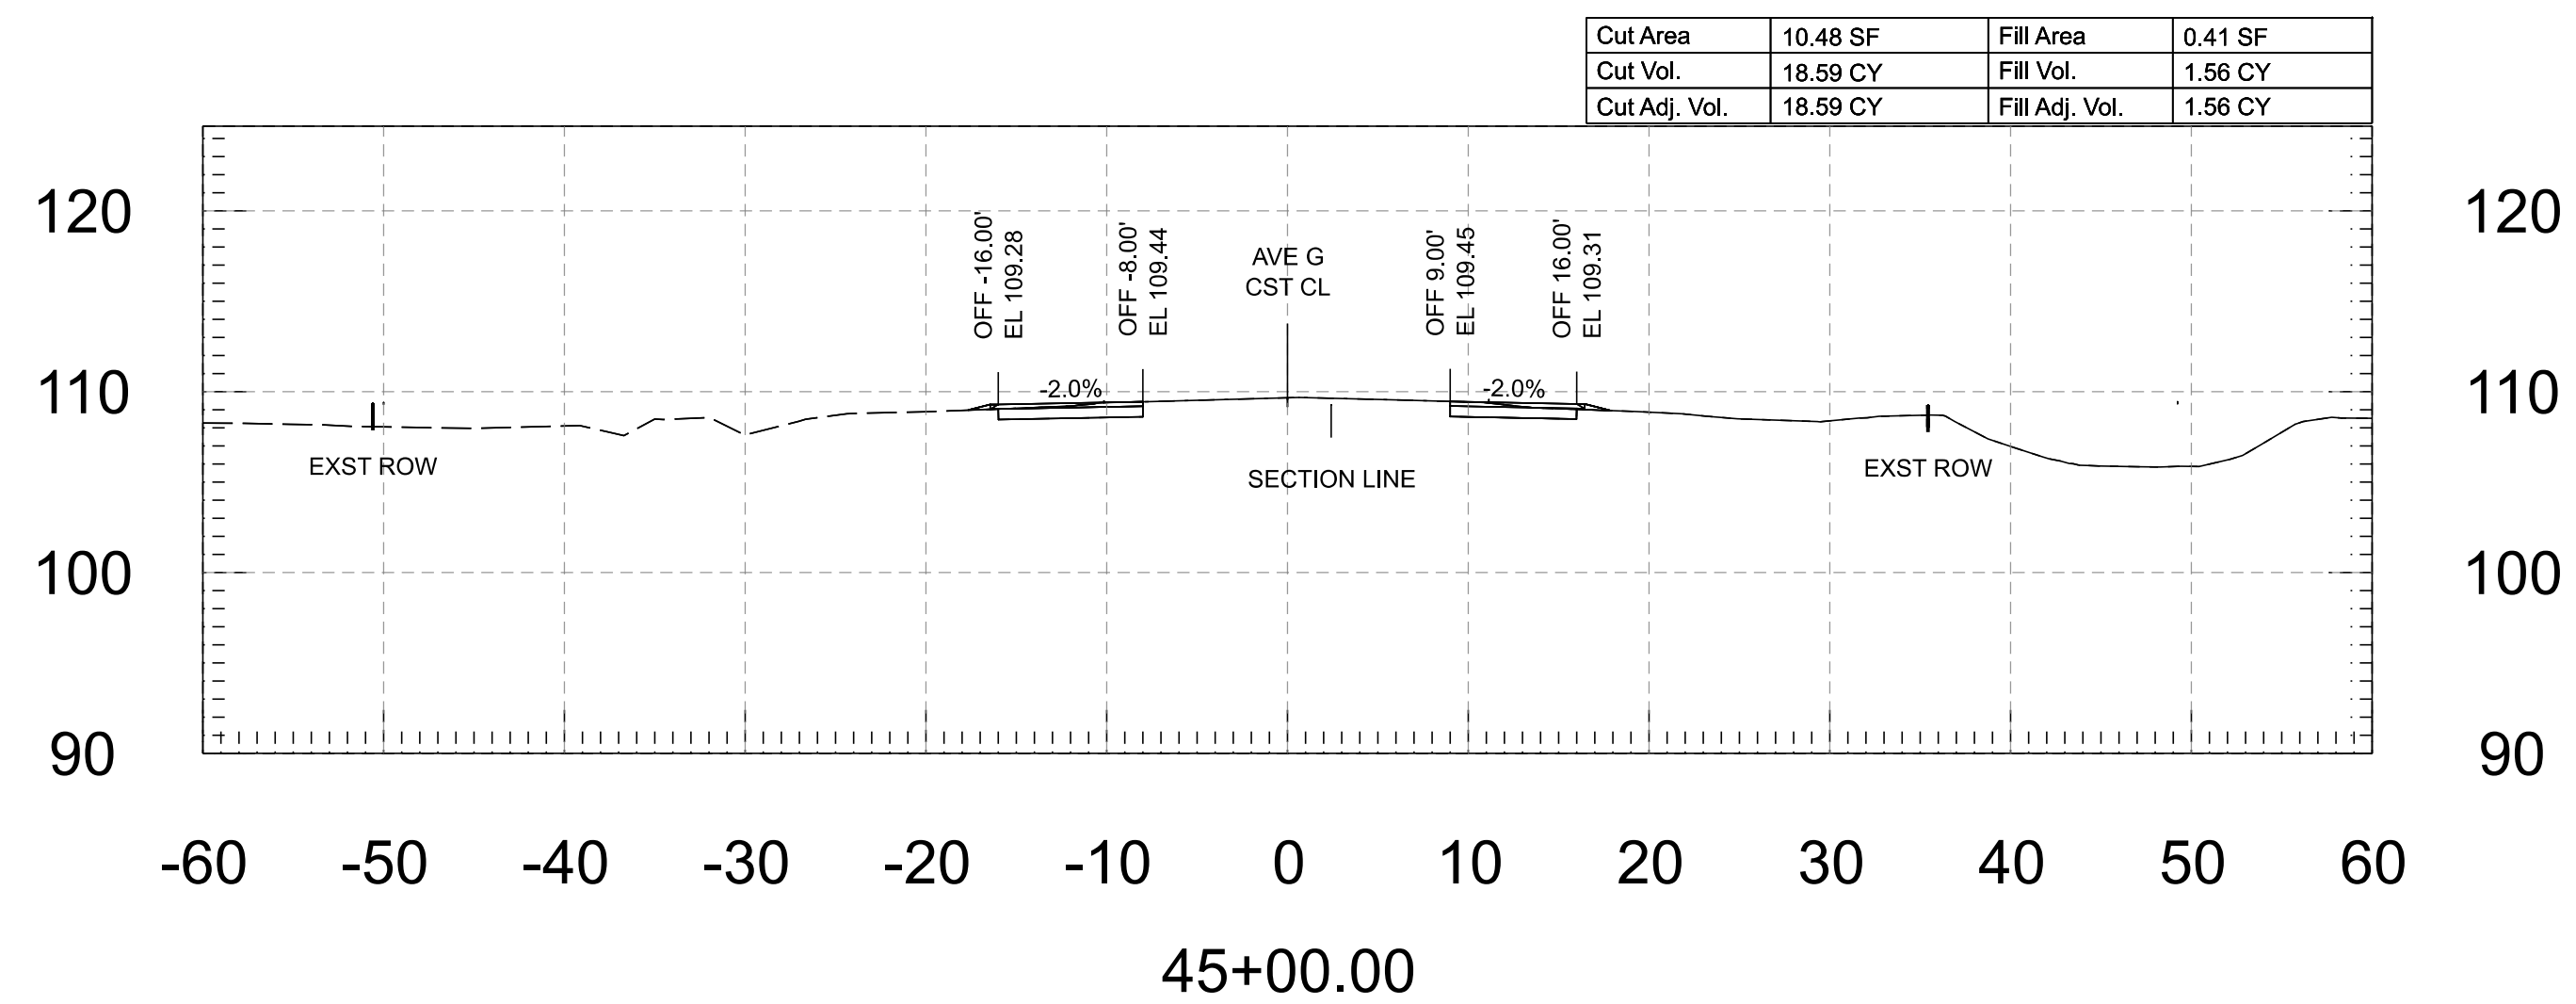





FOR INFORMATION ONLY		NAME	DATE	ARIZONA DEPARTMENT OF TRANSPORTATION PROJECT DELIVERY AND OPERATIONS DIVISION ROADWAY DESIGN SERVICES	ROUTE	F.H.W.A. Arizona Division	STATE ARIZ.	PROJECT NO.	FEDERAL ID NO.	SHEET NO.	TOTAL SHEETS	RECORD DRAWING
	DESIGN	M. SCHOEN	07/26		0000 YU YYU			YYU-0(225)T	16	118		
	DRAWN	M. SCHOEN	07/26									
	CHECKED	H. RIOS	07/26	AVENUE G - CROSS SECTIONS	MILEPOST	LOCATION AVENUE G, COUNTY 11TH ST - COUNTY 16TH ST DWG						
	wsp WSP USA Inc. 1280 West Washington Street, Suite 405 Tempe, AZ 85288				STRUCTURE NO.							
					TRACS NO. T0437 01C		____ OF ____					

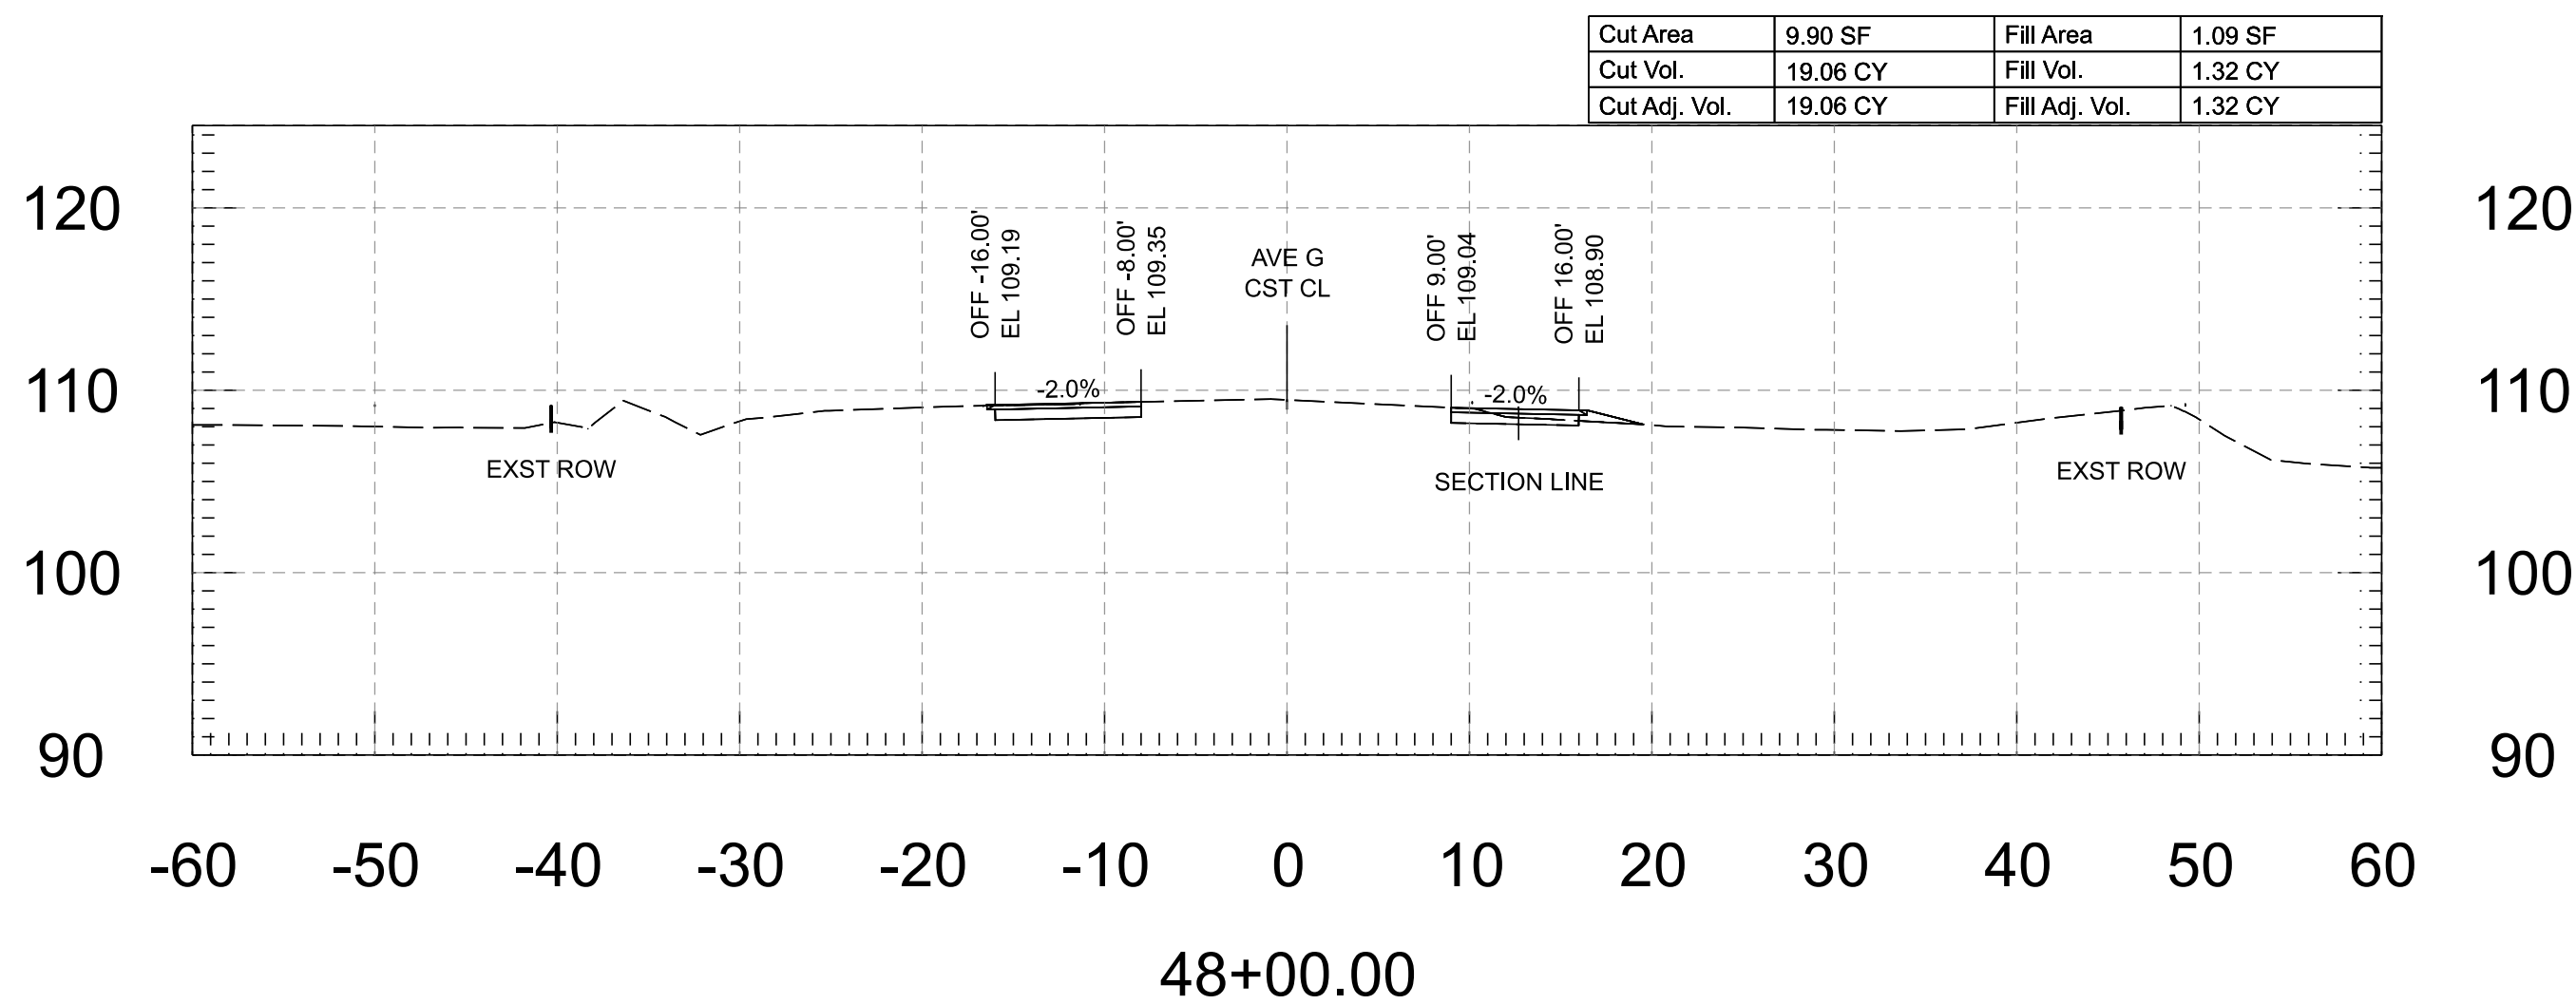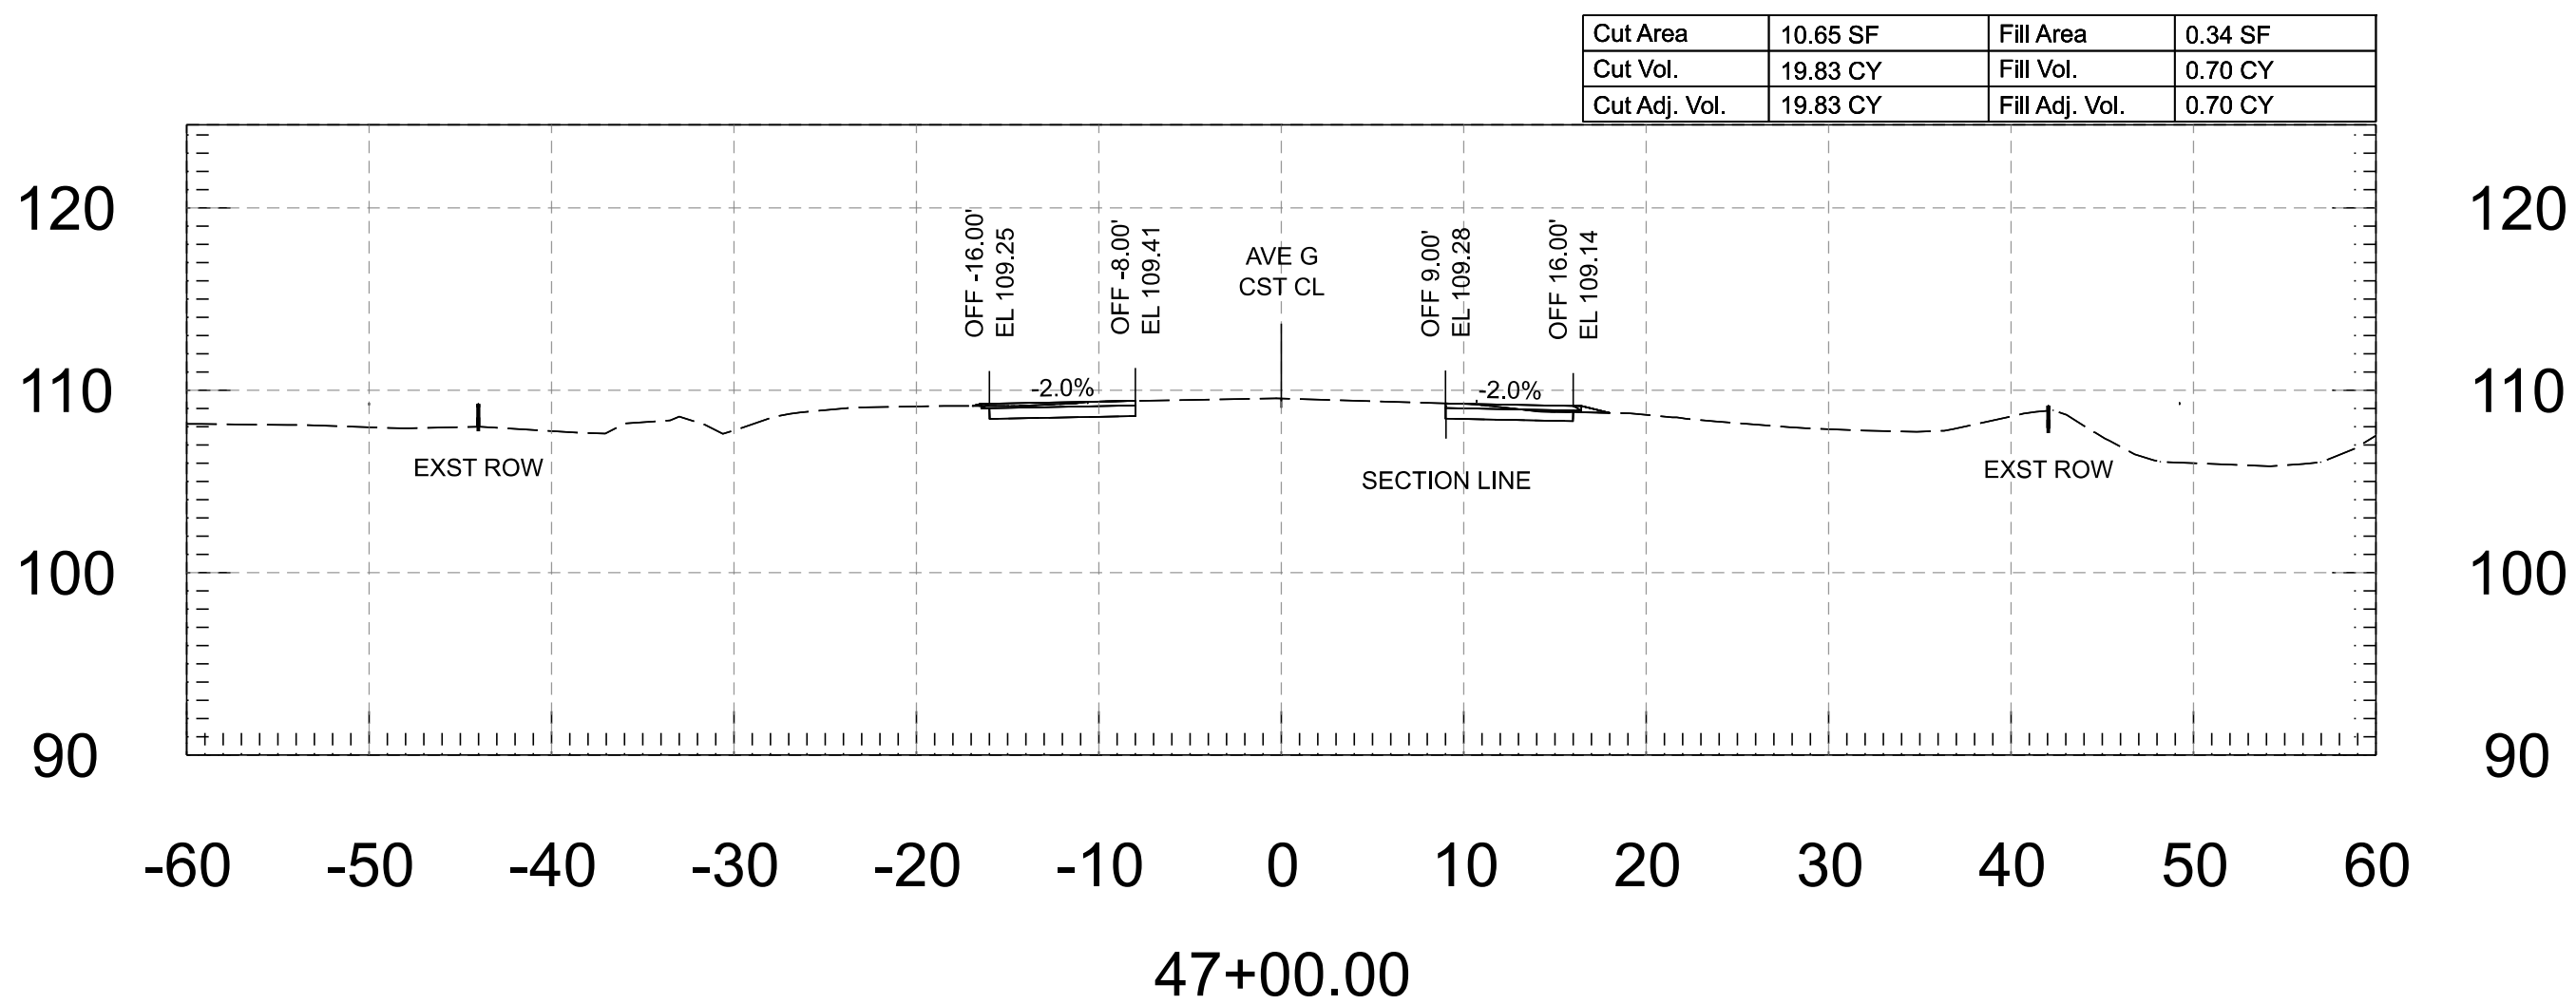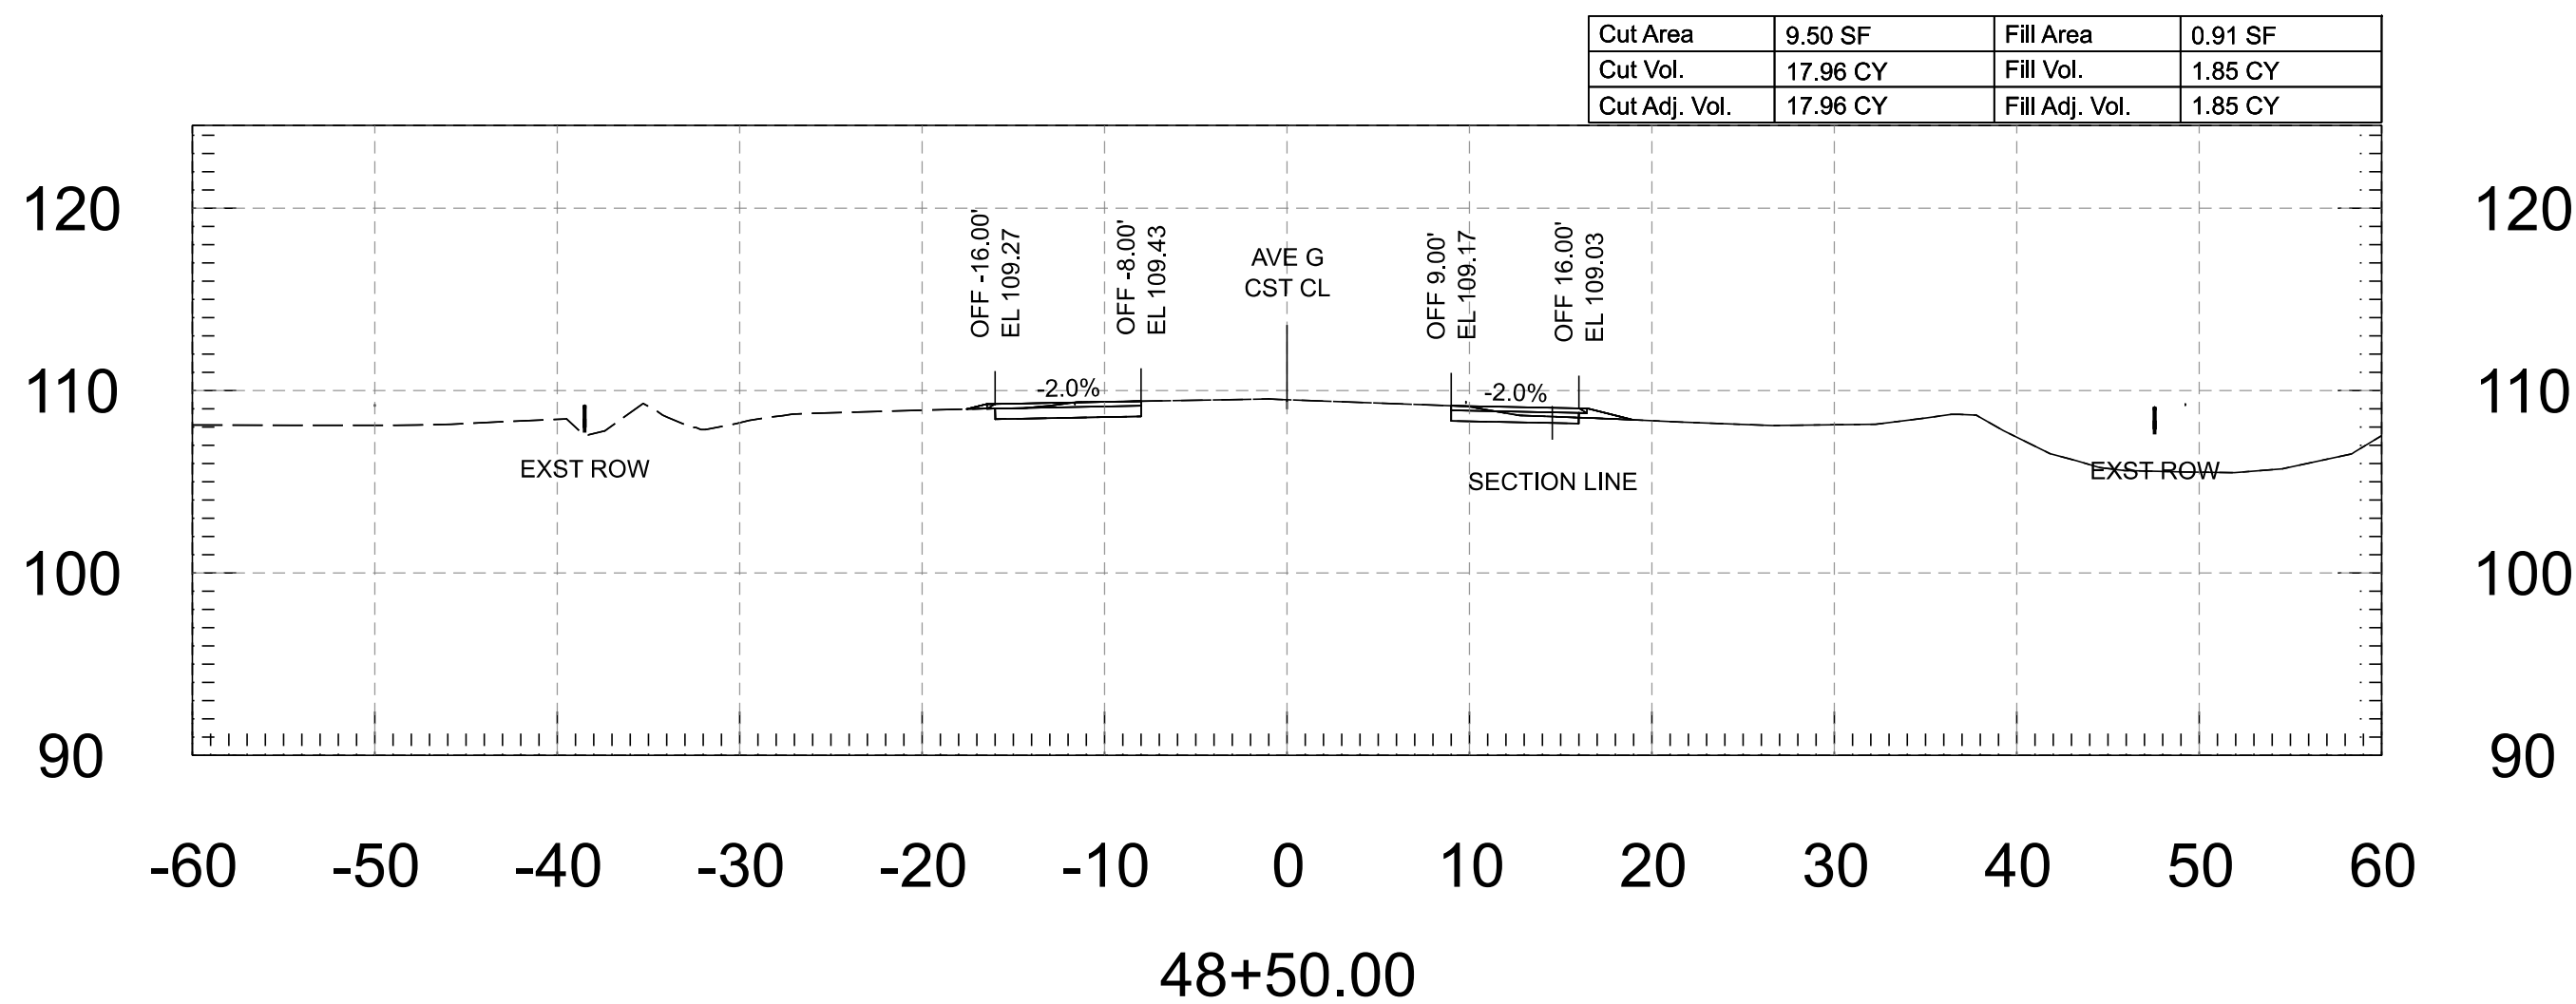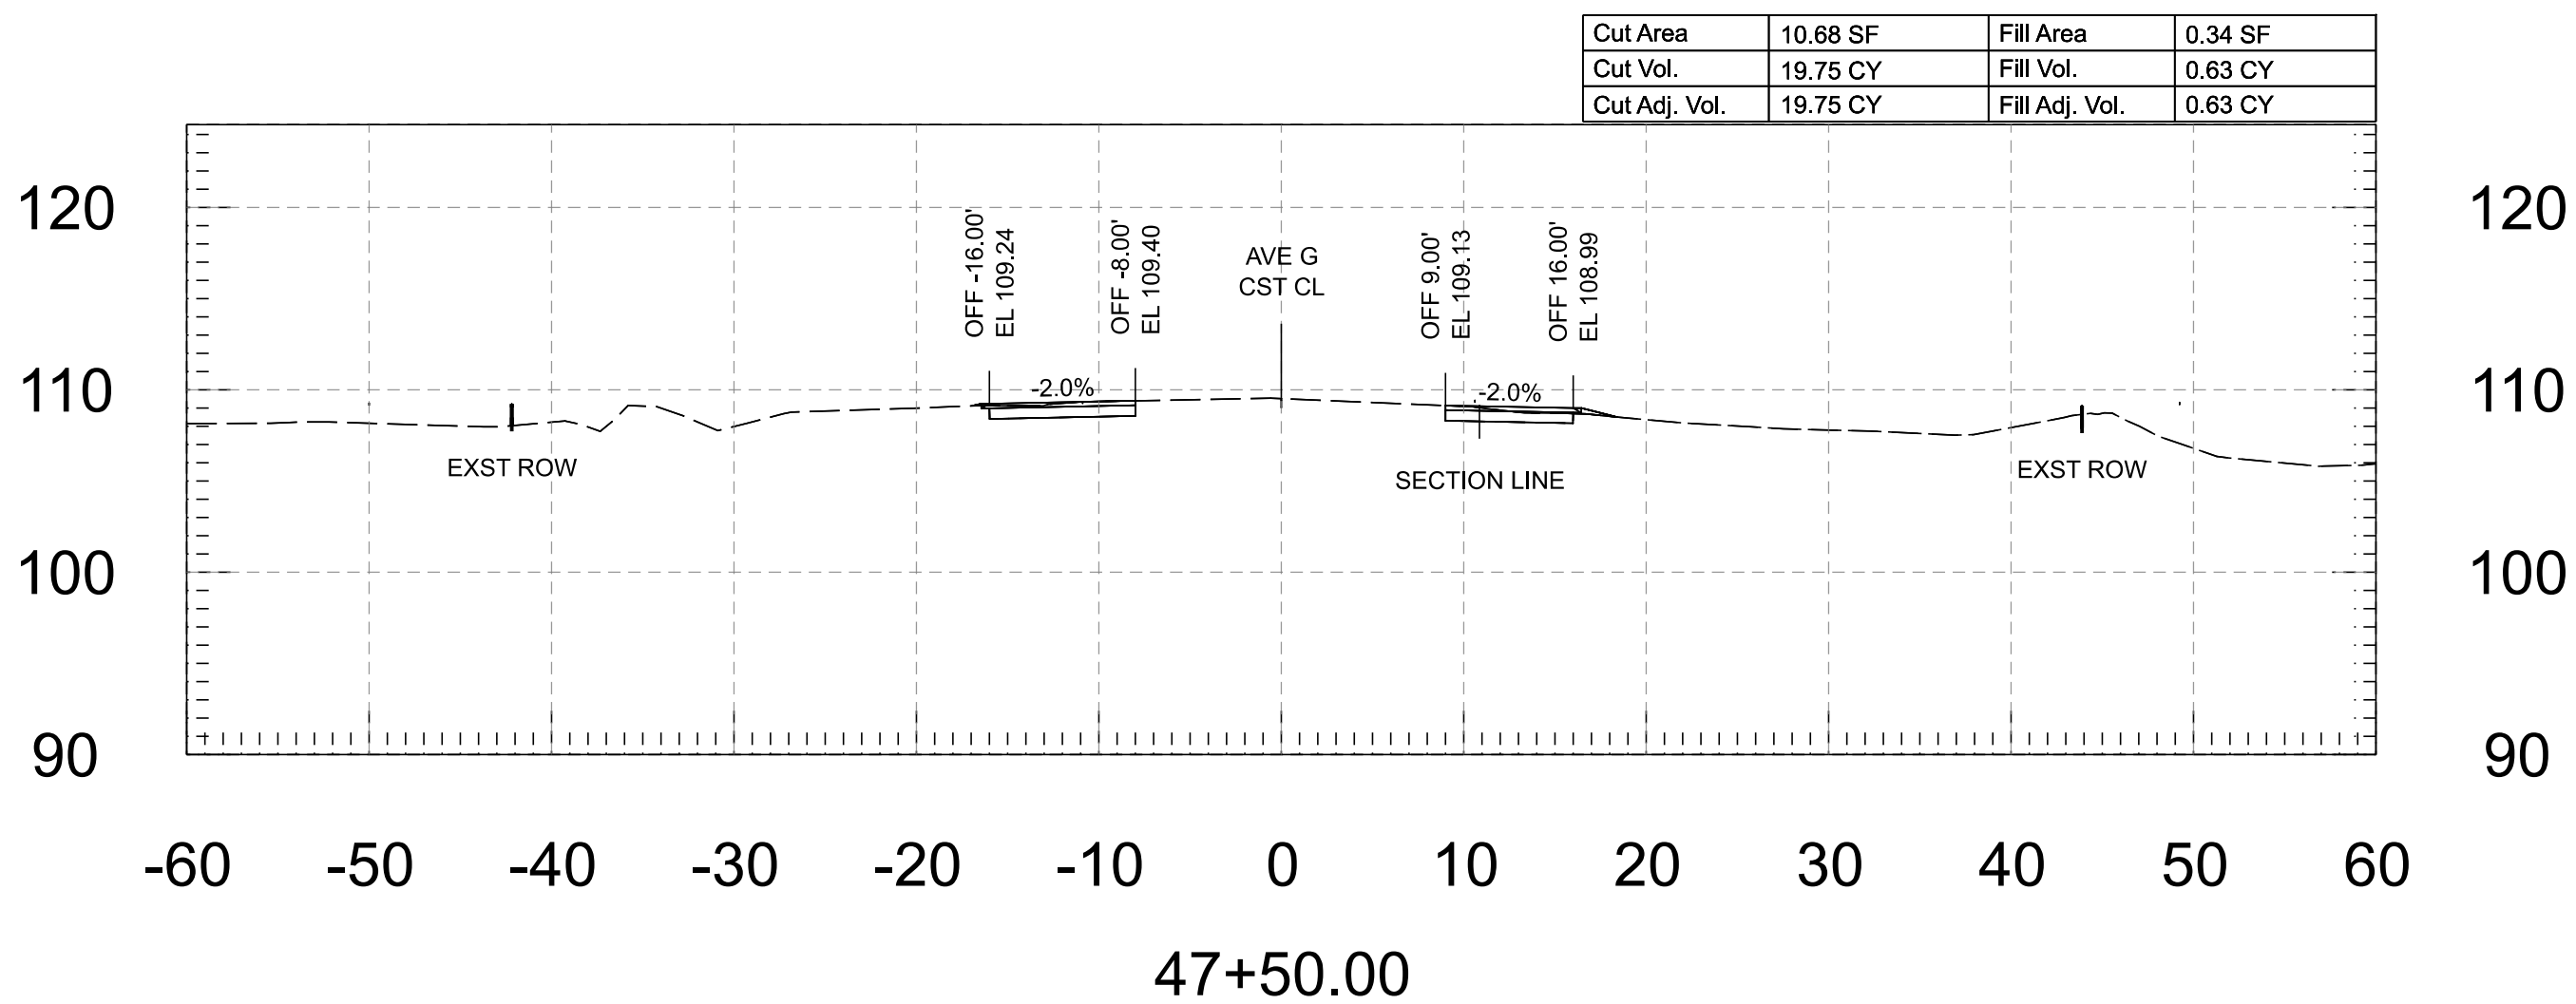





	FOR INFORMATION ONLY		NAME	DATE	ARIZONA DEPARTMENT OF TRANSPORTATION PROJECT DELIVERY AND OPERATIONS DIVISION ROADWAY DESIGN SERVICES	ROUTE	F.H.W.A. Arizona Division	STATE ARIZ.	PROJECT NO.	FEDERAL ID NO.	SHEET NO.	TOTAL SHEETS	RECORD DRAWING
		DESIGN	M. SCHOEN	07/26					0000 YU YYU	YYU-0(225)T	17	118	
		DRAWN	M. SCHOEN	07/26									
		CHECKED	H. RIOS	07/26									
		 WSP USA Inc. 1230 West Washington Street, Suite 405 Tempe, AZ 85288		AVENUE G - CROSS SECTIONS	MILEPOST	LOCATION AVENUE G, COUNTY 11TH ST - COUNTY 16TH ST							DWG
					STRUCTURE NO.	TRACS NO. T0437 01C							___ OF ___

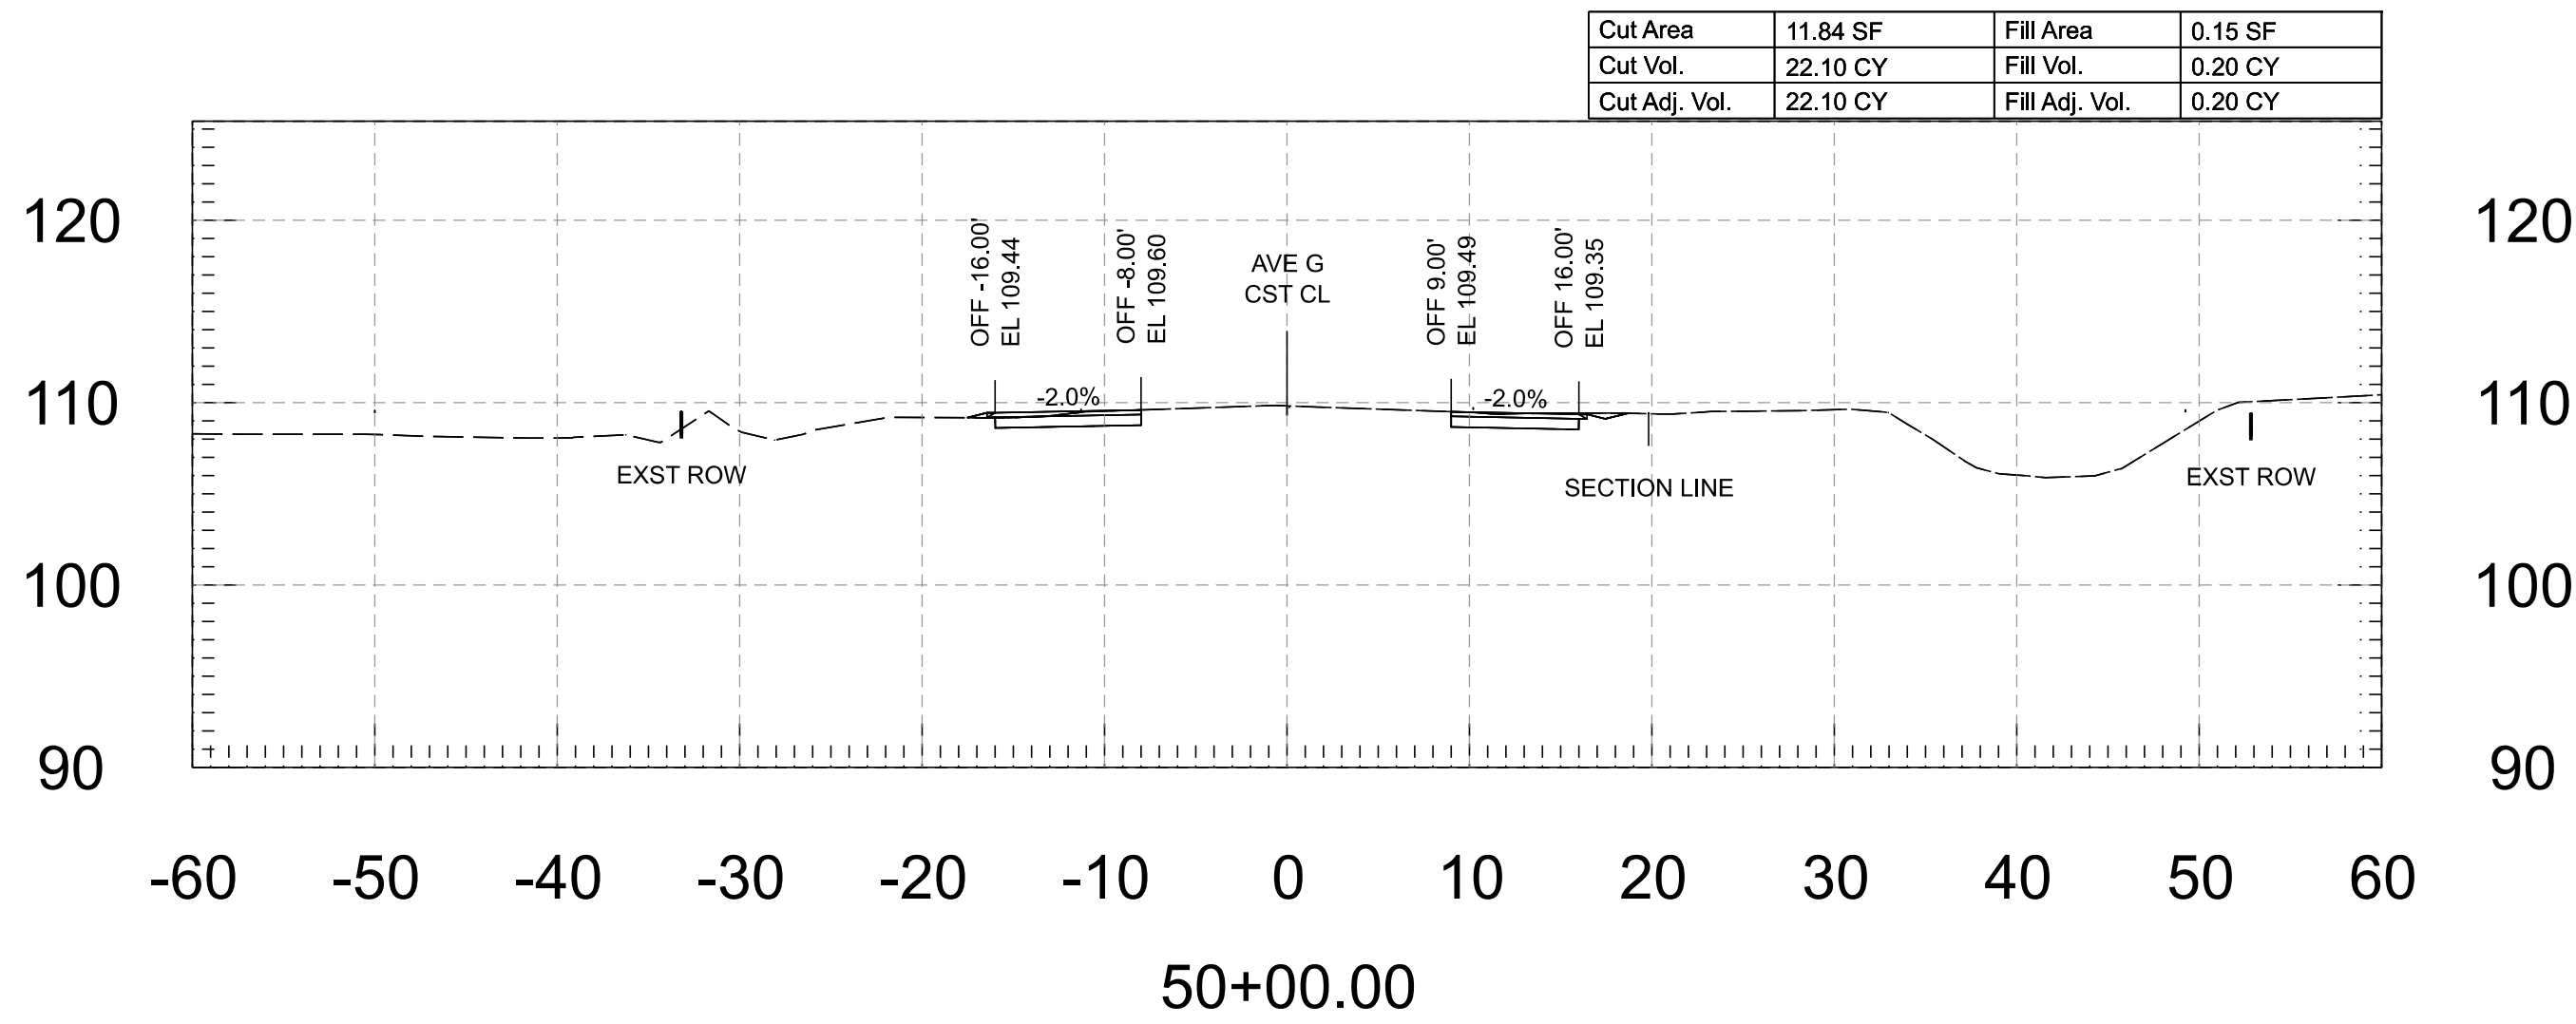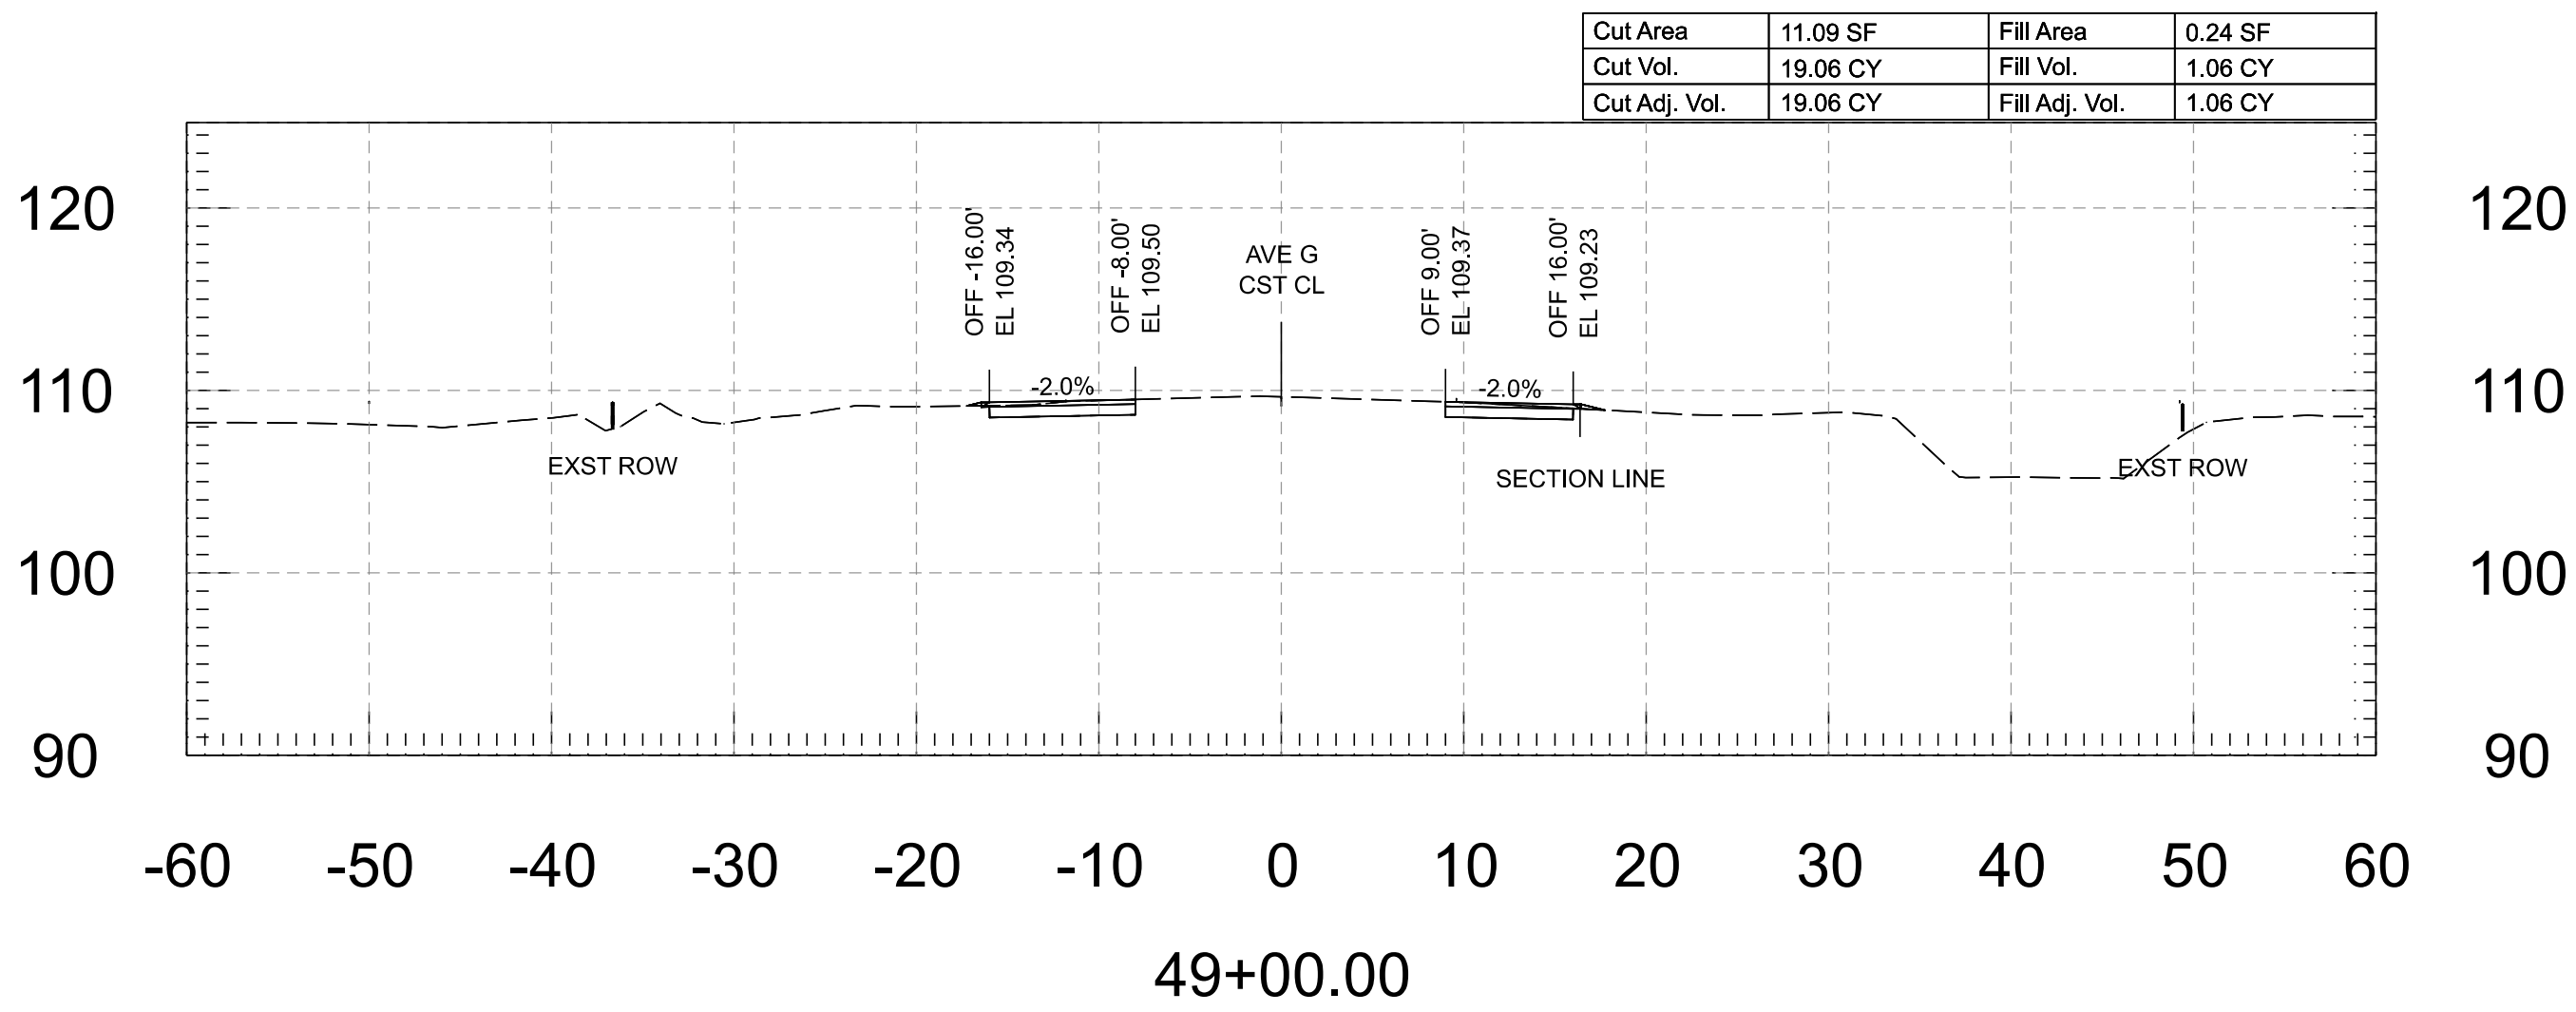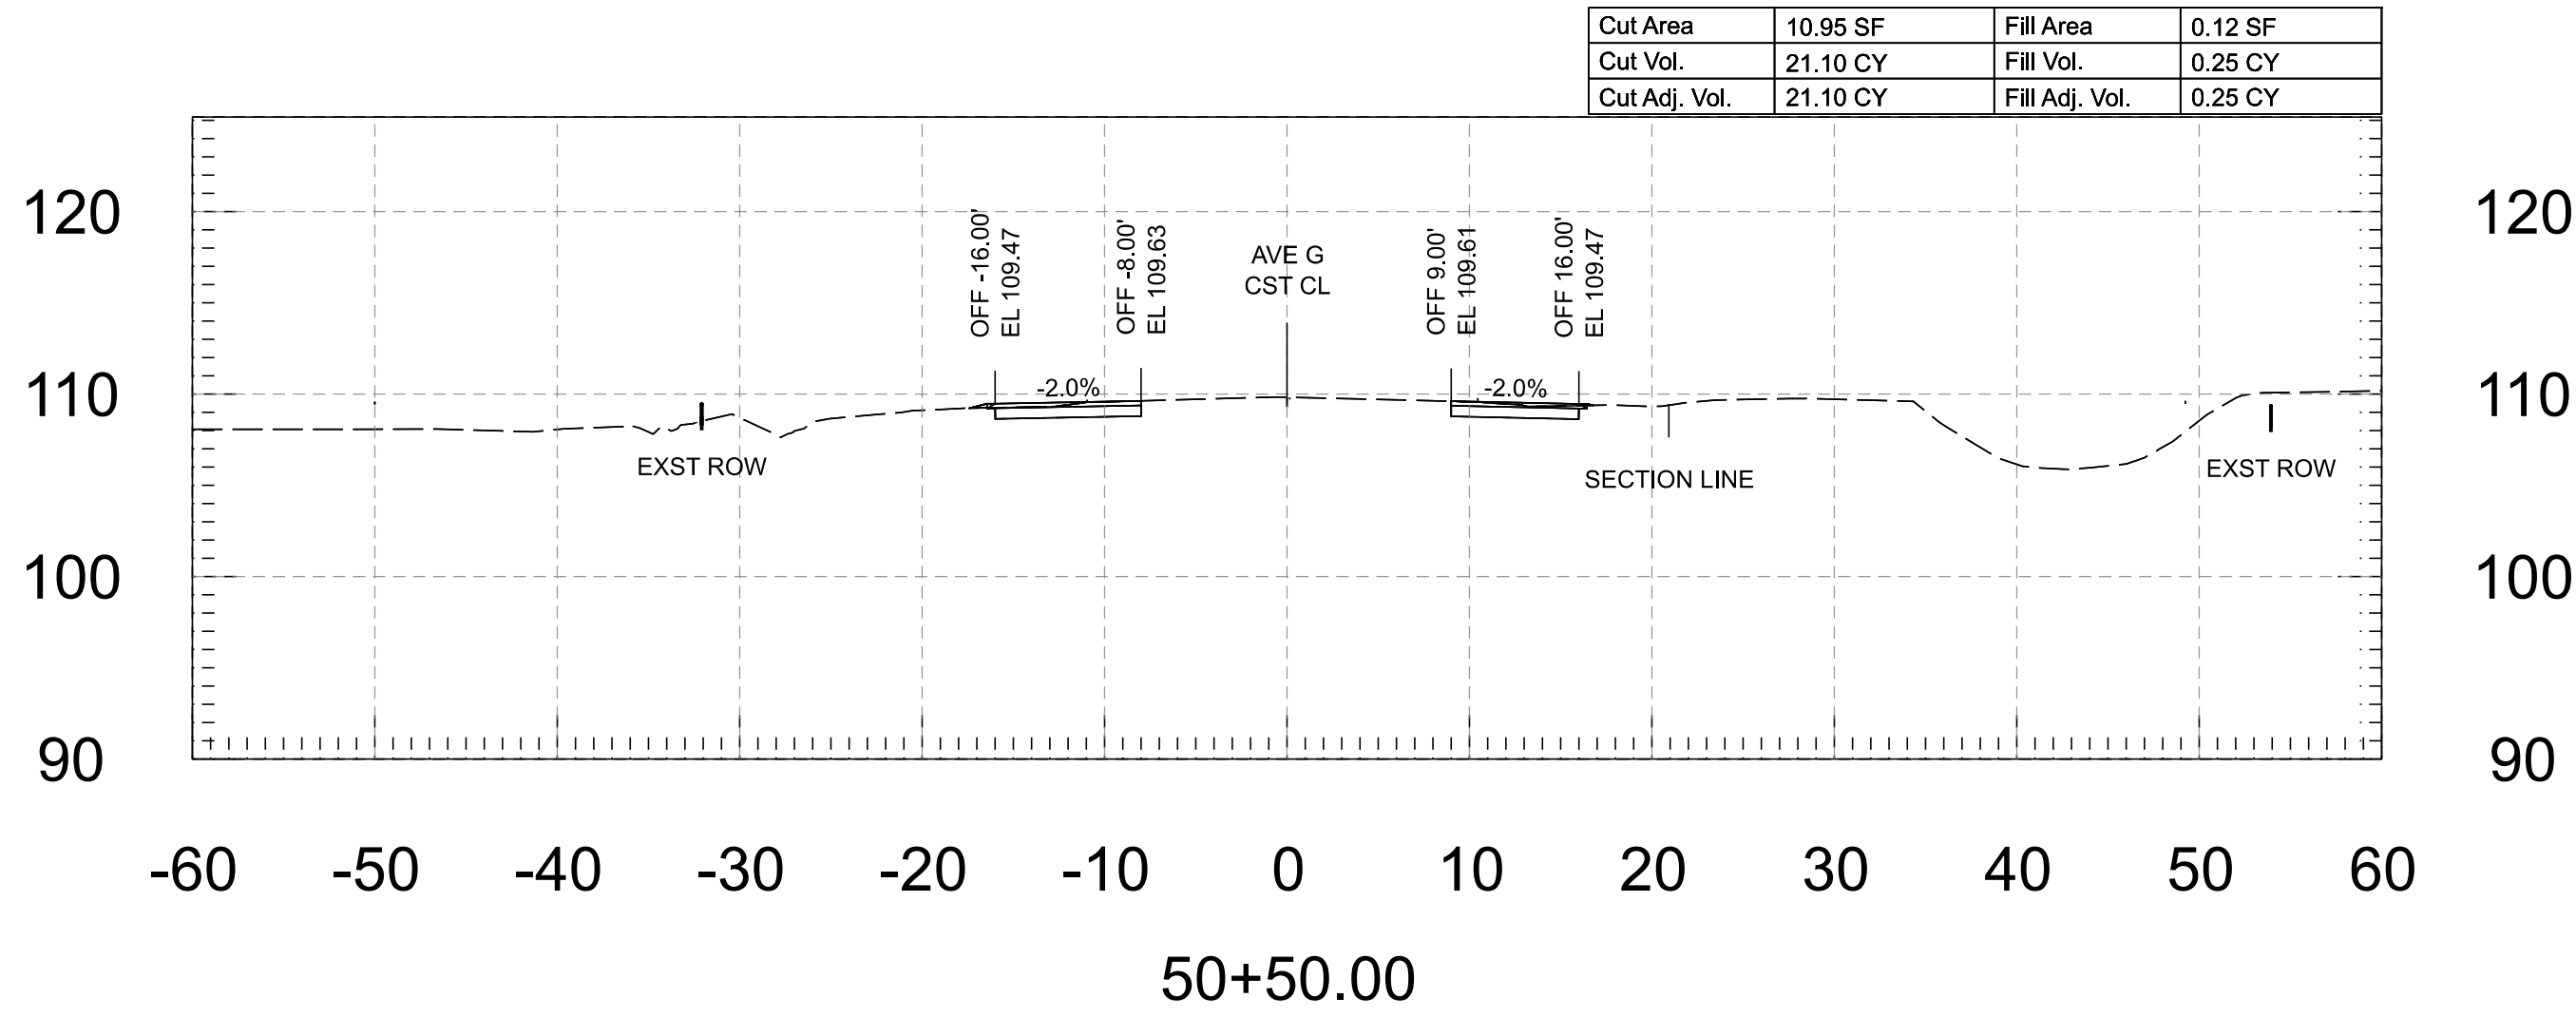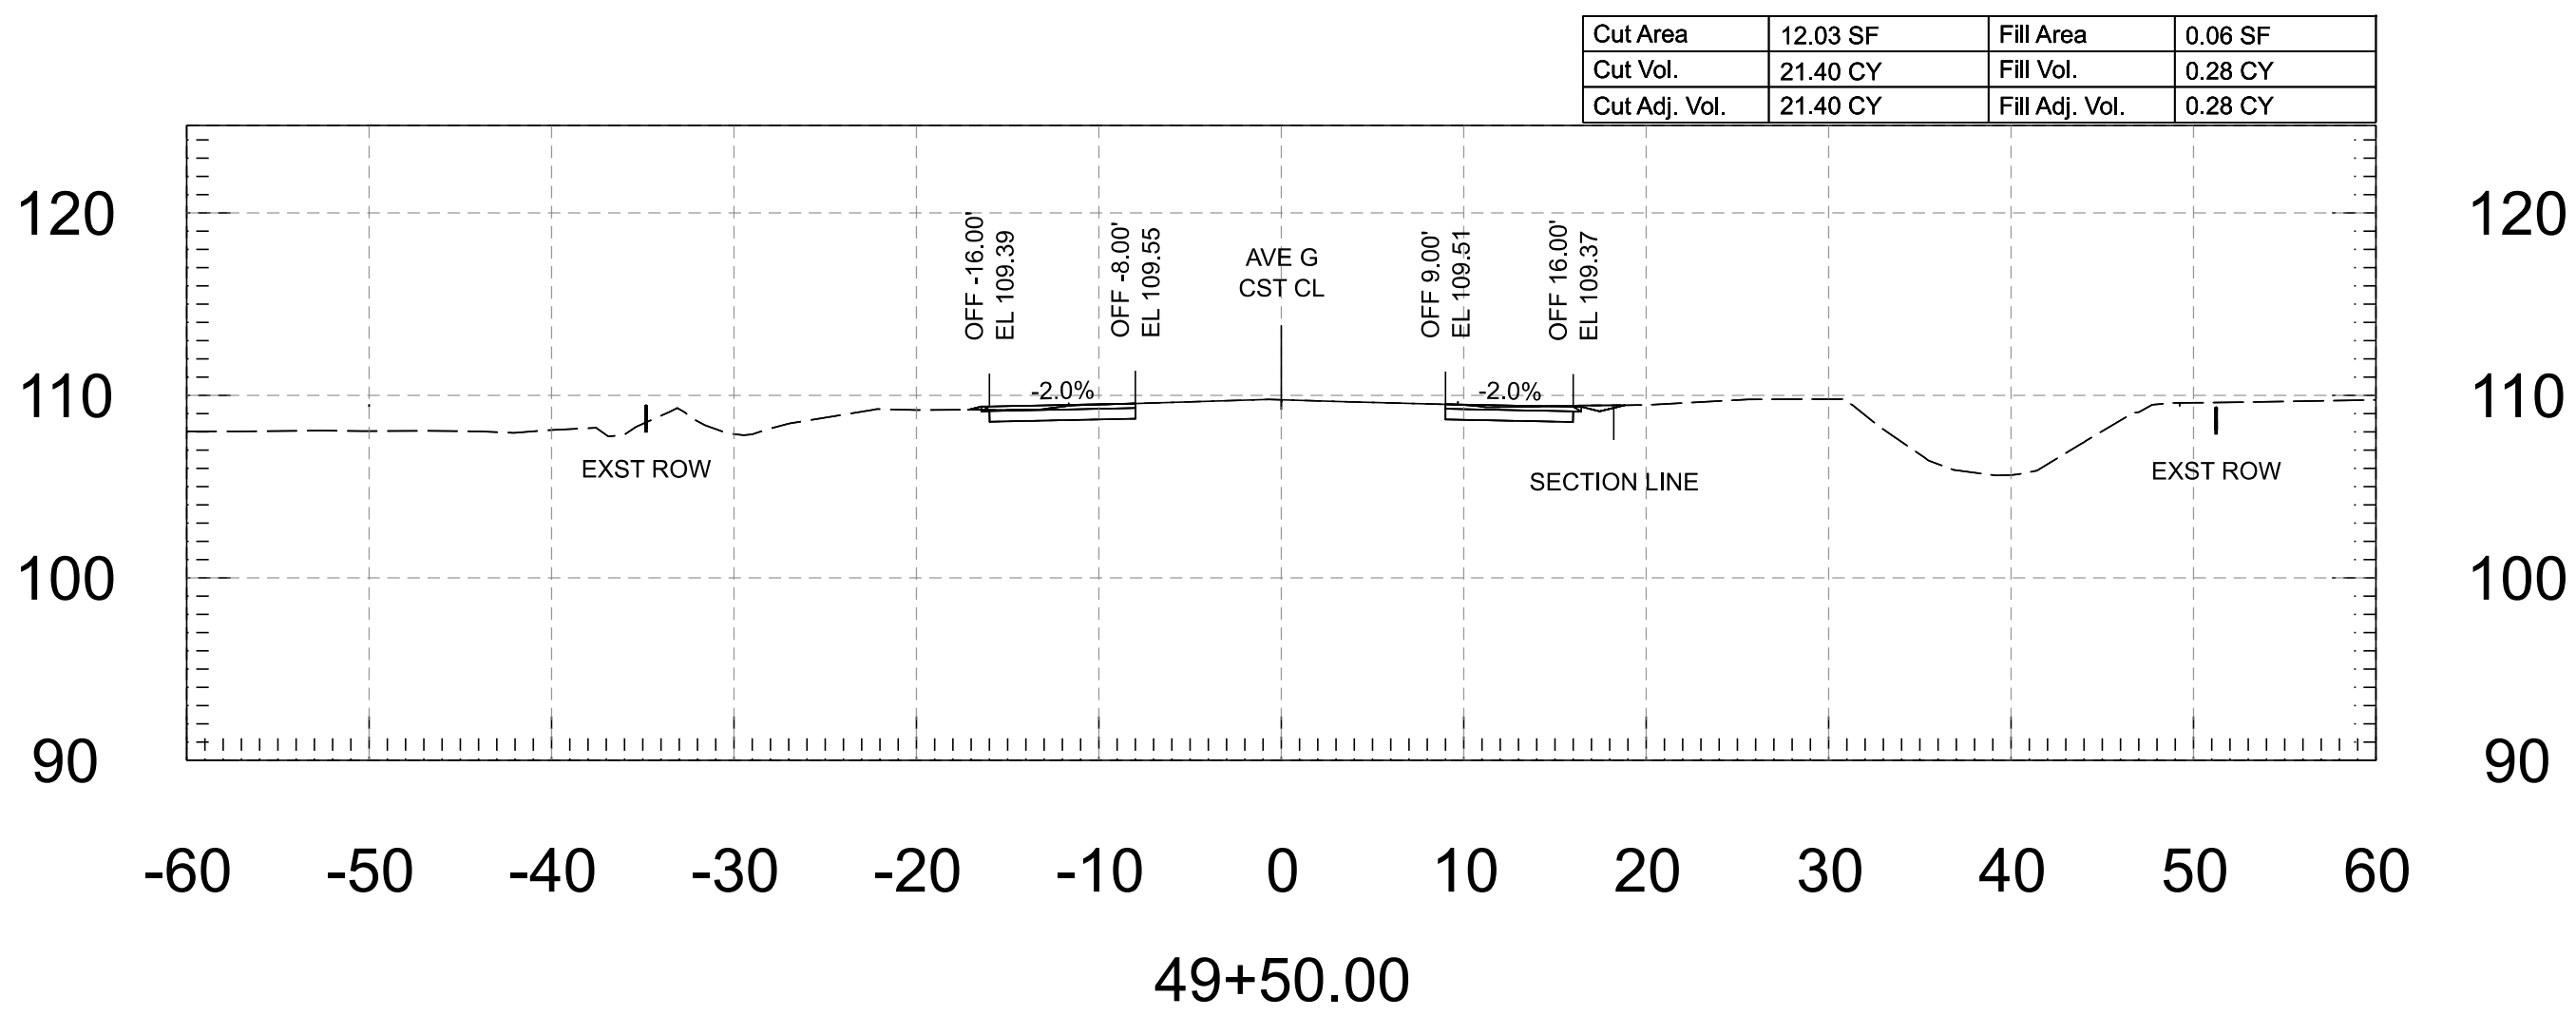





FOR INFORMATION ONLY		NAME	DATE	ARIZONA DEPARTMENT OF TRANSPORTATION PROJECT DELIVERY AND OPERATIONS DIVISION ROADWAY DESIGN SERVICES	ROUTE	F.H.W.A. Arizona Division	STATE ARIZ.	PROJECT NO.	FEDERAL ID NO.	SHEET NO.	TOTAL SHEETS	RECORD DRAWING
	DESIGN	M. SCHOEN	07/26		MILEPOST			0000 YU YYU	YYU-0(225)T	18	118	
	DRAWN	M. SCHOEN	07/26					LOCATION AVENUE G, COUNTY 11TH ST - COUNTY 16TH ST				
	CHECKED	H. RIOS	07/26	 WSP USA Inc. 1230 West Washington Street, Suite 405 Tempe, AZ 85288	AVENUE G - CROSS SECTIONS	STRUCTURE NO.	TRACS NO. T0437 01C				___ OF ___	

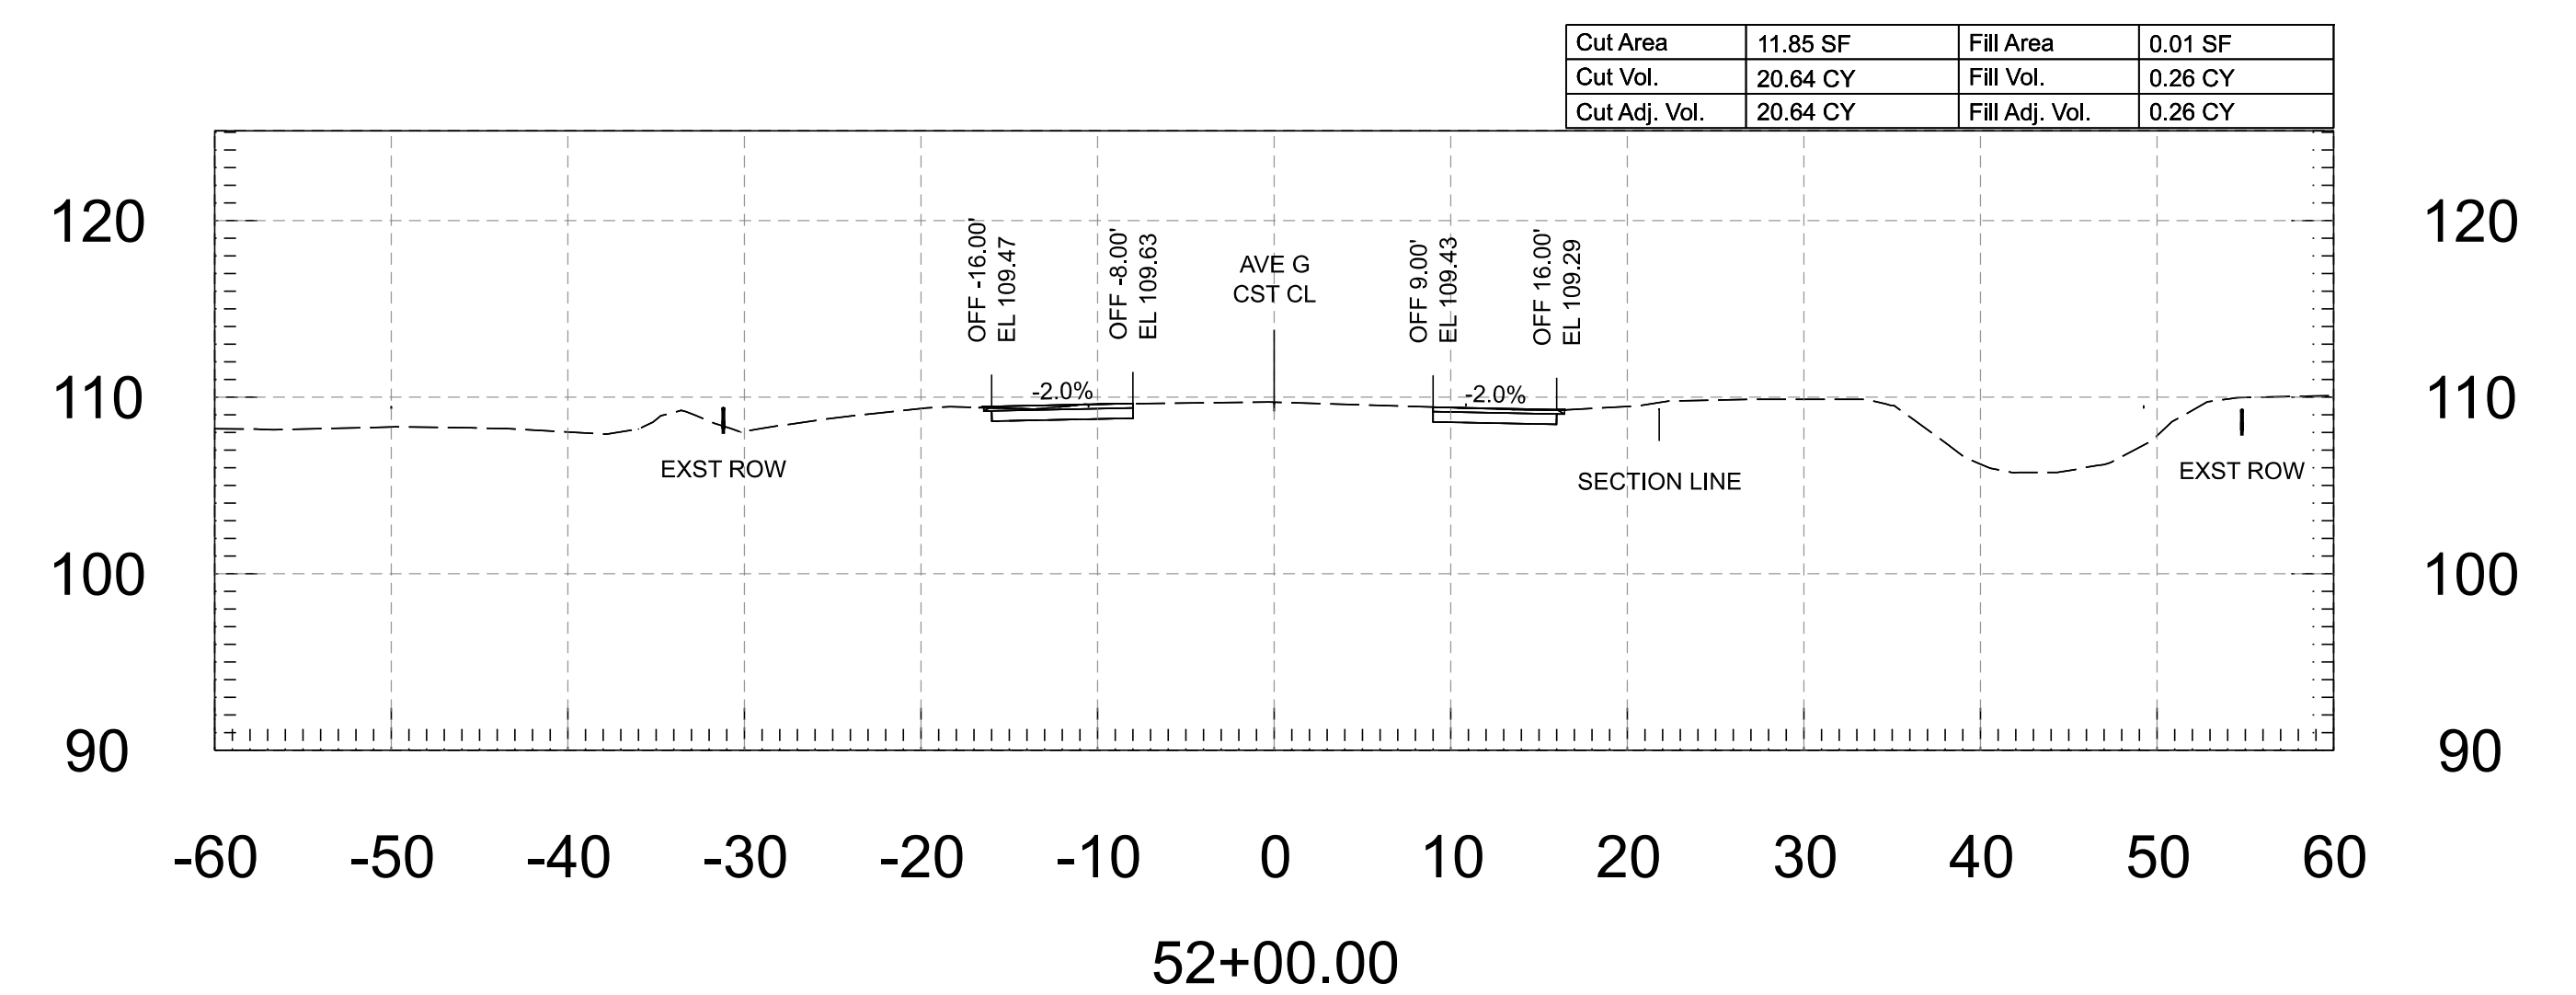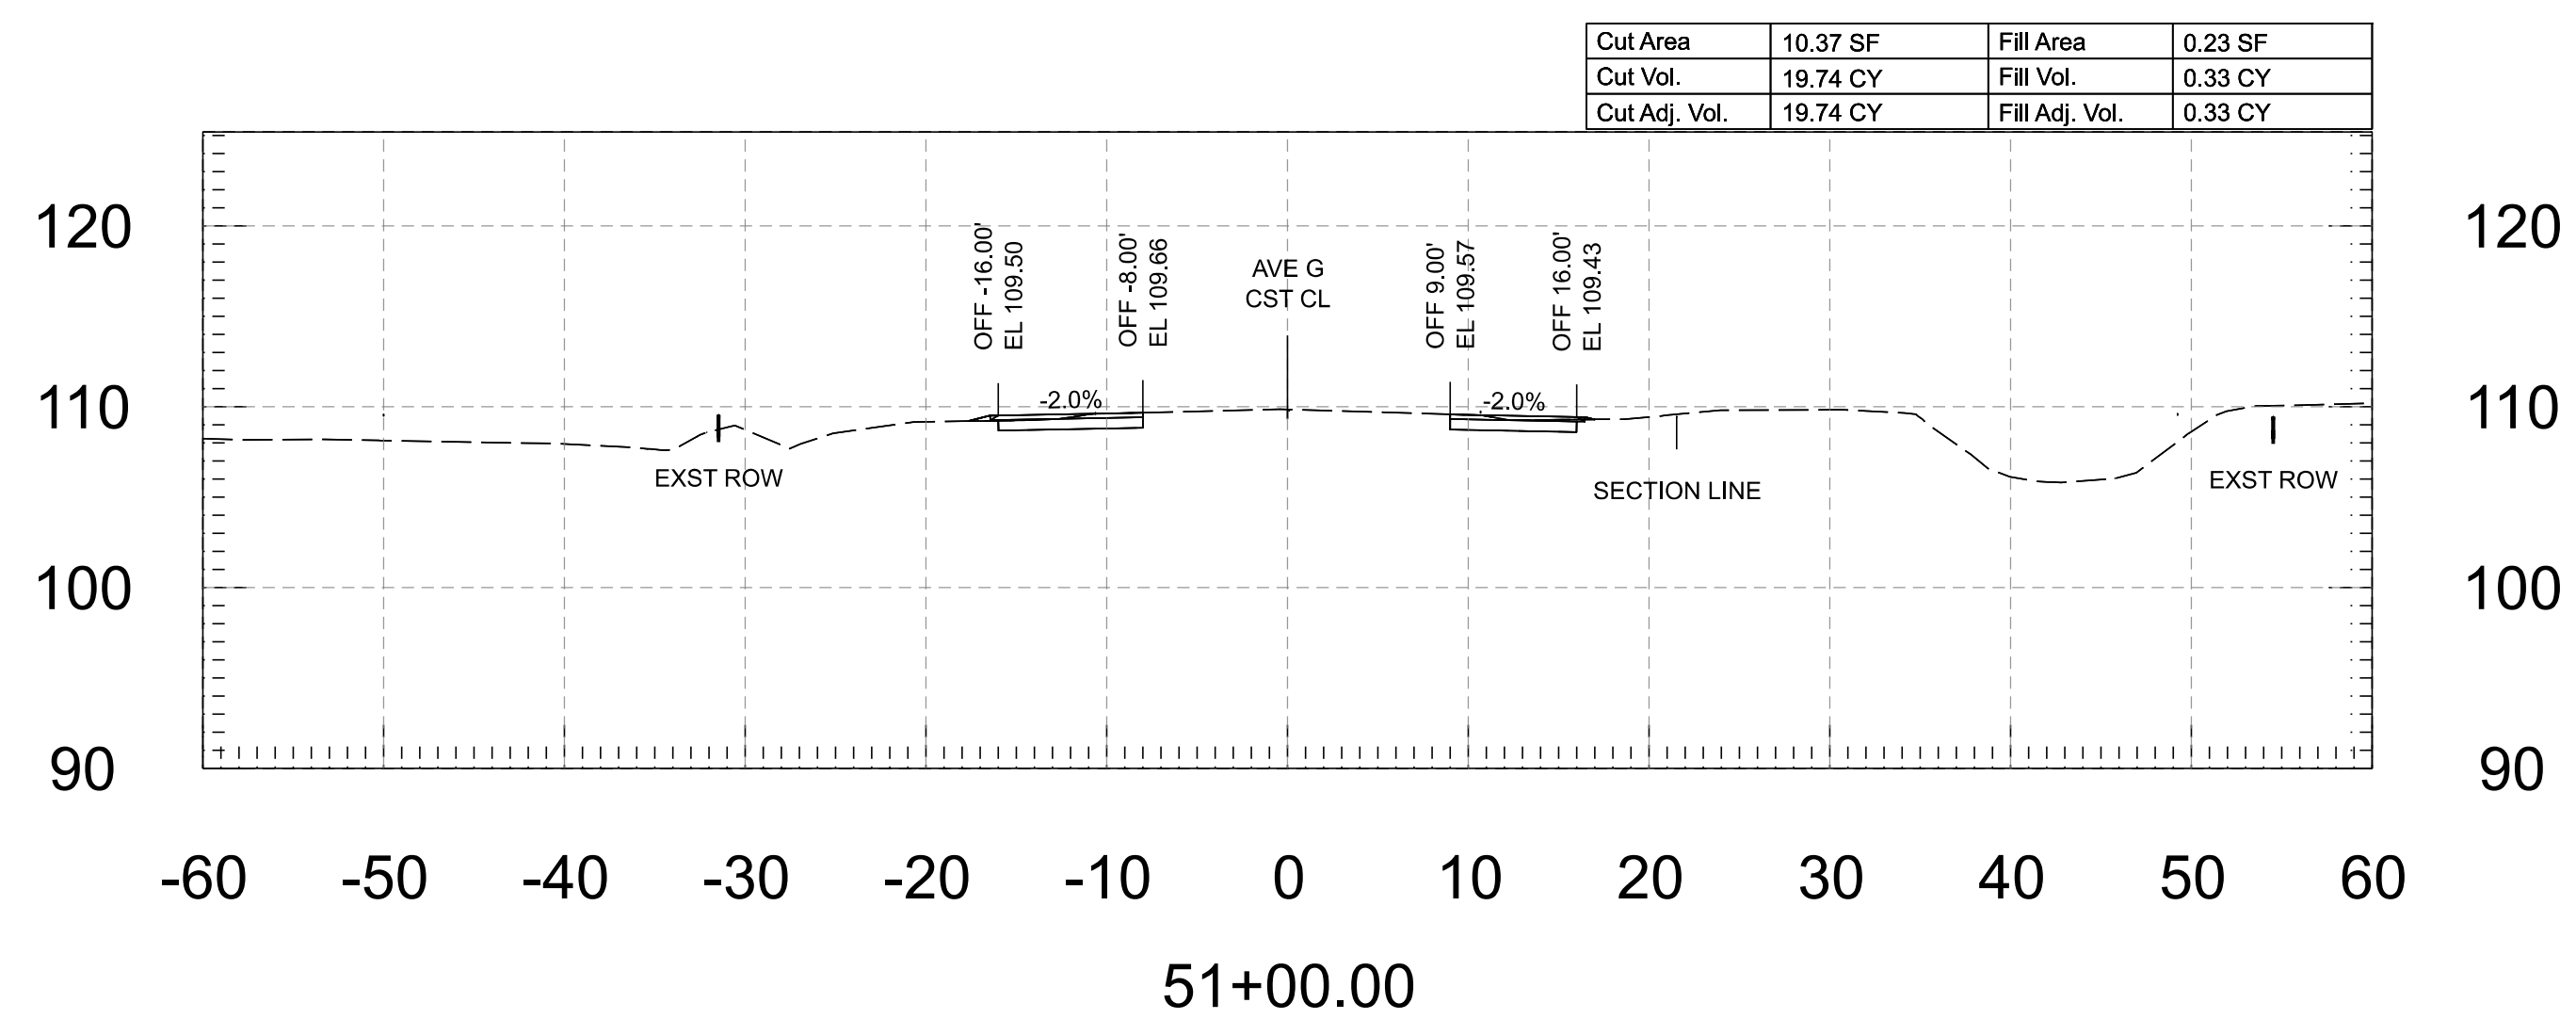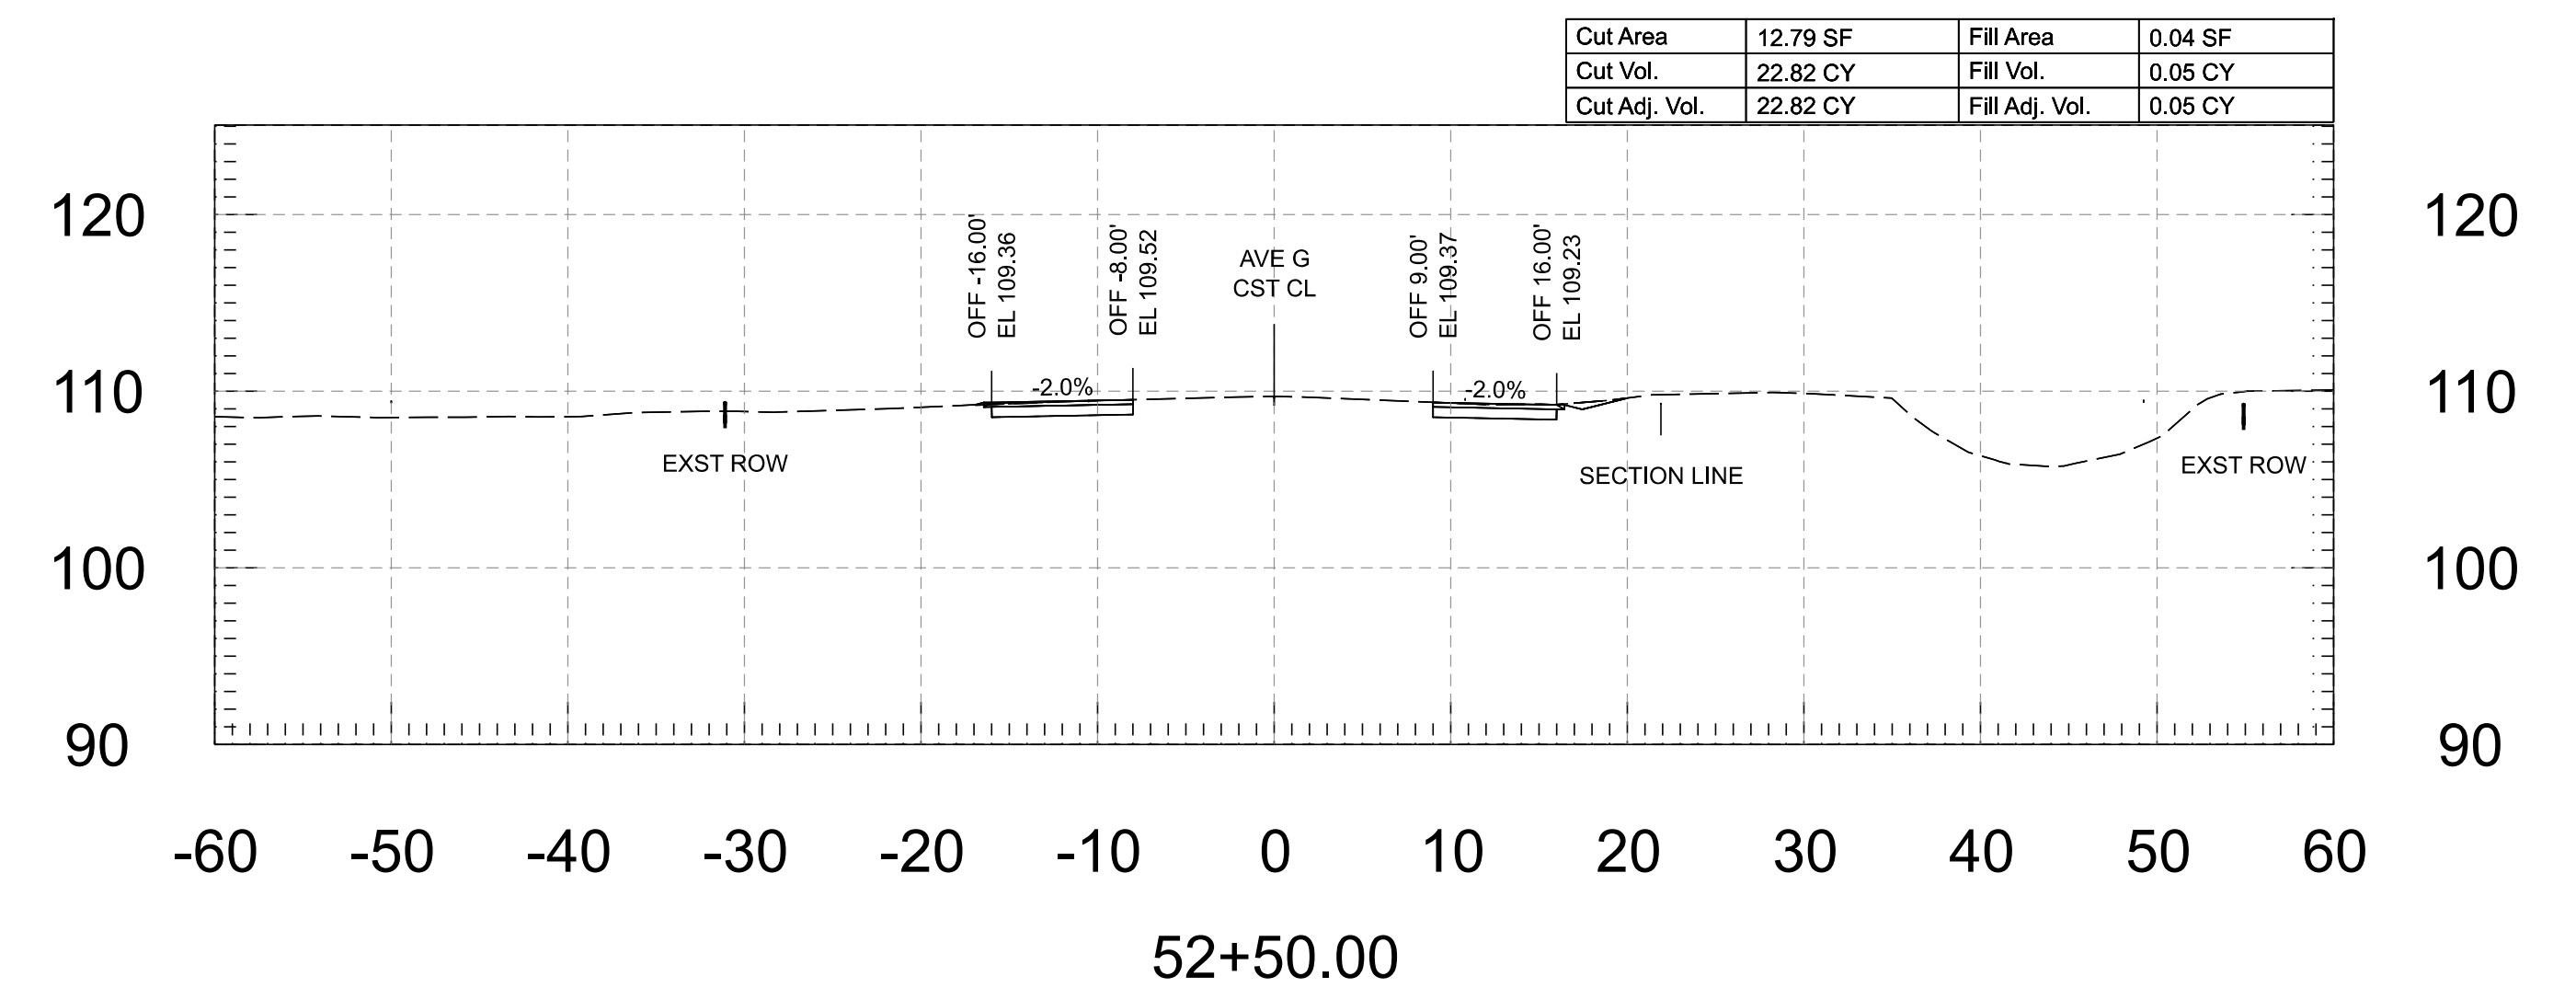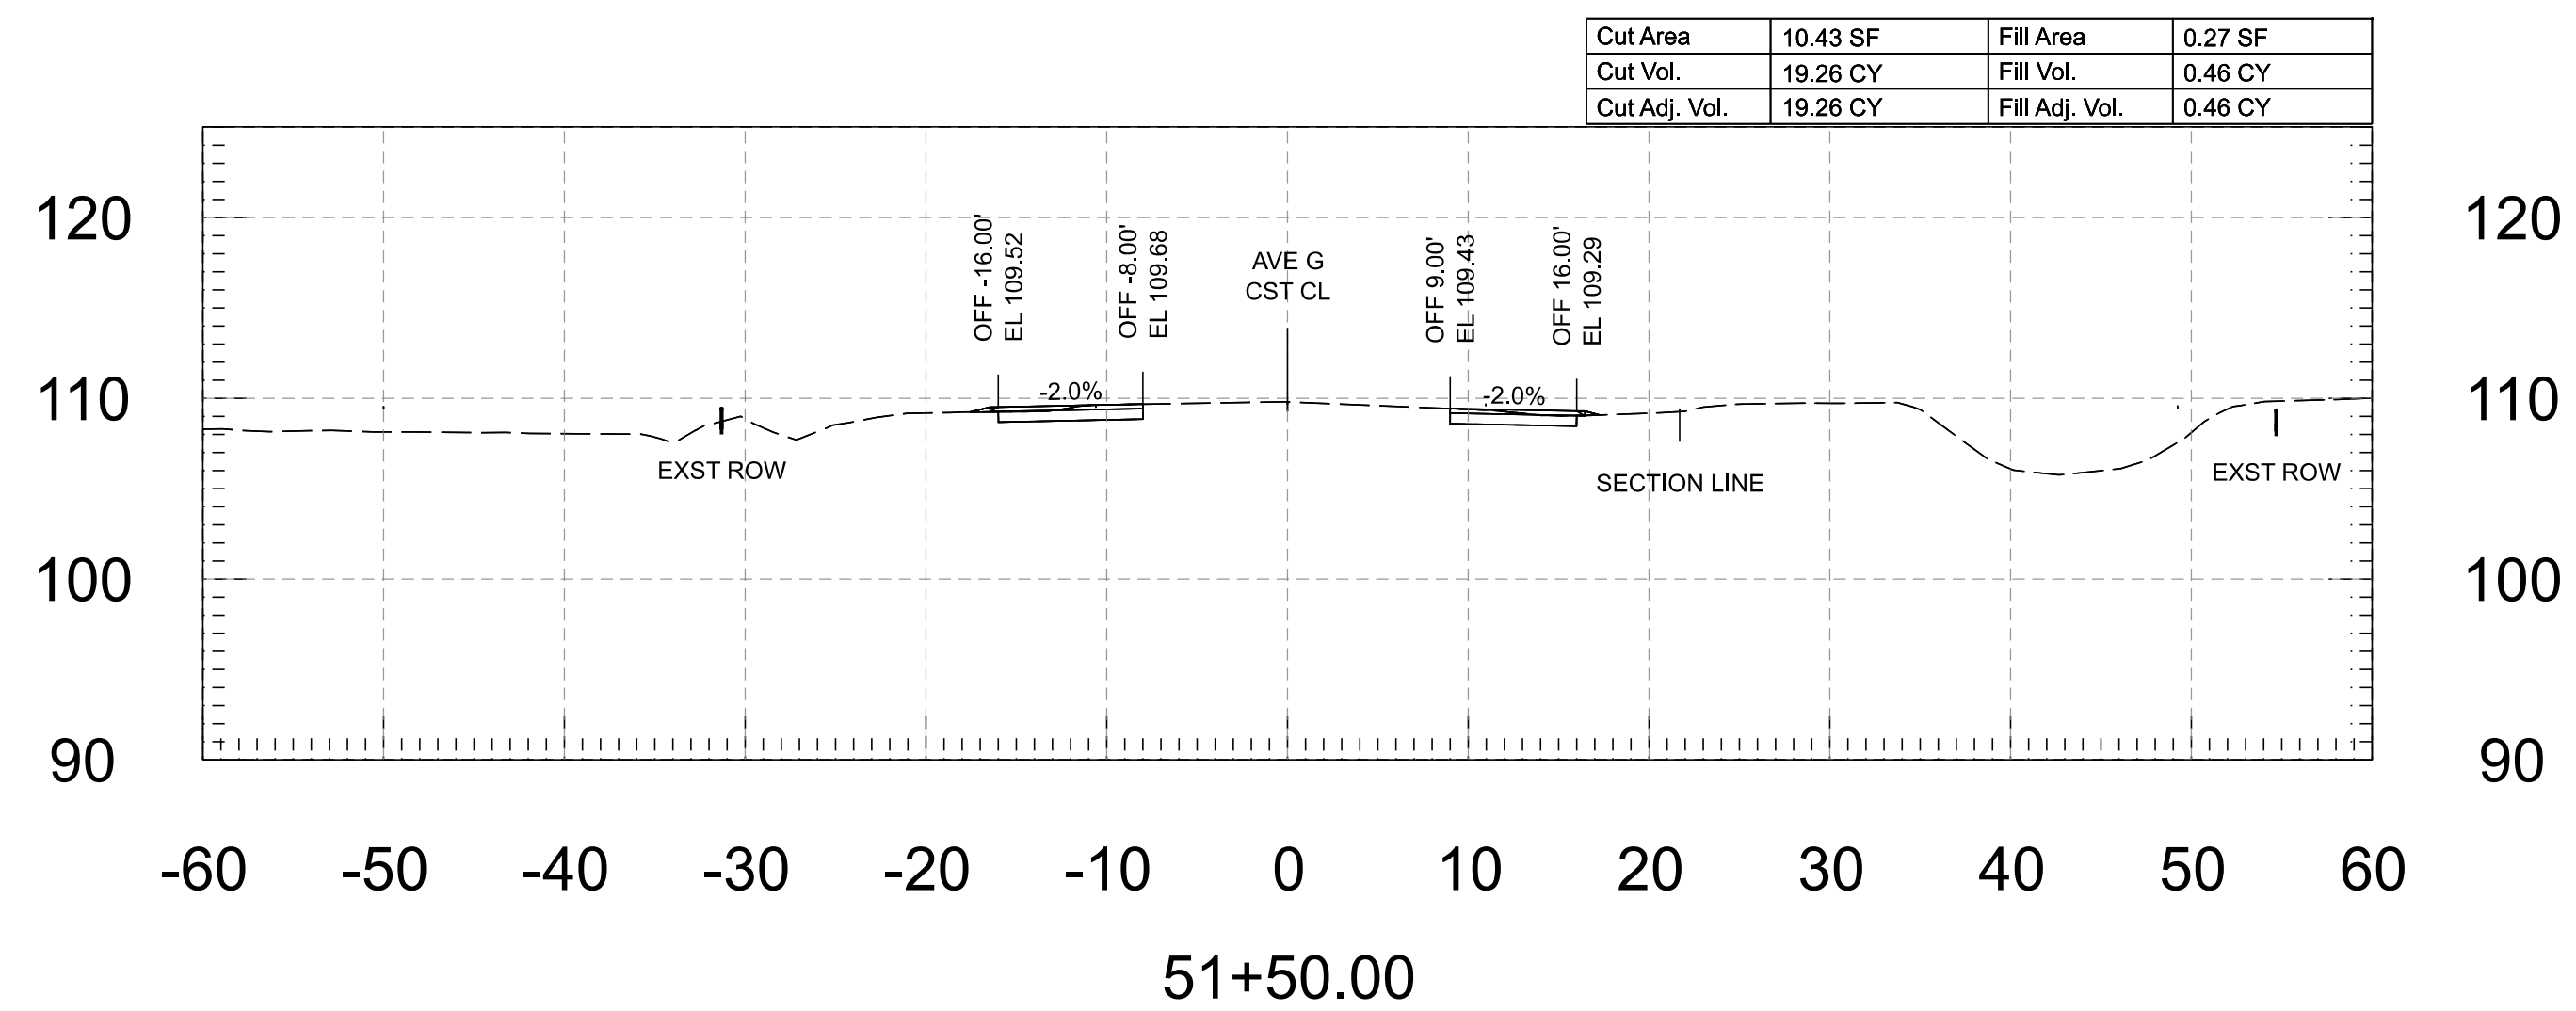





FOR INFORMATION ONLY			NAME	DATE	ARIZONA DEPARTMENT OF TRANSPORTATION PROJECT DELIVERY AND OPERATIONS DIVISION ROADWAY DESIGN SERVICES	ROUTE	F.H.W.A. Arizona Division	STATE ARIZ.	PROJECT NO.	FEDERAL ID NO.	SHEET NO.	TOTAL SHEETS	RECORD DRAWING
	DESIGN	M. SCHOEN	07/26			0000 YU YYU			YYU-0(225)T	19	118		
	DRAWN	M. SCHOEN	07/26										
	CHECKED	H. RIOS	07/26										
		wsp WSP USA Inc. 1200 West Washington Street, Suite 405 Tempe, AZ 85280				AVENUE G - CROSS SECTIONS		LOCATION AVENUE G, COUNTY 11TH ST - COUNTY 16TH ST					
						STRUCTURE NO.	TRACS NO. T0437 01C					___ OF ___	

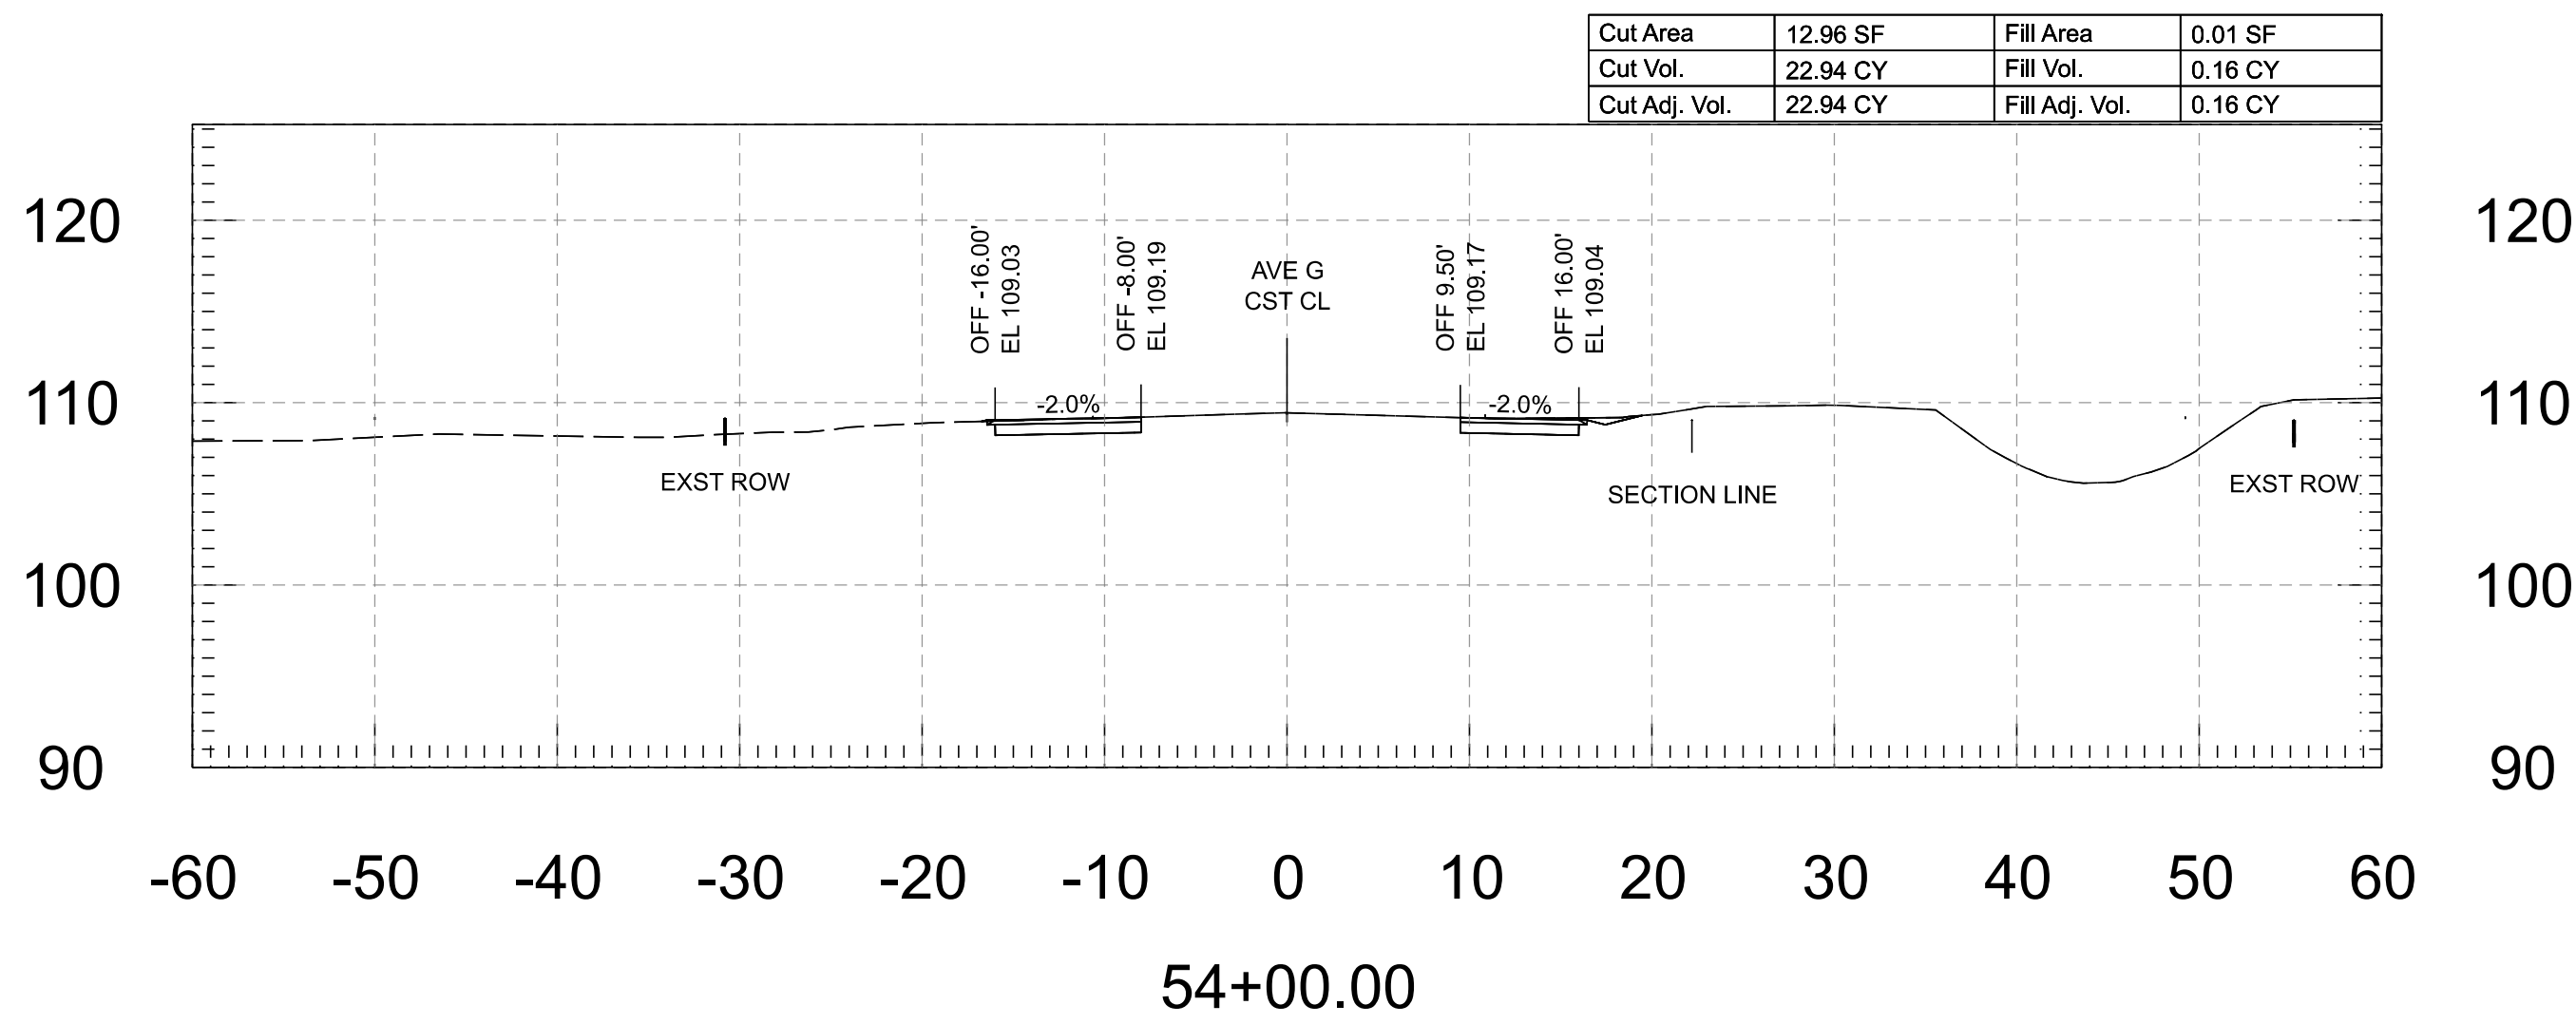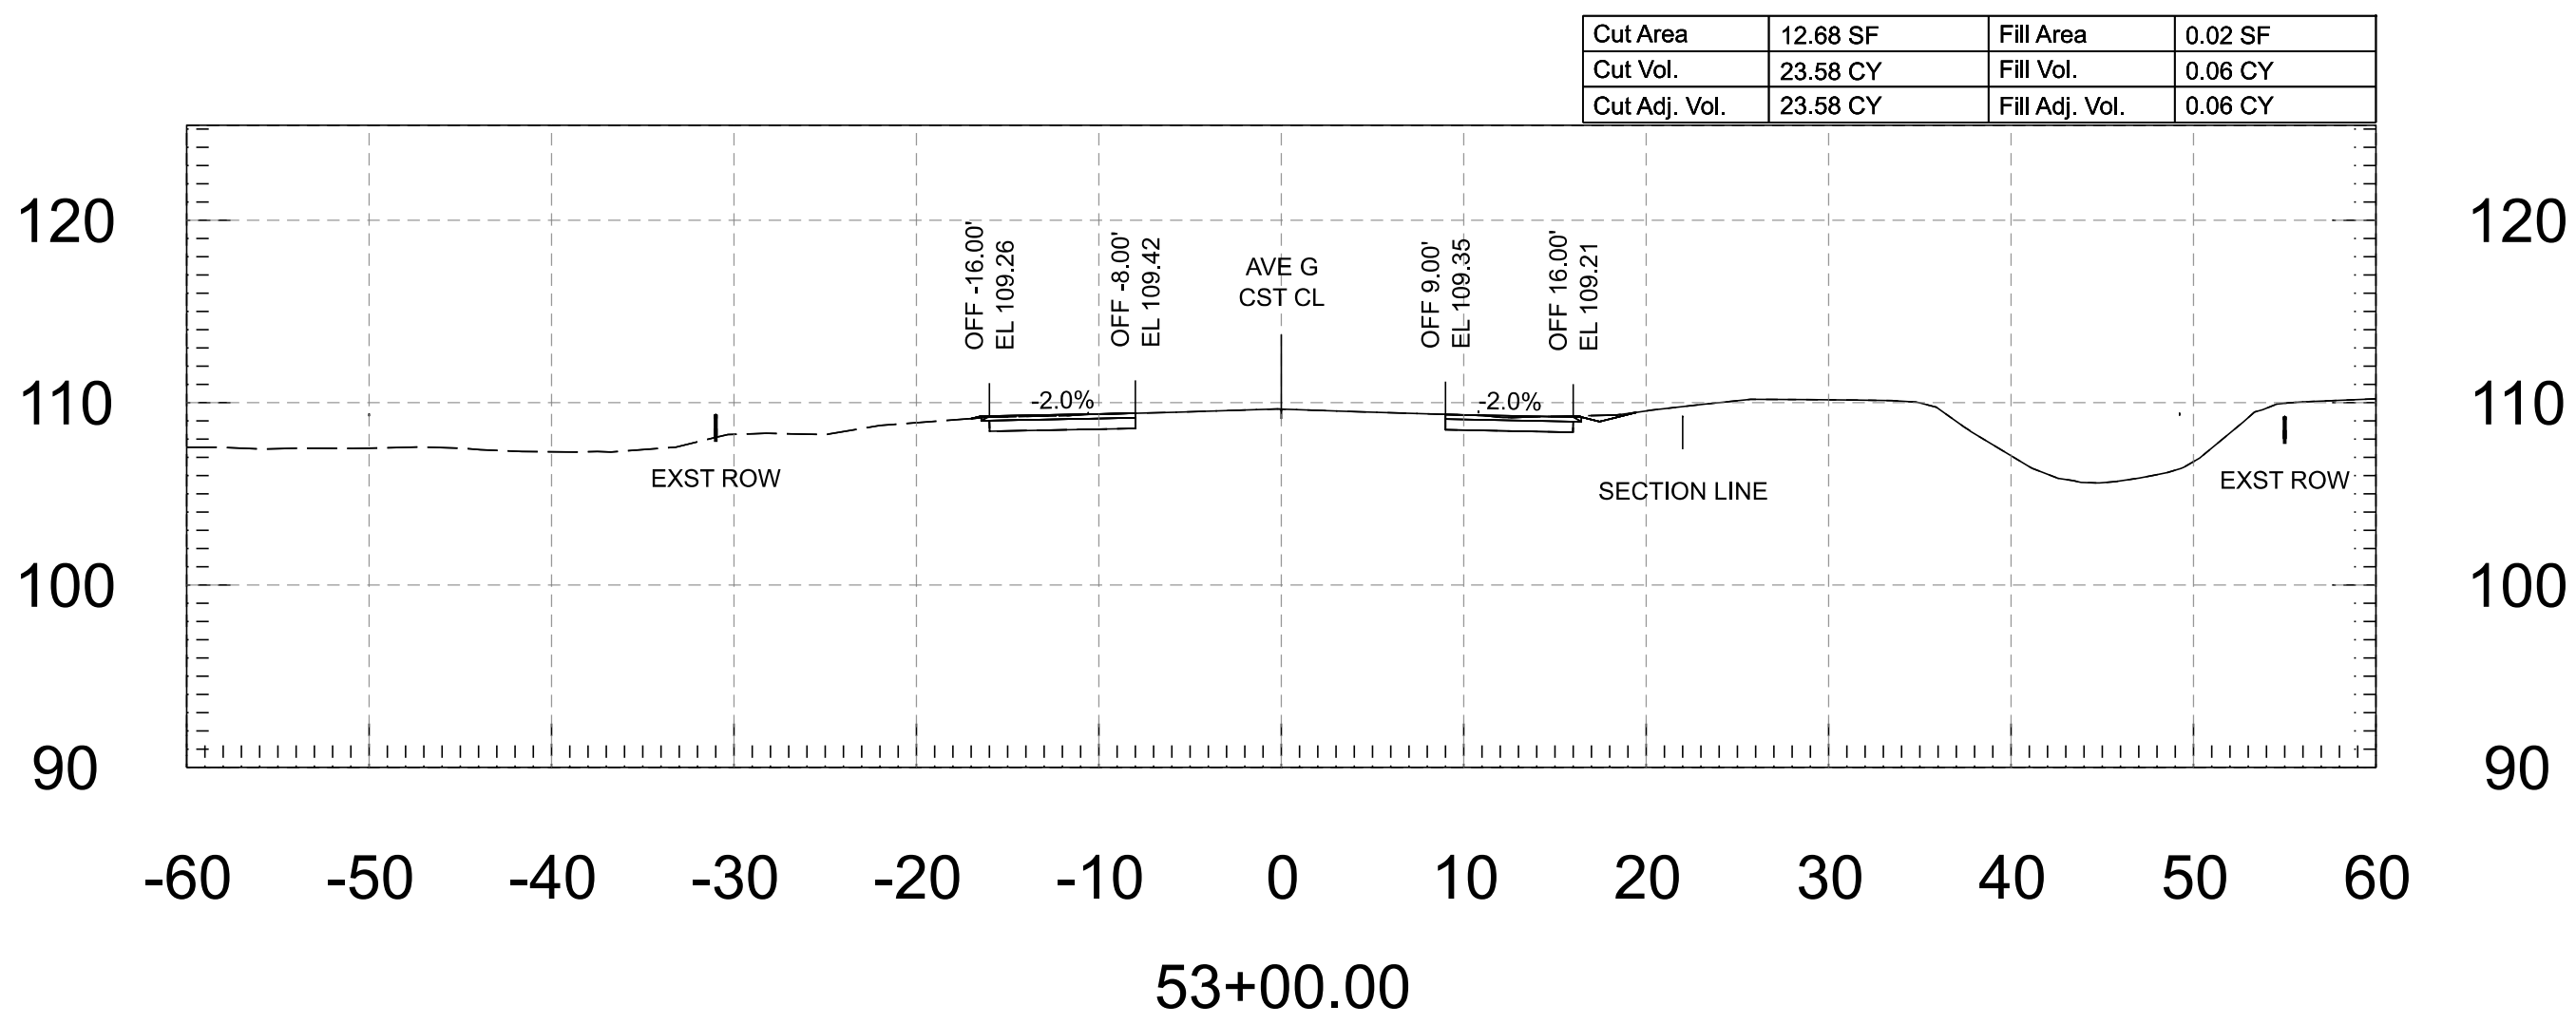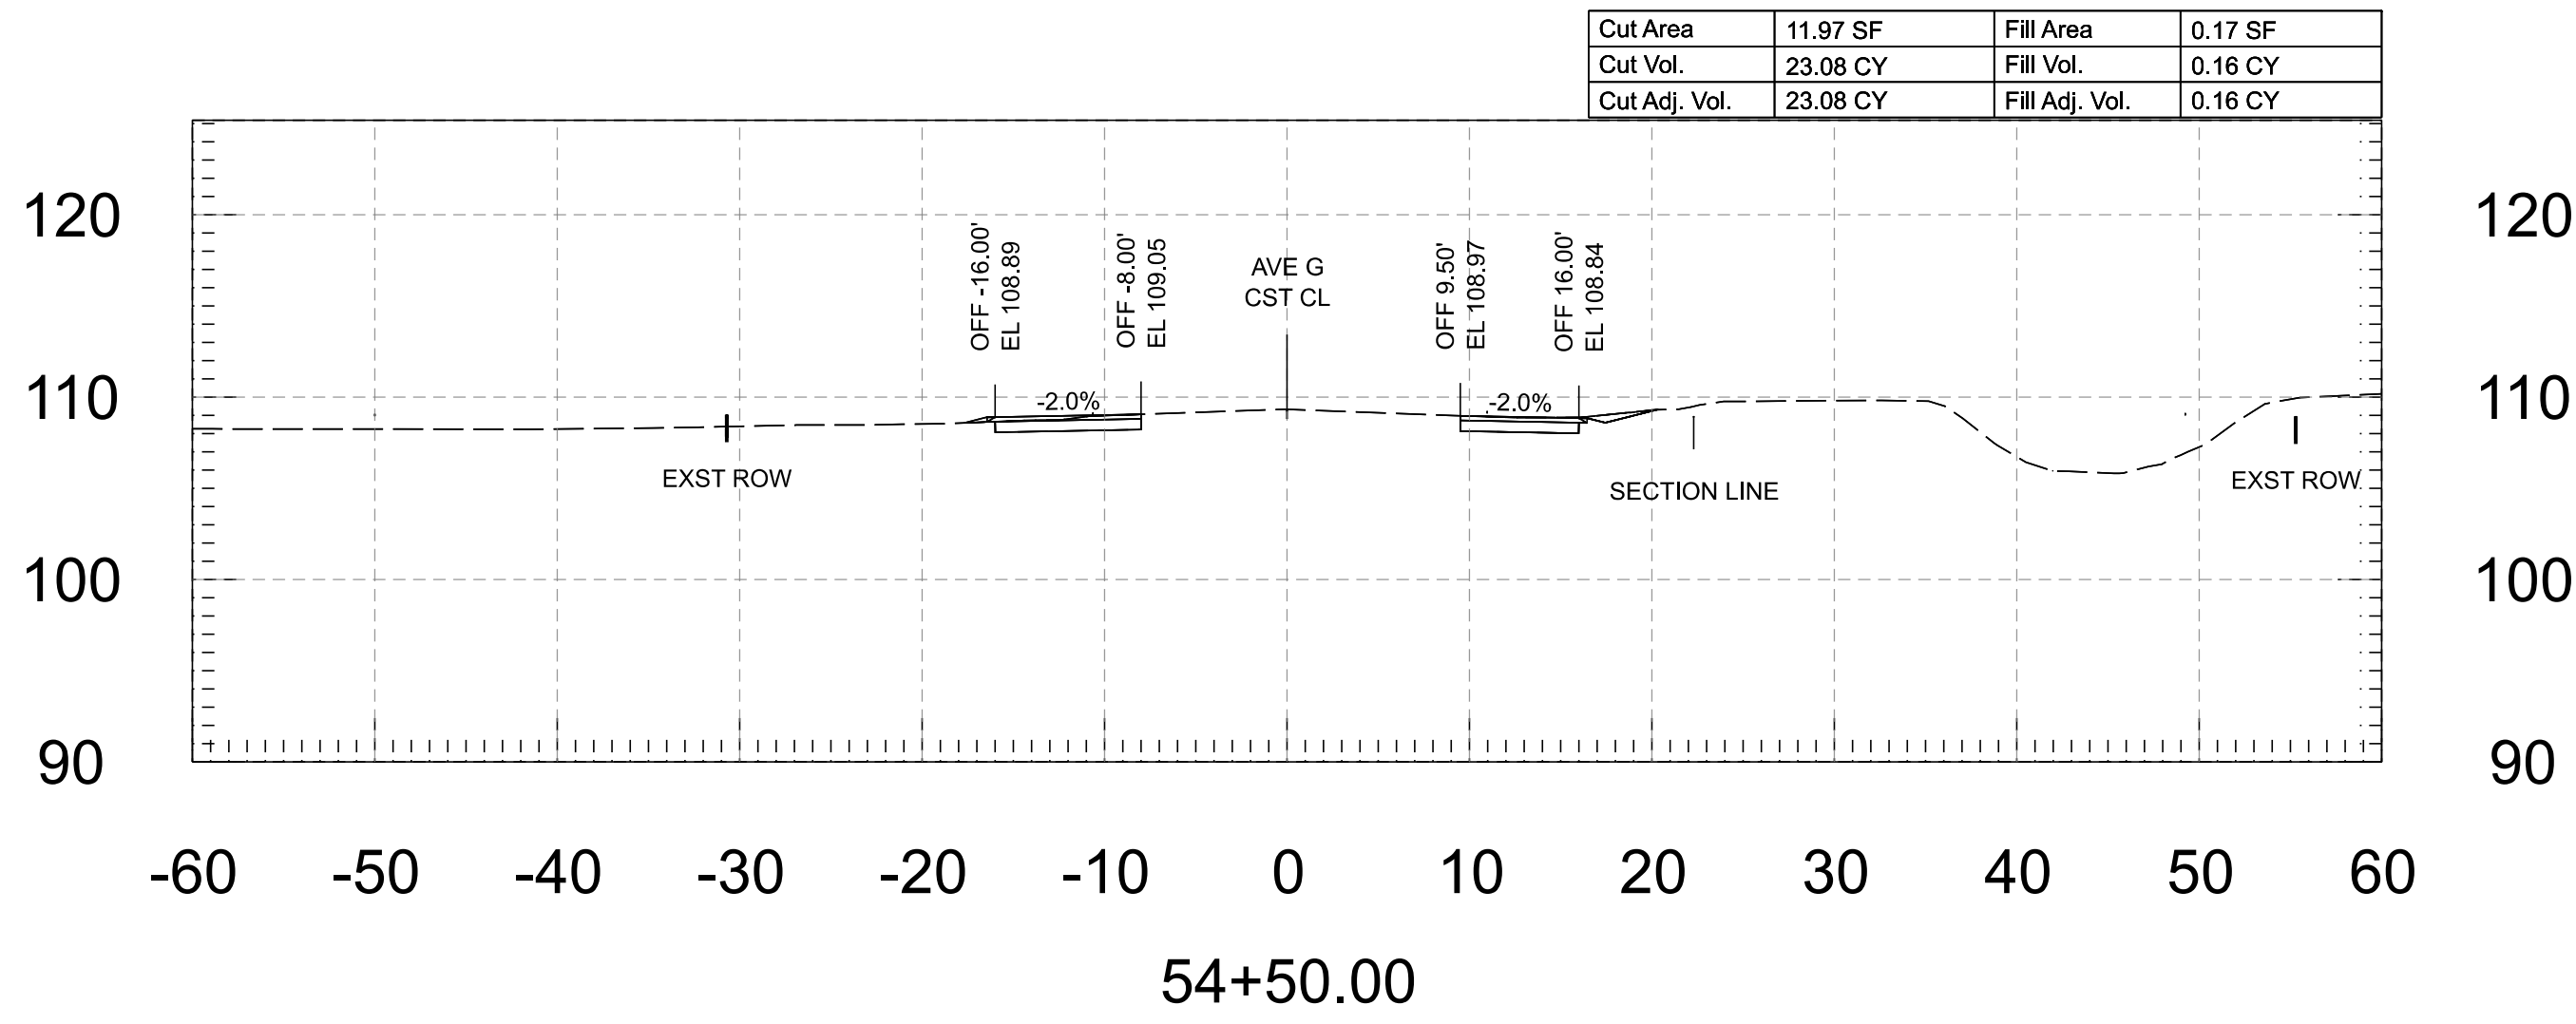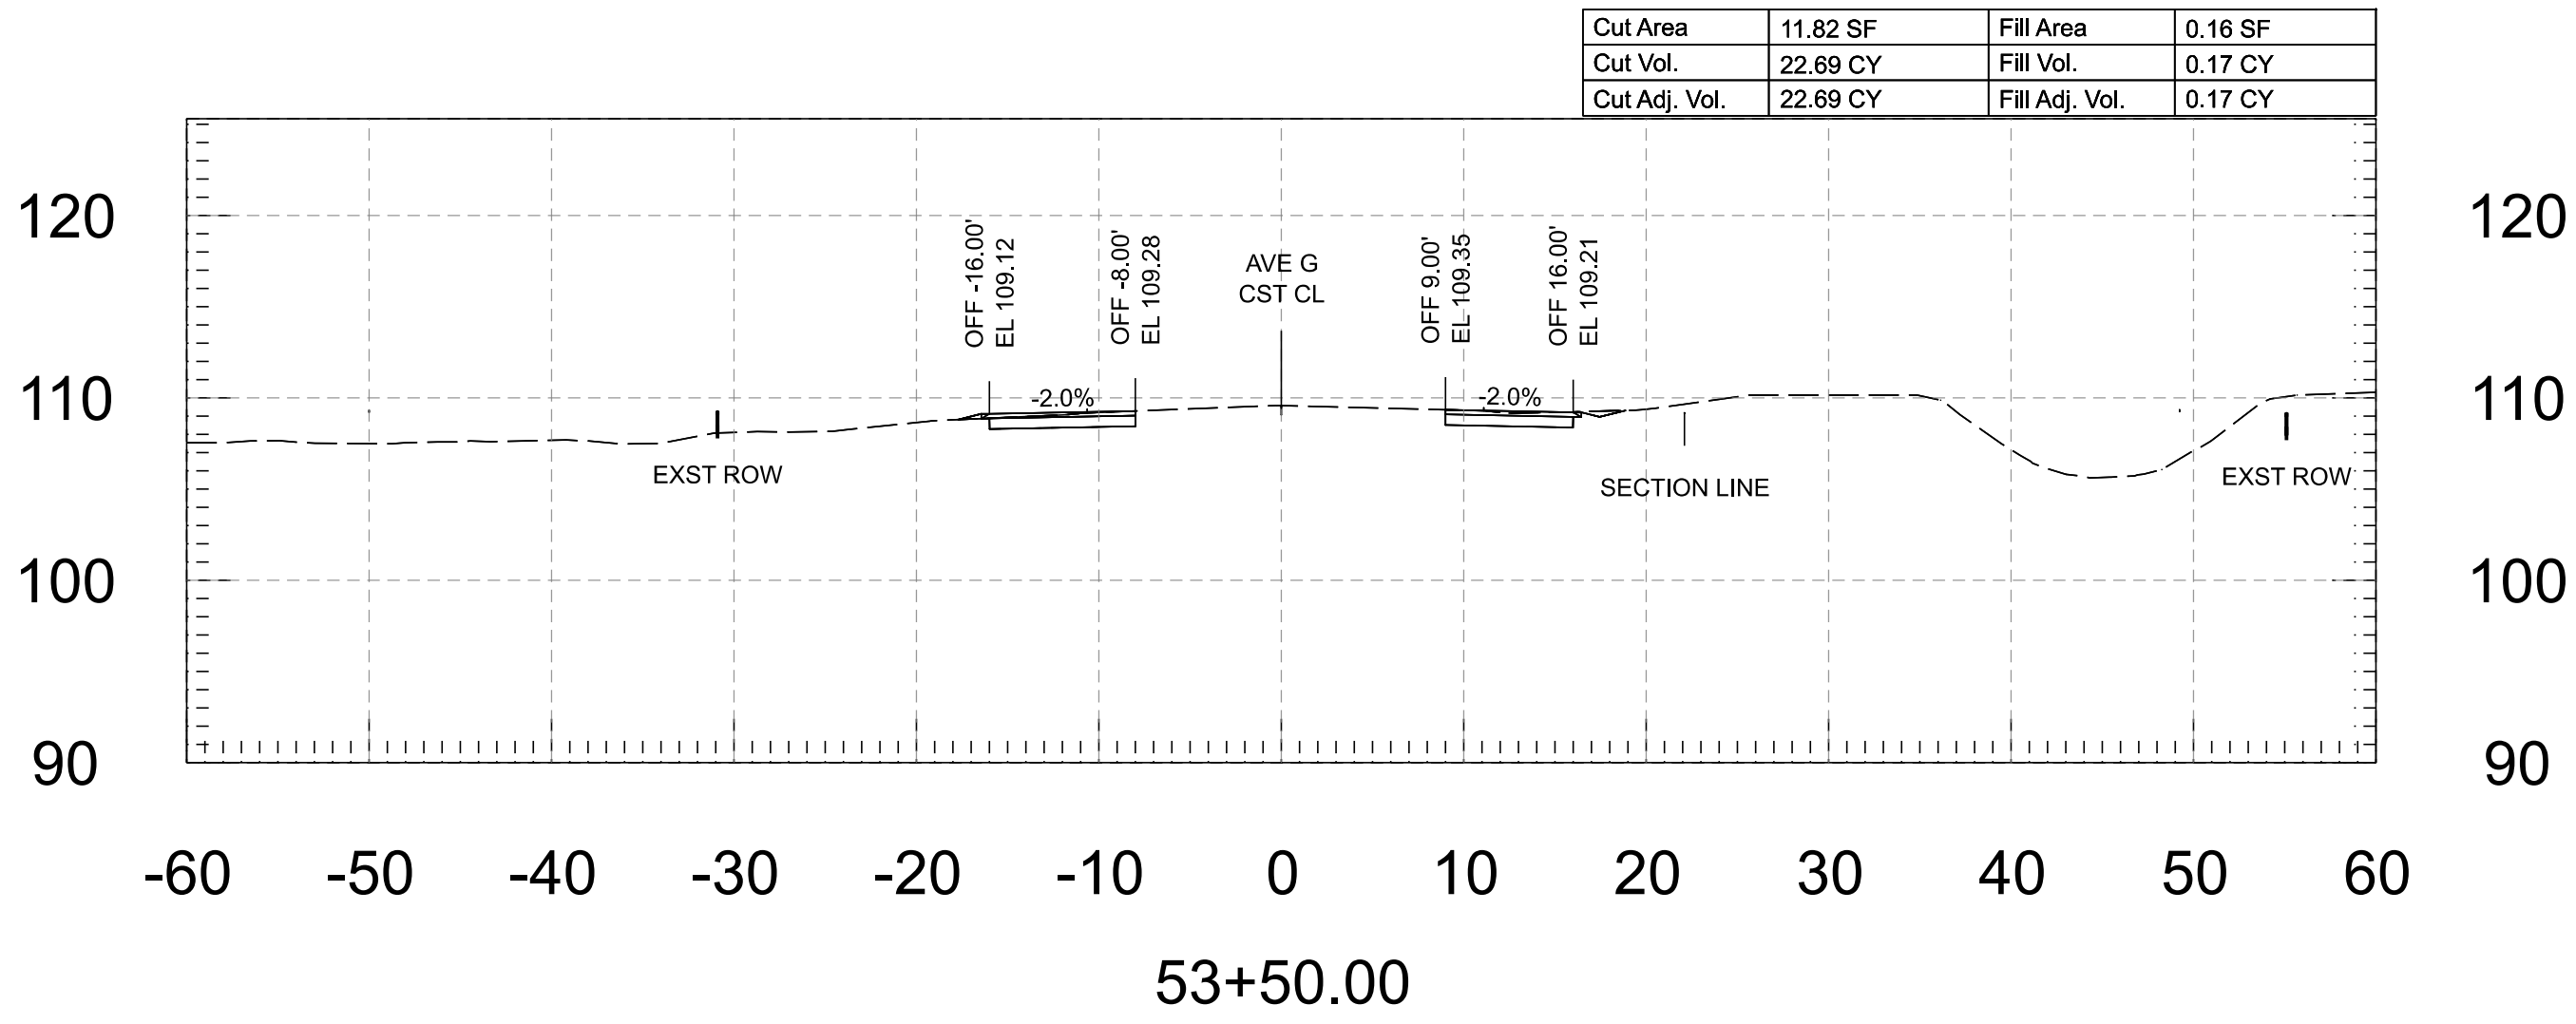

FOR INFORMATION ONLY		NAME	DATE	ARIZONA DEPARTMENT OF TRANSPORTATION PROJECT DELIVERY AND OPERATIONS DIVISION ROADWAY DESIGN SERVICES	ROUTE	F.H.W.A. Arizona Division	STATE ARIZ.	PROJECT NO.	FEDERAL ID NO.	SHEET NO.	TOTAL SHEETS	RECORD DRAWING
	DESIGN	M. SCHOEN	07/26		MILEPOST			0000 YU YYU	YYU-0(225)T	20	118	
	DRAWN	M. SCHOEN	07/26					LOCATION AVENUE G, COUNTY 11TH ST - COUNTY 16TH ST				
	CHECKED	H. RIOS	07/26	STRUCTURE NO.								
	 WSP USA Inc. 1200 West Washington Street, Suite 405 Tempe, AZ 85288		AVENUE G - CROSS SECTIONS									

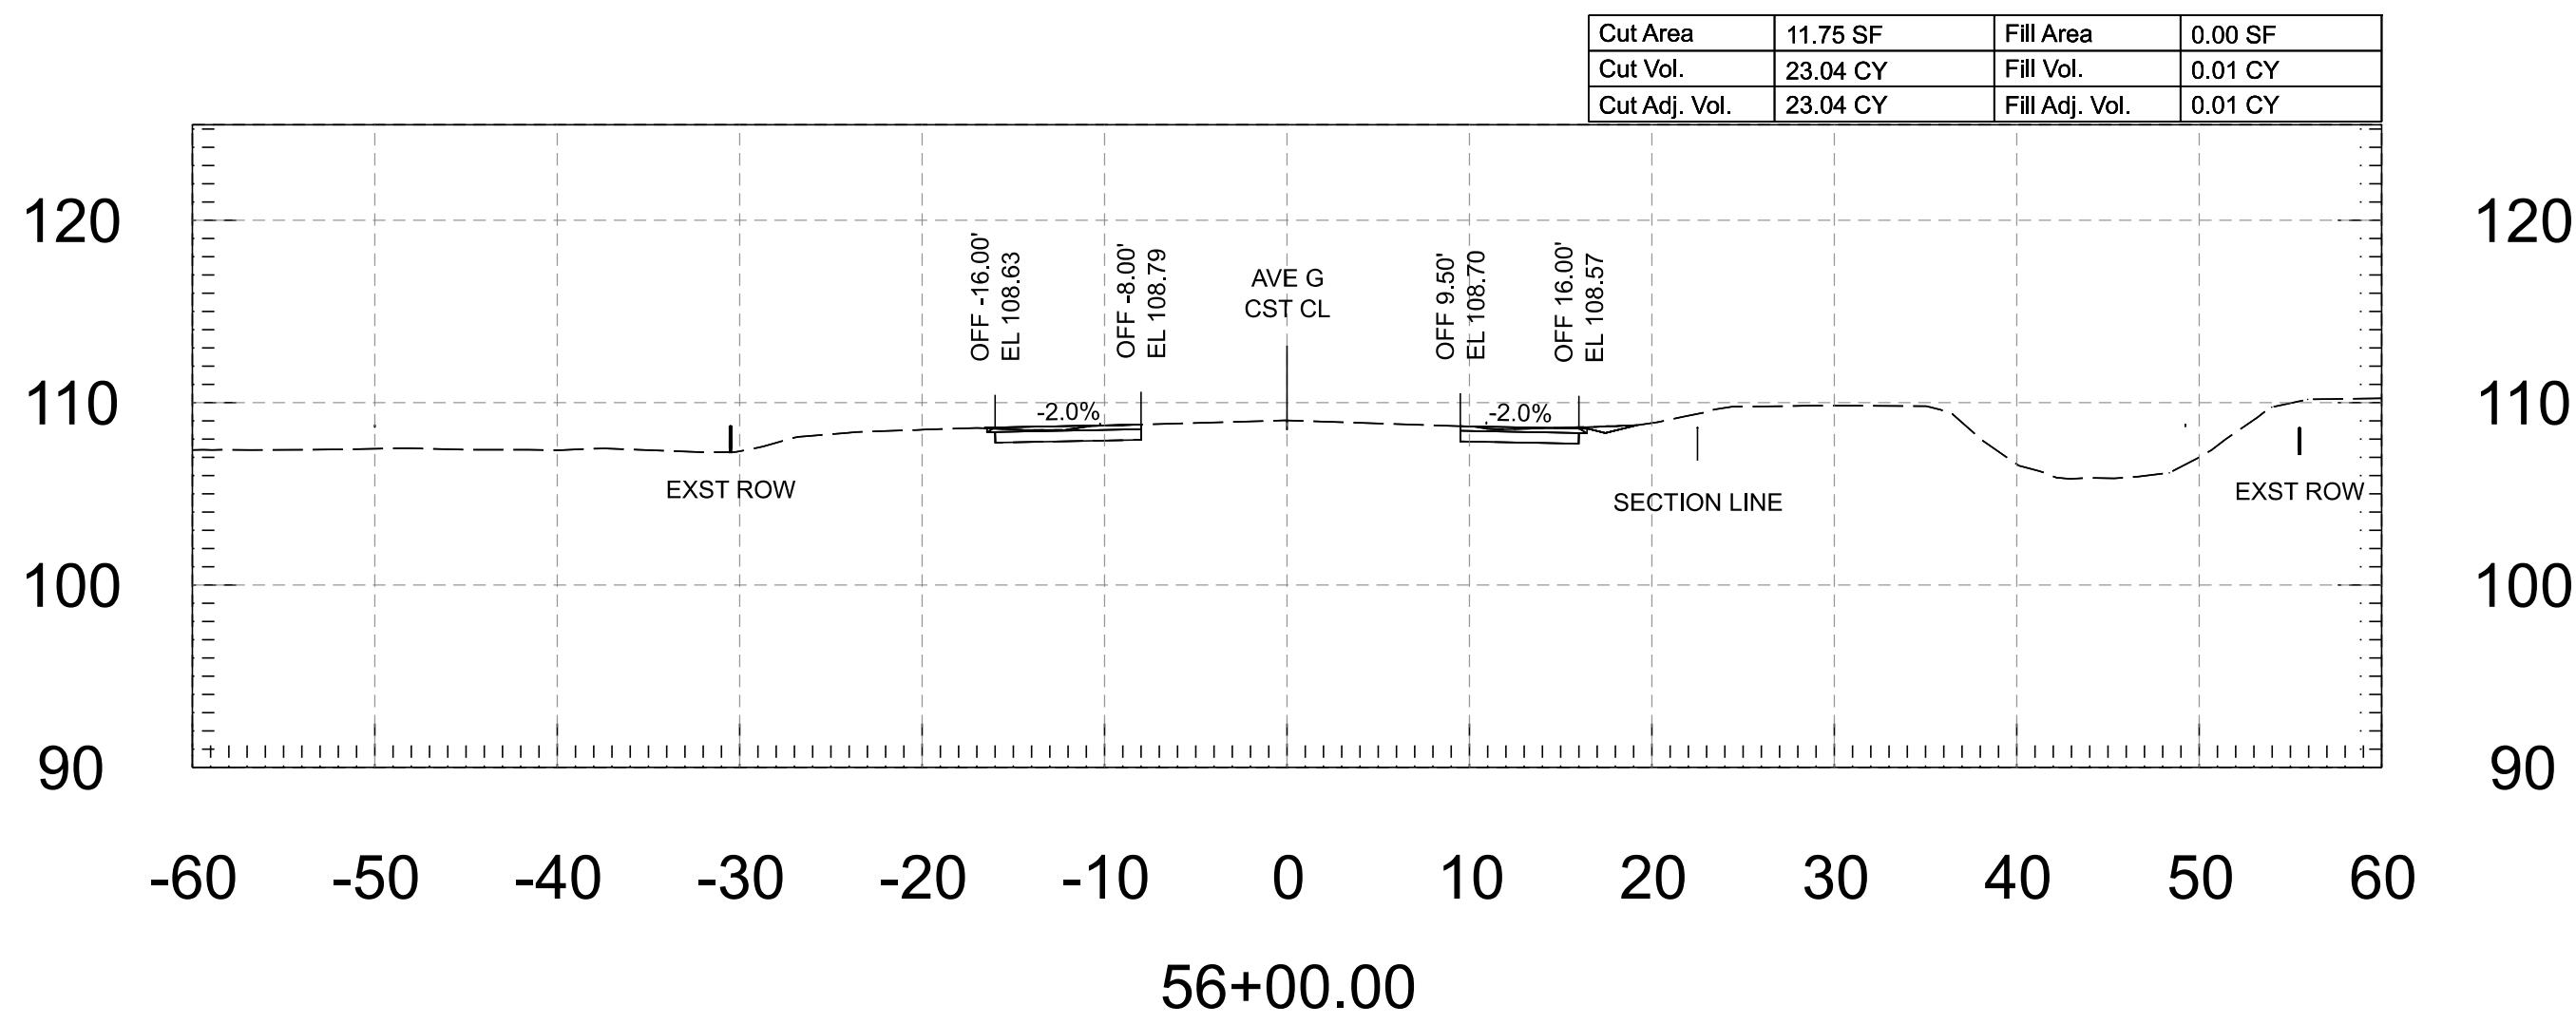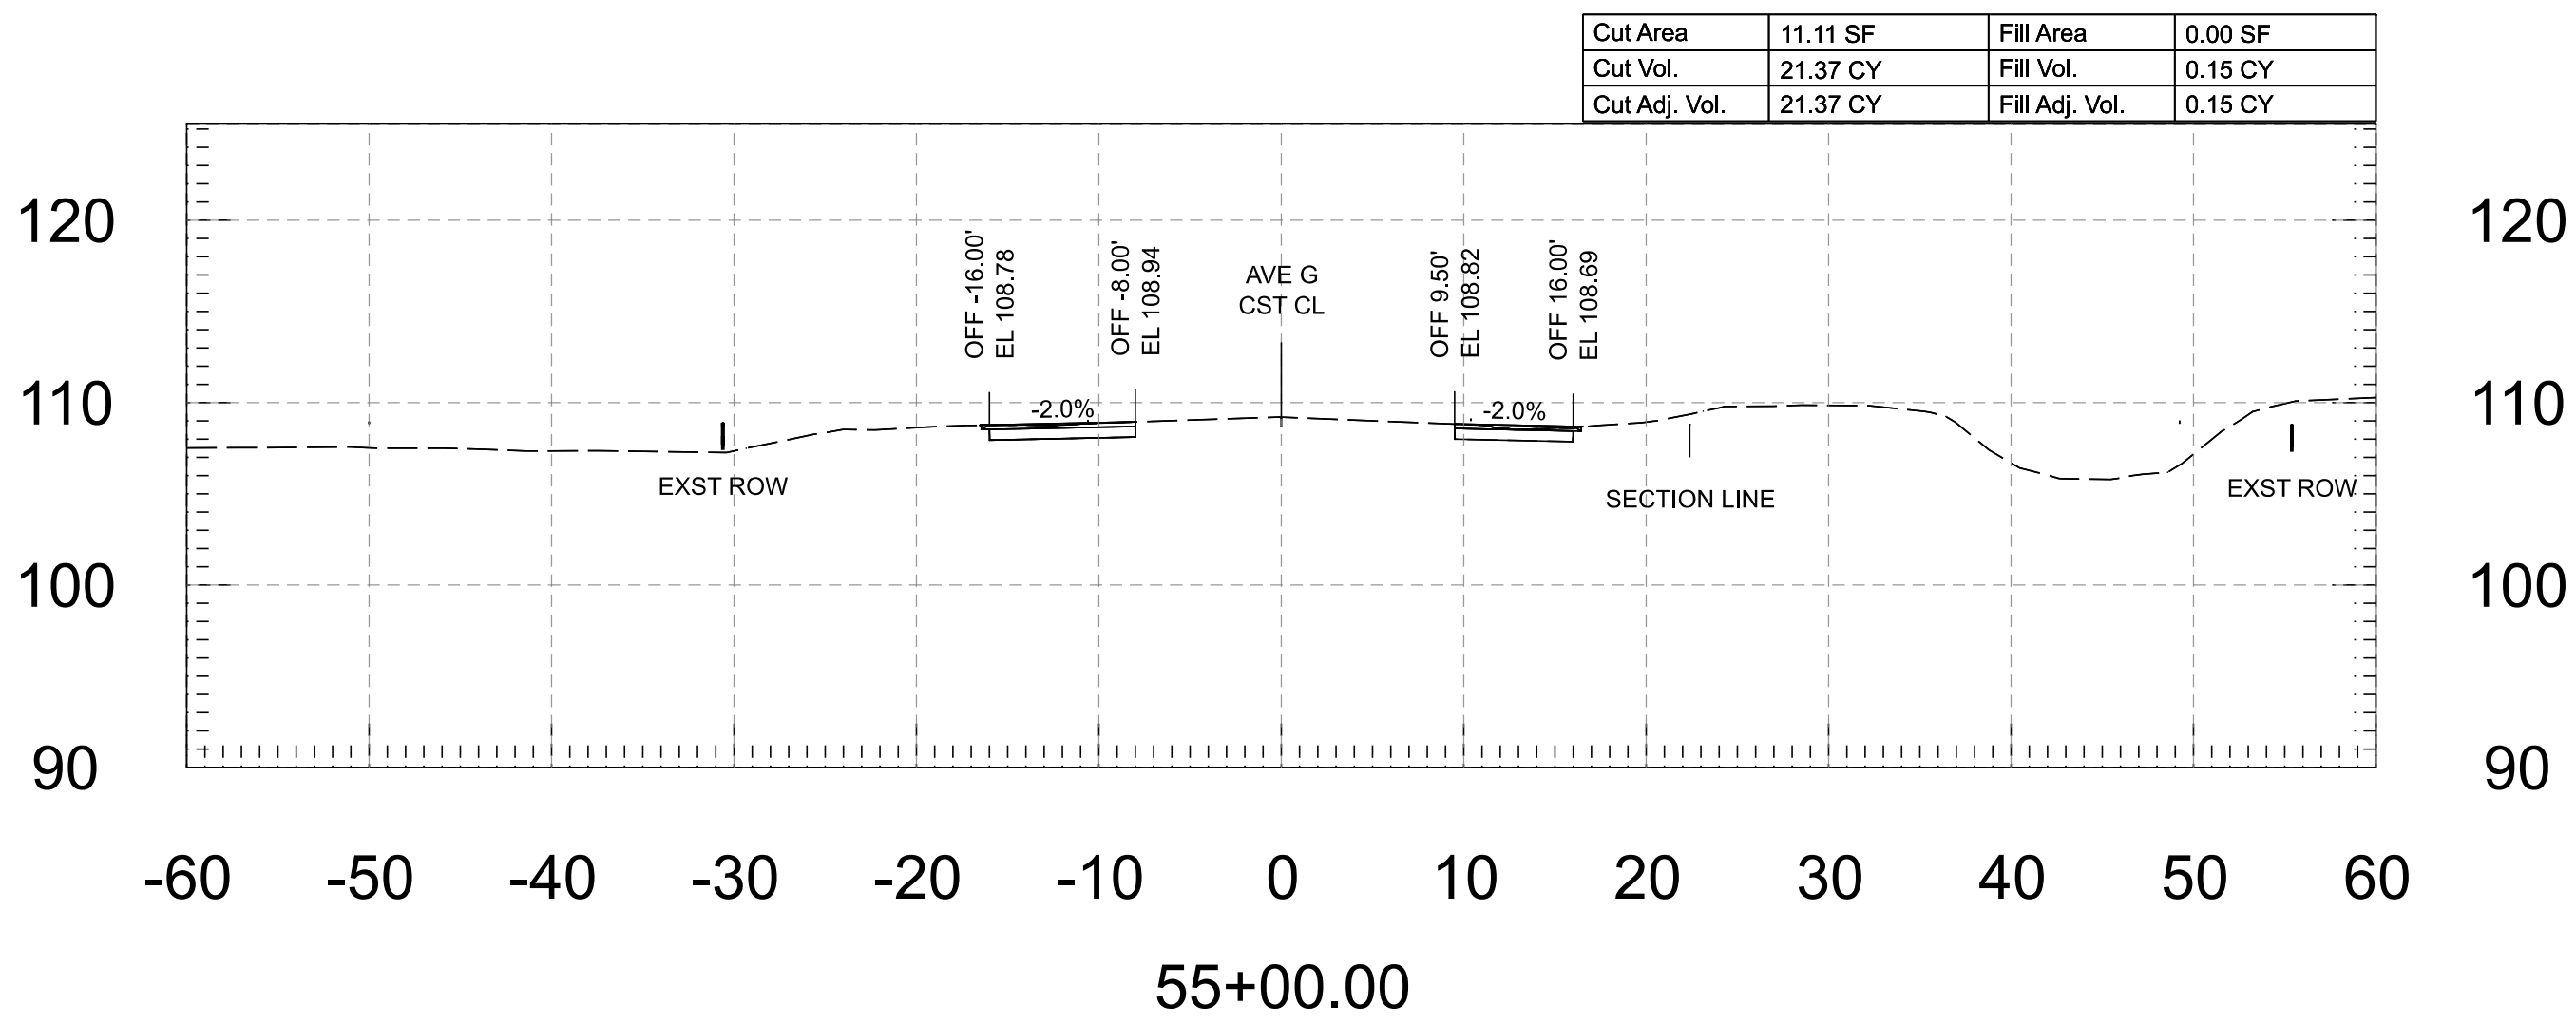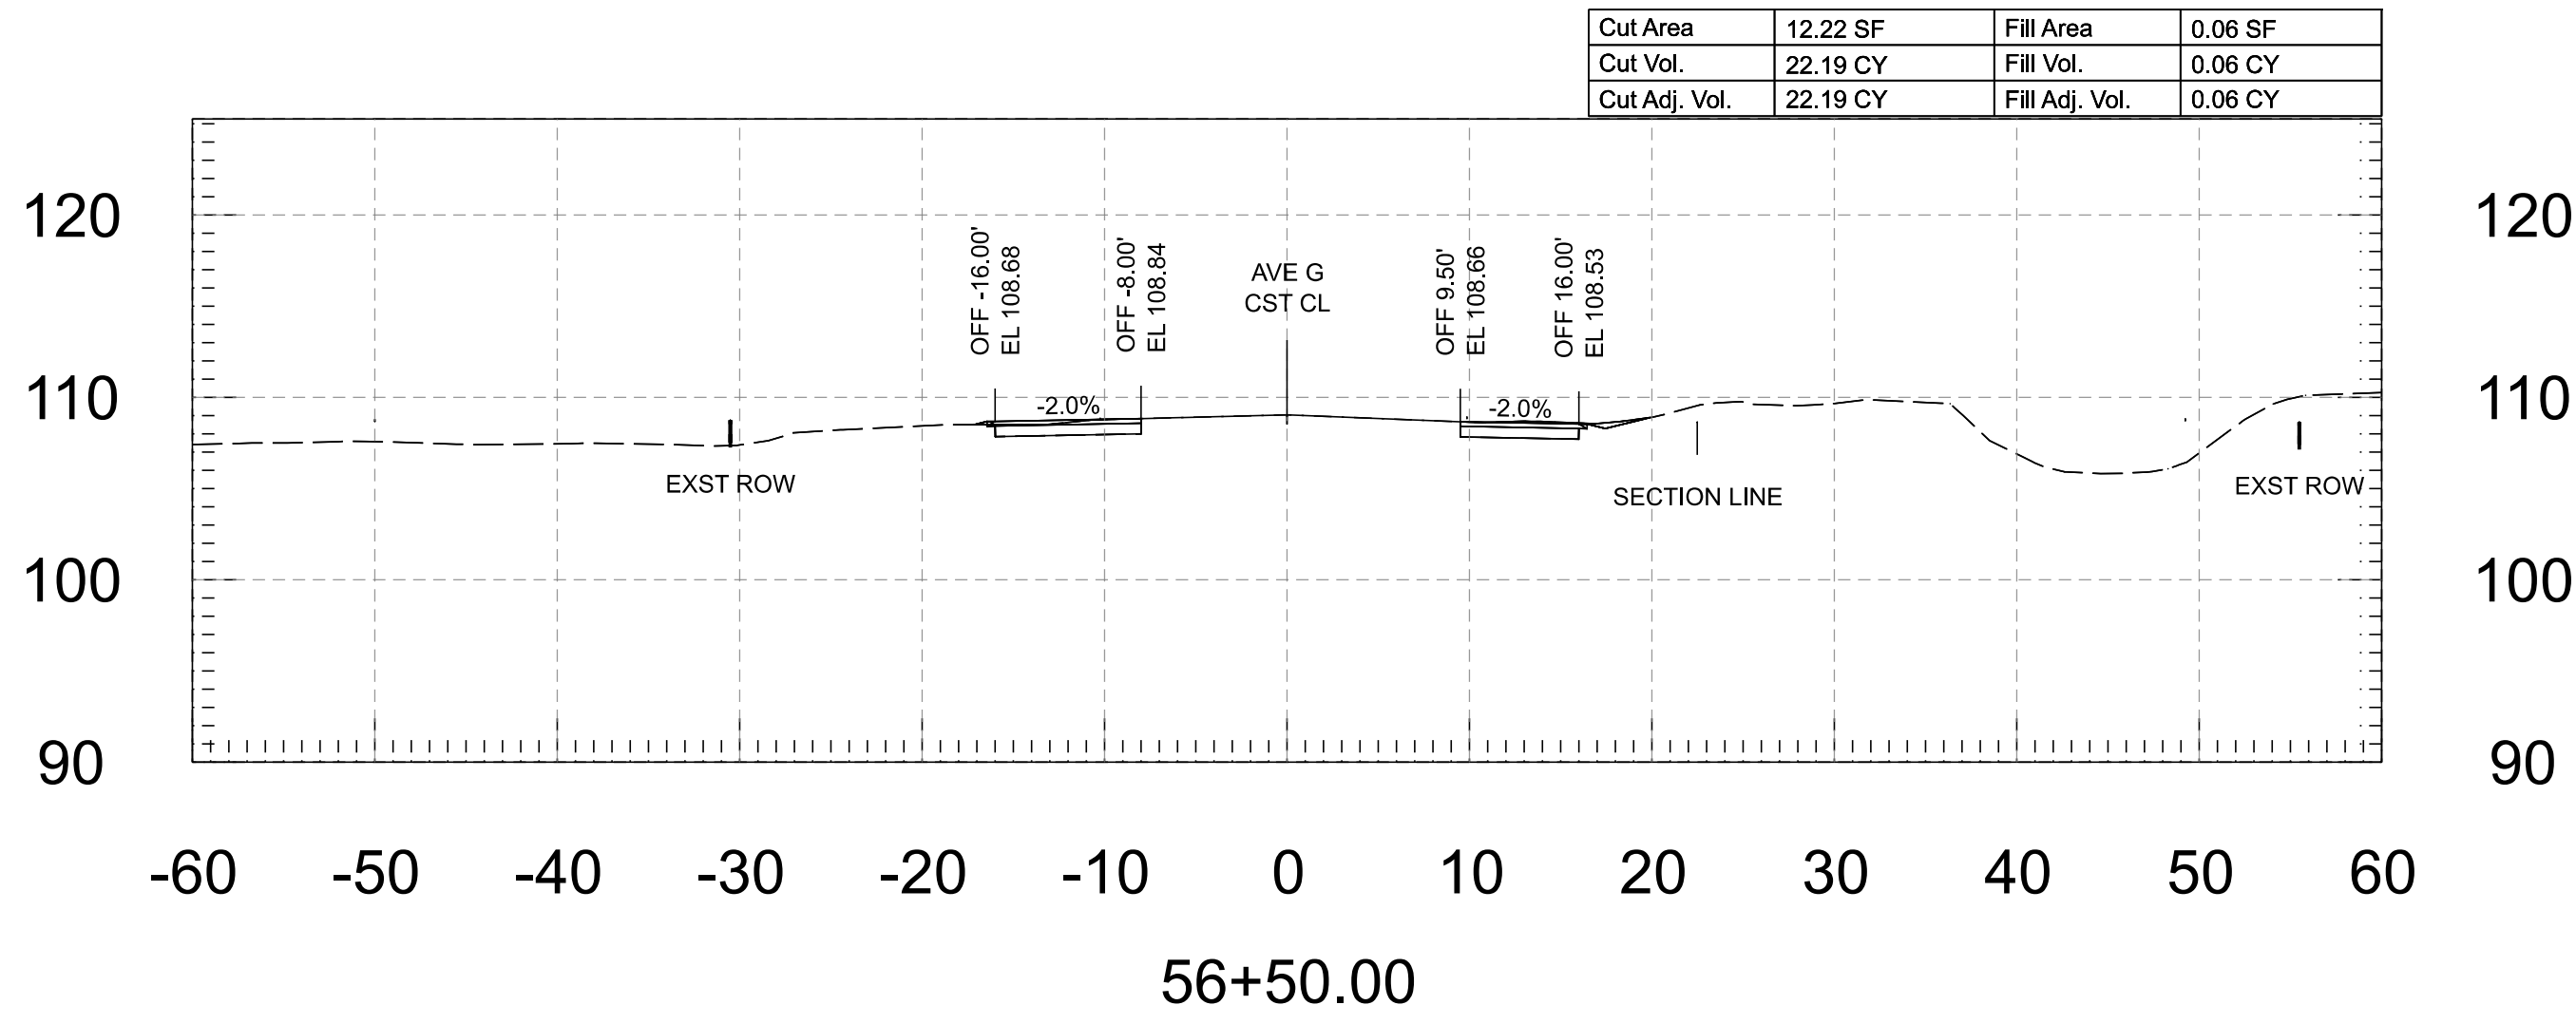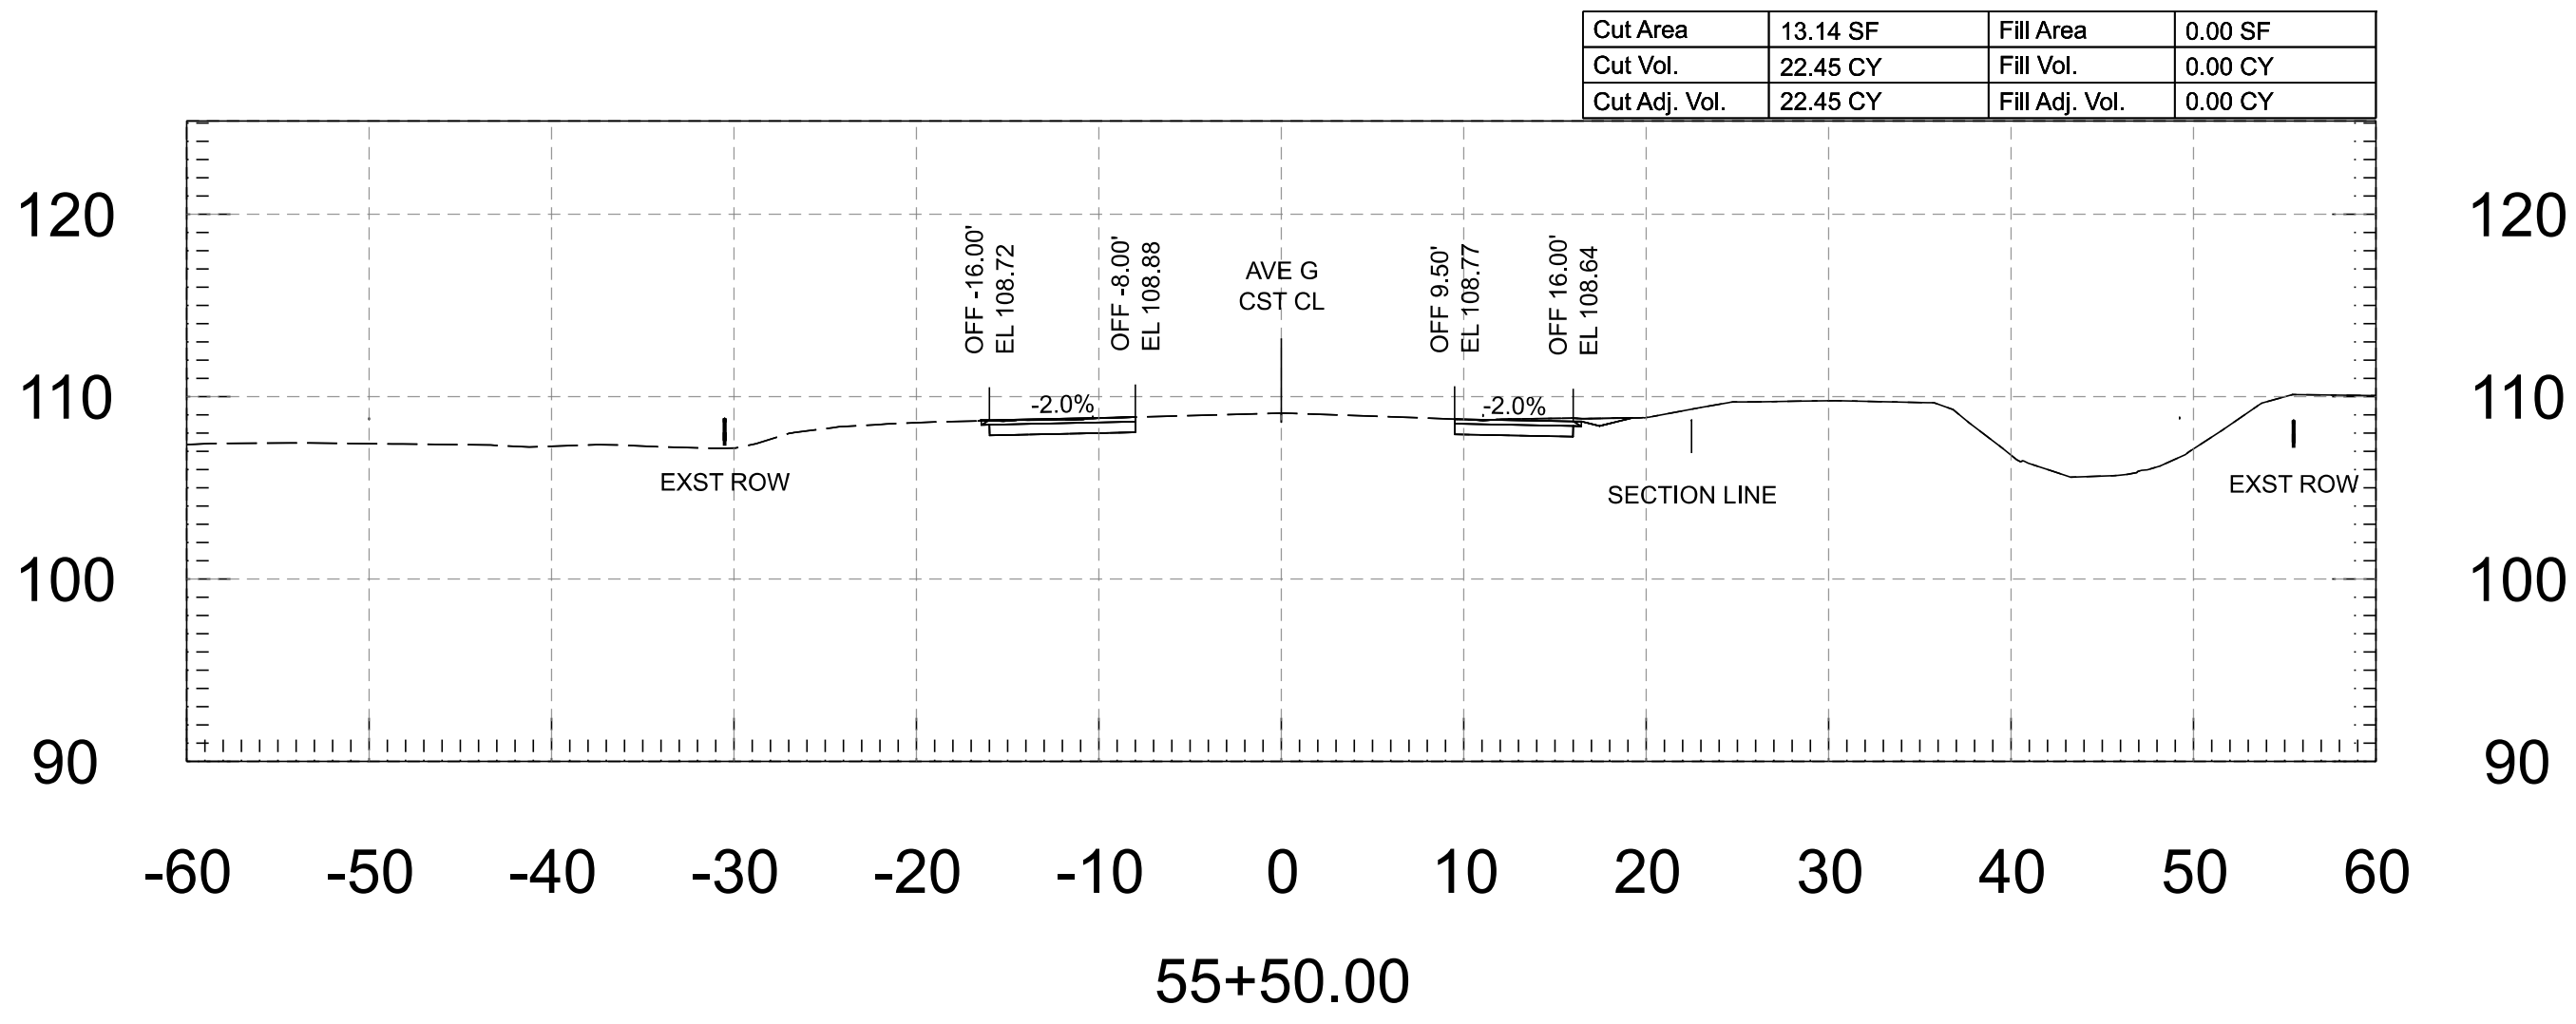

FOR INFORMATION ONLY		NAME	DATE	ARIZONA DEPARTMENT OF TRANSPORTATION PROJECT DELIVERY AND OPERATIONS DIVISION ROADWAY DESIGN SERVICES	ROUTE	F.H.W.A. Arizona Division	STATE ARIZ.	PROJECT NO.	FEDERAL ID NO.	SHEET NO.	TOTAL SHEETS	RECORD DRAWING
	DESIGN	M. SCHOEN	07/26		MILEPOST			0000 YU YYU	YYU-0(225)T	21	118	
	DRAWN	M. SCHOEN	07/26		AVENUE G - CROSS SECTIONS							
	CHECKED	H. RIOS	07/26									
	wsp WSP USA Inc. 1200 West Washington Street, Suite 405 Tempe, AZ 85288			TRACS NO. T0437 01C								

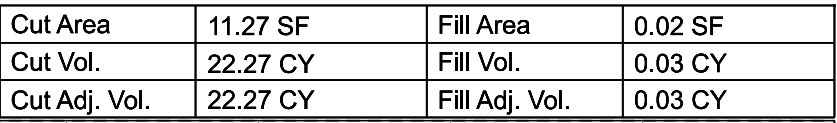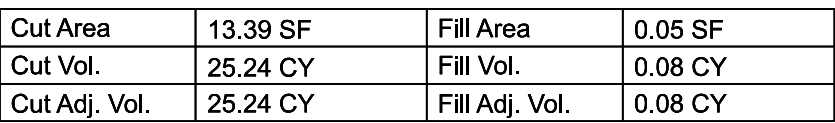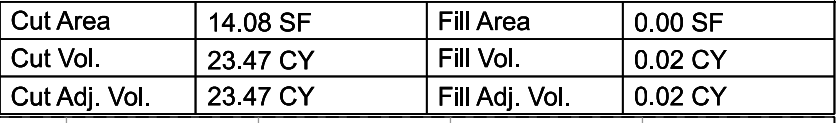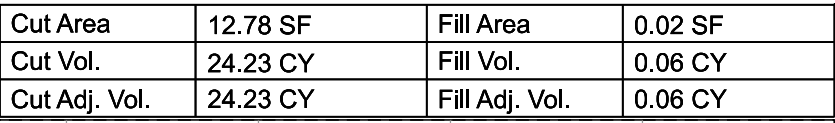

FOR
INFORMATIC
ONLY

	NAME	DATE
DESIGN	M. SCHOEN	07/26
DRAWN	M. SCHOEN	07/26
CHECKED	H. RIOS	07/26

WSP | WSP USA Inc.
1230 West Washington Street, Suite 405
Tempe, AZ 85288

ARIZONA DEPARTMENT OF TRANSPORTATION
PROJECT DELIVERY AND OPERATIONS DIVISION
ROADWAY DESIGN SERVICES

AVENUE G - CROSS SECTIONS

ROUTE

MILEPOST[®]

STRUCTURE NO.

F.H.W.A. Arizona Division

ARIZ.

PROJECT NO.

0000 YU YY

FEDERAL ID NO.

YYU-0(225)T

SHEET
NO.



23

TOTAL
SHEETS





118

RECO



— C

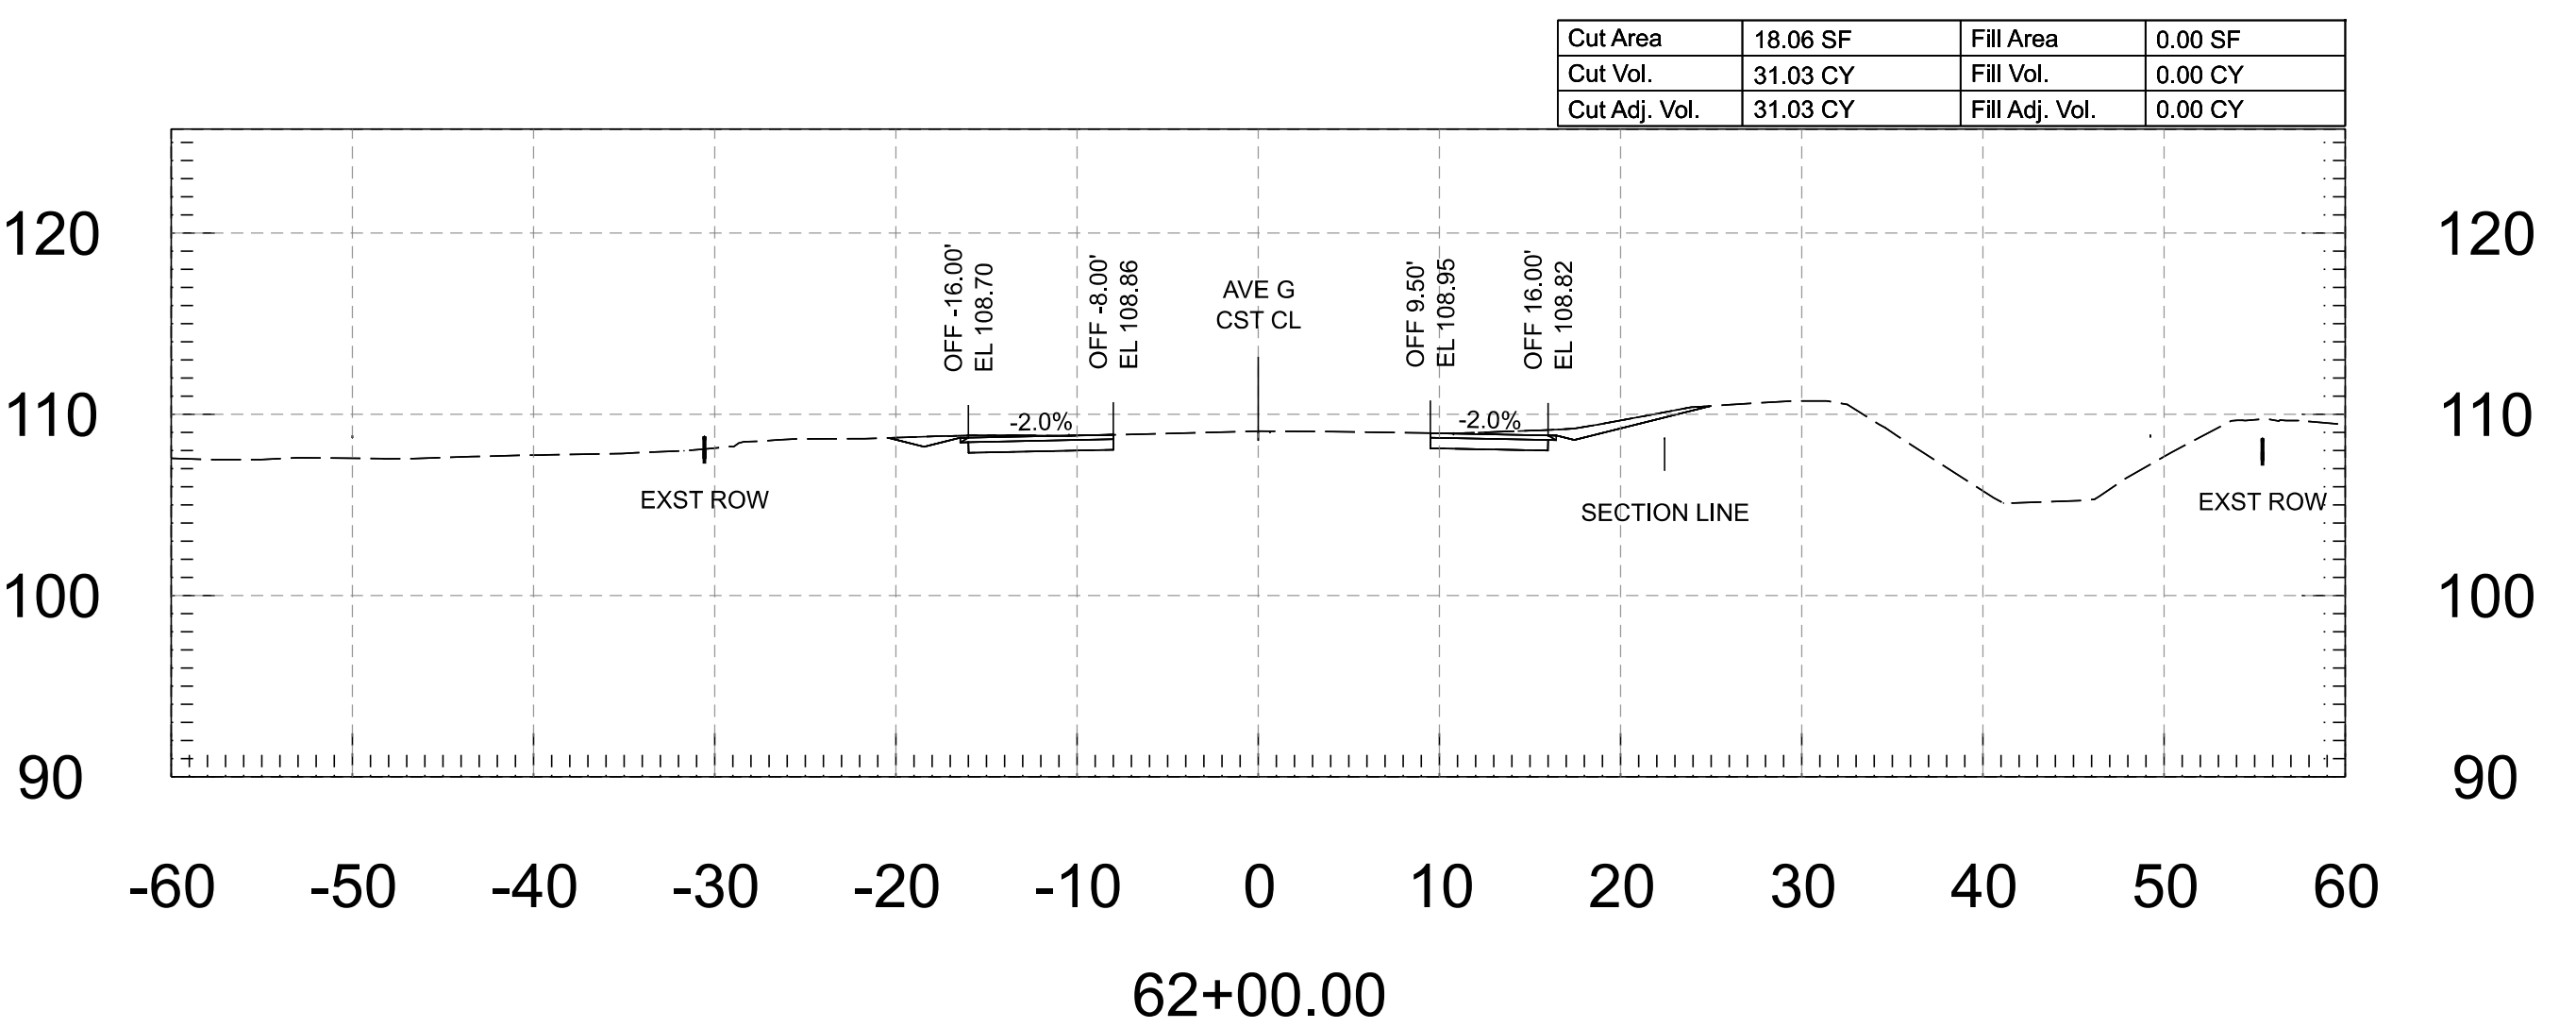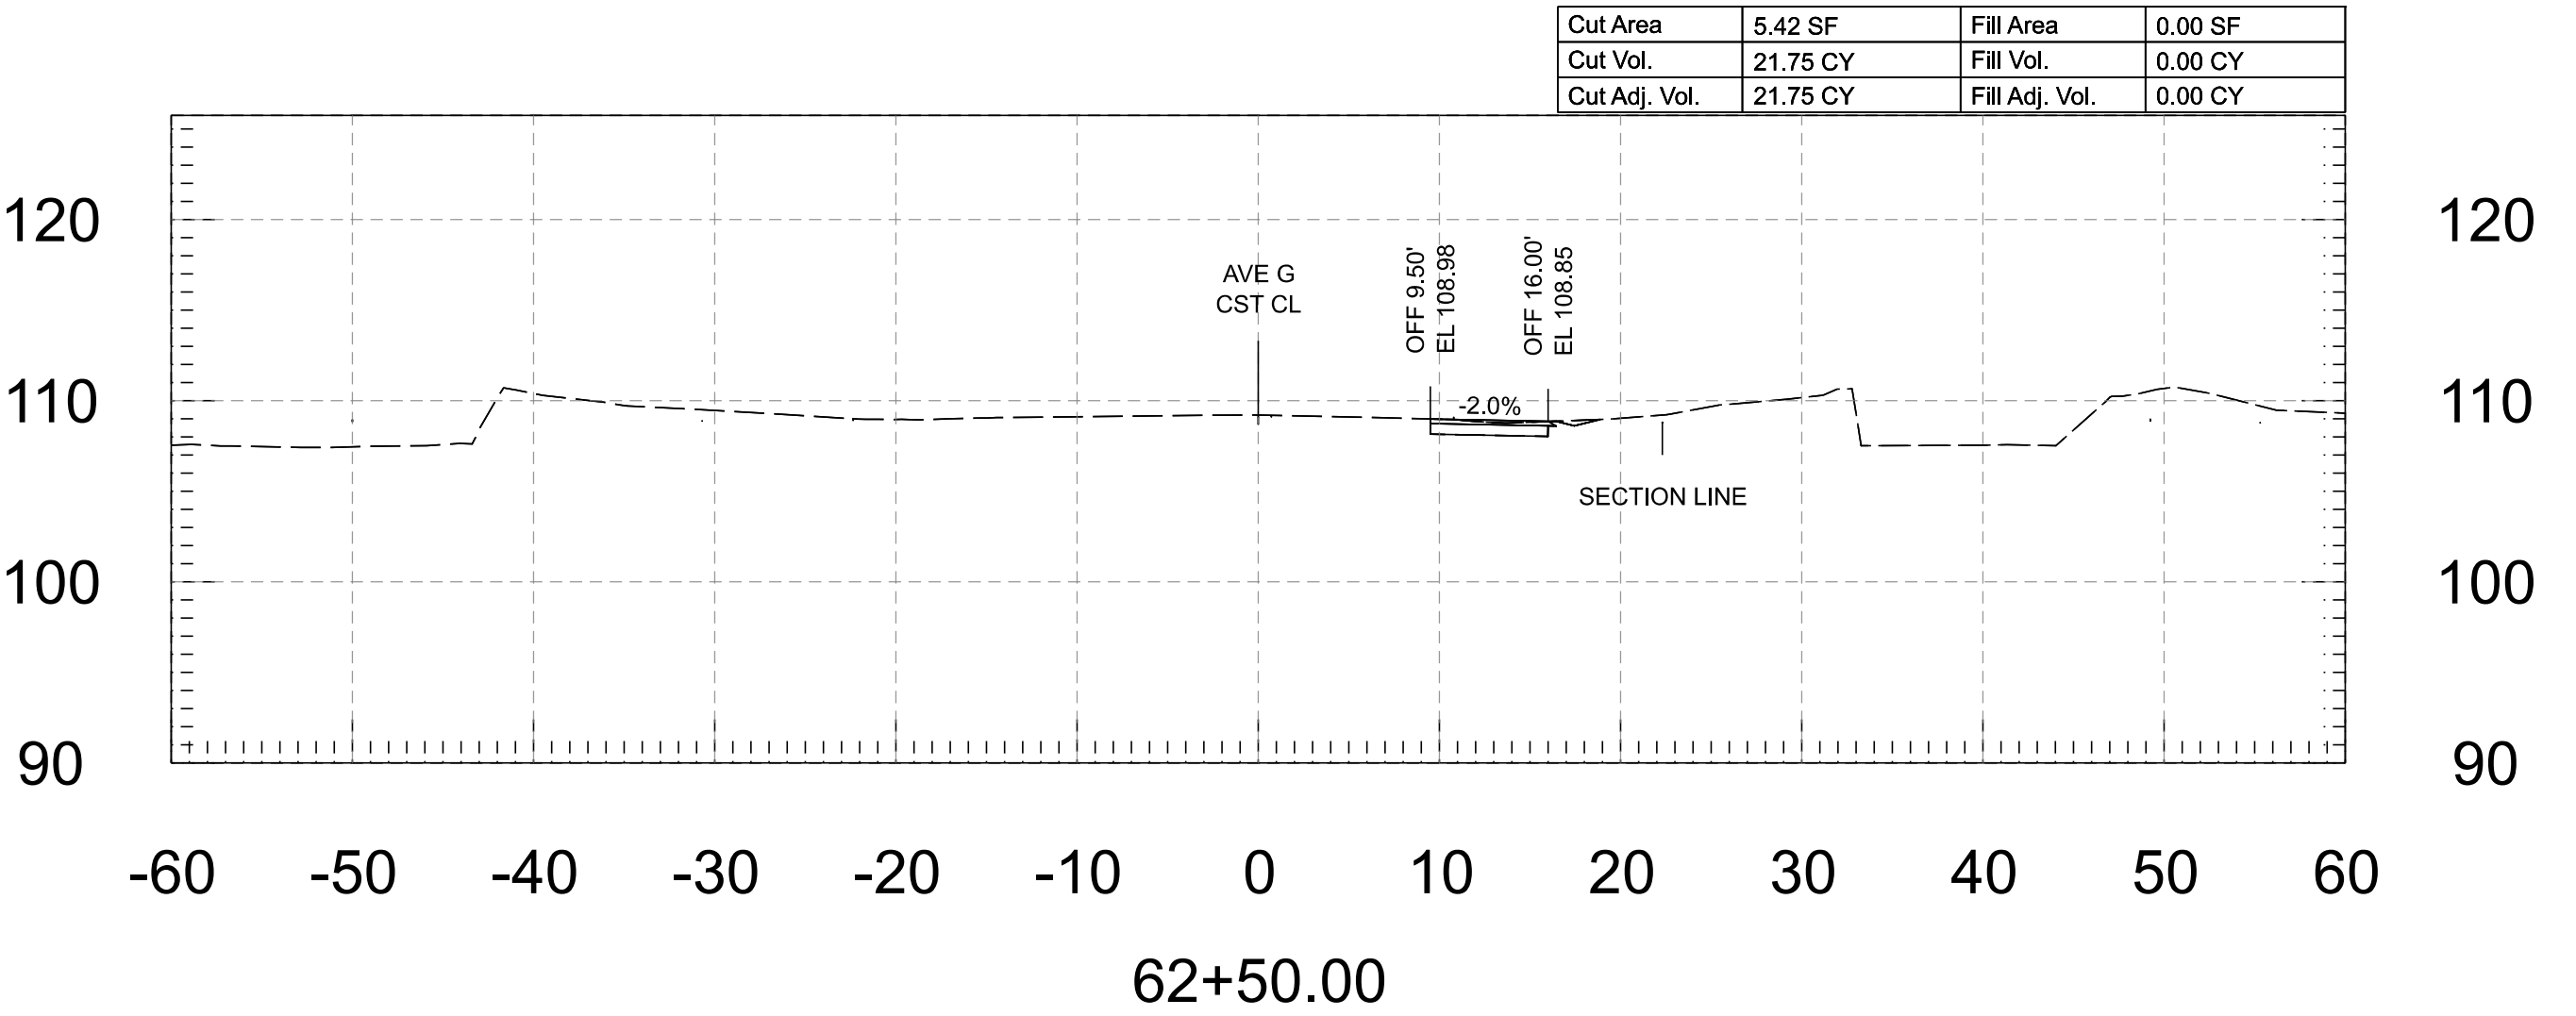





FOR INFORMATION ONLY		NAME	DATE	ARIZONA DEPARTMENT OF TRANSPORTATION PROJECT DELIVERY AND OPERATIONS DIVISION ROADWAY DESIGN SERVICES	ROUTE	F.H.W.A. Arizona Division	STATE ARIZ.	PROJECT NO.	FEDERAL ID NO.	SHEET NO.	TOTAL SHEETS	RECORD DRAWING
	DESIGN	M. SCHOEN	07/26		MILEPOST			0000 YU YYU	YYU-0(225)T	24	118	
	DRAWN	M. SCHOEN	07/26		STRUCTURE NO.	LOCATION AVENUE G, COUNTY 11TH ST - COUNTY 16TH ST DWG						
	CHECKED	H. RIOS	07/26			TRACS NO. T0437 01C OF						
	 WSP USA Inc. 1230 West Washington Street, Suite 405 Tempe, AZ 85288			AVENUE G - CROSS SECTIONS								

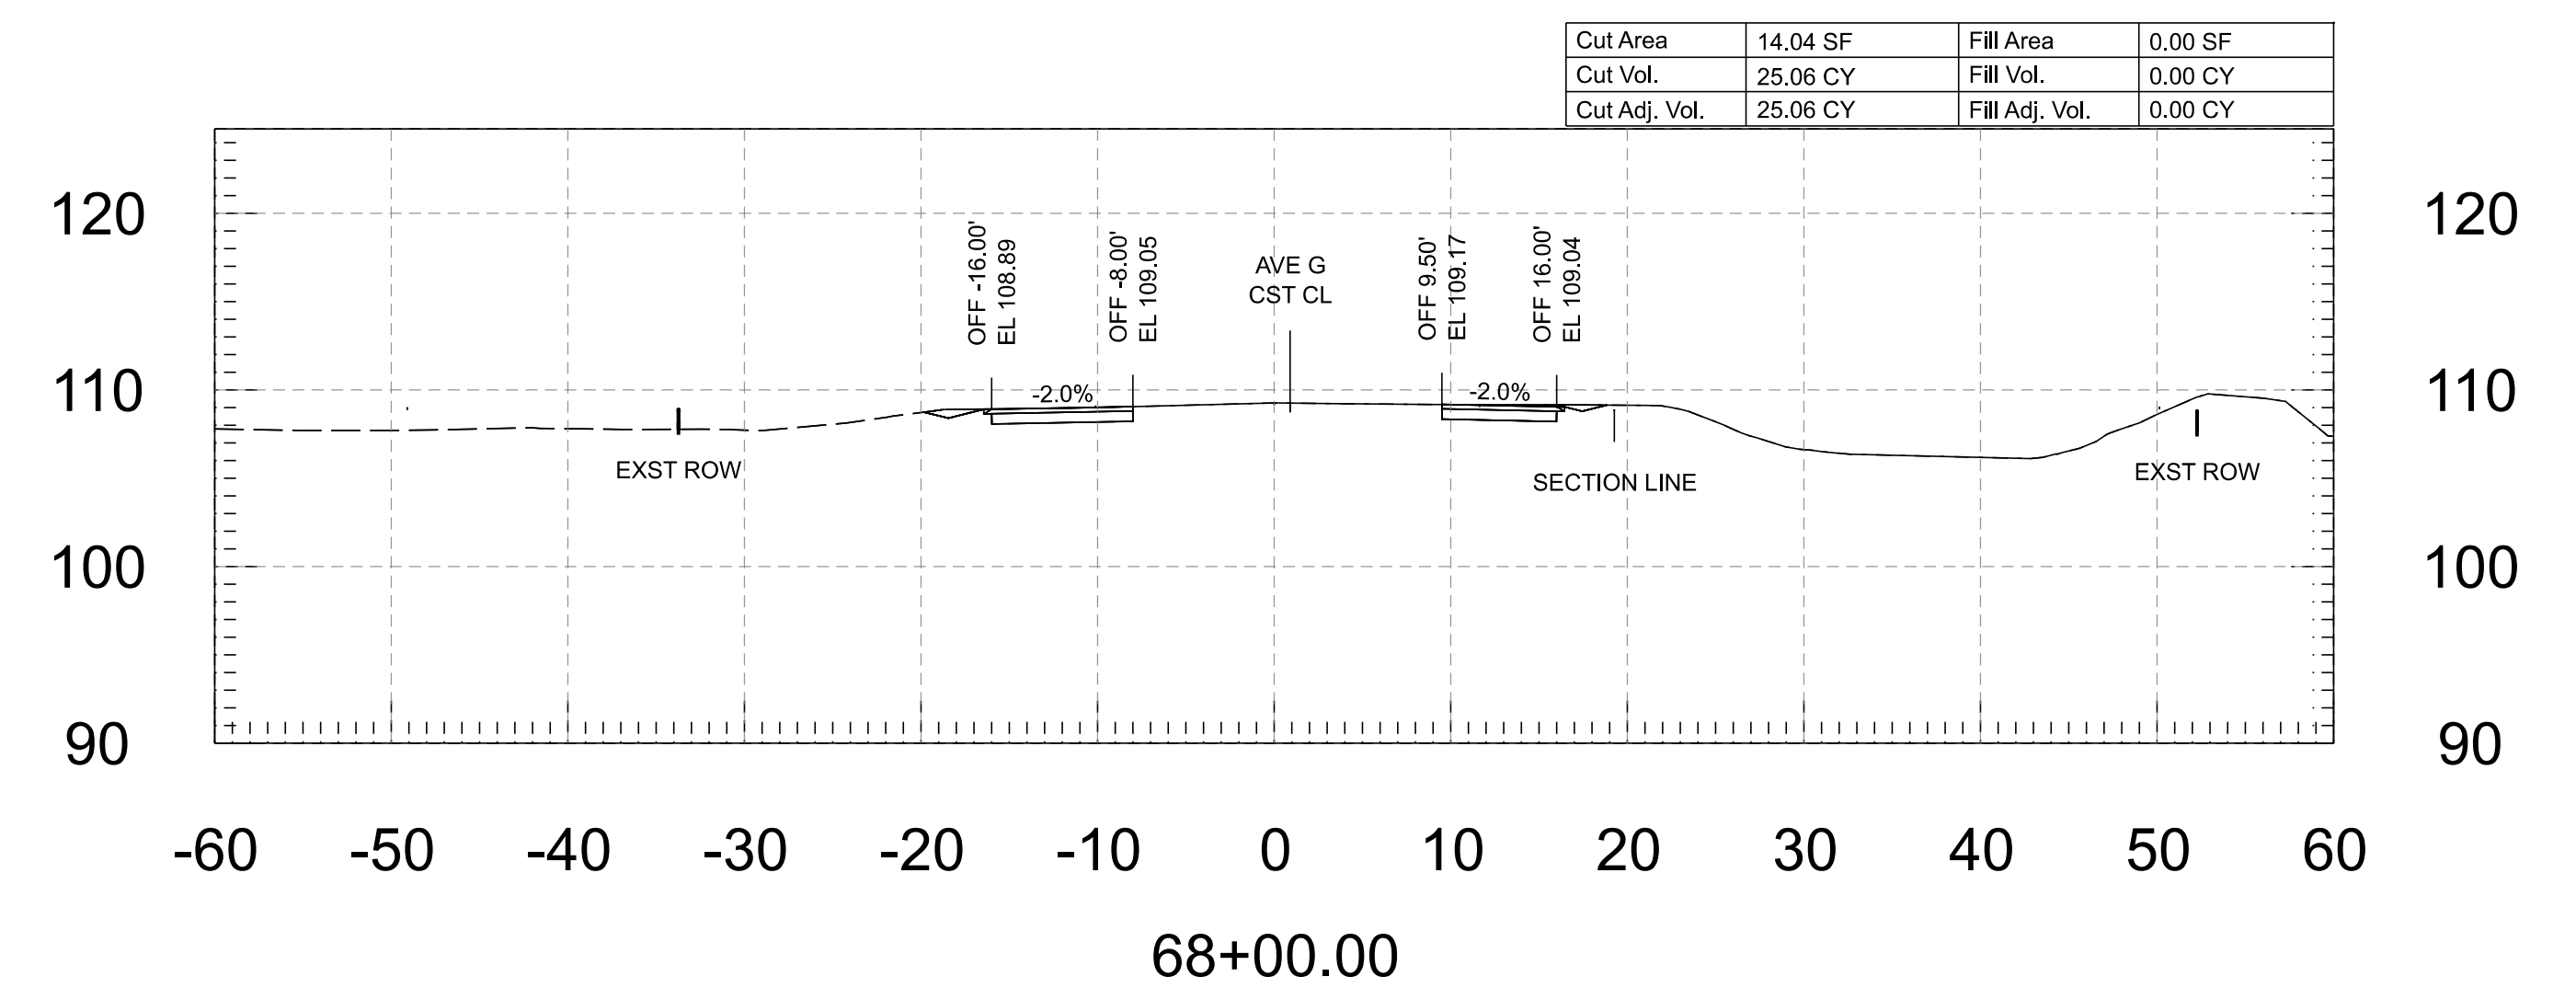
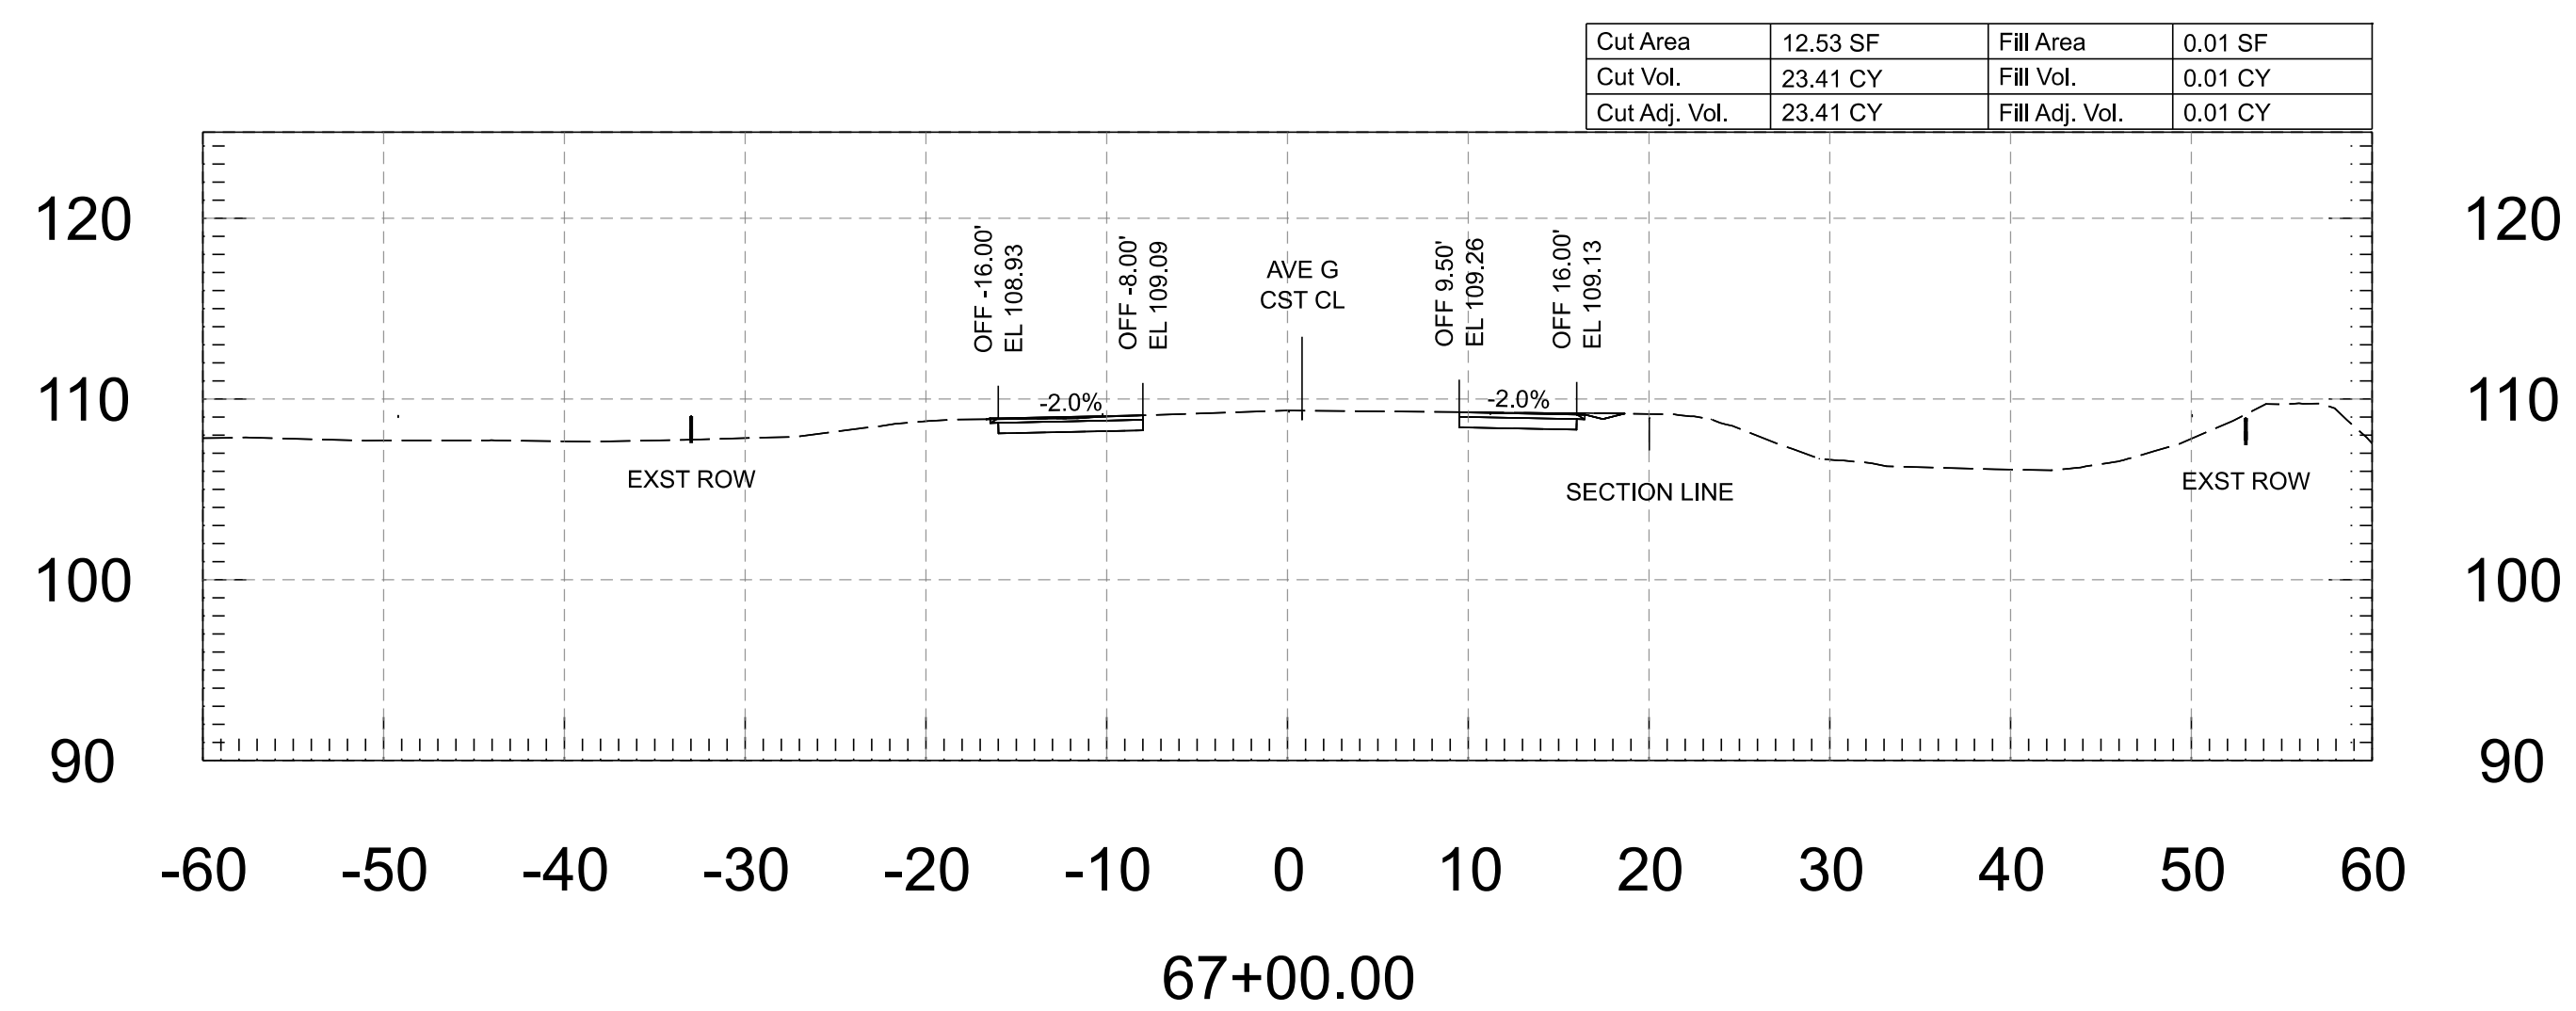
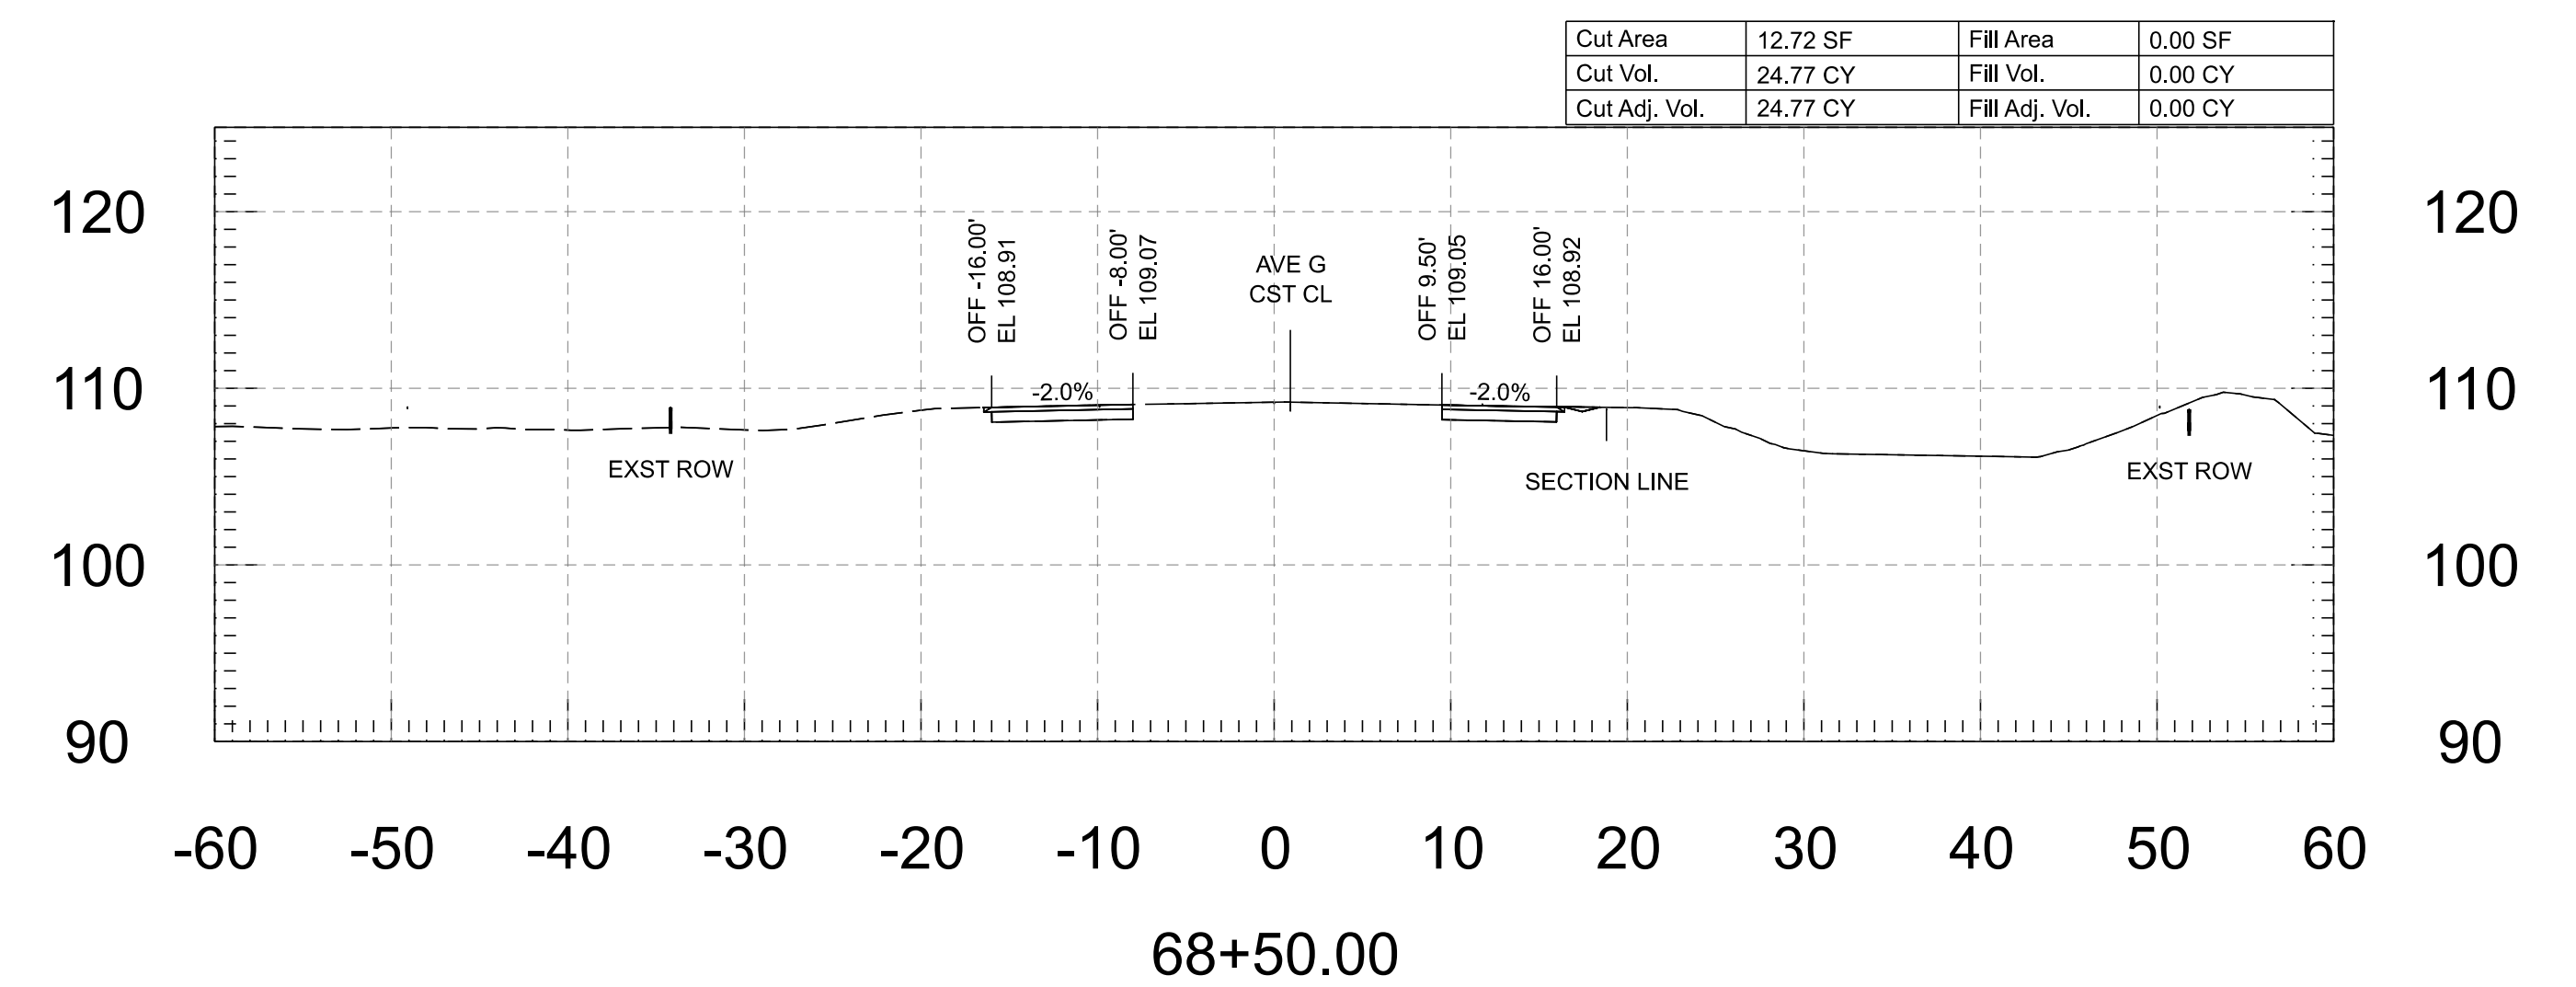
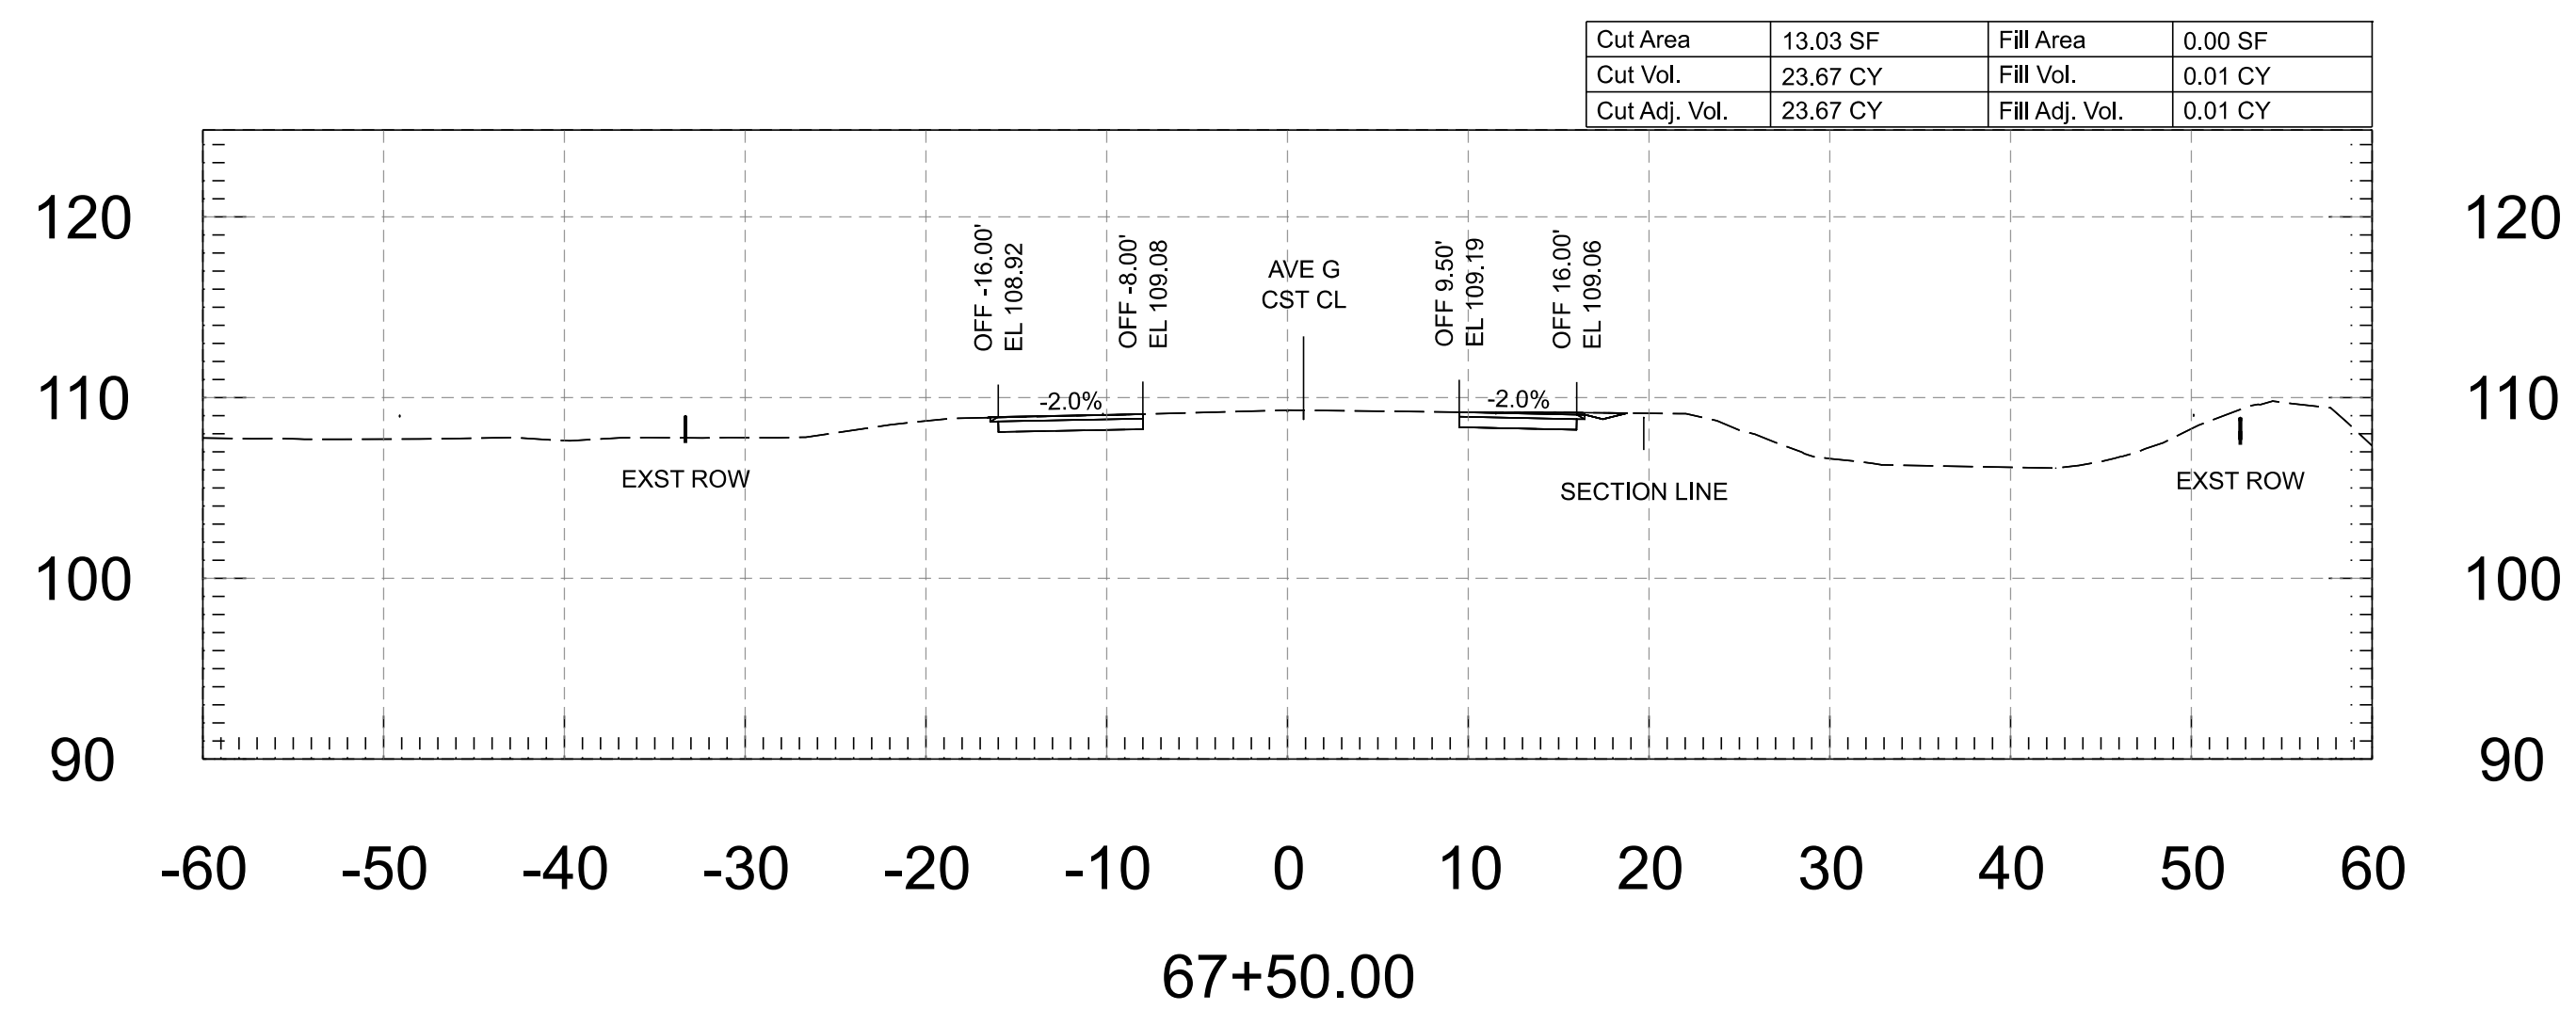


FOR INFORMATION ONLY				ARIZONA DEPARTMENT OF TRANSPORTATION PROJECT DELIVERY AND OPERATIONS DIVISION ROADWAY DESIGN SERVICES	ROUTE	F.H.W.A. Arizona Division	STATE ARIZ.	PROJECT NO.	FEDERAL ID NO.	SHEET NO.	TOTAL SHEETS	RECORD DRAWING	
	DESIGN	M. SCHOEN	07/26										
	DRAWN	M. SCHOEN	07/26			0000 YU YYU	YYU-0(225)T	27	118				
	CHECKED	H. RIOS	07/26										
			WSP USA Inc. 1200 West Washington Street, Suite 405 Tempe, AZ 85288			AVENUE G - CROSS SECTIONS	LOCATION AVENUE G, COUNTY 11TH ST - COUNTY 16TH ST						
					TRACS NO. T0437 01C							___ OF ___	

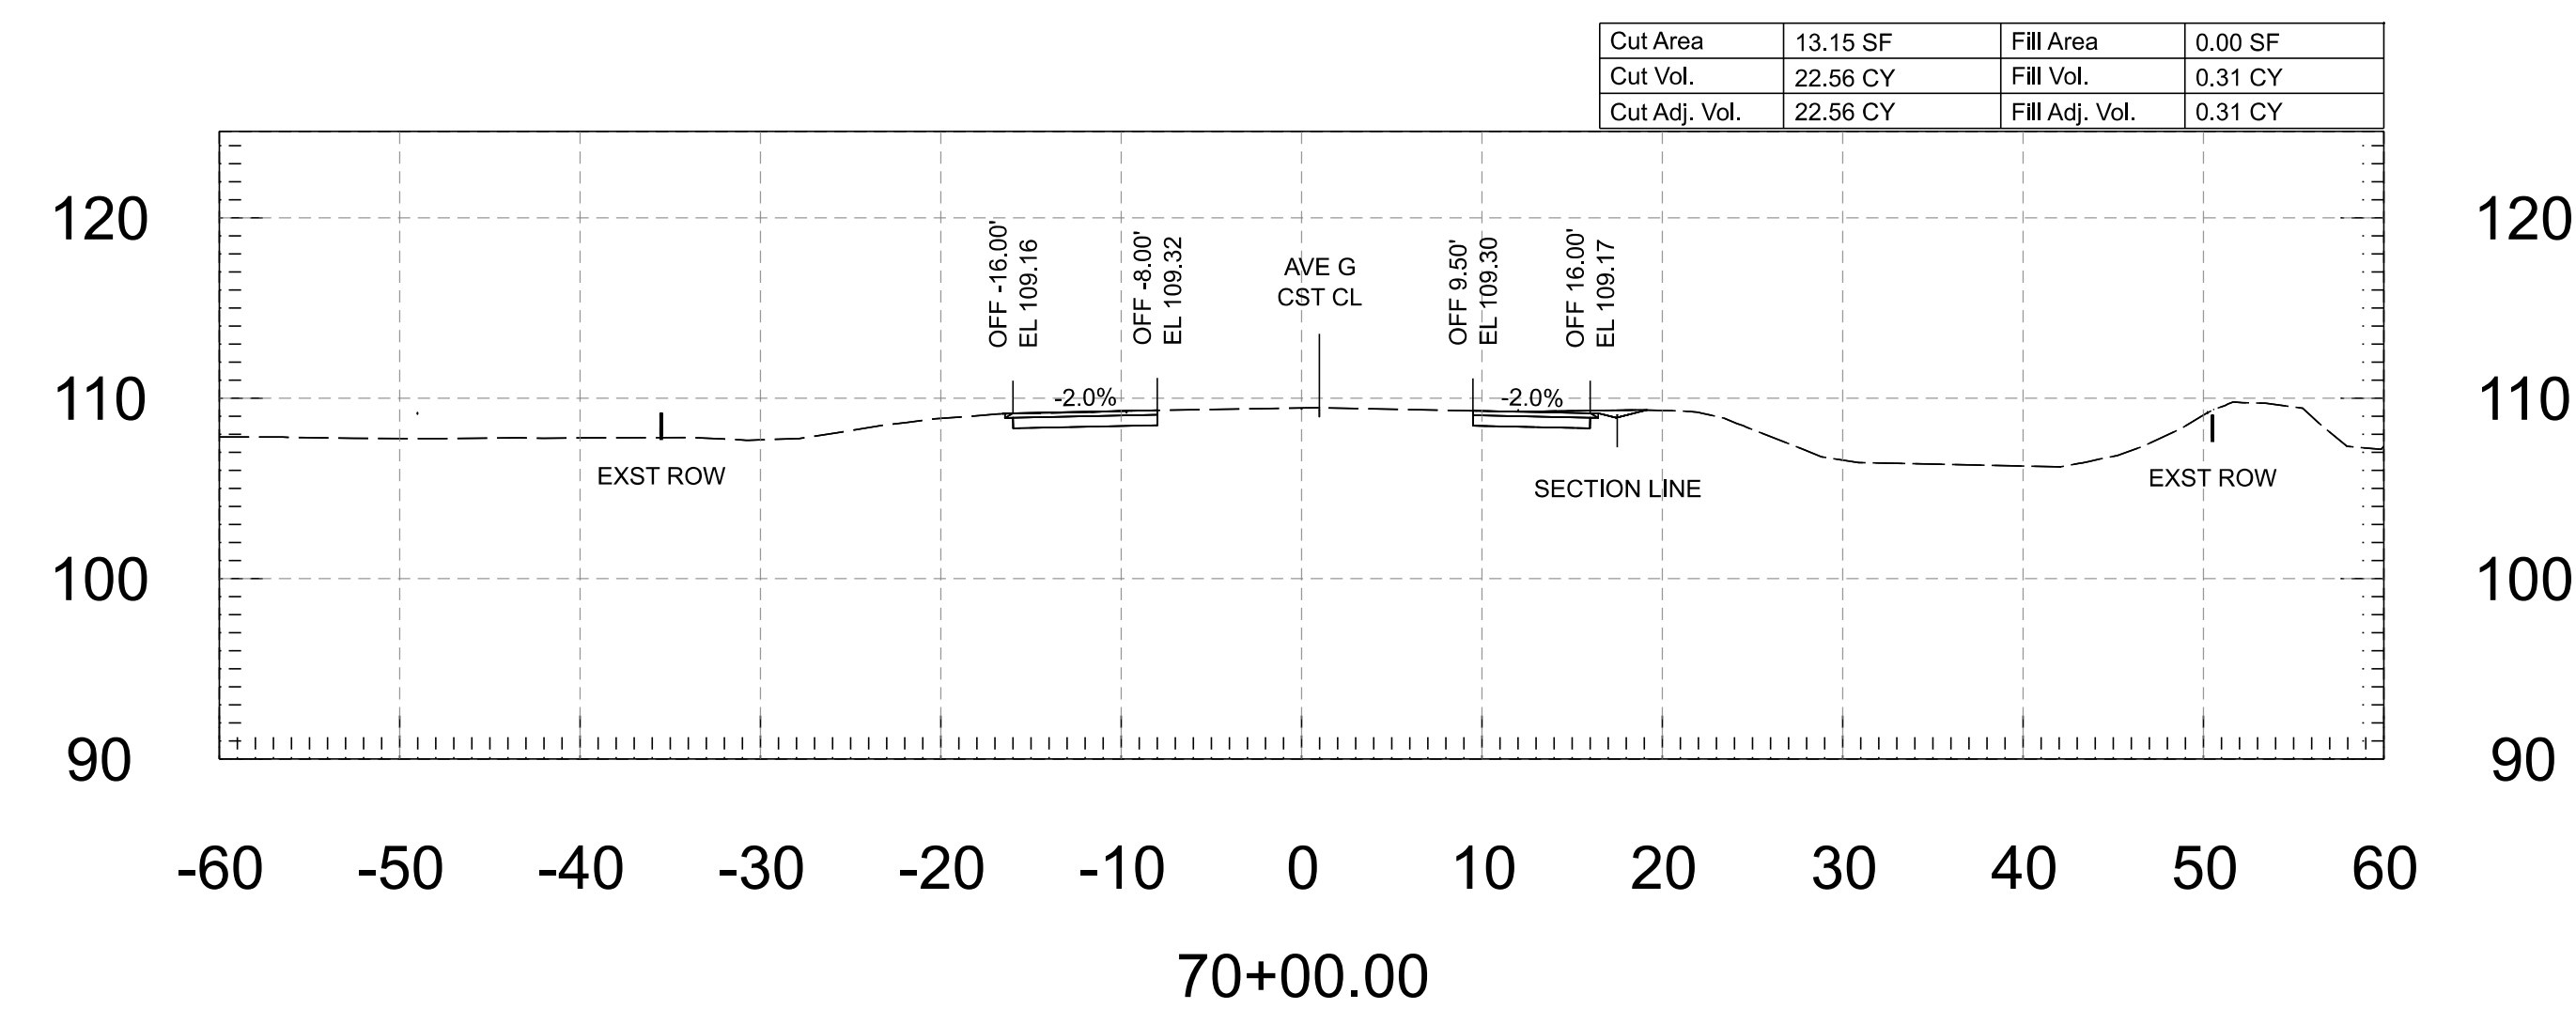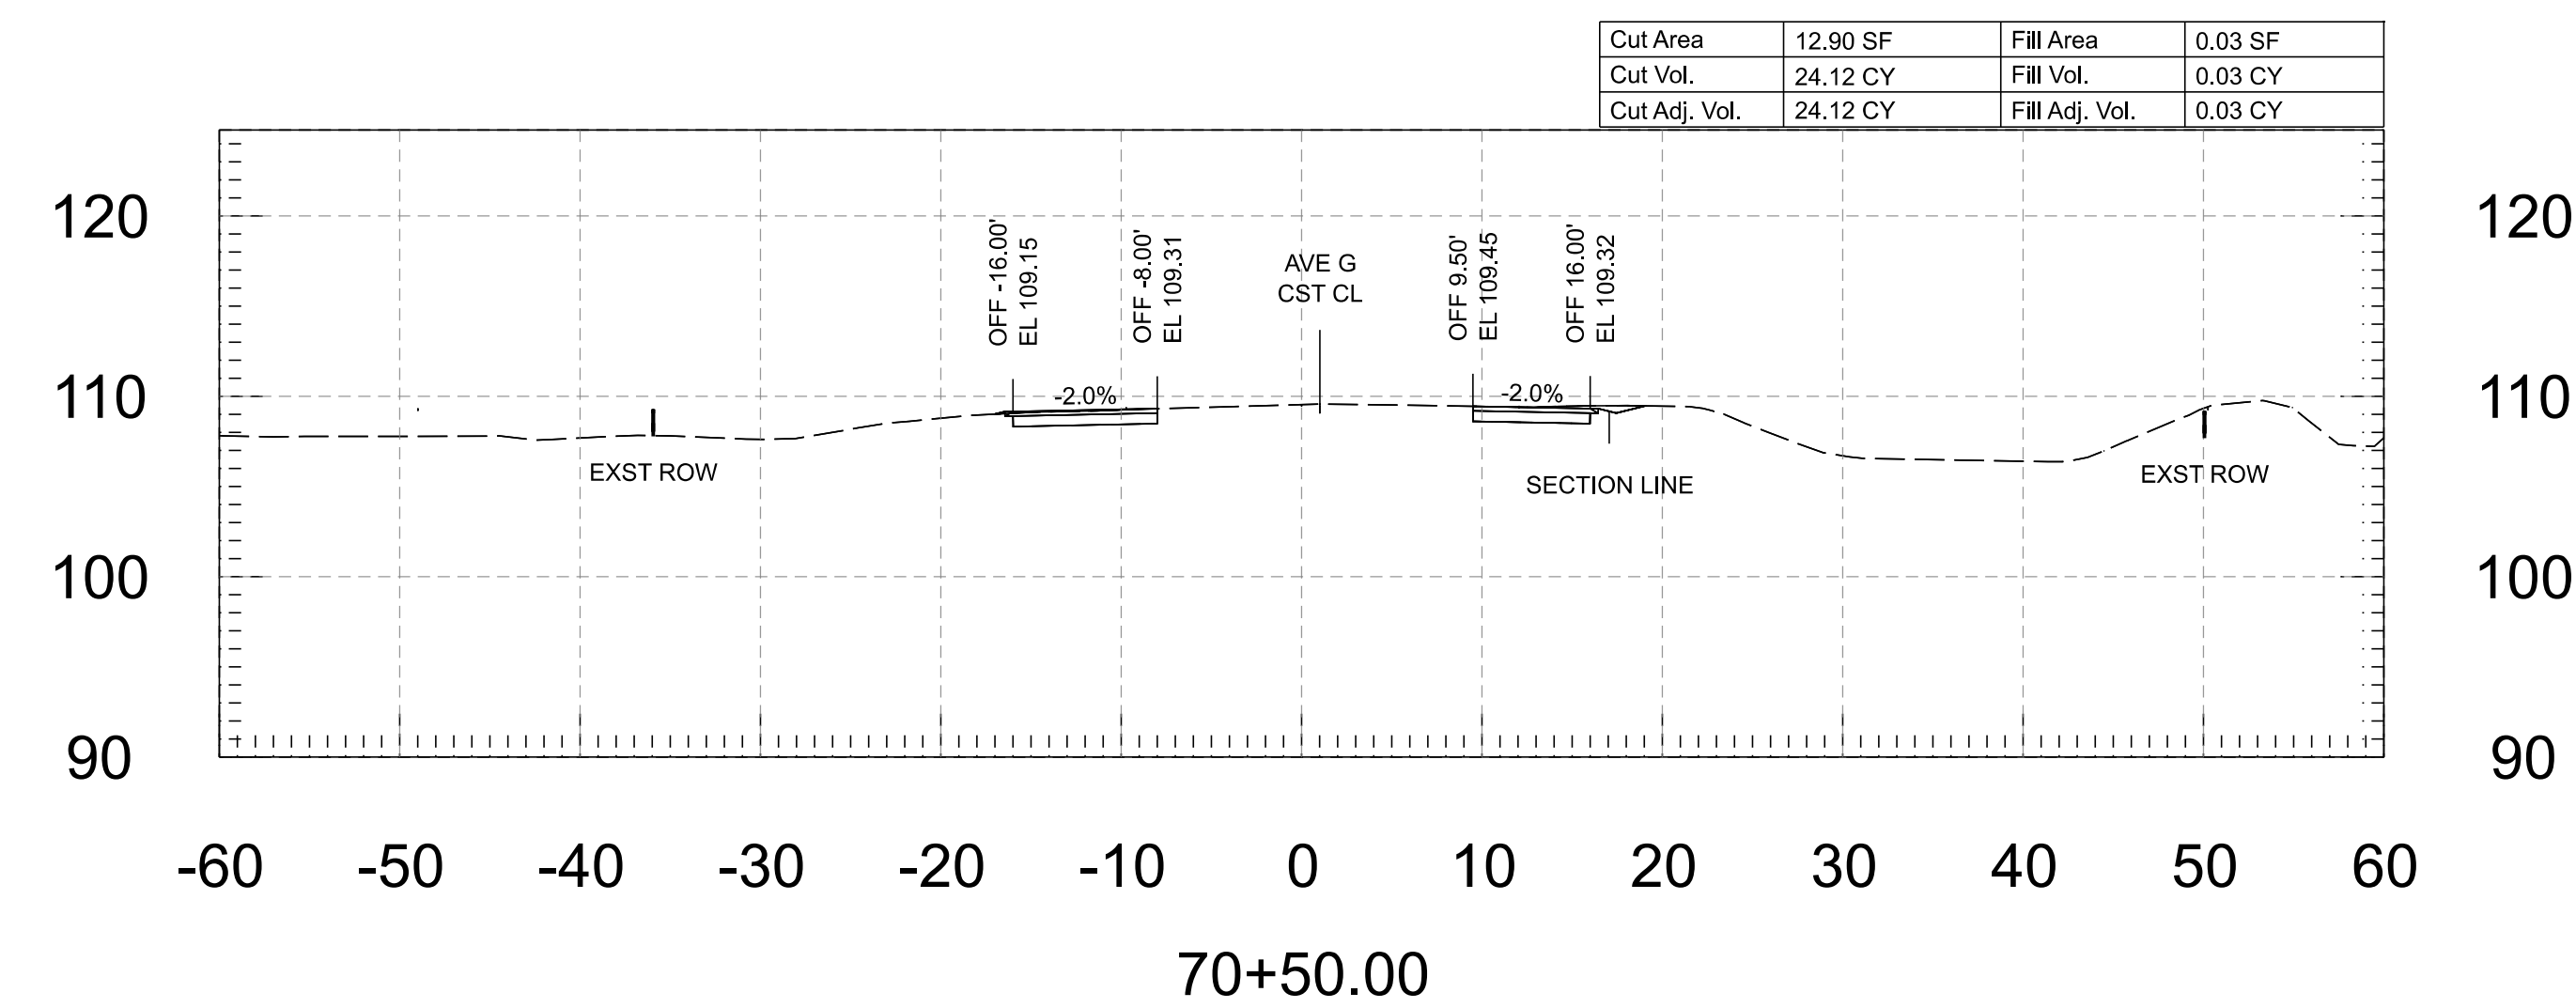






FOR INFORMATION ONLY		NAME	DATE	ARIZONA DEPARTMENT OF TRANSPORTATION PROJECT DELIVERY AND OPERATIONS DIVISION ROADWAY DESIGN SERVICES	ROUTE	F.H.W.A. Arizona Division	STATE ARIZ.	PROJECT NO.	FEDERAL ID NO.	SHEET NO.	TOTAL SHEETS	RECORD DRAWING
	DESIGN	M. SCHOEN	07/26		0000 YU YYU			YYU-0(225)T	28	118		
	DRAWN	M. SCHOEN	07/26									
	CHECKED	H. RIOS	07/26	AVENUE G - CROSS SECTIONS	MILEPOST	LOCATION AVENUE G, COUNTY 11TH ST - COUNTY 16TH ST DWG						
	wsp WSP USA Inc. 1280 West Washington Street, Suite 405 Tempe, AZ 85288				STRUCTURE NO.							

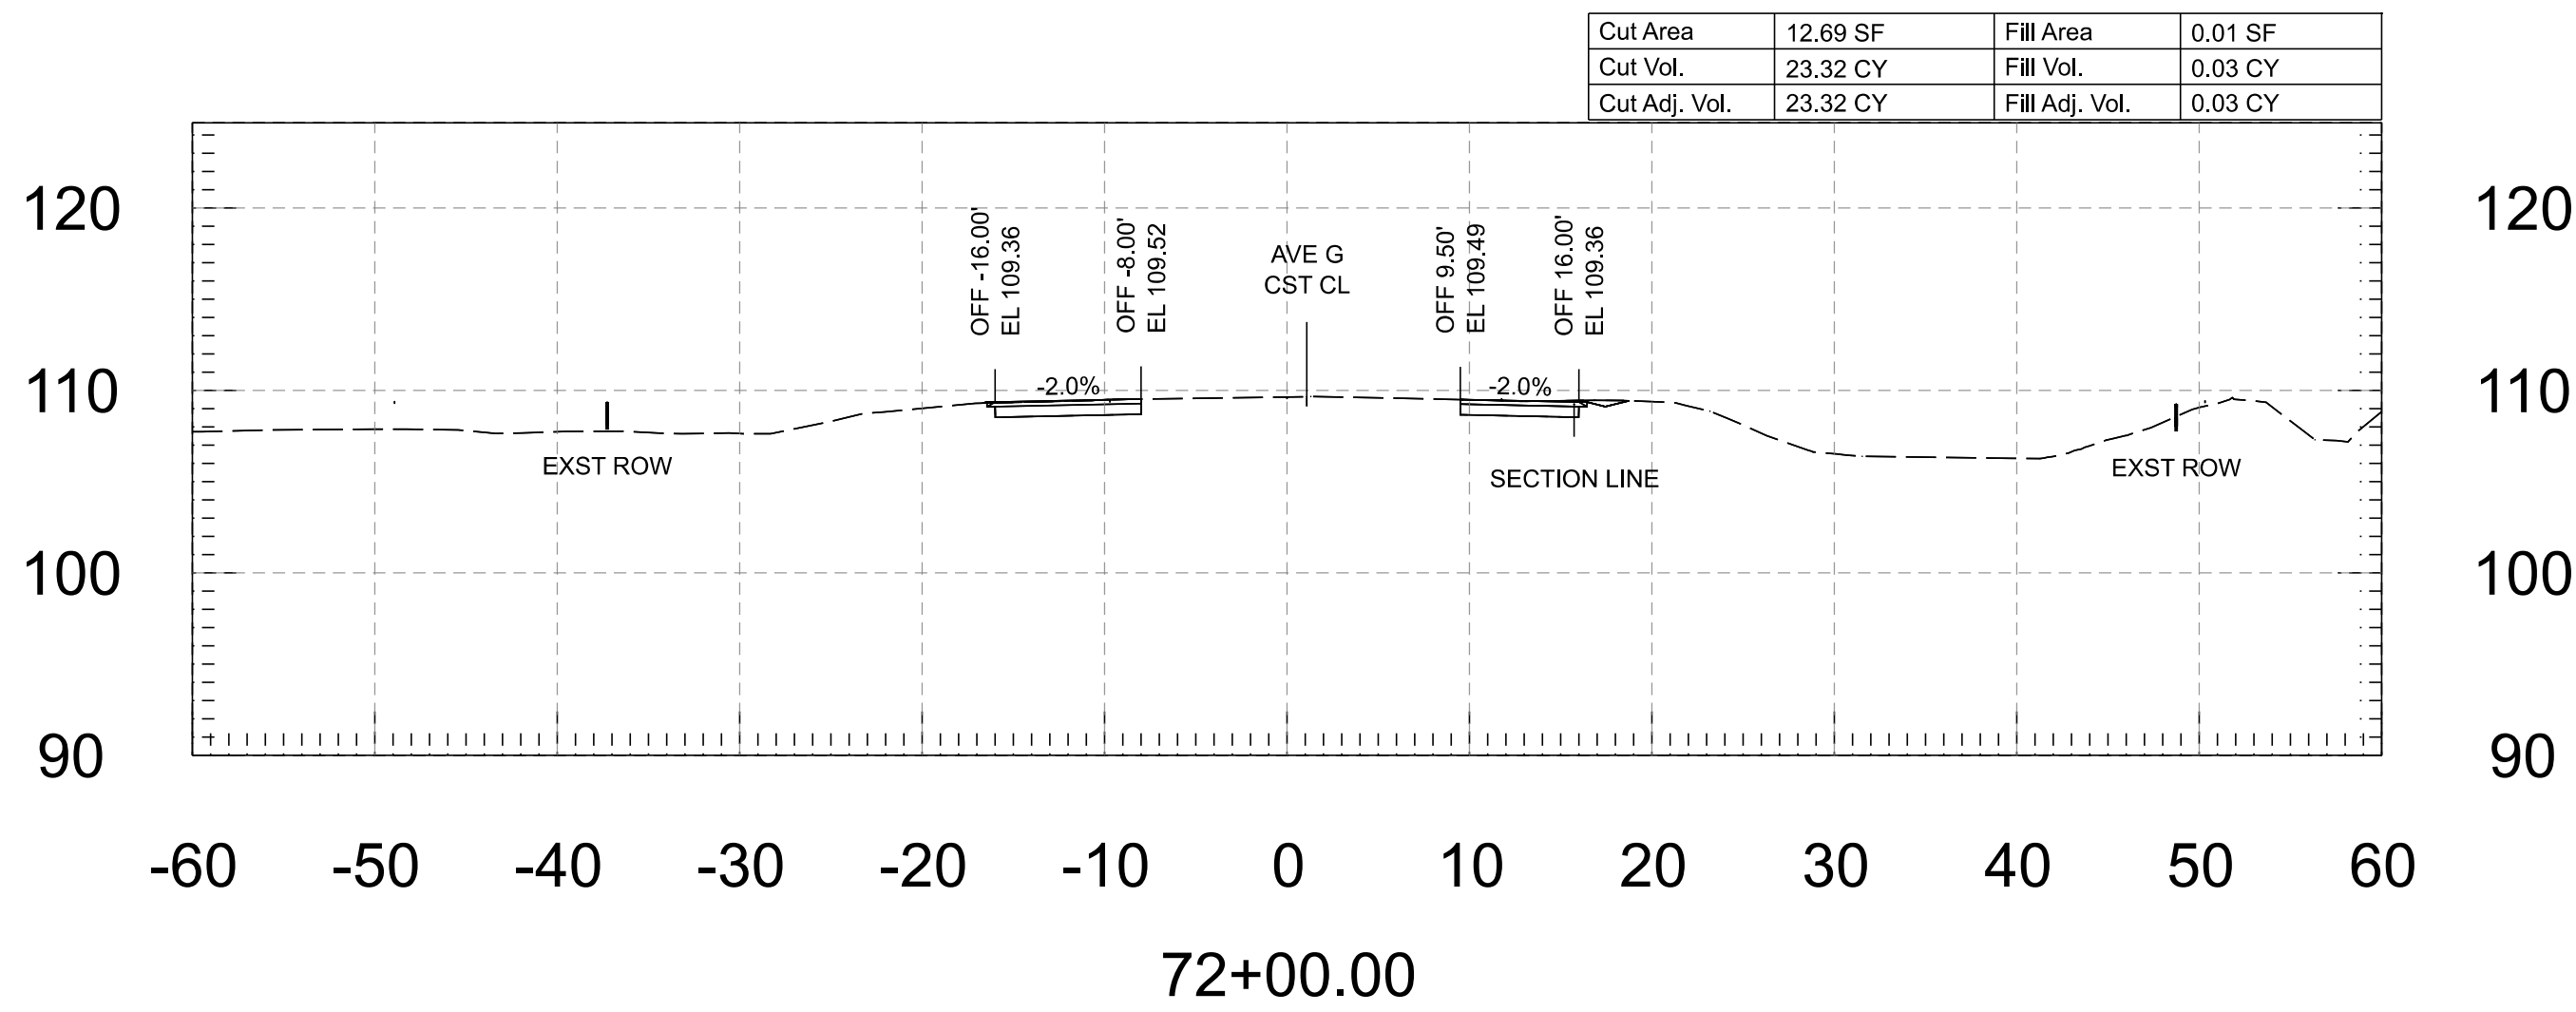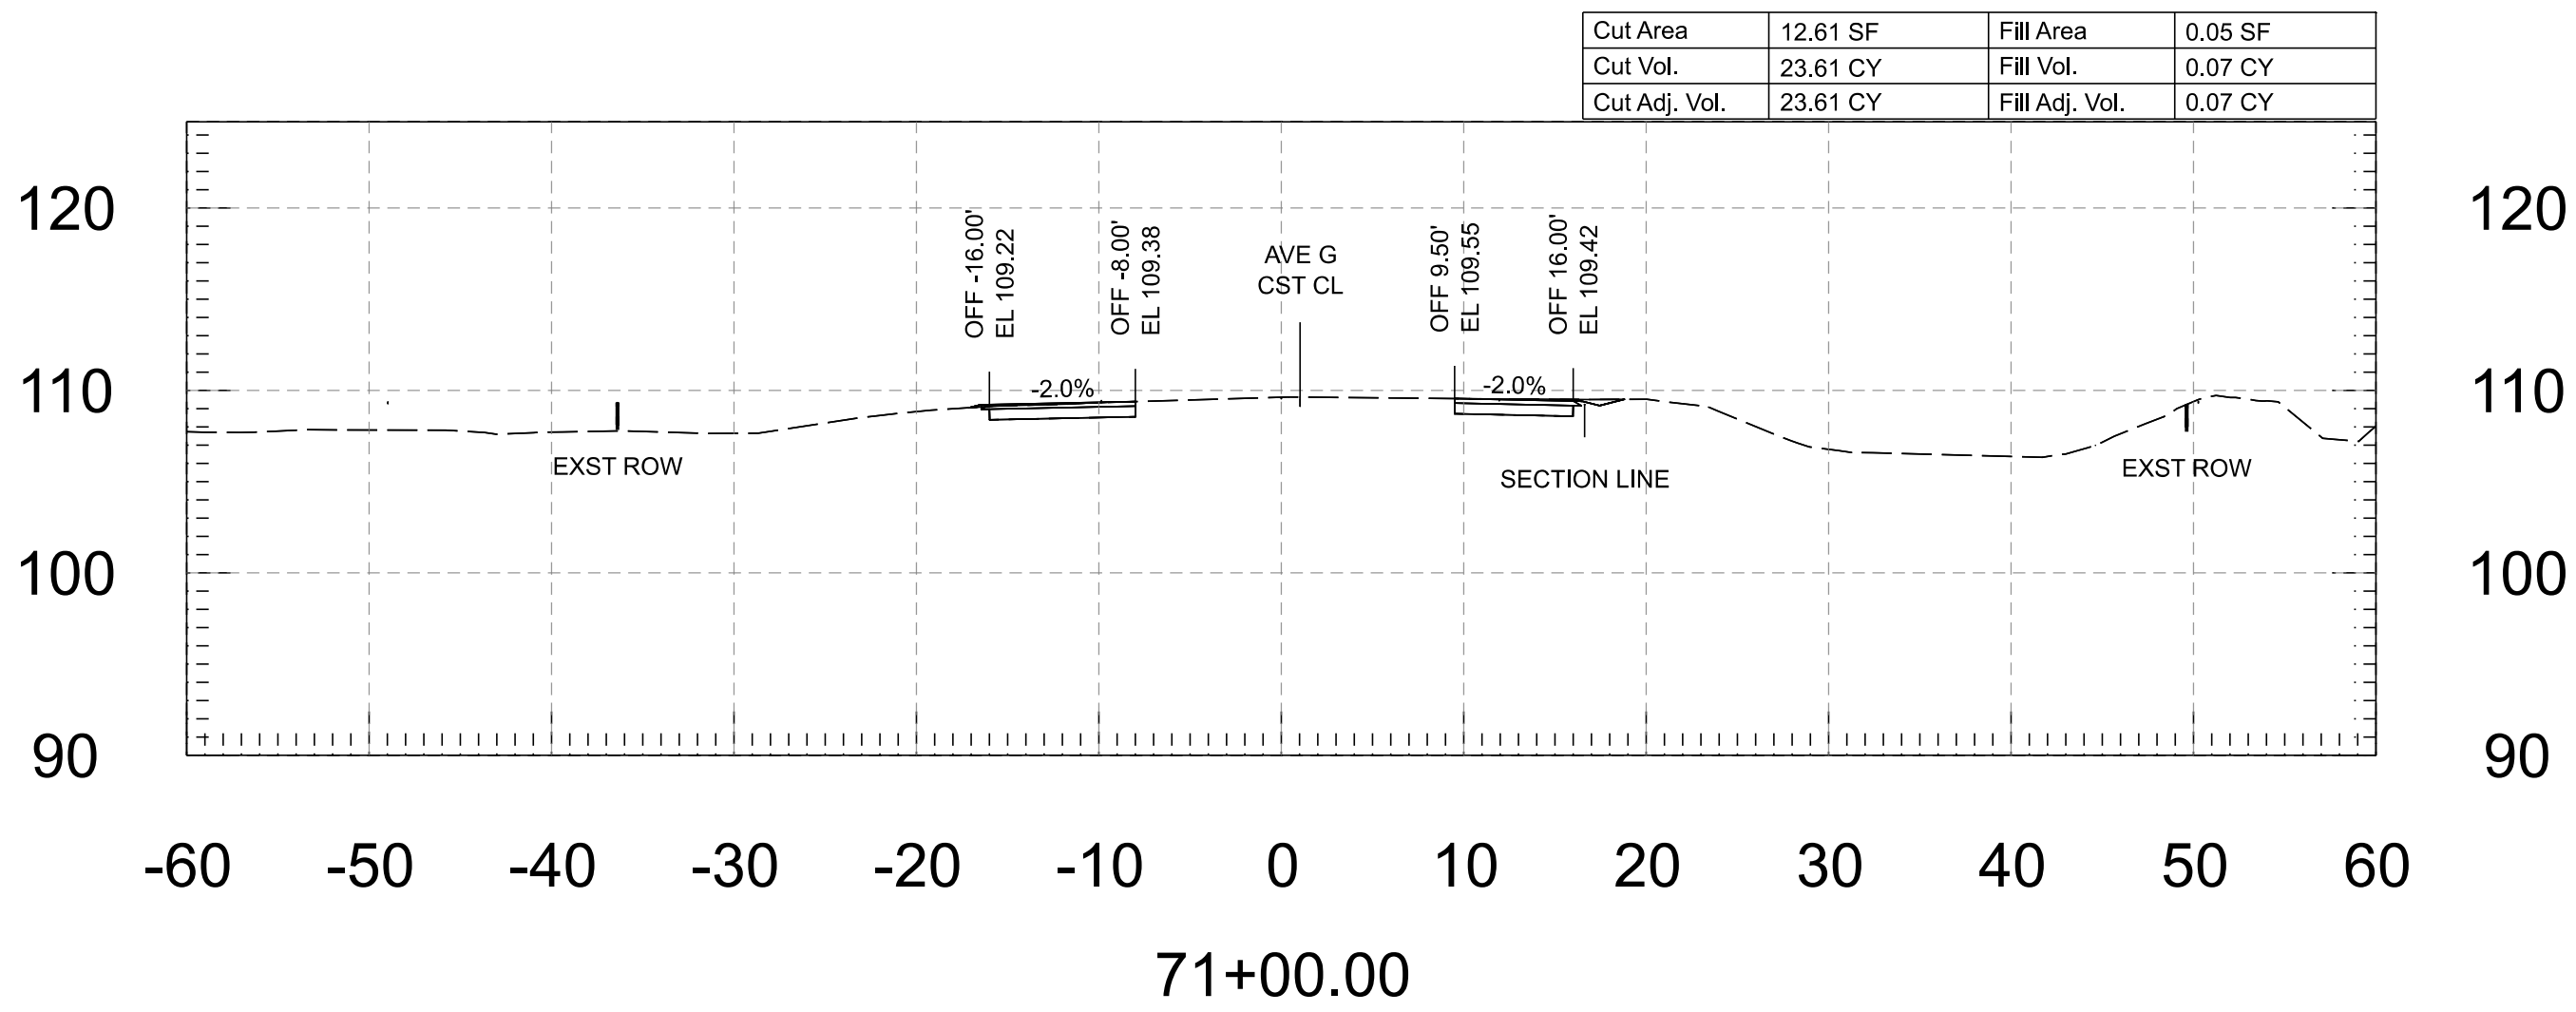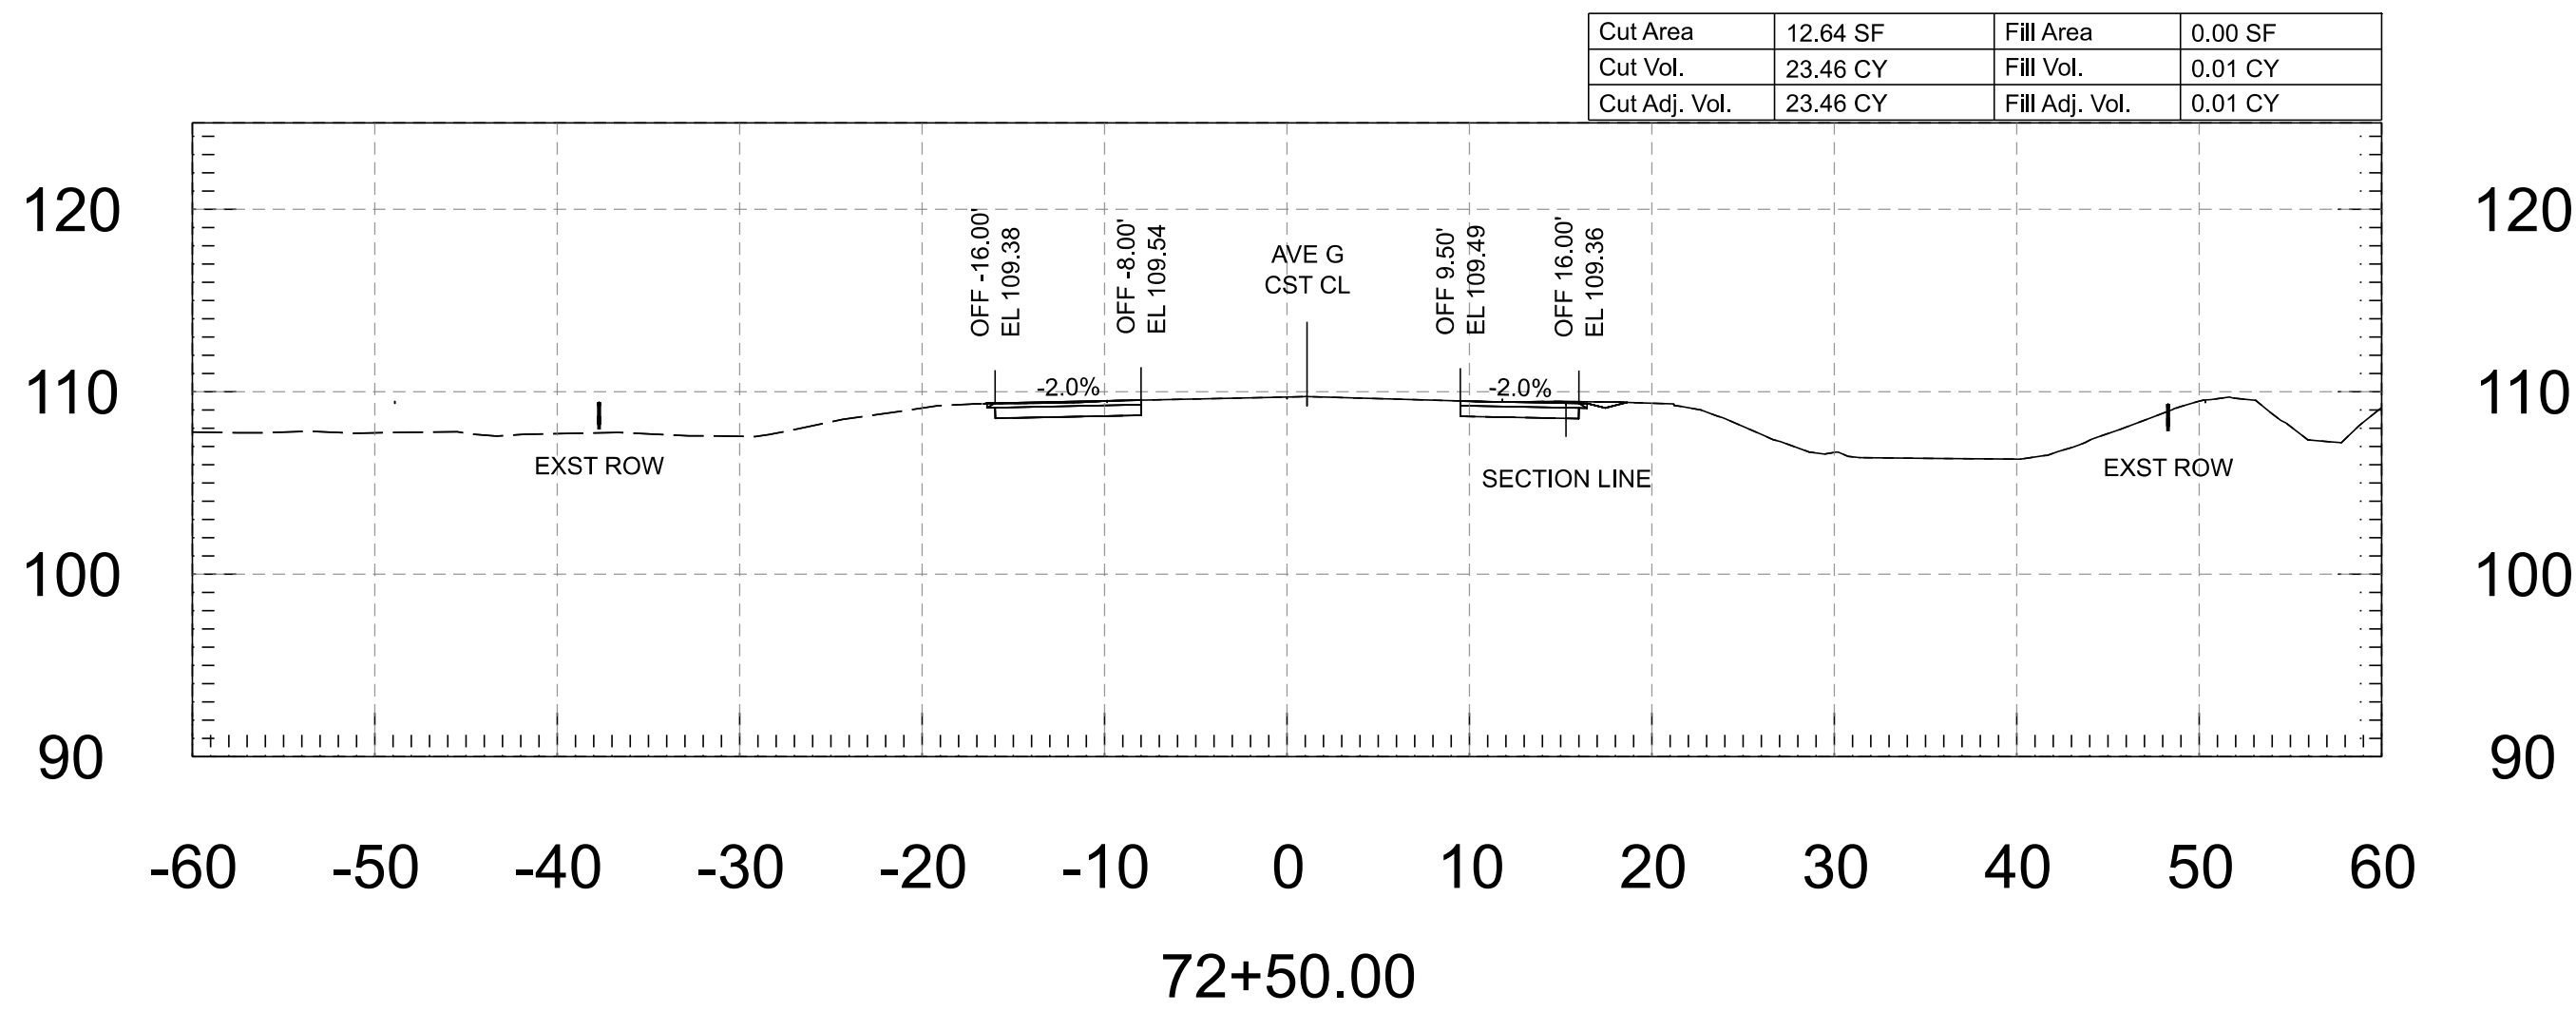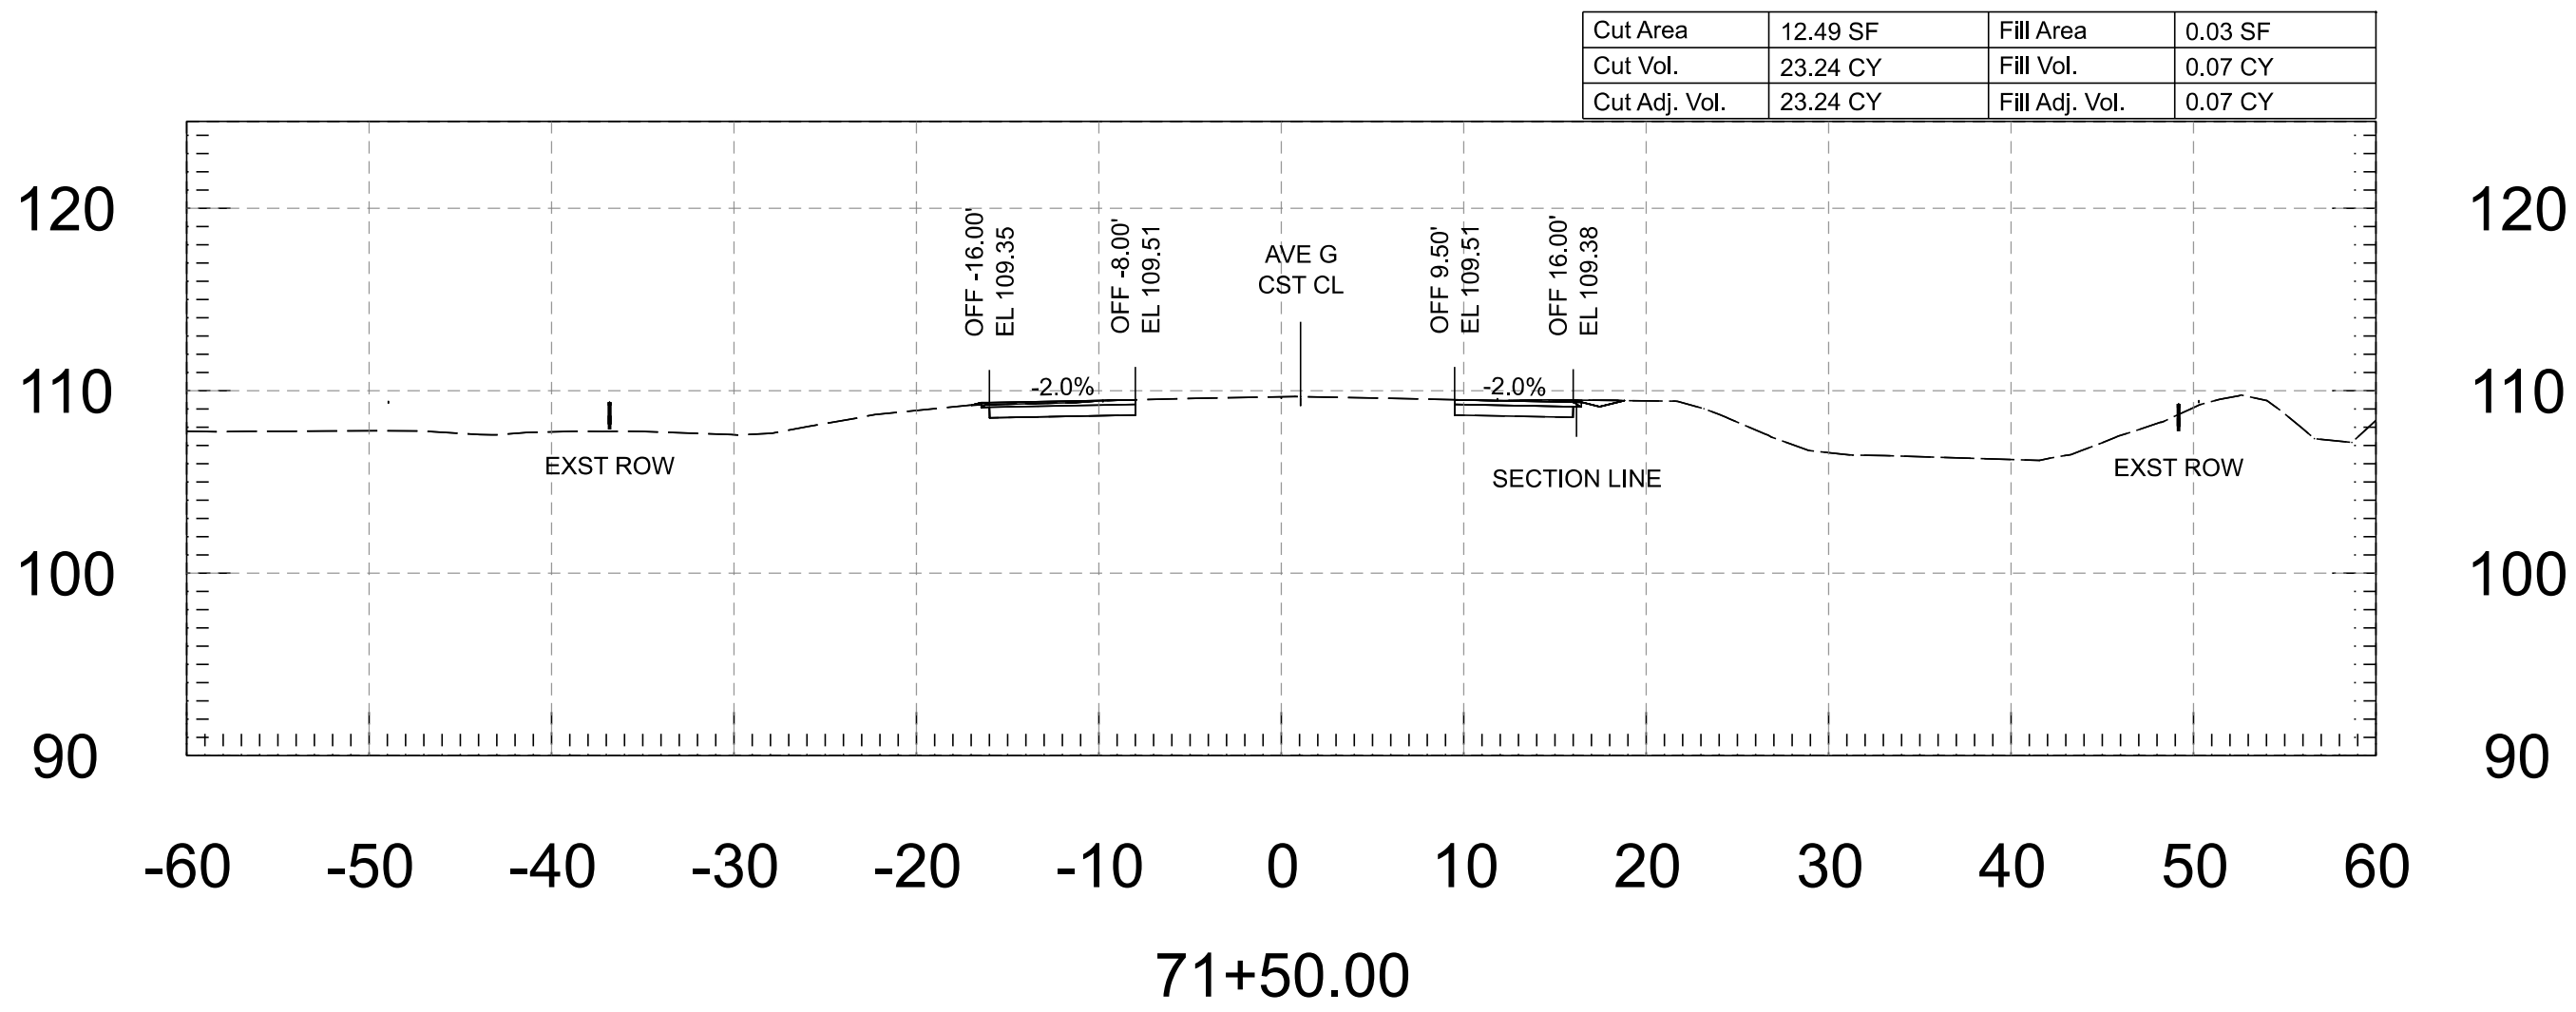

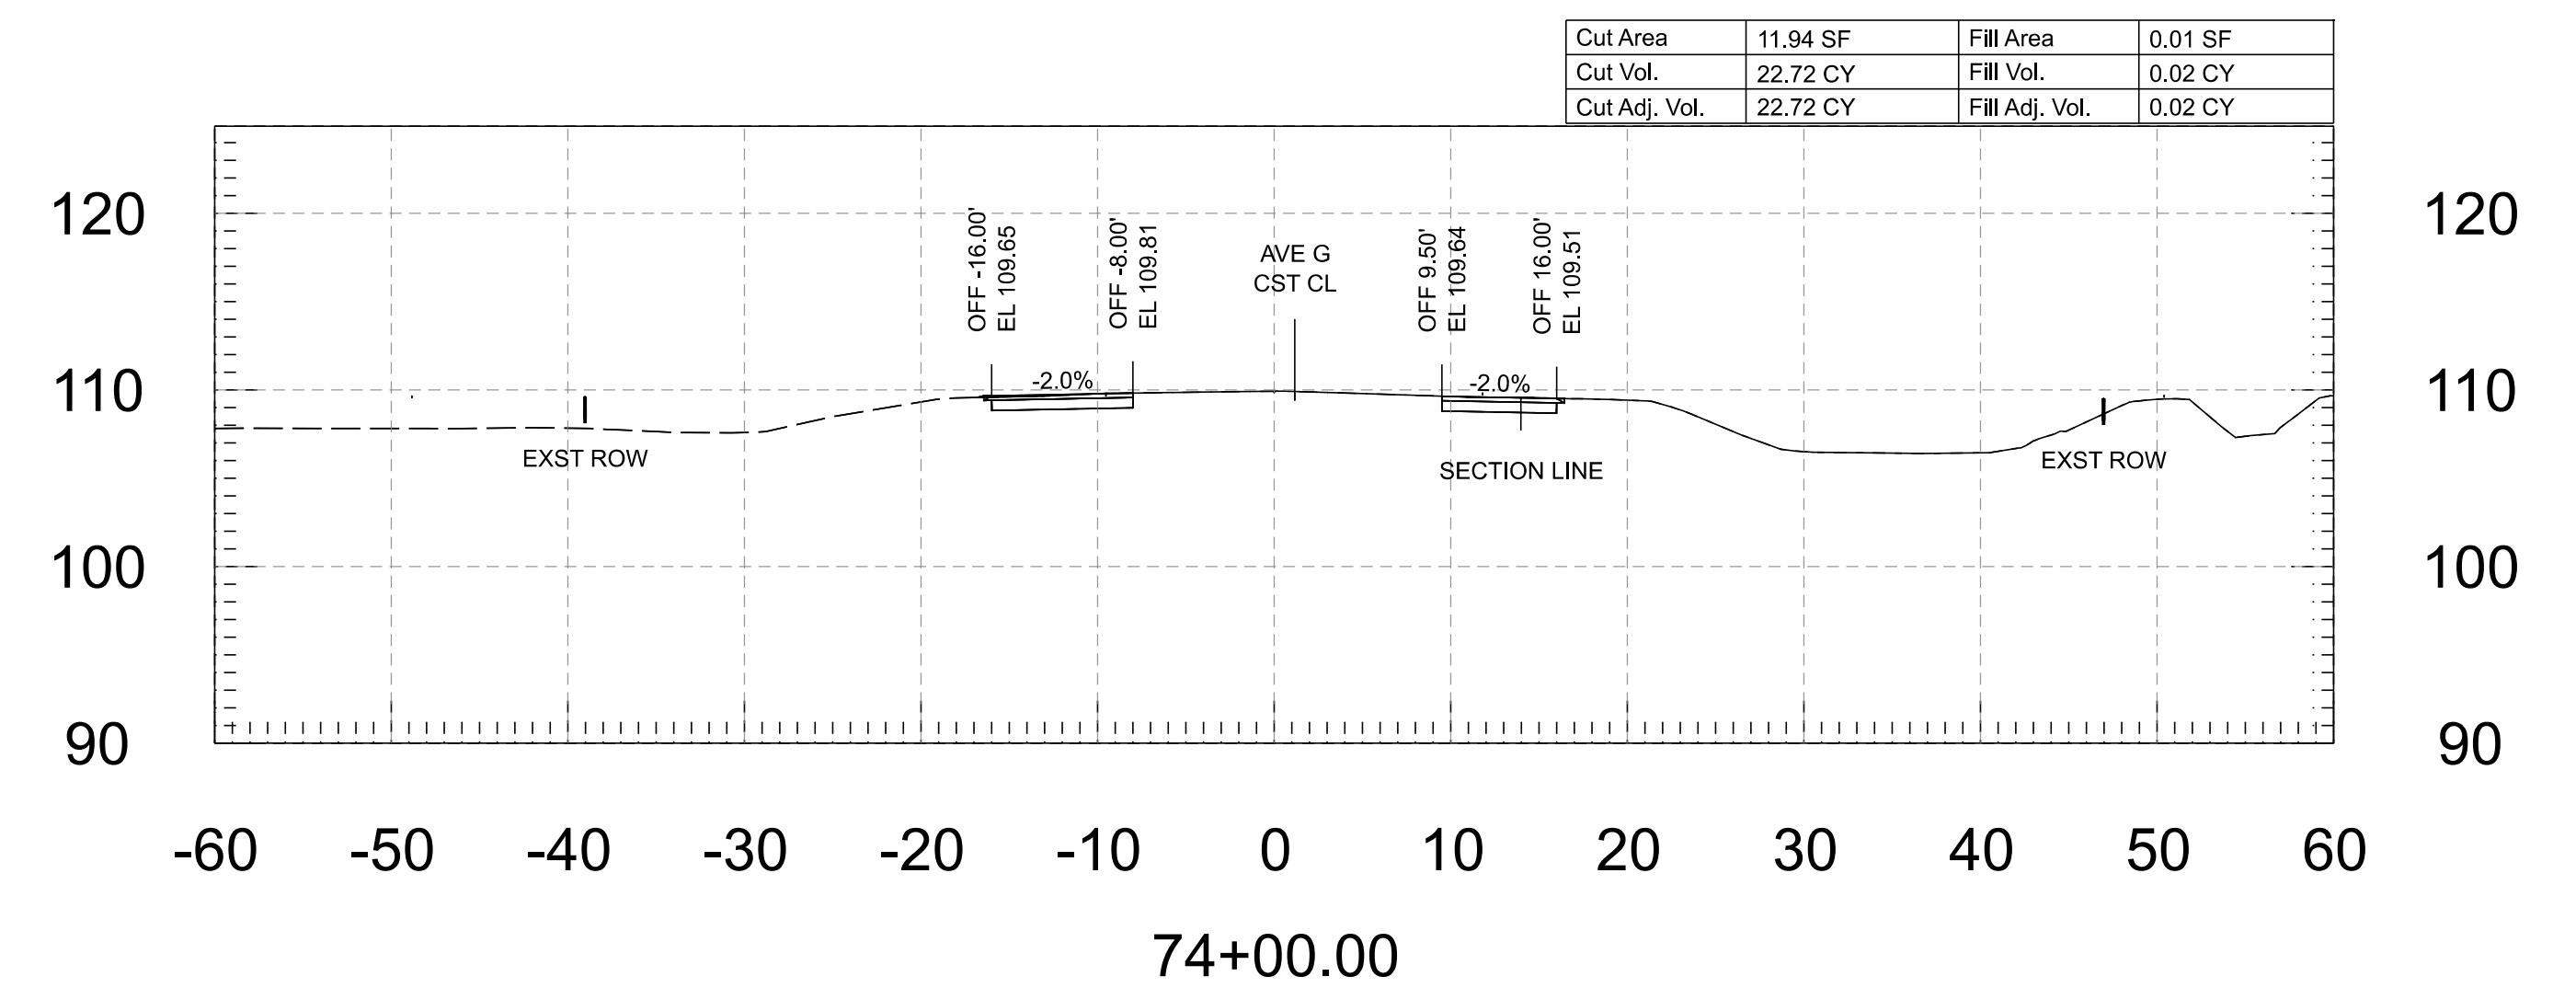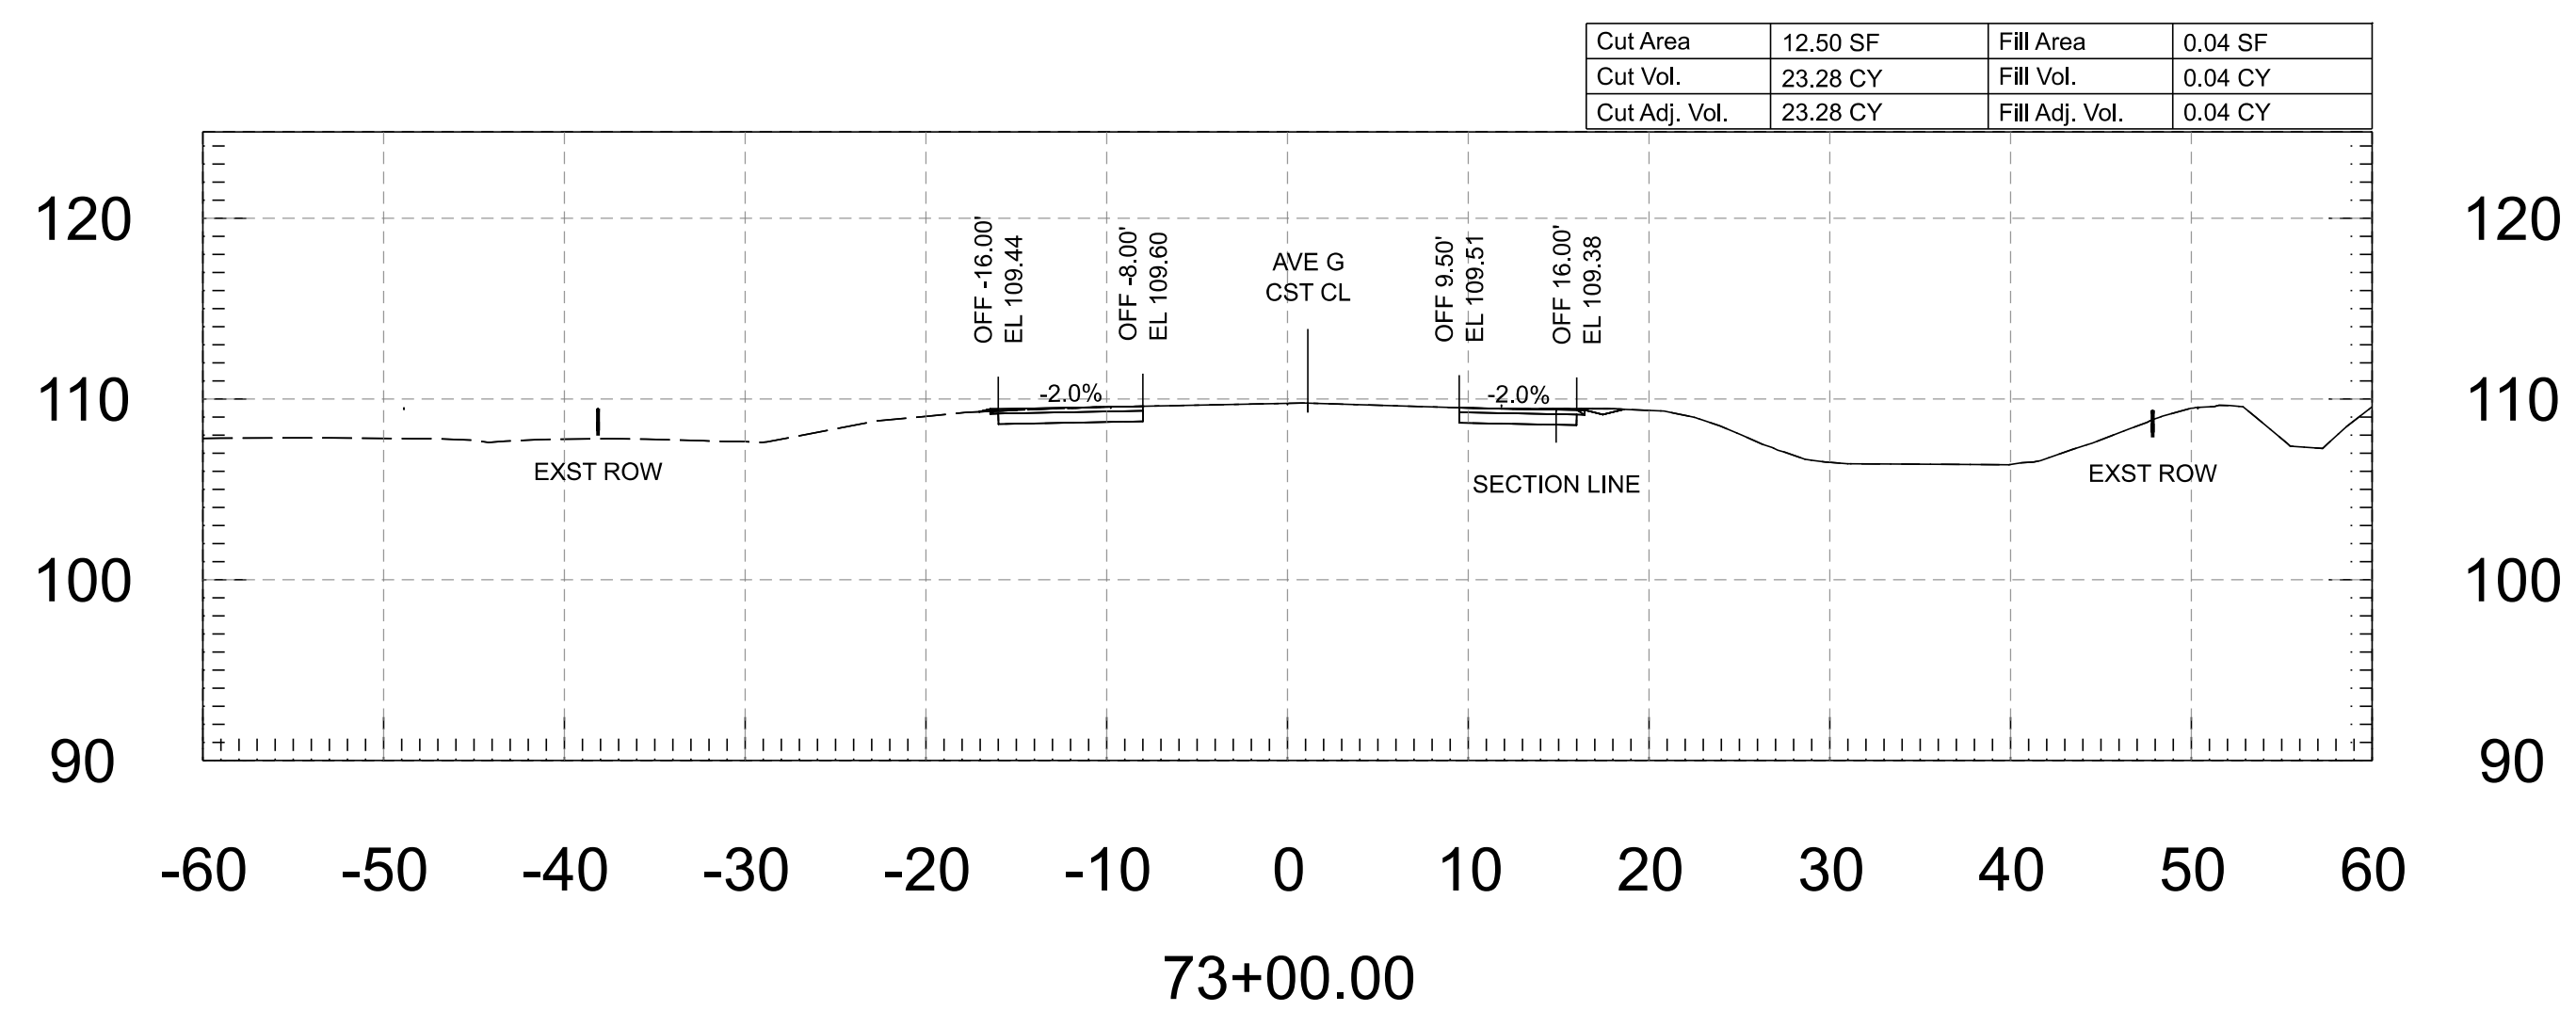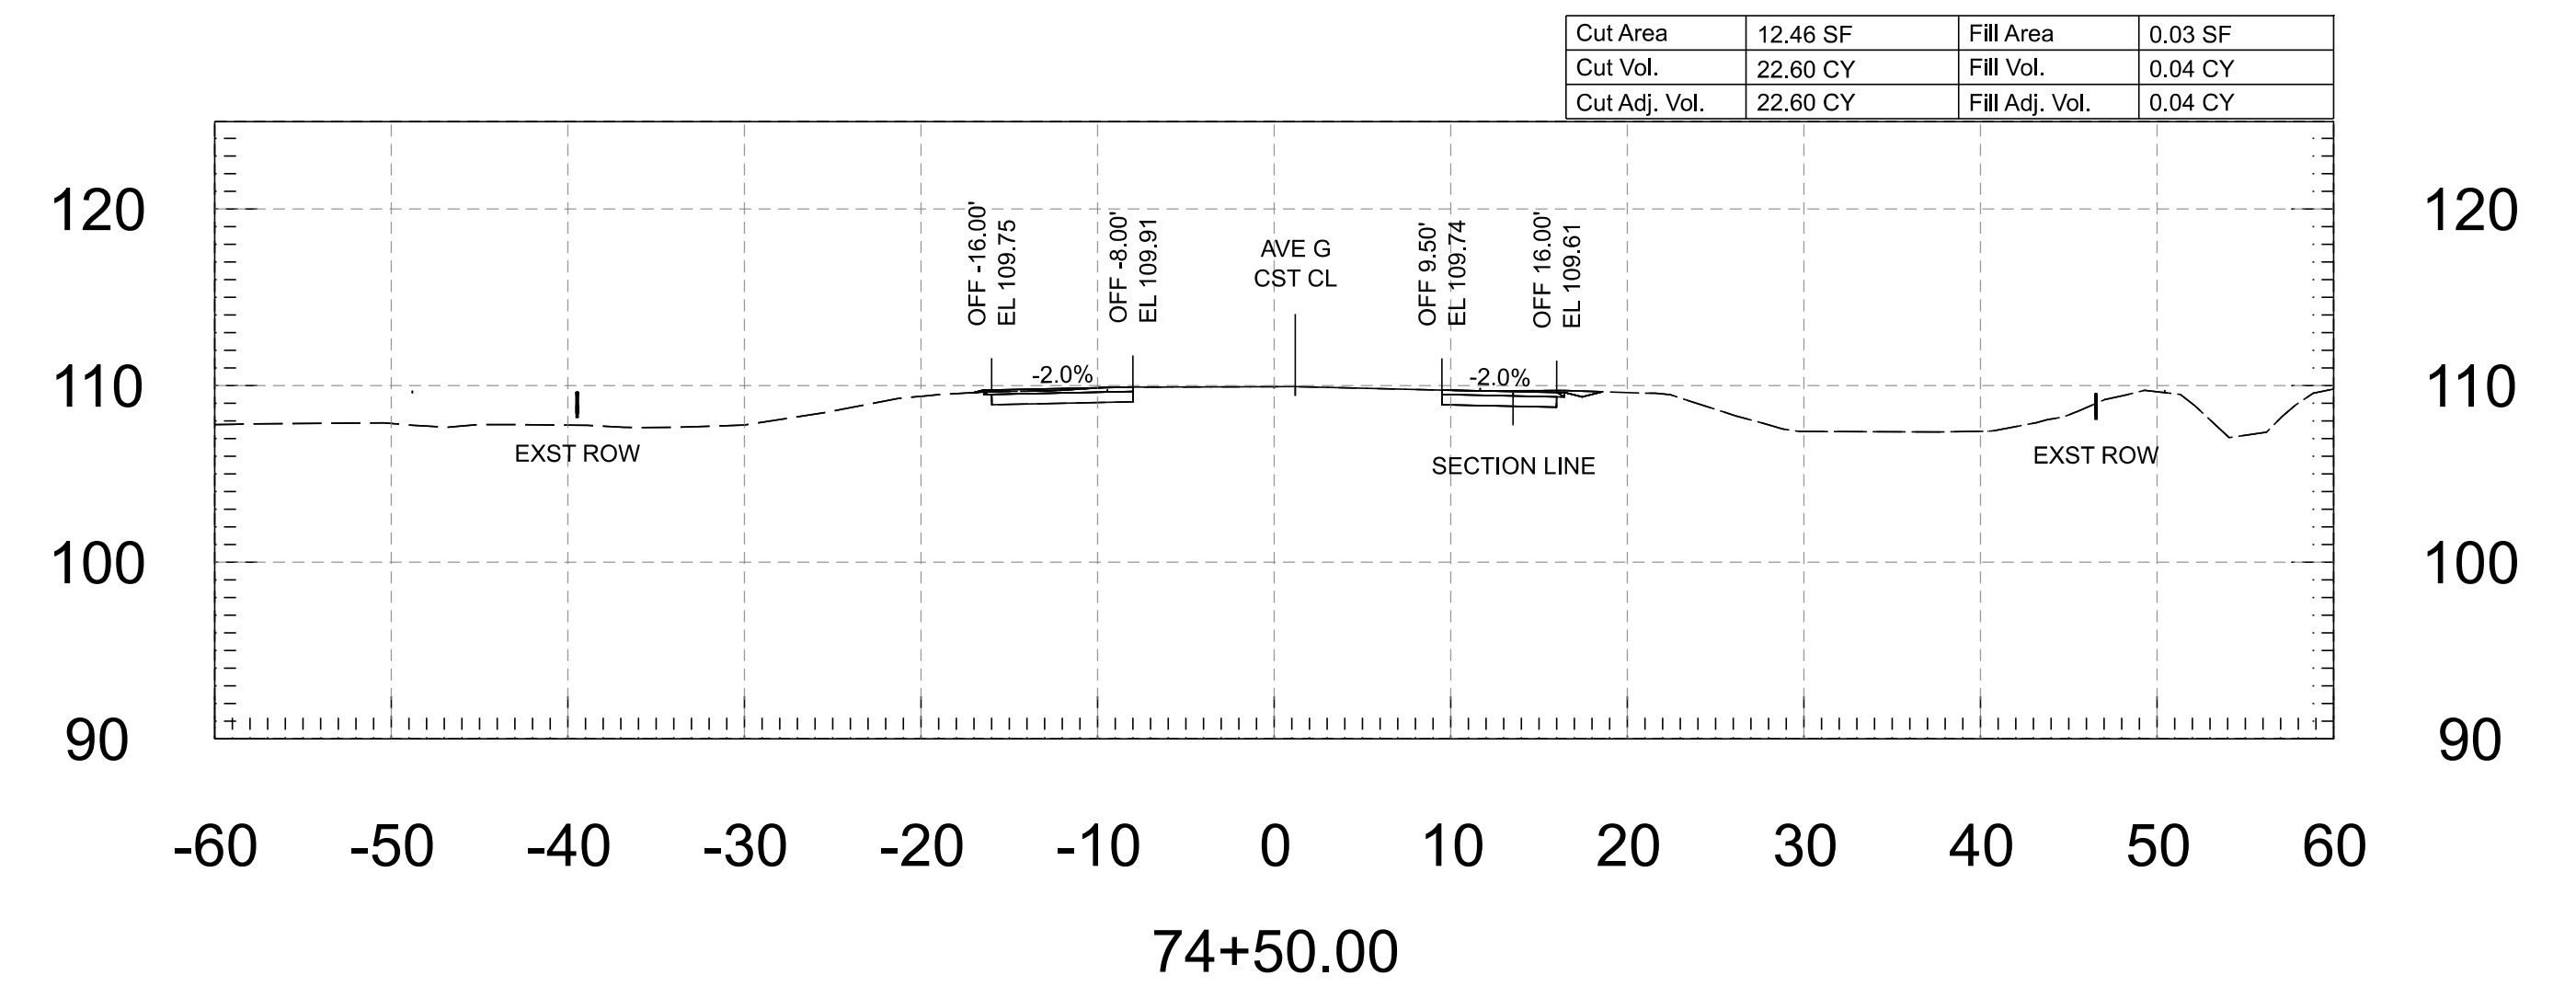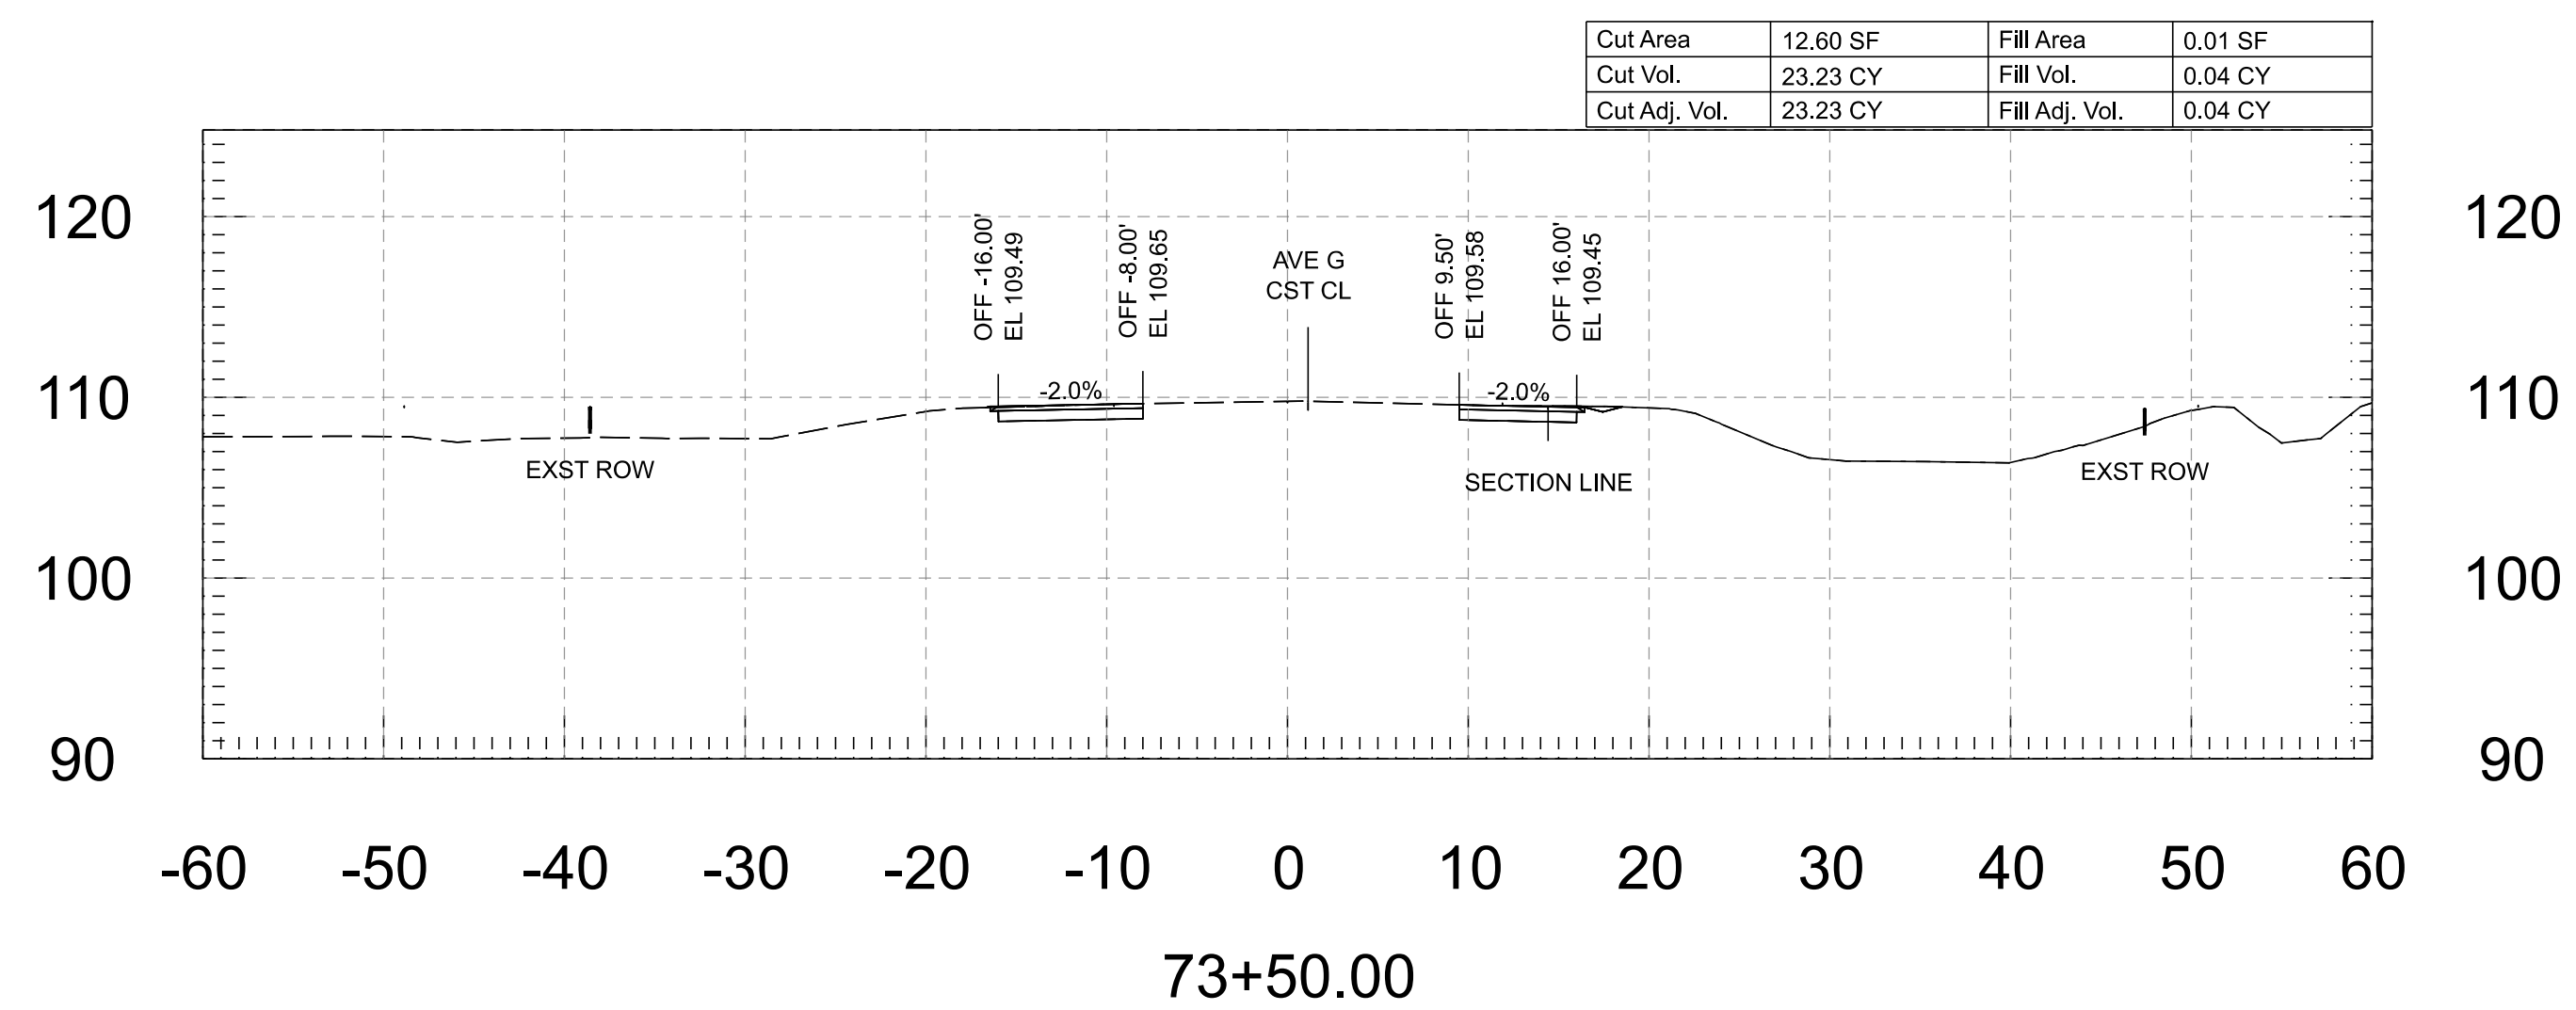


FOR INFORMATION ONLY		NAME	DATE	ARIZONA DEPARTMENT OF TRANSPORTATION PROJECT DELIVERY AND OPERATIONS DIVISION ROADWAY DESIGN SERVICES	ROUTE	F.H.W.A. Arizona Division	STATE	PROJECT NO.	FEDERAL ID NO.	SHEET NO.	TOTAL SHEETS	RECORD DRAWING
	DESIGN	M. SCHOEN	07/26		MILEPOST		ARIZ.	0000 YU YUU	YUU-0(225)T	30	118	
	DRAWN	M. SCHOEN	07/26		STRUCTURE NO.	LOCATION AVENUE G, COUNTY 11TH ST - COUNTY 16TH ST						
	CHECKED	H. RIOS	07/26			DWG						
	 WSP USA Inc. 1230 West Washington Street, Suite 405 Tempe, AZ 85288			AVENUE G - CROSS SECTIONS	TRACS NO. T0437 01C					___ OF ___		

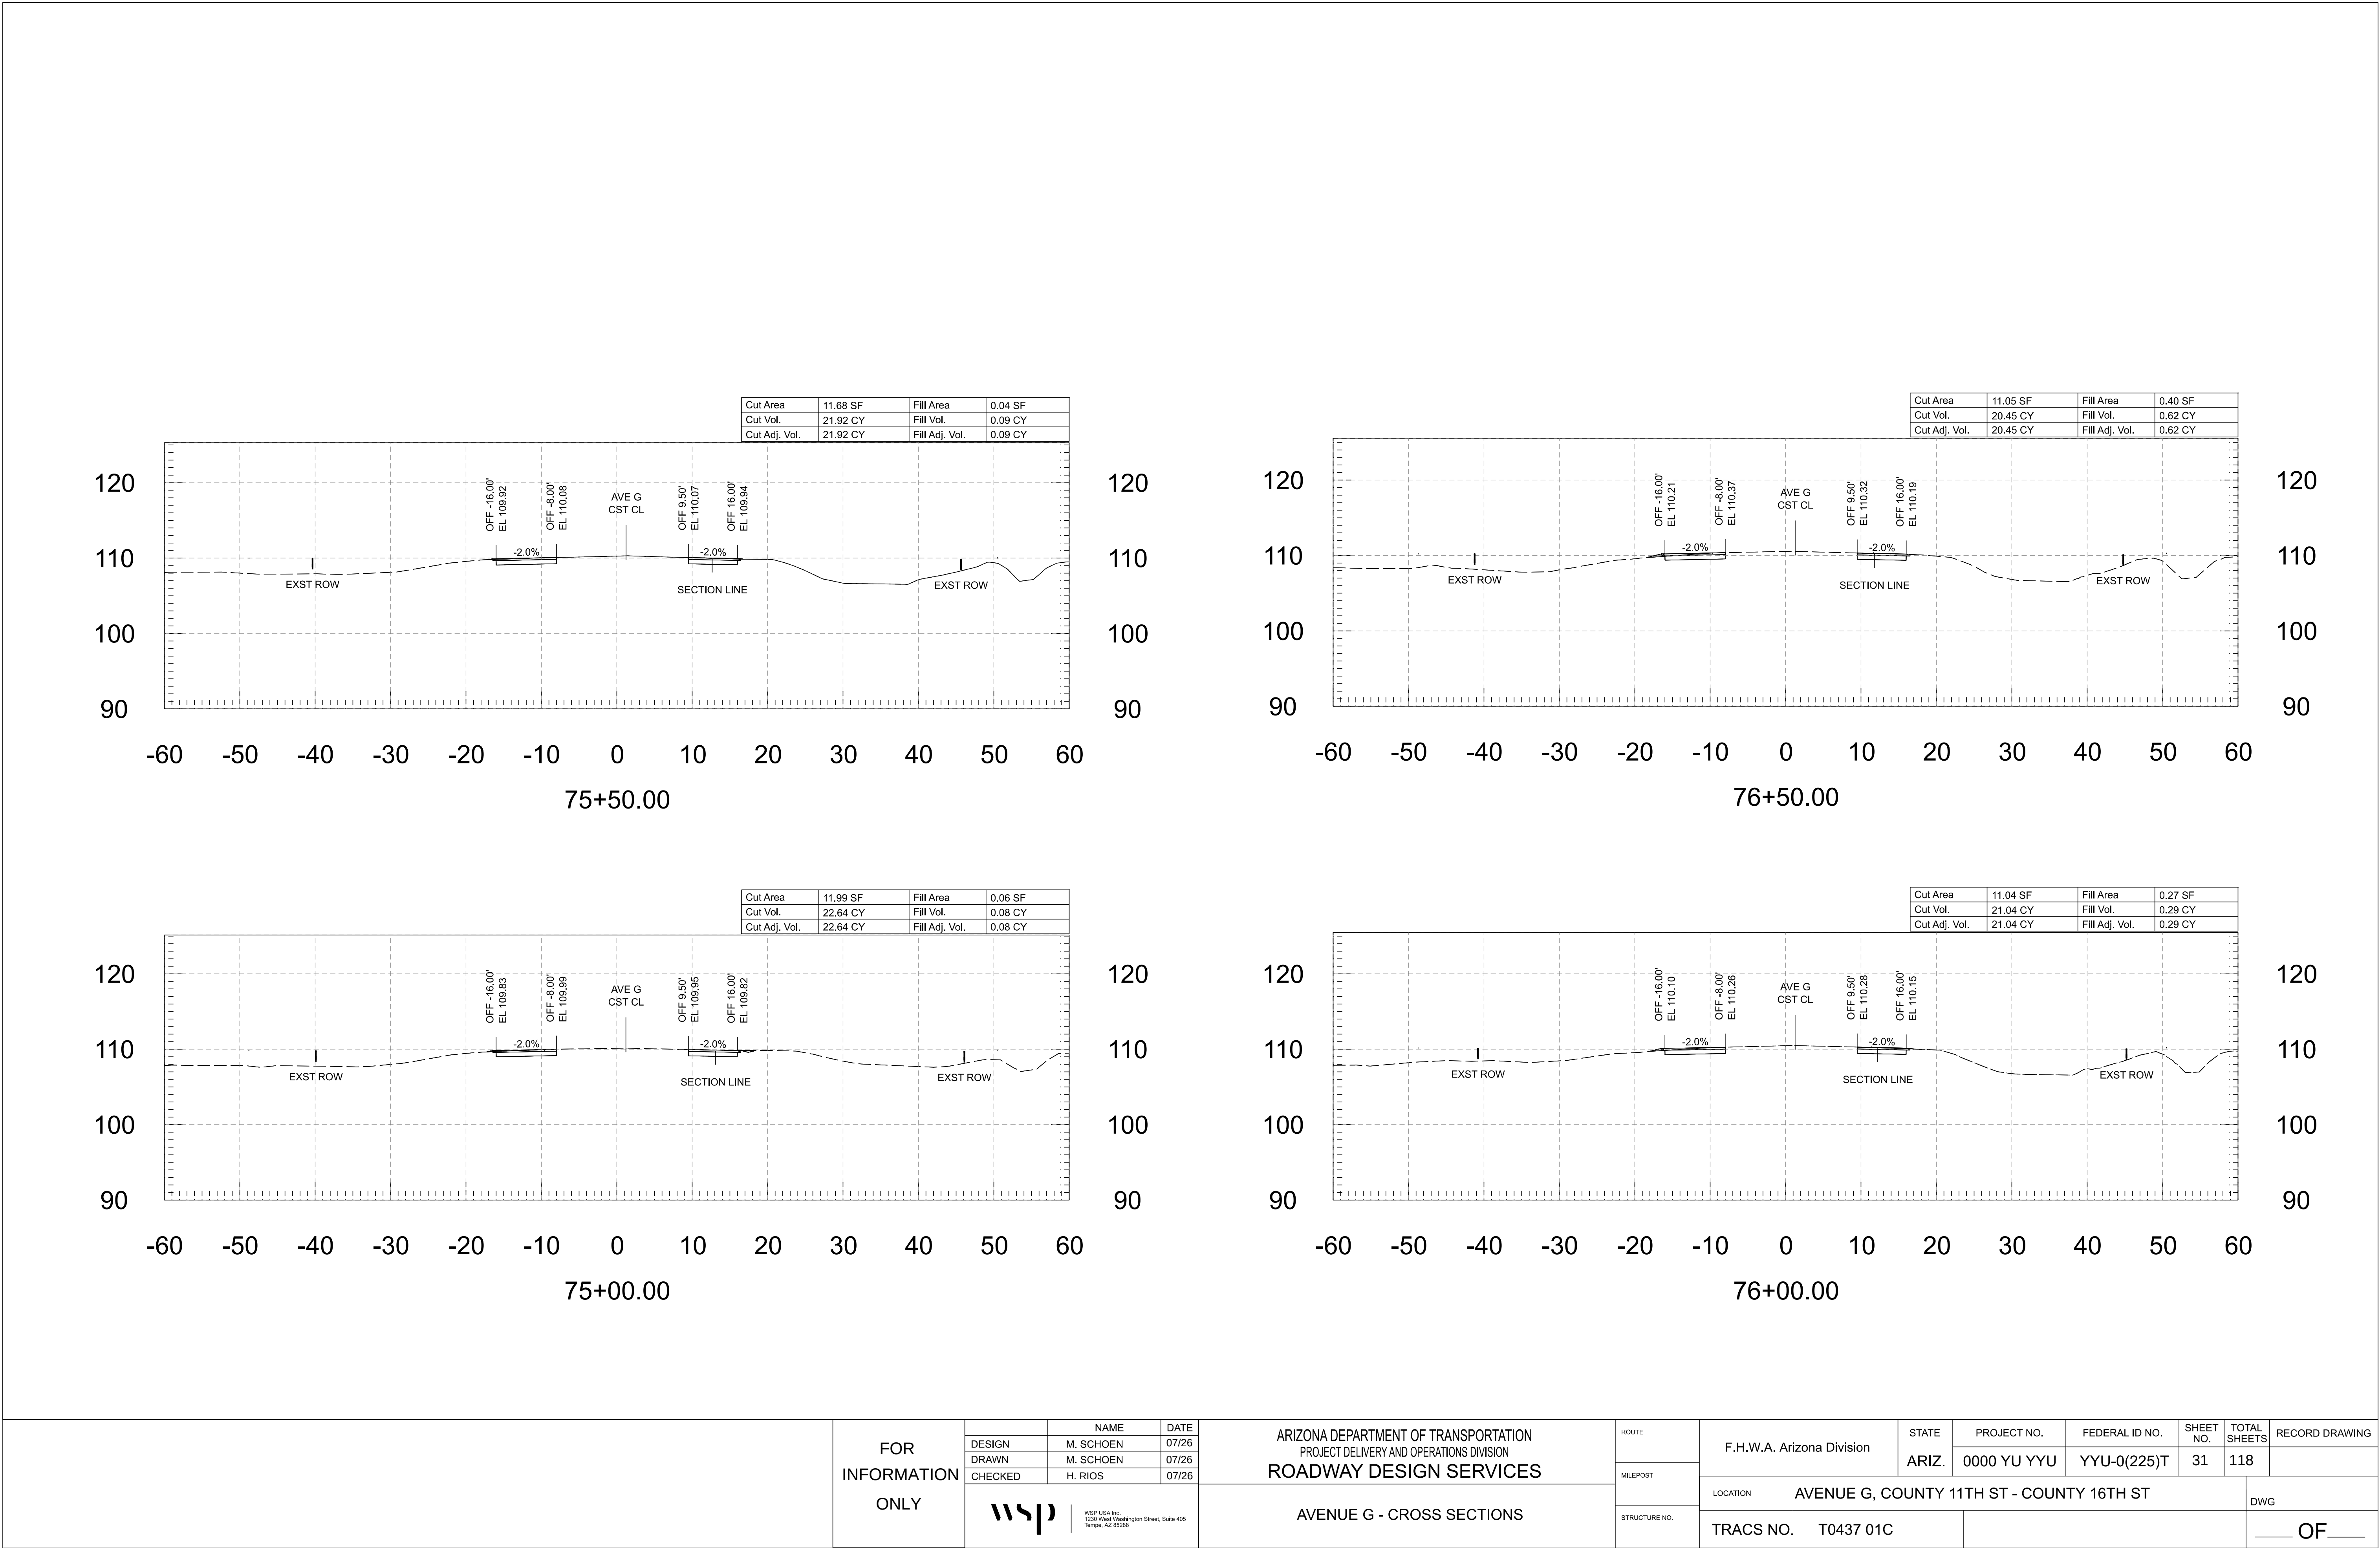

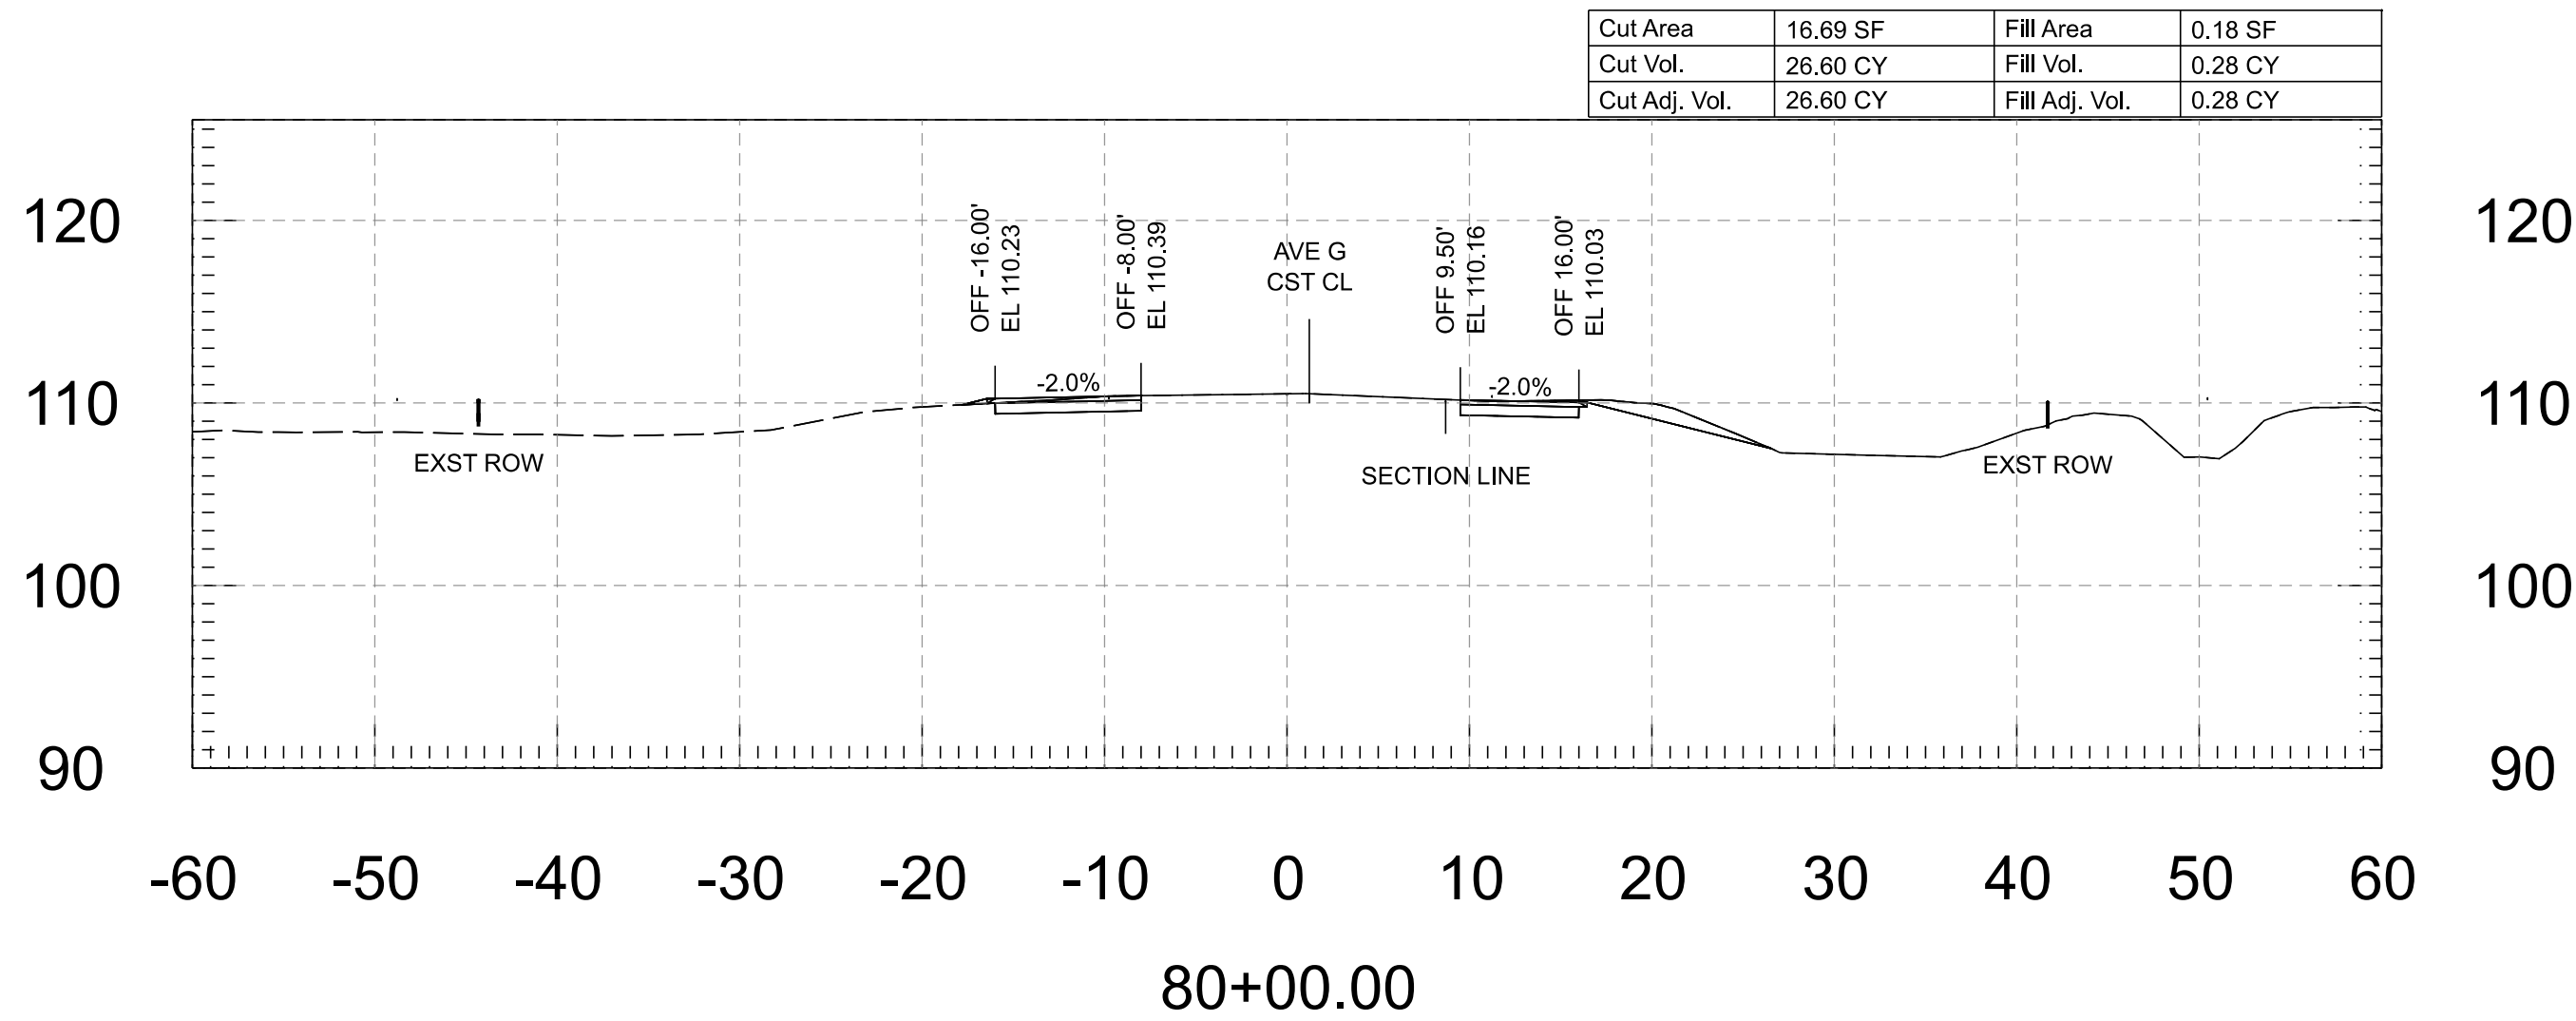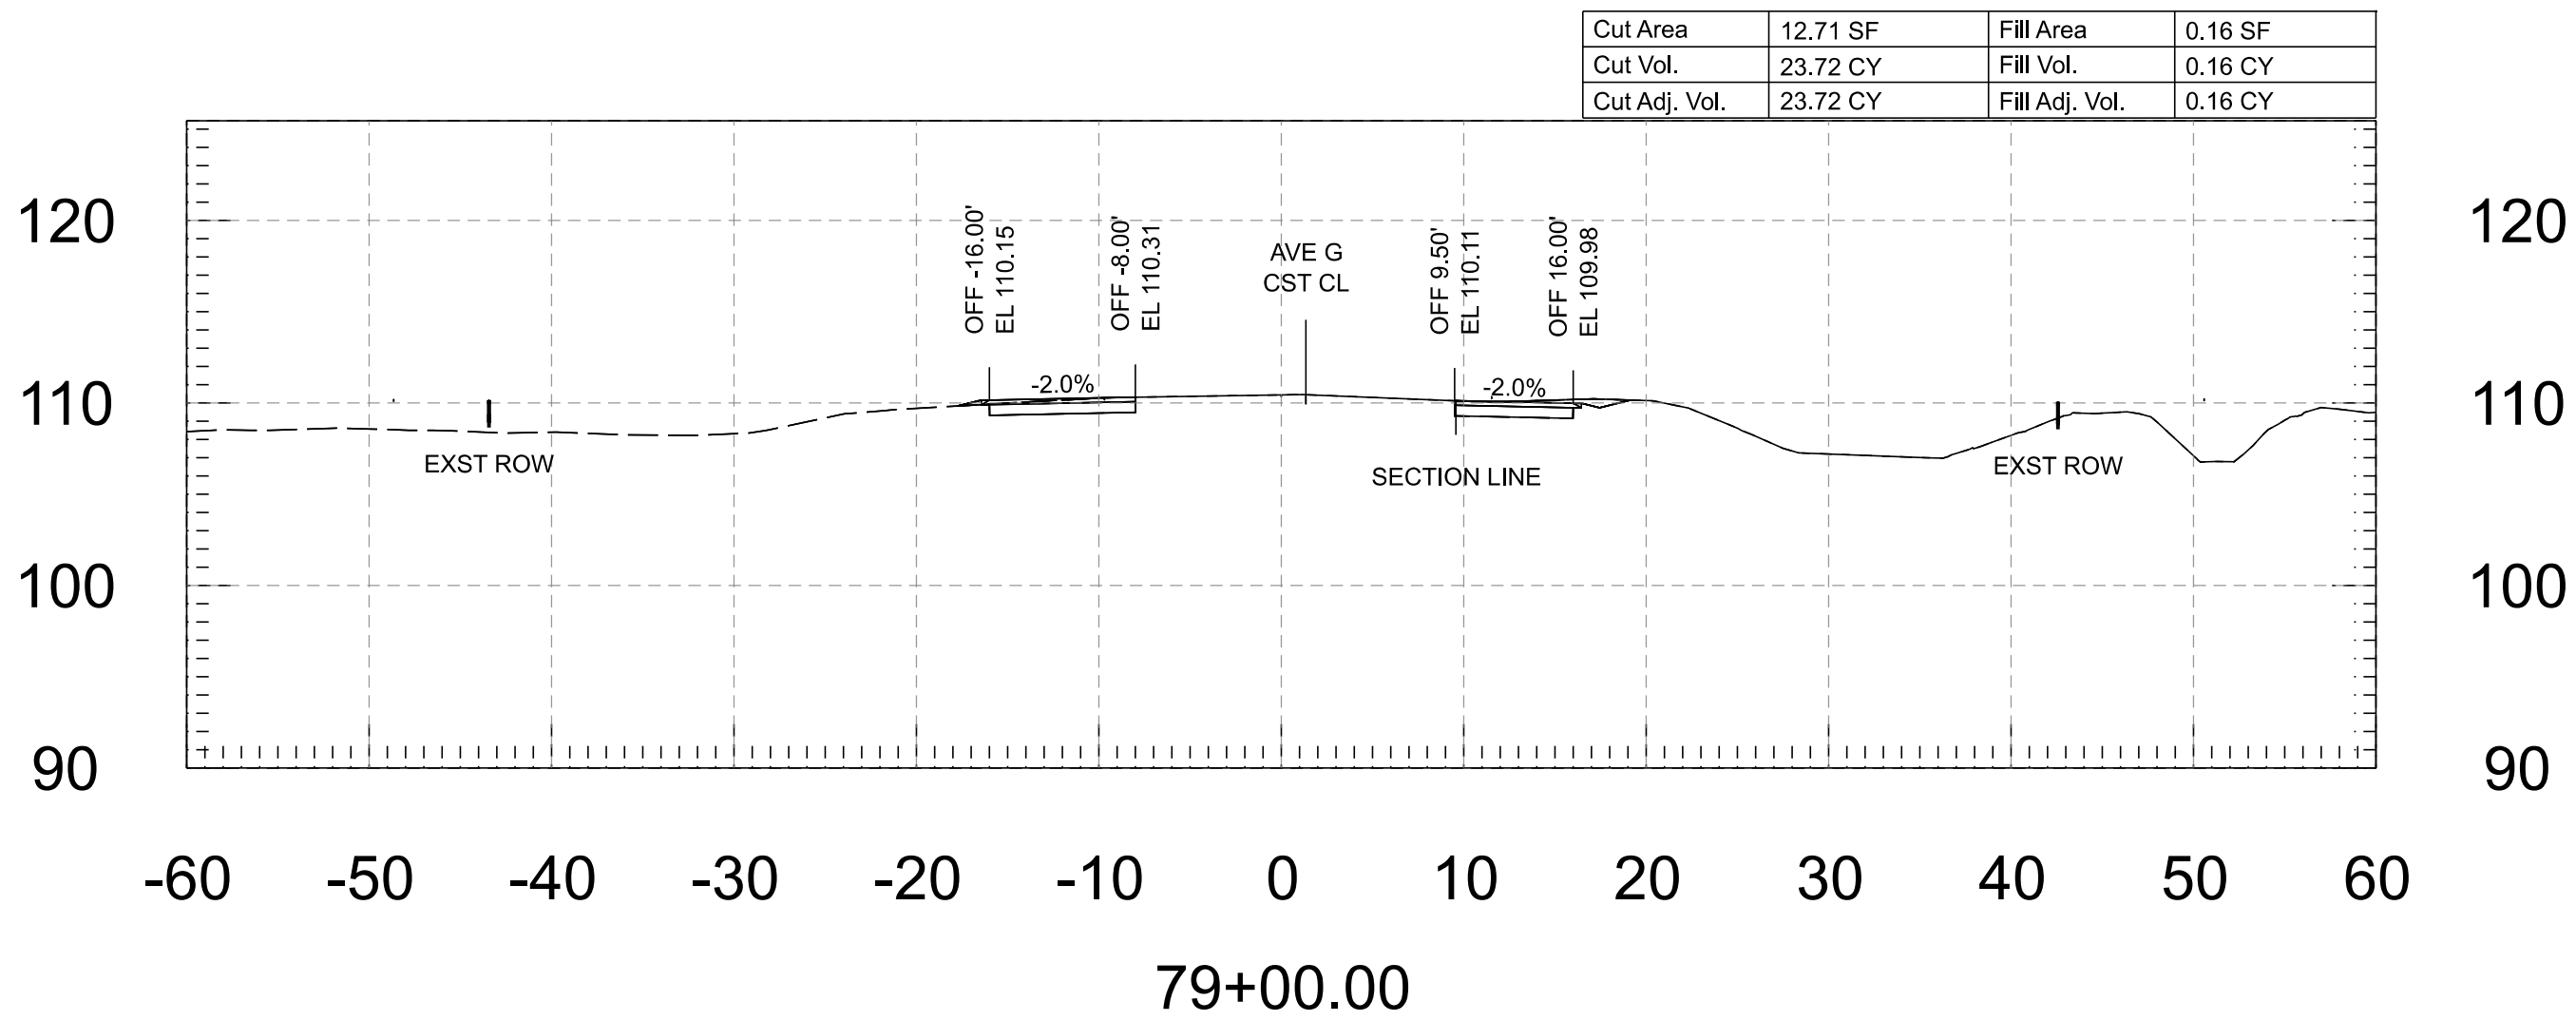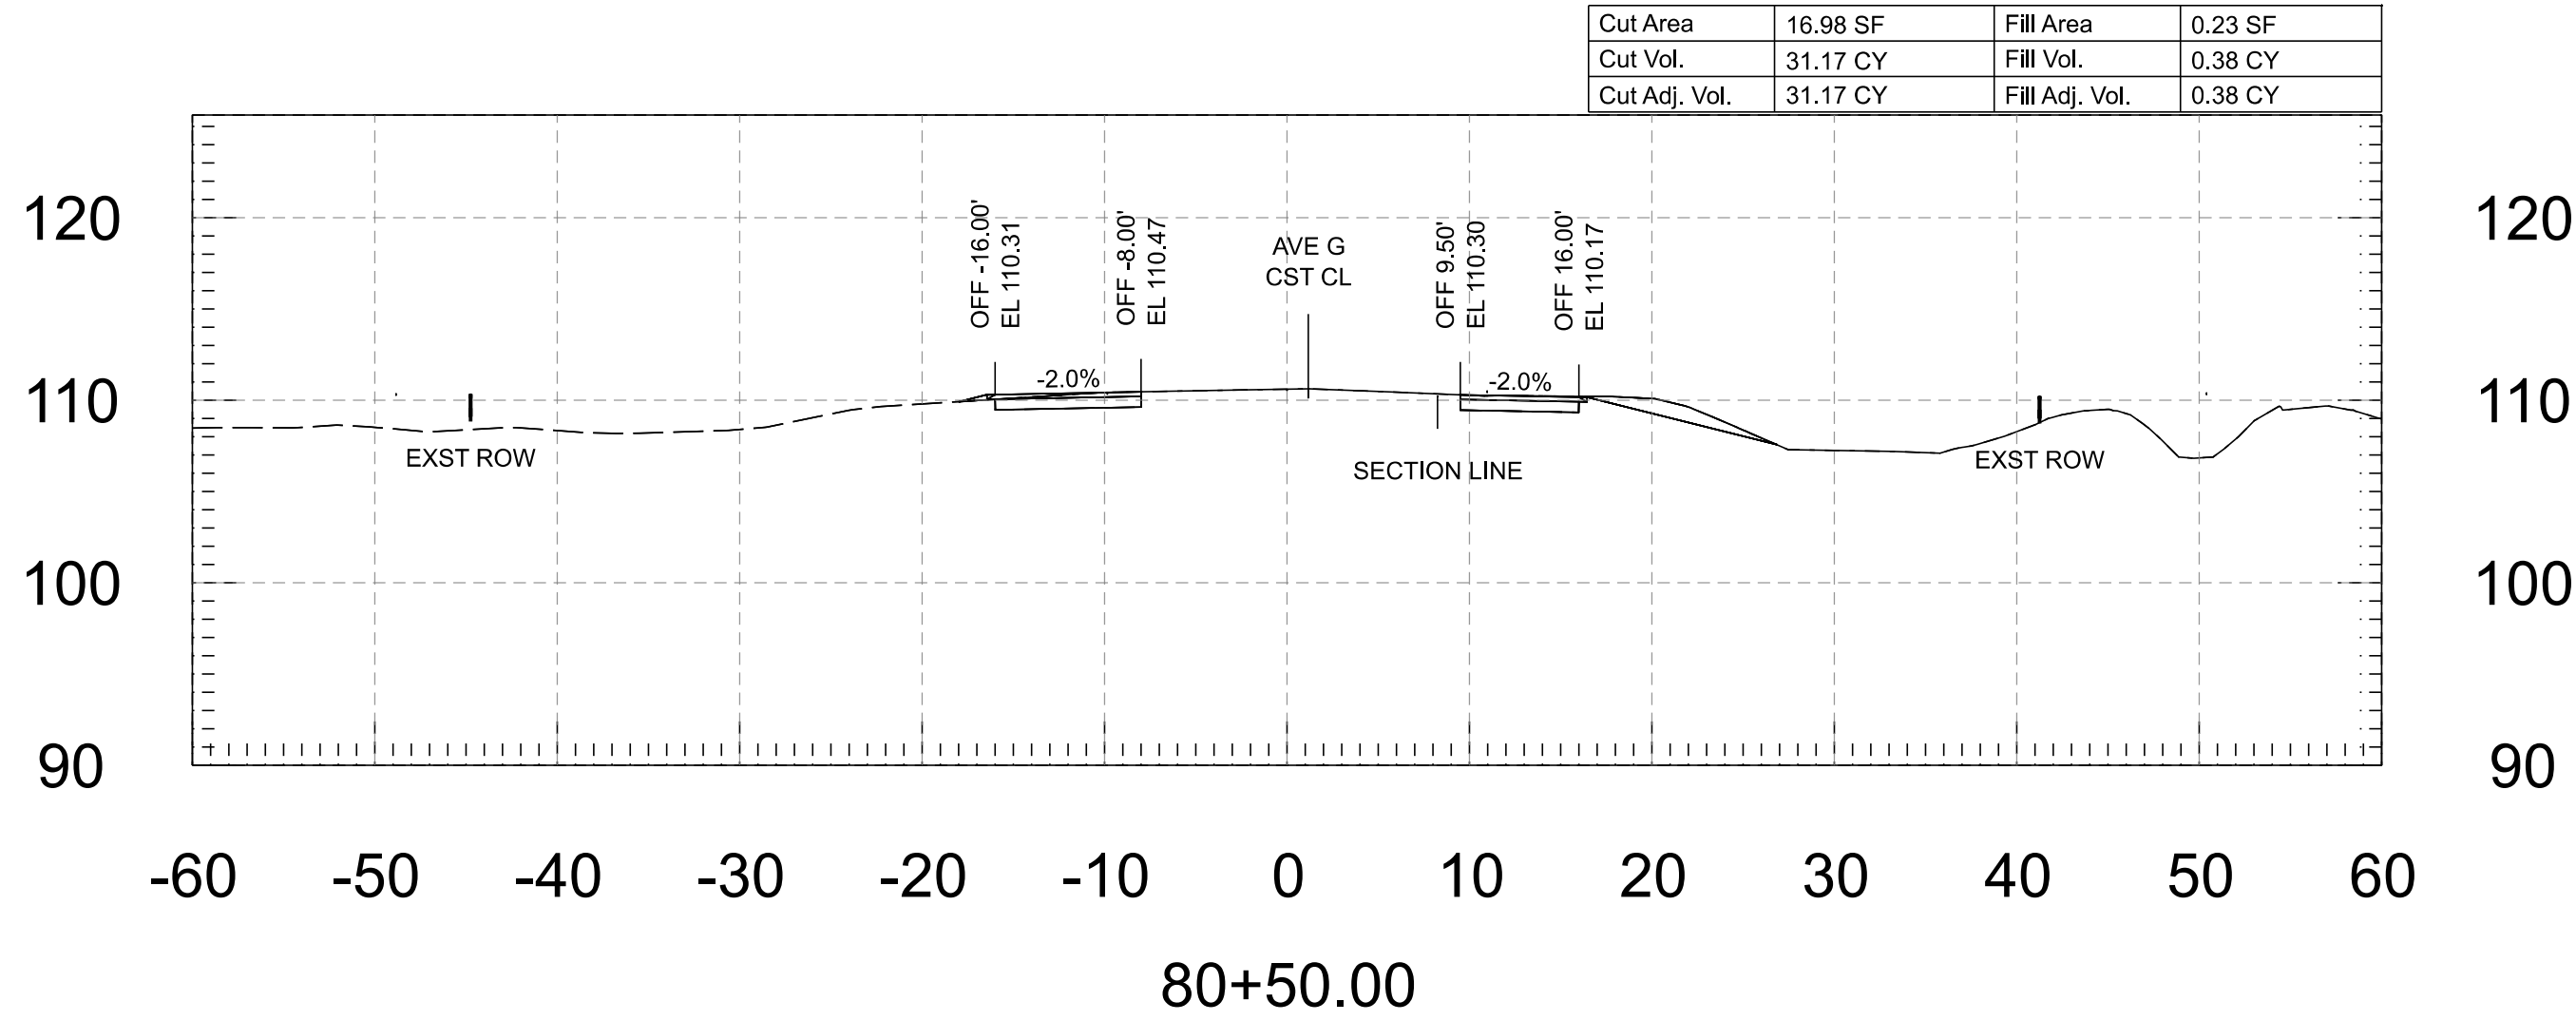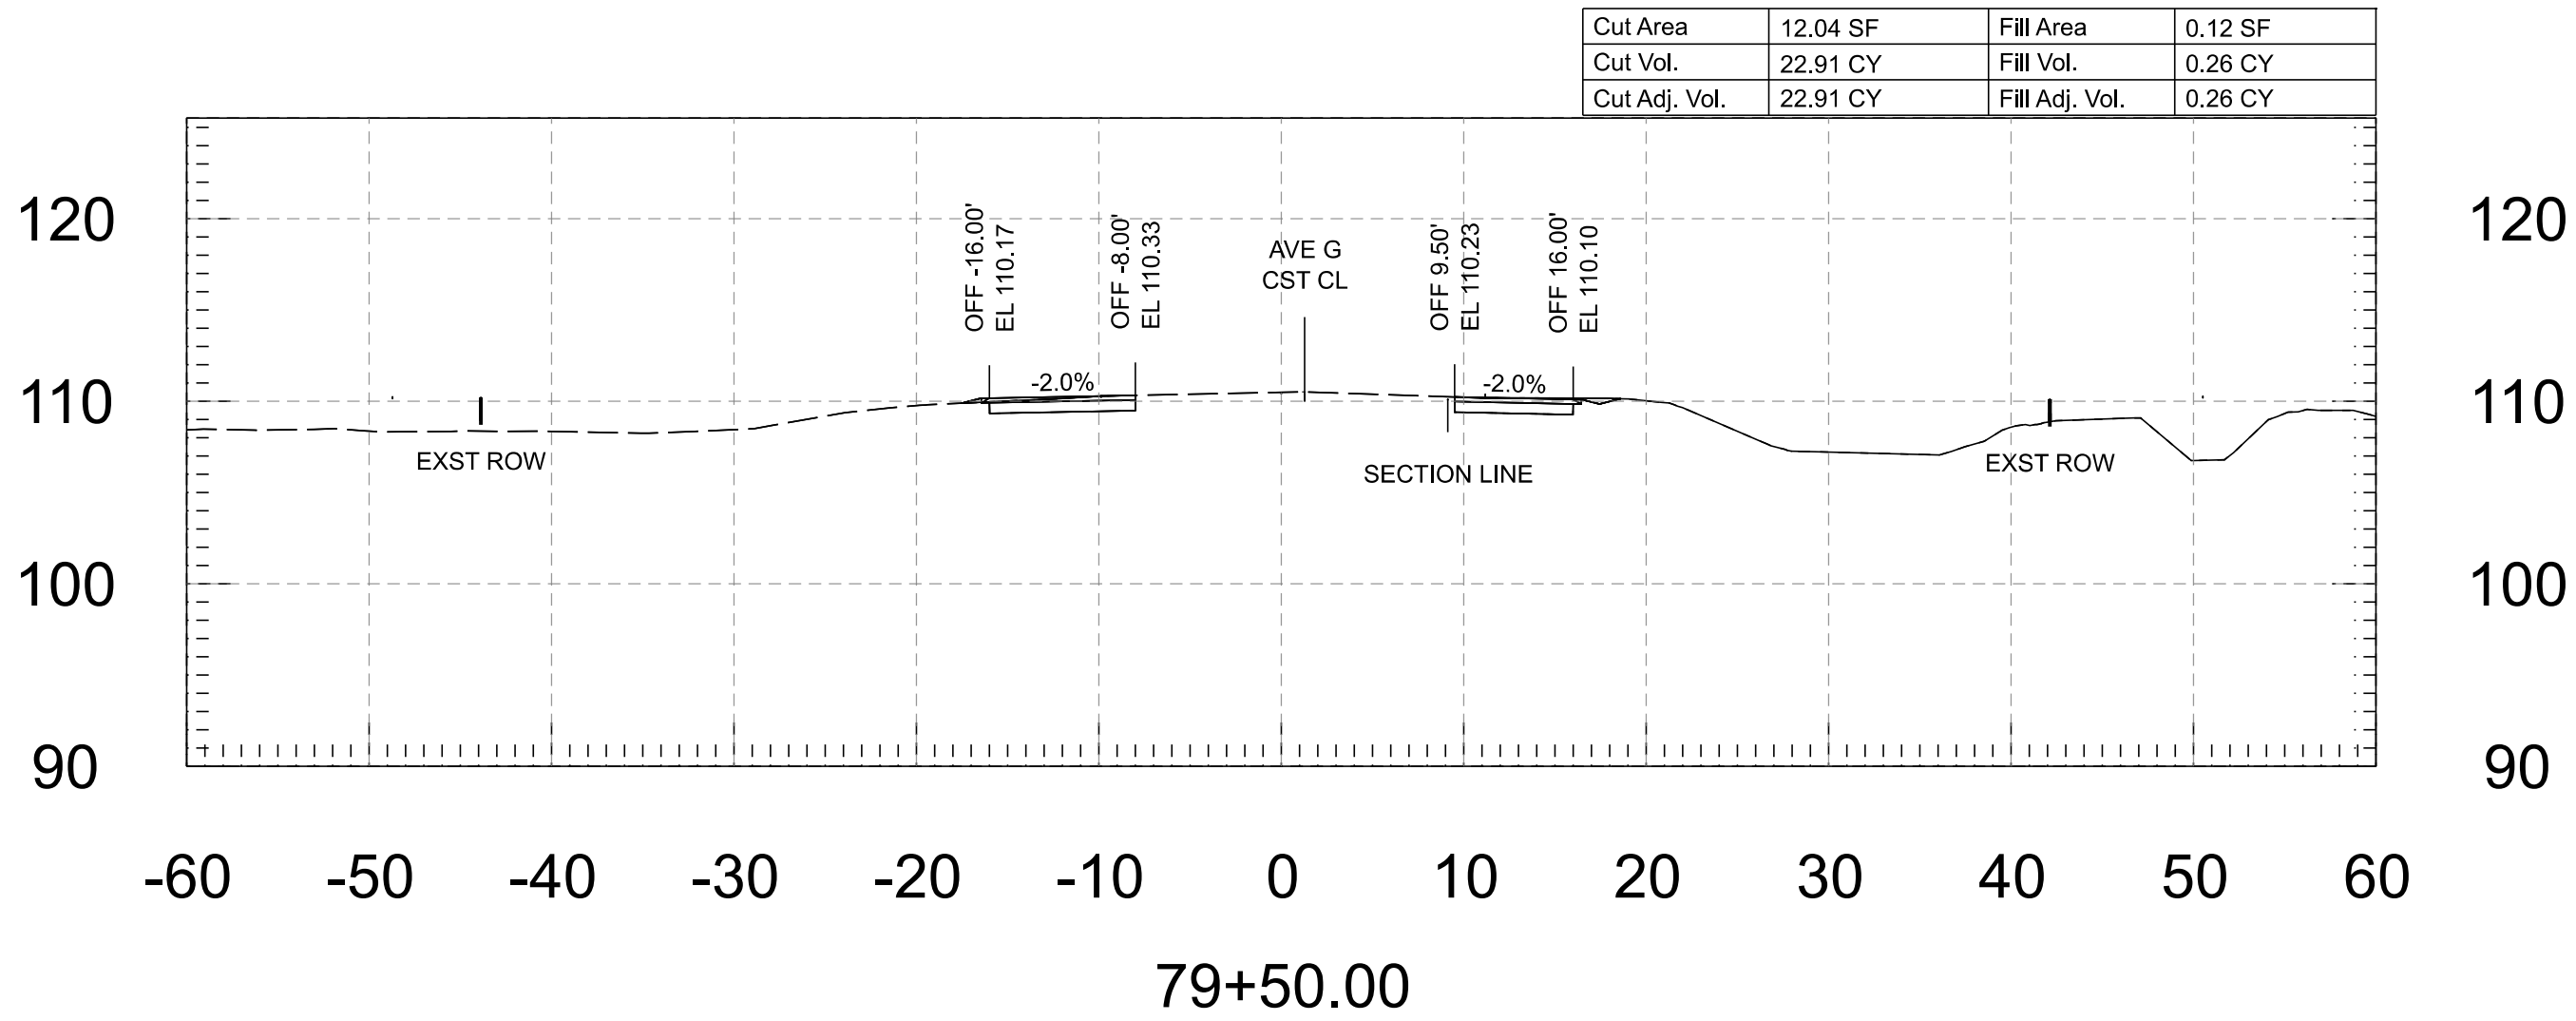


FOR INFORMATION ONLY		NAME	DATE	ARIZONA DEPARTMENT OF TRANSPORTATION PROJECT DELIVERY AND OPERATIONS DIVISION ROADWAY DESIGN SERVICES	ROUTE	F.H.W.A. Arizona Division	STATE ARIZ.	PROJECT NO.	FEDERAL ID NO.	SHEET NO.	TOTAL SHEETS	RECORD DRAWING	
	DESIGN	M. SCHOEN	07/26		MILEPOST			0000 YU YYU	YYU-0(225)T	33	118		
	DRAWN	M. SCHOEN	07/26		LOCATION AVENUE G, COUNTY 11TH ST - COUNTY 16TH ST								
	CHECKED	H. RIOS	07/26	 WSP USA Inc. 1230 West Washington Street, Suite 405 Tempe, AZ 85288	STRUCTURE NO.	TRACS NO. T0437 01C					___ OF ___		
					AVENUE G - CROSS SECTIONS								


Cut Area	18.75 SF	Fill Area	0.00 SF
Cut Vol.	33.50 CY	Fill Vol.	0.18 CY
Cut Adj. Vol.	33.50 CY	Fill Adj. Vol.	0.18 CY

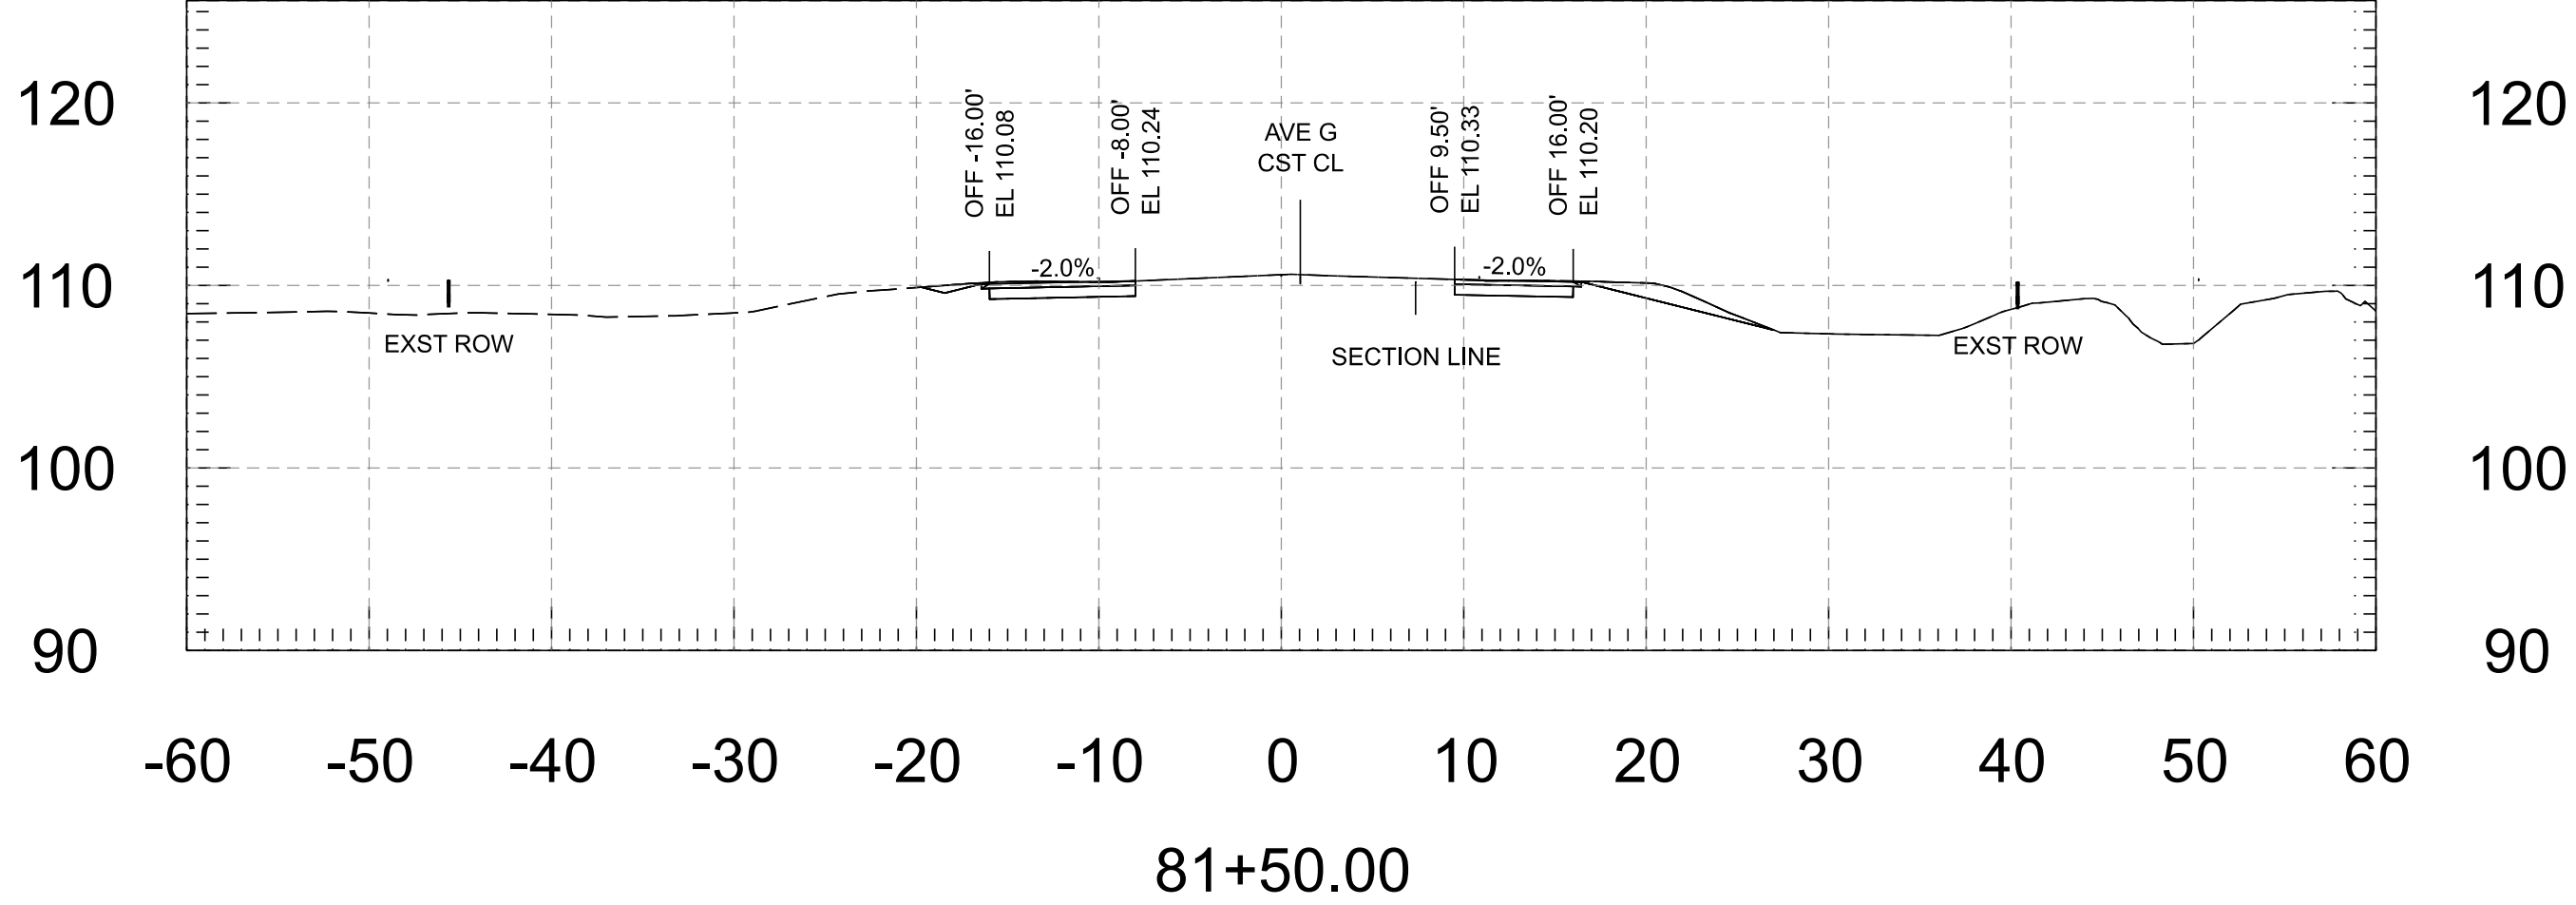


Cut Area	13.98 SF	Fill Area	0.00 SF
Cut Vol.	29.84 CY	Fill Vol.	0.00 CY
Cut Adj. Vol.	29.84 CY	Fill Adj. Vol.	0.00 CY

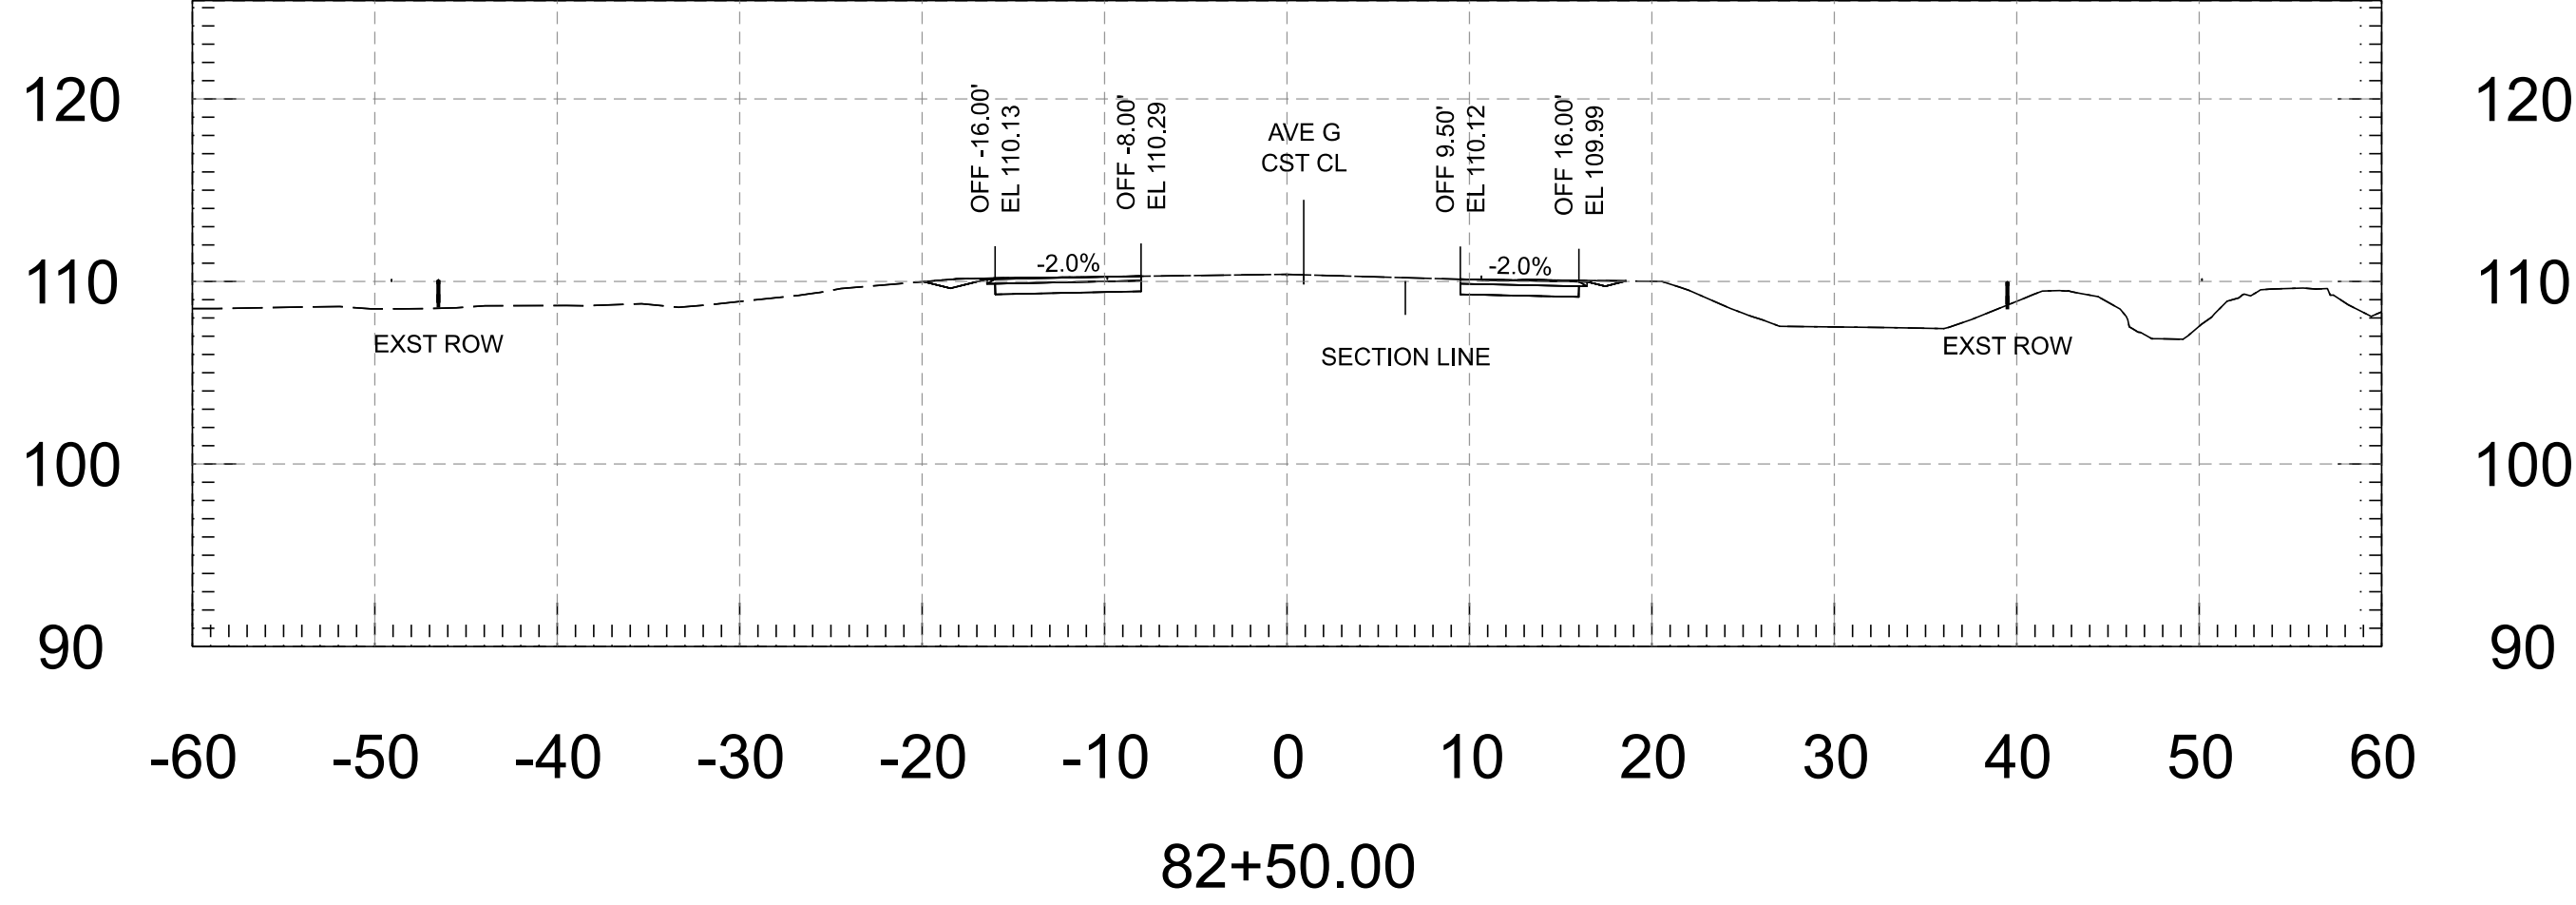

Cut Area	17.43 SF	Fill Area	0.19 SF
Cut Vol.	31.86 CY	Fill Vol.	0.39 CY
Cut Adj. Vol.	31.86 CY	Fill Adj. Vol.	0.39 CY

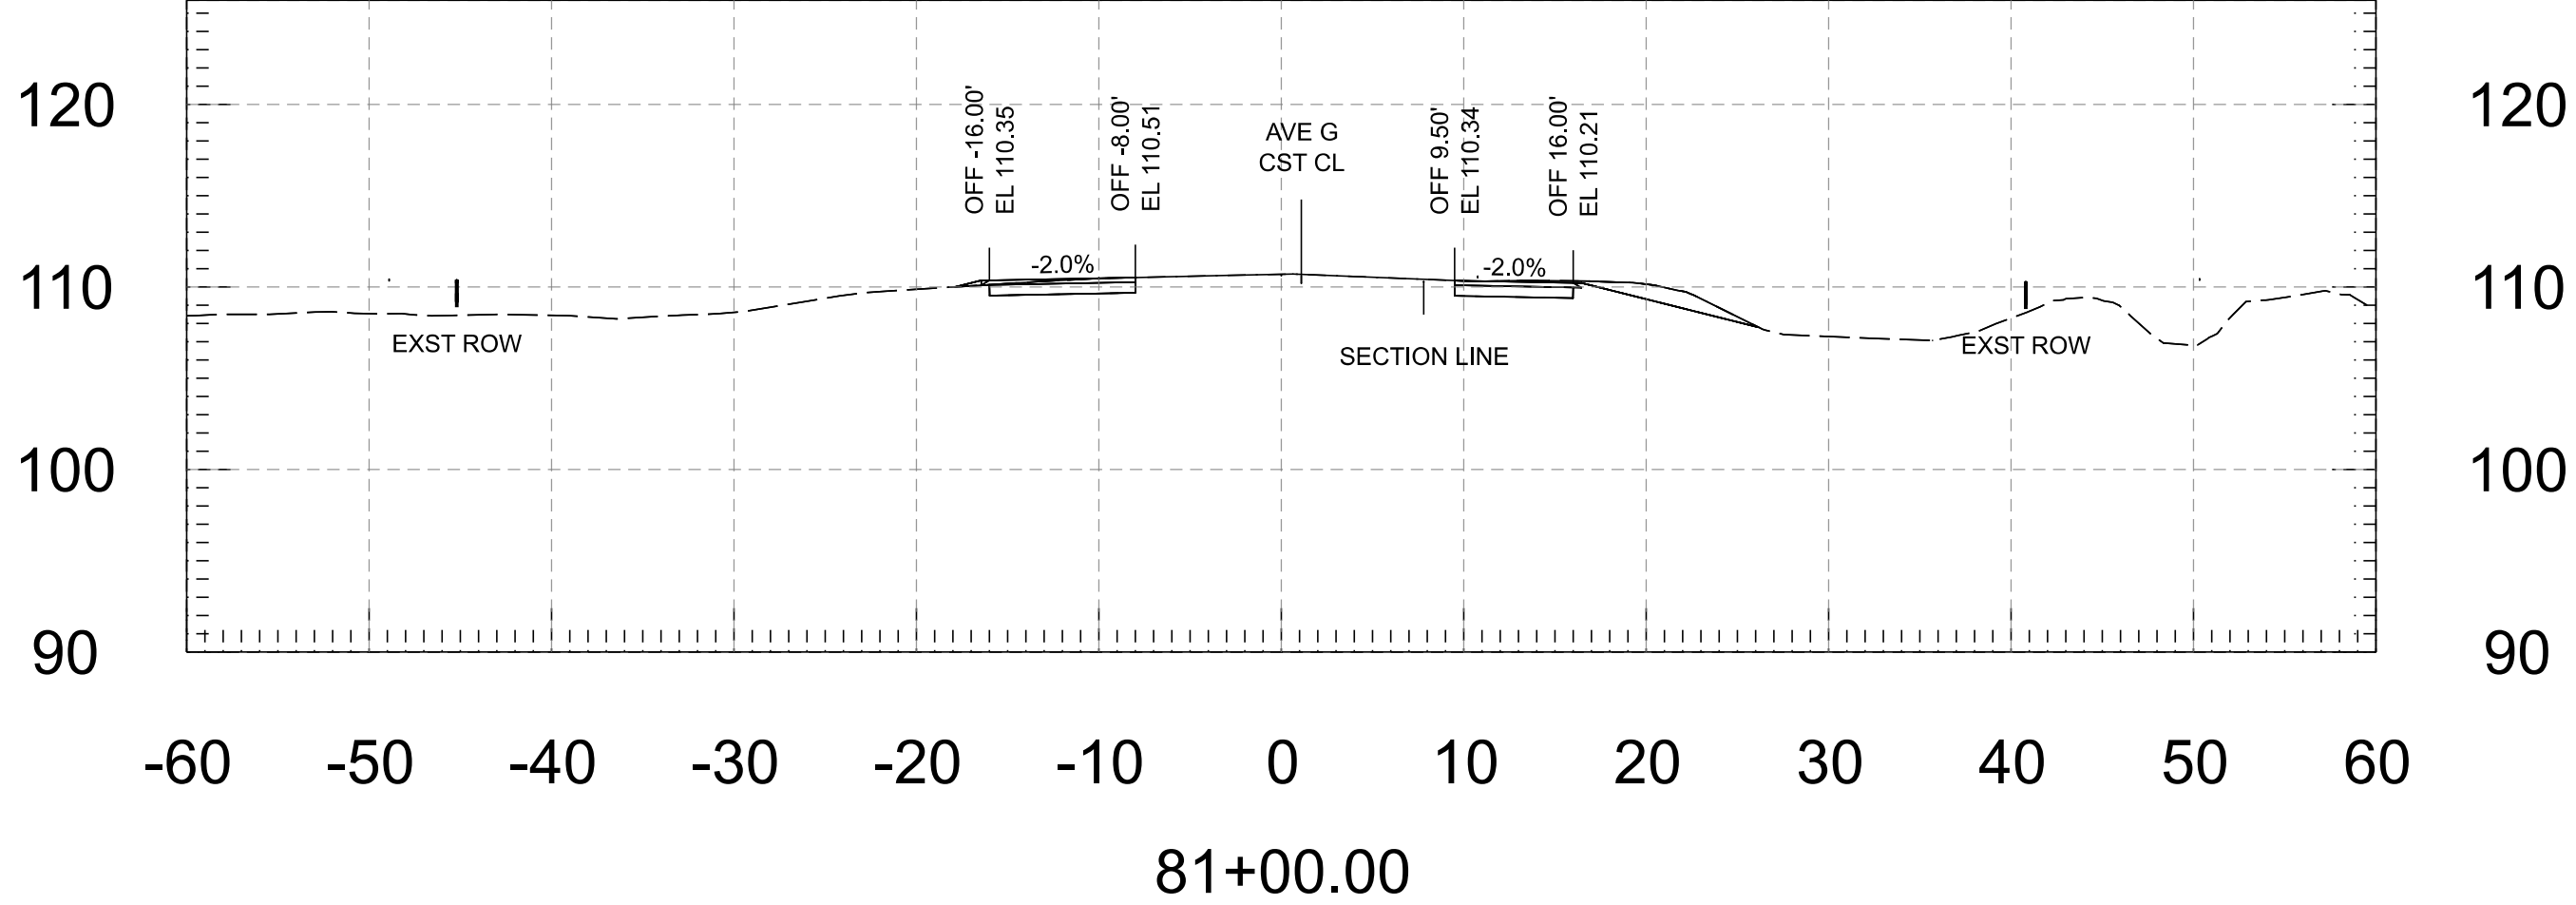


Cut Area	18.24 SF	Fill Area	0.00 SF
Cut Vol.	34.25 CY	Fill Vol.	0.00 CY
Cut Adj. Vol.	34.25 CY	Fill Adj. Vol.	0.00 CY

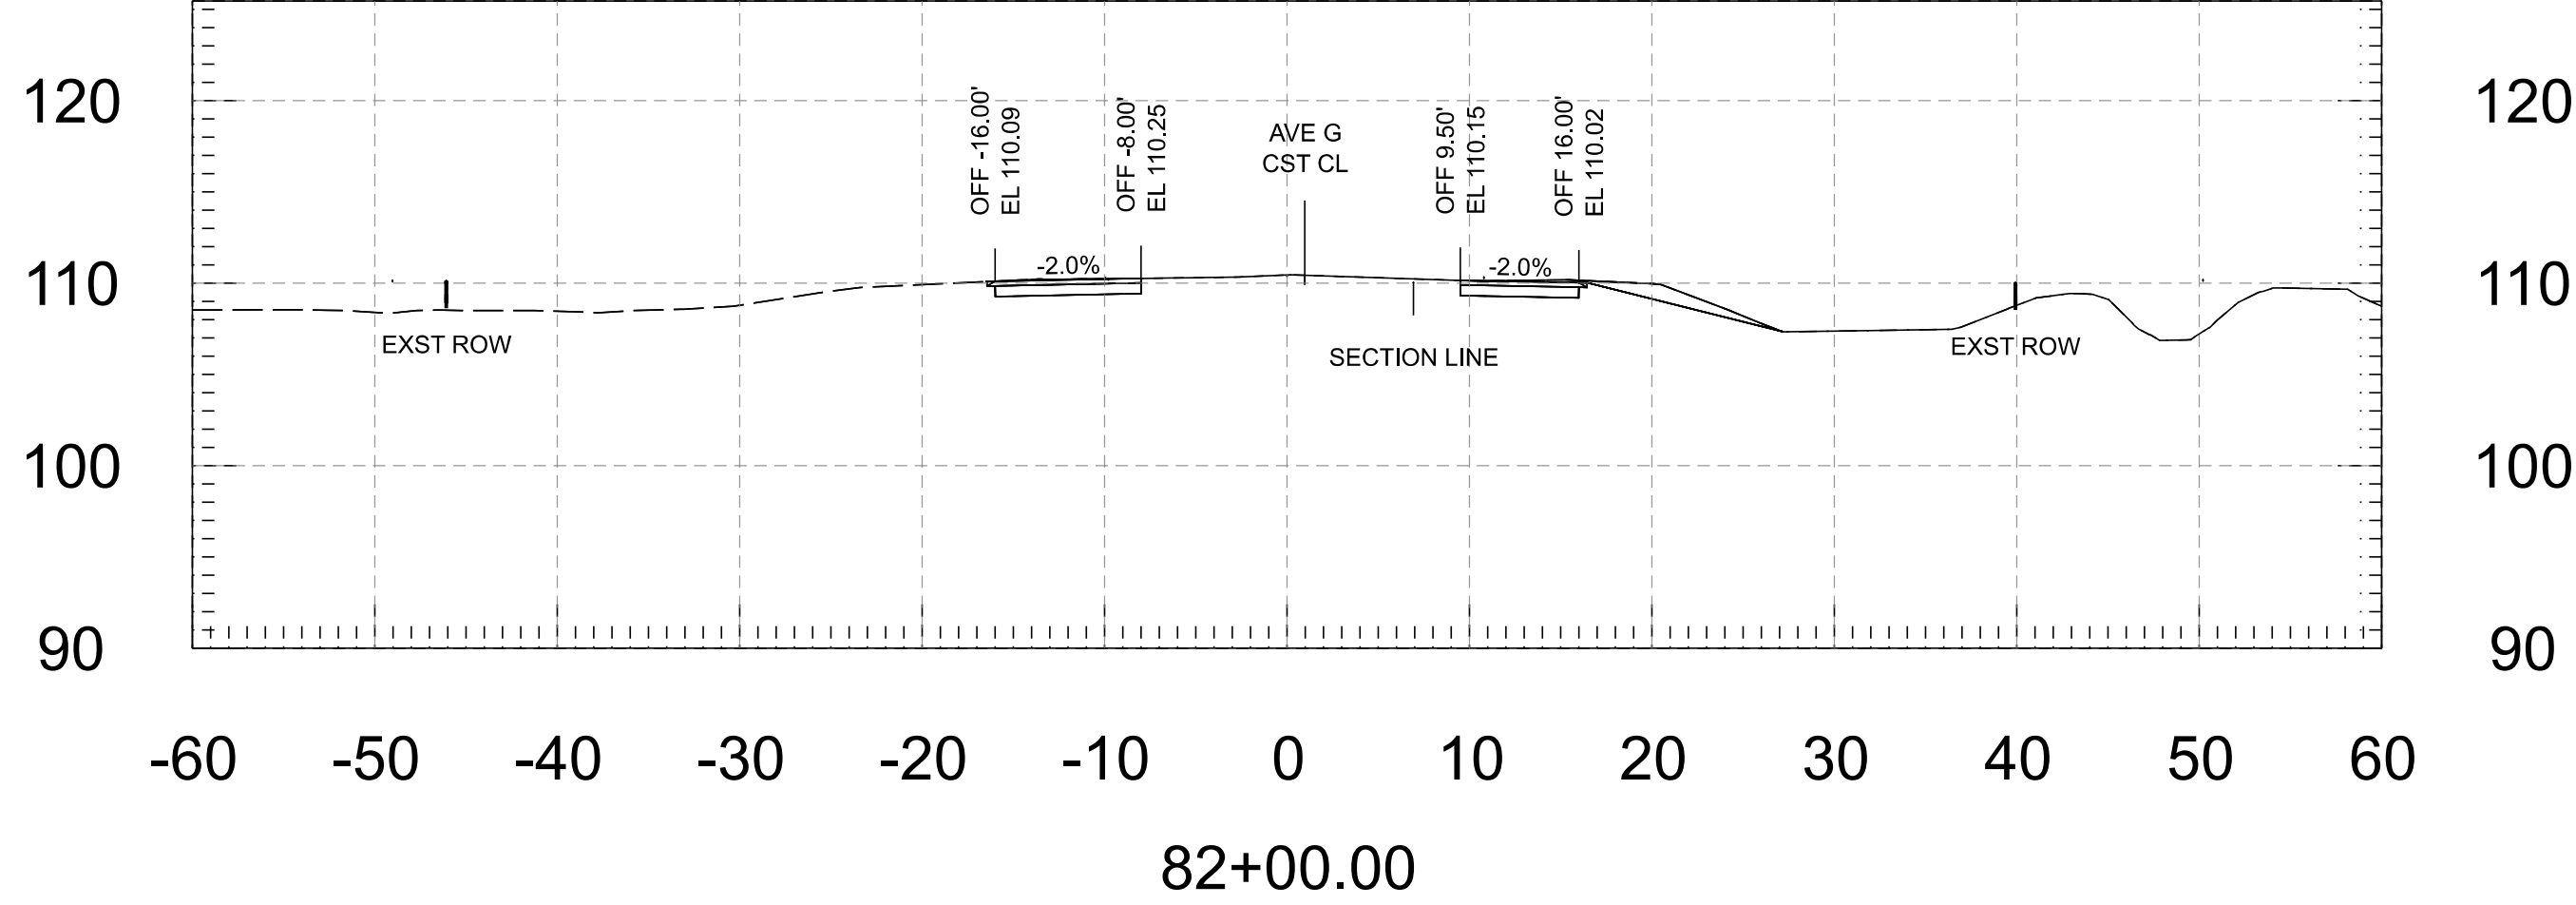


FOR INFORMATION ONLY		NAME	DATE	ARIZONA DEPARTMENT OF TRANSPORTATION PROJECT DELIVERY AND OPERATIONS DIVISION ROADWAY DESIGN SERVICES	ROUTE	F.H.W.A. Arizona Division	STATE ARIZ.	PROJECT NO.	FEDERAL ID NO.	SHEET NO.	TOTAL SHEETS	RECORD DRAWING
	DESIGN	M. SCHOEN	07/26		MILEPOST			0000 YU YYU	YYU-0(225)T	34	118	
	DRAWN	M. SCHOEN	07/26		LOCATION	AVENUE G, COUNTY 11TH ST - COUNTY 16TH ST					DWG	
	CHECKED	H. RIOS	07/26				STRUCTURE NO.	TRACS NO.	T0437 01C			
	wsp WSP USA Inc. 1230 West Washington Street, Suite 405 Tempe, AZ 85288				AVENUE G - CROSS SECTIONS		____ OF ____					


Cut Area	14.58 SF	Fill Area	0.00 SF
Cut Vol.	26.68 CY	Fill Vol.	0.00 CY
Cut Adj. Vol.	26.68 CY	Fill Adj. Vol.	0.00 CY

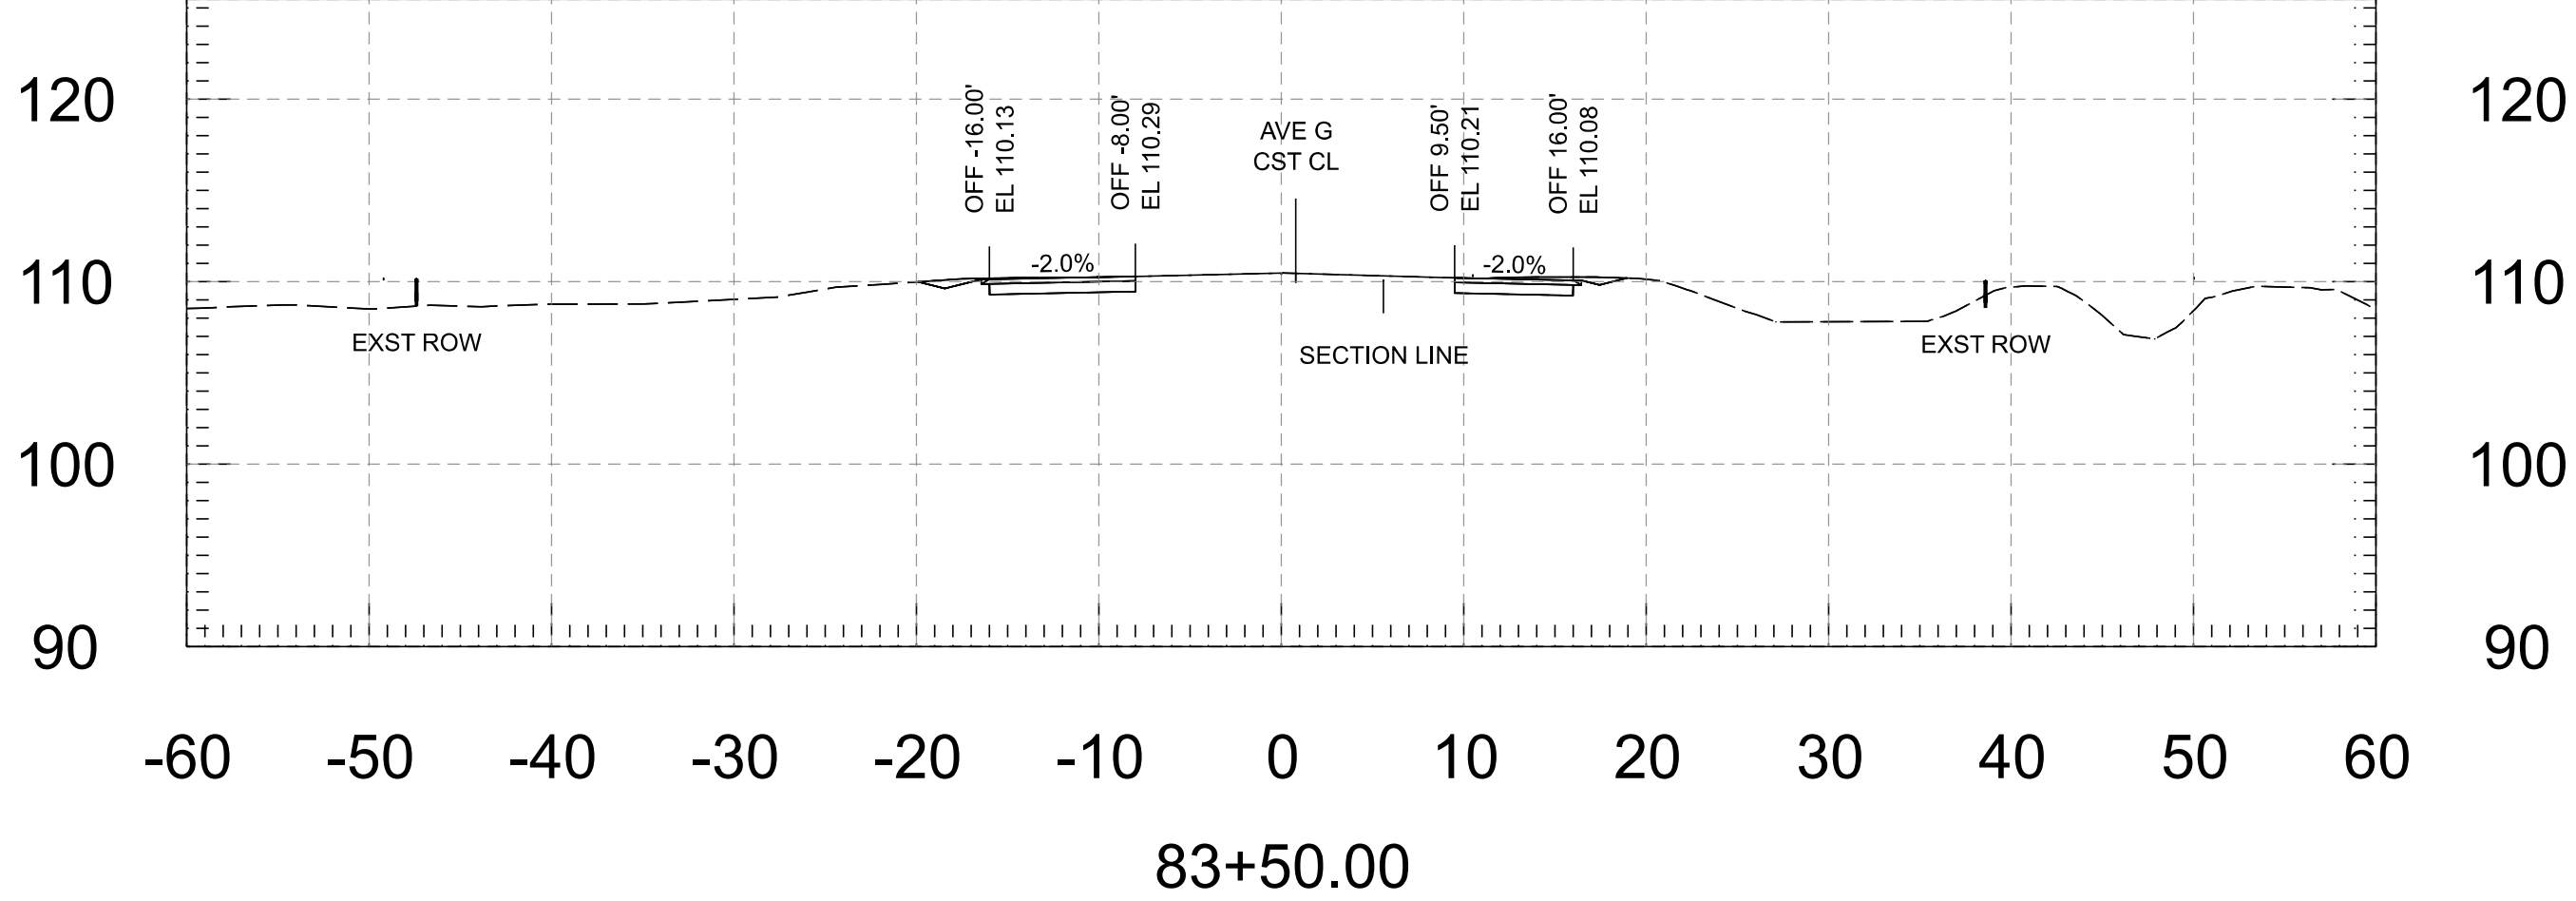


Cut Area	13.90 SF	Fill Area	0.00 SF
Cut Vol.	26.15 CY	Fill Vol.	0.00 CY
Cut Adj. Vol.	26.15 CY	Fill Adj. Vol.	0.00 CY

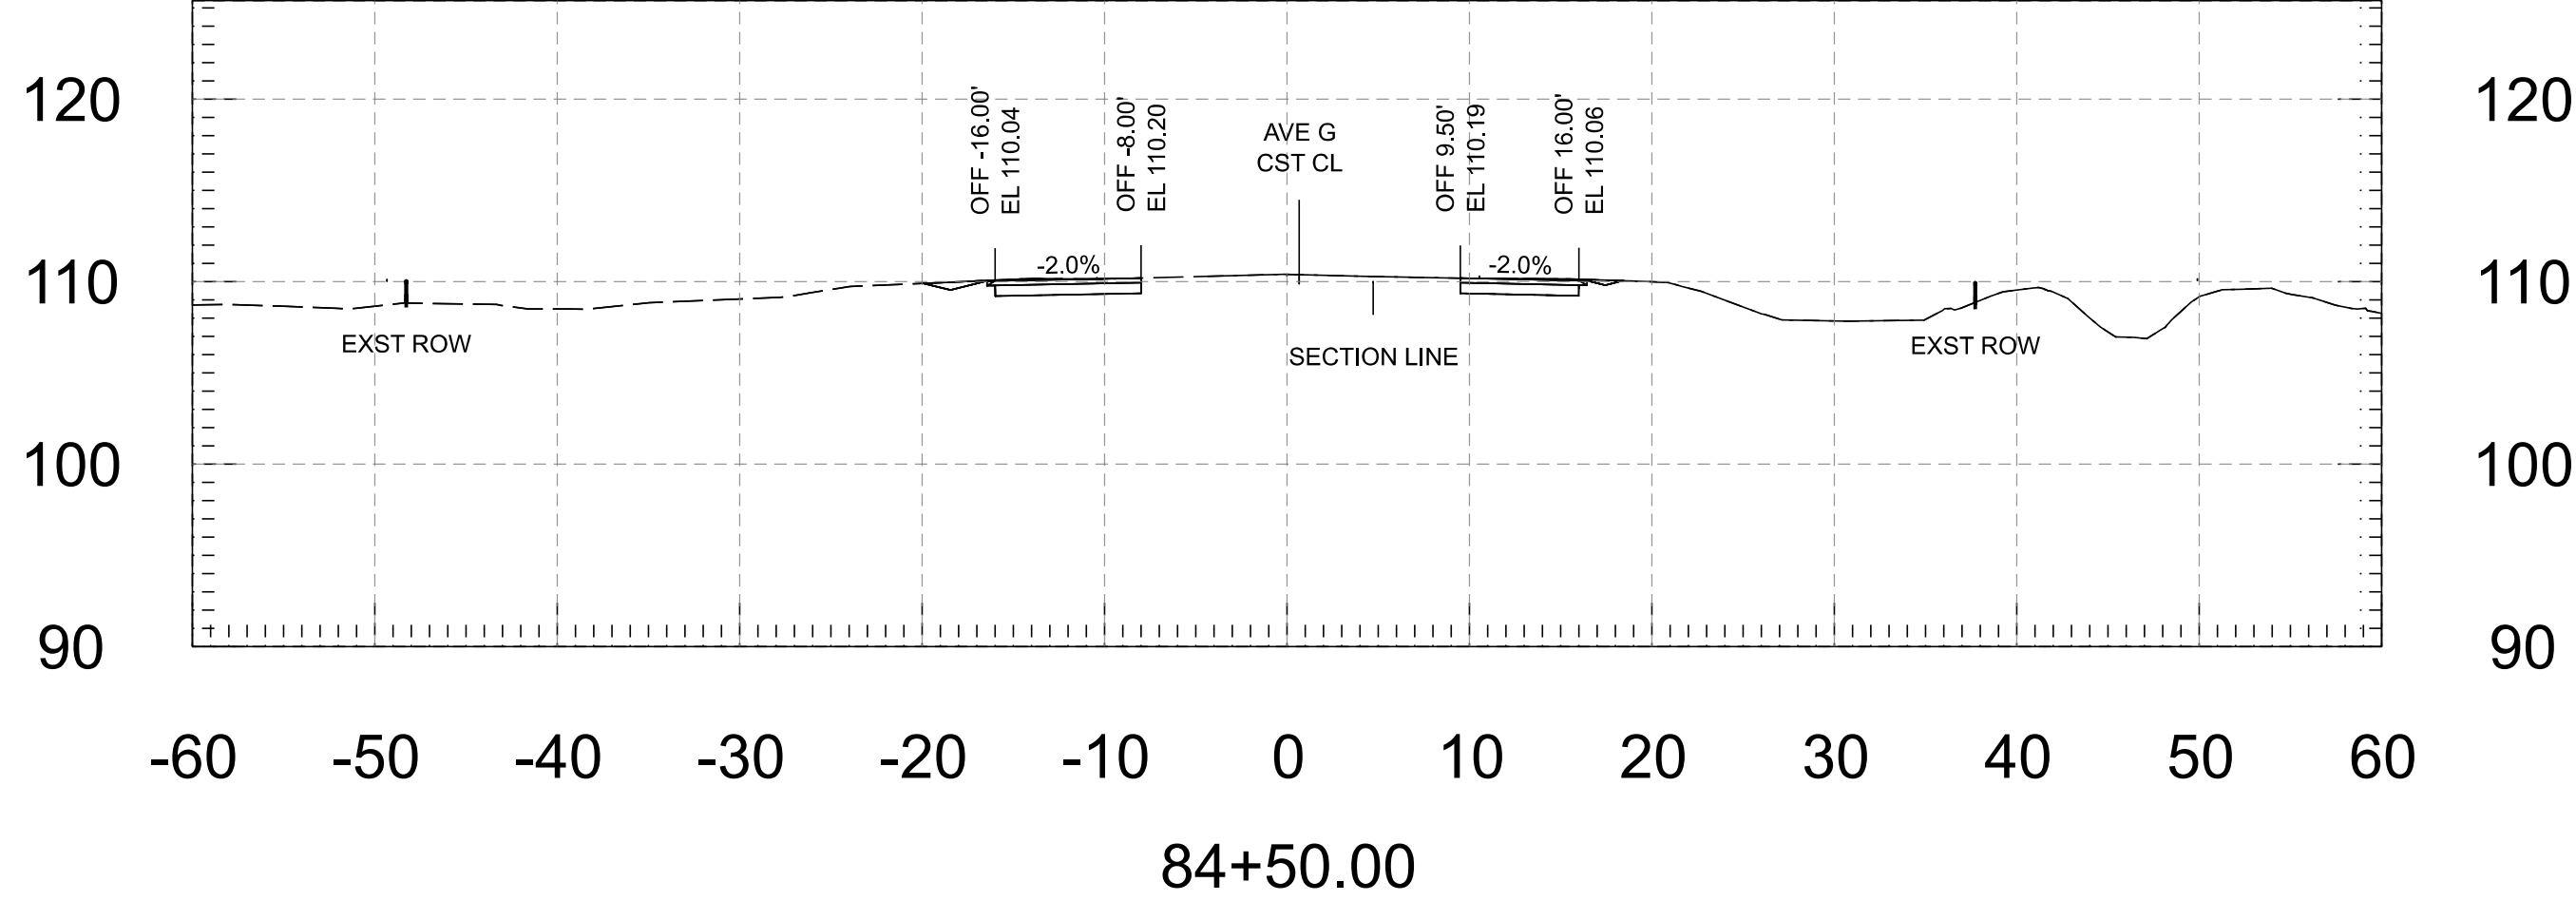





Cut Area	14.23 SF	Fill Area	0.00 SF
Cut Vol.	26.12 CY	Fill Vol.	0.00 CY
Cut Adj. Vol.	26.12 CY	Fill Adj. Vol.	0.00 CY

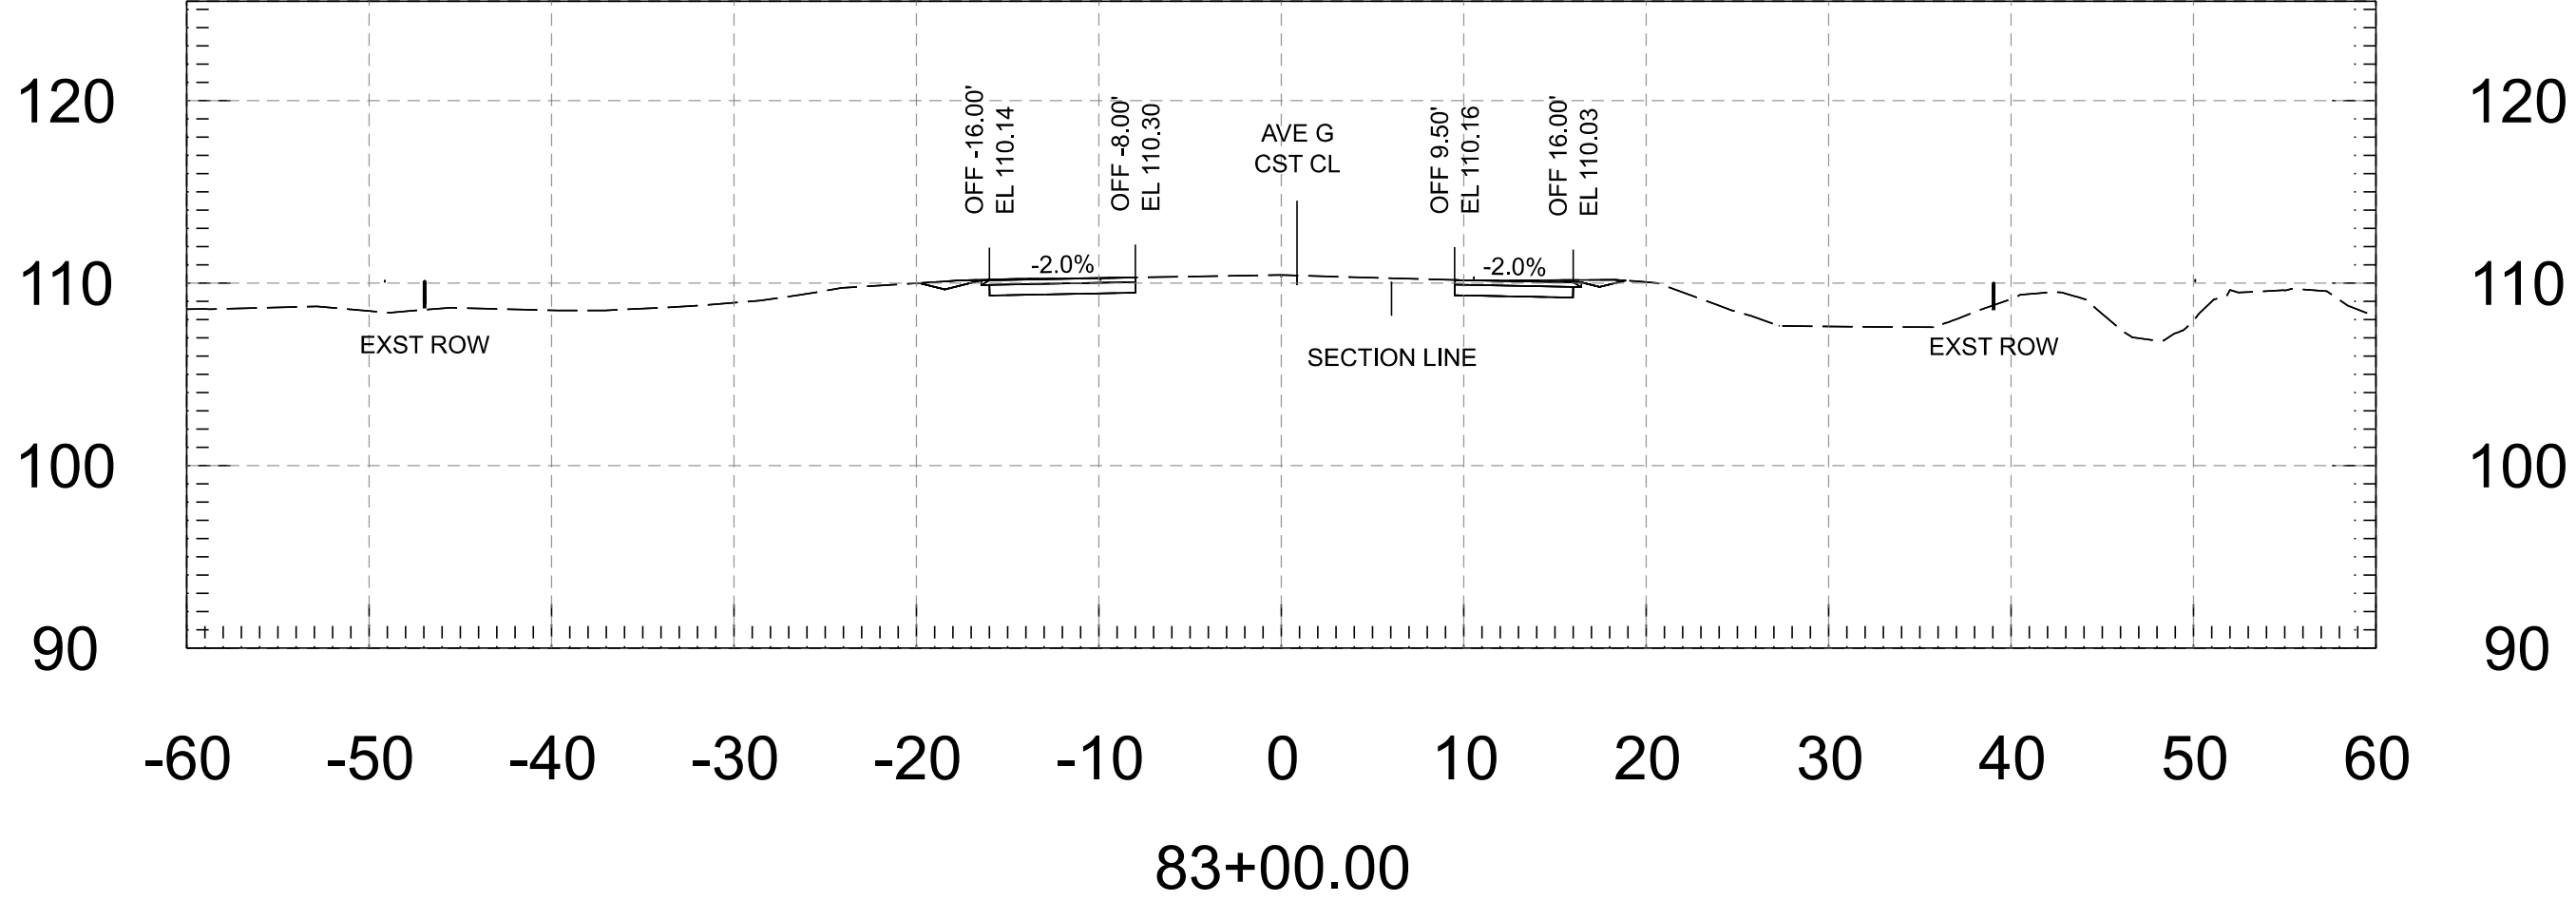





Cut Area	14.34 SF	Fill Area	0.00 SF
Cut Vol.	26.79 CY	Fill Vol.	0.00 CY
Cut Adj. Vol.	26.79 CY	Fill Adj. Vol.	0.00 CY

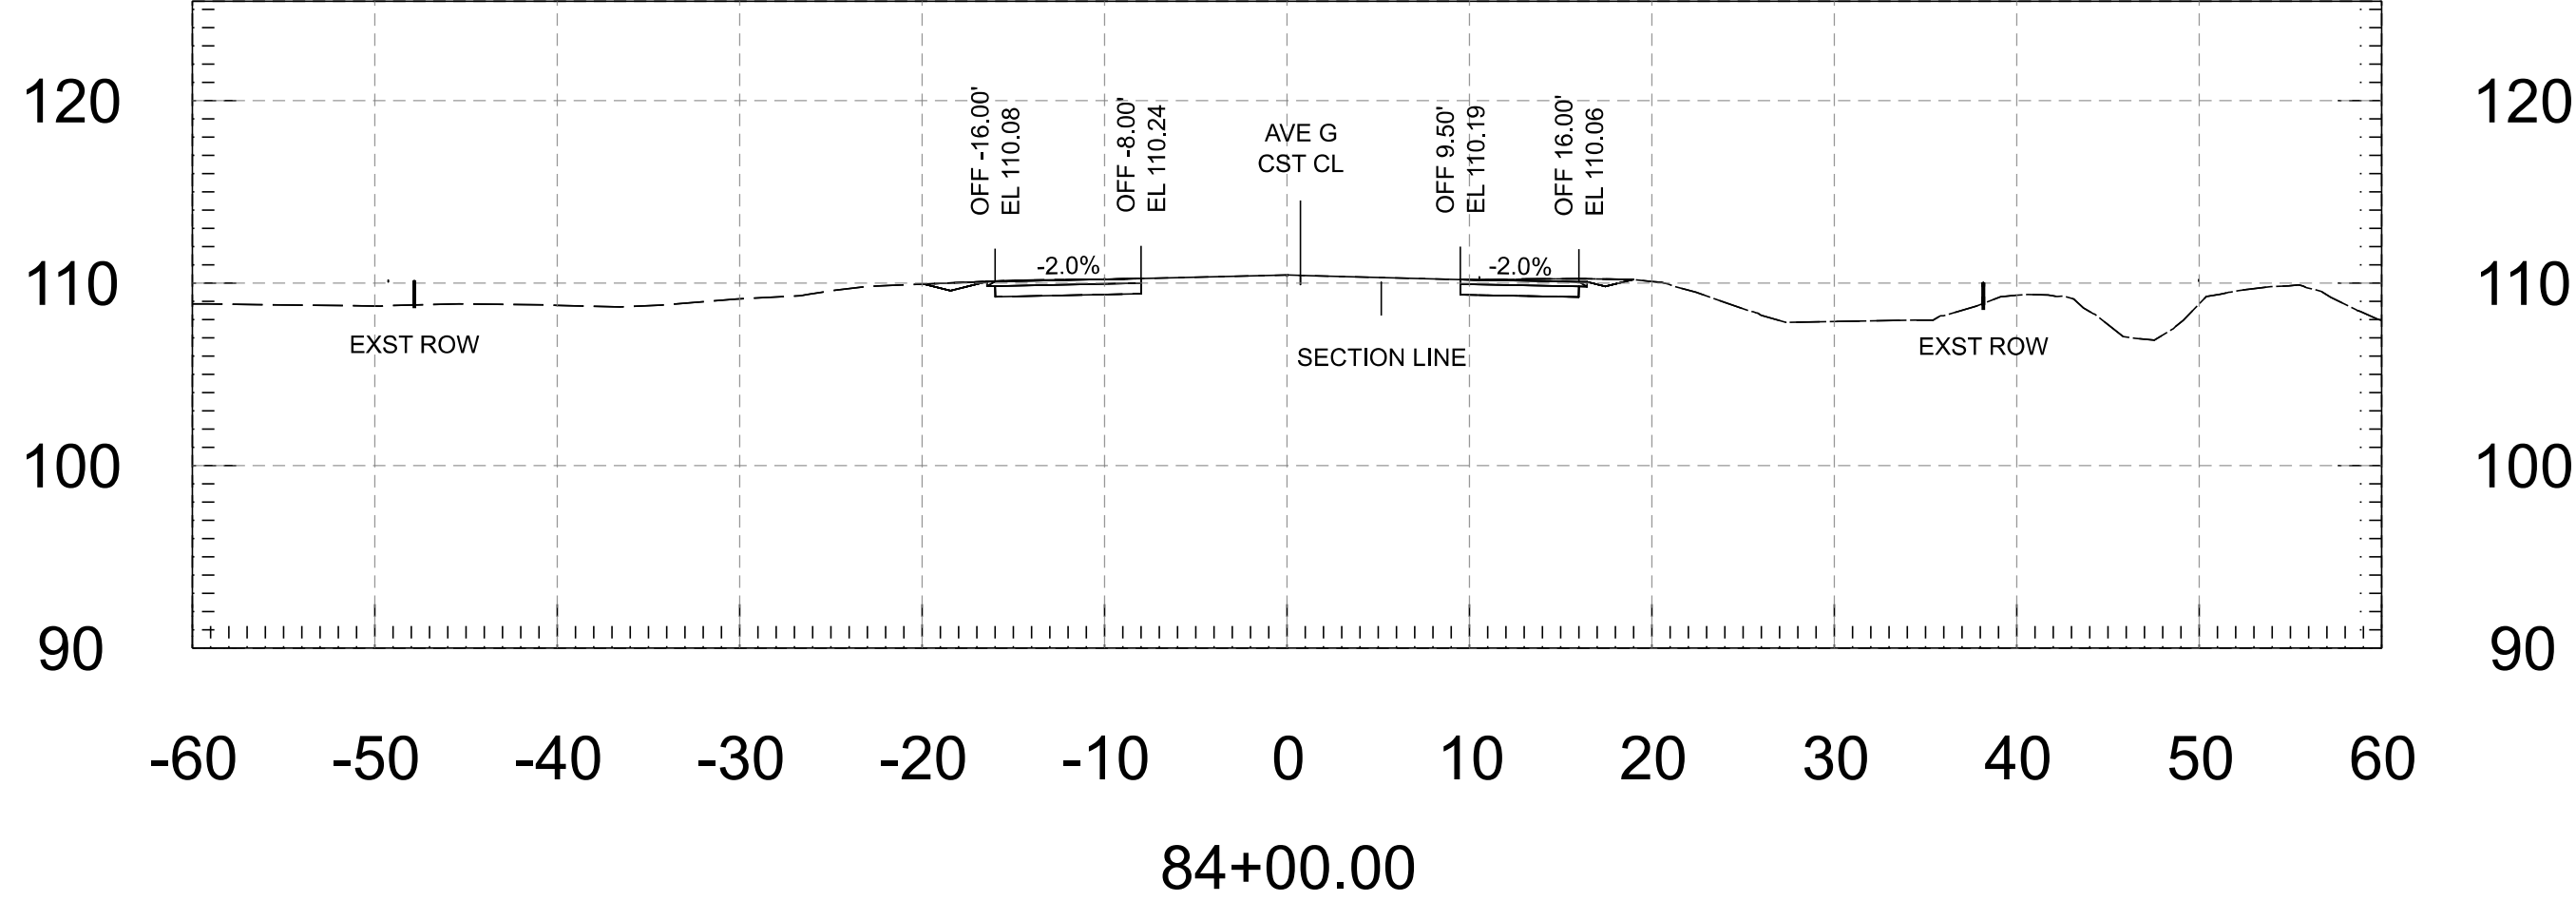

FOR INFORMATION ONLY		NAME	DATE	ARIZONA DEPARTMENT OF TRANSPORTATION PROJECT DELIVERY AND OPERATIONS DIVISION ROADWAY DESIGN SERVICES	ROUTE	F.H.W.A. Arizona Division	STATE ARIZ.	PROJECT NO.	FEDERAL ID NO.	SHEET NO.	TOTAL SHEETS	RECORD DRAWING
	DESIGN	M. SCHOEN	07/26		MILEPOST			0000 YU YYU	YYU-0(225)T	35	118	
	DRAWN	M. SCHOEN	07/26					LOCATION				AVENUE G, COUNTY 11TH ST - COUNTY 16TH ST
	CHECKED	H. RIOS	07/26	AVENUE G - CROSS SECTIONS	STRUCTURE NO.	TRACS NO. T0437 01C				___ OF ___		
	 WSP USA Inc. 1230 West Washington Street, Suite 405 Tempe, AZ 85288											

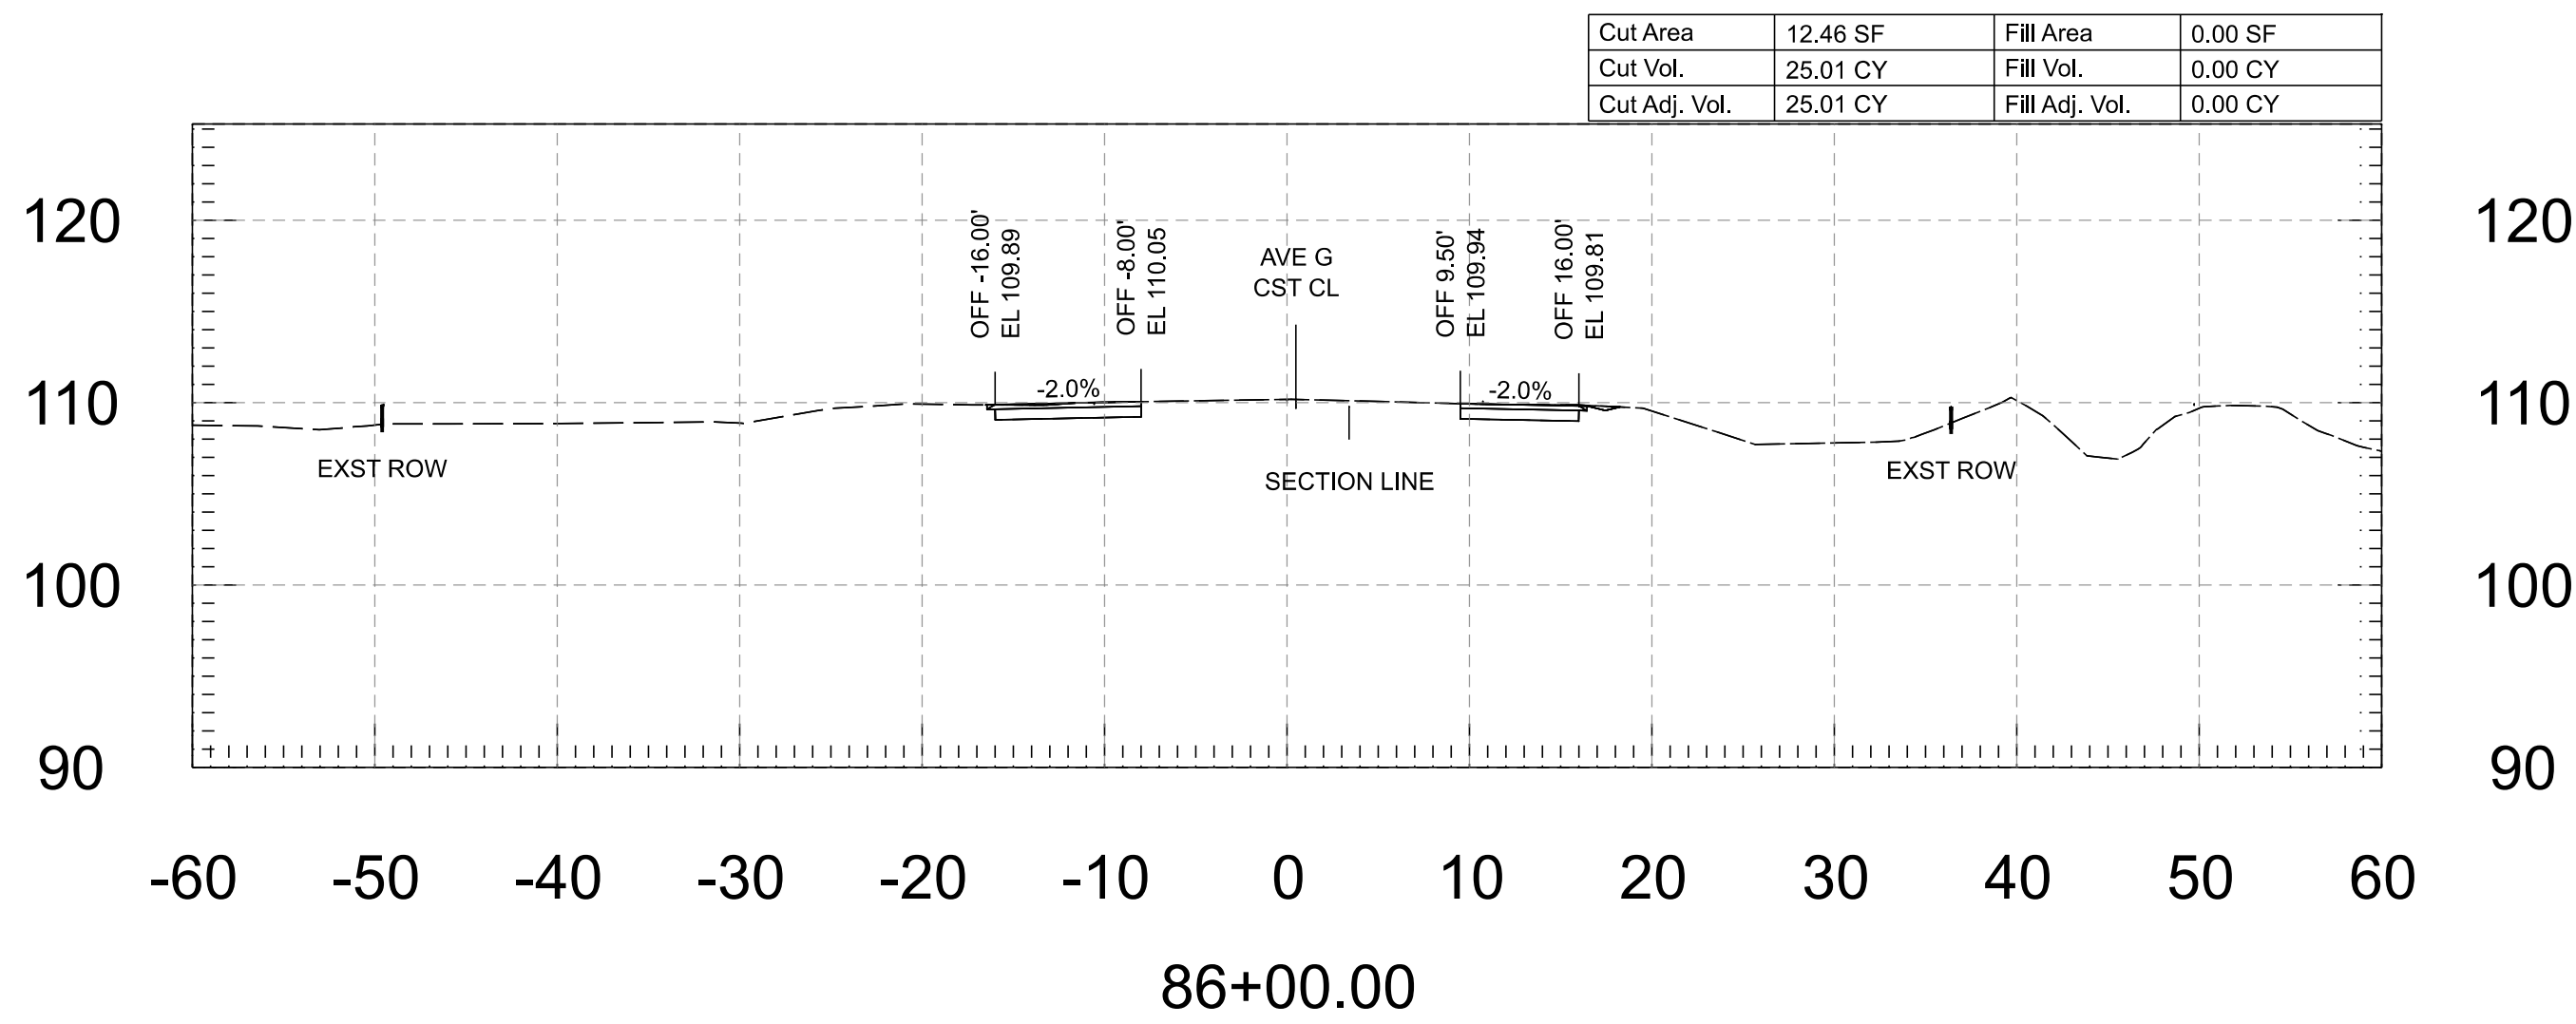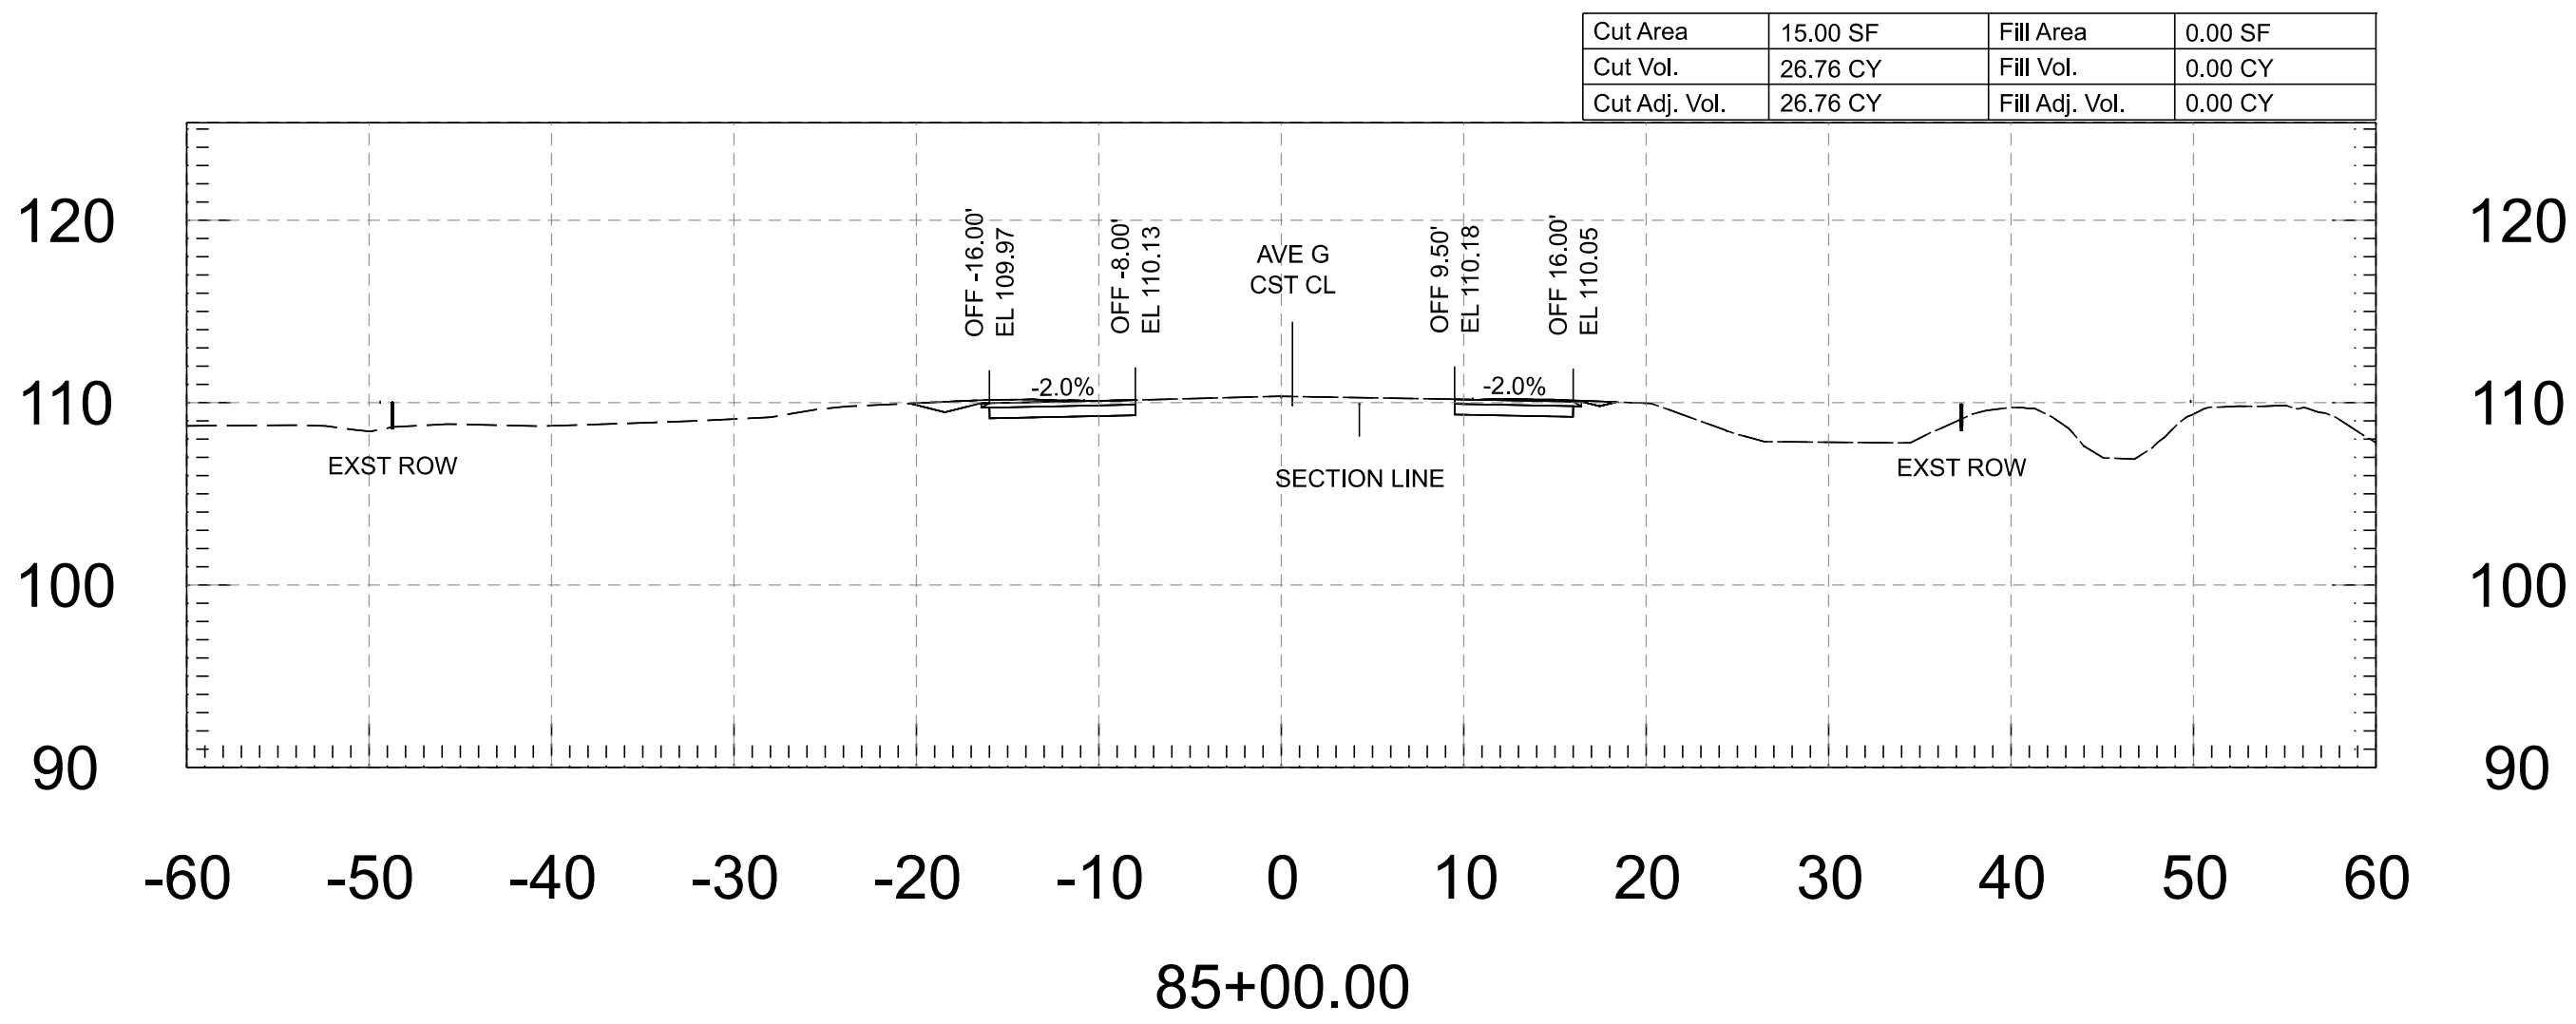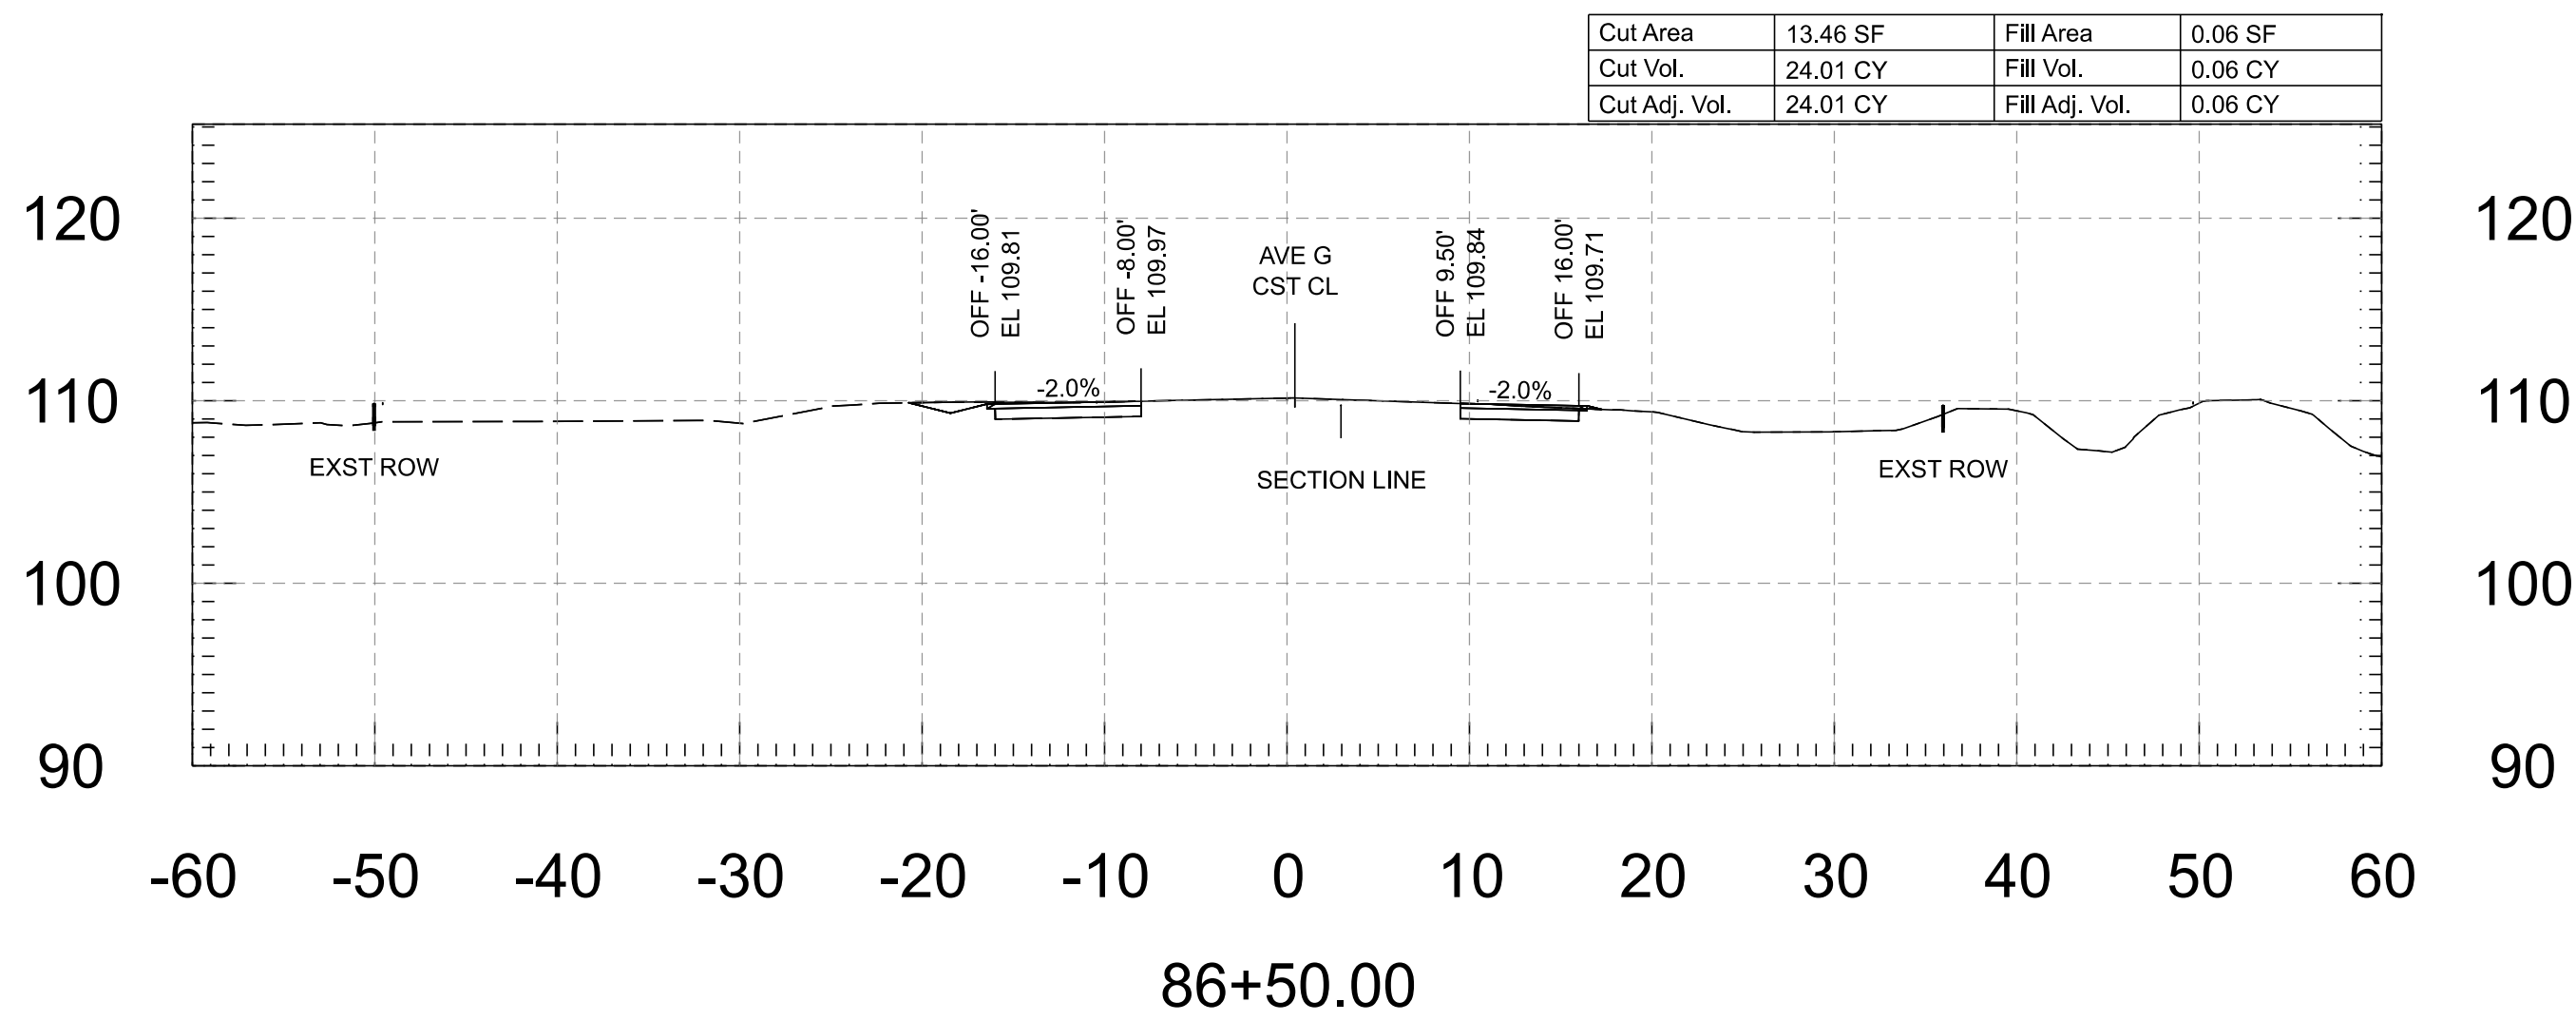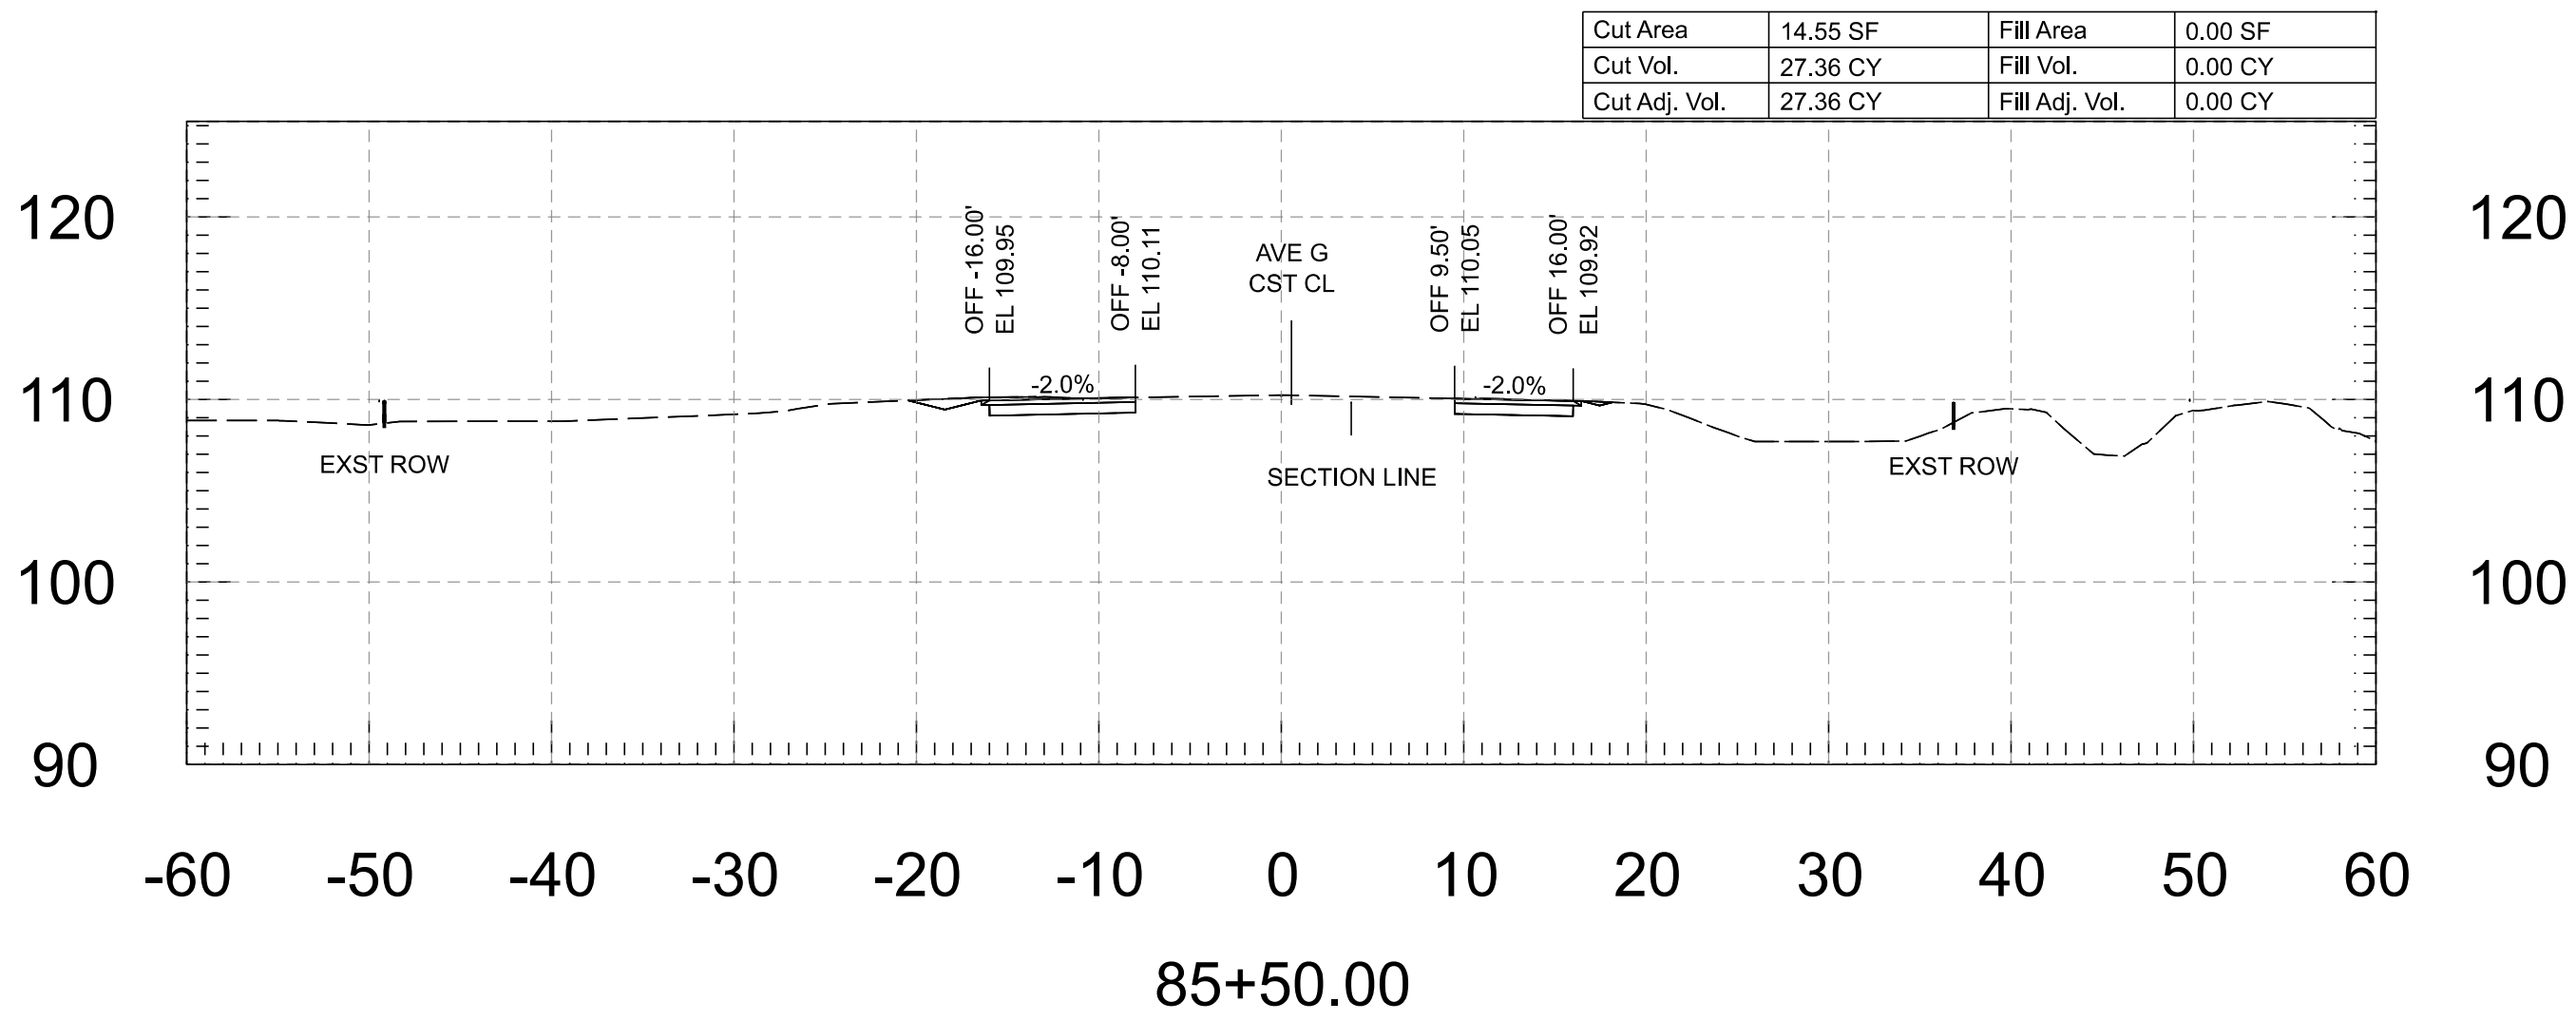


FOR INFORMATION ONLY		NAME	DATE	ARIZONA DEPARTMENT OF TRANSPORTATION PROJECT DELIVERY AND OPERATIONS DIVISION ROADWAY DESIGN SERVICES	ROUTE	F.H.W.A. Arizona Division	STATE ARIZ.	PROJECT NO.	FEDERAL ID NO.	SHEET NO.	TOTAL SHEETS	RECORD DRAWING
	DESIGN	M. SCHOEN	07/26		MILEPOST			0000 YU YYU	YYU-0(225)T	36	118	
	DRAWN	M. SCHOEN	07/26					LOCATION AVENUE G, COUNTY 11TH ST - COUNTY 16TH ST				
	CHECKED	H. RIOS	07/26	 WSP USA Inc. 1230 West Washington Street, Suite 405 Tempe, AZ 85288	AVENUE G - CROSS SECTIONS	STRUCTURE NO.	TRACS NO. T0437 01C				___ OF ___	

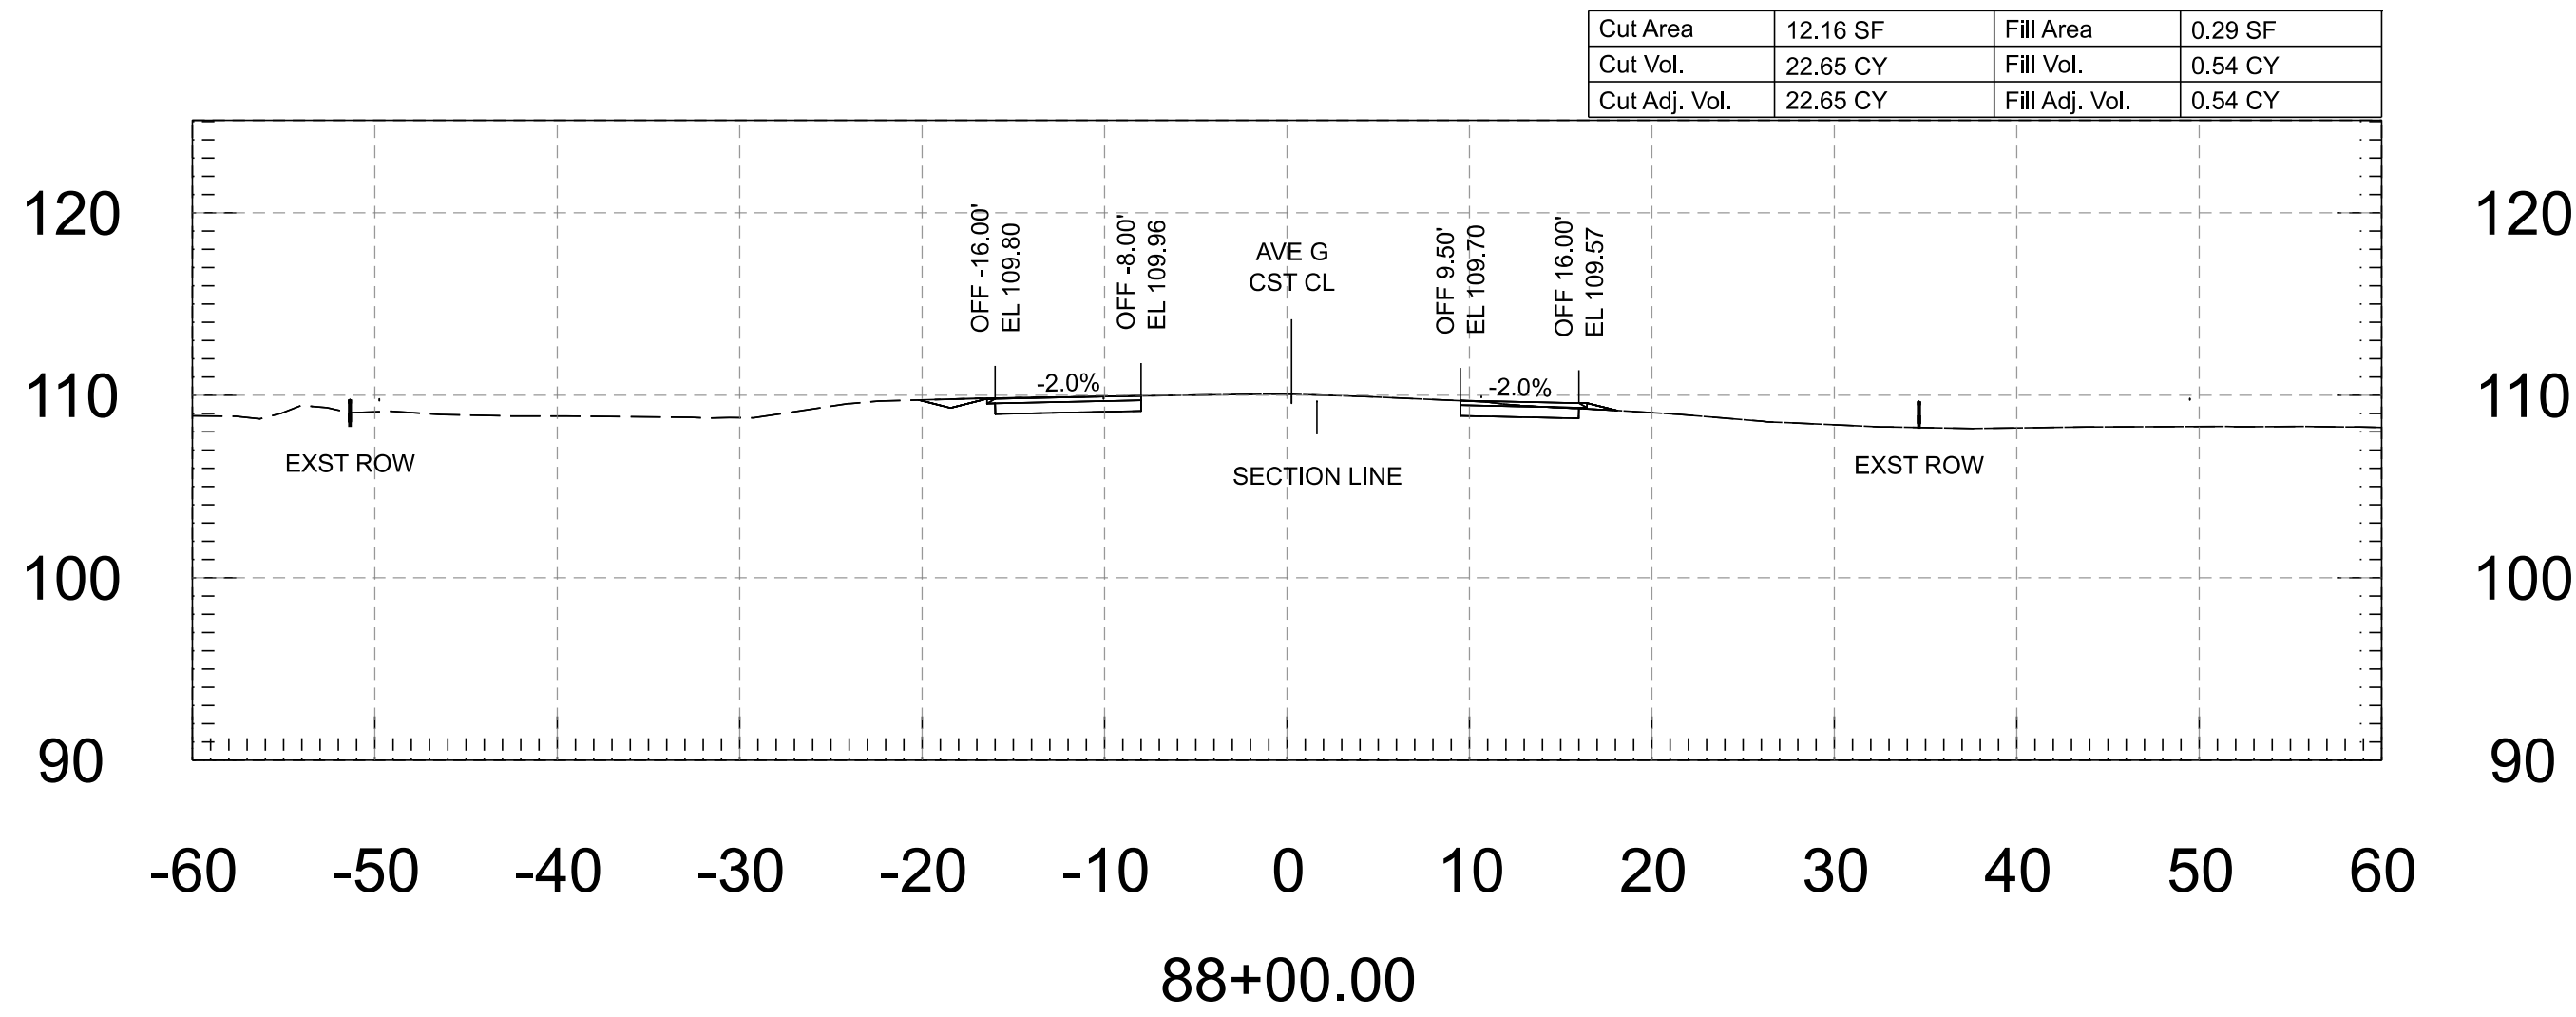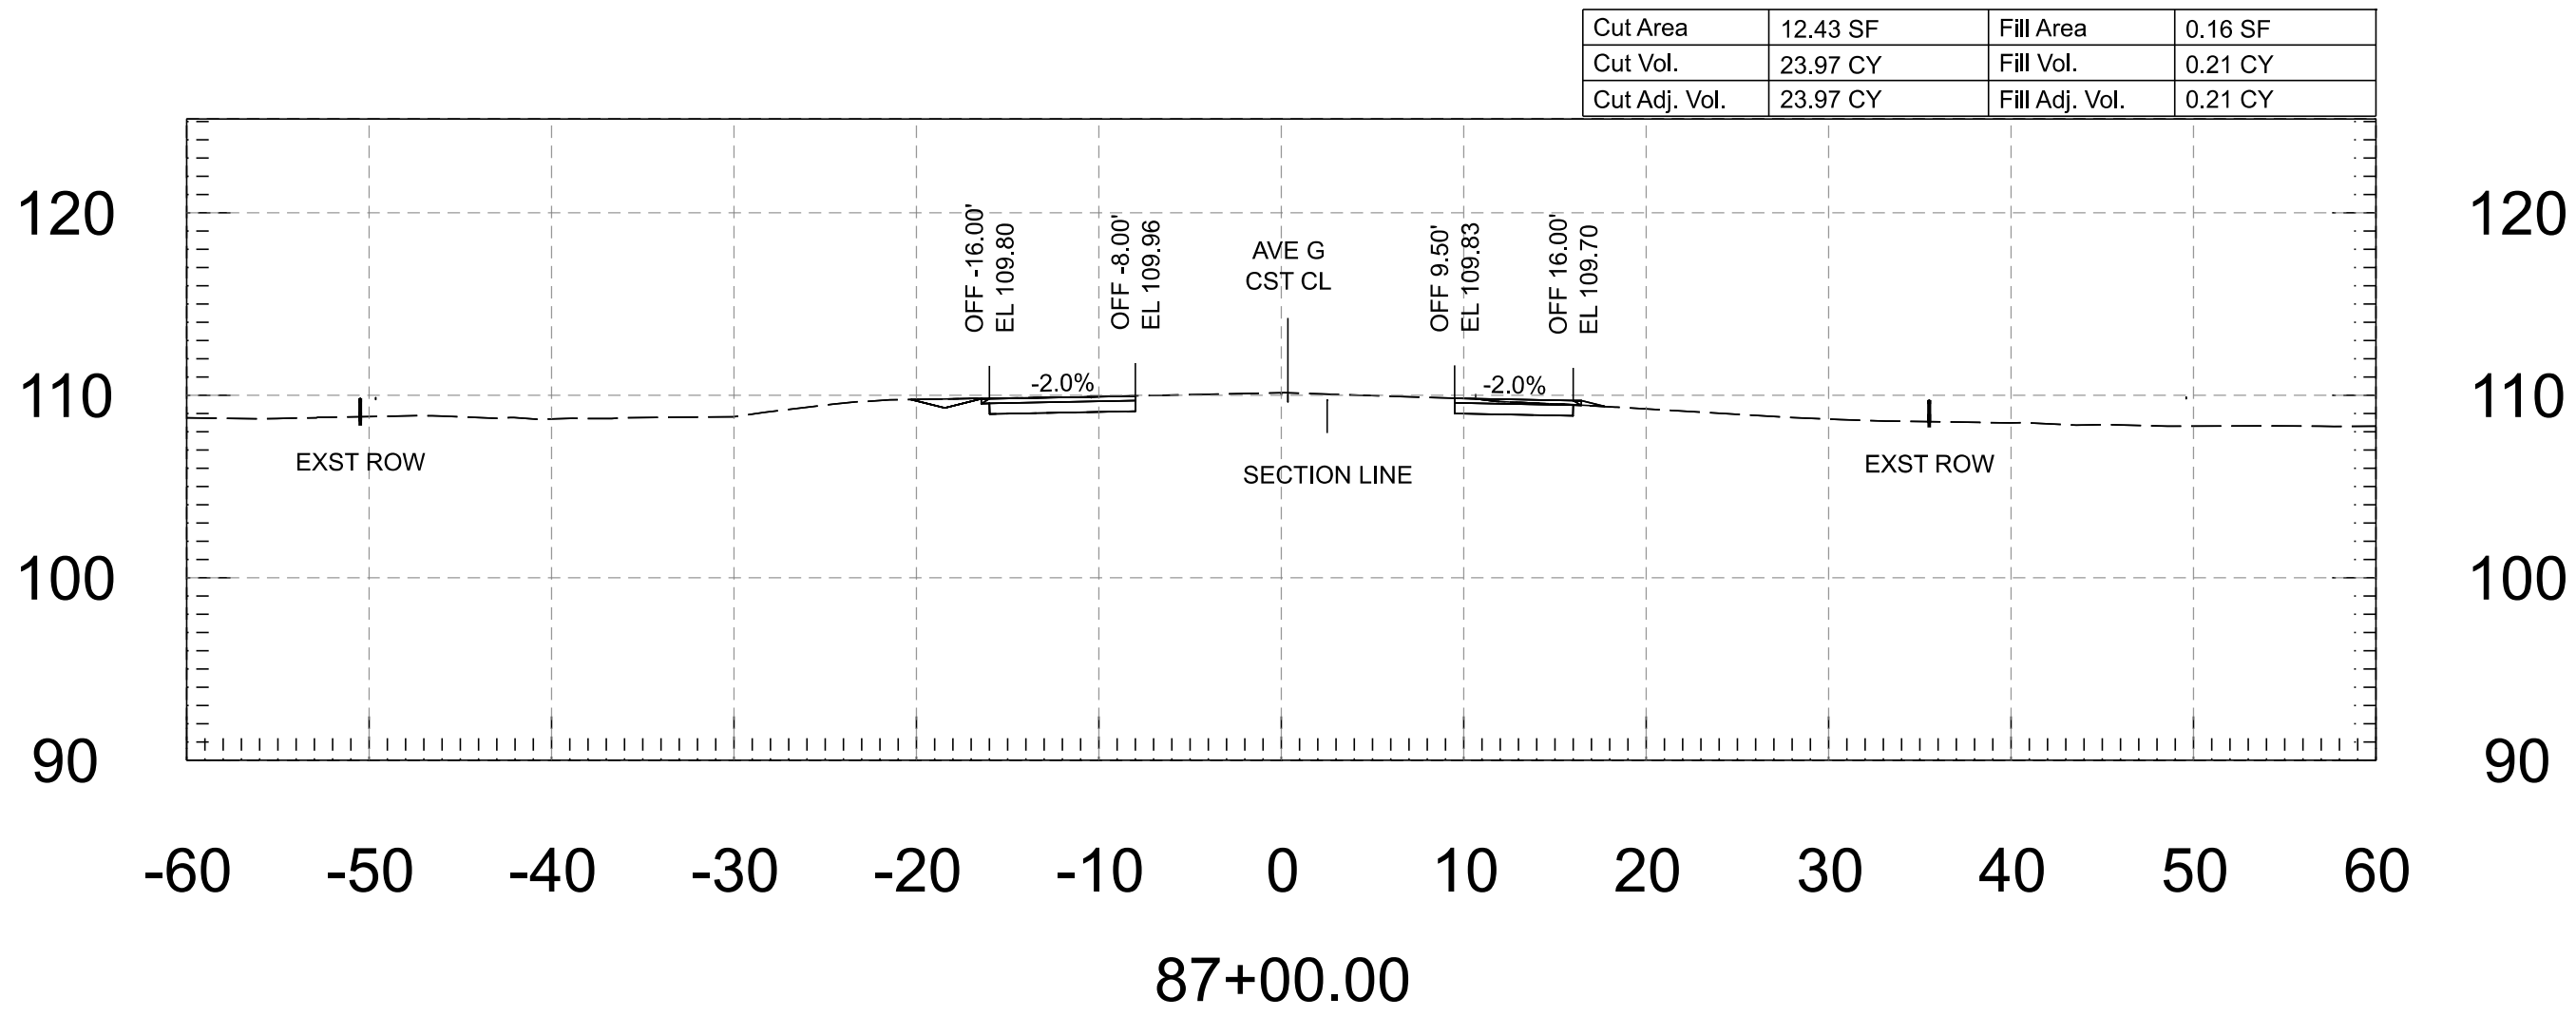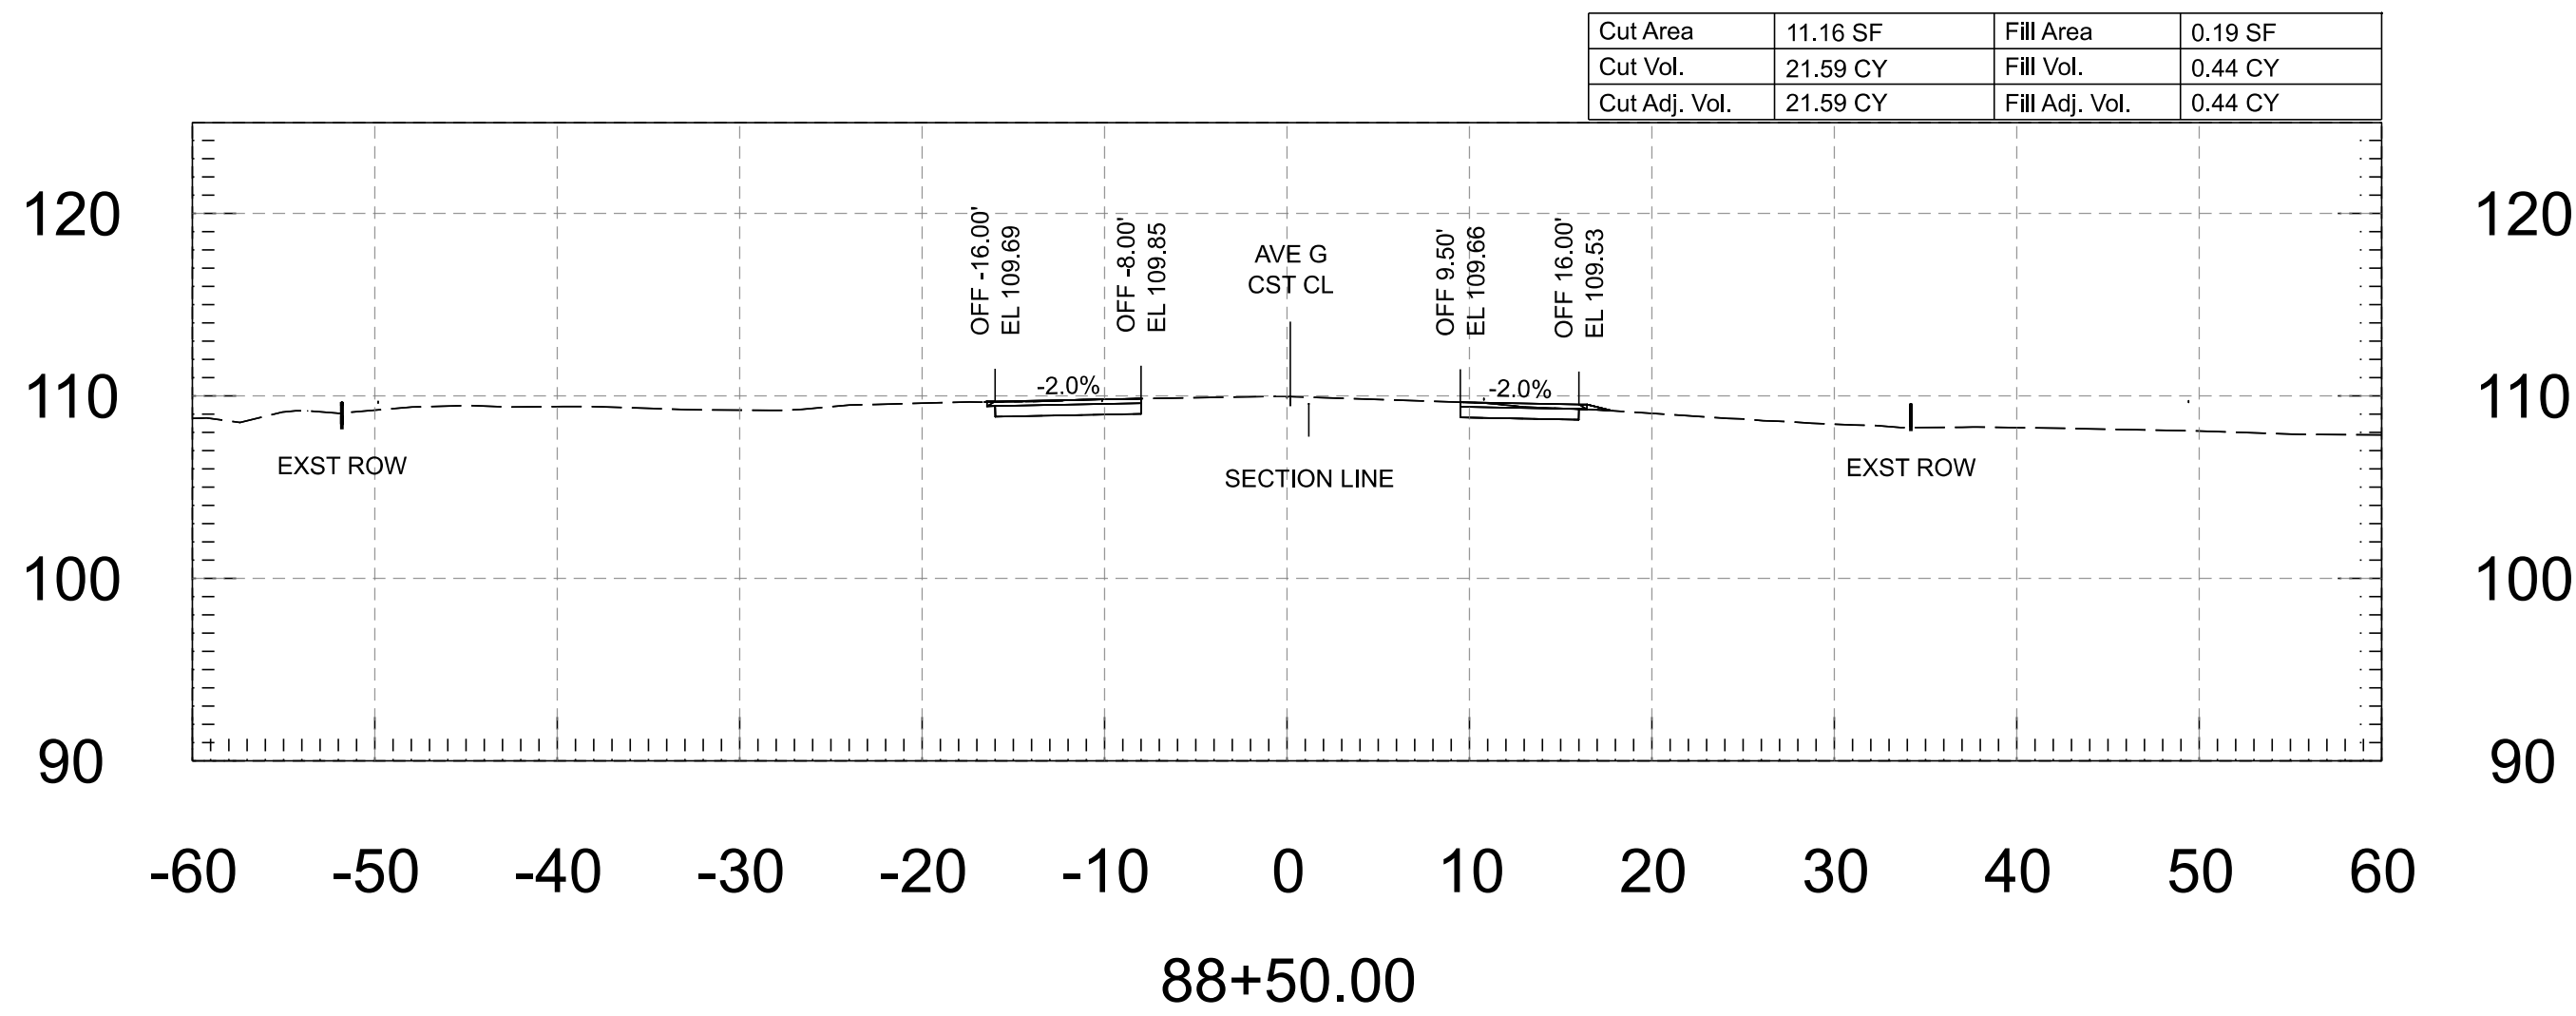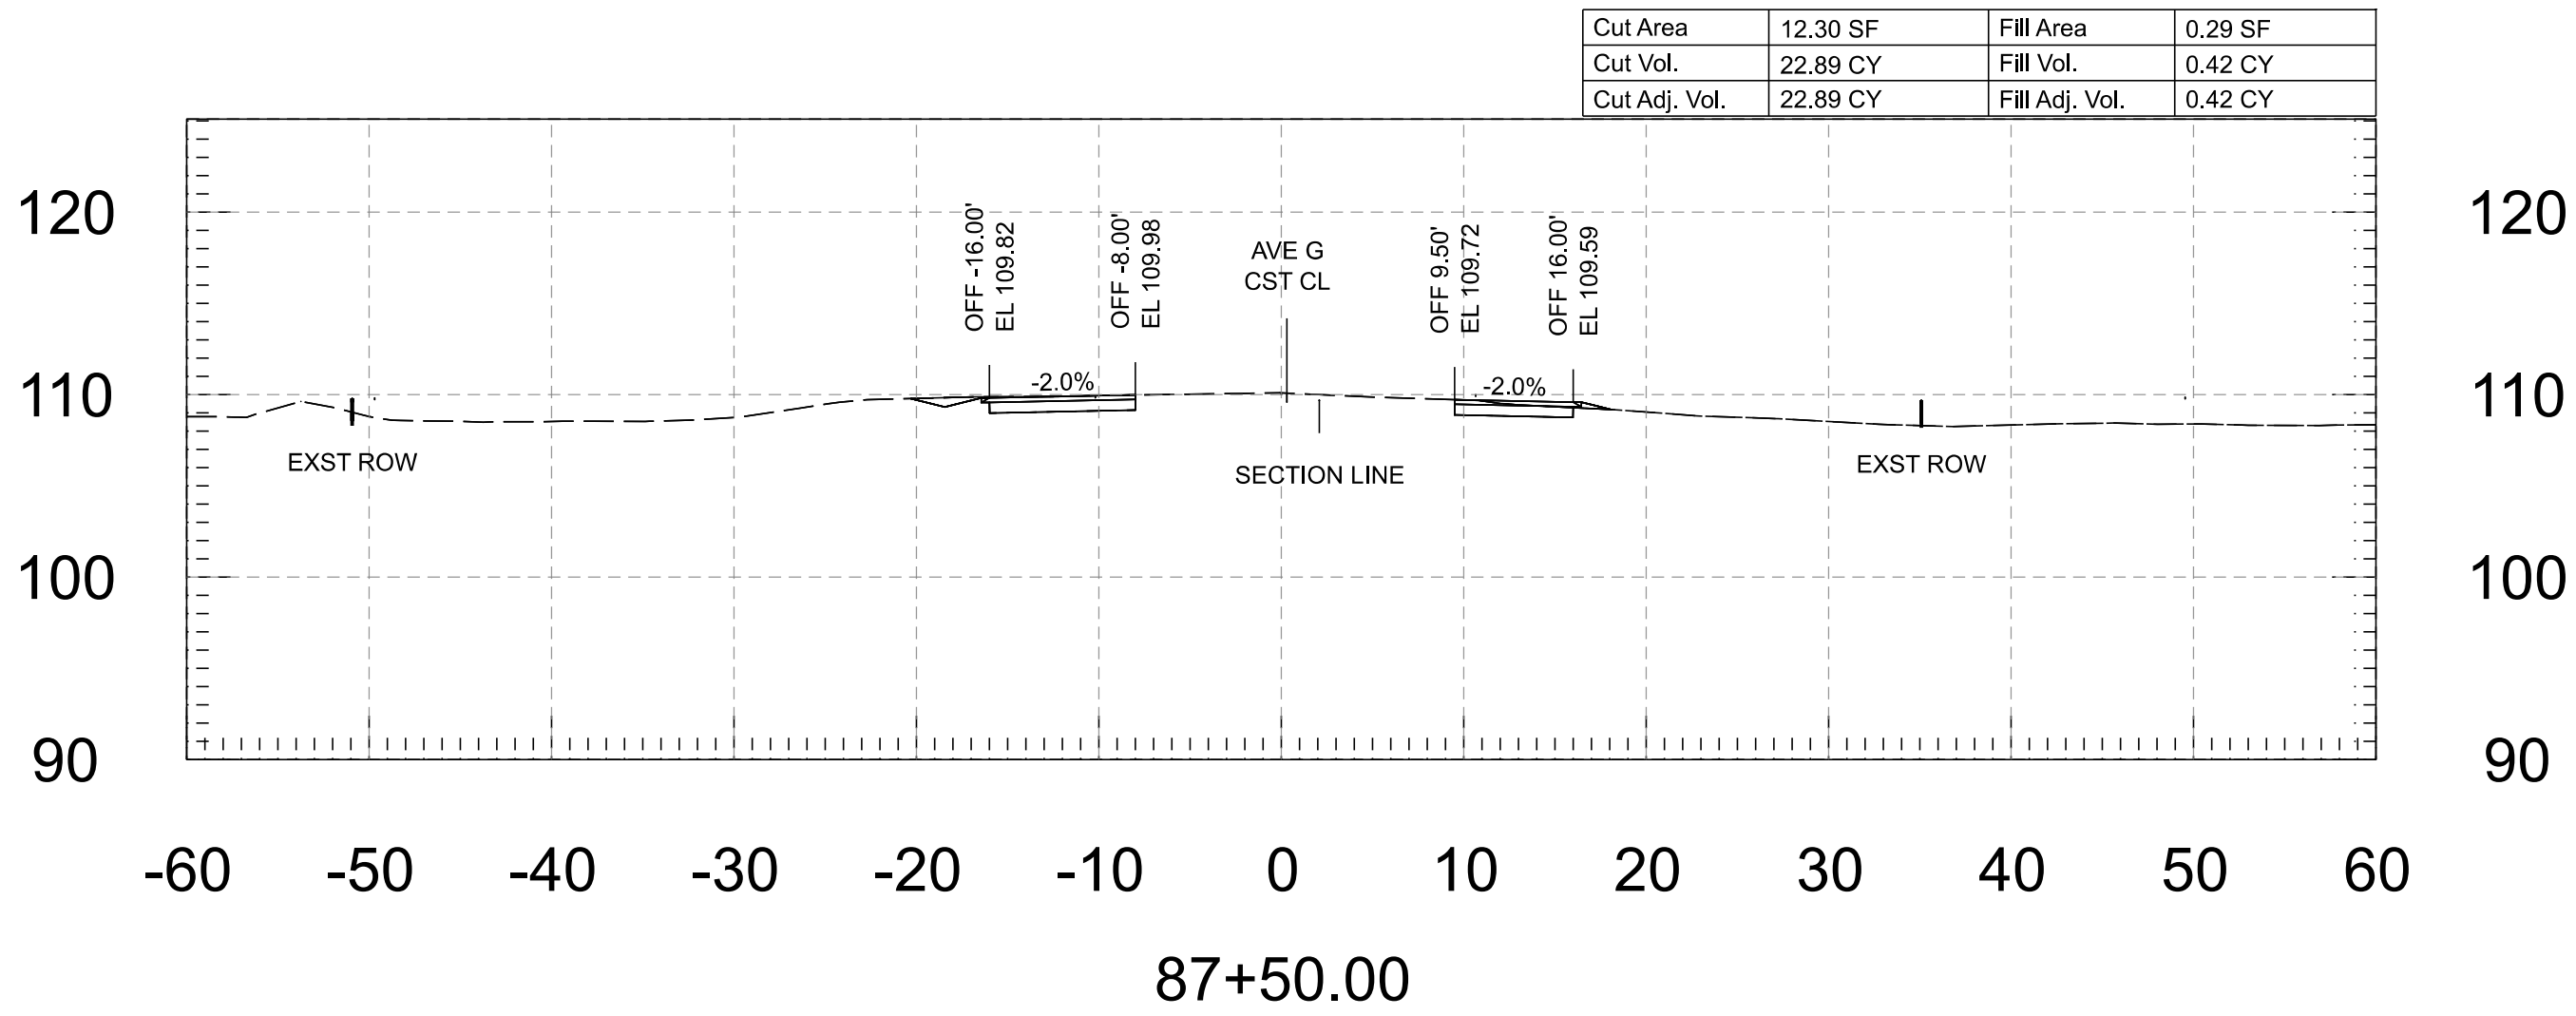


	FOR INFORMATION ONLY		NAME	DATE	ARIZONA DEPARTMENT OF TRANSPORTATION PROJECT DELIVERY AND OPERATIONS DIVISION ROADWAY DESIGN SERVICES	ROUTE	F.H.W.A. Arizona Division	STATE ARIZ.	PROJECT NO.	FEDERAL ID NO.	SHEET NO.	TOTAL SHEETS	RECORD DRAWING		
		DESIGN	M. SCHOEN	07/26		MILEPOST									
		DRAWN	M. SCHOEN	07/26											
		CHECKED	H. RIOS	07/26											
				wsp				AVENUE G - CROSS SECTIONS					DWG		
				WSP USA Inc. 1230 West Washington Street, Suite 405 Tempe, AZ 85288									____ OF ____		


Cut Area	14.86 SF	Fill Area	0.00 SF
Cut Vol.	27.38 CY	Fill Vol.	0.00 CY
Cut Adj. Vol.	27.38 CY	Fill Adj. Vol.	0.00 CY

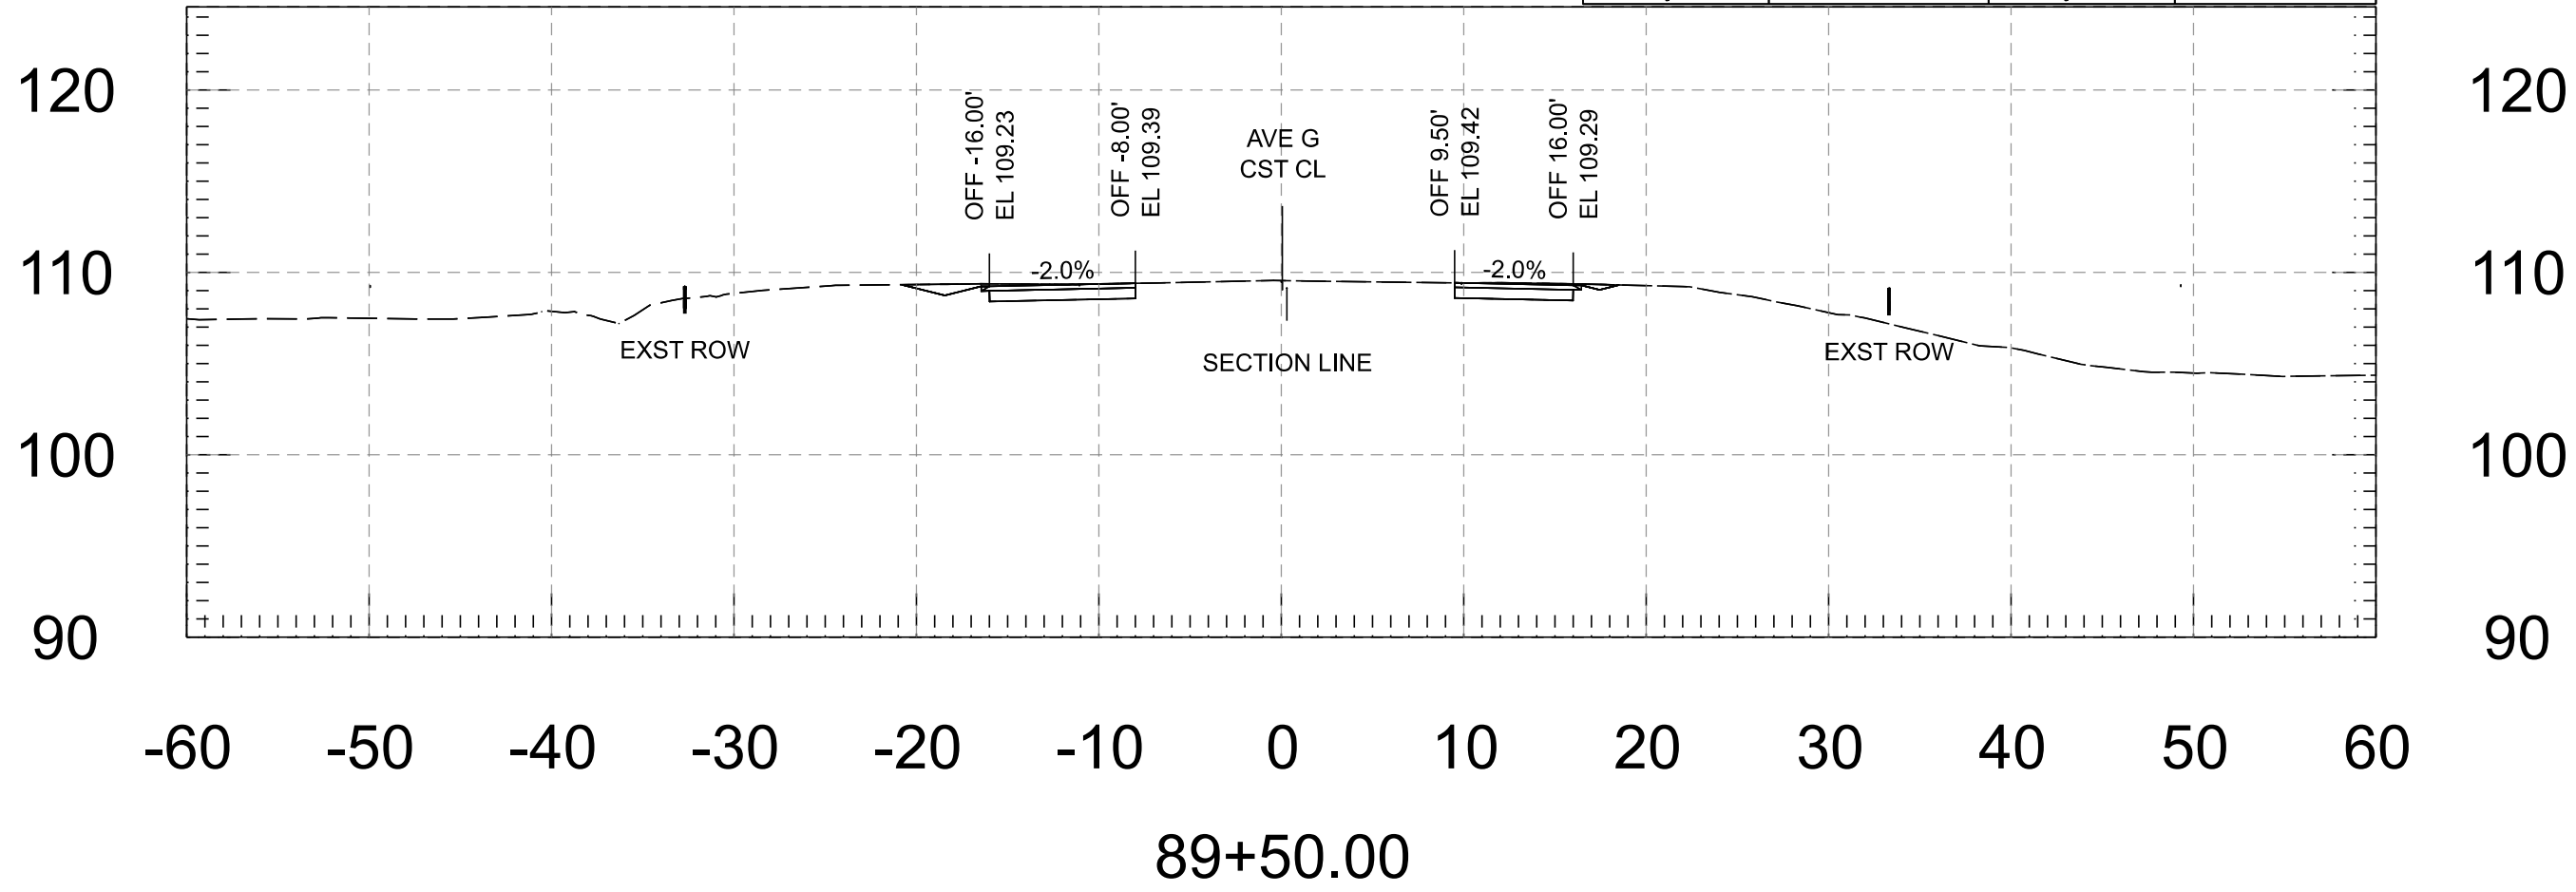


Cut Area	12.09 SF	Fill Area	0.00 SF
Cut Vol.	22.83 CY	Fill Vol.	0.00 CY
Cut Adj. Vol.	22.83 CY	Fill Adj. Vol.	0.00 CY

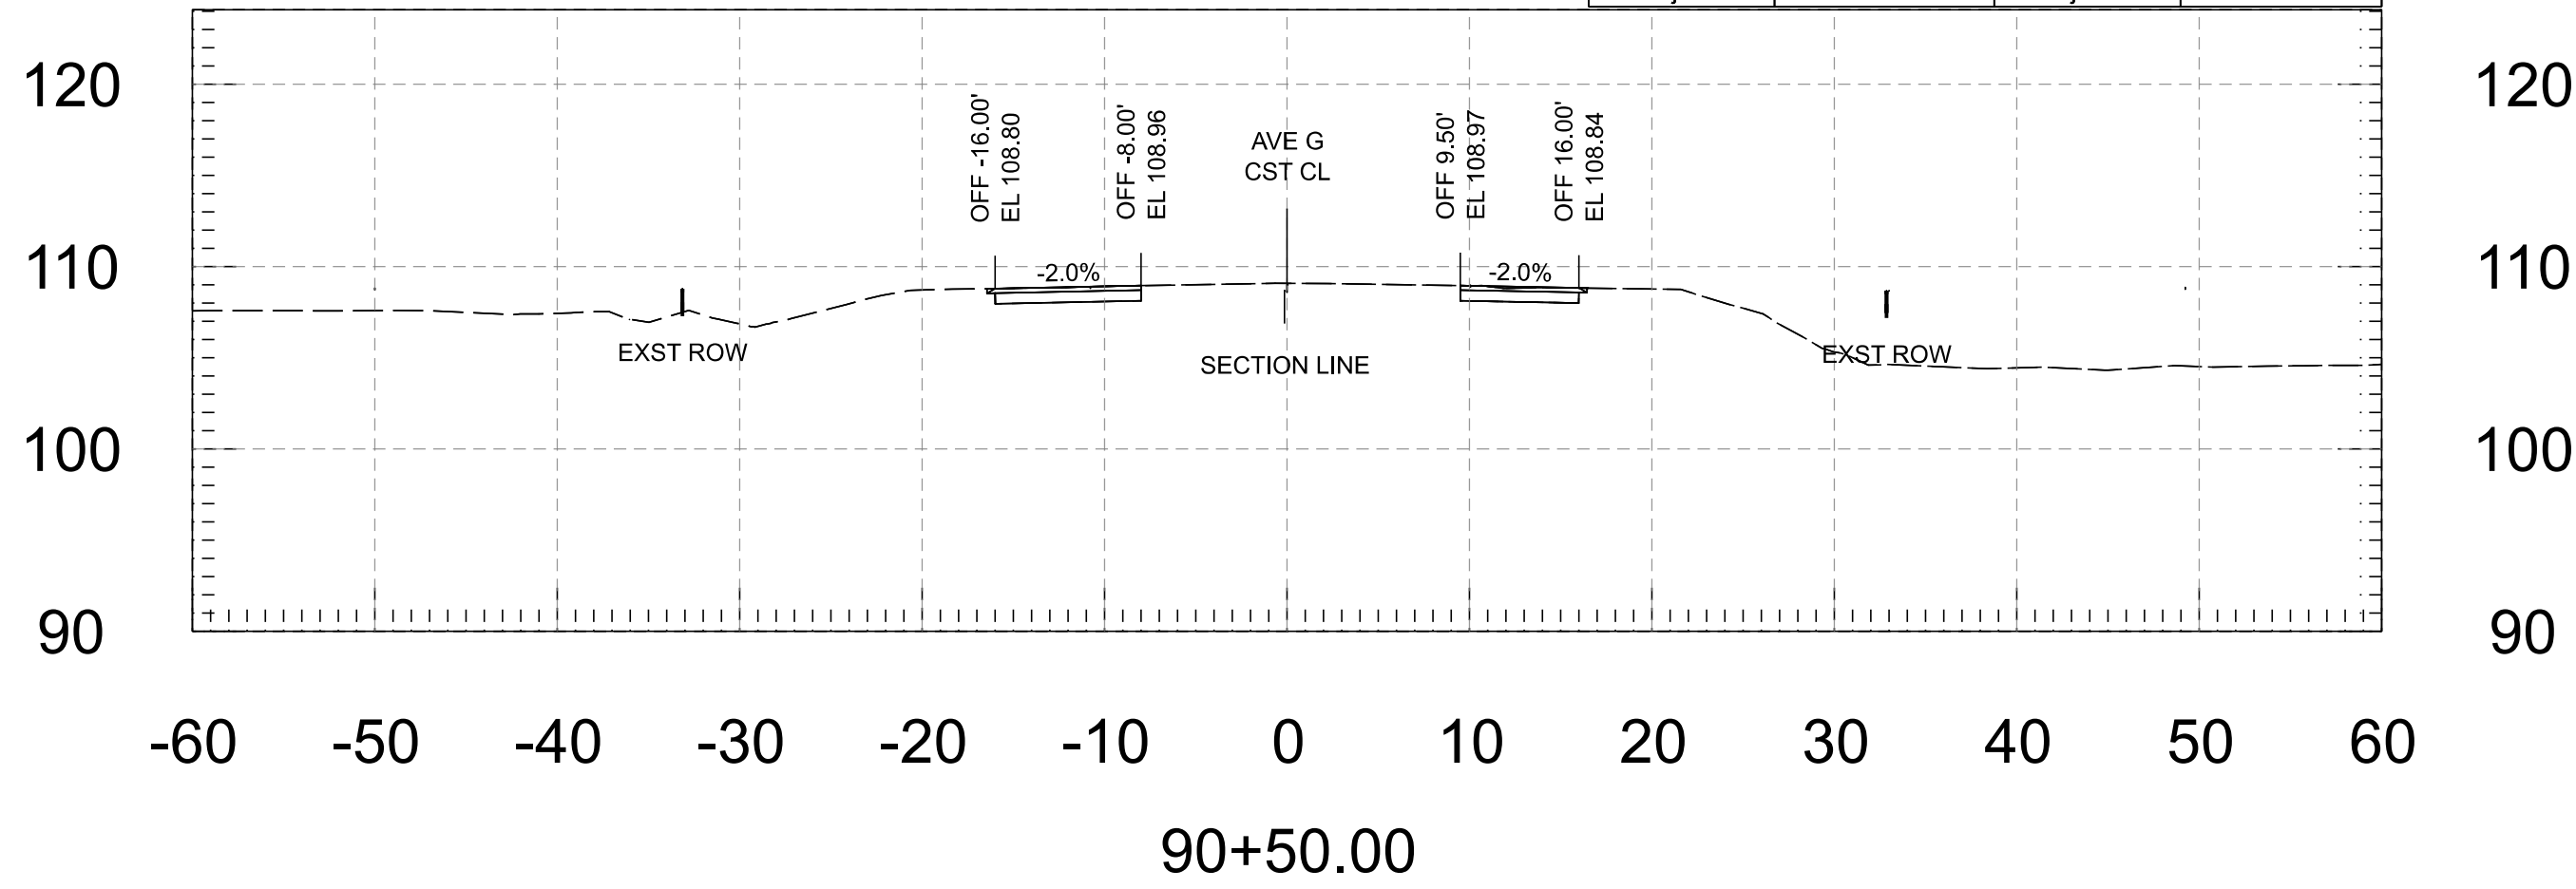





Cut Area	14.71 SF	Fill Area	0.00 SF
Cut Vol.	23.96 CY	Fill Vol.	0.17 CY
Cut Adj. Vol.	23.96 CY	Fill Adj. Vol.	0.17 CY

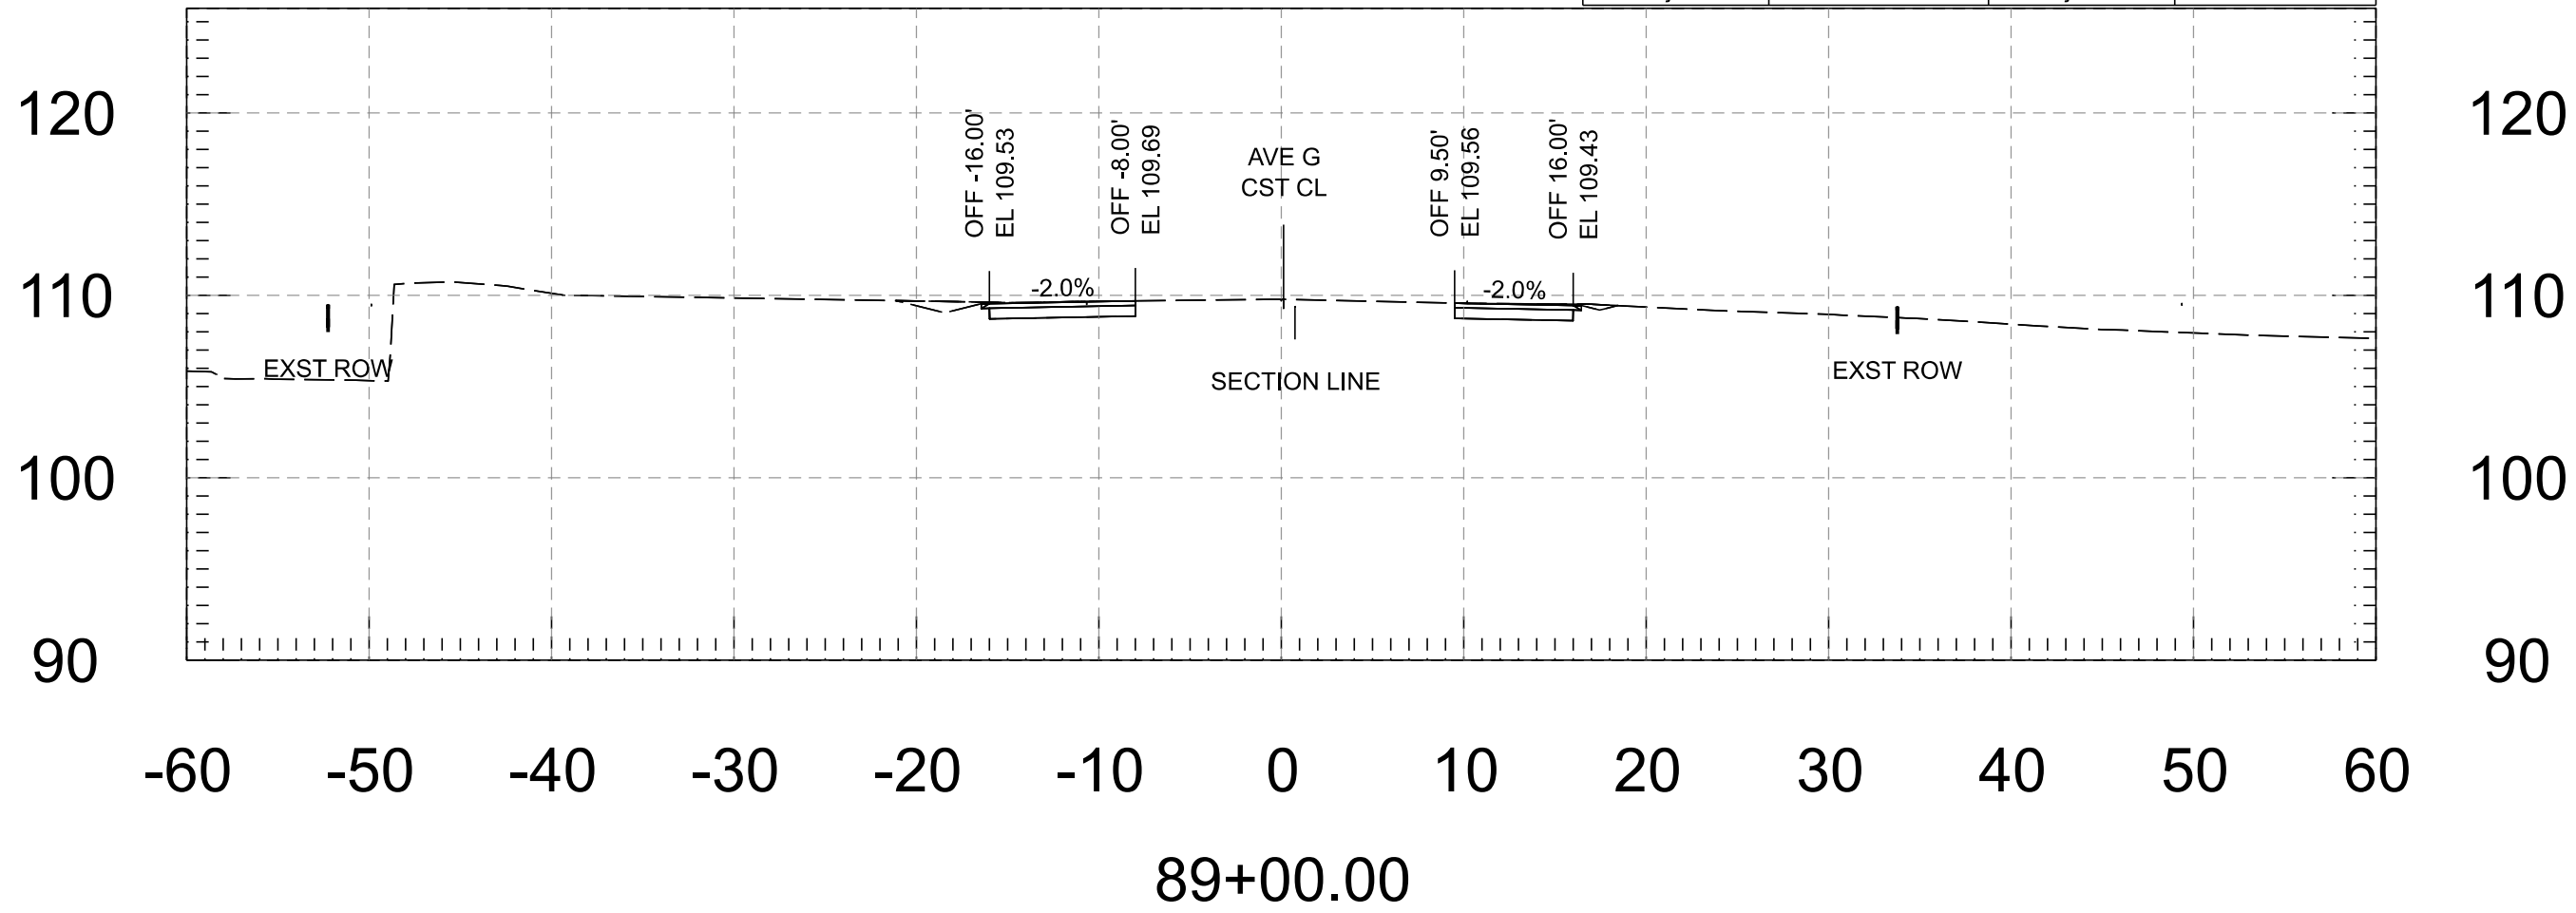

Cut Area	12.56 SF	Fill Area	0.00 SF
Cut Vol.	25.39 CY	Fill Vol.	0.00 CY
Cut Adj. Vol.	25.39 CY	Fill Adj. Vol.	0.00 CY

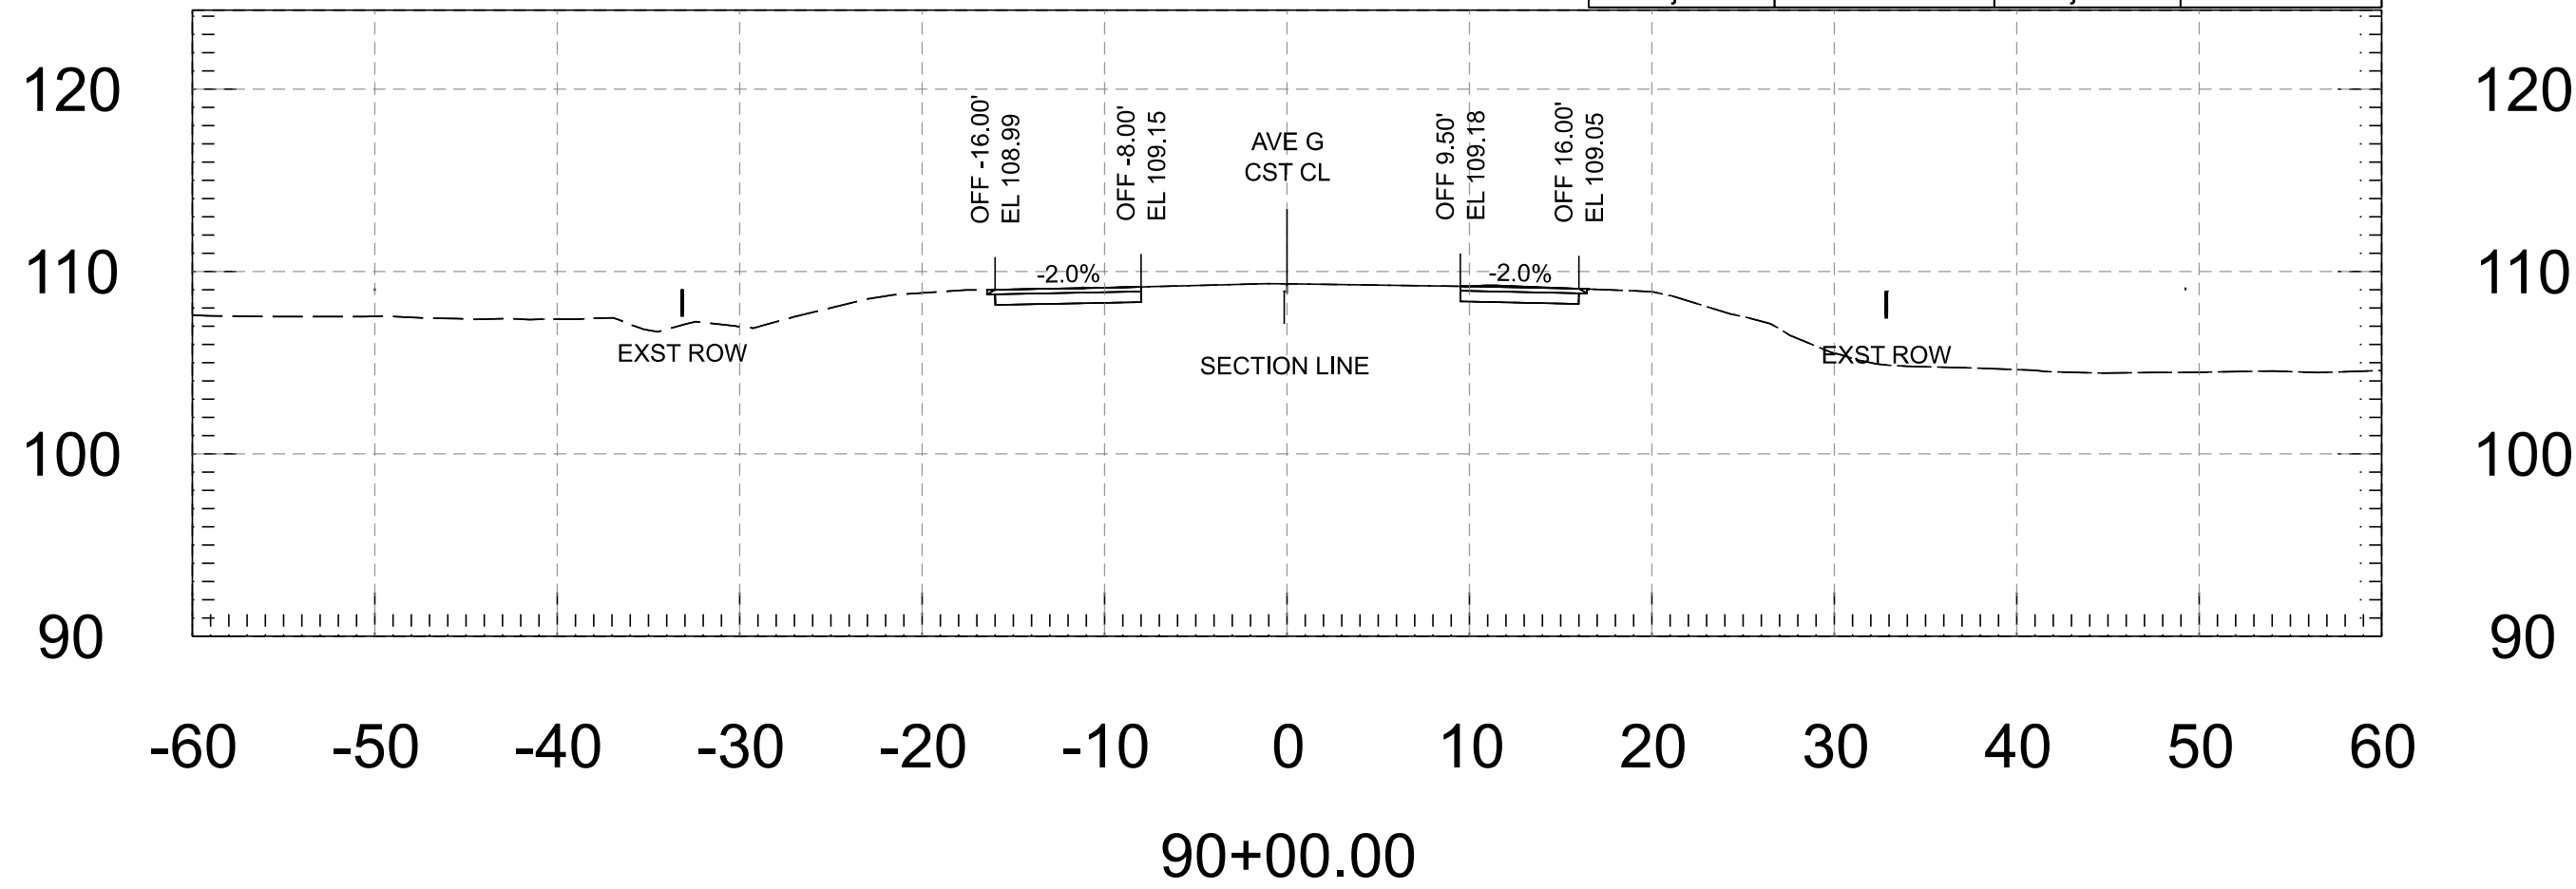


FOR INFORMATION ONLY		NAME	DATE	ARIZONA DEPARTMENT OF TRANSPORTATION PROJECT DELIVERY AND OPERATIONS DIVISION ROADWAY DESIGN SERVICES	ROUTE	F.H.W.A. Arizona Division	STATE ARIZ.	PROJECT NO.	FEDERAL ID NO.	SHEET NO.	TOTAL SHEETS	RECORD DRAWING
	DESIGN	M. SCHOEN	07/26		MILEPOST			0000 YU YYU	YYU-0(225)T	38	118	
	DRAWN	M. SCHOEN	07/26		LOCATION	AVENUE G, COUNTY 11TH ST - COUNTY 16TH ST						
	CHECKED	H. RIOS	07/26				STRUCTURE NO.	TRACS NO.	T0437 01C			DWG ____ OF ____
	wsp WSP USA Inc. 1230 West Washington Street, Suite 405 Tempe, AZ 85288				AVENUE G - CROSS SECTIONS							

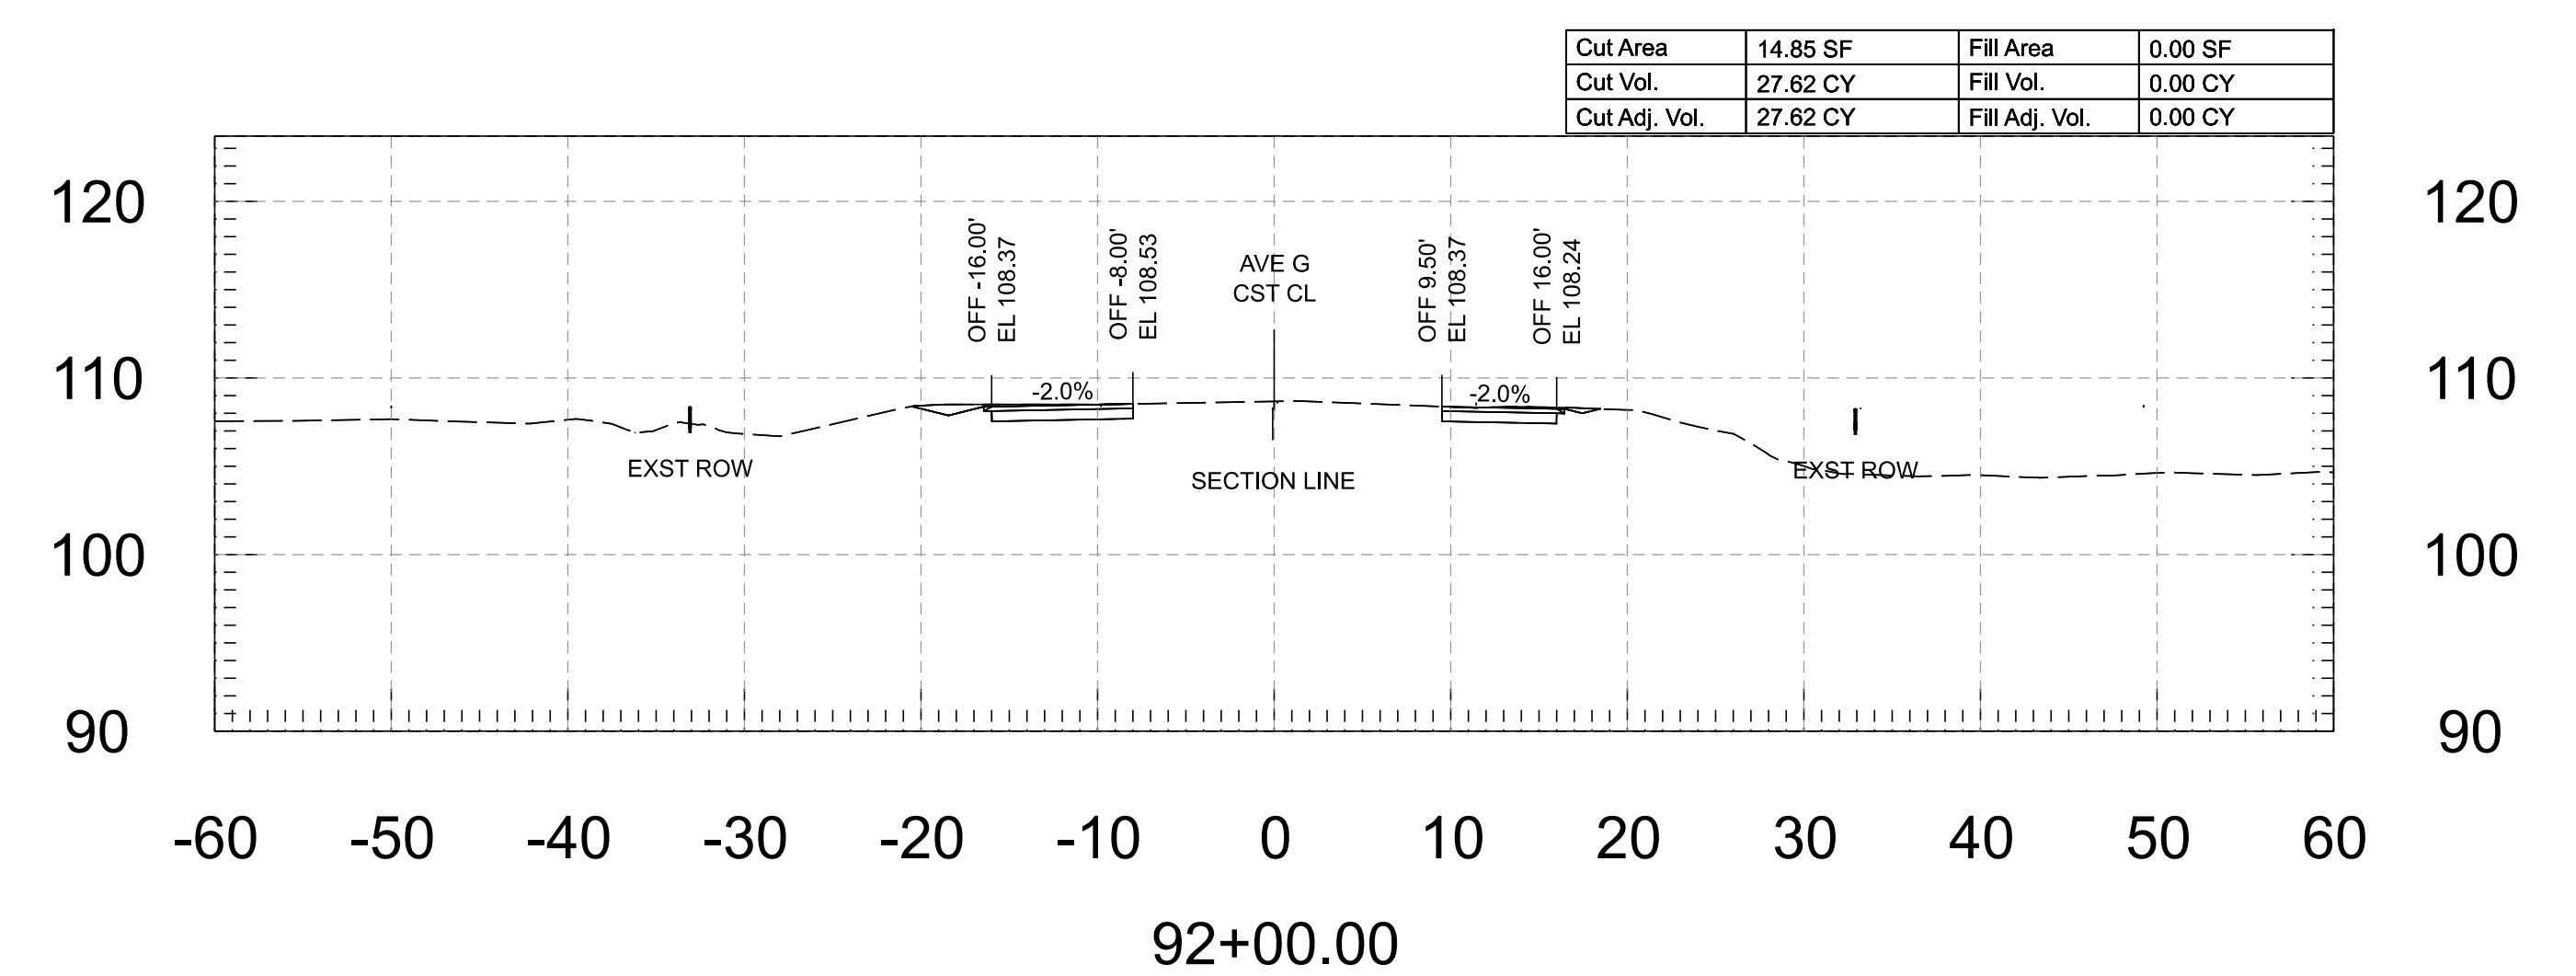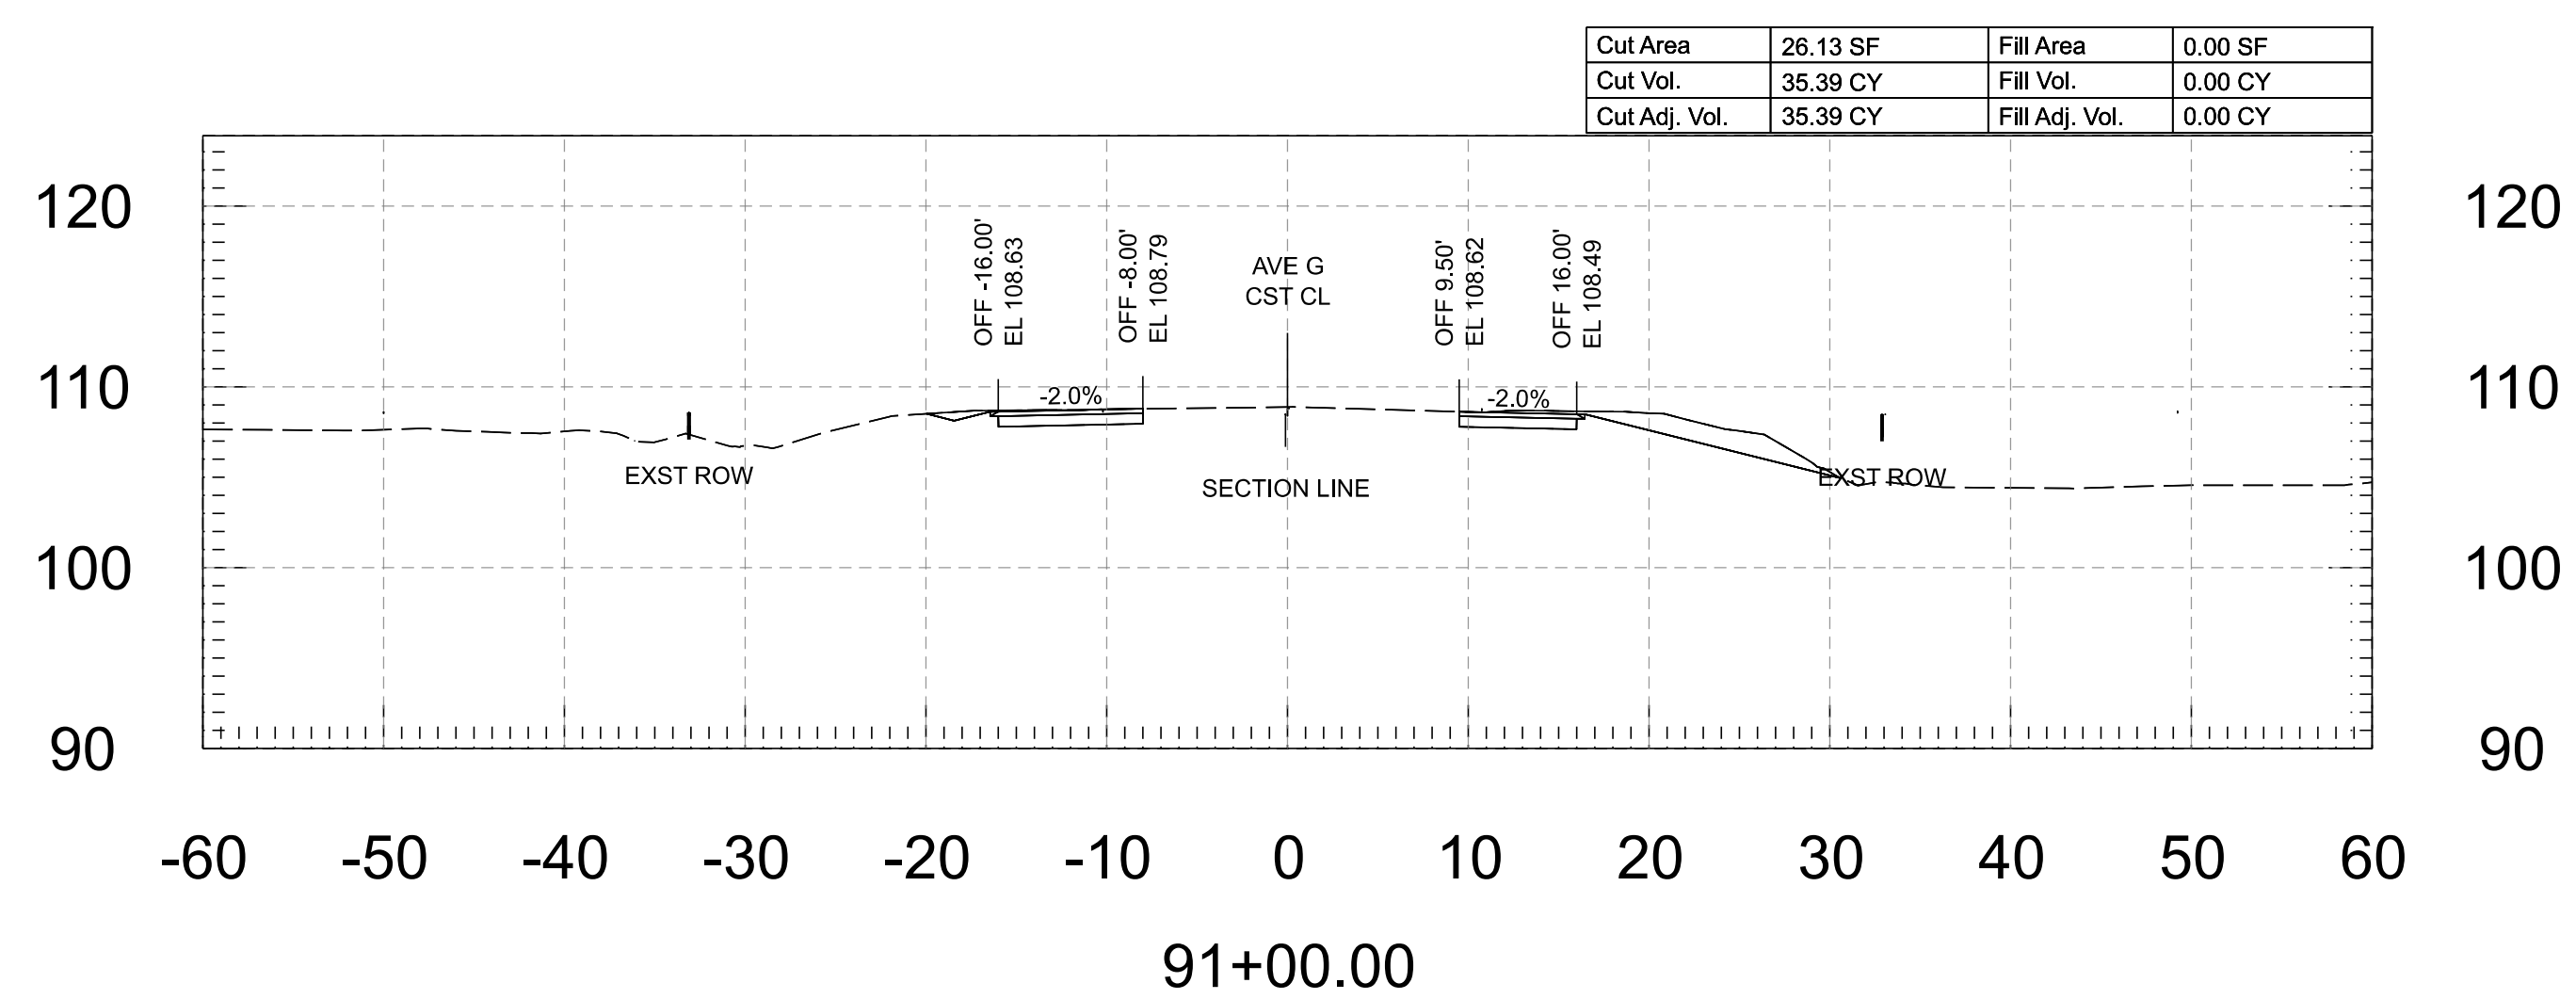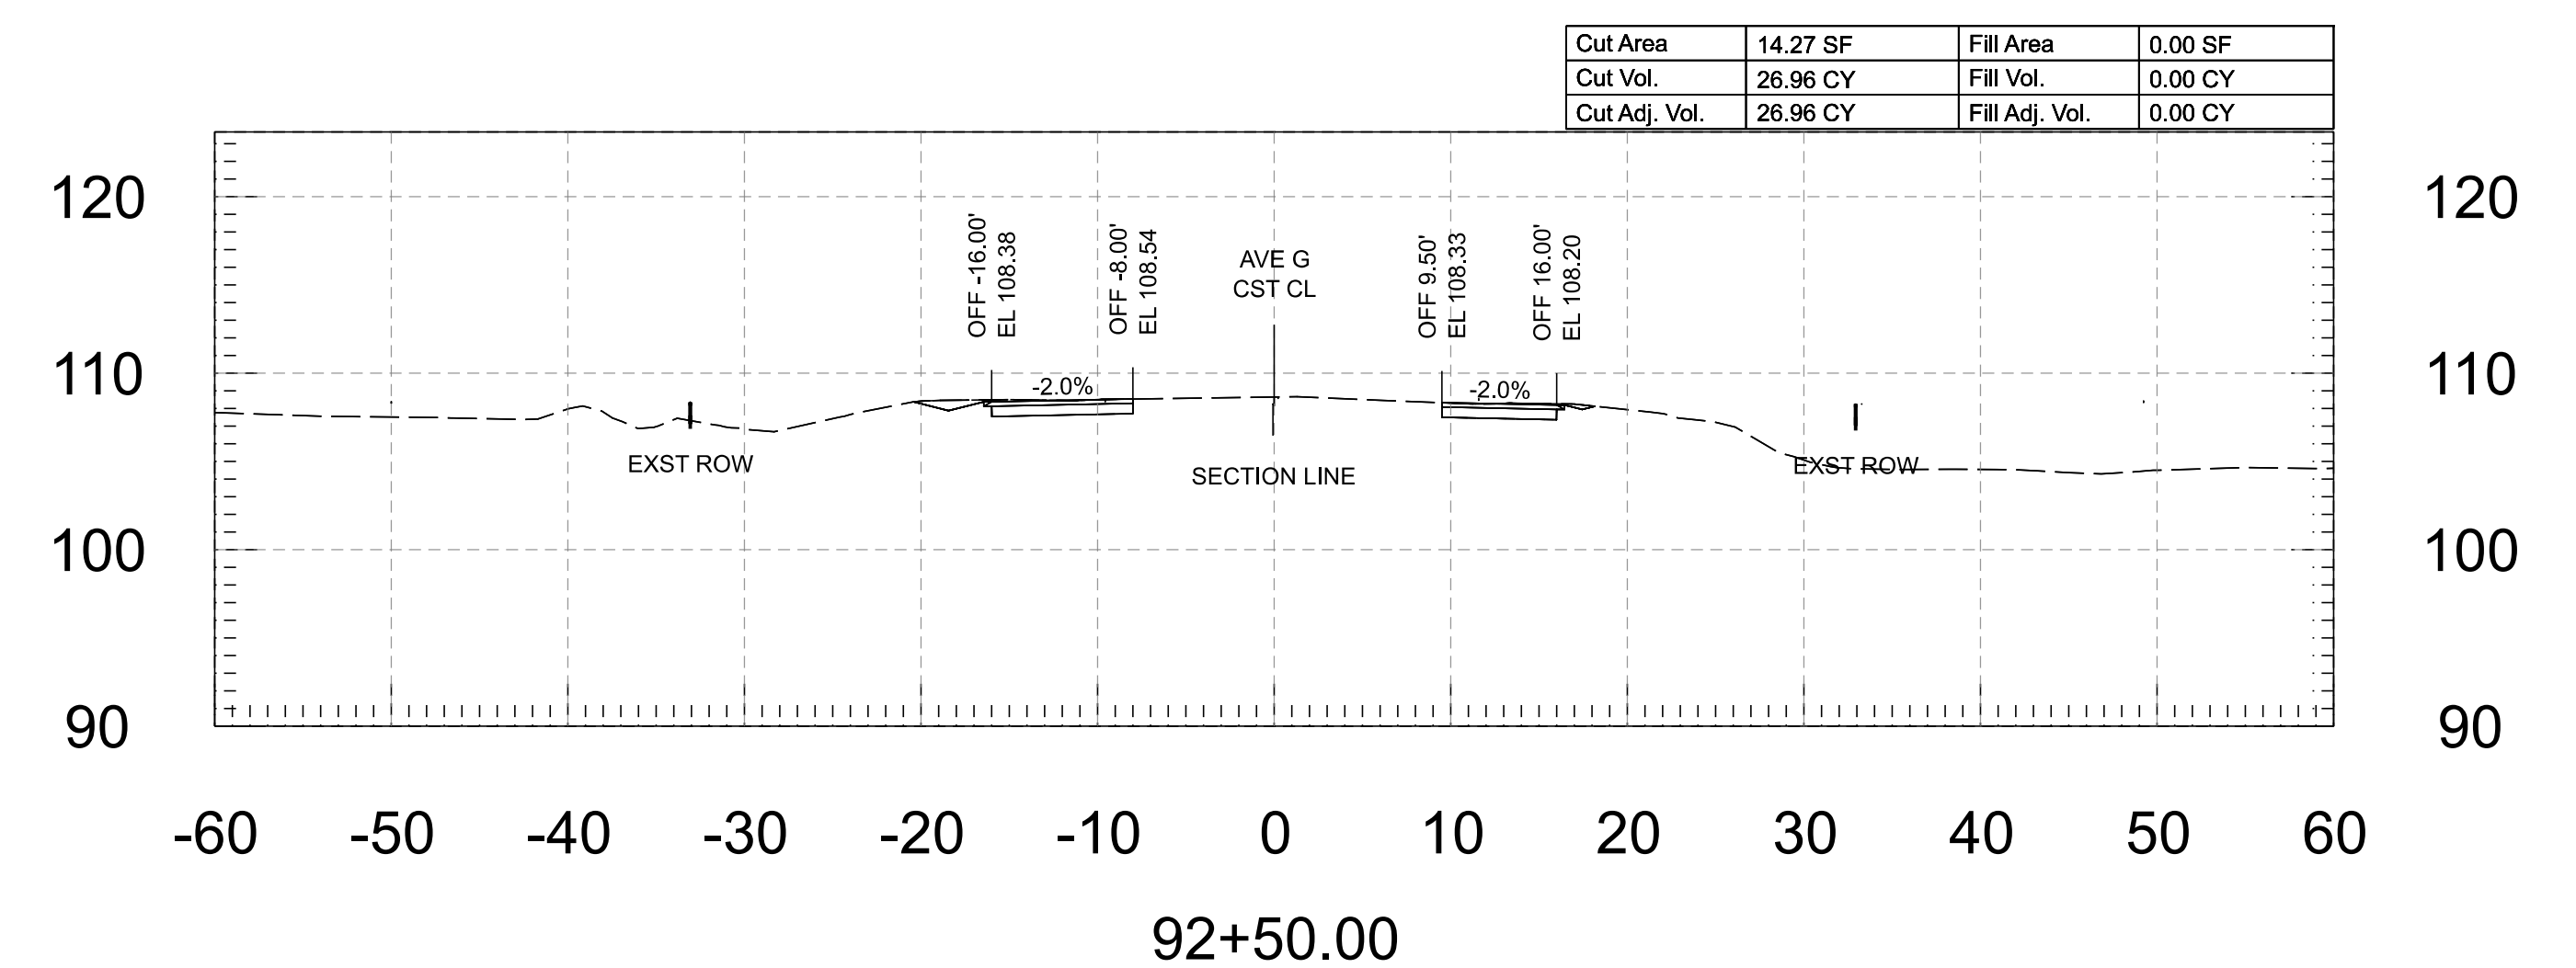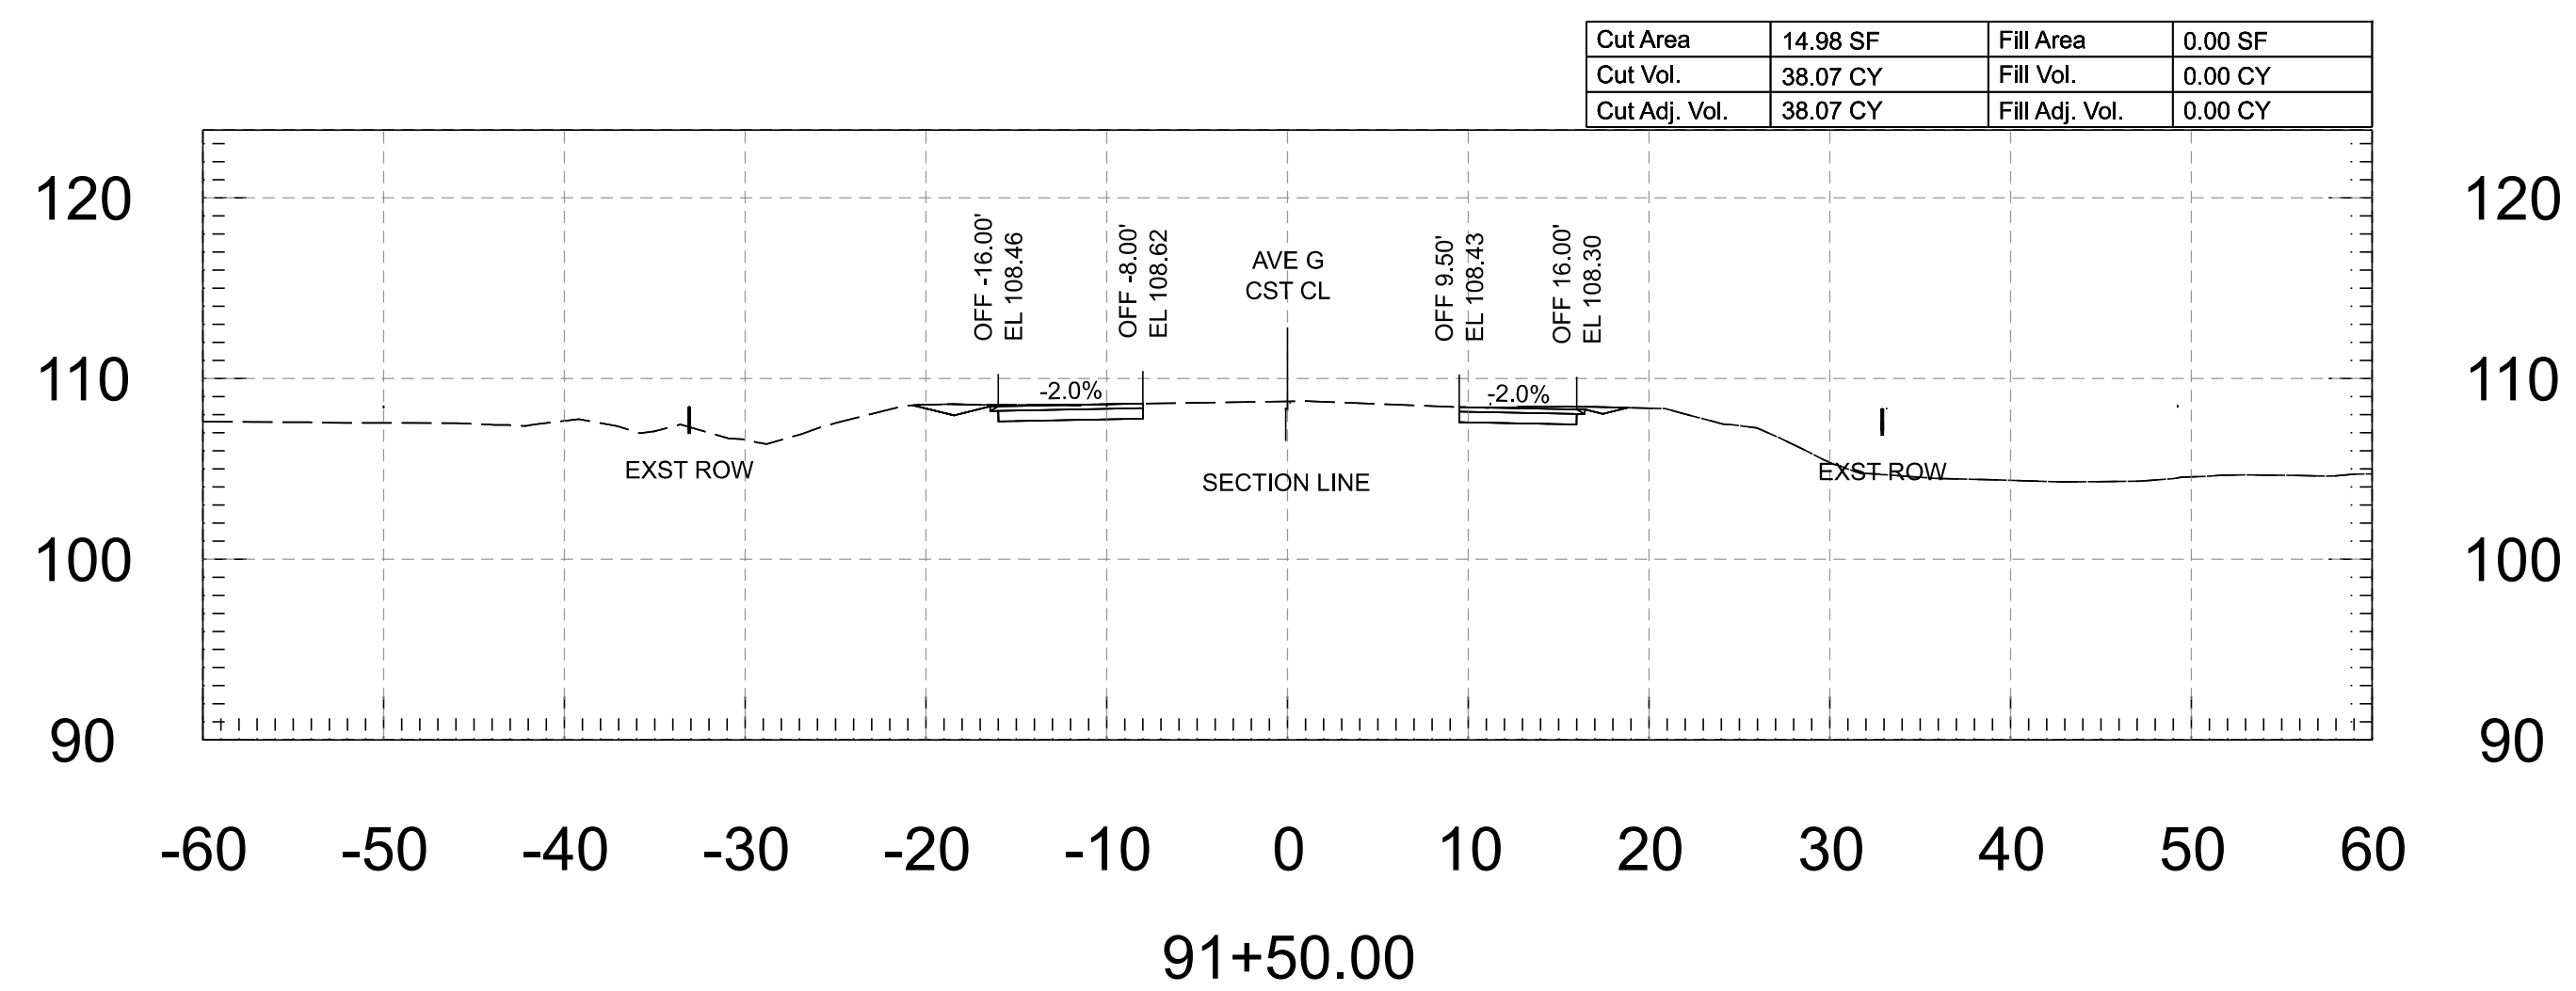


FOR INFORMATION ONLY		NAME	DATE	ARIZONA DEPARTMENT OF TRANSPORTATION PROJECT DELIVERY AND OPERATIONS DIVISION ROADWAY DESIGN SERVICES	ROUTE	F.H.W.A. Arizona Division	STATE ARIZ.	PROJECT NO.	FEDERAL ID NO.	SHEET NO.	TOTAL SHEETS	RECORD DRAWING
	DESIGN	M. SCHOEN	07/26		MILEPOST			0000 YU YYU	YYU-0(225)T	39	118	
	DRAWN	M. SCHOEN	07/26			STRUCTURE NO.	LOCATION AVENUE G, COUNTY 11TH ST - COUNTY 16TH ST					
	CHECKED	H. RIOS	07/26	TRACS NO. T0437 01C						____ OF ____		
	wsp WSP USA Inc. 1230 West Washington Street, Suite 405 Tempe, AZ 85288			AVENUE G - CROSS SECTIONS								


Cut Area	13.76 SF	Fill Area	0.00 SF
Cut Vol.	26.46 CY	Fill Vol.	0.00 CY
Cut Adj. Vol.	26.46 CY	Fill Adj. Vol.	0.00 CY

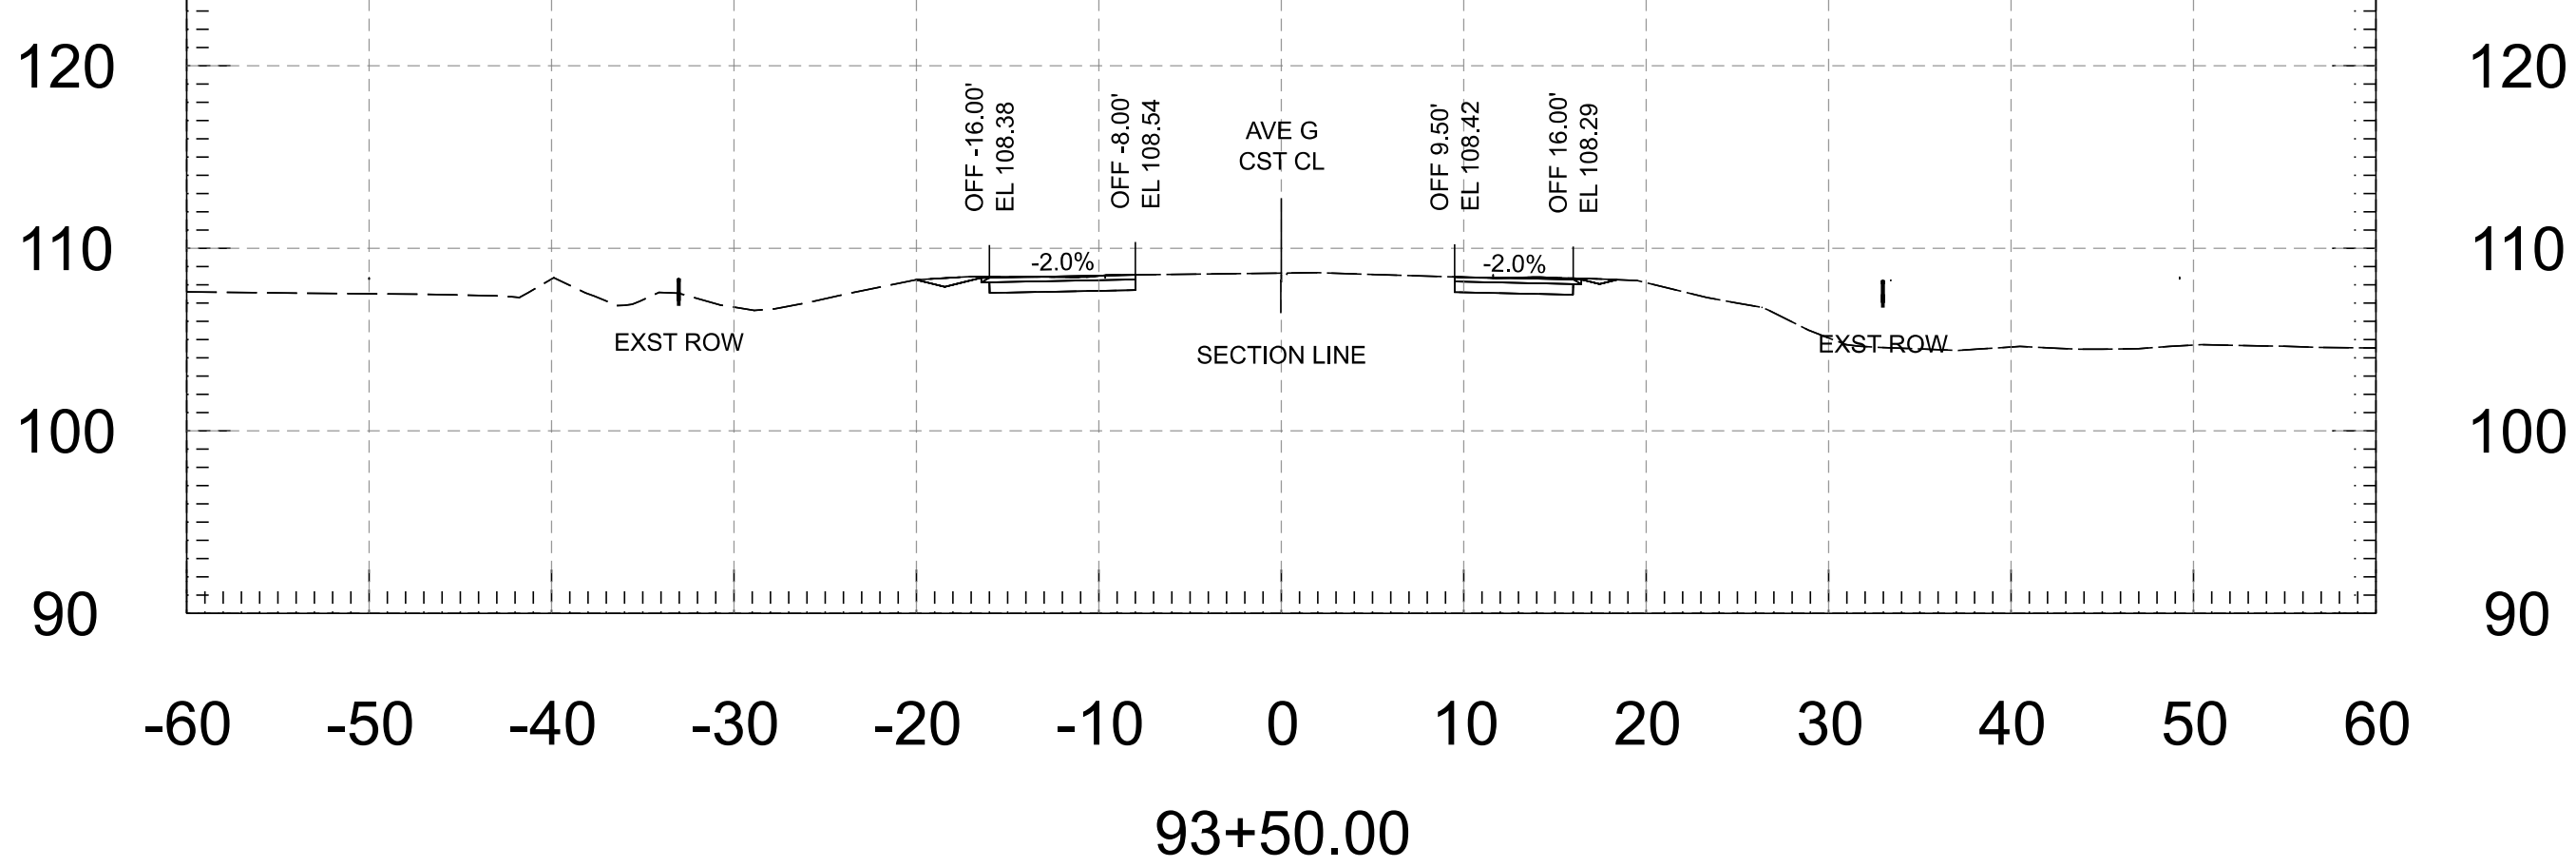


Cut Area	19.38 SF	Fill Area	0.00 SF
Cut Vol.	29.94 CY	Fill Vol.	0.00 CY
Cut Adj. Vol.	29.94 CY	Fill Adj. Vol.	0.00 CY

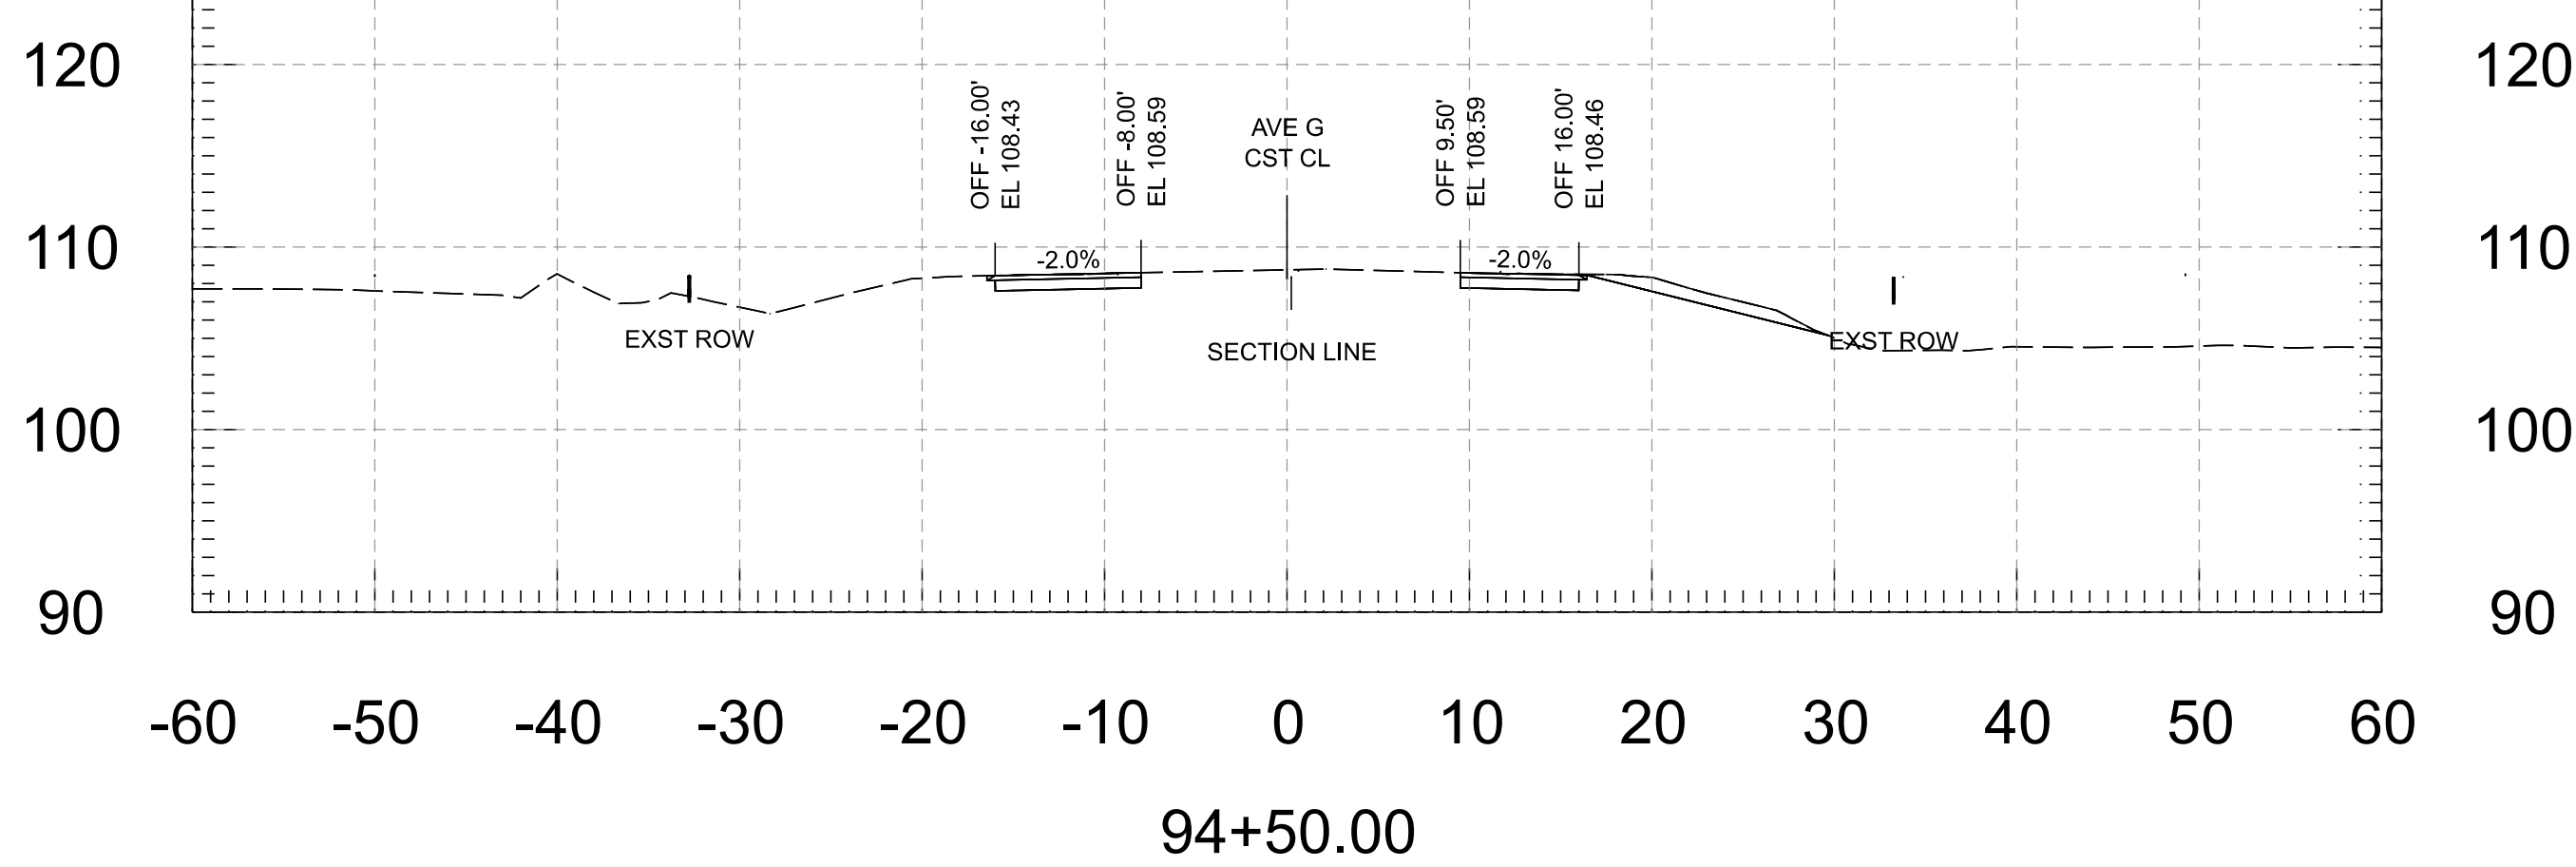

Cut Area	14.82 SF	Fill Area	0.00 SF
Cut Vol.	26.93 CY	Fill Vol.	0.00 CY
Cut Adj. Vol.	26.93 CY	Fill Adj. Vol.	0.00 CY

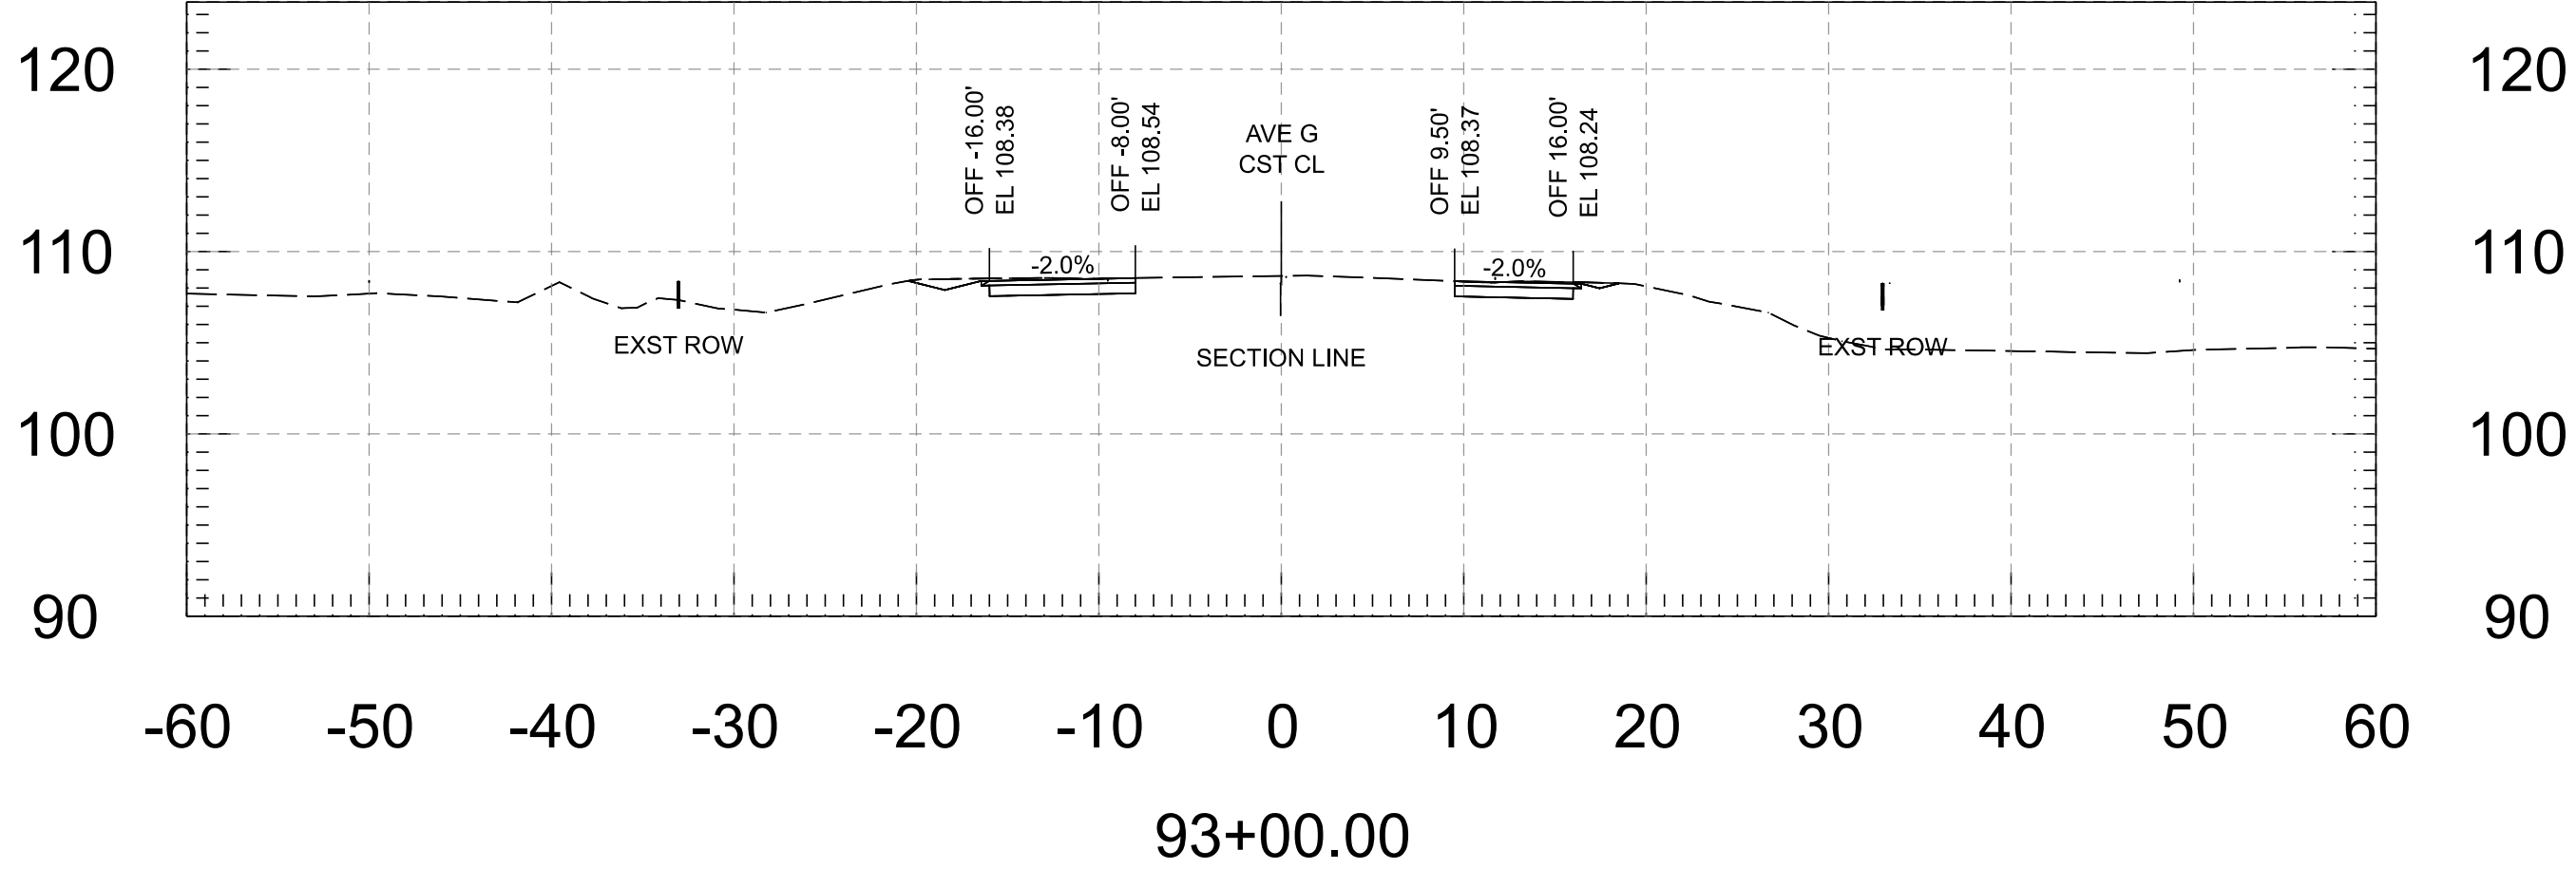

Cut Area	12.96 SF	Fill Area	0.00 SF
Cut Vol.	24.74 CY	Fill Vol.	0.00 CY
Cut Adj. Vol.	24.74 CY	Fill Adj. Vol.	0.00 CY

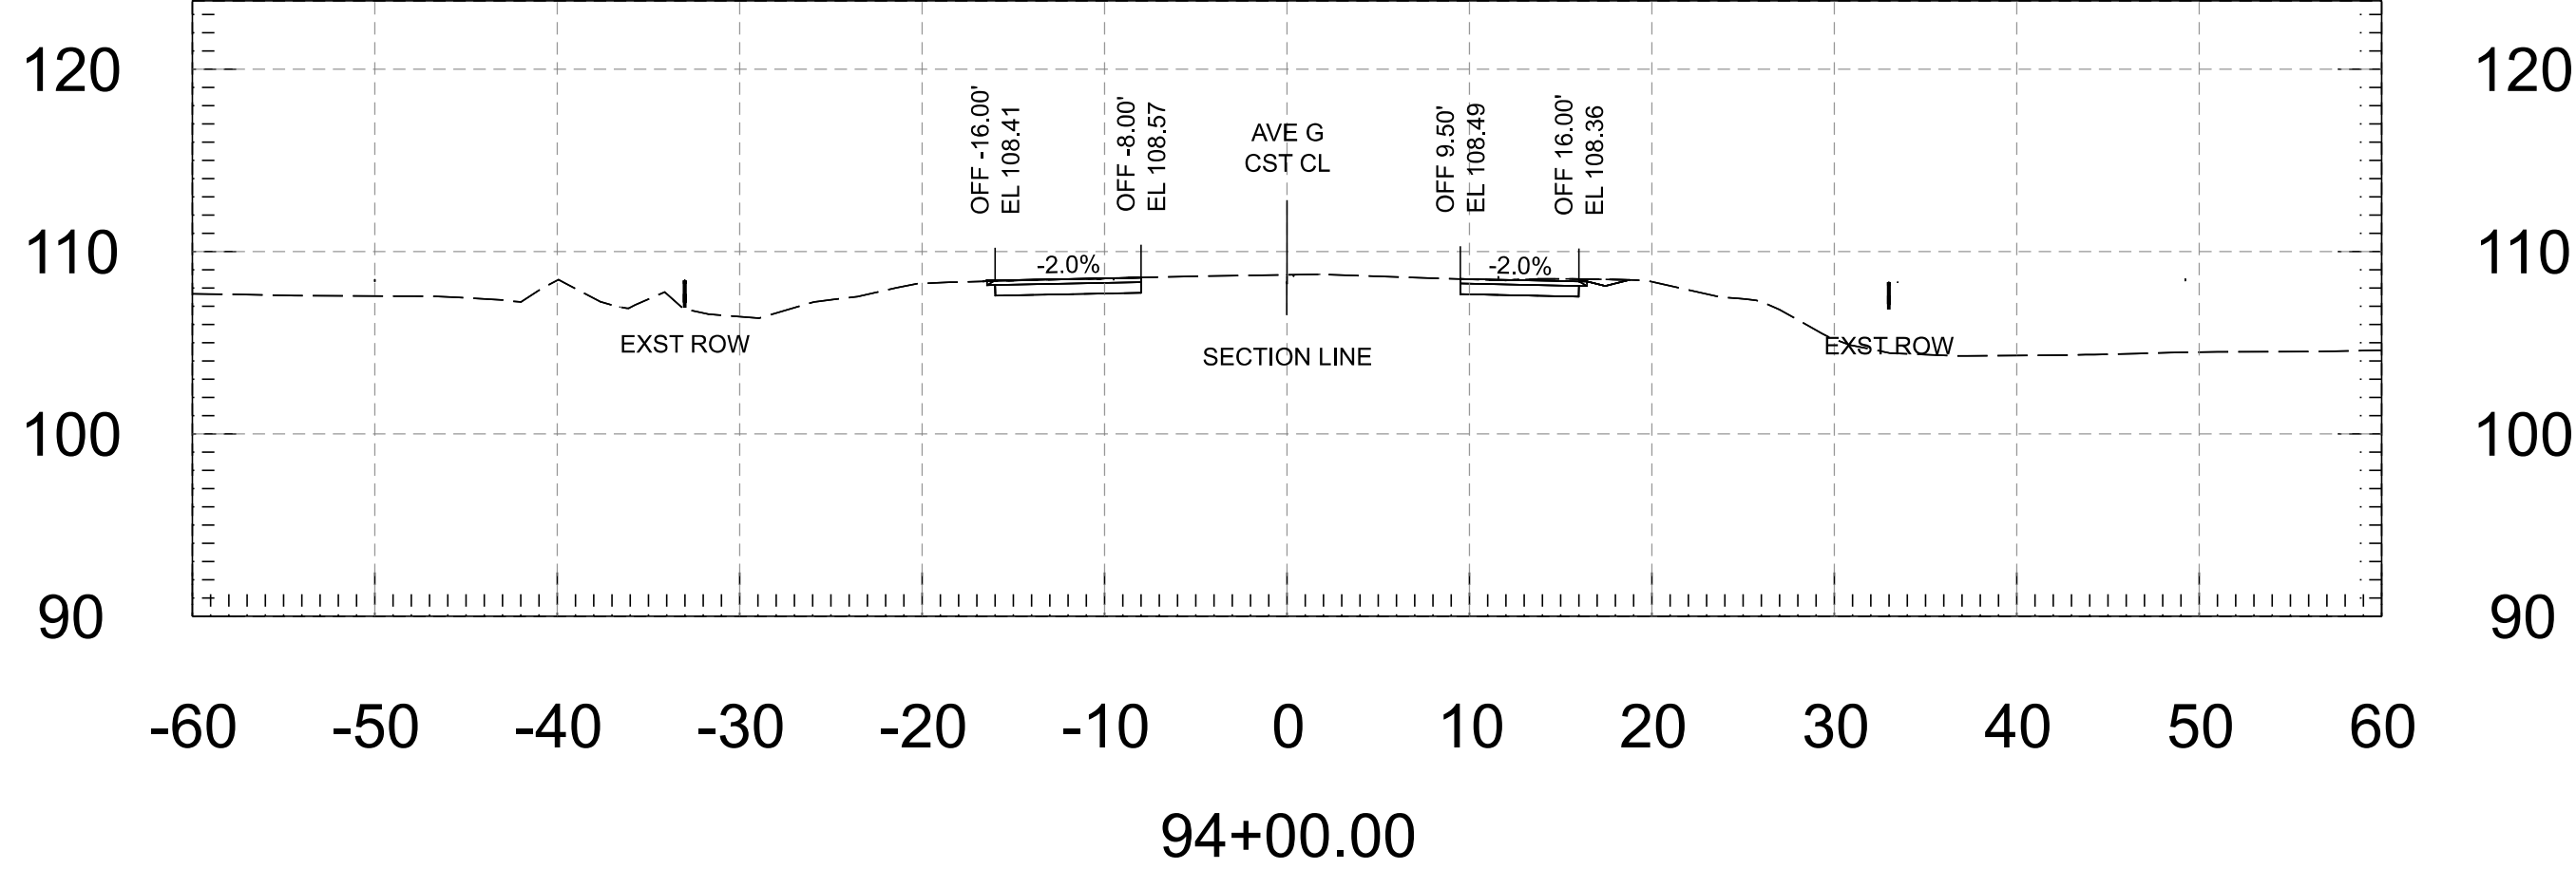

FOR
INFORMATION
ONLY

	NAME	DATE
DESIGN	M. SCHOEN	07/26
DRAWN	M. SCHOEN	07/26
CHECKED	H. RIOS	07/26



WSP USA Inc.
1230 West Washington Street, Suite 405
Tempe, AZ 85288

ARIZONA DEPARTMENT OF TRANSPORTATION
PROJECT DELIVERY AND OPERATIONS DIVISION
ROADWAY DESIGN SERVICES

AVENUE G - CROSS SECTIONS

ROUTE
MILEPOST
STRUCTURE NO.

F.H.W.A. Arizona Division

STATE

PROJECT NO.

FEDERAL ID NO.

SHEET NO.

TOTAL SHEETS

RECORD DRAWING

ARIZ.

0000 YU YYU

YYU-0(225)T

40





118

LOCATION AVENUE G, COUNTY 11TH ST - COUNTY 16TH ST

TRACS NO. T0437 01C


DWG

____ OF ____

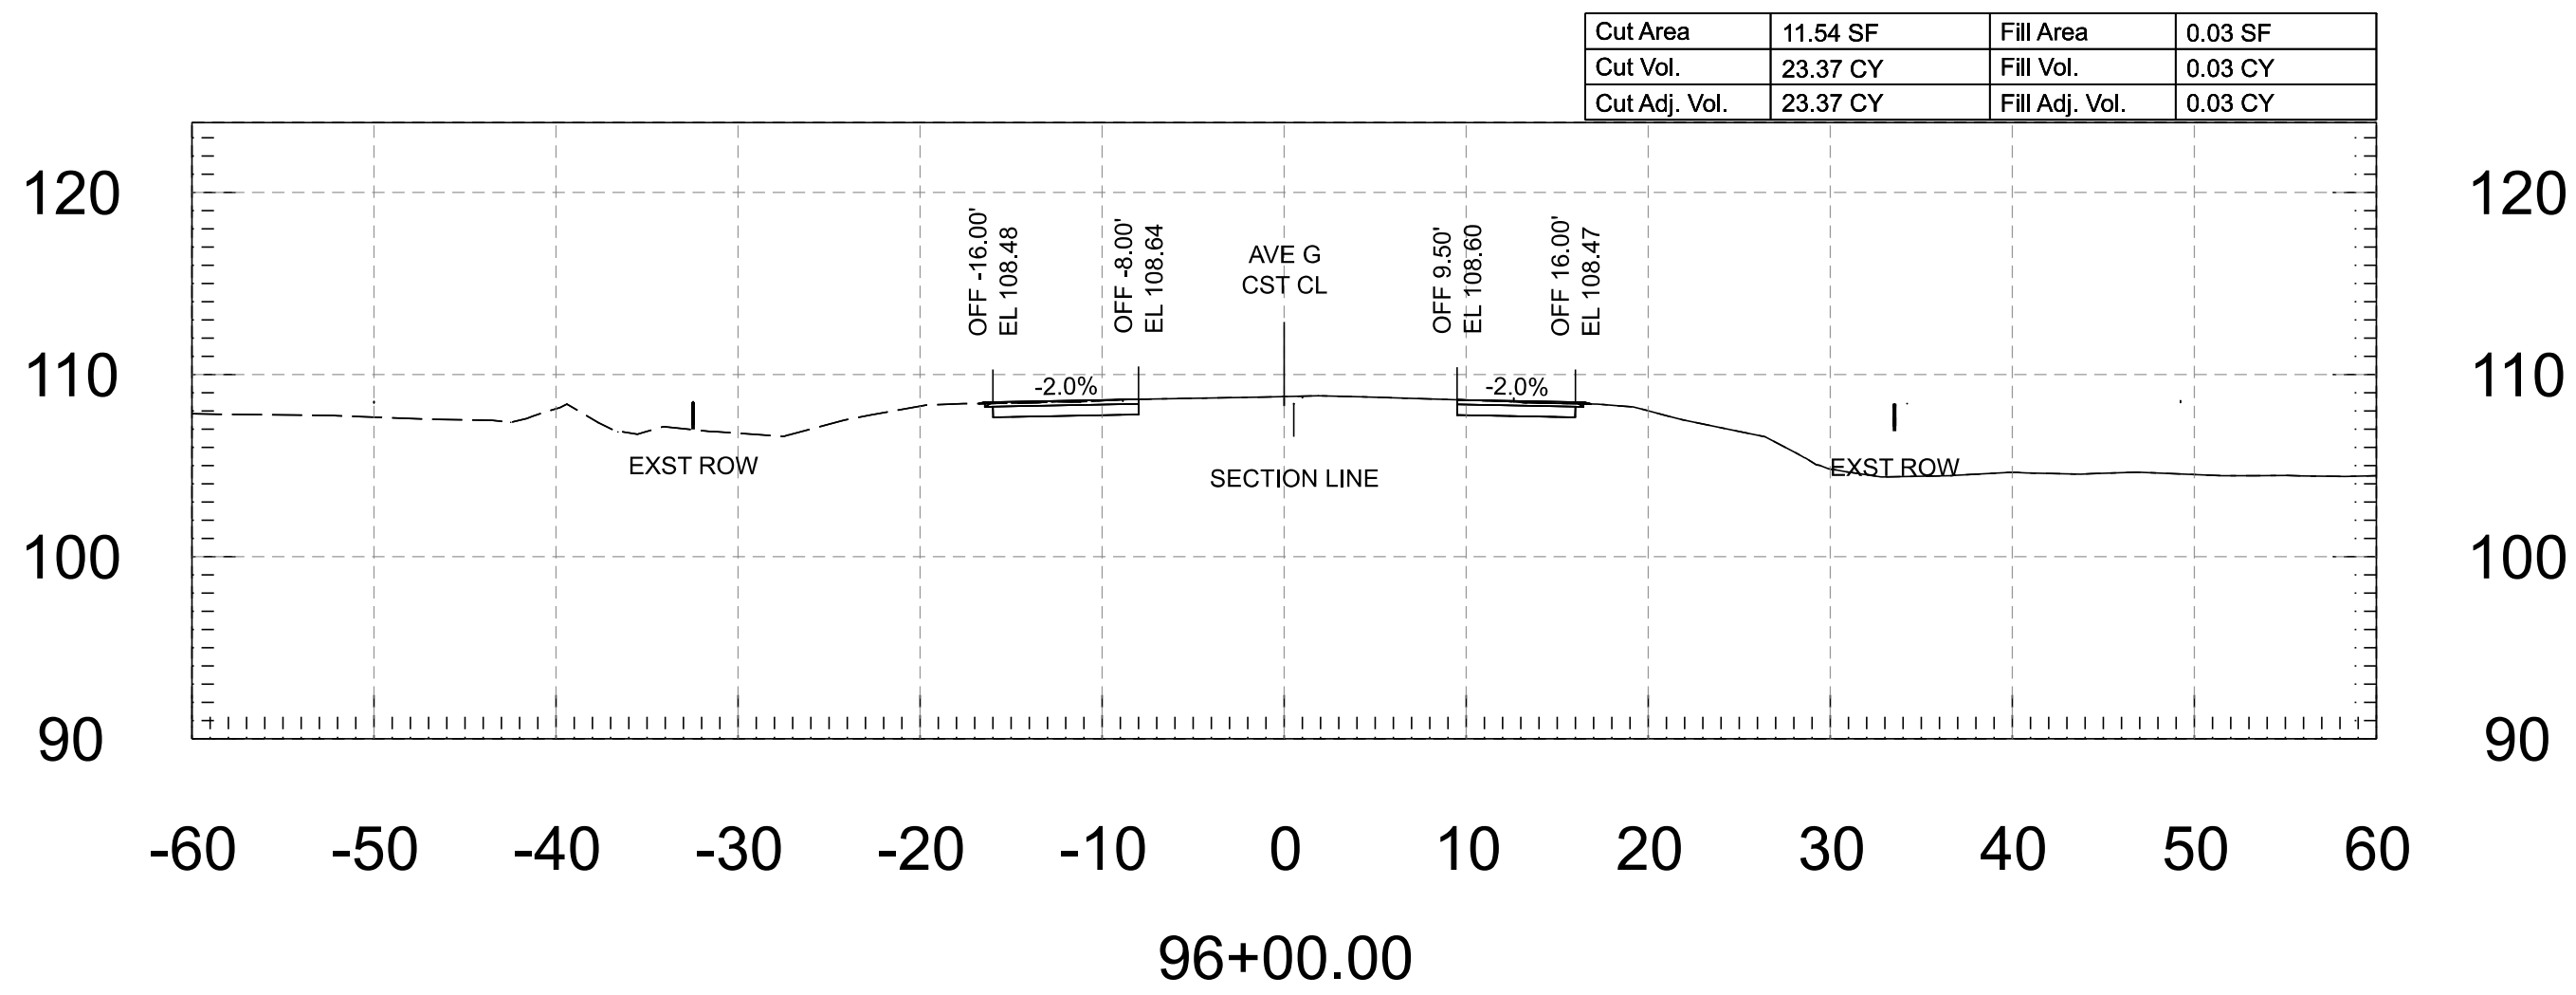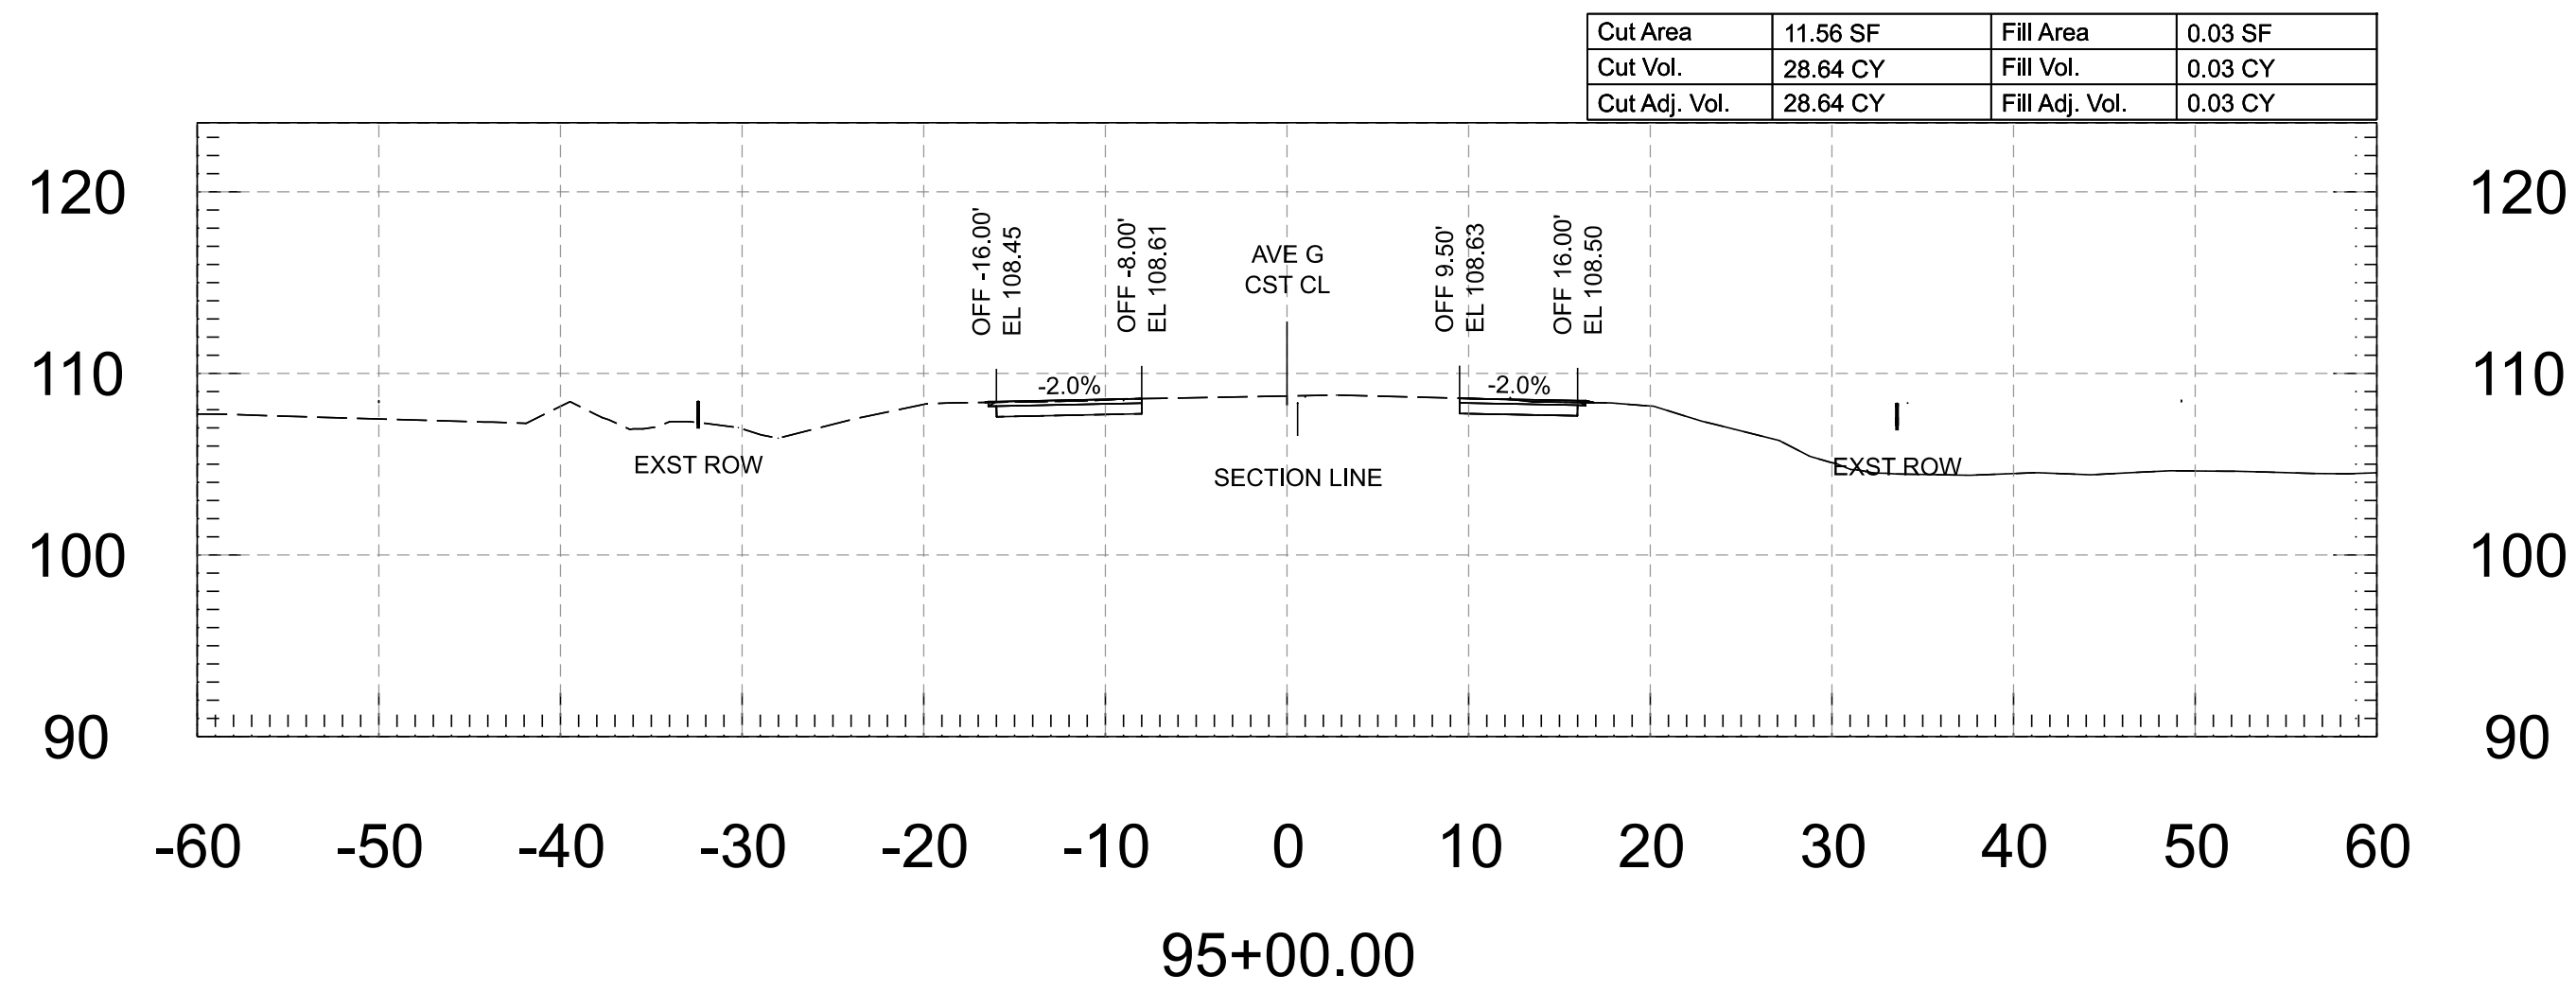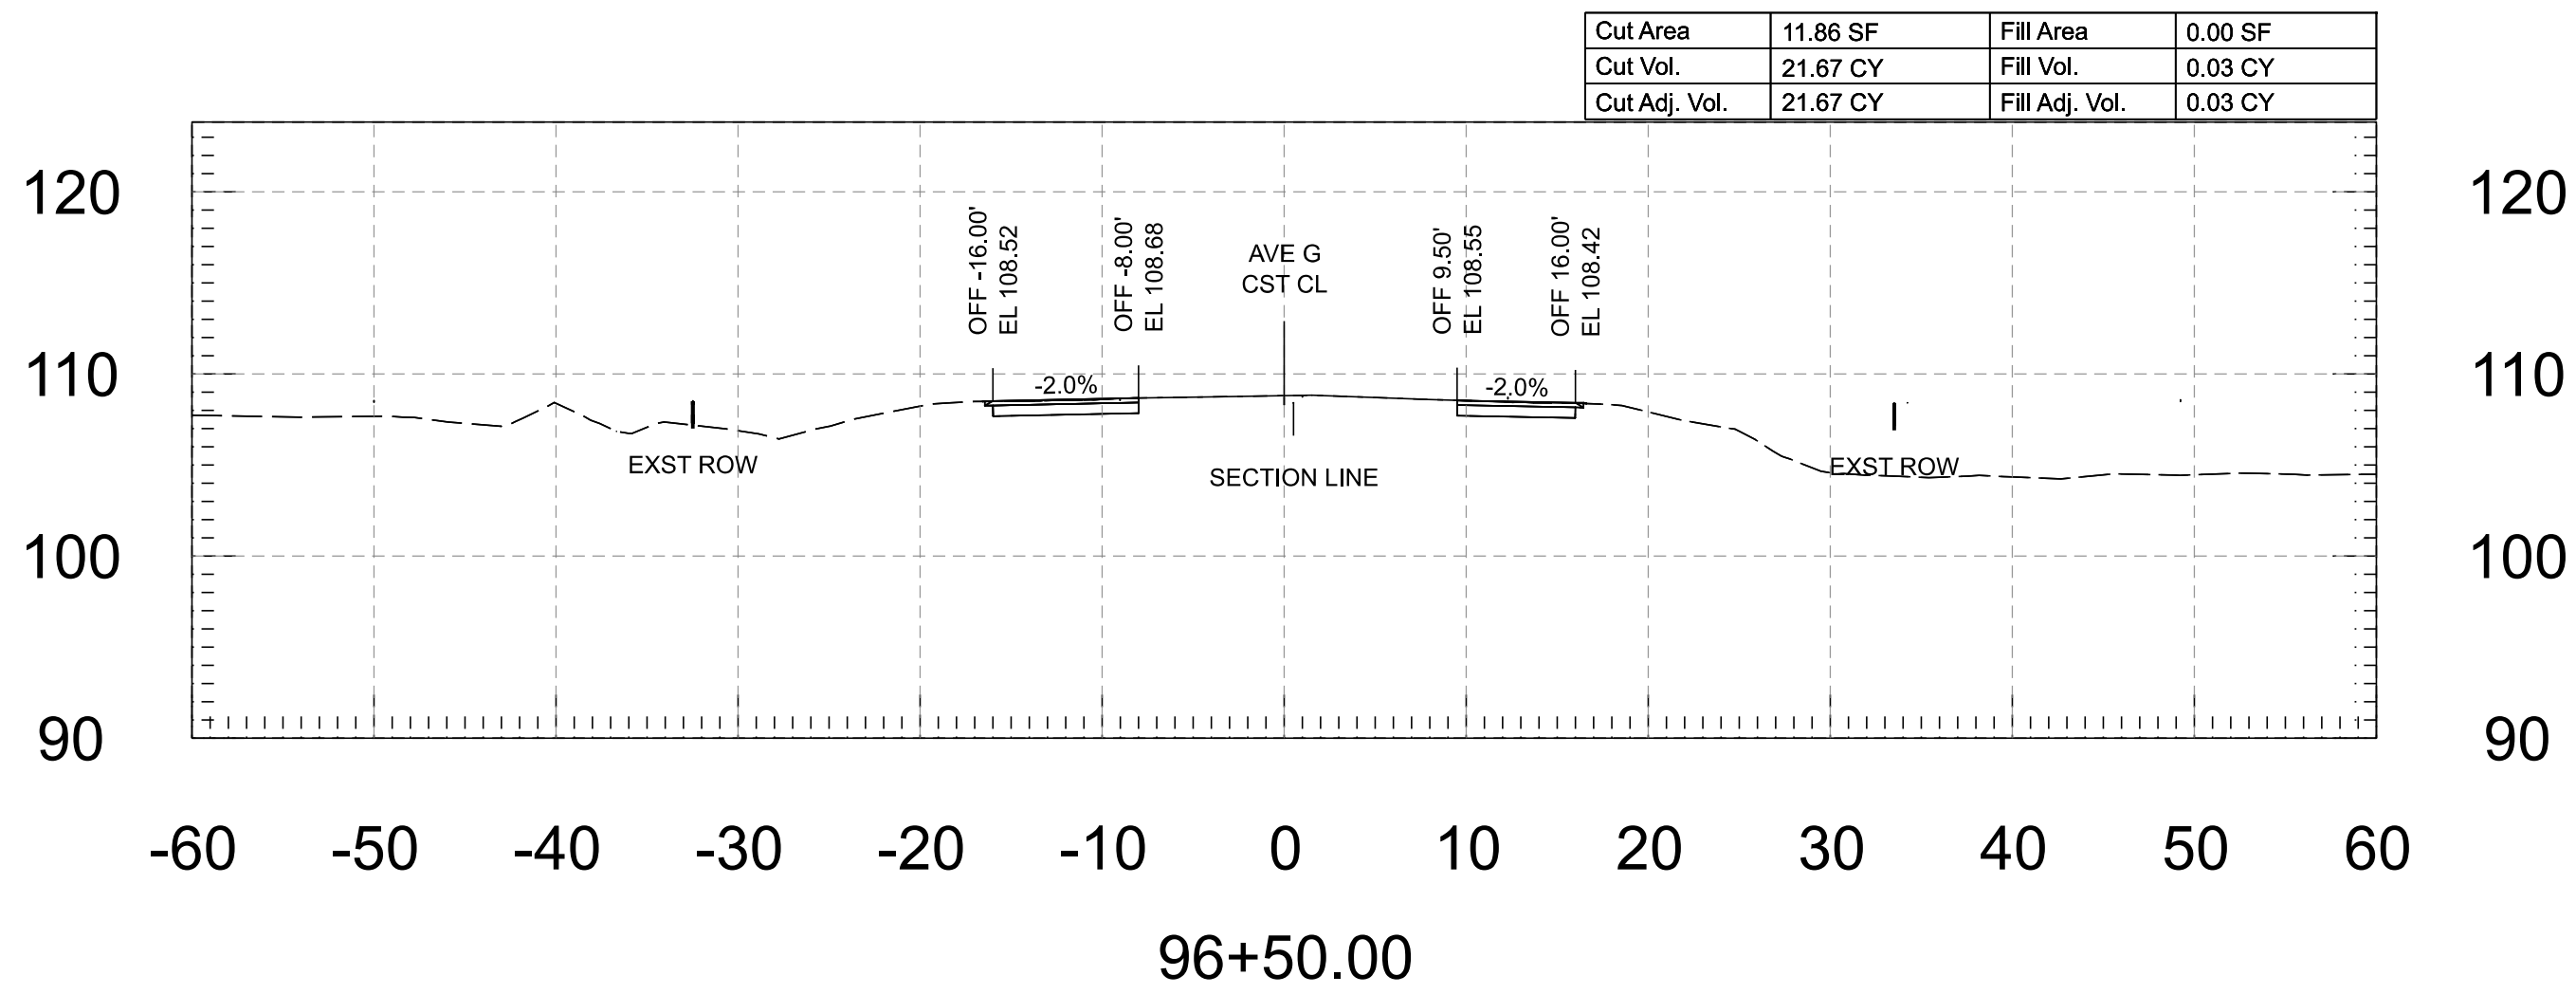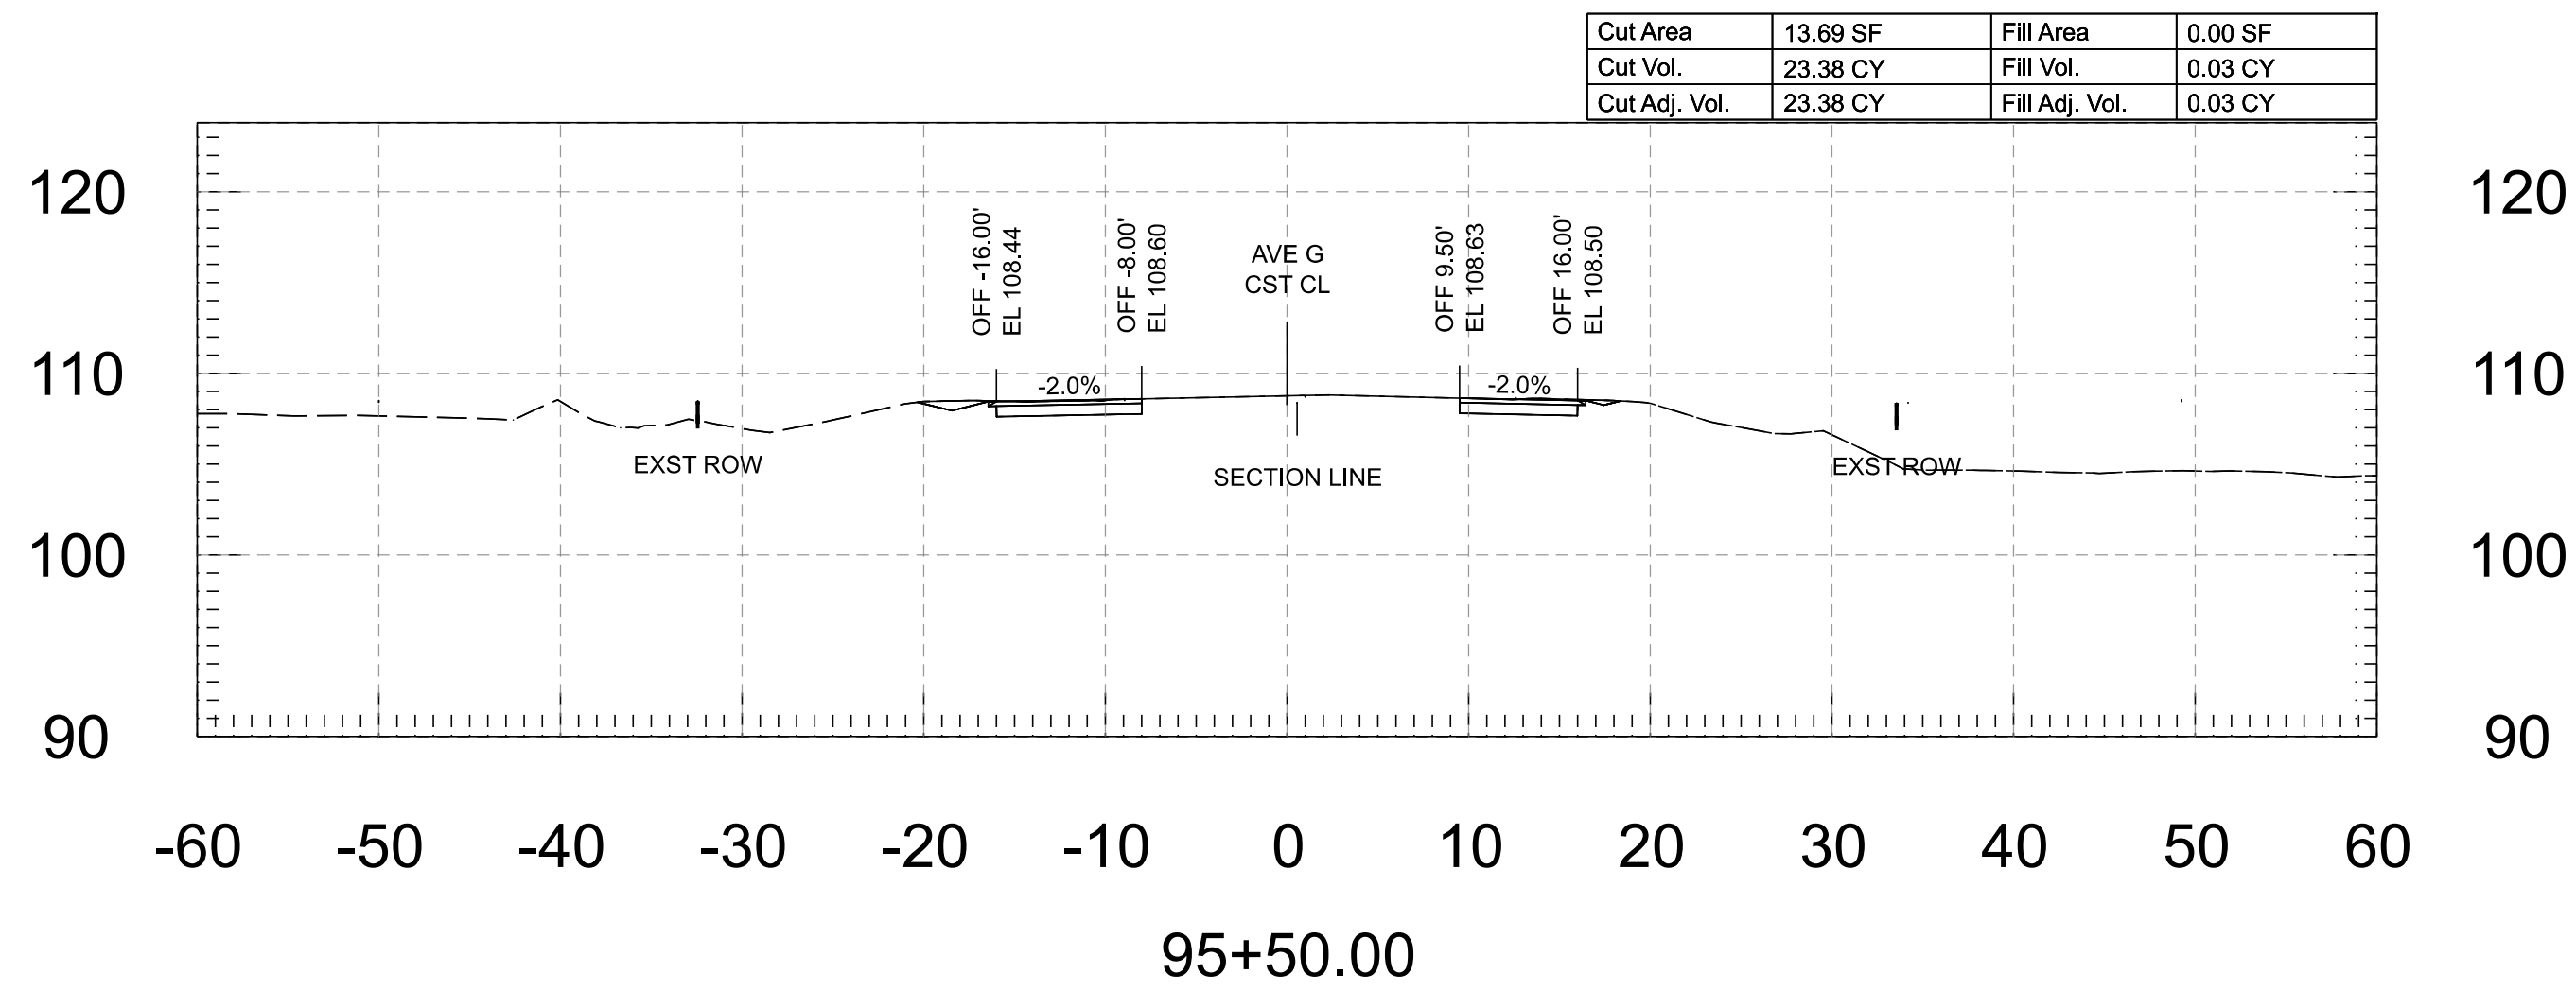


	FOR INFORMATION ONLY		NAME	DATE	ARIZONA DEPARTMENT OF TRANSPORTATION PROJECT DELIVERY AND OPERATIONS DIVISION ROADWAY DESIGN SERVICES	ROUTE	F.H.W.A. Arizona Division	STATE ARIZ.	PROJECT NO.	FEDERAL ID NO.	SHEET NO.	TOTAL SHEETS	RECORD DRAWING	
		DESIGN	M. SCHOEN	07/26					0000 YU YYU	YYU-0(225)T	41	118		
		DRAWN	M. SCHOEN	07/26		STRUCTURE NO.	LOCATION AVENUE G, COUNTY 11TH ST - COUNTY 16TH ST							DWG
		CHECKED	H. RIOS	07/26			TRACS NO. T0437 01C							
					 WSP USA Inc. 1230 West Washington Street, Suite 405 Tempe, AZ 85286			AVENUE G - CROSS SECTIONS			____ OF ____			


Cut Area	12.43 SF	Fill Area	0.01 SF
Cut Vol.	29.03 CY	Fill Vol.	0.01 CY
Cut Adj. Vol.	29.03 CY	Fill Adj. Vol.	0.01 CY

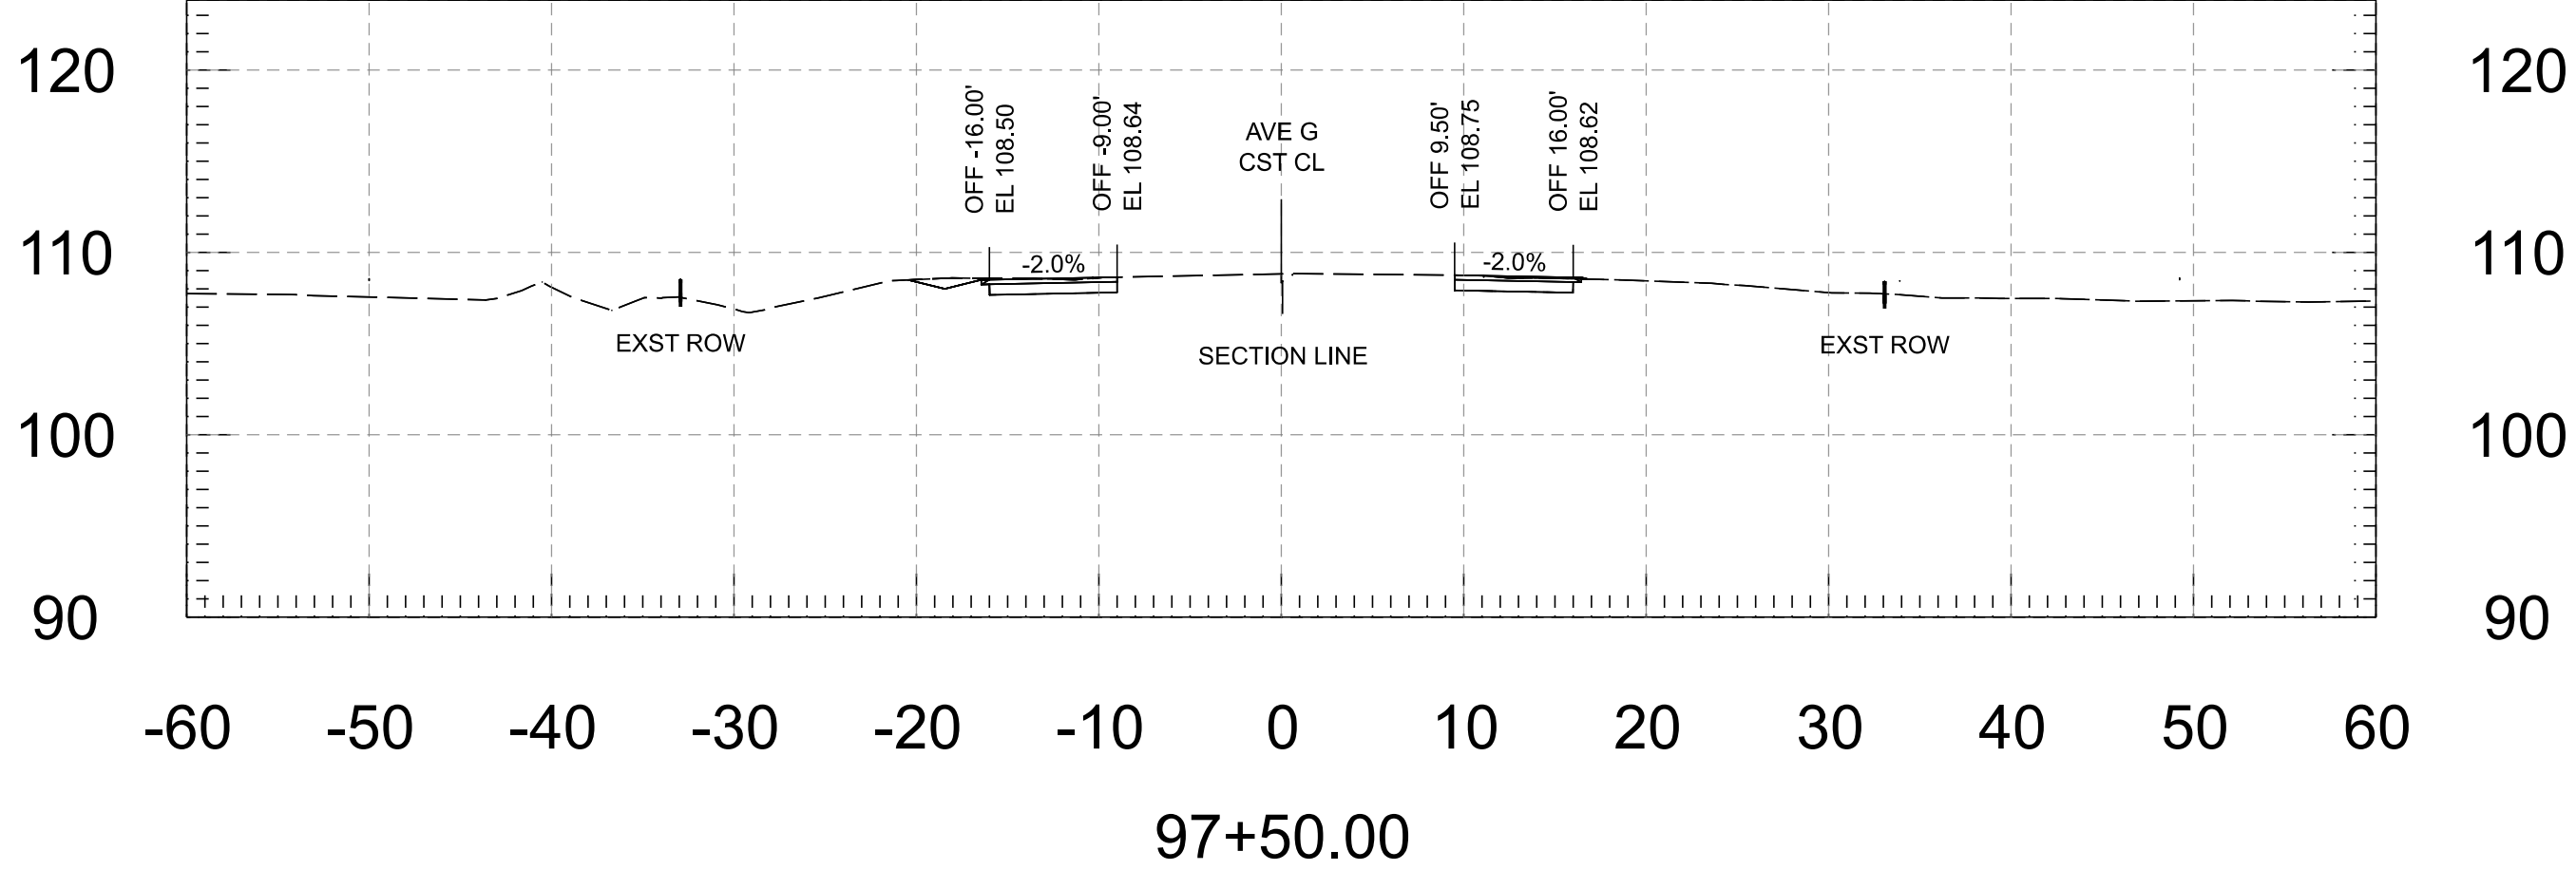


Cut Area	12.48 SF	Fill Area	0.00 SF
Cut Vol.	23.54 CY	Fill Vol.	0.03 CY
Cut Adj. Vol.	23.54 CY	Fill Adj. Vol.	0.03 CY

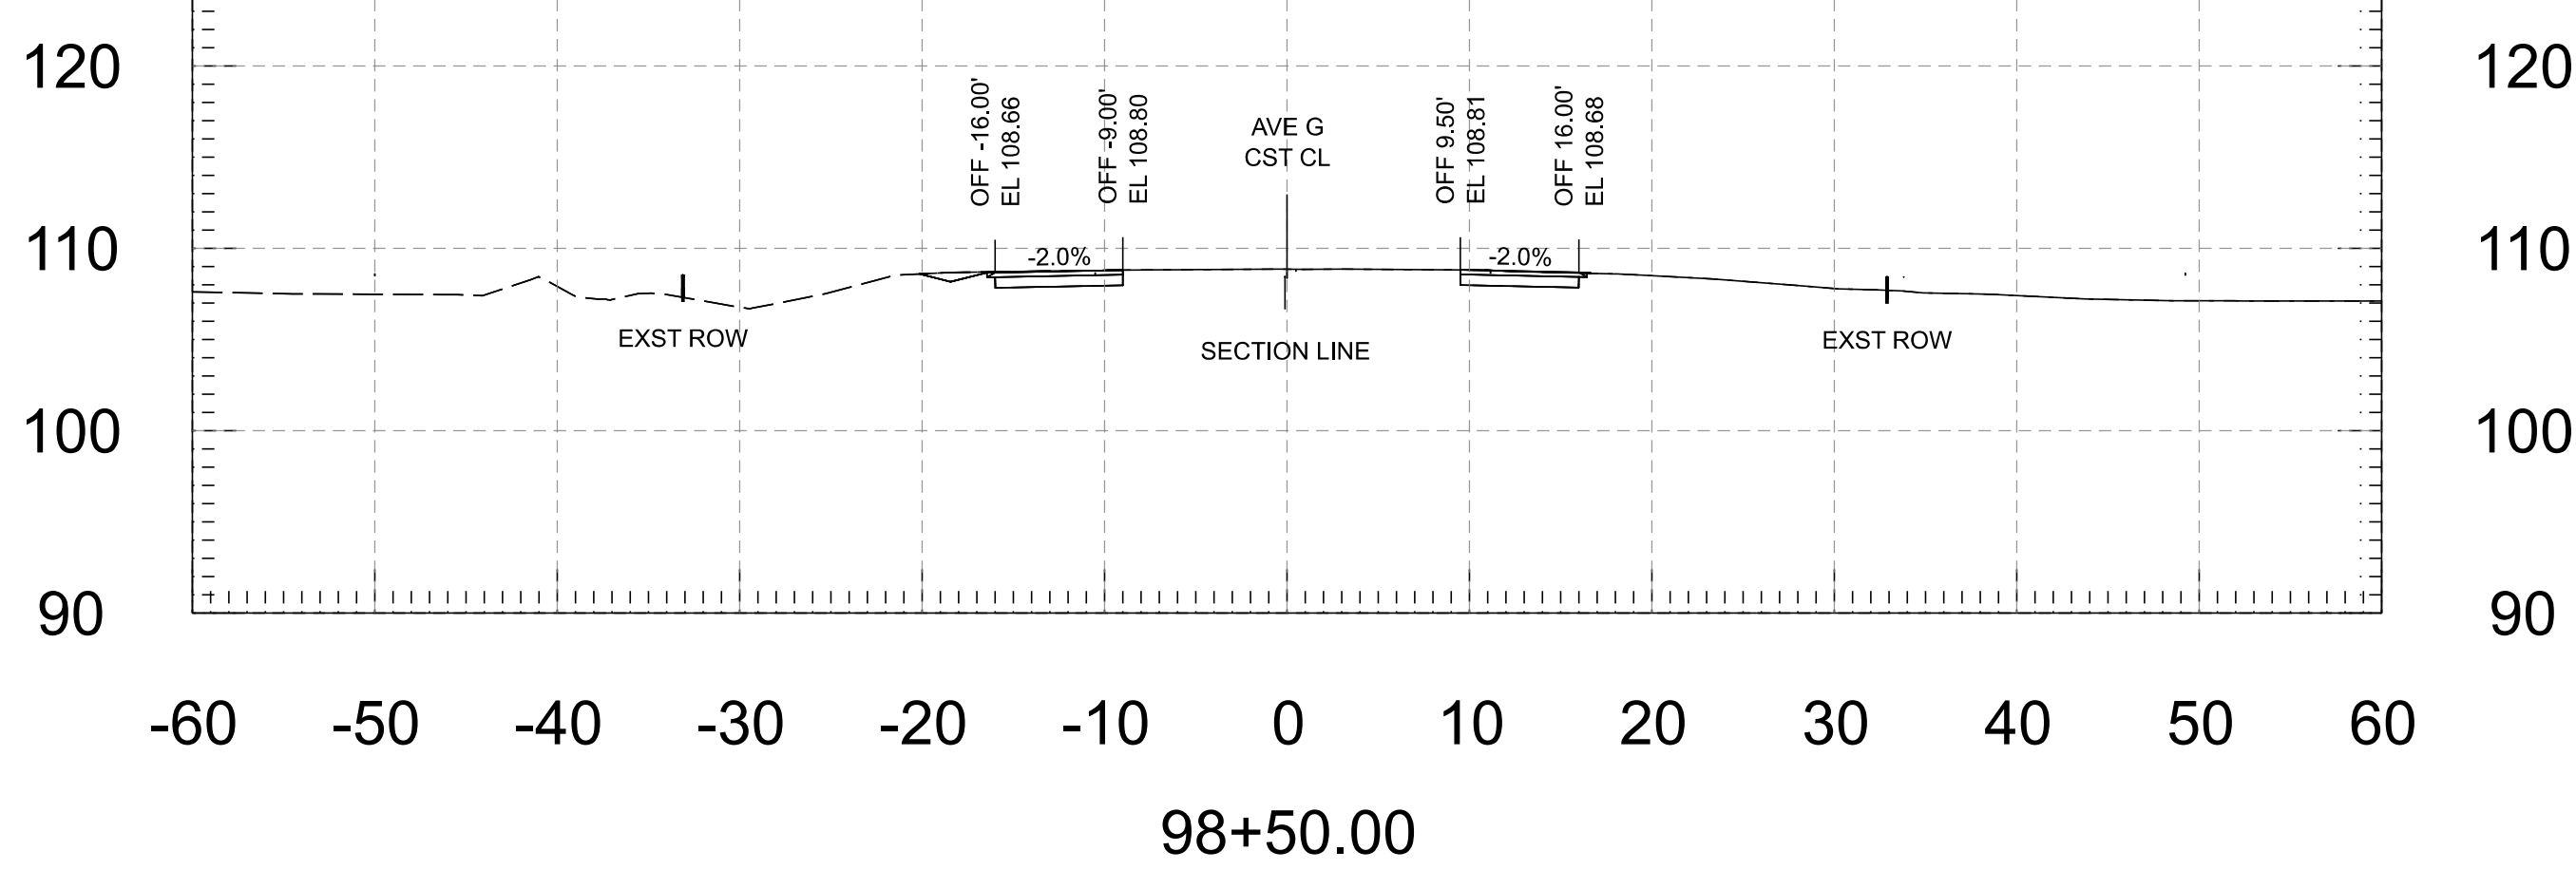



Cut Area	18.93 SF	Fill Area	0.00 SF
Cut Vol.	28.51 CY	Fill Vol.	0.00 CY
Cut Adj. Vol.	28.51 CY	Fill Adj. Vol.	0.00 CY

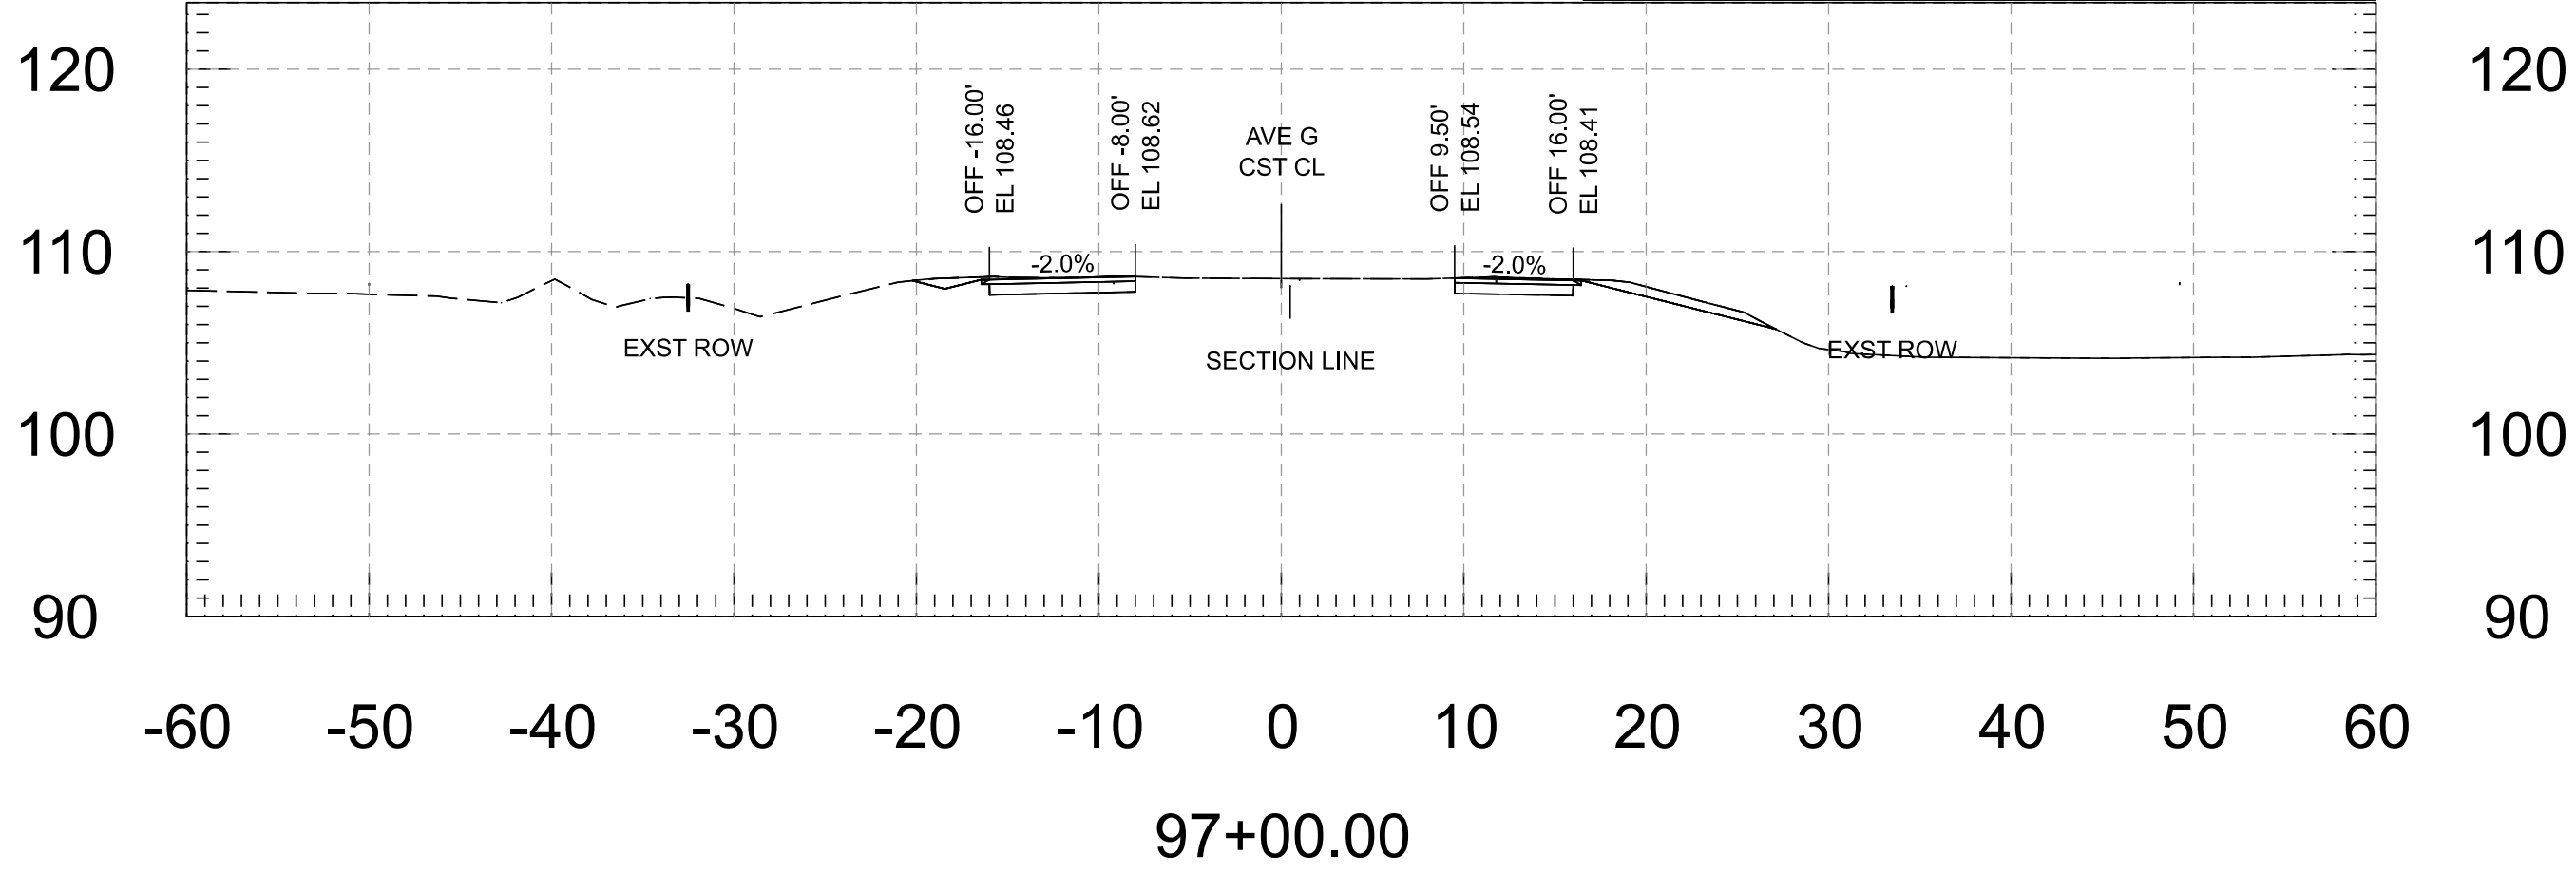


Cut Area	12.94 SF	Fill Area	0.03 SF
Cut Vol.	23.49 CY	Fill Vol.	0.04 CY
Cut Adj. Vol.	23.49 CY	Fill Adj. Vol.	0.04 CY

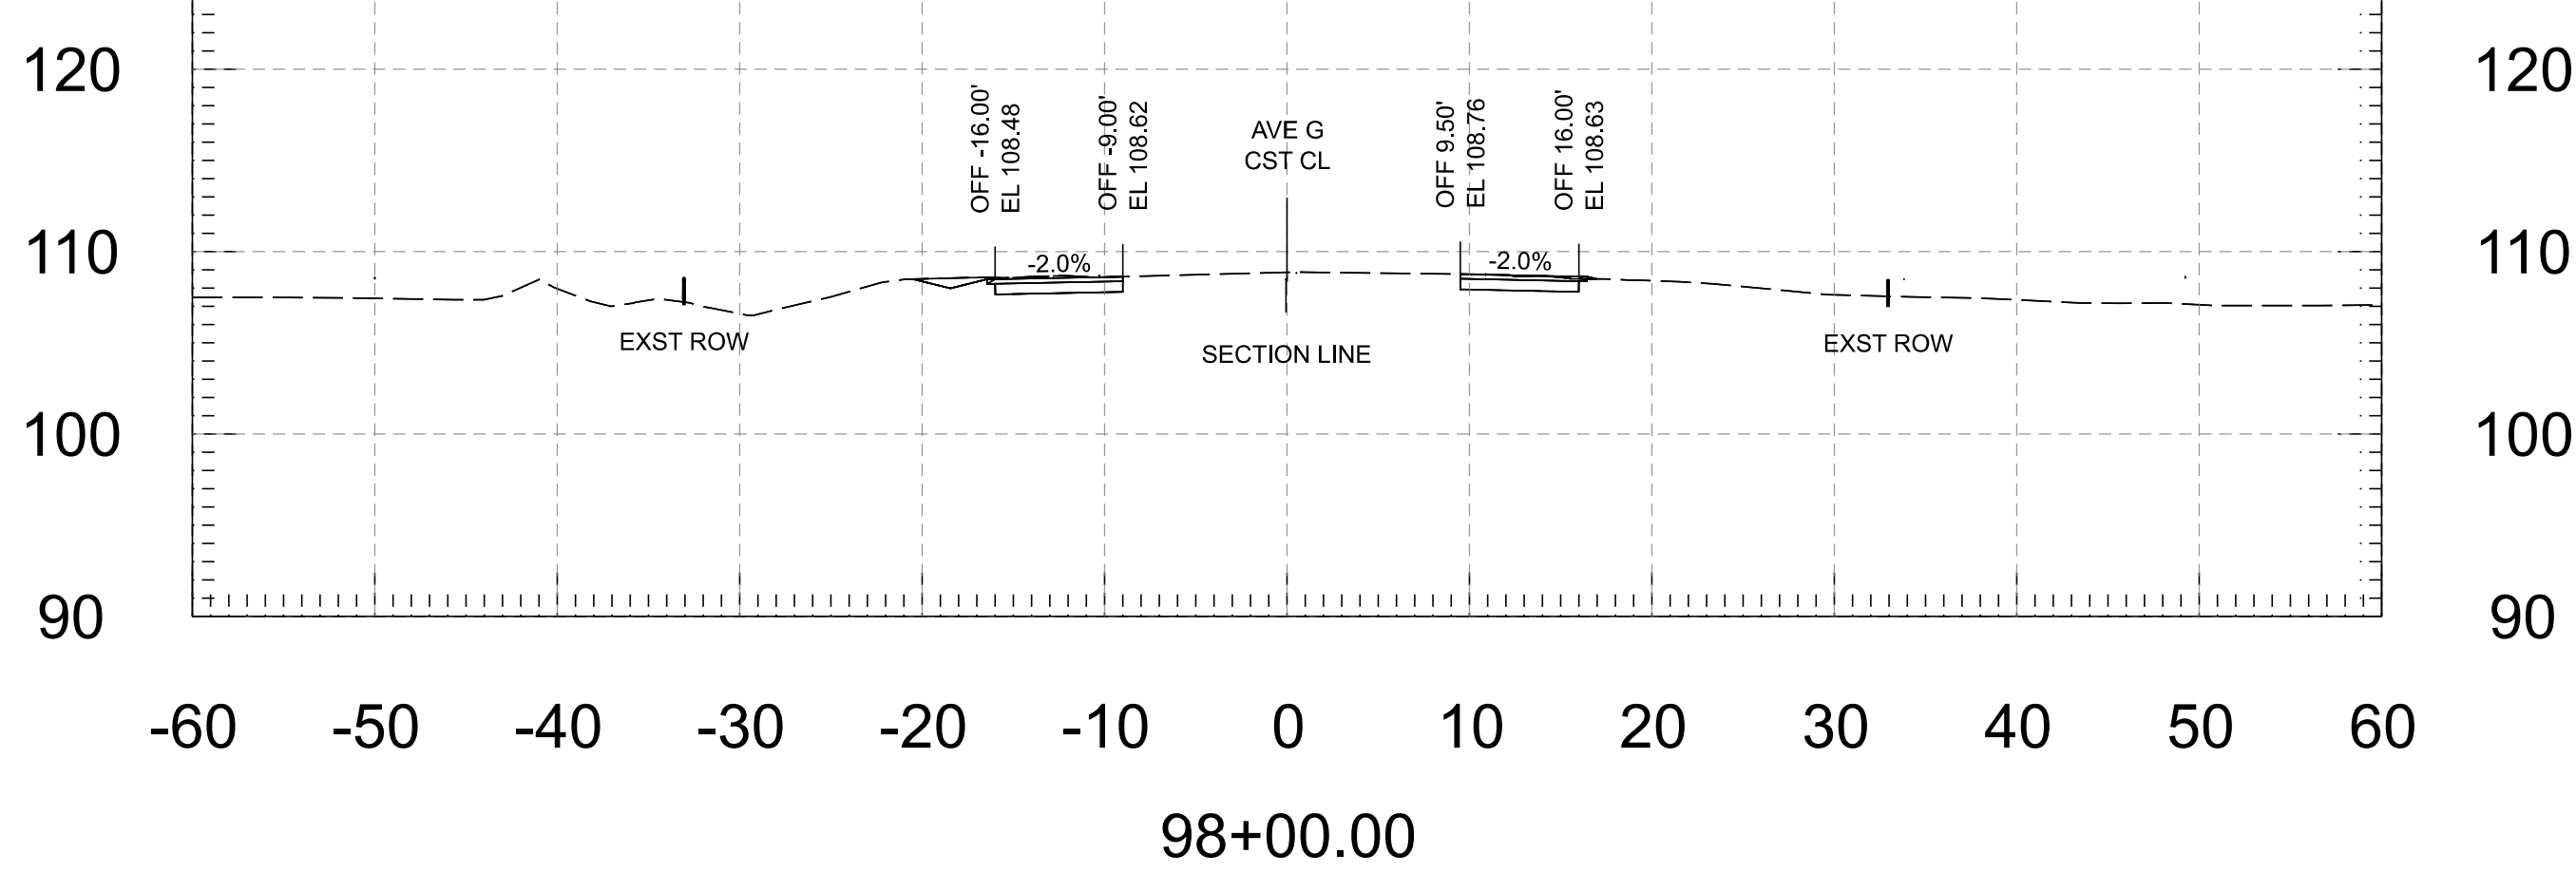


FOR INFORMATION ONLY		NAME	DATE	ARIZONA DEPARTMENT OF TRANSPORTATION PROJECT DELIVERY AND OPERATIONS DIVISION ROADWAY DESIGN SERVICES	ROUTE	F.H.W.A. Arizona Division	STATE ARIZ.	PROJECT NO.	FEDERAL ID NO.	SHEET NO.	TOTAL SHEETS	RECORD DRAWING
	DESIGN	M. SCHOEN	07/26		MILEPOST			0000 YU YYU	YYU-0(225)T	42	118	
	DRAWN	M. SCHOEN	07/26					LOCATION			AVENUE G, COUNTY 11TH ST - COUNTY 16TH ST	
	CHECKED	H. RIOS	07/26	STRUCTURE NO.	TRACS NO.		T0437 01C					___ OF ___
	 WSP USA Inc. 1230 West Washington Street, Suite 405 Tempe, AZ 85288		AVENUE G - CROSS SECTIONS									

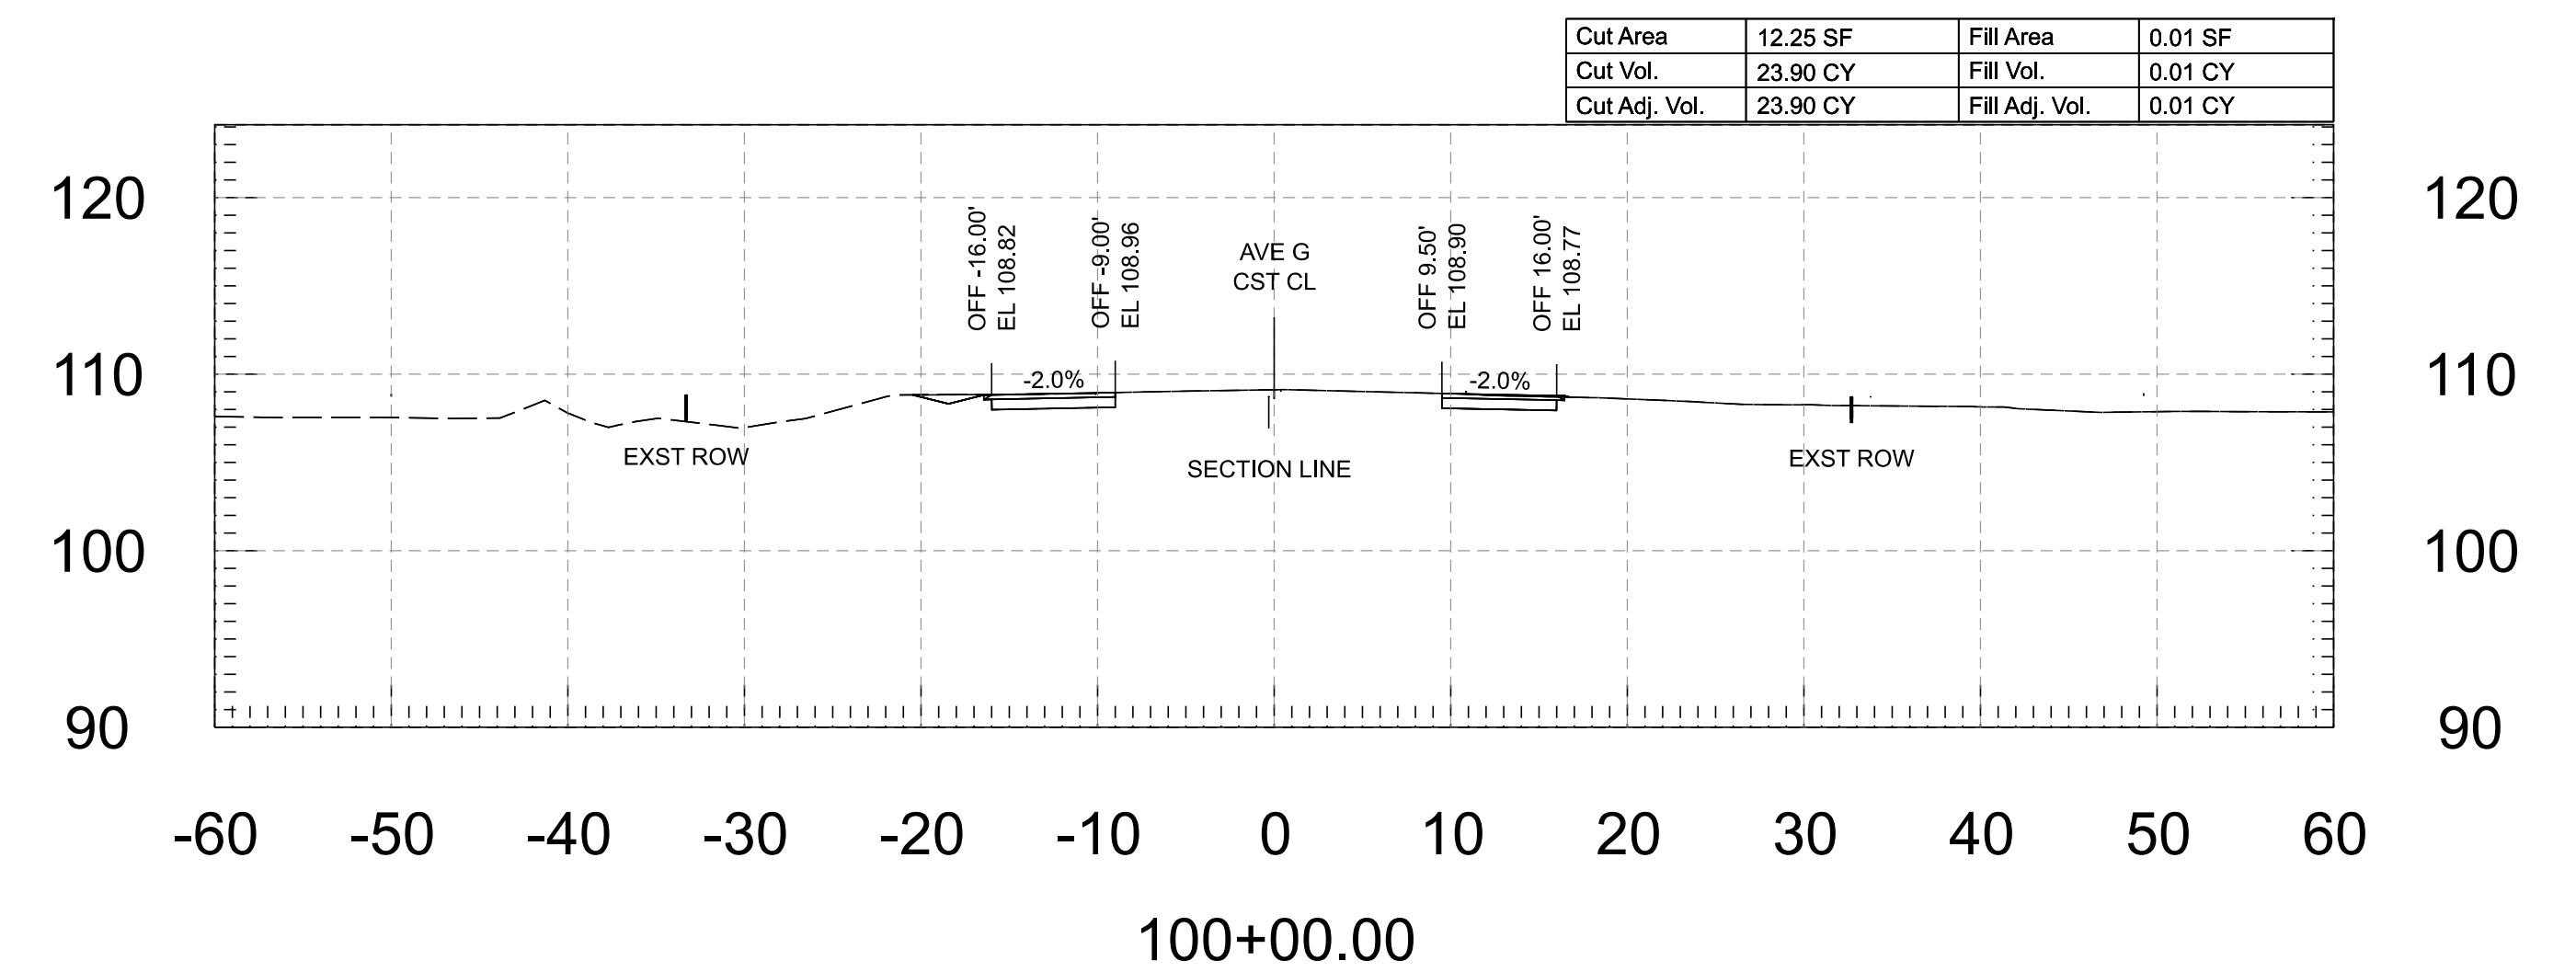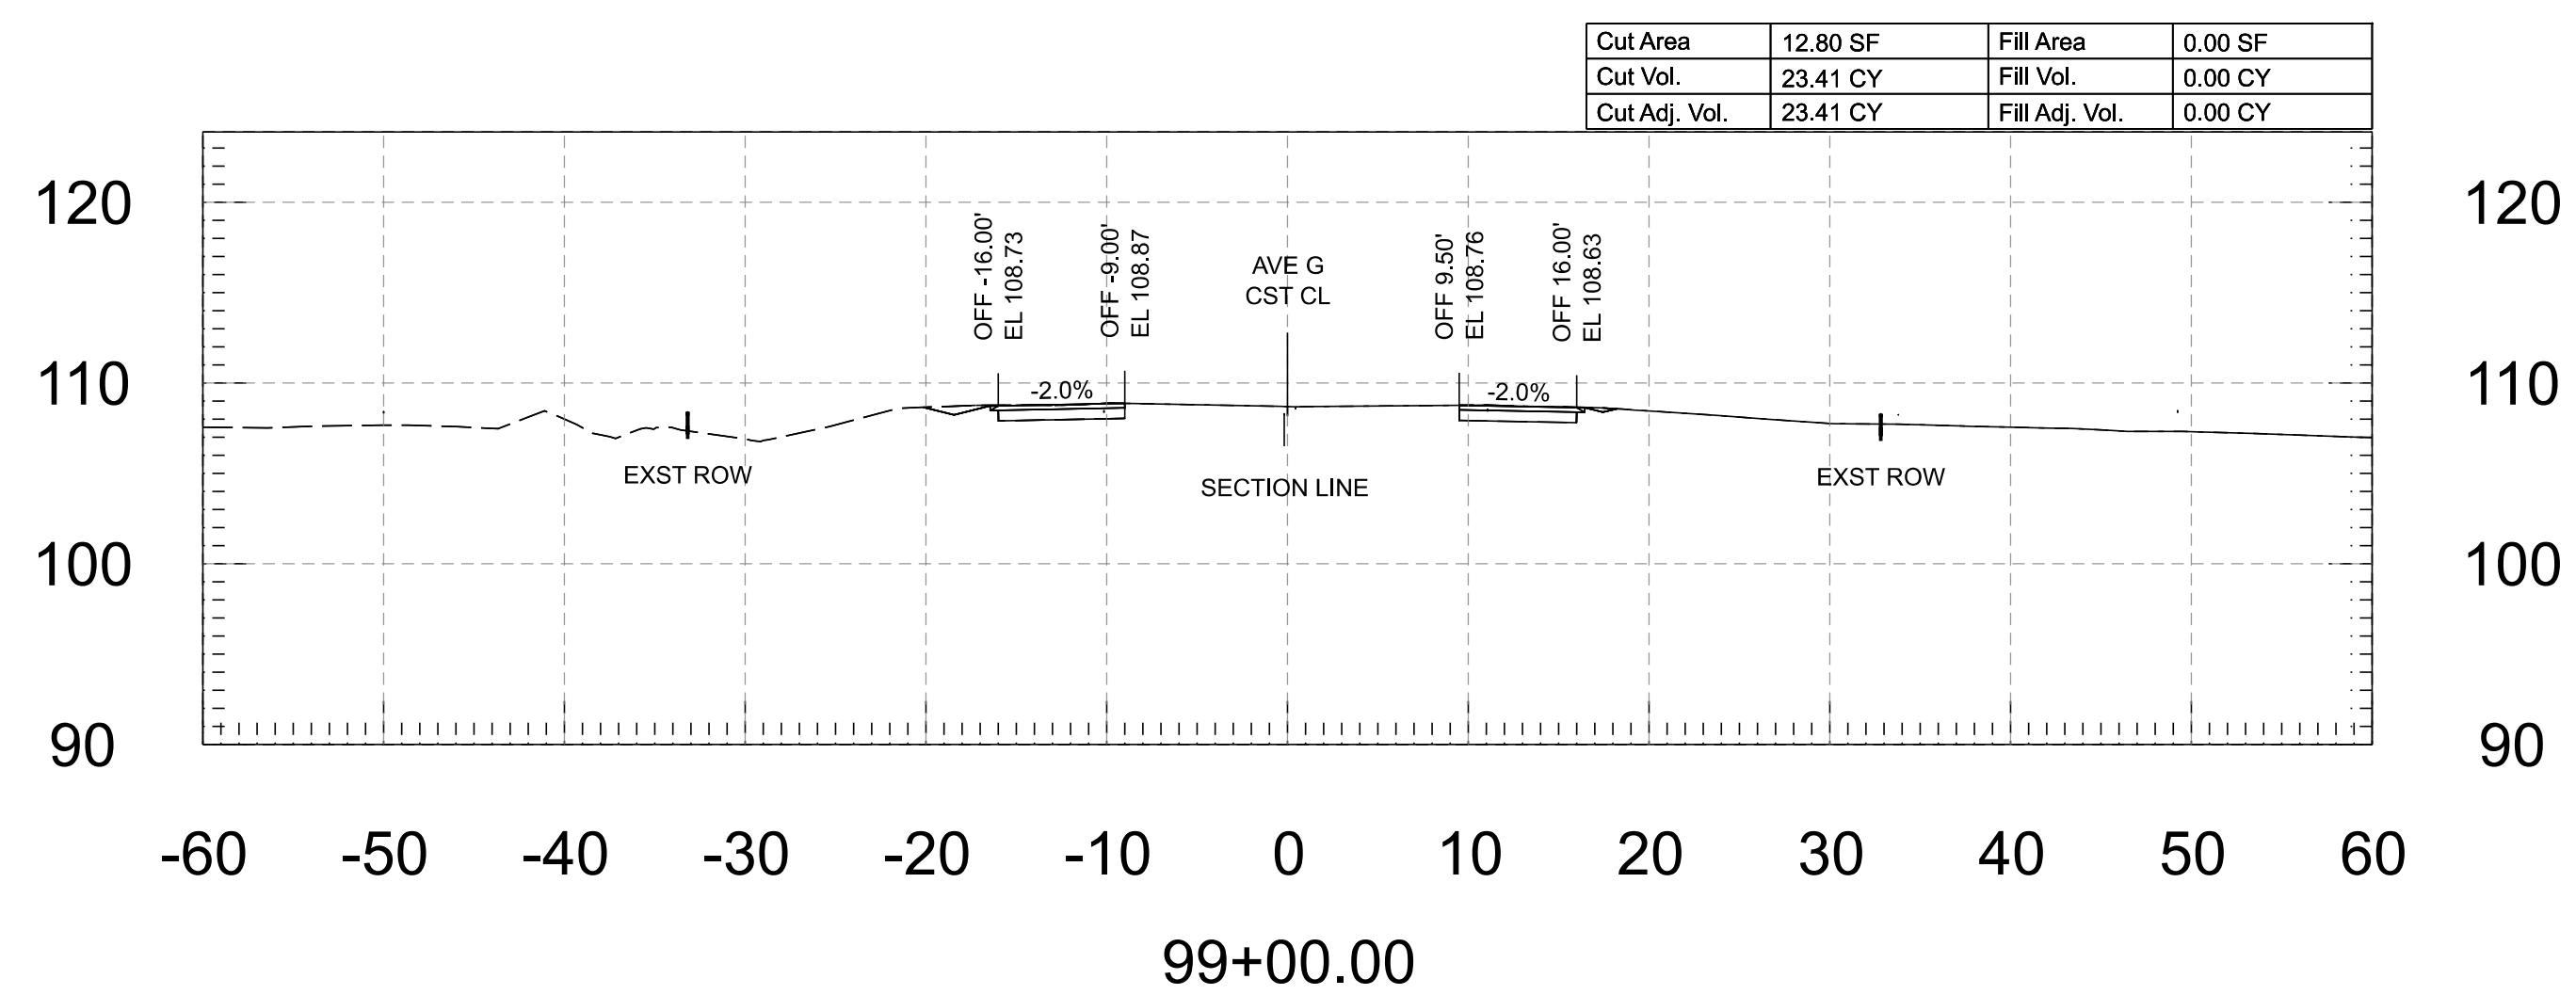


FOR INFORMATION ONLY		NAME	DATE	ARIZONA DEPARTMENT OF TRANSPORTATION PROJECT DELIVERY AND OPERATIONS DIVISION ROADWAY DESIGN SERVICES	ROUTE	F.H.W.A. Arizona Division	STATE ARIZ.	PROJECT NO.	FEDERAL ID NO.	SHEET NO.	TOTAL SHEETS	RECORD DRAWING
	DESIGN	M. SCHOEN	07/26		MILEPOST			0000 YU YYU	YYU-0(225)T	43	118	
	DRAWN	M. SCHOEN	07/26			STRUCTURE NO.	LOCATION AVENUE G, COUNTY 11TH ST - COUNTY 16TH ST					
	CHECKED	H. RIOS	07/26	TRACS NO. T0437 01C							___ OF ___	
	wsp WSP USA Inc. 1200 West Washington Street, Suite 405 Tempe, AZ 85285				AVENUE G - CROSS SECTIONS							

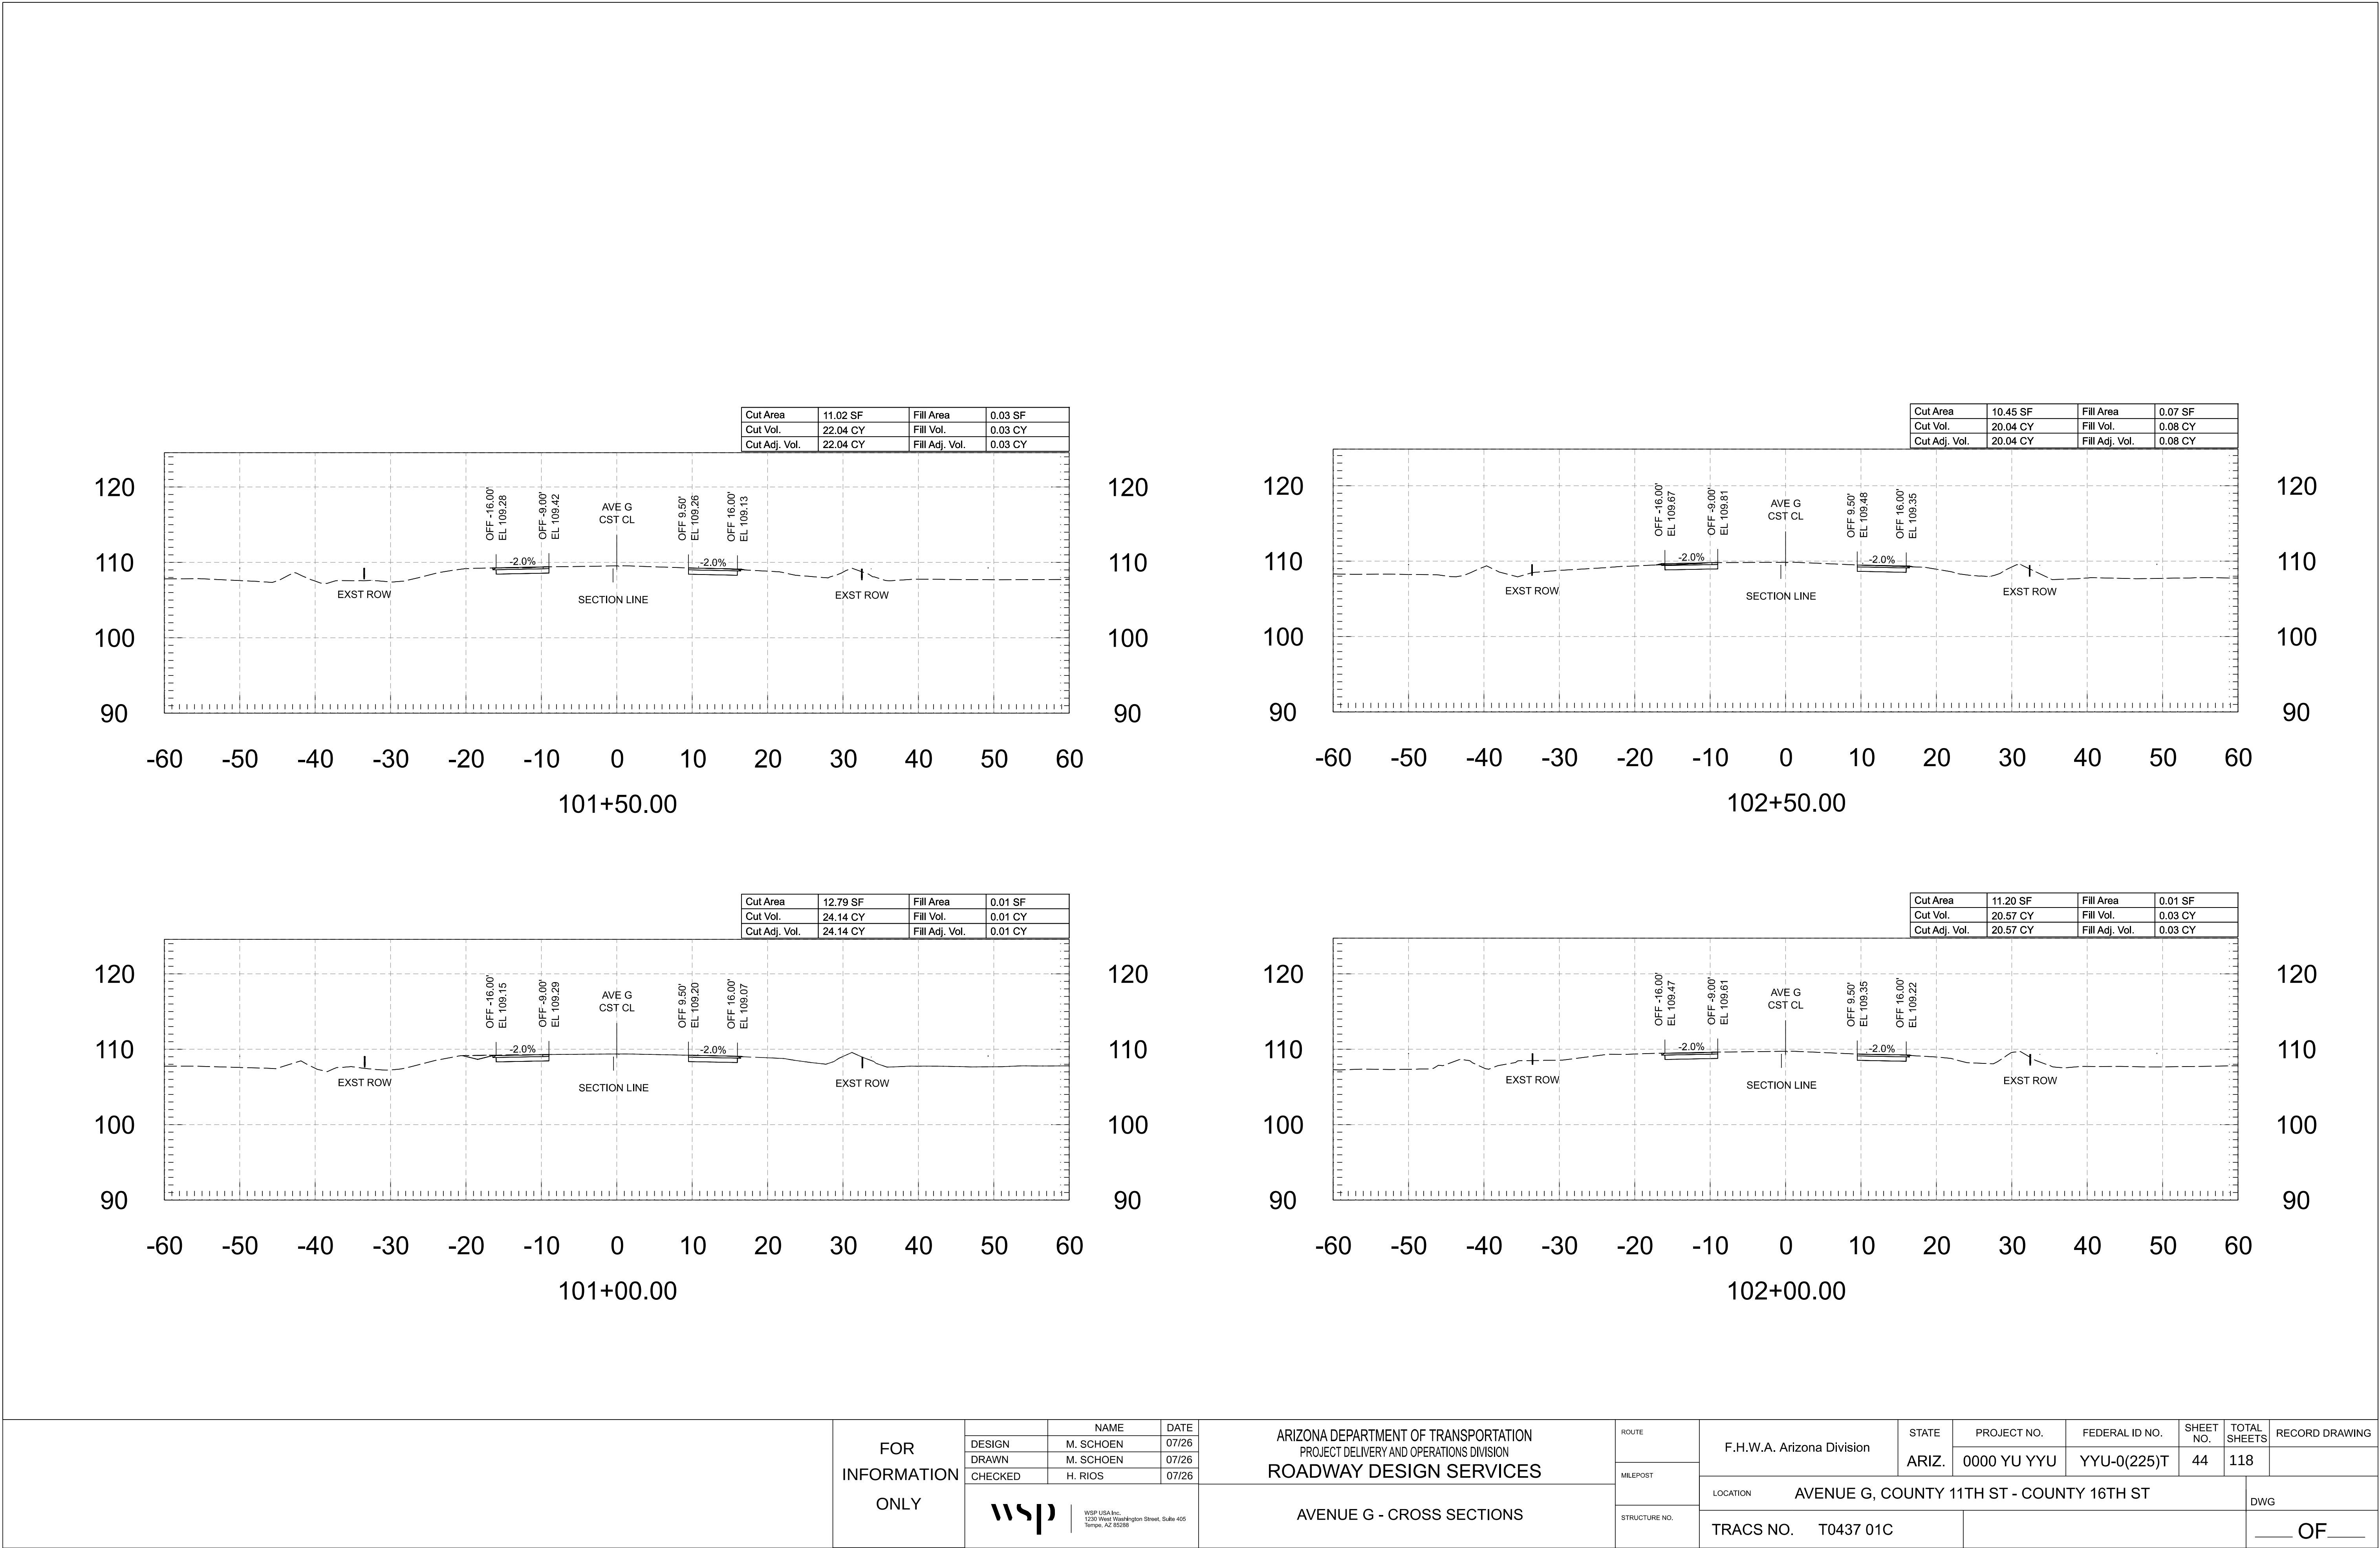


Cut Area	10.78 SF	Fill Area	0.13 SF
Cut Vol.	19.48 CY	Fill Vol.	0.26 CY
Cut Adj. Vol.	19.48 CY	Fill Adj. Vol.	0.26 CY

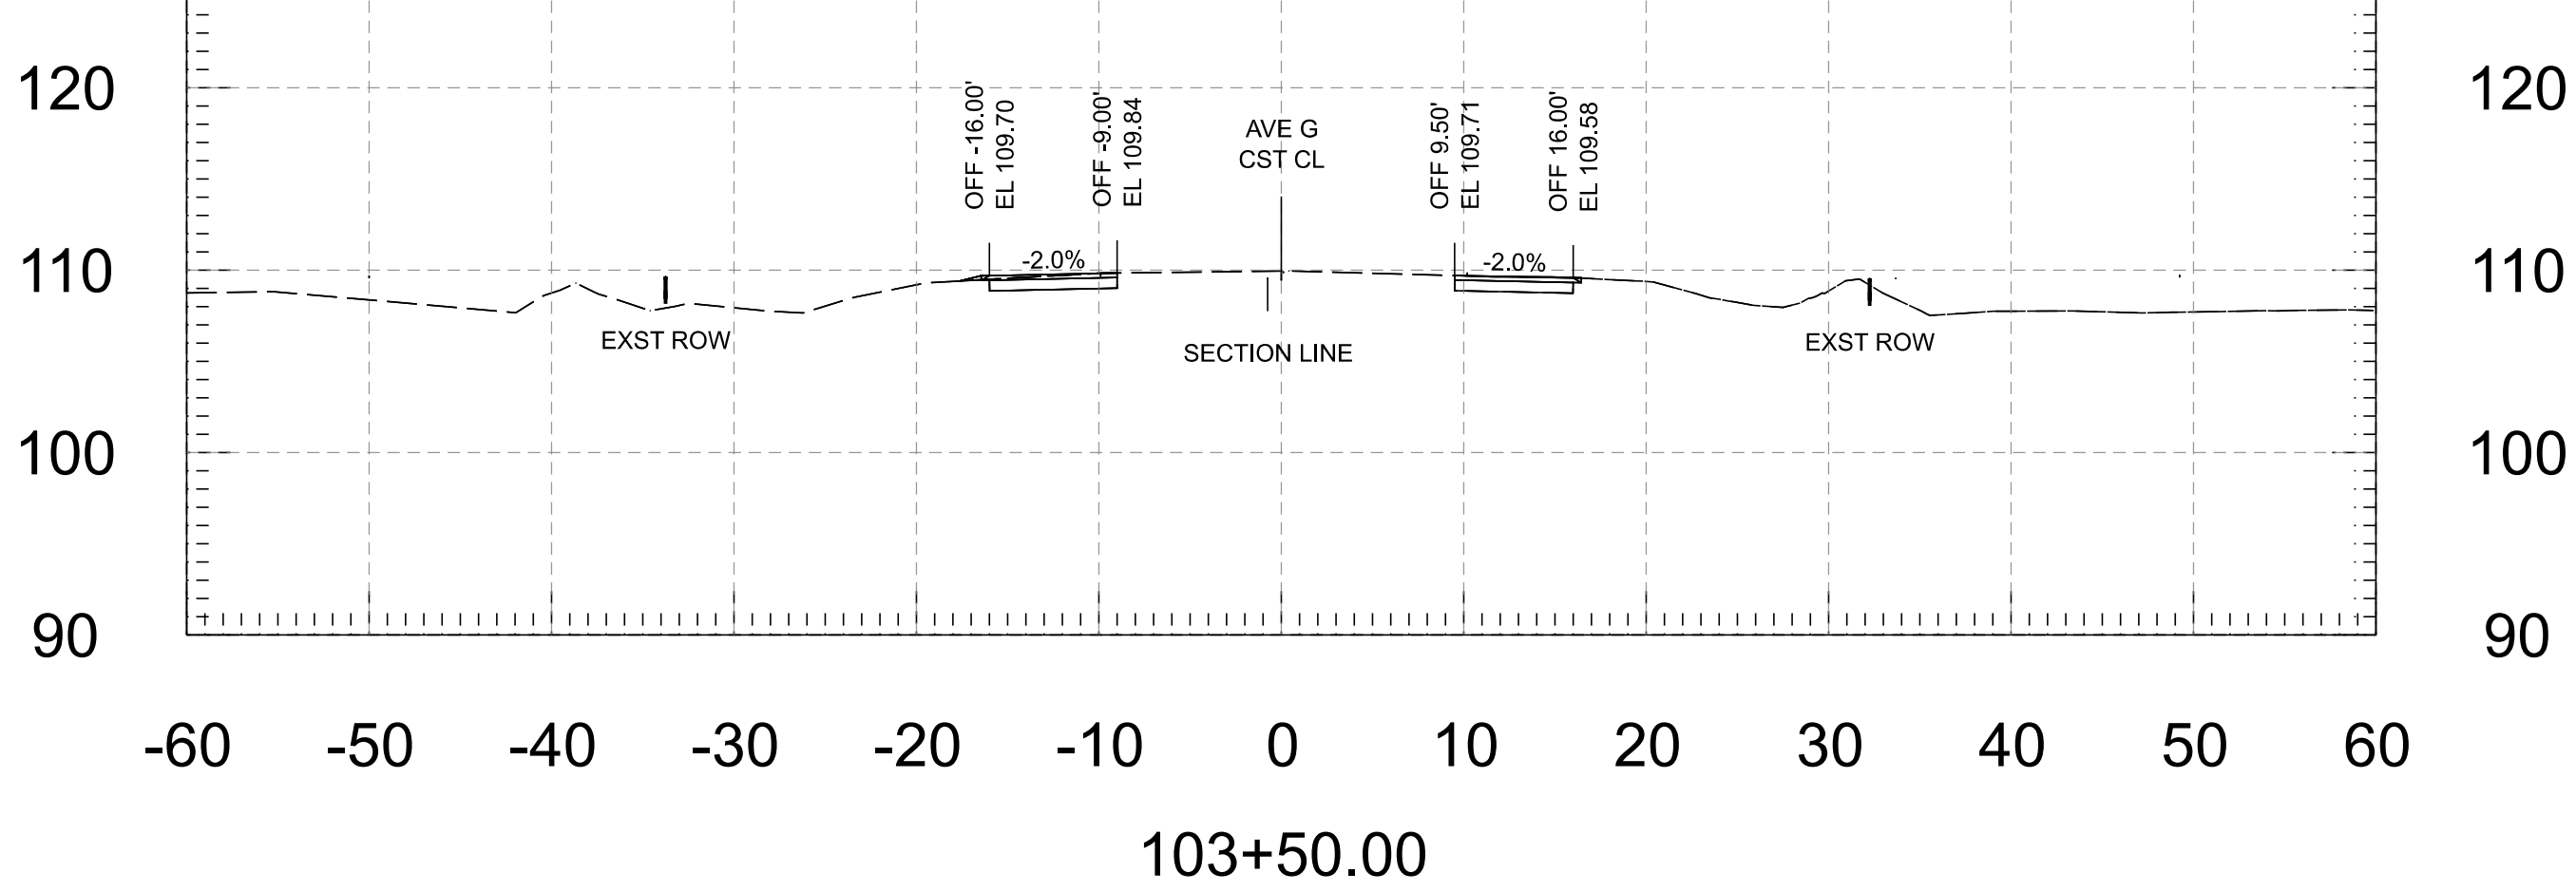


Cut Area	10.95 SF	Fill Area	0.06 SF
Cut Vol.	20.40 CY	Fill Vol.	0.19 CY
Cut Adj. Vol.	20.40 CY	Fill Adj. Vol.	0.19 CY

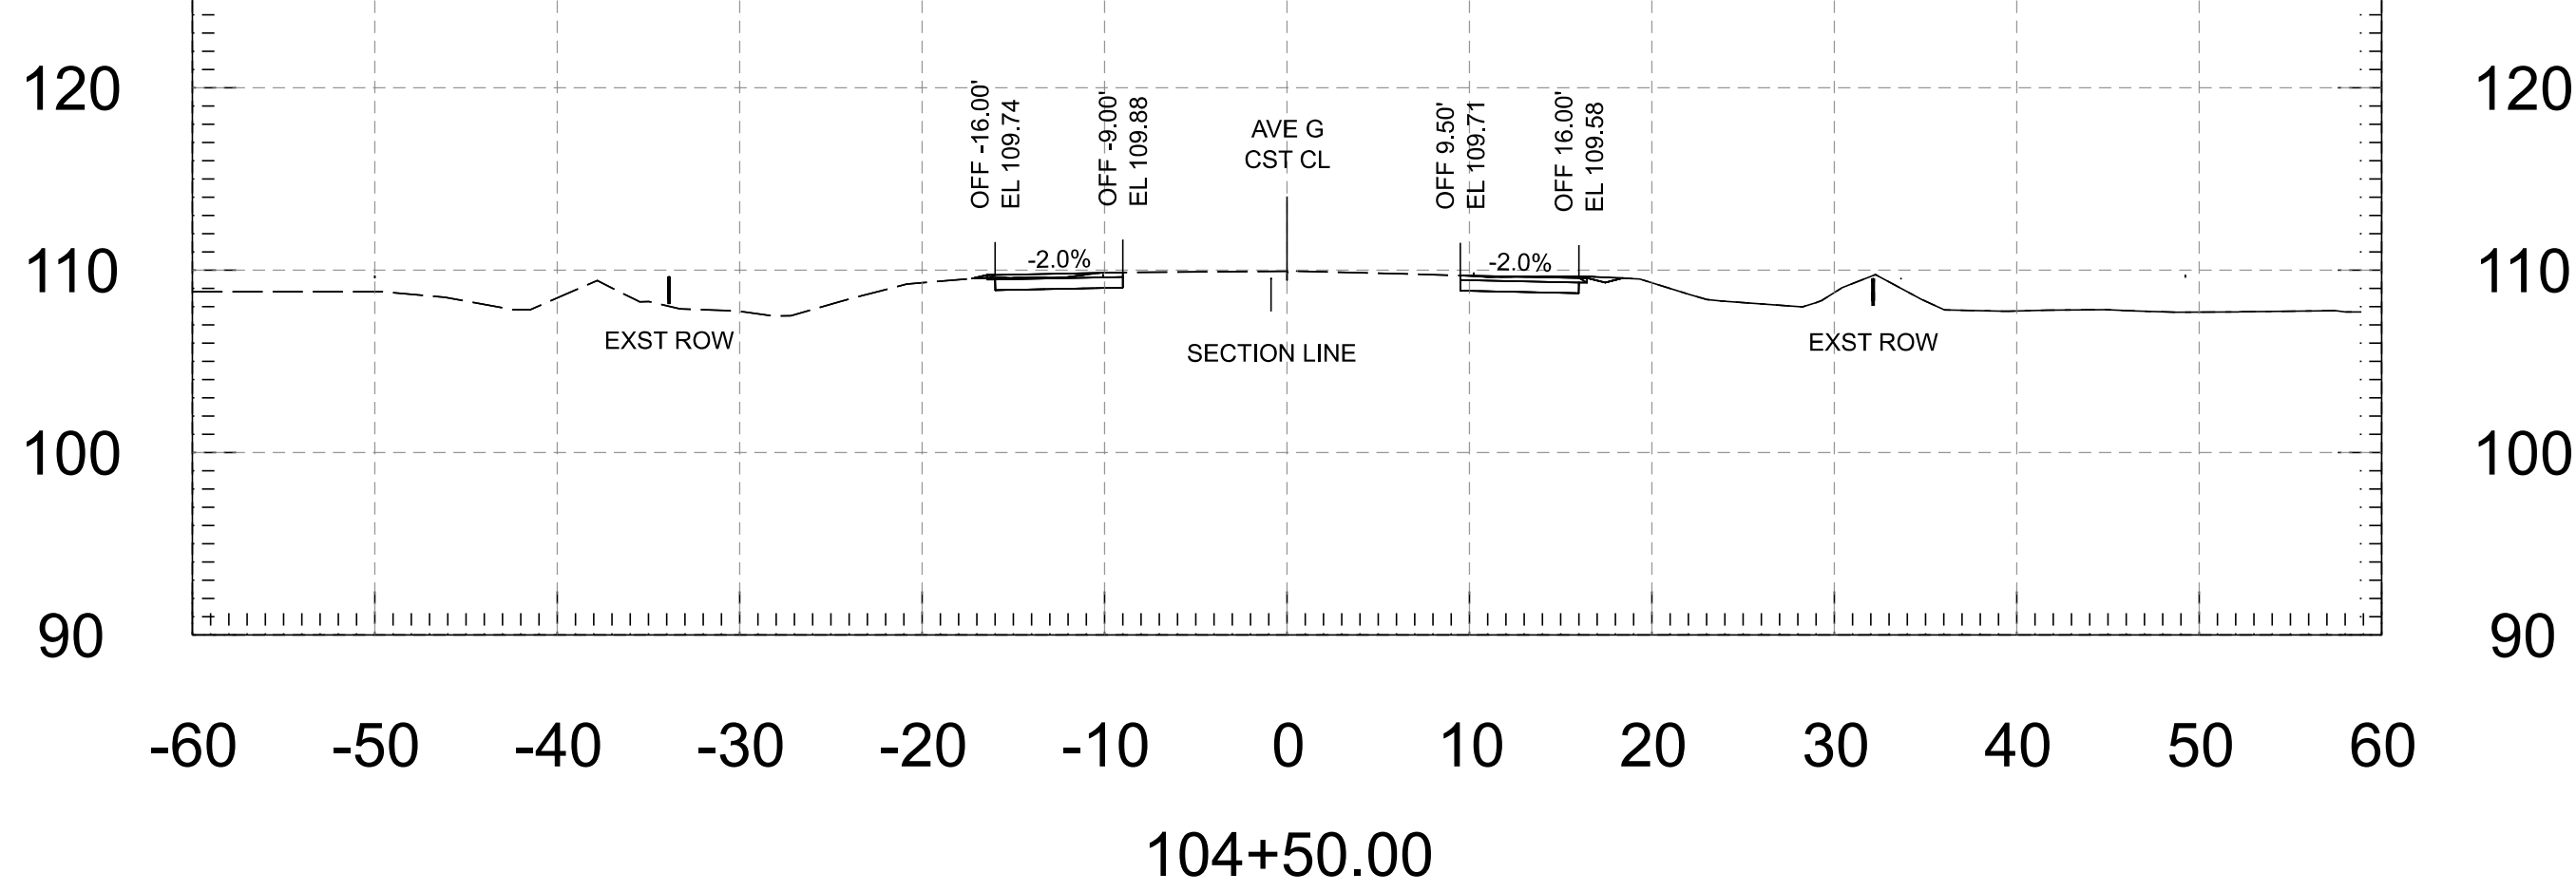





Cut Area	10.26 SF	Fill Area	0.15 SF
Cut Vol.	19.18 CY	Fill Vol.	0.21 CY
Cut Adj. Vol.	19.18 CY	Fill Adj. Vol.	0.21 CY

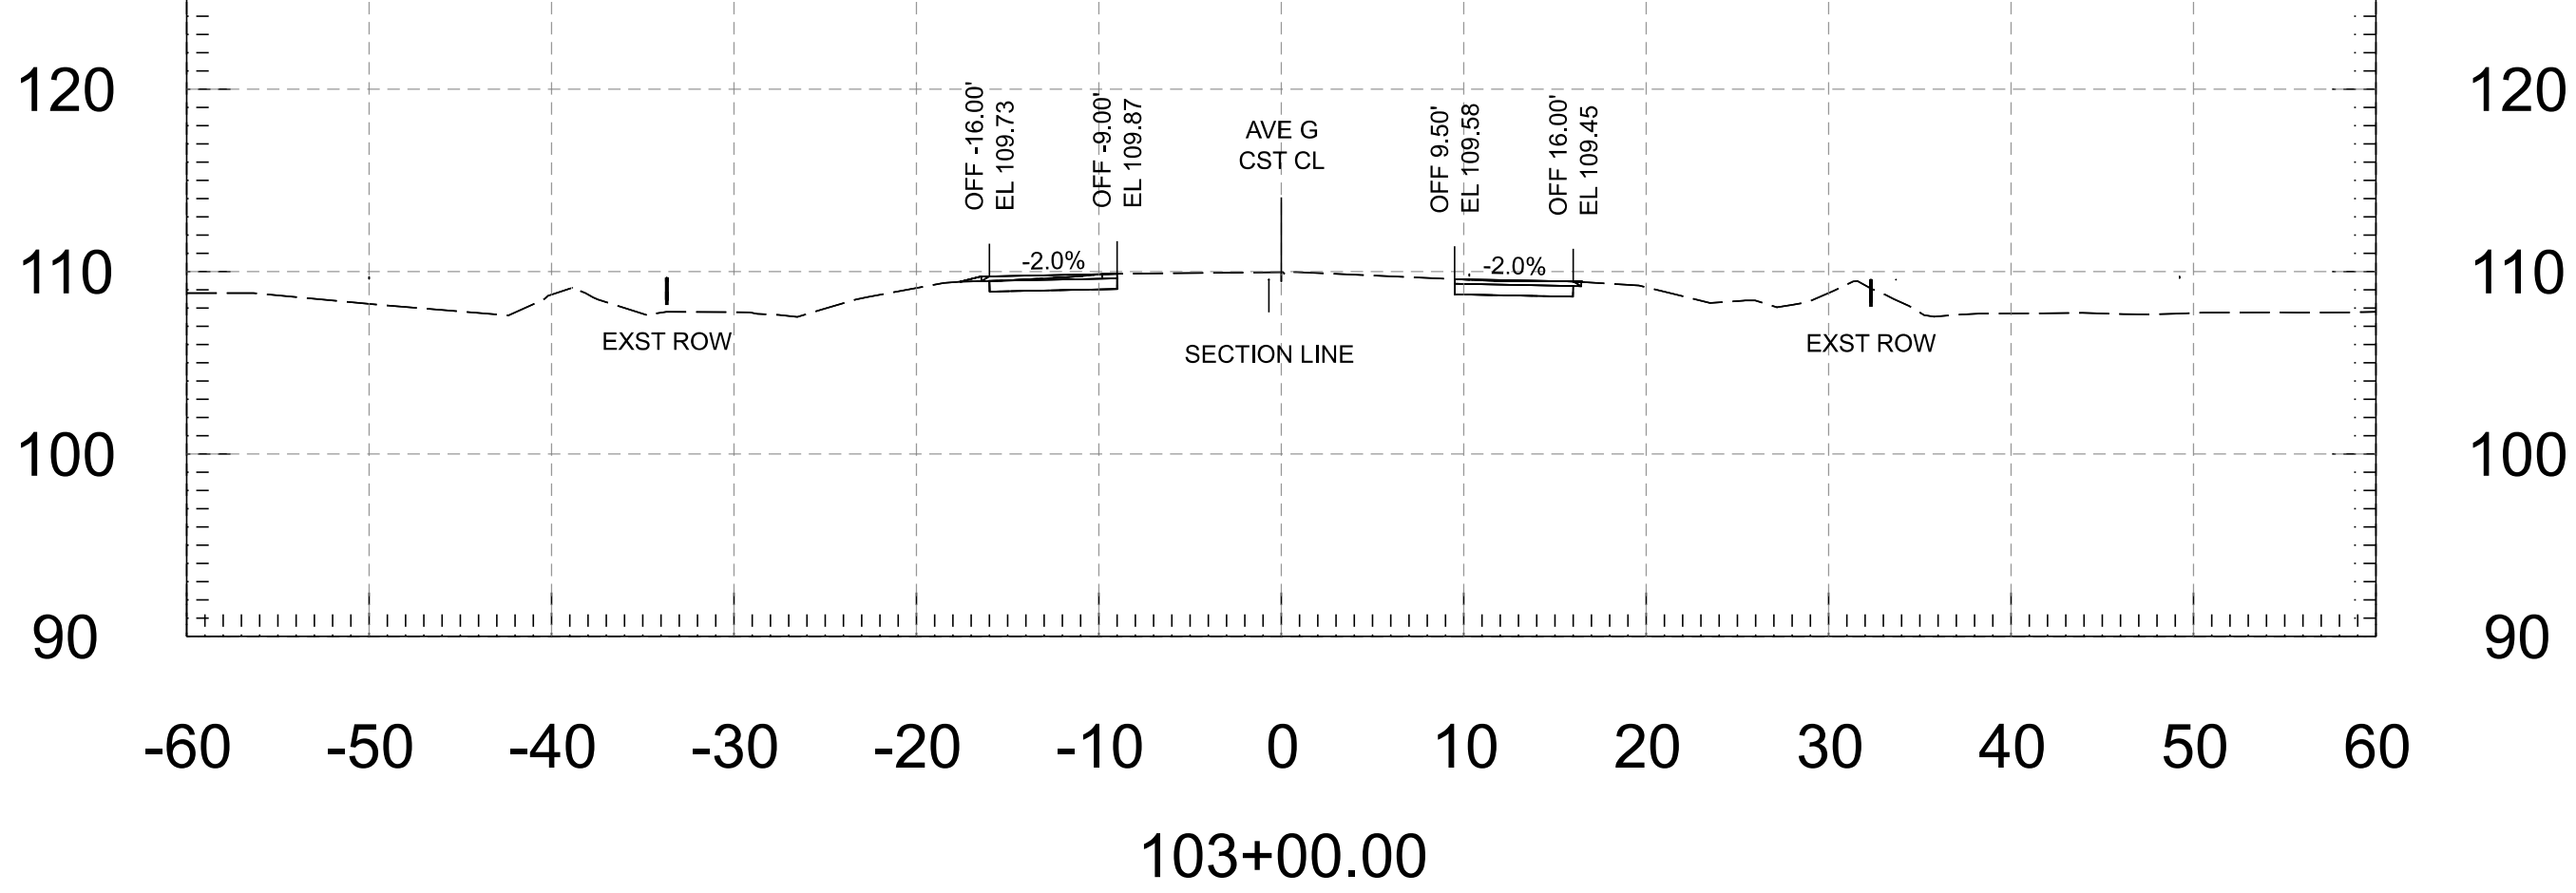





Cut Area	11.08 SF	Fill Area	0.14 SF
Cut Vol.	20.24 CY	Fill Vol.	0.25 CY
Cut Adj. Vol.	20.24 CY	Fill Adj. Vol.	0.25 CY


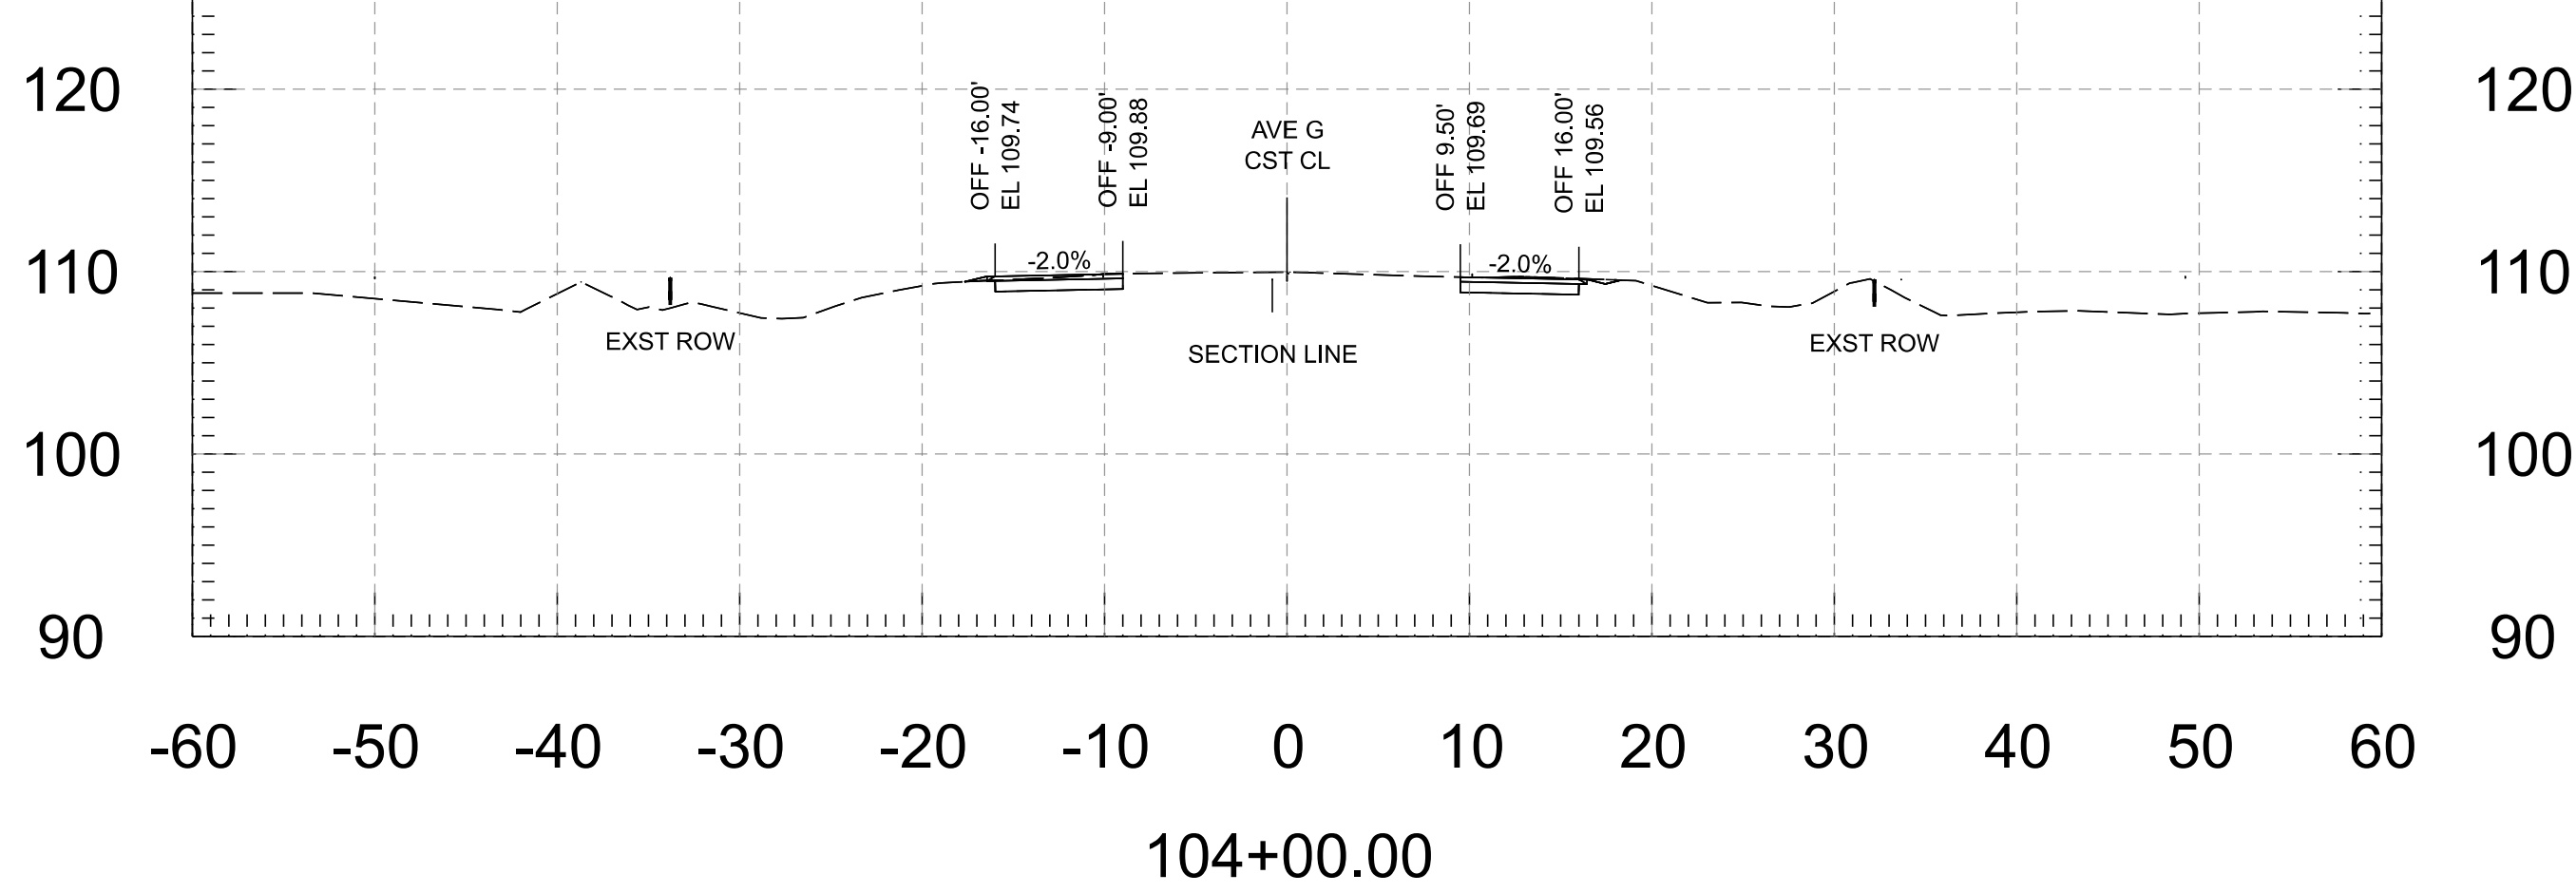


FOR INFORMATION ONLY		NAME	DATE	ARIZONA DEPARTMENT OF TRANSPORTATION PROJECT DELIVERY AND OPERATIONS DIVISION ROADWAY DESIGN SERVICES	ROUTE	F.H.W.A. Arizona Division	STATE ARIZ.	PROJECT NO.	FEDERAL ID NO.	SHEET NO.	TOTAL SHEETS	RECORD DRAWING
	DESIGN	M. SCHOEN	07/26					0000 YU YYU	YYU-0(225)T	45	118	
	DRAWN	M. SCHOEN	07/26									
	CHECKED	H. RIOS	07/26									
		 WSP USA Inc. 1200 West Washington Street, Suite 405 Tempe, AZ 85288	AVENUE G - CROSS SECTIONS			MILEPOST	LOCATION AVENUE G, COUNTY 11TH ST - COUNTY 16TH ST					
					STRUCTURE NO.	TRACS NO. T0437 01C				___ OF ___		

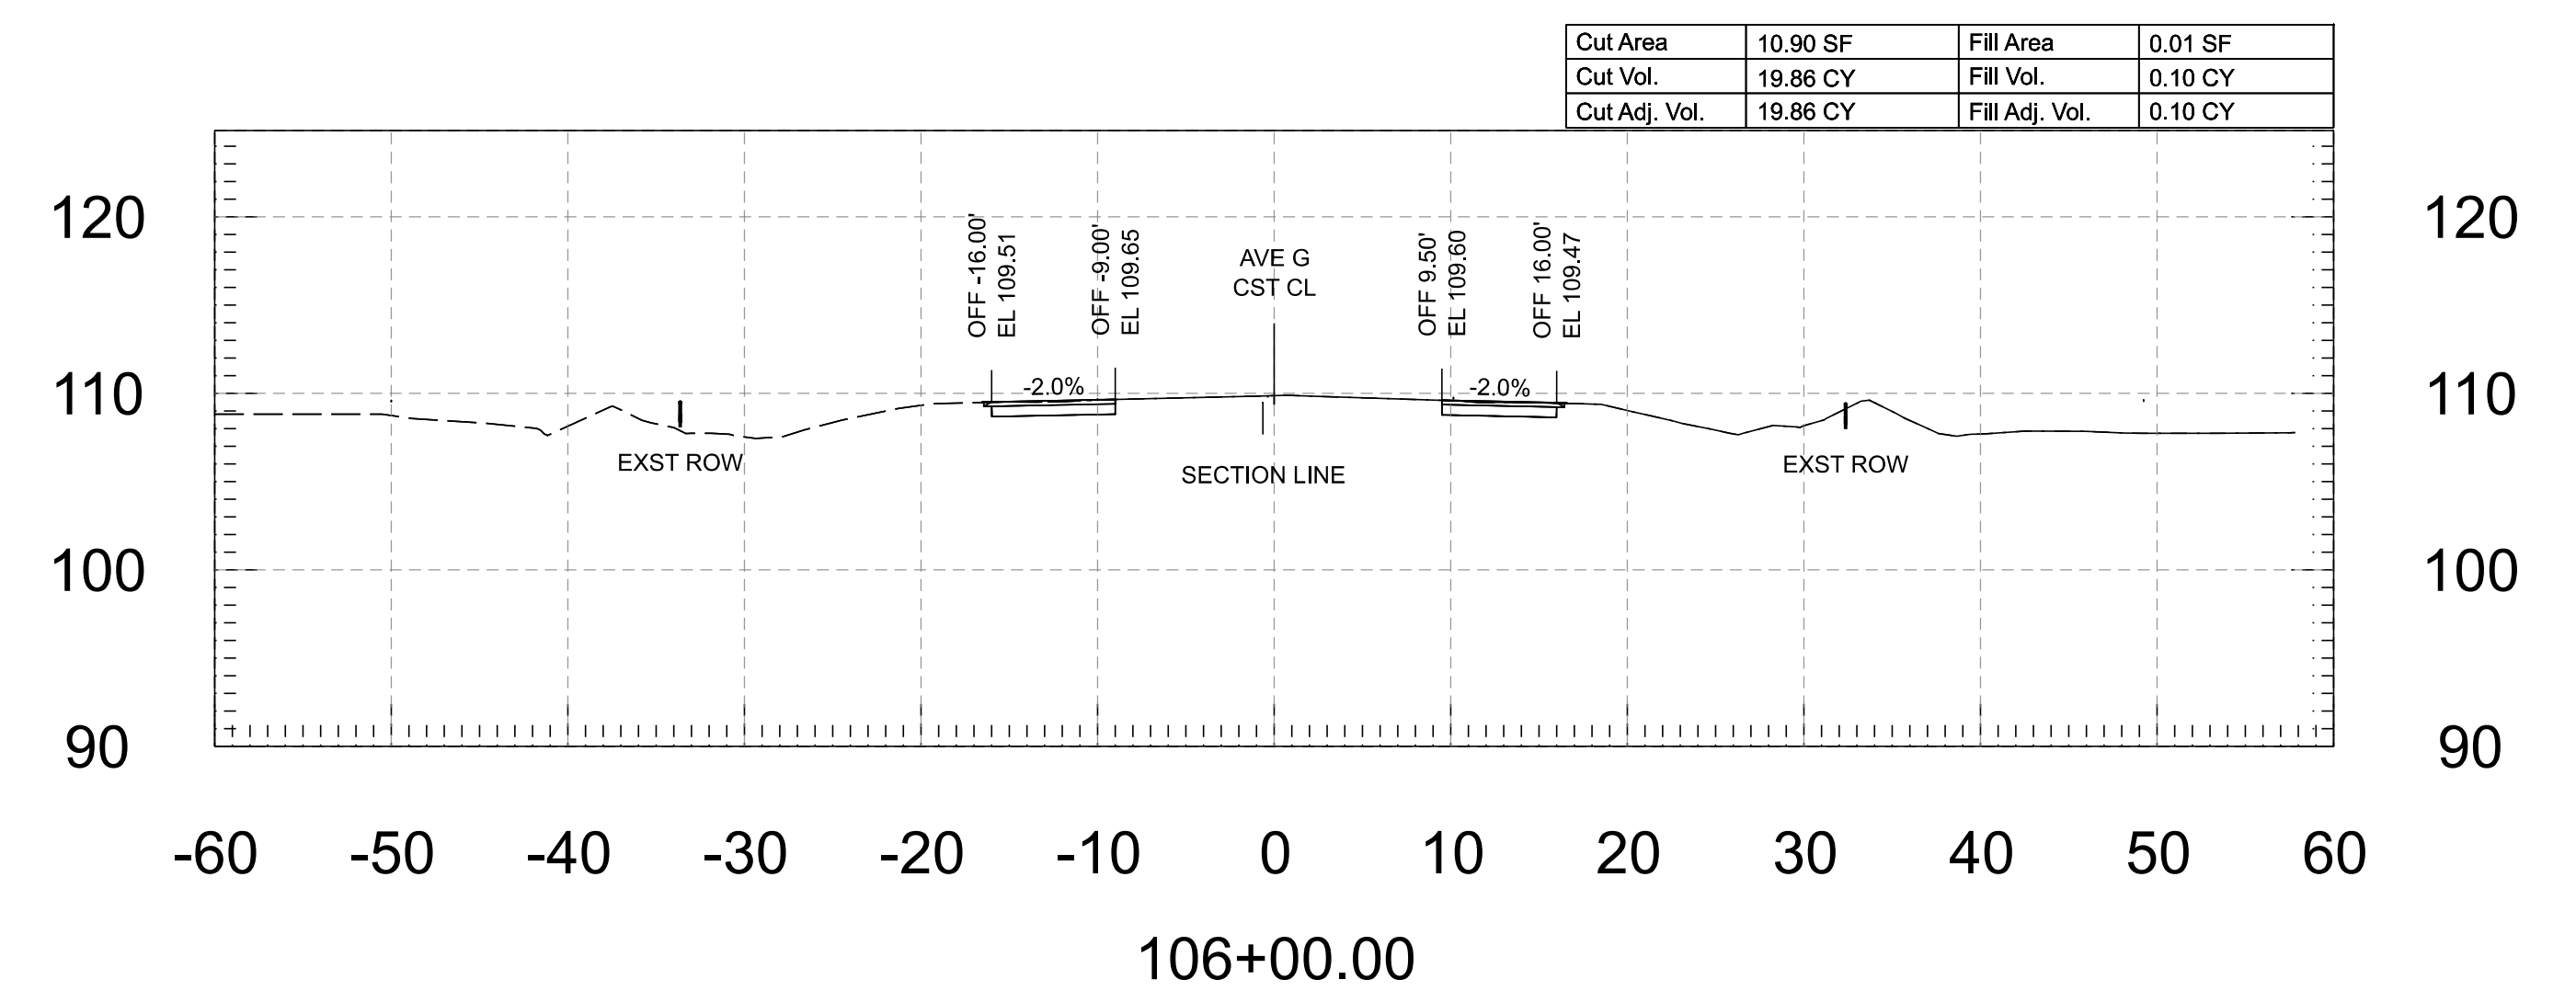
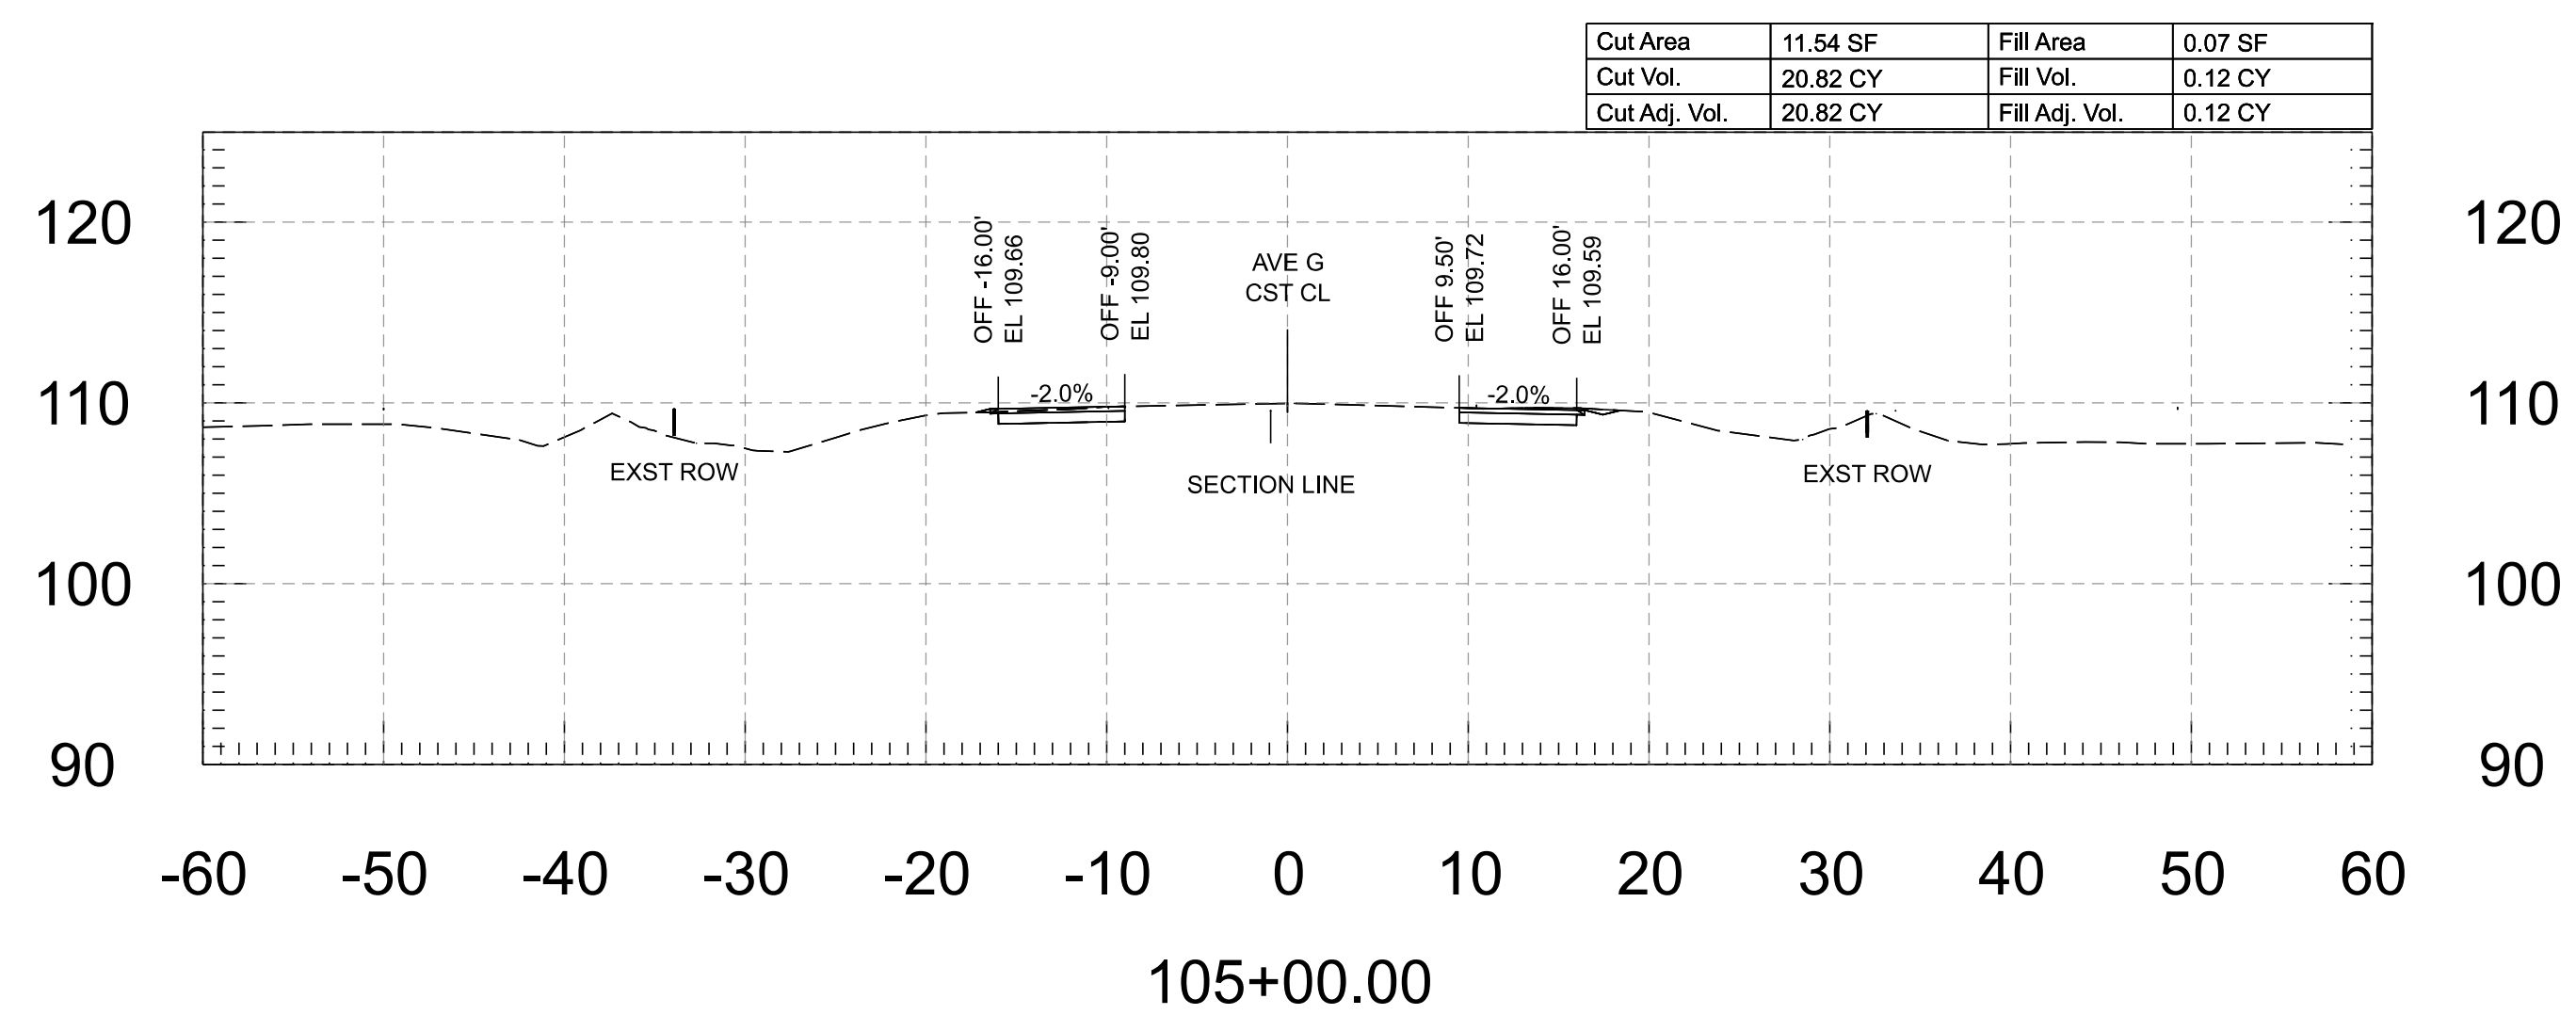
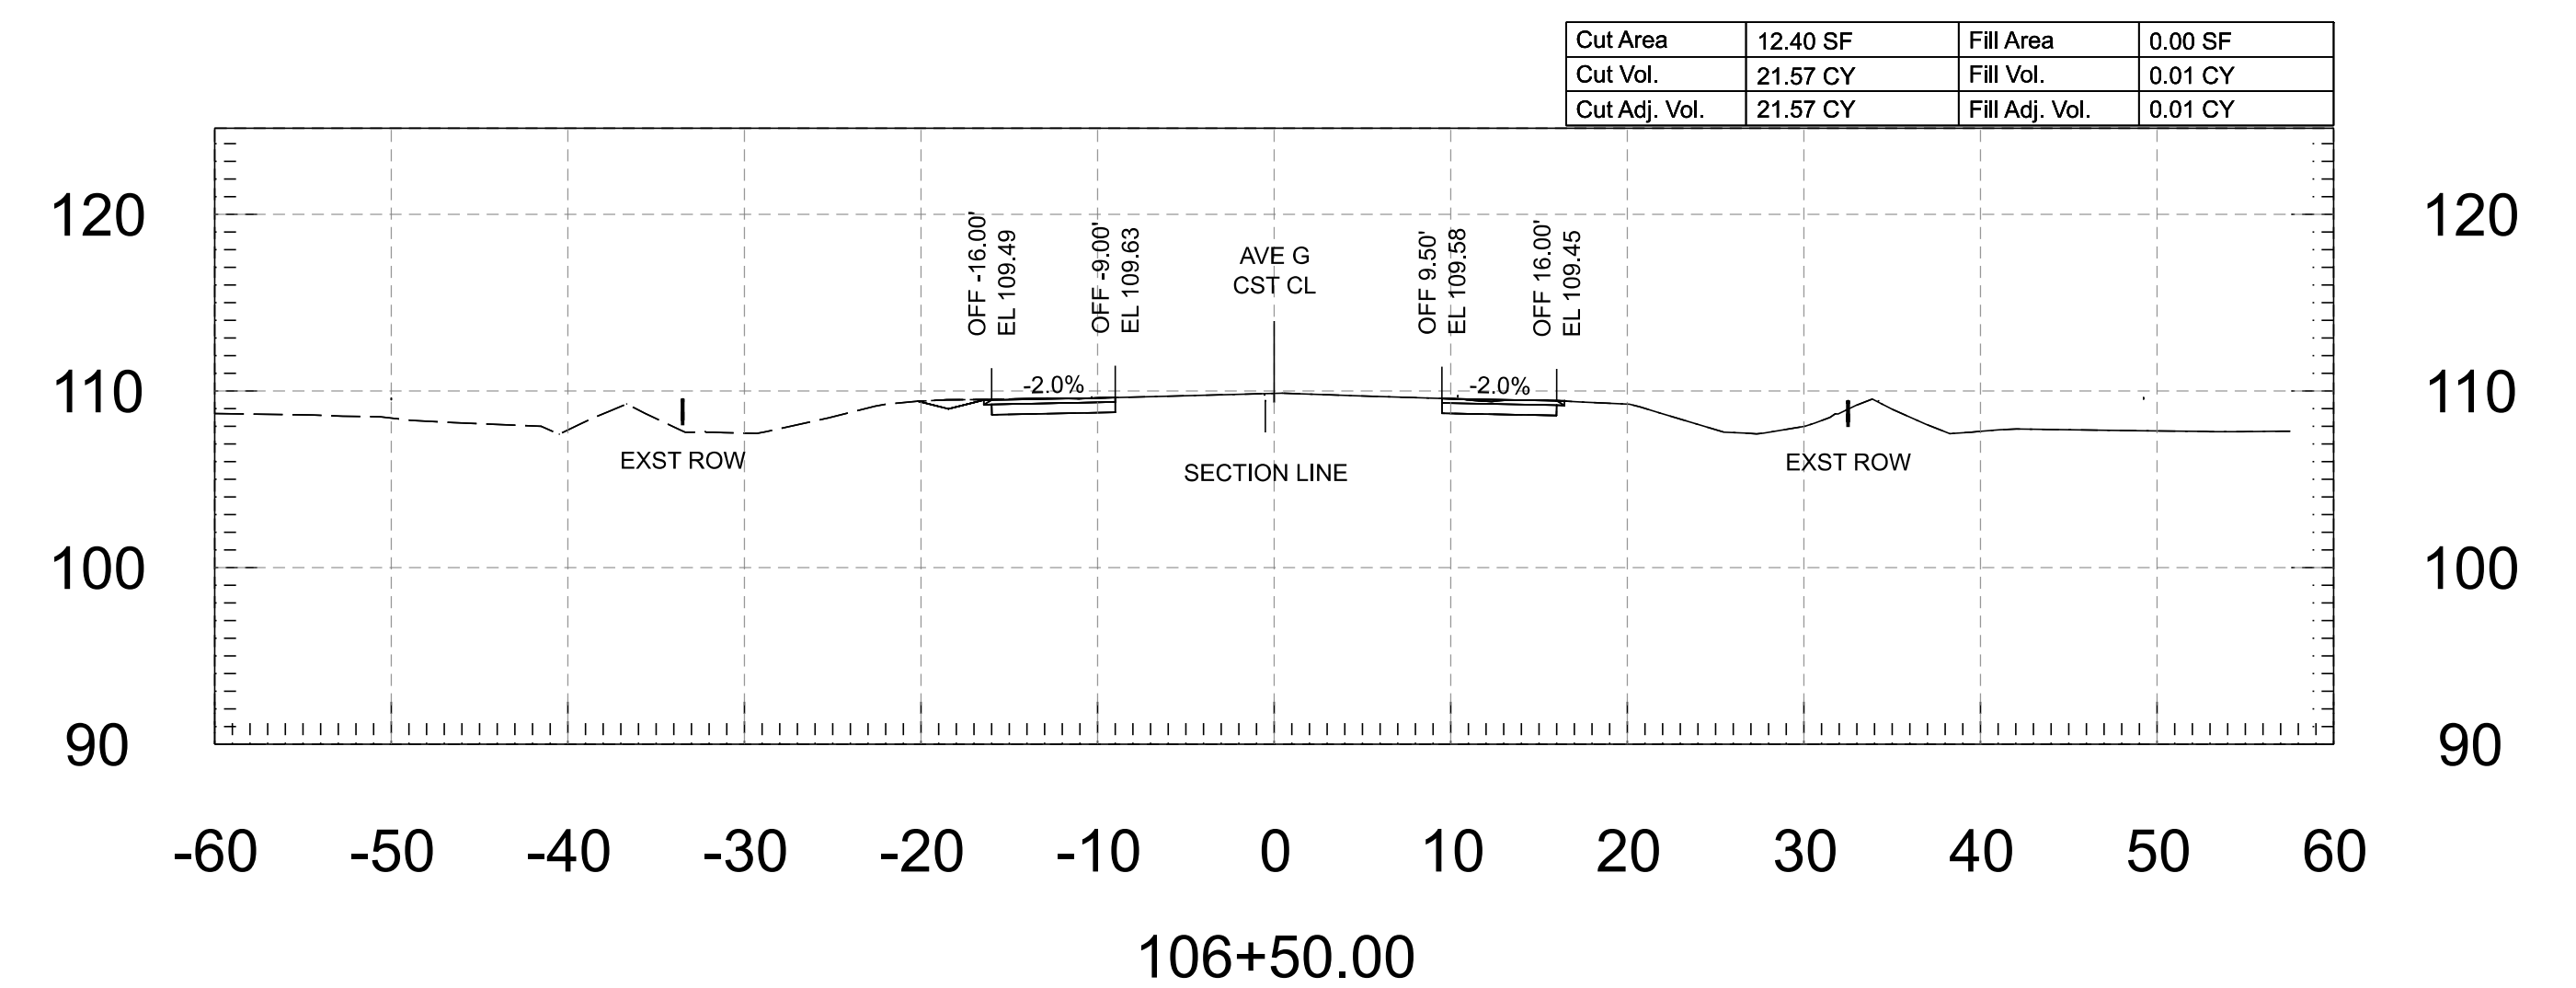
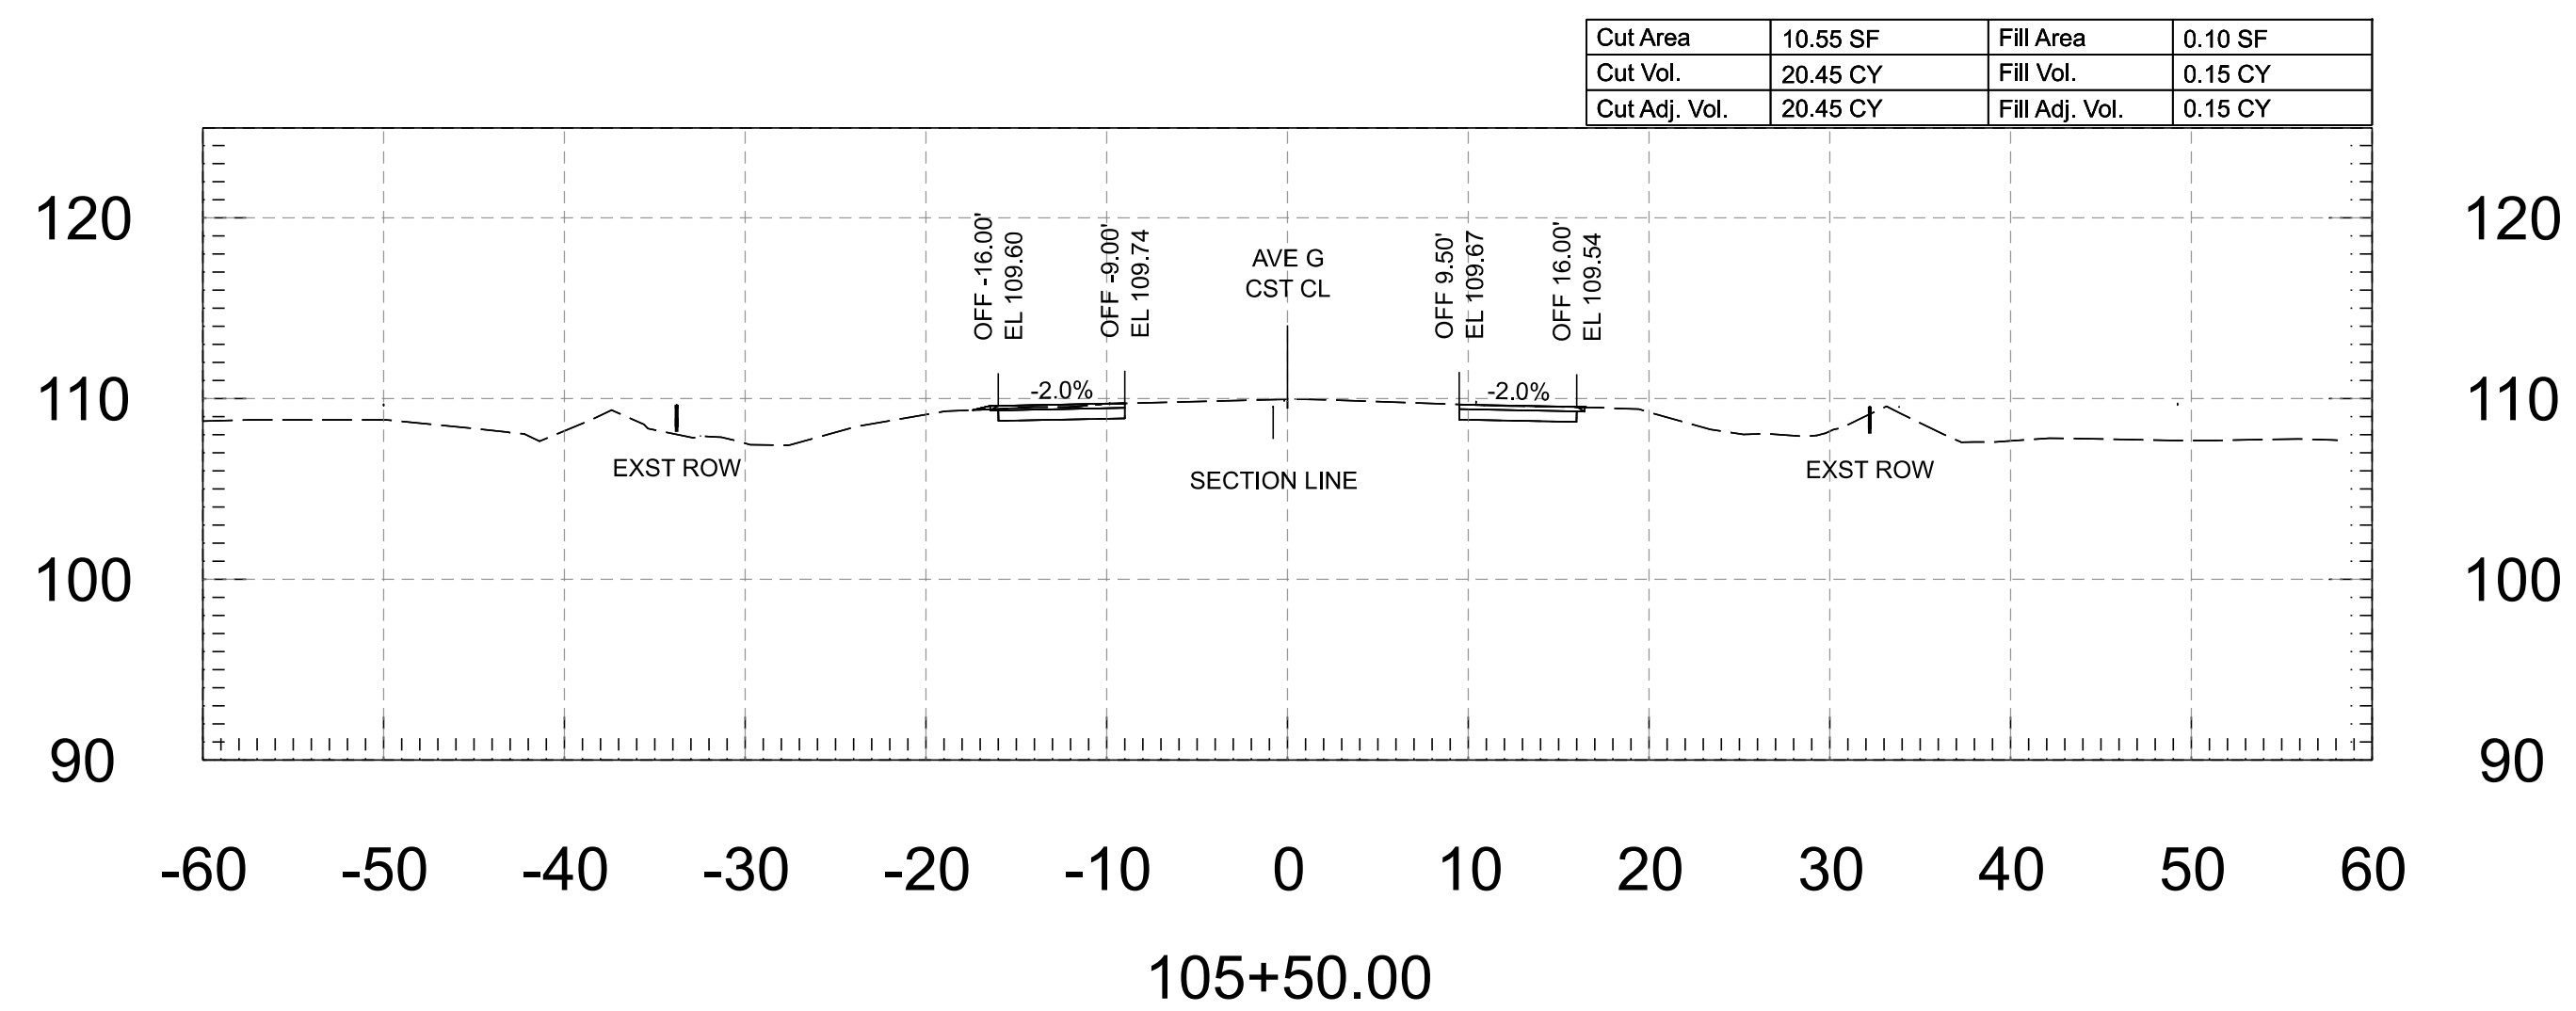


FOR INFORMATION ONLY		NAME	DATE	ARIZONA DEPARTMENT OF TRANSPORTATION PROJECT DELIVERY AND OPERATIONS DIVISION ROADWAY DESIGN SERVICES	ROUTE	F.H.W.A. Arizona Division	STATE	PROJECT NO.	FEDERAL ID NO.	SHEET NO.	TOTAL SHEETS	RECORD DRAWING
	DESIGN	M. SCHOEN	07/26		MILEPOST		ARIZ.	0000 YU YYU	YYU-0(225)T	46	118	
	DRAWN	M. SCHOEN	07/26		 WSP USA Inc. 1220 West Washington Street, Suite 405 Tempe, AZ 85288	STRUCTURE NO.	LOCATION AVENUE G, COUNTY 11TH ST - COUNTY 16TH ST					DWG
	CHECKED	H. RIOS	07/26				TRACS NO. T0437 01C					___ OF ___

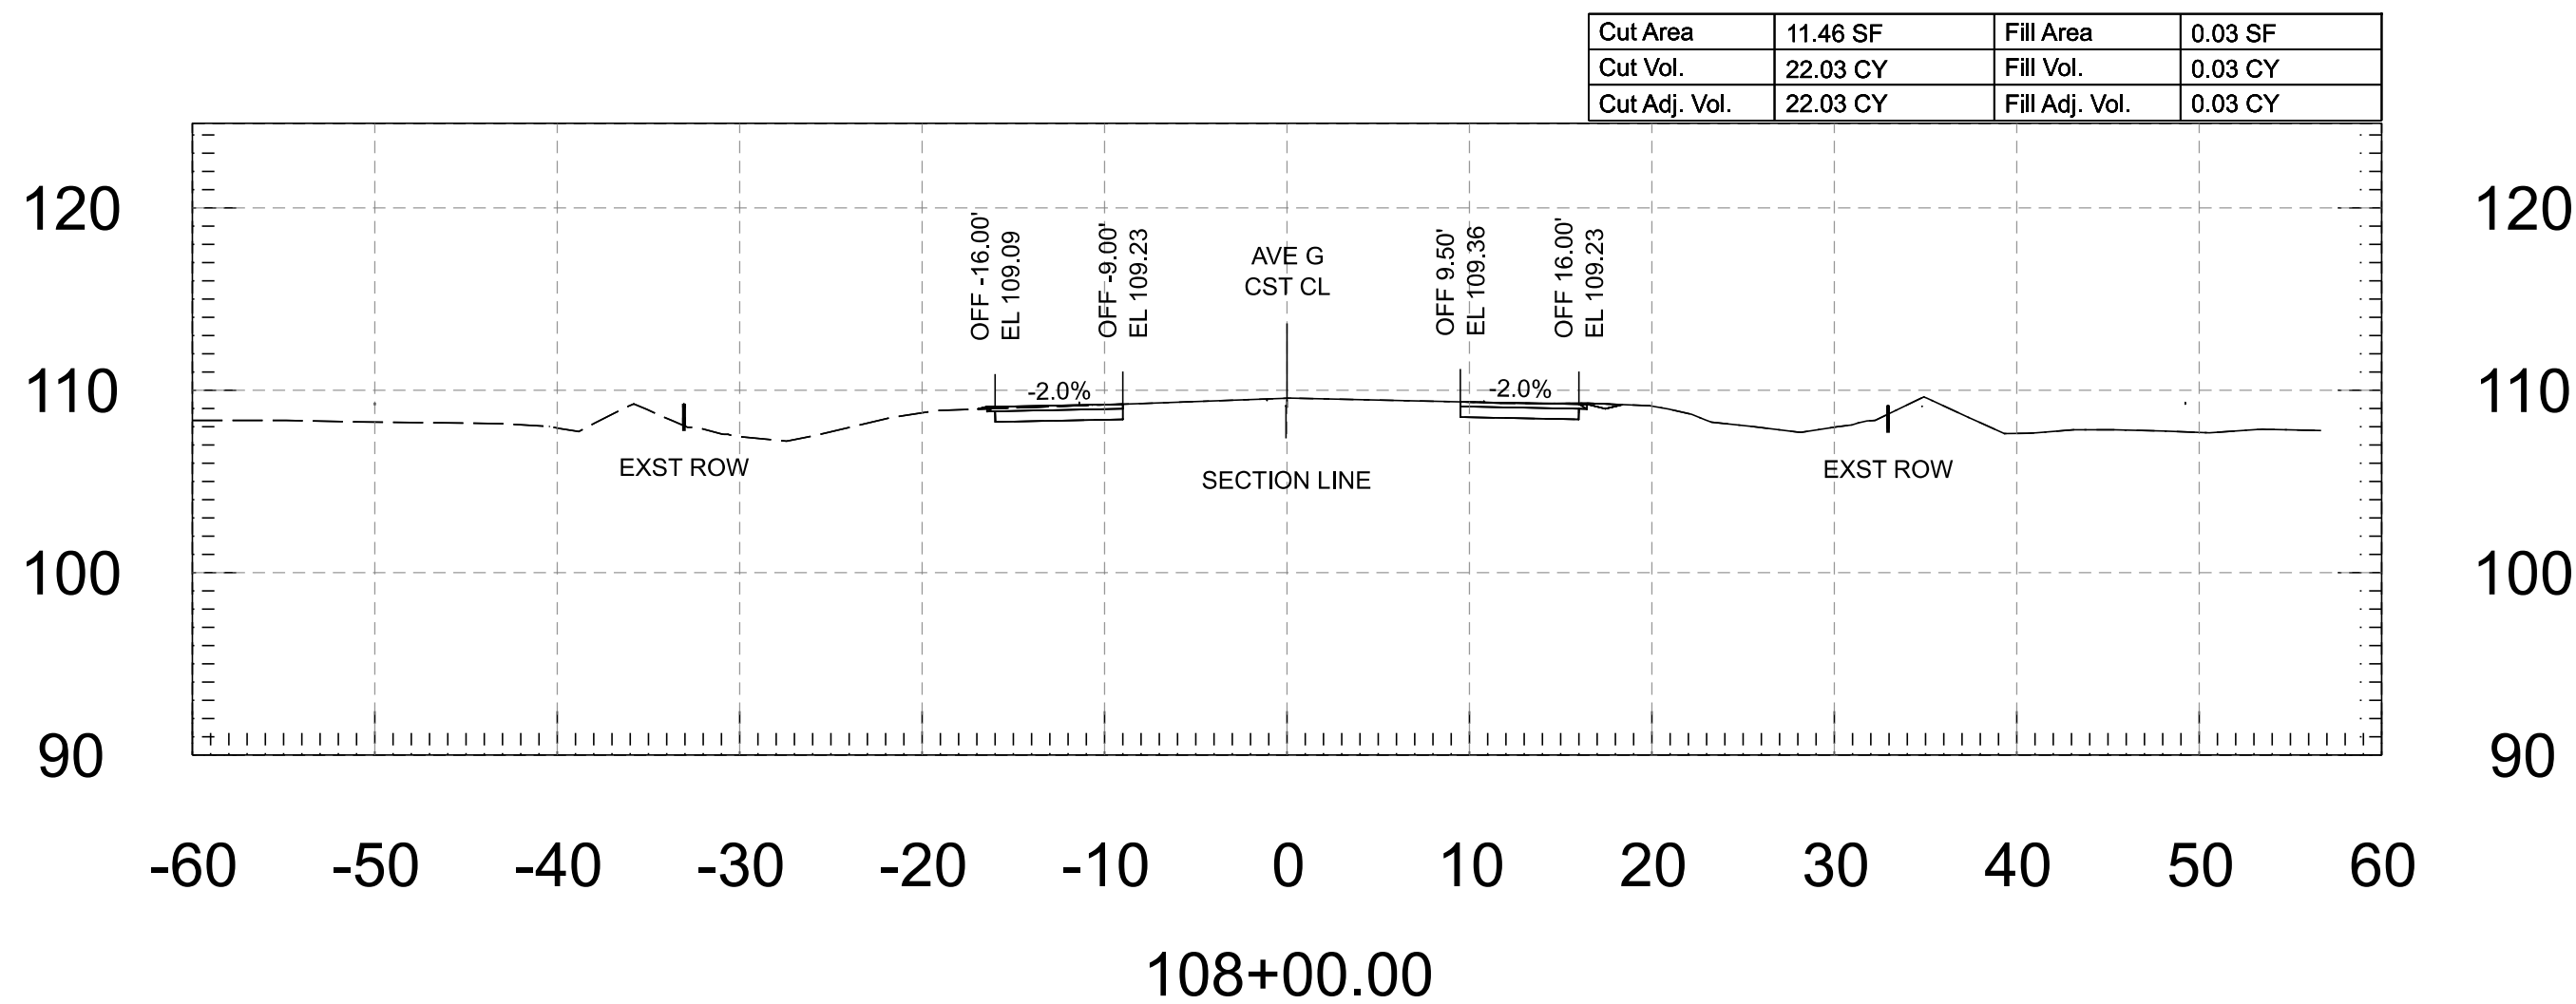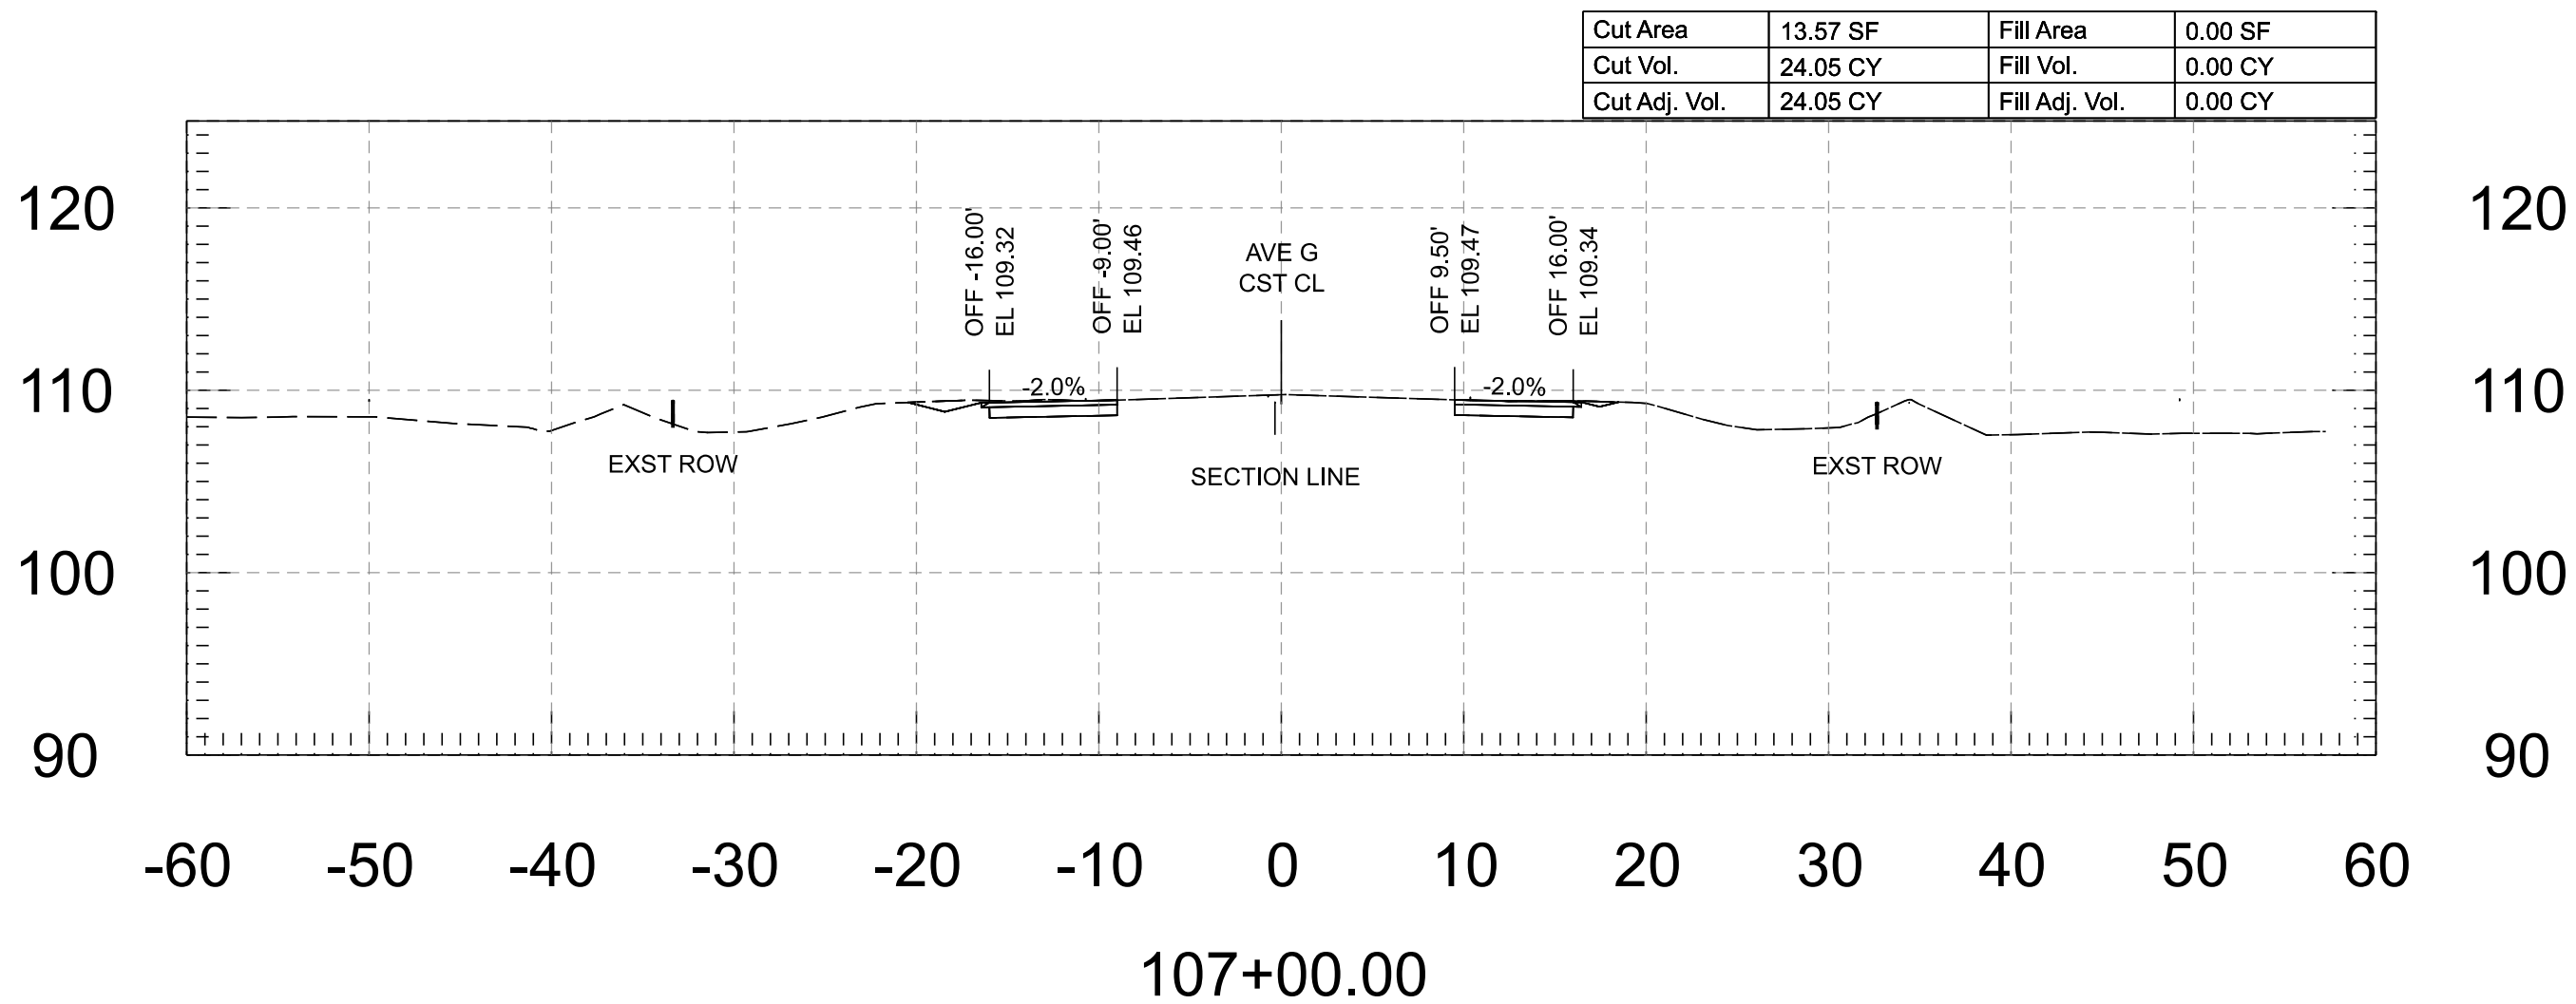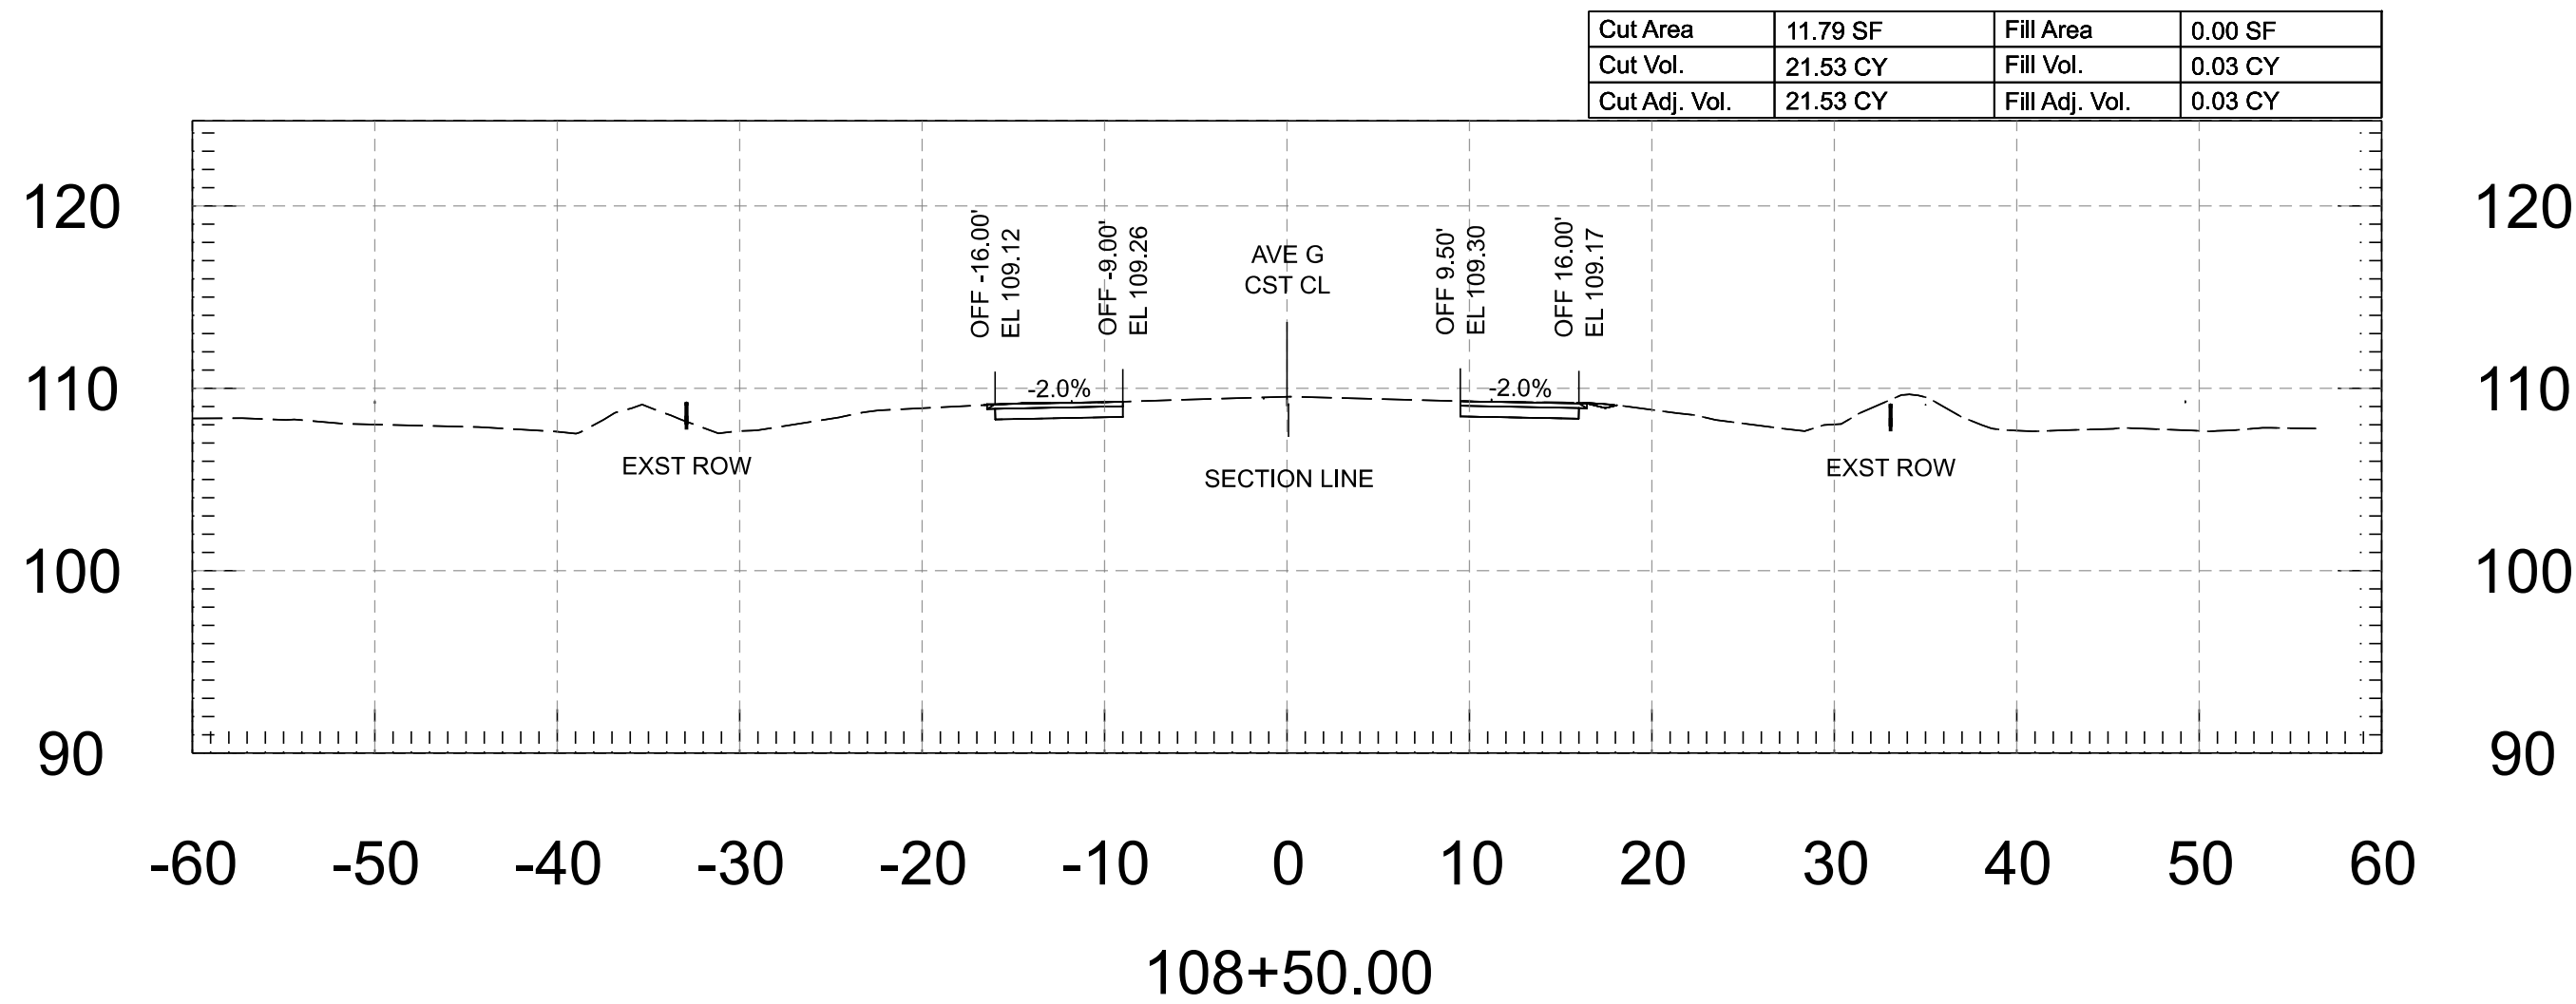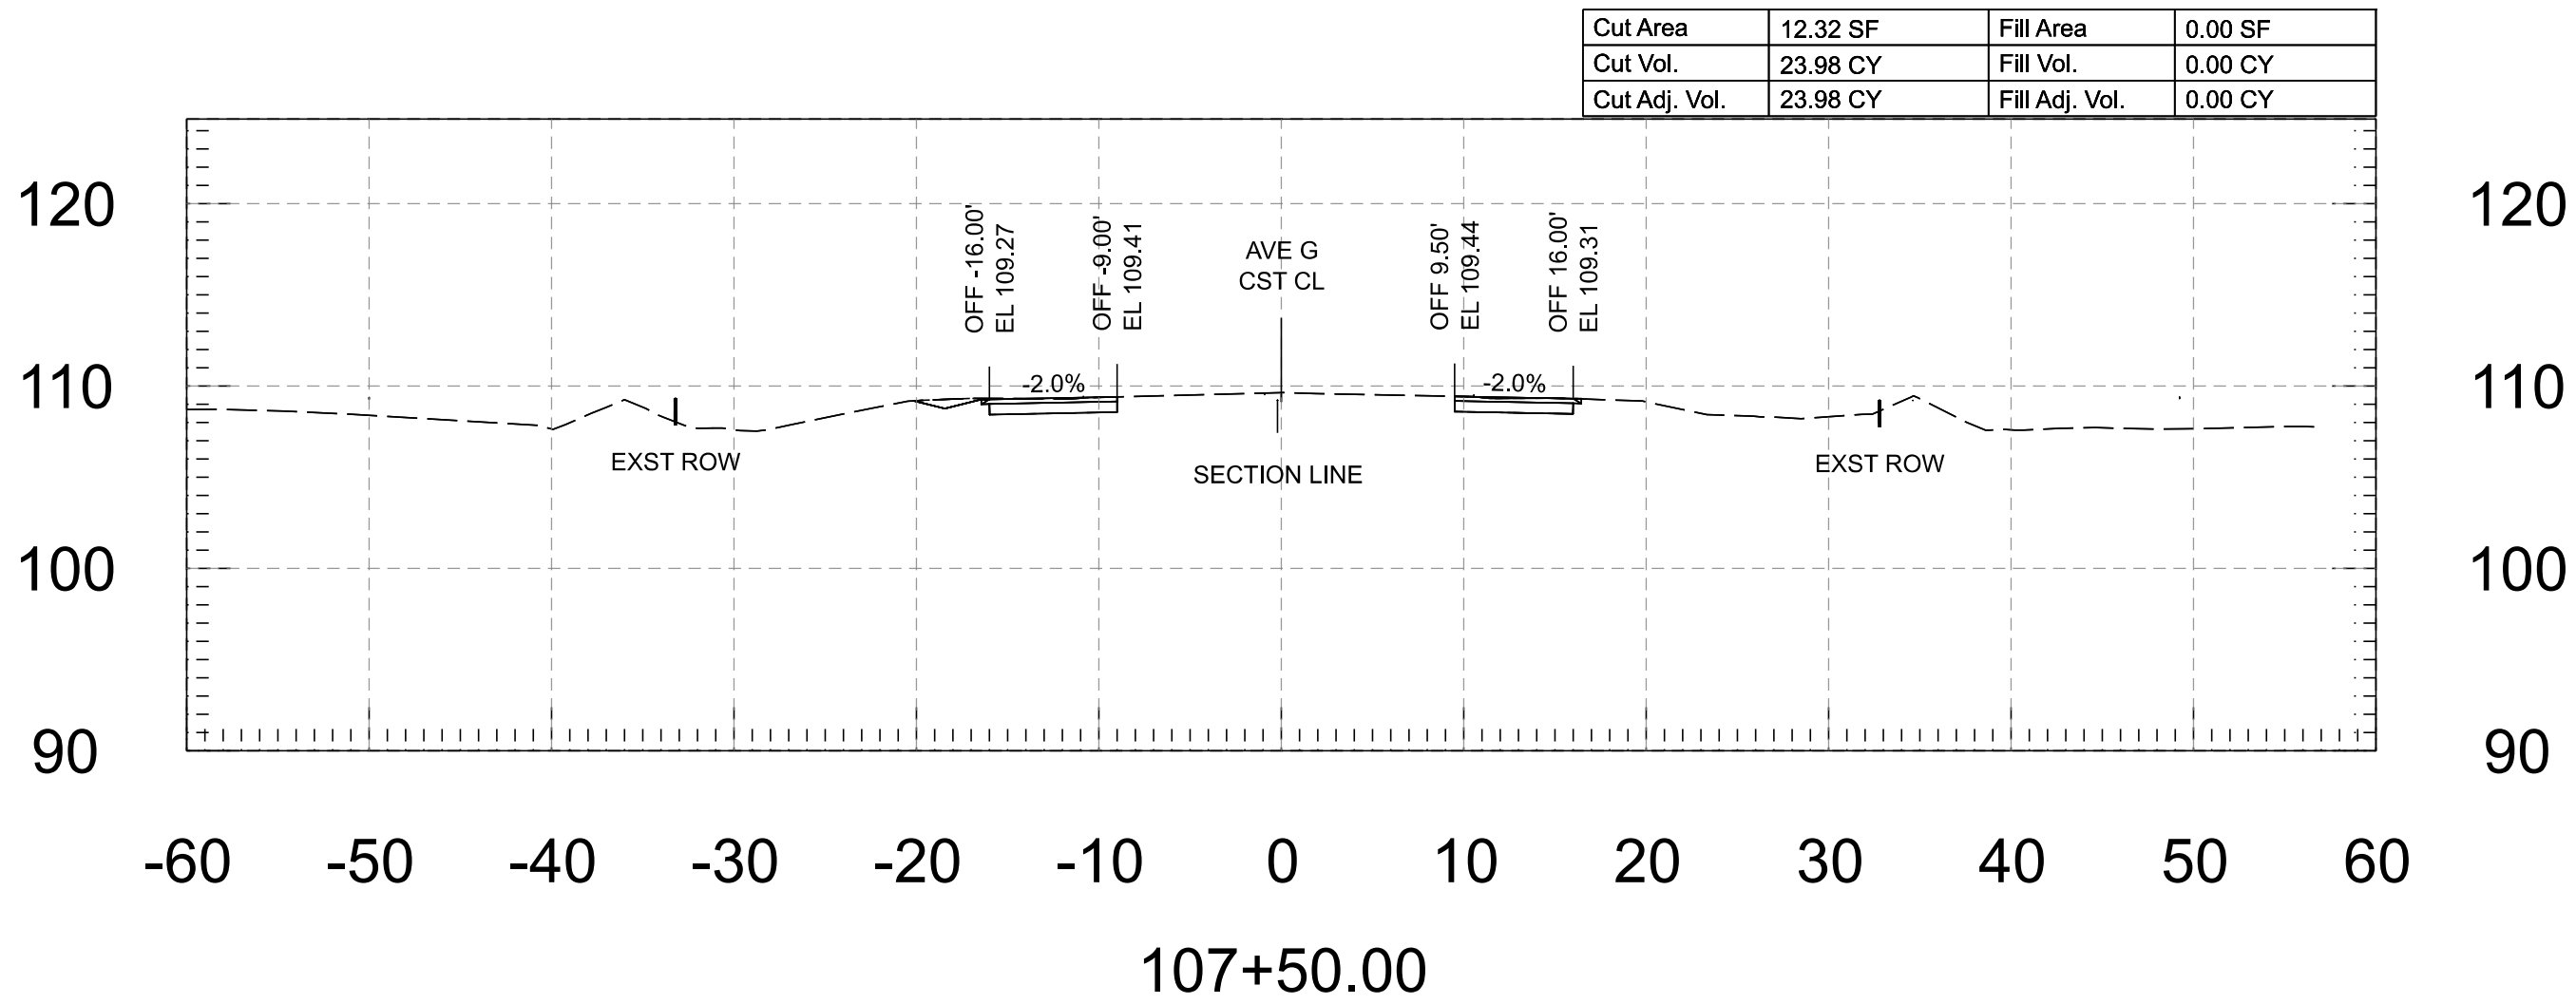


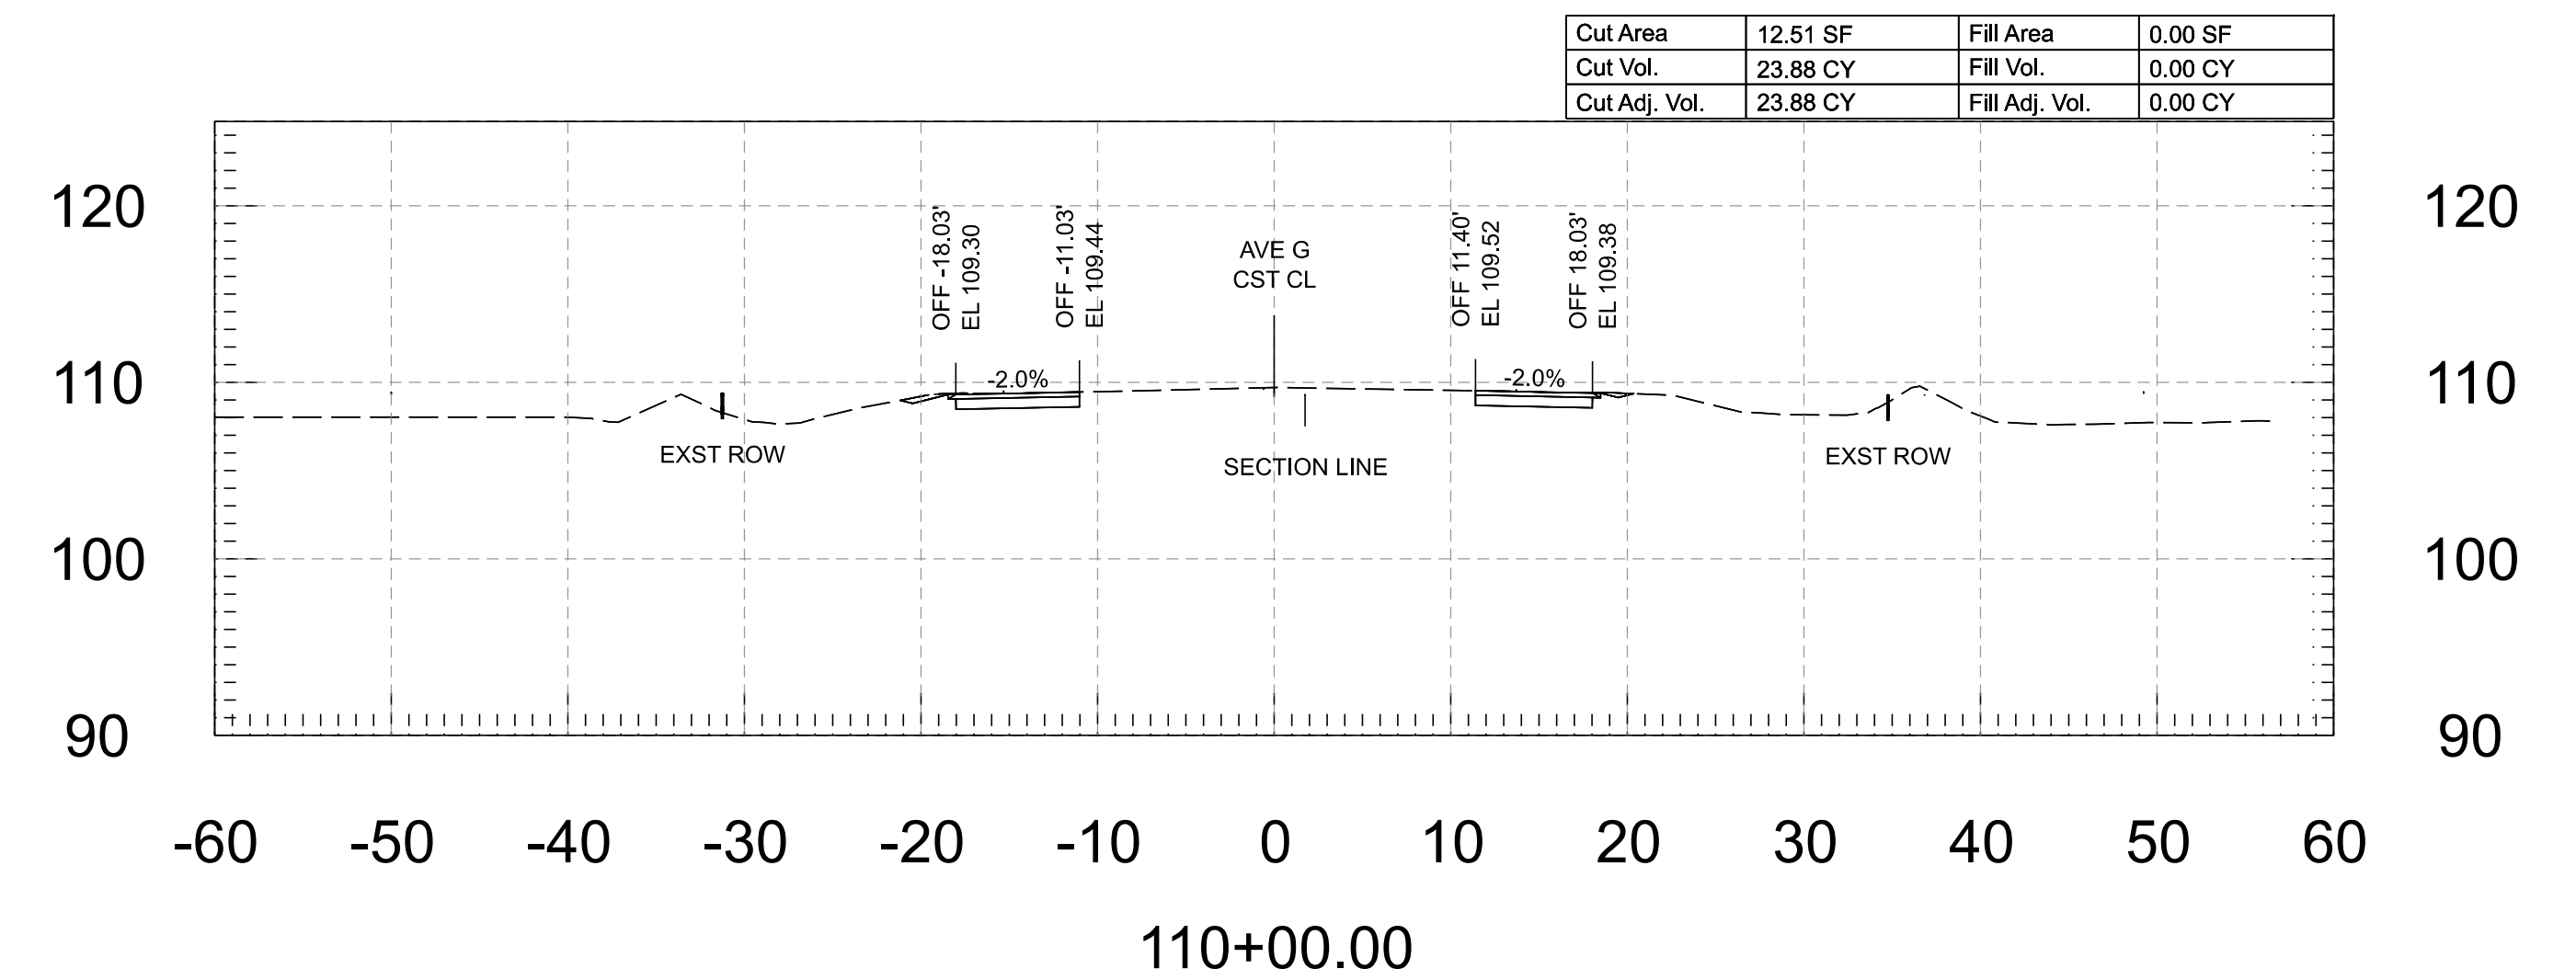
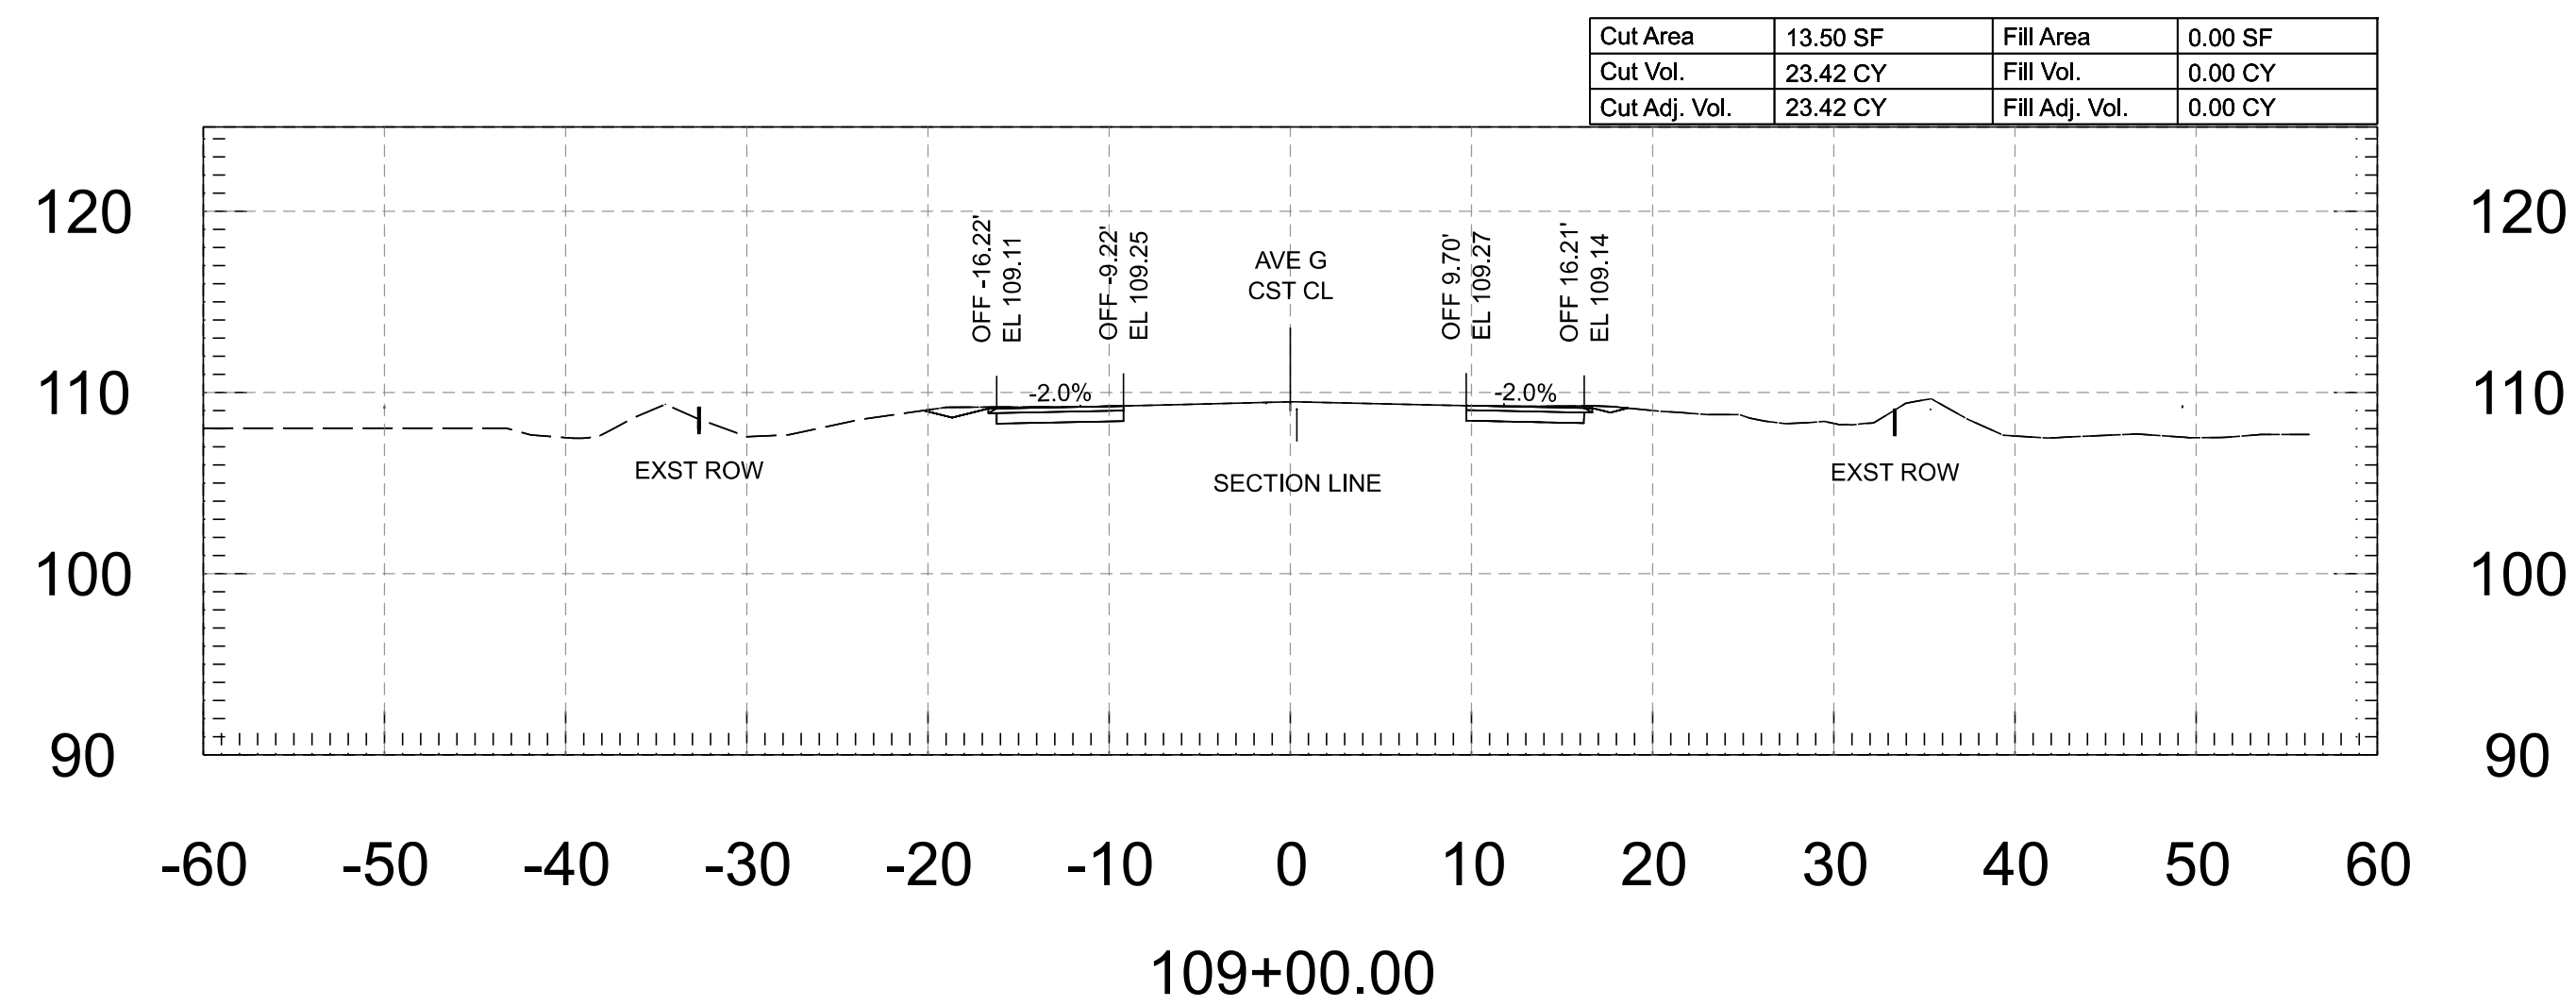


FOR INFORMATION ONLY		NAME	DATE	ARIZONA DEPARTMENT OF TRANSPORTATION PROJECT DELIVERY AND OPERATIONS DIVISION ROADWAY DESIGN SERVICES	ROUTE	F.H.W.A. Arizona Division	STATE ARIZ.	PROJECT NO.	FEDERAL ID NO.	SHEET NO.	TOTAL SHEETS	RECORD DRAWING	
	DESIGN	M. SCHOEN	07/26		MILEPOST			0000 YU YU	YYU-0(225)T	48	118		
	DRAWN	M. SCHOEN	07/26		STRUCTURE NO.	LOCATION AVENUE G, COUNTY 11TH ST - COUNTY 16TH ST							DWG
	CHECKED	H. RIOS	07/26			TRACS NO. T0437 01C							___ OF ___
	 WSP USA Inc. 1200 West Washington Street, Suite 405 Tempe, AZ 85288			AVENUE G - CROSS SECTIONS									

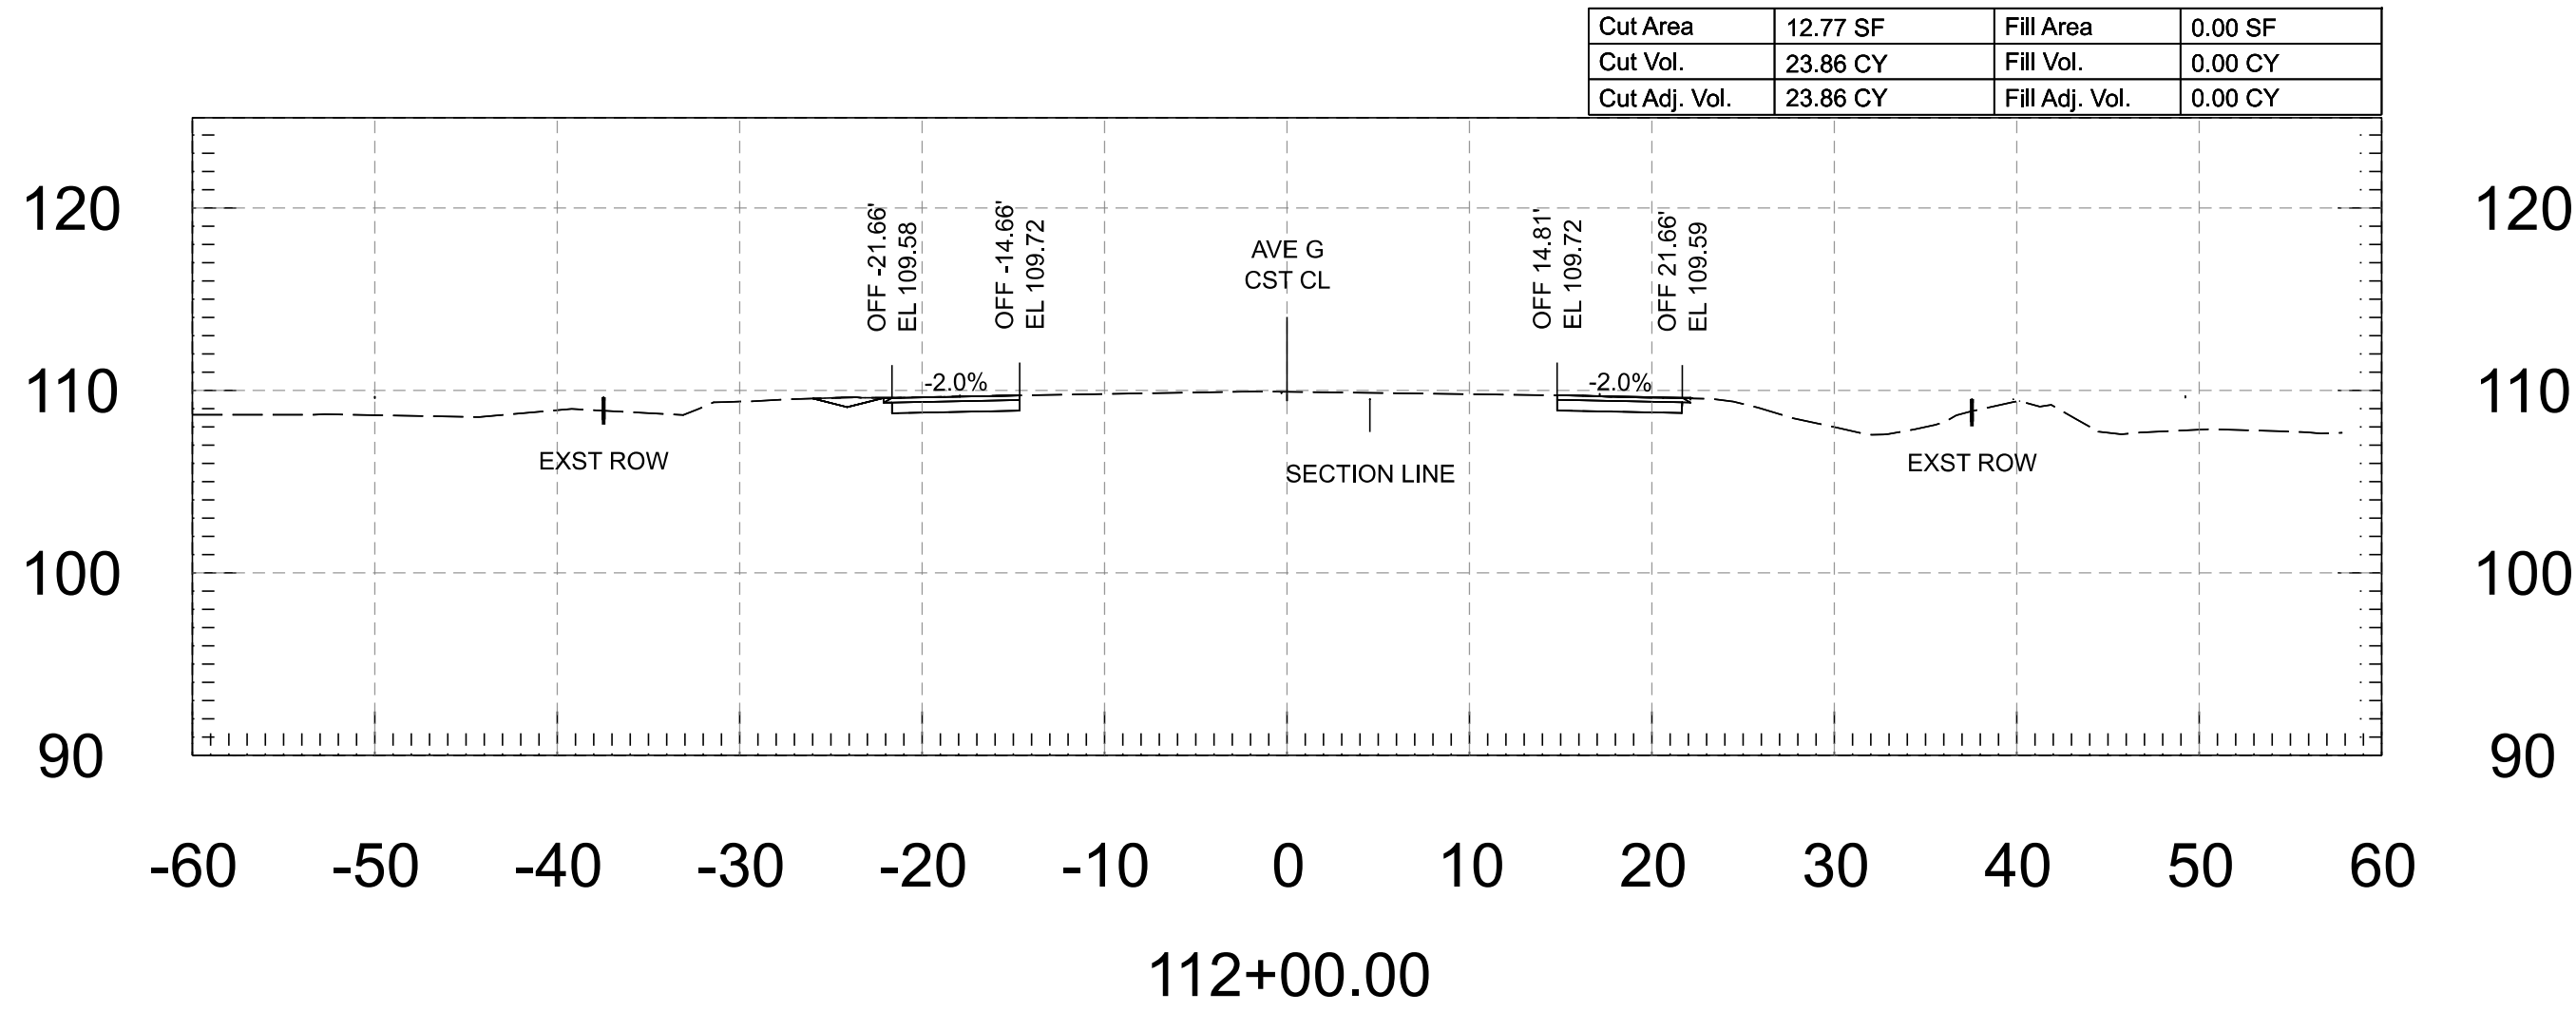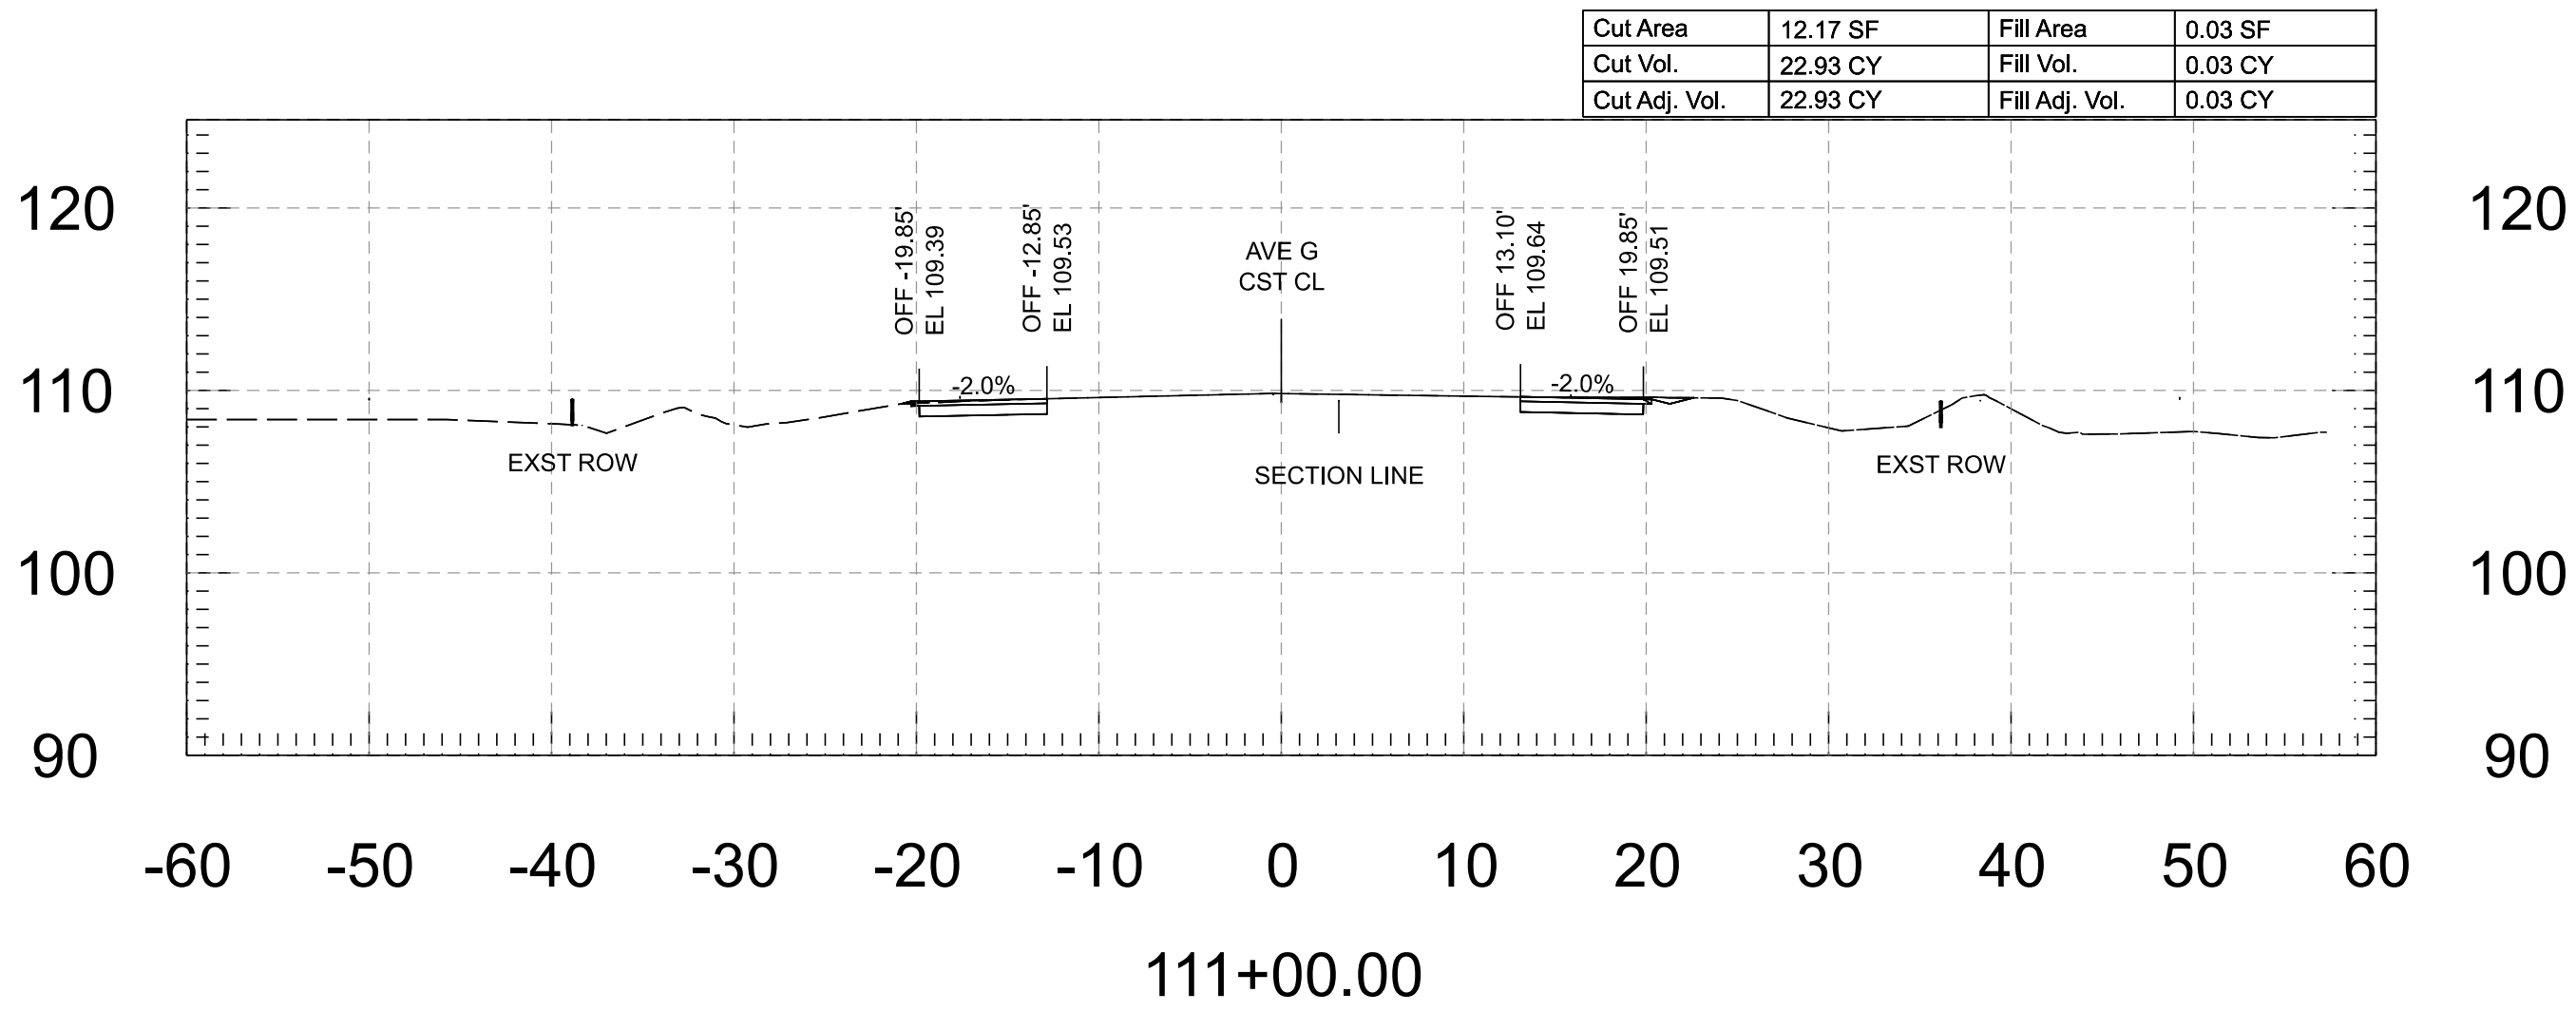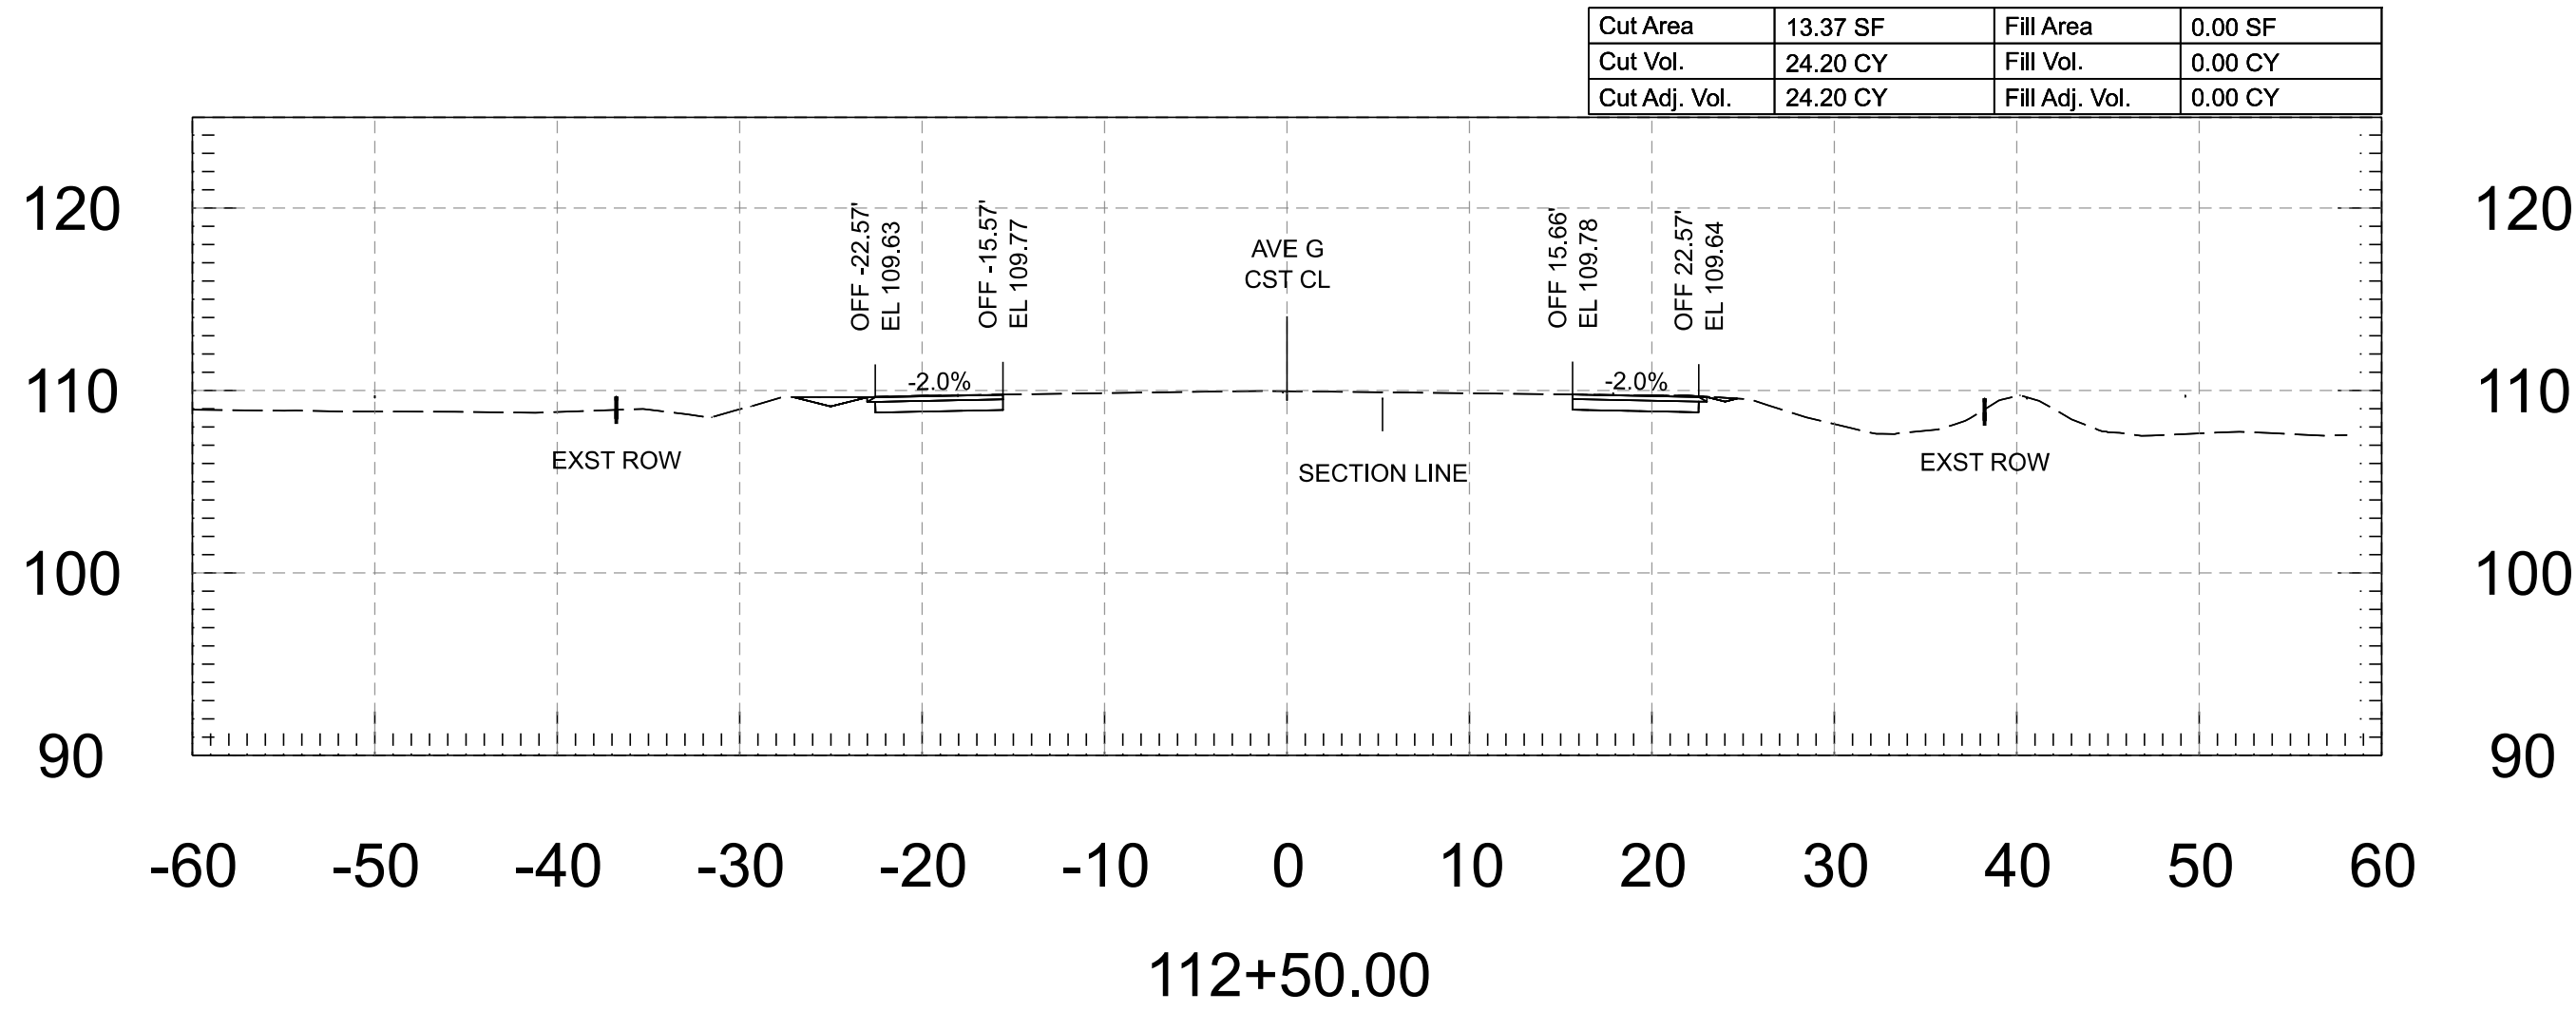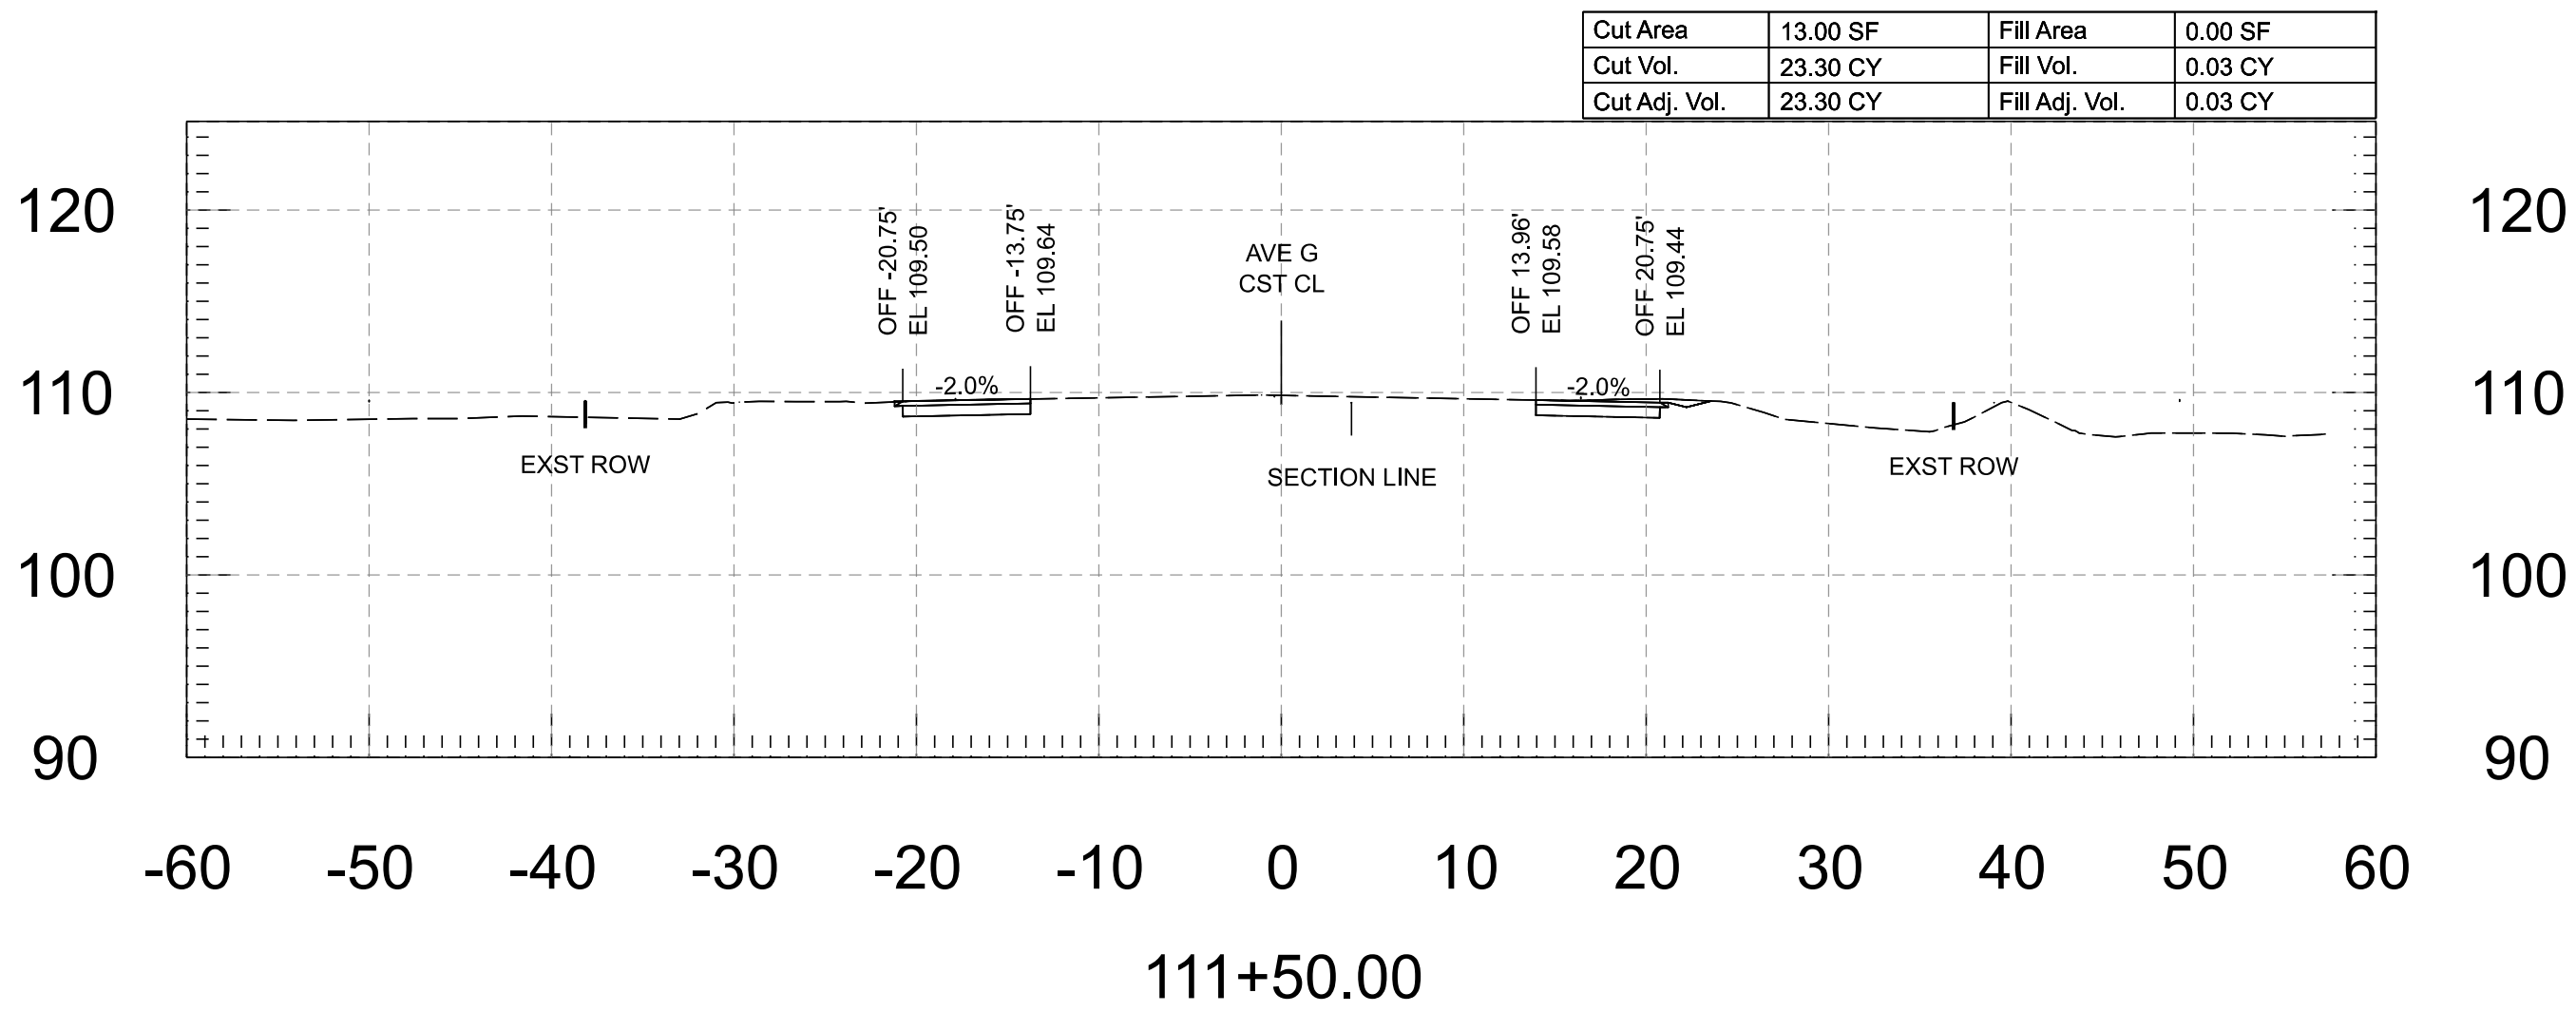






FOR INFORMATION ONLY		NAME	DATE	ARIZONA DEPARTMENT OF TRANSPORTATION PROJECT DELIVERY AND OPERATIONS DIVISION ROADWAY DESIGN SERVICES	ROUTE	F.H.W.A. Arizona Division	STATE ARIZ.	PROJECT NO.	FEDERAL ID NO.	SHEET NO.	TOTAL SHEETS	RECORD DRAWING
	DESIGN	M. SCHOEN	07/26		MILEPOST			0000 YU YYU	YYU-0(225)T	49	118	
	DRAWN	M. SCHOEN	07/26					LOCATION			AVENUE G, COUNTY 11TH ST - COUNTY 16TH ST	
	CHECKED	H. RIOS	07/26	STRUCTURE NO.	TRACS NO.		T0437 01C				___ OF ___	
	 WSP USA Inc. 1230 West Washington Street, Suite 405 Tempe, AZ 85288		AVENUE G - CROSS SECTIONS									

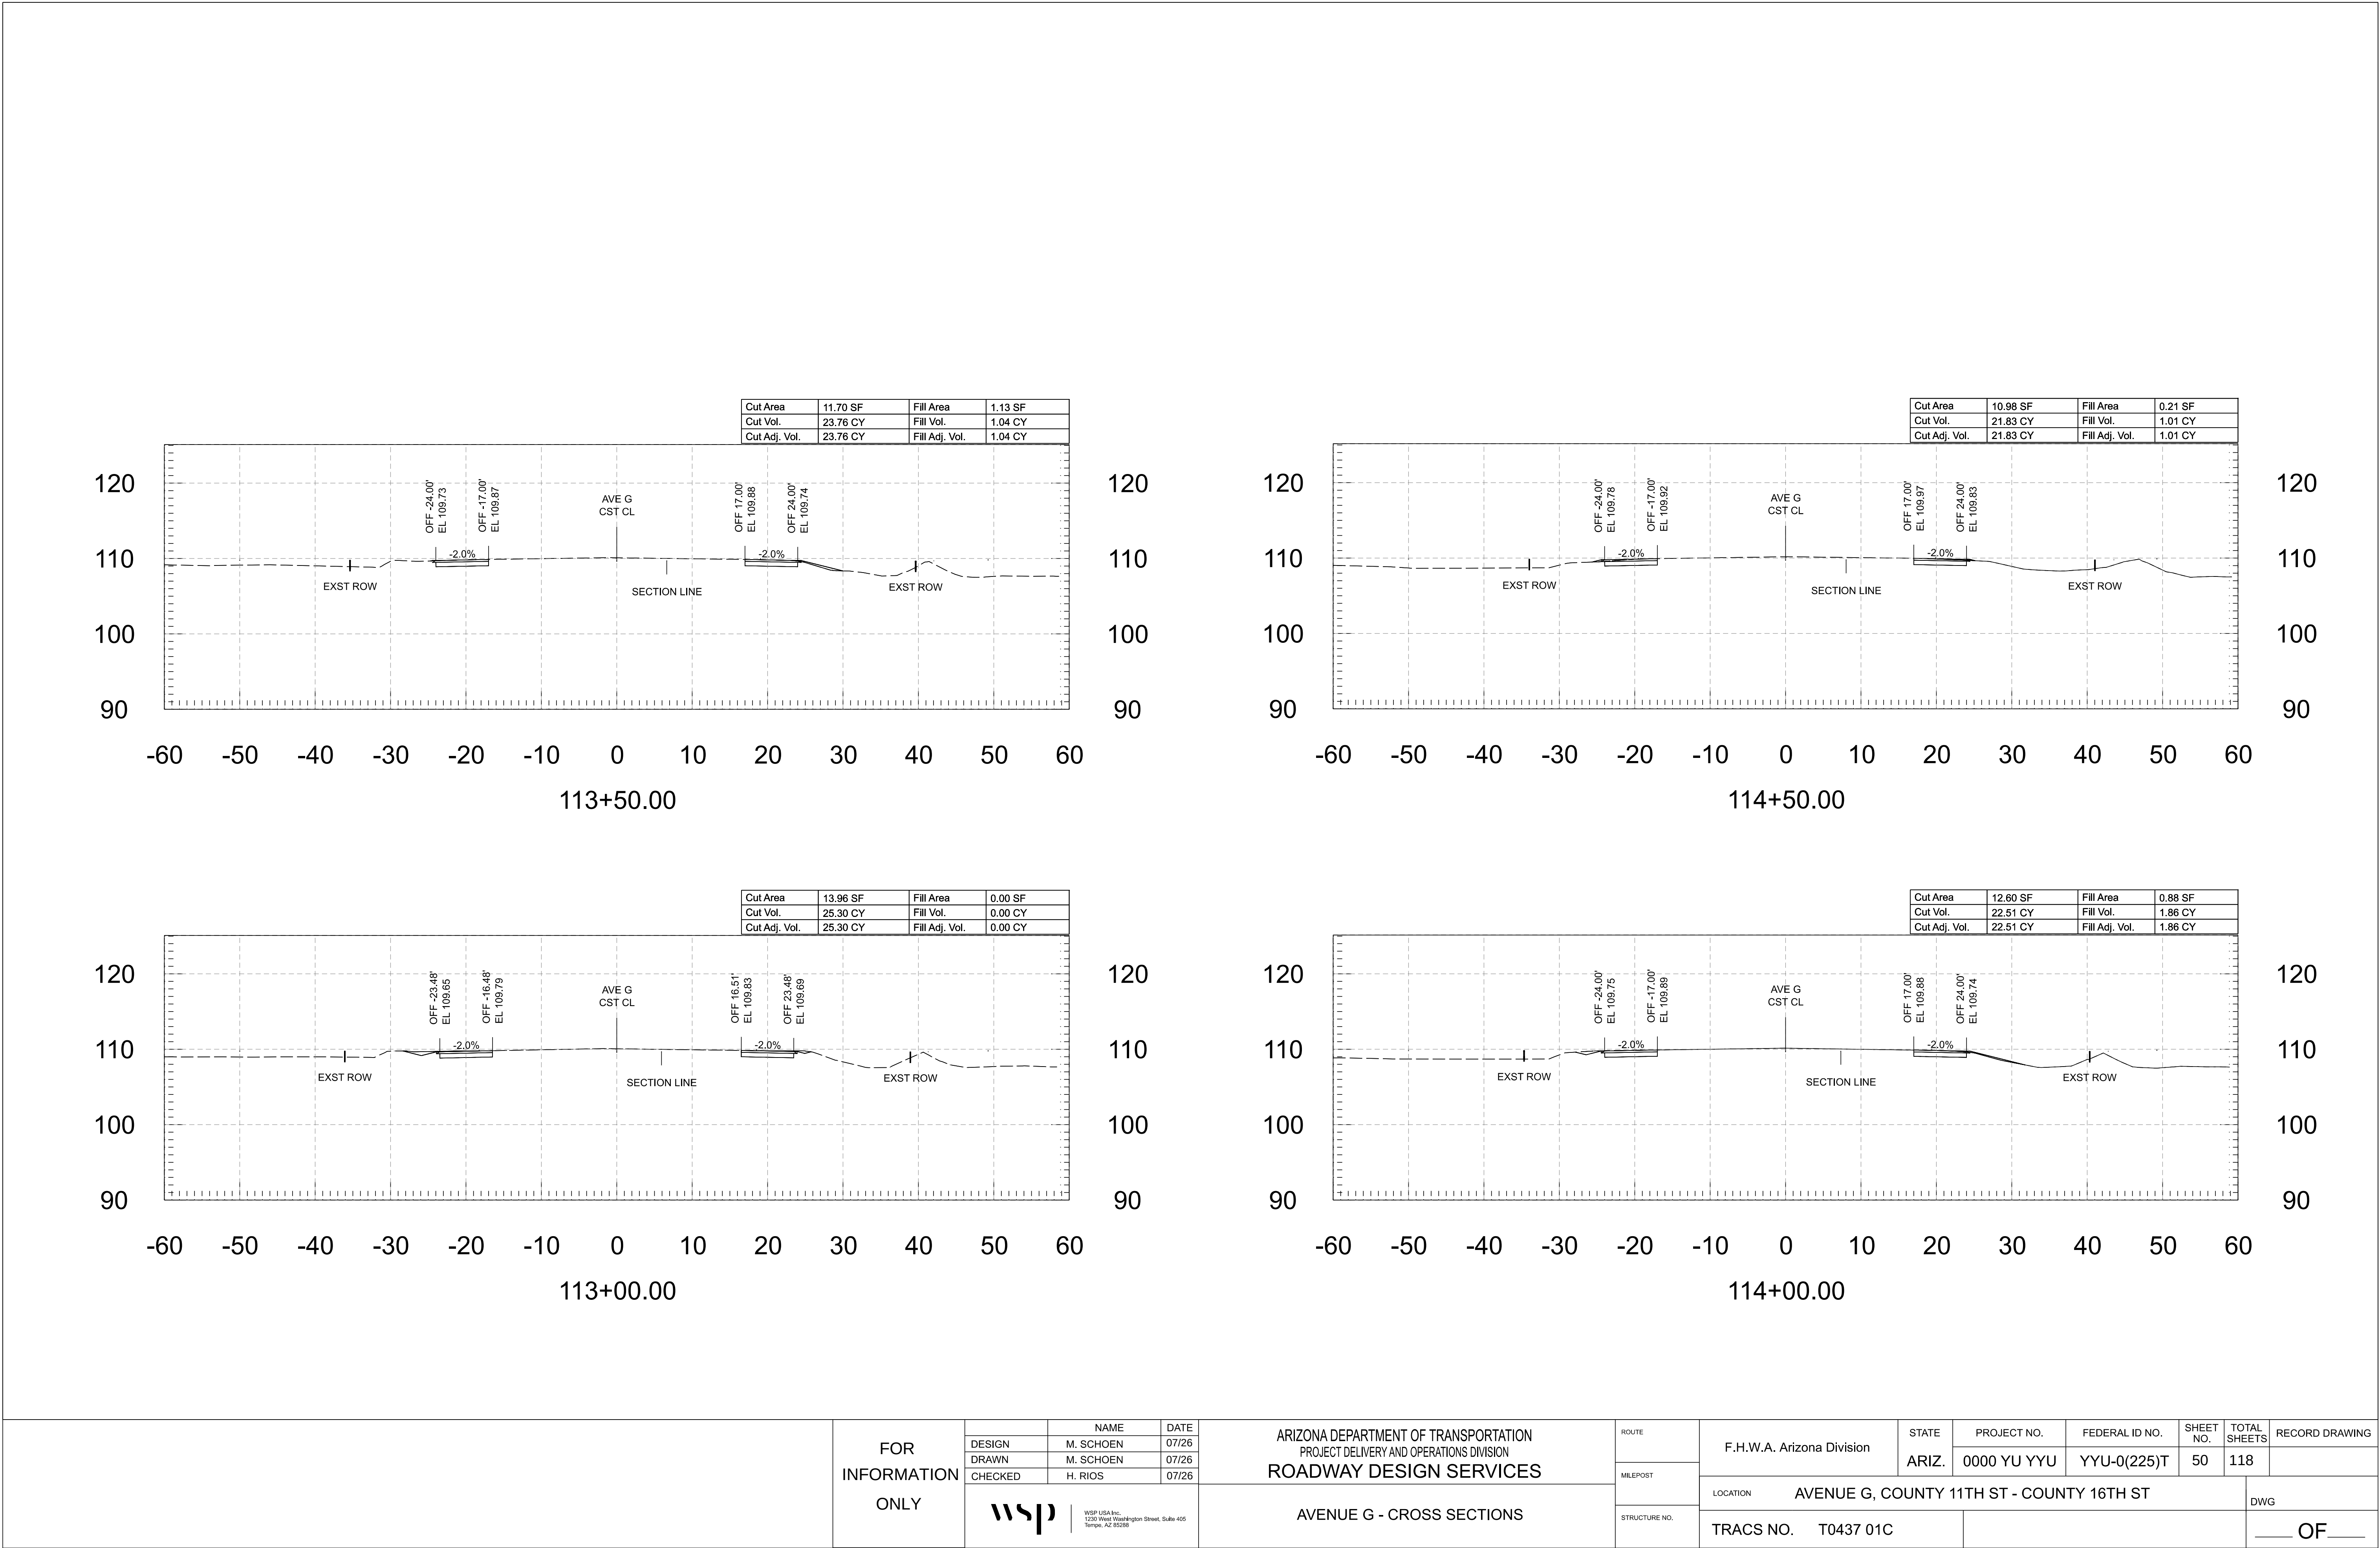

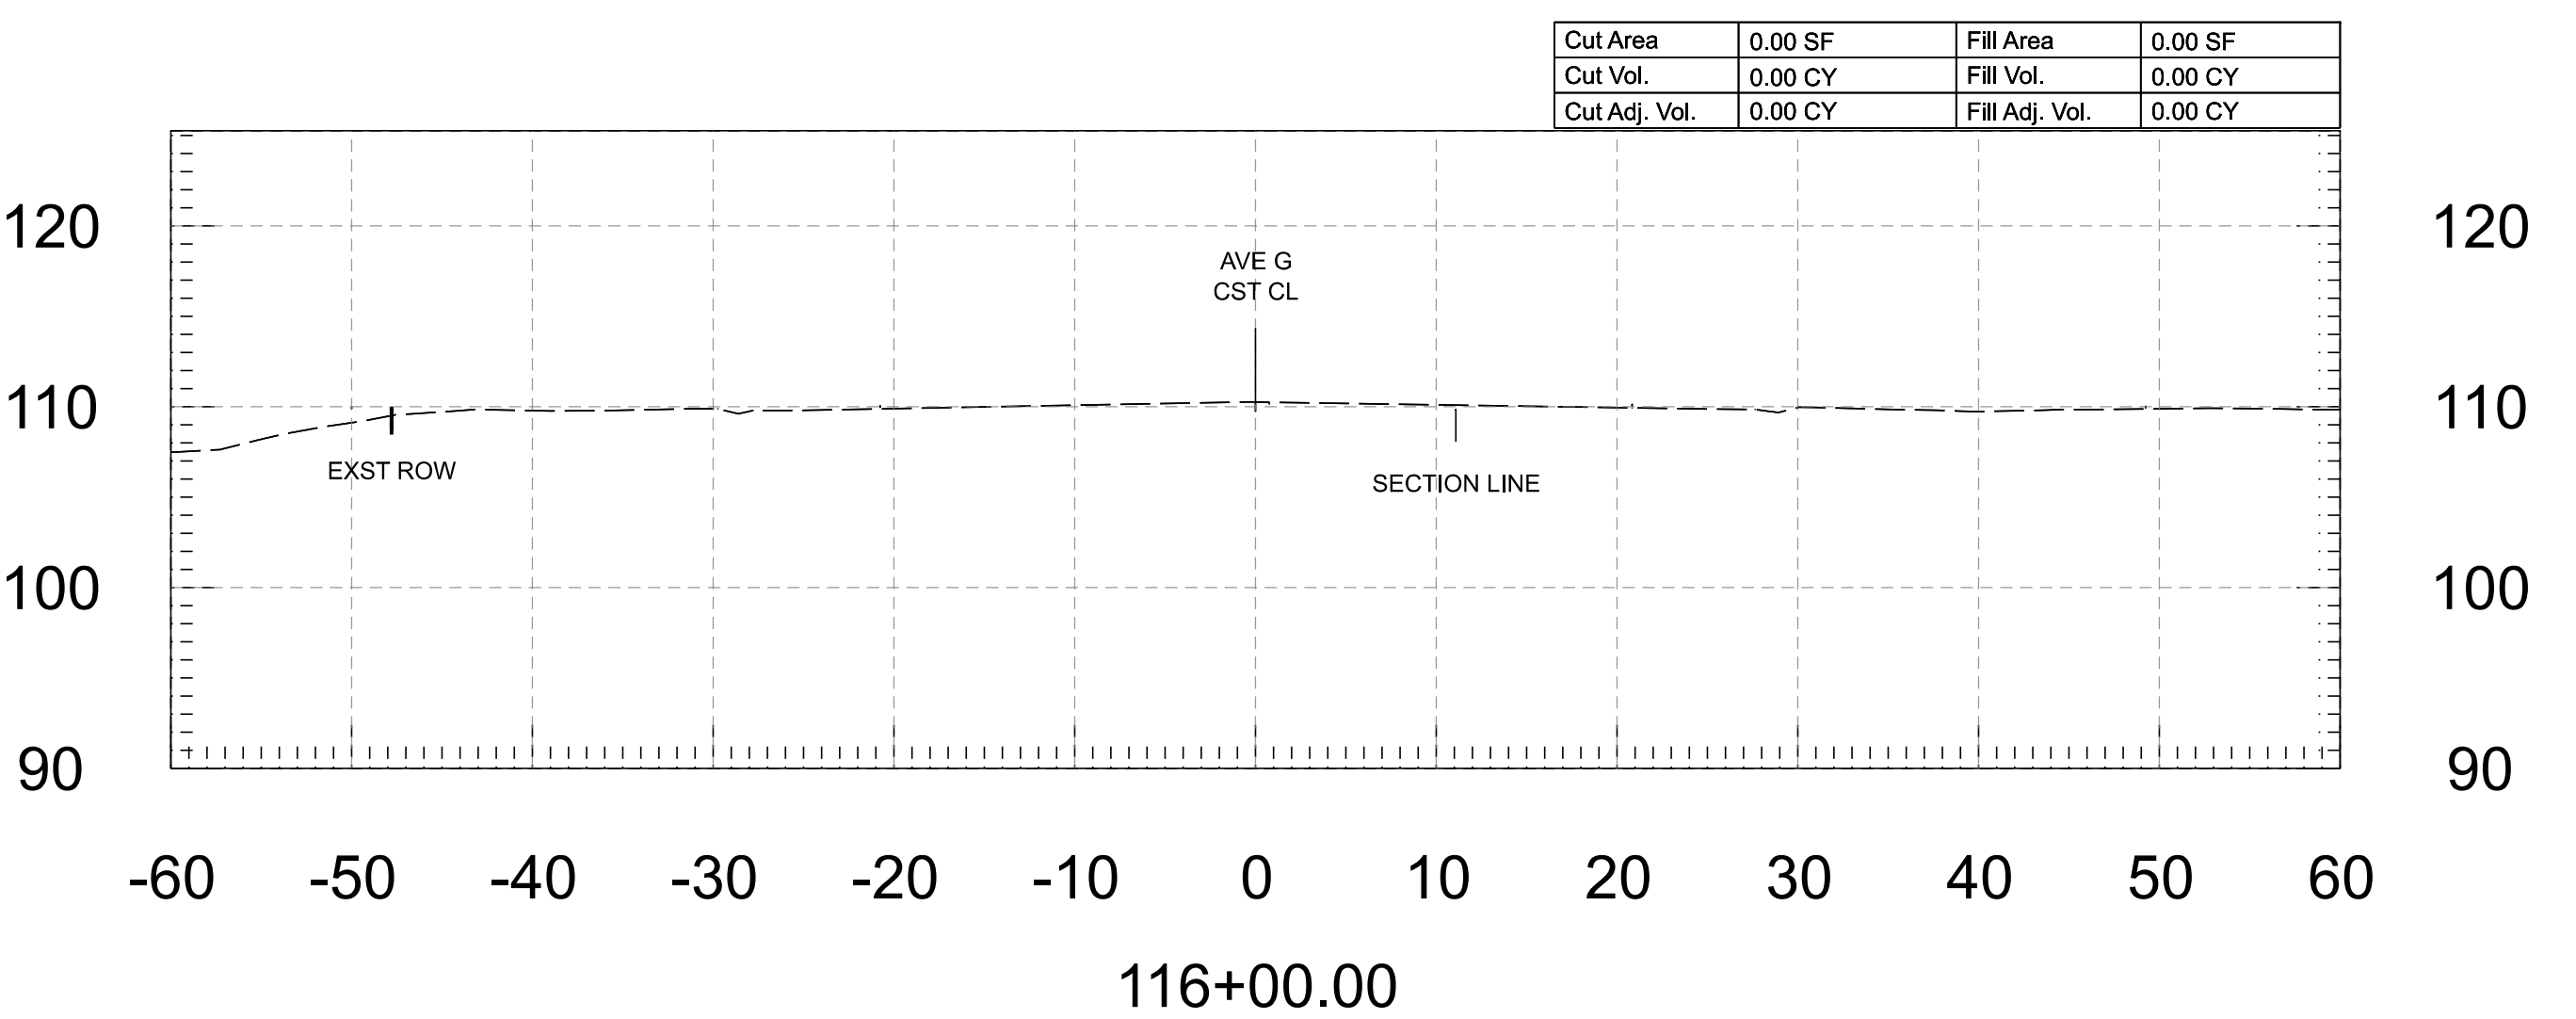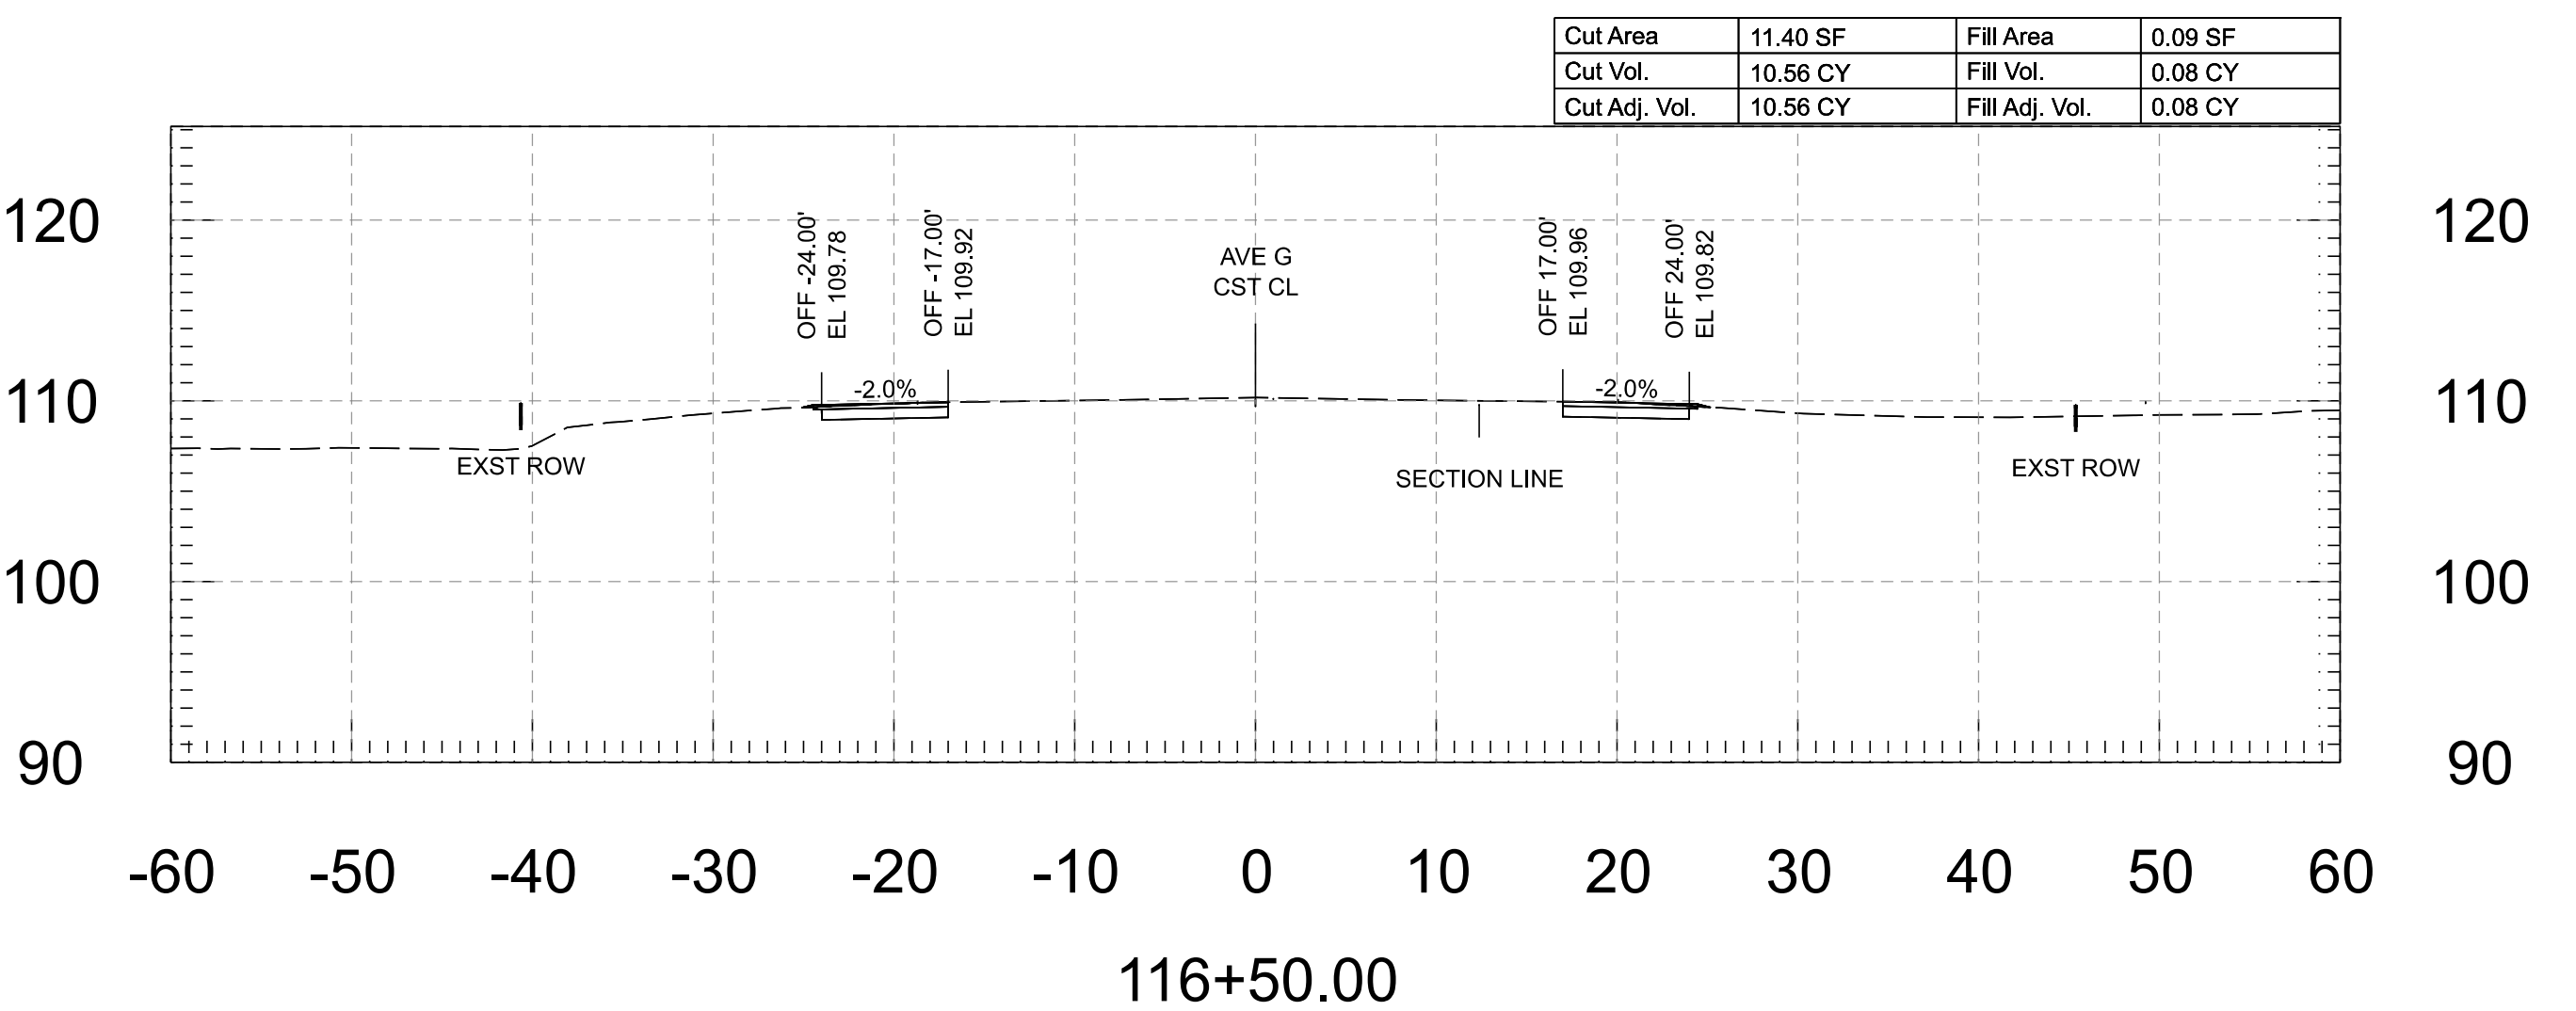


FOR INFORMATION ONLY		NAME	DATE	ARIZONA DEPARTMENT OF TRANSPORTATION PROJECT DELIVERY AND OPERATIONS DIVISION ROADWAY DESIGN SERVICES	ROUTE	F.H.W.A. Arizona Division	STATE ARIZ.	PROJECT NO.	FEDERAL ID NO.	SHEET NO.	TOTAL SHEETS	RECORD DRAWING
	DESIGN	M. SCHOEN	07/26		MILEPOST			0000 YU YUU	YUU-0(225)T	51	118	
	DRAWN	M. SCHOEN	07/26			STRUCTURE NO.	LOCATION AVENUE G, COUNTY 11TH ST - COUNTY 16TH ST					
	CHECKED	H. RIOS	07/26	wsp WSP USA Inc. 1250 West Washington Street, Suite 405 Tempe, AZ 85288			AVENUE G - CROSS SECTIONS		TRACS NO. T0437 01C		____ OF ____	

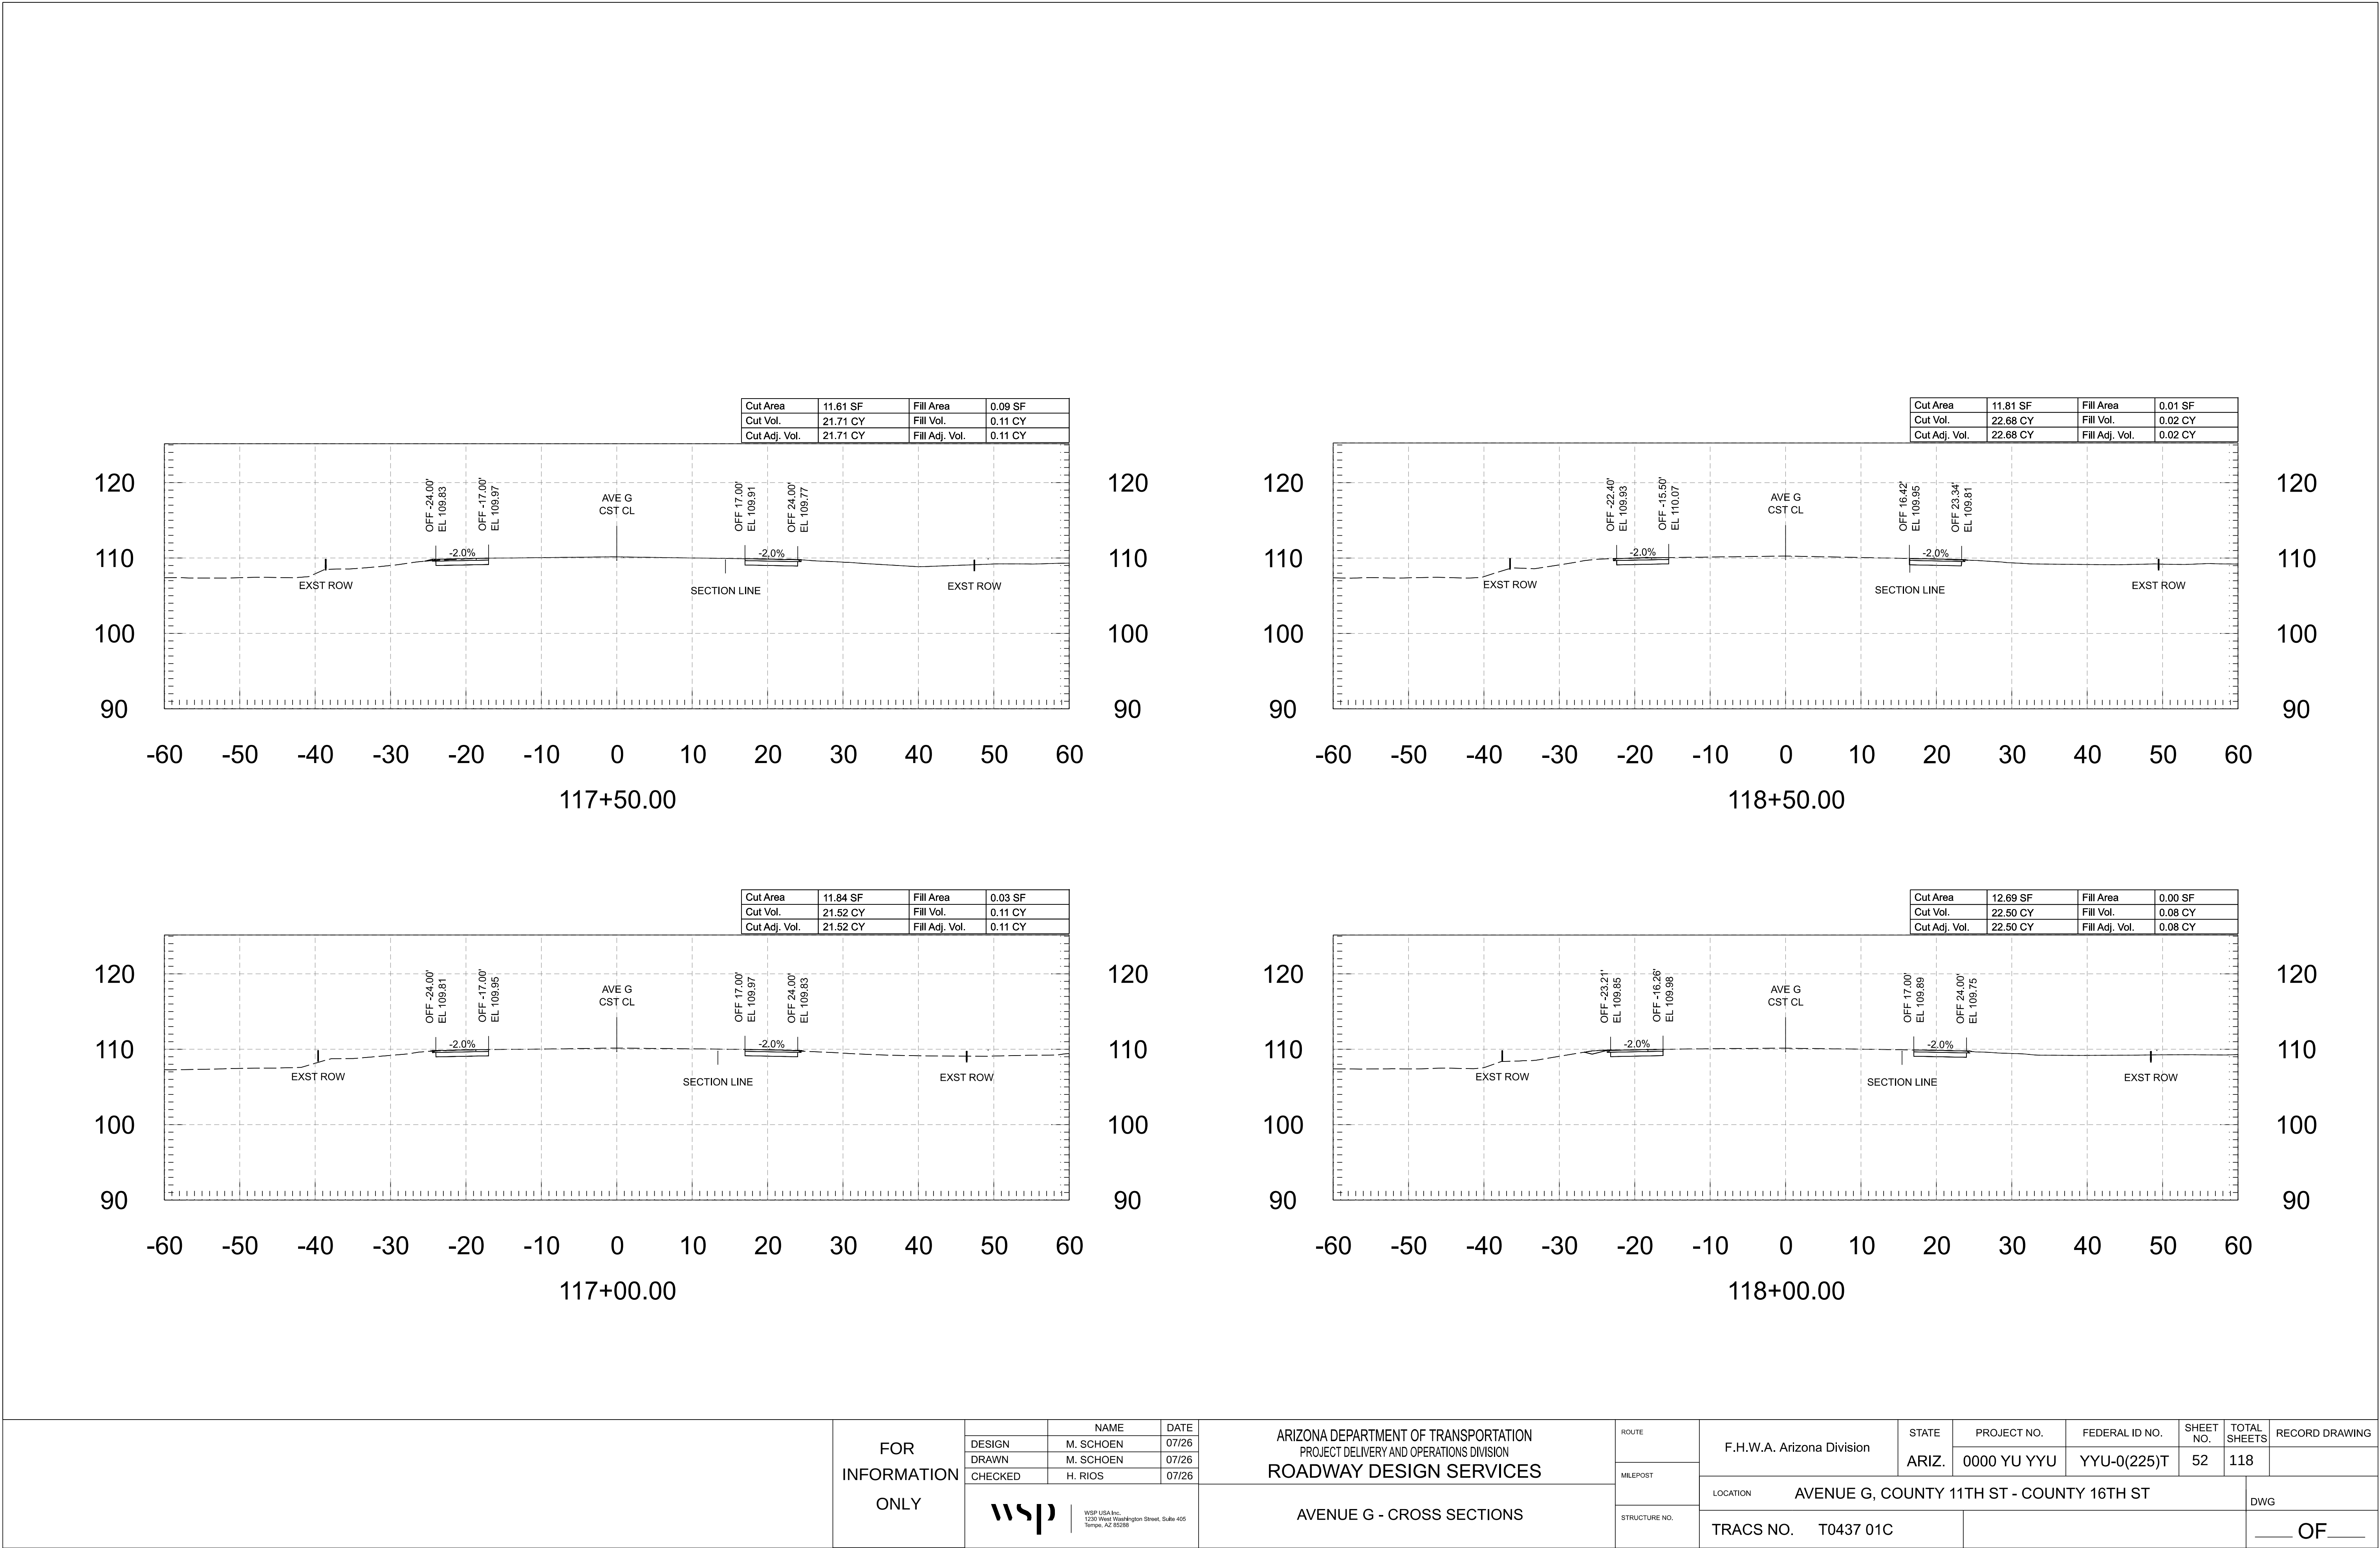

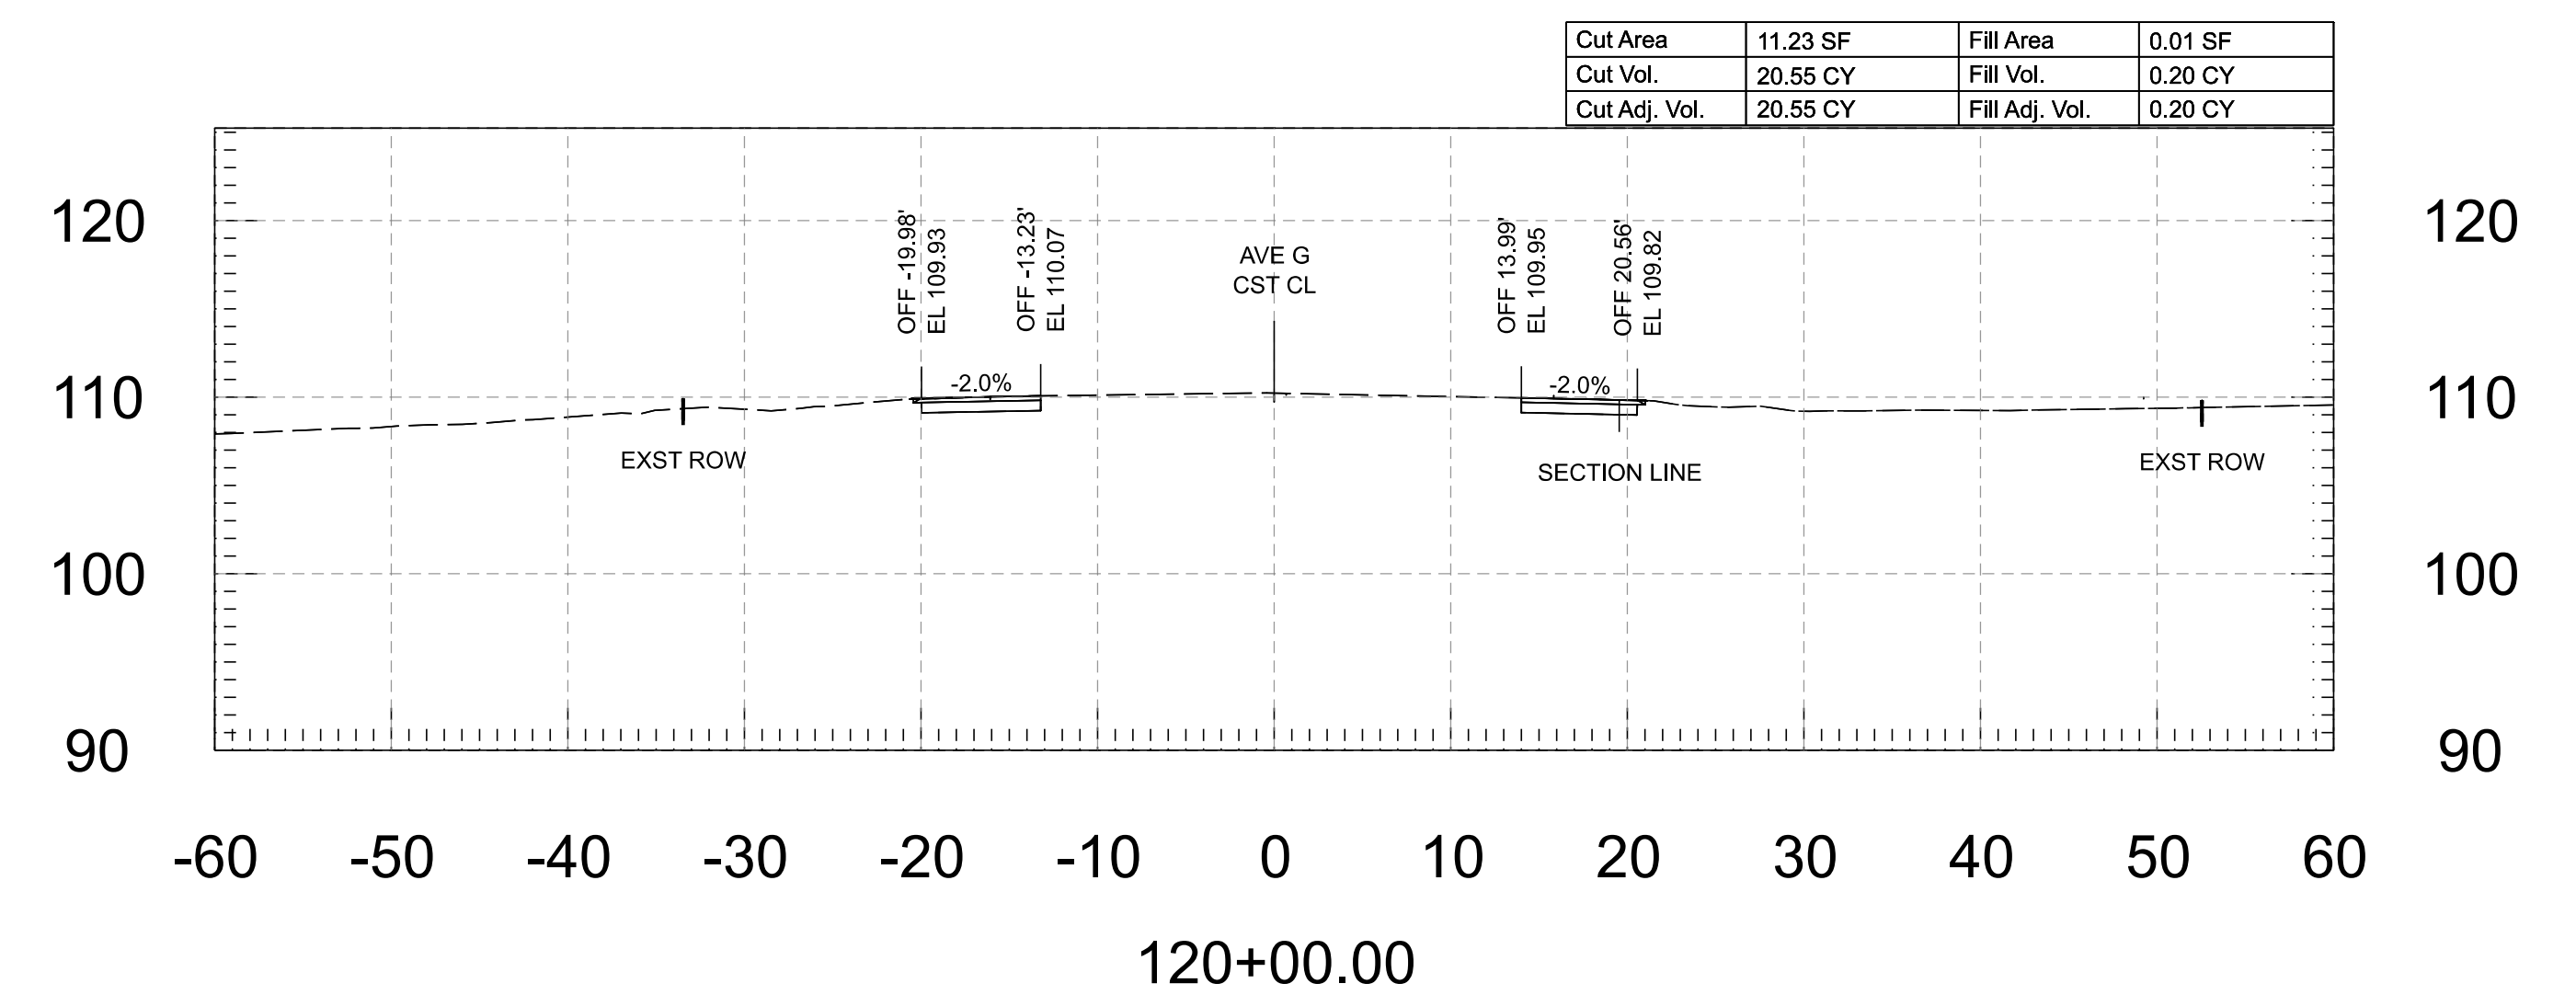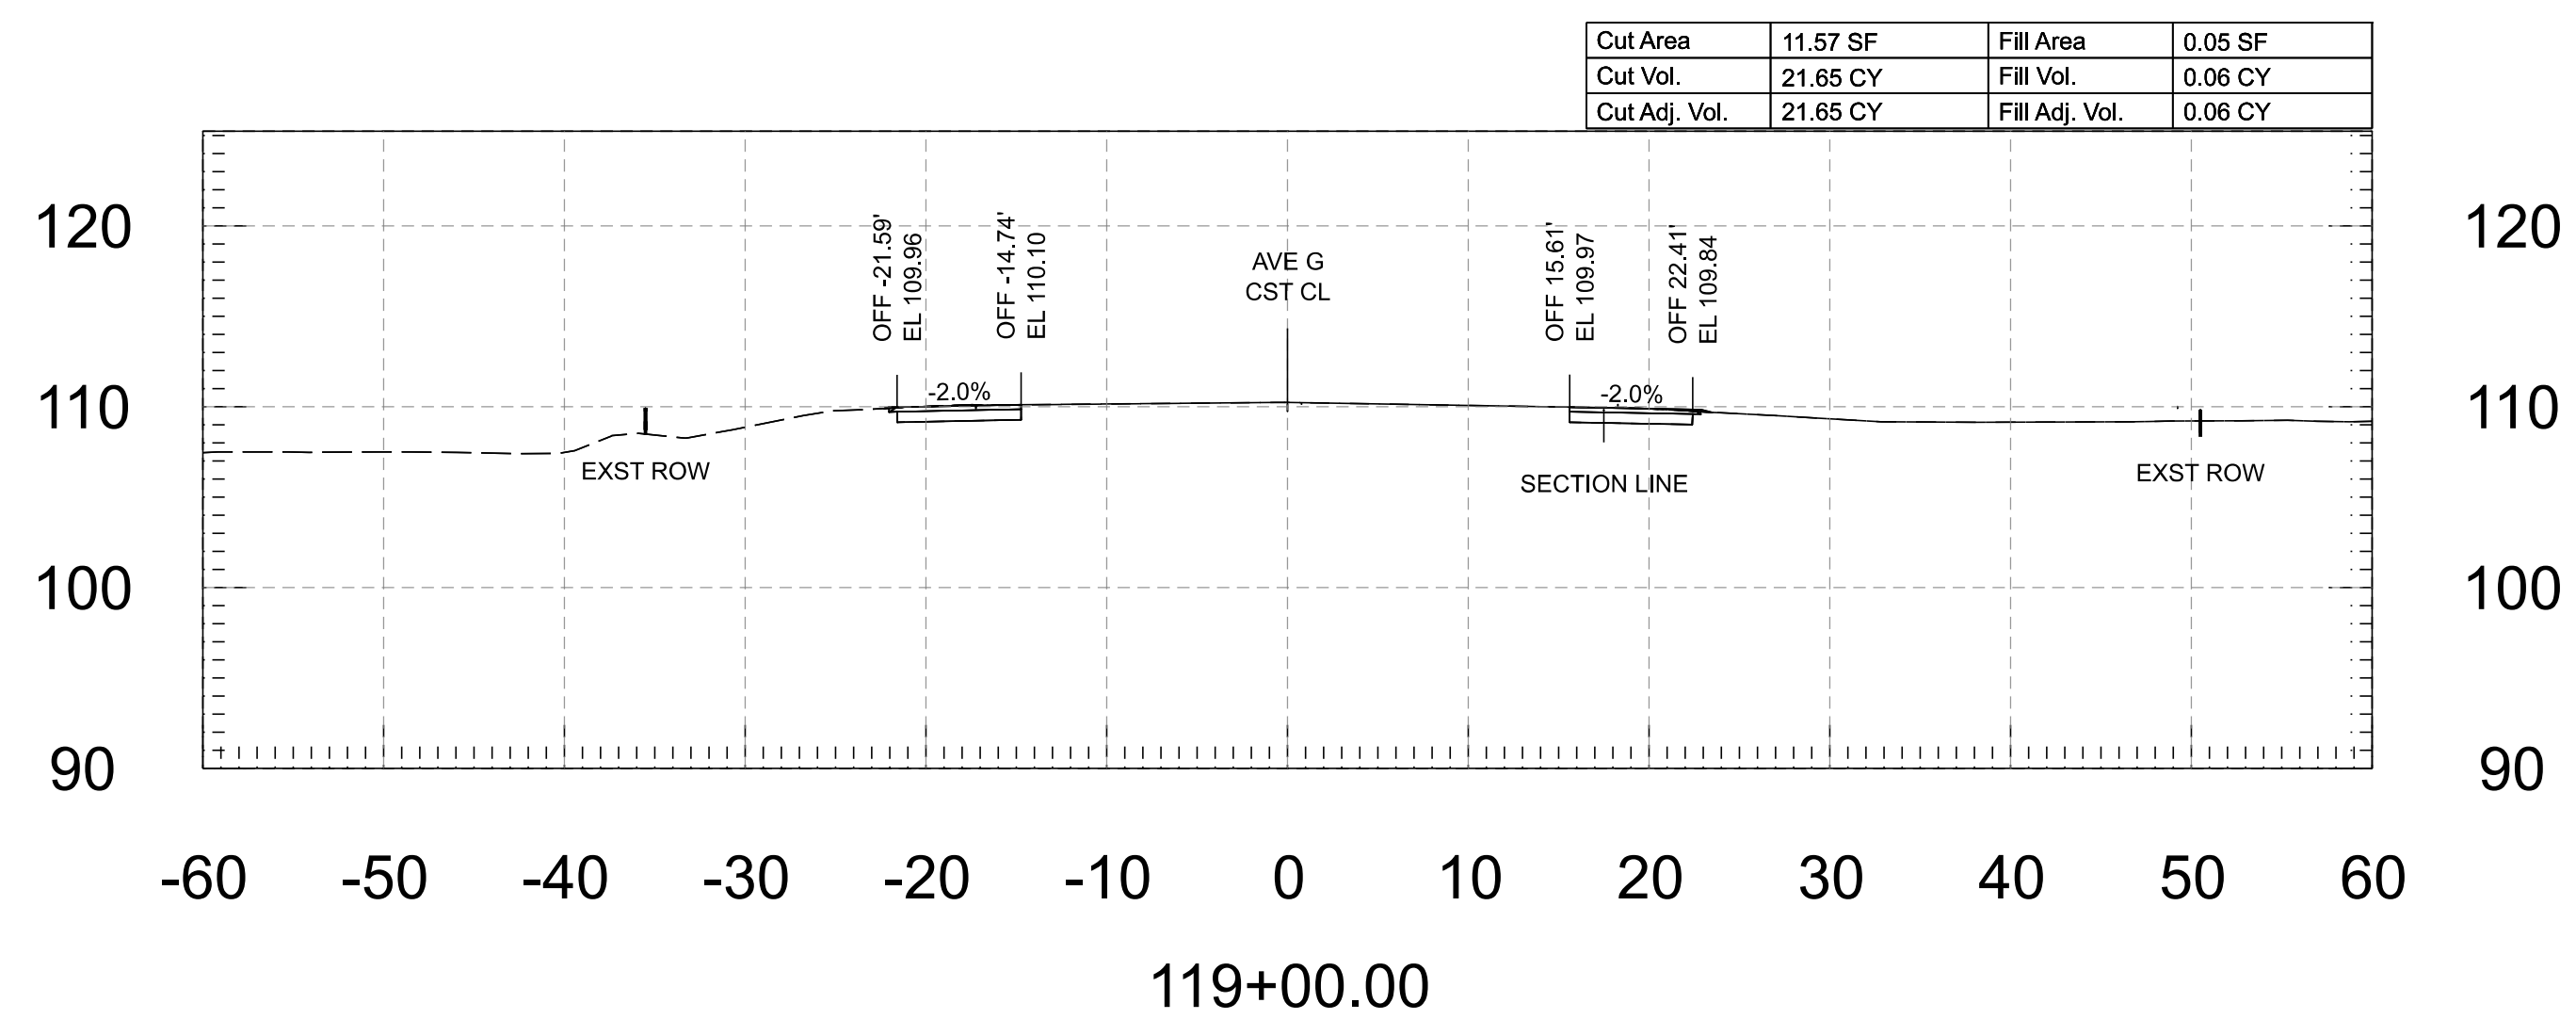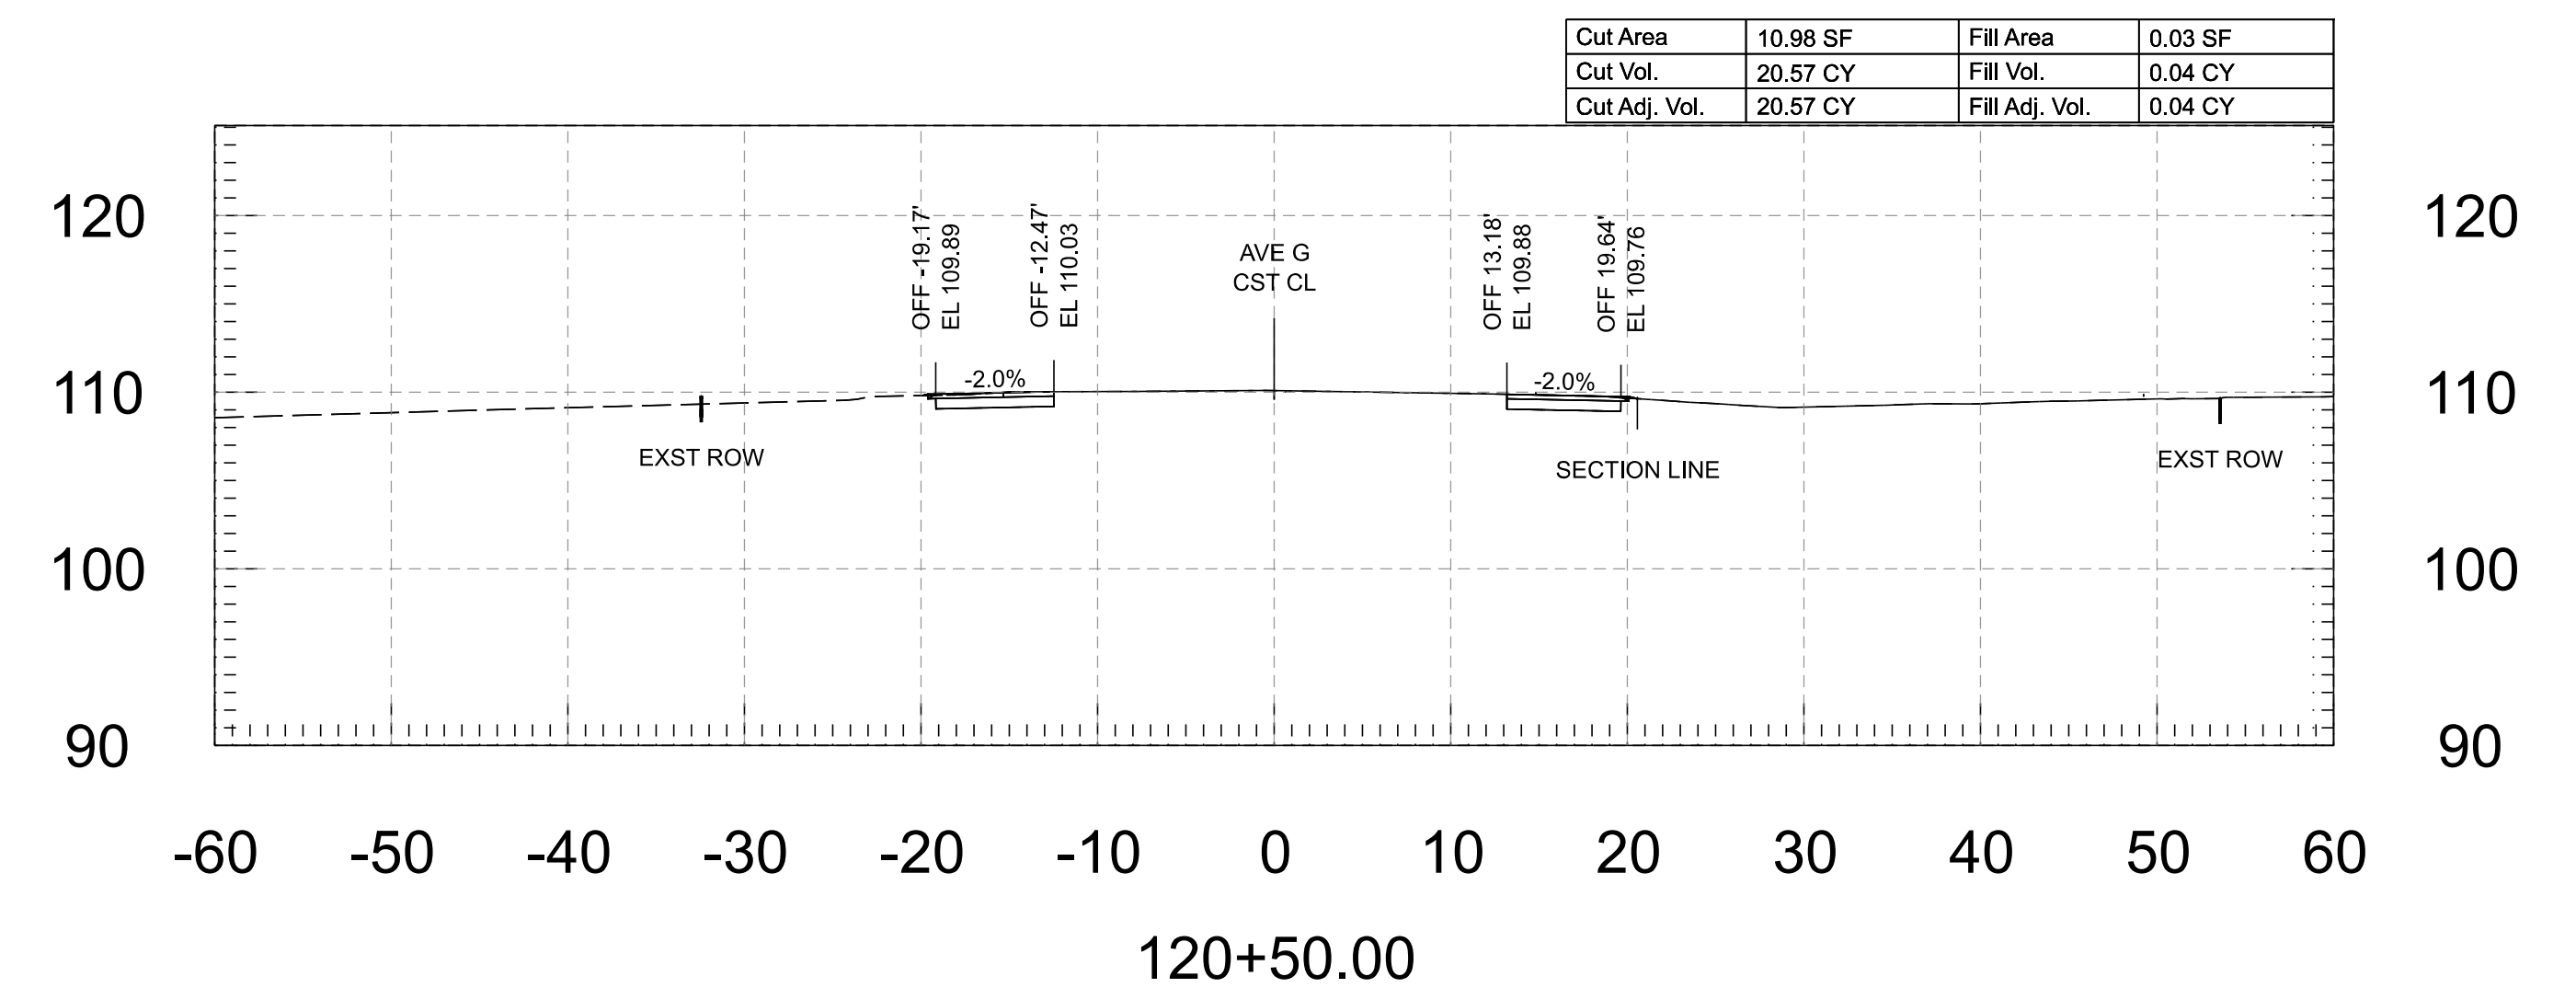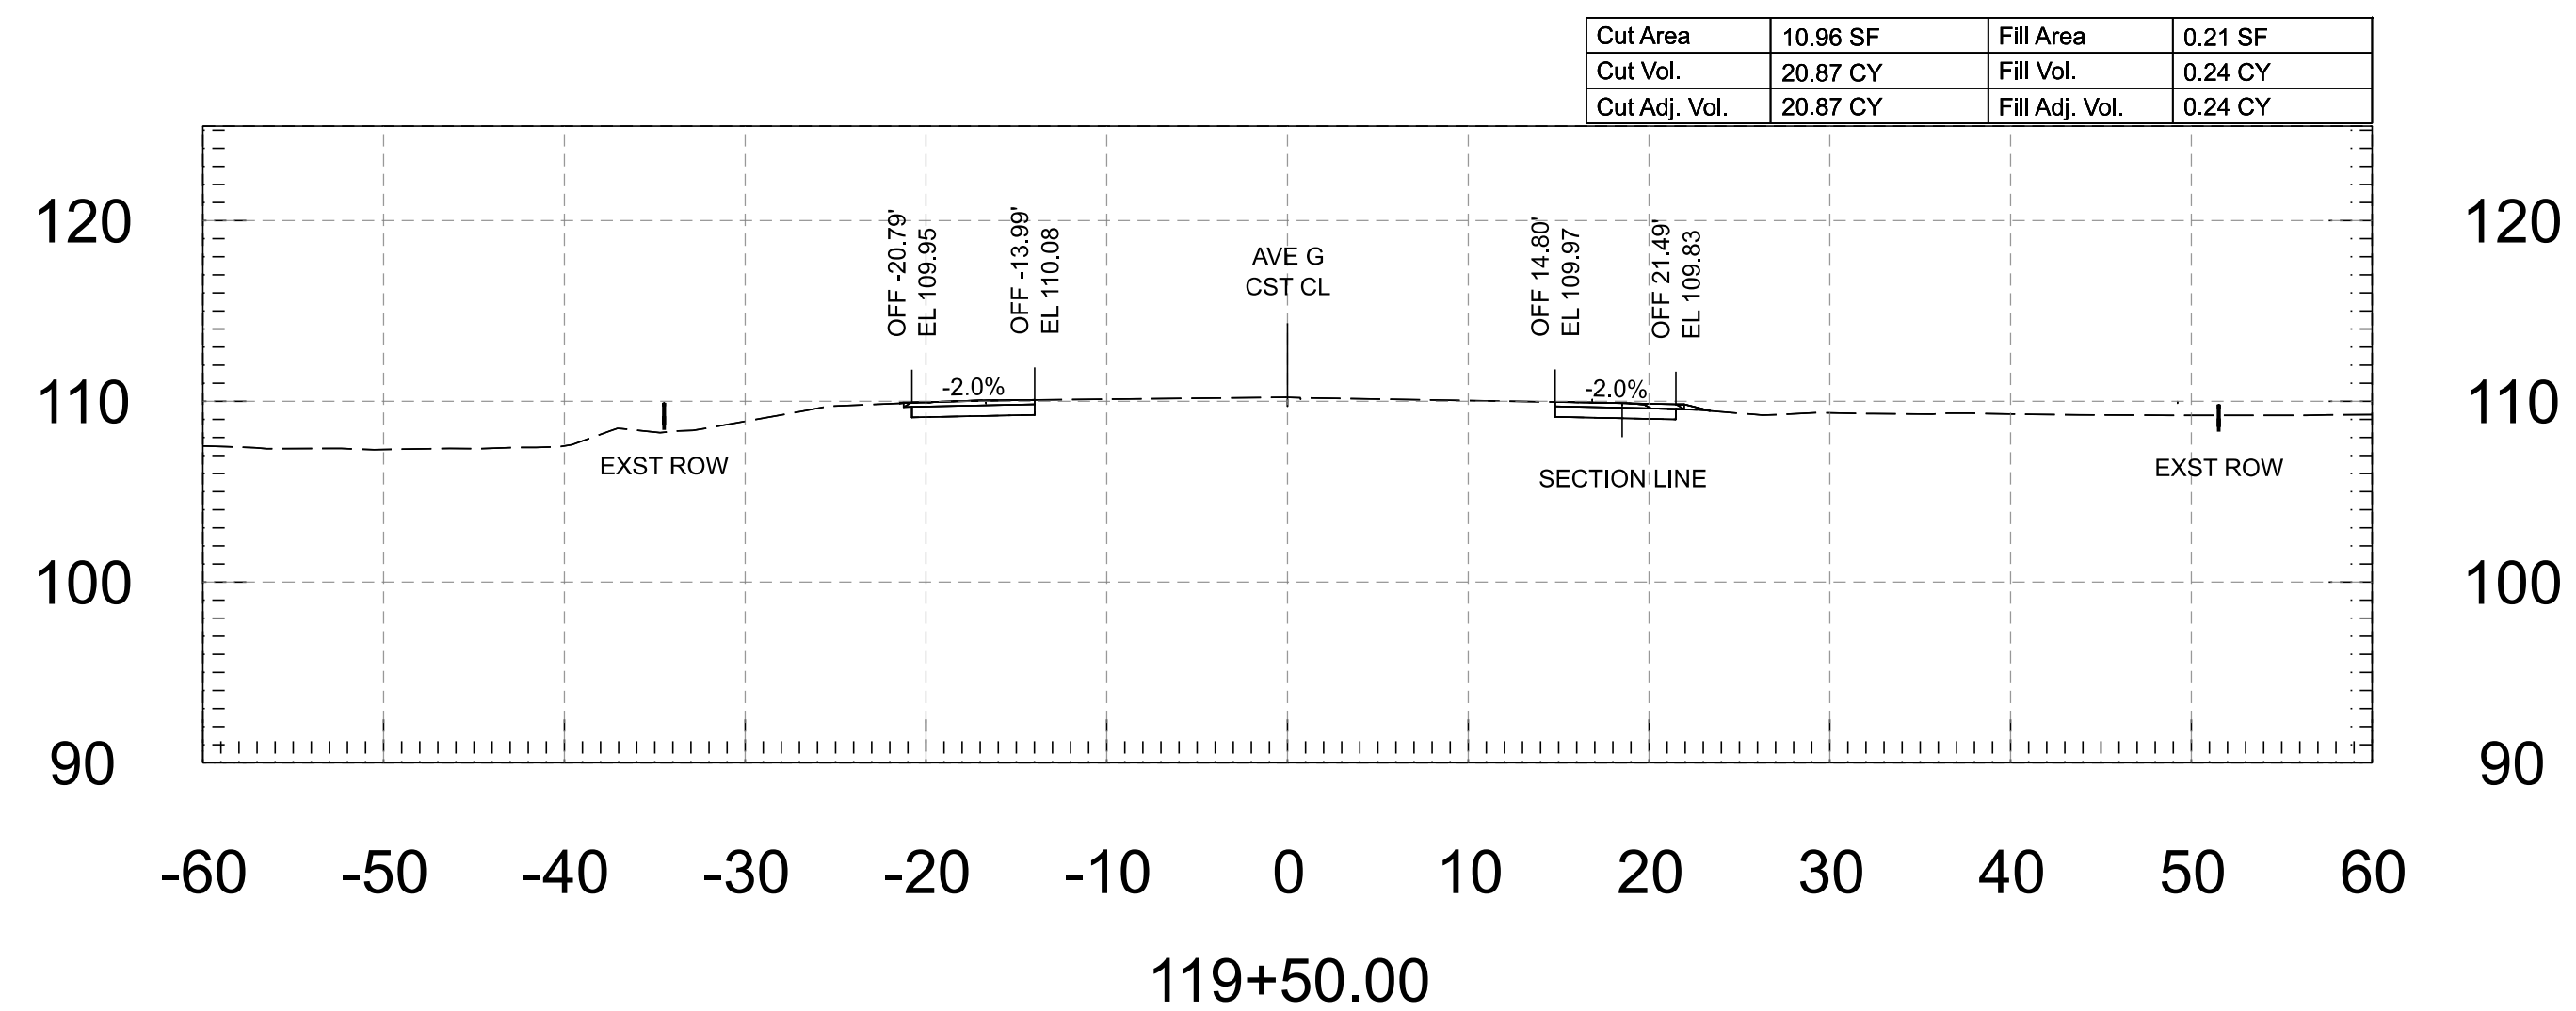


FOR INFORMATION ONLY		NAME	DATE	ARIZONA DEPARTMENT OF TRANSPORTATION PROJECT DELIVERY AND OPERATIONS DIVISION ROADWAY DESIGN SERVICES	ROUTE	F.H.W.A. Arizona Division	STATE ARIZ.	PROJECT NO.	FEDERAL ID NO.	SHEET NO.	TOTAL SHEETS	RECORD DRAWING
	DESIGN	M. SCHOEN	07/26					0000 YU YYU	YYU-0(225)T	53	118	
	DRAWN	M. SCHOEN	07/26									
	CHECKED	H. RIOS	07/26									
		wsp WSP USA Inc. 1200 West Washington Street, Suite 405 Tempe, AZ 85280			AVENUE G - CROSS SECTIONS		LOCATION AVENUE G, COUNTY 11TH ST - COUNTY 16TH ST					
					STRUCTURE NO.	TRACS NO. T0437 01C					___ OF ___	


Cut Area	10.29 SF	Fill Area	0.07 SF
Cut Vol.	20.02 CY	Fill Vol.	0.07 CY
Cut Adj. Vol.	20.02 CY	Fill Adj. Vol.	0.07 CY

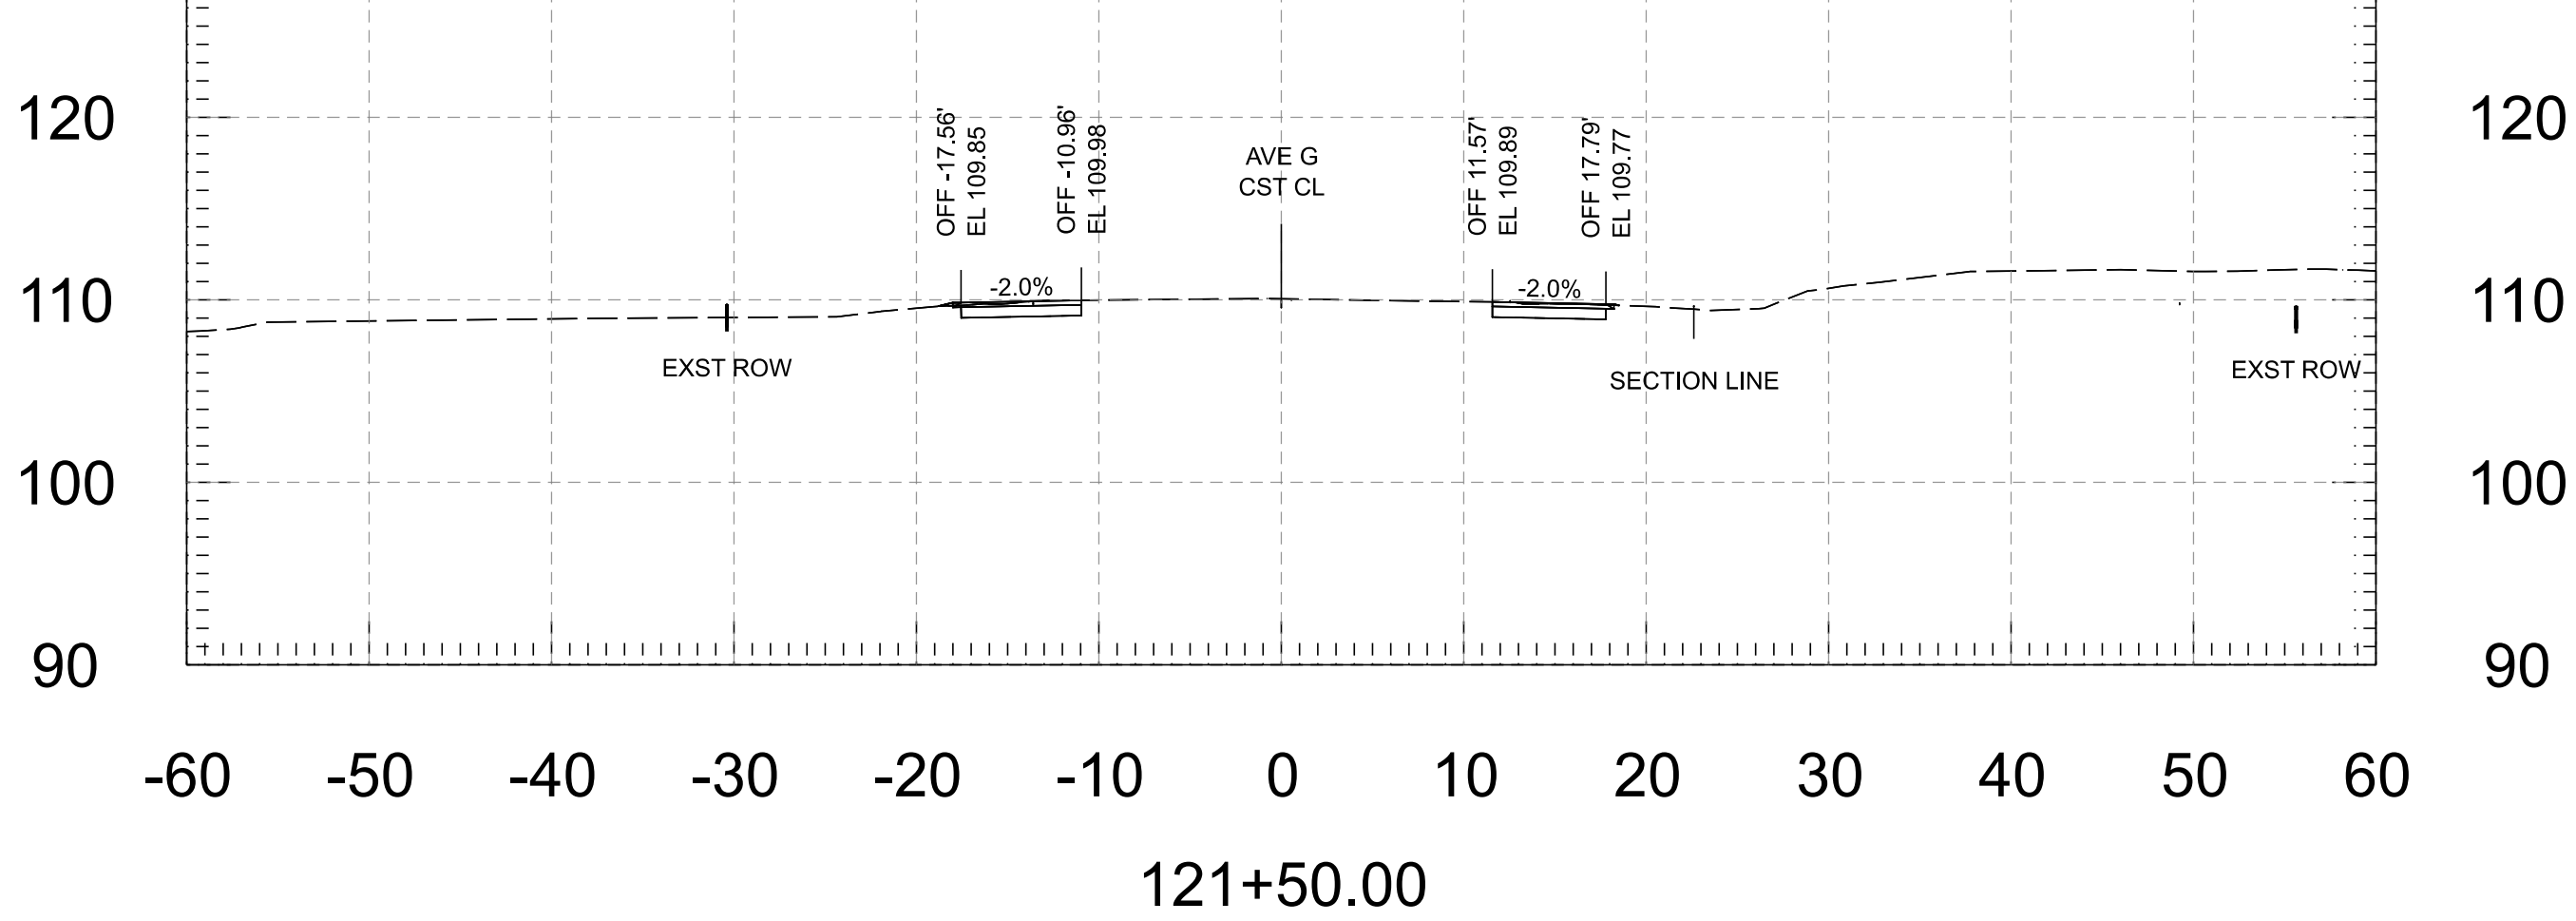


Cut Area	11.79 SF	Fill Area	0.01 SF
Cut Vol.	21.76 CY	Fill Vol.	0.05 CY
Cut Adj. Vol.	21.76 CY	Fill Adj. Vol.	0.05 CY

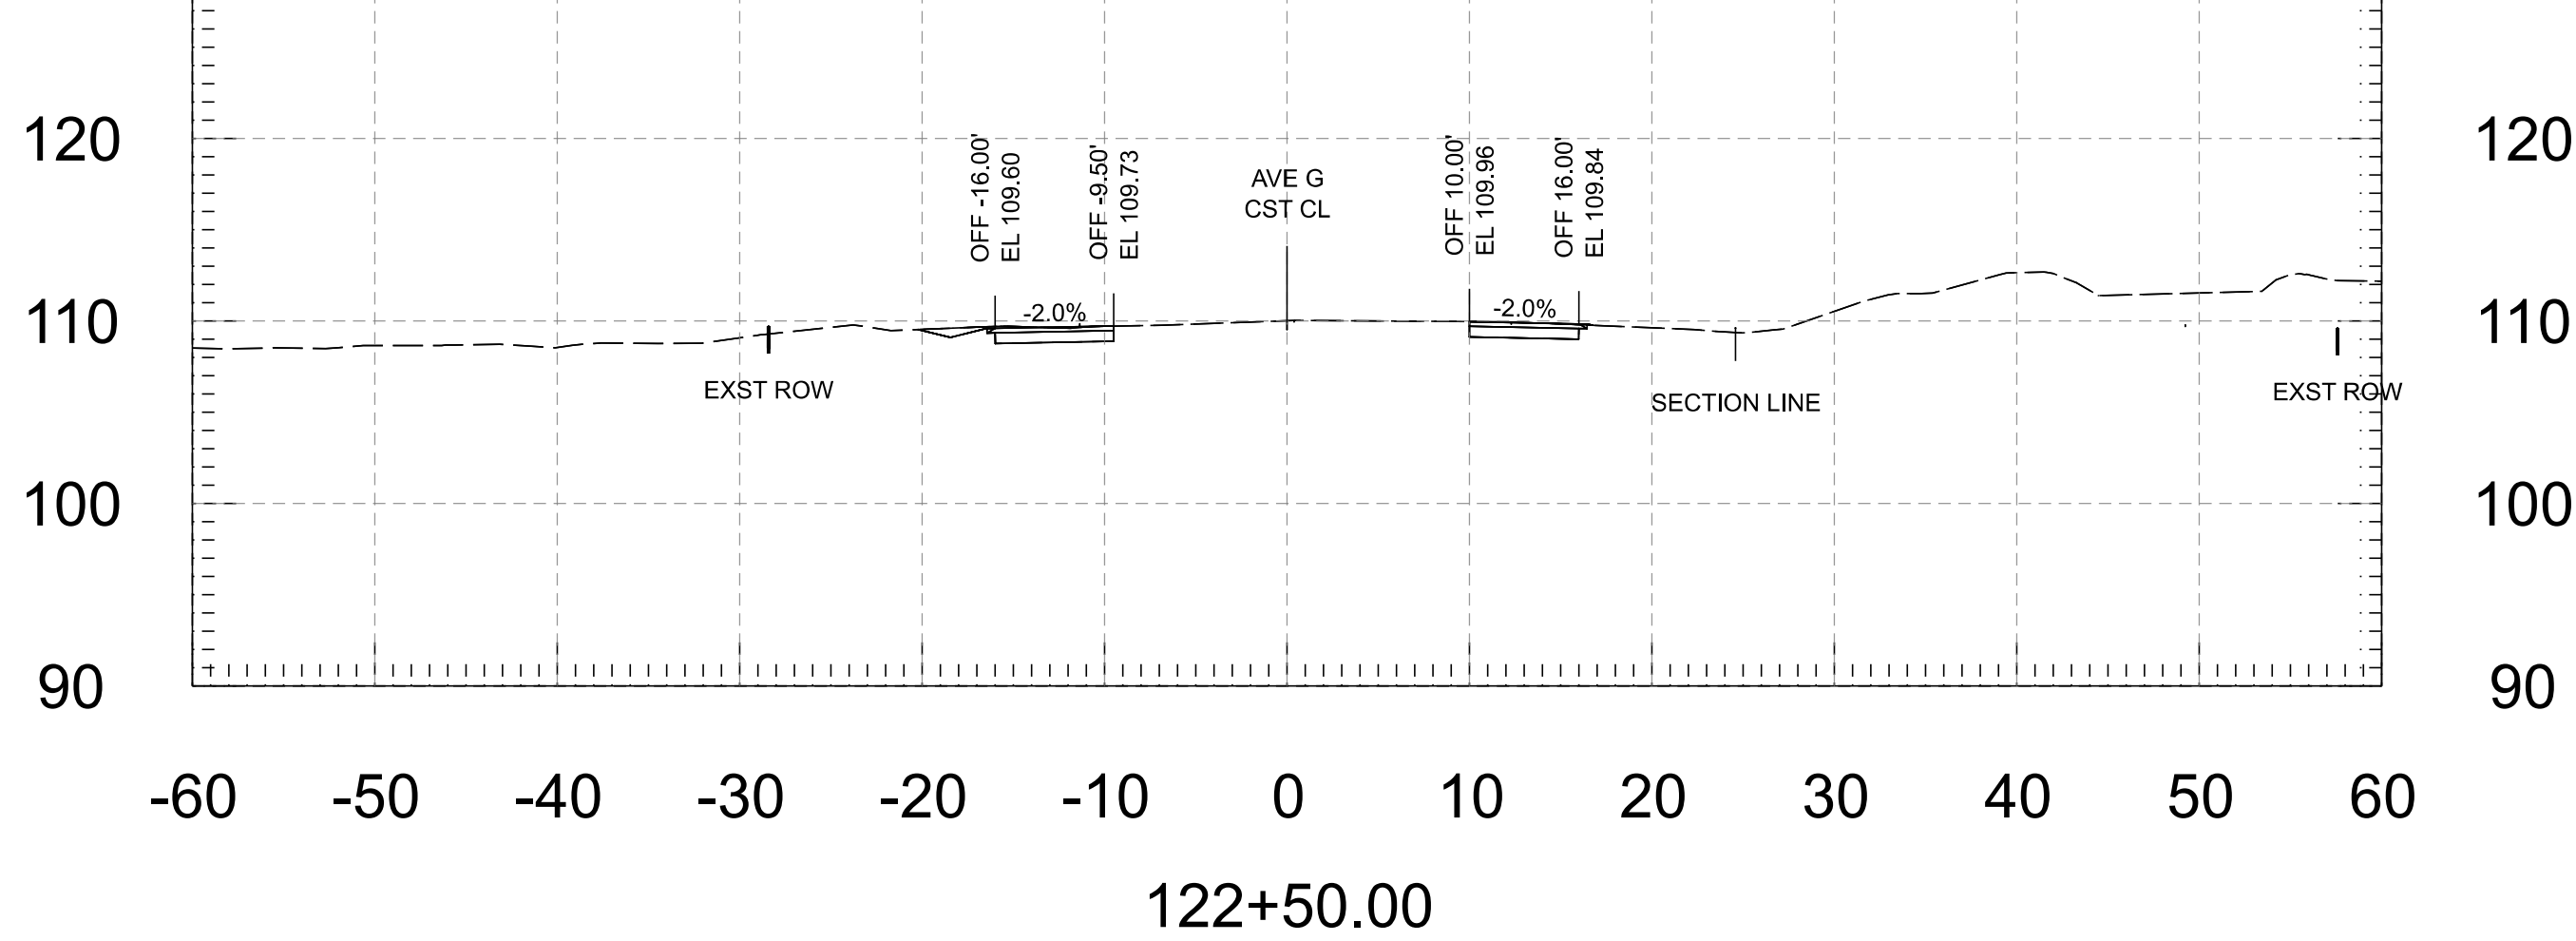

Cut Area	11.33 SF	Fill Area	0.01 SF
Cut Vol.	20.66 CY	Fill Vol.	0.04 CY
Cut Adj. Vol.	20.66 CY	Fill Adj. Vol.	0.04 CY

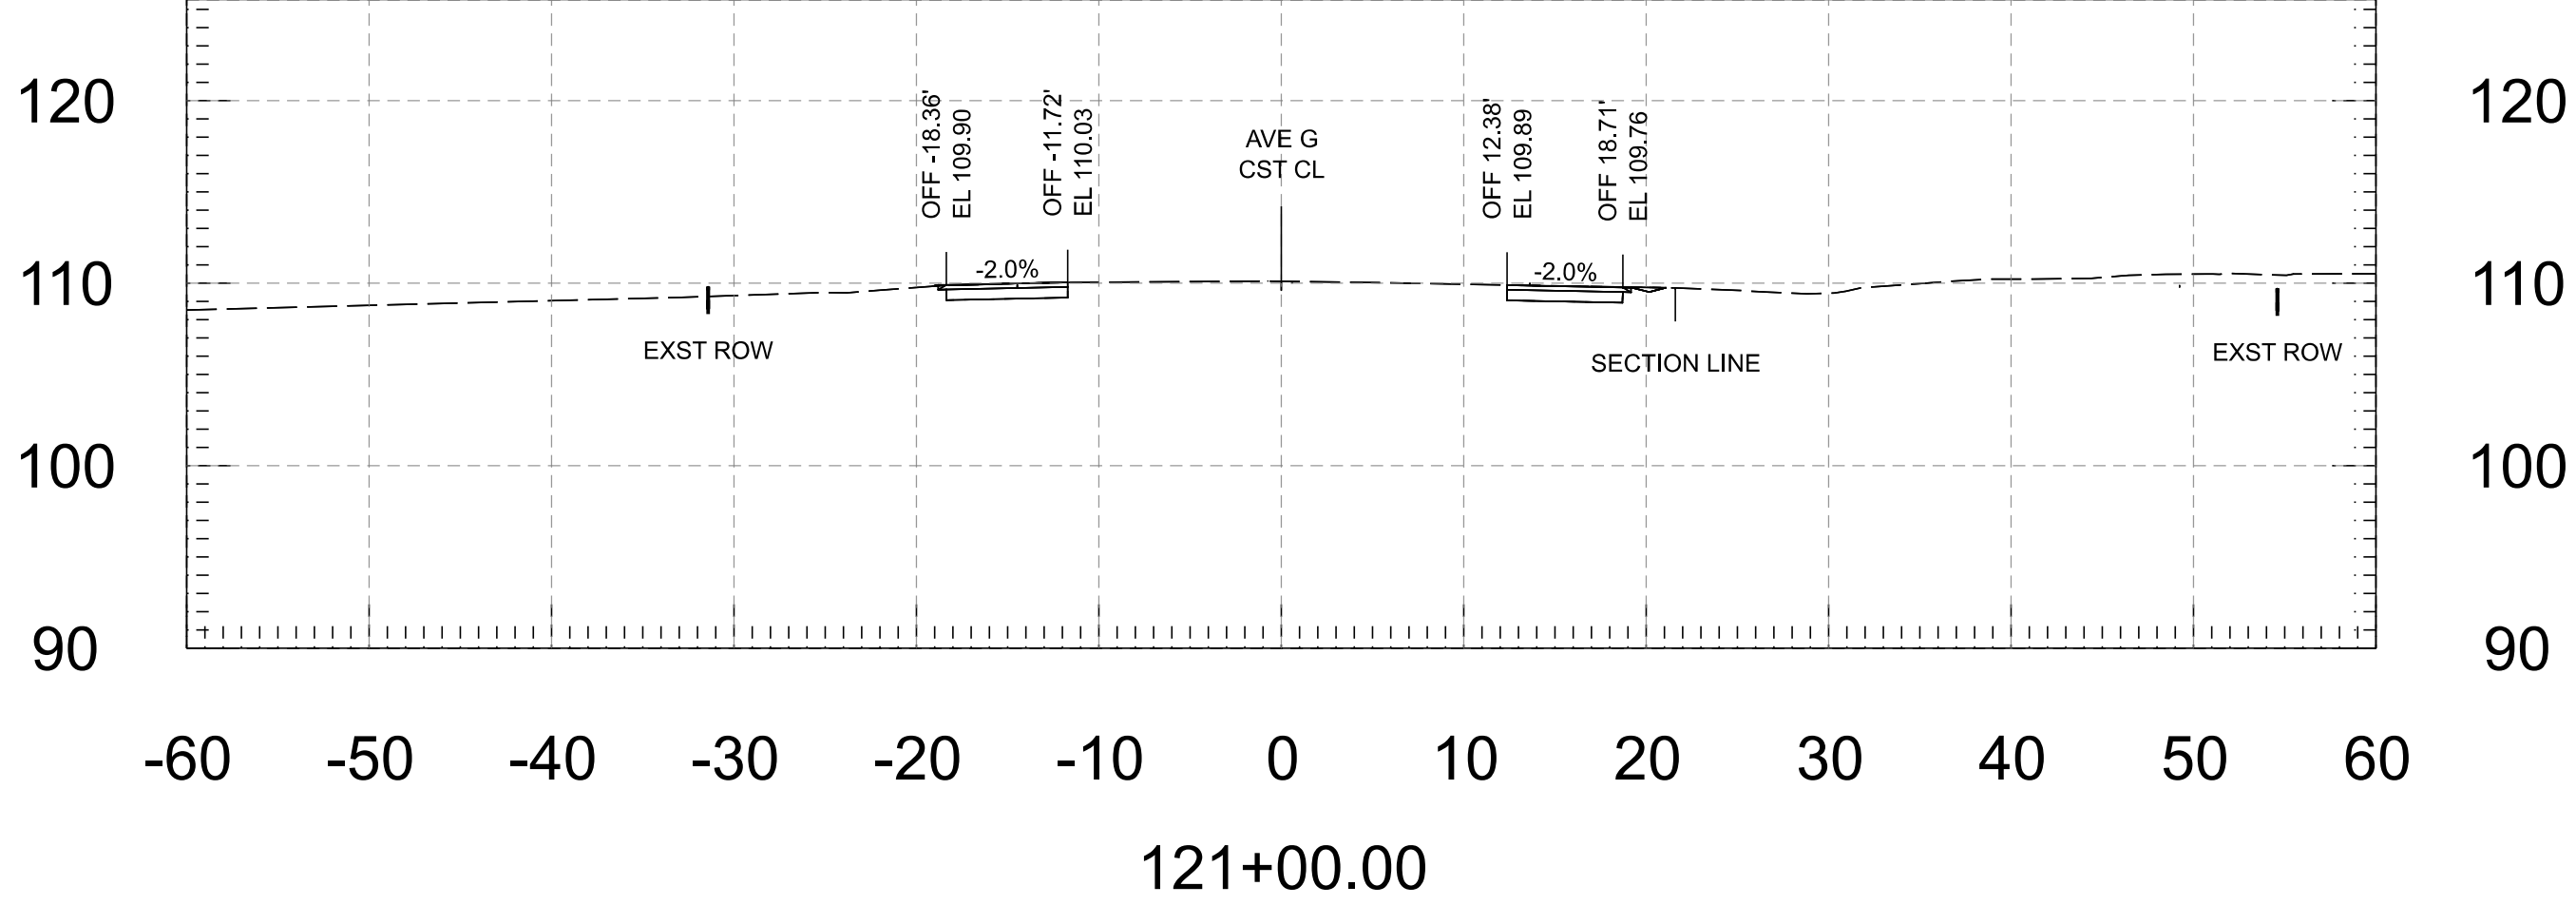


Cut Area	11.71 SF	Fill Area	0.04 SF
Cut Vol.	20.37 CY	Fill Vol.	0.10 CY
Cut Adj. Vol.	20.37 CY	Fill Adj. Vol.	0.10 CY

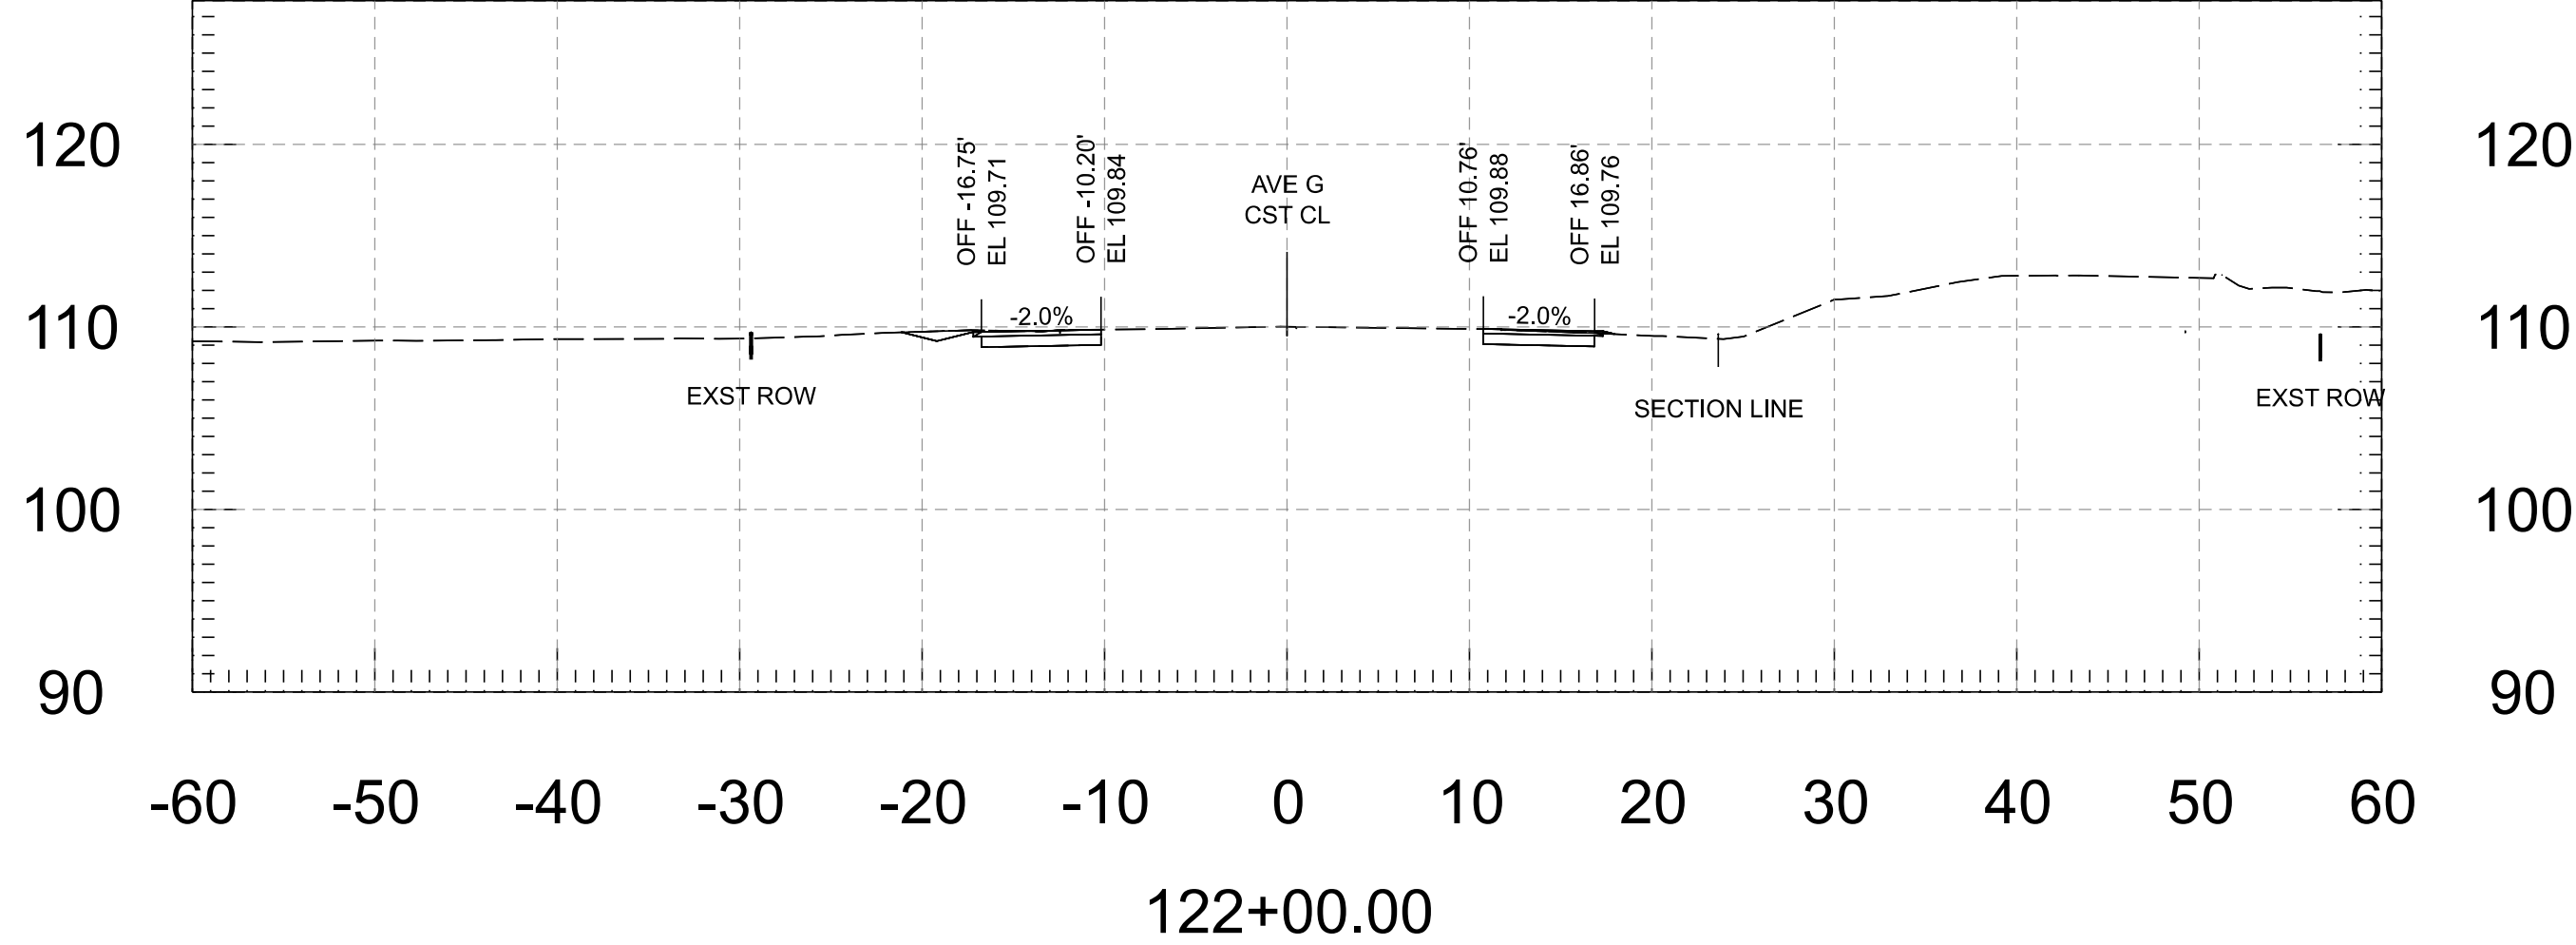


FOR INFORMATION ONLY		NAME	DATE	ARIZONA DEPARTMENT OF TRANSPORTATION PROJECT DELIVERY AND OPERATIONS DIVISION ROADWAY DESIGN SERVICES	ROUTE	F.H.W.A. Arizona Division	STATE ARIZ.	PROJECT NO.	FEDERAL ID NO.	SHEET NO.	TOTAL SHEETS	RECORD DRAWING
	DESIGN	M. SCHOEN	07/26		MILEPOST			0000 YU YYU	YYU-0(225)T	54	118	
	DRAWN	M. SCHOEN	07/26					LOCATION			AVENUE G, COUNTY 11TH ST - COUNTY 16TH ST	
	CHECKED	H. RIOS	07/26	STRUCTURE NO.	TRACS NO.		T0437 01C					___ OF ___
			WSP USA Inc. 1230 West Washington Street, Suite 405 Tempe, AZ 85286		AVENUE G - CROSS SECTIONS							

Cut Area	8.80 SF	Fill Area	0.36 SF
Cut Vol.	16.79 CY	Fill Vol.	0.48 CY
Cut Adj. Vol.	16.79 CY	Fill Adj. Vol.	0.48 CY

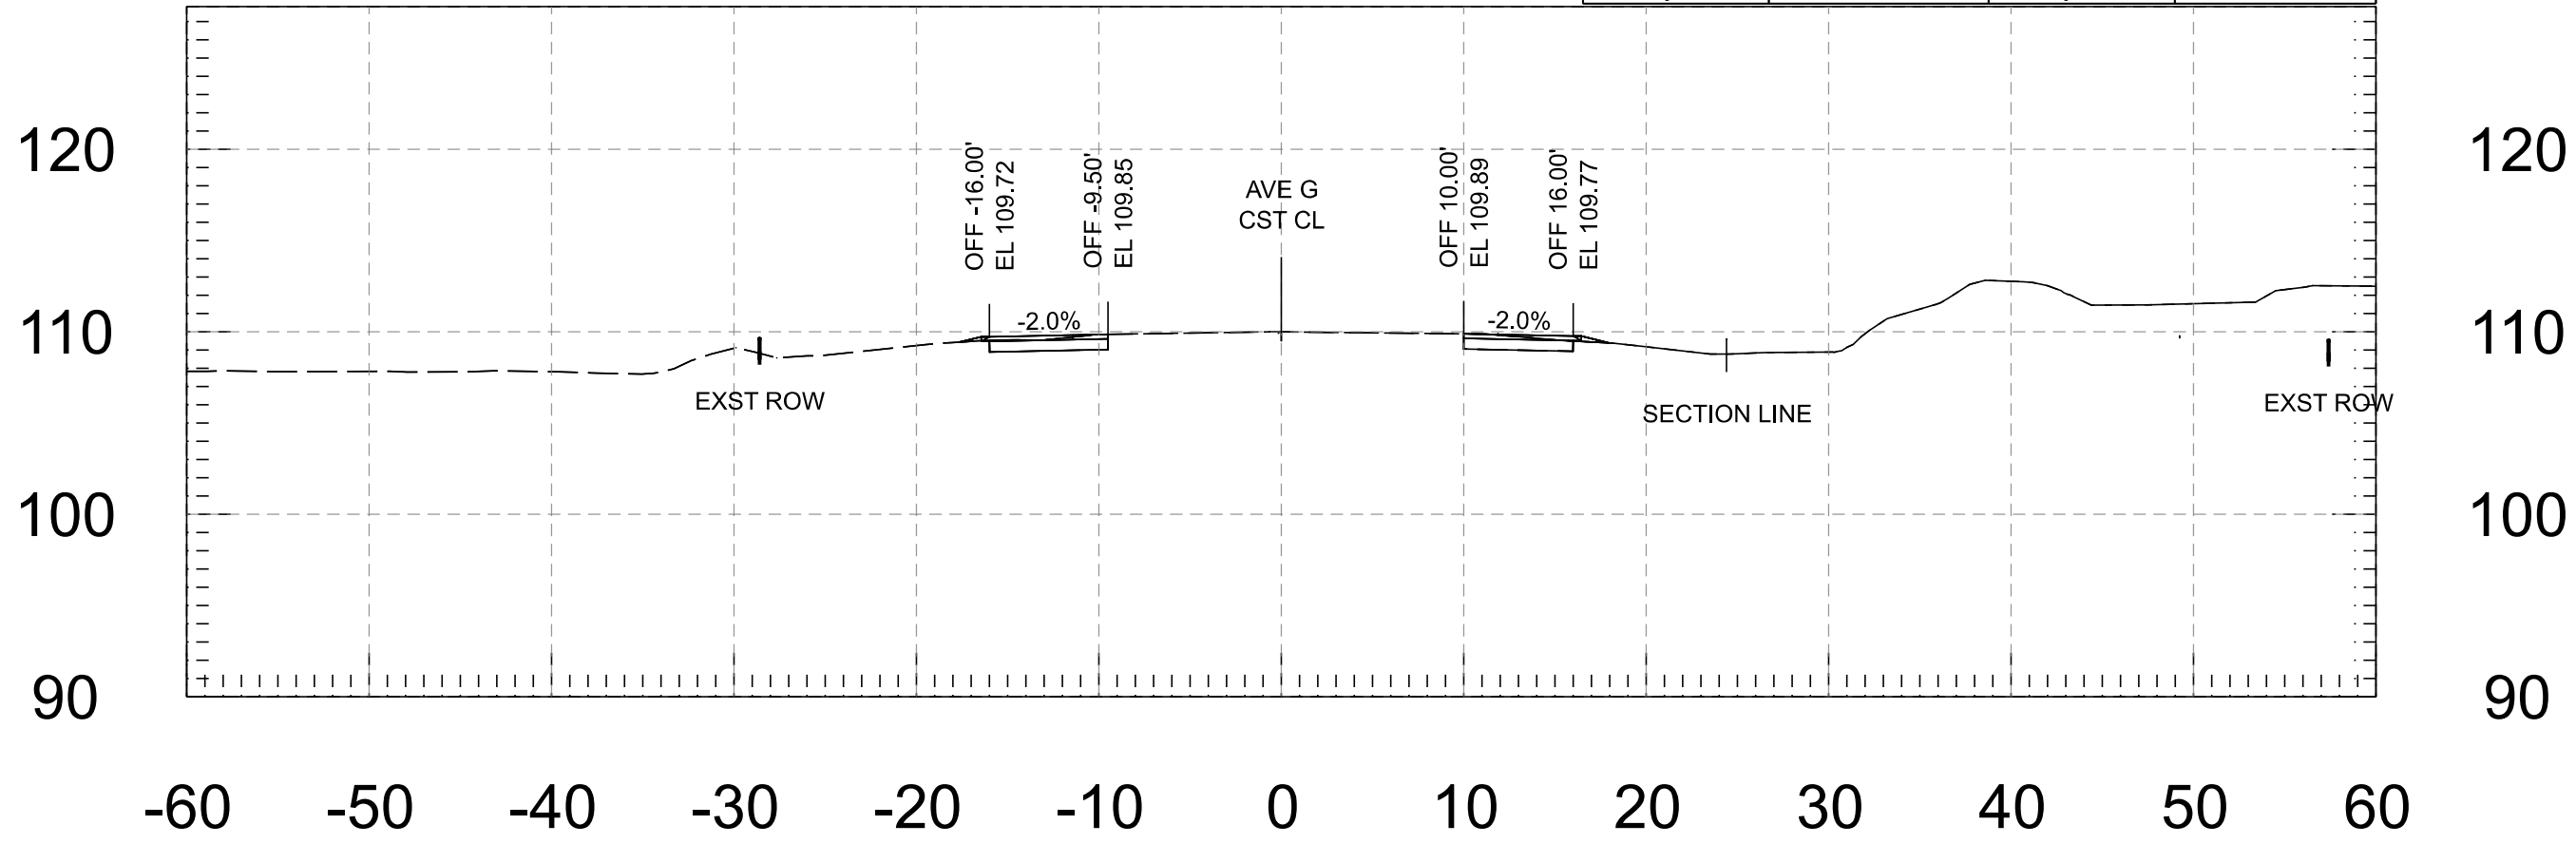


123+50.00

Cut Area	9.18 SF	Fill Area	0.20 SF
Cut Vol.	17.34 CY	Fill Vol.	0.36 CY
Cut Adj. Vol.	17.34 CY	Fill Adj. Vol.	0.36 CY

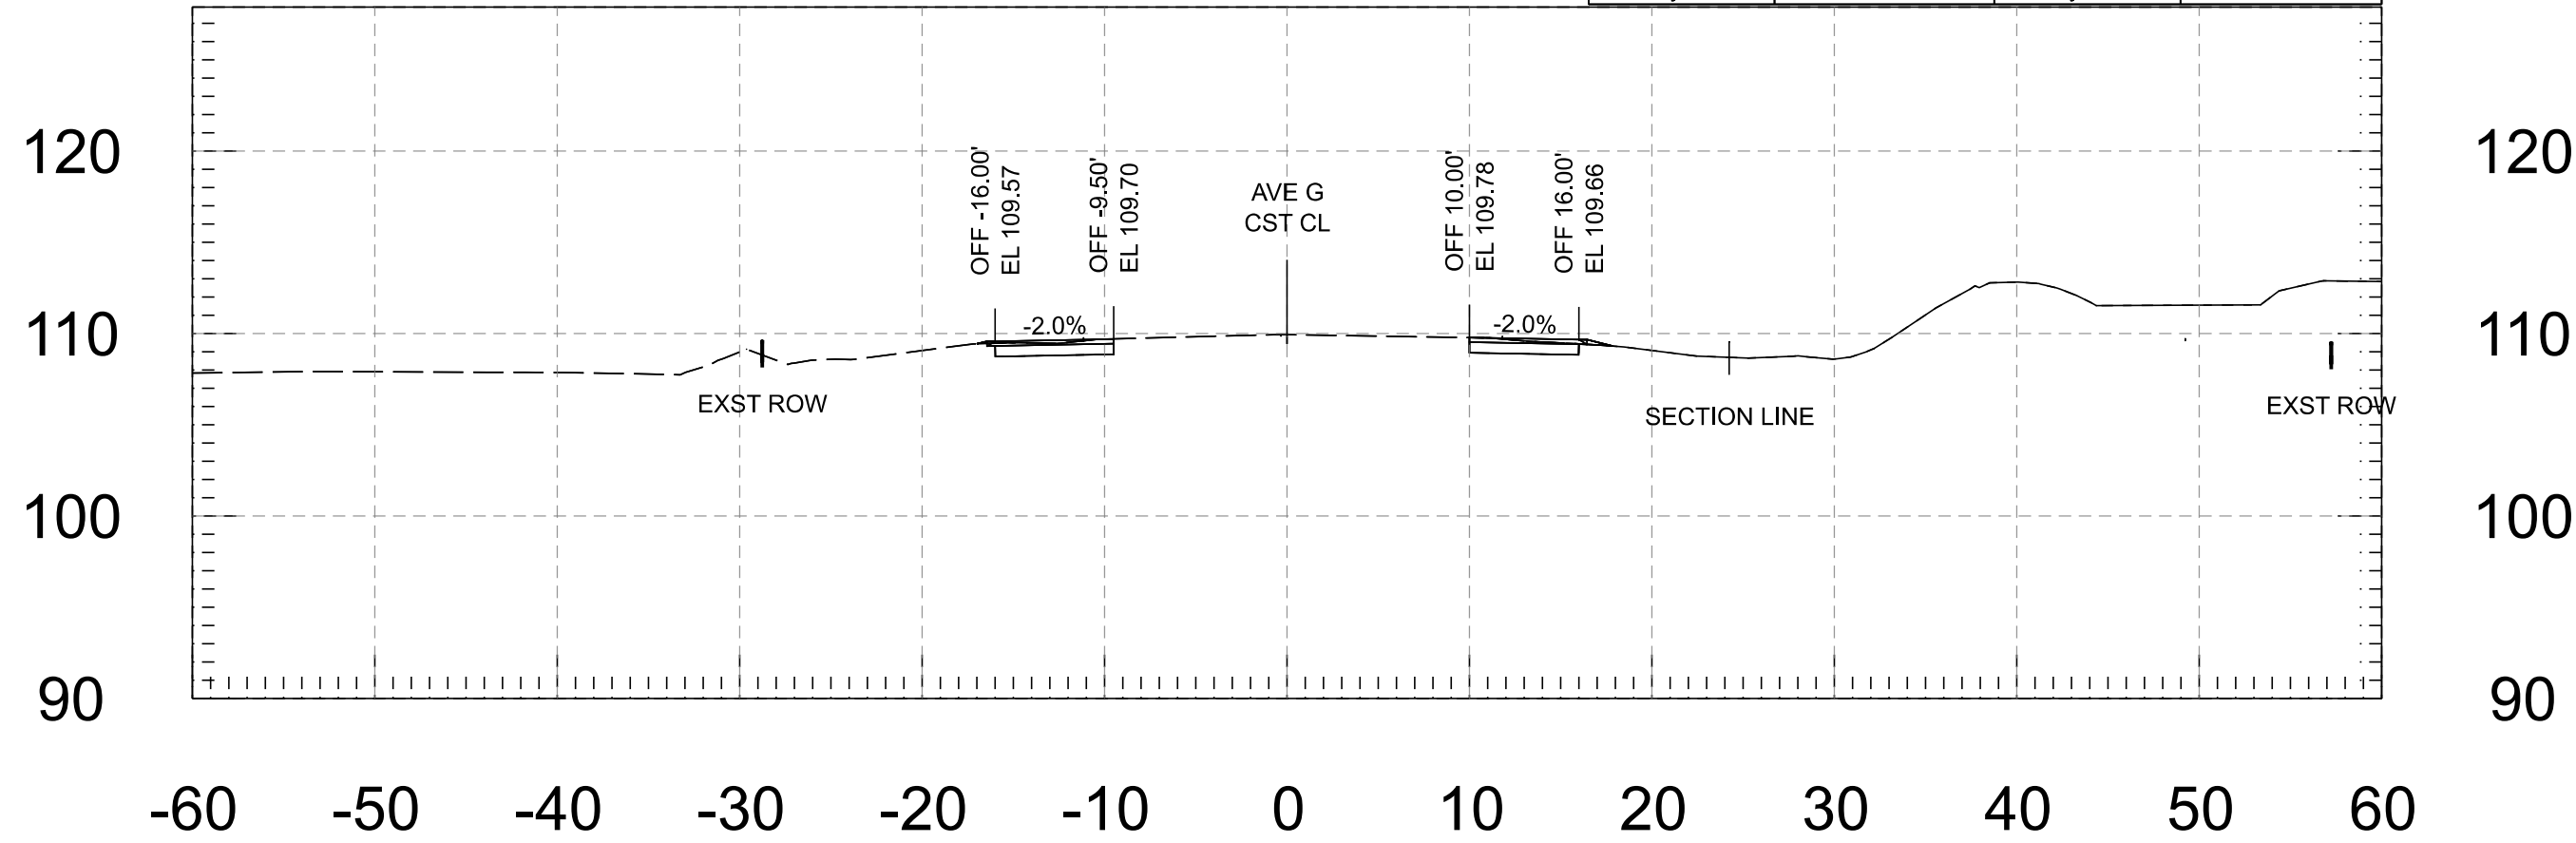


124+50.00

Cut Area	9.33 SF	Fill Area	0.16 SF
Cut Vol.	19.55 CY	Fill Vol.	0.15 CY
Cut Adj. Vol.	19.55 CY	Fill Adj. Vol.	0.15 CY

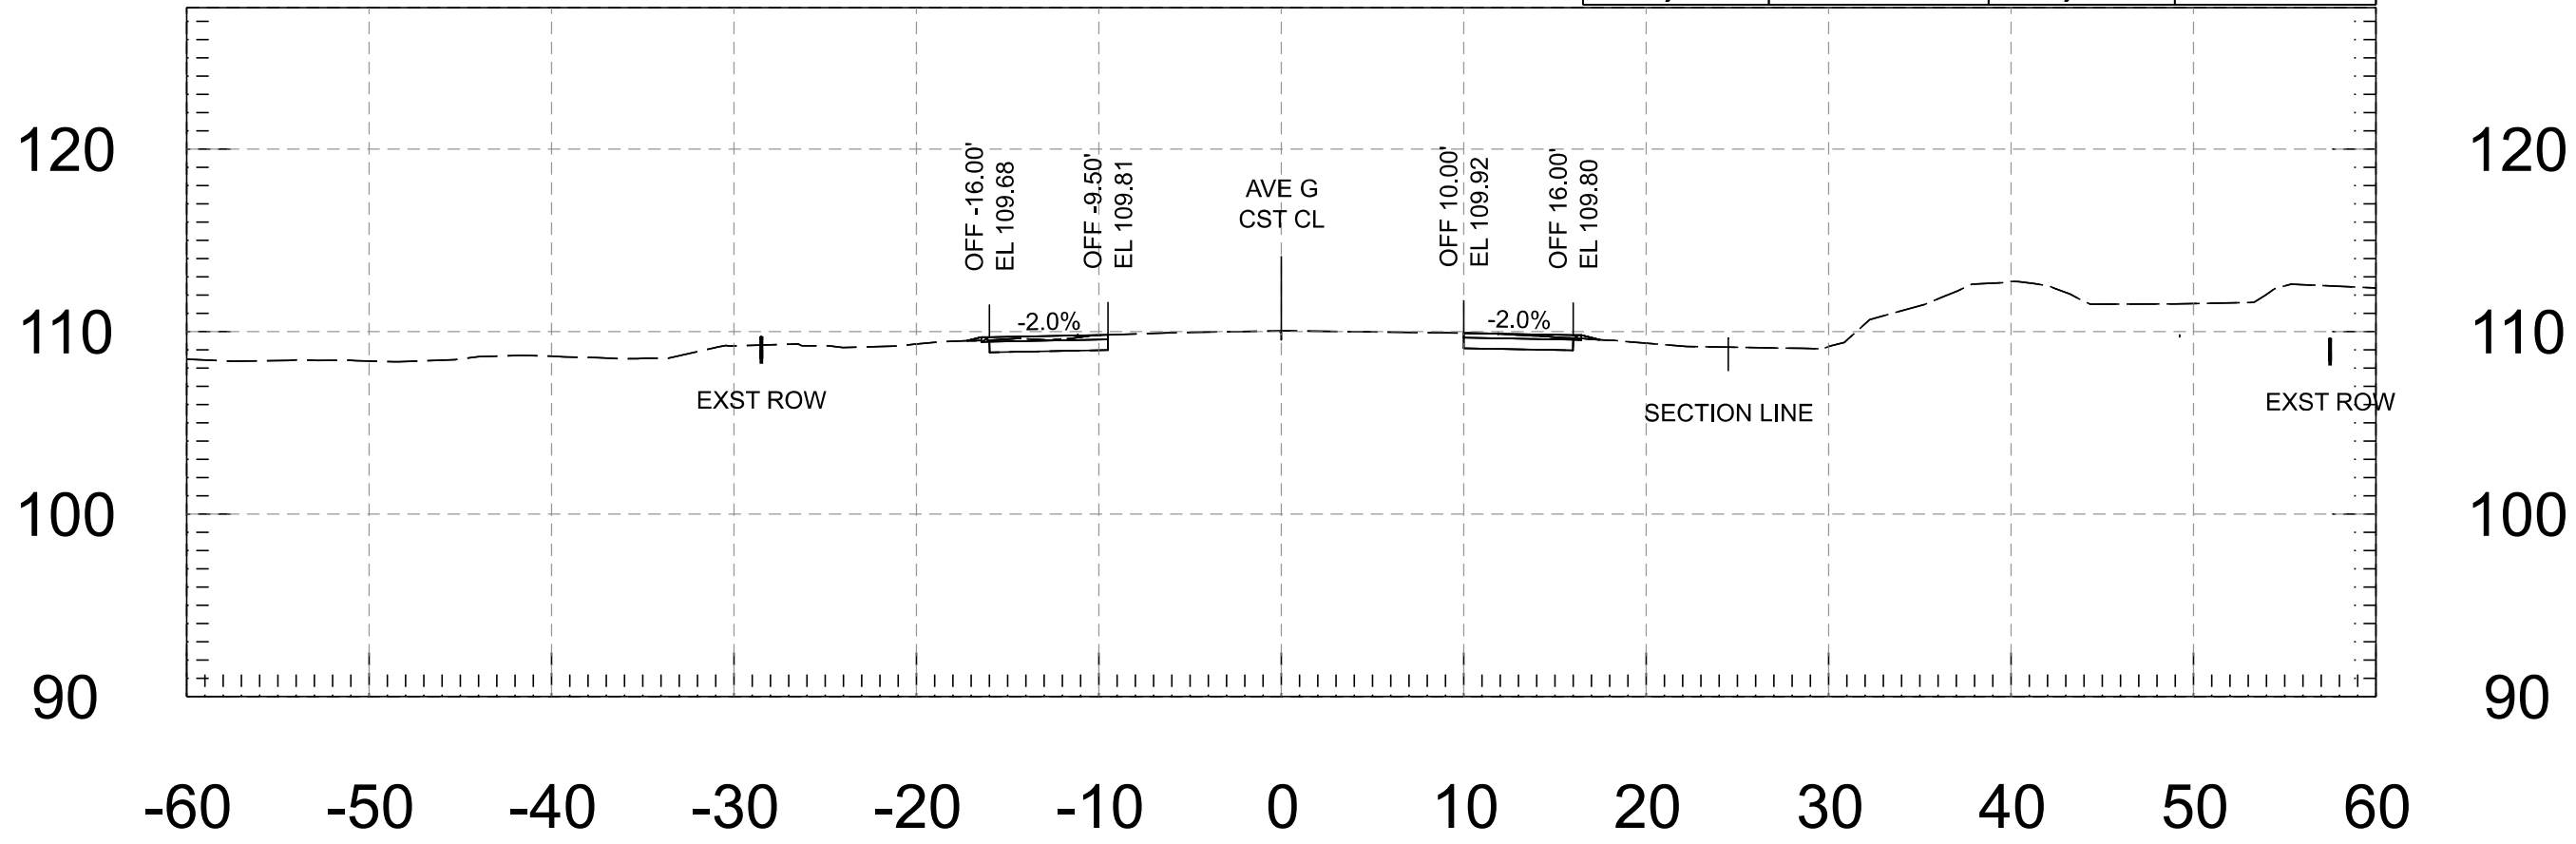





123+00.00

Cut Area	9.55 SF	Fill Area	0.18 SF
Cut Vol.	16.99 CY	Fill Vol.	0.50 CY
Cut Adj. Vol.	16.99 CY	Fill Adj. Vol.	0.50 CY

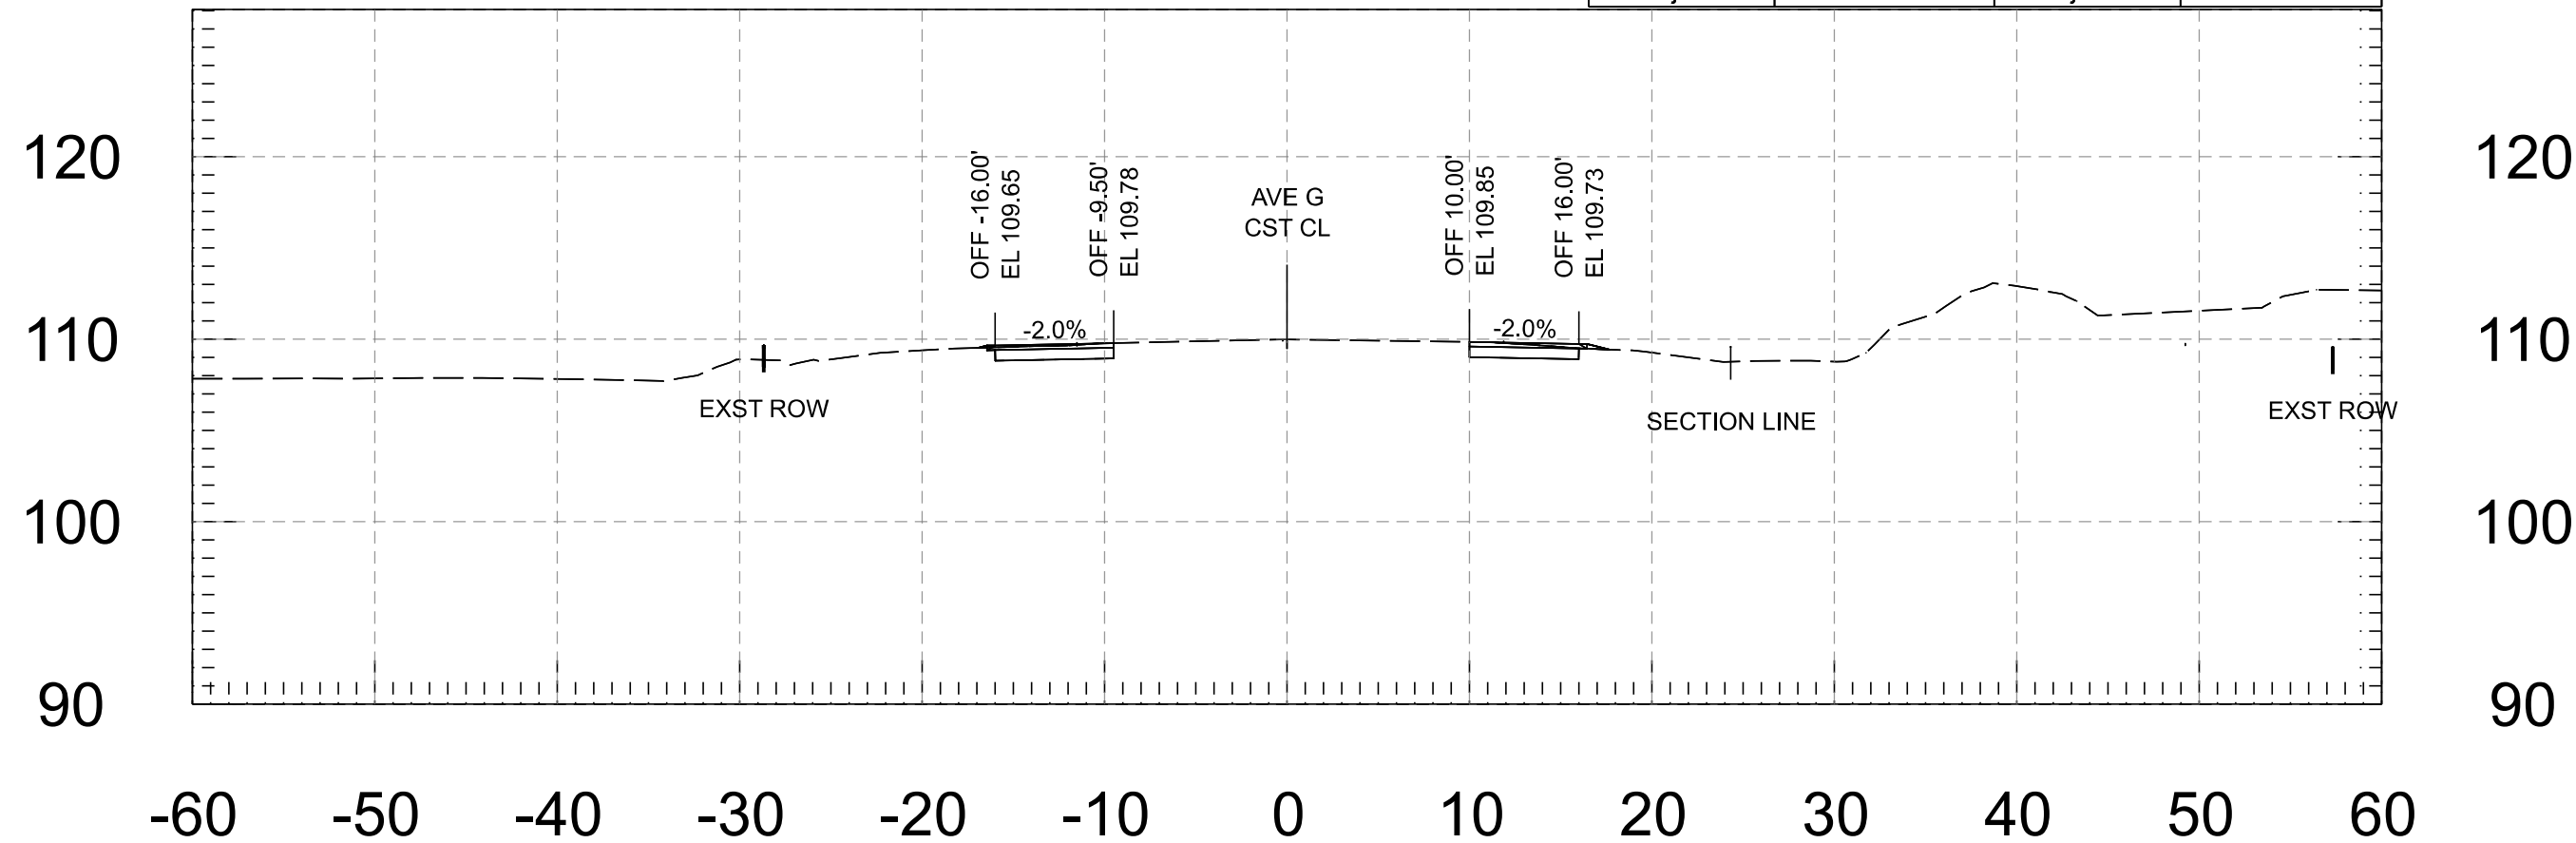


124+00.00


FOR INFORMATION ONLY		NAME	DATE	ARIZONA DEPARTMENT OF TRANSPORTATION PROJECT DELIVERY AND OPERATIONS DIVISION ROADWAY DESIGN SERVICES	ROUTE	F.H.W.A. Arizona Division	STATE ARIZ.	PROJECT NO.	FEDERAL ID NO.	SHEET NO.	TOTAL SHEETS	RECORD DRAWING
	DESIGN	M. SCHOEN	07/26		MILEPOST			0000 YU YYU	YYU-0(225)T	55	118	
	DRAWN	M. SCHOEN	07/26					LOCATION AVENUE G, COUNTY 11TH ST - COUNTY 16TH ST				
	CHECKED	H. RIOS	07/26	wsp WSP USA Inc. 1200 West Washington Street, Suite 405 Tempe, AZ 85286	AVENUE G - CROSS SECTIONS	STRUCTURE NO.	TRACS NO. T0437 01C					___ OF ___

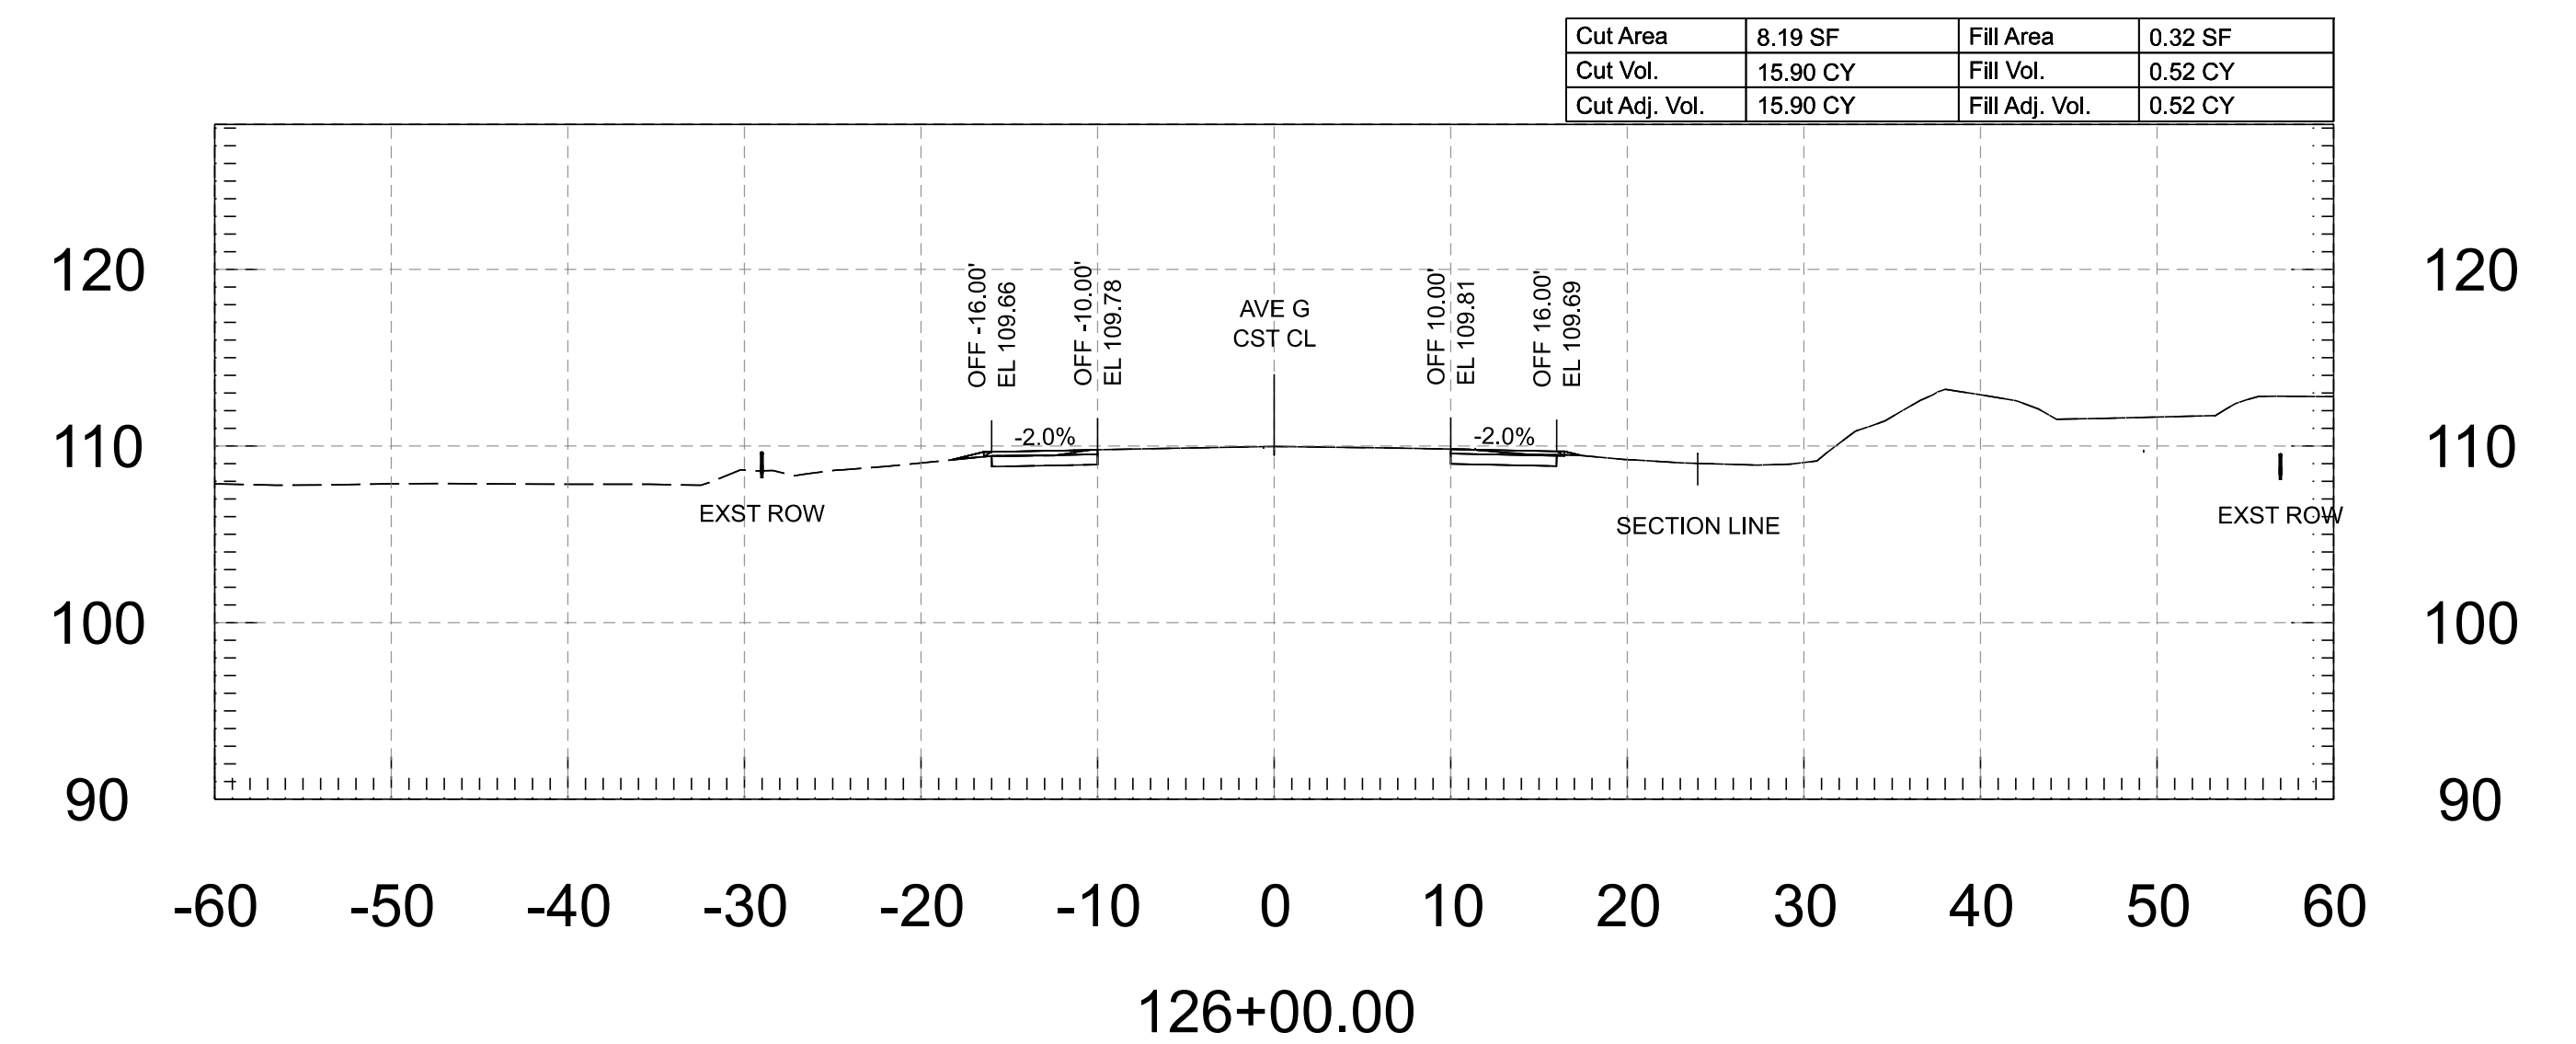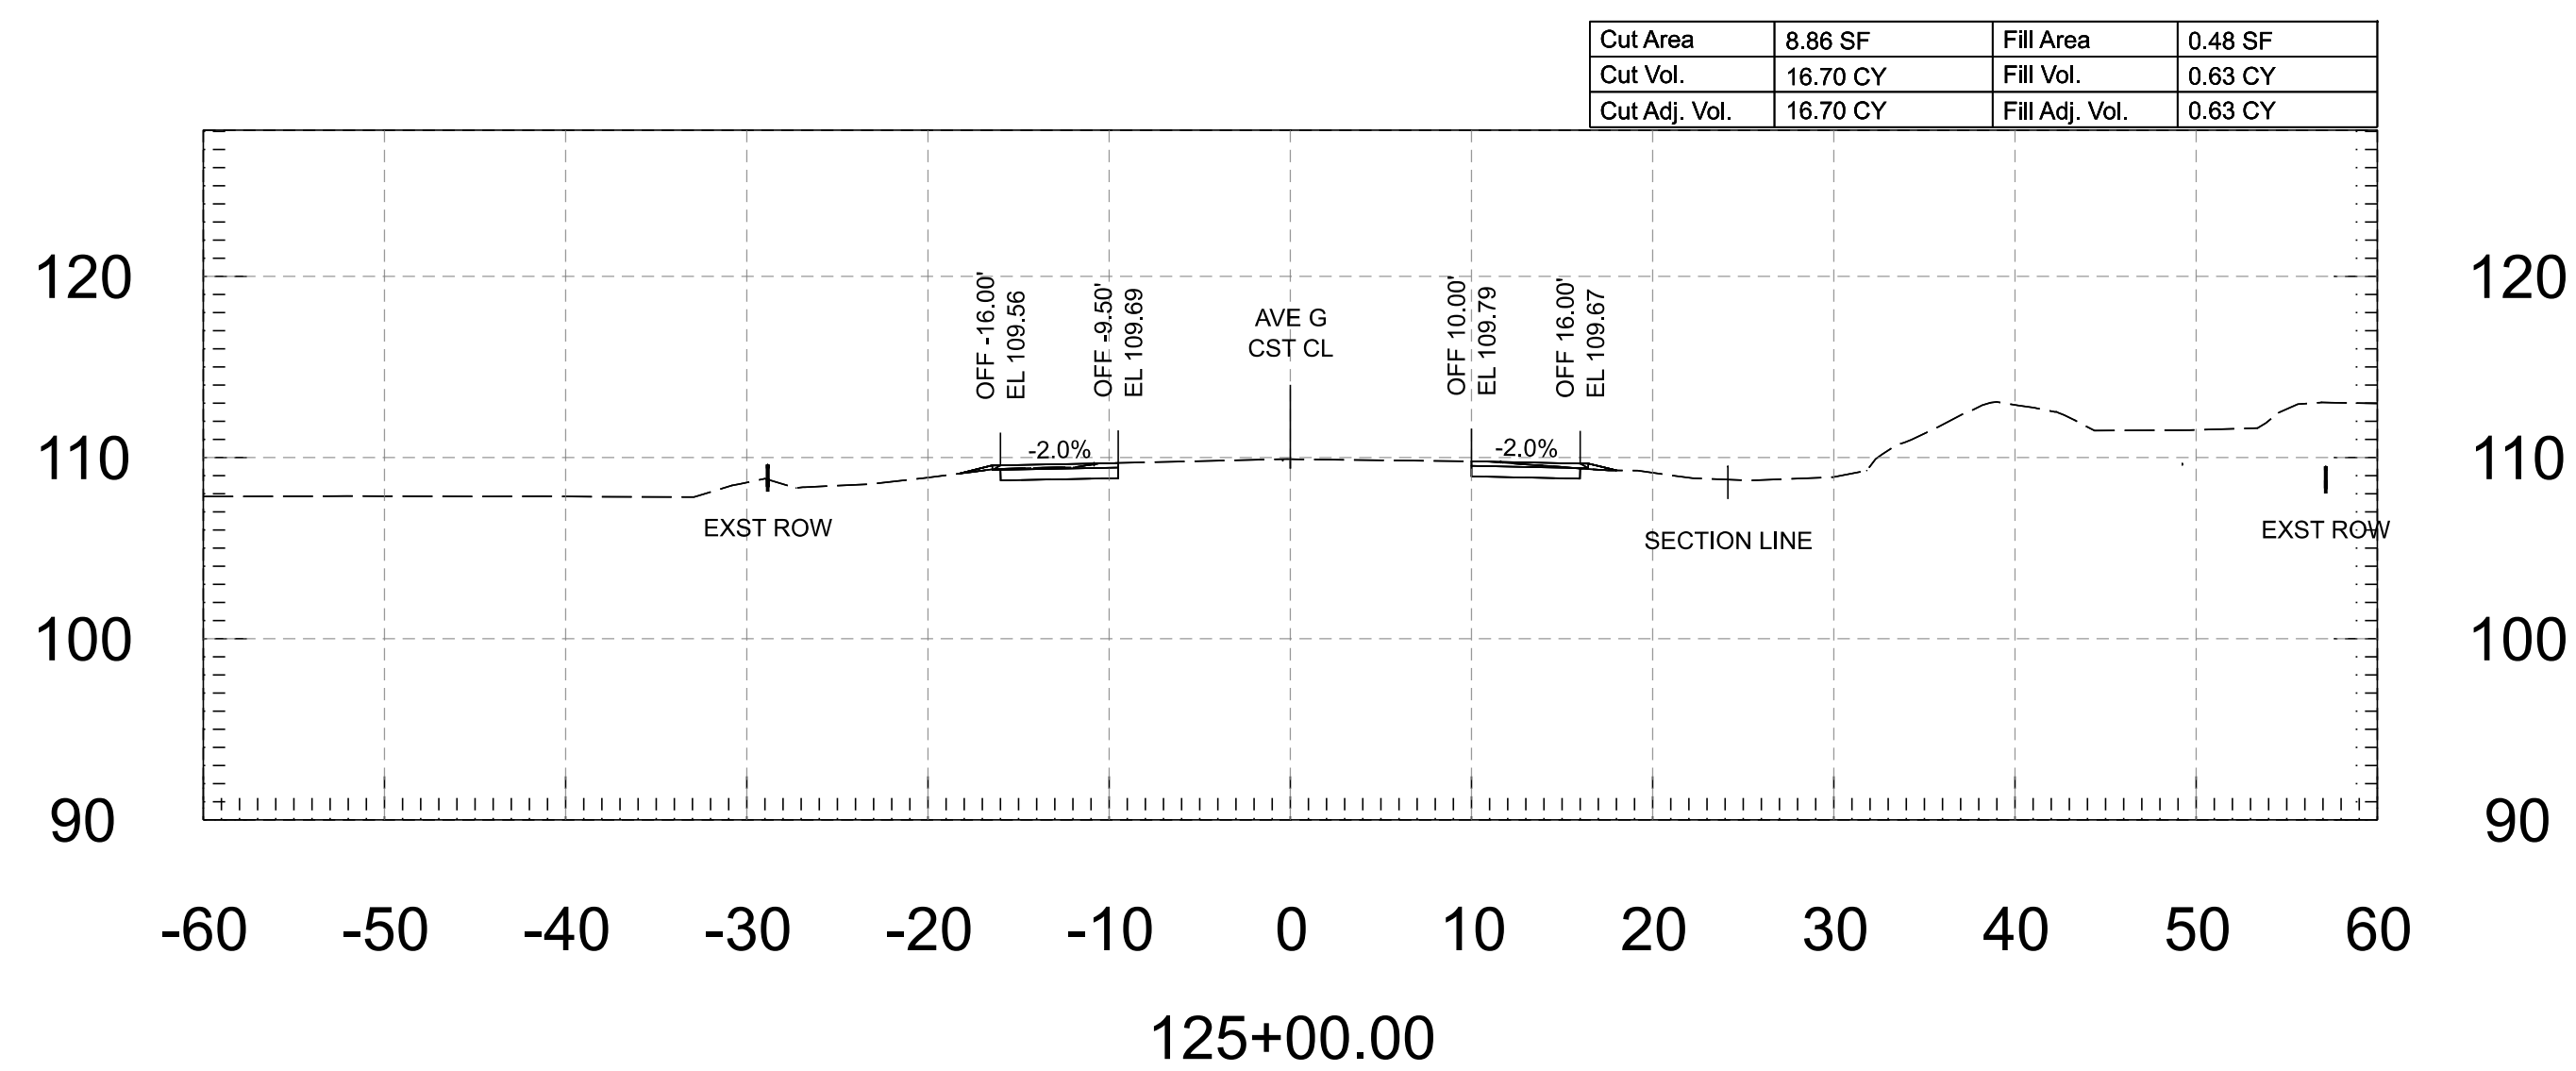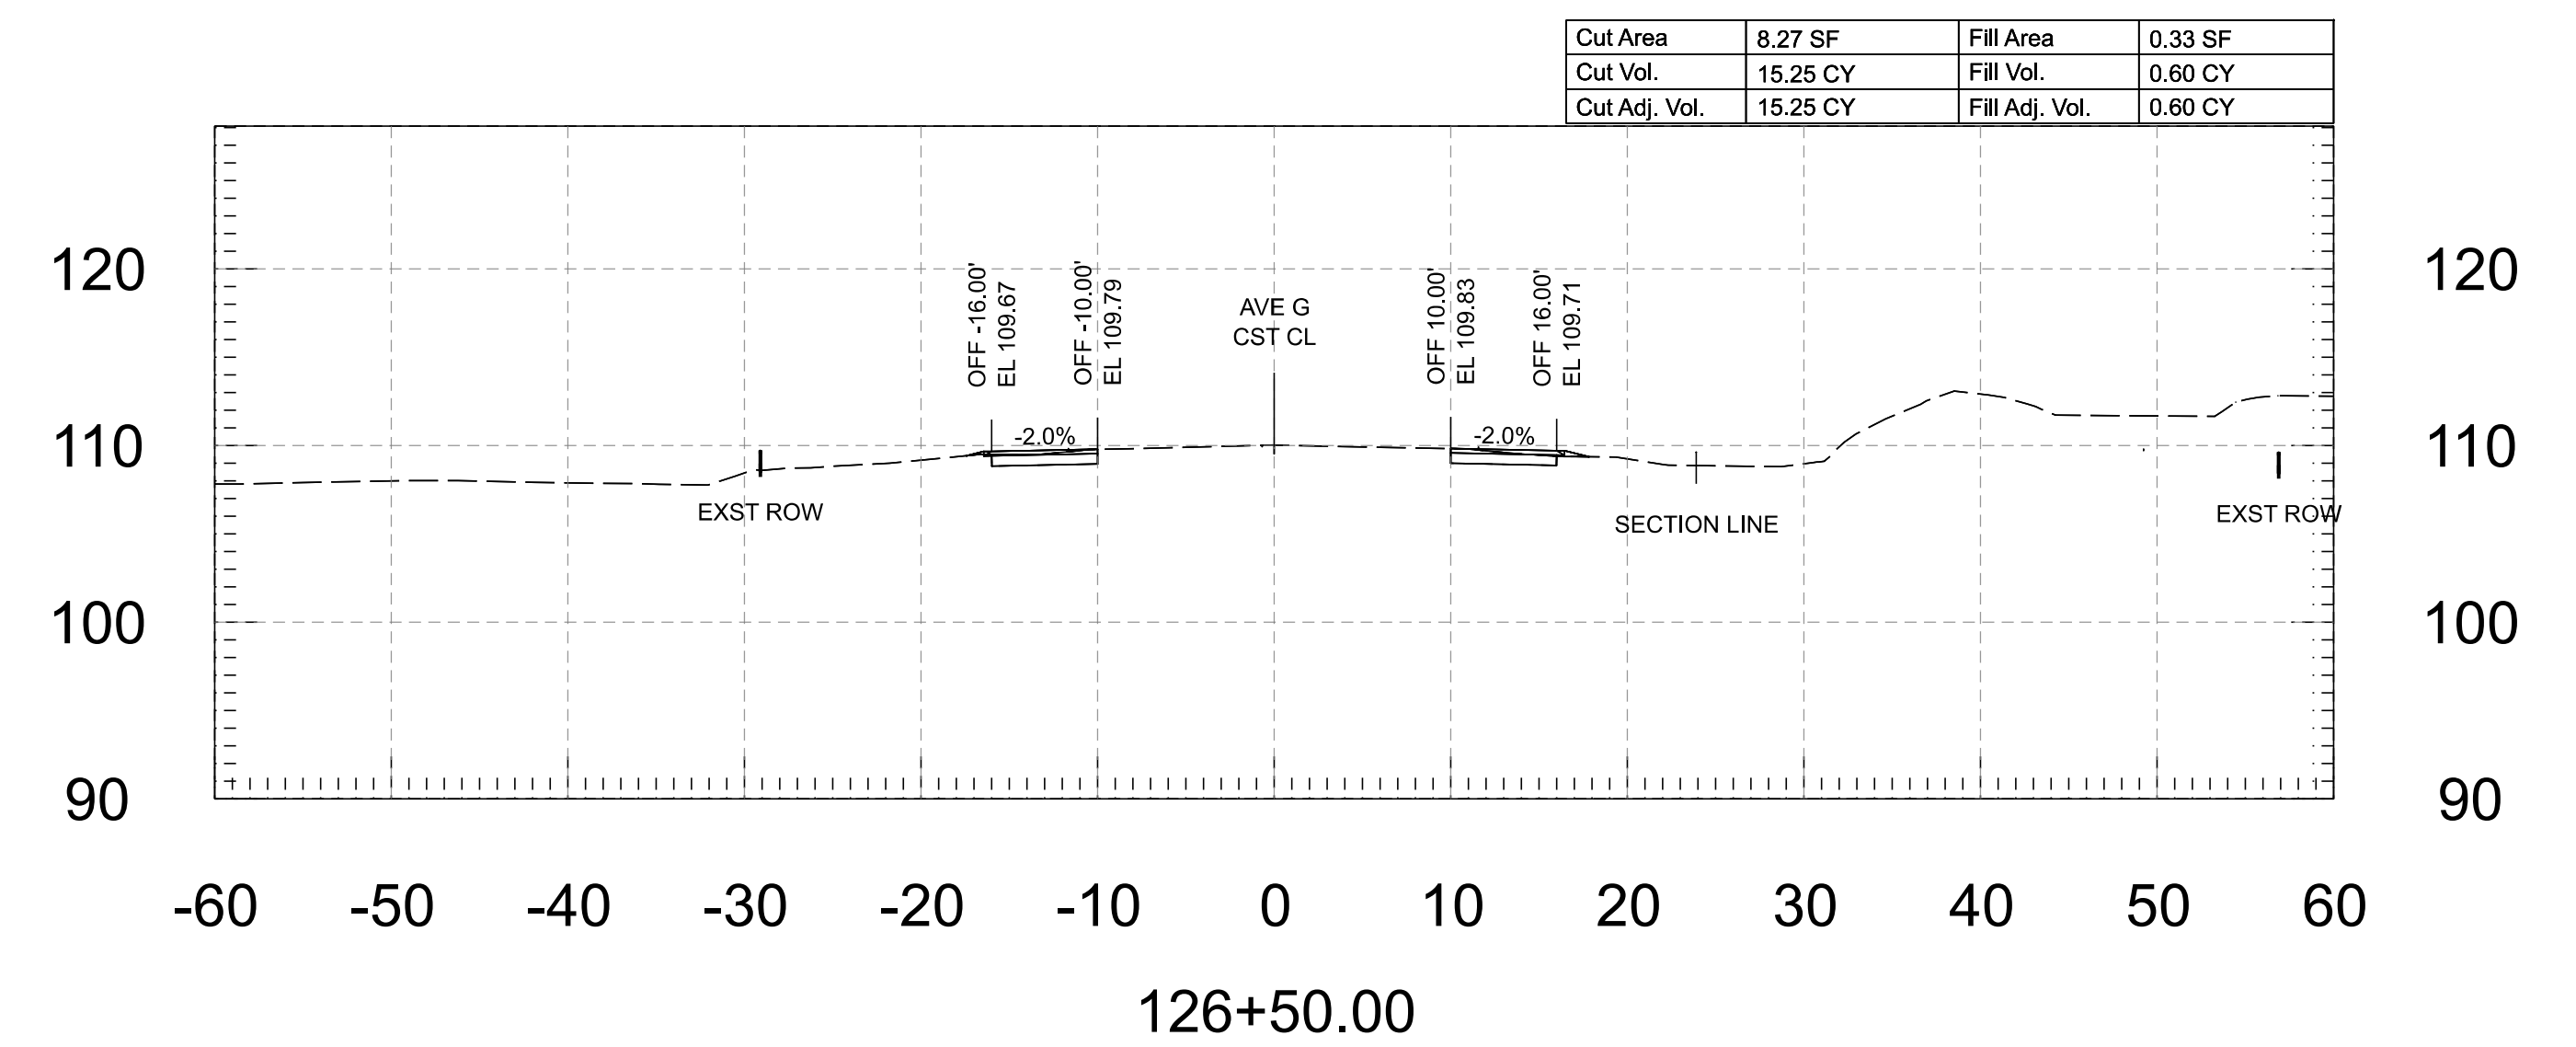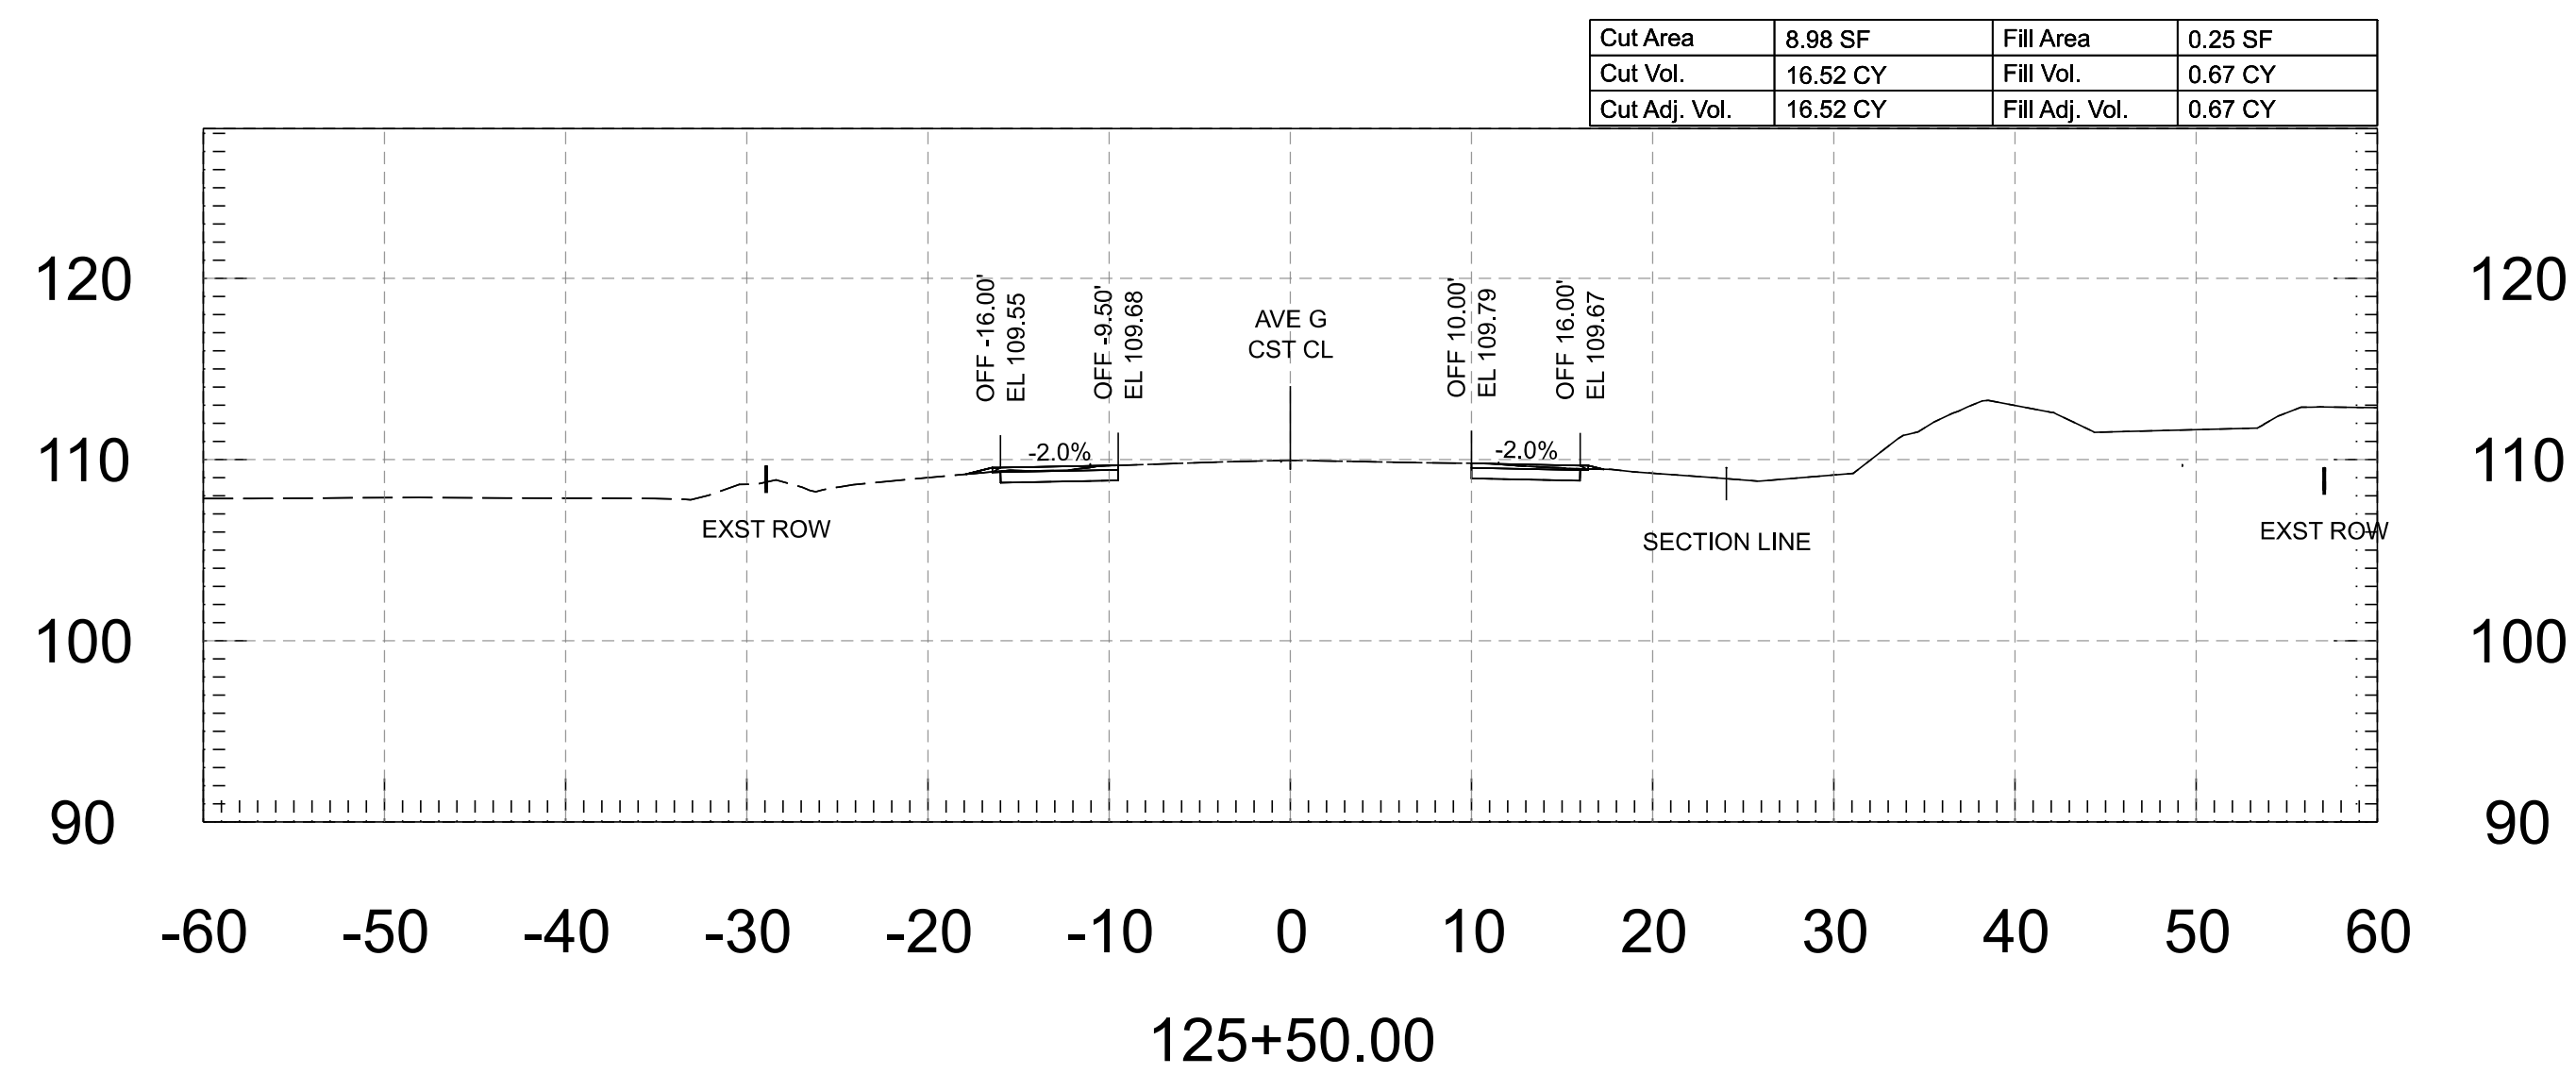


Cut Area	7.99 SF	Fill Area	0.69 SF
Cut Vol.	15.27 CY	Fill Vol.	1.00 CY
Cut Adj. Vol.	15.27 CY	Fill Adj. Vol.	1.00 CY

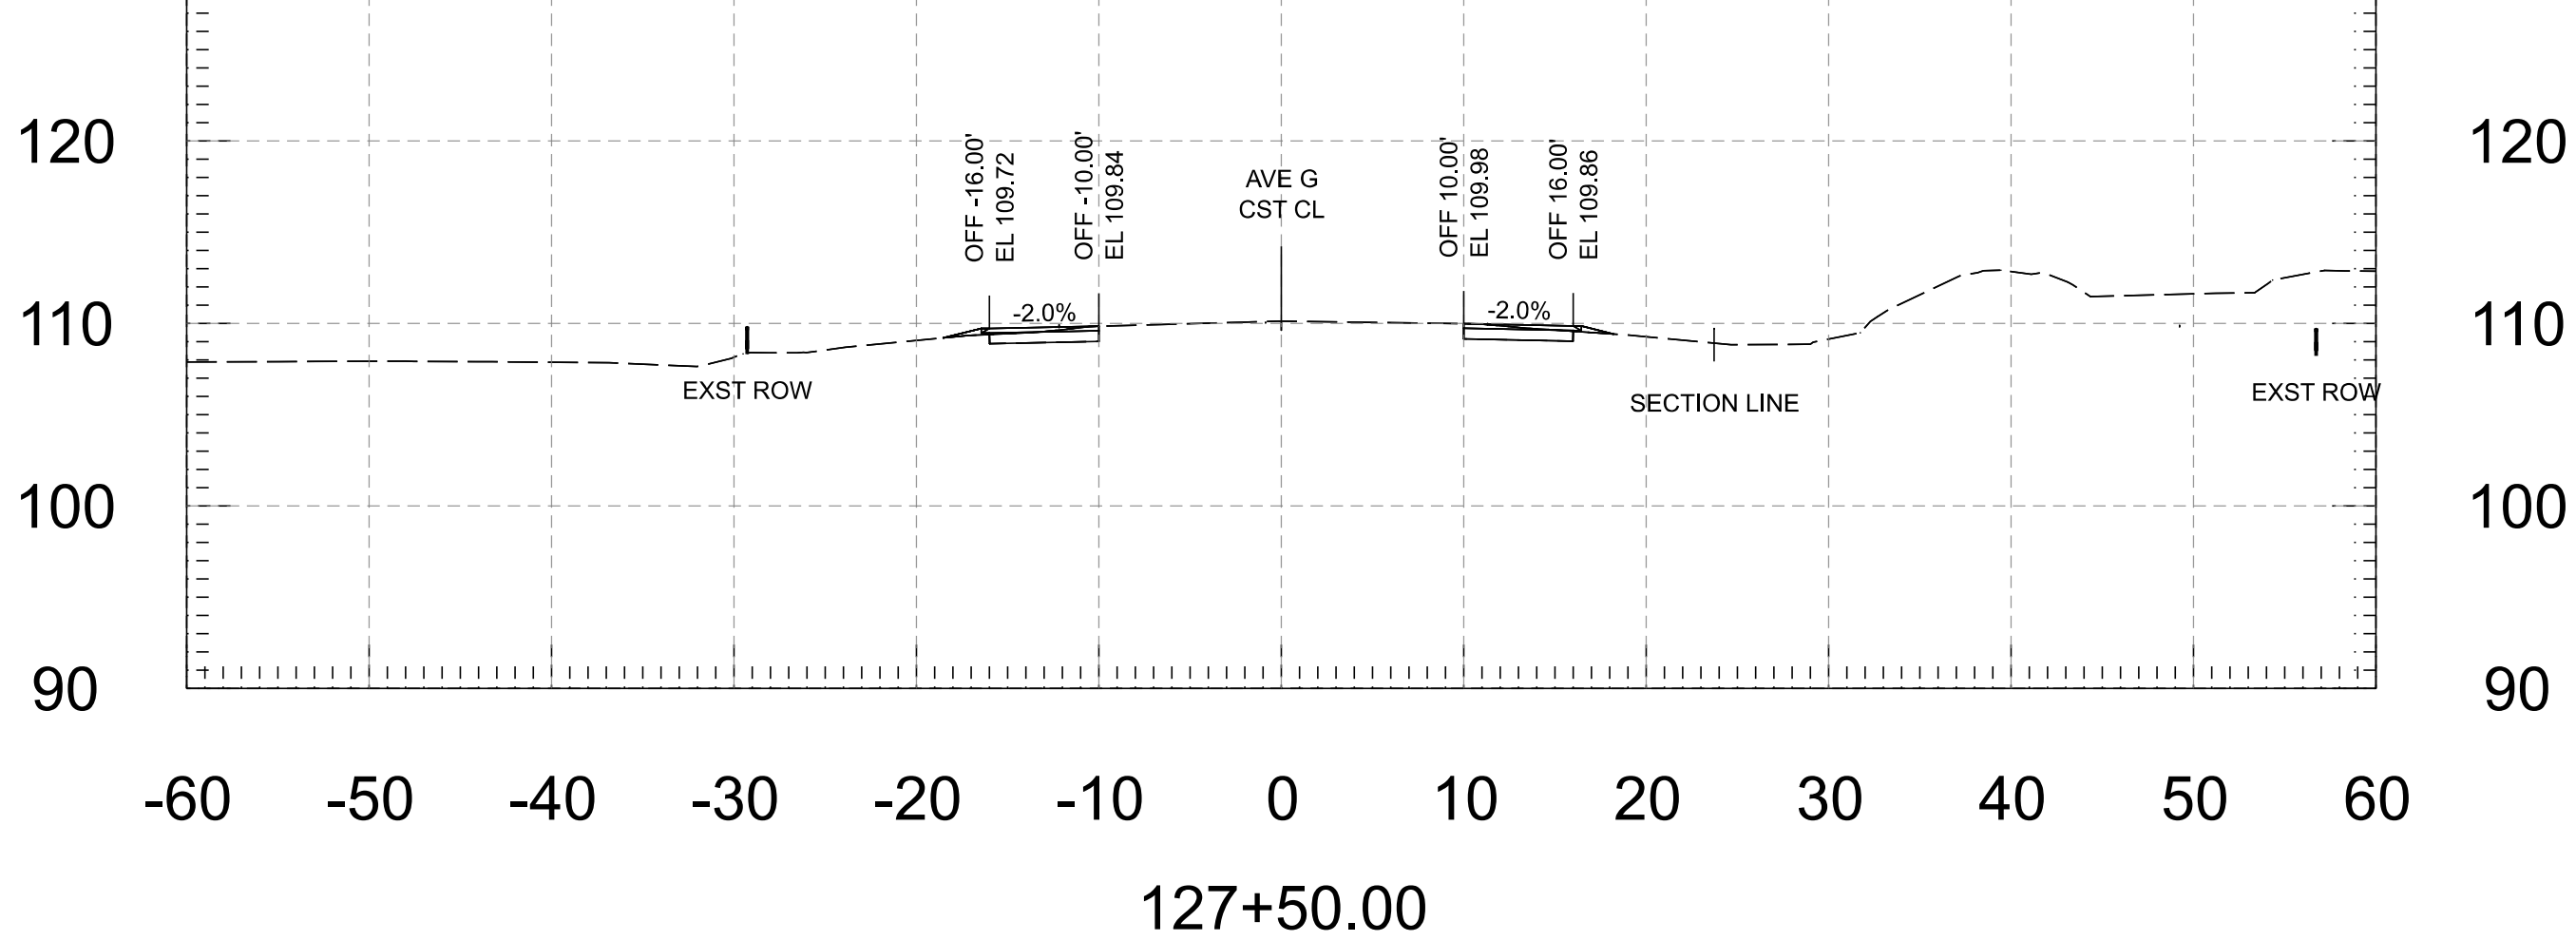


Cut Area	8.94 SF	Fill Area	0.22 SF
Cut Vol.	15.59 CY	Fill Vol.	1.30 CY
Cut Adj. Vol.	15.59 CY	Fill Adj. Vol.	1.30 CY

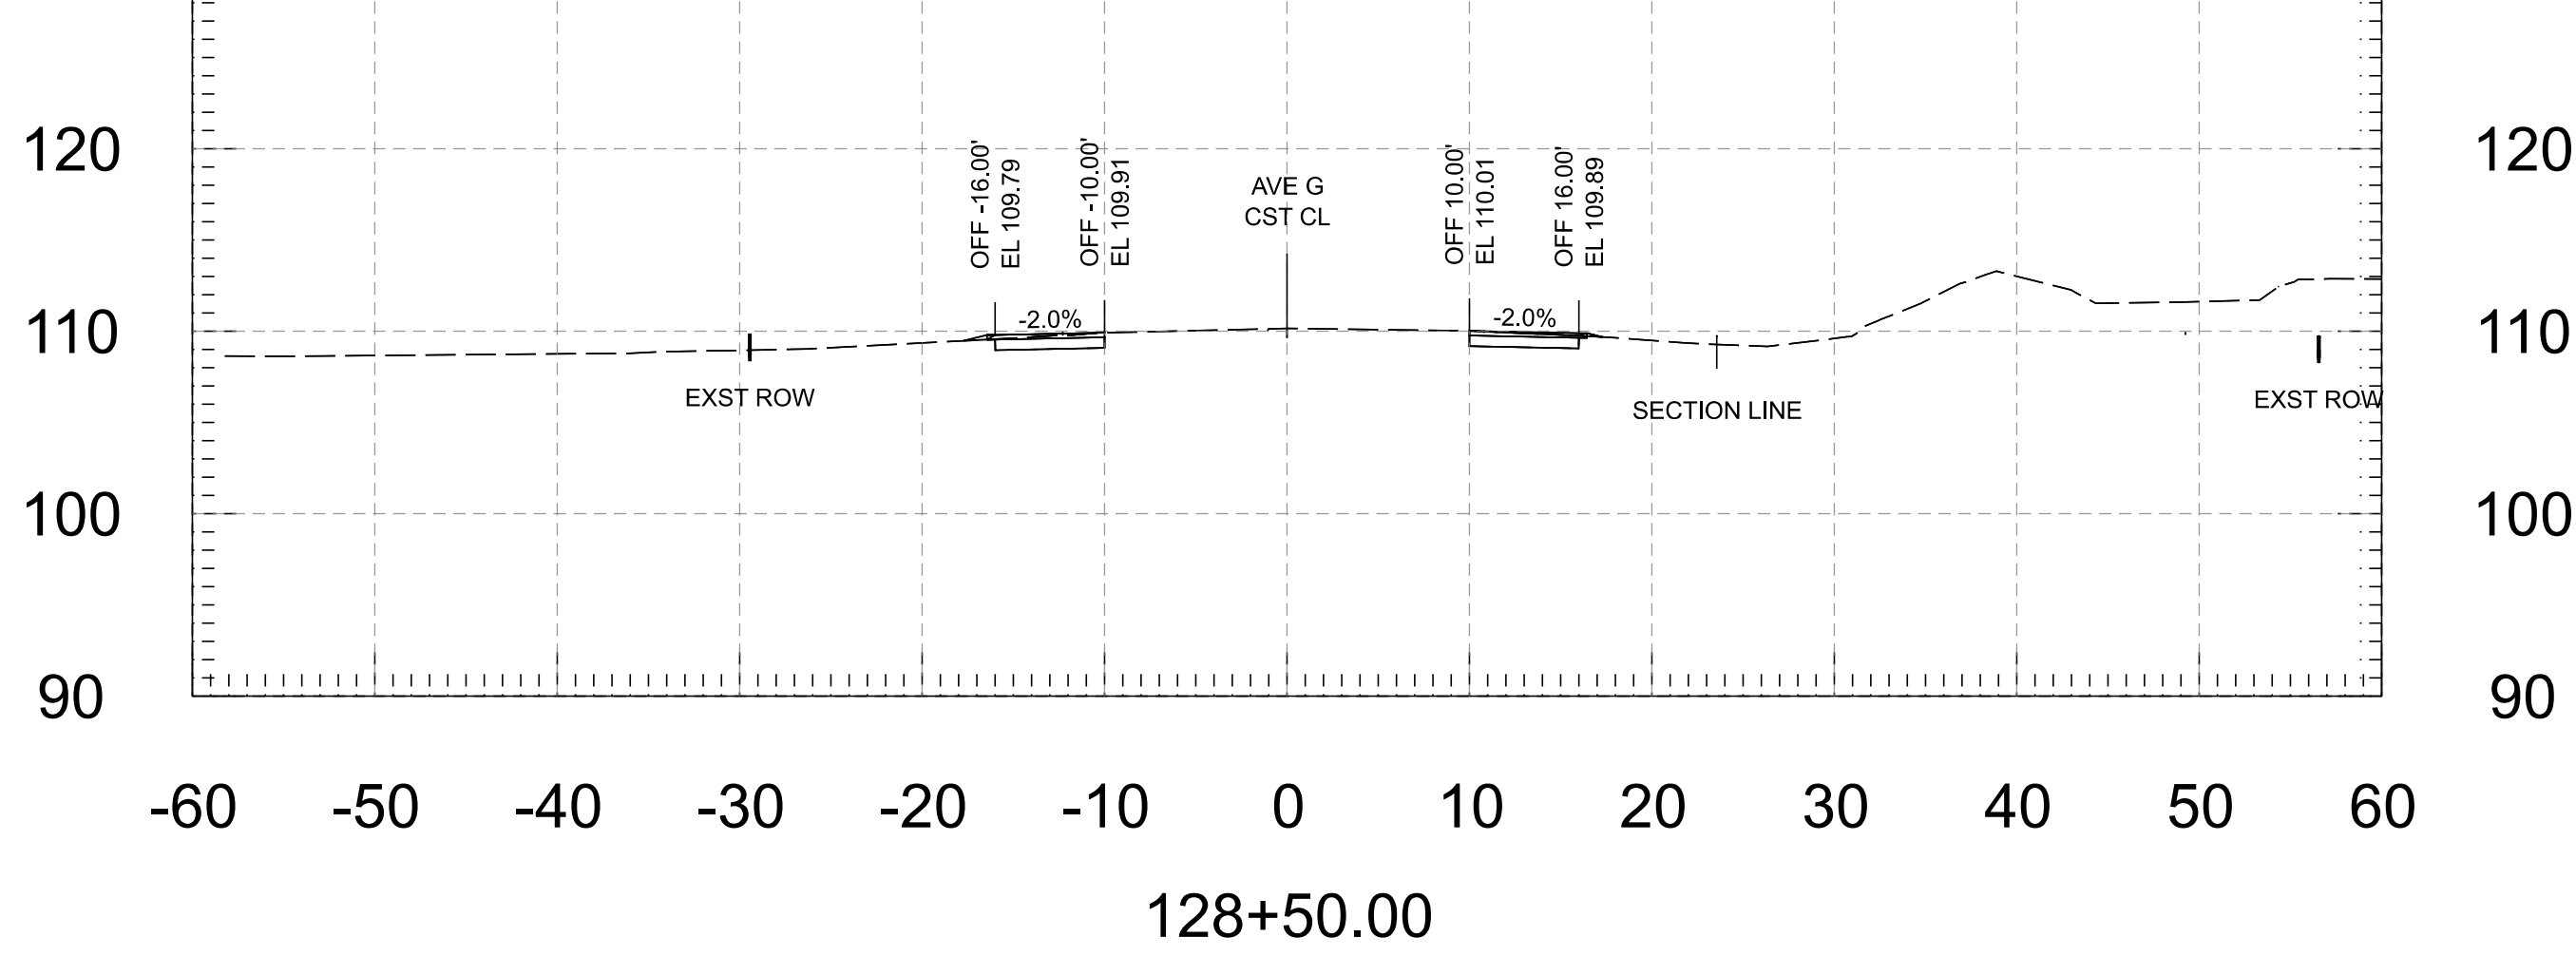






Cut Area	8.50 SF	Fill Area	0.39 SF
Cut Vol.	15.53 CY	Fill Vol.	0.67 CY
Cut Adj. Vol.	15.53 CY	Fill Adj. Vol.	0.67 CY


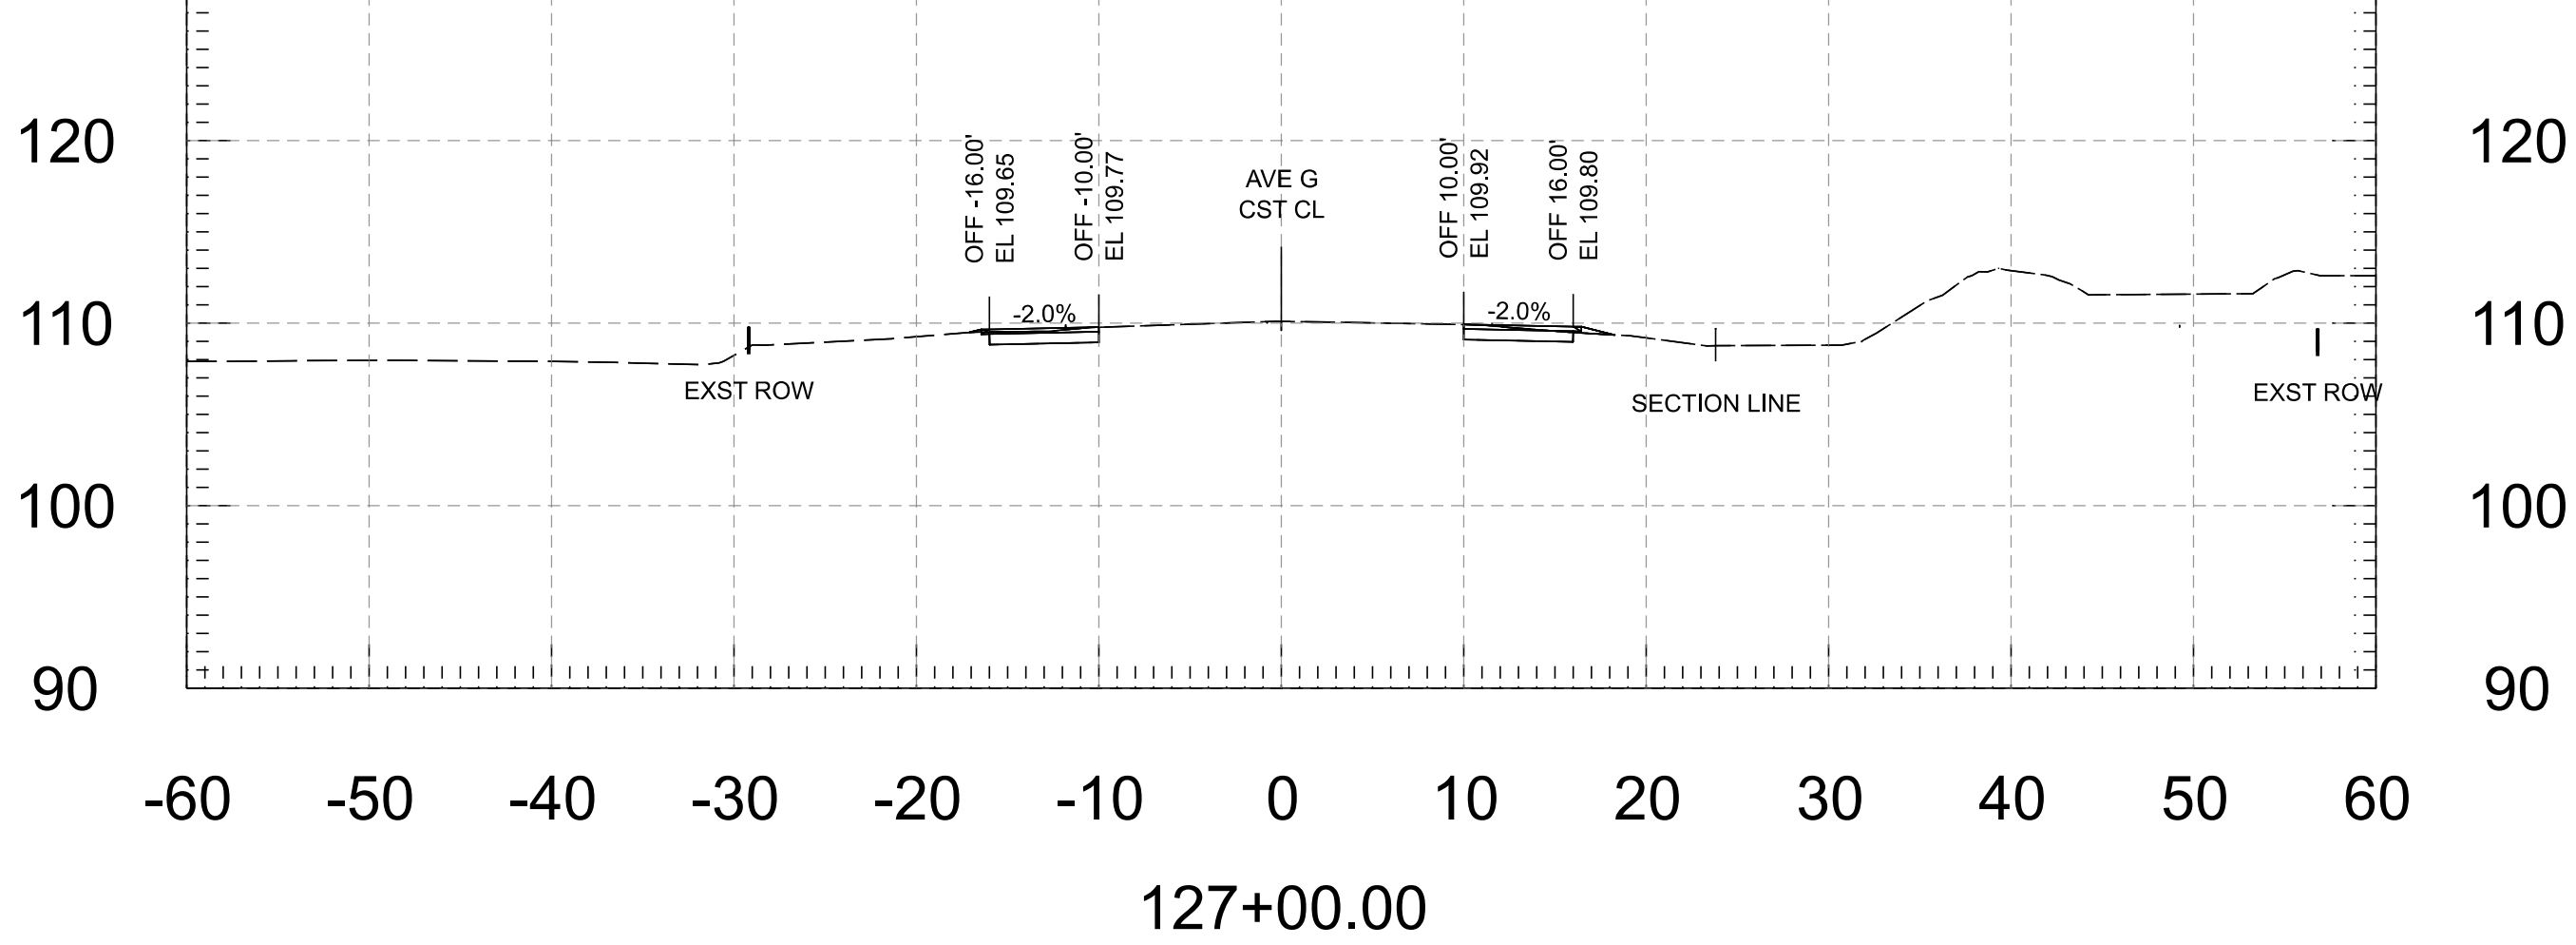


Cut Area	7.89 SF	Fill Area	1.18 SF
Cut Vol.	14.70 CY	Fill Vol.	1.73 CY
Cut Adj. Vol.	14.70 CY	Fill Adj. Vol.	1.73 CY




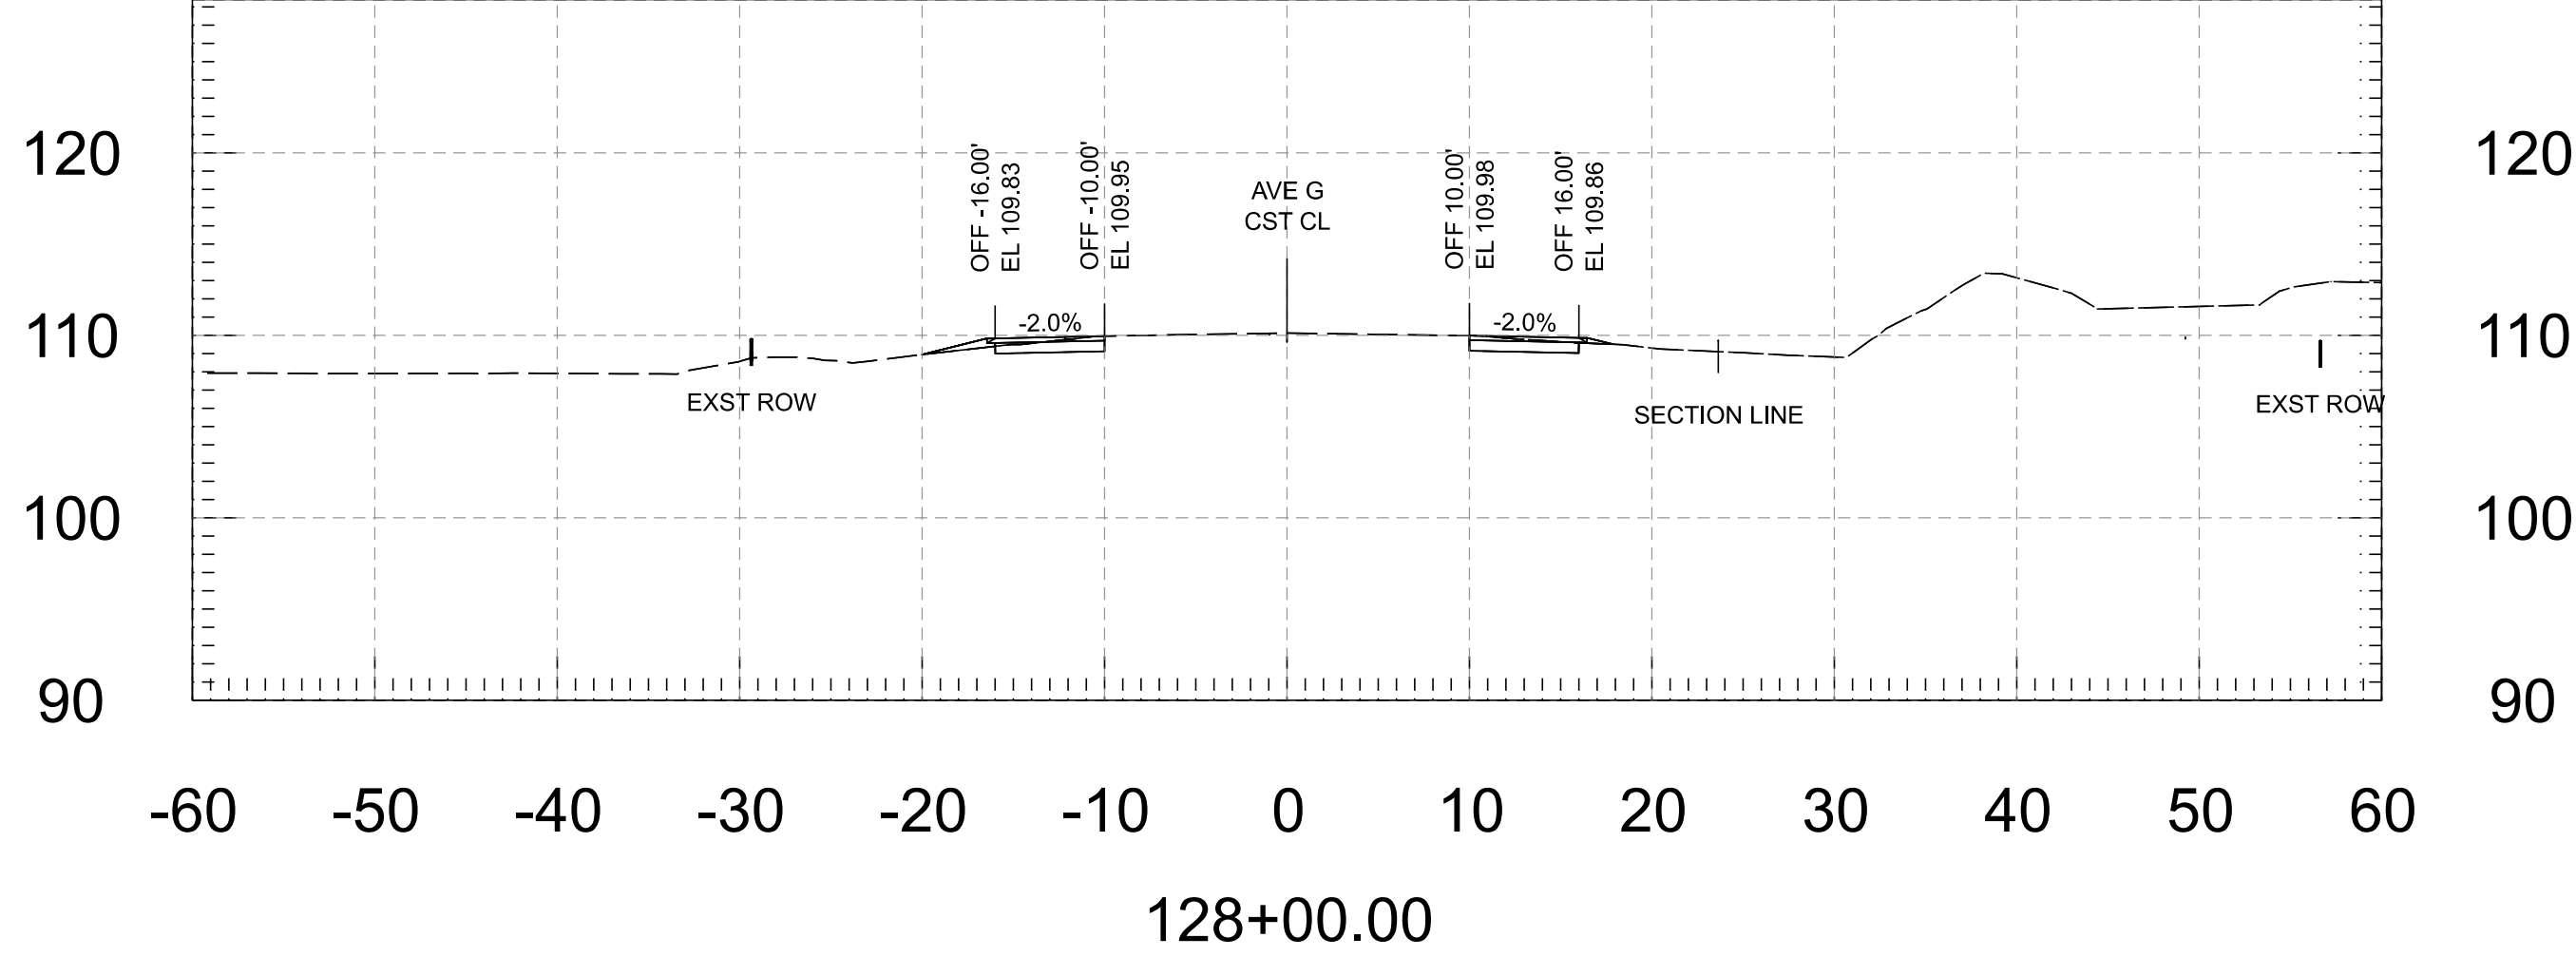


 FOR INFORMATION ONLY		NAME	DATE	ARIZONA DEPARTMENT OF TRANSPORTATION PROJECT DELIVERY AND OPERATIONS DIVISION ROADWAY DESIGN SERVICES	ROUTE	F.H.W.A. Arizona Division	STATE ARIZ.	PROJECT NO.	FEDERAL ID NO.	SHEET NO.	TOTAL SHEETS	RECORD DRAWING
	DESIGN	M. SCHOEN	07/26		MILEPOST			0000 YU YYU	YYU-0(225)T	57	118	
	DRAWN	M. SCHOEN	07/26		LOCATION AVENUE G, COUNTY 11TH ST - COUNTY 16TH ST	STRUCTURE NO.						
	CHECKED	H. RIOS	07/26	TRACS NO. T0437 01C				DWG ___ OF ___				
	 WSP USA Inc. 1200 West Washington Street, Suite 405 Tempe, AZ 85288		AVENUE G - CROSS SECTIONS									

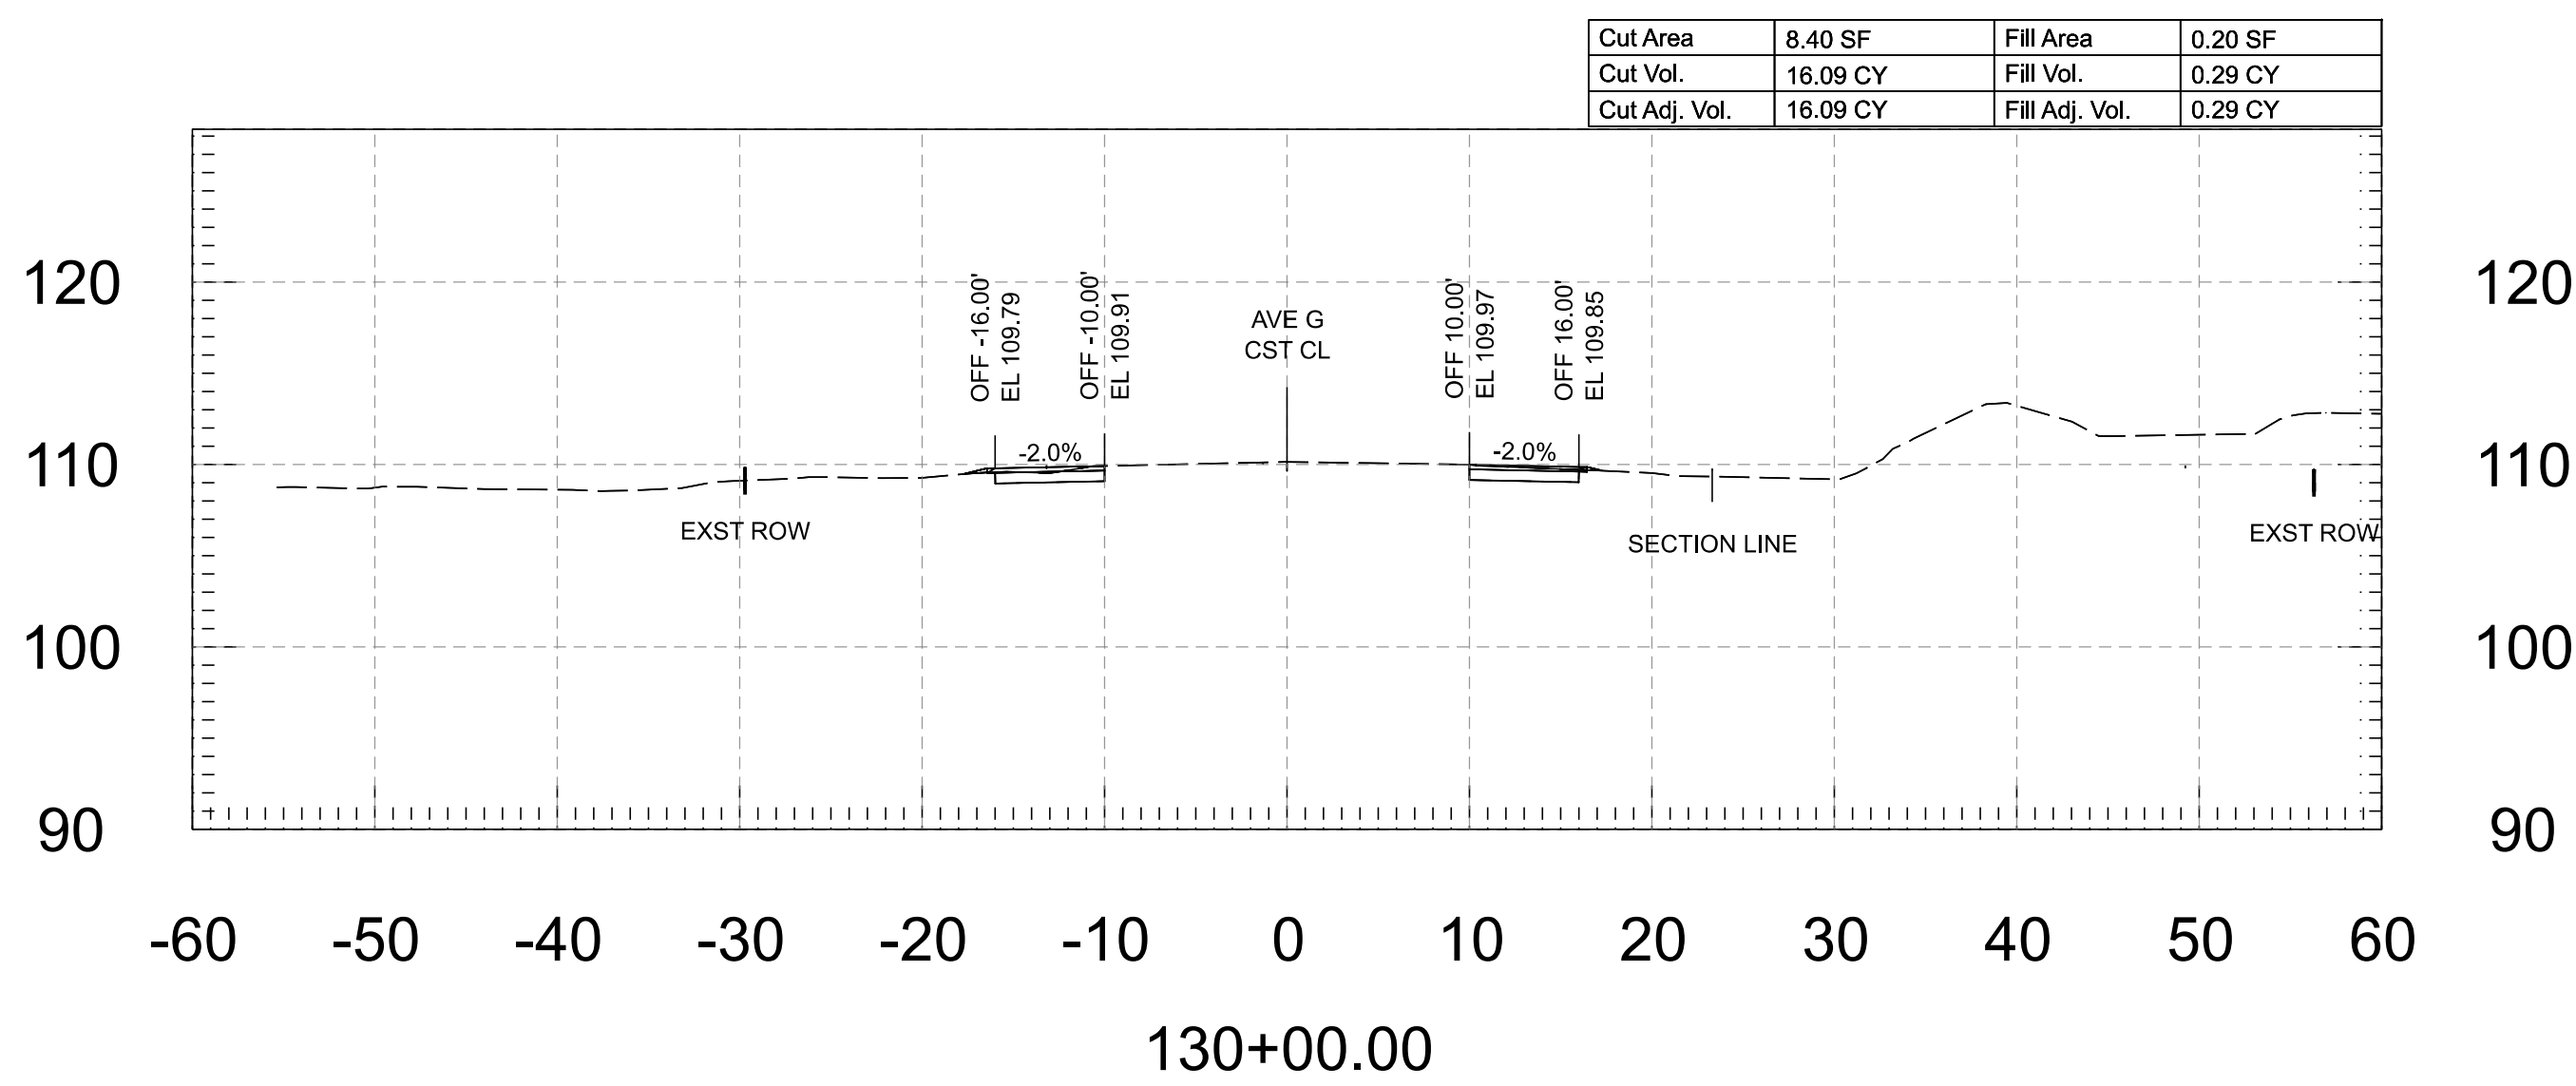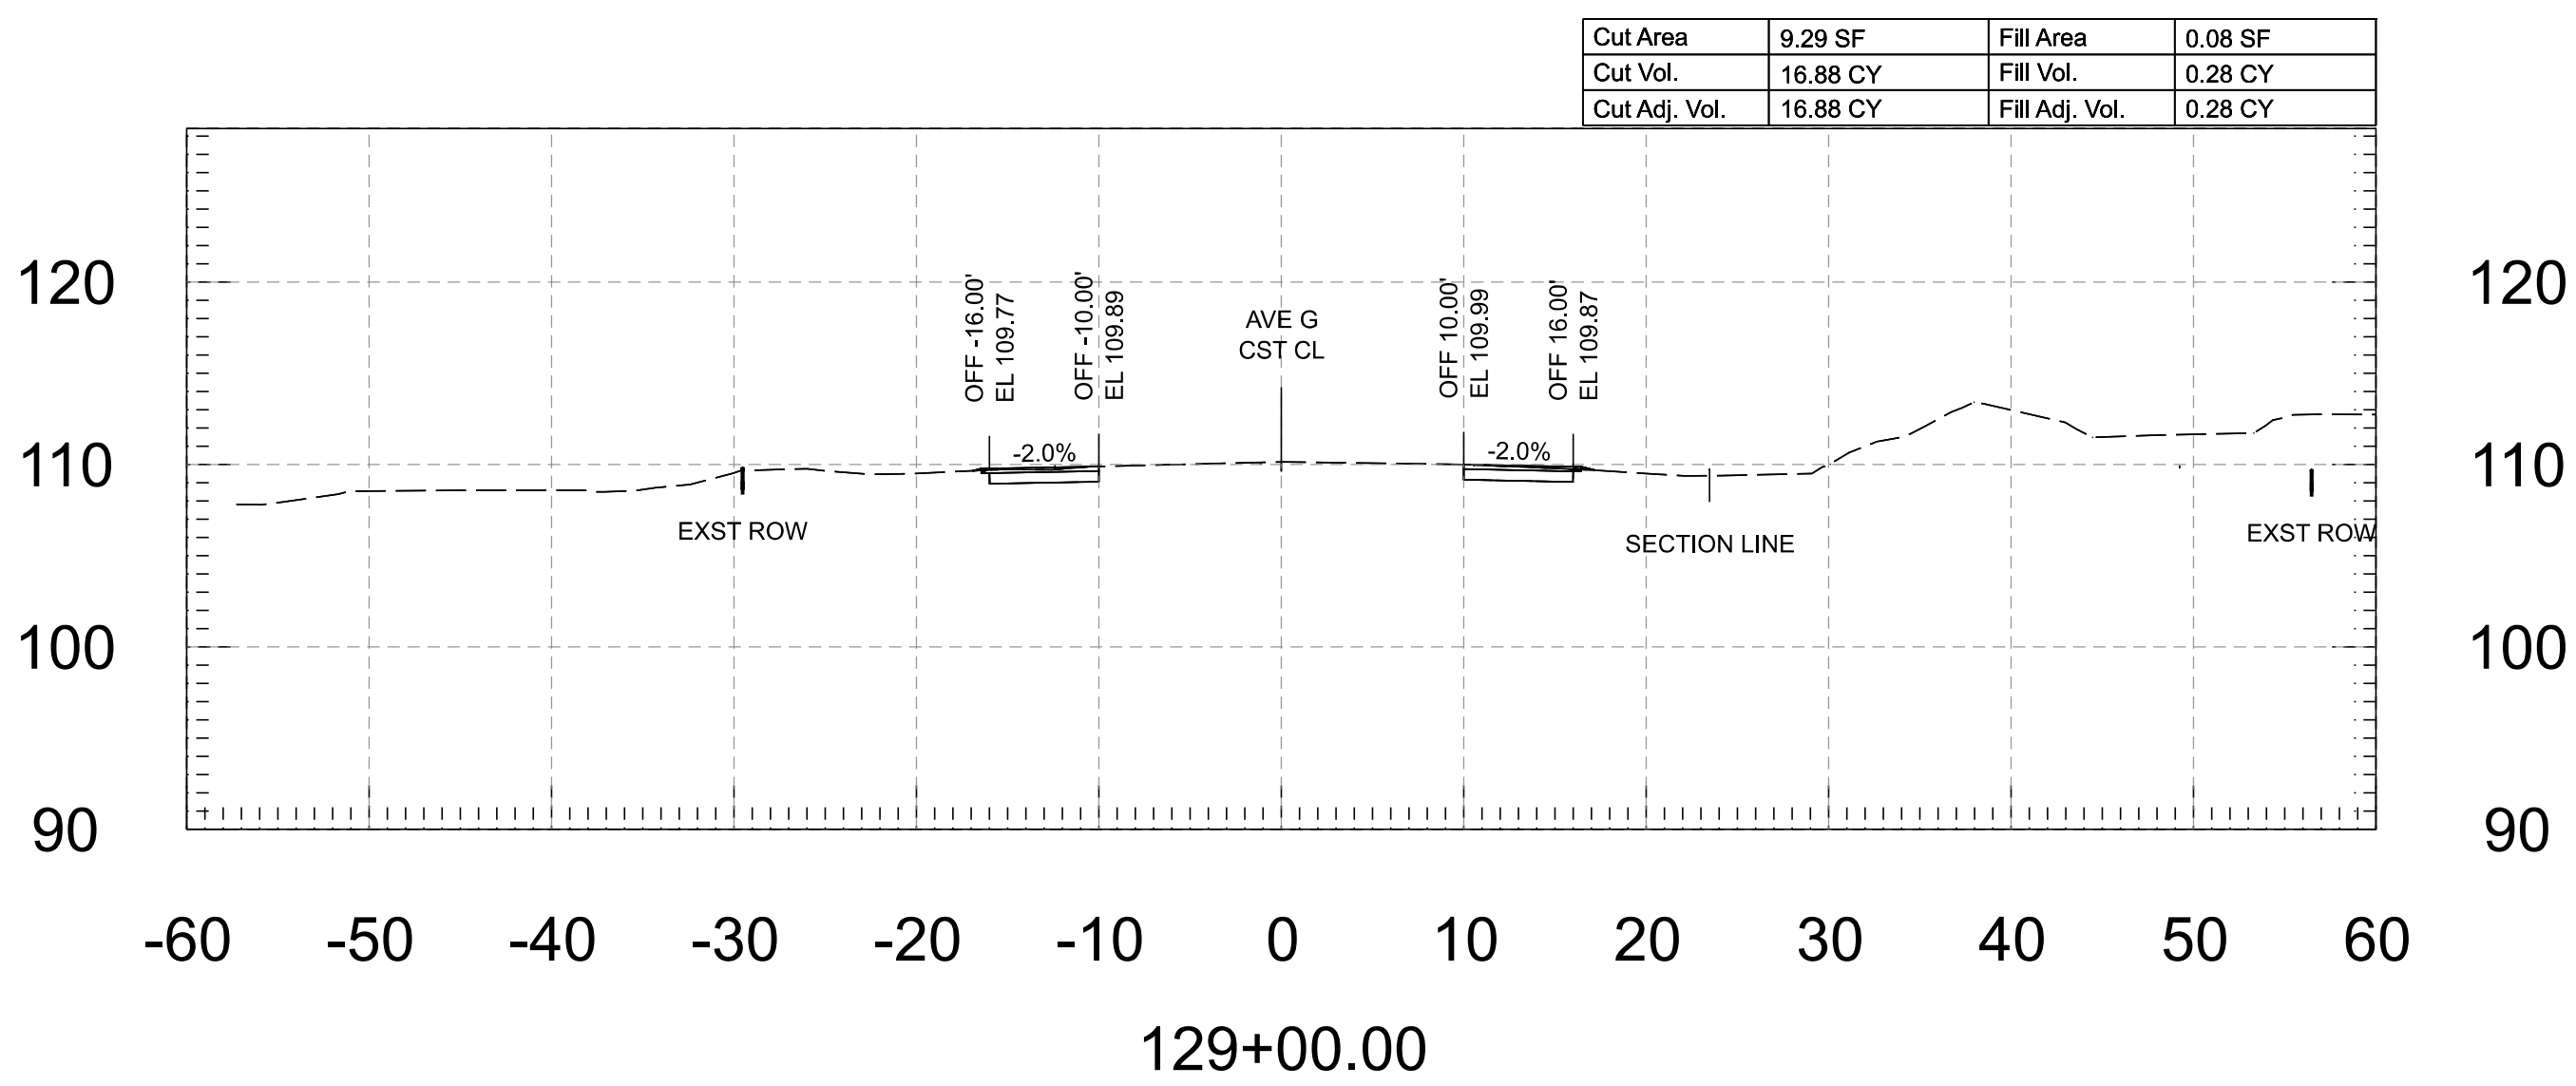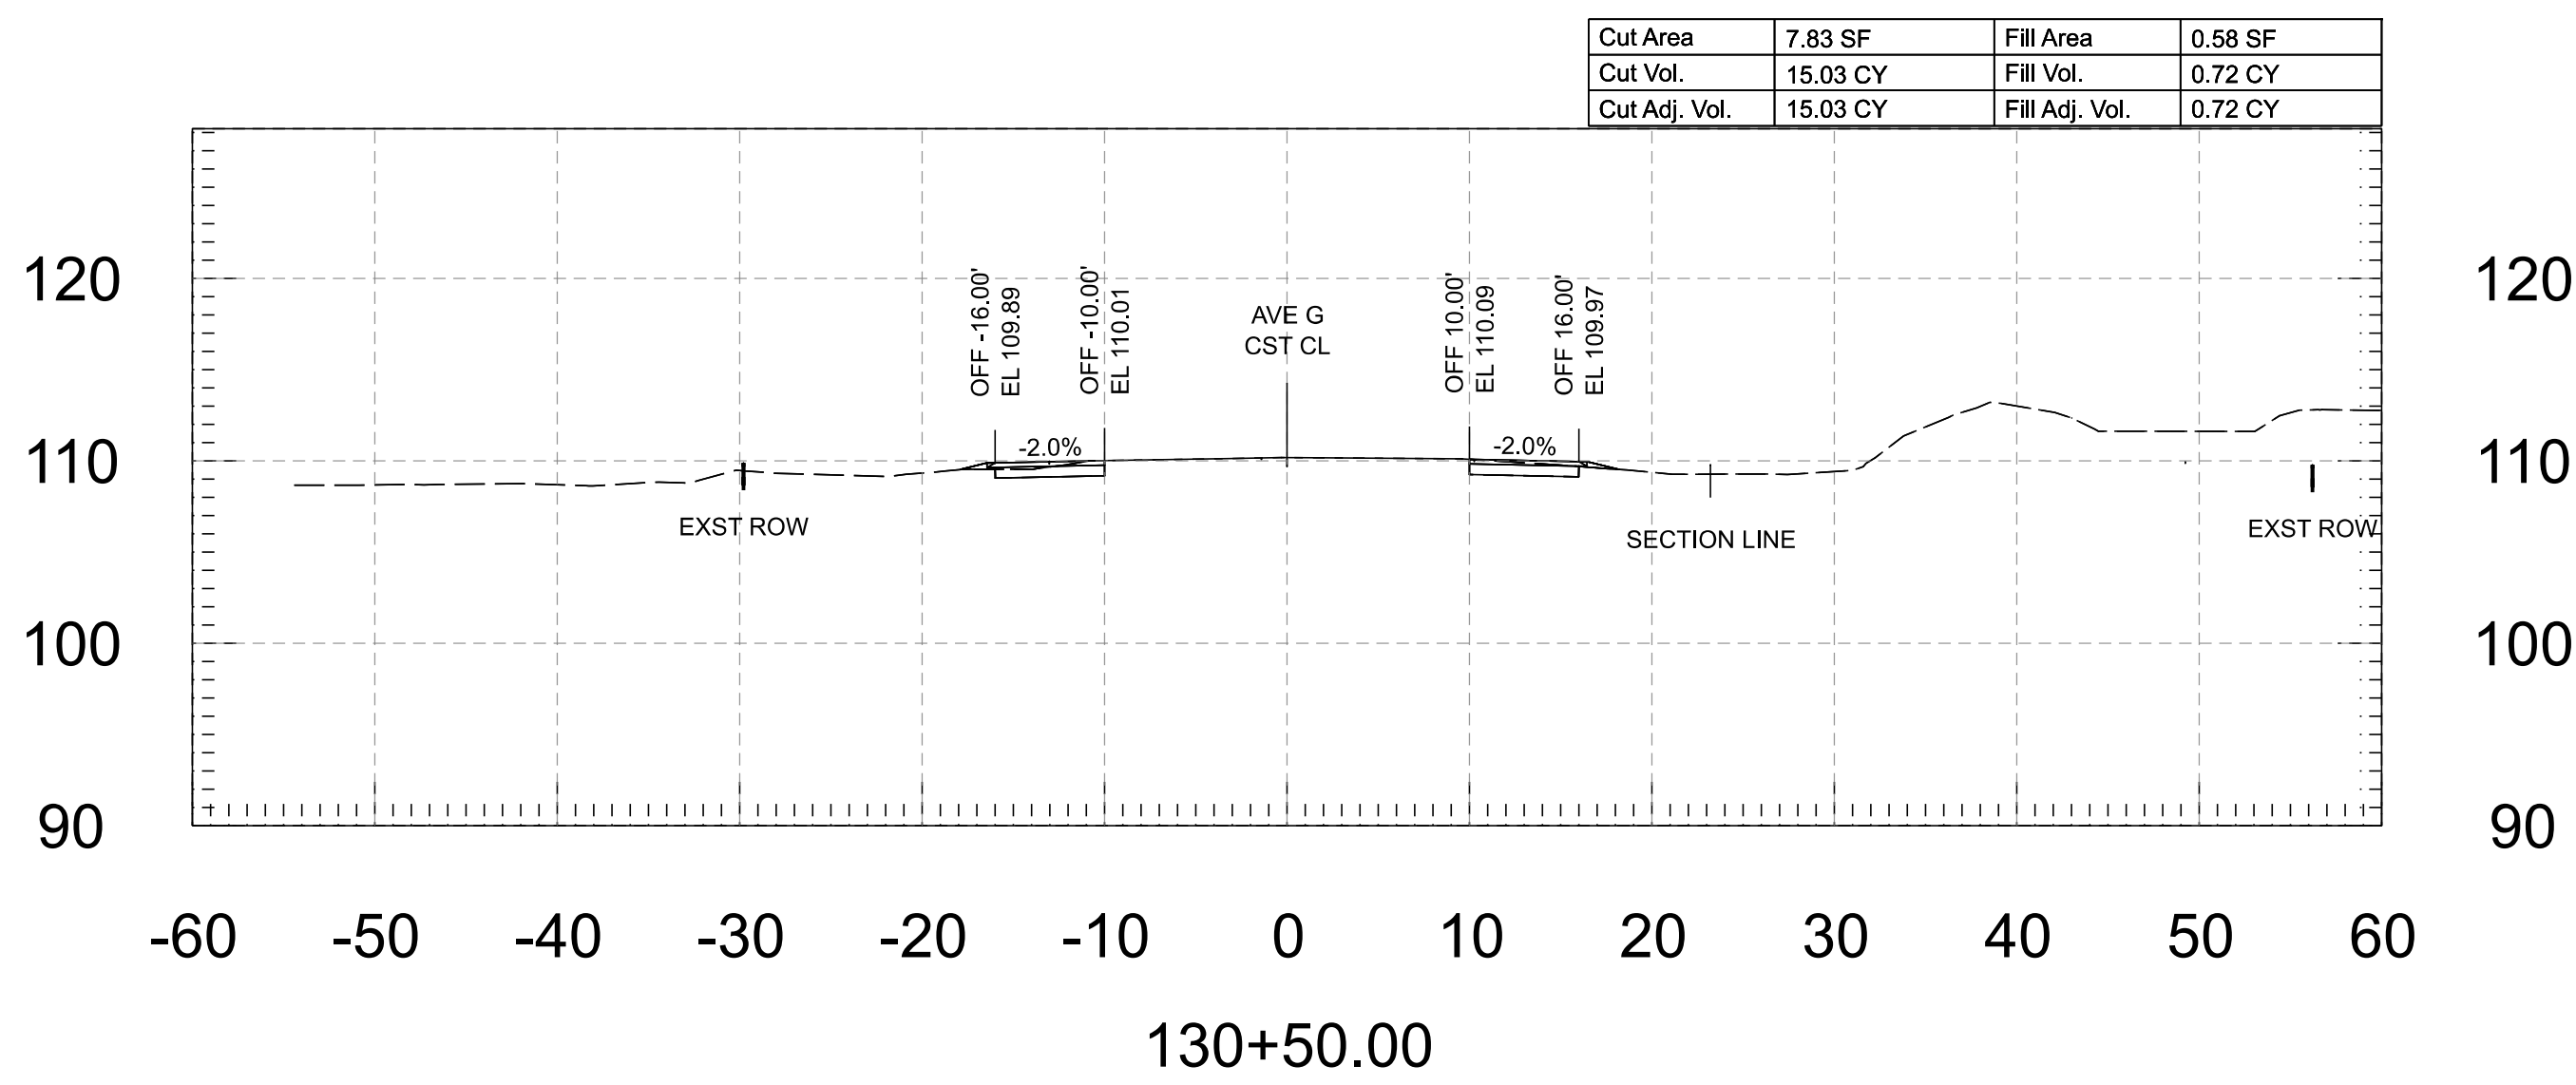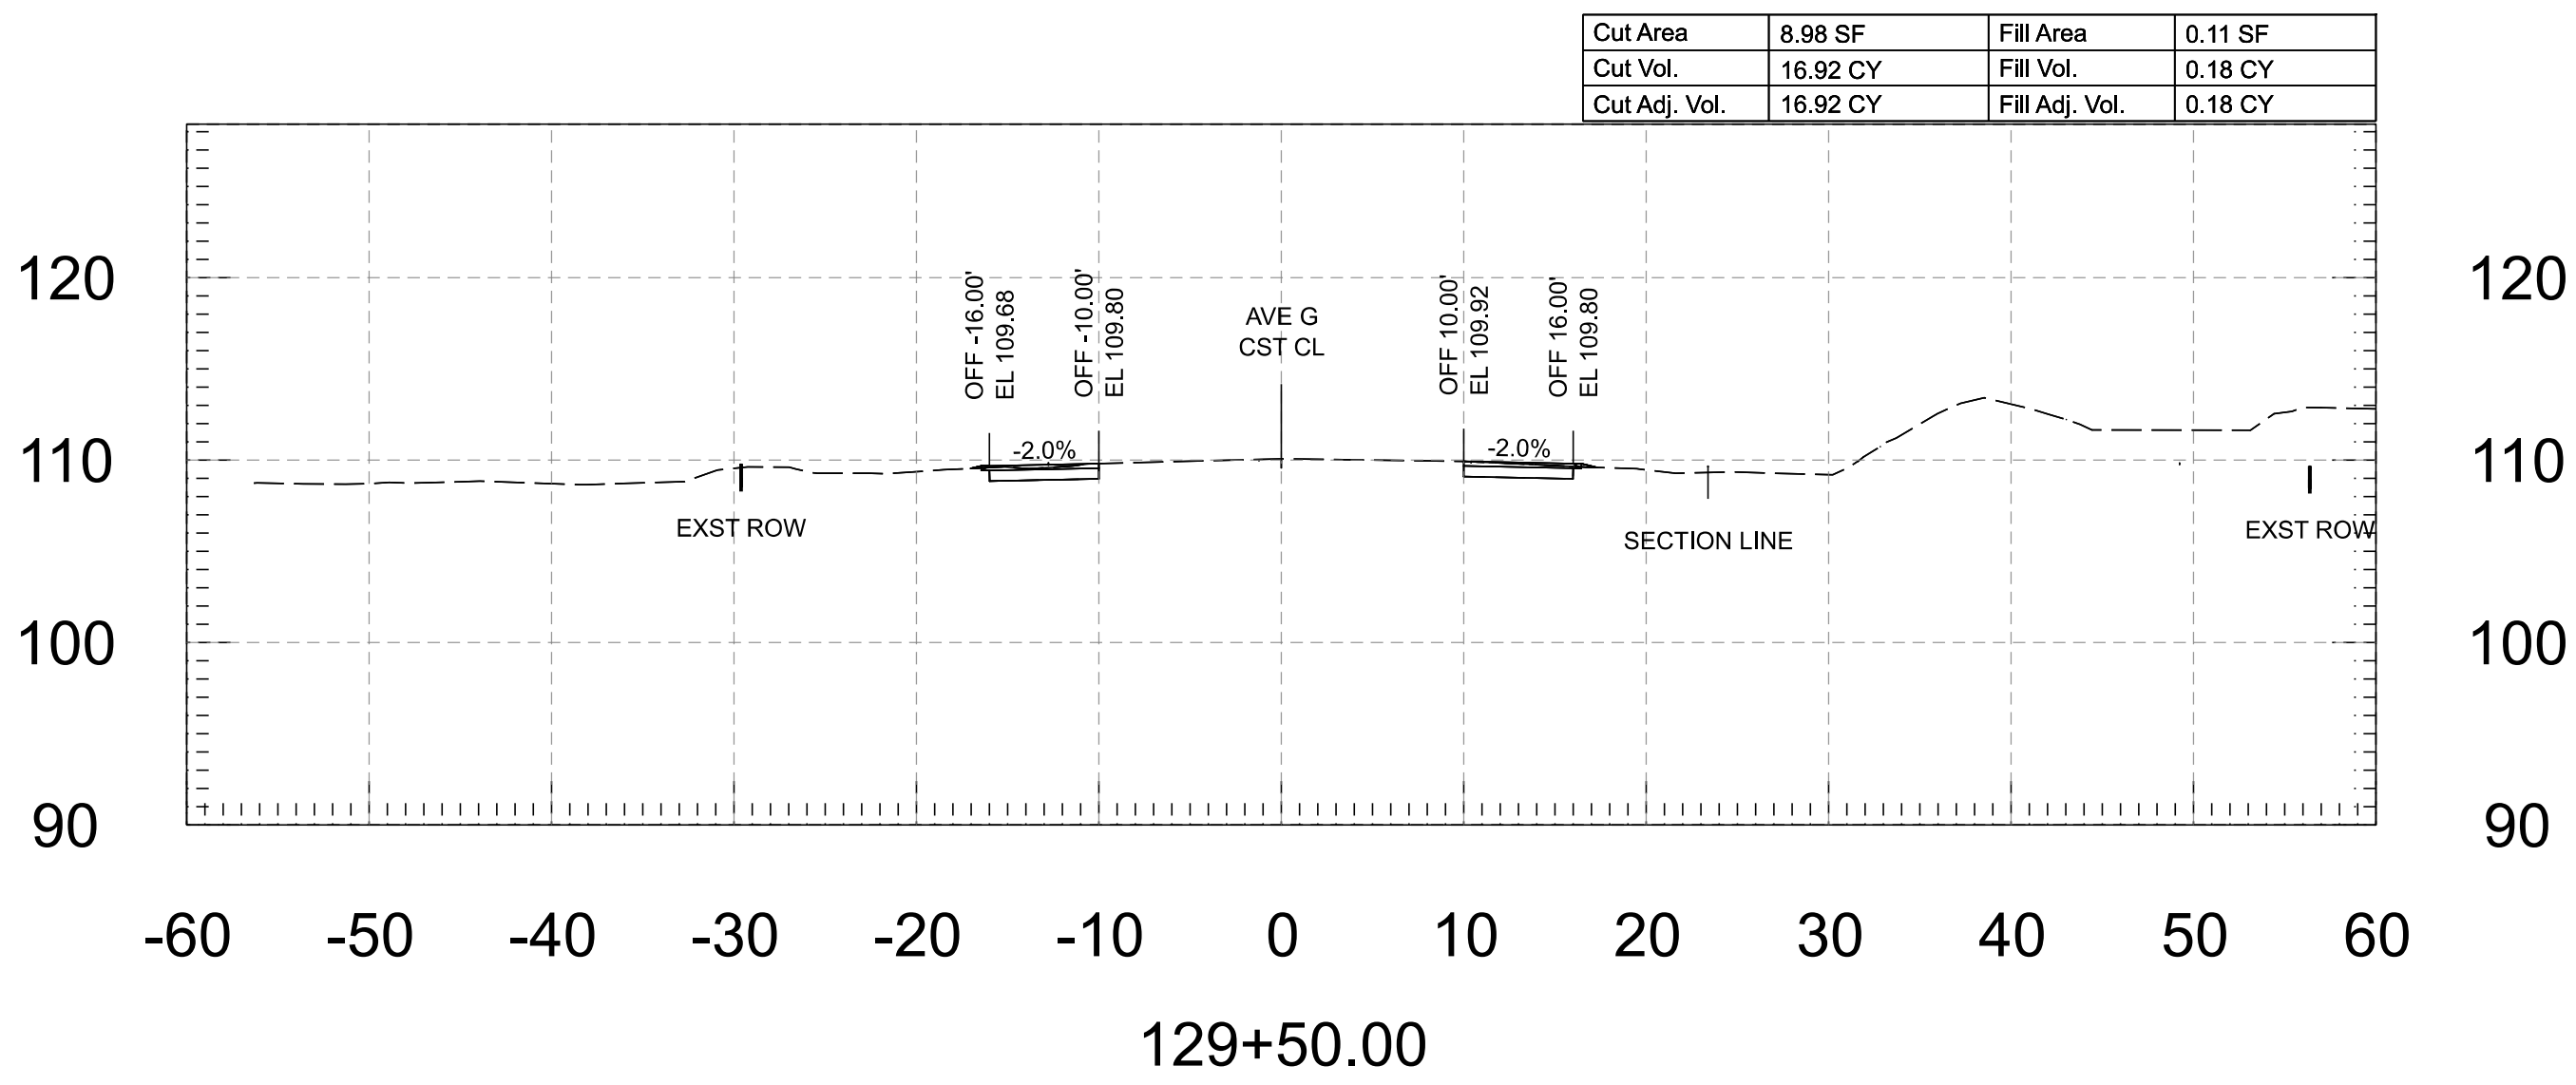

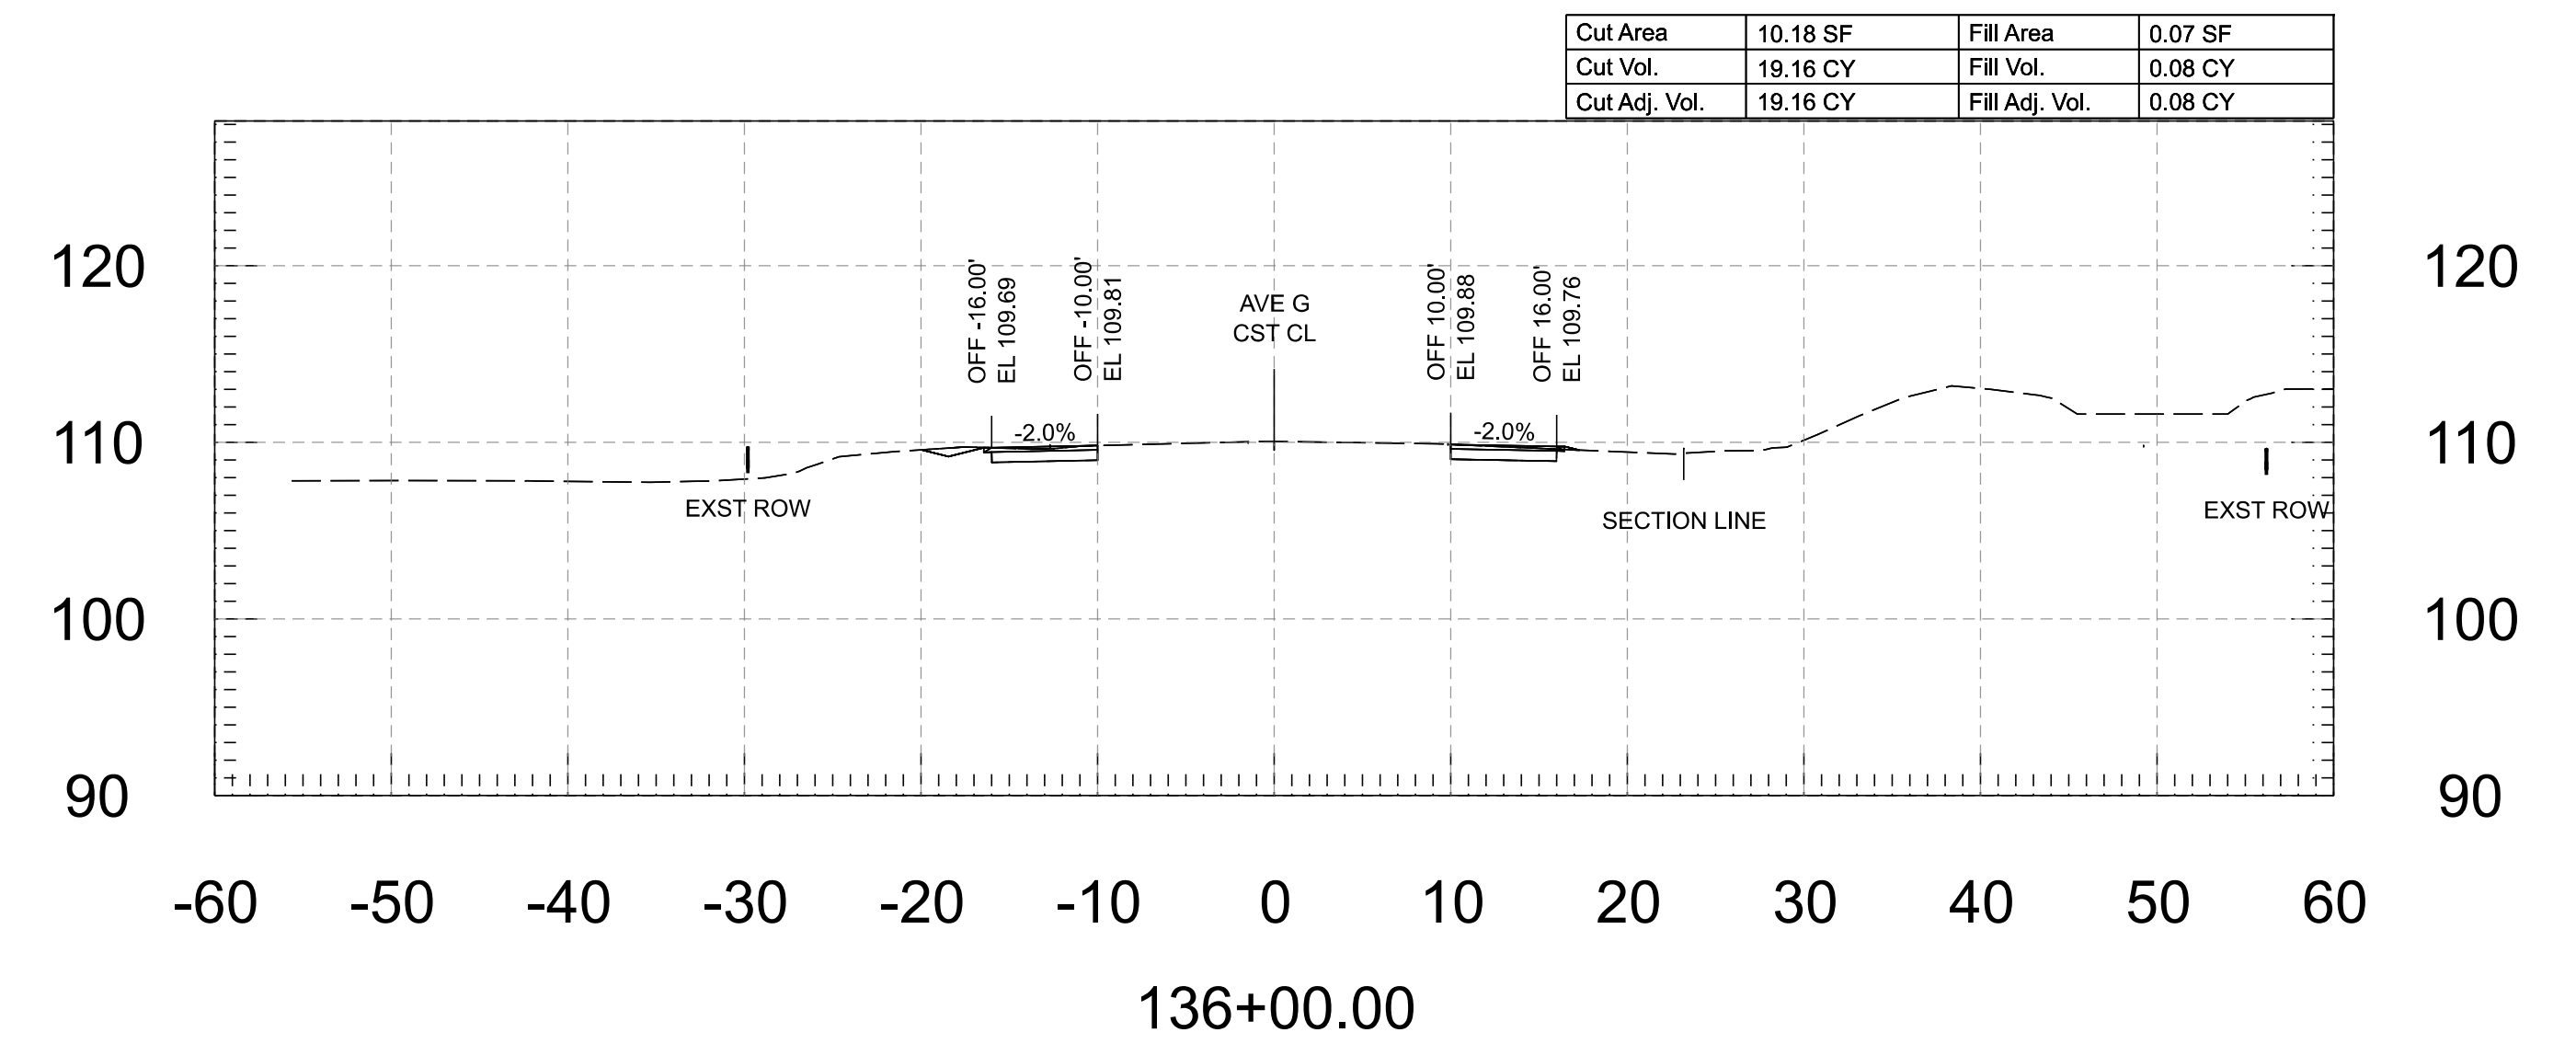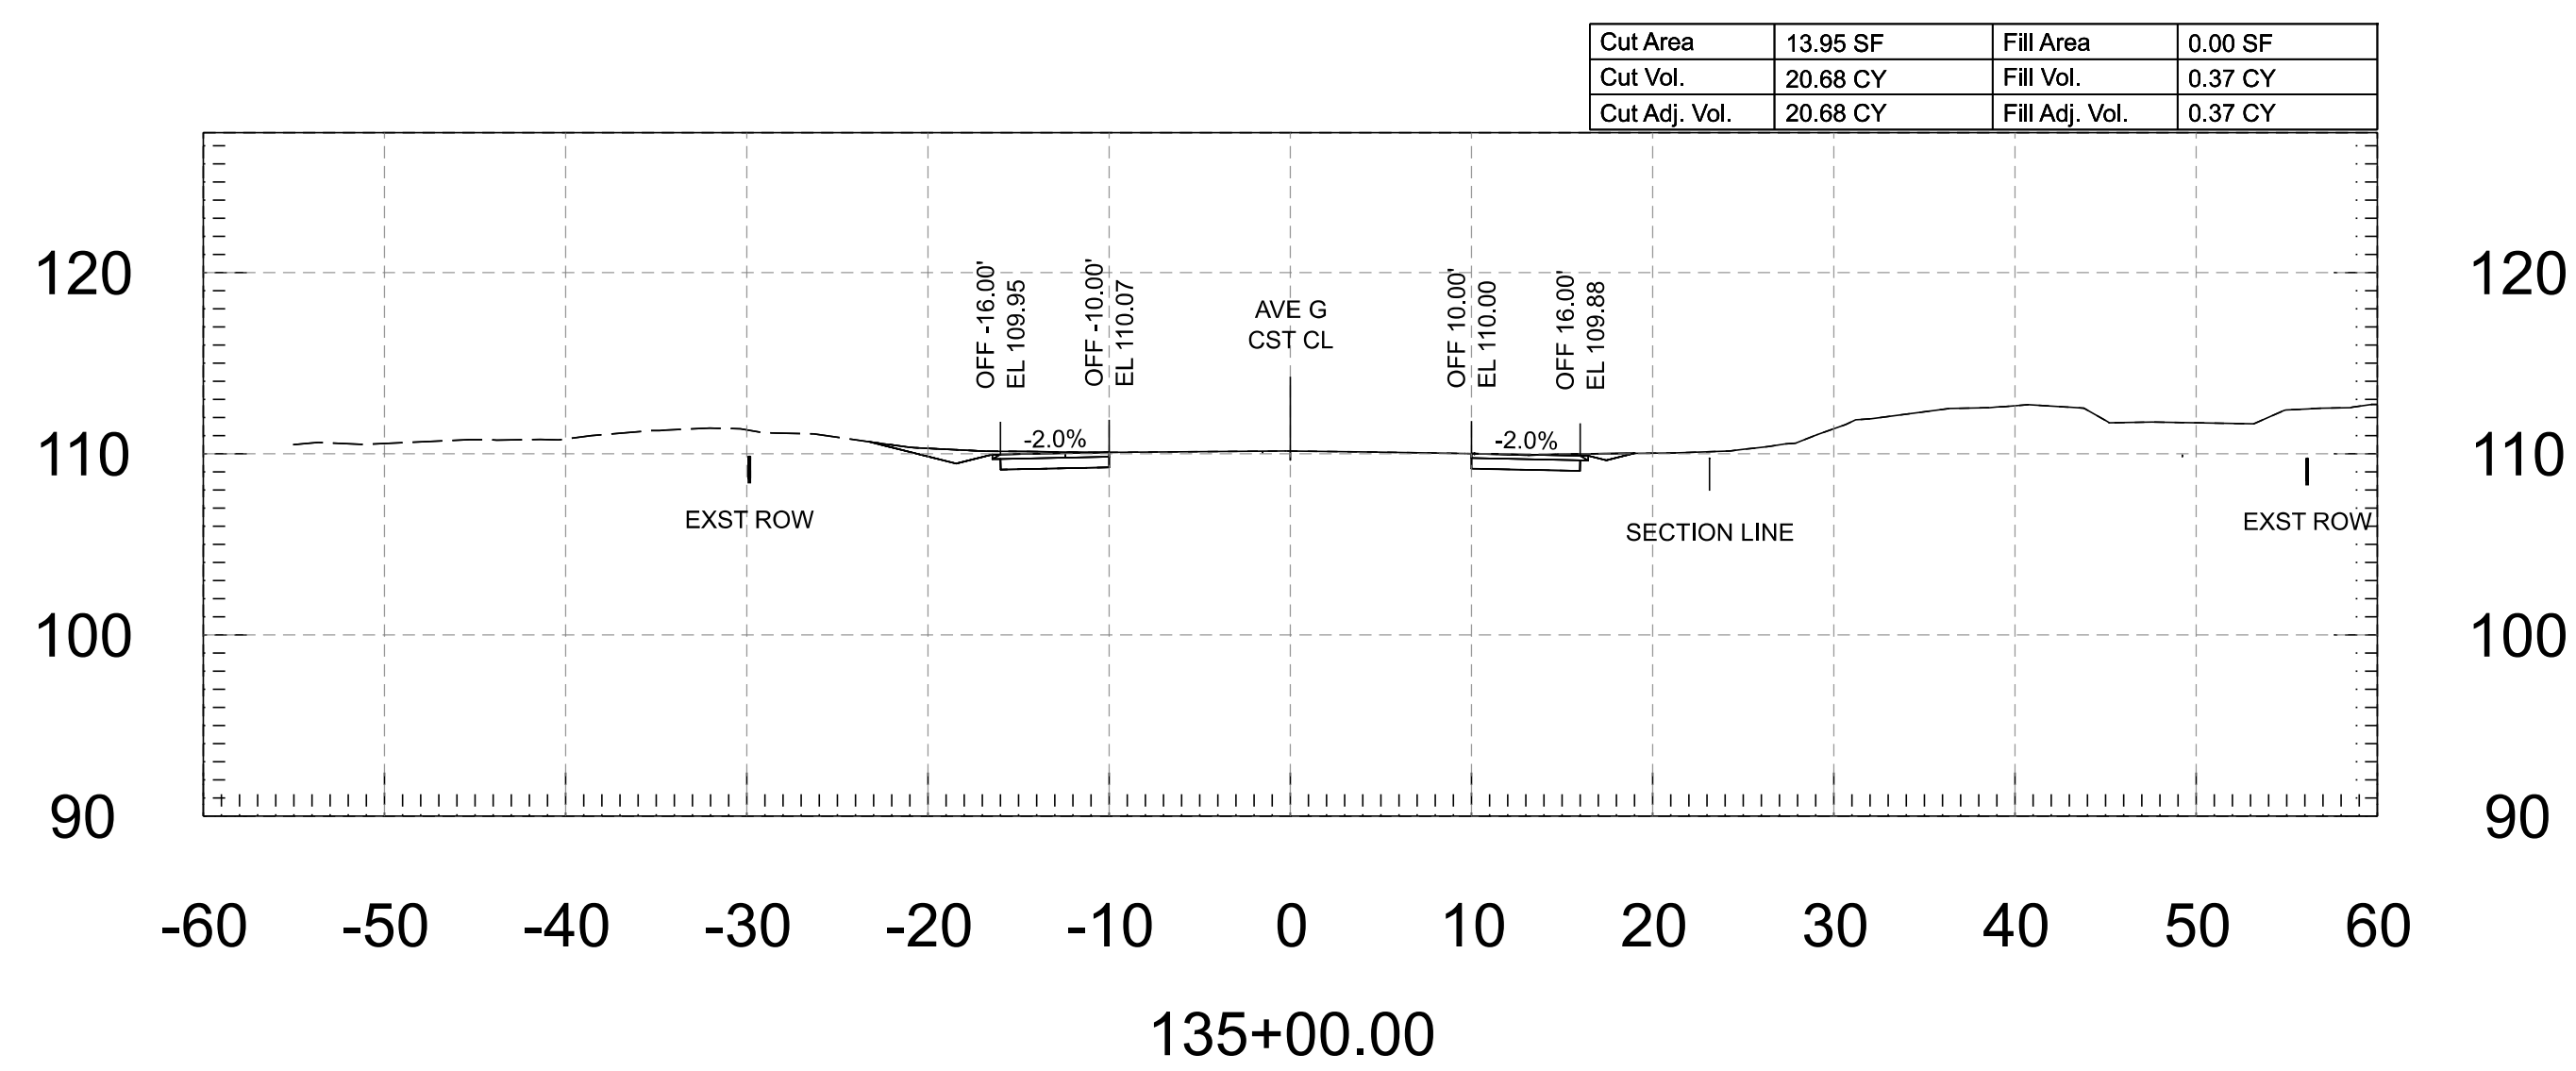


FOR INFORMATION ONLY		NAME	DATE	ARIZONA DEPARTMENT OF TRANSPORTATION PROJECT DELIVERY AND OPERATIONS DIVISION ROADWAY DESIGN SERVICES	ROUTE	F.H.W.A. Arizona Division	STATE	PROJECT NO.	FEDERAL ID NO.	SHEET NO.	TOTAL SHEETS	RECORD DRAWING
	DESIGN	M. SCHOEN	07/26		MILEPOST		ARIZ.	0000 YU YUY	YYU-0(225)T	61	118	
	DRAWN	M. SCHOEN	07/26		STRUCTURE NO.	LOCATION AVENUE G, COUNTY 11TH ST - COUNTY 16TH ST DWG						
	CHECKED	H. RIOS	07/26			TRACS NO. T0437 01C						
	 WSP USA Inc. 1230 West Washington Street, Suite 405 Tempe, AZ 85288			AVENUE G - CROSS SECTIONS								

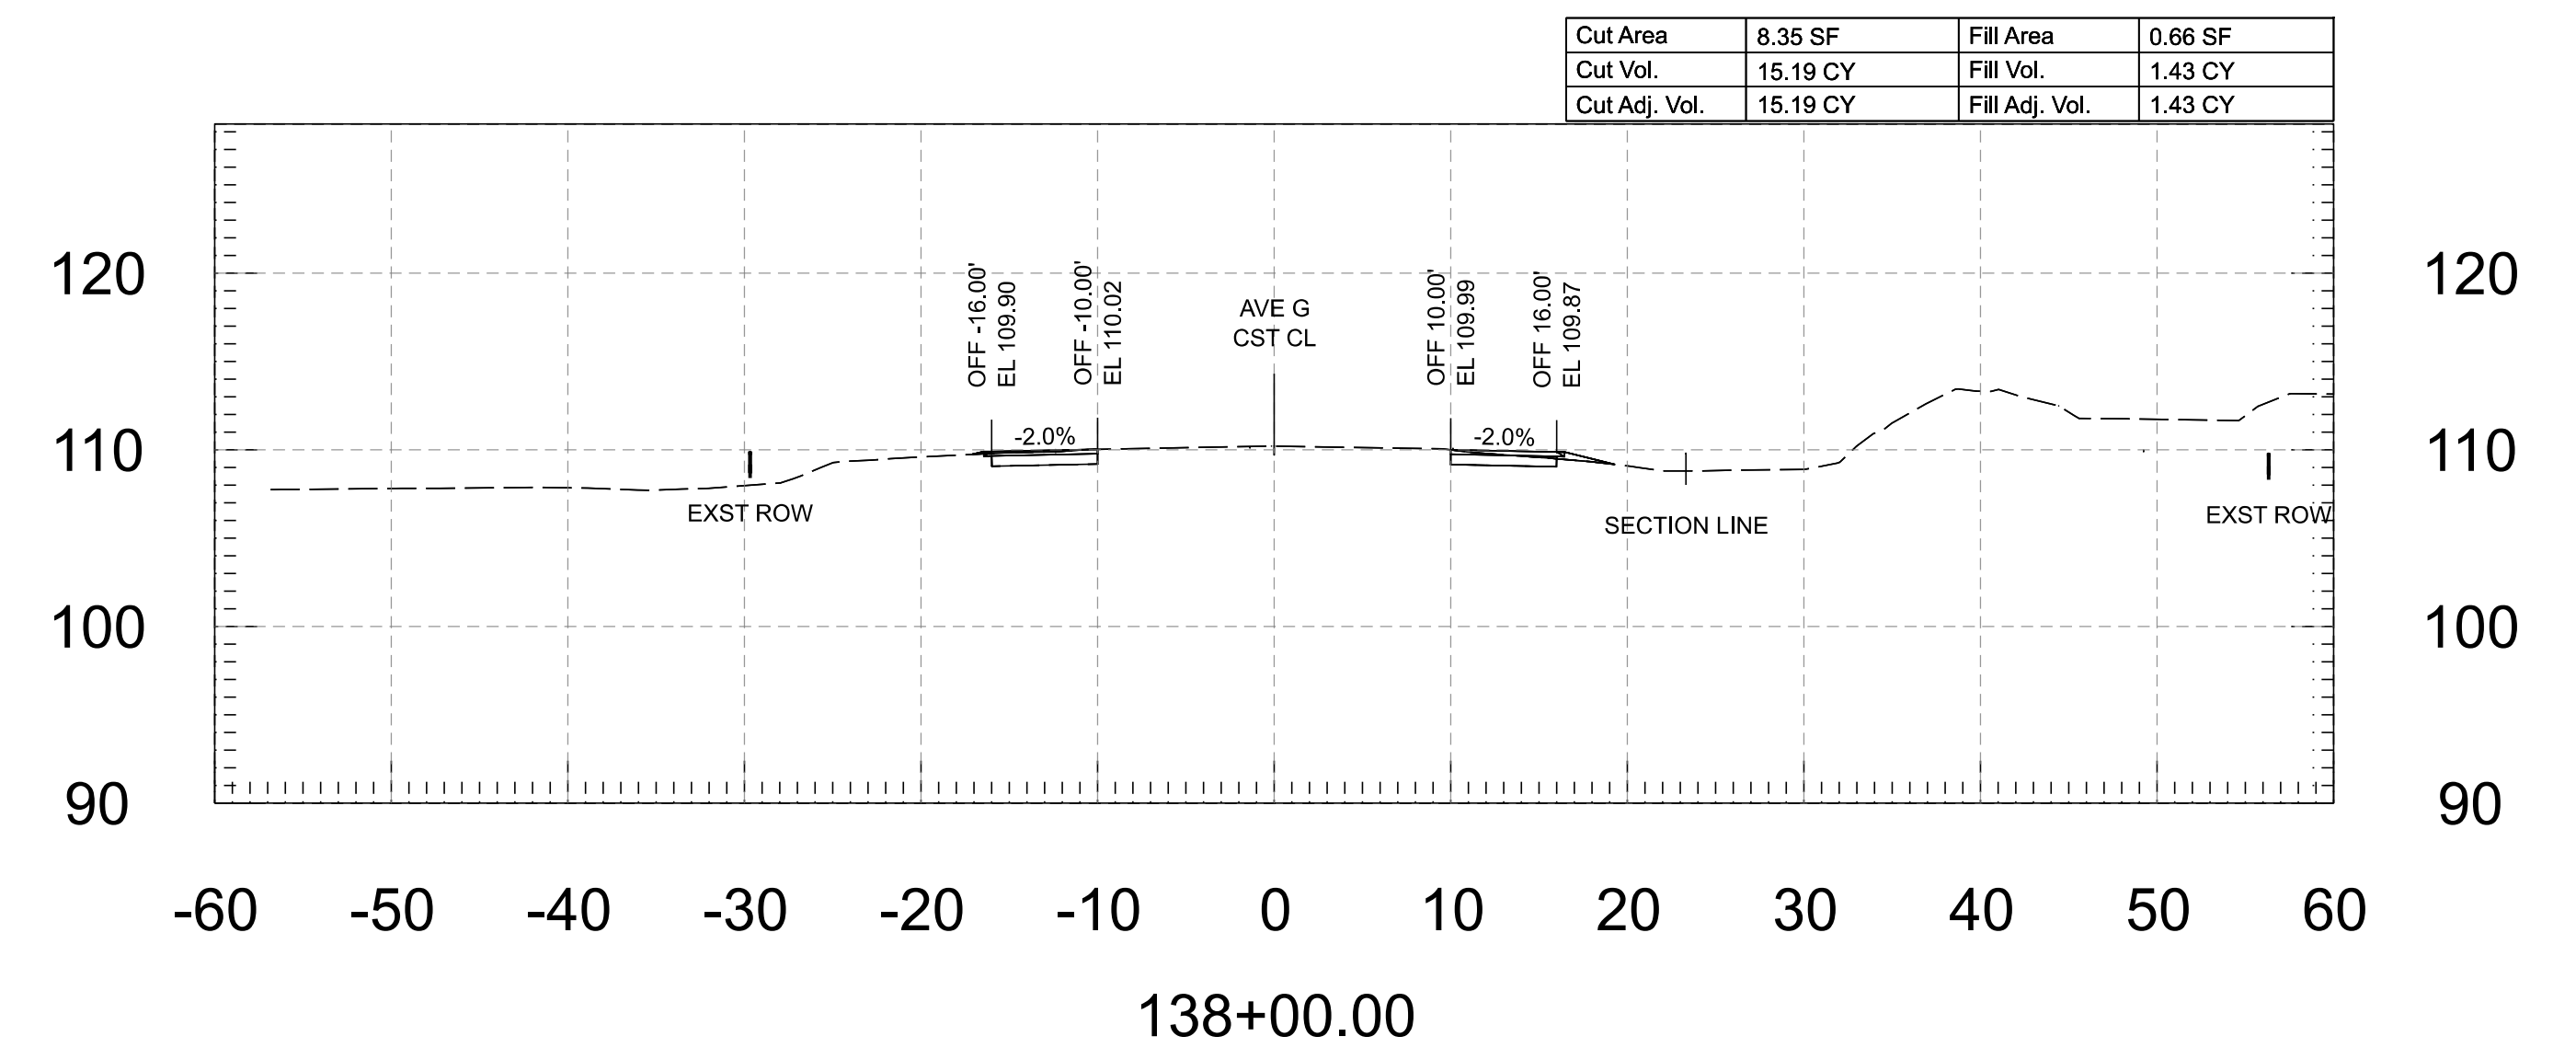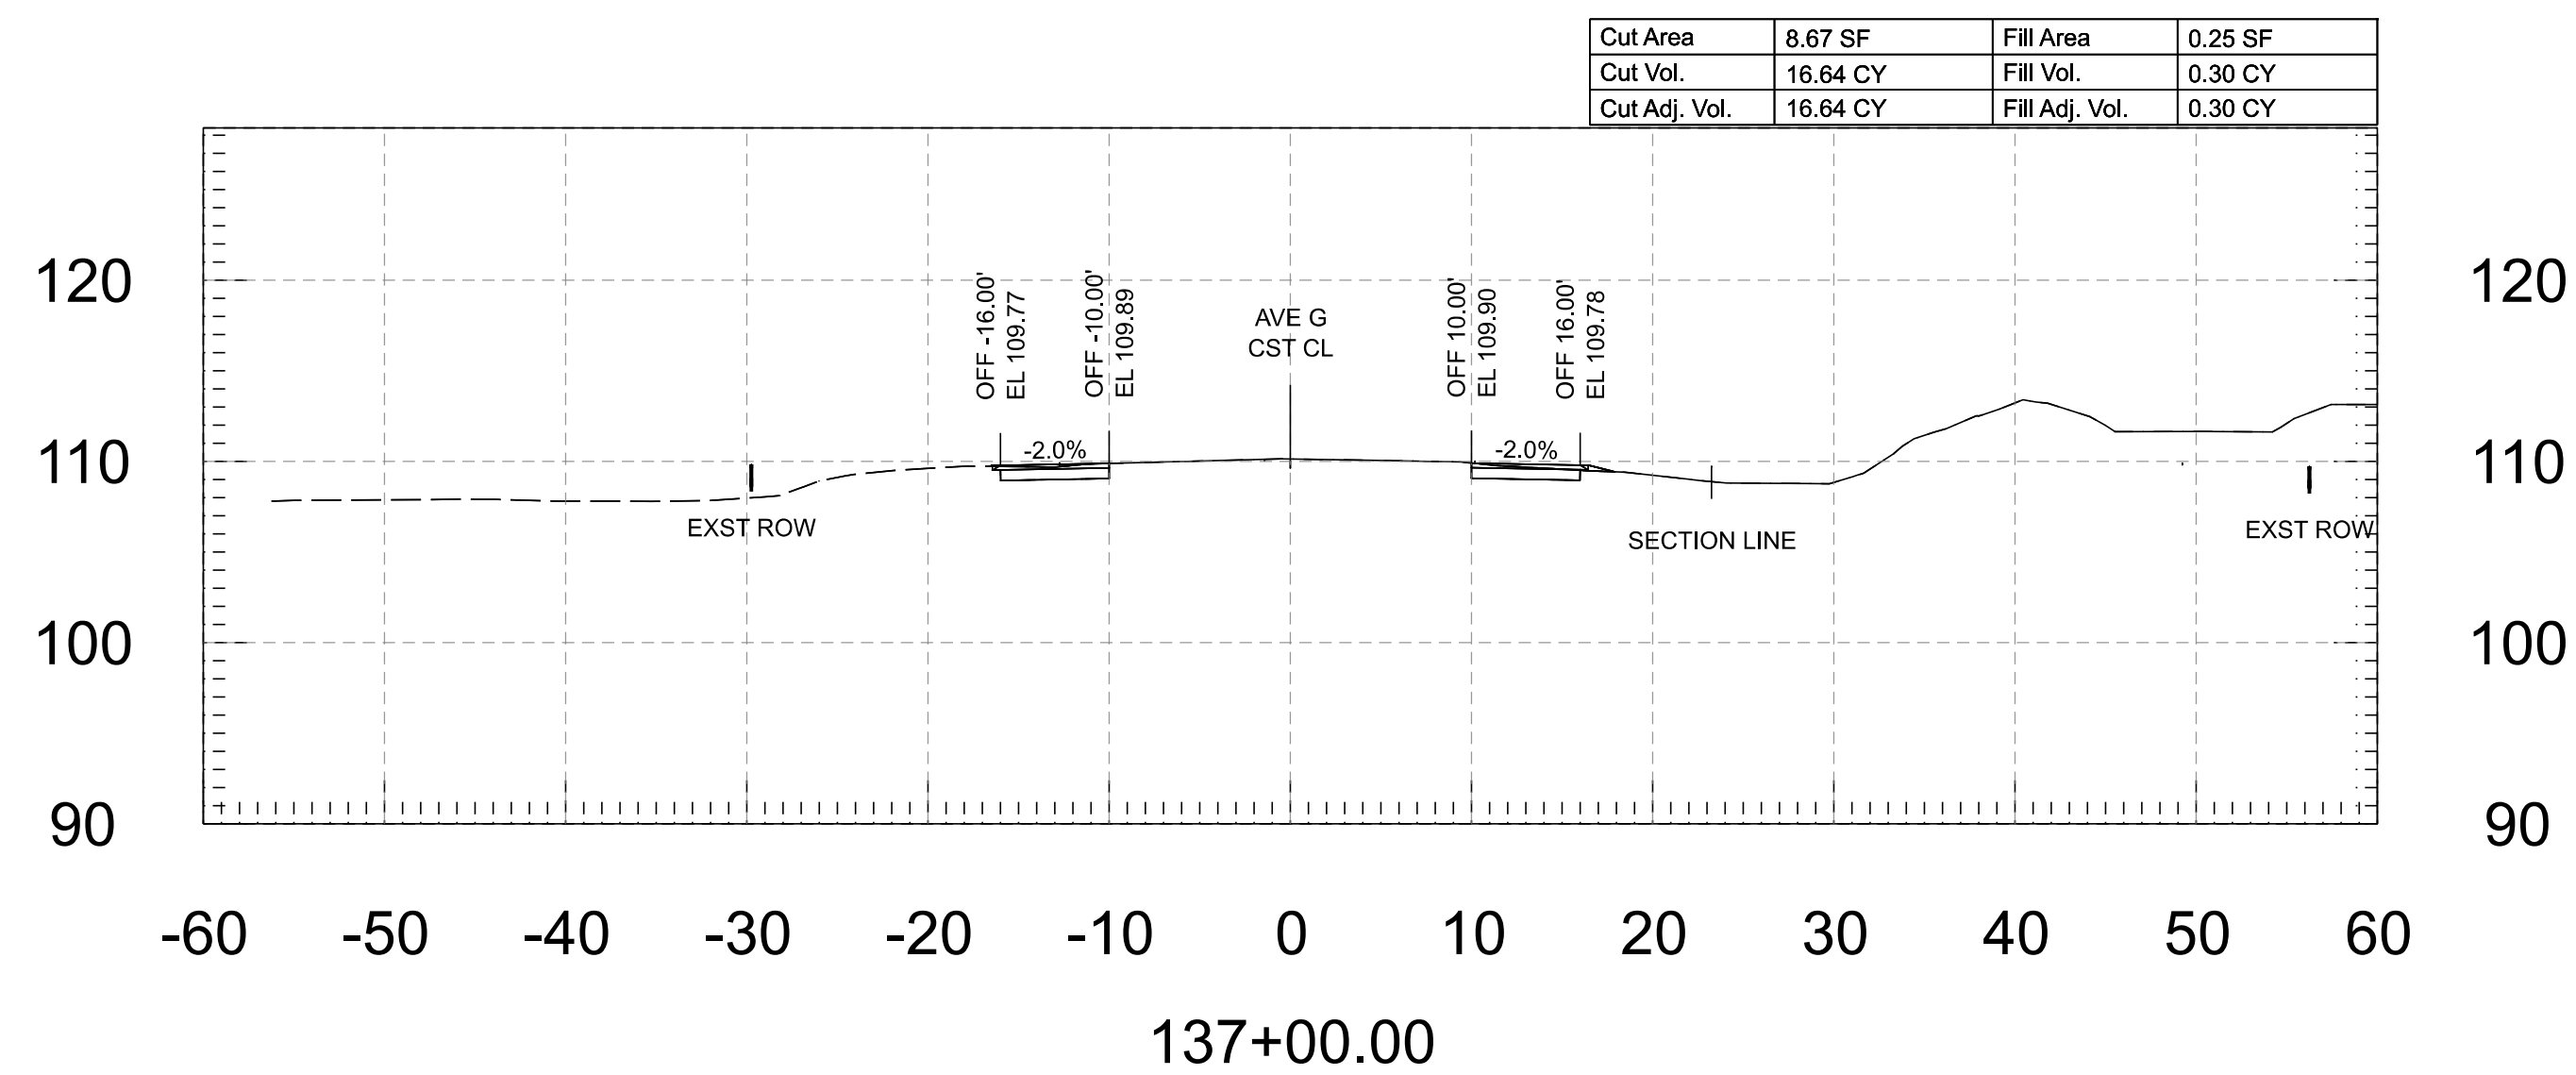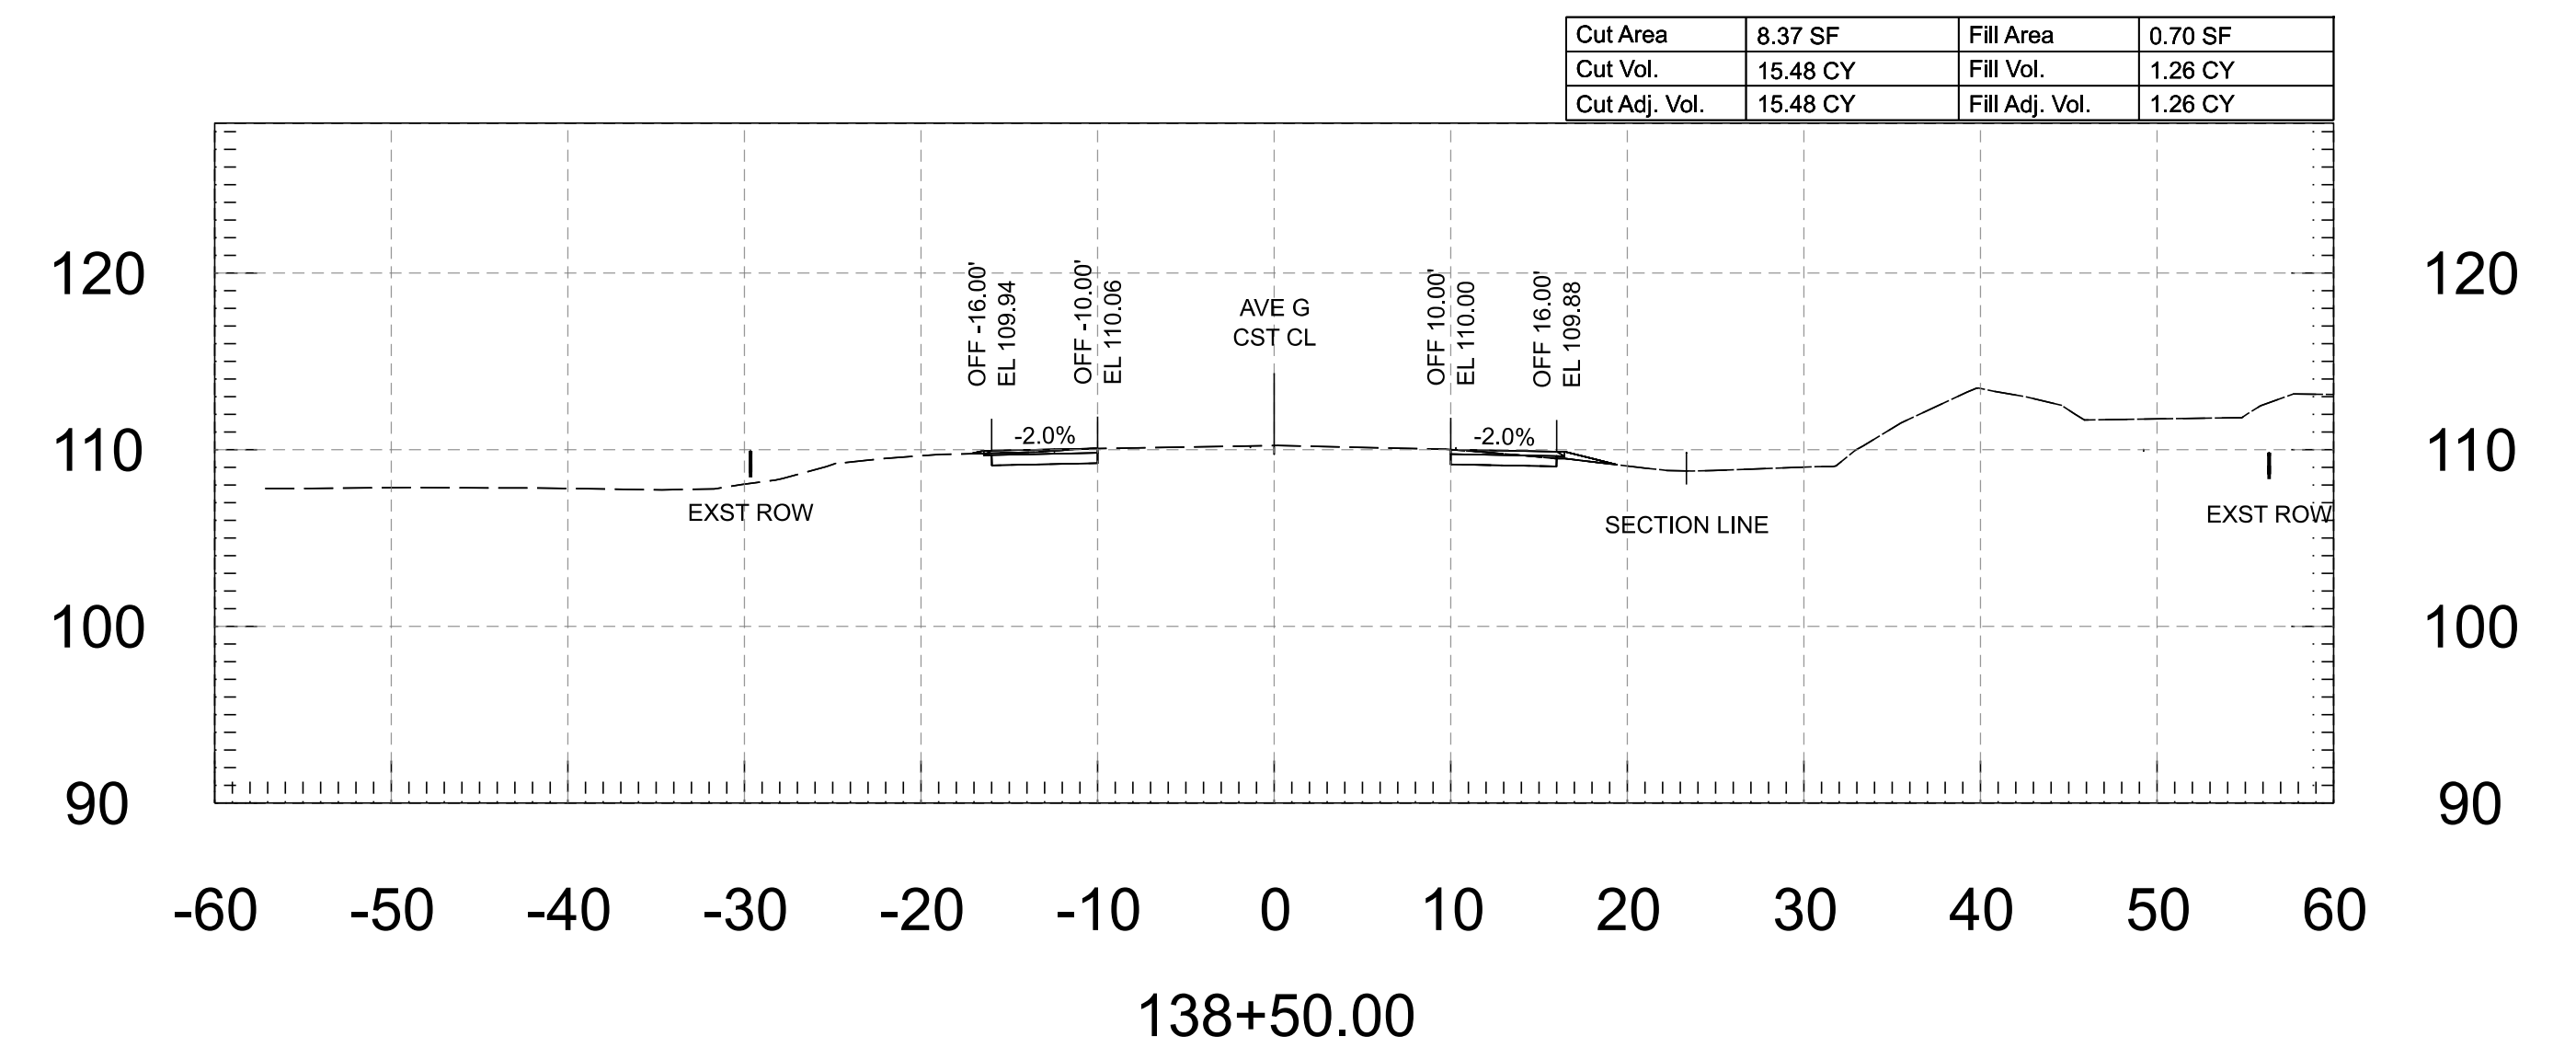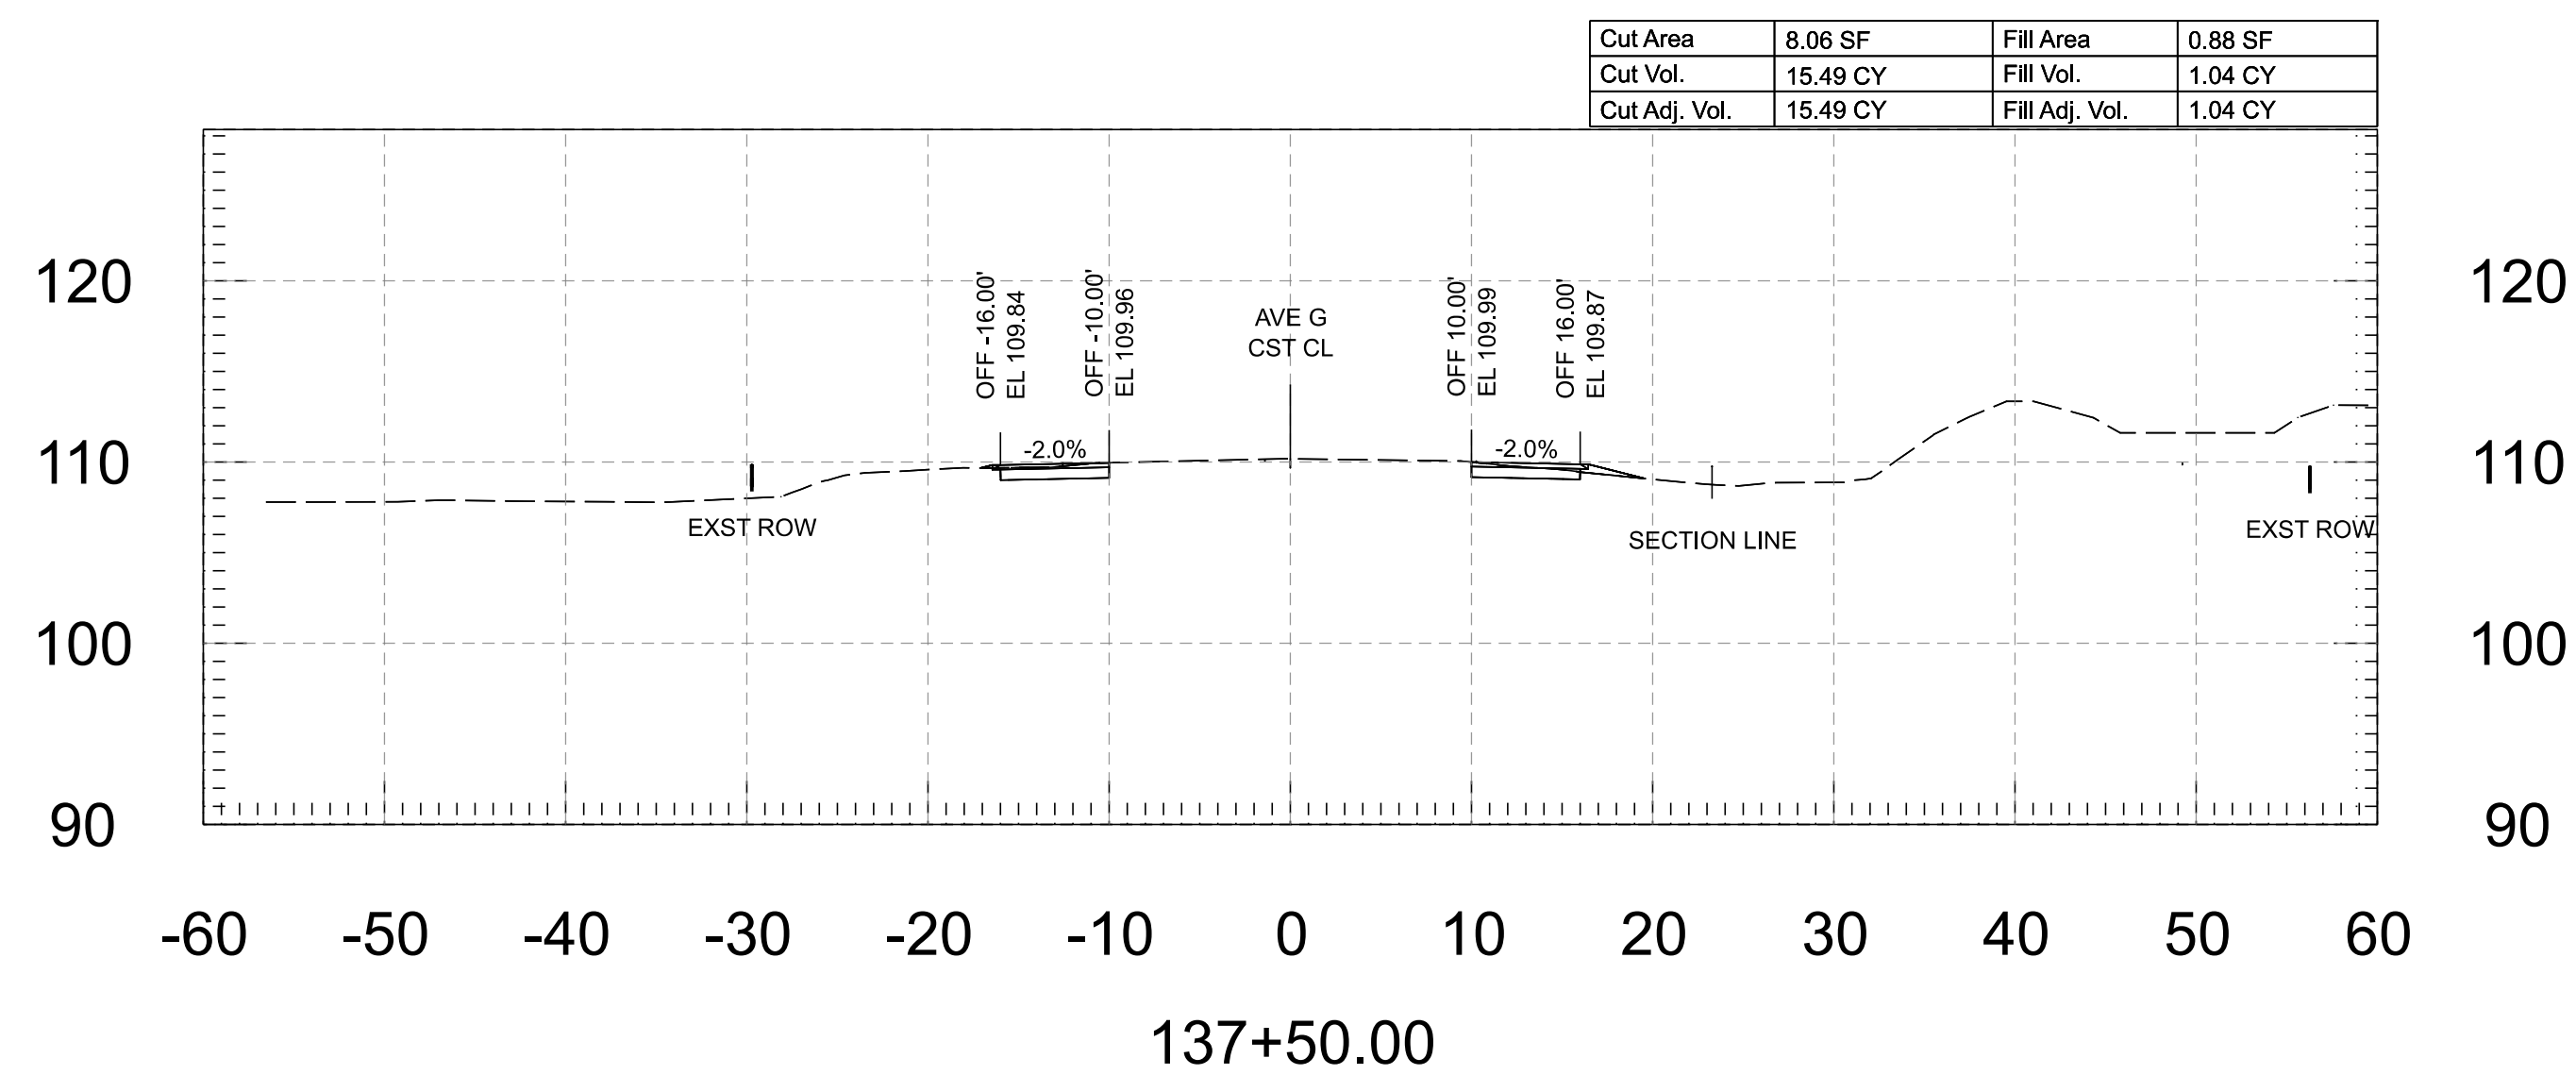


FOR INFORMATION ONLY		NAME	DATE	ARIZONA DEPARTMENT OF TRANSPORTATION PROJECT DELIVERY AND OPERATIONS DIVISION ROADWAY DESIGN SERVICES	ROUTE	F.H.W.A. Arizona Division	STATE ARIZ.	PROJECT NO.	FEDERAL ID NO.	SHEET NO.	TOTAL SHEETS	RECORD DRAWING
	DESIGN	M. SCHOEN	07/26		MILEPOST			0000 YU YU	YYU-0(225)T	62	118	
	DRAWN	M. SCHOEN	07/26		STRUCTURE NO.	LOCATION AVENUE G, COUNTY 11TH ST - COUNTY 16TH ST DWG _____ OF _____						
	CHECKED	H. RIOS	07/26									
	 WSP USA Inc. 1230 West Washington Street, Suite 405 Tempe, AZ 85288			AVENUE G - CROSS SECTIONS								


Cut Area	8.53 SF	Fill Area	0.57 SF
Cut Vol.	16.03 CY	Fill Vol.	0.92 CY
Cut Adj. Vol.	16.03 CY	Fill Adj. Vol.	0.92 CY

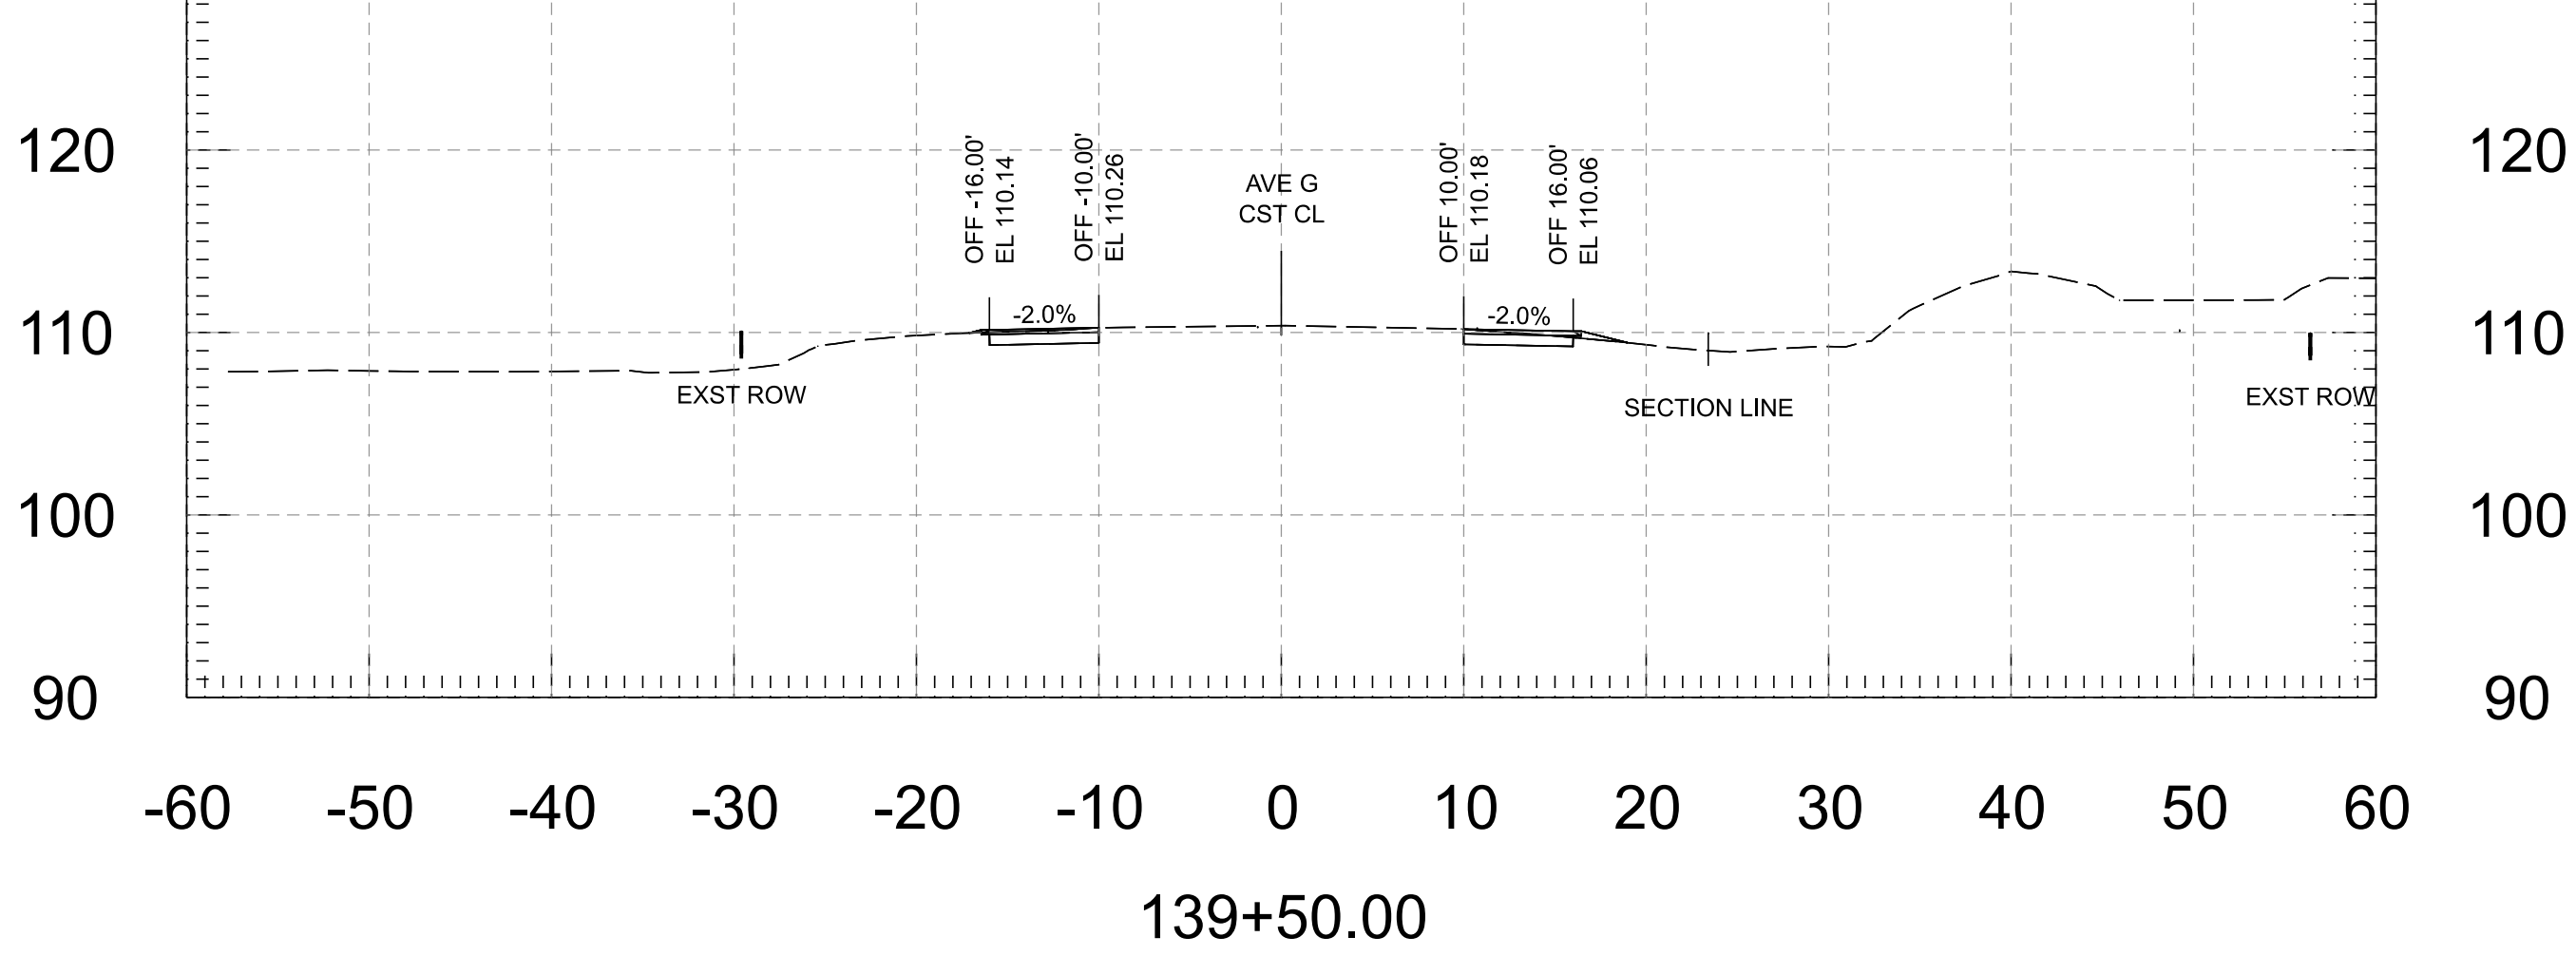


Cut Area	8.21 SF	Fill Area	0.87 SF
Cut Vol.	15.94 CY	Fill Vol.	1.37 CY
Cut Adj. Vol.	15.94 CY	Fill Adj. Vol.	1.37 CY

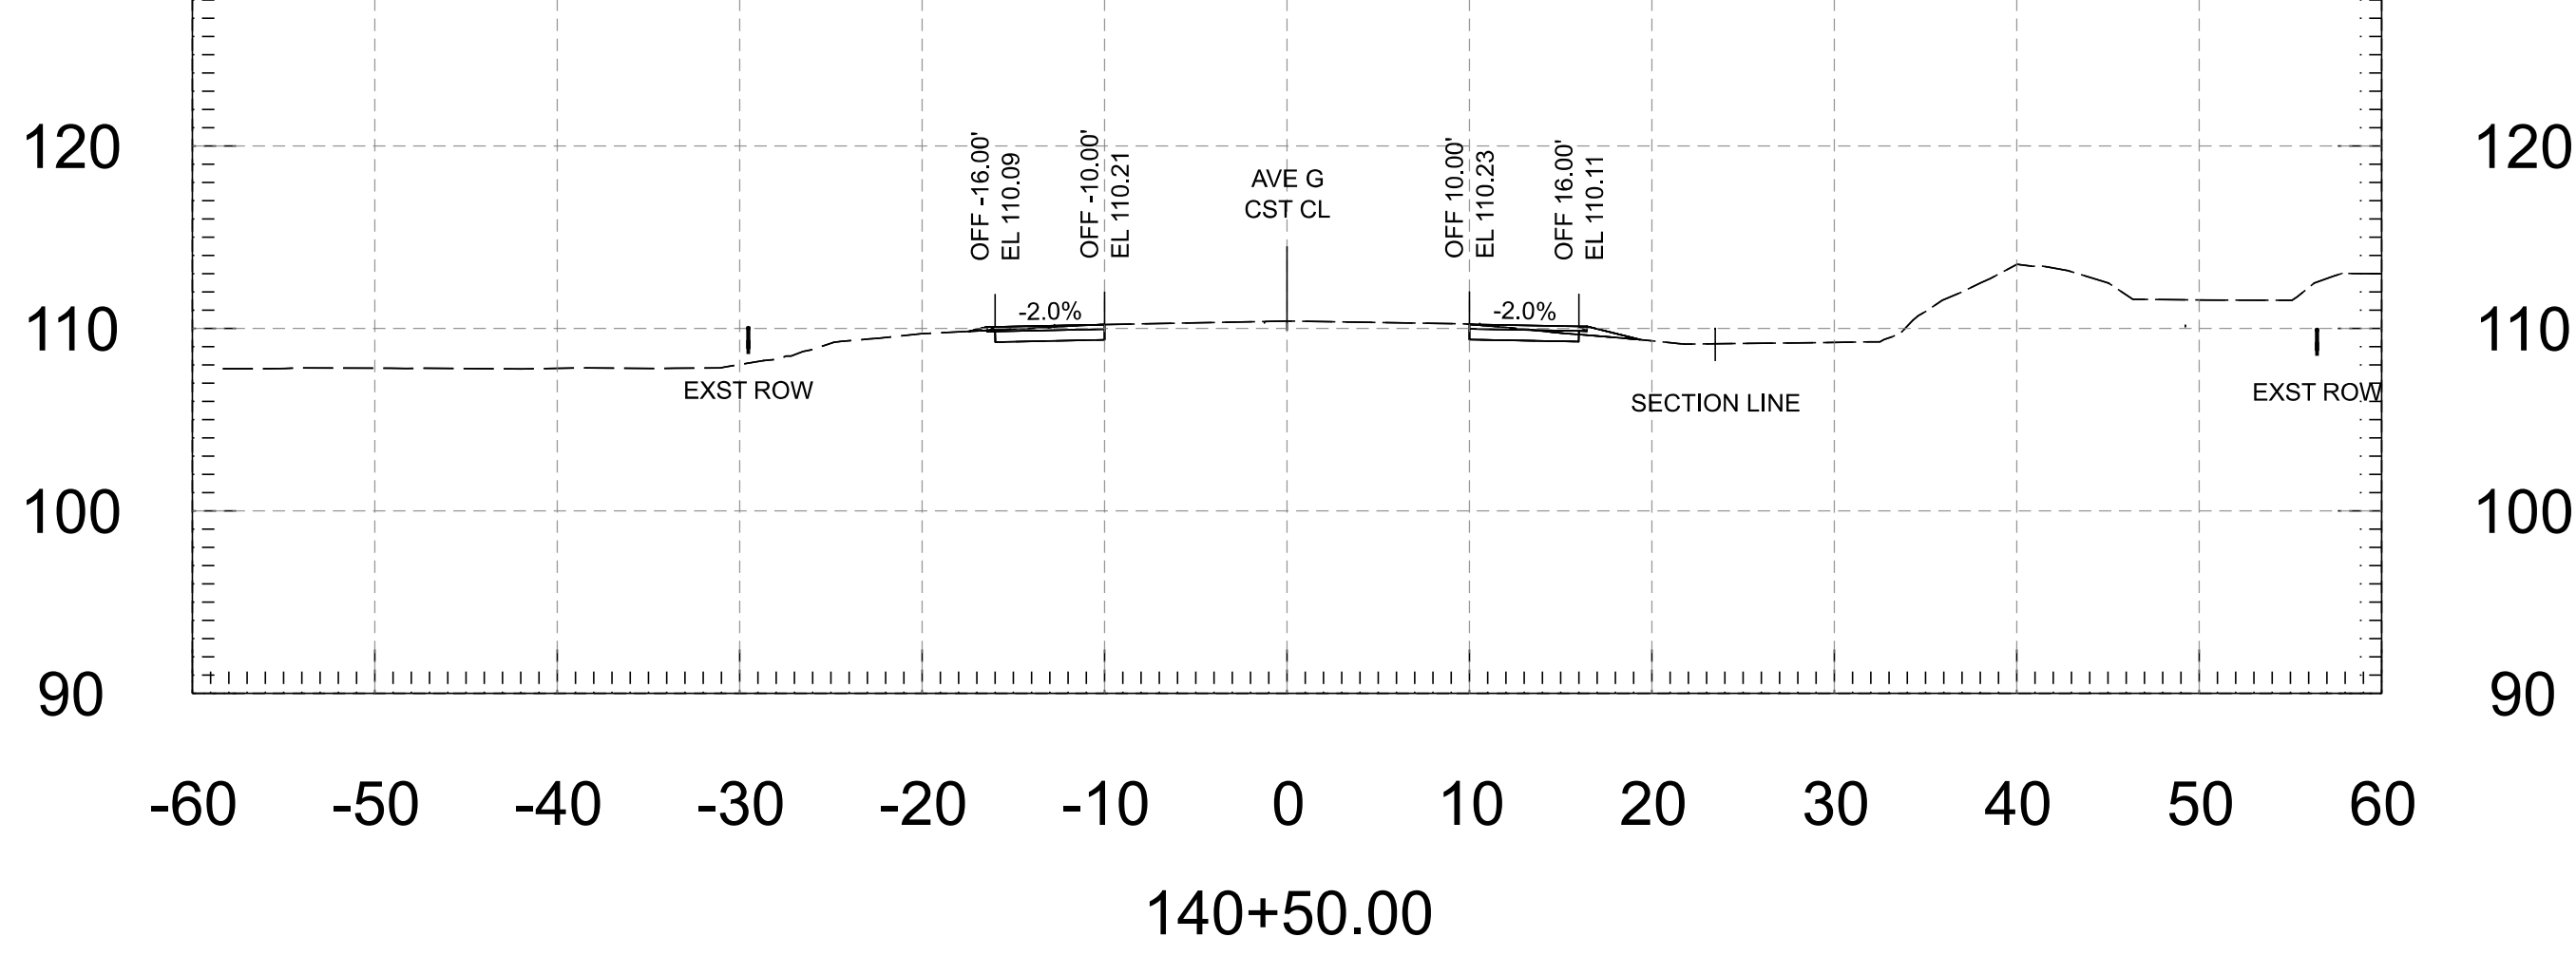





Cut Area	8.79 SF	Fill Area	0.42 SF
Cut Vol.	15.89 CY	Fill Vol.	1.04 CY
Cut Adj. Vol.	15.89 CY	Fill Adj. Vol.	1.04 CY

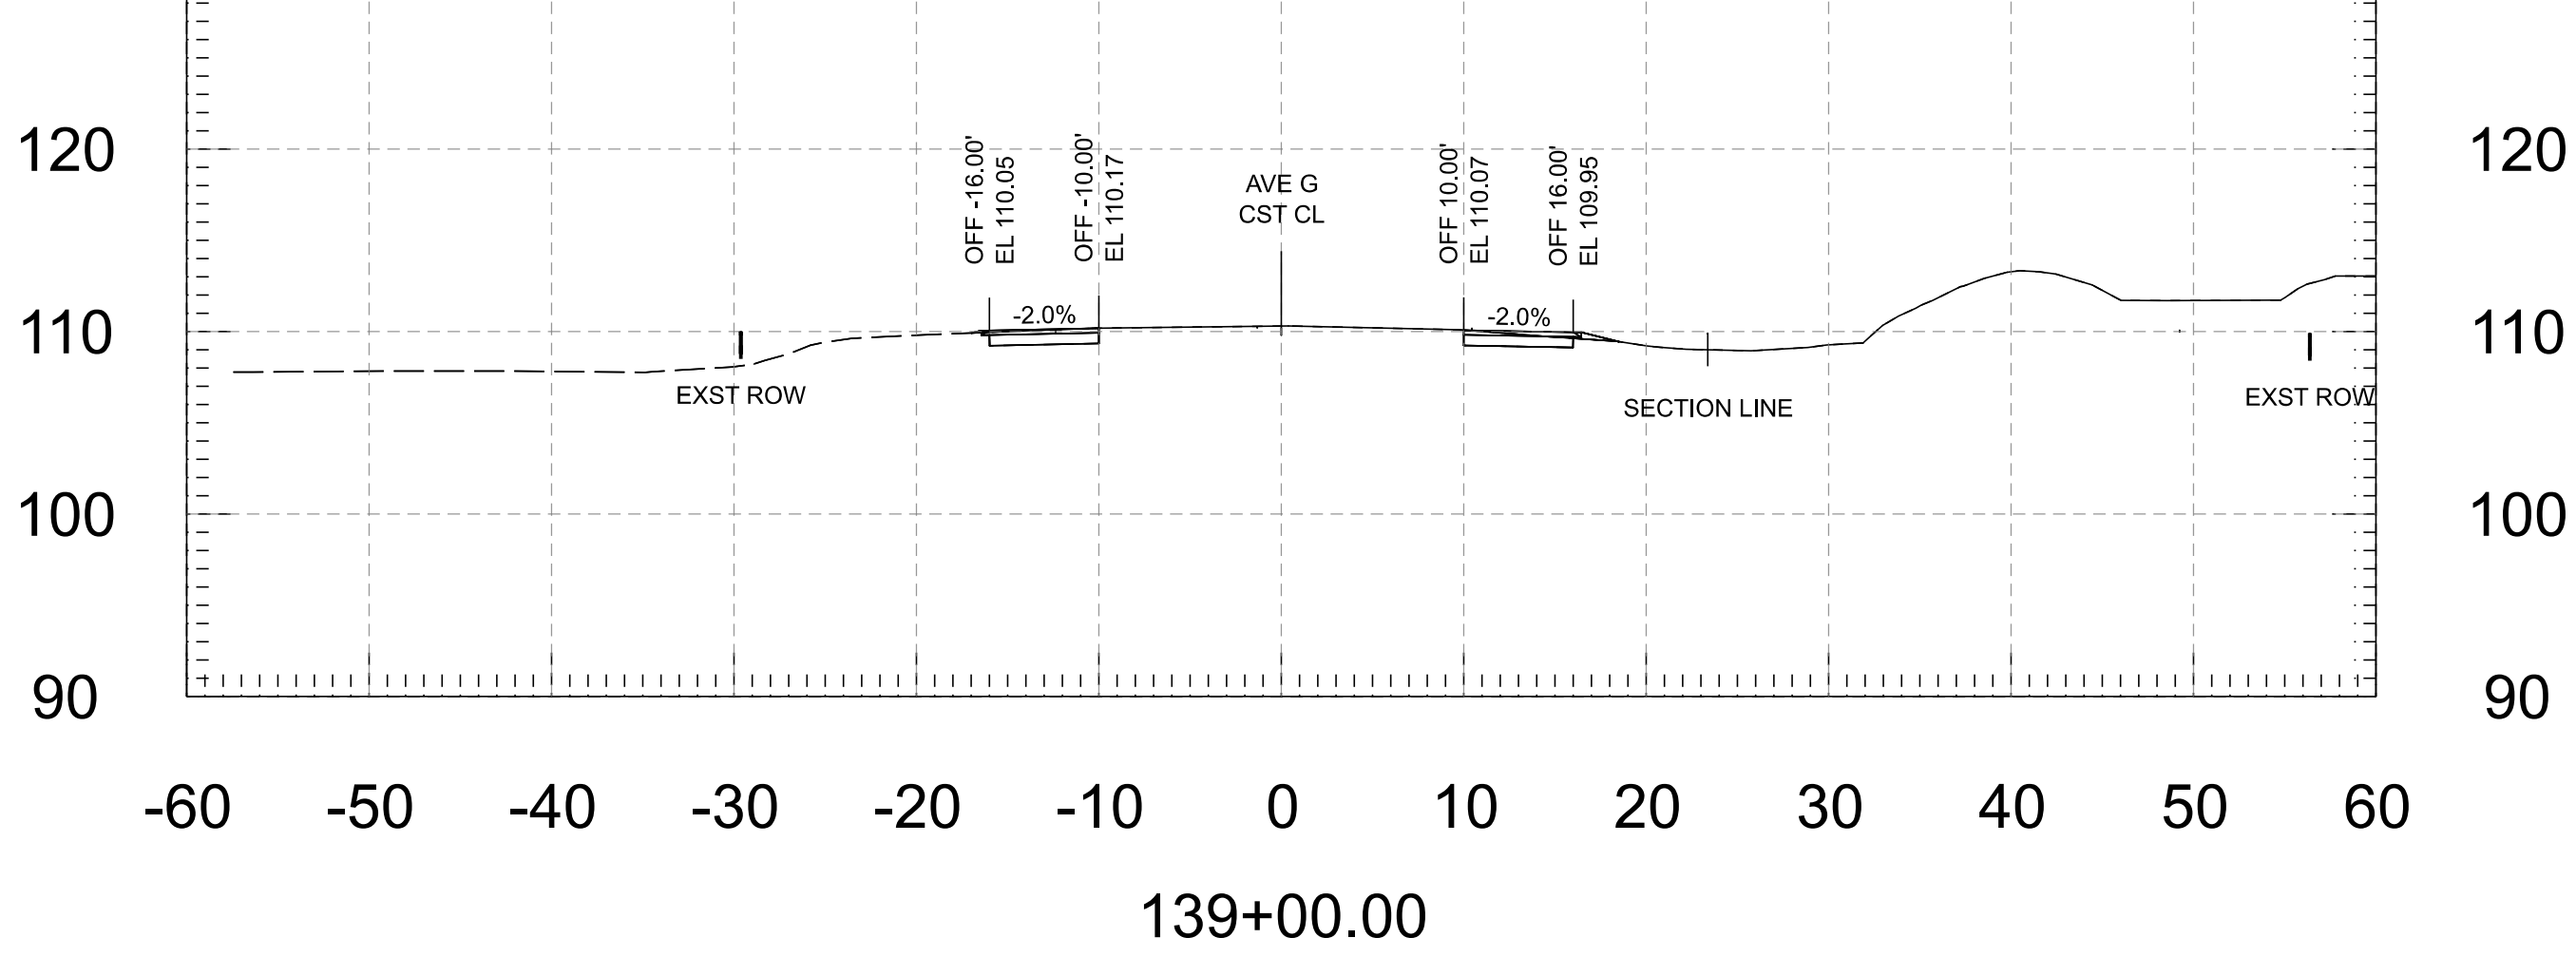


Cut Area	9.01 SF	Fill Area	0.60 SF
Cut Vol.	16.24 CY	Fill Vol.	1.09 CY
Cut Adj. Vol.	16.24 CY	Fill Adj. Vol.	1.09 CY

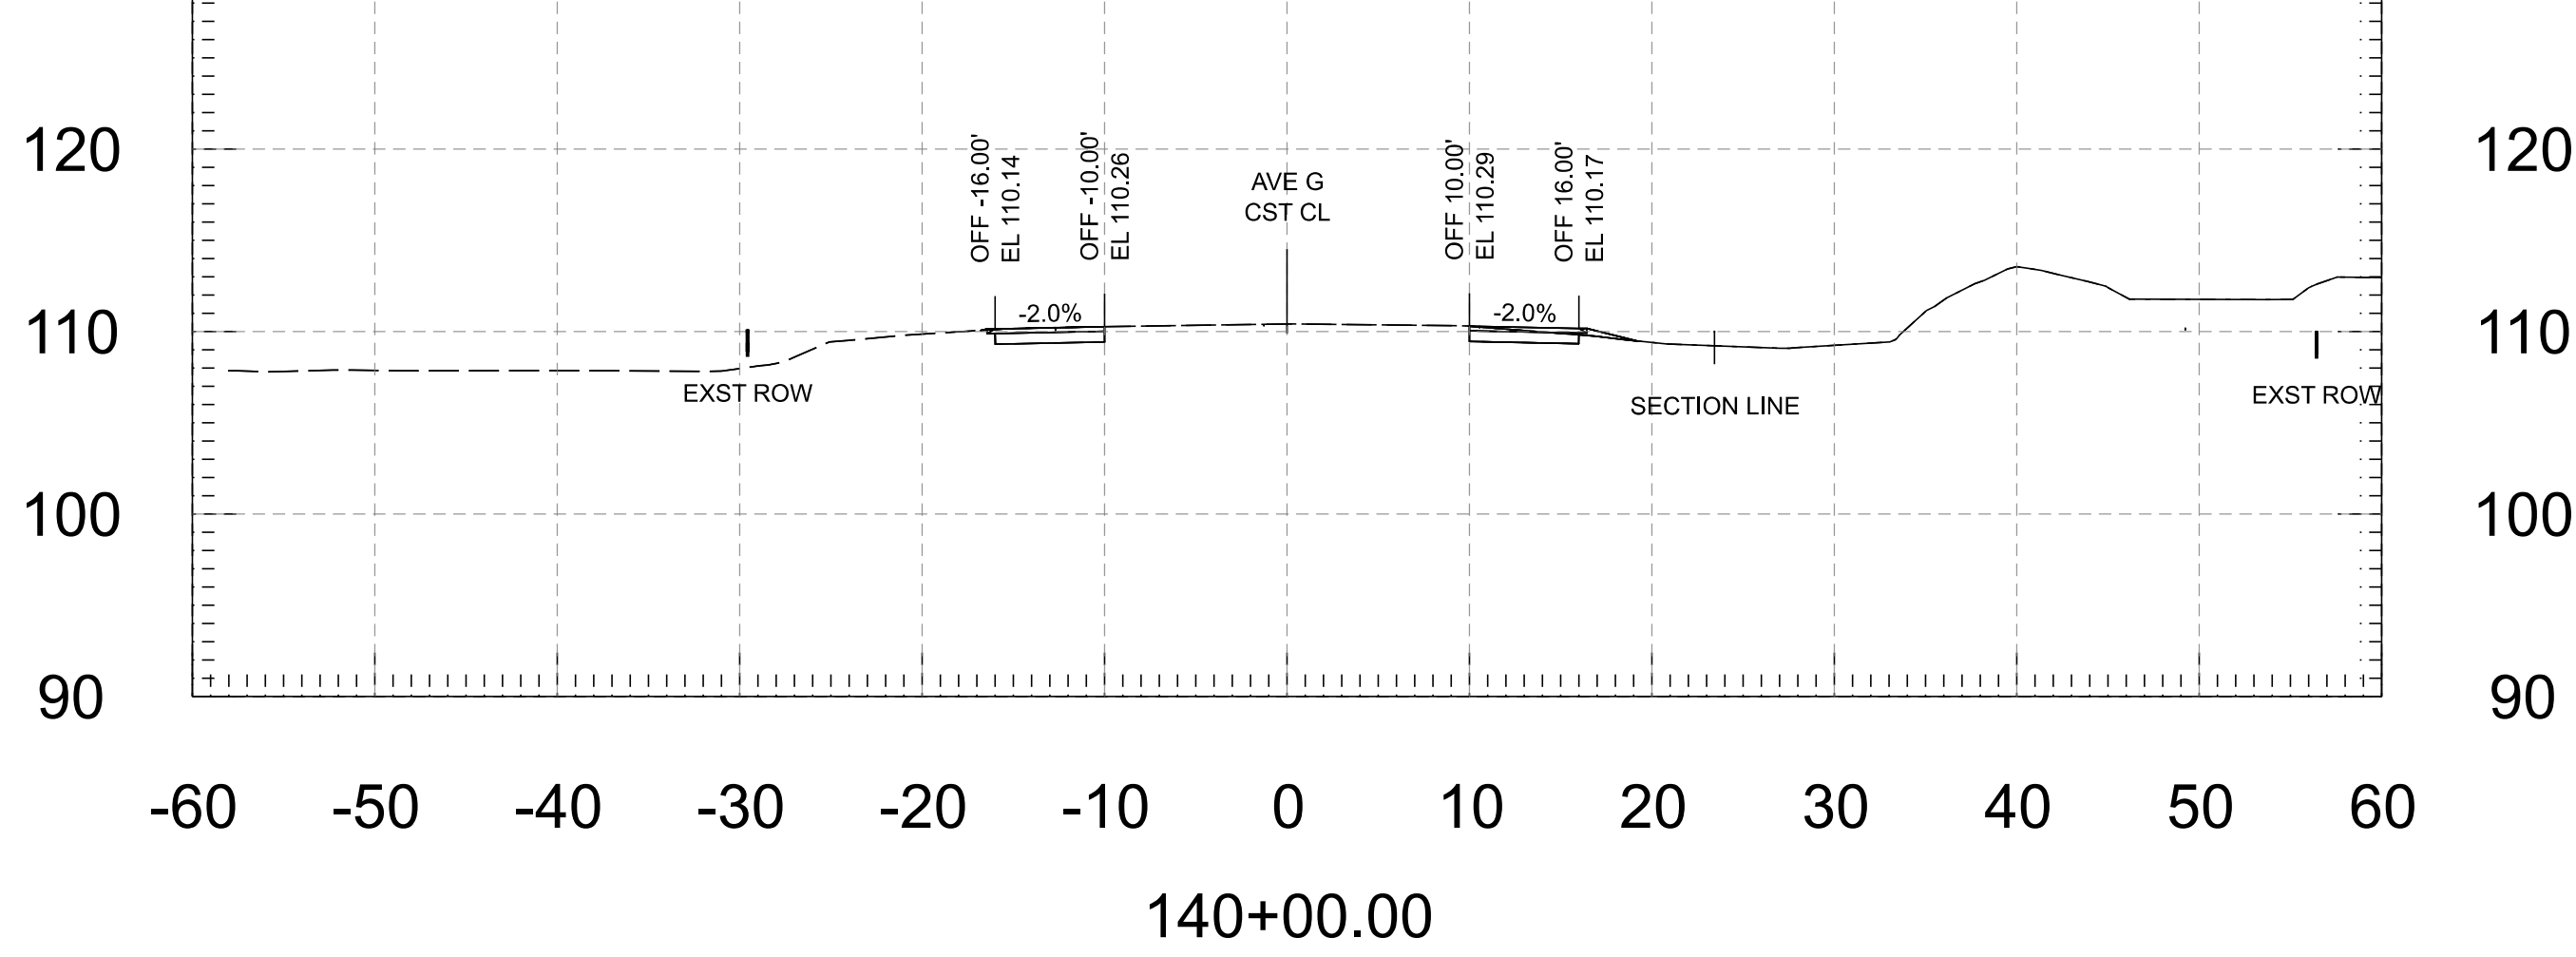


	FOR INFORMATION ONLY		NAME	DATE	ARIZONA DEPARTMENT OF TRANSPORTATION PROJECT DELIVERY AND OPERATIONS DIVISION ROADWAY DESIGN SERVICES	ROUTE	F.H.W.A. Arizona Division	STATE ARIZ.	PROJECT NO.	FEDERAL ID NO.	SHEET NO.	TOTAL SHEETS	RECORD DRAWING
		DESIGN	M. SCHOEN	07/26		MILEPOST			0000 YU YYU	YYU-0(225)T	63	118	
		DRAWN	M. SCHOEN	07/26			LOCATION	AVENUE G, COUNTY 11TH ST - COUNTY 16TH ST				DWG	
		CHECKED	H. RIOS	07/26				TRACS NO. T0437 01C					
		 WSP USA Inc. 1230 West Washington Street, Suite 405 Tempe, AZ 85288			AVENUE G - CROSS SECTIONS						____ OF ____		

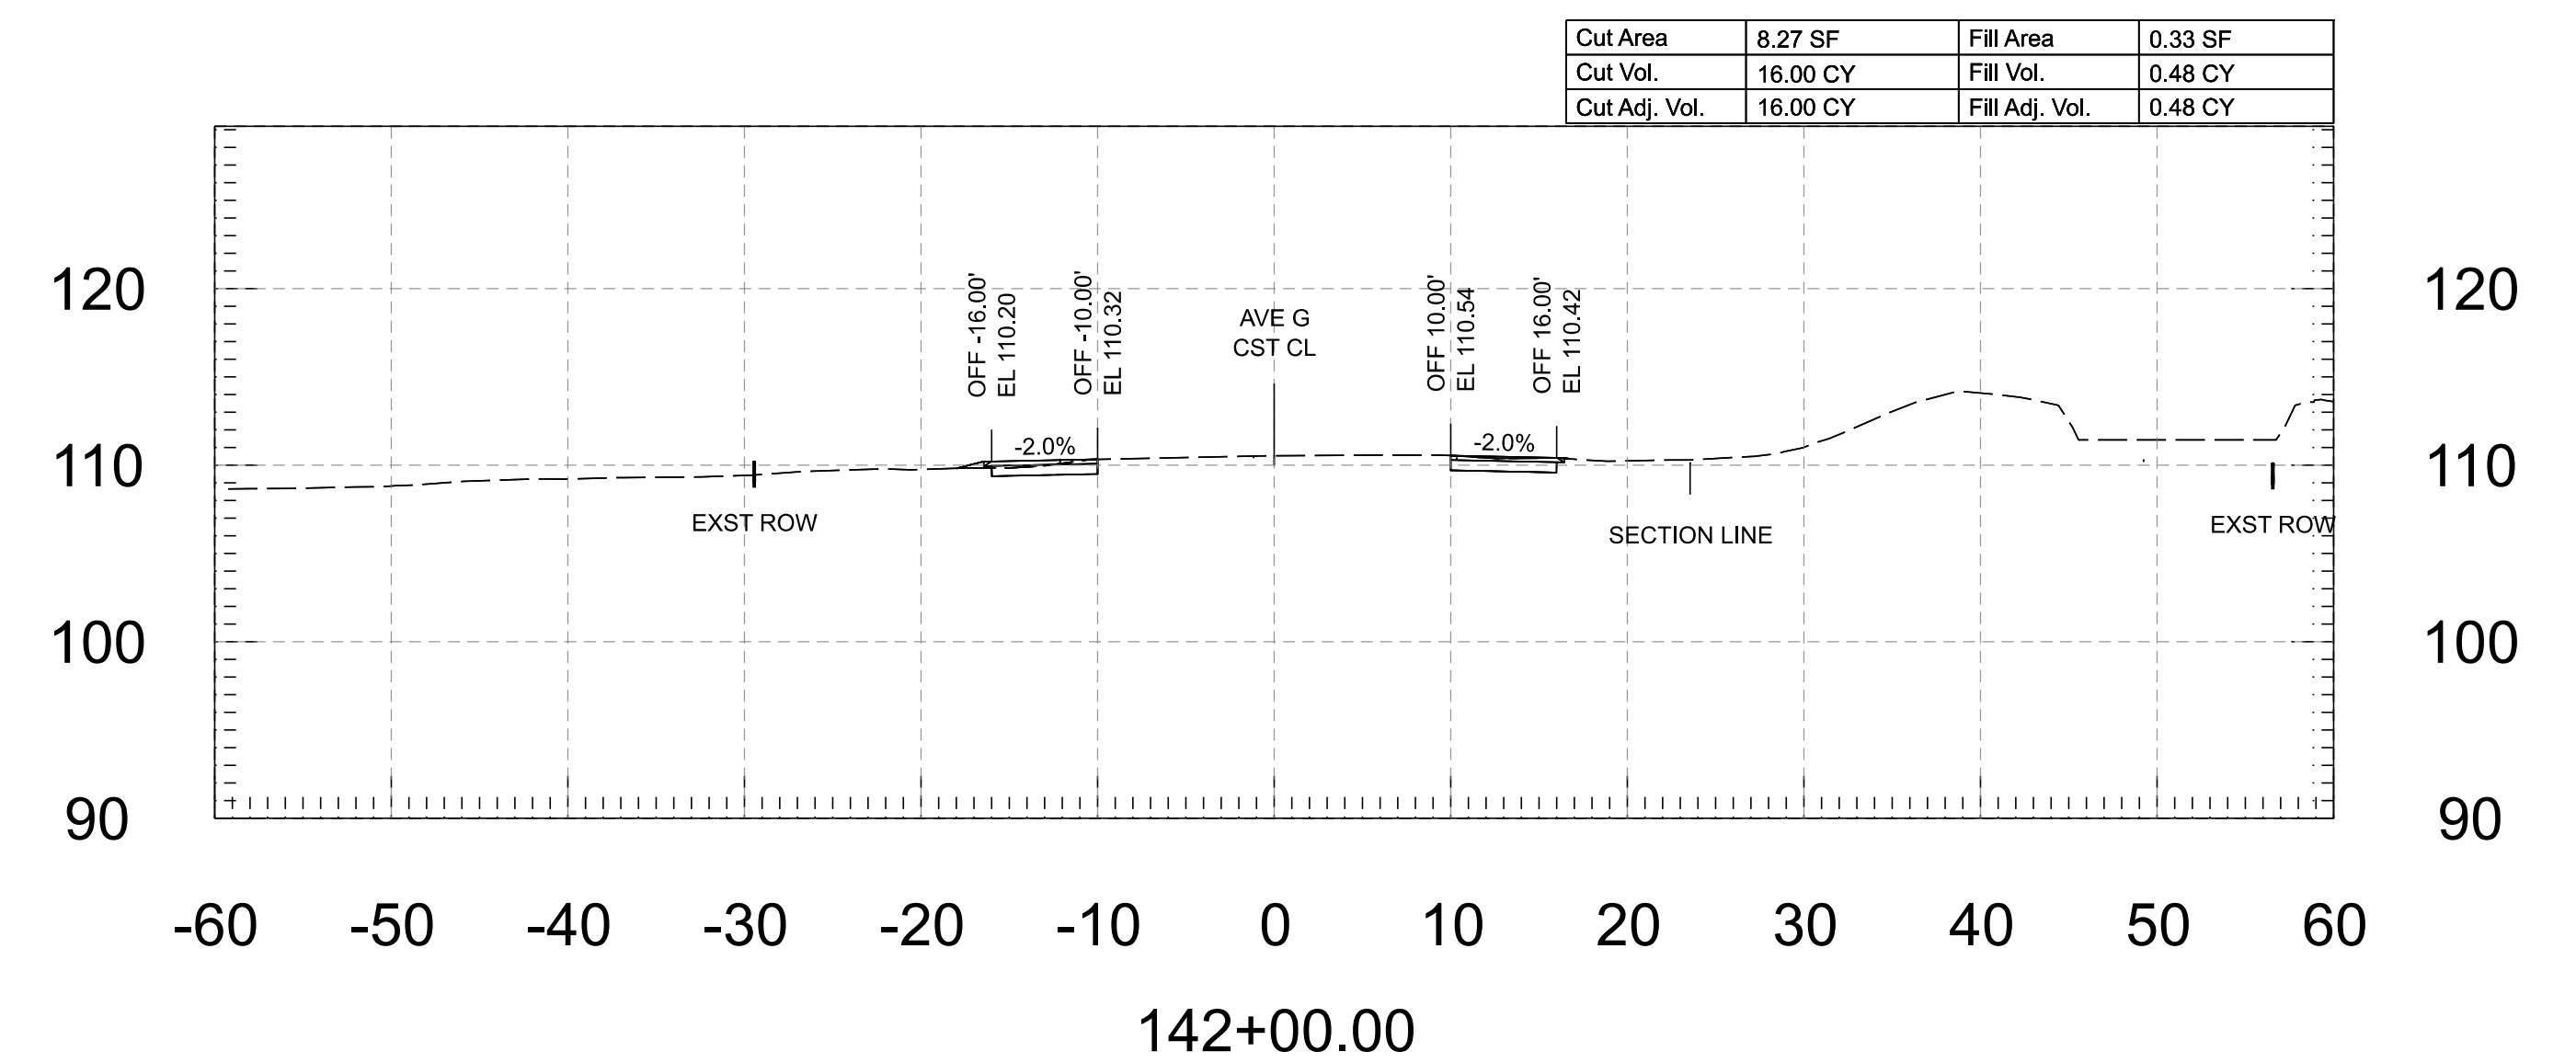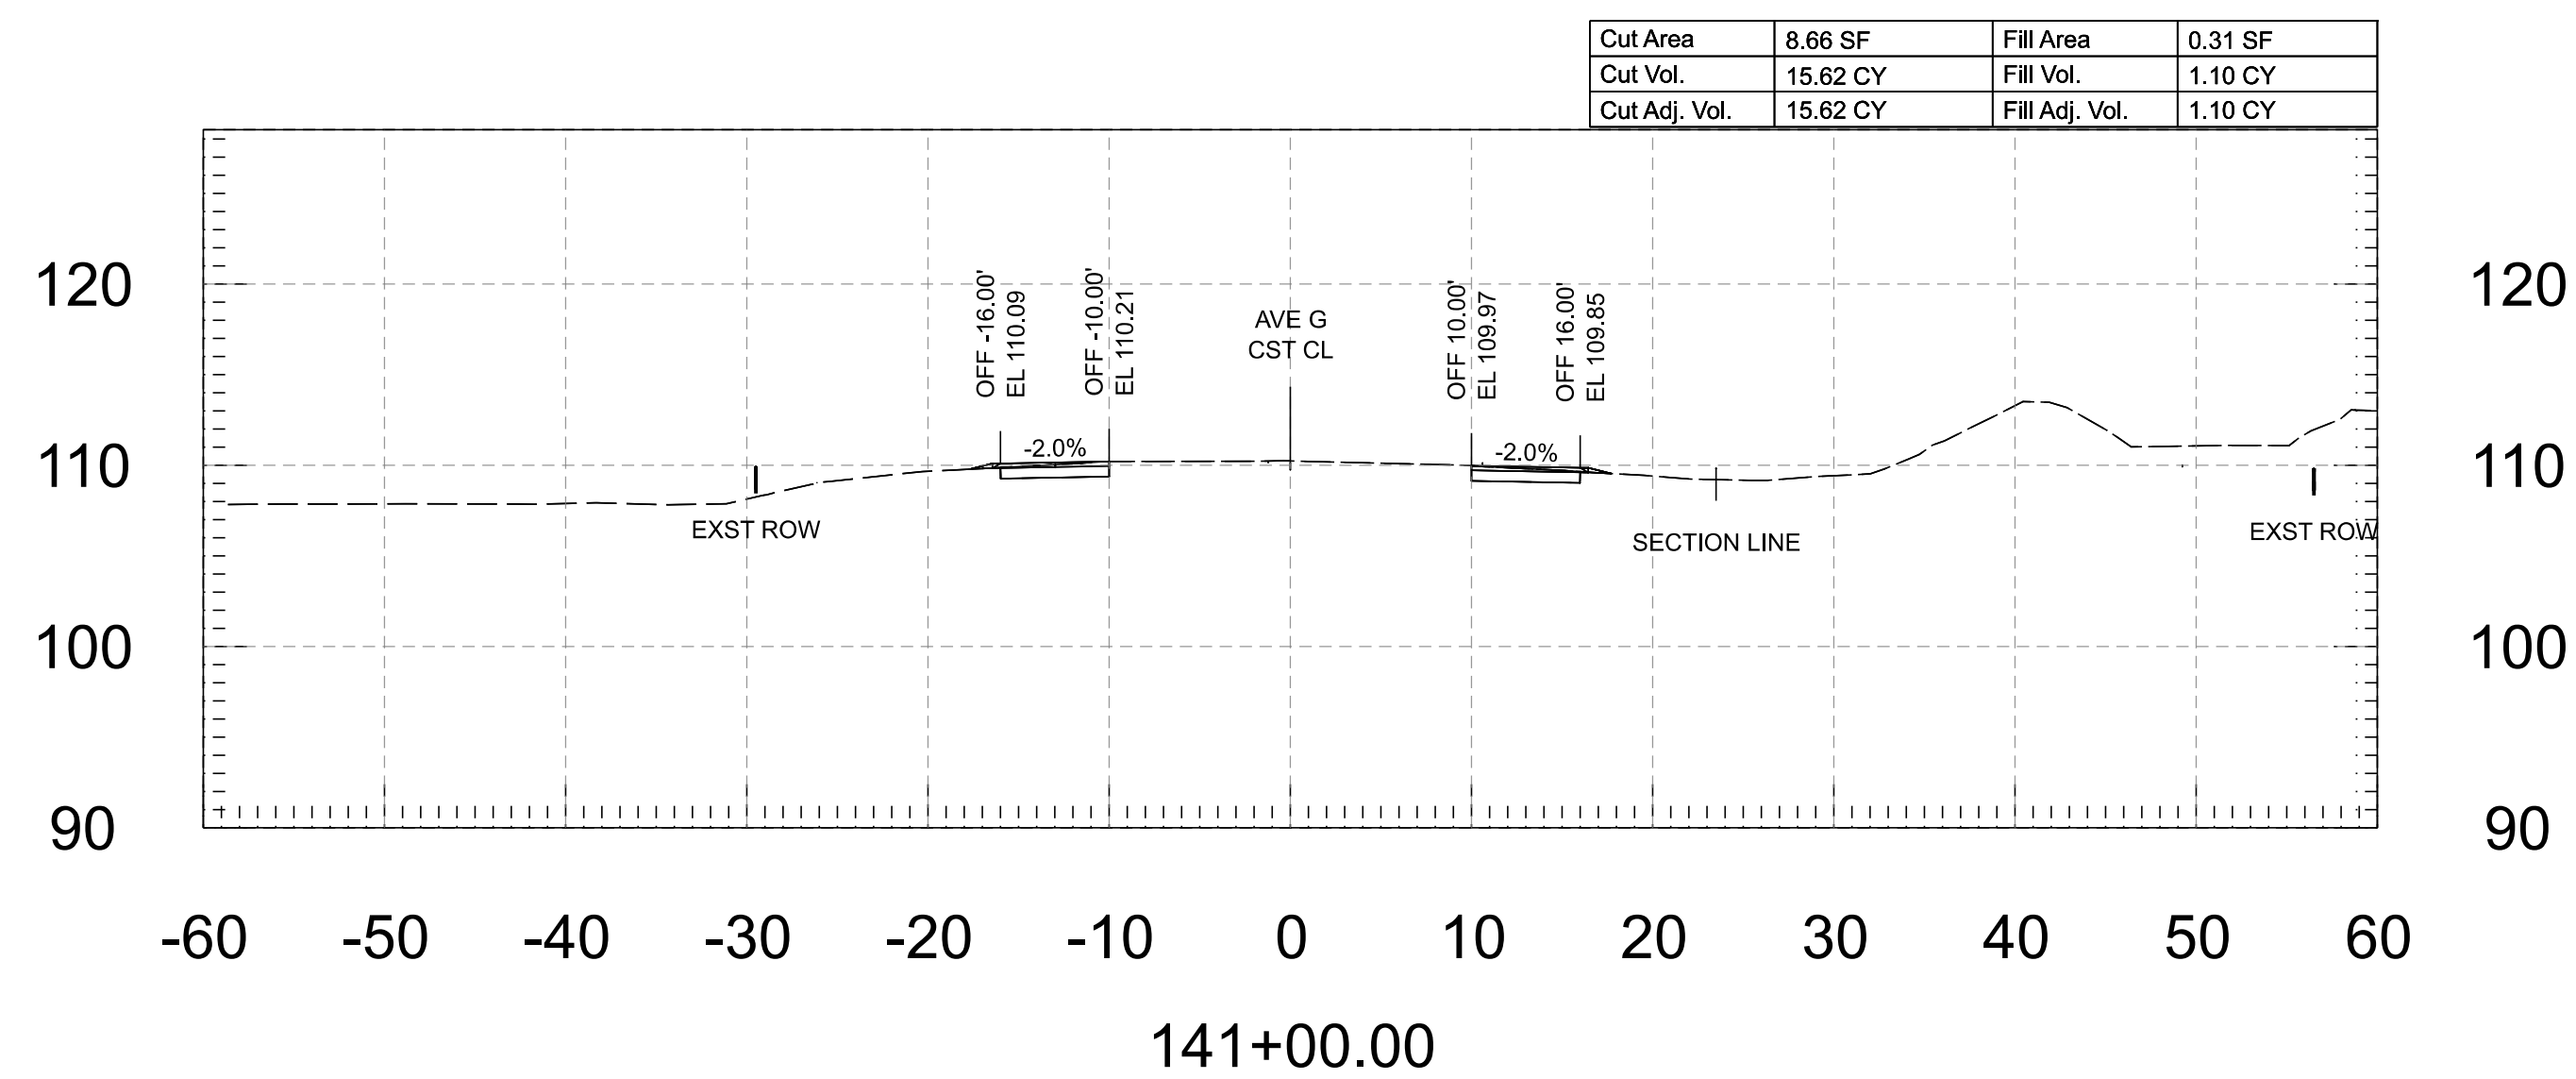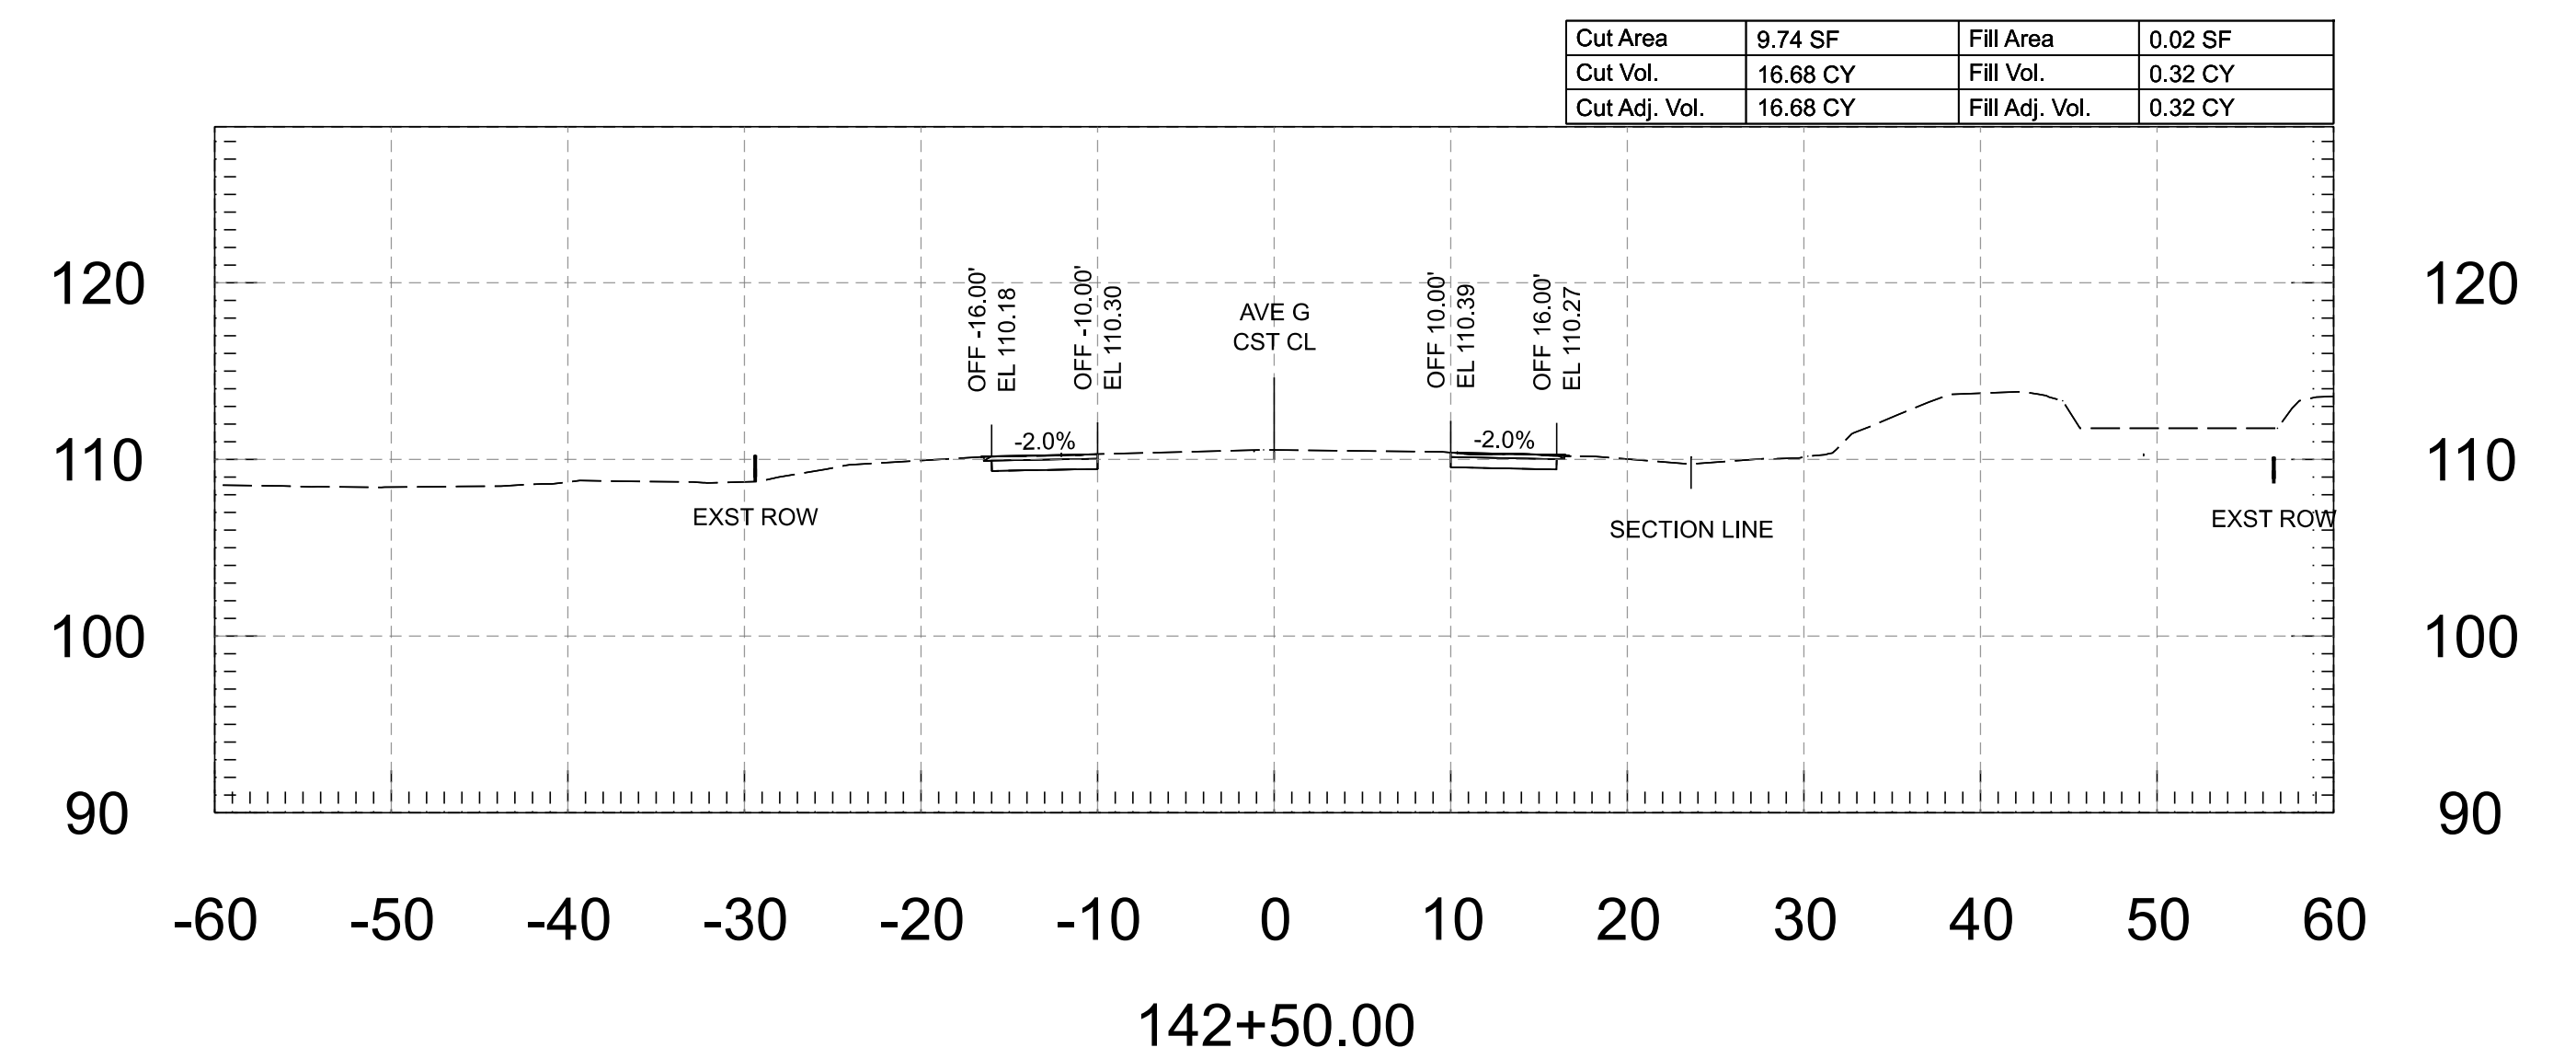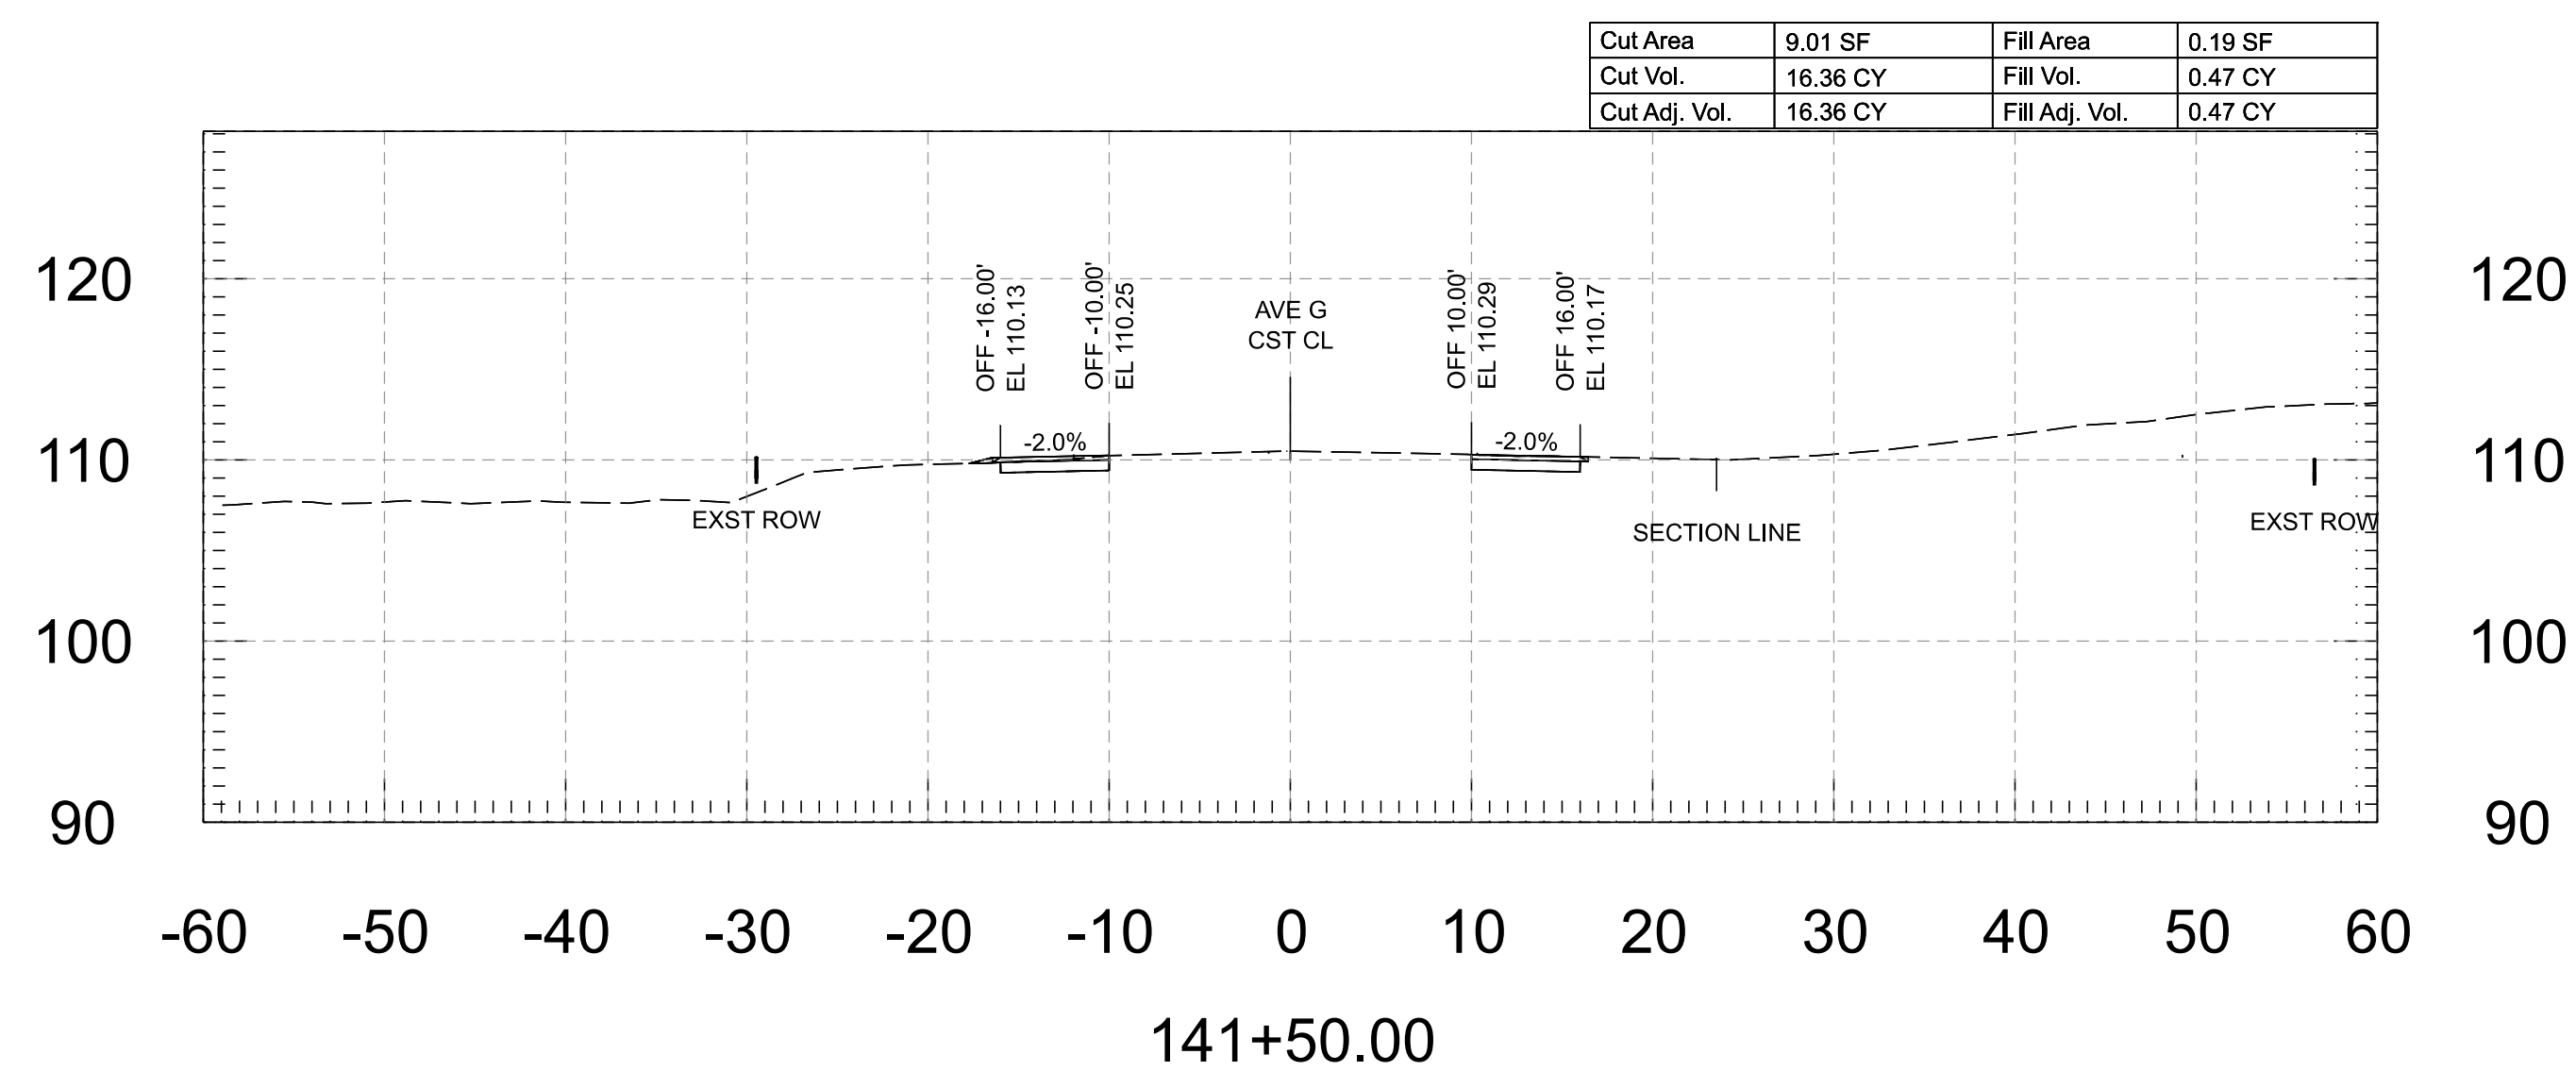


Cut Area	8.65 SF	Fill Area	0.20 SF
Cut Vol.	16.03 CY	Fill Vol.	0.37 CY
Cut Adj. Vol.	16.03 CY	Fill Adj. Vol.	0.37 CY

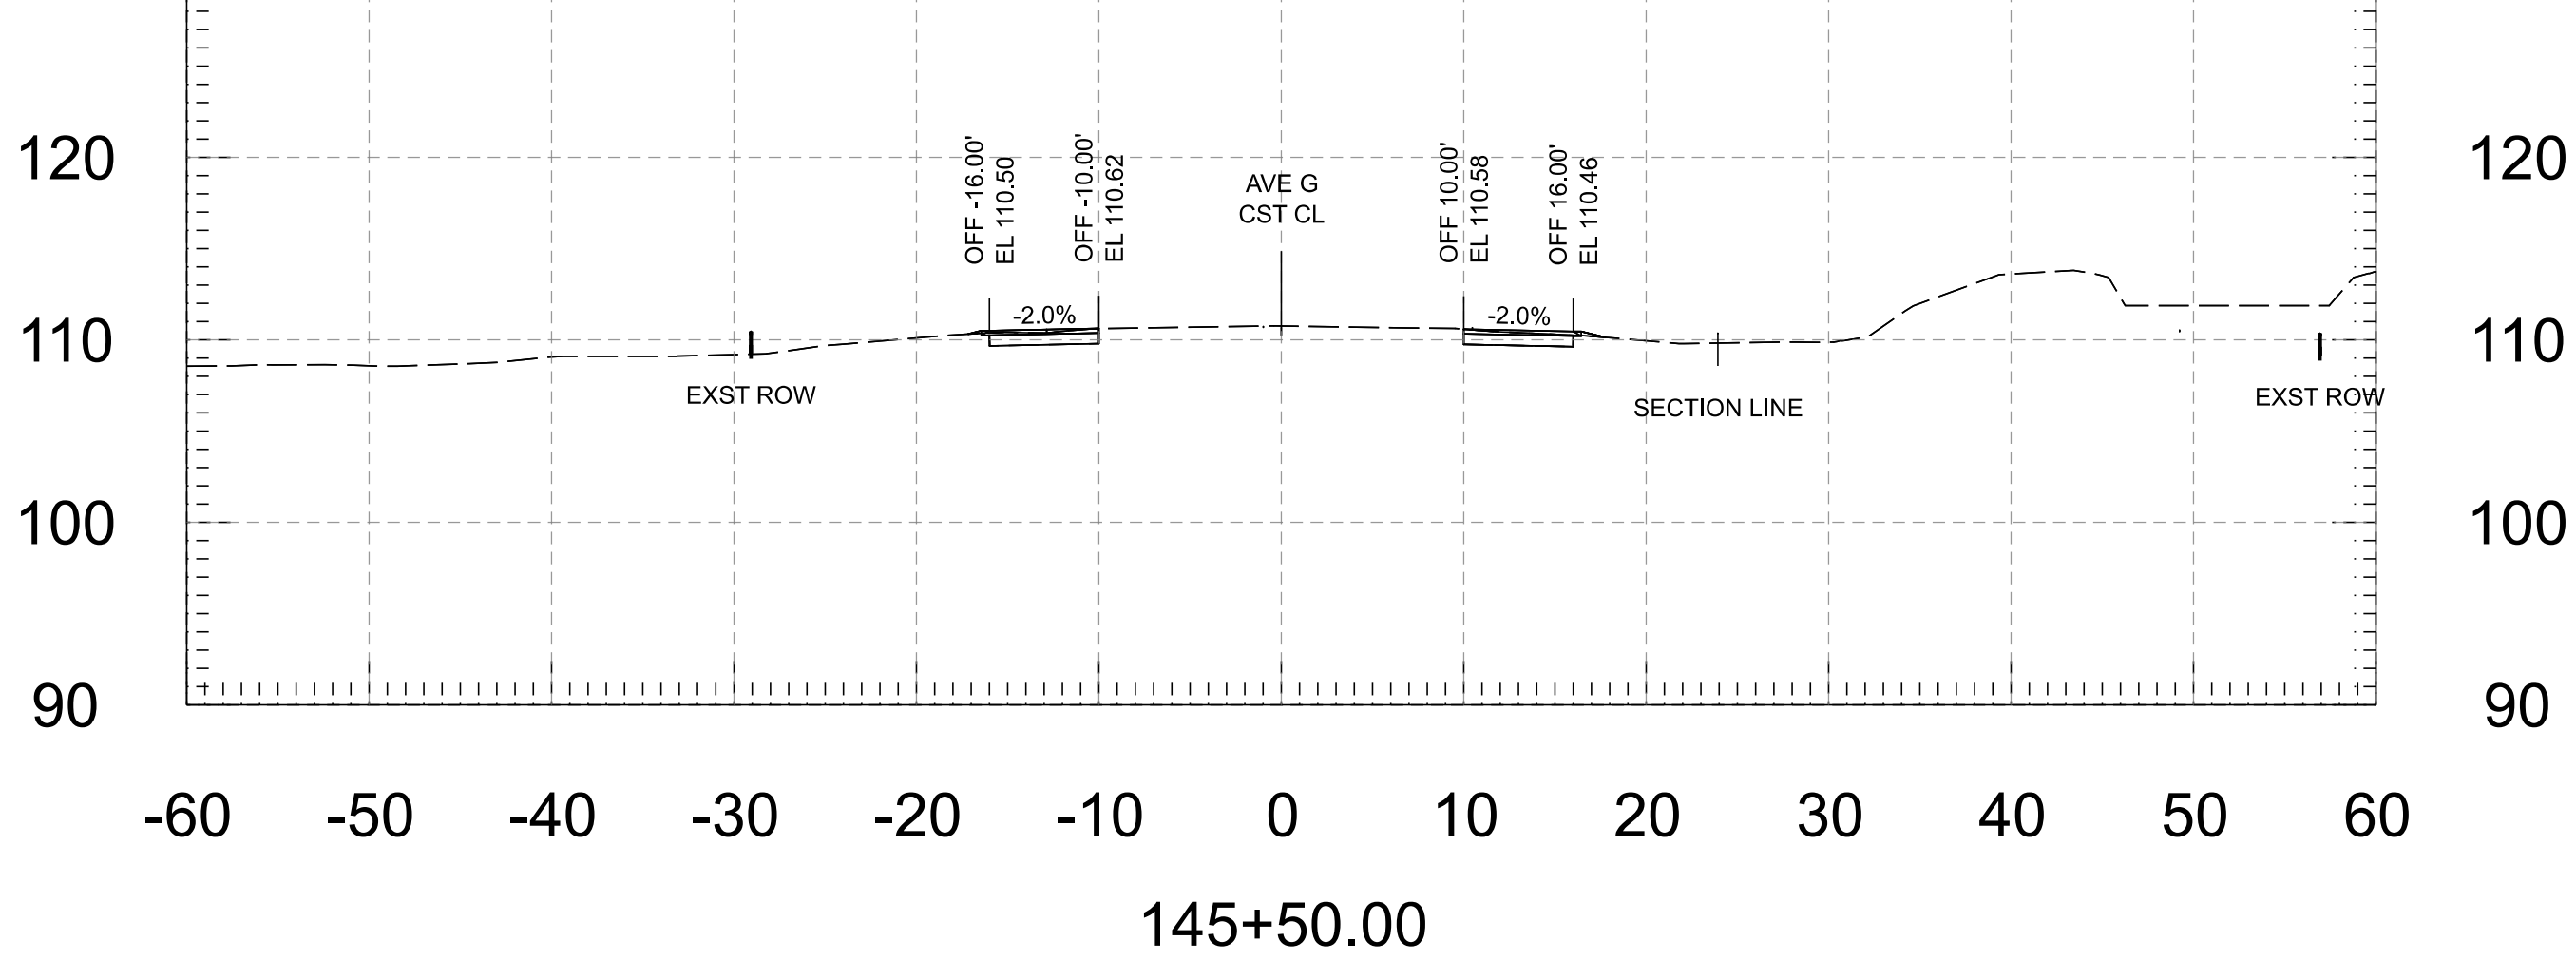


Cut Area	8.06 SF	Fill Area	0.54 SF
Cut Vol.	15.85 CY	Fill Vol.	0.62 CY
Cut Adj. Vol.	15.85 CY	Fill Adj. Vol.	0.62 CY

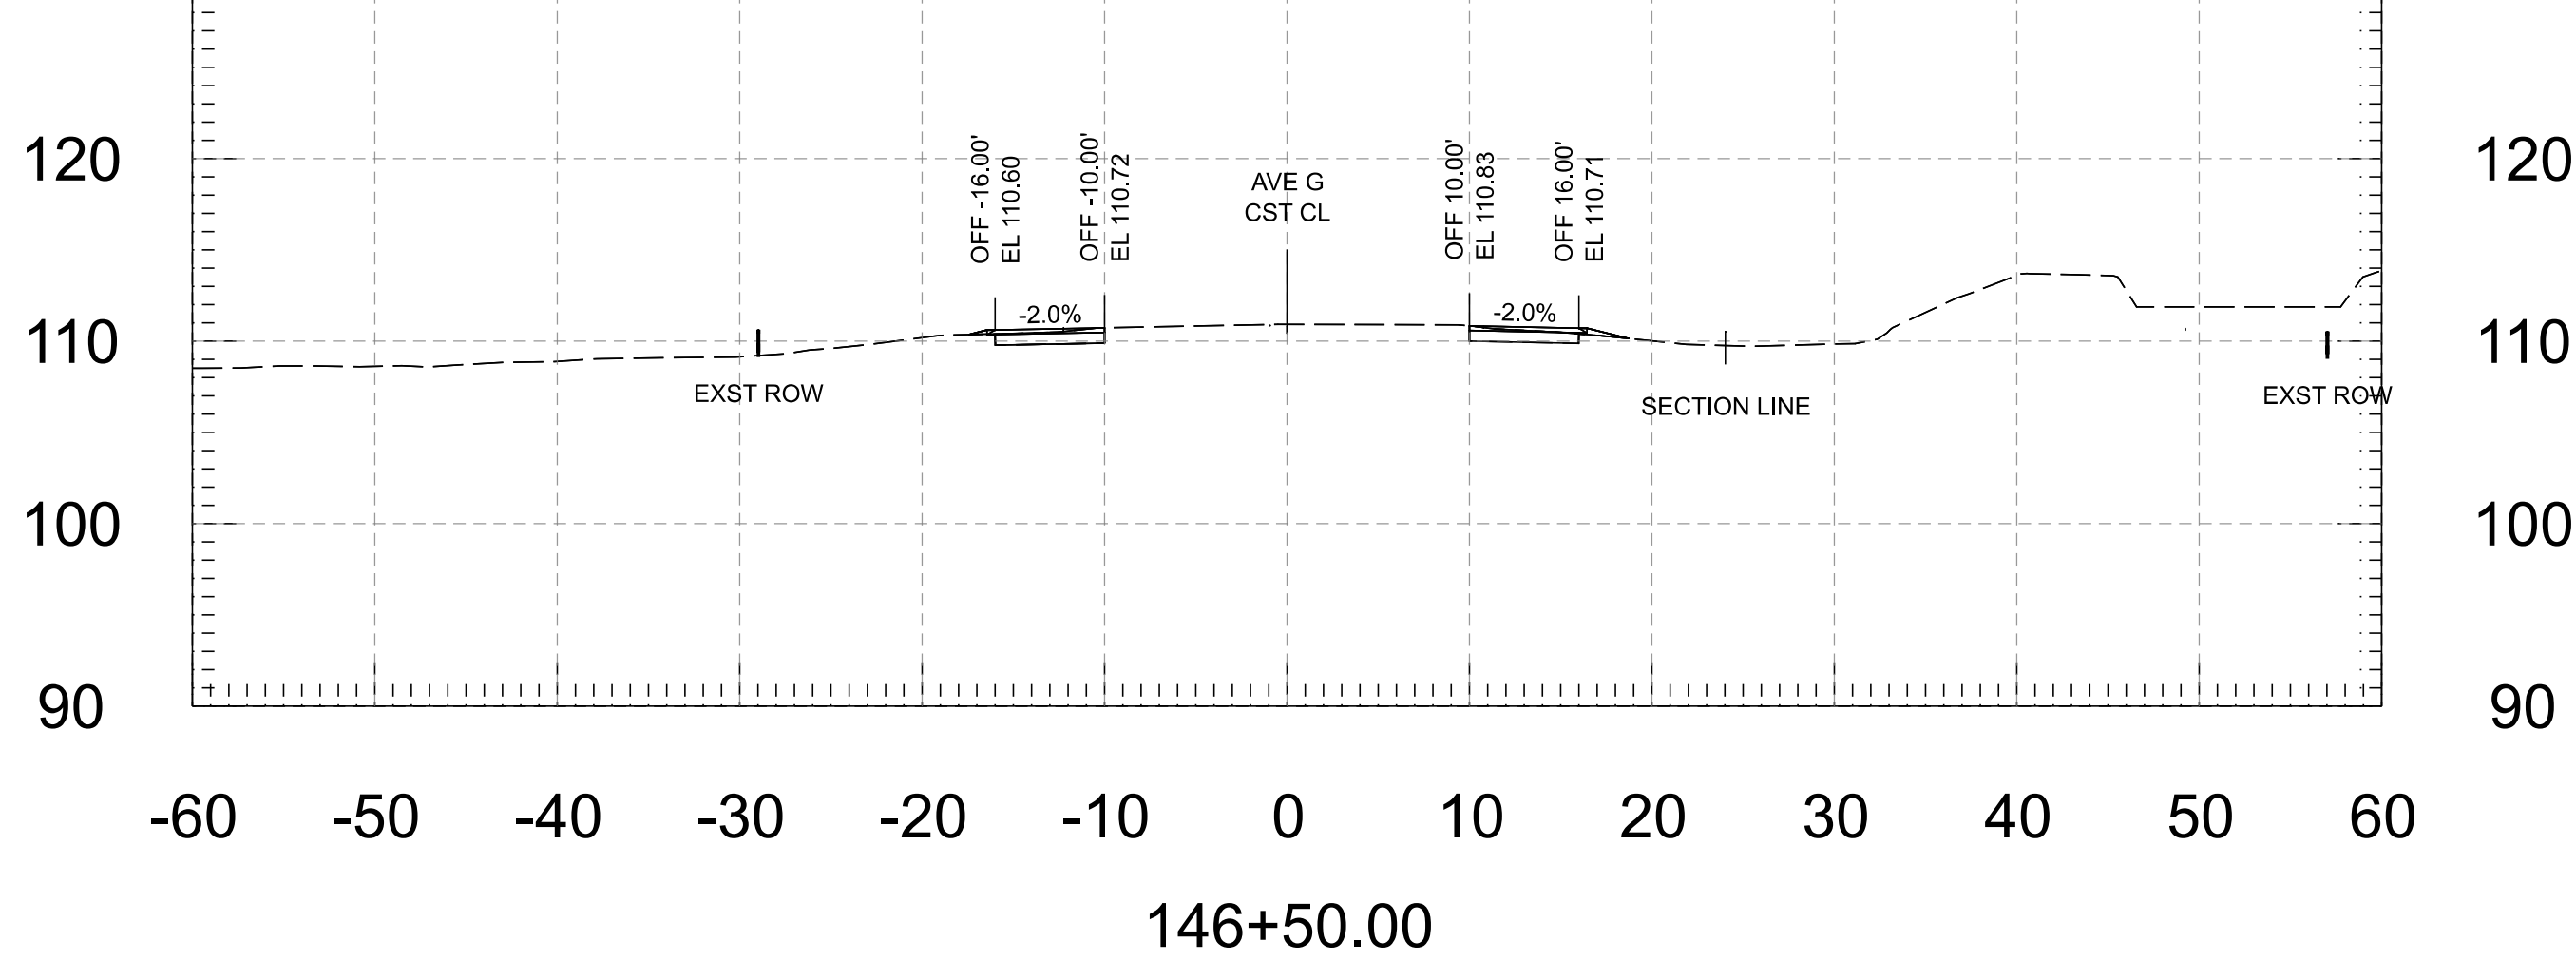

Cut Area	8.66 SF	Fill Area	0.21 SF
Cut Vol.	16.38 CY	Fill Vol.	0.37 CY
Cut Adj. Vol.	16.38 CY	Fill Adj. Vol.	0.37 CY

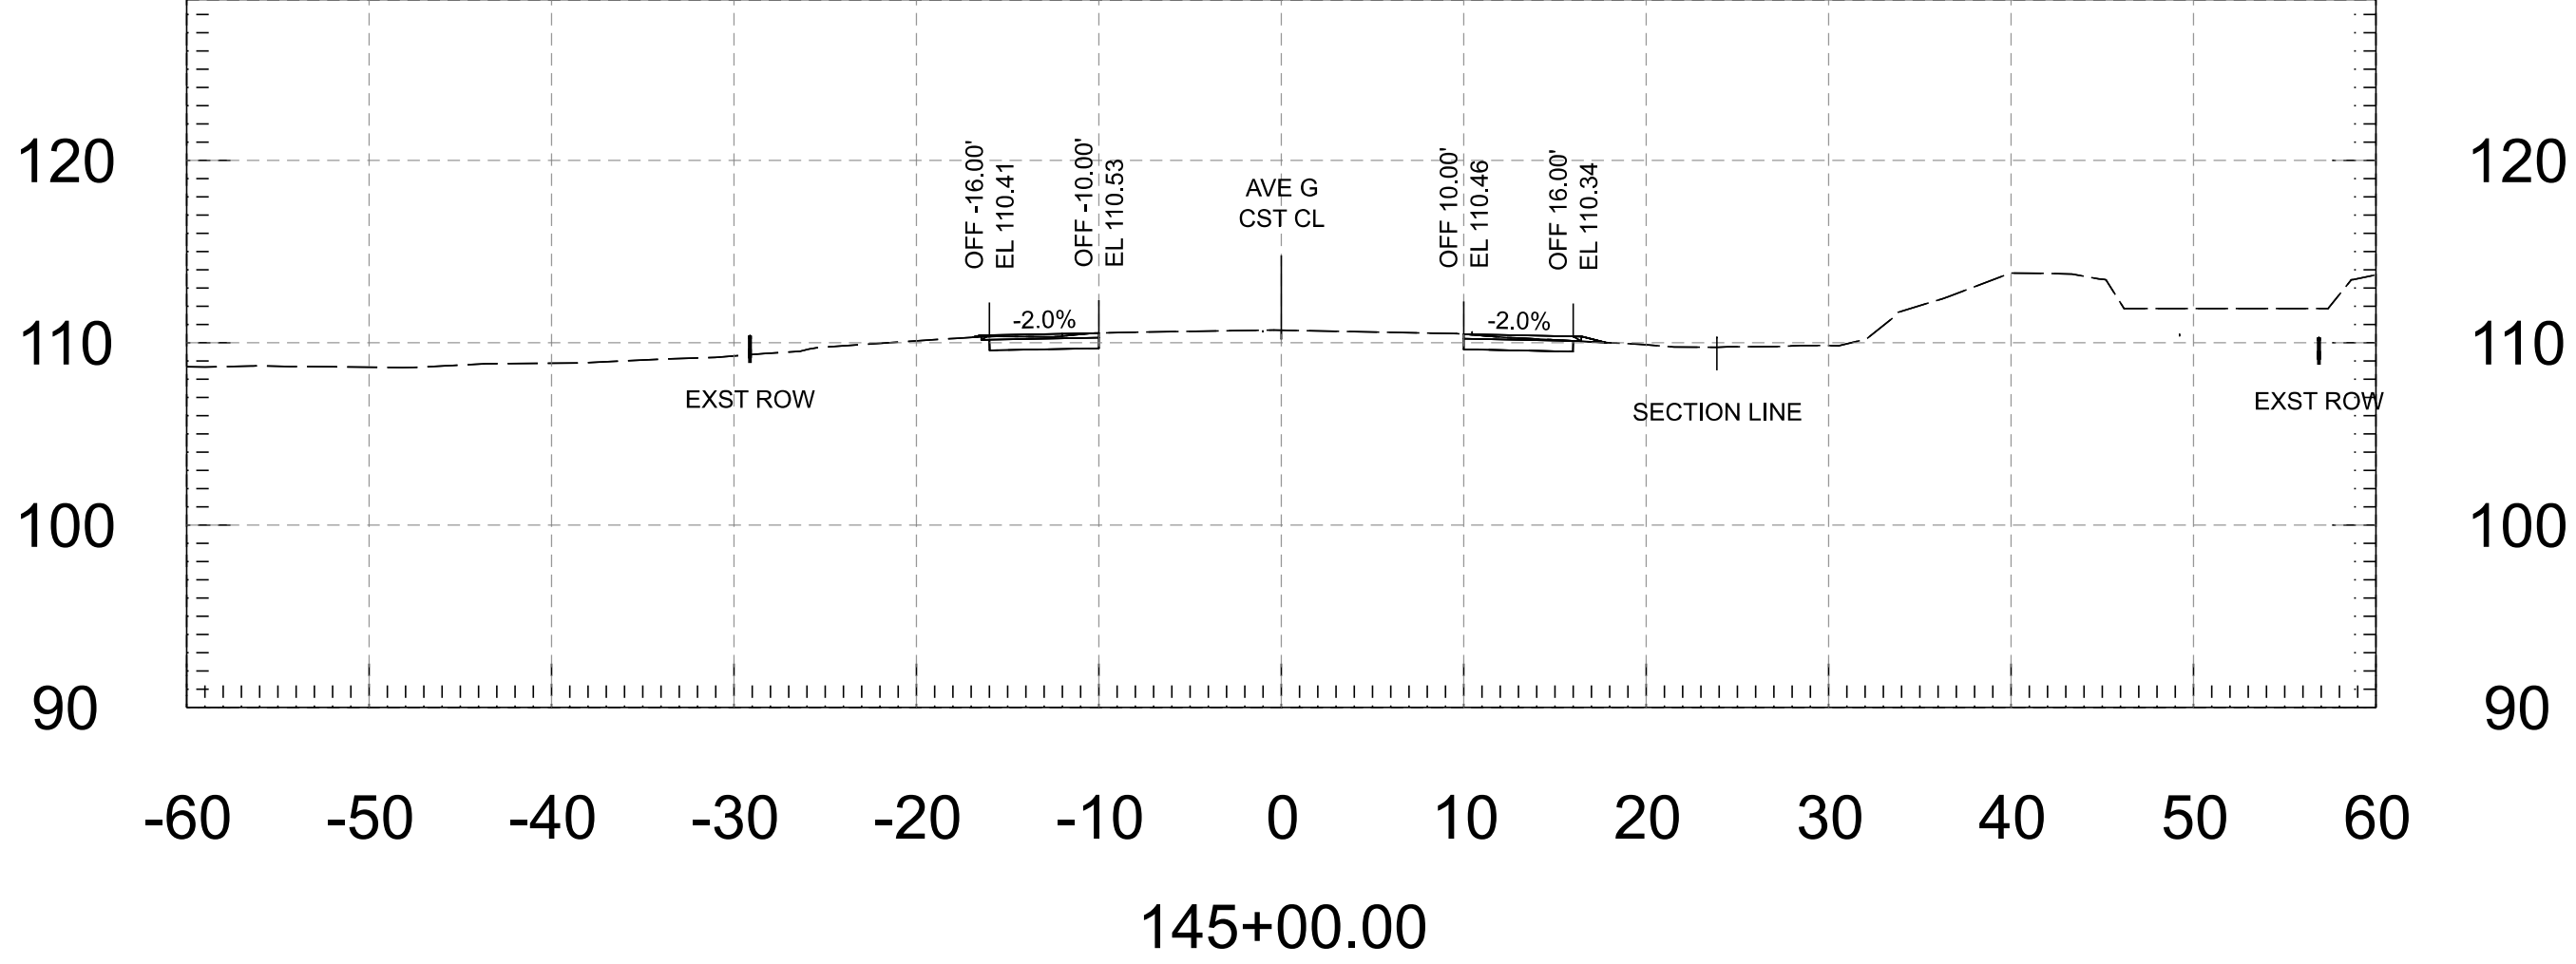


Cut Area	9.06 SF	Fill Area	0.14 SF
Cut Vol.	16.40 CY	Fill Vol.	0.31 CY
Cut Adj. Vol.	16.40 CY	Fill Adj. Vol.	0.31 CY

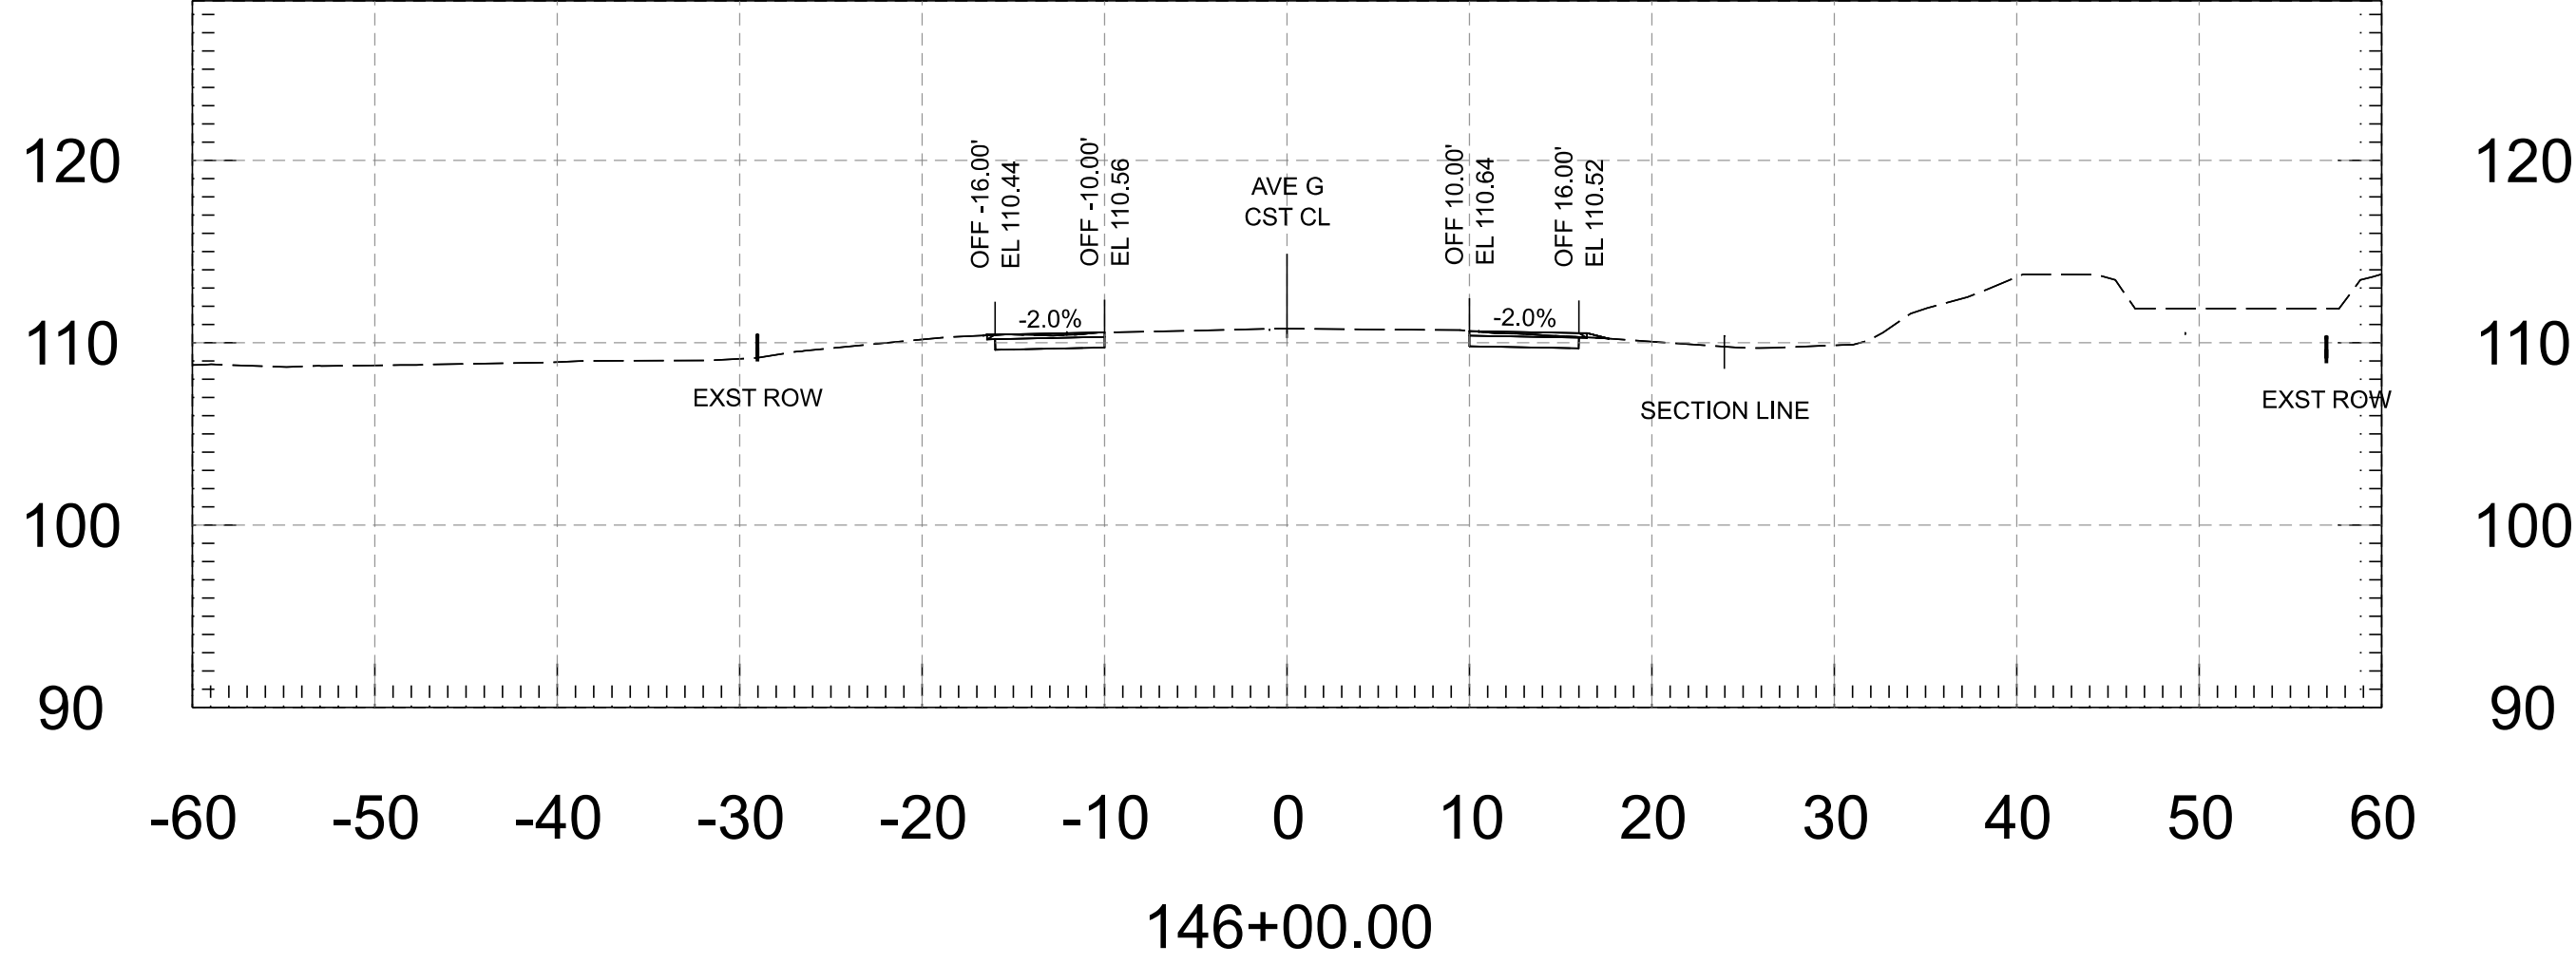


FOR INFORMATION ONLY		NAME	DATE	ARIZONA DEPARTMENT OF TRANSPORTATION PROJECT DELIVERY AND OPERATIONS DIVISION ROADWAY DESIGN SERVICES	ROUTE	F.H.W.A. Arizona Division	STATE ARIZ.	PROJECT NO.	FEDERAL ID NO.	SHEET NO.	TOTAL SHEETS	RECORD DRAWING
	DESIGN	M. SCHOEN	07/26		MILEPOST			0000 YU YYU	YYU-0(225)T	66	118	
	DRAWN	M. SCHOEN	07/26					LOCATION AVENUE G, COUNTY 11TH ST - COUNTY 16TH ST				DWG
	CHECKED	H. RIOS	07/26	AVENUE G - CROSS SECTIONS	STRUCTURE NO.	TRACS NO. T0437 01C				___ OF ___		
	 WSP USA Inc. 1230 West Washington Street, Suite 405 Tempe, AZ 85288											


Cut Area	8.00 SF	Fill Area	0.72 SF
Cut Vol.	14.54 CY	Fill Vol.	1.27 CY
Cut Adj. Vol.	14.54 CY	Fill Adj. Vol.	1.27 CY

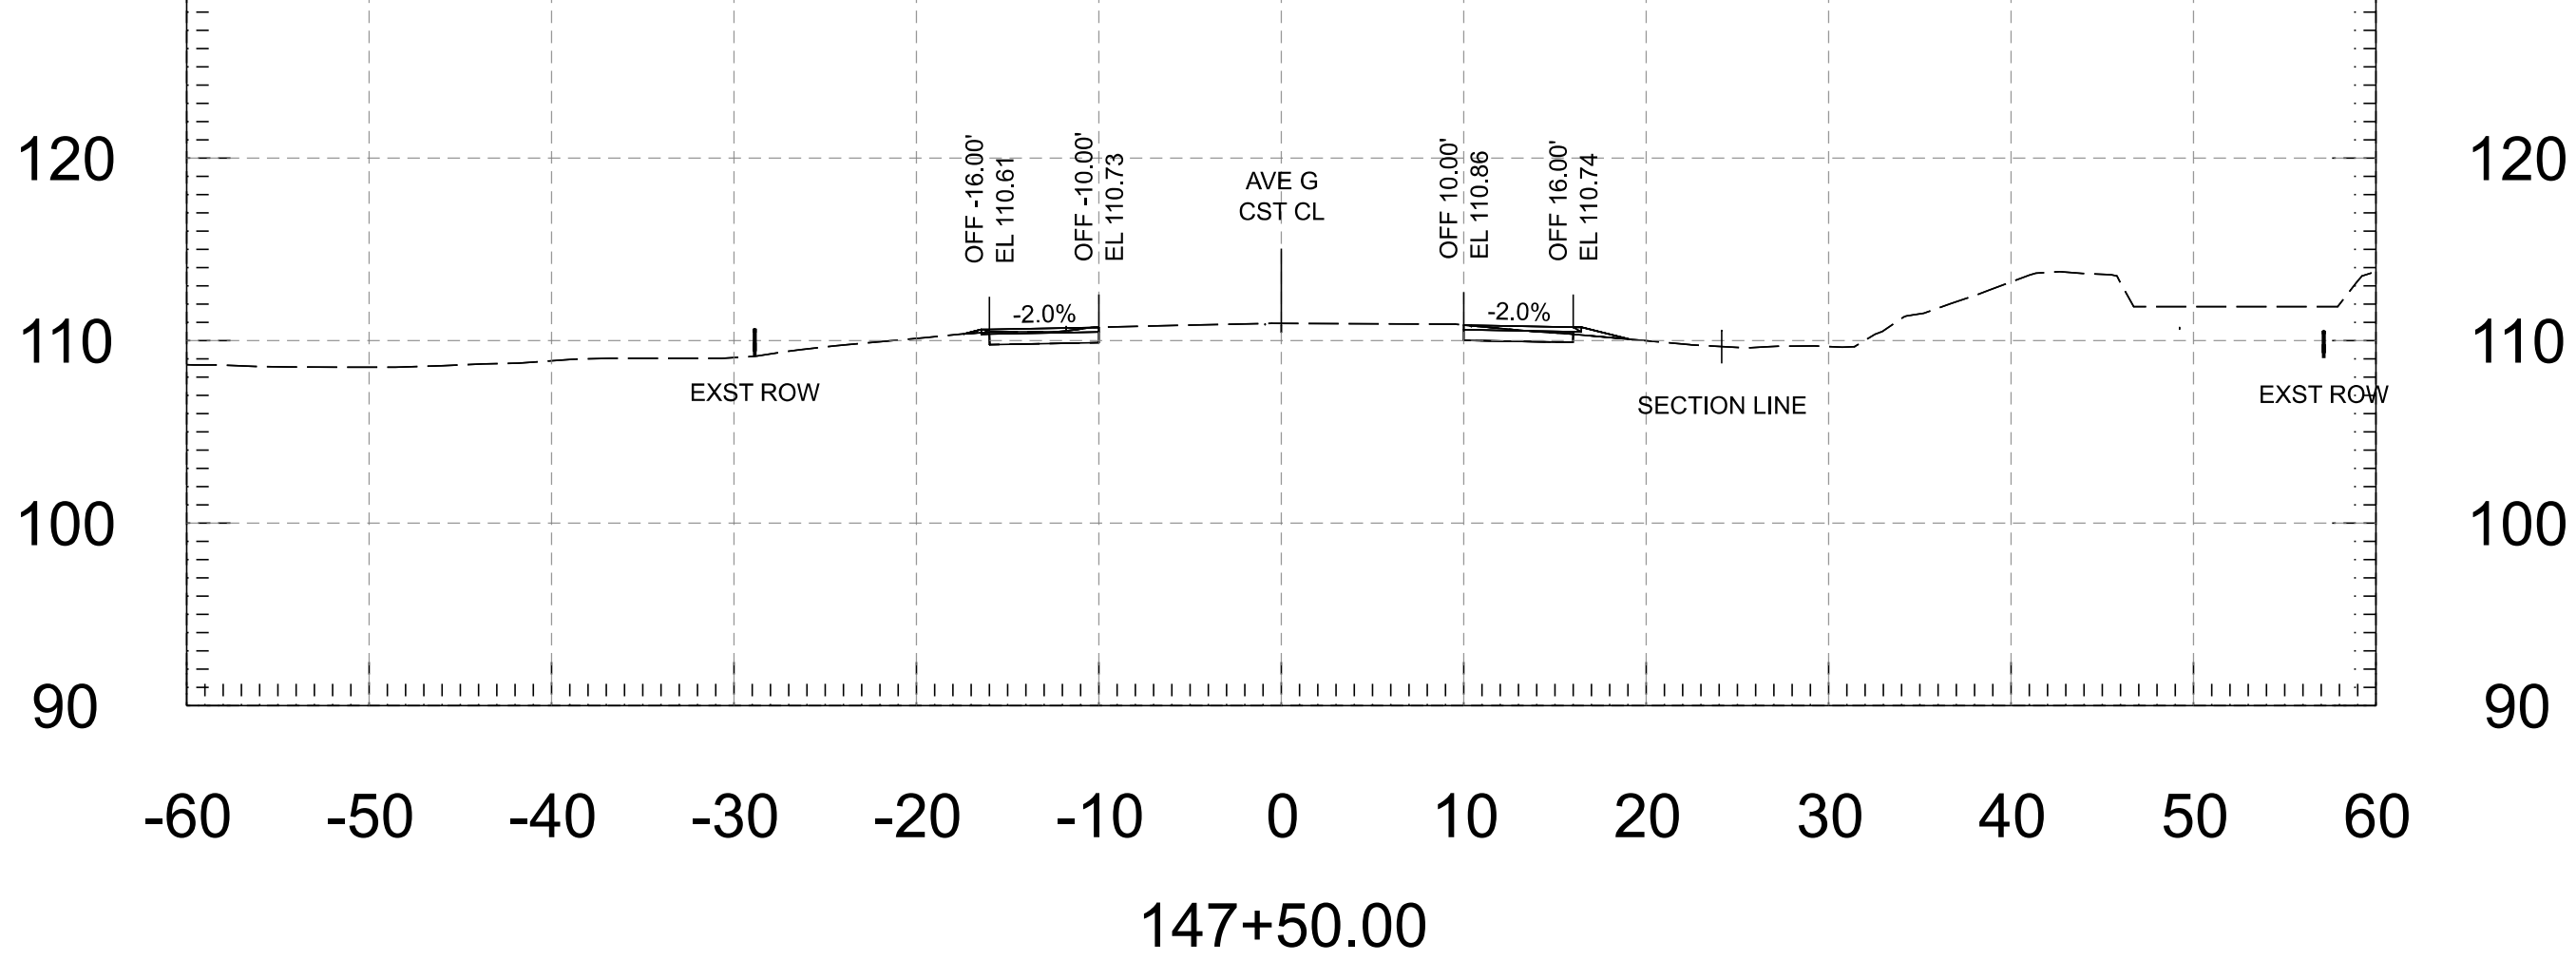


Cut Area	7.49 SF	Fill Area	1.02 SF
Cut Vol.	14.30 CY	Fill Vol.	1.66 CY
Cut Adj. Vol.	14.30 CY	Fill Adj. Vol.	1.66 CY

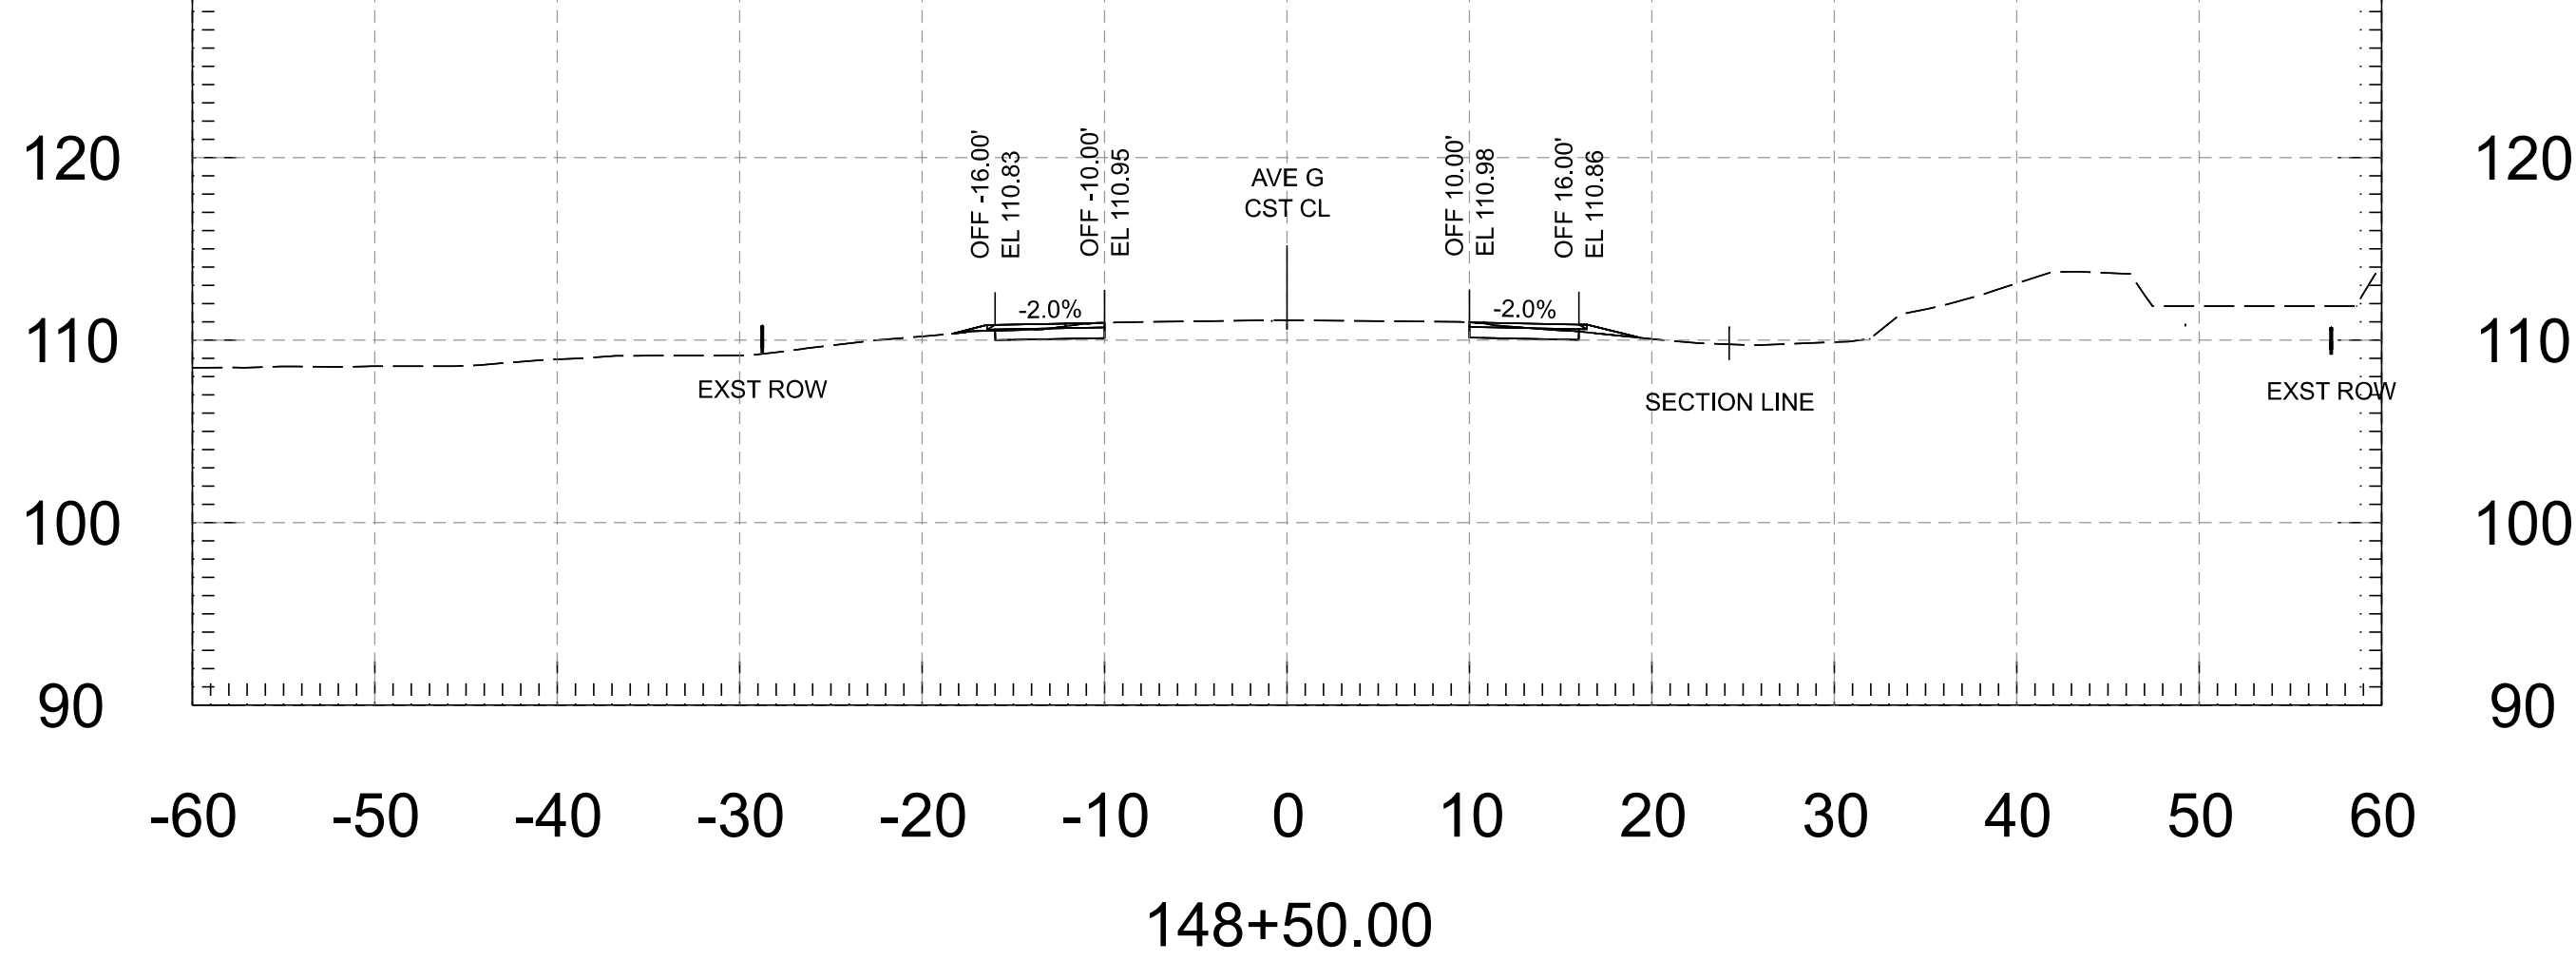





Cut Area	7.70 SF	Fill Area	0.65 SF
Cut Vol.	14.59 CY	Fill Vol.	1.10 CY
Cut Adj. Vol.	14.59 CY	Fill Adj. Vol.	1.10 CY

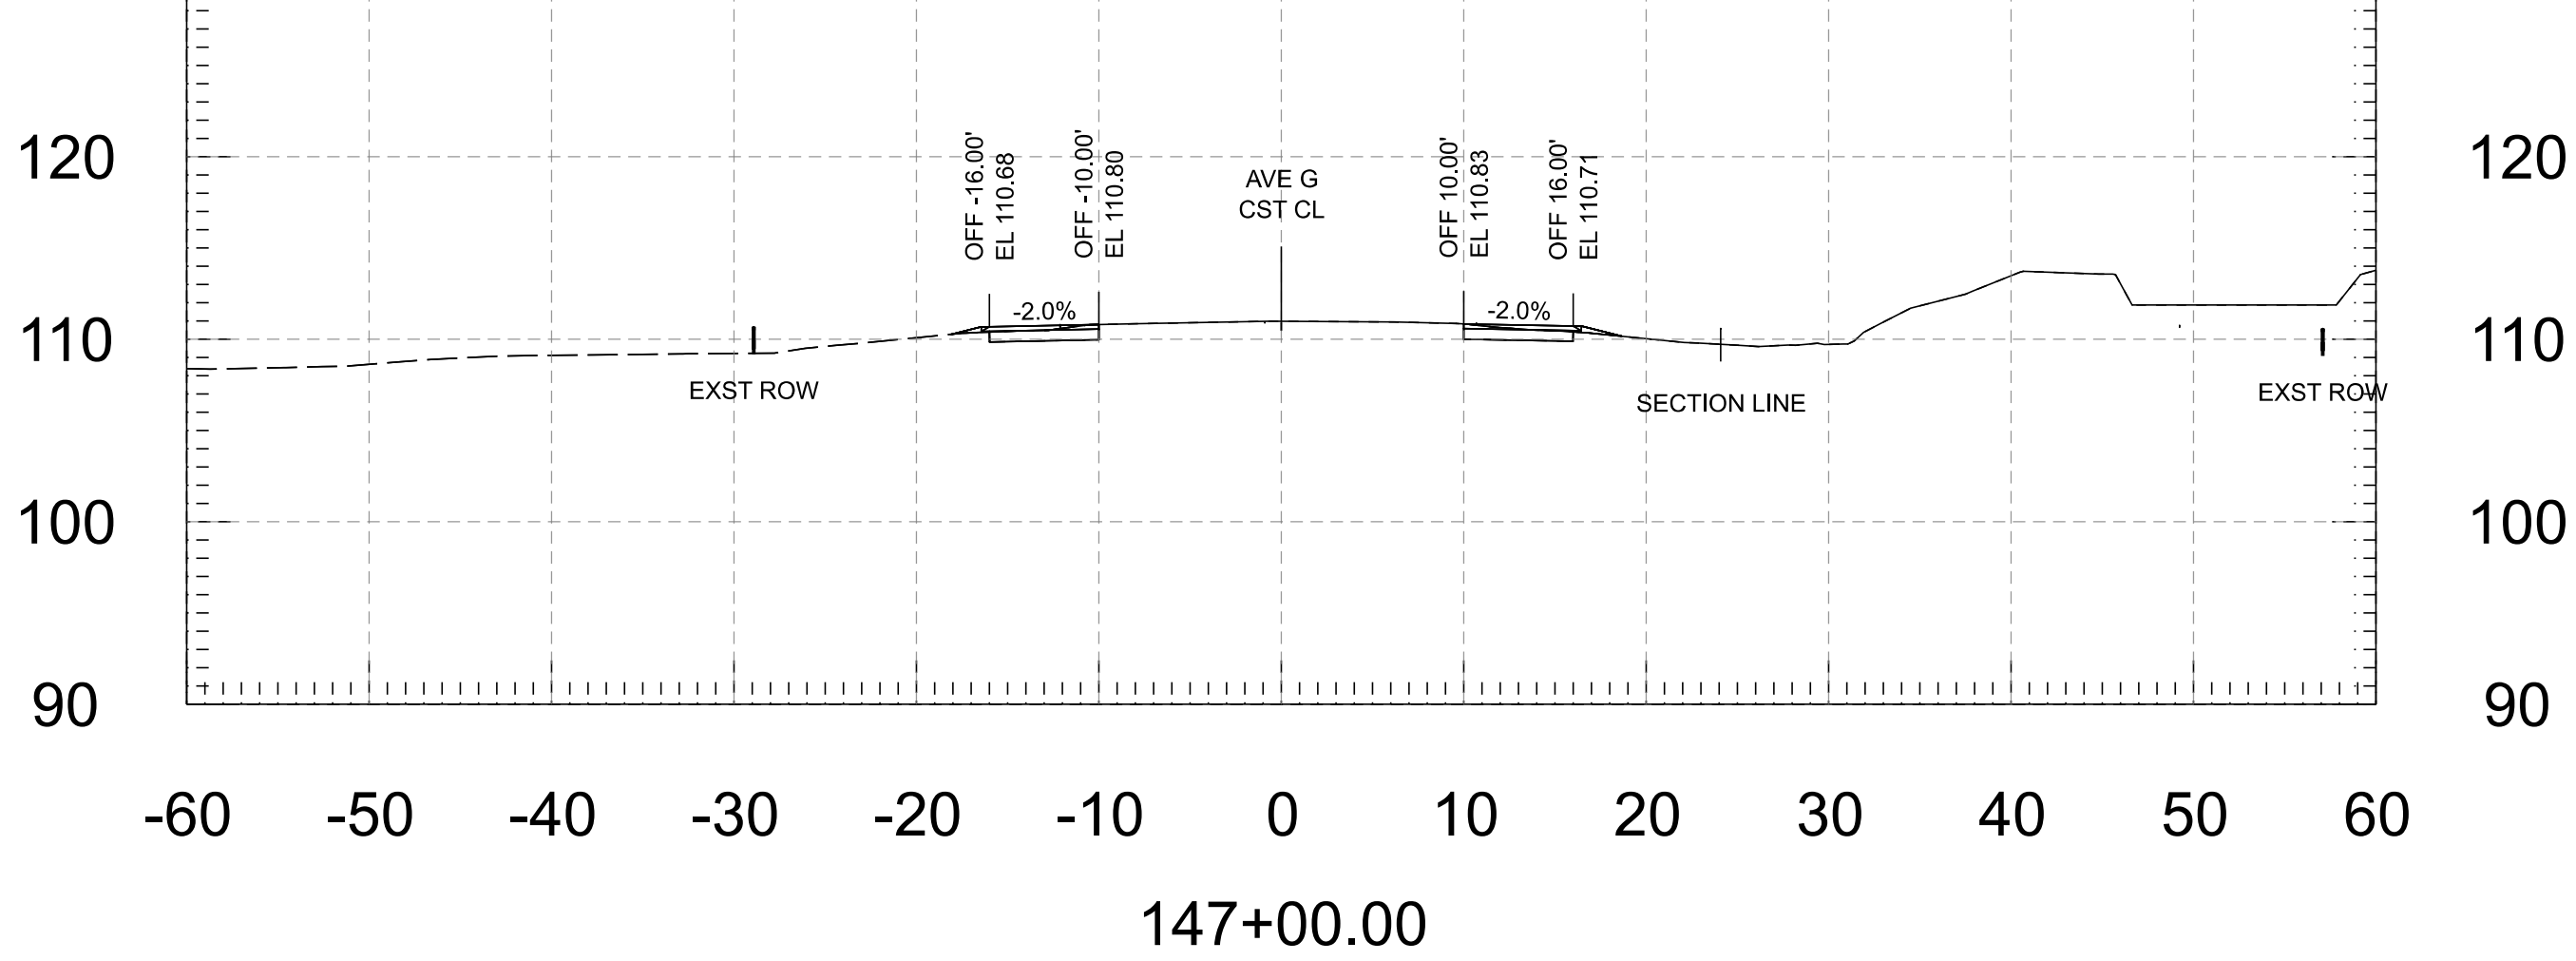

Cut Area	7.95 SF	Fill Area	0.77 SF
Cut Vol.	14.77 CY	Fill Vol.	1.38 CY
Cut Adj. Vol.	14.77 CY	Fill Adj. Vol.	1.38 CY

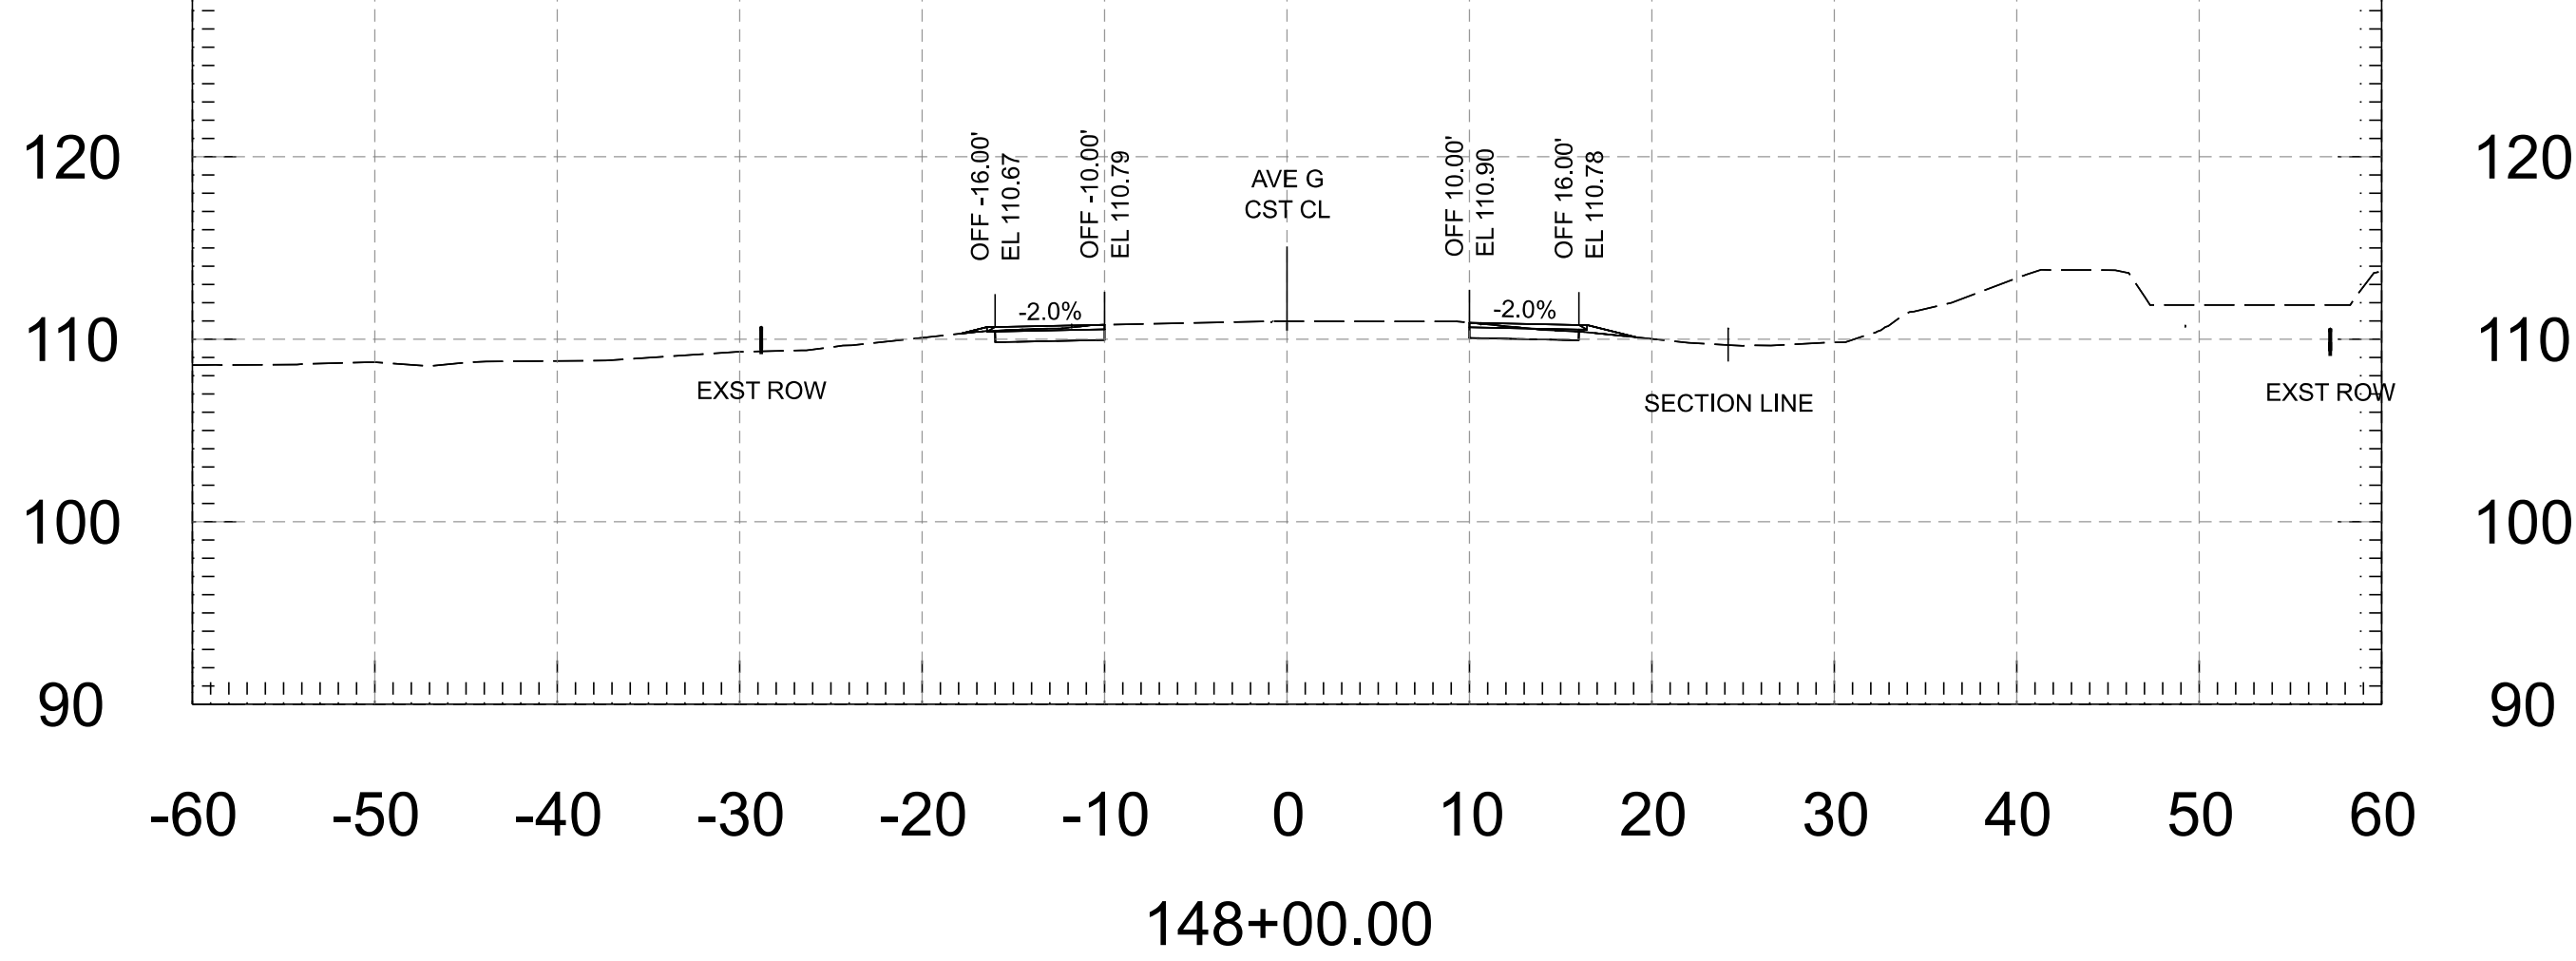


FOR INFORMATION ONLY		NAME	DATE	ARIZONA DEPARTMENT OF TRANSPORTATION PROJECT DELIVERY AND OPERATIONS DIVISION ROADWAY DESIGN SERVICES	ROUTE	F.H.W.A. Arizona Division	STATE ARIZ.	PROJECT NO.	FEDERAL ID NO.	SHEET NO.	TOTAL SHEETS	RECORD DRAWING
	DESIGN	M. SCHOEN	07/26		0000 YU YYU			YYU-0(225)T	67	118		
	DRAWN	M. SCHOEN	07/26		MILEPOST	LOCATION AVENUE G, COUNTY 11TH ST - COUNTY 16TH ST						
	CHECKED	H. RIOS	07/26	TRACS NO. T0437 01C								
			WSP USA Inc. 1200 West Washington Street, Suite 405 Tempe, AZ 85288		AVENUE G - CROSS SECTIONS		____ OF ____					

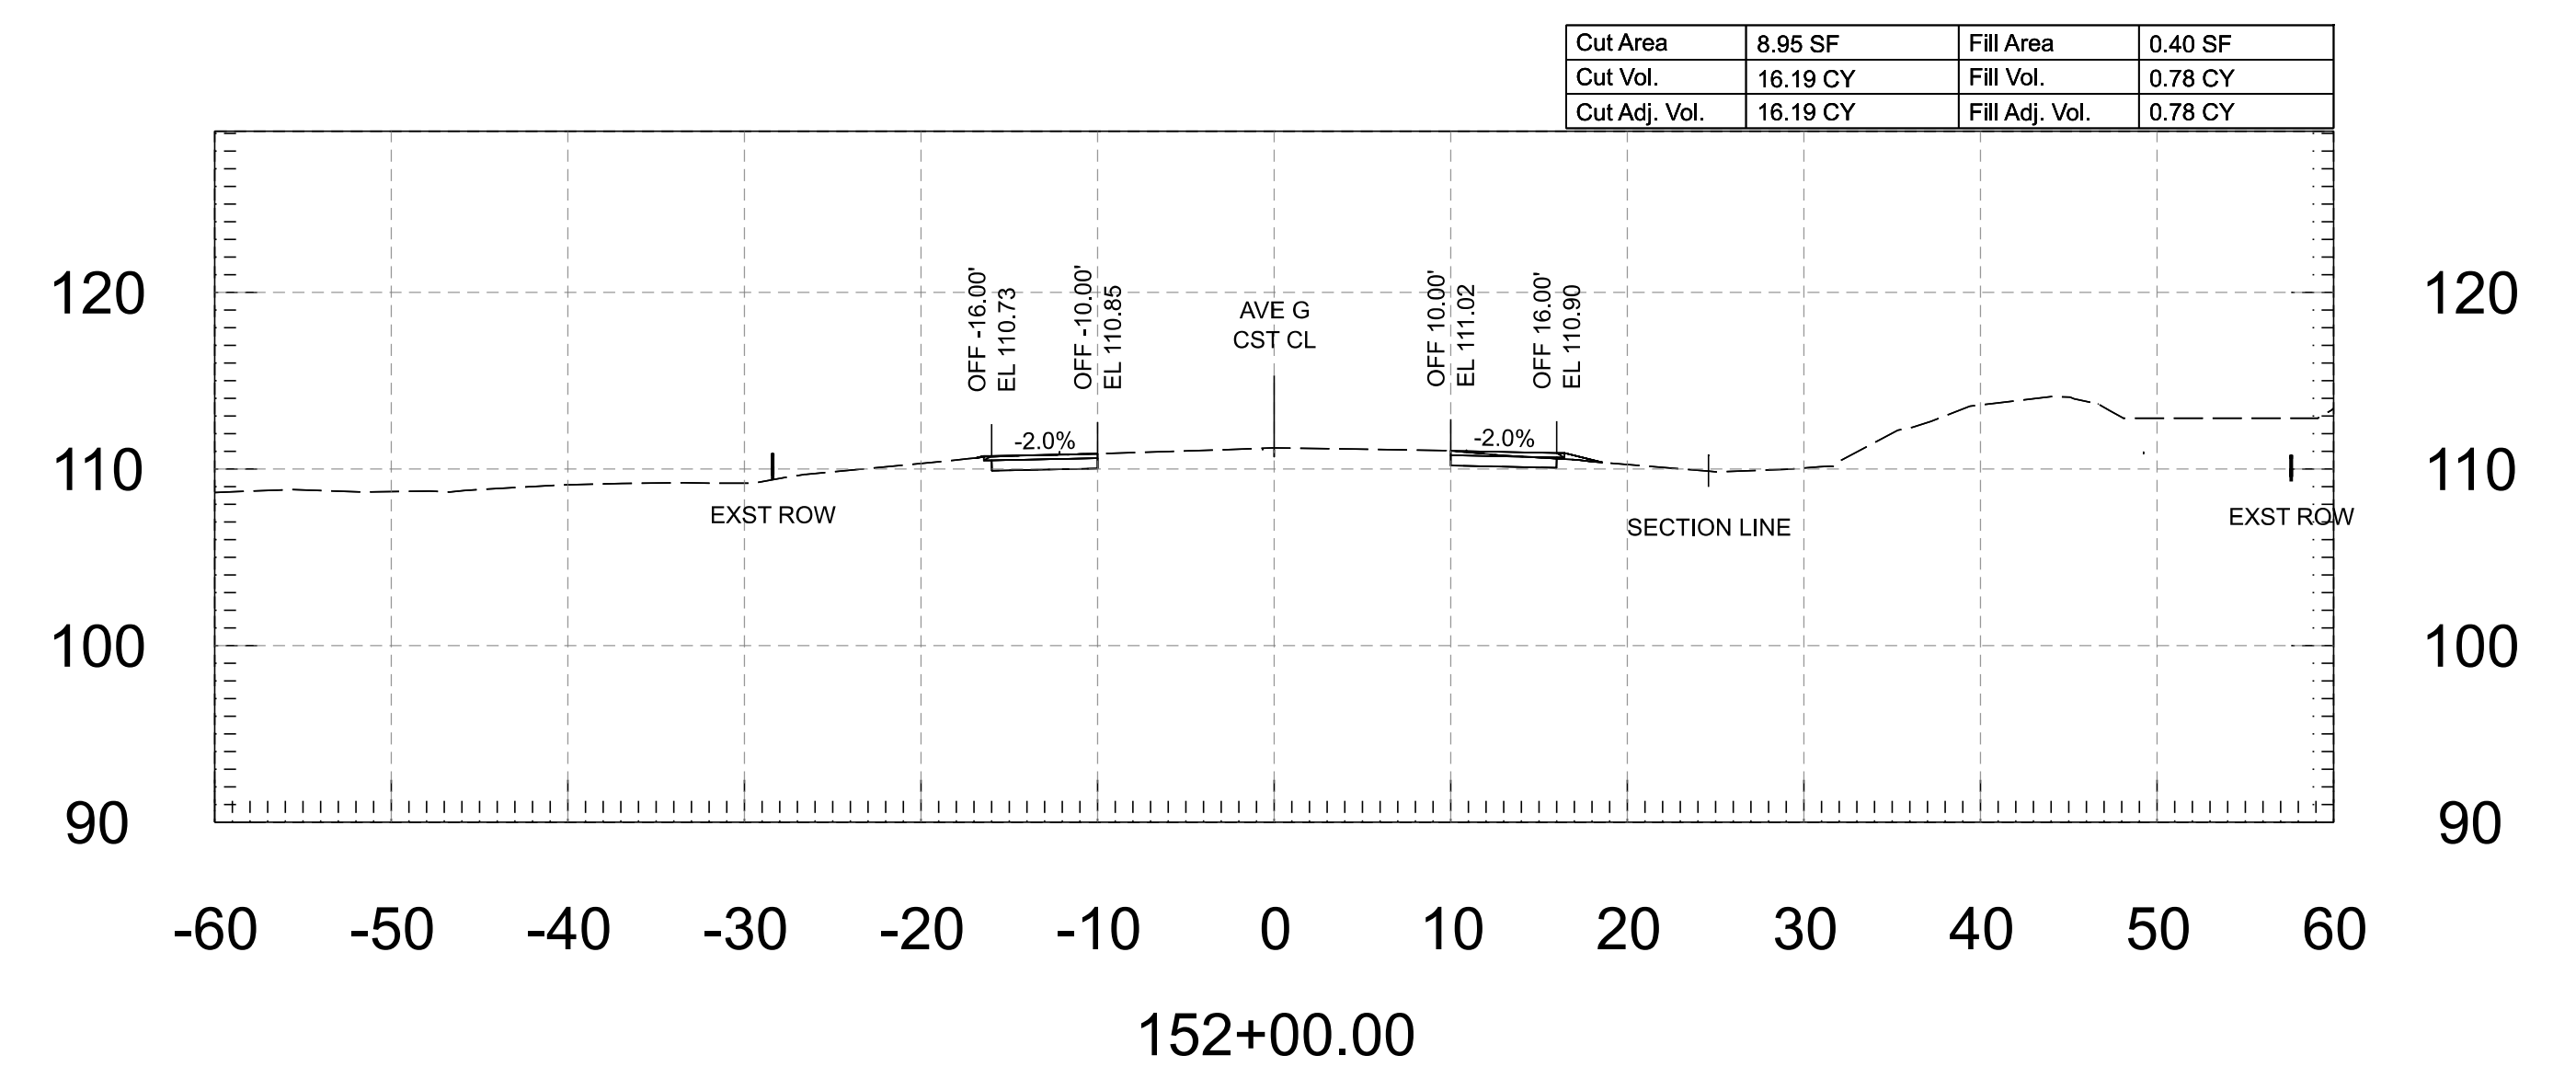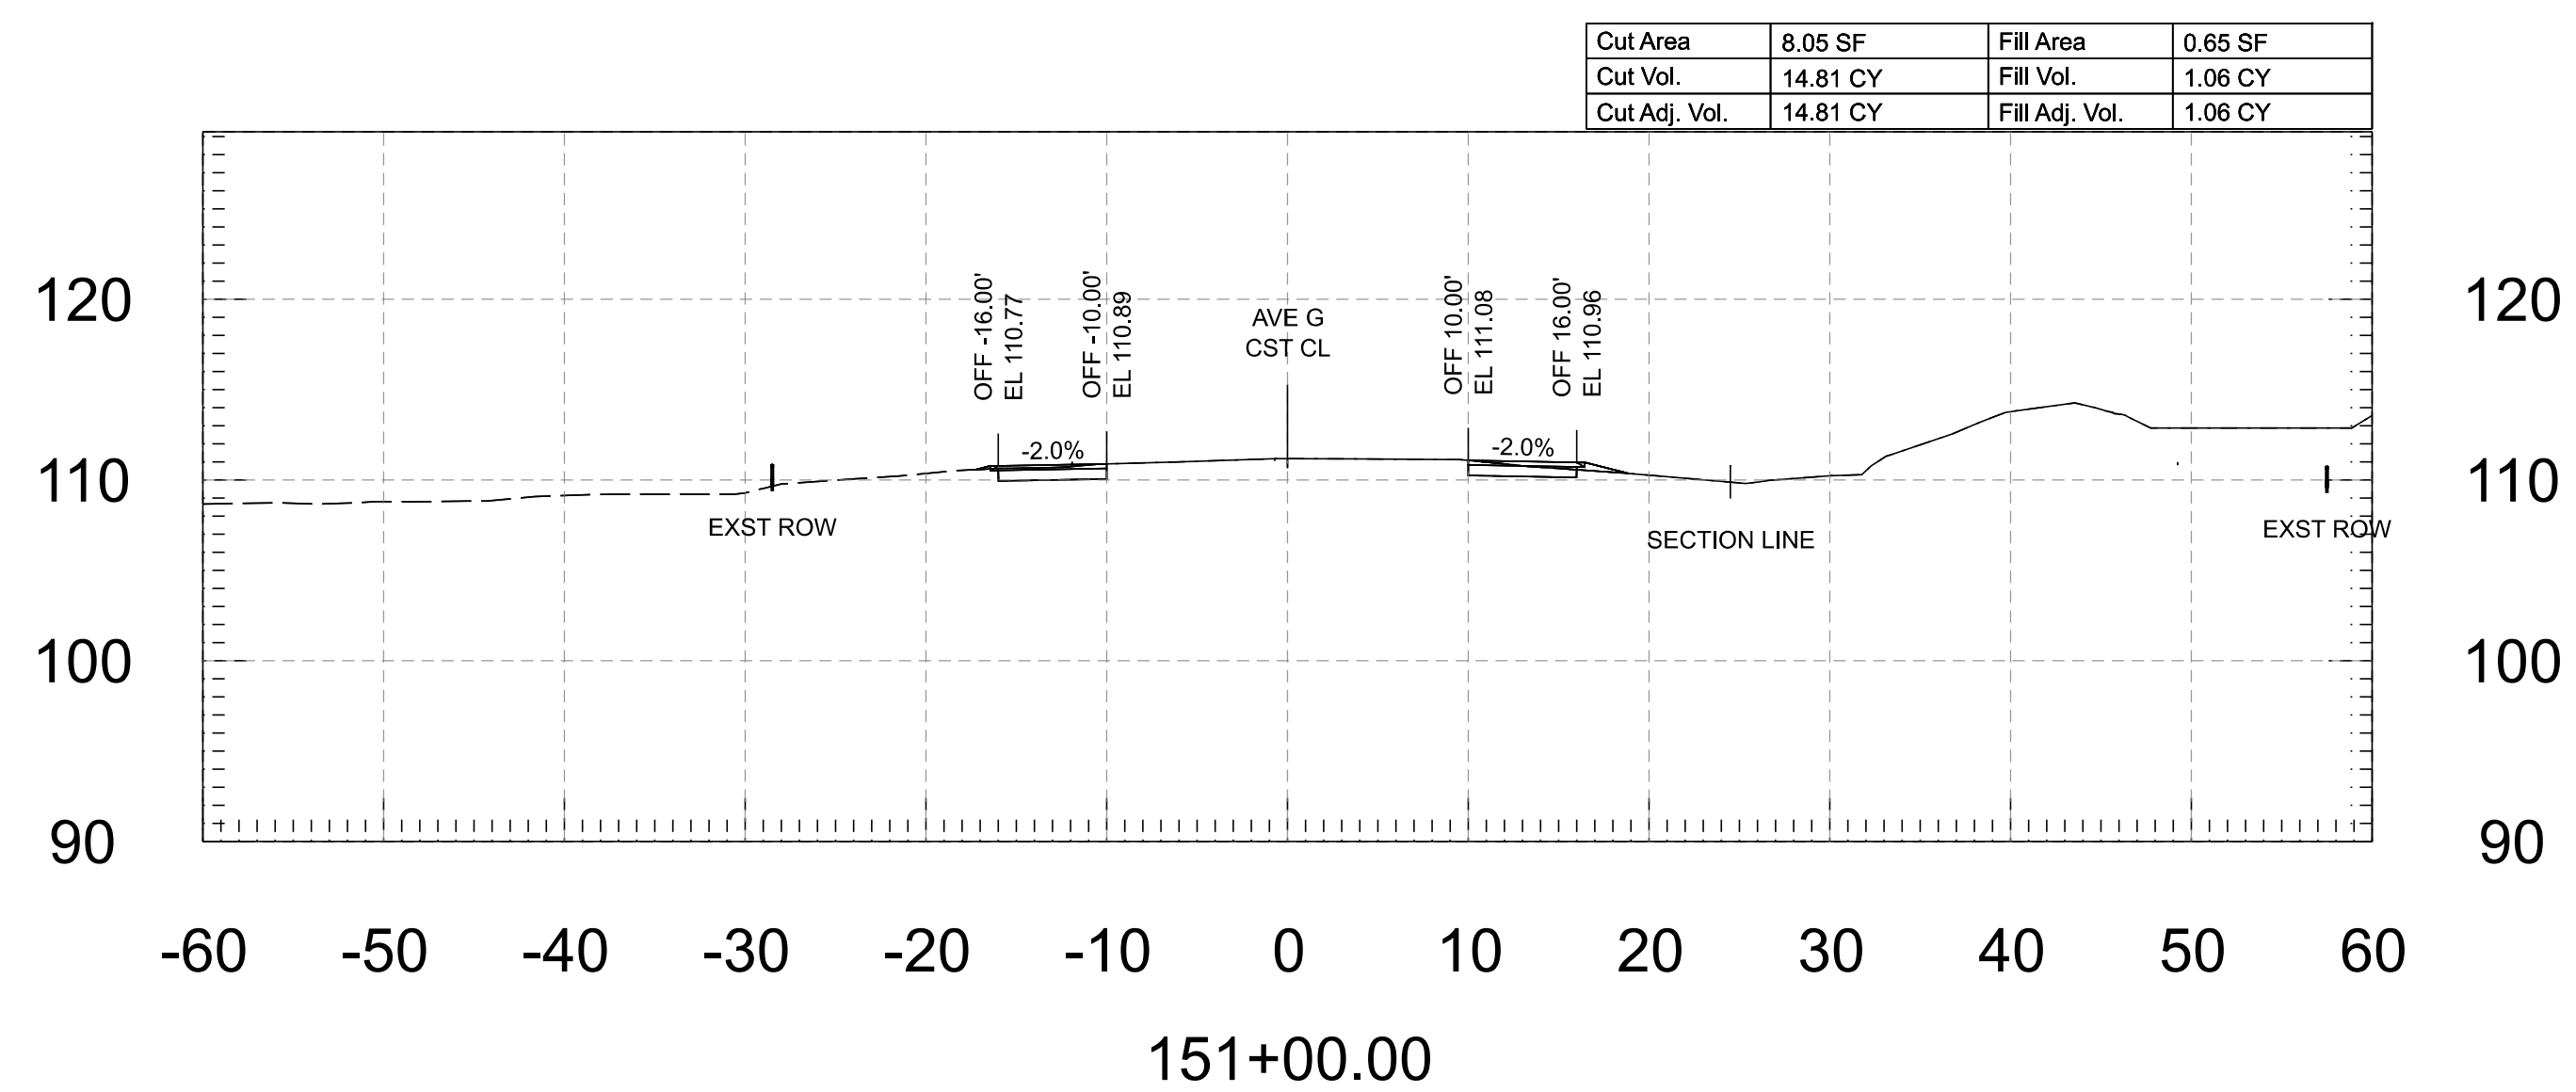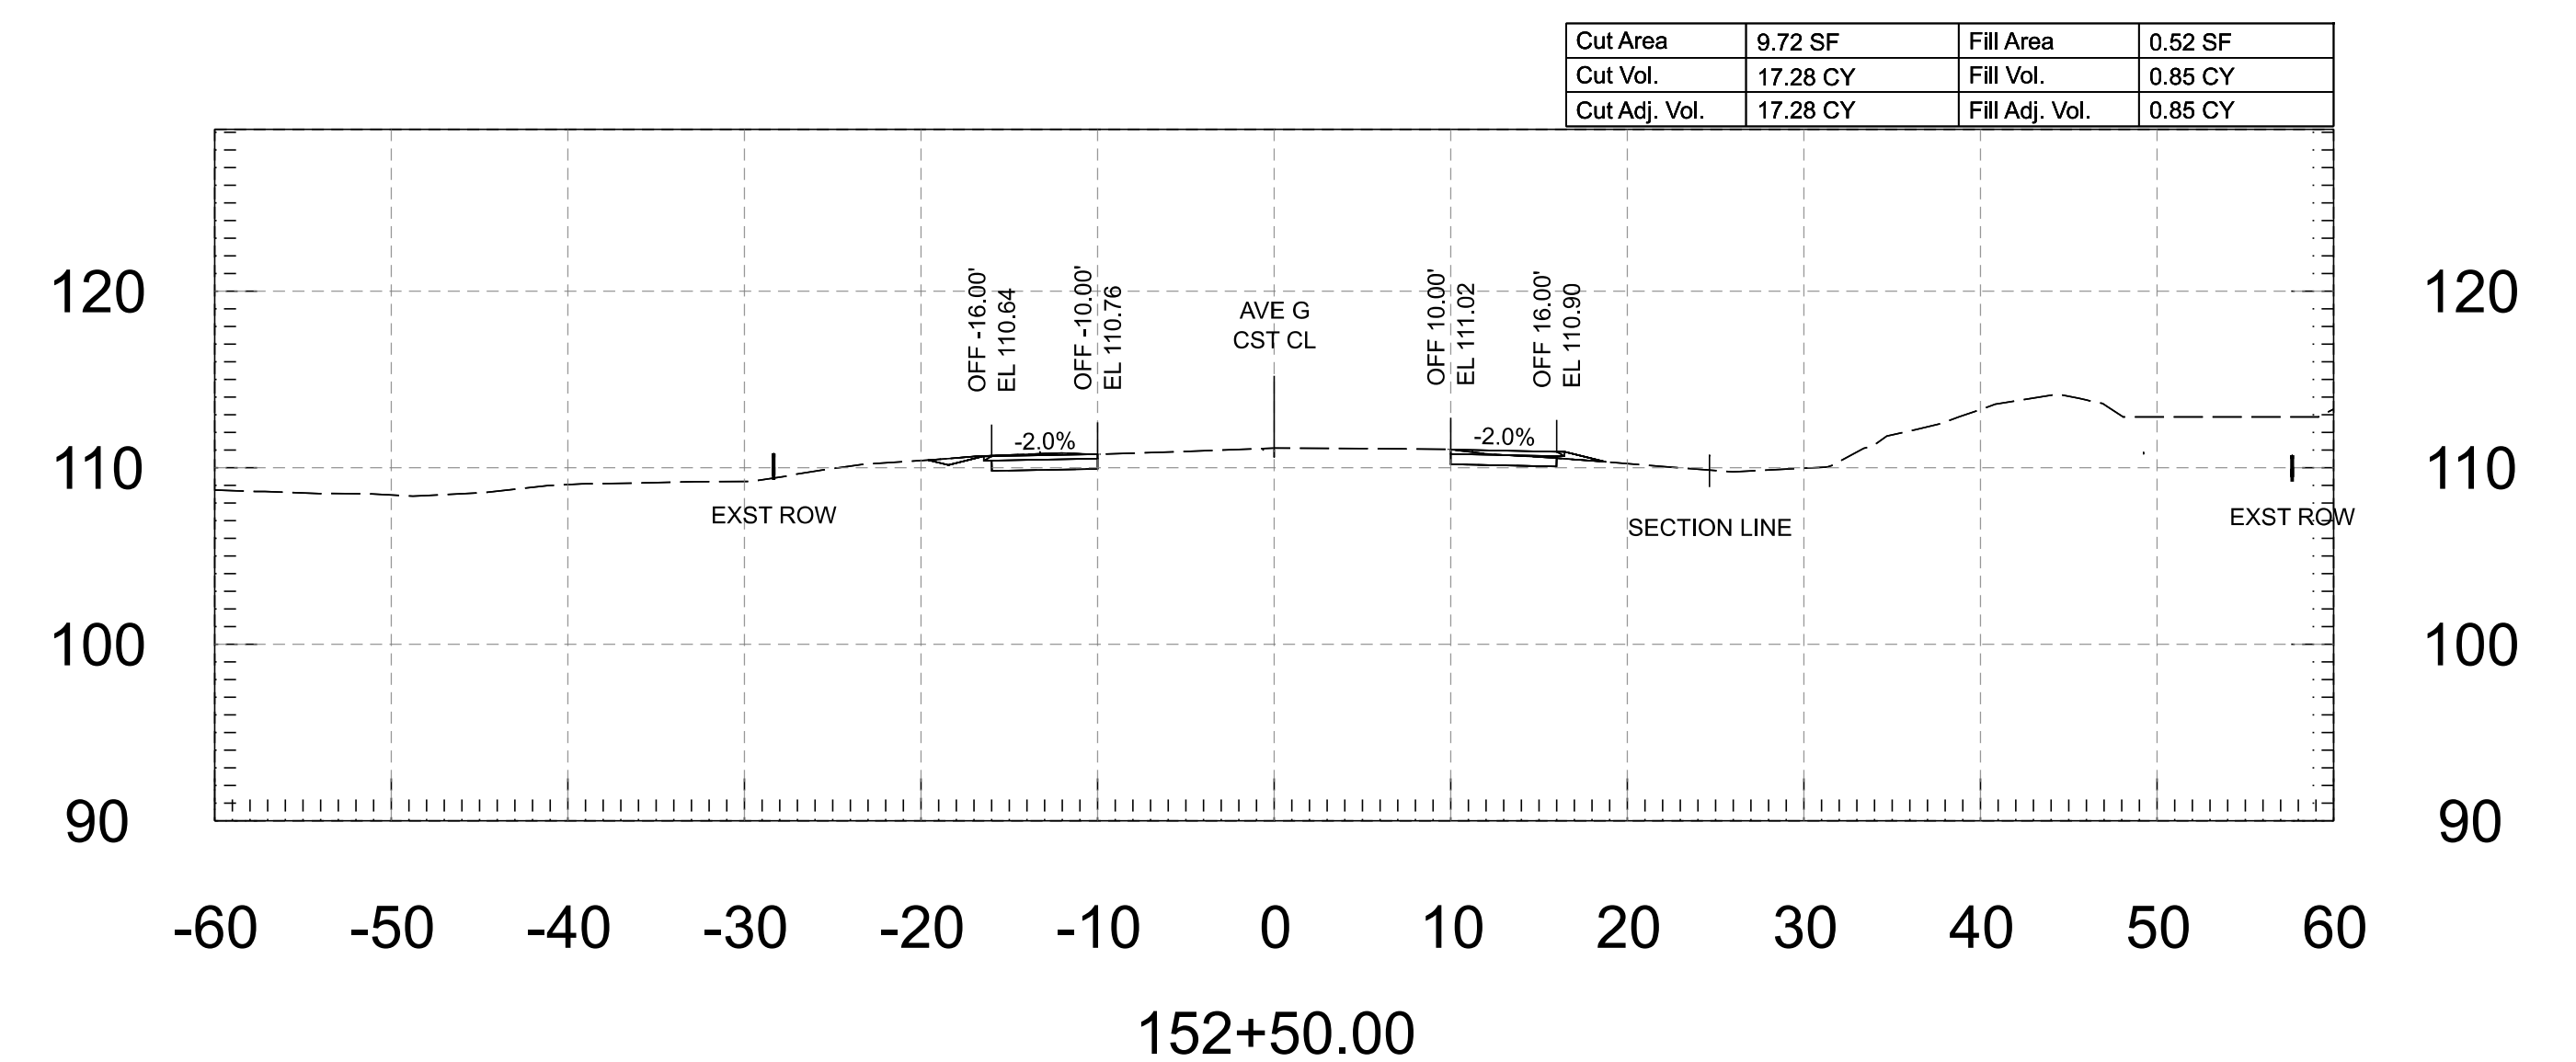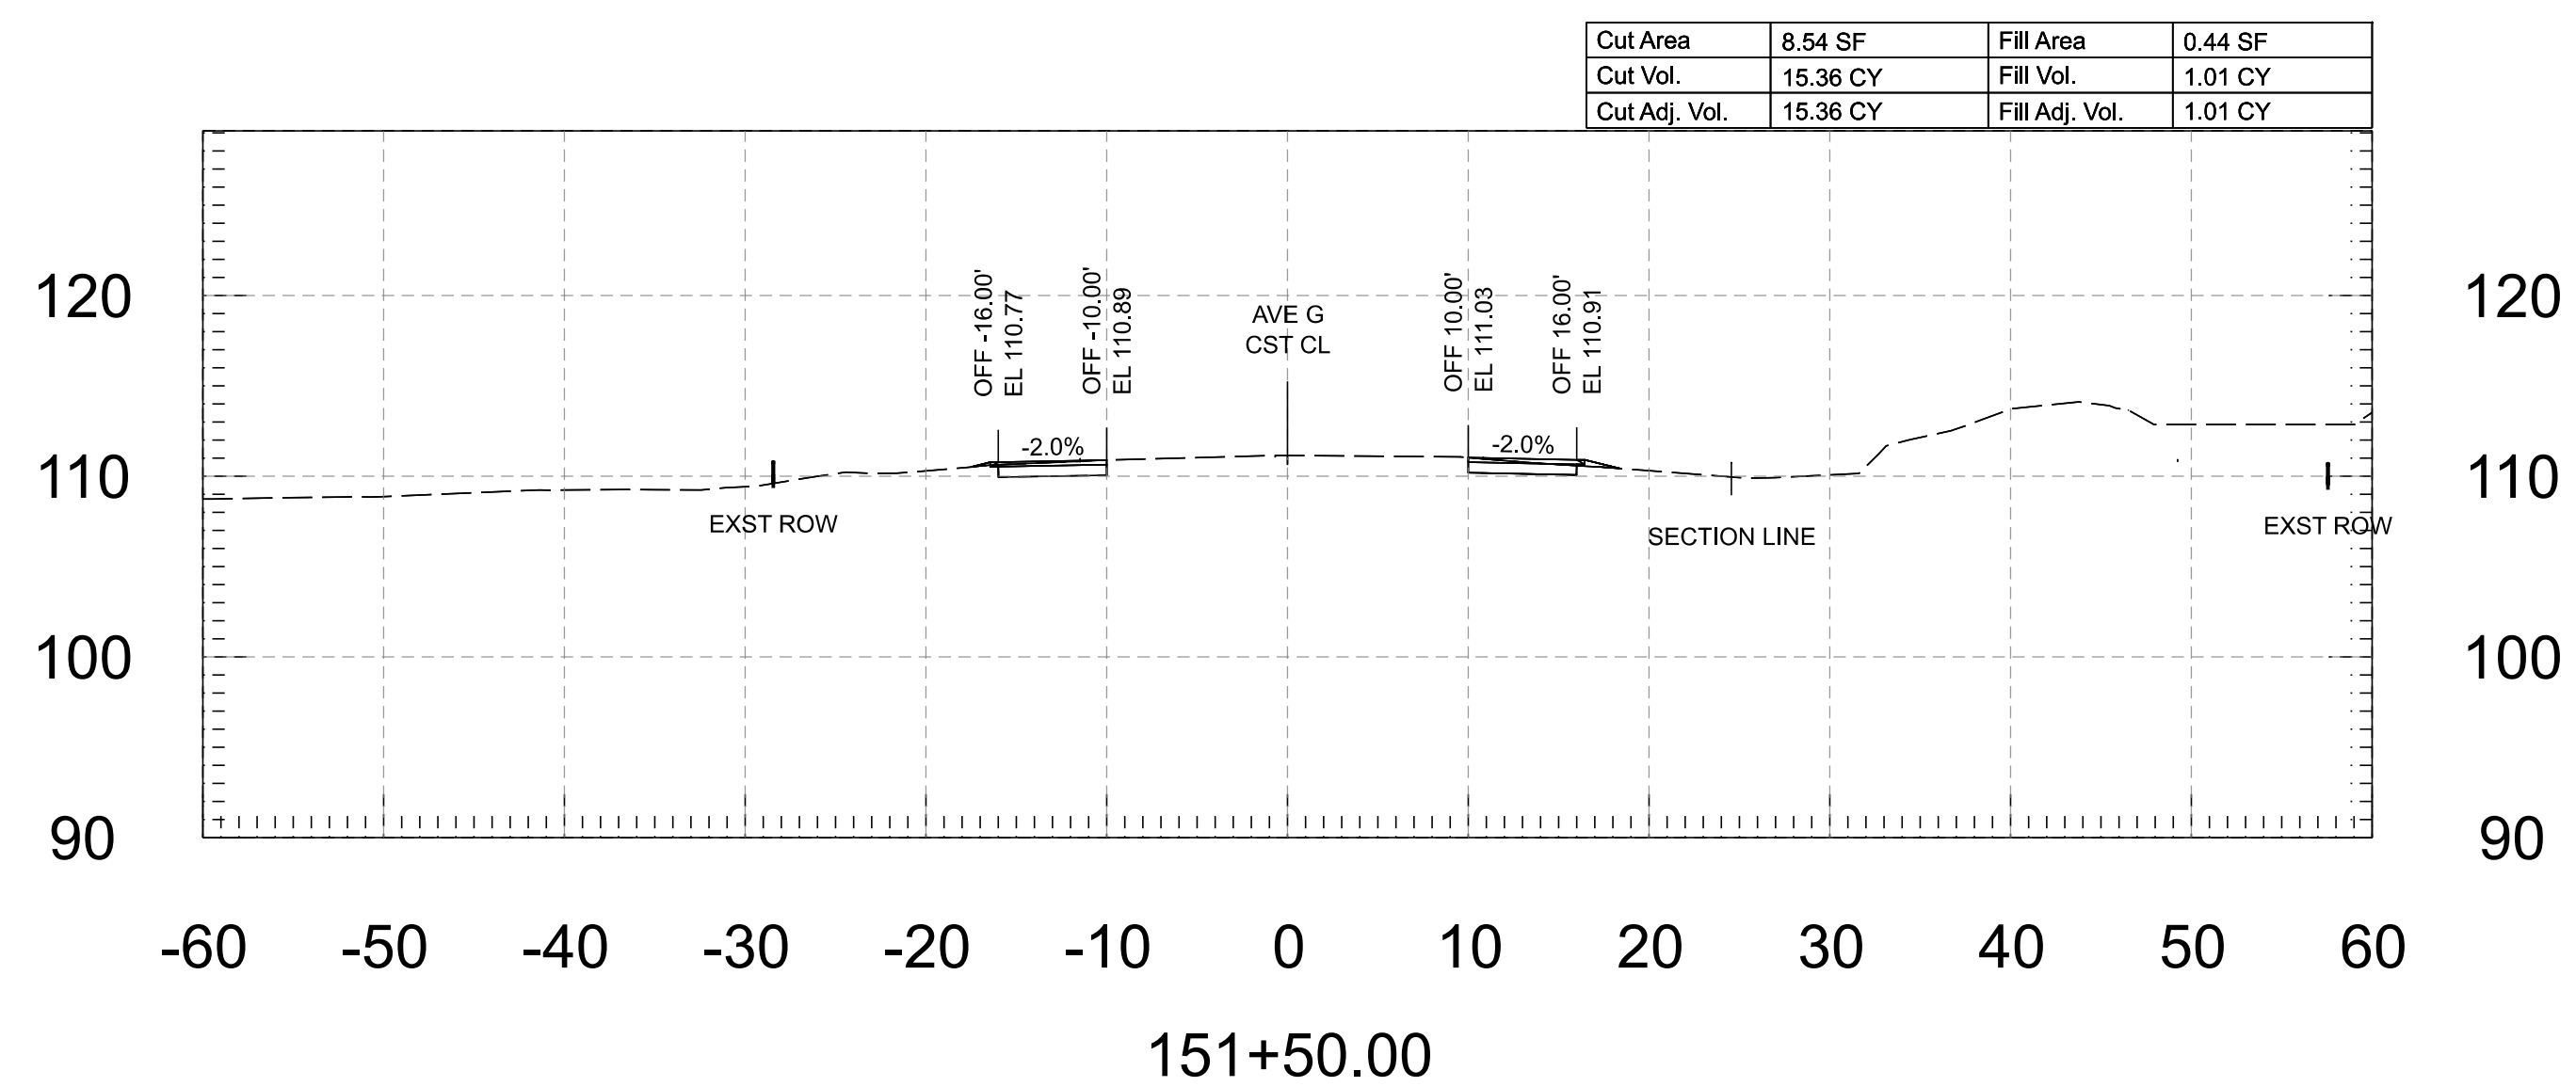


FOR INFORMATION ONLY		NAME	DATE	ARIZONA DEPARTMENT OF TRANSPORTATION PROJECT DELIVERY AND OPERATIONS DIVISION ROADWAY DESIGN SERVICES	ROUTE	F.H.W.A. Arizona Division	STATE ARIZ.	PROJECT NO.	FEDERAL ID NO.	SHEET NO.	TOTAL SHEETS	RECORD DRAWING
	DESIGN	M. SCHOEN	07/26		MILEPOST			0000 YU YYU	YYU-0(225)T	69	118	
	DRAWN	M. SCHOEN	07/26			STRUCTURE NO.	LOCATION AVENUE G, COUNTY 11TH ST - COUNTY 16TH ST					
	CHECKED	H. RIOS	07/26	TRACS NO. T0437 01C						___ OF ___		
	wsp WSP USA Inc. 1280 West Washington Street, Suite 405 Tempe, AZ 85289			AVENUE G - CROSS SECTIONS								

Cut Area	8.30 SF	Fill Area	0.31 SF
Cut Vol.	15.88 CY	Fill Vol.	0.62 CY
Cut Adj. Vol.	15.88 CY	Fill Adj. Vol.	0.62 CY

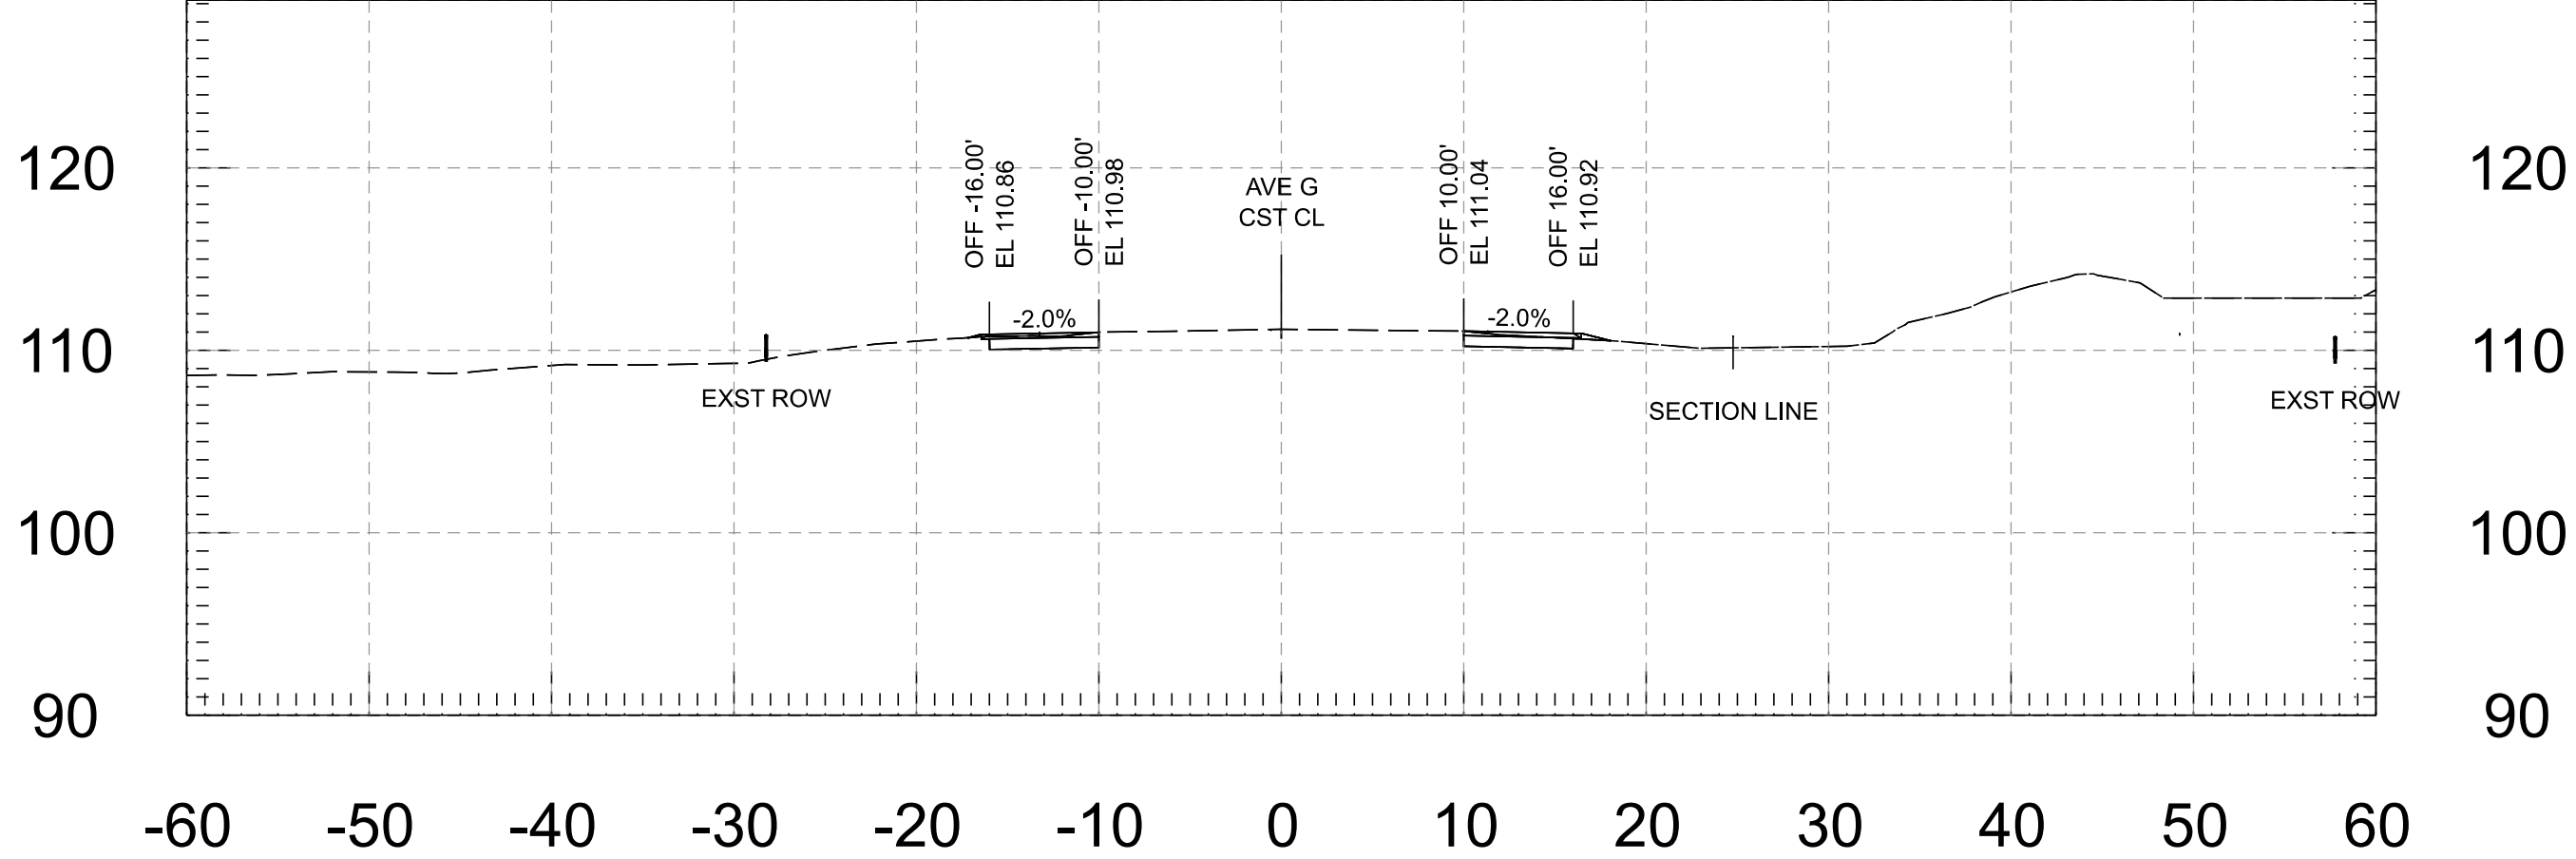


153+50.00

Cut Area	7.97 SF	Fill Area	0.63 SF
Cut Vol.	14.44 CY	Fill Vol.	1.63 CY
Cut Adj. Vol.	14.44 CY	Fill Adj. Vol.	1.63 CY

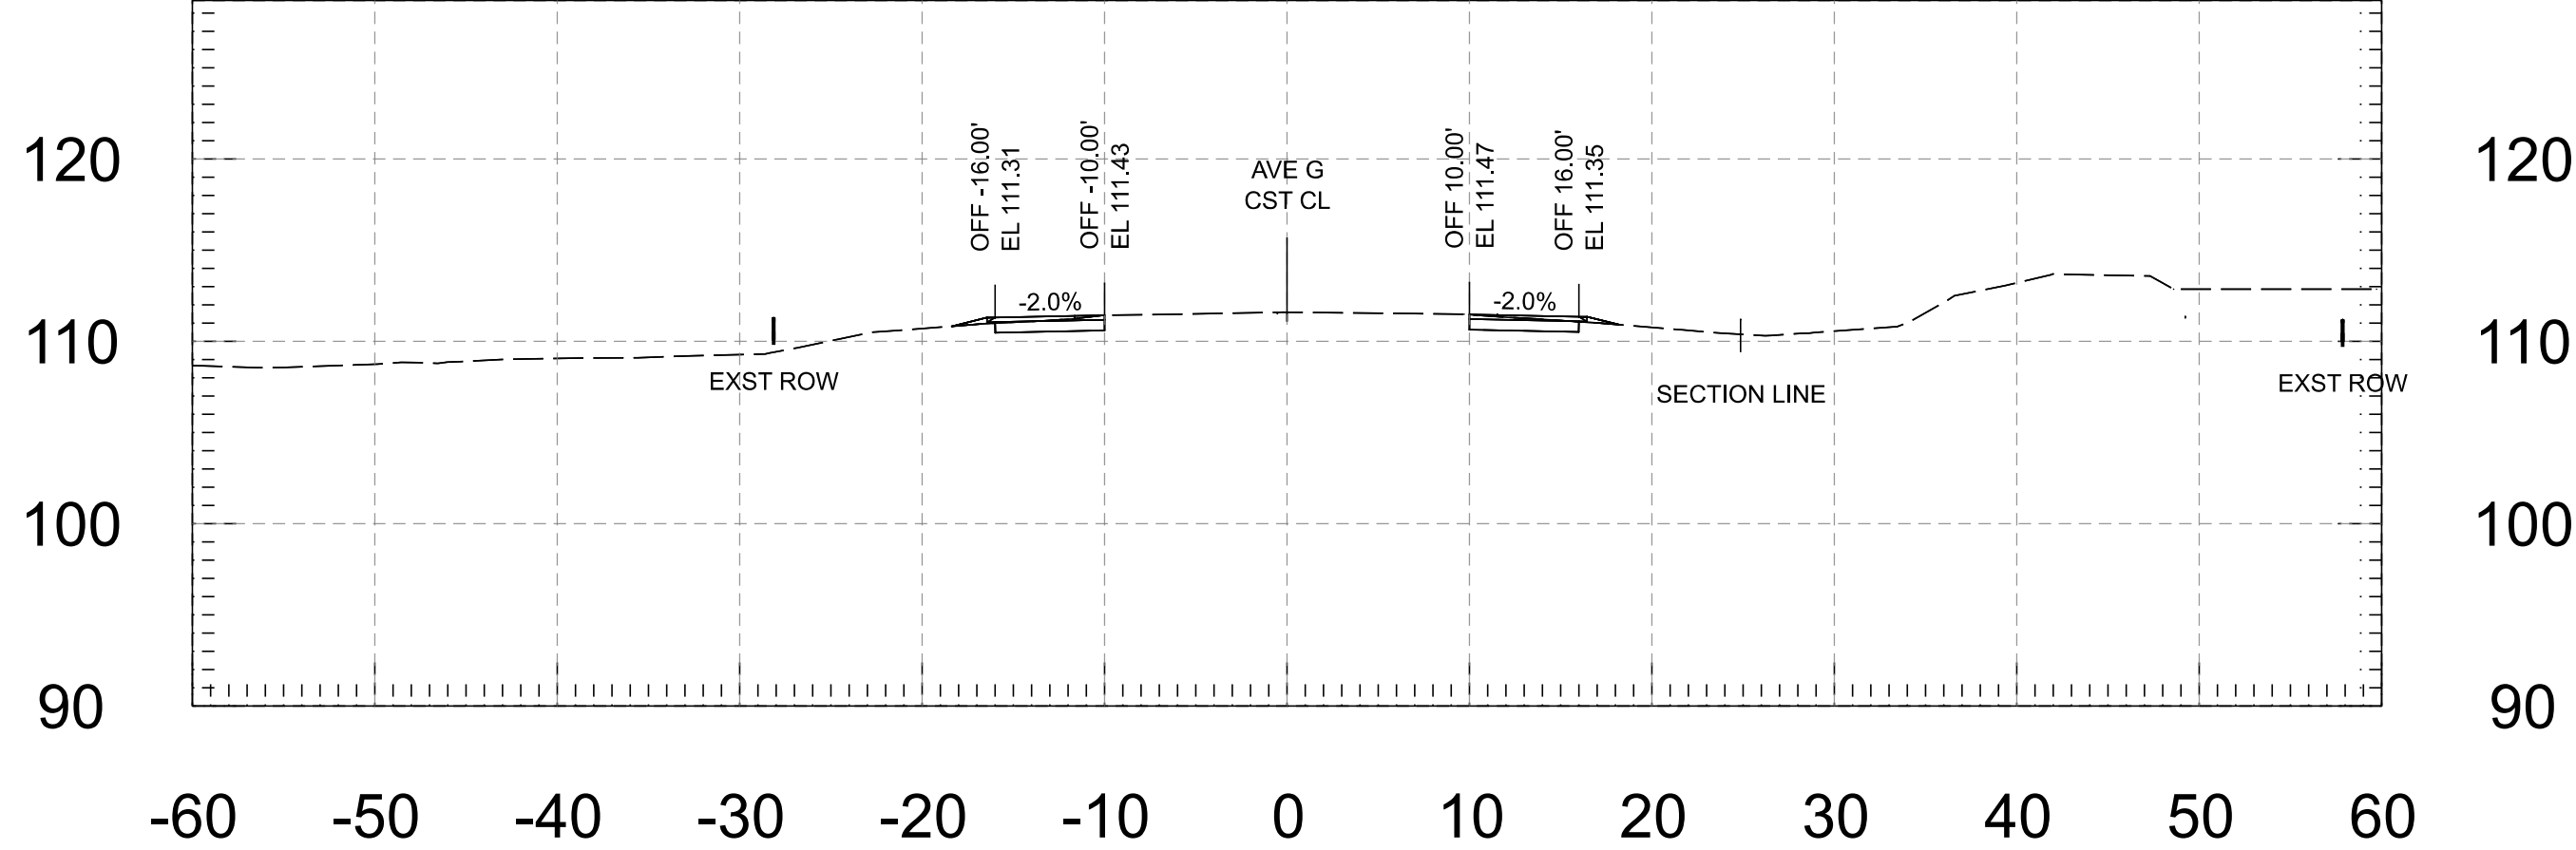


154+50.00

Cut Area	8.85 SF	Fill Area	0.36 SF
Cut Vol.	17.19 CY	Fill Vol.	0.81 CY
Cut Adj. Vol.	17.19 CY	Fill Adj. Vol.	0.81 CY

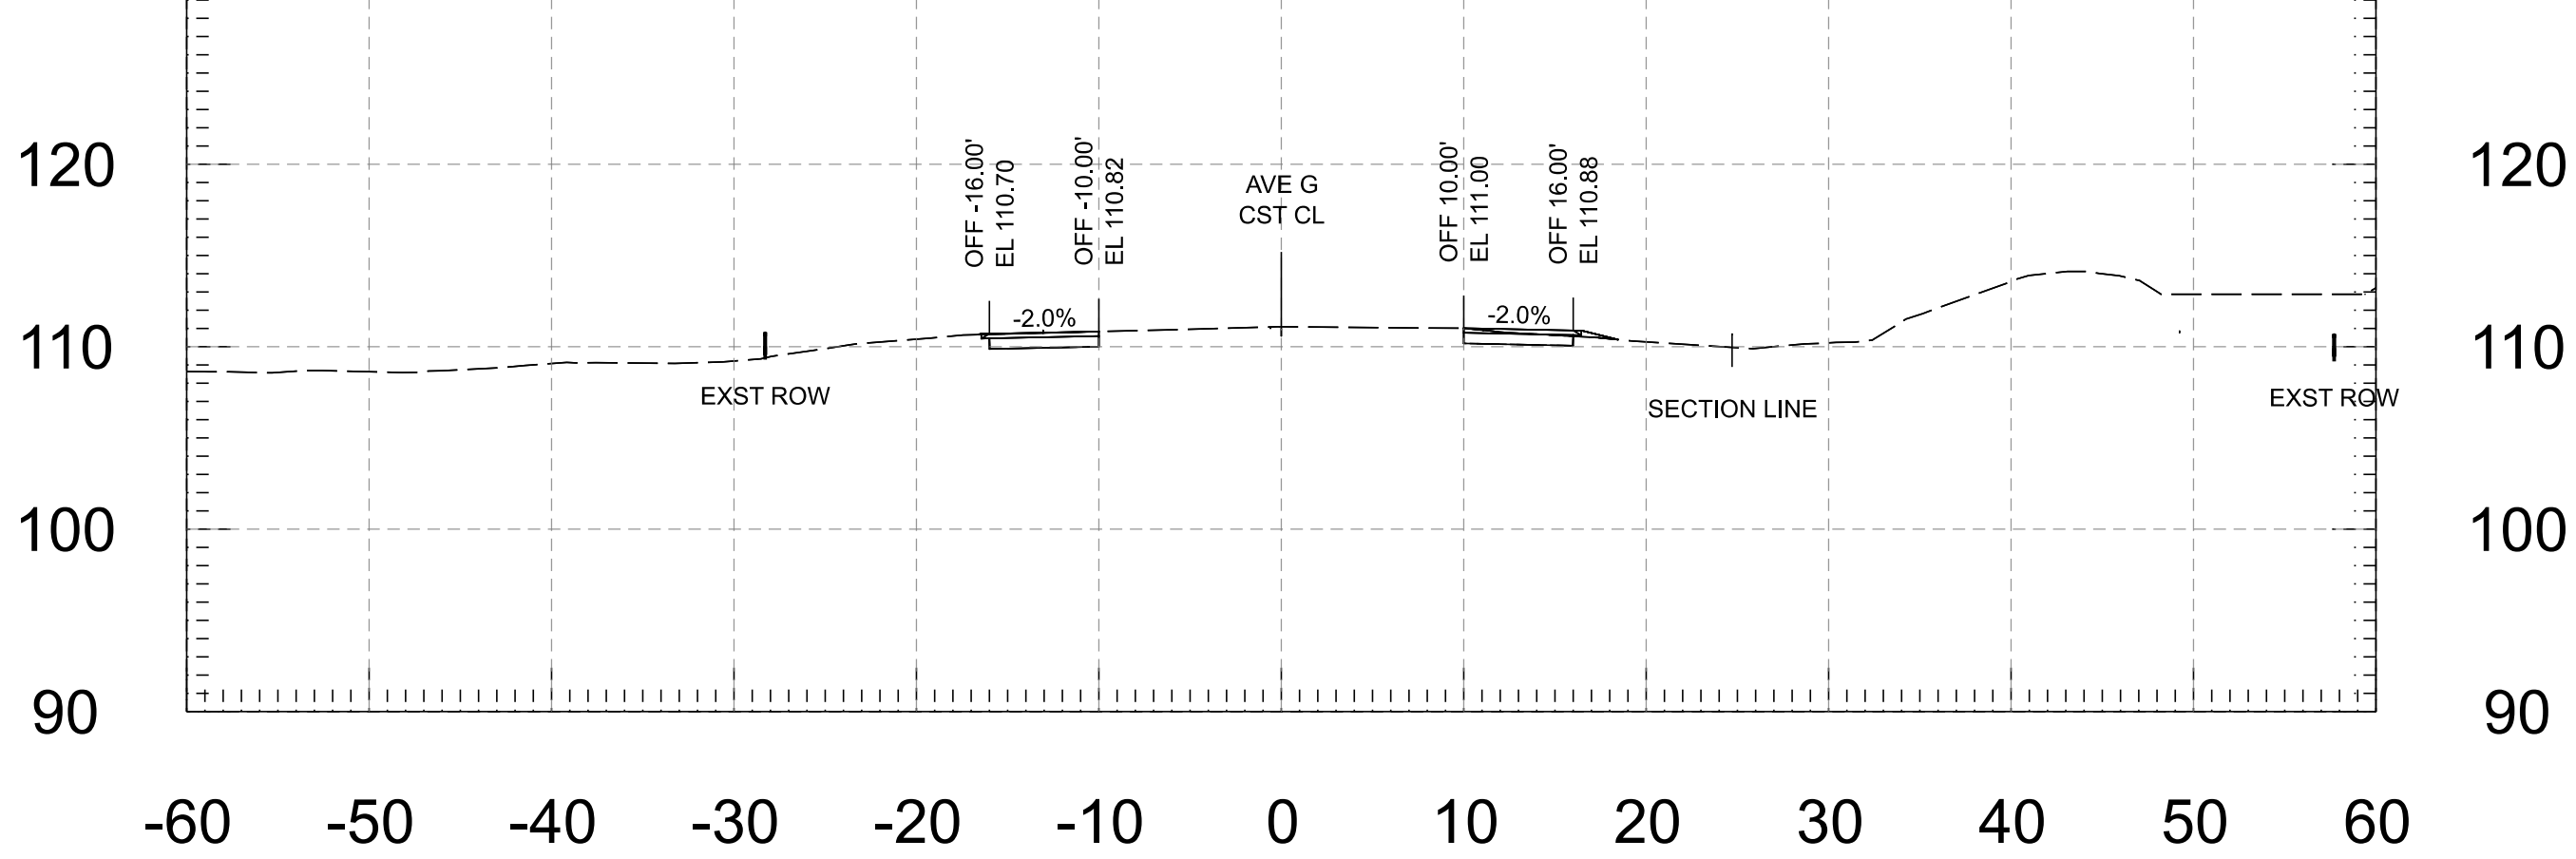






153+00.00

Cut Area	7.63 SF	Fill Area	1.14 SF
Cut Vol.	14.75 CY	Fill Vol.	1.34 CY
Cut Adj. Vol.	14.75 CY	Fill Adj. Vol.	1.34 CY


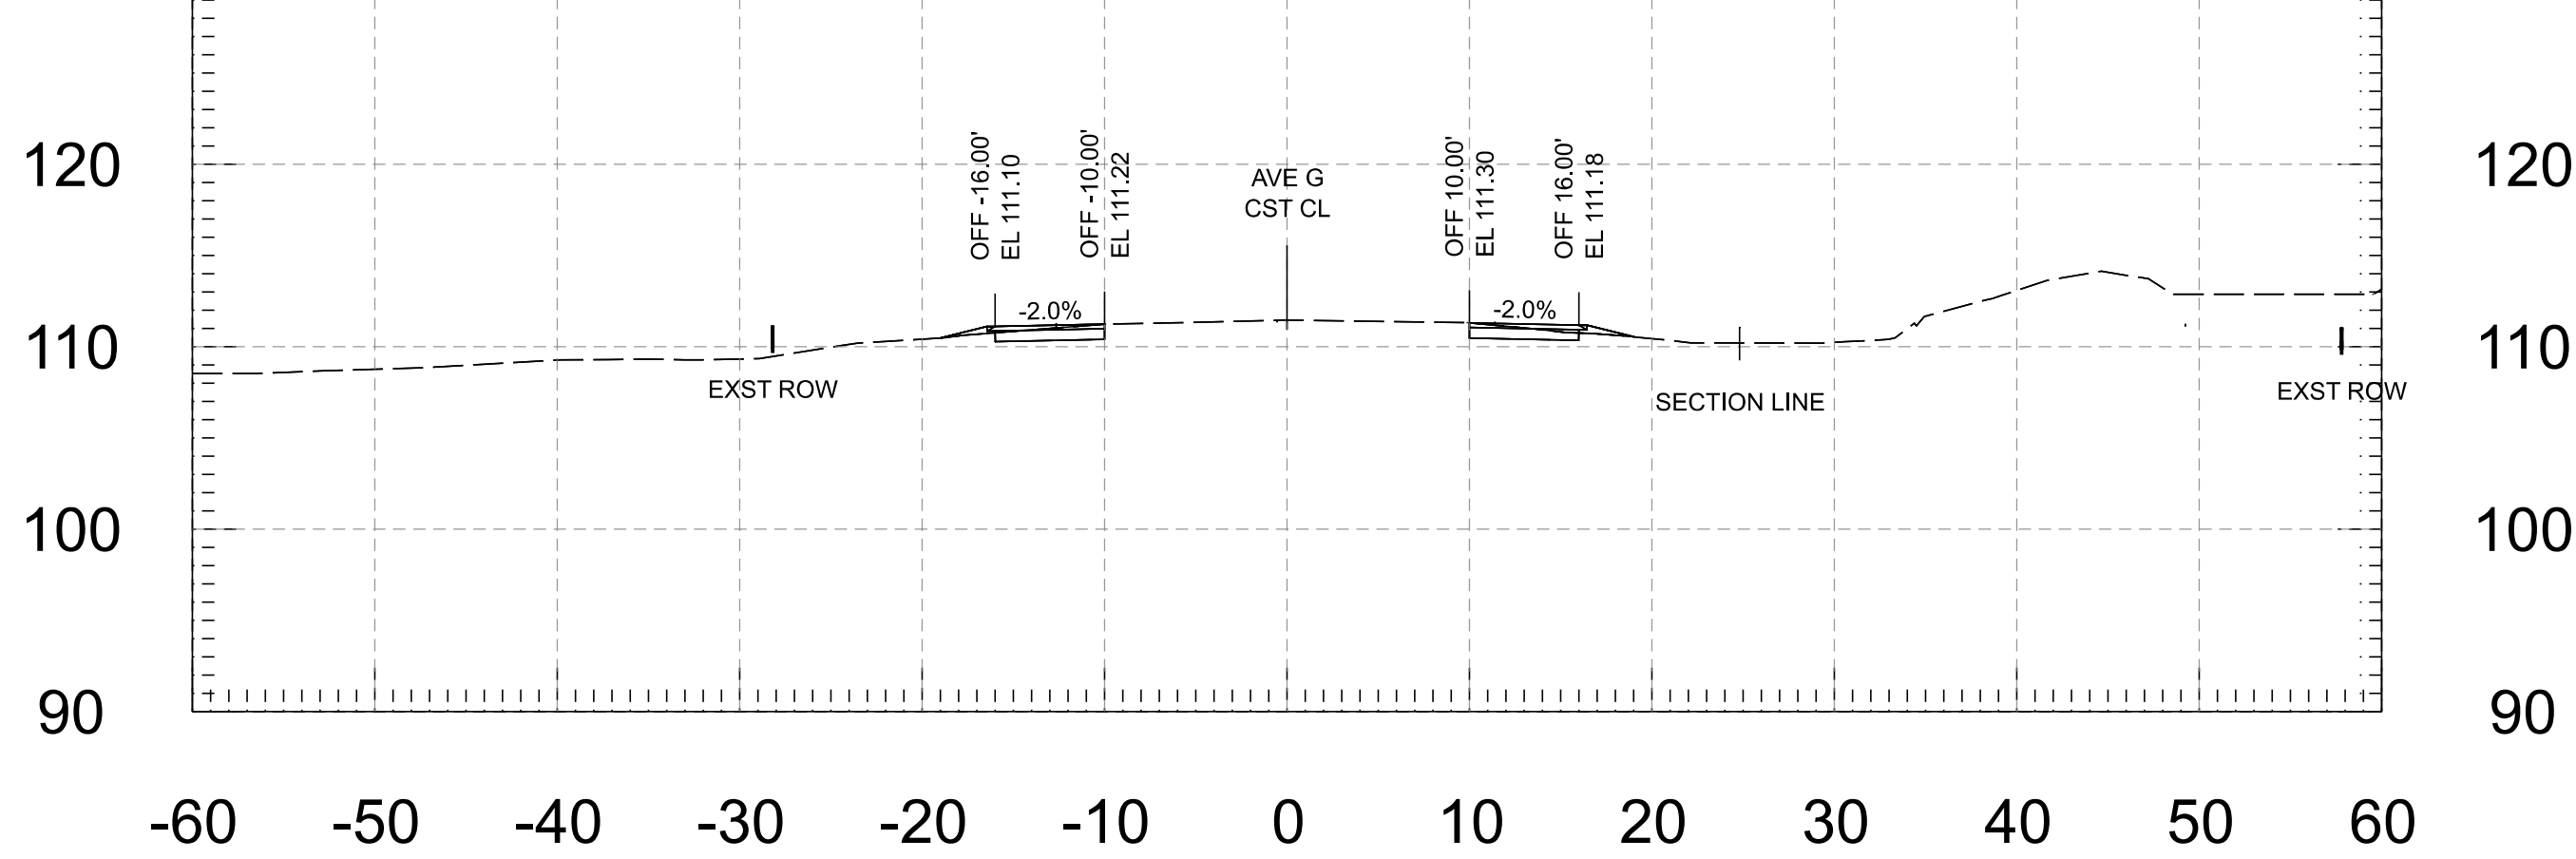


154+00.00




 
FOR INFORMATION ONLY		NAME	DATE	ARIZONA DEPARTMENT OF TRANSPORTATION PROJECT DELIVERY AND OPERATIONS DIVISION ROADWAY DESIGN SERVICES	ROUTE	F.H.W.A. Arizona Division	STATE ARIZ.	PROJECT NO.	FEDERAL ID NO.	SHEET NO.	TOTAL SHEETS	RECORD DRAWING
	DESIGN	M. SCHOEN	07/26		MILEPOST			0000 YU YYU	YYU-0(225)T	70	118	
	DRAWN	M. SCHOEN	07/26					LOCATION AVENUE G, COUNTY 11TH ST - COUNTY 16TH ST				DWG
	CHECKED	H. RIOS	07/26	 WSP USA Inc. 1200 West Washington Street, Suite 405 Tempe, AZ 85288	STRUCTURE NO.	TRACS NO. T0437 01C		___ OF ___				
					AVENUE G - CROSS SECTIONS							

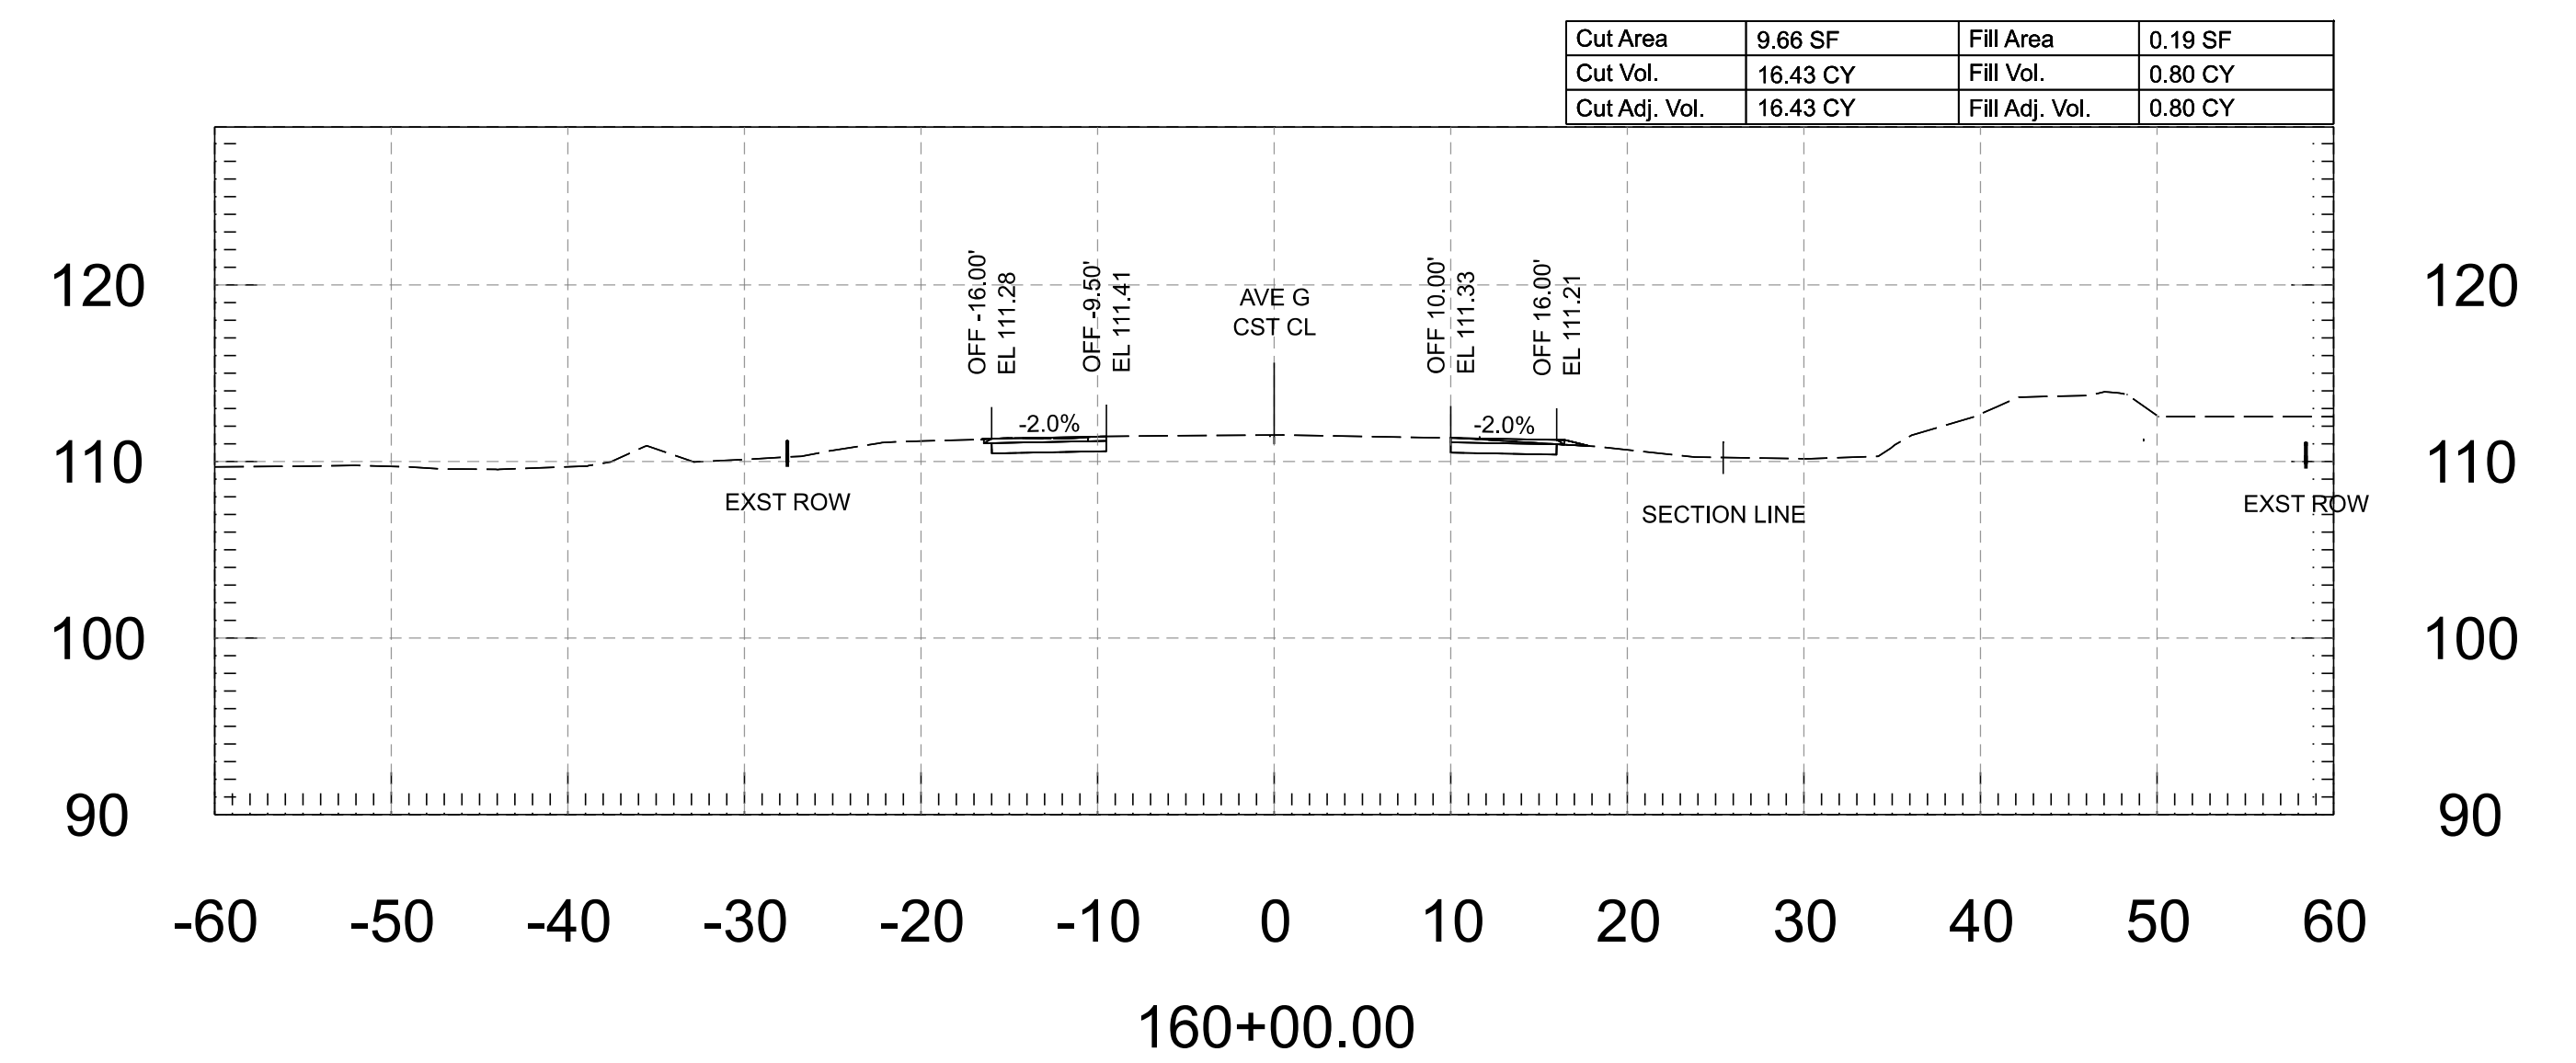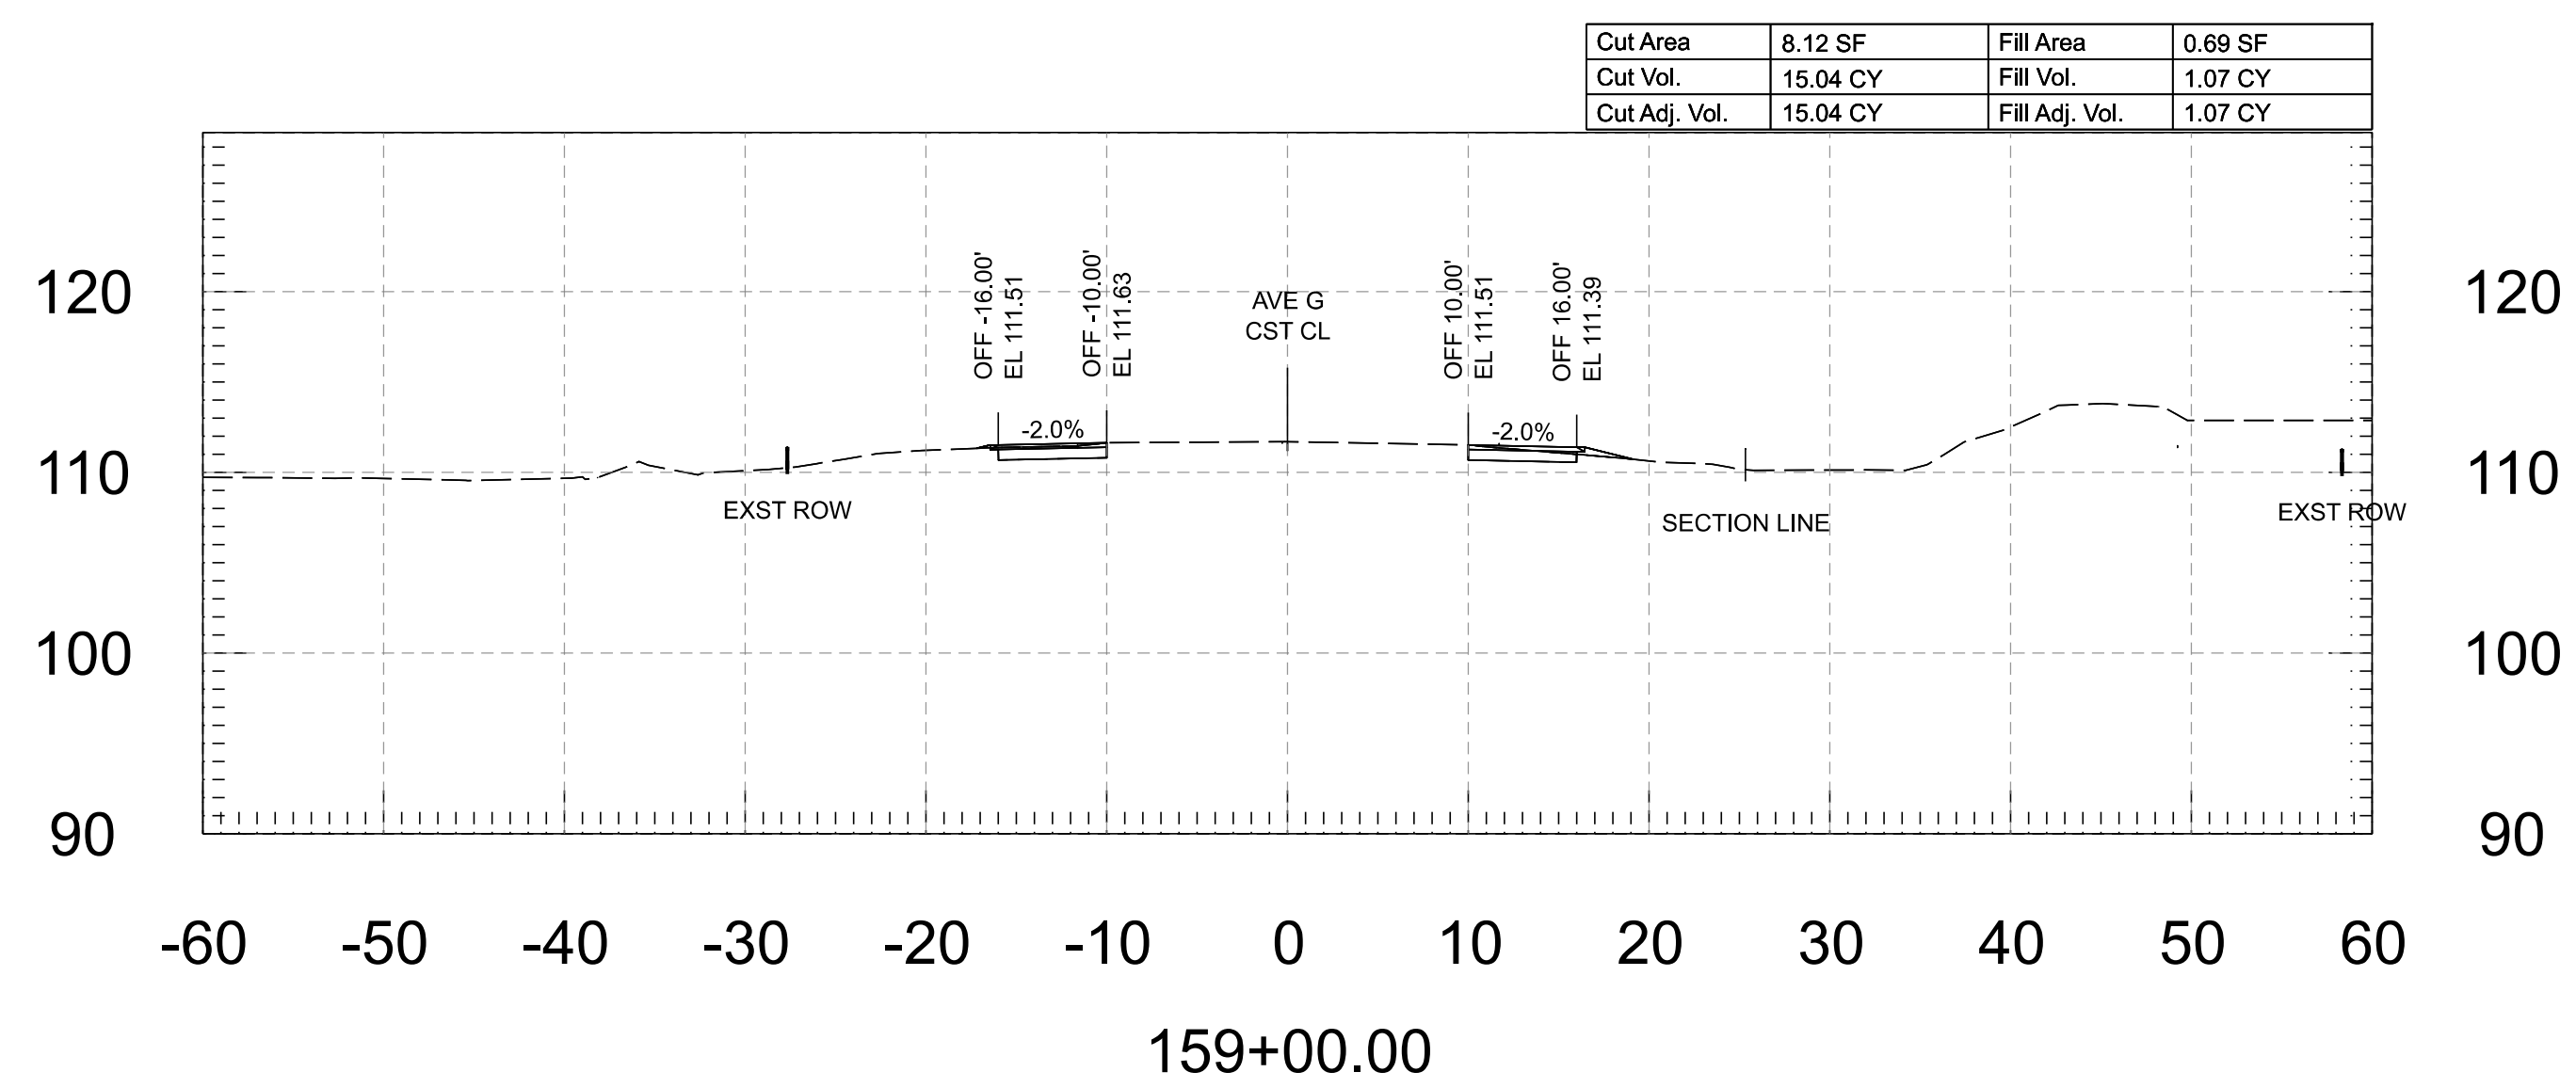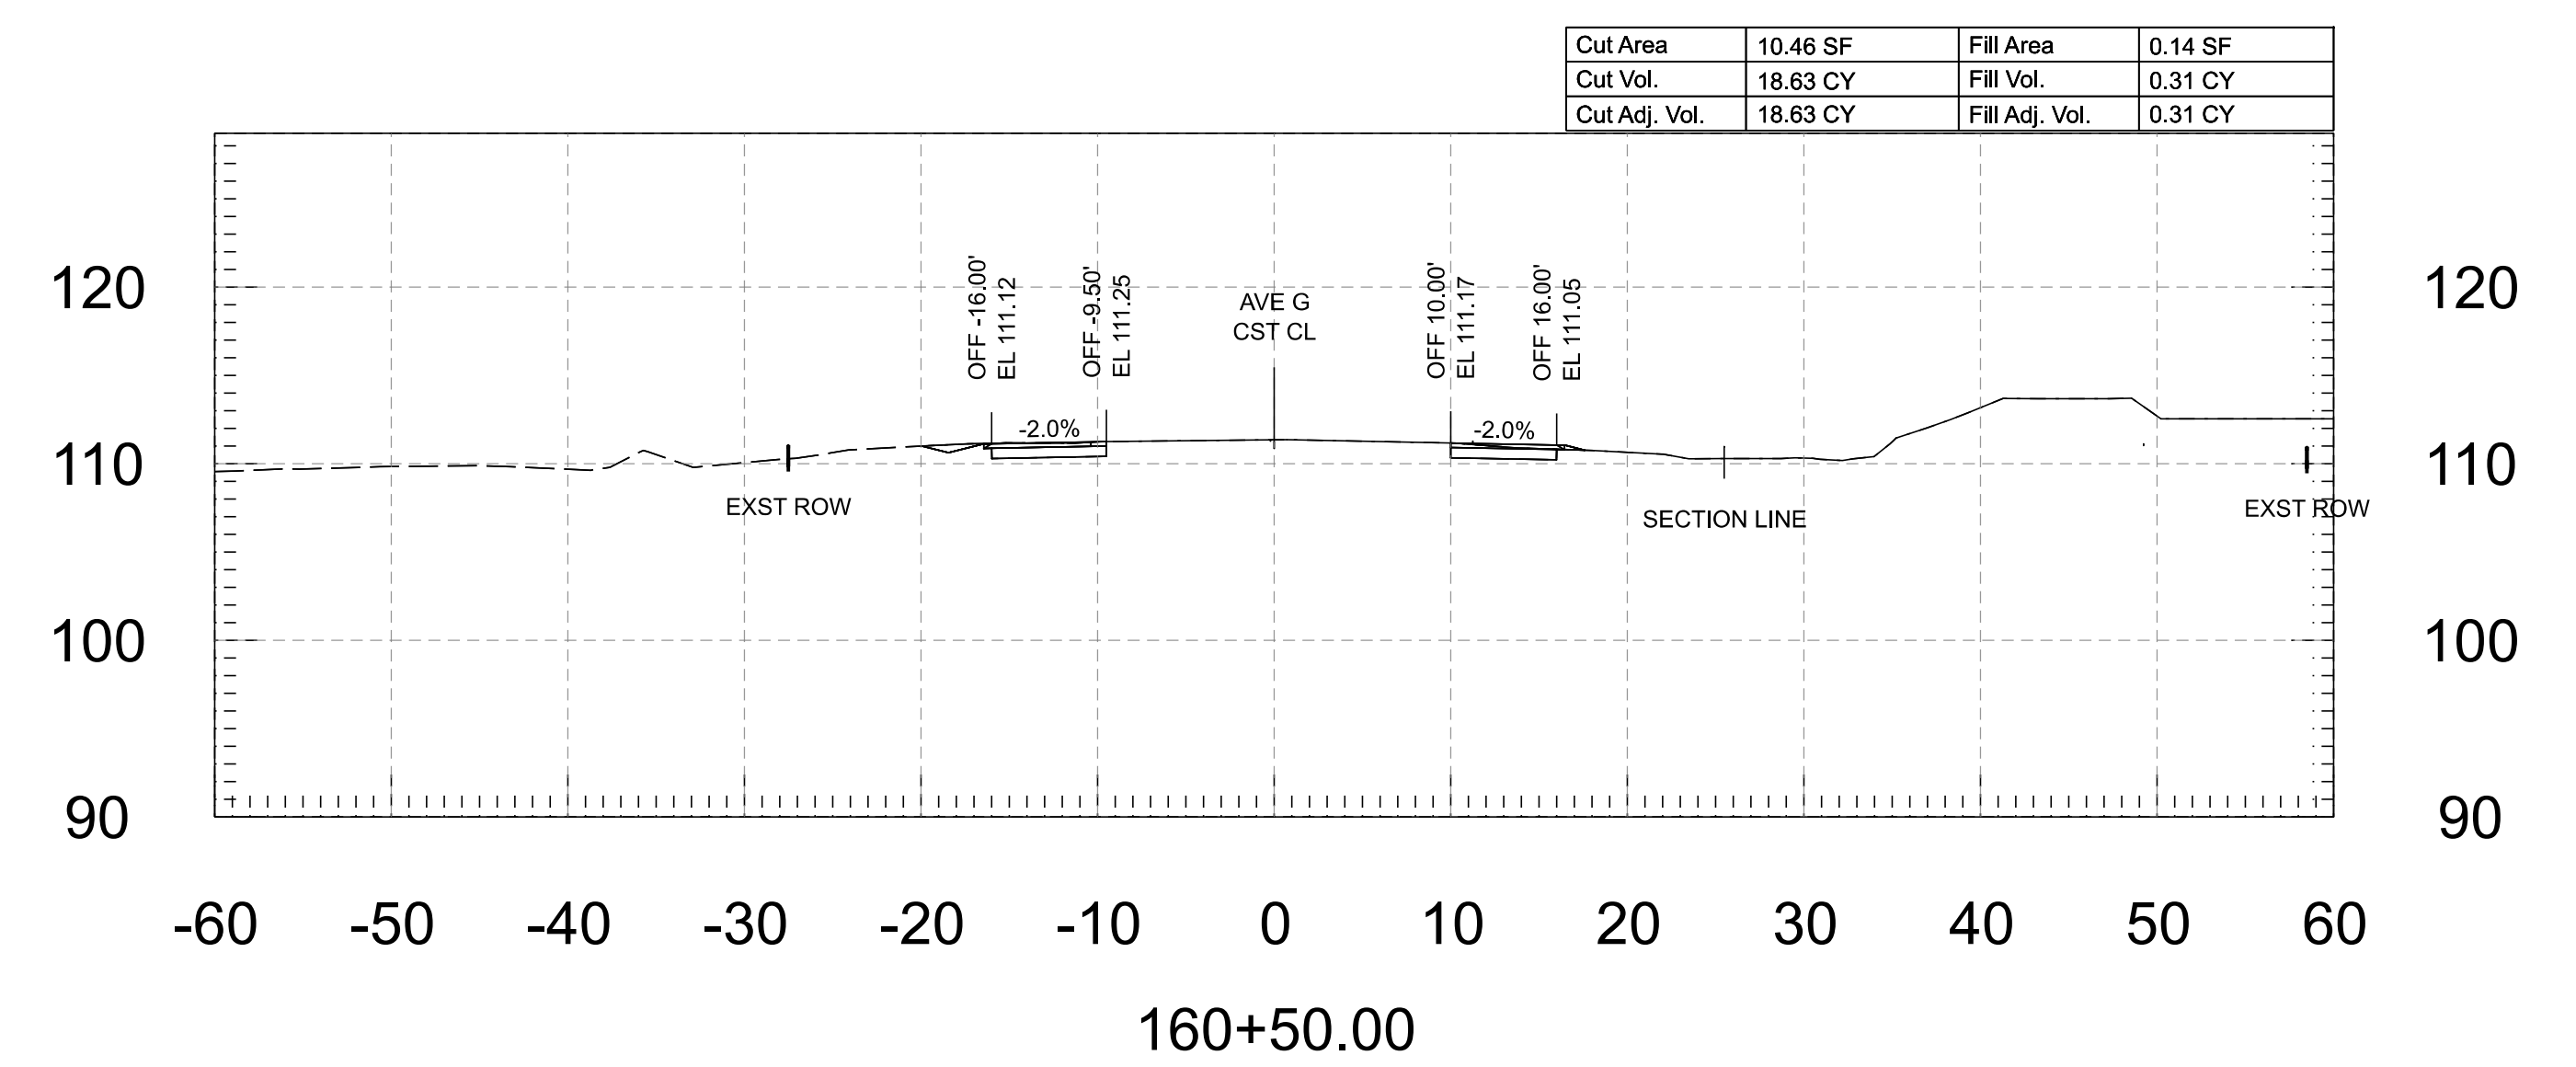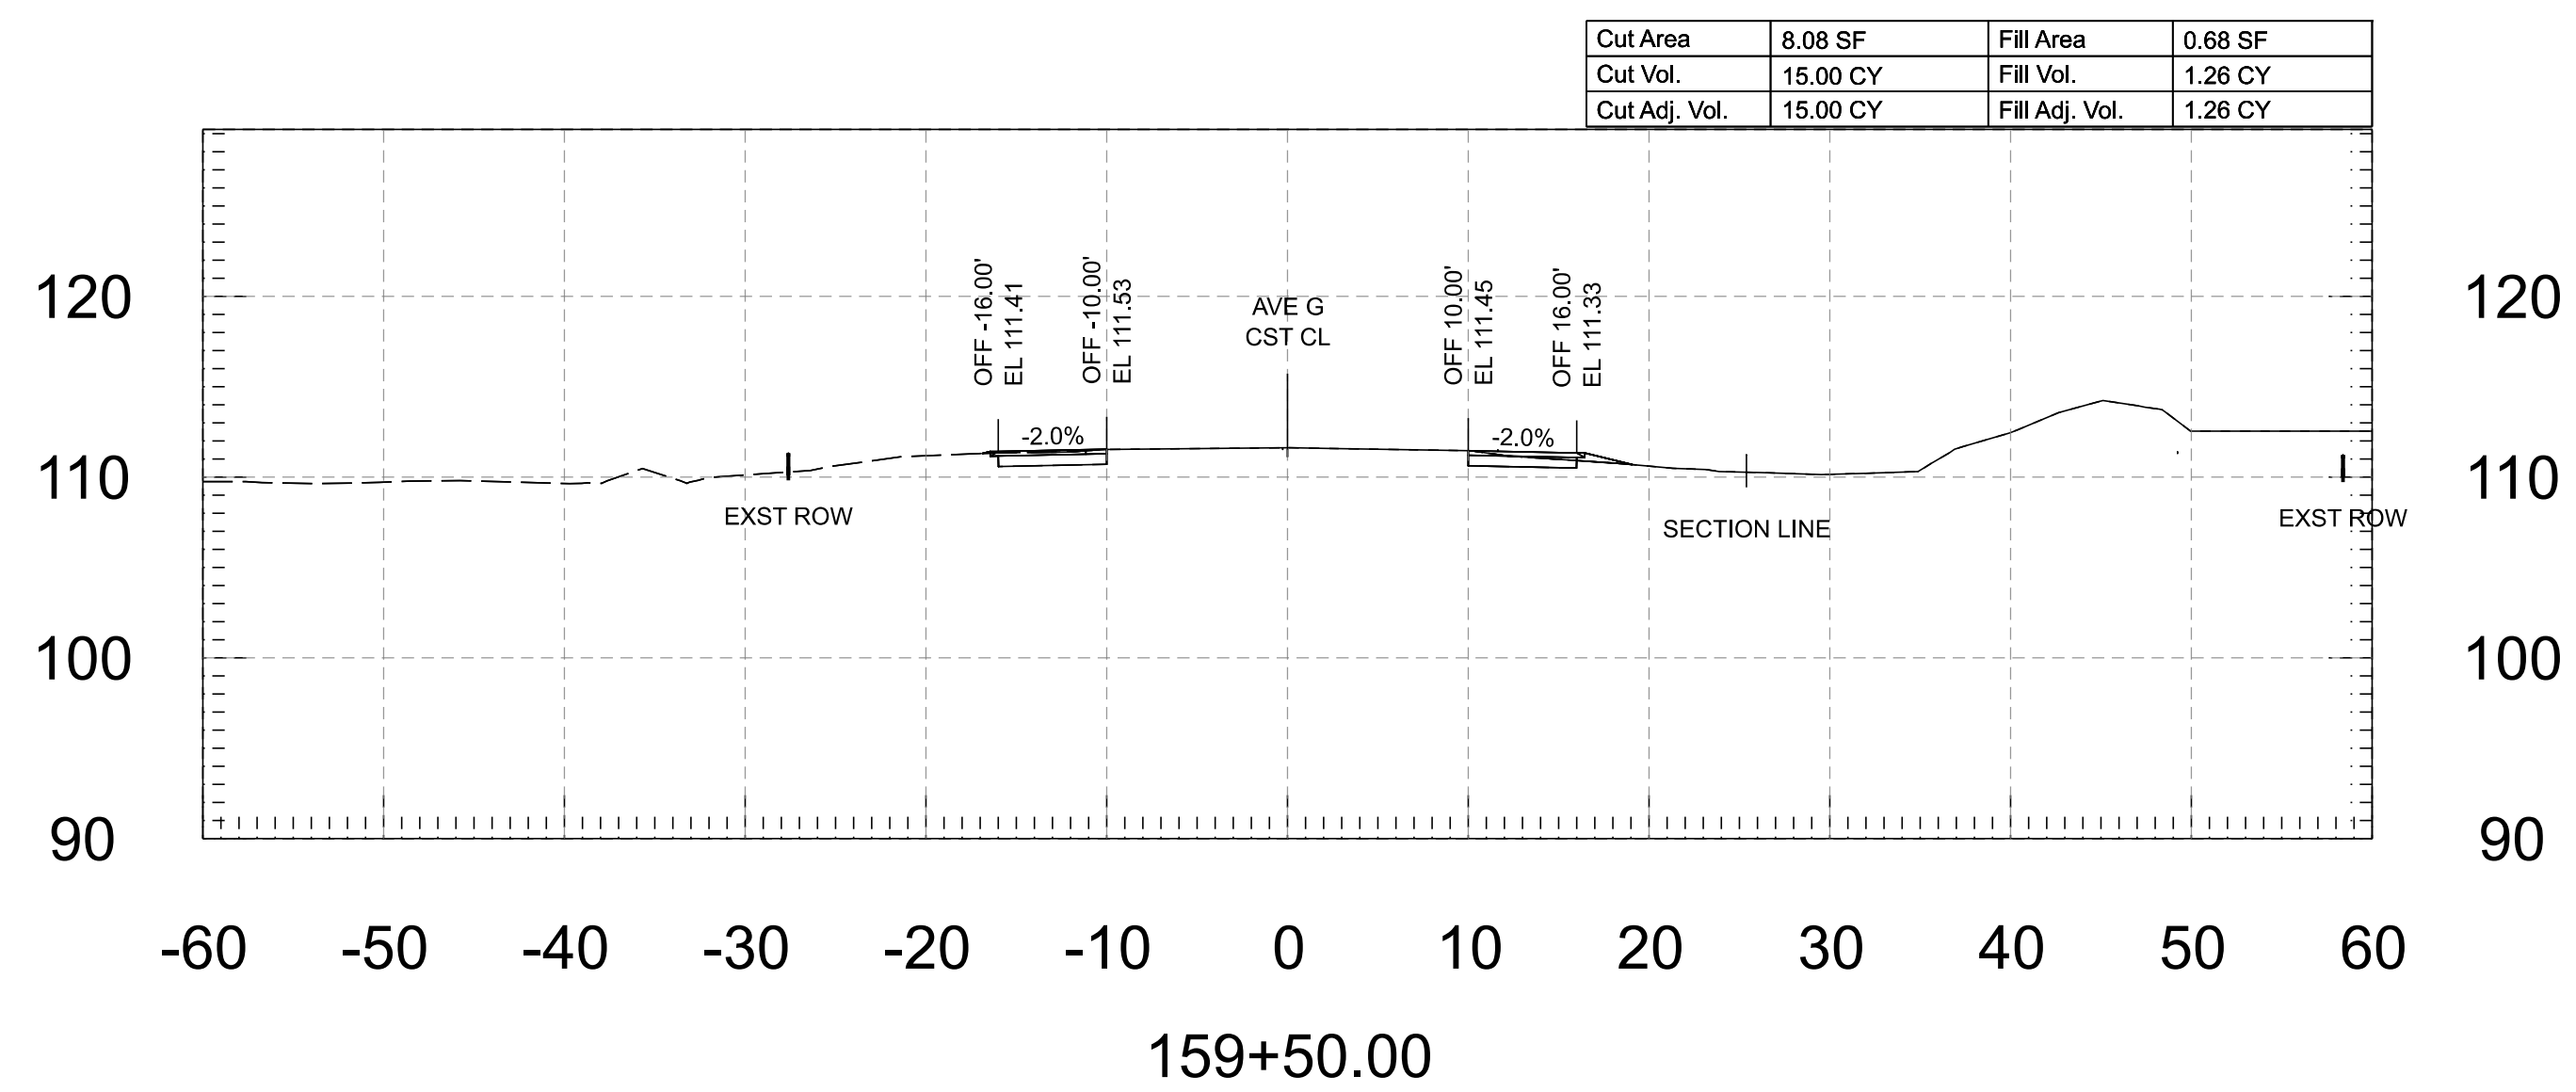

FOR INFORMATION ONLY			NAME	DATE	ARIZONA DEPARTMENT OF TRANSPORTATION PROJECT DELIVERY AND OPERATIONS DIVISION ROADWAY DESIGN SERVICES	ROUTE	F.H.W.A. Arizona Division	STATE ARIZ.	PROJECT NO.	FEDERAL ID NO.	SHEET NO.	TOTAL SHEETS	RECORD DRAWING
	DESIGN	M. SCHOEN	07/26			0000 YU YYU			YYU-0(225)T	73	118		
	DRAWN	M. SCHOEN	07/26										
	CHECKED	H. RIOS	07/26										
				WSP USA Inc. 1230 West Wardington Street, Suite 405 Tempe, AZ 85280		AVENUE G - CROSS SECTIONS		LOCATION AVENUE G, COUNTY 11TH ST - COUNTY 16TH ST					DWG
						STRUCTURE NO.	TRACS NO. T0437 01C					___ OF ___	

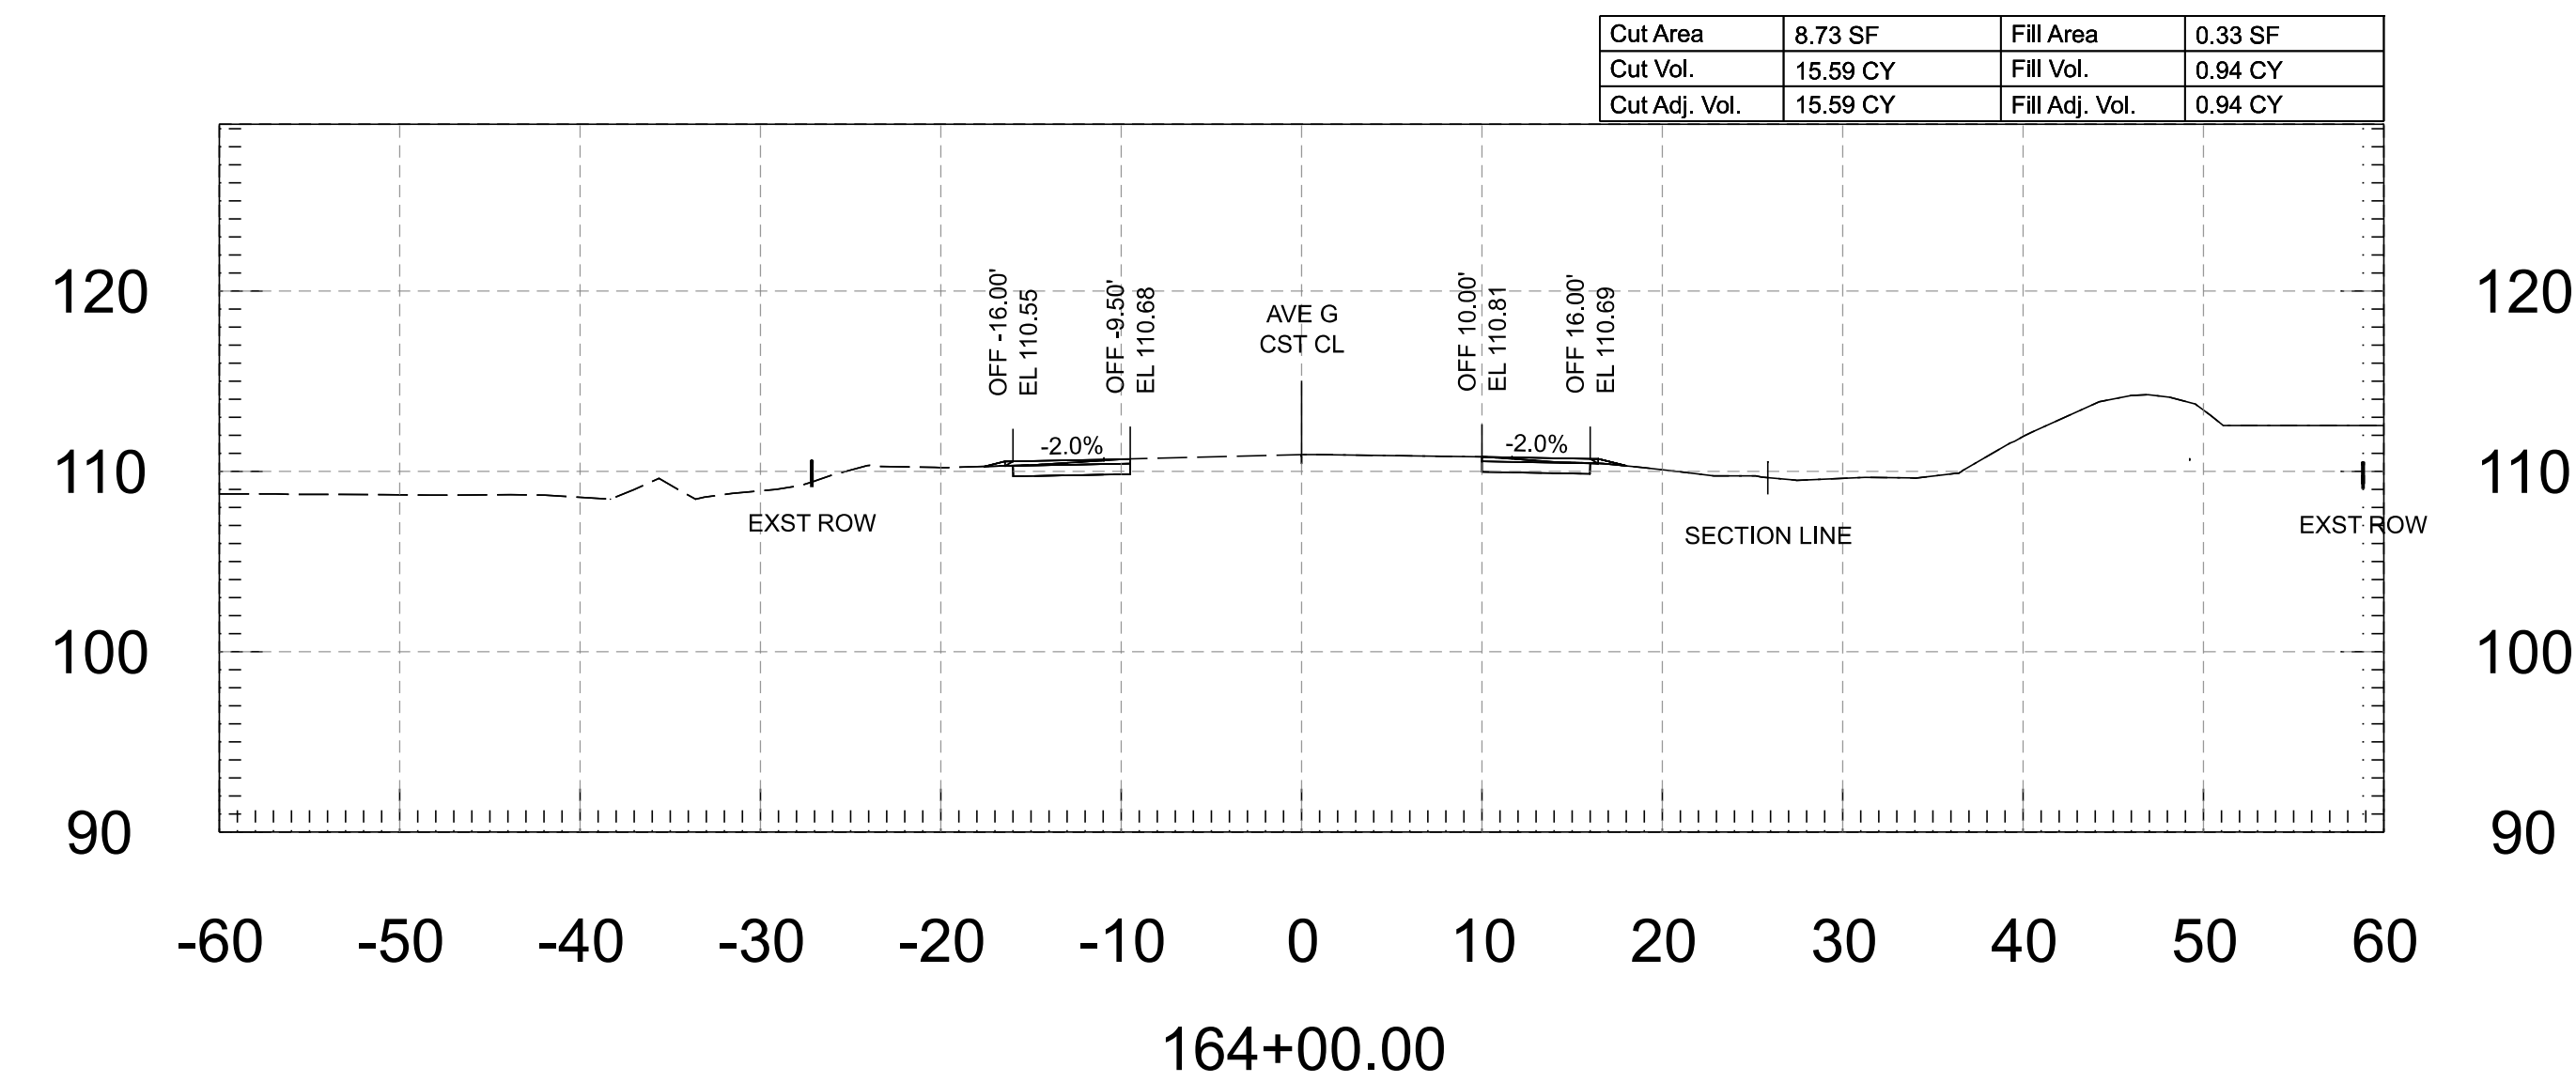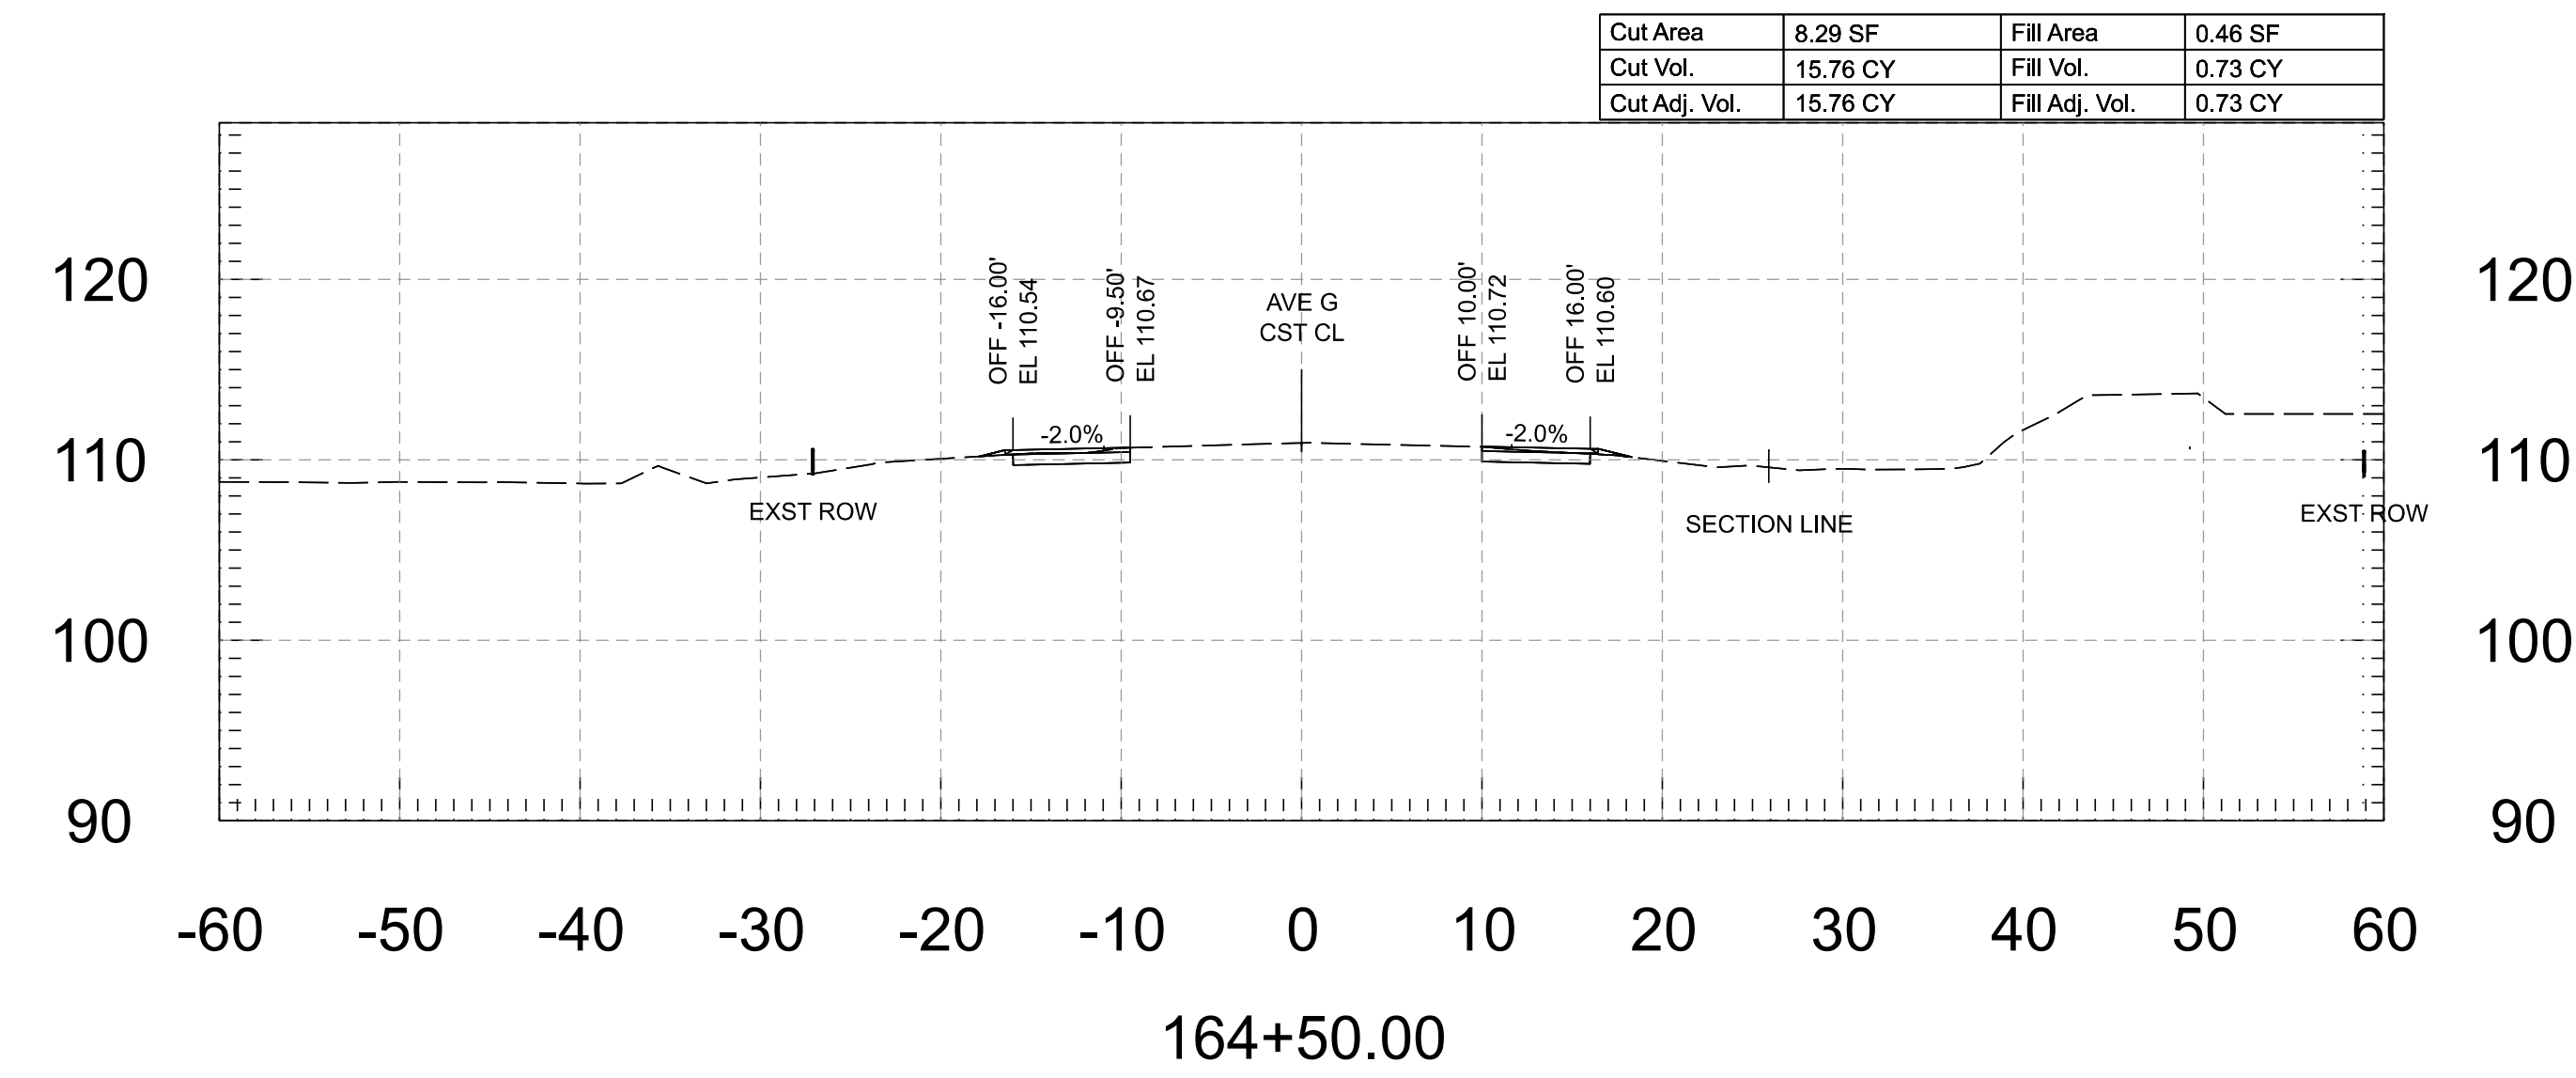


FOR INFORMATION ONLY		NAME	DATE	ARIZONA DEPARTMENT OF TRANSPORTATION PROJECT DELIVERY AND OPERATIONS DIVISION ROADWAY DESIGN SERVICES	ROUTE	F.H.W.A. Arizona Division	STATE ARIZ.	PROJECT NO.	FEDERAL ID NO.	SHEET NO.	TOTAL SHEETS	RECORD DRAWING
	DESIGN	M. SCHOEN	07/26					0000 YU YU	YYU-0(225)T	75	118	
	DRAWN	M. SCHOEN	07/26									
	CHECKED	H. RIOS	07/26									
		wsp WSP USA Inc. 1200 West Washington Street, Suite 405 Tempe, AZ 85288			AVENUE G - CROSS SECTIONS	MILEPOST	LOCATION AVENUE G, COUNTY 11TH ST - COUNTY 16TH ST					
					STRUCTURE NO.	TRACS NO. T0437 01C					___ OF ___	

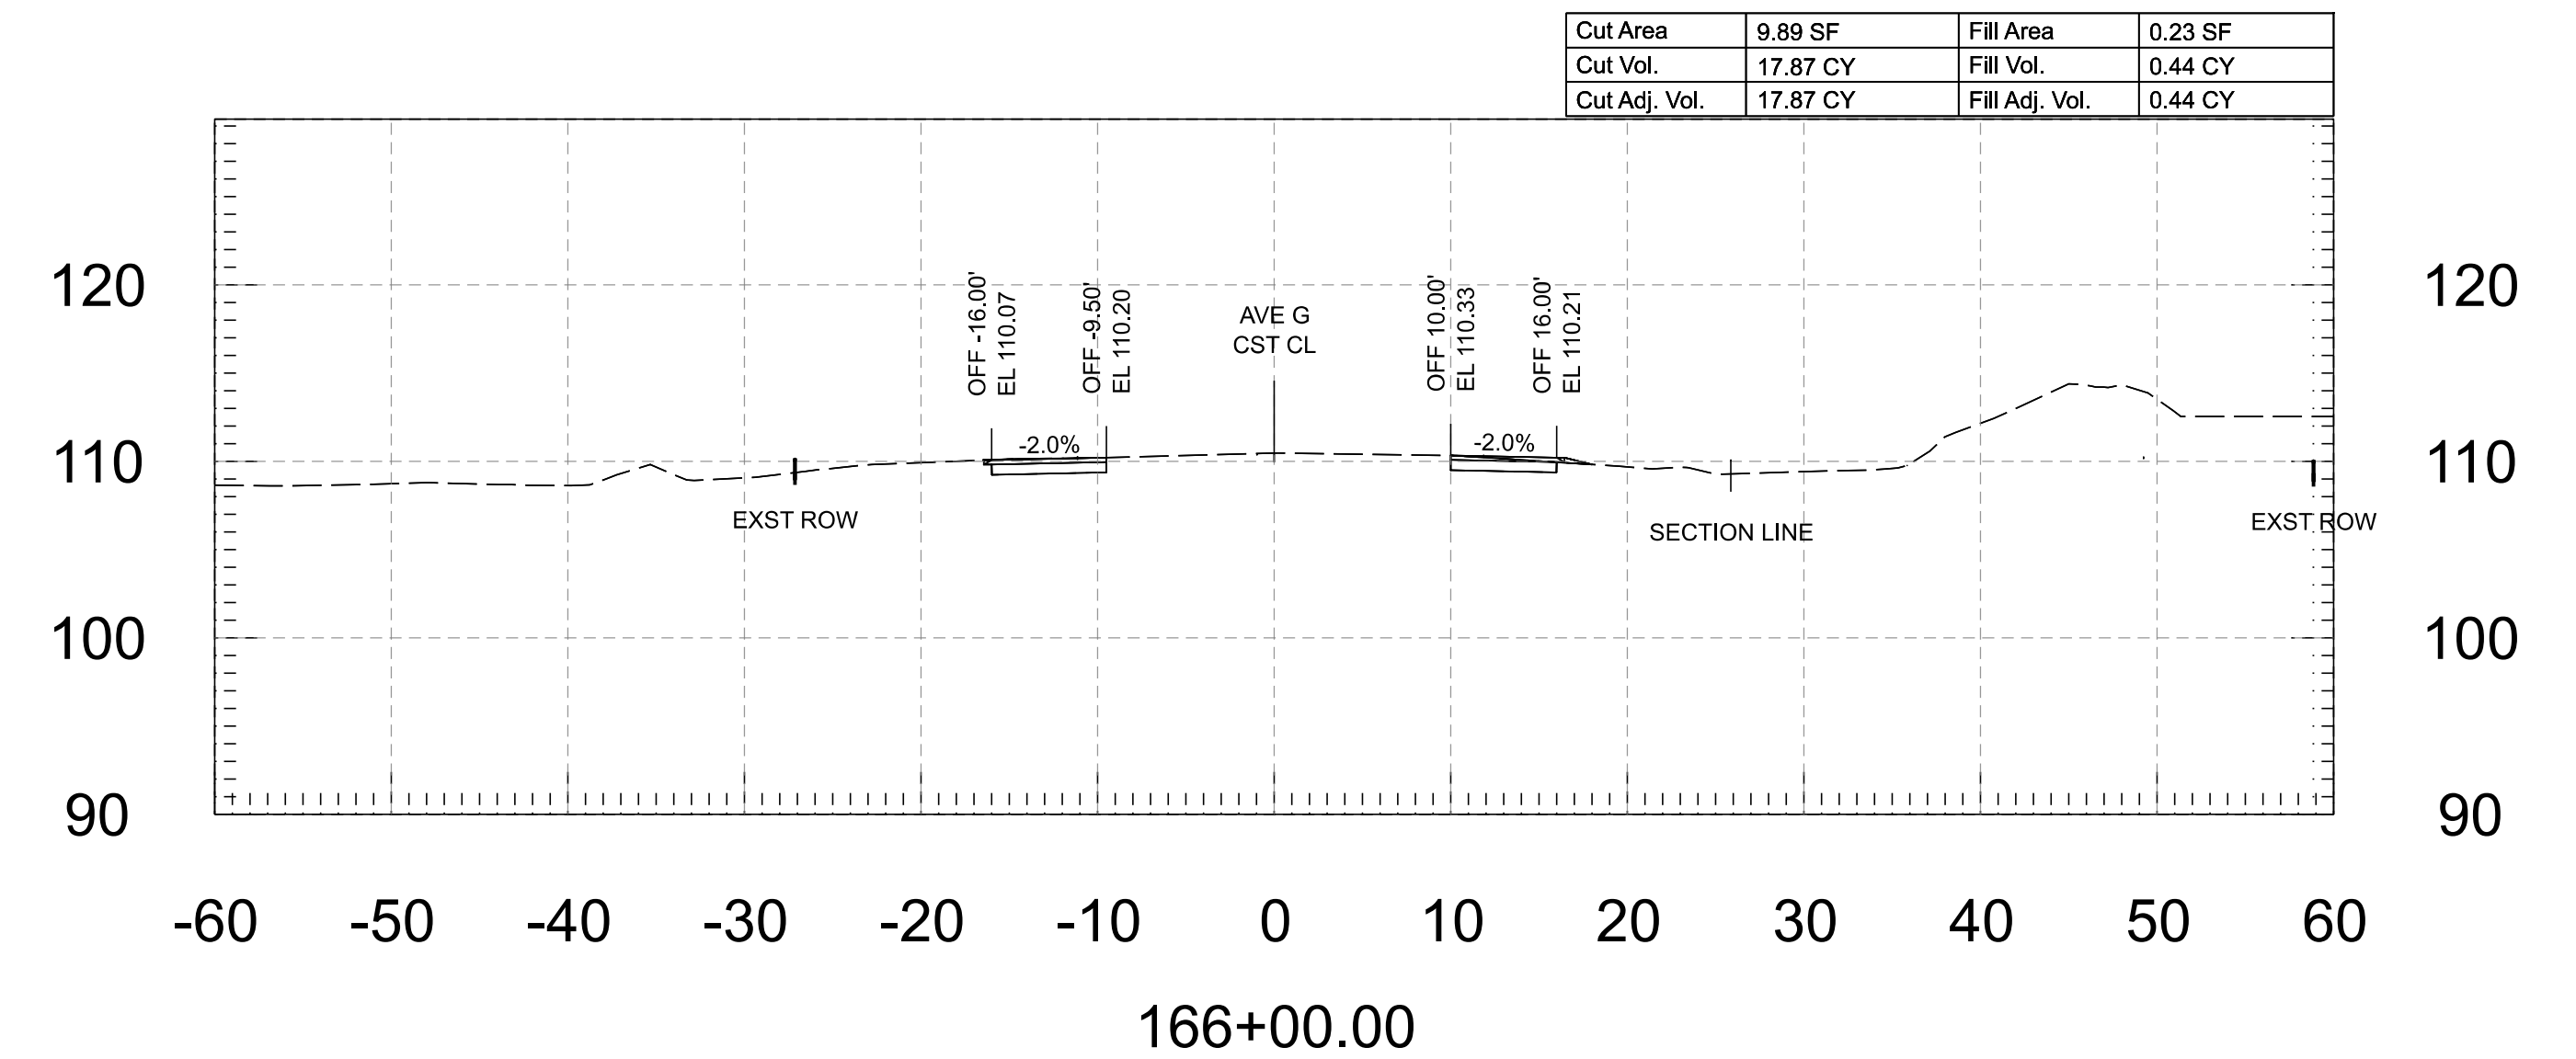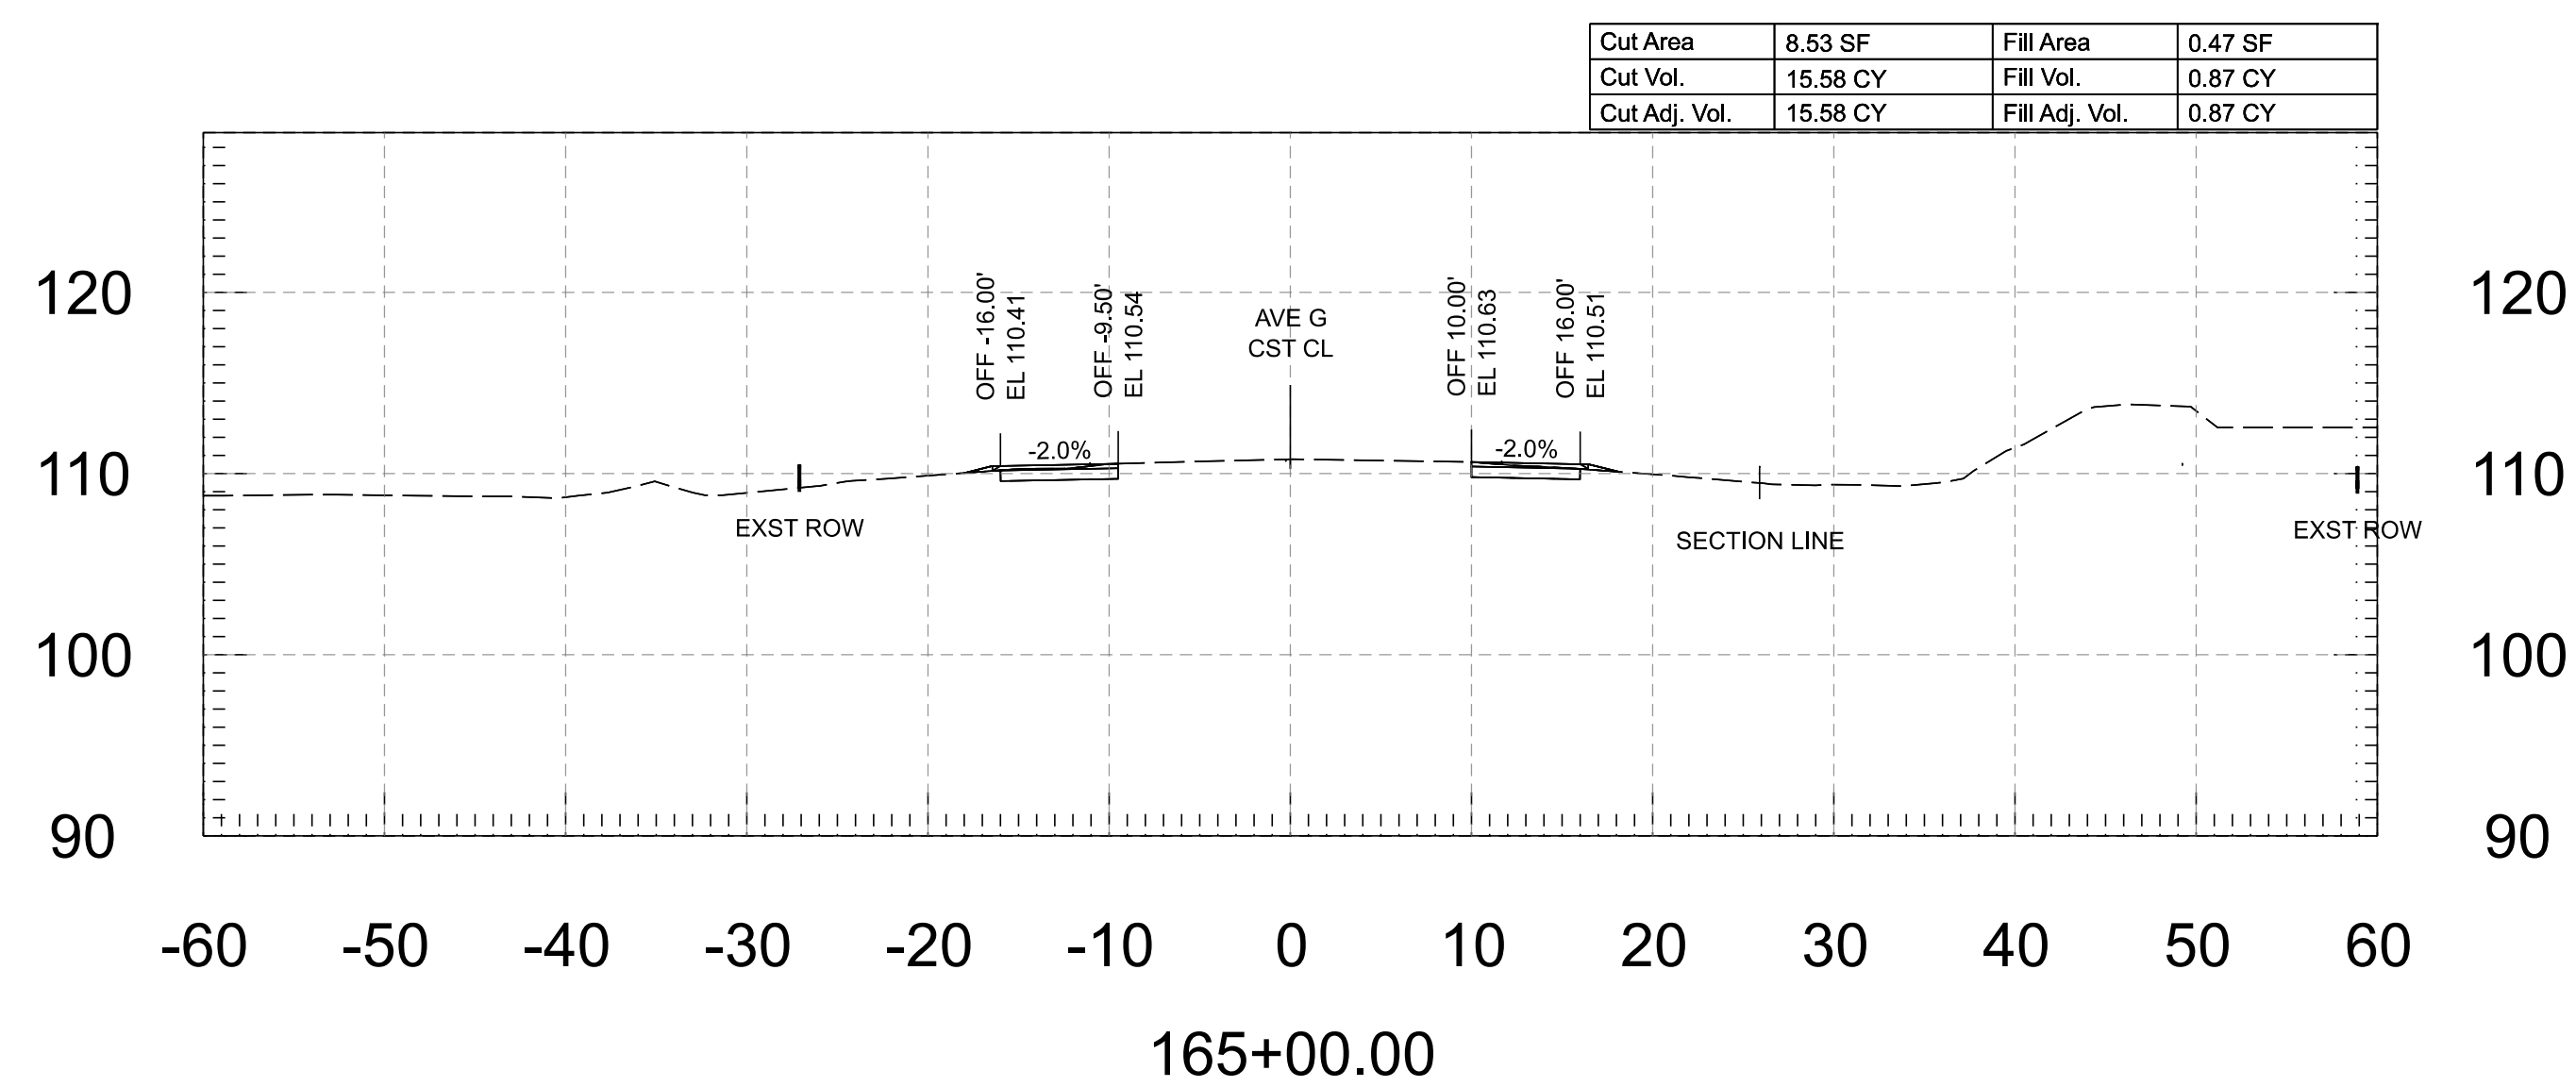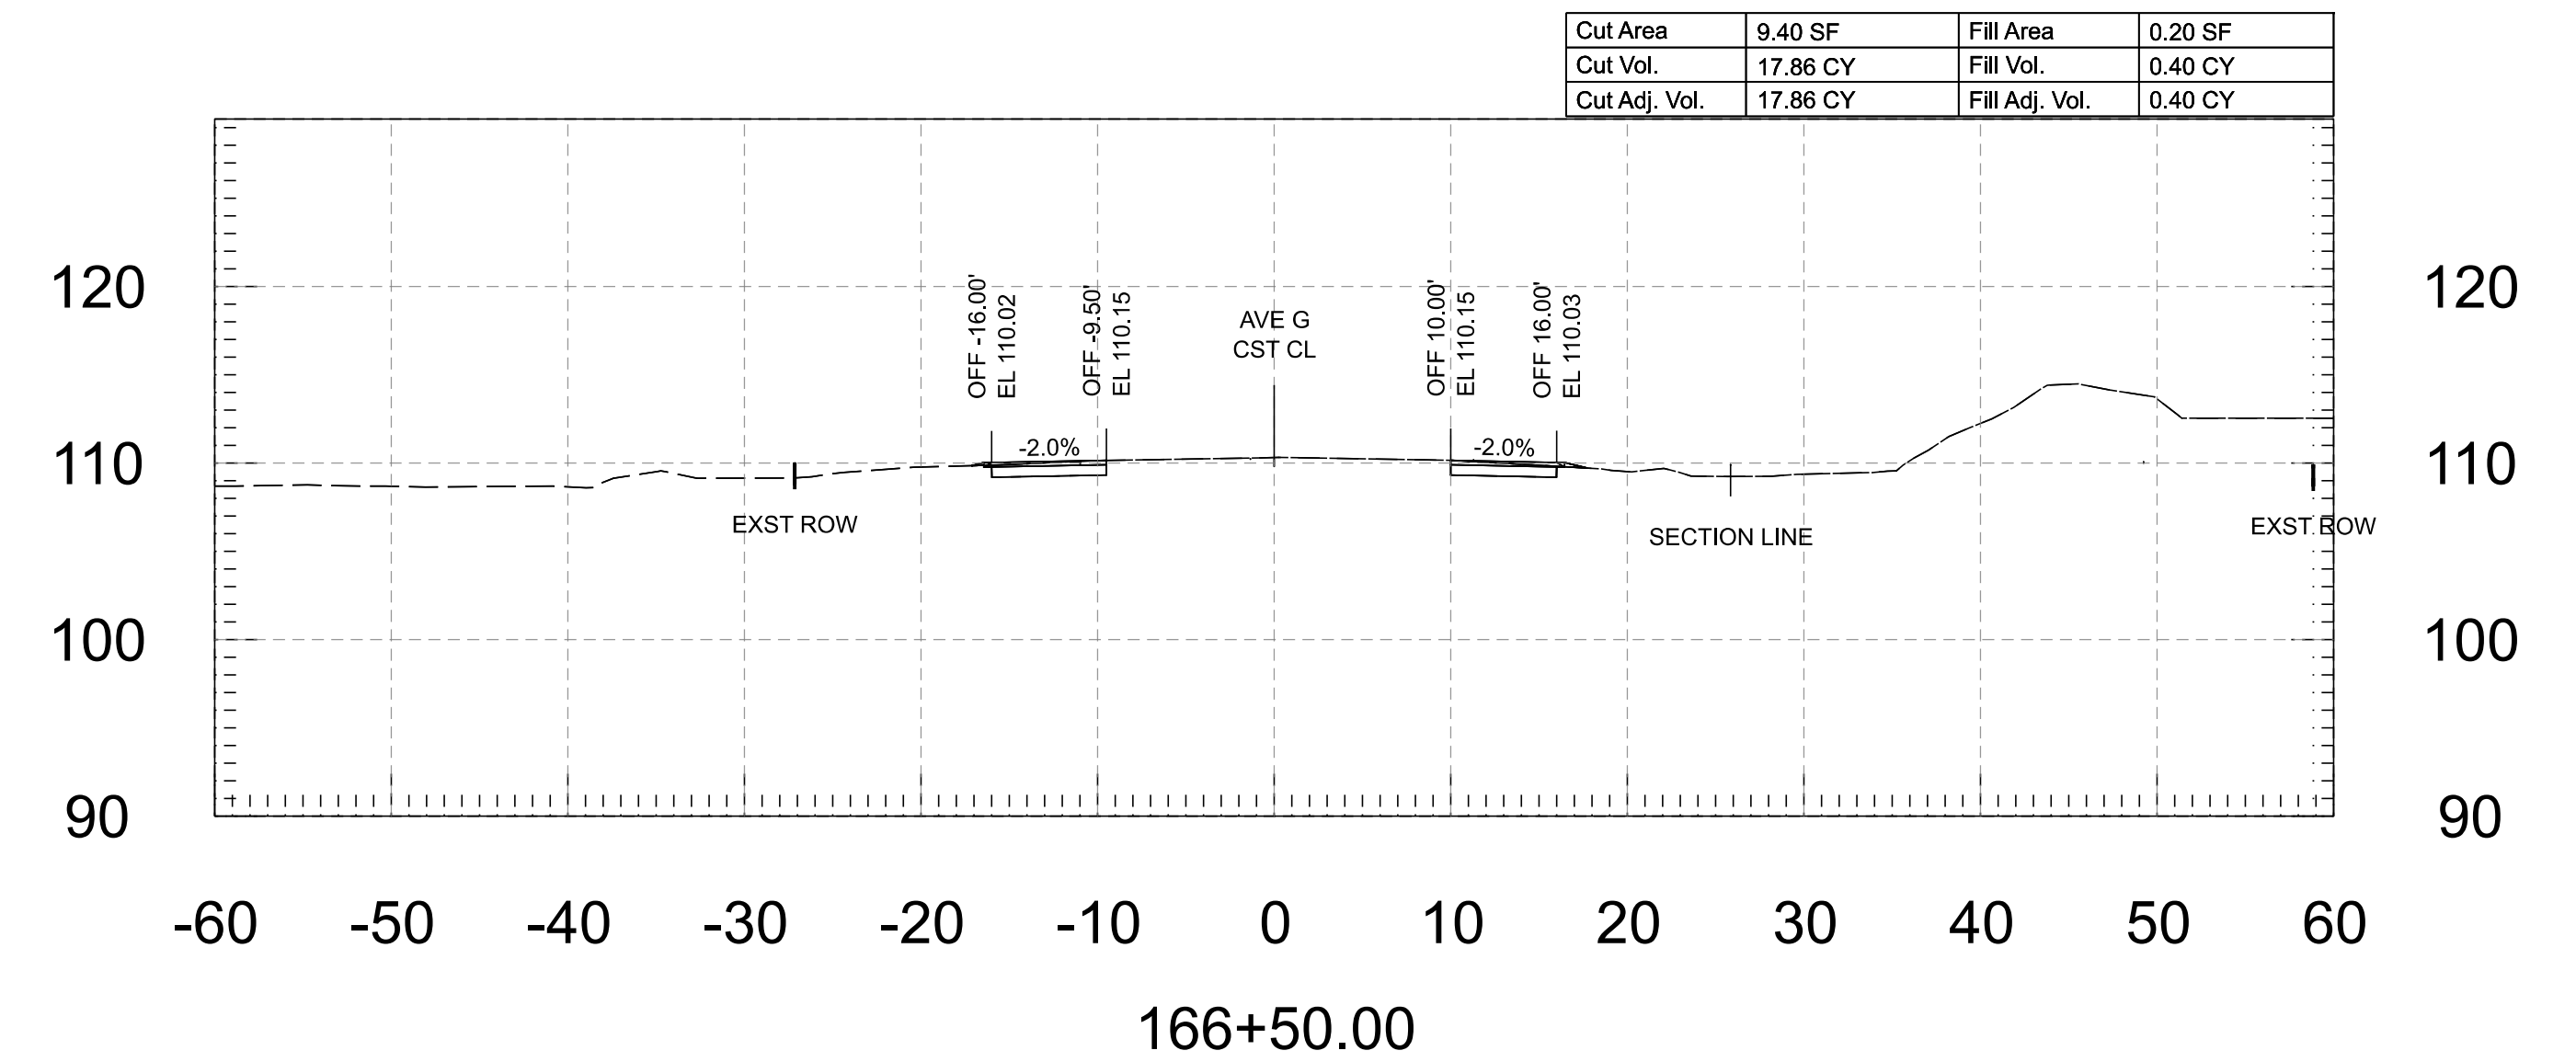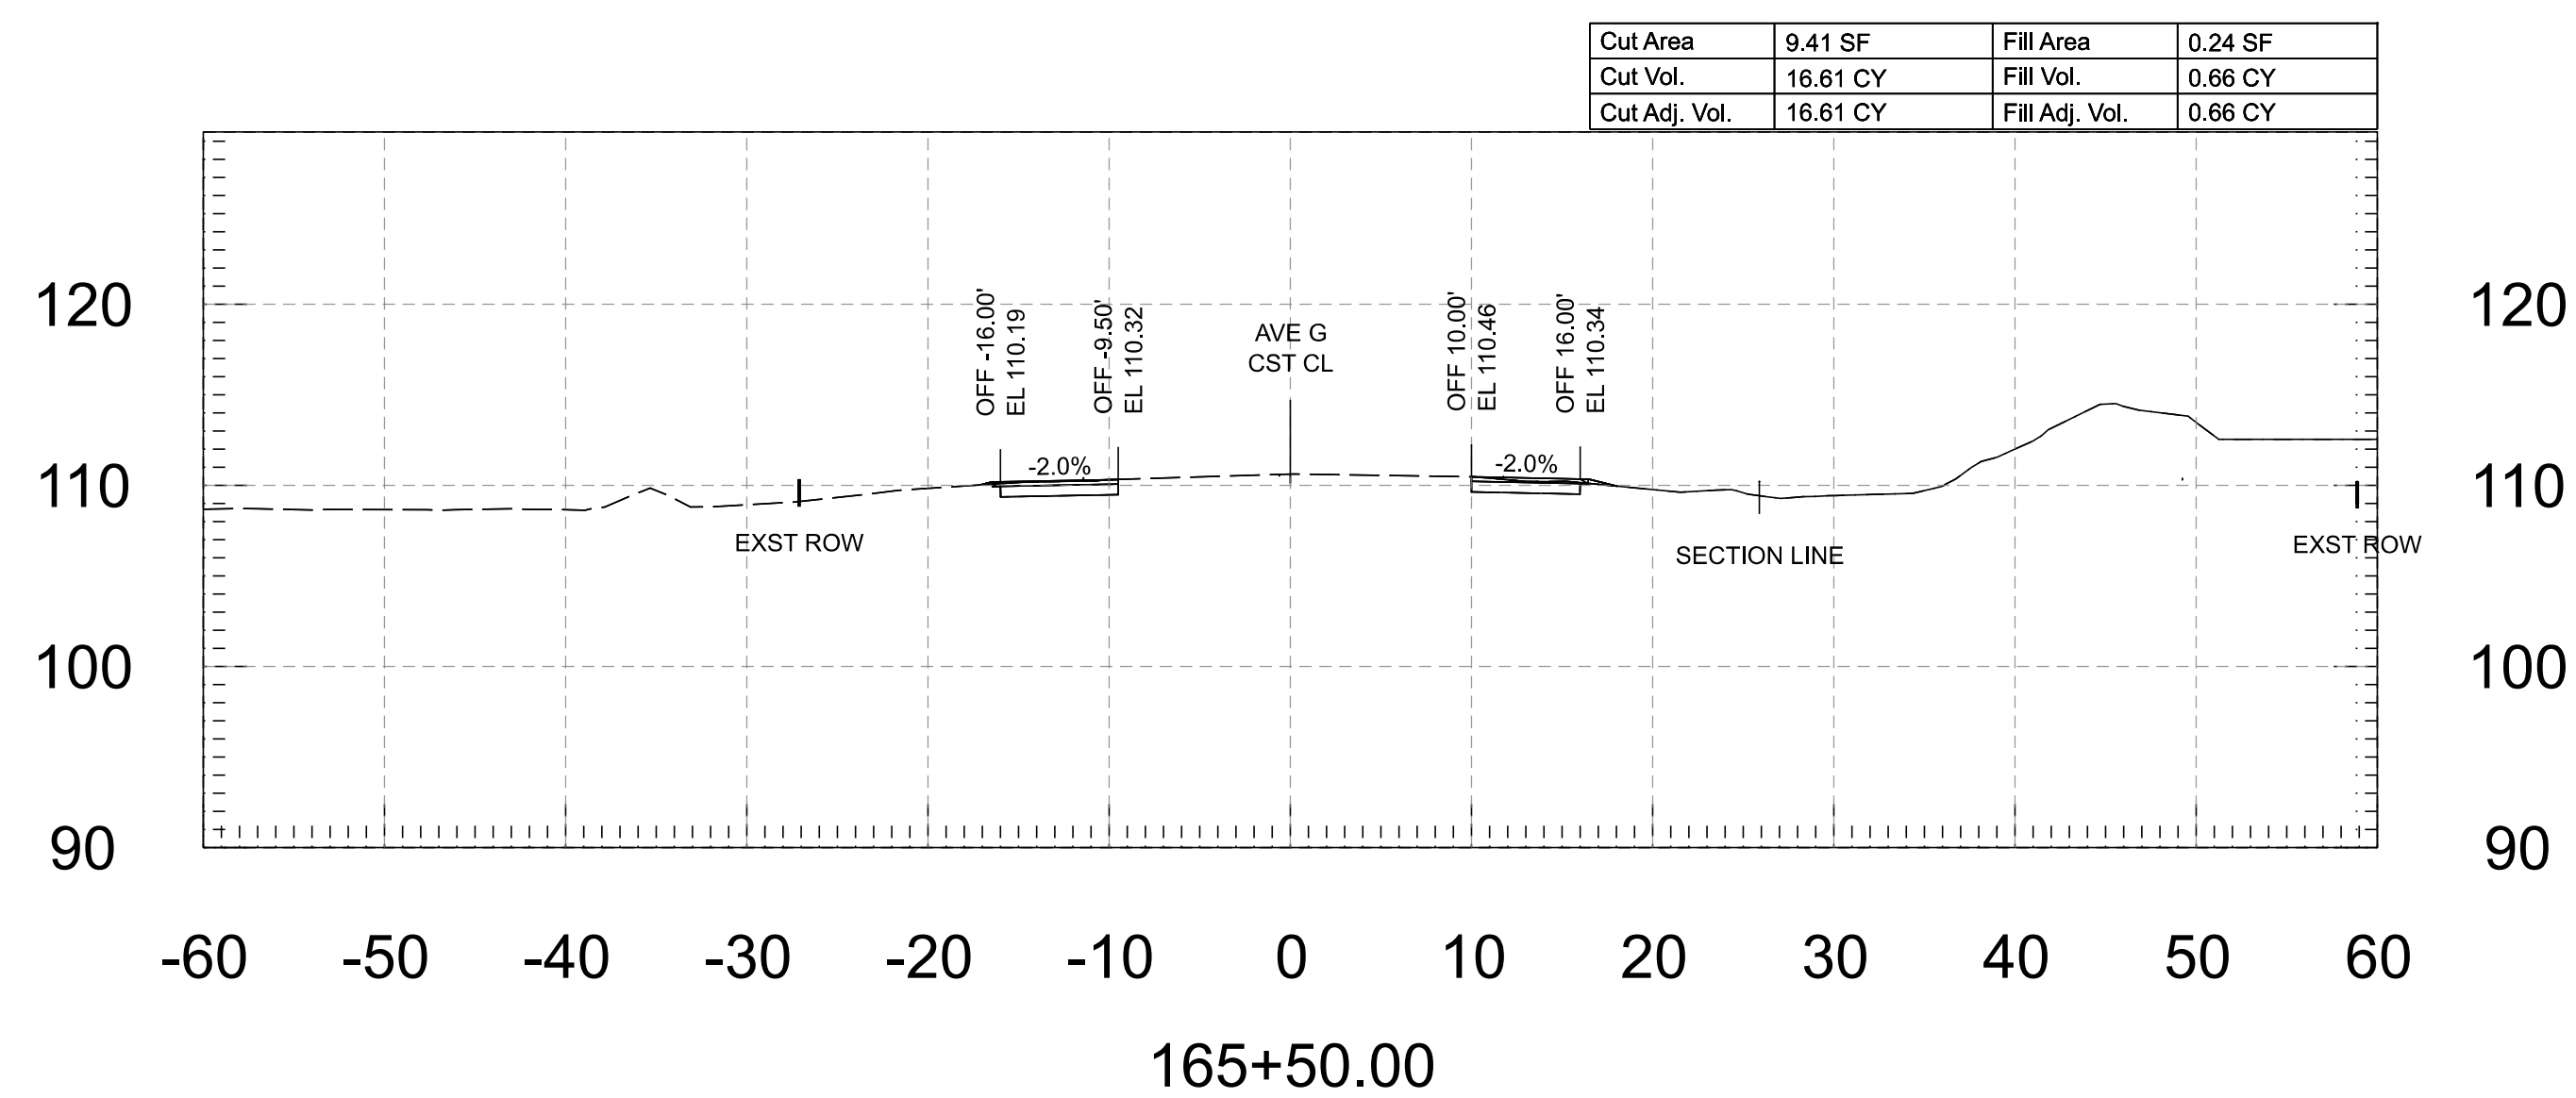


FOR INFORMATION ONLY			NAME	DATE	ARIZONA DEPARTMENT OF TRANSPORTATION PROJECT DELIVERY AND OPERATIONS DIVISION ROADWAY DESIGN SERVICES	ROUTE	F.H.W.A. Arizona Division	STATE ARIZ.	PROJECT NO.	FEDERAL ID NO.	SHEET NO.	TOTAL SHEETS	RECORD DRAWING
	DESIGN	M. SCHOEN	07/26			0000 YU YYU			YYU-0(225)T	76	118		
	DRAWN	M. SCHOEN	07/26										
	CHECKED	H. RIOS	07/26										
		wsp WSP USA Inc. 1200 West Washington Street, Suite 405 Tempe, AZ 85280				AVENUE G - CROSS SECTIONS		LOCATION AVENUE G, COUNTY 11TH ST - COUNTY 16TH ST					
						STRUCTURE NO.	TRACS NO. T0437 01C					____ OF ____	


Cut Area	9.38 SF	Fill Area	0.25 SF
Cut Vol.	17.51 CY	Fill Vol.	0.37 CY
Cut Adj. Vol.	17.51 CY	Fill Adj. Vol.	0.37 CY

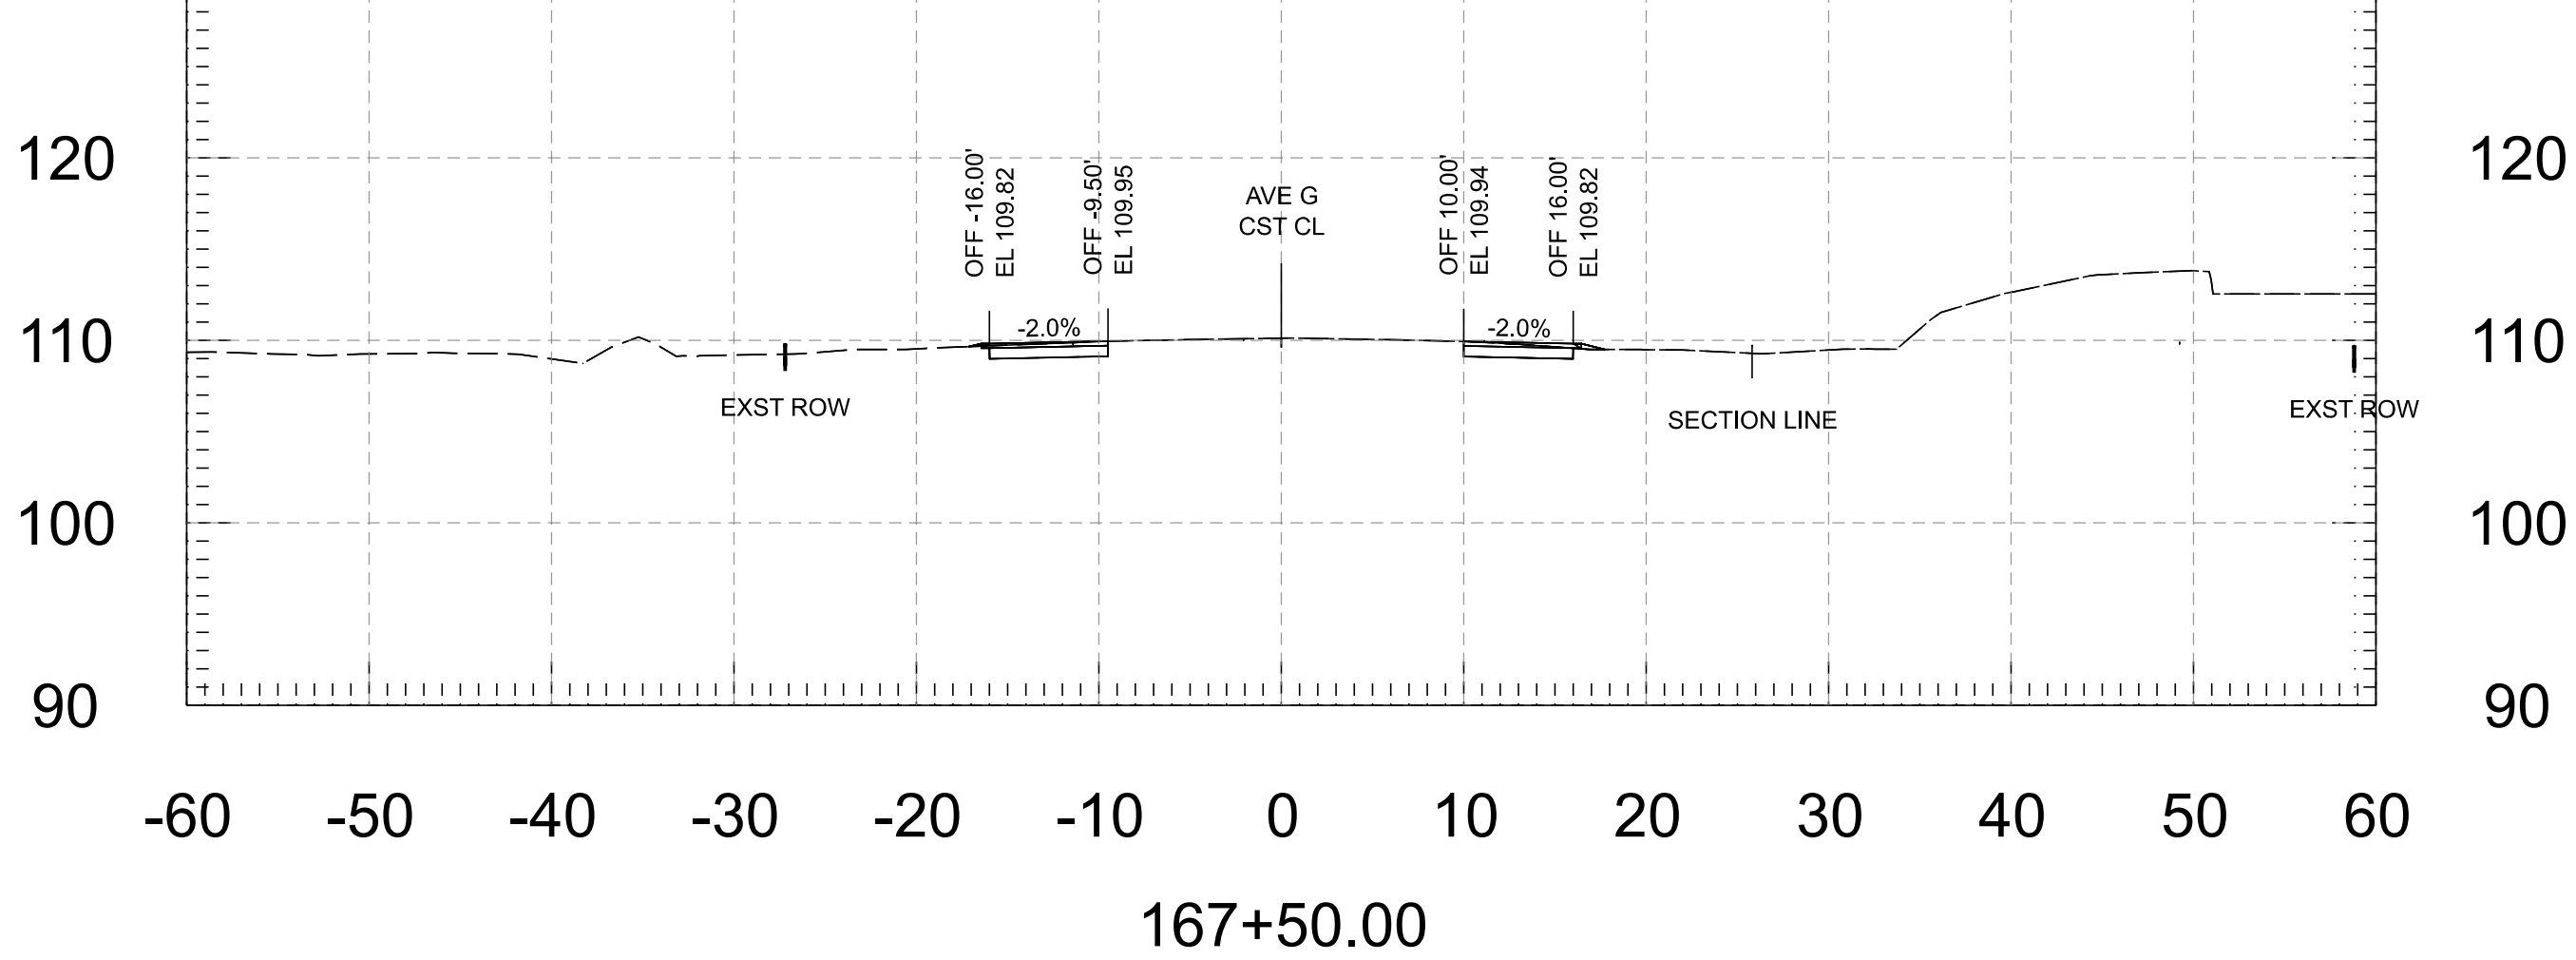


Cut Area	12.61 SF	Fill Area	0.04 SF
Cut Vol.	23.77 CY	Fill Vol.	0.08 CY
Cut Adj. Vol.	23.77 CY	Fill Adj. Vol.	0.08 CY

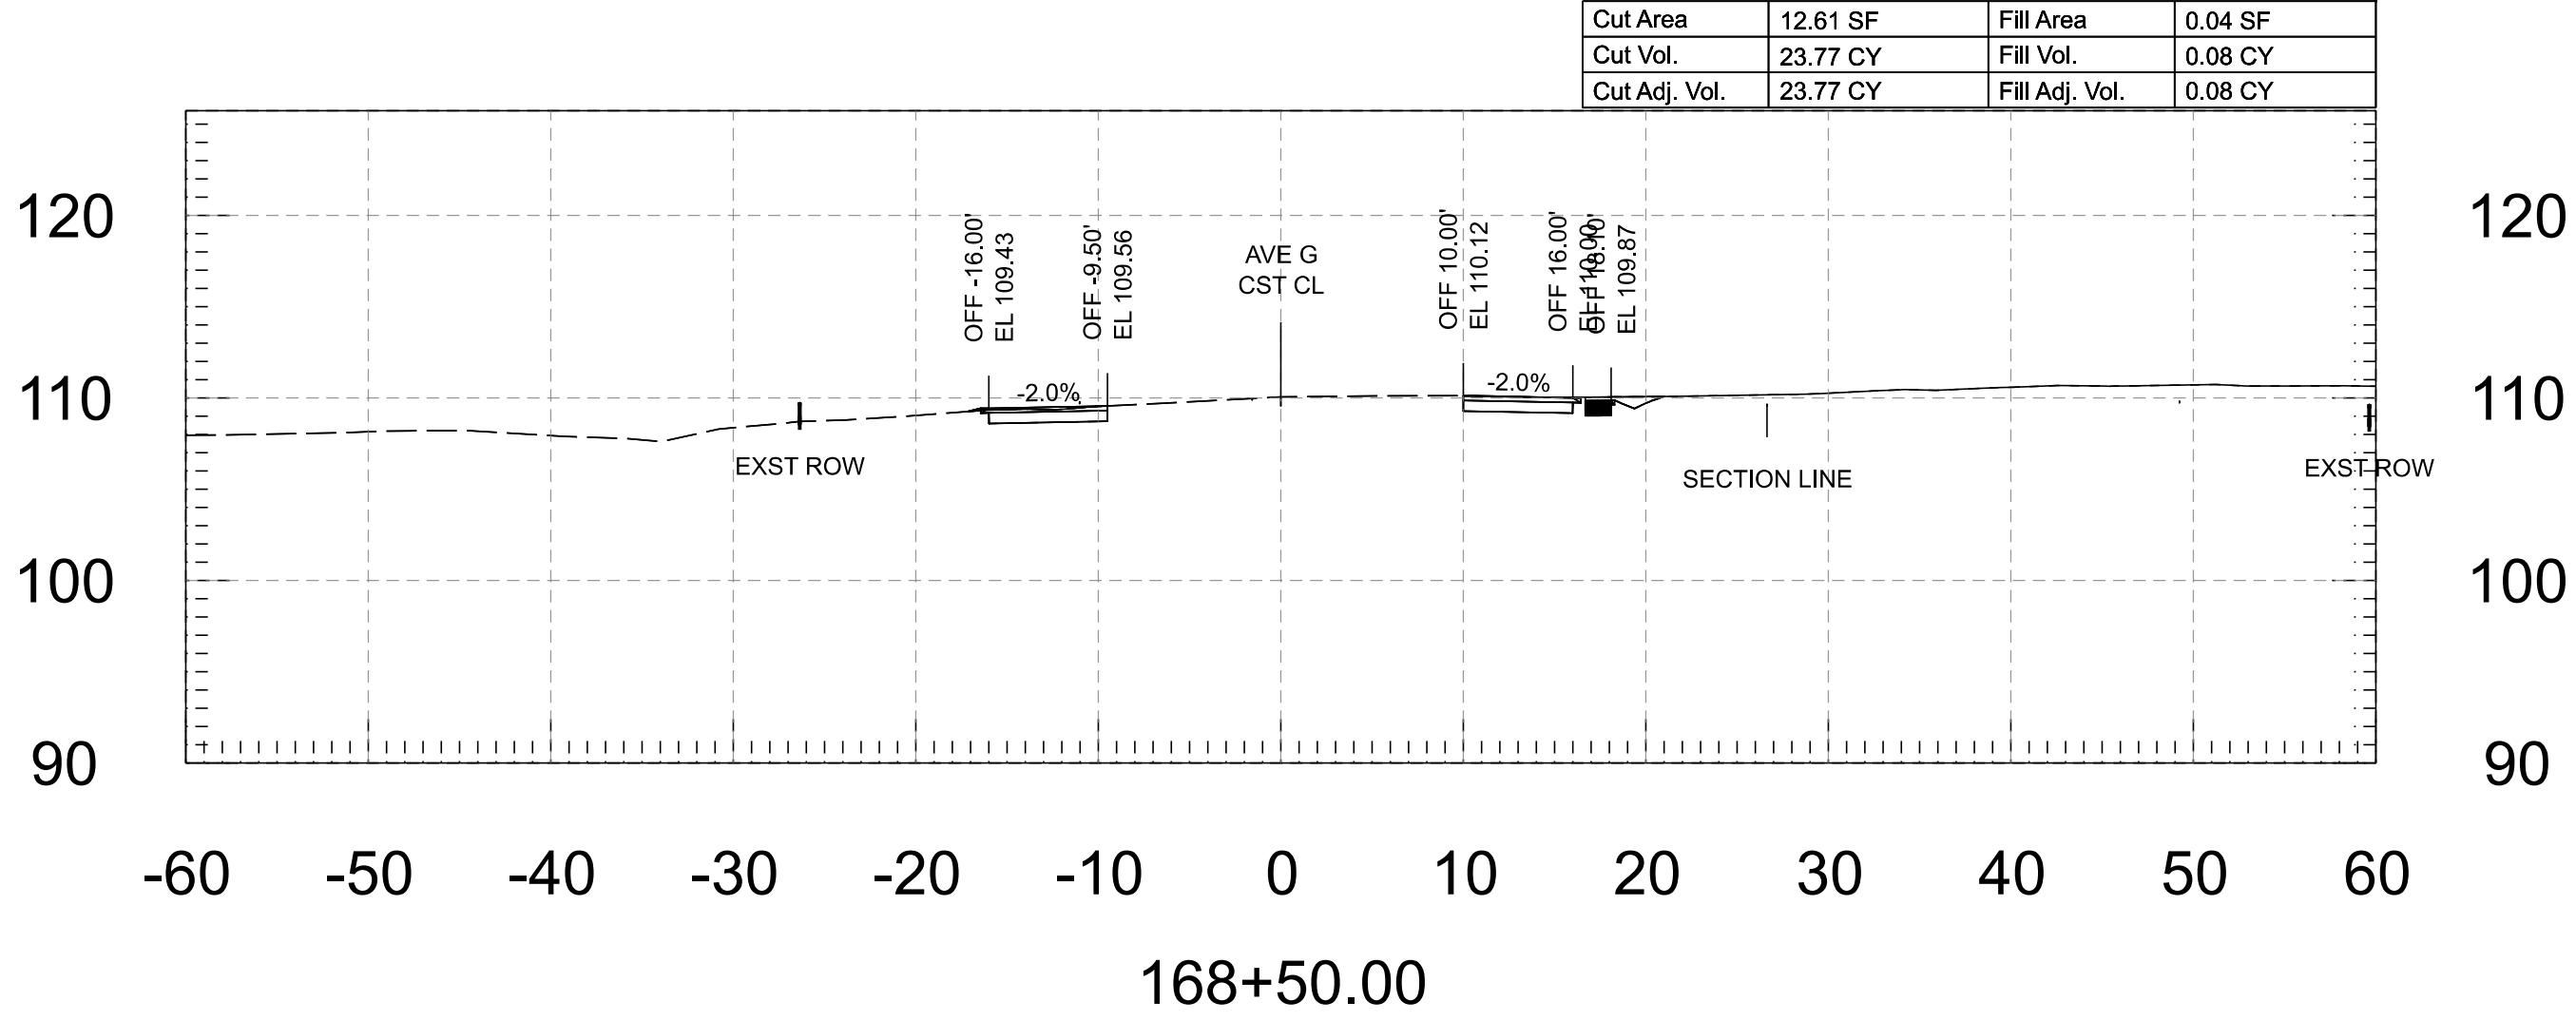



Cut Area	9.52 SF	Fill Area	0.15 SF
Cut Vol.	17.52 CY	Fill Vol.	0.33 CY
Cut Adj. Vol.	17.52 CY	Fill Adj. Vol.	0.33 CY

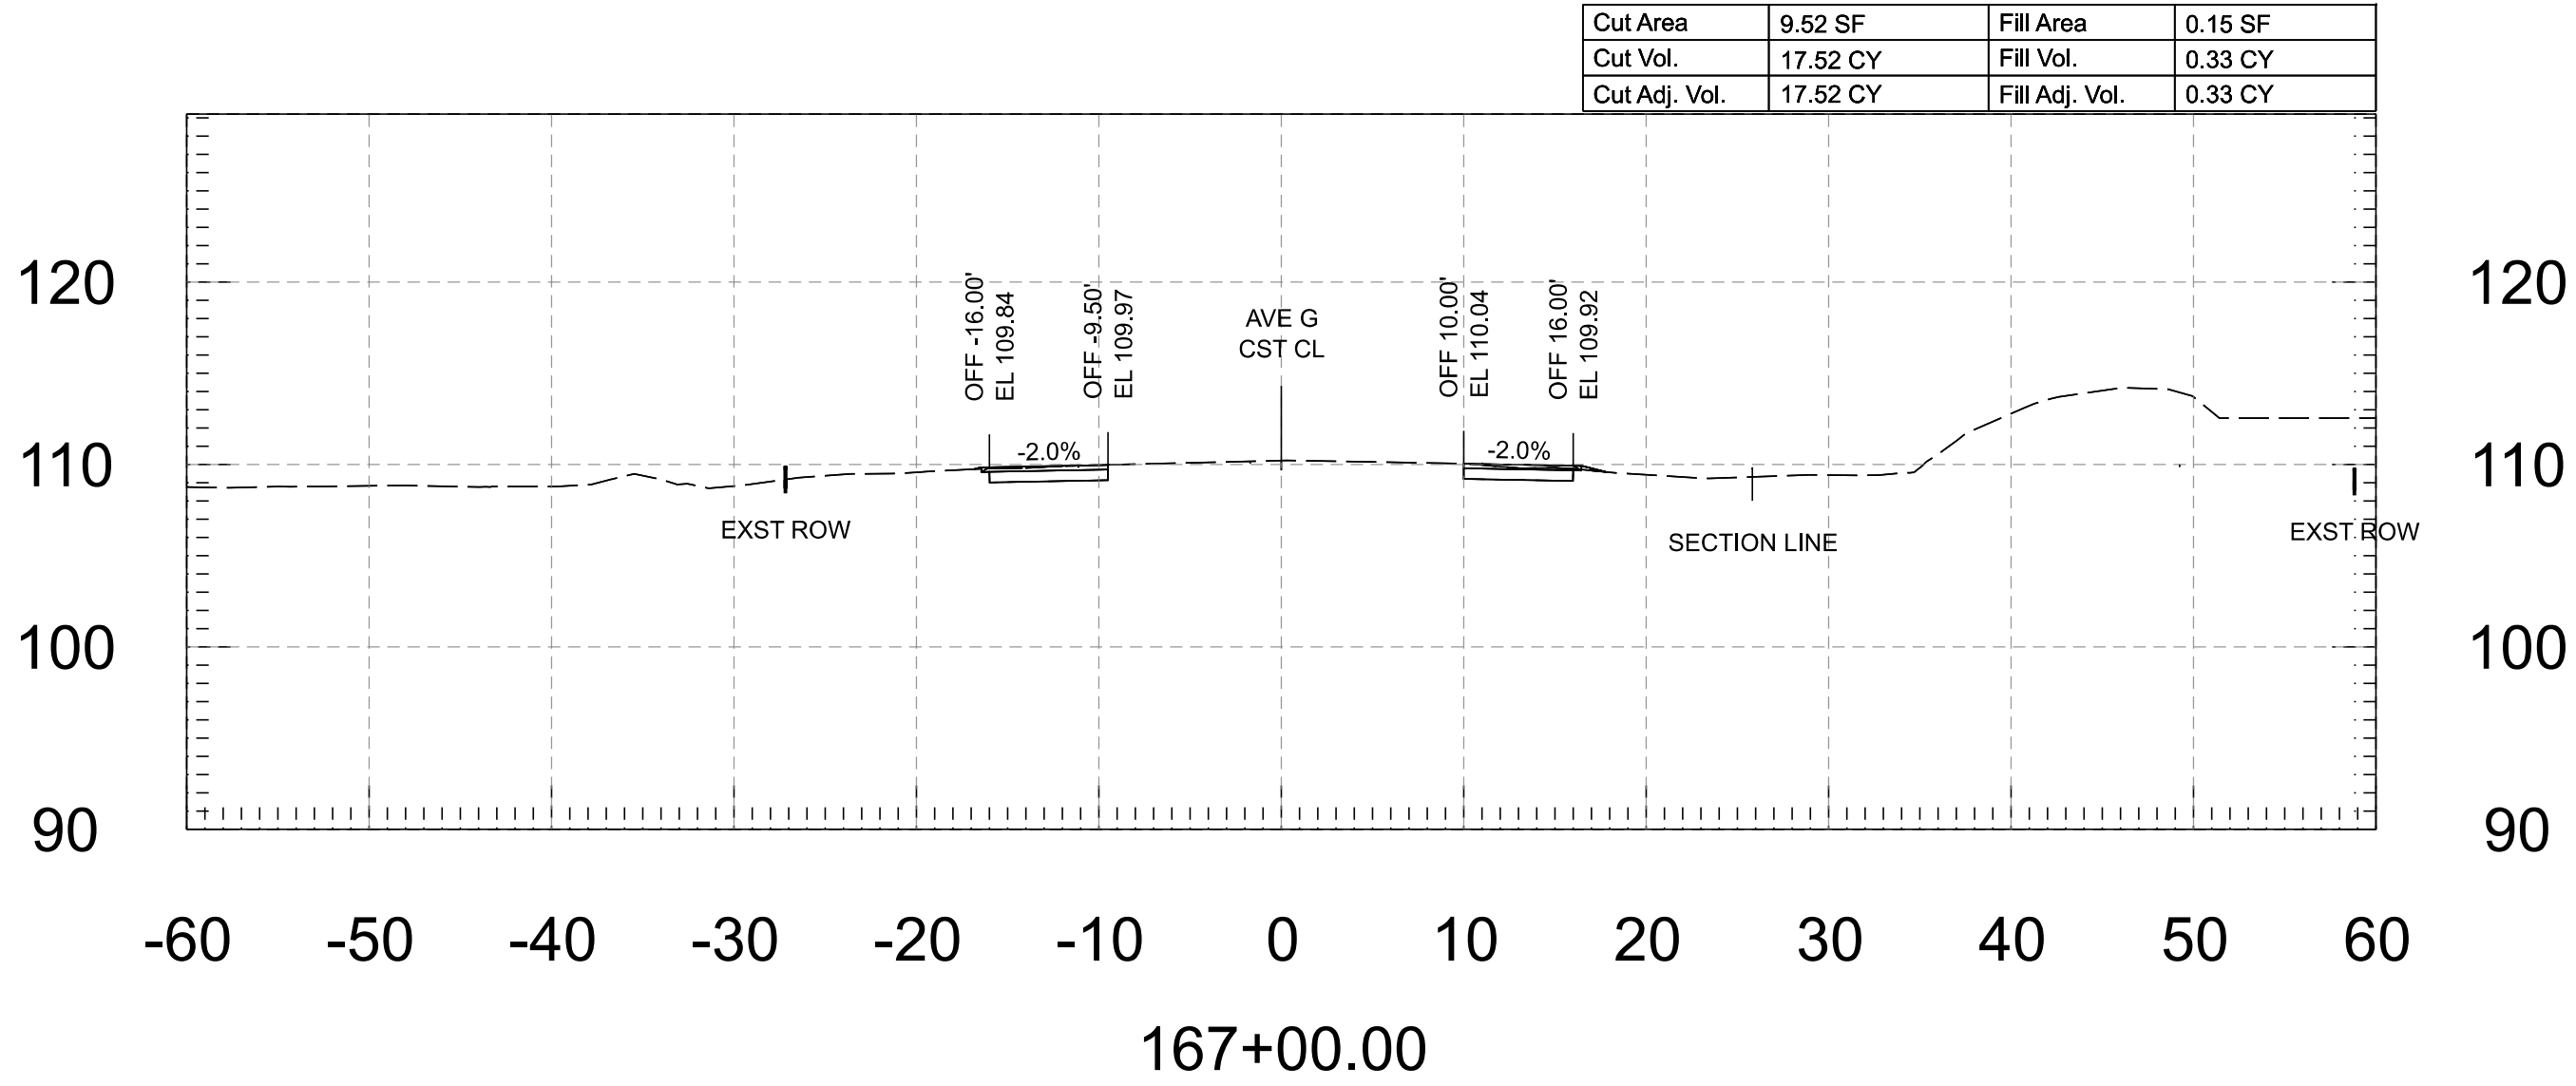






Cut Area	13.07 SF	Fill Area	0.04 SF
Cut Vol.	20.79 CY	Fill Vol.	0.27 CY
Cut Adj. Vol.	20.79 CY	Fill Adj. Vol.	0.27 CY




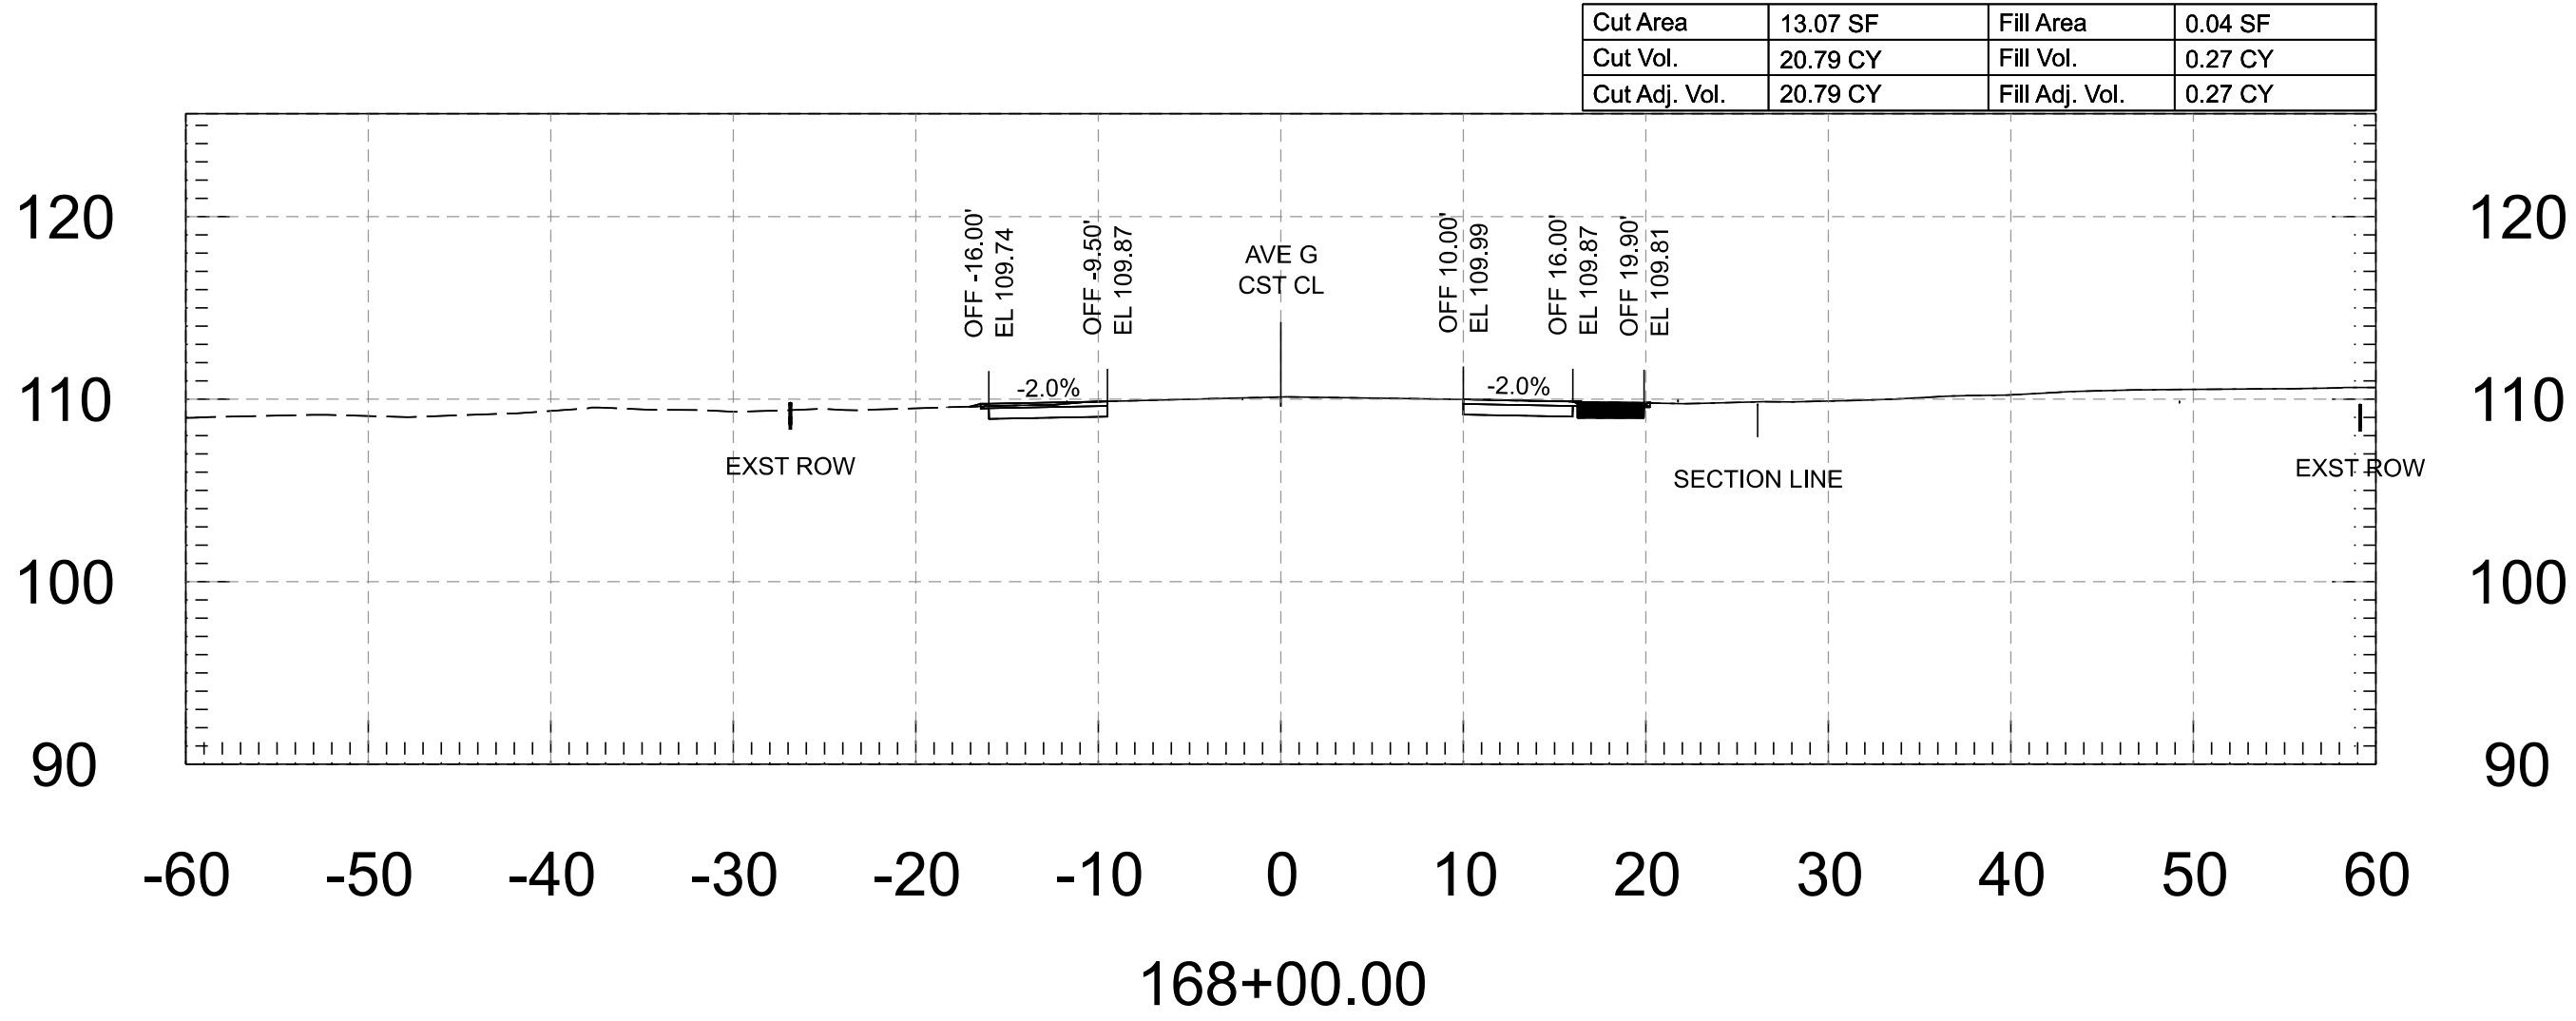


 FOR INFORMATION ONLY		NAME	DATE	ARIZONA DEPARTMENT OF TRANSPORTATION PROJECT DELIVERY AND OPERATIONS DIVISION ROADWAY DESIGN SERVICES	ROUTE	F.H.W.A. Arizona Division	STATE ARIZ.	PROJECT NO.	FEDERAL ID NO.	SHEET NO.	TOTAL SHEETS	RECORD DRAWING
	DESIGN	M. SCHOEN	07/26		MILEPOST			0000 YU YYU	YYU-0(225)T	77	118	
	DRAWN	M. SCHOEN	07/26					LOCATION AVENUE G, COUNTY 11TH ST - COUNTY 16TH ST				
	CHECKED	H. RIOS	07/26	AVENUE G - CROSS SECTIONS		STRUCTURE NO.	TRACS NO. T0437 01C					
			WSP USA Inc. 1230 West Washington Street, Suite 405 Tempe, AZ 85288		____ OF ____							




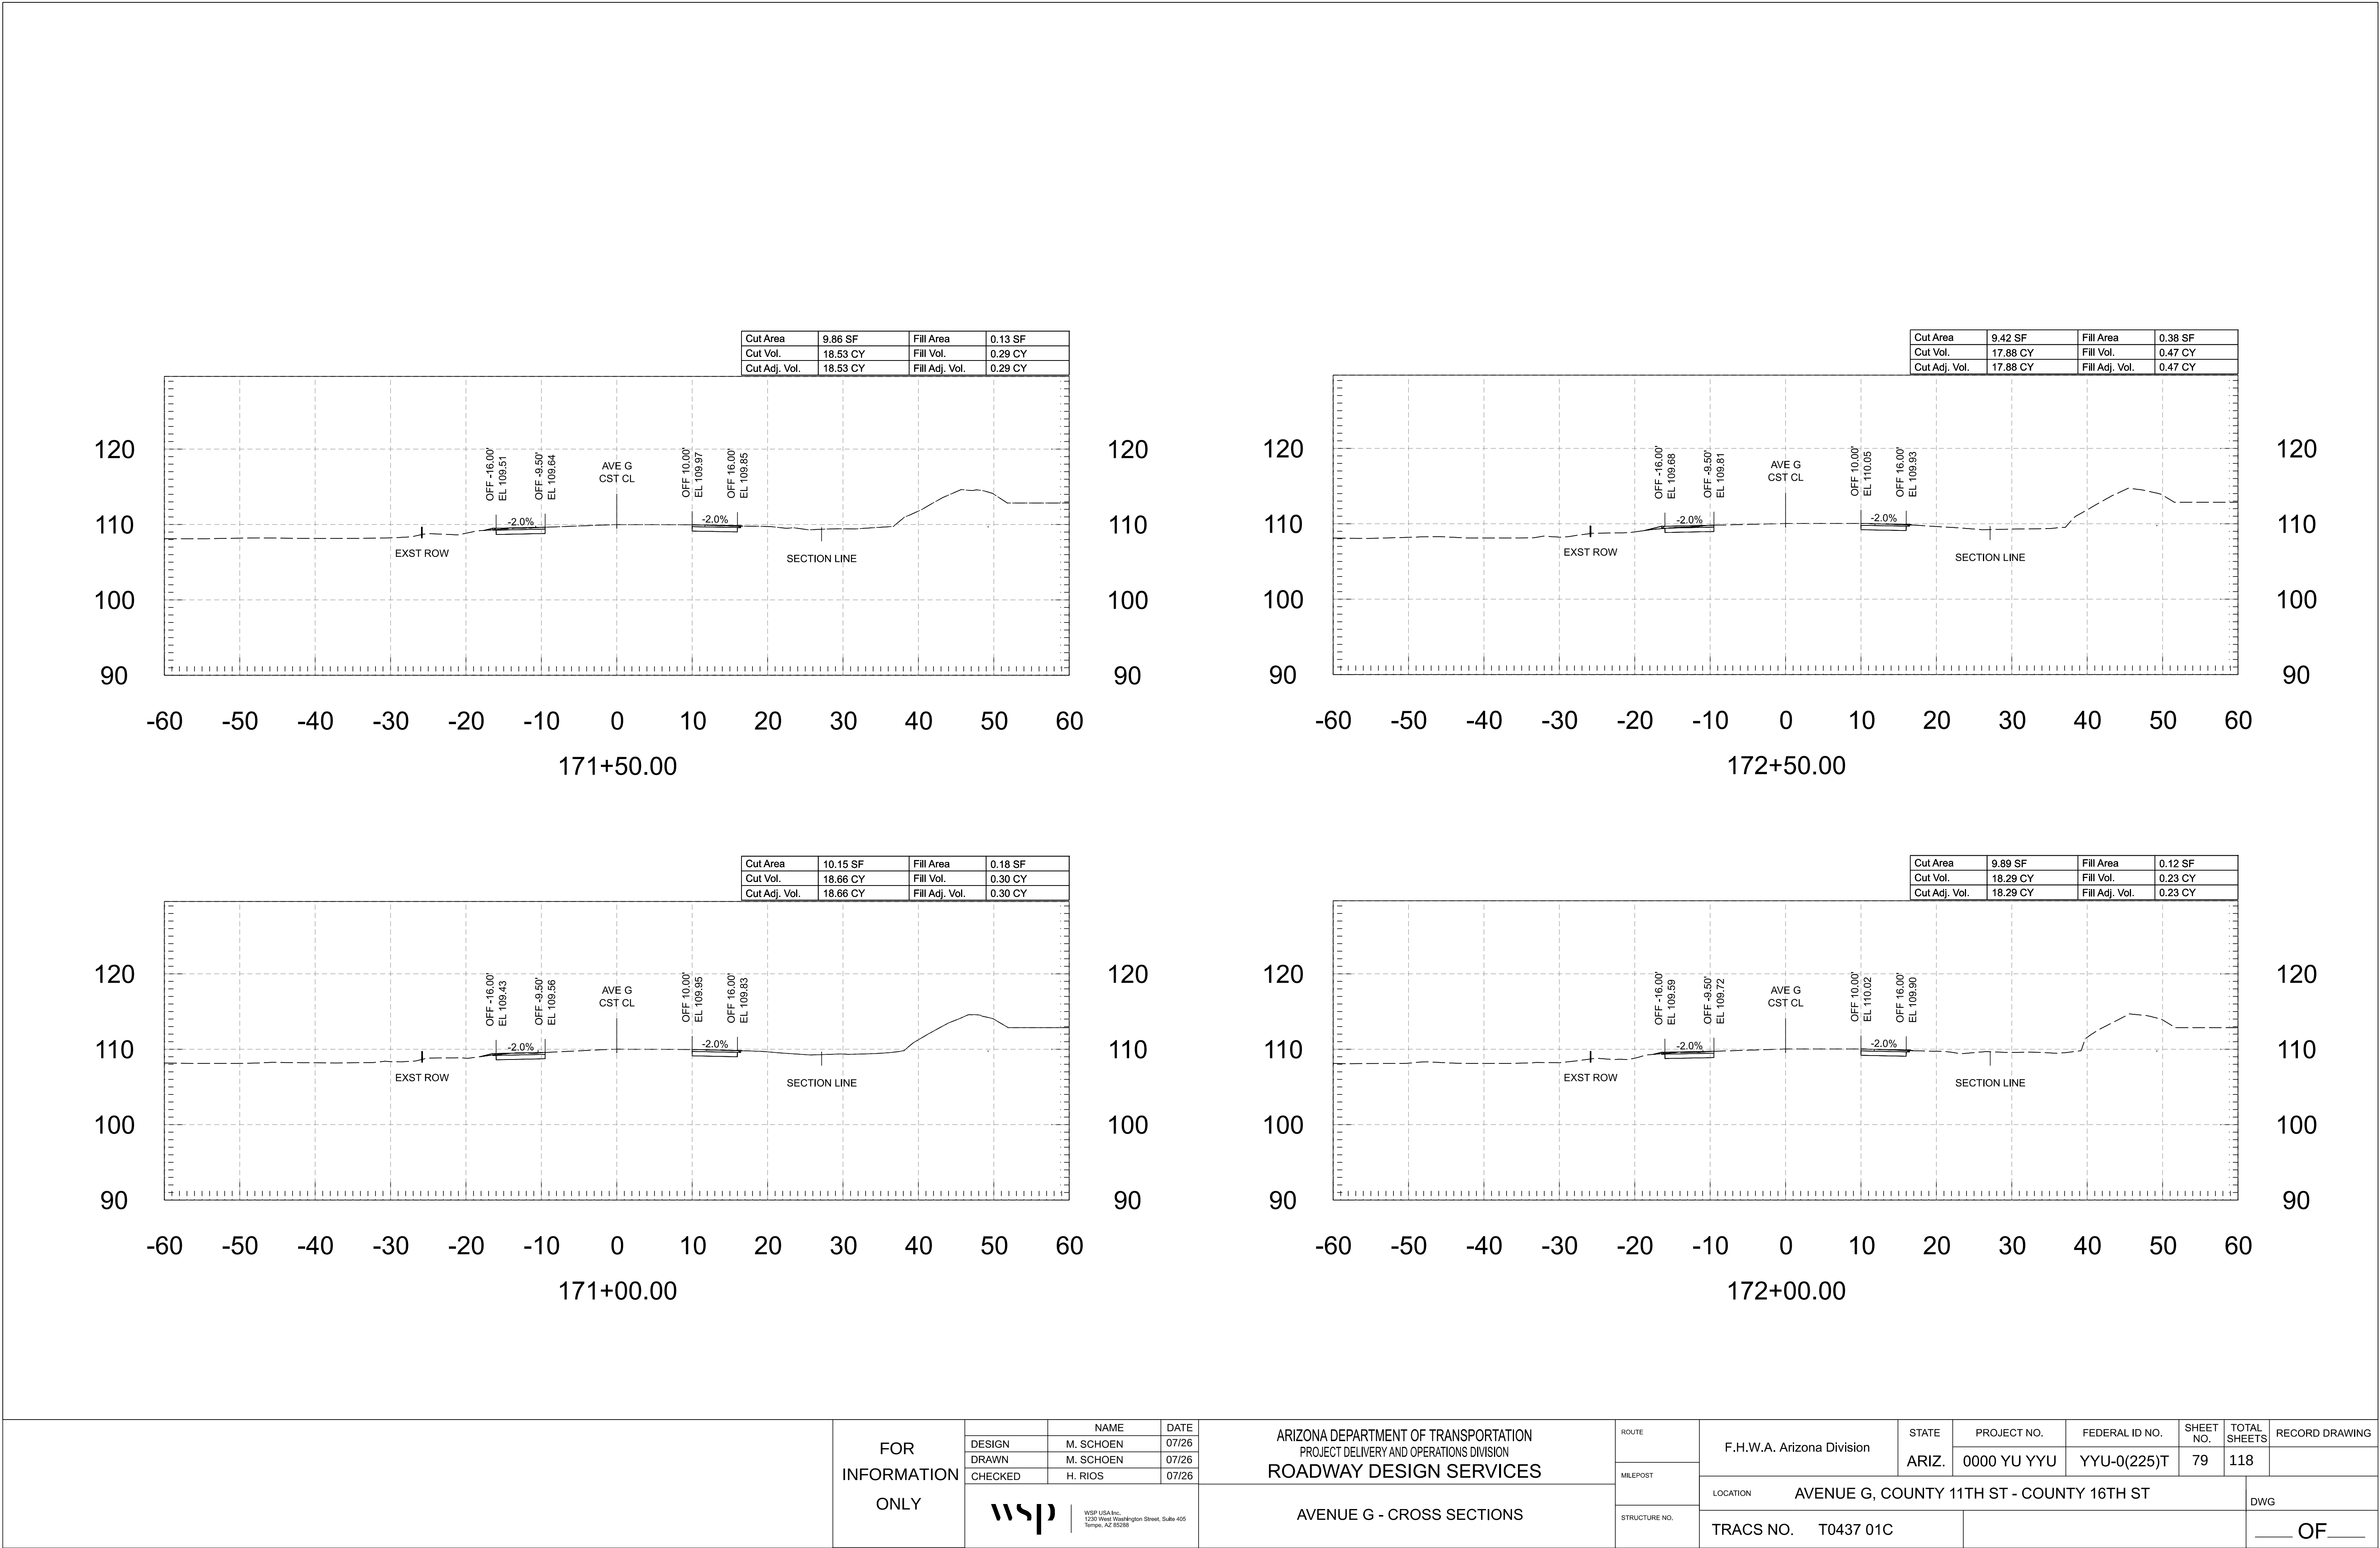


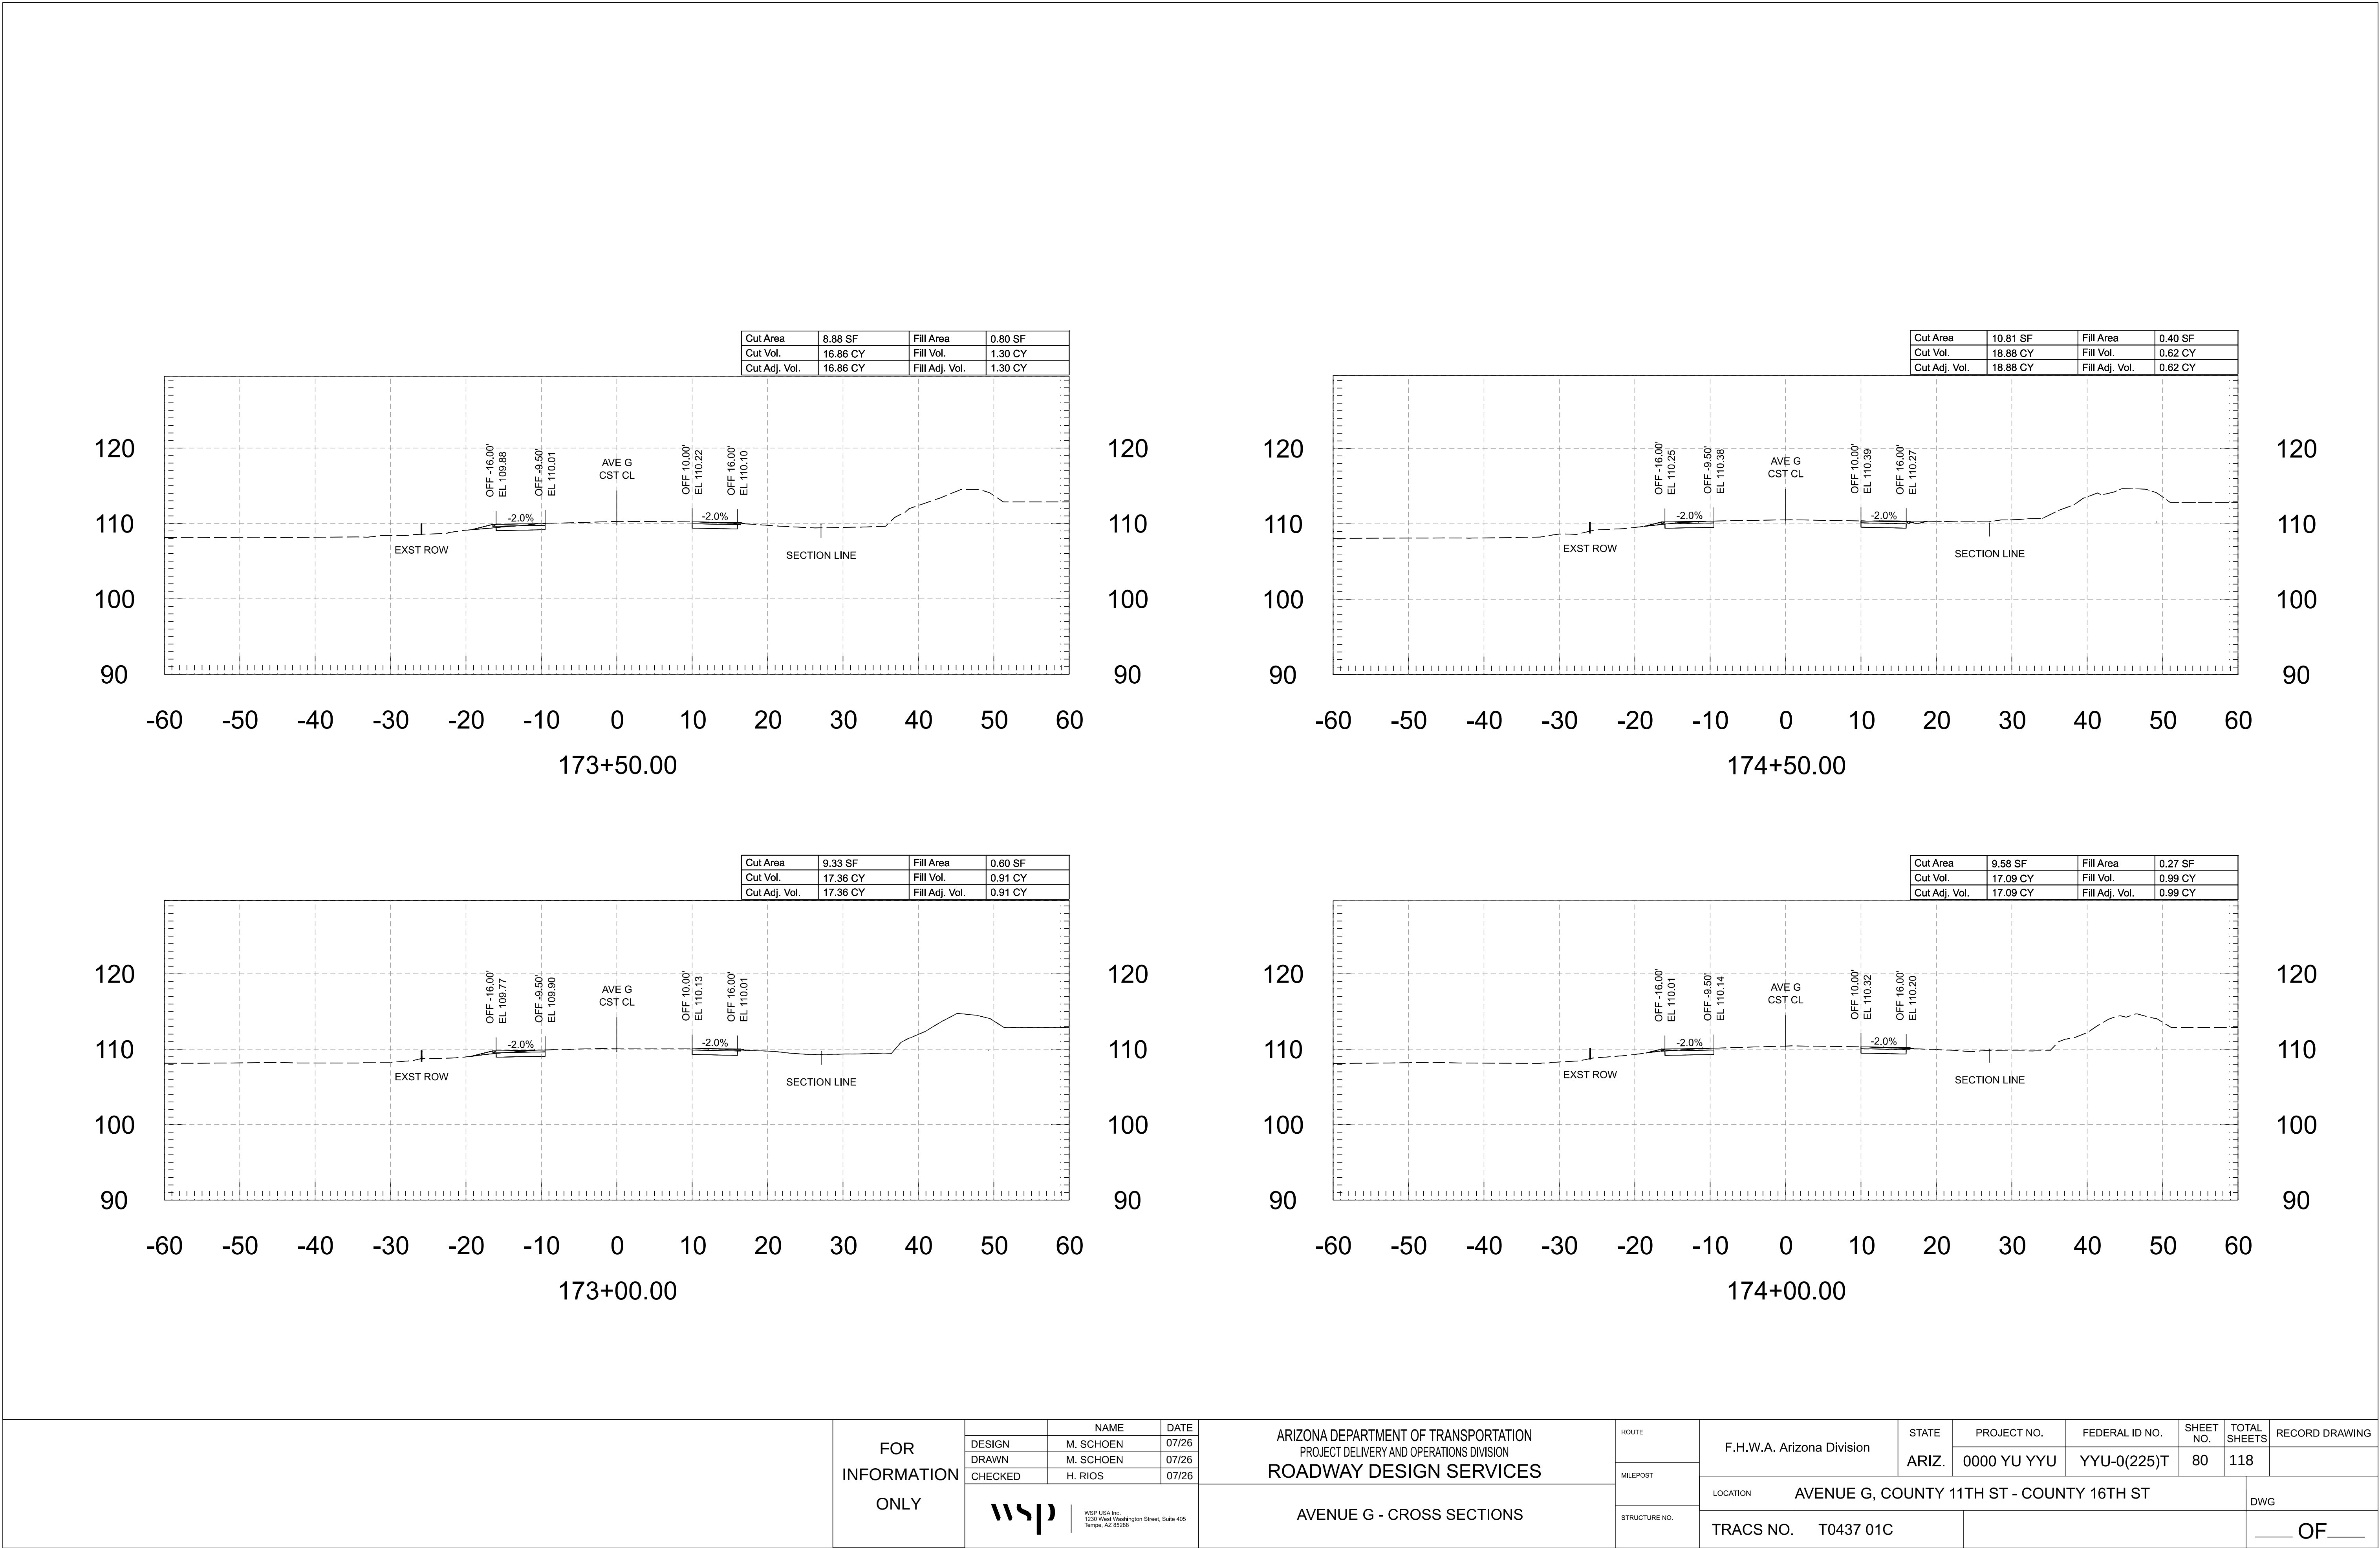


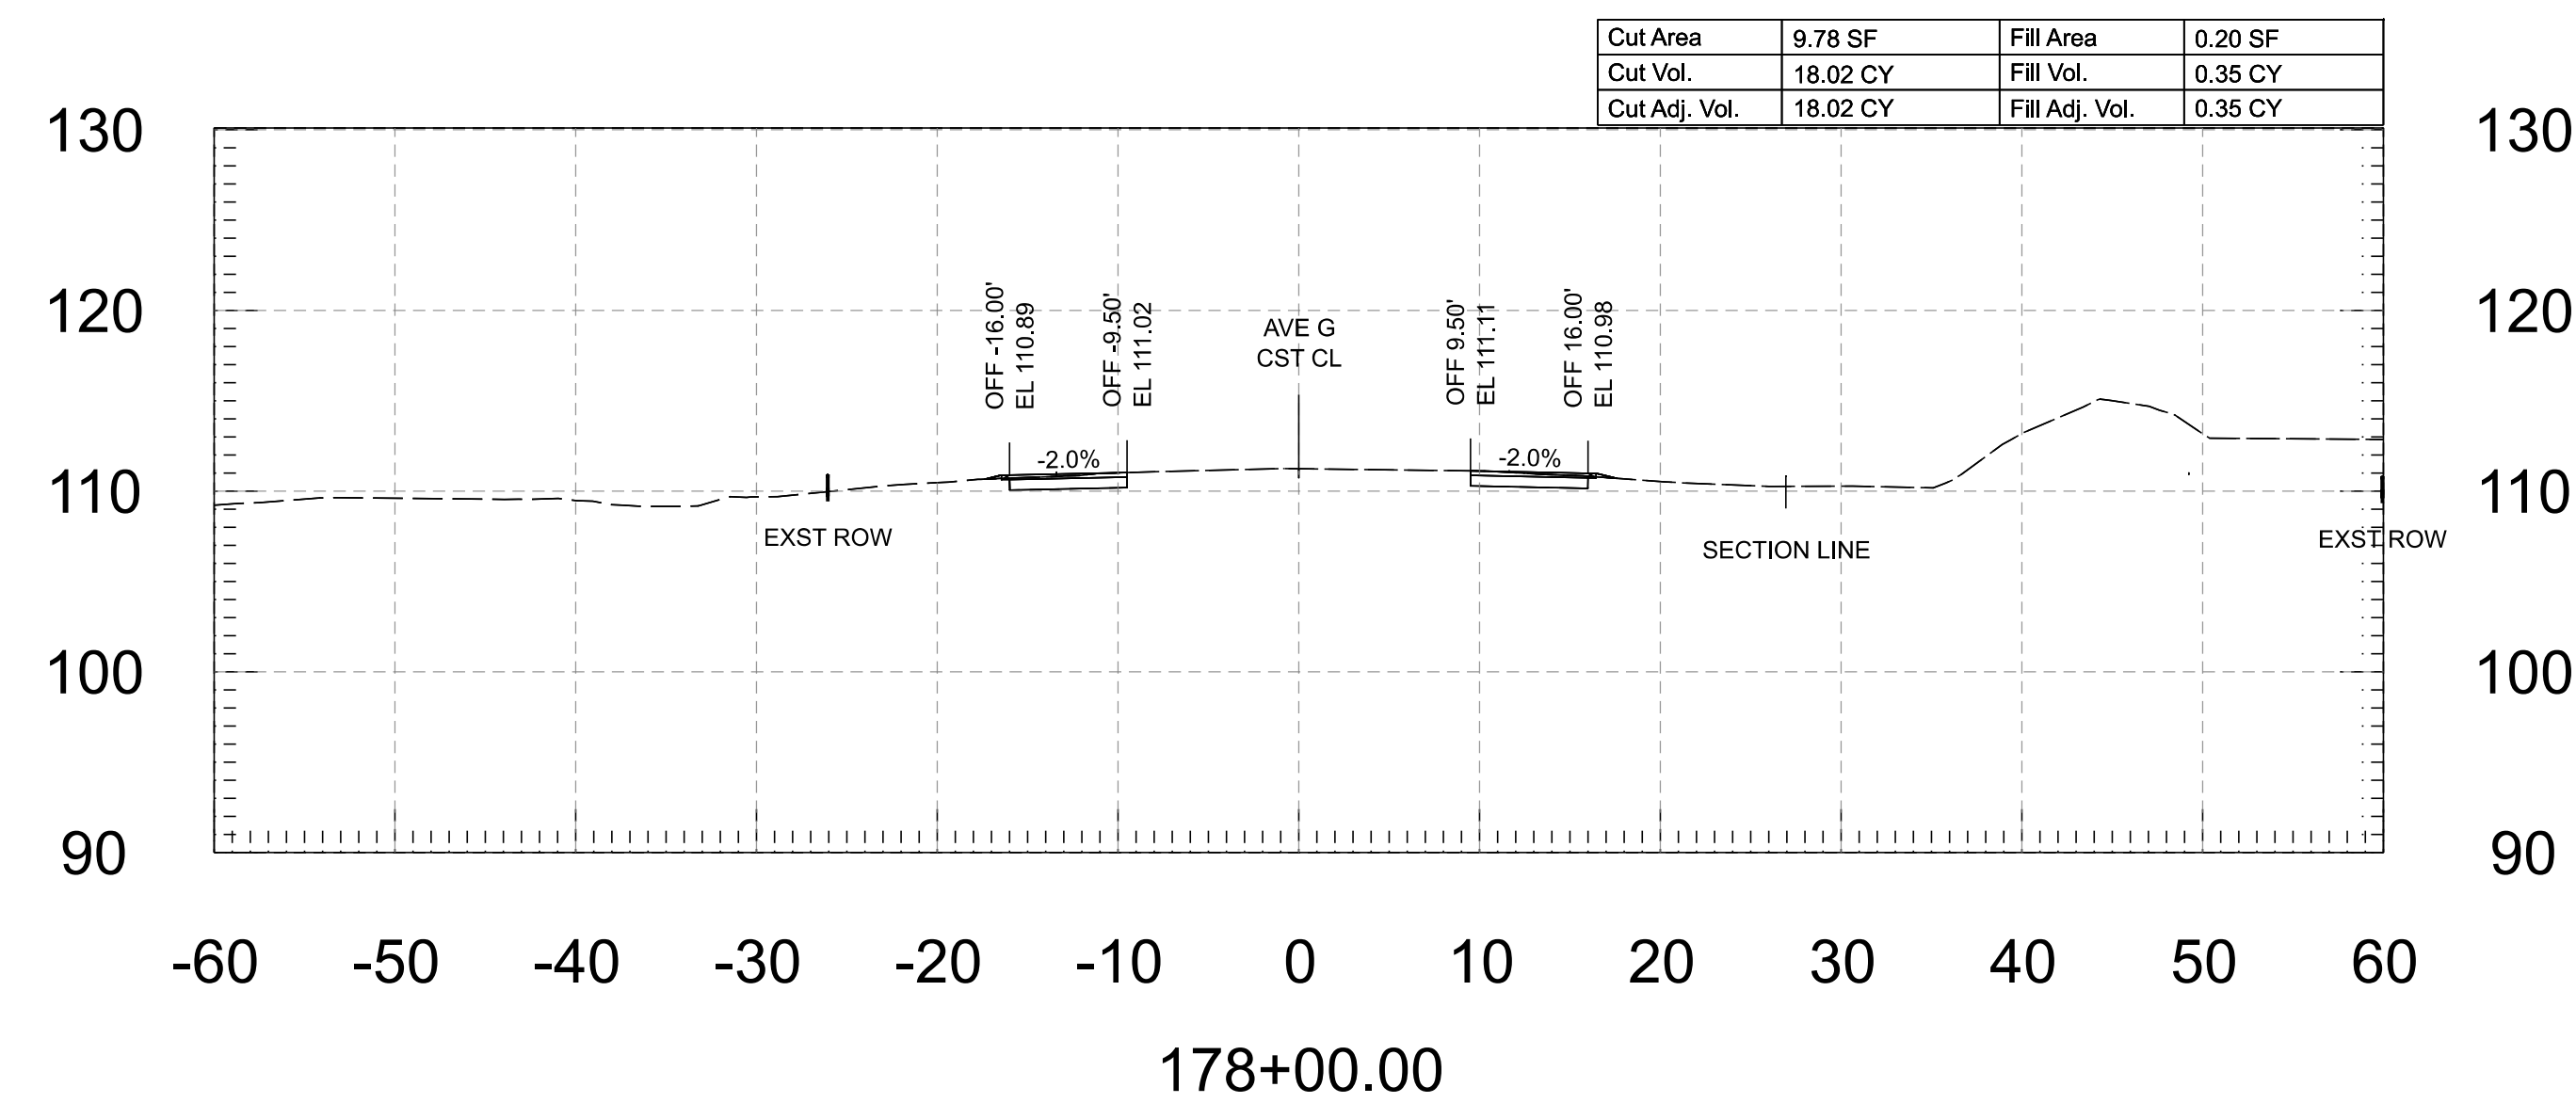
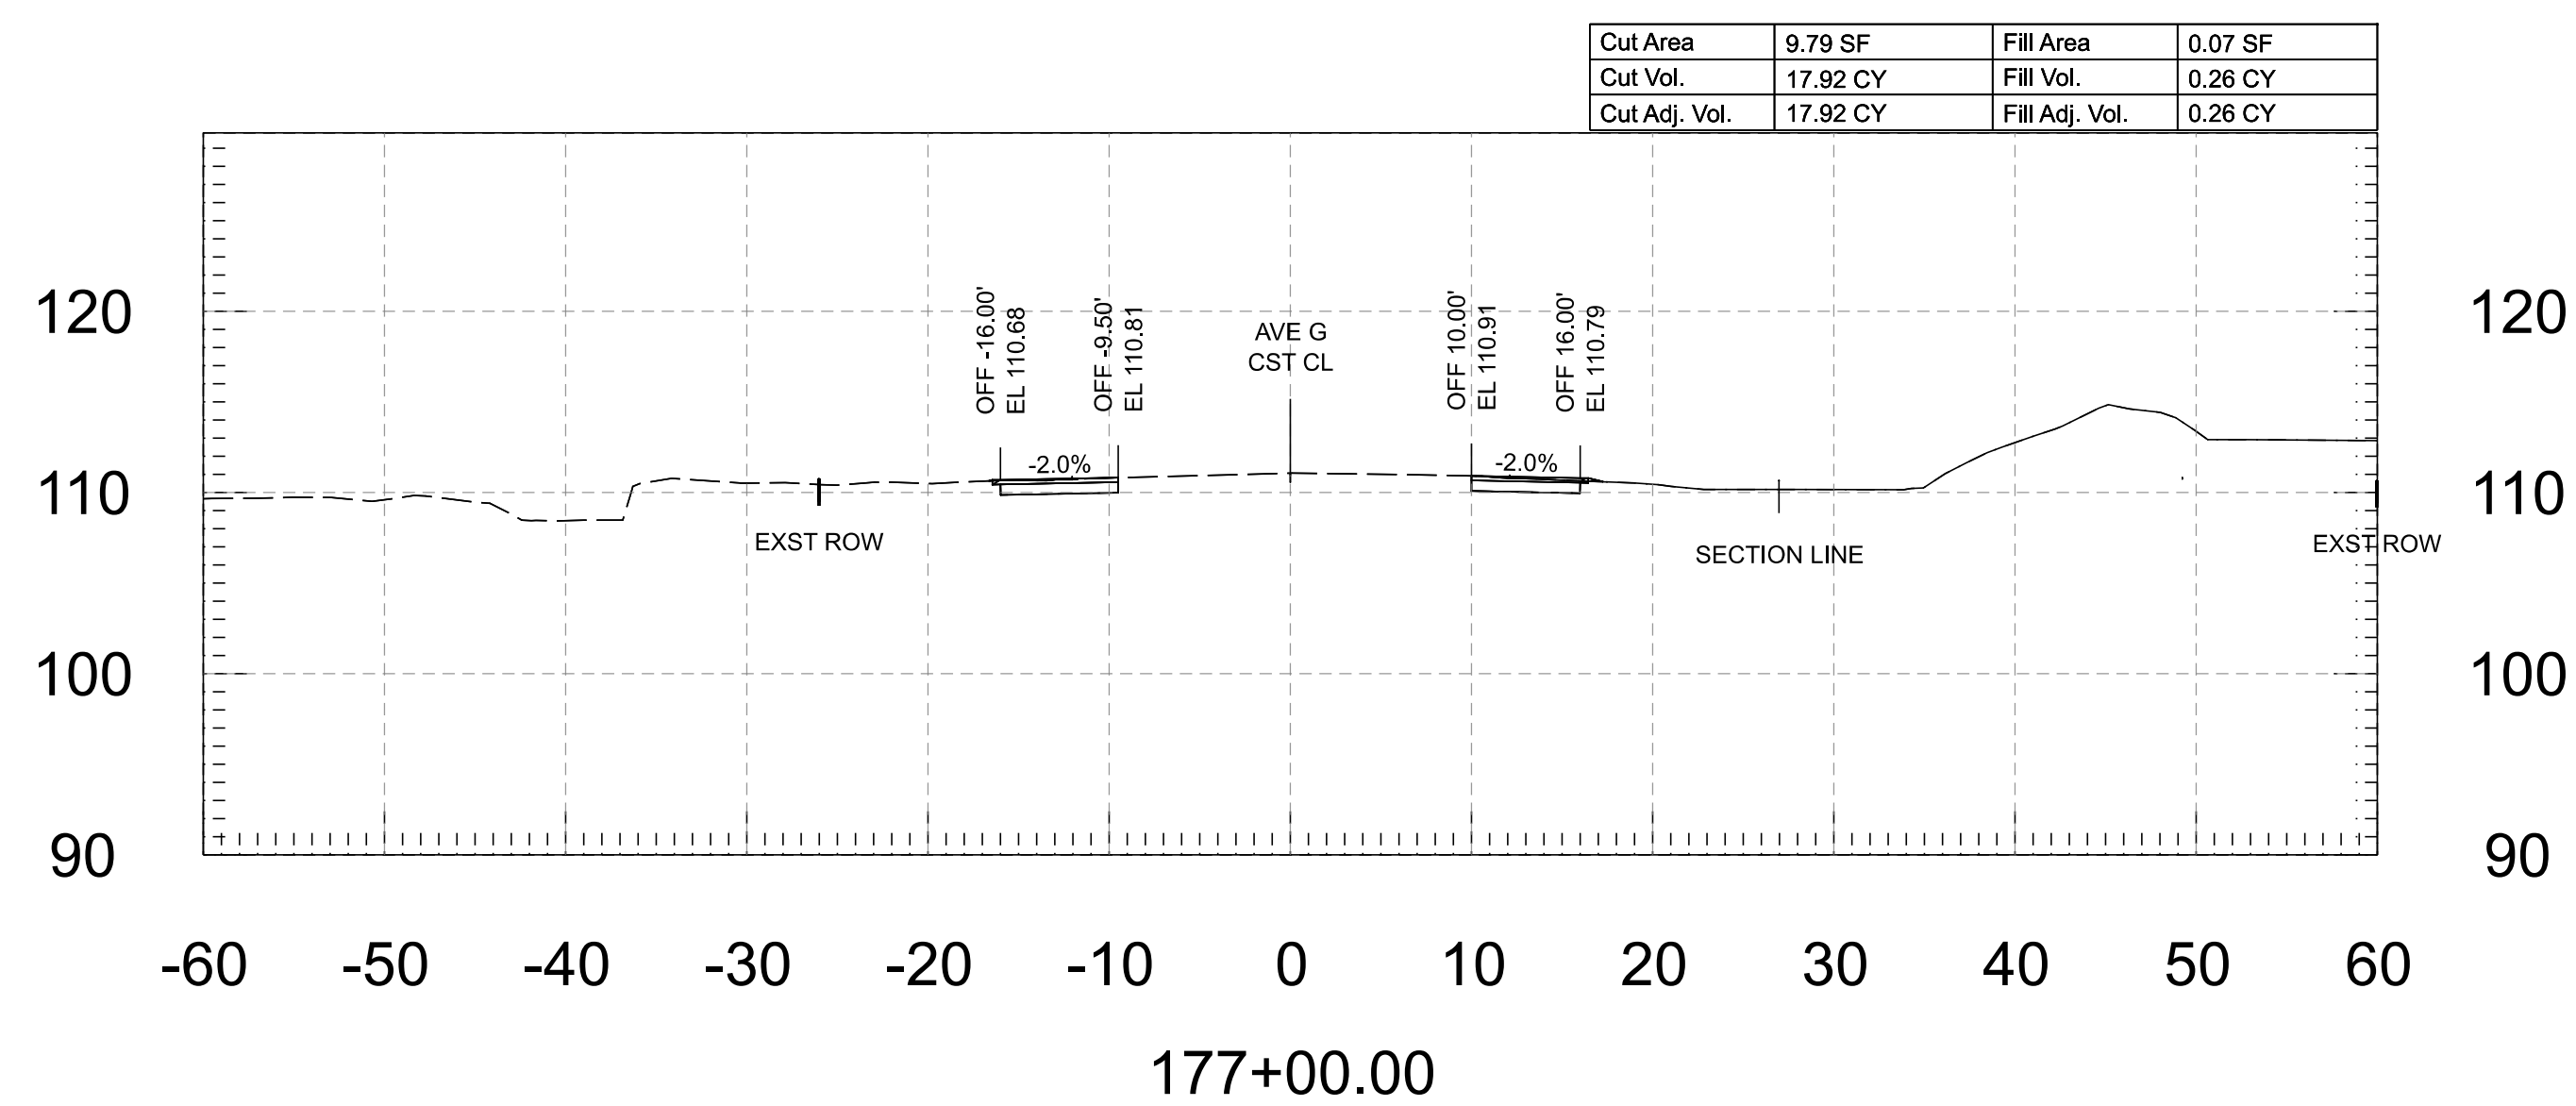
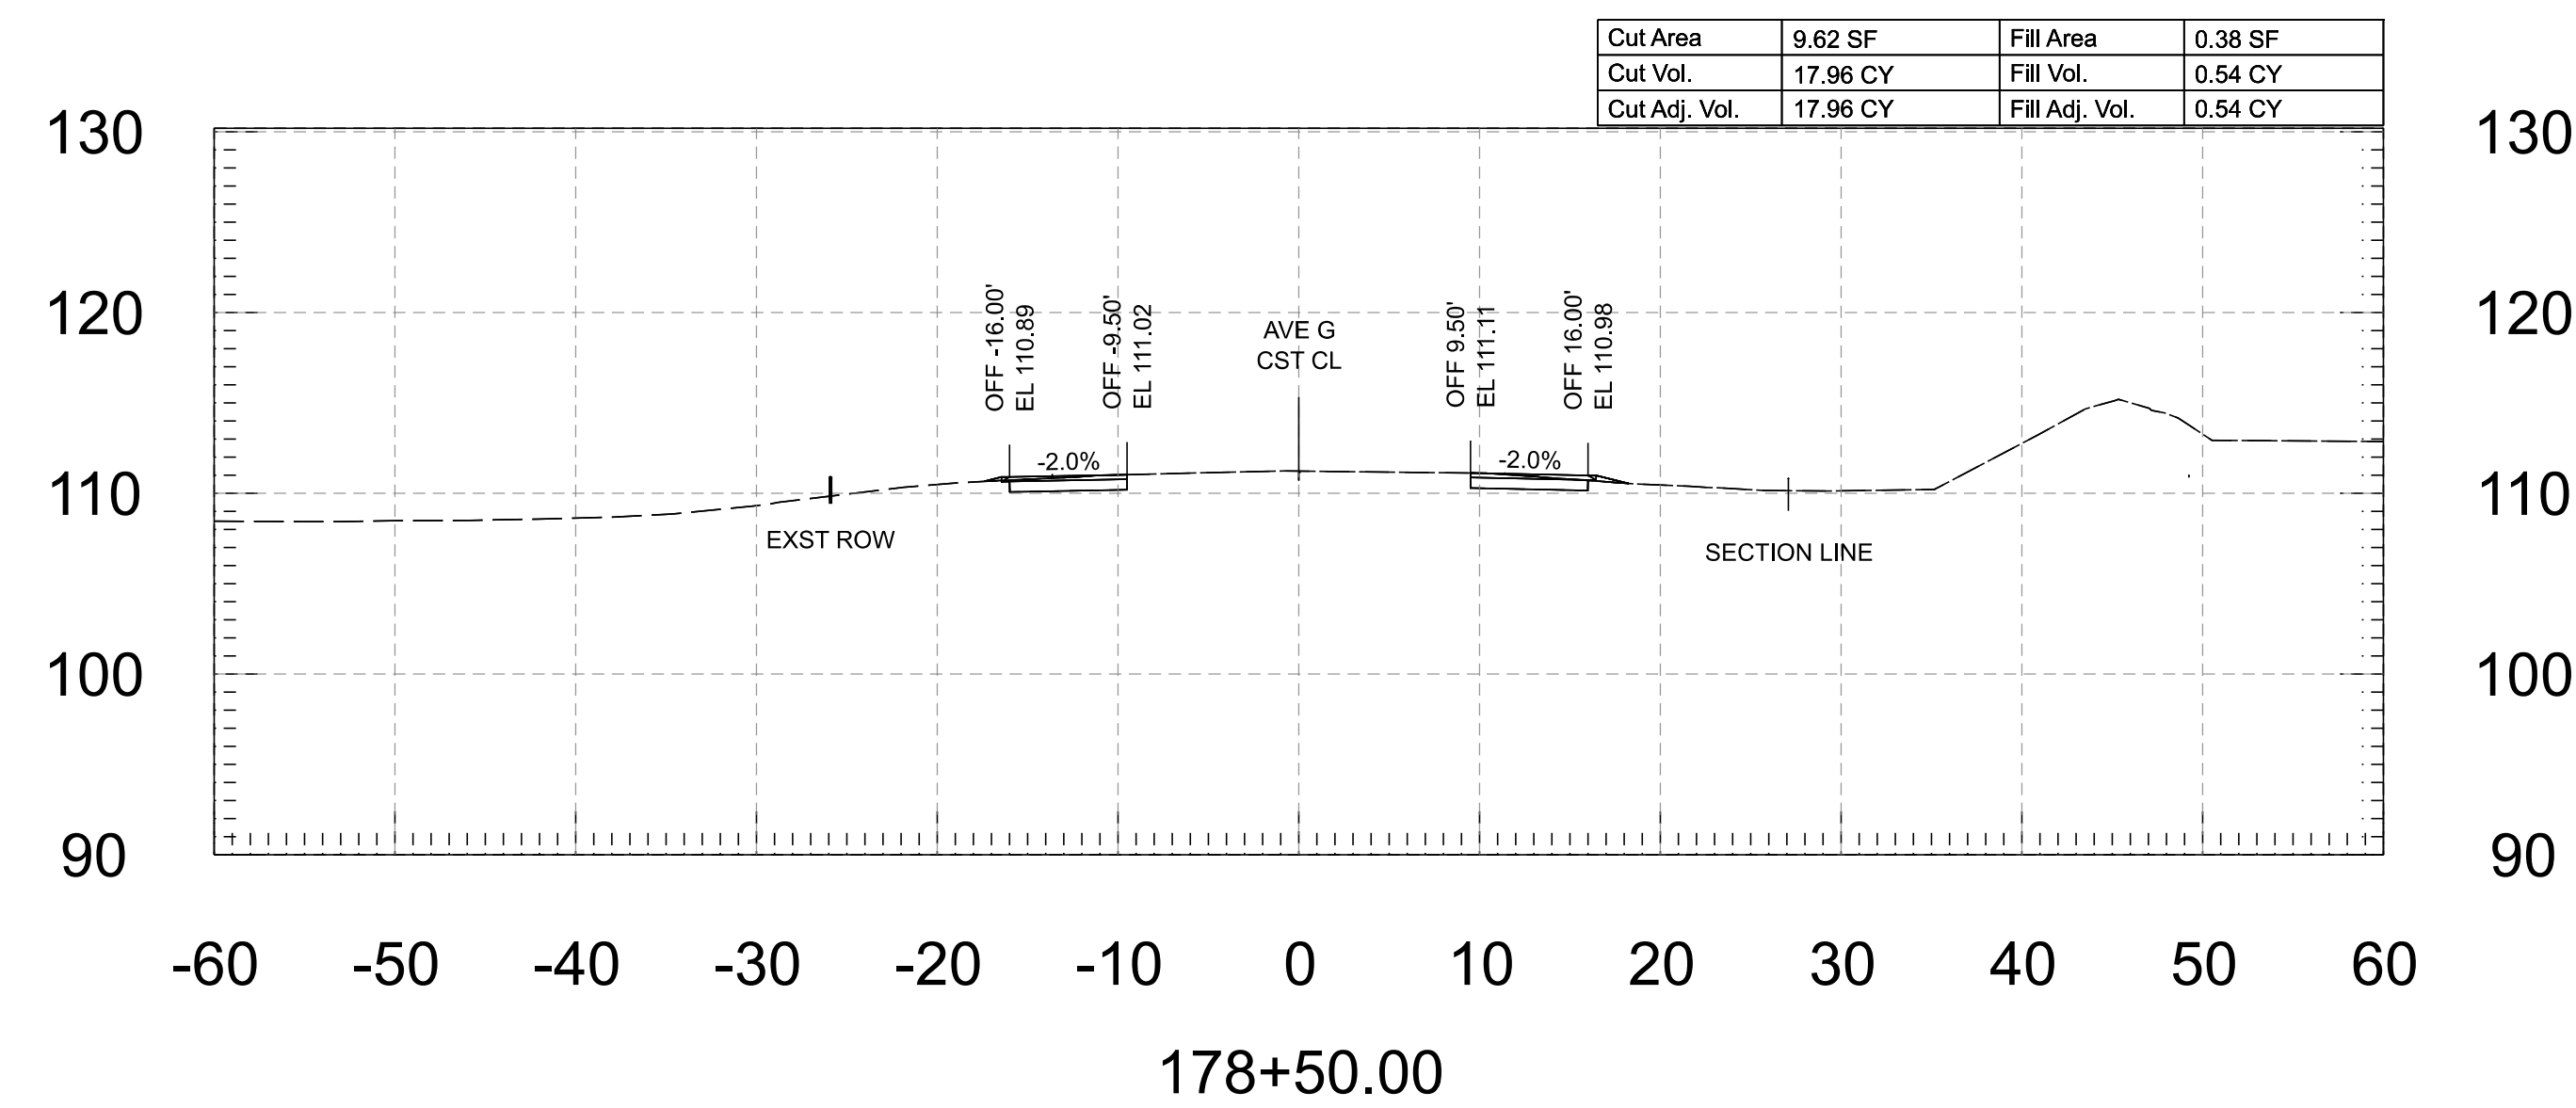
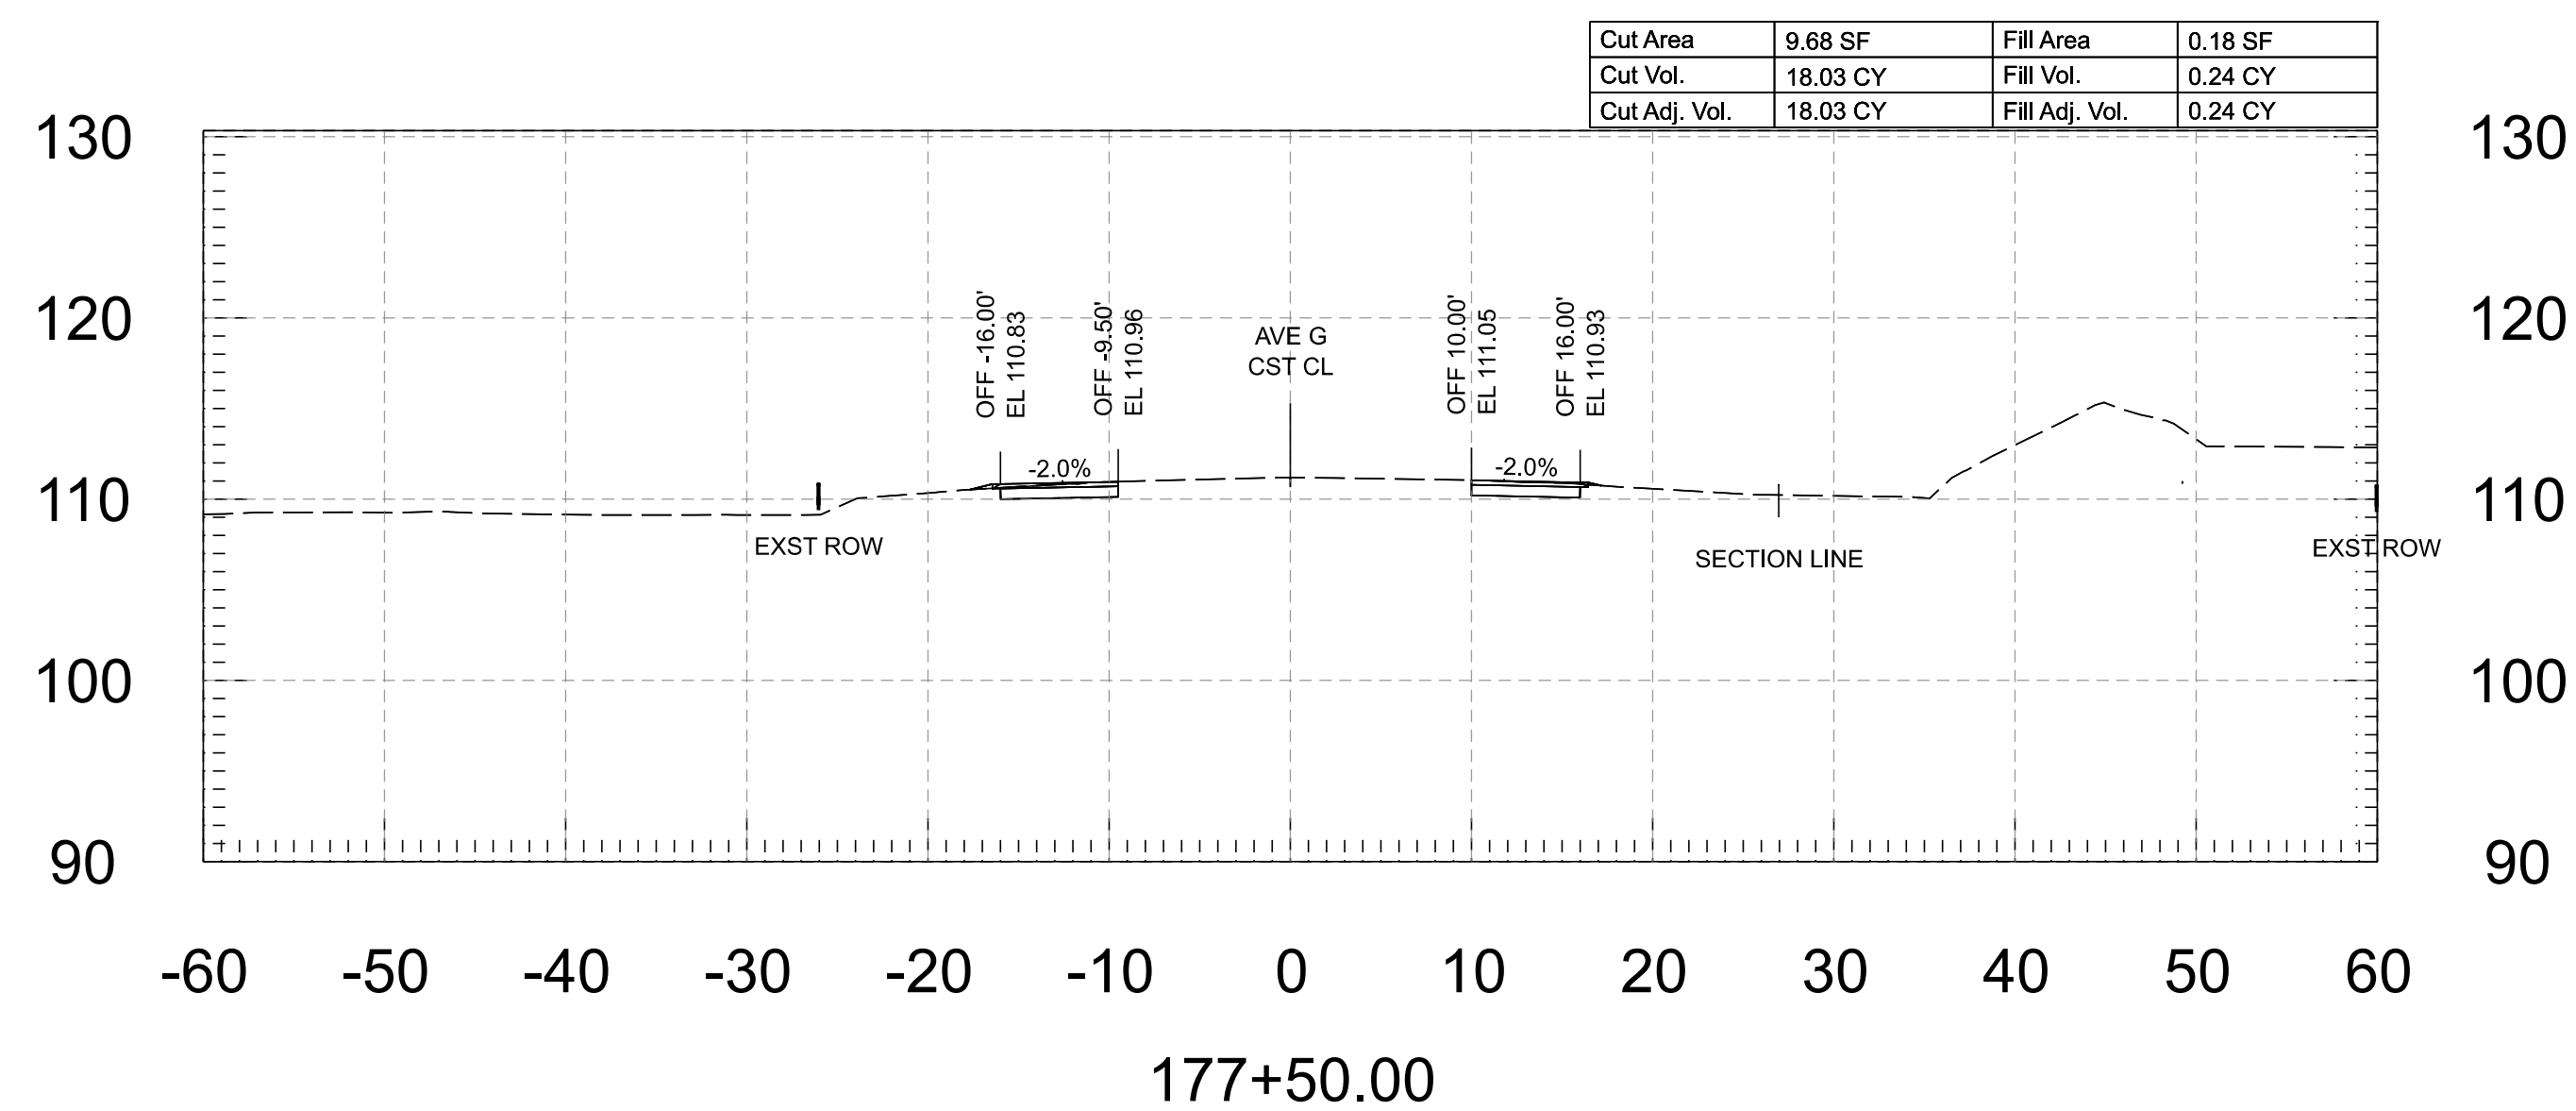


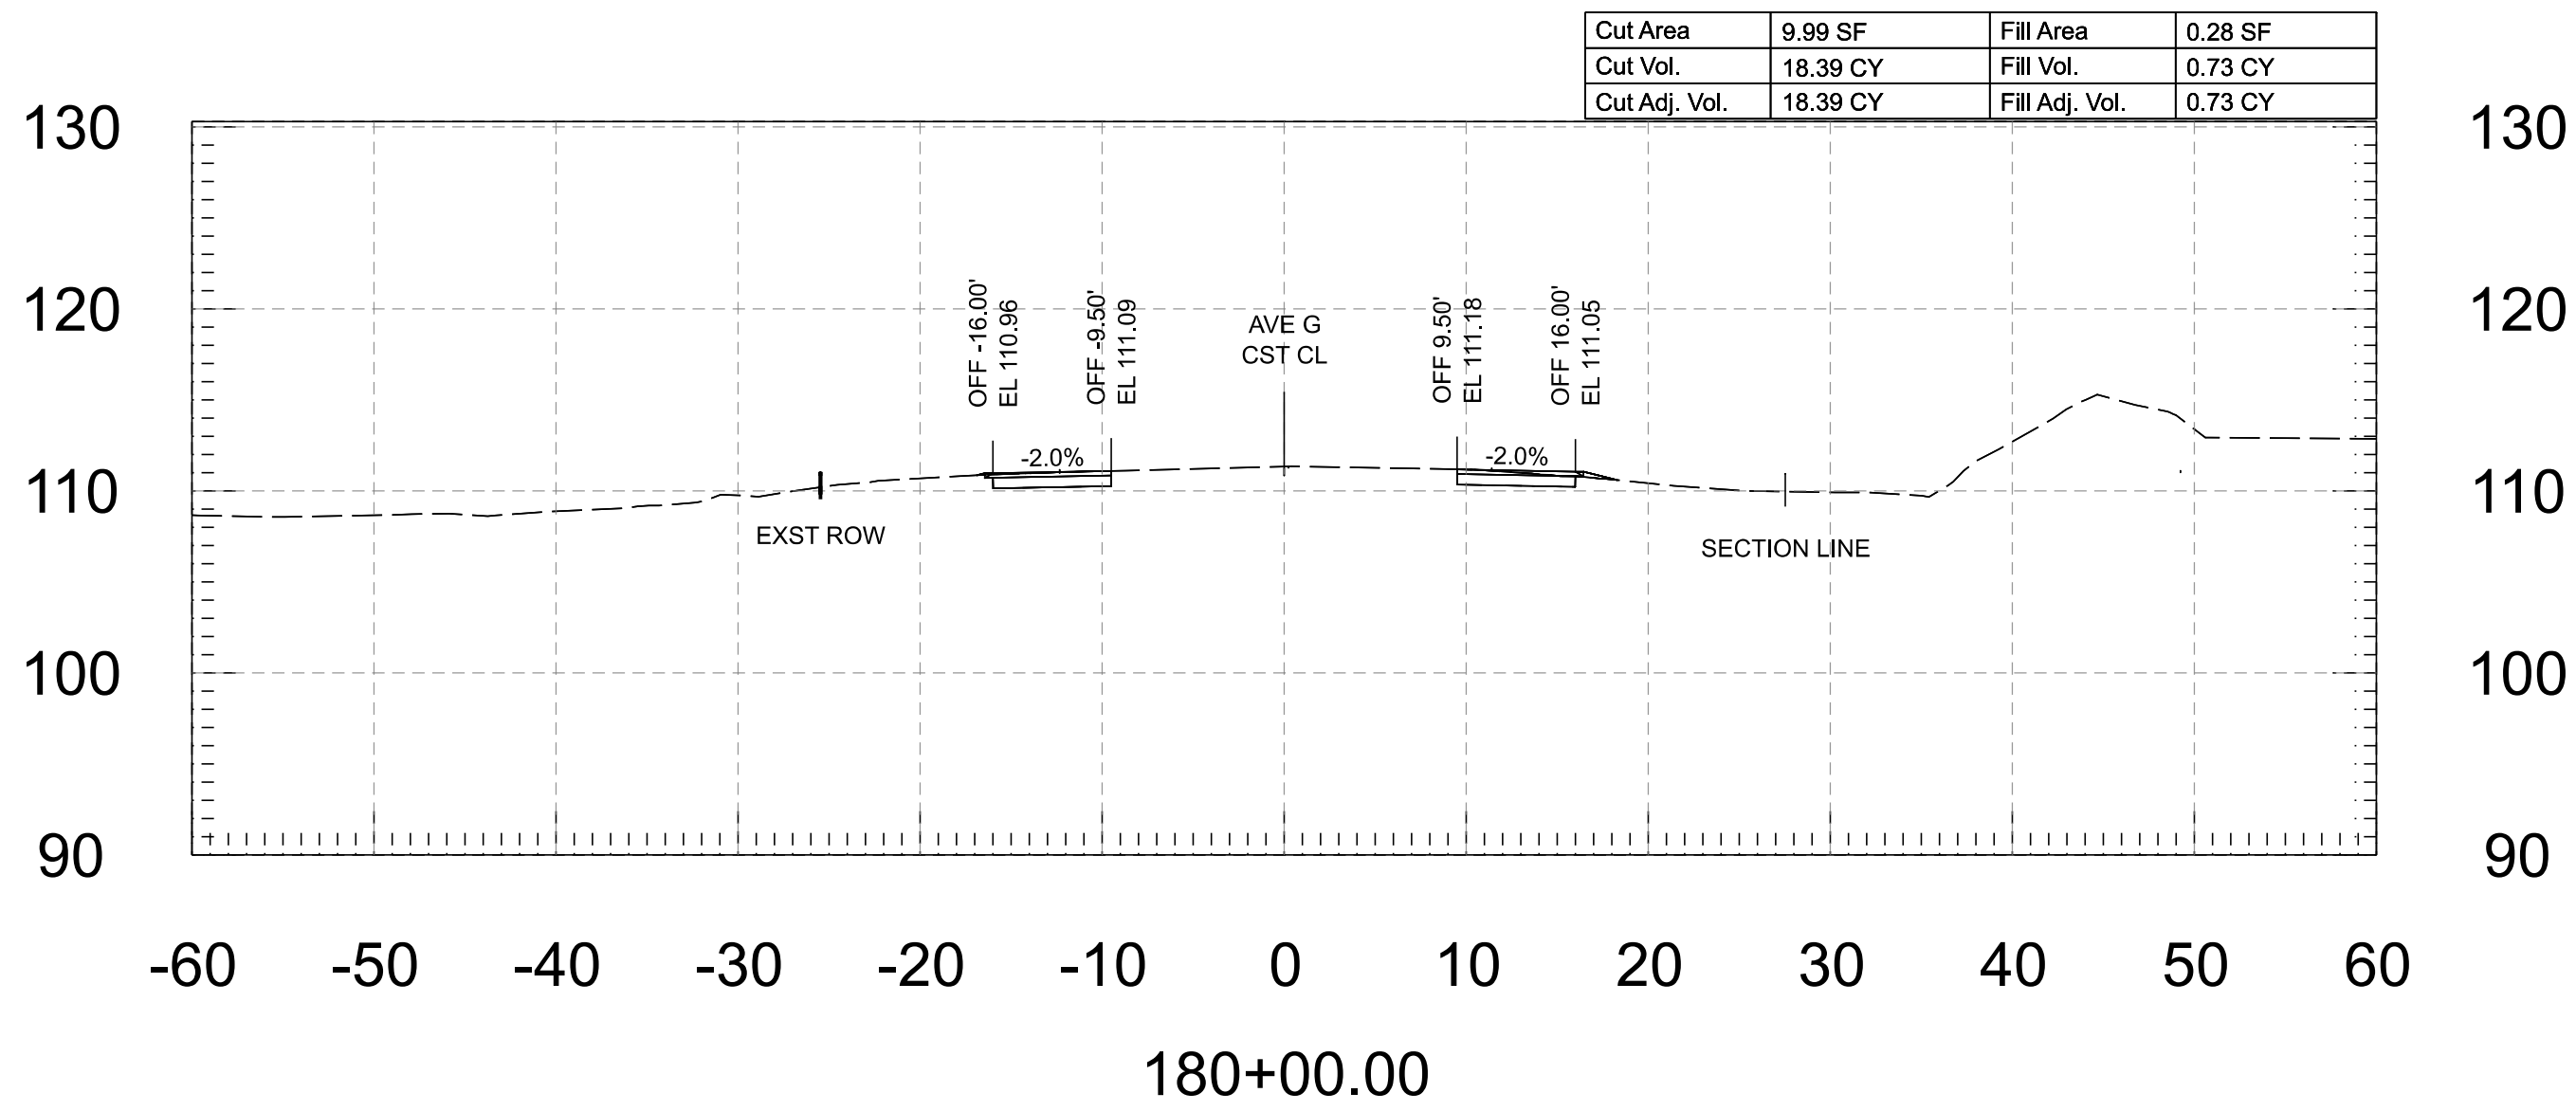
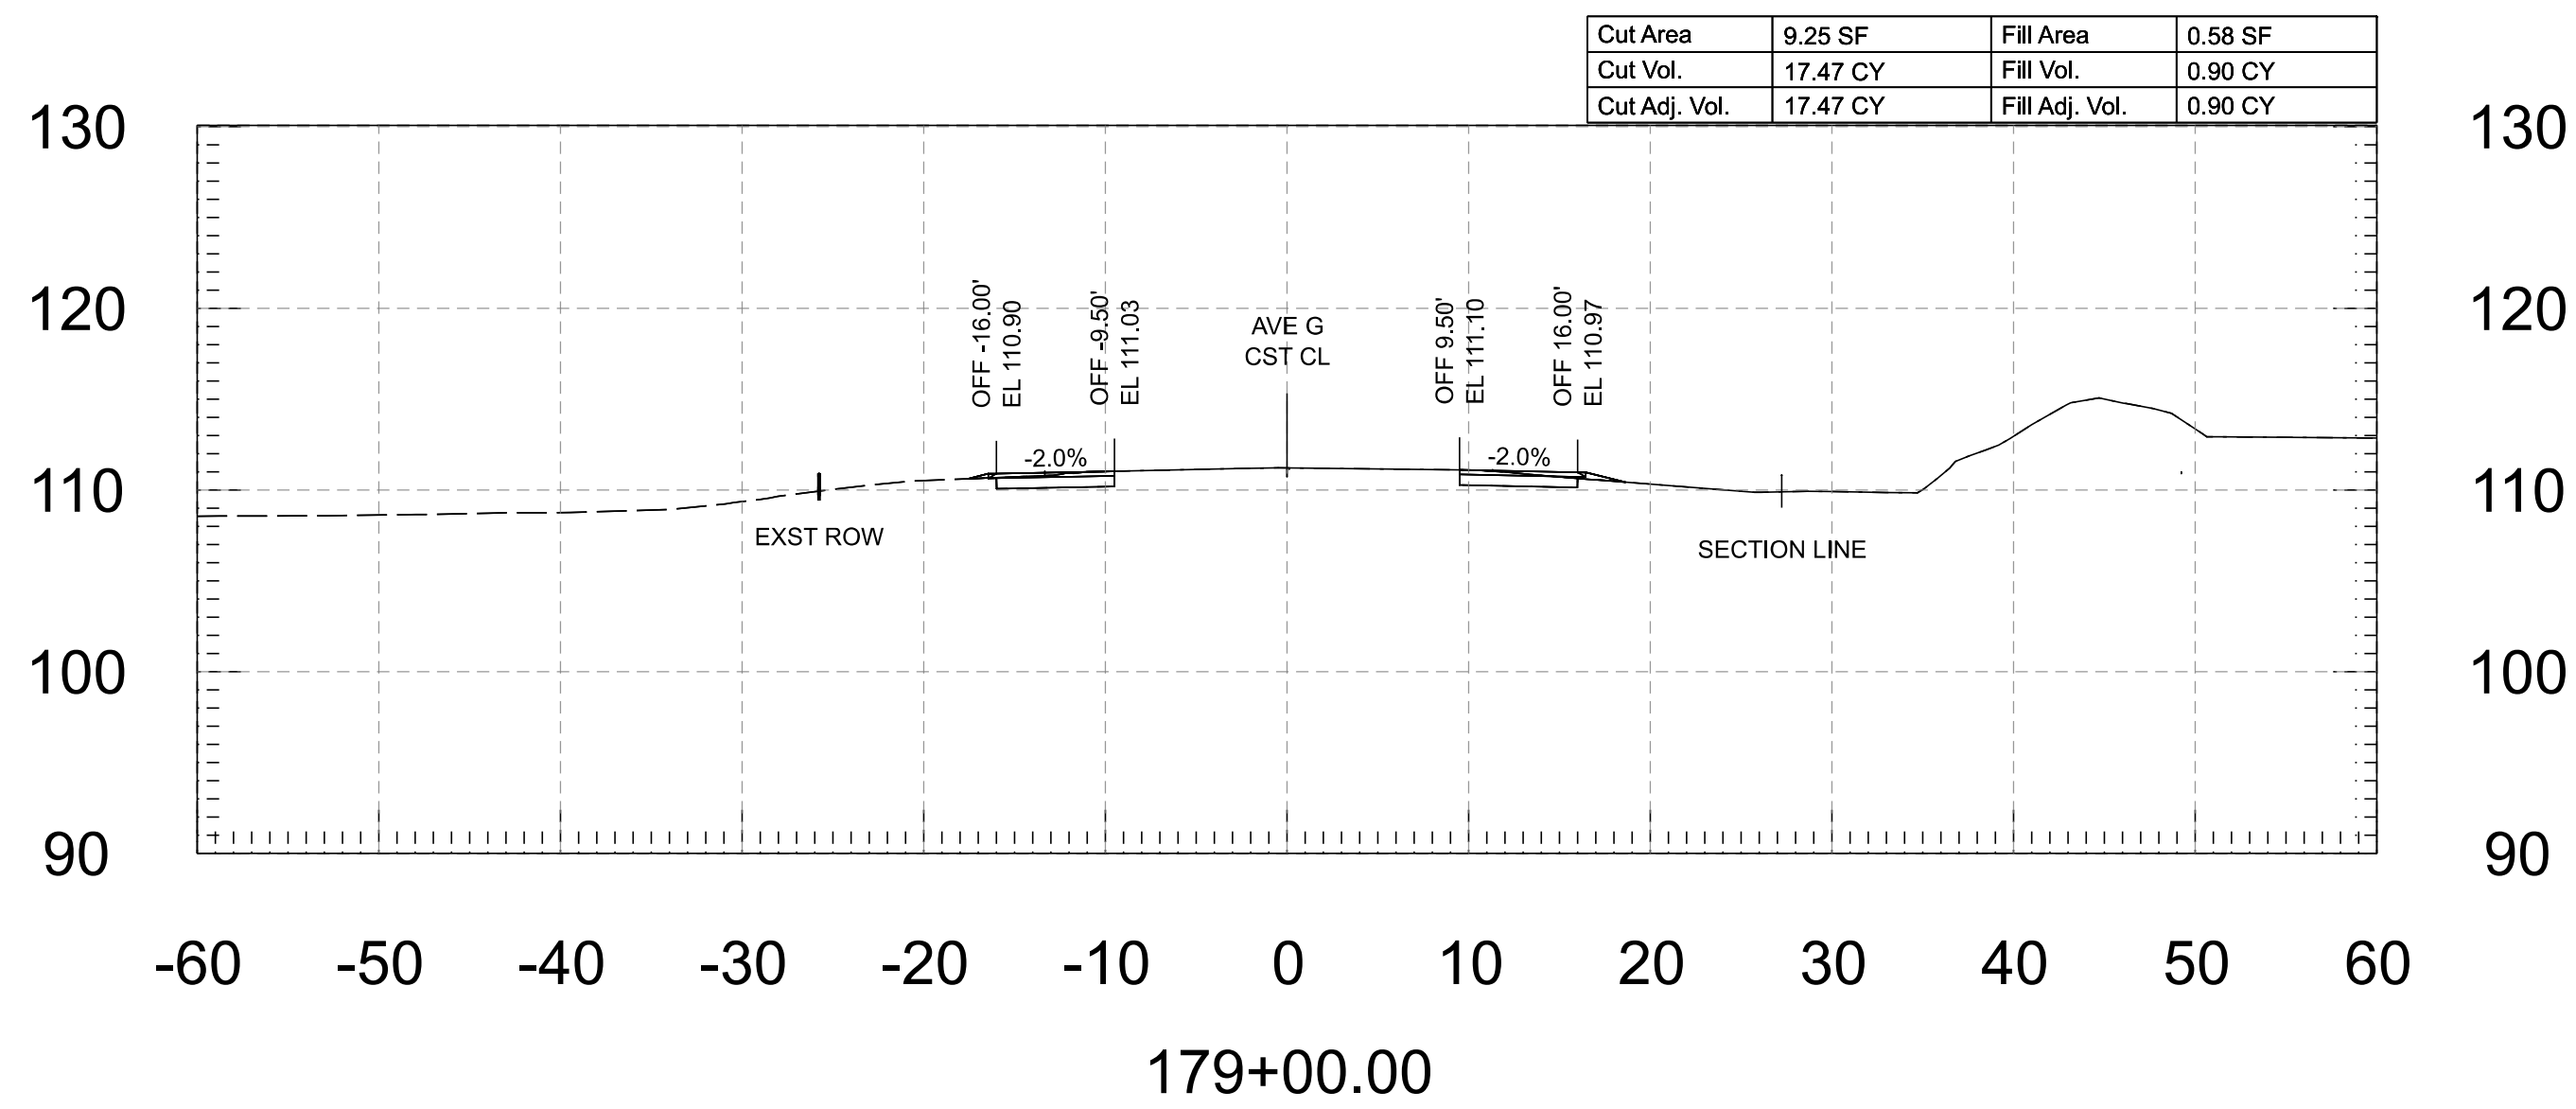
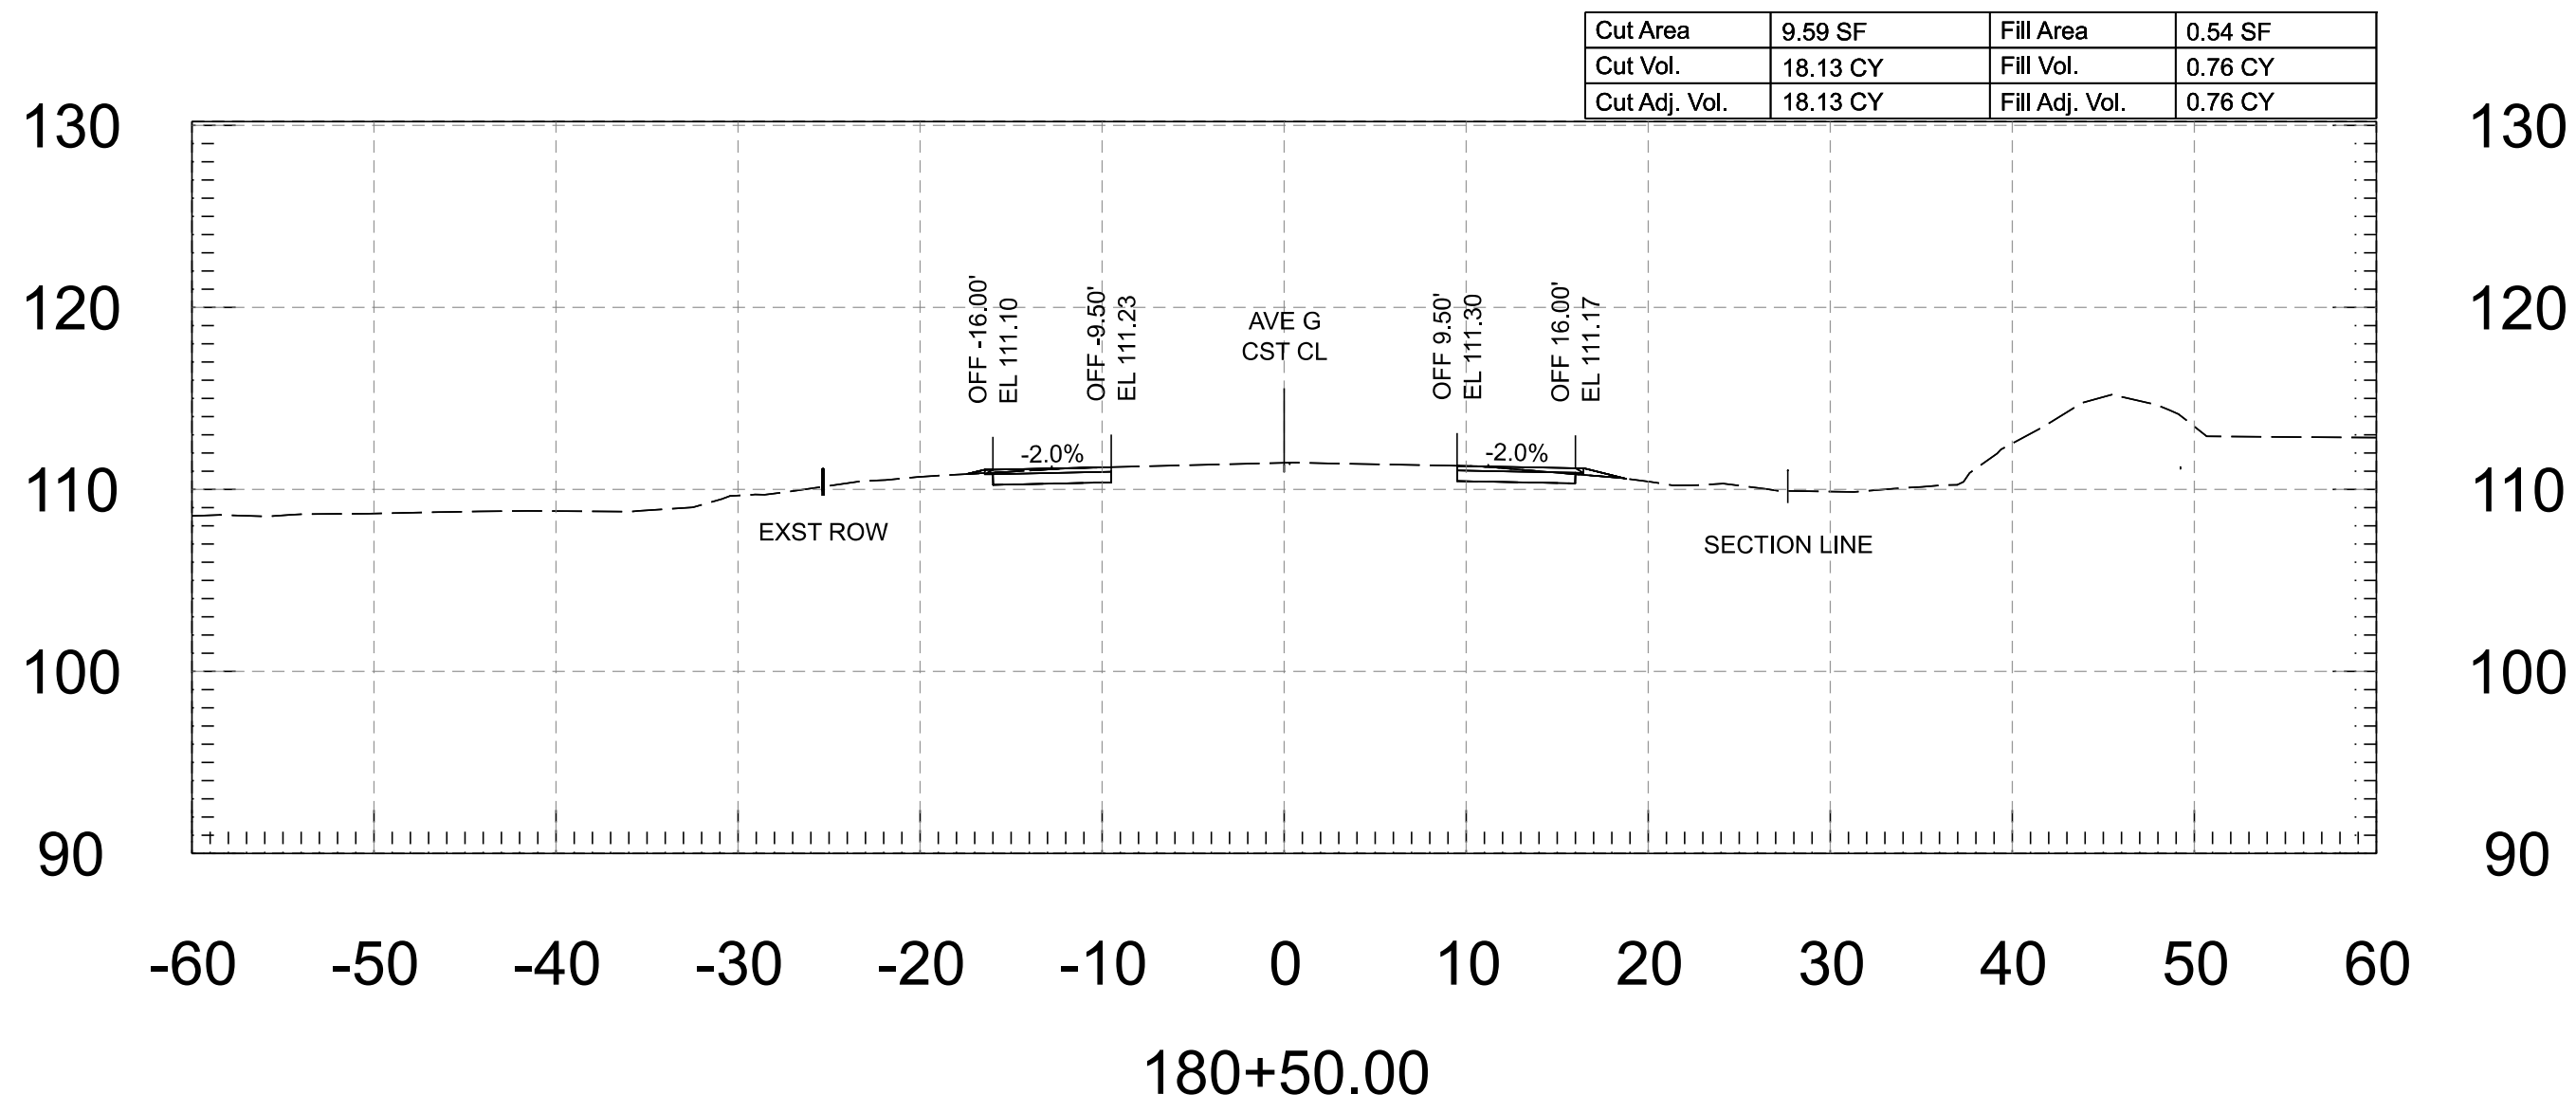
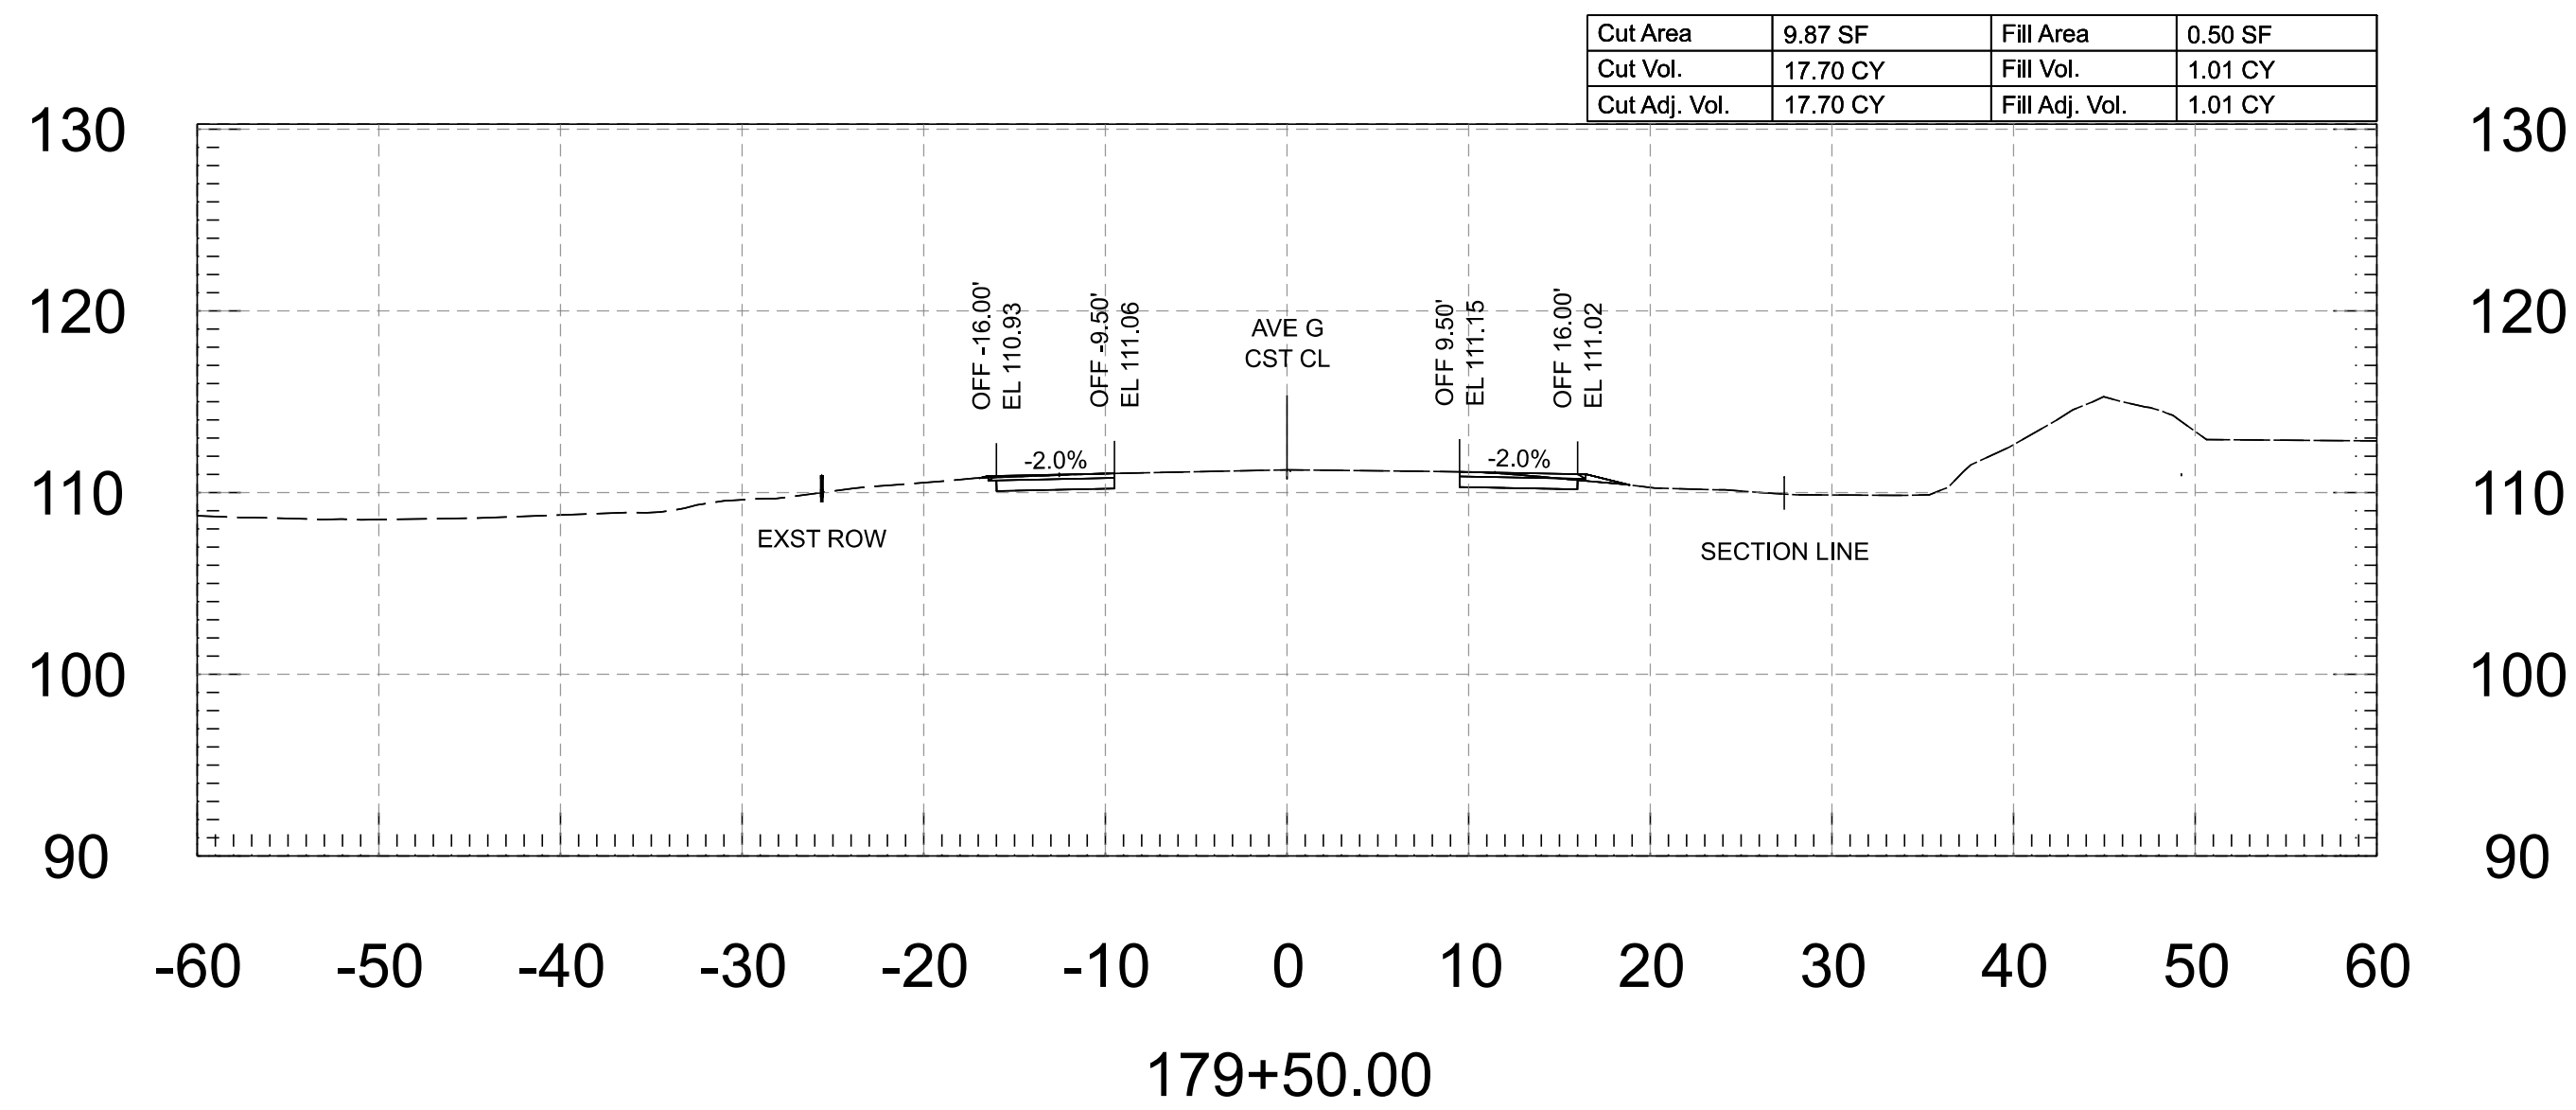


FOR INFORMATION ONLY		NAME	DATE	ARIZONA DEPARTMENT OF TRANSPORTATION PROJECT DELIVERY AND OPERATIONS DIVISION ROADWAY DESIGN SERVICES	ROUTE	F.H.W.A. Arizona Division	STATE ARIZ.	PROJECT NO.	FEDERAL ID NO.	SHEET NO.	TOTAL SHEETS	RECORD DRAWING
	DESIGN	M. SCHOEN	07/26		0000 YU YYU			YYU-0(225)T	83	118		
	DRAWN	M. SCHOEN	07/26		MILEPOST	LOCATION AVENUE G, COUNTY 11TH ST - COUNTY 16TH ST						
	CHECKED	H. RIOS	07/26	STRUCTURE NO.	TRACS NO. T0437 01C							___ OF ___
	 WSP USA Inc. 1230 West Washington Street, Suite 405 Tempe, AZ 85288		AVENUE G - CROSS SECTIONS									

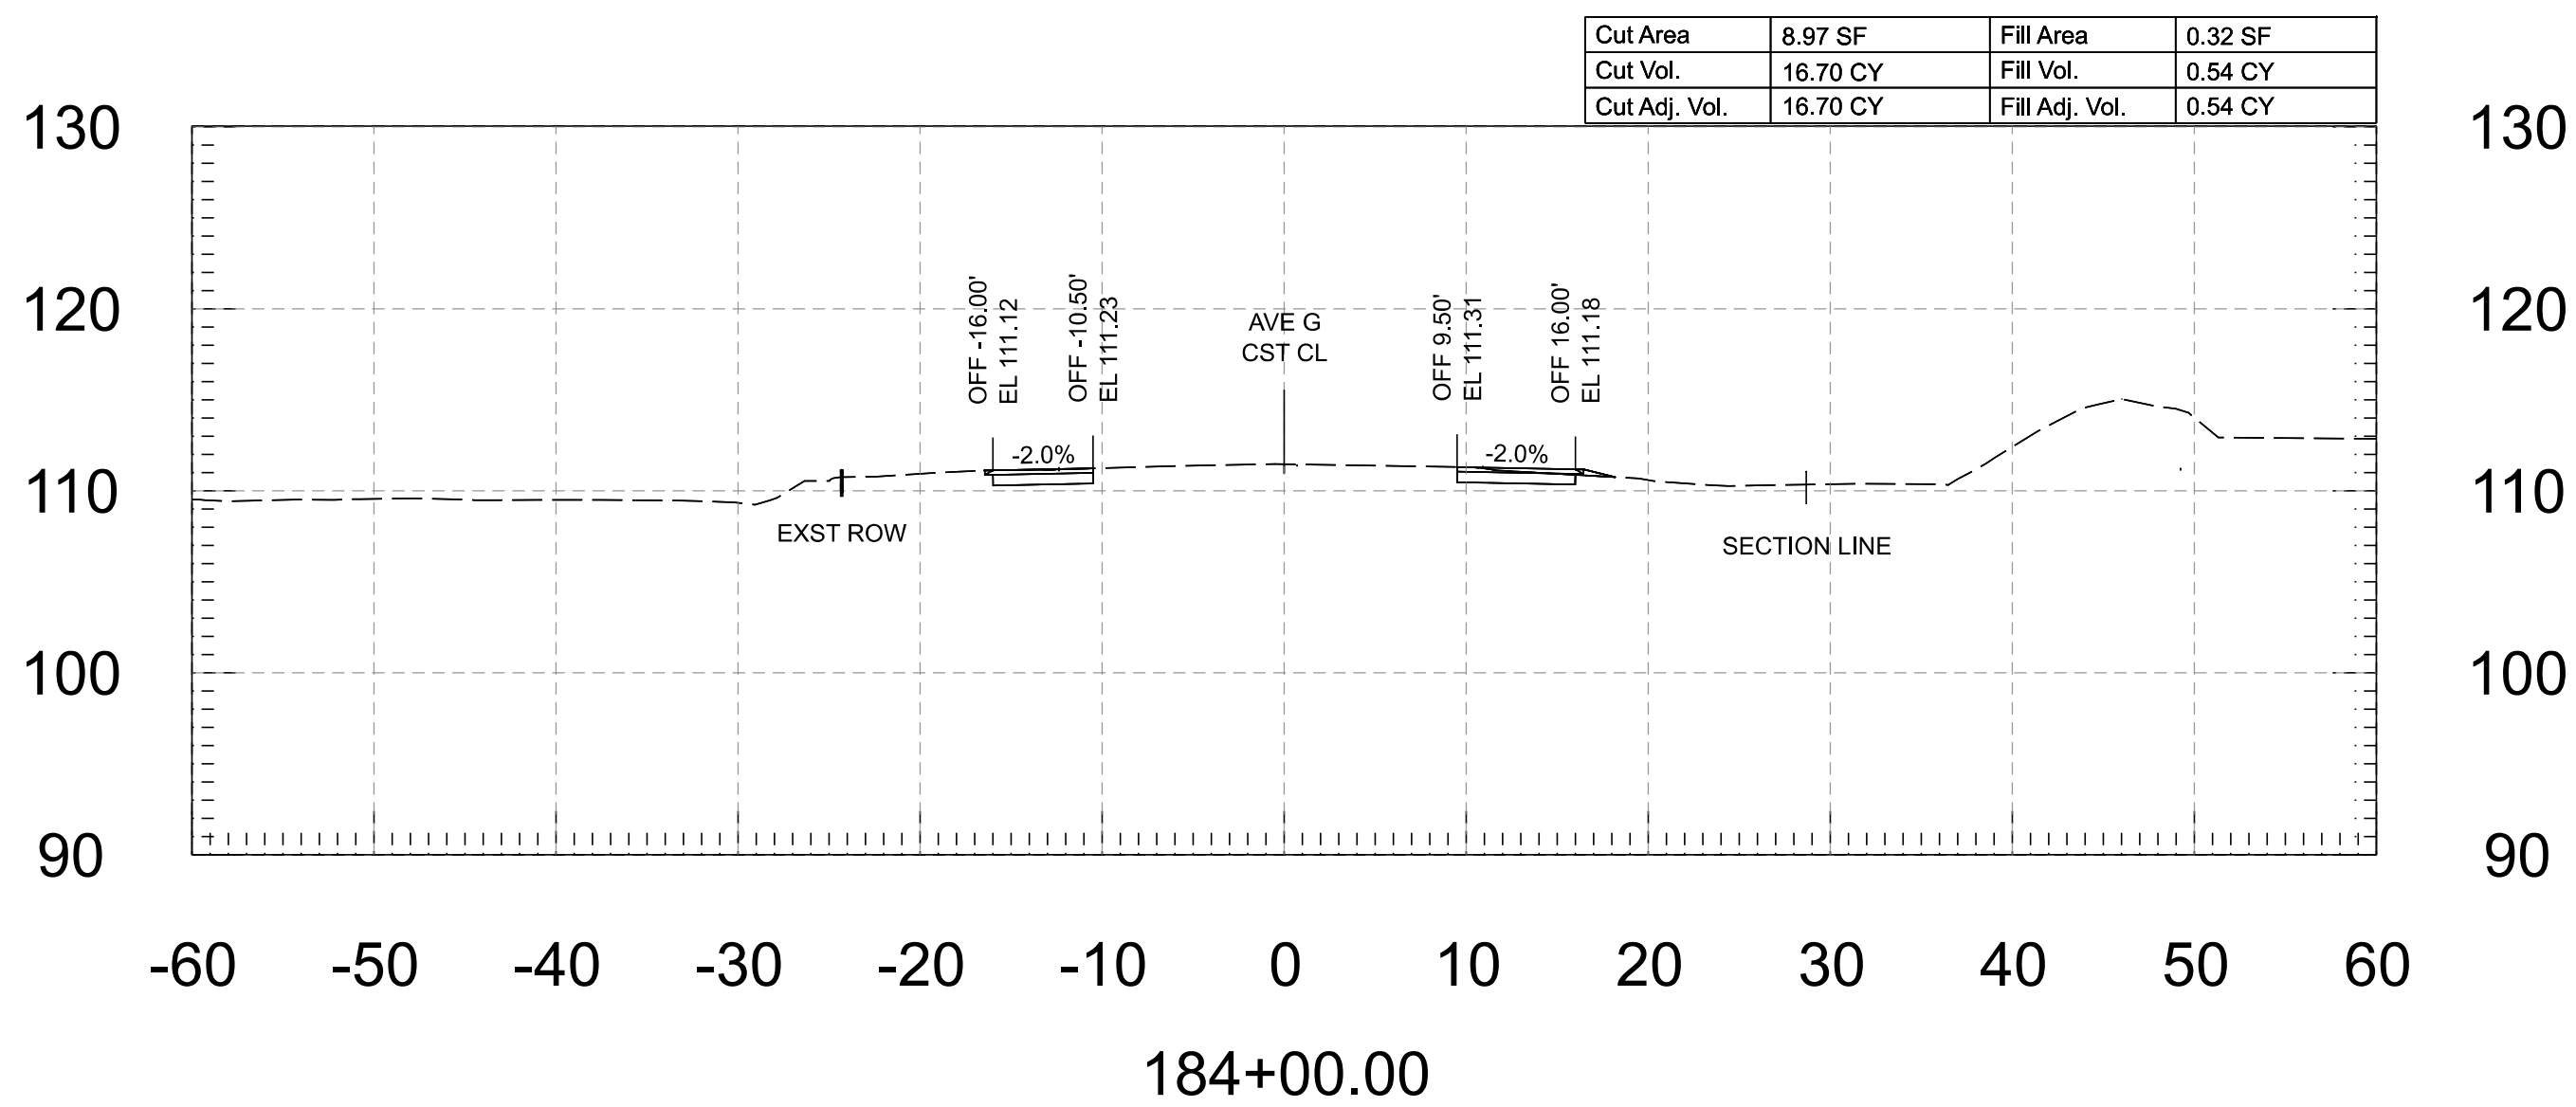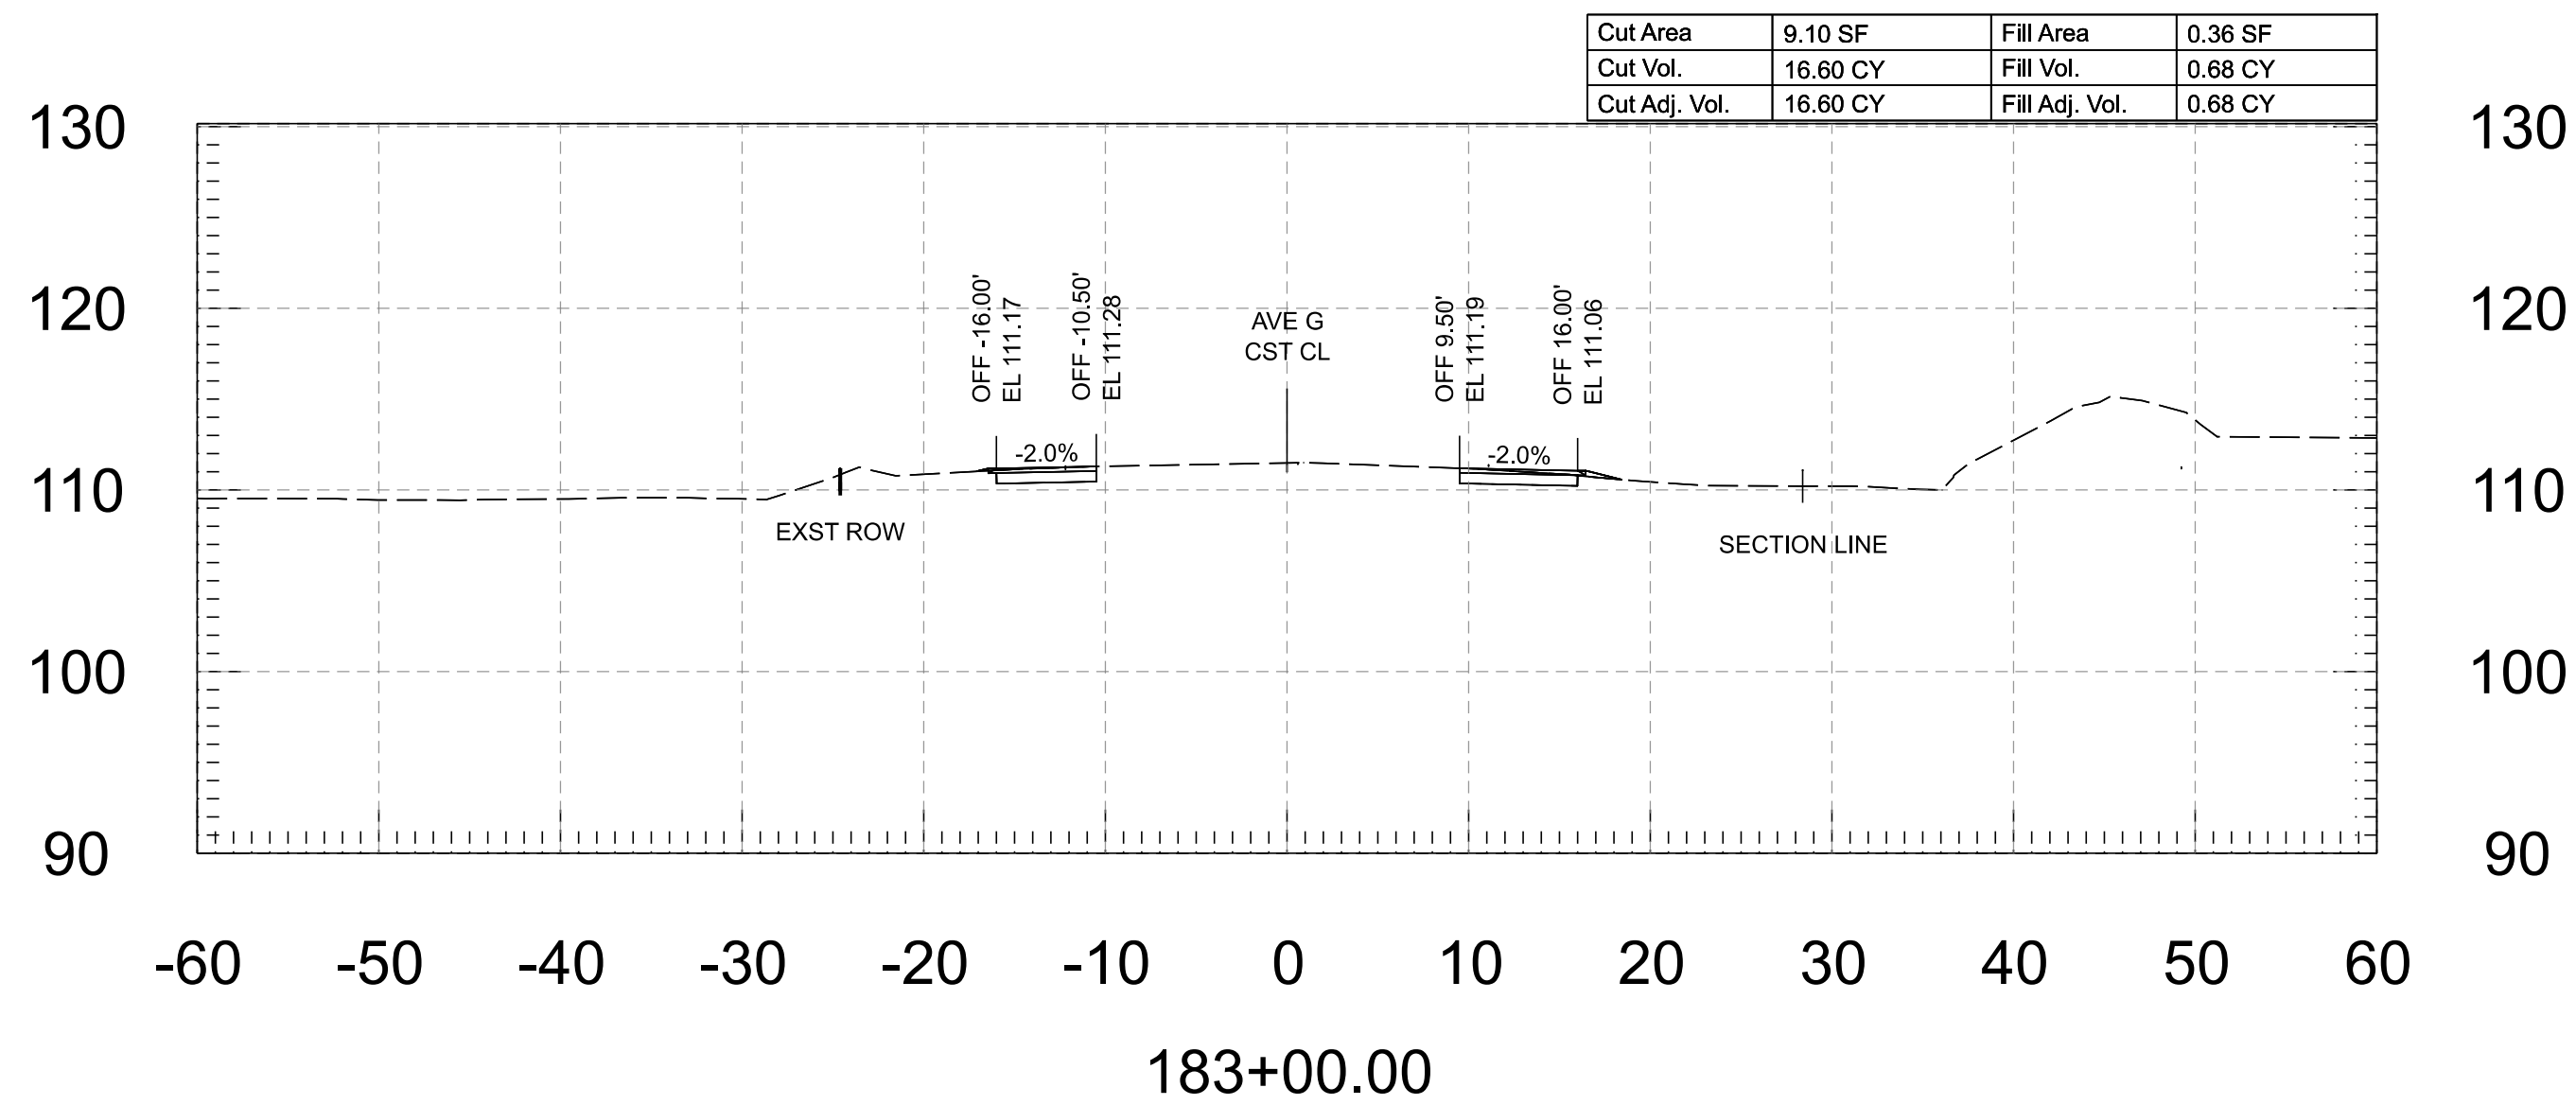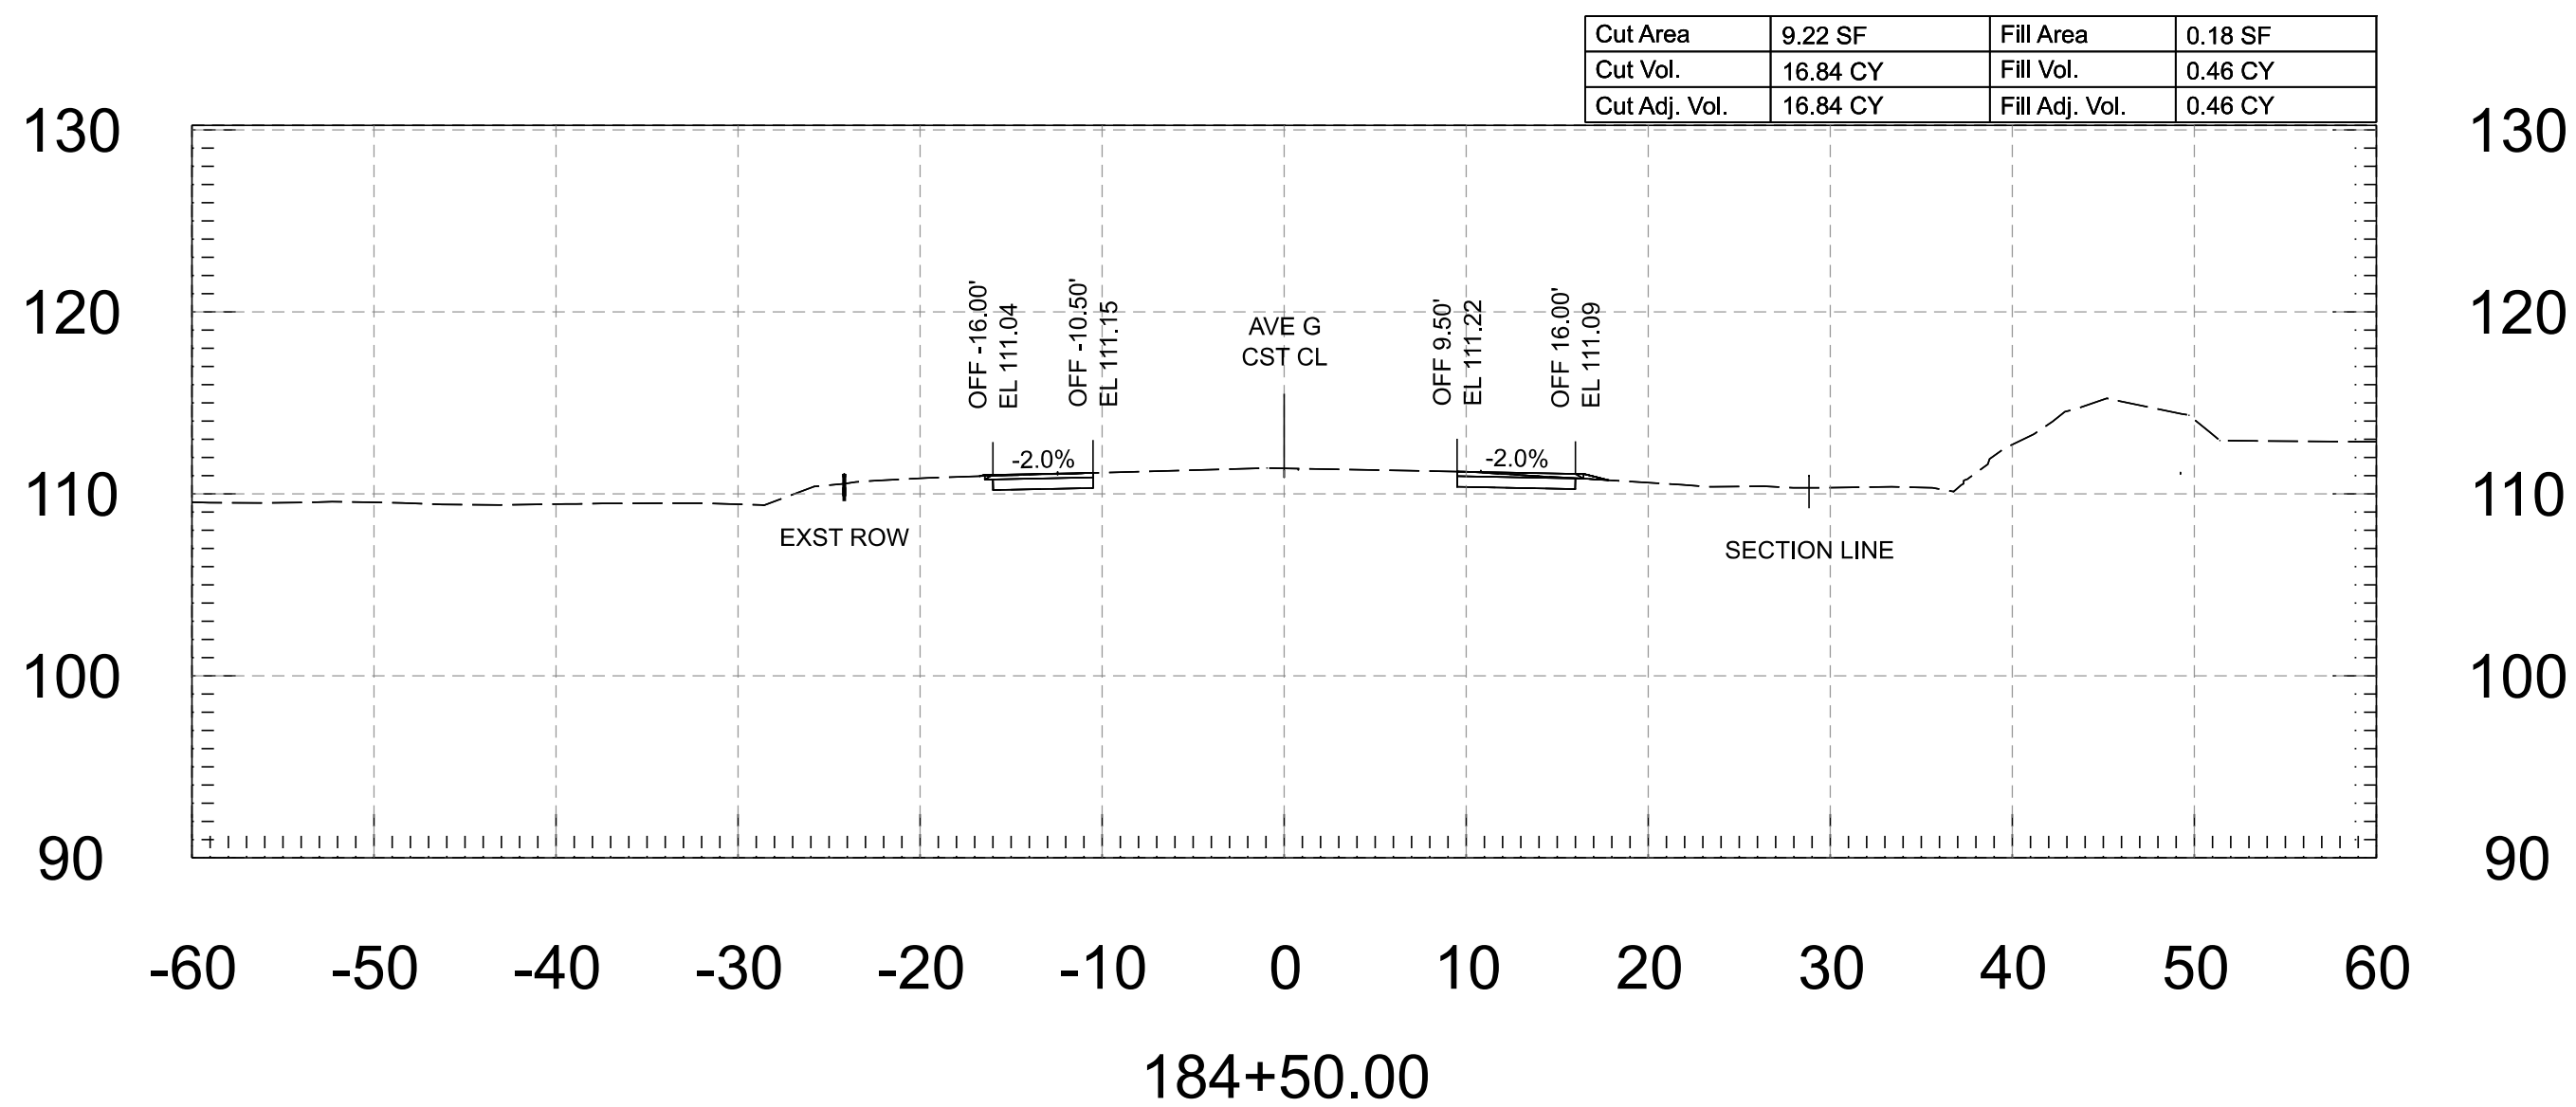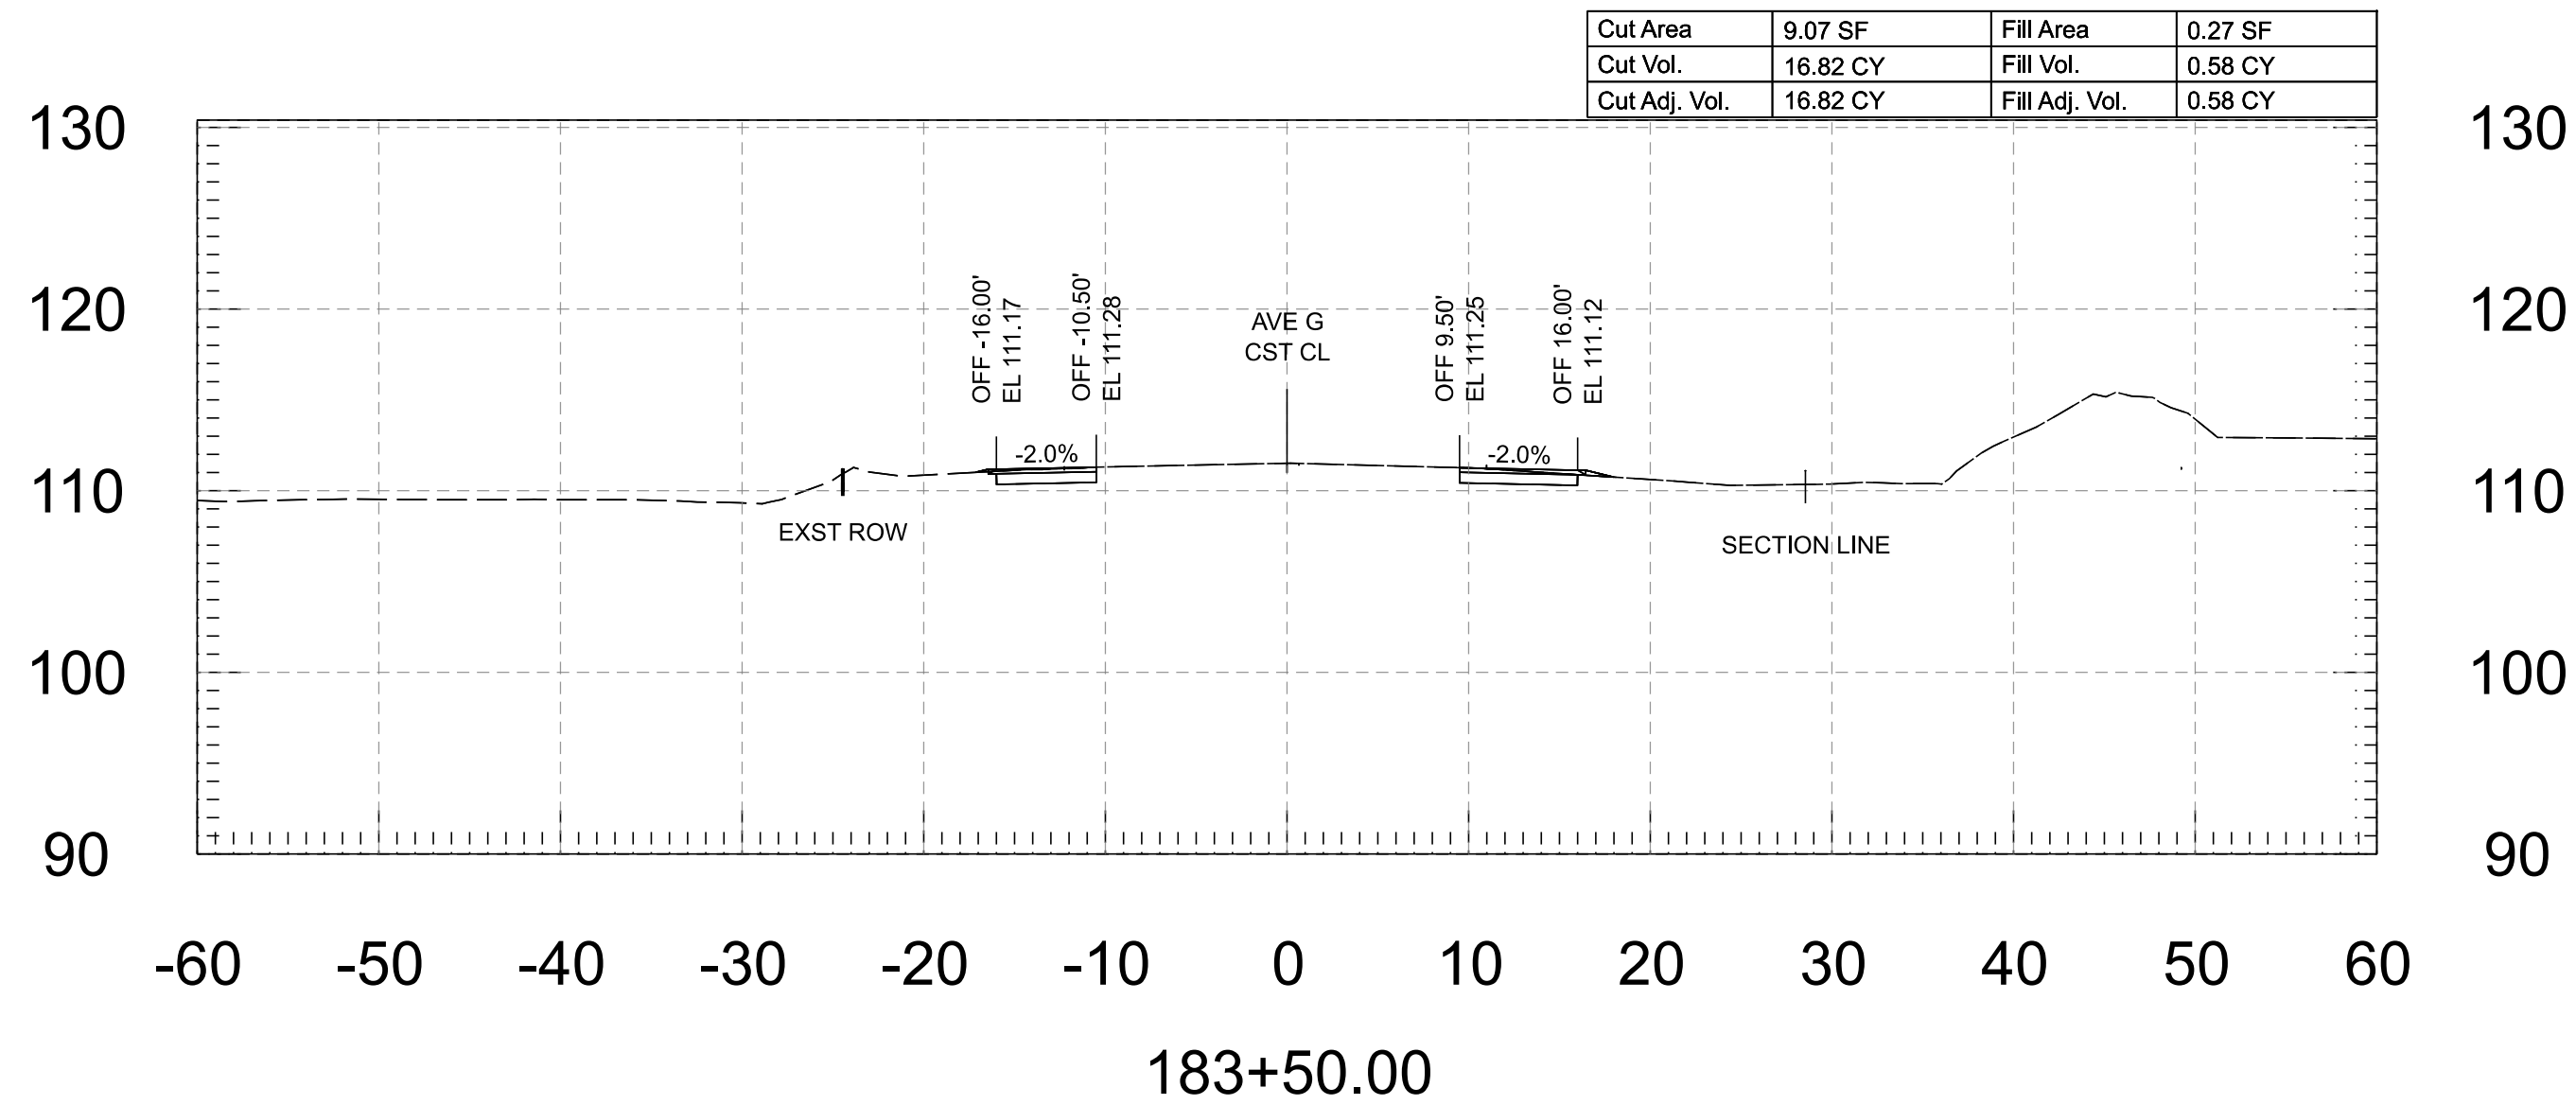

 
FOR INFORMATION ONLY		NAME	DATE	ARIZONA DEPARTMENT OF TRANSPORTATION PROJECT DELIVERY AND OPERATIONS DIVISION ROADWAY DESIGN SERVICES	ROUTE	F.H.W.A. Arizona Division	STATE ARIZ.	PROJECT NO.	FEDERAL ID NO.	SHEET NO.	TOTAL SHEETS	RECORD DRAWING
	DESIGN	M. SCHOEN	07/26		0000 YU YYU			YYU-0(225)T	85	118		
	DRAWN	M. SCHOEN	07/26		LOCATION	AVENUE G, COUNTY 11TH ST - COUNTY 16TH ST						
	CHECKED	H. RIOS	07/26	STRUCTURE NO.			TRACS NO. T0437 01C					___ OF ___
	 WSP USA Inc. 1230 West Washington Street, Suite 405 Tempe, AZ 85288	AVENUE G - CROSS SECTIONS										

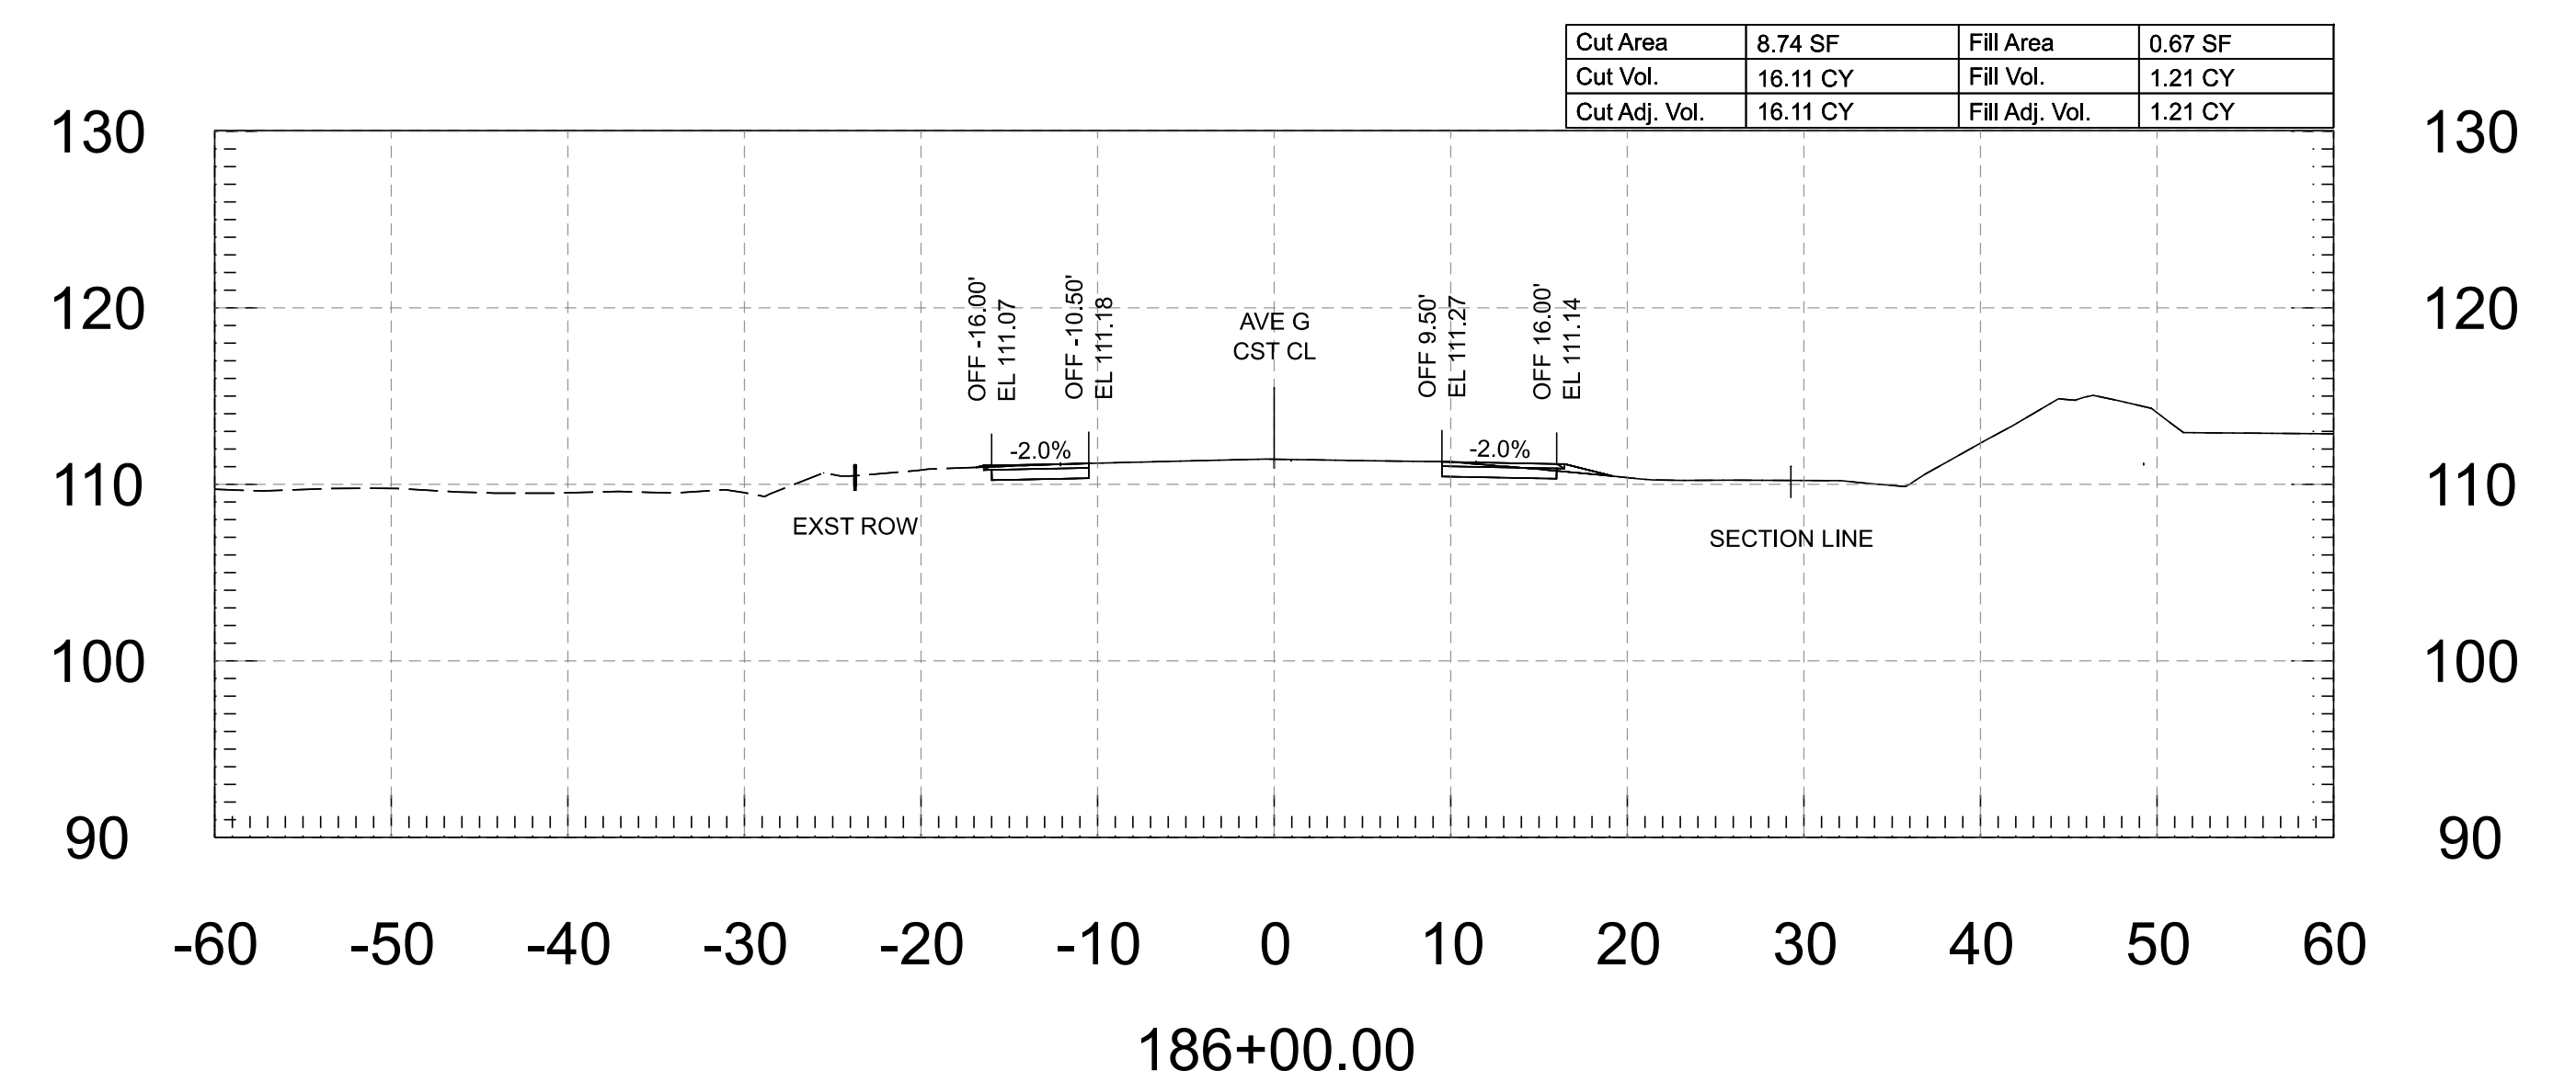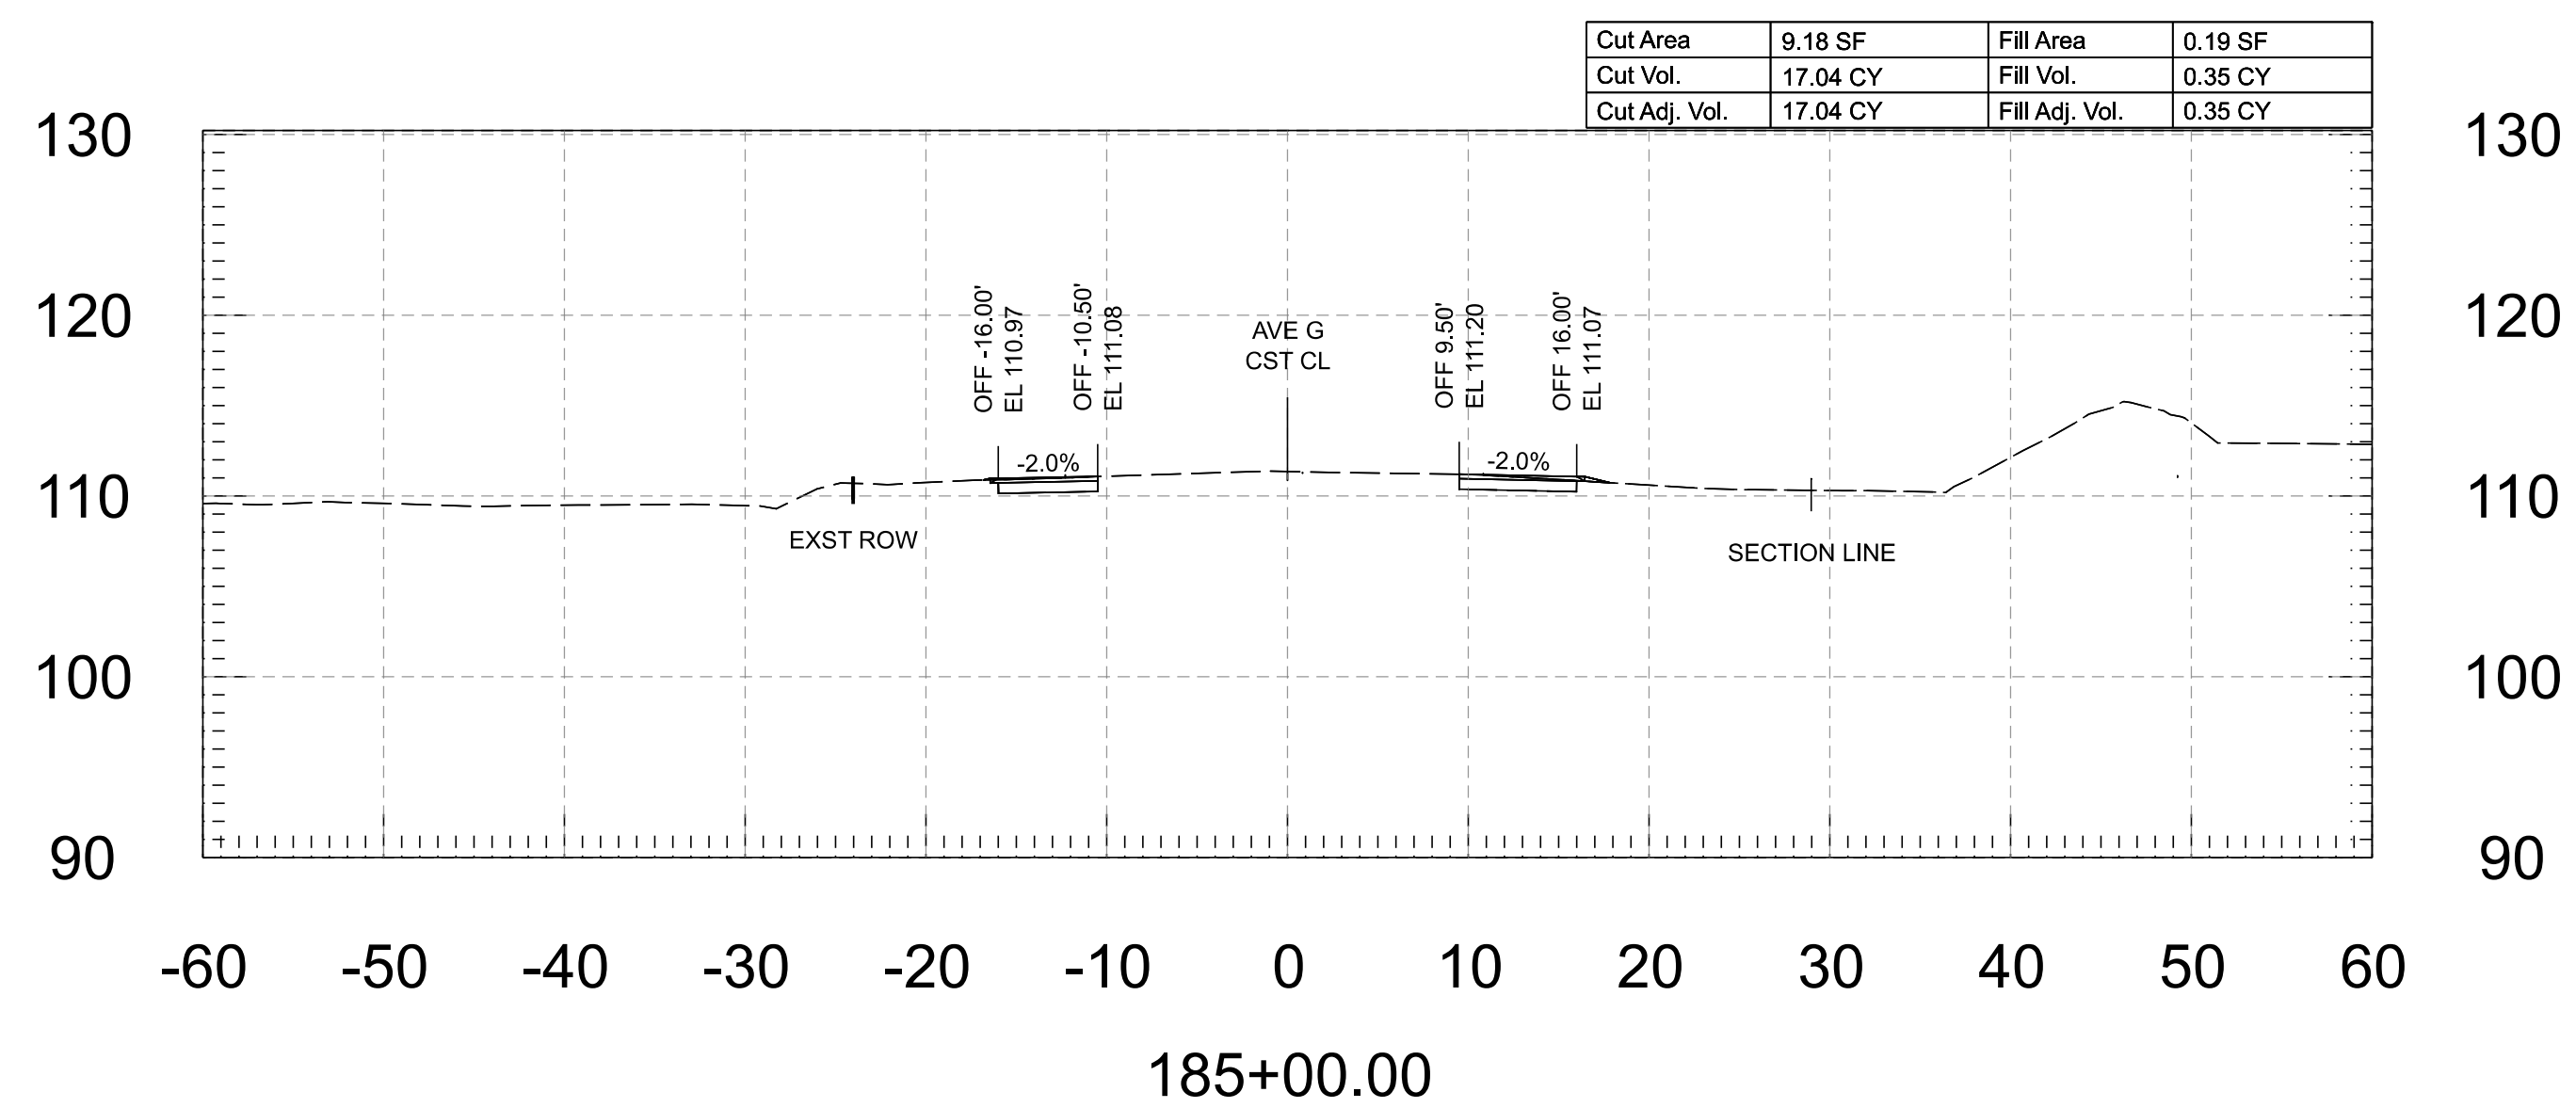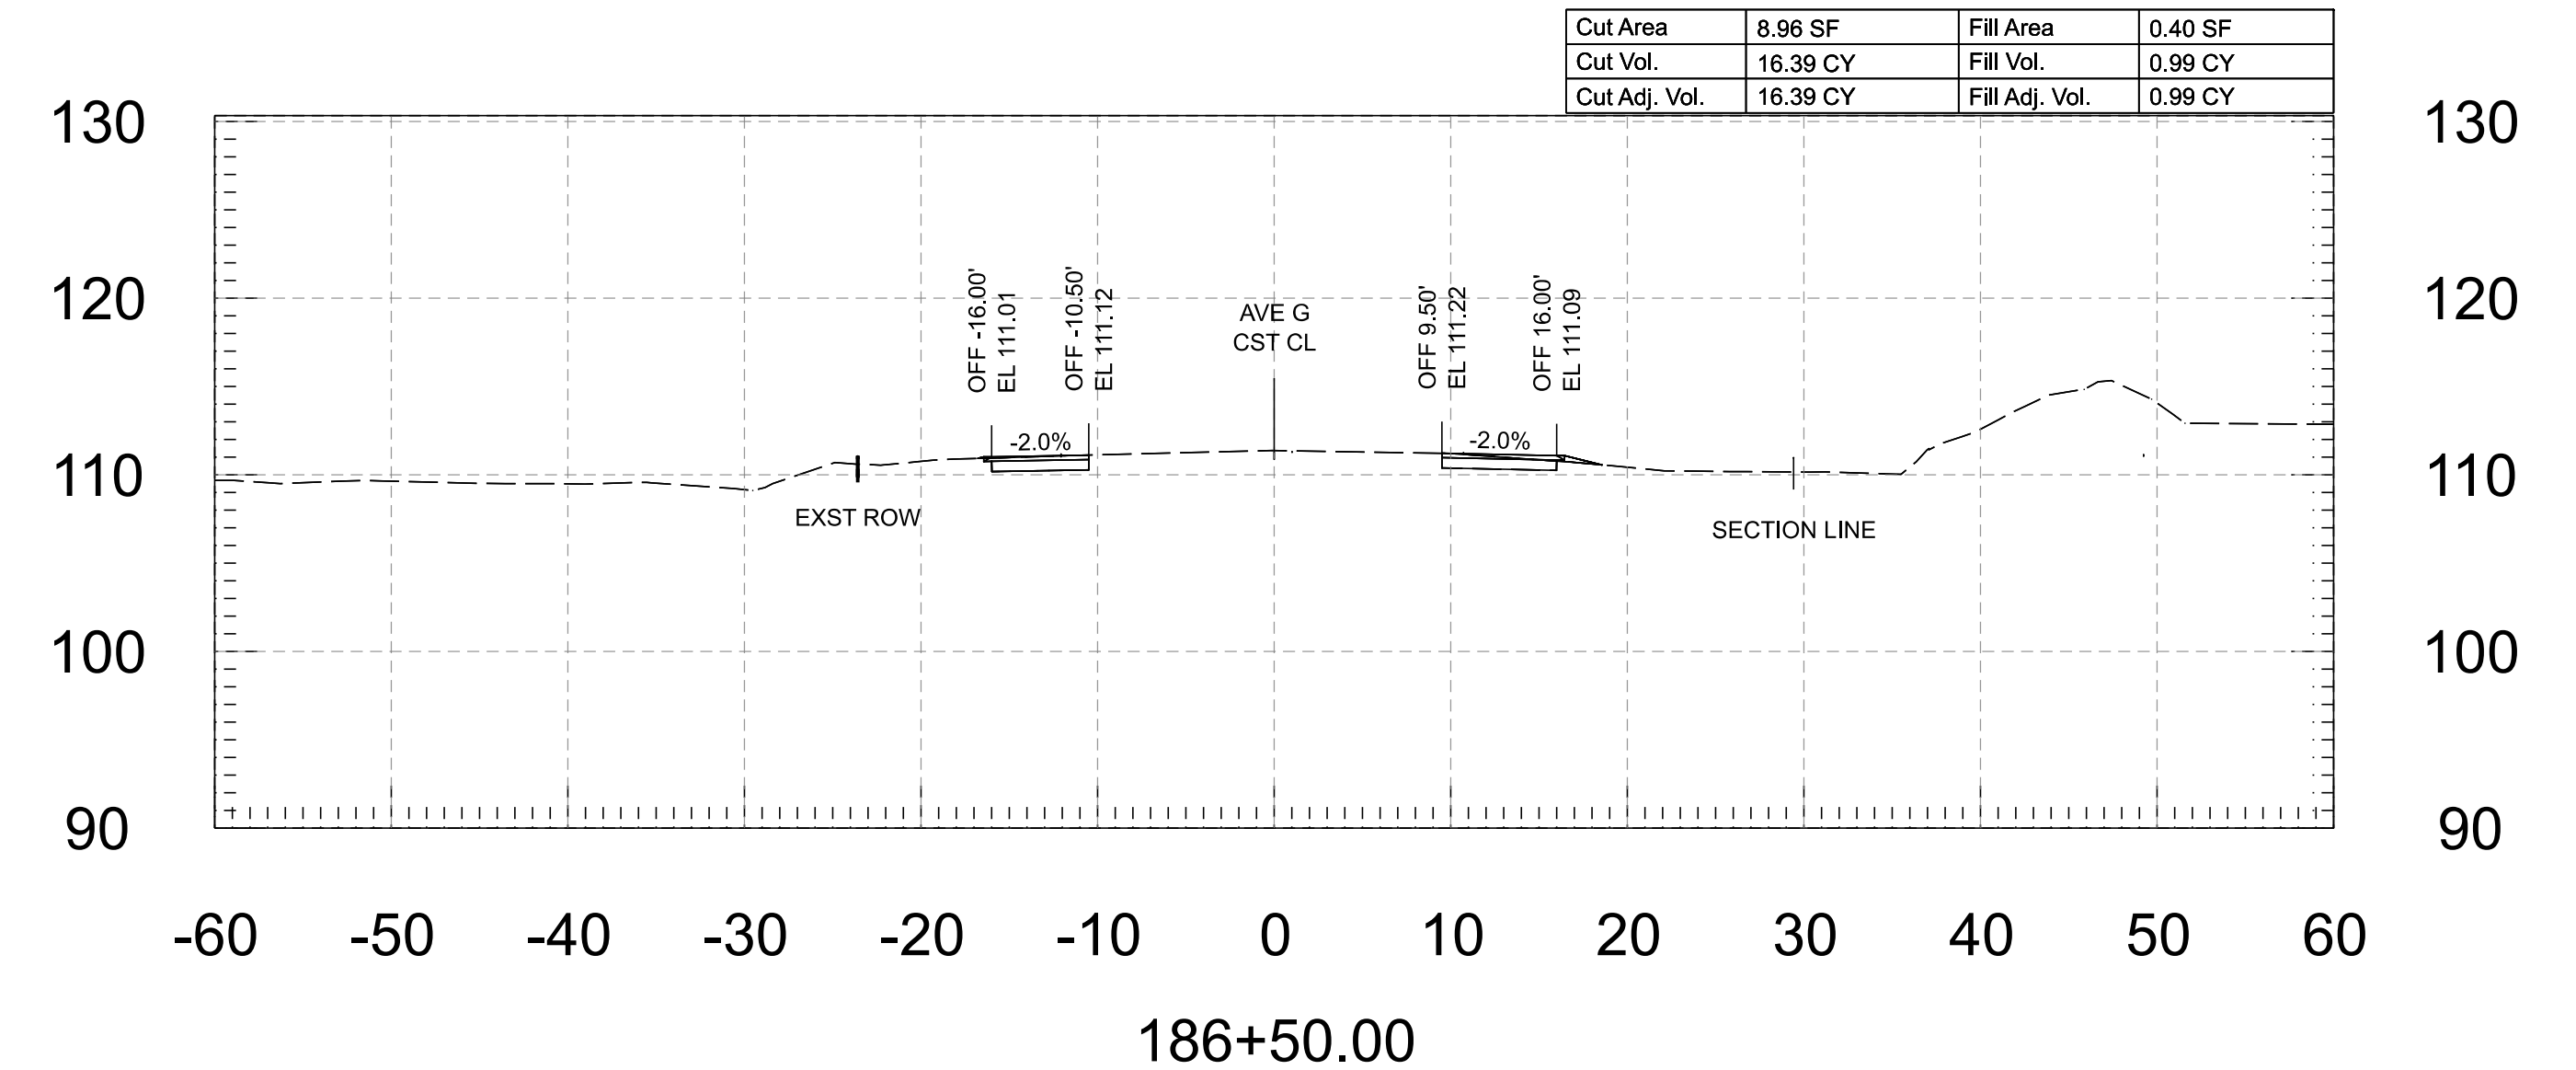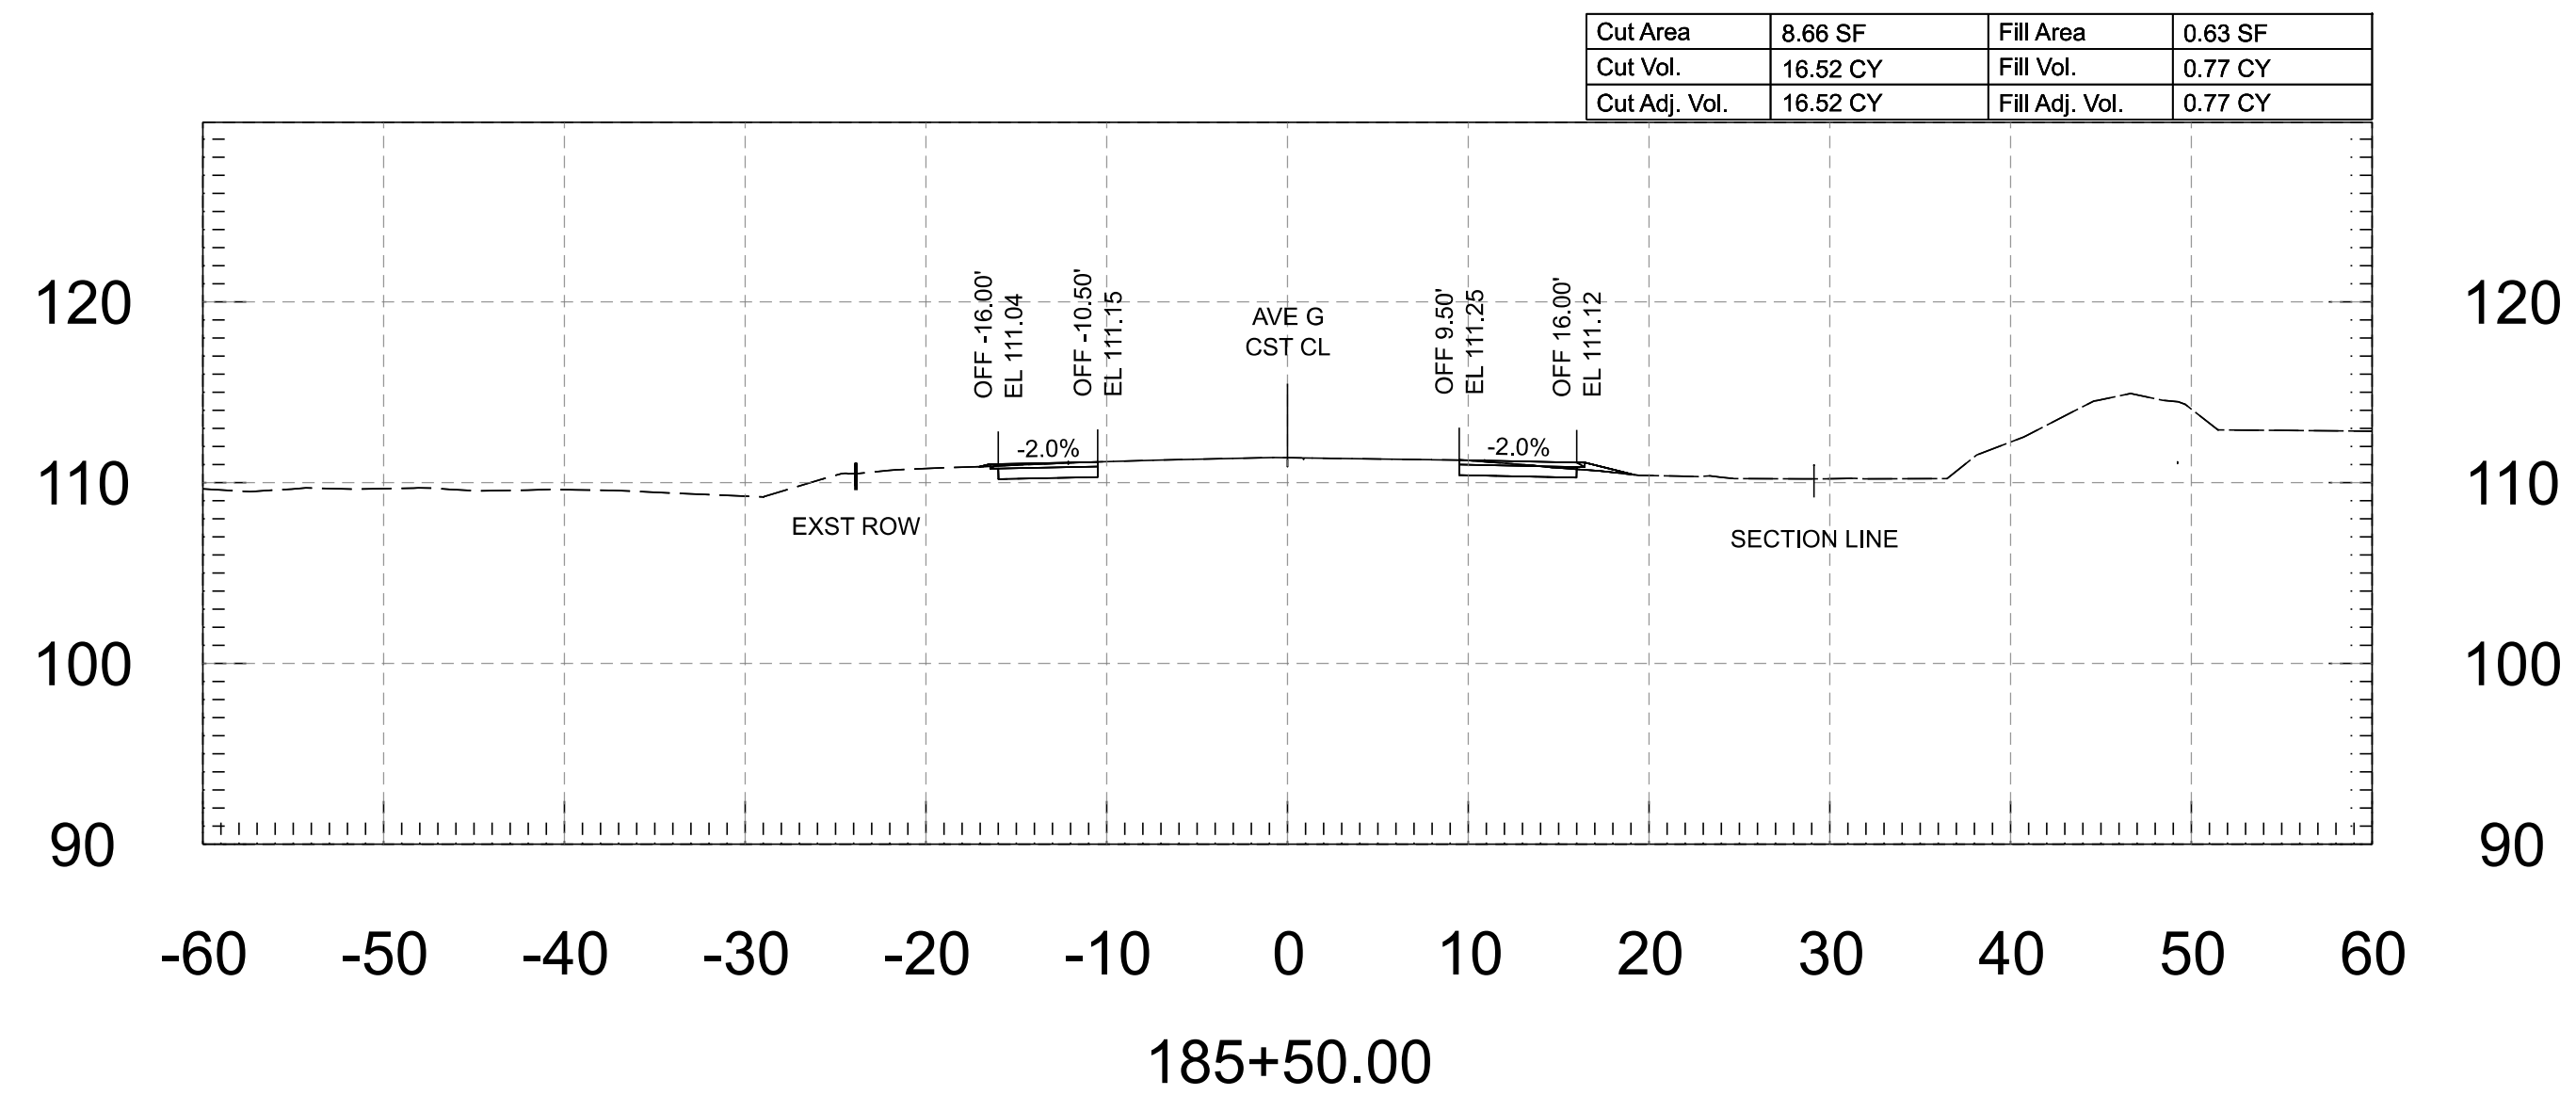

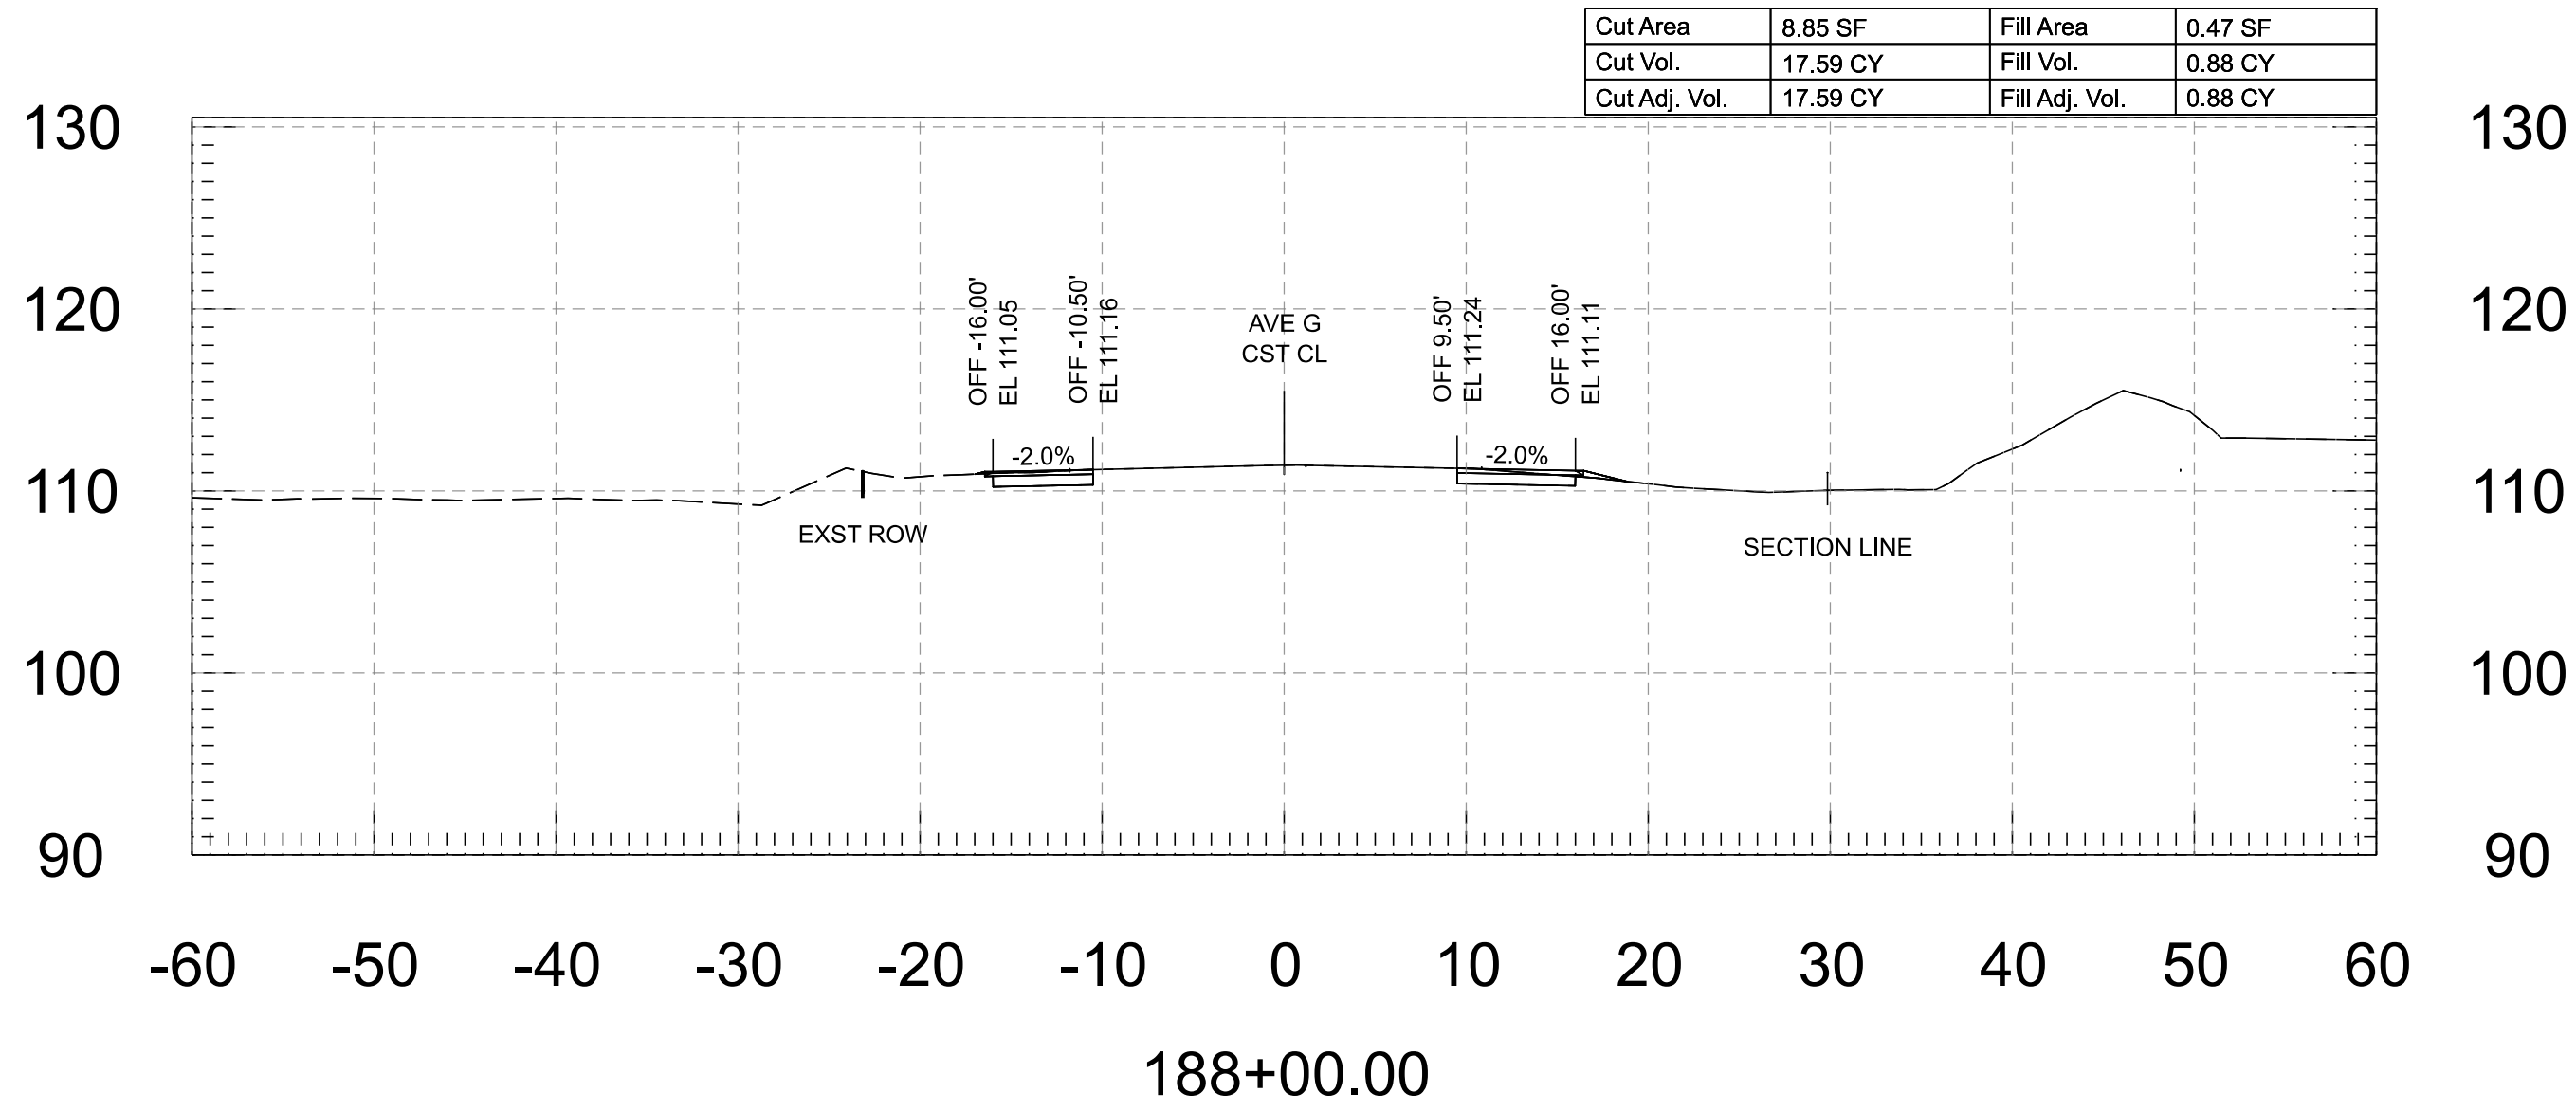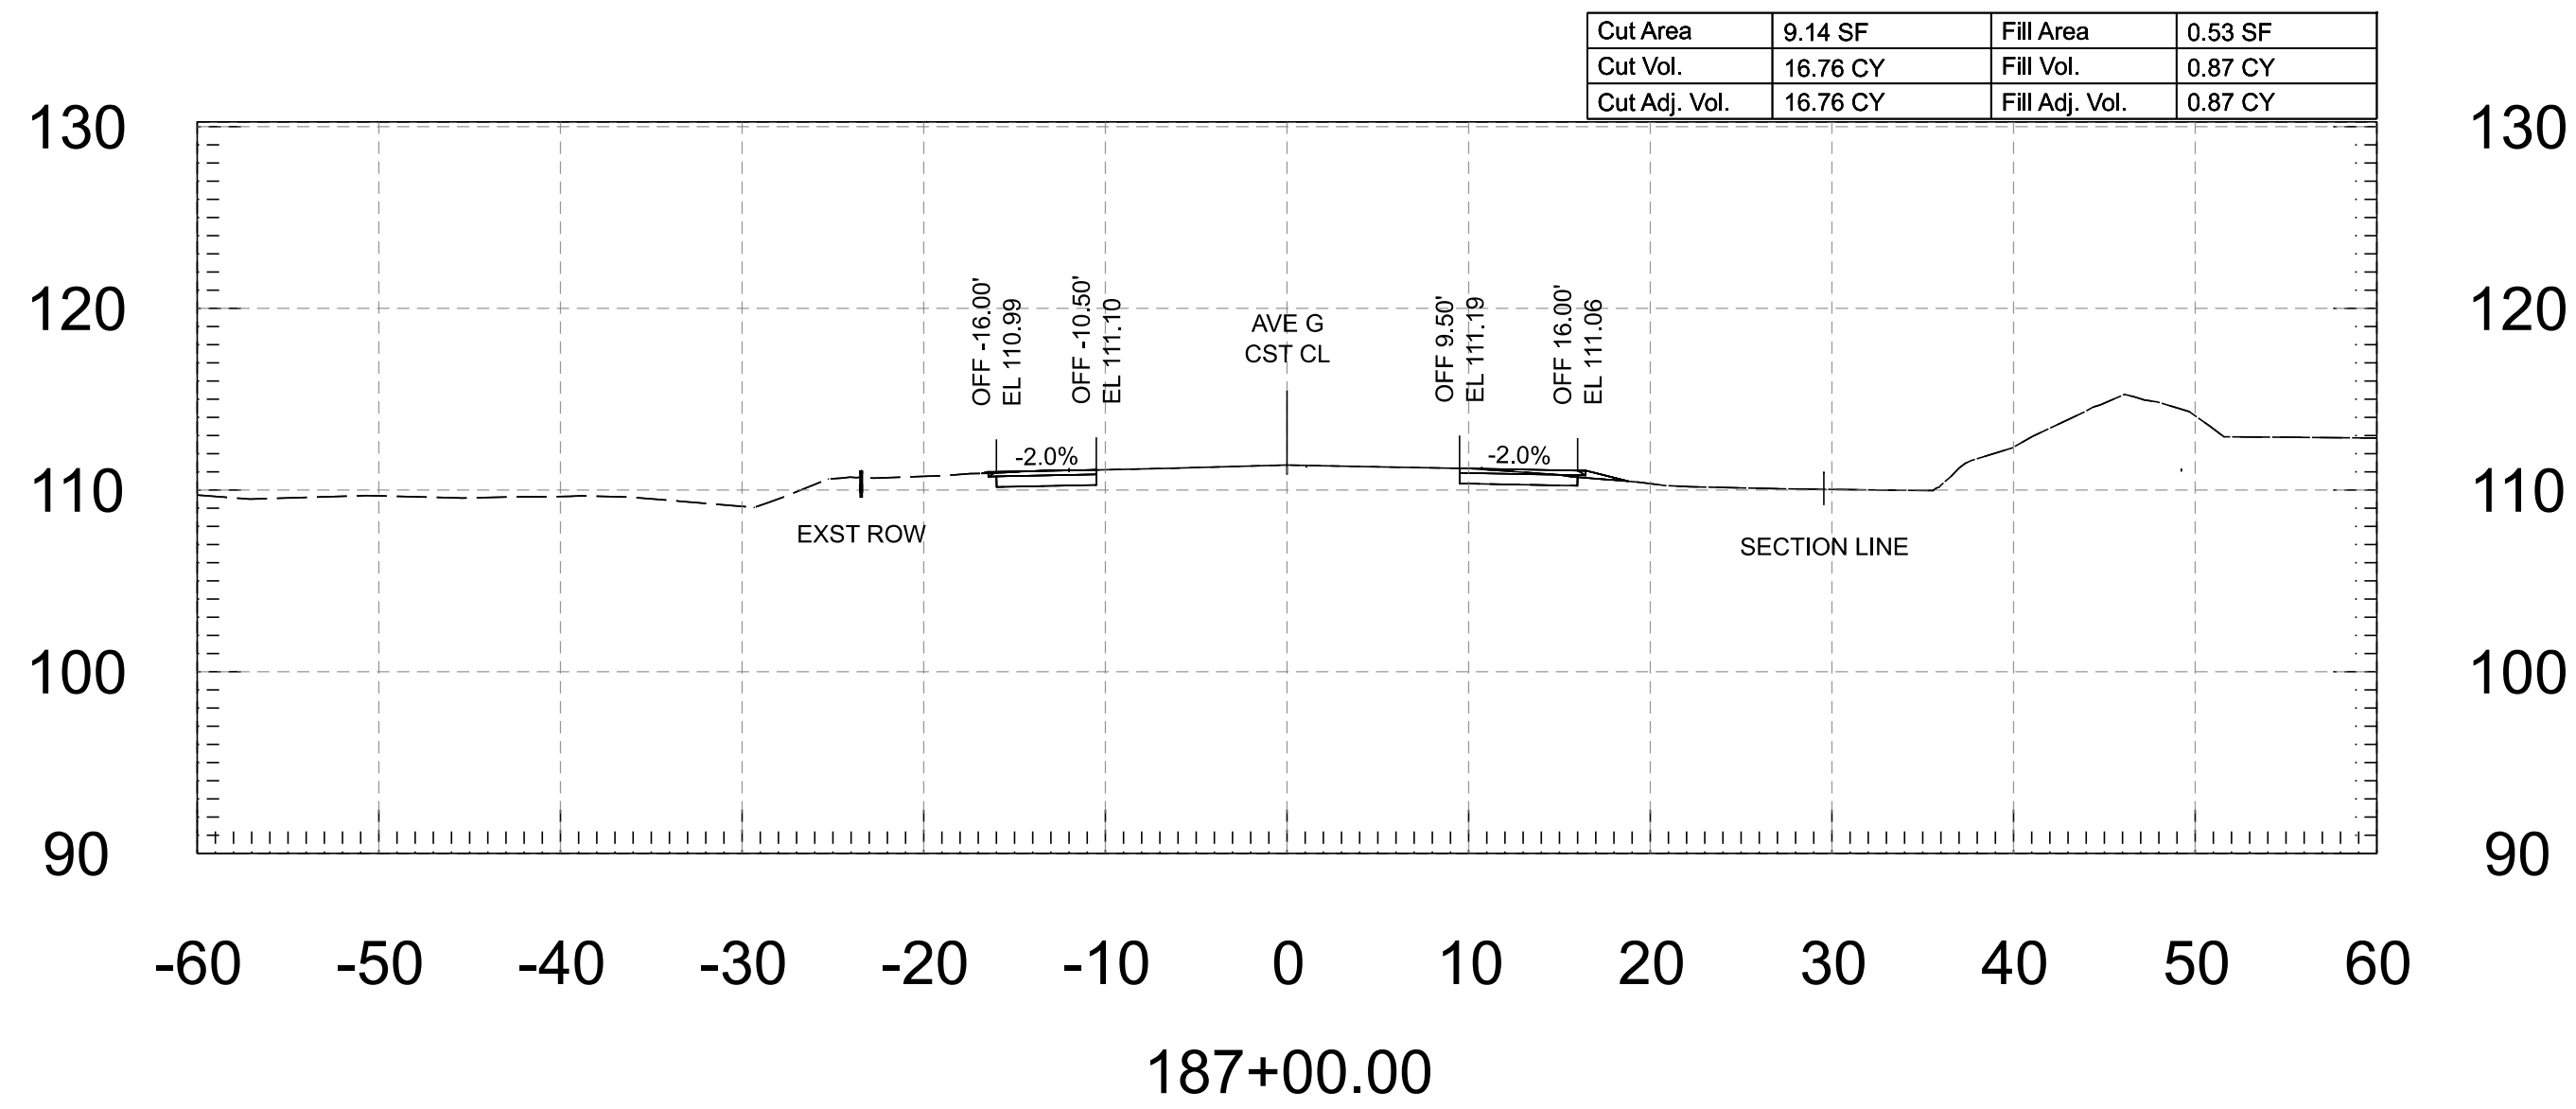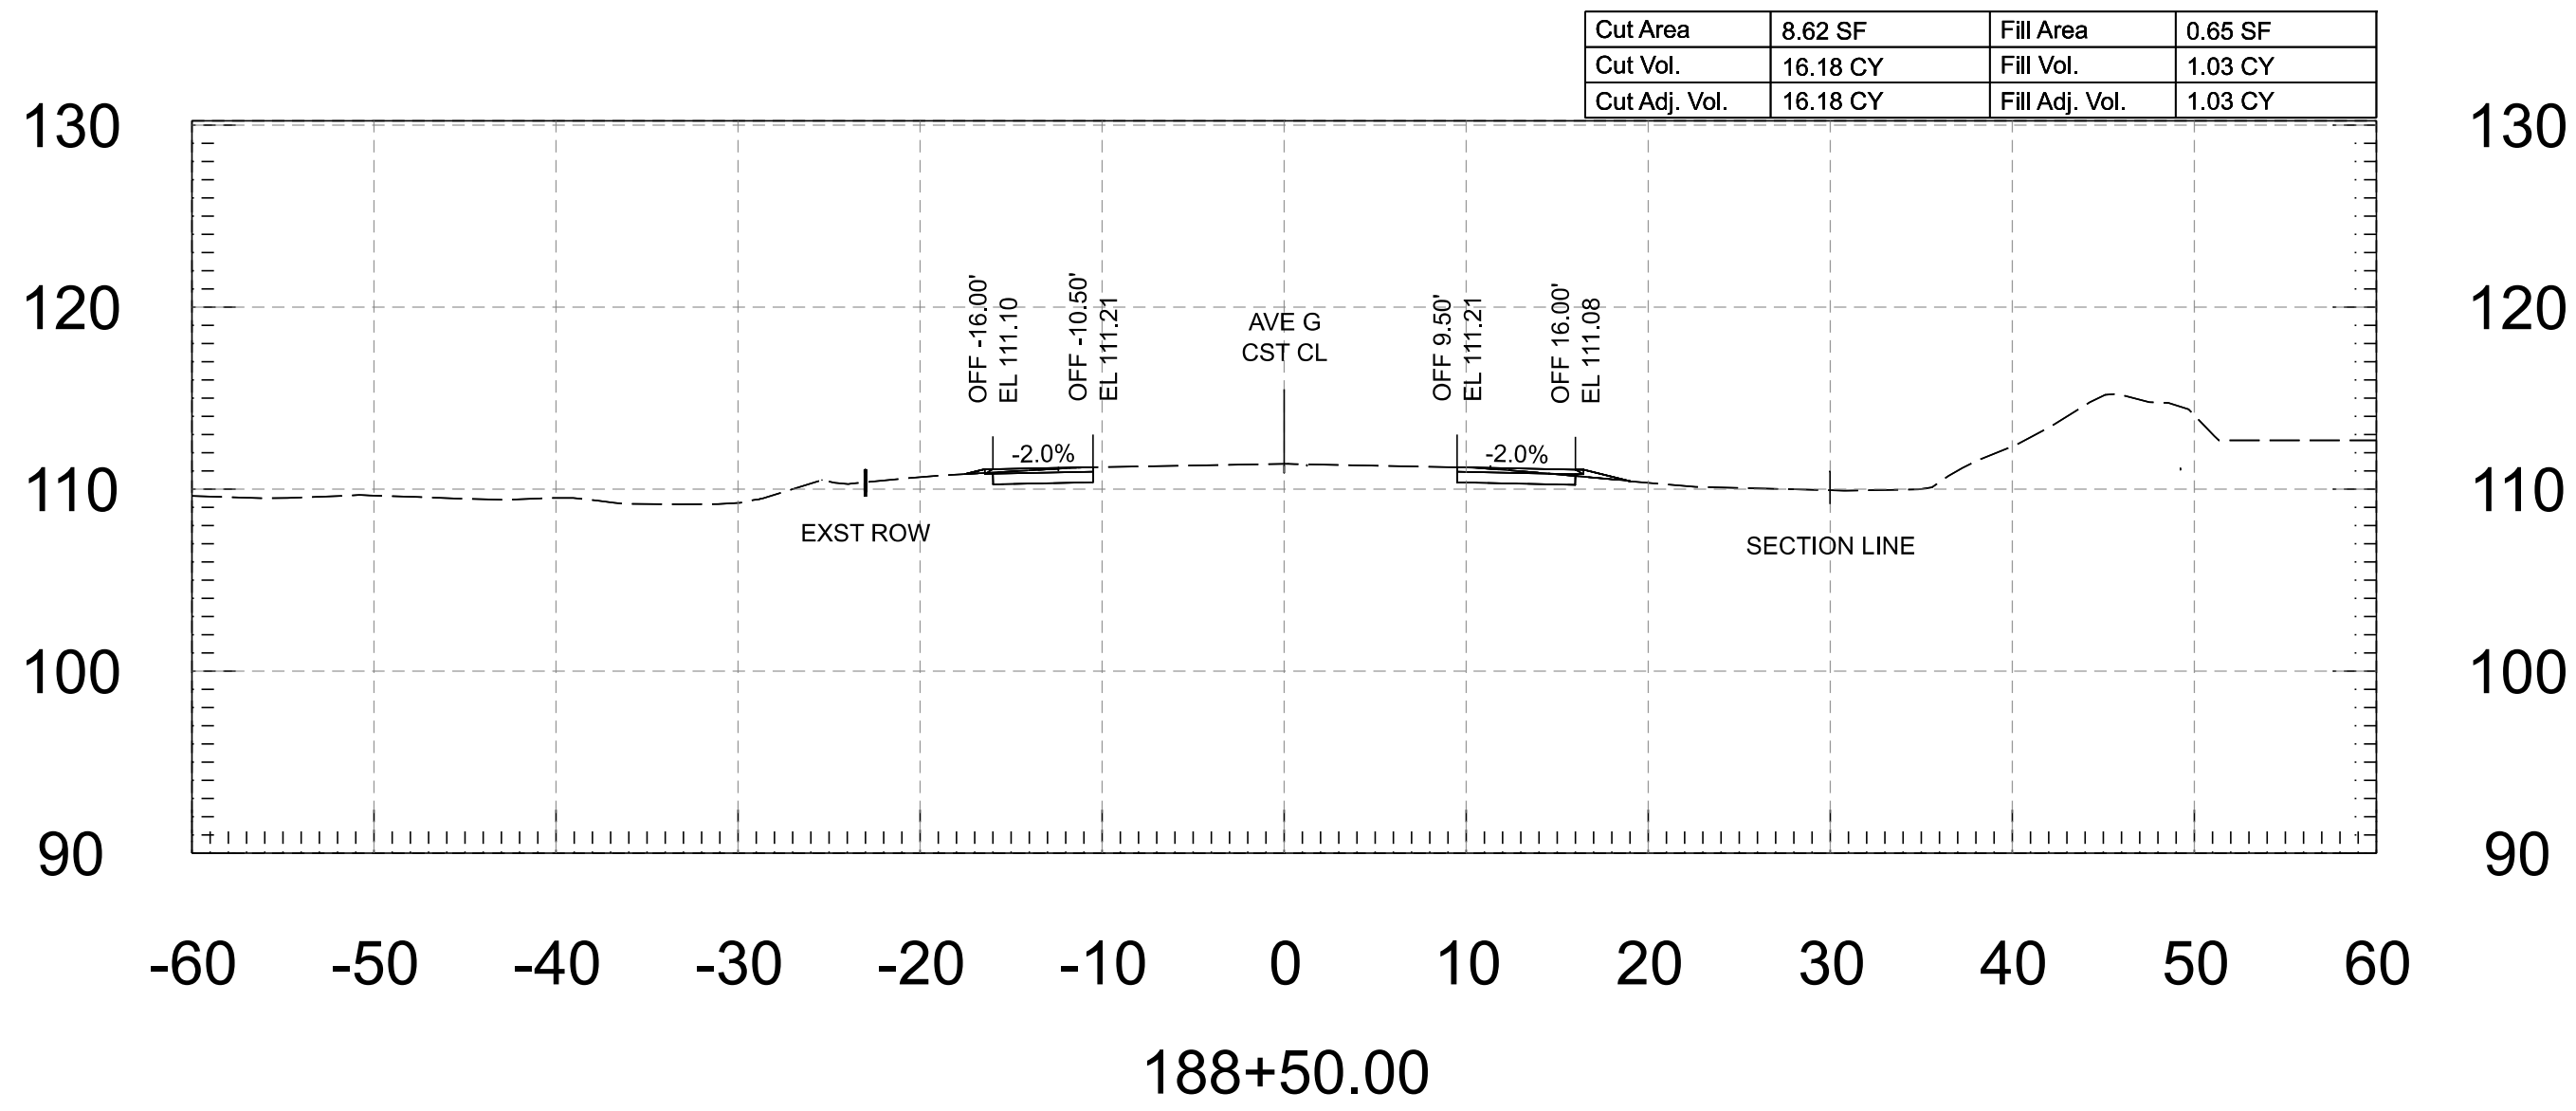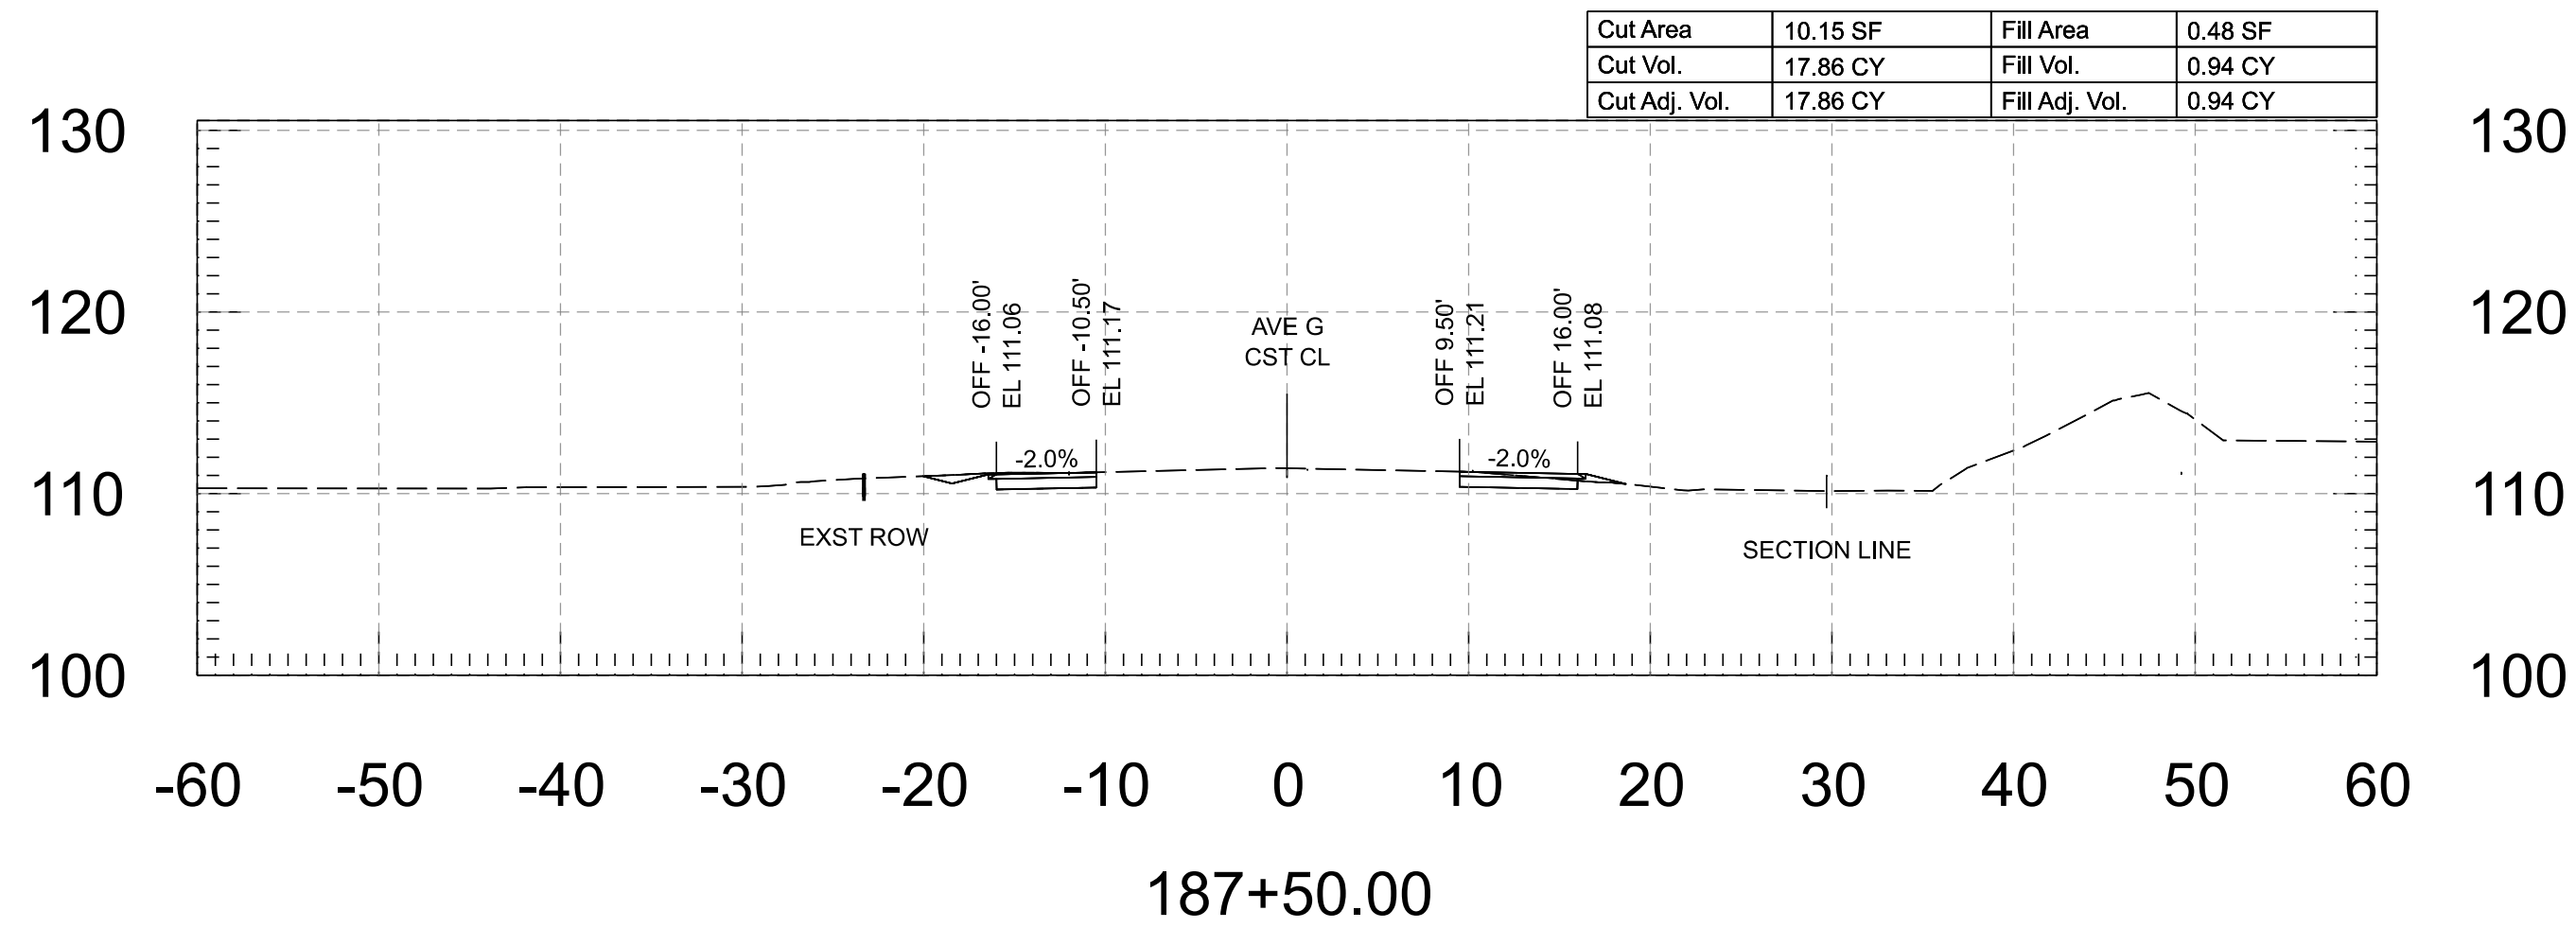


FOR INFORMATION ONLY		NAME	DATE	ARIZONA DEPARTMENT OF TRANSPORTATION PROJECT DELIVERY AND OPERATIONS DIVISION ROADWAY DESIGN SERVICES	ROUTE	F.H.W.A. Arizona Division	STATE ARIZ.	PROJECT NO.	FEDERAL ID NO.	SHEET NO.	TOTAL SHEETS	RECORD DRAWING
	DESIGN	M. SCHOEN	07/26		MILEPOST			0000 YU YYU	YYU-0(225)T	87	118	
	DRAWN	M. SCHOEN	07/26		LOCATION	AVENUE G, COUNTY 11TH ST - COUNTY 16TH ST						
	CHECKED	H. RIOS	07/26				STRUCTURE NO.	TRACS NO.	T0437 01C			
			WSP USA Inc. 1230 West Washington Street, Suite 405 Tempe, AZ 85288		AVENUE G - CROSS SECTIONS		DWG					___ OF ___


Cut Area	9.02 SF	Fill Area	0.53 SF
Cut Vol.	16.71 CY	Fill Vol.	1.01 CY
Cut Adj. Vol.	16.71 CY	Fill Adj. Vol.	1.01 CY

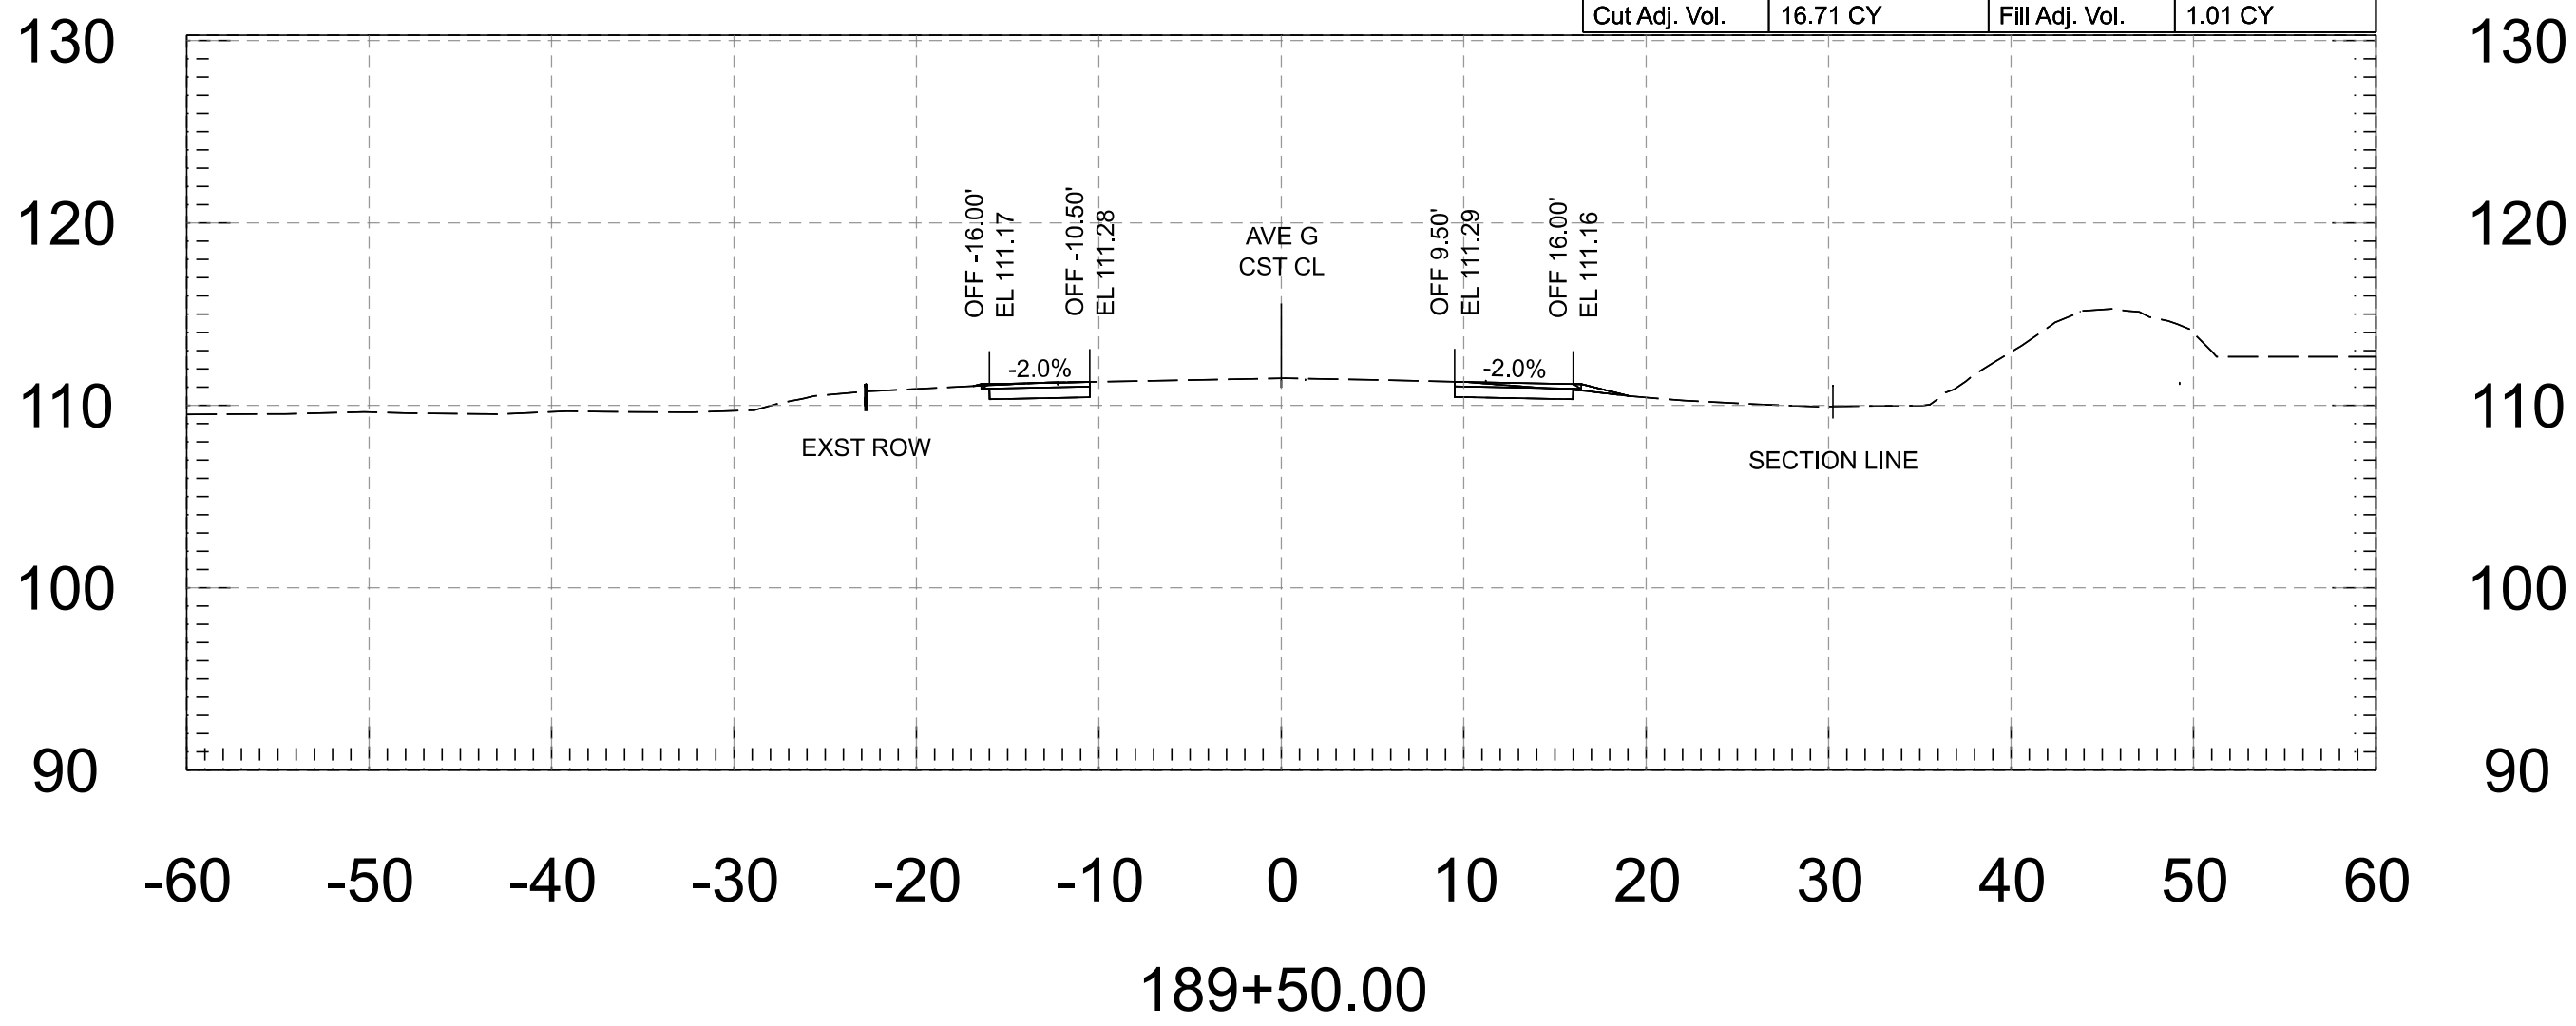


Cut Area	7.68 SF	Fill Area	0.61 SF
Cut Vol.	15.09 CY	Fill Vol.	1.12 CY
Cut Adj. Vol.	15.09 CY	Fill Adj. Vol.	1.12 CY

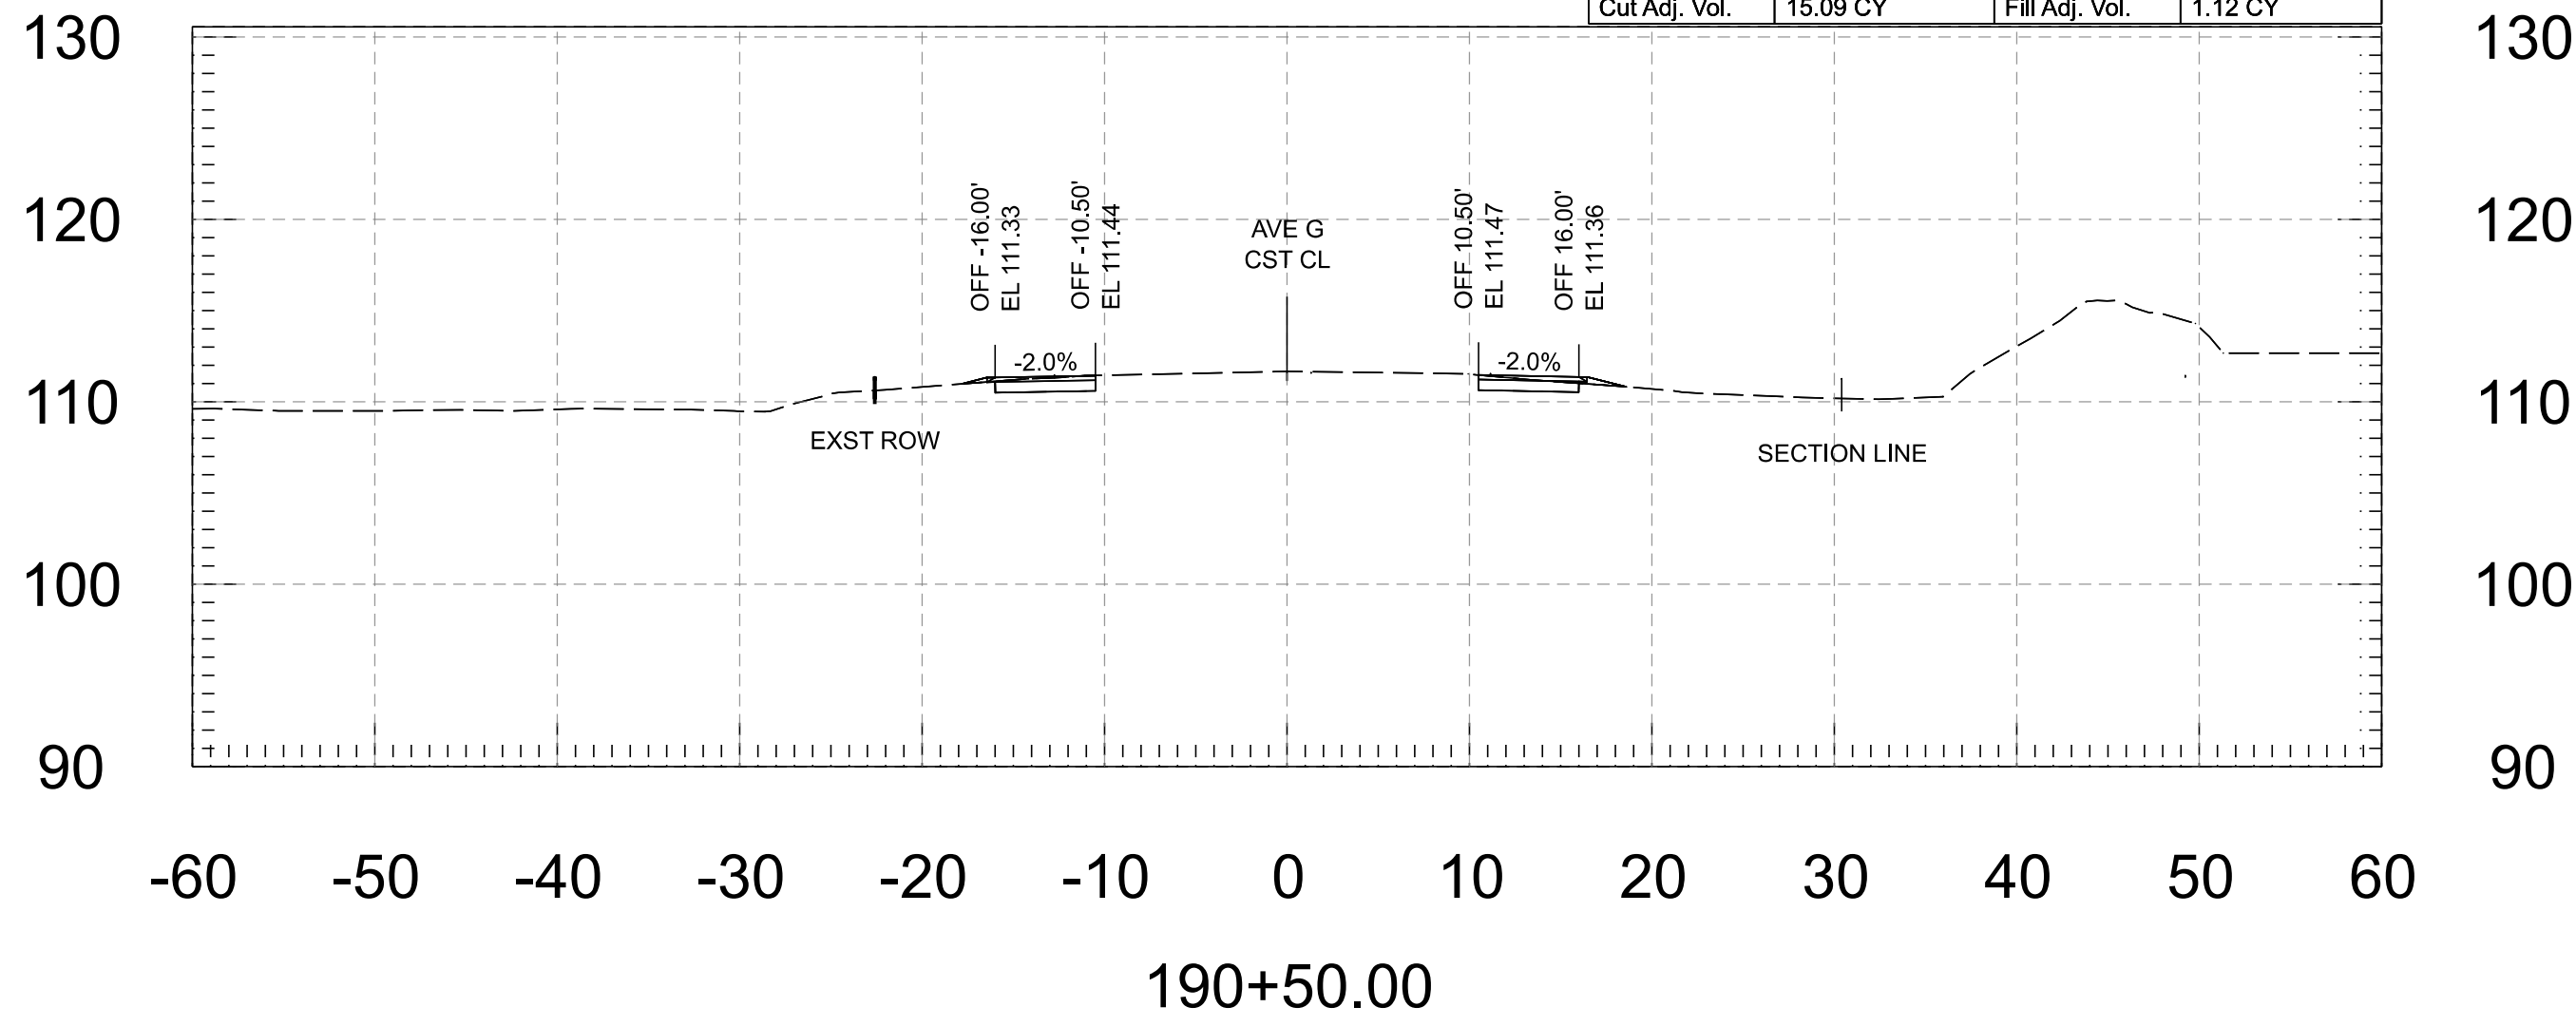

Cut Area	9.02 SF	Fill Area	0.56 SF
Cut Vol.	16.34 CY	Fill Vol.	1.12 CY
Cut Adj. Vol.	16.34 CY	Fill Adj. Vol.	1.12 CY

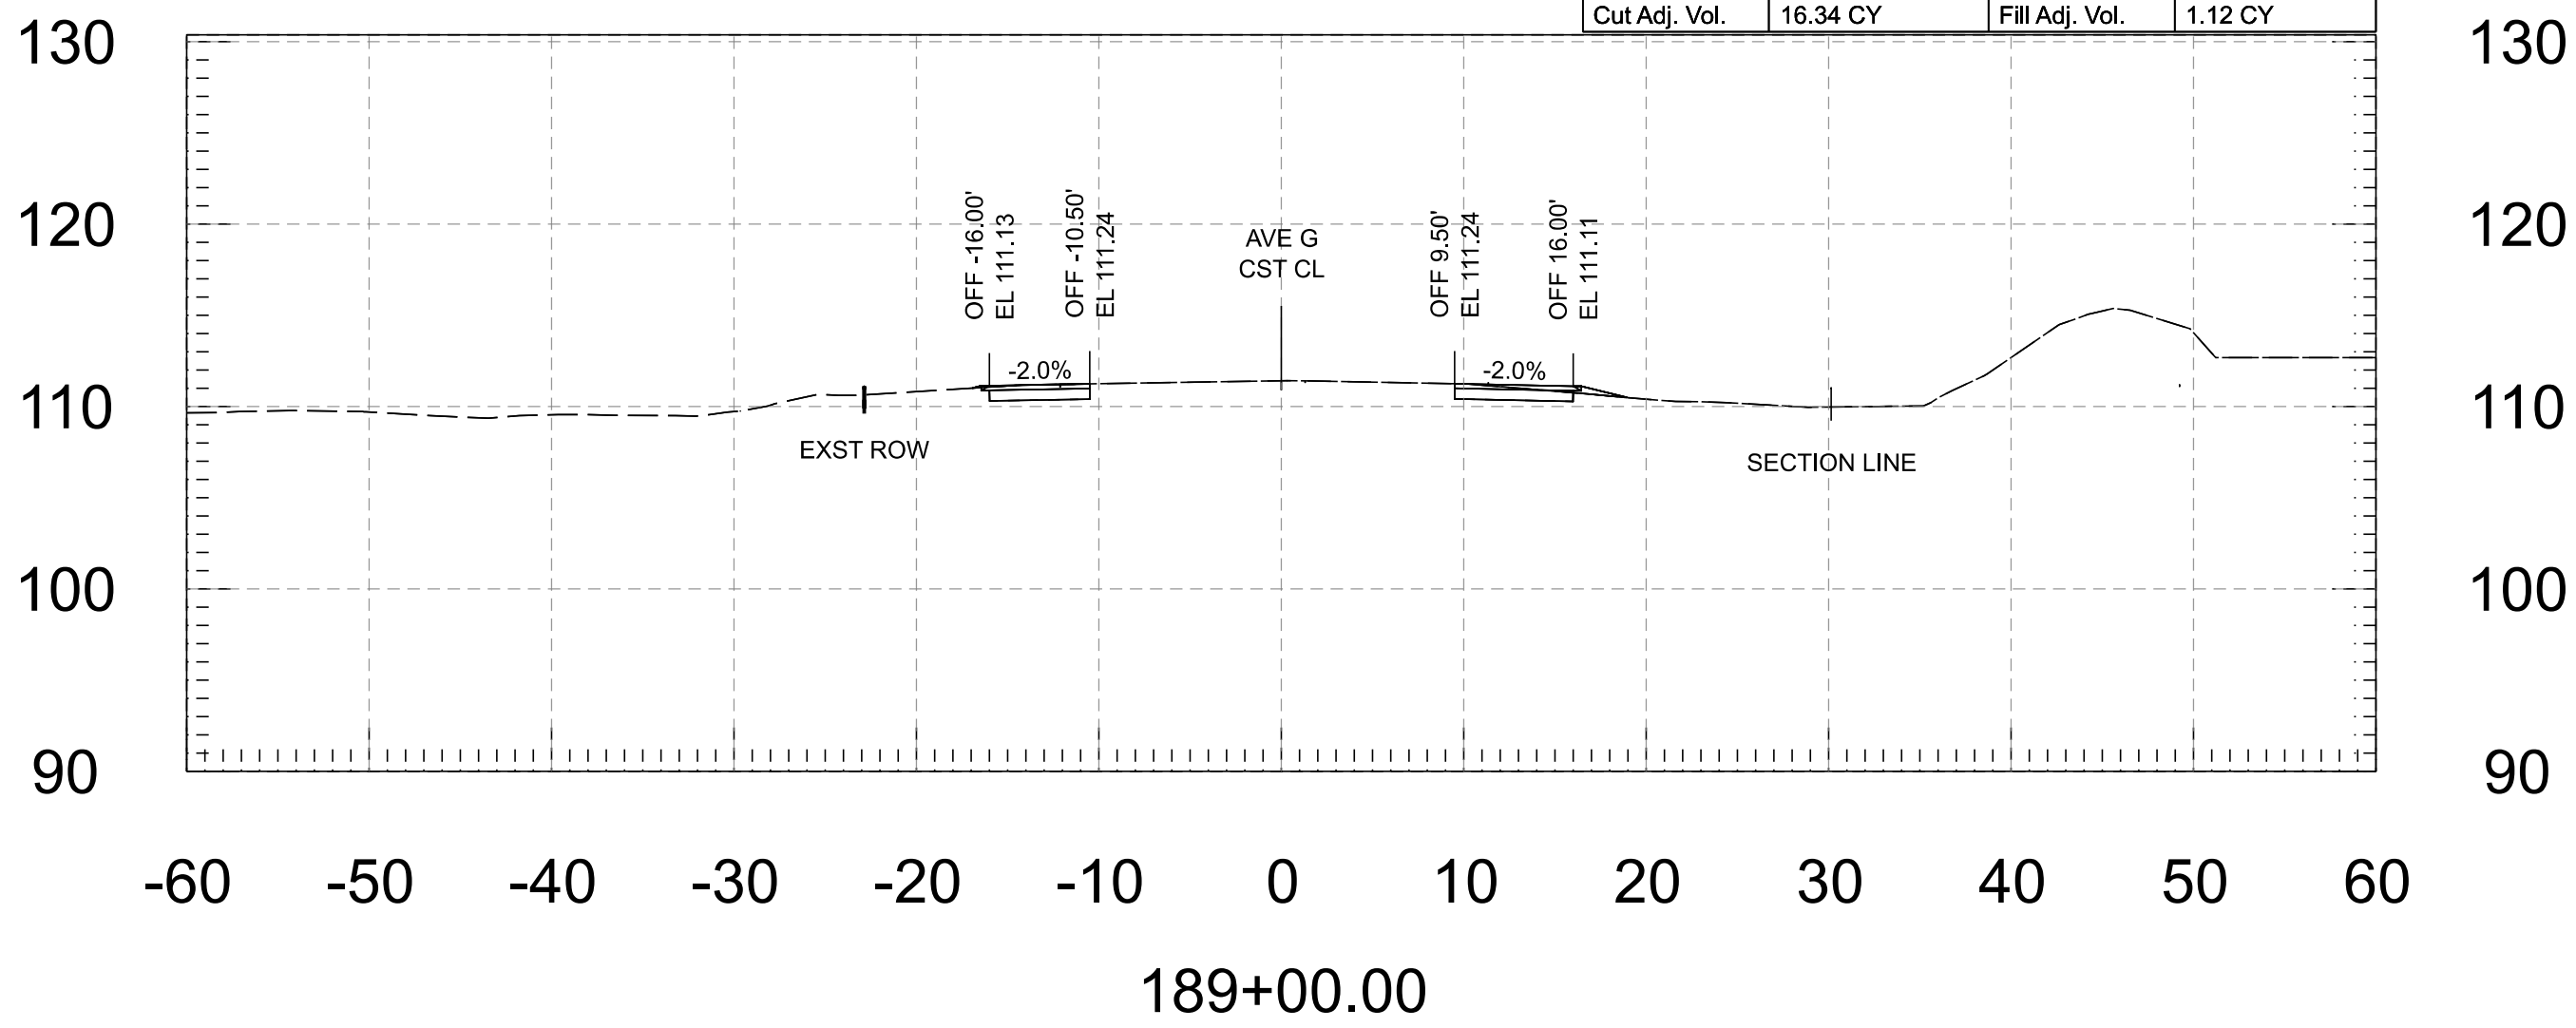

Cut Area	8.61 SF	Fill Area	0.59 SF
Cut Vol.	16.33 CY	Fill Vol.	1.04 CY
Cut Adj. Vol.	16.33 CY	Fill Adj. Vol.	1.04 CY

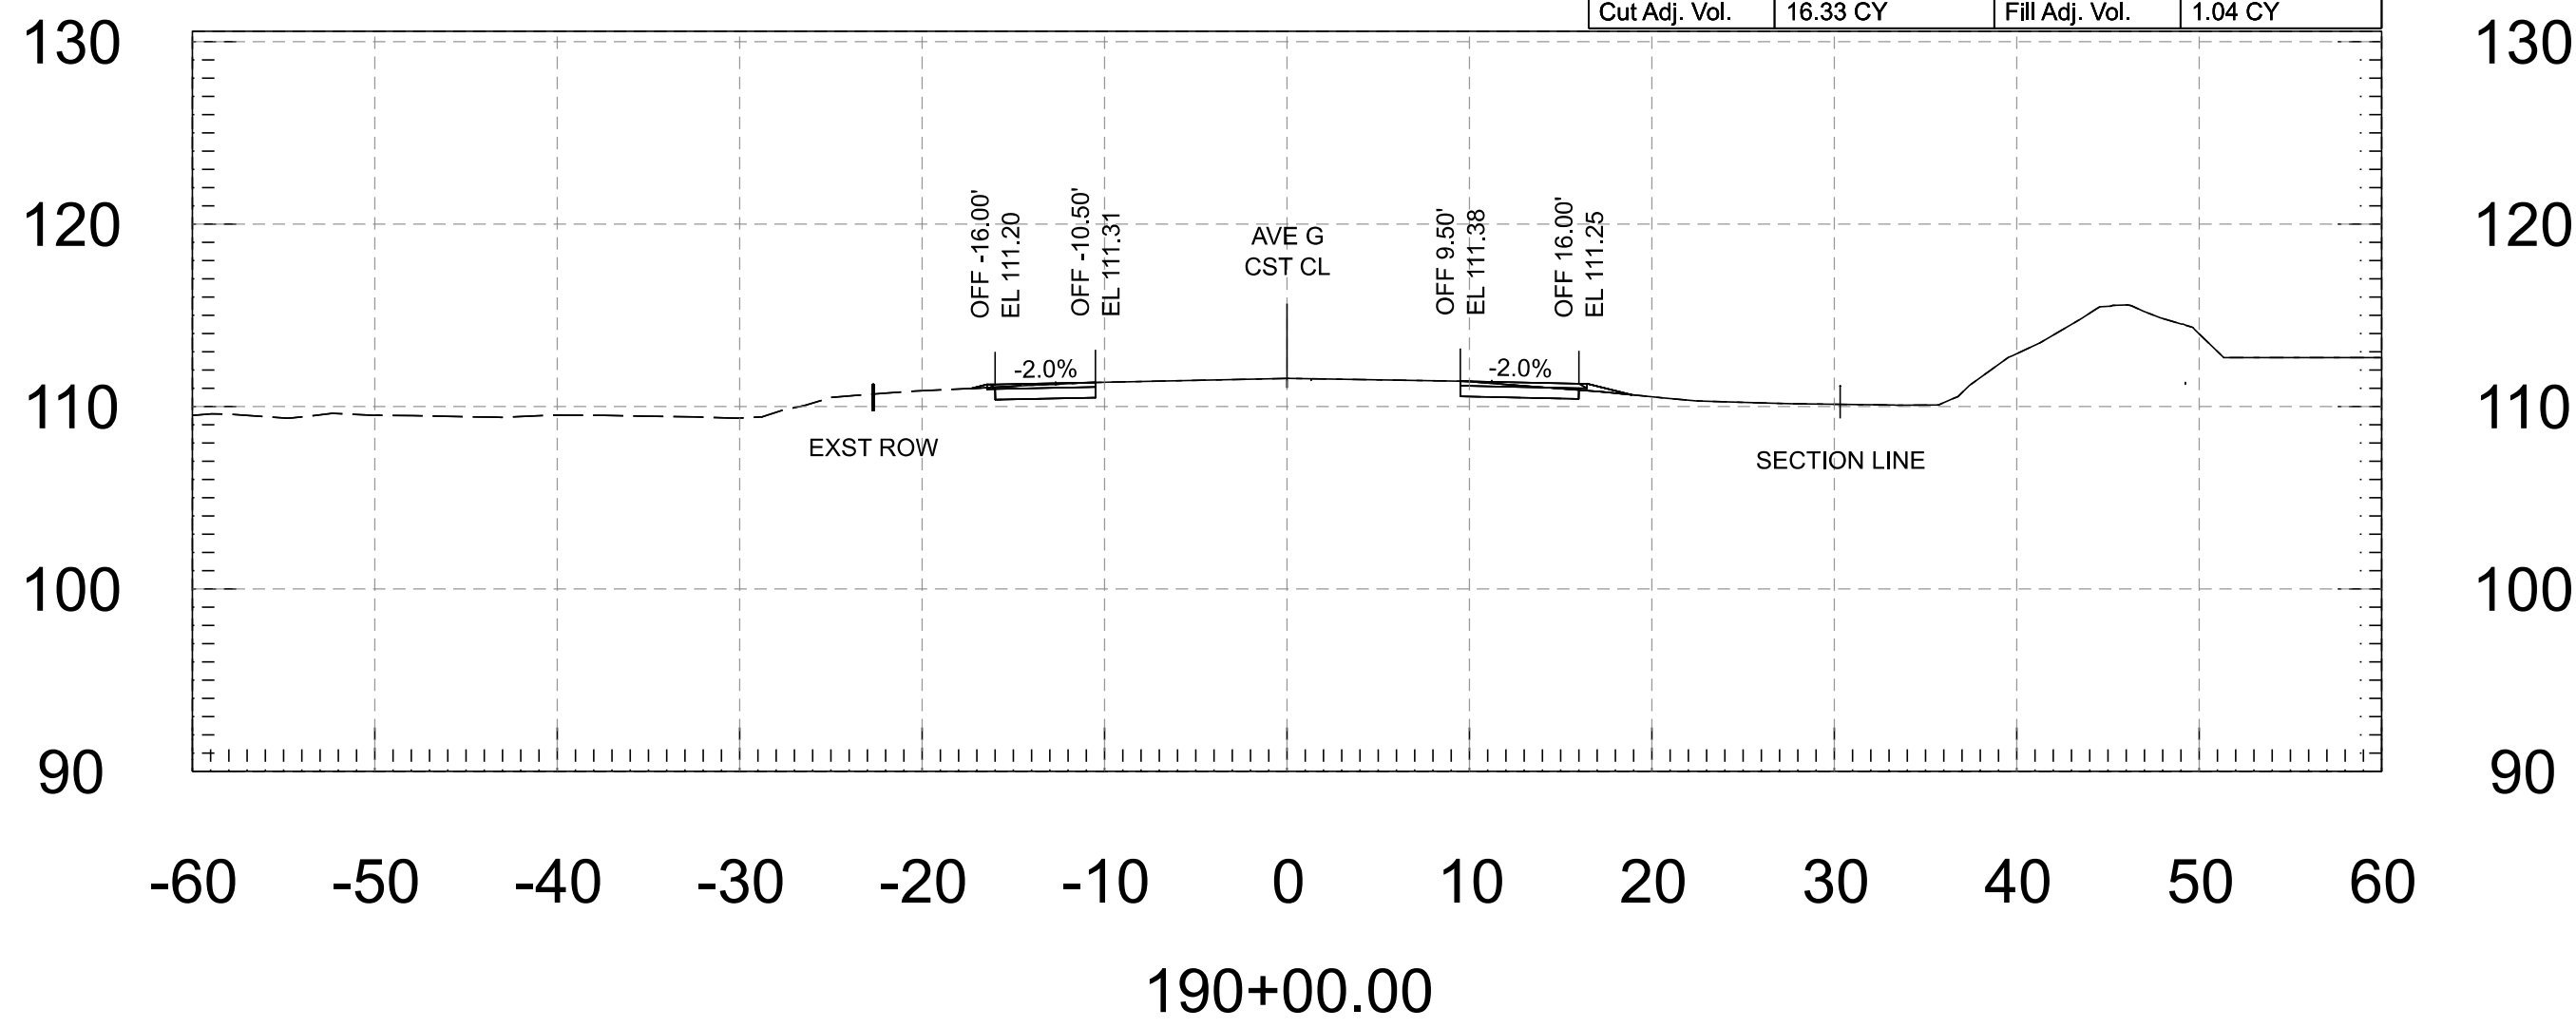

FOR
INFORMATION
ONLY

	NAME	DATE
DESIGN	M. SCHOEN	07/26
DRAWN	M. SCHOEN	07/26
CHECKED	H. RIOS	07/26



WSP USA Inc.
1230 West Washington Street, Suite 405
Tempe, AZ 85288

ARIZONA DEPARTMENT OF TRANSPORTATION
PROJECT DELIVERY AND OPERATIONS DIVISION
ROADWAY DESIGN SERVICES

AVENUE G - CROSS SECTIONS

ROUTE

MILEPOST

STRUCTURE NO.

F.H.W.A. Arizona Division

LOCATION

TRACS NO. T0437 01C

STATE

ARIZ.

PROJECT NO.

0000 YU YYU

FEDERAL ID NO.

YYU-0(225)T

SHEET NO.

88





TOTAL SHEETS

118





RECORD DRAWING

DWG


____ OF ____

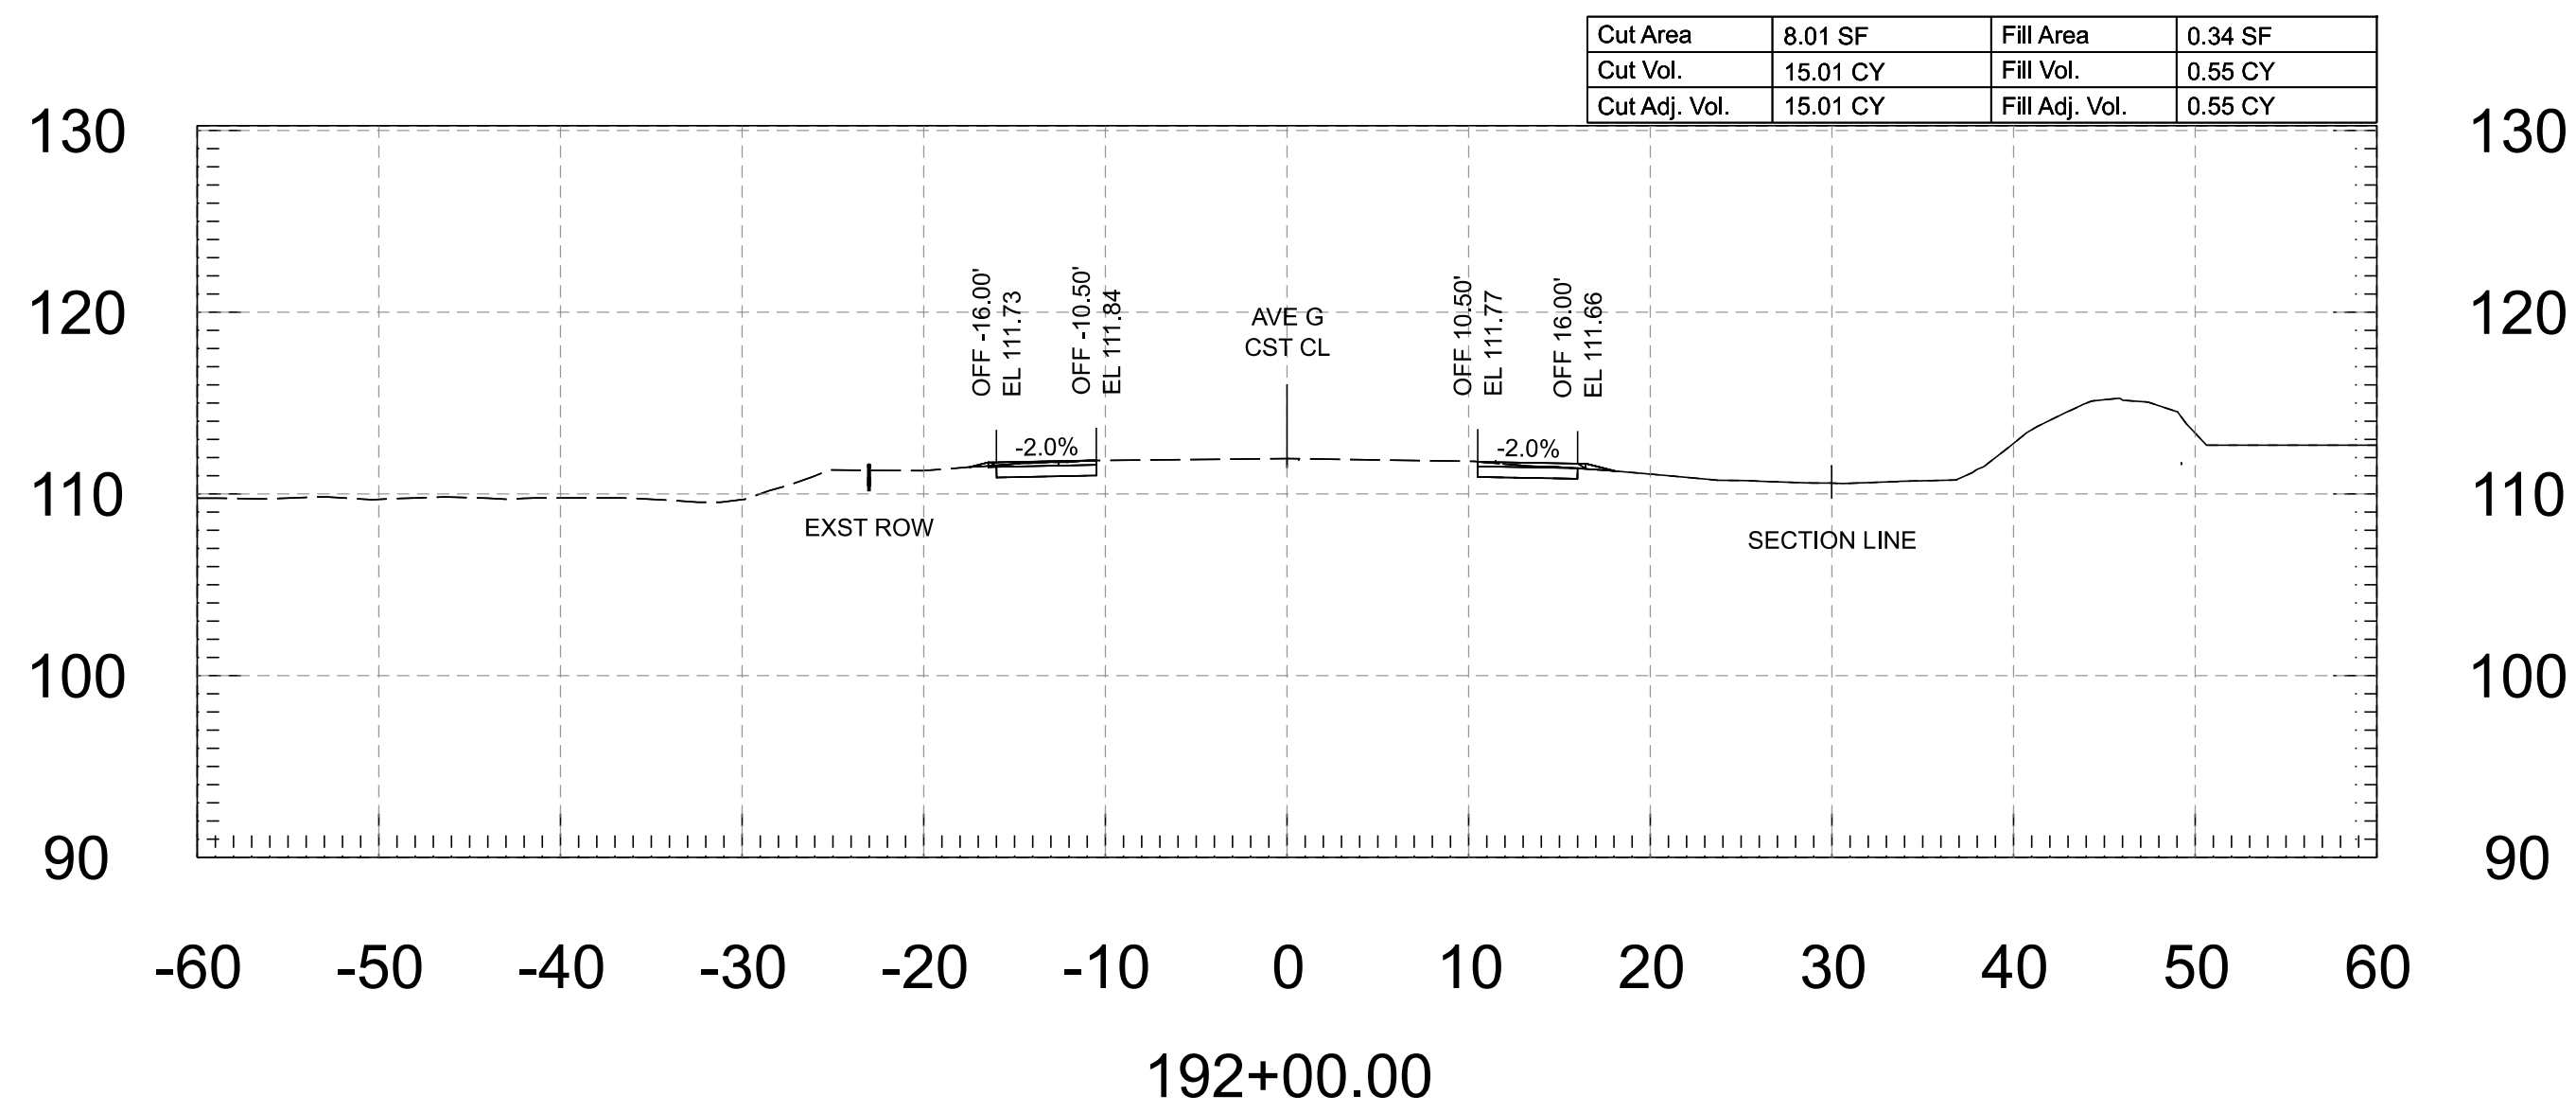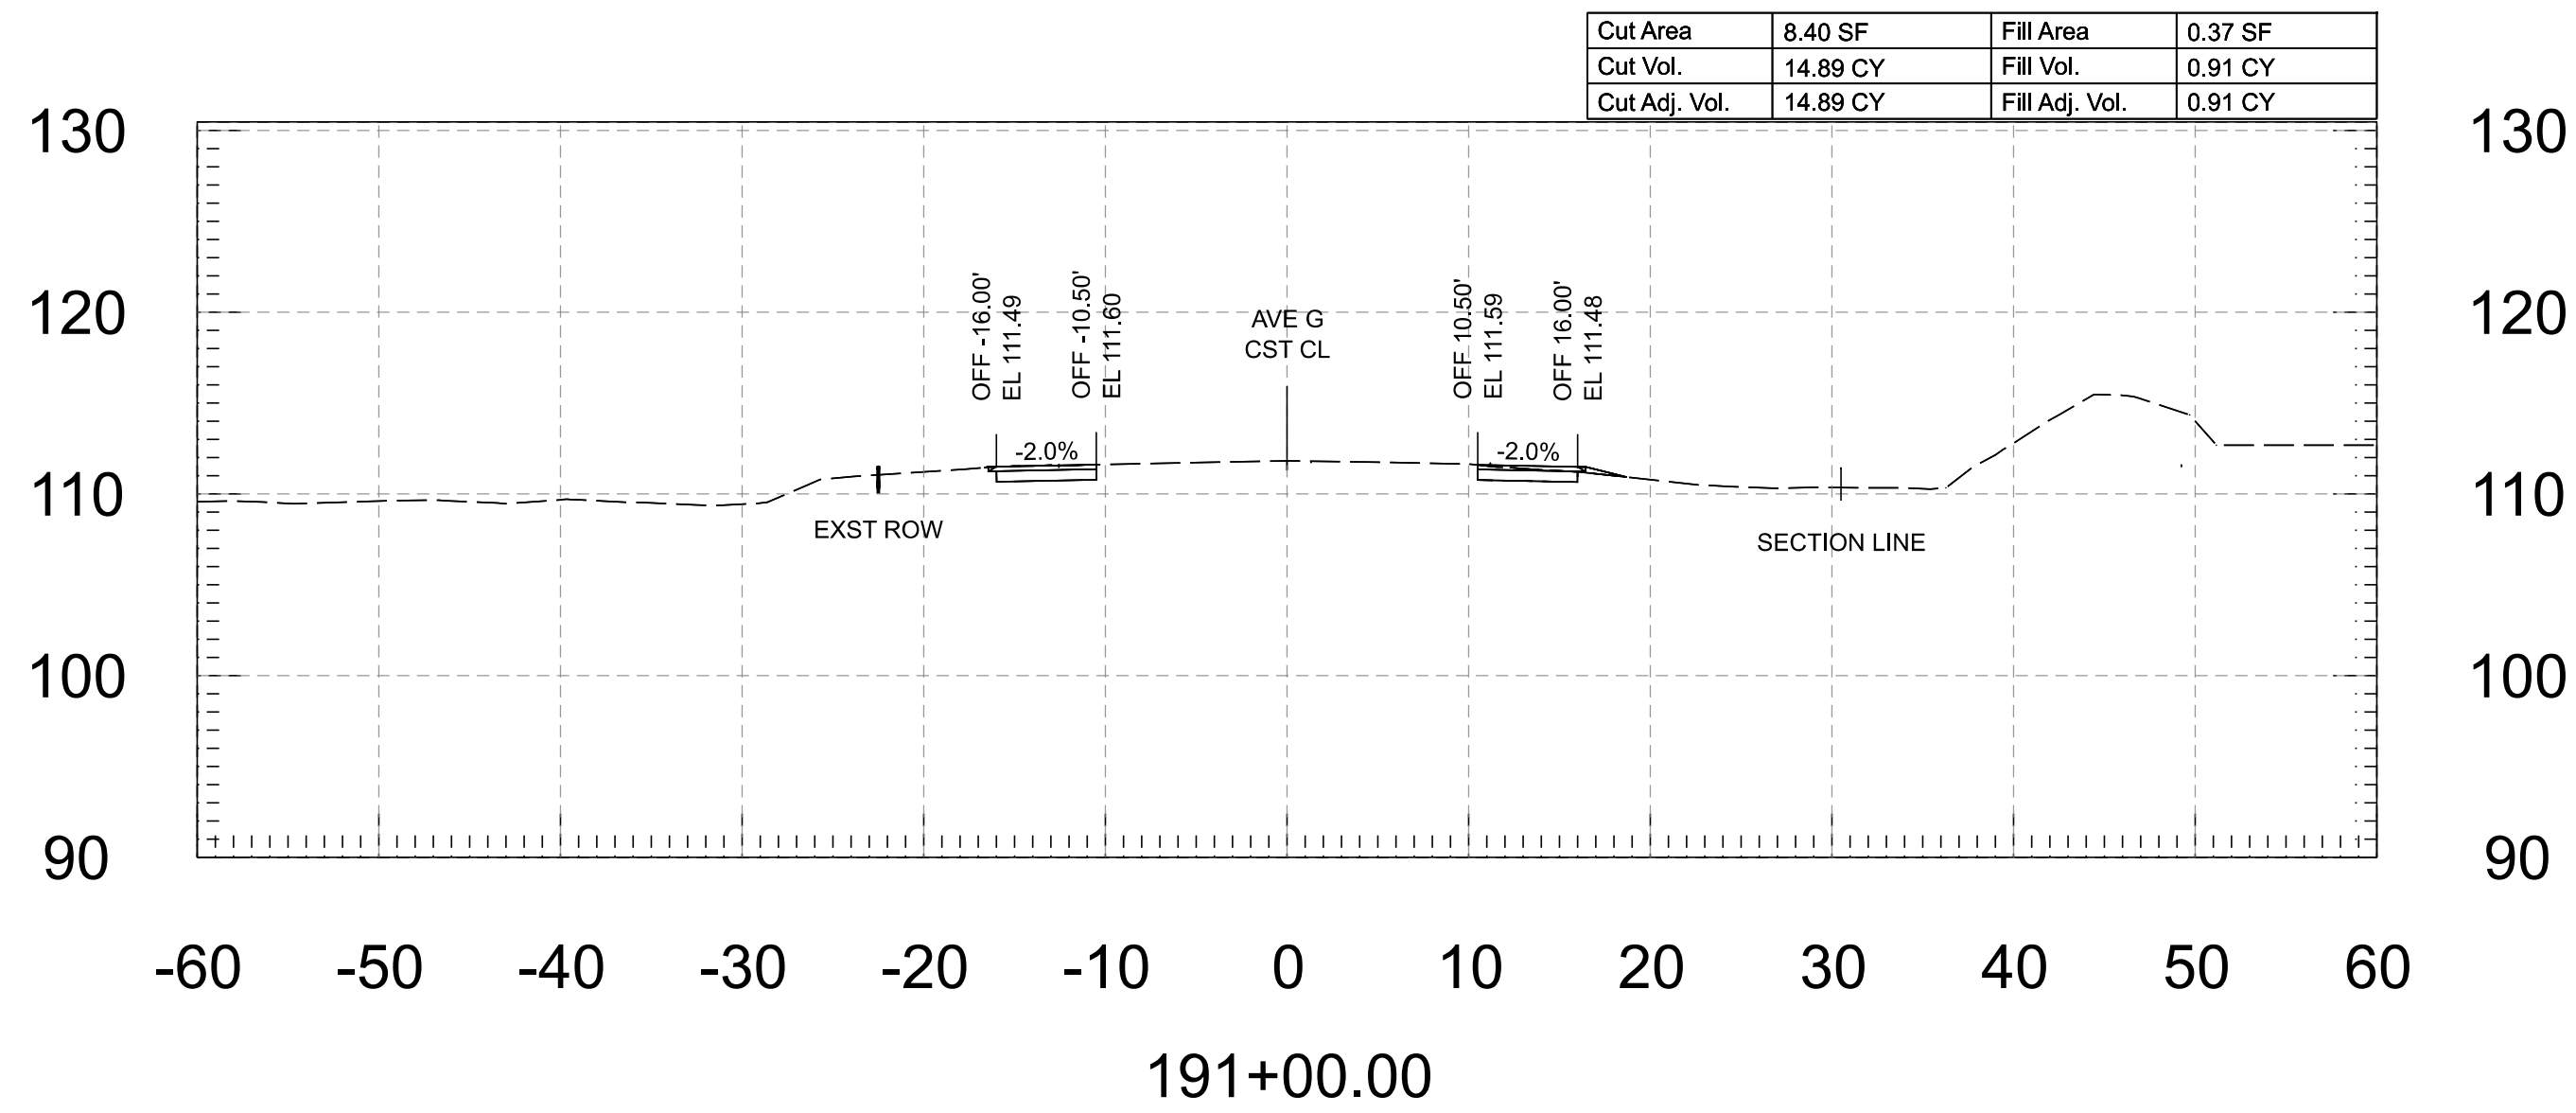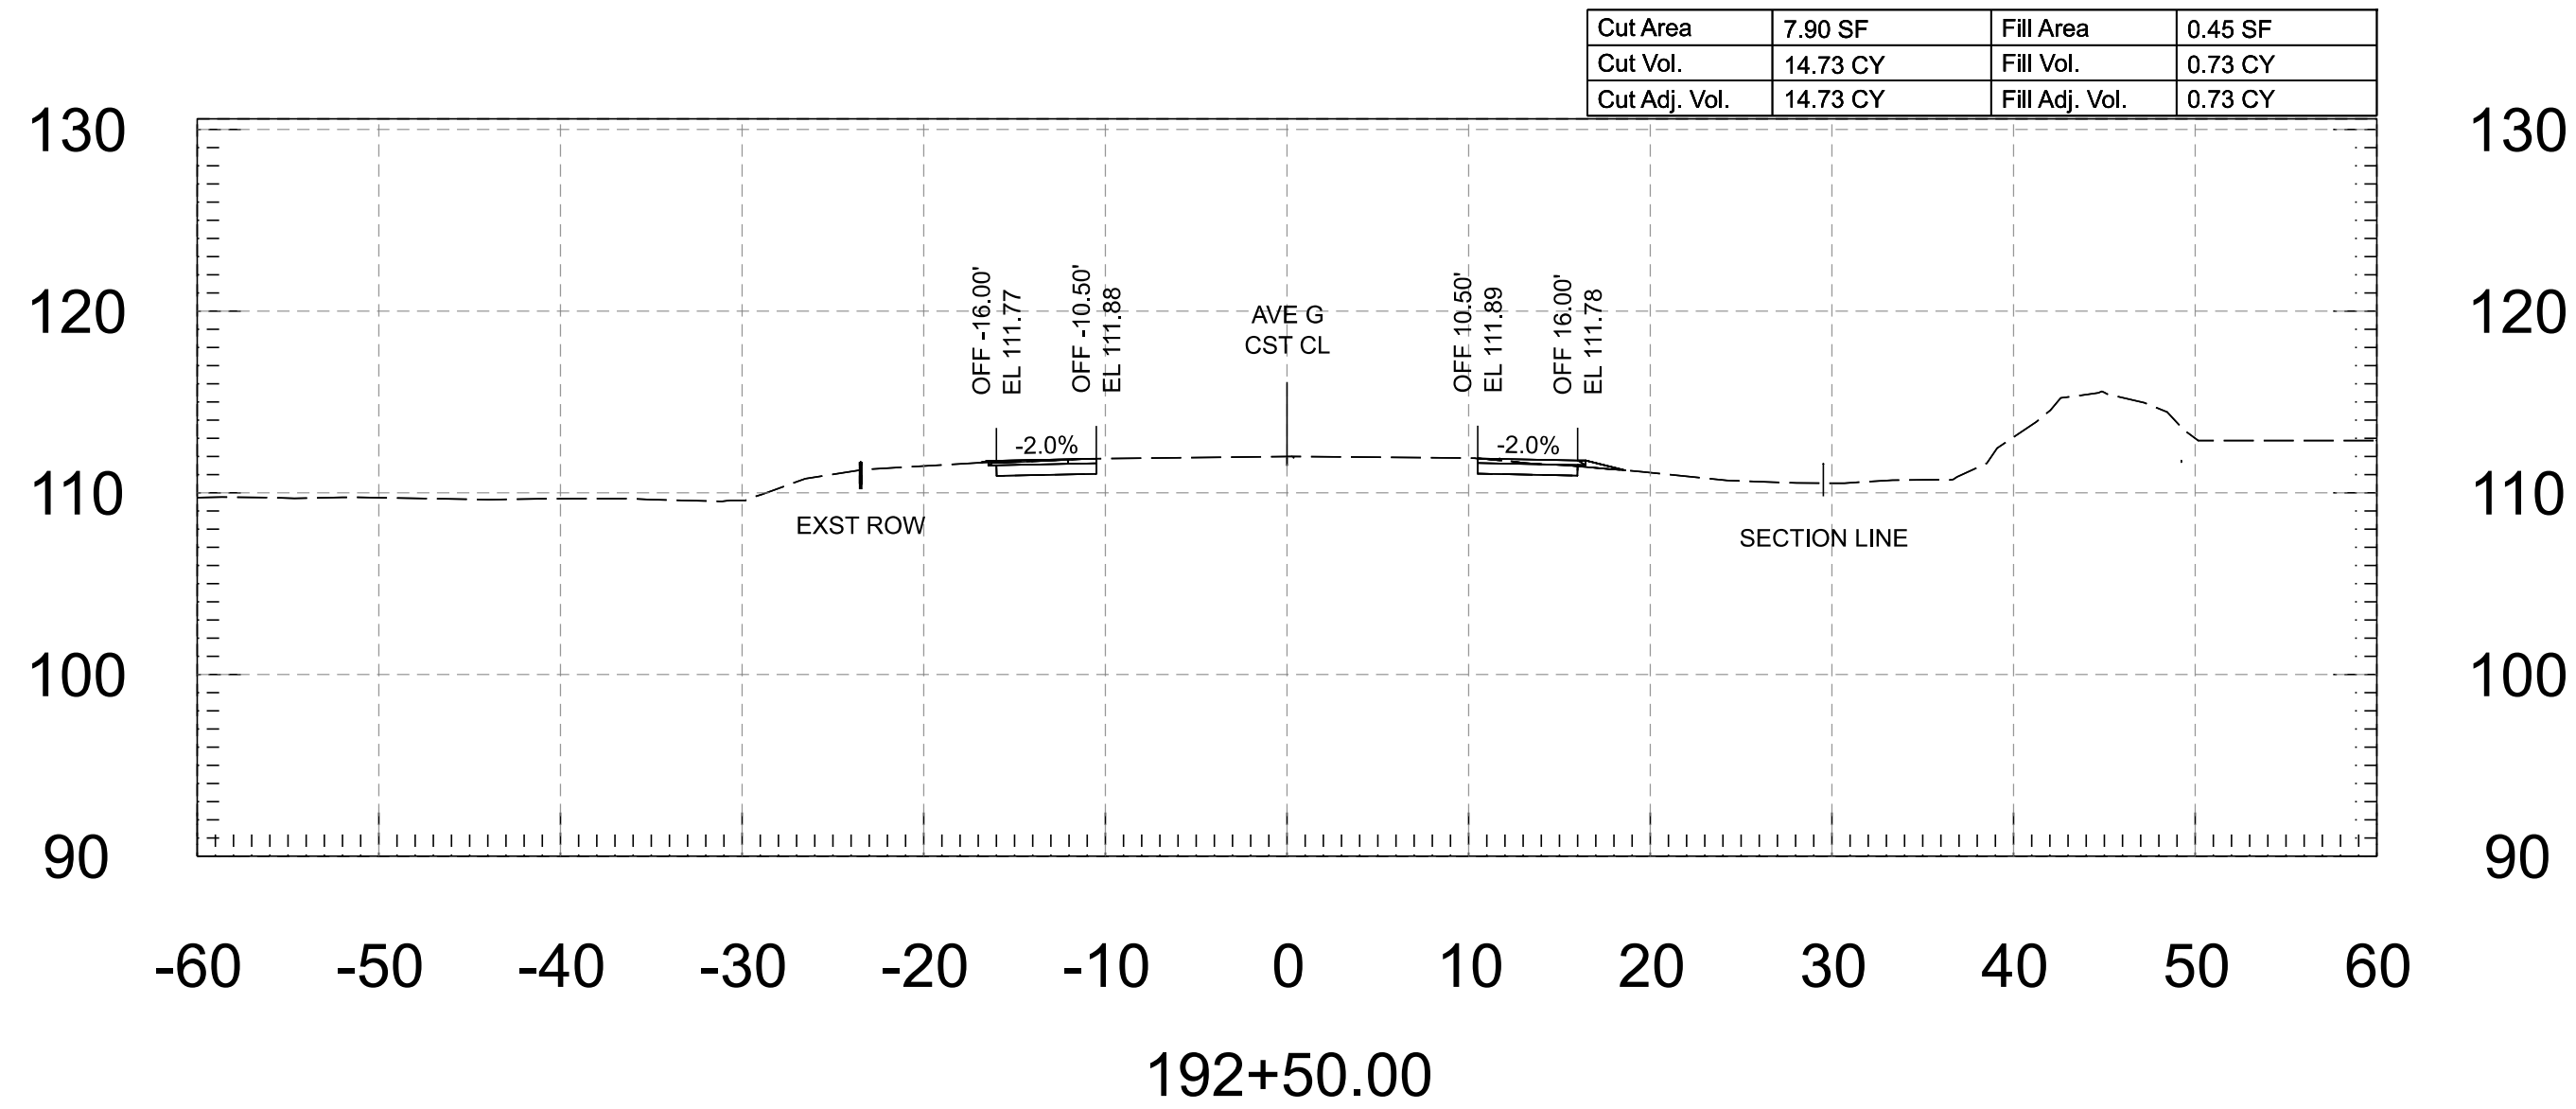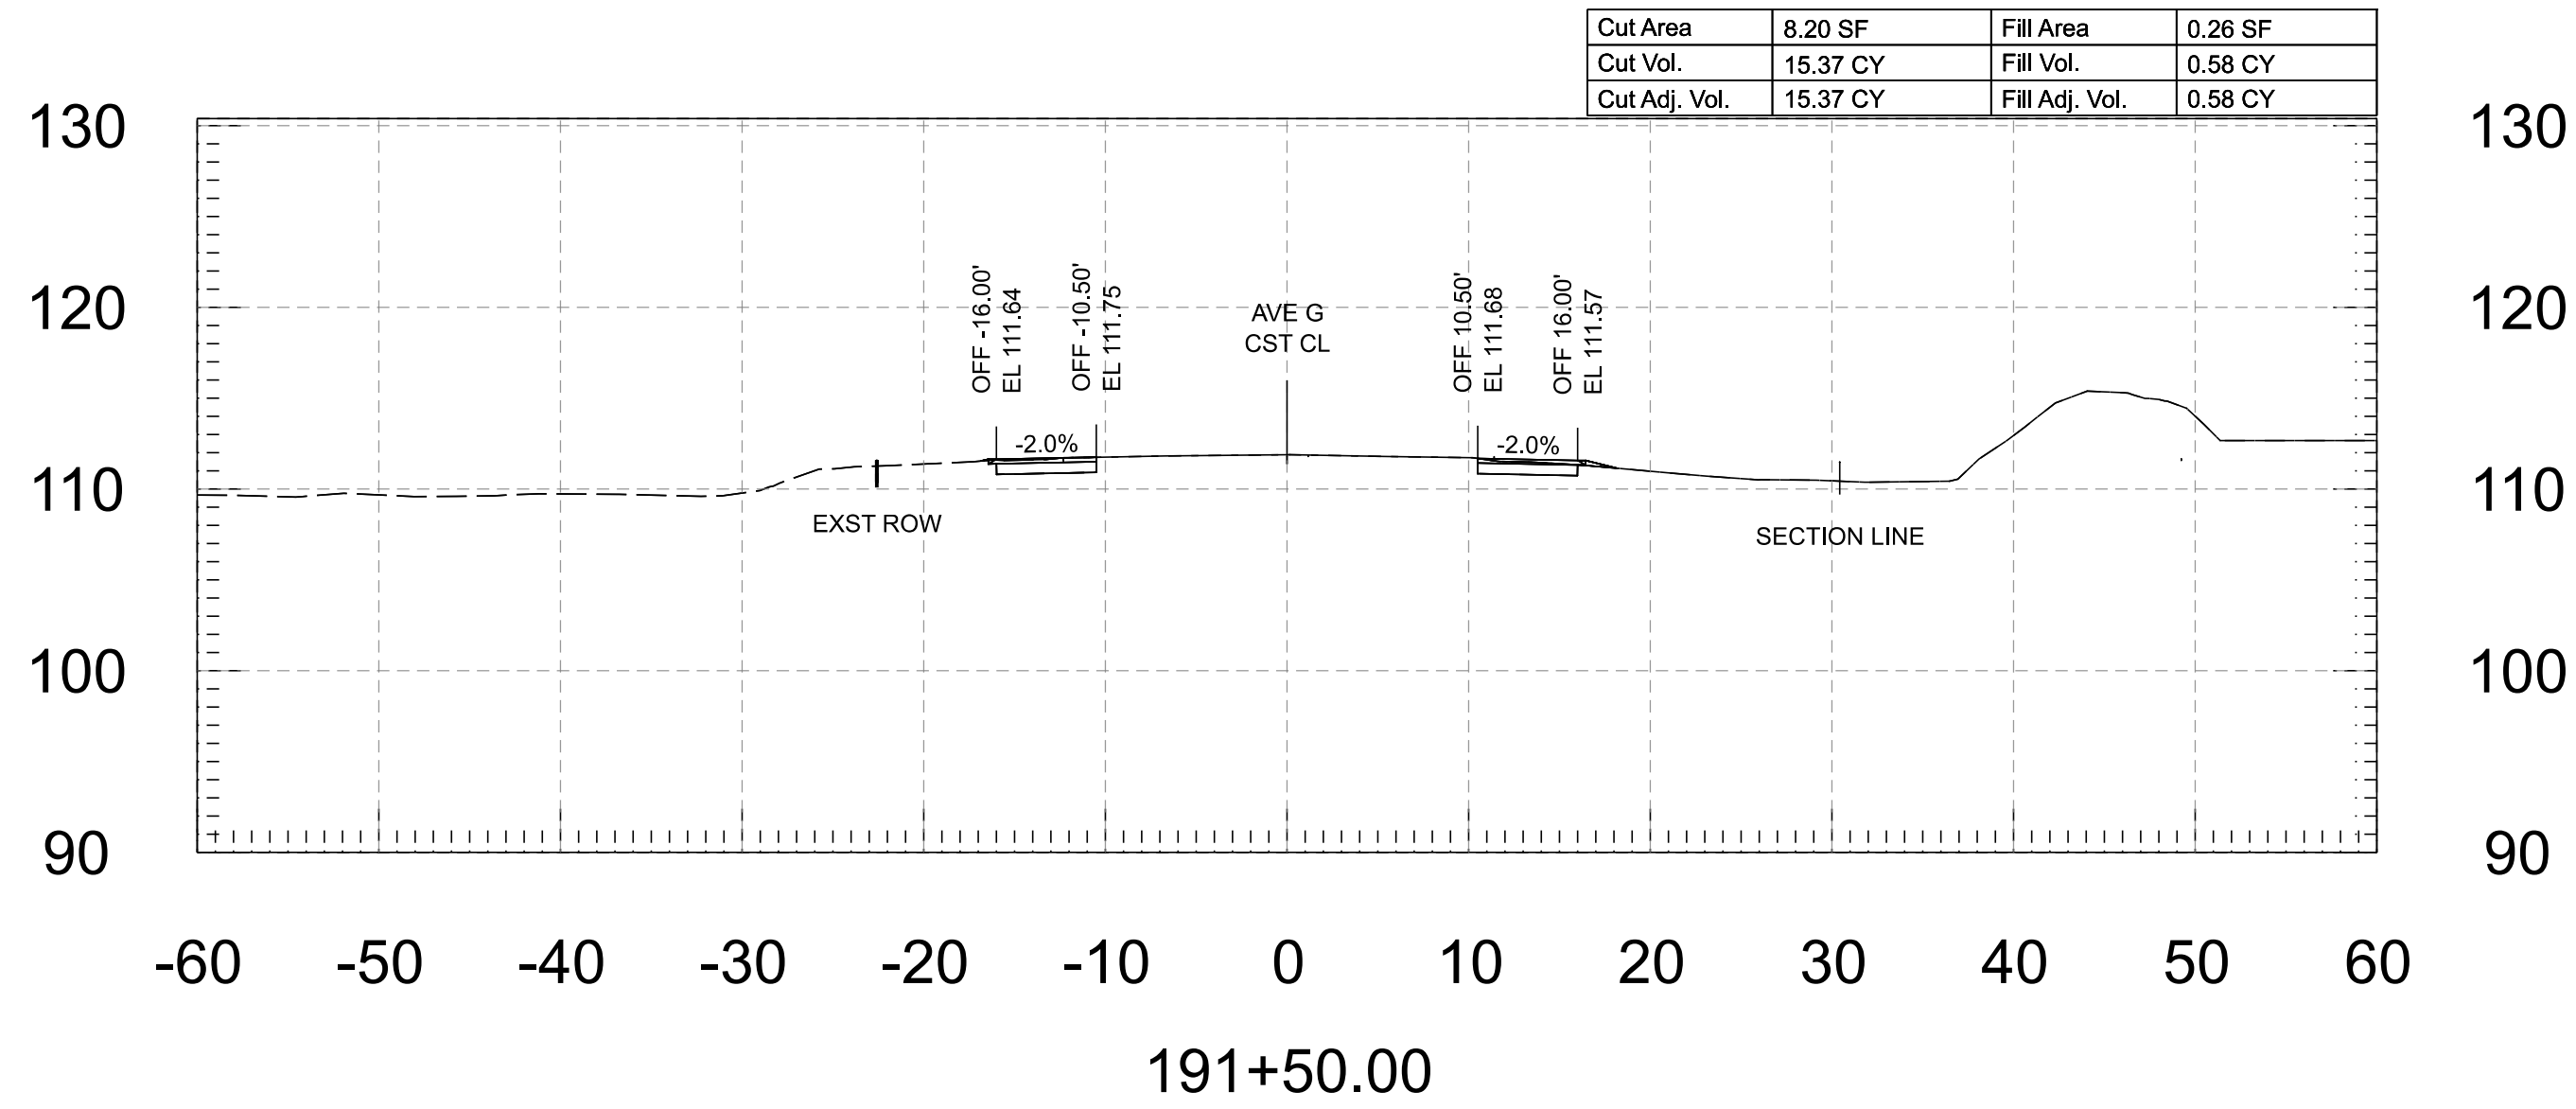



FOR INFORMATION ONLY		NAME	DATE	ARIZONA DEPARTMENT OF TRANSPORTATION PROJECT DELIVERY AND OPERATIONS DIVISION ROADWAY DESIGN SERVICES	ROUTE	F.H.W.A. Arizona Division	STATE ARIZ.	PROJECT NO.	FEDERAL ID NO.	SHEET NO.	TOTAL SHEETS	RECORD DRAWING
	DESIGN	M. SCHOEN	07/26		MILEPOST			0000 YU YYU	YYU-0(225)T	89	118	
	DRAWN	M. SCHOEN	07/26					LOCATION AVENUE G, COUNTY 11TH ST - COUNTY 16TH ST				DWG
	CHECKED	H. RIOS	07/26	wsp WSP USA Inc. 1200 West Washington Street, Suite 405 Tempe, AZ 85288	AVENUE G - CROSS SECTIONS	STRUCTURE NO.	TRACS NO. T0437 01C		___ OF ___			

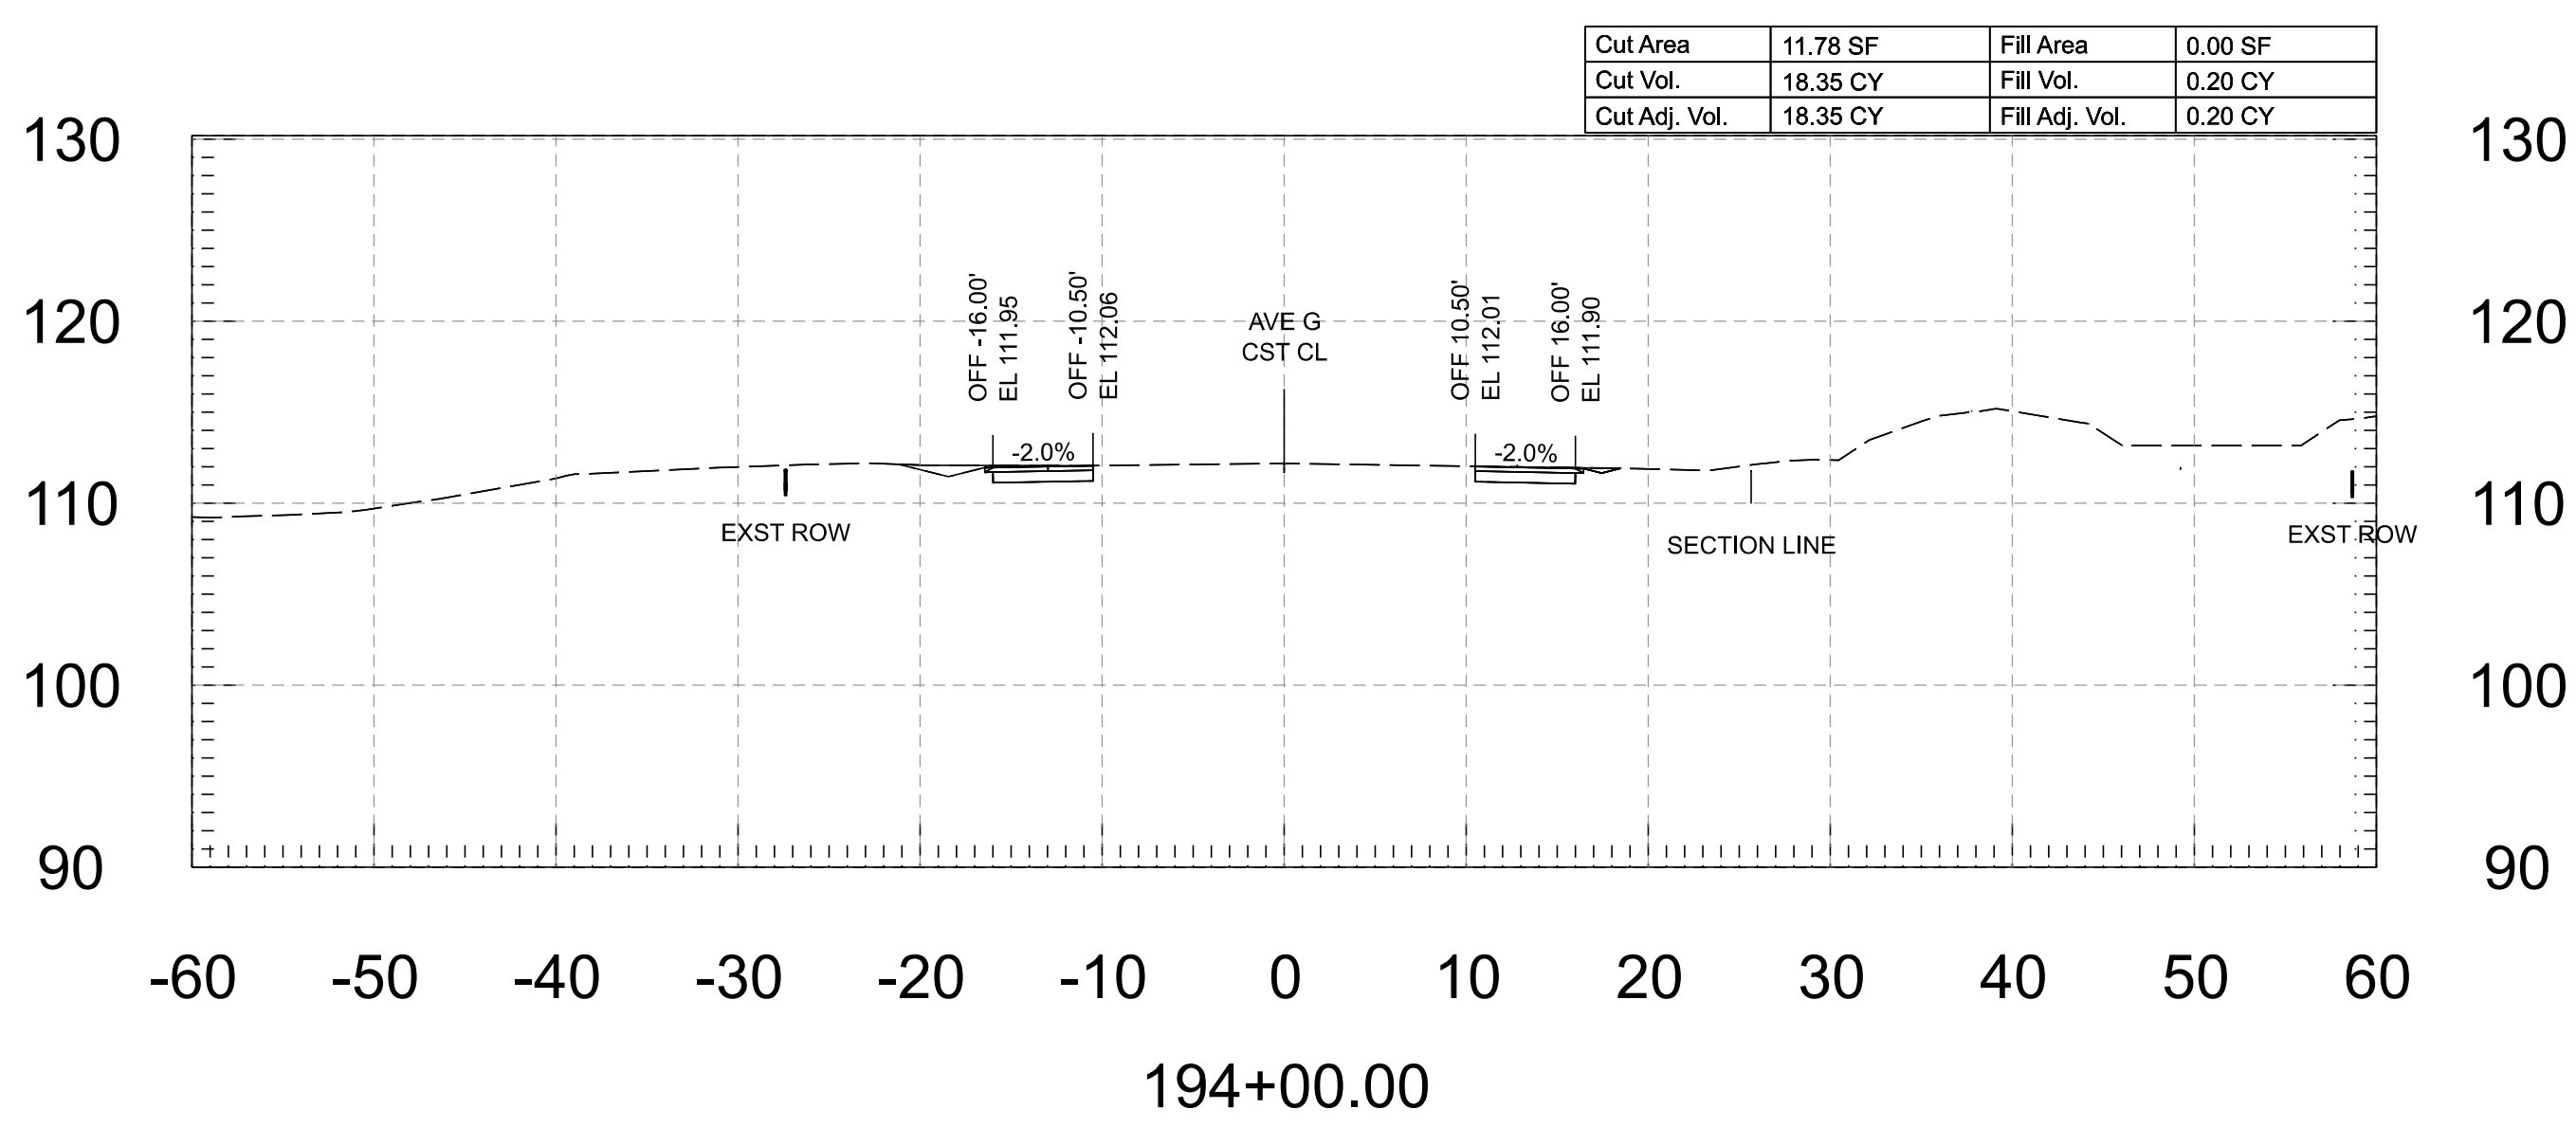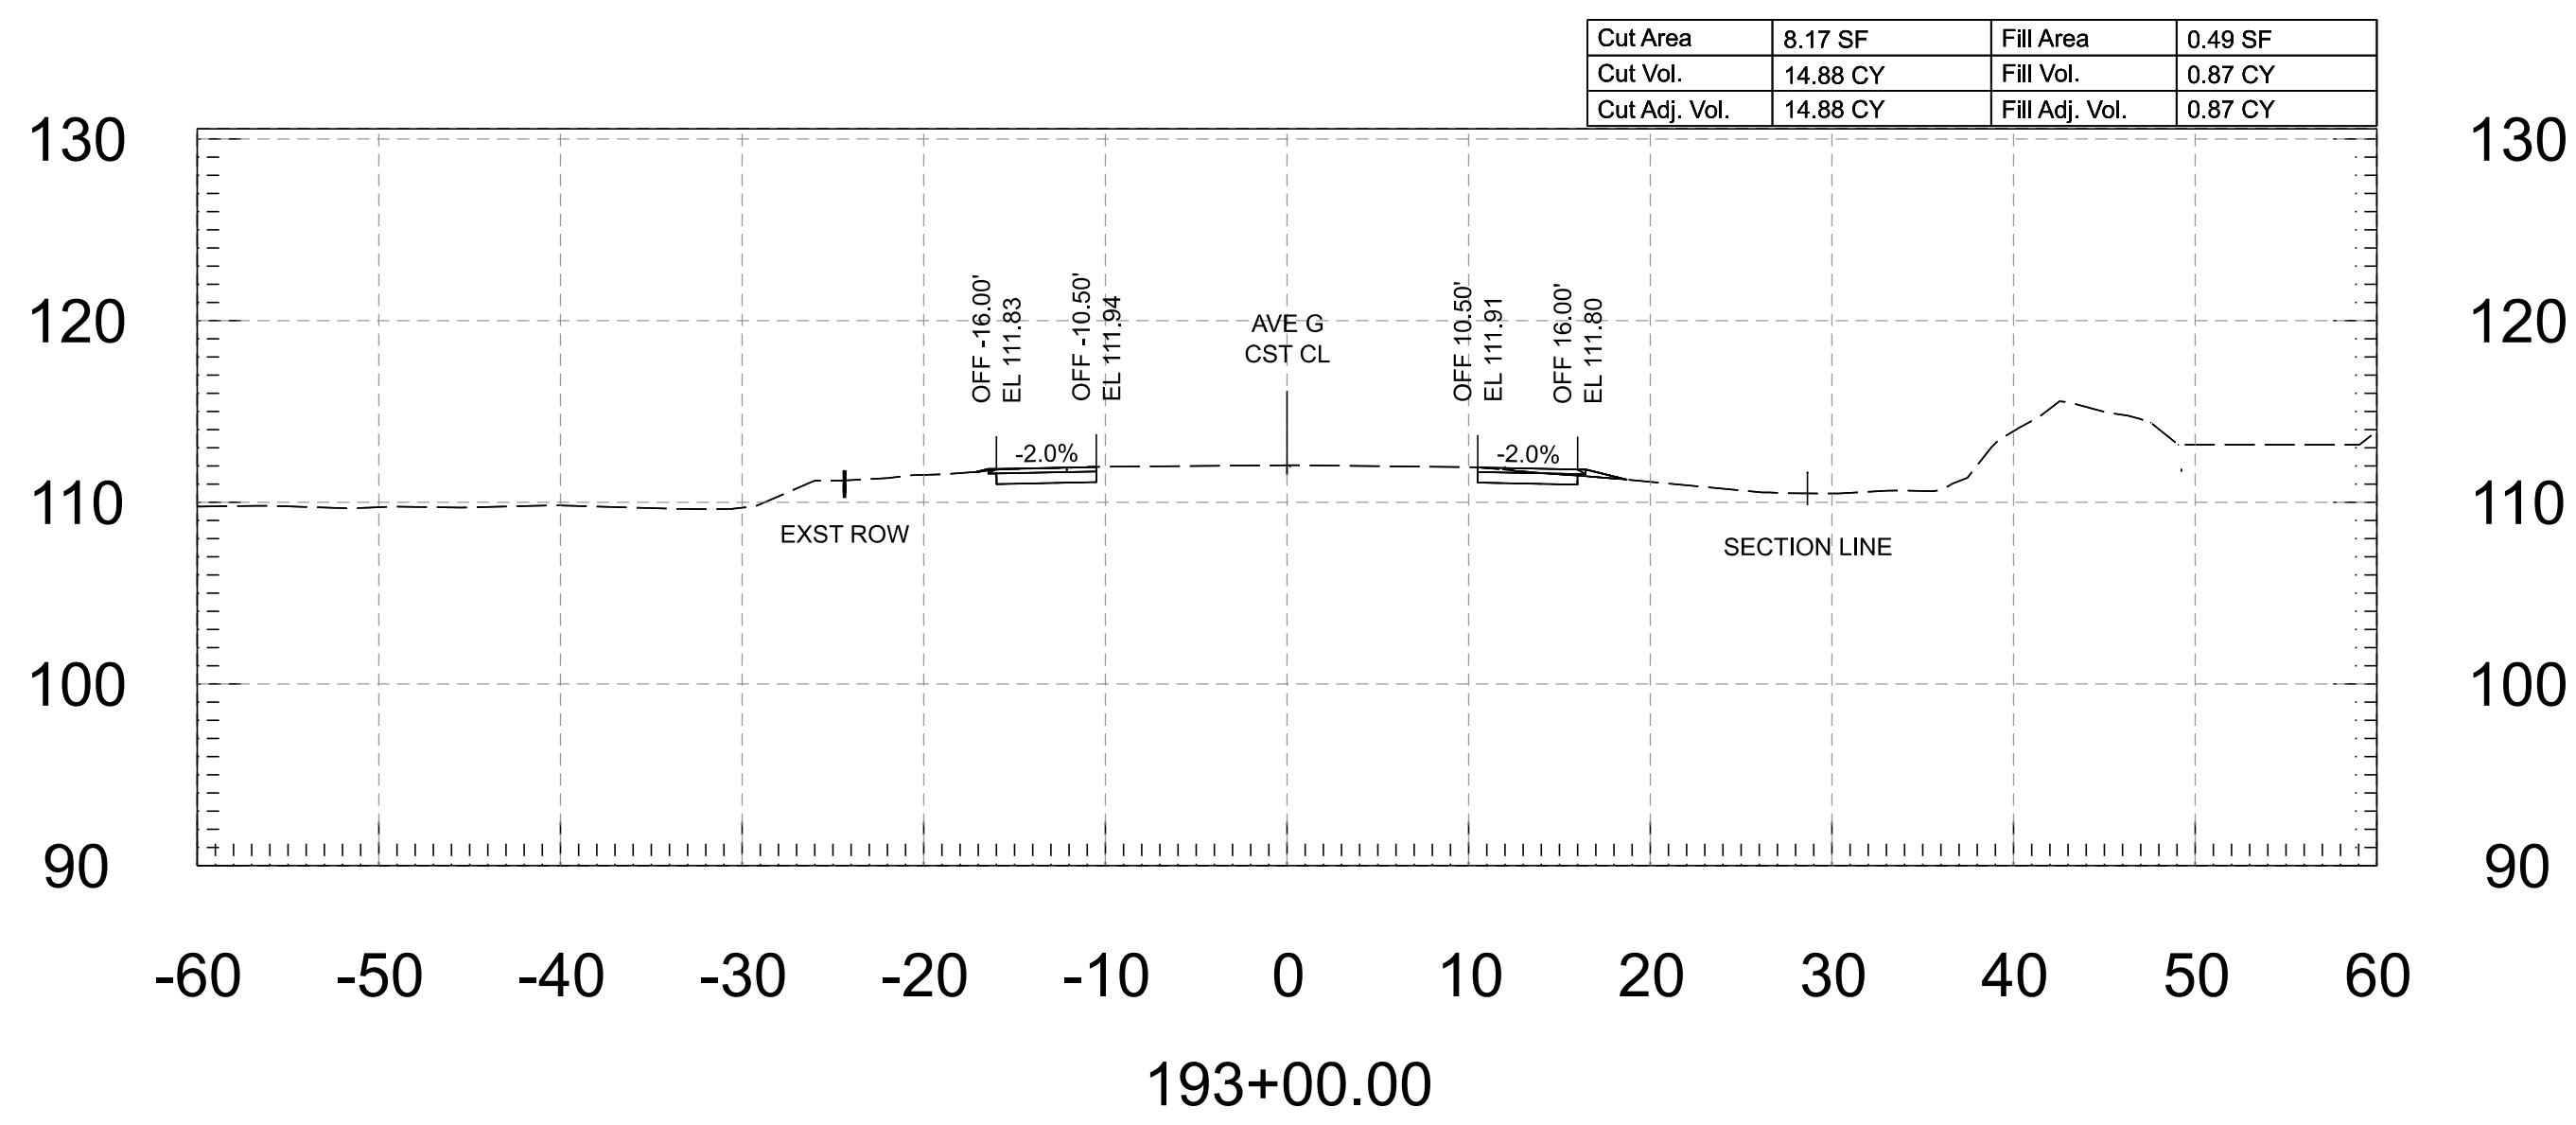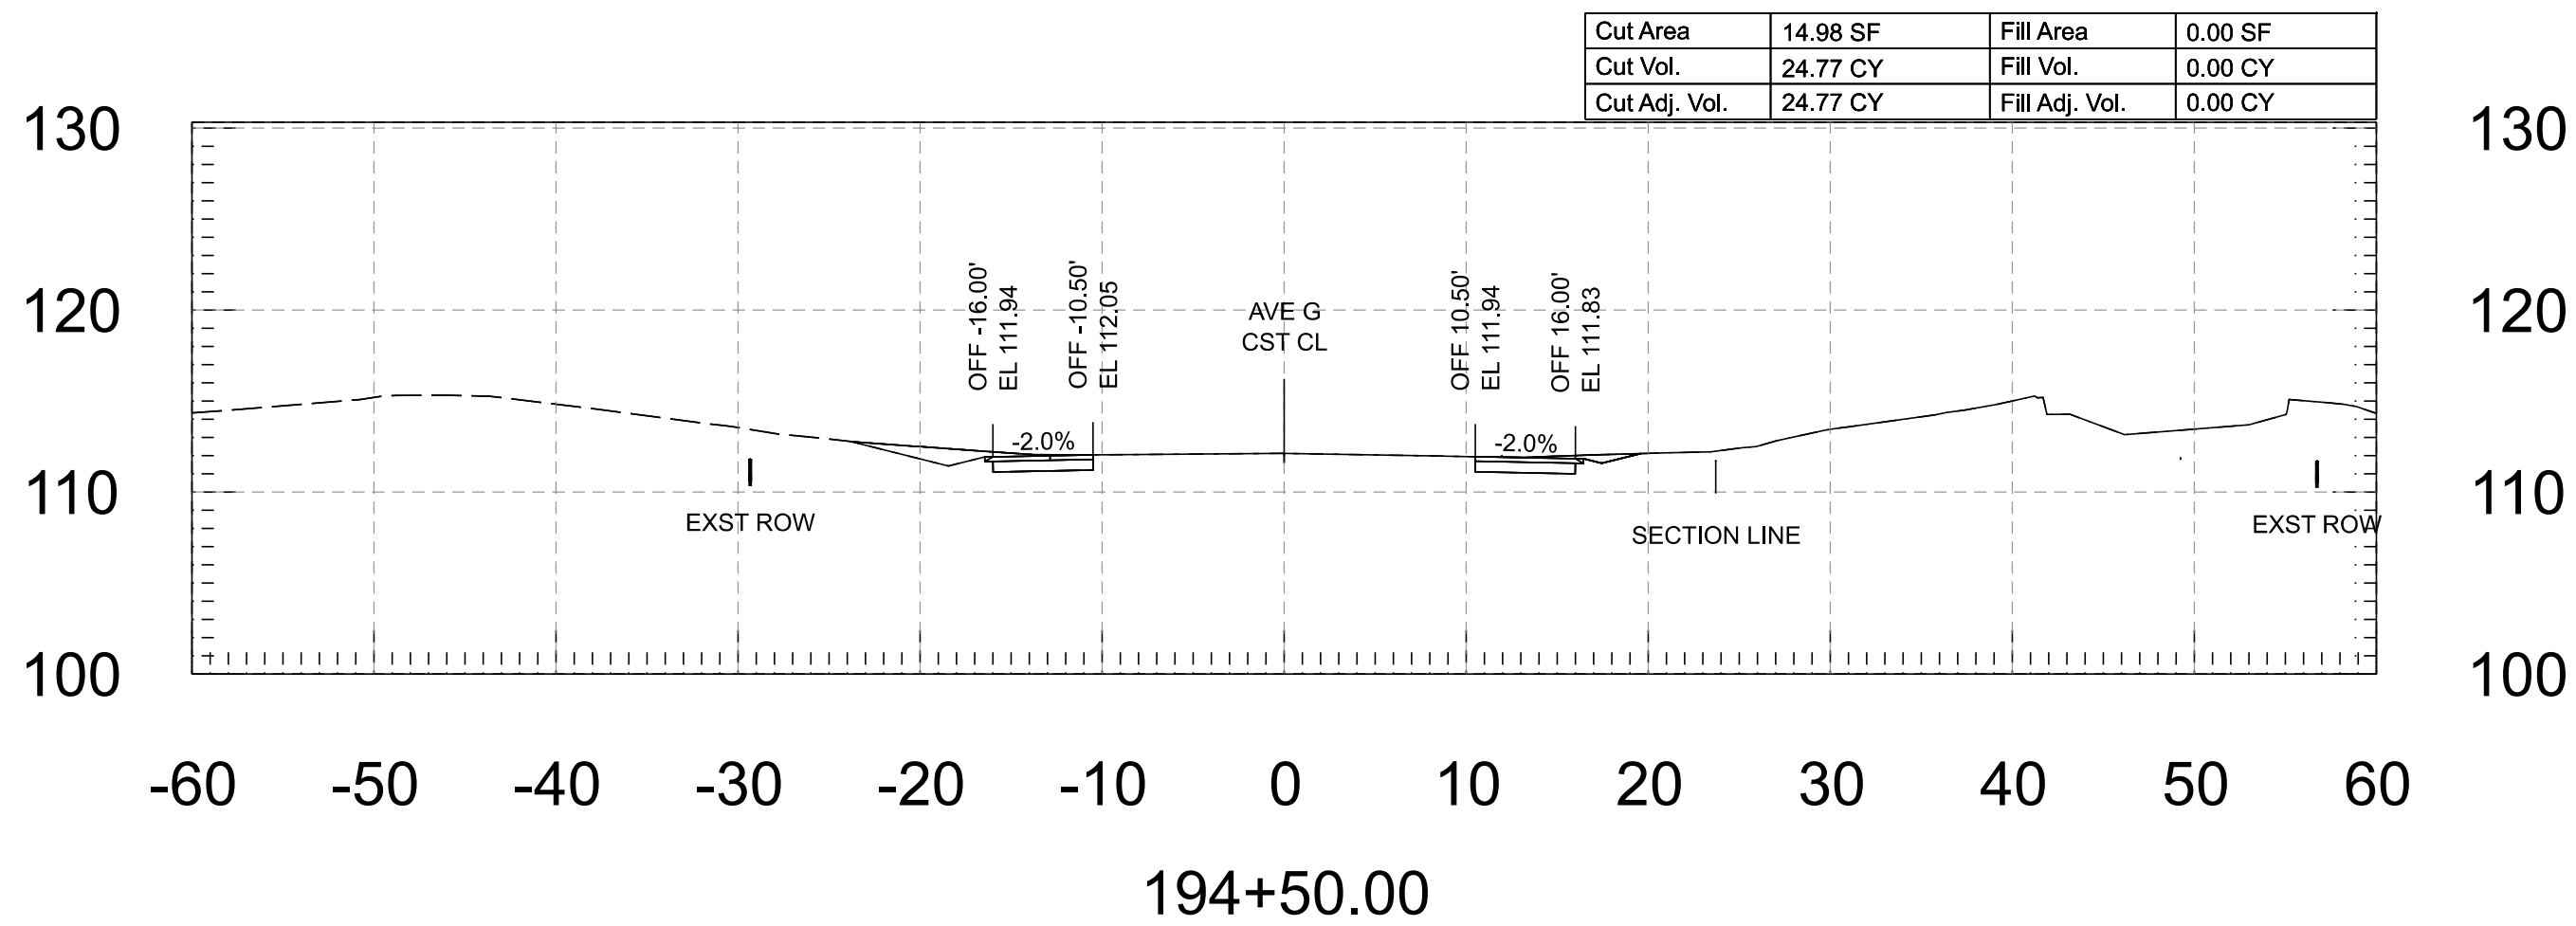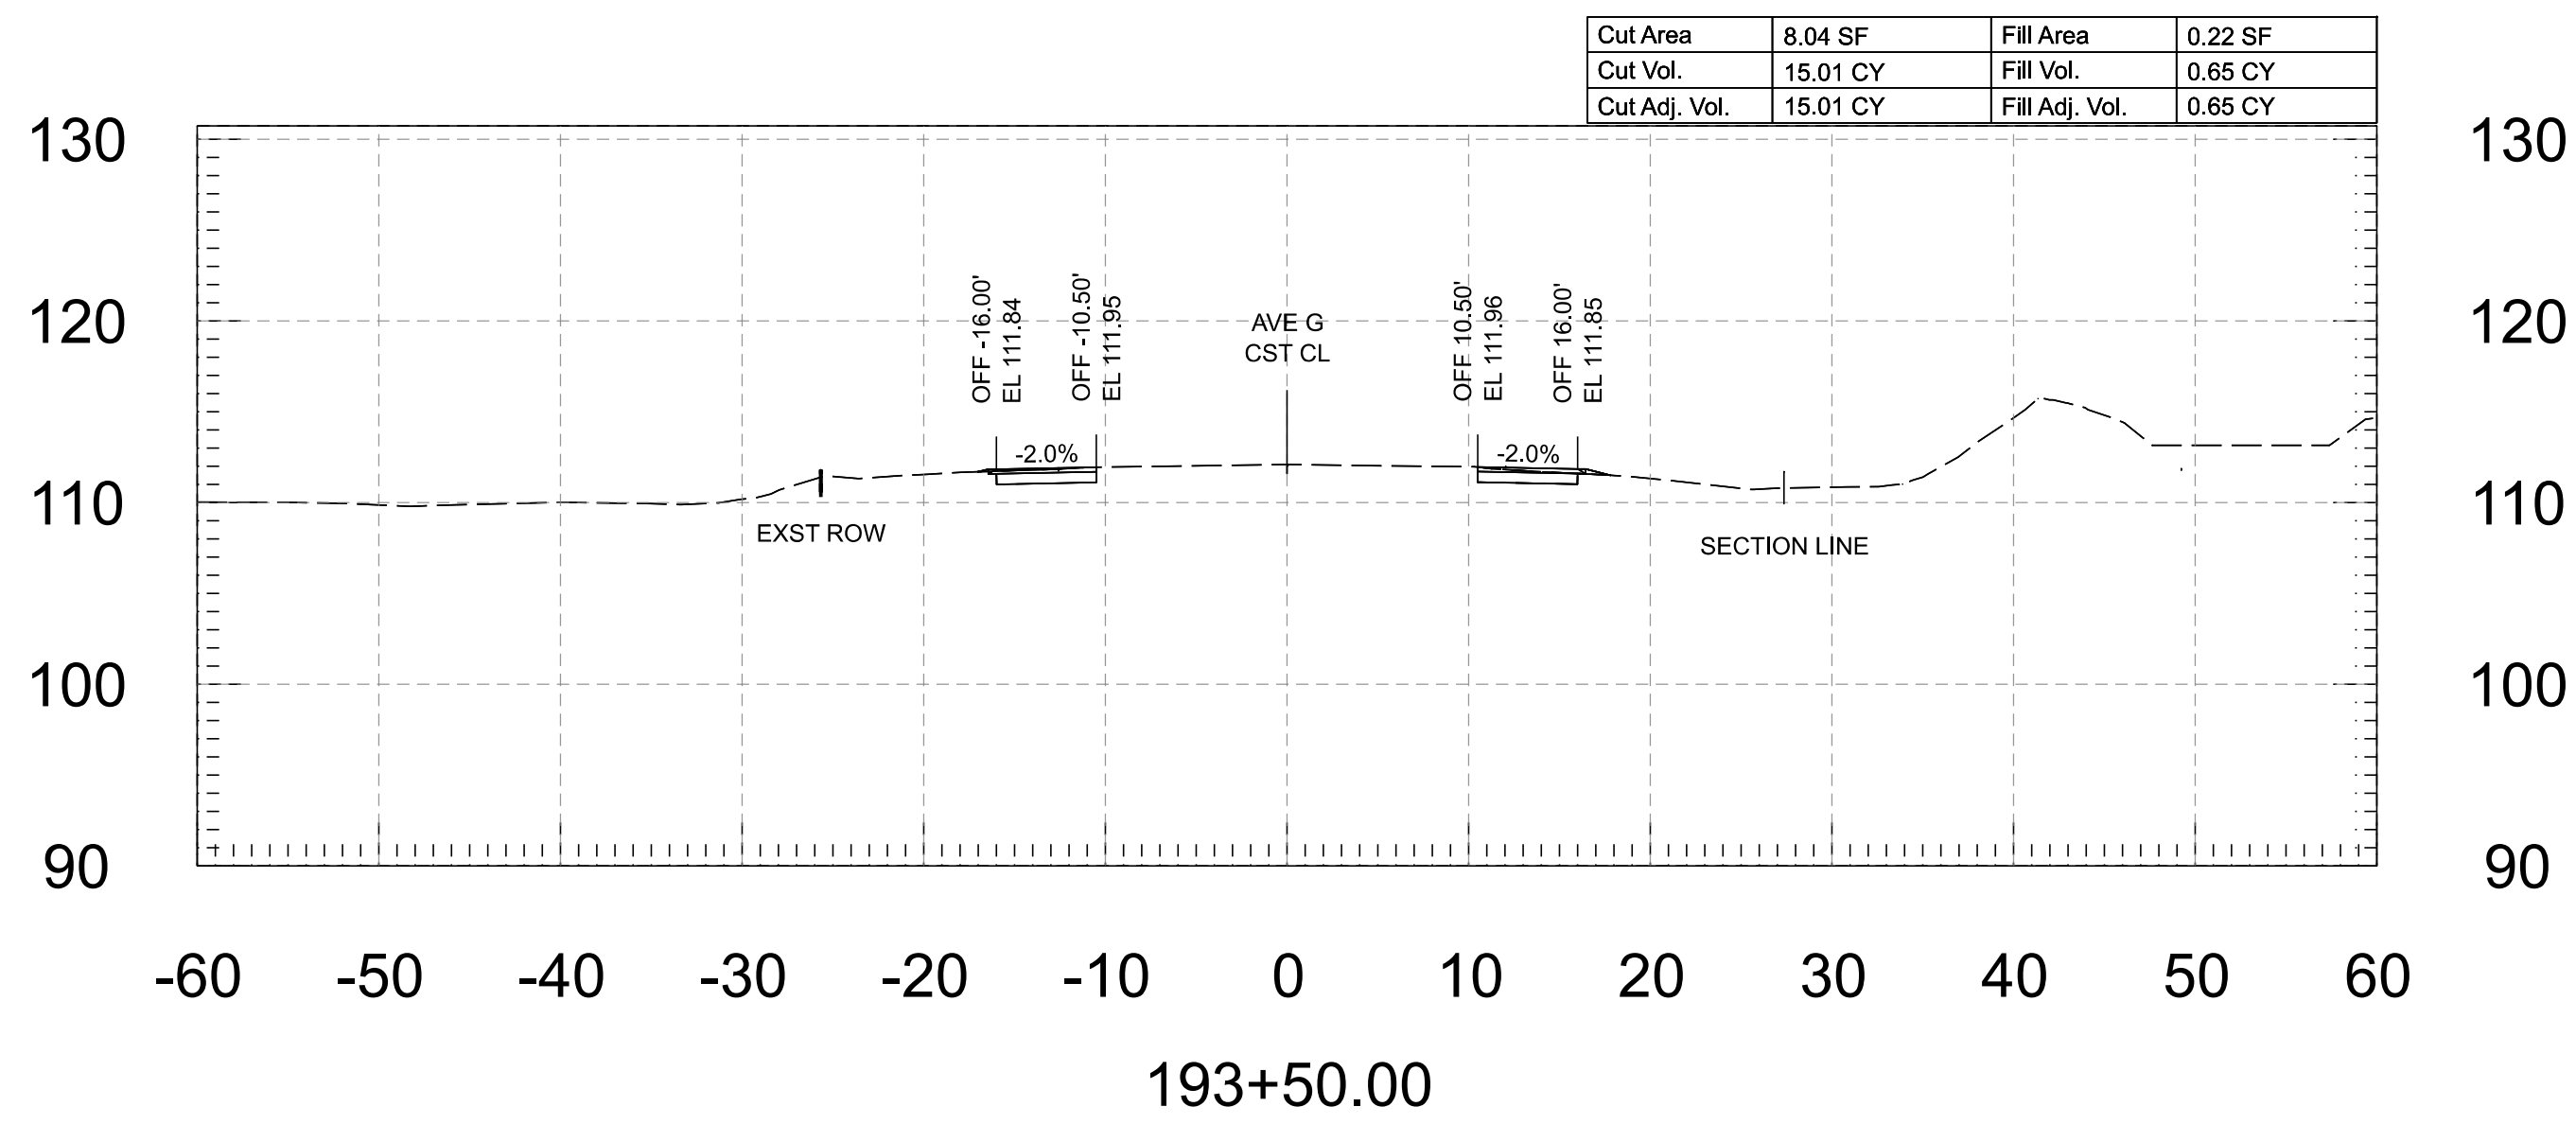






FOR INFORMATION ONLY	DESIGN	NAME	DATE	ARIZONA DEPARTMENT OF TRANSPORTATION PROJECT DELIVERY AND OPERATIONS DIVISION ROADWAY DESIGN SERVICES	ROUTE	F.H.W.A. Arizona Division	STATE ARIZ.	PROJECT NO.	FEDERAL ID NO.	SHEET NO.	TOTAL SHEETS	RECORD DRAWING
	DRAWN	M. SCHOEN	07/26		MILEPOST			0000 YU YYU	YYU-0(225)T	90	118	
	CHECKED	H. RIOS	07/26		STRUCTURE NO.			LOCATION AVENUE G, COUNTY 11TH ST - COUNTY 16TH ST			DWG	
								TRACS NO. T0437 01C			____ OF ____	

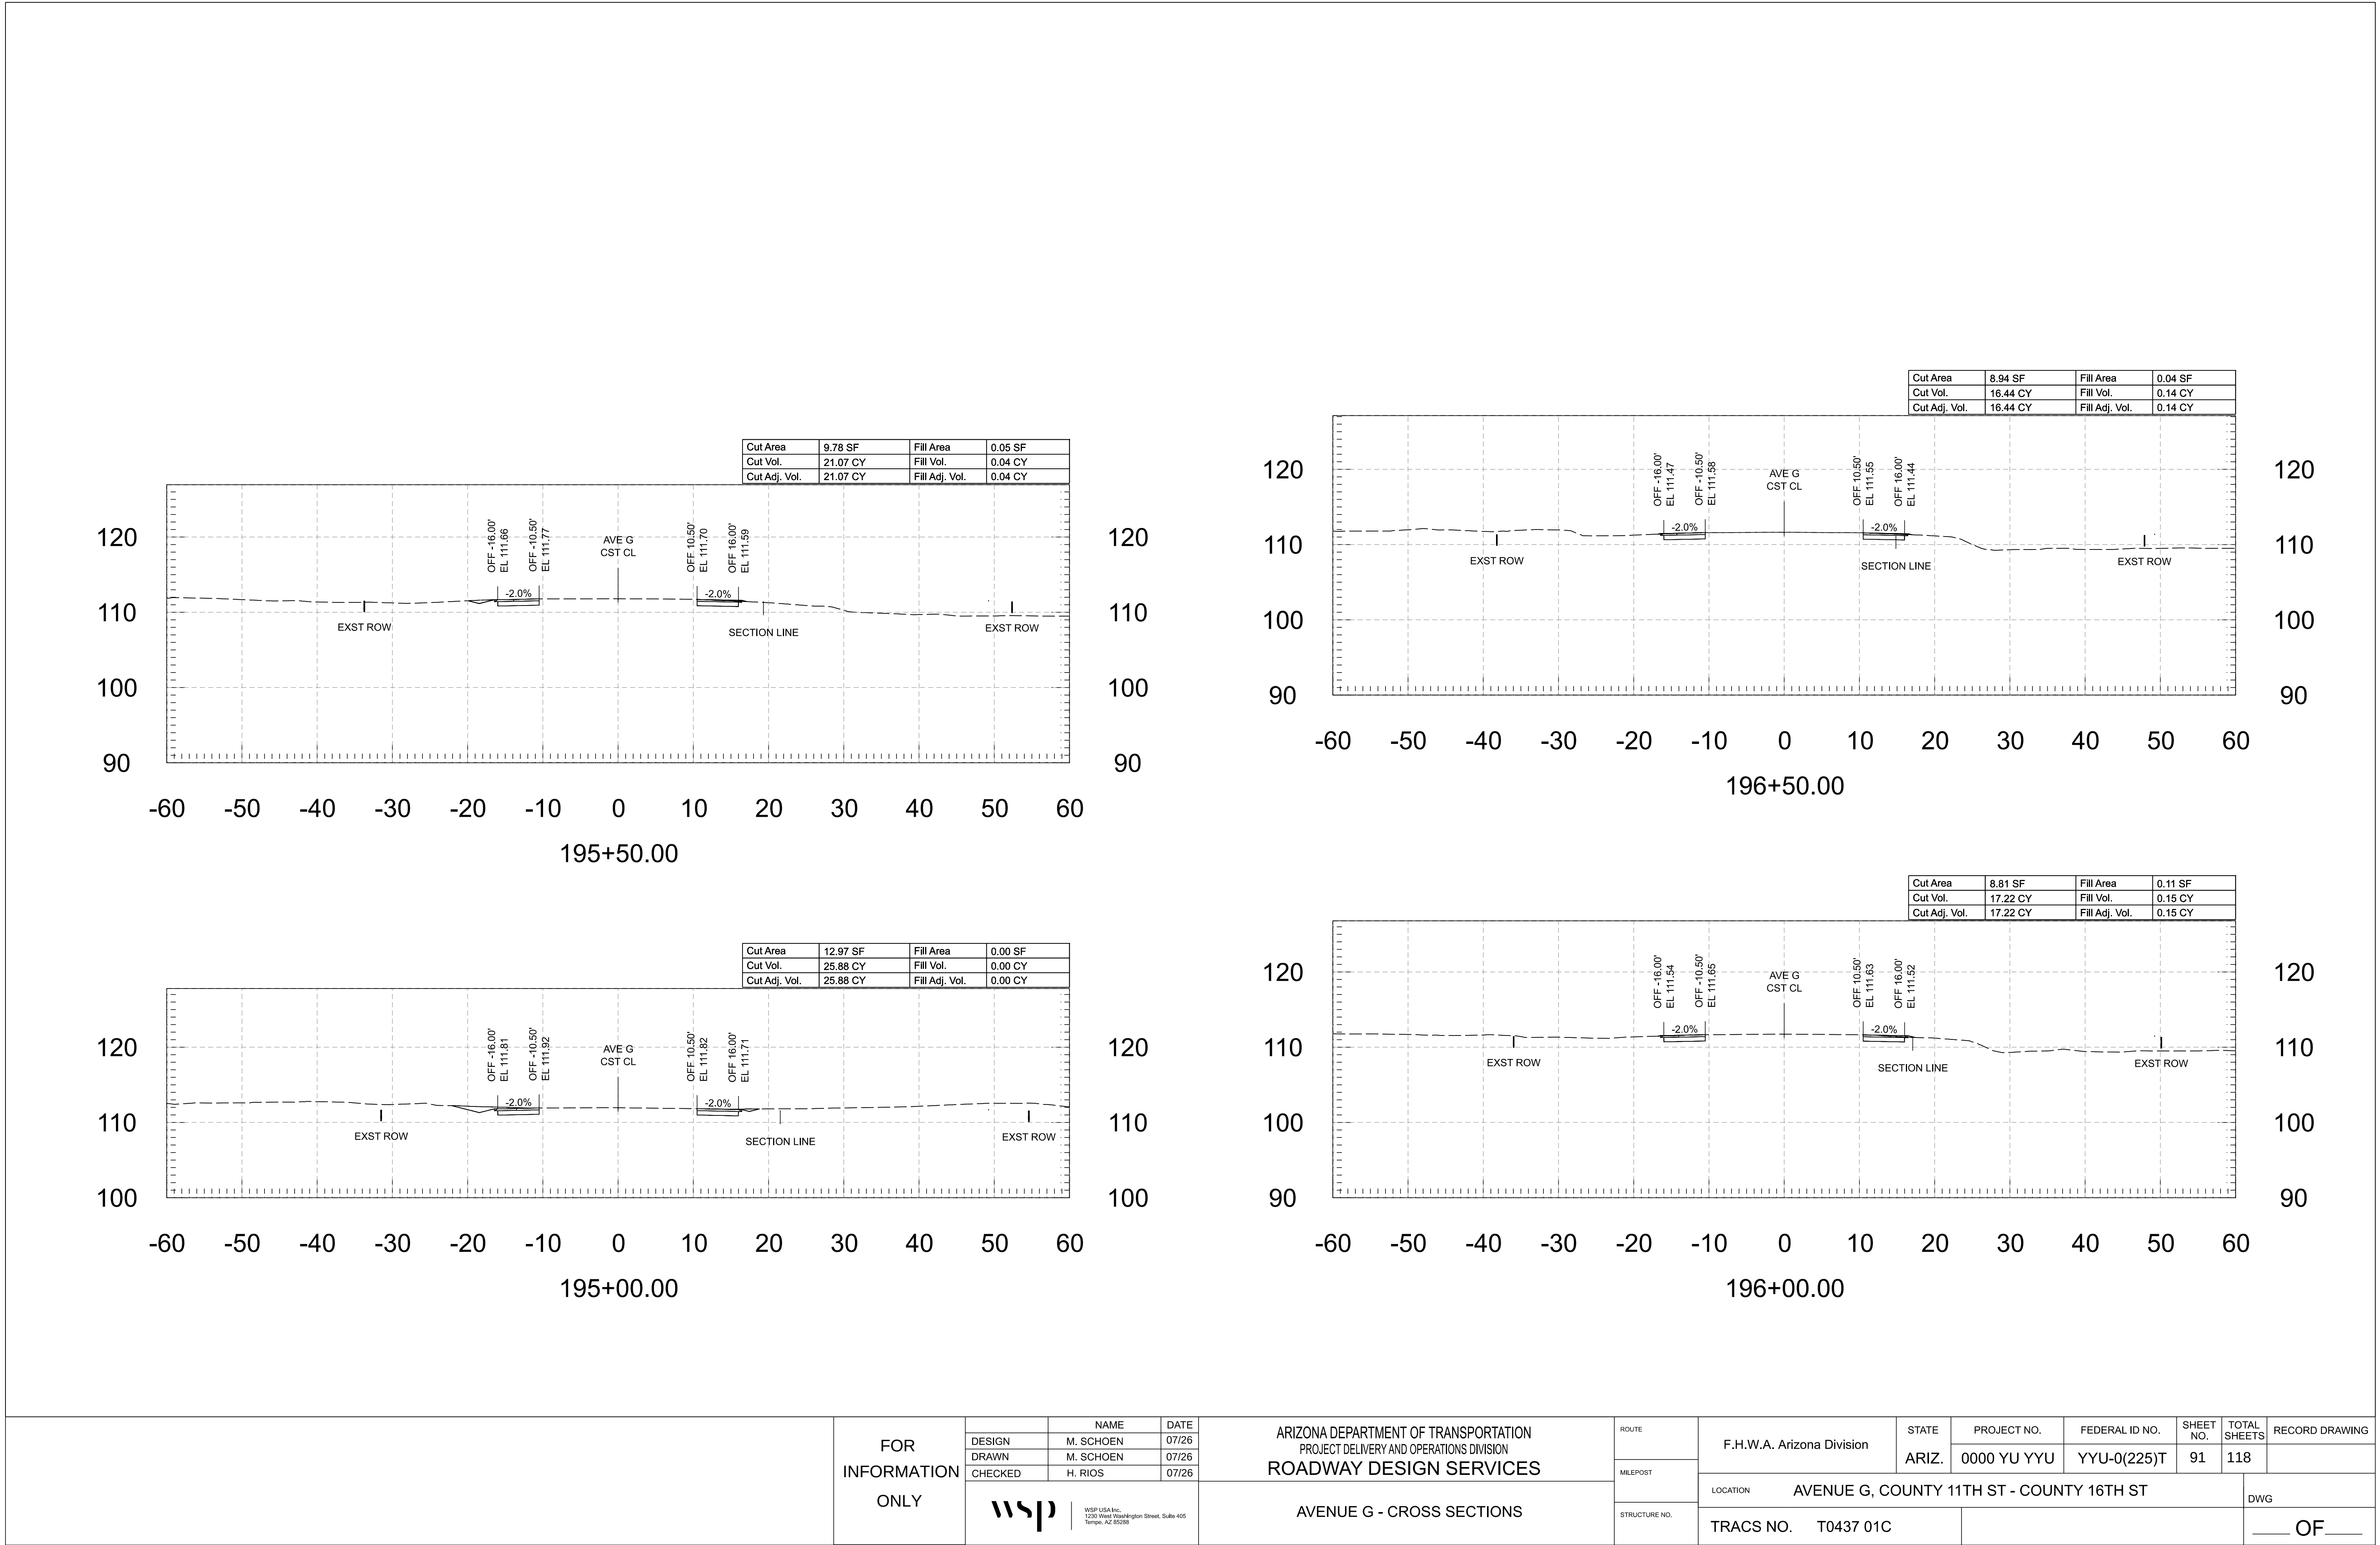





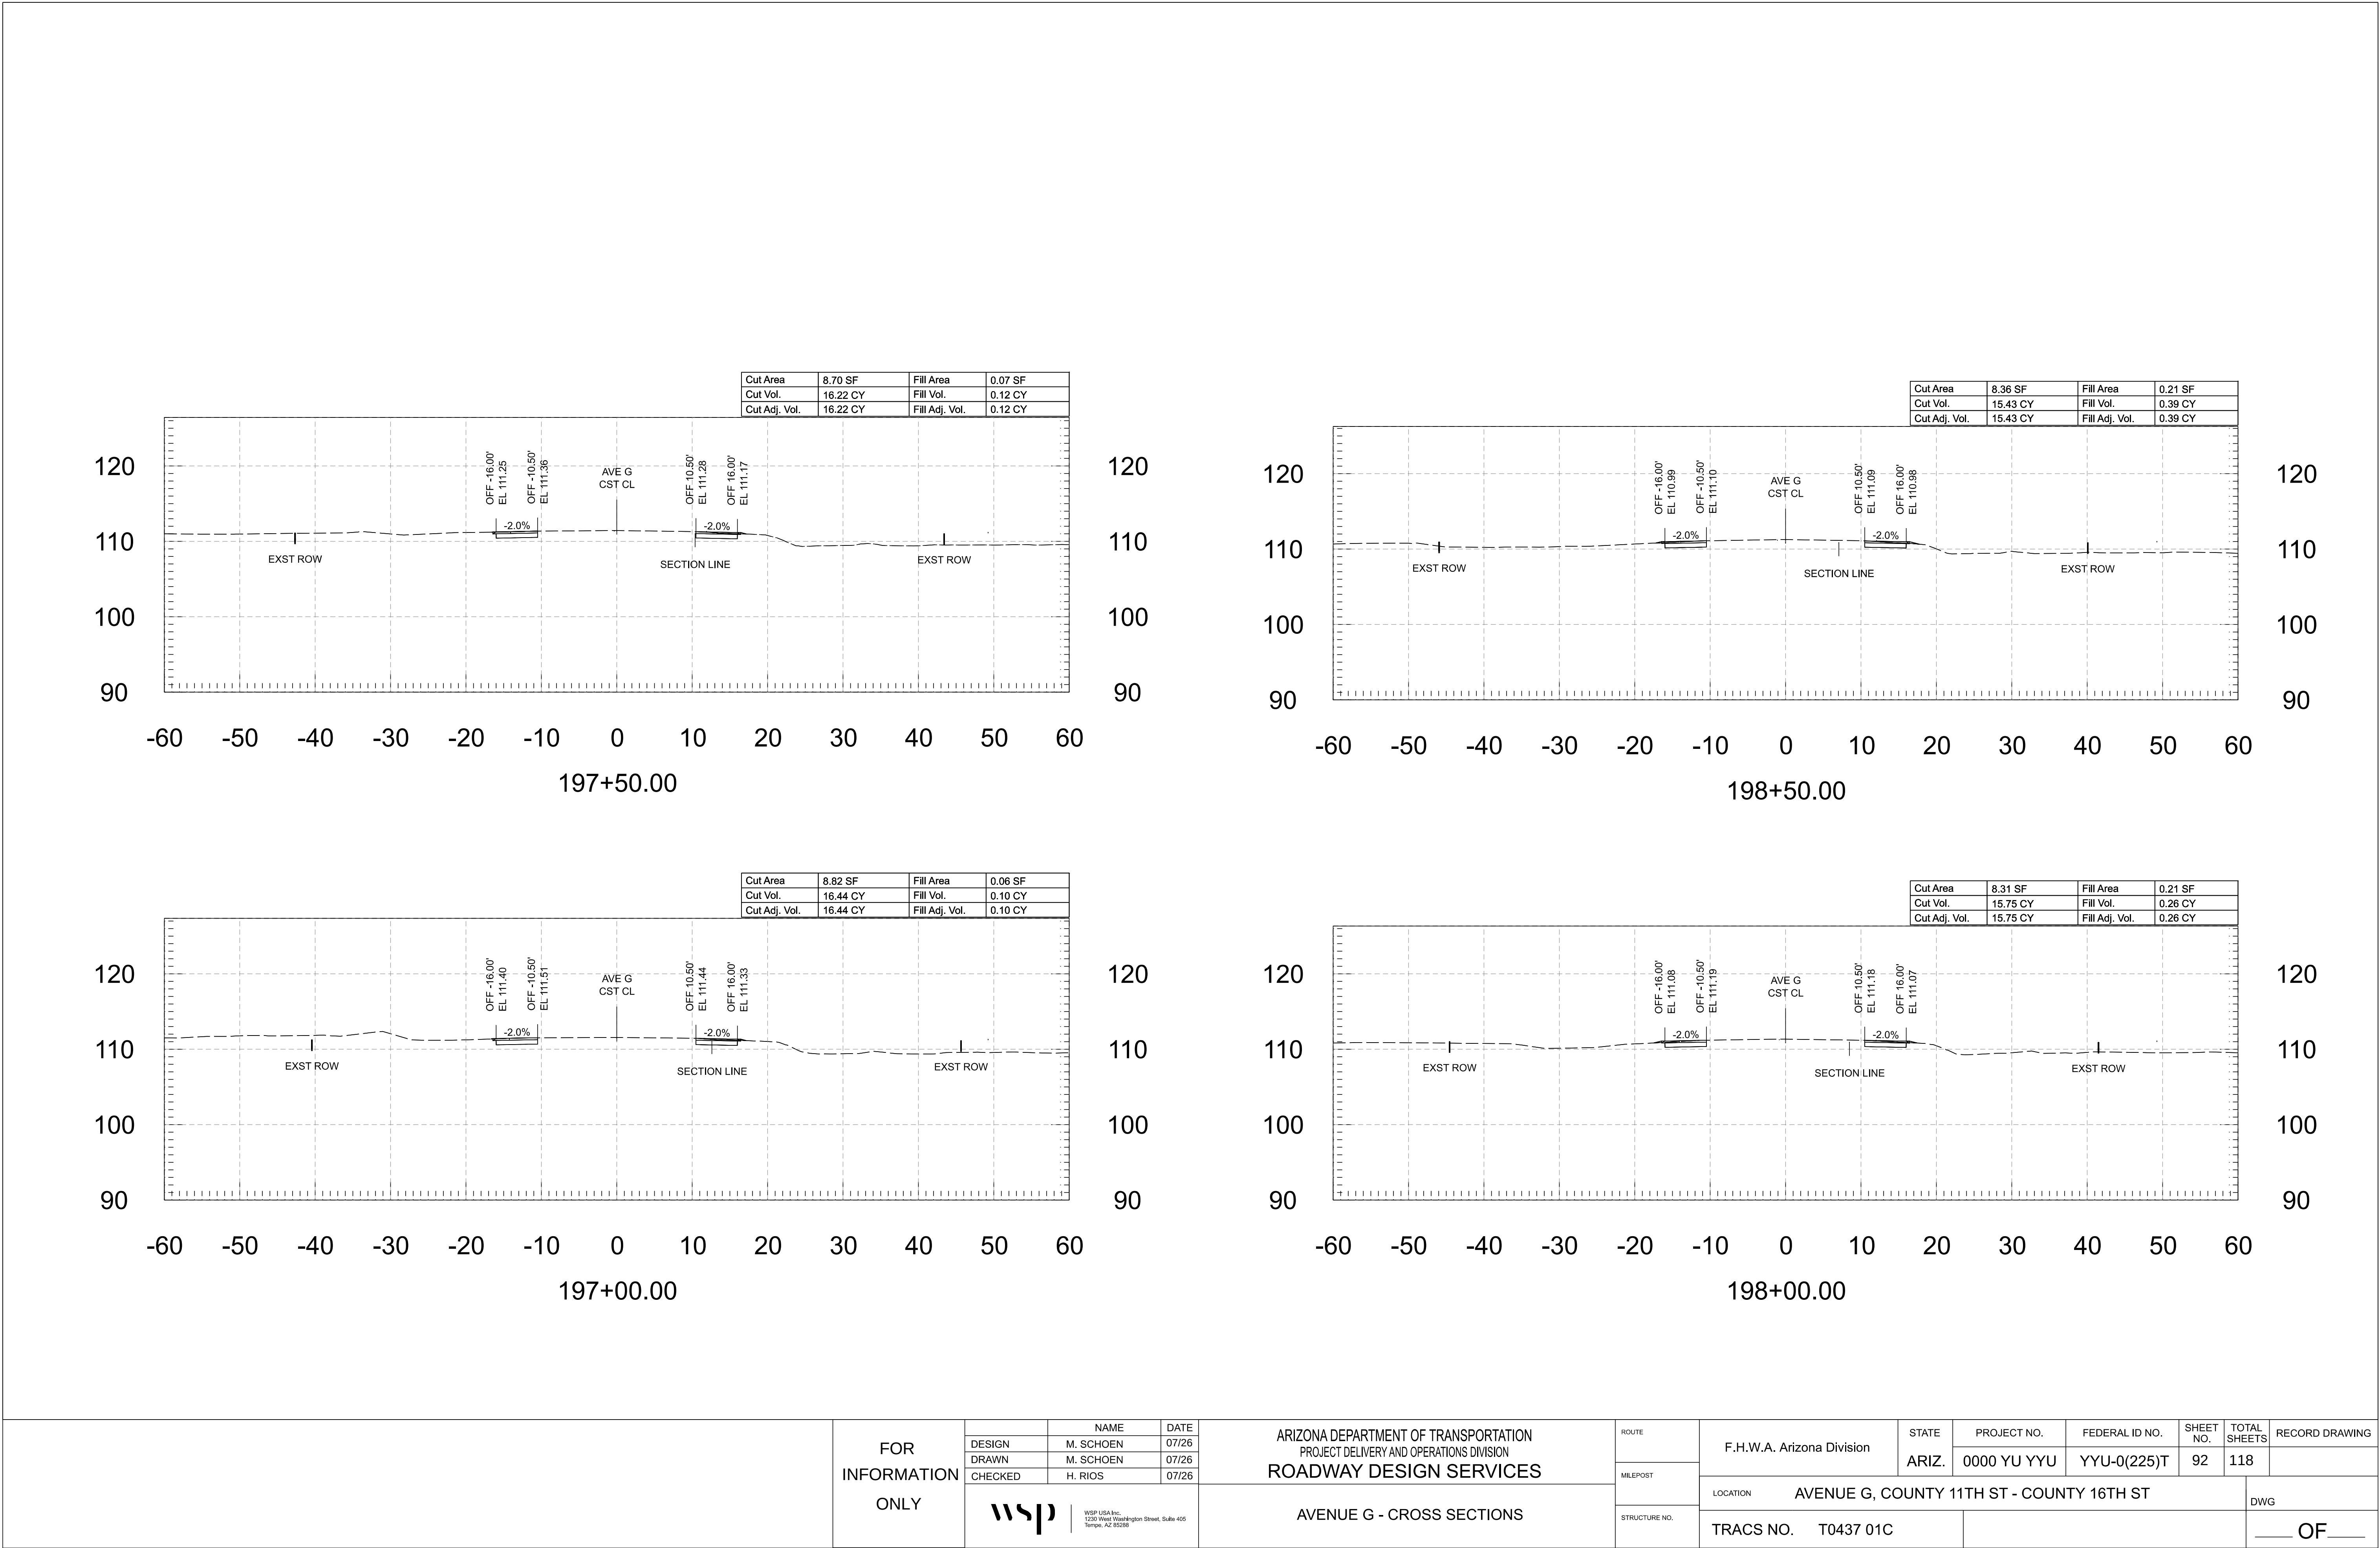


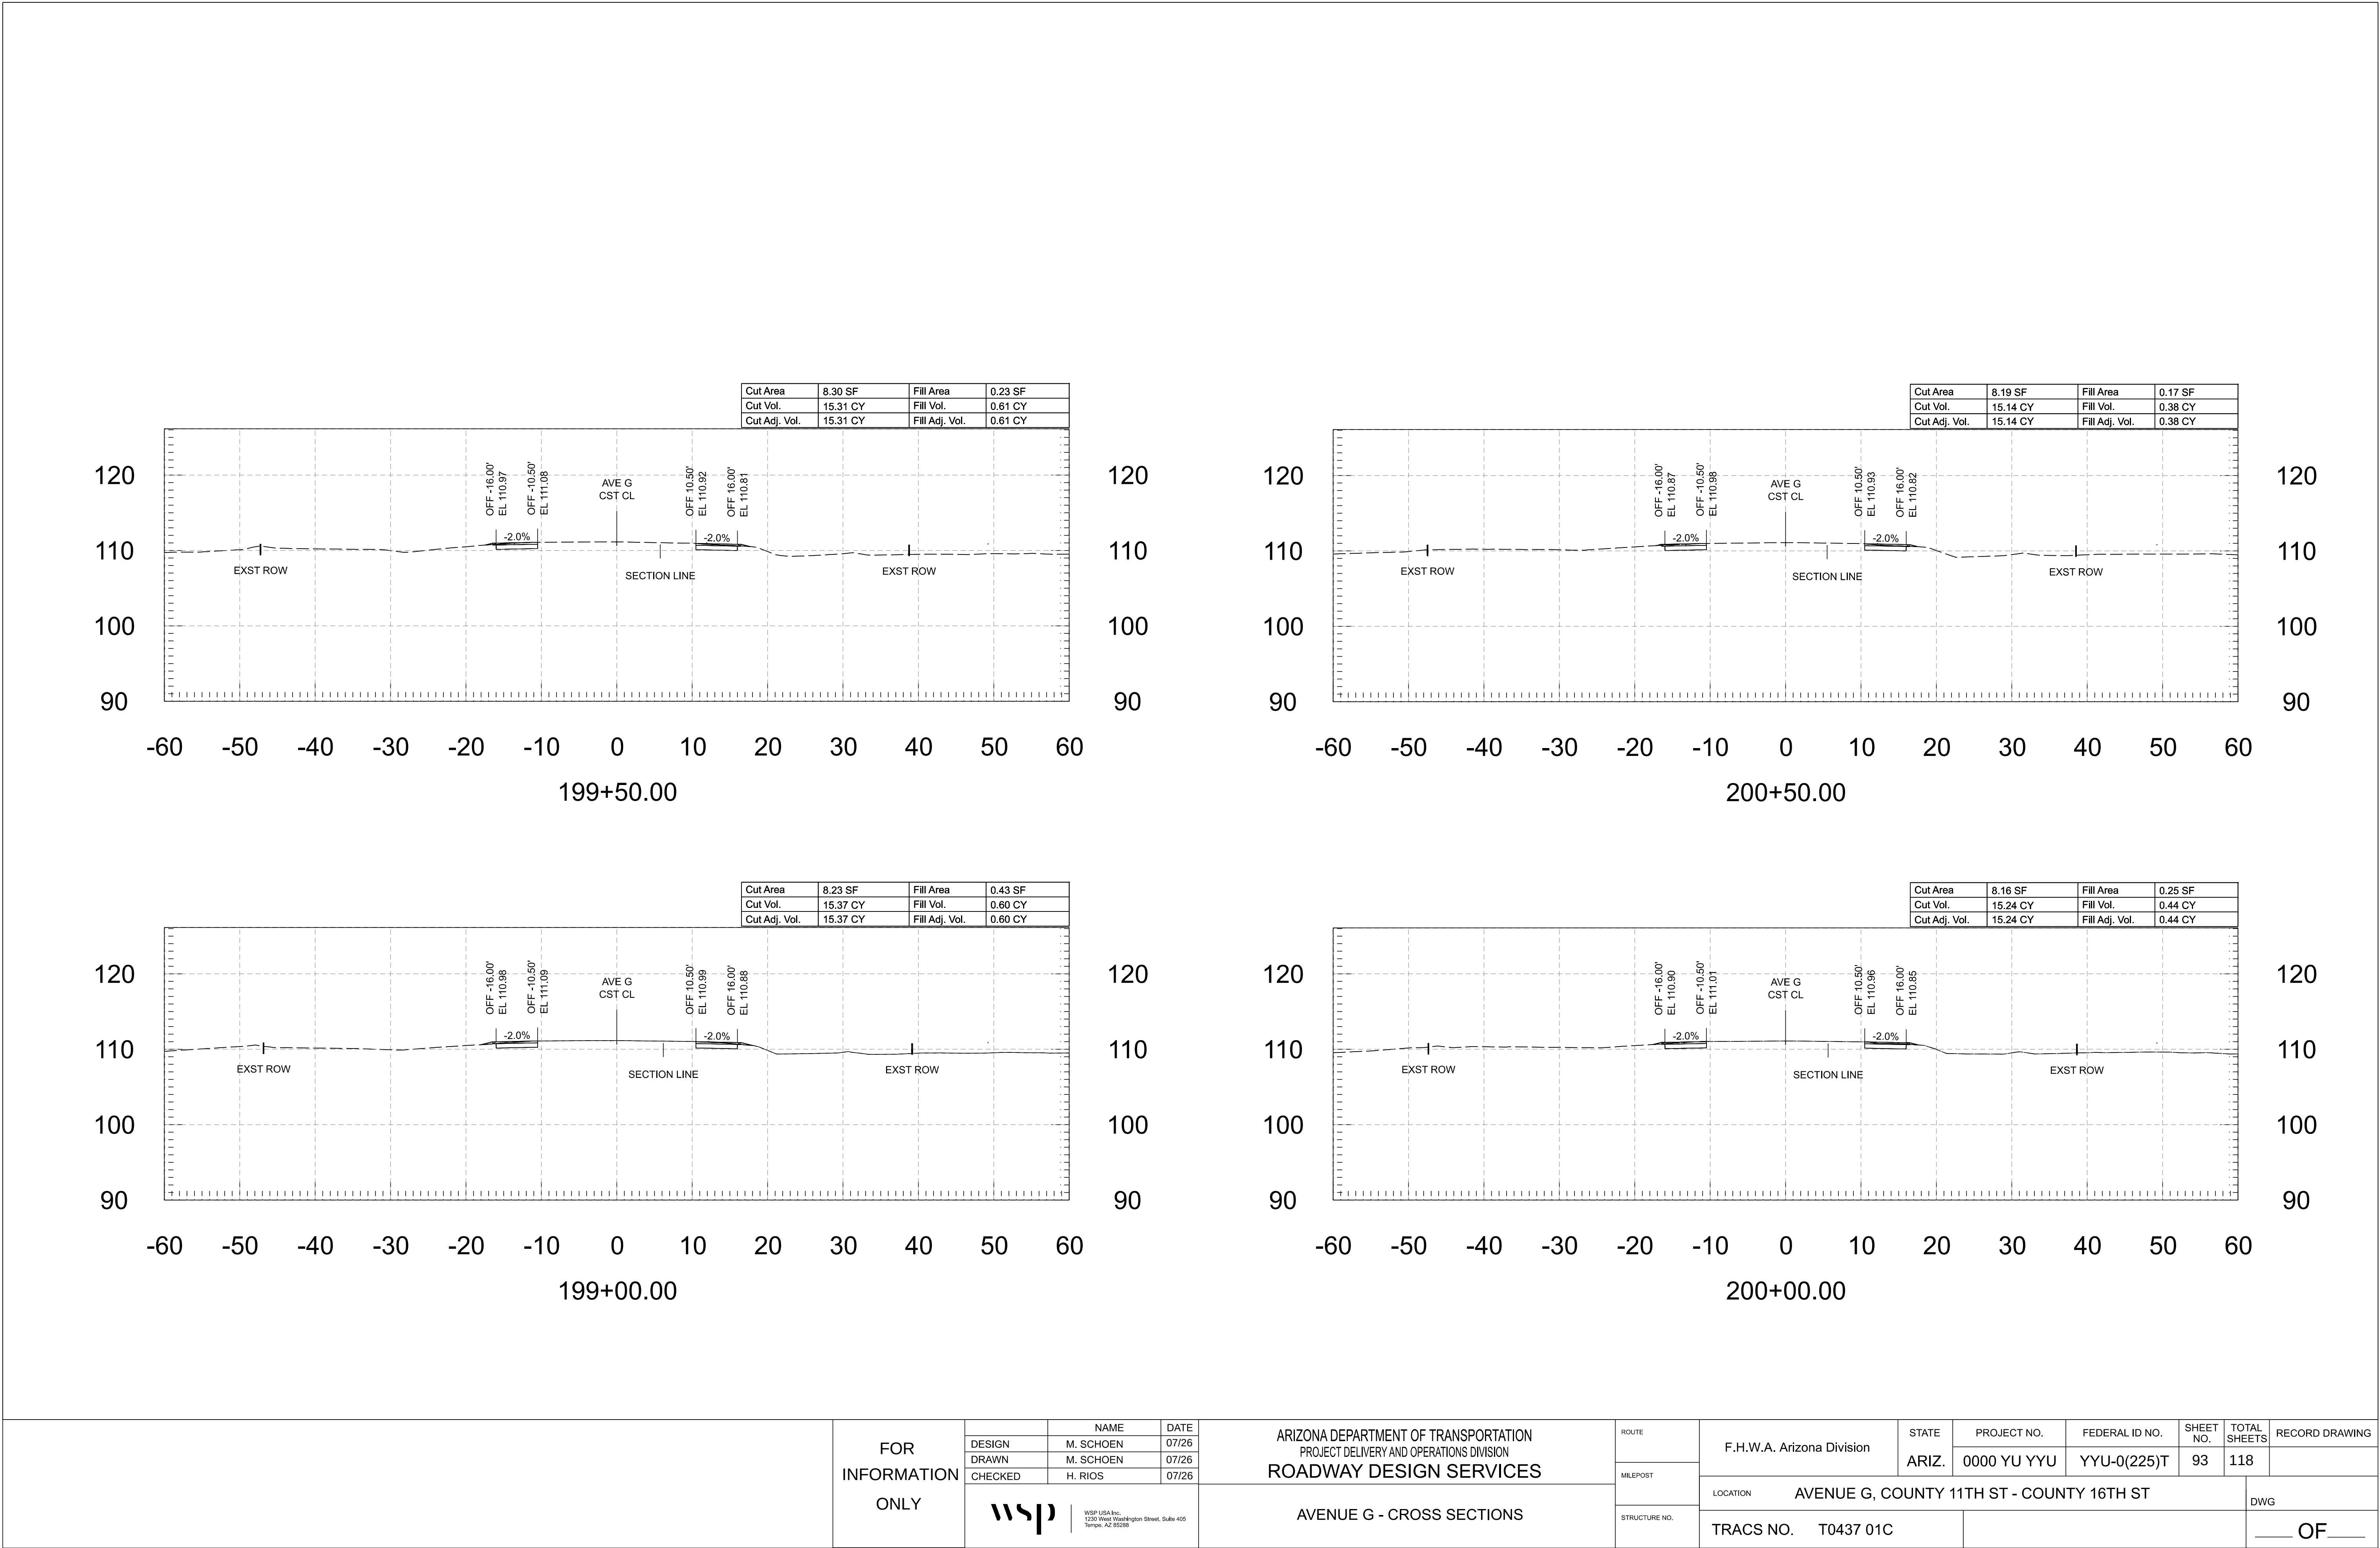

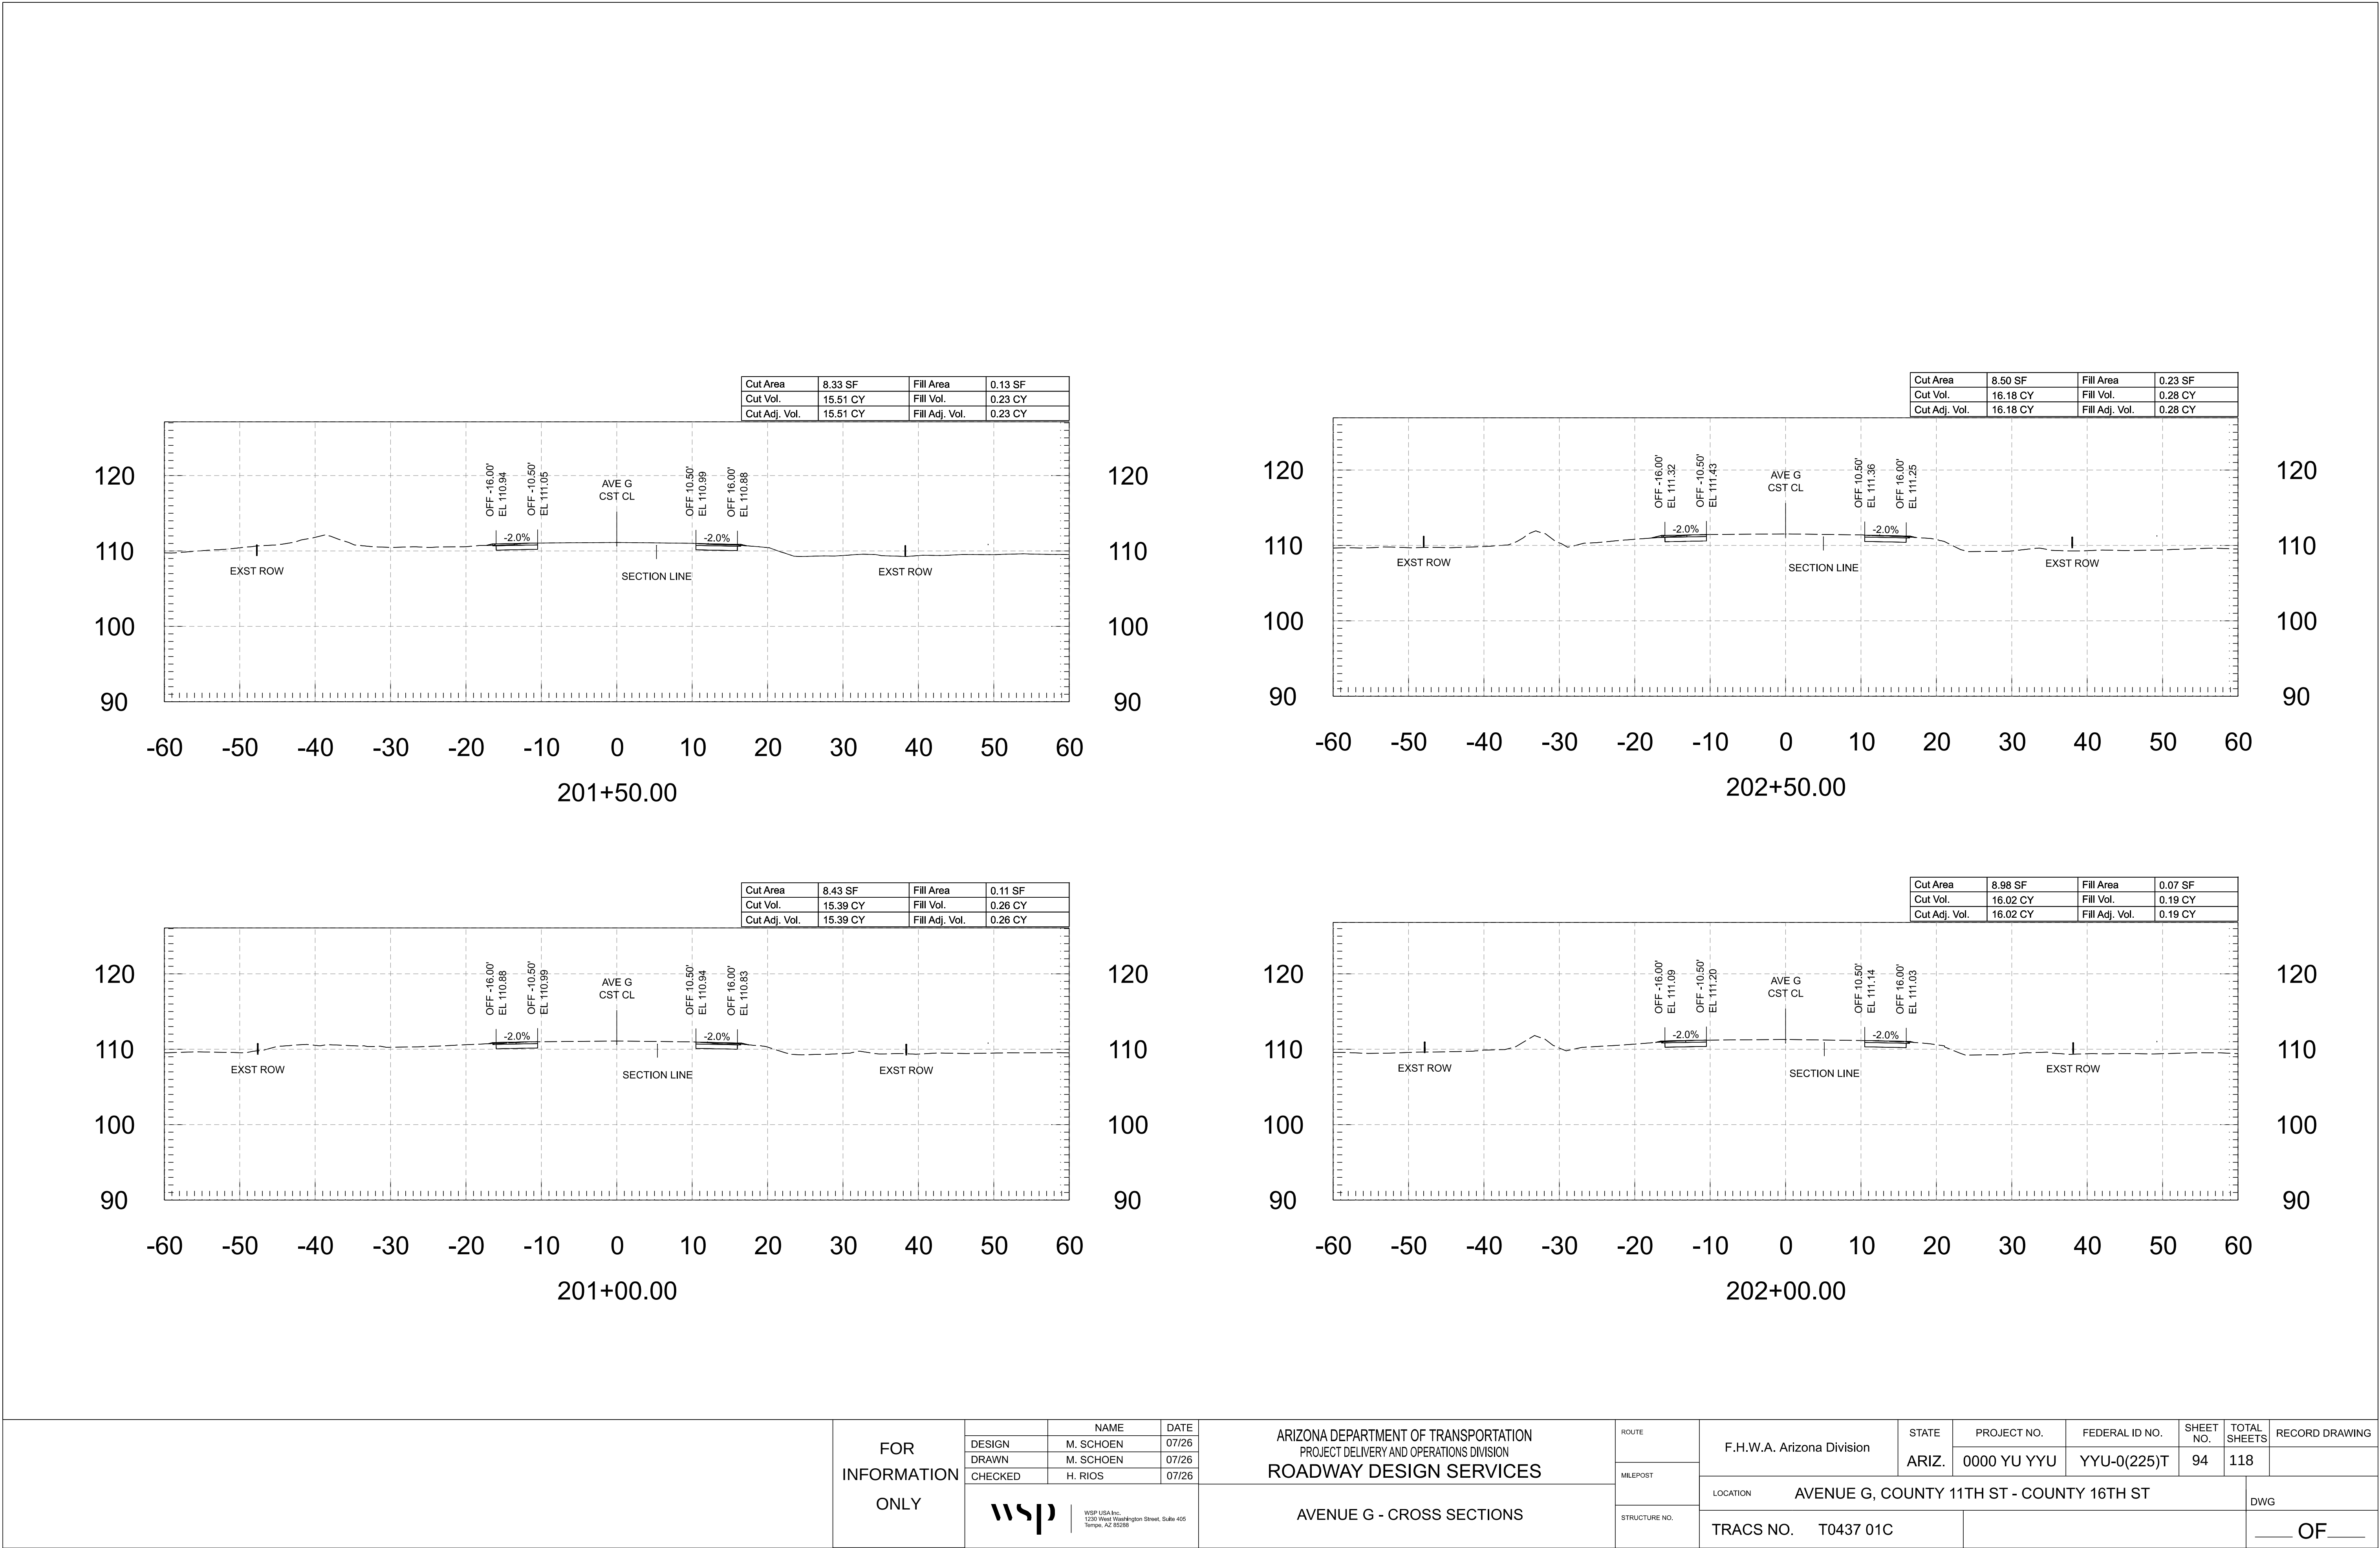

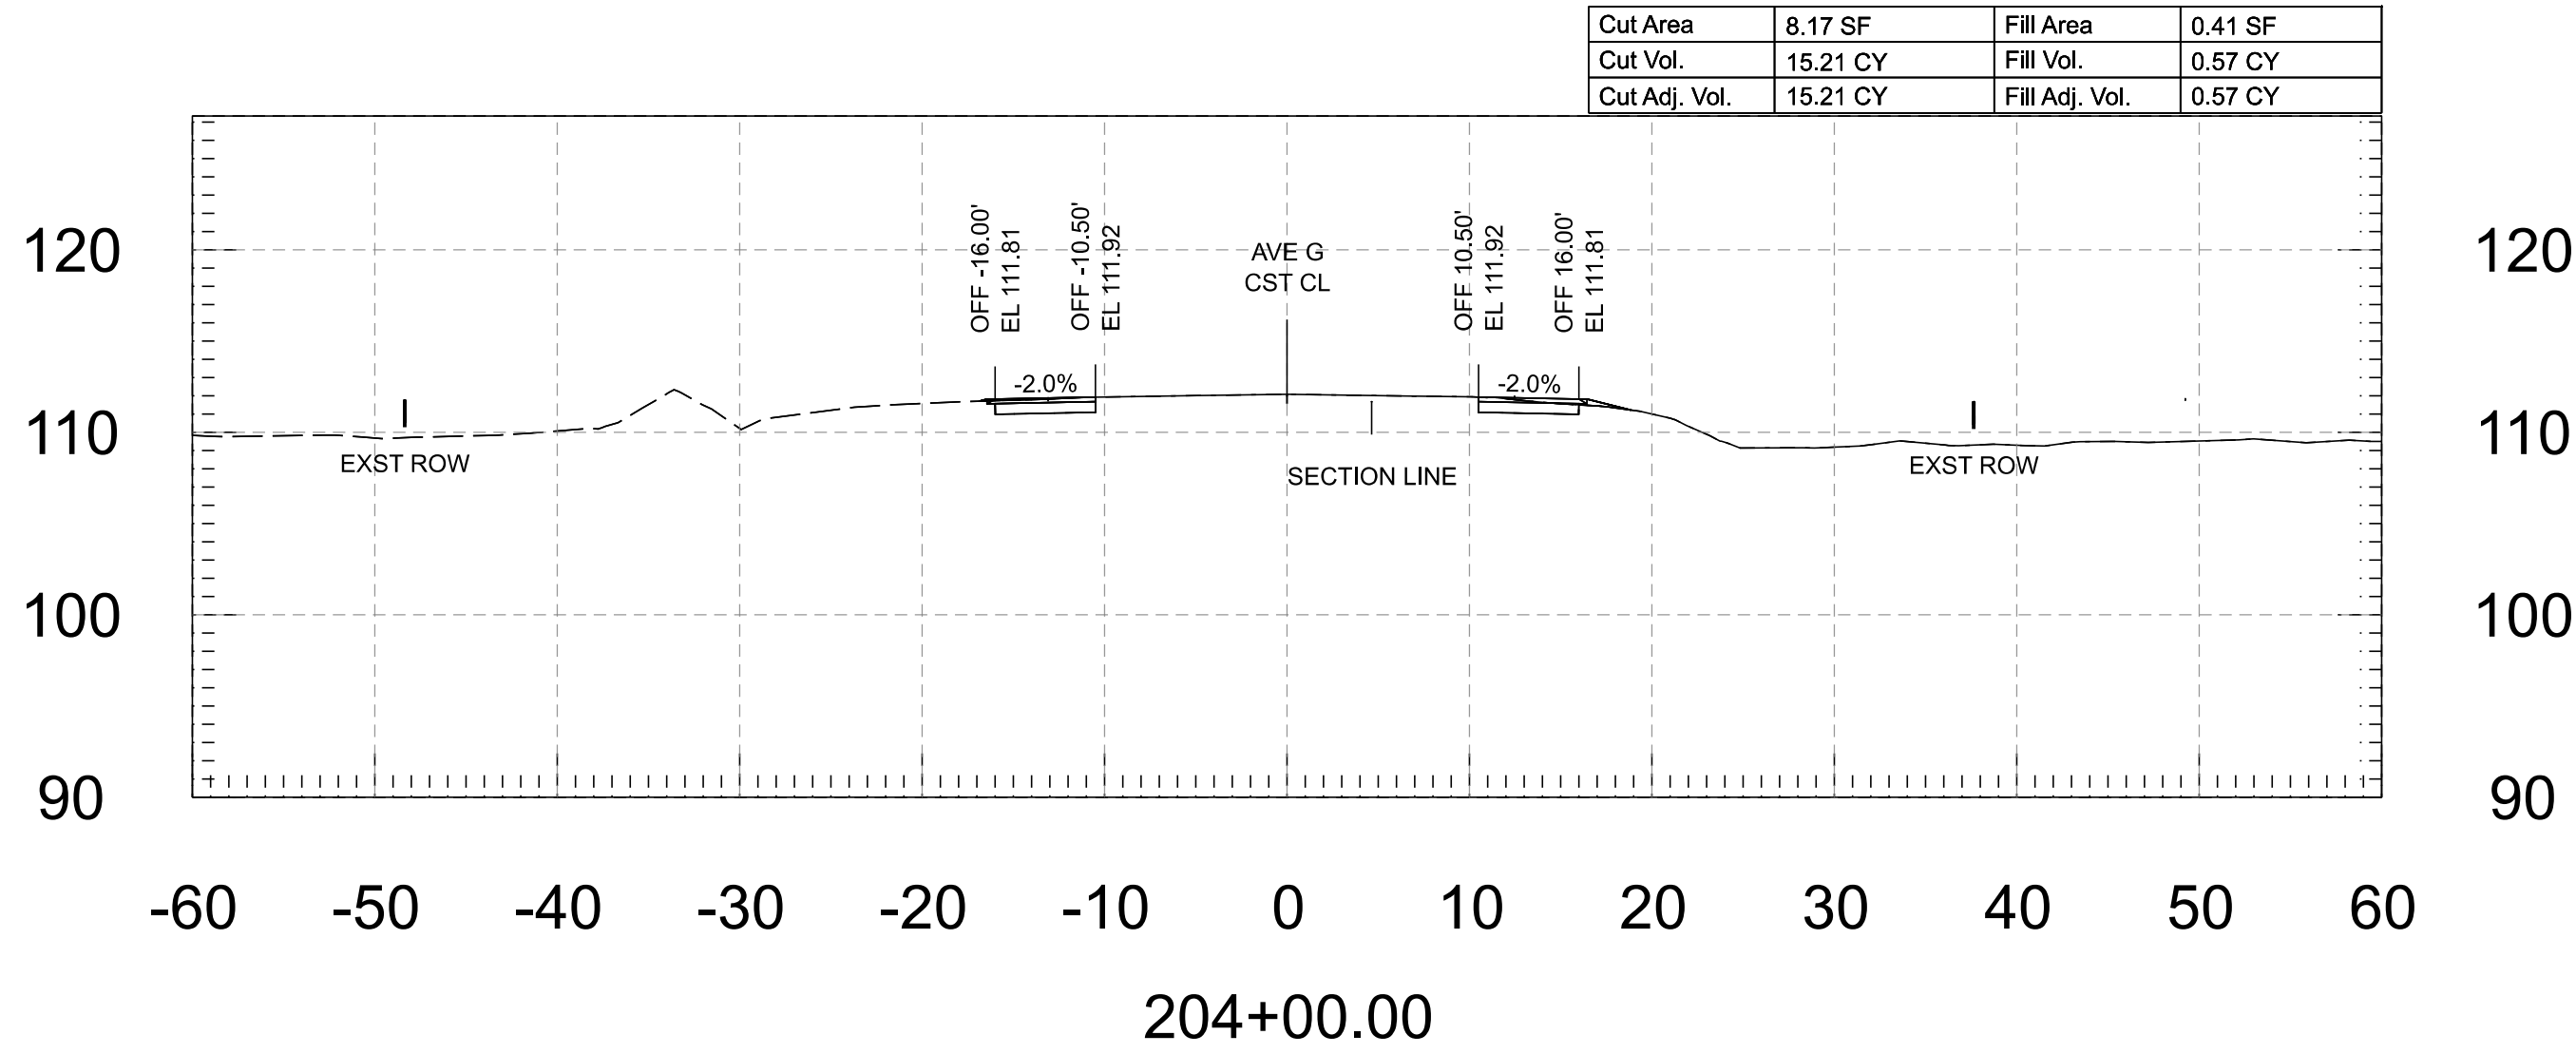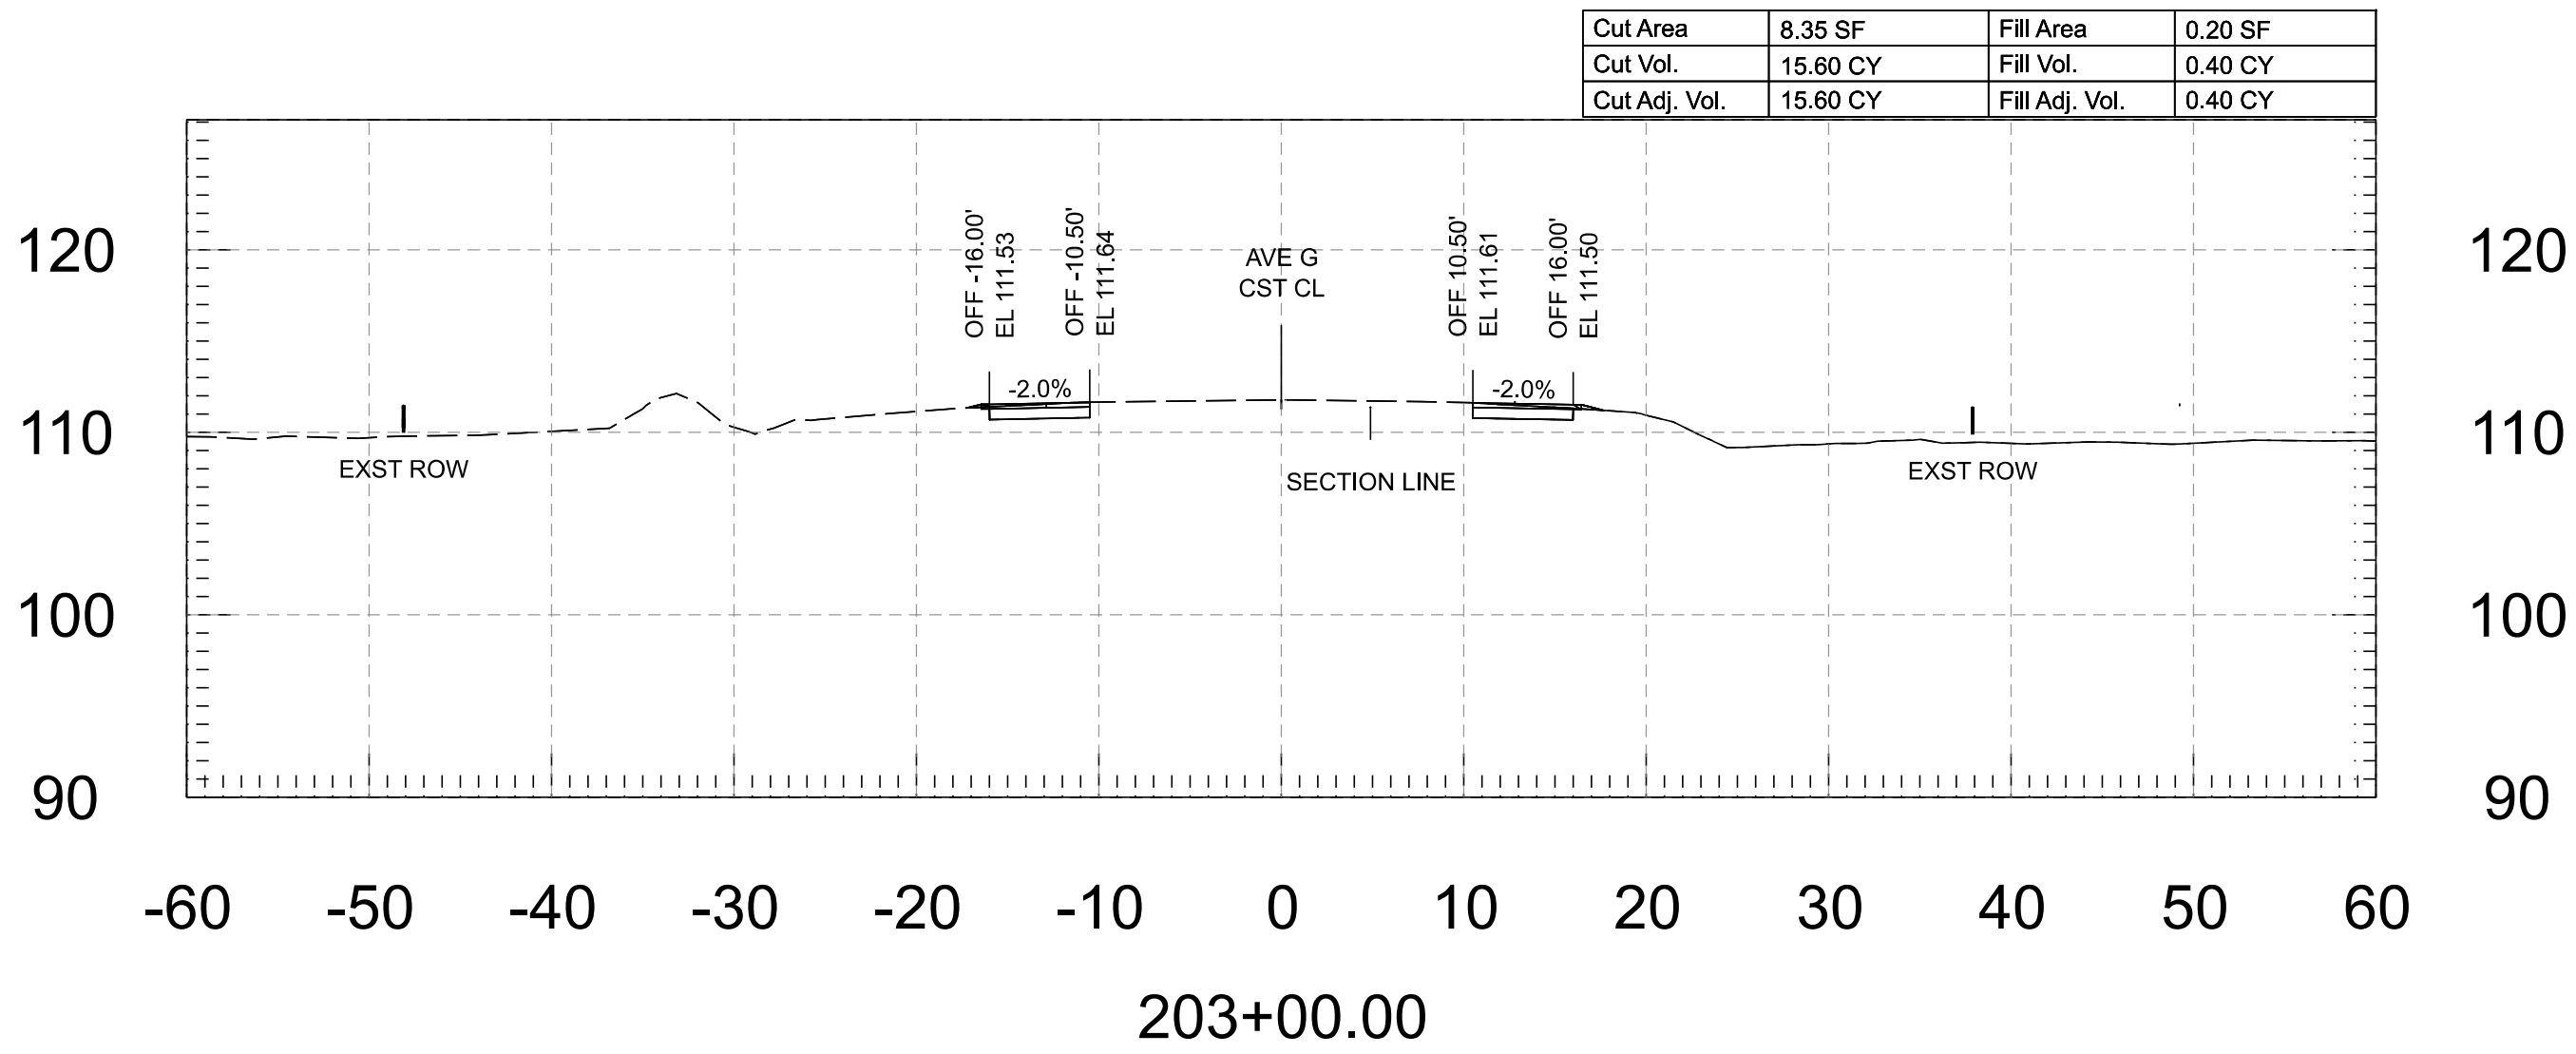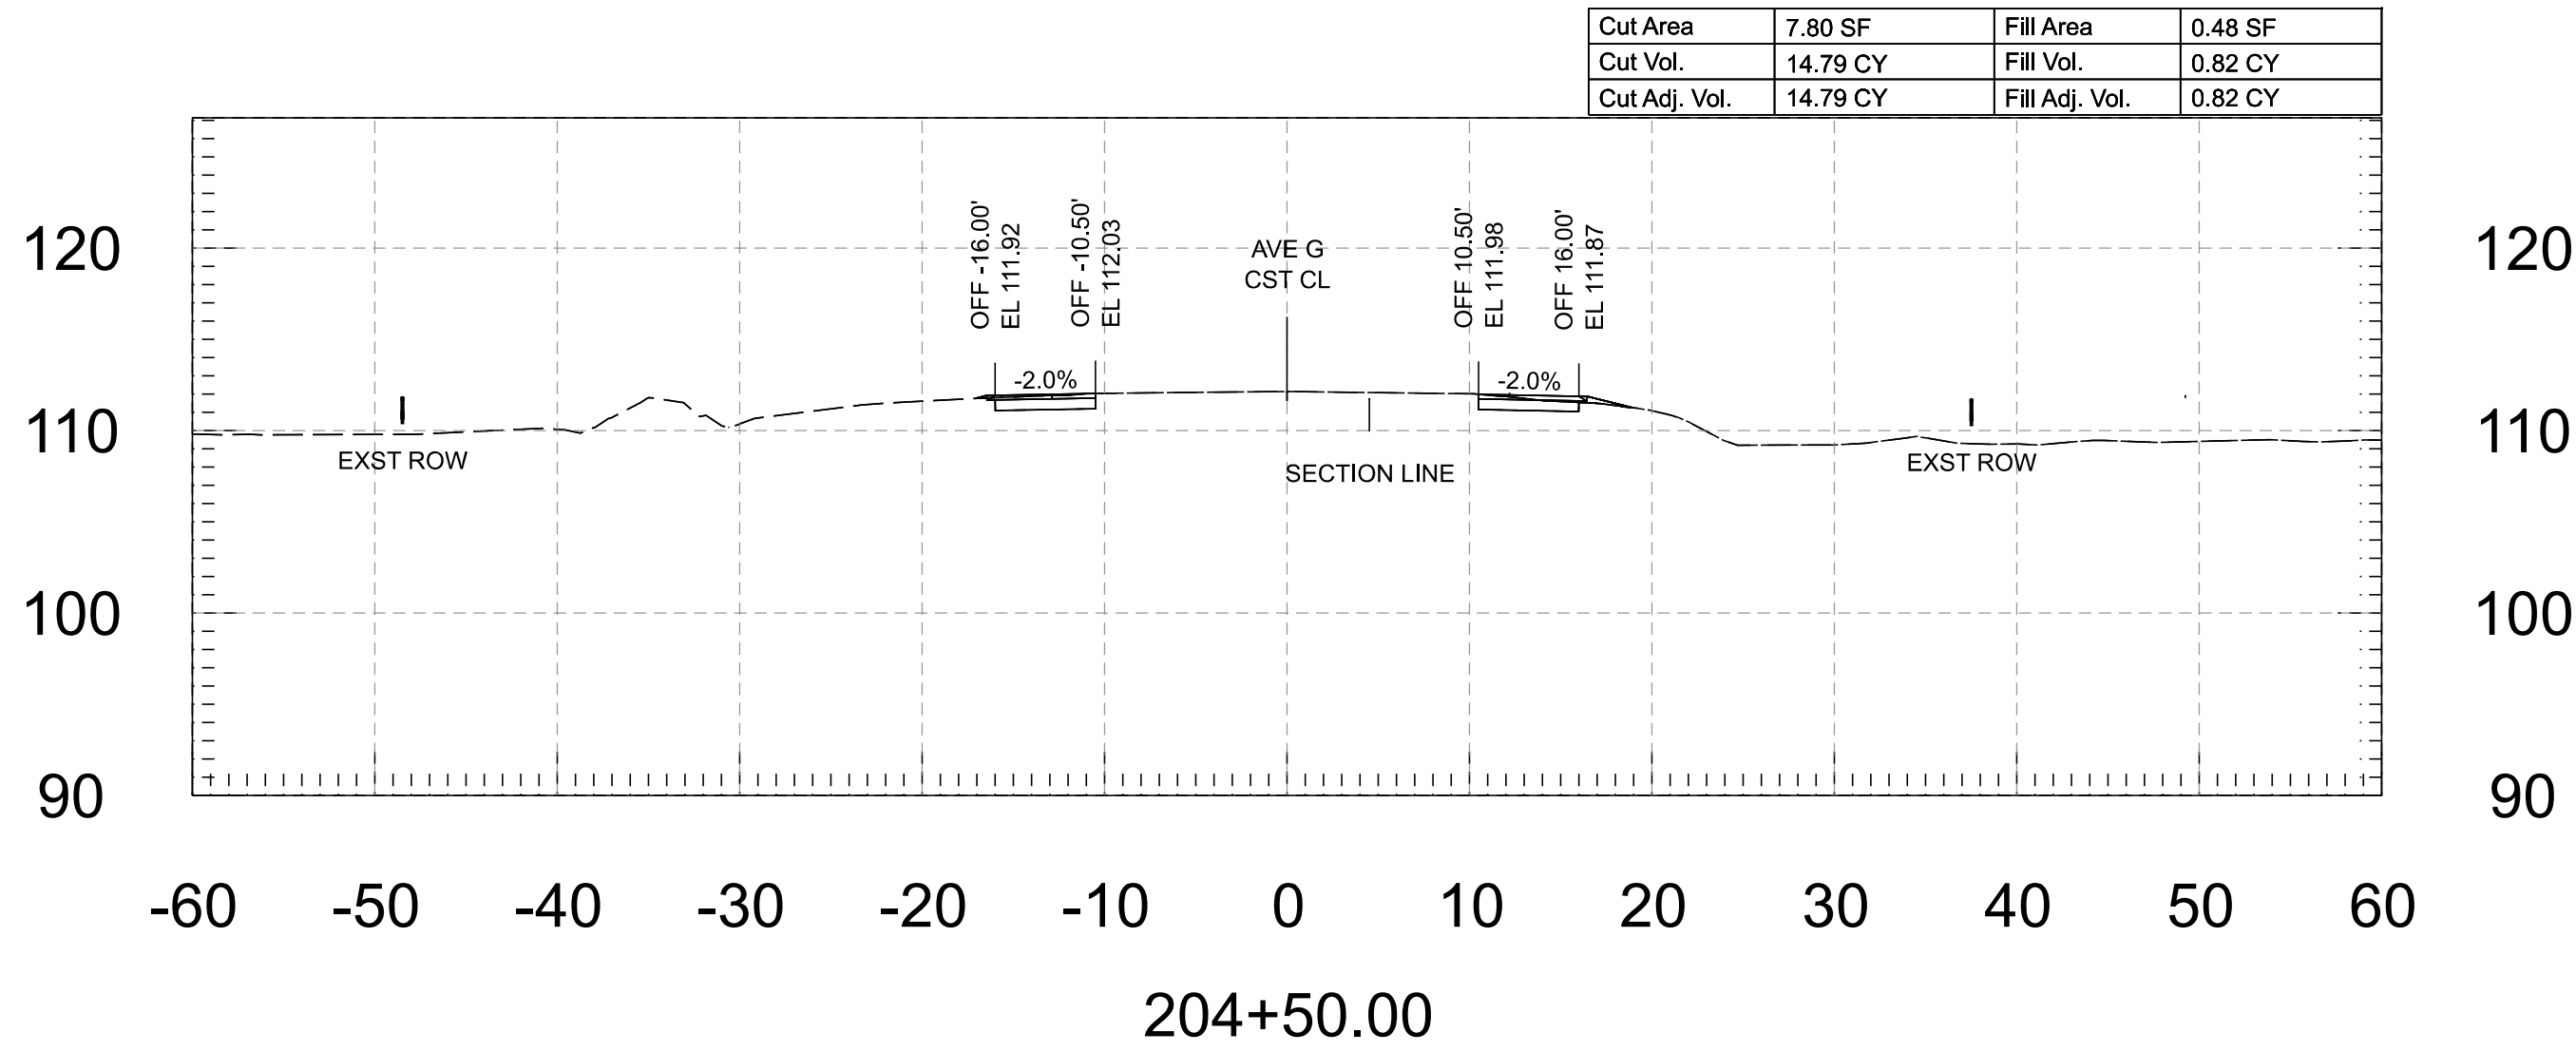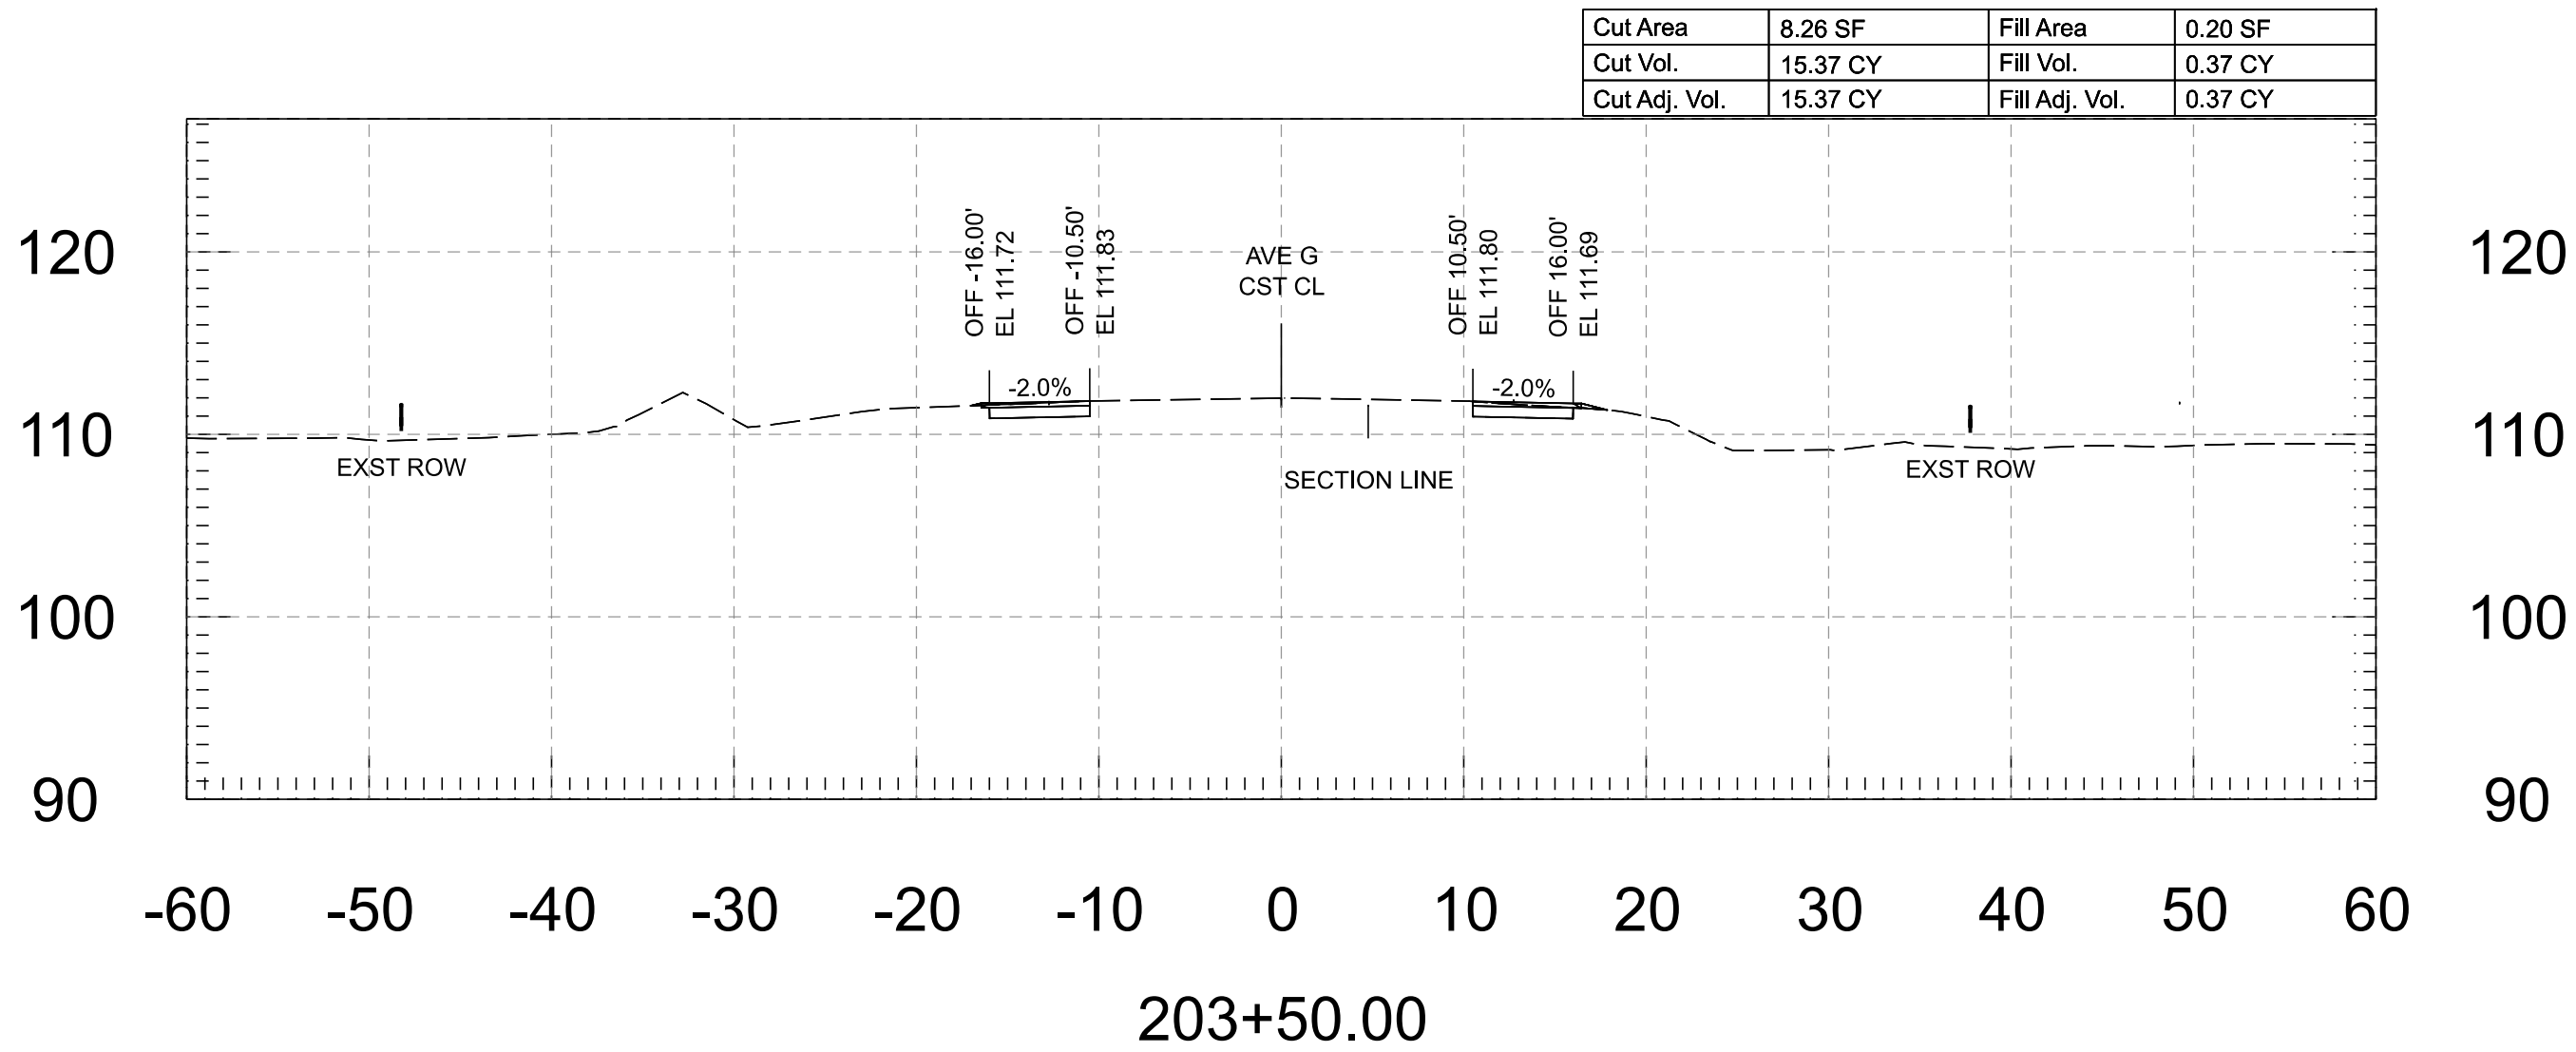


FOR INFORMATION ONLY		NAME	DATE	ARIZONA DEPARTMENT OF TRANSPORTATION PROJECT DELIVERY AND OPERATIONS DIVISION ROADWAY DESIGN SERVICES	ROUTE	F.H.W.A. Arizona Division	STATE ARIZ.	PROJECT NO.	FEDERAL ID NO.	SHEET NO.	TOTAL SHEETS	RECORD DRAWING	
	DESIGN	M. SCHOEN	07/26		MILEPOST			0000 YU YYU	YYU-0(225)T	95	118		
	DRAWN	M. SCHOEN	07/26		LOCATION AVENUE G, COUNTY 11TH ST - COUNTY 16TH ST								
	CHECKED	H. RIOS	07/26										
			WSP USA Inc. 1200 West Washington Street, Suite 405 Tempe, AZ 85288		AVENUE G - CROSS SECTIONS		STRUCTURE NO.		TRACS NO. T0437 01C				___ OF ___

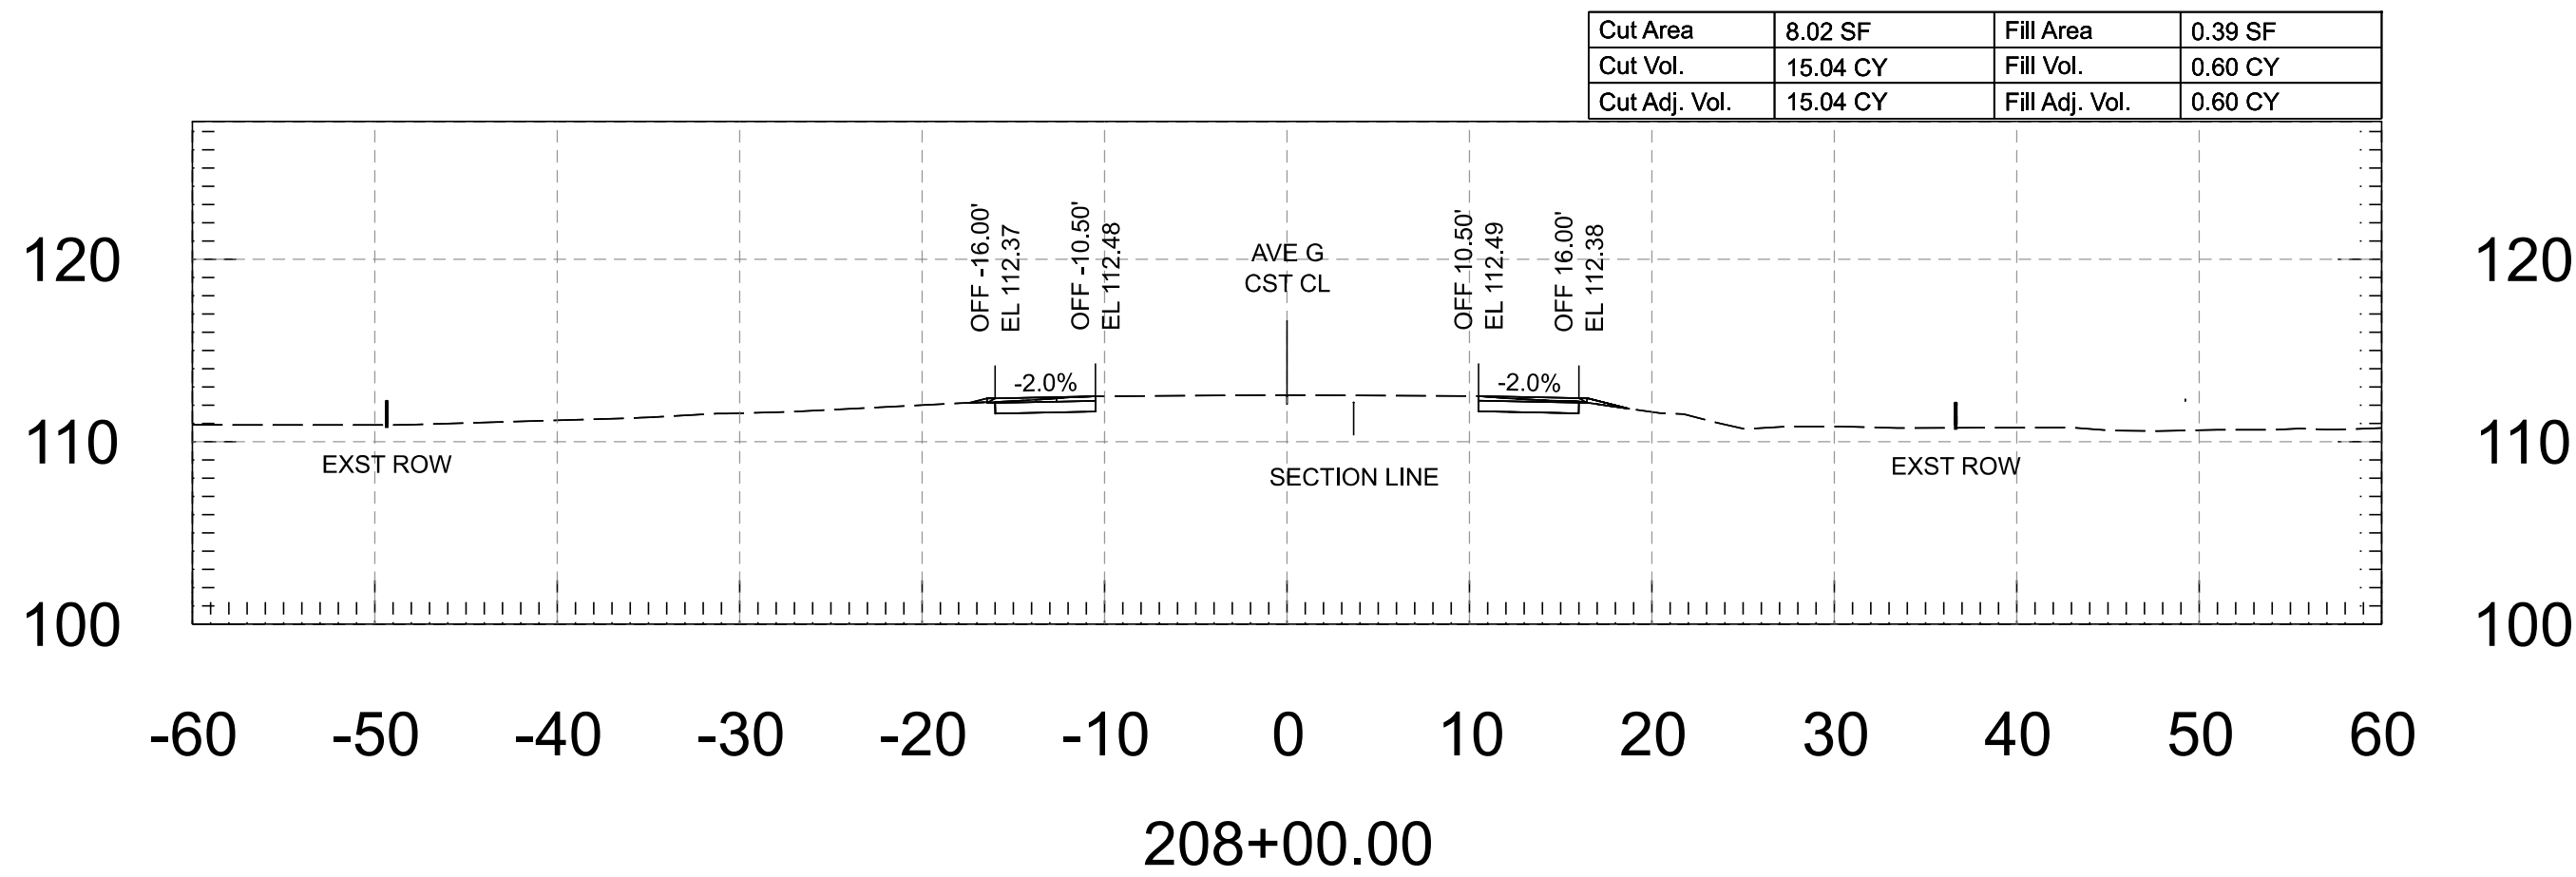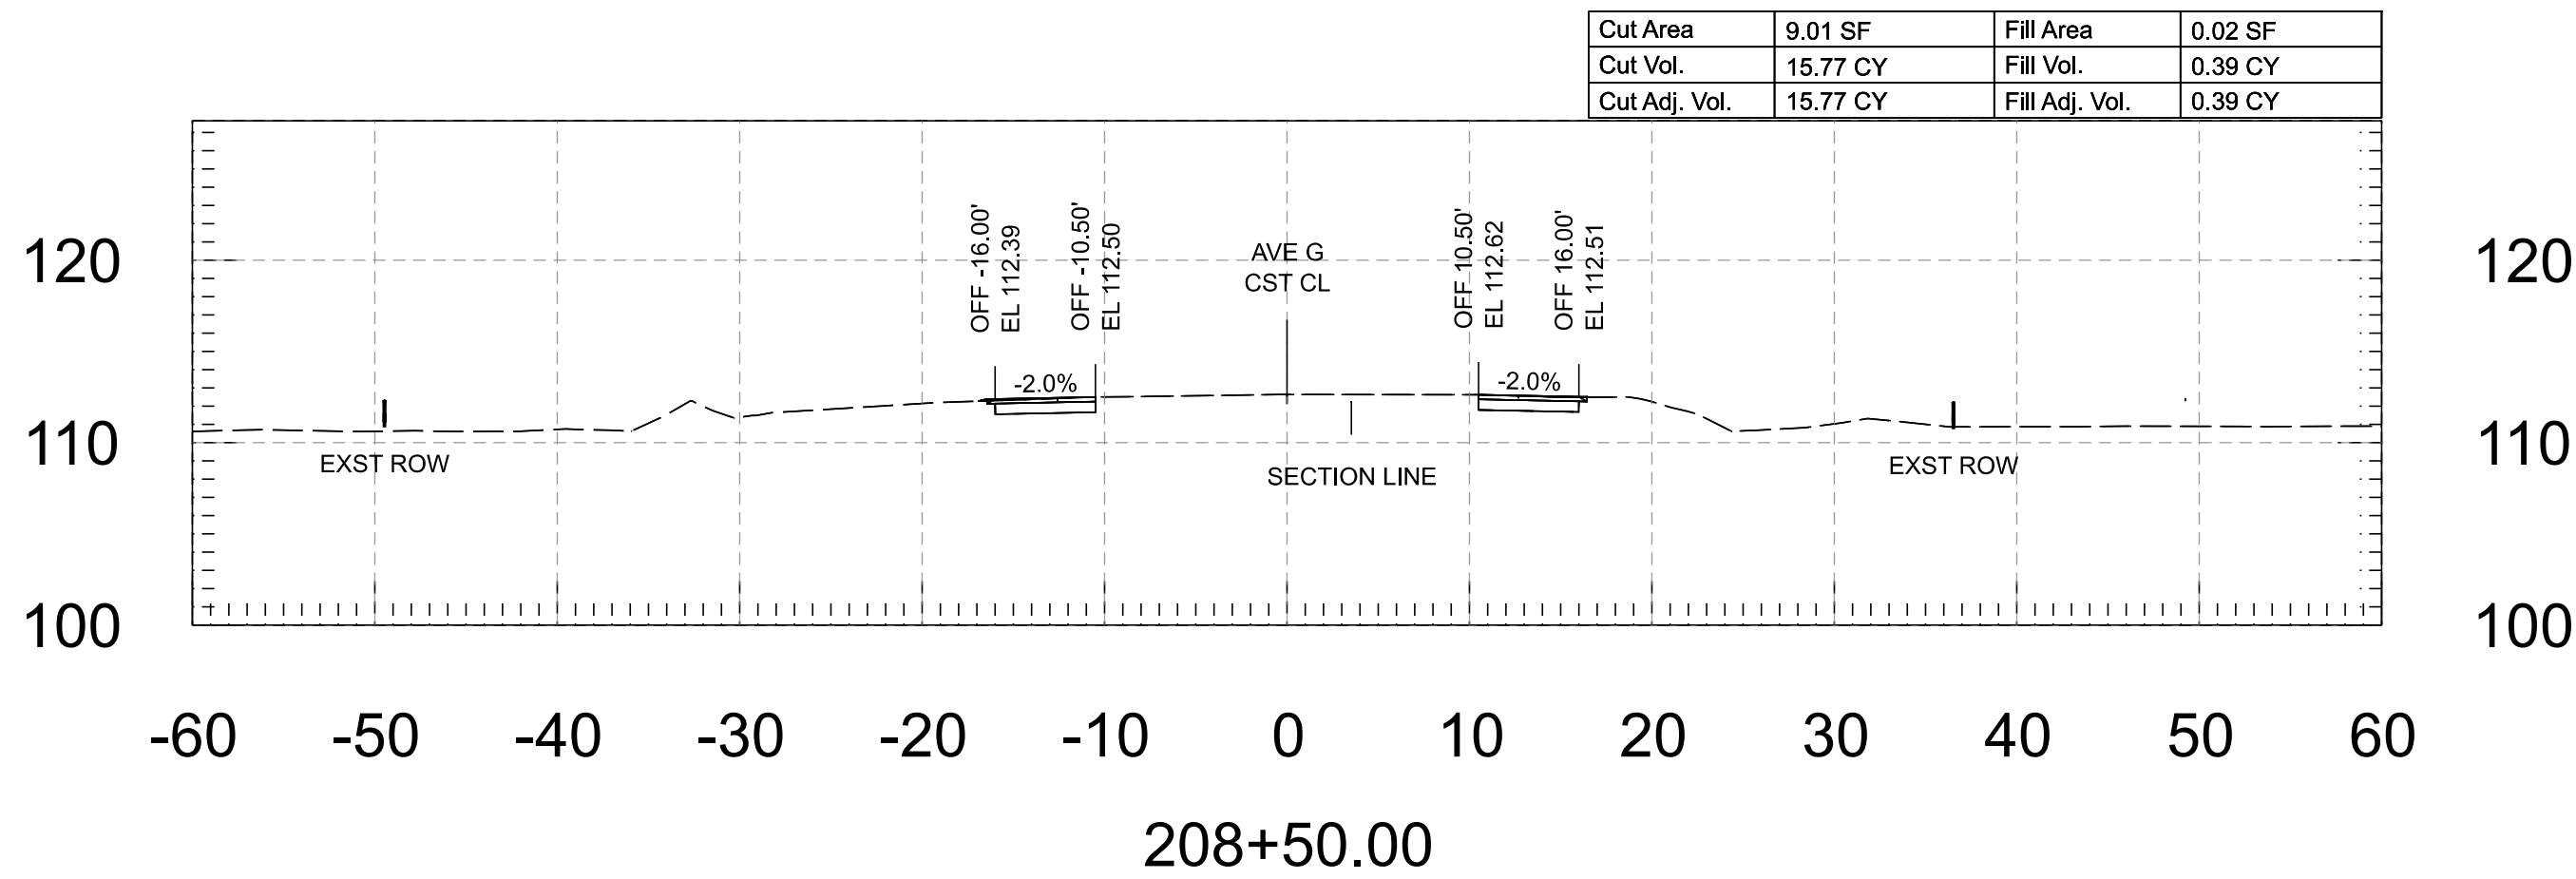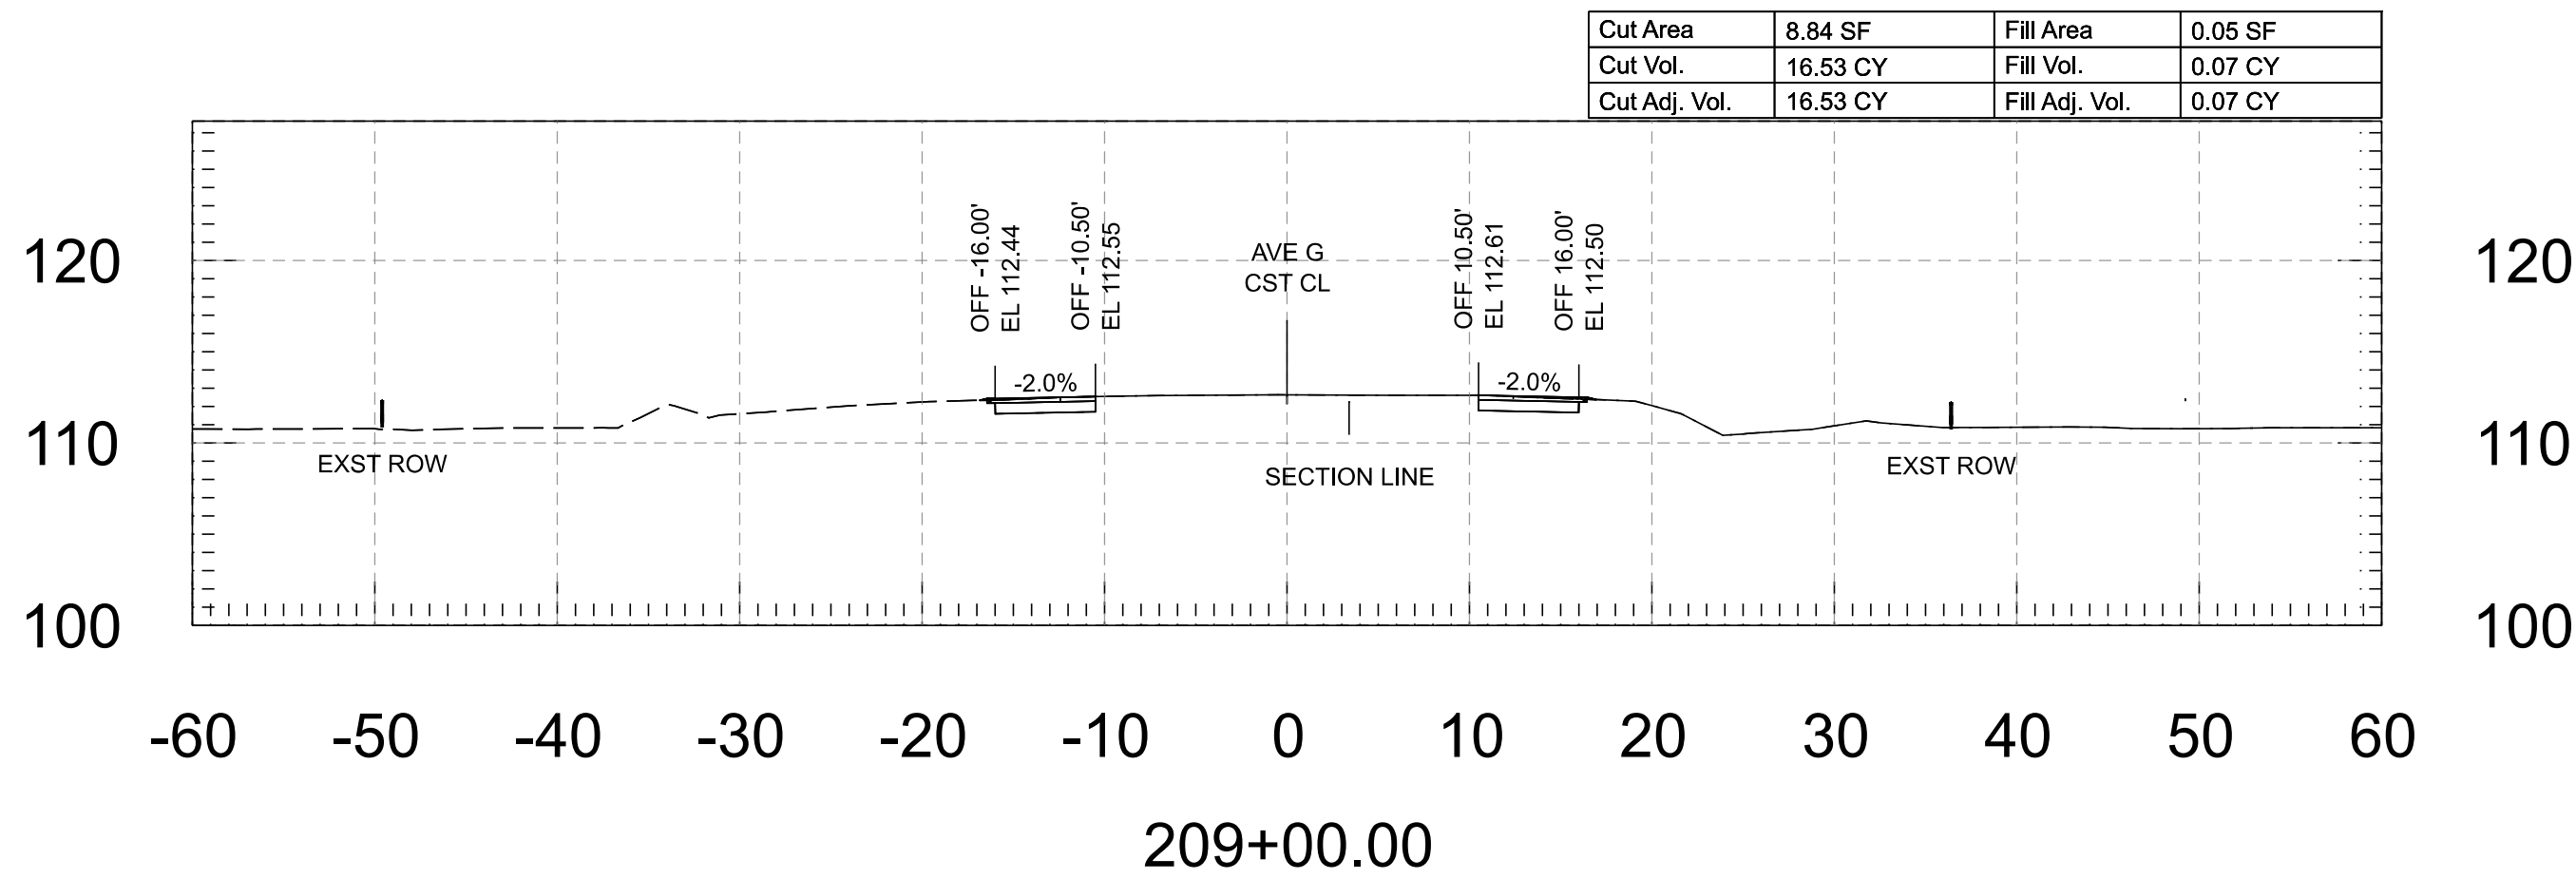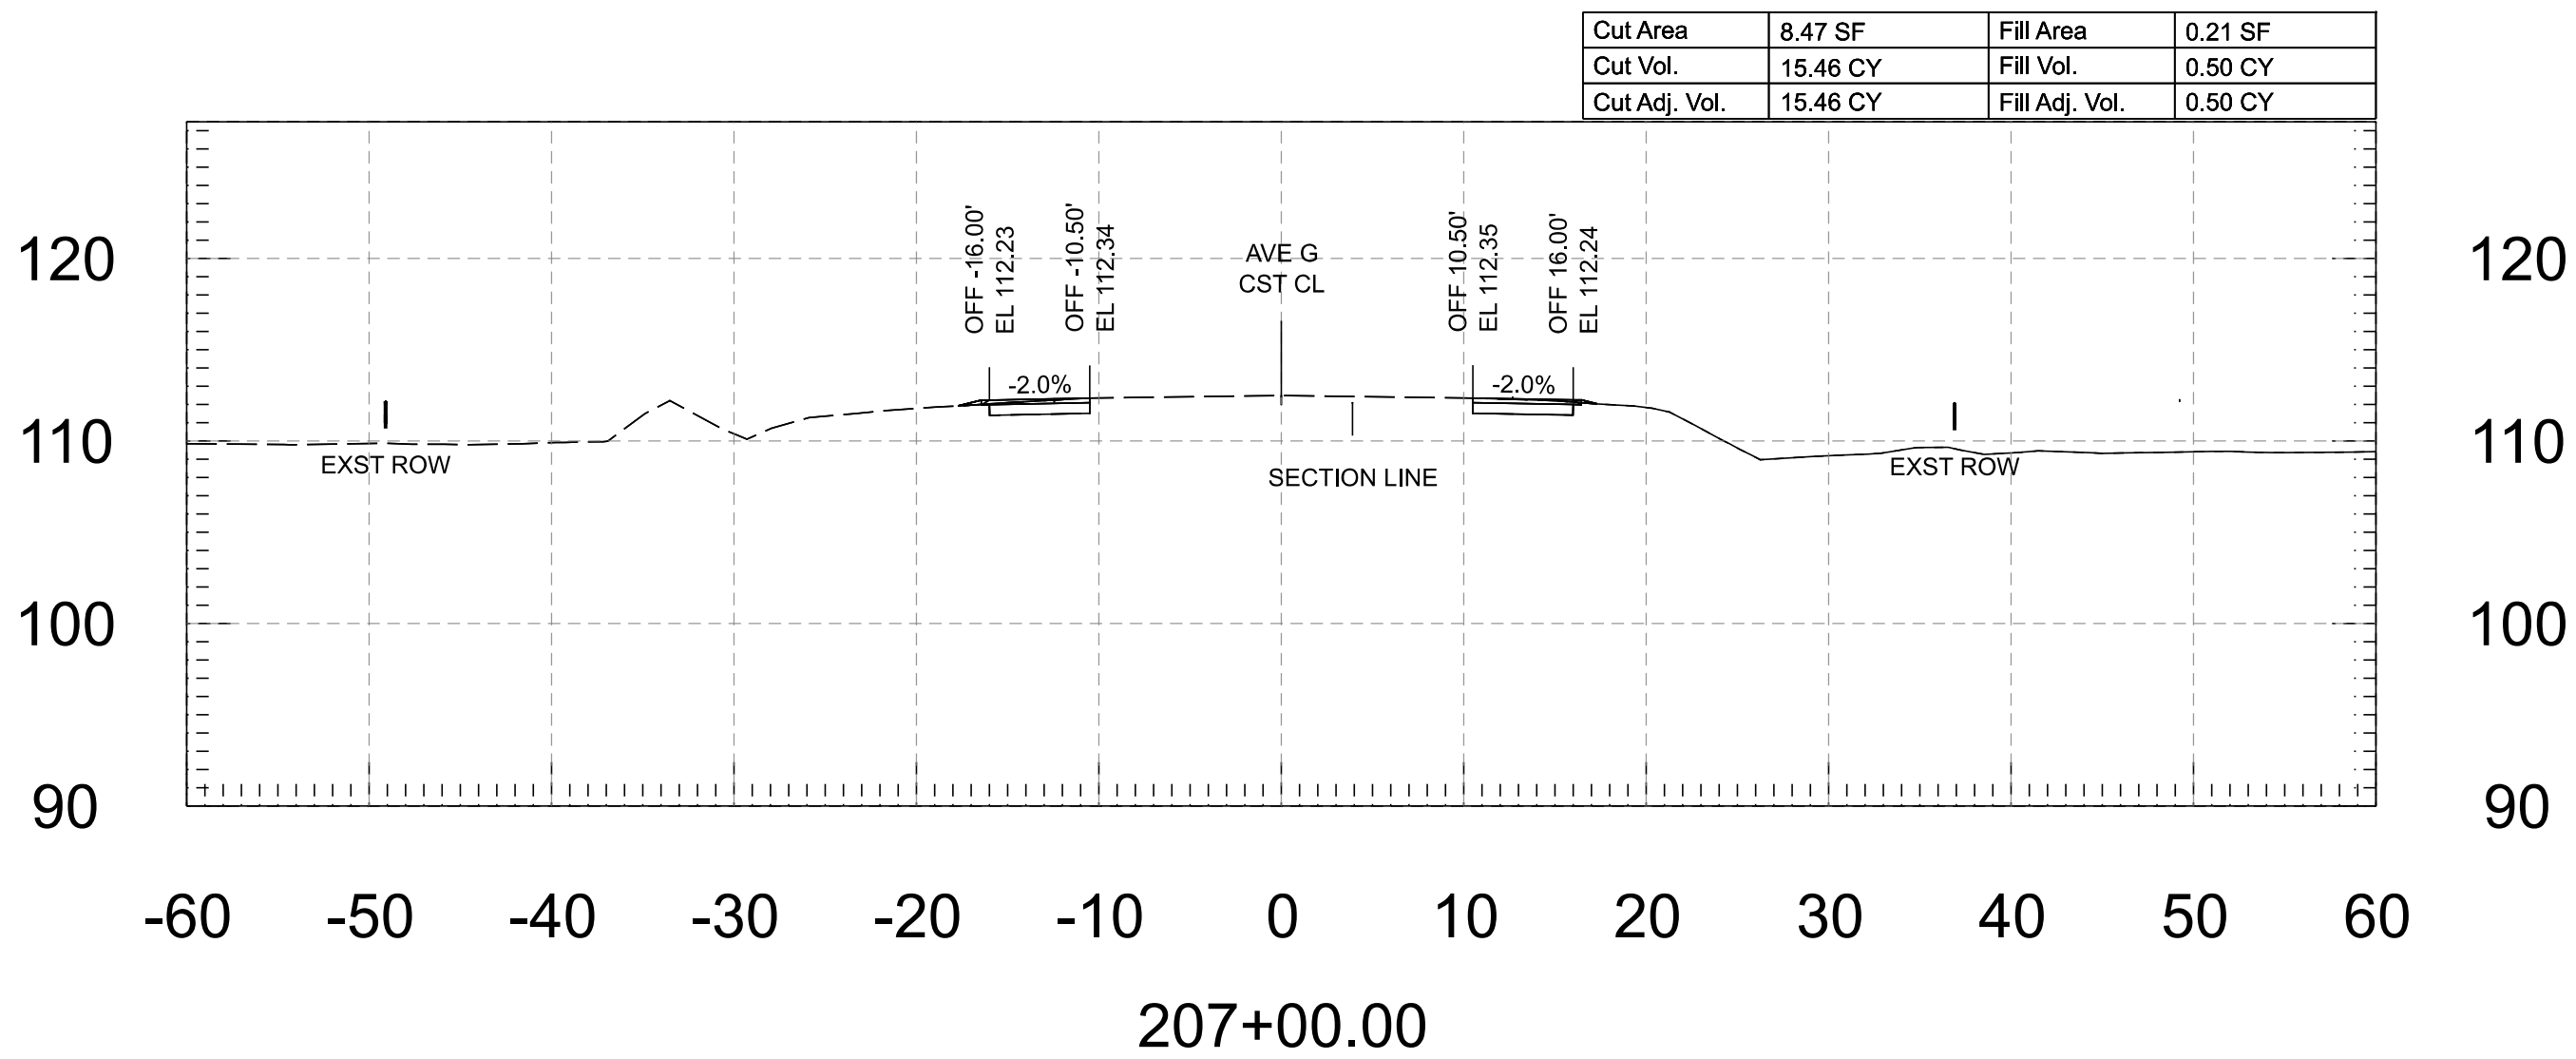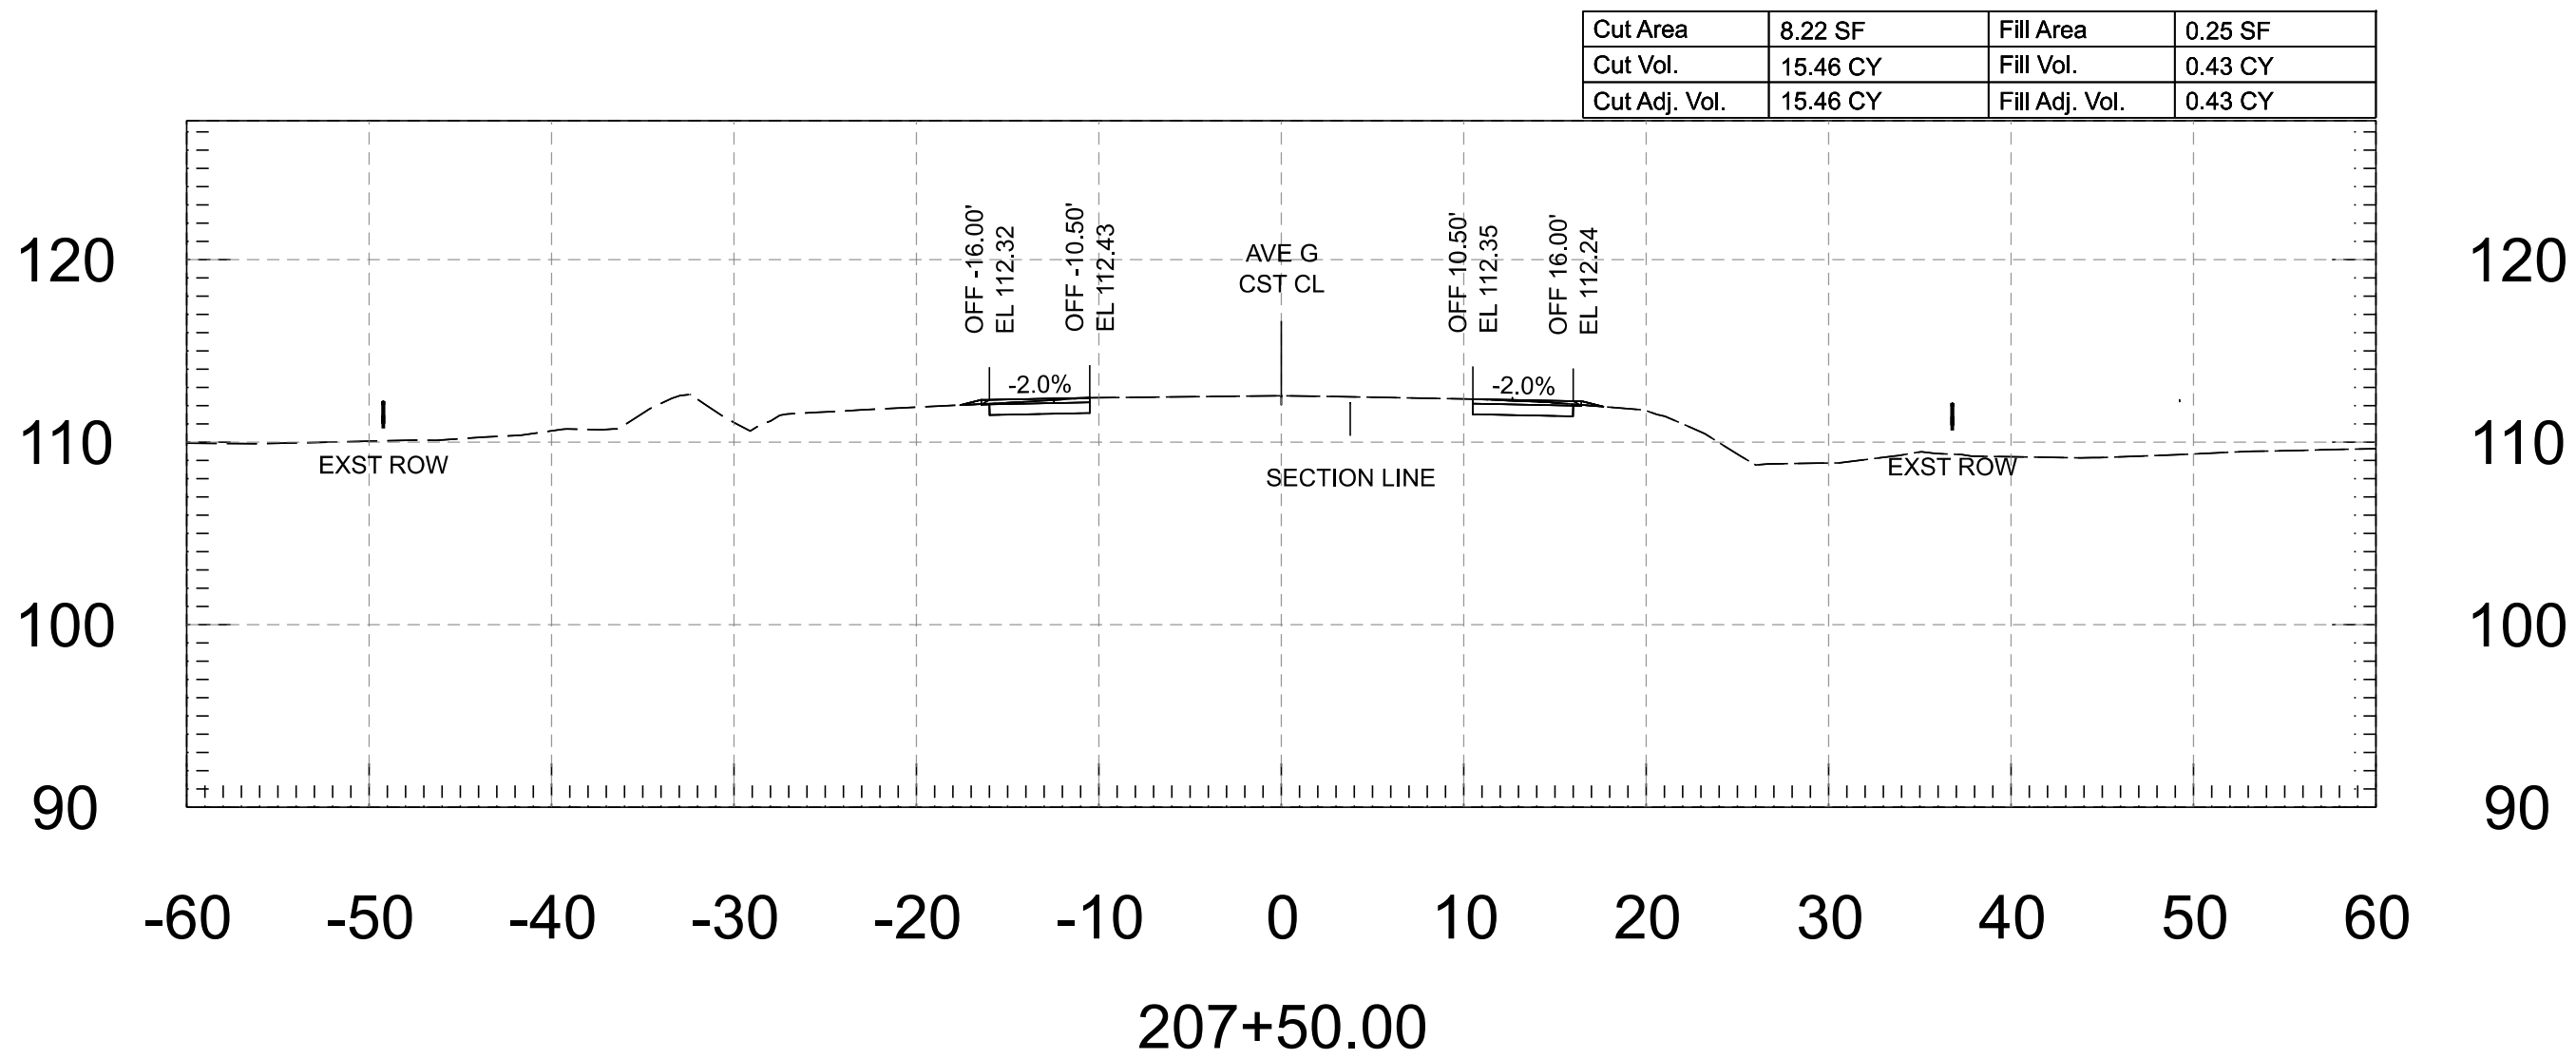


FOR INFORMATION ONLY		NAME	DATE	ARIZONA DEPARTMENT OF TRANSPORTATION PROJECT DELIVERY AND OPERATIONS DIVISION ROADWAY DESIGN SERVICES	ROUTE	F.H.W.A. Arizona Division	STATE ARIZ.	PROJECT NO.	FEDERAL ID NO.	SHEET NO.	TOTAL SHEETS	RECORD DRAWING
	DESIGN	M. SCHOEN	07/26		MILEPOST			0000 YU YYU	YYU-0(225)T	97	118	
	DRAWN	M. SCHOEN	07/26					LOCATION AVENUE G, COUNTY 11TH ST - COUNTY 16TH ST			DWG	
	CHECKED	H. RIOS	07/26	STRUCTURE NO.	TRACS NO. T0437 01C			OF				
	wsp WSP USA Inc. 1230 West Washington Street, Suite 405 Tempe, AZ 85288				AVENUE G - CROSS SECTIONS							


Cut Area	8.77 SF	Fill Area	0.03 SF
Cut Vol.	16.27 CY	Fill Vol.	0.07 CY
Cut Adj. Vol.	16.27 CY	Fill Adj. Vol.	0.07 CY

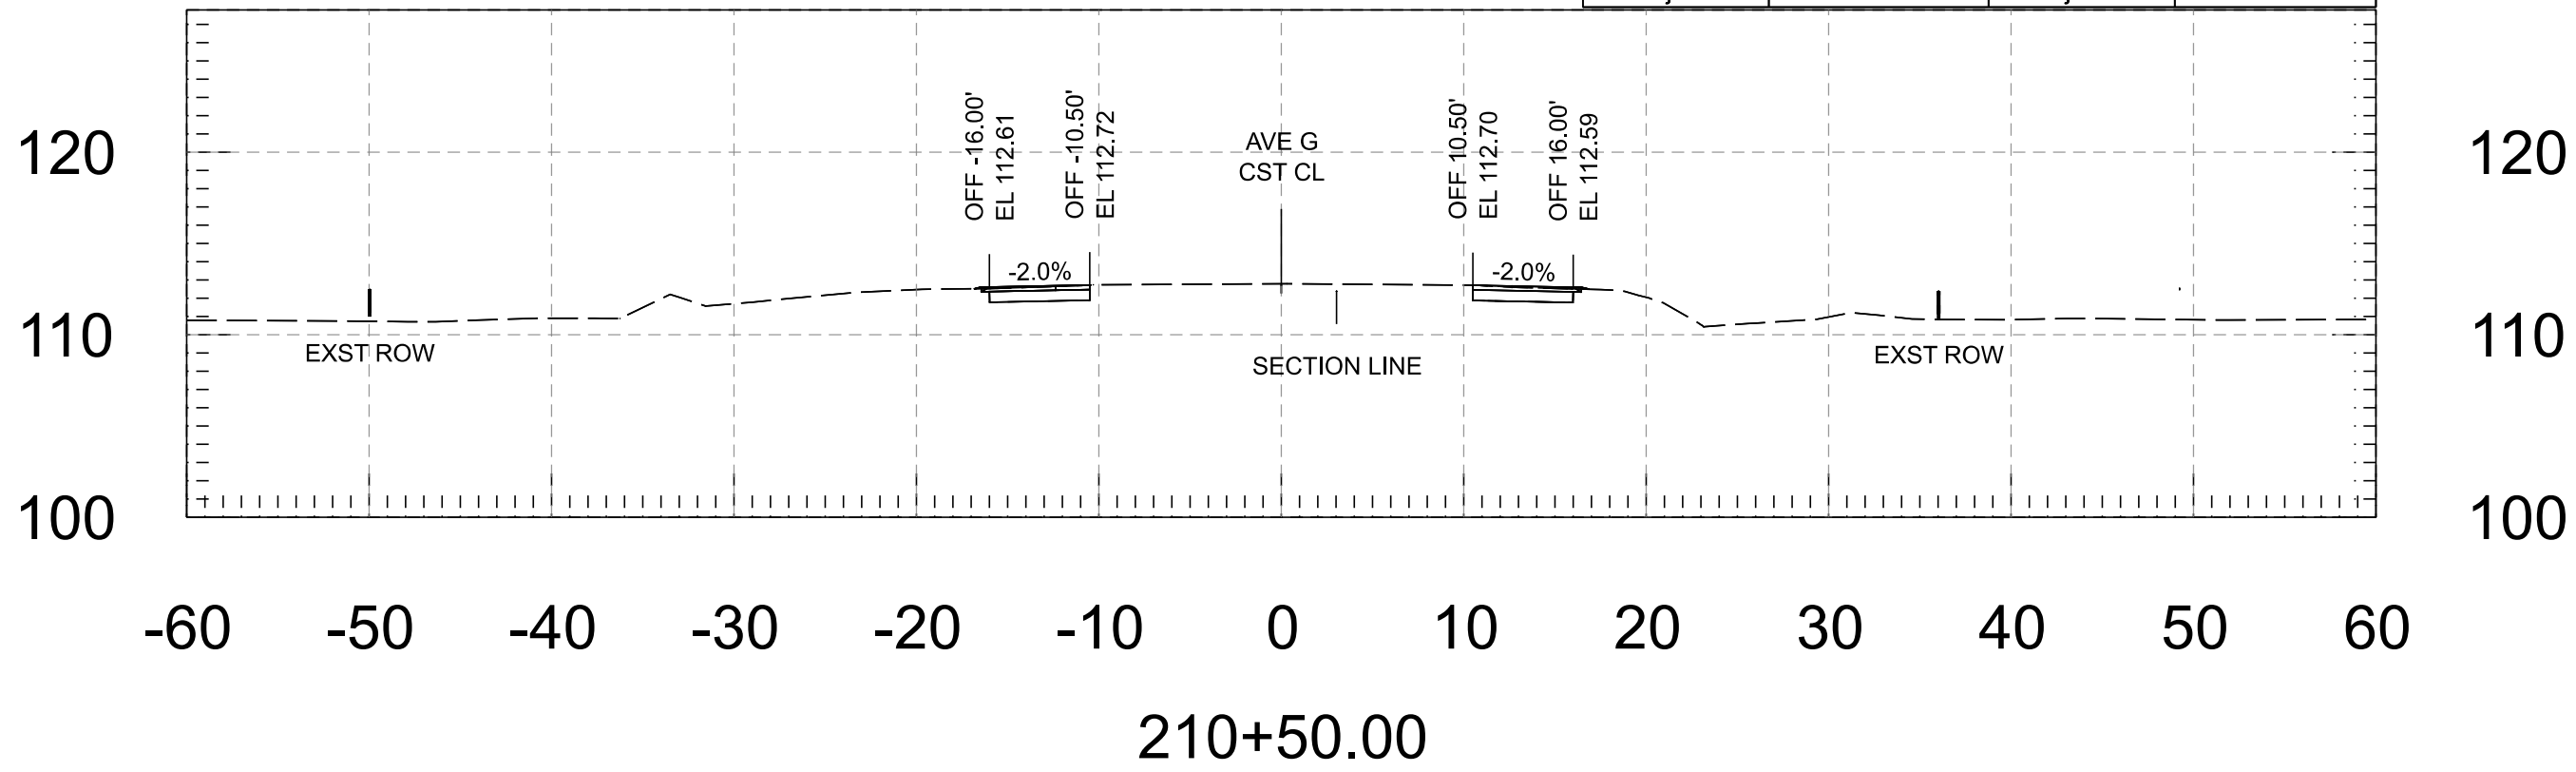


Cut Area	12.60 SF	Fill Area	0.02 SF
Cut Vol.	22.20 CY	Fill Vol.	0.03 CY
Cut Adj. Vol.	22.20 CY	Fill Adj. Vol.	0.03 CY

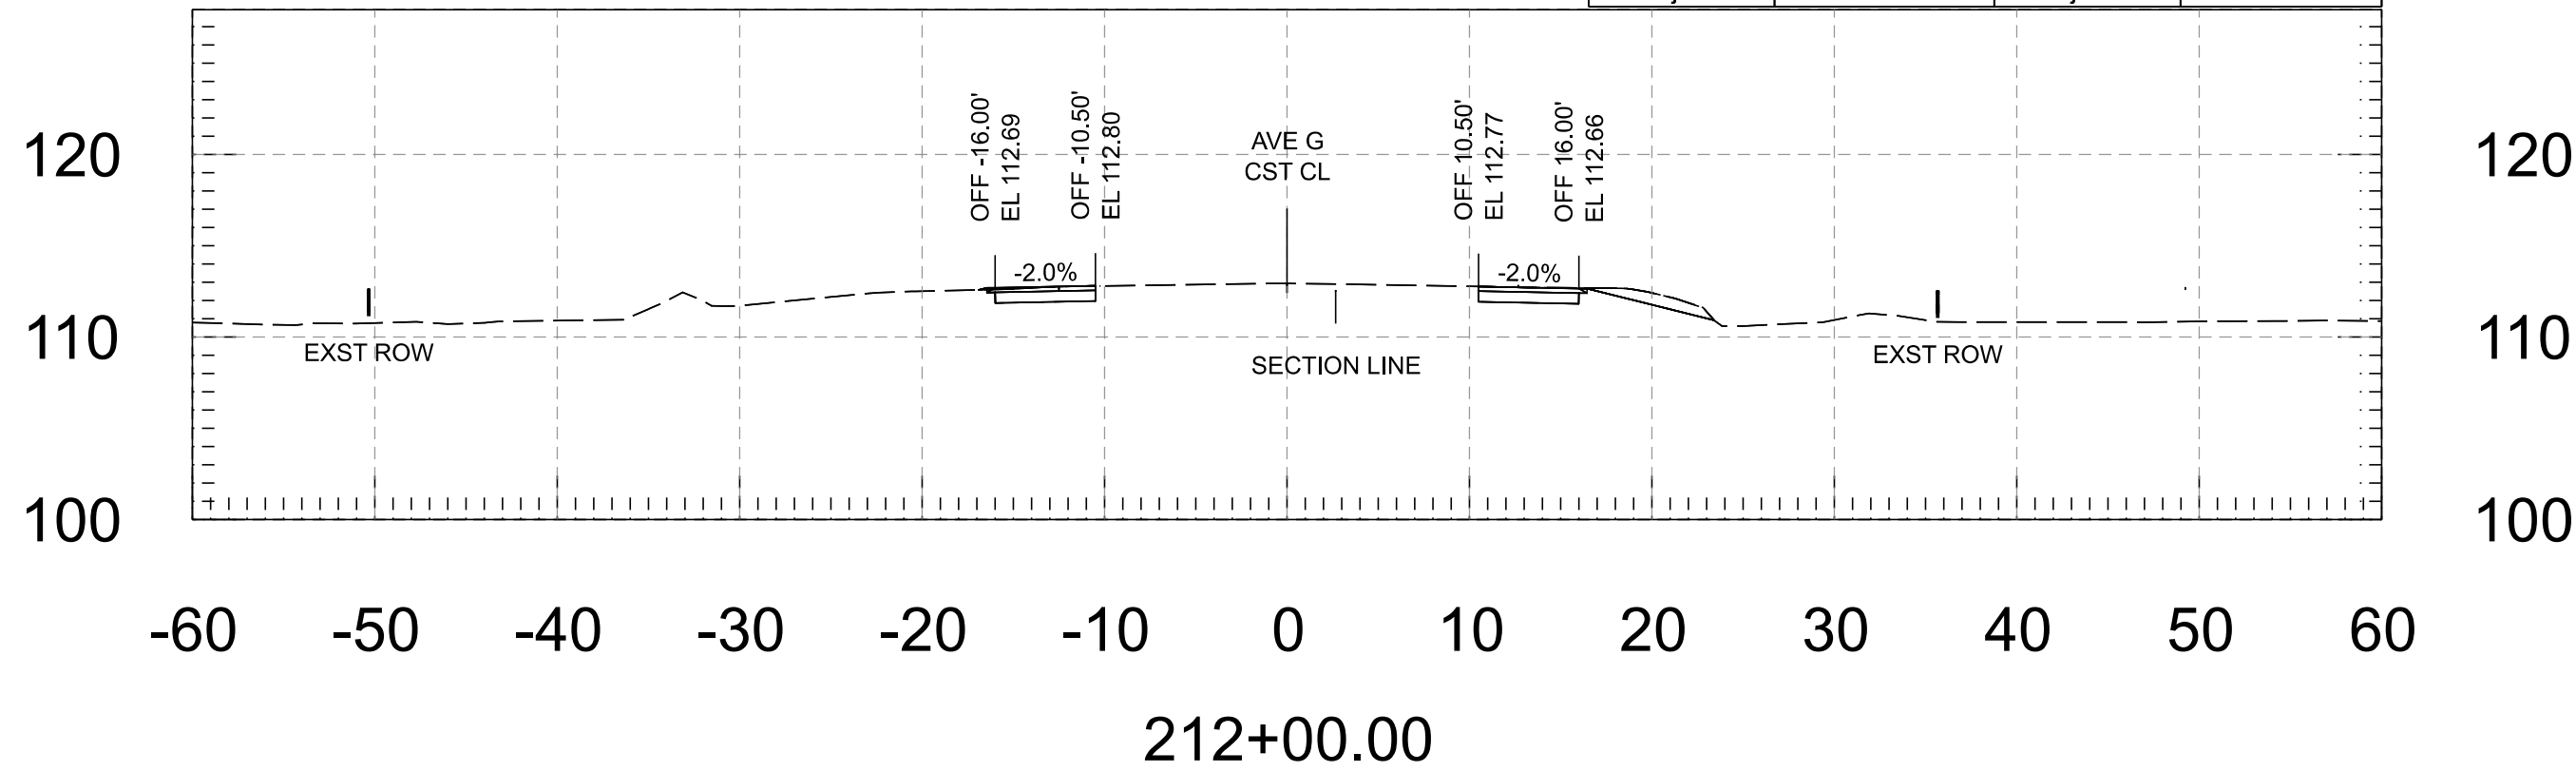


Cut Area	8.80 SF	Fill Area	0.04 SF
Cut Vol.	16.26 CY	Fill Vol.	0.12 CY
Cut Adj. Vol.	16.26 CY	Fill Adj. Vol.	0.12 CY

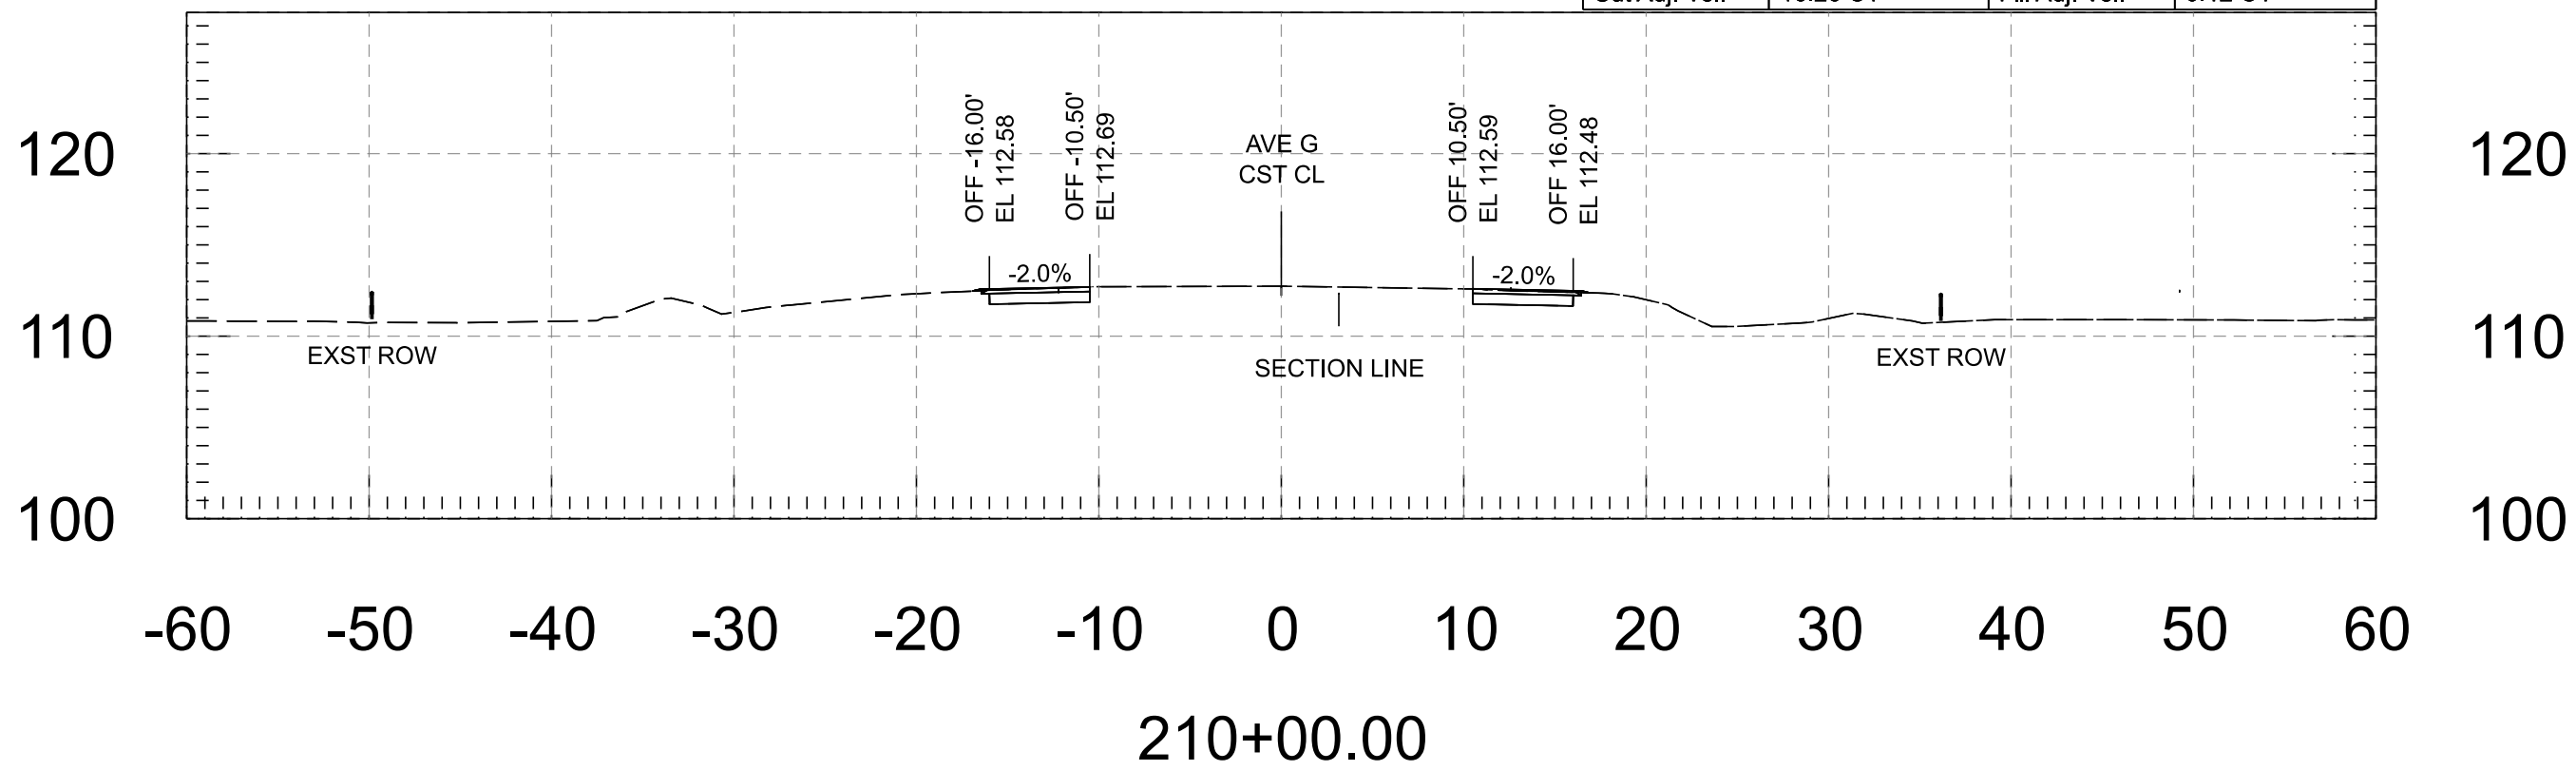


Cut Area	11.38 SF	Fill Area	0.01 SF
Cut Vol.	18.79 CY	Fill Vol.	0.03 CY
Cut Adj. Vol.	18.79 CY	Fill Adj. Vol.	0.03 CY

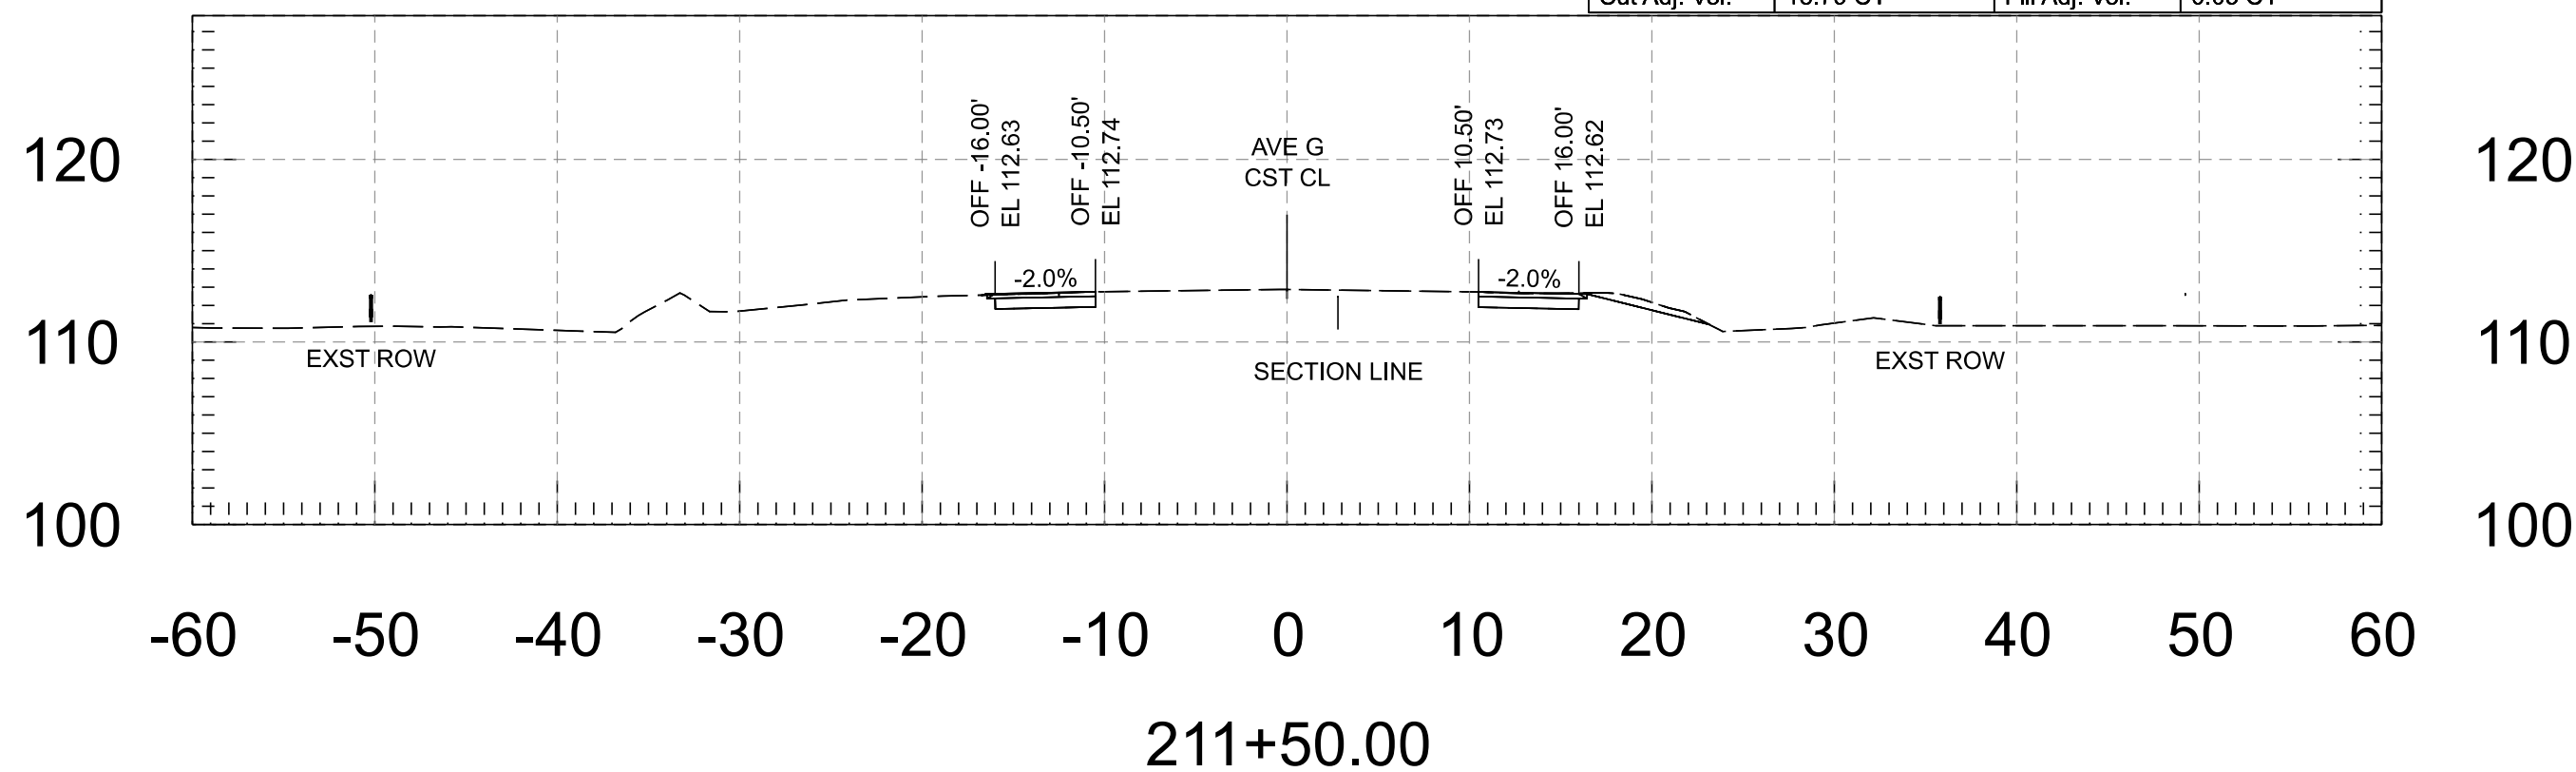


Cut Area	8.76 SF	Fill Area	0.08 SF
Cut Vol.	16.30 CY	Fill Vol.	0.12 CY
Cut Adj. Vol.	16.30 CY	Fill Adj. Vol.	0.12 CY

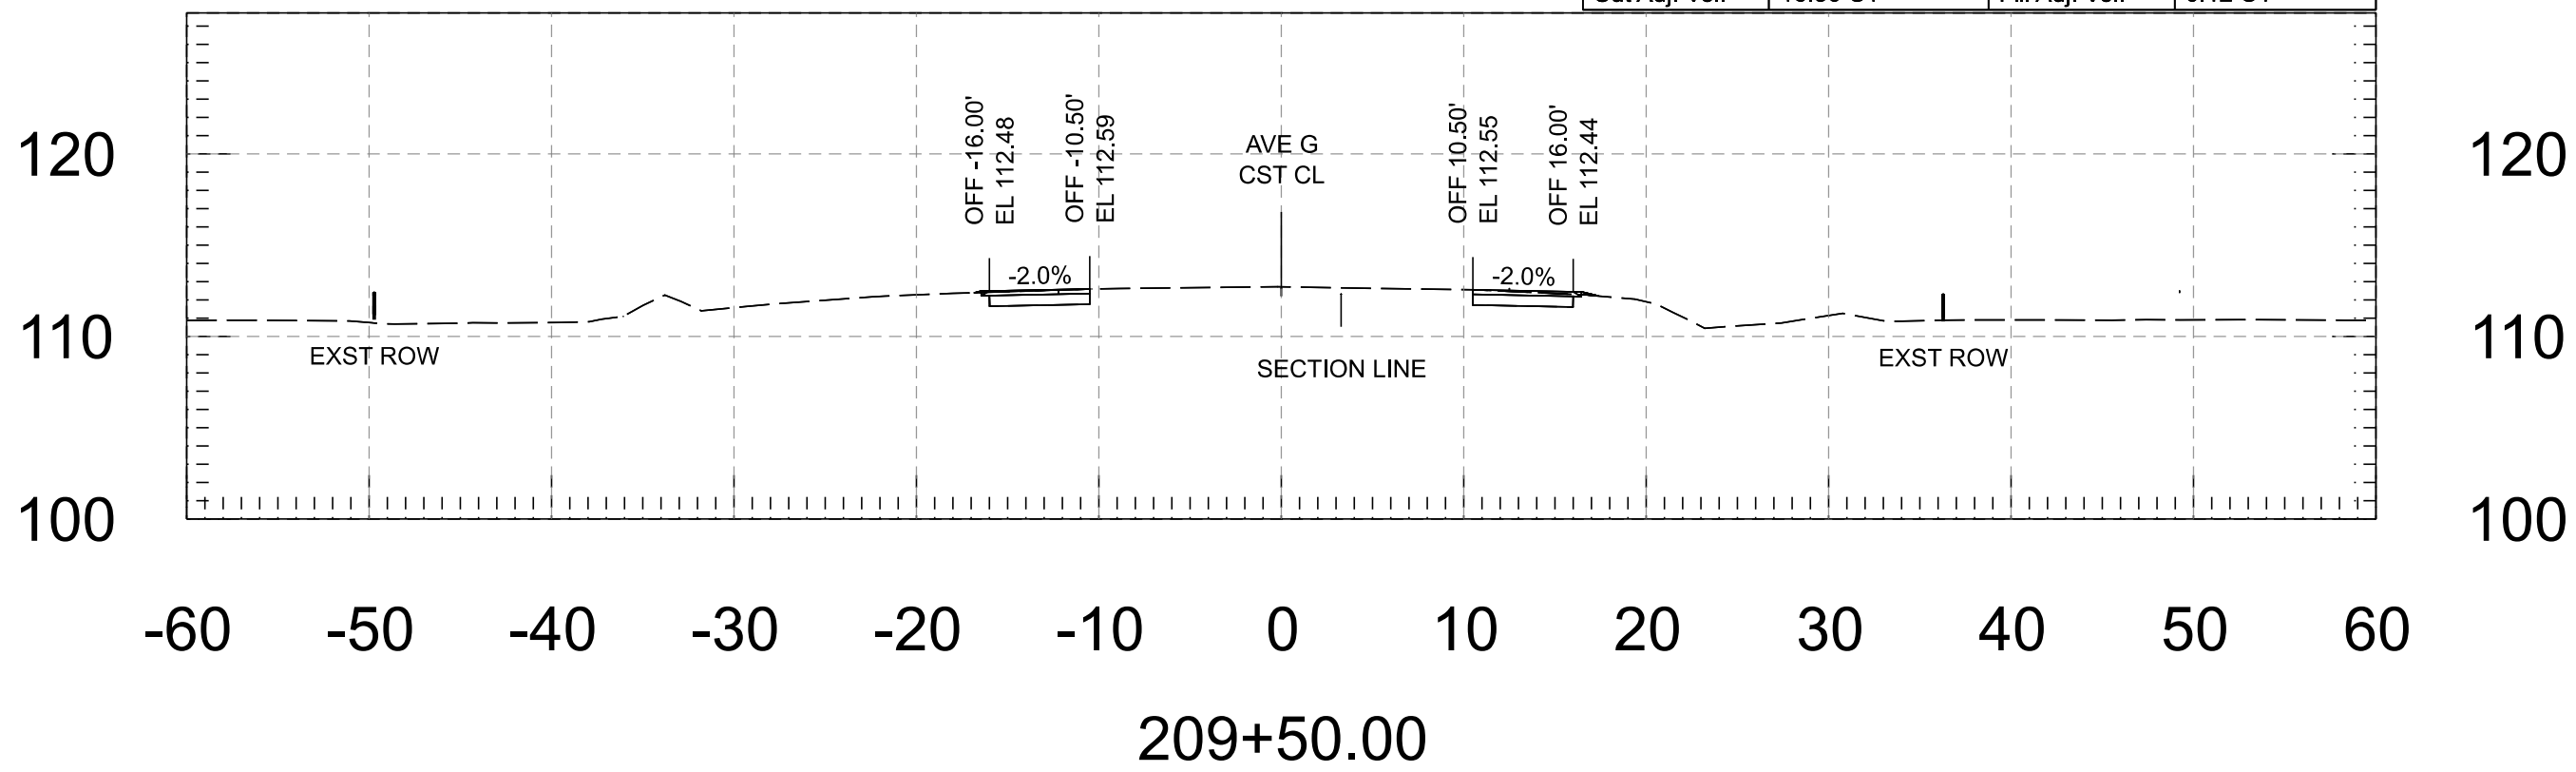


Cut Area	8.92 SF	Fill Area	0.02 SF
Cut Vol.	16.38 CY	Fill Vol.	0.05 CY
Cut Adj. Vol.	16.38 CY	Fill Adj. Vol.	0.05 CY

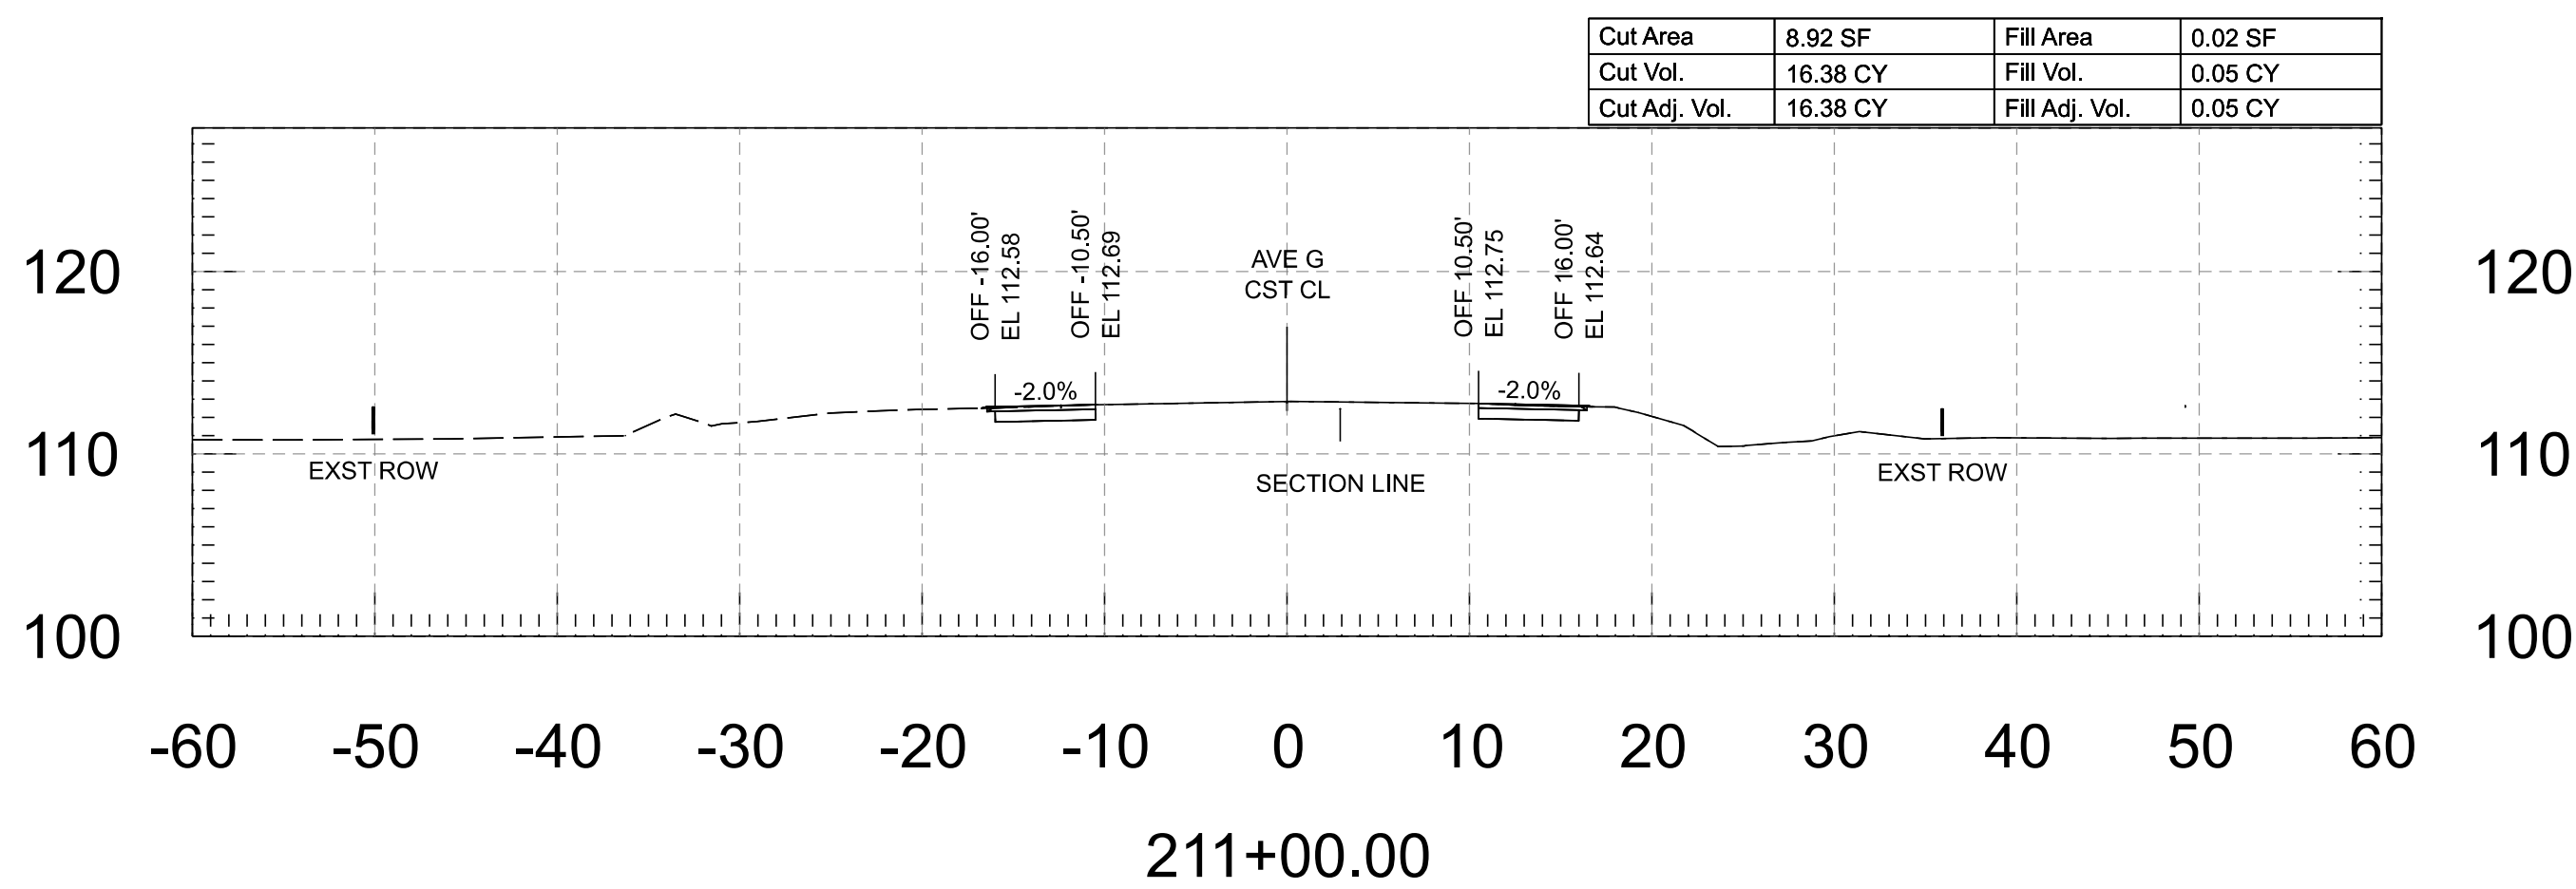


FOR INFORMATION ONLY		NAME	DATE	ARIZONA DEPARTMENT OF TRANSPORTATION PROJECT DELIVERY AND OPERATIONS DIVISION ROADWAY DESIGN SERVICES	ROUTE	F.H.W.A. Arizona Division	STATE ARIZ.	PROJECT NO.	FEDERAL ID NO.	SHEET NO.	TOTAL SHEETS	RECORD DRAWING
	DESIGN	M. SCHOEN	07/26					0000 YU YYU	YYU-0(225)T	98	118	
	DRAWN	M. SCHOEN	07/26									
	CHECKED	H. RIOS	07/26									
			WSP USA Inc. 1230 West Washington Street, Suite 405 Tempe, AZ 85288		AVENUE G - CROSS SECTIONS	STRUCTURE NO.	LOCATION AVENUE G, COUNTY 11TH ST - COUNTY 16TH ST					
						TRACS NO. T0437 01C					___ OF ___	

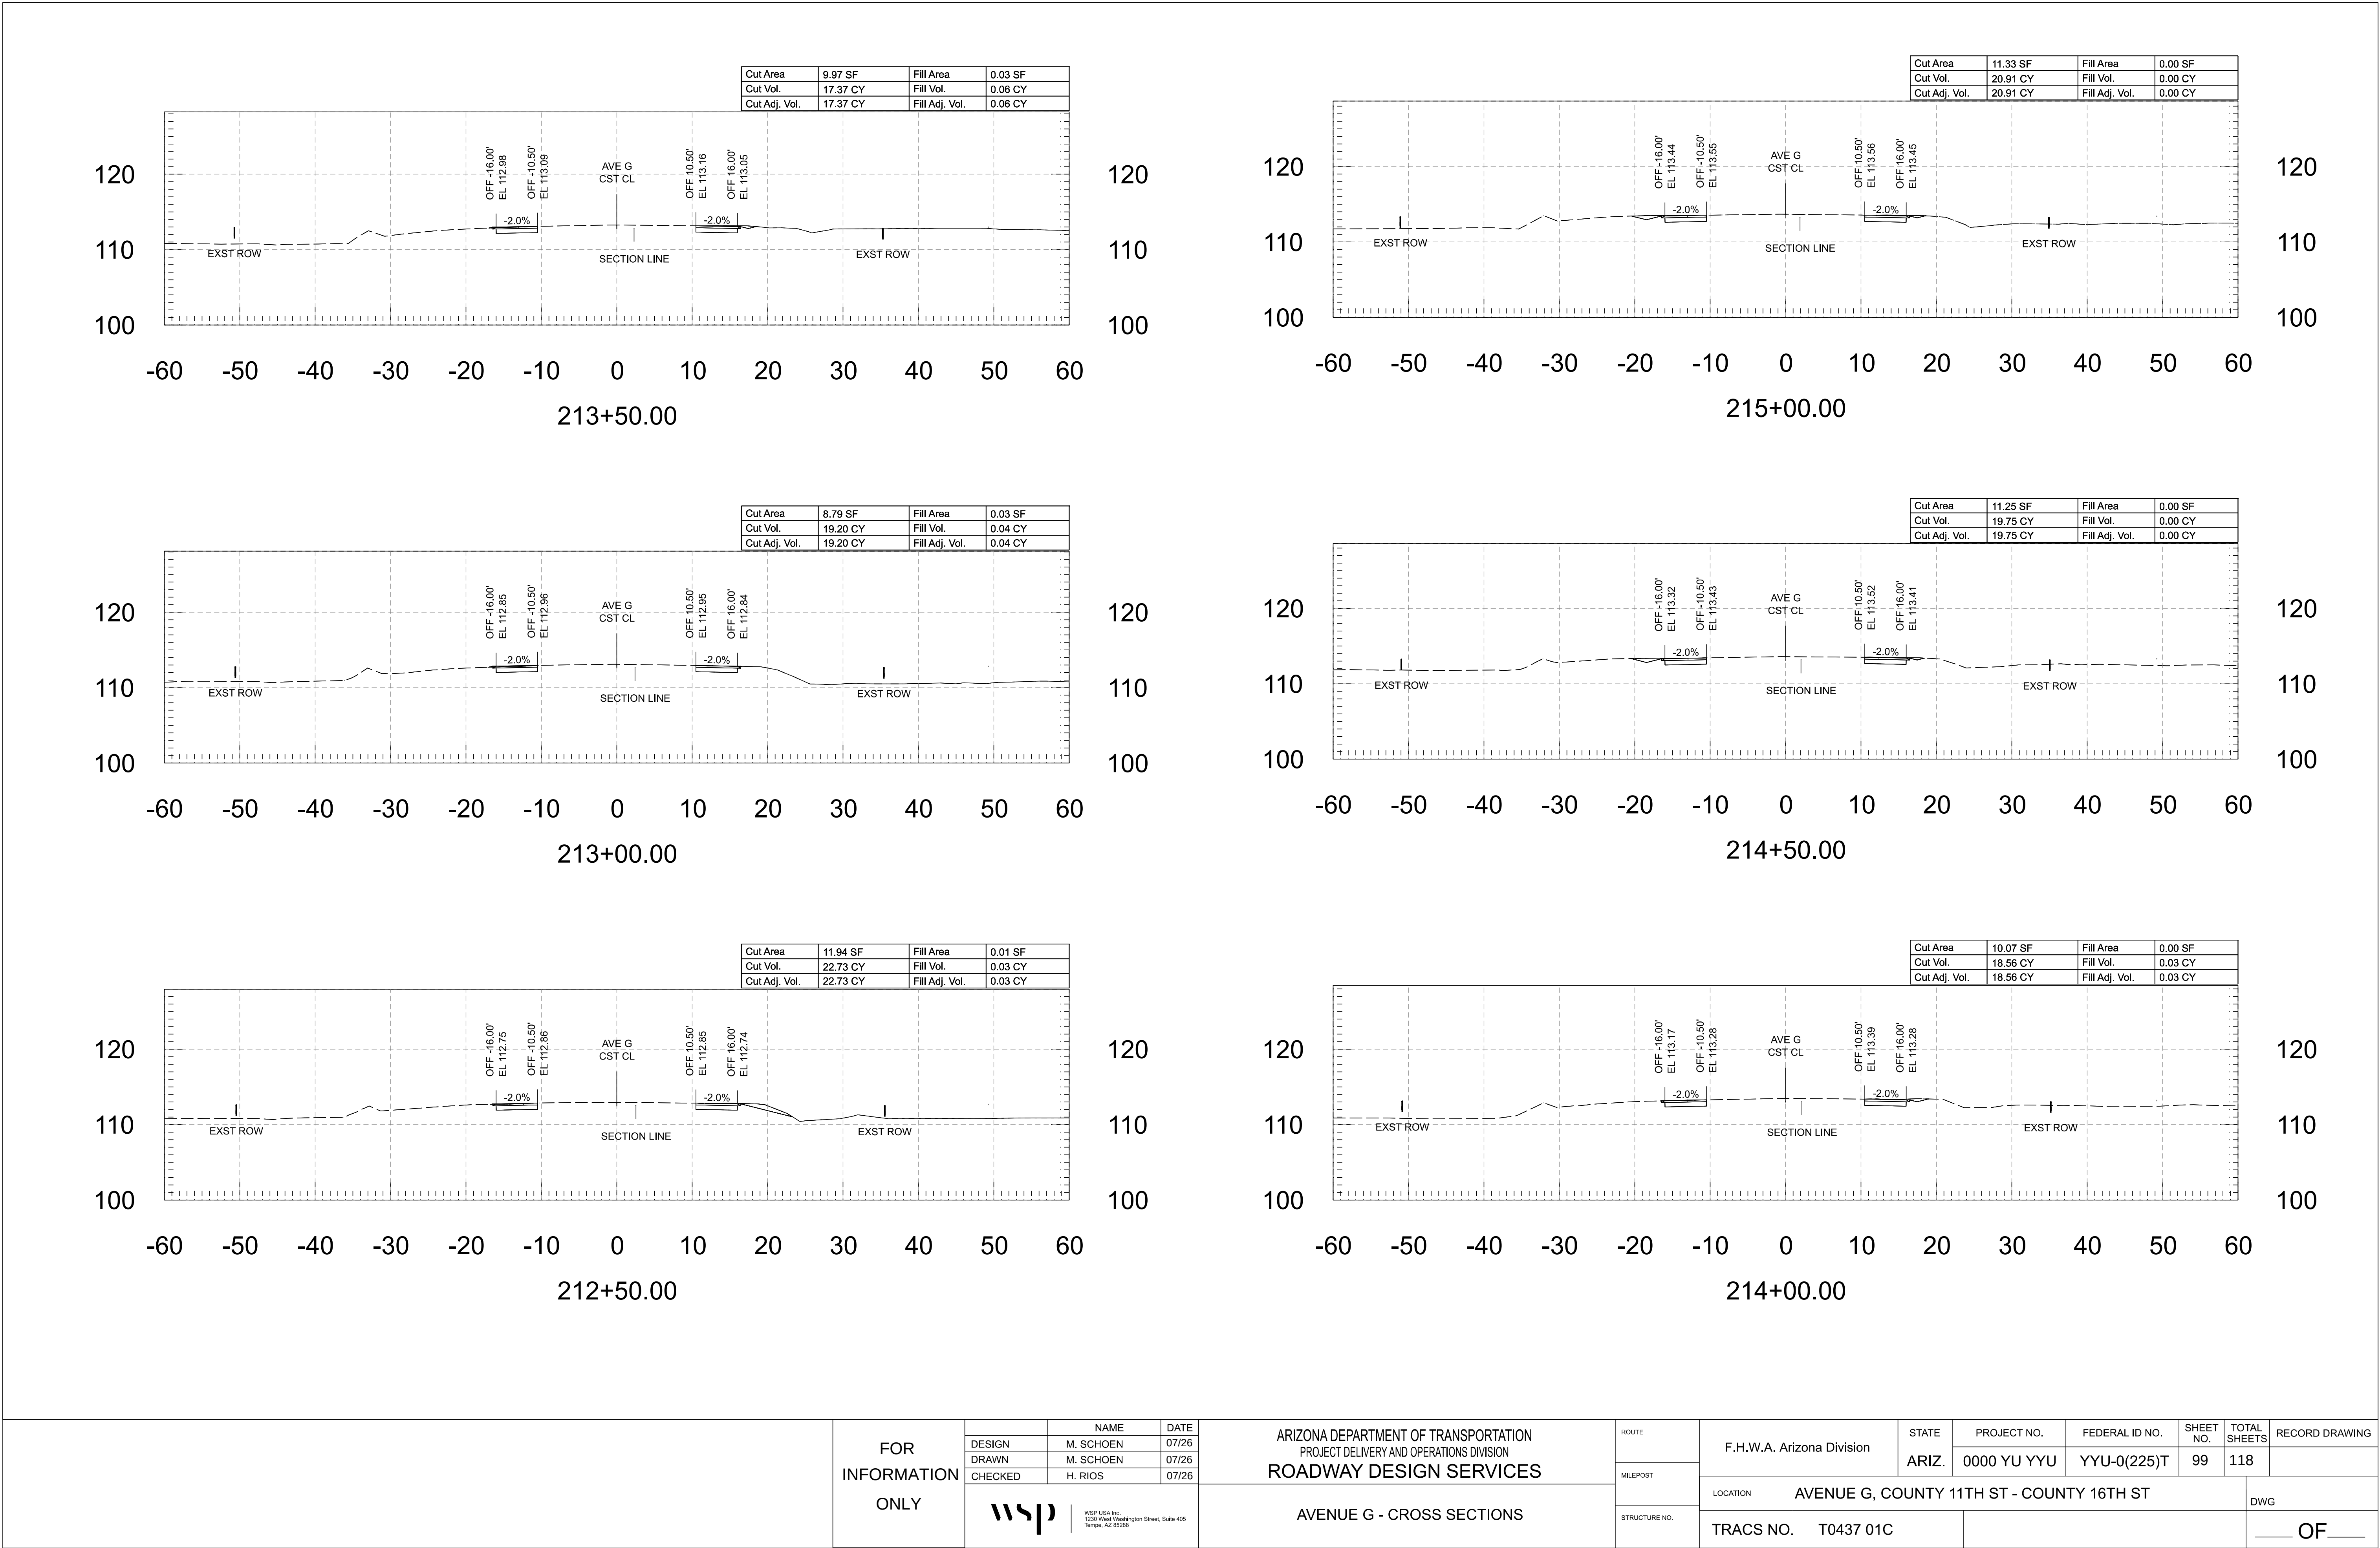


Cut Area	8.72 SF	Fill Area	0.07 SF
Cut Vol.	16.40 CY	Fill Vol.	0.09 CY
Cut Adj. Vol.	16.40 CY	Fill Adj. Vol.	0.09 CY

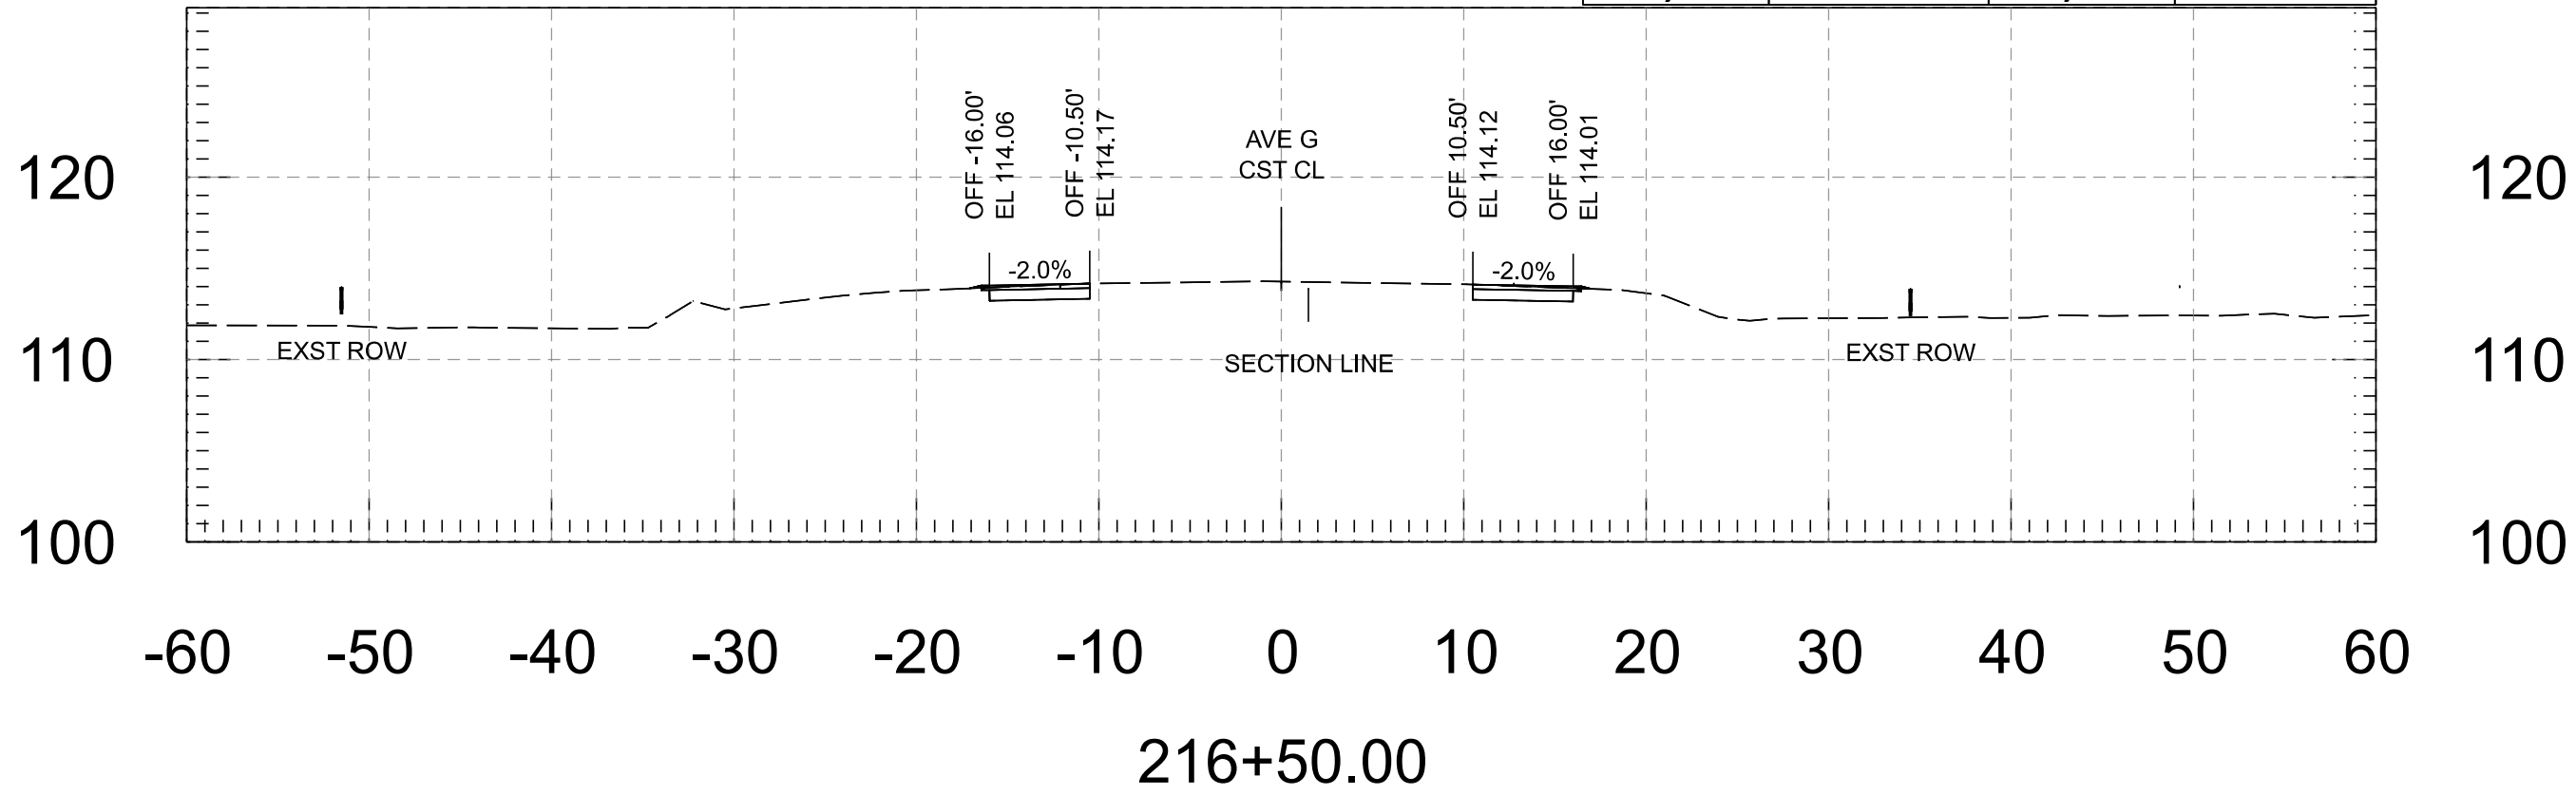


Cut Area	8.72 SF	Fill Area	0.11 SF
Cut Vol.	16.66 CY	Fill Vol.	0.18 CY
Cut Adj. Vol.	16.66 CY	Fill Adj. Vol.	0.18 CY

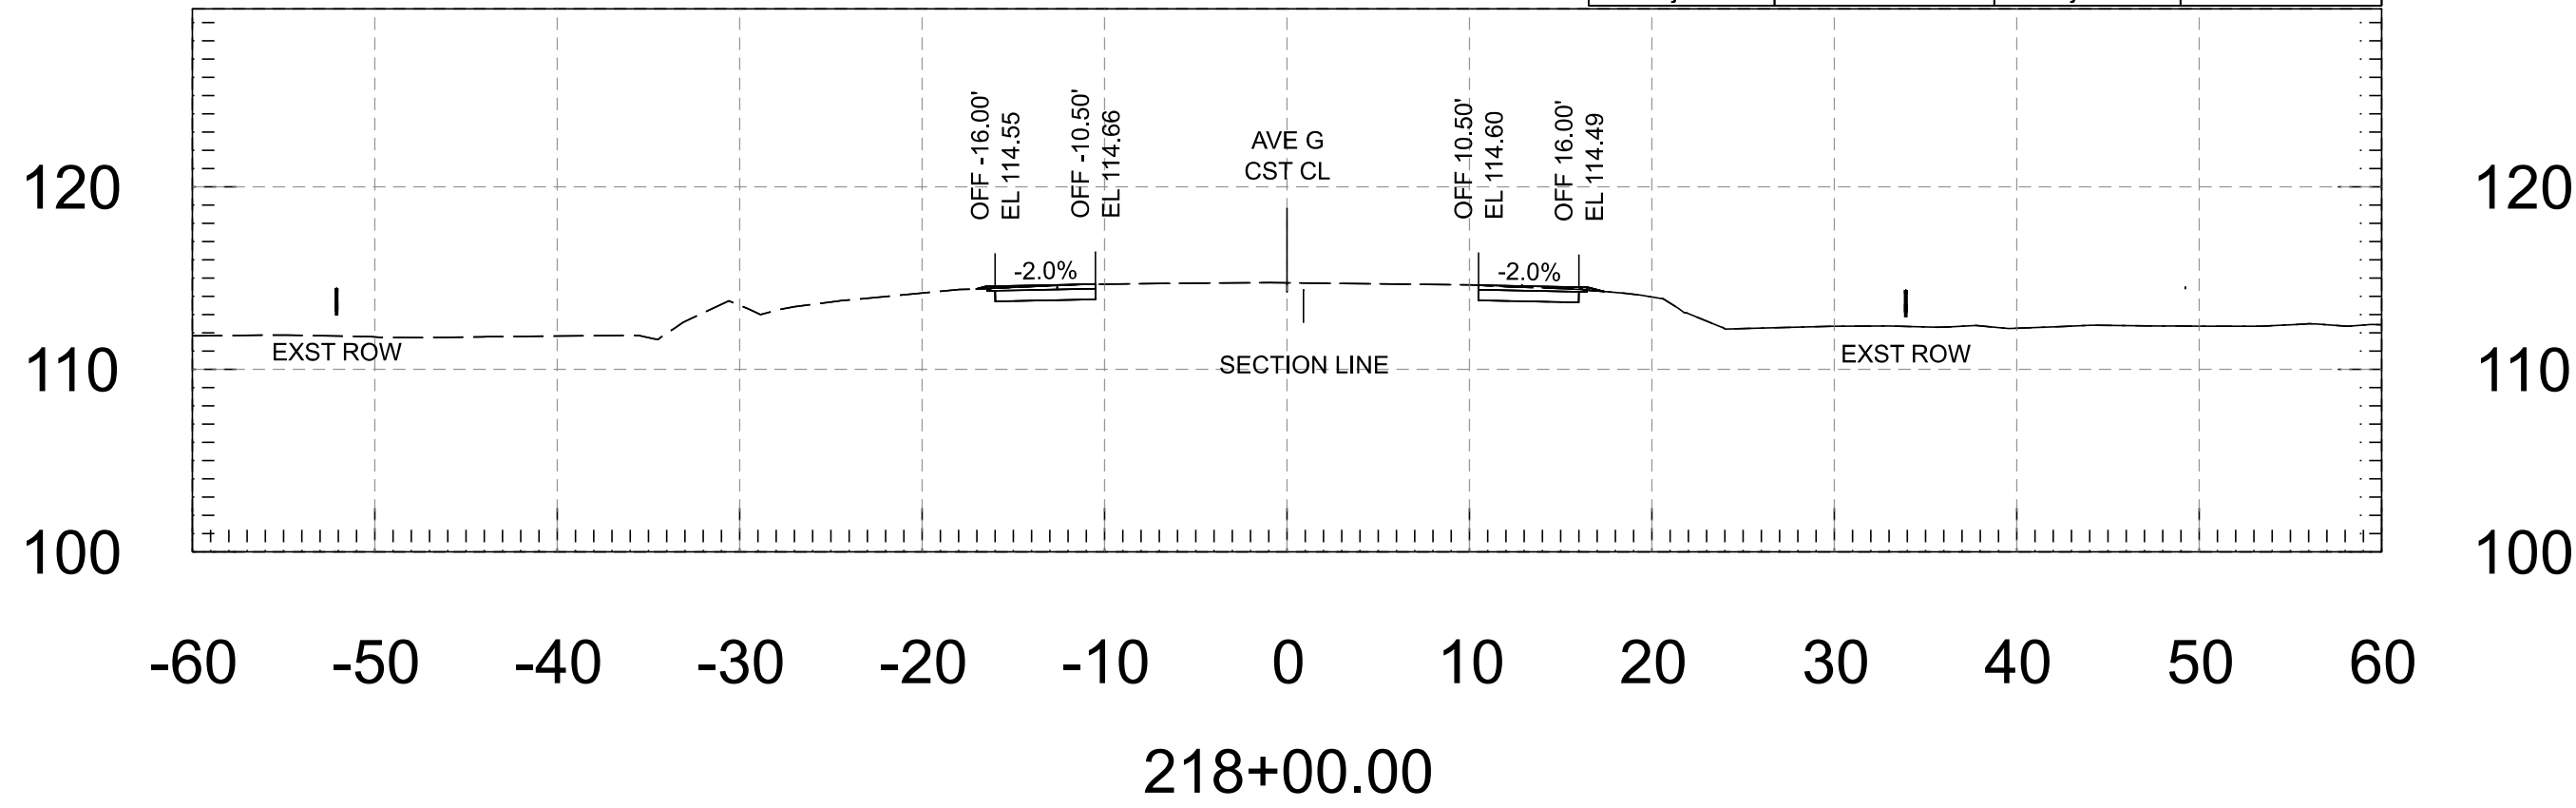


Cut Area	8.99 SF	Fill Area	0.02 SF
Cut Vol.	16.89 CY	Fill Vol.	0.03 CY
Cut Adj. Vol.	16.89 CY	Fill Adj. Vol.	0.03 CY

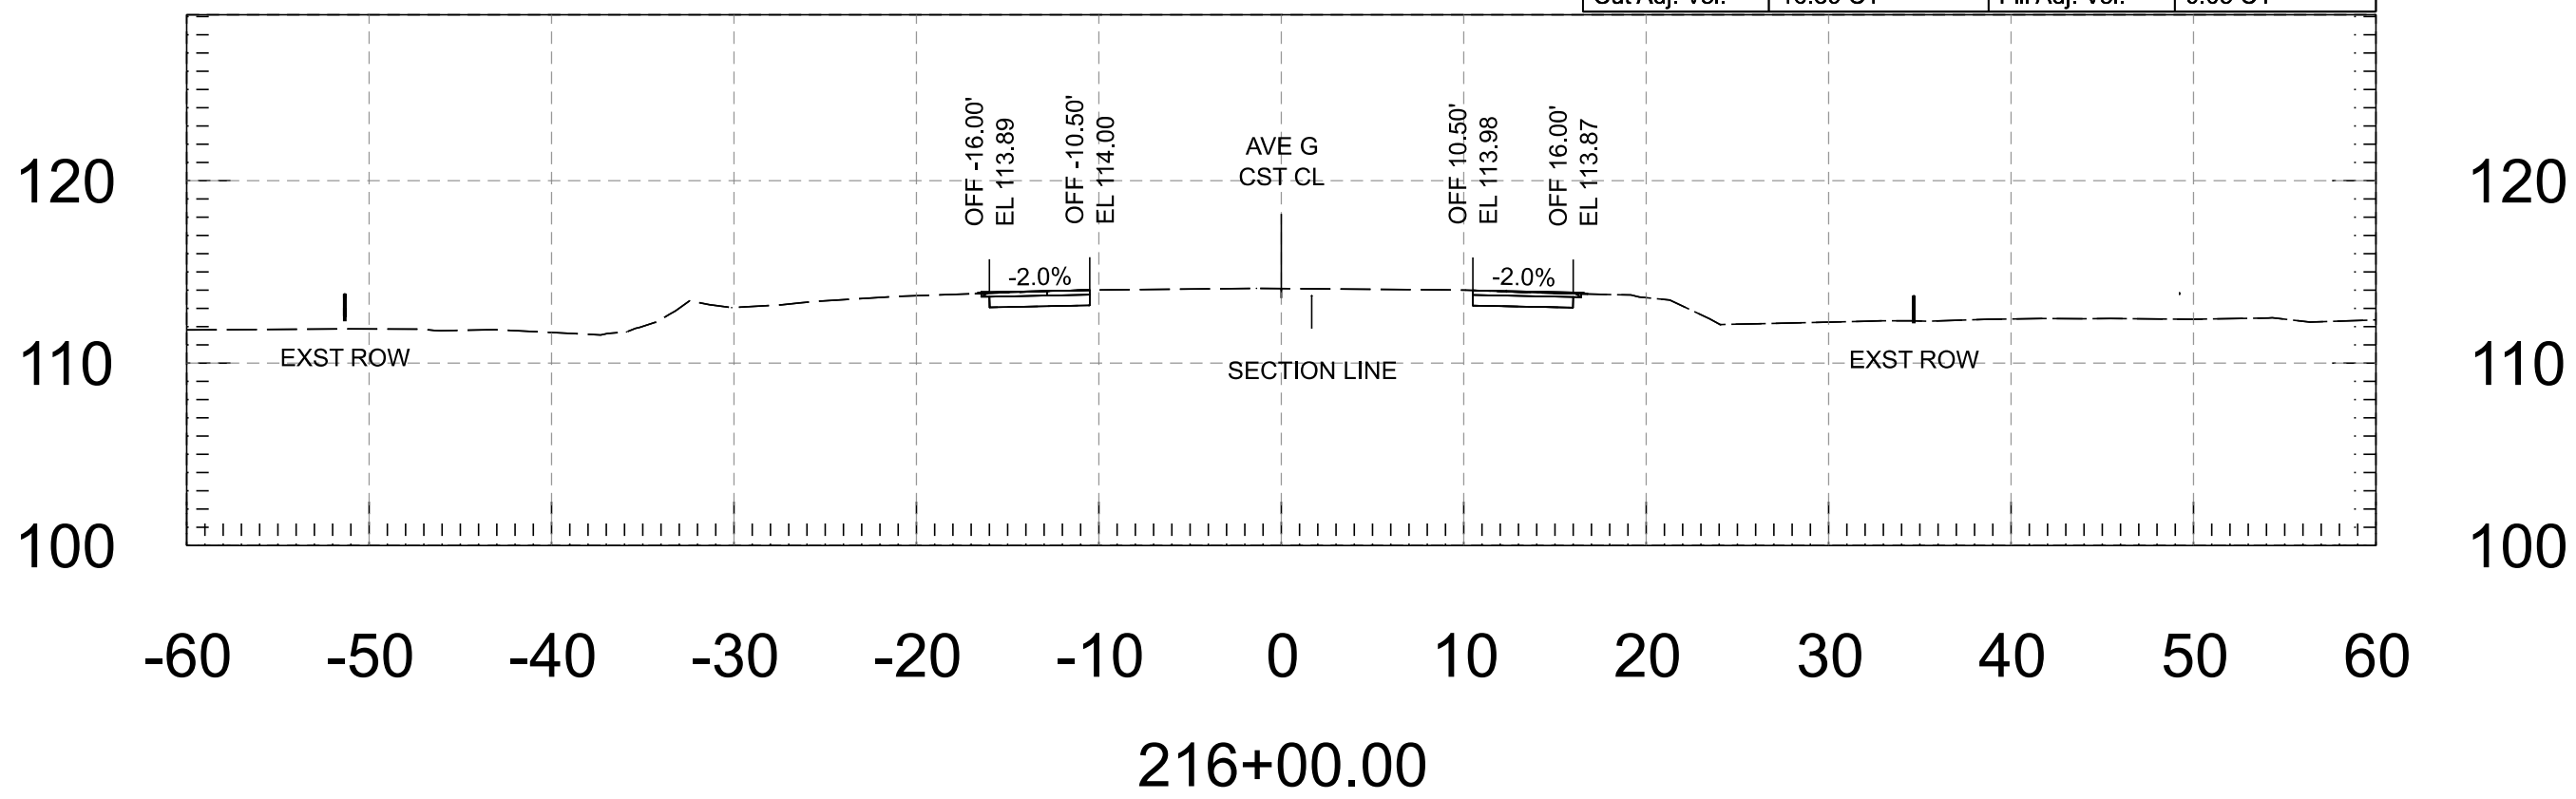


Cut Area	9.27 SF	Fill Area	0.08 SF
Cut Vol.	17.07 CY	Fill Vol.	0.14 CY
Cut Adj. Vol.	17.07 CY	Fill Adj. Vol.	0.14 CY

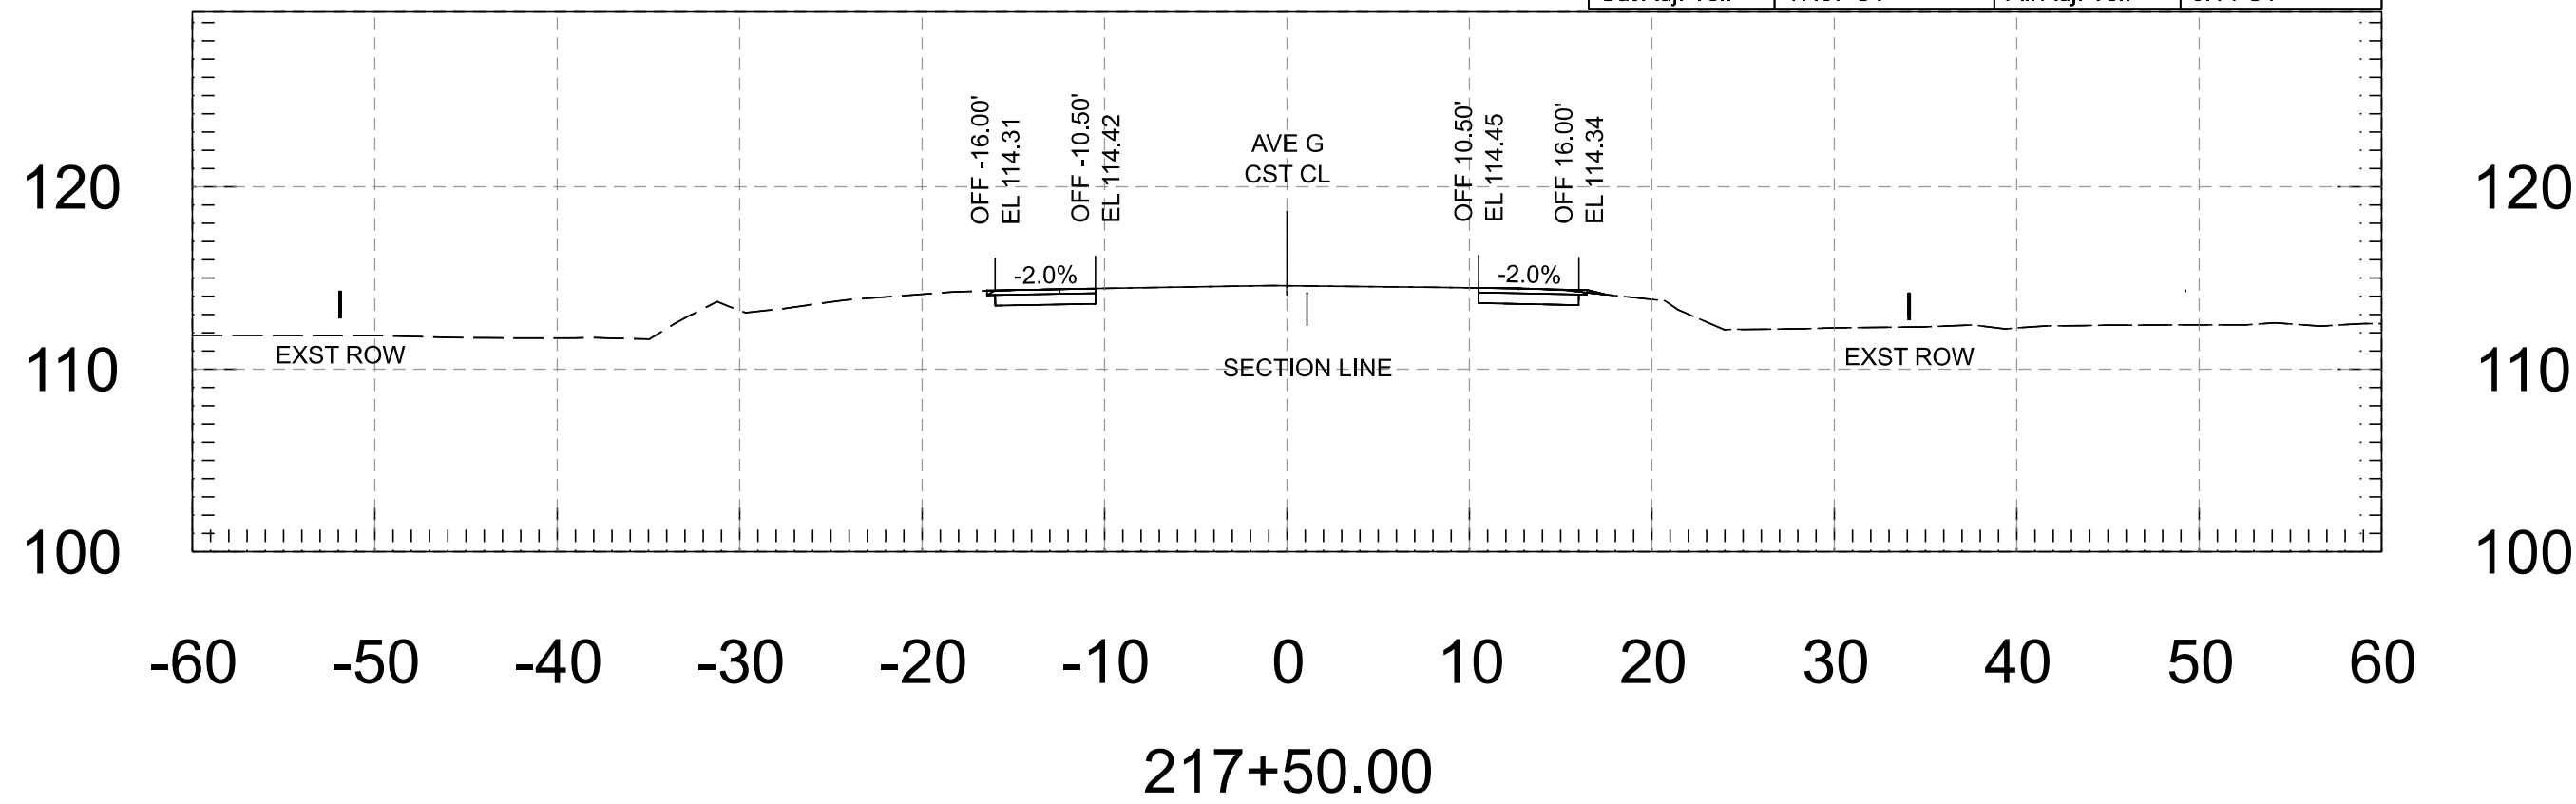


Cut Area	9.25 SF	Fill Area	0.00 SF
Cut Vol.	19.06 CY	Fill Vol.	0.00 CY
Cut Adj. Vol.	19.06 CY	Fill Adj. Vol.	0.00 CY




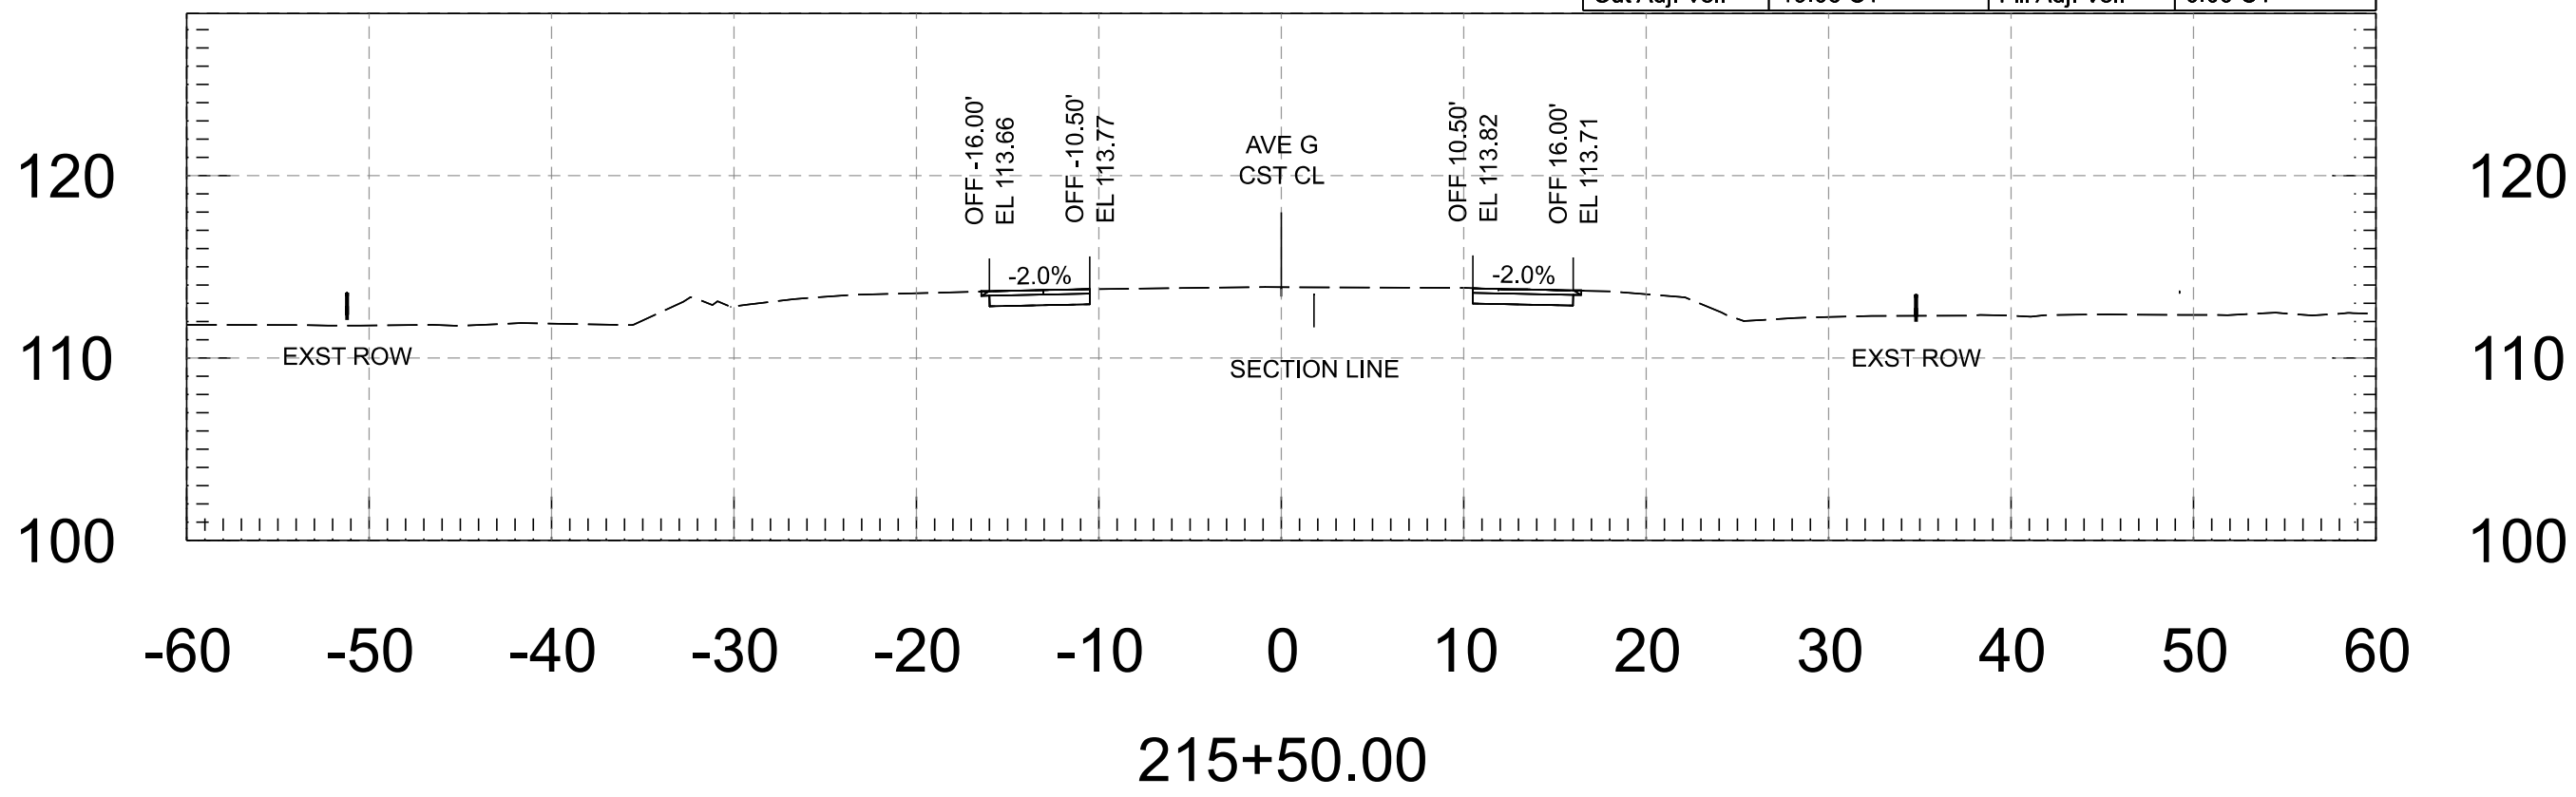


Cut Area	9.17 SF	Fill Area	0.07 SF
Cut Vol.	16.56 CY	Fill Vol.	0.13 CY
Cut Adj. Vol.	16.56 CY	Fill Adj. Vol.	0.13 CY




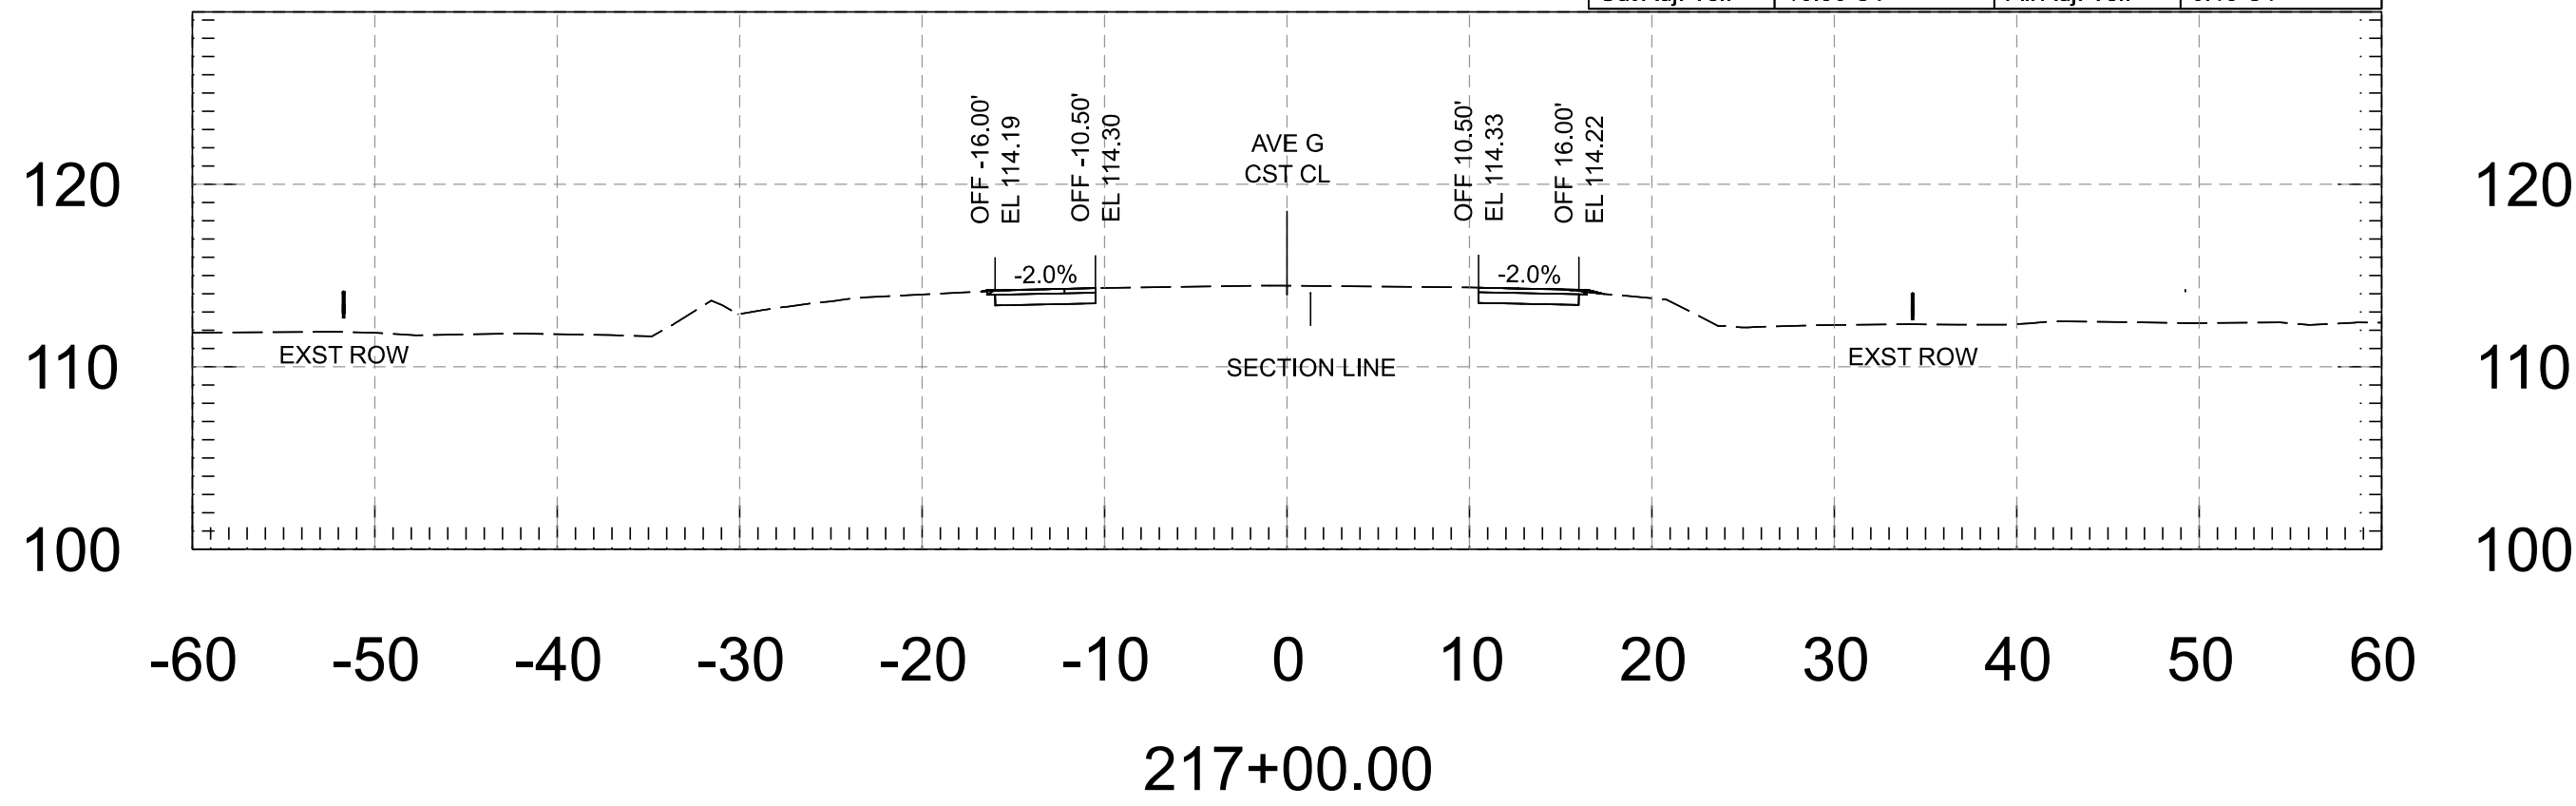


FOR INFORMATION ONLY		NAME	DATE	ARIZONA DEPARTMENT OF TRANSPORTATION PROJECT DELIVERY AND OPERATIONS DIVISION ROADWAY DESIGN SERVICES	ROUTE	F.H.W.A. Arizona Division	STATE ARIZ.	PROJECT NO.	FEDERAL ID NO.	SHEET NO.	TOTAL SHEETS	RECORD DRAWING
	DESIGN	M. SCHOEN	07/26					0000 YU YYU	YYU-0(225)T	100	118	
	DRAWN	M. SCHOEN	07/26									
	CHECKED	H. RIOS	07/26									
		 WSP USA Inc. 1230 West Washington Street, Suite 405 Tempe, AZ 85288	AVENUE G - CROSS SECTIONS			MILEPOST	LOCATION AVENUE G, COUNTY 11TH ST - COUNTY 16TH ST					
					STRUCTURE NO.	TRACS NO. T0437 01C					___ OF ___	

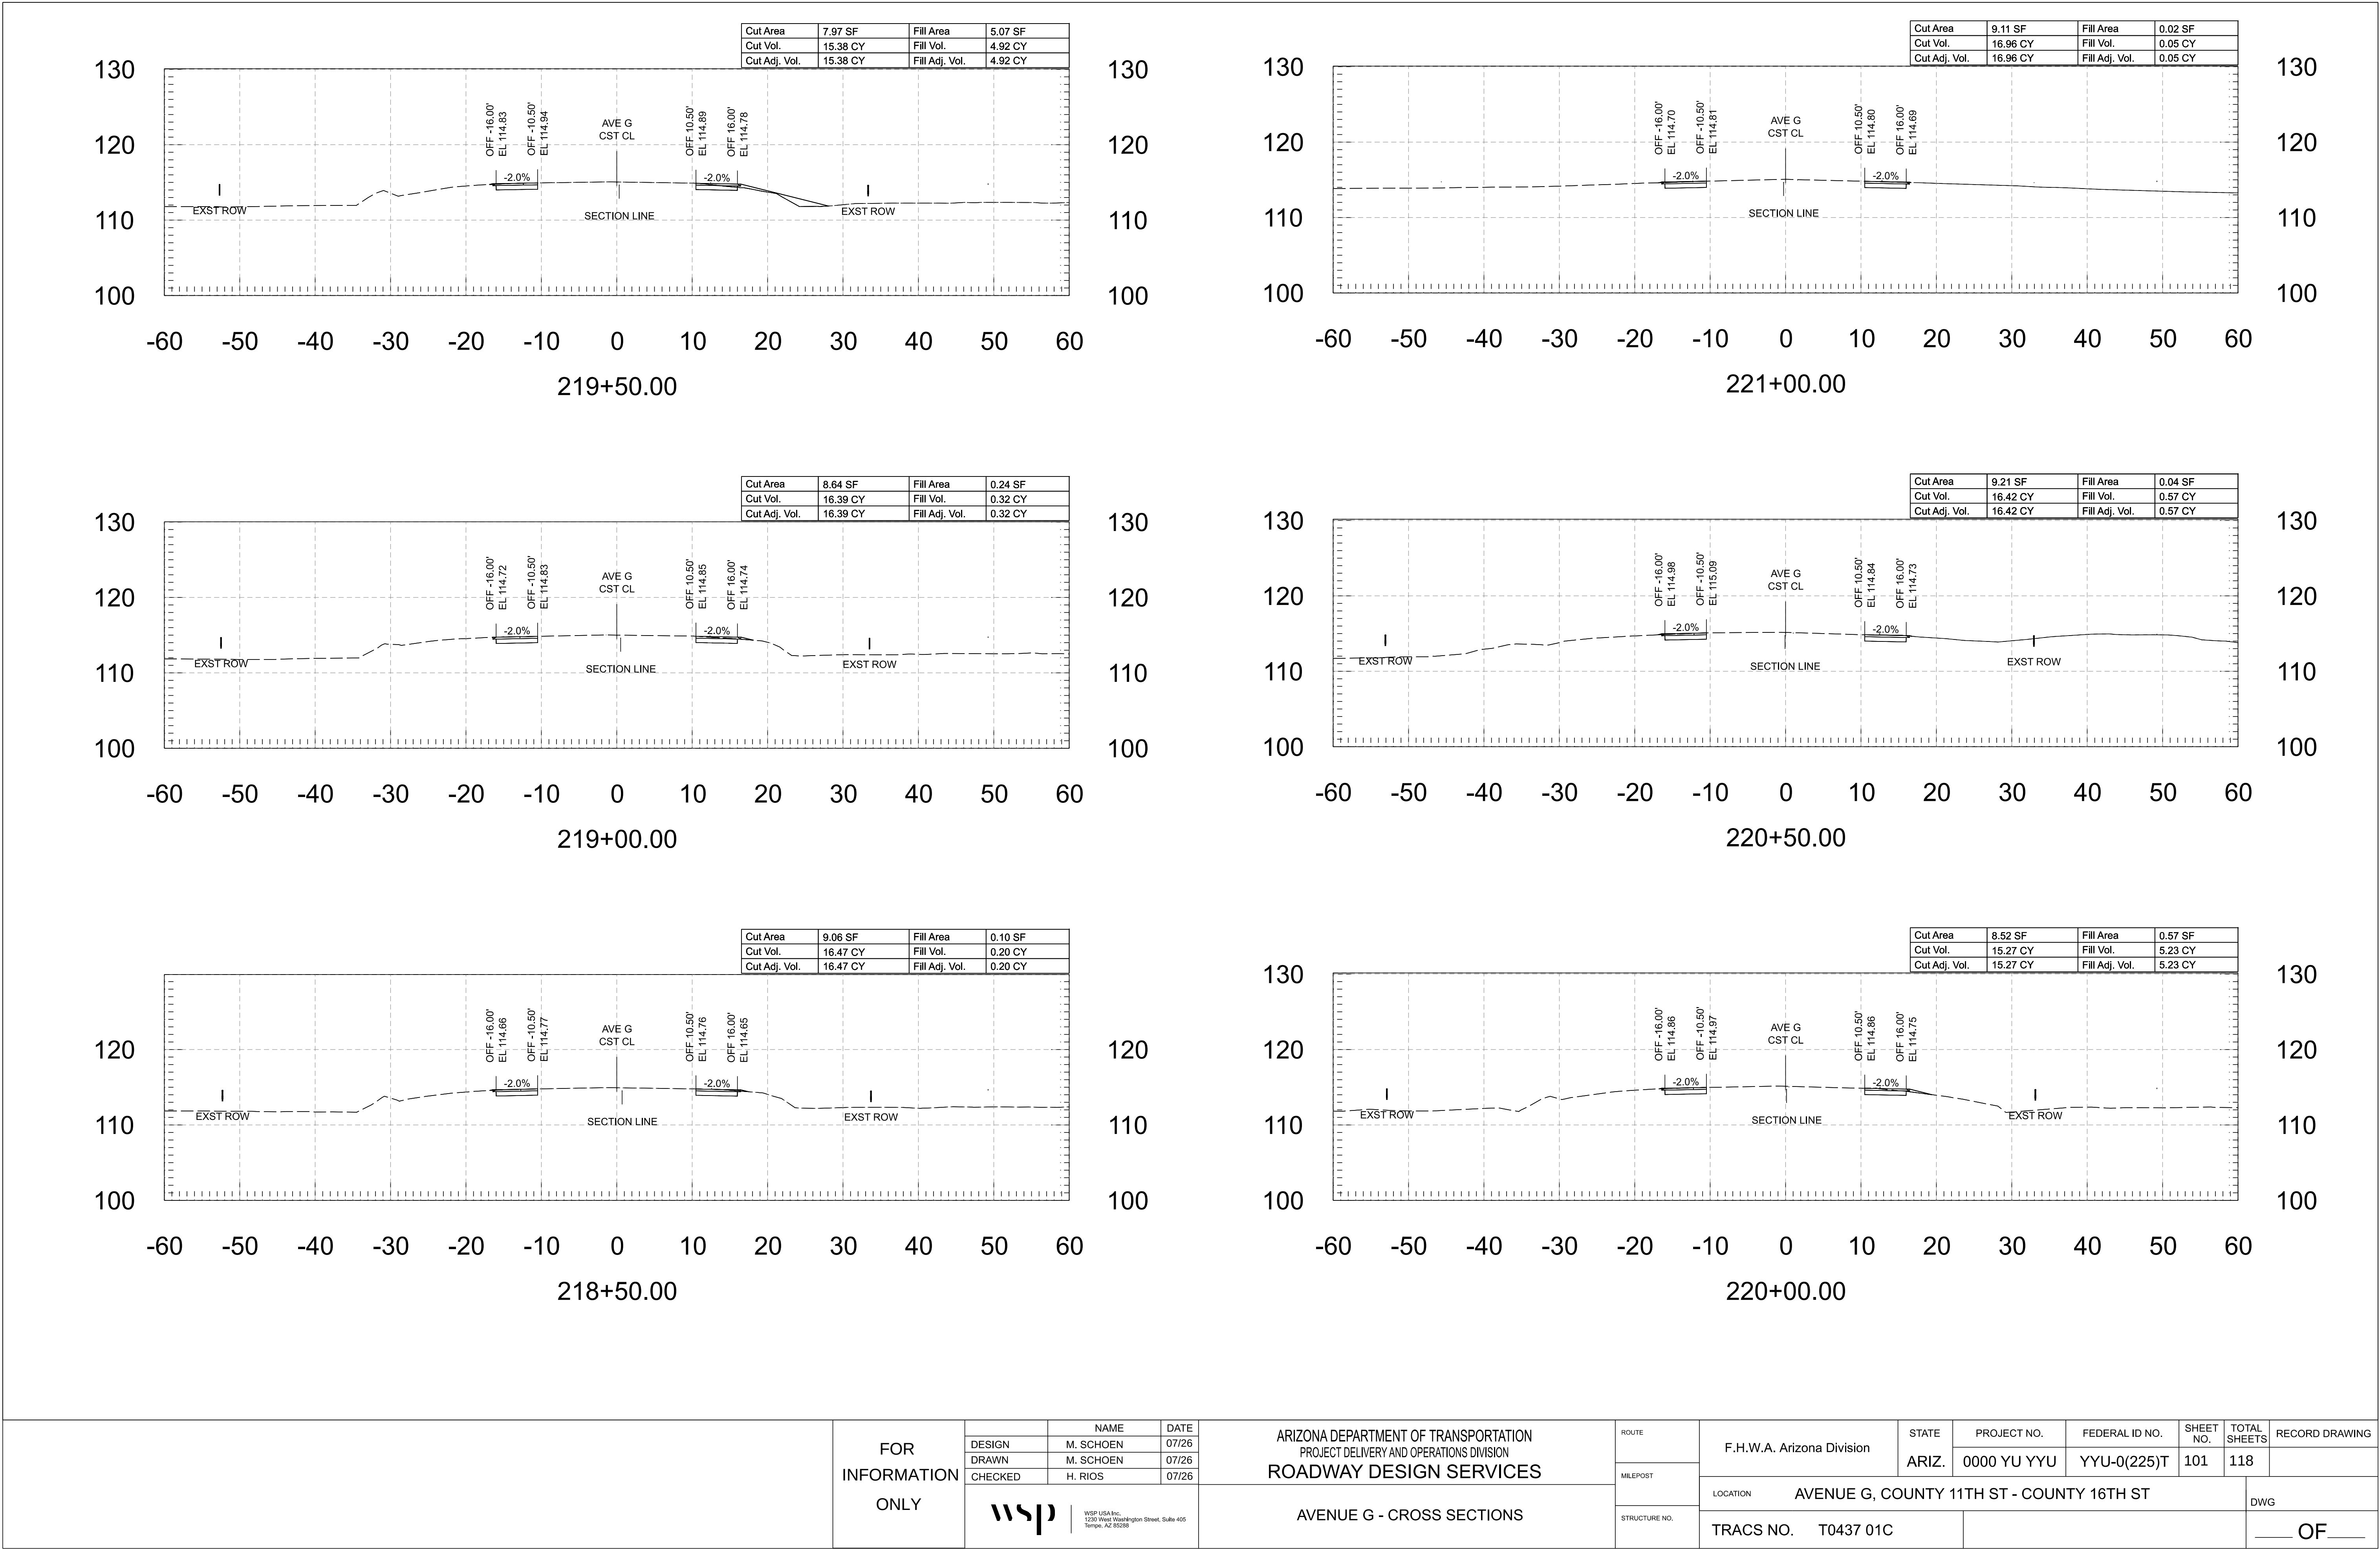


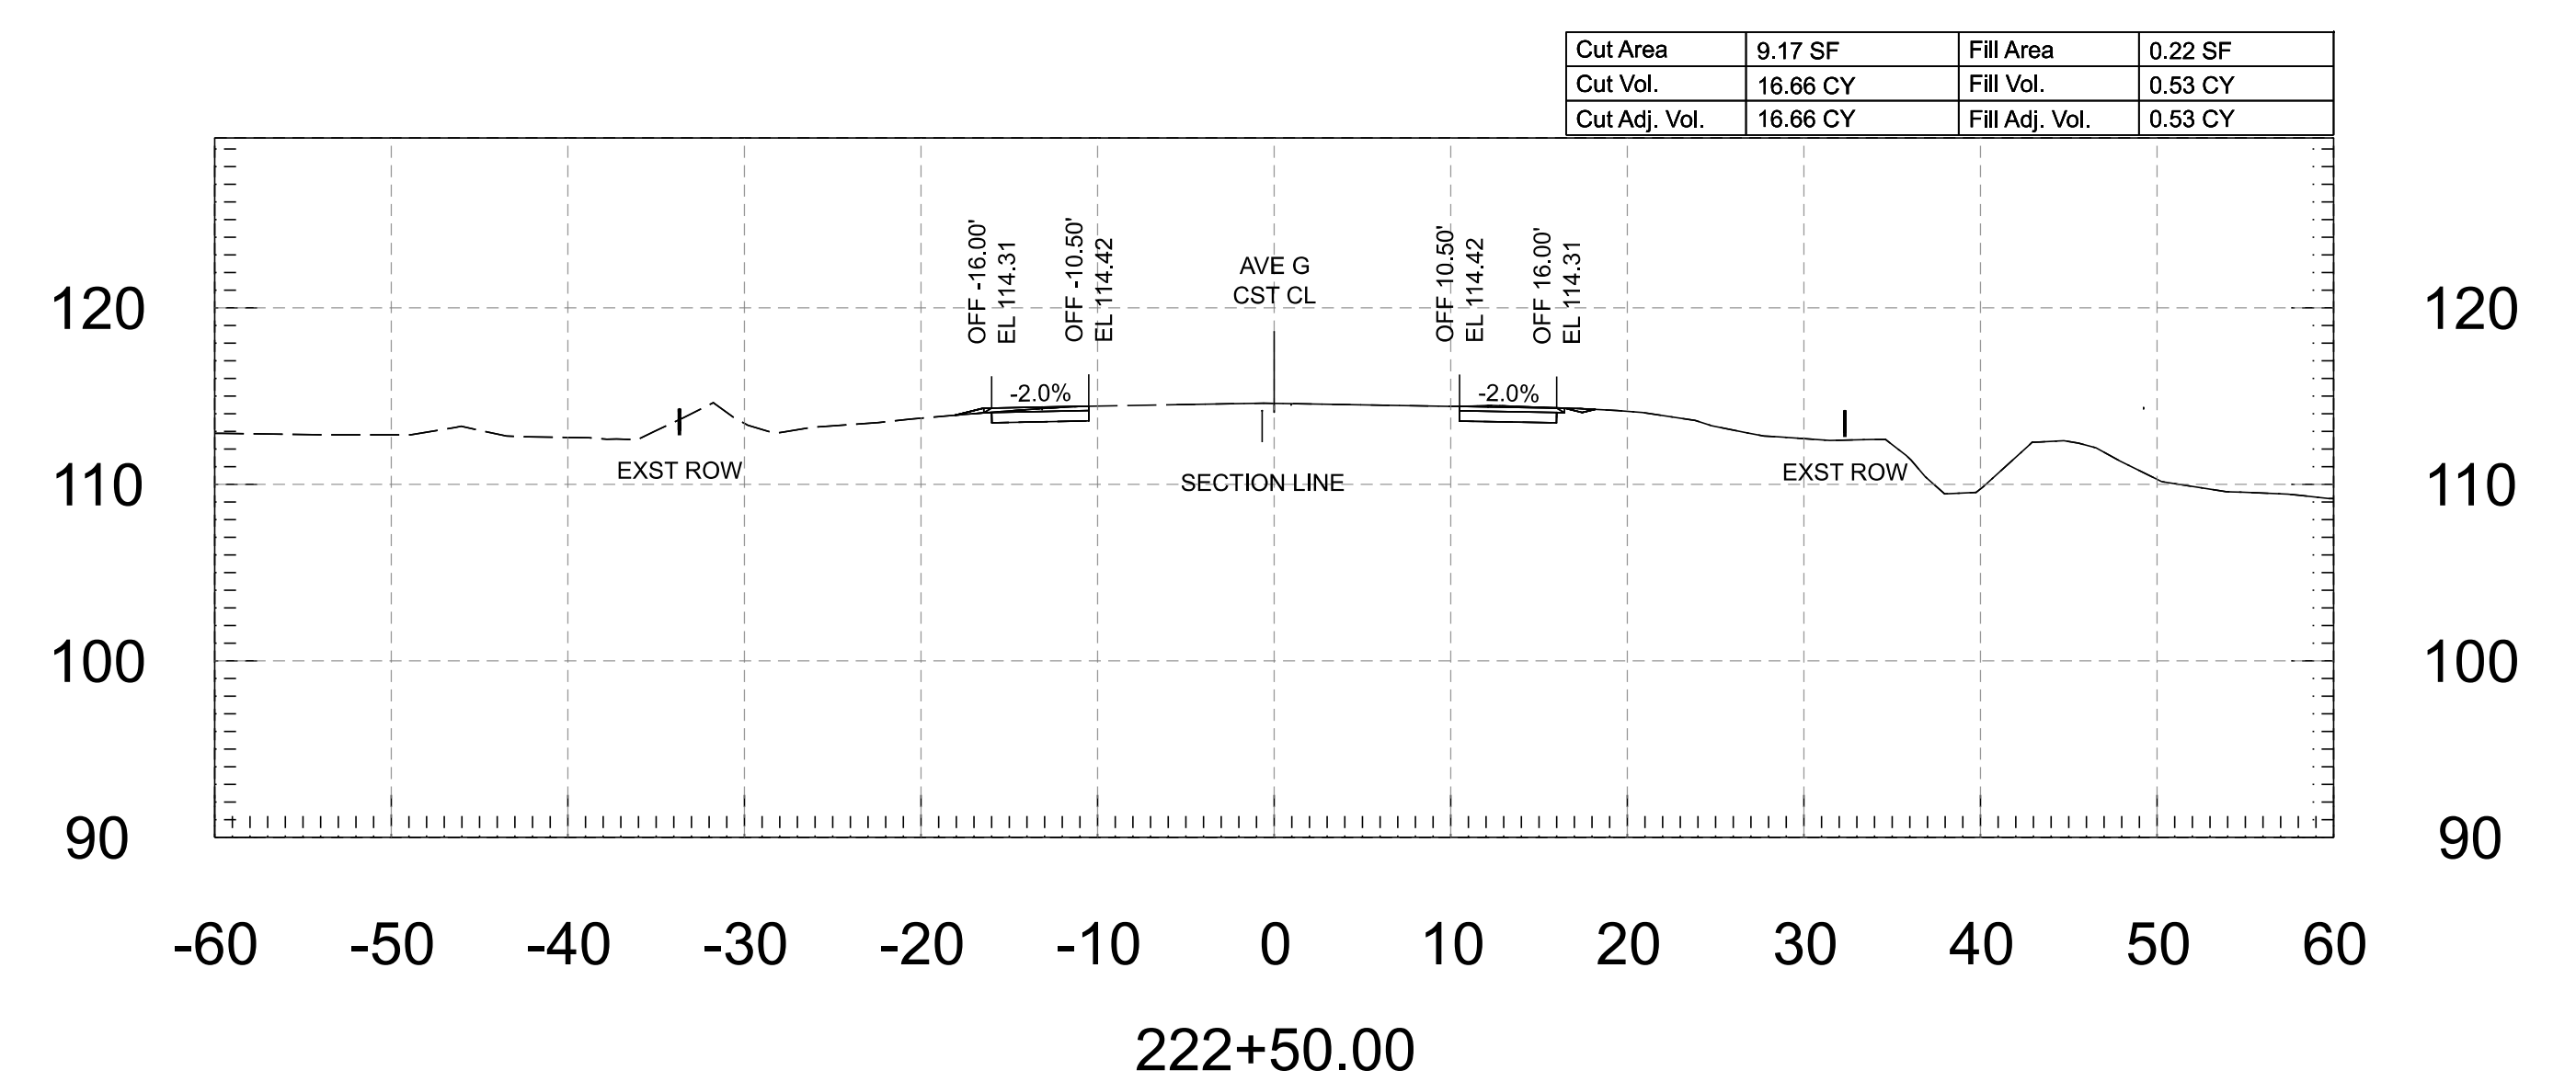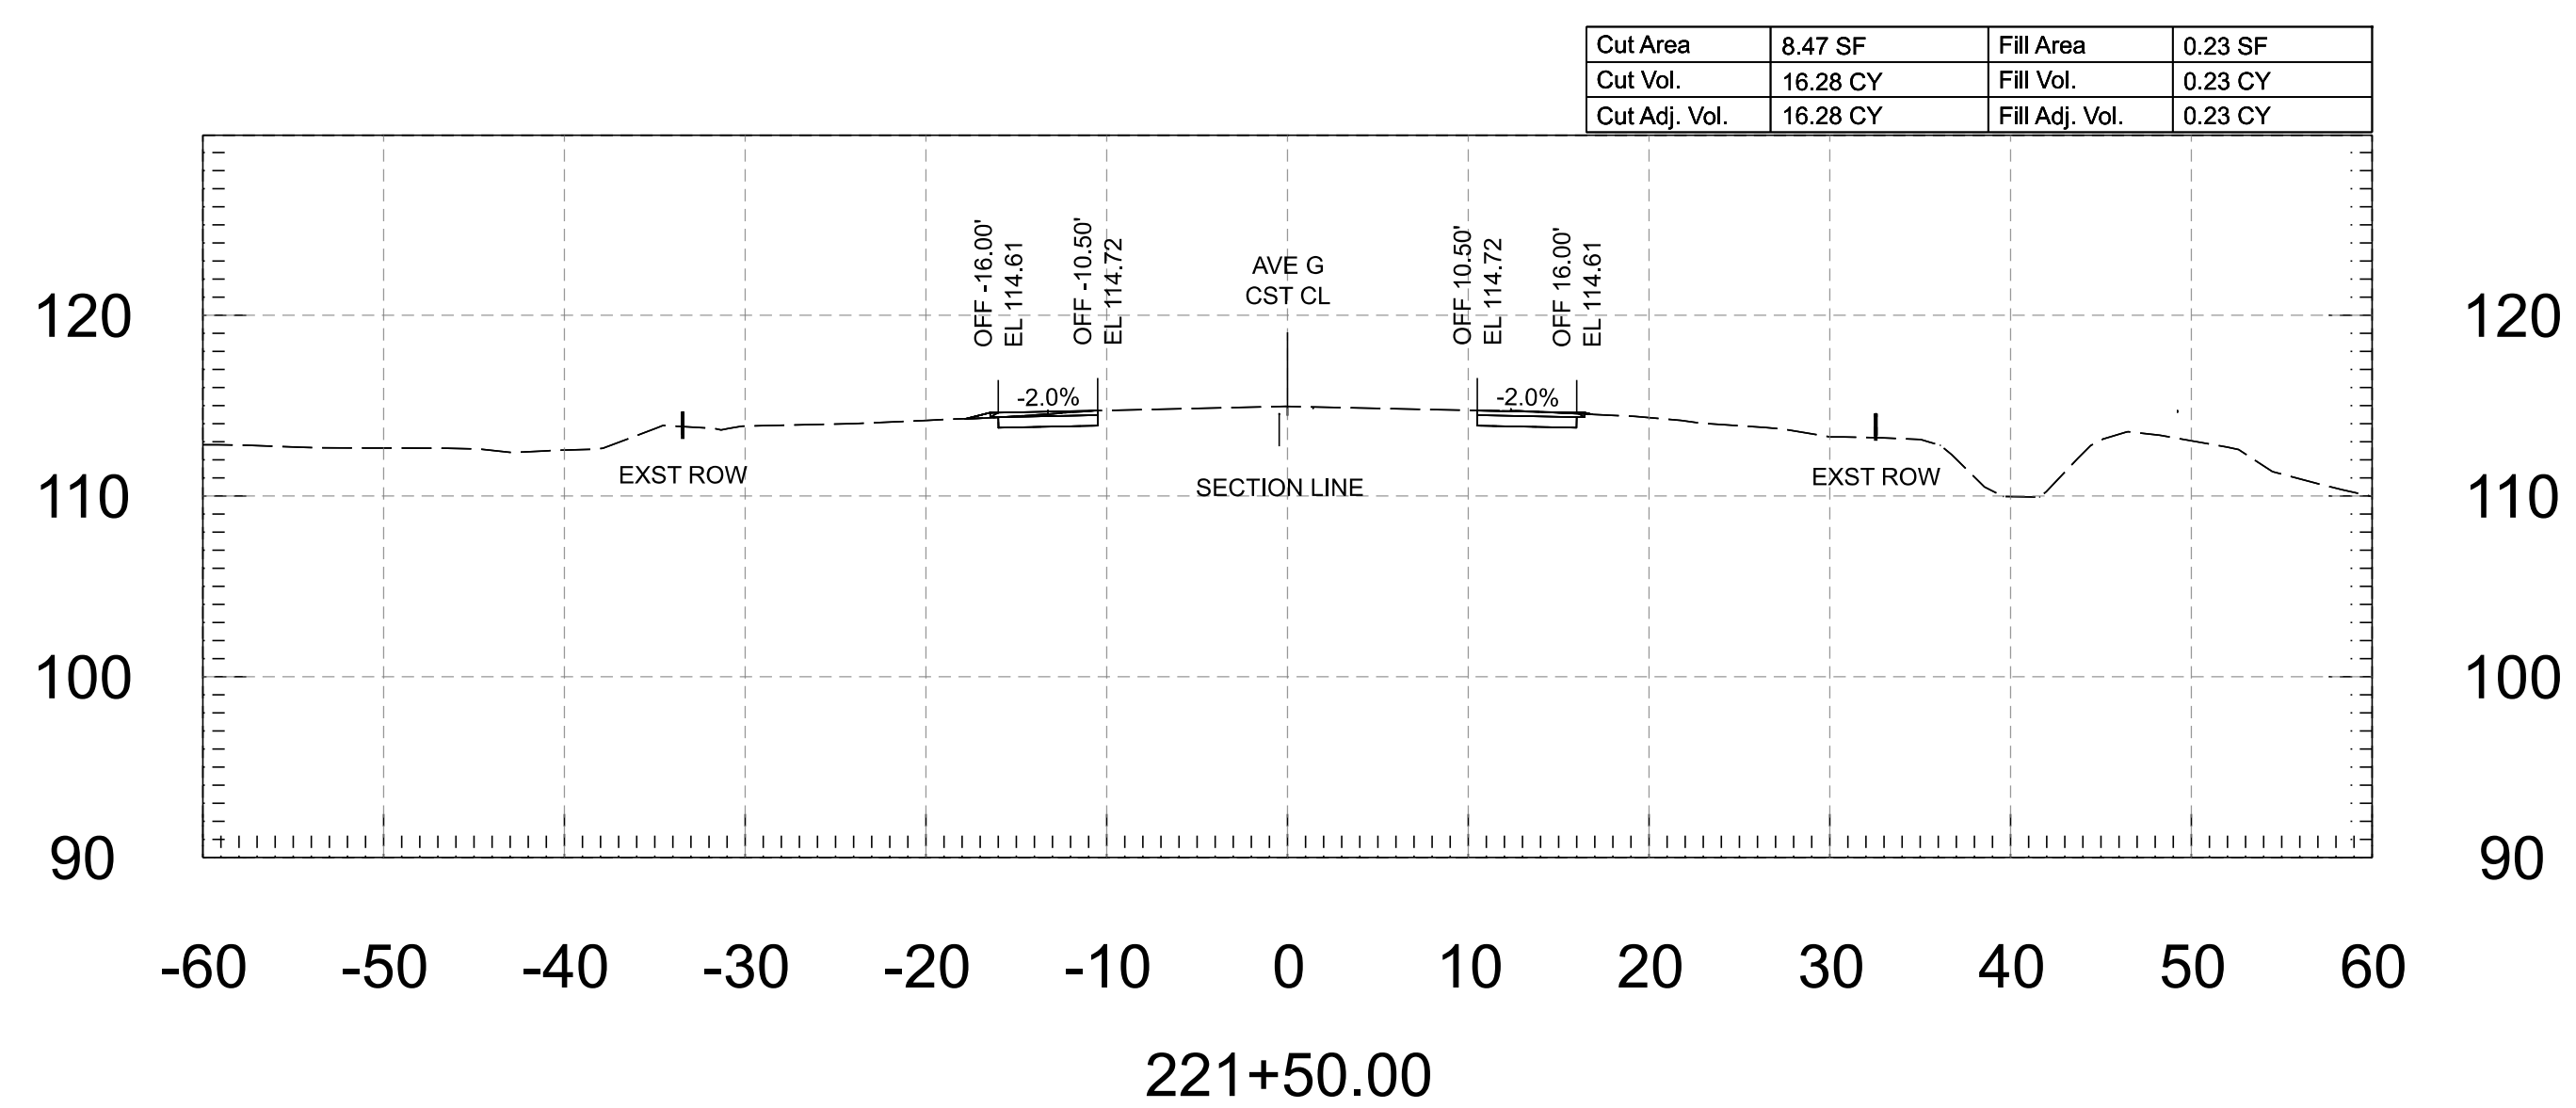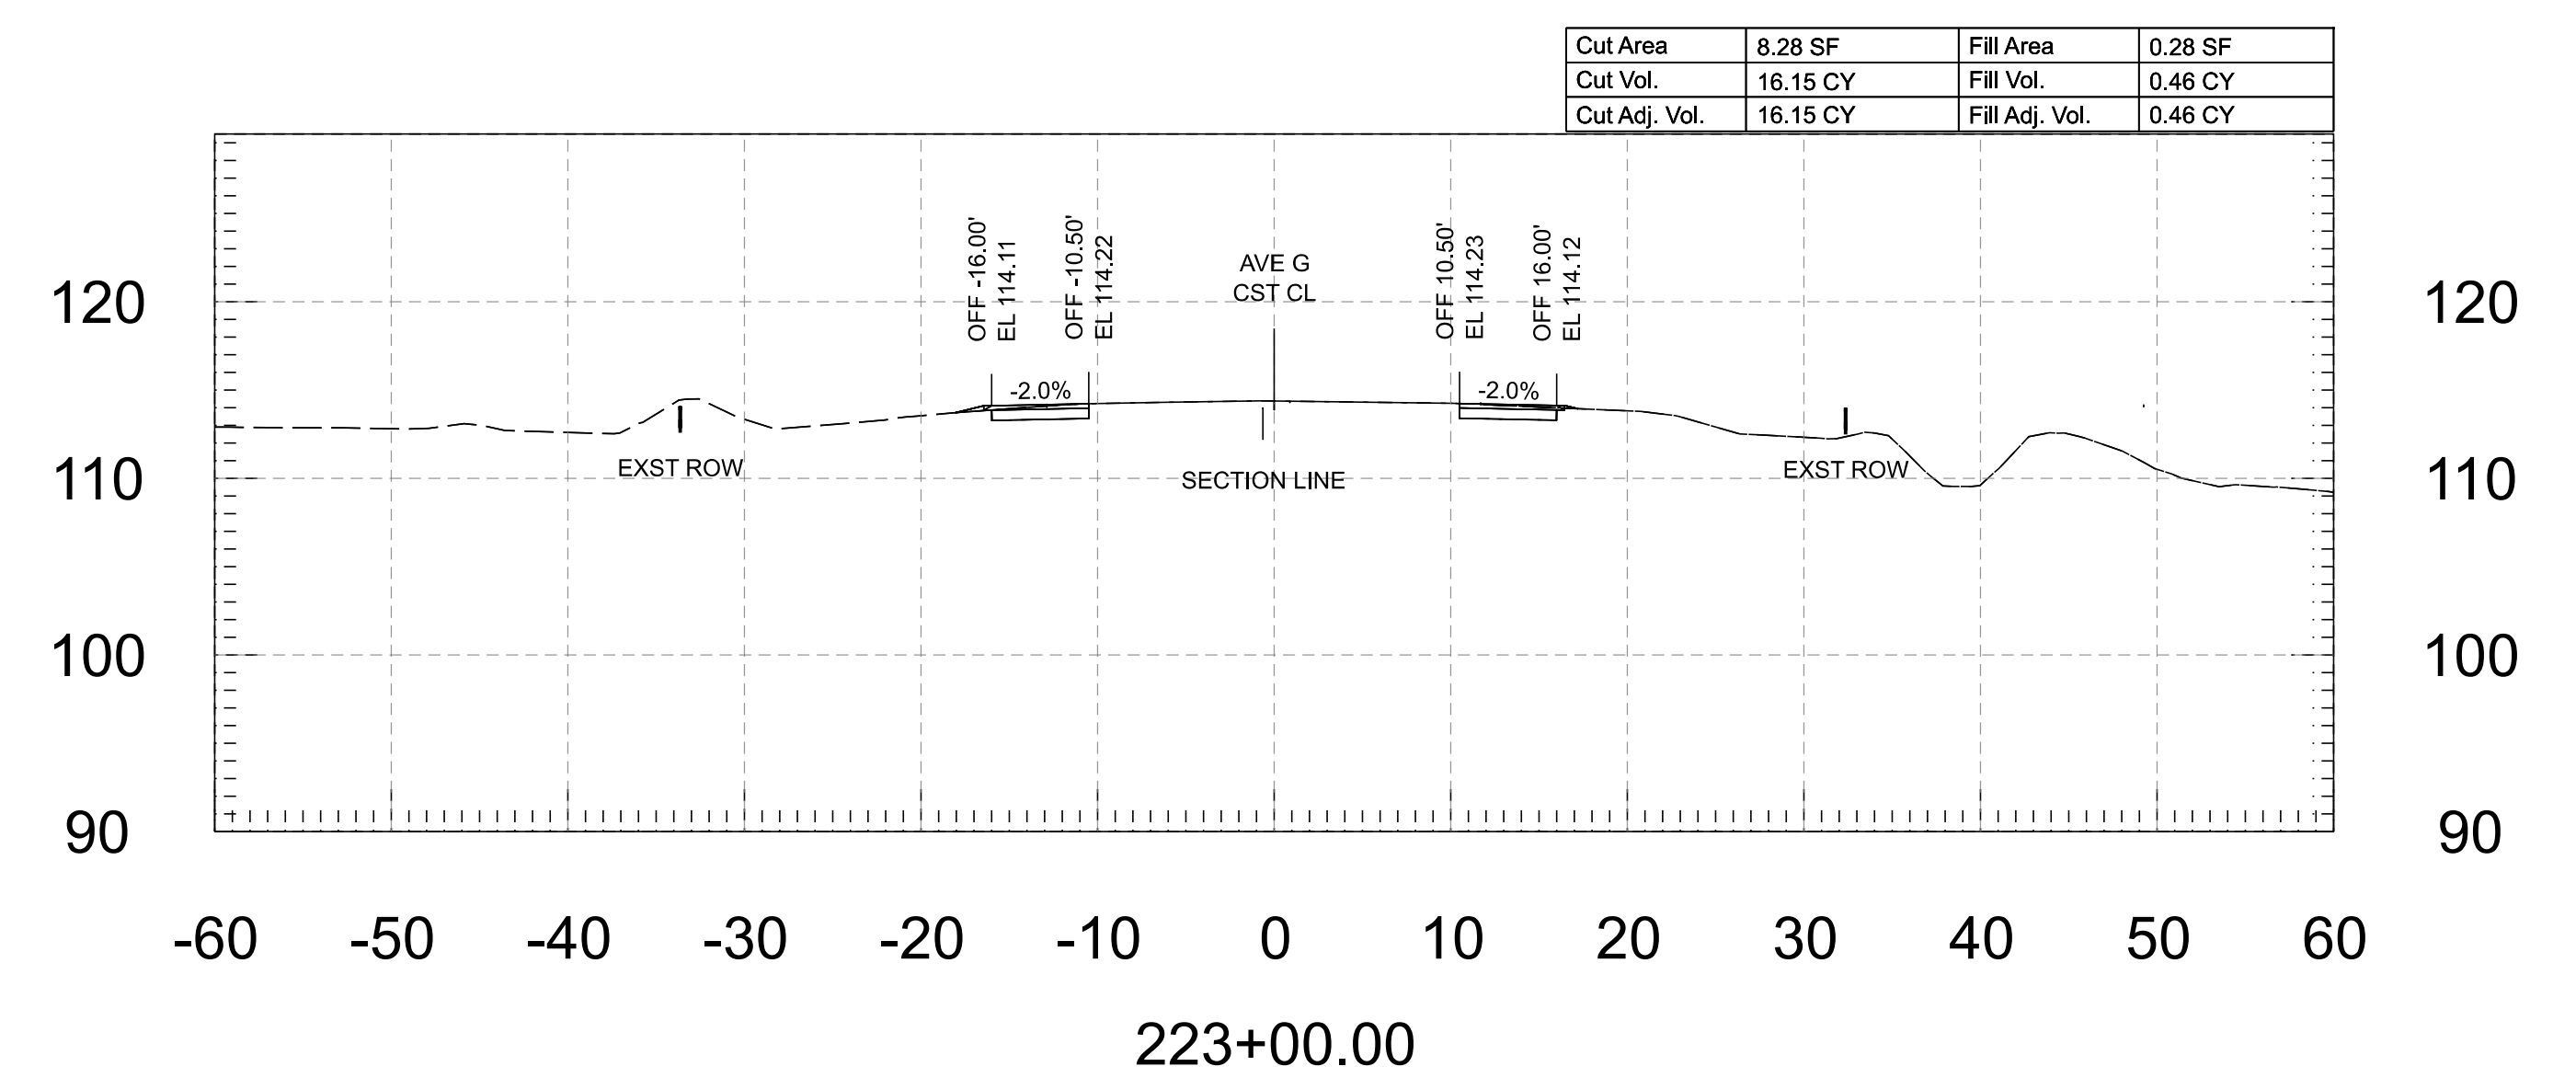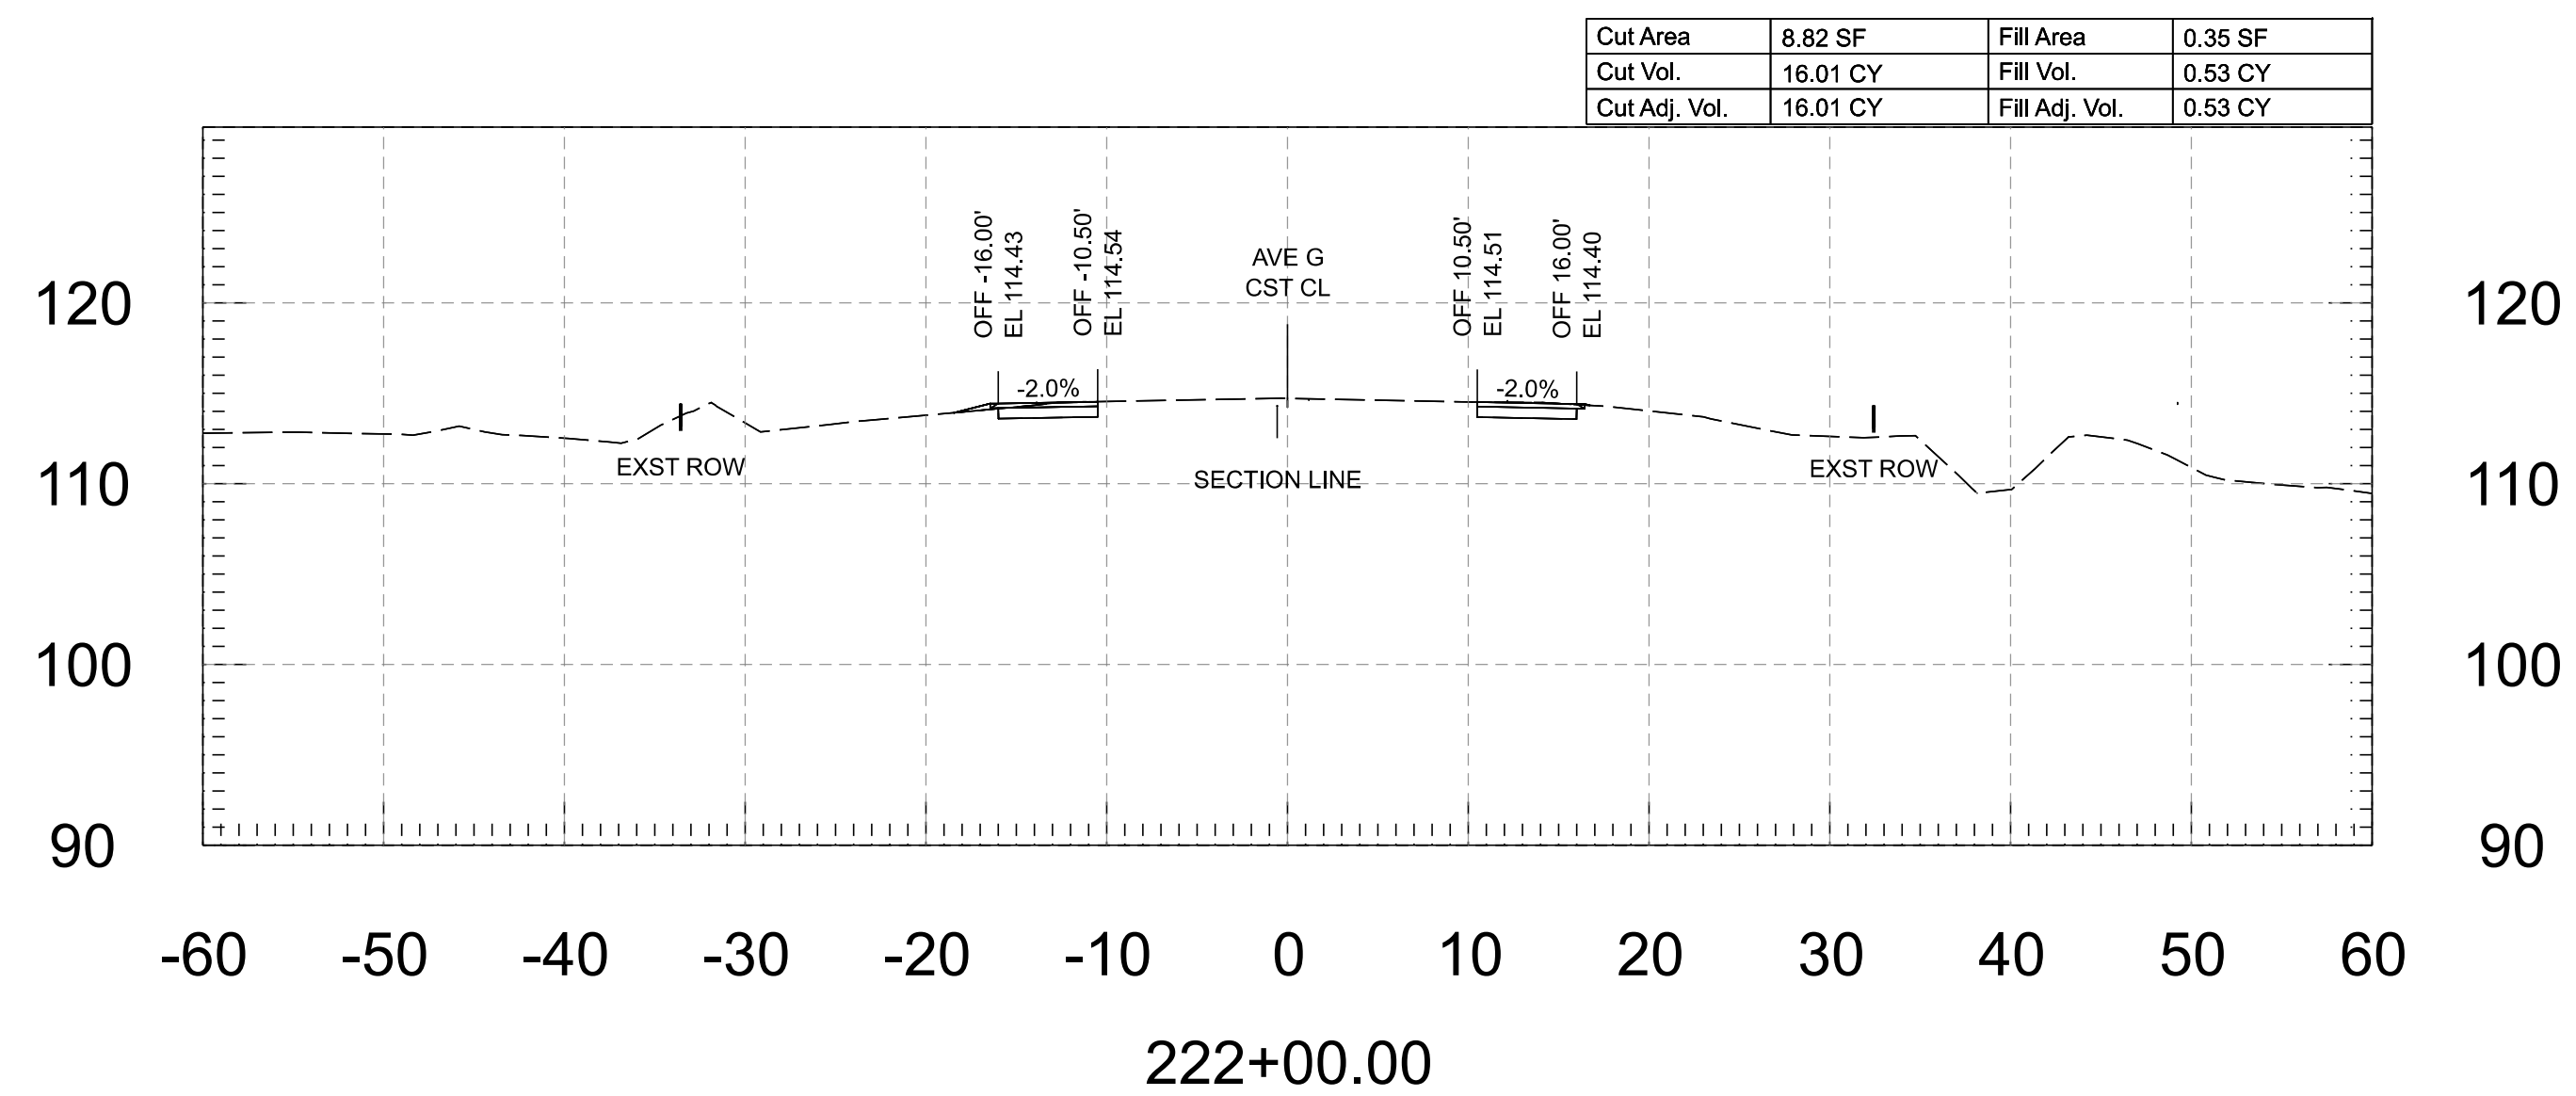


FOR INFORMATION ONLY			NAME	DATE	ARIZONA DEPARTMENT OF TRANSPORTATION PROJECT DELIVERY AND OPERATIONS DIVISION ROADWAY DESIGN SERVICES	ROUTE	F.H.W.A. Arizona Division	STATE ARIZ.	PROJECT NO.	FEDERAL ID NO.	SHEET NO.	TOTAL SHEETS	RECORD DRAWING
	DESIGN	M. SCHOEN	07/26			0000 YU YYU			YYU-0(225)T	102	118		
	DRAWN	M. SCHOEN	07/26										
	CHECKED	H. RIOS	07/26										
	 WSP USA Inc. 1230 West Washington Street, Suite 405 Tempe, AZ 85280			AVENUE G - CROSS SECTIONS			MILEPOST	LOCATION AVENUE G, COUNTY 11TH ST - COUNTY 16TH ST					
					STRUCTURE NO.	TRACS NO. T0437 01C					___ OF ___		

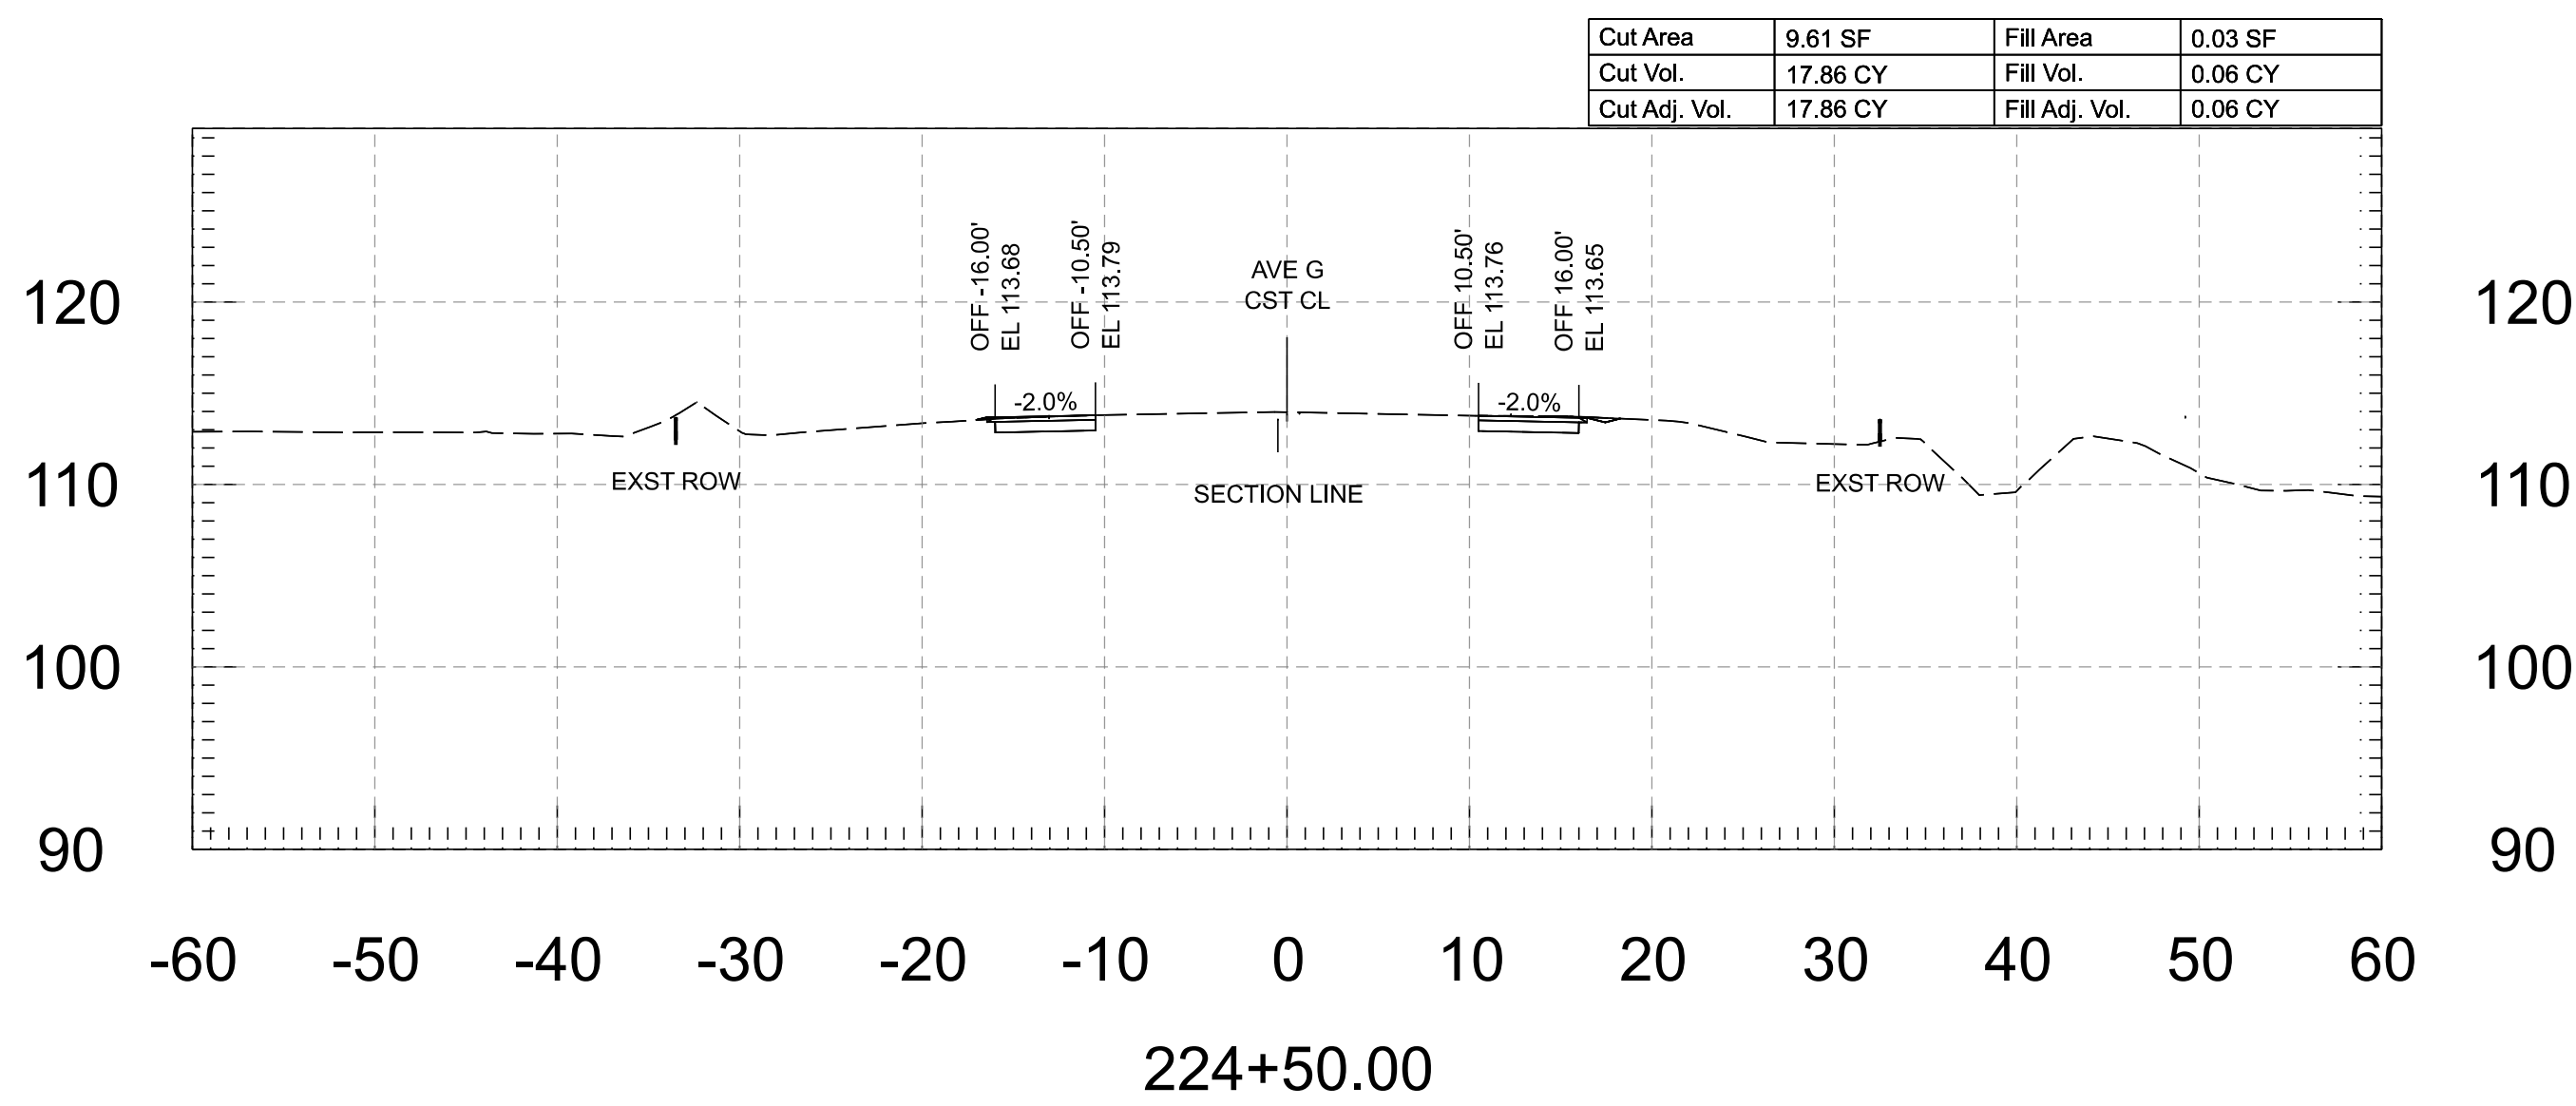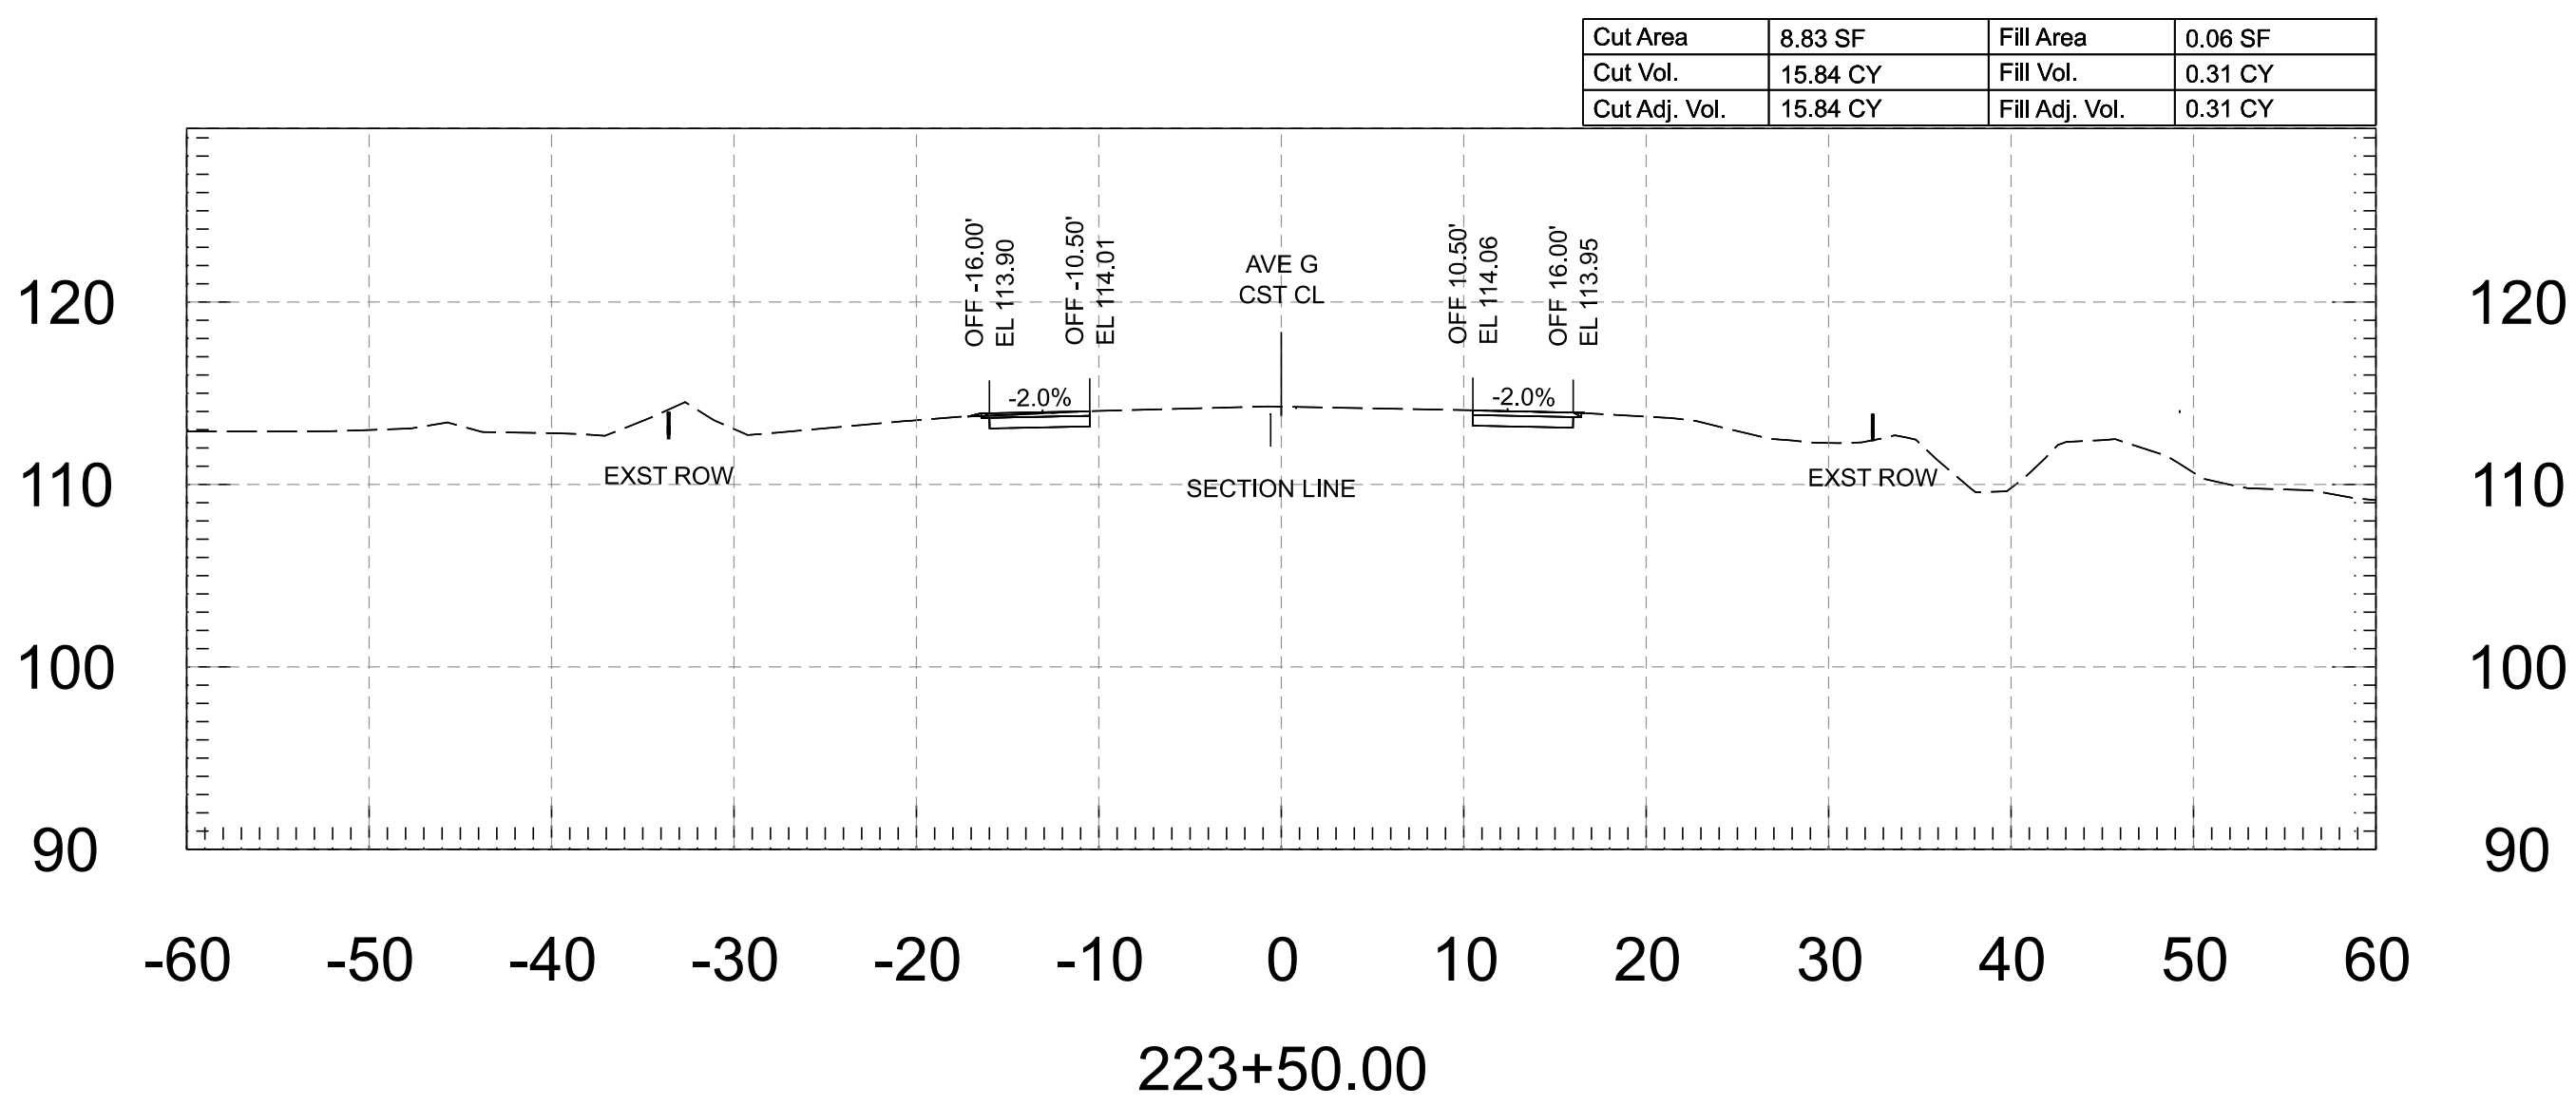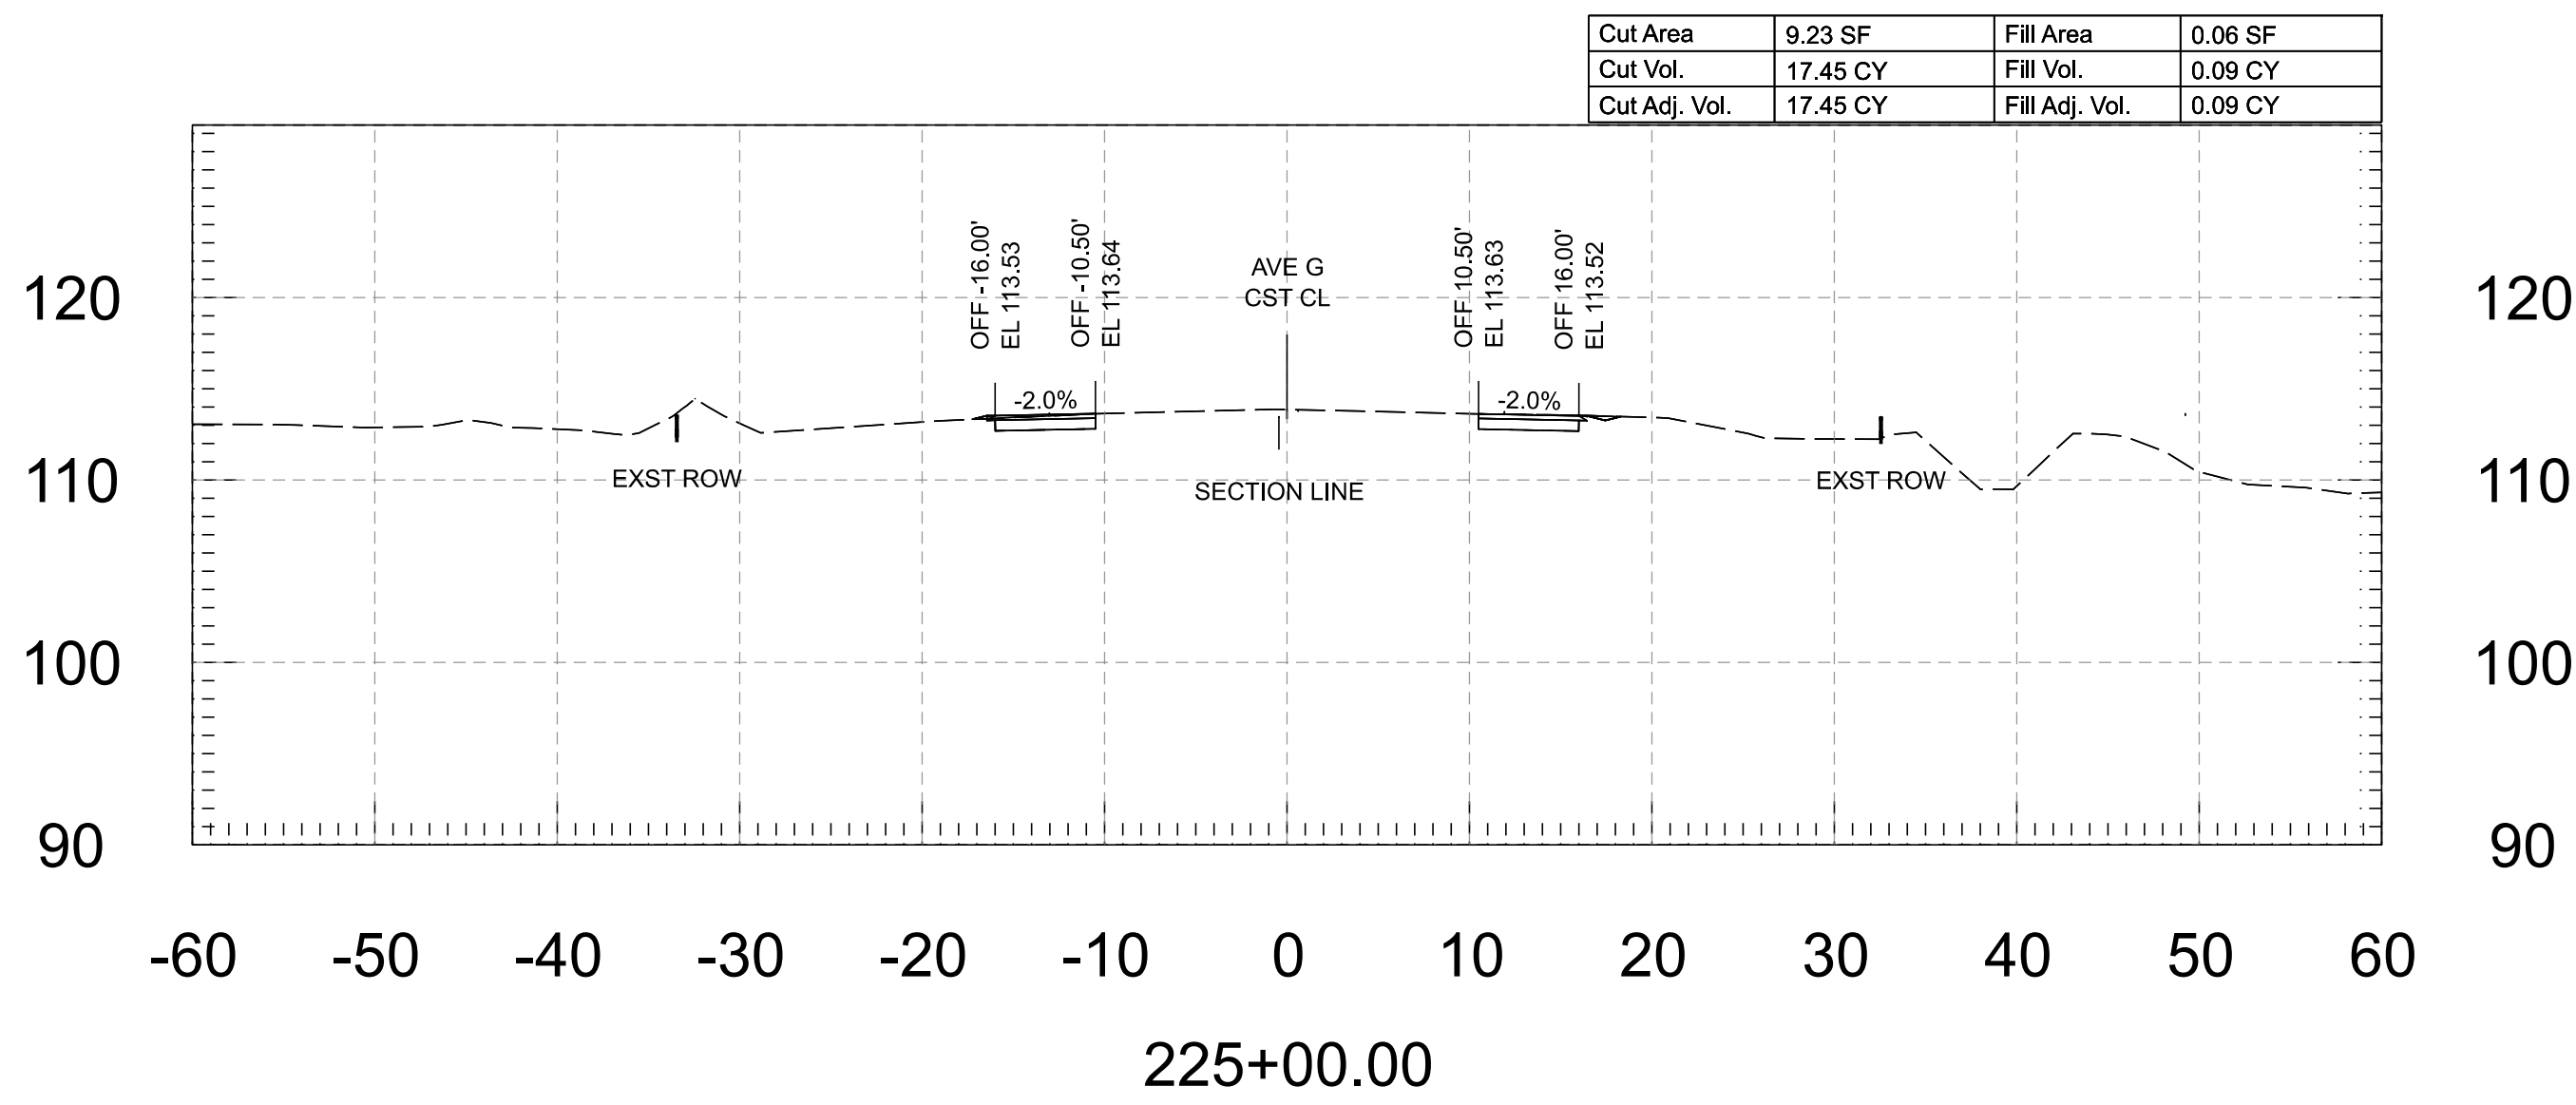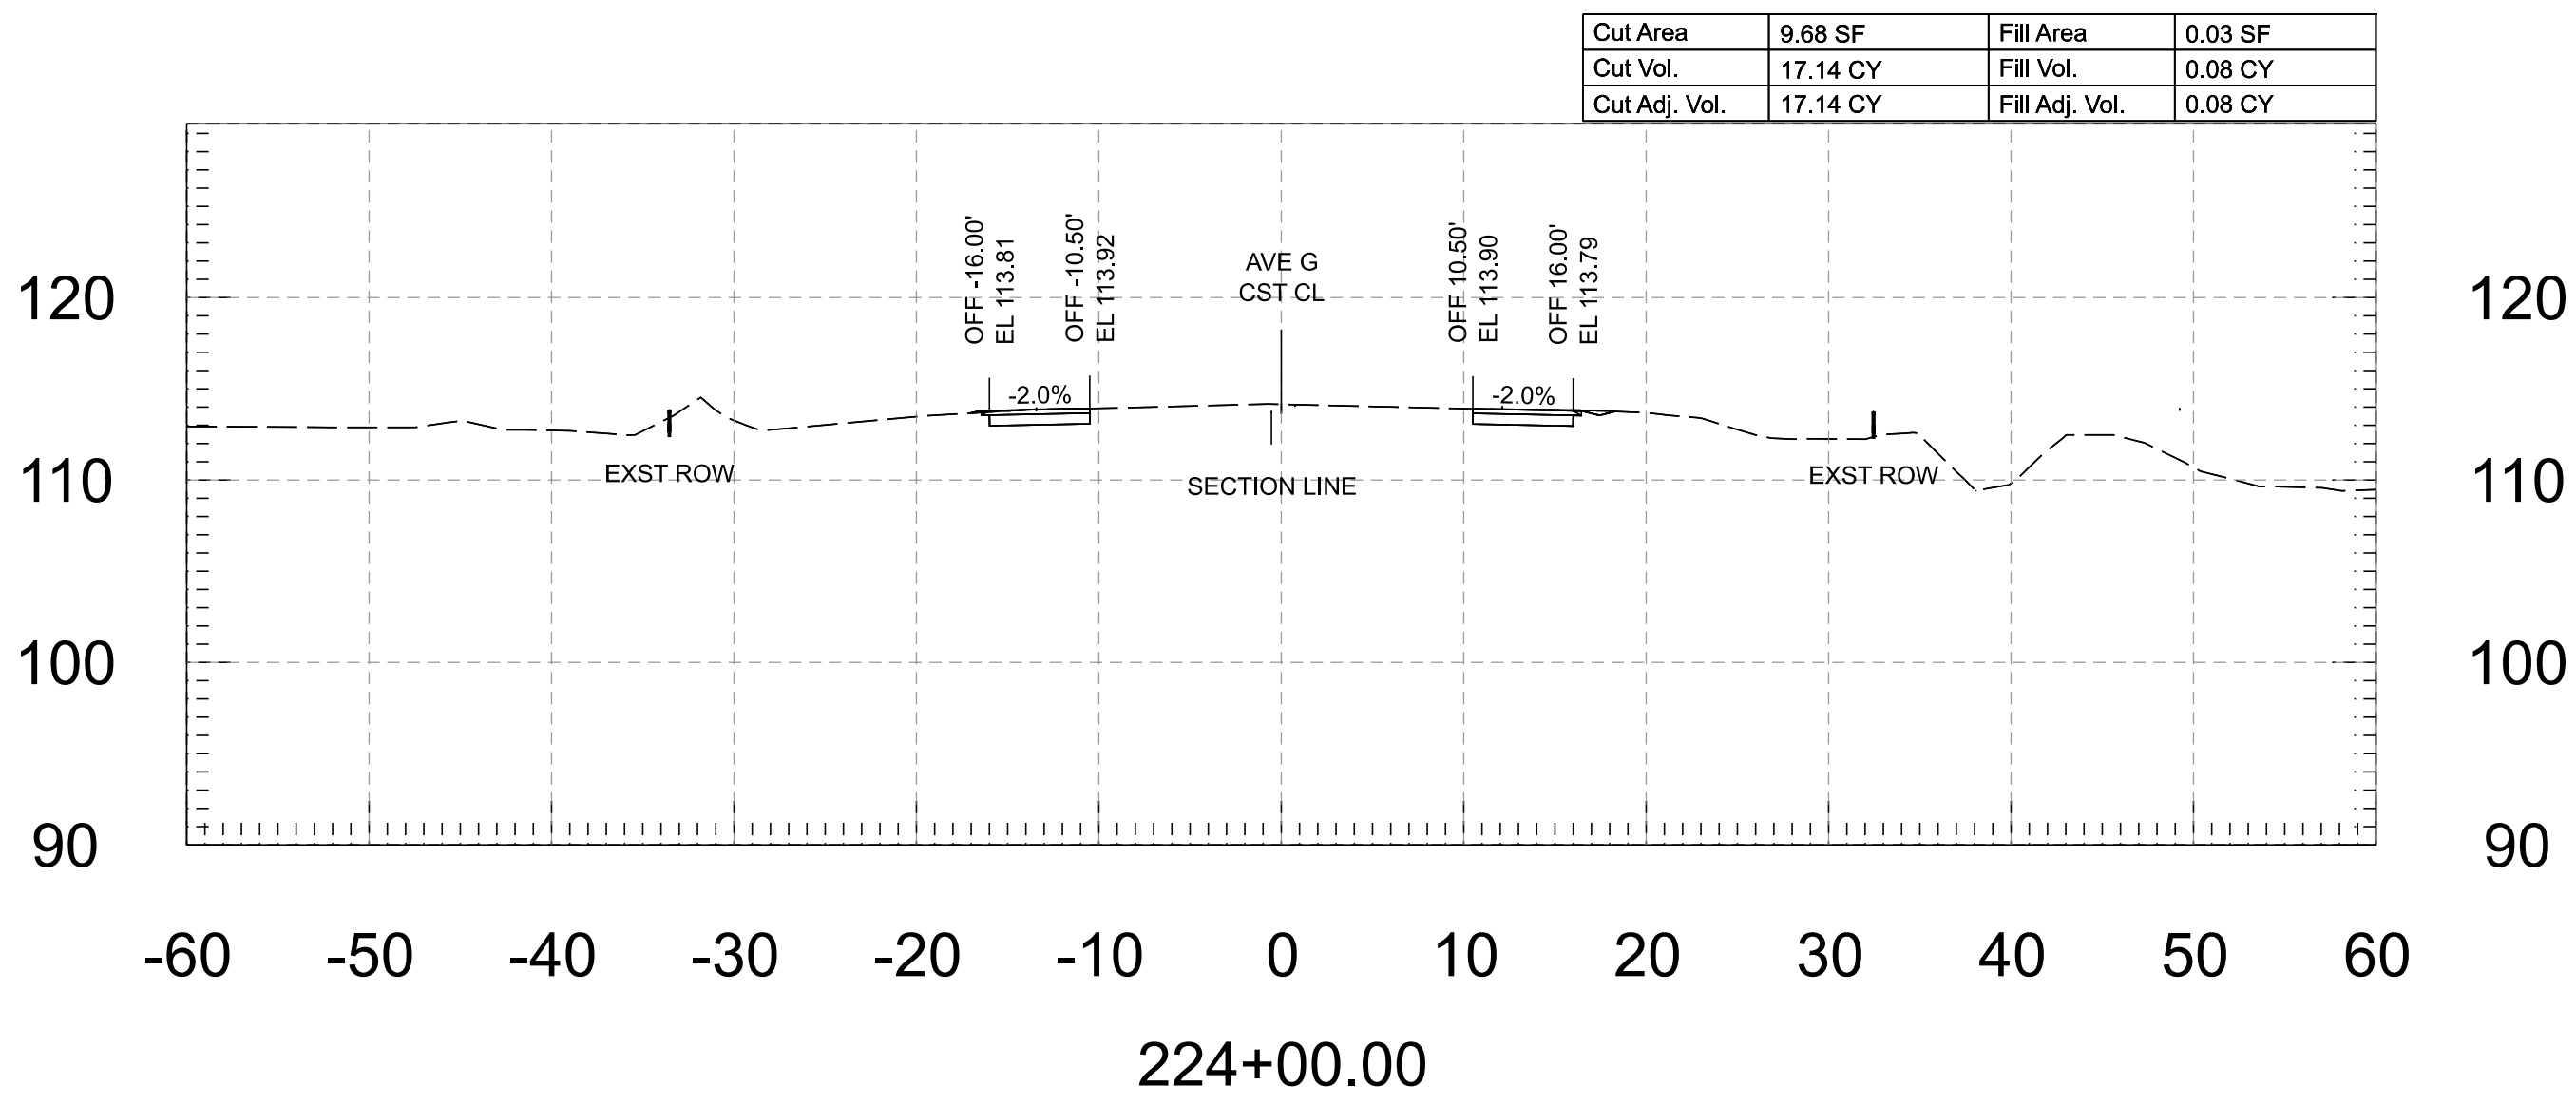


Cut Area	9.43 SF	Fill Area	0.11 SF
Cut Vol.	18.07 CY	Fill Vol.	0.12 CY
Cut Adj. Vol.	18.07 CY	Fill Adj. Vol.	0.12 CY

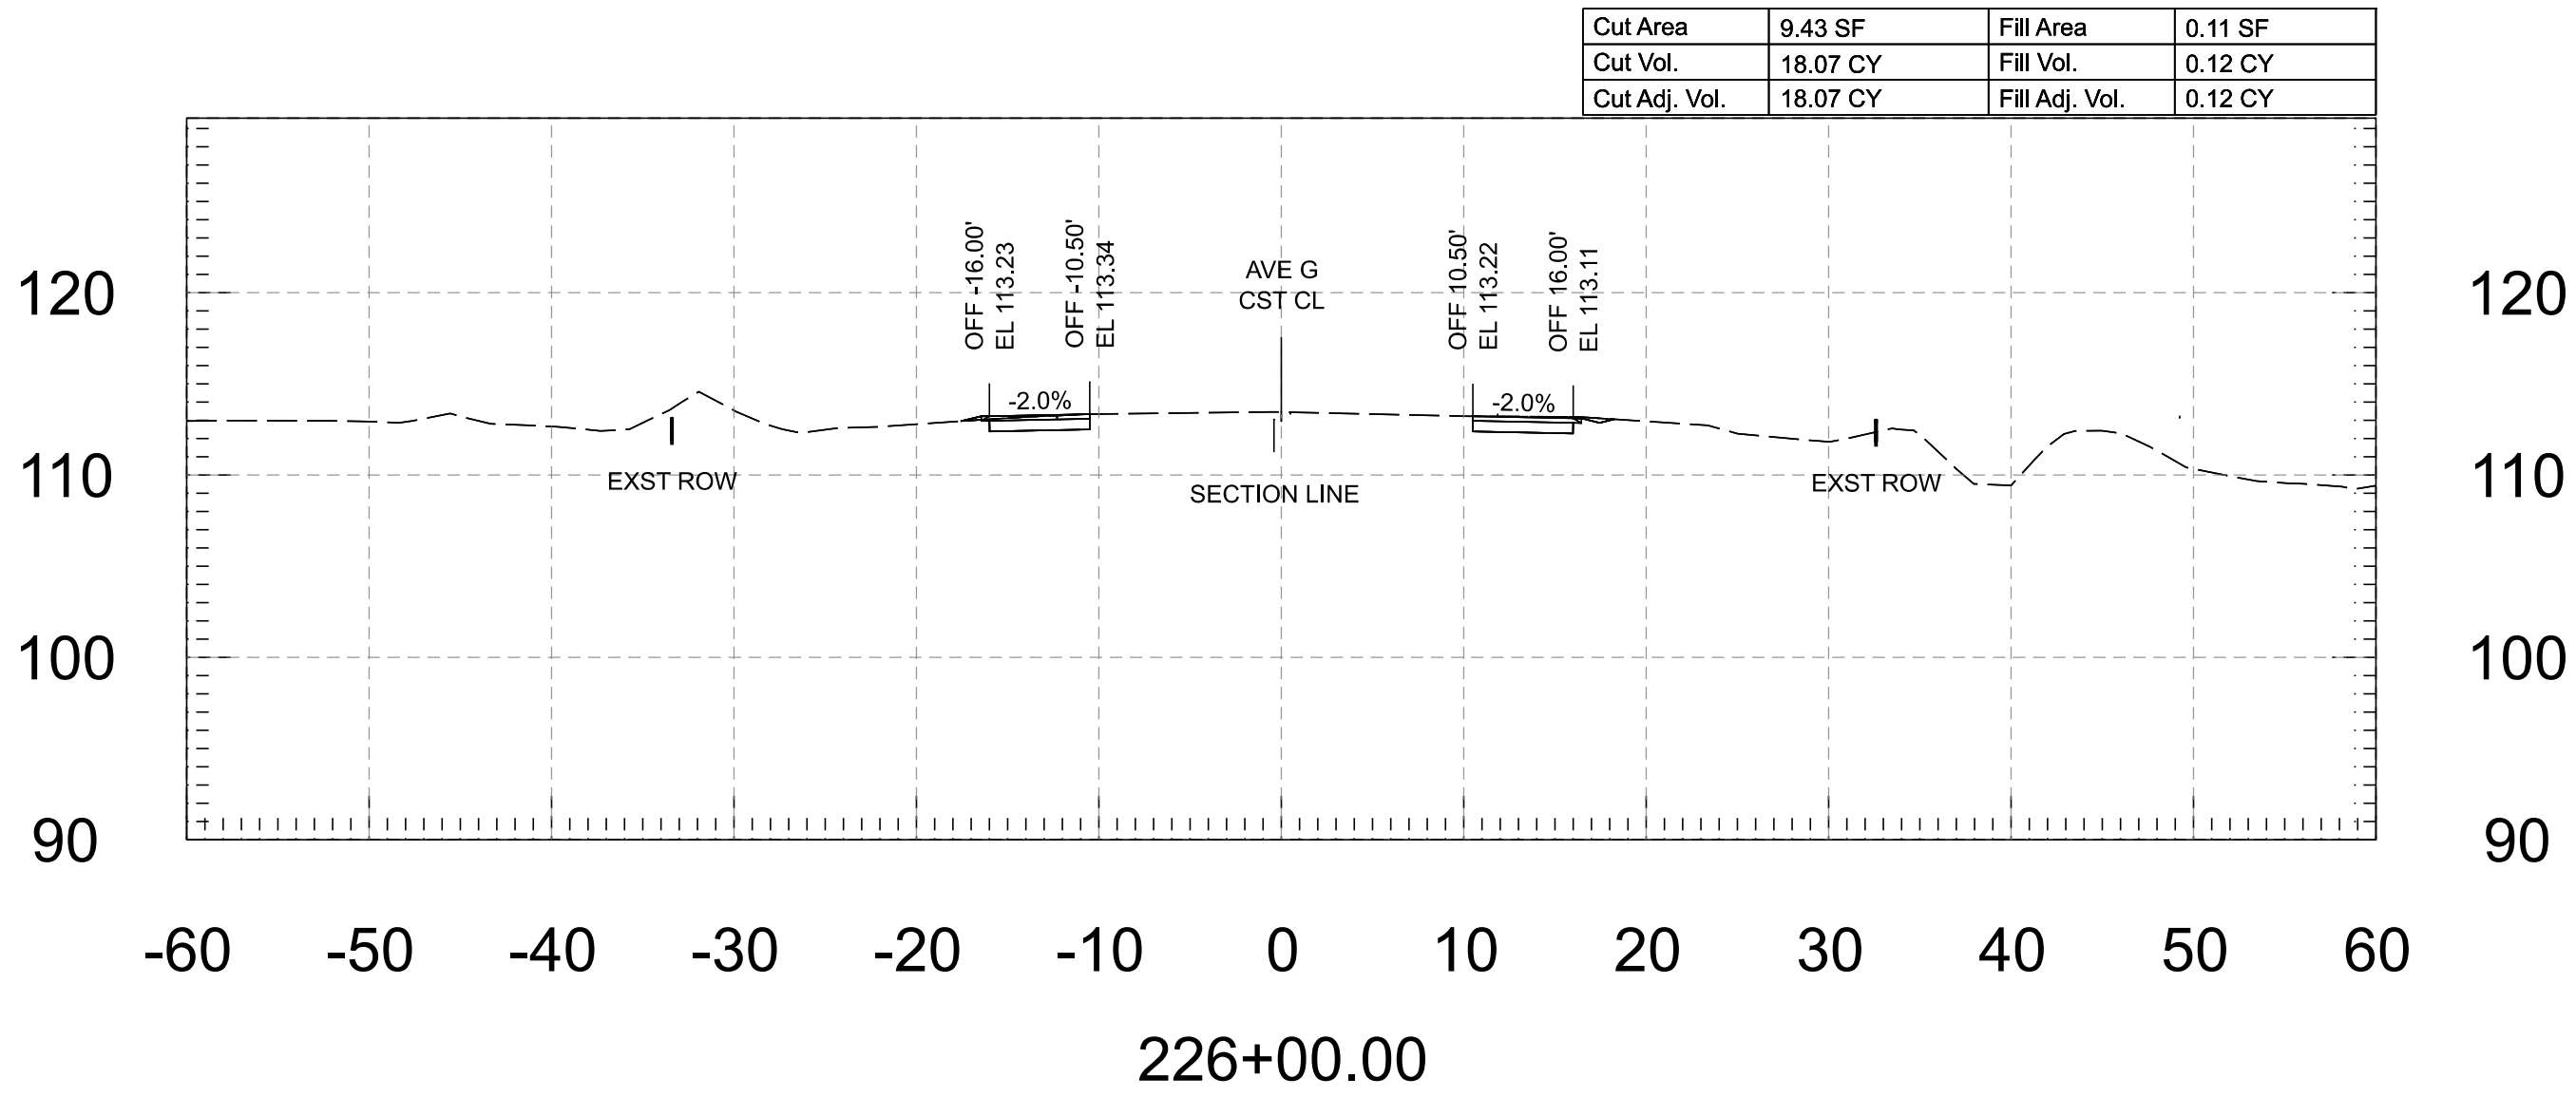


Cut Area	9.94 SF	Fill Area	0.01 SF
Cut Vol.	17.67 CY	Fill Vol.	0.03 CY
Cut Adj. Vol.	17.67 CY	Fill Adj. Vol.	0.03 CY

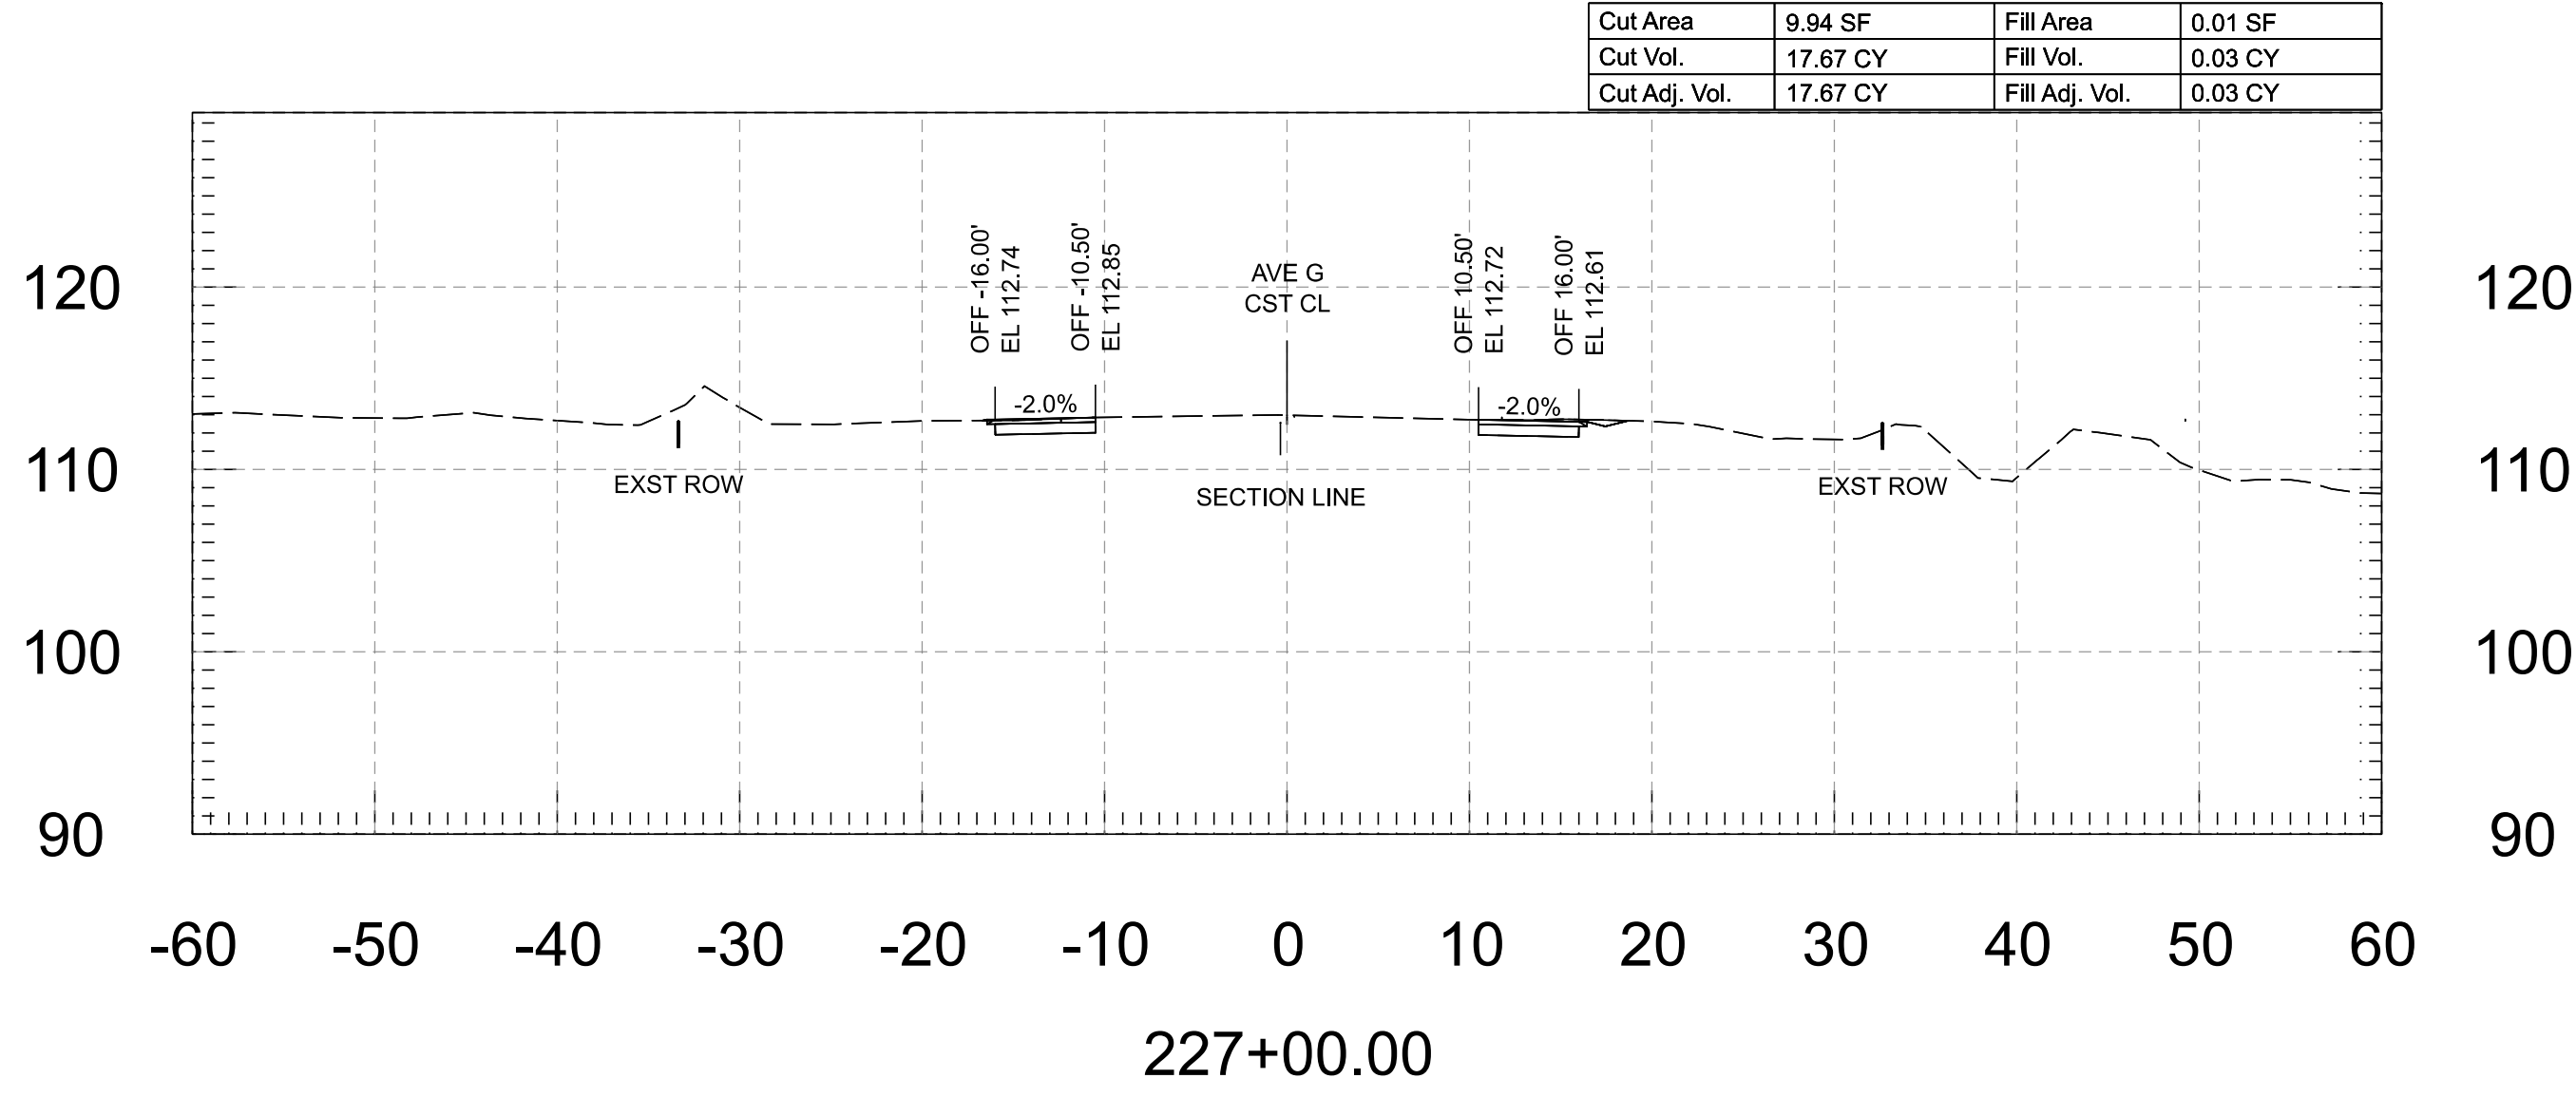

Cut Area	10.08 SF	Fill Area	0.02 SF
Cut Vol.	17.89 CY	Fill Vol.	0.08 CY
Cut Adj. Vol.	17.89 CY	Fill Adj. Vol.	0.08 CY

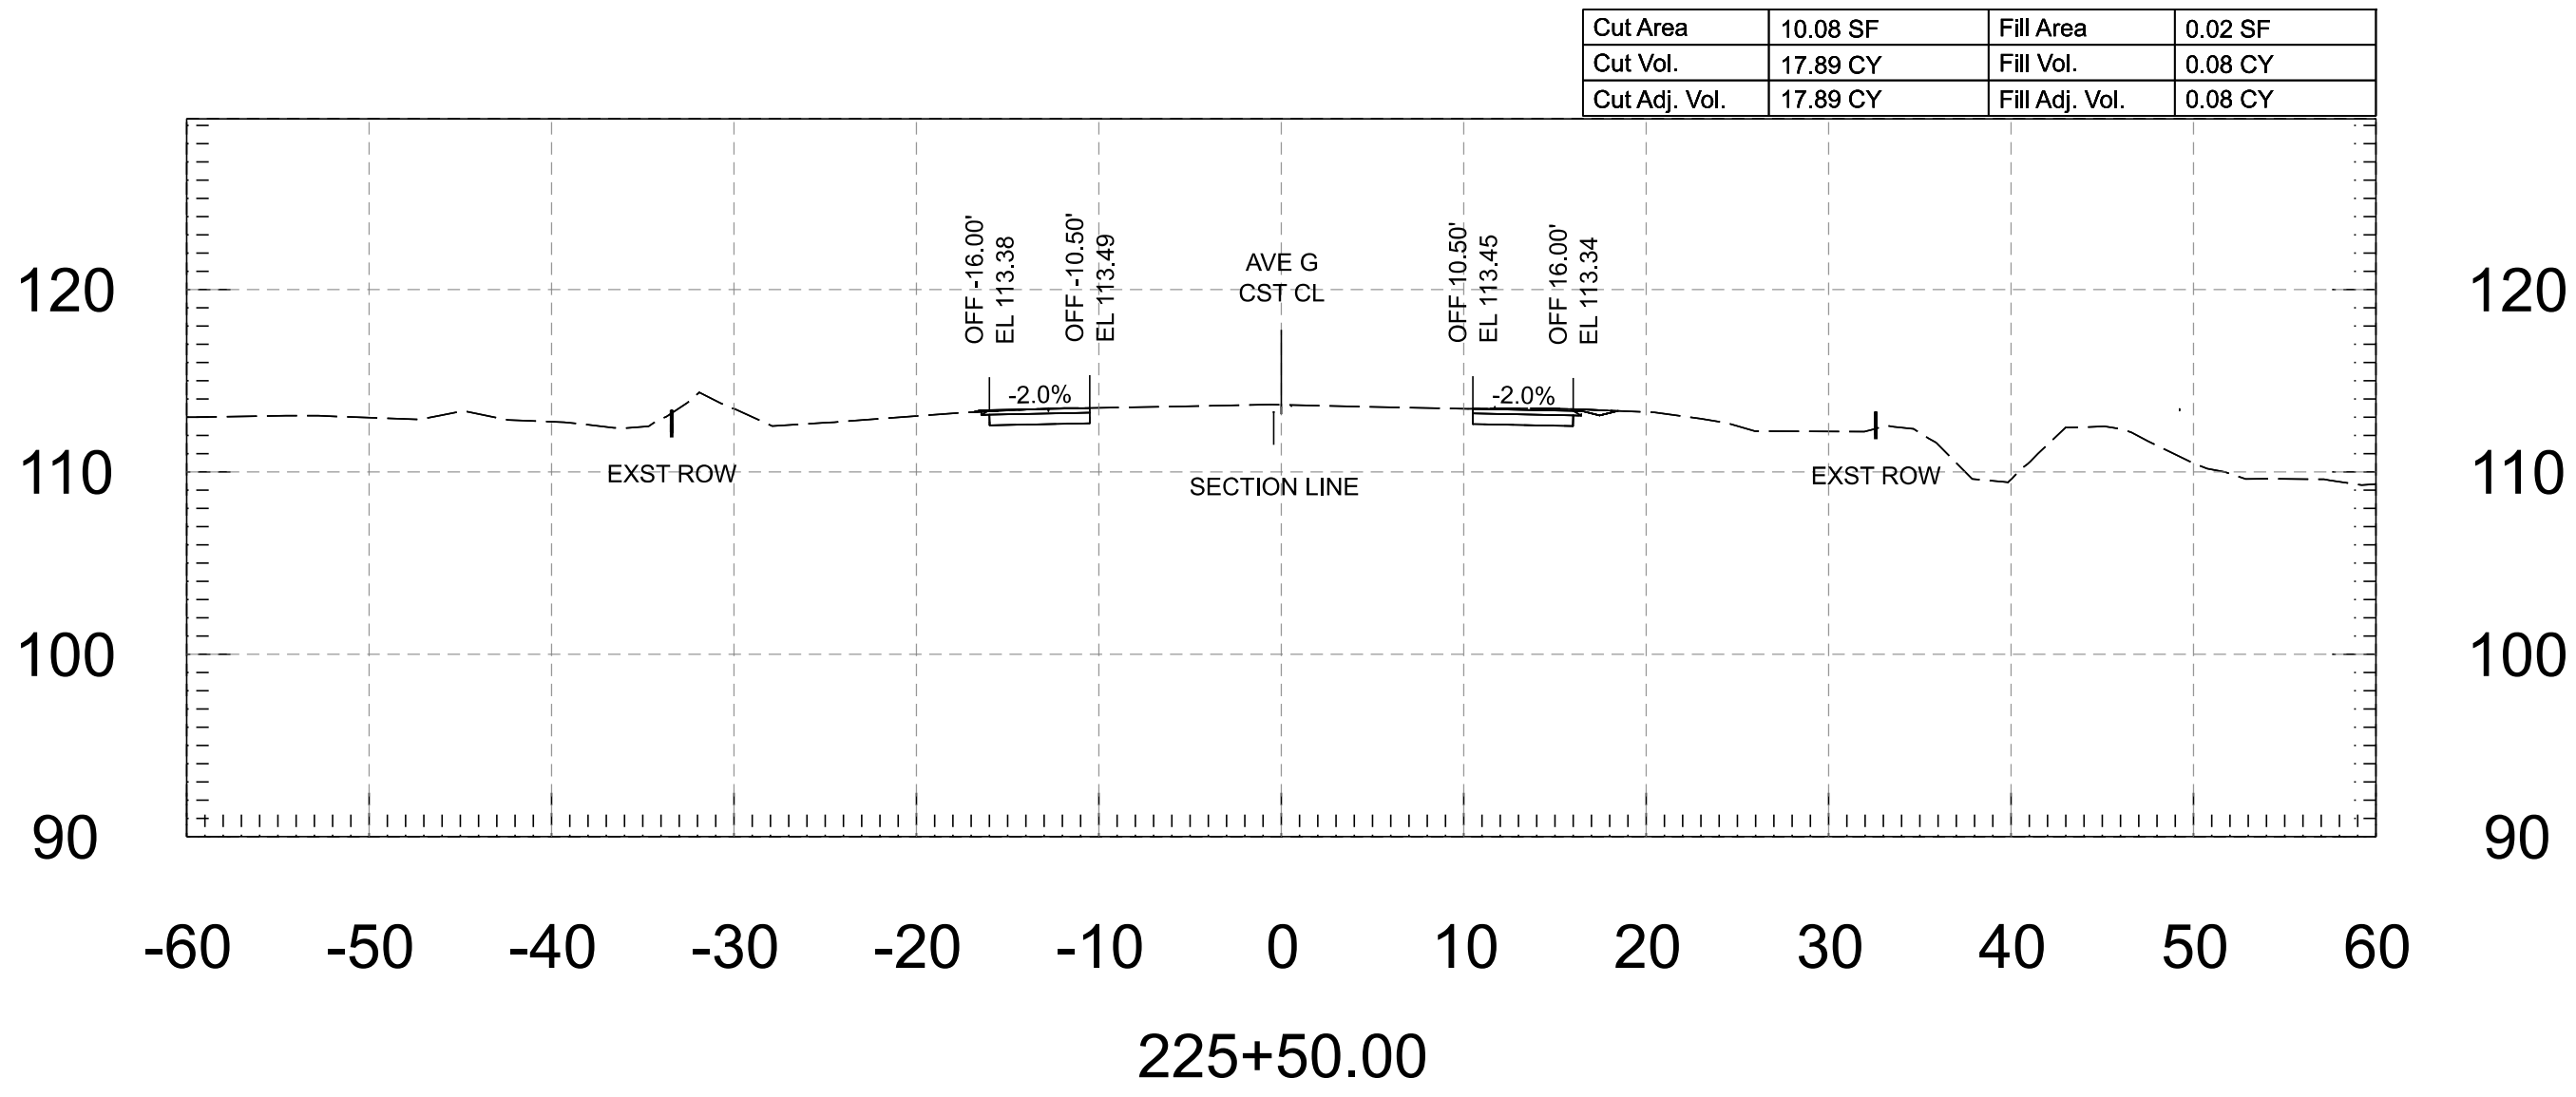


Cut Area	9.15 SF	Fill Area	0.02 SF
Cut Vol.	17.20 CY	Fill Vol.	0.12 CY
Cut Adj. Vol.	17.20 CY	Fill Adj. Vol.	0.12 CY

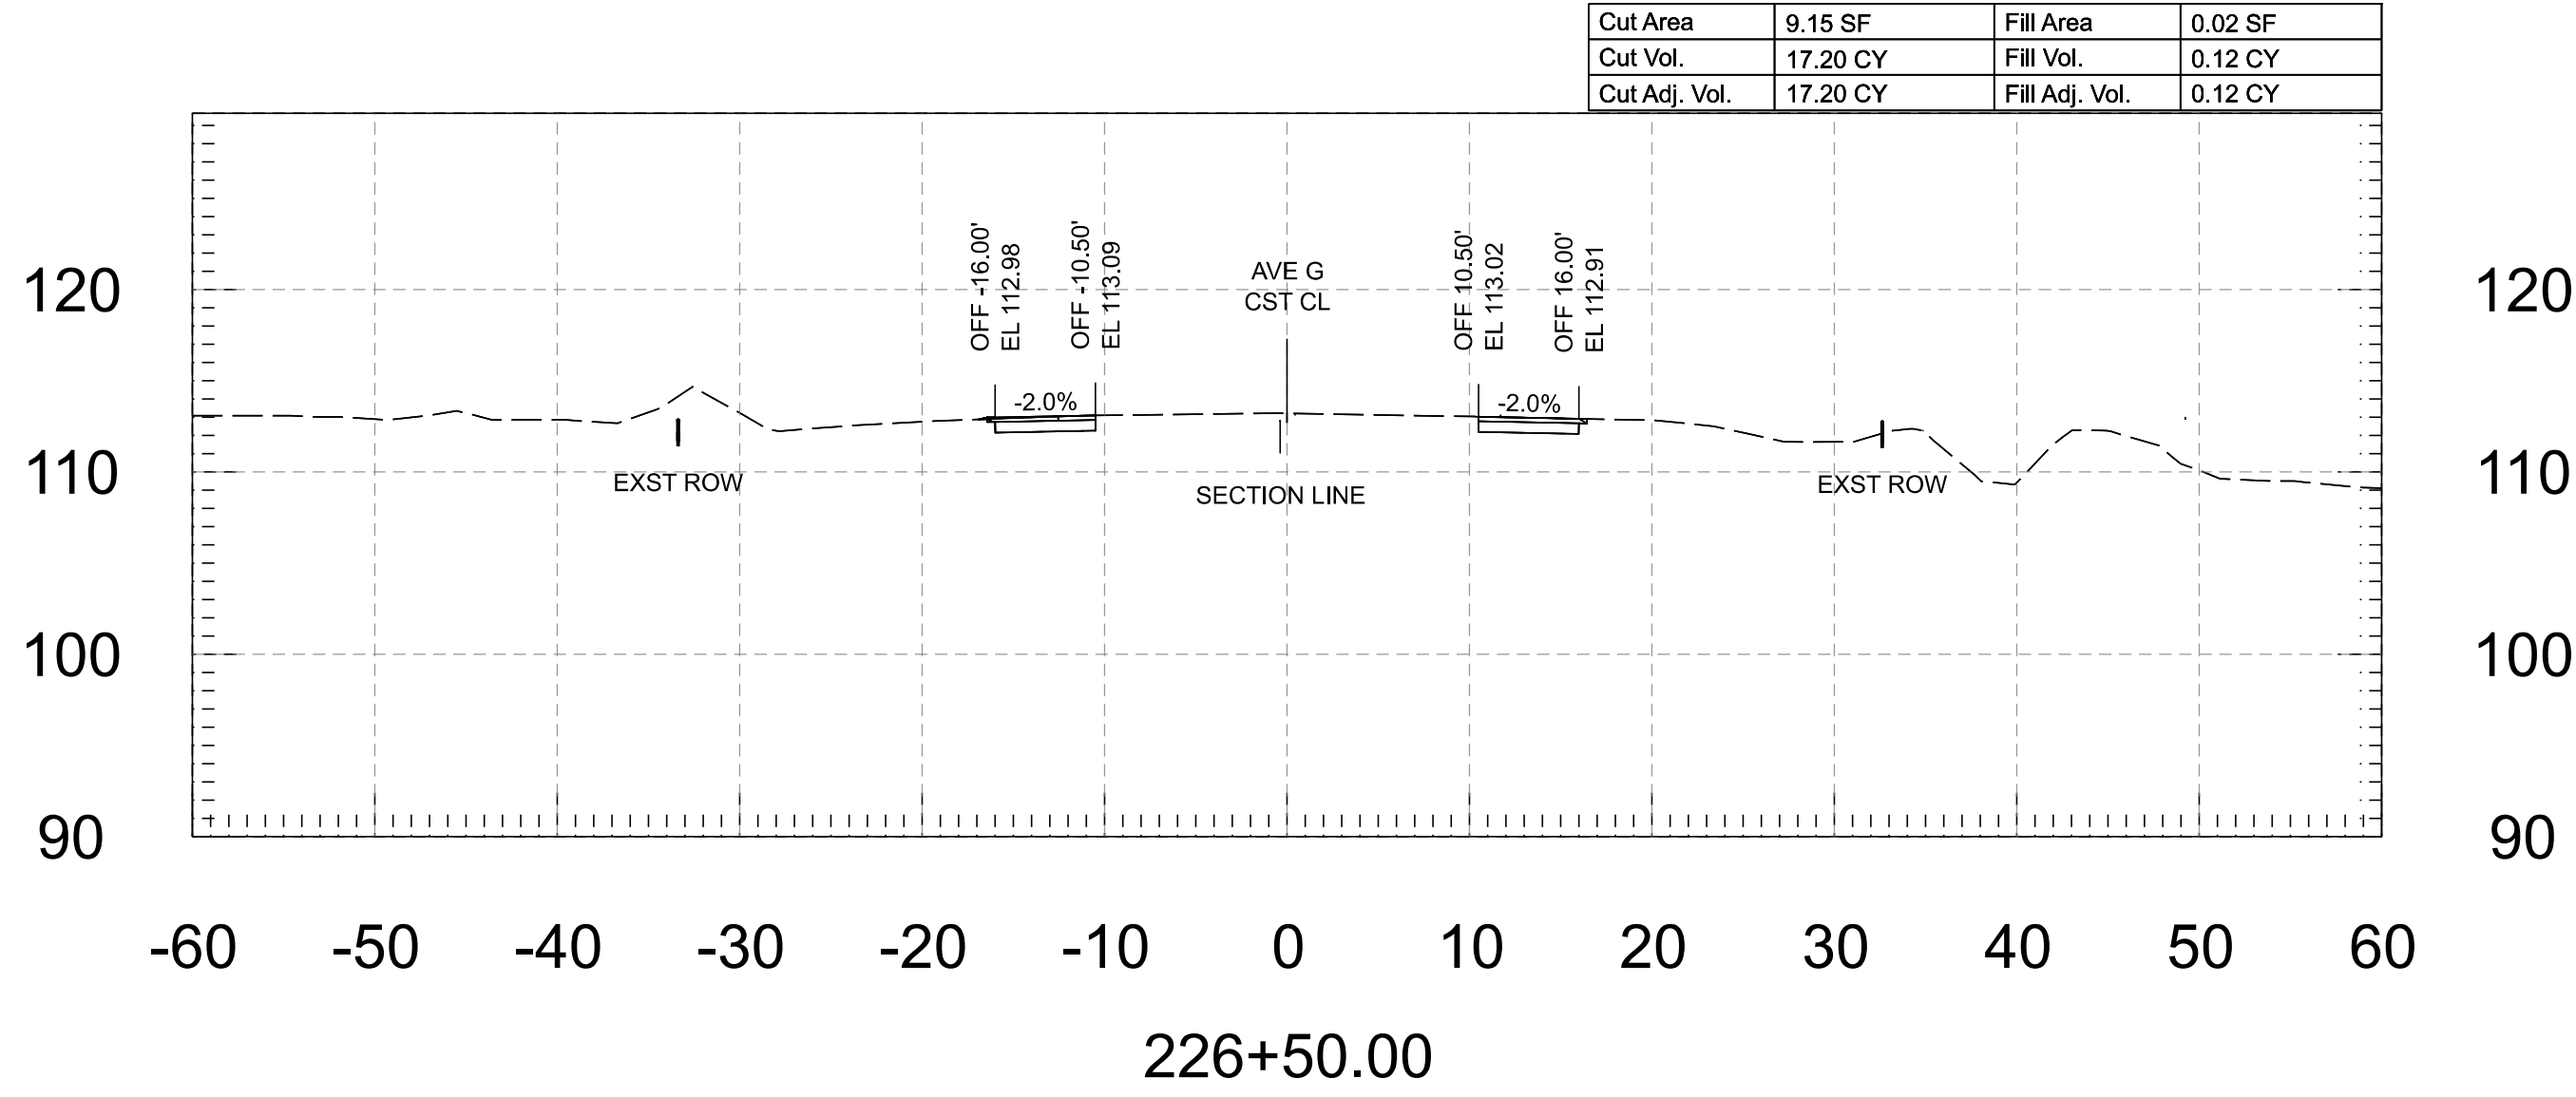


FOR INFORMATION ONLY		NAME	DATE	ARIZONA DEPARTMENT OF TRANSPORTATION PROJECT DELIVERY AND OPERATIONS DIVISION ROADWAY DESIGN SERVICES	ROUTE	F.H.W.A. Arizona Division	STATE ARIZ.	PROJECT NO.	FEDERAL ID NO.	SHEET NO.	TOTAL SHEETS	RECORD DRAWING
	DESIGN	M. SCHOEN	07/26		MILEPOST			0000 YU YYU	YYU-0(225)T	104	118	
	DRAWN	M. SCHOEN	07/26					LOCATION AVENUE G, COUNTY 11TH ST - COUNTY 16TH ST				
	CHECKED	H. RIOS	07/26		STRUCTURE NO.	TRACS NO. T0437 01C						
	 WSP USA Inc. 1230 West Washington Street, Suite 405 Tempe, AZ 85288		AVENUE G - CROSS SECTIONS		____ OF ____							


Cut Area	10.97 SF	Fill Area	0.04 SF
Cut Vol.	19.73 CY	Fill Vol.	0.04 CY
Cut Adj. Vol.	19.73 CY	Fill Adj. Vol.	0.04 CY

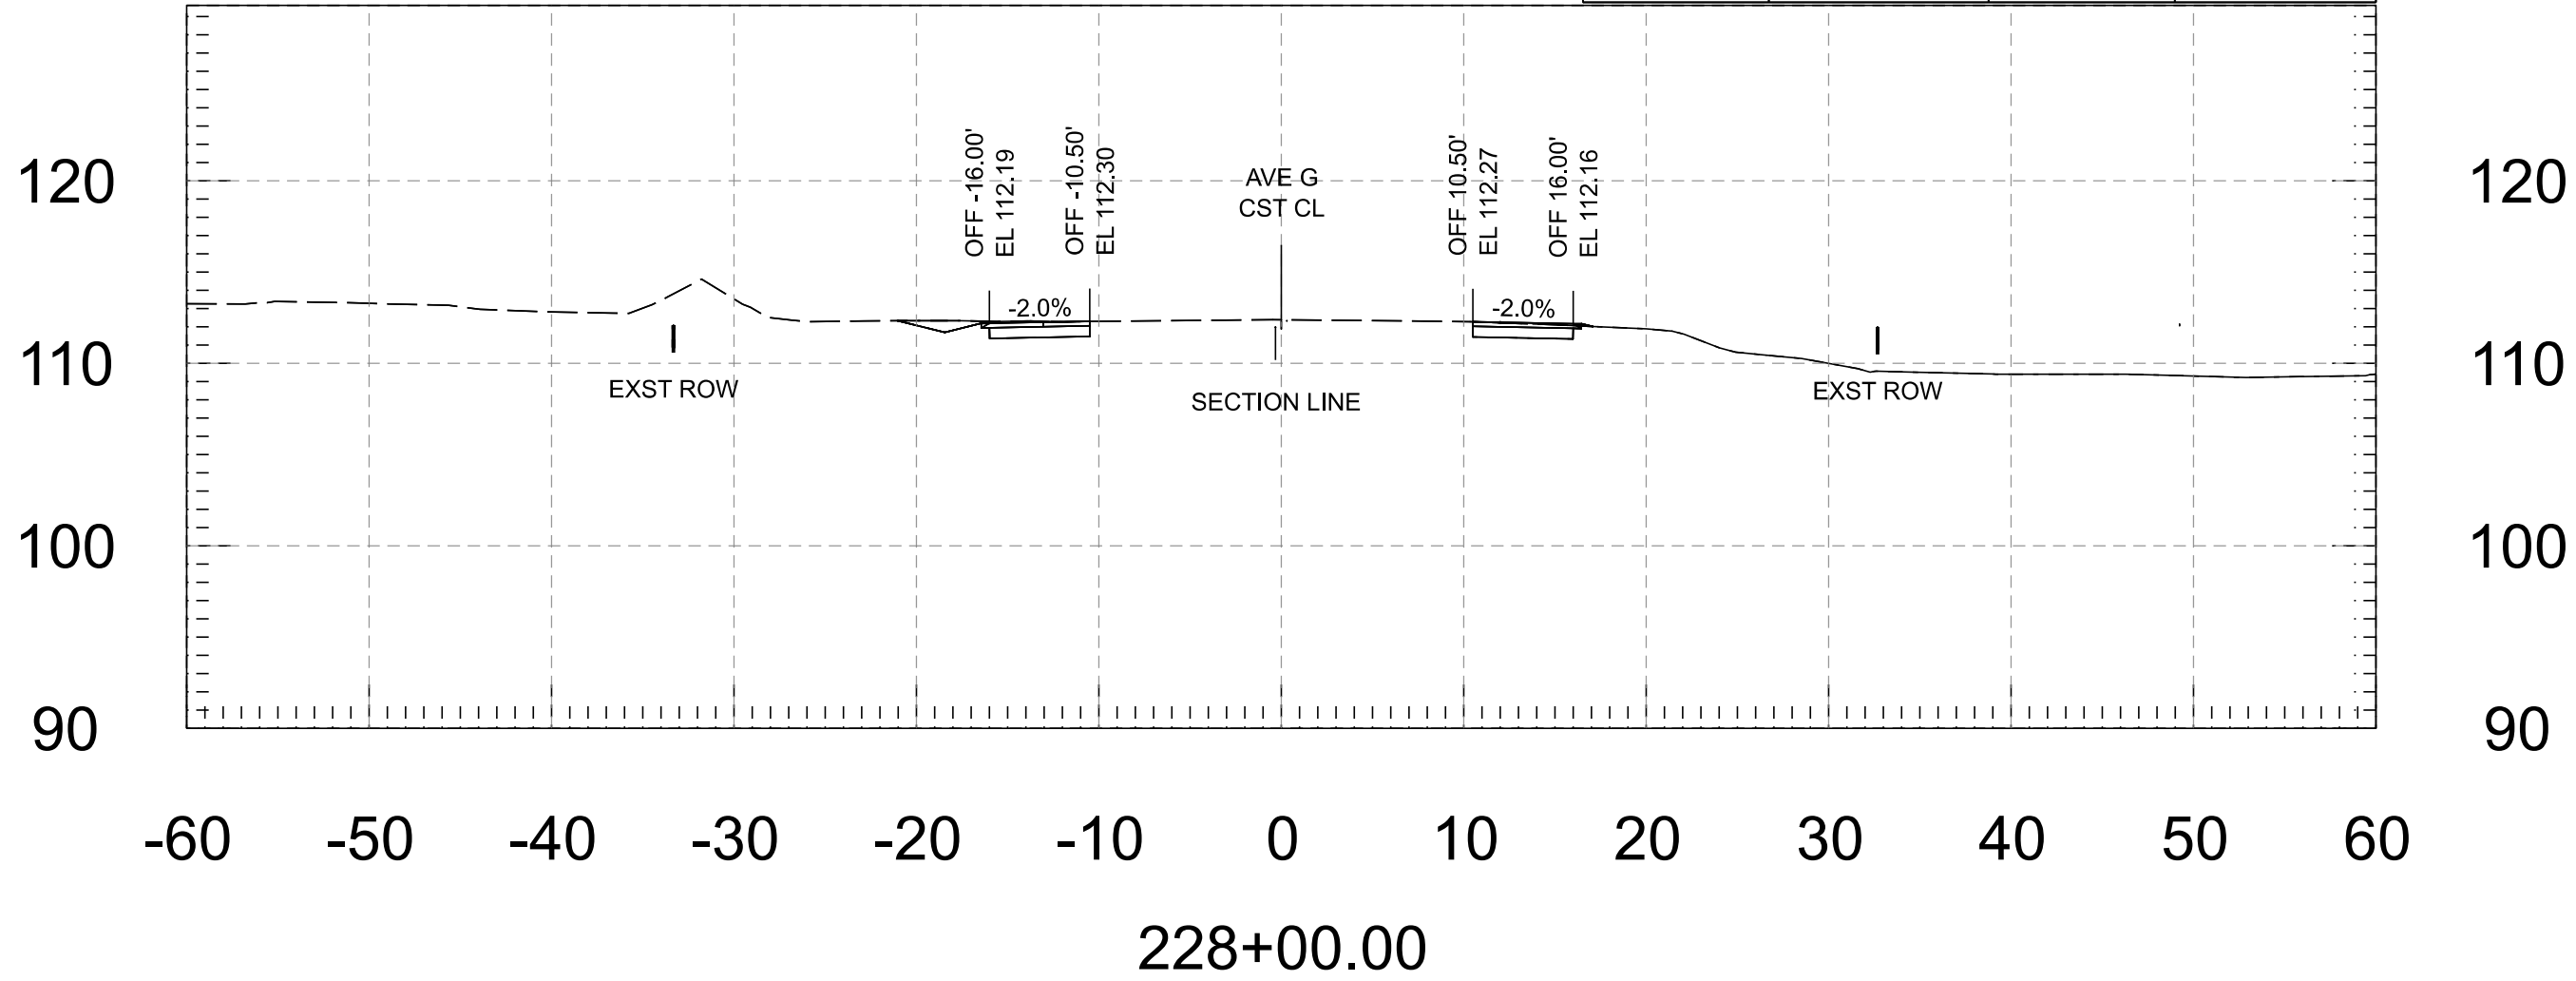


Cut Area	8.81 SF	Fill Area	0.08 SF
Cut Vol.	18.60 CY	Fill Vol.	0.07 CY
Cut Adj. Vol.	18.60 CY	Fill Adj. Vol.	0.07 CY

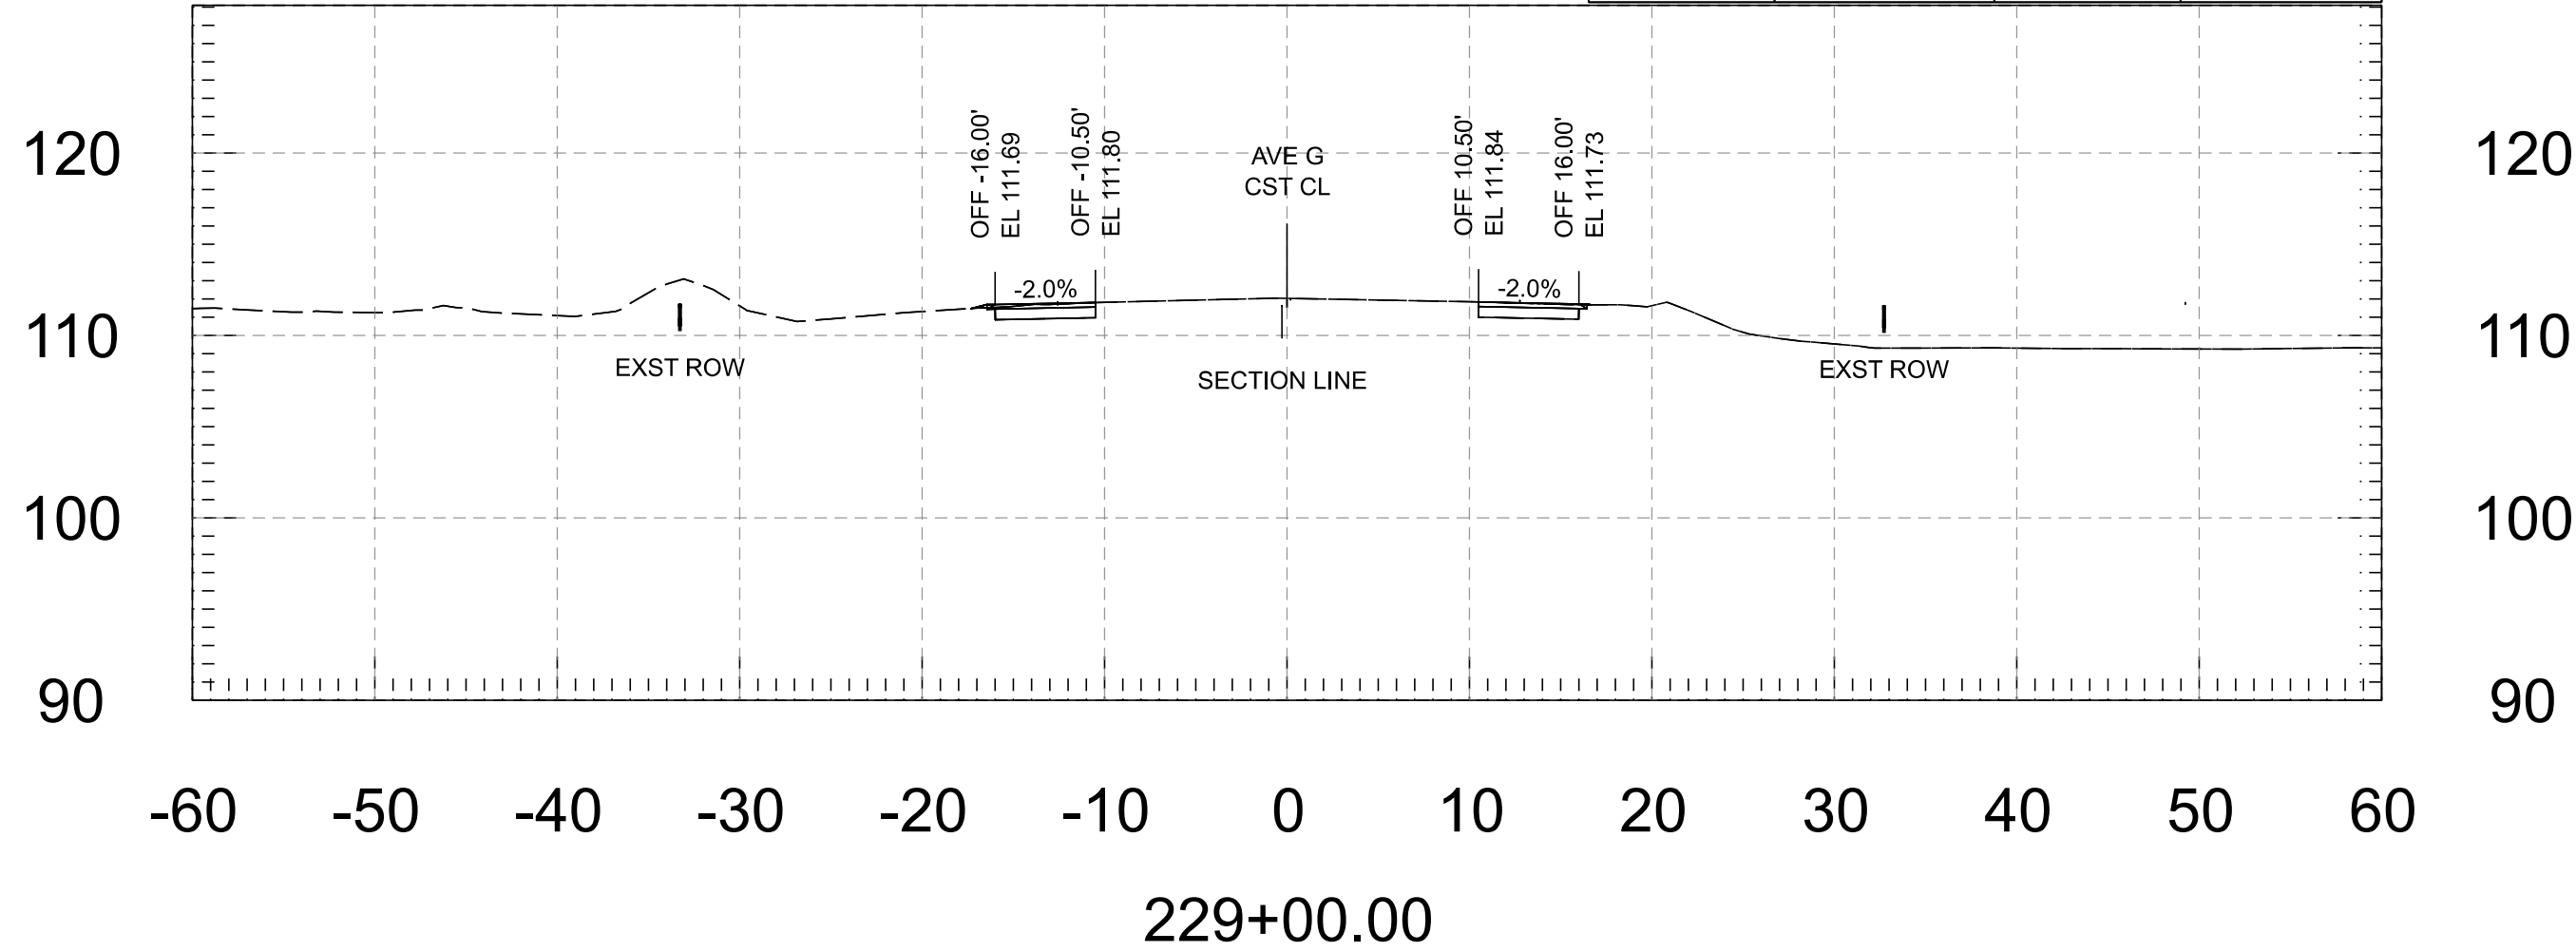





Cut Area	10.34 SF	Fill Area	0.00 SF
Cut Vol.	18.77 CY	Fill Vol.	0.01 CY
Cut Adj. Vol.	18.77 CY	Fill Adj. Vol.	0.01 CY

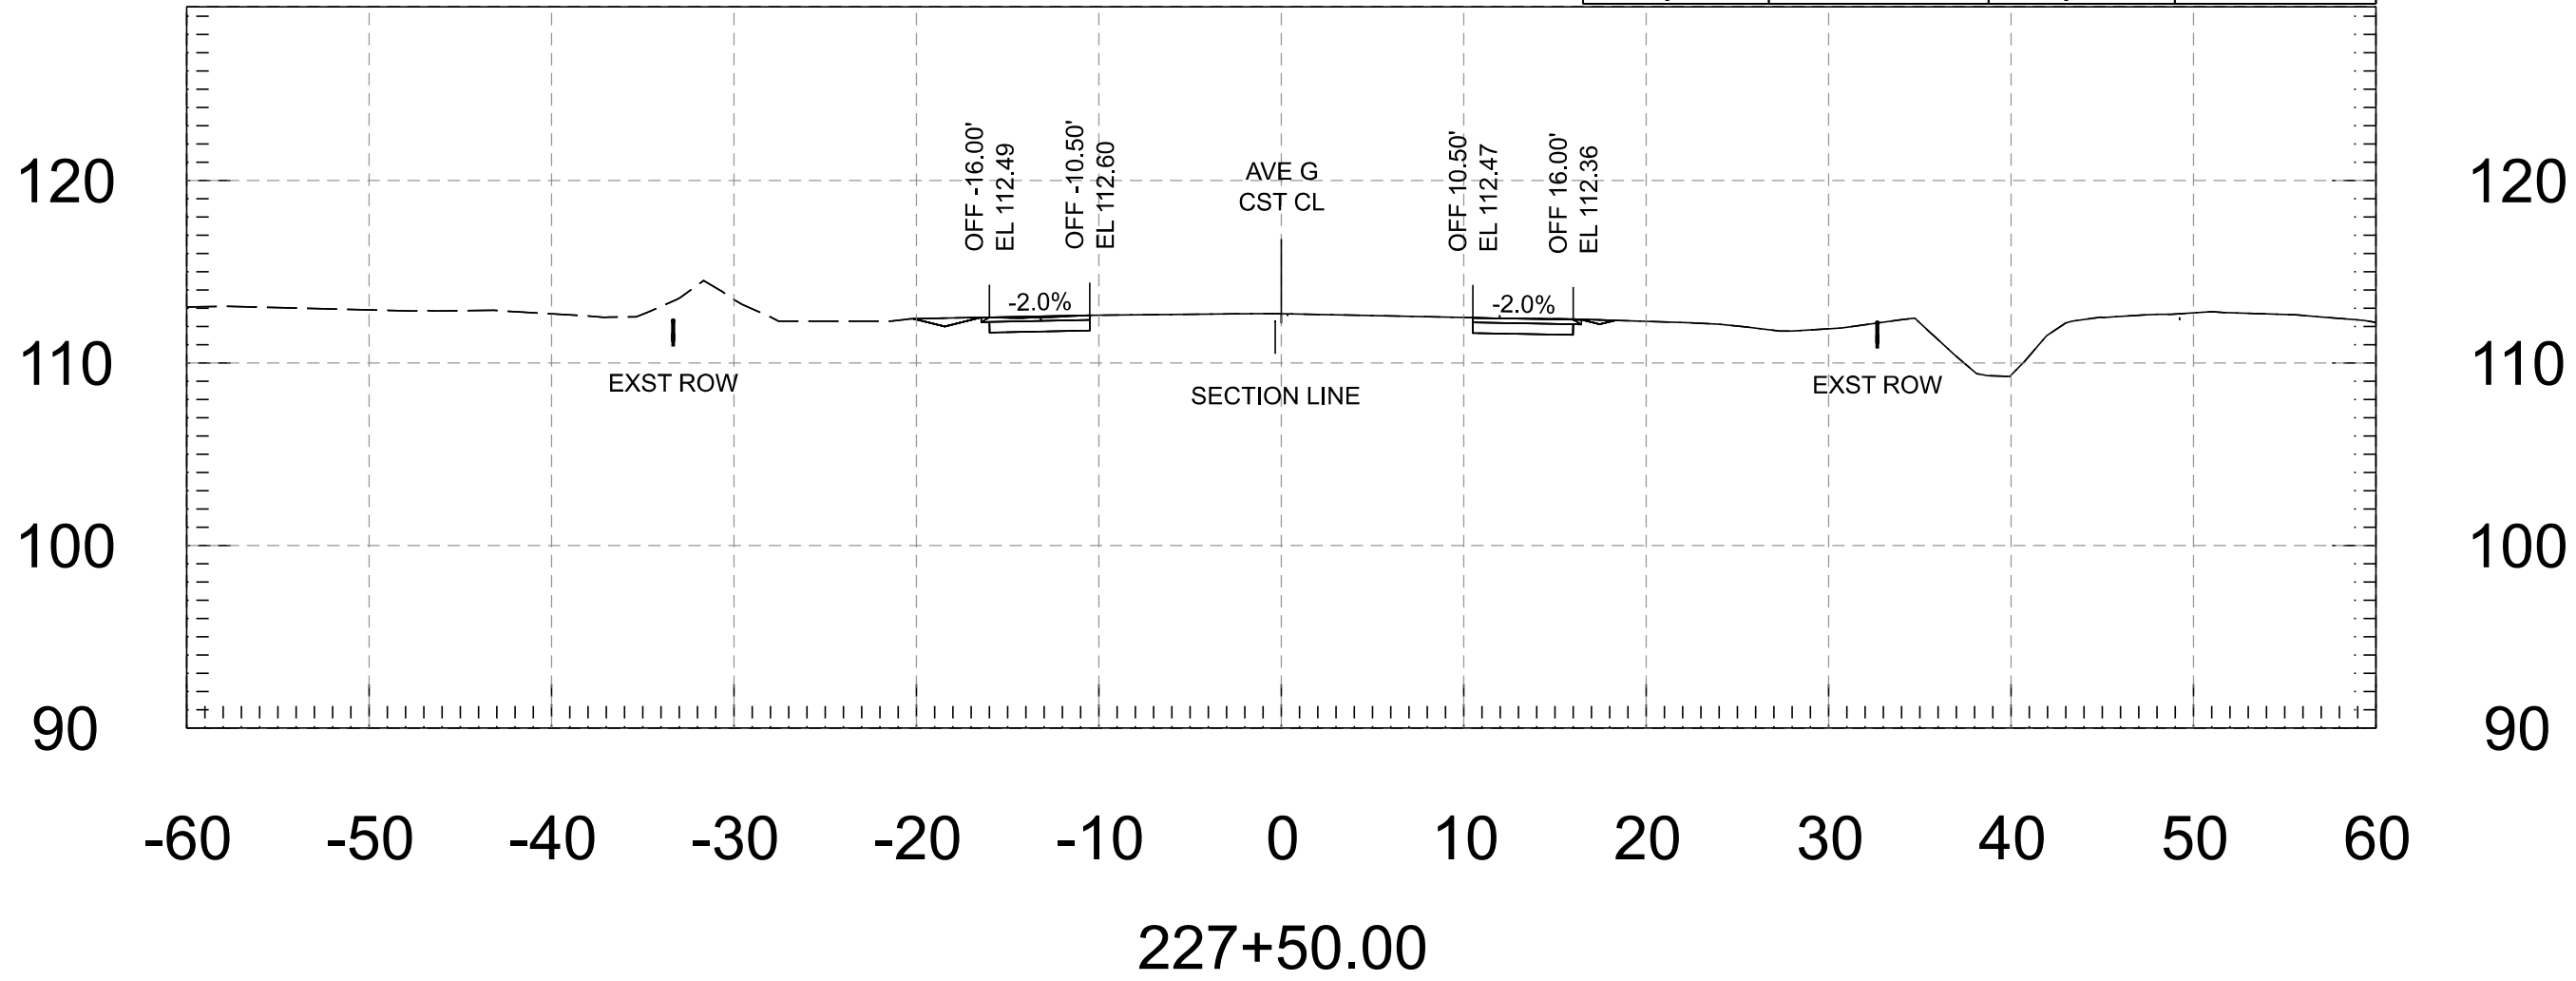

Cut Area	11.28 SF	Fill Area	0.00 SF
Cut Vol.	20.60 CY	Fill Vol.	0.04 CY
Cut Adj. Vol.	20.60 CY	Fill Adj. Vol.	0.04 CY

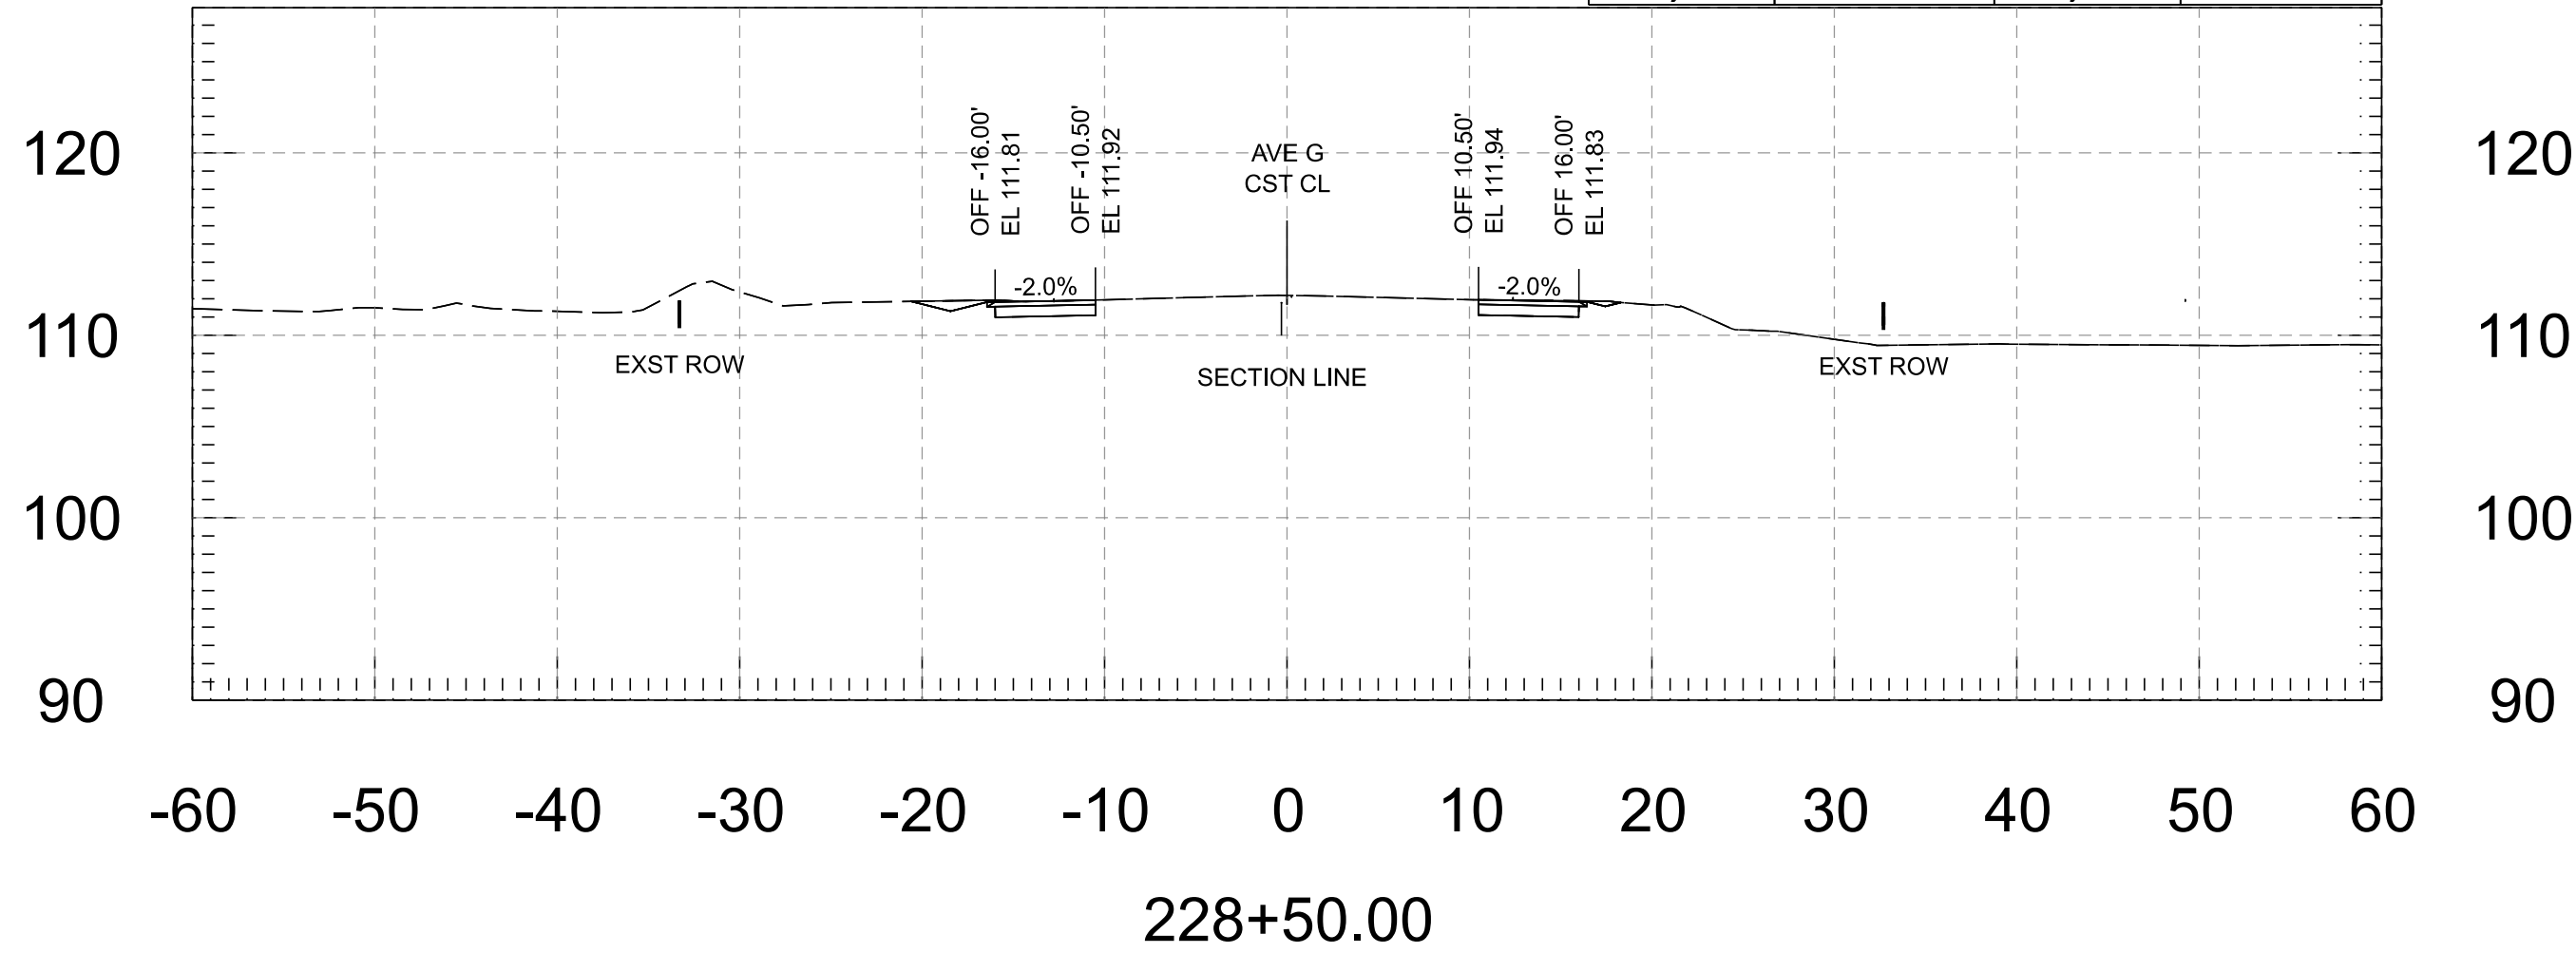


FOR INFORMATION ONLY		NAME	DATE	ARIZONA DEPARTMENT OF TRANSPORTATION PROJECT DELIVERY AND OPERATIONS DIVISION ROADWAY DESIGN SERVICES	ROUTE	F.H.W.A. Arizona Division	STATE ARIZ.	PROJECT NO.	FEDERAL ID NO.	SHEET NO.	TOTAL SHEETS	RECORD DRAWING
	DESIGN	M. SCHOEN	07/26		MILEPOST			0000 YU YYU	YYU-0(225)T	105	118	
	DRAWN	M. SCHOEN	07/26					LOCATION AVENUE G, COUNTY 11TH ST - COUNTY 16TH ST				
	CHECKED	H. RIOS	07/26	STRUCTURE NO.	TRACS NO. T0437 01C					___ OF ___		
	 WSP USA Inc. 1200 West Washington Street, Suite 405 Tempe, AZ 85288		AVENUE G - CROSS SECTIONS									

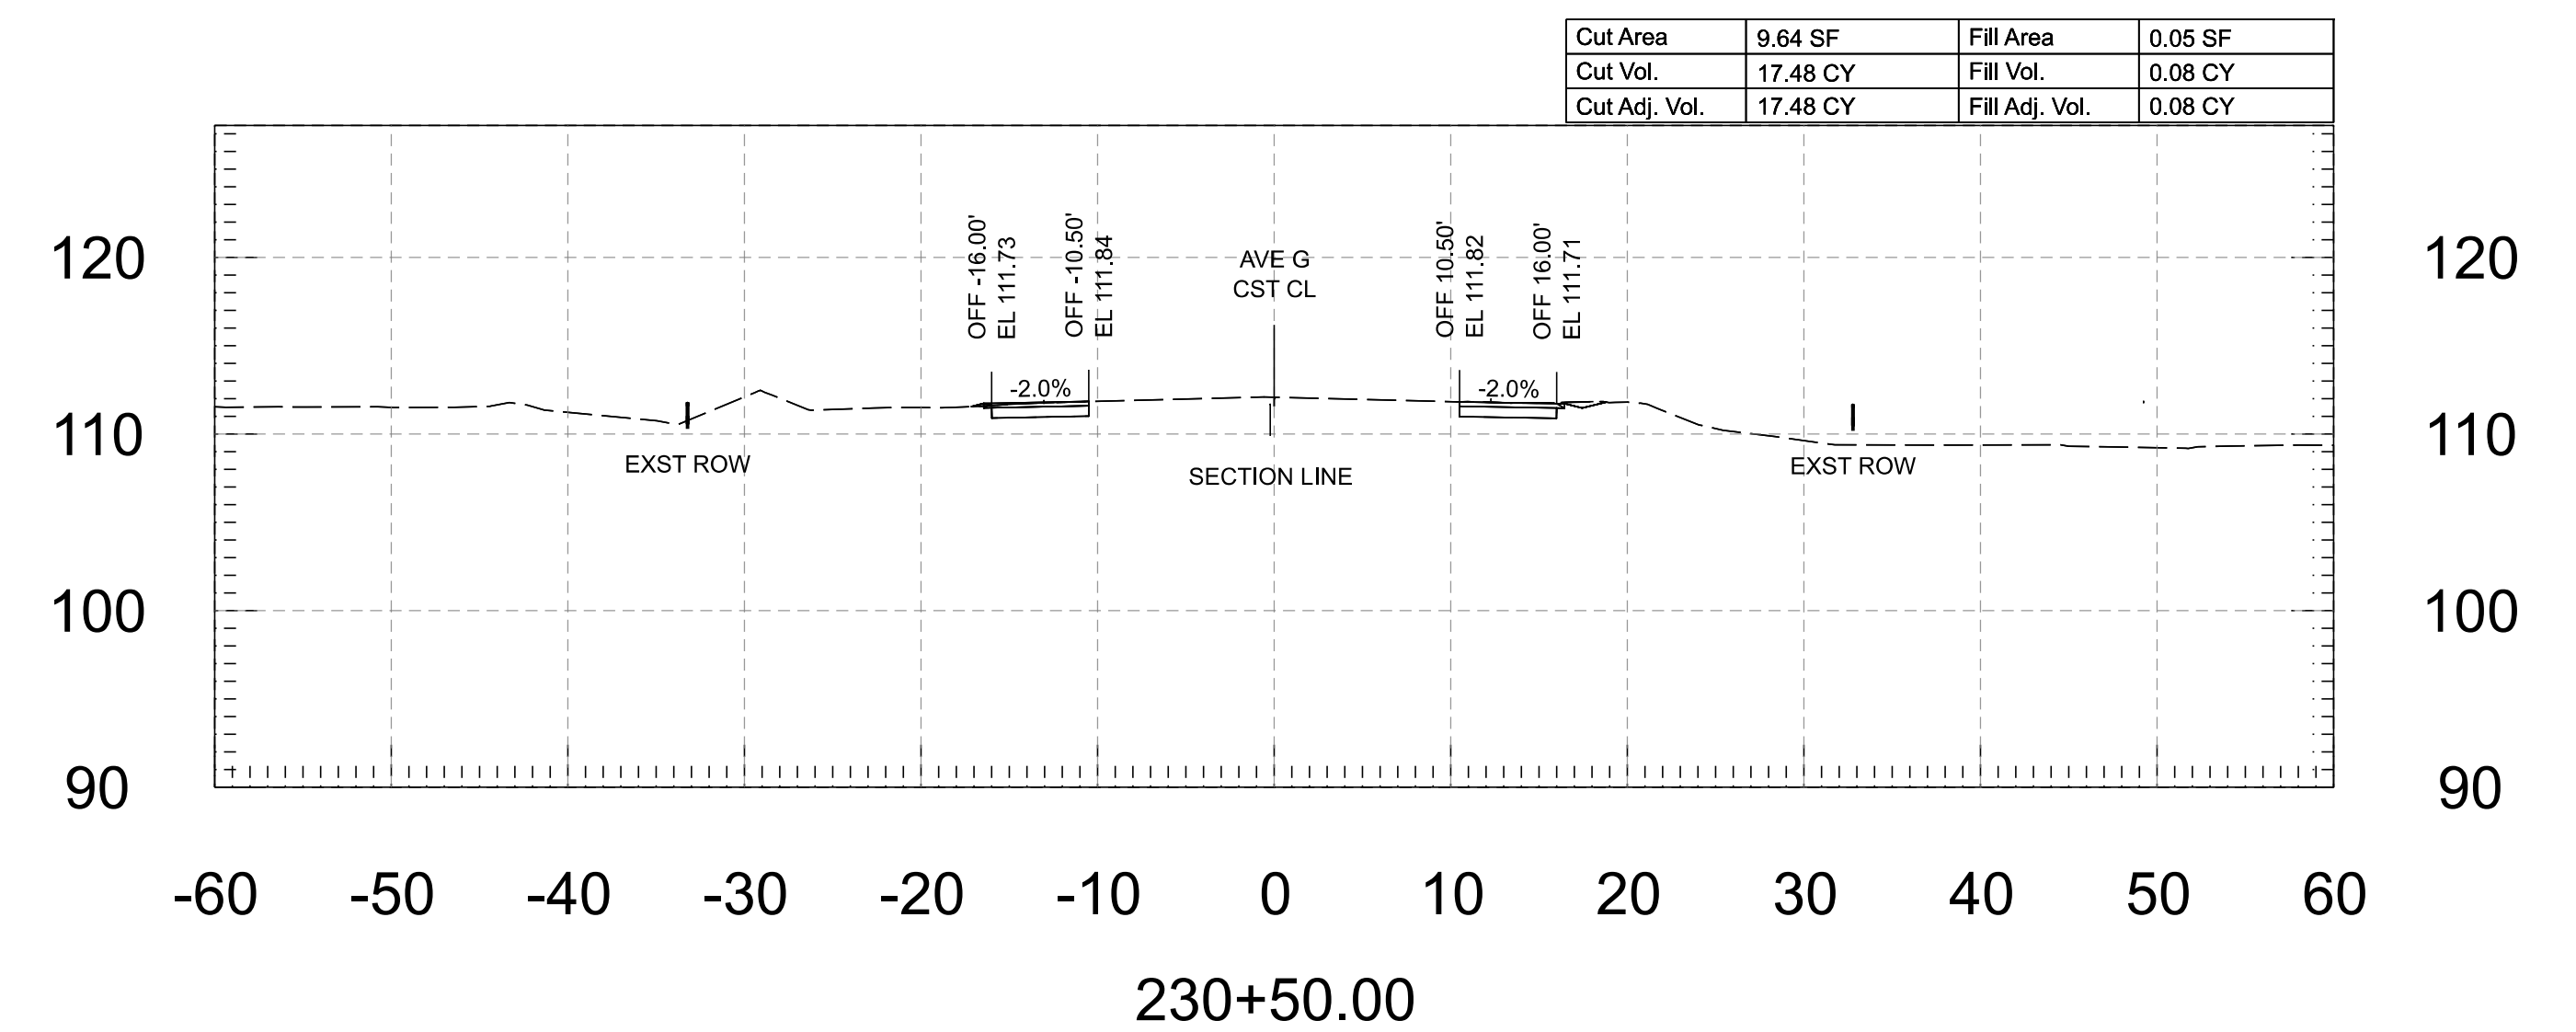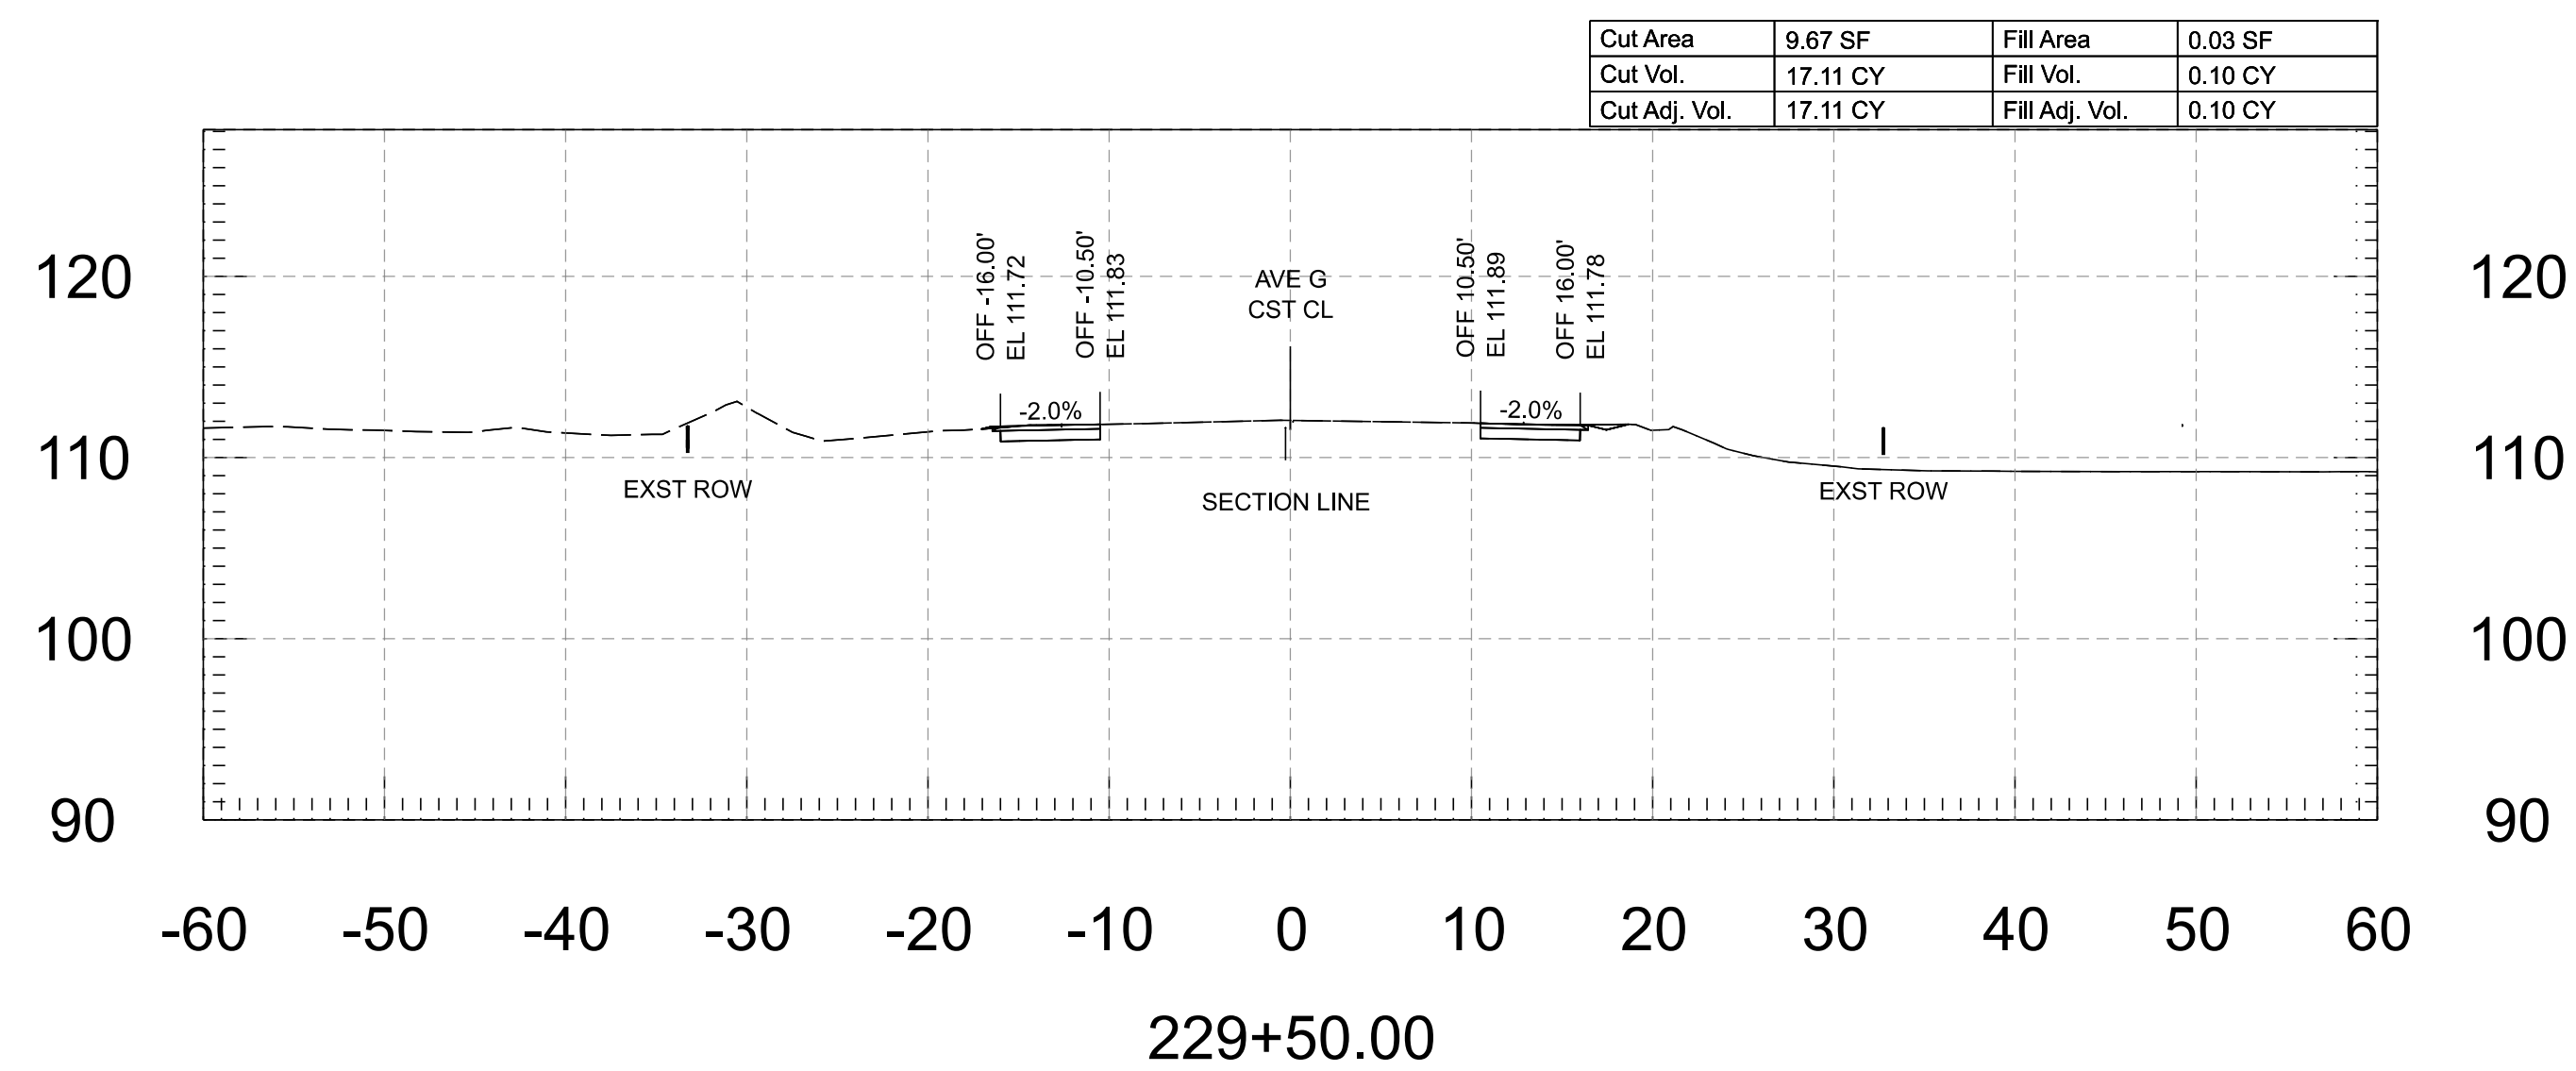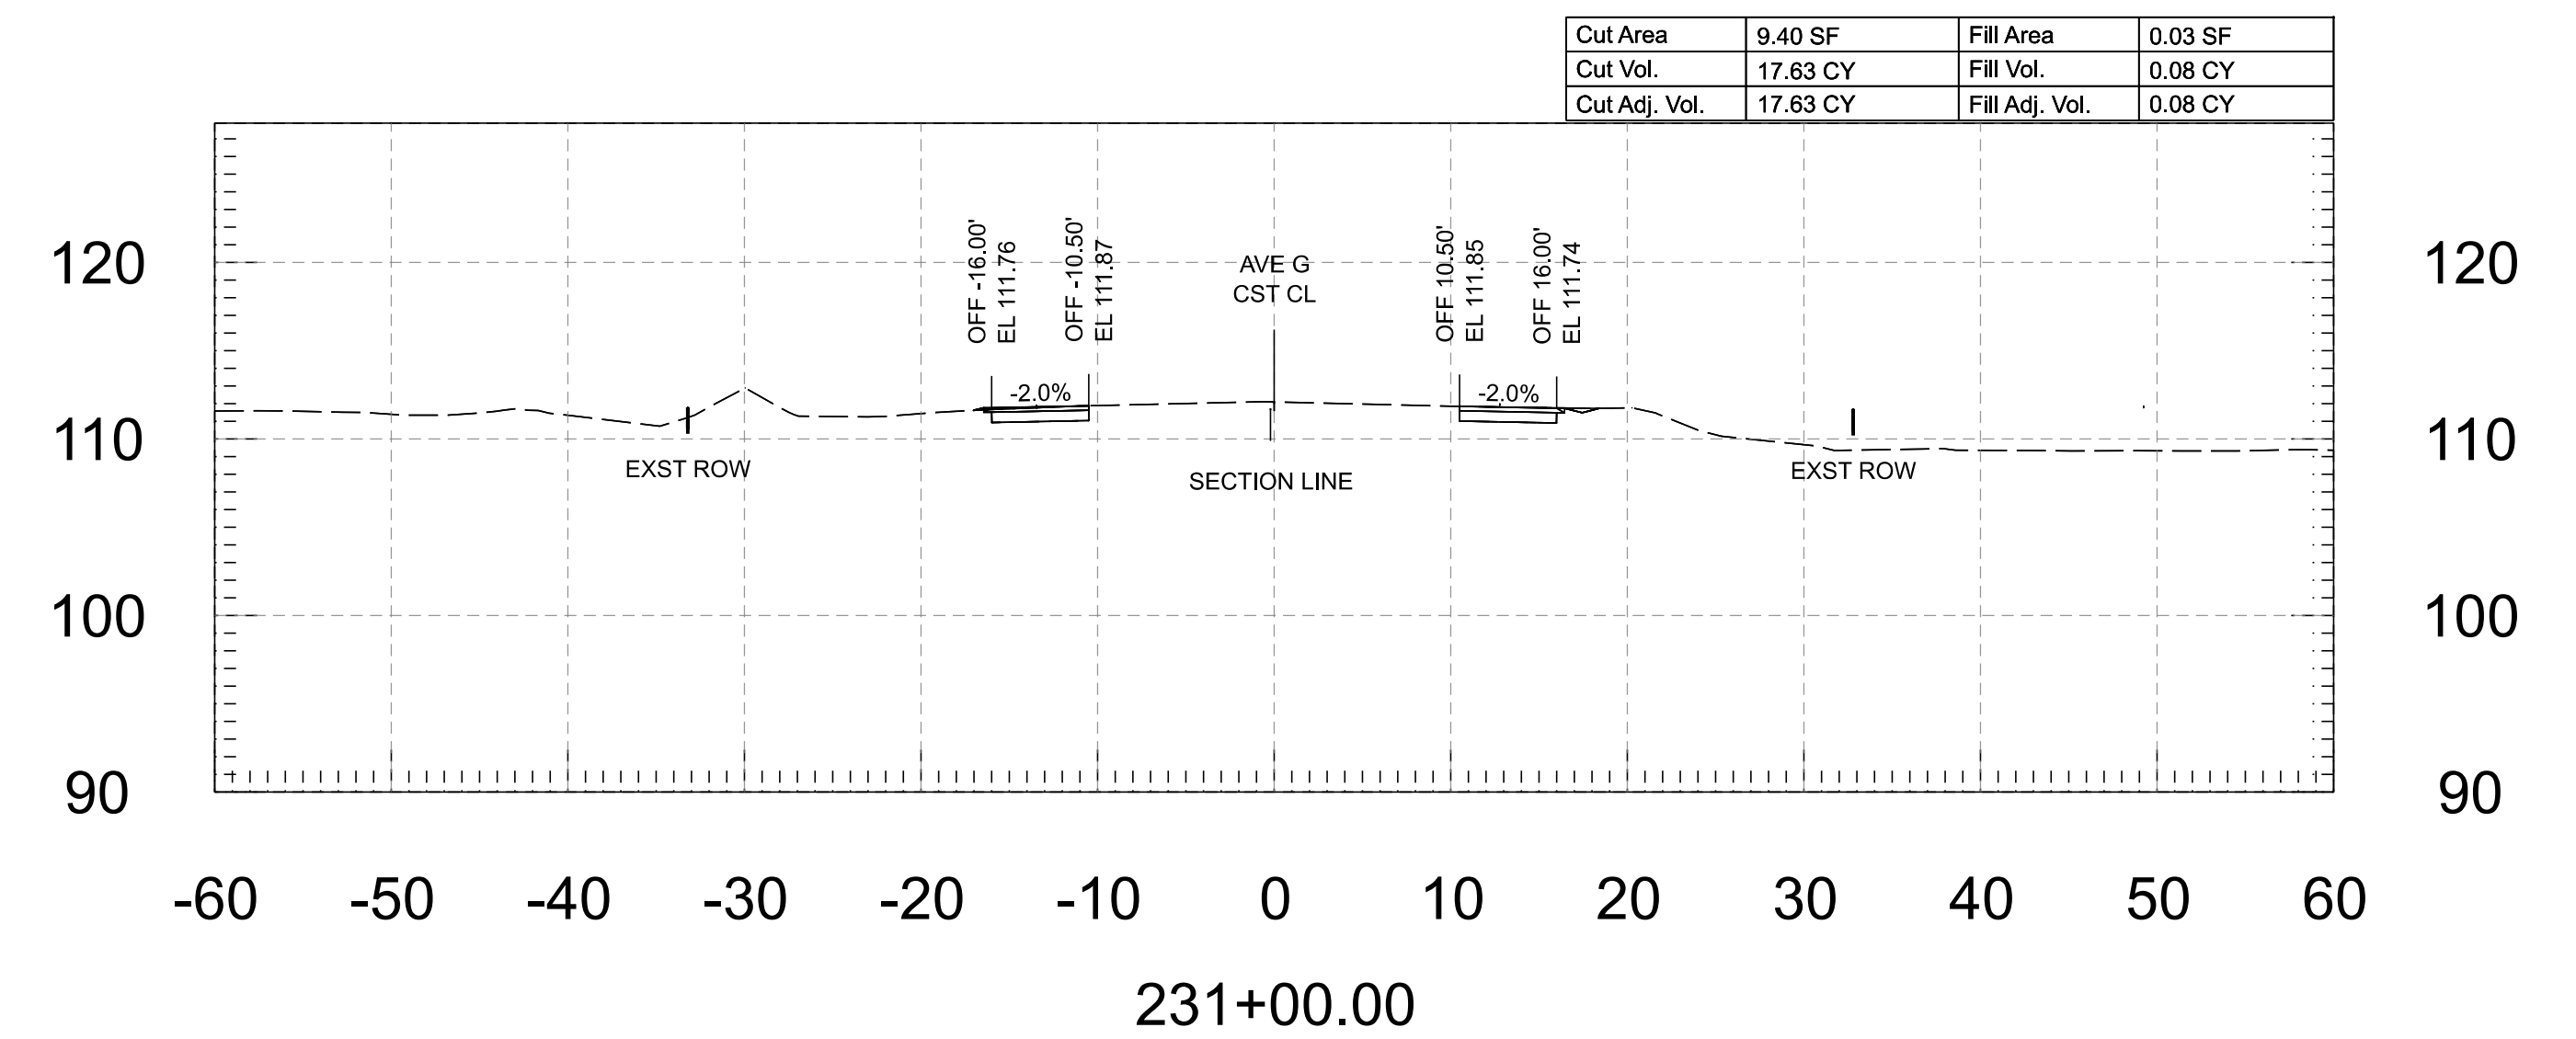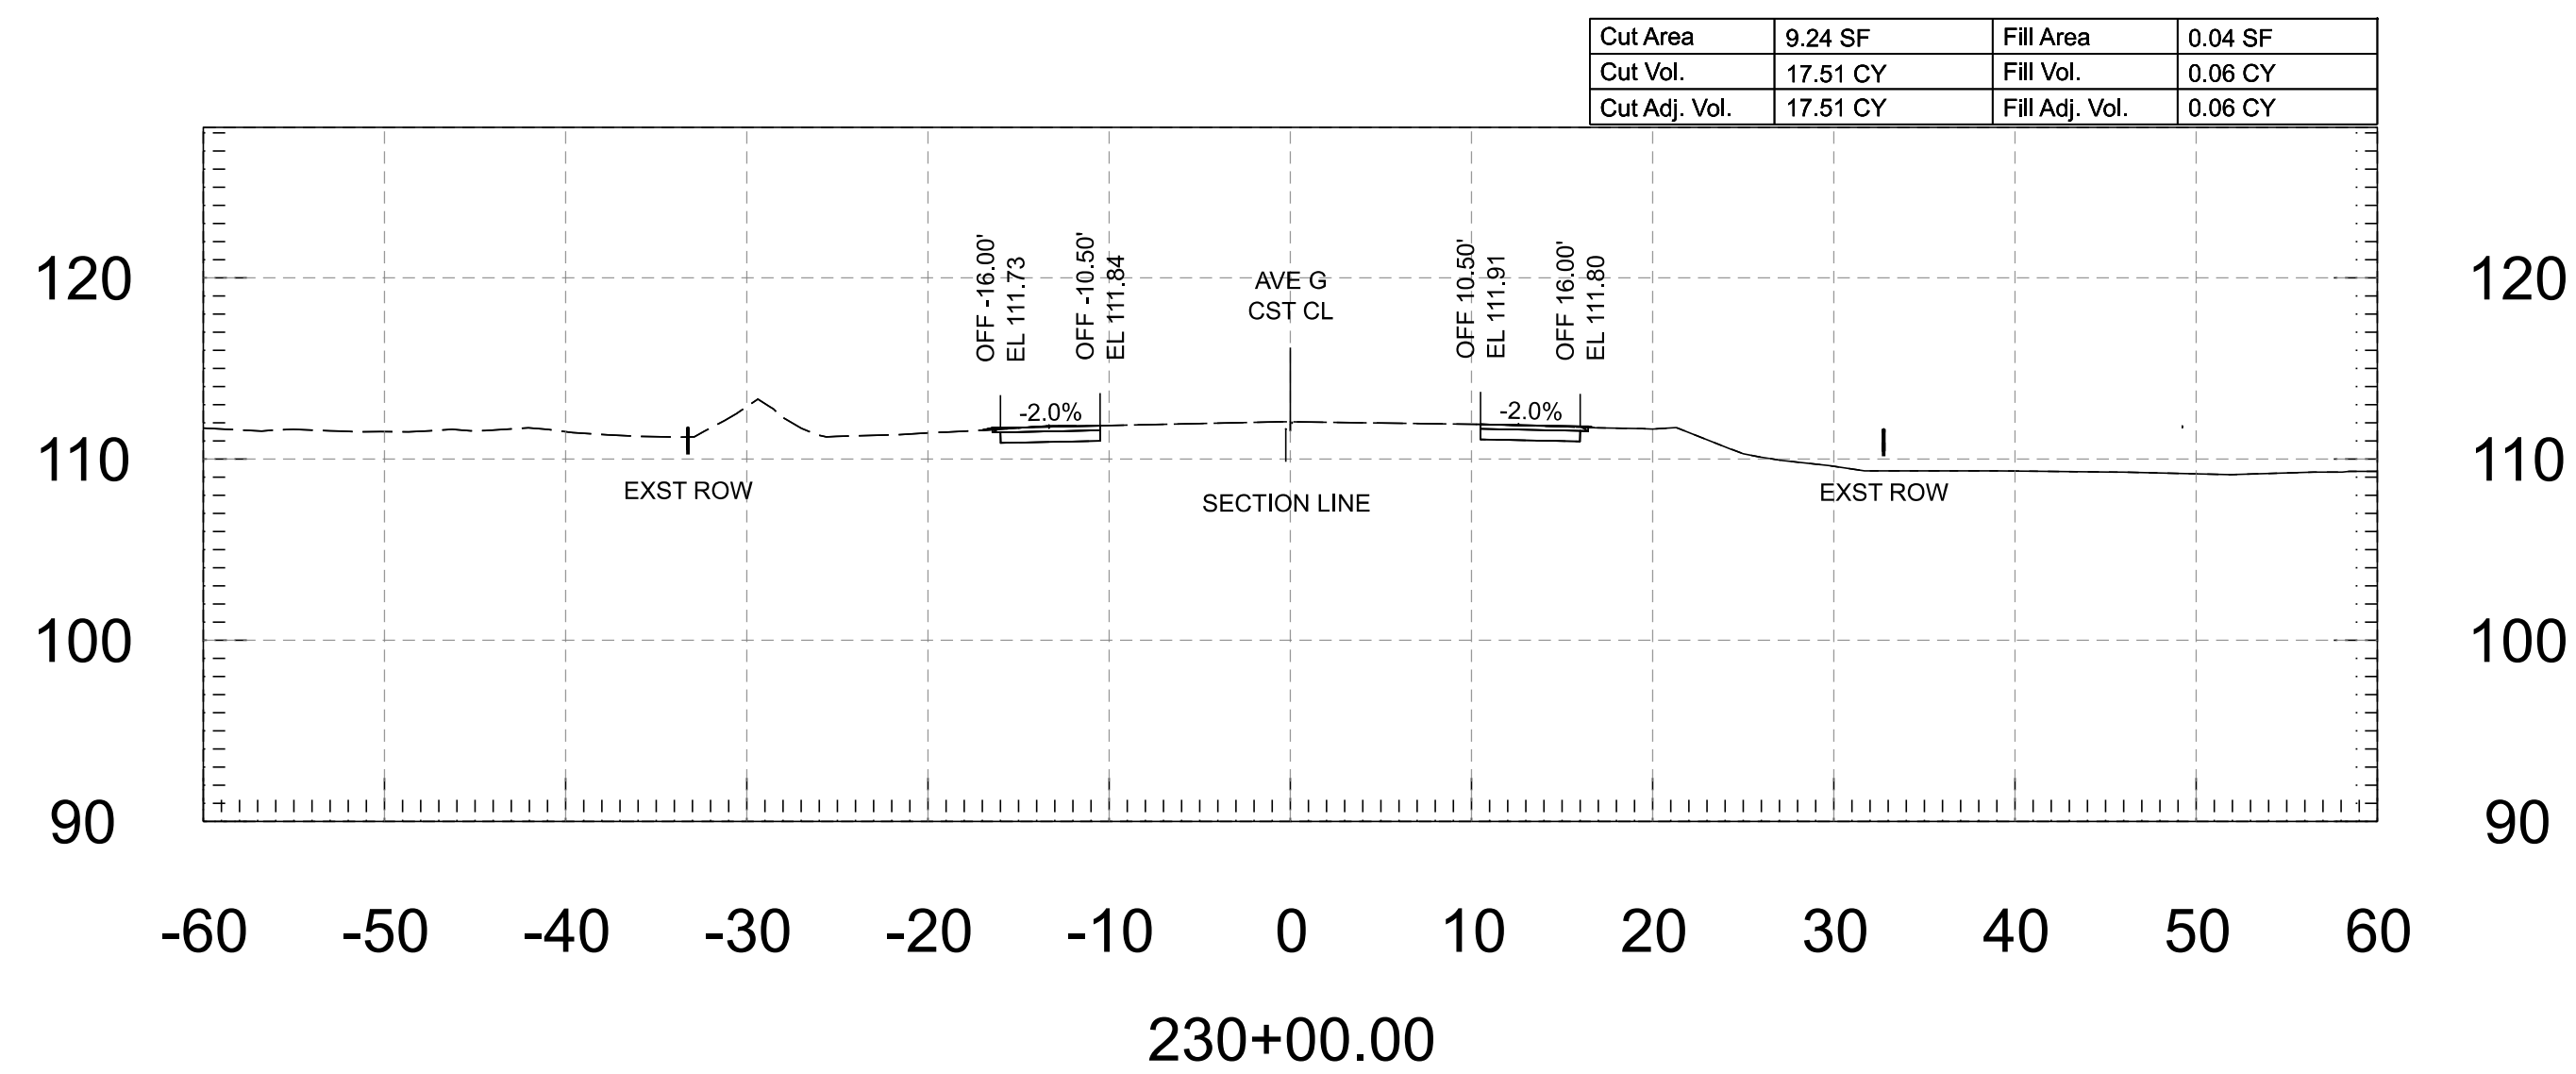


FOR INFORMATION ONLY			NAME	DATE	ARIZONA DEPARTMENT OF TRANSPORTATION PROJECT DELIVERY AND OPERATIONS DIVISION ROADWAY DESIGN SERVICES	ROUTE	F.H.W.A. Arizona Division	STATE ARIZ.	PROJECT NO.	FEDERAL ID NO.	SHEET NO.	TOTAL SHEETS	RECORD DRAWING
	DESIGN	M. SCHOEN	07/26	0000 YU YYU		YYU-0(225)T			106	118			
	DRAWN	M. SCHOEN	07/26										
	CHECKED	H. RIOS	07/26										
	wsp WSP USA Inc. 1230 West Washington Street, Suite 405 Tempe, AZ 85280	AVENUE G - CROSS SECTIONS				STRUCTURE NO.	LOCATION AVENUE G, COUNTY 11TH ST - COUNTY 16TH ST DWG						
						TRACS NO. T0437 01C						___ OF ___	


Cut Area	9.32 SF	Fill Area	0.02 SF
Cut Vol.	17.88 CY	Fill Vol.	0.02 CY
Cut Adj. Vol.	17.88 CY	Fill Adj. Vol.	0.02 CY

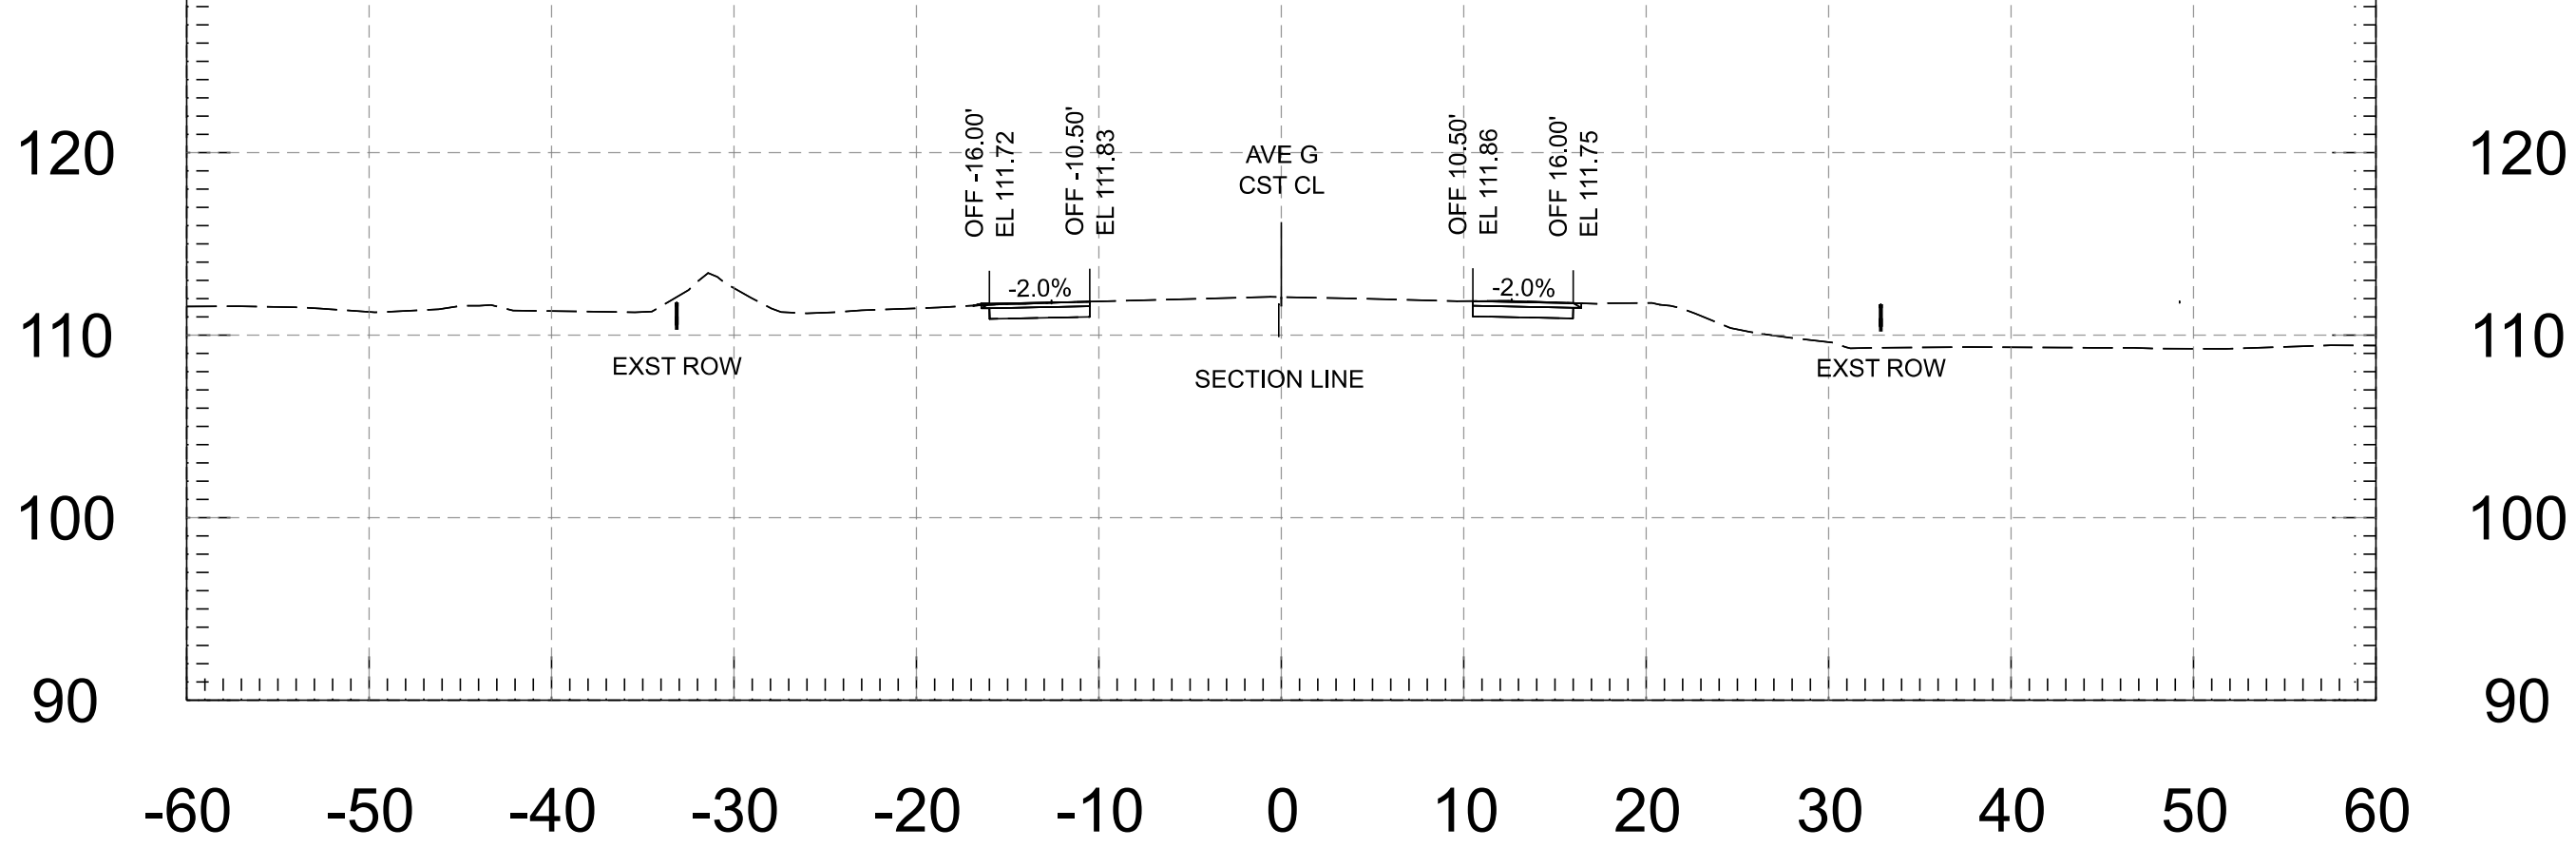


Cut Area	9.38 SF	Fill Area	0.04 SF
Cut Vol.	17.62 CY	Fill Vol.	0.10 CY
Cut Adj. Vol.	17.62 CY	Fill Adj. Vol.	0.10 CY

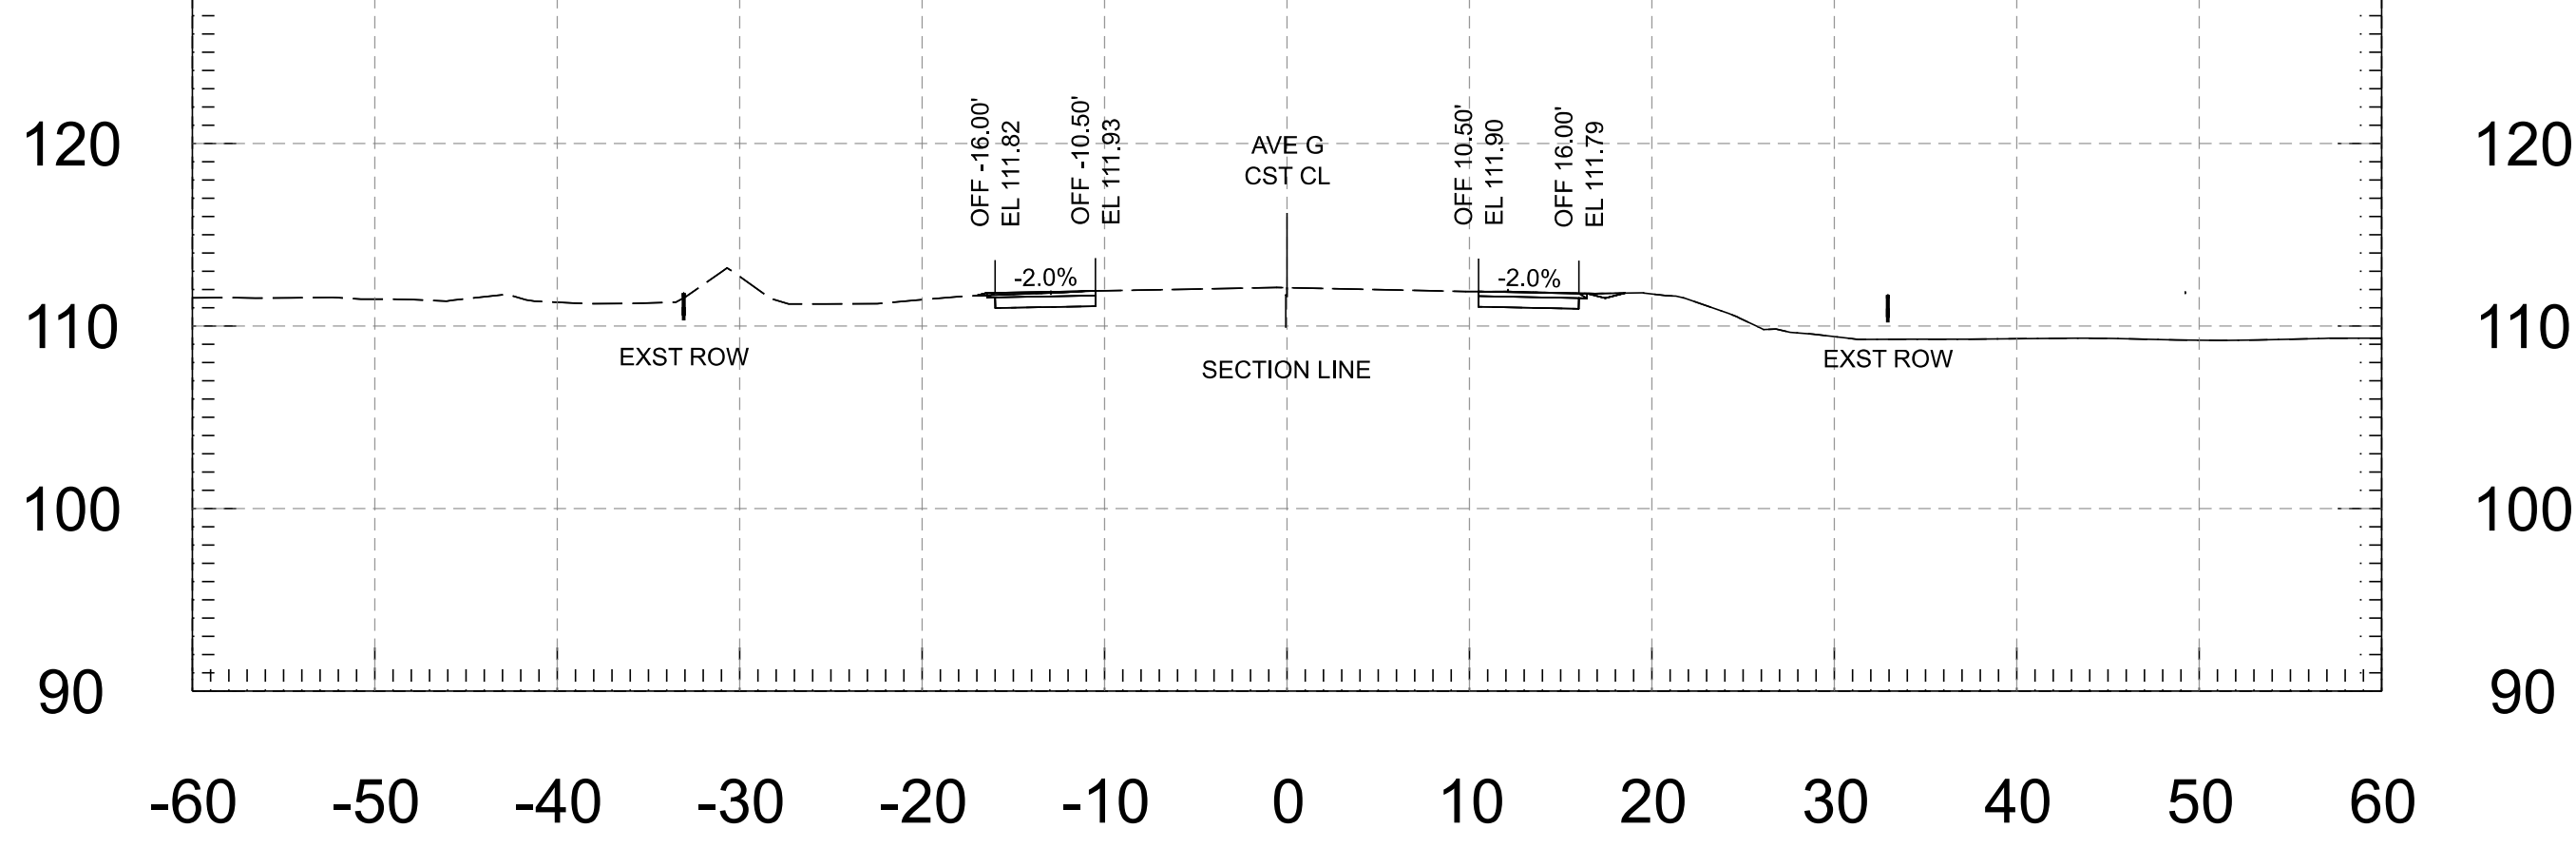


Cut Area	9.99 SF	Fill Area	0.00 SF
Cut Vol.	17.96 CY	Fill Vol.	0.03 CY
Cut Adj. Vol.	17.96 CY	Fill Adj. Vol.	0.03 CY

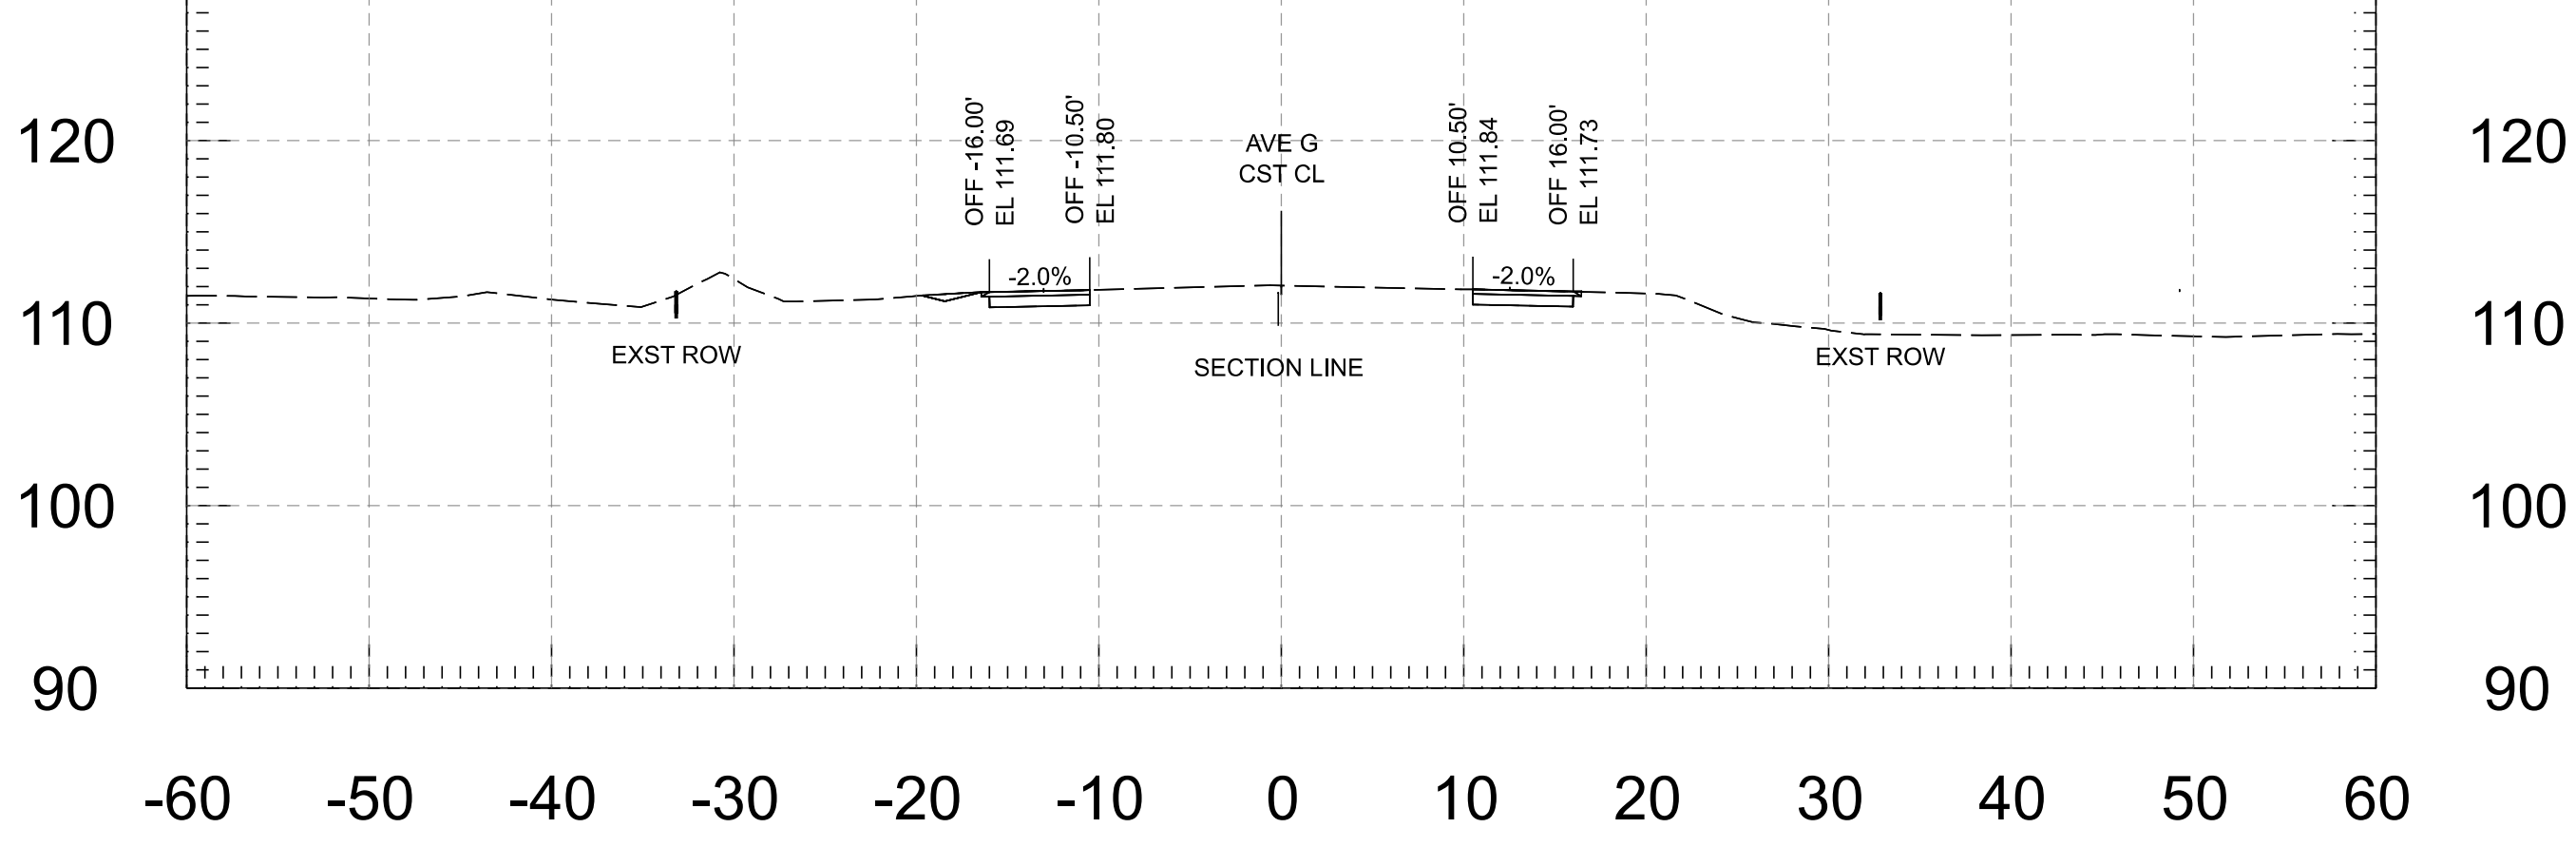


Cut Area	9.65 SF	Fill Area	0.07 SF
Cut Vol.	17.57 CY	Fill Vol.	0.08 CY
Cut Adj. Vol.	17.57 CY	Fill Adj. Vol.	0.08 CY

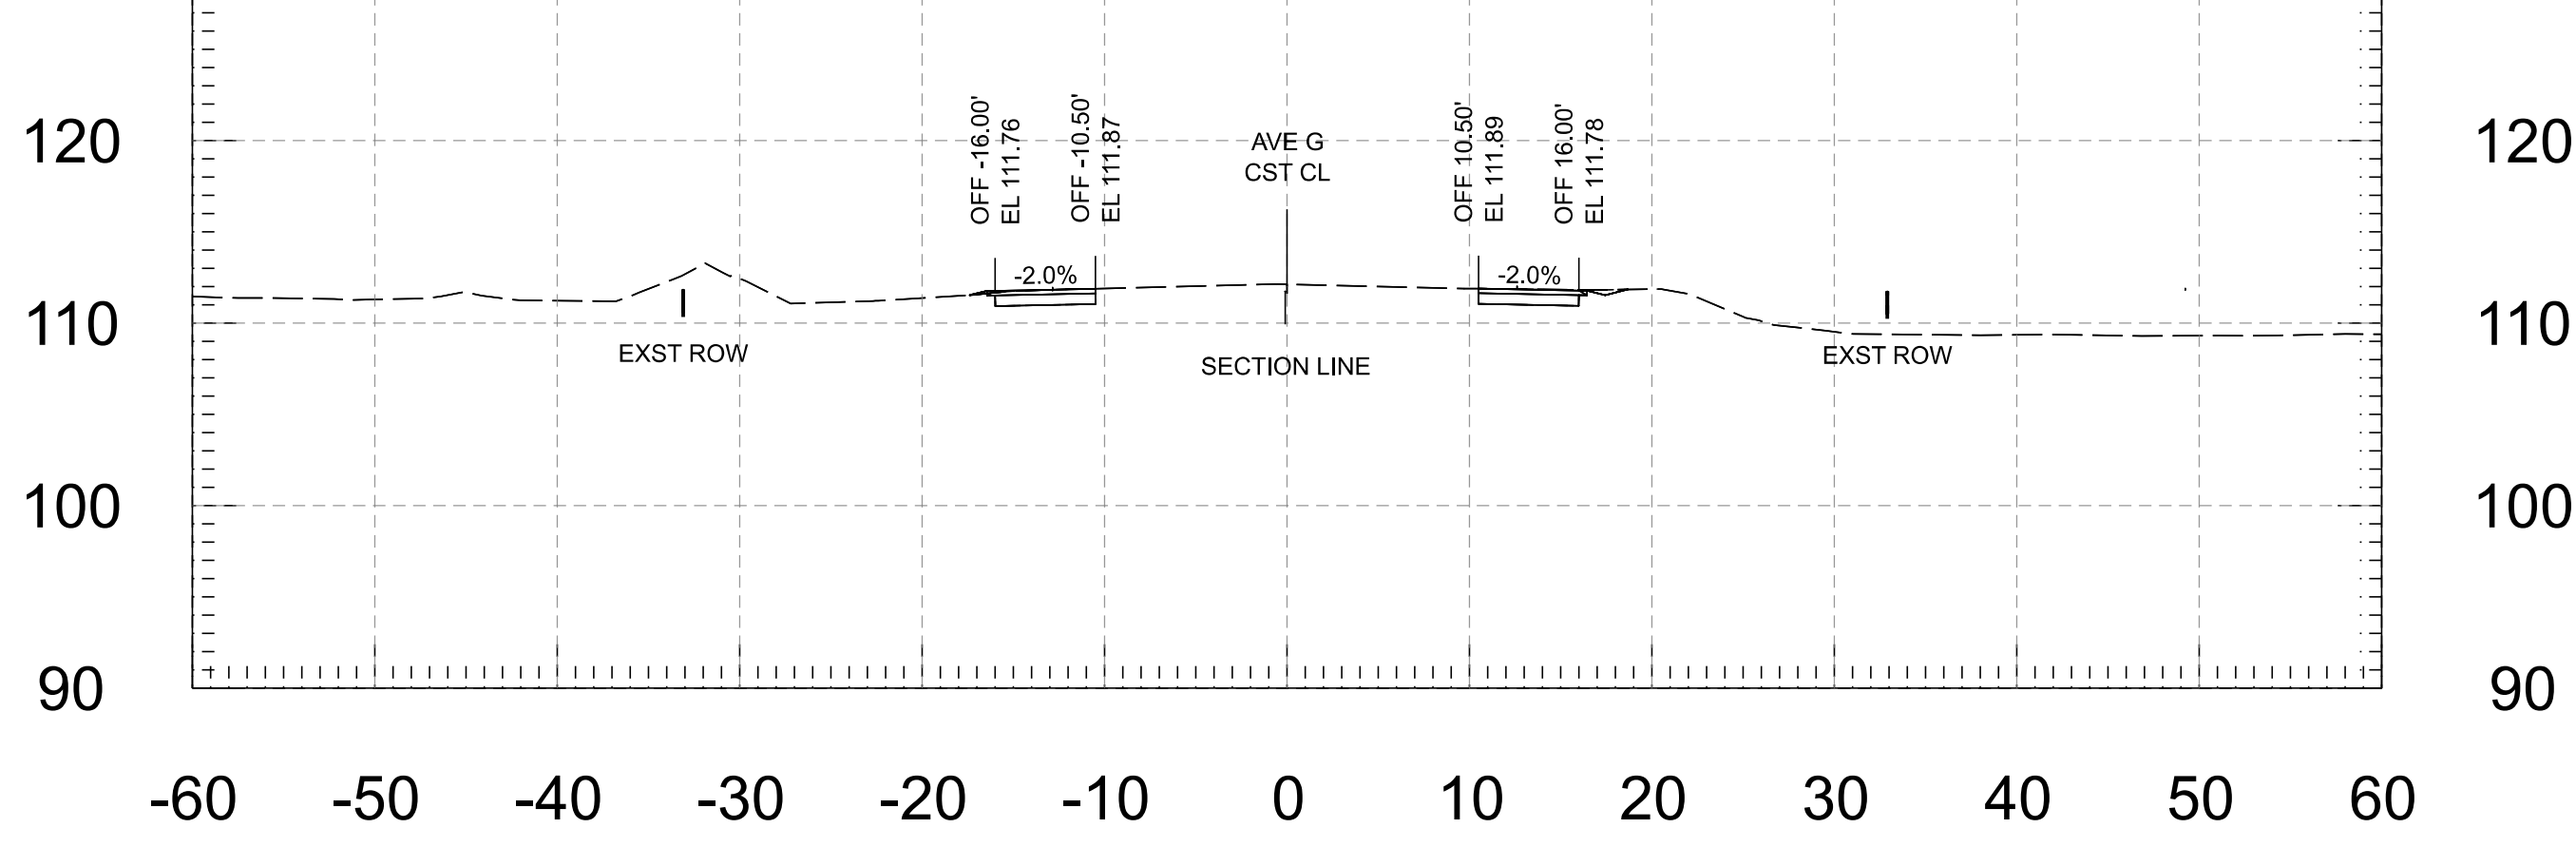


	FOR INFORMATION ONLY		NAME	DATE	ARIZONA DEPARTMENT OF TRANSPORTATION PROJECT DELIVERY AND OPERATIONS DIVISION ROADWAY DESIGN SERVICES	ROUTE	F.H.W.A. Arizona Division	STATE ARIZ.	PROJECT NO.	FEDERAL ID NO.	SHEET NO.	TOTAL SHEETS	RECORD DRAWING	
		DESIGN	M. SCHOEN	07/26		0000 YU YYU			YYU-0(225)T	107	118			
		DRAWN	M. SCHOEN	07/26		LOCATION AVENUE G, COUNTY 11TH ST - COUNTY 16TH ST								DWG
		CHECKED	H. RIOS	07/26										
		 WSP USA Inc. 1230 West Washington Street, Suite 405 Tempe, AZ 85288			AVENUE G - CROSS SECTIONS			TRACS NO. T0437 01C					___ OF ___	

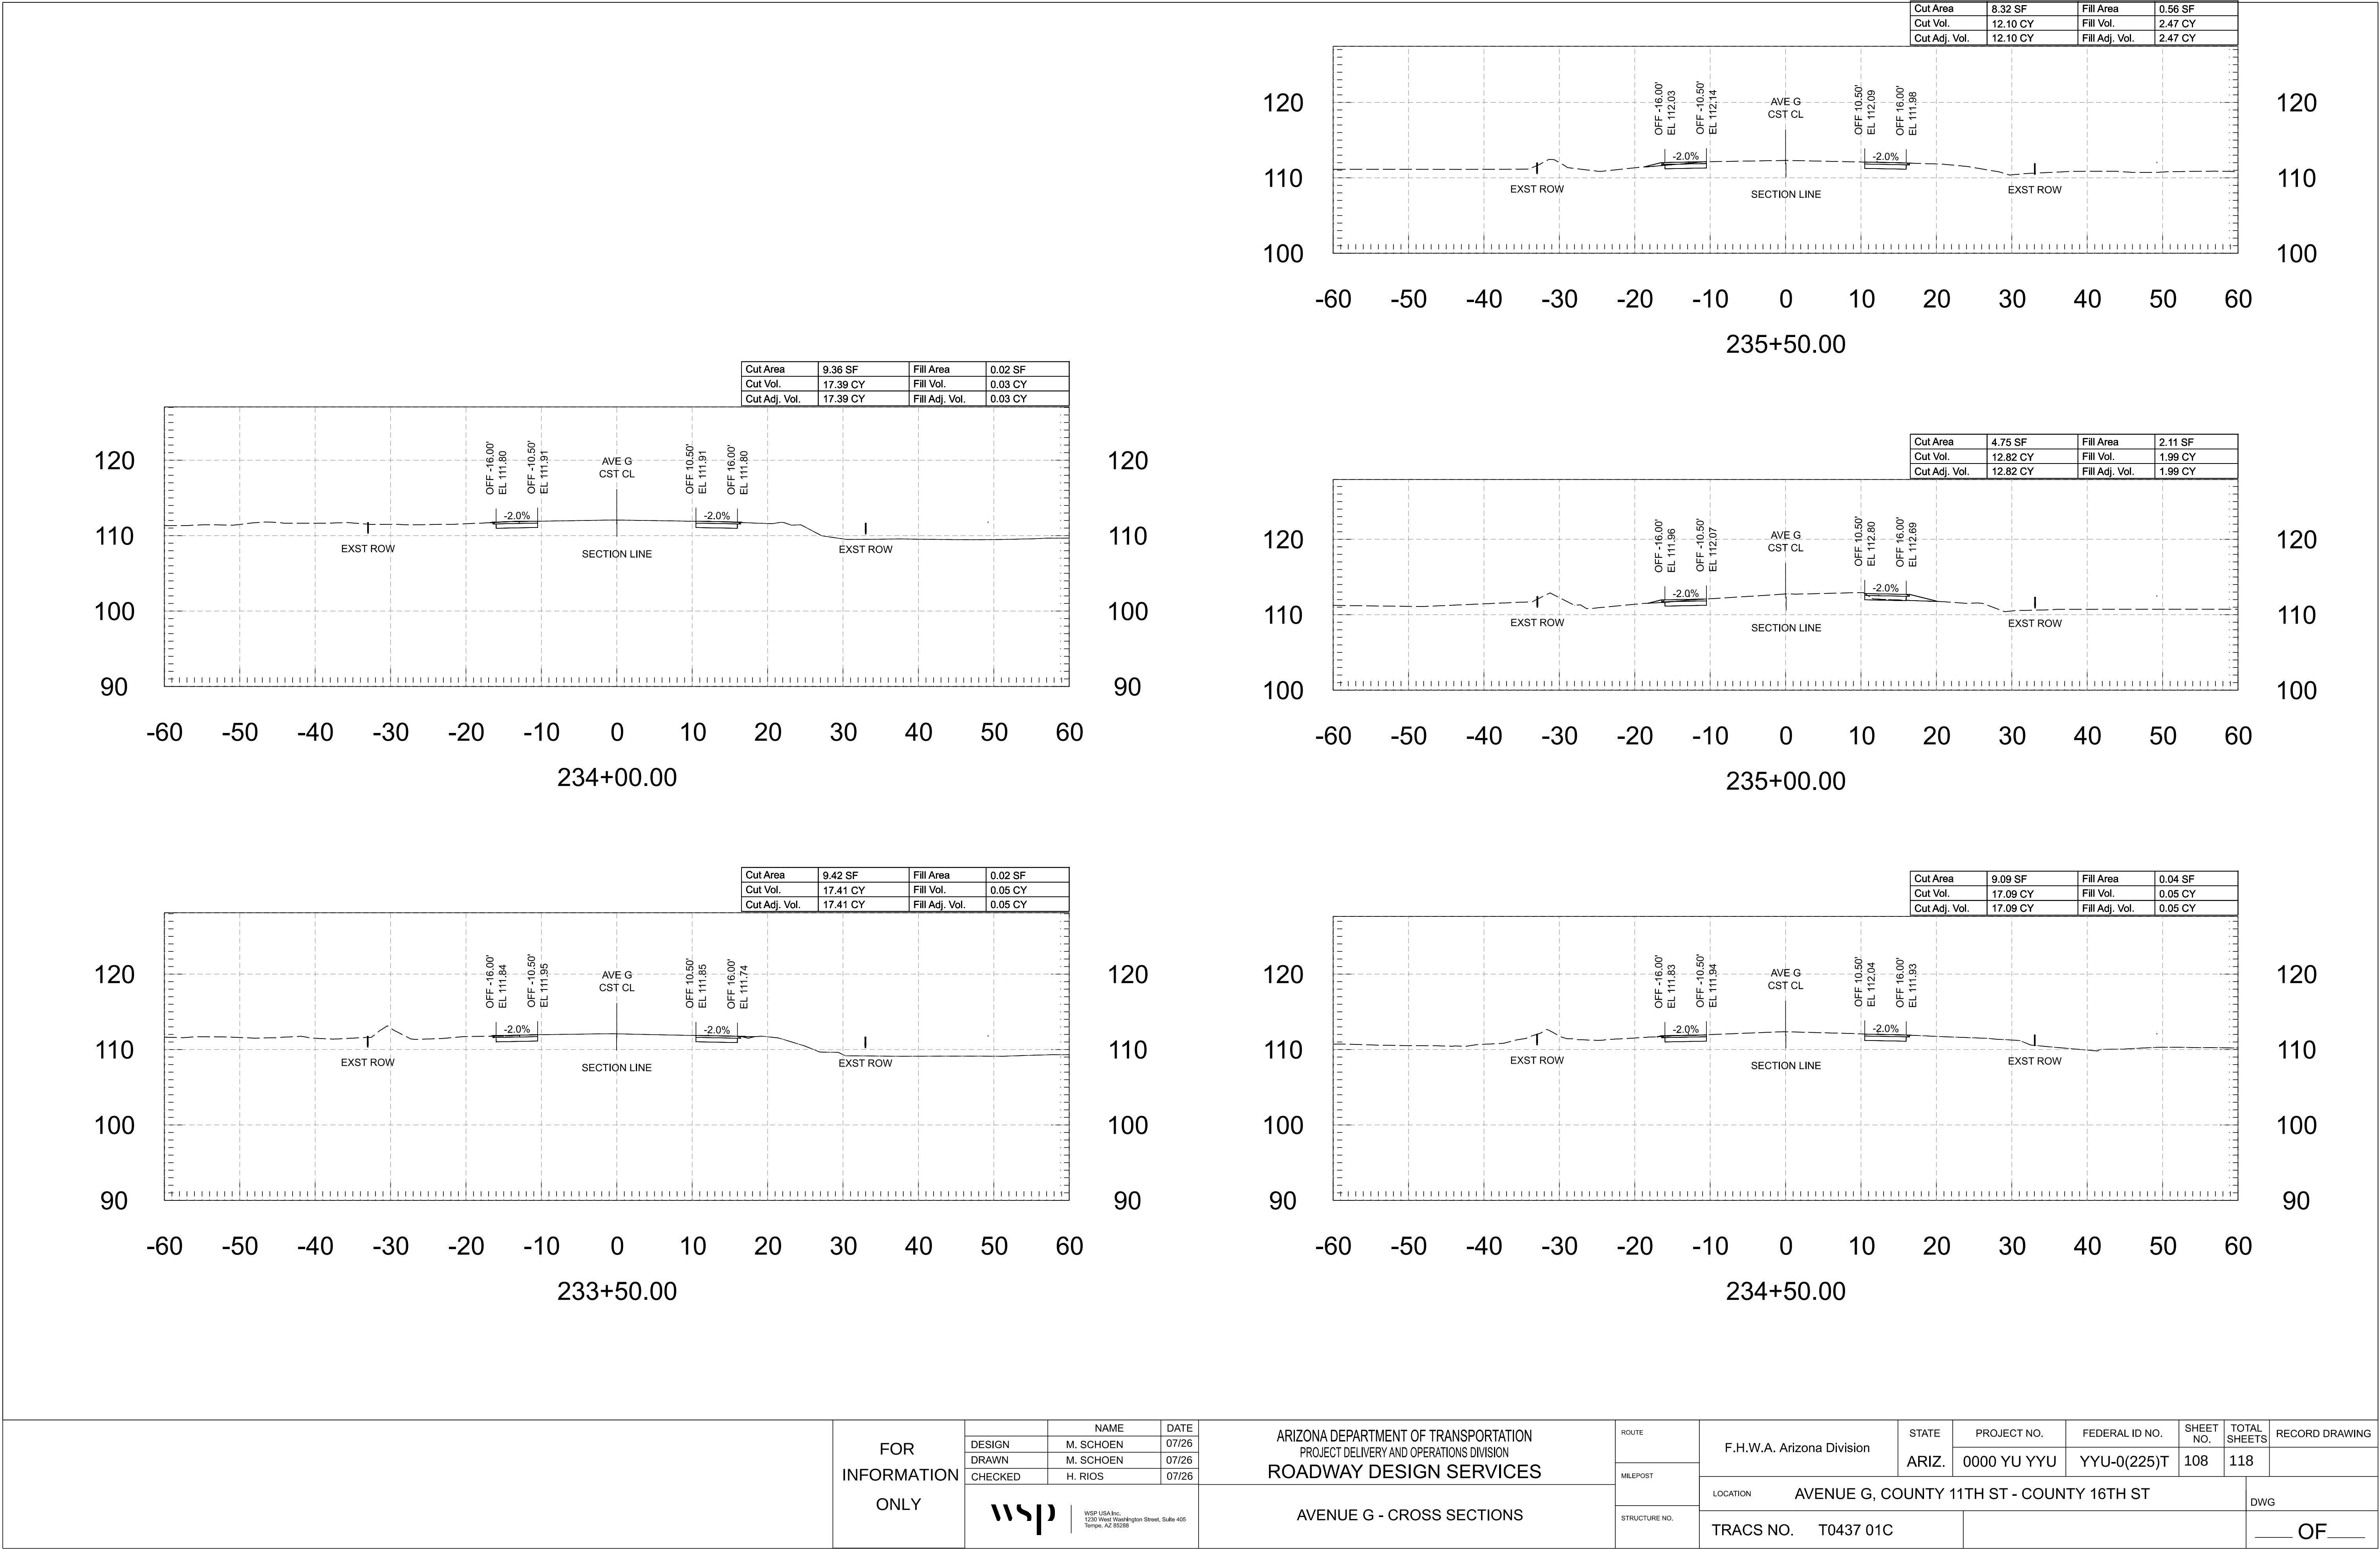


Cut Area	8.62 SF	Fill Area	0.23 SF
Cut Vol.	16.00 CY	Fill Vol.	0.39 CY
Cut Adj. Vol.	16.00 CY	Fill Adj. Vol.	0.39 CY

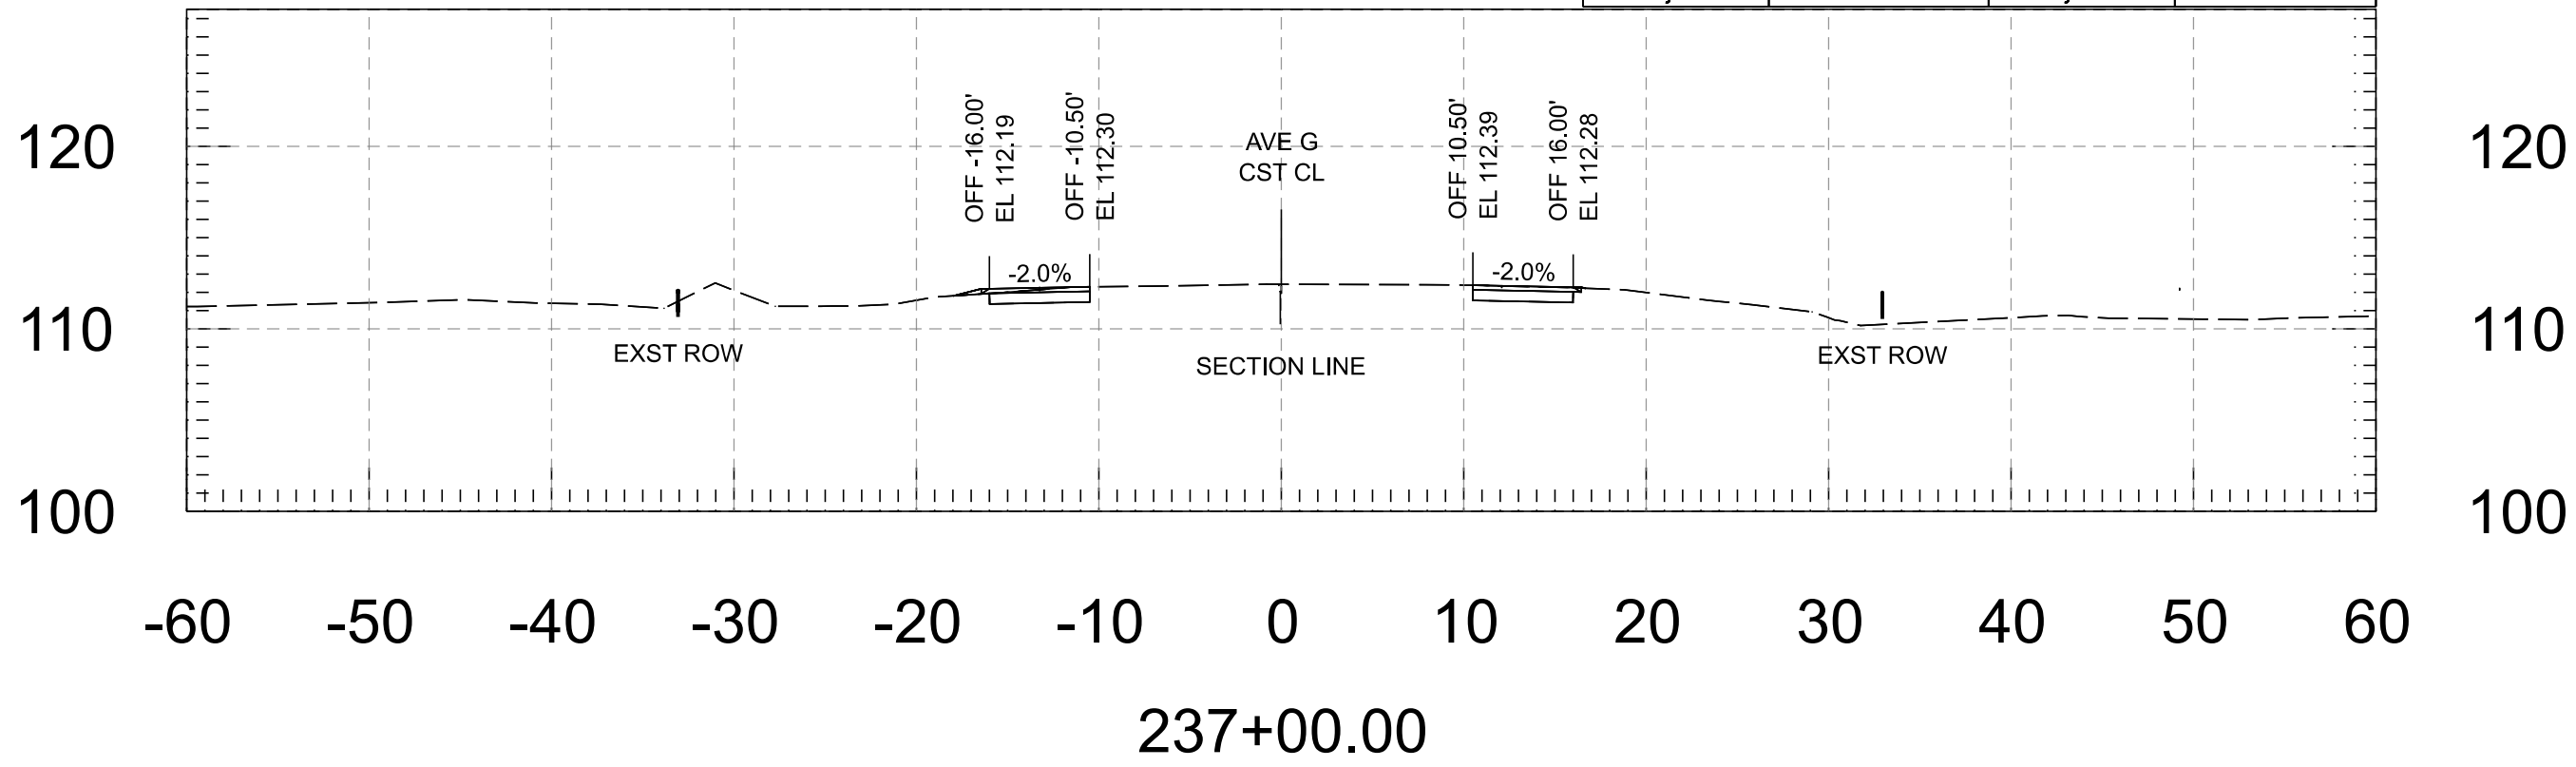


Cut Area	8.63 SF	Fill Area	0.24 SF
Cut Vol.	15.86 CY	Fill Vol.	0.60 CY
Cut Adj. Vol.	15.86 CY	Fill Adj. Vol.	0.60 CY

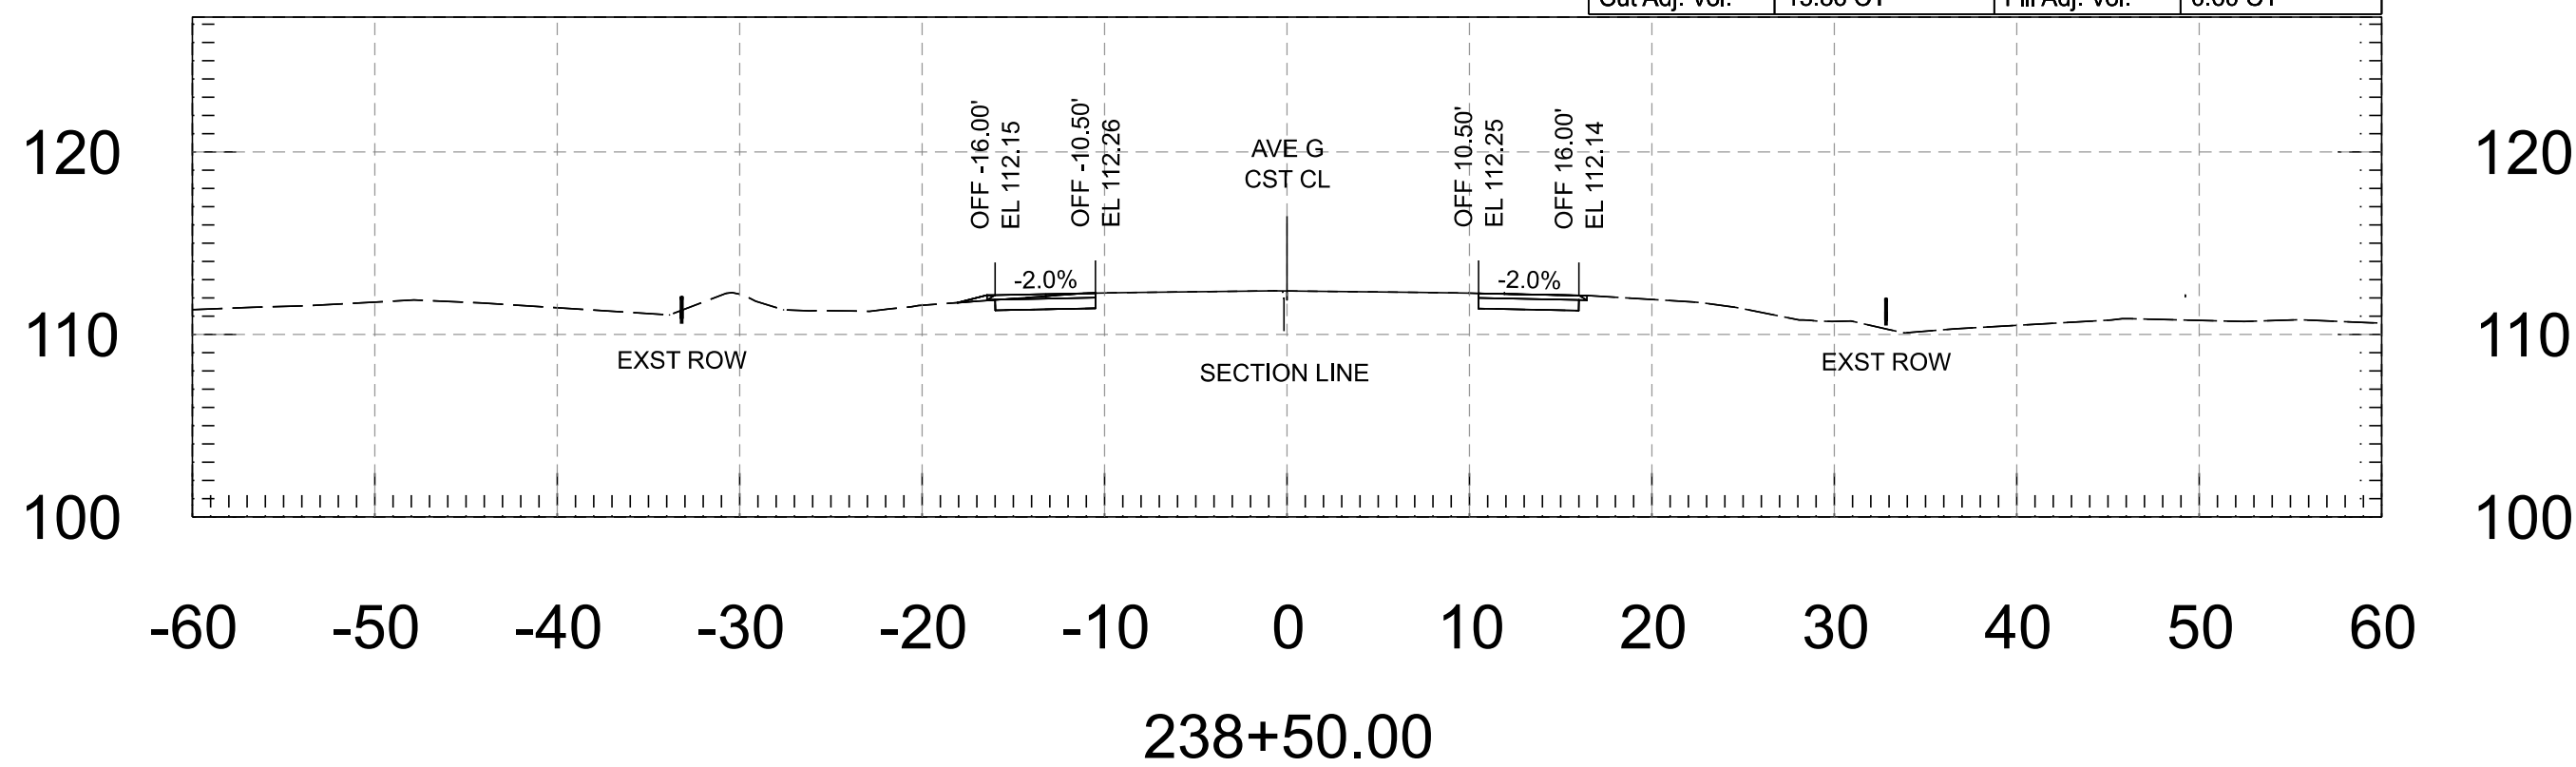


Cut Area	8.65 SF	Fill Area	0.20 SF
Cut Vol.	15.78 CY	Fill Vol.	0.52 CY
Cut Adj. Vol.	15.78 CY	Fill Adj. Vol.	0.52 CY

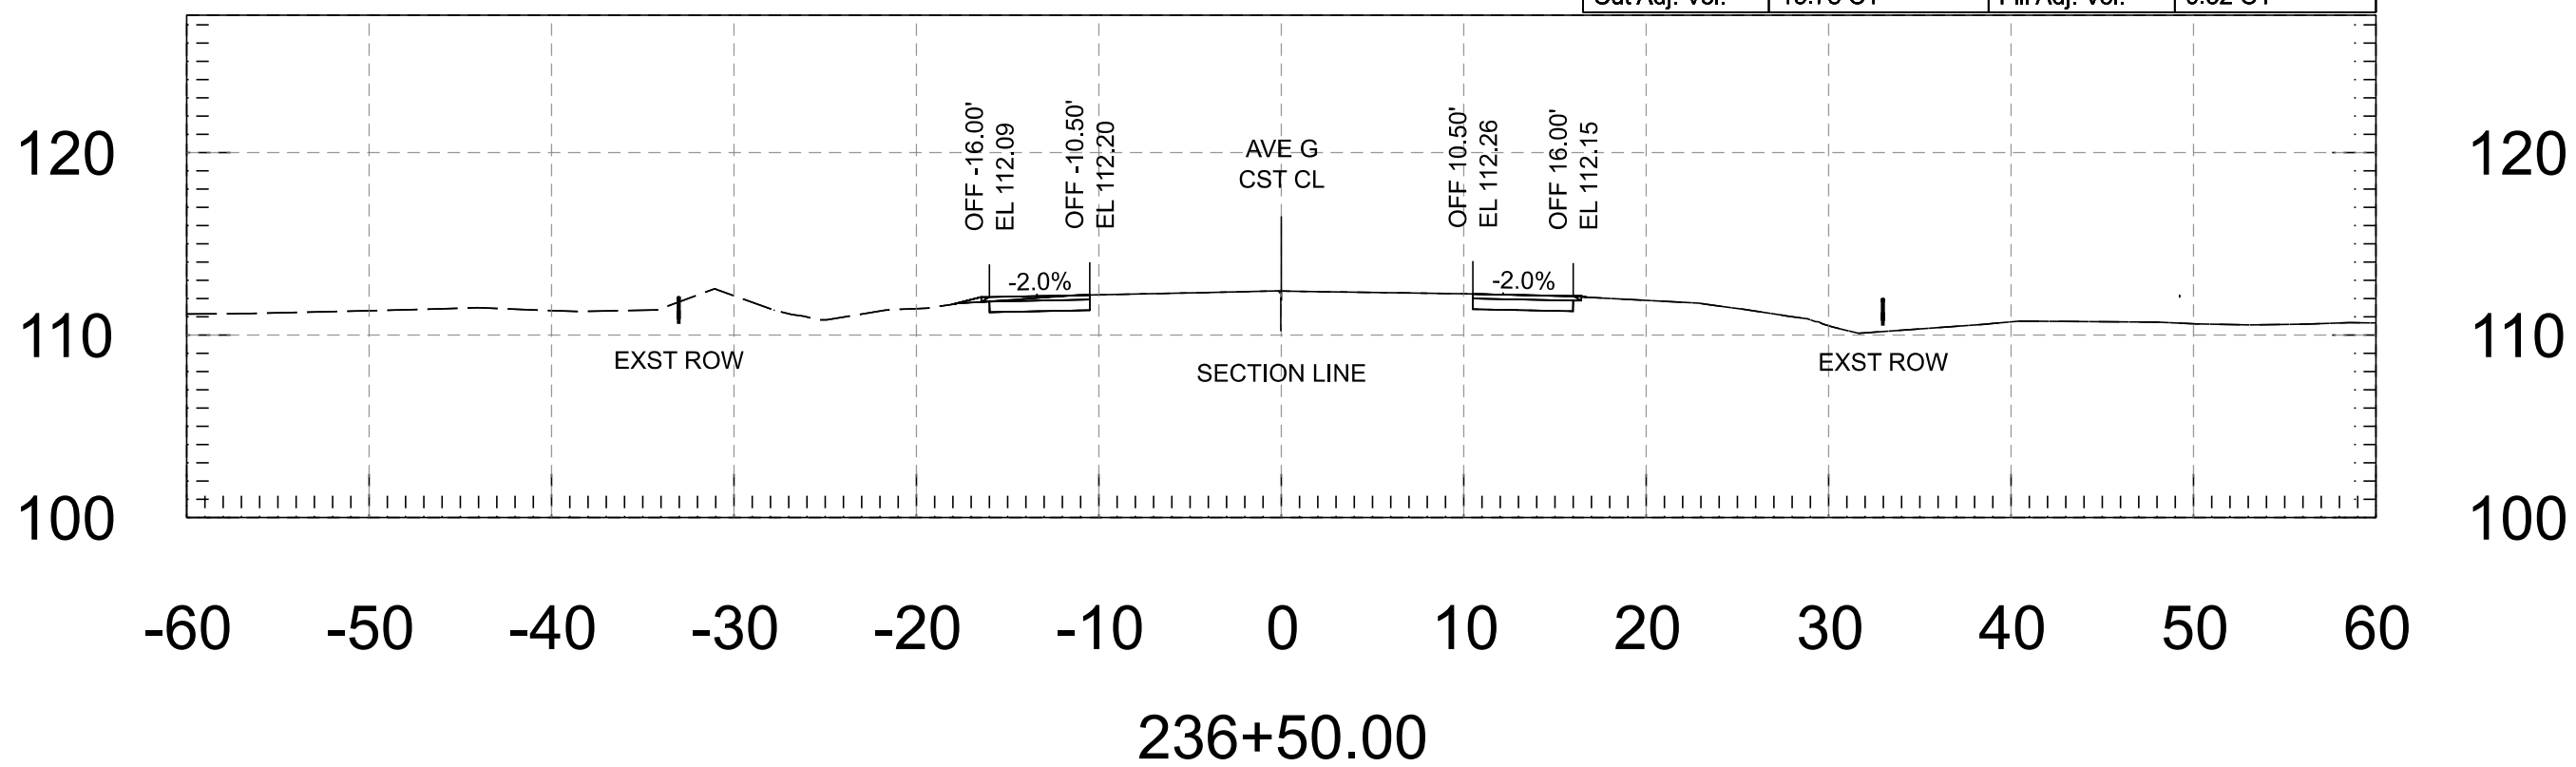


Cut Area	8.50 SF	Fill Area	0.40 SF
Cut Vol.	15.67 CY	Fill Vol.	0.64 CY
Cut Adj. Vol.	15.67 CY	Fill Adj. Vol.	0.64 CY

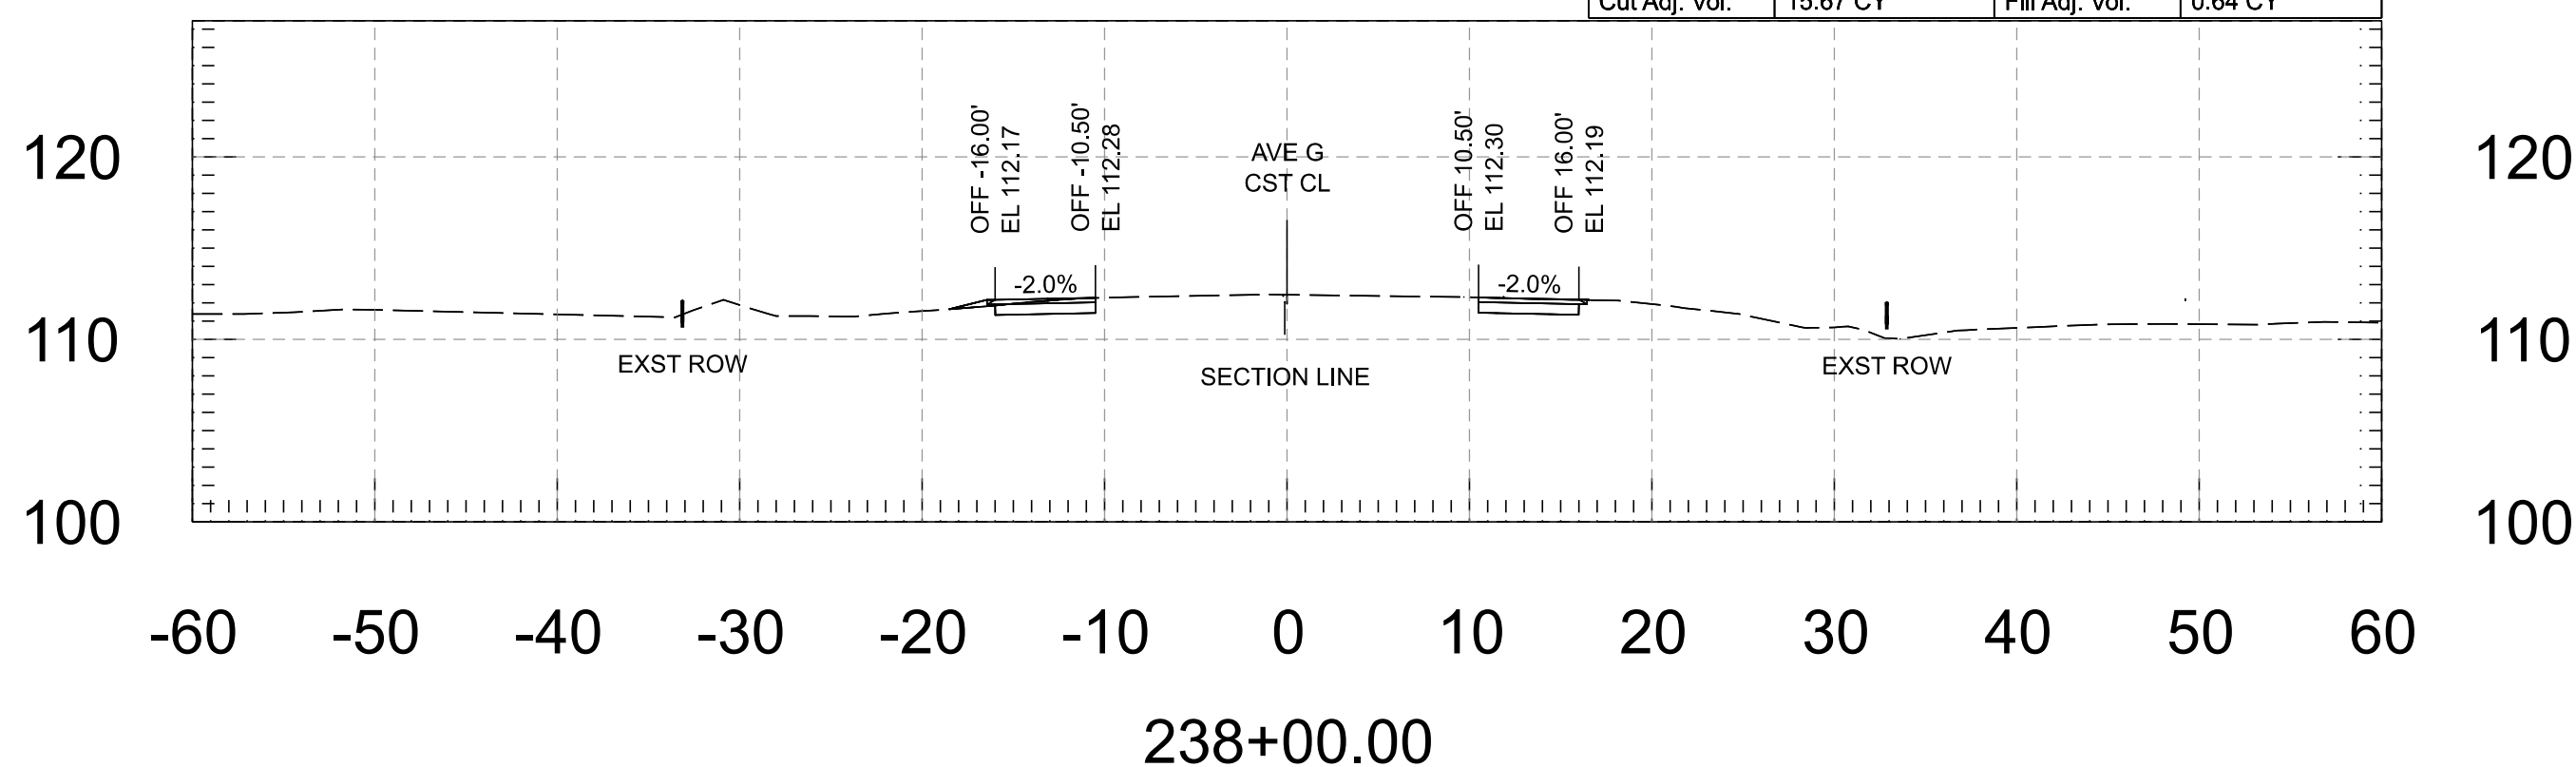







Cut Area	8.39 SF	Fill Area	0.36 SF
Cut Vol.	15.47 CY	Fill Vol.	0.85 CY
Cut Adj. Vol.	15.47 CY	Fill Adj. Vol.	0.85 CY

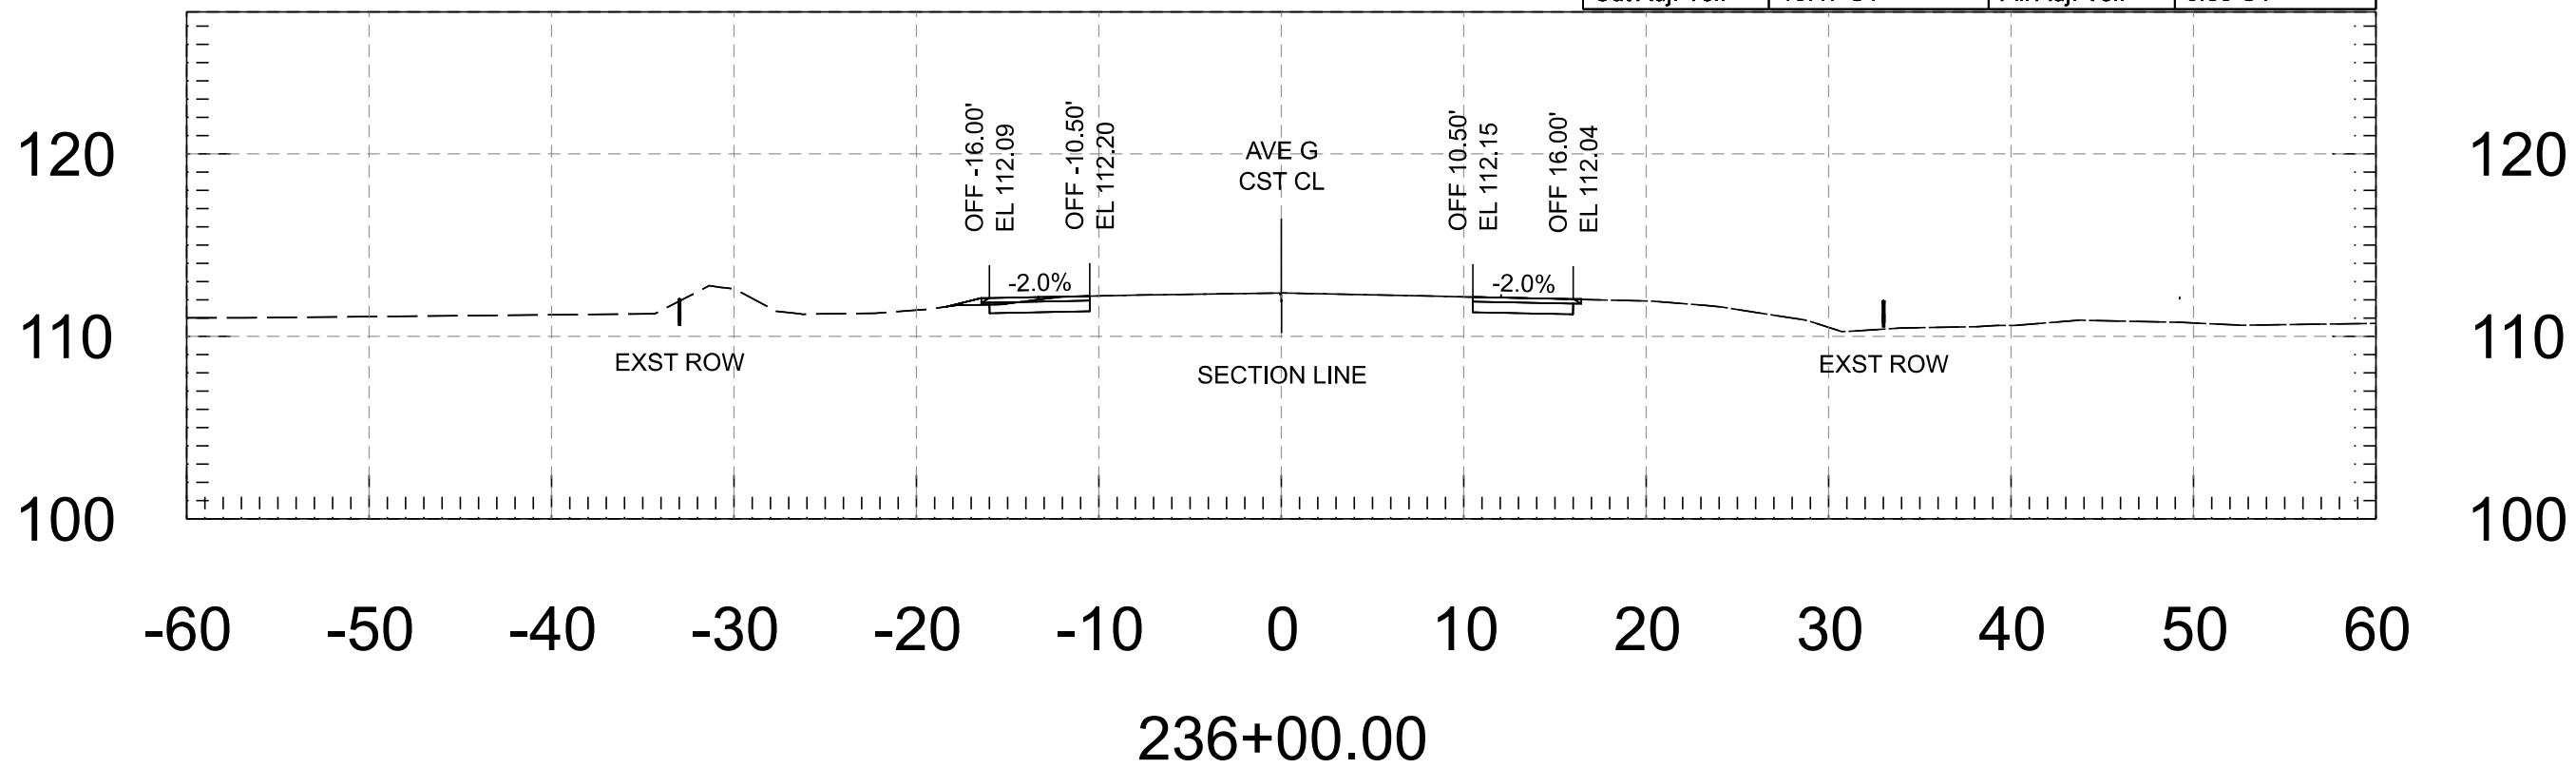




Cut Area	8.42 SF	Fill Area	0.29 SF
Cut Vol.	15.78 CY	Fill Vol.	0.48 CY
Cut Adj. Vol.	15.78 CY	Fill Adj. Vol.	0.48 CY

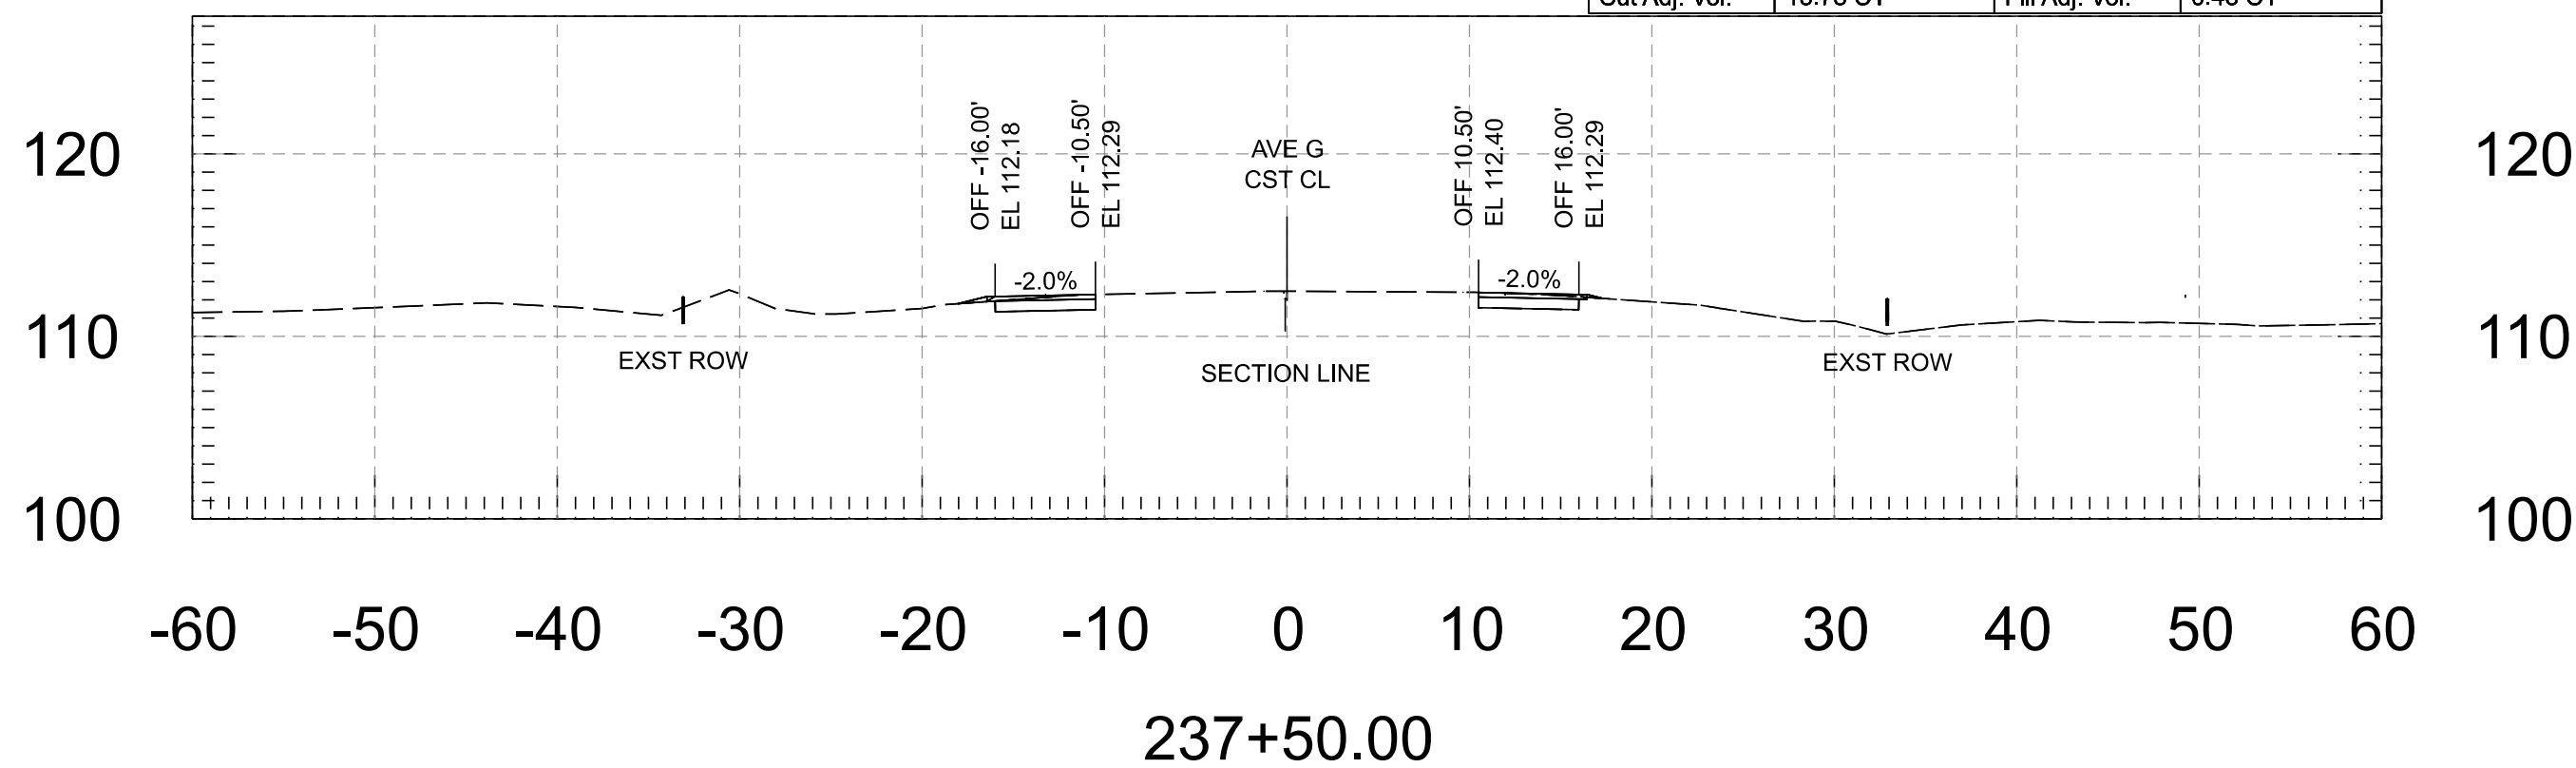

FOR INFORMATION ONLY		NAME	DATE	ARIZONA DEPARTMENT OF TRANSPORTATION PROJECT DELIVERY AND OPERATIONS DIVISION ROADWAY DESIGN SERVICES	ROUTE	F.H.W.A. Arizona Division	STATE ARIZ.	PROJECT NO.	FEDERAL ID NO.	SHEET NO.	TOTAL SHEETS	RECORD DRAWING
	DESIGN	M. SCHOEN	07/26					0000 YU YYU	YYU-0(225)T	109	118	
	DRAWN	M. SCHOEN	07/26									
	CHECKED	H. RIOS	07/26									
			WSP USA Inc. 1230 West Washington Street, Suite 405 Tempe, AZ 85288		AVENUE G - CROSS SECTIONS	STRUCTURE NO.	LOCATION AVENUE G, COUNTY 11TH ST - COUNTY 16TH ST					
						TRACS NO. T0437 01C					___ OF ___	

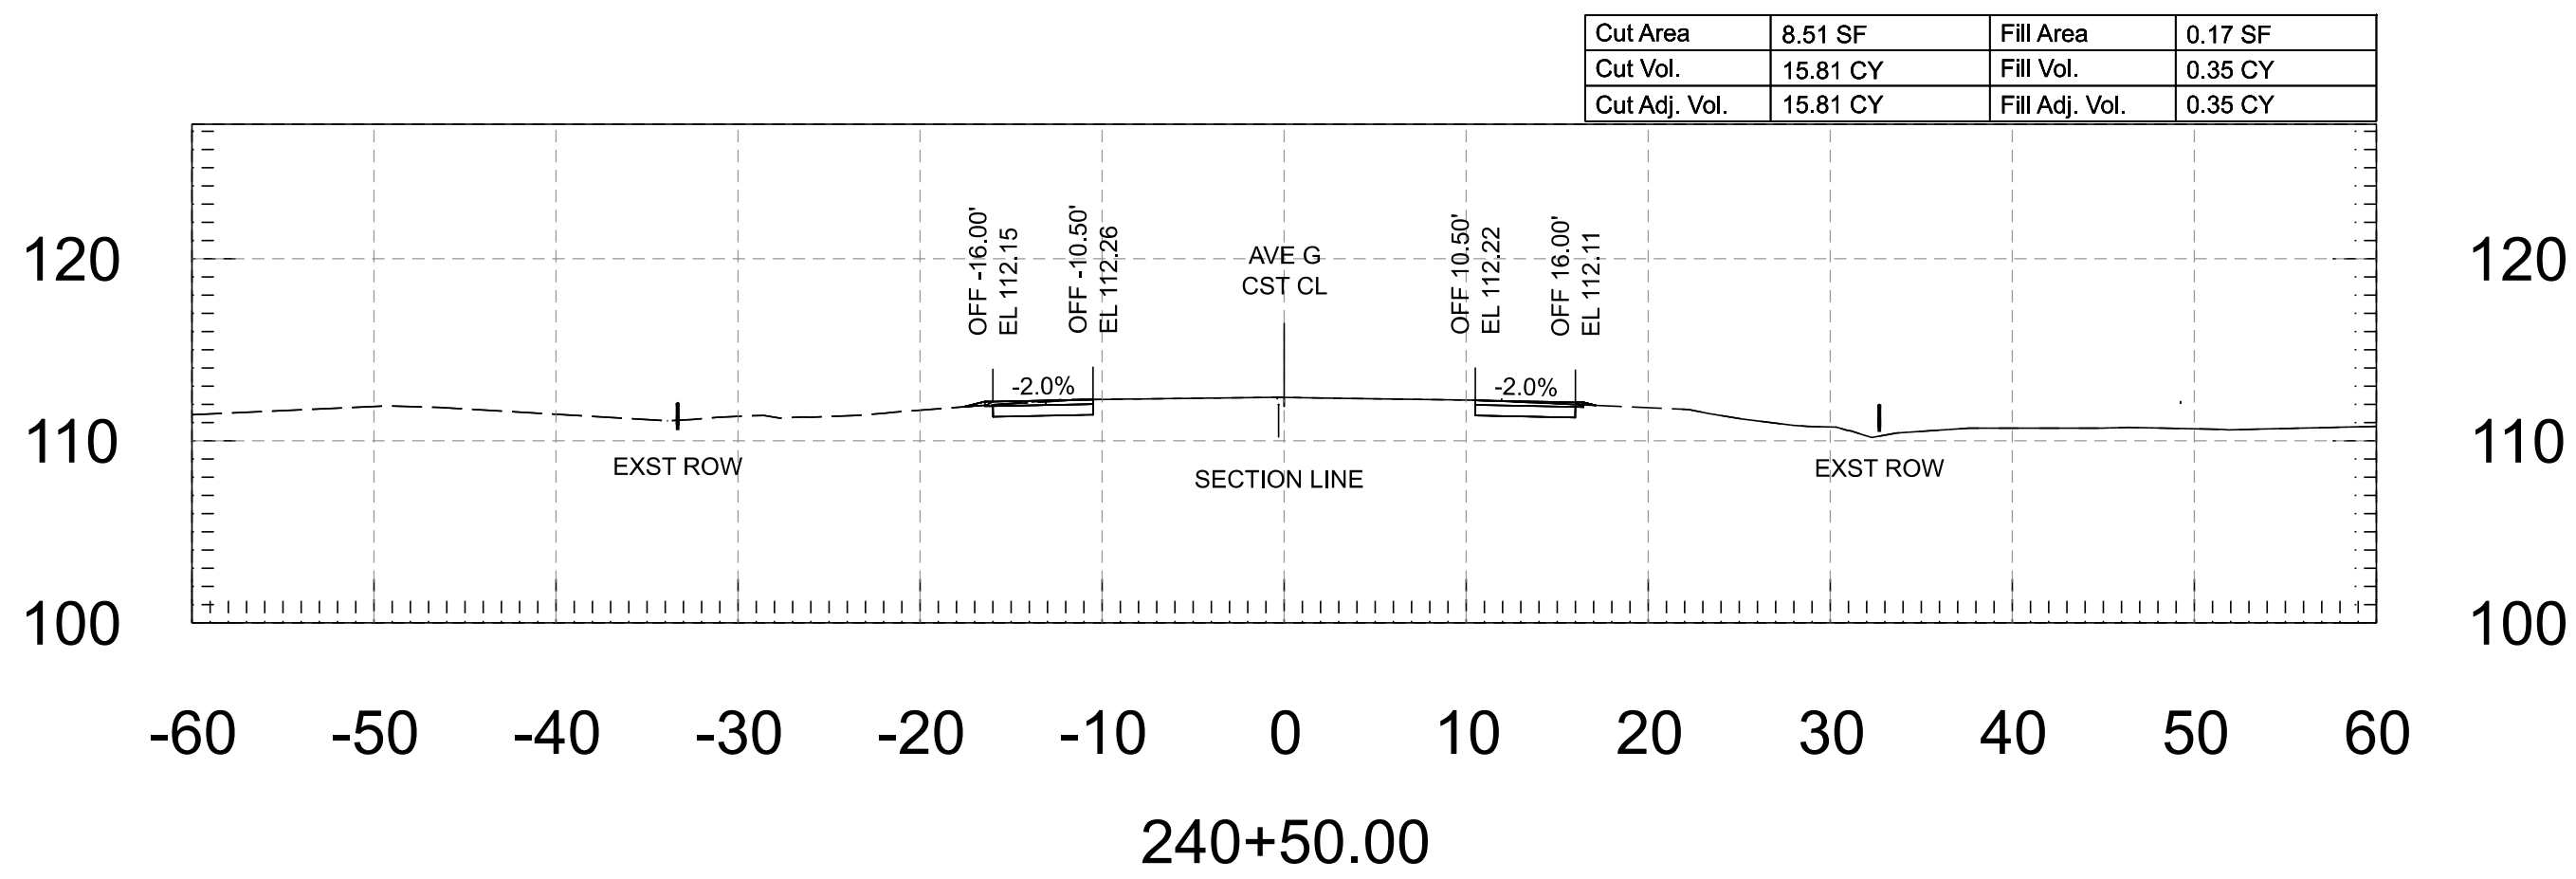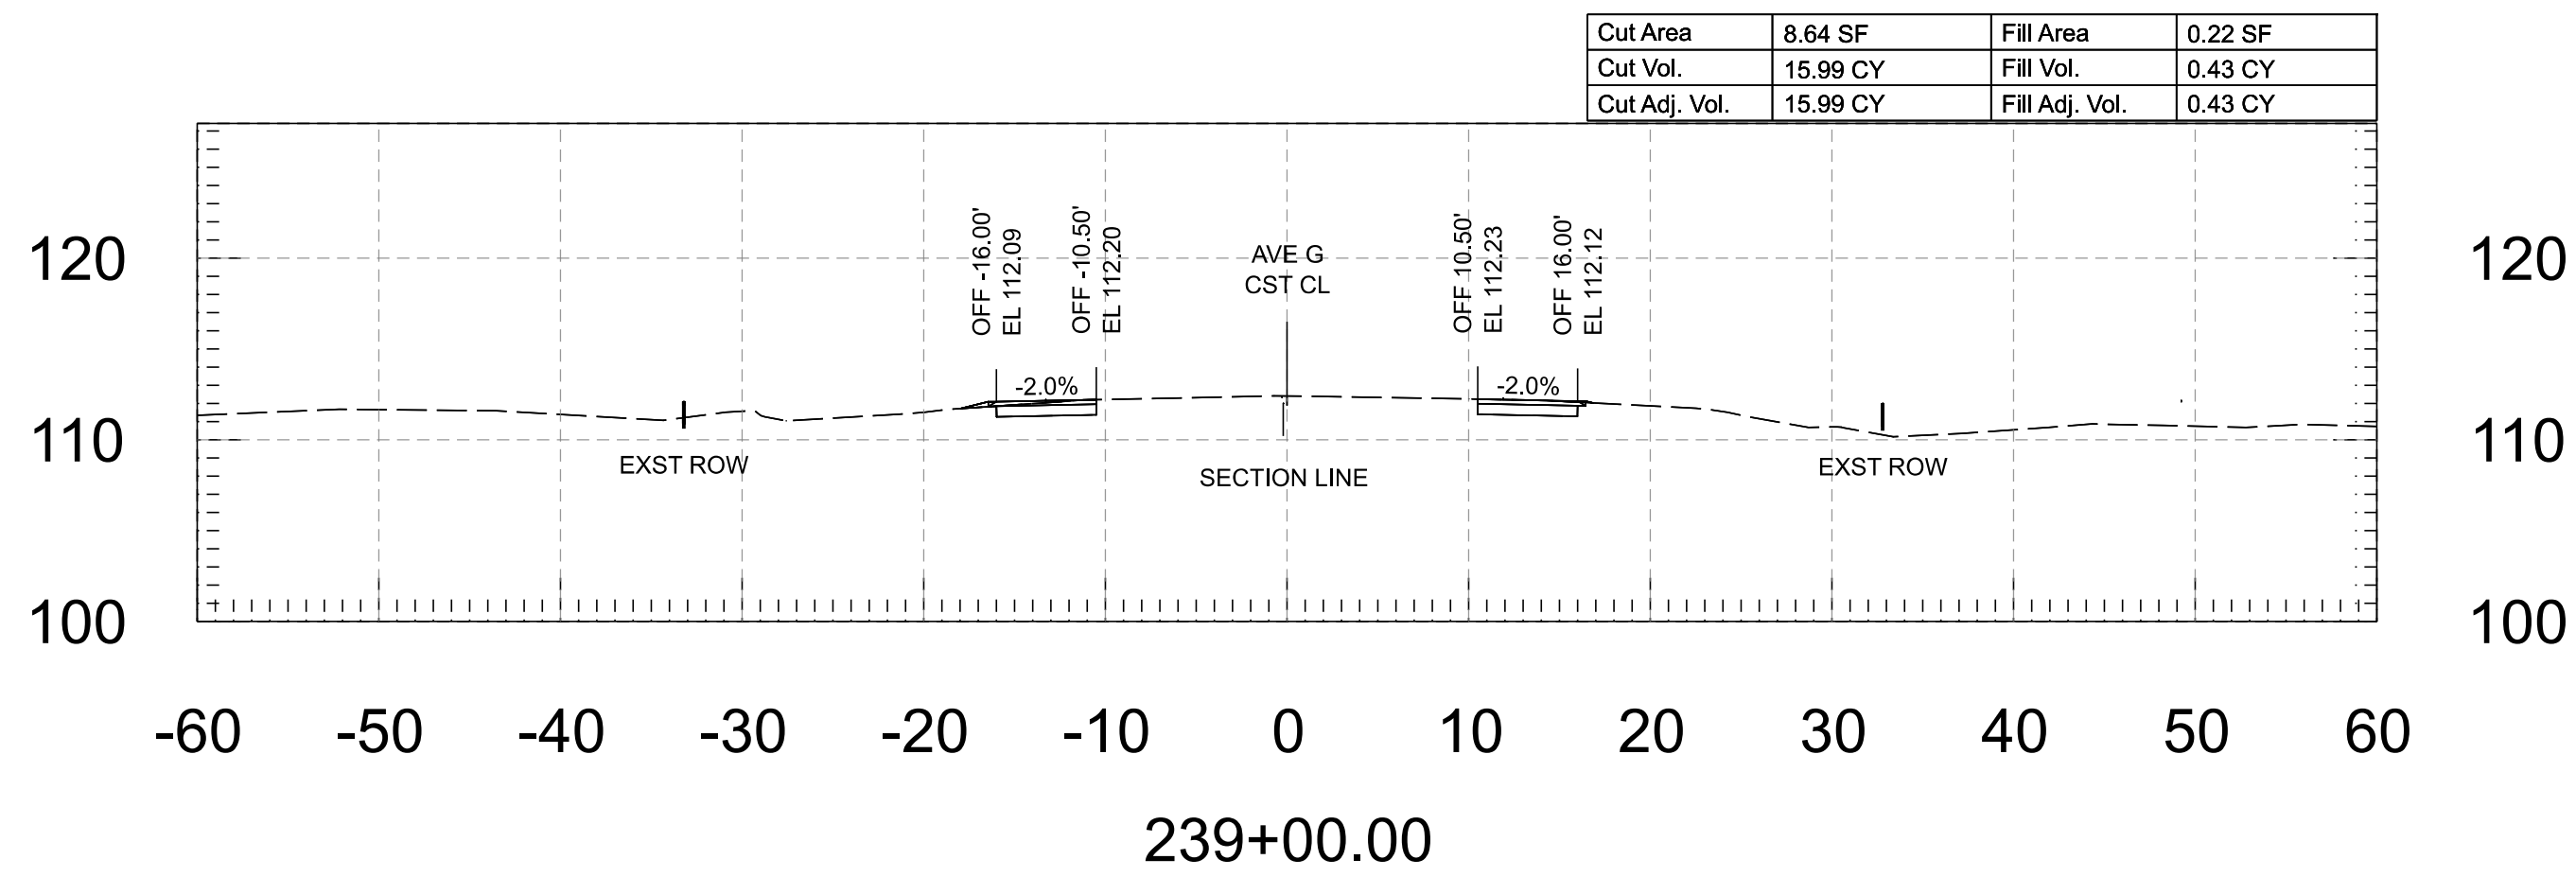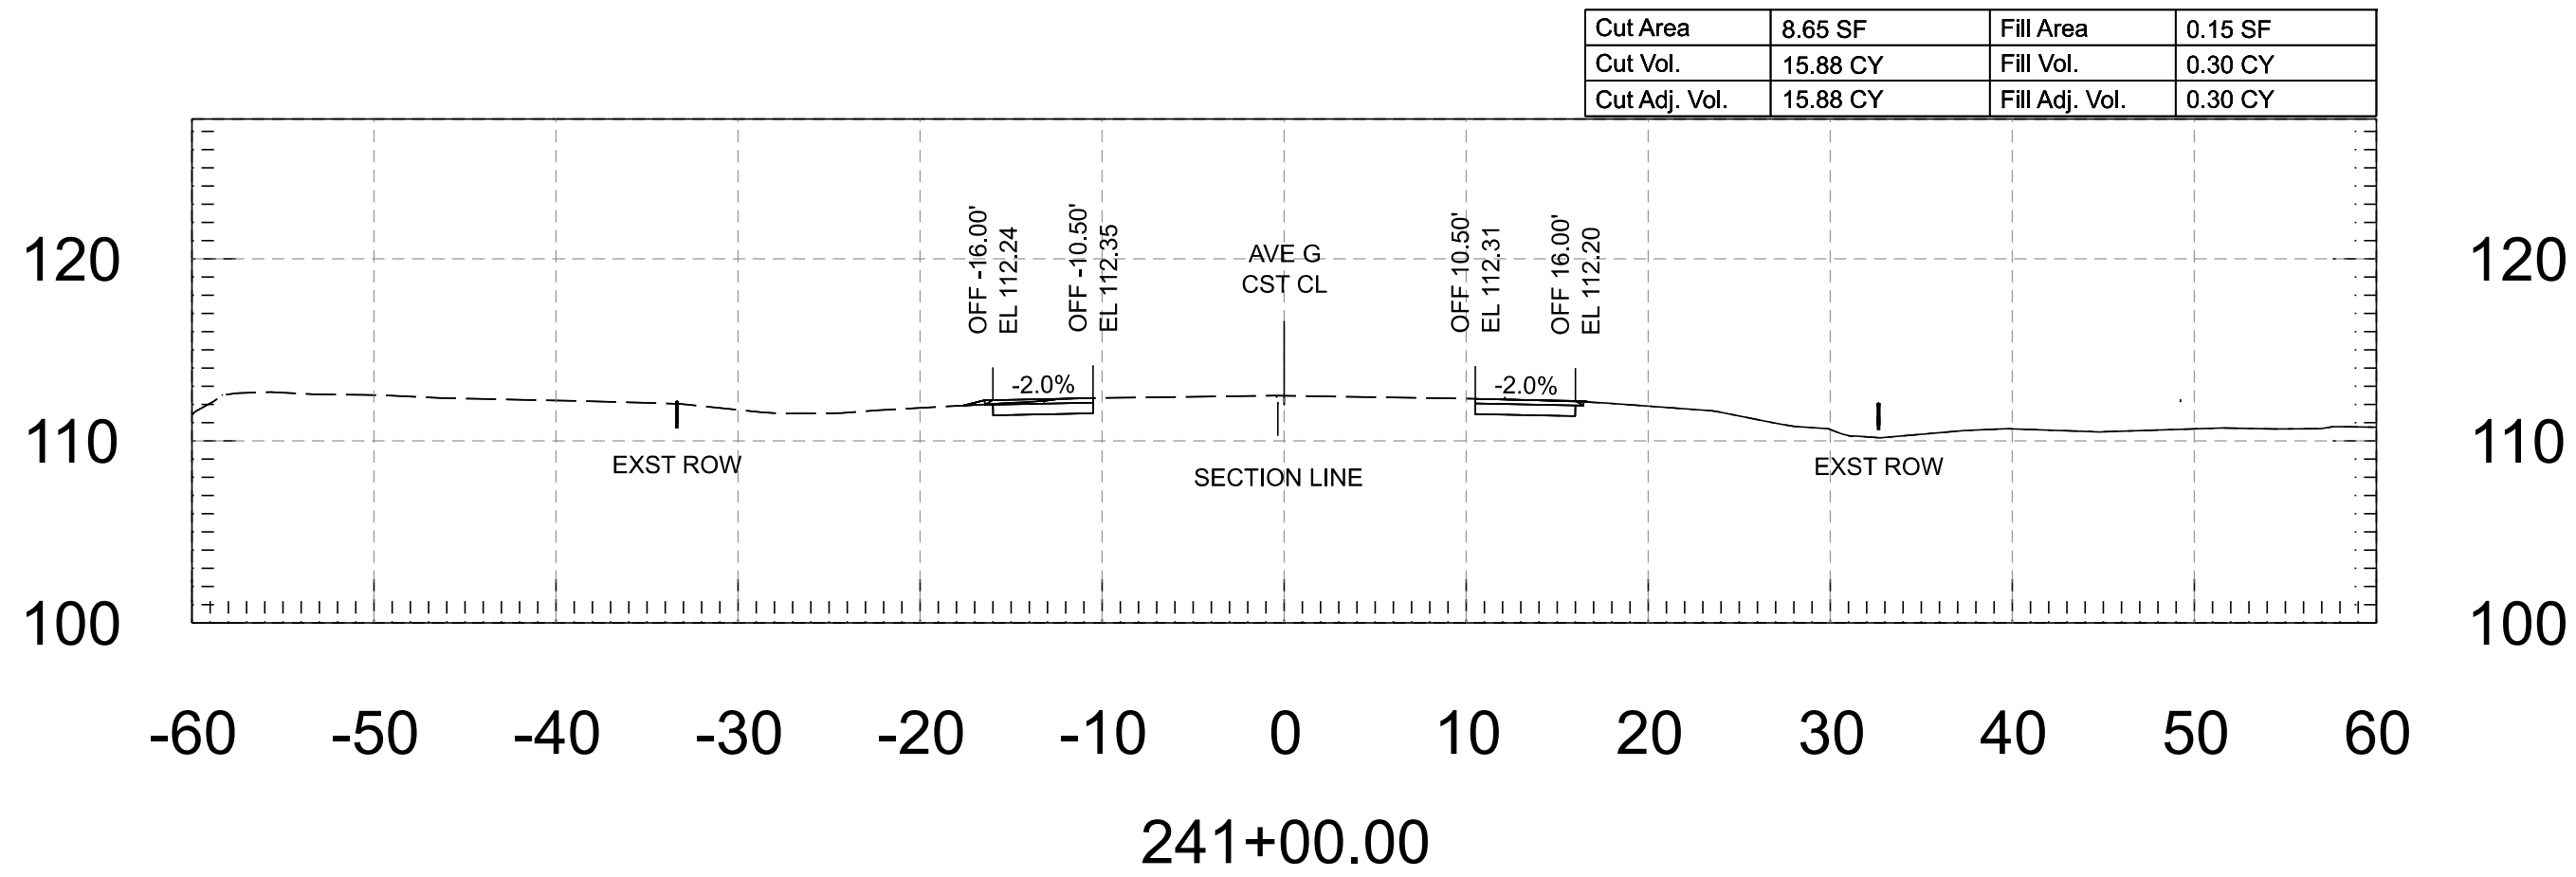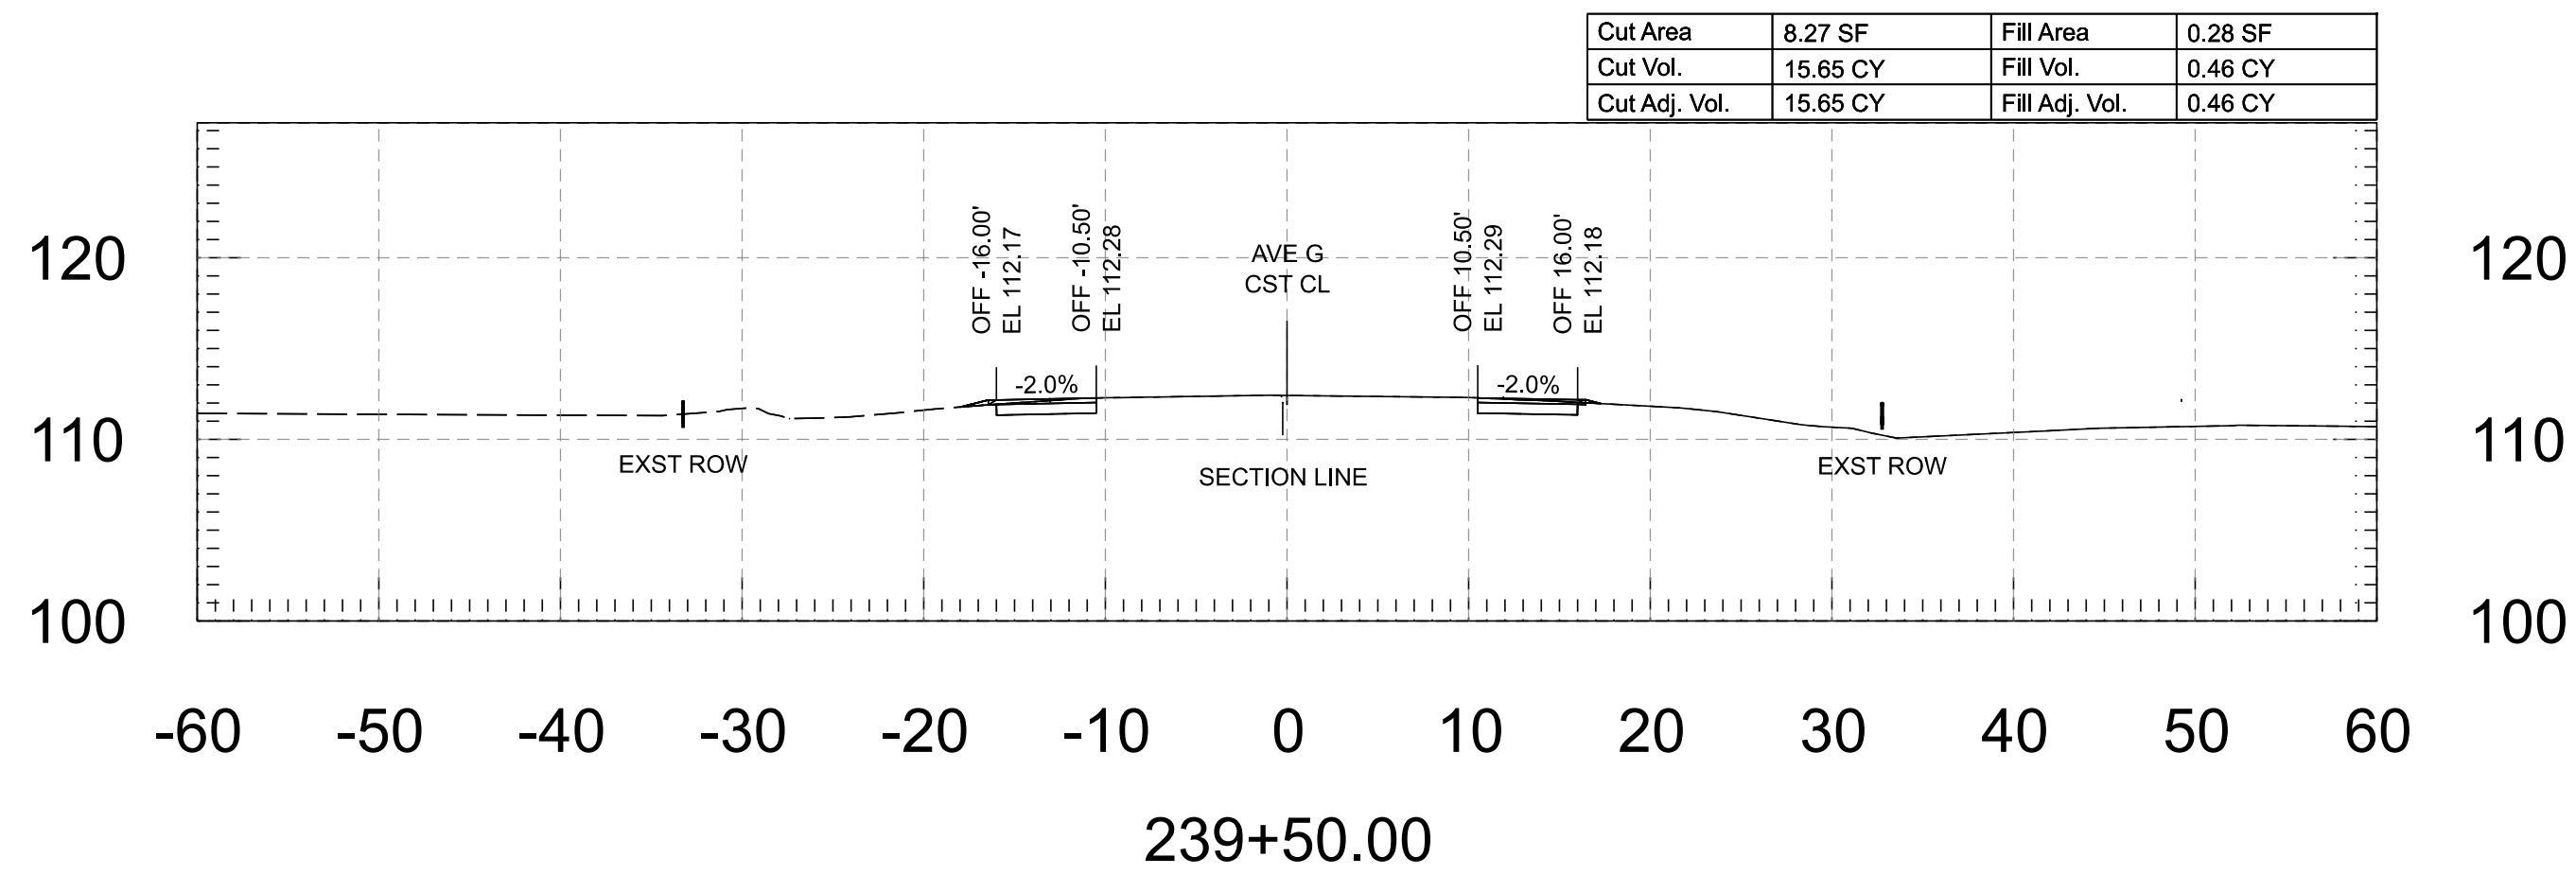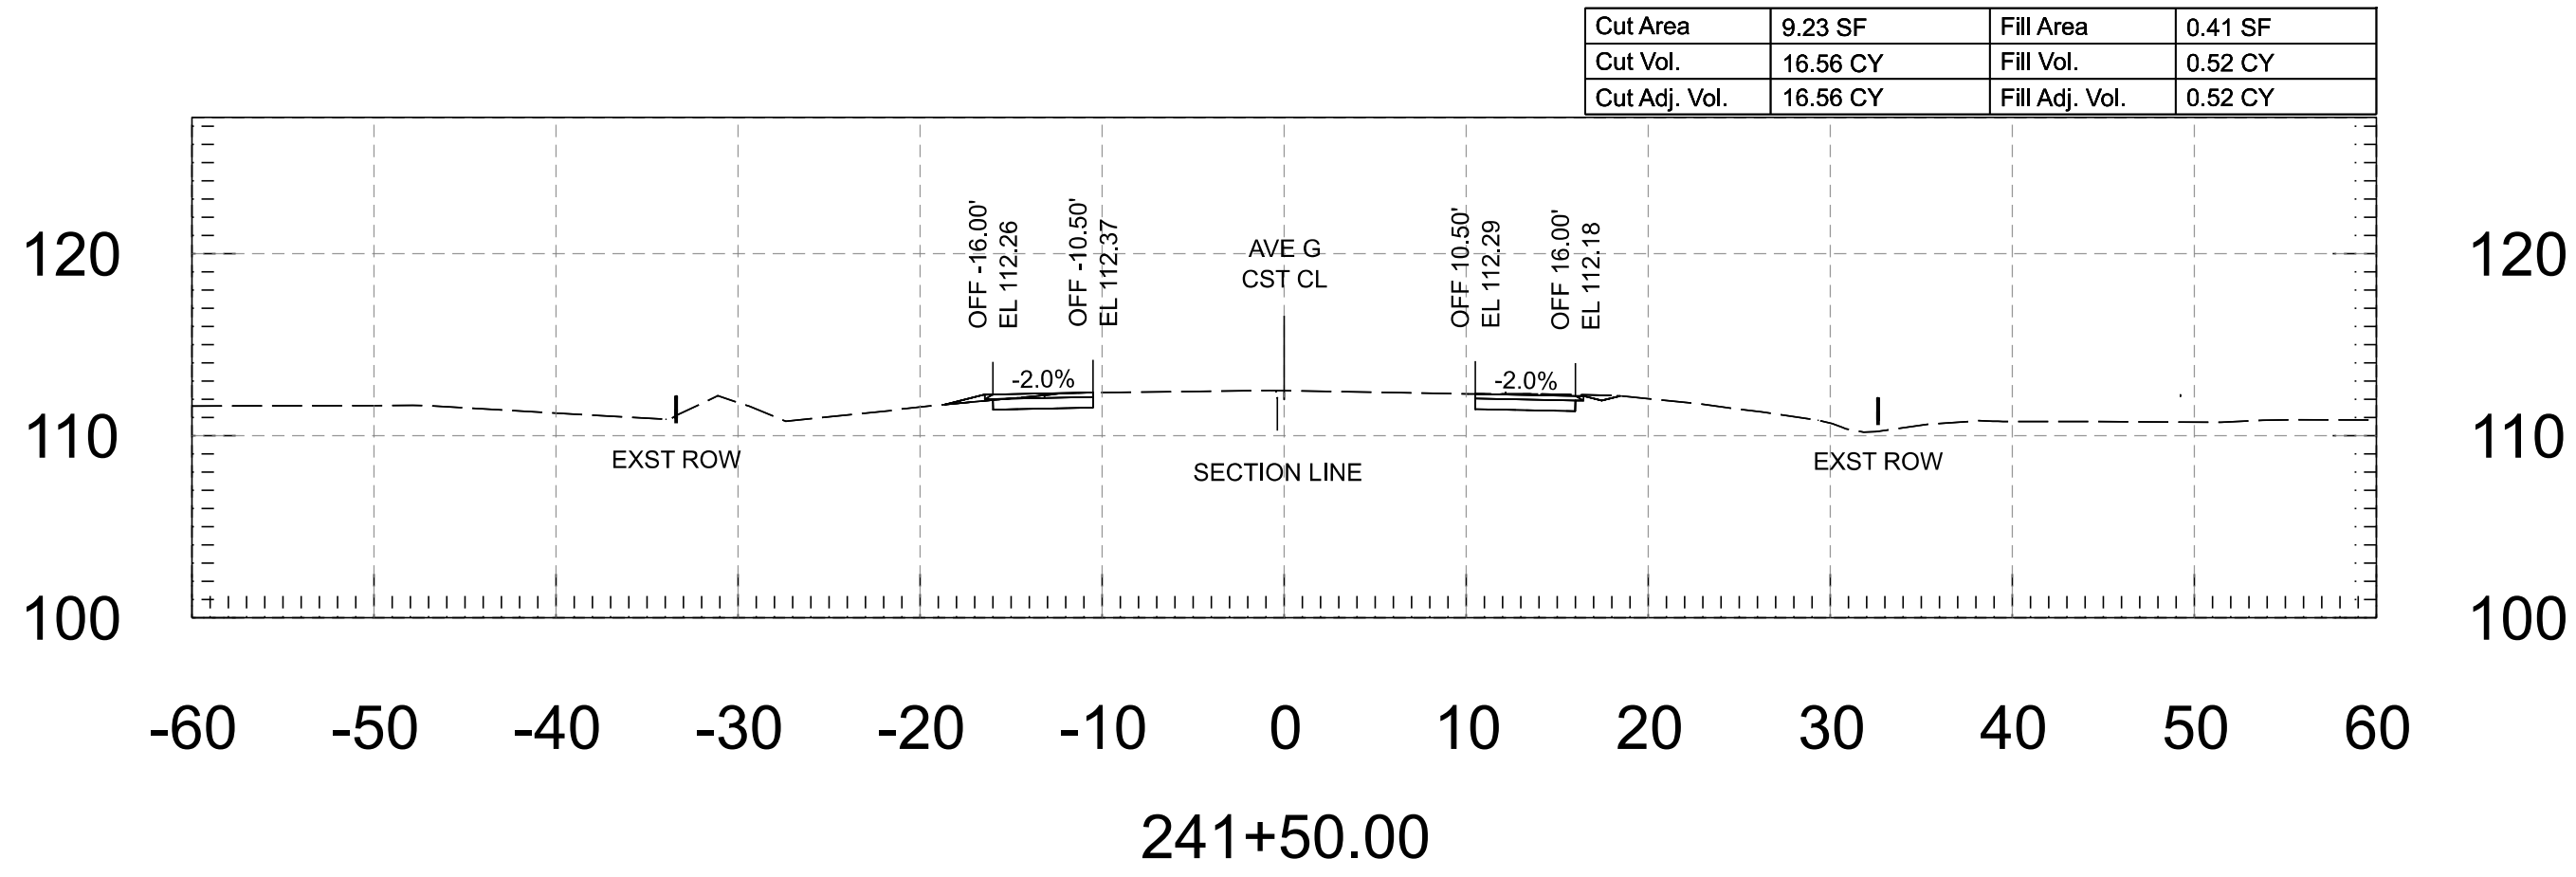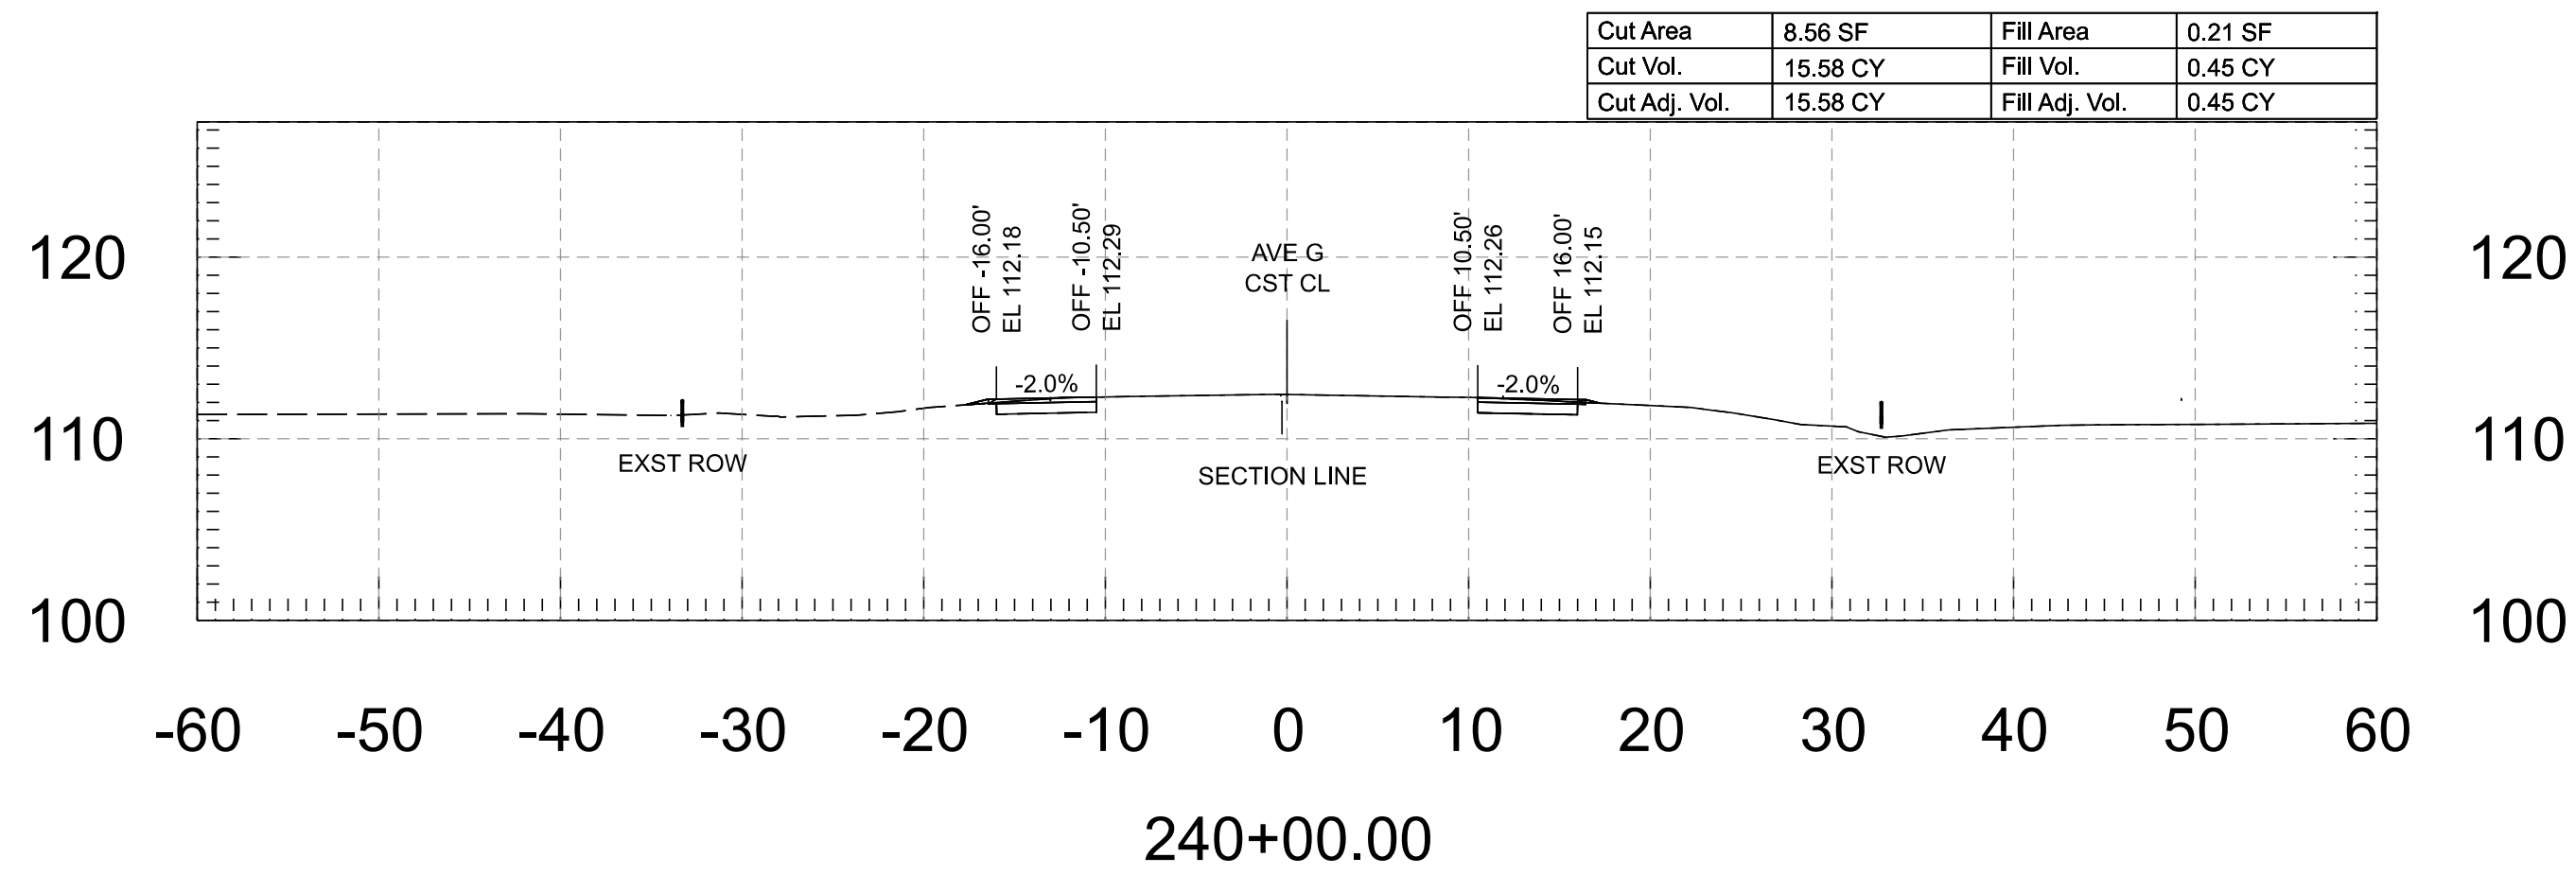


FOR INFORMATION ONLY		NAME	DATE	ARIZONA DEPARTMENT OF TRANSPORTATION PROJECT DELIVERY AND OPERATIONS DIVISION ROADWAY DESIGN SERVICES	ROUTE	F.H.W.A. Arizona Division	STATE ARIZ.	PROJECT NO.	FEDERAL ID NO.	SHEET NO.	TOTAL SHEETS	RECORD DRAWING
	DESIGN	M. SCHOEN	07/26		MILEPOST			0000 YU YYU	YYU-0(225)T	110	118	
	DRAWN	M. SCHOEN	07/26					LOCATION AVENUE G, COUNTY 11TH ST - COUNTY 16TH ST			DWG	
	CHECKED	H. RIOS	07/26	wsp WSP USA Inc. 1230 West Washington Street, Suite 405 Tempe, AZ 85288	STRUCTURE NO.	TRACS NO. T0437 01C			____ OF ____			
					AVENUE G - CROSS SECTIONS							

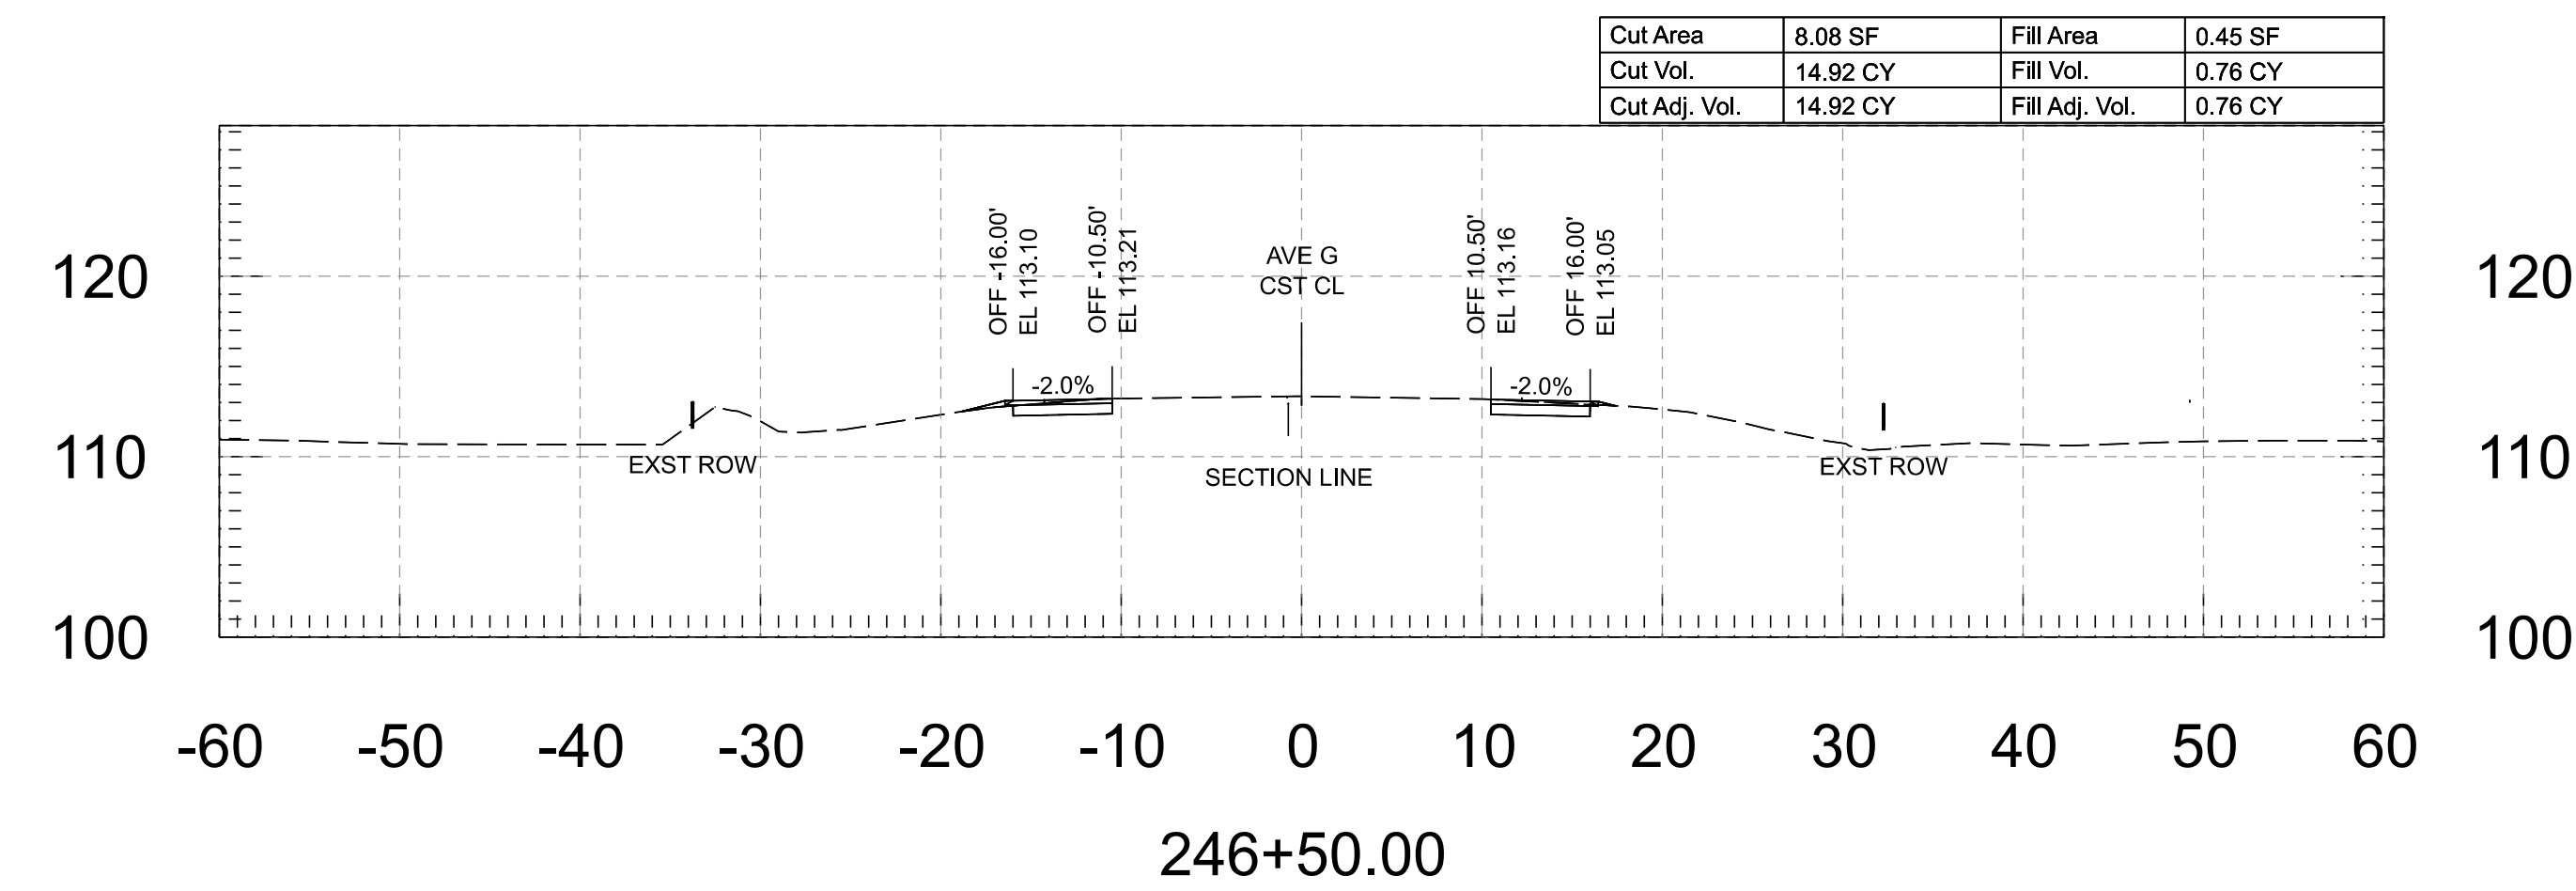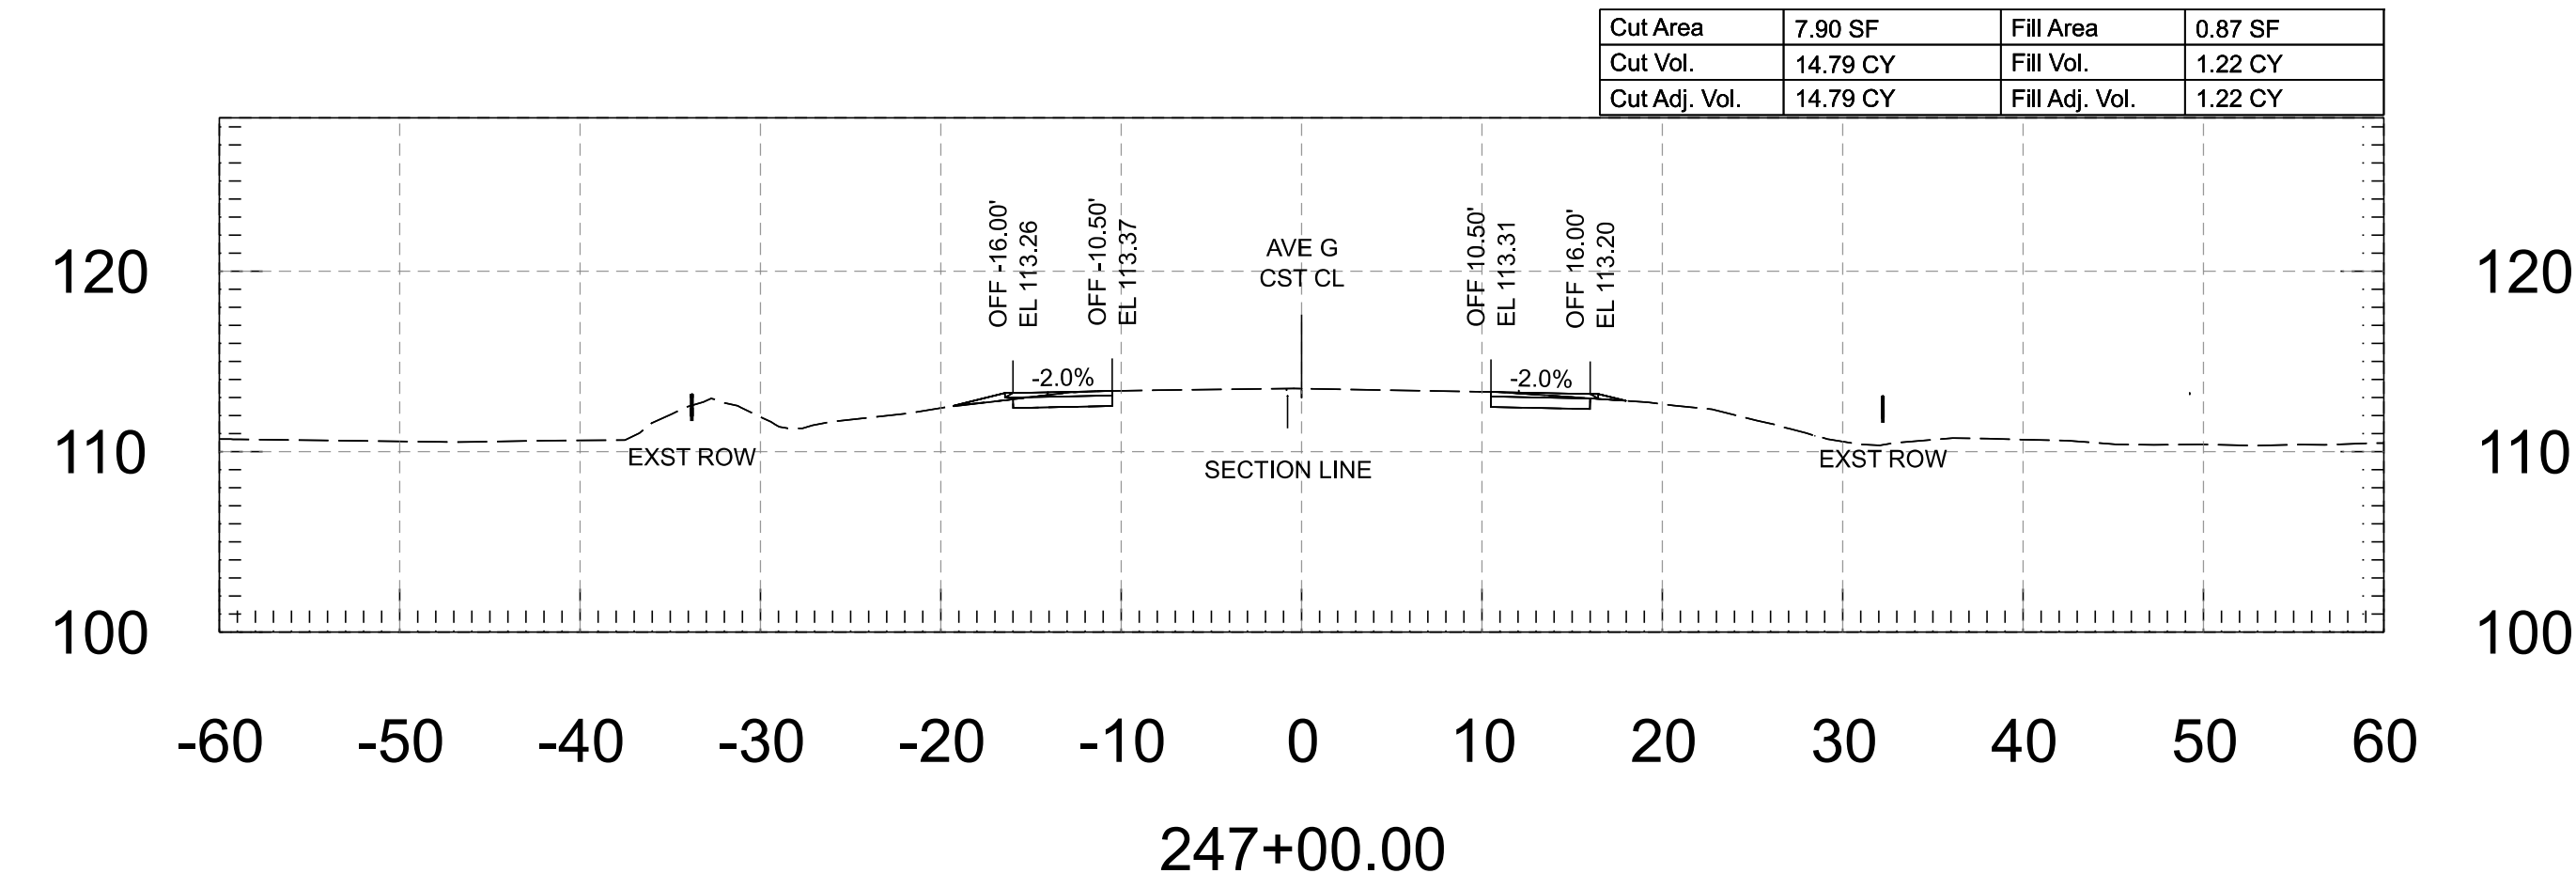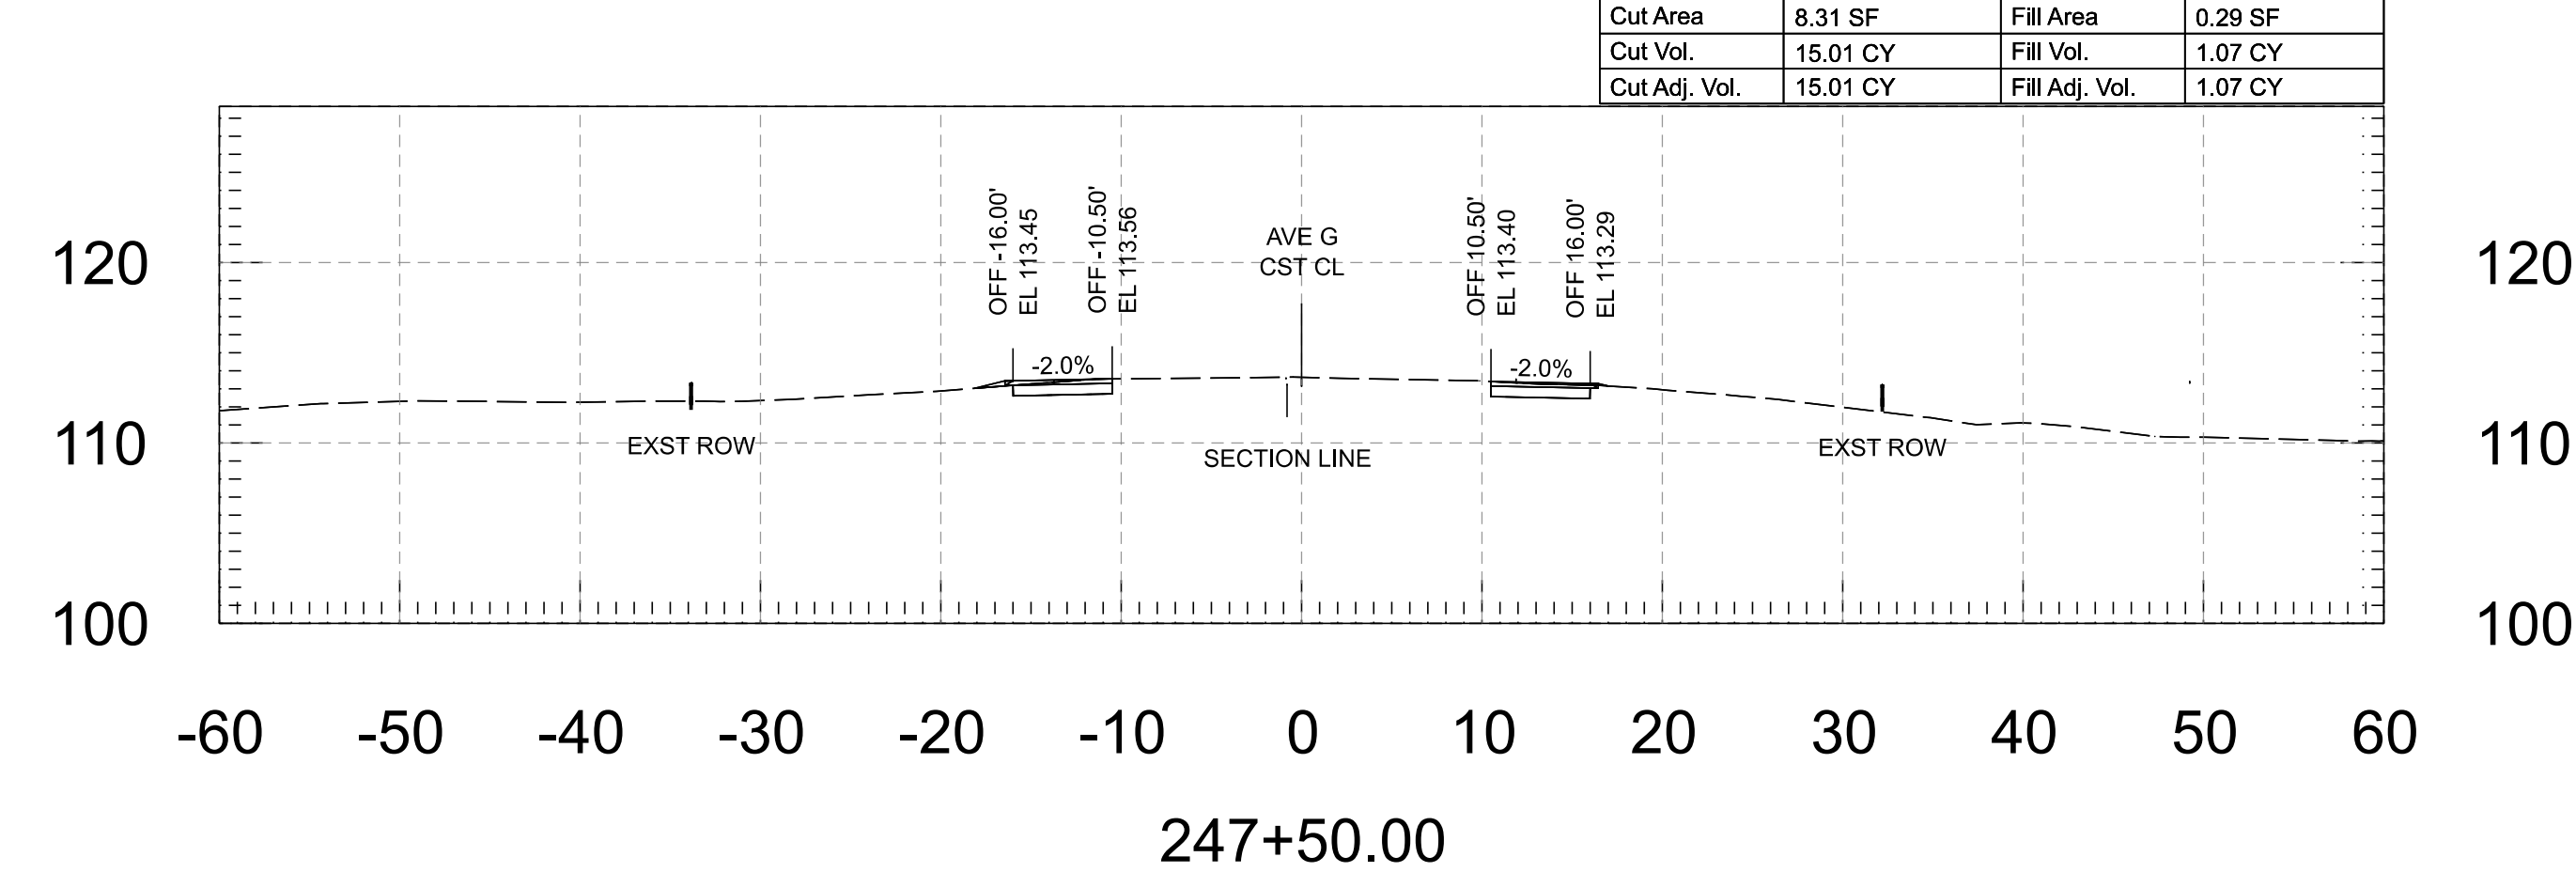


FOR INFORMATION ONLY		NAME	DATE	ARIZONA DEPARTMENT OF TRANSPORTATION PROJECT DELIVERY AND OPERATIONS DIVISION ROADWAY DESIGN SERVICES	ROUTE	F.H.W.A. Arizona Division	STATE ARIZ.	PROJECT NO.	FEDERAL ID NO.	SHEET NO.	TOTAL SHEETS	RECORD DRAWING	
	DESIGN	M. SCHOEN	07/26		MILEPOST			0000 YU YUU	YUU-0(225)T	112	118		
	DRAWN	M. SCHOEN	07/26		STRUCTURE NO.	LOCATION AVENUE G, COUNTY 11TH ST - COUNTY 16TH ST							DWG
	CHECKED	H. RIOS	07/26			TRACS NO. T0437 01C							___ OF ___
	 WSP USA Inc. 1230 West Washington Street, Suite 405 Tempe, AZ 85288			AVENUE G - CROSS SECTIONS									


Cut Area	8.07 SF	Fill Area	0.49 SF
Cut Vol.	14.67 CY	Fill Vol.	1.31 CY
Cut Adj. Vol.	14.67 CY	Fill Adj. Vol.	1.31 CY

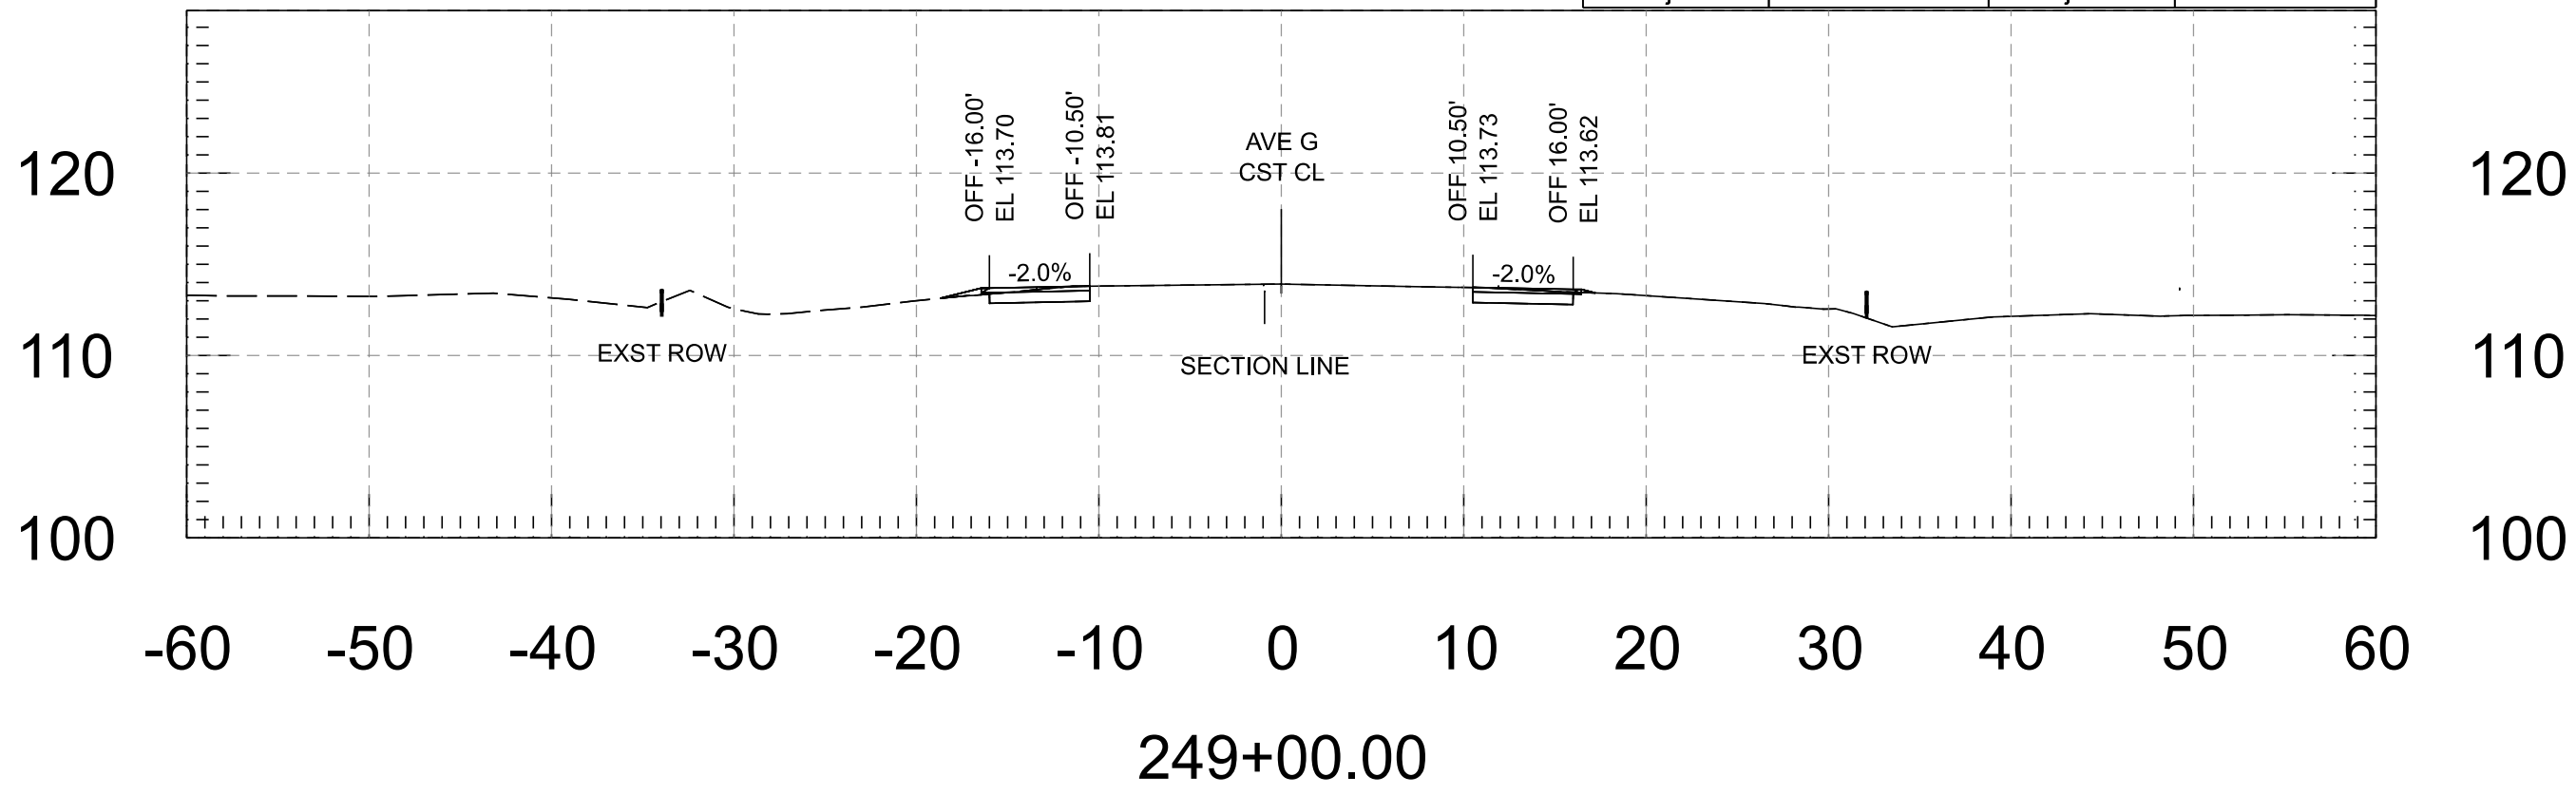


Cut Area	8.13 SF	Fill Area	0.49 SF
Cut Vol.	15.09 CY	Fill Vol.	0.89 CY
Cut Adj. Vol.	15.09 CY	Fill Adj. Vol.	0.89 CY

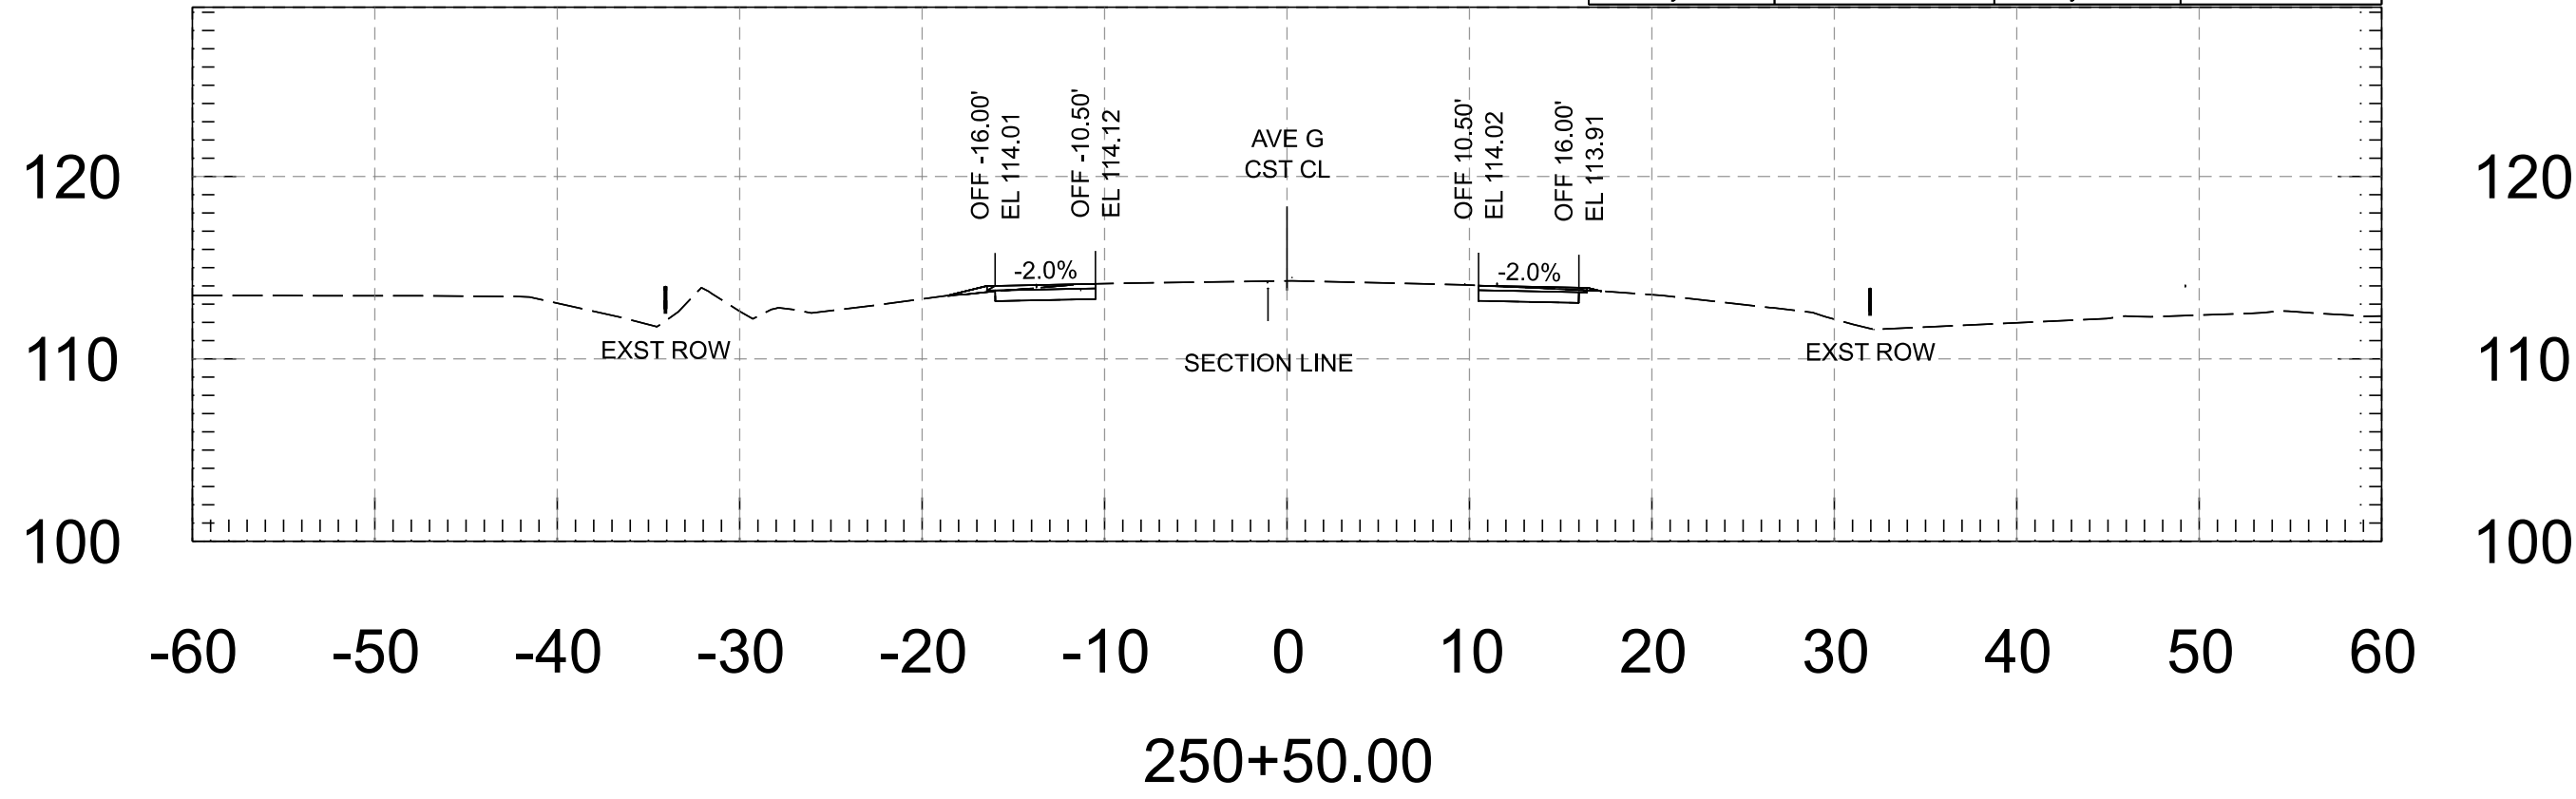


Cut Area	7.77 SF	Fill Area	0.92 SF
Cut Vol.	14.66 CY	Fill Vol.	1.39 CY
Cut Adj. Vol.	14.66 CY	Fill Adj. Vol.	1.39 CY

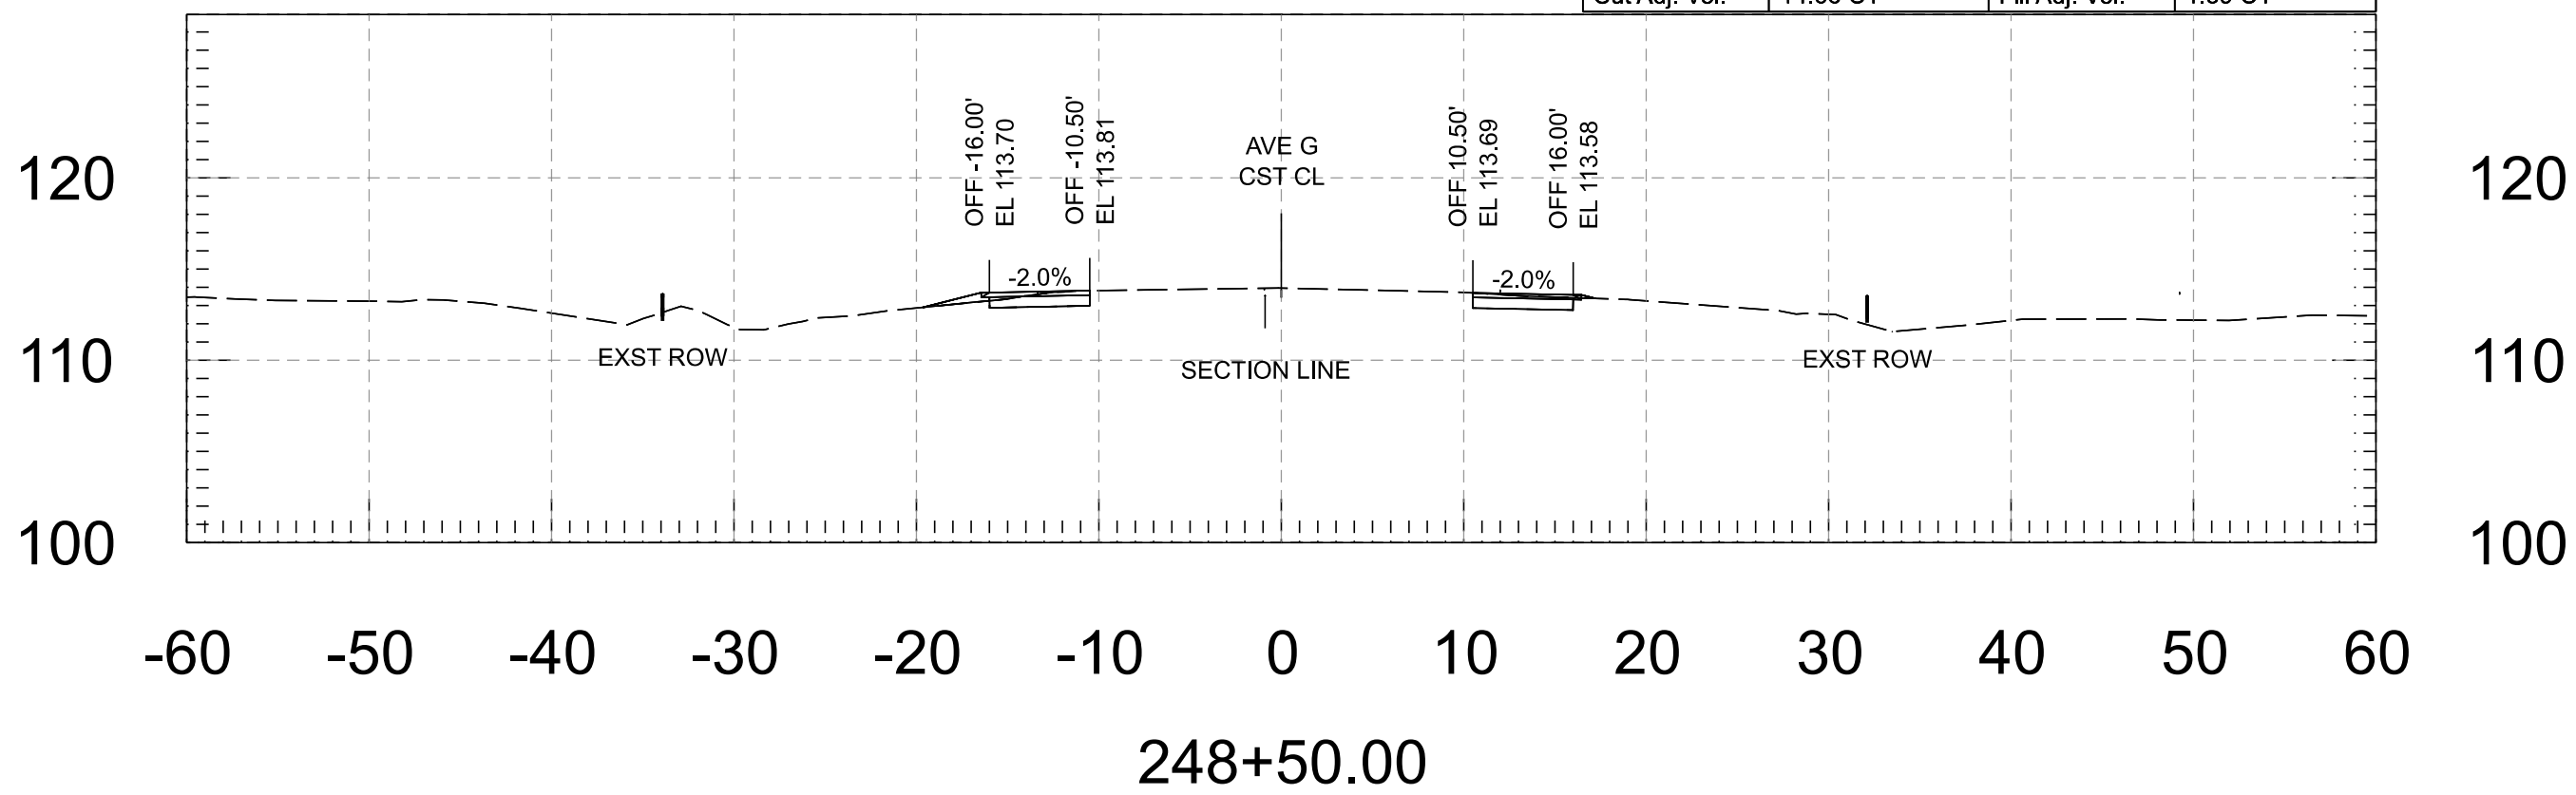


Cut Area	8.17 SF	Fill Area	0.47 SF
Cut Vol.	14.90 CY	Fill Vol.	0.75 CY
Cut Adj. Vol.	14.90 CY	Fill Adj. Vol.	0.75 CY

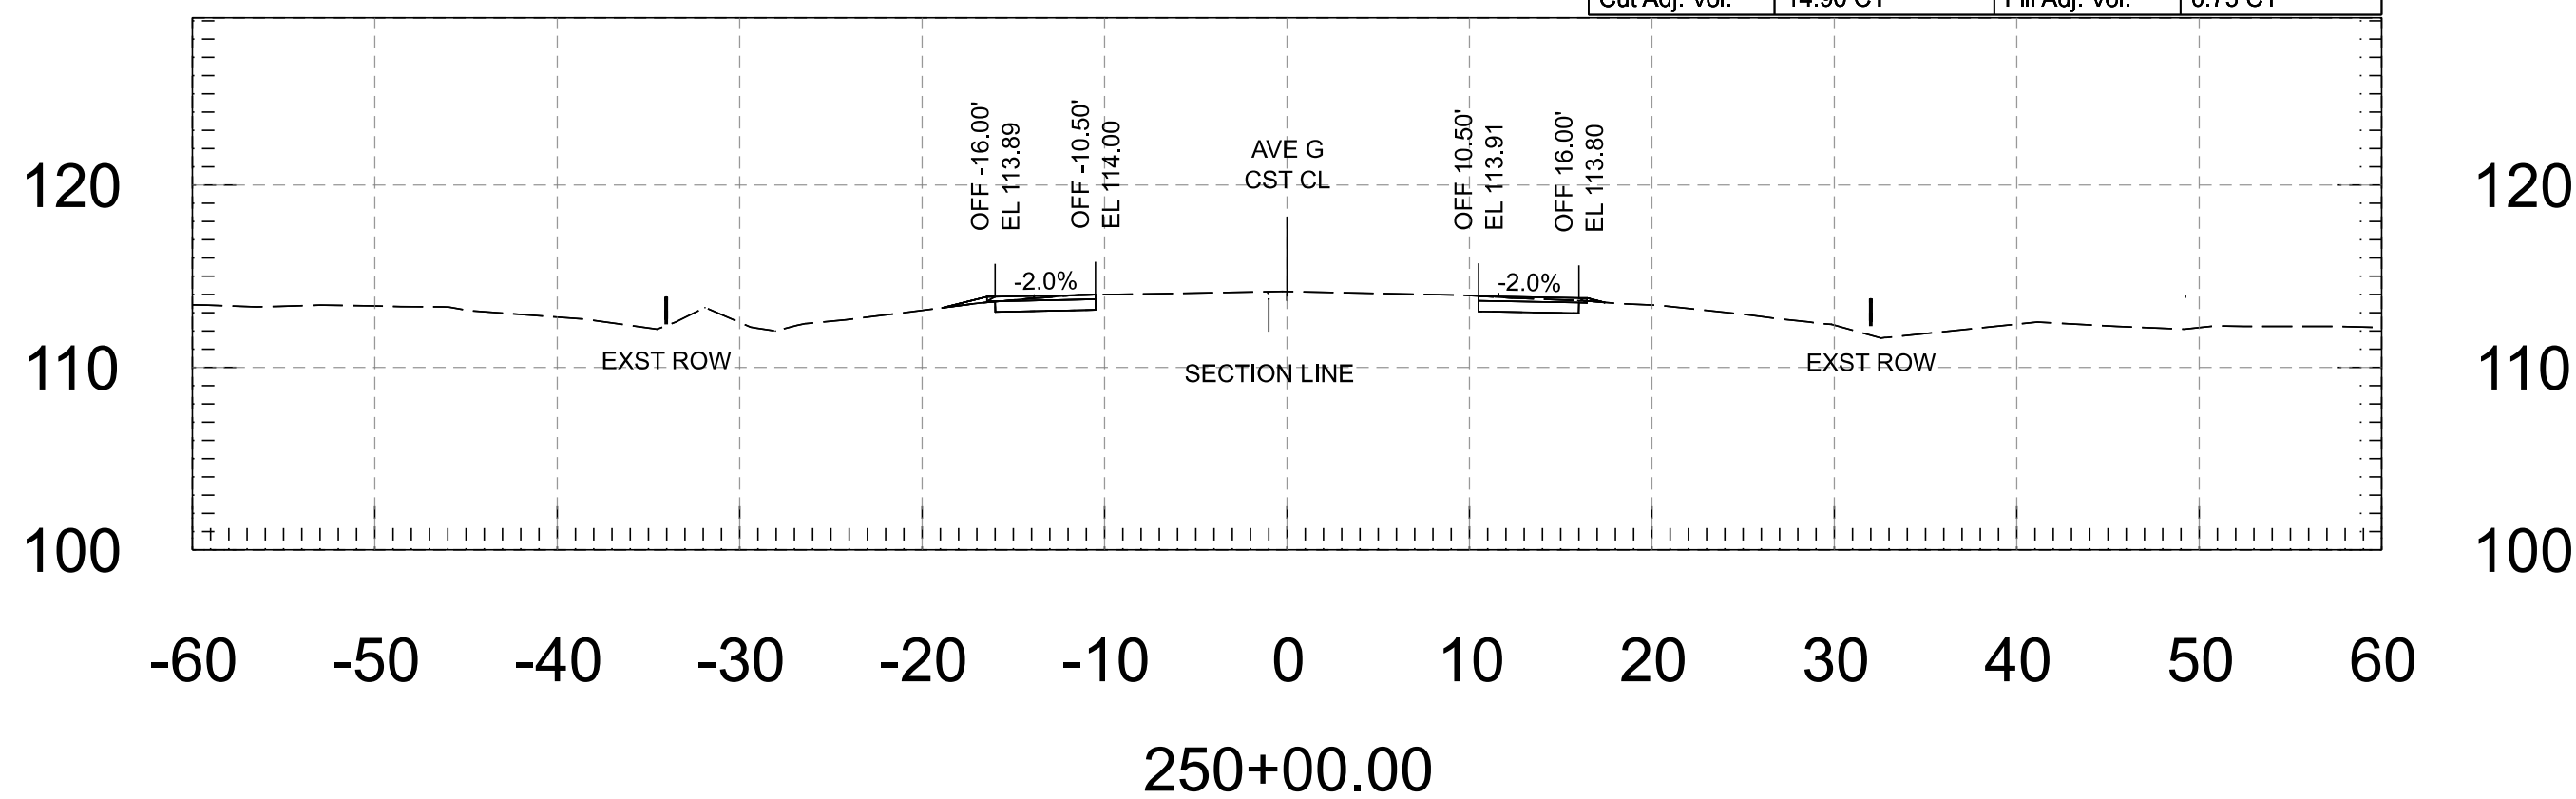

Cut Area	8.06 SF	Fill Area	0.58 SF
Cut Vol.	15.16 CY	Fill Vol.	0.80 CY
Cut Adj. Vol.	15.16 CY	Fill Adj. Vol.	0.80 CY

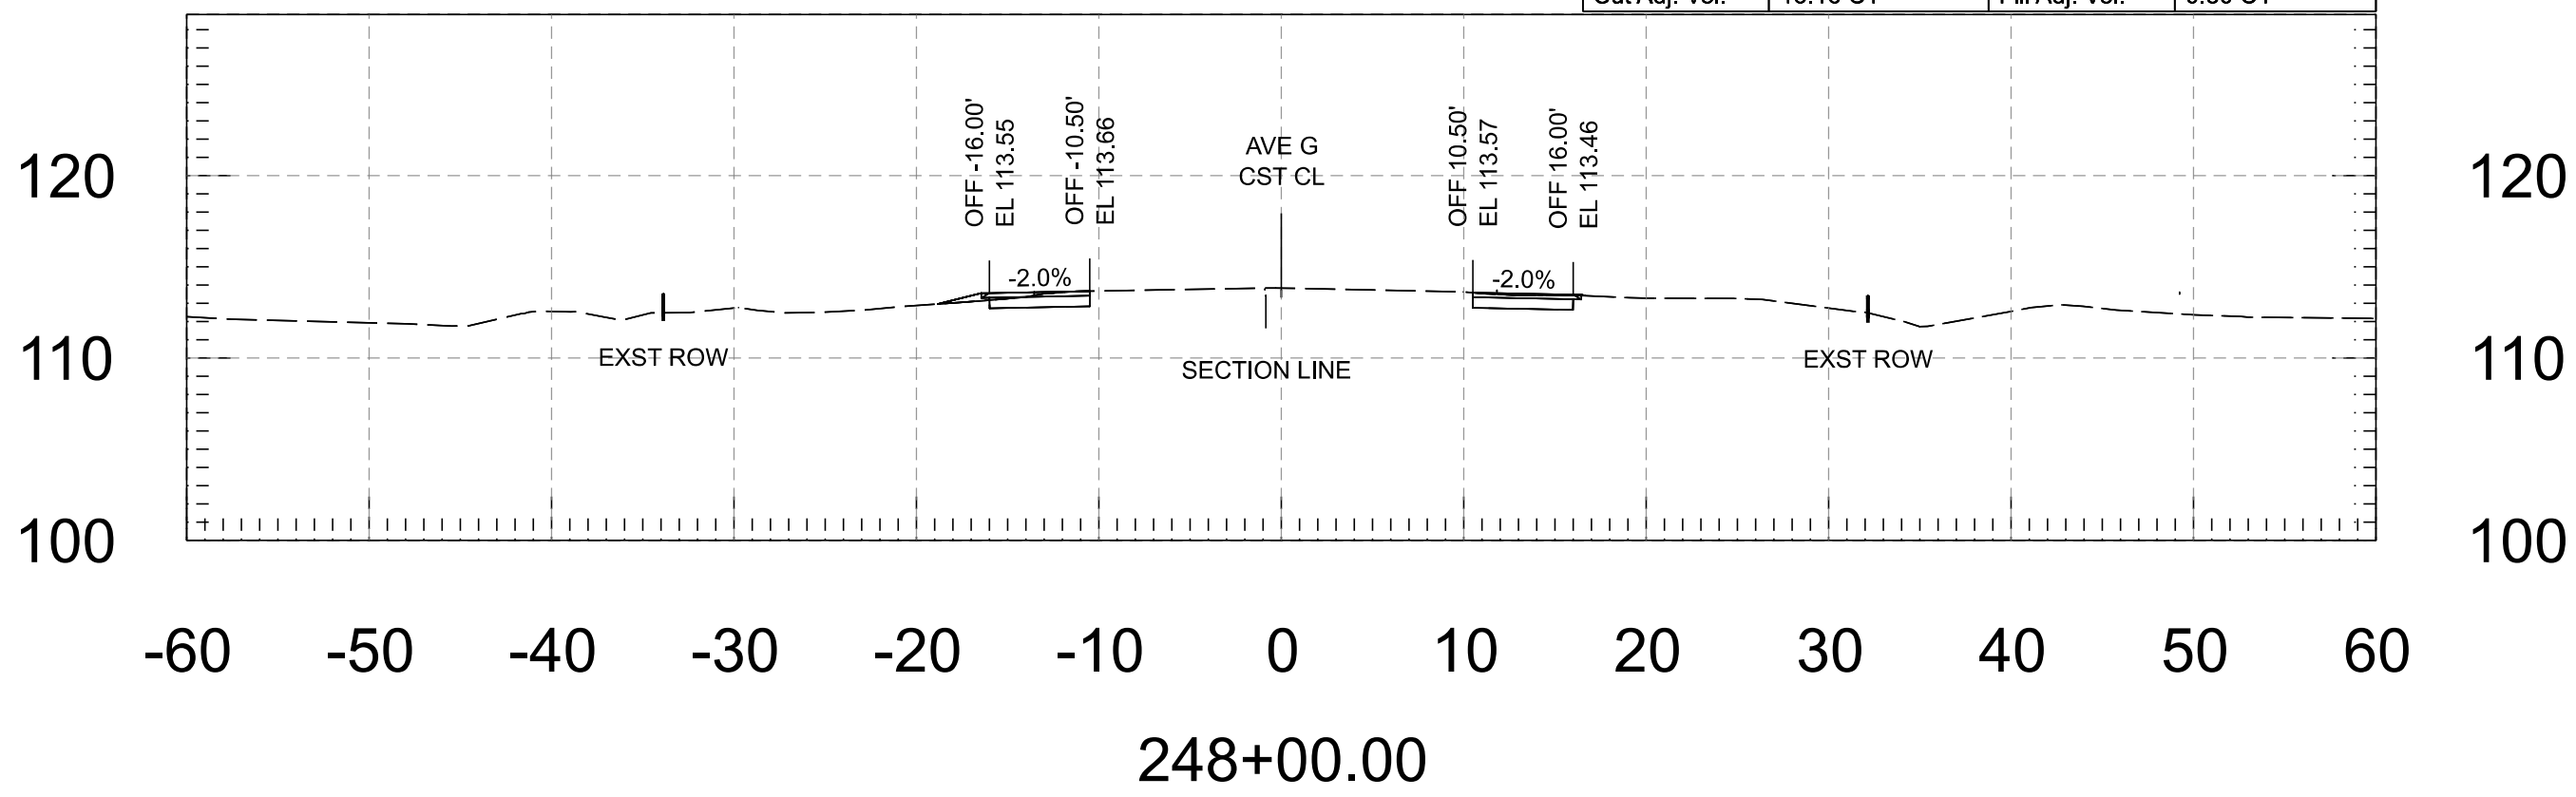


Cut Area	7.92 SF	Fill Area	0.34 SF
Cut Vol.	14.80 CY	Fill Vol.	0.77 CY
Cut Adj. Vol.	14.80 CY	Fill Adj. Vol.	0.77 CY

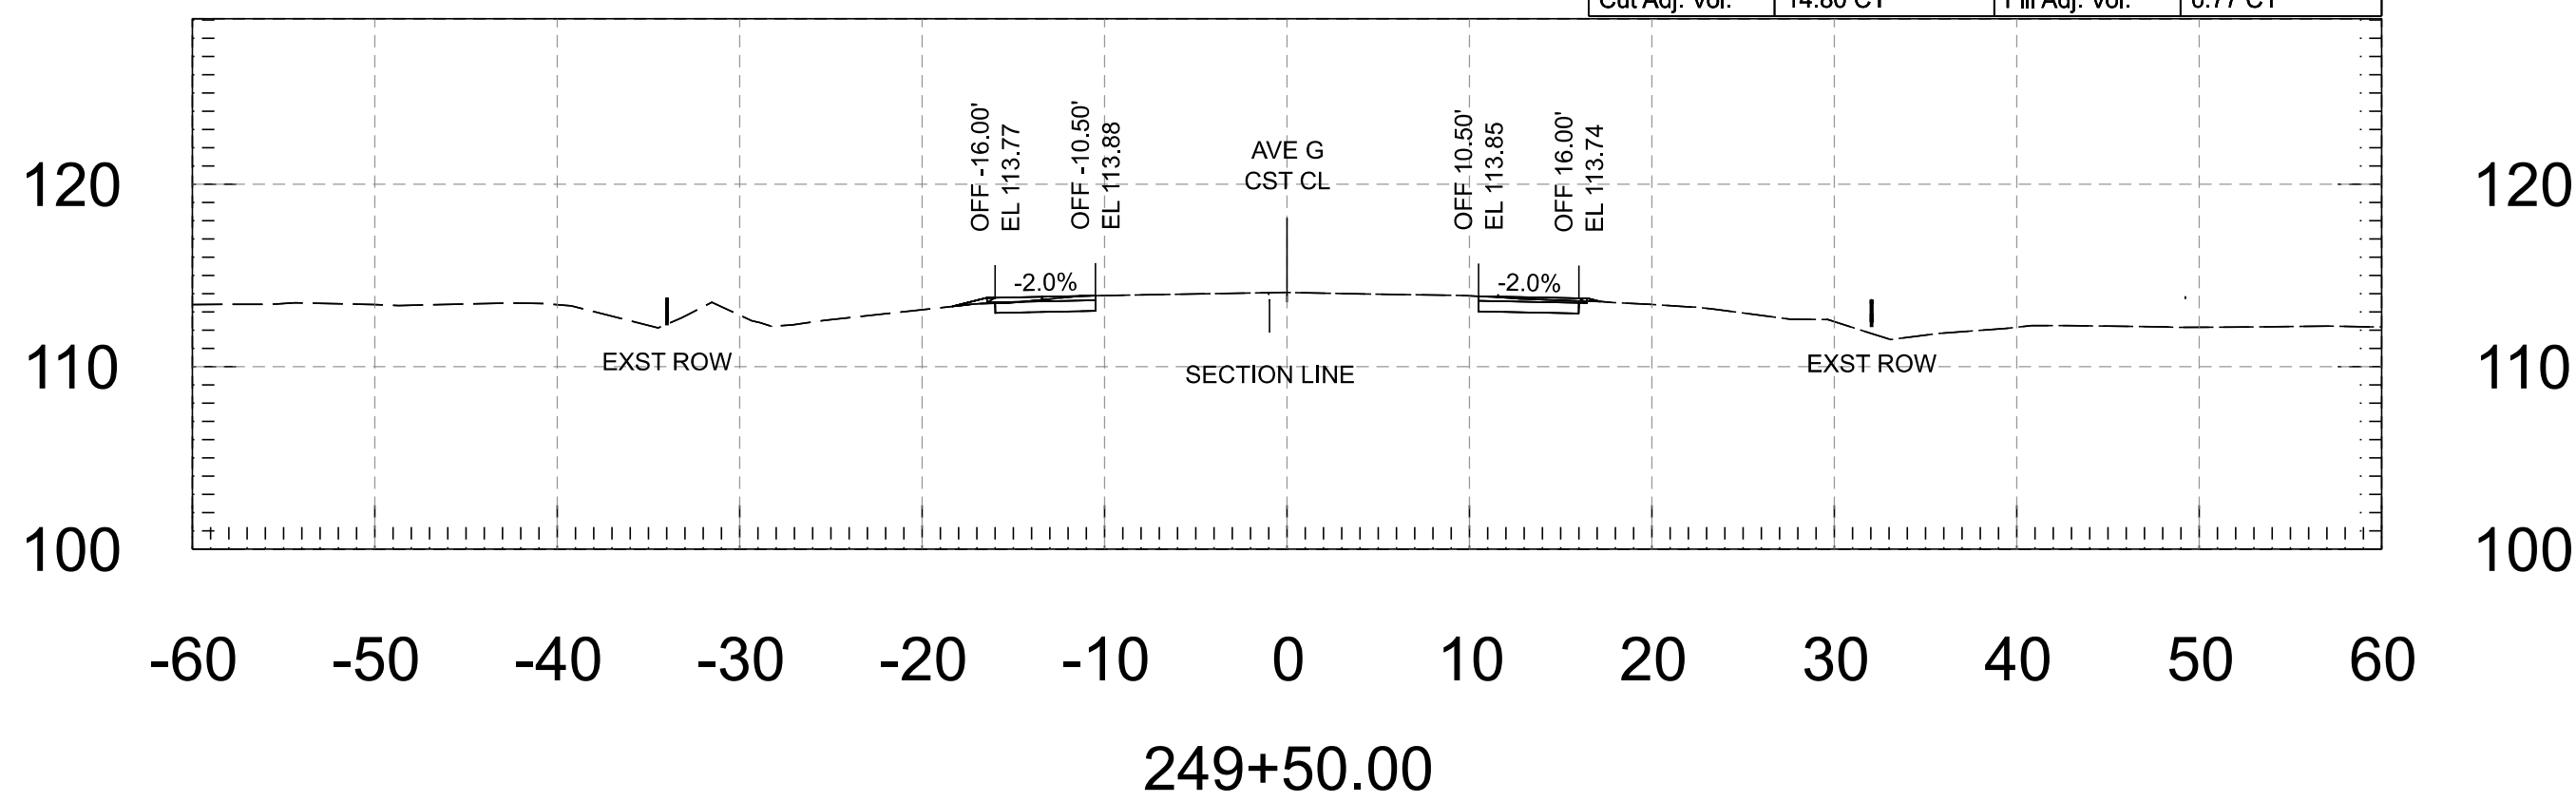


FOR INFORMATION ONLY		NAME	DATE	ARIZONA DEPARTMENT OF TRANSPORTATION PROJECT DELIVERY AND OPERATIONS DIVISION ROADWAY DESIGN SERVICES	ROUTE	F.H.W.A. Arizona Division	STATE ARIZ.	PROJECT NO.	FEDERAL ID NO.	SHEET NO.	TOTAL SHEETS	RECORD DRAWING
	DESIGN	M. SCHOEN	07/26					0000 YU YYU	YYU-0(225)T	113	118	
	DRAWN	M. SCHOEN	07/26									
	CHECKED	H. RIOS	07/26									
			WSP USA Inc. 1230 West Washington Street, Suite 405 Tempe, AZ 85288		AVENUE G - CROSS SECTIONS	STRUCTURE NO.	LOCATION AVENUE G, COUNTY 11TH ST - COUNTY 16TH ST					
					TRACS NO. T0437 01C						___ OF ___	


Cut Area	7.88 SF	Fill Area	0.80 SF
Cut Vol.	15.16 CY	Fill Vol.	1.17 CY
Cut Adj. Vol.	15.16 CY	Fill Adj. Vol.	1.17 CY

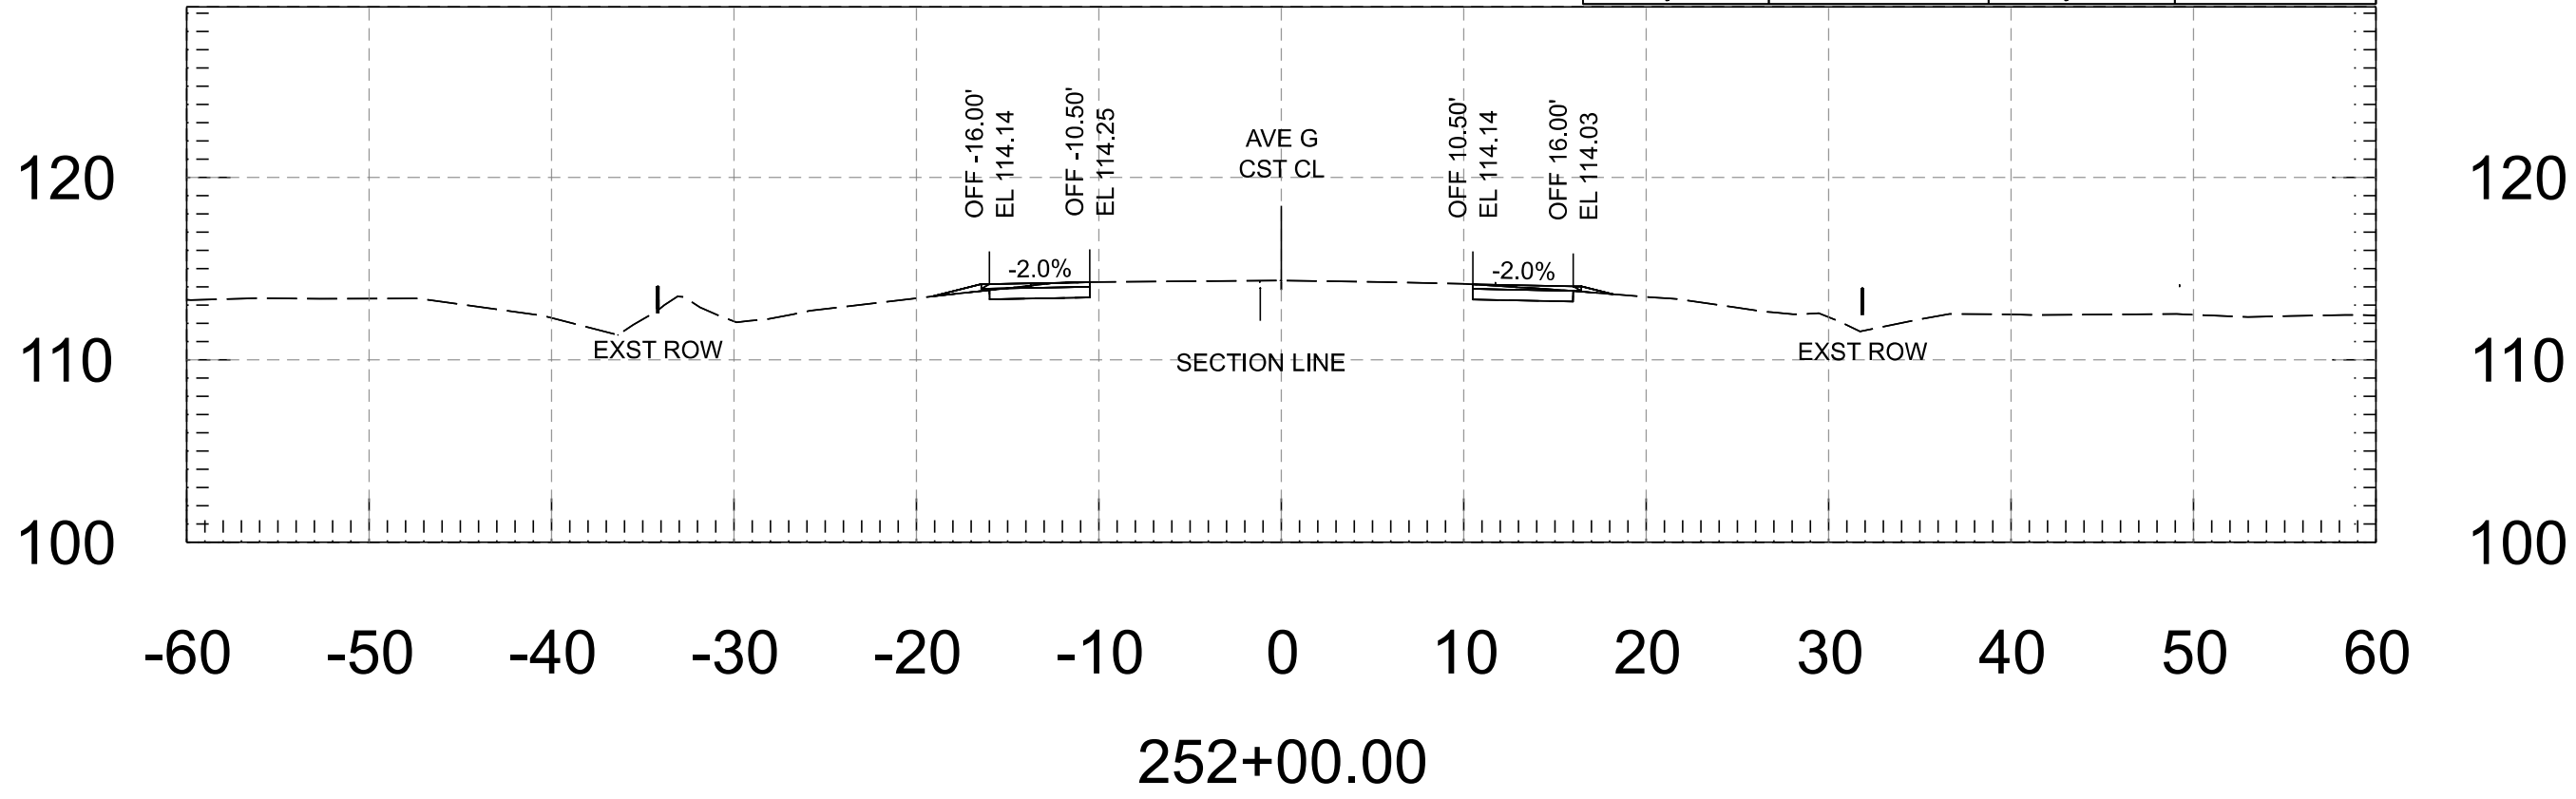


Cut Area	8.57 SF	Fill Area	0.25 SF
Cut Vol.	15.42 CY	Fill Vol.	0.61 CY
Cut Adj. Vol.	15.42 CY	Fill Adj. Vol.	0.61 CY

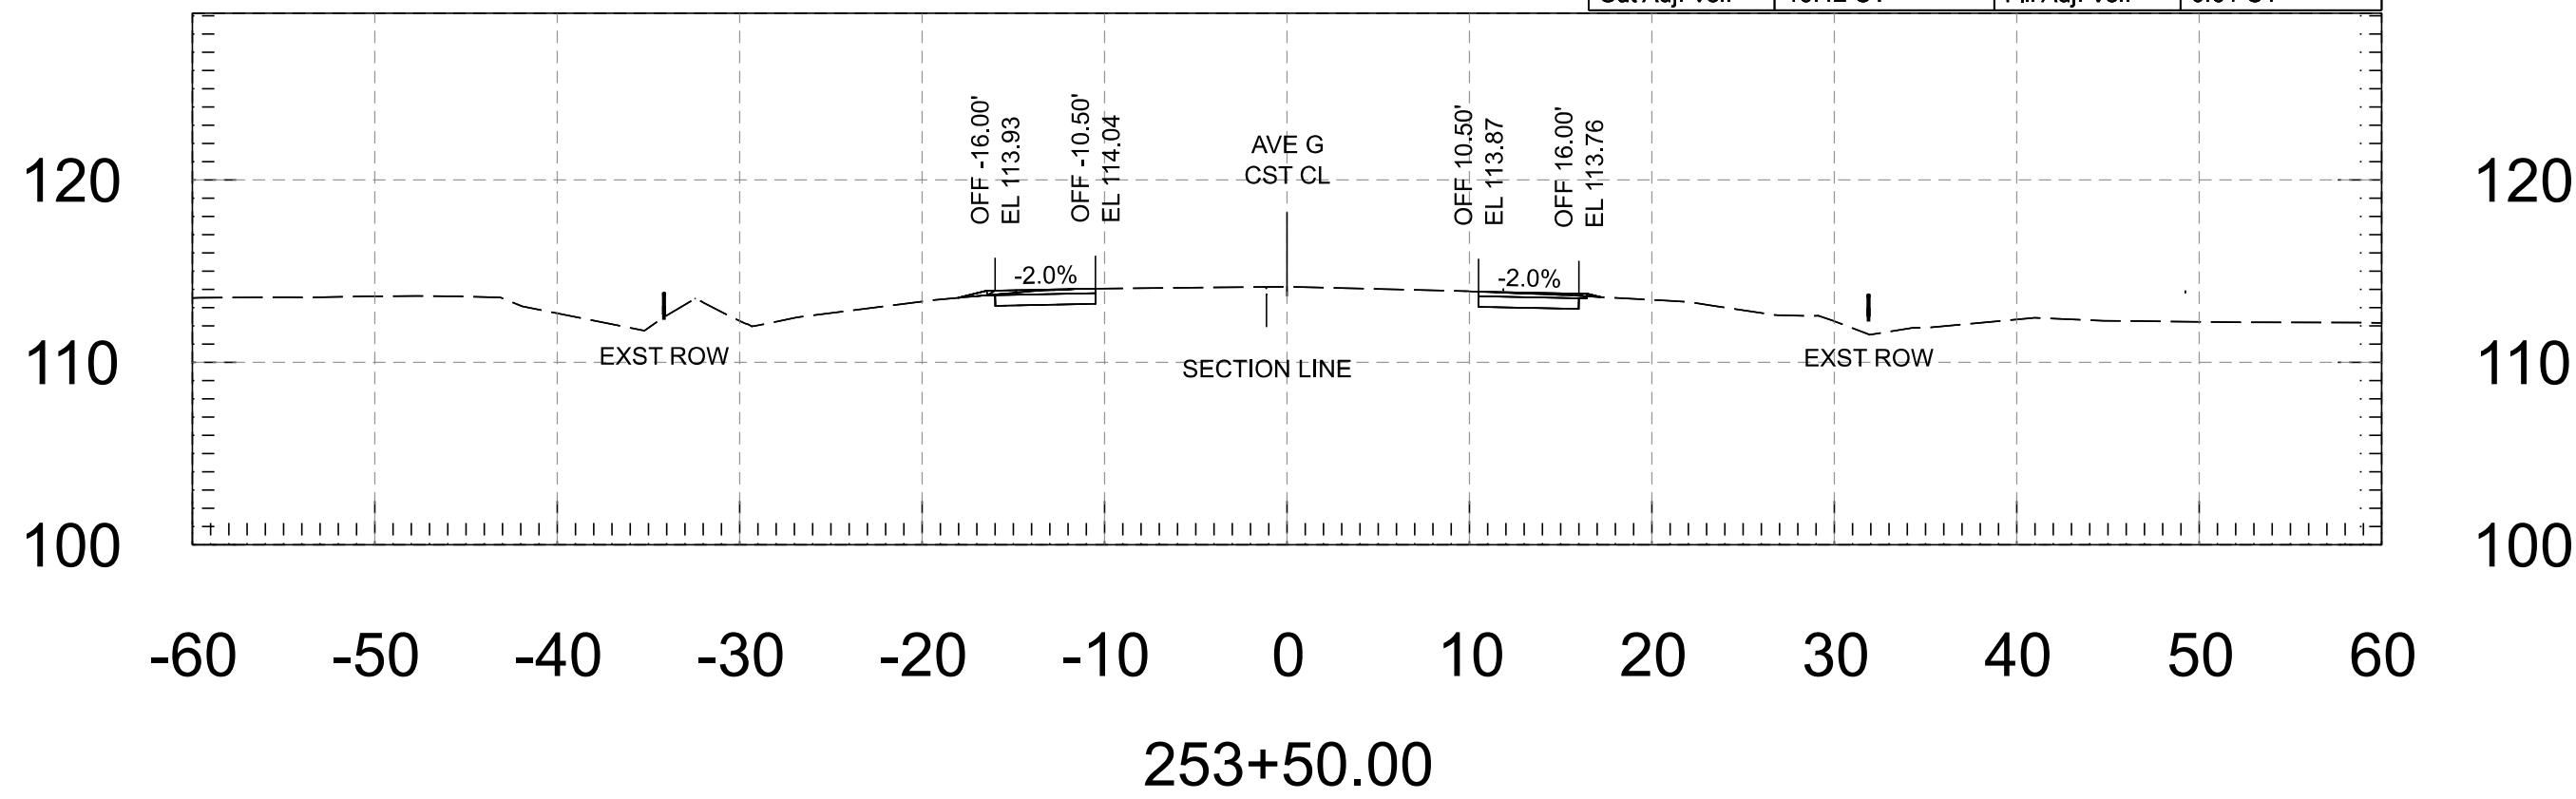


Cut Area	8.49 SF	Fill Area	0.46 SF
Cut Vol.	15.46 CY	Fill Vol.	0.84 CY
Cut Adj. Vol.	15.46 CY	Fill Adj. Vol.	0.84 CY

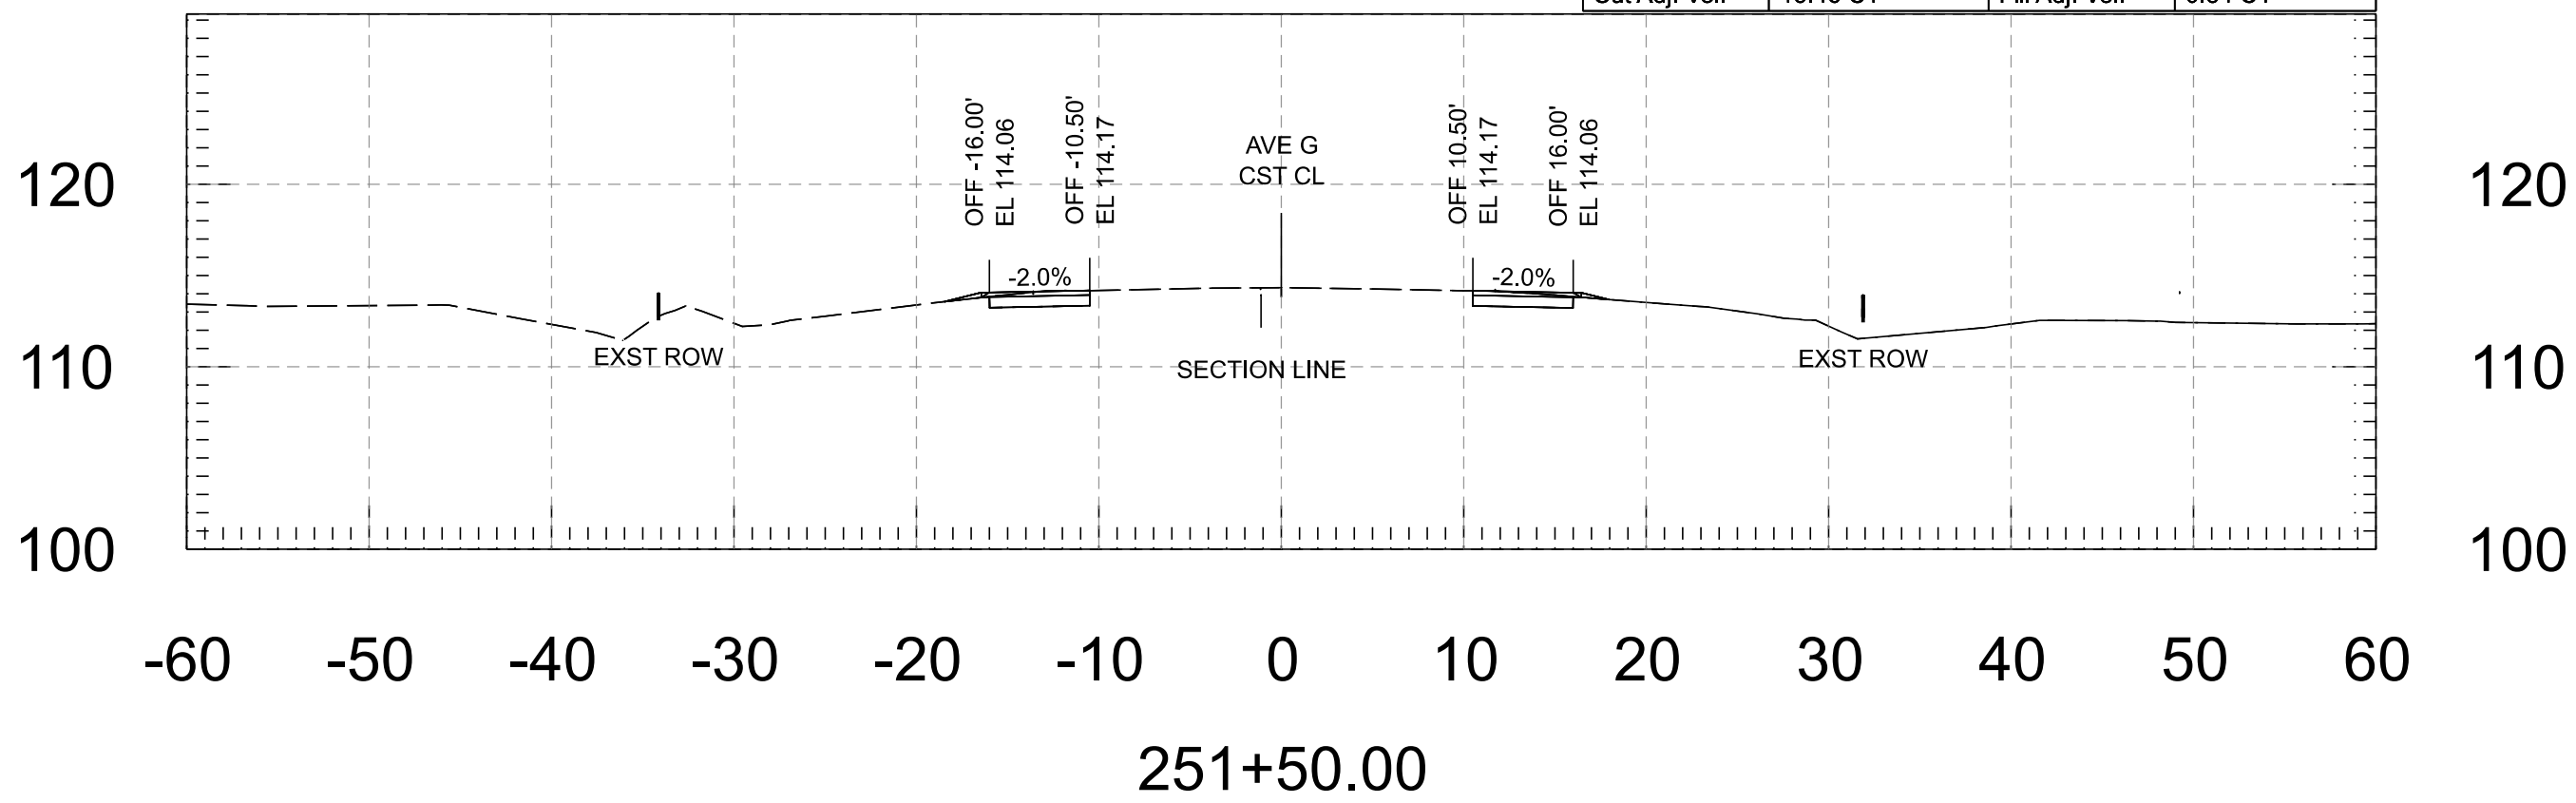


Cut Area	8.09 SF	Fill Area	0.42 SF
Cut Vol.	14.96 CY	Fill Vol.	0.85 CY
Cut Adj. Vol.	14.96 CY	Fill Adj. Vol.	0.85 CY

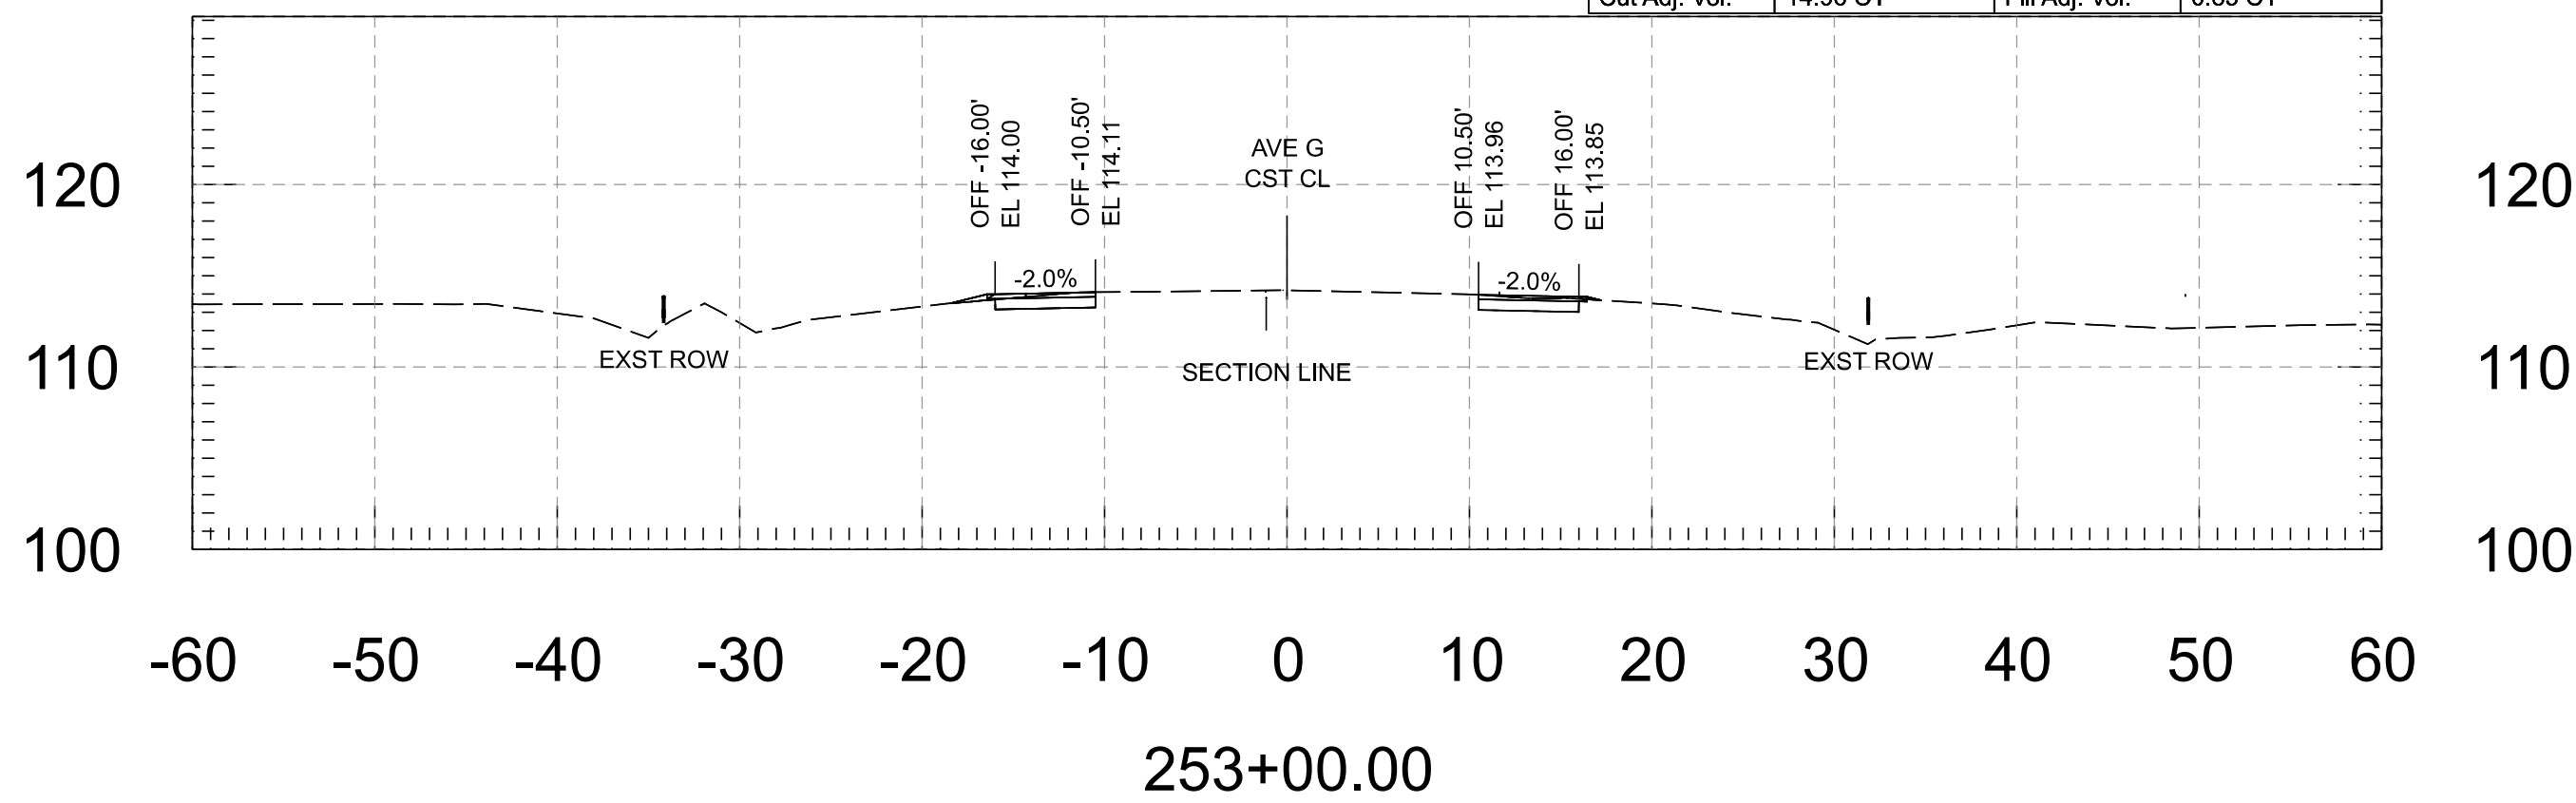







Cut Area	8.20 SF	Fill Area	0.44 SF
Cut Vol.	15.12 CY	Fill Vol.	0.87 CY
Cut Adj. Vol.	15.12 CY	Fill Adj. Vol.	0.87 CY

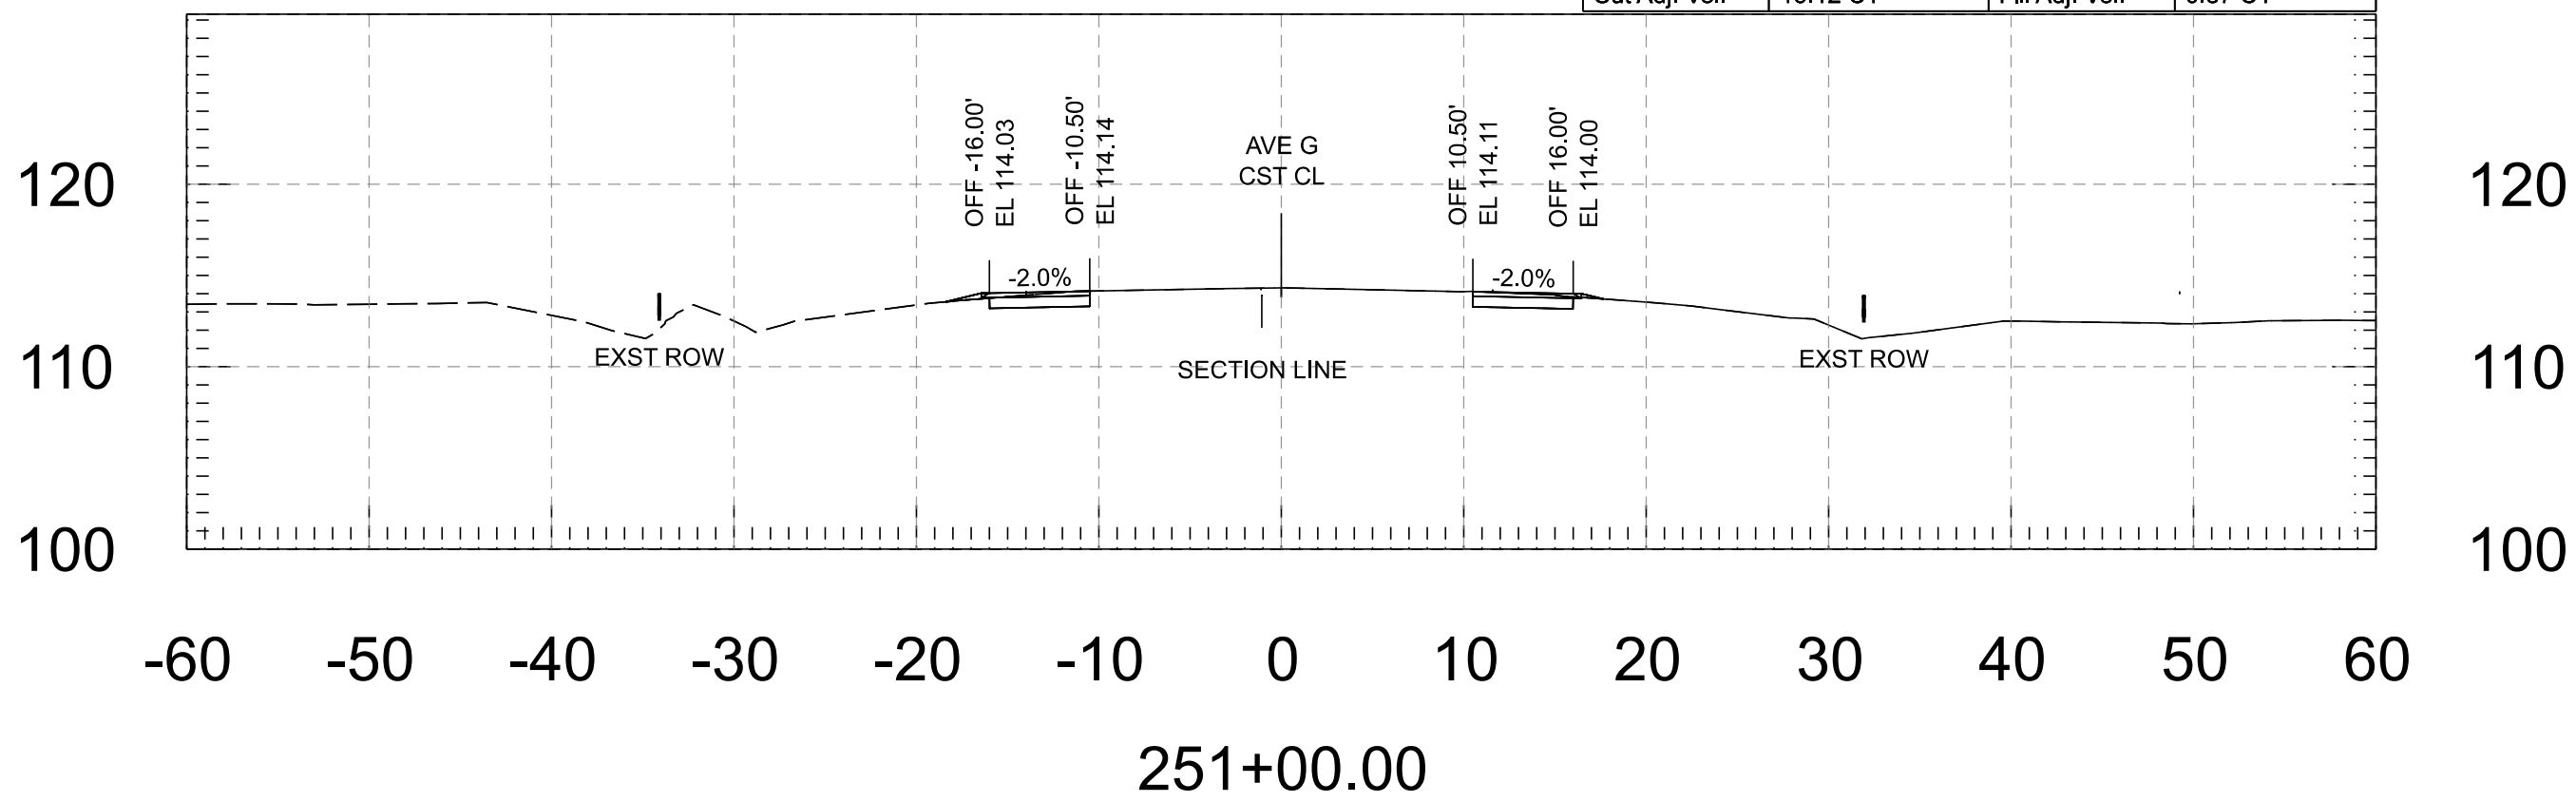







Cut Area	8.06 SF	Fill Area	0.50 SF
Cut Vol.	14.76 CY	Fill Vol.	1.21 CY
Cut Adj. Vol.	14.76 CY	Fill Adj. Vol.	1.21 CY

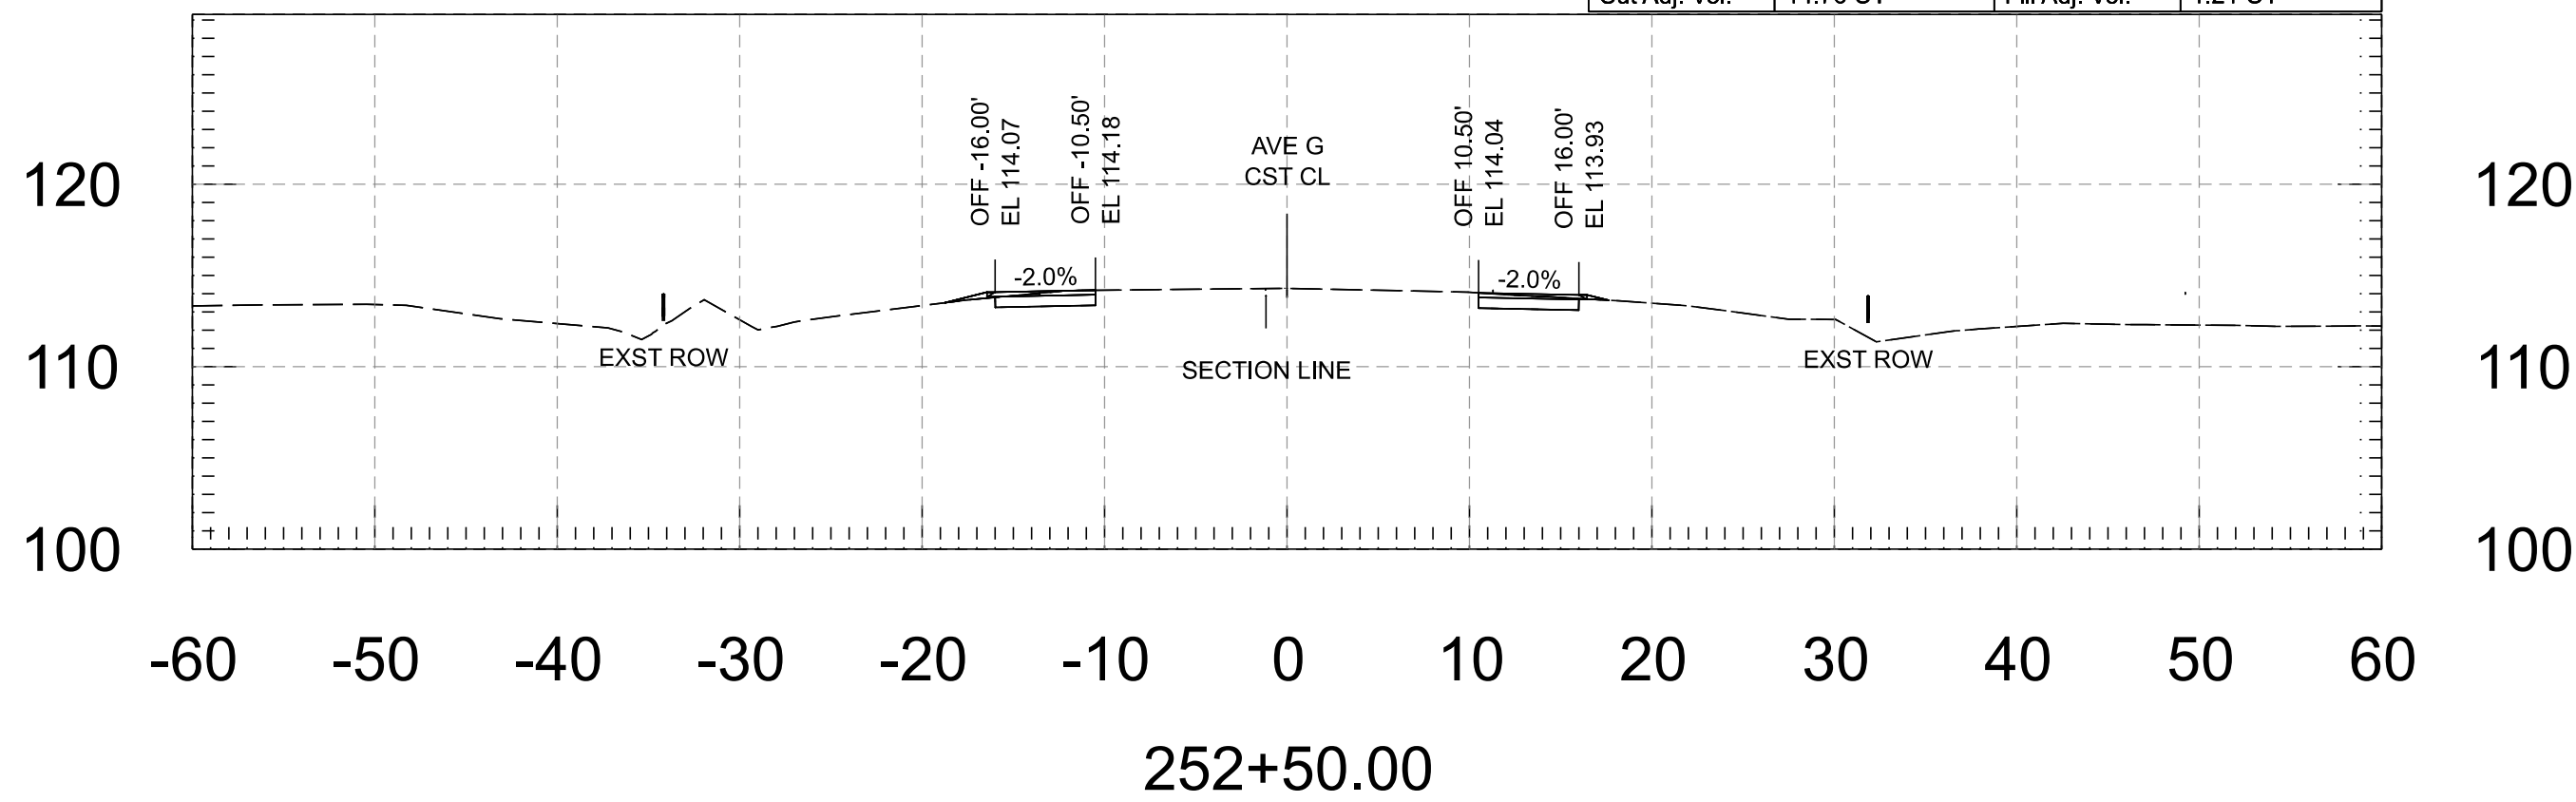

FOR INFORMATION ONLY		NAME	DATE	ARIZONA DEPARTMENT OF TRANSPORTATION PROJECT DELIVERY AND OPERATIONS DIVISION ROADWAY DESIGN SERVICES	ROUTE	F.H.W.A. Arizona Division	STATE ARIZ.	PROJECT NO.	FEDERAL ID NO.	SHEET NO.	TOTAL SHEETS	RECORD DRAWING
	DESIGN	M. SCHOEN	07/26		MILEPOST			0000 YU YYU	YYU-0(225)T	114	118	
	DRAWN	M. SCHOEN	07/26					LOCATION AVENUE G, COUNTY 11TH ST - COUNTY 16TH ST			DWG	
	CHECKED	H. RIOS	07/26	AVENUE G - CROSS SECTIONS		STRUCTURE NO.	TRACS NO. T0437 01C			___ OF ___		
	 WSP USA Inc. 1230 West Washington Street, Suite 405 Tempe, AZ 85288											

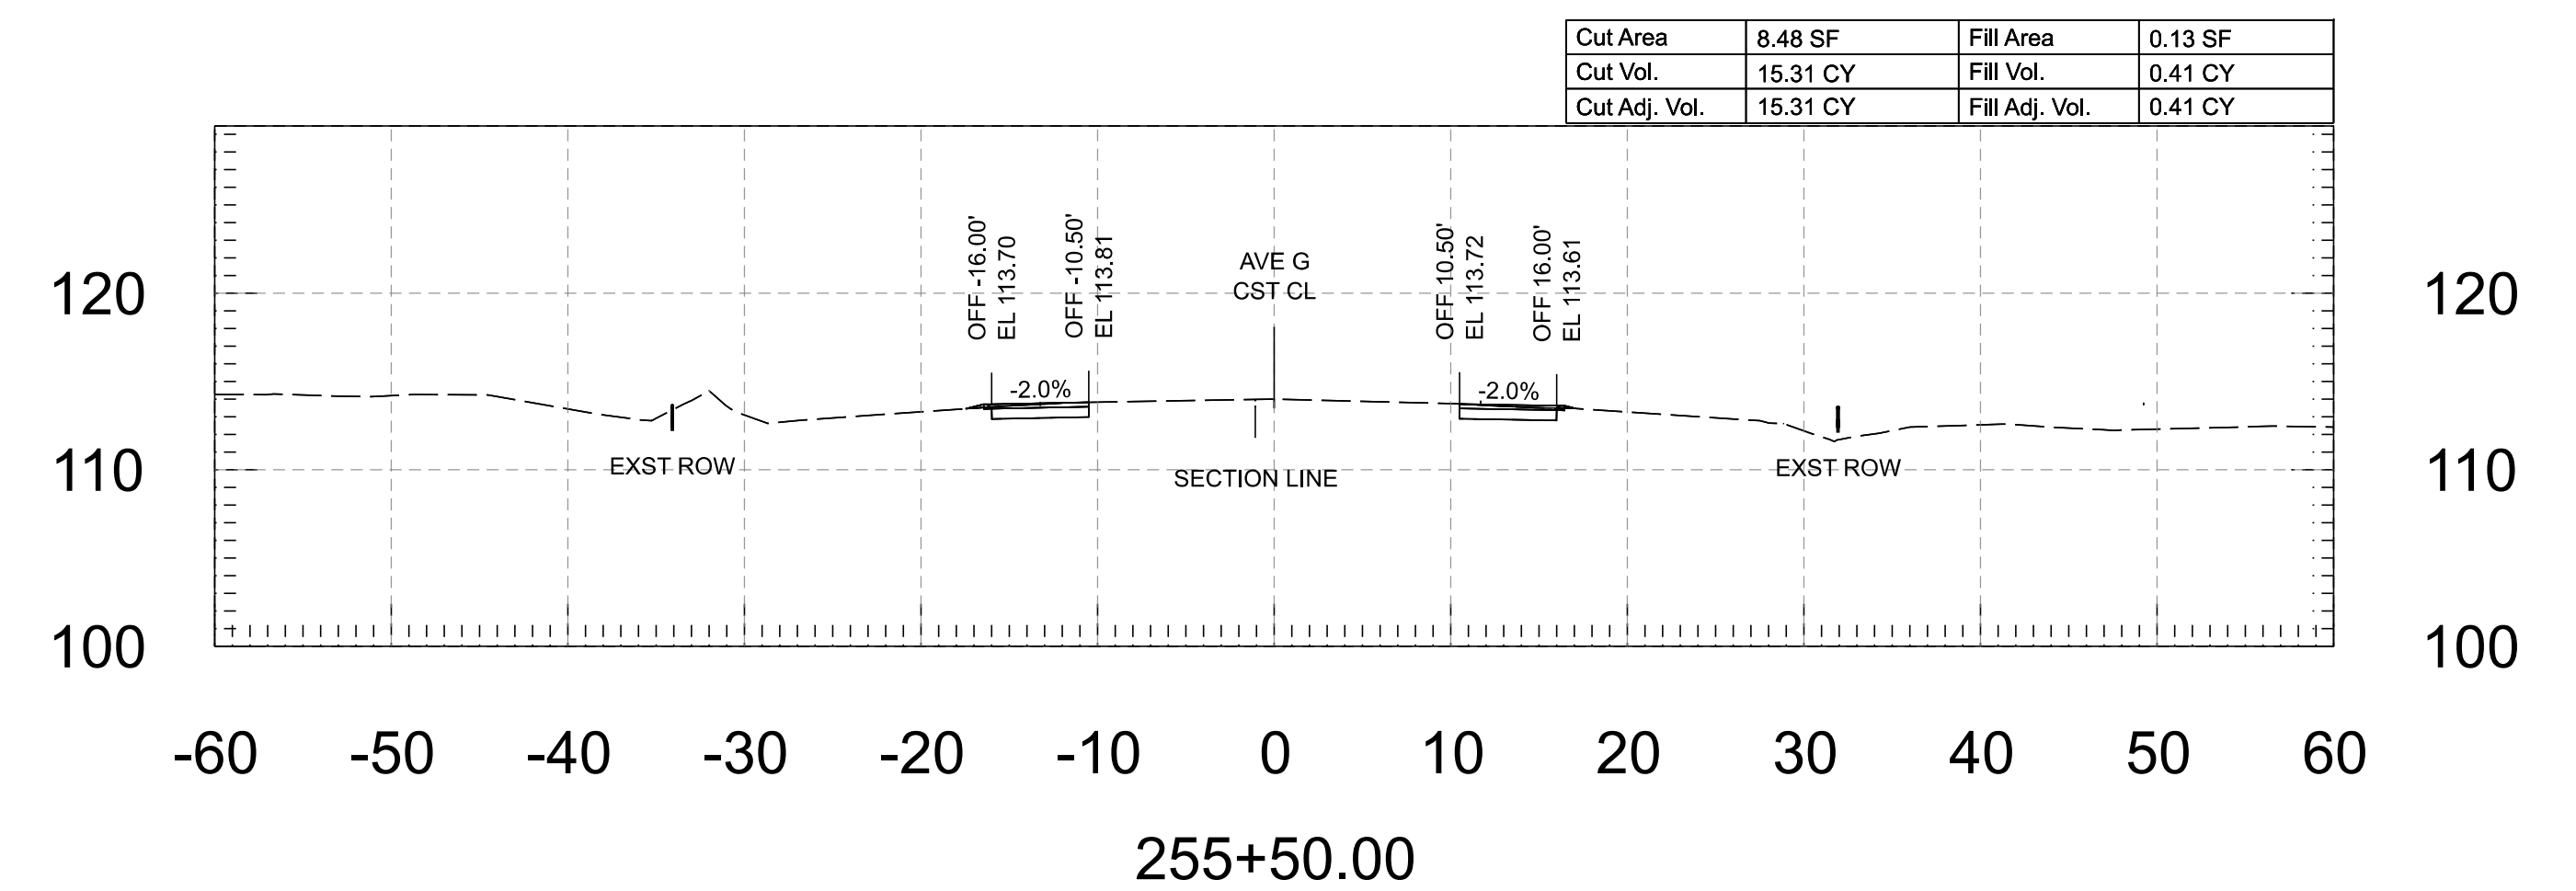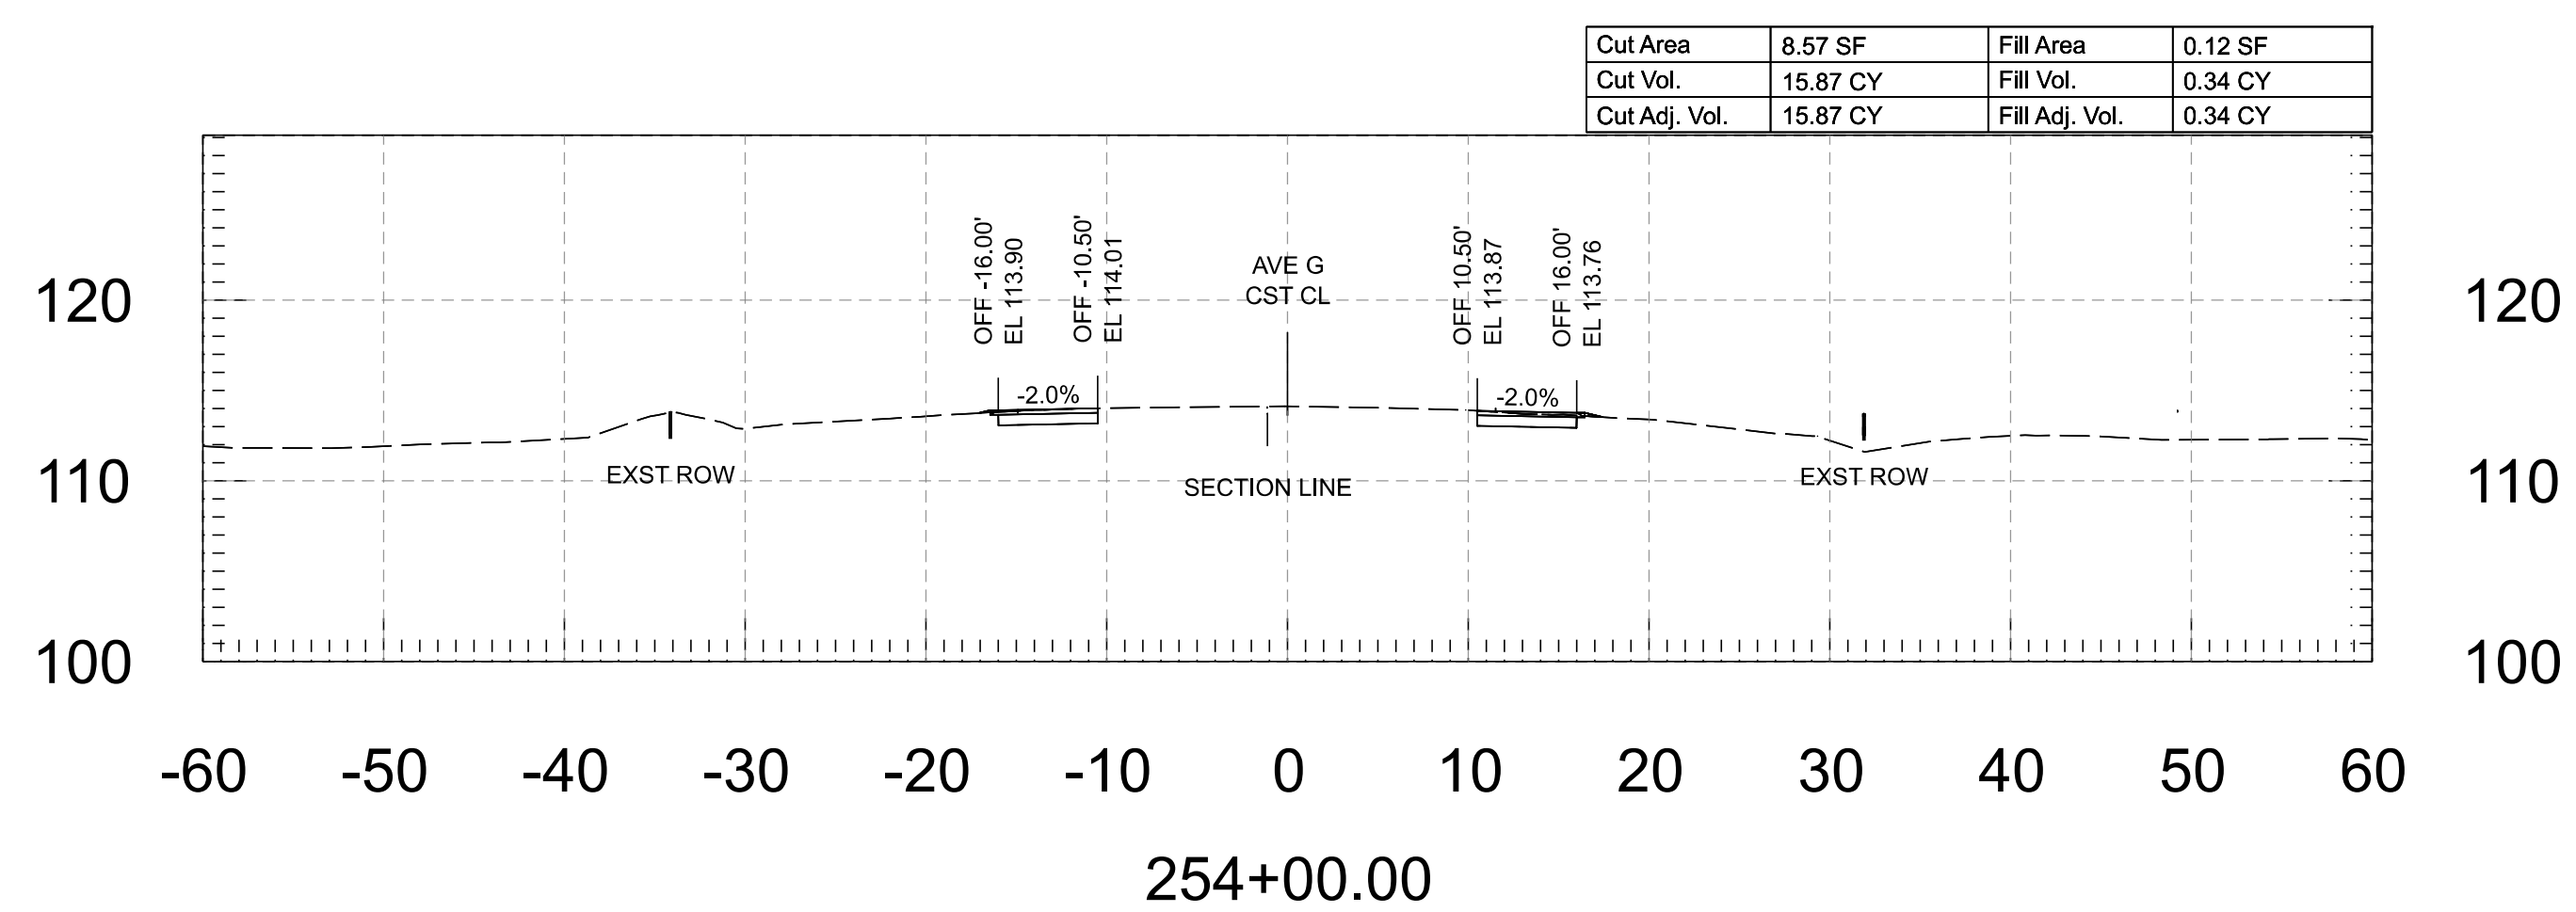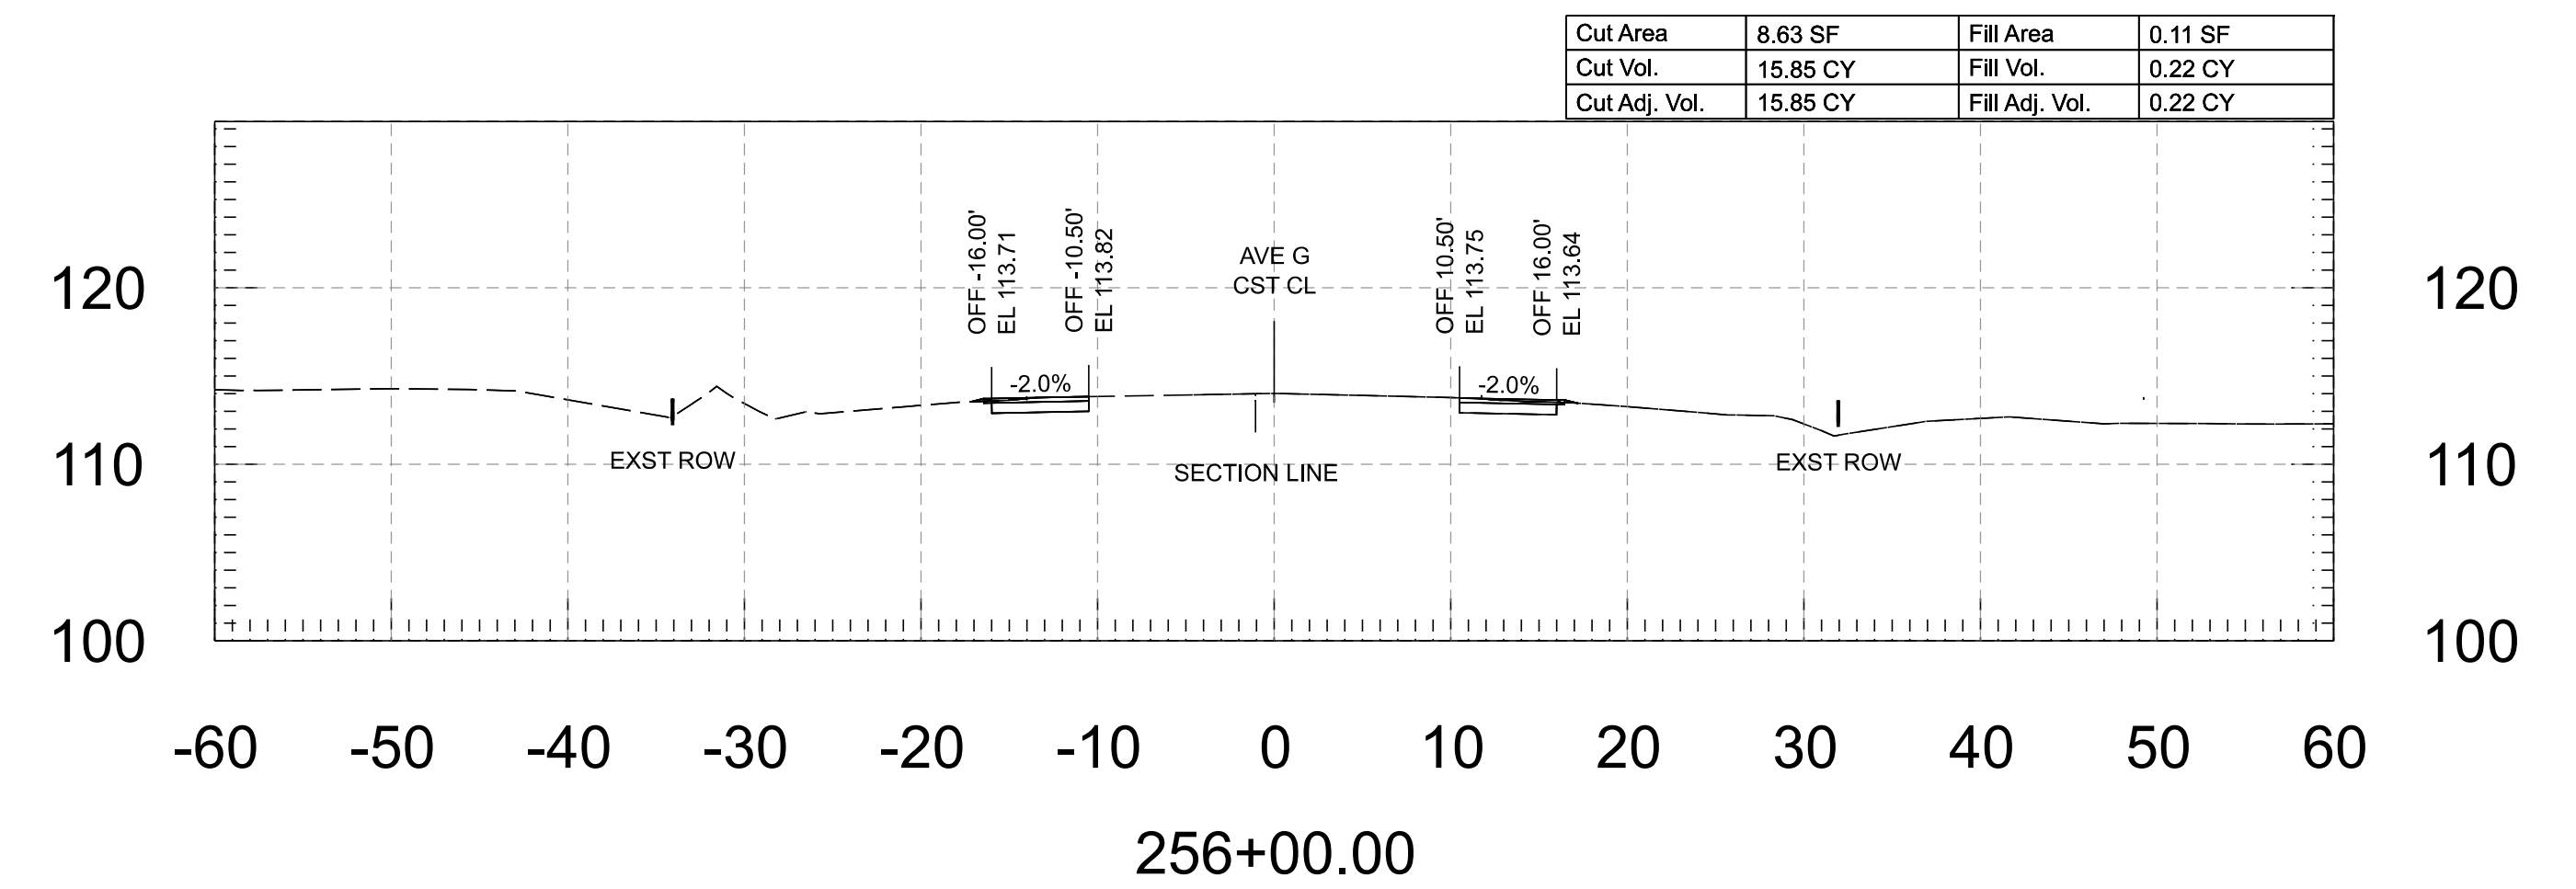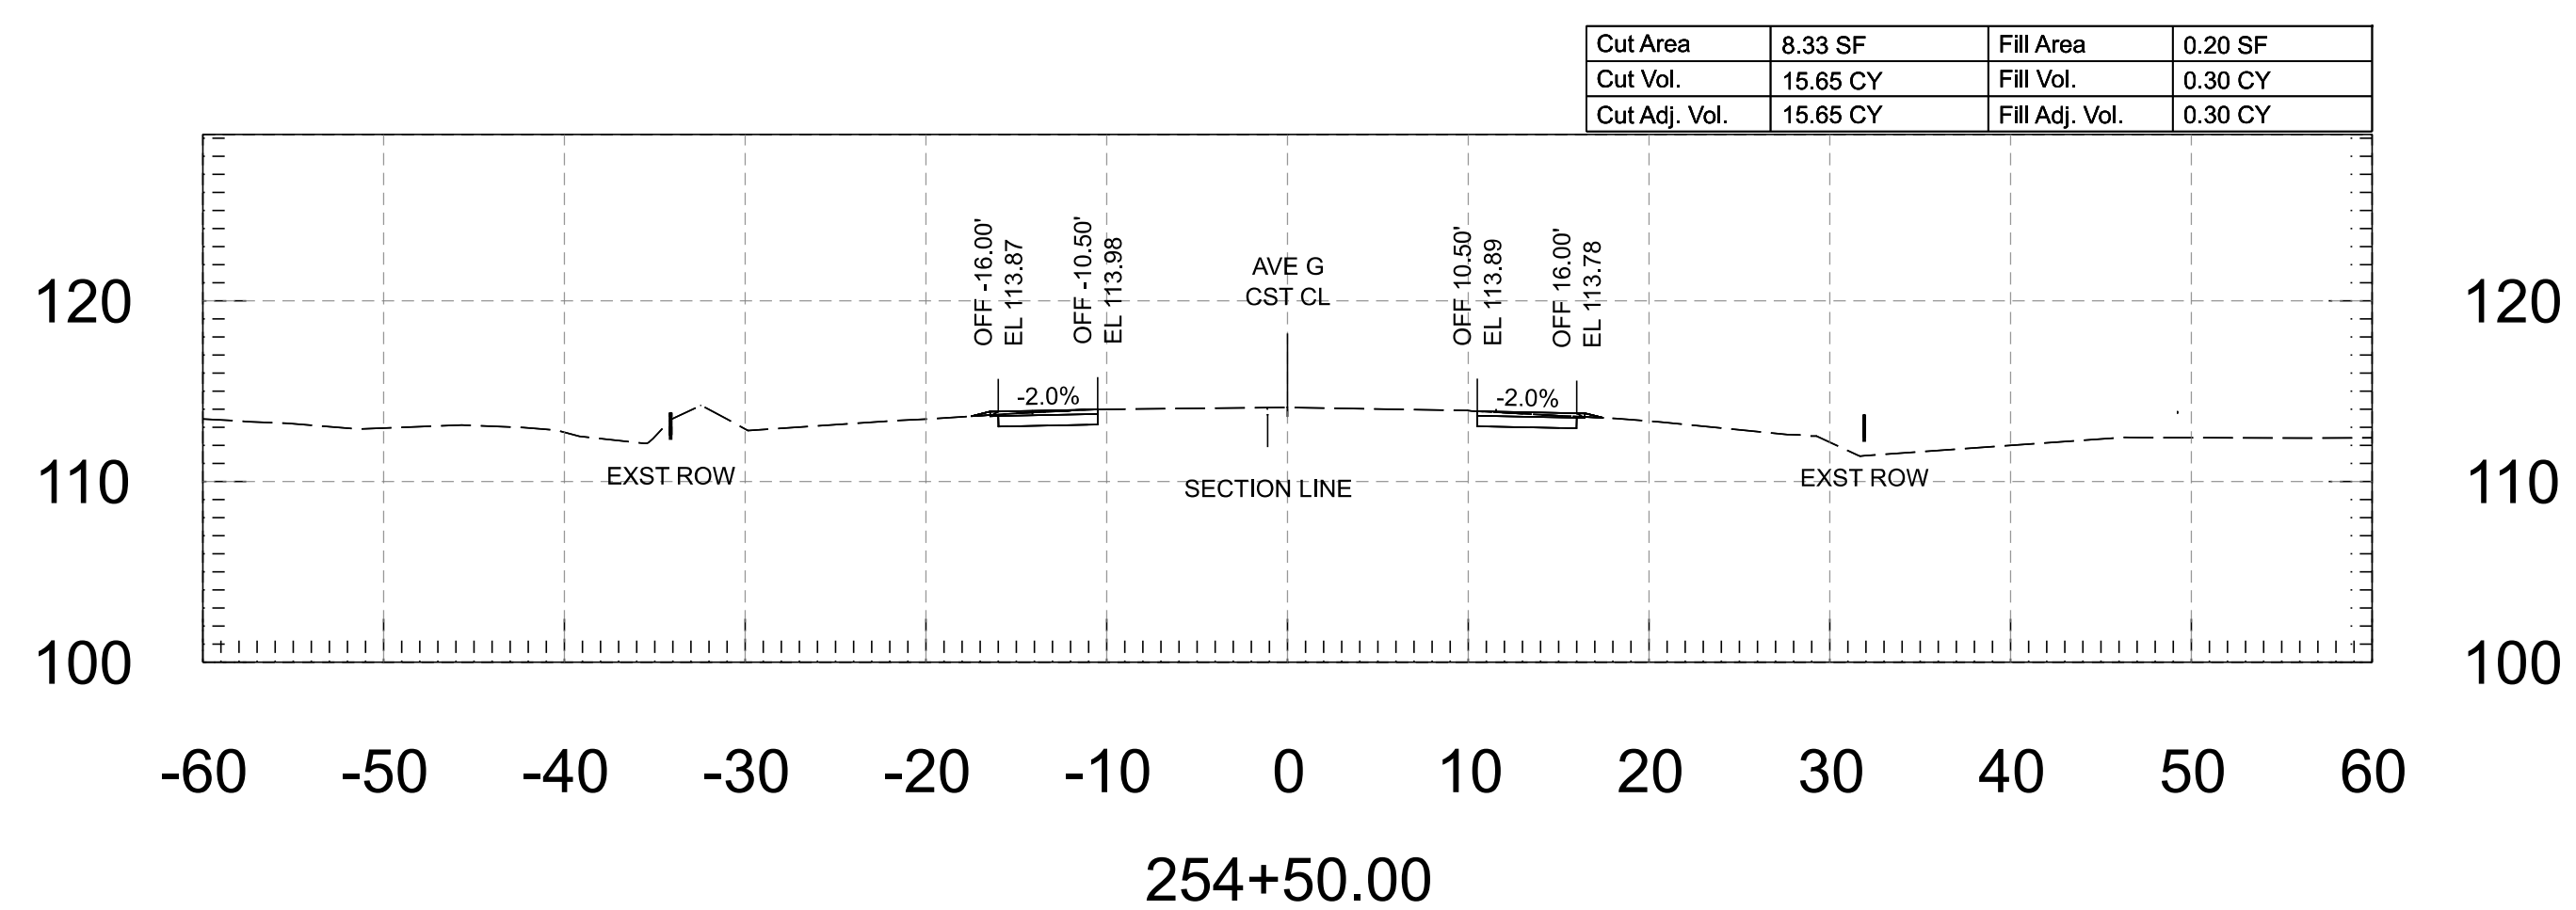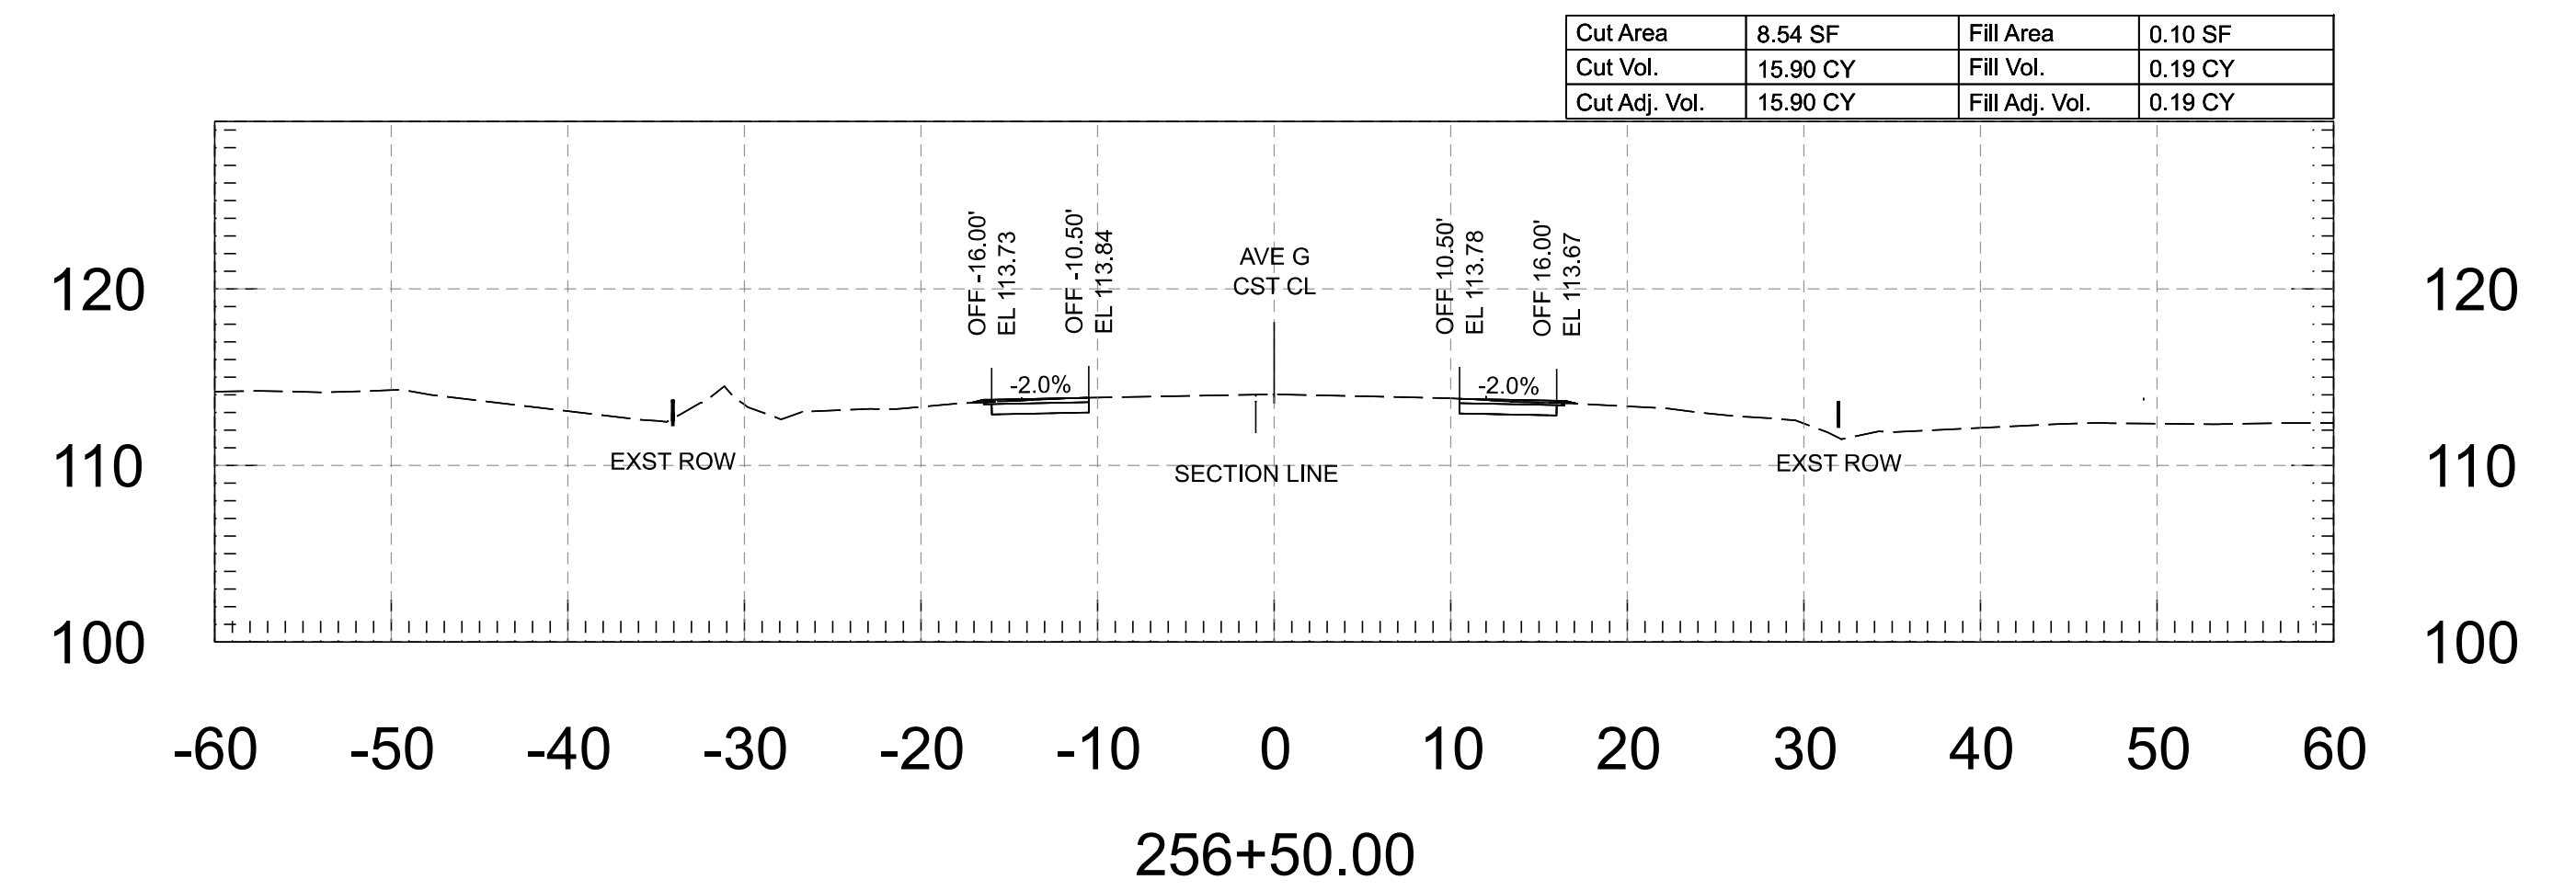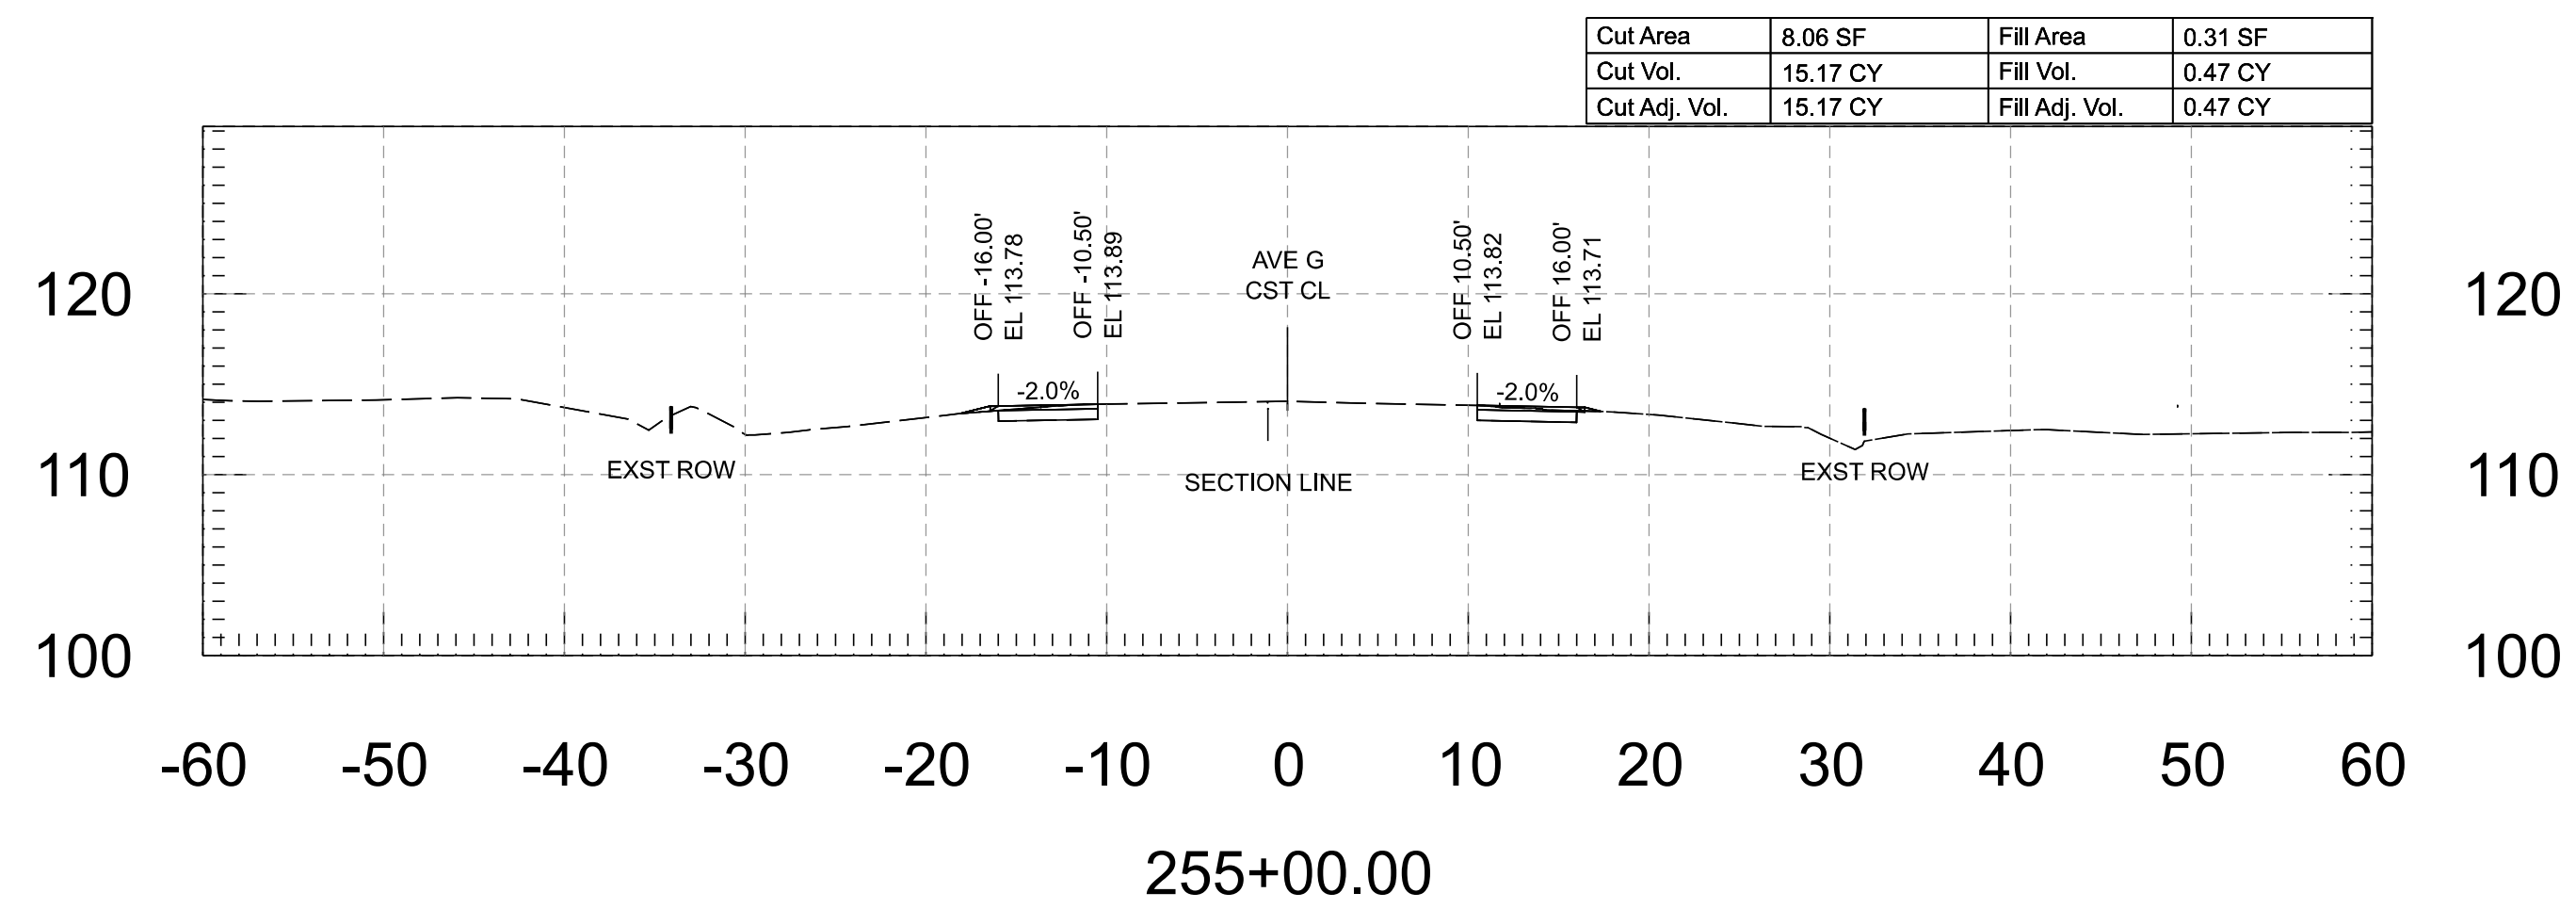


FOR INFORMATION ONLY		NAME	DATE	ARIZONA DEPARTMENT OF TRANSPORTATION PROJECT DELIVERY AND OPERATIONS DIVISION ROADWAY DESIGN SERVICES	ROUTE	F.H.W.A. Arizona Division	STATE	PROJECT NO.	FEDERAL ID NO.	SHEET NO.	TOTAL SHEETS	RECORD DRAWING
	DESIGN	M. SCHOEN	07/26		MILEPOST		ARIZ.	0000 YU YYU	YYU-0(225)T	115	118	
	DRAWN	M. SCHOEN	07/26			STRUCTURE NO.						
	CHECKED	H. RIOS	07/26	TRACS NO. T0437 01C						OF		
	 WSP USA INC. 1201 West Newington Street, Suite 405 Tempe, AZ 85286			AVENUE G - CROSS SECTIONS								

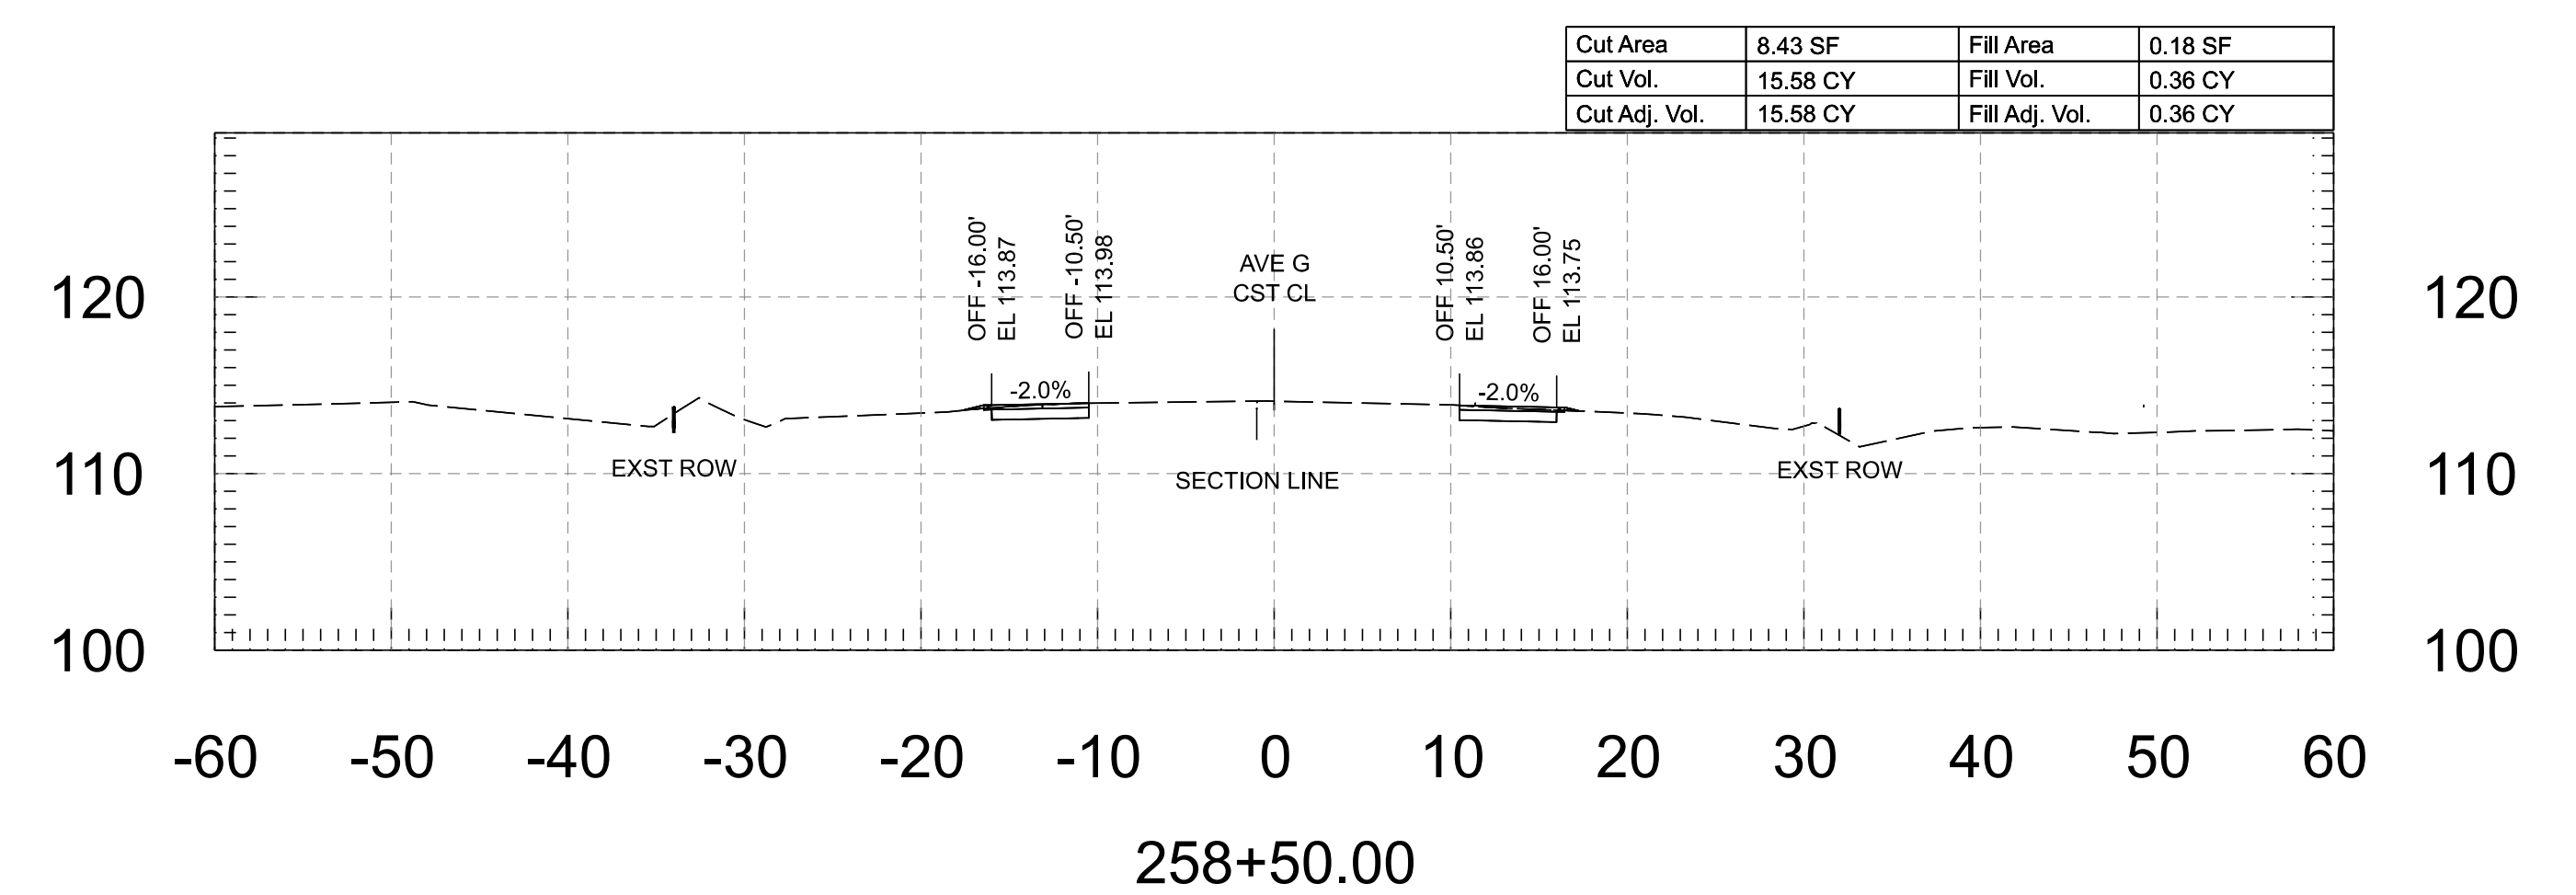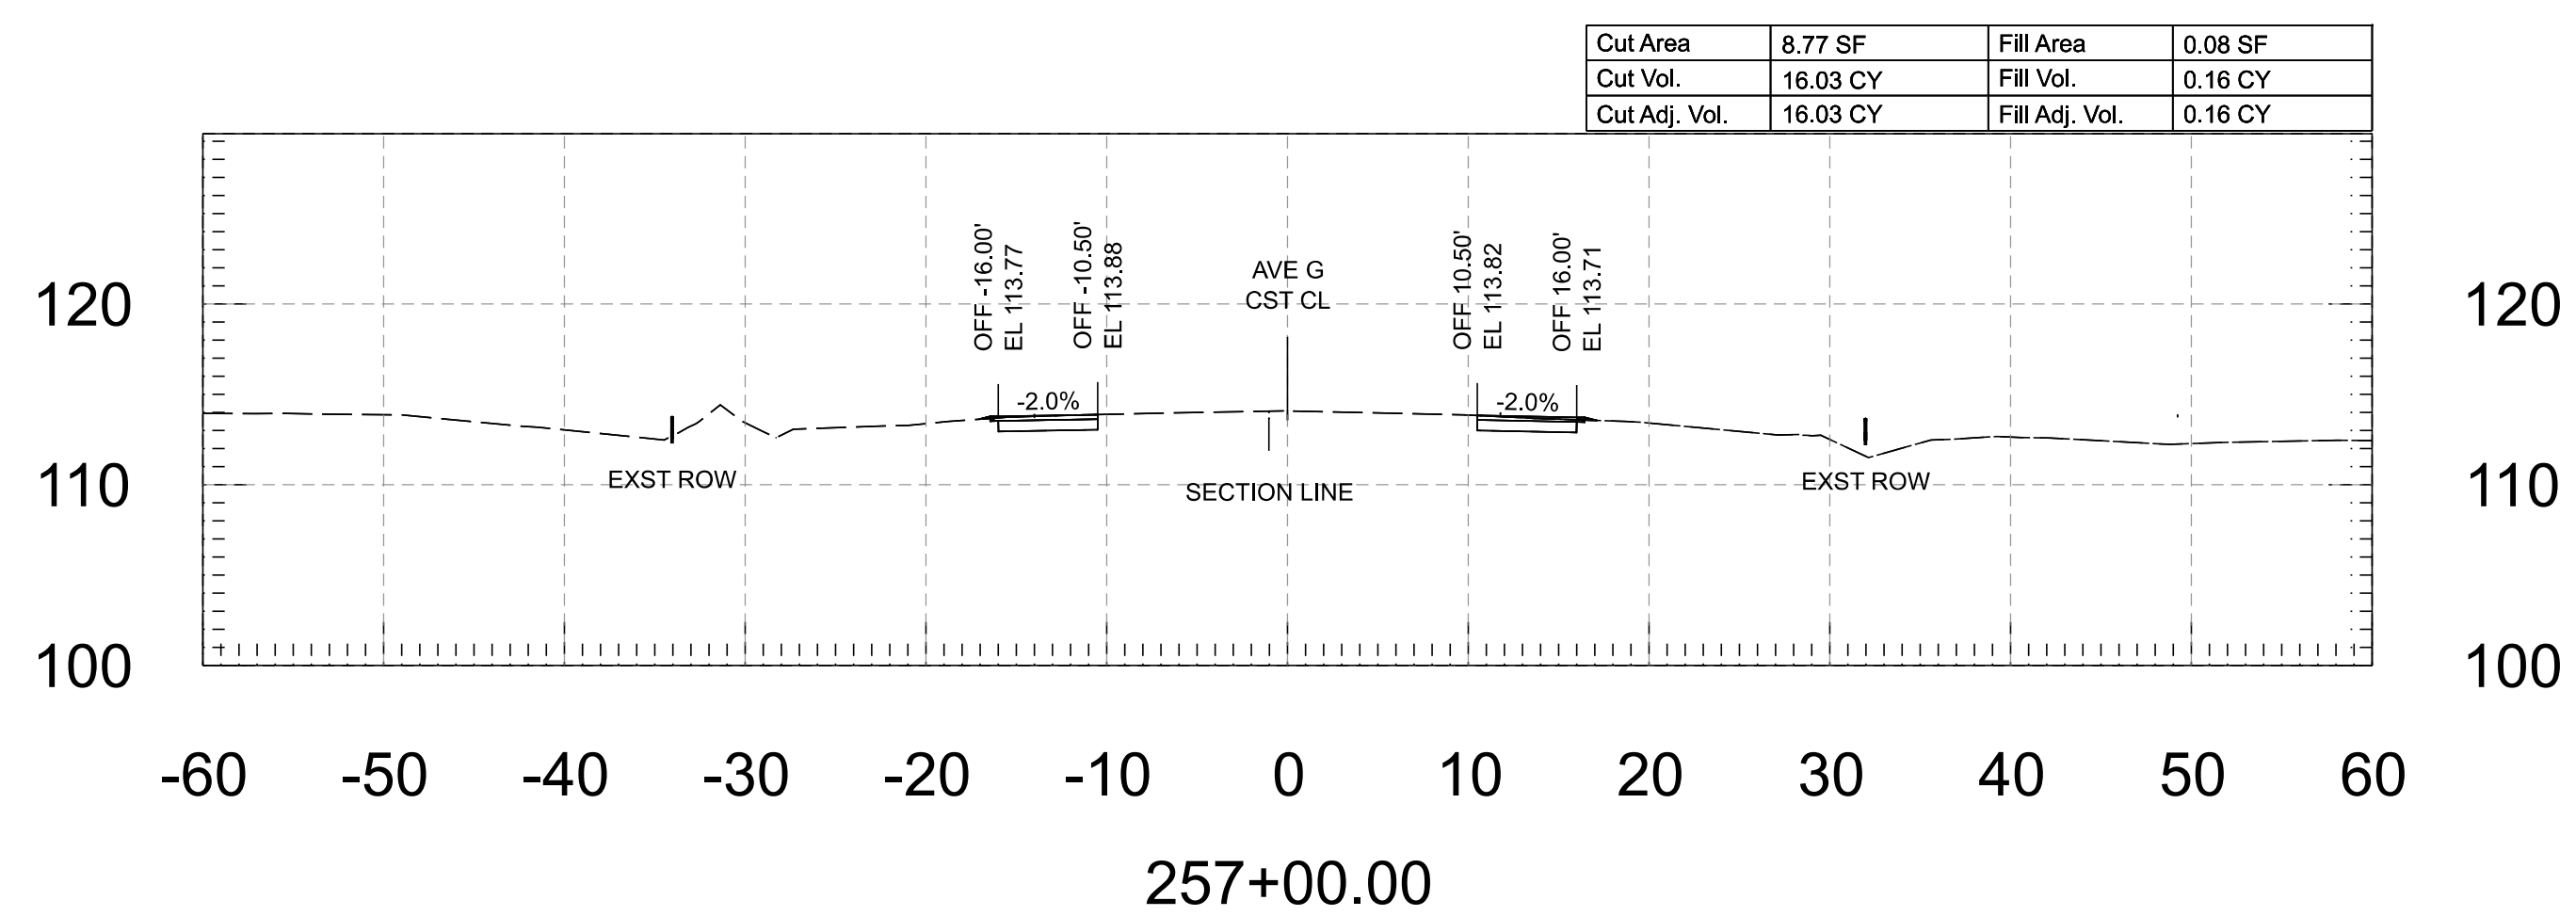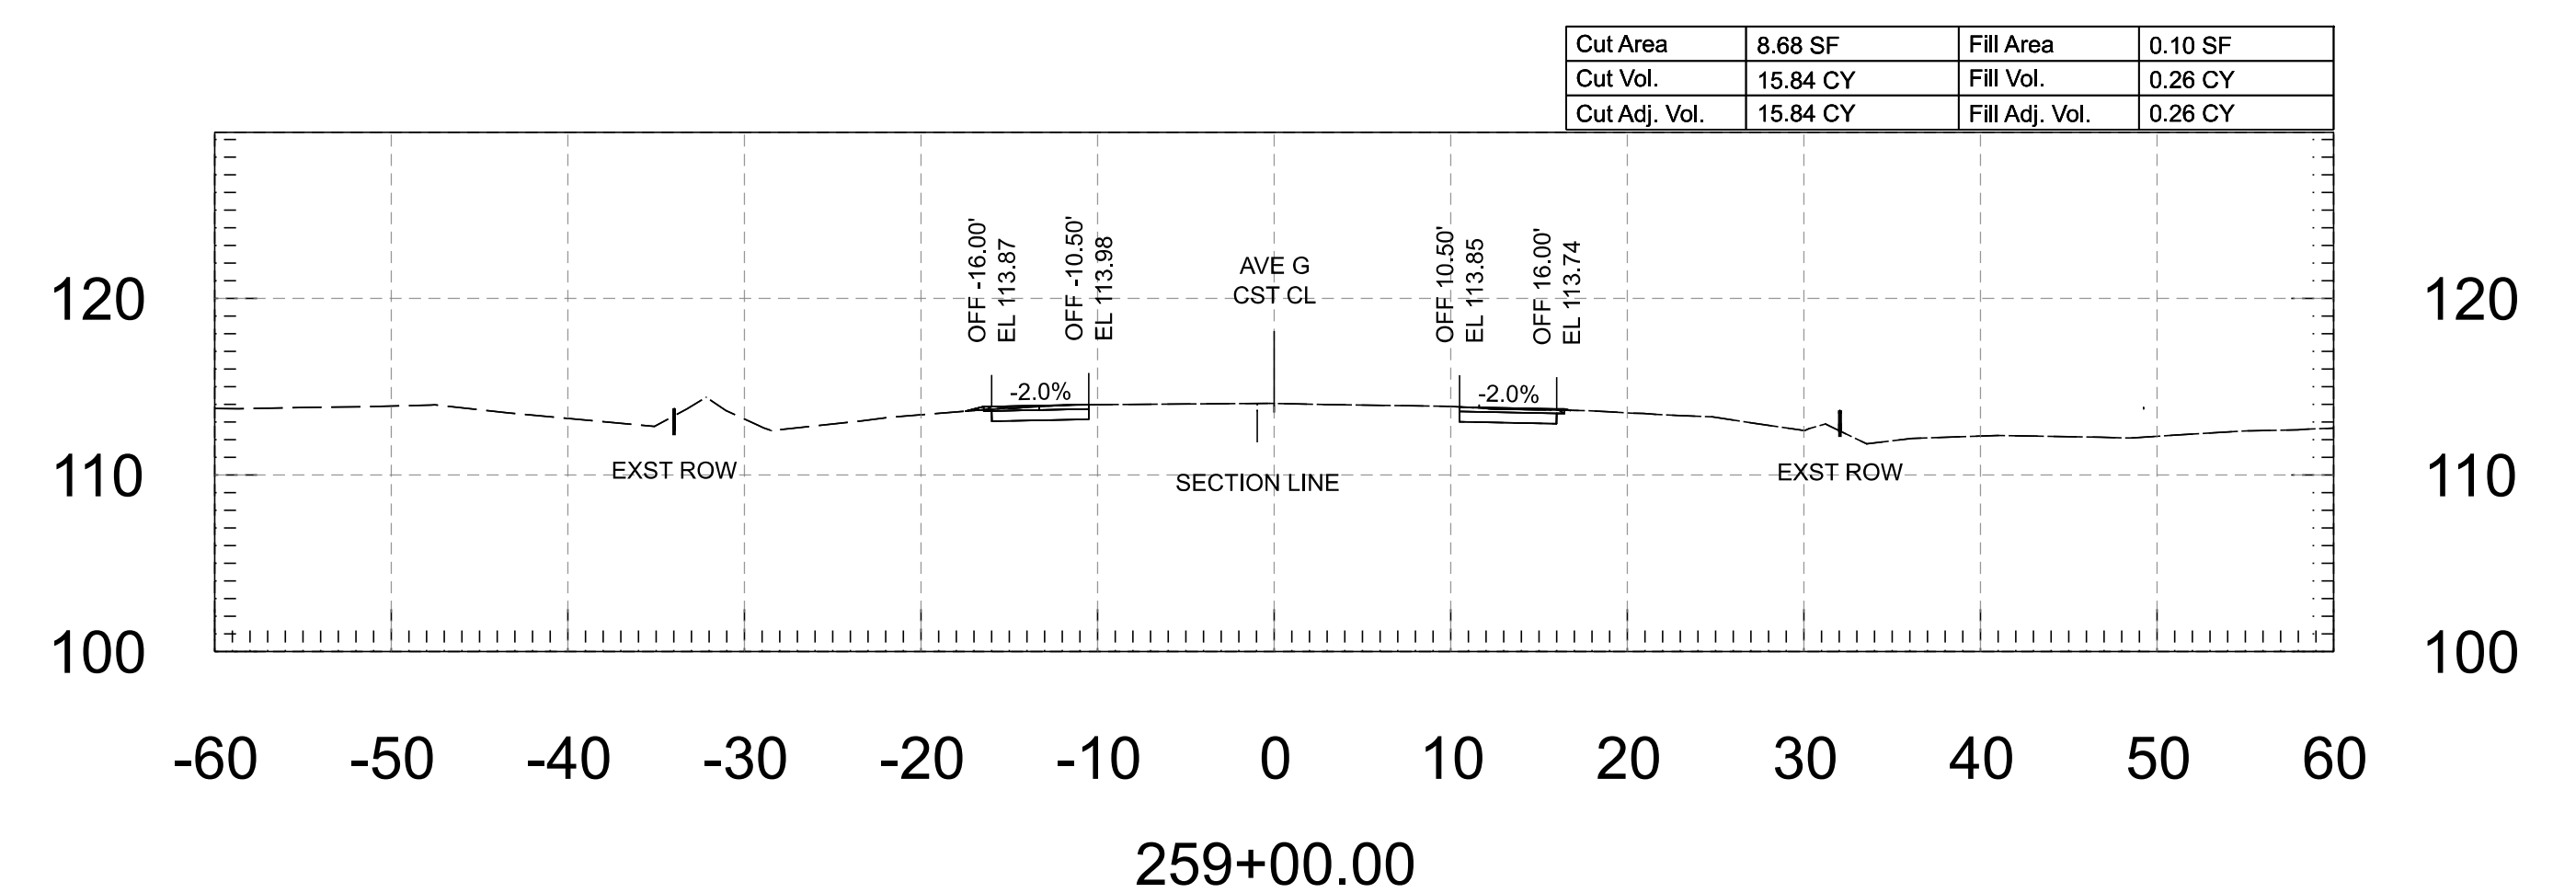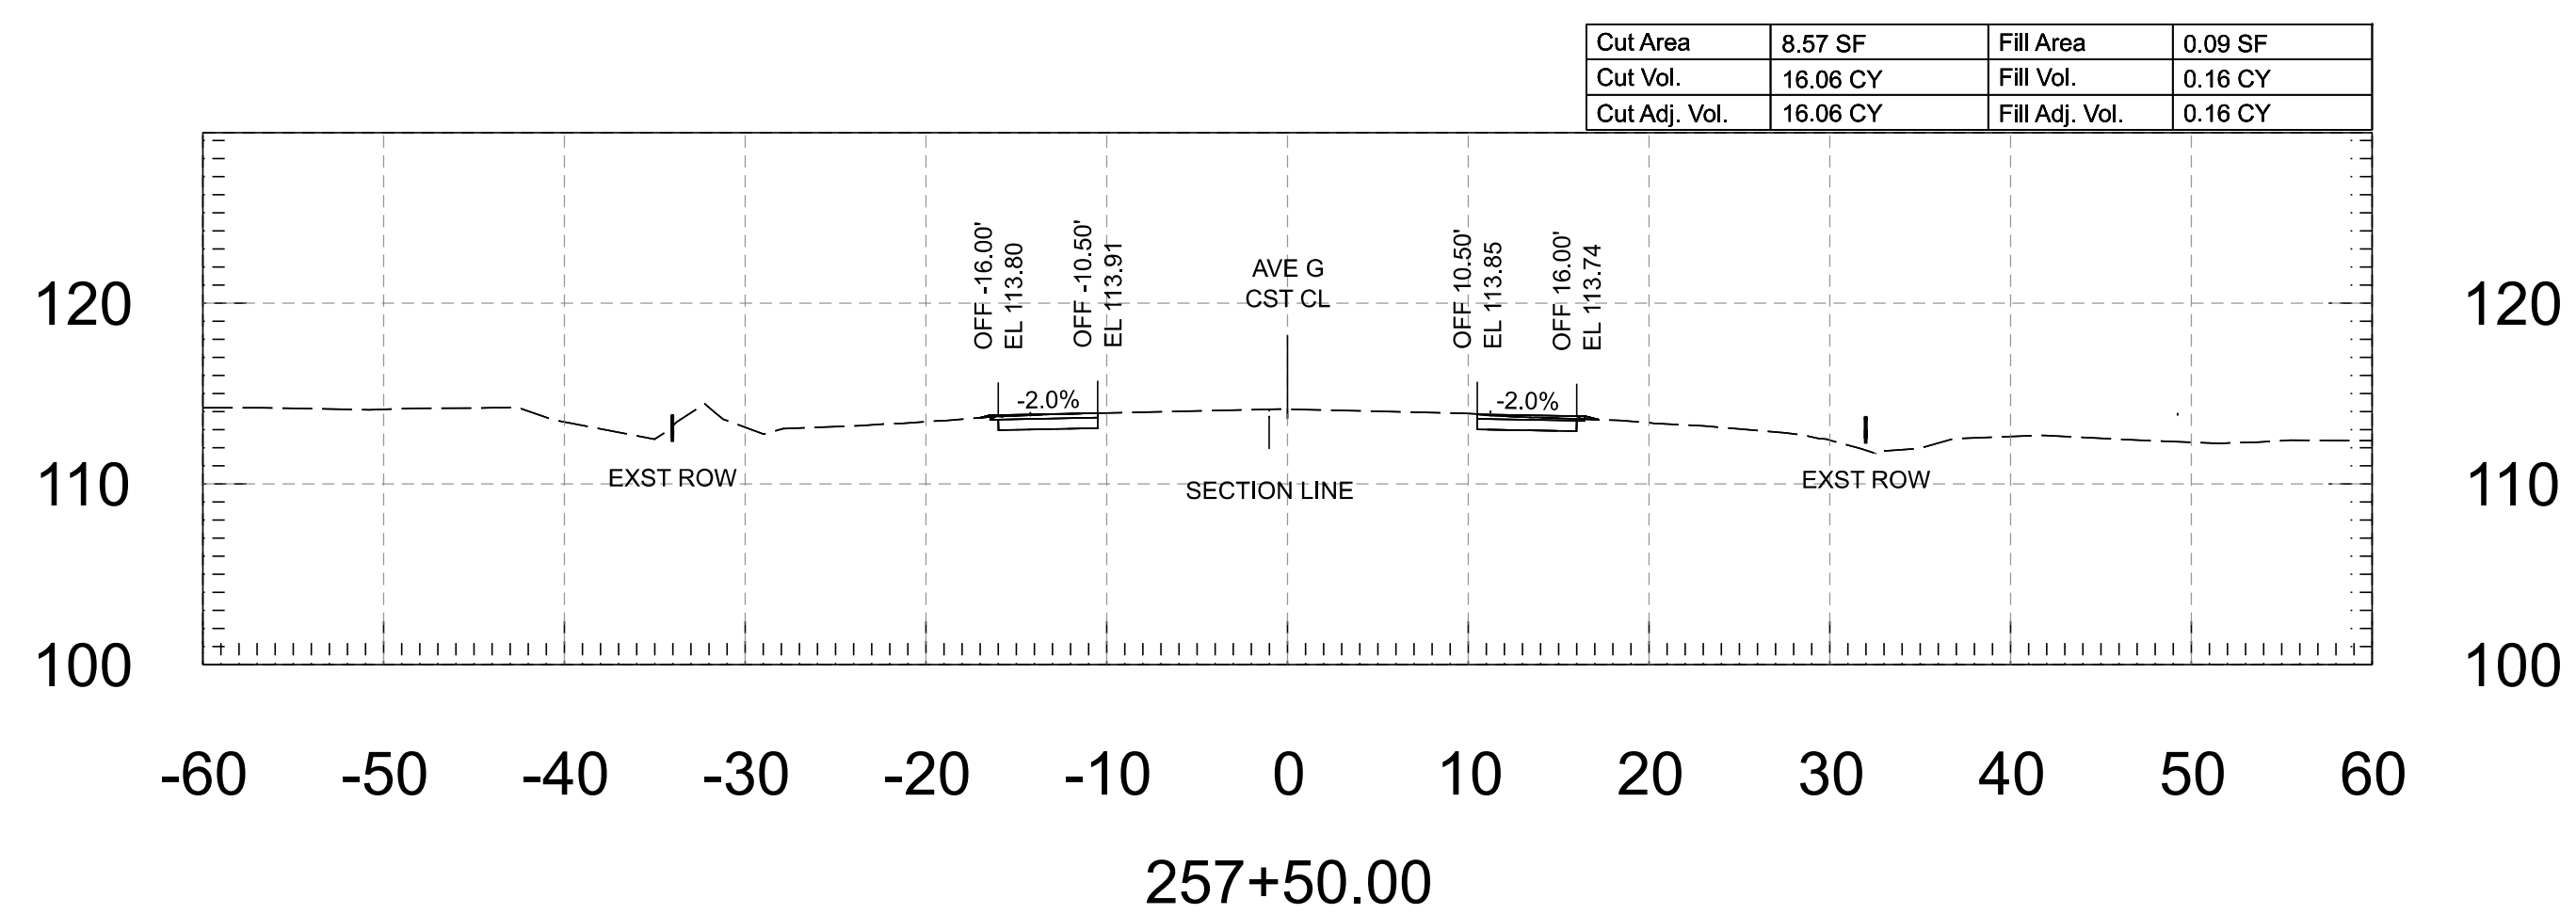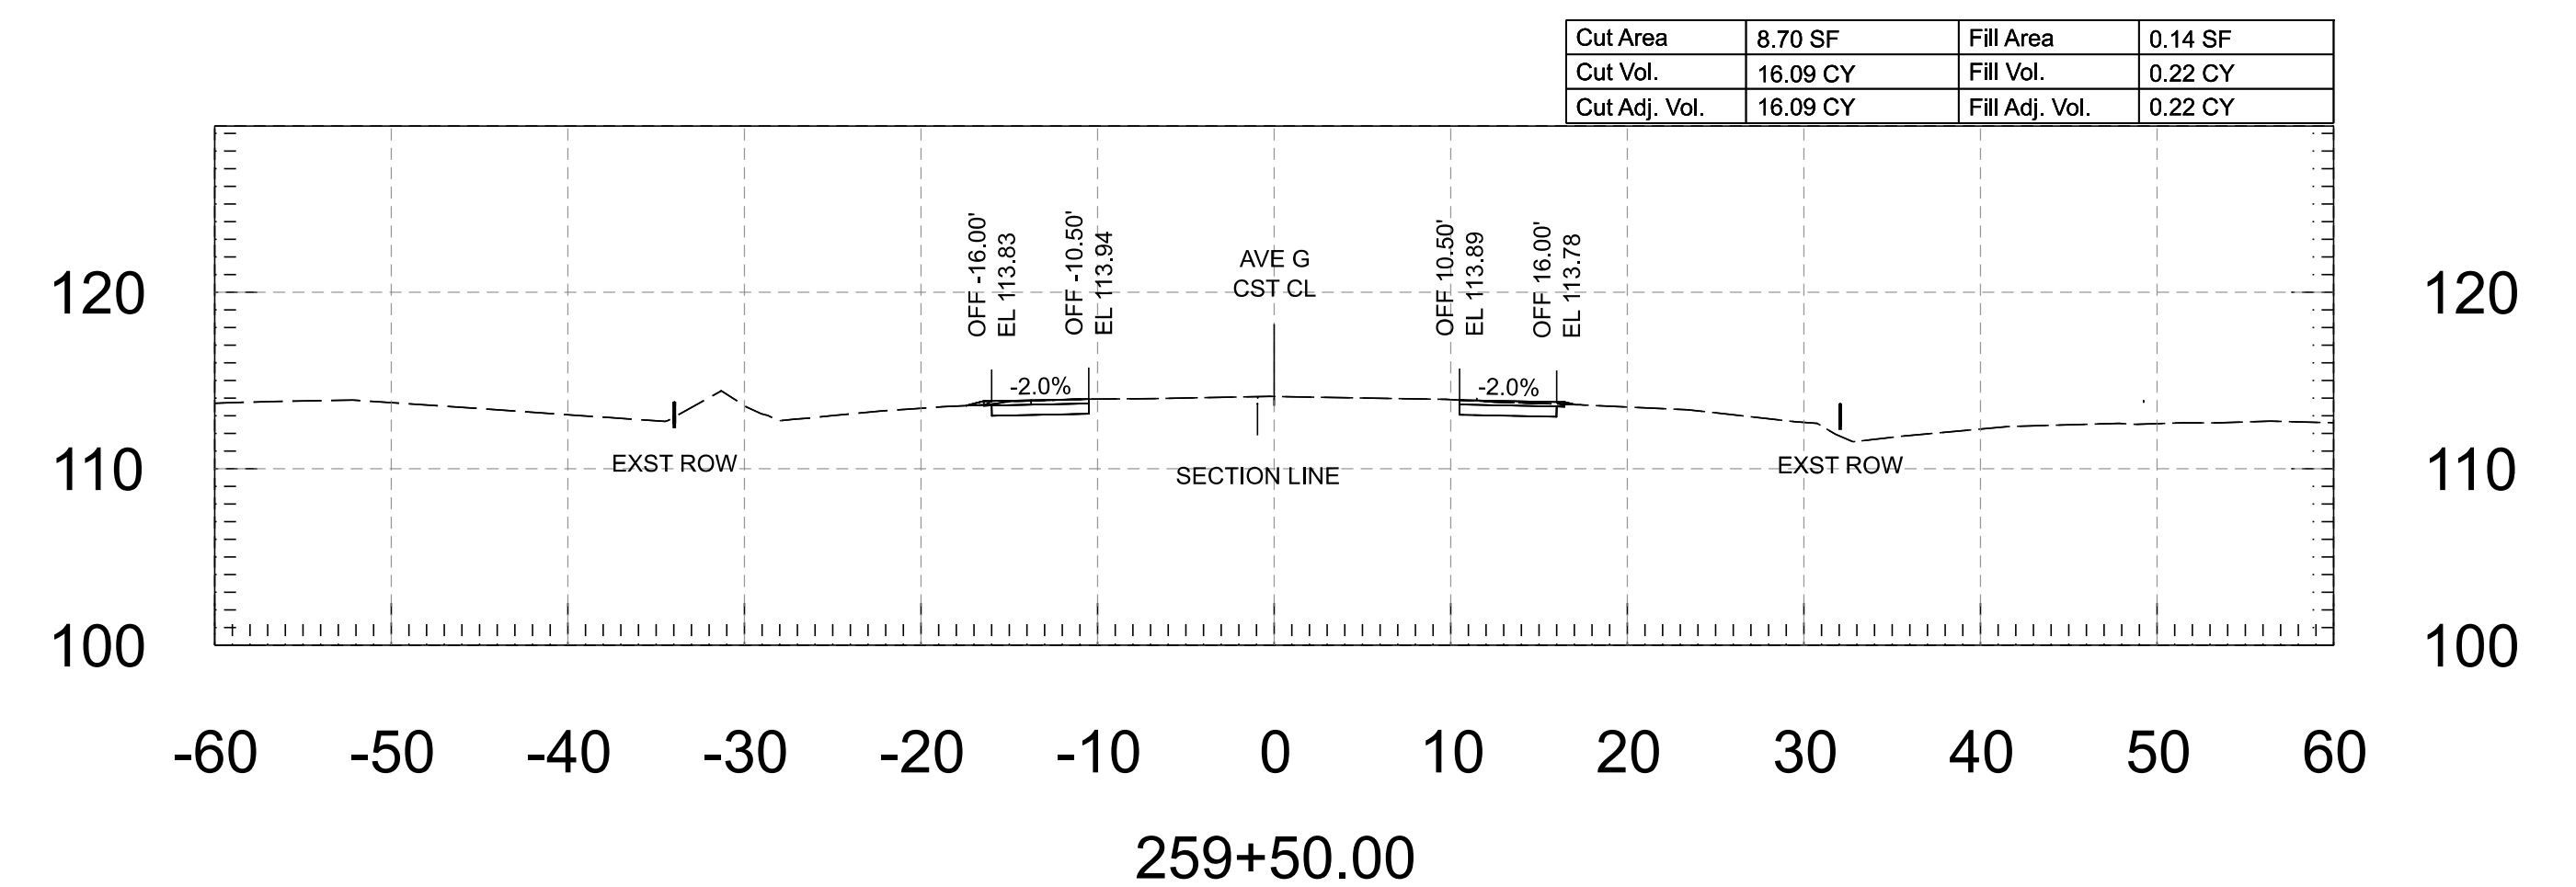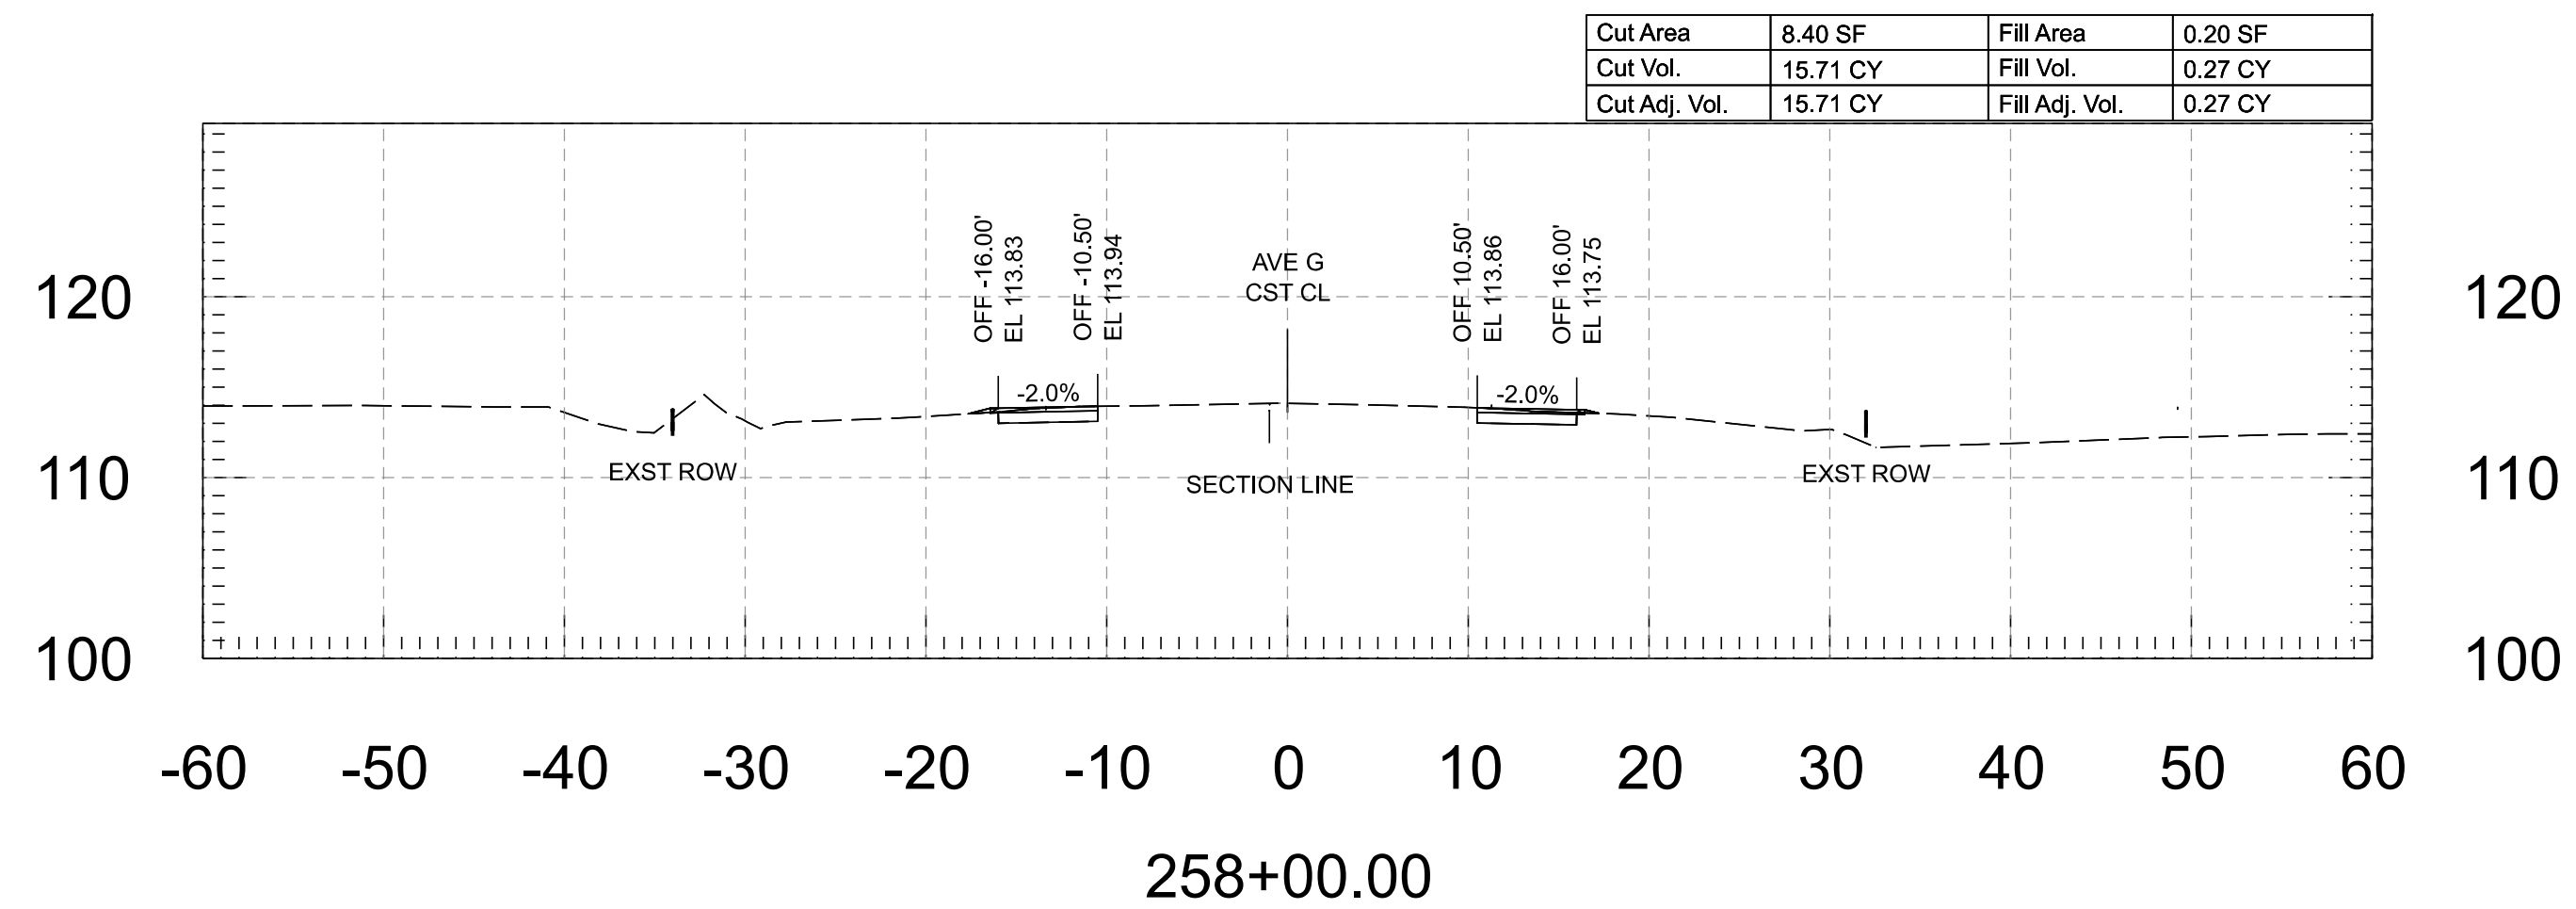


FOR INFORMATION ONLY		NAME	DATE	ARIZONA DEPARTMENT OF TRANSPORTATION PROJECT DELIVERY AND OPERATIONS DIVISION ROADWAY DESIGN SERVICES	ROUTE	F.H.W.A. Arizona Division	STATE ARIZ.	PROJECT NO.	FEDERAL ID NO.	SHEET NO.	TOTAL SHEETS	RECORD DRAWING
	DESIGN	M. SCHOEN	07/26		MILEPOST			0000 YU YYU	YYU-0(225)T	116	118	
	DRAWN	M. SCHOEN	07/26			STRUCTURE NO.	LOCATION AVENUE G, COUNTY 11TH ST - COUNTY 16TH ST					
	CHECKED	H. RIOS	07/26	TRACS NO. T0437 01C						___ OF ___		
	 WSP USA Inc. 1200 West Washington Street, Suite 405 Tempe, AZ 85280			AVENUE G - CROSS SECTIONS								

Cut Area	9.69 SF	Fill Area	0.03 SF
Cut Vol.	17.75 CY	Fill Vol.	0.03 CY
Cut Adj. Vol.	17.75 CY	Fill Adj. Vol.	0.03 CY

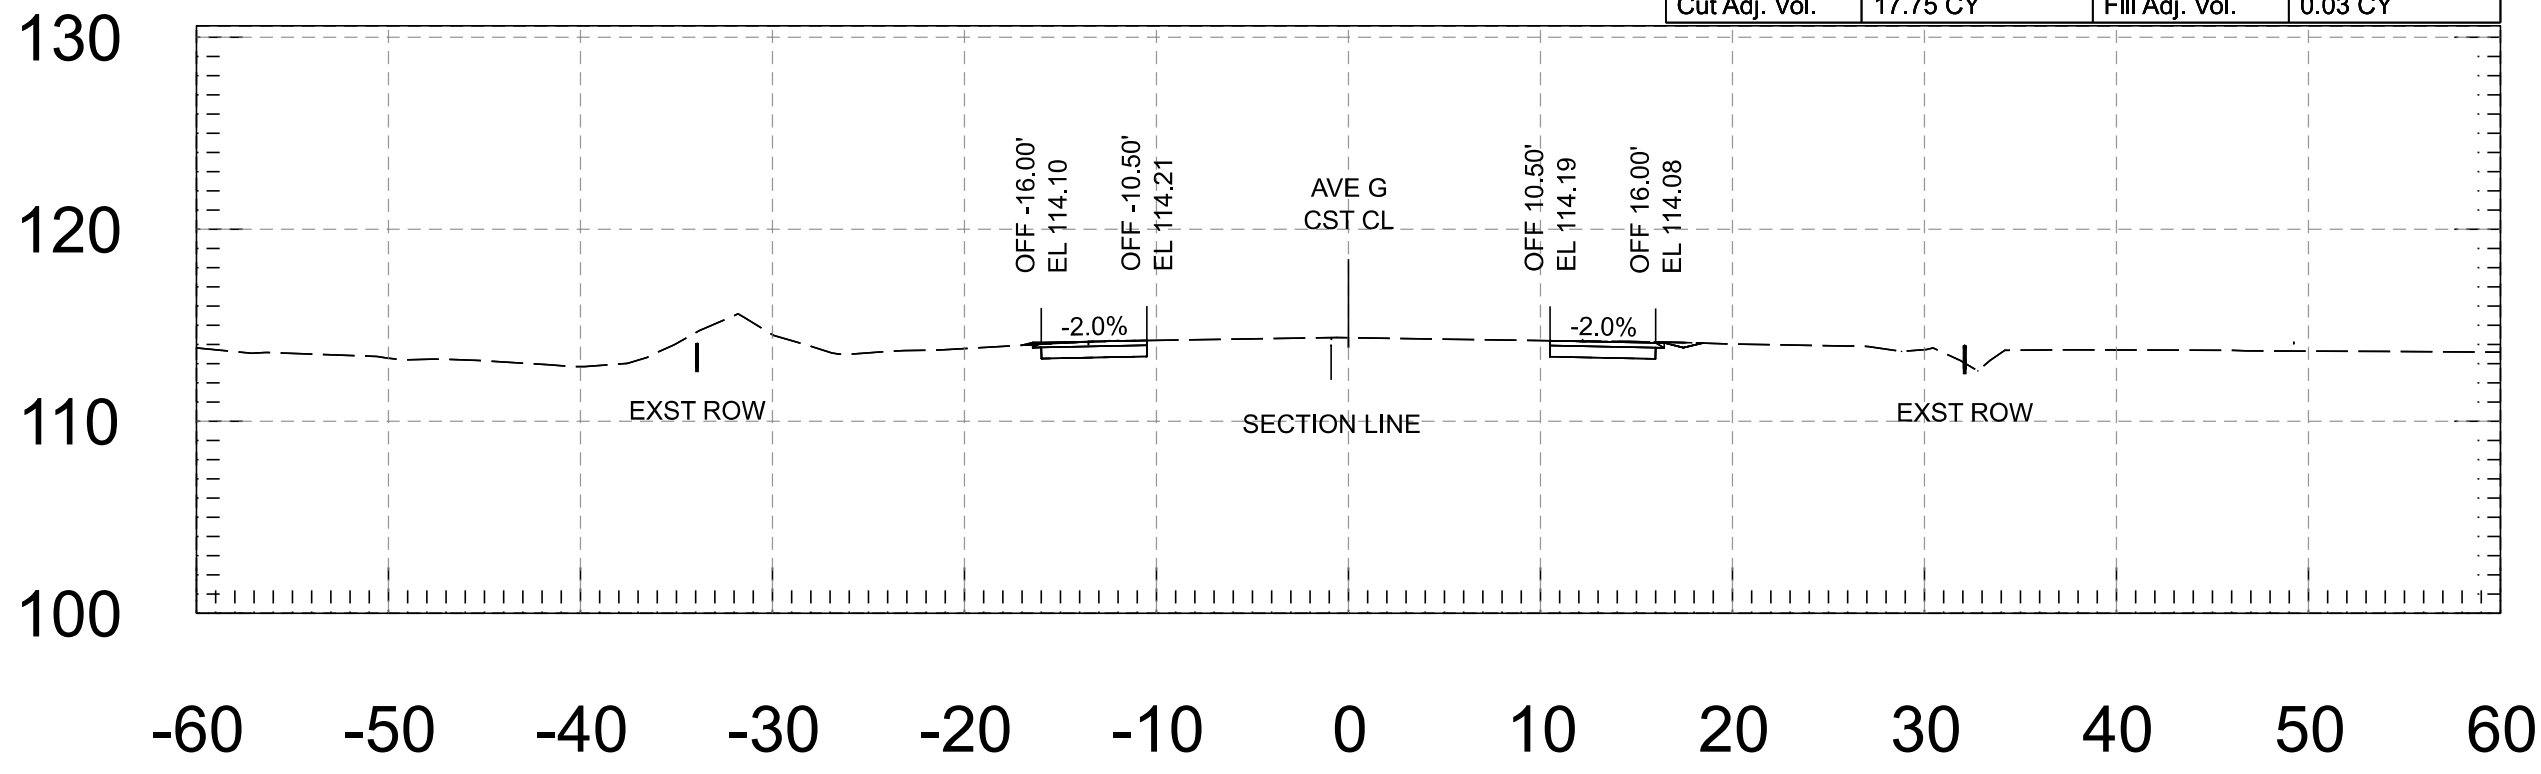


261+00.00

Cut Area	9.16 SF	Fill Area	0.02 SF
Cut Vol.	17.51 CY	Fill Vol.	0.04 CY
Cut Adj. Vol.	17.51 CY	Fill Adj. Vol.	0.04 CY

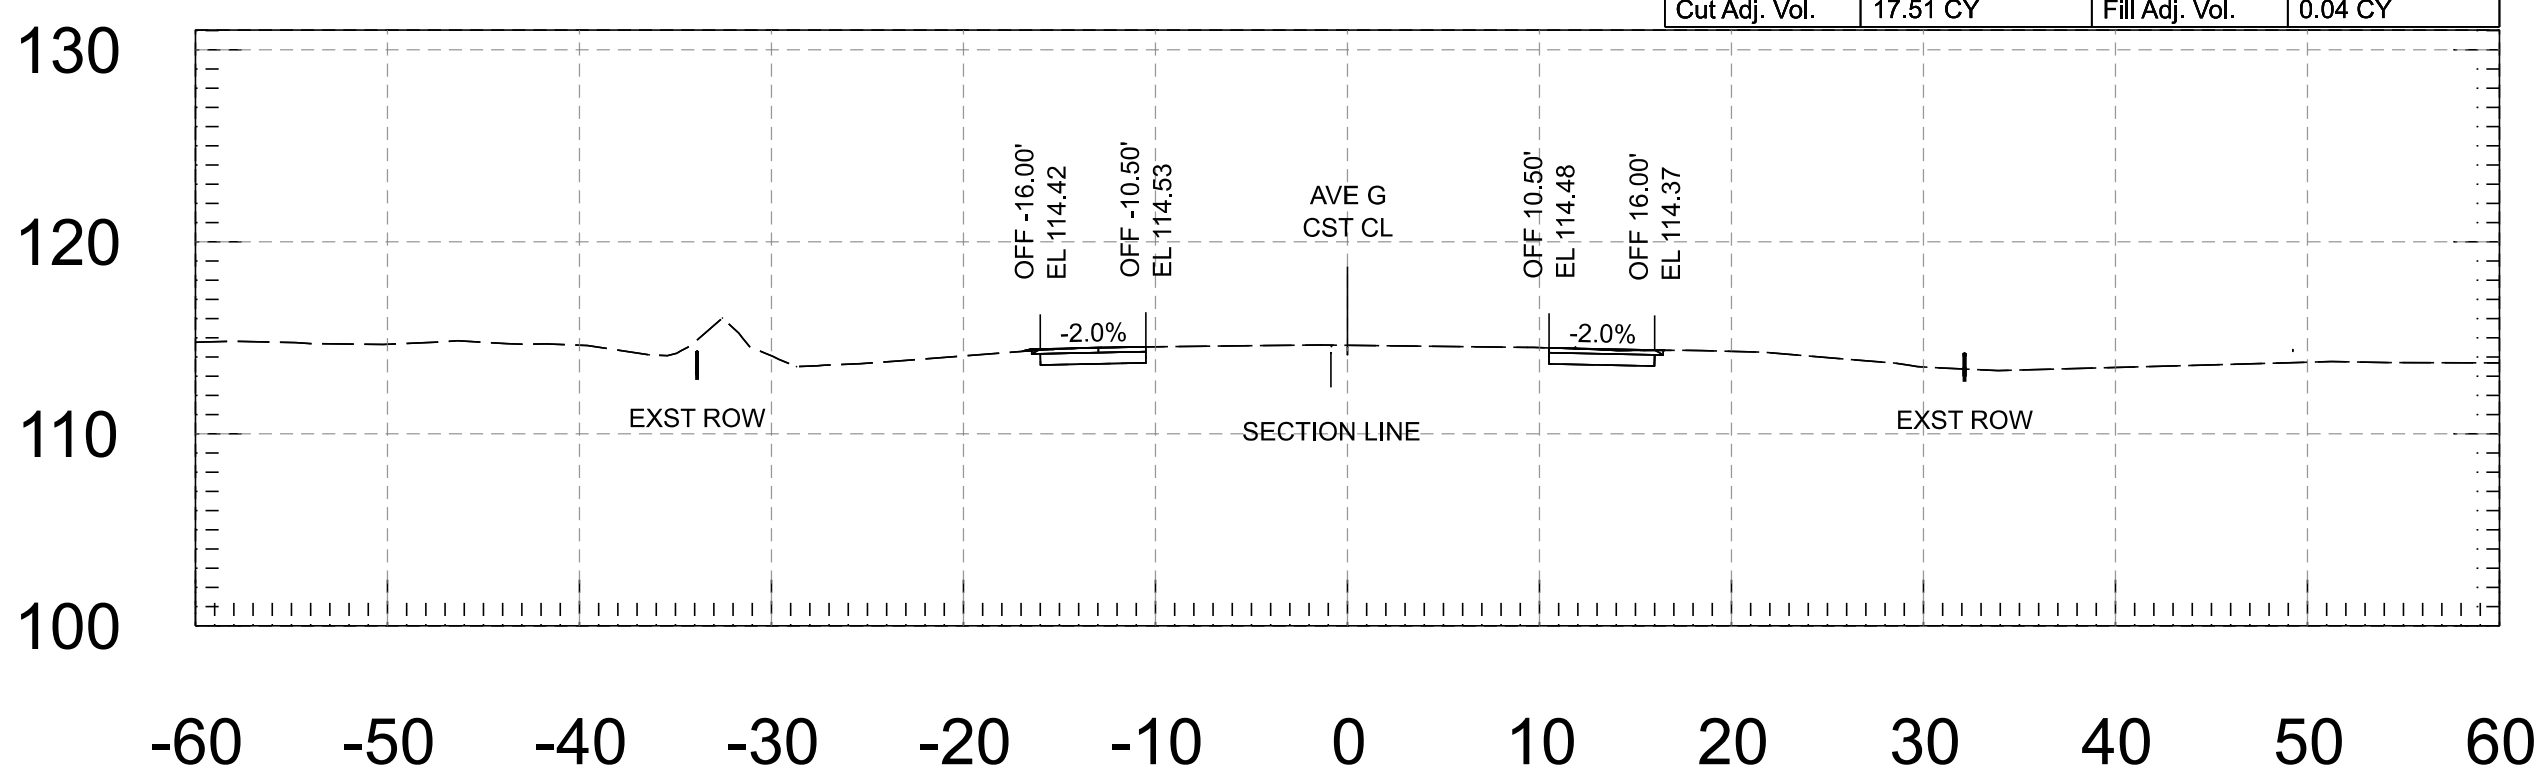


262+50.00

Cut Area	9.48 SF	Fill Area	0.00 SF
Cut Vol.	16.77 CY	Fill Vol.	0.09 CY
Cut Adj. Vol.	16.77 CY	Fill Adj. Vol.	0.09 CY

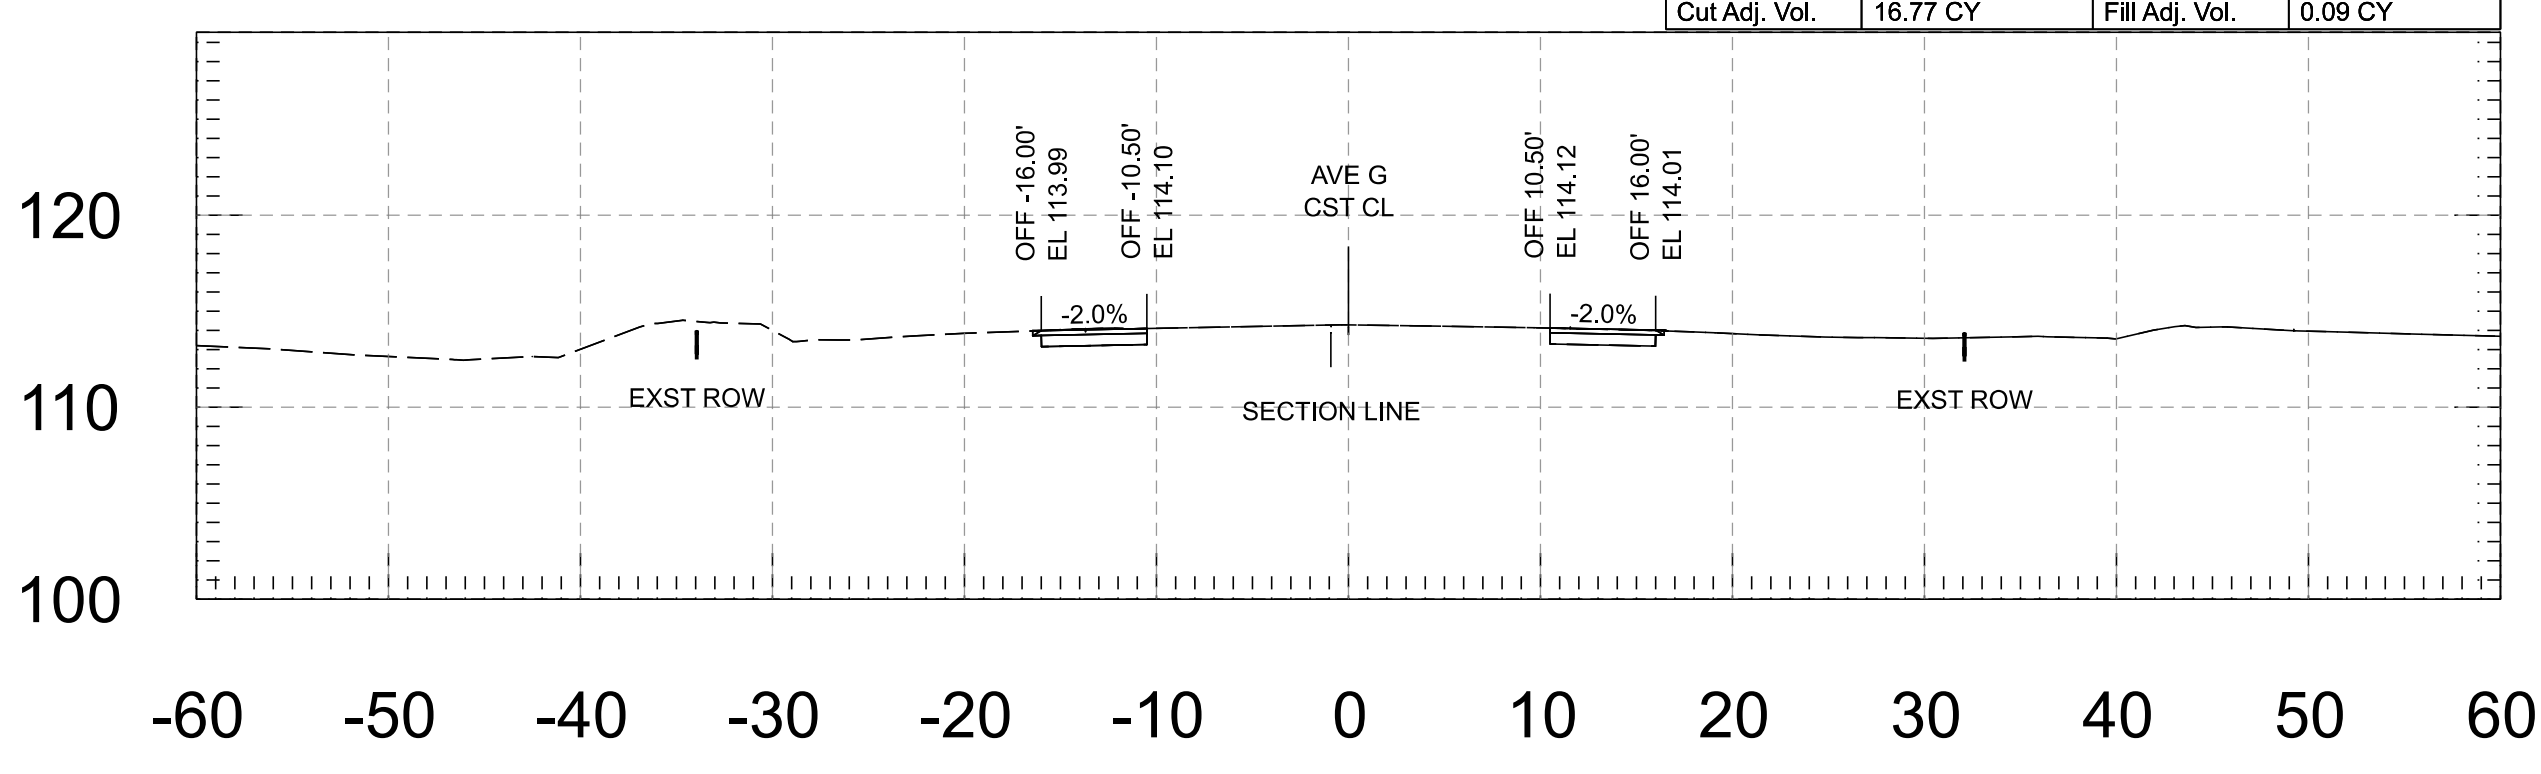


260+50.00

Cut Area	9.75 SF	Fill Area	0.03 SF
Cut Vol.	17.47 CY	Fill Vol.	0.12 CY
Cut Adj. Vol.	17.47 CY	Fill Adj. Vol.	0.12 CY

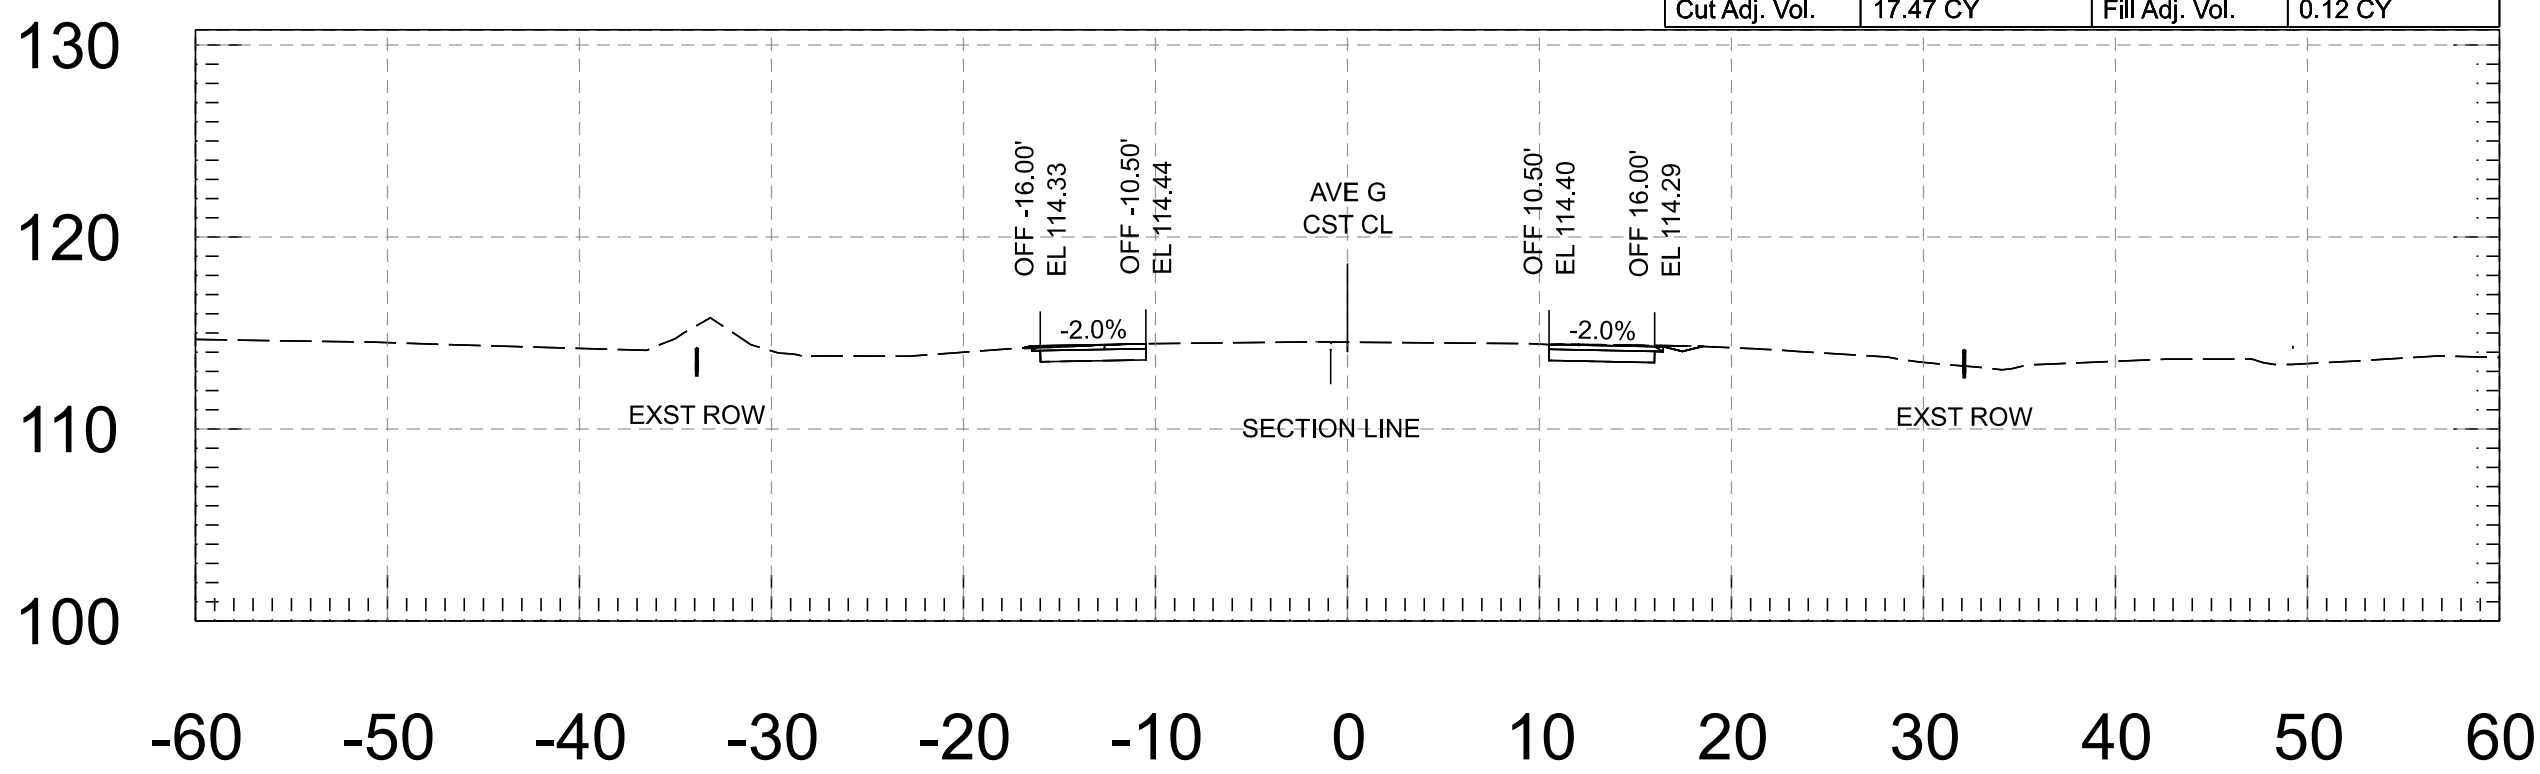


262+00.00

Cut Area	8.63 SF	Fill Area	0.09 SF
Cut Vol.	16.04 CY	Fill Vol.	0.21 CY
Cut Adj. Vol.	16.04 CY	Fill Adj. Vol.	0.21 CY

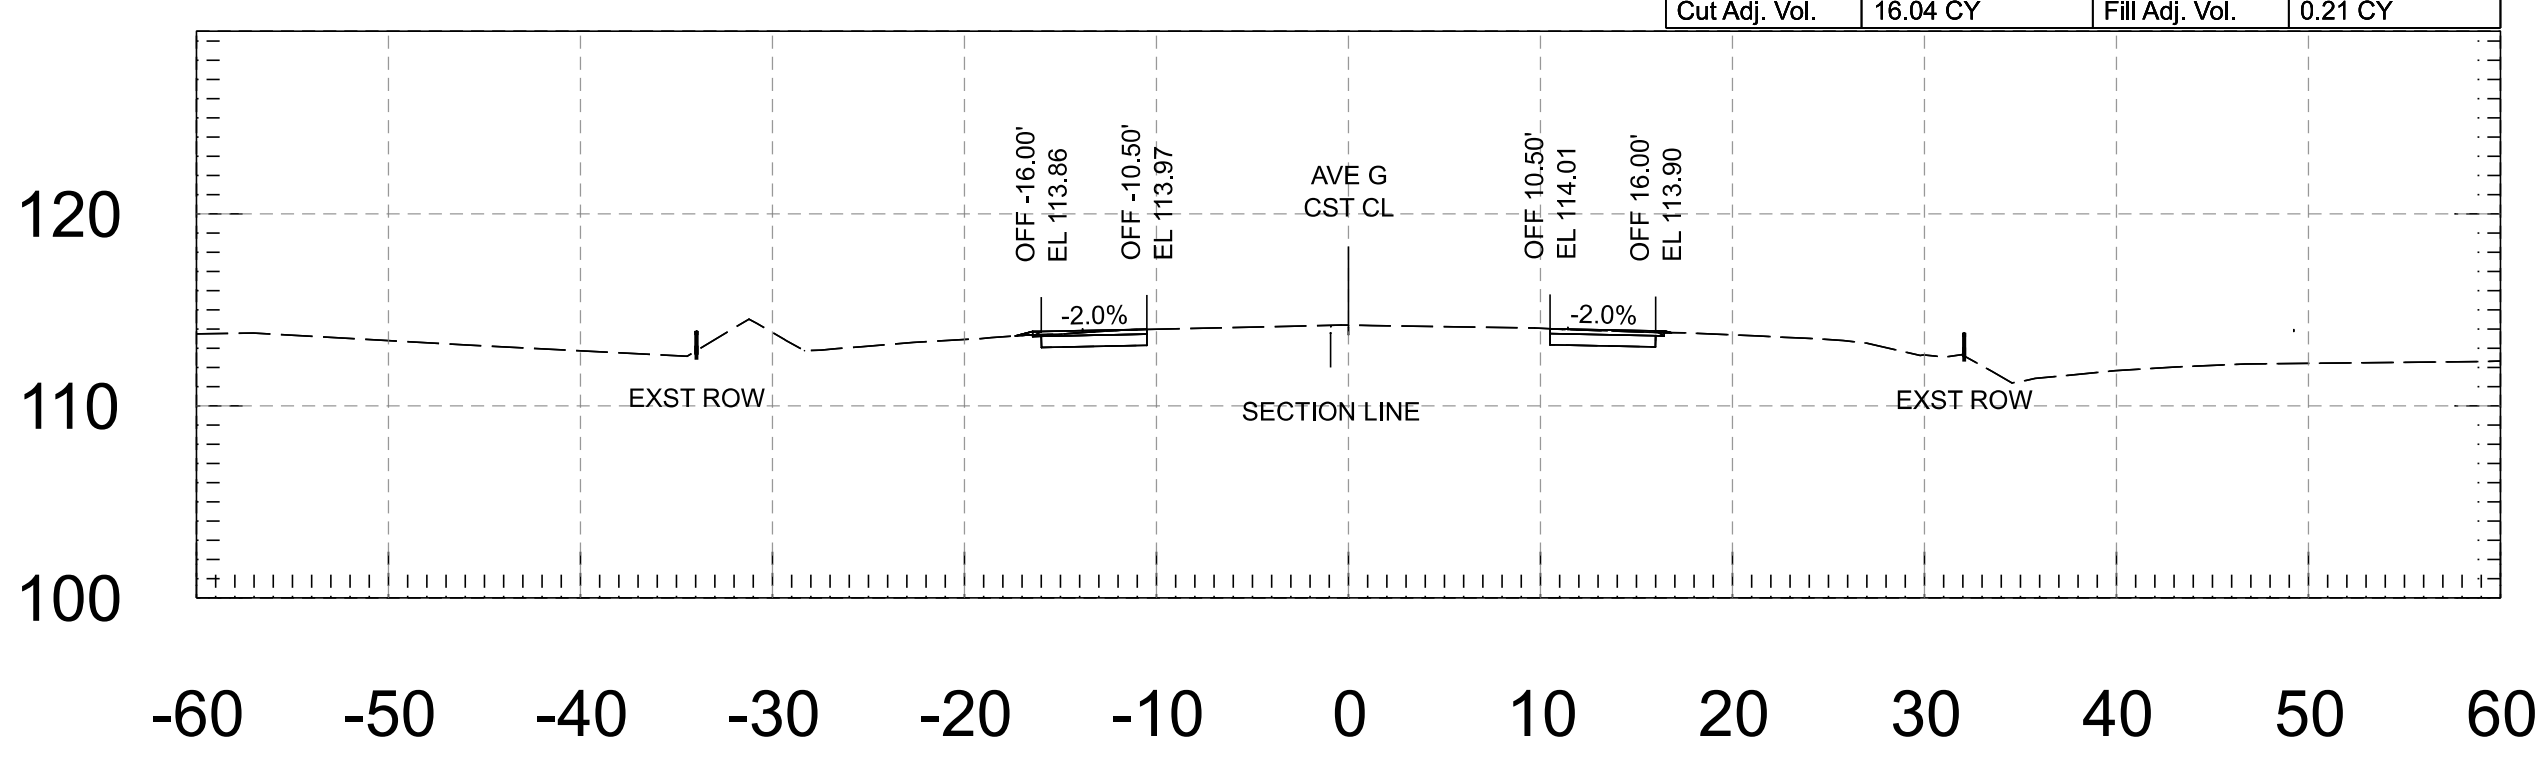

260+00.00

Cut Area	9.12 SF	Fill Area	0.10 SF
Cut Vol.	17.42 CY	Fill Vol.	0.12 CY
Cut Adj. Vol.	17.42 CY	Fill Adj. Vol.	0.12 CY

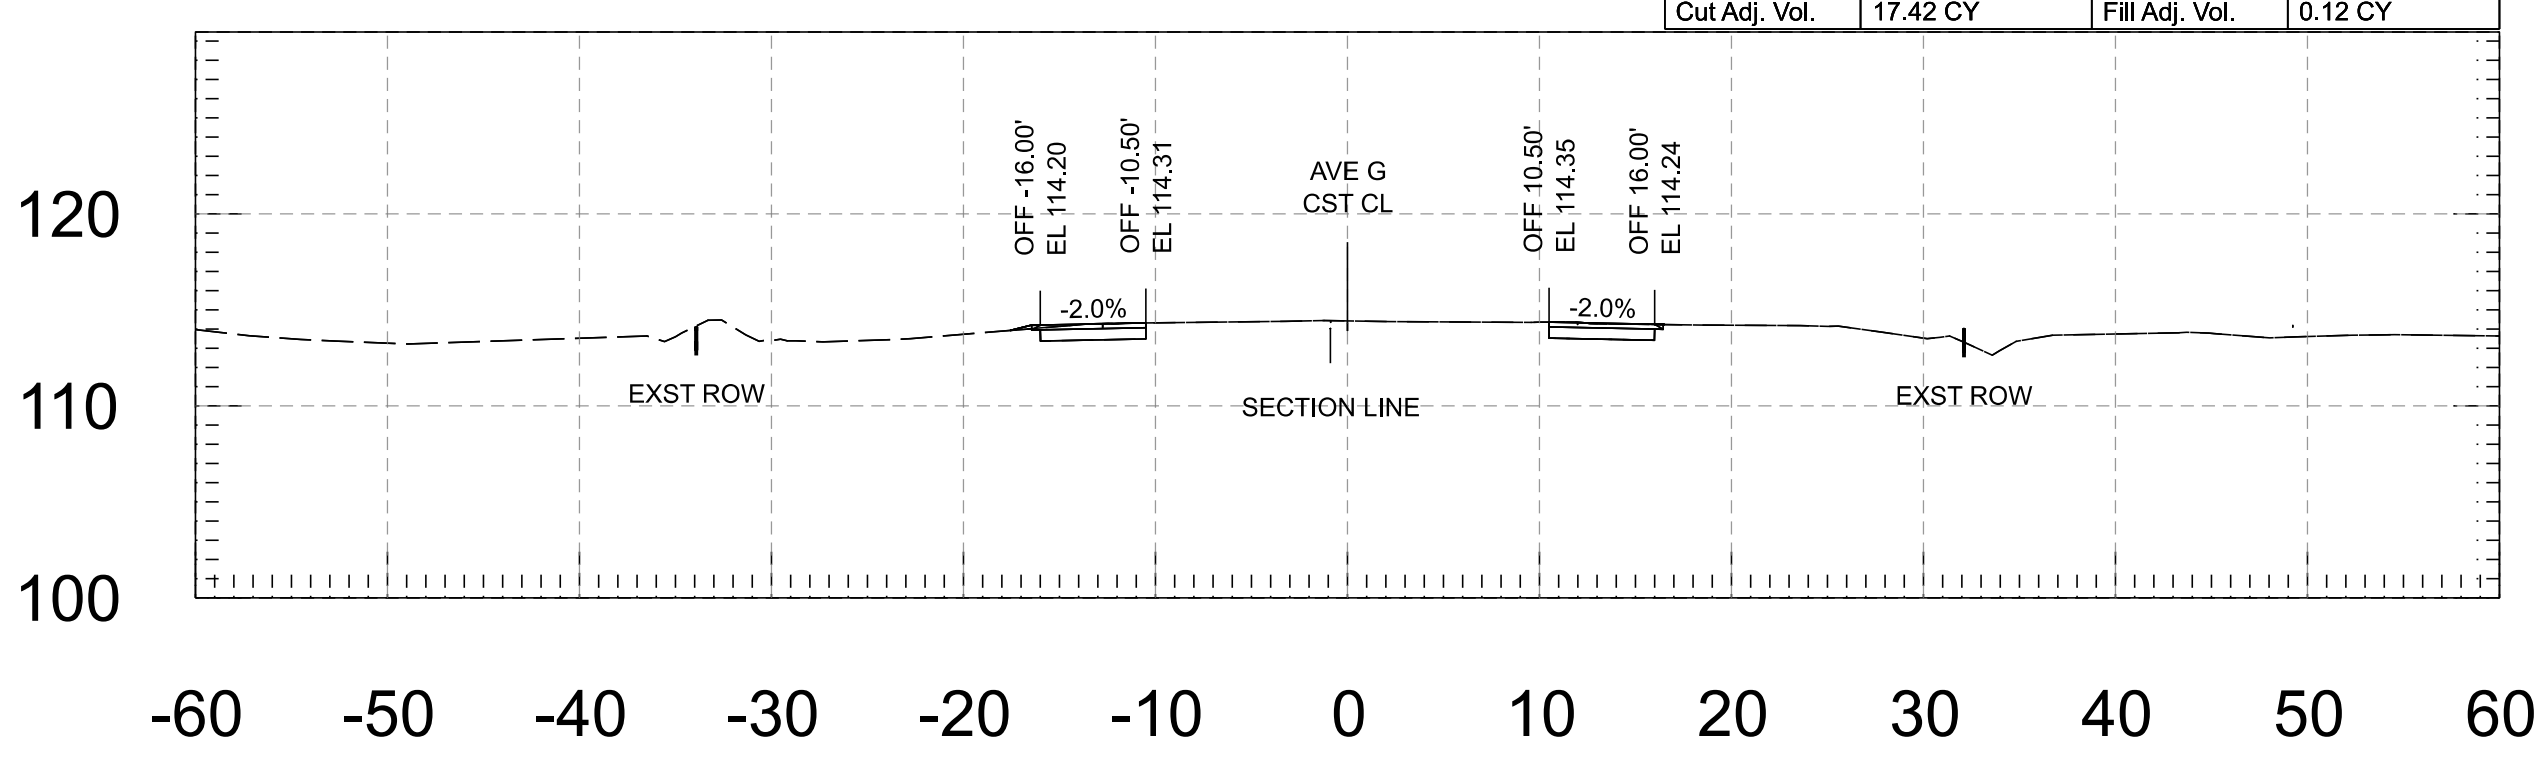

261+50.00

FOR INFORMATION ONLY		NAME	DATE	ARIZONA DEPARTMENT OF TRANSPORTATION PROJECT DELIVERY AND OPERATIONS DIVISION ROADWAY DESIGN SERVICES	ROUTE	F.H.W.A. Arizona Division	STATE ARIZ.	PROJECT NO.	FEDERAL ID NO.	SHEET NO.	TOTAL SHEETS	RECORD DRAWING
	DESIGN	M. SCHOEN	07/26					0000 YU YYU	YYU-0(225)T	117	118	
	DRAWN	M. SCHOEN	07/26		AVENUE G - CROSS SECTIONS	MILEPOST	LOCATION AVENUE G, COUNTY 11TH ST - COUNTY 16TH ST					
	CHECKED	H. RIOS	07/26	STRUCTURE NO.		TRACS NO. T0437 01C						
			WSP USA Inc. 1230 West Washington Street, Suite 405 Tempe, AZ 85288									

