





STATE OF ARIZONA
DEPARTMENT OF TRANSPORTATION
PROJECT DELIVERY AND OPERATIONS DIVISION
CROSS SECTION

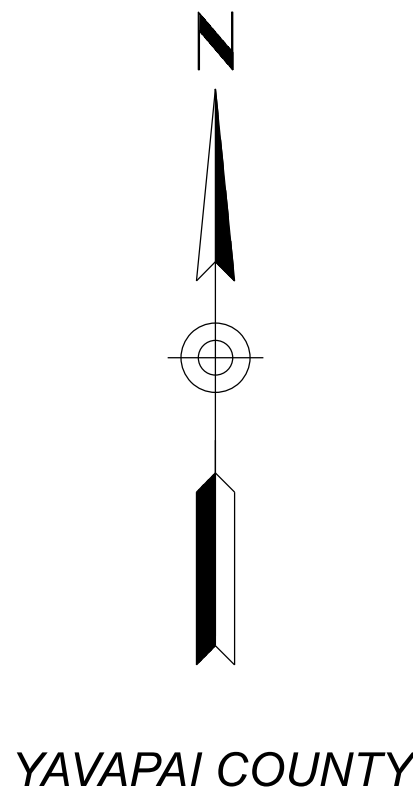

STATE HIGHWAY
CORDES JUNCTION - FLAGSTAFF HIGHWAY
INTERSTATE 17

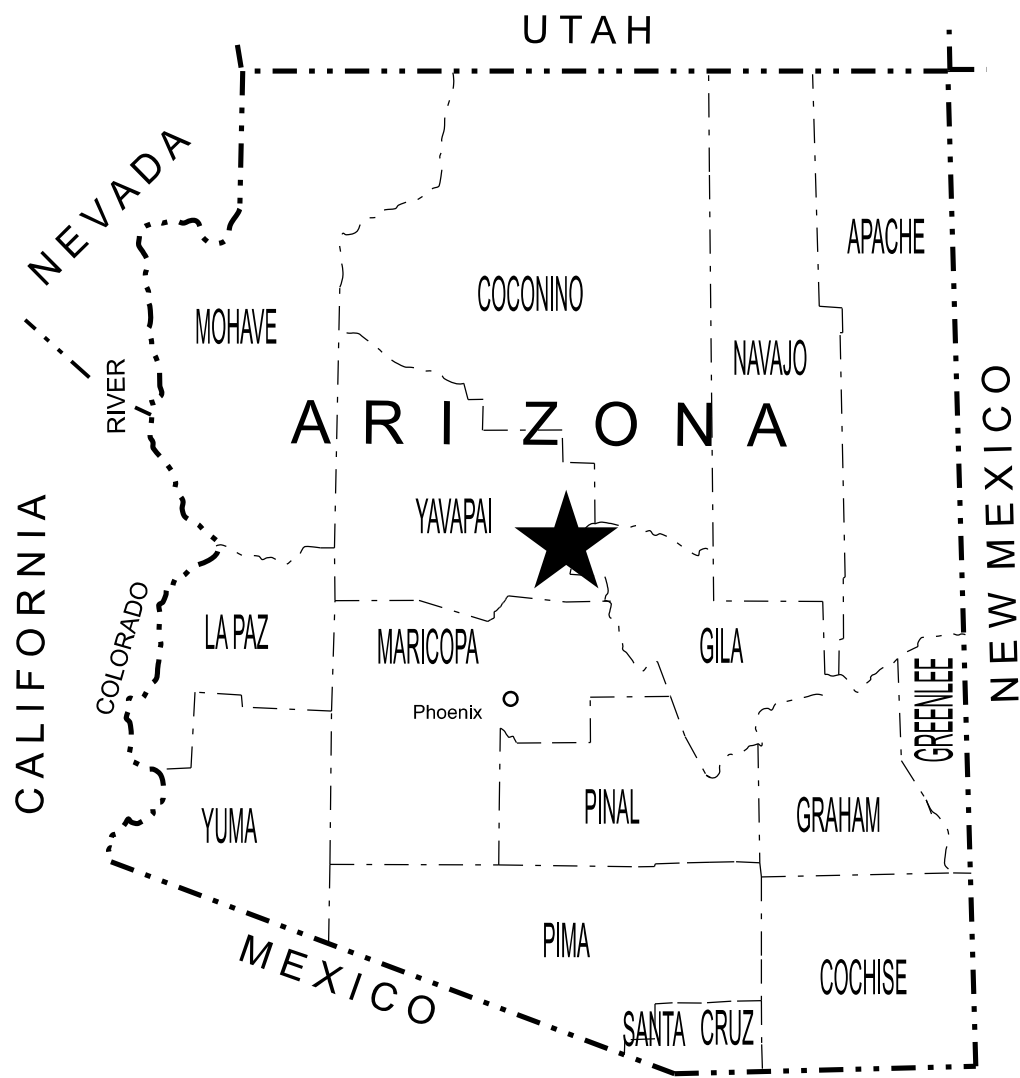

E DUGAS ROAD - MP 275
PROJECT NO. 017 YV 269 F0616 01C
FEDERAL AID NO. 017-B(239)T

Constructed by:

Construction Company

Completion Date

Red-Lines by:

Construction Administrator Name & Company

Completion Date


Record Drawings by:

Record Drawings Designer Name & Company

Completion Date




ARIZONA DEPARTMENT OF TRANSPORTATION
PROJECT DELIVERY AND OPERATIONS DIVISION
AUDRA MERRICK, P.E., STATE ENGINEER

REC. DWGS. DATA	REC. DWG. DATE	OF
--------------------	----------------	----



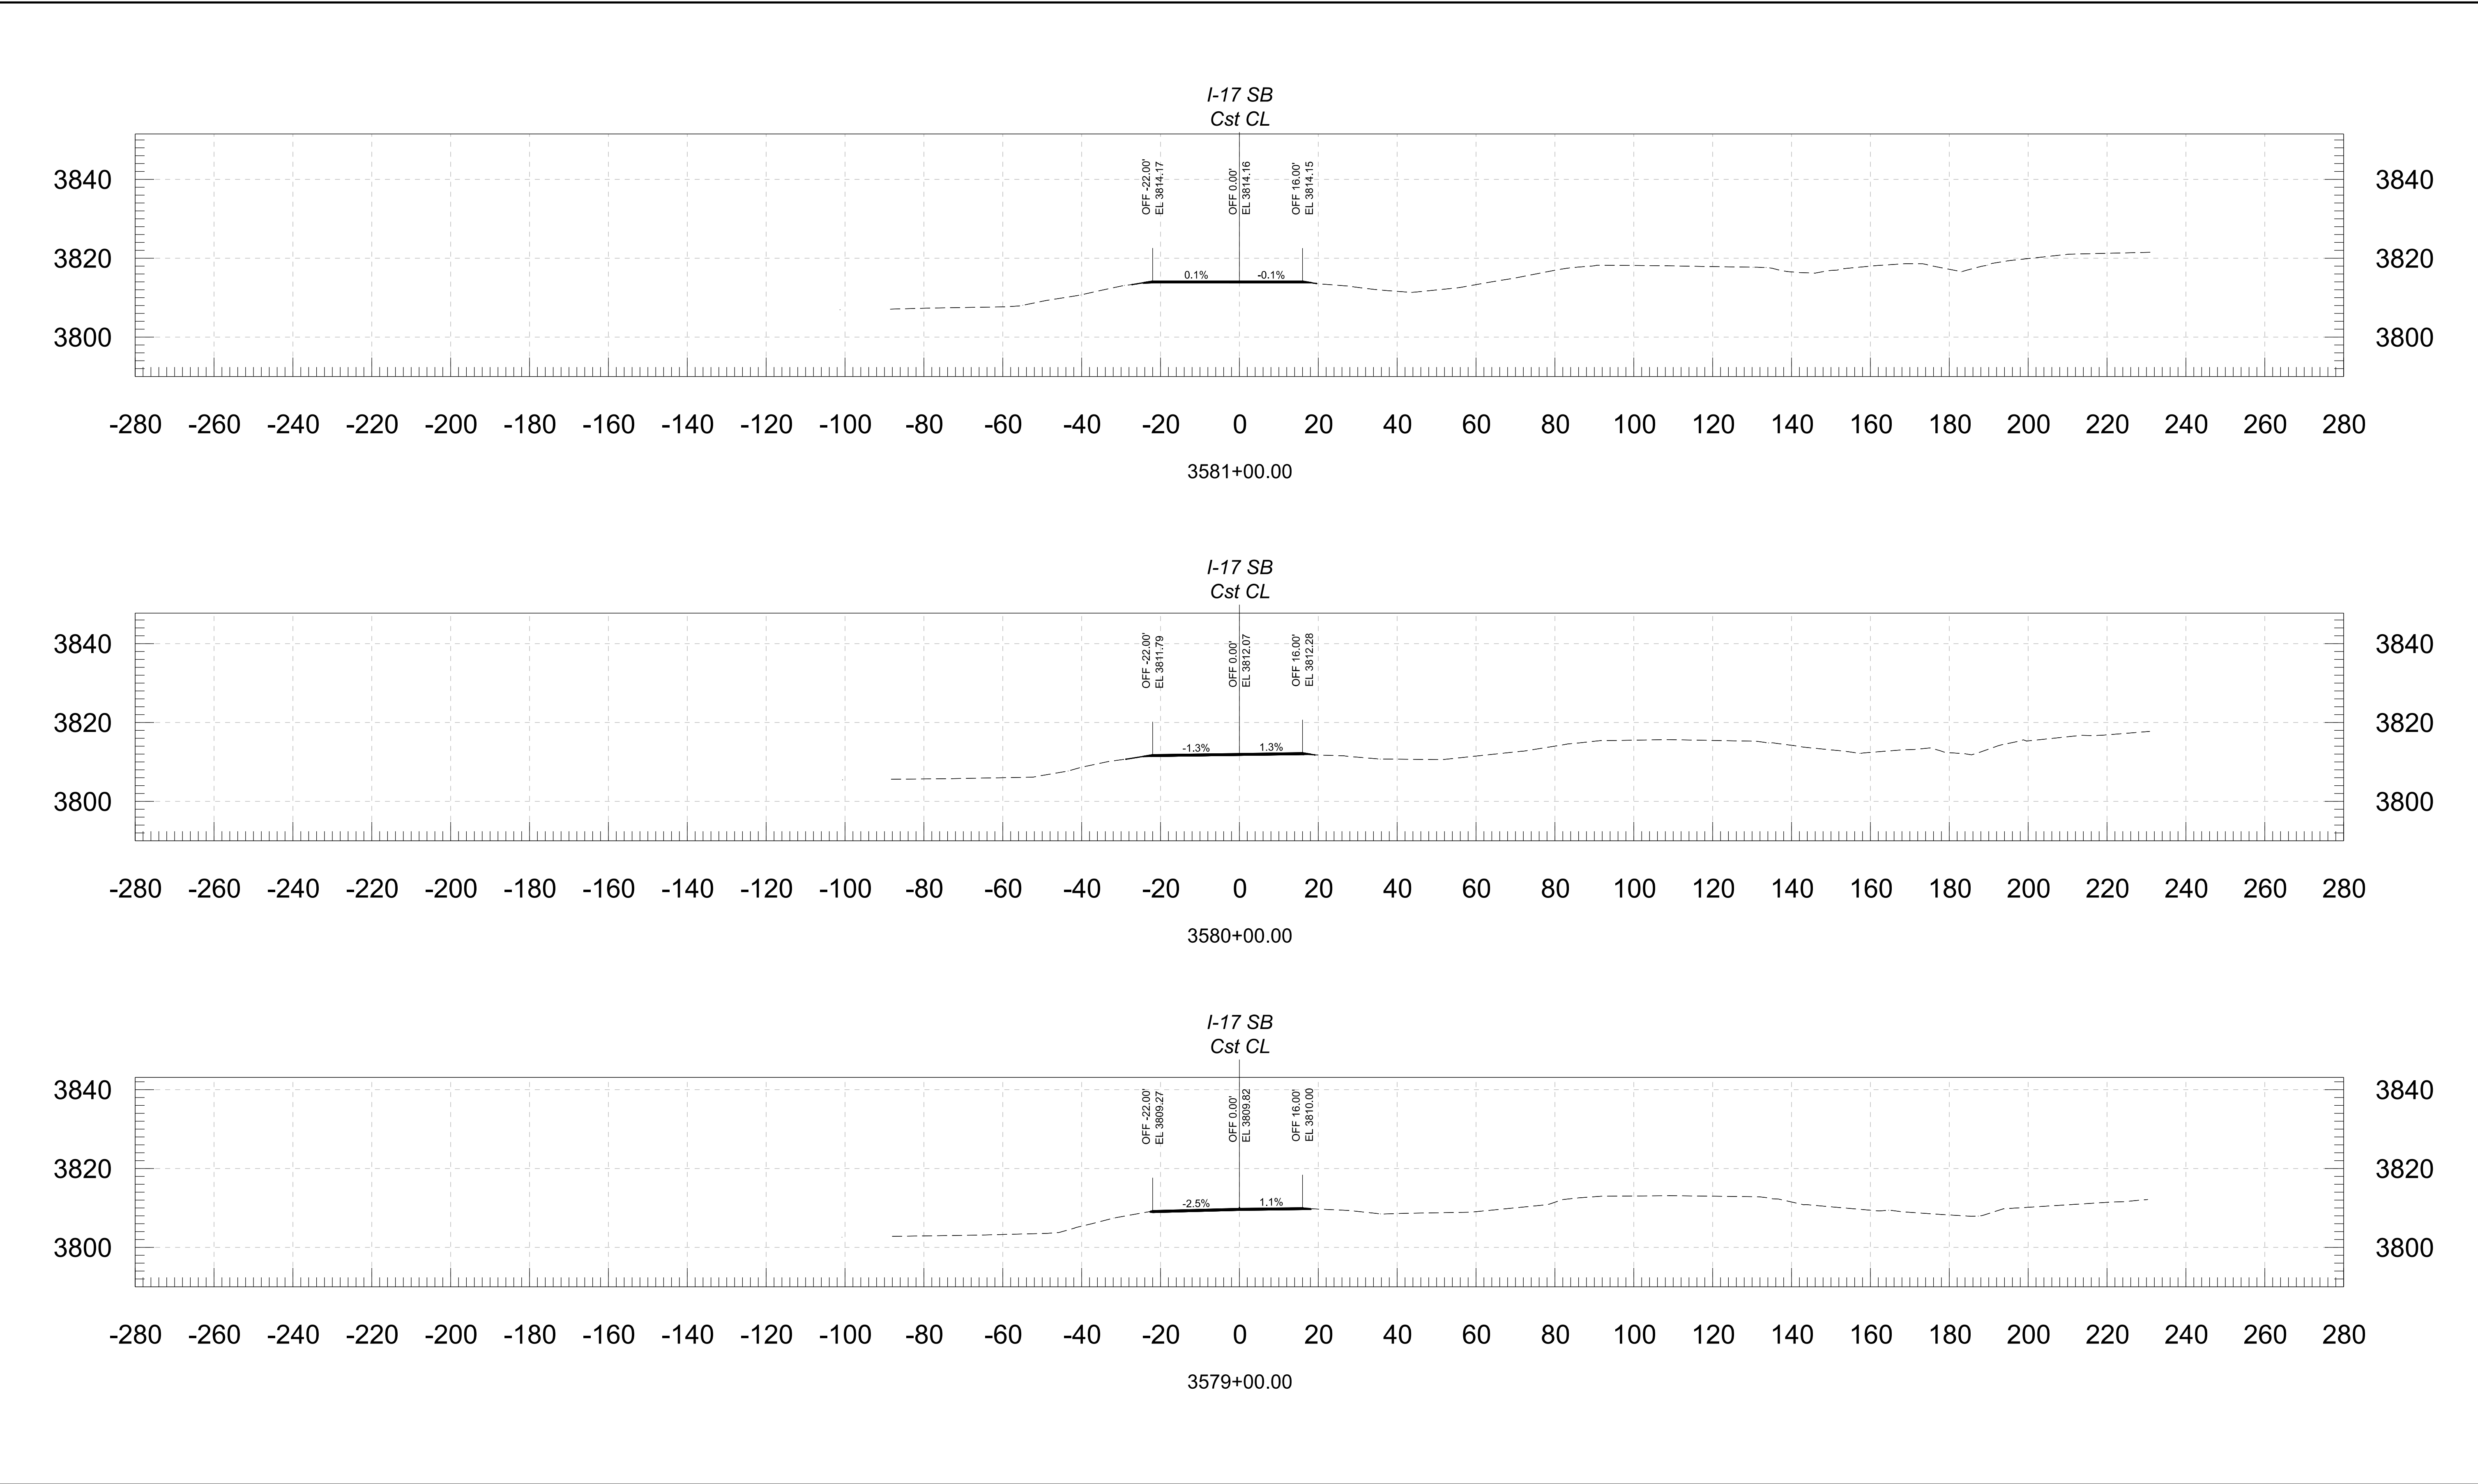


 
				NAME	DATE	ARIZONA DEPARTMENT OF TRANSPORTATION PROJECT DELIVERY AND OPERATIONS DIVISION ROADWAY DESIGN SERVICES	ROUTE	F.H.W.A. Arizona Division	STATE ARIZ.	PROJECT NO.	FEDERAL ID NO.	SHEET NO.	TOTAL SHEETS	RECORD DRAWING
			DESIGN	BAP	06/26		MILEPOST			017 YV 269	017-B(239)T	2	146	
			DRAWN	RM	06/26									
			CHECKED	KCH	06/26			STRUCTURE NO.	E DUGAS ROAD - MP 275				DWG NO.	
			 3133 East Camelback Road, Suite 100 Phoenix, Arizona 85016 Phone: 602.333-2200 Stanley Consultants INC.				CROSS SECTION			TRACS NO. F0616 01C		____ OF ____		






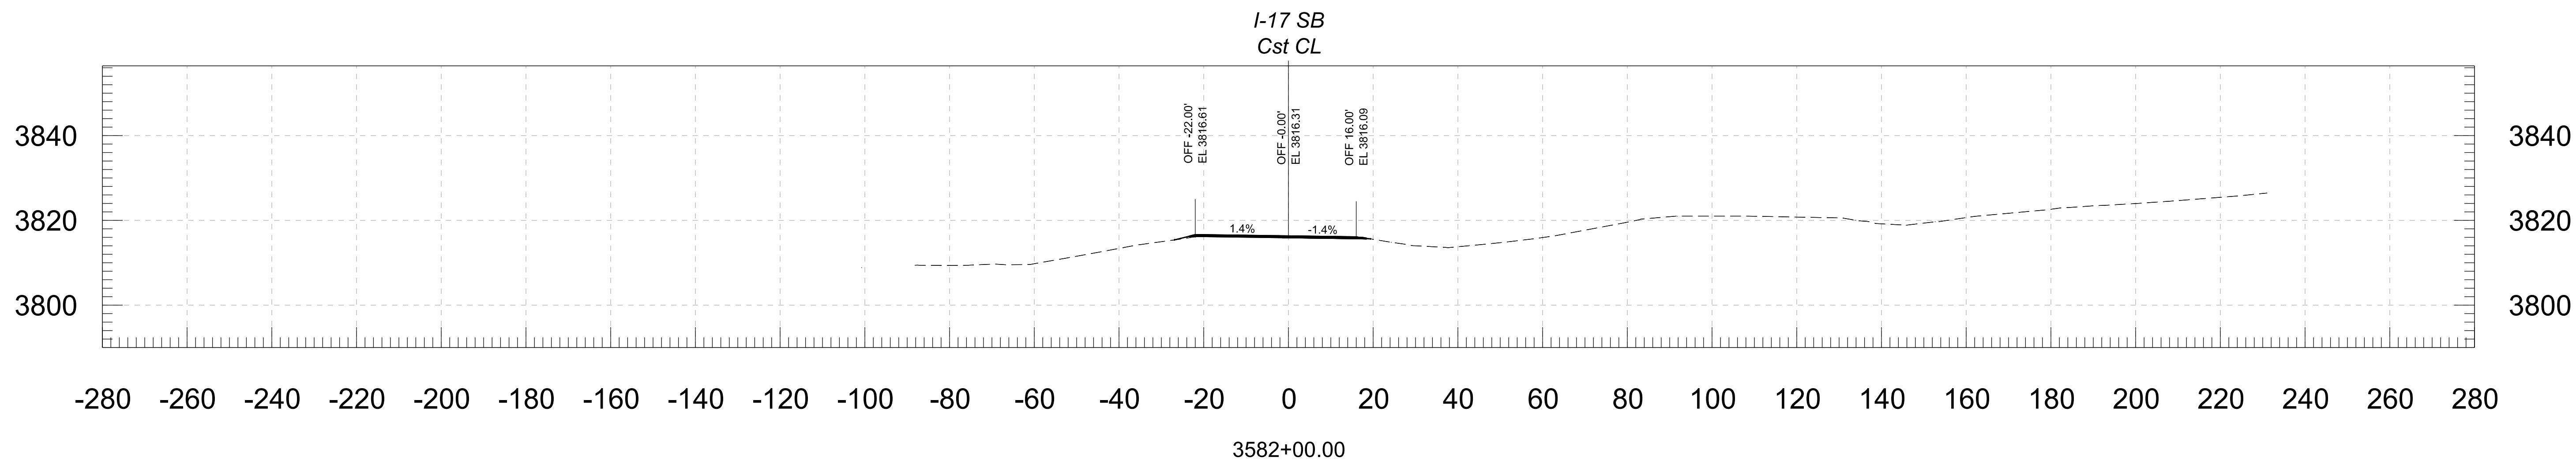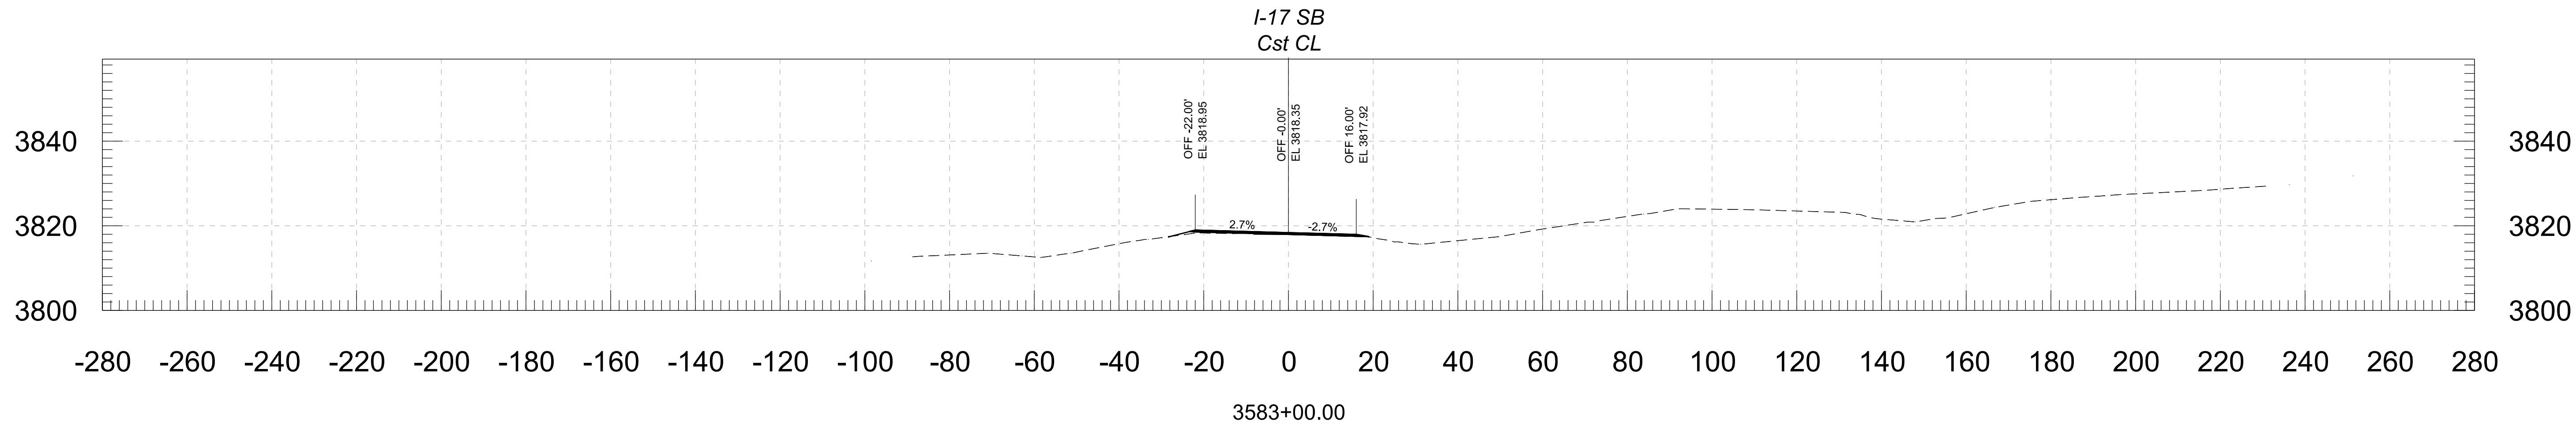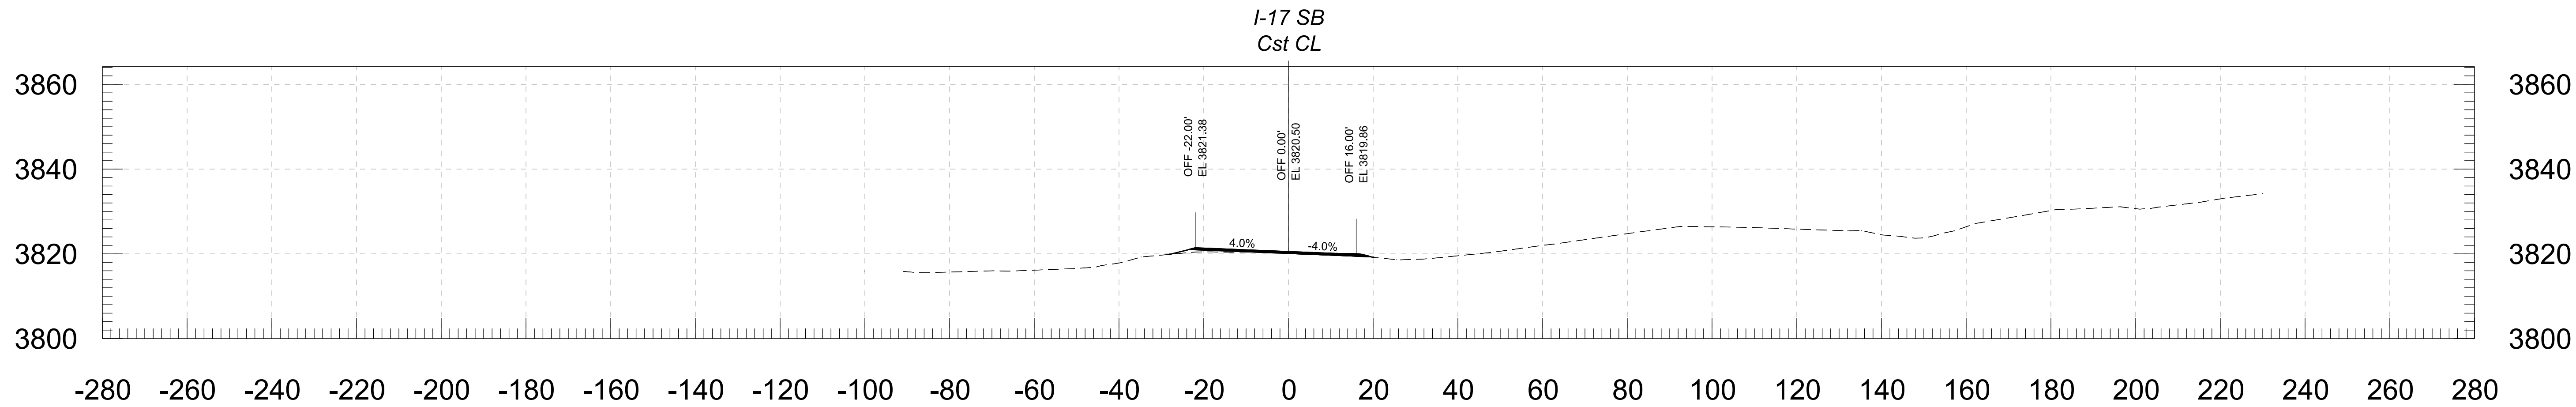



			NAME	DATE	ARIZONA DEPARTMENT OF TRANSPORTATION PROJECT DELIVERY AND OPERATIONS DIVISION ROADWAY DESIGN SERVICES	ROUTE	F.H.W.A. Arizona Division	STATE	PROJECT NO.	FEDERAL ID NO.	SHEET NO.	TOTAL SHEETS	RECORD DRAWING
		DESIGN	BAP	06/26		I-17							
		DRAWN	RM	06/26		MILEPOST	LOCATION	E DUGAS ROAD - MP 275	DWG NO.				
		CHECKED	KCH	06/26						STRUCTURE NO.	TRACS NO.	F0616 01C	OF
		 Stanley Consultants INC.	3133 East Camelback Road, Suite 100 Phoenix, Arizona 85016 Phone: 602. 333-2000		CROSS SECTION								

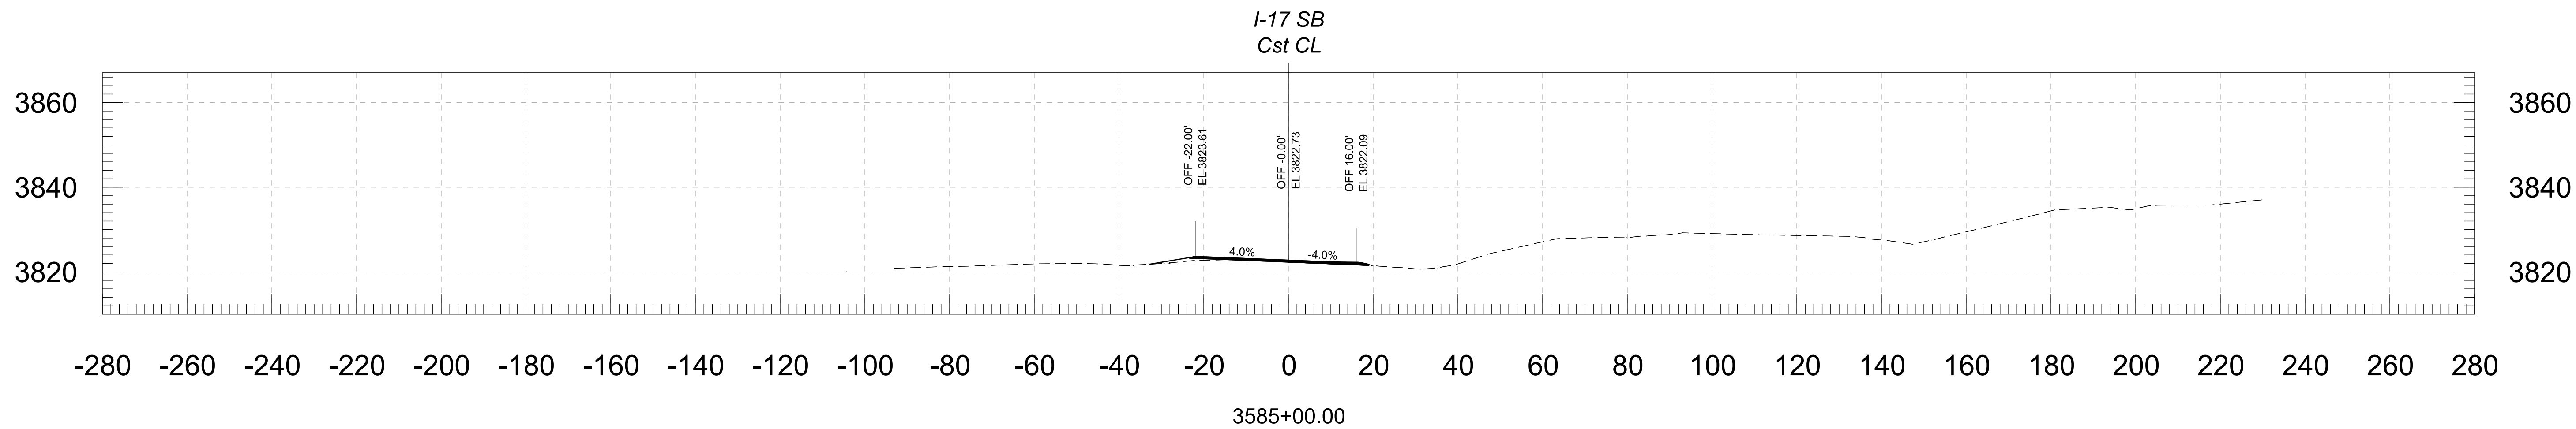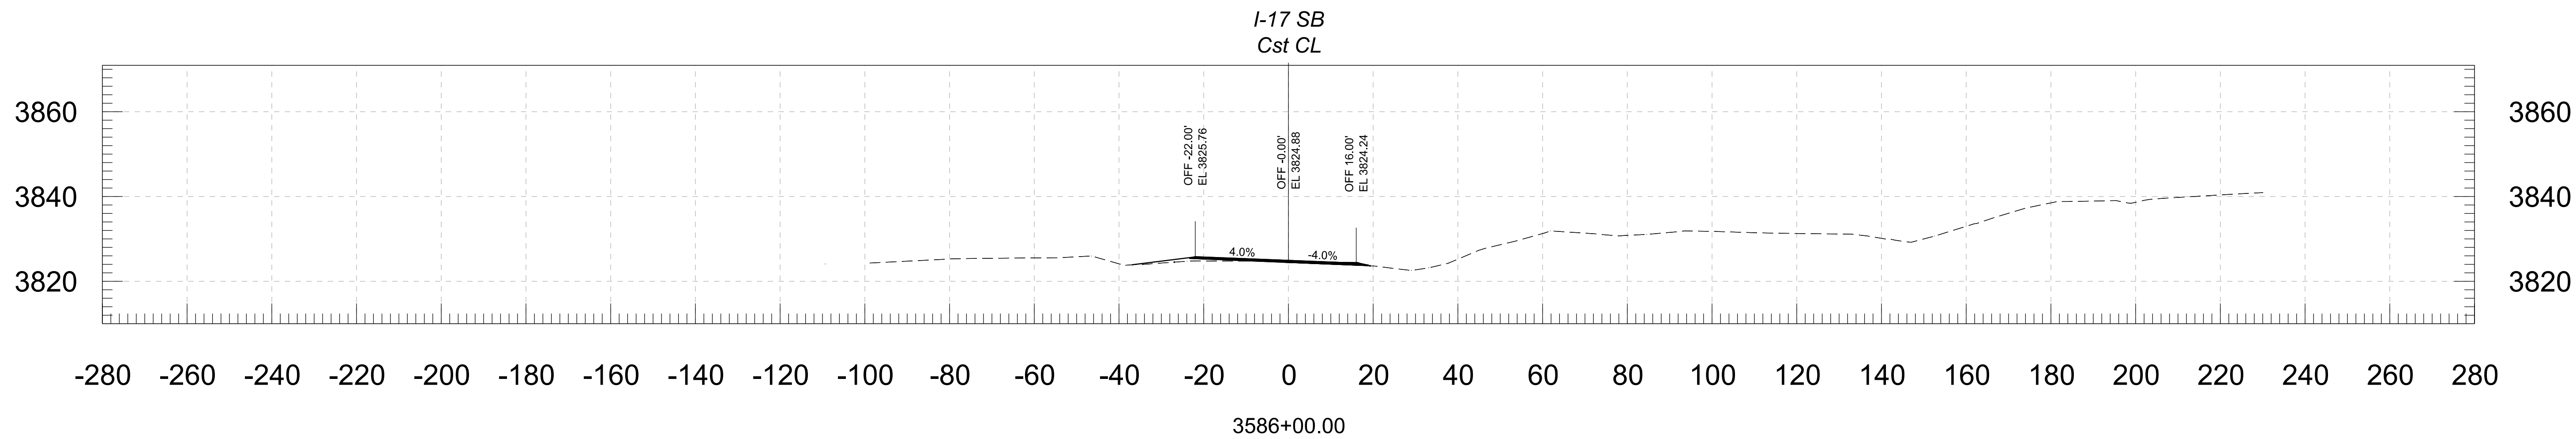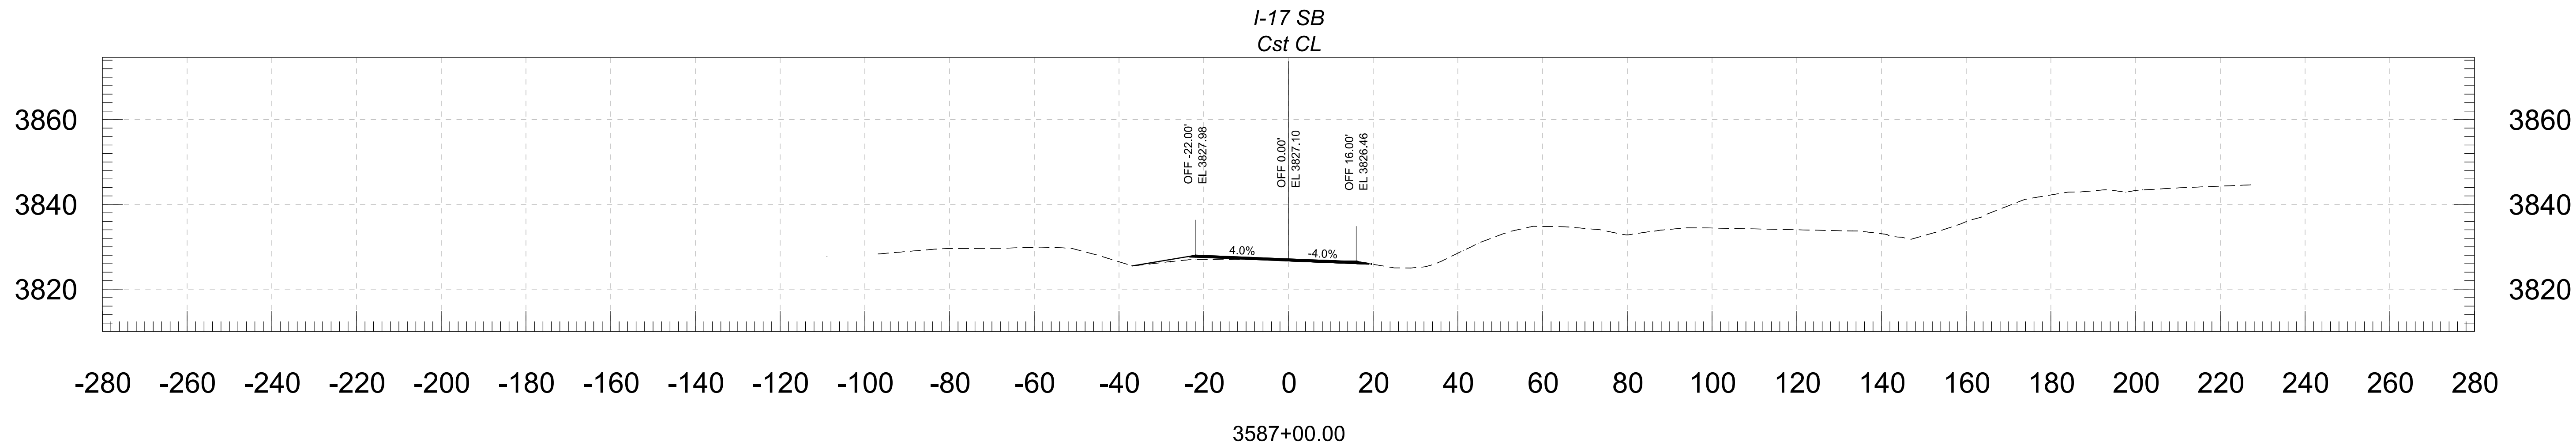



				NAME	DATE	ARIZONA DEPARTMENT OF TRANSPORTATION PROJECT DELIVERY AND OPERATIONS DIVISION ROADWAY DESIGN SERVICES	ROUTE	F.H.W.A. Arizona Division	STATE ARIZ.	PROJECT NO.	FEDERAL ID NO.	SHEET NO.	TOTAL SHEETS	RECORD DRAWING	
			DESIGN	BAP	06/26		I-17			017 YV 269	017-B(239)T	4	146		
			DRAWN	RM	06/26					LOCATION	E DUGAS ROAD - MP 275				DWG NO.
			CHECKED	KCH	06/26										
			 3133 East Camelback Road, Suite 100 Phoenix, Arizona 85016 Phone: 602) 333-2200				CROSS SECTION								

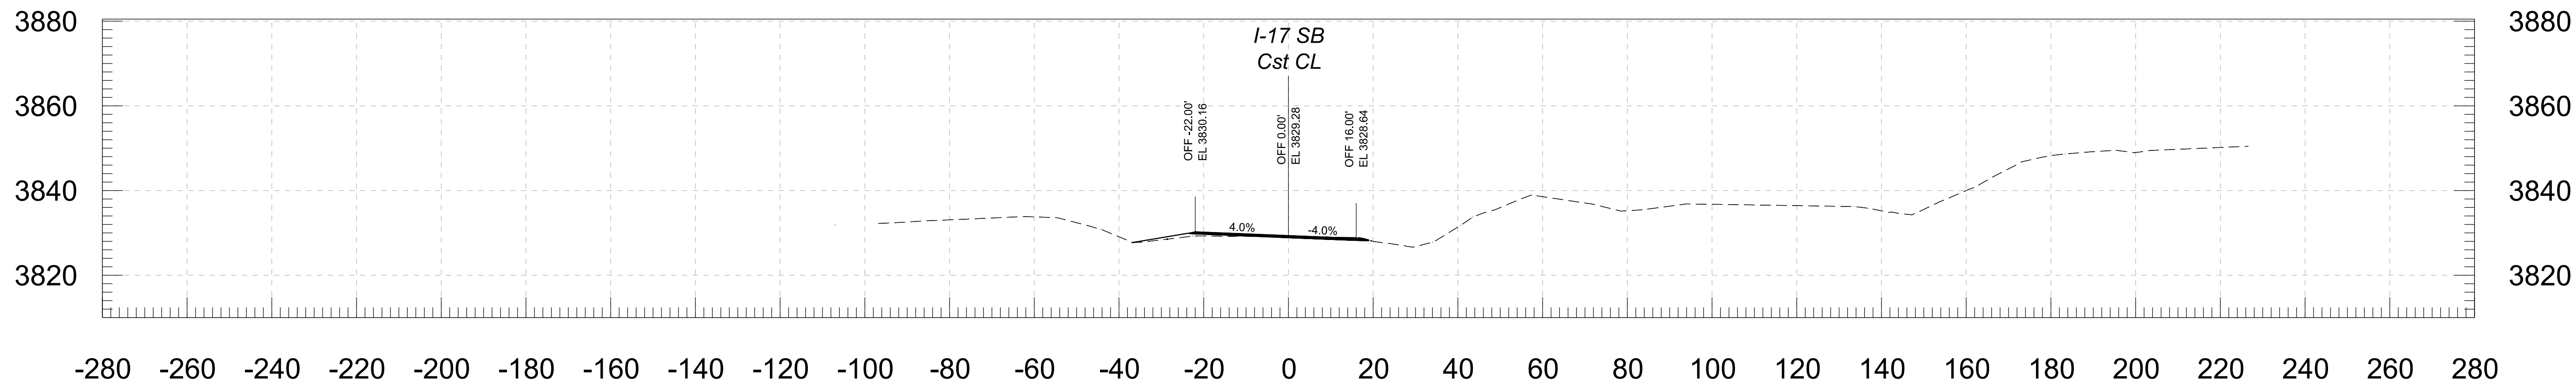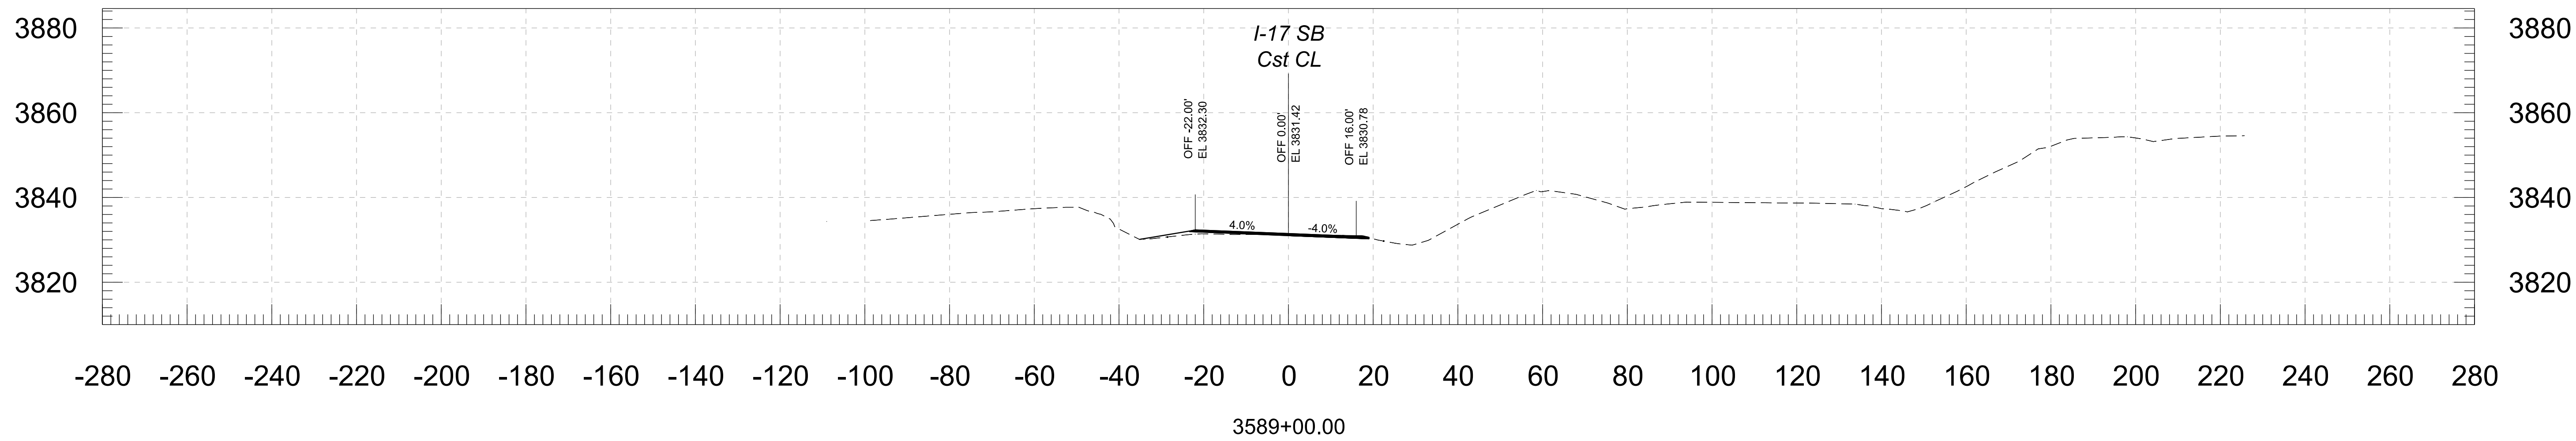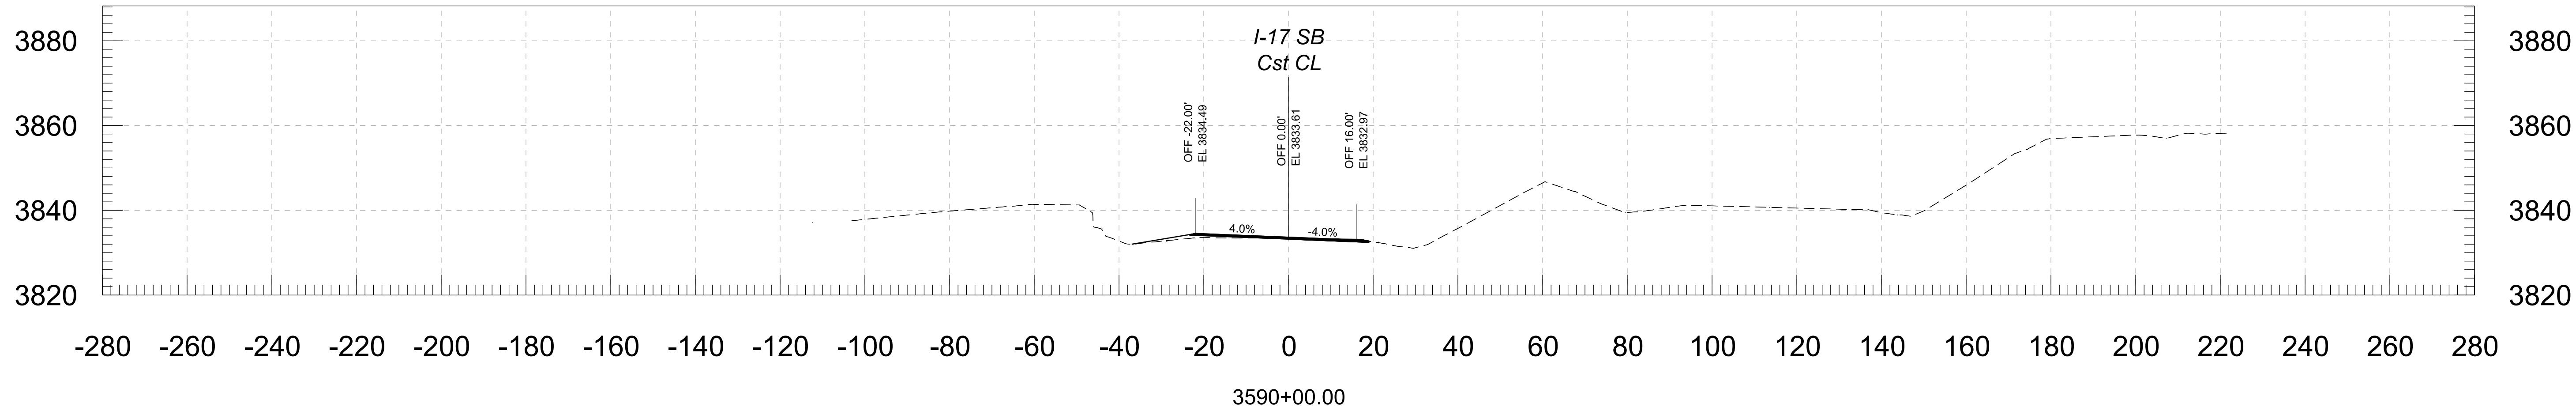



				NAME	DATE	ARIZONA DEPARTMENT OF TRANSPORTATION PROJECT DELIVERY AND OPERATIONS DIVISION ROADWAY DESIGN SERVICES	ROUTE	F.H.W.A. Arizona Division	STATE ARIZ.	PROJECT NO.	FEDERAL ID NO.	SHEET NO.	TOTAL SHEETS	RECORD DRAWING
			DESIGN	BAP	06/26		I-17			017 YV 269	017-B(239)T	5	146	
			DRAWN	RM	06/26									
			CHECKED	KCH	06/26									
			 Stanley Consultants INC.				3133 East Camelback Road, Suite 100 Phoenix, Arizona 85016 Phone: 602.335.2000			CROSS SECTION	MILEPOST	E DUGAS ROAD - MP 275		
						STRUCTURE NO.	TRACS NO. F0616 01C					___ OF ___		

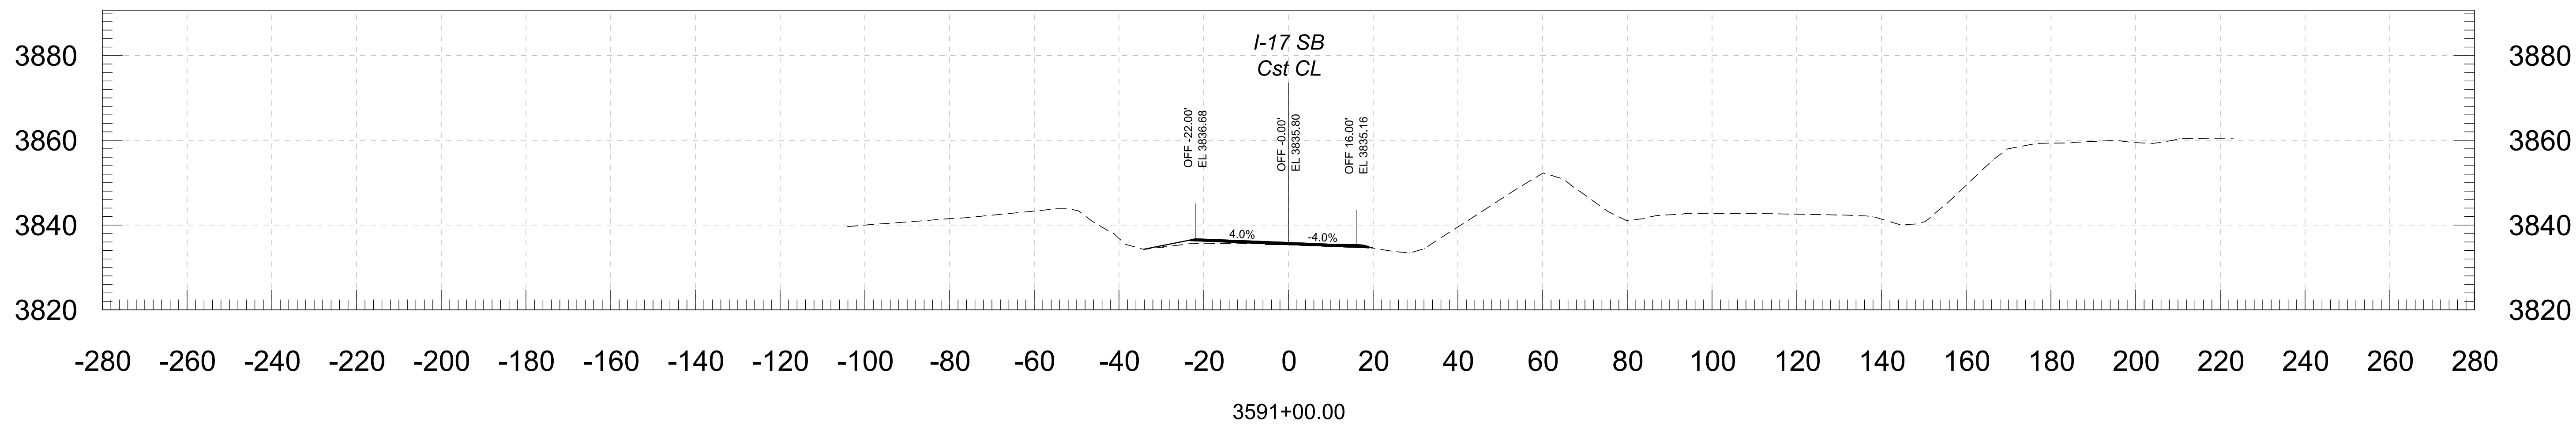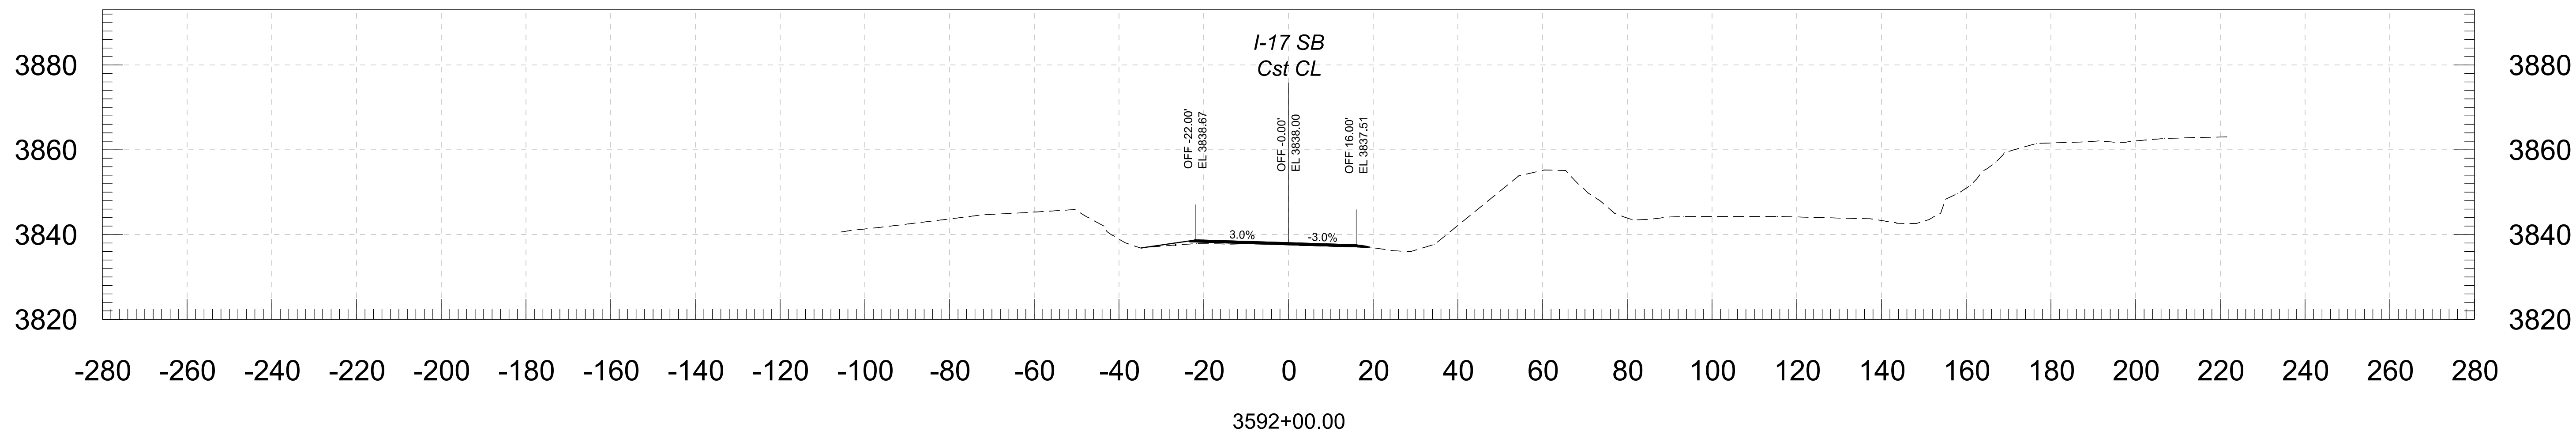



				NAME	DATE	ARIZONA DEPARTMENT OF TRANSPORTATION PROJECT DELIVERY AND OPERATIONS DIVISION ROADWAY DESIGN SERVICES	ROUTE	F.H.W.A. Arizona Division	STATE	PROJECT NO.	FEDERAL ID NO.	SHEET NO.	TOTAL SHEETS	RECORD DRAWING	
			DESIGN	BAP	06/26		I-17			017 YV 269	017-B(239)T	6	146		
			DRAWN	RM	06/26		MILEPOST	E DUGAS ROAD - MP 275							
			CHECKED	KCH	06/26										
			 Stanley Consultants INC.				3133 East Camelback Road, Suite 100 Phoenix, Arizona 85016 Phone: 602.335.2000	CROSS SECTION	STRUCTURE NO.	LOCATION	DWG NO.				
						TRACS NO.	F0616 01C	____ OF ____							

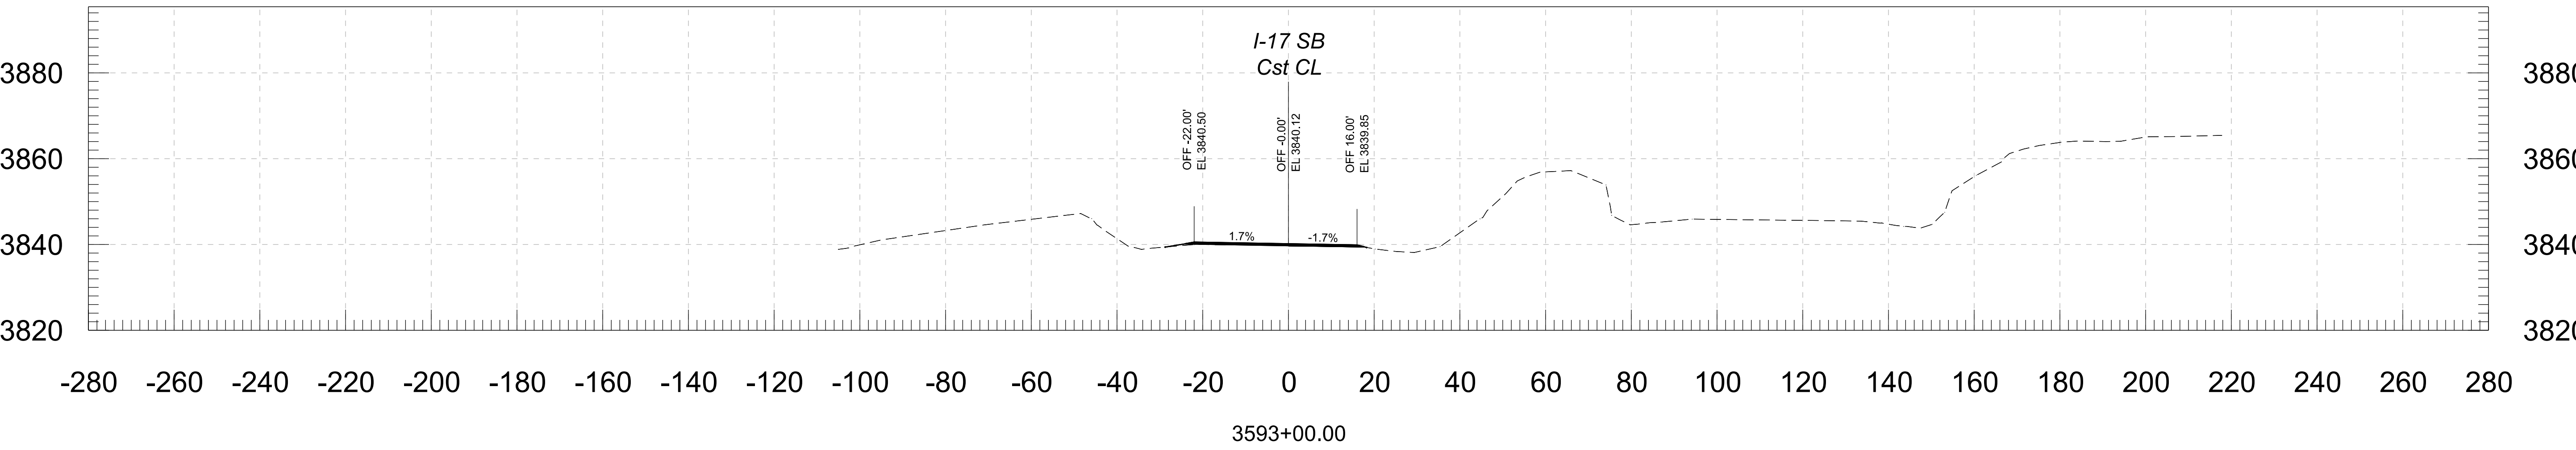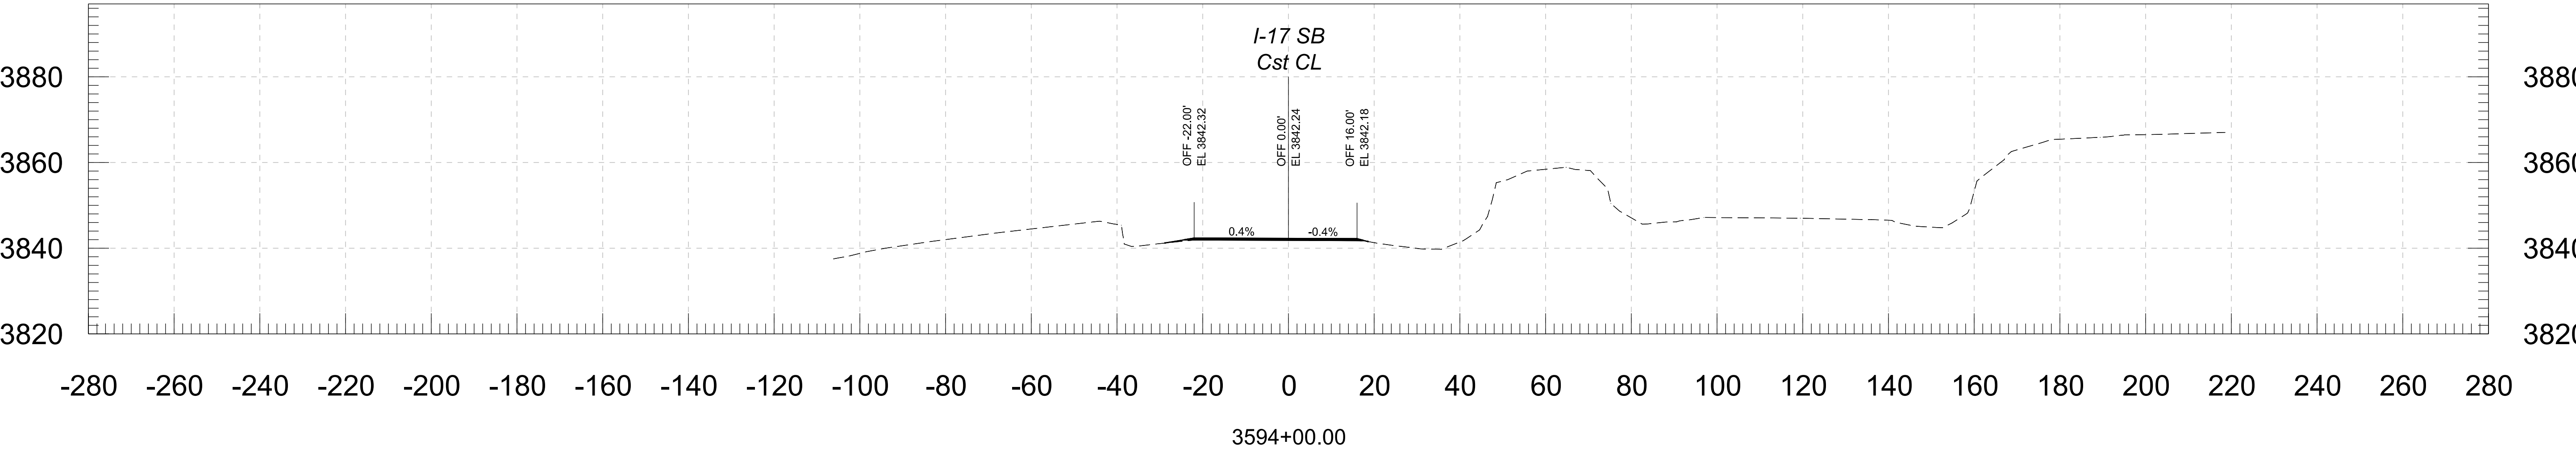



						ARIZONA DEPARTMENT OF TRANSPORTATION PROJECT DELIVERY AND OPERATIONS DIVISION ROADWAY DESIGN SERVICES		ROUTE I-17		F.H.W.A. Arizona Division		STATE ARIZ.		PROJECT NO.		FEDERAL ID NO.		SHEET NO.		TOTAL SHEETS		RECORD DRAWING	
								017 YV 269						017-B(239)T		7		146					
								MILEPOST		E DUGAS ROAD - MP 275										DWG NO.			
								STRUCTURE NO.															
								TRACS NO.		F0616 01C										____ OF ____			

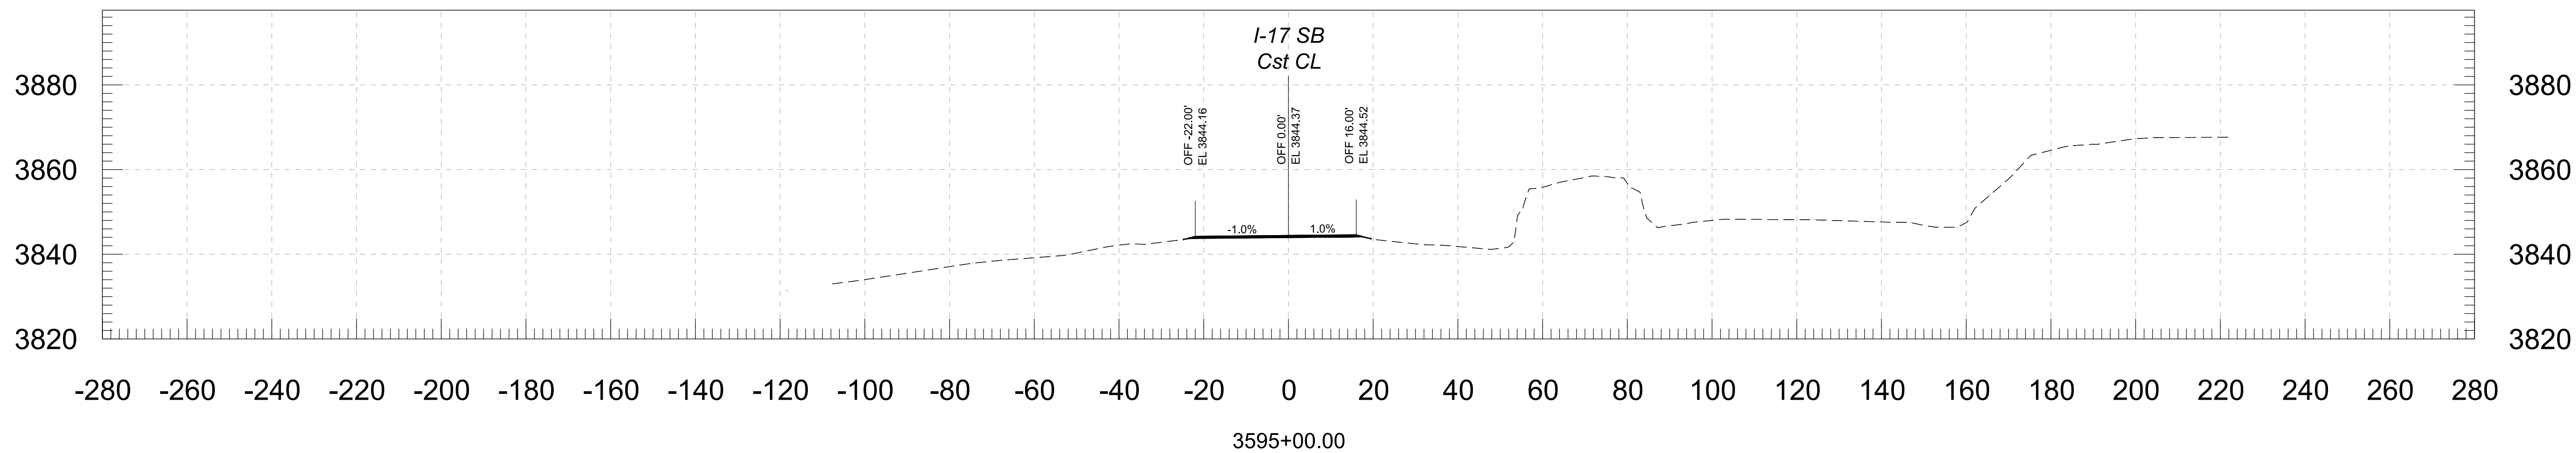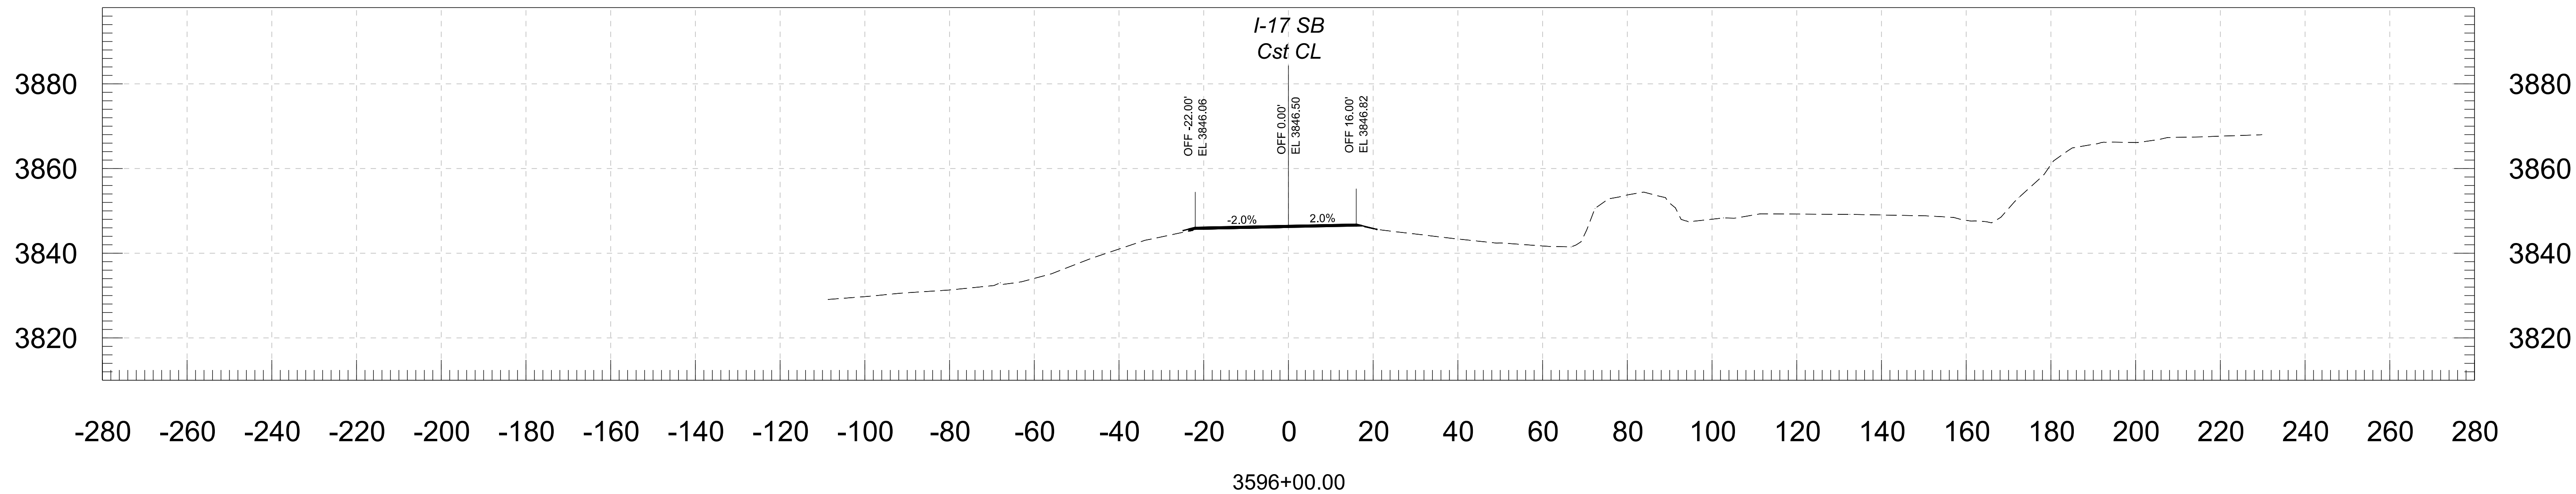


				NAME	DATE	ARIZONA DEPARTMENT OF TRANSPORTATION PROJECT DELIVERY AND OPERATIONS DIVISION ROADWAY DESIGN SERVICES	ROUTE	F.H.W.A. Arizona Division	STATE ARIZ.	PROJECT NO.	FEDERAL ID NO.	SHEET NO.	TOTAL SHEETS	RECORD DRAWING
			DESIGN	BAP	06/26		I-17			017 YV 269	017-B(239)T	8	146	
			DRAWN	RM	06/26									
			CHECKED	KCH	06/26									
			 3133 East Camelback Road, Suite 100 Phoenix, Arizona 85016 Phone: 602 333-2200				CROSS SECTION			MILEPOST	E DUGAS ROAD - MP 275			
						STRUCTURE NO.	TRACS NO. F0616 01C		OF					

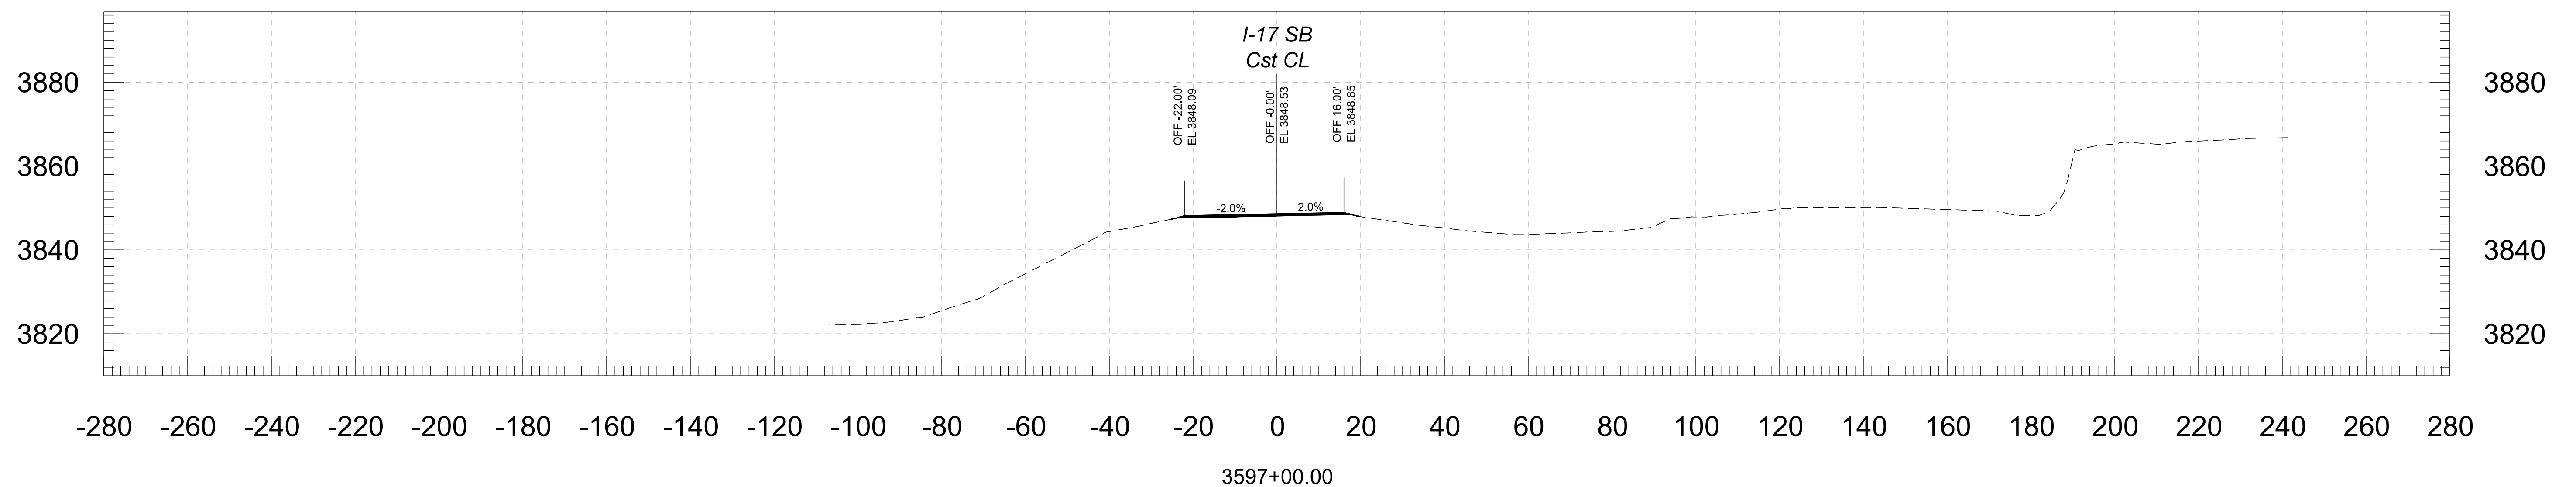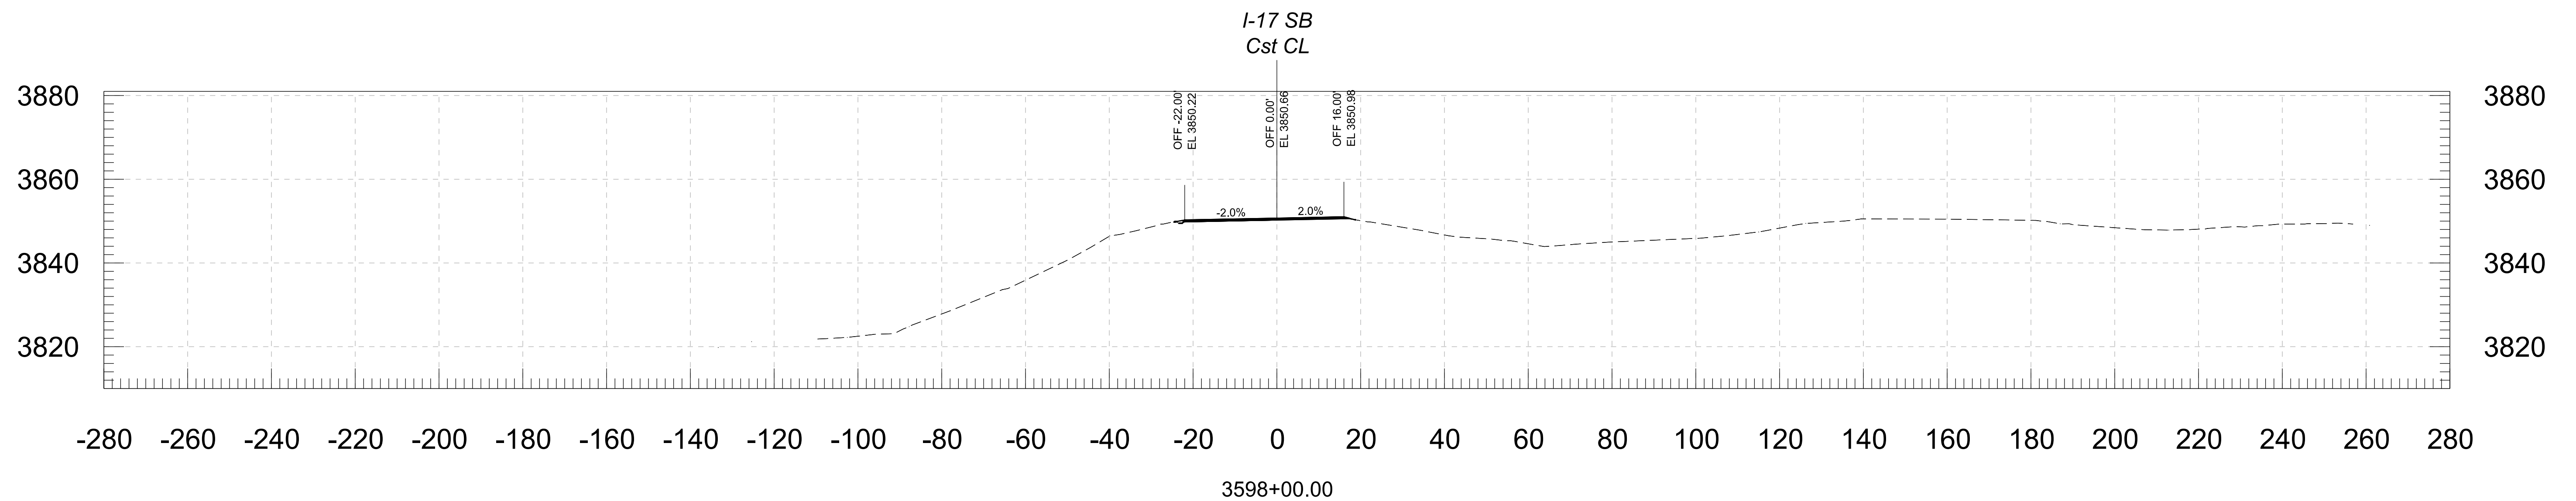

3133 East Camelback Road, Suite 100 Phoenix, Arizona 85016 Phone: (602) 333-2200 Stanley Consultants INC.	<table><tr><th></th><th>NAME</th><th>DATE</th></tr><tr><td>DESIGN</td><td>BAP</td><td>06/26</td></tr><tr><td>DRAWN</td><td>RM</td><td>06/26</td></tr><tr><td>CHECKED</td><td>KCH</td><td>06/26</td></tr></table>		NAME	DATE	DESIGN	BAP	06/26	DRAWN	RM	06/26	CHECKED	KCH	06/26	ARIZONA DEPARTMENT OF TRANSPORTATION PROJECT DELIVERY AND OPERATIONS DIVISION ROADWAY DESIGN SERVICES CROSS SECTION	<table><tr><td>ROUTE</td><td rowspan="2">I-17</td><td rowspan="2">F.H.W.A. Arizona Division</td><td rowspan="2">STATE</td><td>PROJECT NO.</td><td>FEDERAL ID NO.</td><td>SHEET NO.</td><td>TOTAL SHEETS</td><td rowspan="2">RECORD DRAWING</td></tr><tr><td>MILEPOST</td><td>017 YV 269</td><td>017-B(239)T</td><td>9</td><td>146</td></tr><tr><td rowspan="2">STRUCTURE NO.</td><td colspan="7">LOCATION</td><td>DWG NO.</td></tr><tr><td colspan="2">TRACS NO. F0616 01C</td><td colspan="4"></td><td>___ OF ___</td></tr></table>	ROUTE	I-17	F.H.W.A. Arizona Division	STATE	PROJECT NO.	FEDERAL ID NO.	SHEET NO.	TOTAL SHEETS	RECORD DRAWING	MILEPOST	017 YV 269	017-B(239)T	9	146	STRUCTURE NO.	LOCATION							DWG NO.	TRACS NO. F0616 01C						___ OF ___
		NAME	DATE																																										
	DESIGN	BAP	06/26																																										
	DRAWN	RM	06/26																																										
	CHECKED	KCH	06/26																																										
ROUTE	I-17	F.H.W.A. Arizona Division	STATE	PROJECT NO.	FEDERAL ID NO.	SHEET NO.	TOTAL SHEETS	RECORD DRAWING																																					
MILEPOST				017 YV 269	017-B(239)T	9	146																																						
STRUCTURE NO.	LOCATION							DWG NO.																																					
	TRACS NO. F0616 01C						___ OF ___																																						
E DUGAS ROAD - MP 275																																													


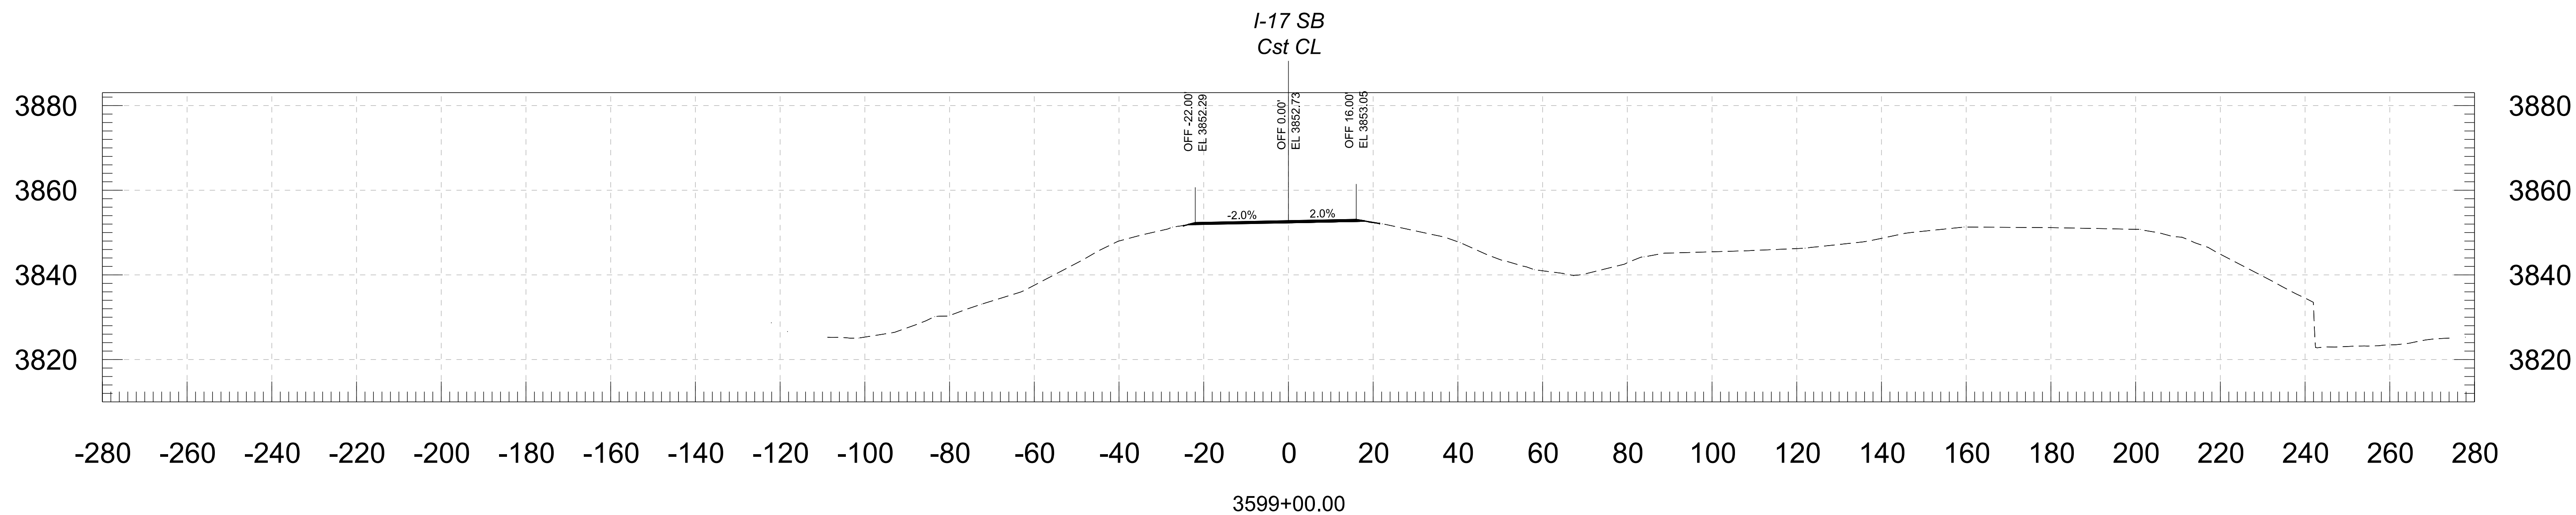
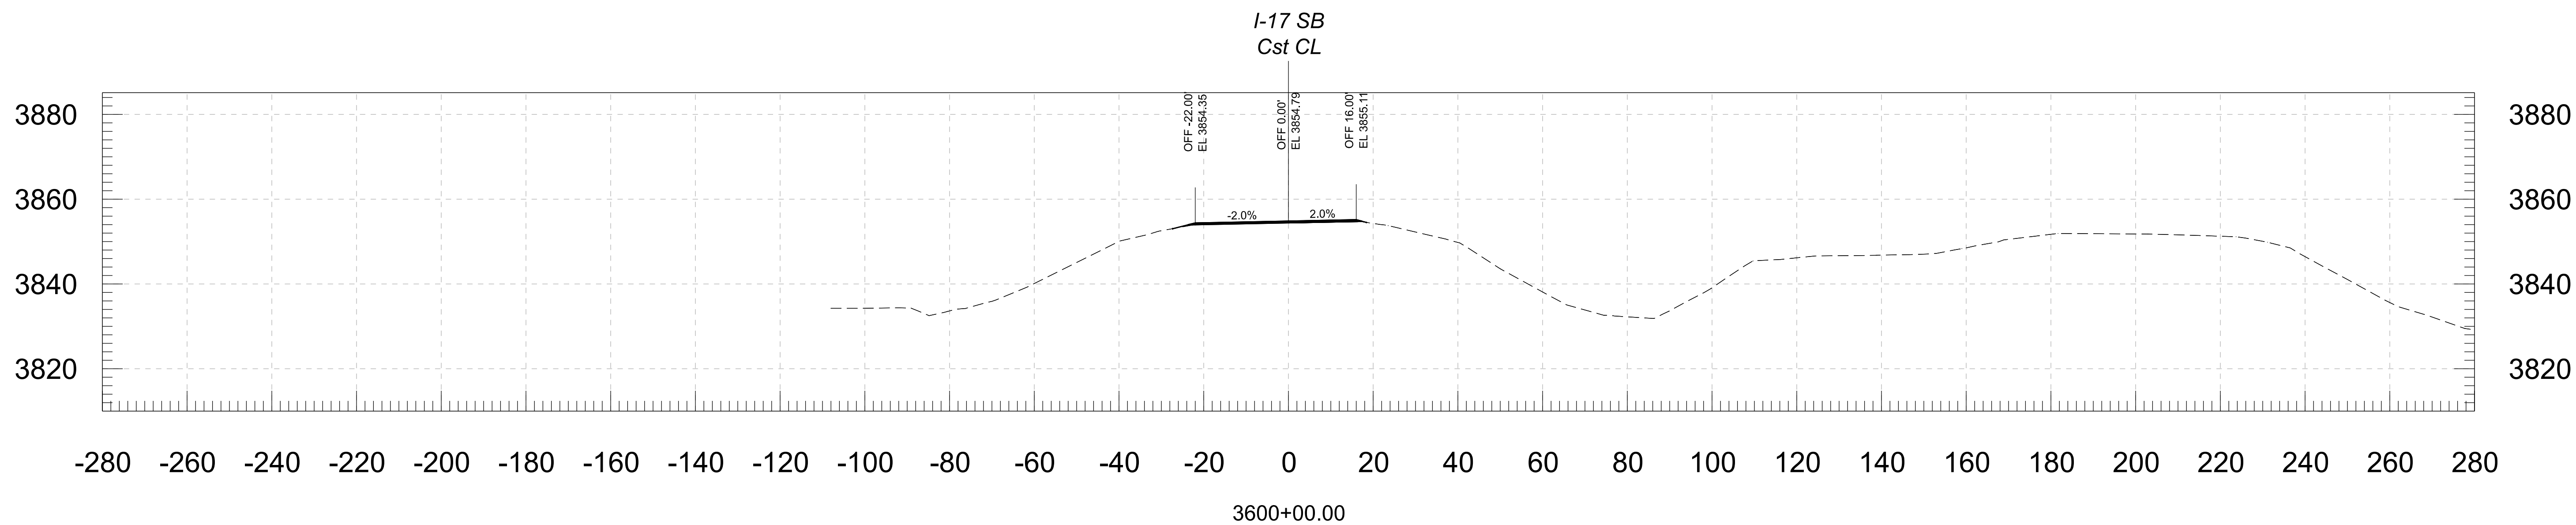


--	--	


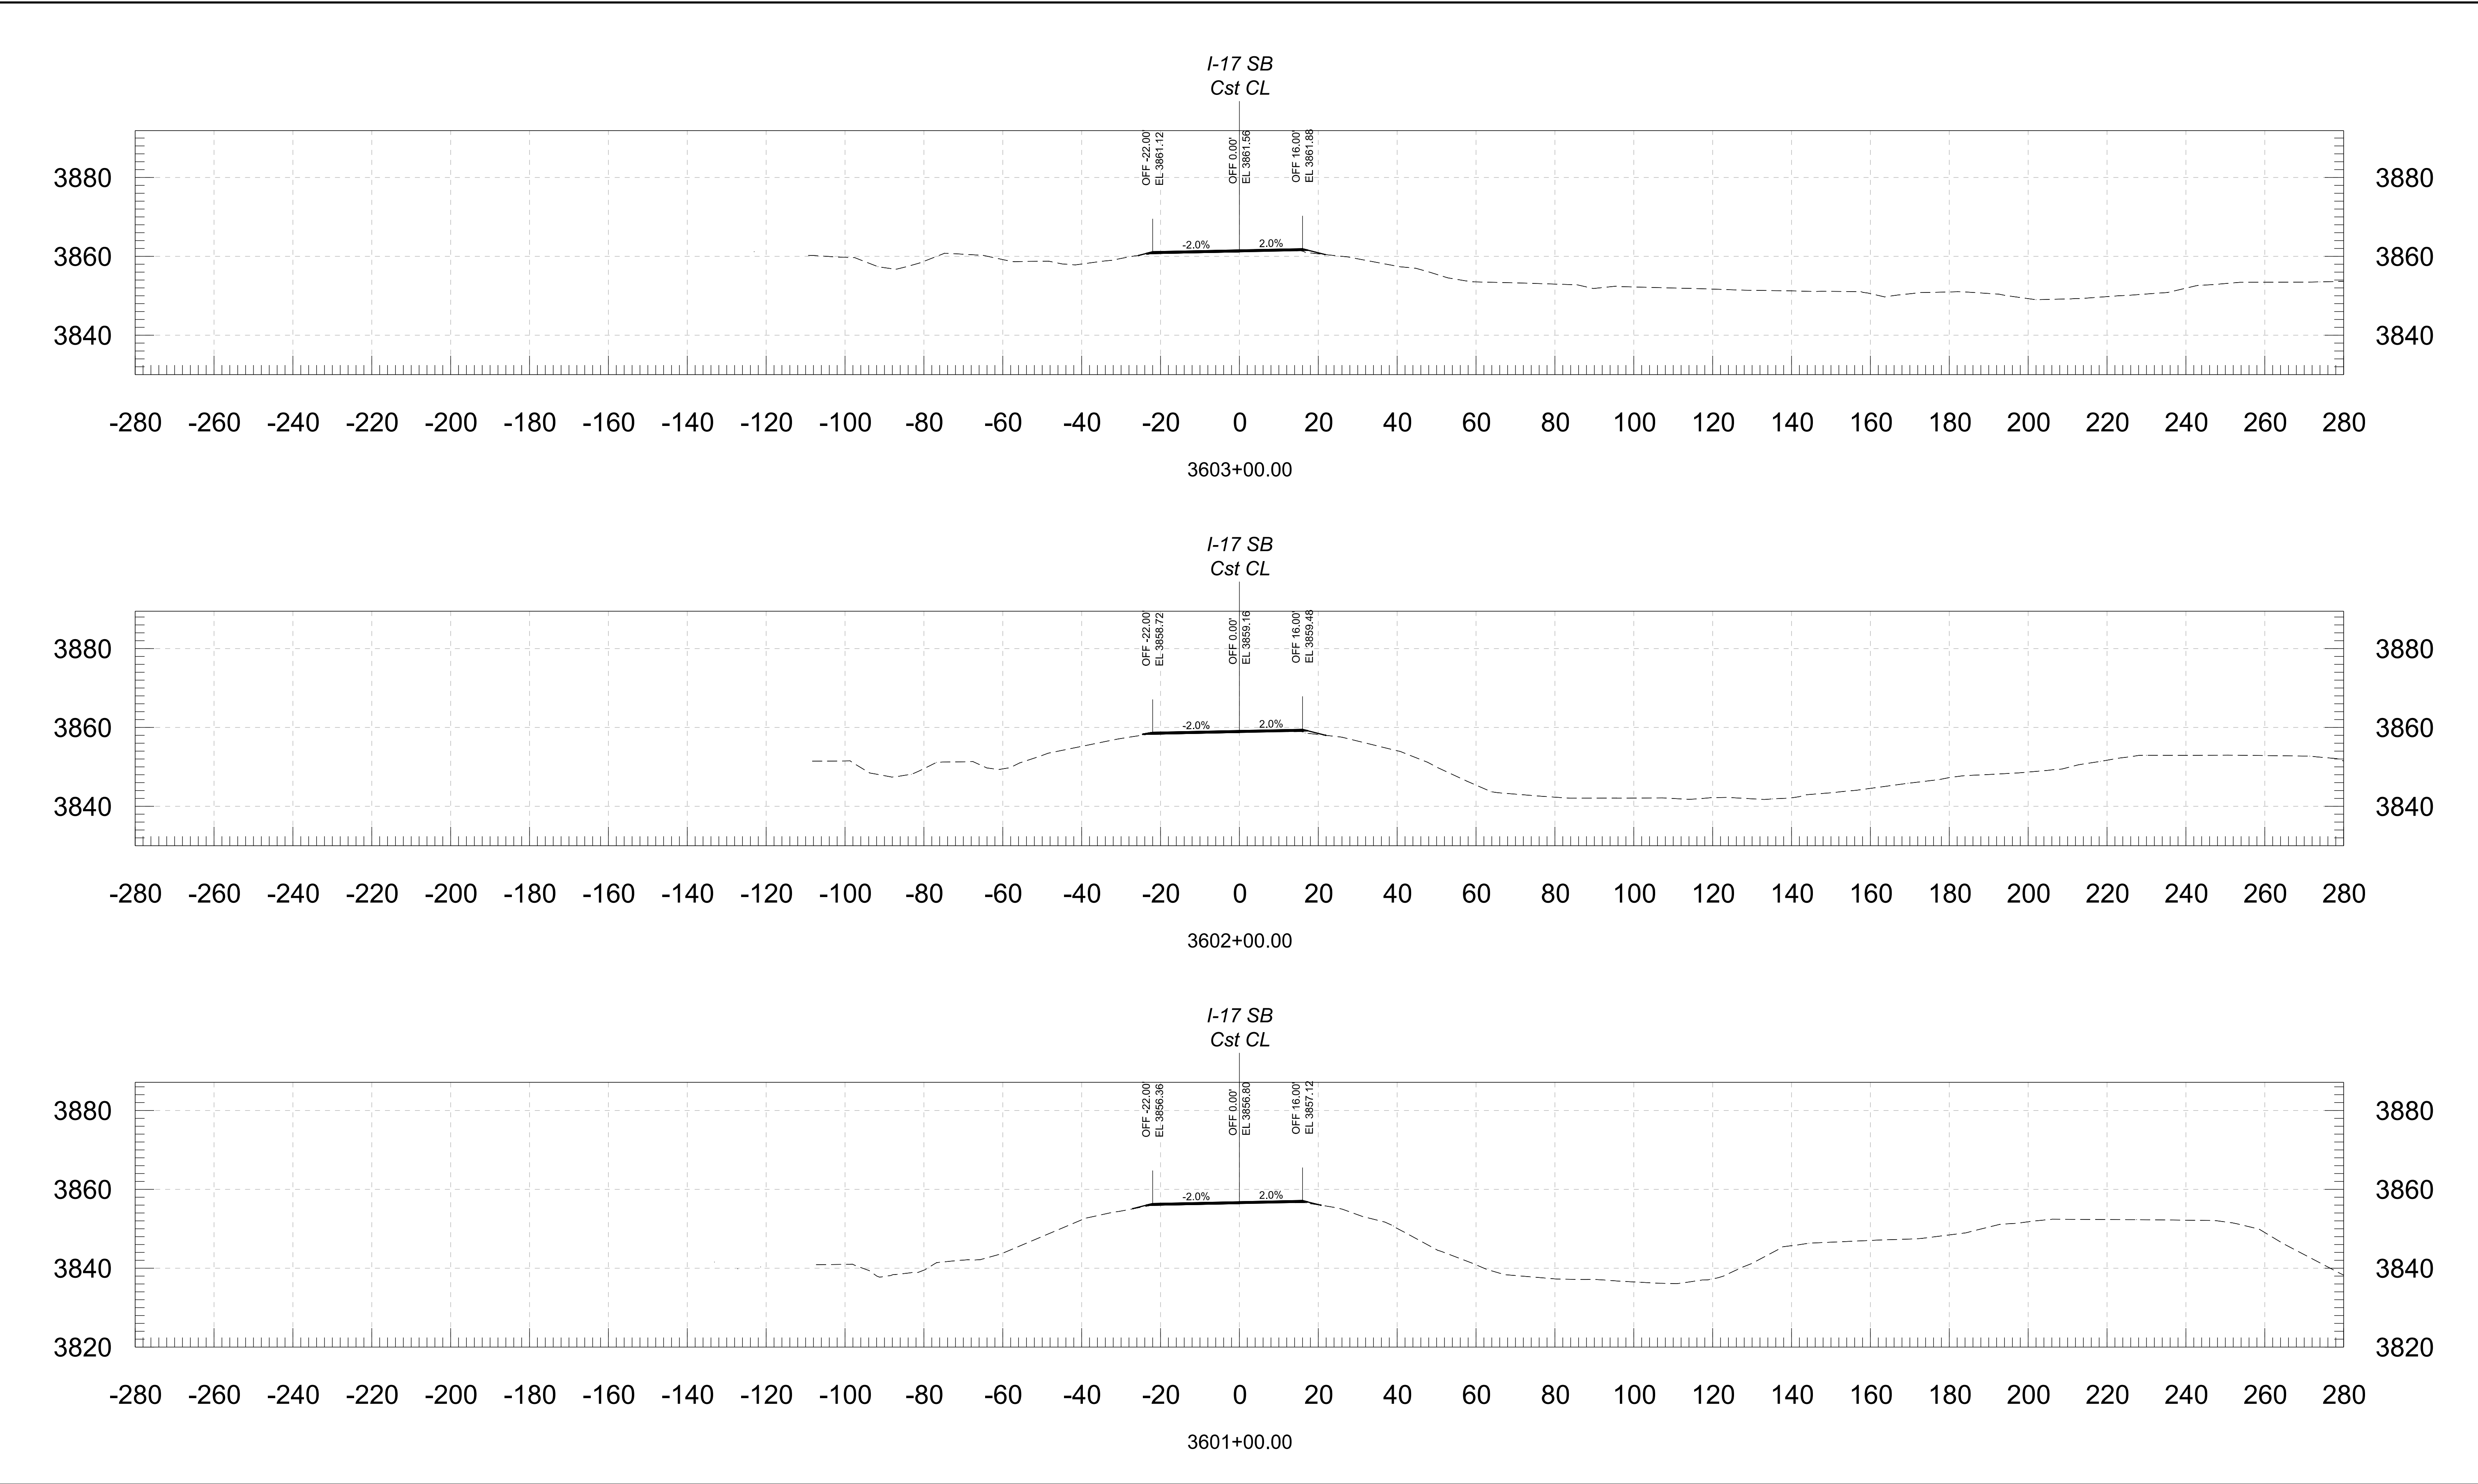


				NAME	DATE	ARIZONA DEPARTMENT OF TRANSPORTATION PROJECT DELIVERY AND OPERATIONS DIVISION ROADWAY DESIGN SERVICES	ROUTE	F.H.W.A. Arizona Division	STATE ARIZ.	PROJECT NO.	FEDERAL ID NO.	SHEET NO.	TOTAL SHEETS	RECORD DRAWING
			DESIGN	BAP	06/26		I-17			017 YV 269	017-B(239)T	11	146	
			DRAWN	RM	06/26									
			CHECKED	KCH	06/26									
			 3135 East Camelback Road, Suite 100 Phoenix, Arizona 85016 Phone: 602.333-2200 Stanley Consultants INC.											
			STRUCTURE NO.	TRACS NO. F0616 01C				___ OF ___						





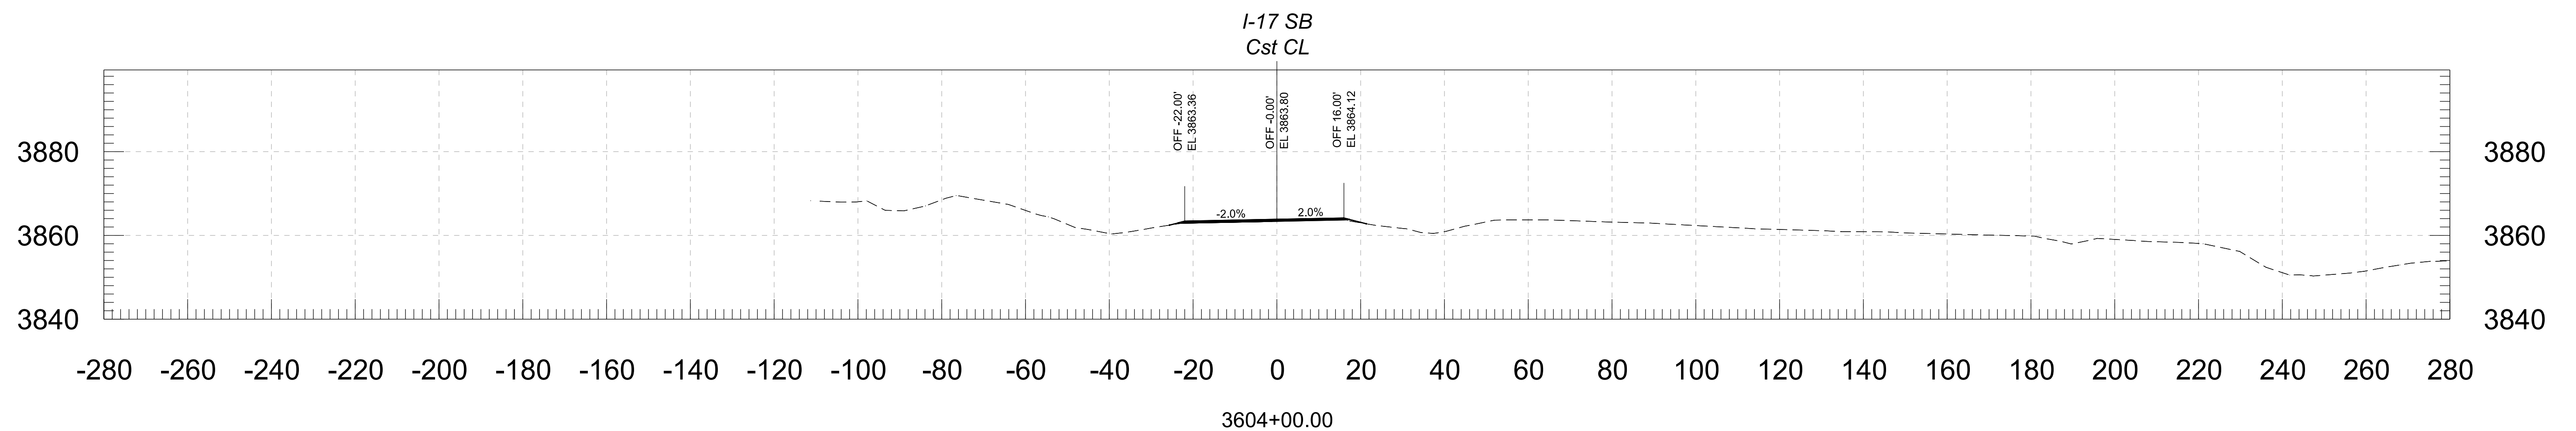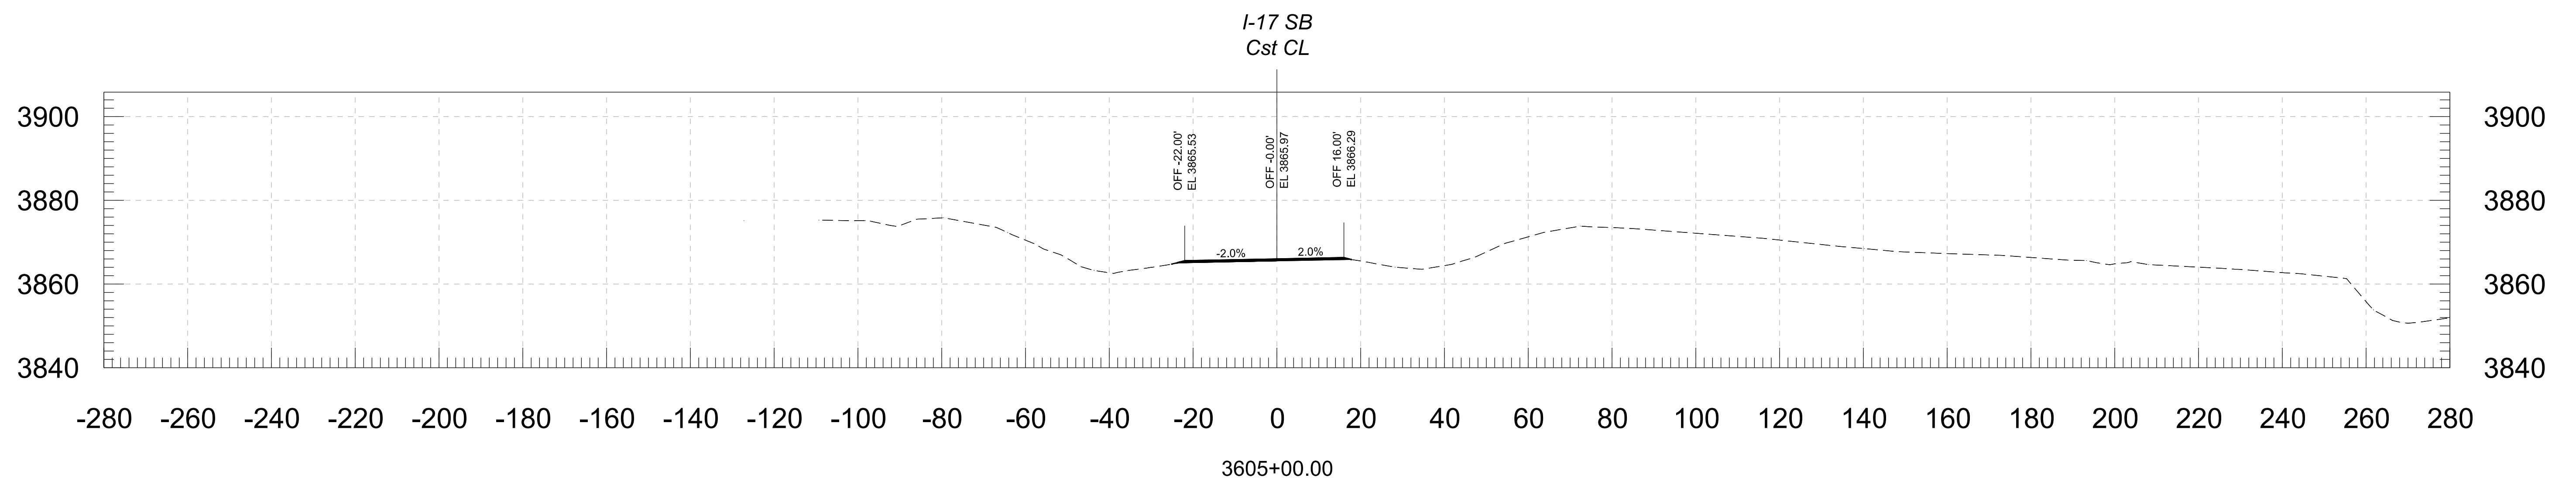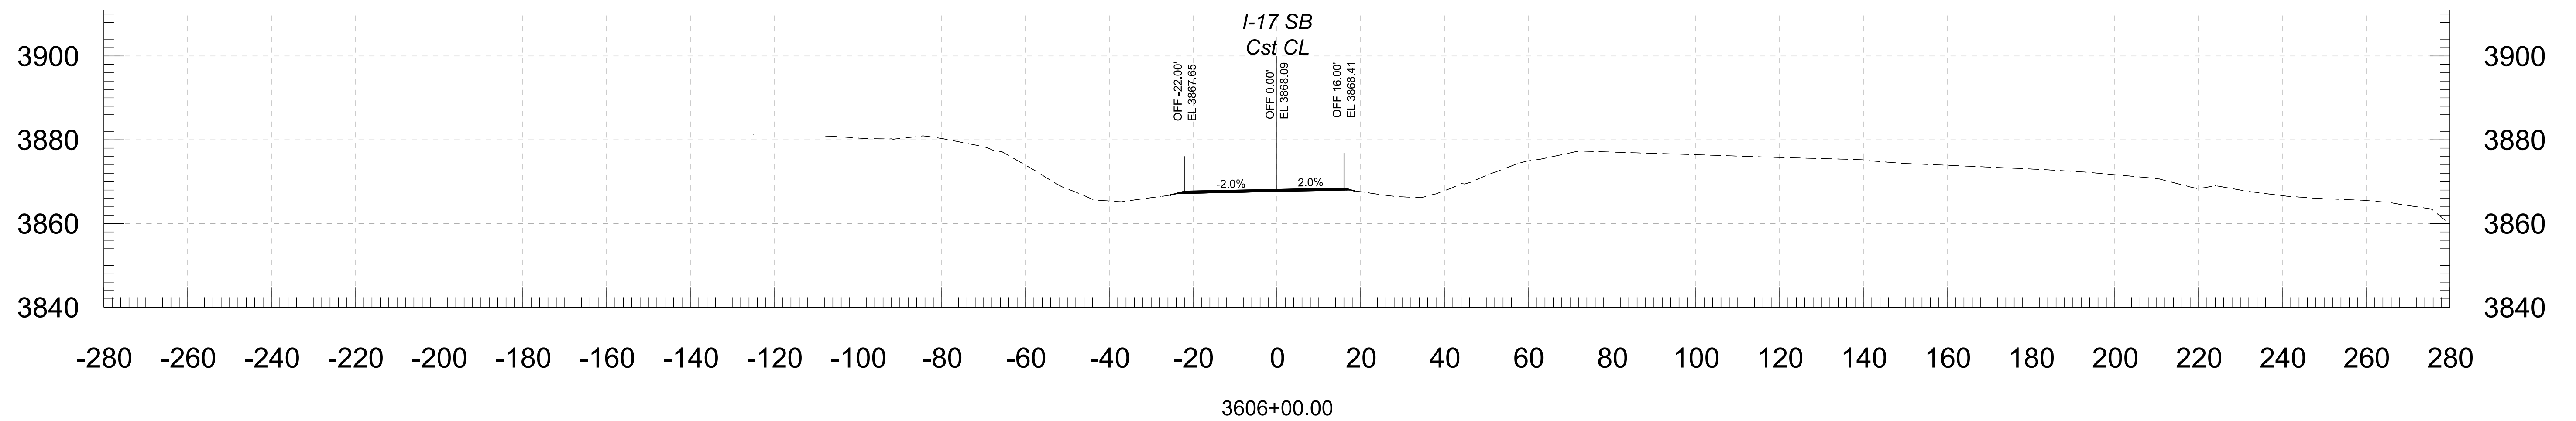



 Stanley Consultants INC. 3133 East Camelback Road, Suite 100 Phoenix, Arizona 85016 Phone: (602) 333-2200	<table><tr><th></th><th>NAME</th><th>DATE</th></tr><tr><td>DESIGN</td><td>BAP</td><td>06/26</td></tr><tr><td>DRAWN</td><td>RM</td><td>06/26</td></tr><tr><td>CHECKED</td><td>KCH</td><td>06/26</td></tr></table>		NAME	DATE	DESIGN	BAP	06/26	DRAWN	RM	06/26	CHECKED	KCH	06/26	ARIZONA DEPARTMENT OF TRANSPORTATION PROJECT DELIVERY AND OPERATIONS DIVISION ROADWAY DESIGN SERVICES	<table><tr><td>ROUTE</td><td>I-17</td><td rowspan="2"> F.H.W.A. Arizona Division STATE ARIZ. </td><td>PROJECT NO.</td><td>FEDERAL ID NO.</td><td>SHEET NO.</td><td>TOTAL SHEETS</td><td>RECORD DRAWING</td></tr><tr><td>MILEPOST</td><td></td><td>017 YV 269</td><td>017-B(239)T</td><td>12</td><td>146</td><td></td></tr></table>	ROUTE	I-17	F.H.W.A. Arizona Division STATE ARIZ.	PROJECT NO.	FEDERAL ID NO.	SHEET NO.	TOTAL SHEETS	RECORD DRAWING	MILEPOST		017 YV 269	017-B(239)T	12	146	
		NAME	DATE																											
	DESIGN	BAP	06/26																											
	DRAWN	RM	06/26																											
	CHECKED	KCH	06/26																											
ROUTE	I-17	F.H.W.A. Arizona Division STATE ARIZ.	PROJECT NO.	FEDERAL ID NO.	SHEET NO.	TOTAL SHEETS	RECORD DRAWING																							
MILEPOST			017 YV 269	017-B(239)T	12	146																								
		CROSS SECTION	LOCATIONE DUGAS ROAD - MP 275DWG NO.																											
			TRACS NO. F0616 01C_____ OF _____																											

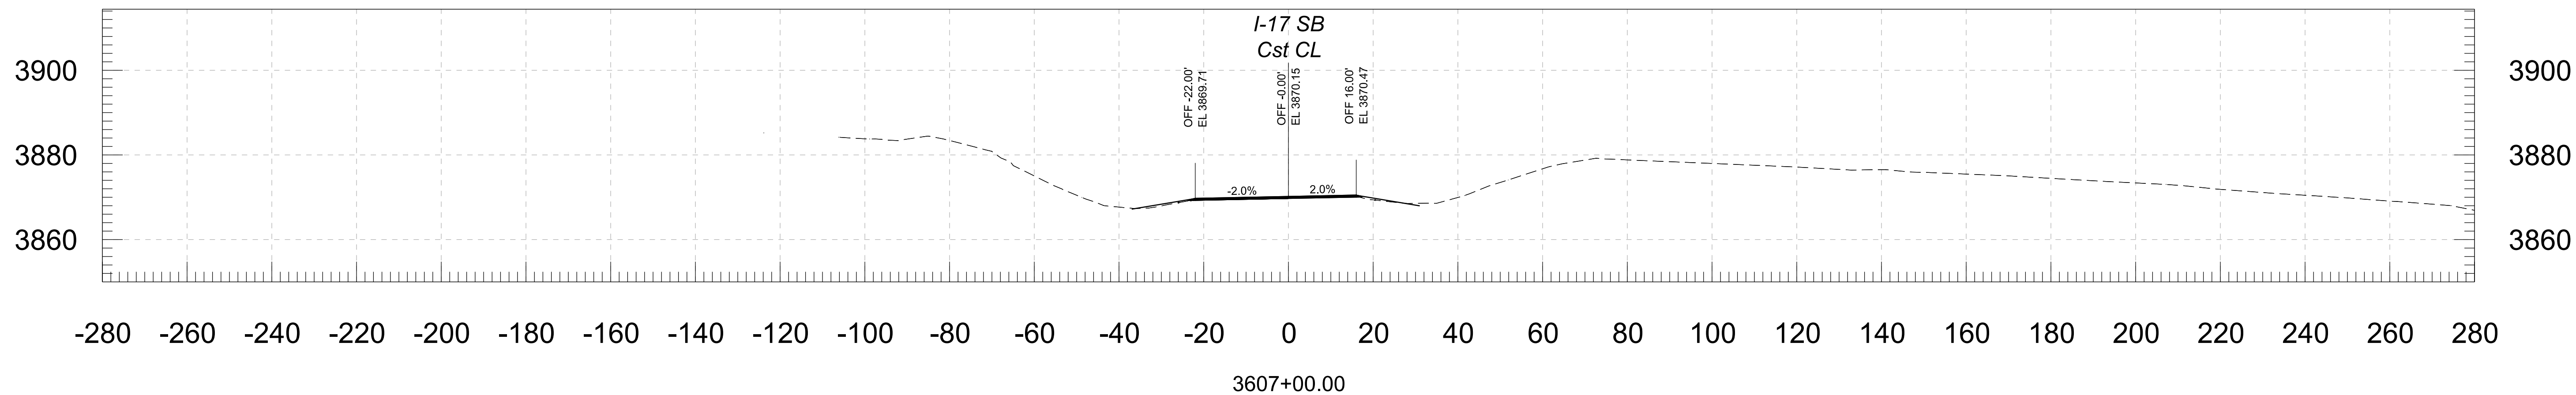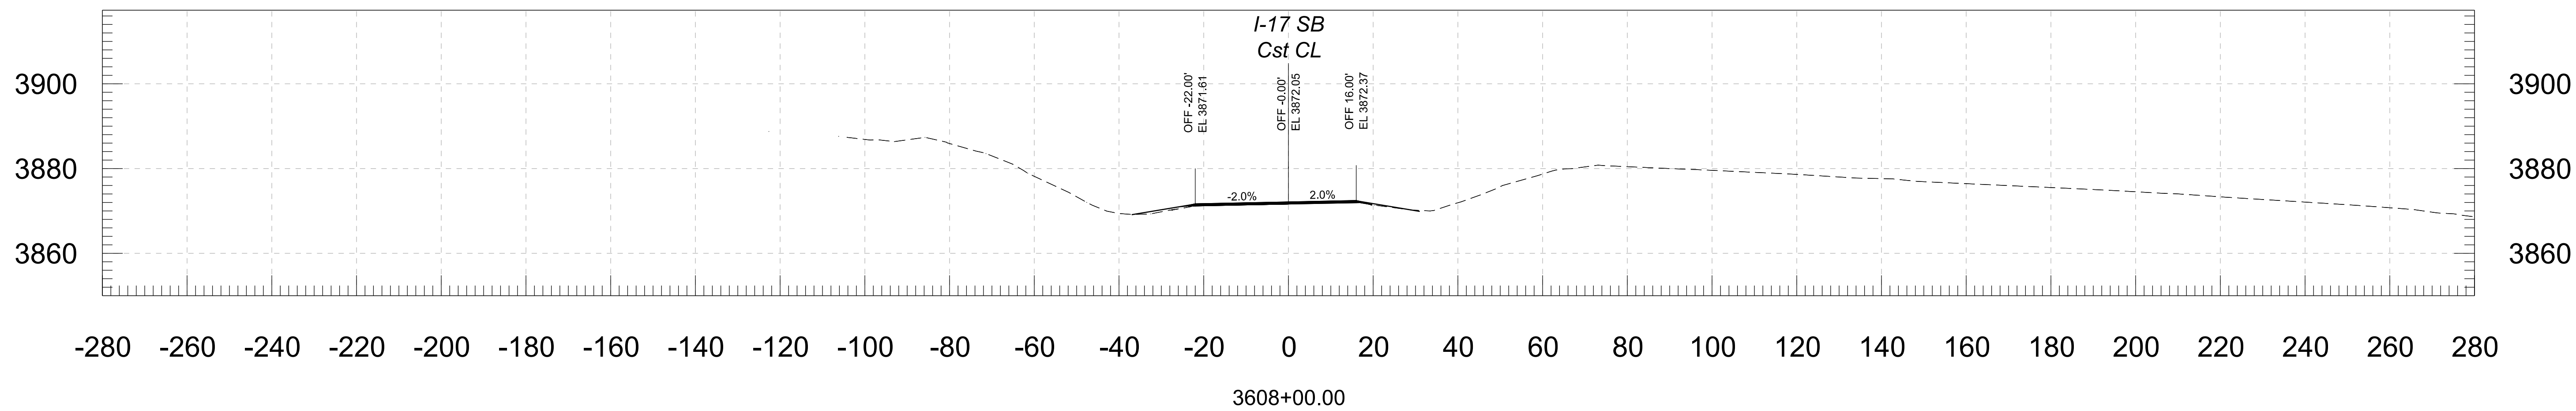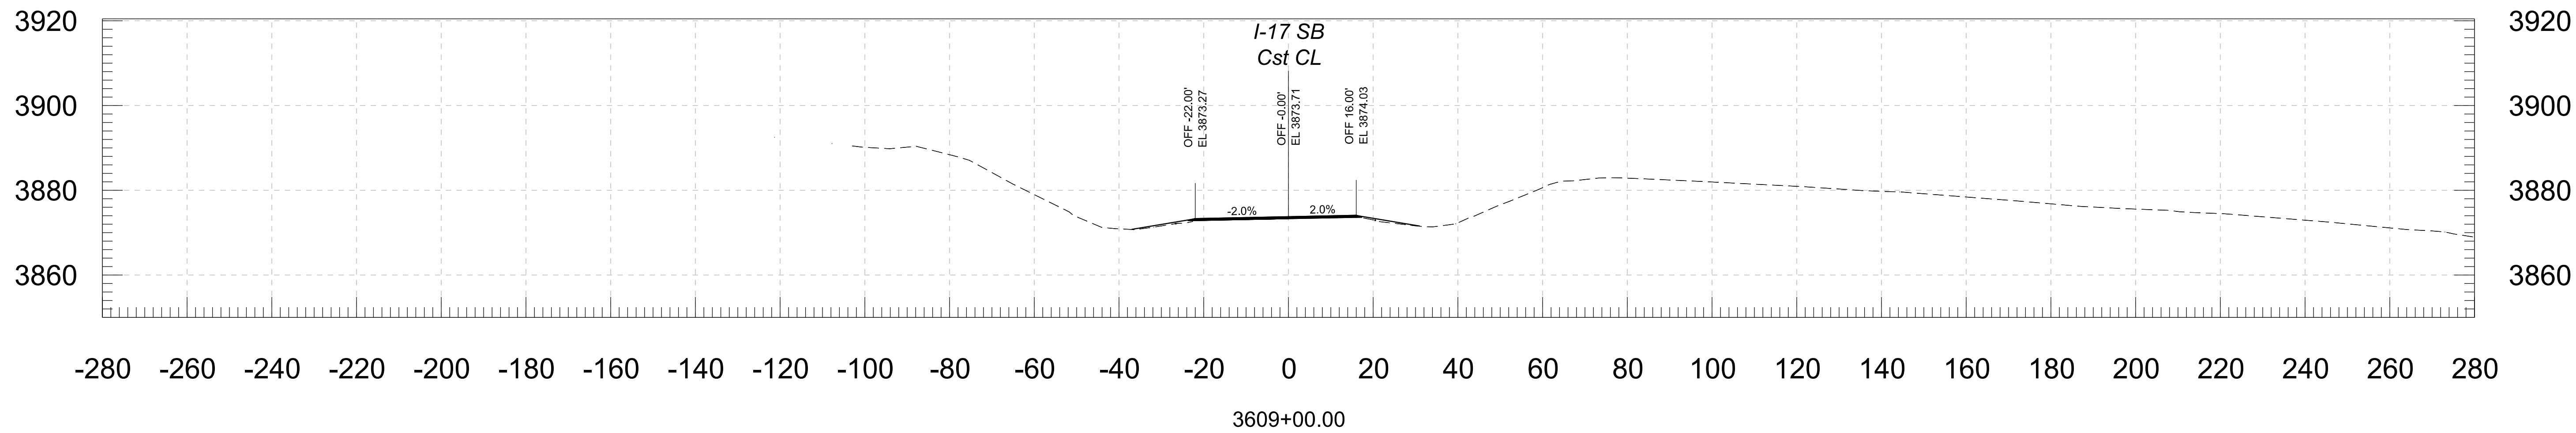



			NAME	DATE	ARIZONA DEPARTMENT OF TRANSPORTATION PROJECT DELIVERY AND OPERATIONS DIVISION ROADWAY DESIGN SERVICES	ROUTE	F.H.W.A. Arizona Division	STATE	PROJECT NO.	FEDERAL ID NO.	SHEET NO.	TOTAL SHEETS	RECORD DRAWING		
		DESIGN	BAP	06/26		I-17			017 YV 269	017-B(239)T	13	146			
		DRAWN	RM	06/26			MILEPOST	LOCATION E DUGAS ROAD - MP 275							DWG NO.
		CHECKED	KCH	06/26				STRUCTURE NO.	TRACS NO. F0616 01C						
		 Stanley Consultants INC.			3133 East Camelback Road, Suite 100 Phoenix, Arizona 85016 Phone 602. 333-2200		CROSS SECTION								

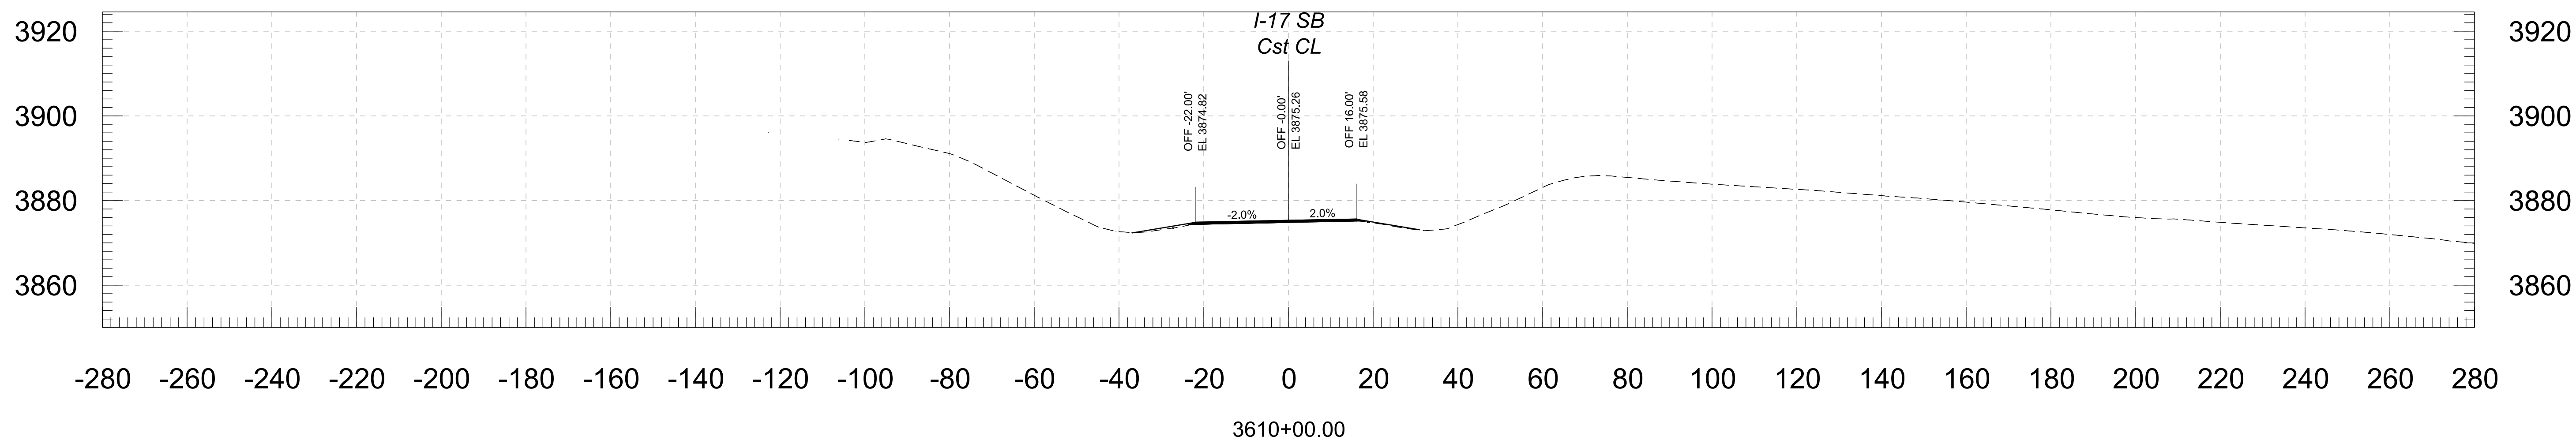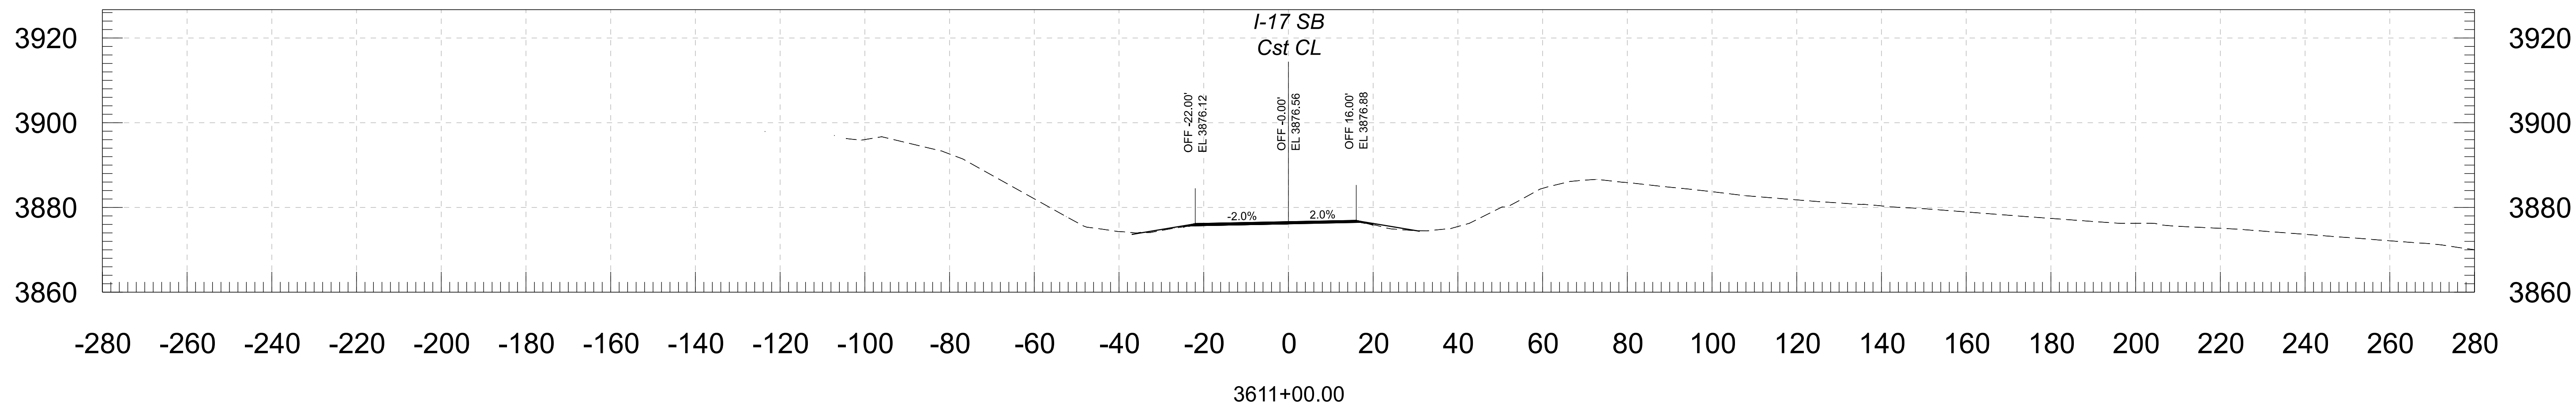 




				NAME	DATE	ARIZONA DEPARTMENT OF TRANSPORTATION PROJECT DELIVERY AND OPERATIONS DIVISION ROADWAY DESIGN SERVICES	ROUTE	F.H.W.A. Arizona Division	STATE ARIZ.	PROJECT NO.	FEDERAL ID NO.	SHEET NO.	TOTAL SHEETS	RECORD DRAWING
			DESIGN	BAP	06/26		I-17			017 YV 269	017-B(239)T	14	146	
			DRAWN	RM	06/26									
			CHECKED	KCH	06/26									
			 Stanley Consultants INC.				3133 East Camelback Road, Suite 100 Phoenix, Arizona 85016 Phone: 602.333.2000			CROSS SECTION	MILEPOST	E DUGAS ROAD - MP 275		
						STRUCTURE NO.	TRACS NO. F0616 01C				___ OF ___			

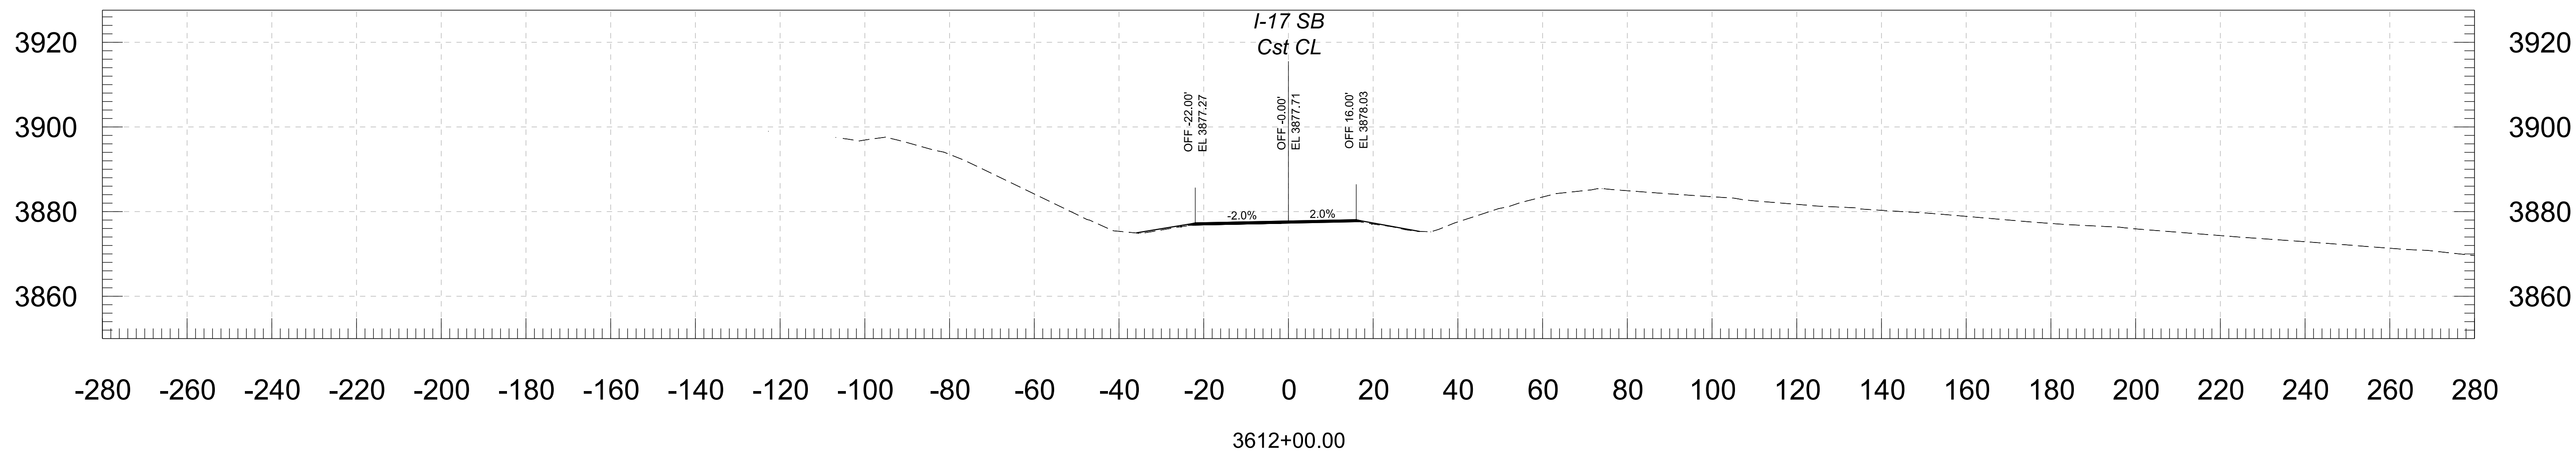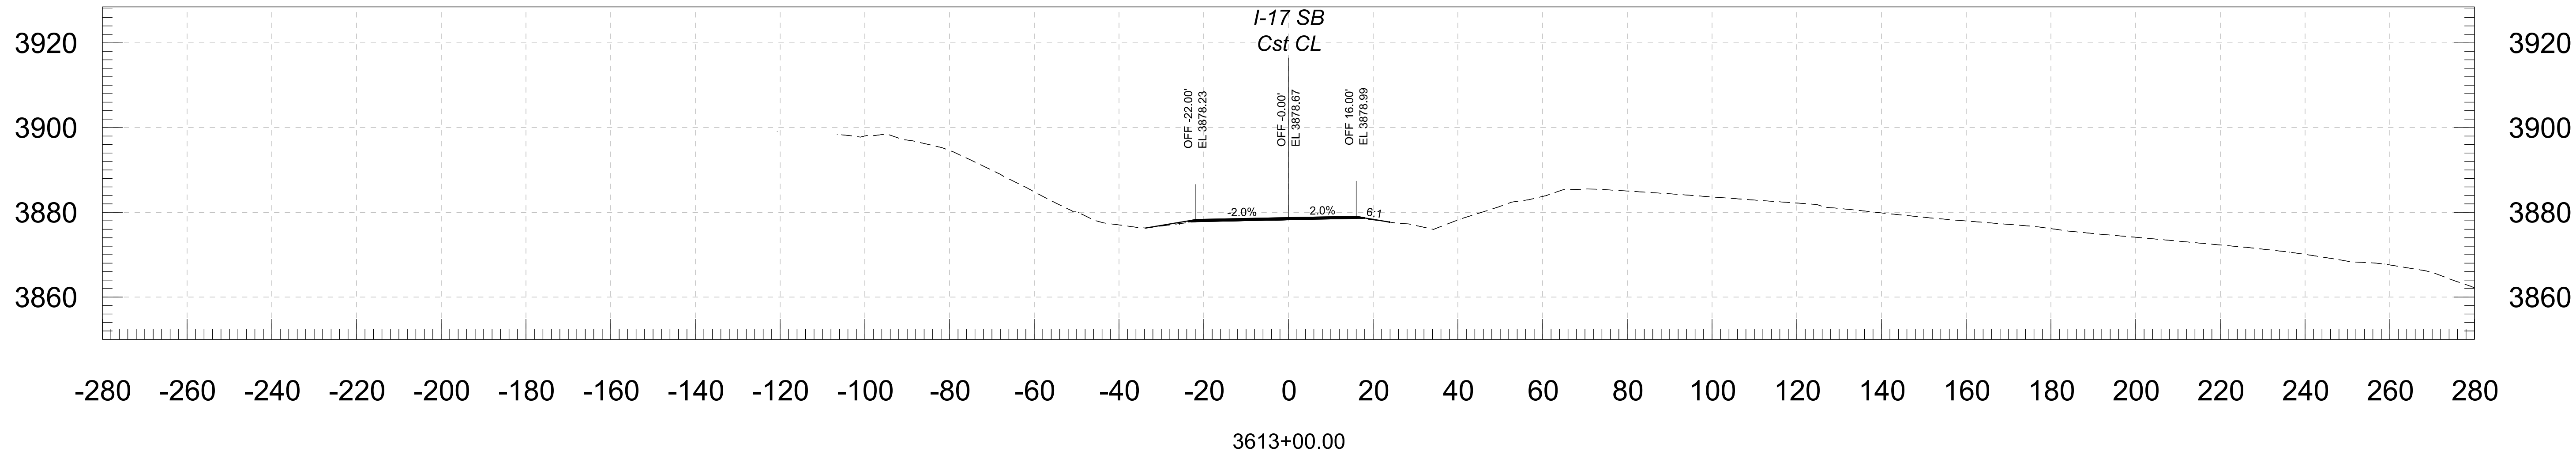



		Stanley Consultants INC.		NAME	DATE	ARIZONA DEPARTMENT OF TRANSPORTATION PROJECT DELIVERY AND OPERATIONS DIVISION ROADWAY DESIGN SERVICES	ROUTE	F.H.W.A. Arizona Division	STATE ARIZ.	PROJECT NO.	FEDERAL ID NO.	SHEET NO.	TOTAL SHEETS	RECORD DRAWING
			DESIGN	BAP	06/26		I-17			017 YV 269	017-B(239)T	15	146	
			DRAWN	RM	06/26					E DUGAS ROAD - MP 275	DWG NO.			
			CHECKED	KCH	06/26									
			Stanley Consultants INC. 3133 East Camelback Road, Suite 100 Phoenix, Arizona 85016 Phone: 602.333.2000						CROSS SECTION	TRACS NO. F0616 01C				

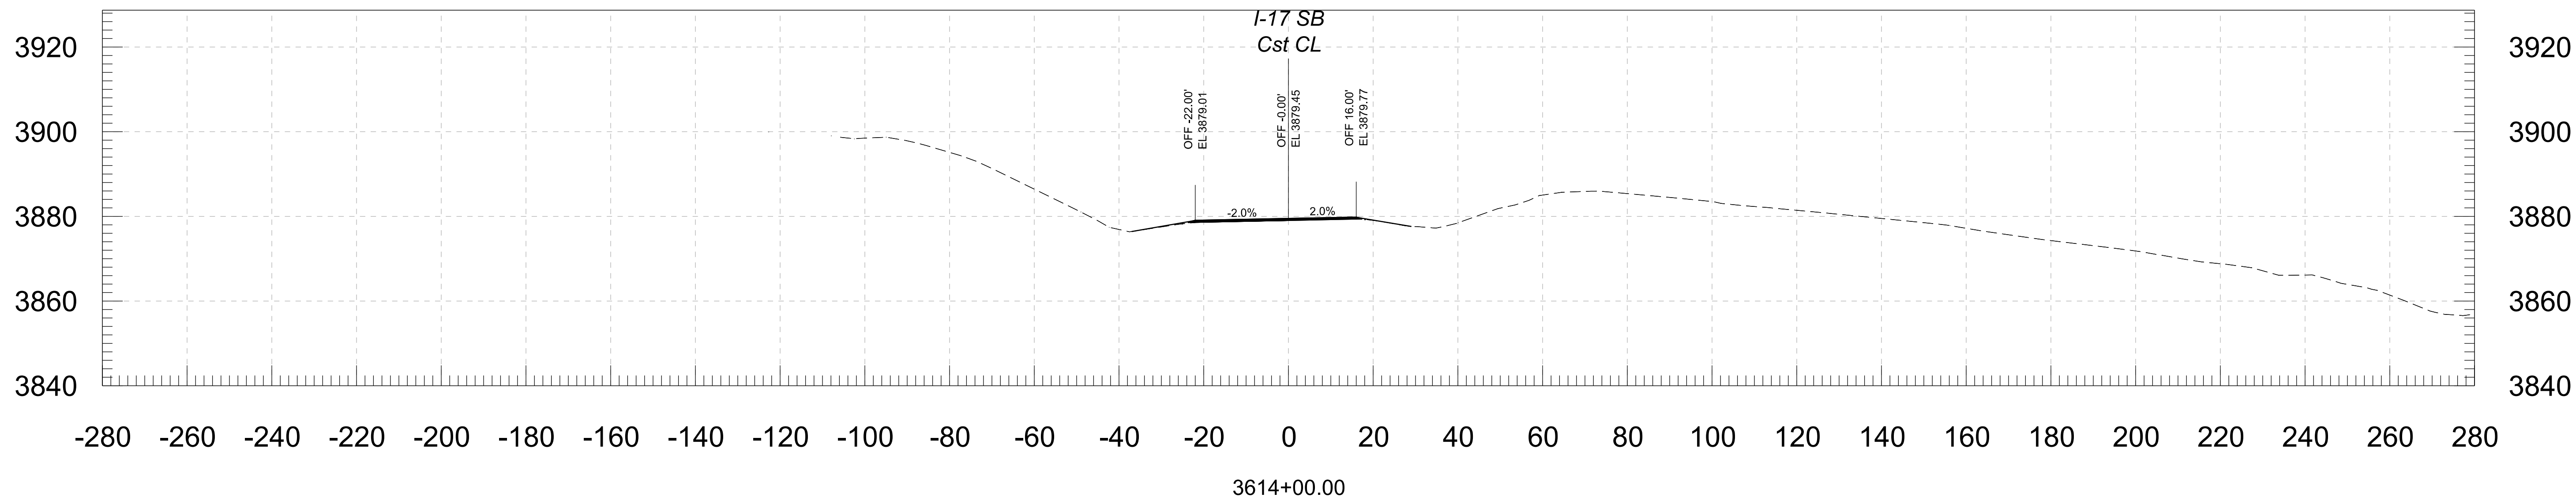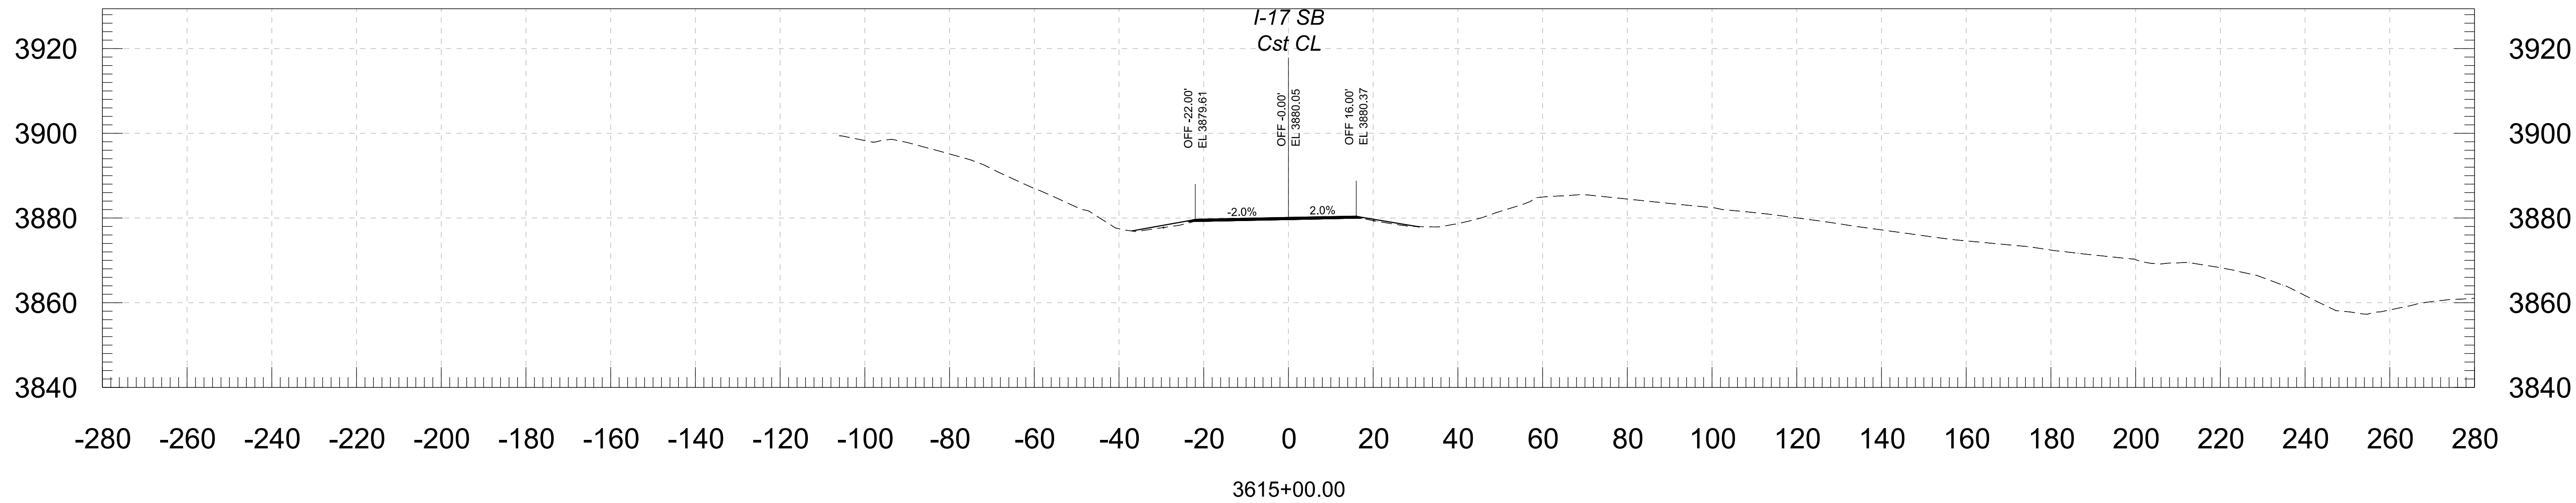



		<table><tr><td></td><td>NAME</td><td>DATE</td></tr><tr><td>DESIGN</td><td>BAP</td><td>06/26</td></tr><tr><td>DRAWN</td><td>RM</td><td>06/26</td></tr><tr><td>CHECKED</td><td>KCH</td><td>06/26</td></tr></table>		NAME	DATE	DESIGN	BAP	06/26	DRAWN	RM	06/26	CHECKED	KCH	06/26	ARIZONA DEPARTMENT OF TRANSPORTATION PROJECT DELIVERY AND OPERATIONS DIVISION ROADWAY DESIGN SERVICES	<table><tr><td>ROUTE</td><td>I-17</td></tr><tr><td>MILEPOST</td><td></td></tr><tr><td>STRUCTURE NO.</td><td></td></tr></table>	ROUTE	I-17	MILEPOST		STRUCTURE NO.		<table><tr><td>F.H.W.A. Arizona Division</td><td>STATE</td><td>PROJECT NO.</td><td>FEDERAL ID NO.</td><td>SHEET NO.</td><td>TOTAL SHEETS</td><td>RECORD DRAWING</td></tr><tr><td></td><td>ARIZ.</td><td>017 YV 269</td><td>017-B(239)T</td><td>16</td><td>146</td><td></td></tr></table>	F.H.W.A. Arizona Division	STATE	PROJECT NO.	FEDERAL ID NO.	SHEET NO.	TOTAL SHEETS	RECORD DRAWING		ARIZ.	017 YV 269	017-B(239)T	16	146	
			NAME	DATE																																	
		DESIGN	BAP	06/26																																	
		DRAWN	RM	06/26																																	
CHECKED	KCH	06/26																																			
ROUTE	I-17																																				
MILEPOST																																					
STRUCTURE NO.																																					
F.H.W.A. Arizona Division	STATE	PROJECT NO.	FEDERAL ID NO.	SHEET NO.	TOTAL SHEETS	RECORD DRAWING																															
	ARIZ.	017 YV 269	017-B(239)T	16	146																																
 3133 East Camelback Road, Suite 100 Phoenix, Arizona 85016 Phone: (602) 333-2200 Stanley Consultants INC.	CROSS SECTION	<table><tr><td>LOCATION</td><td>E DUGAS ROAD - MP 275</td><td>DWG NO.</td></tr><tr><td>TRACS NO.</td><td>F0616 01C</td><td>___ OF ___</td></tr></table>	LOCATION	E DUGAS ROAD - MP 275	DWG NO.	TRACS NO.	F0616 01C	___ OF ___																													
LOCATION	E DUGAS ROAD - MP 275	DWG NO.																																			
TRACS NO.	F0616 01C	___ OF ___																																			

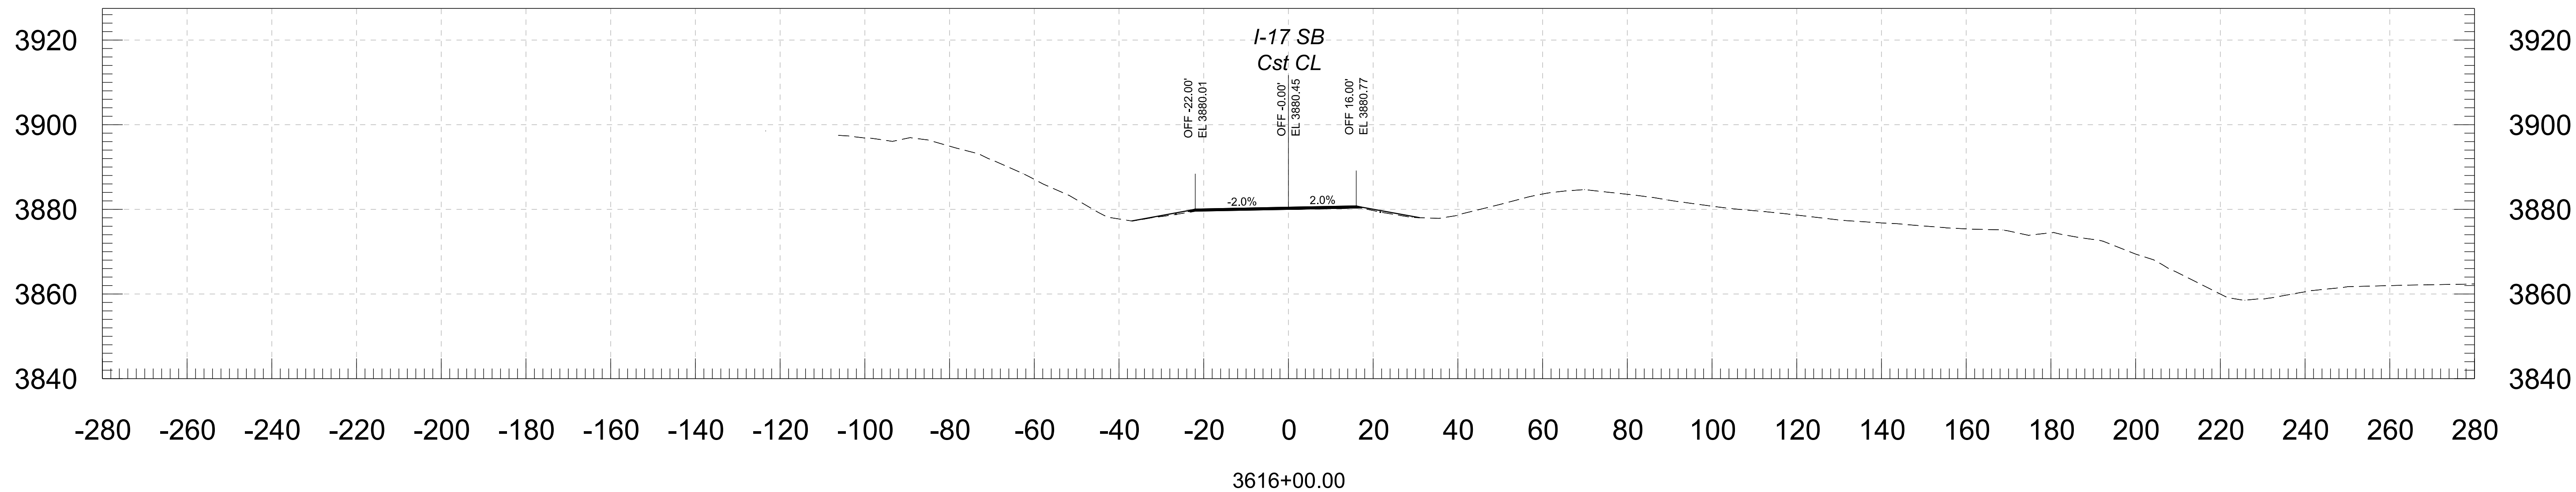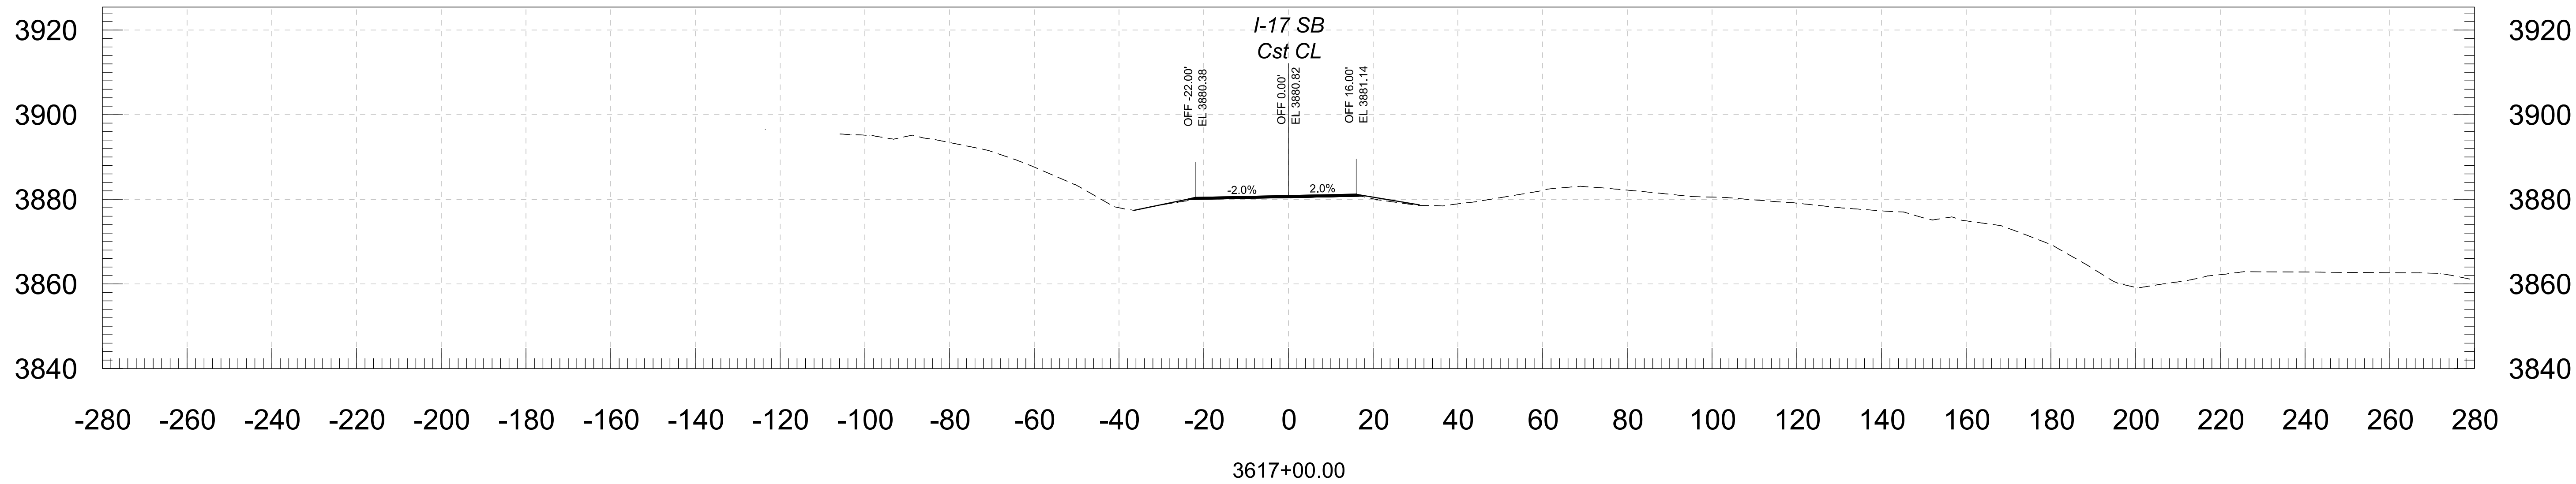


		<table><tr><td></td><td>NAME</td><td>DATE</td></tr><tr><td>DESIGN</td><td>BAP</td><td>06/26</td></tr><tr><td>DRAWN</td><td>RM</td><td>06/26</td></tr><tr><td>CHECKED</td><td>KCH</td><td>06/26</td></tr></table>		NAME	DATE	DESIGN	BAP	06/26	DRAWN	RM	06/26	CHECKED	KCH	06/26	<table><tr><td colspan="2">ARIZONA DEPARTMENT OF TRANSPORTATION PROJECT DELIVERY AND OPERATIONS DIVISION ROADWAY DESIGN SERVICES</td></tr><tr><td colspan="2">CROSS SECTION</td></tr></table>	ARIZONA DEPARTMENT OF TRANSPORTATION PROJECT DELIVERY AND OPERATIONS DIVISION ROADWAY DESIGN SERVICES		CROSS SECTION		<table><tr><td>ROUTE</td><td rowspan="2">I-17</td><td rowspan="2">F.H.W.A. Arizona Division</td><td rowspan="2">STATE</td><td rowspan="2">ARIZ.</td><td>PROJECT NO.</td><td>FEDERAL ID NO.</td><td>SHEET NO.</td><td>TOTAL SHEETS</td><td rowspan="2">RECORD DRAWING</td></tr><tr><td>MILEPOST</td><td>017 YV 269</td><td>017-B(239)T</td><td>17</td><td>146</td></tr></table>	ROUTE	I-17	F.H.W.A. Arizona Division	STATE	ARIZ.	PROJECT NO.	FEDERAL ID NO.	SHEET NO.	TOTAL SHEETS	RECORD DRAWING	MILEPOST	017 YV 269	017-B(239)T	17	146
				NAME	DATE																														
			DESIGN	BAP	06/26																														
			DRAWN	RM	06/26																														
			CHECKED	KCH	06/26																														
ARIZONA DEPARTMENT OF TRANSPORTATION PROJECT DELIVERY AND OPERATIONS DIVISION ROADWAY DESIGN SERVICES																																			
CROSS SECTION																																			
ROUTE	I-17	F.H.W.A. Arizona Division	STATE	ARIZ.	PROJECT NO.	FEDERAL ID NO.	SHEET NO.	TOTAL SHEETS	RECORD DRAWING																										
MILEPOST					017 YV 269	017-B(239)T	17	146																											
E DUGAS ROAD - MP 275								DWG NO.																											
TRACS NO. F0616 01C								___ OF ___																											

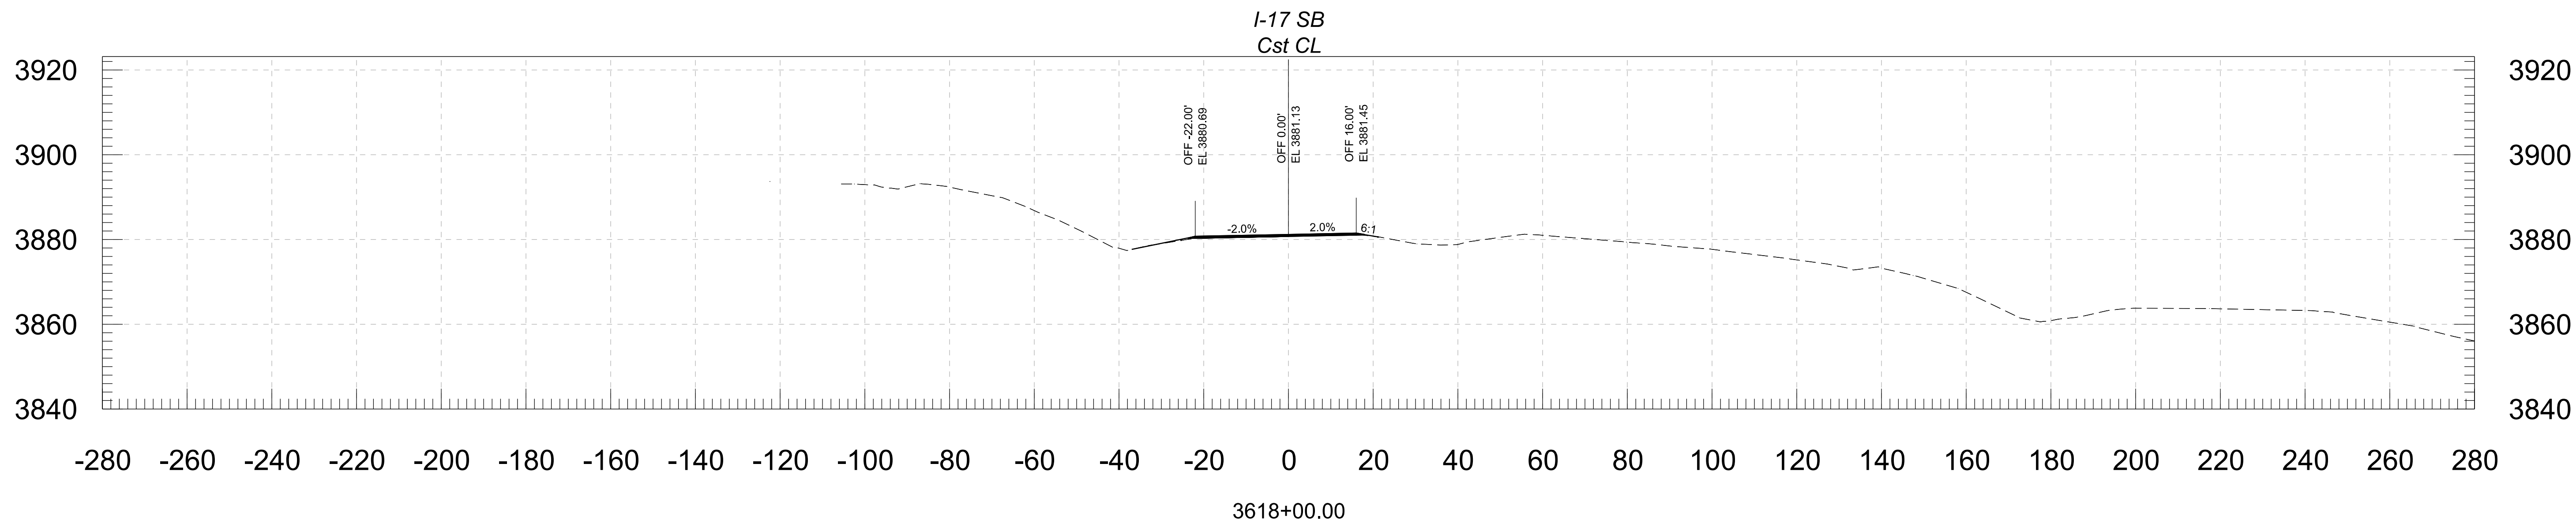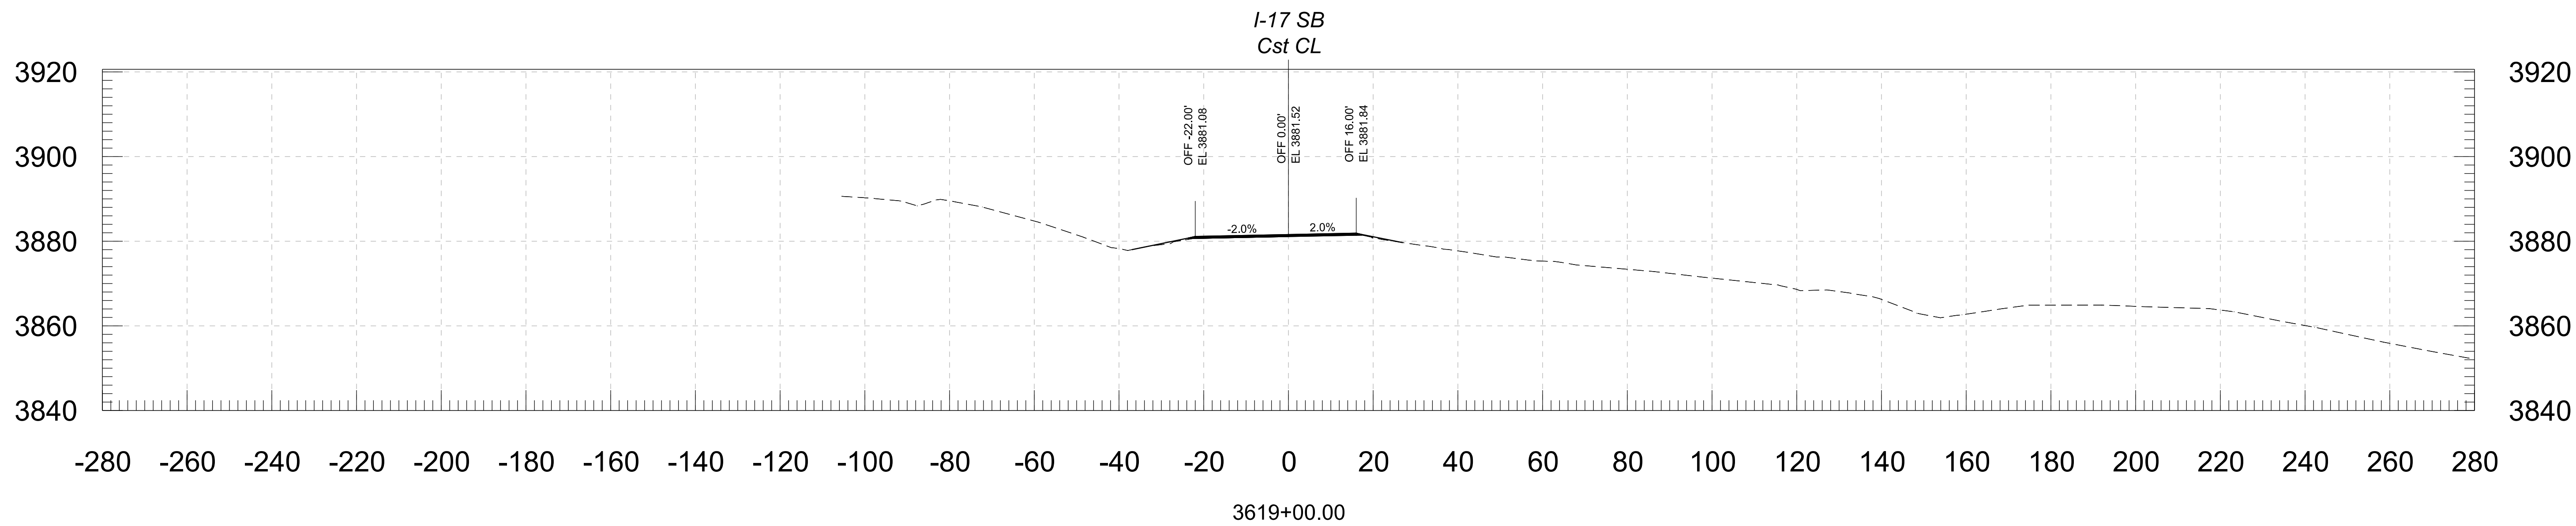


				NAME	DATE	ARIZONA DEPARTMENT OF TRANSPORTATION PROJECT DELIVERY AND OPERATIONS DIVISION ROADWAY DESIGN SERVICES	ROUTE	F.H.W.A. Arizona Division	STATE ARIZ.	PROJECT NO.	FEDERAL ID NO.	SHEET NO.	TOTAL SHEETS	RECORD DRAWING
			DESIGN	BAP	06/26		I-17							
			DRAWN	RM	06/26					E DUGAS ROAD - MP 275	18	146		
			CHECKED	KCH	06/26									
			 333 East Camelback Road, Suite 100 Phoenix, Arizona 85016 Phone: 602) 333-2200 Stanley Consultants INC.				CROSS SECTION							
						STRUCTURE NO.	TRACS NO. F0616 01C							____ OF ____

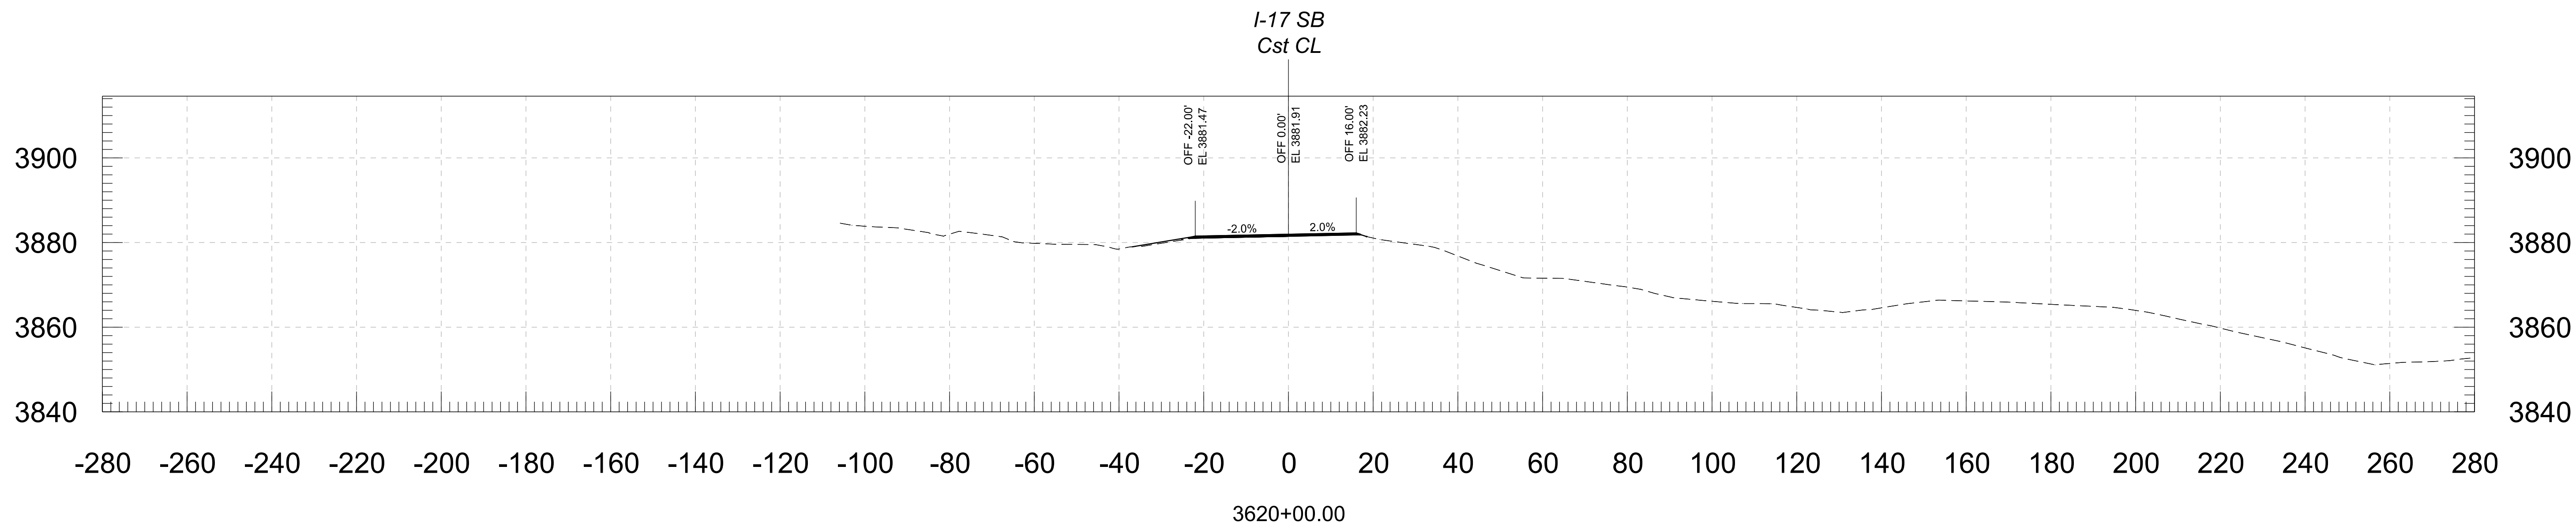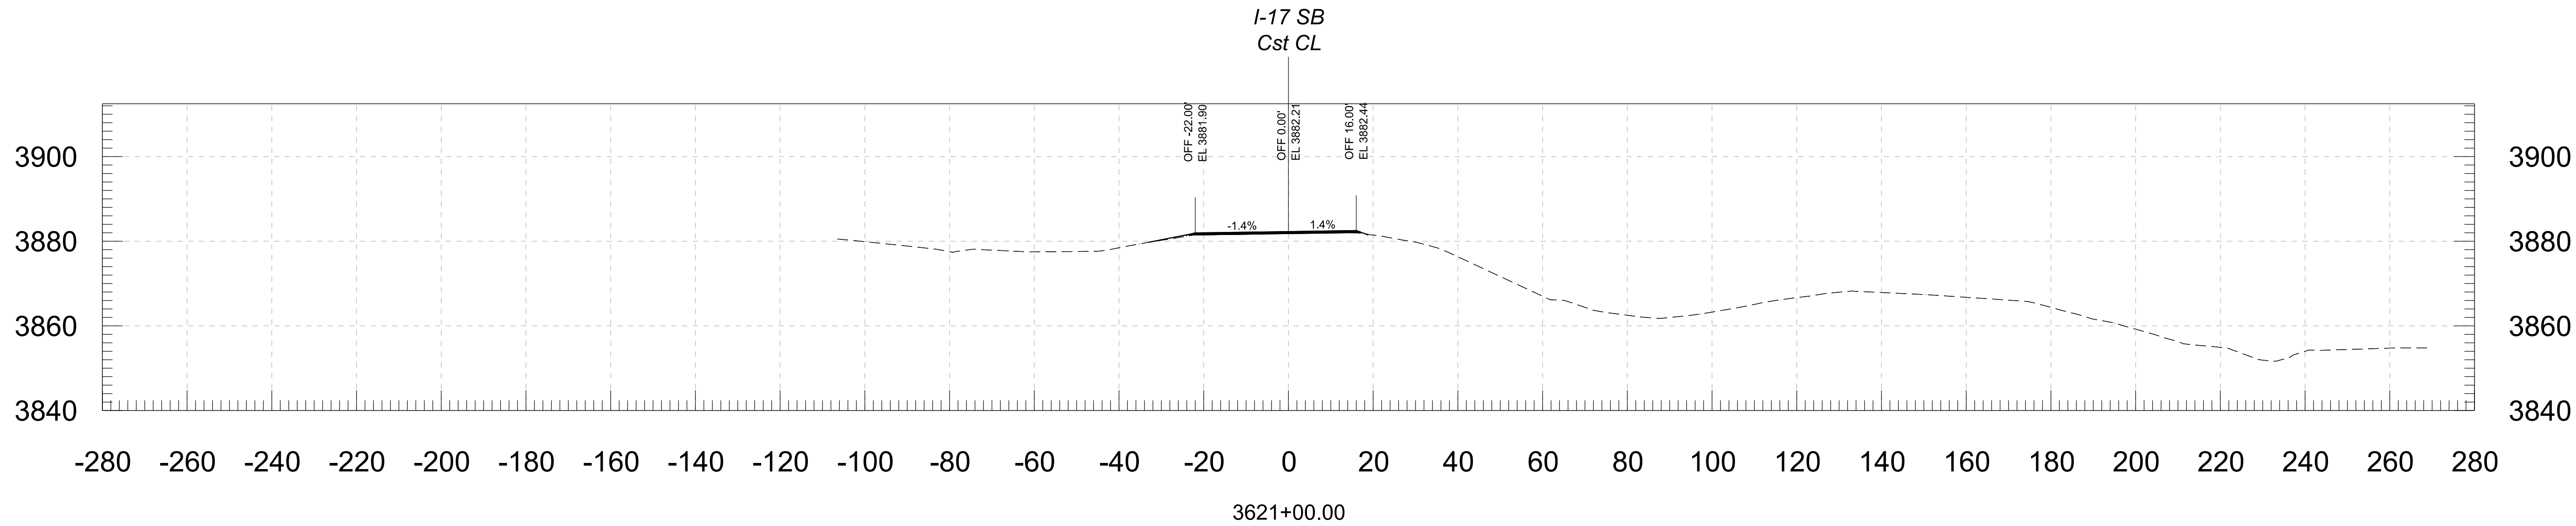



		NAME		DATE	ARIZONA DEPARTMENT OF TRANSPORTATION PROJECT DELIVERY AND OPERATIONS DIVISION ROADWAY DESIGN SERVICES		ROUTE I-17	F.H.W.A. Arizona Division		STATE ARIZ.	PROJECT NO. 017 YV 269	FEDERAL ID NO. 017-B(239)T	SHEET NO. 19	TOTAL SHEETS 146	RECORD DRAWING
		DESIGN	BAP	06/26			MILEPOST	LOCATION E DUGAS ROAD - MP 275							DWG NO.
		DRAWN	RM	06/26			STRUCTURE NO.	TRACS NO. F0616 01C							____ OF ____
		CHECKED	KCH	06/26											
		 Stanley Consultants INC. 3133 East Camelback Road, Suite 100 Phoenix, Arizona 85016 Phone: 602/333-2200				CROSS SECTION									

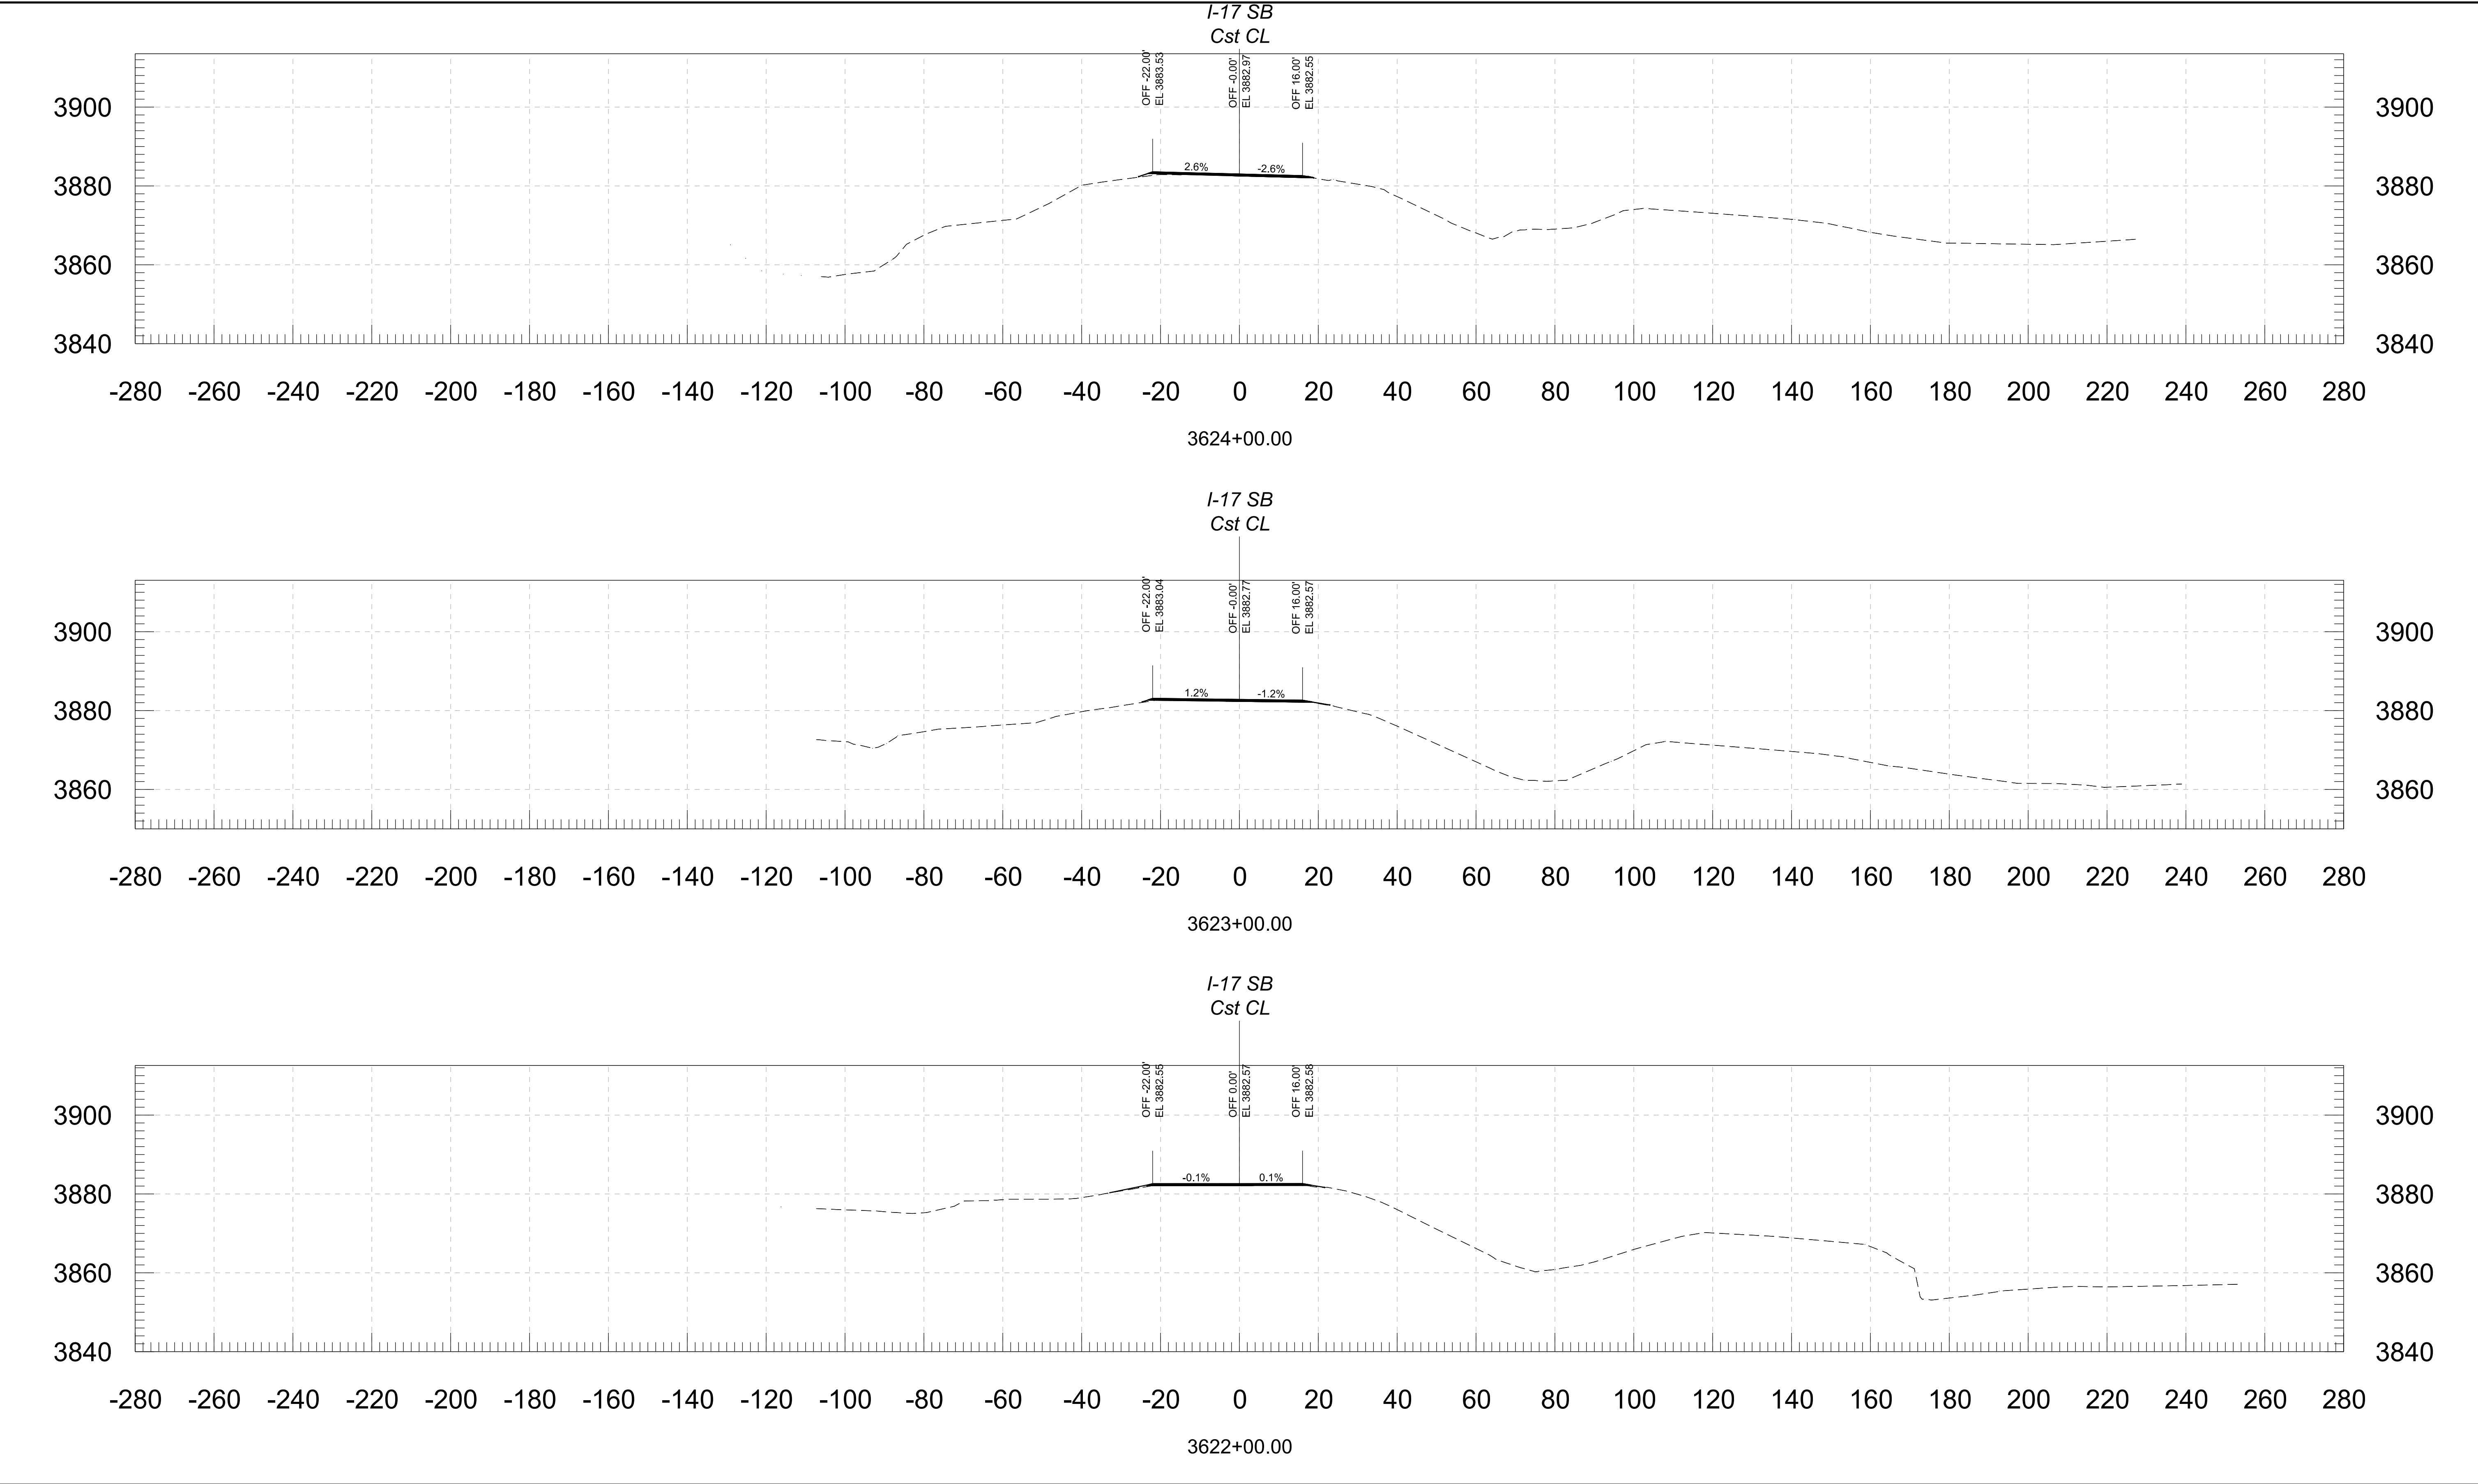



		DESIGN	NAME	DATE	ARIZONA DEPARTMENT OF TRANSPORTATION PROJECT DELIVERY AND OPERATIONS DIVISION ROADWAY DESIGN SERVICES		ROUTE	F.H.W.A. Arizona Division		STATE	PROJECT NO.	FEDERAL ID NO.	SHEET NO.	TOTAL SHEETS	RECORD DRAWING
		DRAWN	RM	06/26			I-17			ARIZ.	017 YV 269	017-B(239)T	20	146	
		CHECKED	KCH	06/26			MILEPOST	LOCATION E DUGAS ROAD - MP 275							DWG NO.
					CROSS SECTION		STRUCTURE NO.	TRACS NO. F0616 01C						____ OF ____	

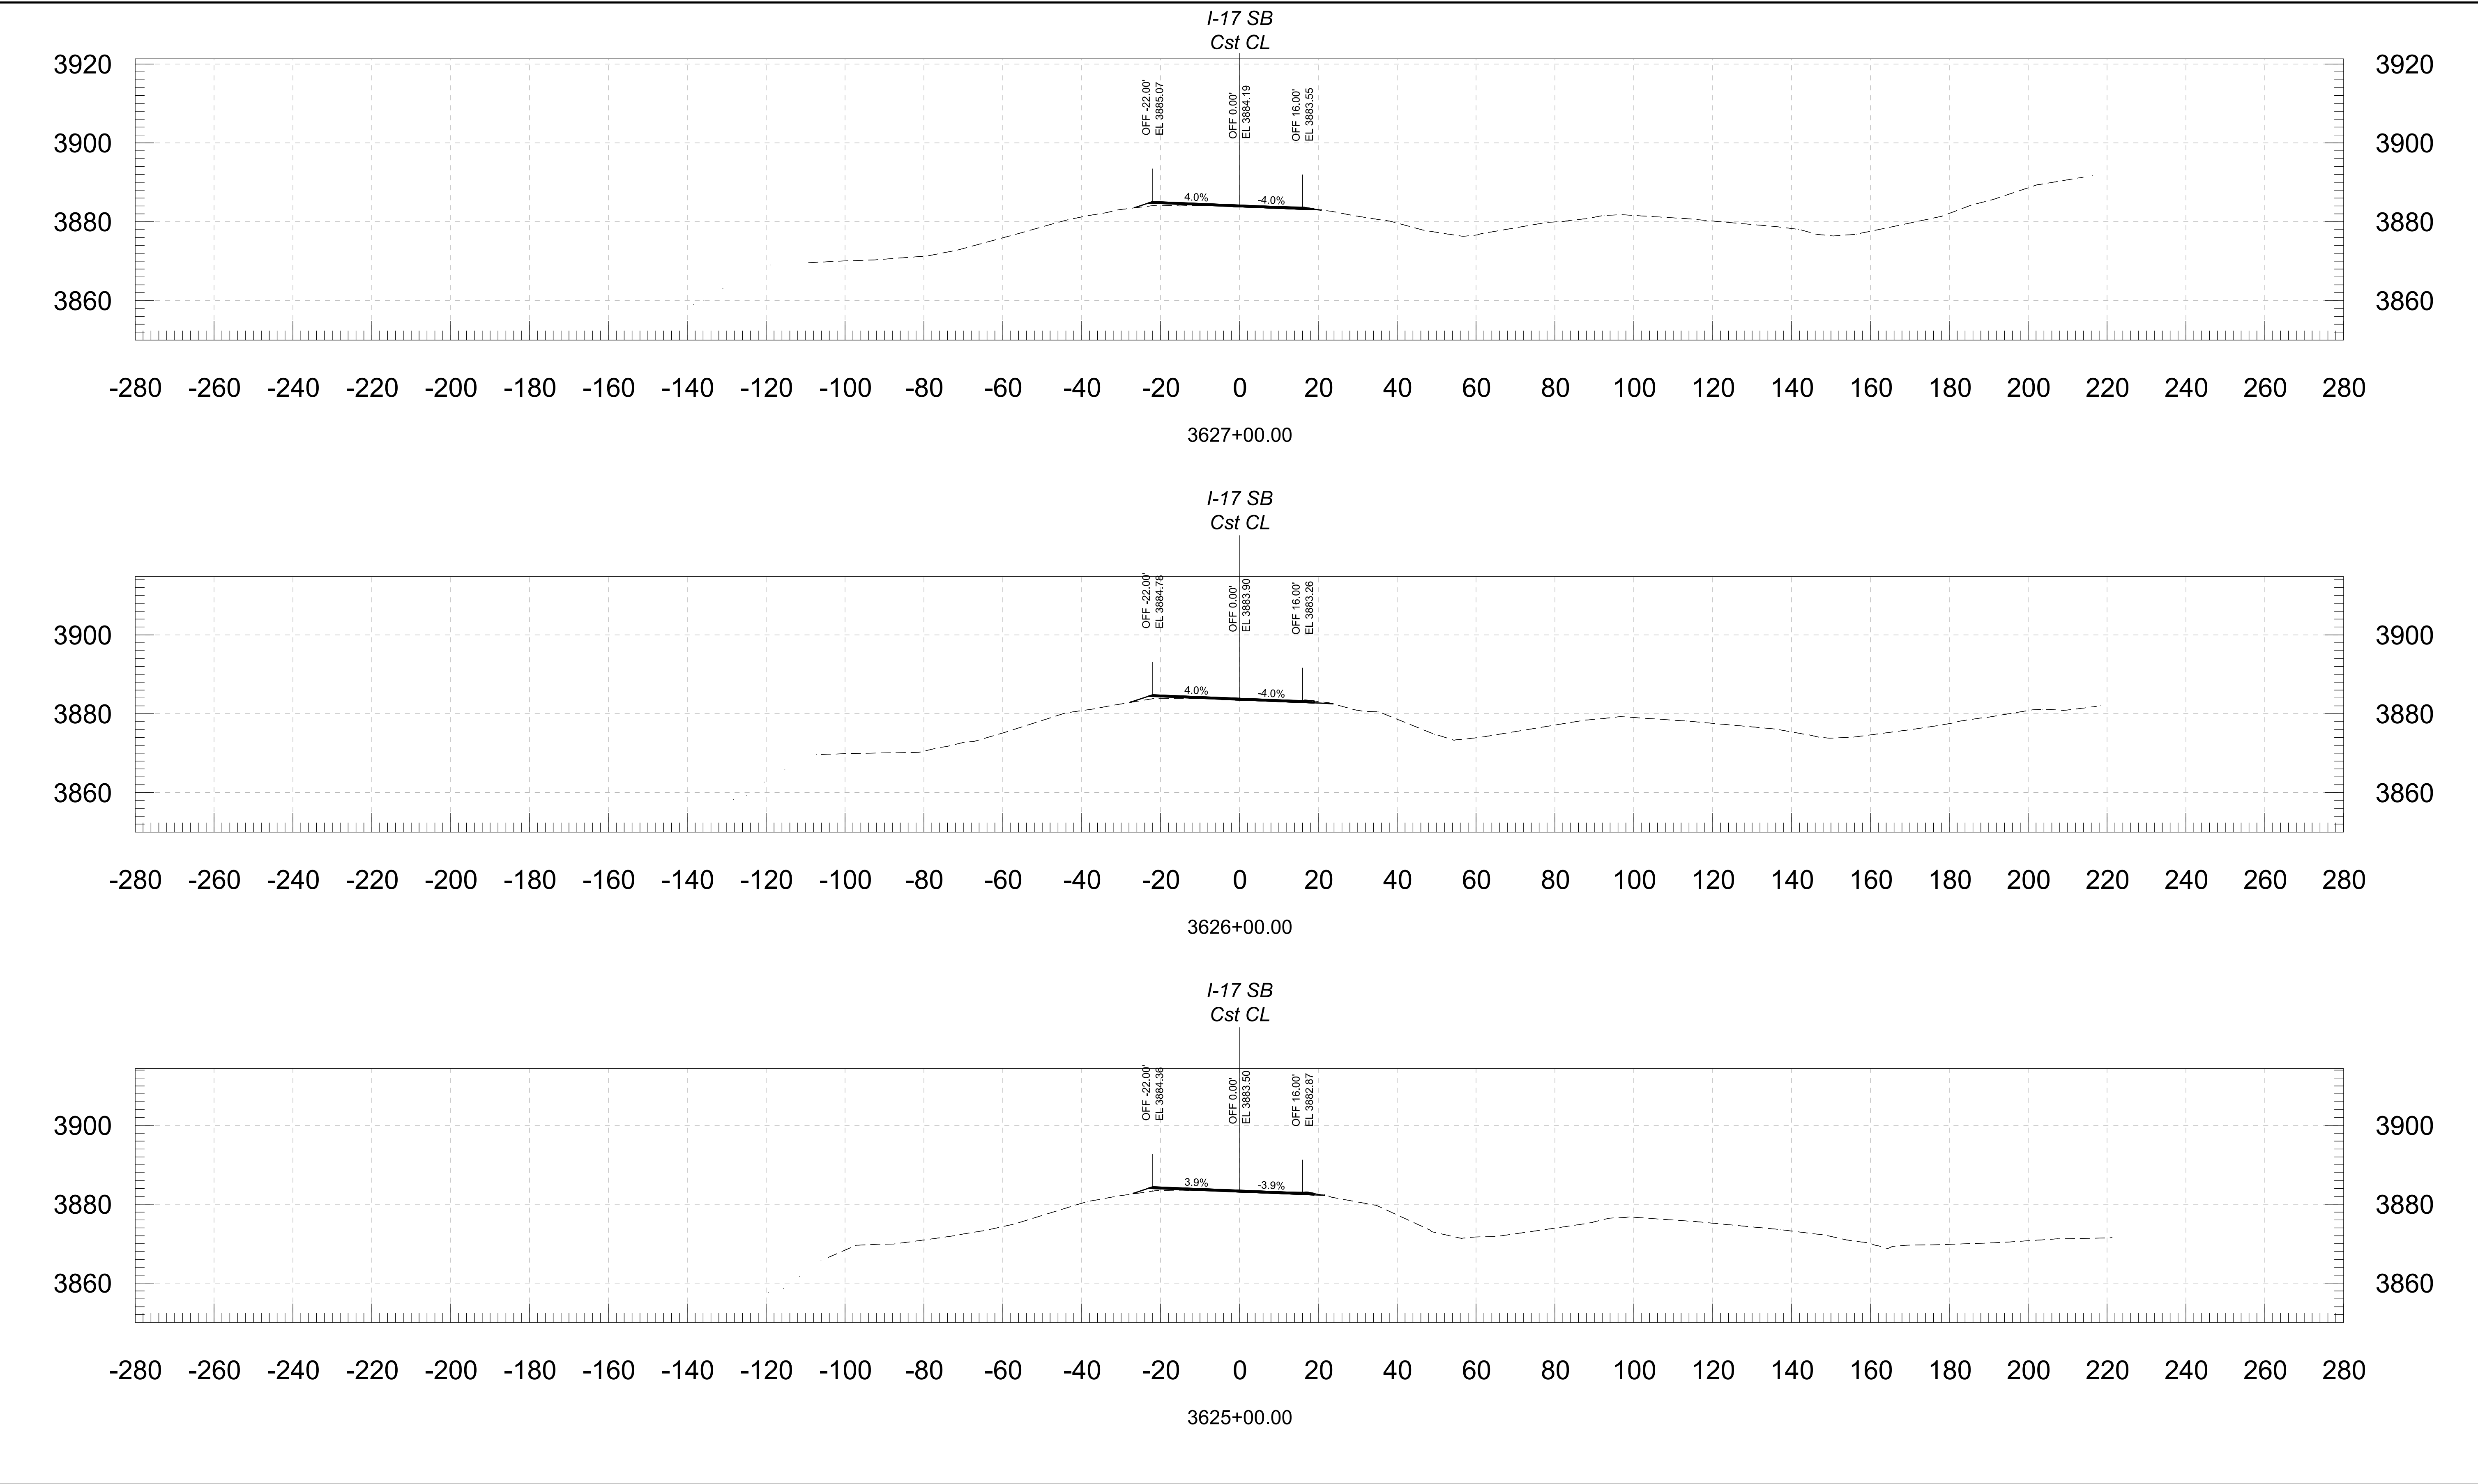



			NAME	DATE	ARIZONA DEPARTMENT OF TRANSPORTATION PROJECT DELIVERY AND OPERATIONS DIVISION ROADWAY DESIGN SERVICES	ROUTE	F.H.W.A. Arizona Division	STATE ARIZ.	PROJECT NO.	FEDERAL ID NO.	SHEET NO.	TOTAL SHEETS	RECORD DRAWING
		DESIGN	BAP	06/26		I-17			017 YV 269	017-B(239)T	21	146	
		DRAWN	RM	06/26									
		CHECKED	KCH	06/26									
		 3135 East Camelback Road, Suite 100 Phoenix, Arizona 85016 Phone: 602.333-2200 Stanley Consultants INC.					CROSS SECTION	MILEPOST	E DUGAS ROAD - MP 275				
					STRUCTURE NO.	TRACS NO. F0616 01C					___ OF ___		

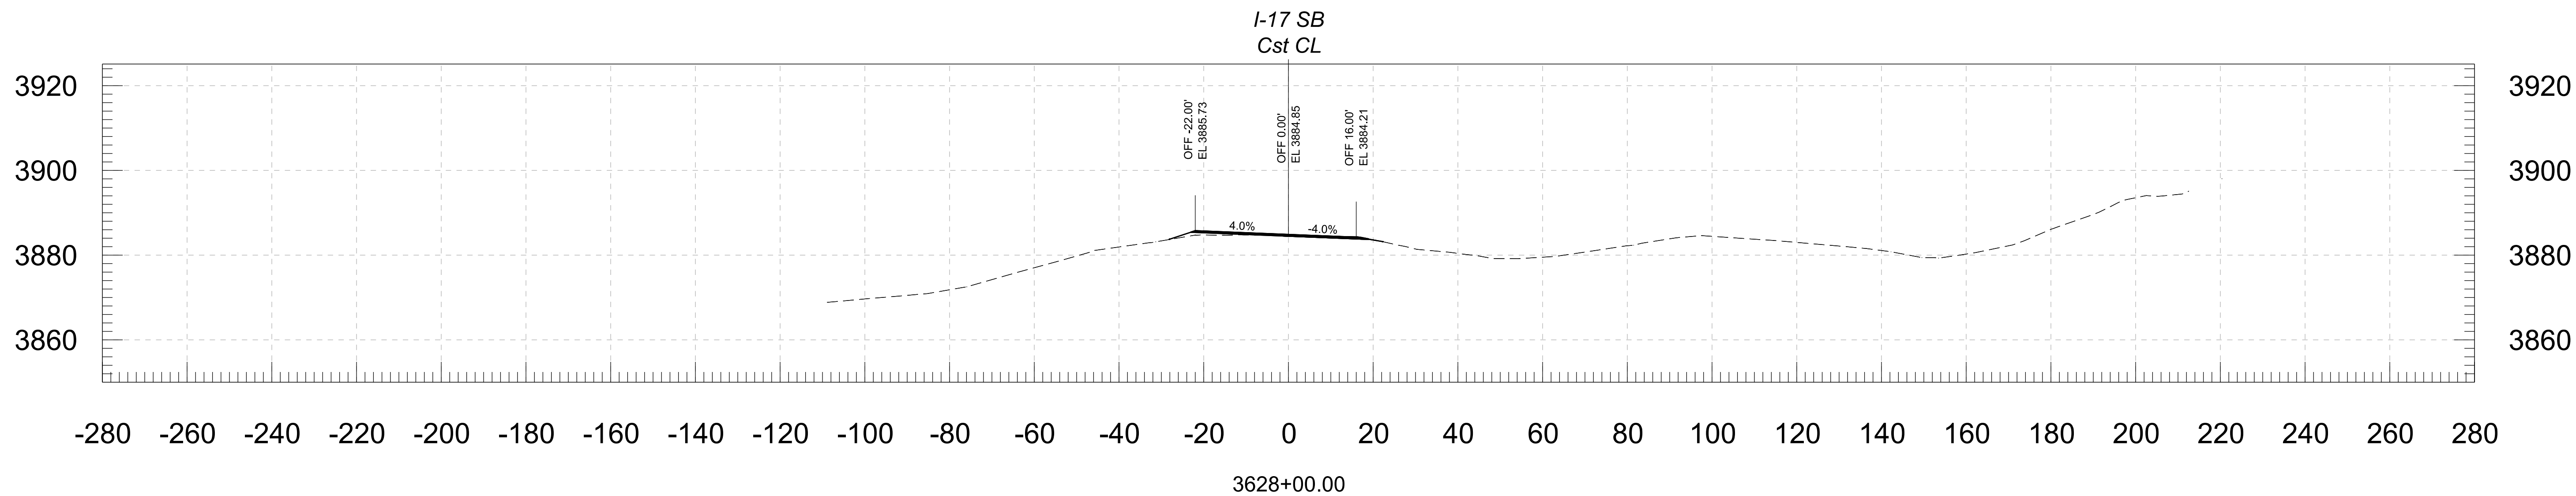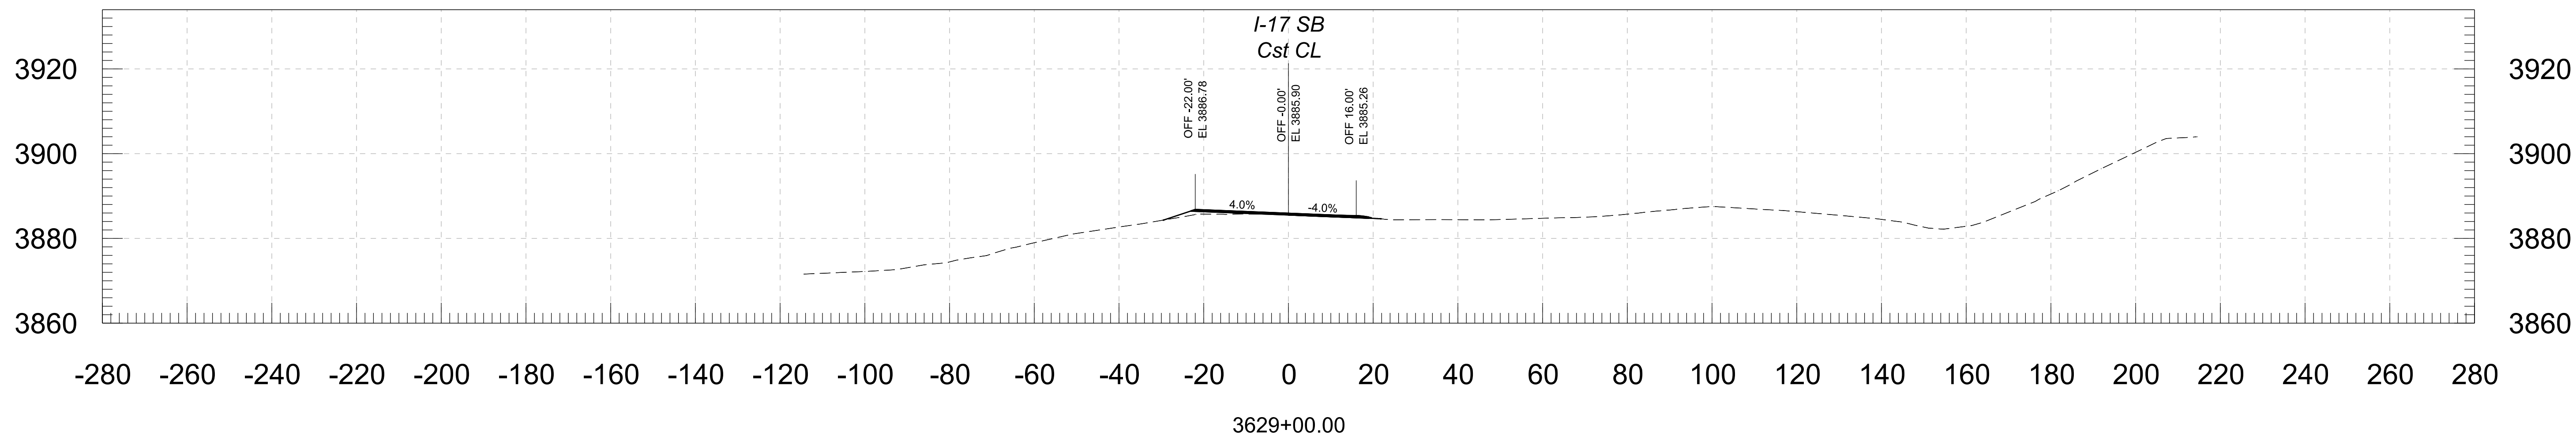



--	--	
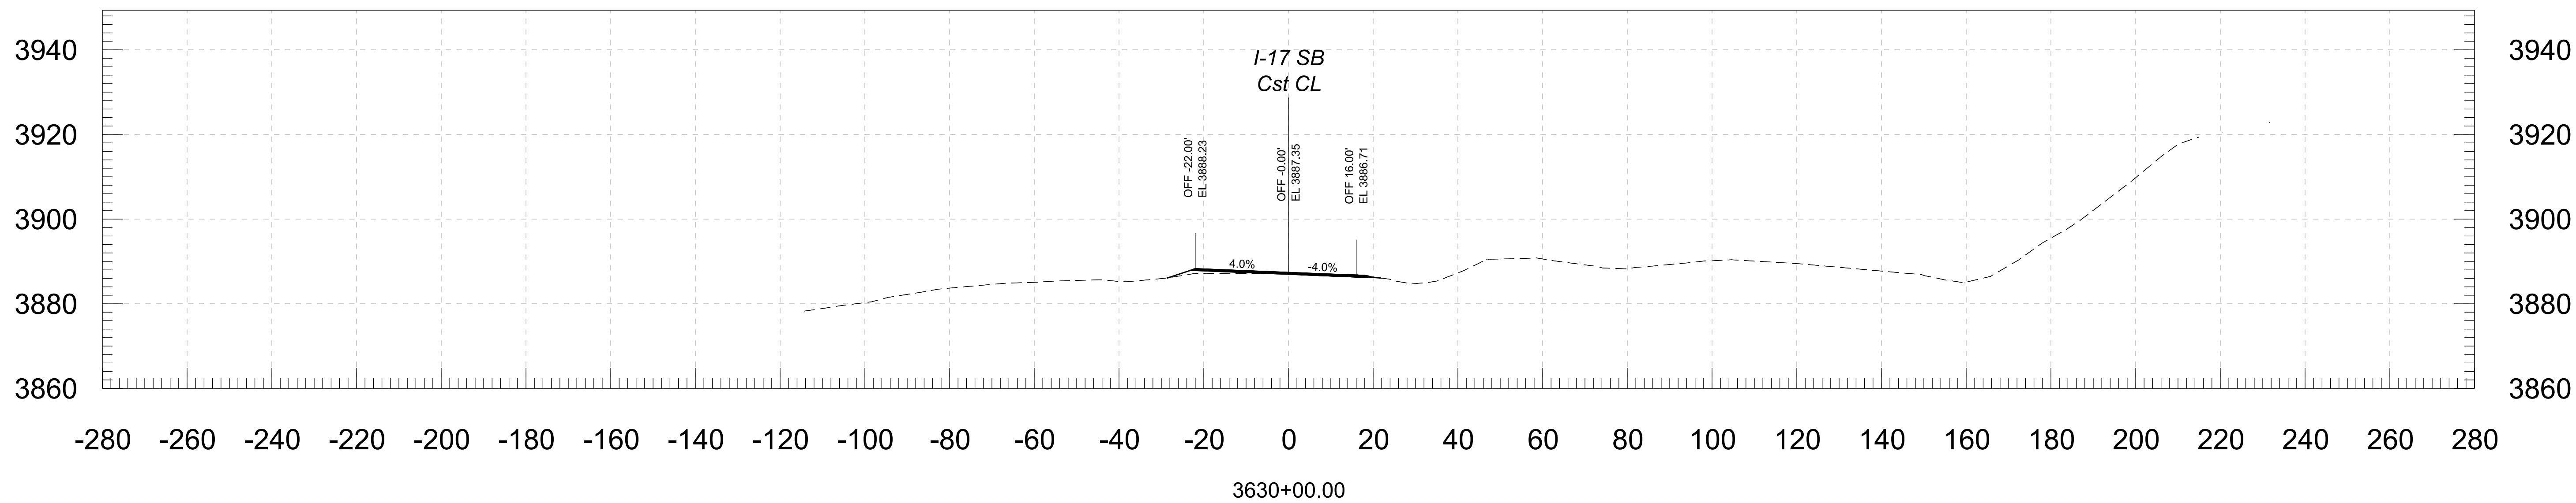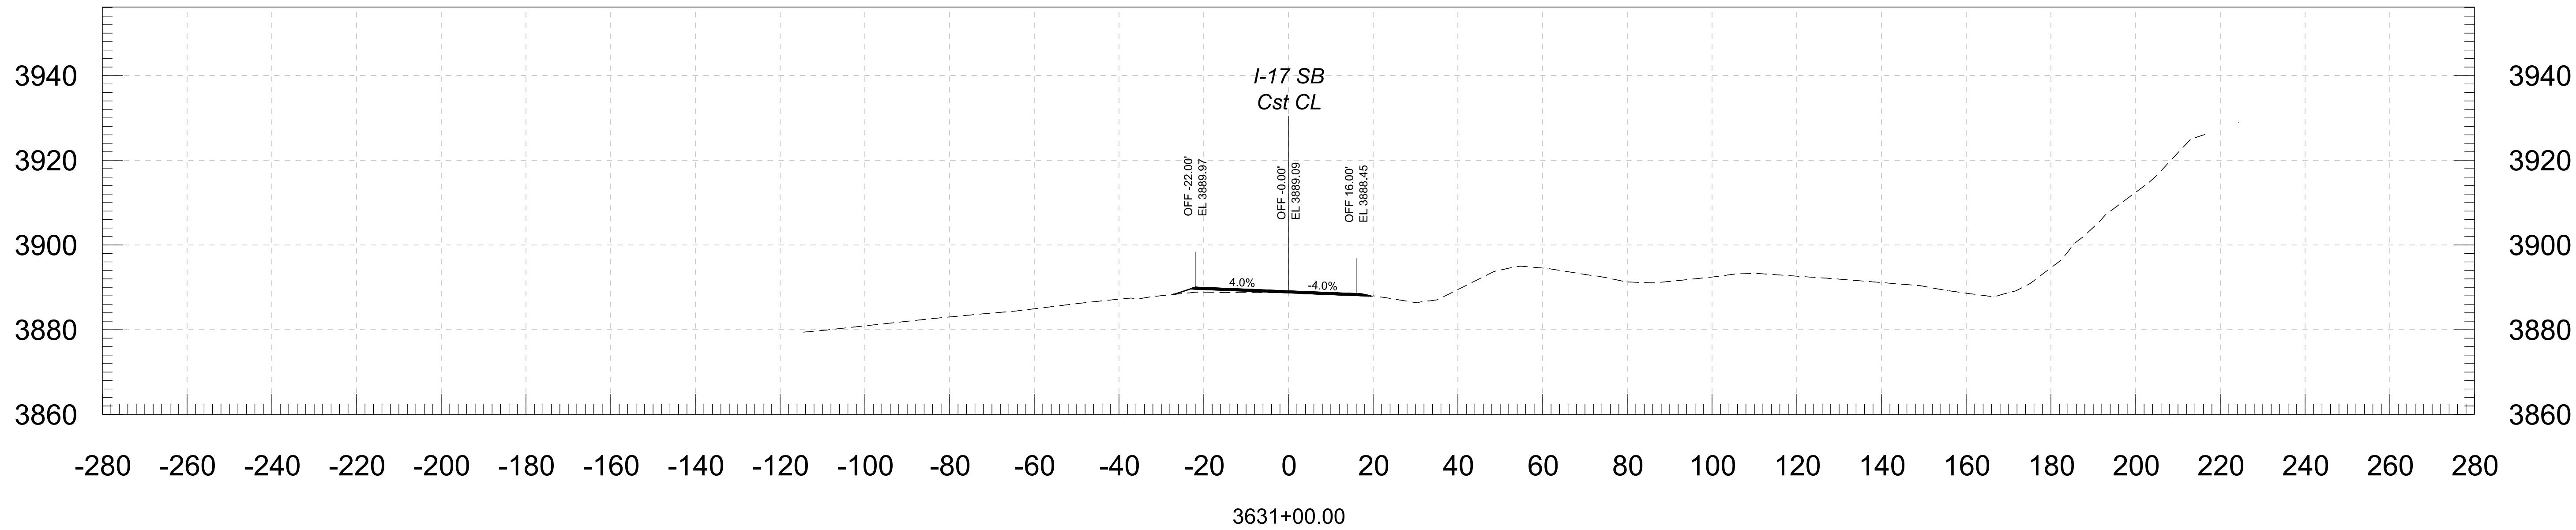



			NAME	DATE	ARIZONA DEPARTMENT OF TRANSPORTATION PROJECT DELIVERY AND OPERATIONS DIVISION ROADWAY DESIGN SERVICES	ROUTE	F.H.W.A. Arizona Division	STATE ARIZ.	PROJECT NO.	FEDERAL ID NO.	SHEET NO.	TOTAL SHEETS	RECORD DRAWING
		DESIGN	BAP	06/26		I-17			017 YV 269	017-B(239)T	23	146	
		DRAWN	RM	06/26									
		CHECKED	KCH	06/26									
		 Stanley Consultants INC.			3133 East Camelback Road, Suite 100 Phoenix, Arizona 85016 Phone 602. 333-2200			CROSS SECTION	MILEPOST	E DUGAS ROAD - MP 275			
						STRUCTURE NO.	TRACS NO. F0616 01C		____ OF ____				

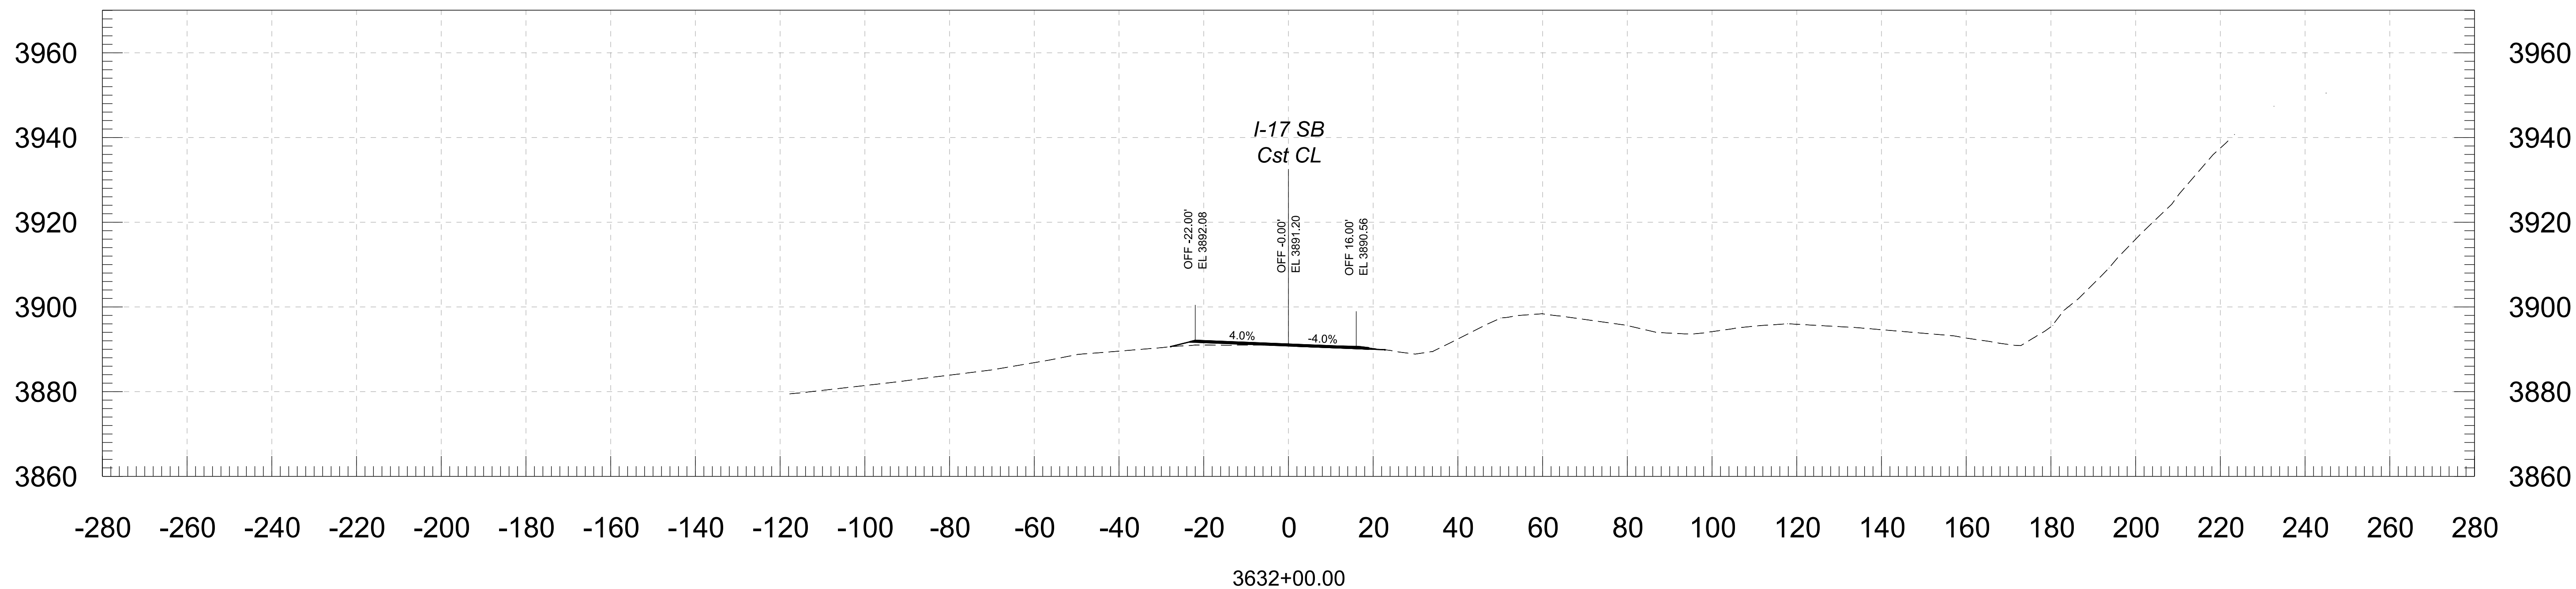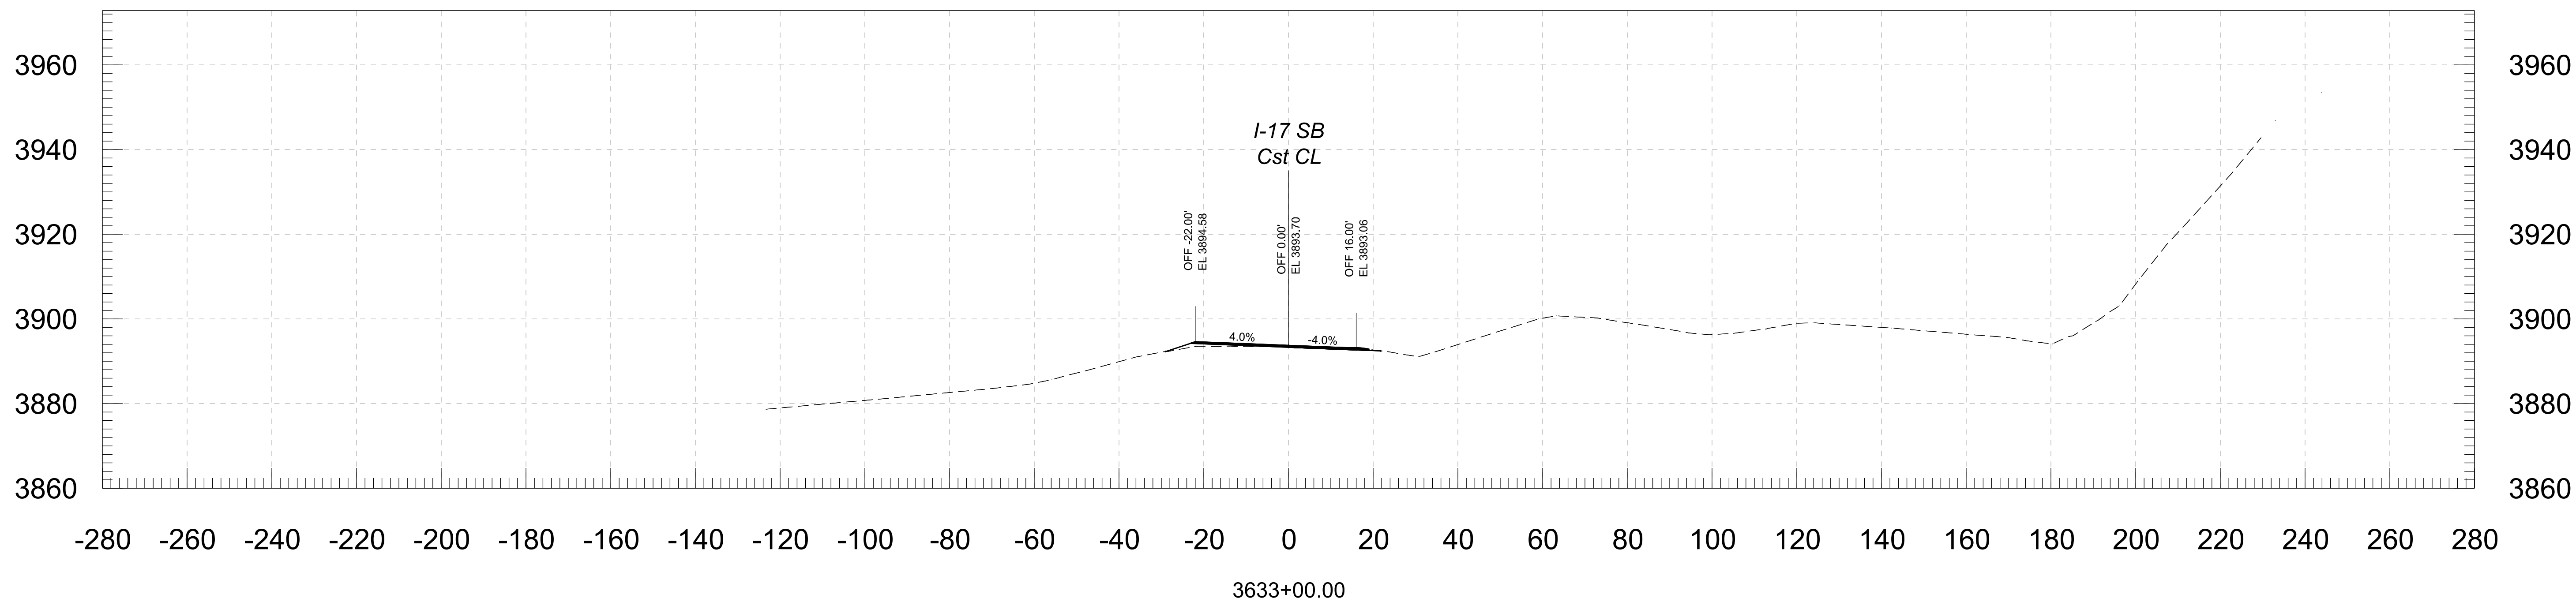



			NAME	DATE	ARIZONA DEPARTMENT OF TRANSPORTATION PROJECT DELIVERY AND OPERATIONS DIVISION ROADWAY DESIGN SERVICES	ROUTE	F.H.W.A. Arizona Division	STATE	PROJECT NO.	FEDERAL ID NO.	SHEET NO.	TOTAL SHEETS	RECORD DRAWING
		DESIGN	BAP	06/26		I-17							
		DRAWN	RM	06/26		MILEPOST	ARIZ.	017 YV 269	017-B(239)T	24	146		
		CHECKED	KCH	06/26									
		 333 East Camelback Road, Suite 100 Phoenix, Arizona 85016 Phone: 602) 333-2200 Stanley Consultants INC.				CROSS SECTION			LOCATION	E DUGAS ROAD - MP 275			
						TRACS NO. F0616 01C					___ OF ___		

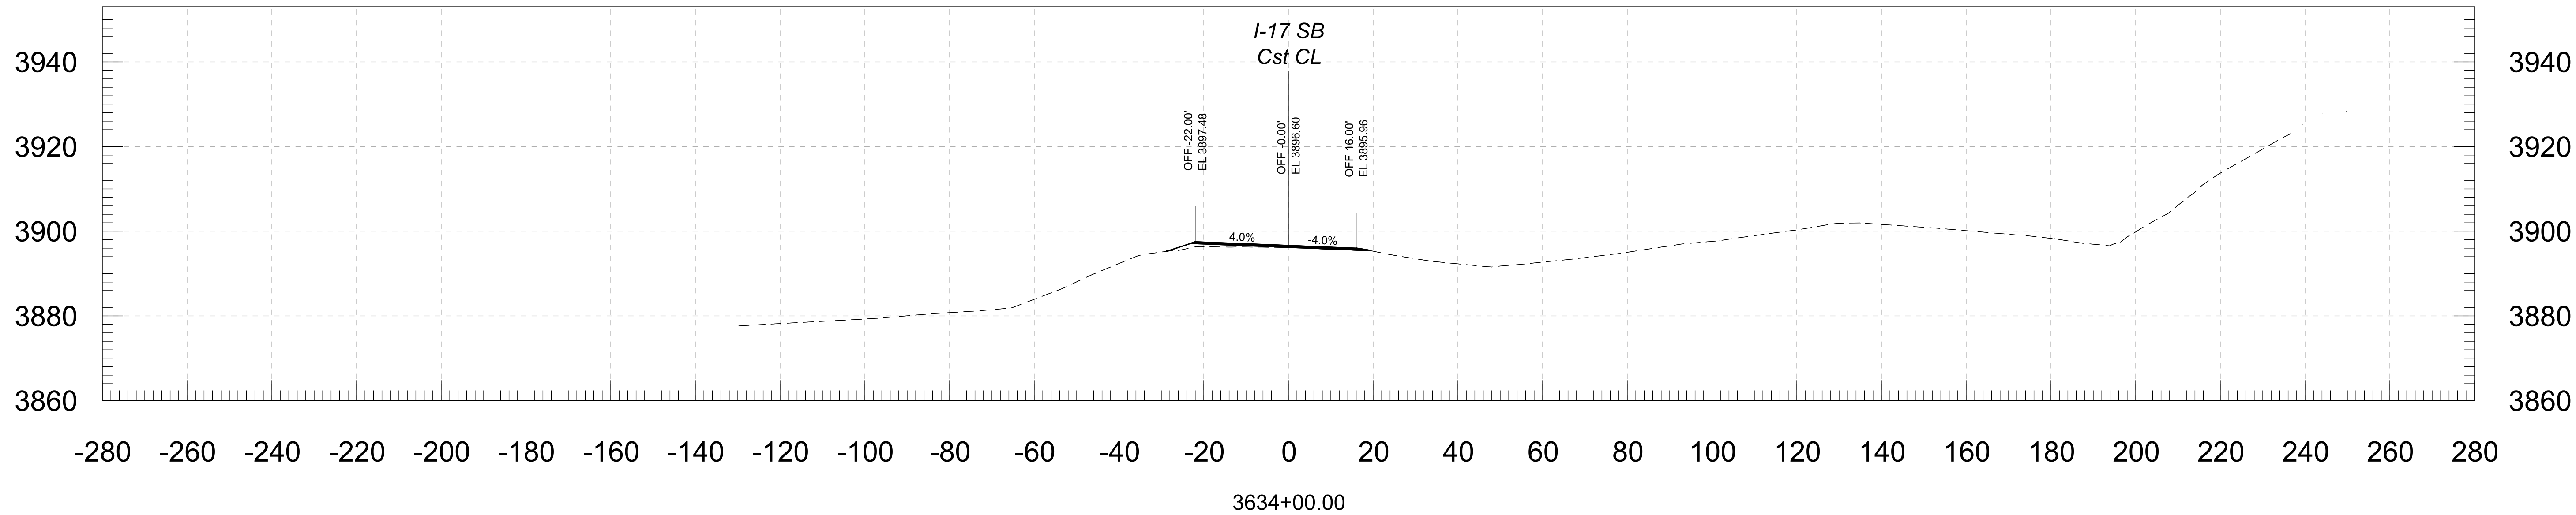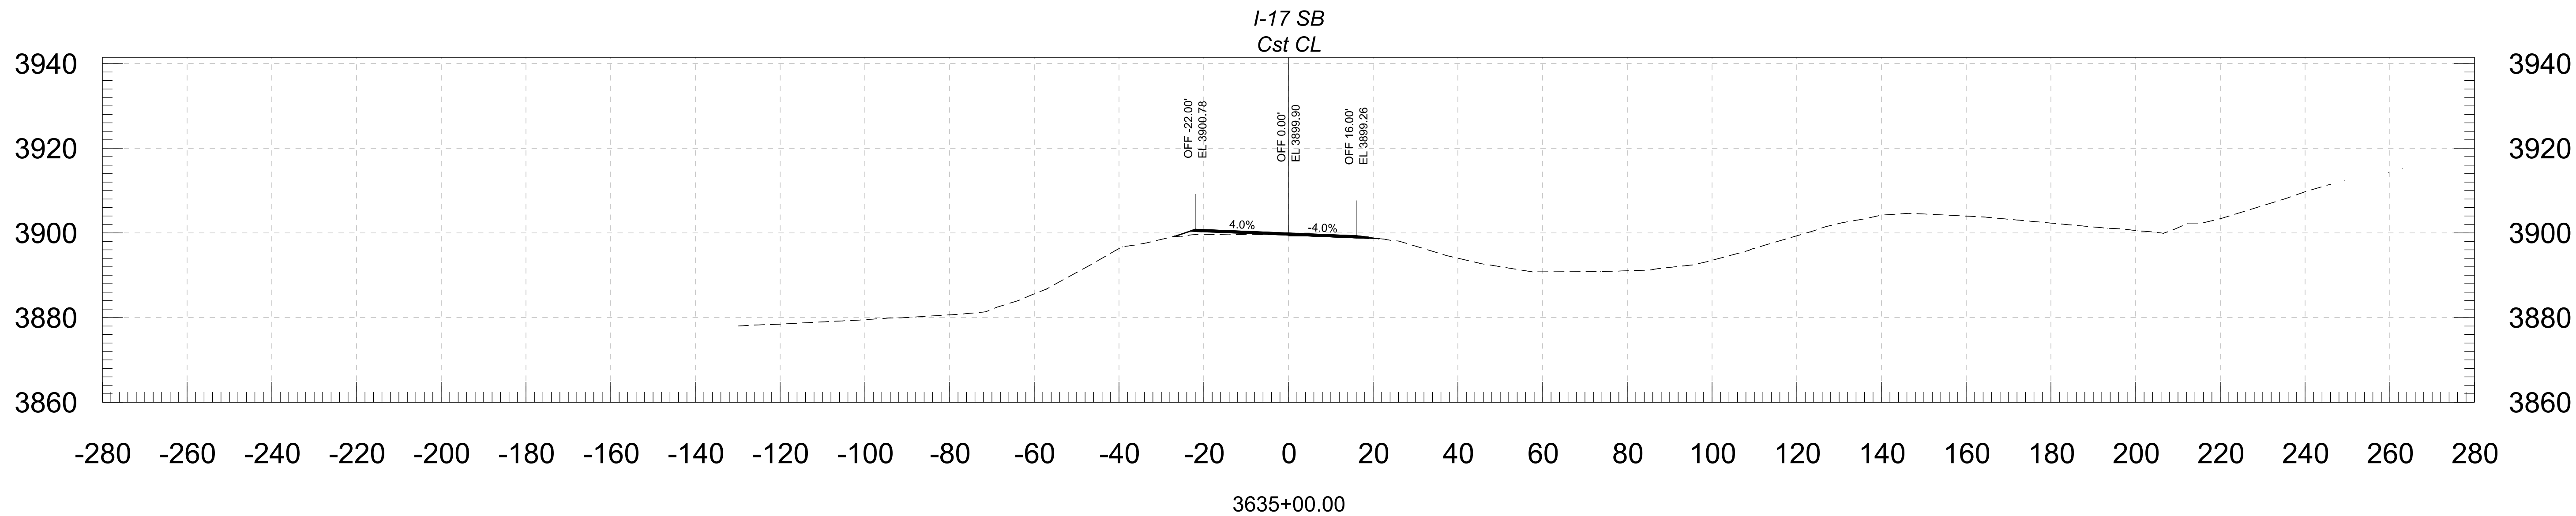


				NAME	DATE	ARIZONA DEPARTMENT OF TRANSPORTATION PROJECT DELIVERY AND OPERATIONS DIVISION ROADWAY DESIGN SERVICES	ROUTE	F.H.W.A. Arizona Division	STATE ARIZ.	PROJECT NO.	FEDERAL ID NO.	SHEET NO.	TOTAL SHEETS	RECORD DRAWING
			DESIGN	BAP	06/26		I-17			017 YV 269	017-B(239)T	25	146	
			DRAWN	RM	06/26									
			CHECKED	KCH	06/26									
			 Stanley Consultants INC.				3133 East Camelback Road, Suite 100 Phoenix, Arizona 85016 Phone: 602.333.2000			CROSS SECTION	MILEPOST	E DUGAS ROAD - MP 275		
TRACS NO. F0616 01C						OF								

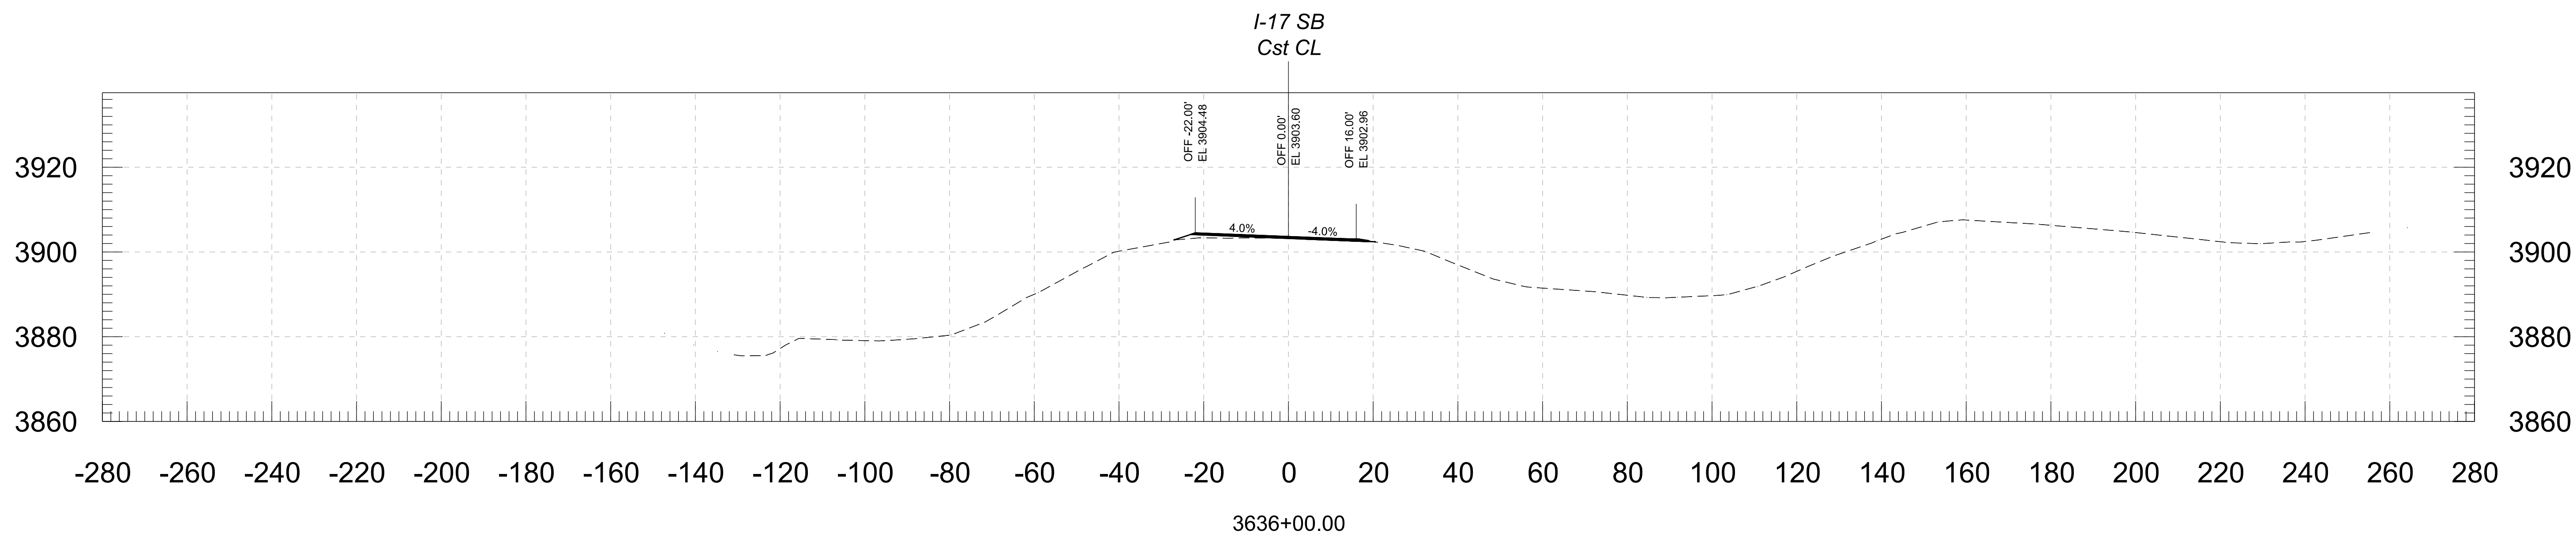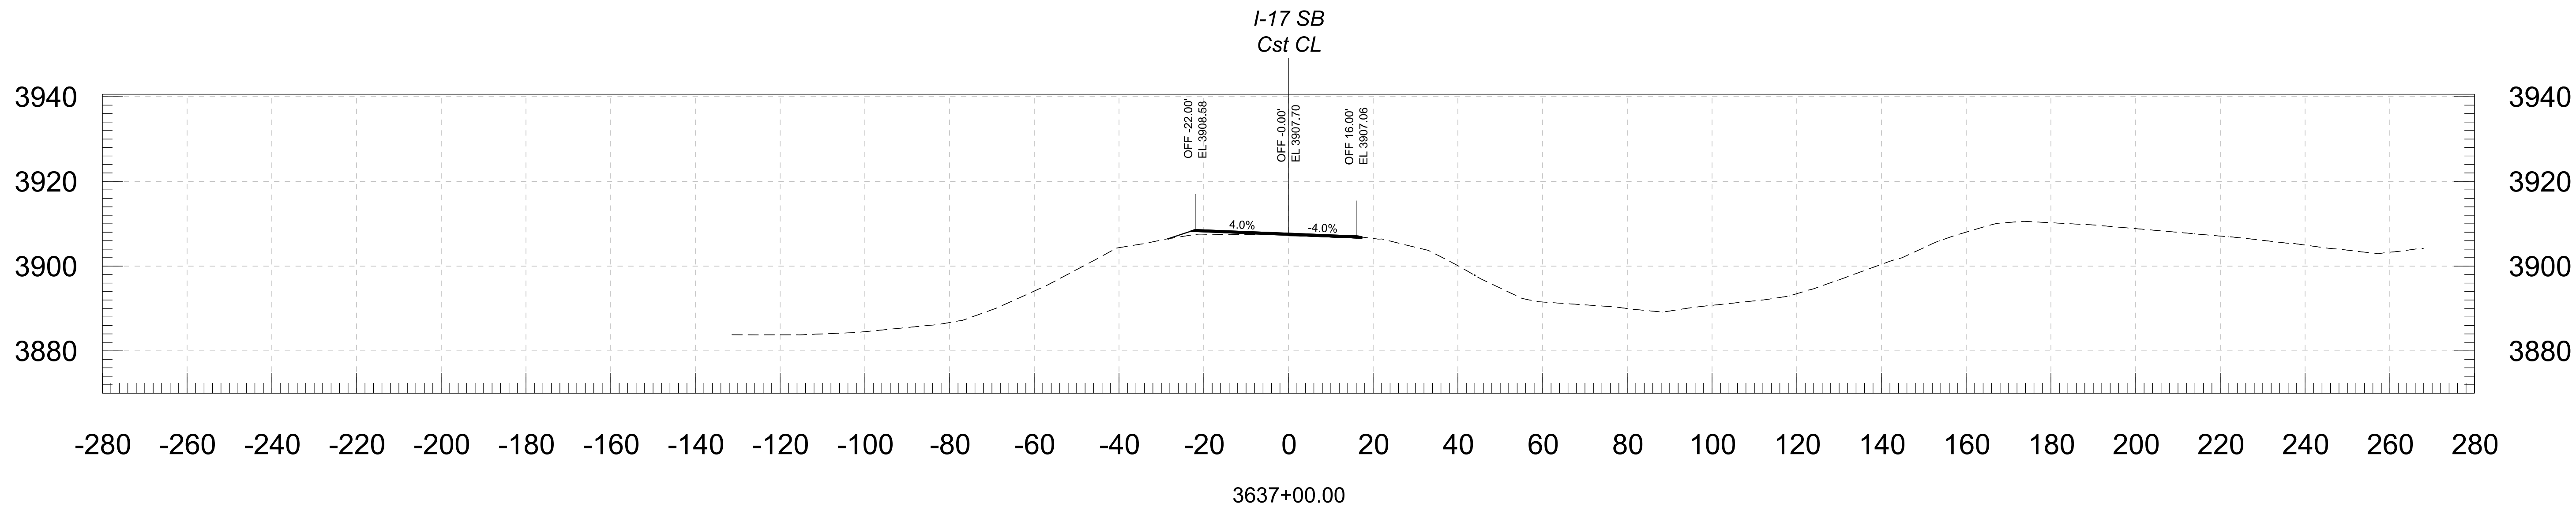




		<table><tr><td></td><td>NAME</td><td>DATE</td></tr><tr><td>DESIGN</td><td>BAP</td><td>06/26</td></tr><tr><td>DRAWN</td><td>RM</td><td>06/26</td></tr><tr><td>CHECKED</td><td>KCH</td><td>06/26</td></tr><tr><td colspan="3">  333 East Camelback Road, Suite 100 Phoenix, Arizona 85016 Phone: 602/333-2200 Stanley Consultants inc. </td></tr></table>		NAME	DATE	DESIGN	BAP	06/26	DRAWN	RM	06/26	CHECKED	KCH	06/26	 333 East Camelback Road, Suite 100 Phoenix, Arizona 85016 Phone: 602/333-2200 Stanley Consultants inc.			<table><tr><td colspan="2">ARIZONA DEPARTMENT OF TRANSPORTATION PROJECT DELIVERY AND OPERATIONS DIVISION ROADWAY DESIGN SERVICES</td></tr><tr><td colspan="2">CROSS SECTION</td></tr></table>	ARIZONA DEPARTMENT OF TRANSPORTATION PROJECT DELIVERY AND OPERATIONS DIVISION ROADWAY DESIGN SERVICES		CROSS SECTION		<table><tr><td>ROUTE I-17</td><td rowspan="2">F.H.W.A. Arizona Division</td><td rowspan="2">STATE ARIZ.</td><td>PROJECT NO.</td><td>FEDERAL ID NO.</td><td>SHEET NO.</td><td>TOTAL SHEETS</td><td>RECORD DRAWING</td></tr><tr><td>MILEPOST</td><td>017 YV 269</td><td>017-B(239)T</td><td>26</td><td>146</td><td></td></tr><tr><td rowspan="2">STRUCTURE NO.</td><td colspan="6">LOCATION E DUGAS ROAD - MP 275</td><td>DWG NO.</td></tr><tr><td colspan="6">TRACS NO. F0616 01C</td><td>___ OF ___</td></tr></table>	ROUTE I-17	F.H.W.A. Arizona Division	STATE ARIZ.	PROJECT NO.	FEDERAL ID NO.	SHEET NO.	TOTAL SHEETS	RECORD DRAWING	MILEPOST	017 YV 269	017-B(239)T	26	146		STRUCTURE NO.	LOCATION E DUGAS ROAD - MP 275						DWG NO.	TRACS NO. F0616 01C						___ OF ___
	NAME	DATE																																																		
DESIGN	BAP	06/26																																																		
DRAWN	RM	06/26																																																		
CHECKED	KCH	06/26																																																		
 333 East Camelback Road, Suite 100 Phoenix, Arizona 85016 Phone: 602/333-2200 Stanley Consultants inc.																																																				
ARIZONA DEPARTMENT OF TRANSPORTATION PROJECT DELIVERY AND OPERATIONS DIVISION ROADWAY DESIGN SERVICES																																																				
CROSS SECTION																																																				
ROUTE I-17	F.H.W.A. Arizona Division	STATE ARIZ.	PROJECT NO.	FEDERAL ID NO.	SHEET NO.	TOTAL SHEETS	RECORD DRAWING																																													
MILEPOST			017 YV 269	017-B(239)T	26	146																																														
STRUCTURE NO.	LOCATION E DUGAS ROAD - MP 275						DWG NO.																																													
	TRACS NO. F0616 01C						___ OF ___																																													

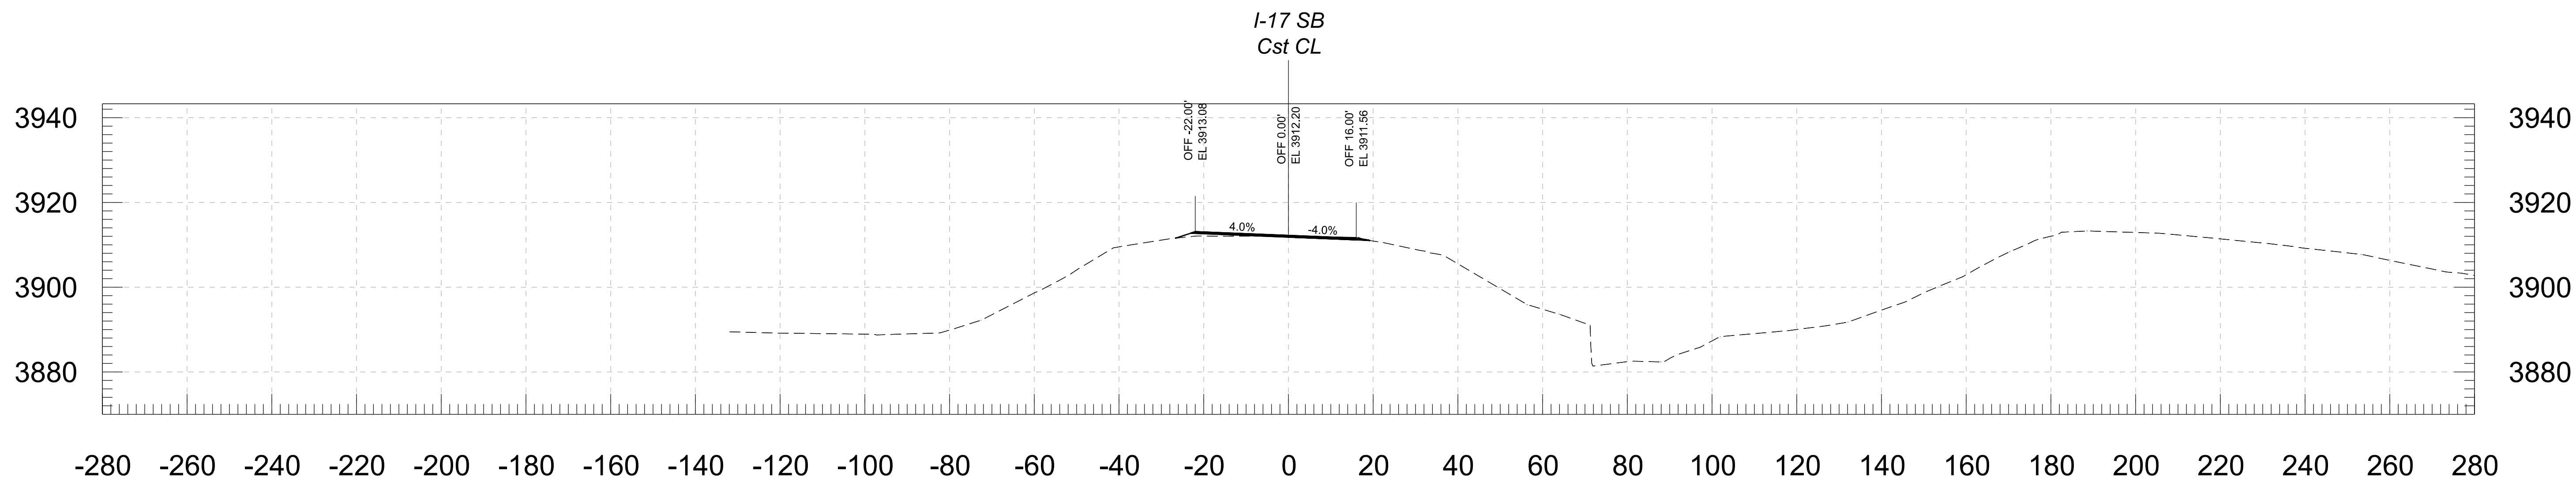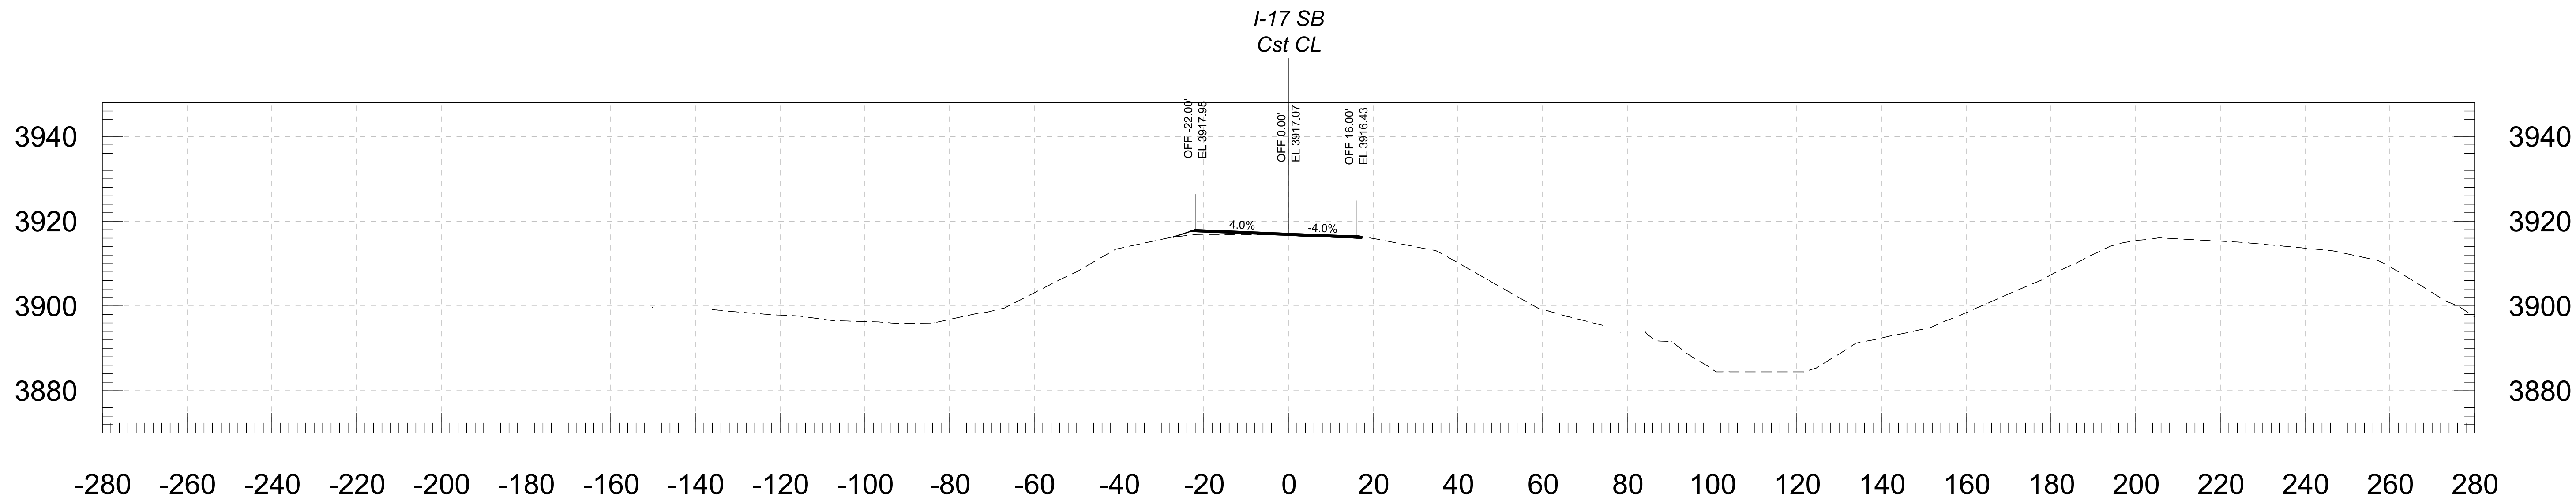




				NAME	DATE	ARIZONA DEPARTMENT OF TRANSPORTATION PROJECT DELIVERY AND OPERATIONS DIVISION ROADWAY DESIGN SERVICES	ROUTE	F.H.W.A. Arizona Division	STATE ARIZ.	PROJECT NO.	FEDERAL ID NO.	SHEET NO.	TOTAL SHEETS	RECORD DRAWING
			DESIGN	BAP	06/26		I-17			017 YV 269	017-B(239)T	27	146	
			DRAWN	RM	06/26									
			CHECKED	KCH	06/26									
			 3133 East Camelback Road, Suite 100 Phoenix, Arizona 85016 Phone: 602.333.2000				CROSS SECTION			MILEPOST	E DUGAS ROAD - MP 275			
						STRUCTURE NO.	TRACS NO. F0616 01C				___ OF ___			

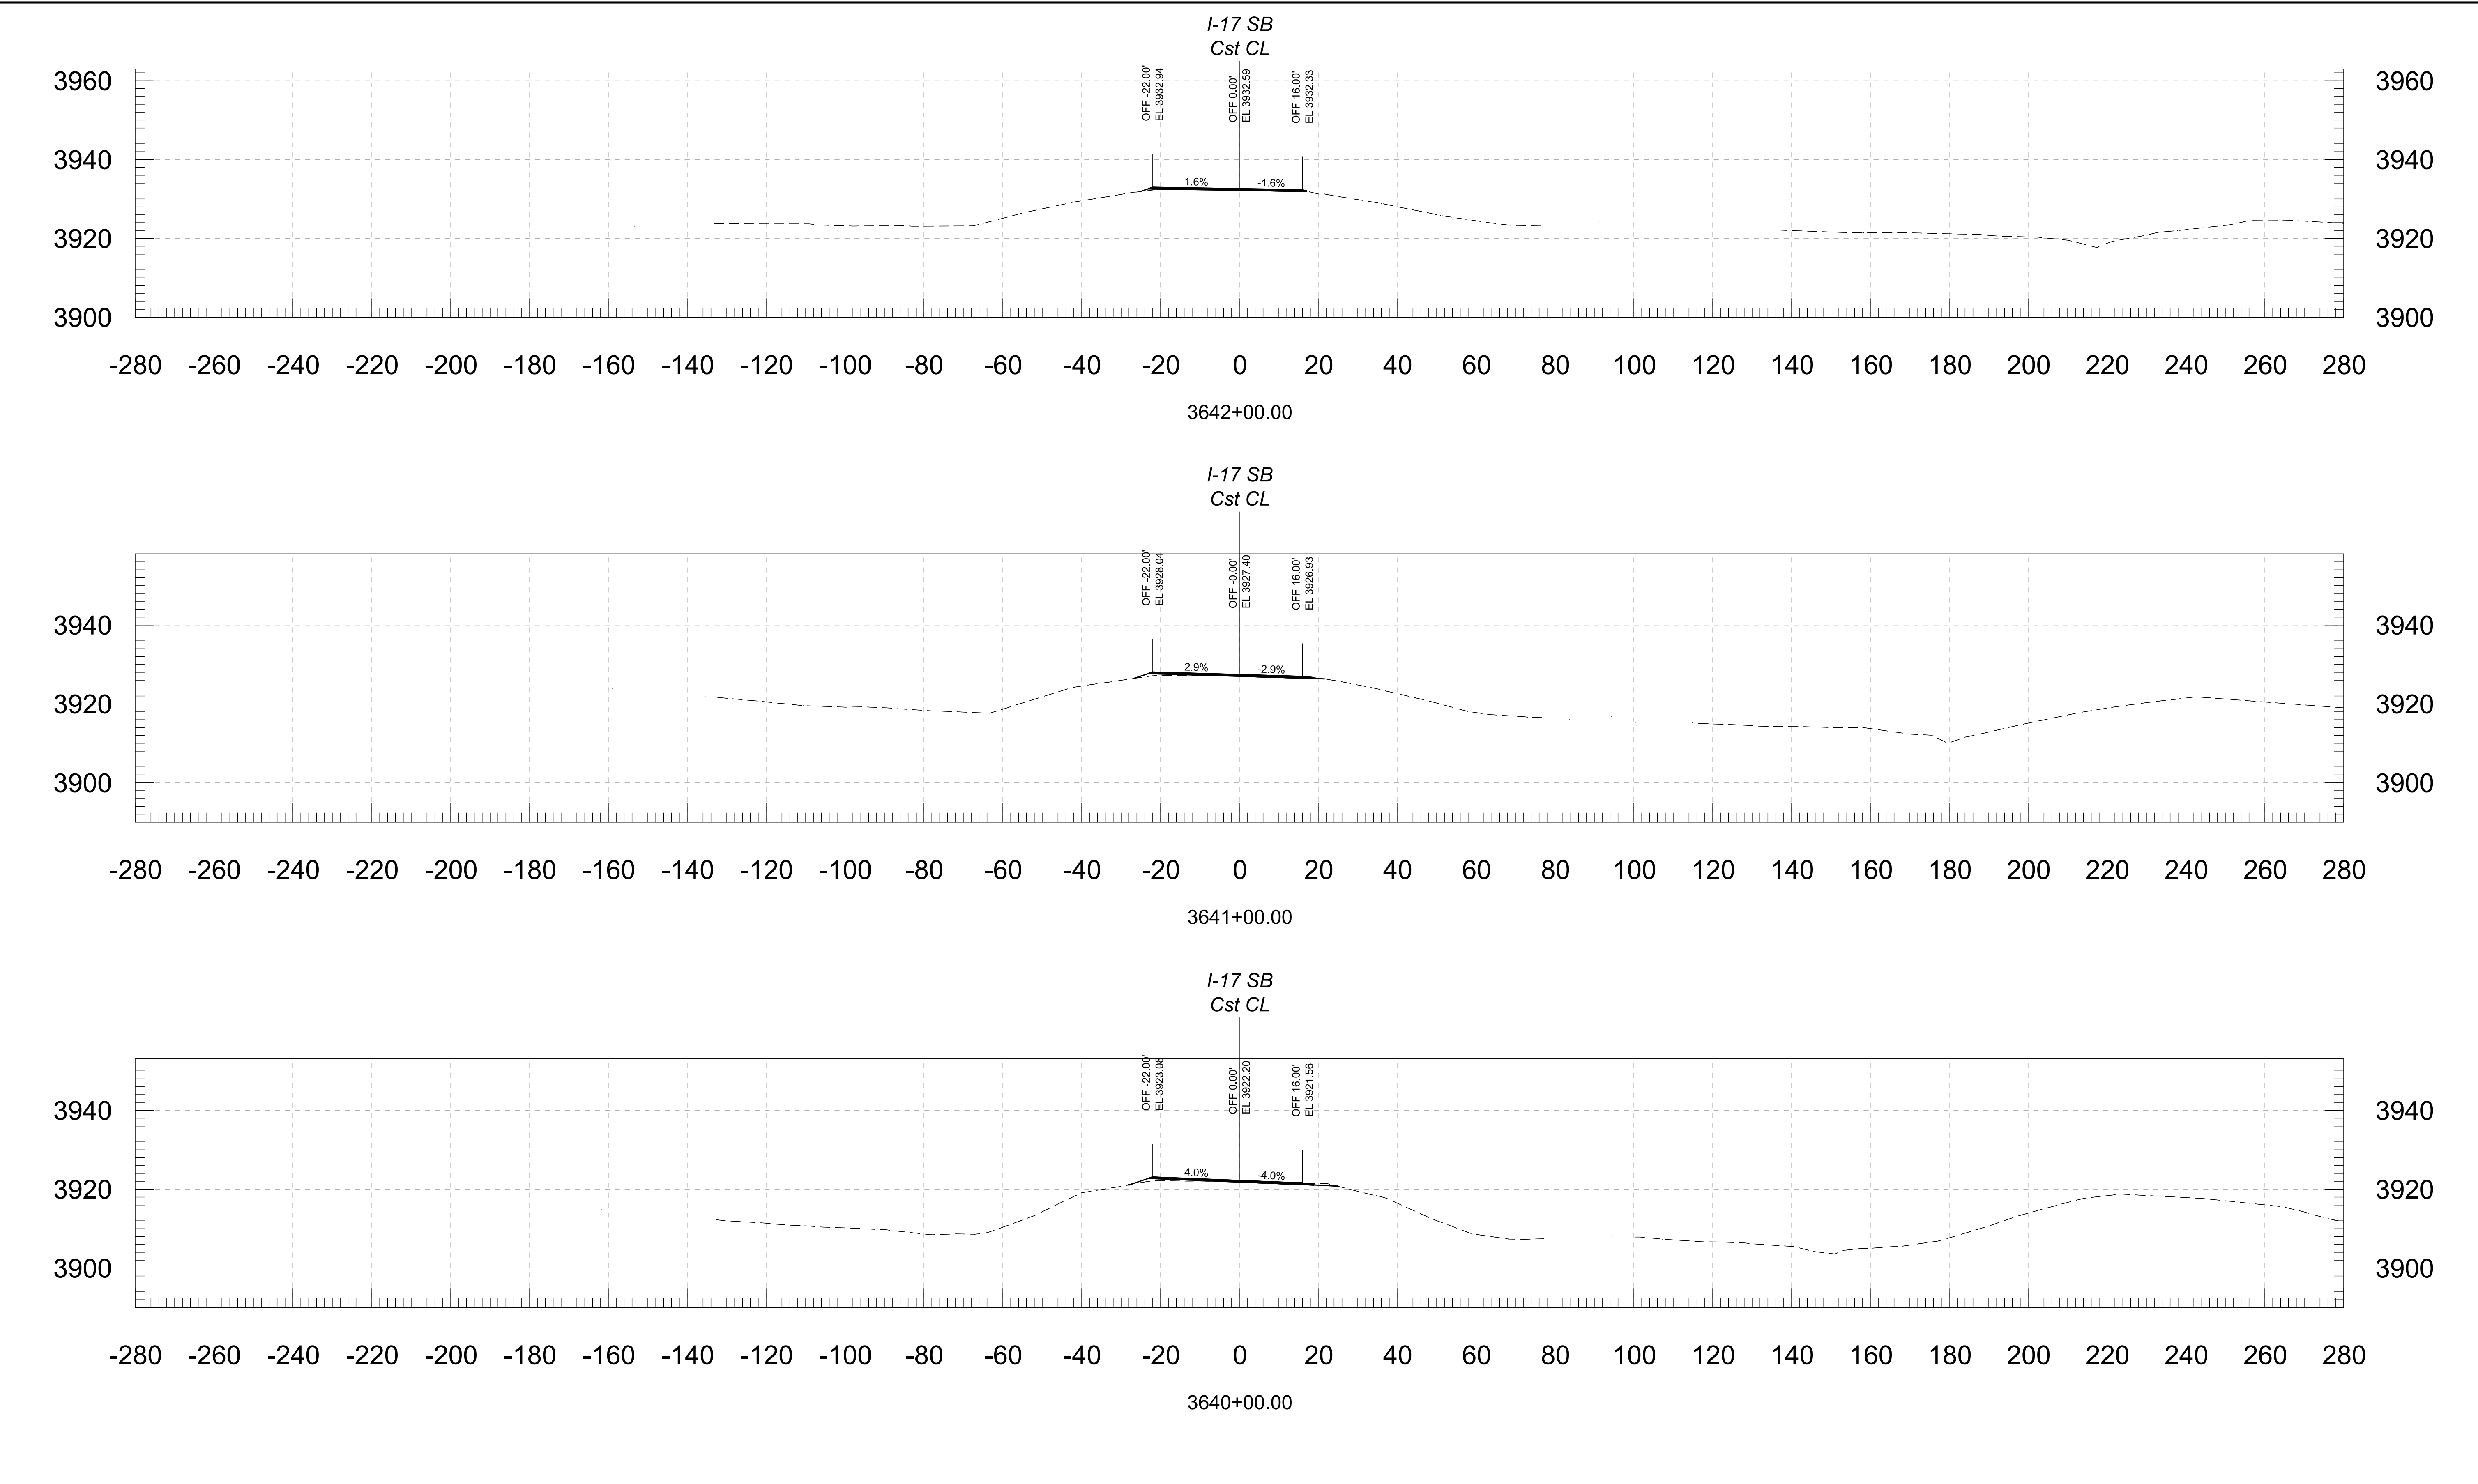



			NAME	DATE	ARIZONA DEPARTMENT OF TRANSPORTATION PROJECT DELIVERY AND OPERATIONS DIVISION ROADWAY DESIGN SERVICES	ROUTE	F.H.W.A. Arizona Division	STATE ARIZ.	PROJECT NO.	FEDERAL ID NO.	SHEET NO.	TOTAL SHEETS	RECORD DRAWING	
		DESIGN	BAP	06/26		I-17			017 YV 269	017-B(239)T	28	146		
		DRAWN	RM	06/26			MILEPOST	E DUGAS ROAD - MP 275						DWG NO.
		CHECKED	KCH	06/26										
		 3133 East Camelback Road, Suite 100 Phoenix, Arizona 85016 Phone: 602.333-2200 Stanley Consultants INC.			CROSS SECTION									

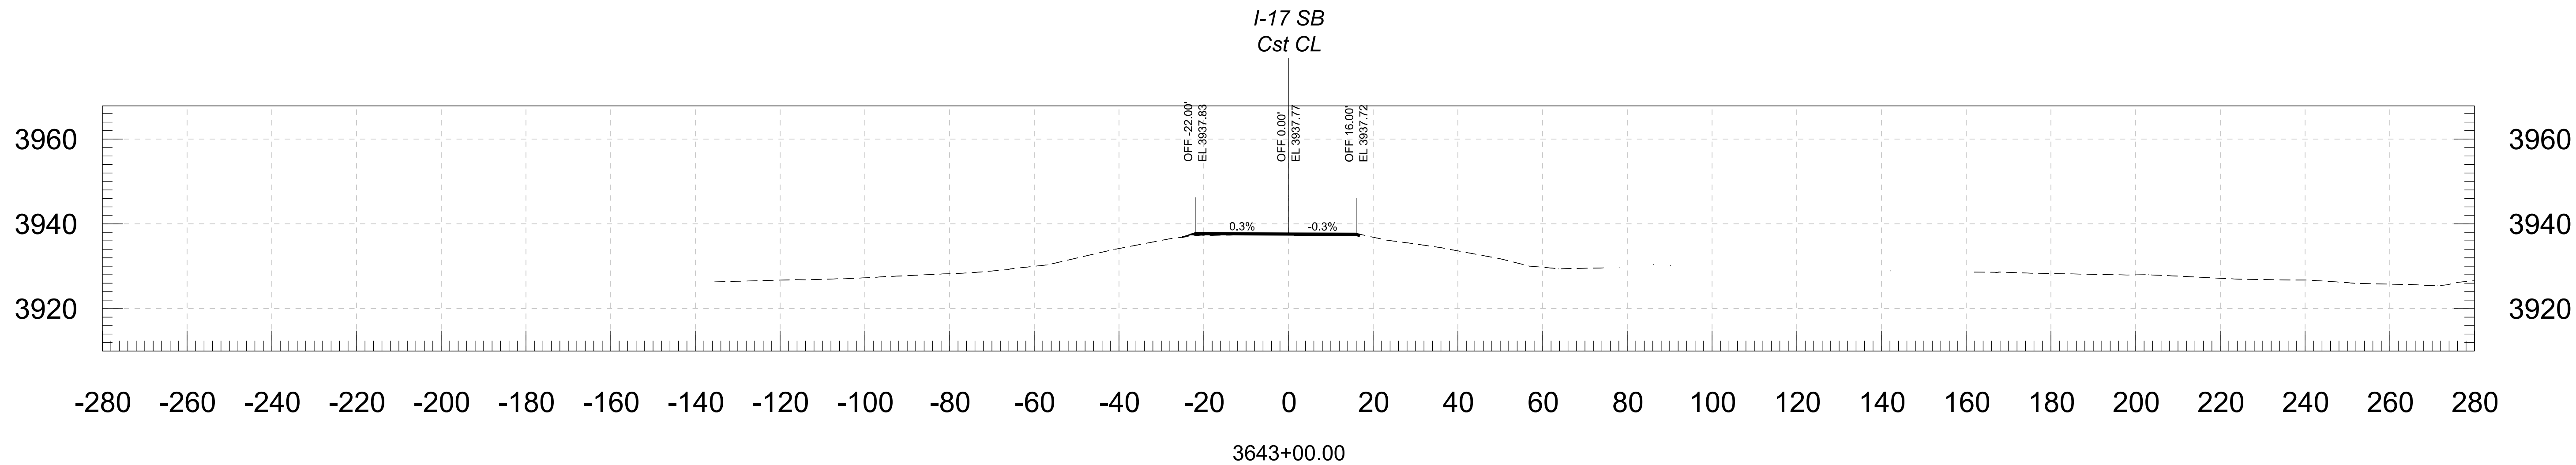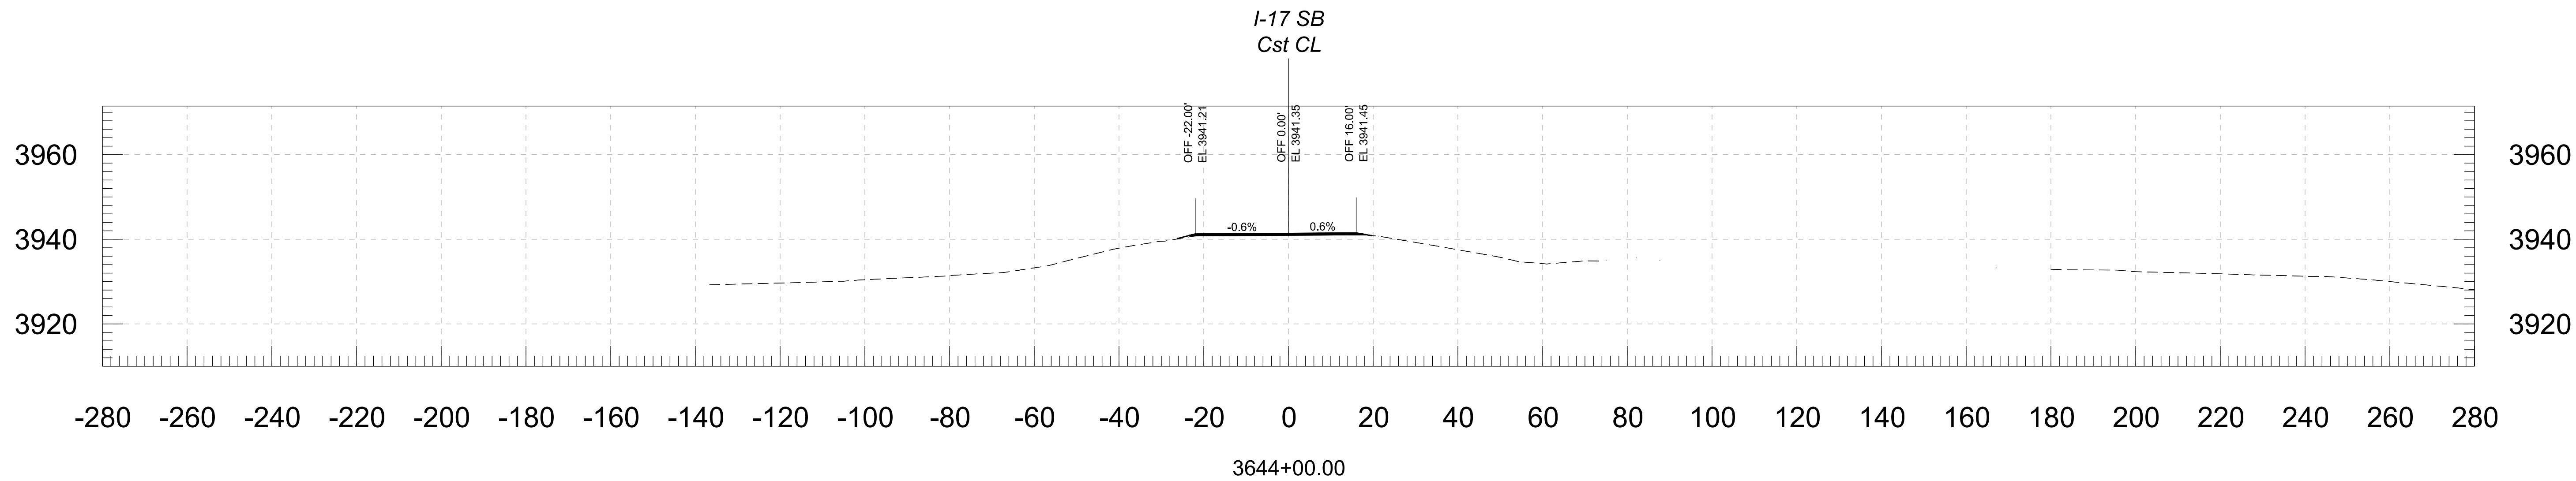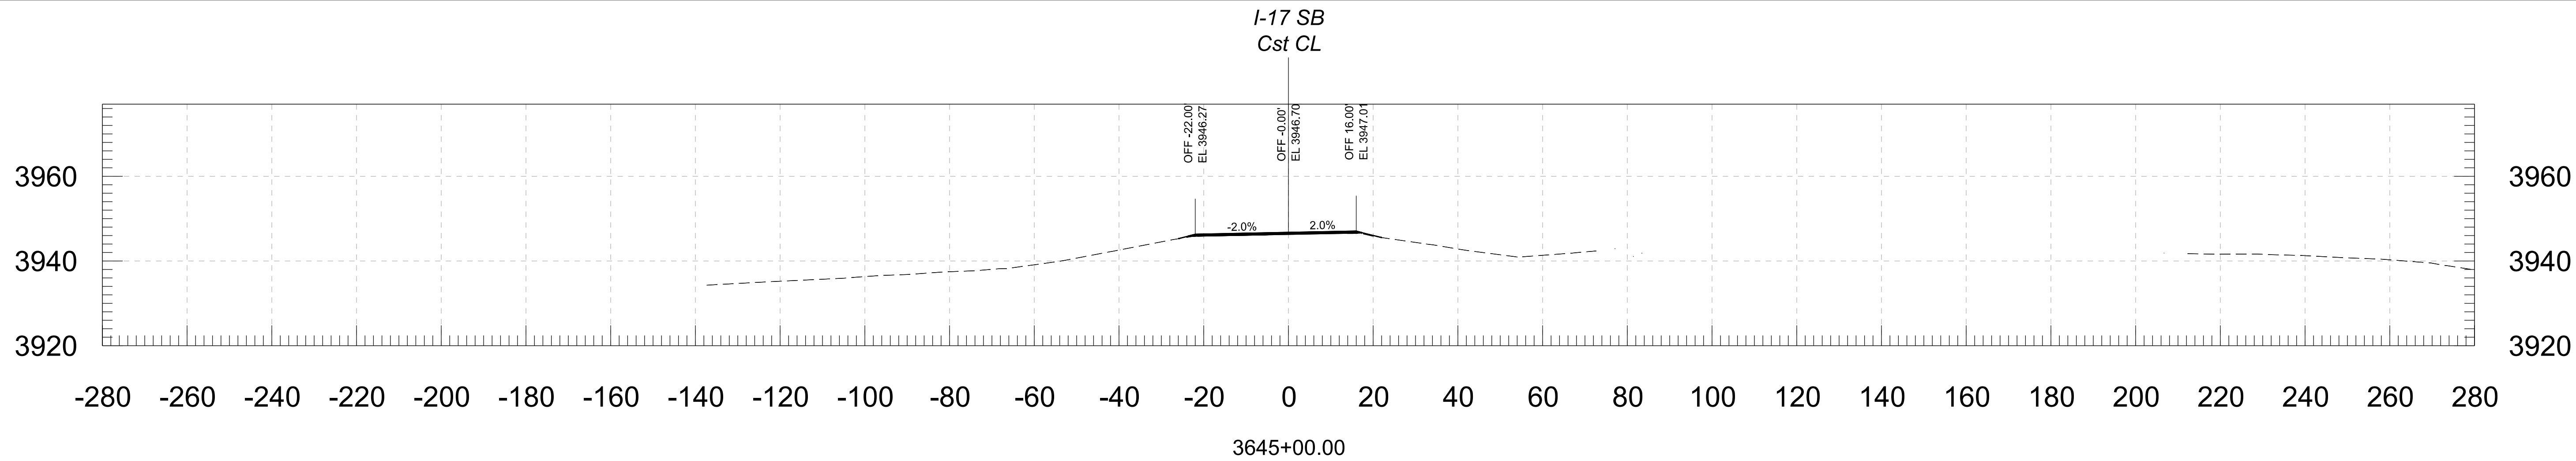



			NAME	DATE	ARIZONA DEPARTMENT OF TRANSPORTATION PROJECT DELIVERY AND OPERATIONS DIVISION ROADWAY DESIGN SERVICES	ROUTE	F.H.W.A. Arizona Division	STATE	PROJECT NO.	FEDERAL ID NO.	SHEET NO.	TOTAL SHEETS	RECORD DRAWING	
		DESIGN	BAP	06/26		I-17			017 YV 269	017-B(239)T	29	146		
		DRAWN	RM	06/26		MILEPOST	E DUGAS ROAD - MP 275							
		CHECKED	KCH	06/26										
		 333 East Camelback Road, Suite 100 Phoenix, Arizona 85016 Phone: 602) 333-2200 Stanley Consultants INC.			CROSS SECTION			TRACS NO. F0616 01C		OF				

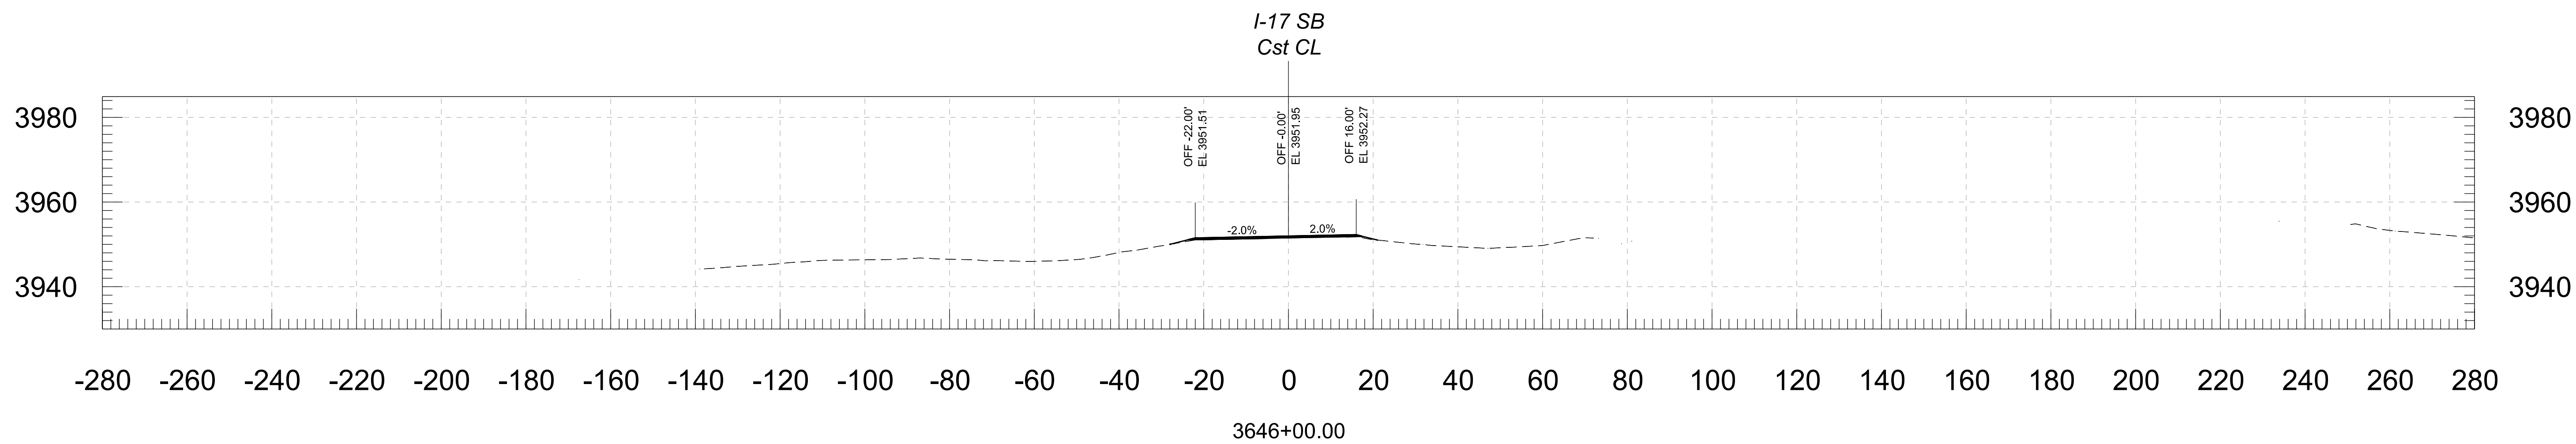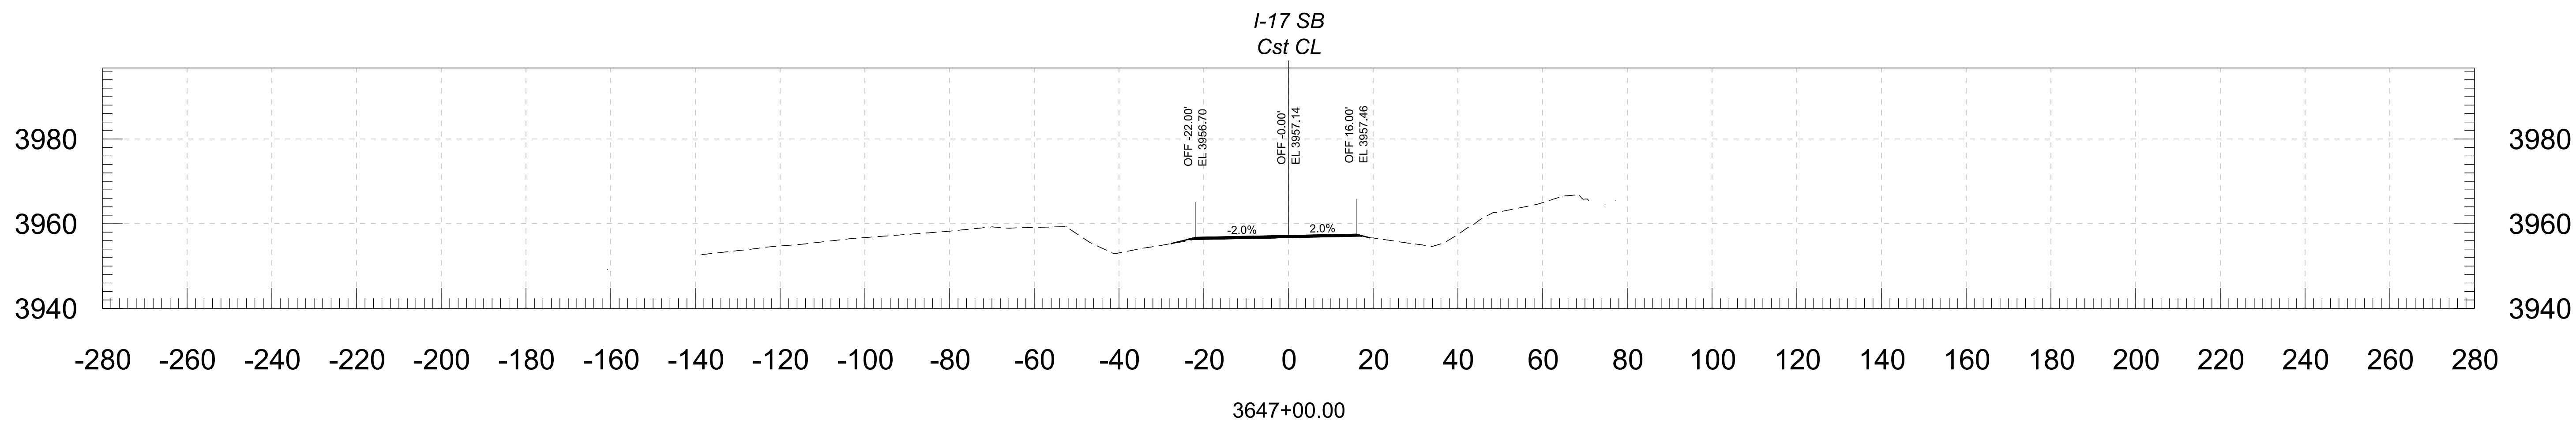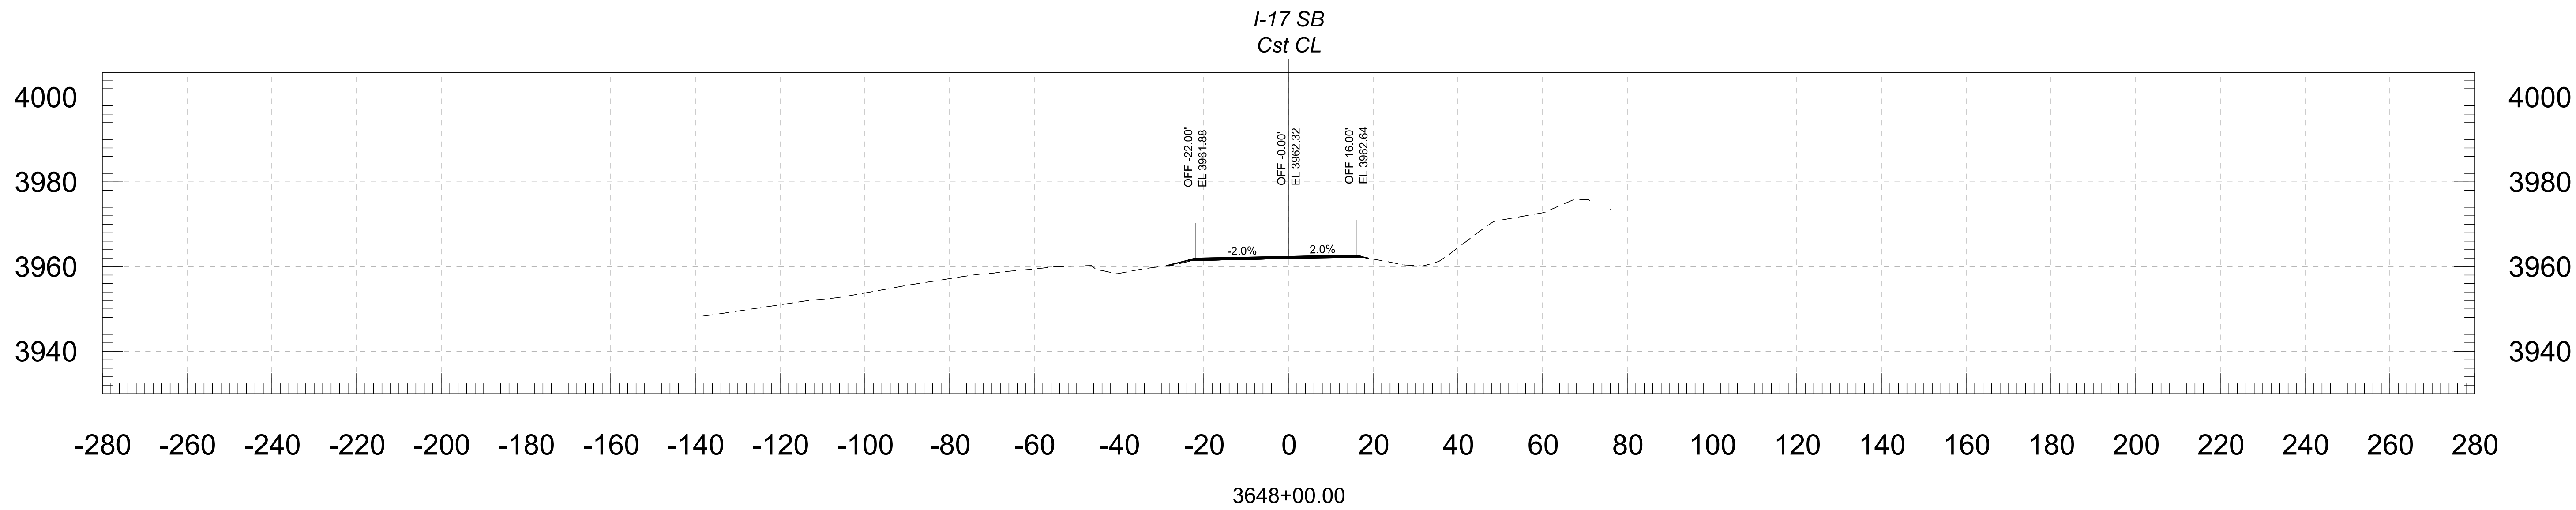


				NAME	DATE	ARIZONA DEPARTMENT OF TRANSPORTATION PROJECT DELIVERY AND OPERATIONS DIVISION ROADWAY DESIGN SERVICES	ROUTE	F.H.W.A. Arizona Division	STATE ARIZ.	PROJECT NO.	FEDERAL ID NO.	SHEET NO.	TOTAL SHEETS	RECORD DRAWING
			DESIGN	BAP	06/26		I-17			017 YV 269	017-B(239)T	30	146	
			DRAWN	RM	06/26									
			CHECKED	KCH	06/26									
			 Stanley Consultants INC.				3133 East Camelback Road, Suite 100 Phoenix, Arizona 85016 Phone 602. 333-2000			CROSS SECTION	MILEPOST	E DUGAS ROAD - MP 275		
							STRUCTURE NO.	TRACS NO. F0616 01C					___ OF ___	

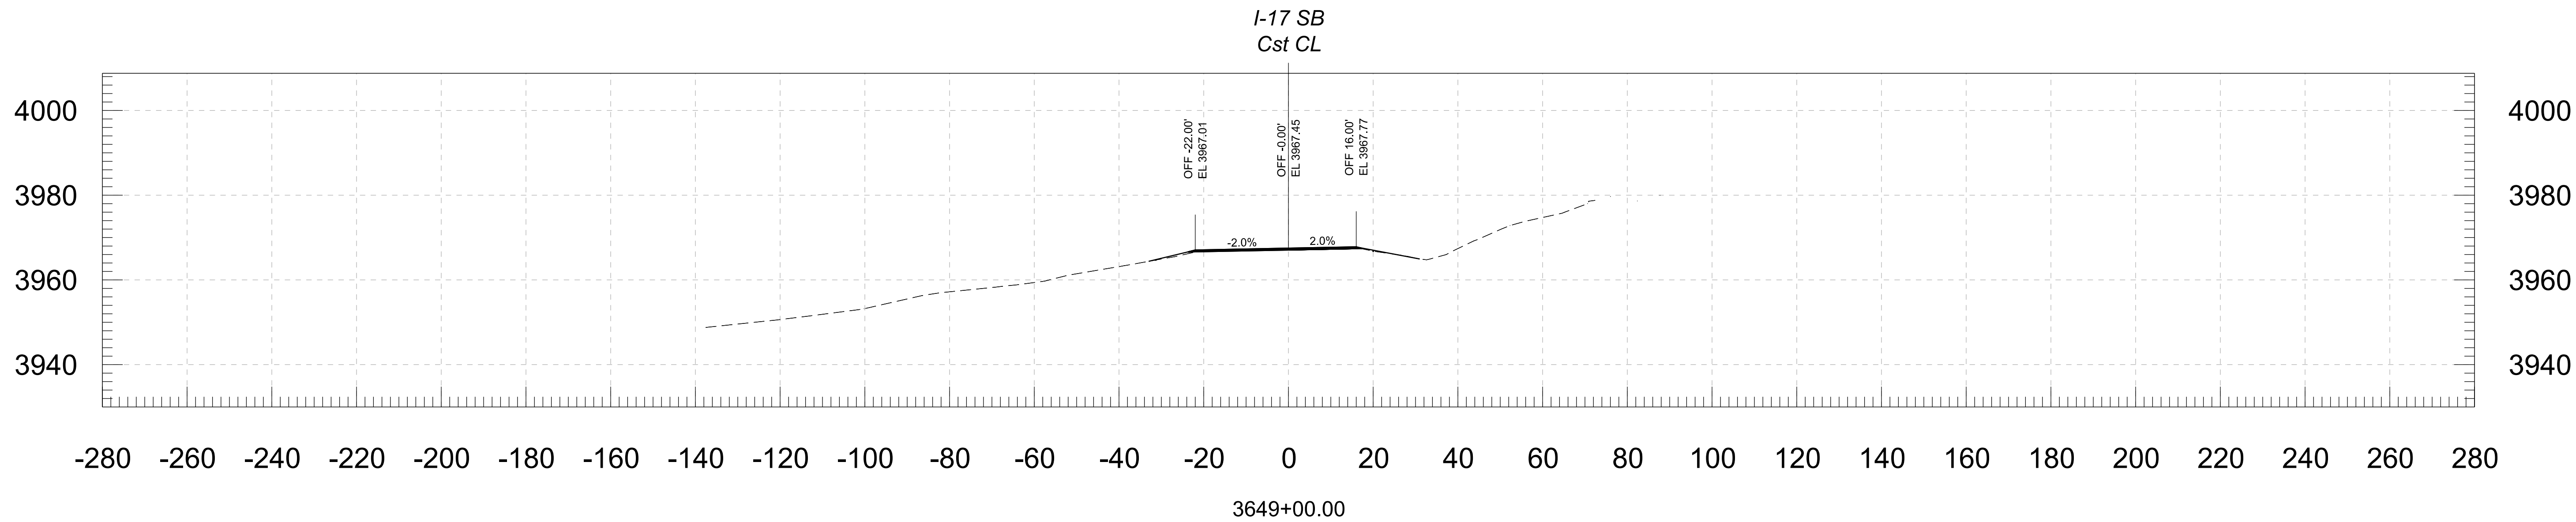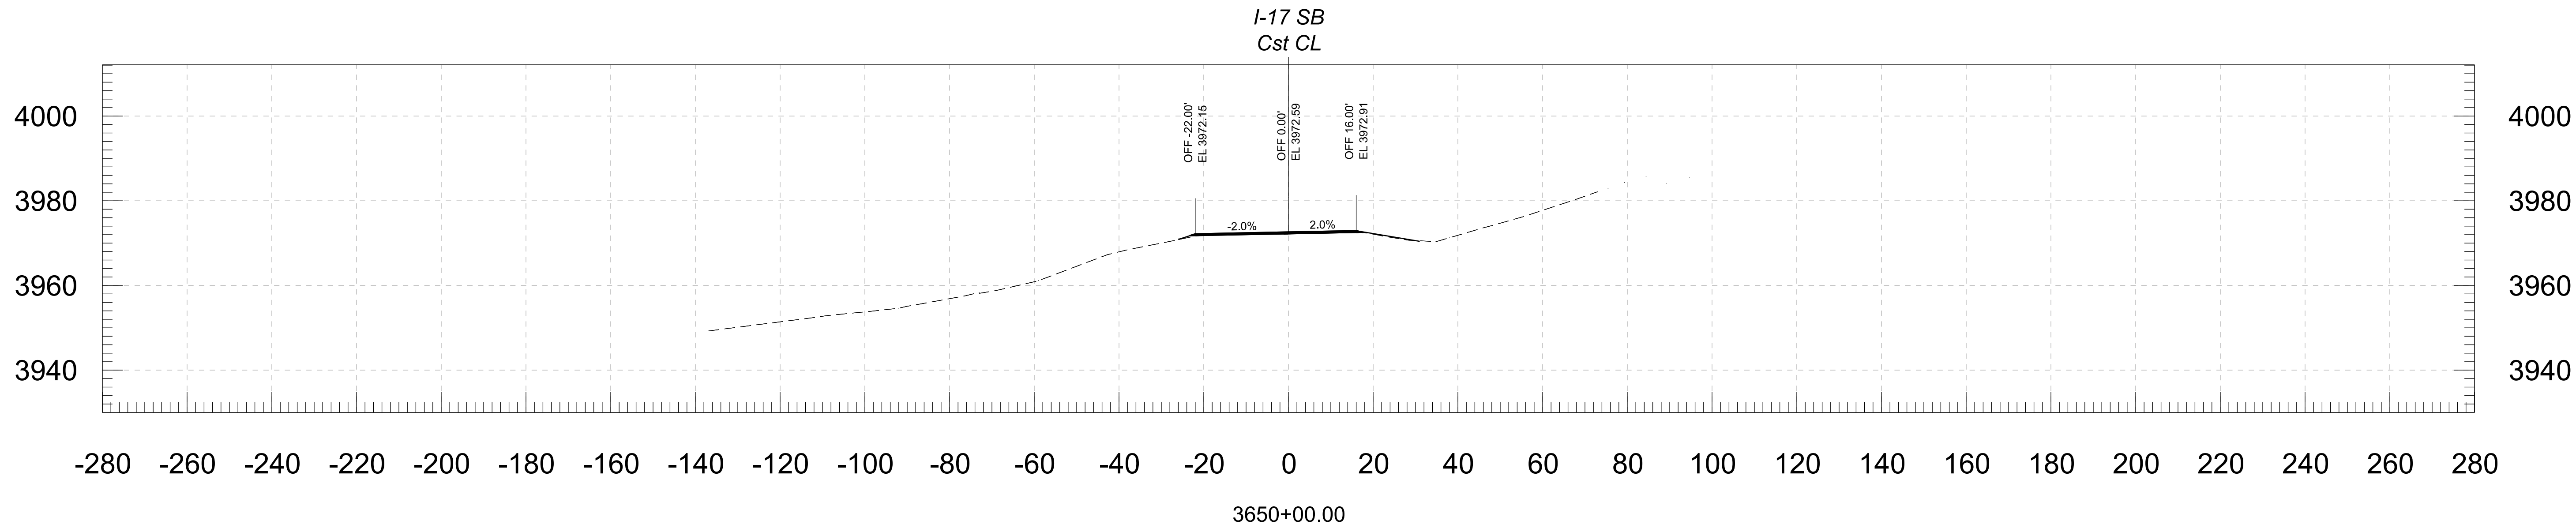 



				NAME	DATE	ARIZONA DEPARTMENT OF TRANSPORTATION PROJECT DELIVERY AND OPERATIONS DIVISION ROADWAY DESIGN SERVICES	ROUTE	F.H.W.A. Arizona Division	STATE ARIZ.	PROJECT NO.	FEDERAL ID NO.	SHEET NO.	TOTAL SHEETS	RECORD DRAWING
			DESIGN	BAP	06/26		I-17			017 YV 269	017-B(239)T	31	146	
			DRAWN	RM	06/26									
			CHECKED	KCH	06/26									
			 3133 East Camelback Road, Suite 100 Phoenix, Arizona 85016 Phone: 602.333.2000				CROSS SECTION			MILEPOST	E DUGAS ROAD - MP 275			
						STRUCTURE NO.	TRACS NO. F0616 01C				___ OF ___			

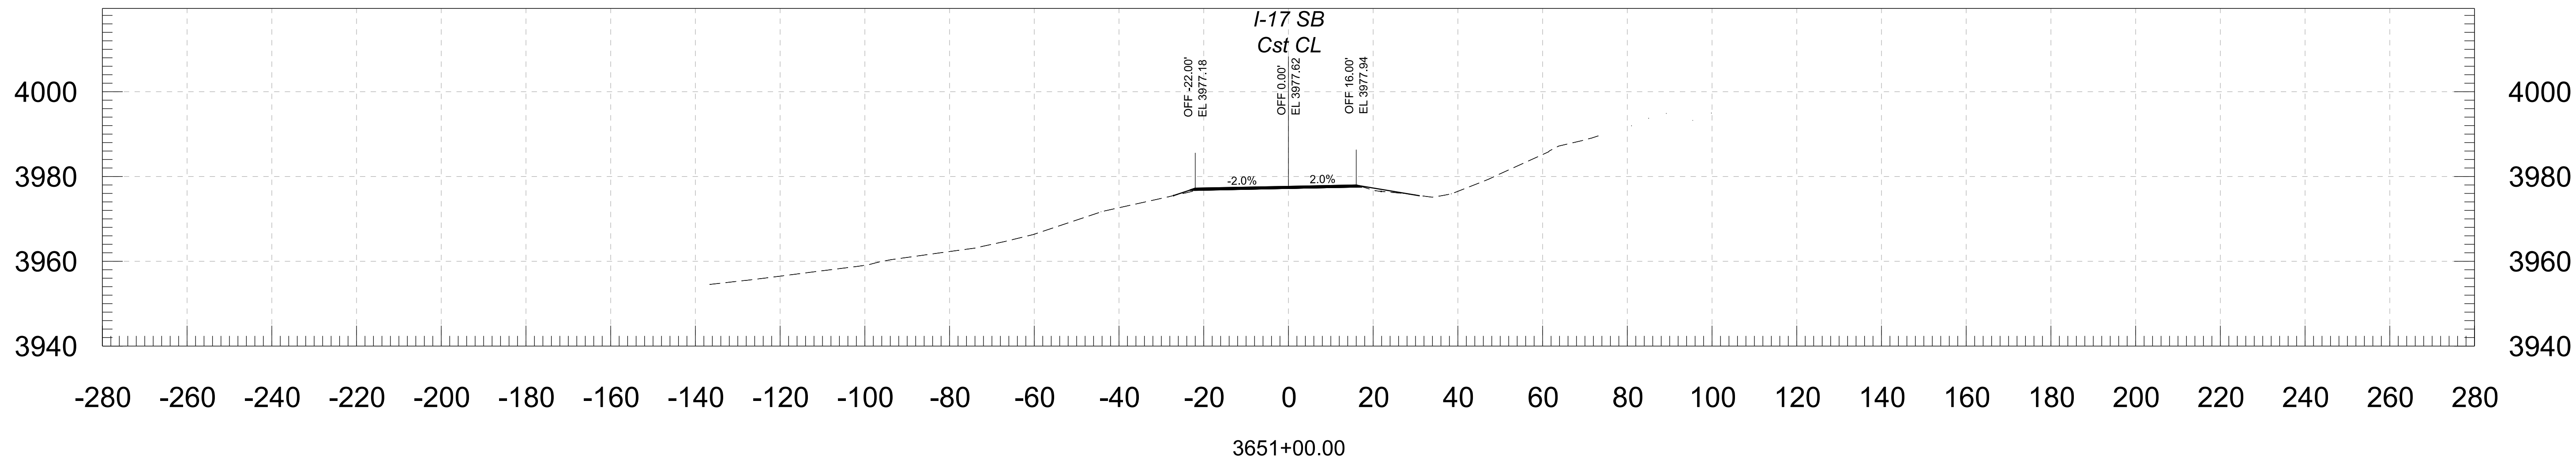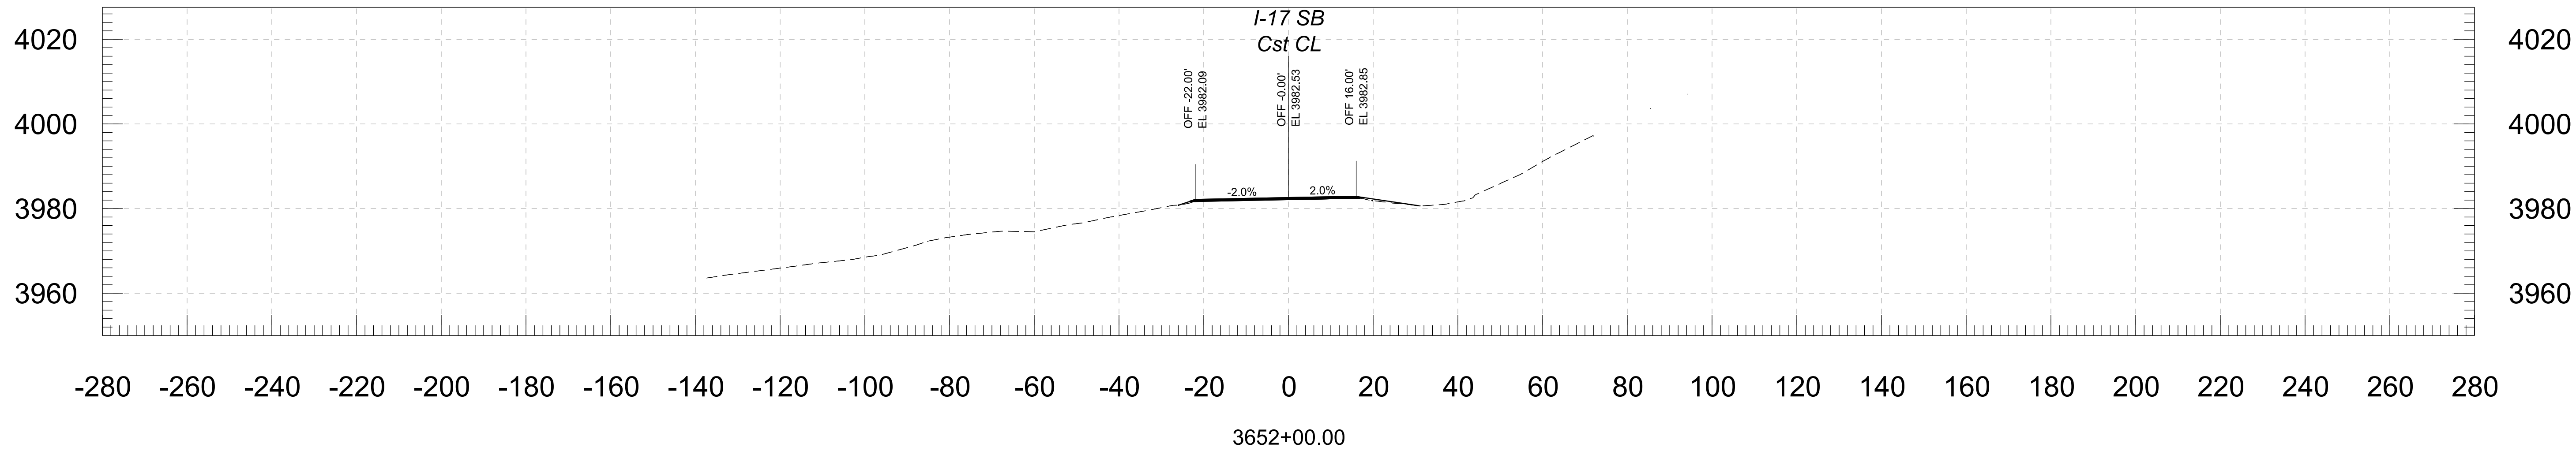



					ARIZONA DEPARTMENT OF TRANSPORTATION PROJECT DELIVERY AND OPERATIONS DIVISION ROADWAY DESIGN SERVICES	ROUTE	F.H.W.A. Arizona Division	STATE ARIZ.	PROJECT NO.	FEDERAL ID NO.	SHEET NO.	TOTAL SHEETS	RECORD DRAWING		
		DESIGN	BAP	06/26					017 YV 269	017-B(239)T	32	146			
		DRAWN	RM	06/26		 3133 East Camelback Road, Suite 100 Phoenix, Arizona 85016 Phone 602. 333-2200 Stanley Consultants INC.	MILEPOST	E DUGAS ROAD - MP 275							DWG NO.
		CHECKED	KCH	06/26			STRUCTURE NO.	TRACS NO. F0616 01C							___ OF ___
		CROSS SECTION													

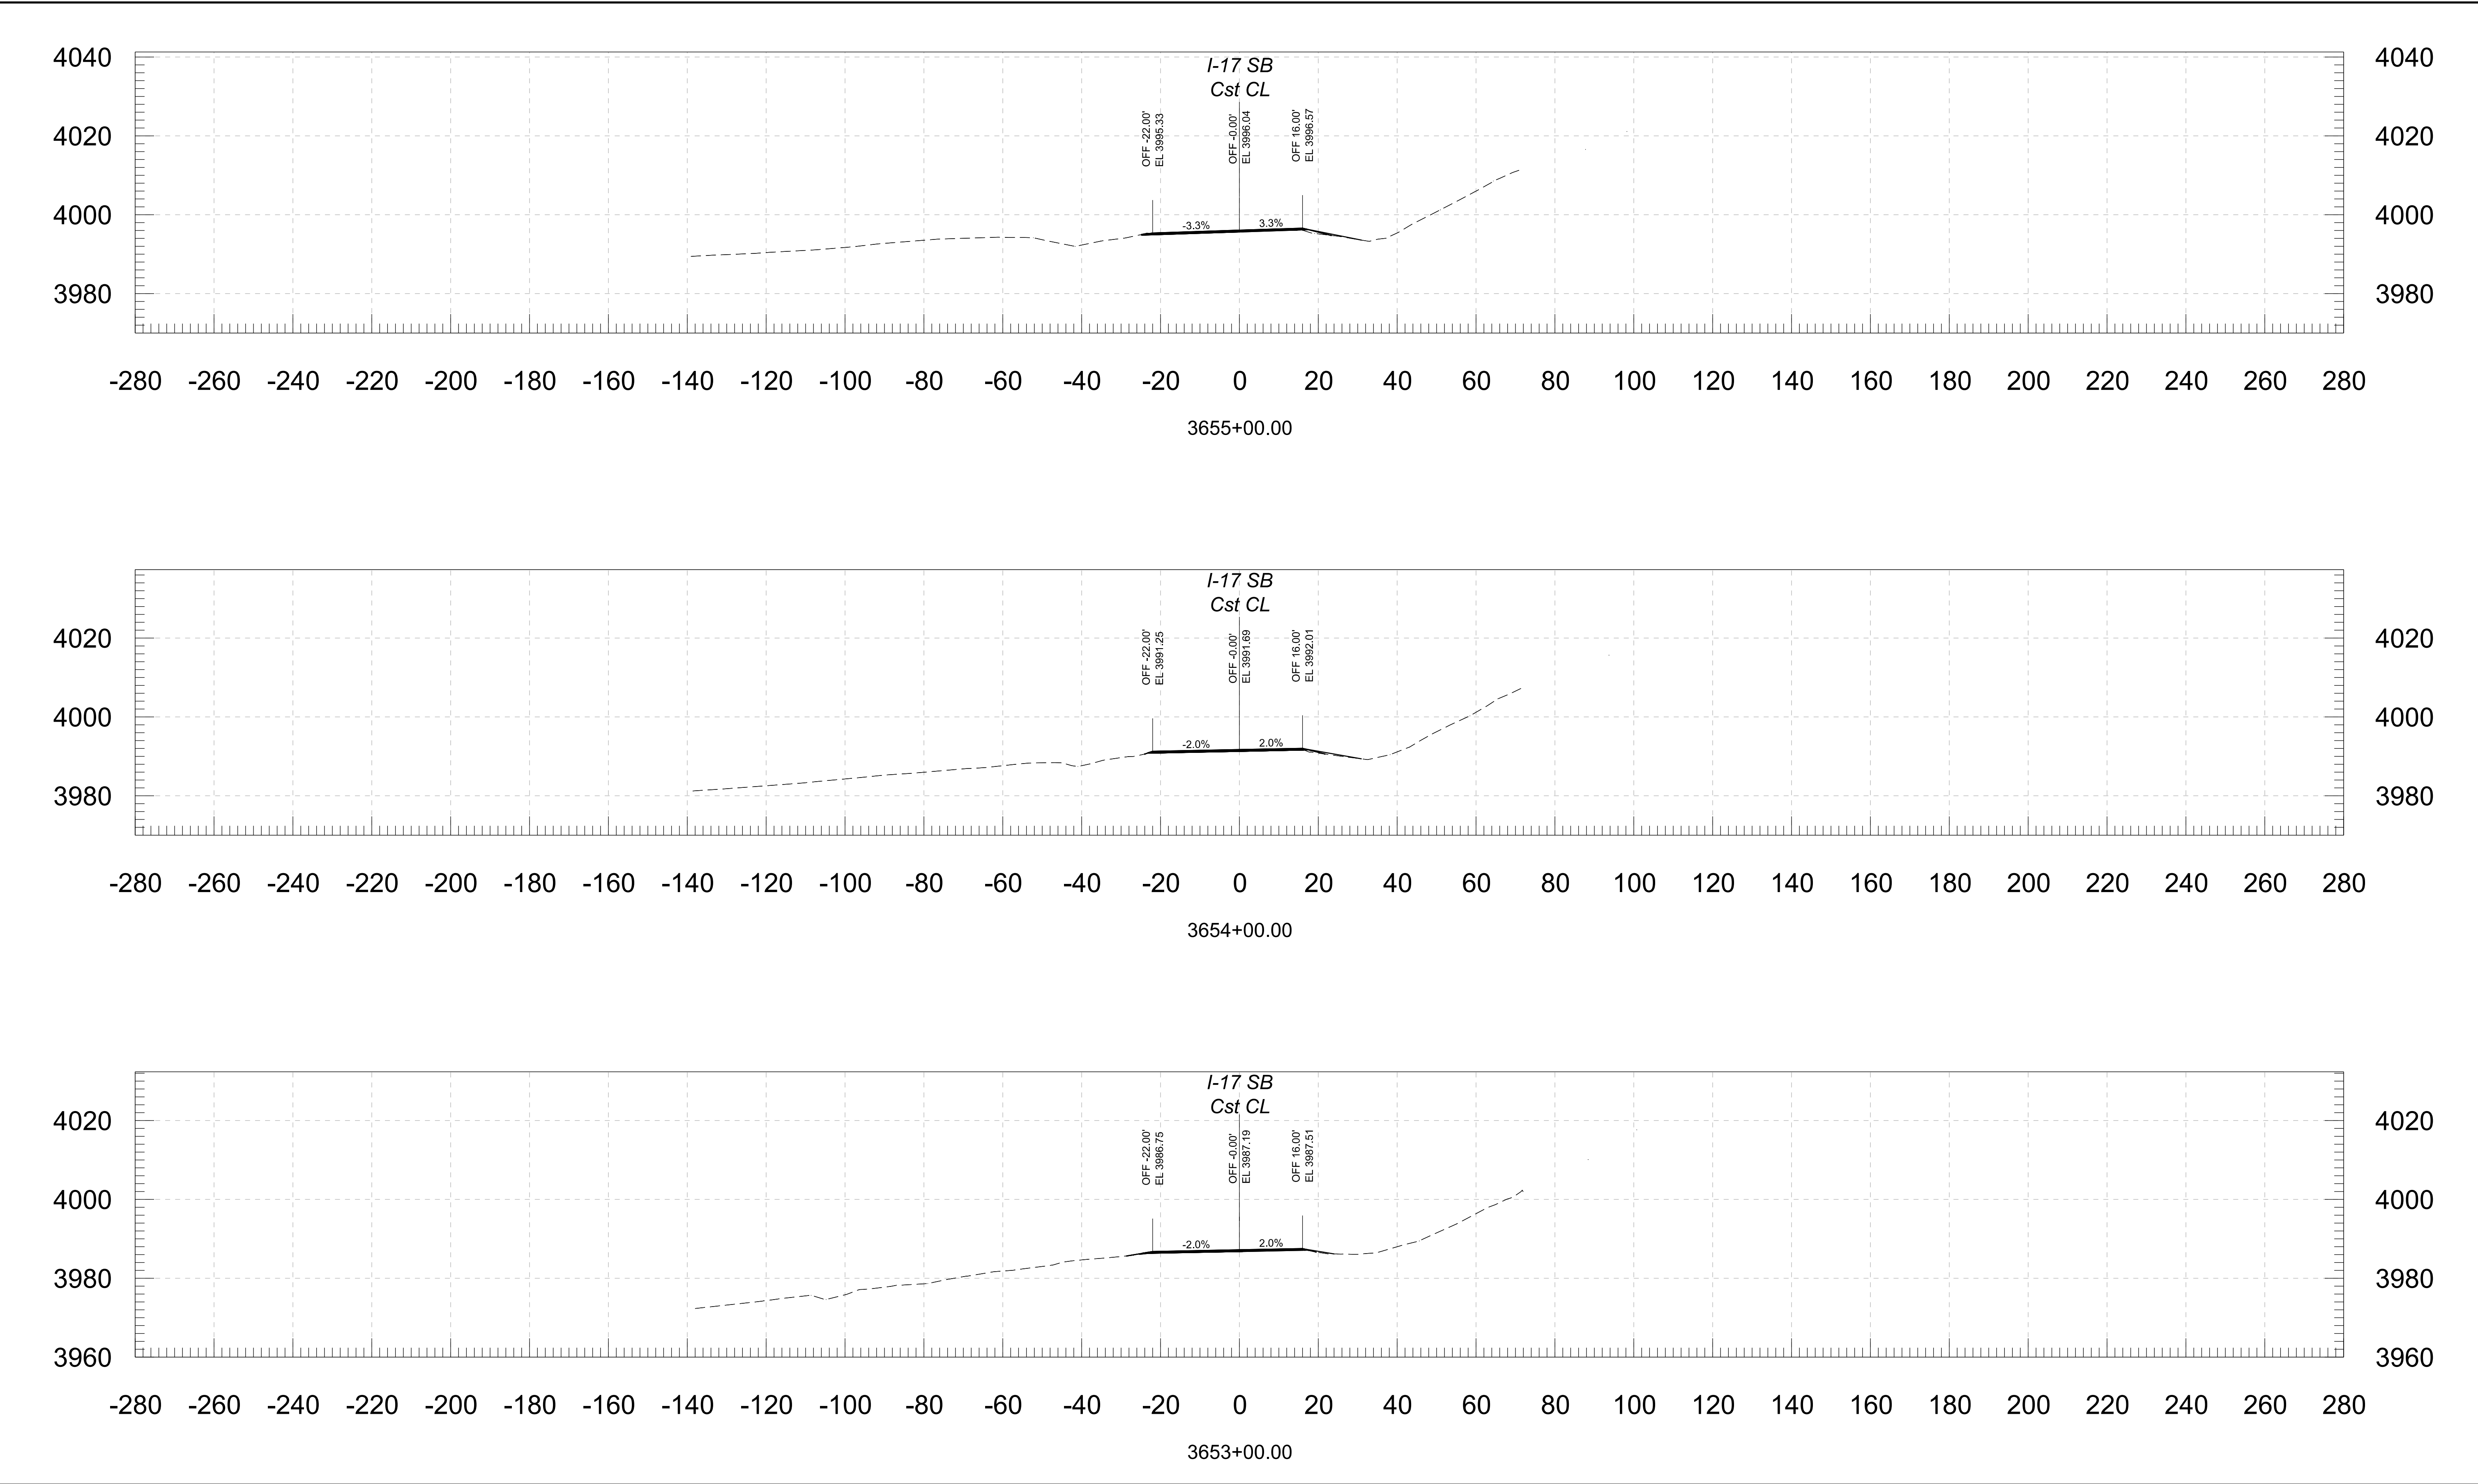



			NAME	DATE	ARIZONA DEPARTMENT OF TRANSPORTATION PROJECT DELIVERY AND OPERATIONS DIVISION ROADWAY DESIGN SERVICES	ROUTE	F.H.W.A. Arizona Division	STATE ARIZ.	PROJECT NO.	FEDERAL ID NO.	SHEET NO.	TOTAL SHEETS	RECORD DRAWING
		DESIGN	BAP	06/26		I-17			017 YV 269	017-B(239)T	33	146	
		DRAWN	RM	06/26									
		CHECKED	KCH	06/26									
		 3133 East Camelback Road, Suite 100 Phoenix, Arizona 85016 Phone: 602.333-2200 Stanley Consultants INC.				CROSS SECTION	MILEPOST	E DUGAS ROAD - MP 275					
					STRUCTURE NO.	TRACS NO. F0616 01C						____ OF ____	

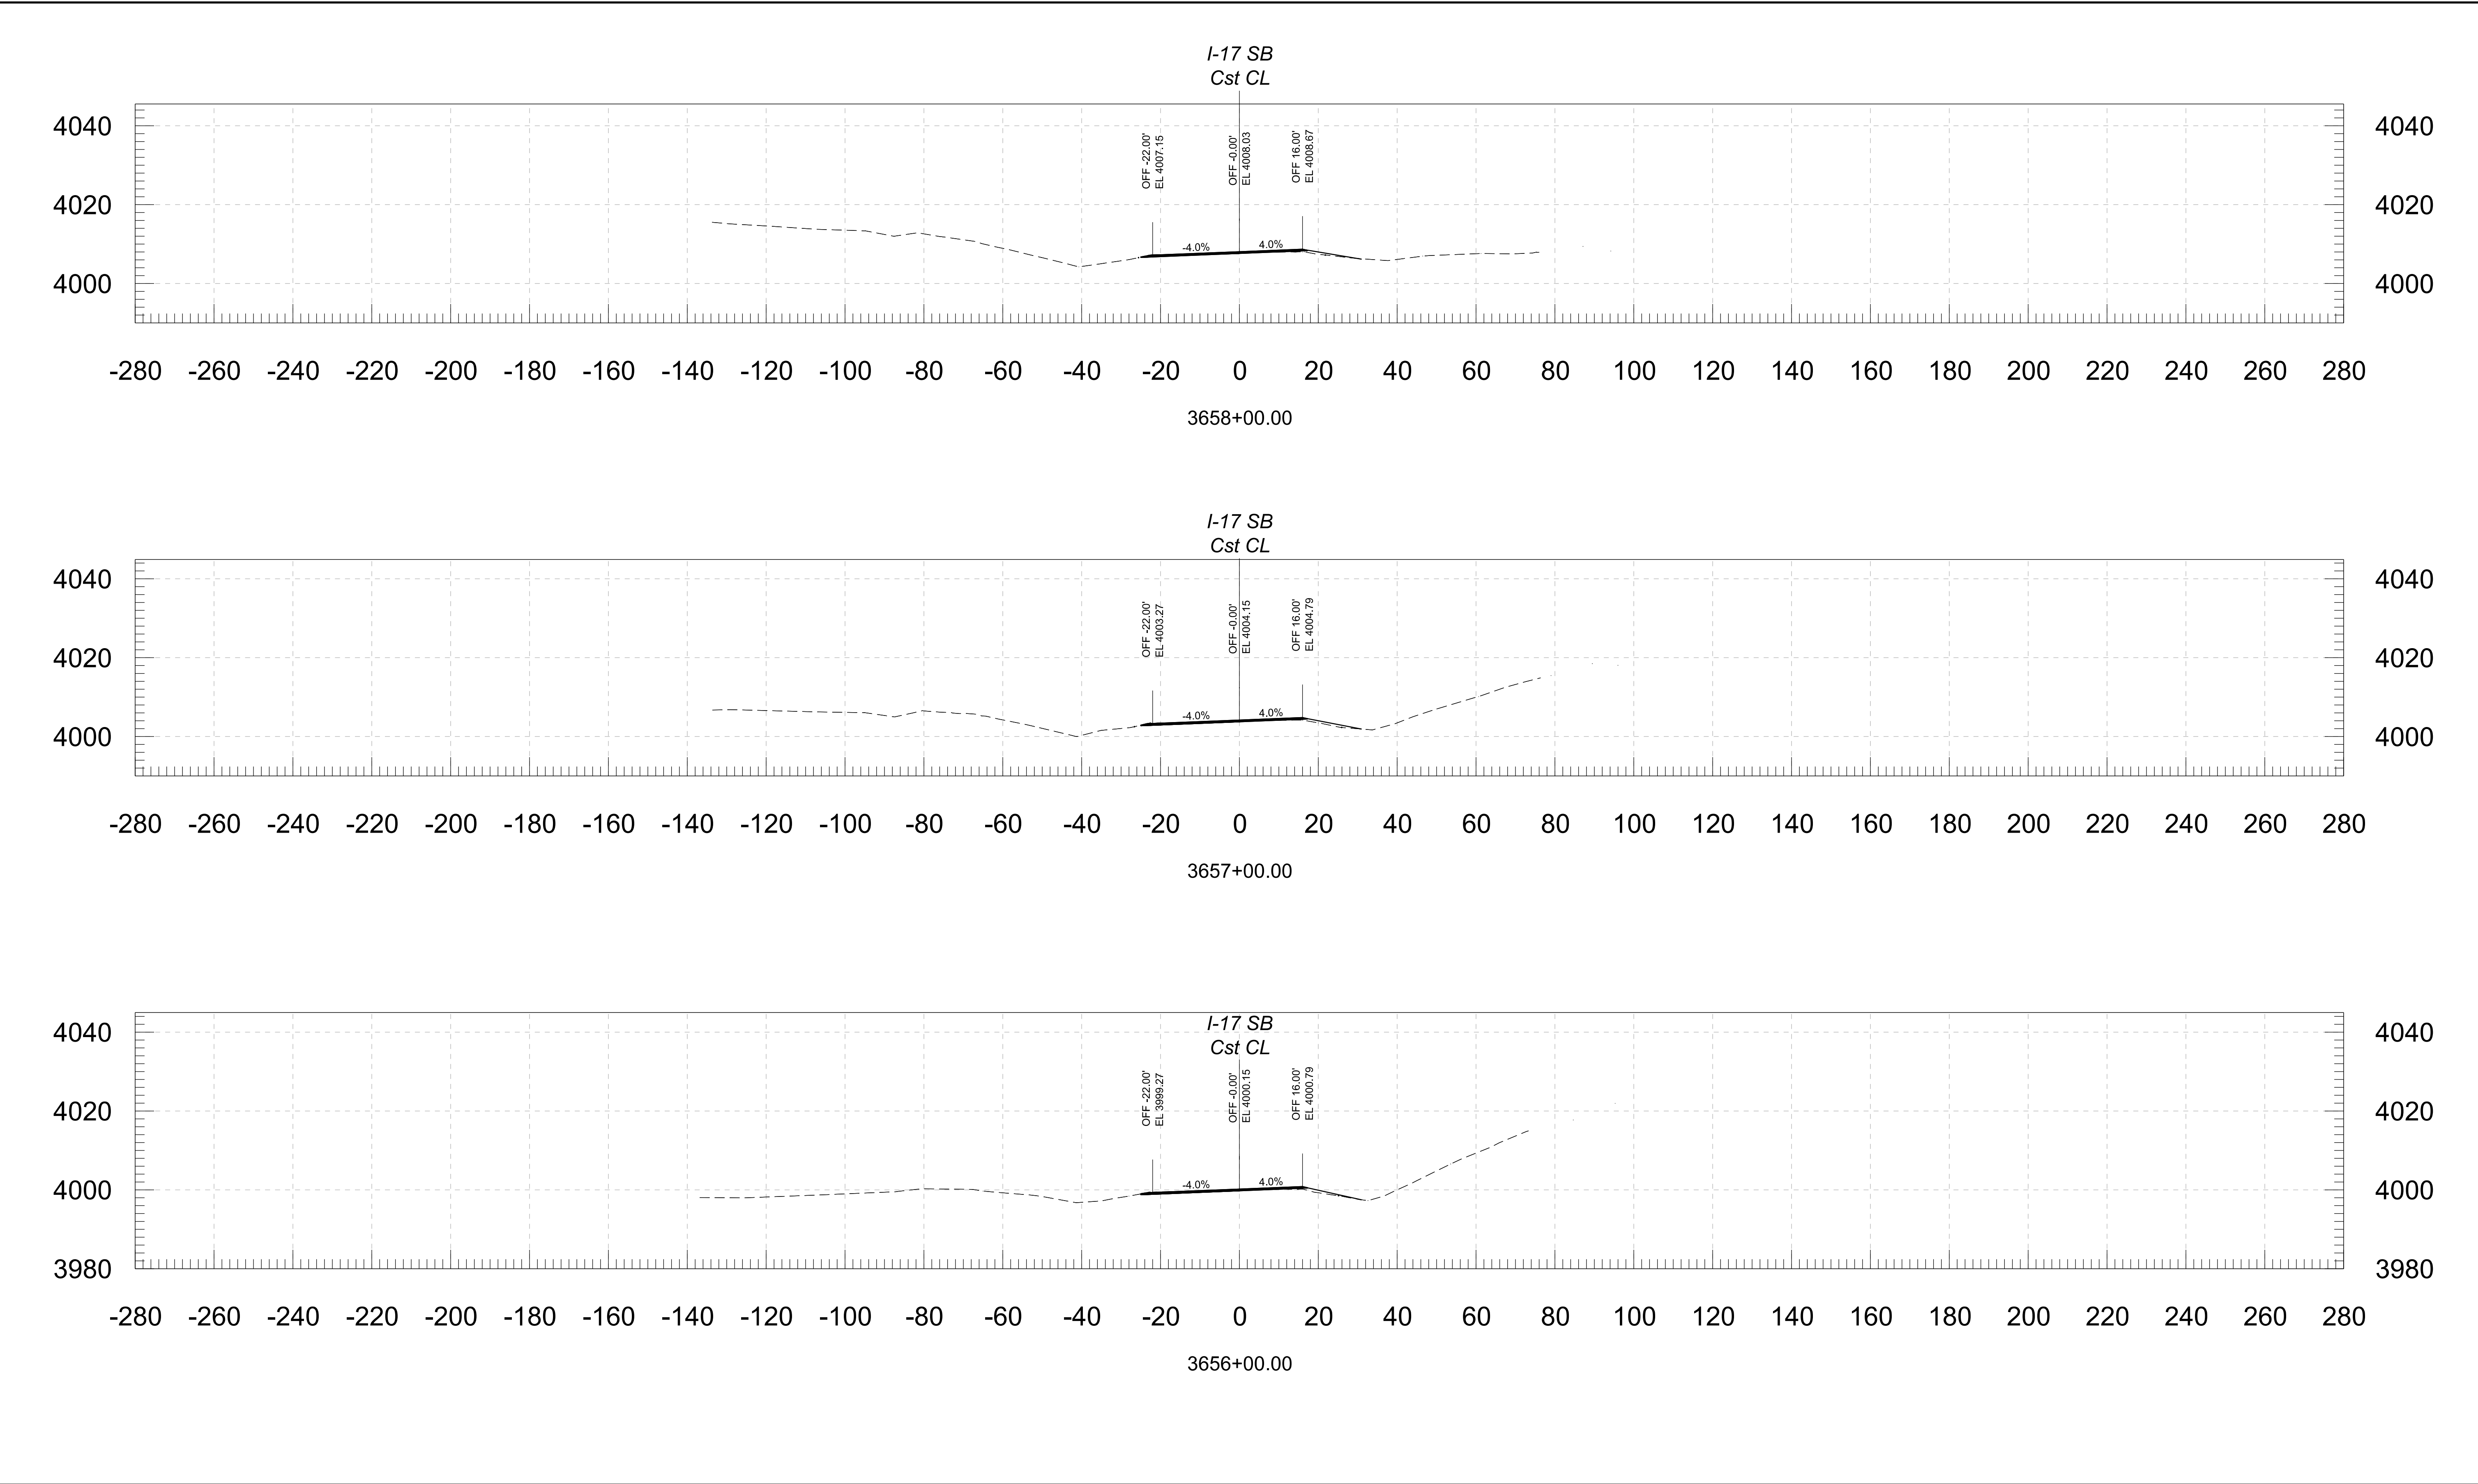



		<table><tr><td></td><td>NAME</td><td>DATE</td></tr><tr><td>DESIGN</td><td>BAP</td><td>06/26</td></tr><tr><td>DRAWN</td><td>RM</td><td>06/26</td></tr><tr><td>CHECKED</td><td>KCH</td><td>06/26</td></tr></table>		NAME	DATE	DESIGN	BAP	06/26	DRAWN	RM	06/26	CHECKED	KCH	06/26	<table><tr><td colspan="2">ARIZONA DEPARTMENT OF TRANSPORTATION</td></tr><tr><td colspan="2">PROJECT DELIVERY AND OPERATIONS DIVISION</td></tr><tr><td colspan="2">ROADWAY DESIGN SERVICES</td></tr></table>	ARIZONA DEPARTMENT OF TRANSPORTATION		PROJECT DELIVERY AND OPERATIONS DIVISION		ROADWAY DESIGN SERVICES		<table><tr><td>ROUTE</td><td>I-17</td></tr></table>	ROUTE	I-17	<table><tr><td>F.H.W.A. Arizona Division</td><td>STATE</td><td>PROJECT NO.</td><td>FEDERAL ID NO.</td><td>SHEET NO.</td><td>TOTAL SHEETS</td><td>RECORD DRAWING</td></tr><tr><td></td><td>ARIZ.</td><td>017 YV 269</td><td>017-B(239)T</td><td>34</td><td>146</td><td></td></tr></table>	F.H.W.A. Arizona Division	STATE	PROJECT NO.	FEDERAL ID NO.	SHEET NO.	TOTAL SHEETS	RECORD DRAWING		ARIZ.	017 YV 269	017-B(239)T	34	146	
				NAME	DATE																																		
			DESIGN	BAP	06/26																																		
			DRAWN	RM	06/26																																		
		CHECKED	KCH	06/26																																			
ARIZONA DEPARTMENT OF TRANSPORTATION																																							
PROJECT DELIVERY AND OPERATIONS DIVISION																																							
ROADWAY DESIGN SERVICES																																							
ROUTE	I-17																																						
F.H.W.A. Arizona Division	STATE	PROJECT NO.	FEDERAL ID NO.	SHEET NO.	TOTAL SHEETS	RECORD DRAWING																																	
	ARIZ.	017 YV 269	017-B(239)T	34	146																																		
<table><tr><td colspan="6">E DUGAS ROAD - MP 275</td><td>DWG NO.</td></tr></table>	E DUGAS ROAD - MP 275						DWG NO.																																
E DUGAS ROAD - MP 275						DWG NO.																																	
<table><tr><td>TRACS NO.</td><td>F0616 01C</td><td colspan="4">____ OF ____</td></tr></table>	TRACS NO.	F0616 01C	____ OF ____																																				
TRACS NO.	F0616 01C	____ OF ____																																					

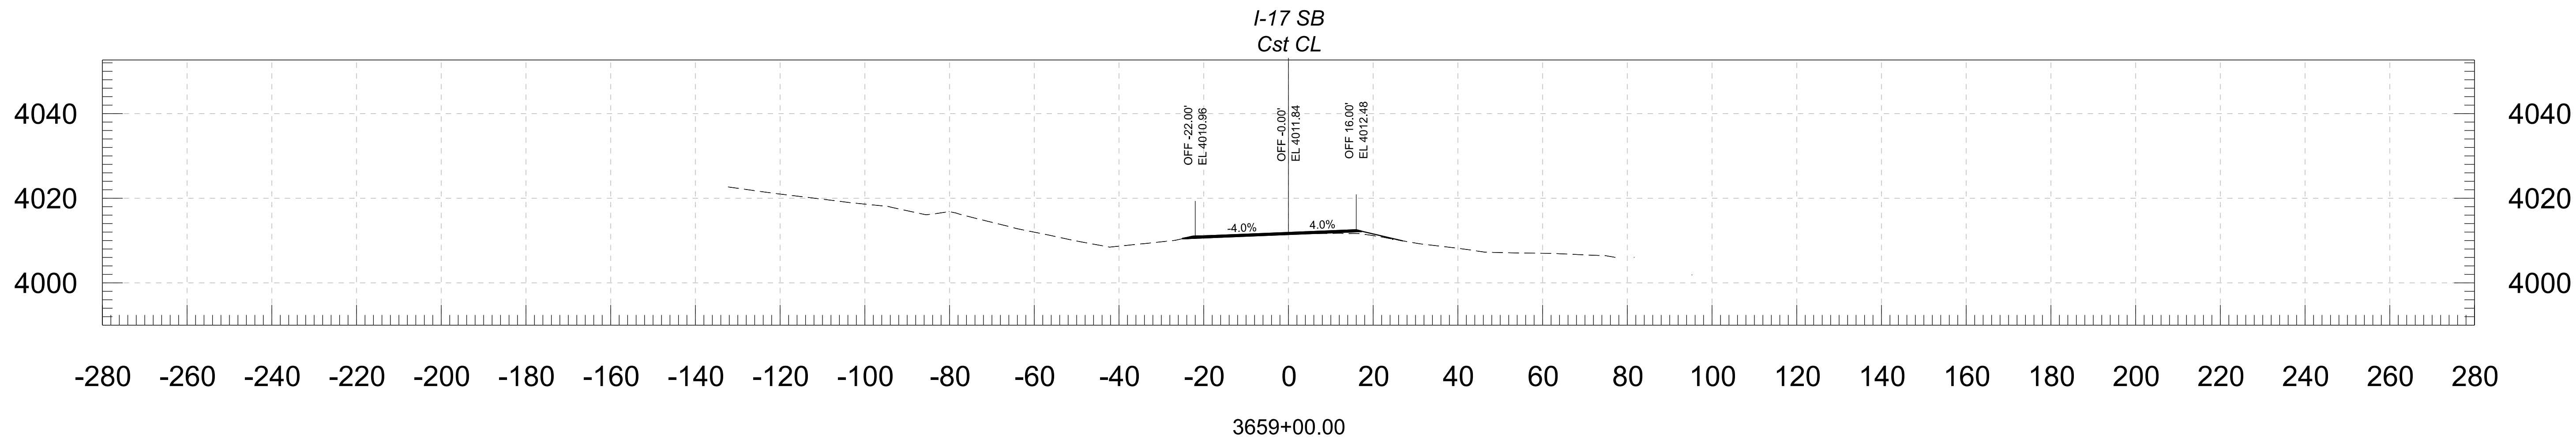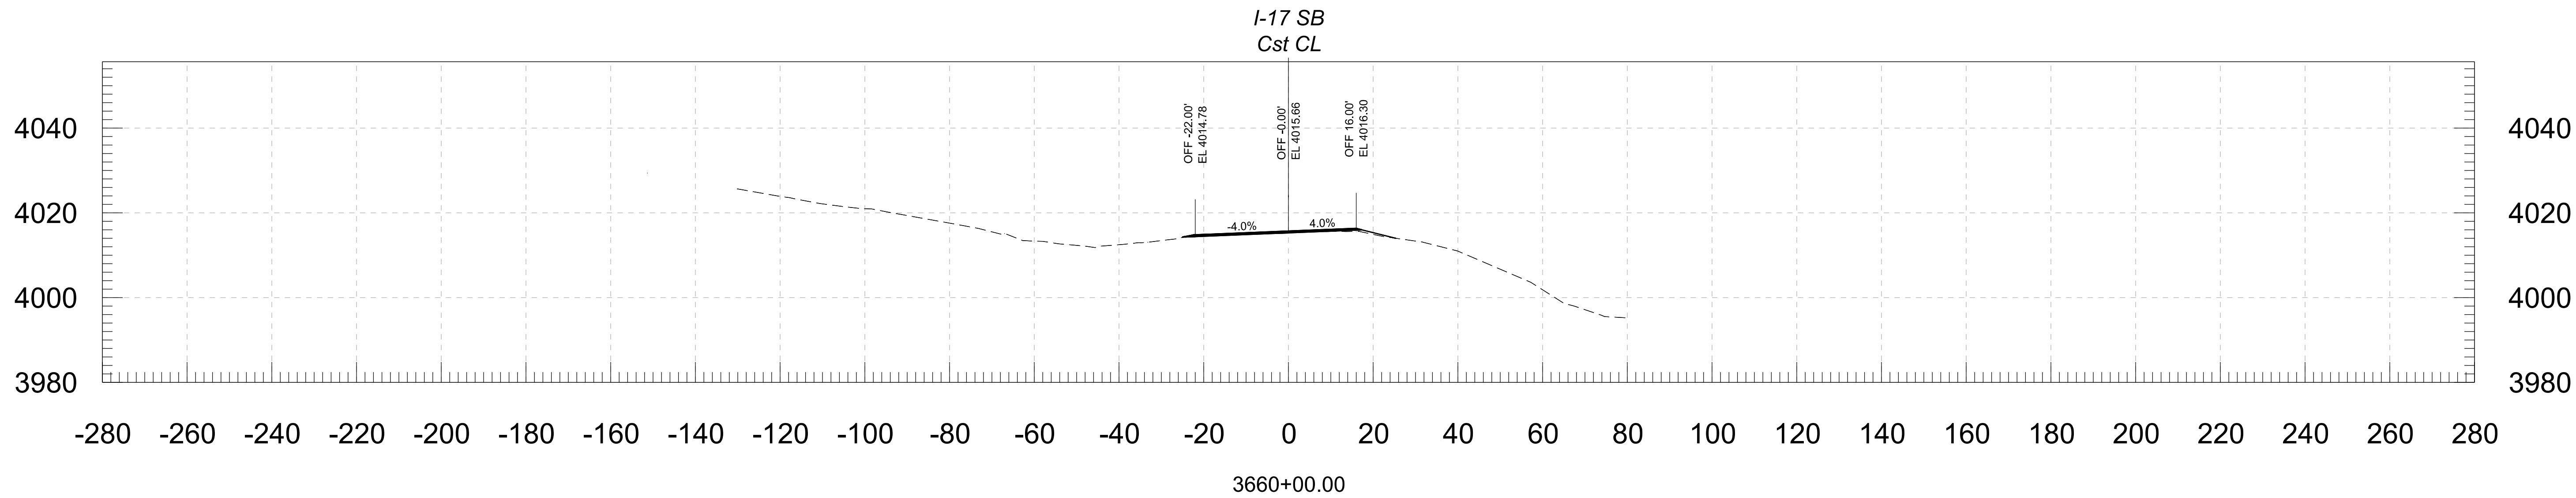



					ARIZONA DEPARTMENT OF TRANSPORTATION PROJECT DELIVERY AND OPERATIONS DIVISION ROADWAY DESIGN SERVICES	ROUTE	F.H.W.A. Arizona Division	STATE ARIZ.	PROJECT NO.	FEDERAL ID NO.	SHEET NO.	TOTAL SHEETS	RECORD DRAWING
		DESIGN	BAP	06/26									
		DRAWN	RM	06/26			017 YV 269	017-B(239)T	35	146			
		CHECKED	KCH	06/26									
				 3133 East Camelback Road, Suite 100 Phoenix, Arizona 85016 Phone 602.333-2000 Stanley Consultants INC.			CROSS SECTION	MILEPOST	E DUGAS ROAD - MP 275				
						STRUCTURE NO.	TRACS NO. F0616 01C						___ OF ___

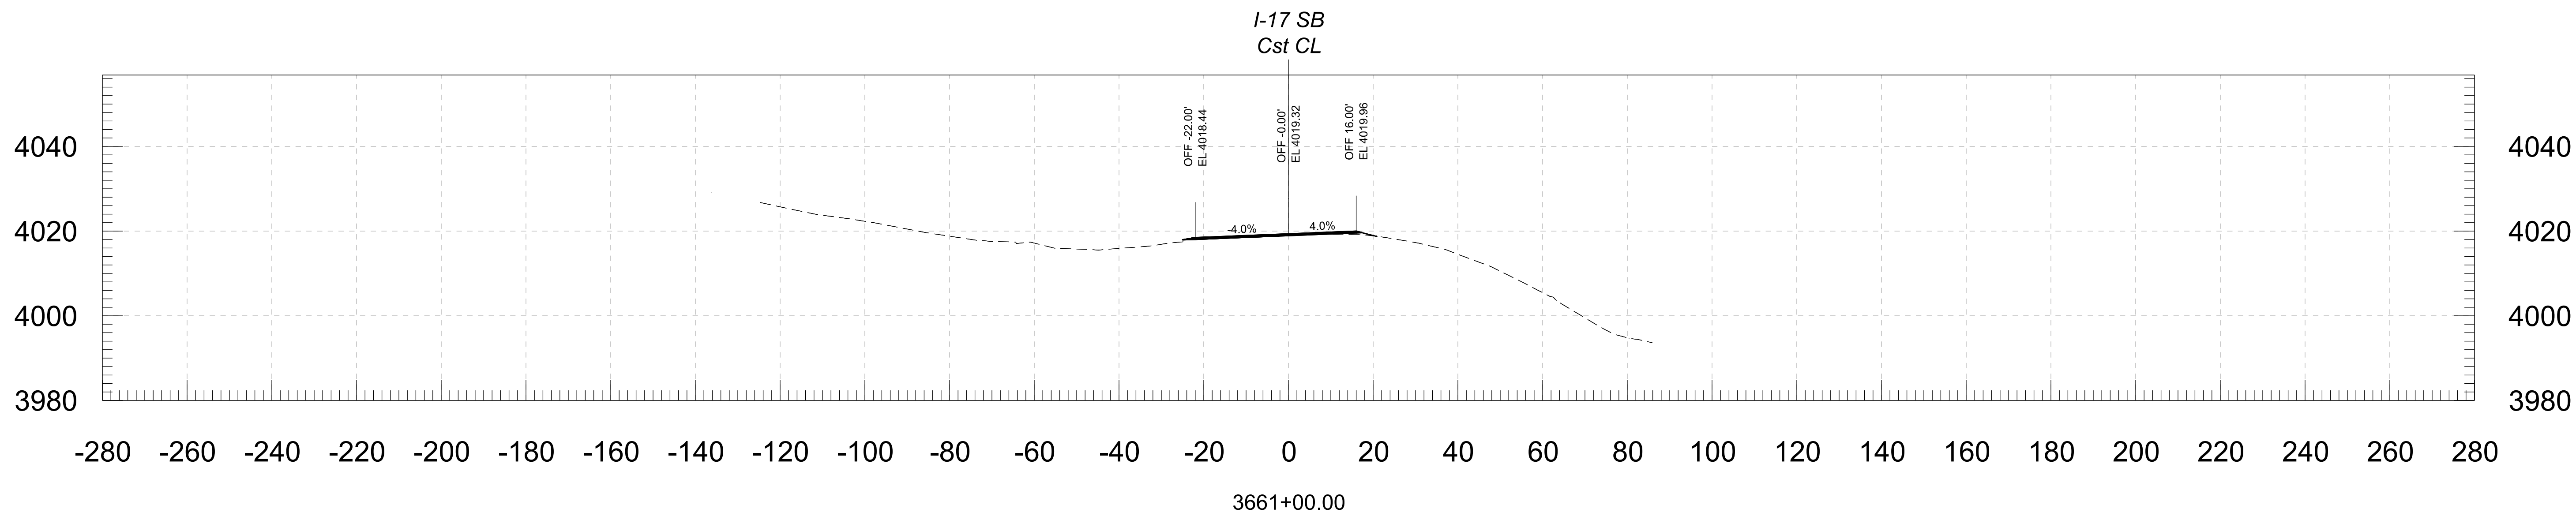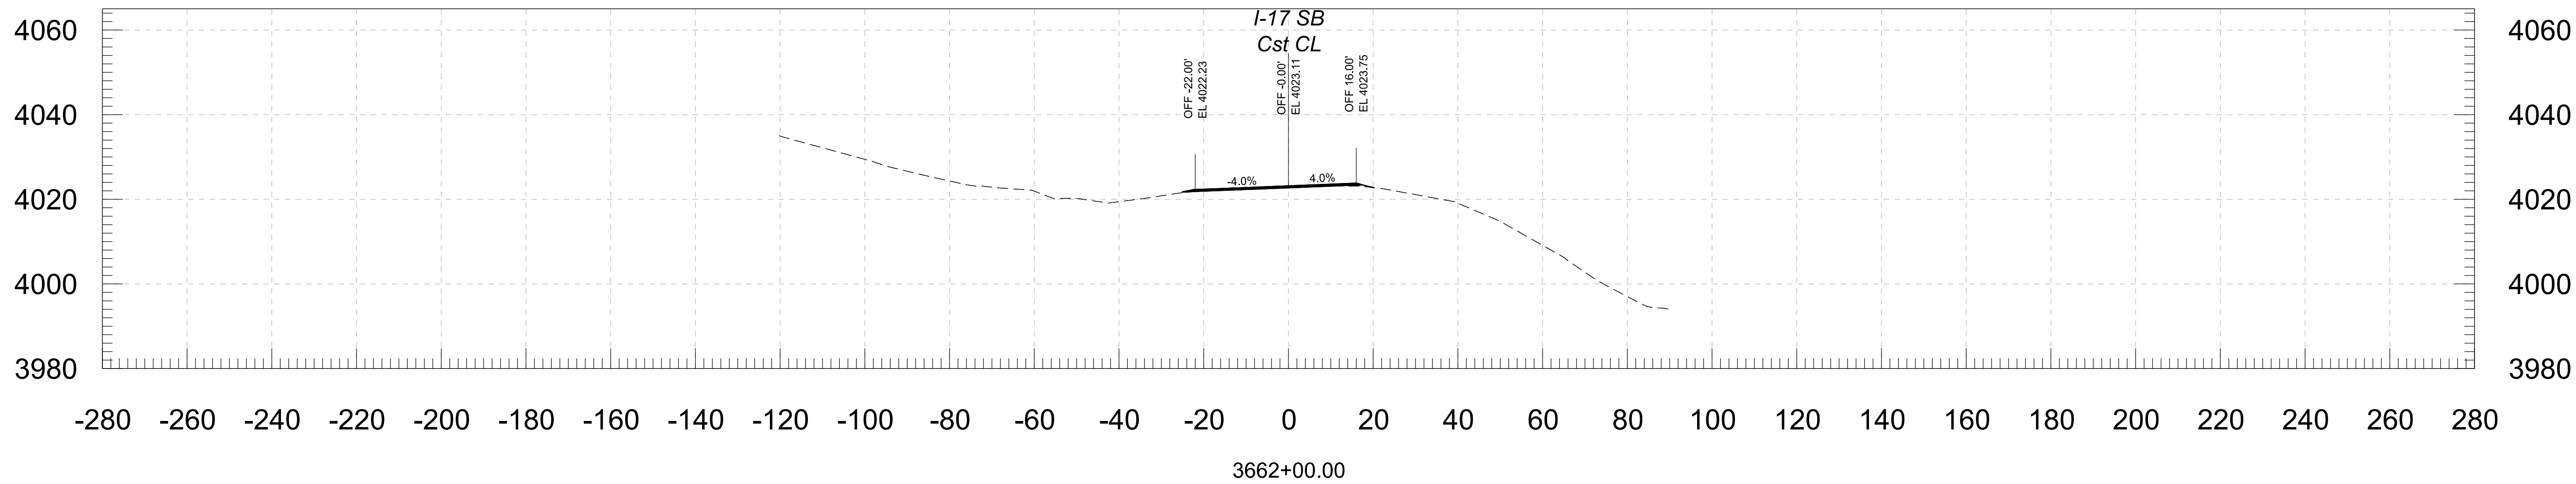



				NAME	DATE	ARIZONA DEPARTMENT OF TRANSPORTATION PROJECT DELIVERY AND OPERATIONS DIVISION ROADWAY DESIGN SERVICES	ROUTE	F.H.W.A. Arizona Division	STATE ARIZ.	PROJECT NO.	FEDERAL ID NO.	SHEET NO.	TOTAL SHEETS	RECORD DRAWING
			DESIGN	BAP	06/26		I-17			017 YV 269	017-B(239)T	36	146	
			DRAWN	RM	06/26									
			CHECKED	KCH	06/26									
			 3133 East Camelback Road, Suite 100 Phoenix, Arizona 85016 Phone: 602 333-2200 Stanley Consultants INC.				CROSS SECTION			MILEPOST	E DUGAS ROAD - MP 275			
						STRUCTURE NO.	TRACS NO. F0616 01C				___ OF ___			

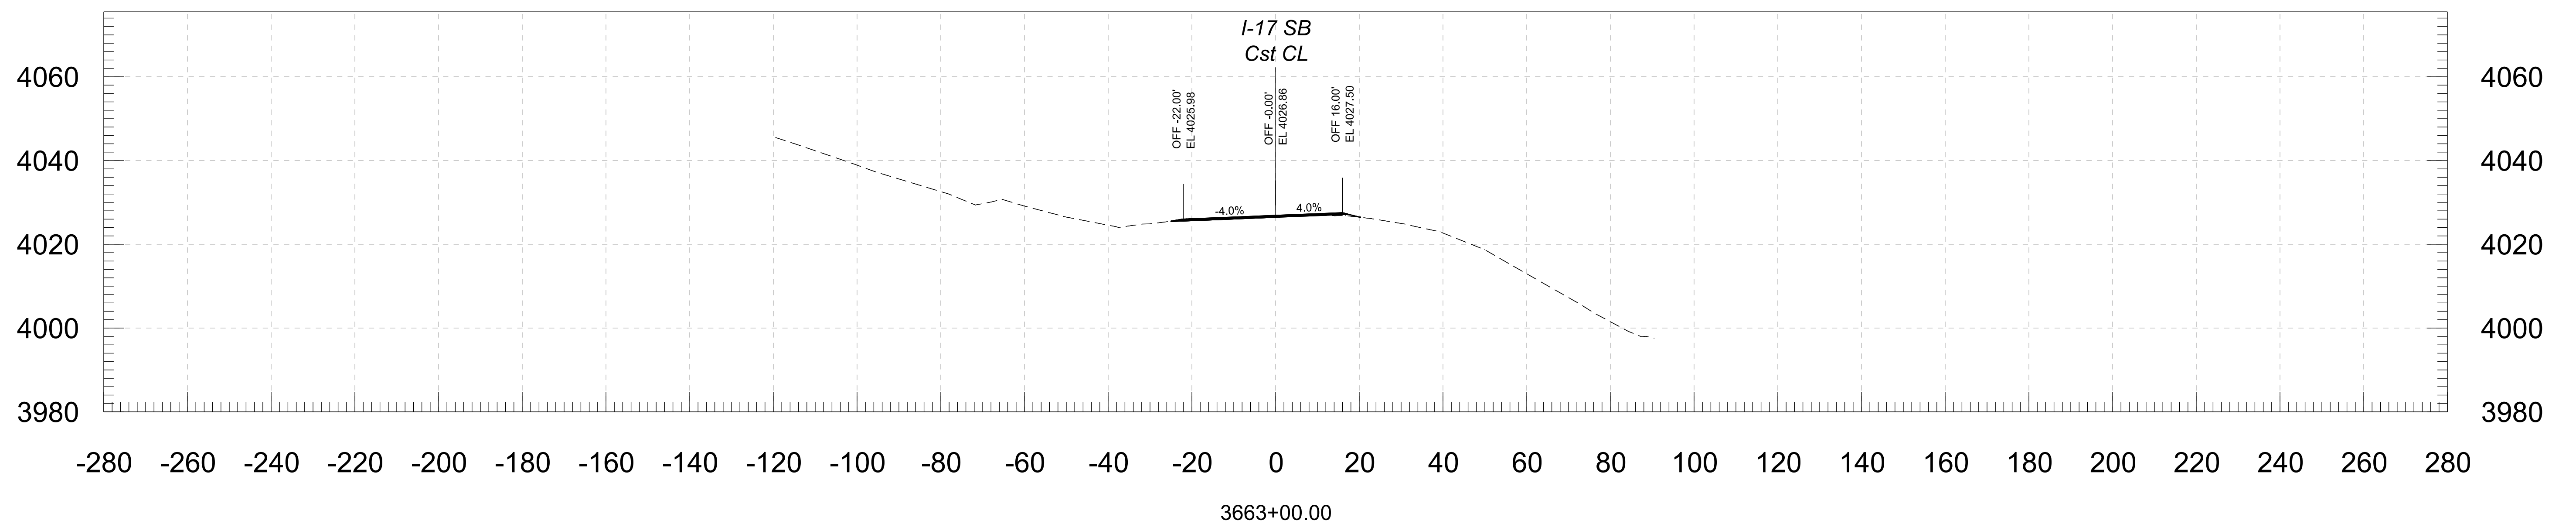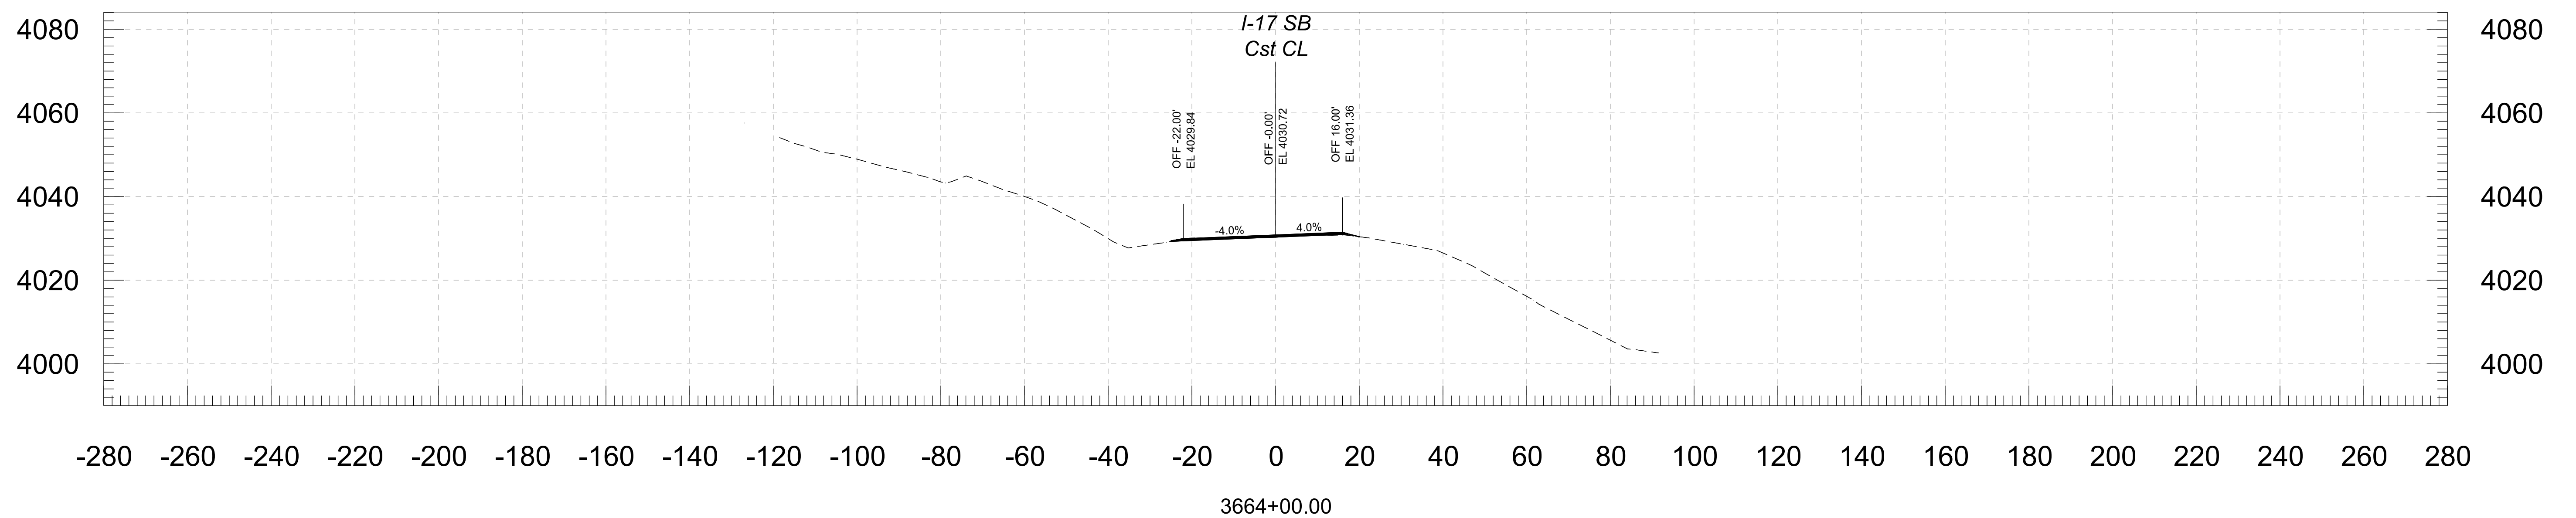



 Stanley Consultants INC. 3133 East Camelback Road, Suite 100 Phoenix, Arizona 85016 Phone: (602) 333-2200	<table><tr><th></th><th>NAME</th><th>DATE</th></tr><tr><td>DESIGN</td><td>BAP</td><td>06/26</td></tr><tr><td>DRAWN</td><td>RM</td><td>06/26</td></tr><tr><td>CHECKED</td><td>KCH</td><td>06/26</td></tr></table>		NAME	DATE	DESIGN	BAP	06/26	DRAWN	RM	06/26	CHECKED	KCH	06/26	ARIZONA DEPARTMENT OF TRANSPORTATION PROJECT DELIVERY AND OPERATIONS DIVISION ROADWAY DESIGN SERVICES	<table><tr><td>ROUTE</td><td>I-17</td></tr><tr><td>MILEPOST</td><td></td></tr><tr><td>STRUCTURE NO.</td><td></td></tr></table>	ROUTE	I-17	MILEPOST		STRUCTURE NO.		<table><tr><td rowspan="2">F.H.W.A. Arizona Division</td><td>STATE</td><td>ARIZ.</td><td>PROJECT NO.</td><td>017 YV 269</td><td>FEDERAL ID NO.</td><td>017-B(239)T</td><td>SHEET NO.</td><td>37</td><td>TOTAL SHEETS</td><td>146</td><td>RECORD DRAWING</td></tr><tr><td colspan="9"></td></tr></table>	F.H.W.A. Arizona Division	STATE	ARIZ.	PROJECT NO.	017 YV 269	FEDERAL ID NO.	017-B(239)T	SHEET NO.	37	TOTAL SHEETS	146	RECORD DRAWING										<table><tr><td>LOCATION</td><td>E DUGAS ROAD - MP 275</td><td>DWG NO.</td></tr><tr><td>TRACS NO.</td><td>F0616 01C</td><td>___ OF ___</td></tr></table>	LOCATION	E DUGAS ROAD - MP 275	DWG NO.	TRACS NO.	F0616 01C	___ OF ___
		NAME	DATE																																															
	DESIGN	BAP	06/26																																															
	DRAWN	RM	06/26																																															
	CHECKED	KCH	06/26																																															
ROUTE	I-17																																																	
MILEPOST																																																		
STRUCTURE NO.																																																		
F.H.W.A. Arizona Division	STATE	ARIZ.	PROJECT NO.	017 YV 269	FEDERAL ID NO.	017-B(239)T	SHEET NO.	37	TOTAL SHEETS	146	RECORD DRAWING																																							
LOCATION	E DUGAS ROAD - MP 275	DWG NO.																																																
TRACS NO.	F0616 01C	___ OF ___																																																
		CROSS SECTION																																																

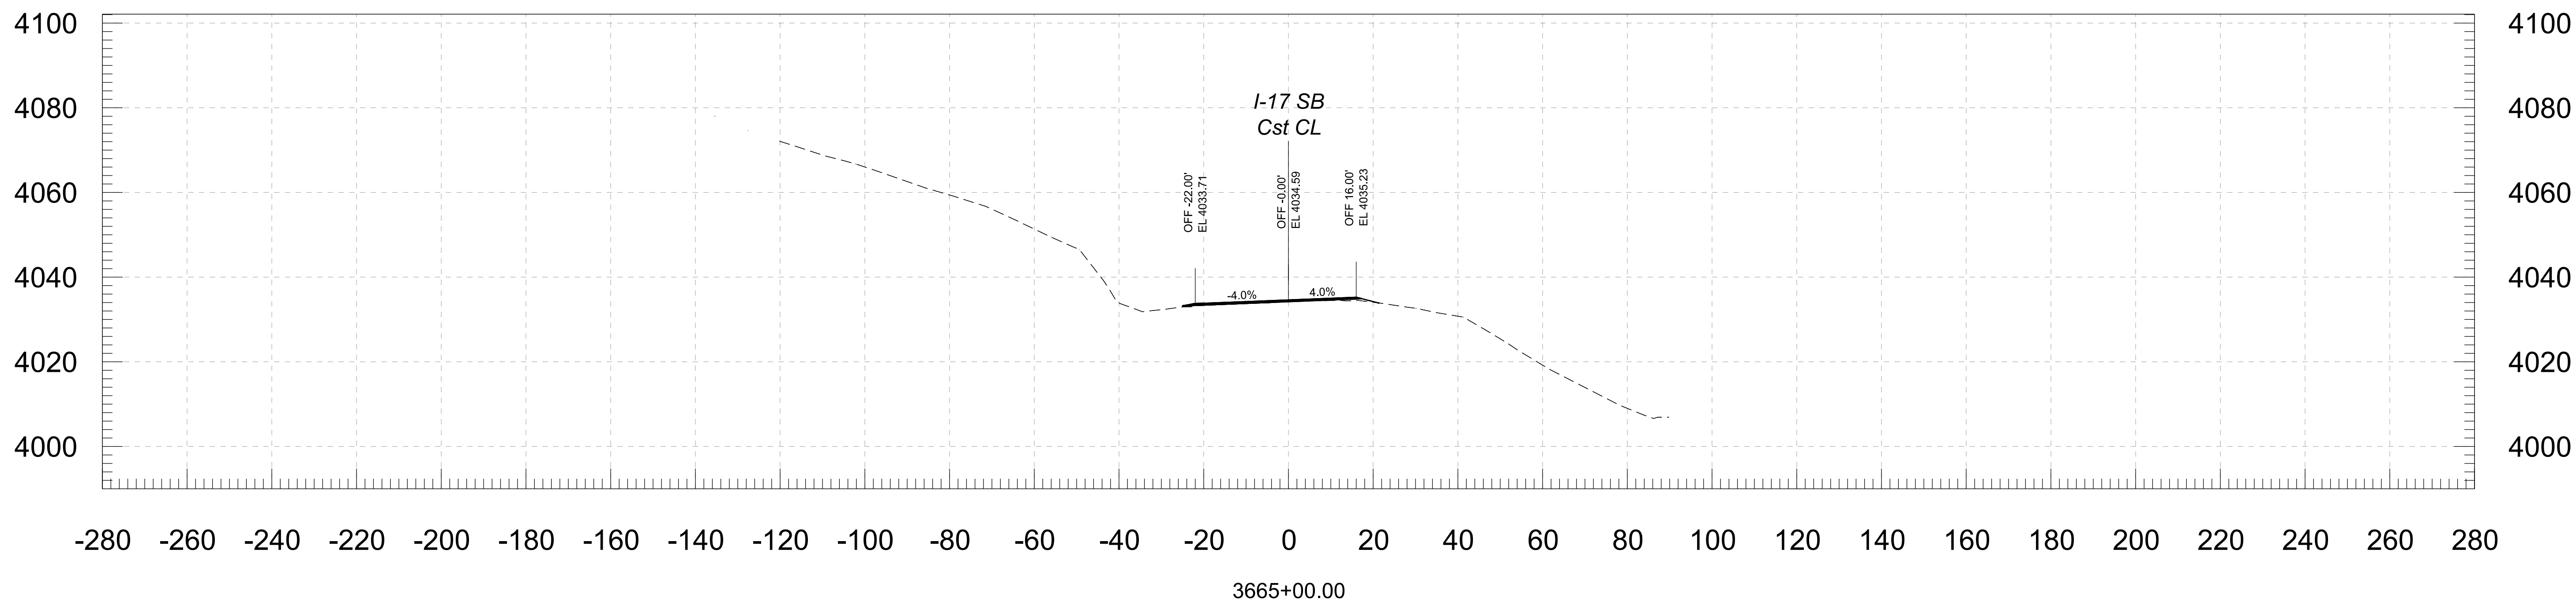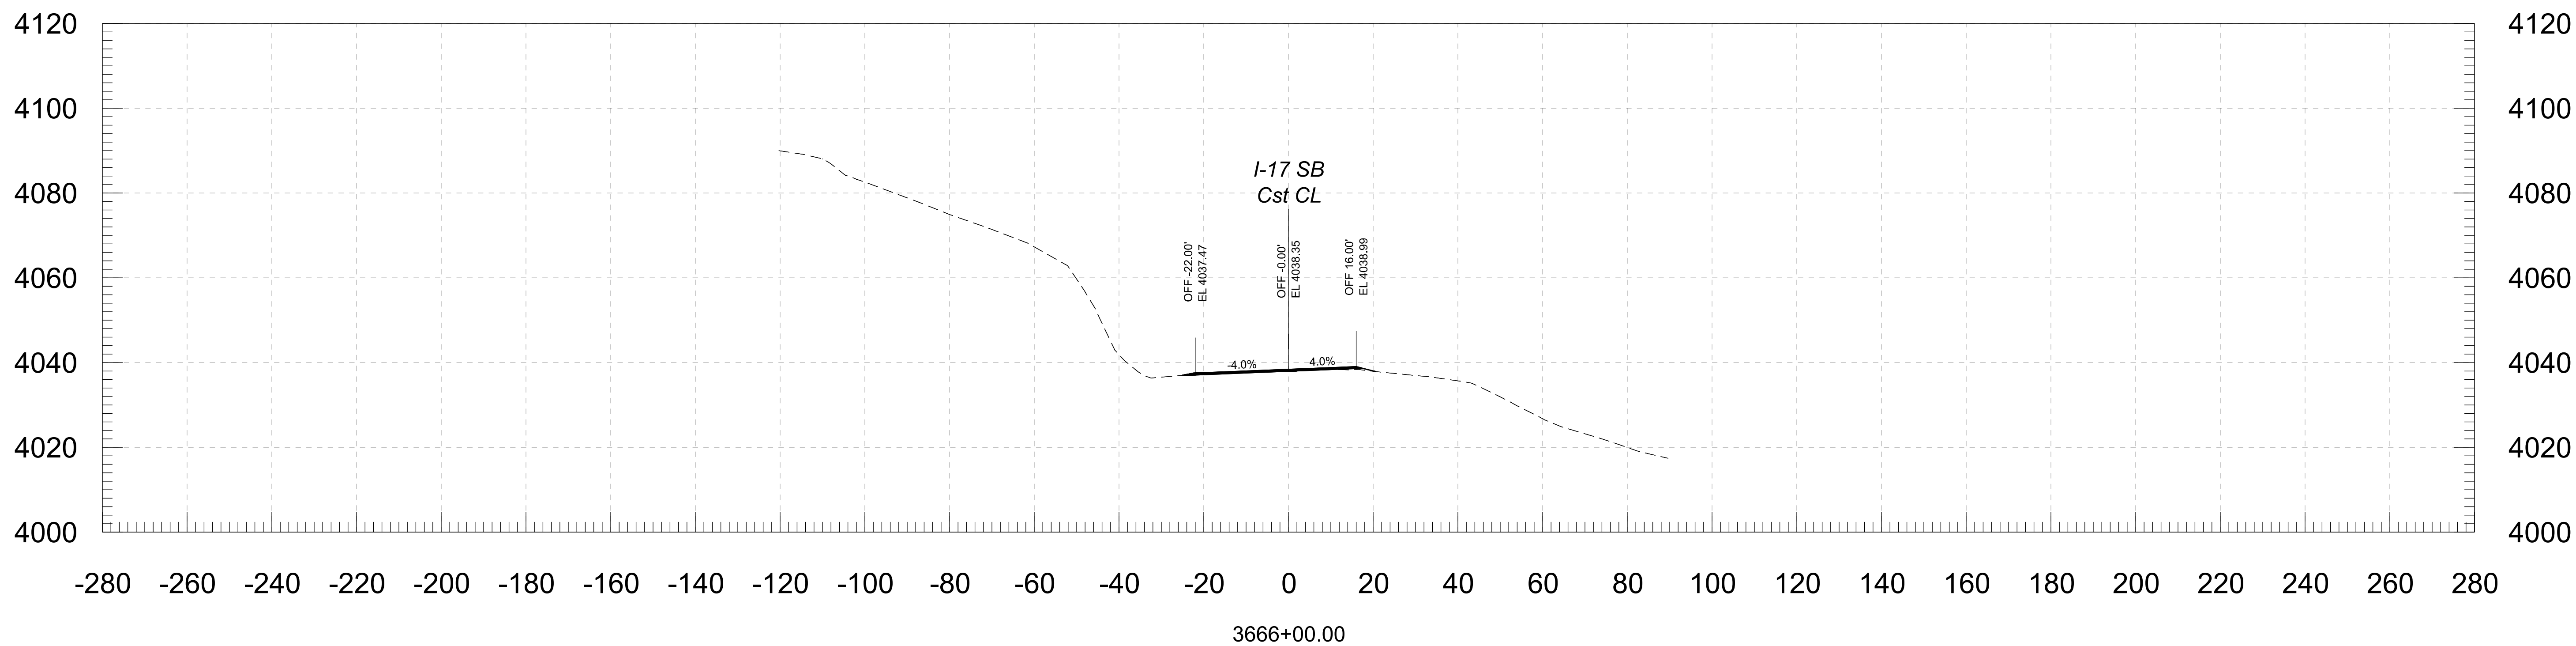 




				NAME	DATE	ARIZONA DEPARTMENT OF TRANSPORTATION PROJECT DELIVERY AND OPERATIONS DIVISION ROADWAY DESIGN SERVICES	ROUTE	F.H.W.A. Arizona Division	STATE ARIZ.	PROJECT NO.	FEDERAL ID NO.	SHEET NO.	TOTAL SHEETS	RECORD DRAWING	
			DESIGN	BAP	06/26		I-17								
			DRAWN	RM	06/26						017 YV 269	017-B(239)T	38		146
			CHECKED	KCH	06/26										
			 3133 East Camelback Road, Suite 100 Phoenix, Arizona 85016 Phone: 602 333-2200 Stanley Consultants INC.				CROSS SECTION				E DUGAS ROAD - MP 275				DWG NO.
						STRUCTURE NO.	TRACS NO. F0616 01C				___ OF ___				

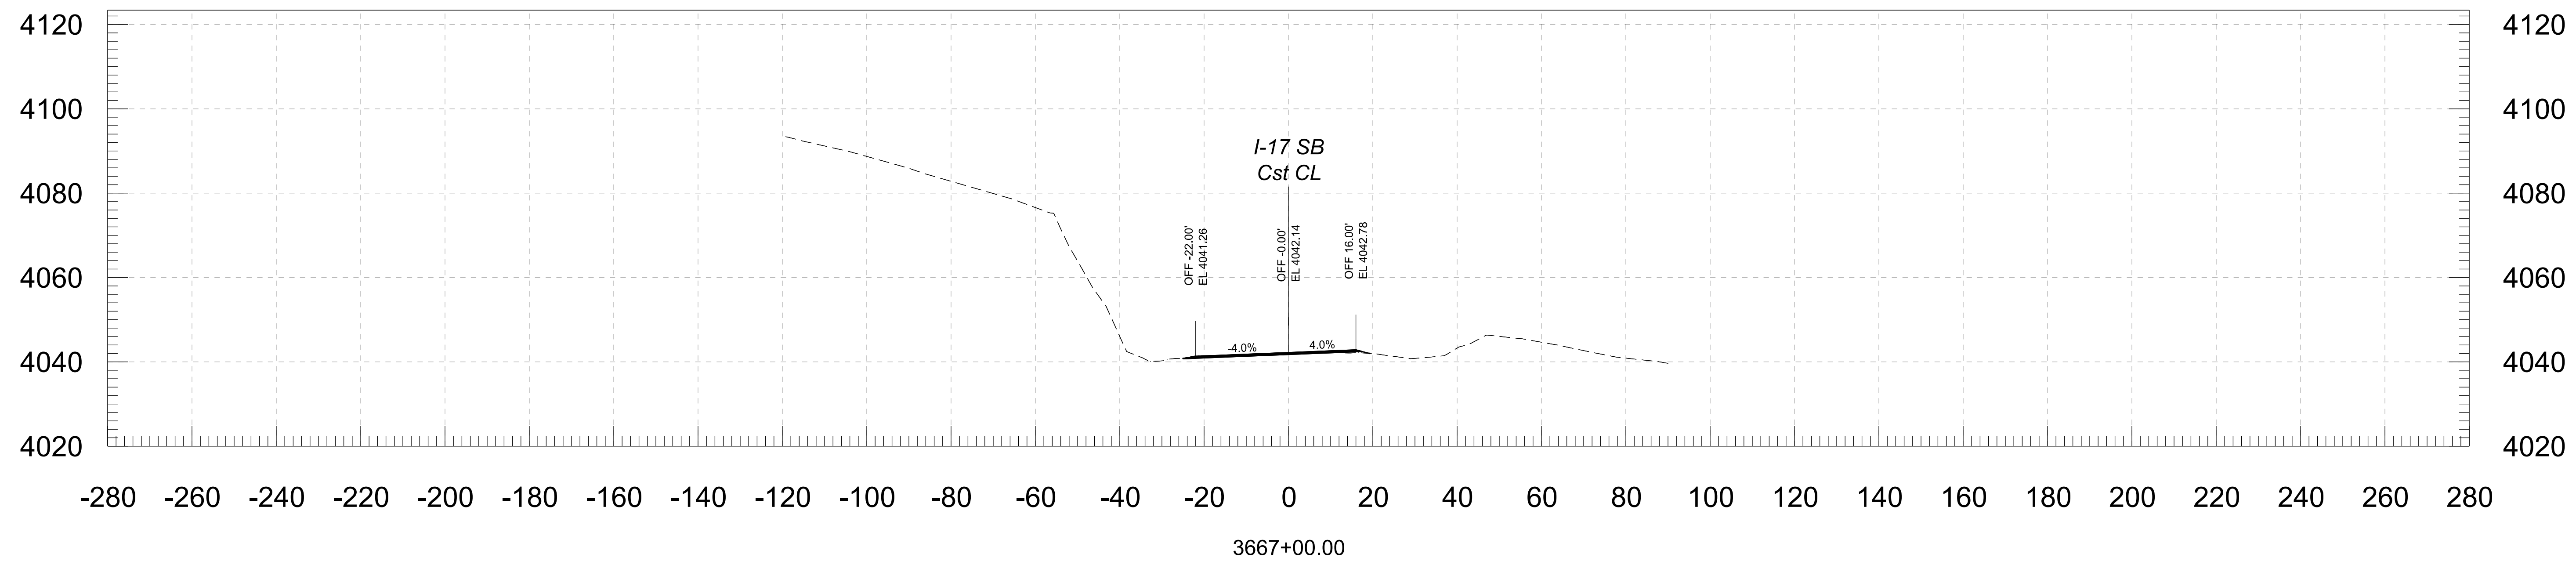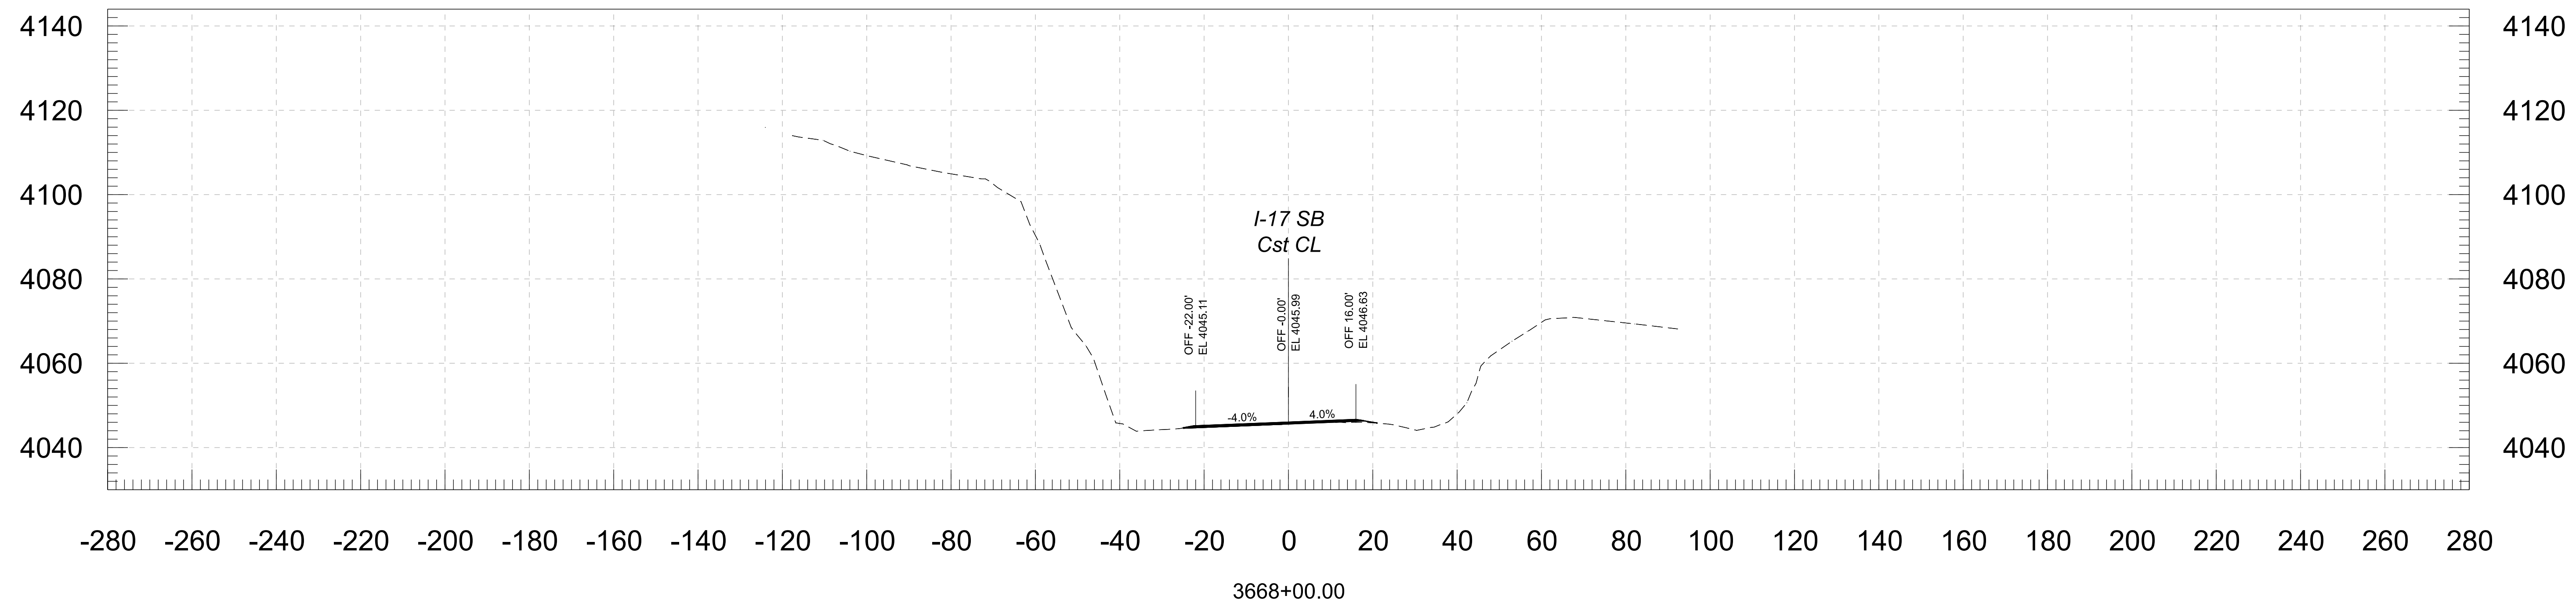



--	--	
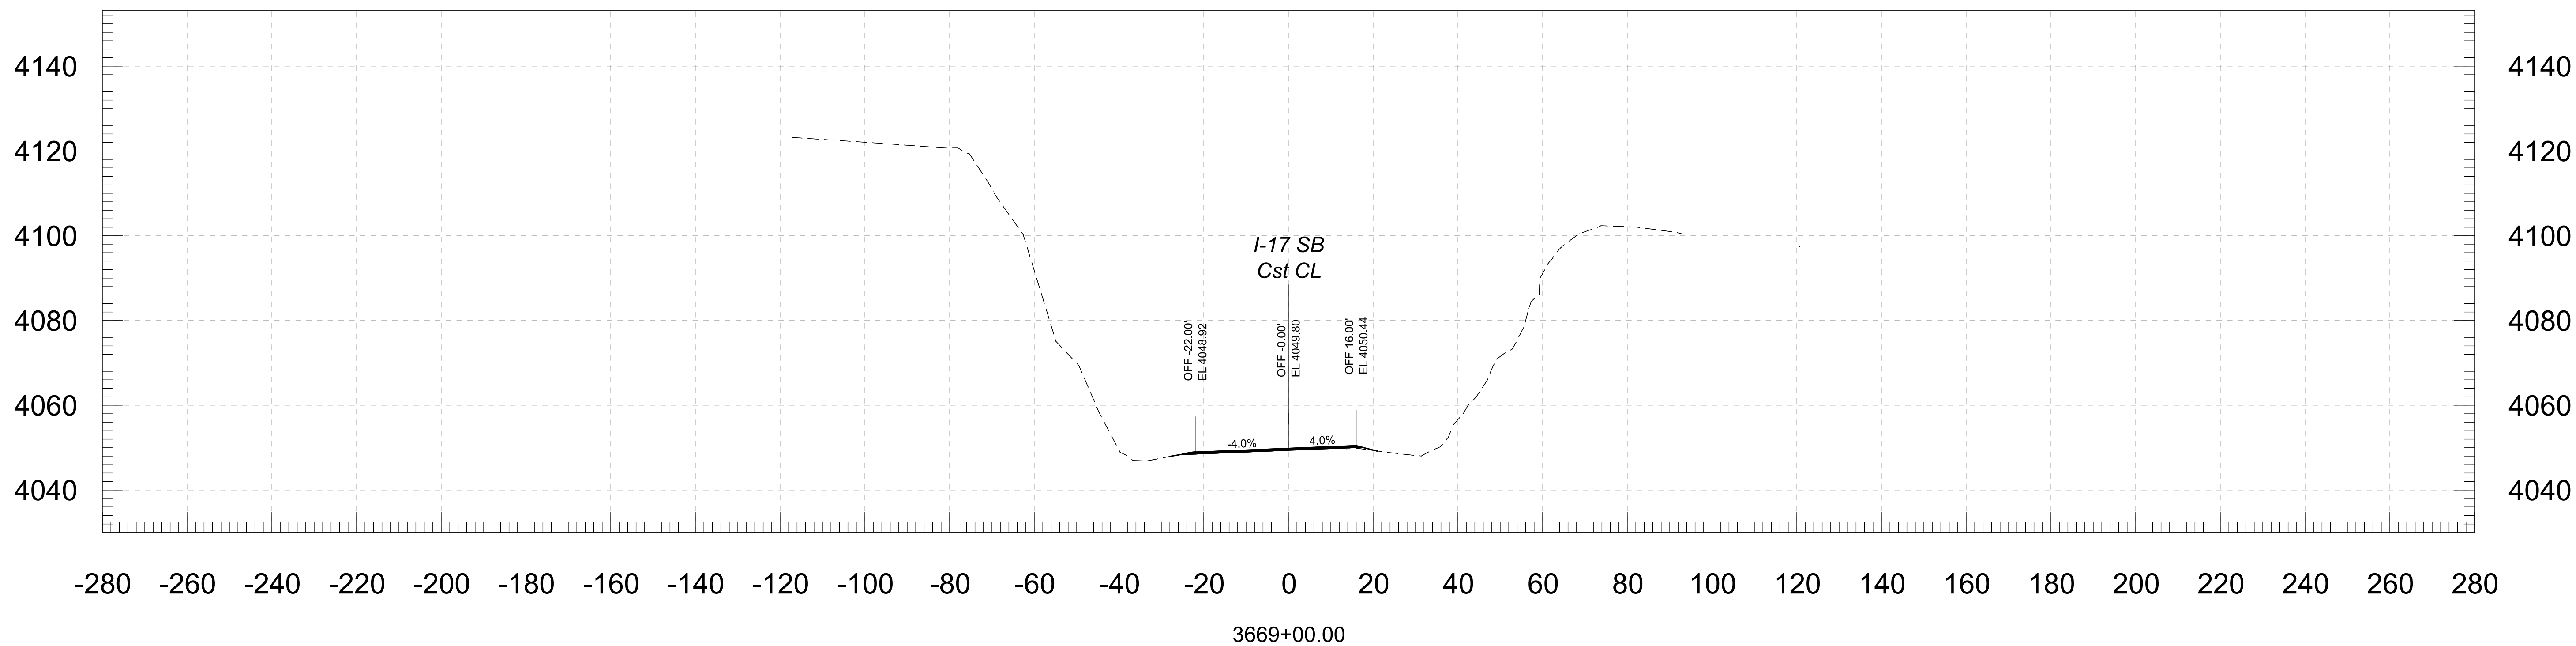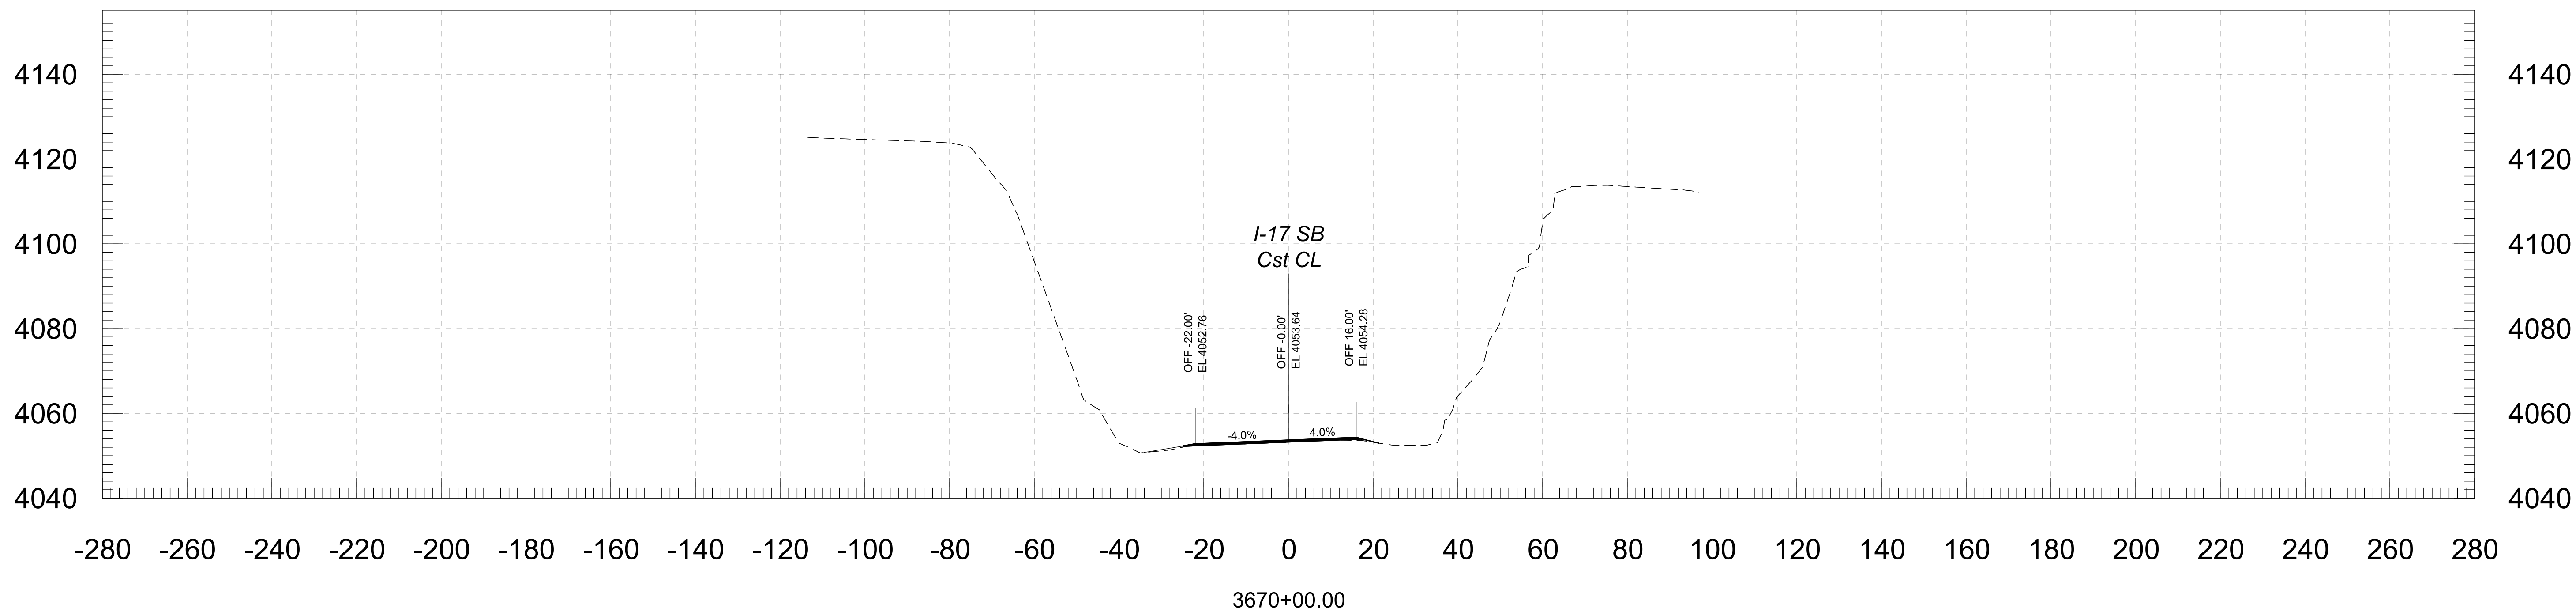



			NAME	DATE	ARIZONA DEPARTMENT OF TRANSPORTATION PROJECT DELIVERY AND OPERATIONS DIVISION ROADWAY DESIGN SERVICES	ROUTE	F.H.W.A. Arizona Division	STATE ARIZ.	PROJECT NO.	FEDERAL ID NO.	SHEET NO.	TOTAL SHEETS	RECORD DRAWING
		DESIGN	BAP	06/26		I-17			017 YV 269	017-B(239)T	40	146	
		DRAWN	RM	06/26									
		CHECKED	KCH	06/26									
		 Stanley Consultants INC.			CROSS SECTION			MILEPOST	LOCATION E DUGAS ROAD - MP 275				
						STRUCTURE NO.	TRACS NO. F0616 01C						___ OF ___

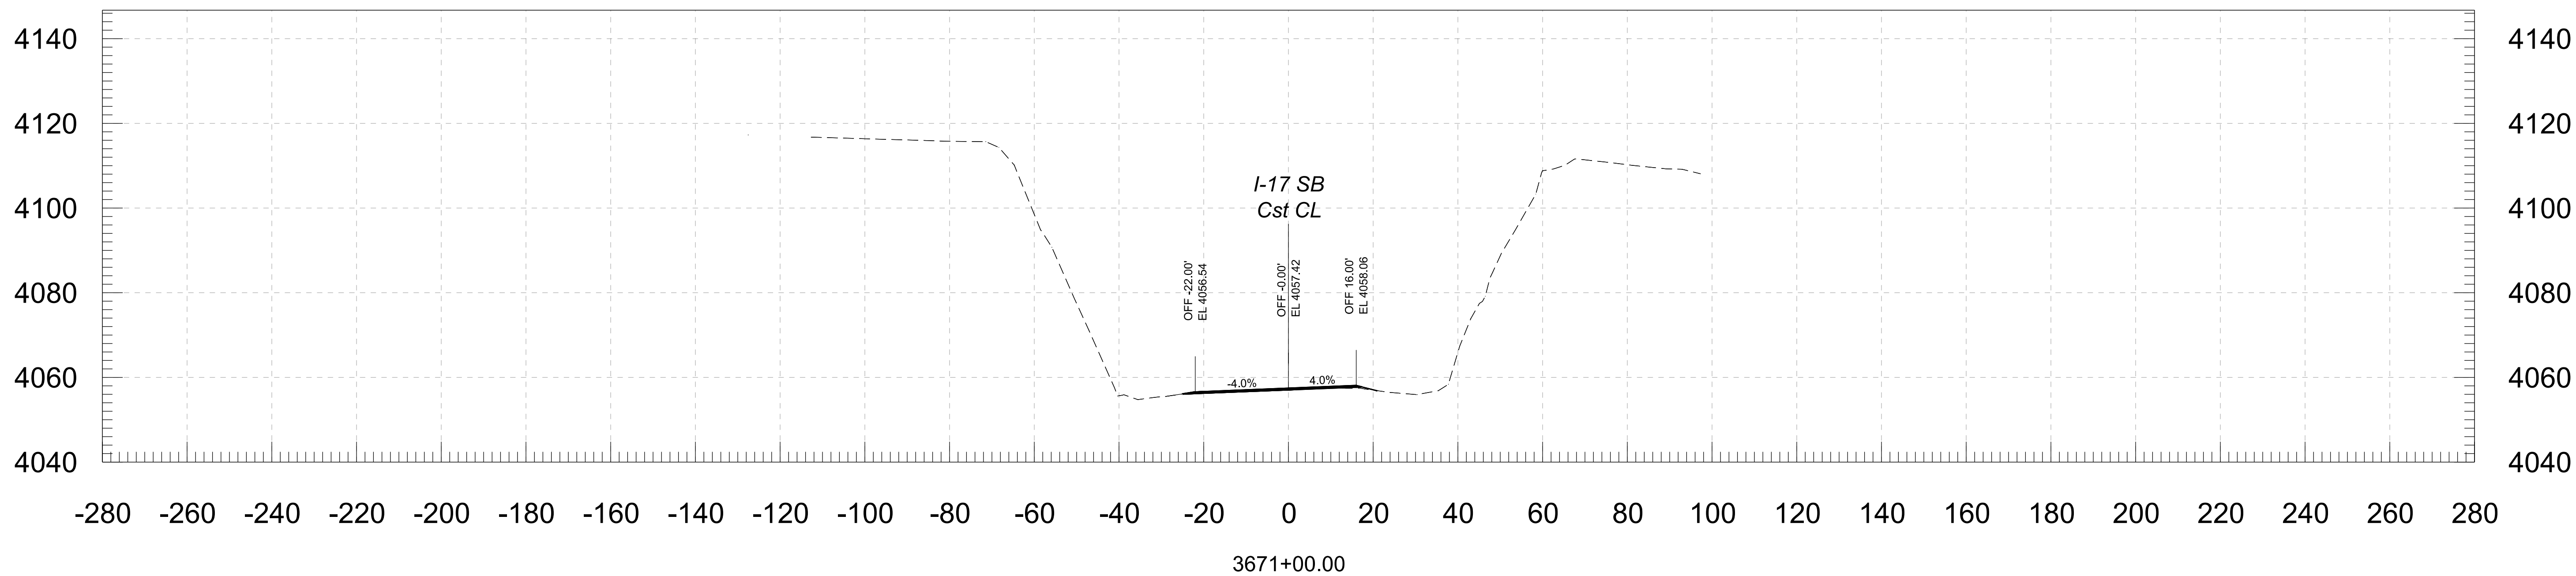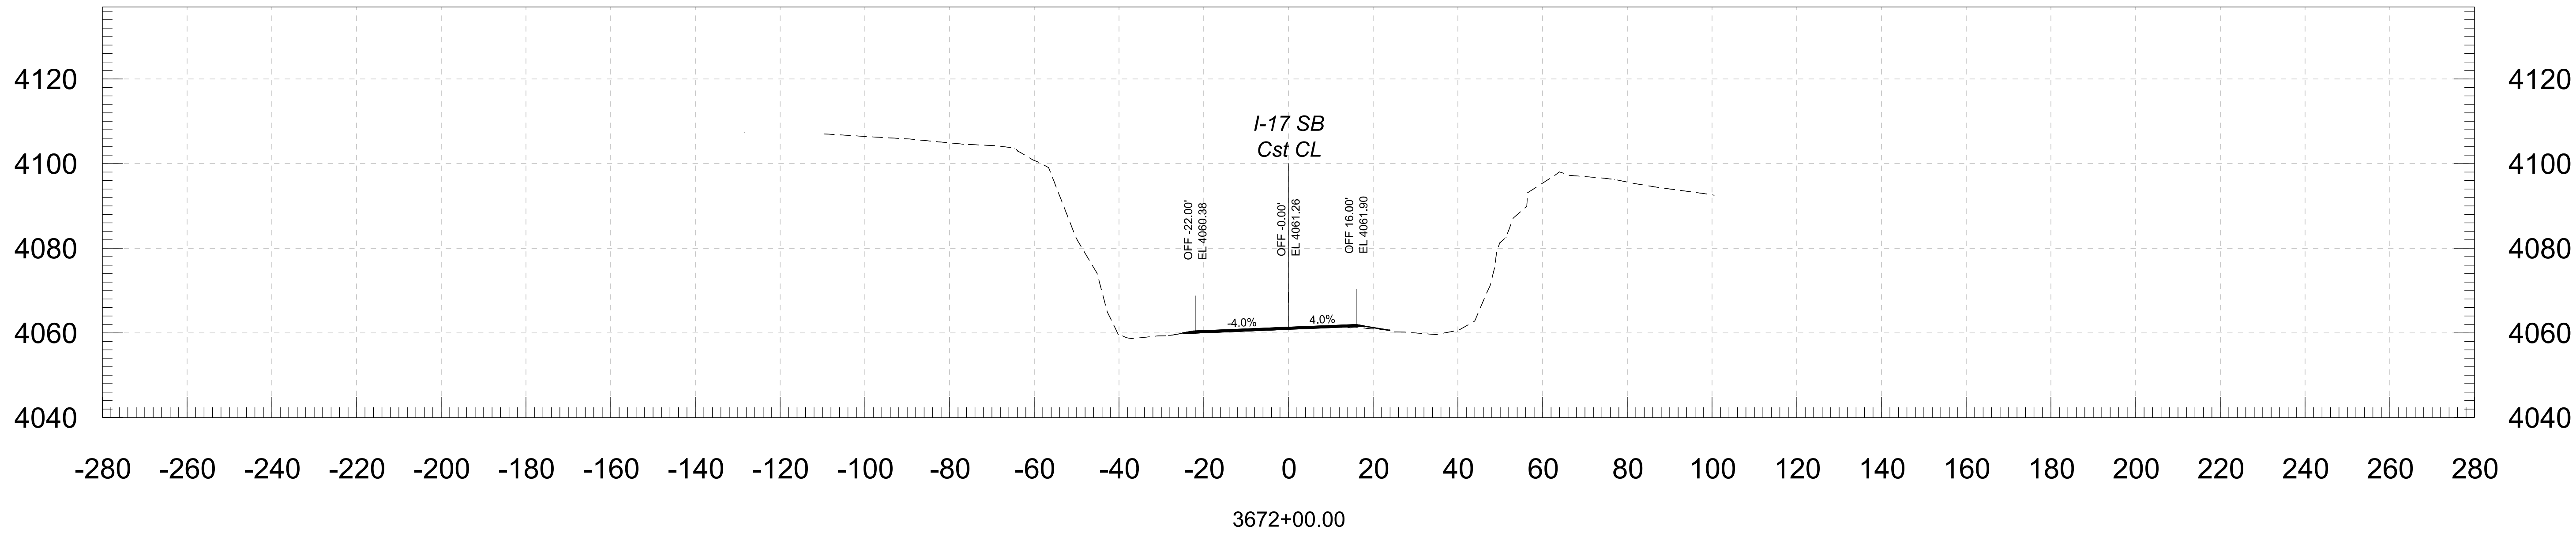



				NAME	DATE	ARIZONA DEPARTMENT OF TRANSPORTATION PROJECT DELIVERY AND OPERATIONS DIVISION ROADWAY DESIGN SERVICES	ROUTE	F.H.W.A. Arizona Division	STATE ARIZ.	PROJECT NO.	FEDERAL ID NO.	SHEET NO.	TOTAL SHEETS	RECORD DRAWING
			DESIGN	BAP	06/26		I-17							
			DRAWN	RM	06/26					017 YV 269	017-B(239)T	41	146	
			CHECKED	KCH	06/26									
			 Stanley Consultants INC.				333 East Camelback Road, Suite 100 Phoenix, Arizona 85016 Phone: 602) 333-2200							
					TRACS NO. F0616 01C	OF								

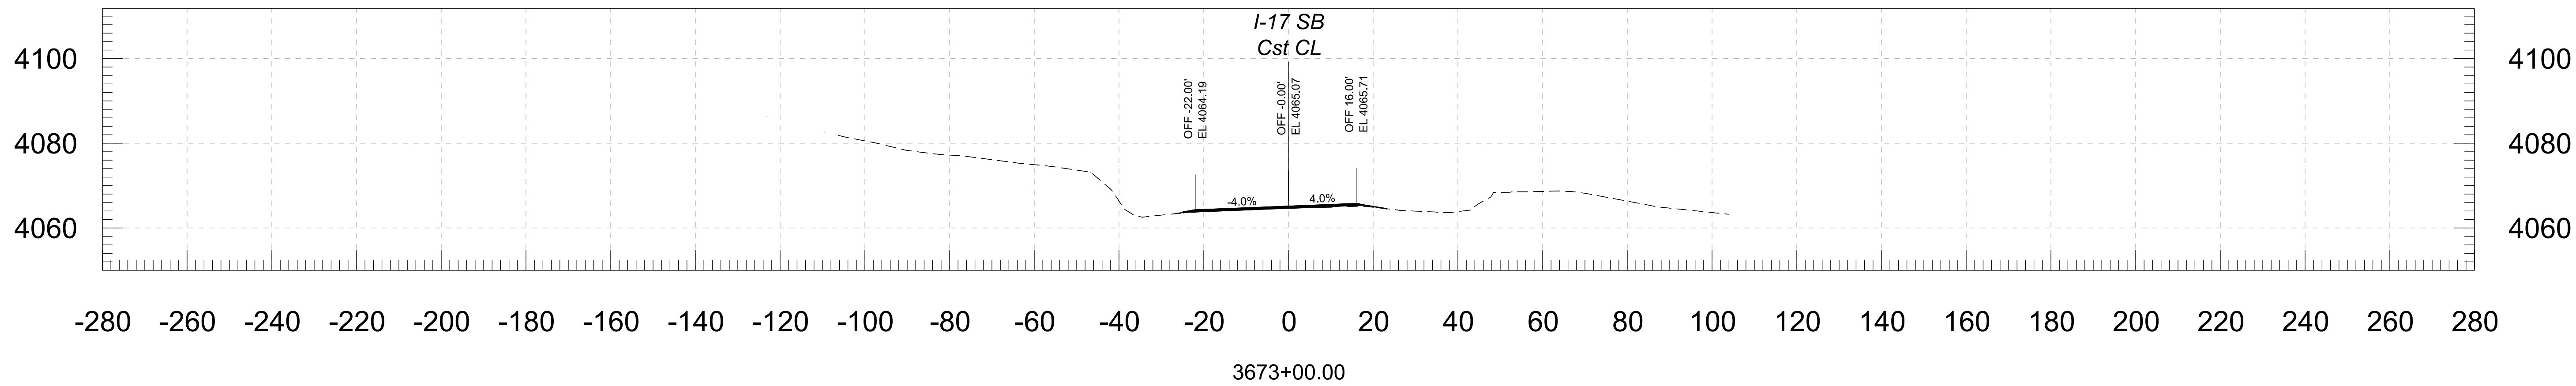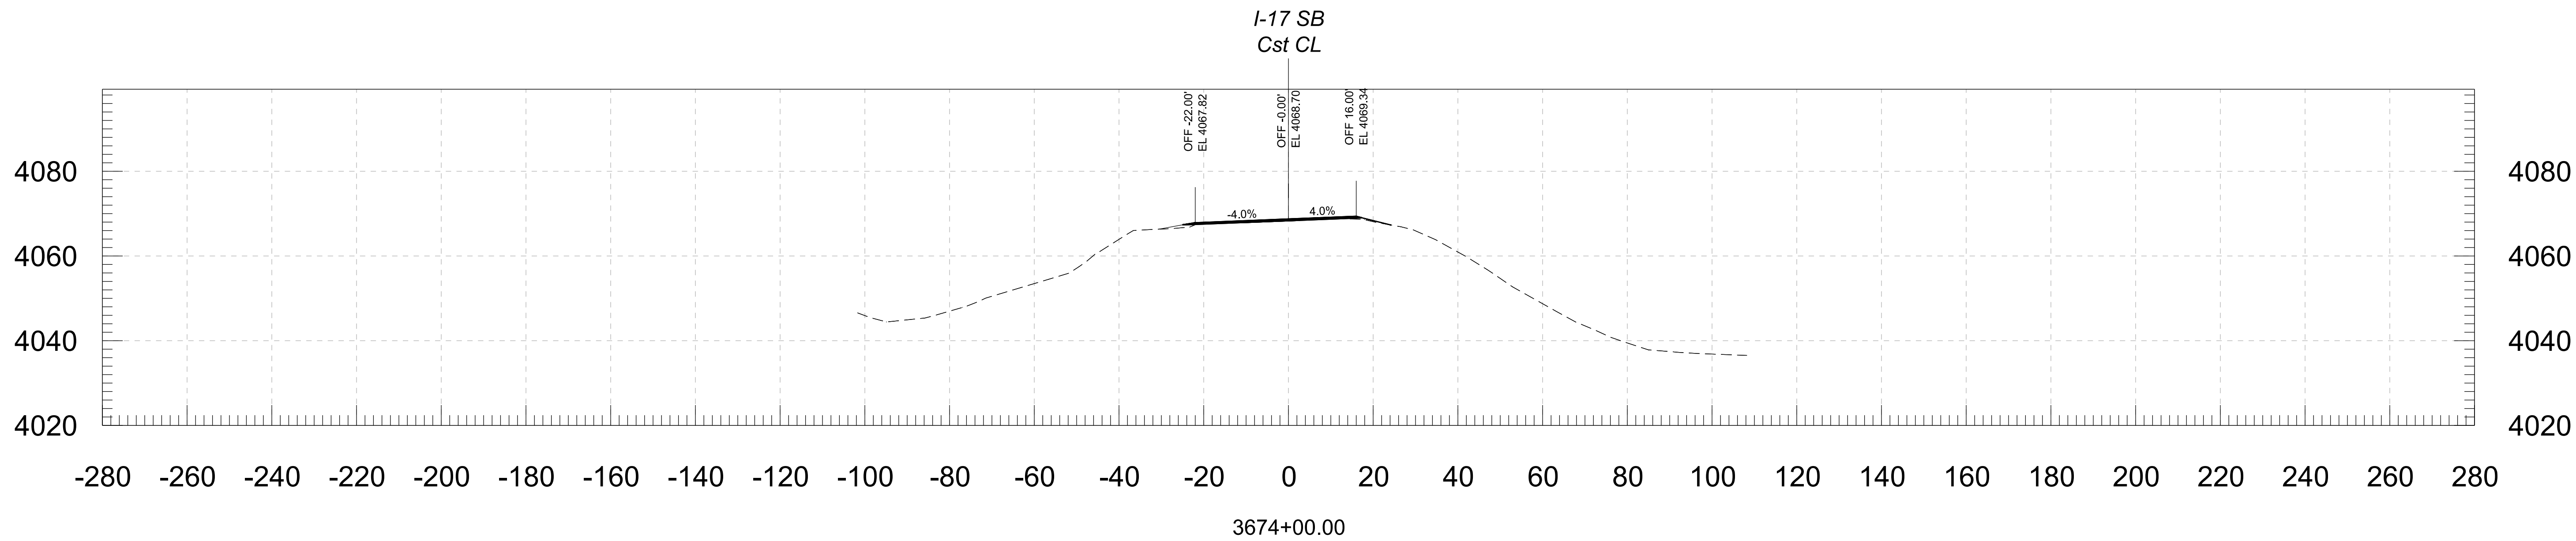



				NAME	DATE	ARIZONA DEPARTMENT OF TRANSPORTATION PROJECT DELIVERY AND OPERATIONS DIVISION ROADWAY DESIGN SERVICES	ROUTE	F.H.W.A. Arizona Division	STATE	PROJECT NO.	FEDERAL ID NO.	SHEET NO.	TOTAL SHEETS	RECORD DRAWING
			DESIGN	BAP	06/26		I-17			017 YV 269	017-B(239)T	42	146	
			DRAWN	RM	06/26			MILEPOST	LOCATION				E DUGAS ROAD - MP 275	DWG NO.
			CHECKED	KCH	06/26				STRUCTURE NO.	TRACS NO. F0616 01C				
			Stanley Consultants INC. 333 East Camelback Road, Suite 100 Phoenix, Arizona 85016 Phone: (602) 333-2200			CROSS SECTION								

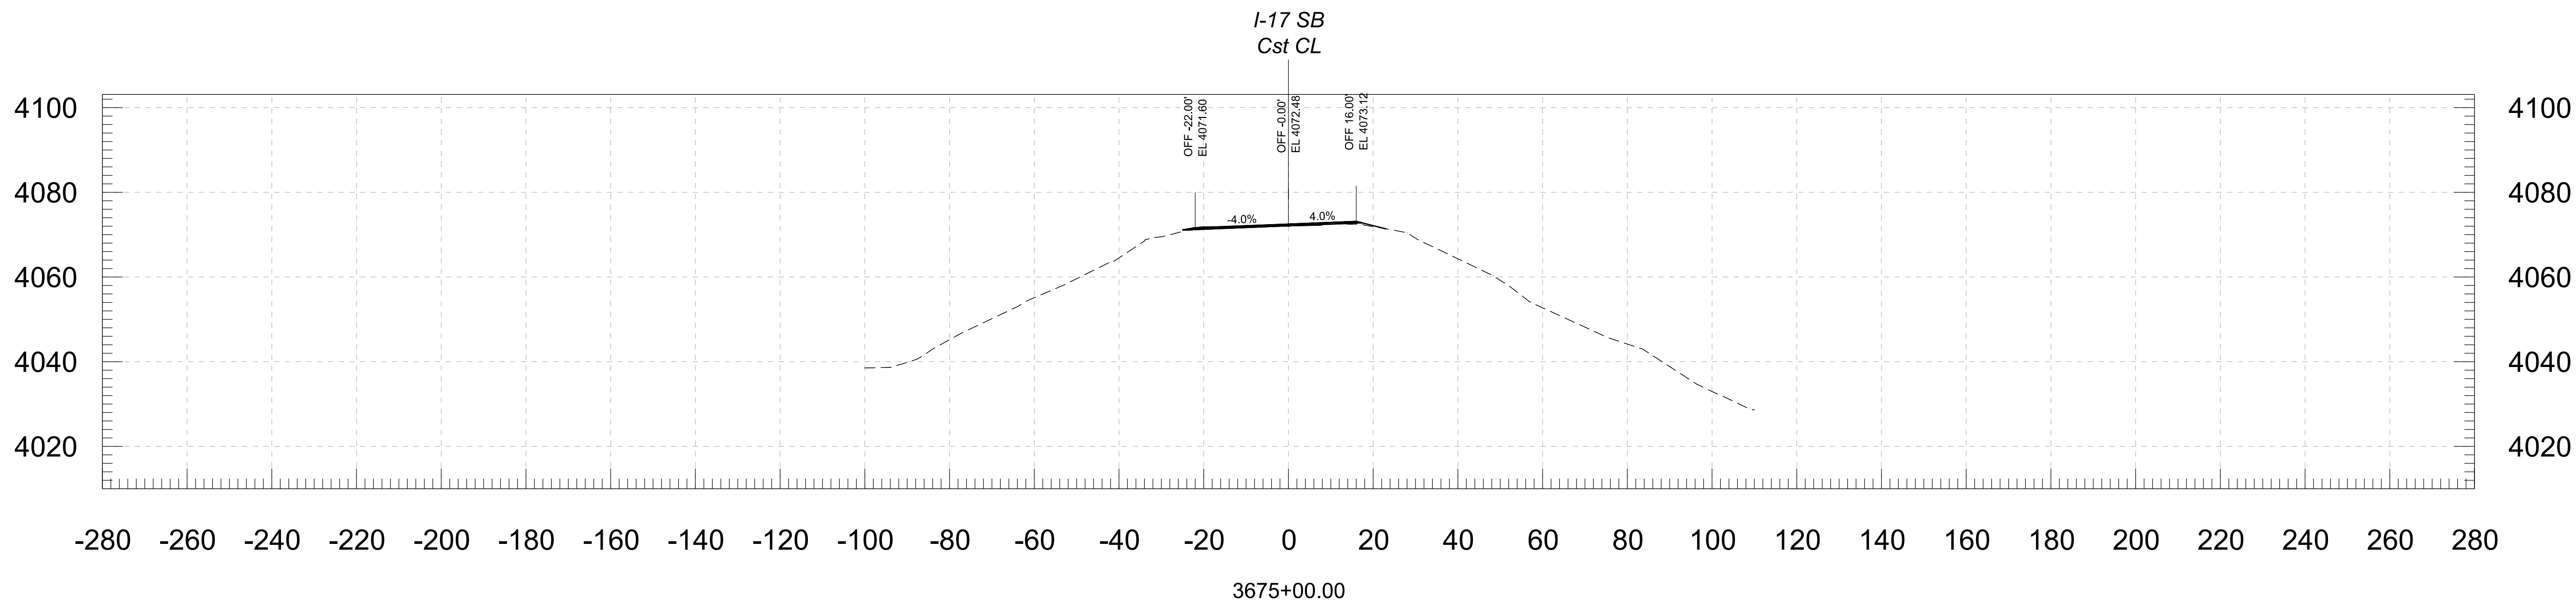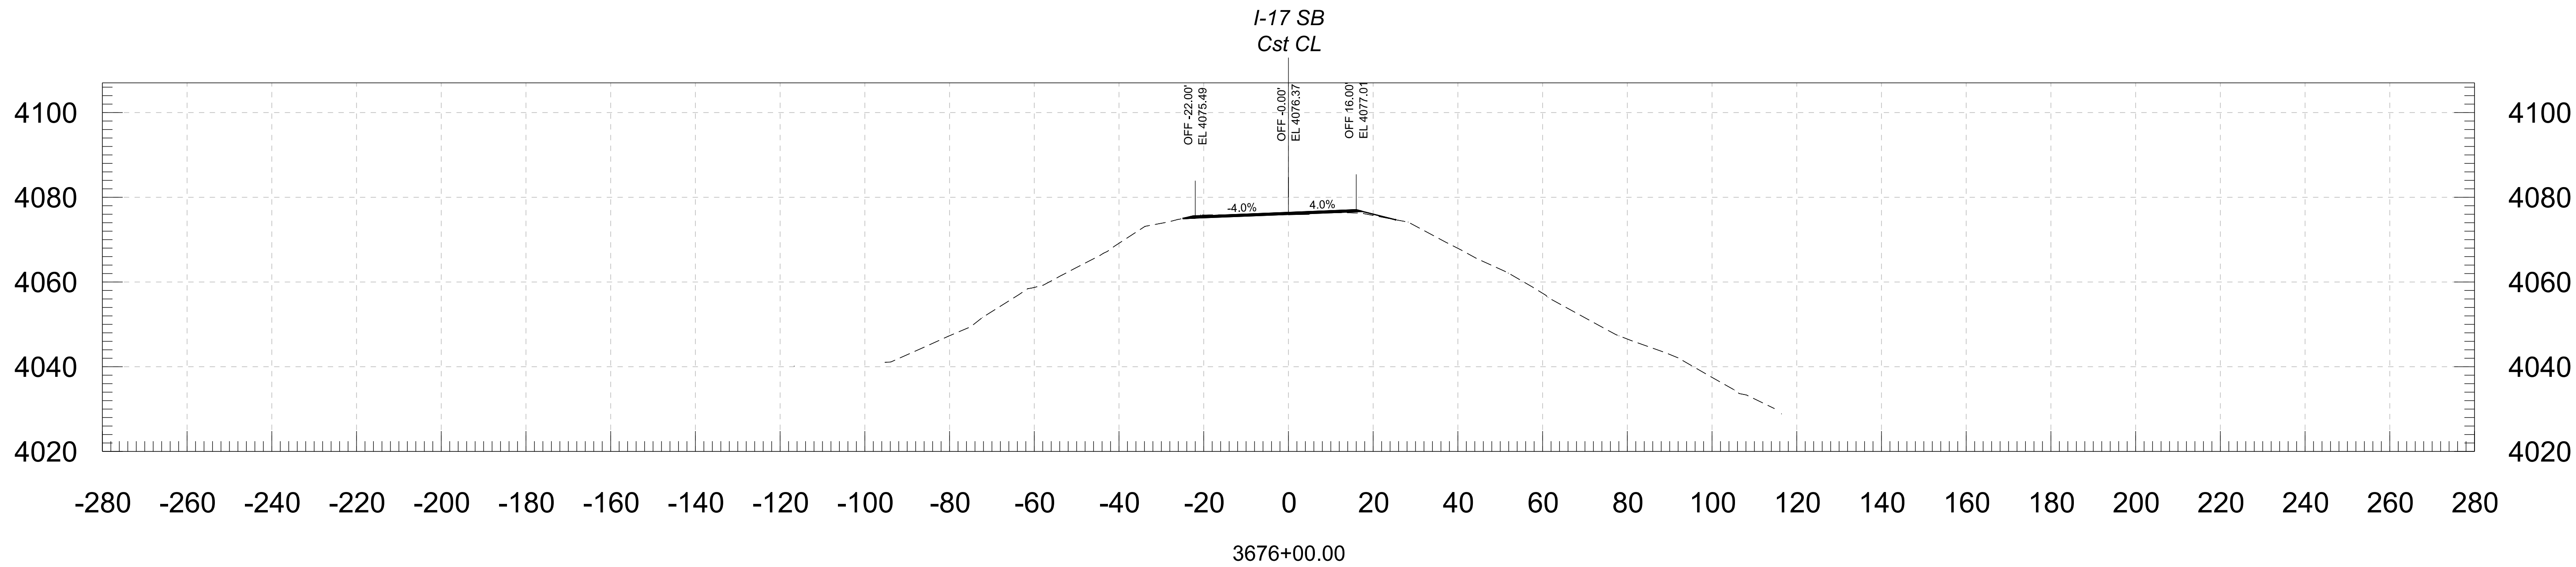



			NAME	DATE	ARIZONA DEPARTMENT OF TRANSPORTATION PROJECT DELIVERY AND OPERATIONS DIVISION ROADWAY DESIGN SERVICES	ROUTE	F.H.W.A. Arizona Division	STATE ARIZ.	PROJECT NO.	FEDERAL ID NO.	SHEET NO.	TOTAL SHEETS	RECORD DRAWING
		DESIGN	BAP	06/26		I-17							
		DRAWN	RM	06/26					017 YV 269	017-B(239)T	43	146	
		CHECKED	KCH	06/26									
		 Stanley Consultants INC.			333 East Camelback Road, Suite 100 Phoenix, Arizona 85016 Phone: 602/333-2200		CROSS SECTION	MILEPOST	E DUGAS ROAD - MP 275				
					STRUCTURE NO.	TRACS NO. F0616 01C						___ OF ___	

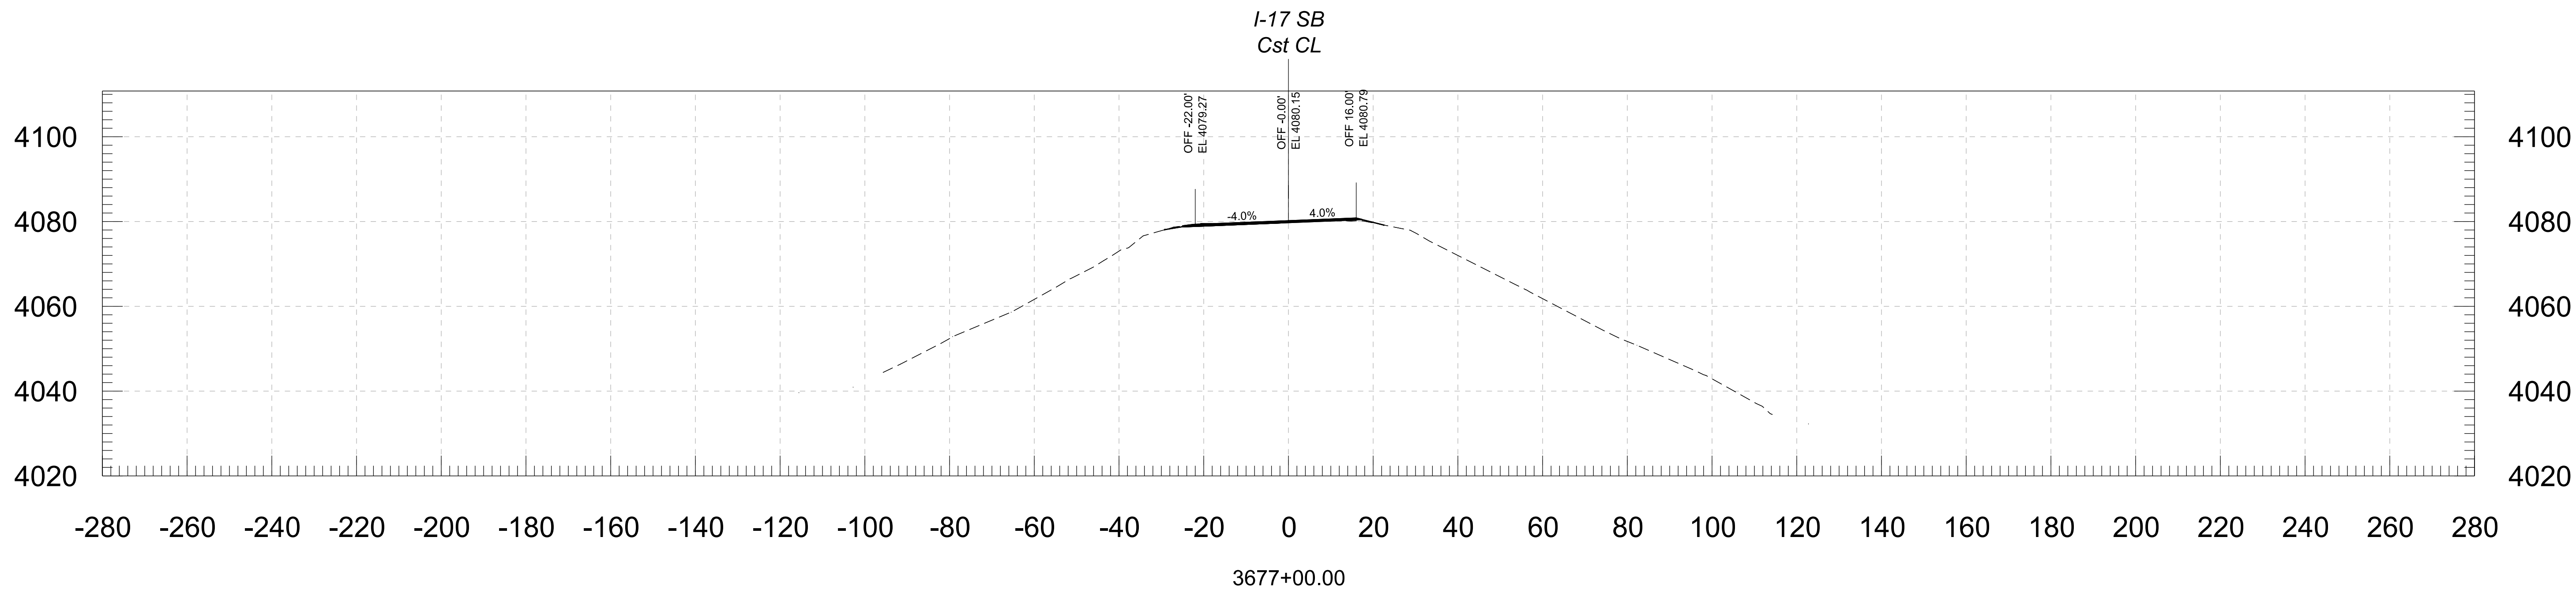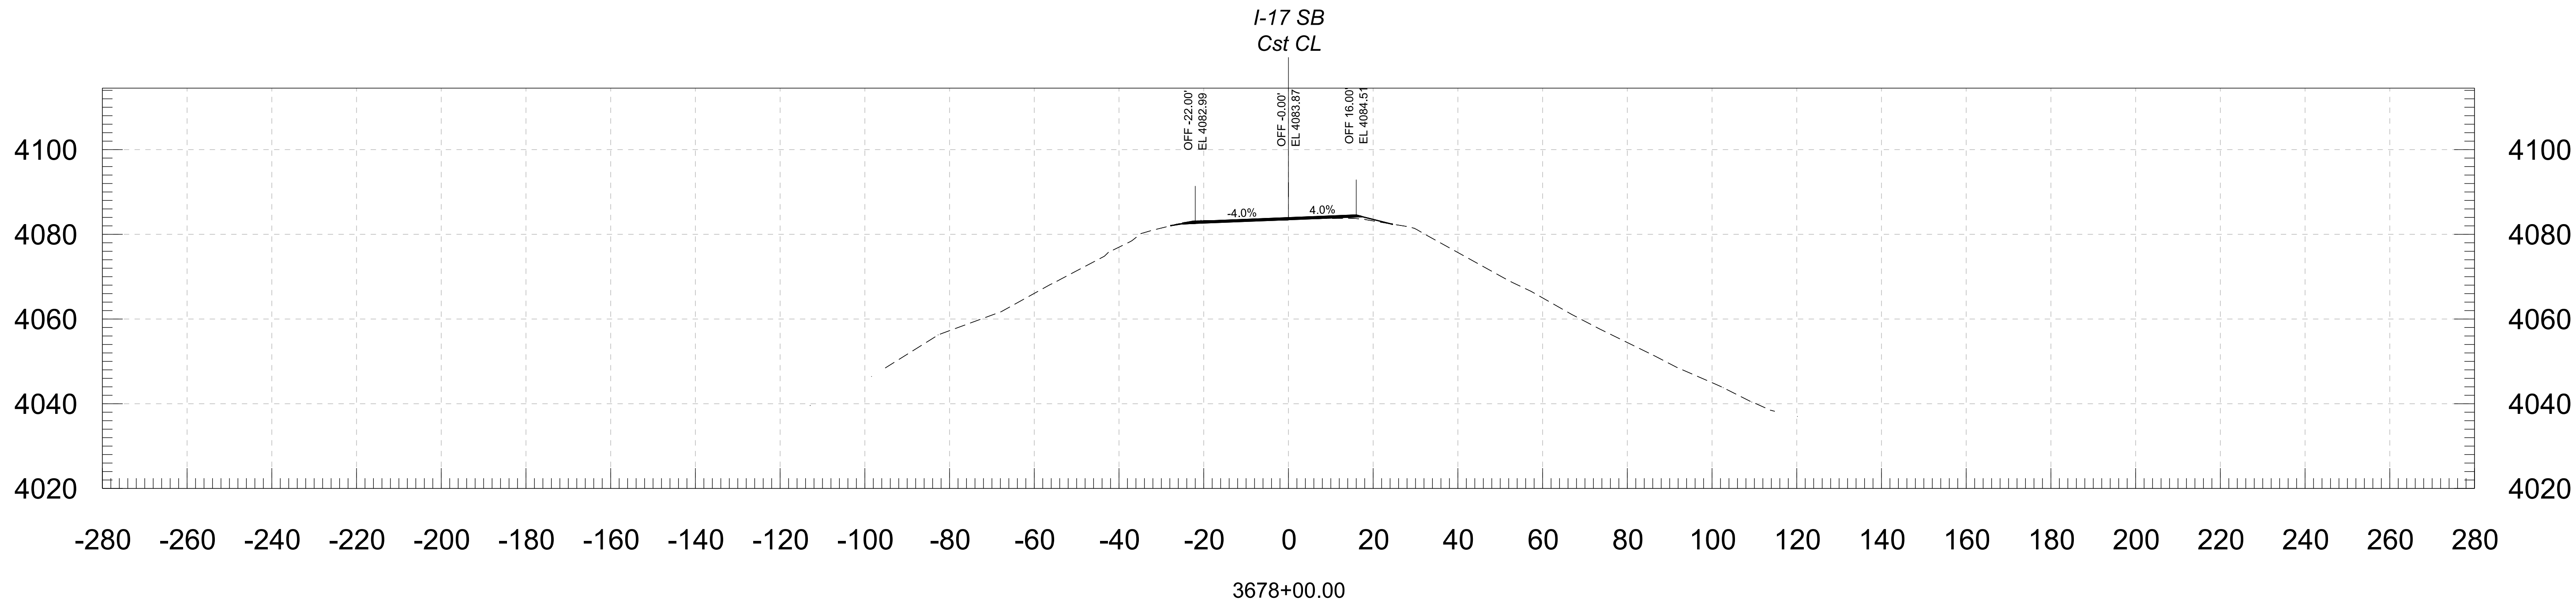



--	--	
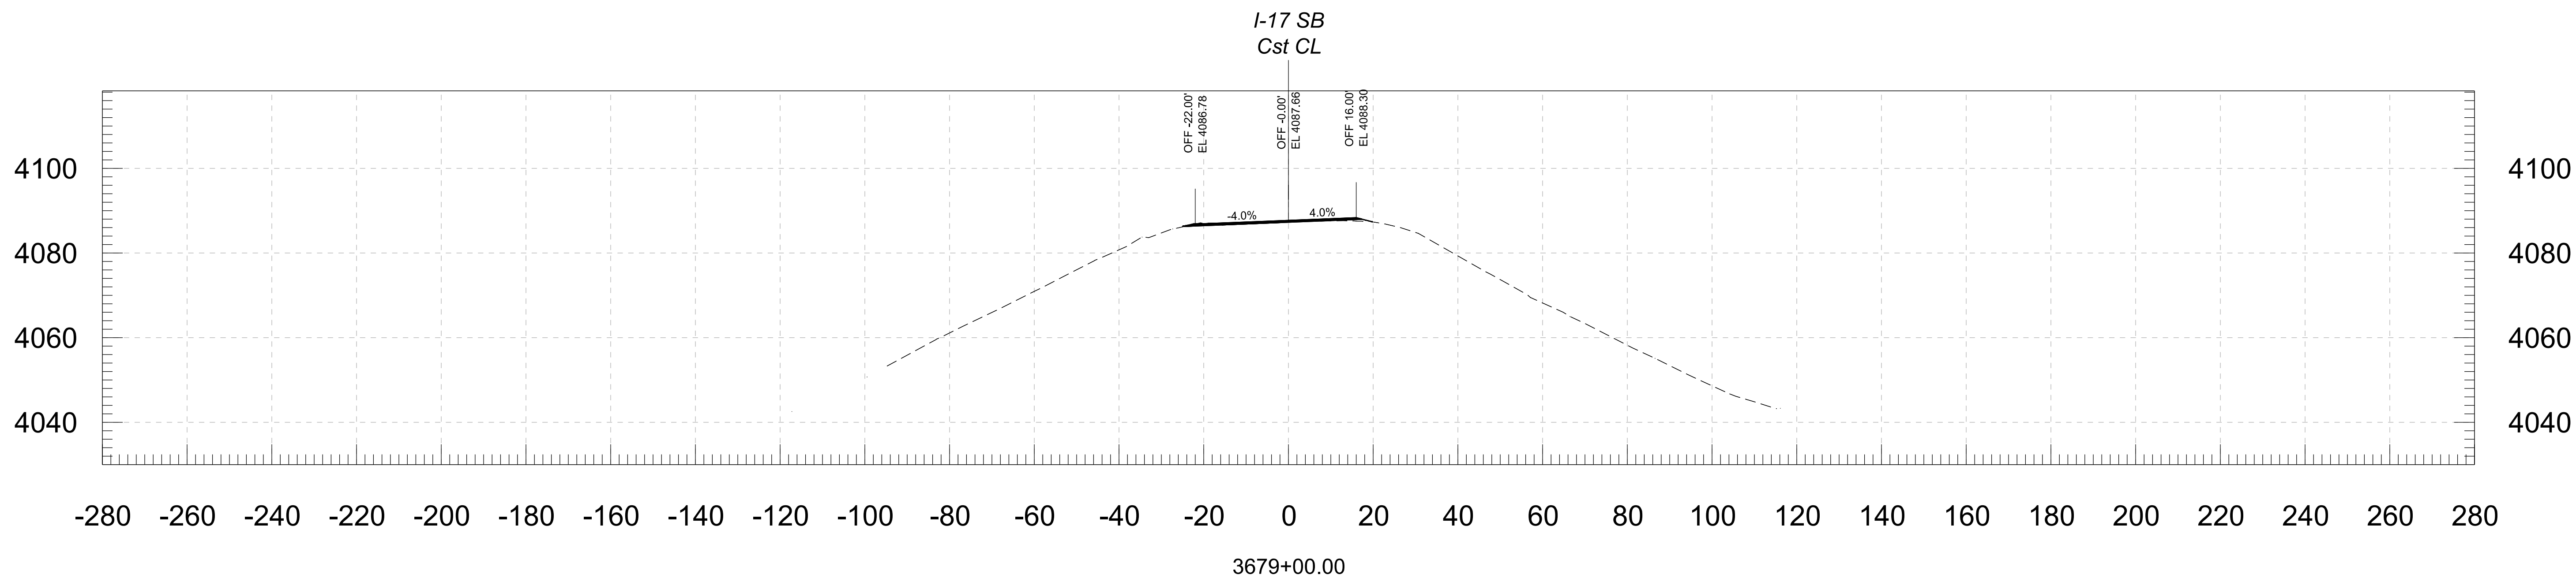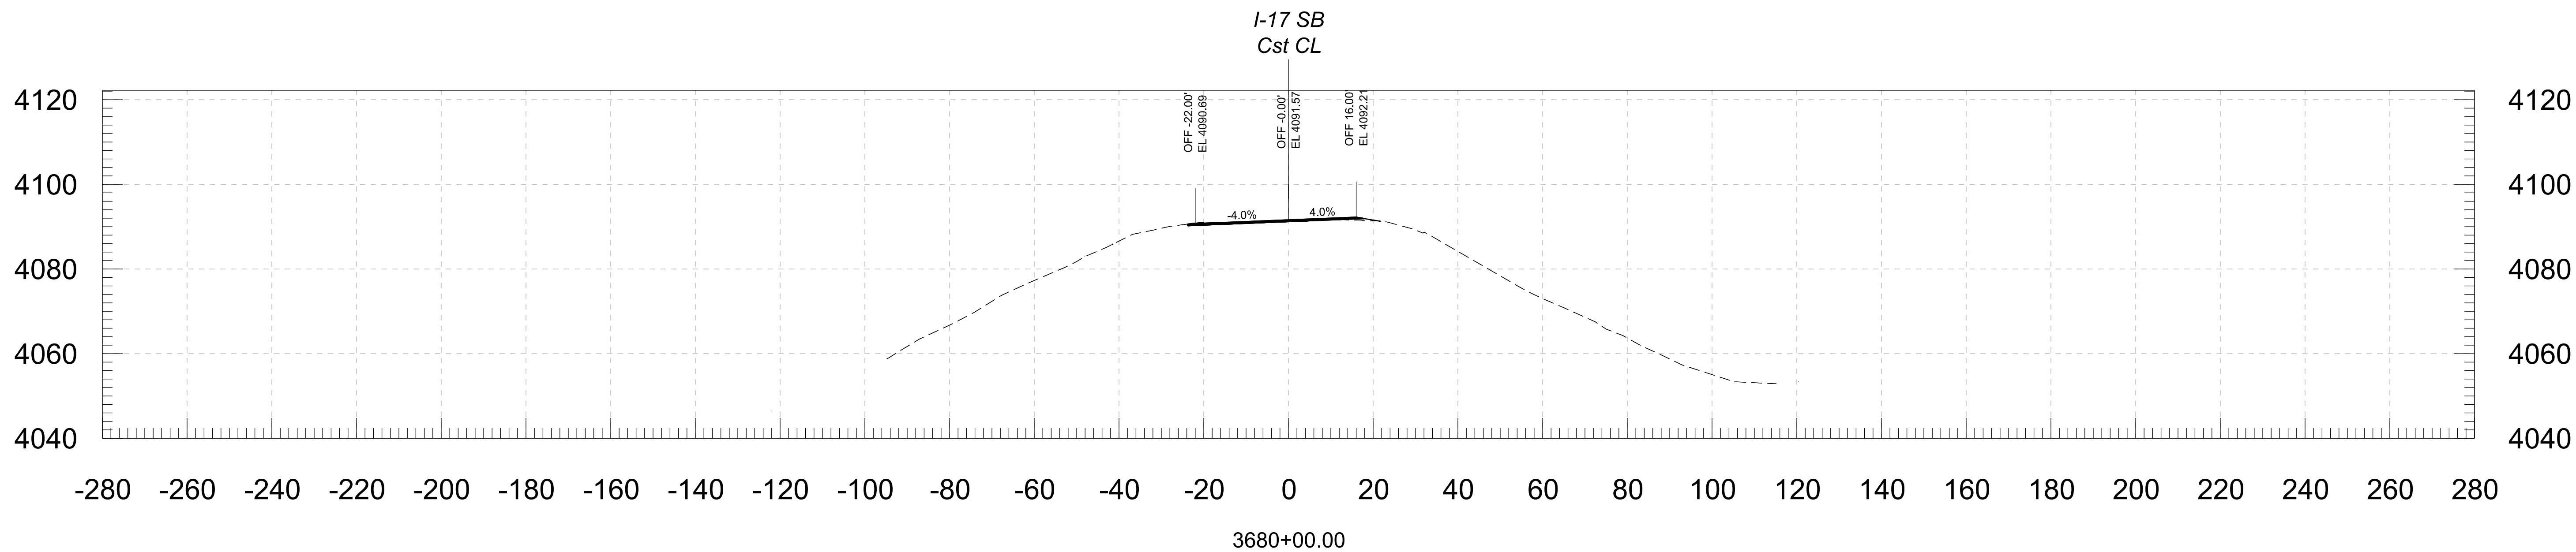



			NAME	DATE	ARIZONA DEPARTMENT OF TRANSPORTATION PROJECT DELIVERY AND OPERATIONS DIVISION ROADWAY DESIGN SERVICES	ROUTE	F.H.W.A. Arizona Division	STATE	PROJECT NO.	FEDERAL ID NO.	SHEET NO.	TOTAL SHEETS	RECORD DRAWING
		DESIGN	BAP	06/26		I-17			017 YV 269	017-B(239)T	45	146	
		DRAWN	RM	06/26			LOCATION	E DUGAS ROAD - MP 275					DWG NO.
		CHECKED	KCH	06/26					STRUCTURE NO.	TRACS NO. F0616 01C	____ OF ____		
		 3133 East Camelback Road, Suite 100 Phoenix, Arizona 85016 Phone 602. 333-2200			CROSS SECTION								

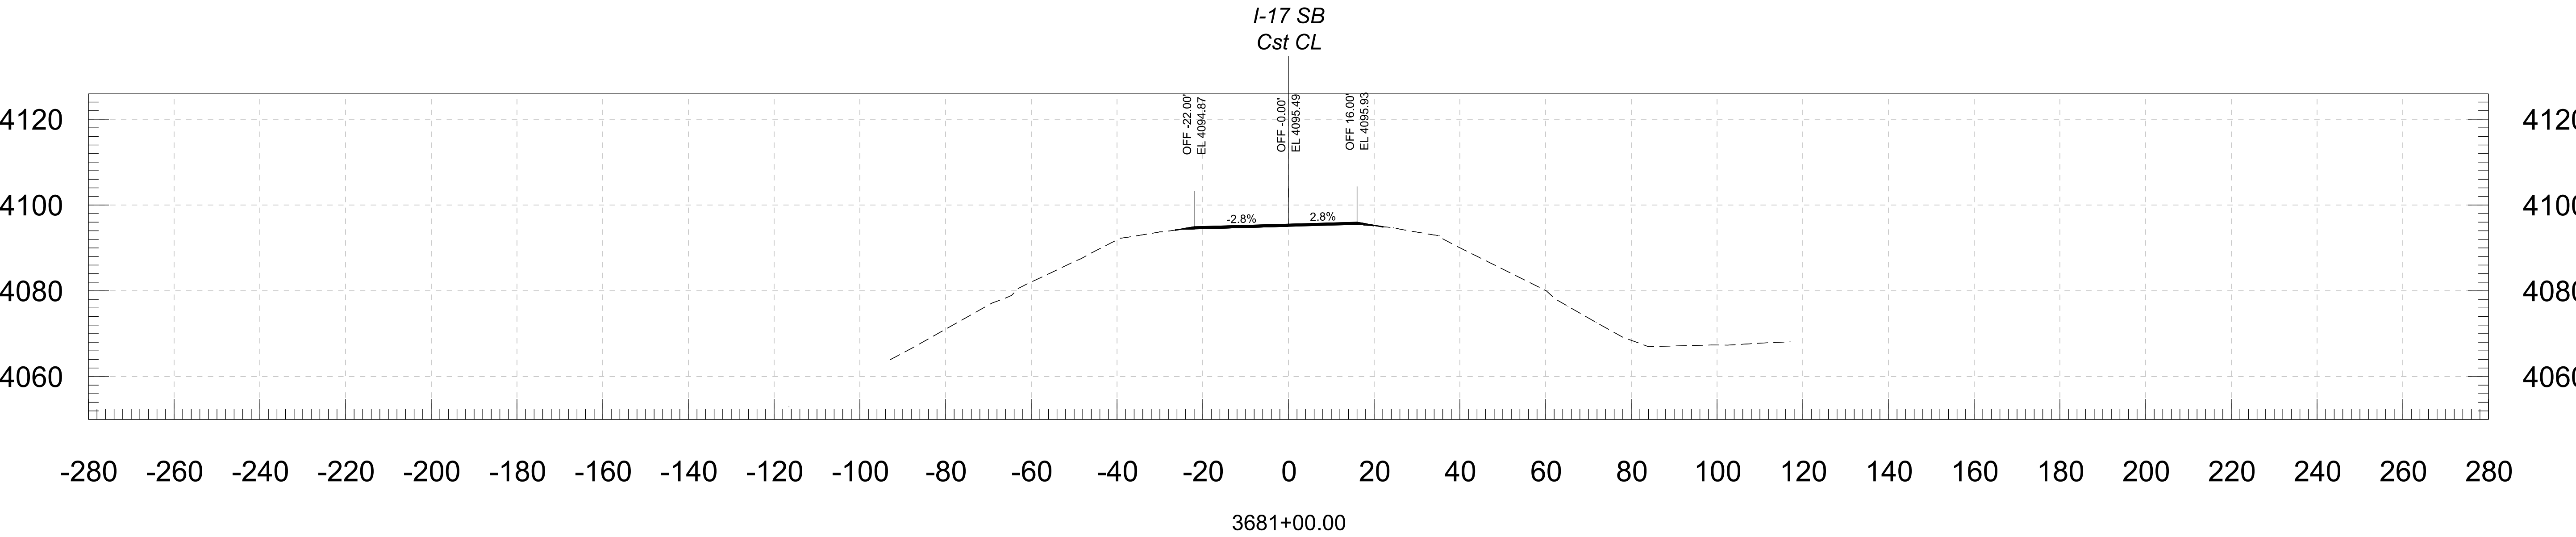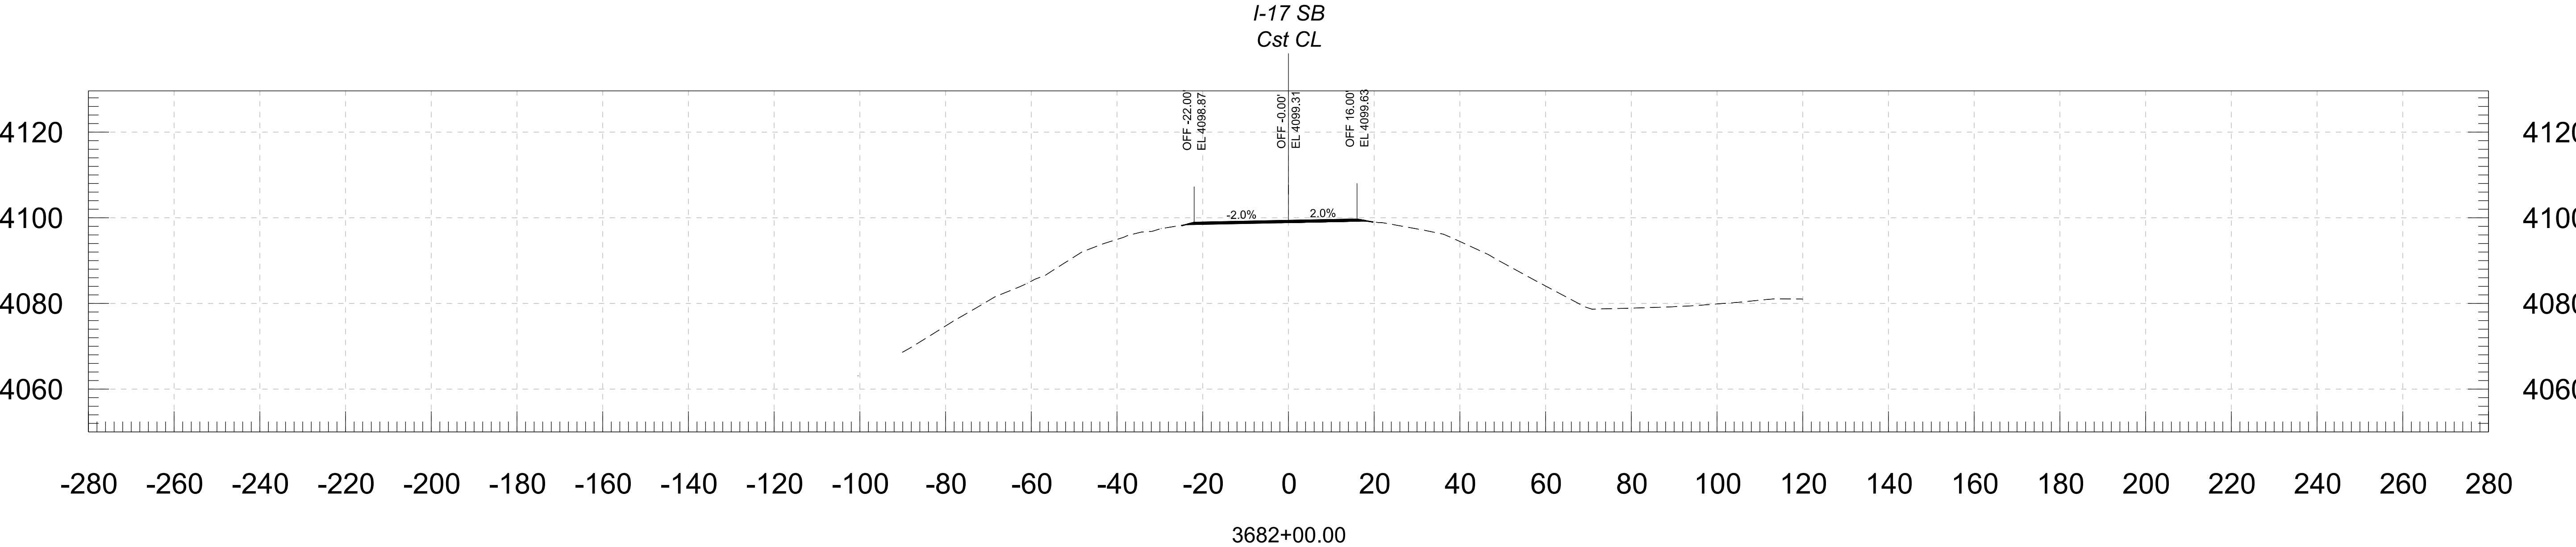



			NAME	DATE	ARIZONA DEPARTMENT OF TRANSPORTATION PROJECT DELIVERY AND OPERATIONS DIVISION ROADWAY DESIGN SERVICES	ROUTE	F.H.W.A. Arizona Division	STATE ARIZ.	PROJECT NO.	FEDERAL ID NO.	SHEET NO.	TOTAL SHEETS	RECORD DRAWING
		DESIGN	BAP	06/26		I-17			017 YV 269	017-B(239)T	46	146	
		DRAWN	RM	06/26									
		CHECKED	KCH	06/26									
		 Stanley Consultants INC.			3133 East Camelback Road, Suite 100 Phoenix, Arizona 85016 Phone: 602. 333-2200			CROSS SECTION	E DUGAS ROAD - MP 275			DWG NO.	
							TRACS NO. F0616 01C			____ OF ____			

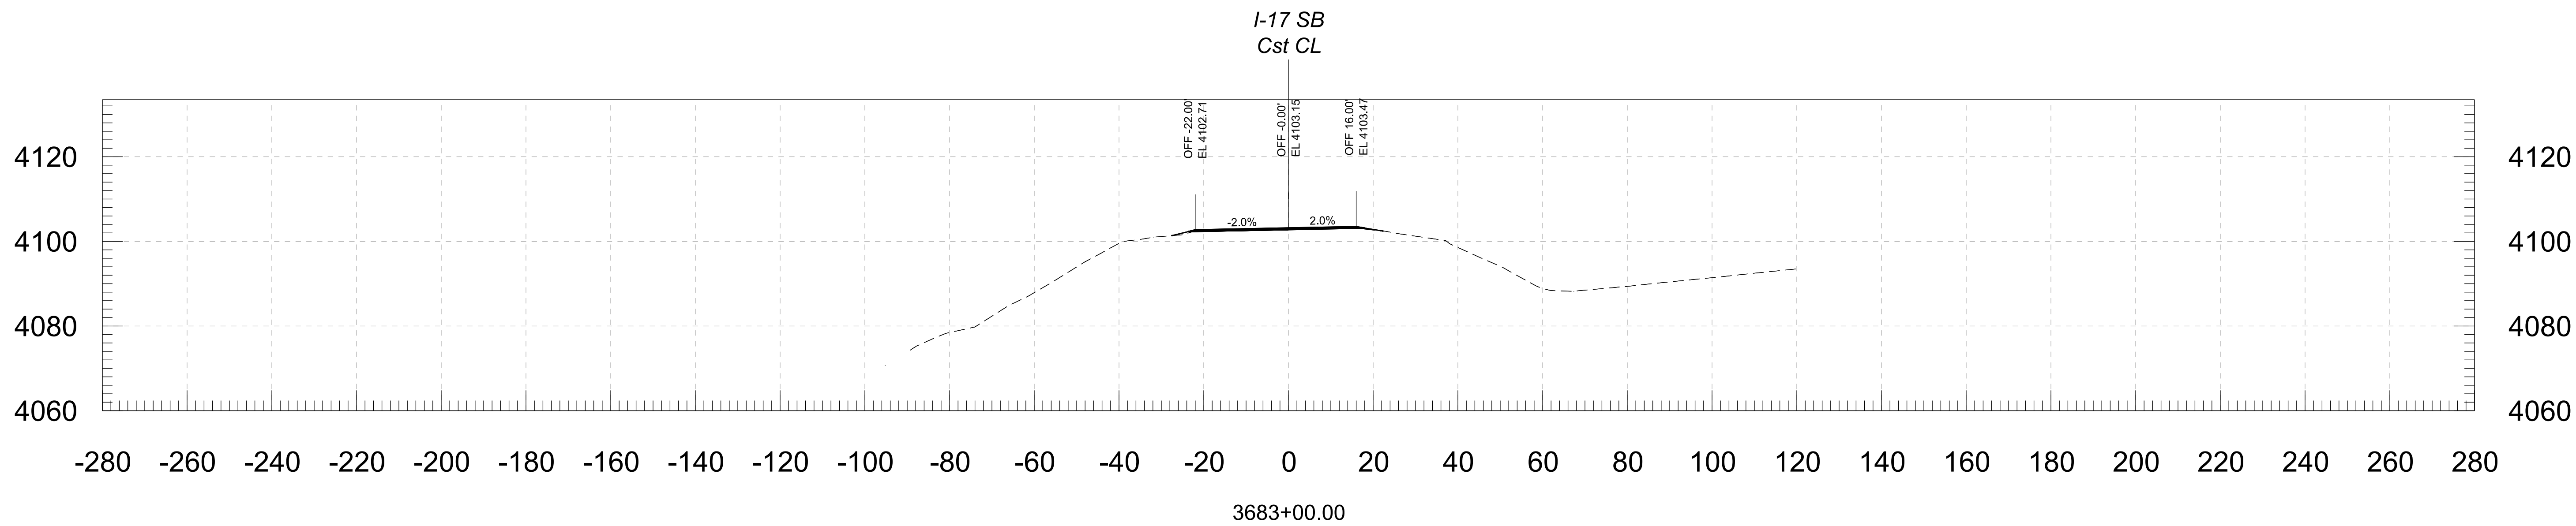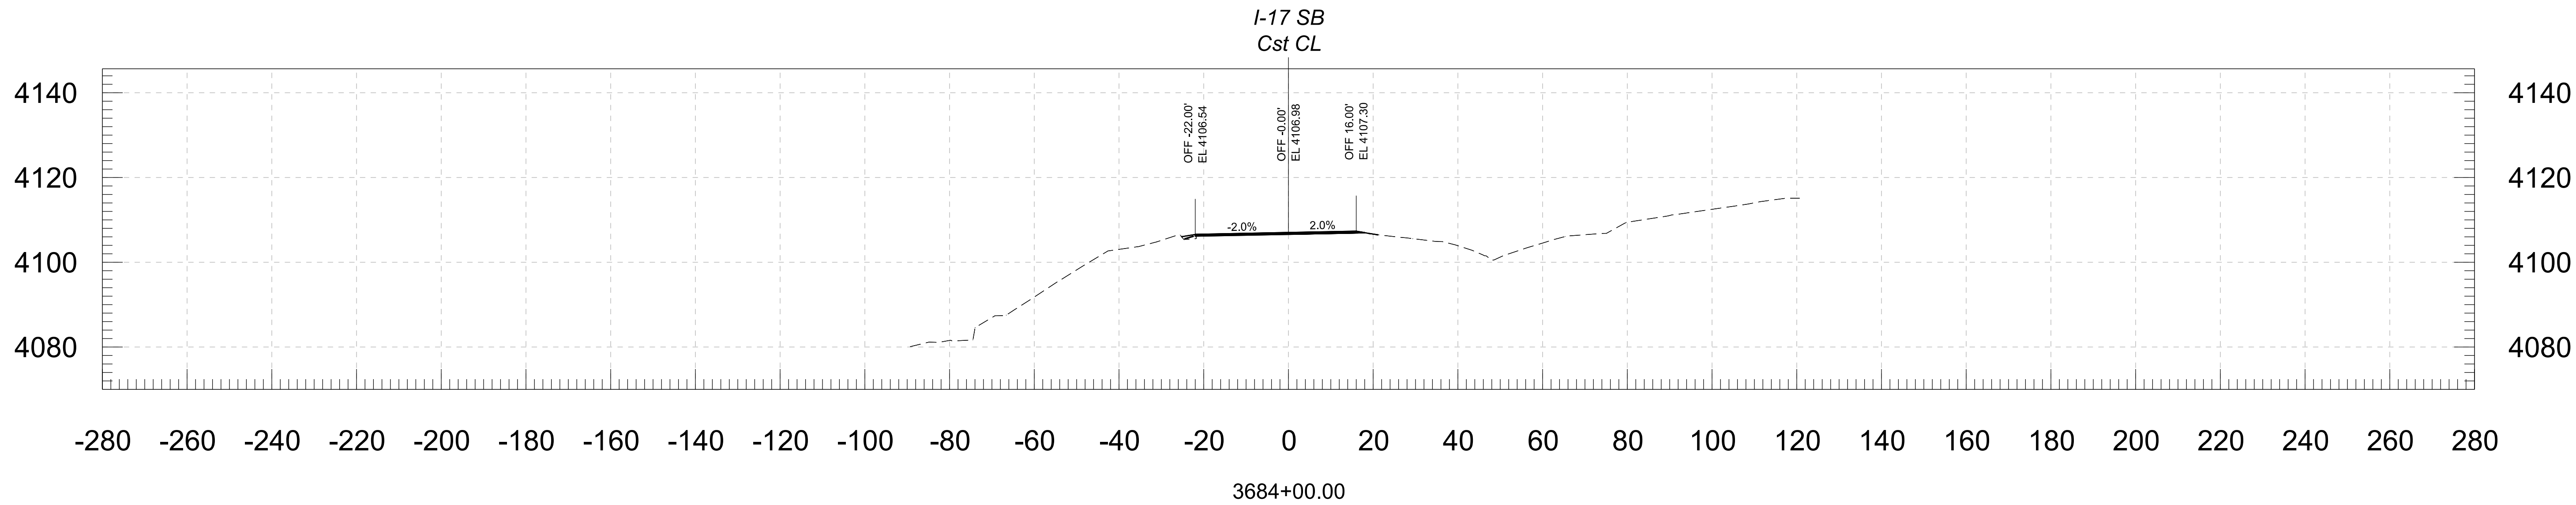




				NAME	DATE	ARIZONA DEPARTMENT OF TRANSPORTATION PROJECT DELIVERY AND OPERATIONS DIVISION ROADWAY DESIGN SERVICES	ROUTE	F.H.W.A. Arizona Division	STATE ARIZ.	PROJECT NO.	FEDERAL ID NO.	SHEET NO.	TOTAL SHEETS	RECORD DRAWING
			DESIGN	BAP	06/26		I-17			017 YV 269	017-B(239)T	47	146	
			DRAWN	RM	06/26									
			CHECKED	KCH	06/26									
			 Stanley Consultants INC.			3131 East Camelback Road, Suite 100 Phoenix, Arizona 85016 Phone 602. 333-2000			CROSS SECTION	MILEPOST	E DUGAS ROAD - MP 275			
							STRUCTURE NO.	TRACS NO. F0616 01C			___ OF ___			

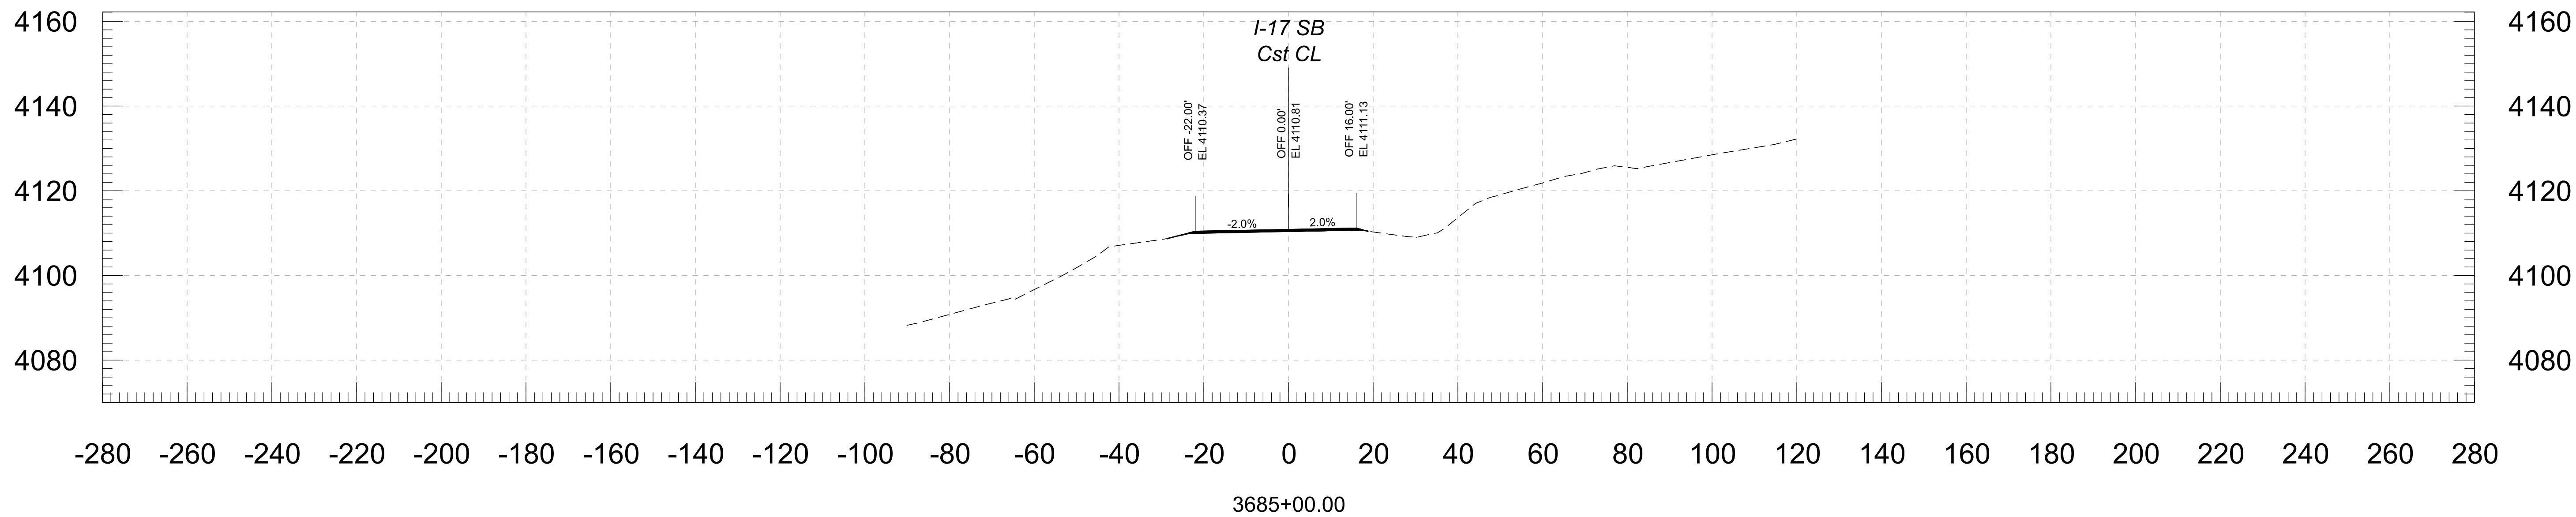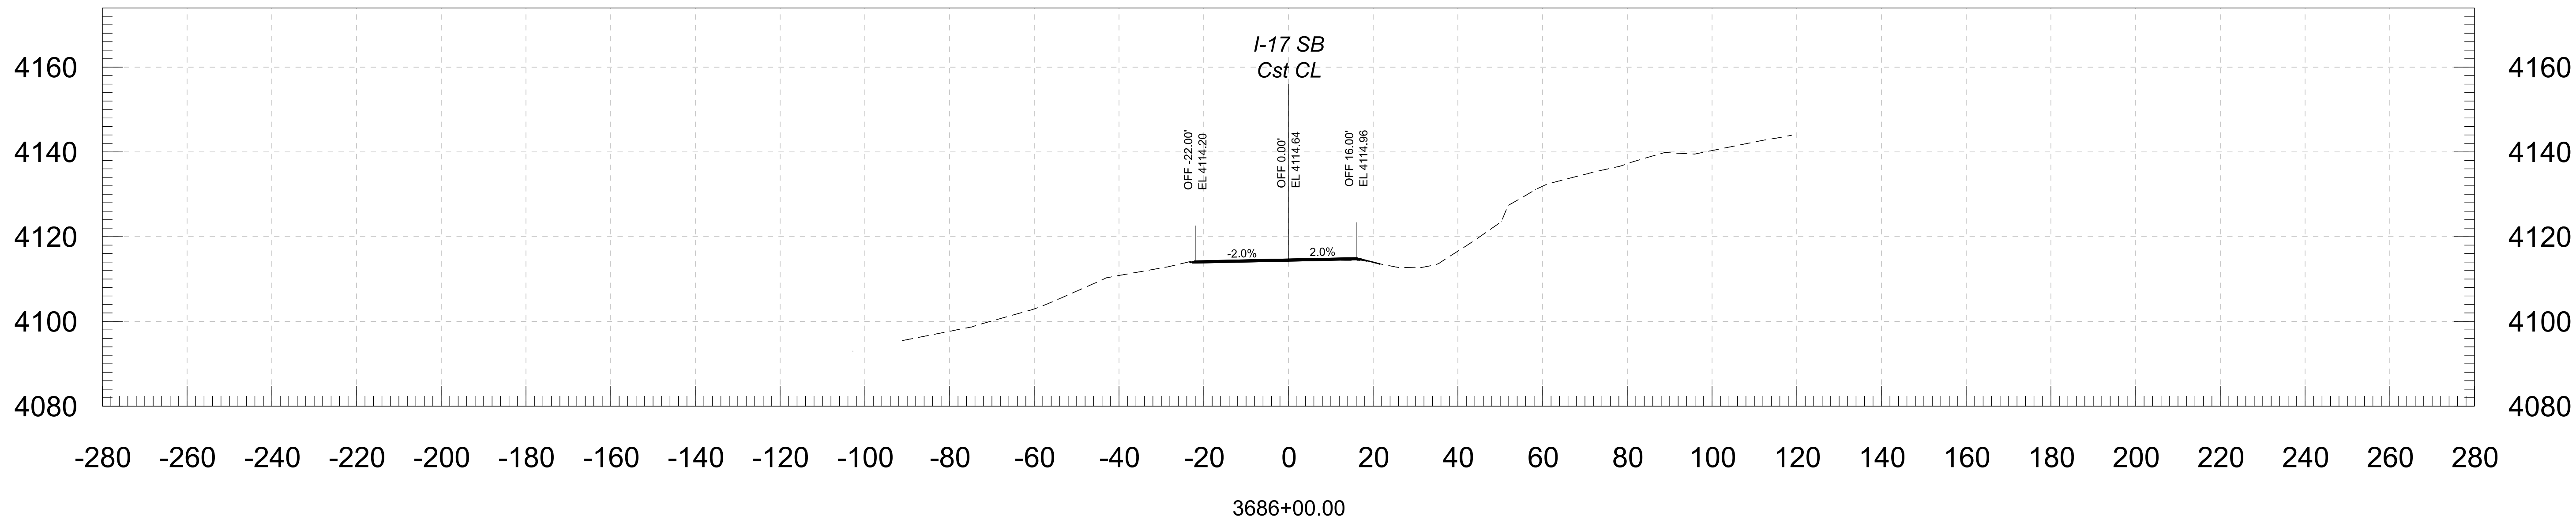




			NAME	DATE	ARIZONA DEPARTMENT OF TRANSPORTATION PROJECT DELIVERY AND OPERATIONS DIVISION ROADWAY DESIGN SERVICES	ROUTE	F.H.W.A. Arizona Division	STATE	PROJECT NO.	FEDERAL ID NO.	SHEET NO.	TOTAL SHEETS	RECORD DRAWING
		DESIGN	BAP	06/26		I-17			ARIZ.	017 YV 269	017-B(239)T	48	
		DRAWN	RM	06/26			MILEPOST	LOCATION				E DUGAS ROAD - MP 275	DWG NO.
		CHECKED	KCH	06/26				STRUCTURE NO.	TRACS NO. F0616 01C				
		 Stanley Consultants INC.			3133 East Camelback Road, Suite 100 Phoenix, Arizona 85016 Phone 602. 333-2000		CROSS SECTION						___ OF ___

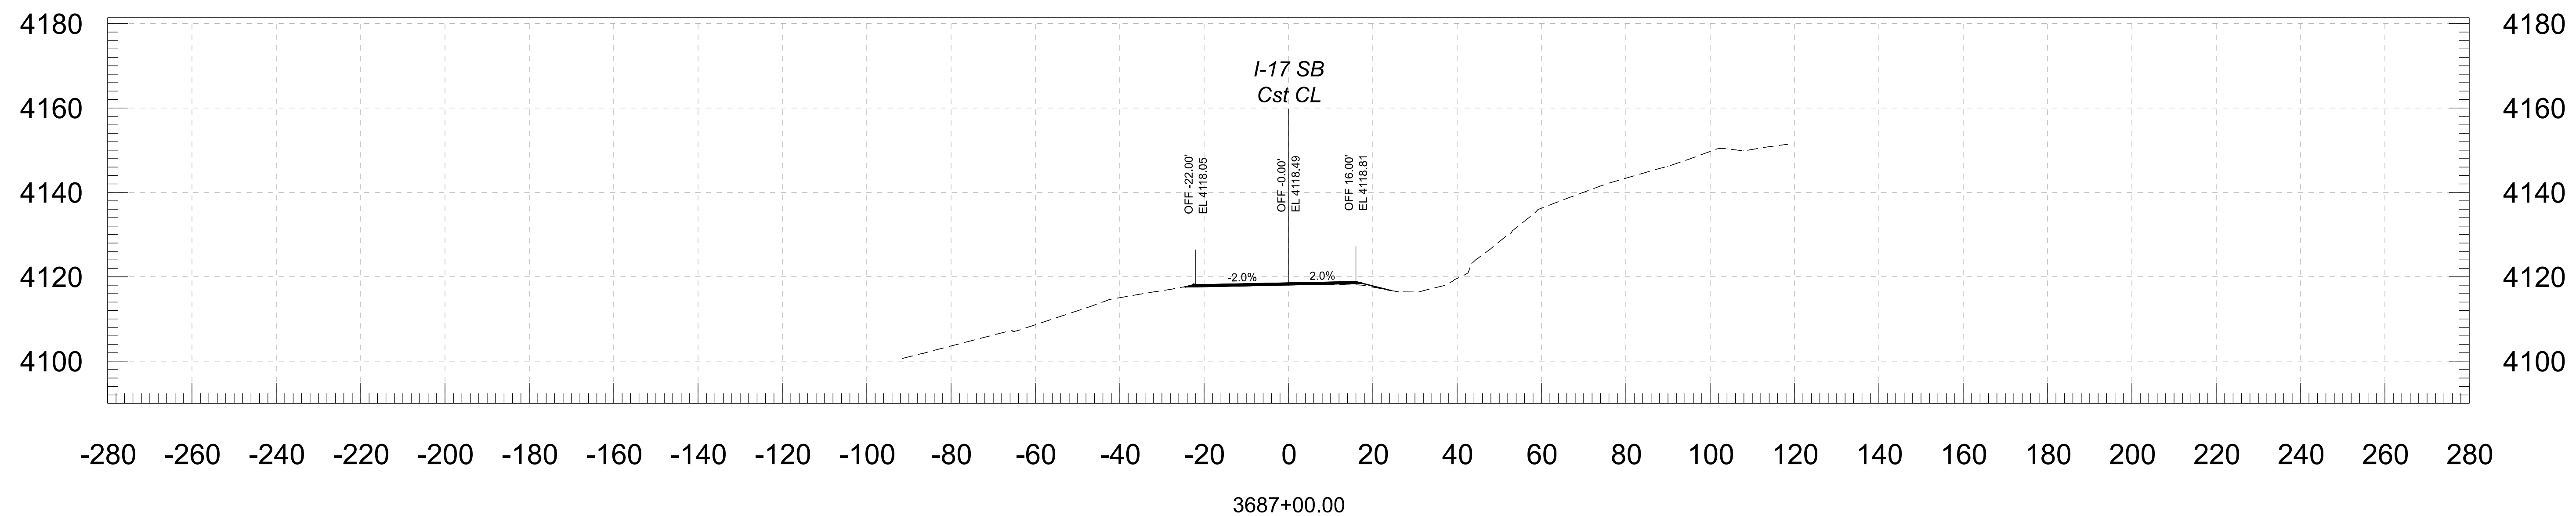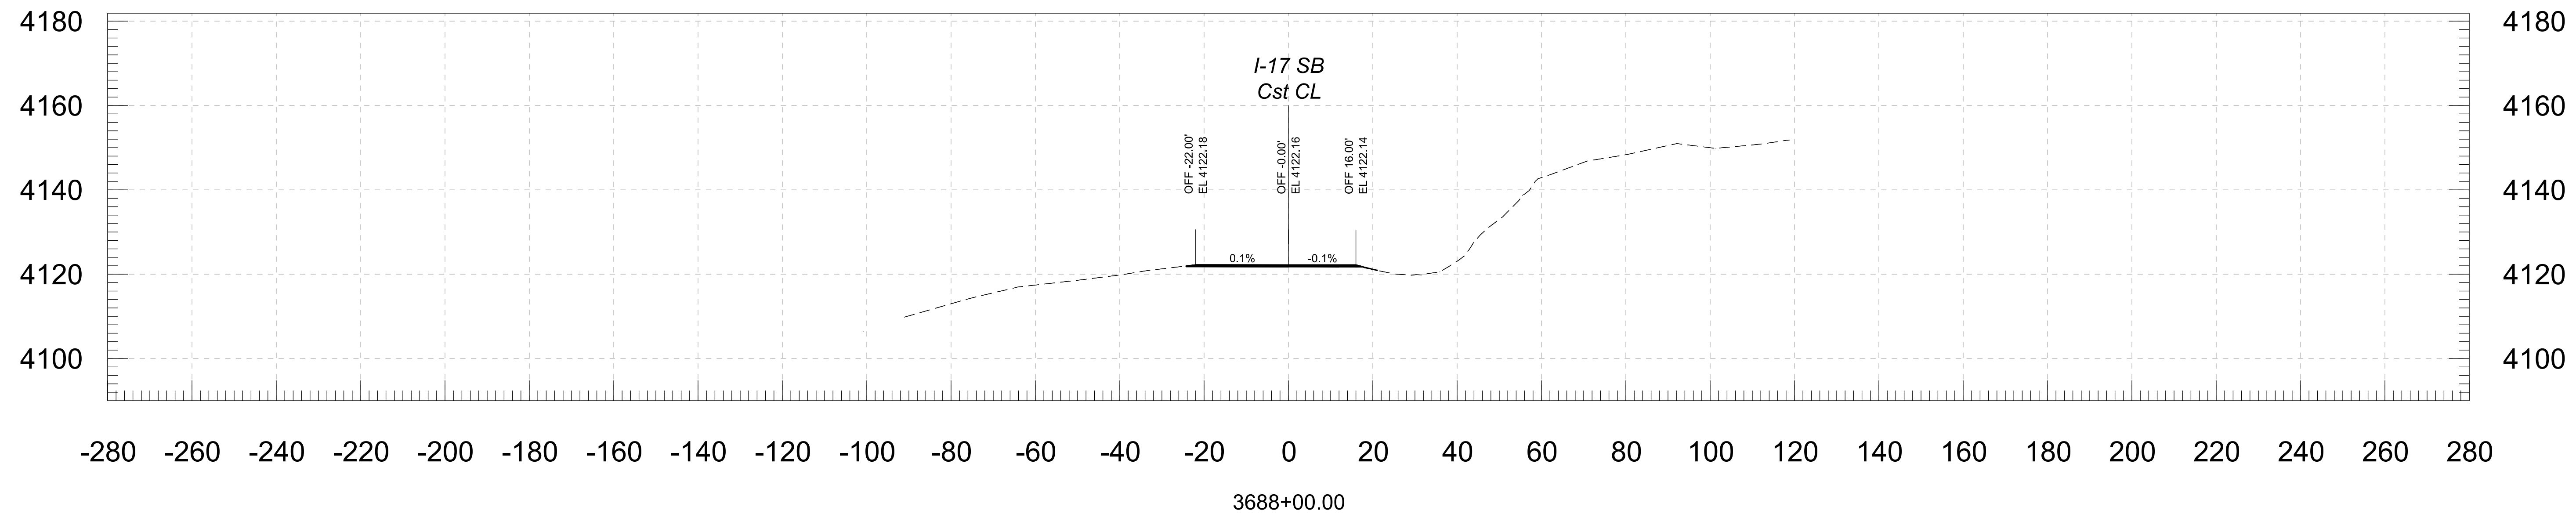




--	--	
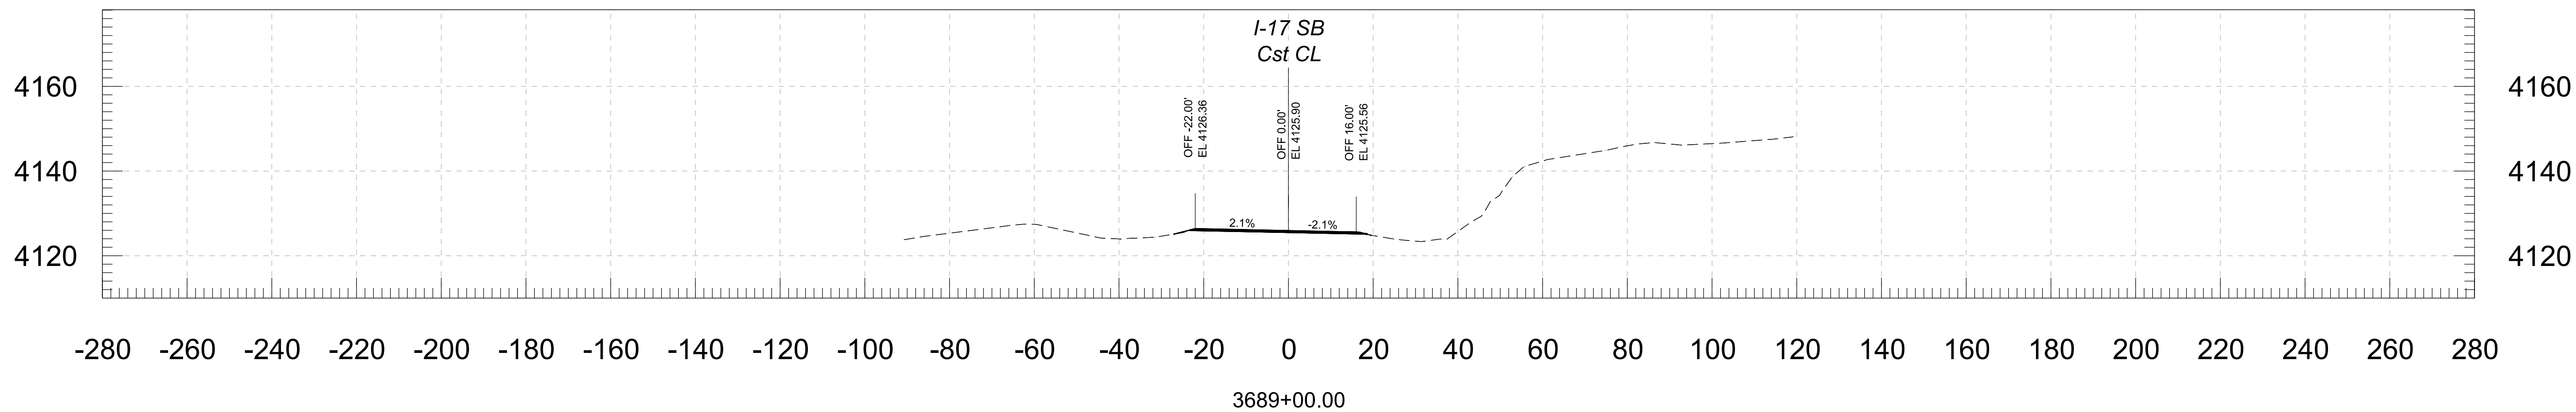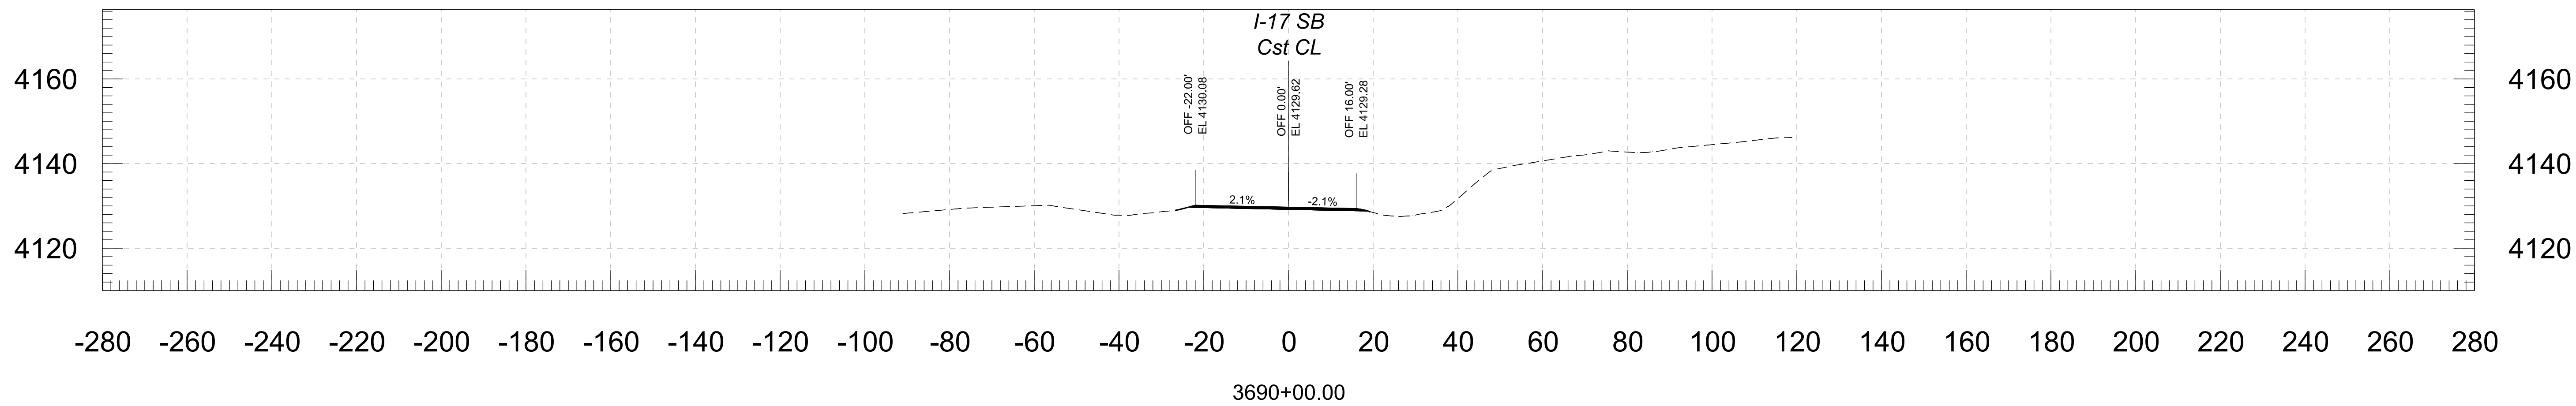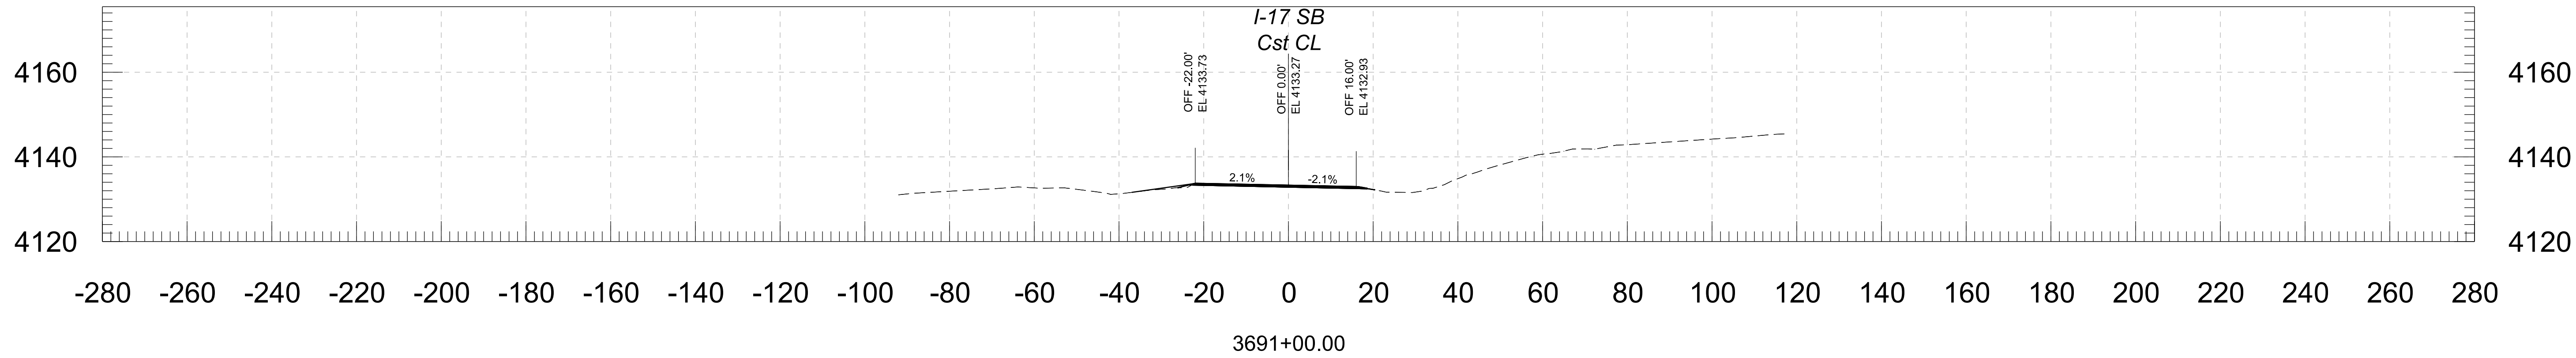




						ROUTE I-17		F.H.W.A. Arizona Division		STATE ARIZ.	PROJECT NO. 017 YV 269	FEDERAL ID NO. 017-B(239)T	SHEET NO. 50	TOTAL SHEETS 146	RECORD DRAWING
						MILEPOST		LOCATION E DUGAS ROAD - MP 275						DWG NO.	
						STRUCTURE NO.		TRACS NO. F0616 01C						____ OF ____	

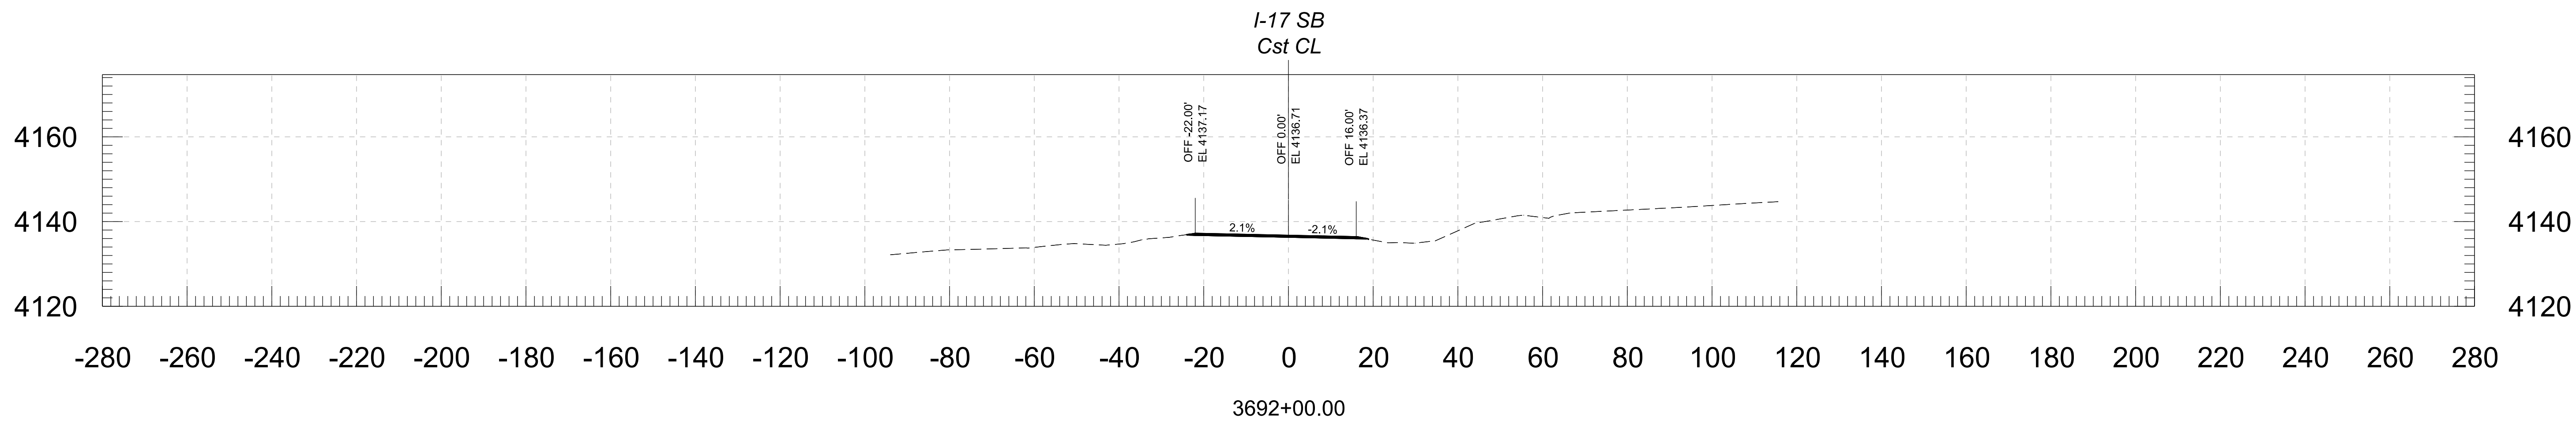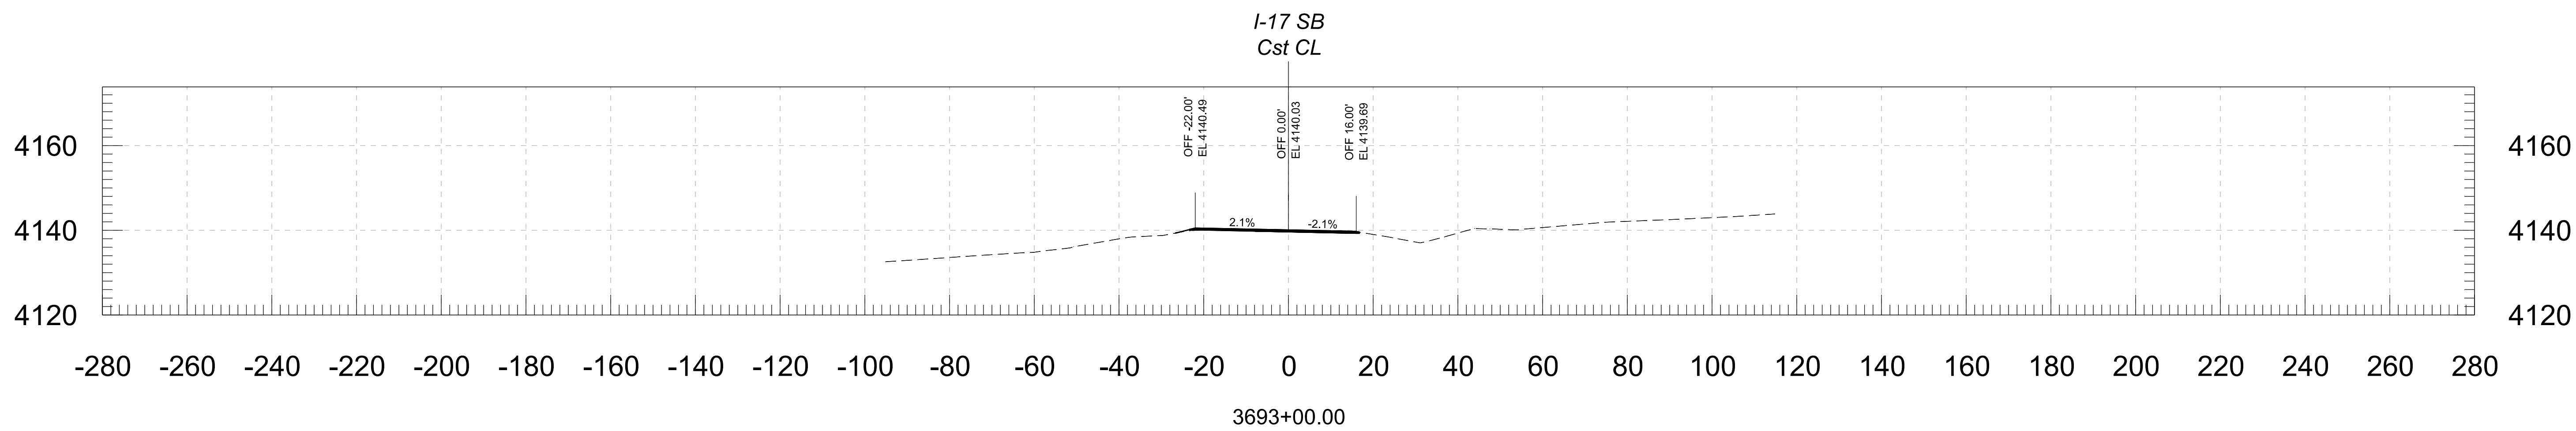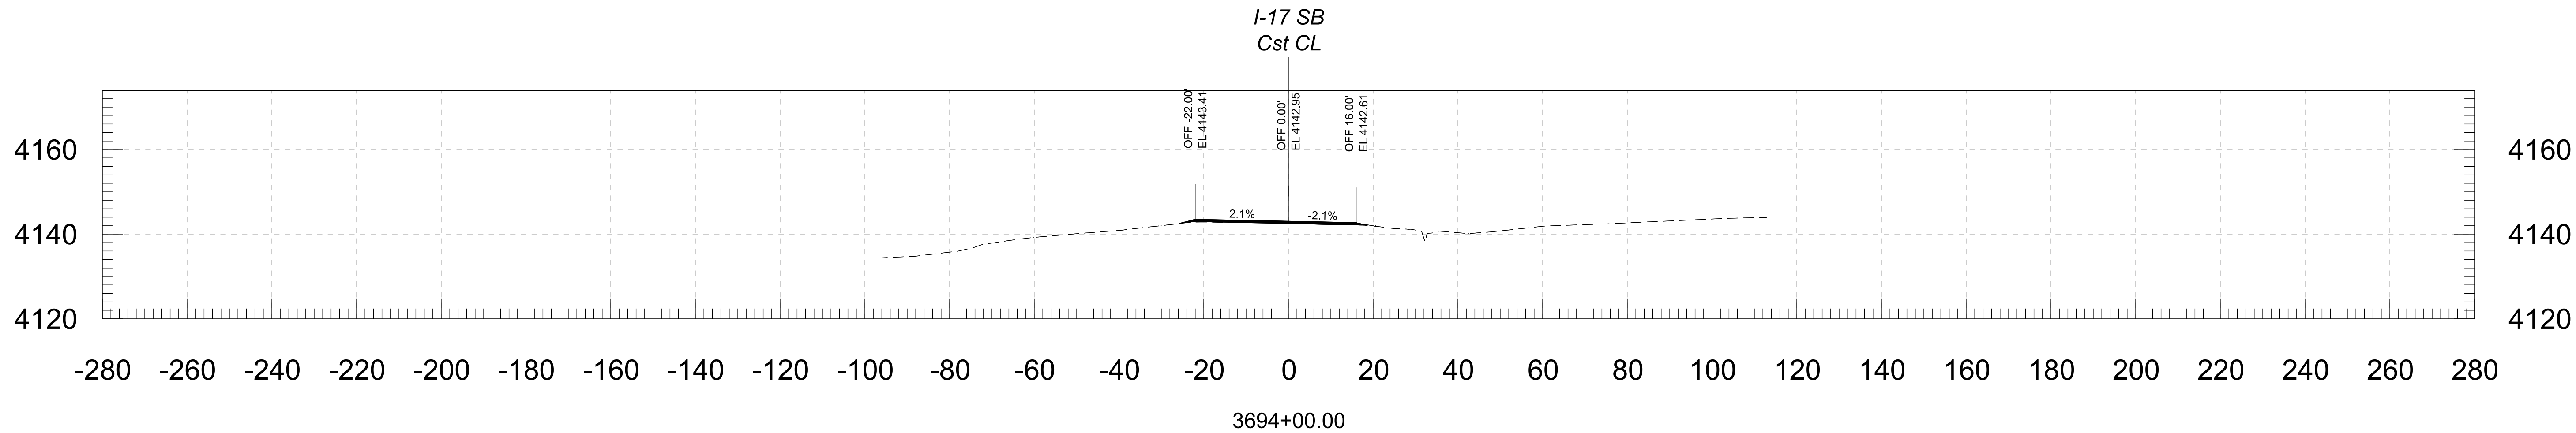




			NAME	DATE	ARIZONA DEPARTMENT OF TRANSPORTATION PROJECT DELIVERY AND OPERATIONS DIVISION ROADWAY DESIGN SERVICES	ROUTE	F.H.W.A. Arizona Division	STATE	PROJECT NO.	FEDERAL ID NO.	SHEET NO.	TOTAL SHEETS	RECORD DRAWING	
		DESIGN	BAP	06/26		I-17			ARIZ.	017 YV 269	017-B(239)T	51		146
		DRAWN	RM	06/26			MILEPOST	LOCATION					E DUGAS ROAD - MP 275	DWG NO.
		CHECKED	KCH	06/26				STRUCTURE NO.	TRACS NO. F0616 01C					
		Stanley Consultants INC. 3133 East Camelback Road, Suite 100 Phoenix, Arizona 85016 Phone 602. 333-2000				CROSS SECTION								

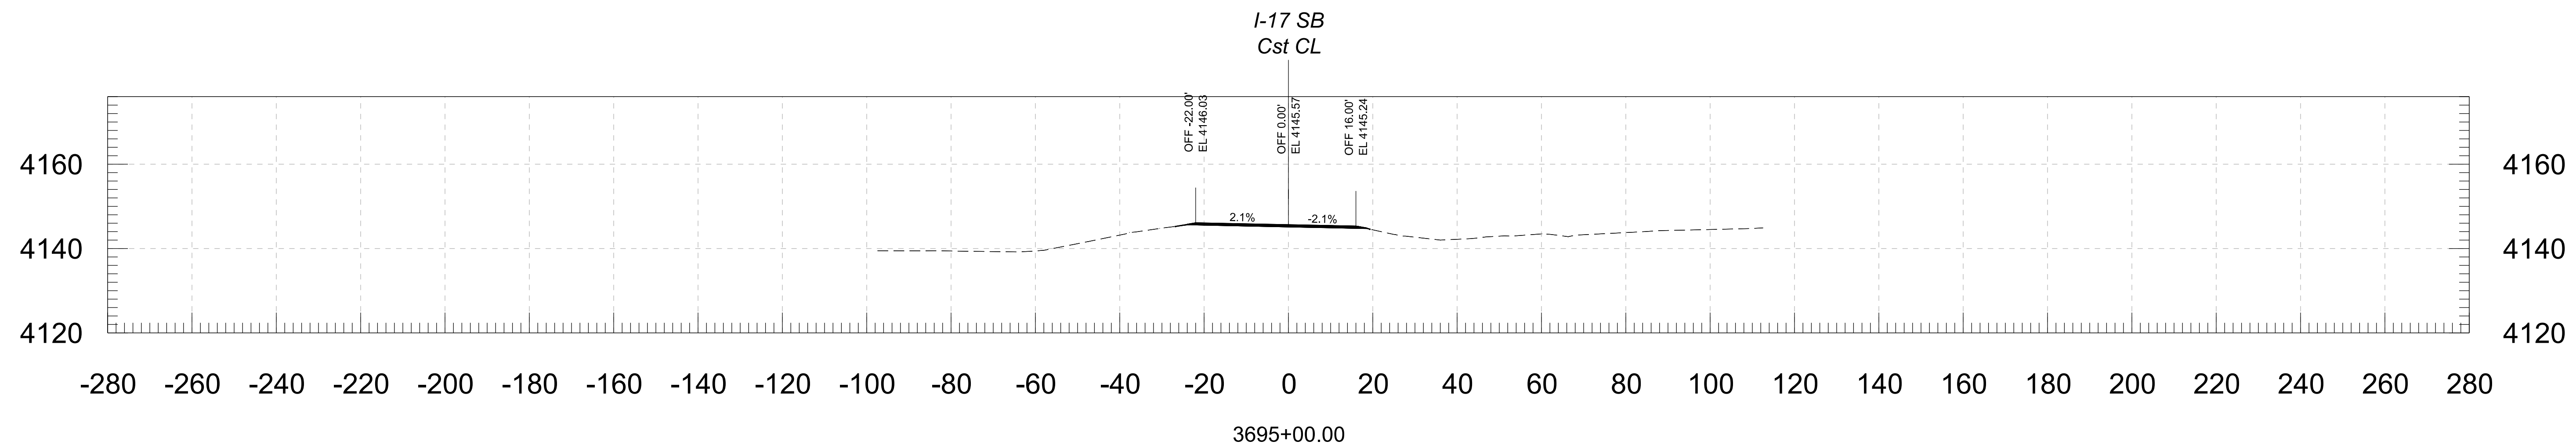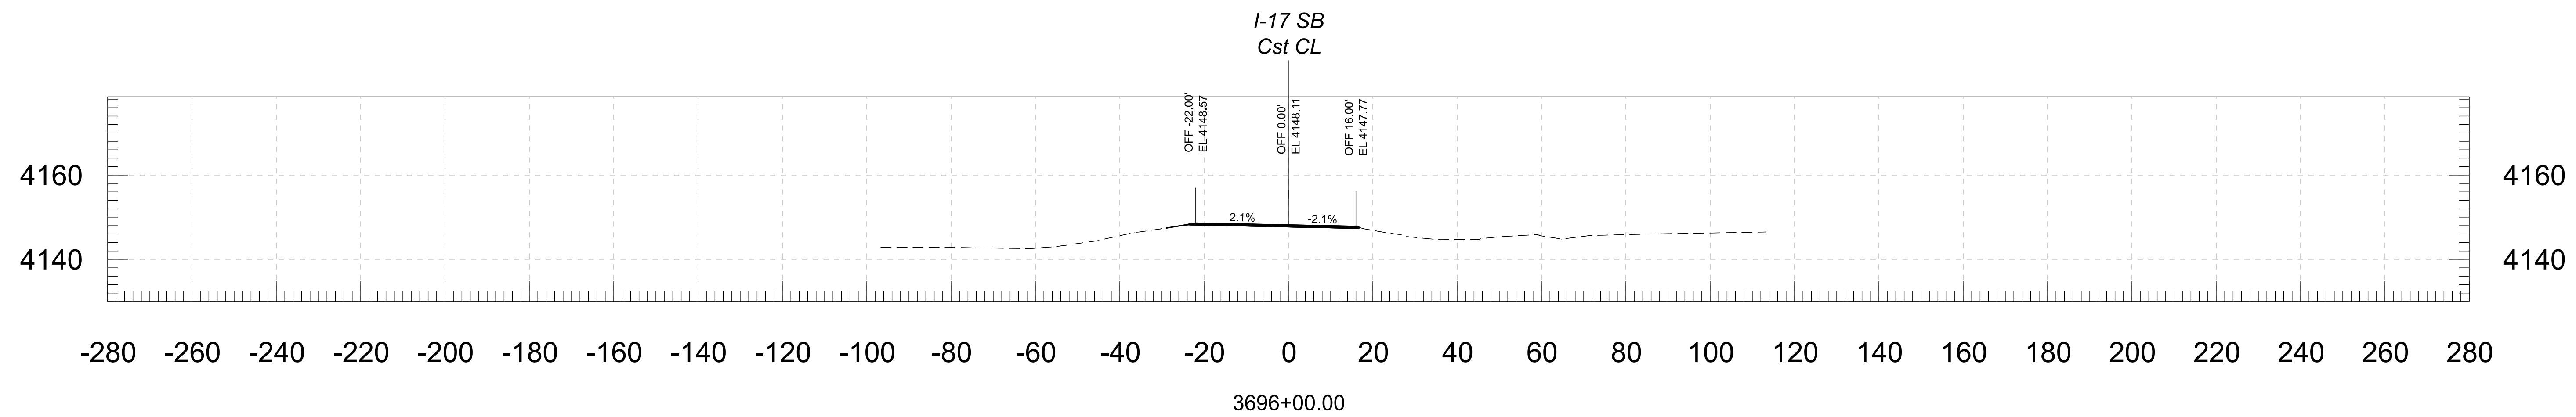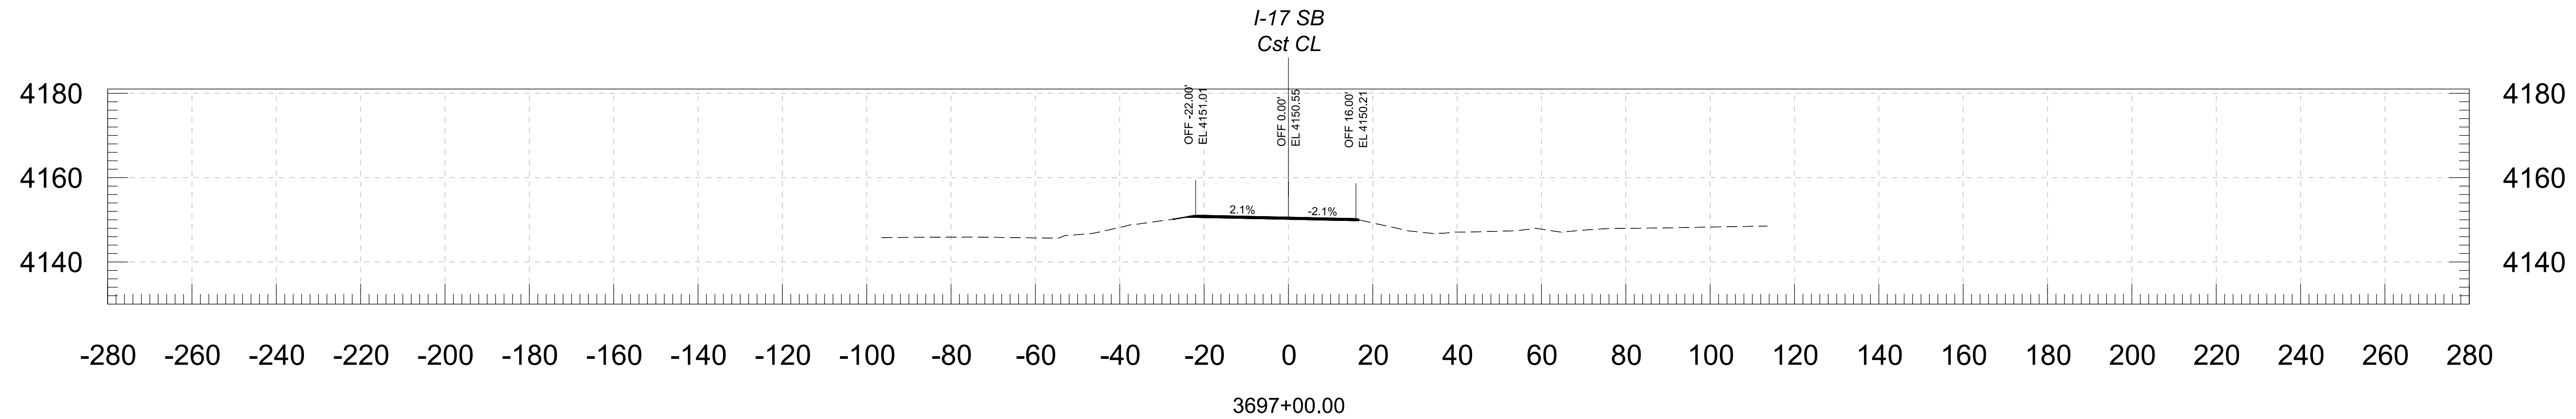




--	--	
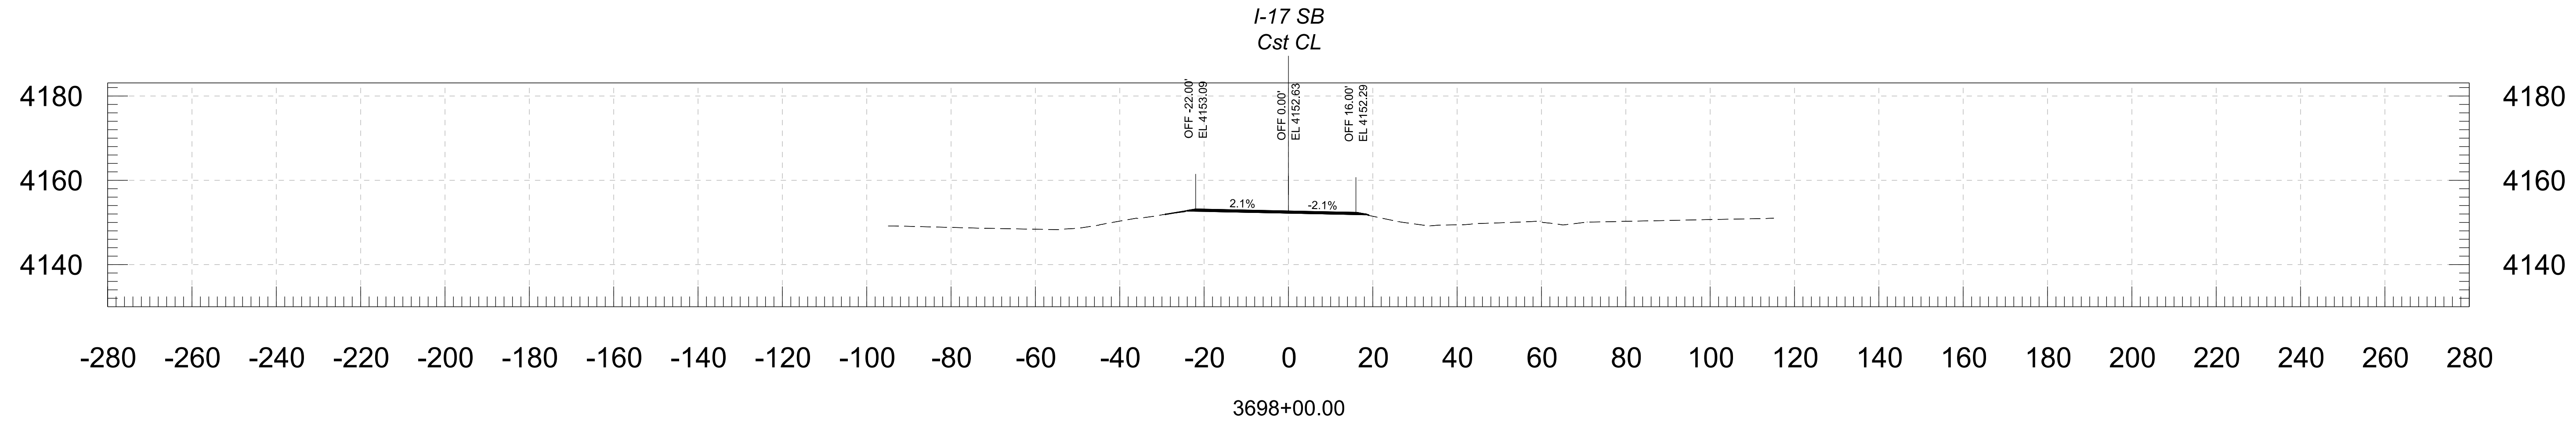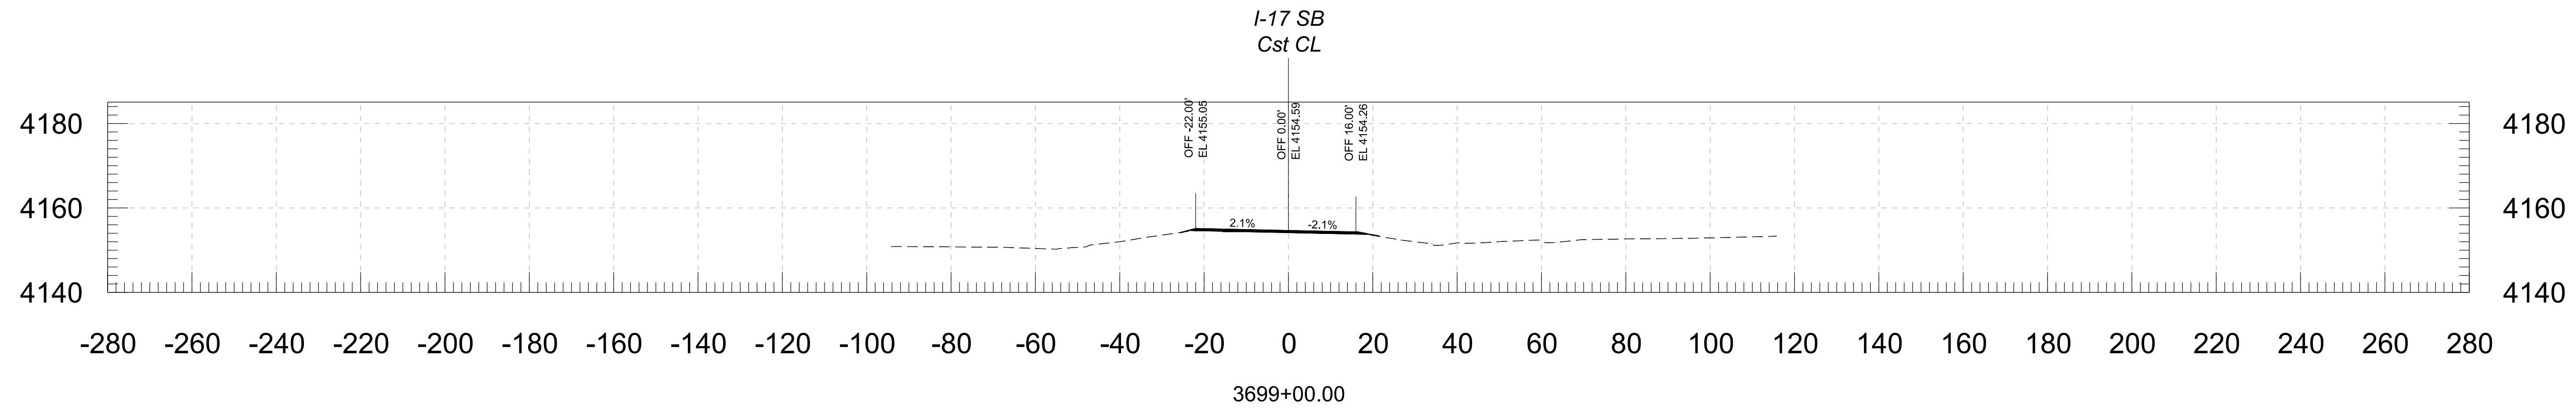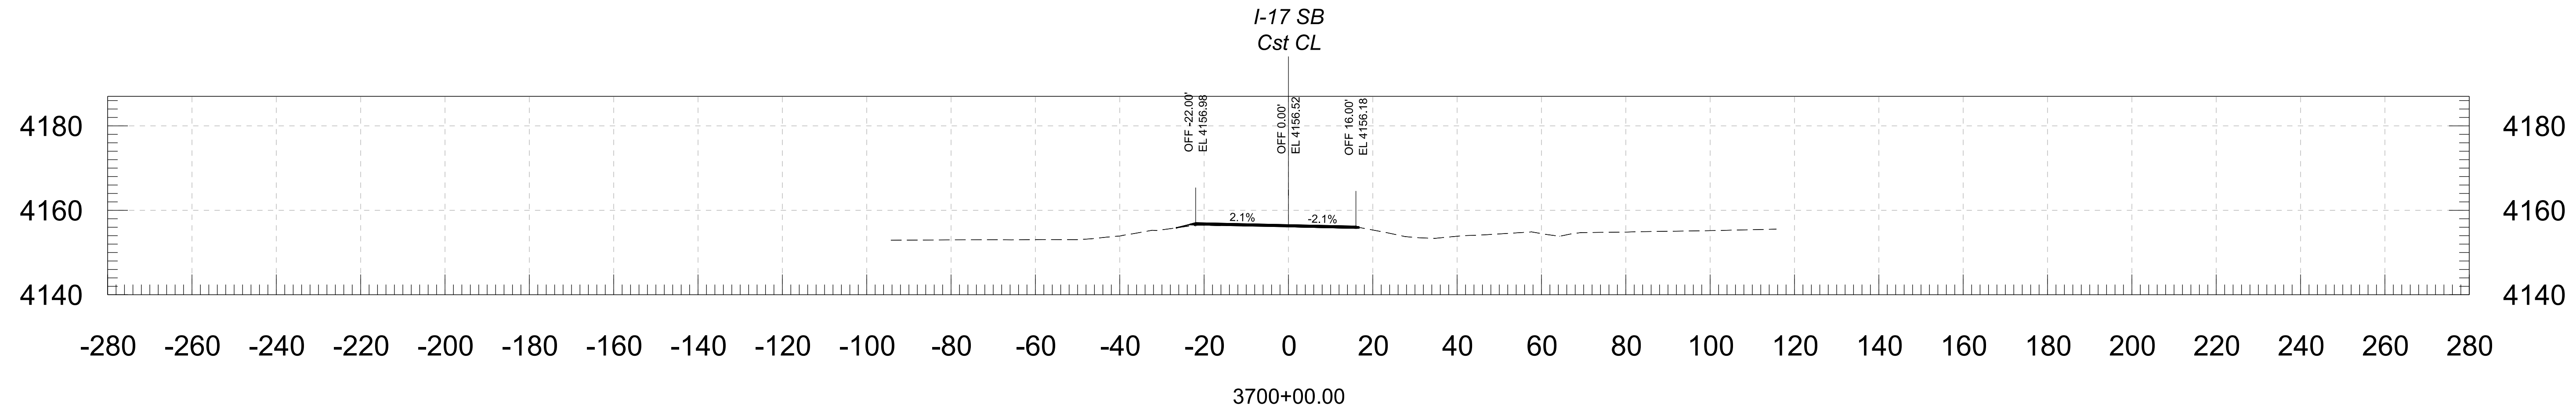

				NAME	DATE	ARIZONA DEPARTMENT OF TRANSPORTATION PROJECT DELIVERY AND OPERATIONS DIVISION ROADWAY DESIGN SERVICES	ROUTE	F.H.W.A. Arizona Division	STATE ARIZ.	PROJECT NO.	FEDERAL ID NO.	SHEET NO.	TOTAL SHEETS	RECORD DRAWING
			DESIGN	BAP	06/26		I-17			017 YV 269	017-B(239)T	53	146	
			DRAWN	RM	06/26									
			CHECKED	KCH	06/26									
			 3133 East Camelback Road, Suite 100 Phoenix, Arizona 85016 Phone: (602) 333-2200			CROSS SECTION	MILEPOST	E DUGAS ROAD - MP 275						DWG NO.
							STRUCTURE NO.	TRACS NO. F0616 01C						___ OF ___

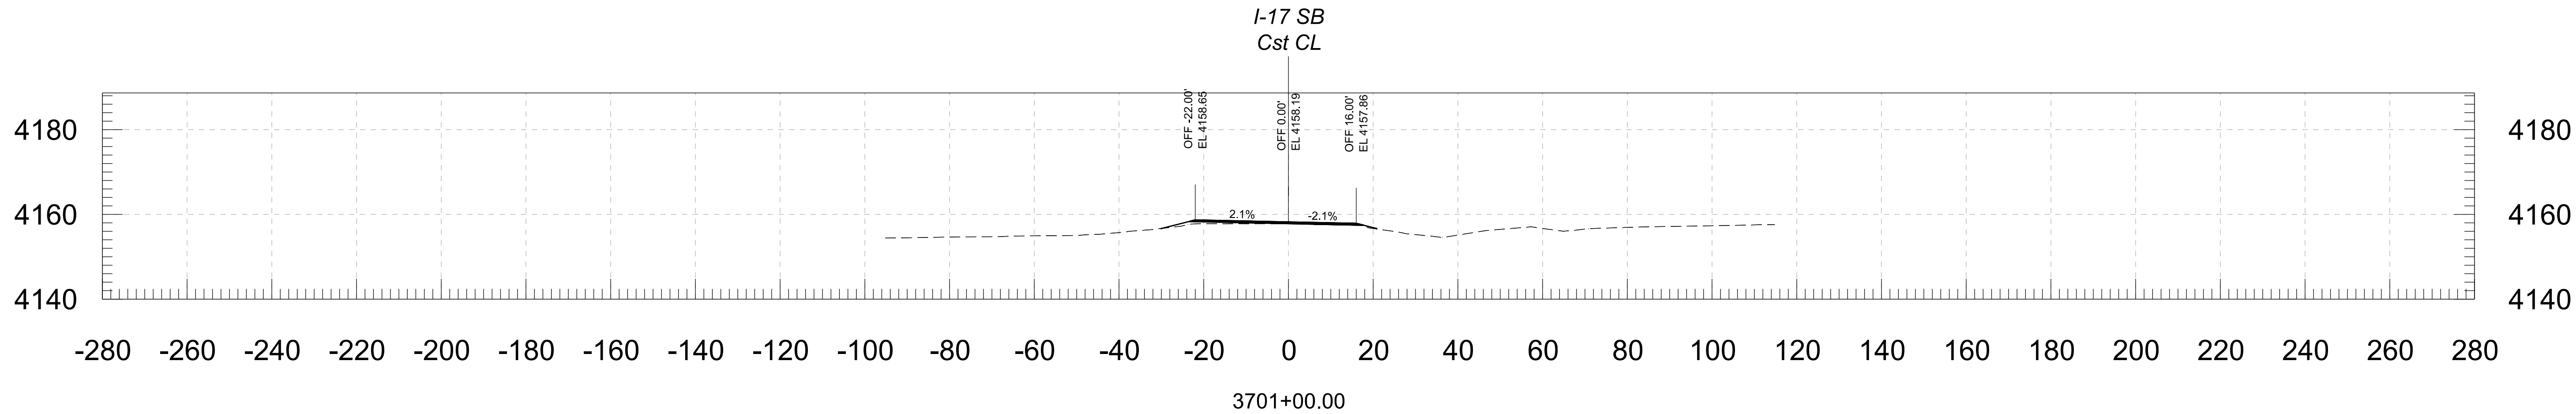
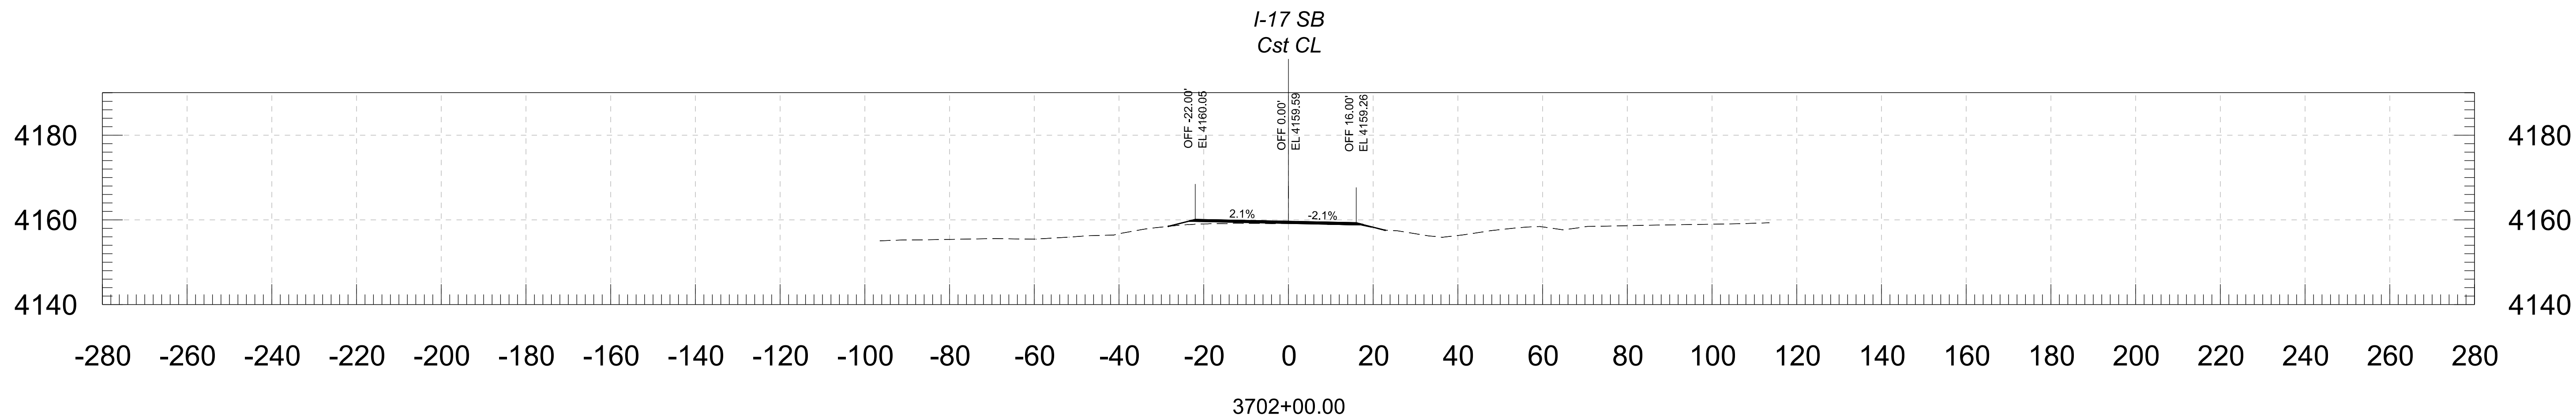
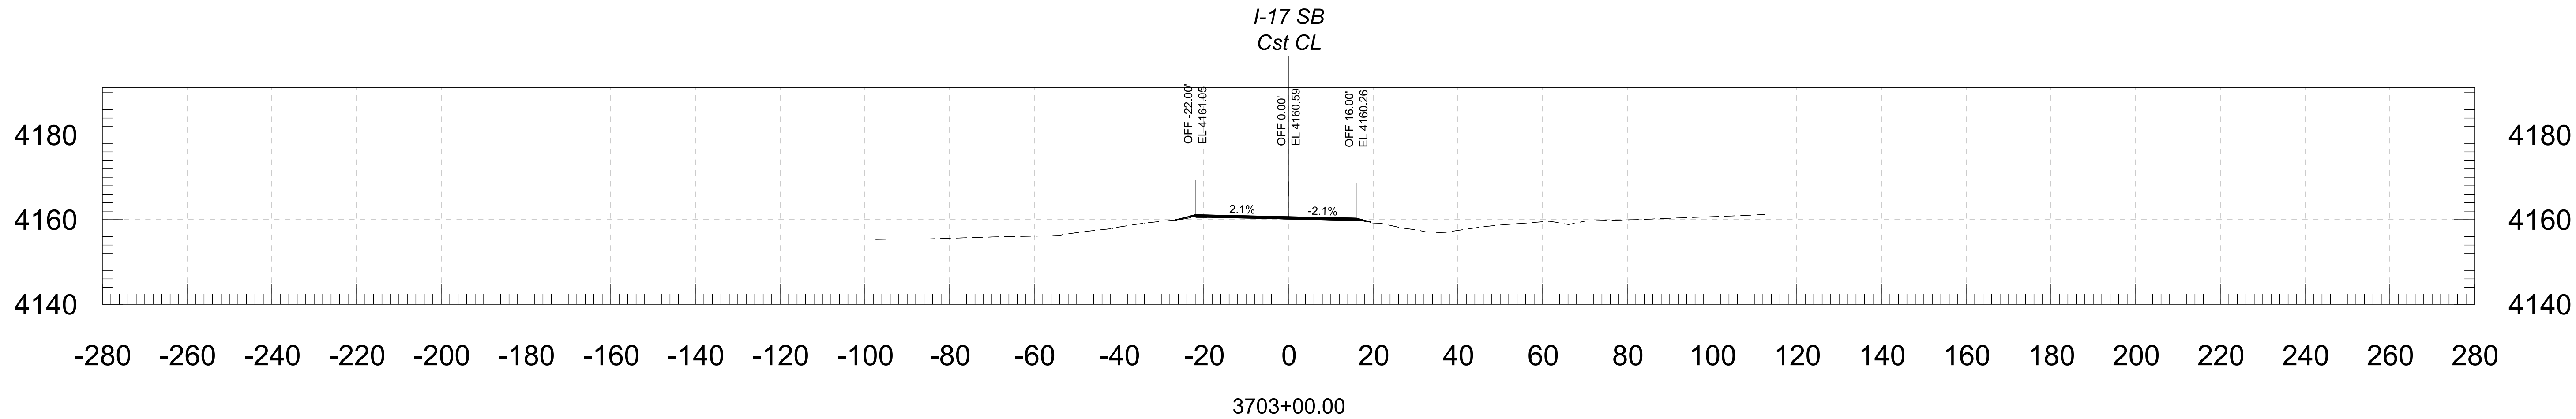


			NAME	DATE	ARIZONA DEPARTMENT OF TRANSPORTATION PROJECT DELIVERY AND OPERATIONS DIVISION ROADWAY DESIGN SERVICES	ROUTE	F.H.W.A. Arizona Division	STATE	PROJECT NO.	FEDERAL ID NO.	SHEET NO.	TOTAL SHEETS	RECORD DRAWING	
		DESIGN	BAP	06/26		I-17			017 YV 269	017-B(239)T	54	146		
		DRAWN	RM	06/26		MILEPOST	E DUGAS ROAD - MP 275							
		CHECKED	KCH	06/26										
		 3133 East Camelback Road, Suite 100 Phoenix, Arizona 85016 Phone: 602. 333-2000 Stanley Consultants INC.			CROSS SECTION			STRUCTURE NO.	TRACS NO. F0616 01C			____ OF ____		

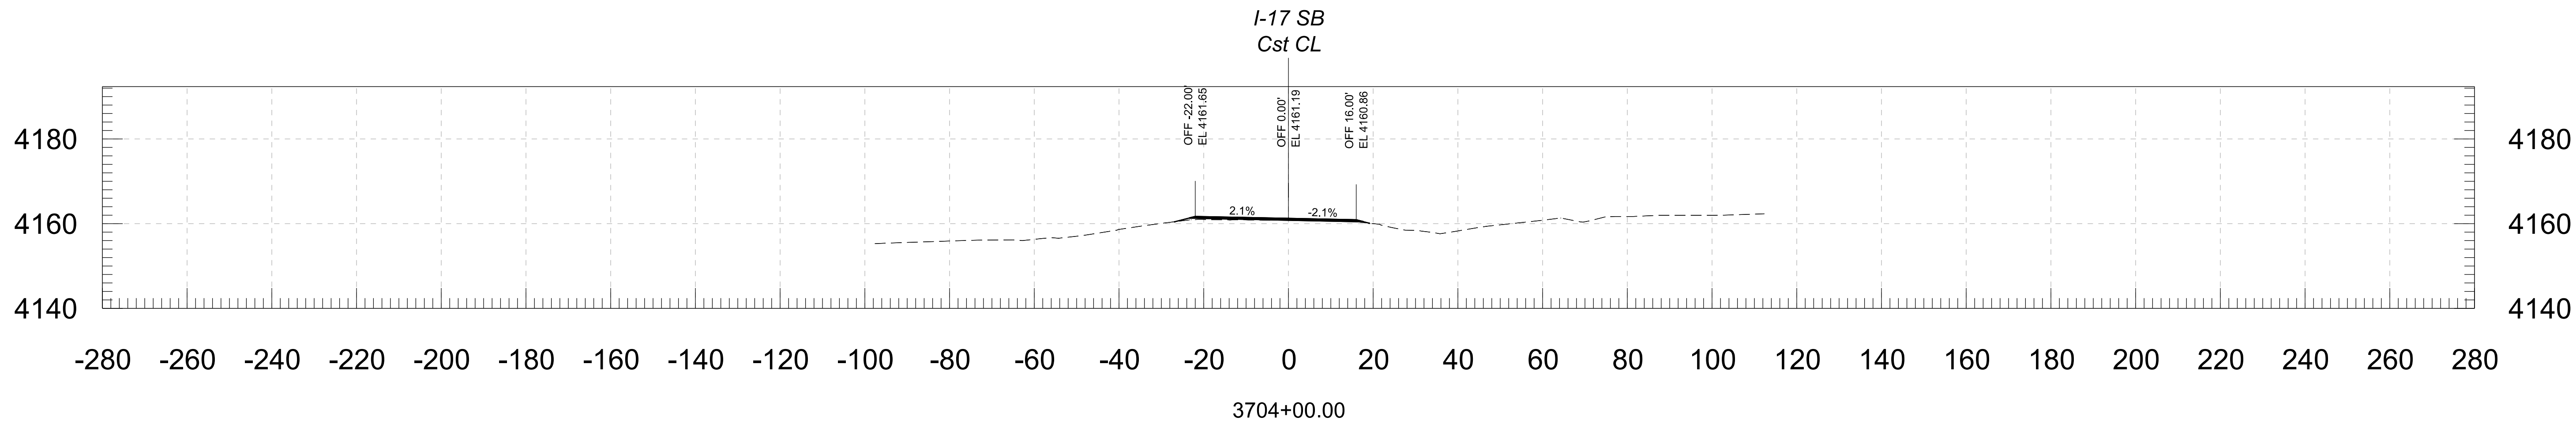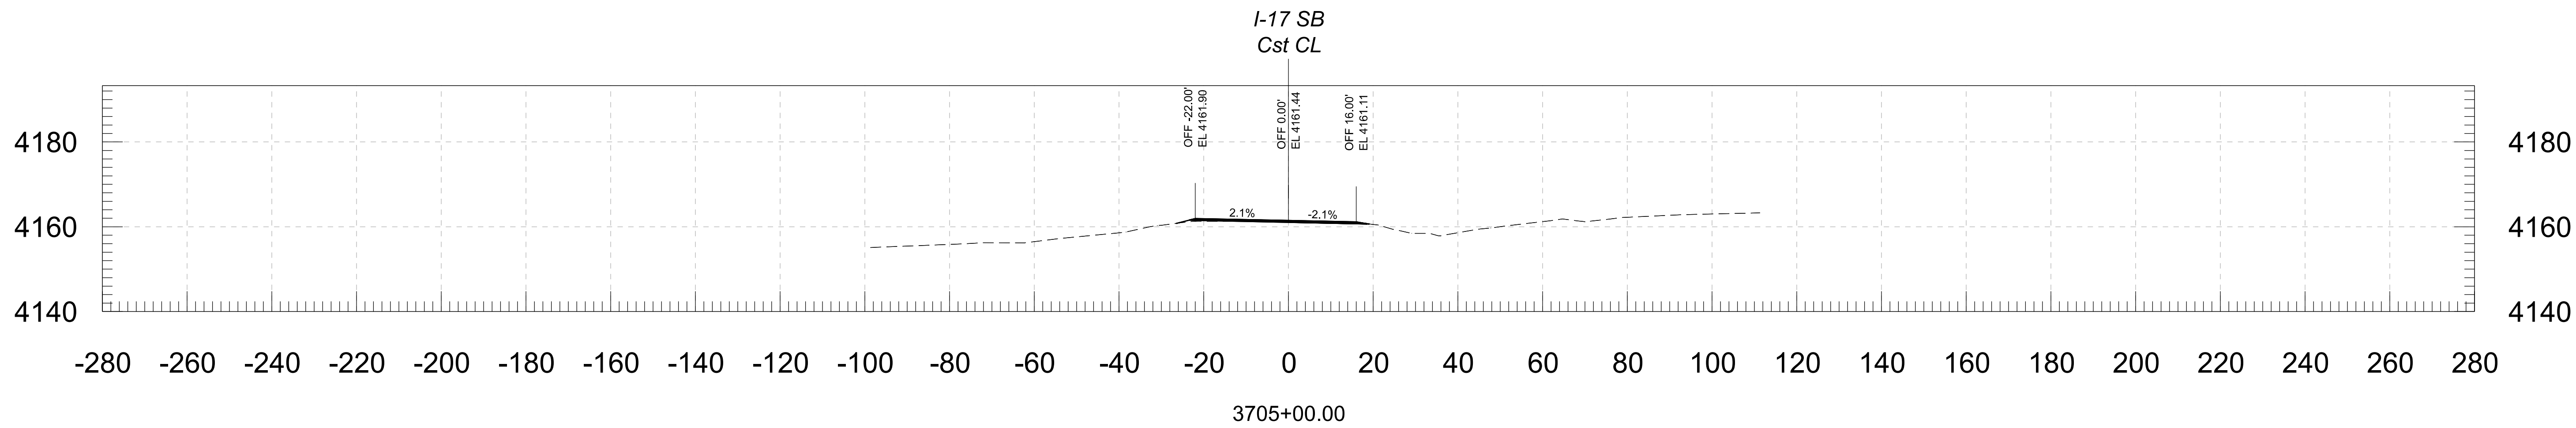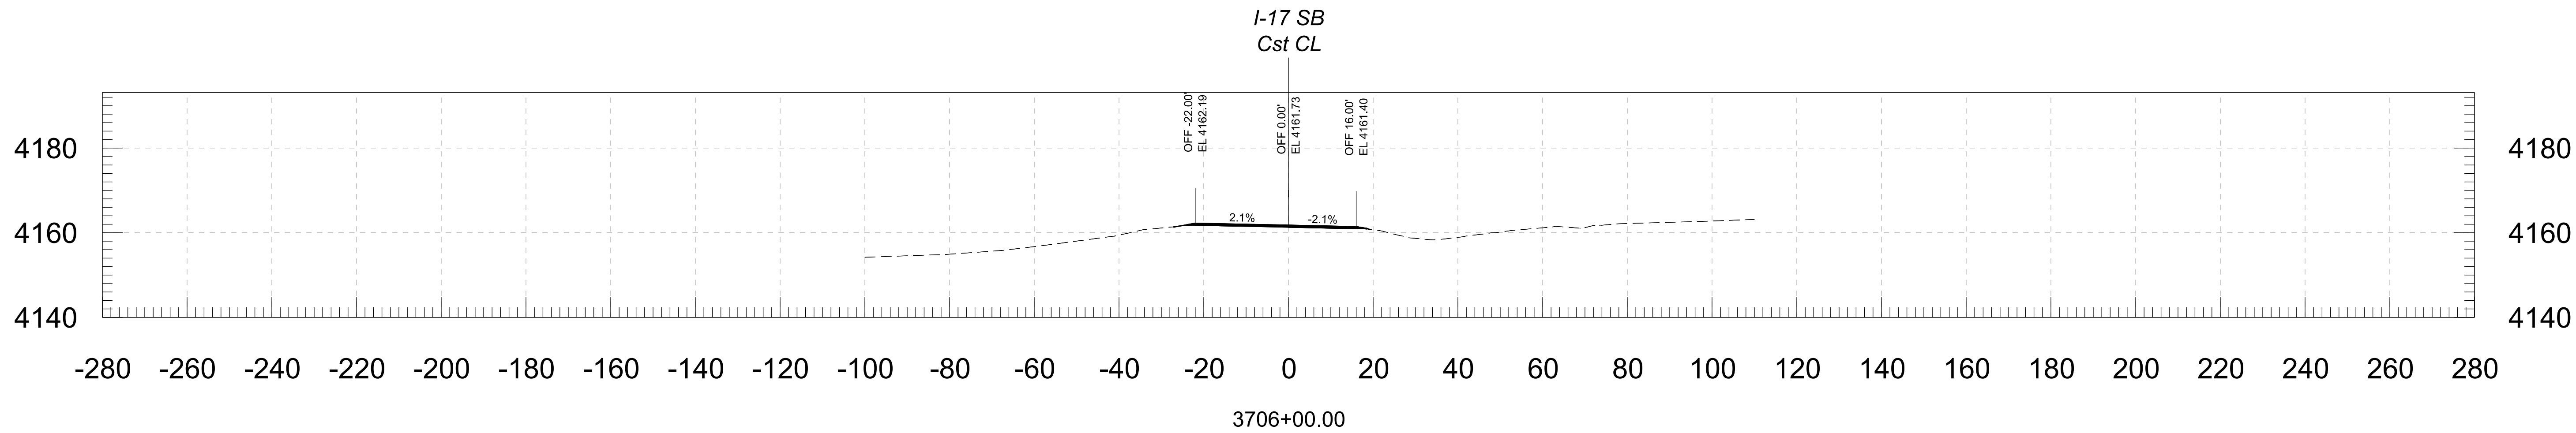


			NAME	DATE	ARIZONA DEPARTMENT OF TRANSPORTATION PROJECT DELIVERY AND OPERATIONS DIVISION ROADWAY DESIGN SERVICES	ROUTE	F.H.W.A. Arizona Division	STATE	PROJECT NO.	FEDERAL ID NO.	SHEET NO.	TOTAL SHEETS	RECORD DRAWING
		DESIGN	BAP	06/26		I-17			017 YV 269	017-B(239)T	55	146	
		DRAWN	RM	06/26		MILEPOST	E DUGAS ROAD - MP 275						
		CHECKED	KCH	06/26									
		 Stanley Consultants INC.			3131 East Camelback Road, Suite 100 Phoenix, Arizona 85016 Phone 602. 333-2000			CROSS SECTION	TRACS NO. F0616 01C		____ OF ____		






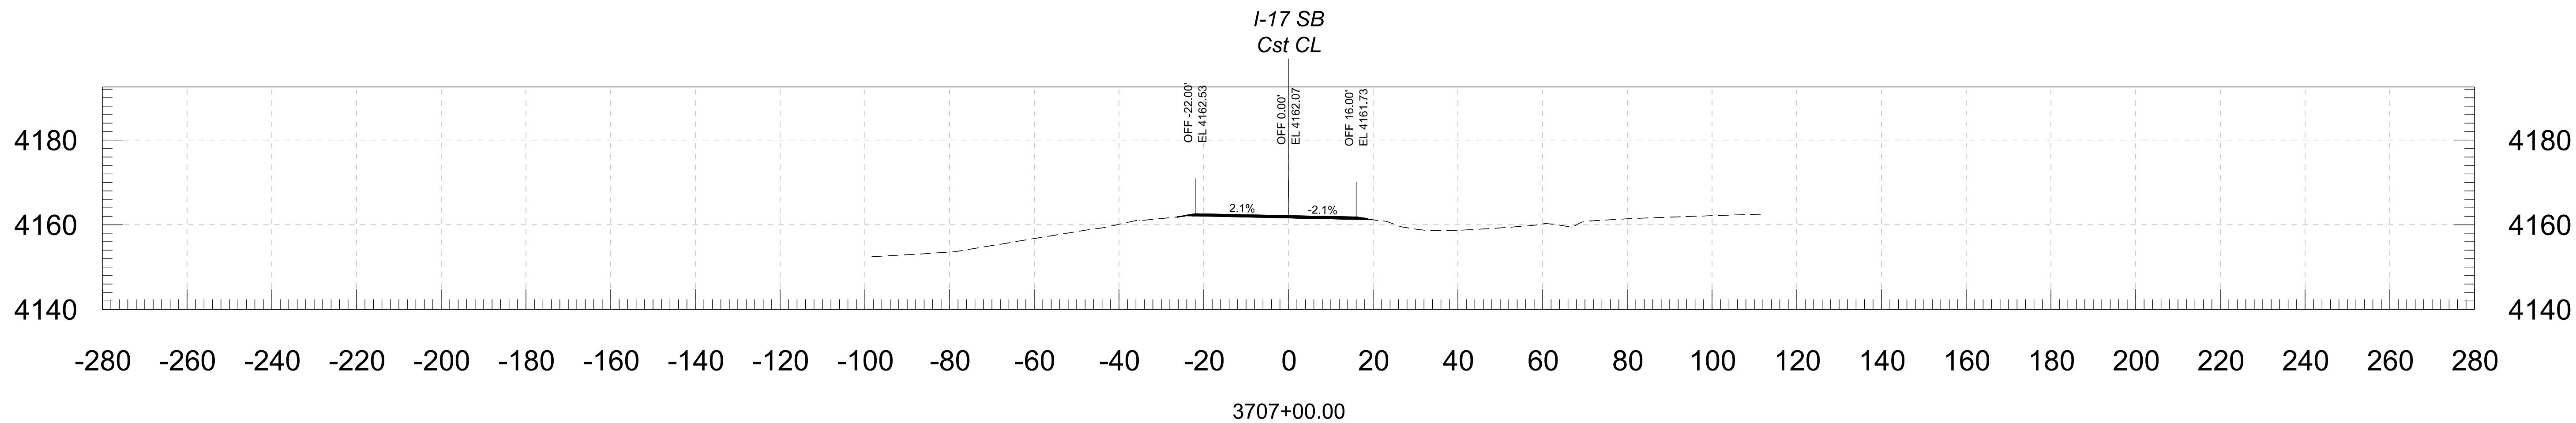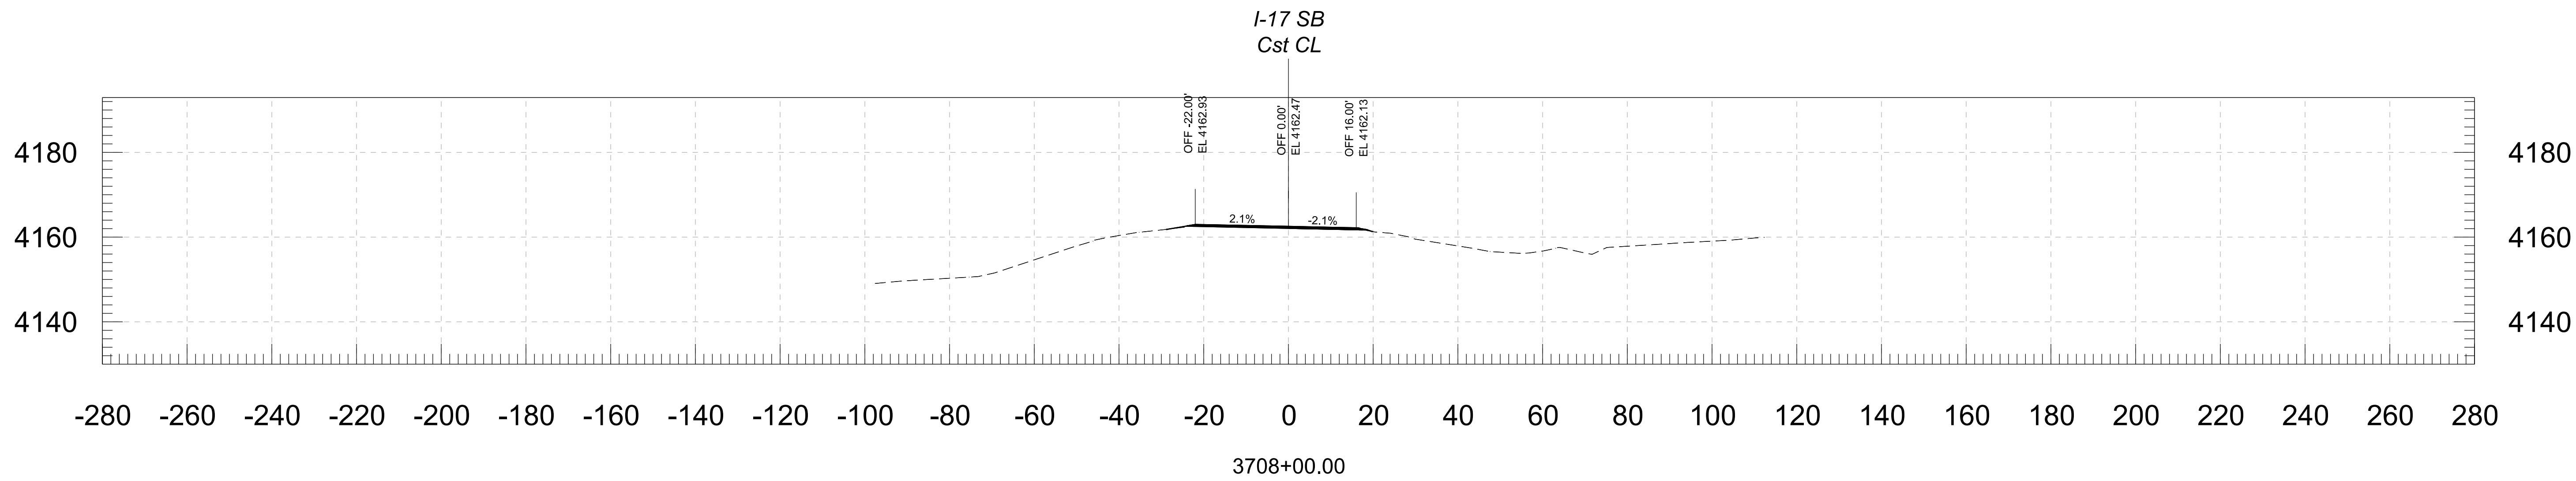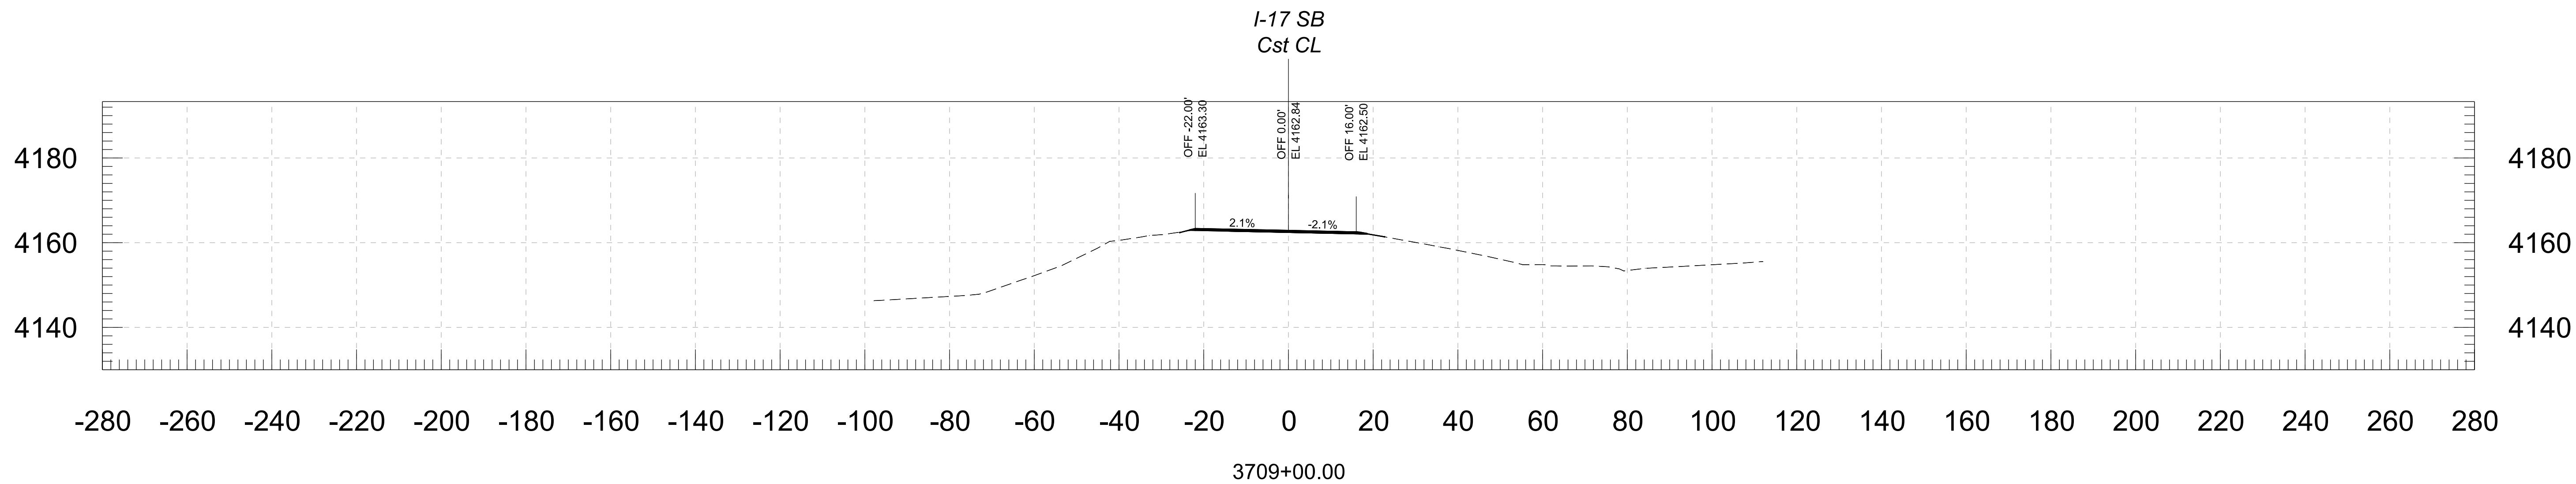


		Stanley Consultants INC.		NAME	DATE	ARIZONA DEPARTMENT OF TRANSPORTATION PROJECT DELIVERY AND OPERATIONS DIVISION ROADWAY DESIGN SERVICES	ROUTE	F.H.W.A. Arizona Division	STATE ARIZ.	PROJECT NO.	FEDERAL ID NO.	SHEET NO.	TOTAL SHEETS	RECORD DRAWING
			DESIGN	BAP	06/26		I-17			017 YV 269	017-B(239)T	56	146	
			DRAWN	RM	06/26									
			CHECKED	KCH	06/26									
						Stanley Consultants INC.			CROSS SECTION	MILEPOST	LOCATION E DUGAS ROAD - MP 275			
							STRUCTURE NO.	TRACS NO. F0616 01C		____ OF ____				

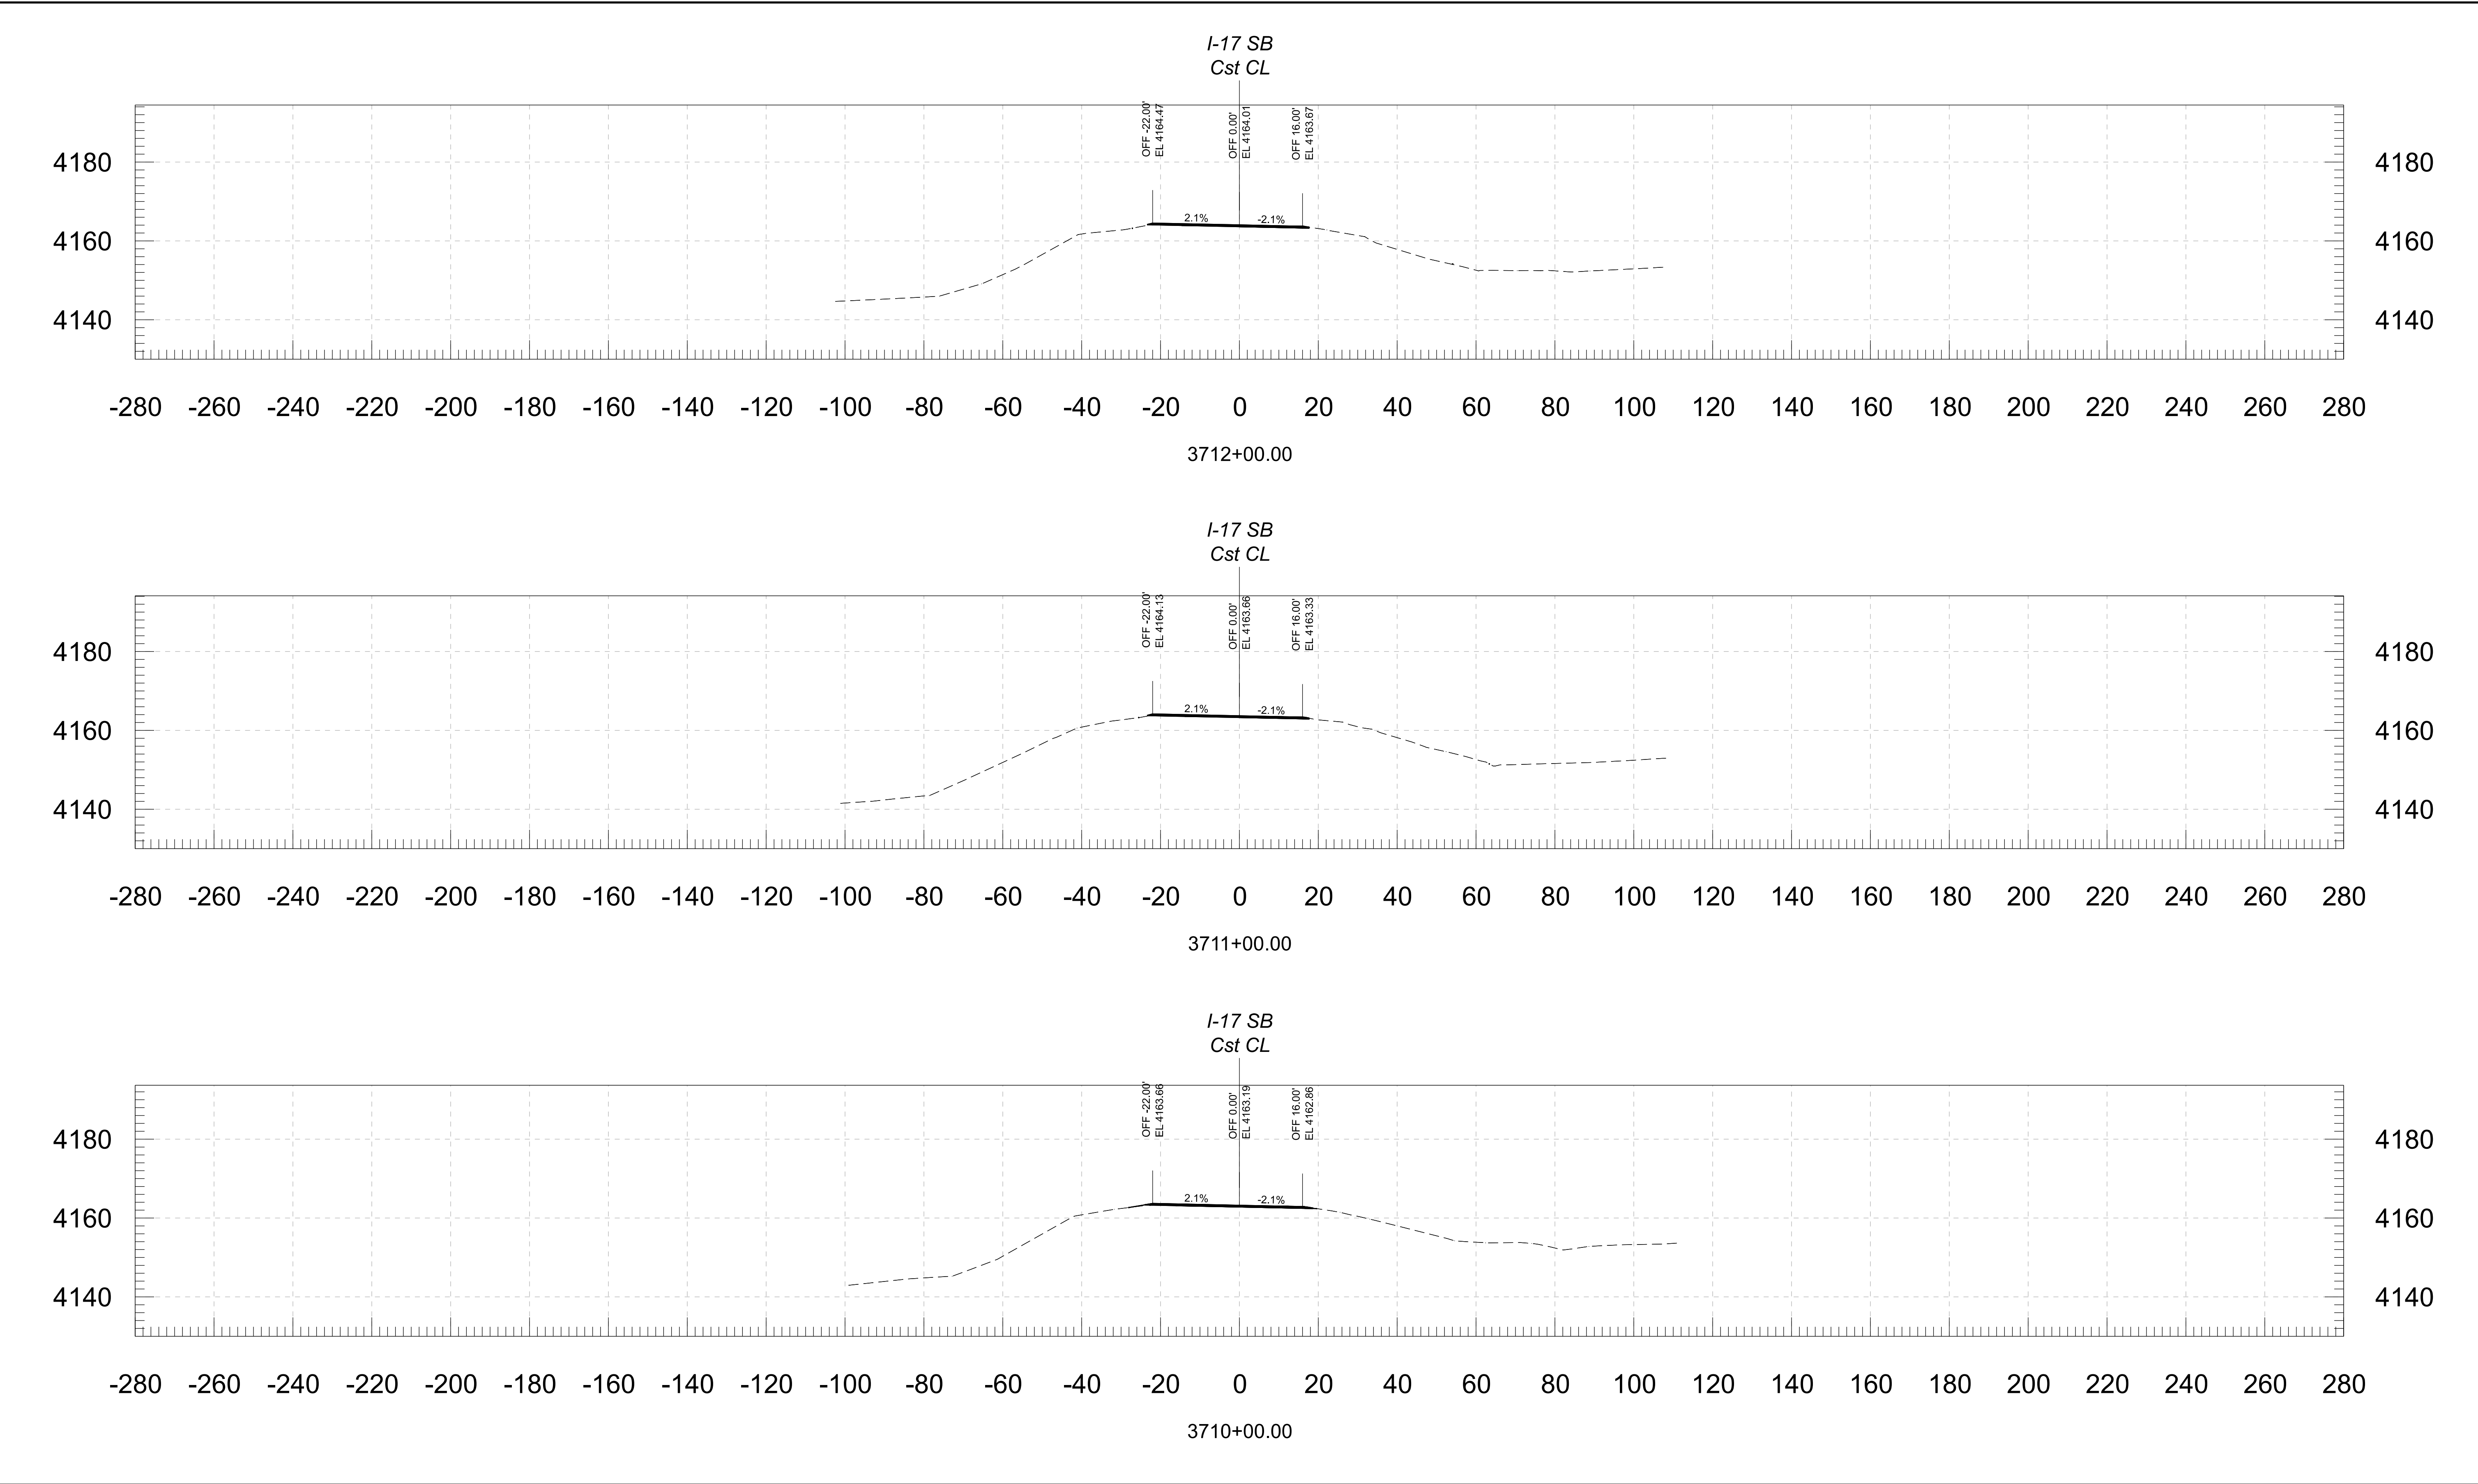




			NAME	DATE	ARIZONA DEPARTMENT OF TRANSPORTATION PROJECT DELIVERY AND OPERATIONS DIVISION ROADWAY DESIGN SERVICES	ROUTE	F.H.W.A. Arizona Division	STATE ARIZ.	PROJECT NO.	FEDERAL ID NO.	SHEET NO.	TOTAL SHEETS	RECORD DRAWING
		DESIGN	BAP	06/26		I-17			017 YV 269	017-B(239)T	57	146	
		DRAWN	RM	06/26			MILEPOST	LOCATION E DUGAS ROAD - MP 275					DWG NO. ____ OF ____
		CHECKED	KCH	06/26				STRUCTURE NO.	TRACS NO. F0616 01C				
		 3133 East Camelback Road, Suite 100 Phoenix, Arizona 85016 Phone: 602.333-2200 Stanley Consultants INC.			CROSS SECTION								

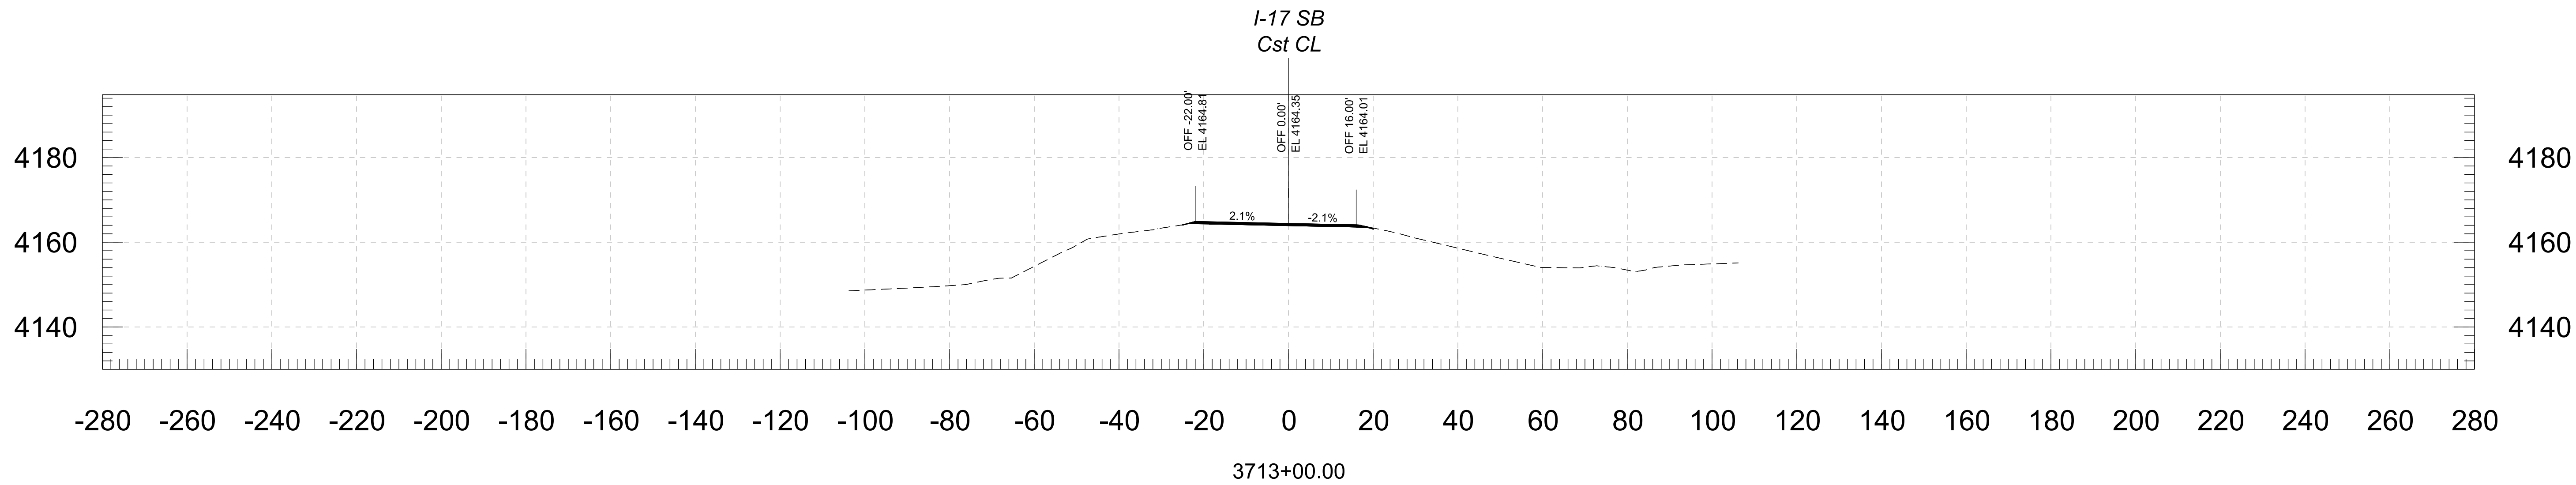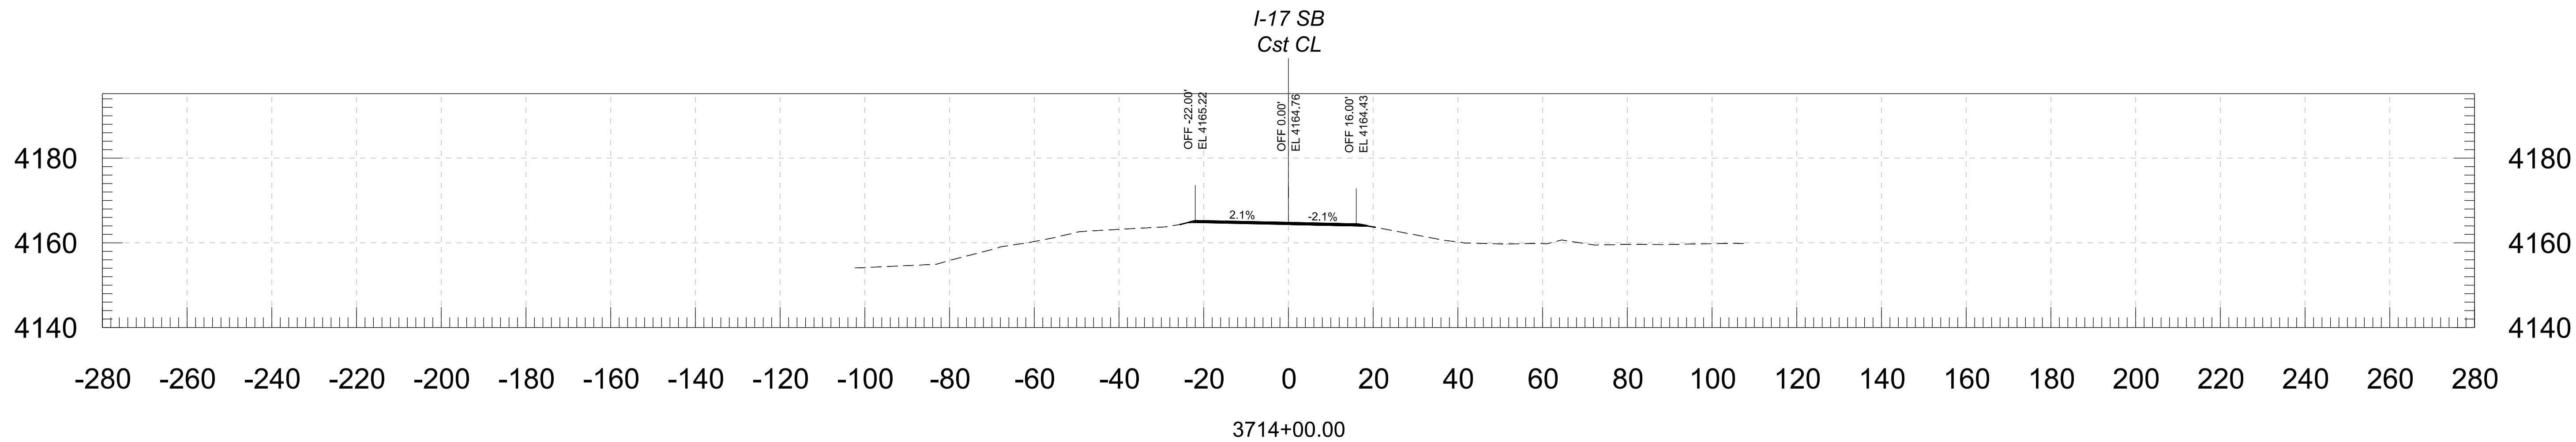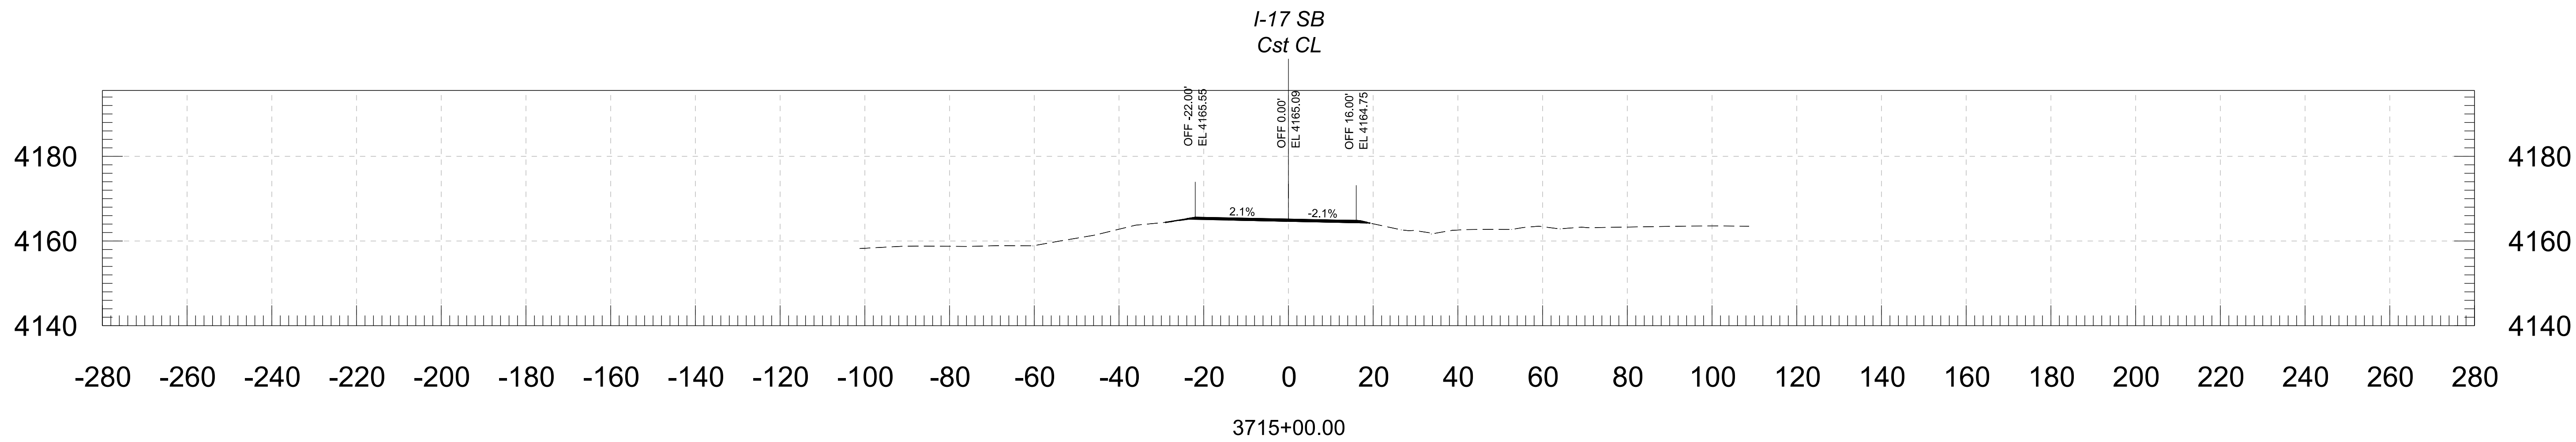



					ARIZONA DEPARTMENT OF TRANSPORTATION PROJECT DELIVERY AND OPERATIONS DIVISION ROADWAY DESIGN SERVICES	ROUTE	F.H.W.A. Arizona Division	STATE ARIZ.	PROJECT NO.	FEDERAL ID NO.	SHEET NO.	TOTAL SHEETS	RECORD DRAWING
		DESIGN	BAP	06/26									
		DRAWN	RM	06/26			017 YV 269	017-B(239)T	58	146			
		CHECKED	KCH	06/26									
		 Stanley Consultants INC.			3133 East Camelback Road, Suite 100 Phoenix, Arizona 85016 Phone 602.333-2000			CROSS SECTION	E DUGAS ROAD - MP 275				DWG NO.
							TRACS NO. F0616 01C		____ OF ____				

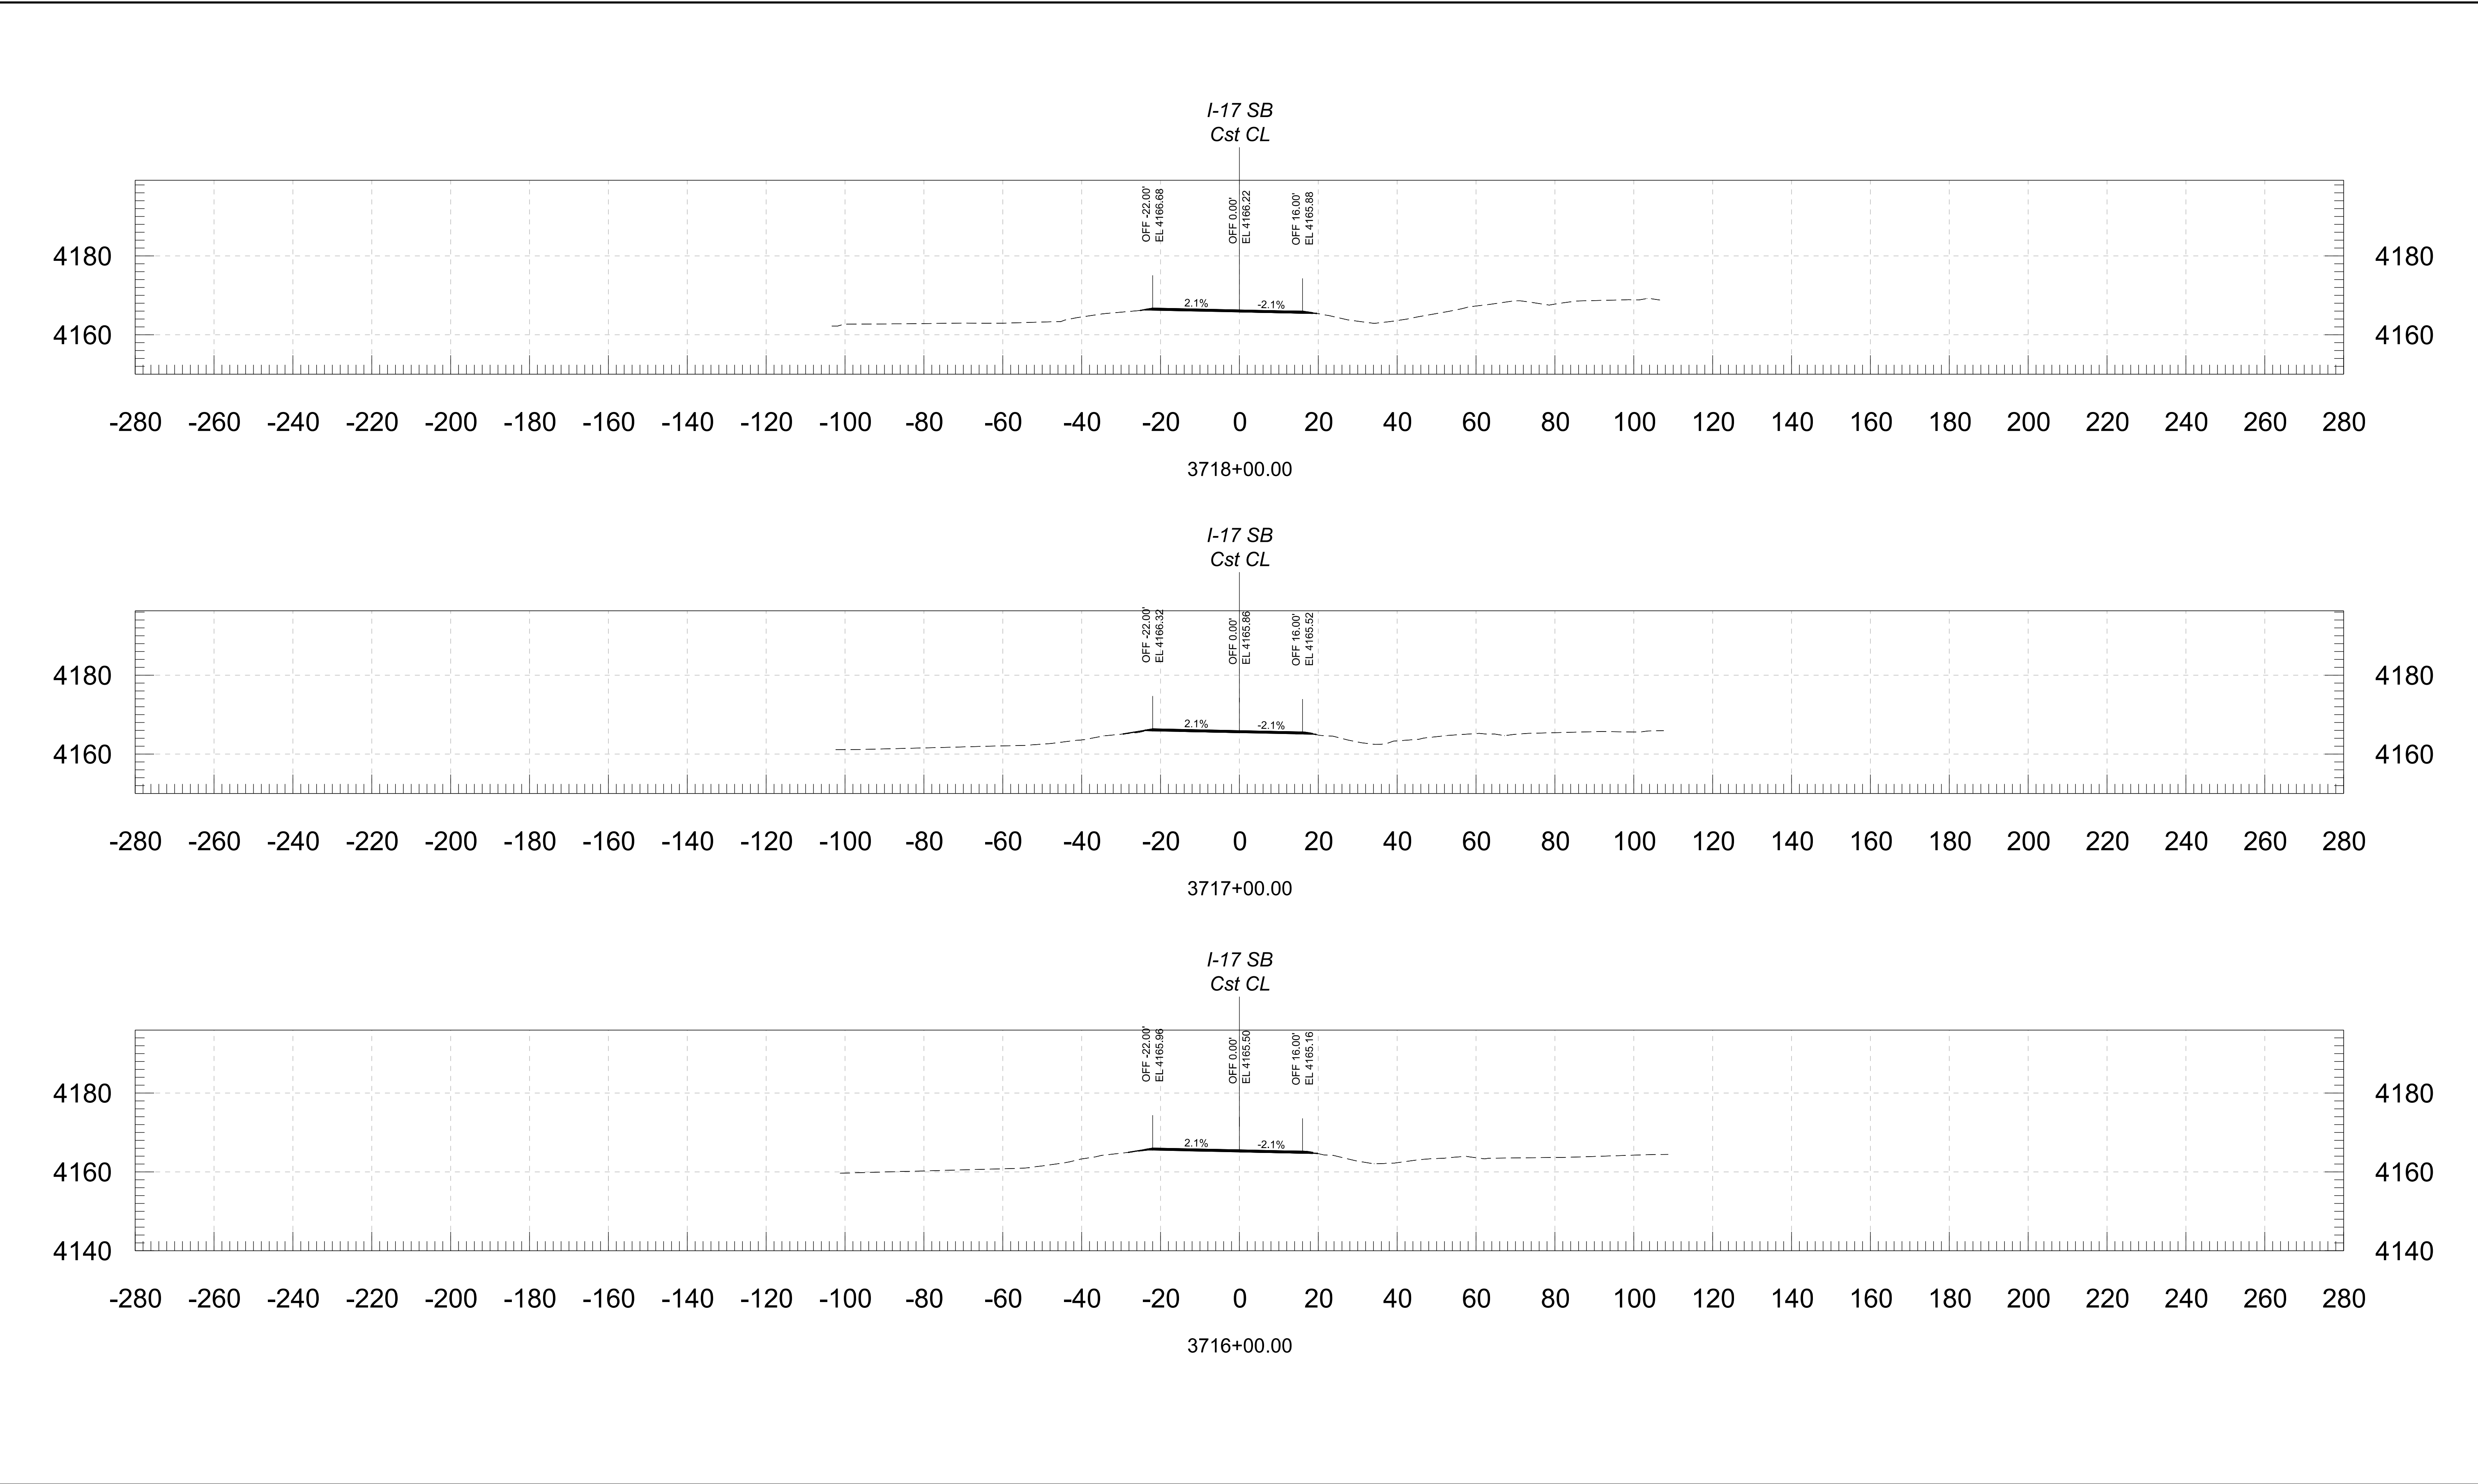



			NAME	DATE	ARIZONA DEPARTMENT OF TRANSPORTATION PROJECT DELIVERY AND OPERATIONS DIVISION ROADWAY DESIGN SERVICES	ROUTE	F.H.W.A. Arizona Division	STATE ARIZ.	PROJECT NO.	FEDERAL ID NO.	SHEET NO.	TOTAL SHEETS	RECORD DRAWING
		DESIGN	BAP	06/26		I-17			017 YV 269	017-B(239)T	59	146	
		DRAWN	RM	06/26									
		CHECKED	KCH	06/26									
		 Stanley Consultants INC.			3133 East Camelback Road, Suite 100 Phoenix, Arizona 85016 Phone: (602) 333-2200		CROSS SECTION	MILEPOST	E DUGAS ROAD - MP 275				
						STRUCTURE NO.	TRACS NO. F0616 01C						____ OF ____

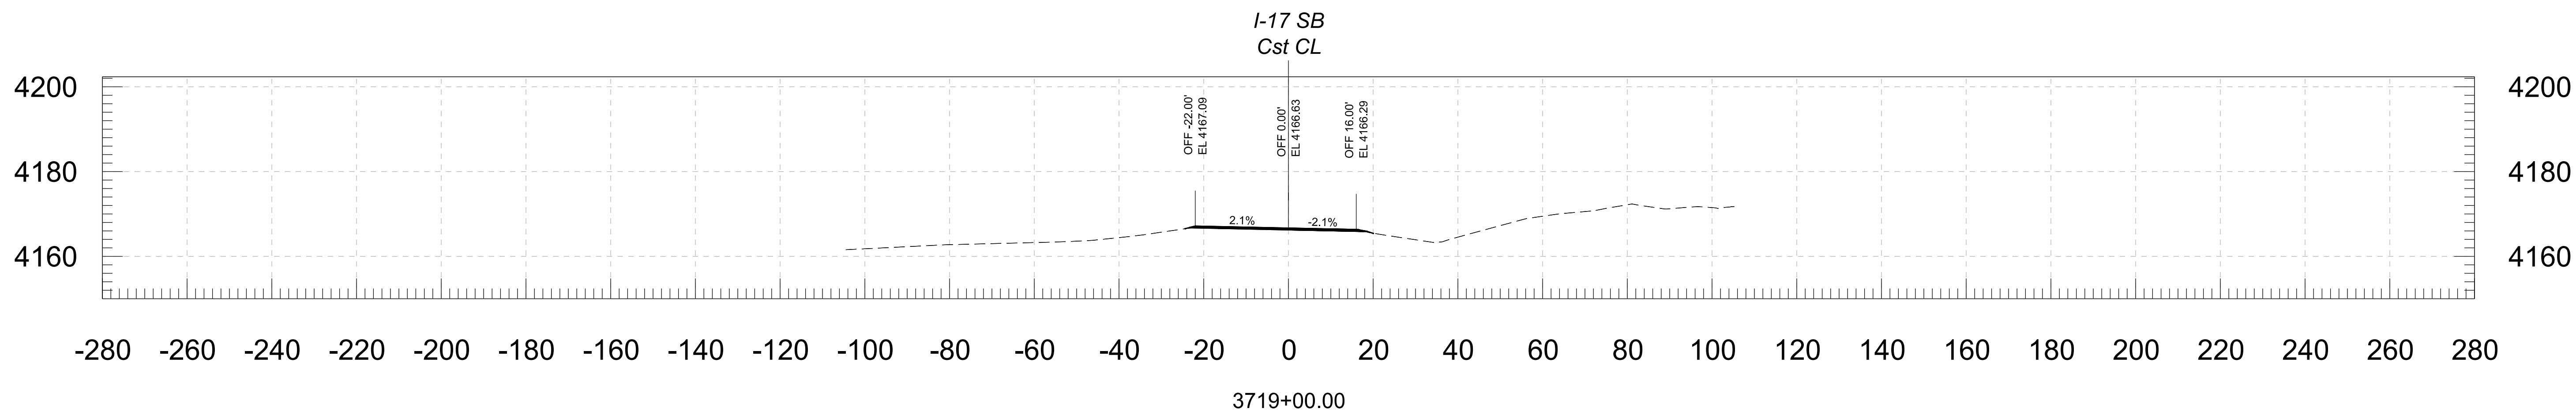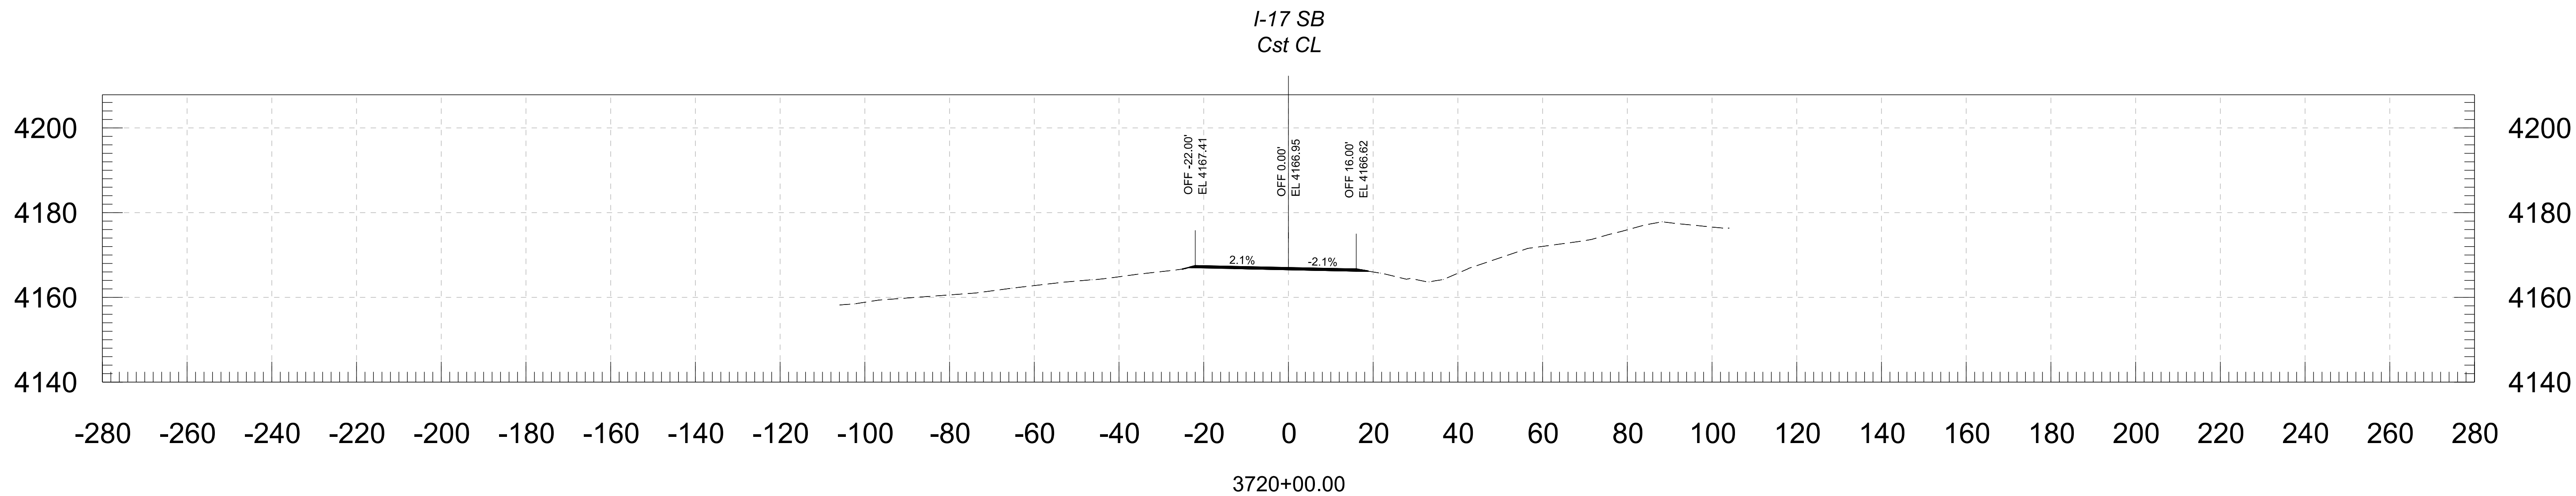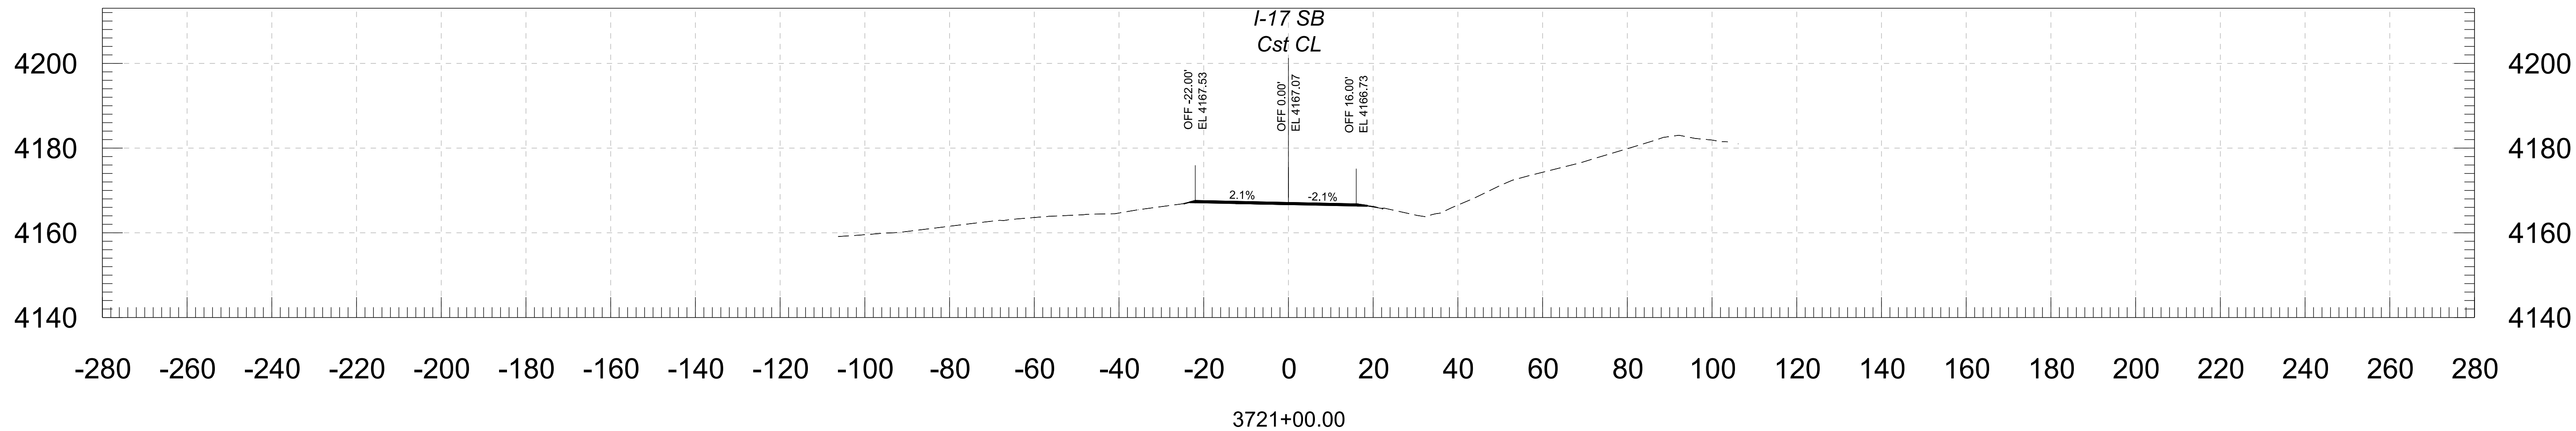



			NAME	DATE	ARIZONA DEPARTMENT OF TRANSPORTATION PROJECT DELIVERY AND OPERATIONS DIVISION ROADWAY DESIGN SERVICES	ROUTE	F.H.W.A. Arizona Division	STATE ARIZ.	PROJECT NO.	FEDERAL ID NO.	SHEET NO.	TOTAL SHEETS	RECORD DRAWING
		DESIGN	BAP	06/26		I-17			017 YV 269	017-B(239)T	60	146	
		DRAWN	RM	06/26		MILEPOST	LOCATION E DUGAS ROAD - MP 275						DWG NO. ____ OF ____
		CHECKED	KCH	06/26		CROSS SECTION	STRUCTURE NO.	TRACS NO. F0616 01C					
		 Stanley Consultants INC. 3133 East Camelback Road, Suite 100 Phoenix, Arizona 85016 Phone: 602-333-2200											

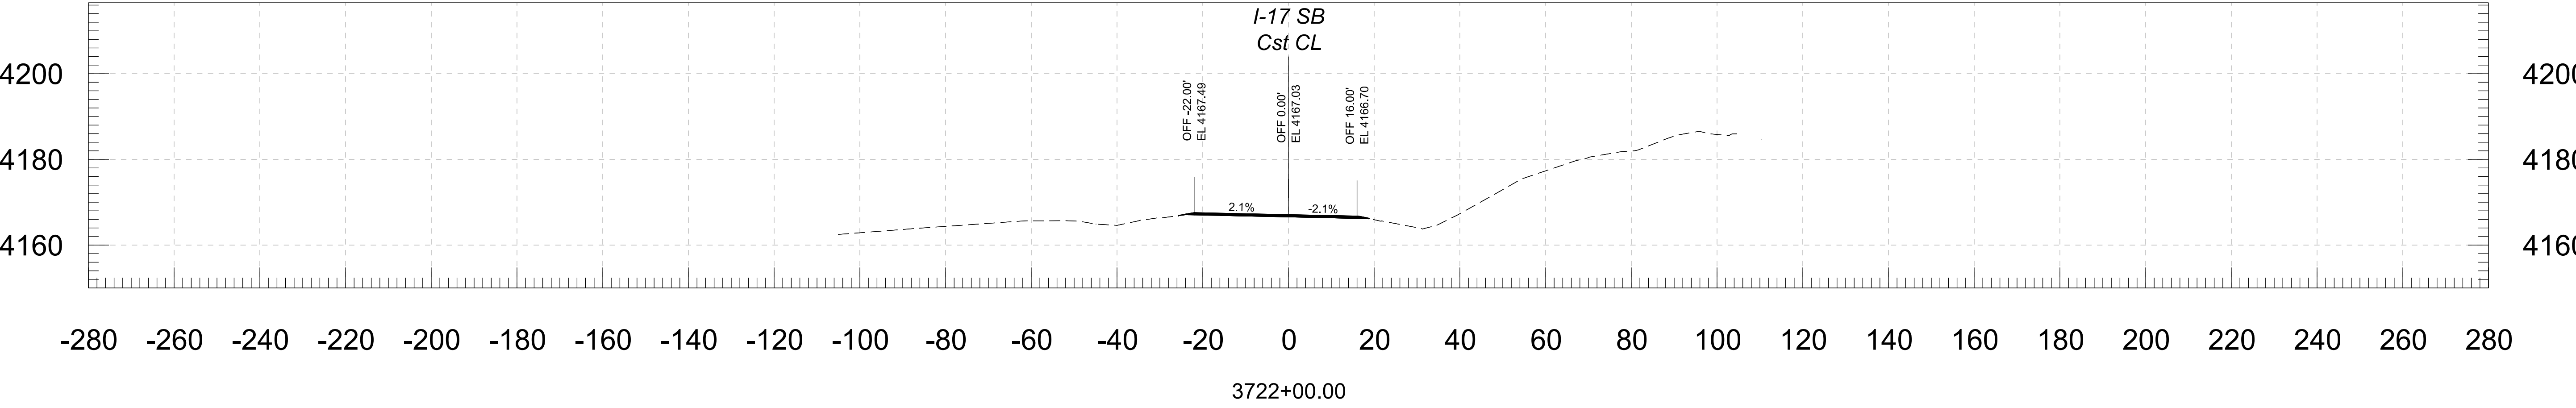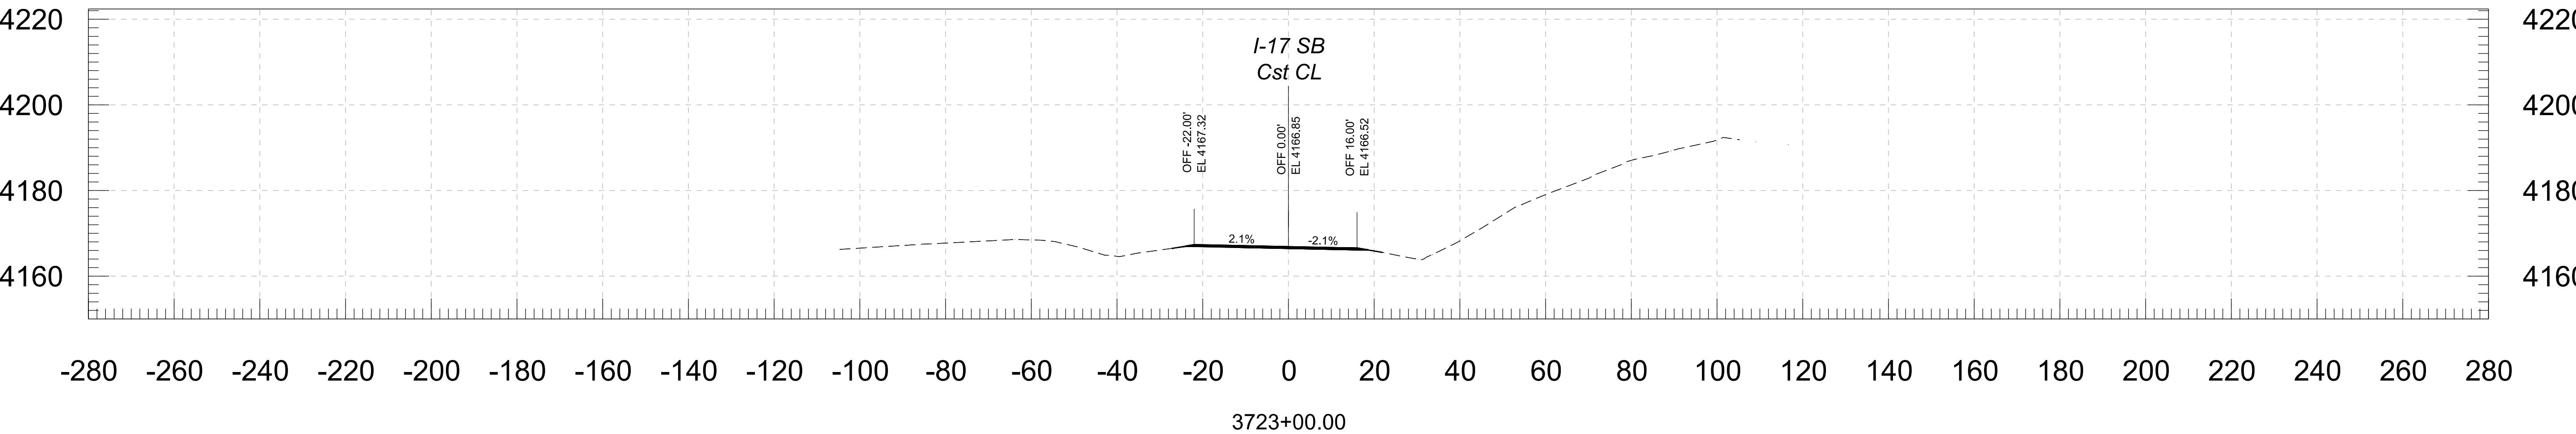

			NAME	DATE	ARIZONA DEPARTMENT OF TRANSPORTATION PROJECT DELIVERY AND OPERATIONS DIVISION ROADWAY DESIGN SERVICES	ROUTE	F.H.W.A. Arizona Division	STATE ARIZ.	PROJECT NO.	FEDERAL ID NO.	SHEET NO.	TOTAL SHEETS	RECORD DRAWING
		DESIGN	BAP	06/26		I-17			017 YV 269	017-B(239)T	61	146	
		DRAWN	RM	06/26									
		CHECKED	KCH	06/26									
			 Stanley Consultants INC.	333 East Camelback Road, Suite 100 Phoenix, Arizona 85016 Phone: 602 333-2200			CROSS SECTION	MILEPOST	E DUGAS ROAD - MP 275				
					STRUCTURE NO.	TRACS NO. F0616 01C					___ OF ___		

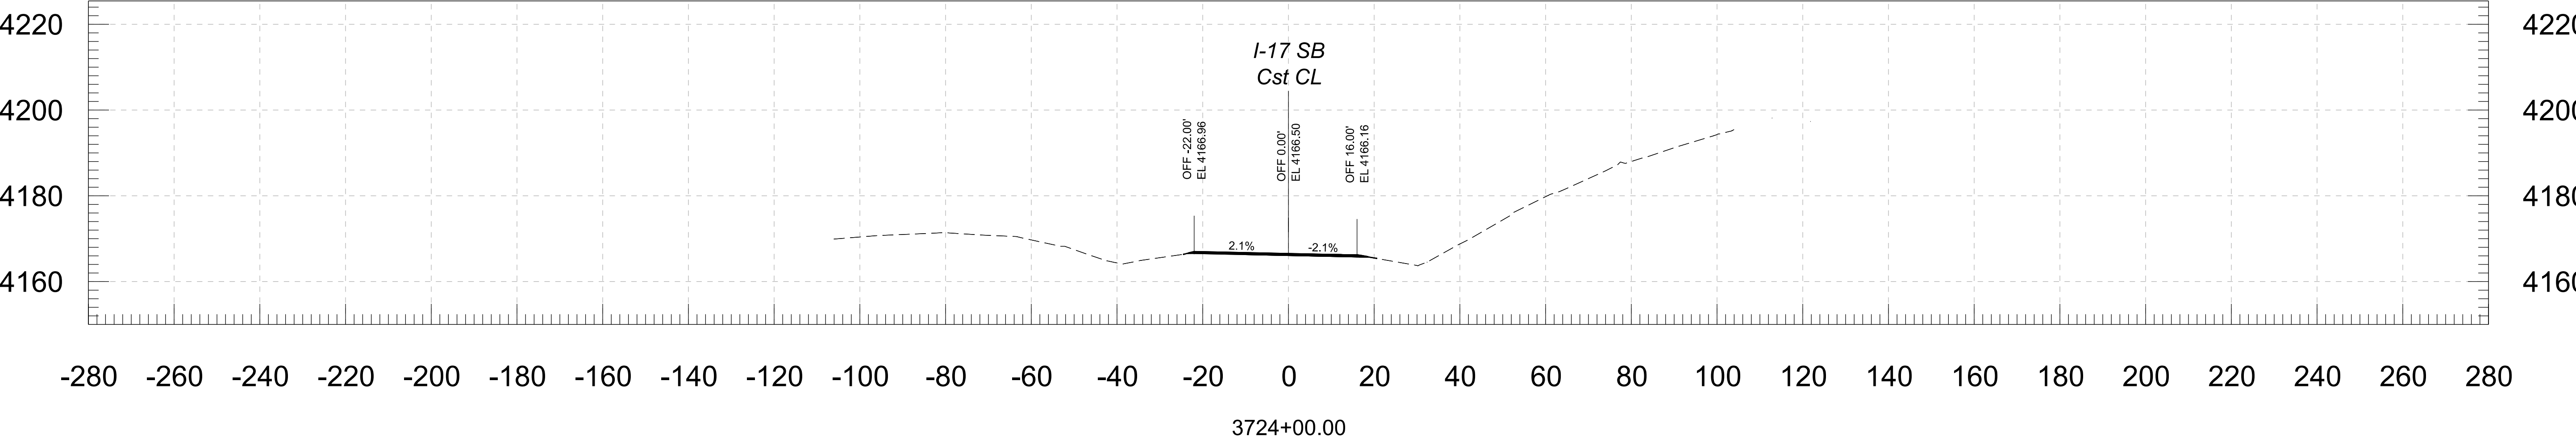
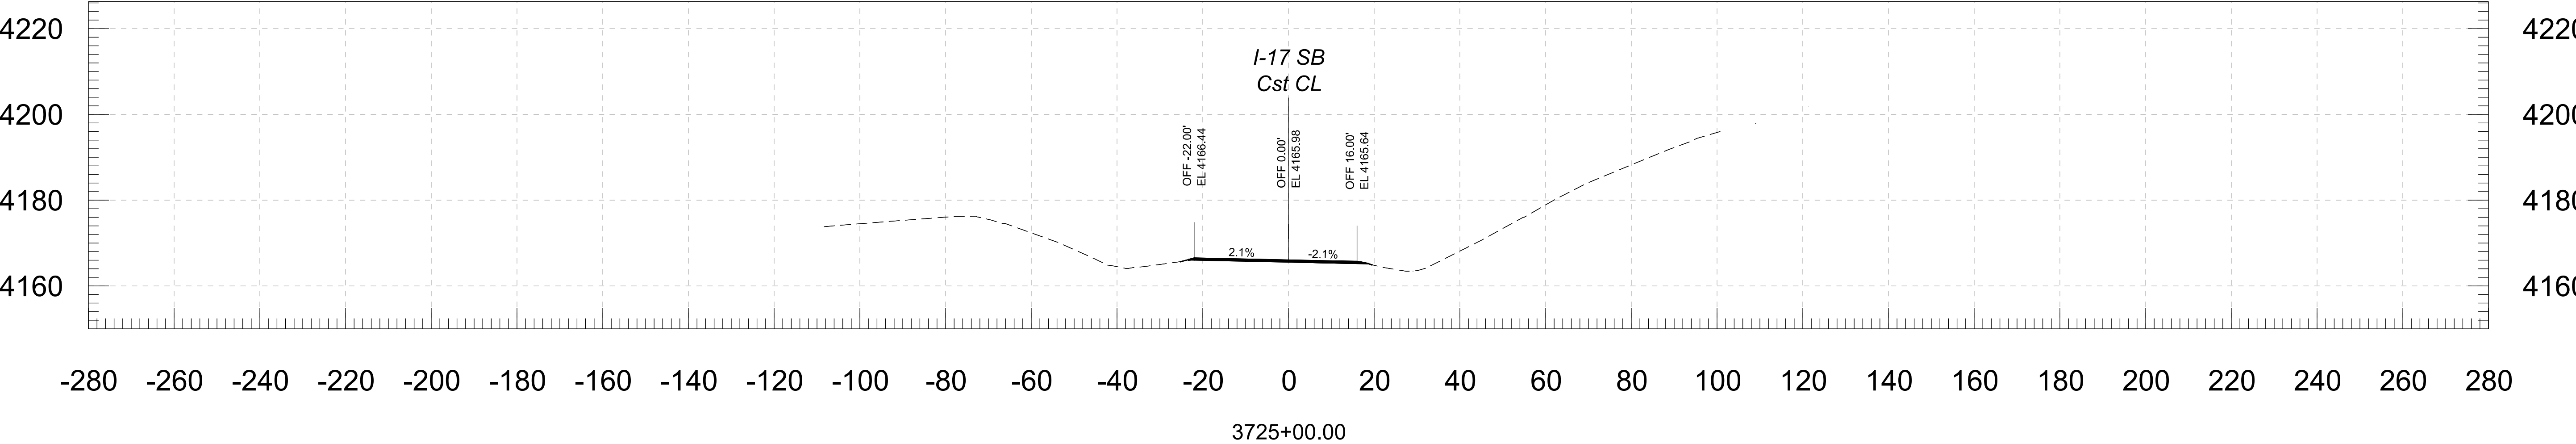


		Stanley Consultants INC.		NAME	DATE	ARIZONA DEPARTMENT OF TRANSPORTATION PROJECT DELIVERY AND OPERATIONS DIVISION ROADWAY DESIGN SERVICES	ROUTE	F.H.W.A. Arizona Division	STATE ARIZ.	PROJECT NO.	FEDERAL ID NO.	SHEET NO.	TOTAL SHEETS	RECORD DRAWING
			DESIGN	BAP	06/26		I-17			017 YV 269	017-B(239)T	62	146	
			DRAWN	RM	06/26			MILEPOST	E DUGAS ROAD - MP 275				DWG NO.	
			CHECKED	KCH	06/26				STRUCTURE NO.	TRACS NO. F0616 01C		____ OF ____		

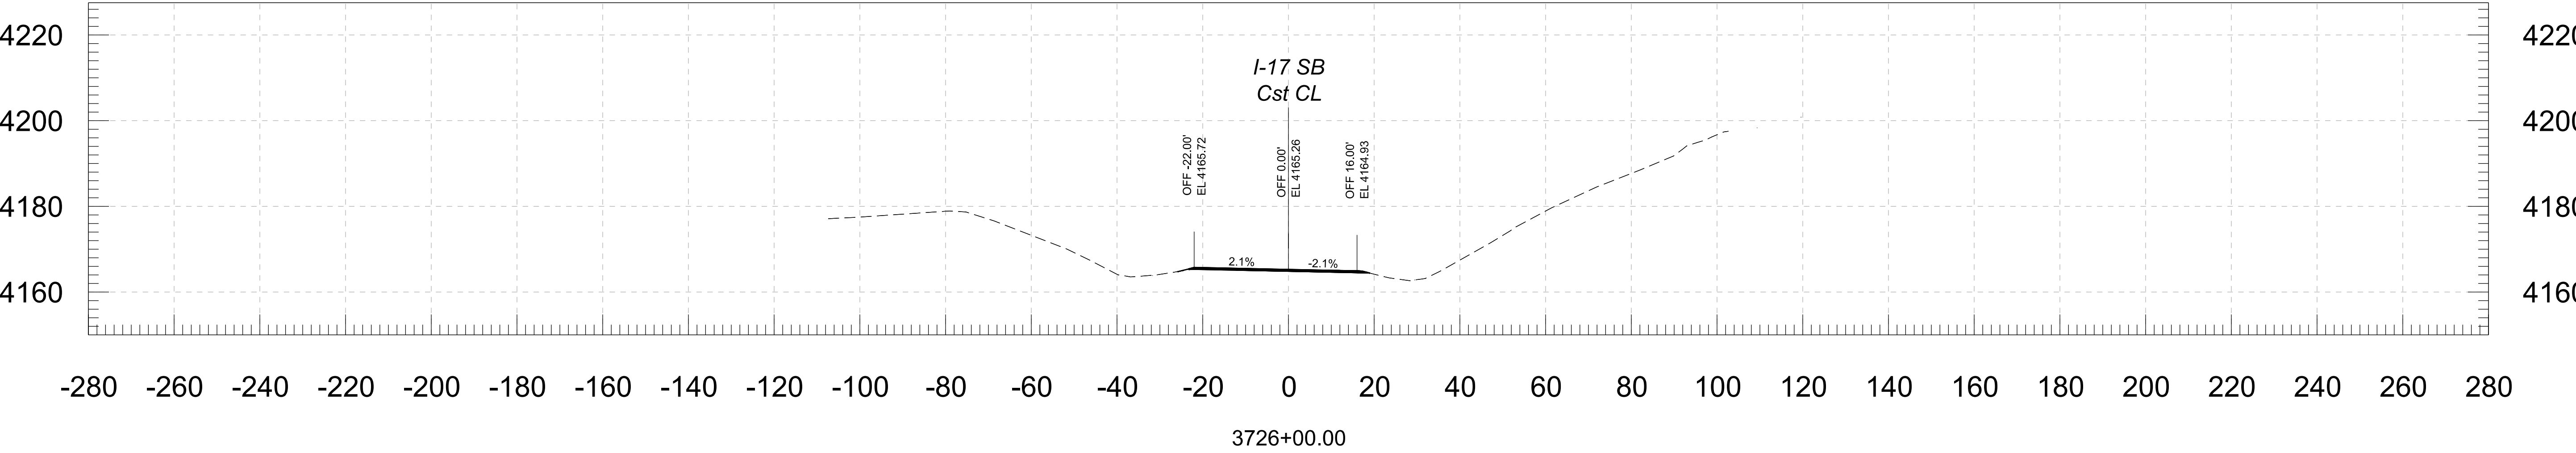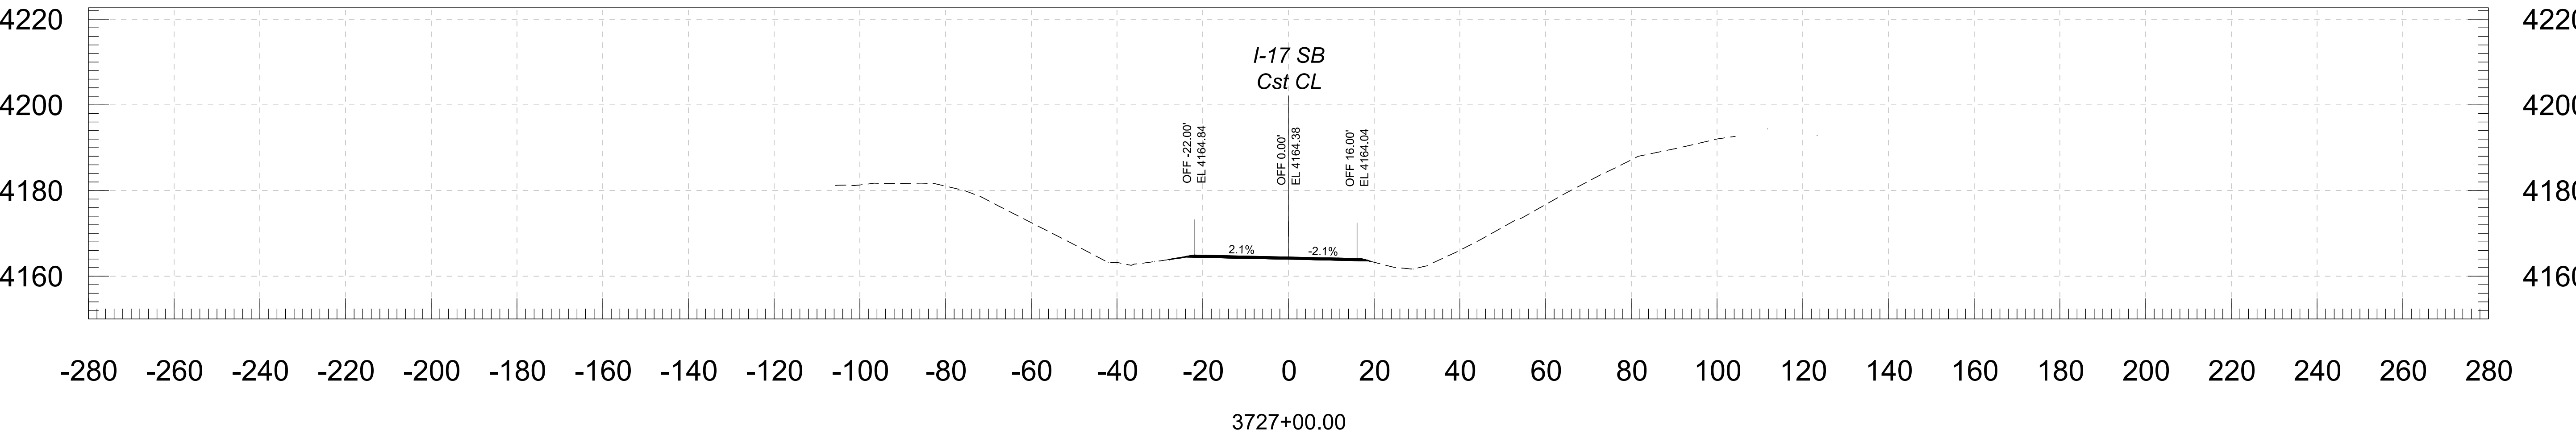


					ARIZONA DEPARTMENT OF TRANSPORTATION PROJECT DELIVERY AND OPERATIONS DIVISION ROADWAY DESIGN SERVICES		F.H.W.A. Arizona Division		STATE	PROJECT NO.	FEDERAL ID NO.	SHEET NO.	TOTAL SHEETS	RECORD DRAWING
		DESIGN	BAP	06/26					ARIZ.	017 YV 269	017-B(239)T	63	146	
		DRAWN	RM	06/26					E DUGAS ROAD - MP 275					DWG NO.
		CHECKED	KCH	06/26					TRACS NO. F0616 01C					____ OF ____
						CROSS SECTION								




 3133 East Camelback Road, Suite 100
Phoenix, Arizona 85016
Phone: 1602 333-2200

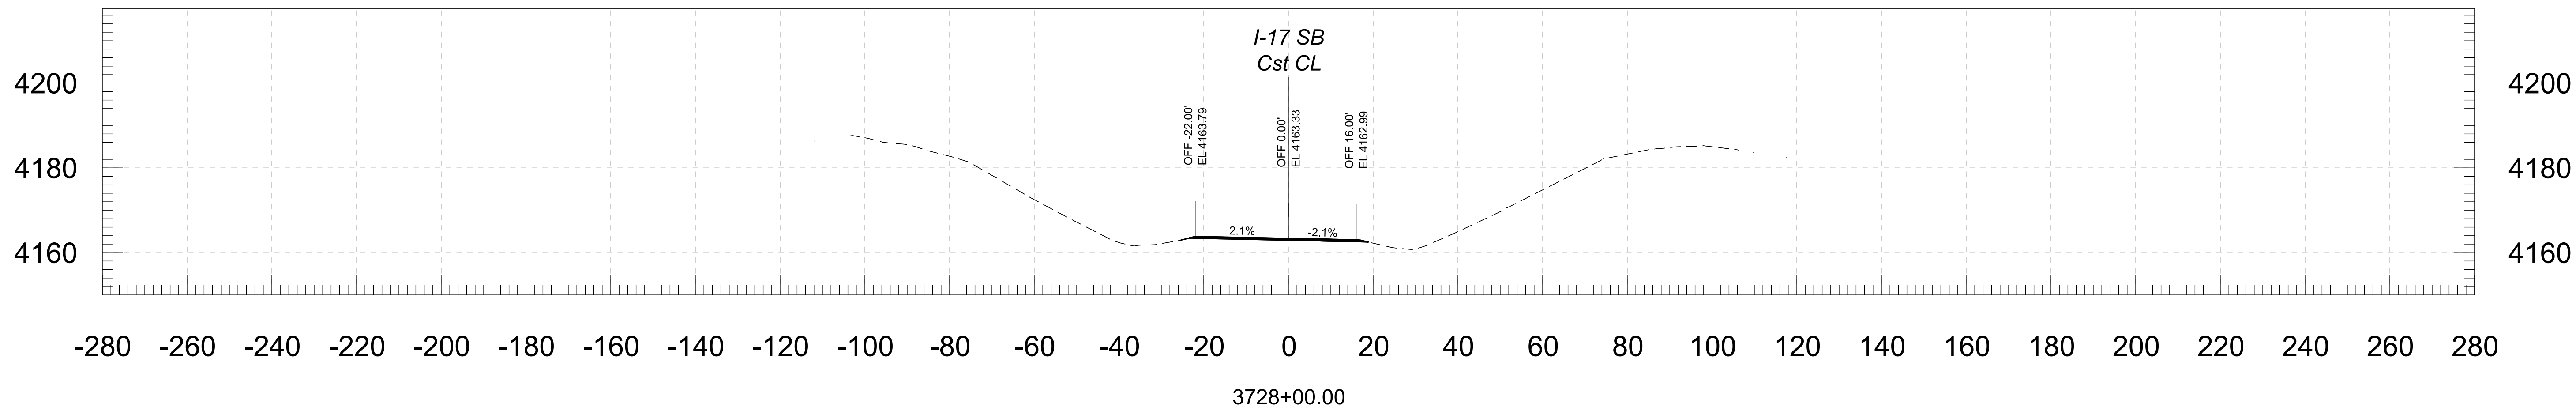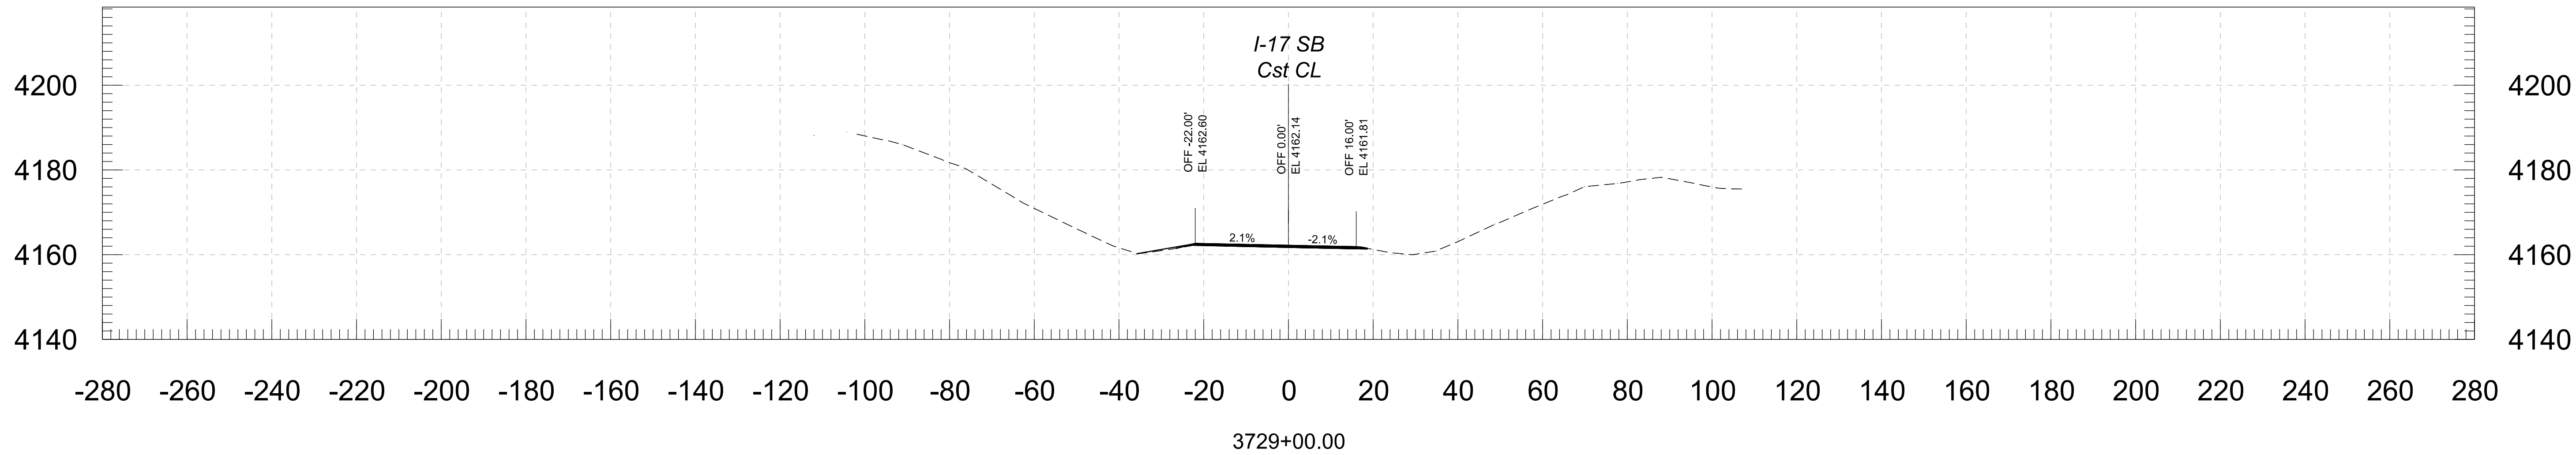


						ARIZONA DEPARTMENT OF TRANSPORTATION PROJECT DELIVERY AND OPERATIONS DIVISION ROADWAY DESIGN SERVICES			F.H.W.A. Arizona Division		STATE	PROJECT NO.	FEDERAL ID NO.	SHEET NO.	TOTAL SHEETS	RECORD DRAWING
			DESIGN	BAP	06/26						ARIZ.	017 YV 269	017-B(239)T	64	146	
			DRAWN	RM	06/26						E DUGAS ROAD - MP 275					DWG NO.
			CHECKED	KCH	06/26											____ OF ____
						CROSS SECTION			TRACS NO. F0616 01C							

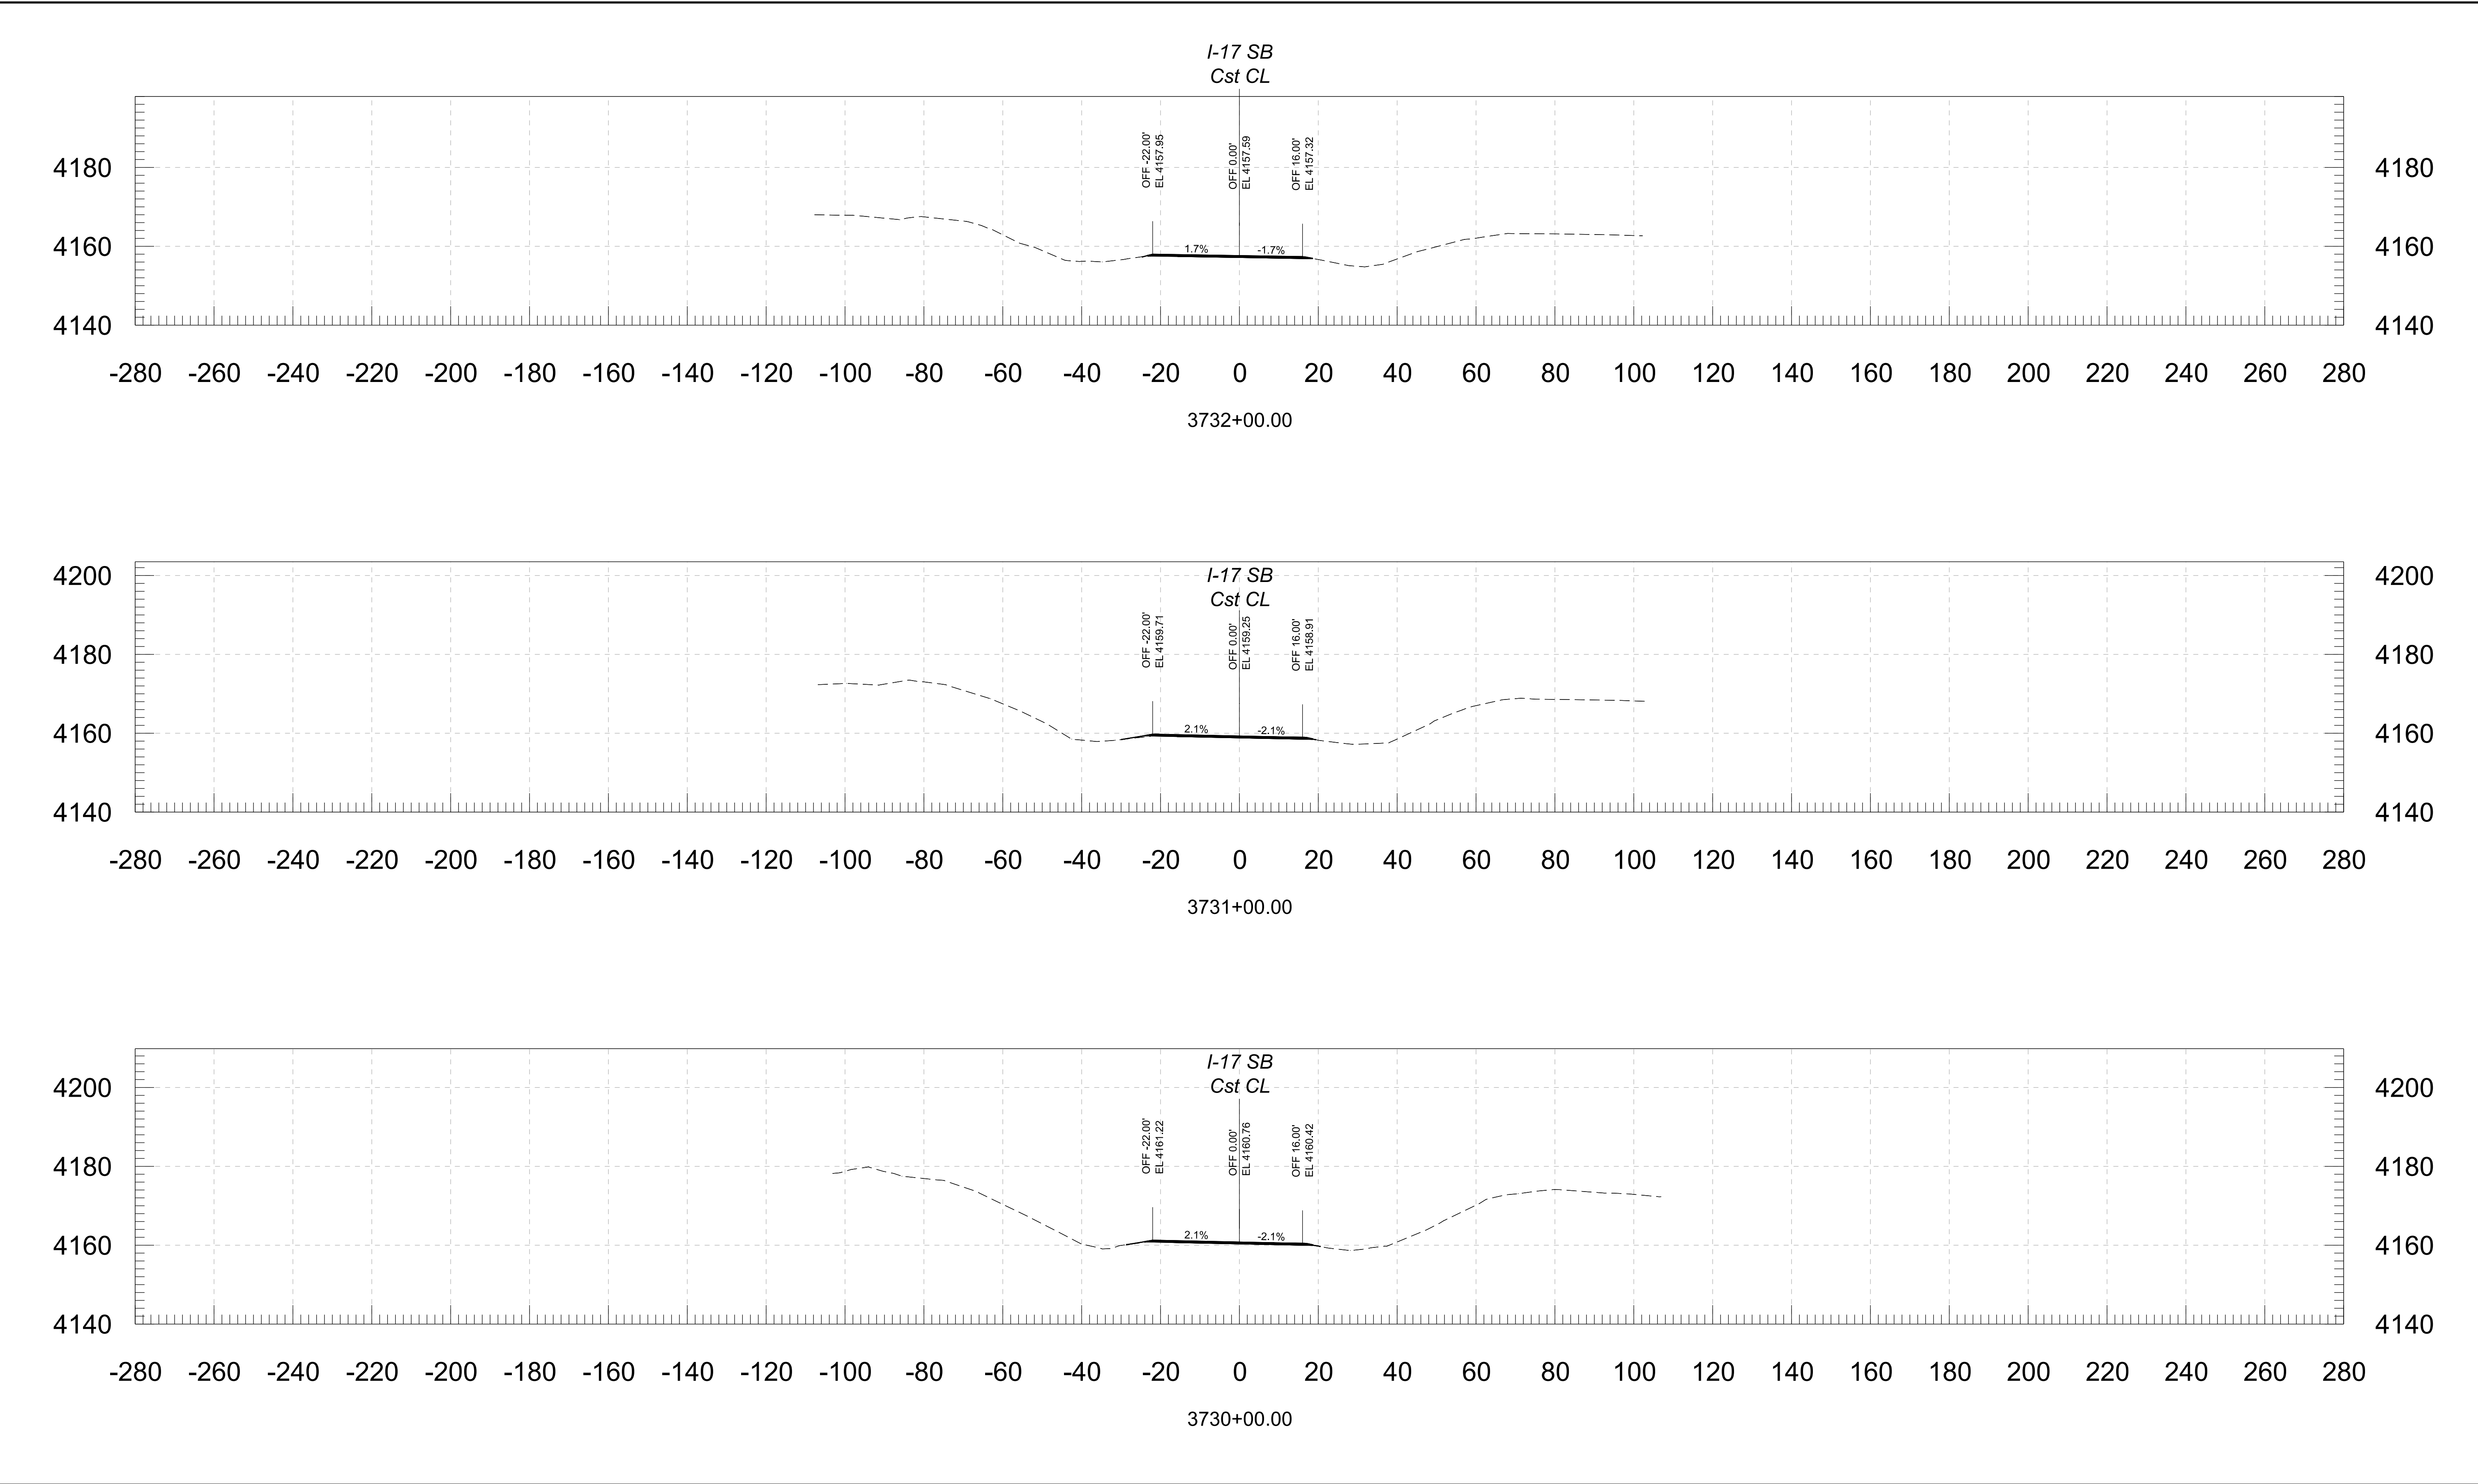




				NAME	DATE	ARIZONA DEPARTMENT OF TRANSPORTATION PROJECT DELIVERY AND OPERATIONS DIVISION ROADWAY DESIGN SERVICES	ROUTE	F.H.W.A. Arizona Division	STATE ARIZ.	PROJECT NO.	FEDERAL ID NO.	SHEET NO.	TOTAL SHEETS	RECORD DRAWING
			DESIGN	BAP	06/26		I-17			017 YV 269	017-B(239)T	65	146	
			DRAWN	RM	06/26									
			CHECKED	KCH	06/26									
			 3133 East Camelback Road, Suite 100 Phoenix, Arizona 85016 Phone: 602.333-2200 Stanley Consultants INC.											
			TRACS NO. F0616 01C		____ OF ____									

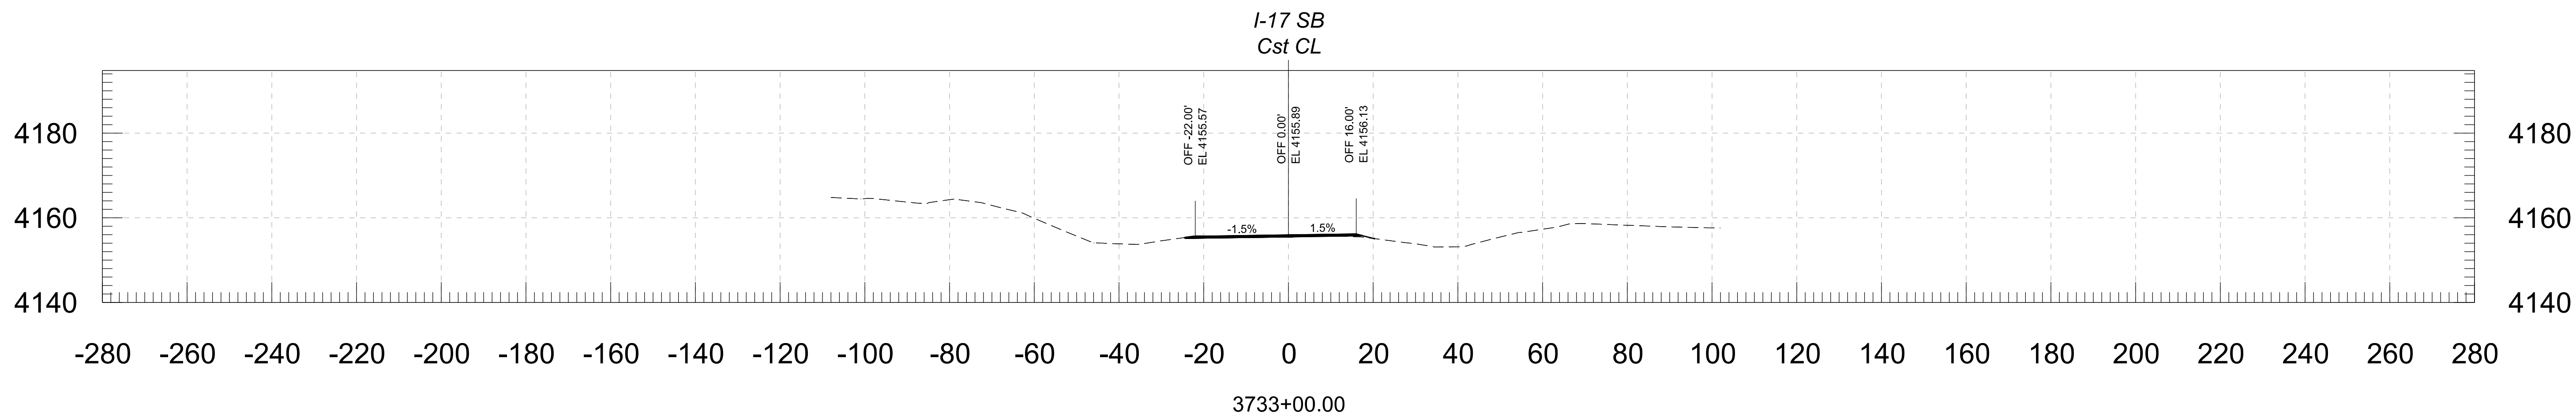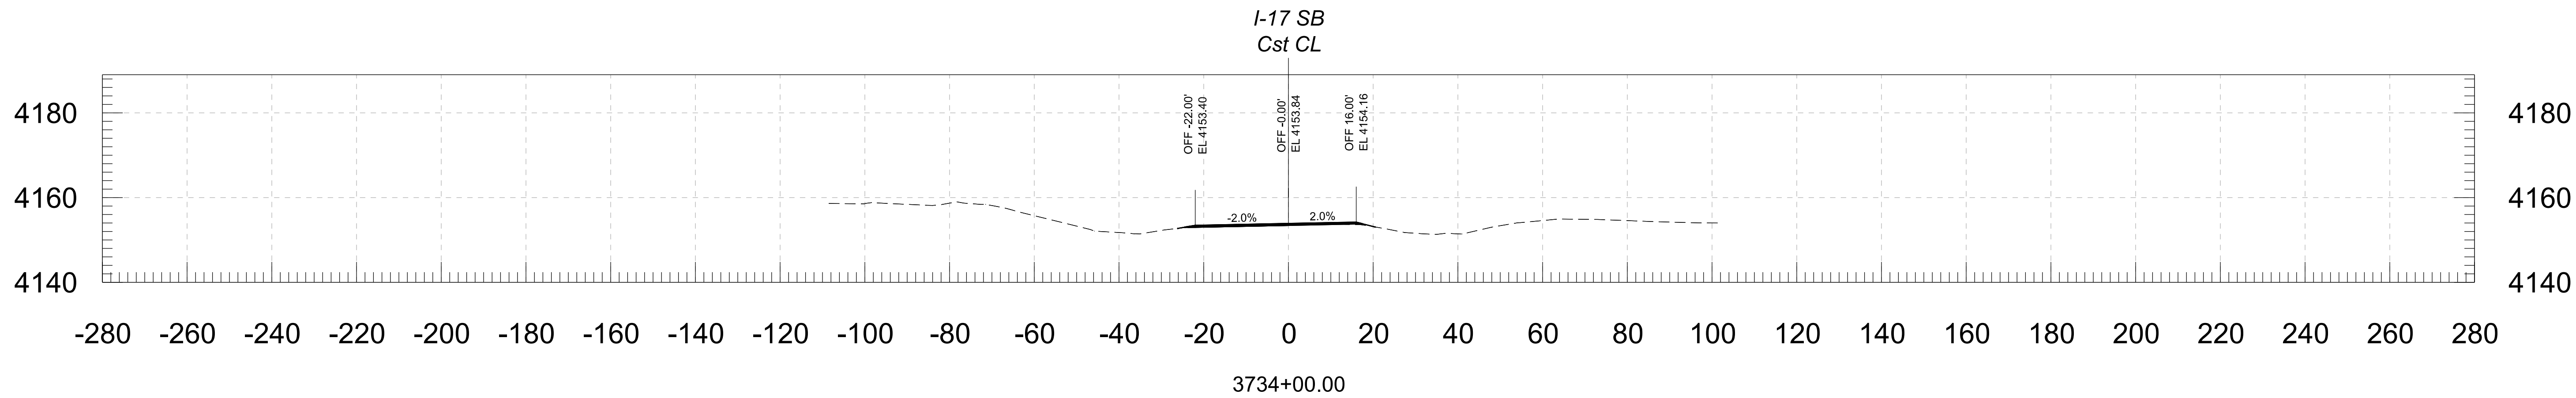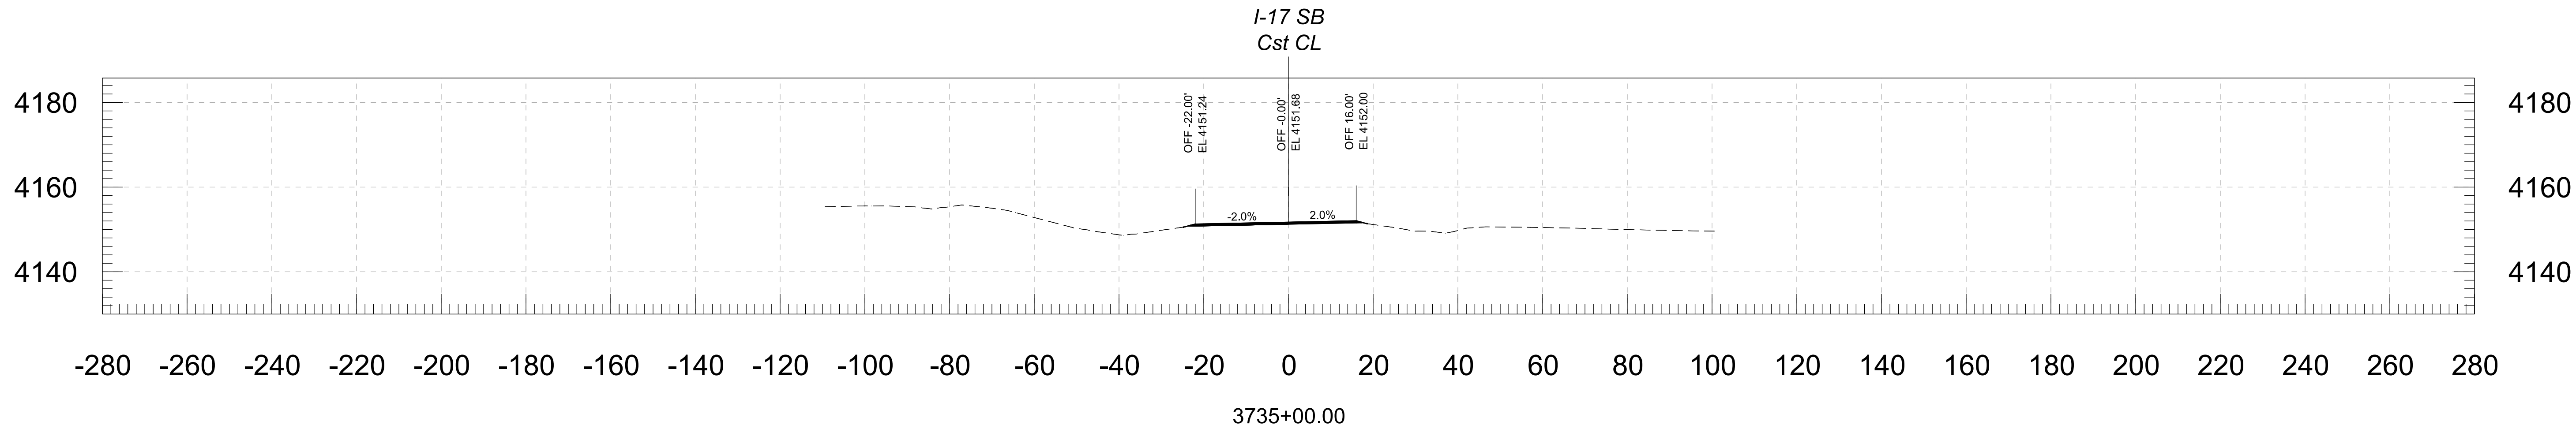


				NAME	DATE	ARIZONA DEPARTMENT OF TRANSPORTATION PROJECT DELIVERY AND OPERATIONS DIVISION ROADWAY DESIGN SERVICES	ROUTE	F.H.W.A. Arizona Division	STATE	PROJECT NO.	FEDERAL ID NO.	SHEET NO.	TOTAL SHEETS	RECORD DRAWING
			DESIGN	BAP	06/26		I-17			ARIZ.	017 YV 269	017-B(239)T	66	
			DRAWN	RM	06/26		MILEPOST							
			CHECKED	KCH	06/26		STRUCTURE NO.	E DUGAS ROAD - MP 275				DWG NO.		
			 3133 East Camelback Road, Suite 100 Phoenix, Arizona 85016 Phone: 602.335.2000 Stanley Consultants INC.					CROSS SECTION			TRACS NO. F0616 01C		____ OF ____	

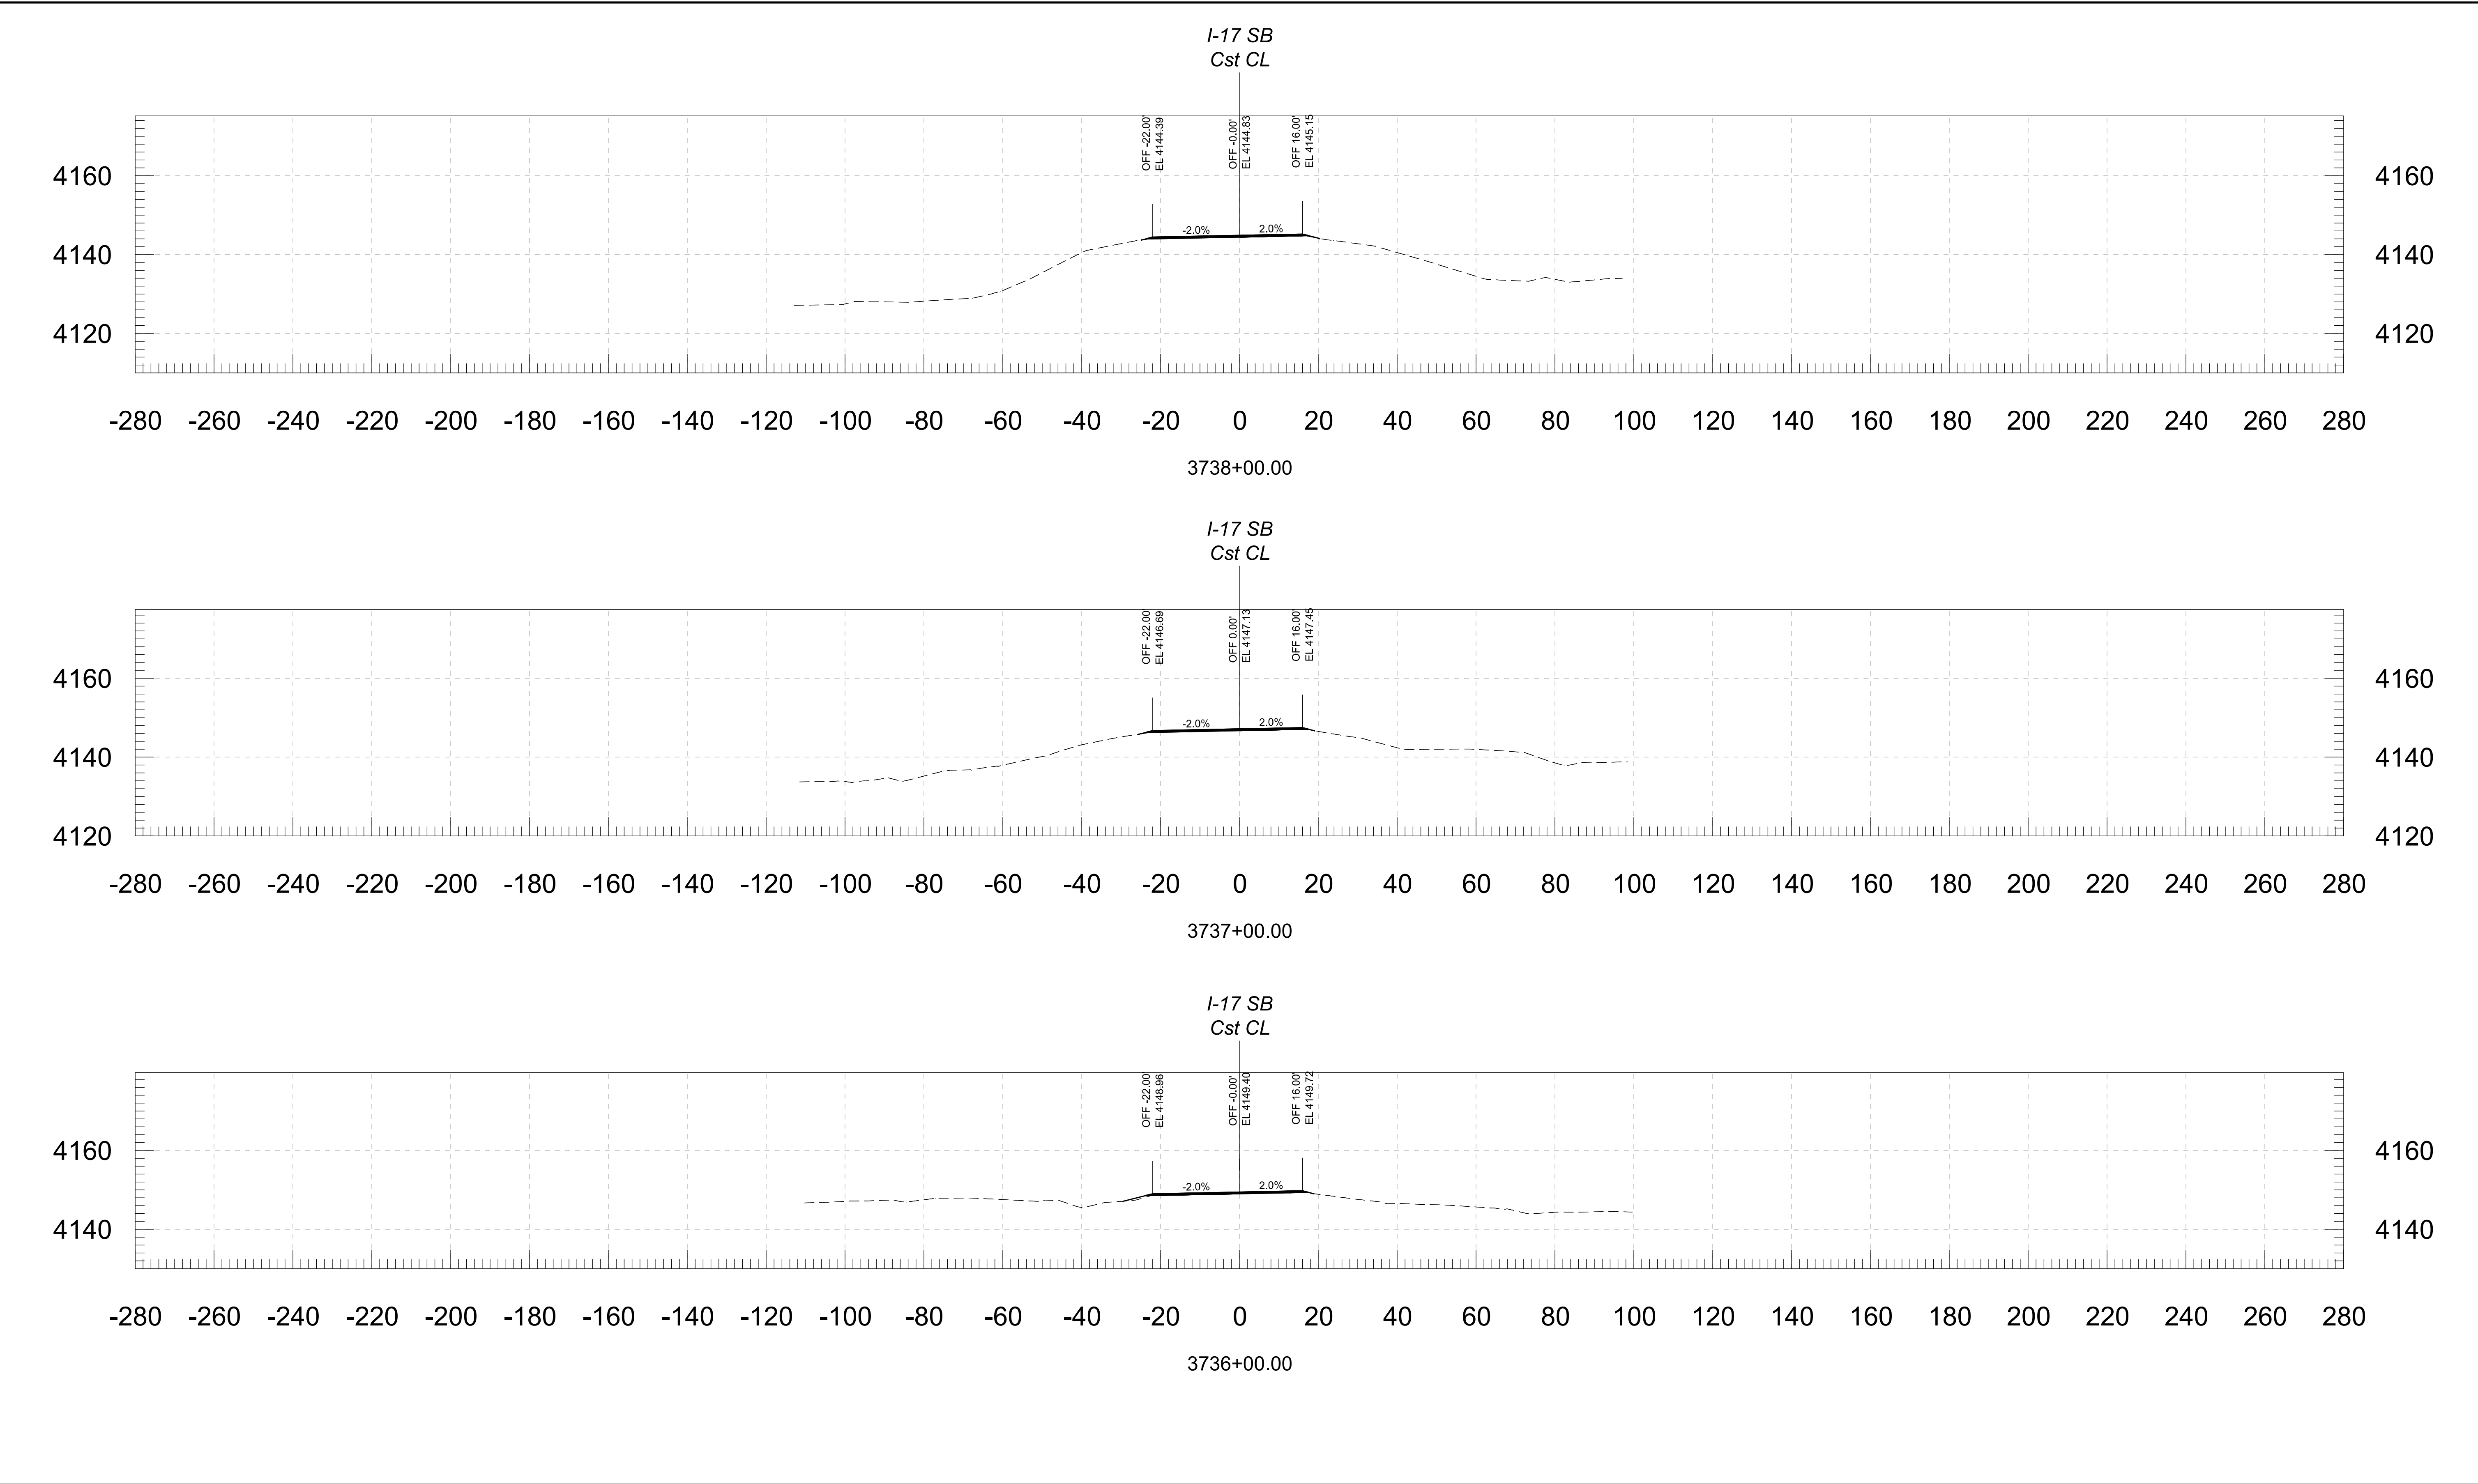 



			NAME	DATE	ARIZONA DEPARTMENT OF TRANSPORTATION PROJECT DELIVERY AND OPERATIONS DIVISION ROADWAY DESIGN SERVICES	ROUTE	F.H.W.A. Arizona Division	STATE ARIZ.	PROJECT NO.	FEDERAL ID NO.	SHEET NO.	TOTAL SHEETS	RECORD DRAWING
		DESIGN	BAP	06/26		I-17			017 YV 269	017-B(239)T	67	146	
		DRAWN	RM	06/26									
		CHECKED	KCH	06/26									
		 3133 East Camelback Road, Suite 100 Phoenix, Arizona 85016 Phone: (602) 333-2200 Stanley Consultants INC.					CROSS SECTION	MILEPOST	E DUGAS ROAD - MP 275				
					STRUCTURE NO.	TRACS NO. F0616 01C					___ OF ___		

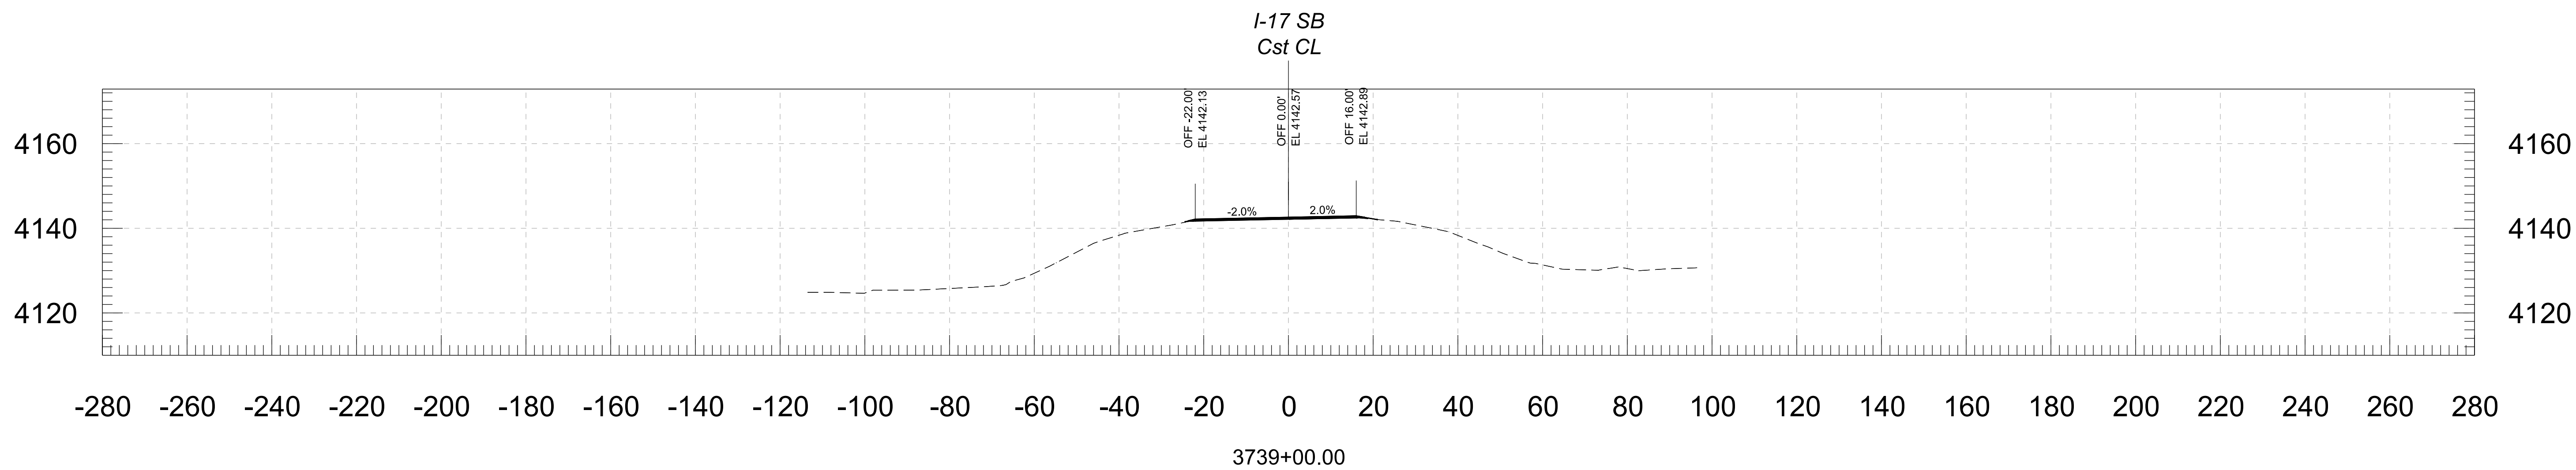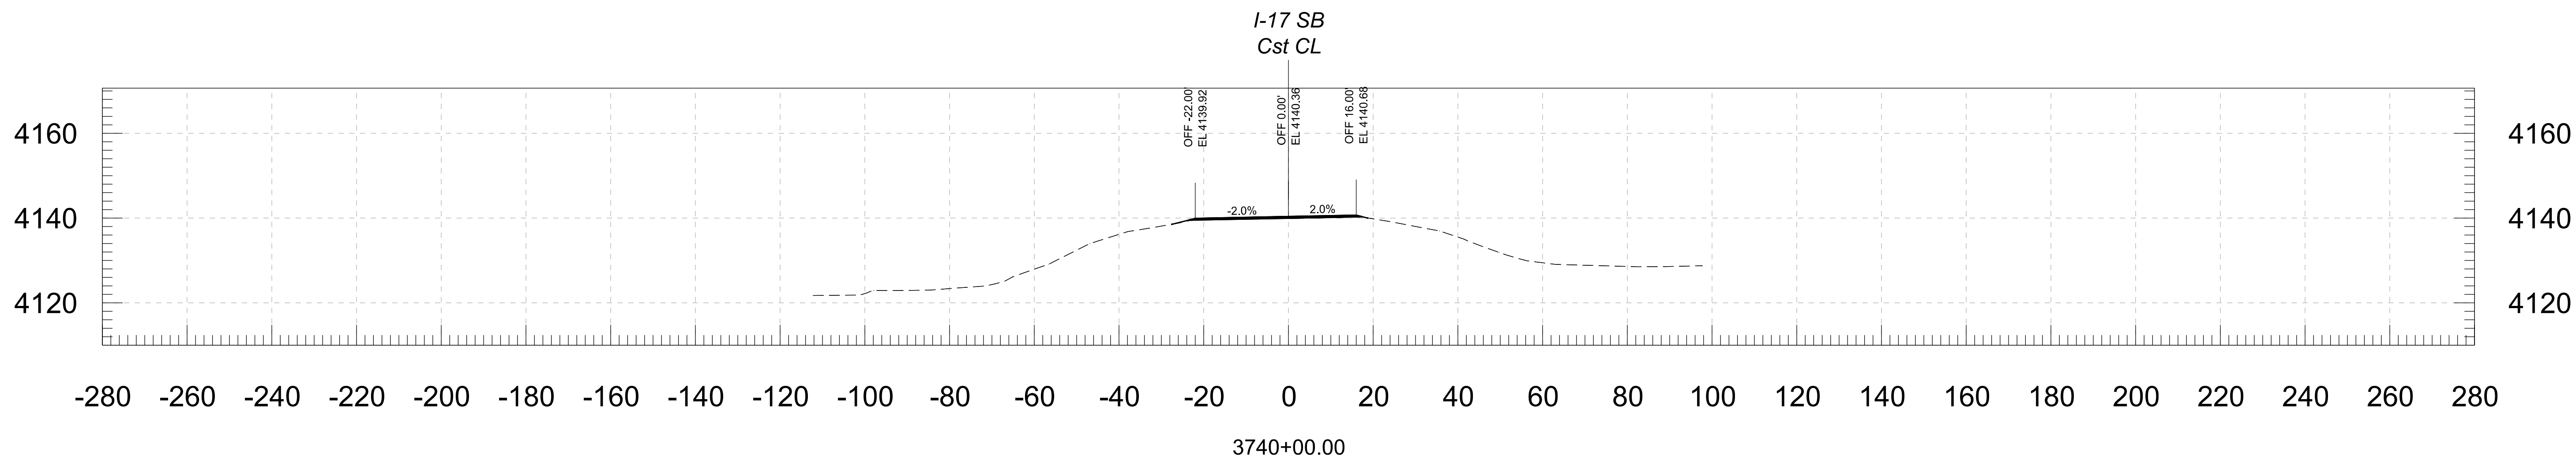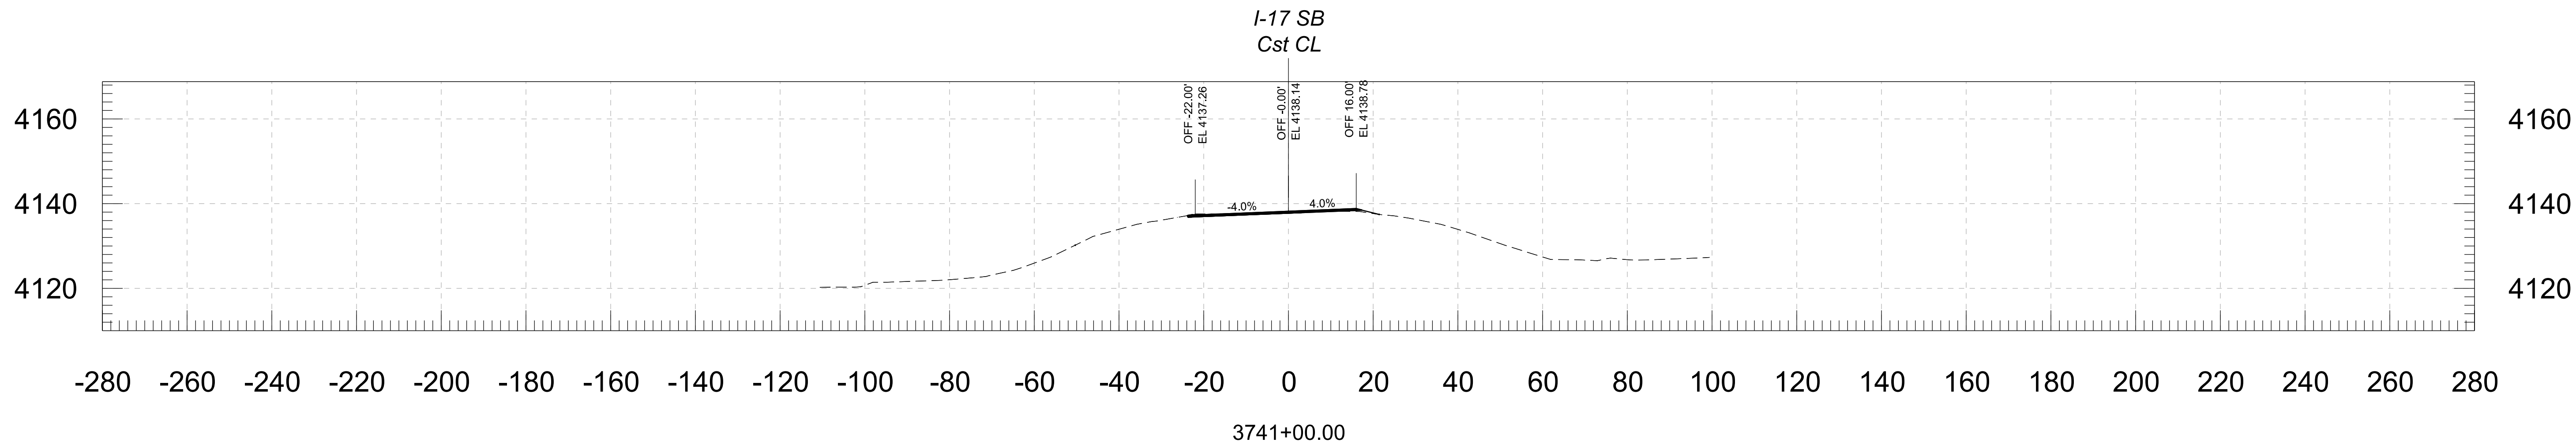




			NAME	DATE	ARIZONA DEPARTMENT OF TRANSPORTATION PROJECT DELIVERY AND OPERATIONS DIVISION ROADWAY DESIGN SERVICES	ROUTE	F.H.W.A. Arizona Division	STATE	PROJECT NO.	FEDERAL ID NO.	SHEET NO.	TOTAL SHEETS	RECORD DRAWING	
		DESIGN	BAP	06/26		I-17			ARIZ.	017 YV 269	017-B(239)T	68		146
		DRAWN	RM	06/26			MILEPOST	LOCATION					DWG NO.	
		CHECKED	KCH	06/26				STRUCTURE NO.	E DUGAS ROAD - MP 275					
		 Stanley Consultants INC.			3133 East Camelback Road, Suite 100 Phoenix, Arizona 85016 Phone 602. 333-2000				CROSS SECTION					TRACS NO. F0616 01C

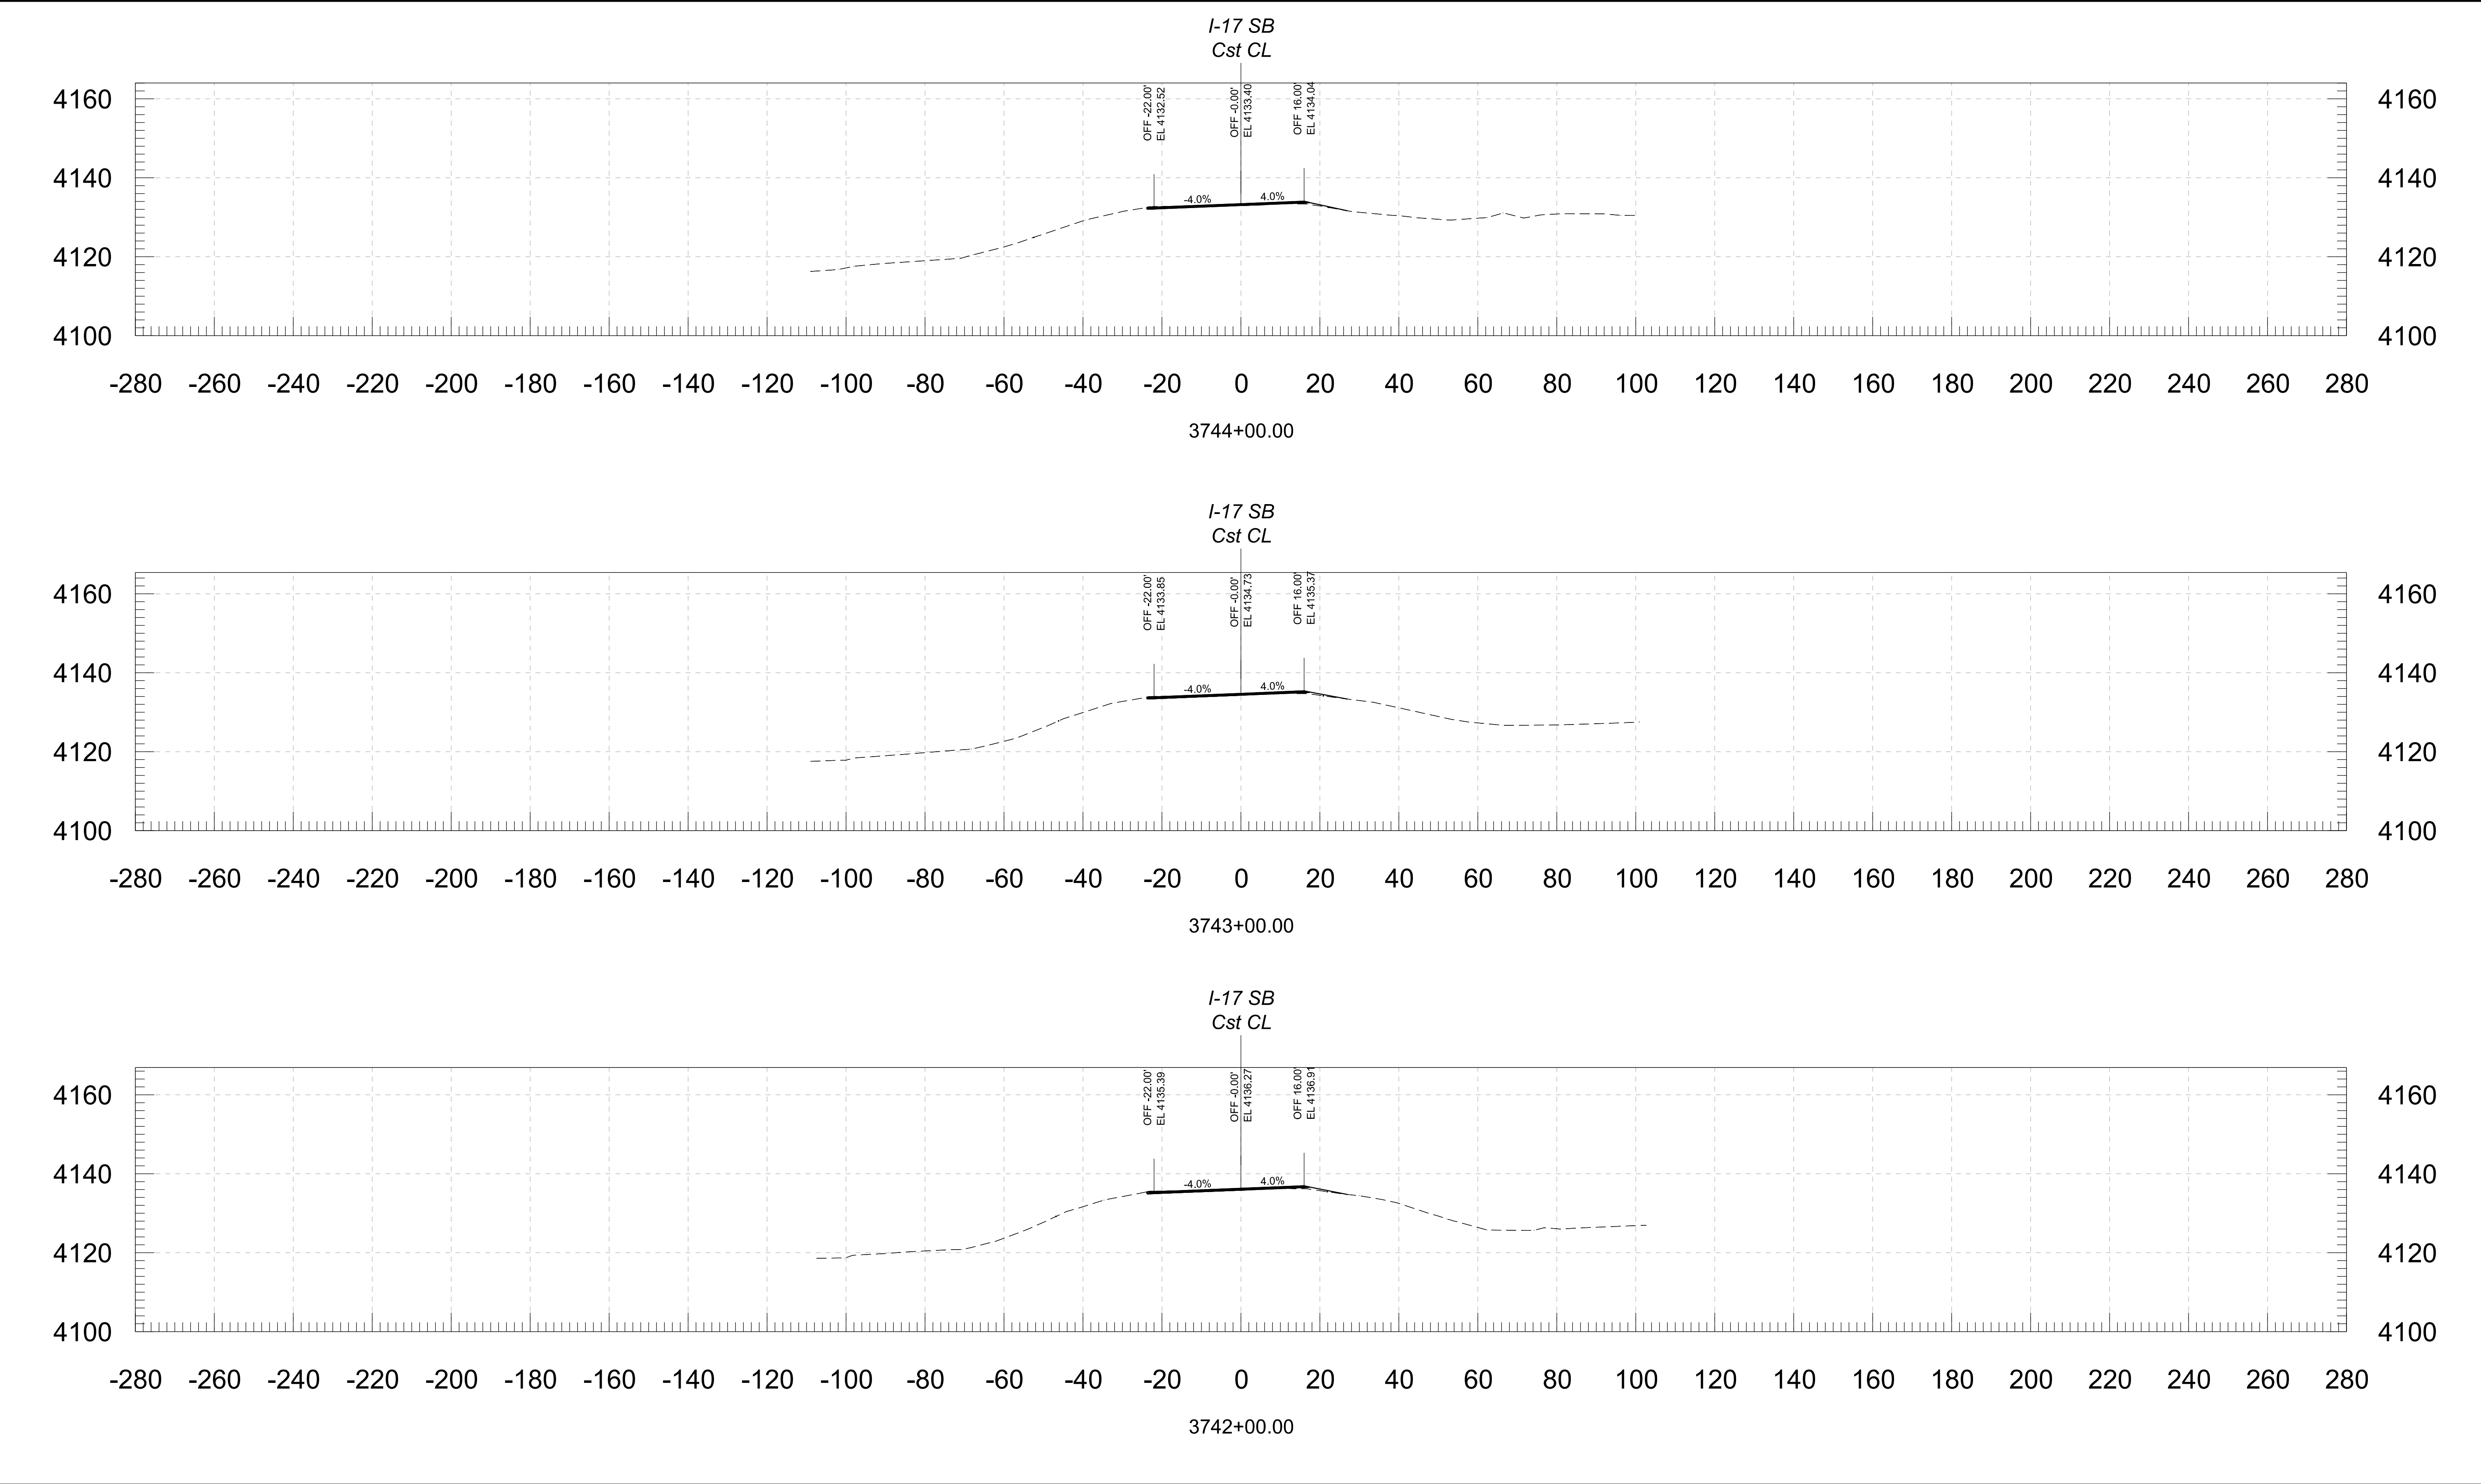


			NAME	DATE	ARIZONA DEPARTMENT OF TRANSPORTATION PROJECT DELIVERY AND OPERATIONS DIVISION ROADWAY DESIGN SERVICES	ROUTE	F.H.W.A. Arizona Division	STATE ARIZ.	PROJECT NO.	FEDERAL ID NO.	SHEET NO.	TOTAL SHEETS	RECORD DRAWING
		DESIGN	BAP	06/26		I-17			017 YV 269	017-B(239)T	69	146	
		DRAWN	RM	06/26			MILEPOST	LOCATION					DWG NO.
		CHECKED	KCH	06/26				E DUGAS ROAD - MP 275					
		 Stanley Consultants INC.			3135 East Camelback Road, Suite 100 Phoenix, Arizona 85016 Phone: 602.333-2200			CROSS SECTION	TRACS NO. F0616 01C		____ OF ____		

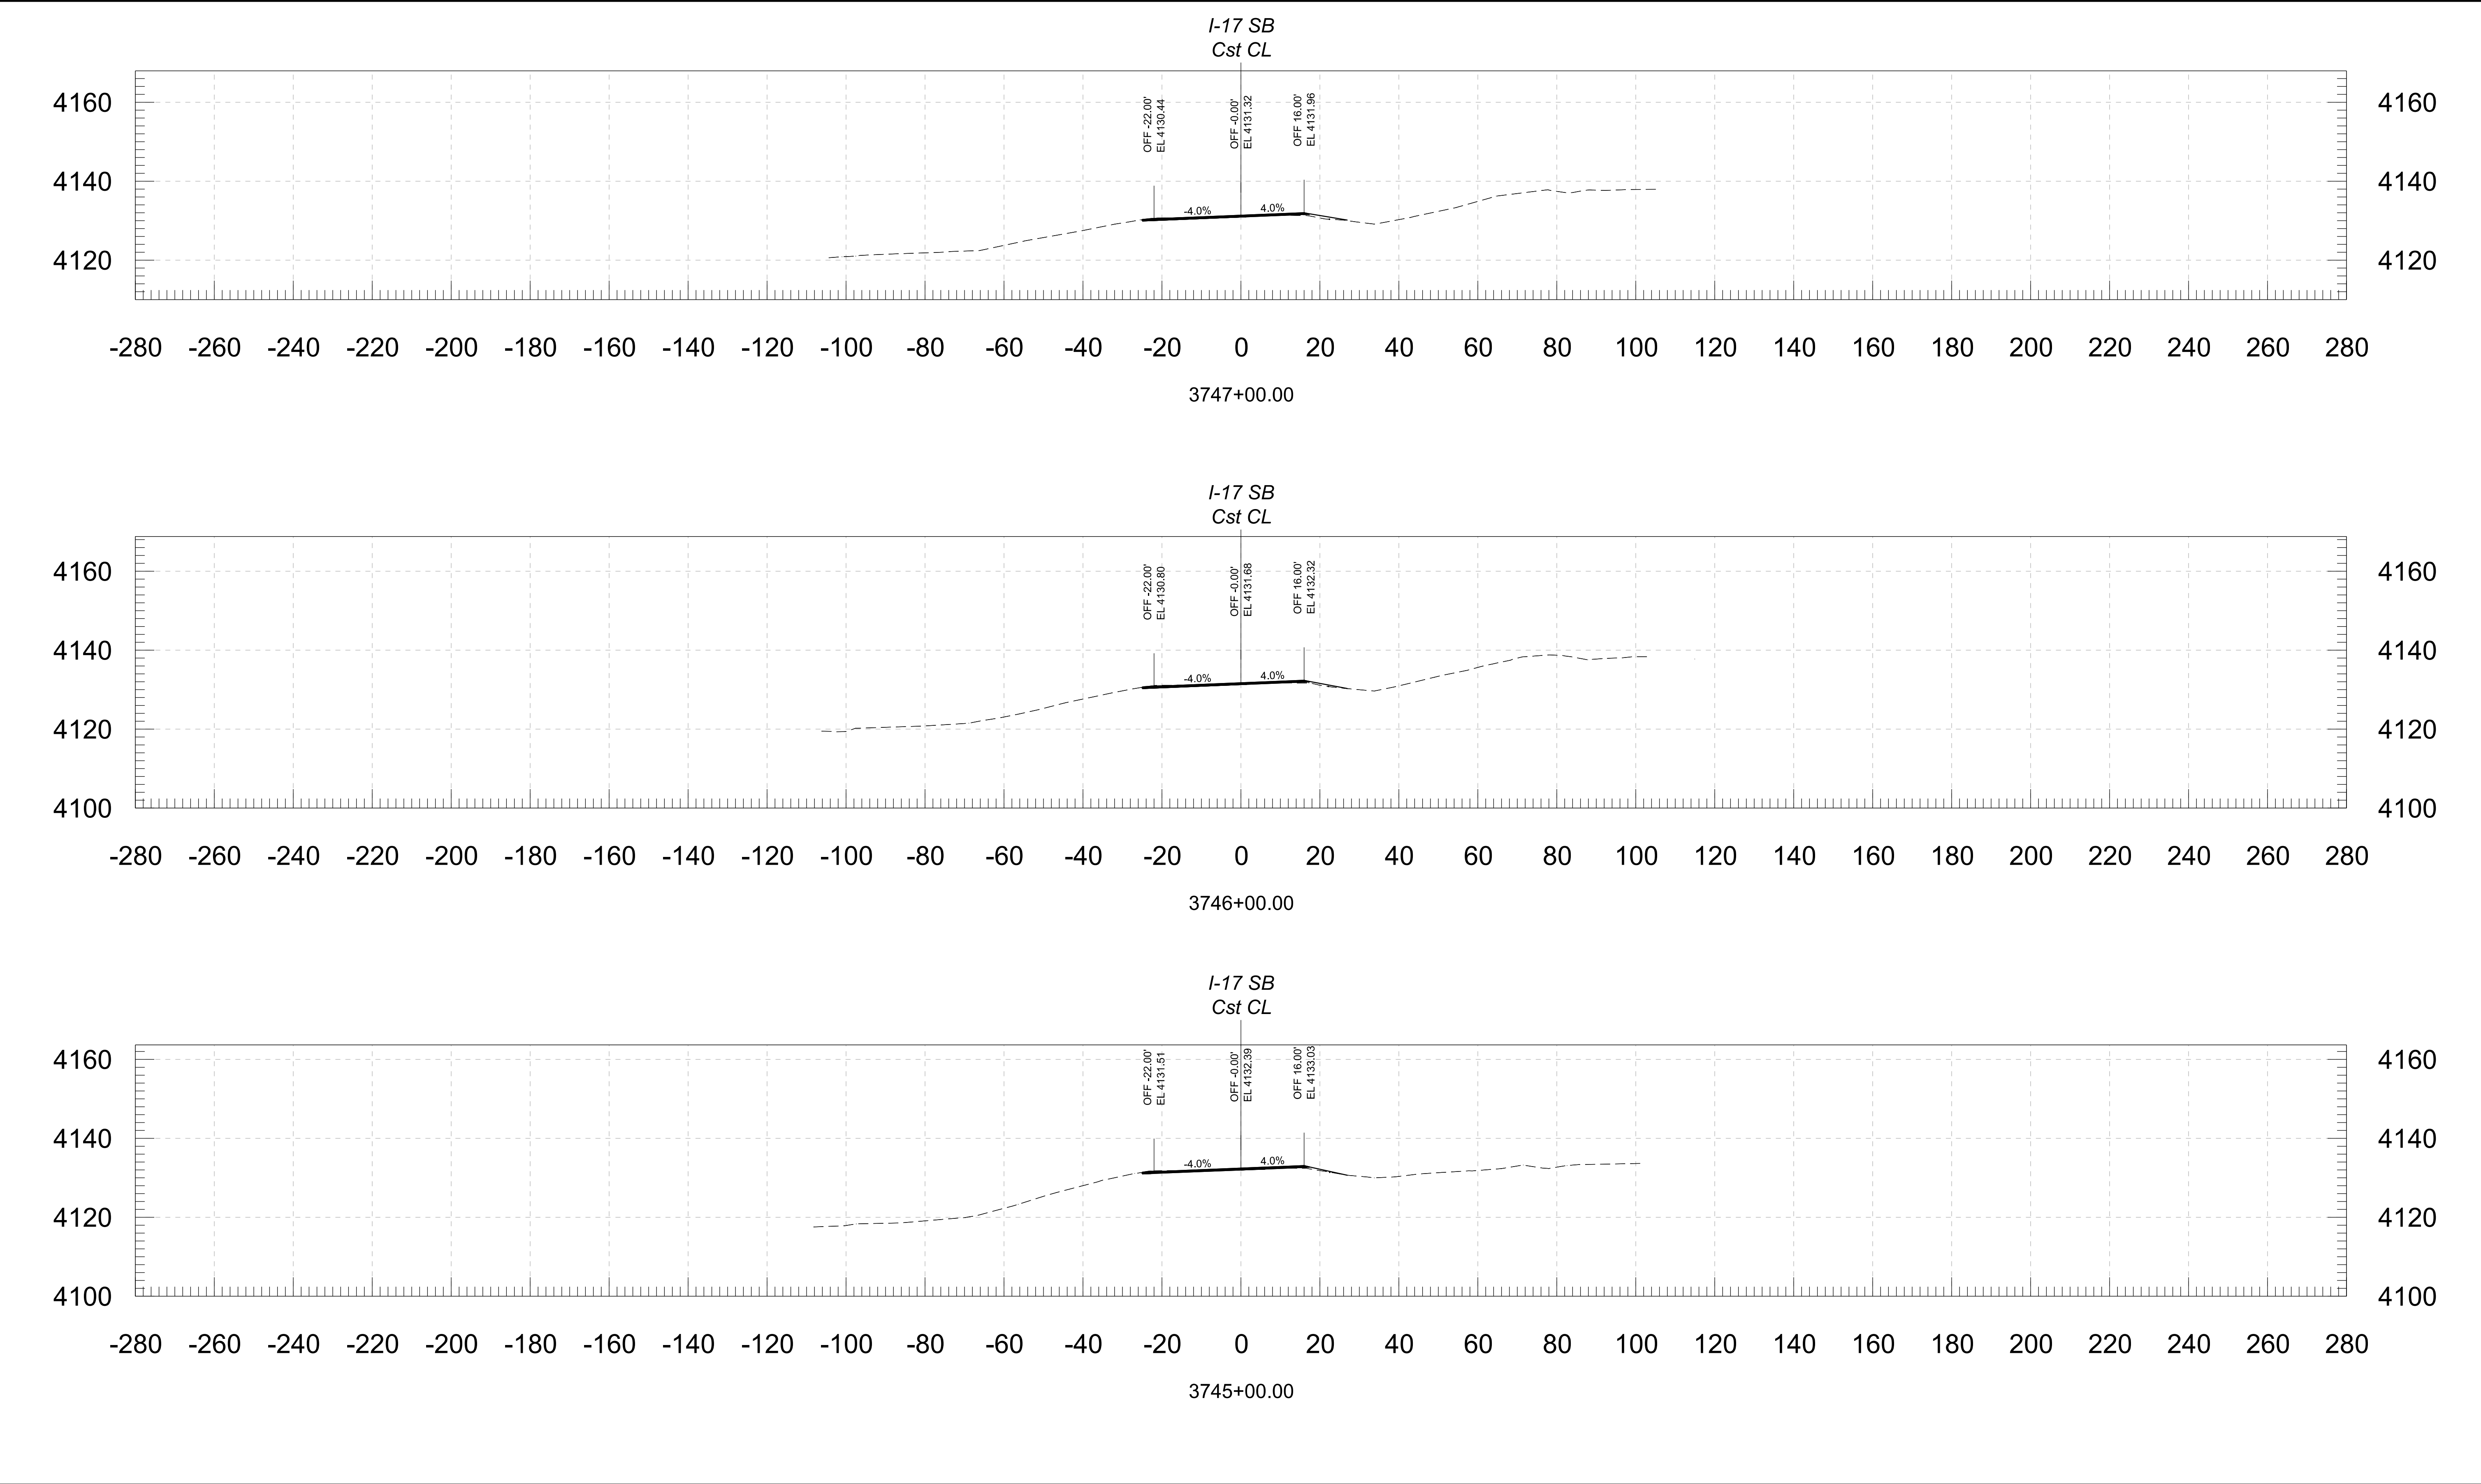


				NAME	DATE	ARIZONA DEPARTMENT OF TRANSPORTATION PROJECT DELIVERY AND OPERATIONS DIVISION ROADWAY DESIGN SERVICES	ROUTE	F.H.W.A. Arizona Division	STATE ARIZ.	PROJECT NO.	FEDERAL ID NO.	SHEET NO.	TOTAL SHEETS	RECORD DRAWING
			DESIGN	BAP	06/26		I-17			017 YV 269	017-B(239)T	70	146	
			DRAWN	RM	06/26									
			CHECKED	KCH	06/26									
			 3133 East Camelback Road, Suite 100 Phoenix, Arizona 85016 Phone: 602.333-2200 Stanley Consultants INC.							MILEPOST	E DUGAS ROAD - MP 275			
STRUCTURE NO.	TRACS NO. F0616 01C							___ OF ___						
CROSS SECTION														

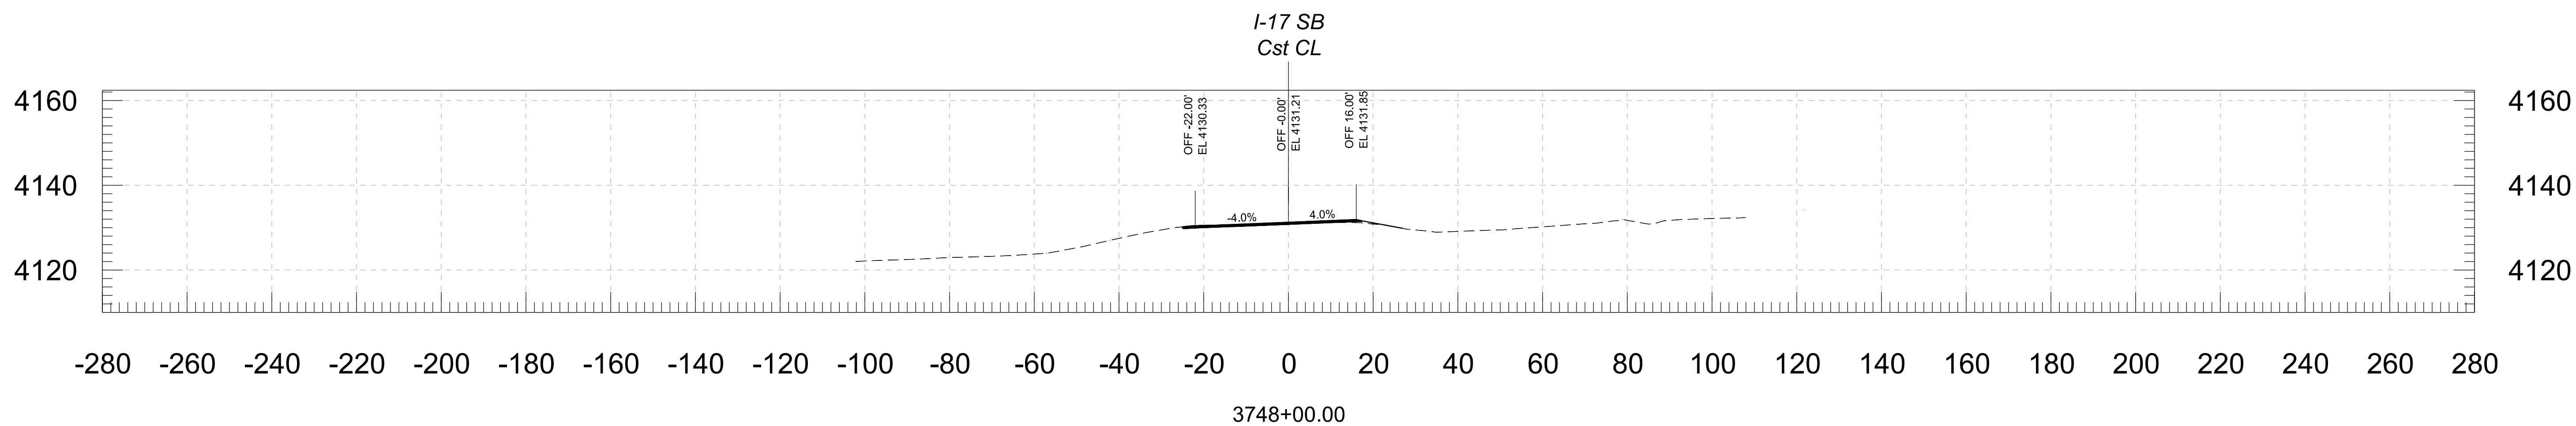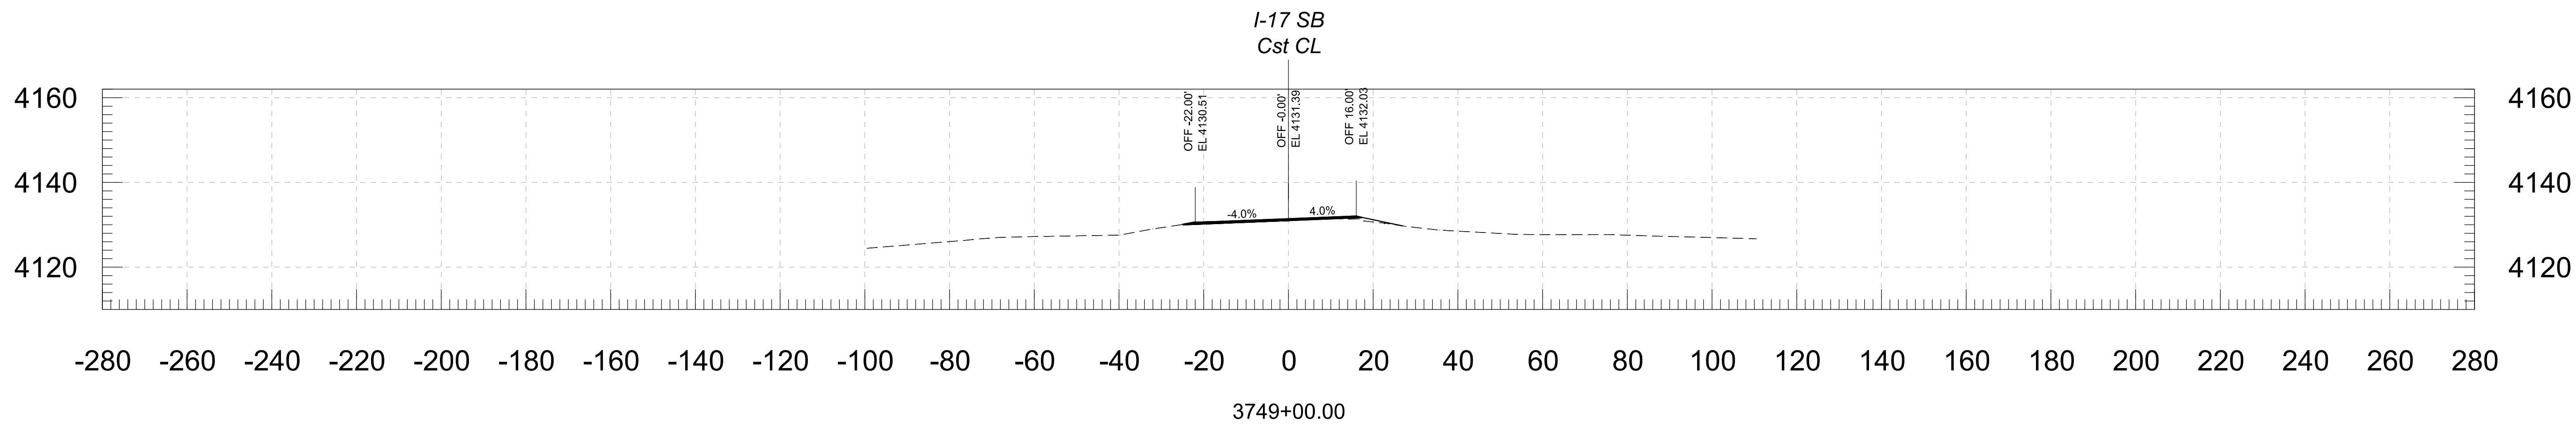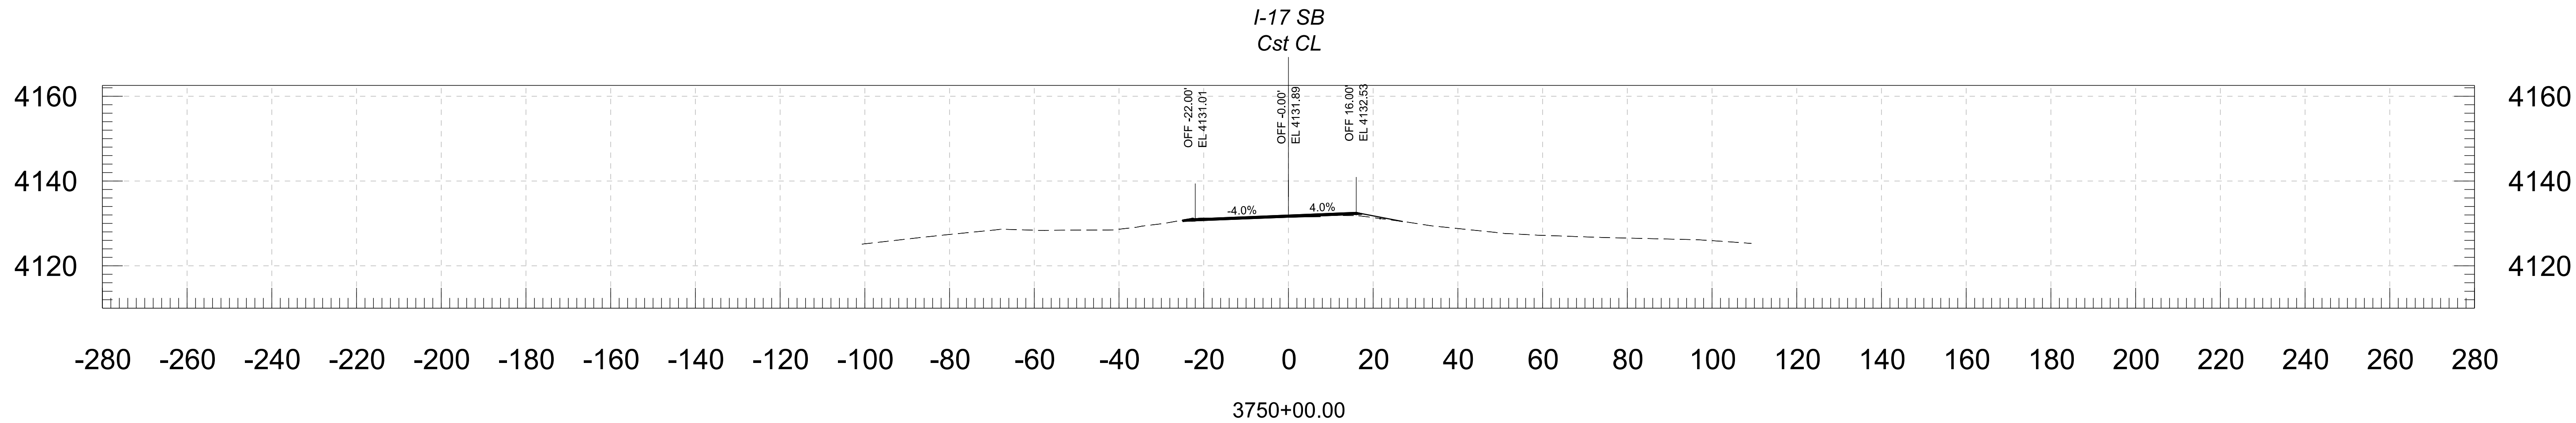


						ARIZONA DEPARTMENT OF TRANSPORTATION PROJECT DELIVERY AND OPERATIONS DIVISION ROADWAY DESIGN SERVICES			ROUTE I-17	F.H.W.A. Arizona Division	STATE ARIZ.	PROJECT NO. 017 YV 269	FEDERAL ID NO. 017-B(239)T	SHEET NO. 71	TOTAL SHEETS 146	RECORD DRAWING
						CROSS SECTION			MILEPOST	E DUGAS ROAD - MP 275					DWG NO.	
									STRUCTURE NO.	TRACS NO. F0616 01C					____ OF ____	

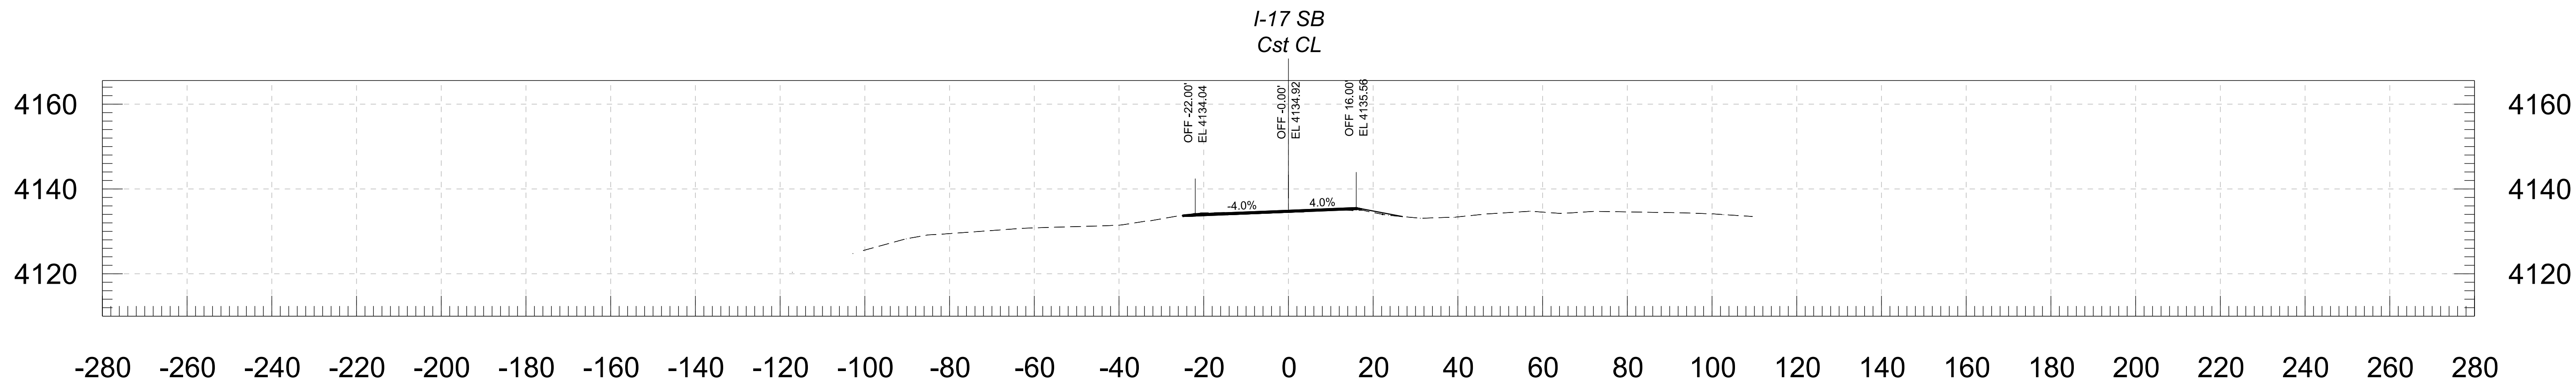

3753+00.00


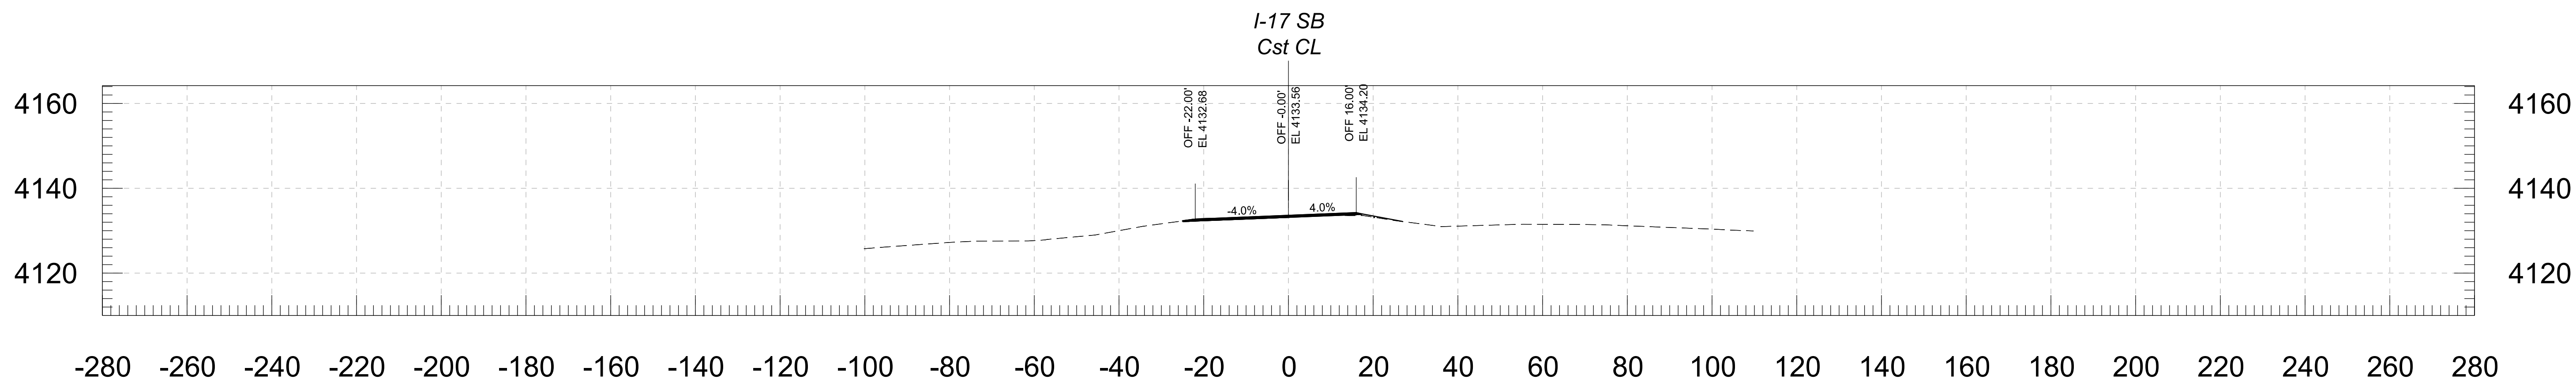


3752+00.00

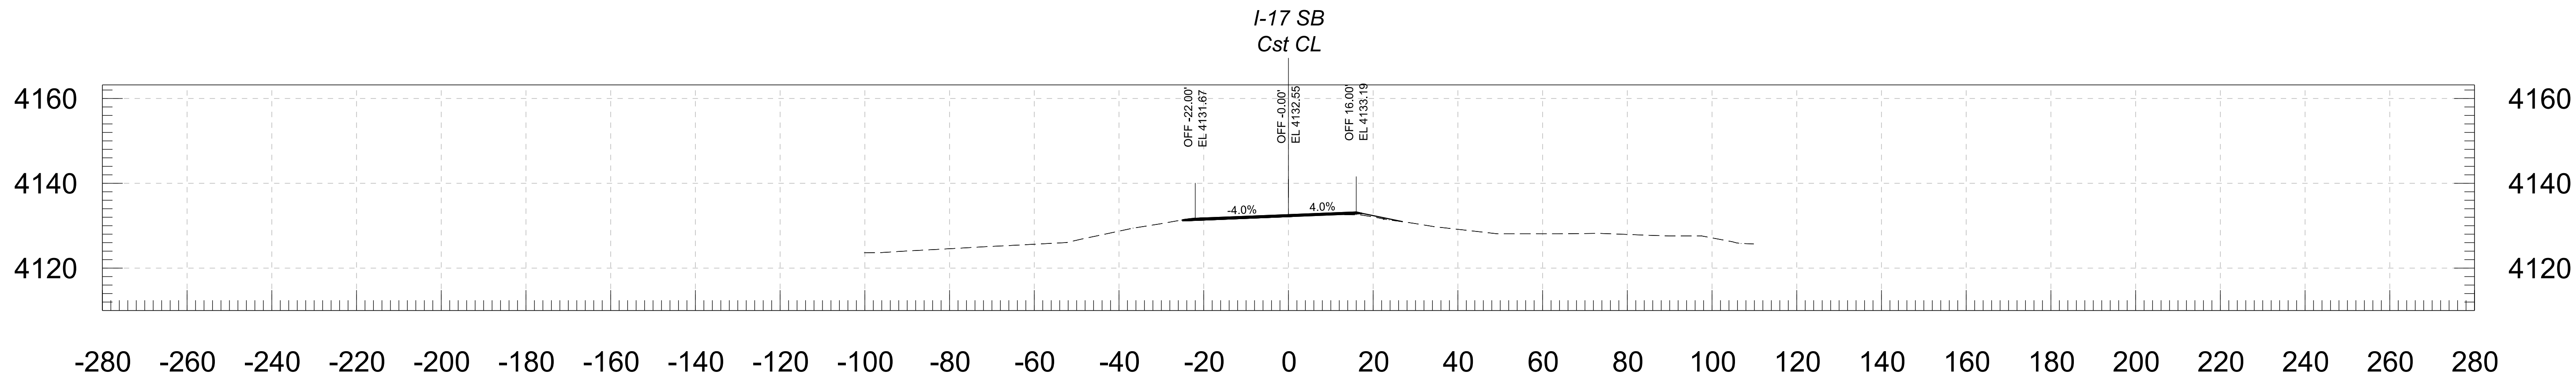


 
3751+00.00




				NAME	DATE	ARIZONA DEPARTMENT OF TRANSPORTATION PROJECT DELIVERY AND OPERATIONS DIVISION ROADWAY DESIGN SERVICES	ROUTE	F.H.W.A. Arizona Division	STATE ARIZ.	PROJECT NO.	FEDERAL ID NO.	SHEET NO.	TOTAL SHEETS	RECORD DRAWING	
			DESIGN	BAP	06/26		I-17								
			DRAWN	RM	06/26						017 YV 269	017-B(239)T	72		146
			CHECKED	KCH	06/26										
			 Stanley Consultants INC. 333 East Camelback Road, Suite 100 Phoenix, Arizona 85016 Phone: 602) 333-2200				CROSS SECTION			MILEPOST	E DUGAS ROAD - MP 275				
						STRUCTURE NO.	TRACS NO. F0616 01C				___ OF ___				

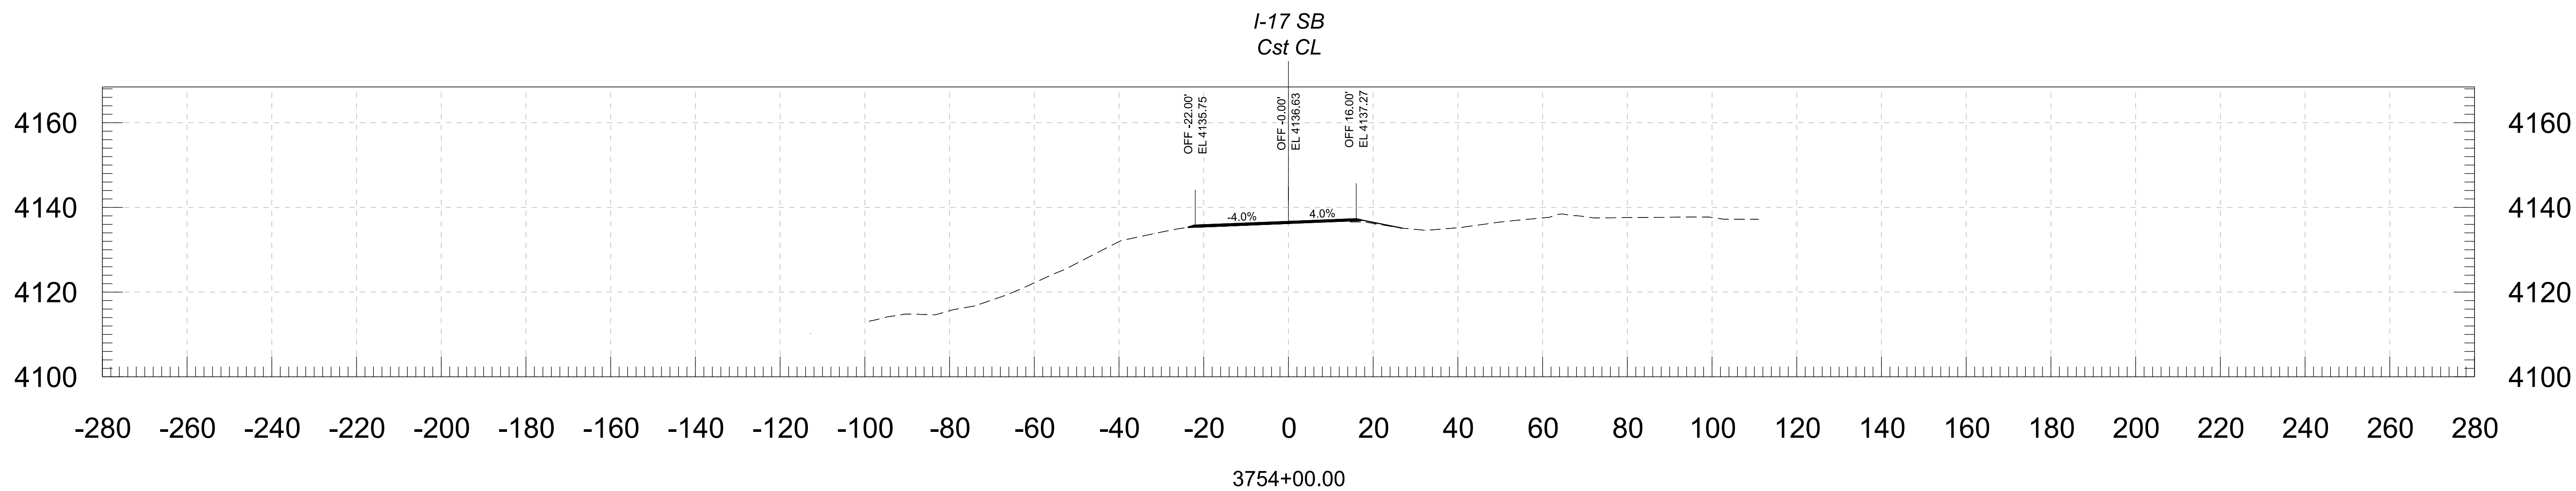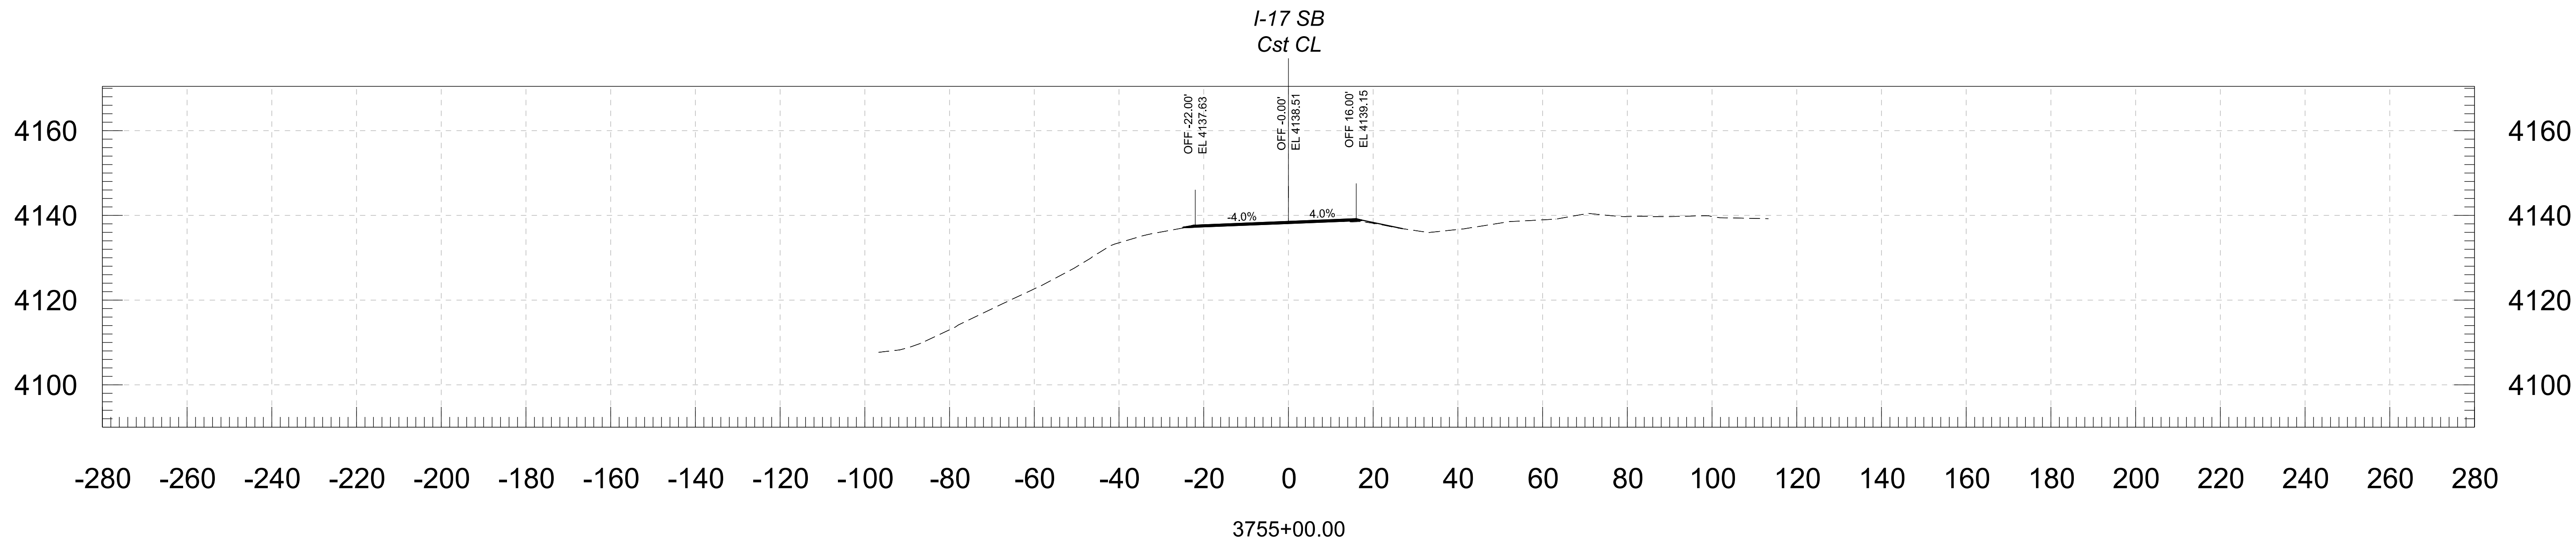


																																																																																																																																																																																																																																																																																																																																																																																																																																																																																																																																																																																																									</
--	--	----

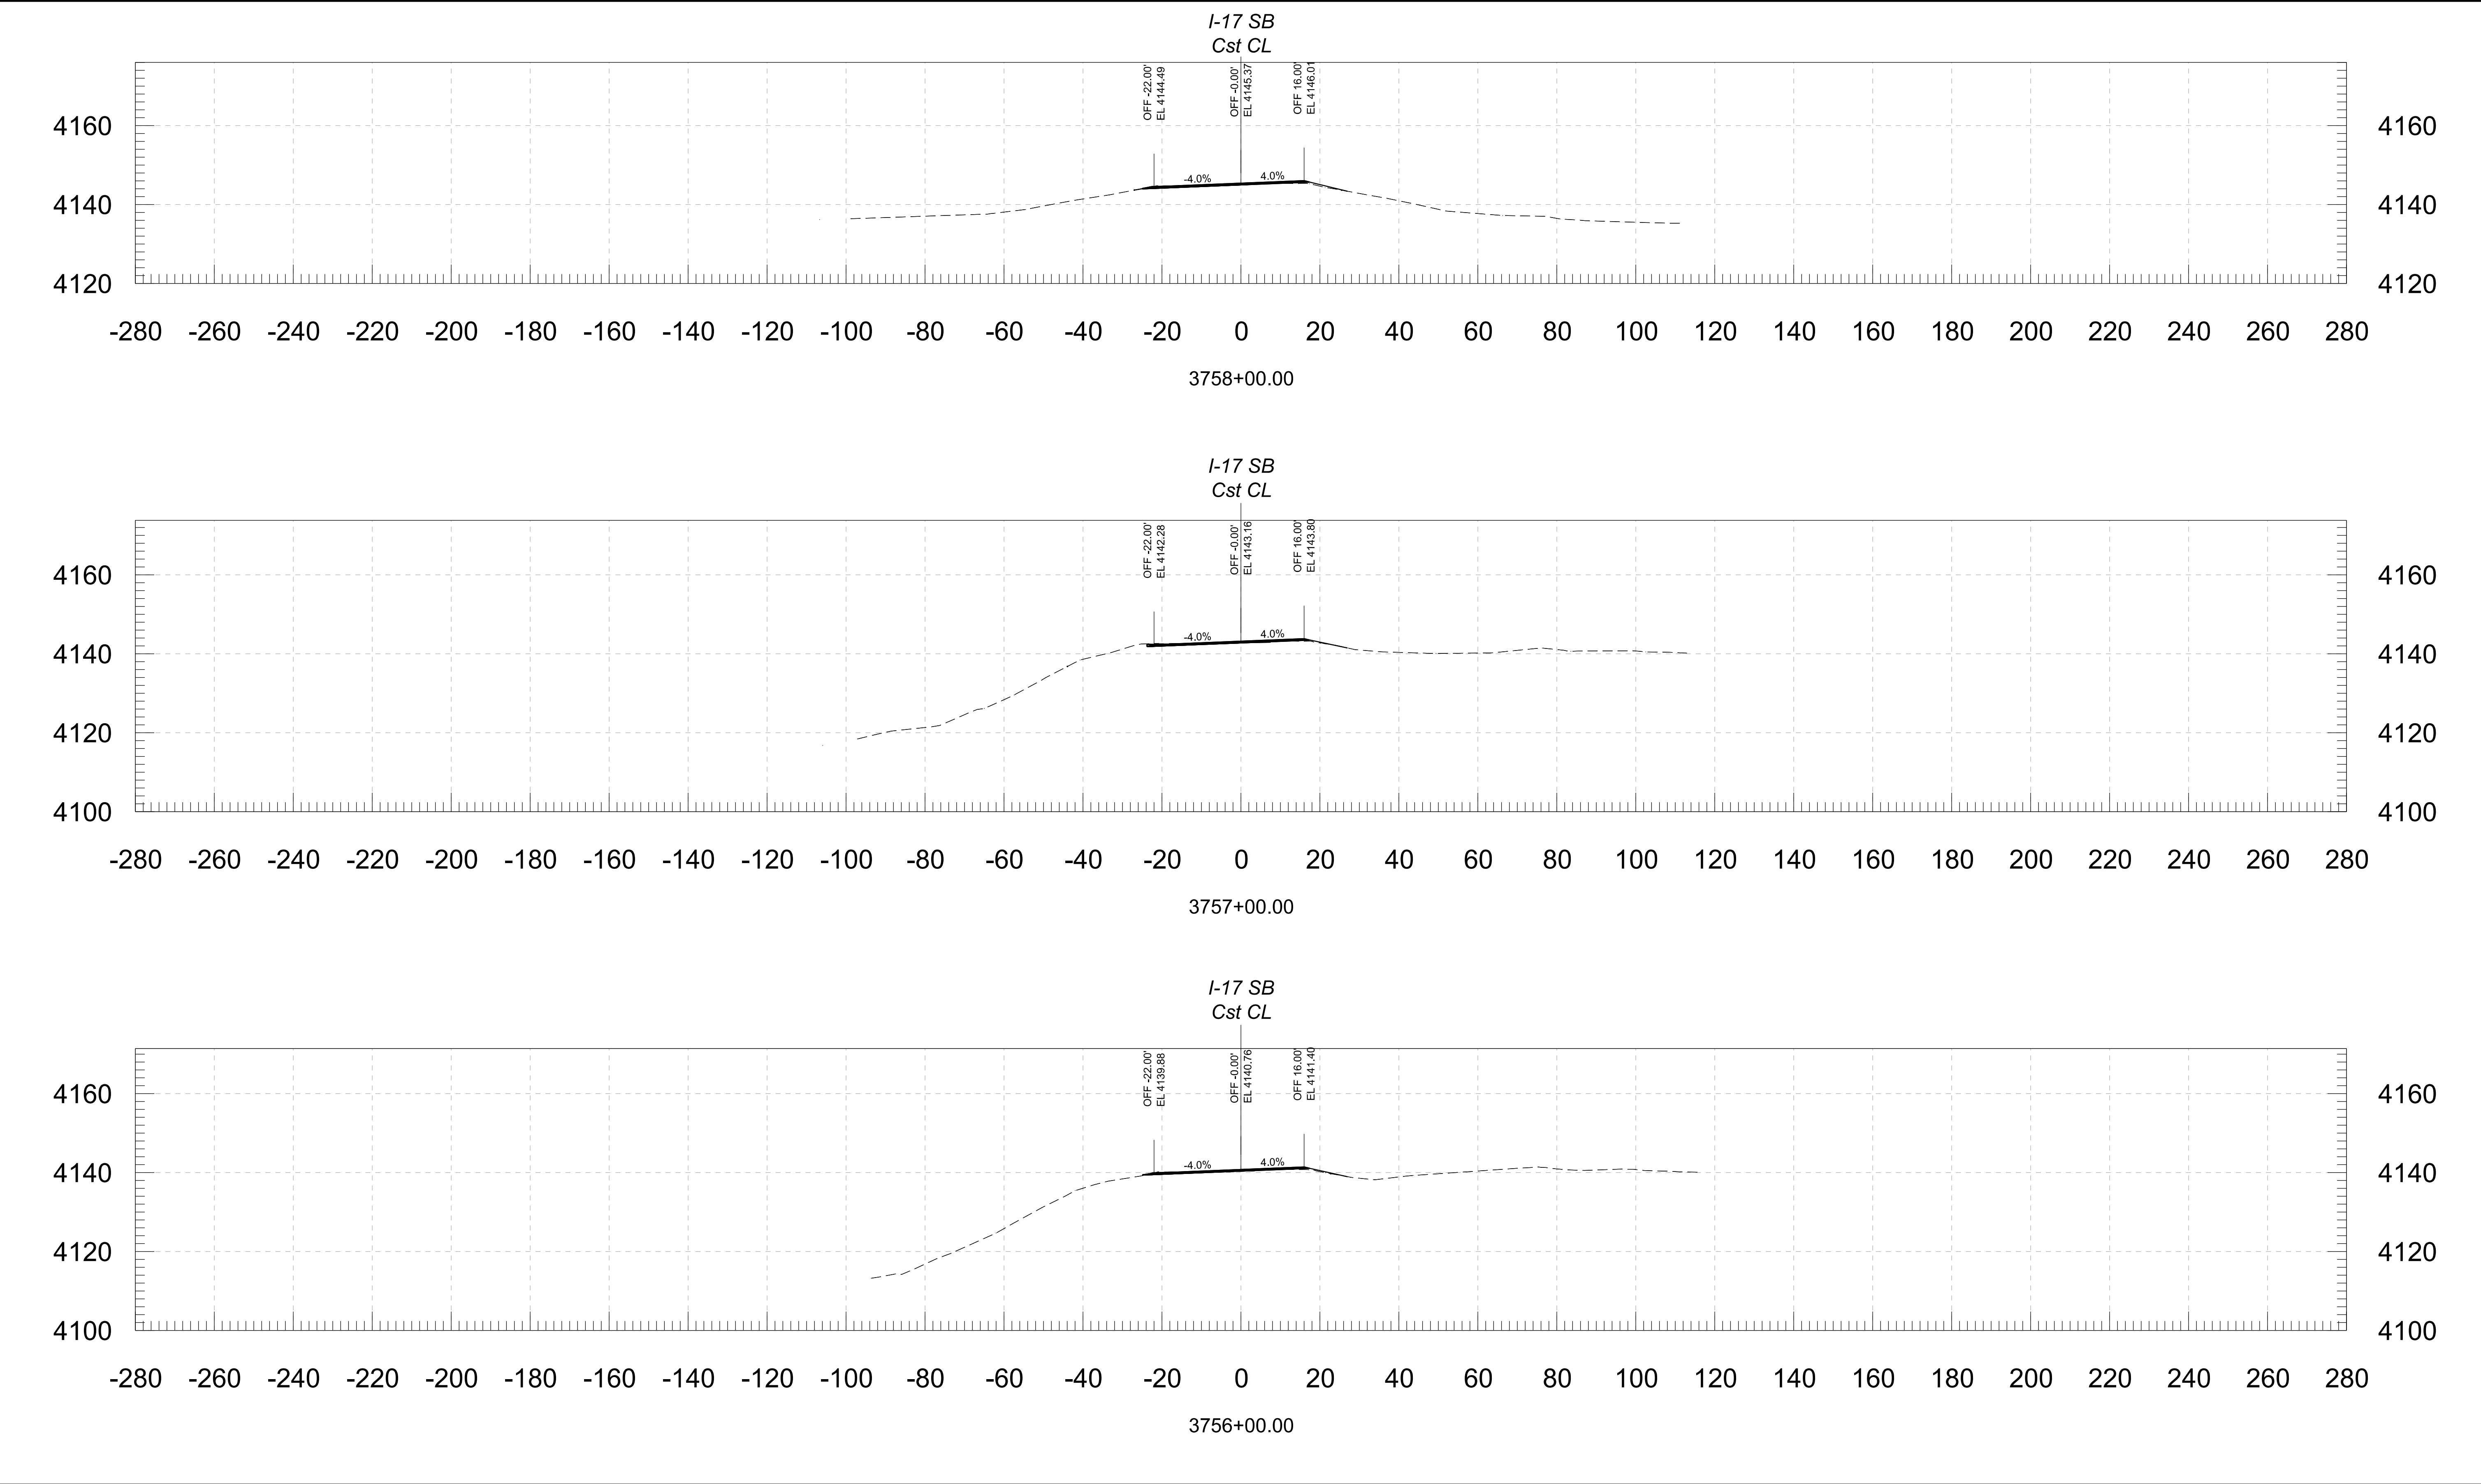




			NAME	DATE	ARIZONA DEPARTMENT OF TRANSPORTATION PROJECT DELIVERY AND OPERATIONS DIVISION ROADWAY DESIGN SERVICES	ROUTE	F.H.W.A. Arizona Division	STATE ARIZ.	PROJECT NO.	FEDERAL ID NO.	SHEET NO.	TOTAL SHEETS	RECORD DRAWING
		DESIGN	BAP	06/26		I-17			017 YV 269	017-B(239)T	74	146	
		DRAWN	RM	06/26									
		CHECKED	KCH	06/26									
		 Stanley Consultants INC.			3133 East Camelback Road, Suite 100 Phoenix, Arizona 85016 Phone: (602) 333-2200		CROSS SECTION	MILEPOST	E DUGAS ROAD - MP 275				
						STRUCTURE NO.	TRACS NO. F0616 01C					____ OF ____	

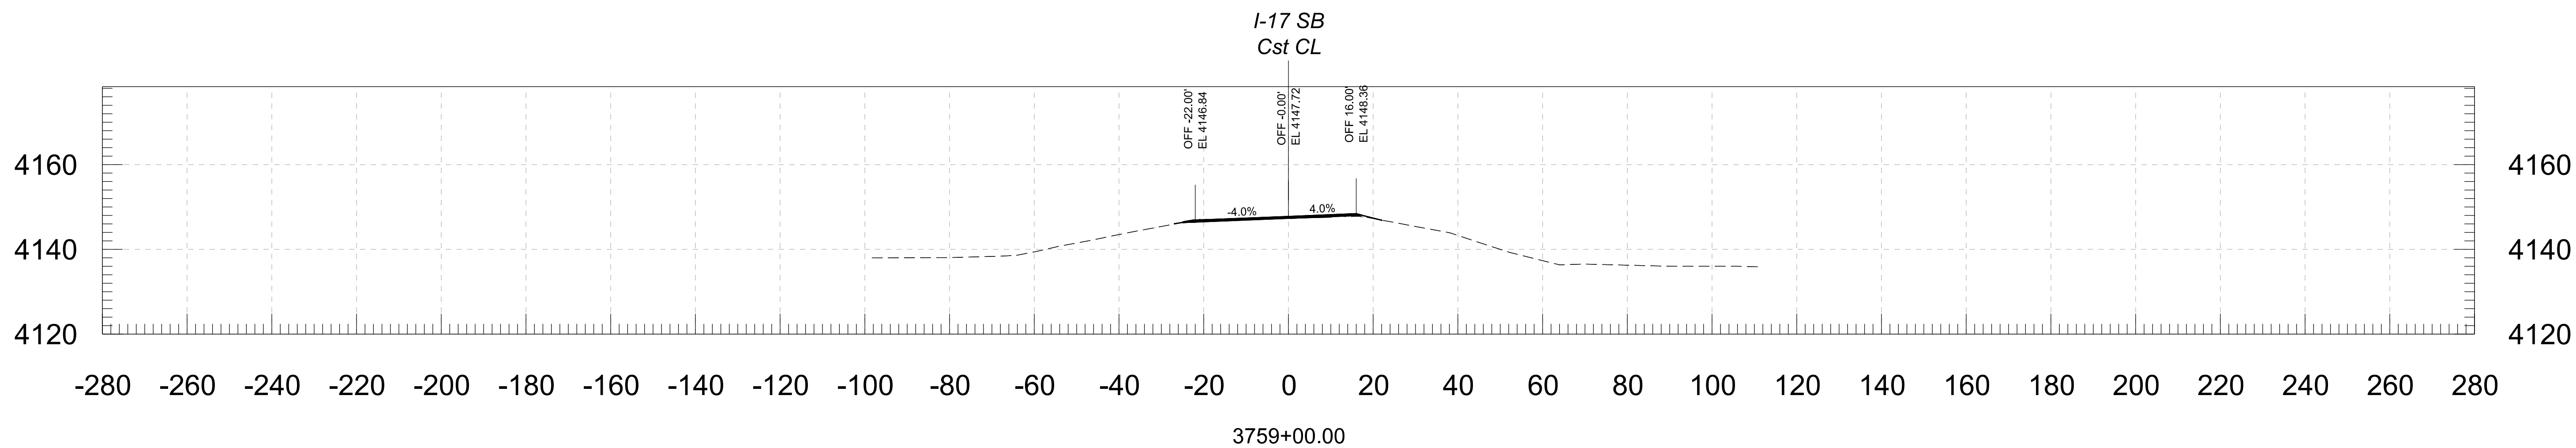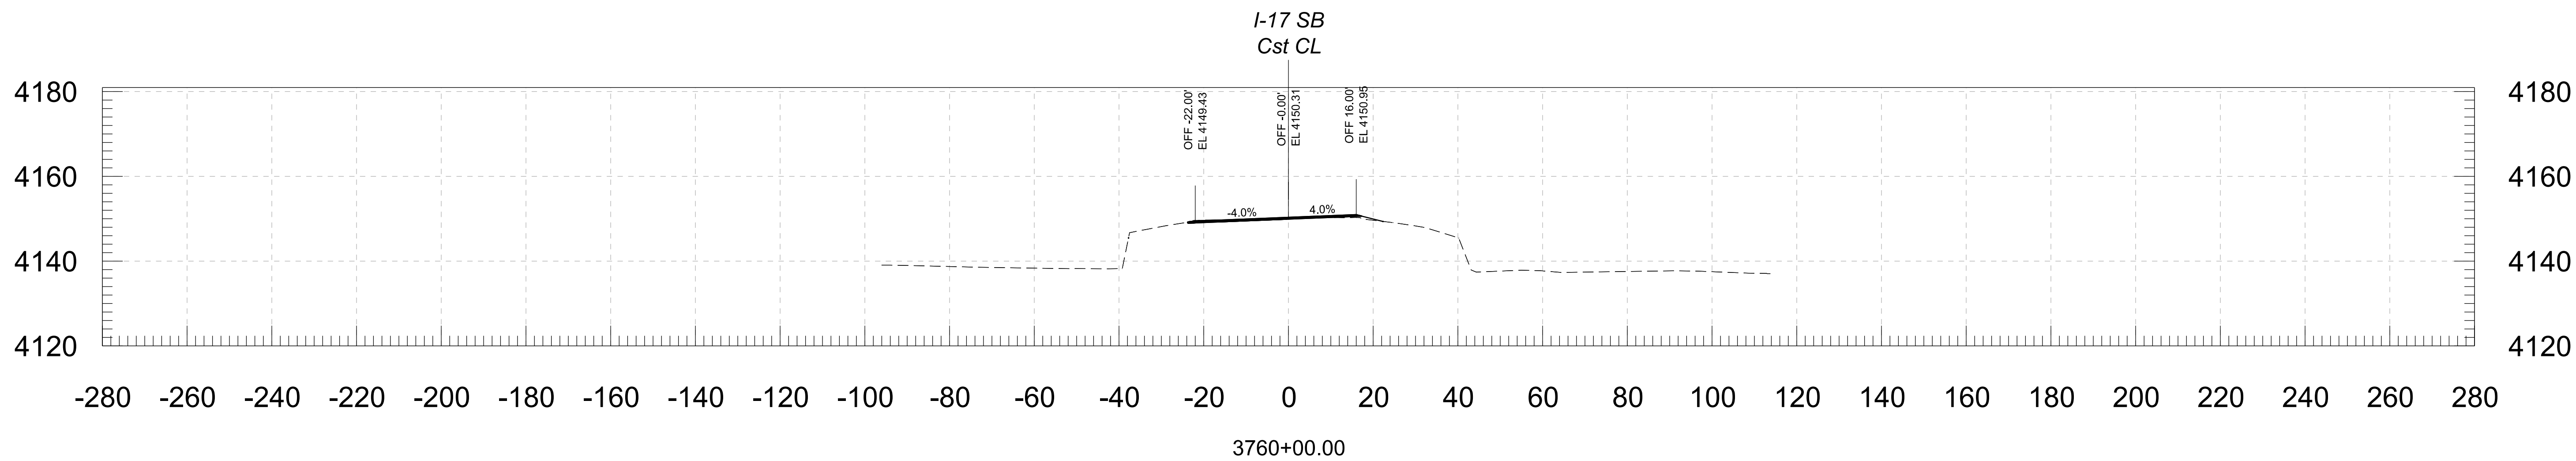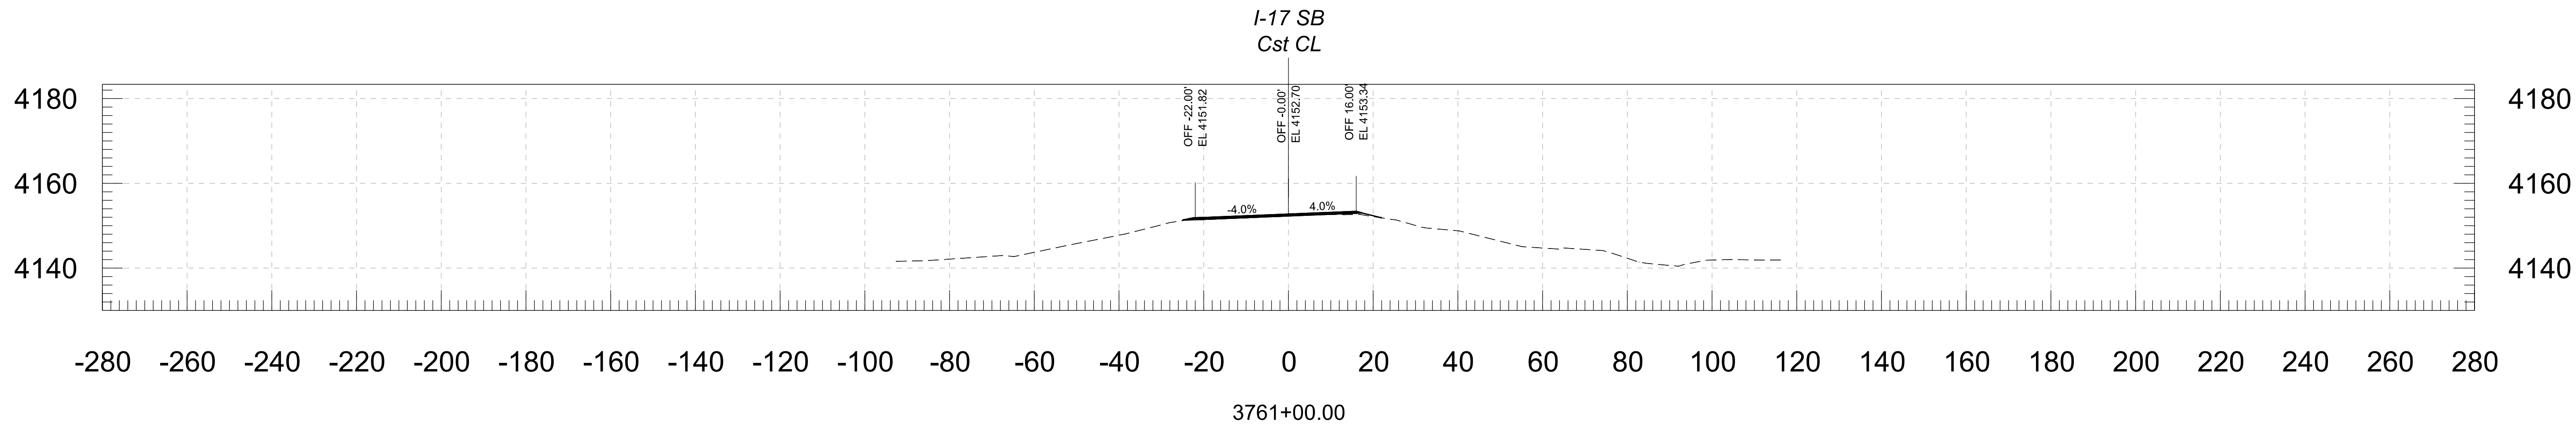




		Stanley Consultants INC.	NAME		DATE	ARIZONA DEPARTMENT OF TRANSPORTATION PROJECT DELIVERY AND OPERATIONS DIVISION ROADWAY DESIGN SERVICES			ROUTE I-17	F.H.W.A. Arizona Division	STATE ARIZ.	PROJECT NO. 017 YV 269	FEDERAL ID NO. 017-B(239)T	SHEET NO. 75	TOTAL SHEETS 146	RECORD DRAWING
			DESIGN	BAP	06/26				MILEPOST	E DUGAS ROAD - MP 275						
			DRAWN	RM	06/26				STRUCTURE NO.	DWG NO.						
			CHECKED	KCH	06/26					TRACS NO.	F0616 01C					____ OF ____

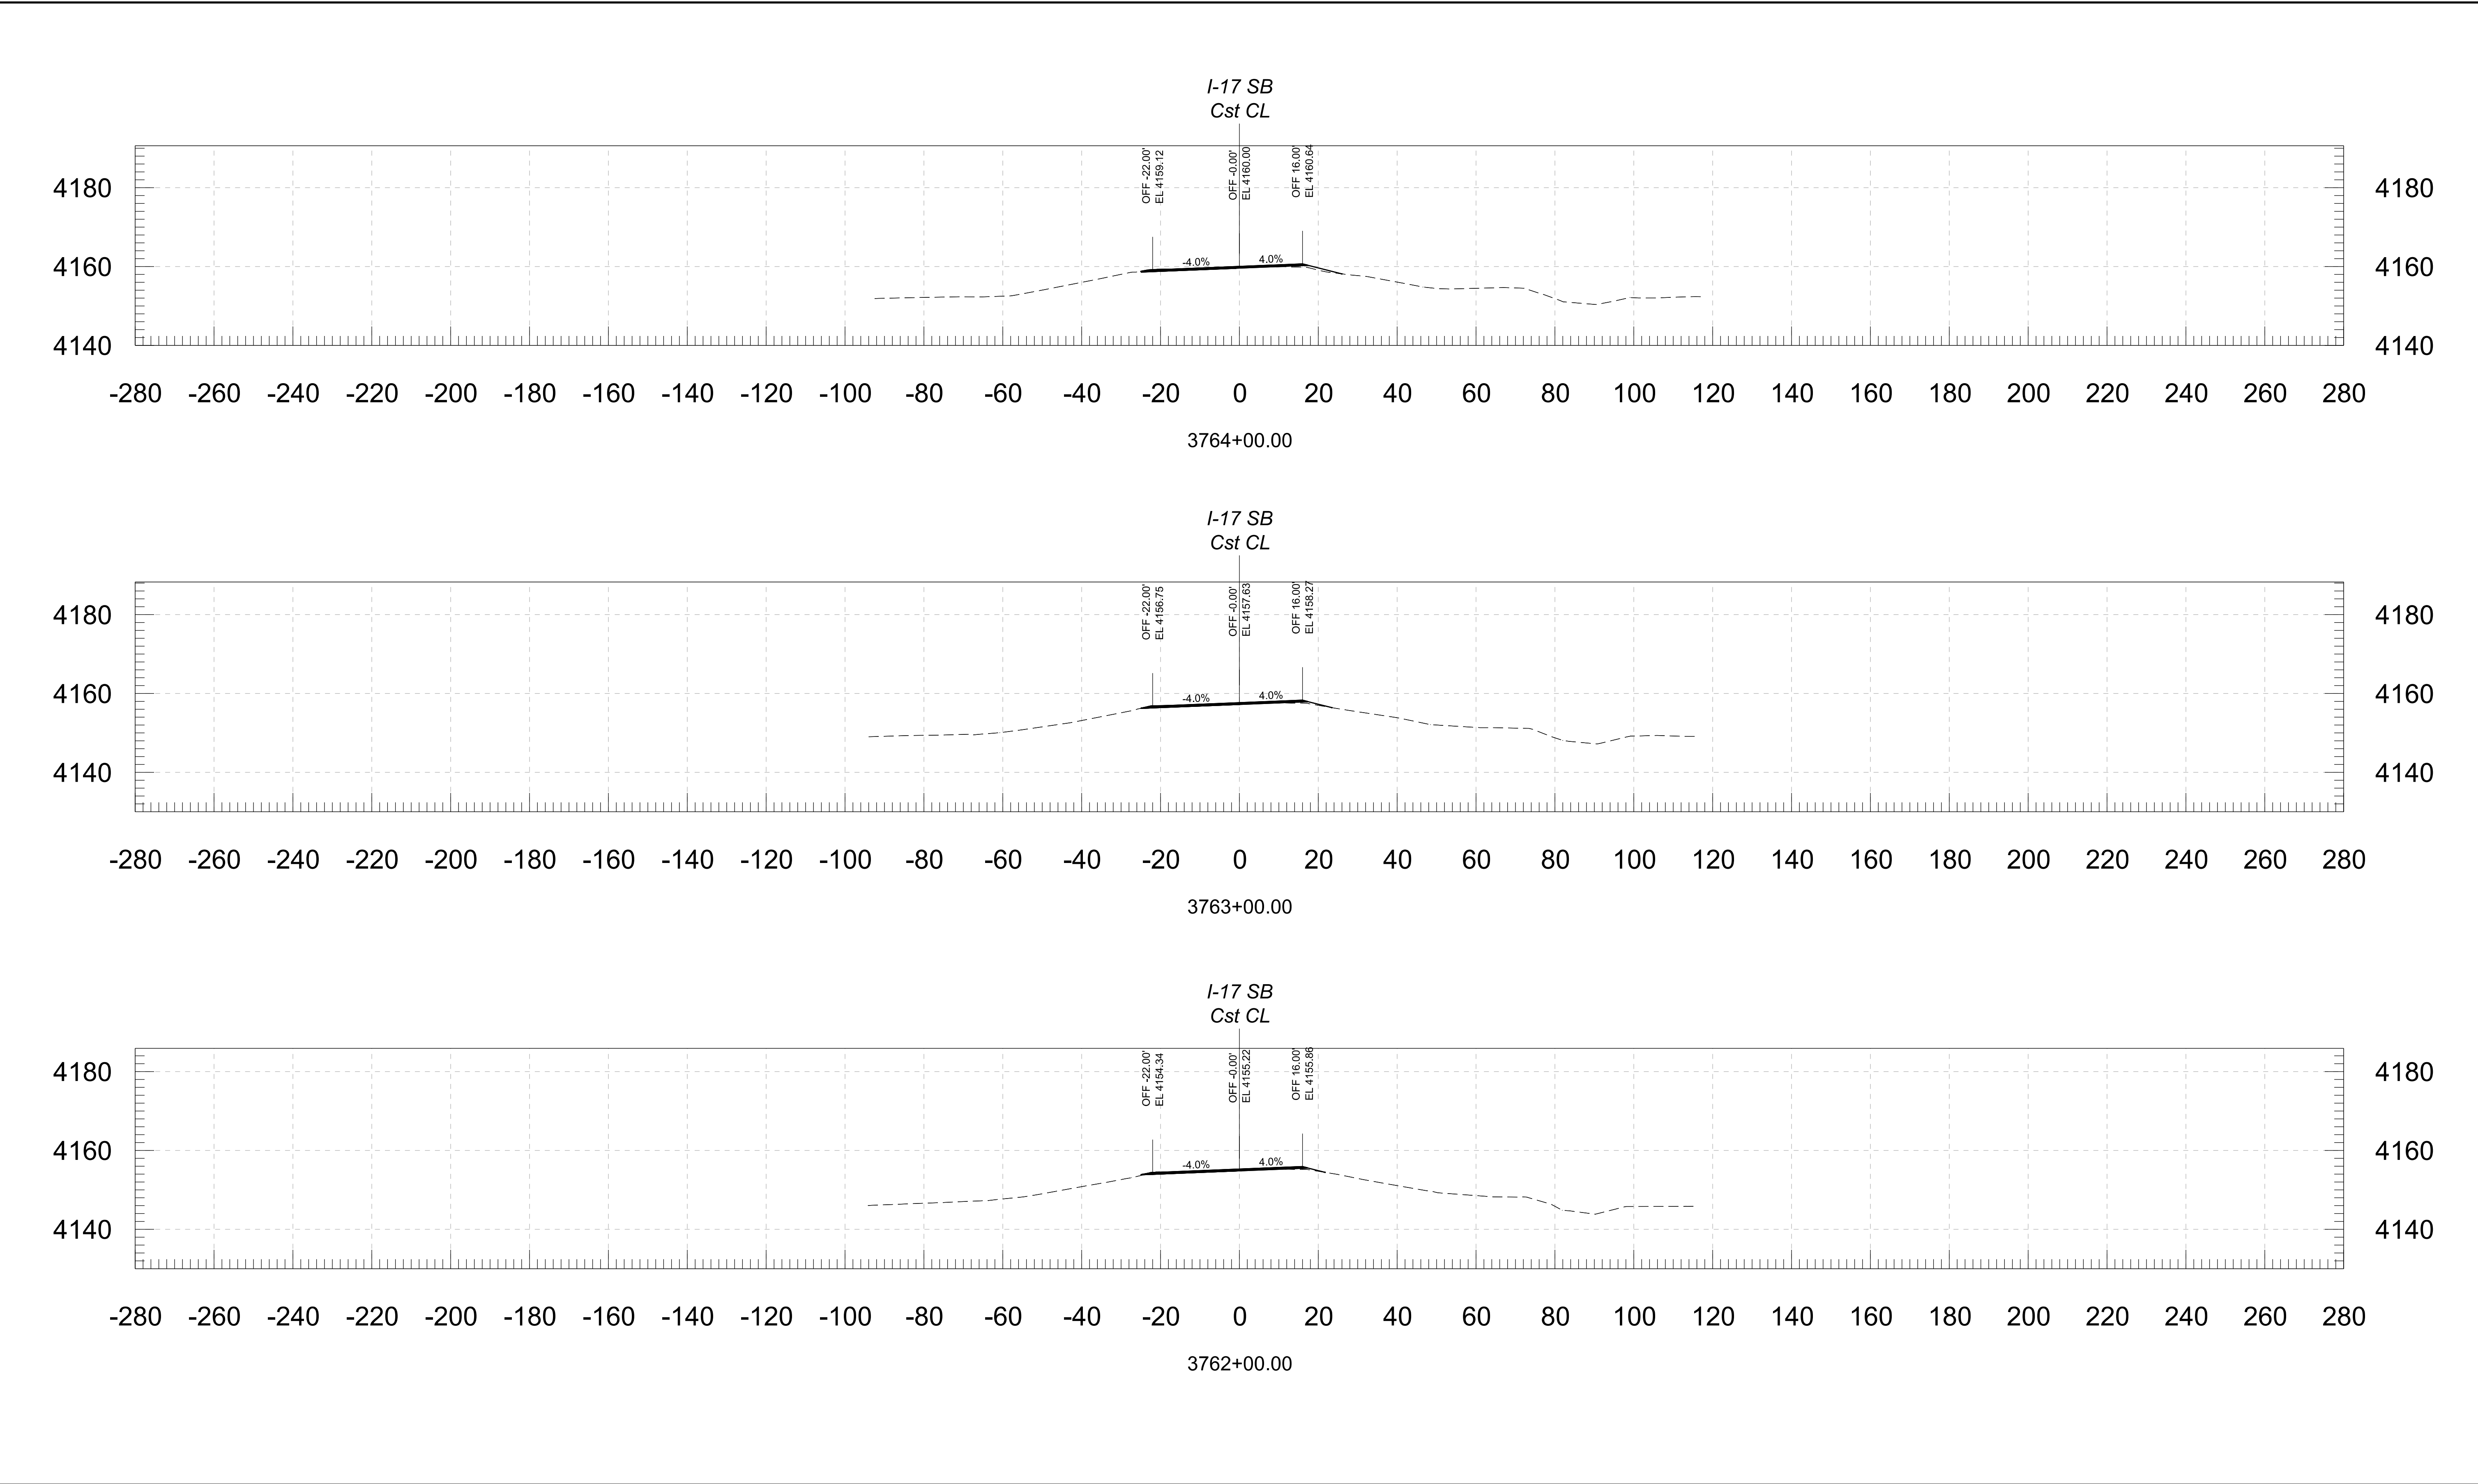




				NAME	DATE	ARIZONA DEPARTMENT OF TRANSPORTATION PROJECT DELIVERY AND OPERATIONS DIVISION ROADWAY DESIGN SERVICES	ROUTE	F.H.W.A. Arizona Division	STATE ARIZ.	PROJECT NO.	FEDERAL ID NO.	SHEET NO.	TOTAL SHEETS	RECORD DRAWING
			DESIGN	BAP	06/26		I-17			017 YV 269	017-B(239)T	76	146	
			DRAWN	RM	06/26			MILEPOST	E DUGAS ROAD - MP 275				DWG NO.	
			CHECKED	KCH	06/26									STRUCTURE NO.
			 3135 East Camelback Road, Suite 100 Phoenix, Arizona 85016 Phone: (602) 333-2200 Stanley Consultants INC.				CROSS SECTION							

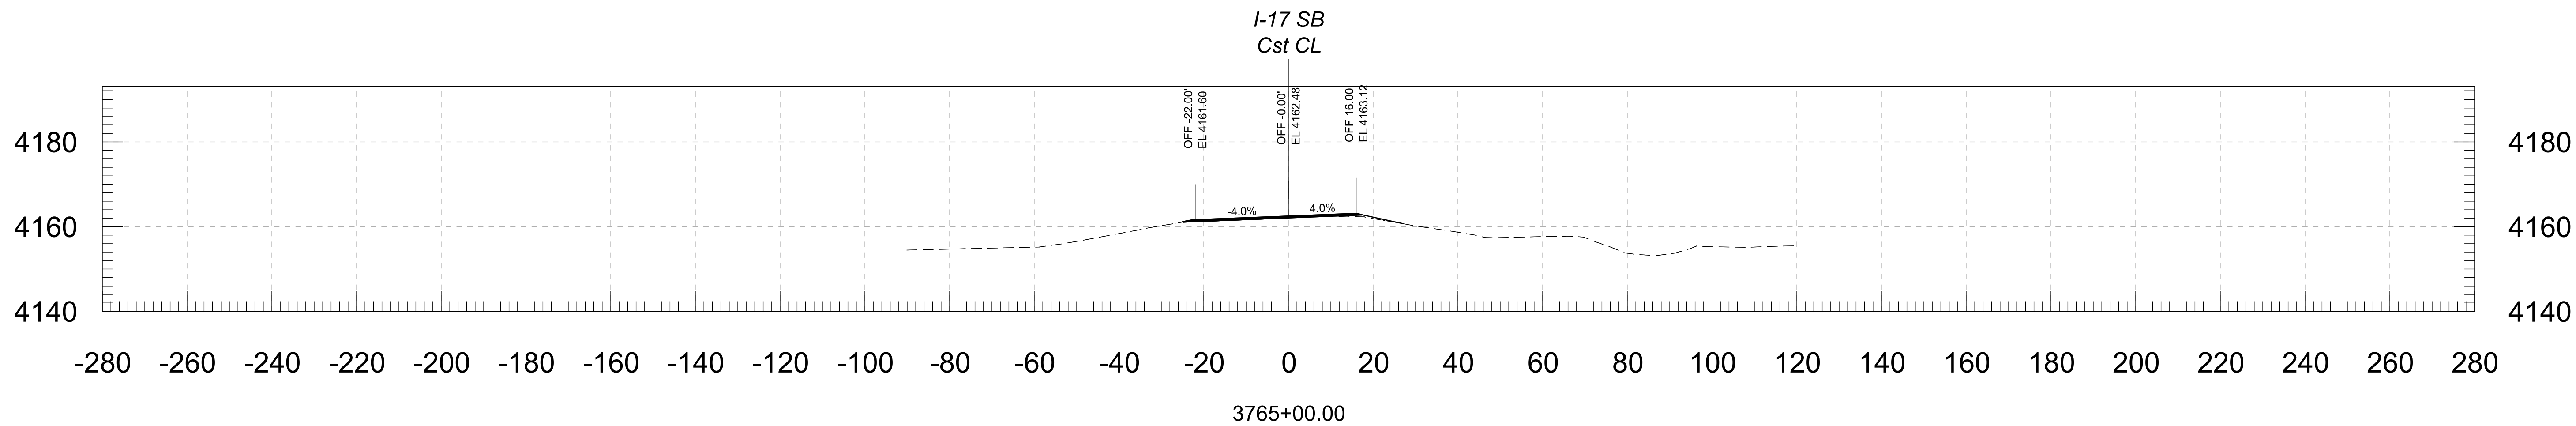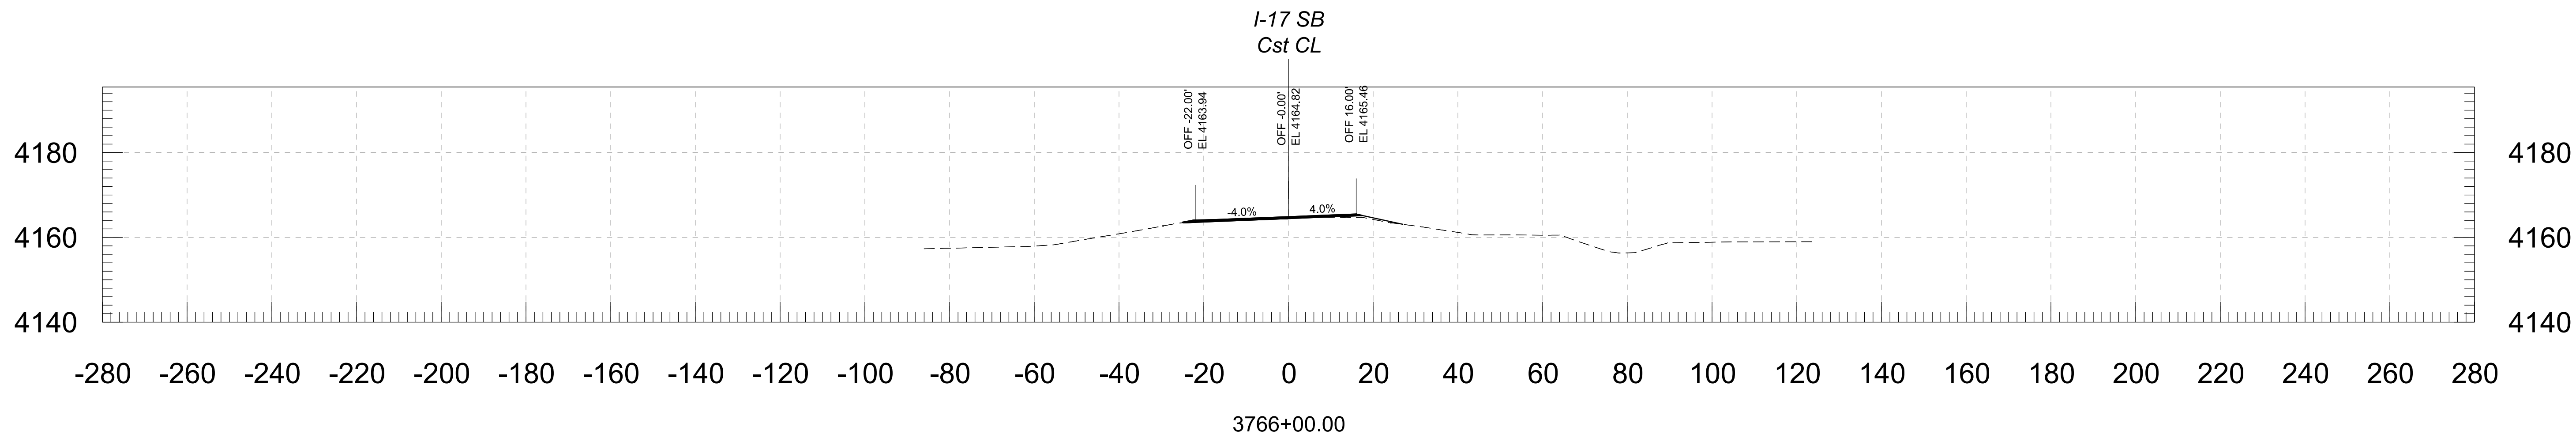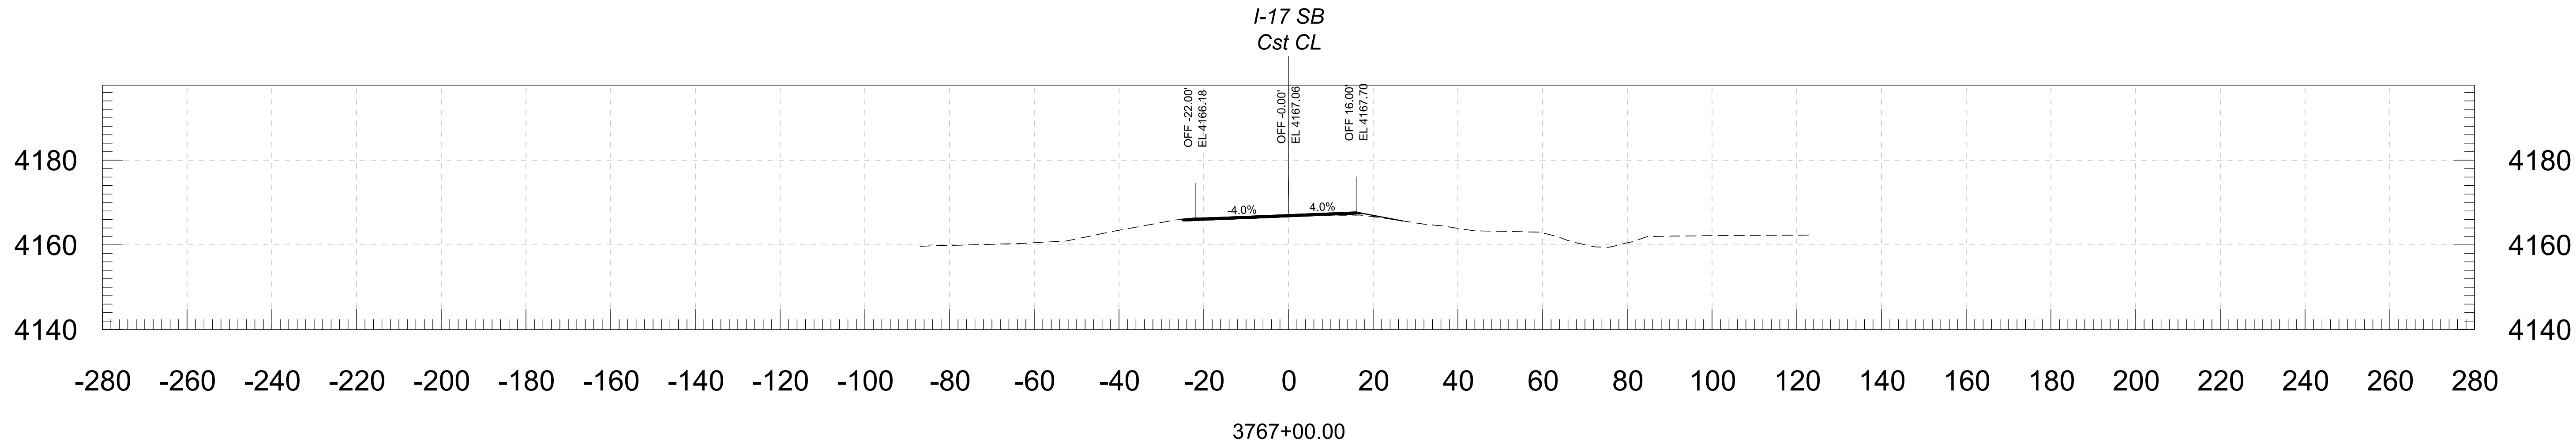




			NAME	DATE	ARIZONA DEPARTMENT OF TRANSPORTATION PROJECT DELIVERY AND OPERATIONS DIVISION ROADWAY DESIGN SERVICES	ROUTE	F.H.W.A. Arizona Division	STATE	PROJECT NO.	FEDERAL ID NO.	SHEET NO.	TOTAL SHEETS	RECORD DRAWING	
		DESIGN	BAP	06/26		I-17			ARIZ.	017 YV 269	017-B(239)T	77		146
		DRAWN	RM	06/26			MILEPOST	LOCATION						DWG NO.
		CHECKED	KCH	06/26				STRUCTURE NO.	E DUGAS ROAD - MP 275					
		 Stanley Consultants INC.			3133 East Camelback Road, Suite 100 Phoenix, Arizona 85016 Phone 602. 333-2000		CROSS SECTION		TRACS NO. F0616 01C			____ OF ____		

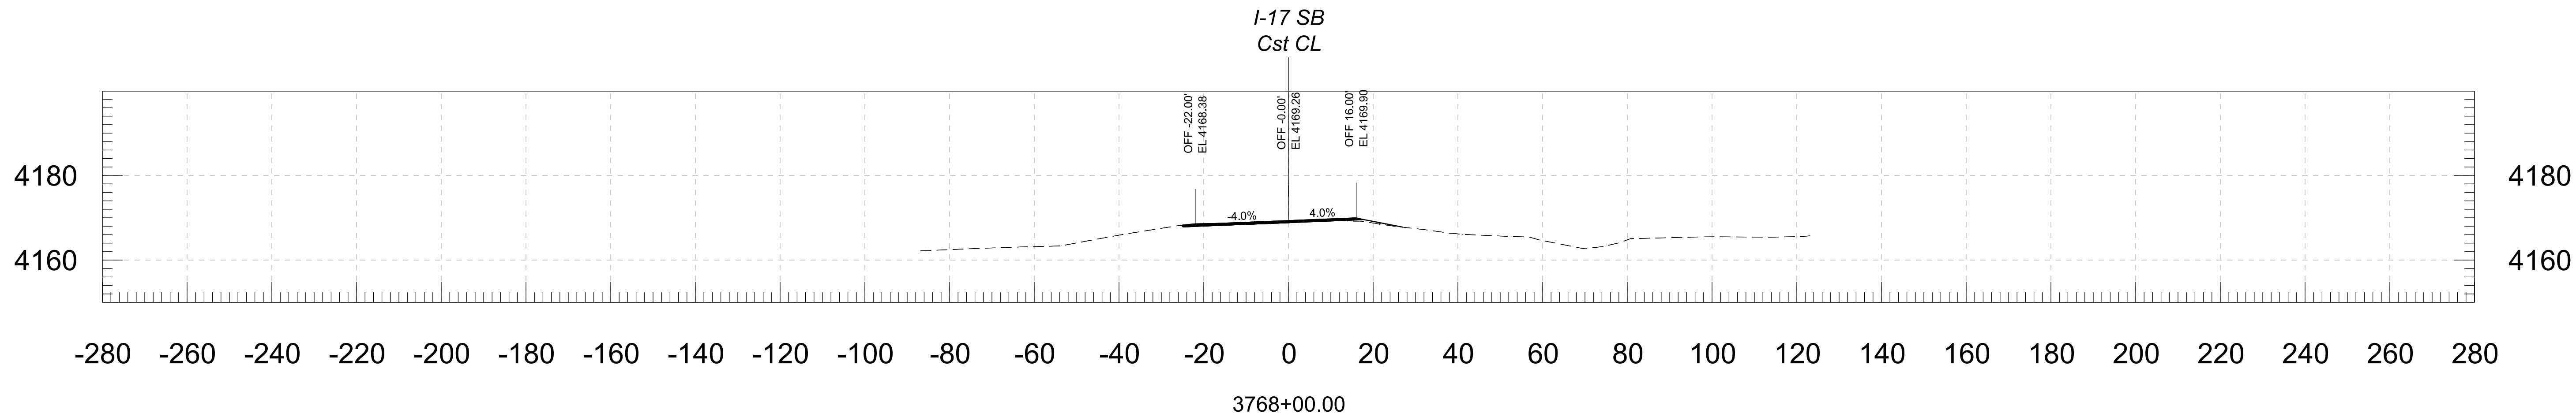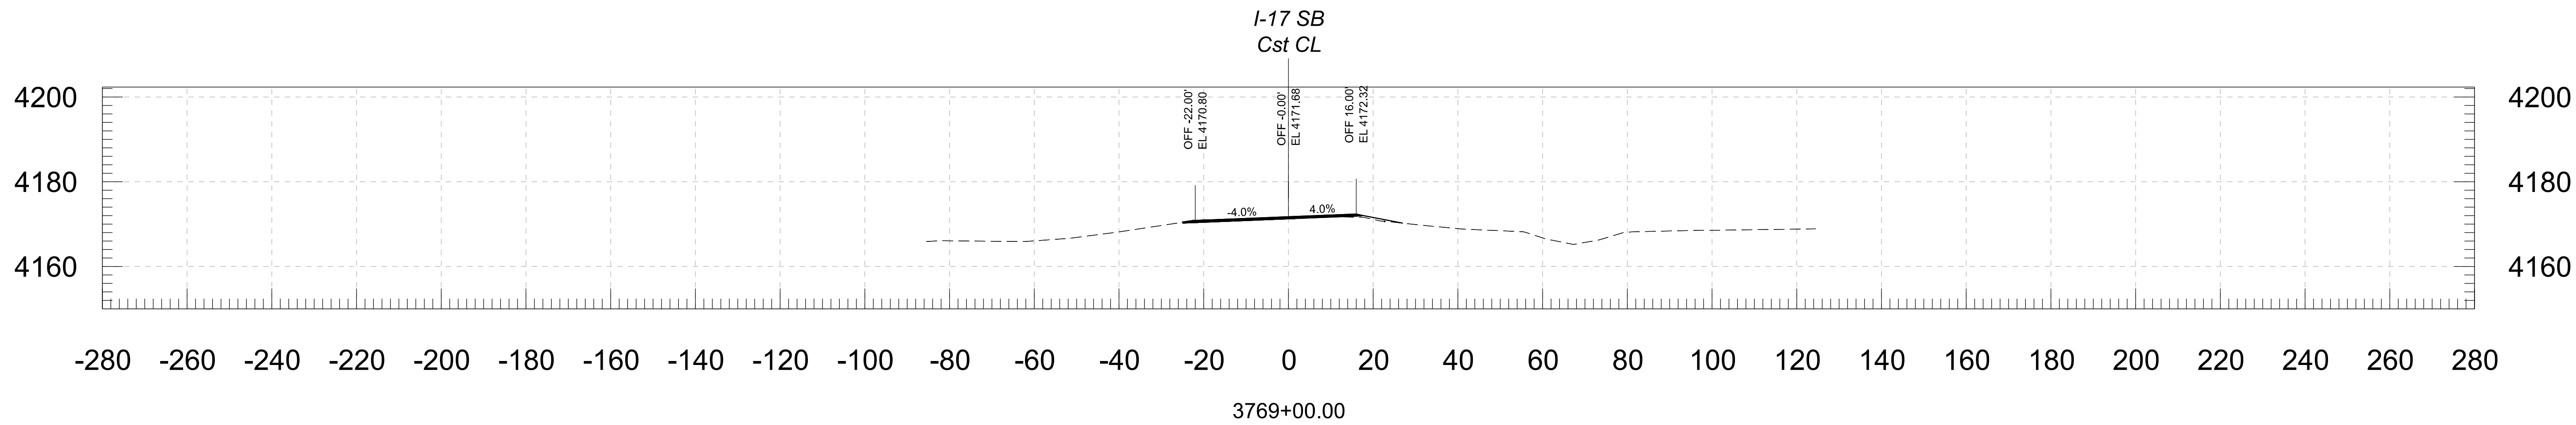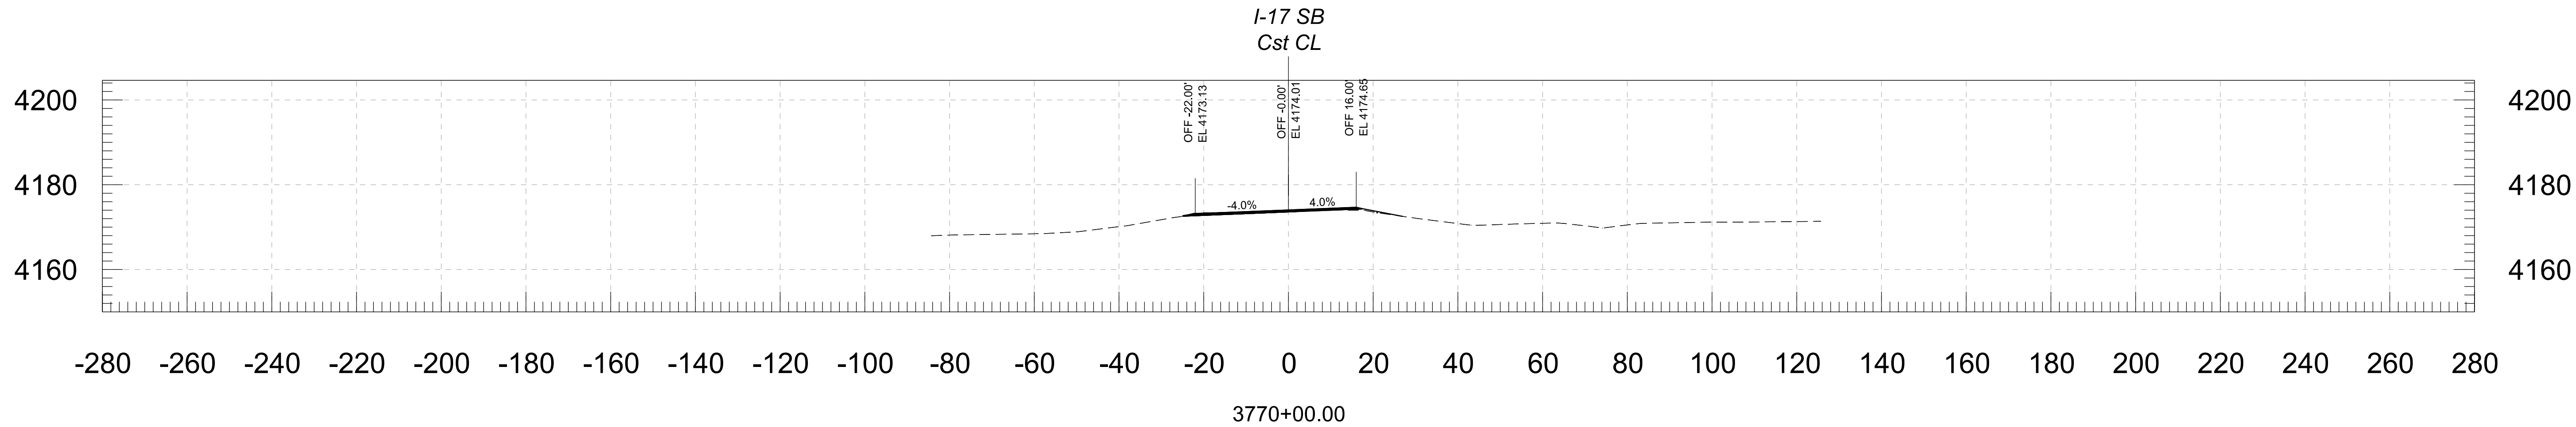




			NAME	DATE	ARIZONA DEPARTMENT OF TRANSPORTATION PROJECT DELIVERY AND OPERATIONS DIVISION ROADWAY DESIGN SERVICES	ROUTE	F.H.W.A. Arizona Division	STATE	PROJECT NO.	FEDERAL ID NO.	SHEET NO.	TOTAL SHEETS	RECORD DRAWING
		DESIGN	BAP	06/26		I-17			017 YV 269	017-B(239)T	78	146	
		DRAWN	RM	06/26		MILEPOST	LOCATION E DUGAS ROAD - MP 275						
		CHECKED	KCH	06/26									
		 Stanley Consultants INC.			3133 East Camelback Road, Suite 100 Phoenix, Arizona 85016 Phone 602. 333-2000			CROSS SECTION	TRACS NO. F0616 01C		OF		

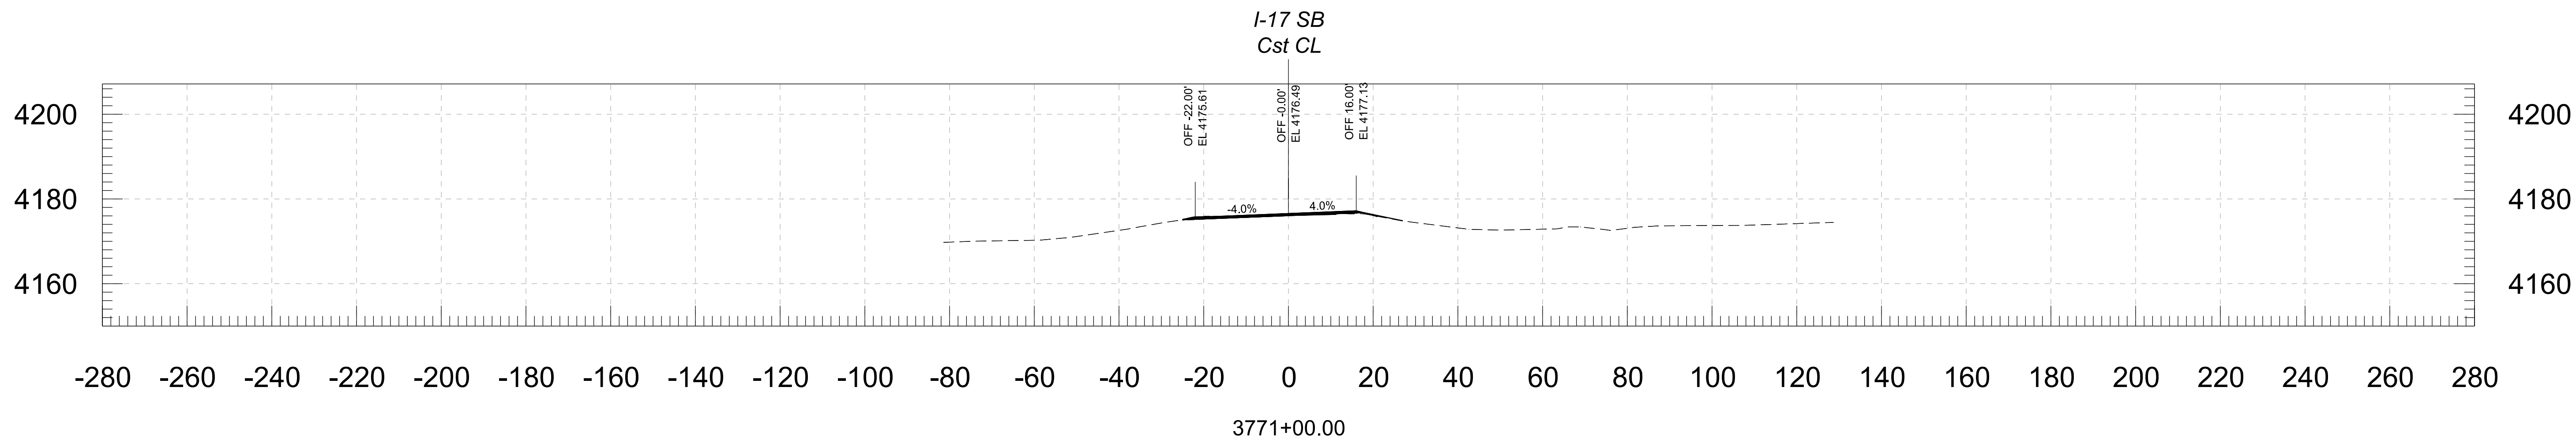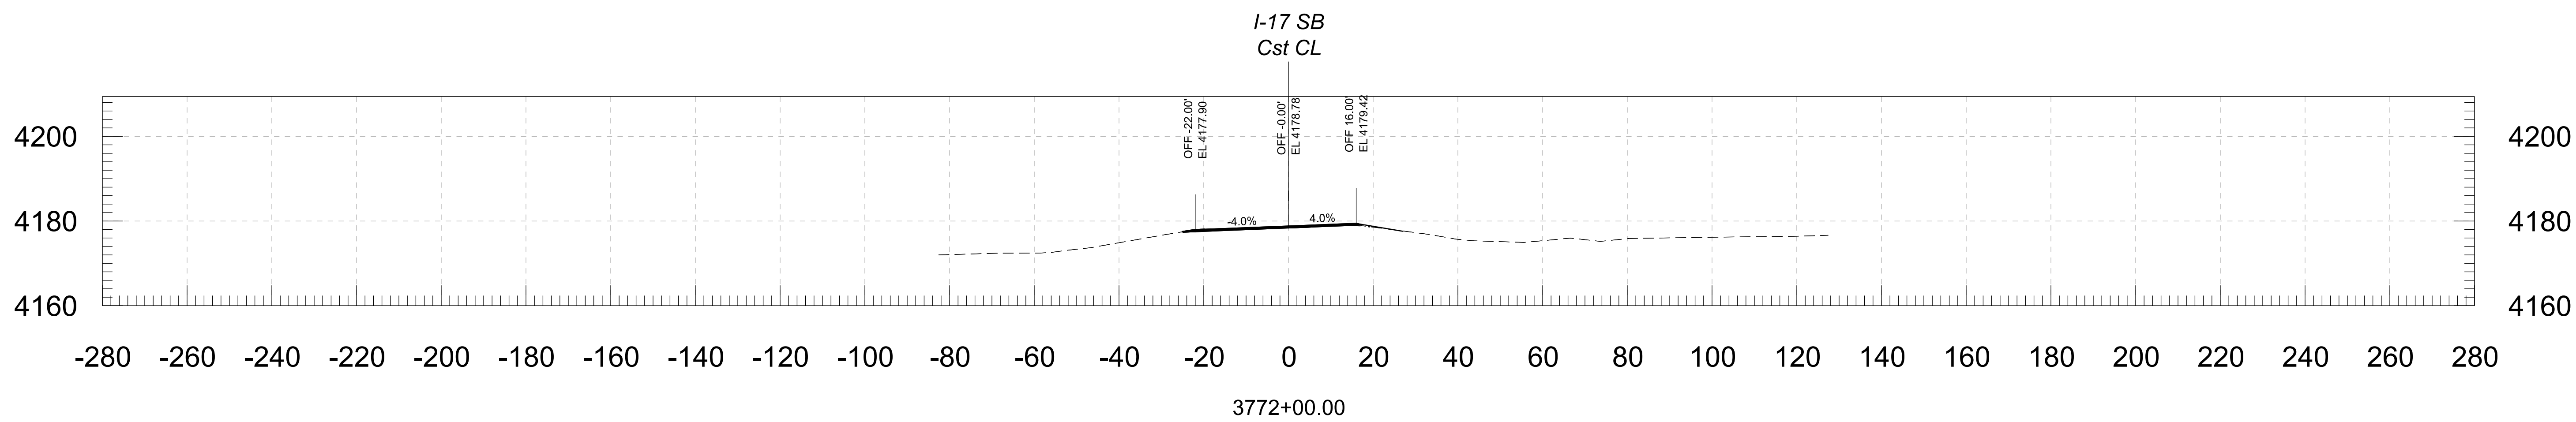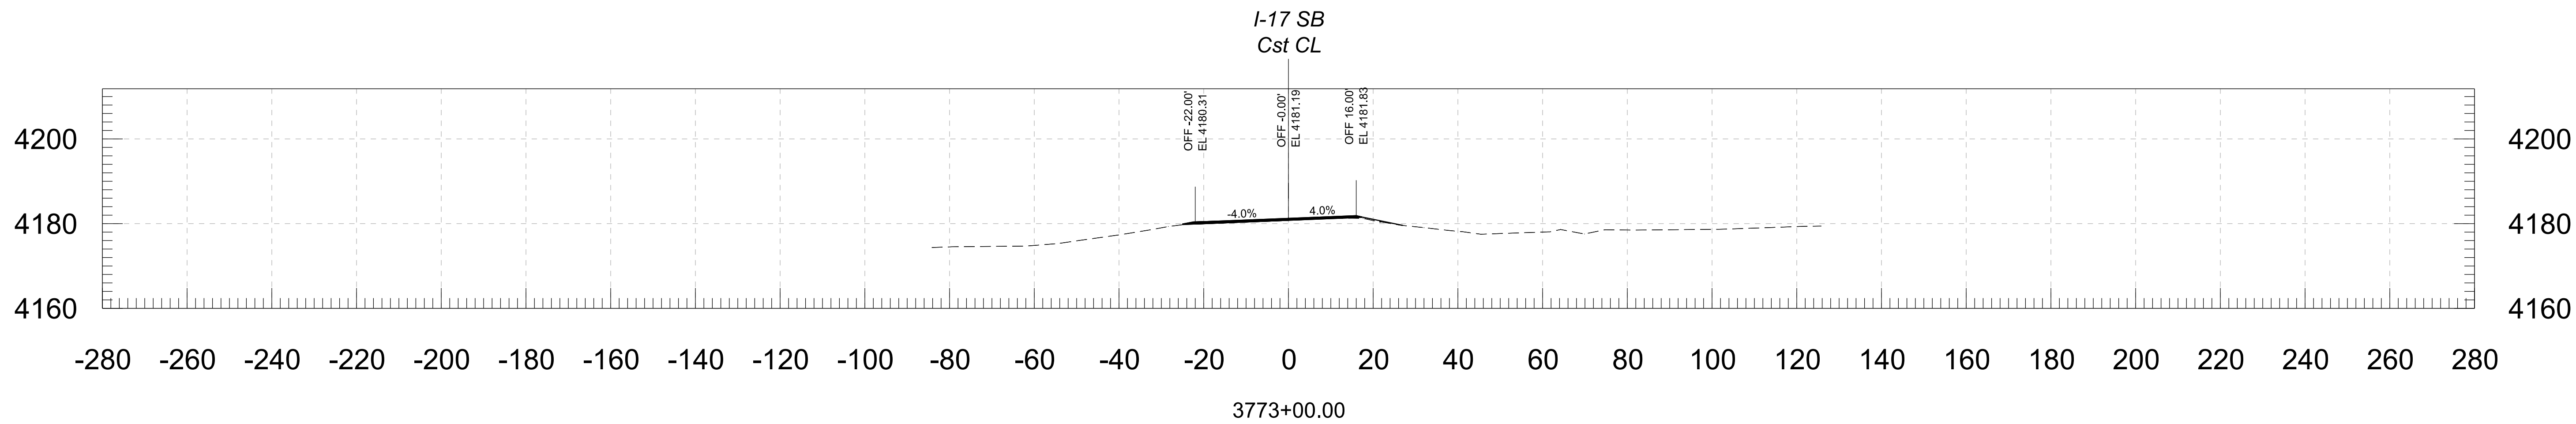


			NAME	DATE	ARIZONA DEPARTMENT OF TRANSPORTATION PROJECT DELIVERY AND OPERATIONS DIVISION ROADWAY DESIGN SERVICES	ROUTE	F.H.W.A. Arizona Division	STATE	PROJECT NO.	FEDERAL ID NO.	SHEET NO.	TOTAL SHEETS	RECORD DRAWING	
		DESIGN	BAP	06/26		I-17			017 YV 269	017-B(239)T	79	146		
		DRAWN	RM	06/26		MILEPOST	LOCATION E DUGAS ROAD - MP 275							
		CHECKED	KCH	06/26										
		Stanley Consultants INC. 3133 East Camelback Road, Suite 100 Phoenix, Arizona 85016 Phone: 602. 333-2200			CROSS SECTION			____ OF ____						

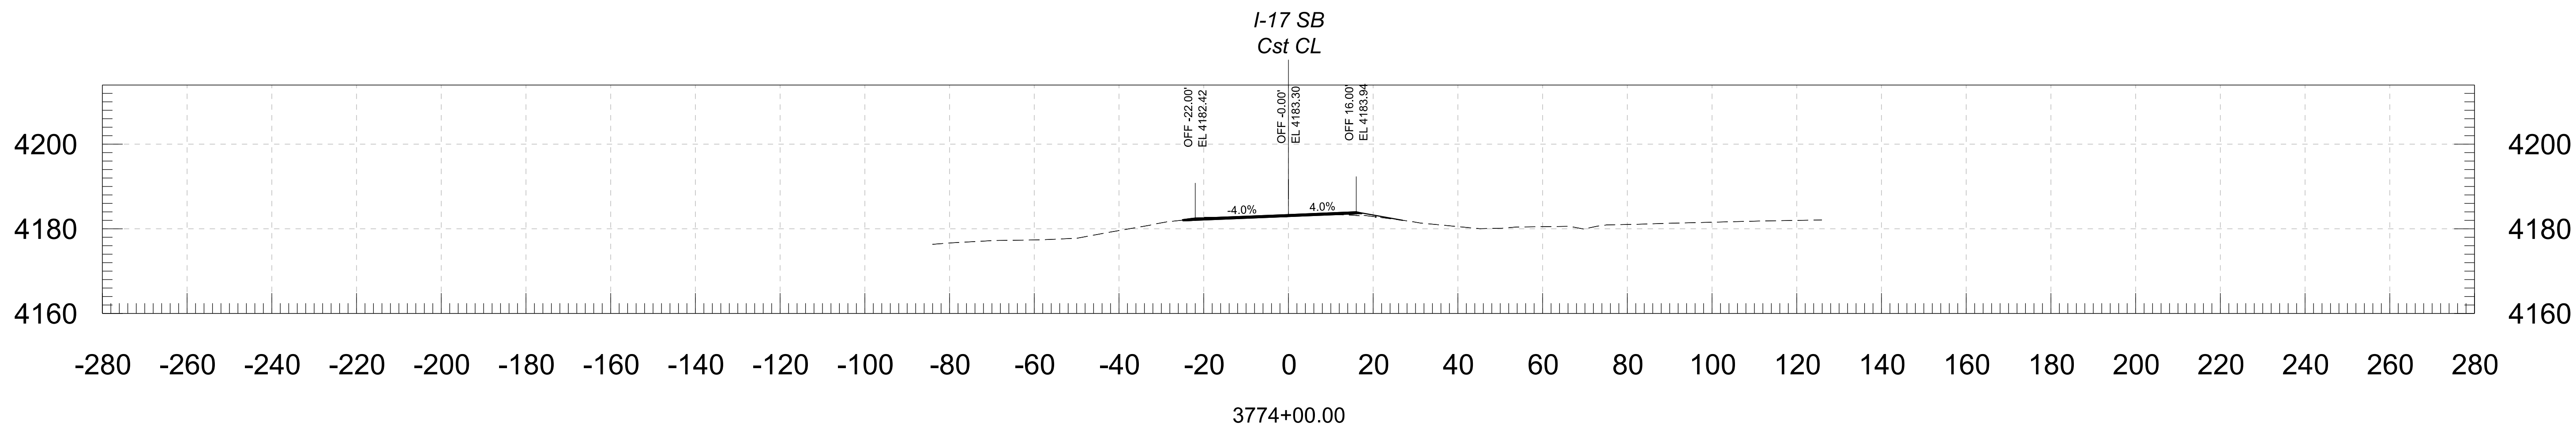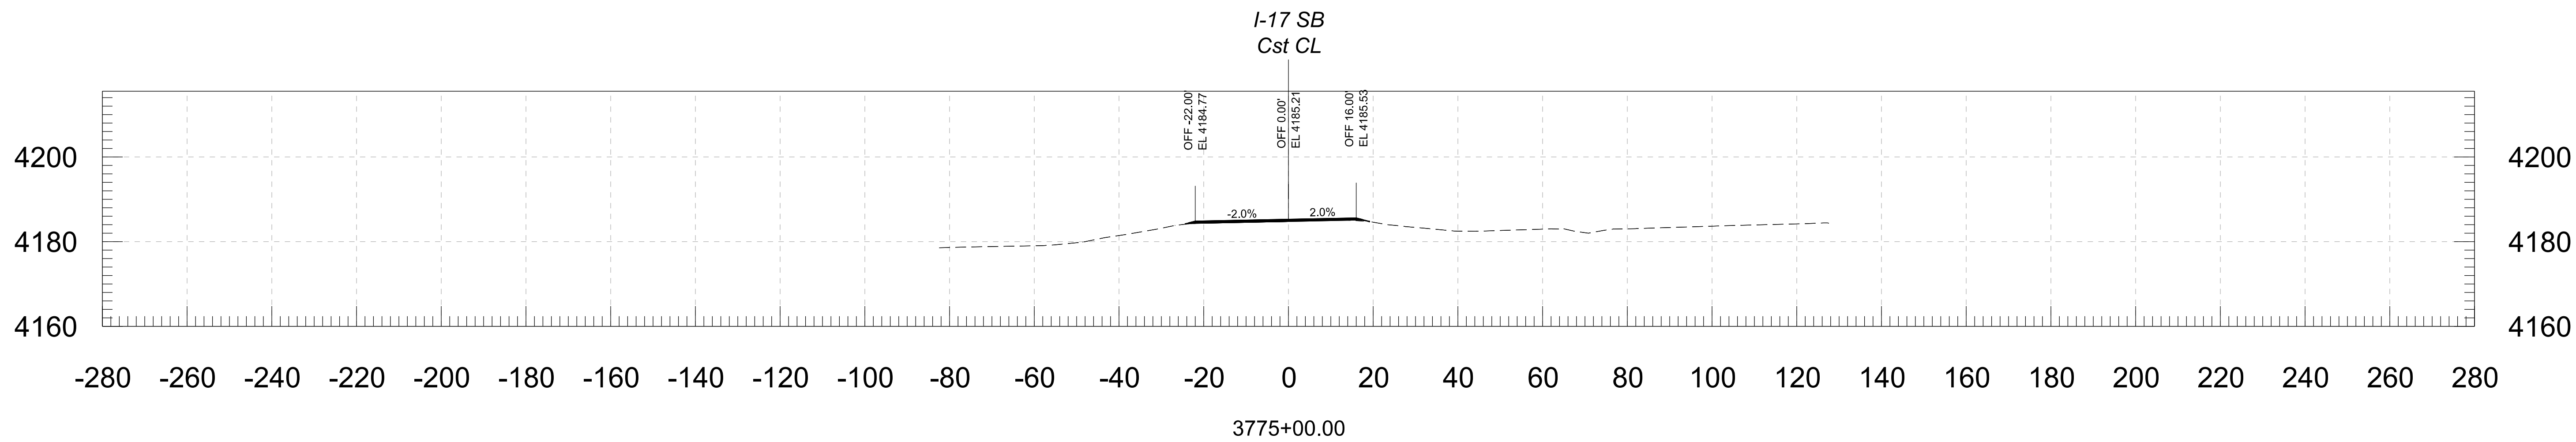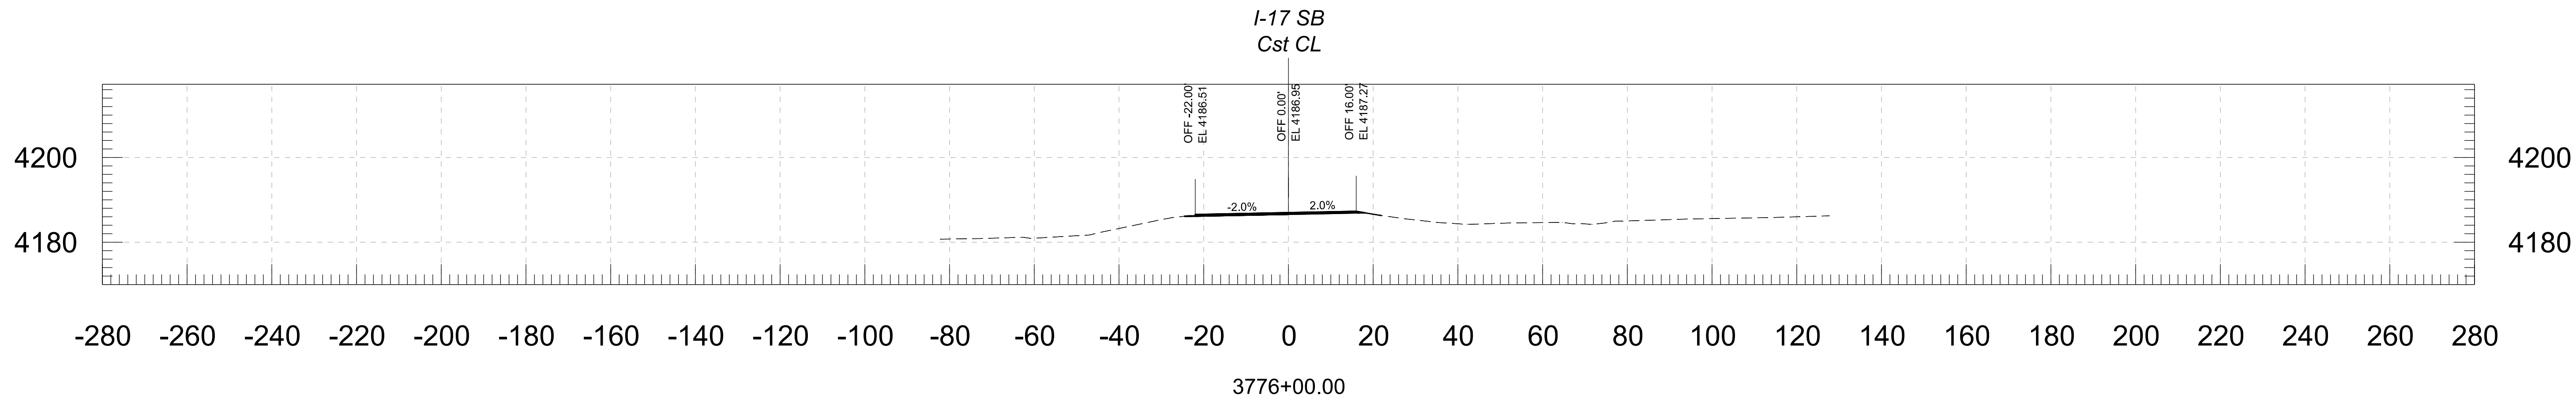


			NAME	DATE	ARIZONA DEPARTMENT OF TRANSPORTATION PROJECT DELIVERY AND OPERATIONS DIVISION ROADWAY DESIGN SERVICES	ROUTE	F.H.W.A. Arizona Division	STATE ARIZ.	PROJECT NO.	FEDERAL ID NO.	SHEET NO.	TOTAL SHEETS	RECORD DRAWING	
		DESIGN	BAP	06/26		I-17			017 YV 269	017-B(239)T	80	146		
		DRAWN	RM	06/26		MILEPOST	LOCATION E DUGAS ROAD - MP 275							
		CHECKED	KCH	06/26										
		 333 East Camelback Road, Suite 100 Phoenix, Arizona 85016 Phone: 602 333-2200 Stanley Consultants INC.			CROSS SECTION			TRACS NO. F0616 01C						

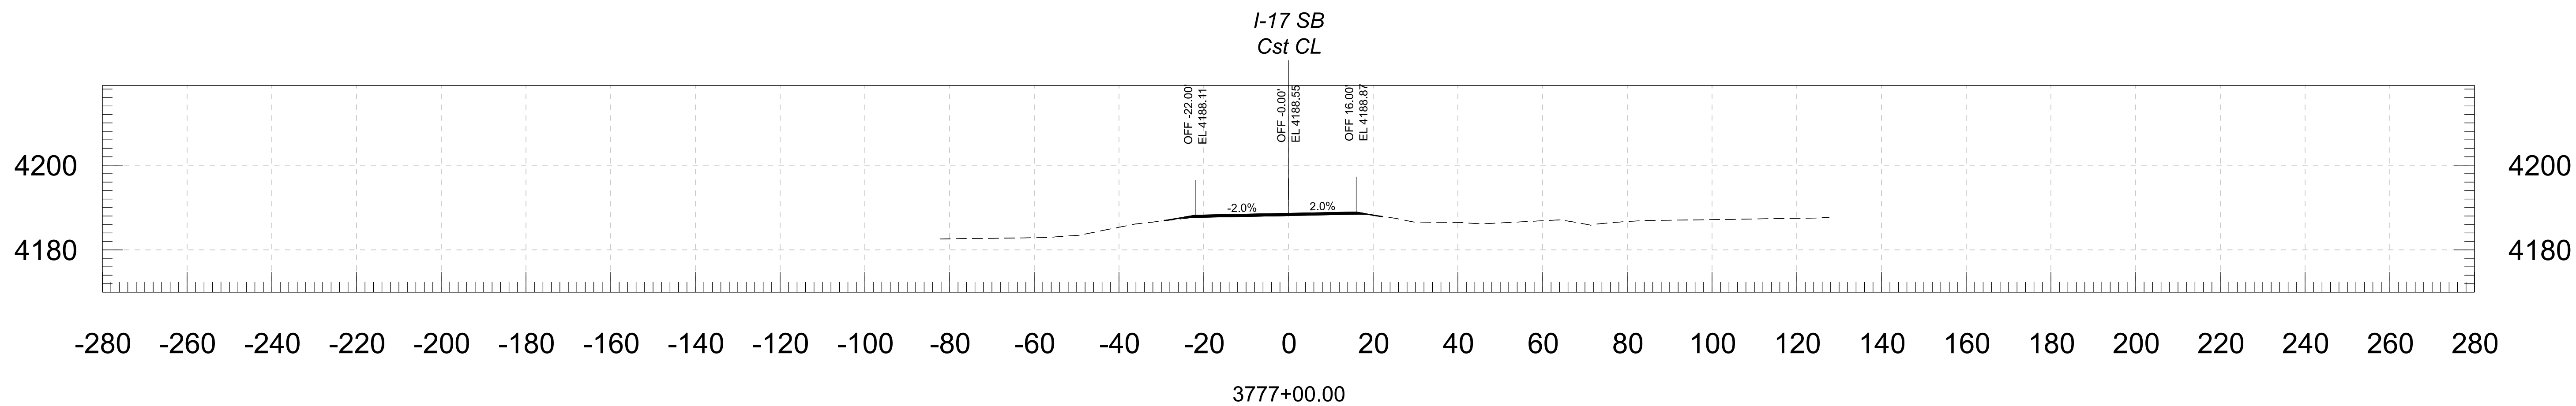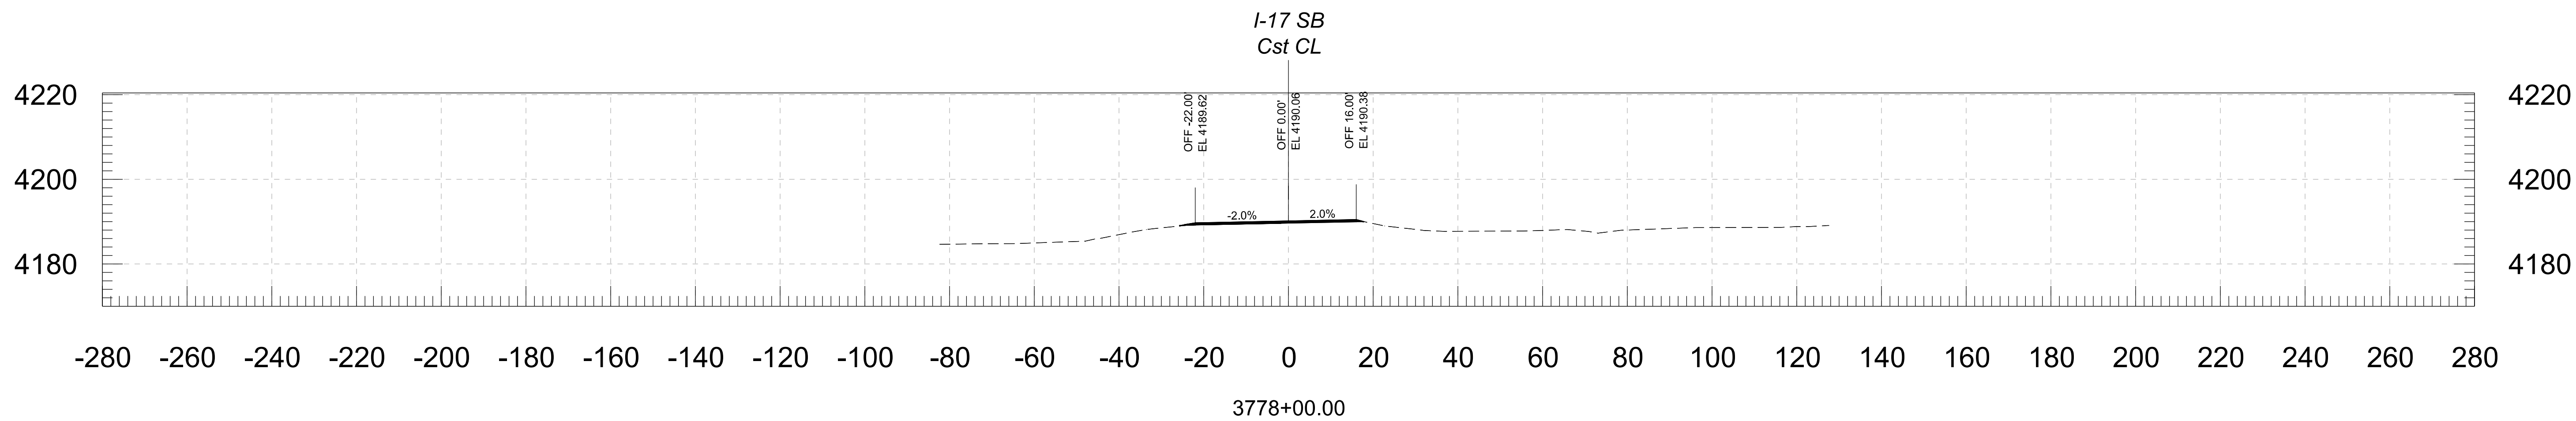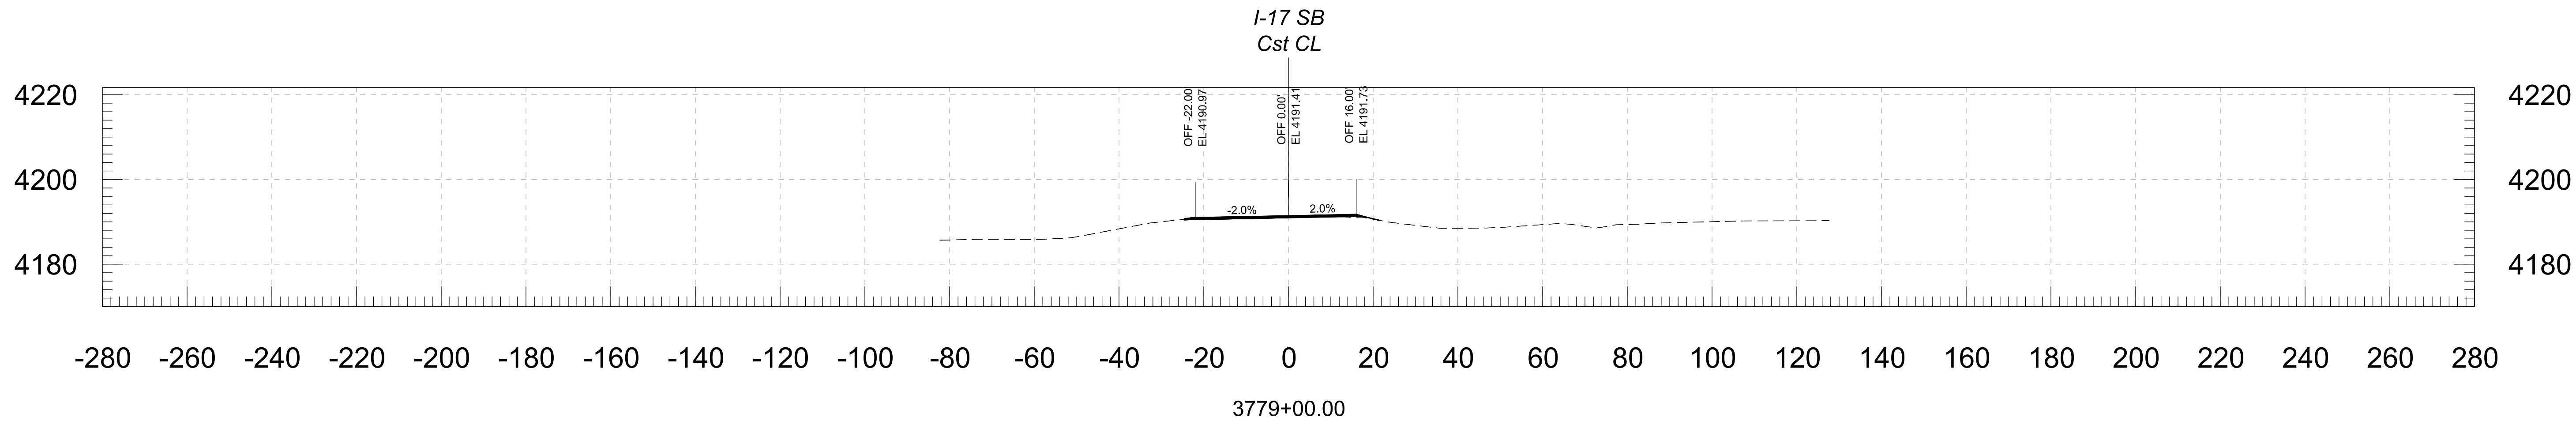


				NAME	DATE	ARIZONA DEPARTMENT OF TRANSPORTATION PROJECT DELIVERY AND OPERATIONS DIVISION ROADWAY DESIGN SERVICES	ROUTE I-17	F.H.W.A. Arizona Division	STATE ARIZ.	PROJECT NO.	FEDERAL ID NO.	SHEET NO.	TOTAL SHEETS	RECORD DRAWING
			DESIGN	BAP	06/26		MILEPOST			017 YV 269	017-B(239)T	81	146	
			DRAWN	RM	06/26		STRUCTURE NO.	LOCATION E DUGAS ROAD - MP 275					DWG NO.	
			CHECKED	KCH	06/26			TRACS NO. F0616 01C					___ OF ___	
			 3133 East Camelback Road, Suite 100 Phoenix, Arizona 85016 Phone: (602) 333-2200 Stanley Consultants INC.			CROSS SECTION								

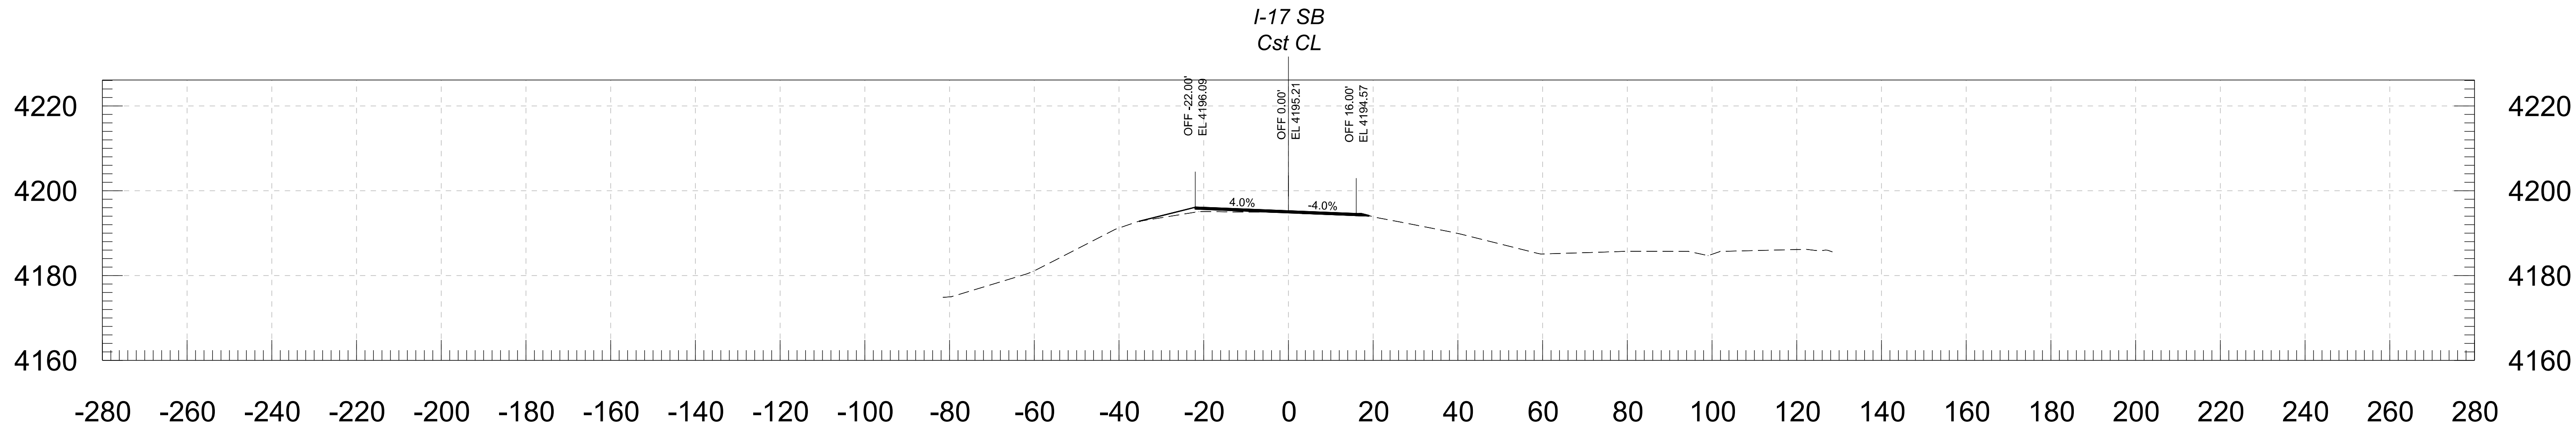

3782+00.00

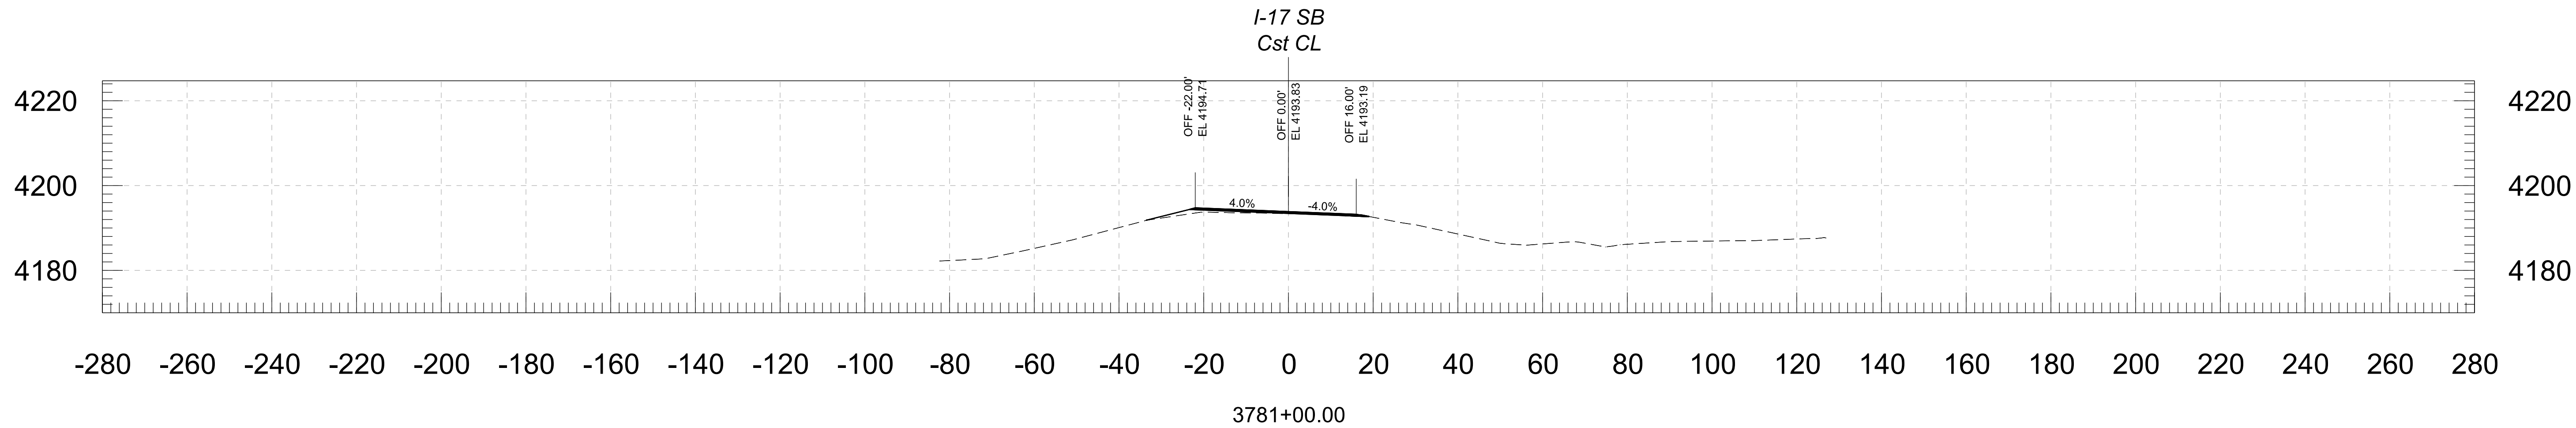


3781+00.00



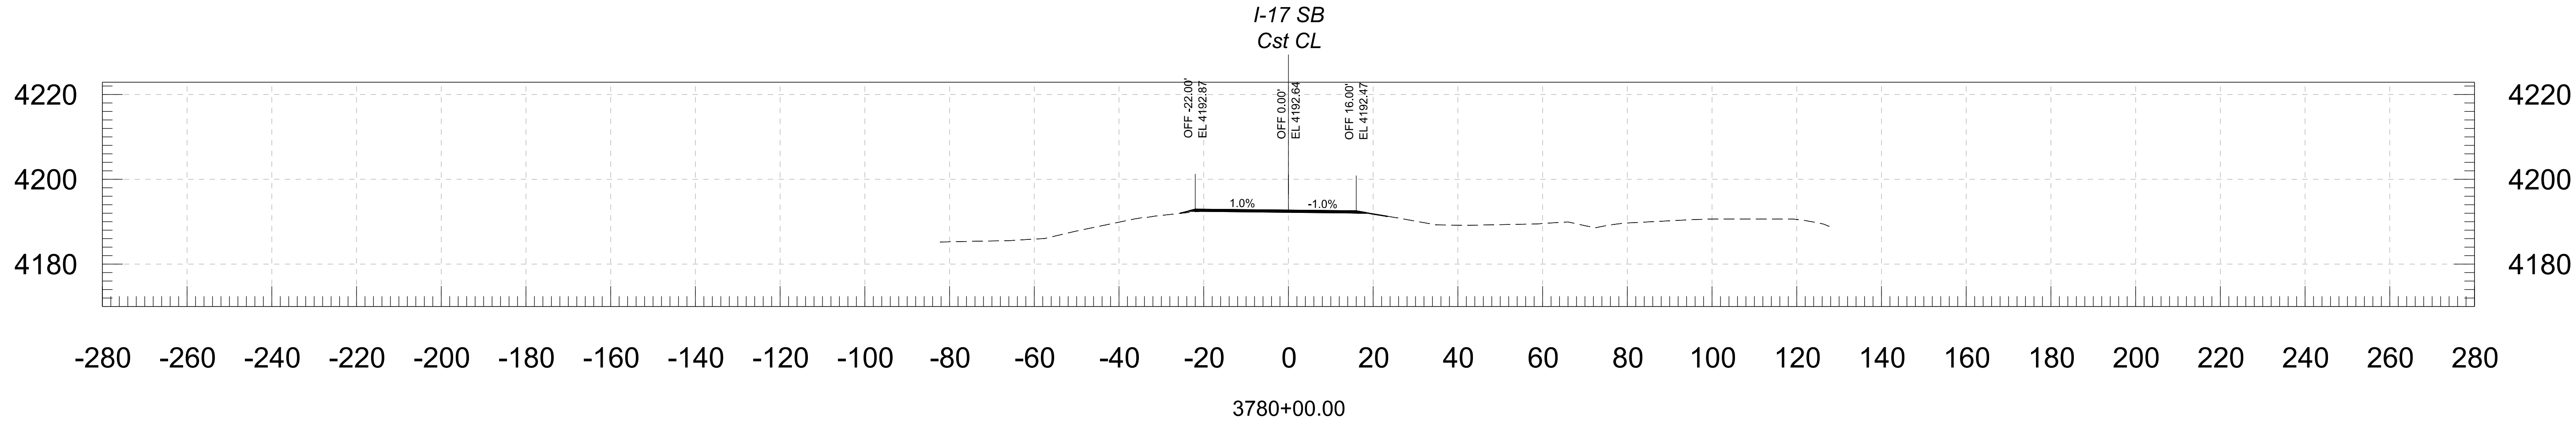


3780+00.00




		DESIGN	BAP	06/26	ARIZONA DEPARTMENT OF TRANSPORTATION PROJECT DELIVERY AND OPERATIONS DIVISION ROADWAY DESIGN SERVICES	ROUTE	F.H.W.A. Arizona Division	STATE ARIZ.	PROJECT NO.	FEDERAL ID NO.	SHEET NO.	TOTAL SHEETS	RECORD DRAWING	
		DRAWN	RM	06/26		017 YV 269			017-B(239)T	82	146			
		CHECKED	KCH	06/26										
		 Stanley Consultants INC.			CROSS SECTION	MILEPOST	E DUGAS ROAD - MP 275							DWG NO.
						STRUCTURE NO.	TRACS NO. F0616 01C							___ OF ___

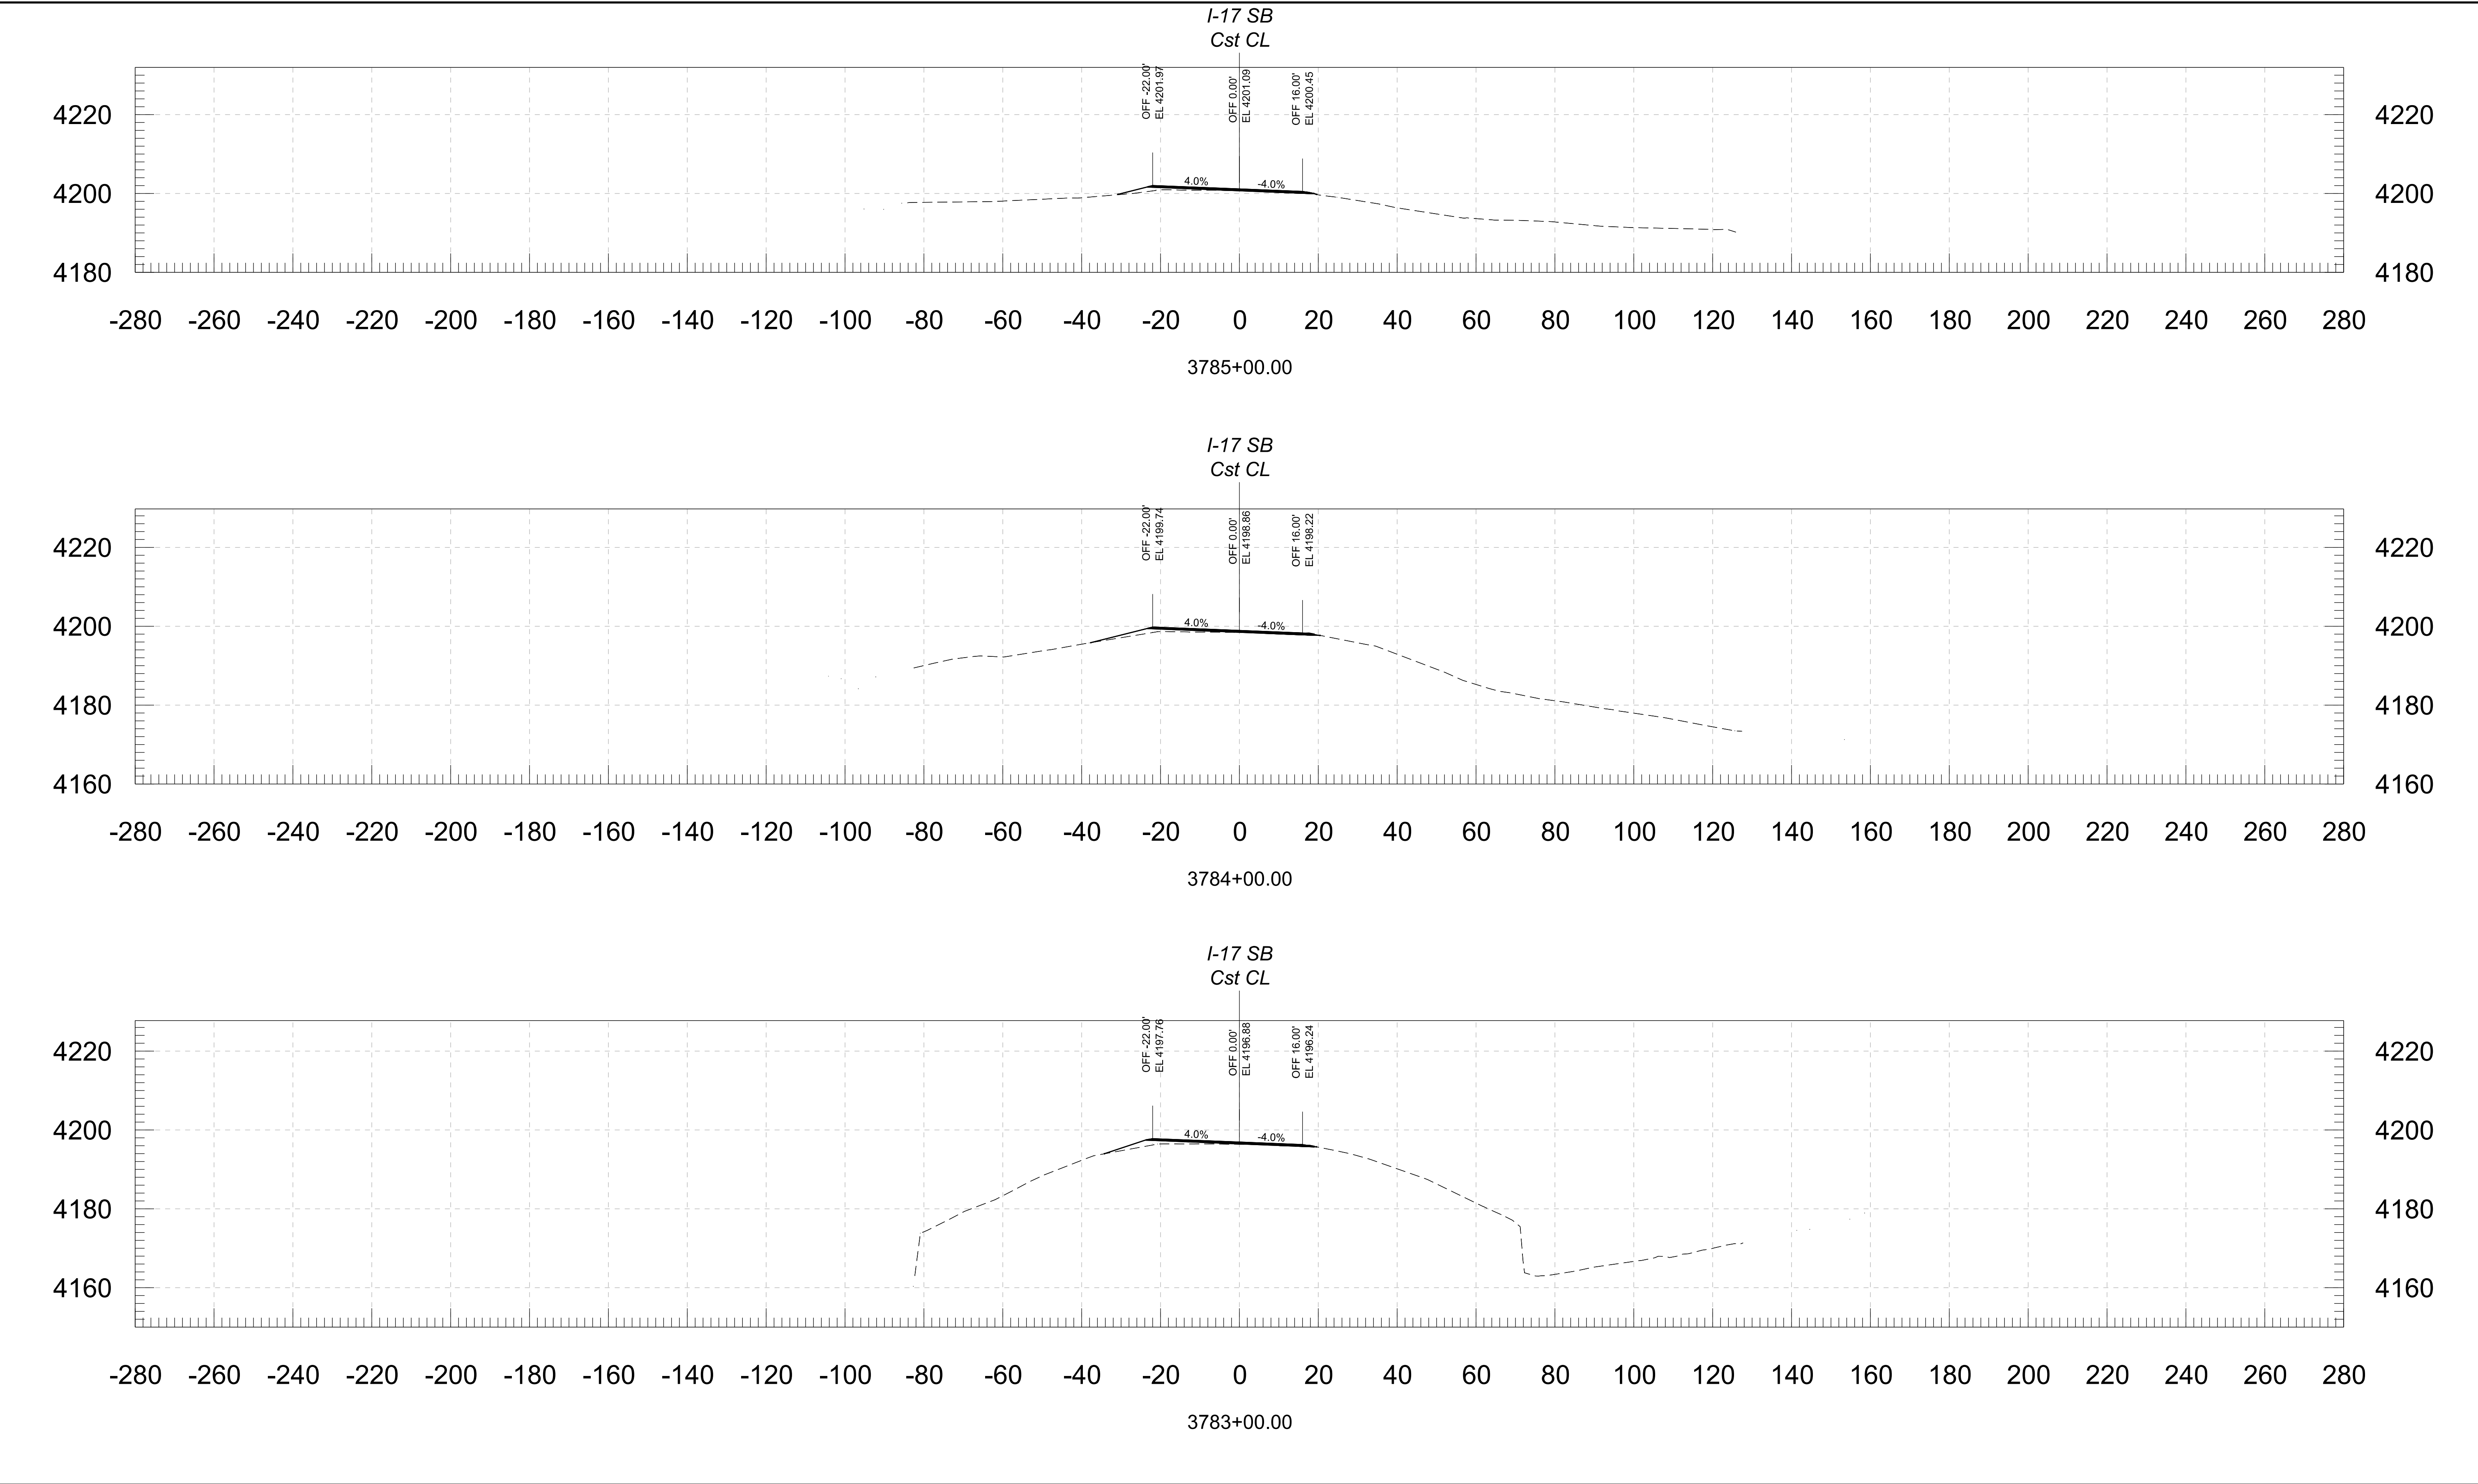


		DESIGN	NAME	DATE	ARIZONA DEPARTMENT OF TRANSPORTATION PROJECT DELIVERY AND OPERATIONS DIVISION ROADWAY DESIGN SERVICES	ROUTE	F.H.W.A. Arizona Division	STATE ARIZ.	PROJECT NO.	FEDERAL ID NO.	SHEET NO.	TOTAL SHEETS	RECORD DRAWING	
			DRAWN	RM		06/26			I-17	017 YV 269	017-B(239)T	83		146
			CHECKED	KCH		06/26								
		 3135 East Camelback Road, Suite 100 Phoenix, Arizona 85016 Phone: (602) 333-2200			CROSS SECTION	MILEPOST	E DUGAS ROAD - MP 275						DWG NO.	
						STRUCTURE NO.	TRACS NO. F0616 01C						___ OF ___	

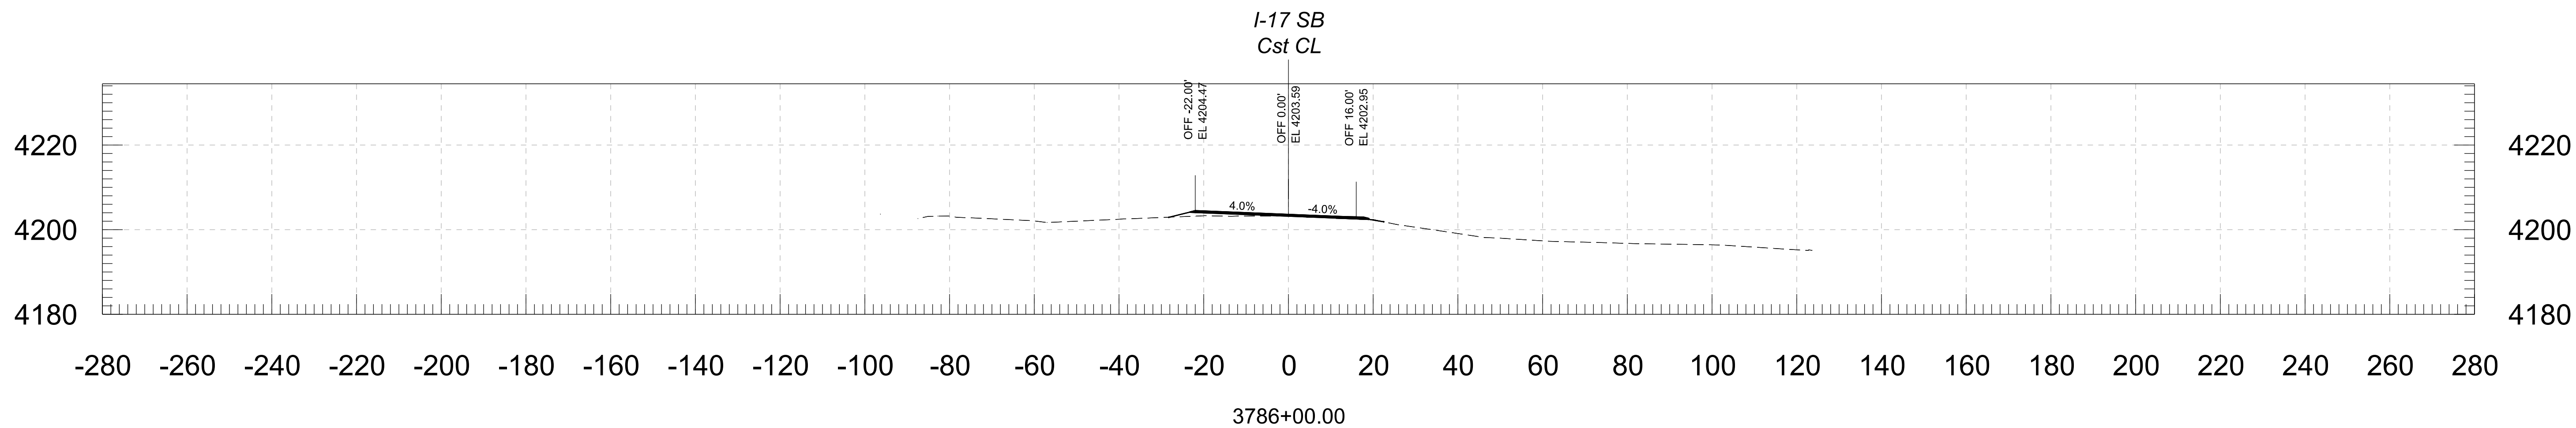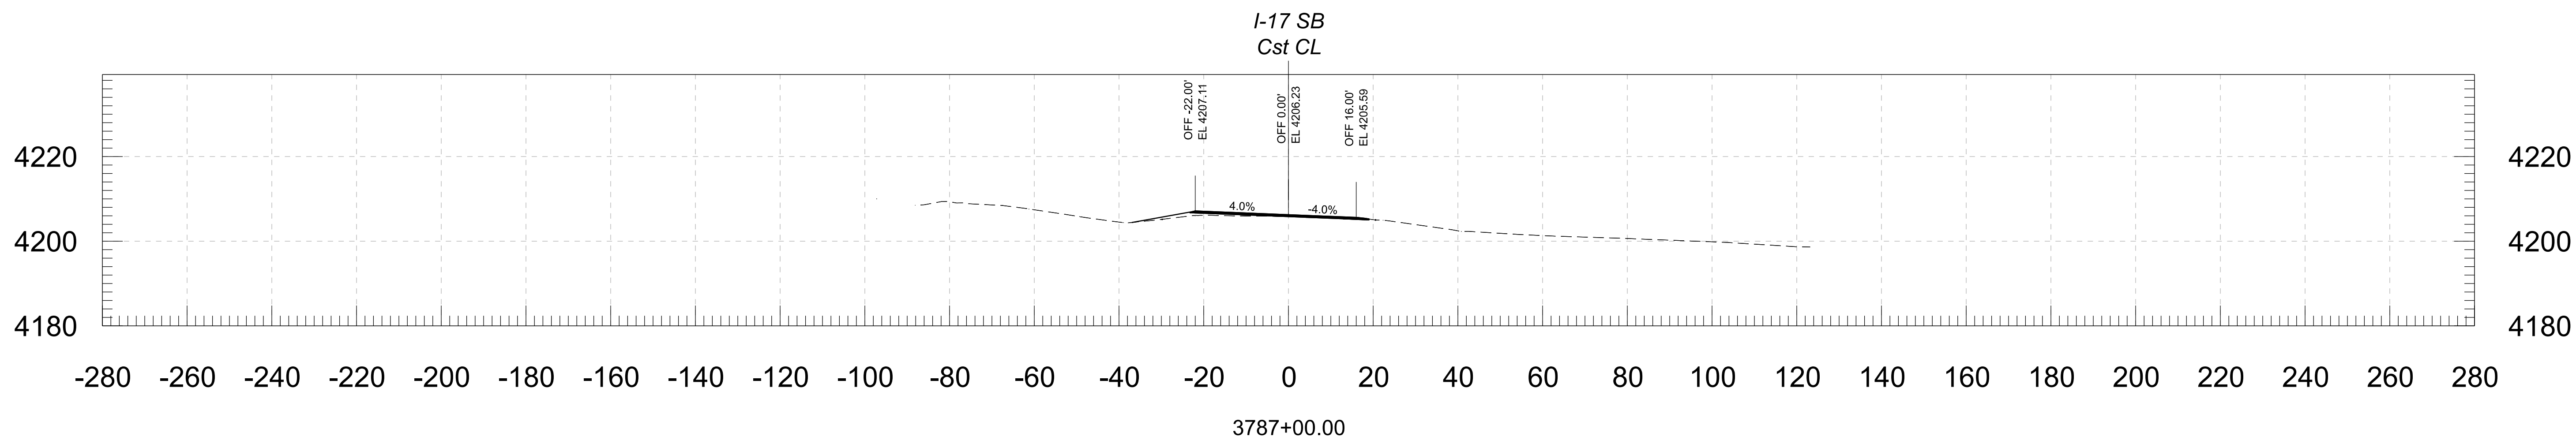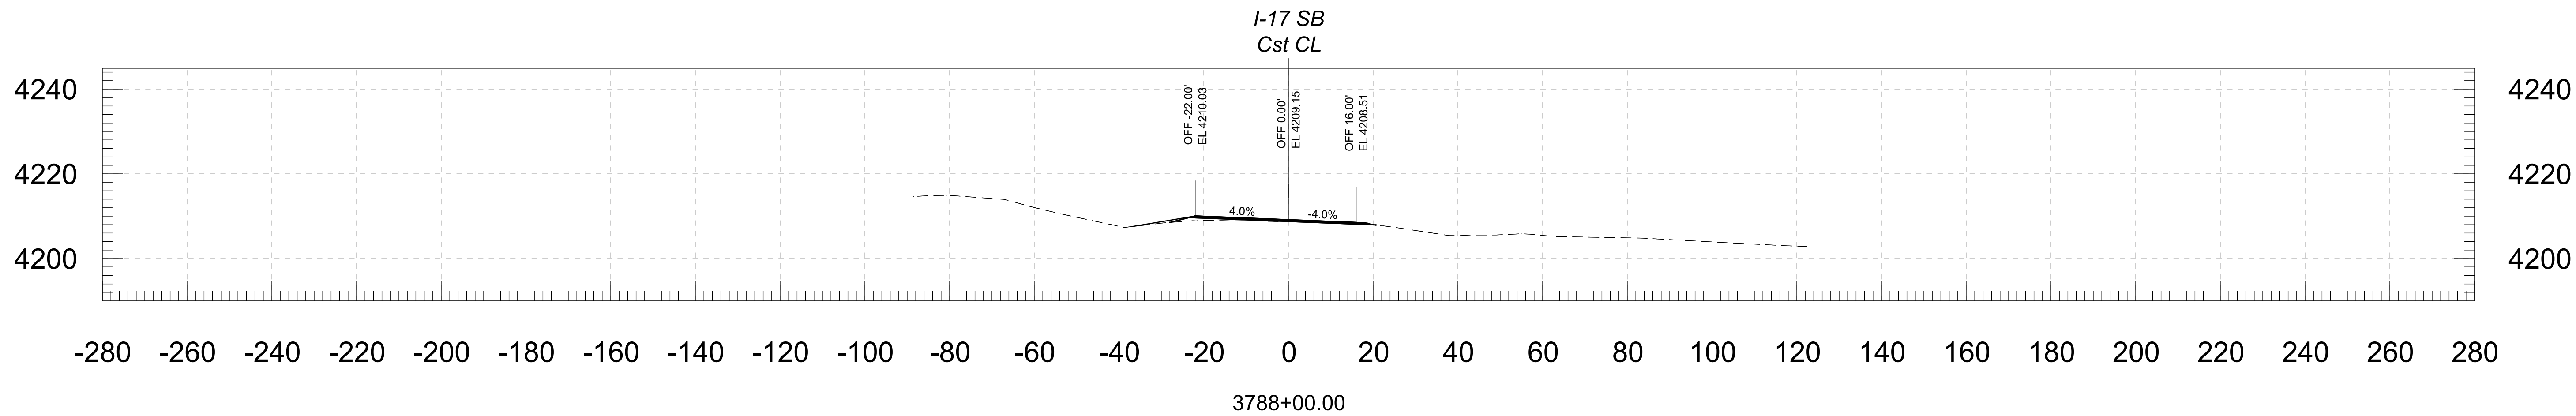


				NAME	DATE	ARIZONA DEPARTMENT OF TRANSPORTATION PROJECT DELIVERY AND OPERATIONS DIVISION ROADWAY DESIGN SERVICES	ROUTE	F.H.W.A. Arizona Division	STATE ARIZ.	PROJECT NO.	FEDERAL ID NO.	SHEET NO.	TOTAL SHEETS	RECORD DRAWING	
			DESIGN	BAP	06/26		I-17			017 YV 269	017-B(239)T	84	146		
			DRAWN	RM	06/26					LOCATION	E DUGAS ROAD - MP 275				DWG NO.
			CHECKED	KCH	06/26						TRACS NO. F0616 01C				
			 3133 East Camelback Road, Suite 100 Phoenix, Arizona 85016 Phone 602.333-2000			CROSS SECTION	STRUCTURE NO.								

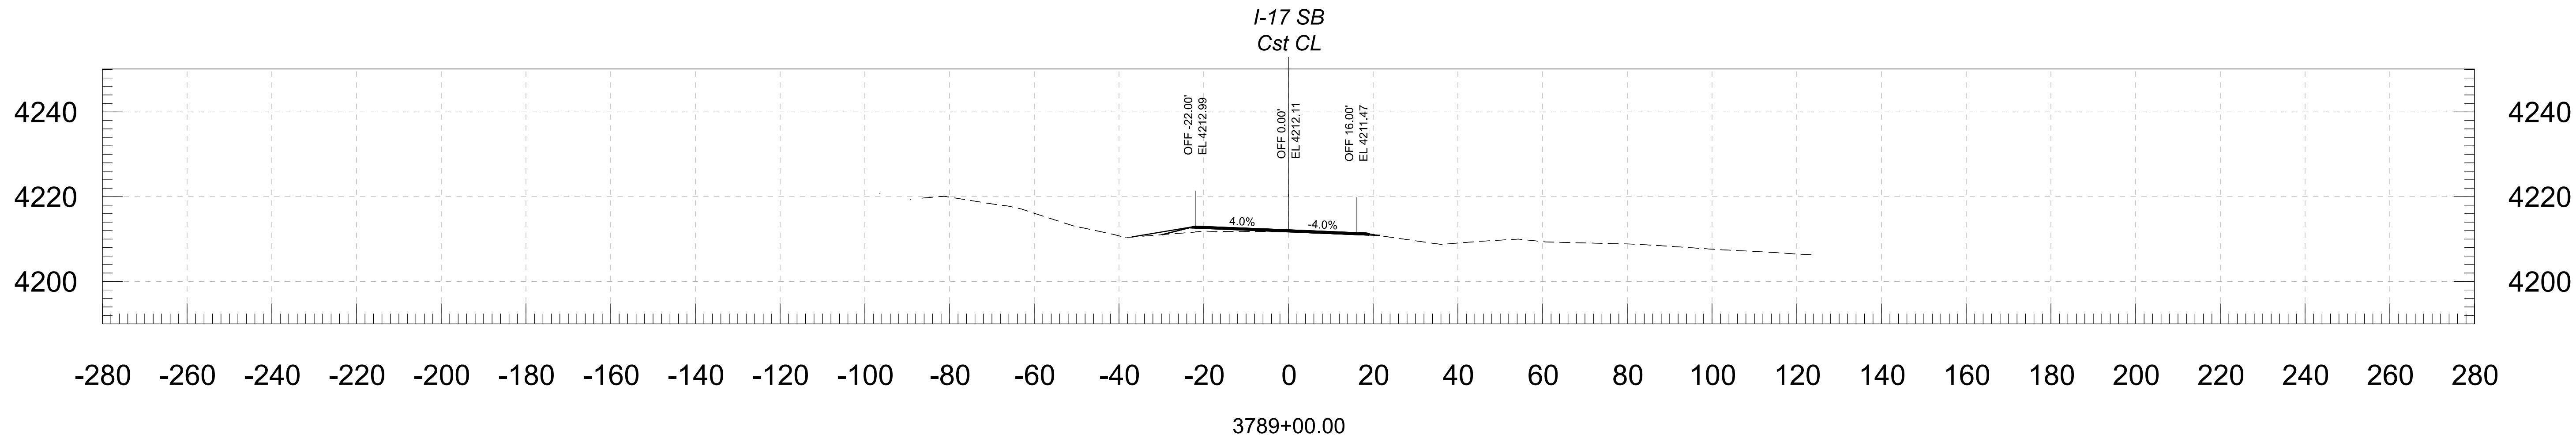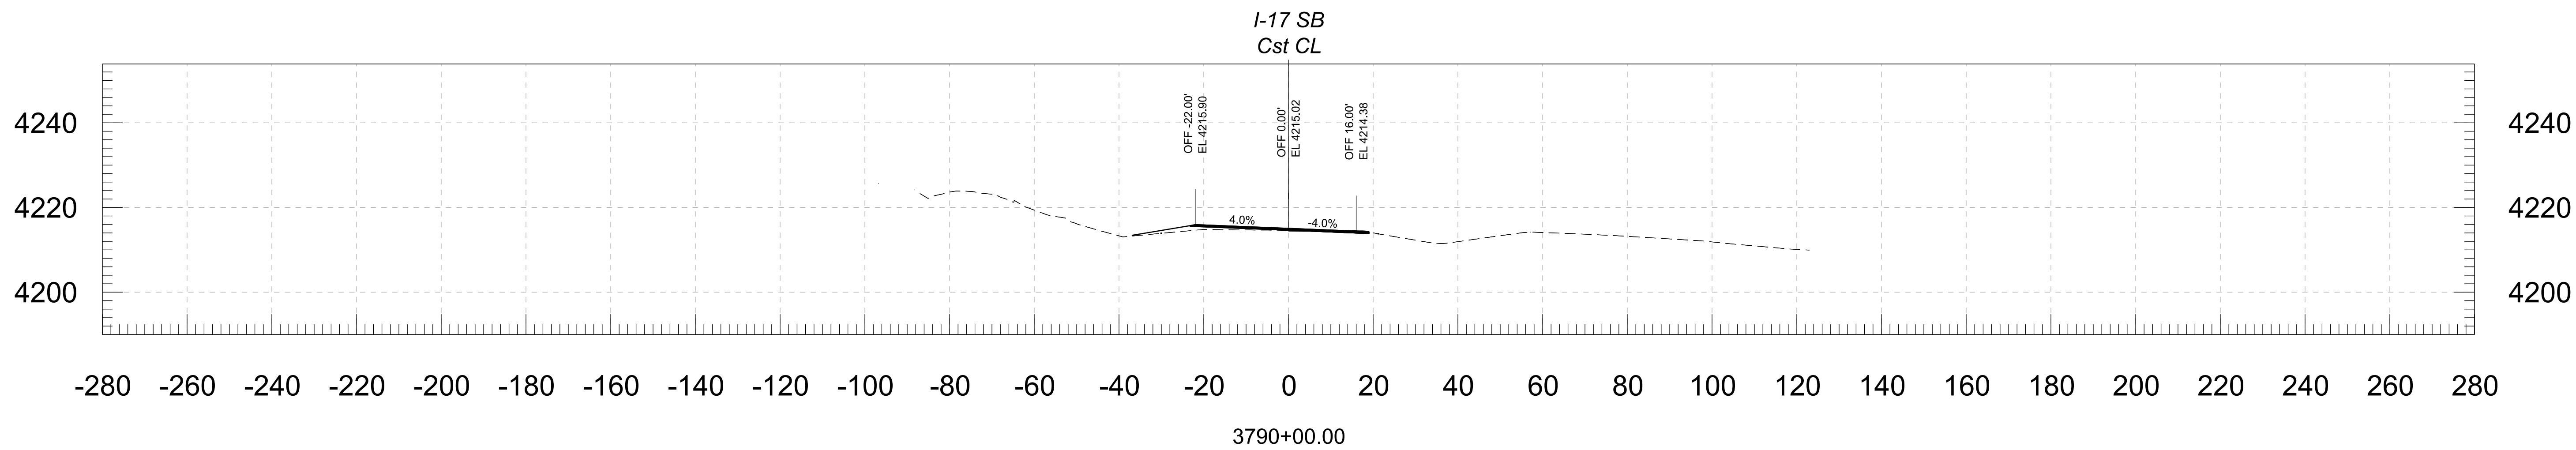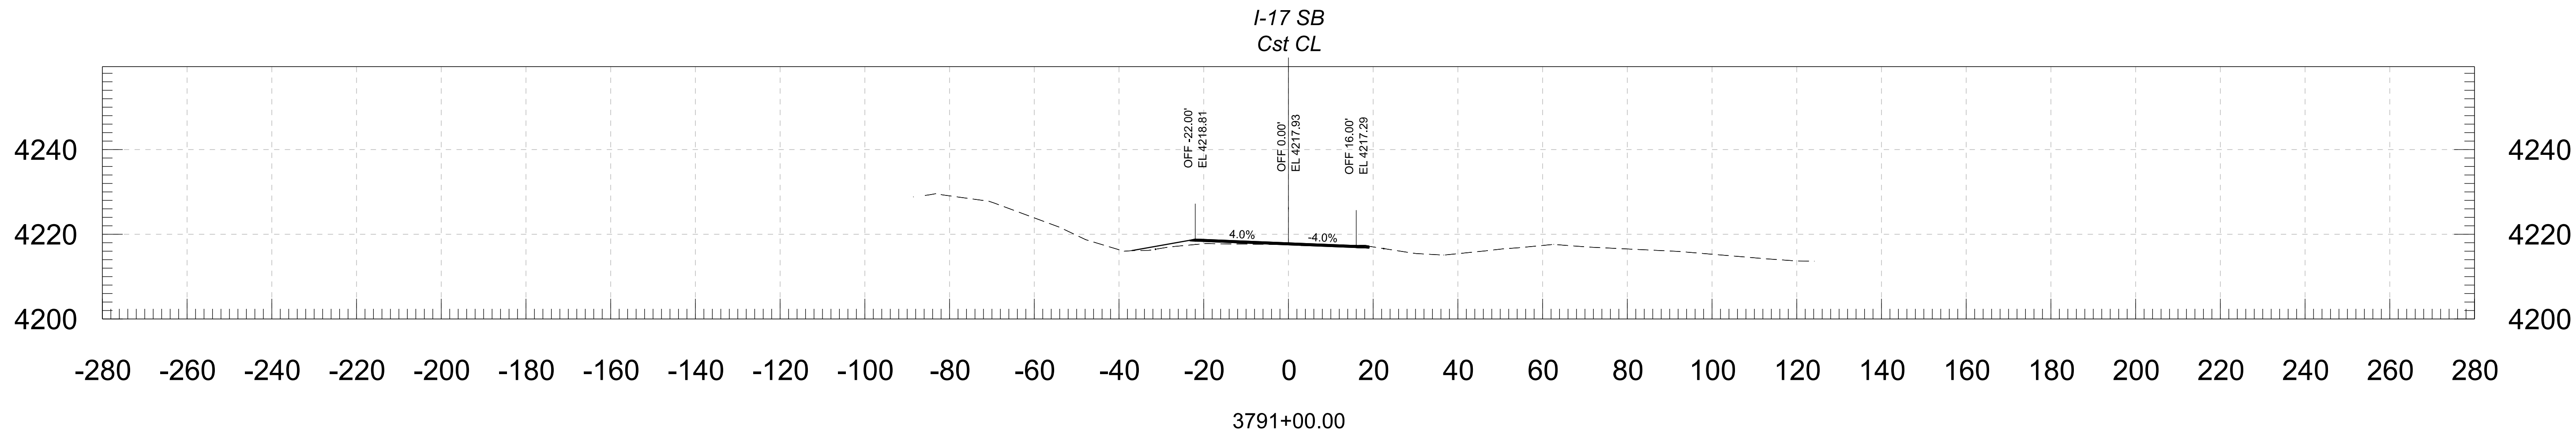


						ARIZONA DEPARTMENT OF TRANSPORTATION PROJECT DELIVERY AND OPERATIONS DIVISION ROADWAY DESIGN SERVICES			ROUTE I-17	F.H.W.A. Arizona Division	STATE ARIZ.	PROJECT NO. 017 YV 269	FEDERAL ID NO. 017-B(239)T	SHEET NO. 85	TOTAL SHEETS 146	RECORD DRAWING
						CROSS SECTION			MILEPOST	E DUGAS ROAD - MP 275					DWG NO.	
									STRUCTURE NO.	TRACS NO. F0616 01C					____ OF ____	

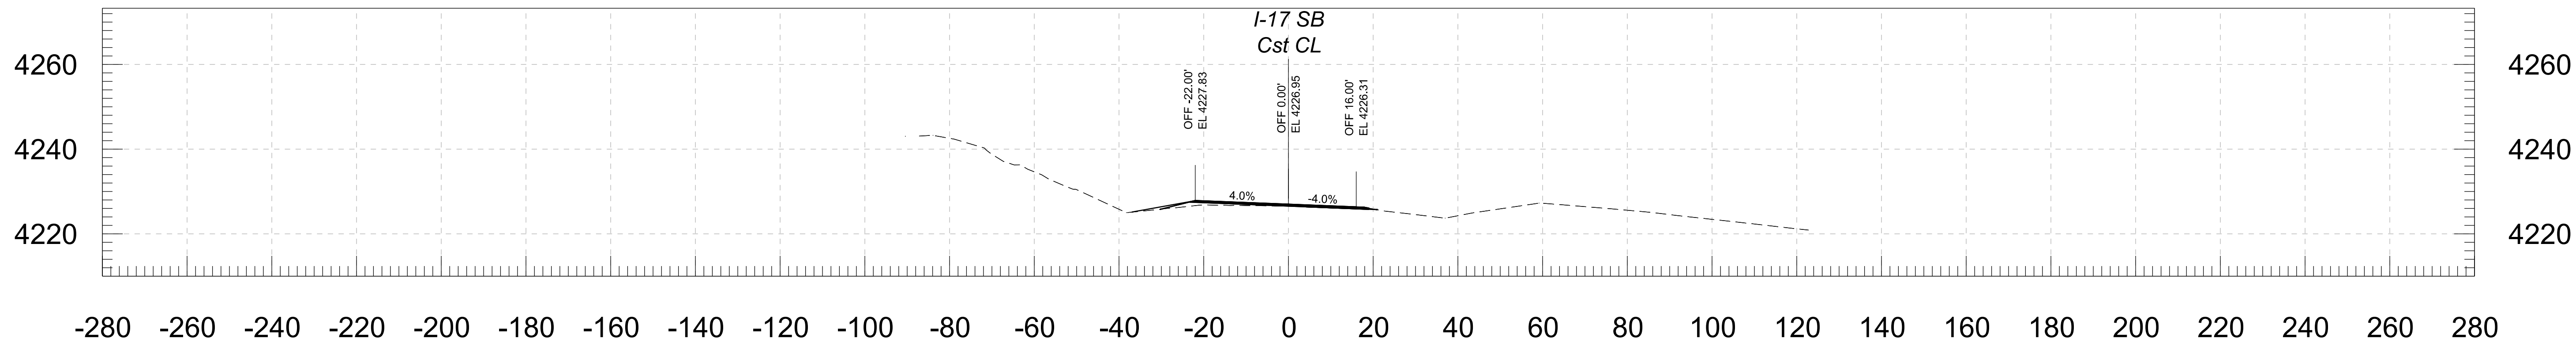

3794+00.00


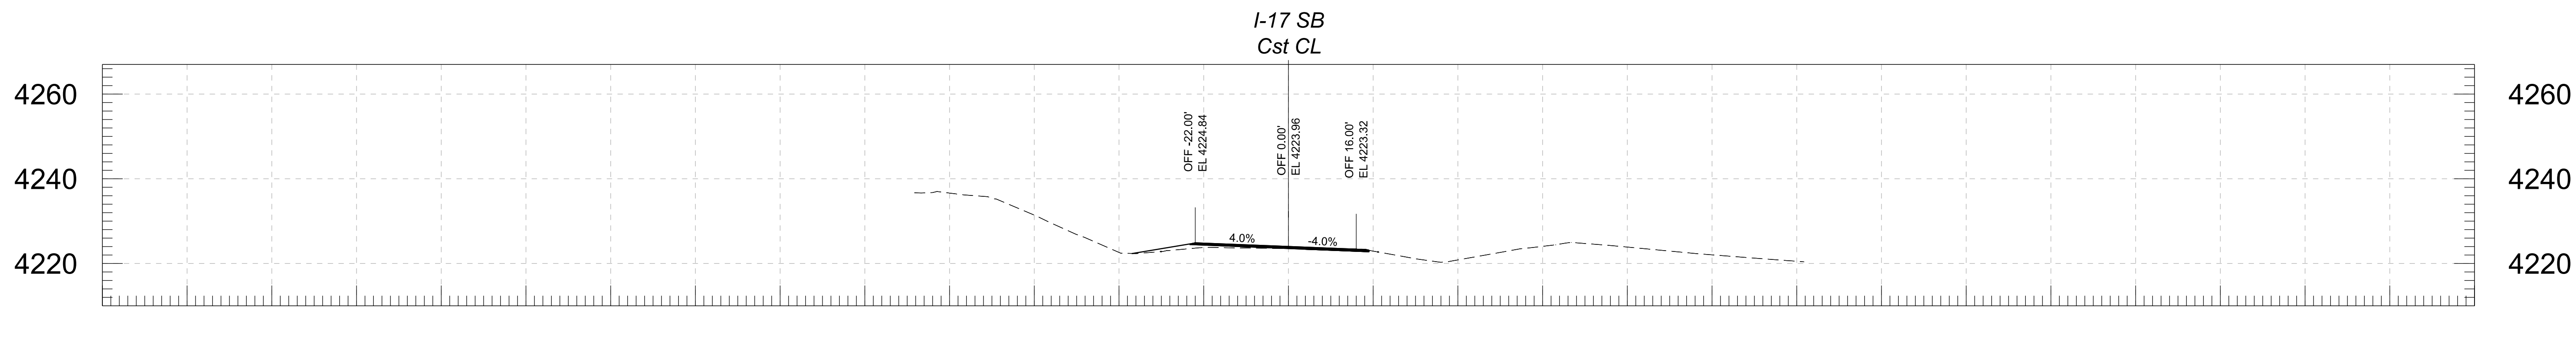


3793+00.00


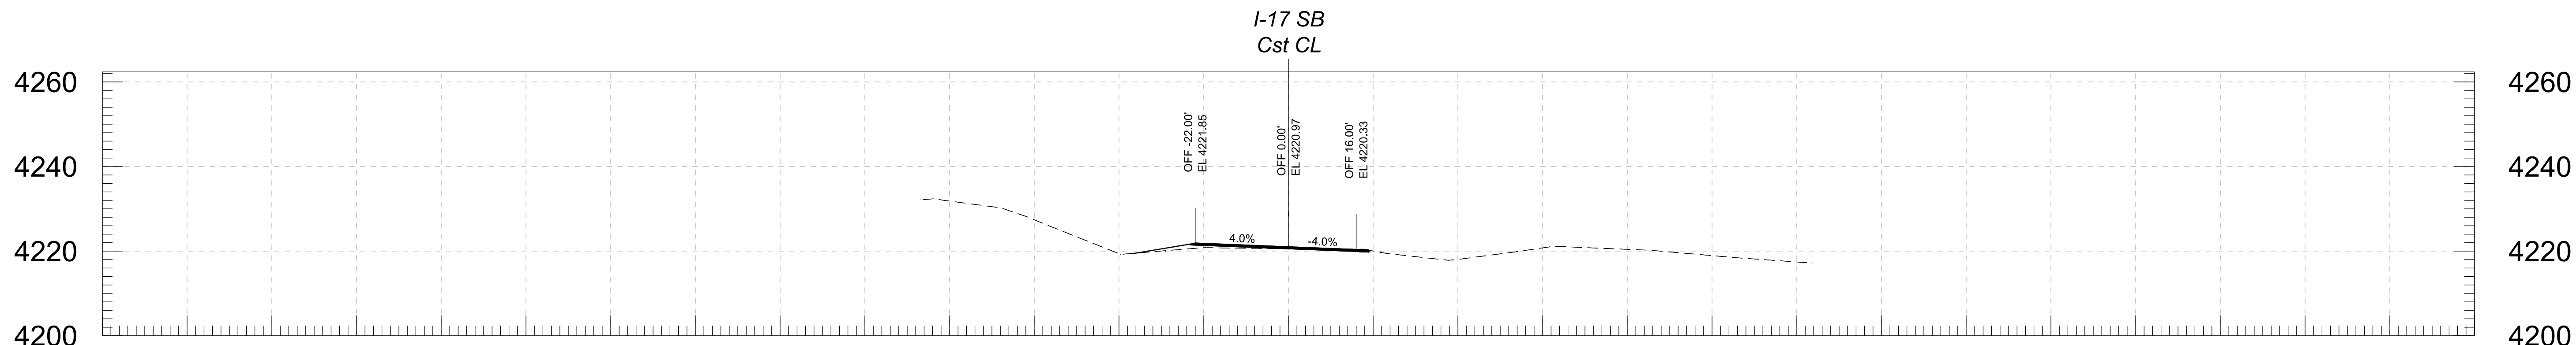


3792+00.00



			NAME	DATE	ARIZONA DEPARTMENT OF TRANSPORTATION PROJECT DELIVERY AND OPERATIONS DIVISION ROADWAY DESIGN SERVICES	ROUTE	F.H.W.A. Arizona Division	STATE	PROJECT NO.	FEDERAL ID NO.	SHEET NO.	TOTAL SHEETS	RECORD DRAWING		
		DESIGN	BAP	06/26		I-17			017 YV 269	017-B(239)T	86	146			
		DRAWN	RM	06/26		MILEPOST	LOCATION								DWG NO.
		CHECKED	KCH	06/26		STRUCTURE NO.	E DUGAS ROAD - MP 275								
 Stanley Consultants INC. 333 East Camelback Road, Suite 100 Phoenix, Arizona 85016 Phone: 602) 333-2200			CROSS SECTION				TRACS NO. F0616 01C		OF						

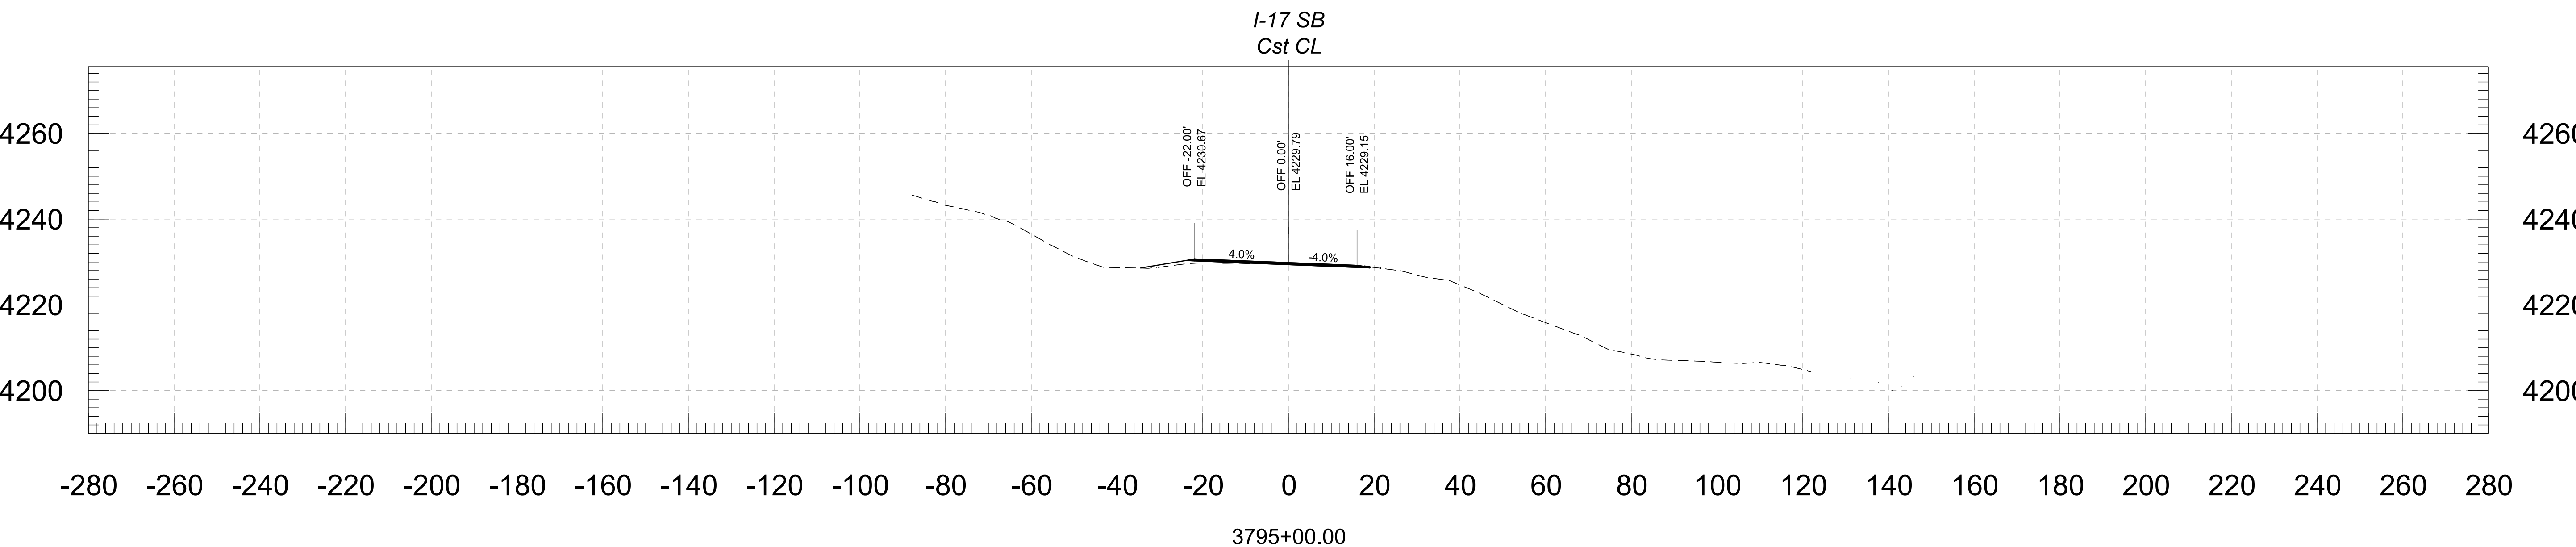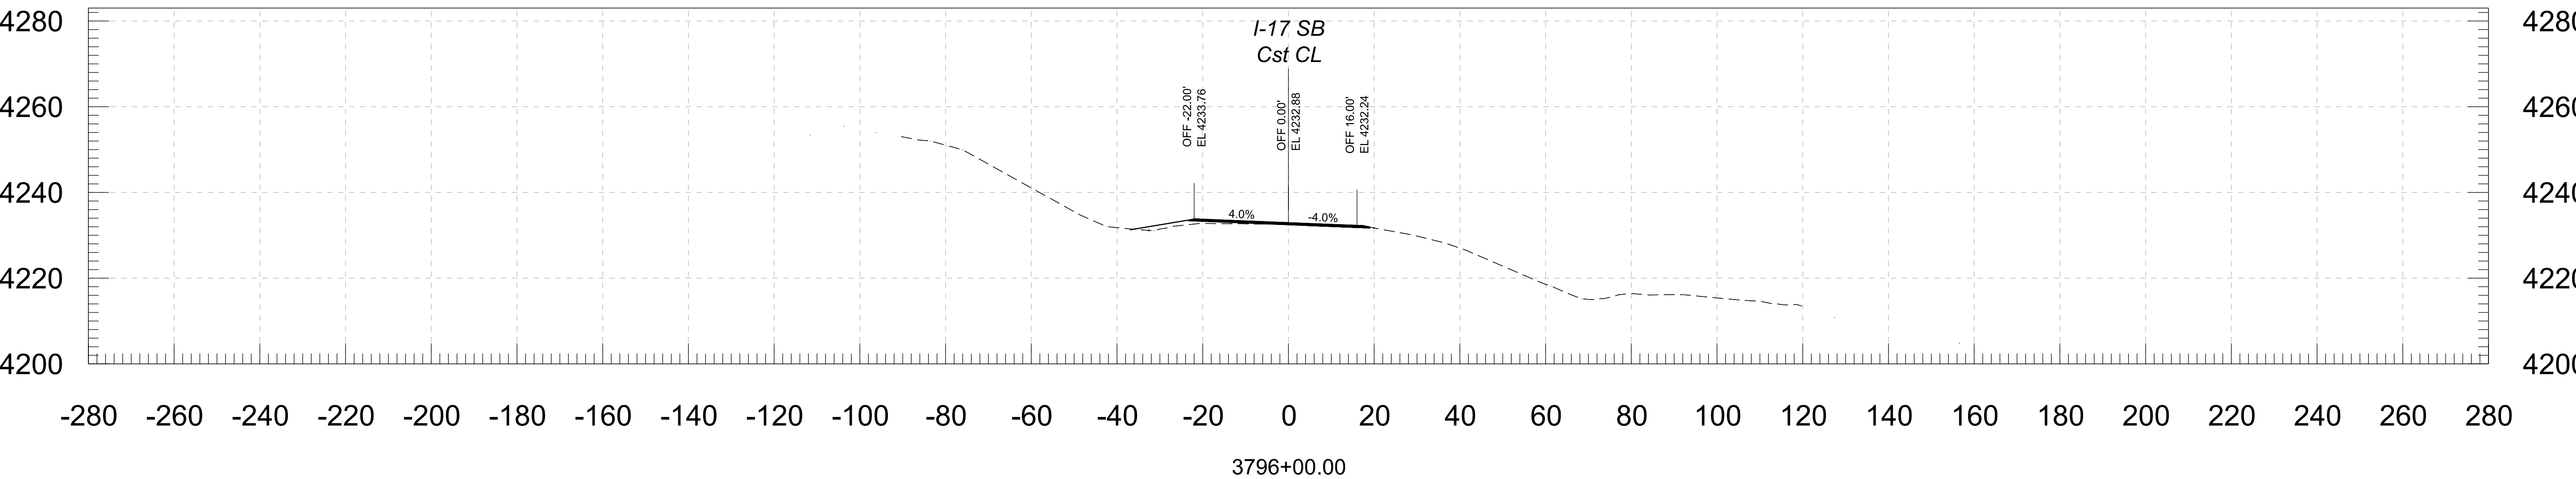



			NAME	DATE	ARIZONA DEPARTMENT OF TRANSPORTATION PROJECT DELIVERY AND OPERATIONS DIVISION ROADWAY DESIGN SERVICES	ROUTE	F.H.W.A. Arizona Division	STATE ARIZ.	PROJECT NO.	FEDERAL ID NO.	SHEET NO.	TOTAL SHEETS	RECORD DRAWING	
		DESIGN	BAP	06/26		I-17			017 YV 269	017-B(239)T	87	146		
		DRAWN	RM	06/26		MILEPOST	LOCATION E DUGAS ROAD - MP 275							
		CHECKED	KCH	06/26										
		 Stanley Consultants INC.			333 East Camelback Road, Suite 100 Phoenix, Arizona 85016 Phone: 602 333-2200			CROSS SECTION	TRACS NO. F0616 01C		____ OF ____			

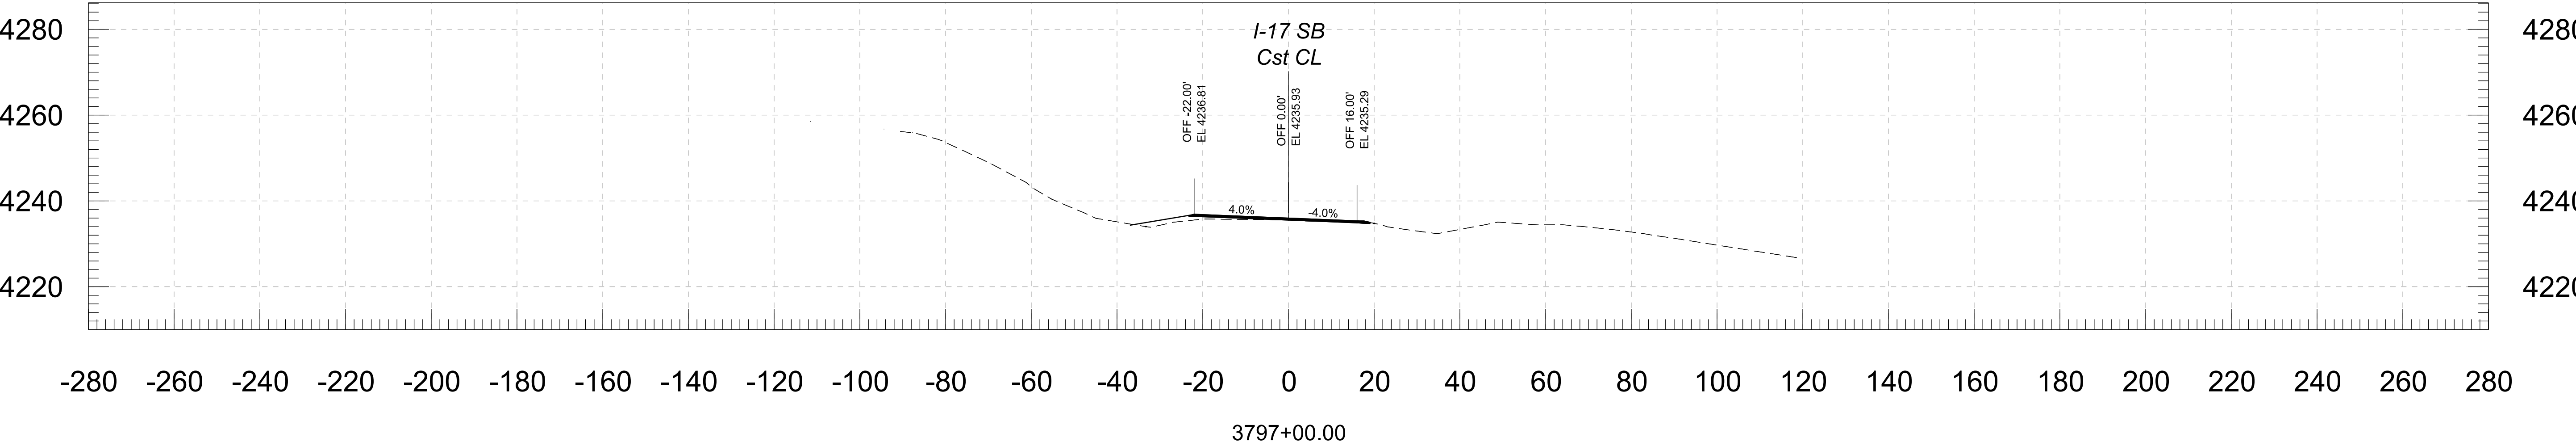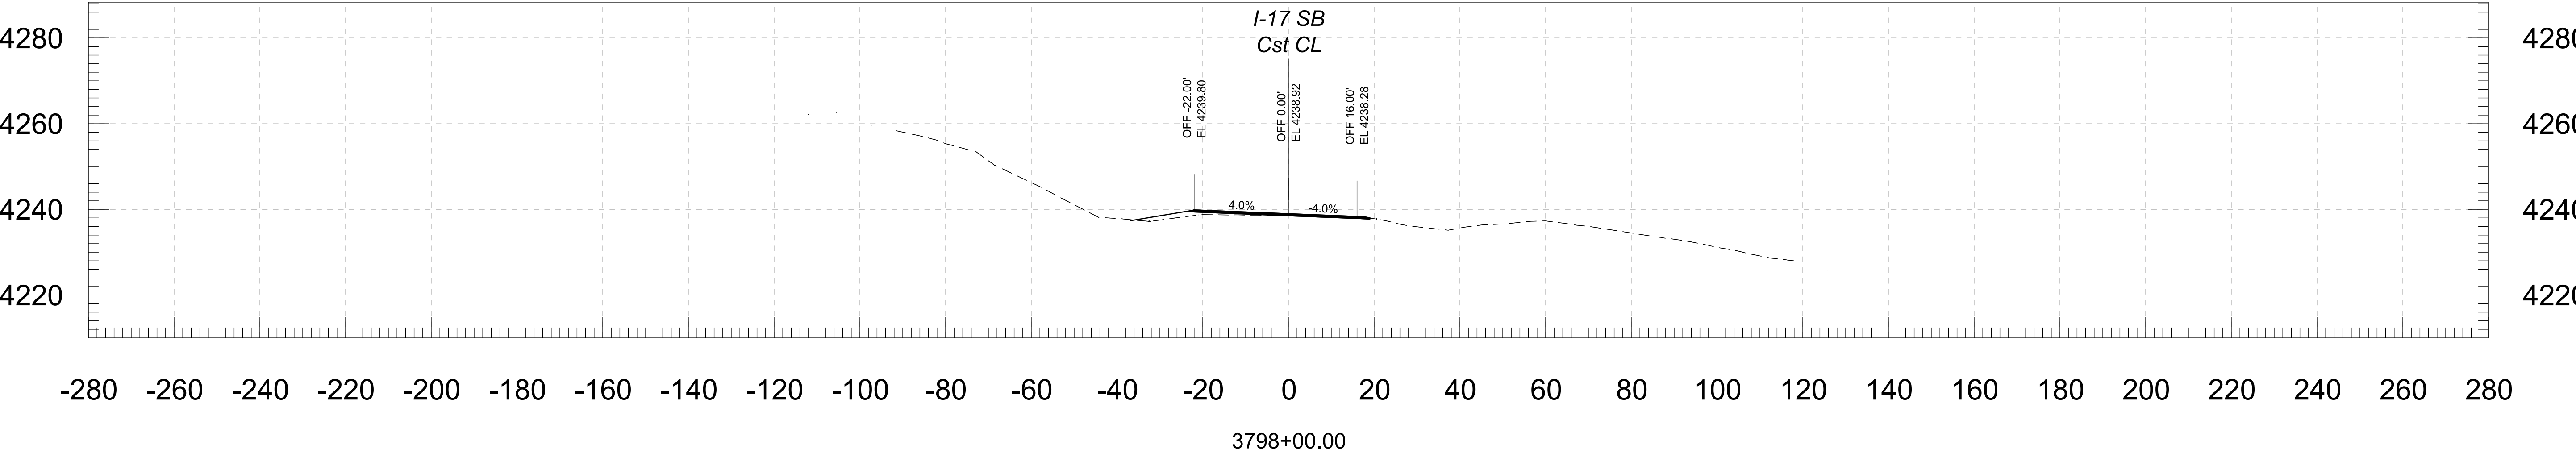



				NAME	DATE	ARIZONA DEPARTMENT OF TRANSPORTATION PROJECT DELIVERY AND OPERATIONS DIVISION ROADWAY DESIGN SERVICES	ROUTE	F.H.W.A. Arizona Division	STATE ARIZ.	PROJECT NO.	FEDERAL ID NO.	SHEET NO.	TOTAL SHEETS	RECORD DRAWING			
			DESIGN	BAP	06/26		I-17			017 YV 269	017-B(239)T	88	146				
			DRAWN	RM	06/26		MILEPOST	LOCATION E DUGAS ROAD - MP 275									DWG NO.
			CHECKED	KCH	06/26			TRACS NO. F0616 01C									___ OF ___
			 Stanley Consultants INC.				333 East Camelback Road, Suite 100 Phoenix, Arizona 85016 Phone: 602 333-2200			CROSS SECTION							

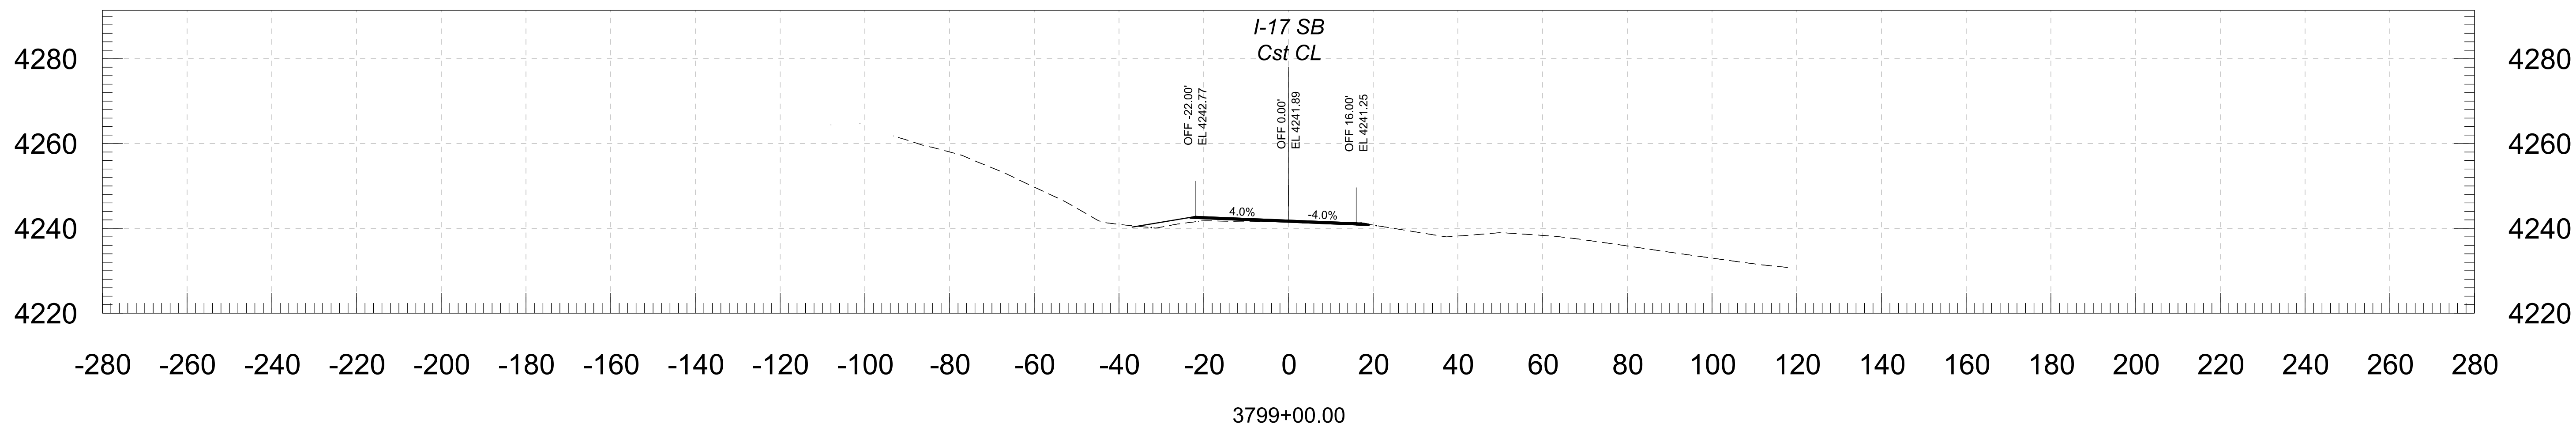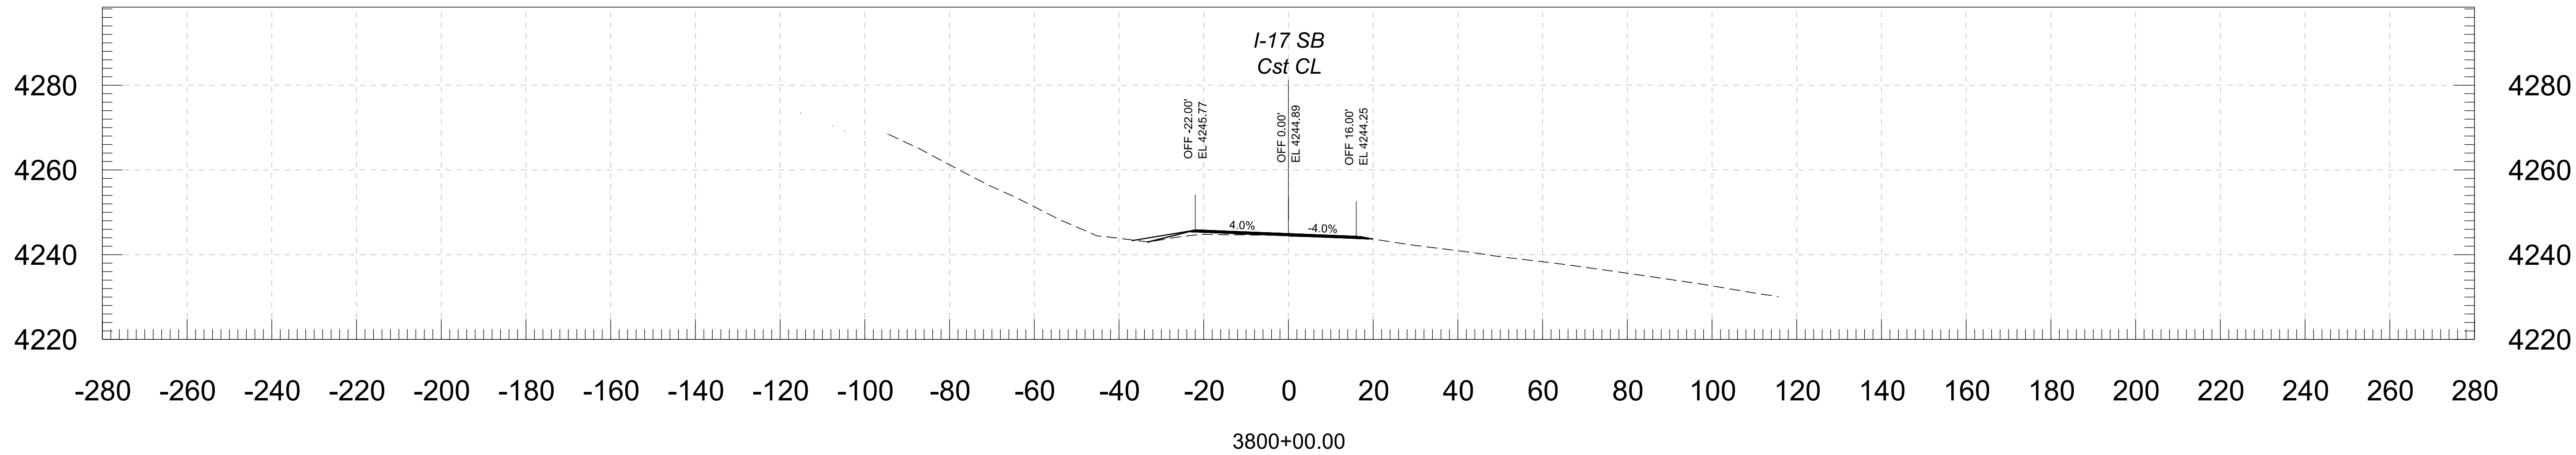



					NAME	DATE	ARIZONA DEPARTMENT OF TRANSPORTATION PROJECT DELIVERY AND OPERATIONS DIVISION ROADWAY DESIGN SERVICES	ROUTE	F.H.W.A. Arizona Division	STATE ARIZ.	PROJECT NO.	FEDERAL ID NO.	SHEET NO.	TOTAL SHEETS	RECORD DRAWING	
				DESIGN	BAP	06/26		I-17			017 YV 269	017-B(239)T	89	146		
				DRAWN	RM	06/26										
				CHECKED	KCH	06/26										
				 3133 East Camelback Road, Suite 100 Phoenix, Arizona 85016 Phone: 602.335.2000				CROSS SECTION								MILEPOST
						STRUCTURE NO.	TRACS NO. F0616 01C								___ OF ___	

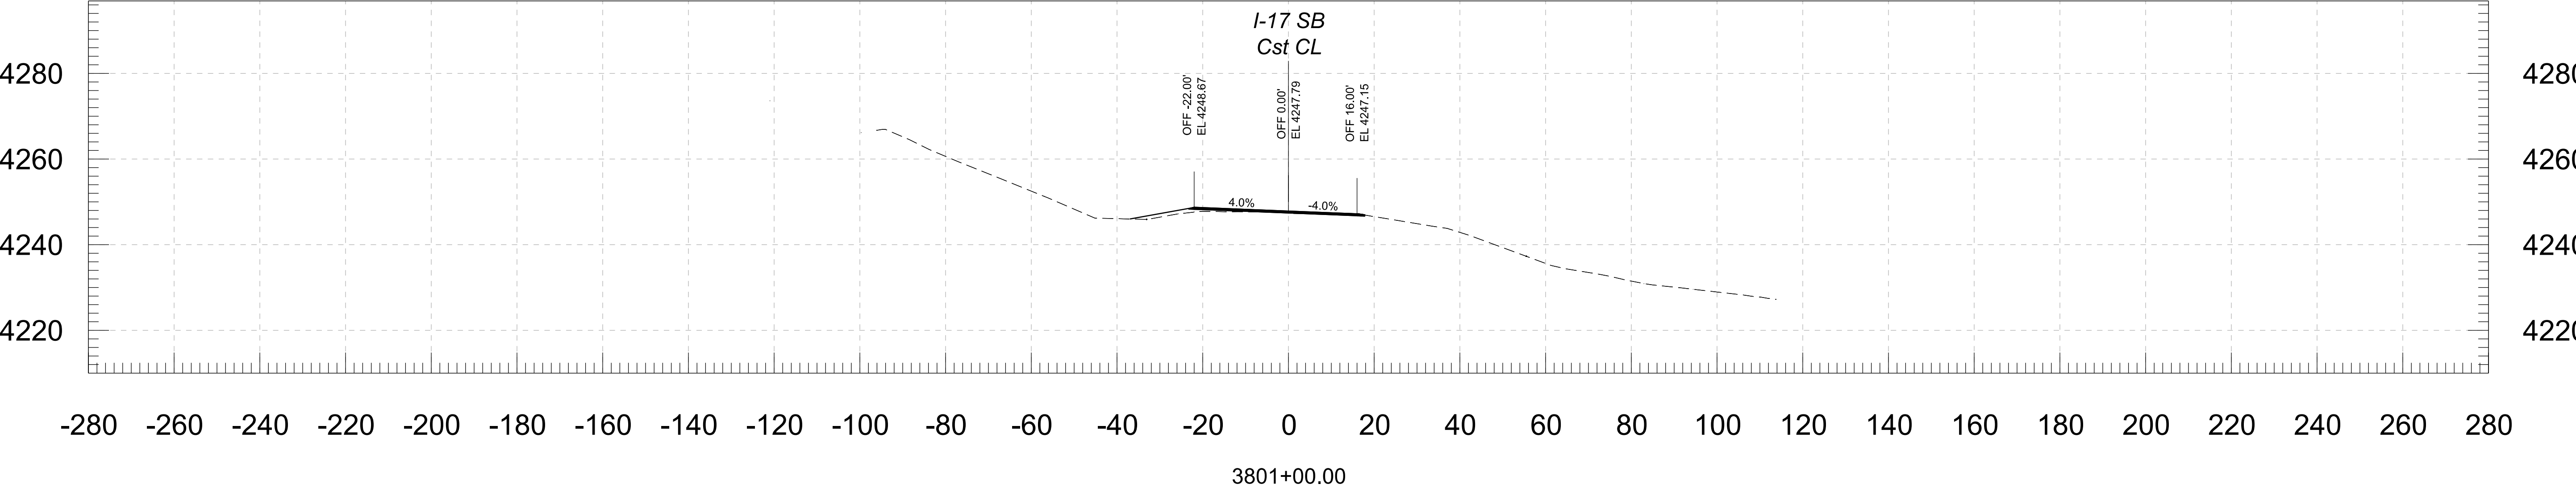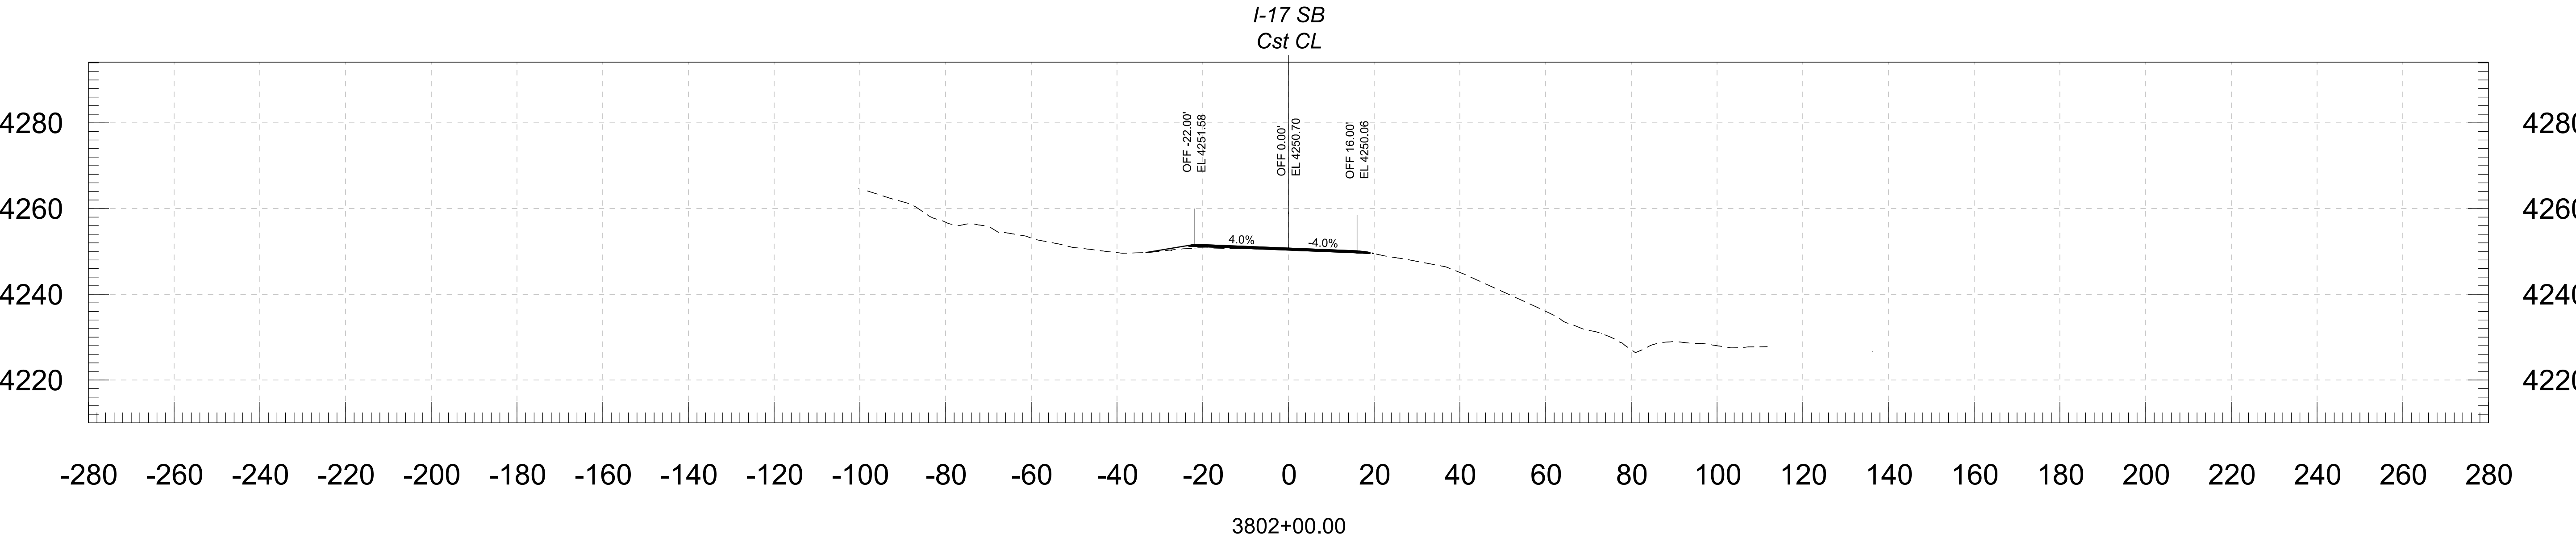



				NAME	DATE	ARIZONA DEPARTMENT OF TRANSPORTATION PROJECT DELIVERY AND OPERATIONS DIVISION ROADWAY DESIGN SERVICES	ROUTE	F.H.W.A. Arizona Division	STATE ARIZ.	PROJECT NO.	FEDERAL ID NO.	SHEET NO.	TOTAL SHEETS	RECORD DRAWING
			DESIGN	BAP	06/26		I-17			017 YV 269	017-B(239)T	90	146	
			DRAWN	RM	06/26									
			CHECKED	KCH	06/26									
			 3133 East Camelback Road, Suite 100 Phoenix, Arizona 85016 Phone: (602) 333-2200 Stanley Consultants INC.											
						STRUCTURE NO.	TRACS NO. F0616 01C			____ OF ____				

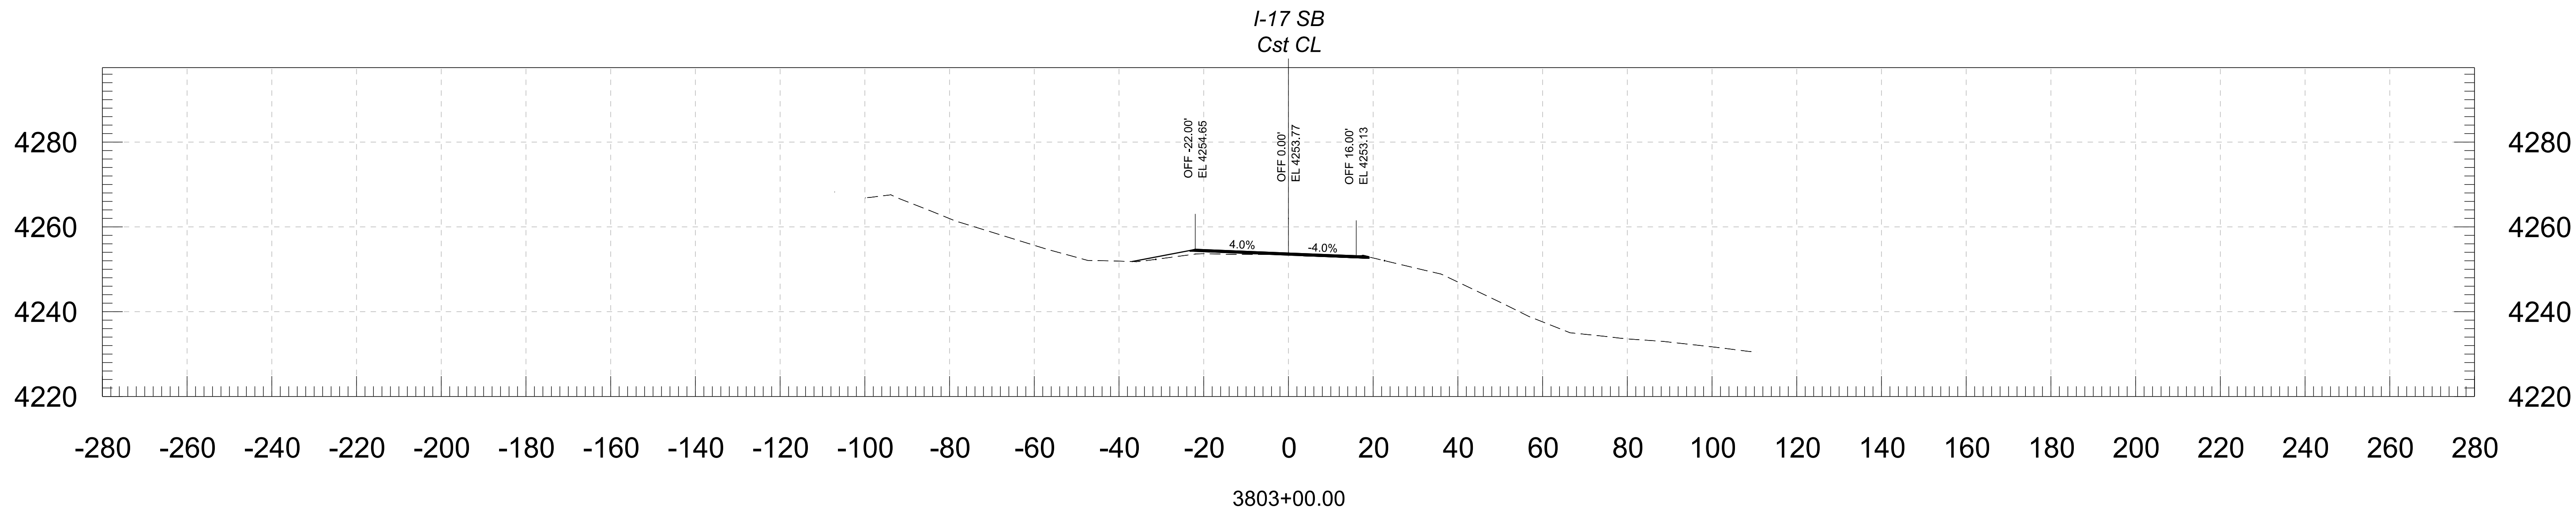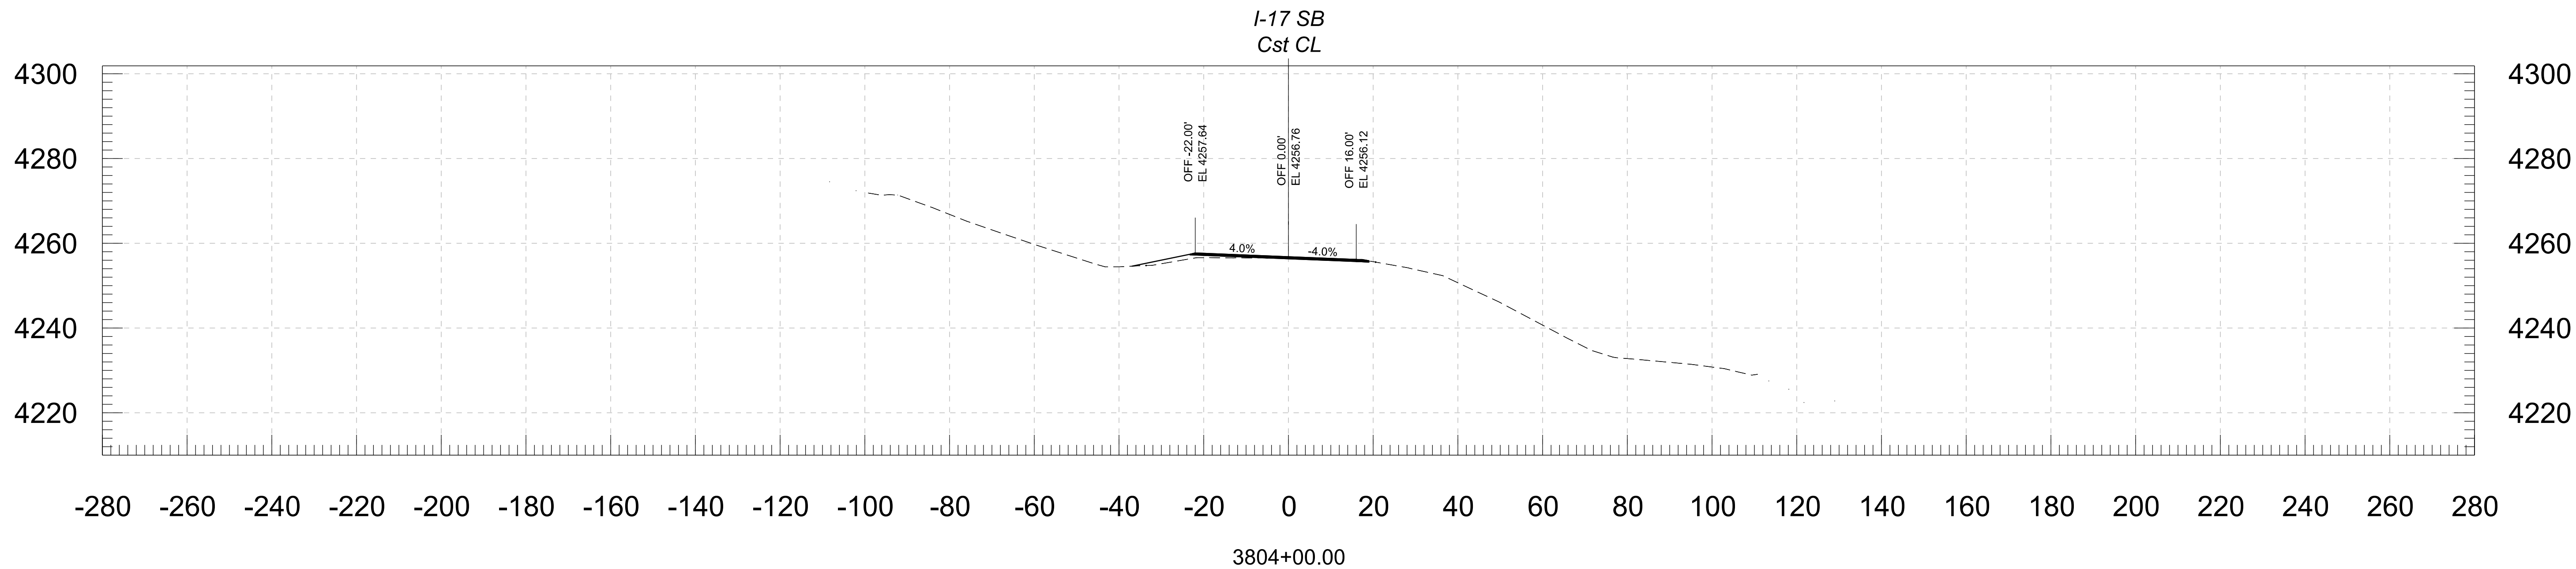



				NAME	DATE	ARIZONA DEPARTMENT OF TRANSPORTATION PROJECT DELIVERY AND OPERATIONS DIVISION ROADWAY DESIGN SERVICES	ROUTE	F.H.W.A. Arizona Division	STATE ARIZ.	PROJECT NO.	FEDERAL ID NO.	SHEET NO.	TOTAL SHEETS	RECORD DRAWING		
			DESIGN	BAP	06/26		I-17			017 YV 269	017-B(239)T	91	146			
			DRAWN	RM	06/26		MILEPOST	E DUGAS ROAD - MP 275								
			CHECKED	KCH	06/26											
			 Stanley Consultants INC.					3133 East Camelback Road, Suite 100 Phoenix, Arizona 85016 Phone: 602.335.2000	CROSS SECTION	STRUCTURE NO.	DWG NO.					
TRACS NO. F0616 01C										OF						

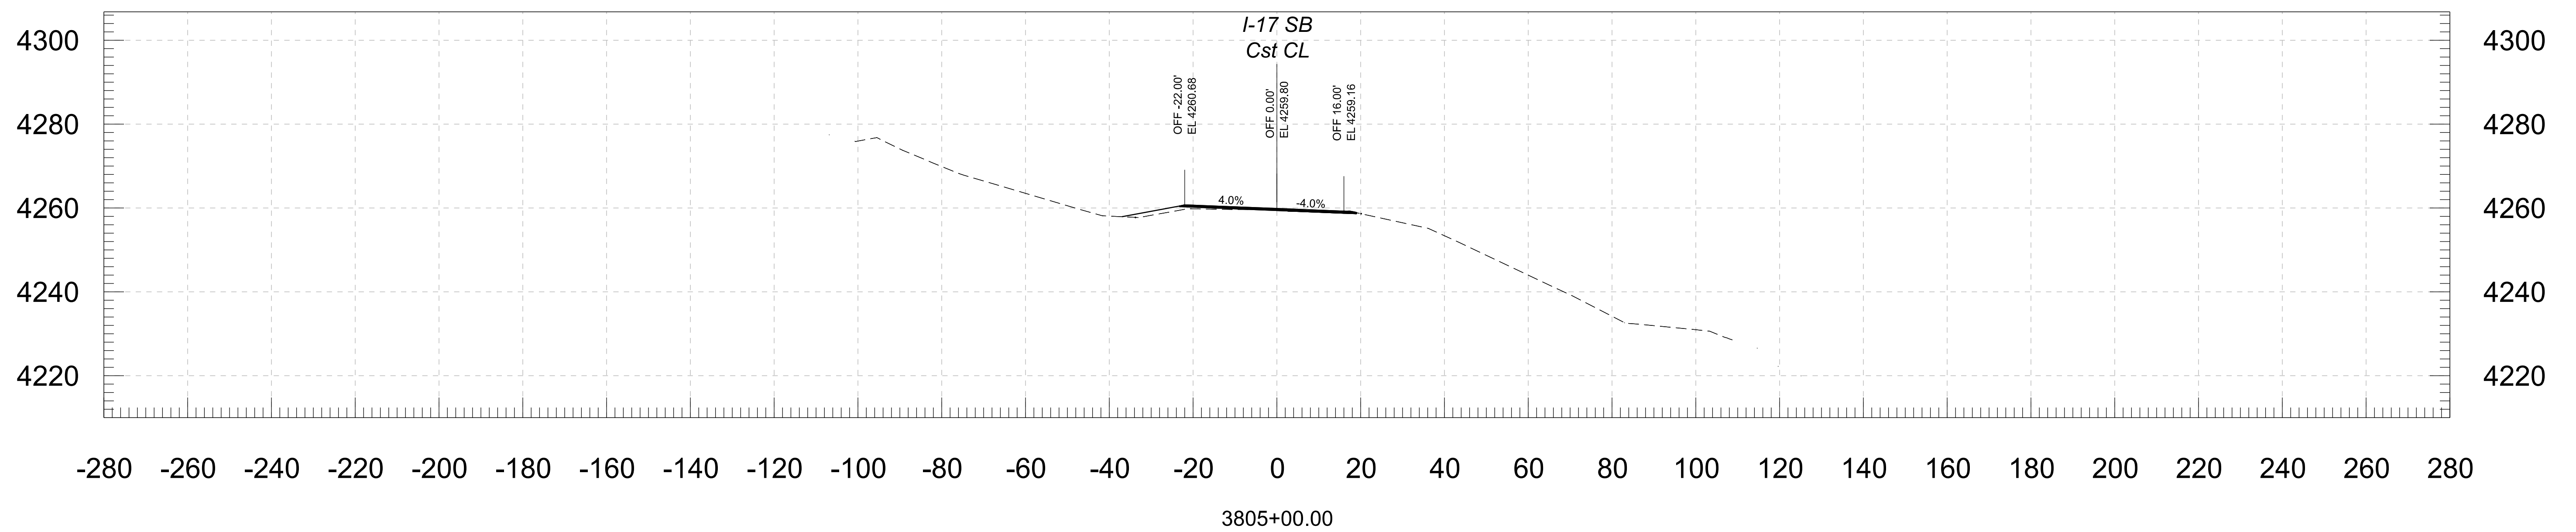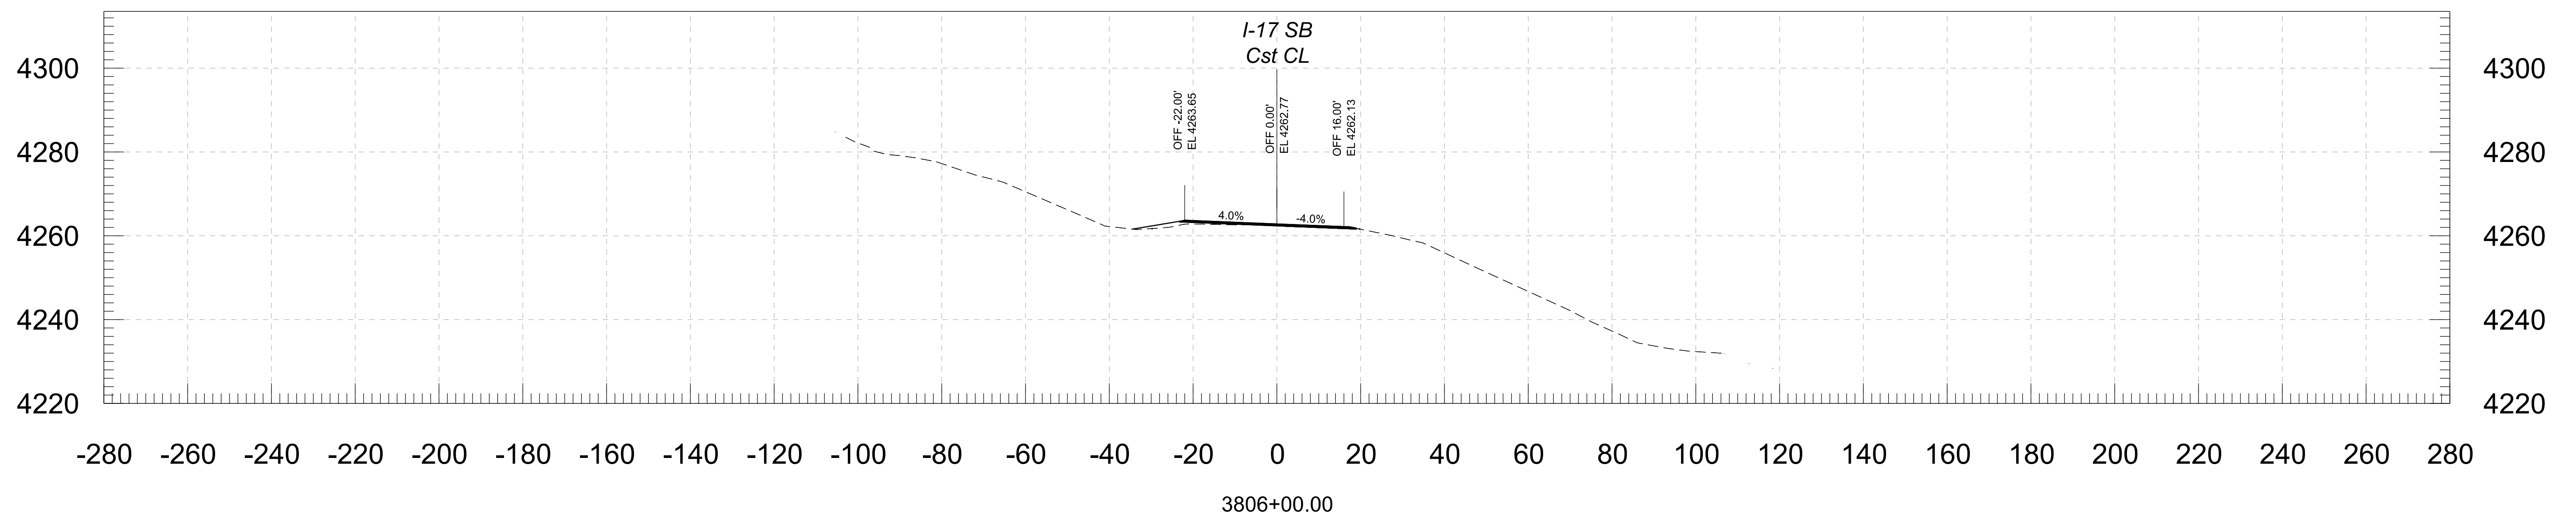



3133 East Camelback Road, Suite 100 Phoenix, Arizona 85016 Phone: (602) 333-2200 Stanley Consultants INC.	<table><tr><th></th><th>NAME</th><th>DATE</th></tr><tr><td>DESIGN</td><td>BAP</td><td>06/26</td></tr><tr><td>DRAWN</td><td>RM</td><td>06/26</td></tr><tr><td>CHECKED</td><td>KCH</td><td>06/26</td></tr></table>		NAME	DATE	DESIGN	BAP	06/26	DRAWN	RM	06/26	CHECKED	KCH	06/26	ARIZONA DEPARTMENT OF TRANSPORTATION PROJECT DELIVERY AND OPERATIONS DIVISION ROADWAY DESIGN SERVICES	<table><tr><td>ROUTE</td><td>I-17</td></tr><tr><td>MILEPOST</td><td></td></tr><tr><td>STRUCTURE NO.</td><td></td></tr></table>	ROUTE	I-17	MILEPOST		STRUCTURE NO.		<table><tr><td rowspan="2">F.H.W.A. Arizona Division</td><td>STATE</td><td>PROJECT NO.</td><td>FEDERAL ID NO.</td><td>SHEET NO.</td><td>TOTAL SHEETS</td><td>RECORD DRAWING</td></tr><tr><td>ARIZ.</td><td>017 YV 269</td><td>017-B(239)T</td><td>92</td><td>146</td><td></td></tr></table>	F.H.W.A. Arizona Division	STATE	PROJECT NO.	FEDERAL ID NO.	SHEET NO.	TOTAL SHEETS	RECORD DRAWING	ARIZ.	017 YV 269	017-B(239)T	92	146		<table><tr><td>LOCATION</td><td>E DUGAS ROAD - MP 275</td><td>DWG NO.</td></tr><tr><td>TRACS NO.</td><td>F0616 01C</td><td>___ OF ___</td></tr></table>	LOCATION	E DUGAS ROAD - MP 275	DWG NO.	TRACS NO.	F0616 01C	___ OF ___
		NAME	DATE																																							
	DESIGN	BAP	06/26																																							
	DRAWN	RM	06/26																																							
	CHECKED	KCH	06/26																																							
ROUTE	I-17																																									
MILEPOST																																										
STRUCTURE NO.																																										
F.H.W.A. Arizona Division	STATE	PROJECT NO.	FEDERAL ID NO.	SHEET NO.	TOTAL SHEETS	RECORD DRAWING																																				
	ARIZ.	017 YV 269	017-B(239)T	92	146																																					
LOCATION	E DUGAS ROAD - MP 275	DWG NO.																																								
TRACS NO.	F0616 01C	___ OF ___																																								

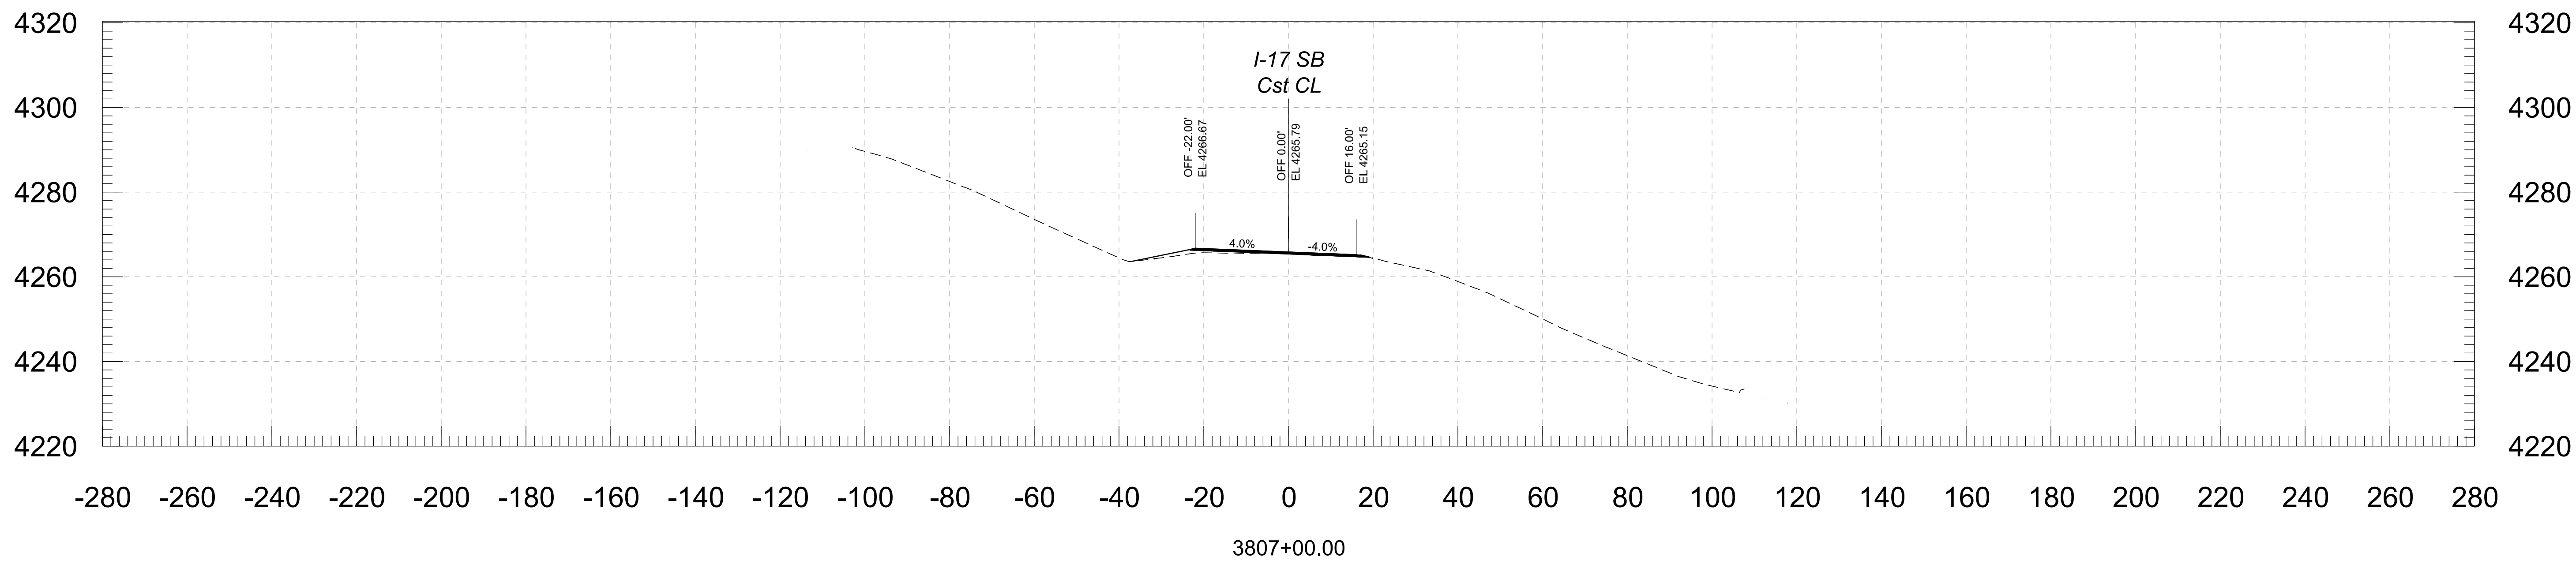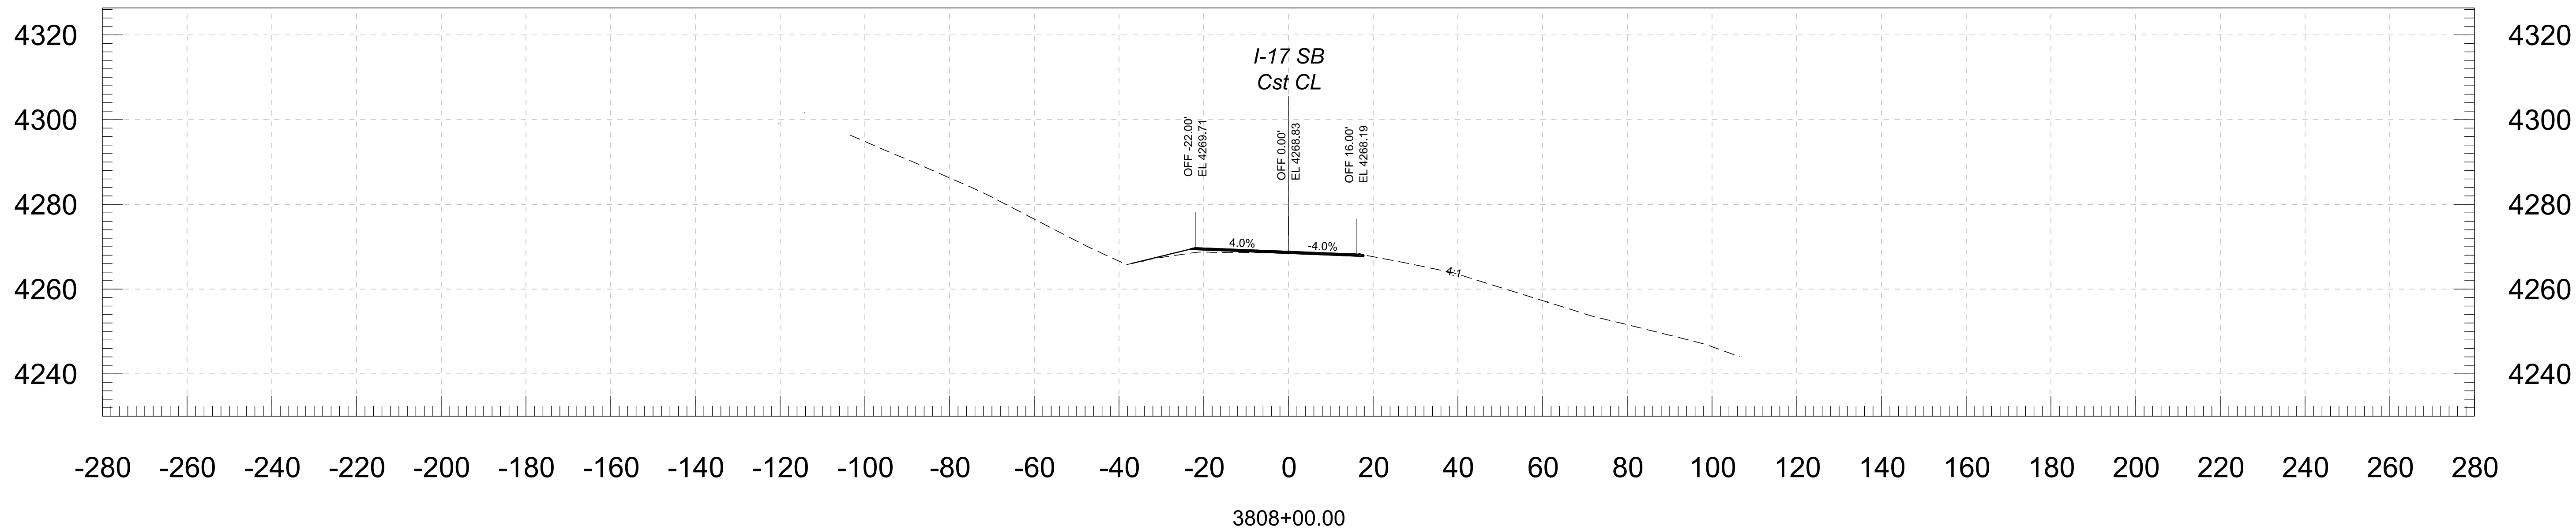



					ARIZONA DEPARTMENT OF TRANSPORTATION PROJECT DELIVERY AND OPERATIONS DIVISION ROADWAY DESIGN SERVICES	ROUTE	F.H.W.A. Arizona Division	STATE ARIZ.	PROJECT NO.	FEDERAL ID NO.	SHEET NO.	TOTAL SHEETS	RECORD DRAWING
		DESIGN	BAP	06/26									
		DRAWN	RM	06/26			017 YV 269	017-B(239)T	93	146			
		CHECKED	KCH	06/26			LOCATION				E DUGAS ROAD - MP 275		DWG NO.
		 Stanley Consultants INC.				3131 East Camelback Road, Suite 100 Phoenix, Arizona 85016 Phone 602. 333-2000			CROSS SECTION			TRACS NO. F0616 01C	

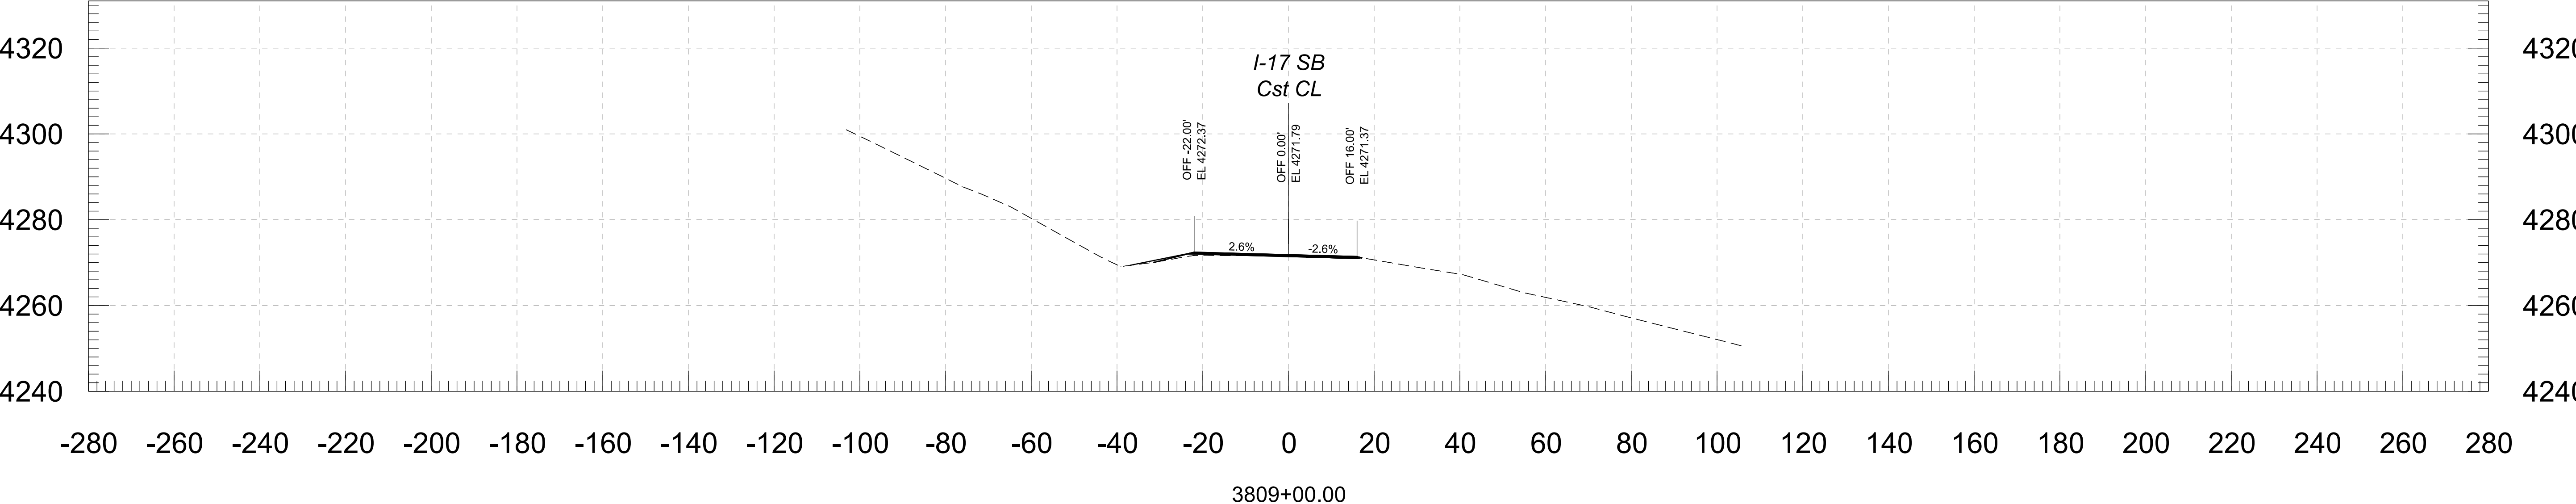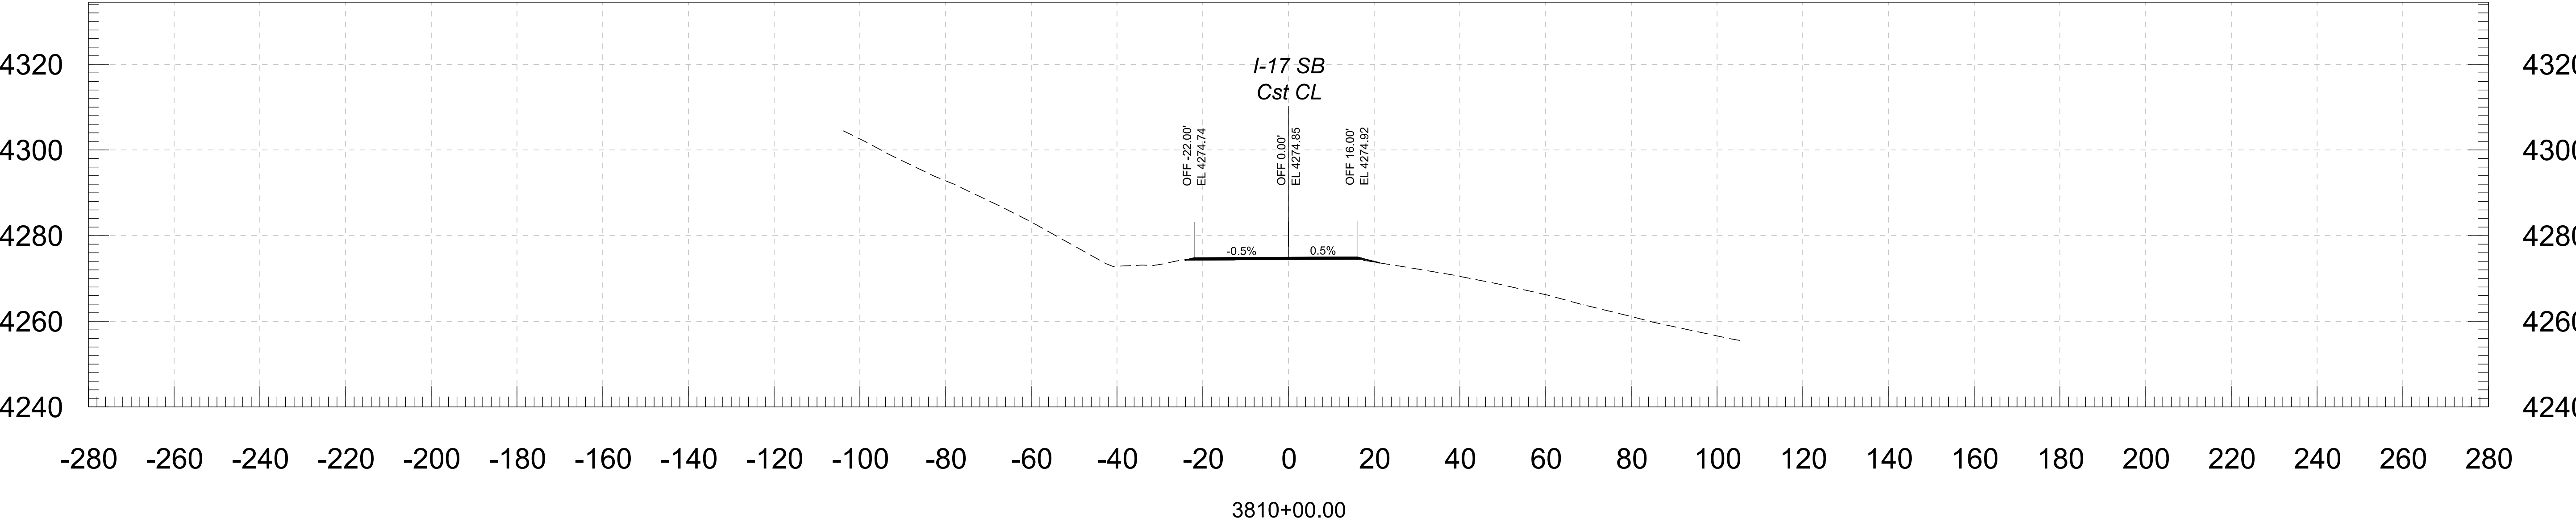



		Stanley Consultants INC. 333 East Camelback Road, Suite 100 Phoenix, Arizona 85016 Phone: 602) 333-2200	NAME		DATE	ARIZONA DEPARTMENT OF TRANSPORTATION PROJECT DELIVERY AND OPERATIONS DIVISION ROADWAY DESIGN SERVICES		ROUTE		F.H.W.A. Arizona Division	STATE ARIZ.	PROJECT NO.	FEDERAL ID NO.	SHEET NO.	TOTAL SHEETS	RECORD DRAWING		
			DESIGN		BAP			06/26	I-17			017 YV 269	017-B(239)T	94	146			
			DRAWN		RM			06/26	MILEPOST			E DUGAS ROAD - MP 275					DWG NO.	
			CHECKED		KCH			06/26										
						CROSS SECTION		STRUCTURE NO.		TRACS NO. F0616 01C				____ OF ____				

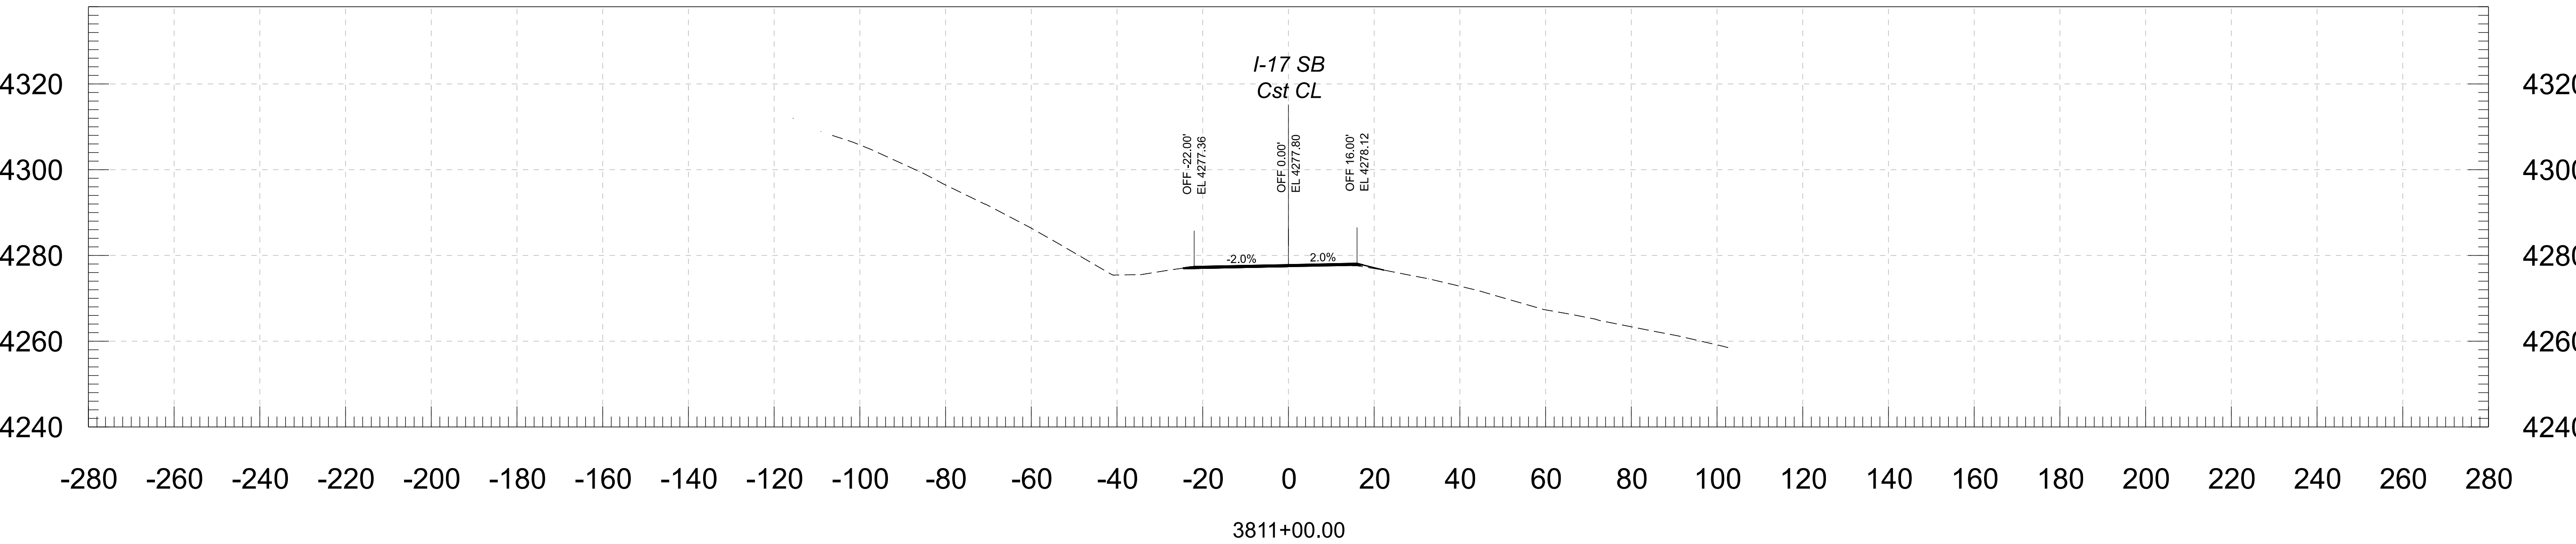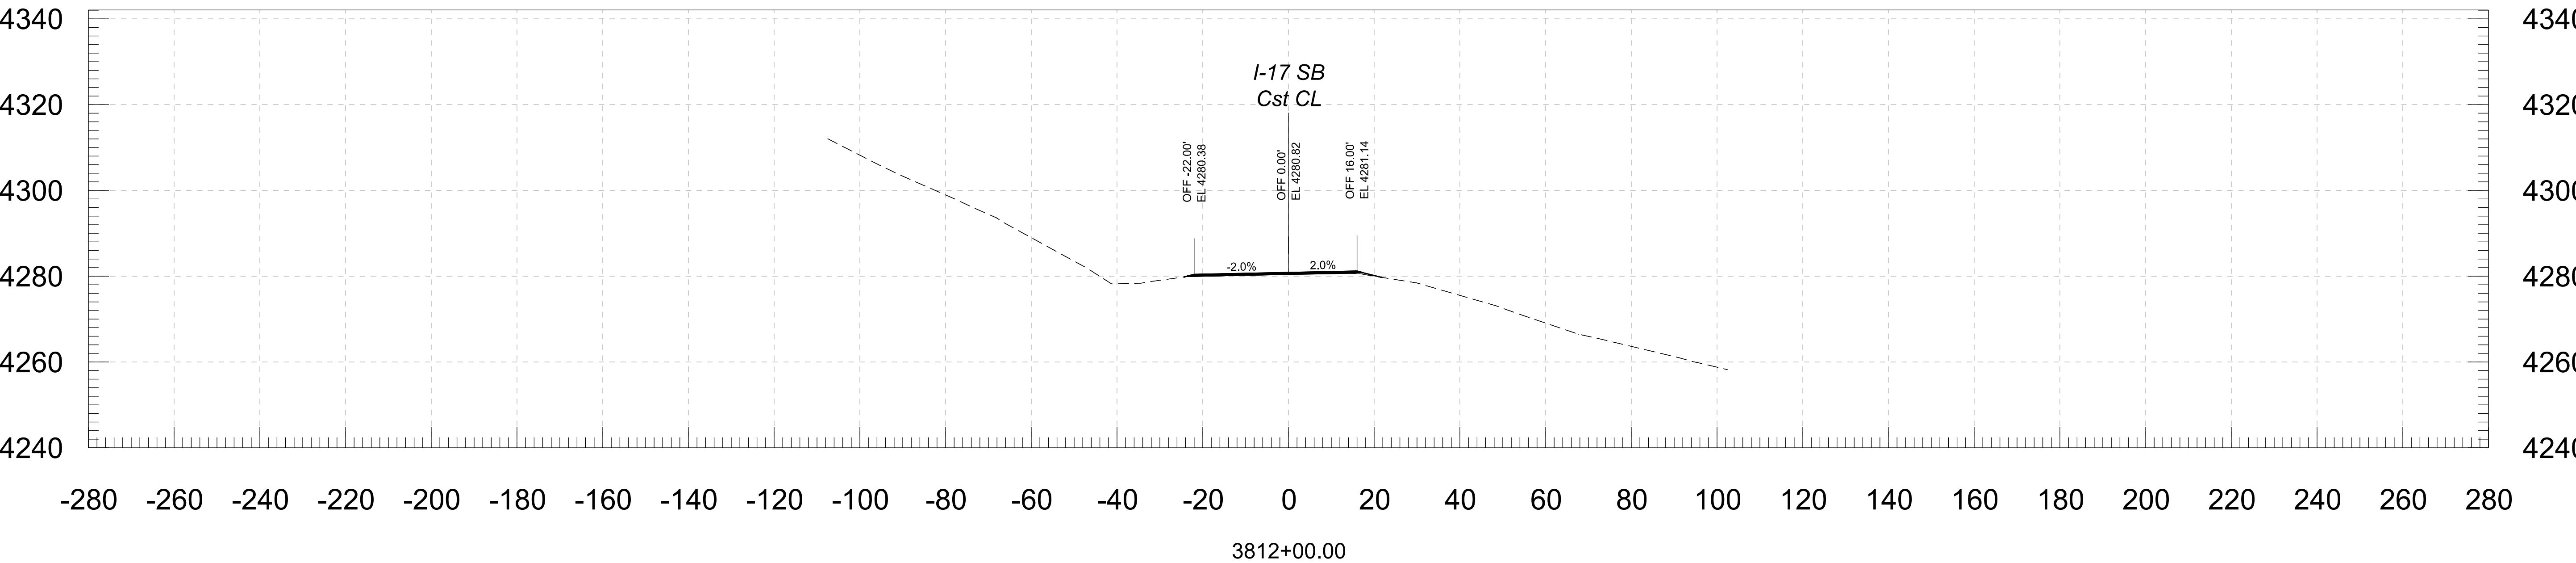



					ARIZONA DEPARTMENT OF TRANSPORTATION PROJECT DELIVERY AND OPERATIONS DIVISION ROADWAY DESIGN SERVICES	ROUTE	F.H.W.A. Arizona Division	STATE	PROJECT NO.	FEDERAL ID NO.	SHEET NO.	TOTAL SHEETS	RECORD DRAWING
		DESIGN	BAP	06/26		I-17		ARIZ.	017 YV 269	017-B(239)T	95	146	
		DRAWN	RM	06/26									
		CHECKED	KCH	06/26			MILEPOST	E DUGAS ROAD - MP 275					
		 3133 East Camelback Road, Suite 100 Phoenix, Arizona 85016 Phone: 602. 333-2200 Stanley Consultants INC.			CROSS SECTION	STRUCTURE NO.	TRACS NO. F0616 01C		____ OF ____				

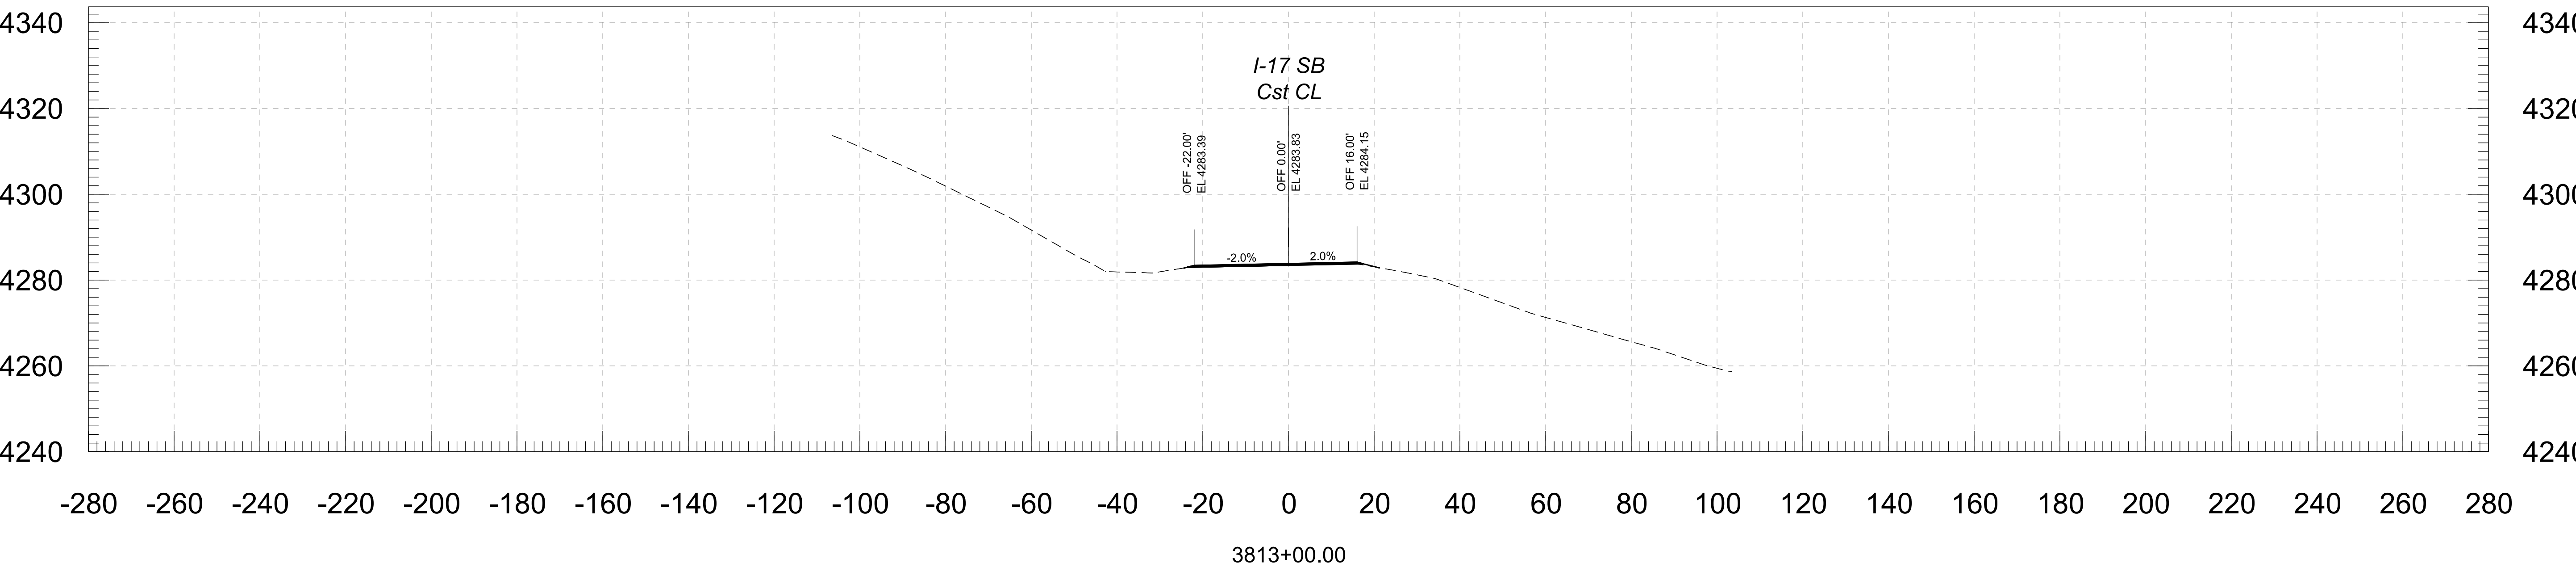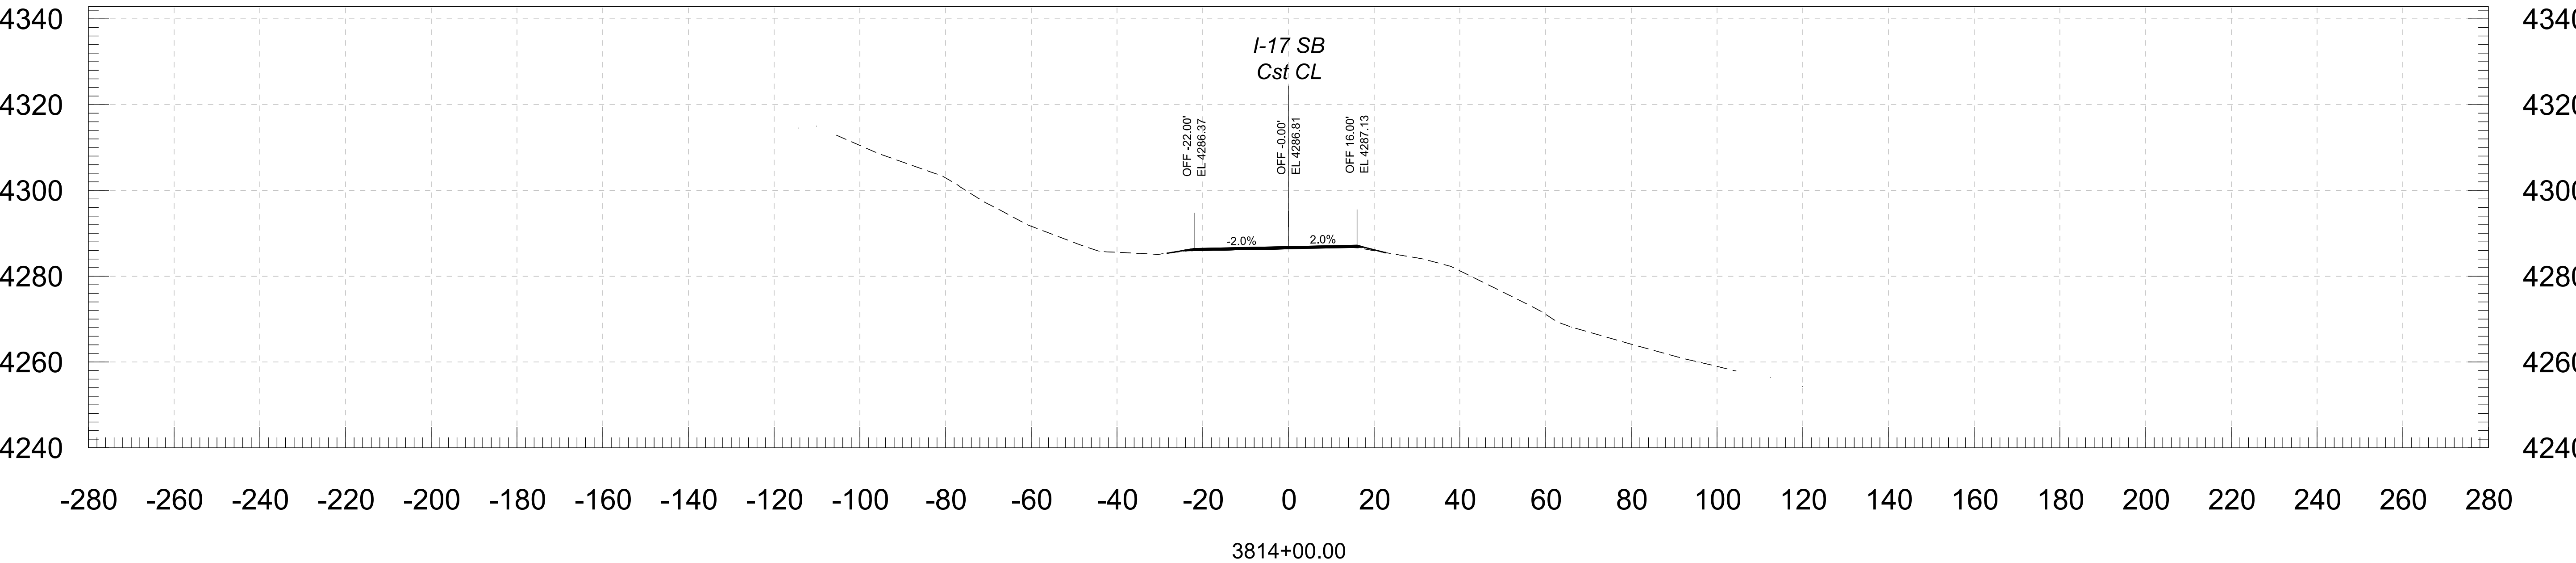


					ARIZONA DEPARTMENT OF TRANSPORTATION PROJECT DELIVERY AND OPERATIONS DIVISION ROADWAY DESIGN SERVICES	ROUTE	F.H.W.A. Arizona Division	STATE	PROJECT NO.	FEDERAL ID NO.	SHEET NO.	TOTAL SHEETS	RECORD DRAWING	
		DESIGN	BAP	06/26		I-17		ARIZ.	017 YV 269	017-B(239)T	96	146		
		DRAWN	RM	06/26		MILEPOST	LOCATION E DUGAS ROAD - MP 275							
		CHECKED	KCH	06/26										
		 Stanley Consultants INC.			3133 East Camelback Road, Suite 100 Phoenix, Arizona 85016 Phone: 602. 333-2000	CROSS SECTION	STRUCTURE NO.	TRACS NO. F0616 01C		____ OF ____				

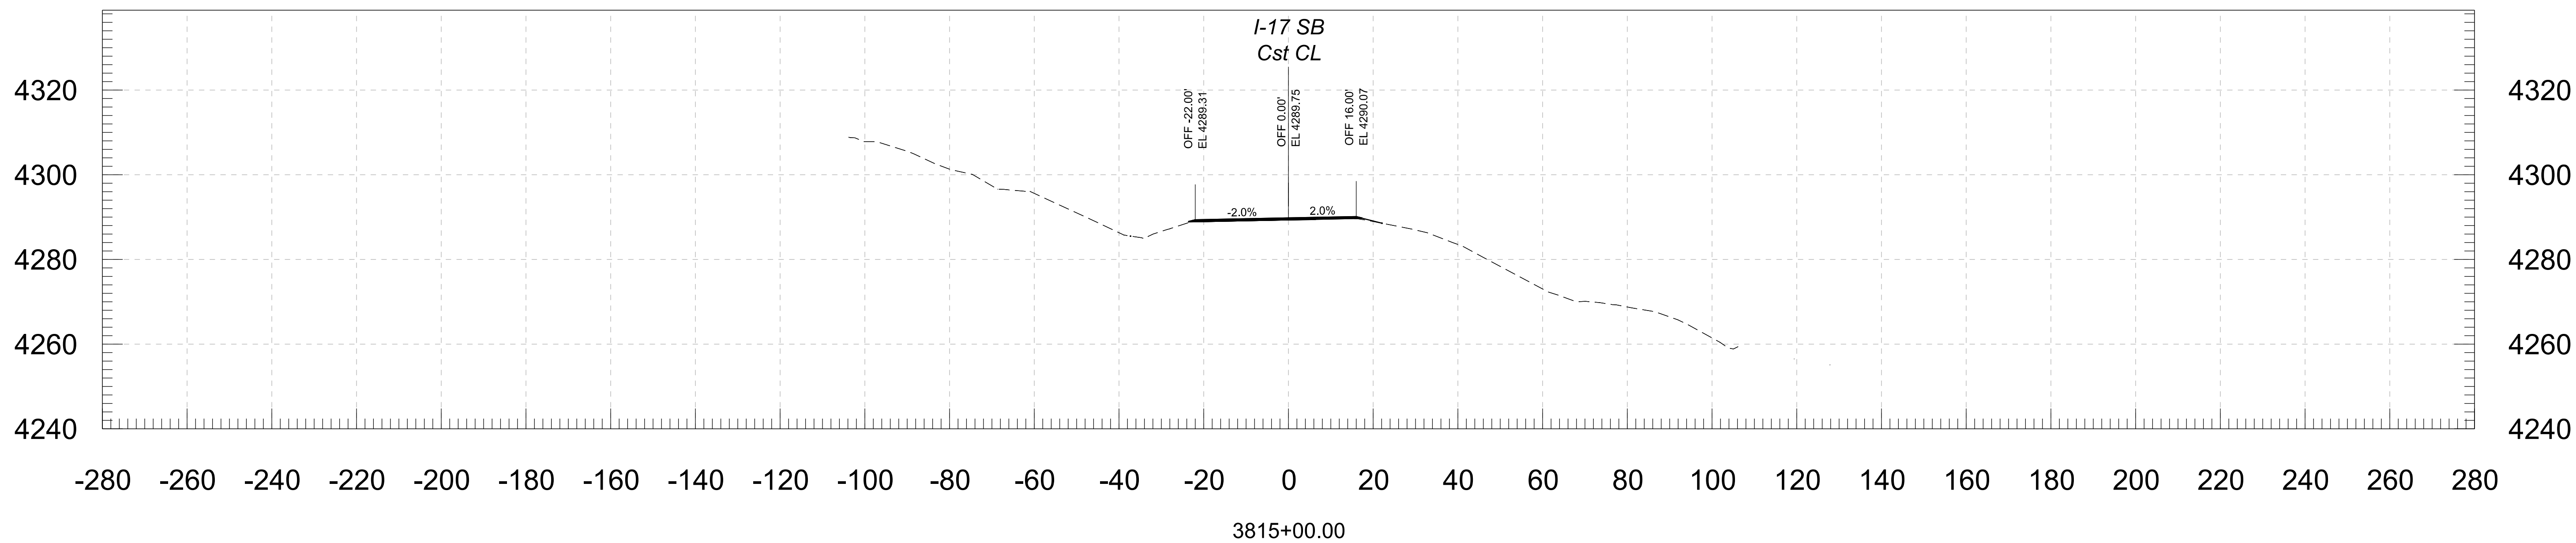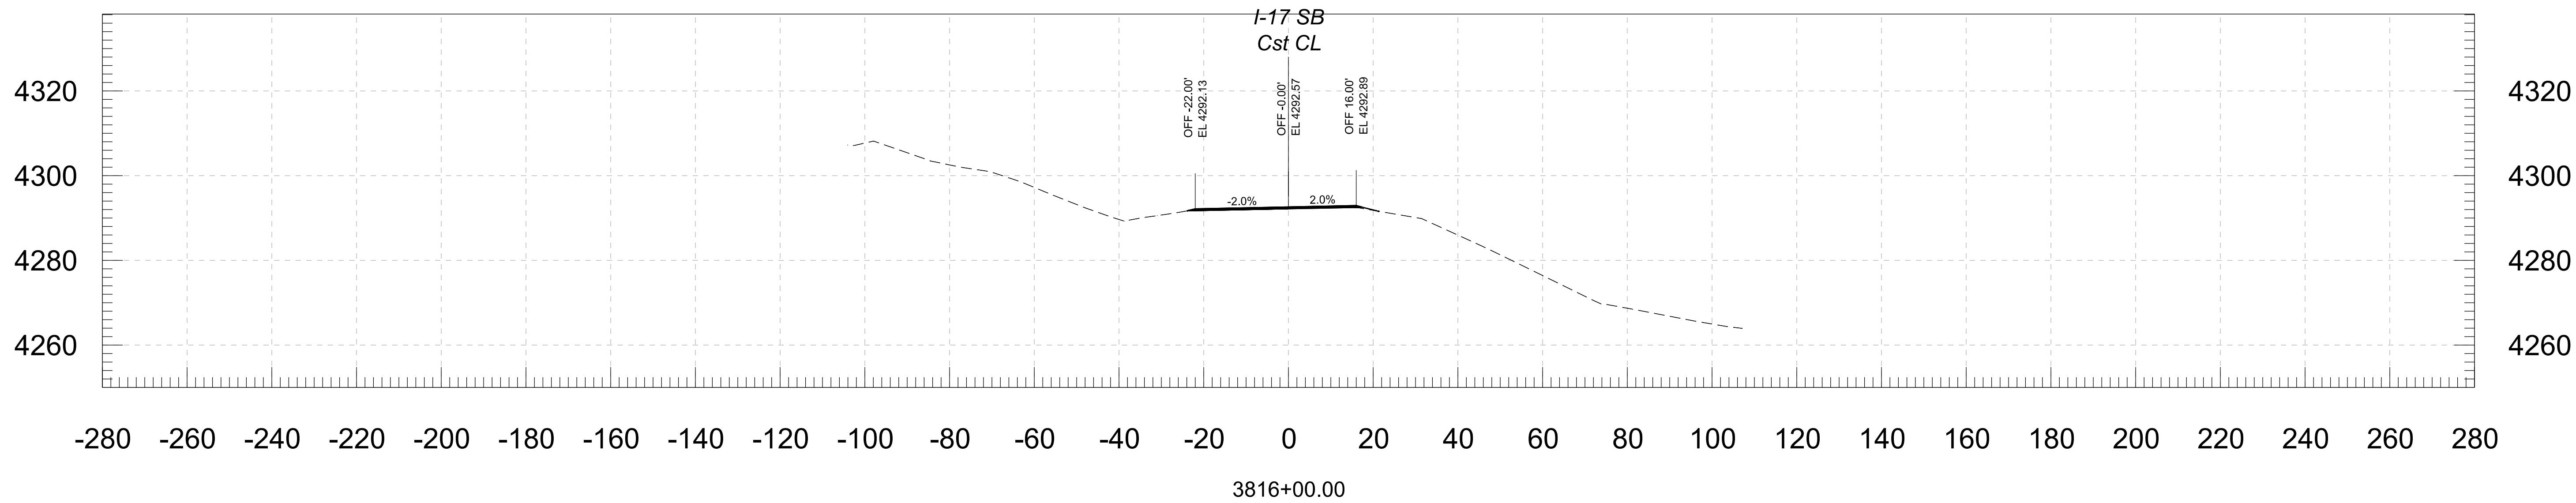




				NAME	DATE	ARIZONA DEPARTMENT OF TRANSPORTATION PROJECT DELIVERY AND OPERATIONS DIVISION ROADWAY DESIGN SERVICES	ROUTE	F.H.W.A. Arizona Division	STATE	PROJECT NO.	FEDERAL ID NO.	SHEET NO.	TOTAL SHEETS	RECORD DRAWING
			DESIGN	BAP	06/26		I-17			ARIZ.	017 YV 269	017-B(239)T	97	
			DRAWN	RM	06/26		MILEPOST	LOCATION	E DUGAS ROAD - MP 275					DWG NO.
			CHECKED	KCH	06/26		STRUCTURE NO.			TRACS NO.	F0616 01C	OF		
			Stanley Consultants INC. 3133 East Camelback Road, Suite 100 Phoenix, Arizona 85016 Phone: 602.333.2000										CROSS SECTION	

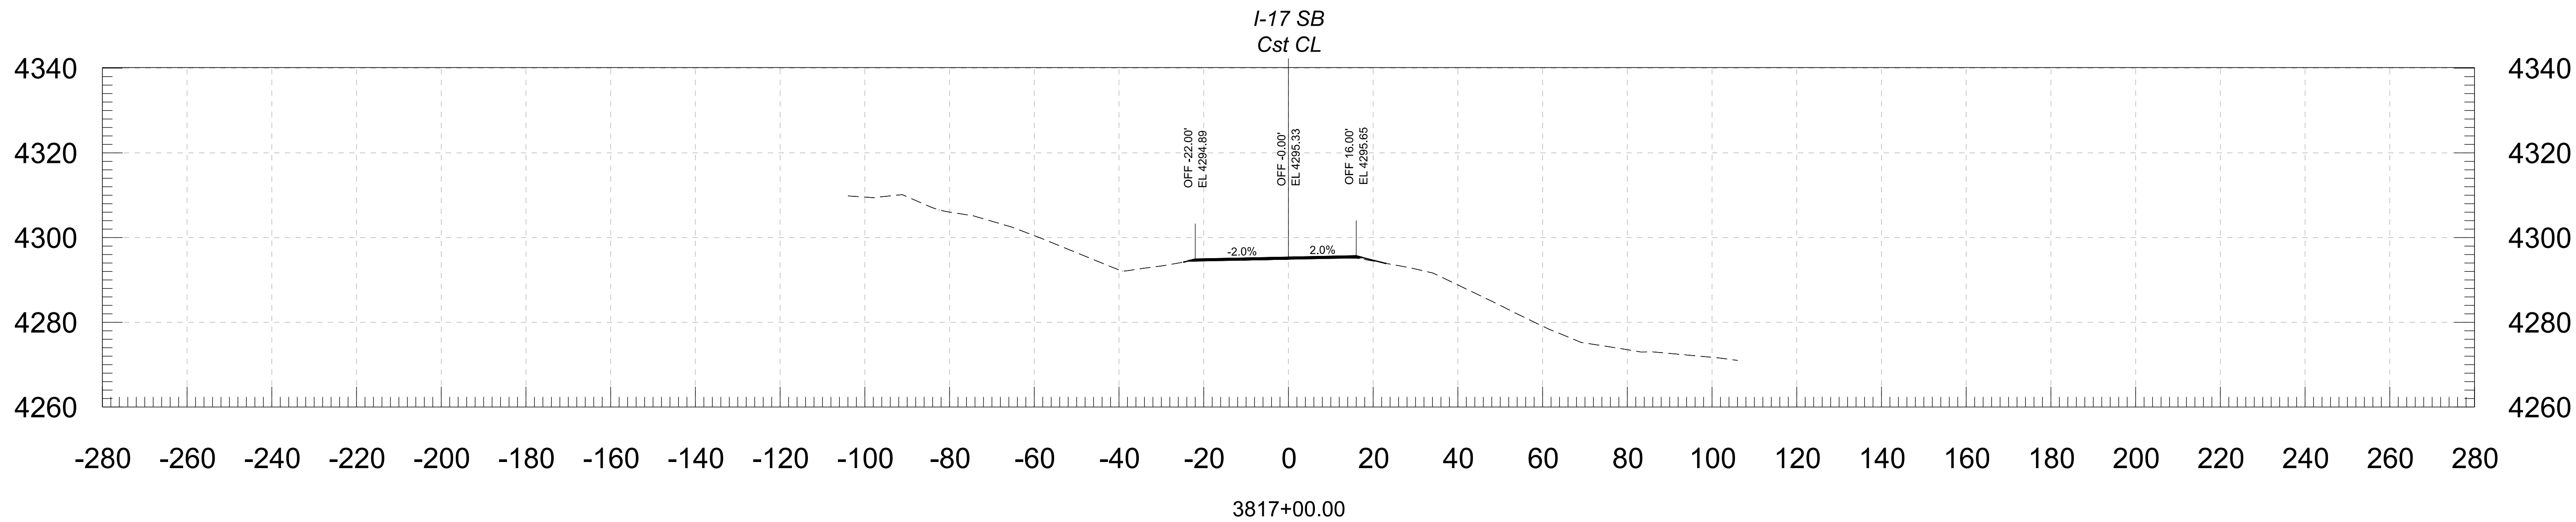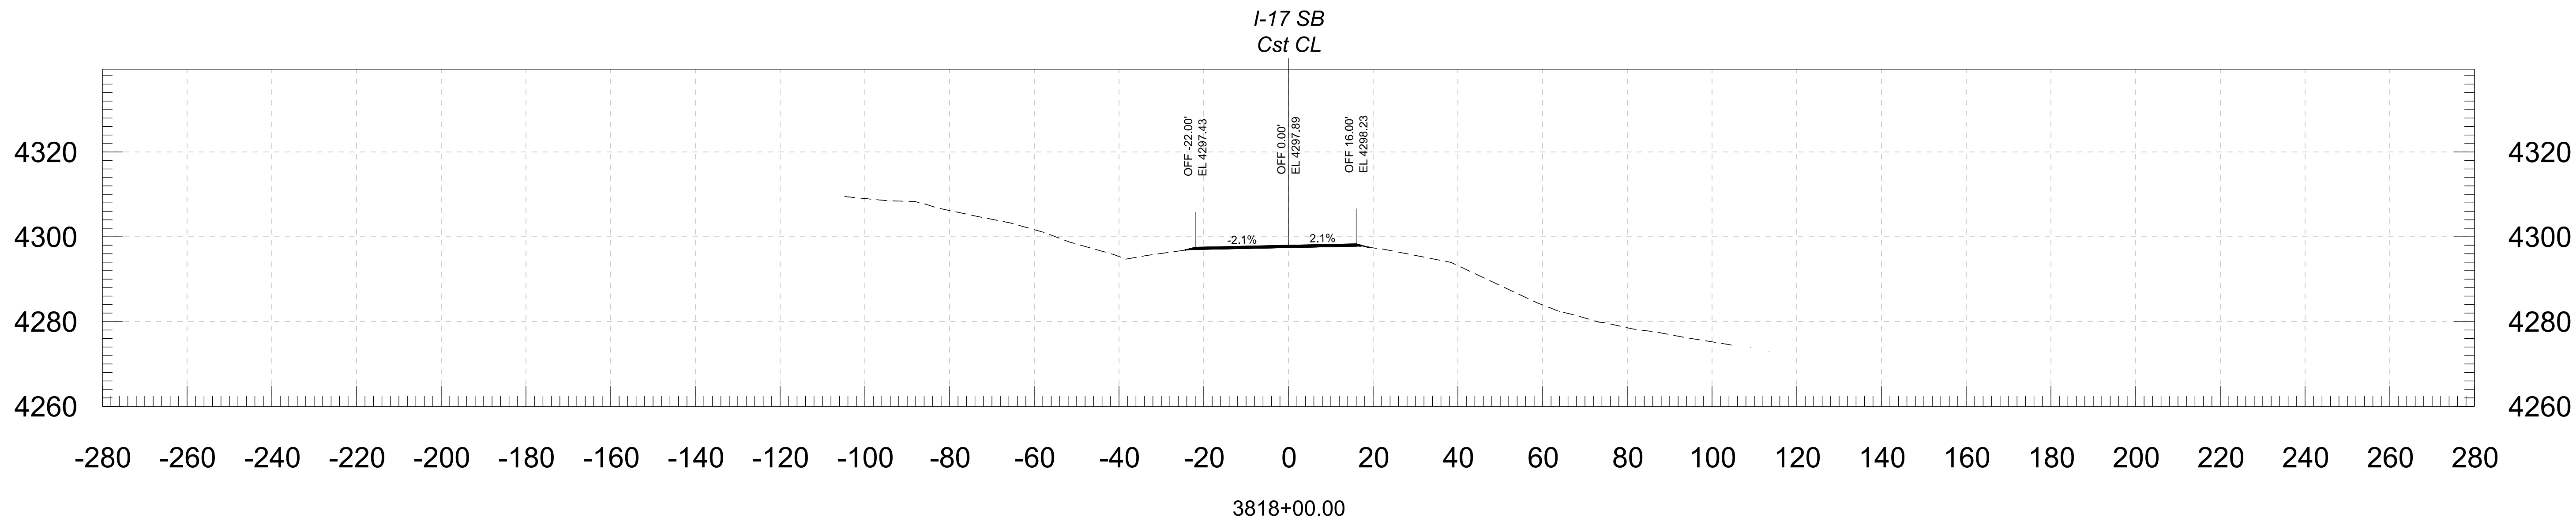 





						ARIZONA DEPARTMENT OF TRANSPORTATION PROJECT DELIVERY AND OPERATIONS DIVISION ROADWAY DESIGN SERVICES			ROUTE I-17	F.H.W.A. Arizona Division	STATE ARIZ.	PROJECT NO. 017 YV 269	FEDERAL ID NO. 017-B(239)T	SHEET NO. 98	TOTAL SHEETS 146	RECORD DRAWING
						CROSS SECTION			MILEPOST	E DUGAS ROAD - MP 275						DWG NO.
									STRUCTURE NO.	TRACS NO. F0616 01C						____ OF ____

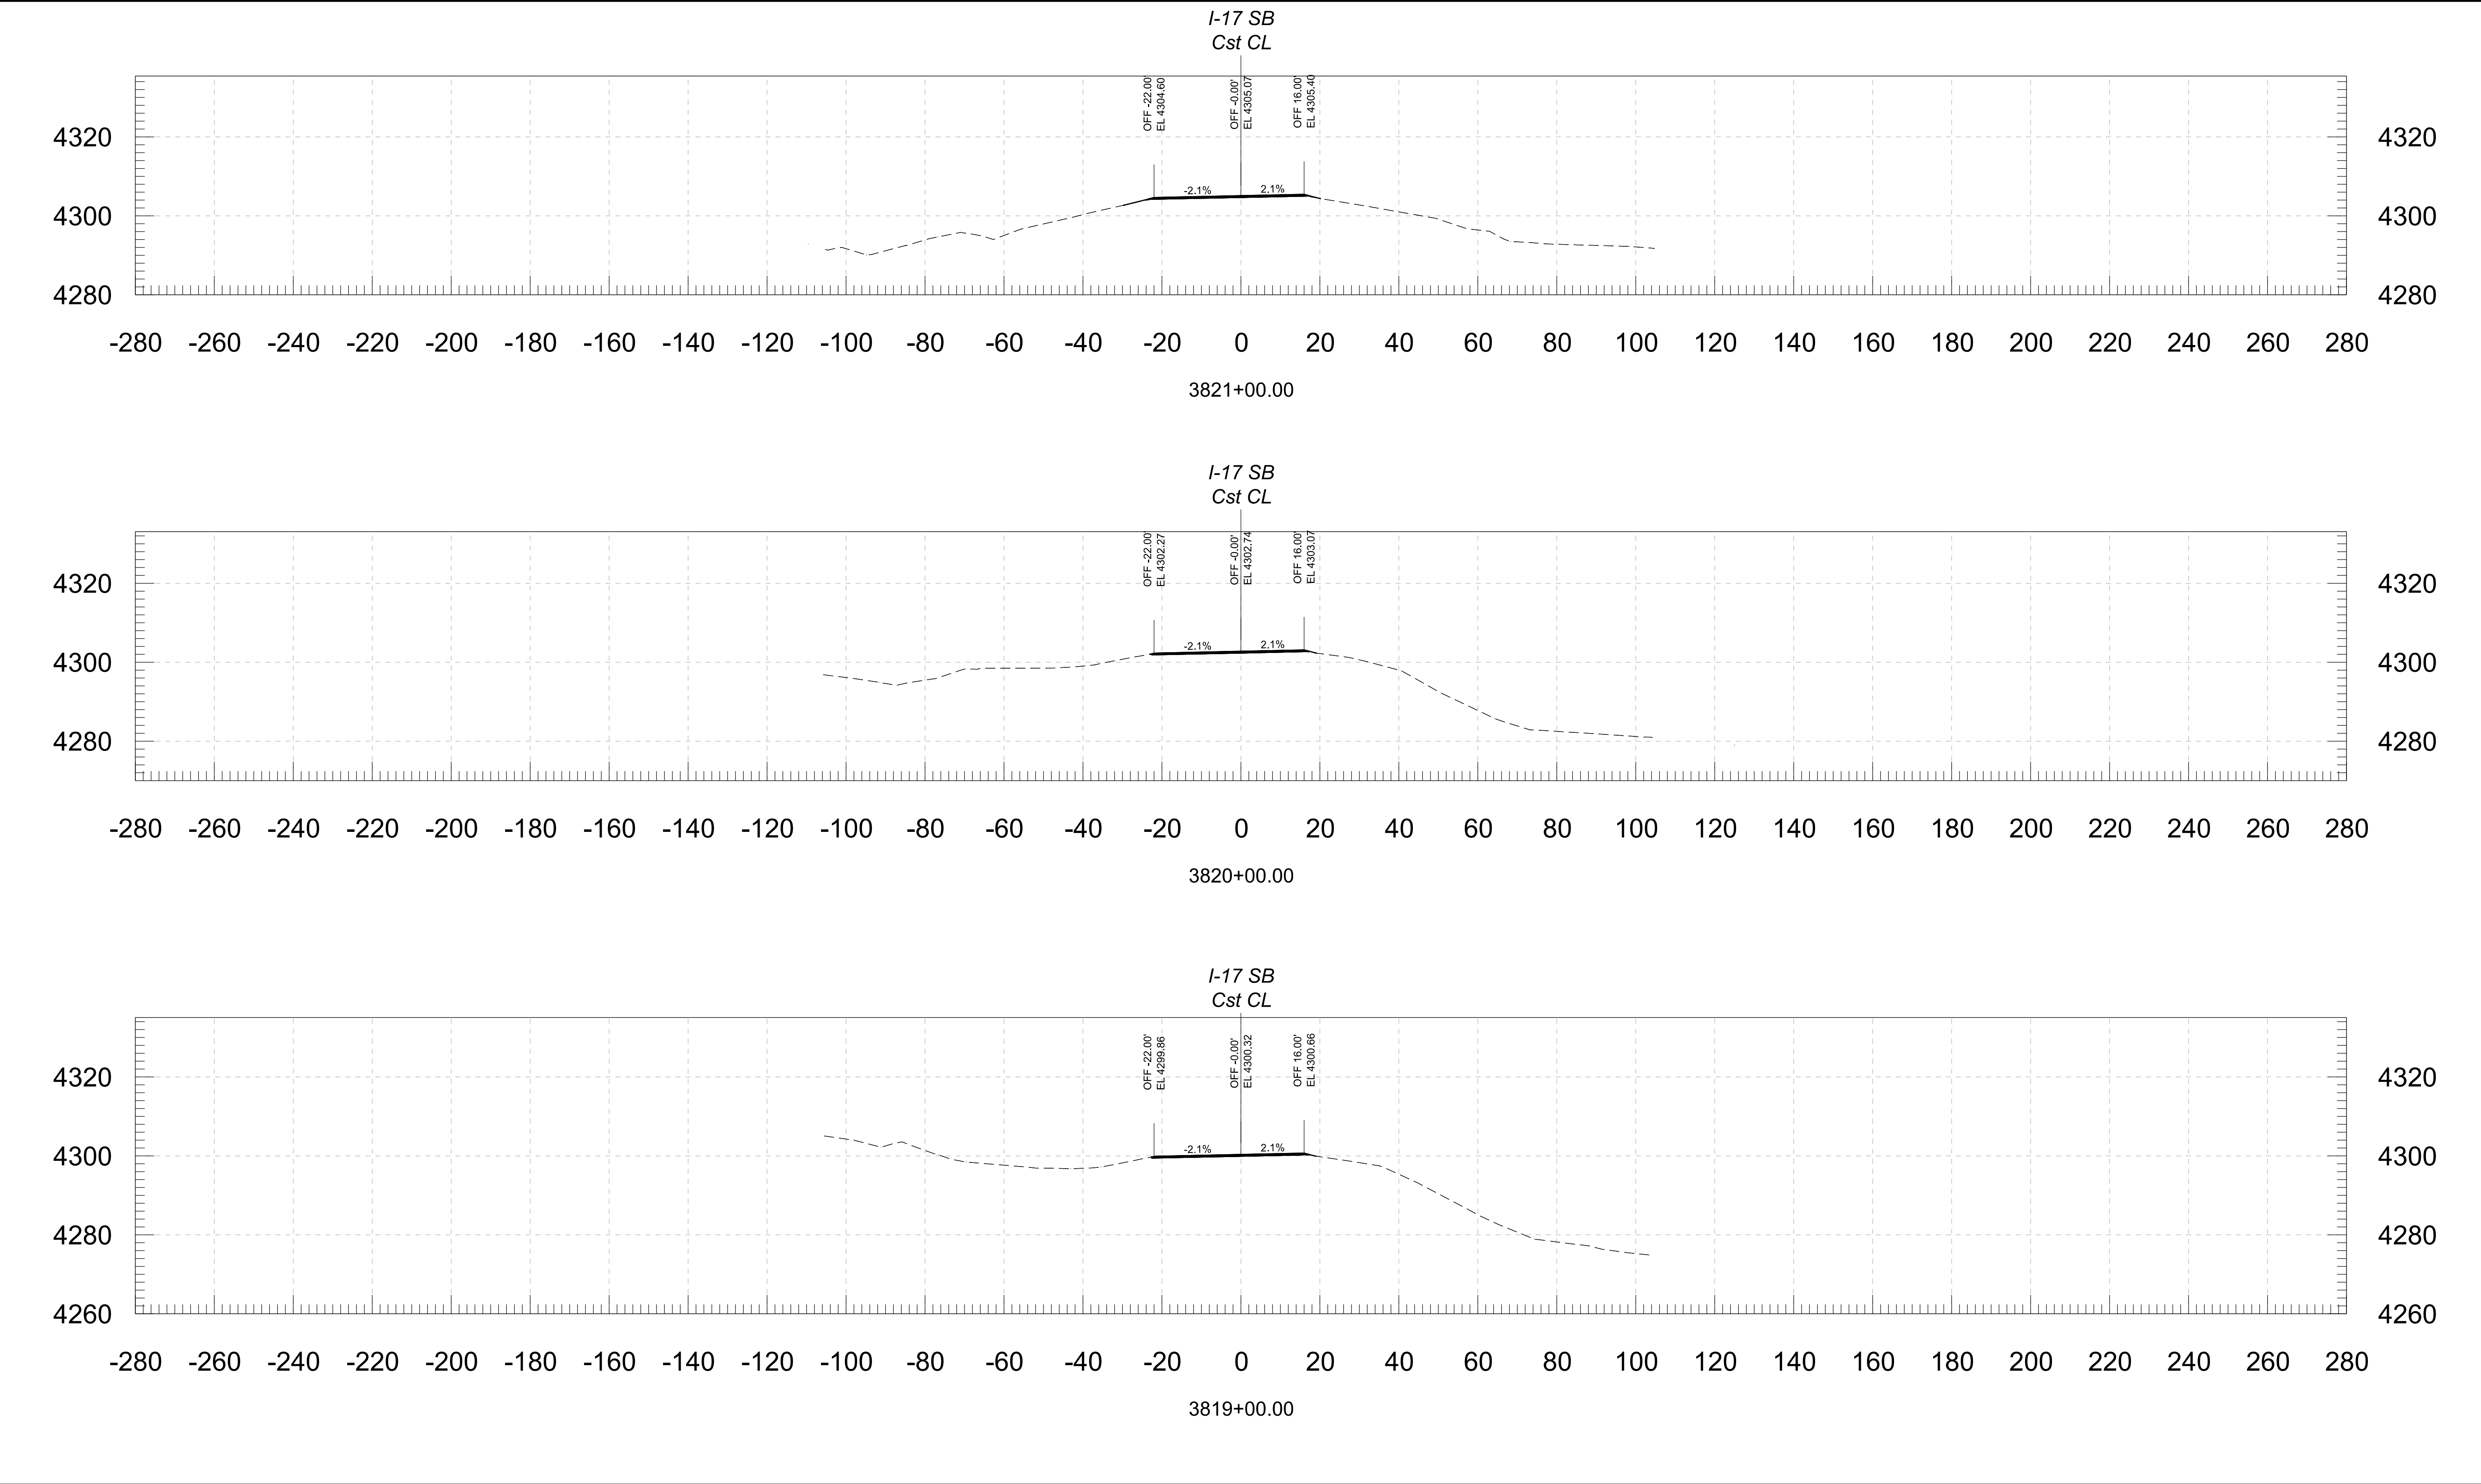




			NAME	DATE	ARIZONA DEPARTMENT OF TRANSPORTATION PROJECT DELIVERY AND OPERATIONS DIVISION ROADWAY DESIGN SERVICES	ROUTE	F.H.W.A. Arizona Division	STATE	PROJECT NO.	FEDERAL ID NO.	SHEET NO.	TOTAL SHEETS	RECORD DRAWING
		DESIGN	BAP	06/26		I-17		ARIZ.	017 YV 269	017-B(239)T	99	146	
		DRAWN	RM	06/26			MILEPOST						
		CHECKED	KCH	06/26			STRUCTURE NO.	TRACS NO. F0616 01C					___ OF ___
		 3135 East Camelback Road, Suite 100 Phoenix, Arizona 85016 Phone: 602.333-2200 Stanley Consultants INC.			CROSS SECTION								

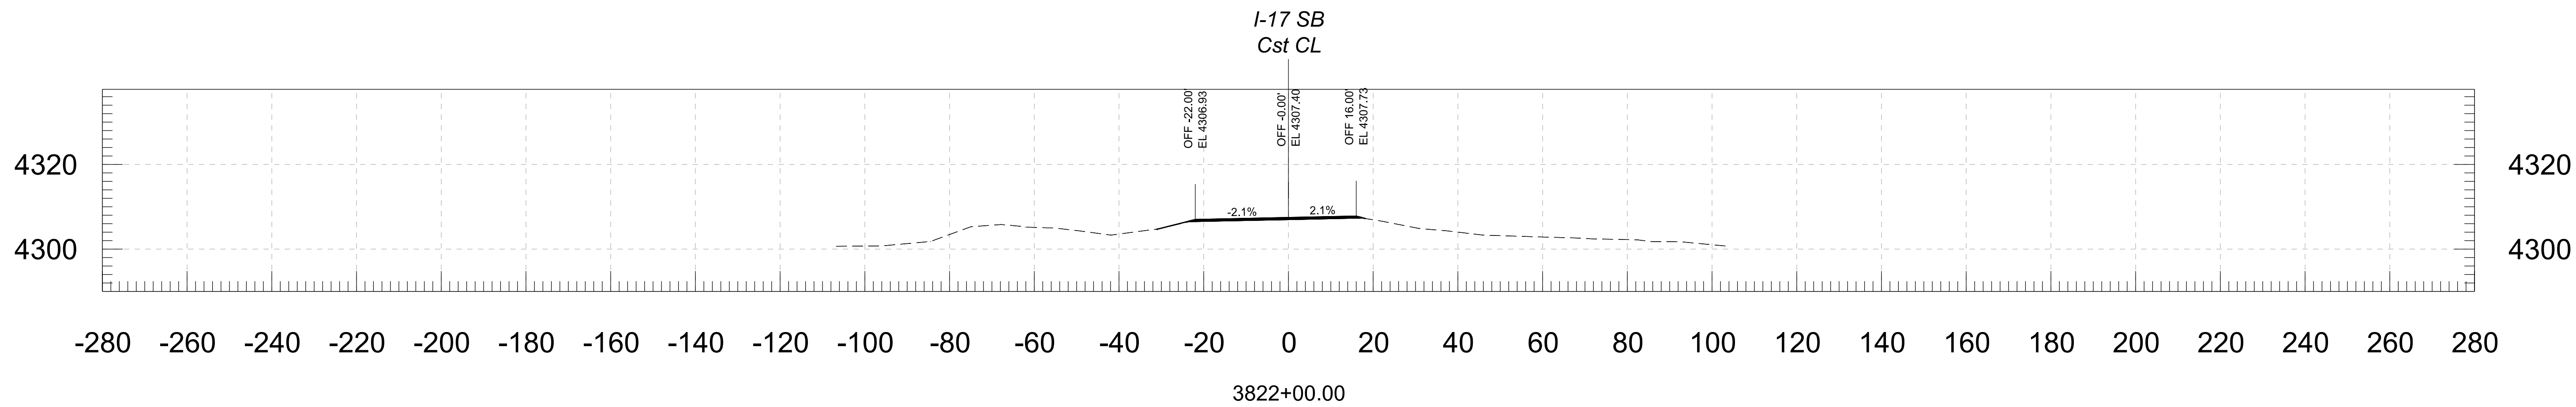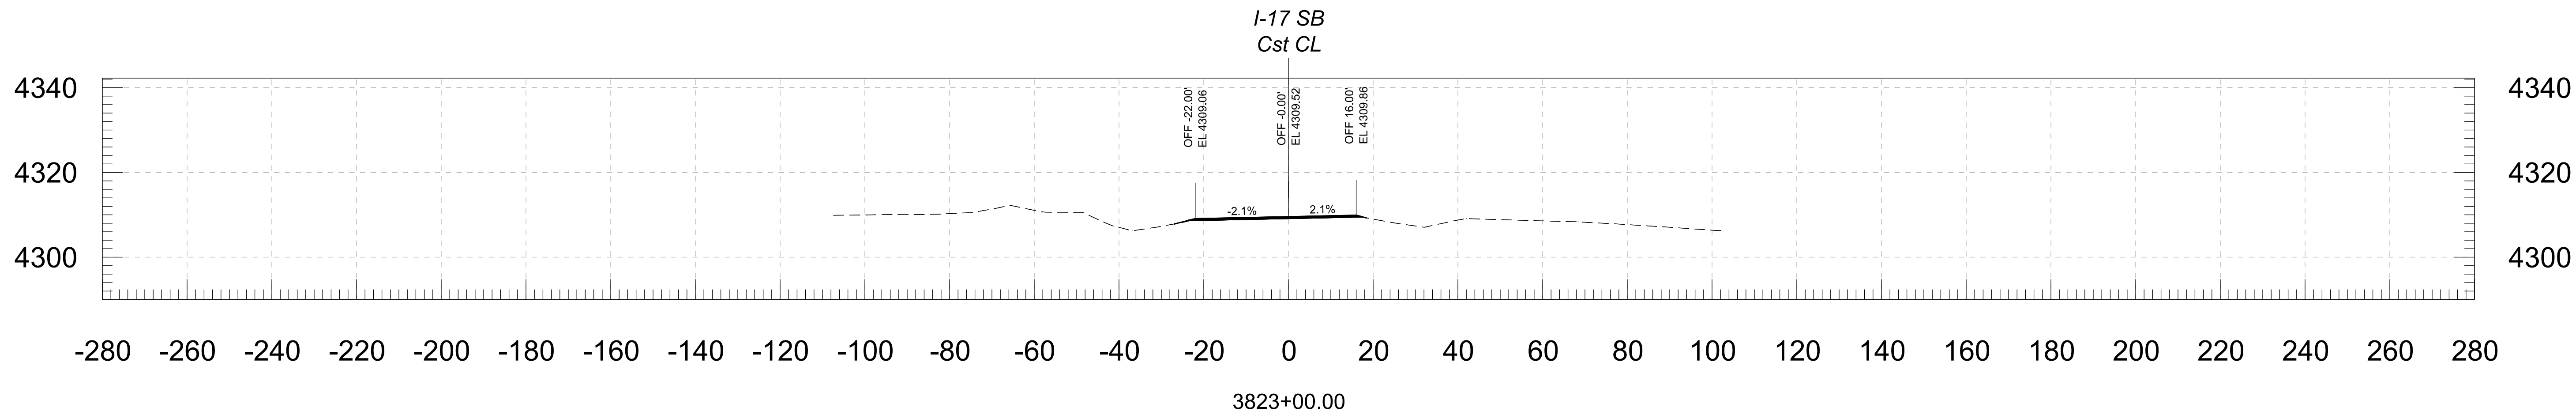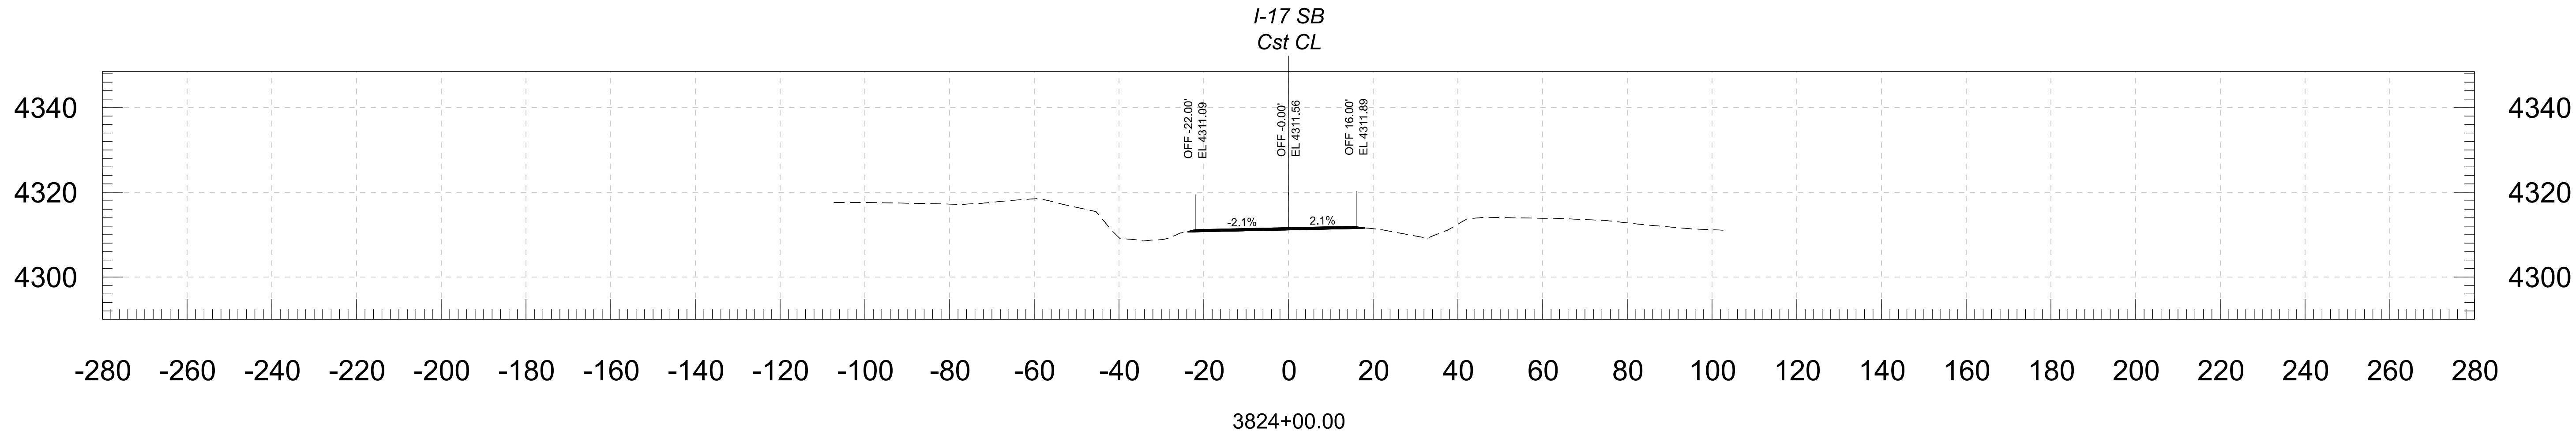

			NAME	DATE	ARIZONA DEPARTMENT OF TRANSPORTATION PROJECT DELIVERY AND OPERATIONS DIVISION ROADWAY DESIGN SERVICES	ROUTE	F.H.W.A. Arizona Division	STATE	PROJECT NO.	FEDERAL ID NO.	SHEET NO.	TOTAL SHEETS	RECORD DRAWING
		DESIGN	BAP	06/26		I-17							
		DRAWN	RM	06/26		MILEPOST	E DUGAS ROAD - MP 275	DWG NO.					
		CHECKED	KCH	06/26									
		 3133 East Camelback Road, Suite 100 Phoenix, Arizona 85016 Phone 602.333-2000			CROSS SECTION	STRUCTURE NO.			TRACS NO. F0616 01C	OF			

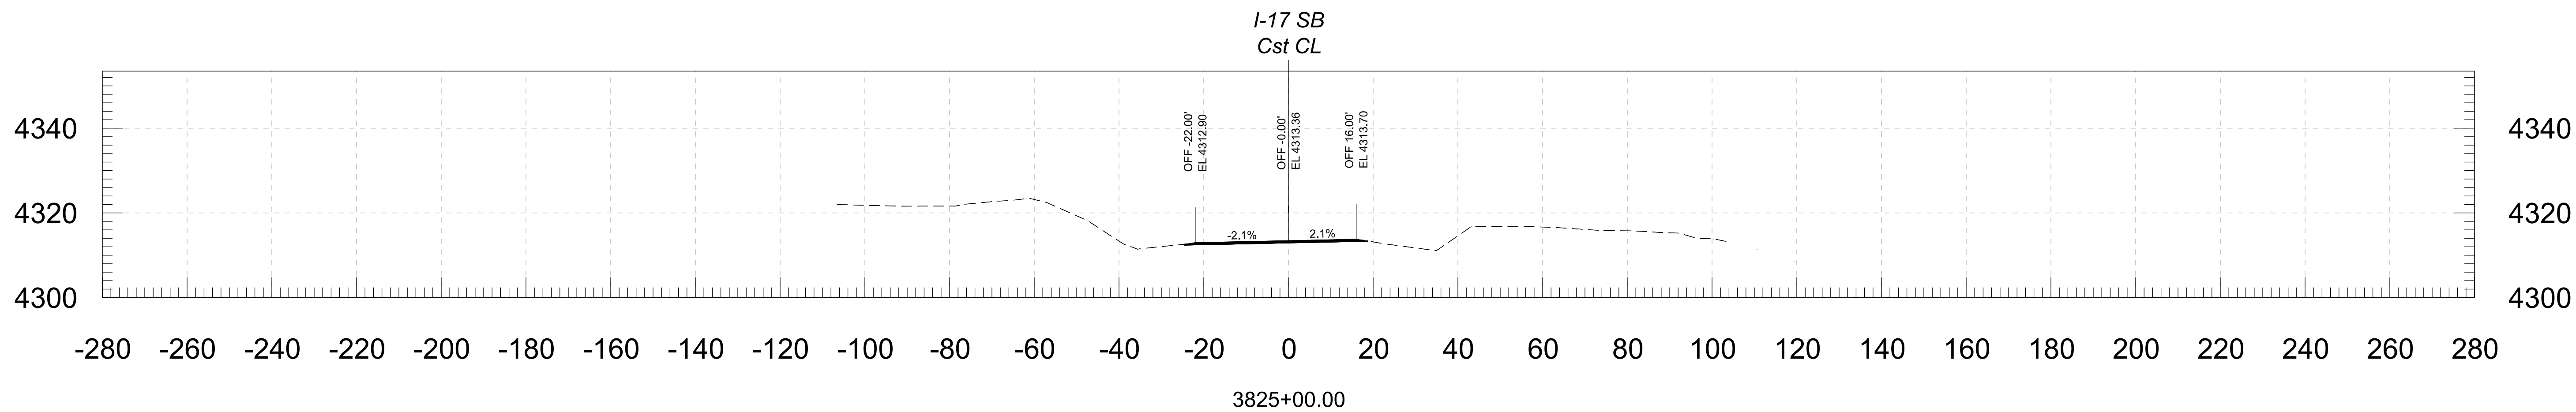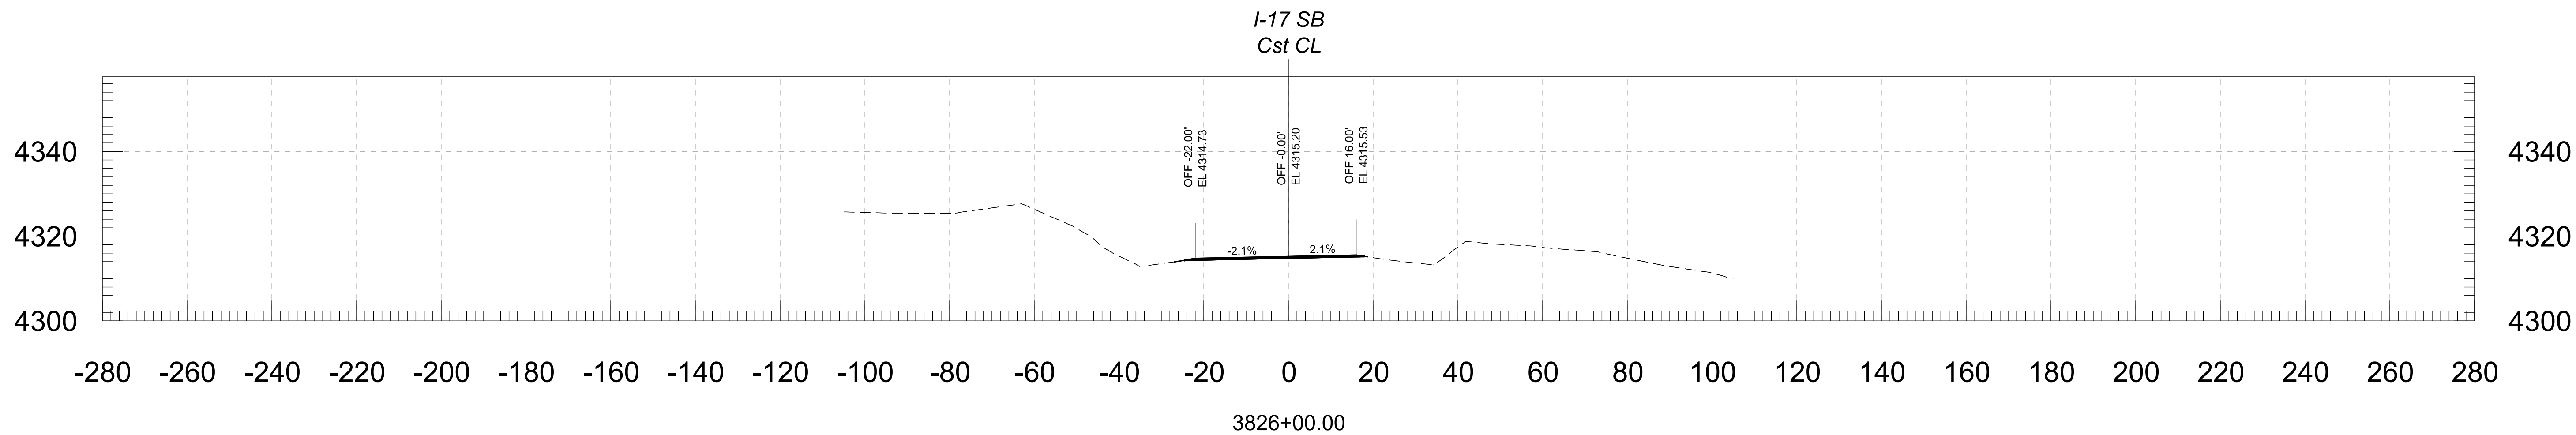
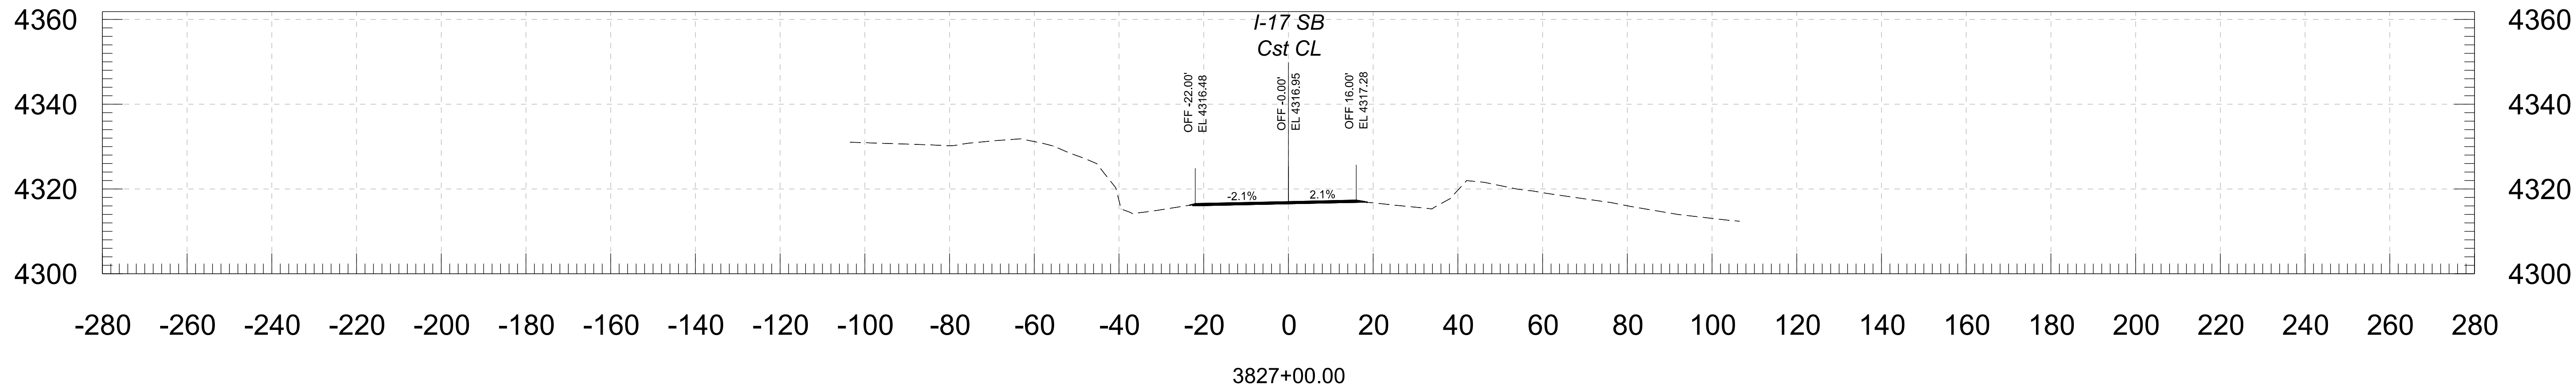


				NAME	DATE	ARIZONA DEPARTMENT OF TRANSPORTATION PROJECT DELIVERY AND OPERATIONS DIVISION ROADWAY DESIGN SERVICES	ROUTE	F.H.W.A. Arizona Division	STATE ARIZ.	PROJECT NO.	FEDERAL ID NO.	SHEET NO.	TOTAL SHEETS	RECORD DRAWING
			DESIGN	BAP	06/26		I-17			017 YV 269	017-B(239)T	101	146	
			DRAWN	RM	06/26									
			CHECKED	KCH	06/26									
			 333 East Camelback Road, Suite 100 Phoenix, Arizona 85016 Phone: 602) 333-2200 Stanley Consultants INC.											
					STRUCTURE NO.	TRACS NO. F0616 01C					___ OF ___			

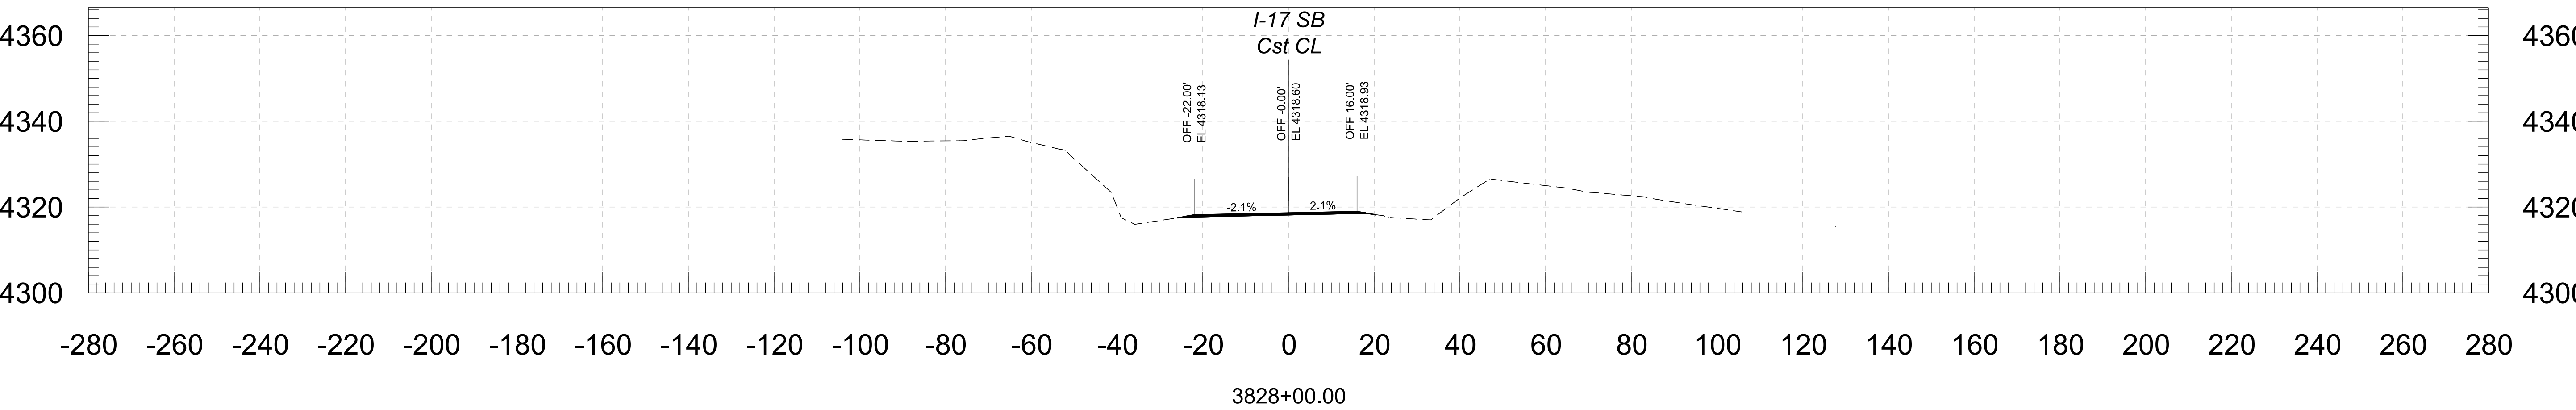
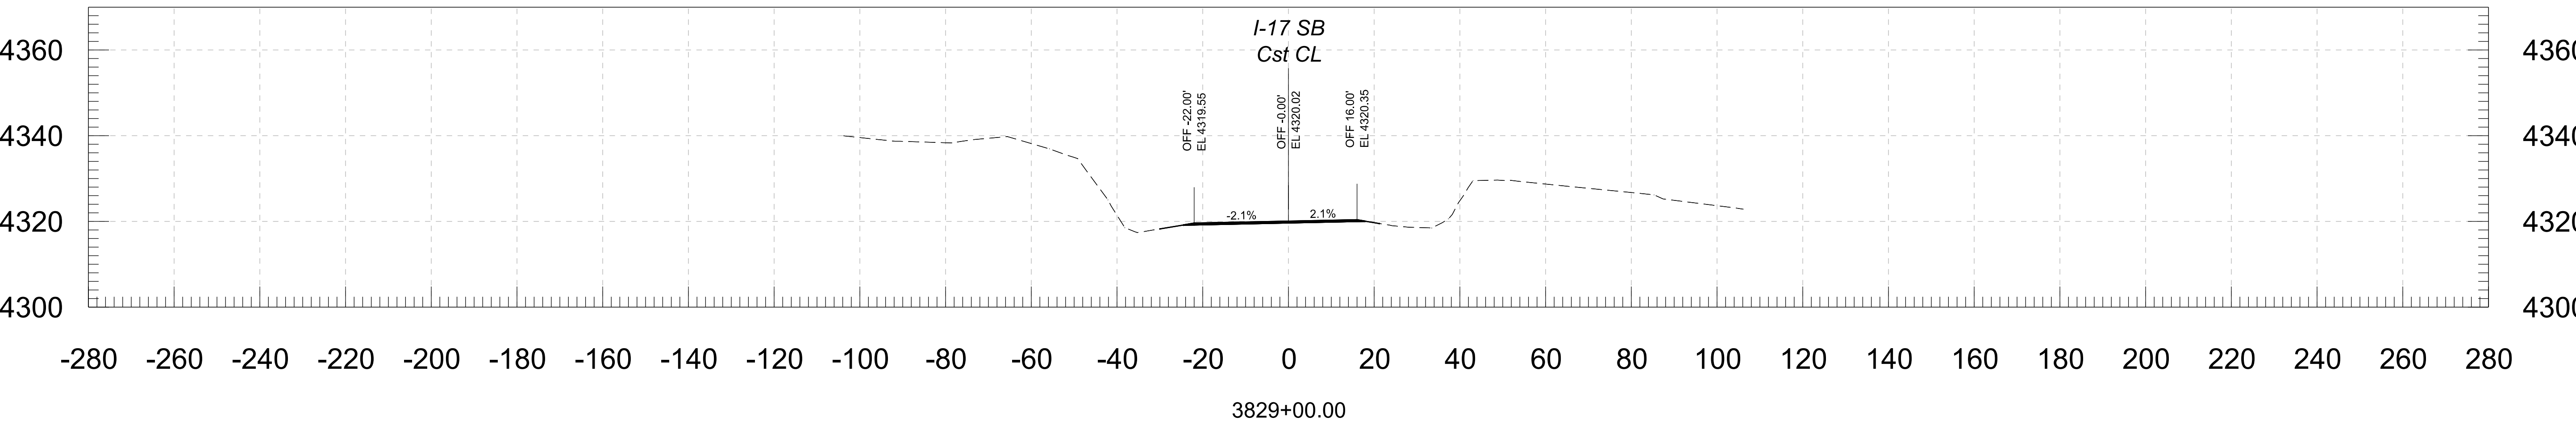
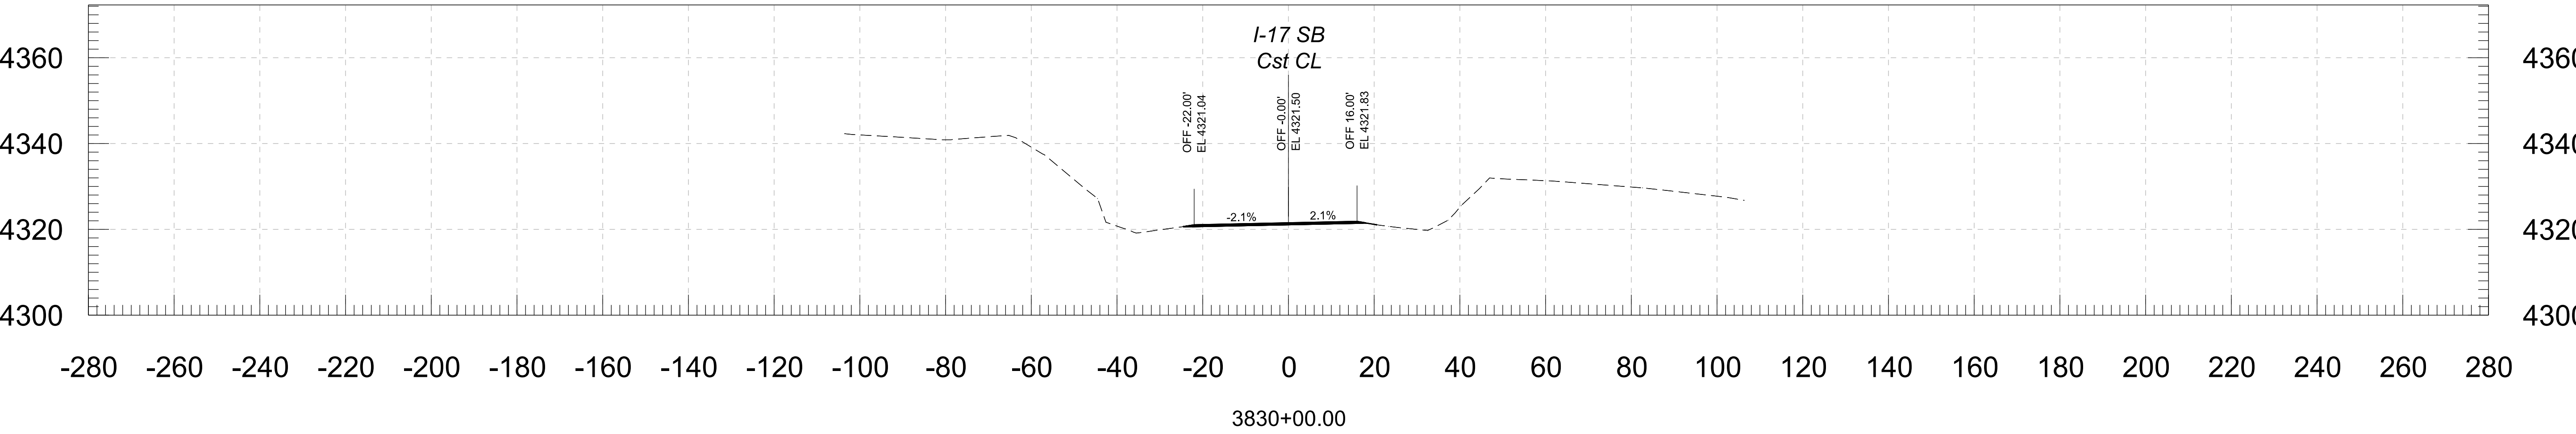


					ARIZONA DEPARTMENT OF TRANSPORTATION PROJECT DELIVERY AND OPERATIONS DIVISION ROADWAY DESIGN SERVICES	ROUTE	F.H.W.A. Arizona Division	STATE ARIZ.	PROJECT NO.	FEDERAL ID NO.	SHEET NO.	TOTAL SHEETS	RECORD DRAWING	
		DESIGN	BAP	06/26		I-17			017 YV 269	017-B(239)T	102	146		
		DRAWN	RM	06/26		MILEPOST	LOCATION E DUGAS ROAD - MP 275							DWG NO.
		CHECKED	KCH	06/26			TRACS NO. F0616 01C							
		 Stanley Consultants INC.			3133 East Camelback Road, Suite 100 Phoenix, Arizona 85016 Phone: 602.333-2000			CROSS SECTION	____ OF ____					




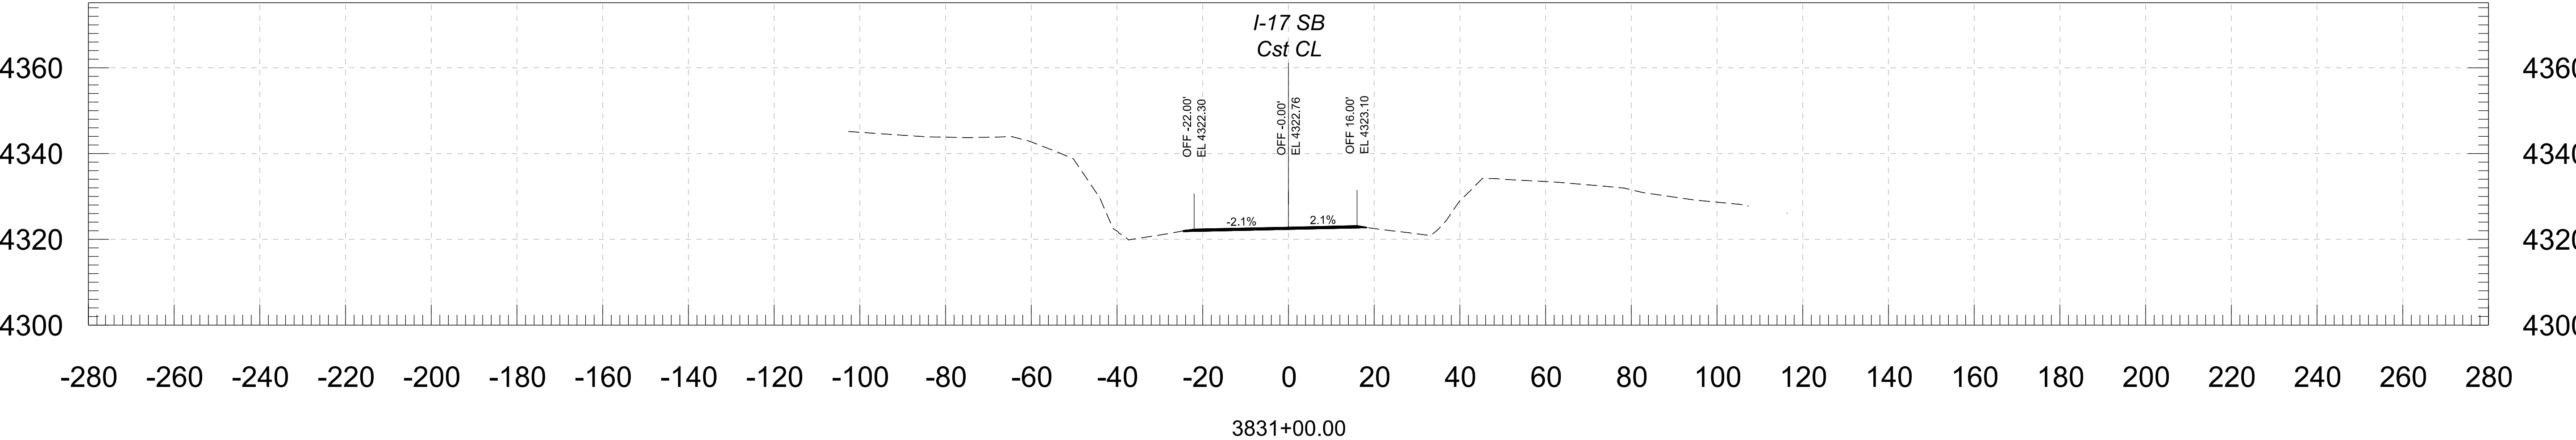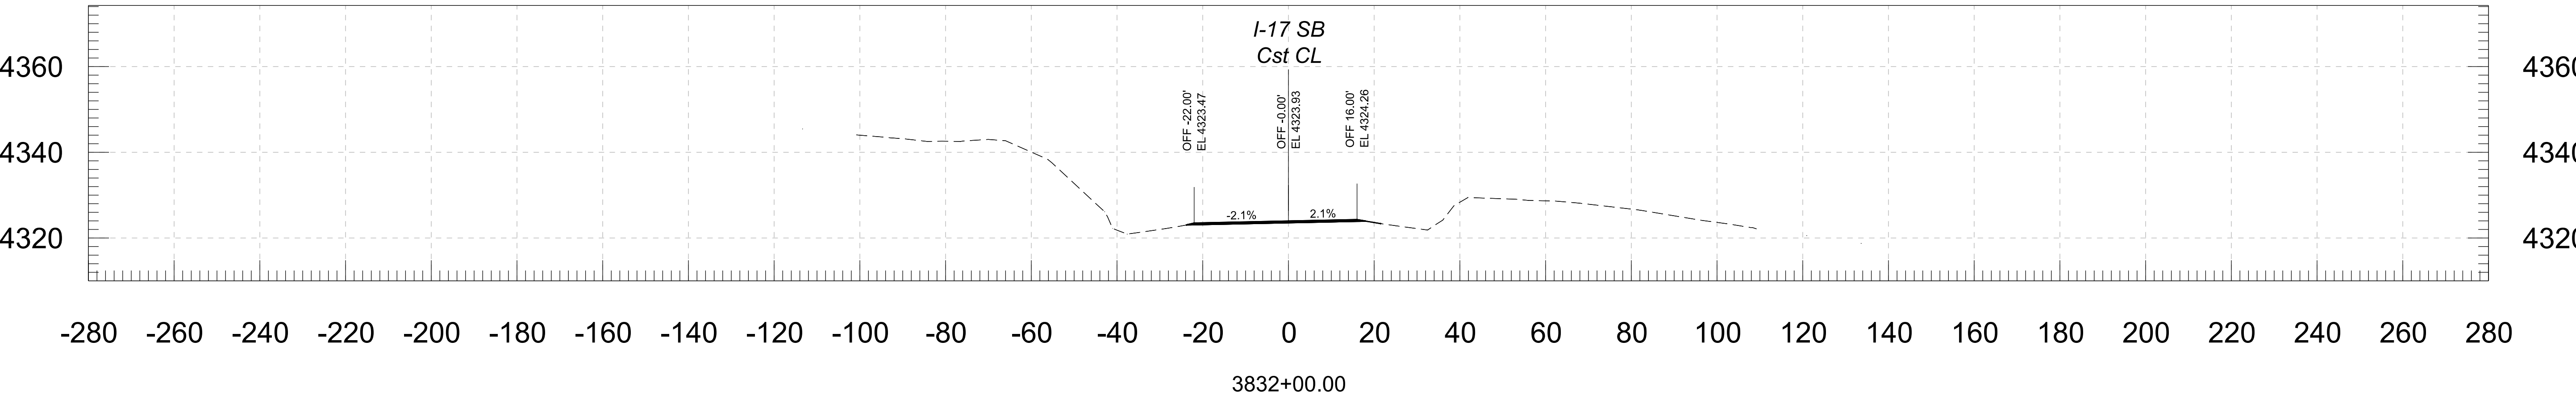


		Stanley Consultants INC.		NAME	DATE	ARIZONA DEPARTMENT OF TRANSPORTATION PROJECT DELIVERY AND OPERATIONS DIVISION ROADWAY DESIGN SERVICES	ROUTE	F.H.W.A. Arizona Division	STATE ARIZ.	PROJECT NO.	FEDERAL ID NO.	SHEET NO.	TOTAL SHEETS	RECORD DRAWING
			DESIGN	BAP	06/26		I-17							
			DRAWN	RM	06/26									
			CHECKED	KCH	06/26									
						Stanley Consultants INC.	3133 East Camelback Road, Suite 100 Phoenix, Arizona 85016 Phones 602. 333-2200	CROSS SECTION	MILEPOST	E DUGAS ROAD - MP 275				DWG NO.
						STRUCTURE NO.	TRACS NO. F0616 01C				____ OF ____			

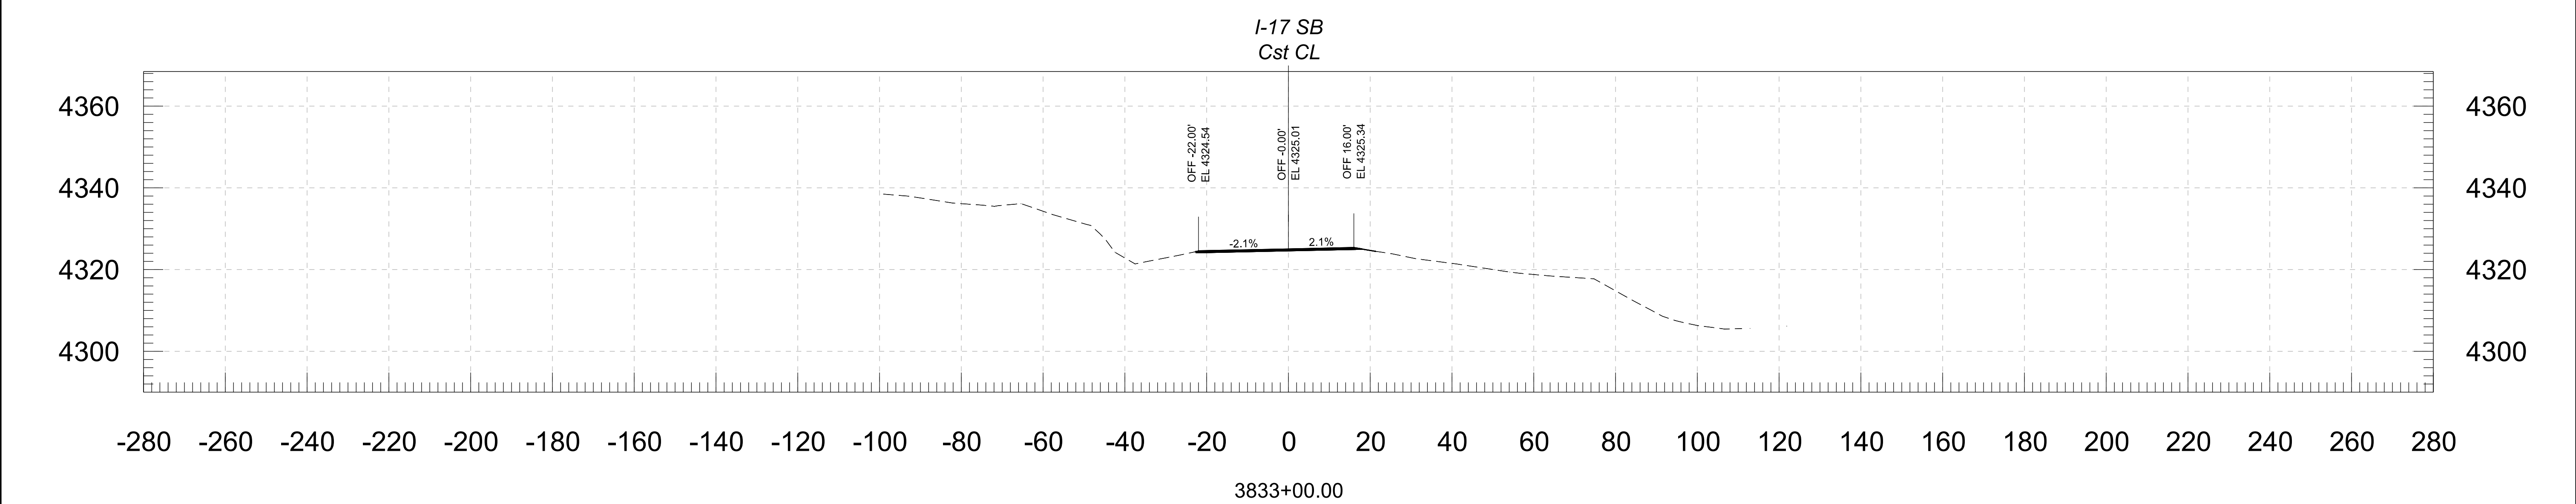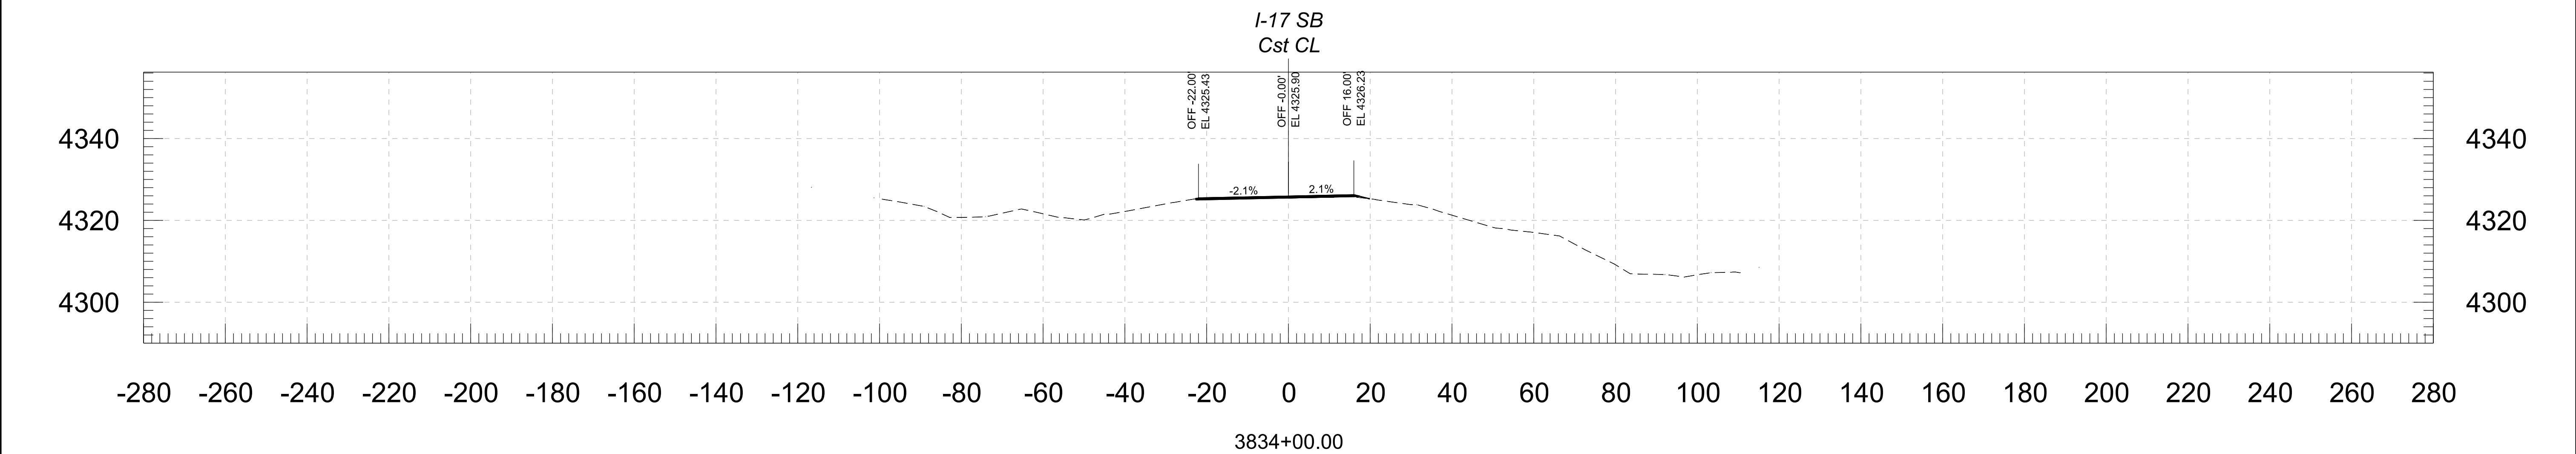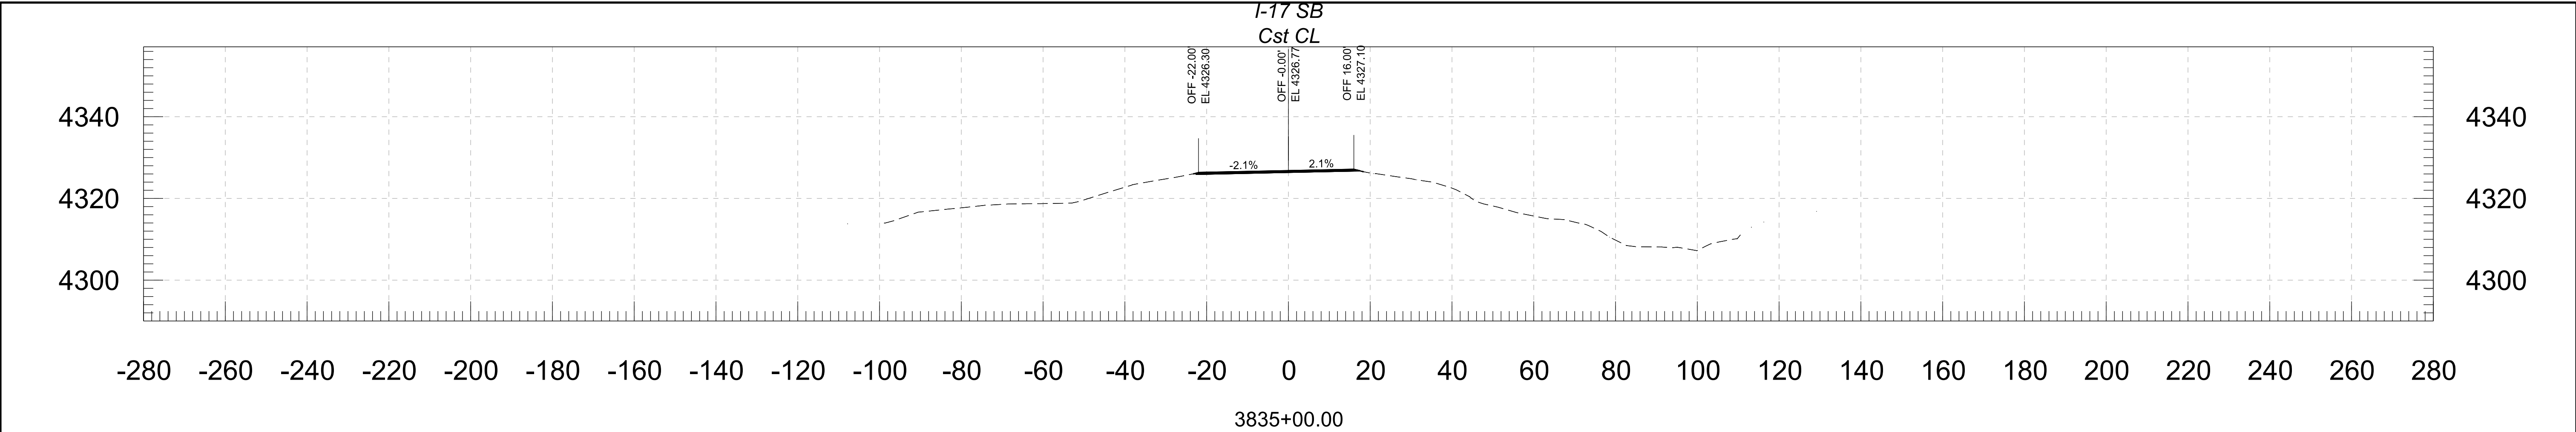 



			NAME	DATE	ARIZONA DEPARTMENT OF TRANSPORTATION PROJECT DELIVERY AND OPERATIONS DIVISION ROADWAY DESIGN SERVICES	ROUTE	F.H.W.A. Arizona Division	STATE ARIZ.	PROJECT NO.	FEDERAL ID NO.	SHEET NO.	TOTAL SHEETS	RECORD DRAWING	
		DESIGN	BAP	06/26		I-17			017 YV 269	017-B(239)T	104	146		
		DRAWN	RM	06/26			MILEPOST	LOCATION					E DUGAS ROAD - MP 275	DWG NO.
		CHECKED	KCH	06/26										
		 3133 East Camelback Road, Suite 100 Phoenix, Arizona 85016 Phone: (602) 333-2200			CROSS SECTION									

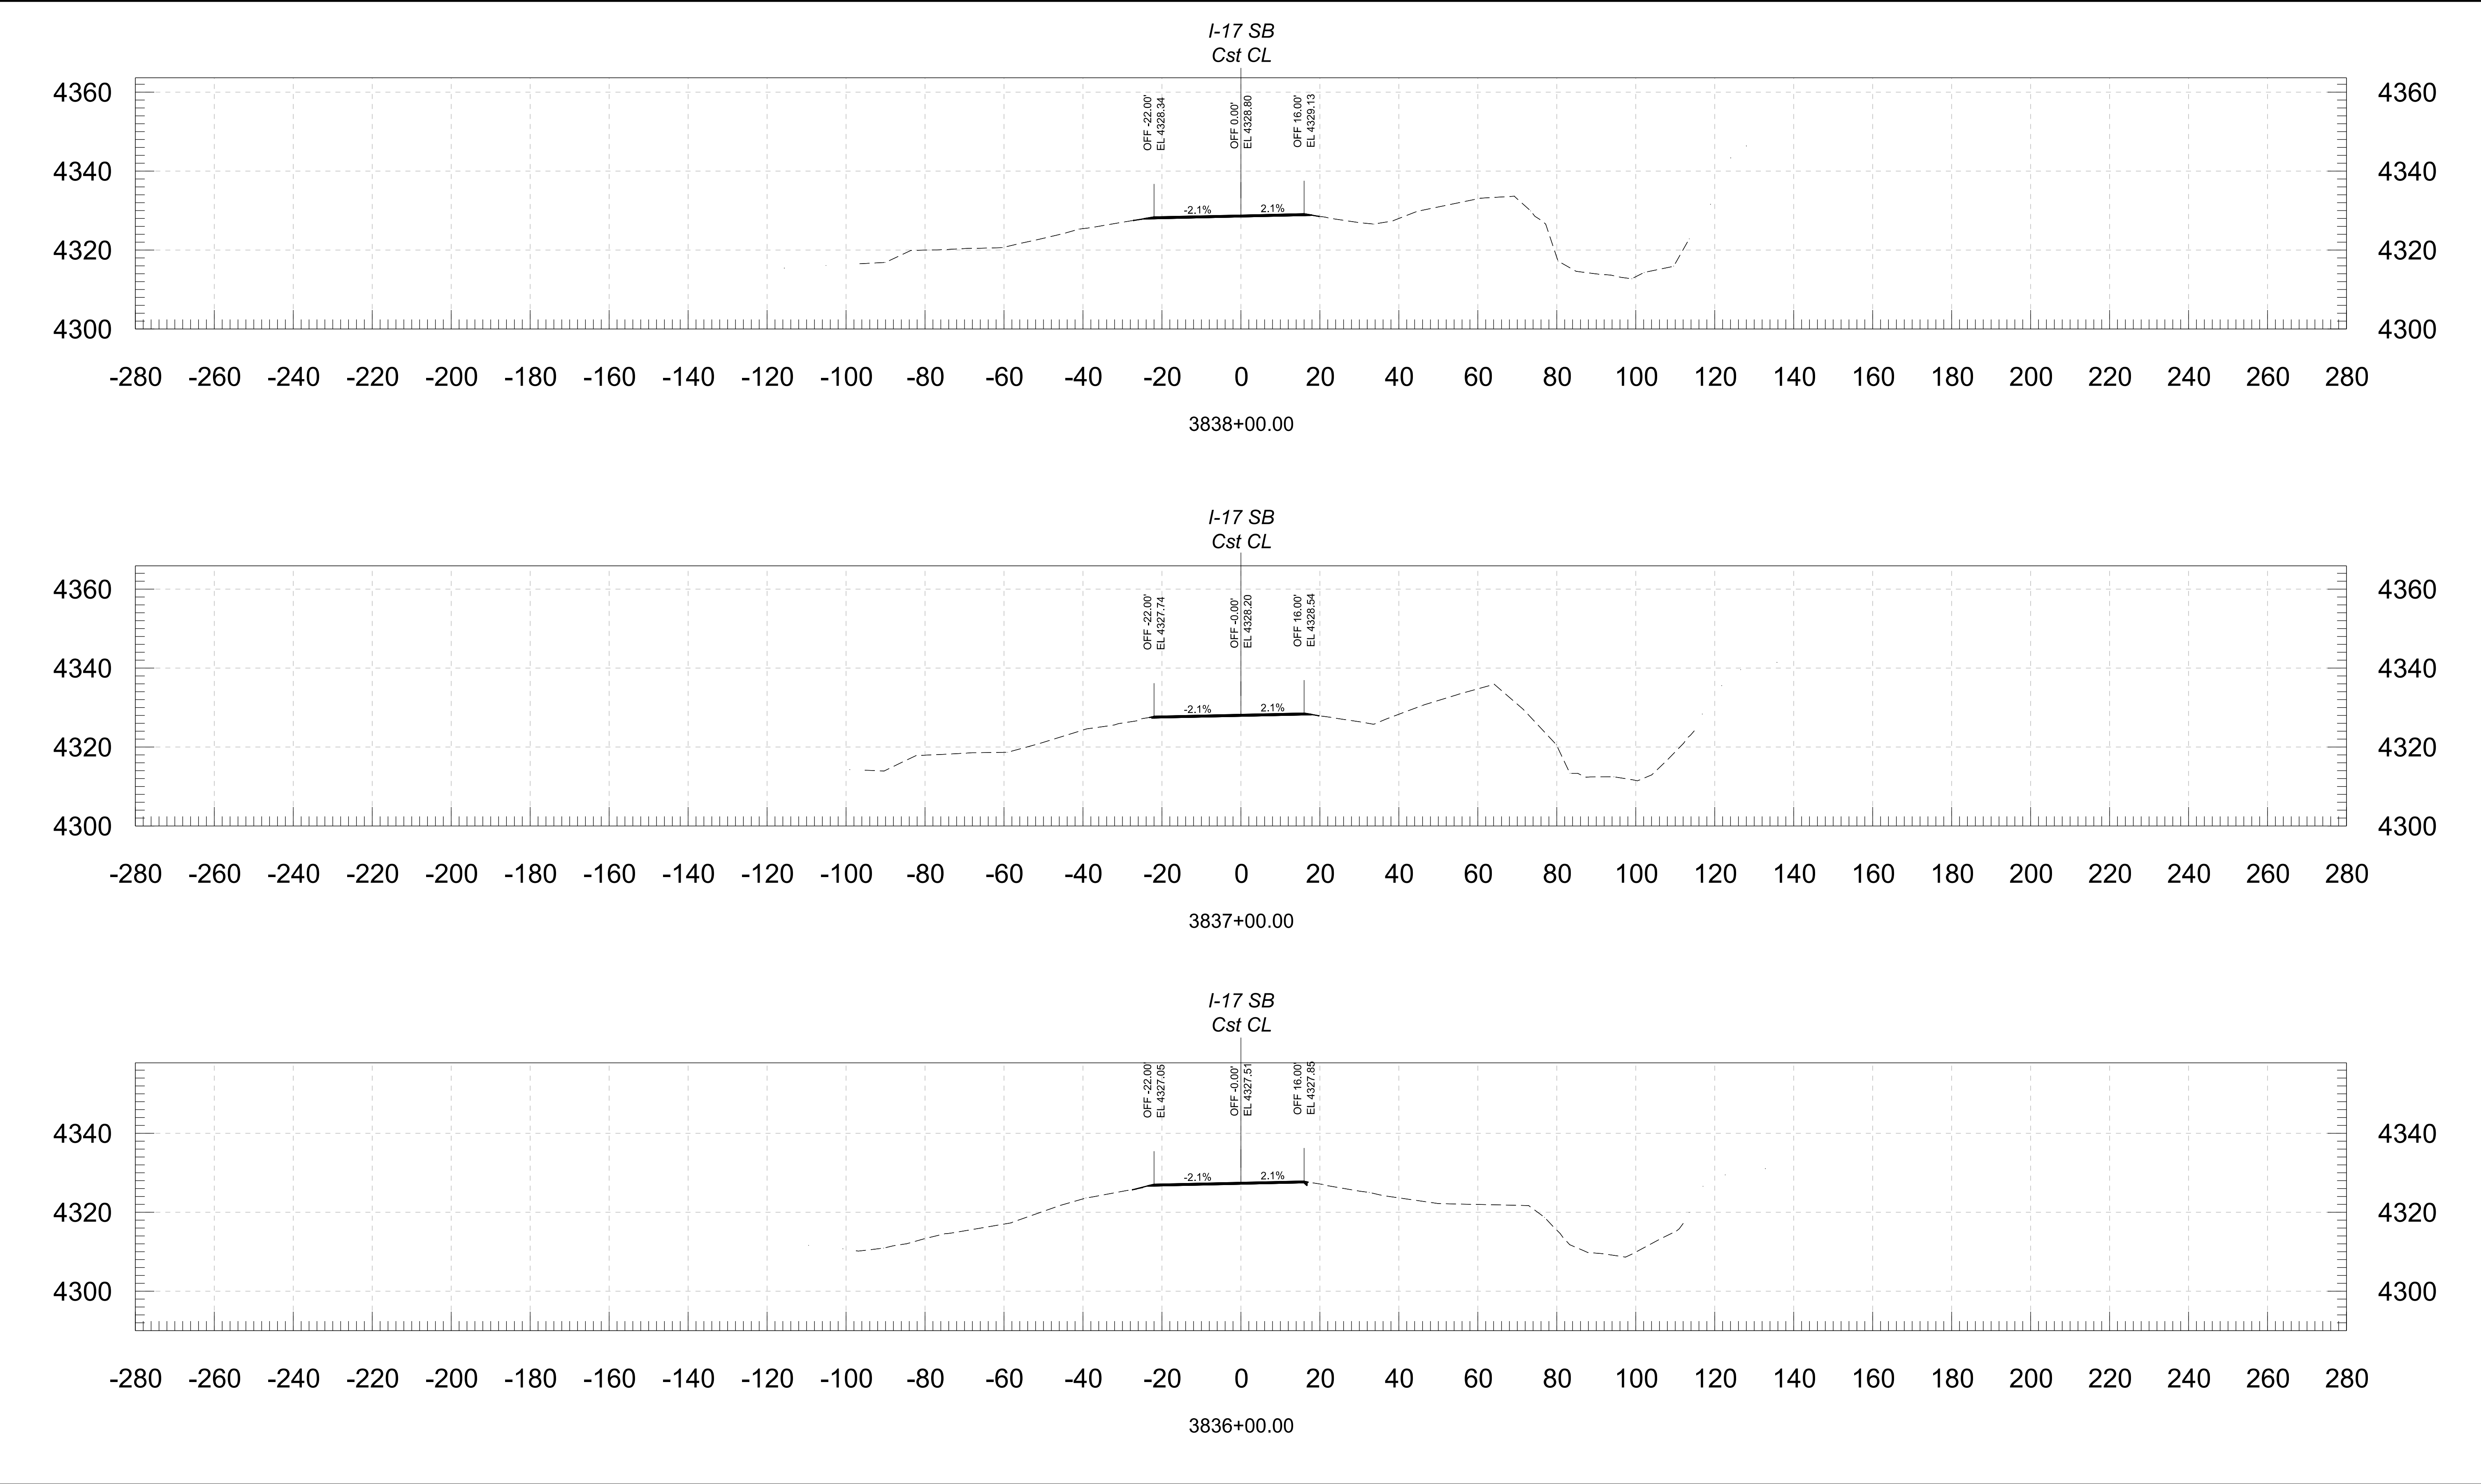


					NAME	DATE	ARIZONA DEPARTMENT OF TRANSPORTATION PROJECT DELIVERY AND OPERATIONS DIVISION ROADWAY DESIGN SERVICES	ROUTE	F.H.W.A. Arizona Division	STATE ARIZ.	PROJECT NO.	FEDERAL ID NO.	SHEET NO.	TOTAL SHEETS	RECORD DRAWING
				DESIGN	BAP	06/26		I-17			017 YV 269	017-B(239)T	105	146	
				DRAWN	RM	06/26									
				CHECKED	KCH	06/26									
				 3133 East Camelback Road, Suite 100 Phoenix, Arizona 85016 Phone: 602/333-2200 Stanley Consultants INC.											
						STRUCTURE NO.	TRACS NO. F0616 01C				____ OF ____				

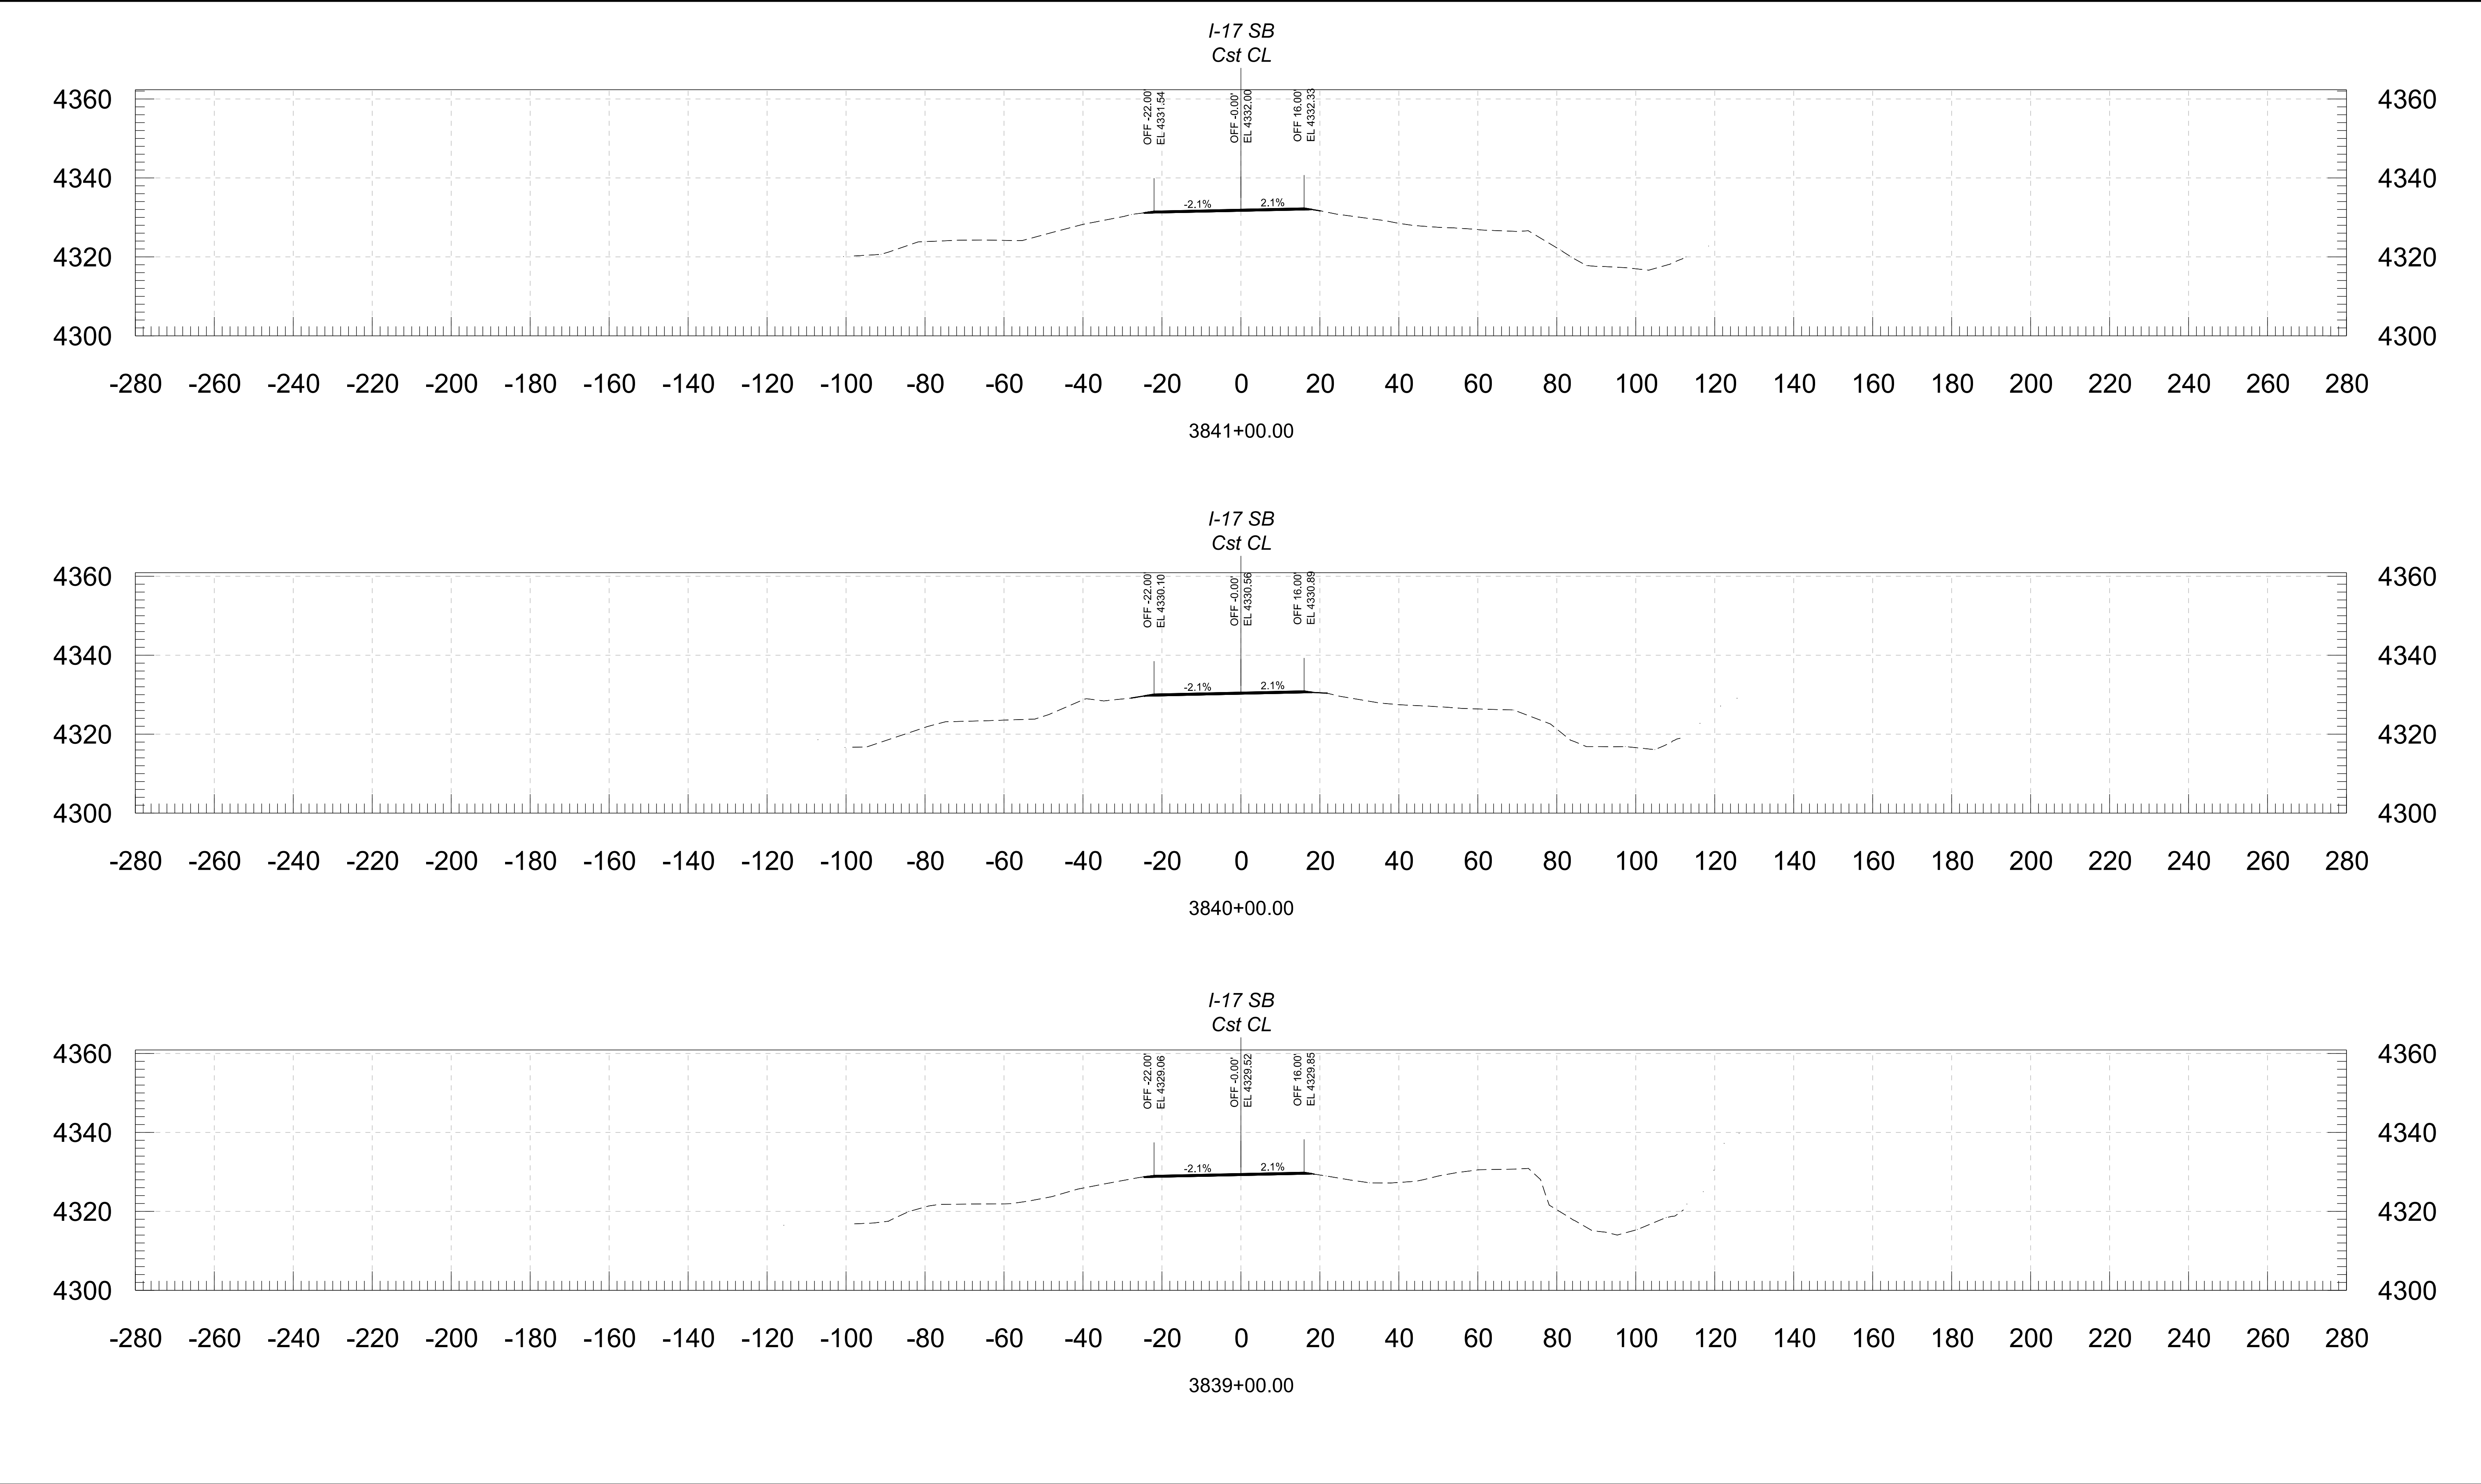


			NAME	DATE	ARIZONA DEPARTMENT OF TRANSPORTATION PROJECT DELIVERY AND OPERATIONS DIVISION ROADWAY DESIGN SERVICES	ROUTE	F.H.W.A. Arizona Division	STATE ARIZ.	PROJECT NO.	FEDERAL ID NO.	SHEET NO.	TOTAL SHEETS	RECORD DRAWING
		DESIGN	BAP	06/26		I-17			106	146			
		DRAWN	RM	06/26									
		CHECKED	KCH	06/26									
		 Stanley Consultants INC.			3135 East Camelback Road, Suite 100 Phoenix, Arizona 85016 Phone: (602) 333-2200		CROSS SECTION	MILEPOST	E DUGAS ROAD - MP 275				
						STRUCTURE NO.	TRACS NO. F0616 01C		____ OF ____				

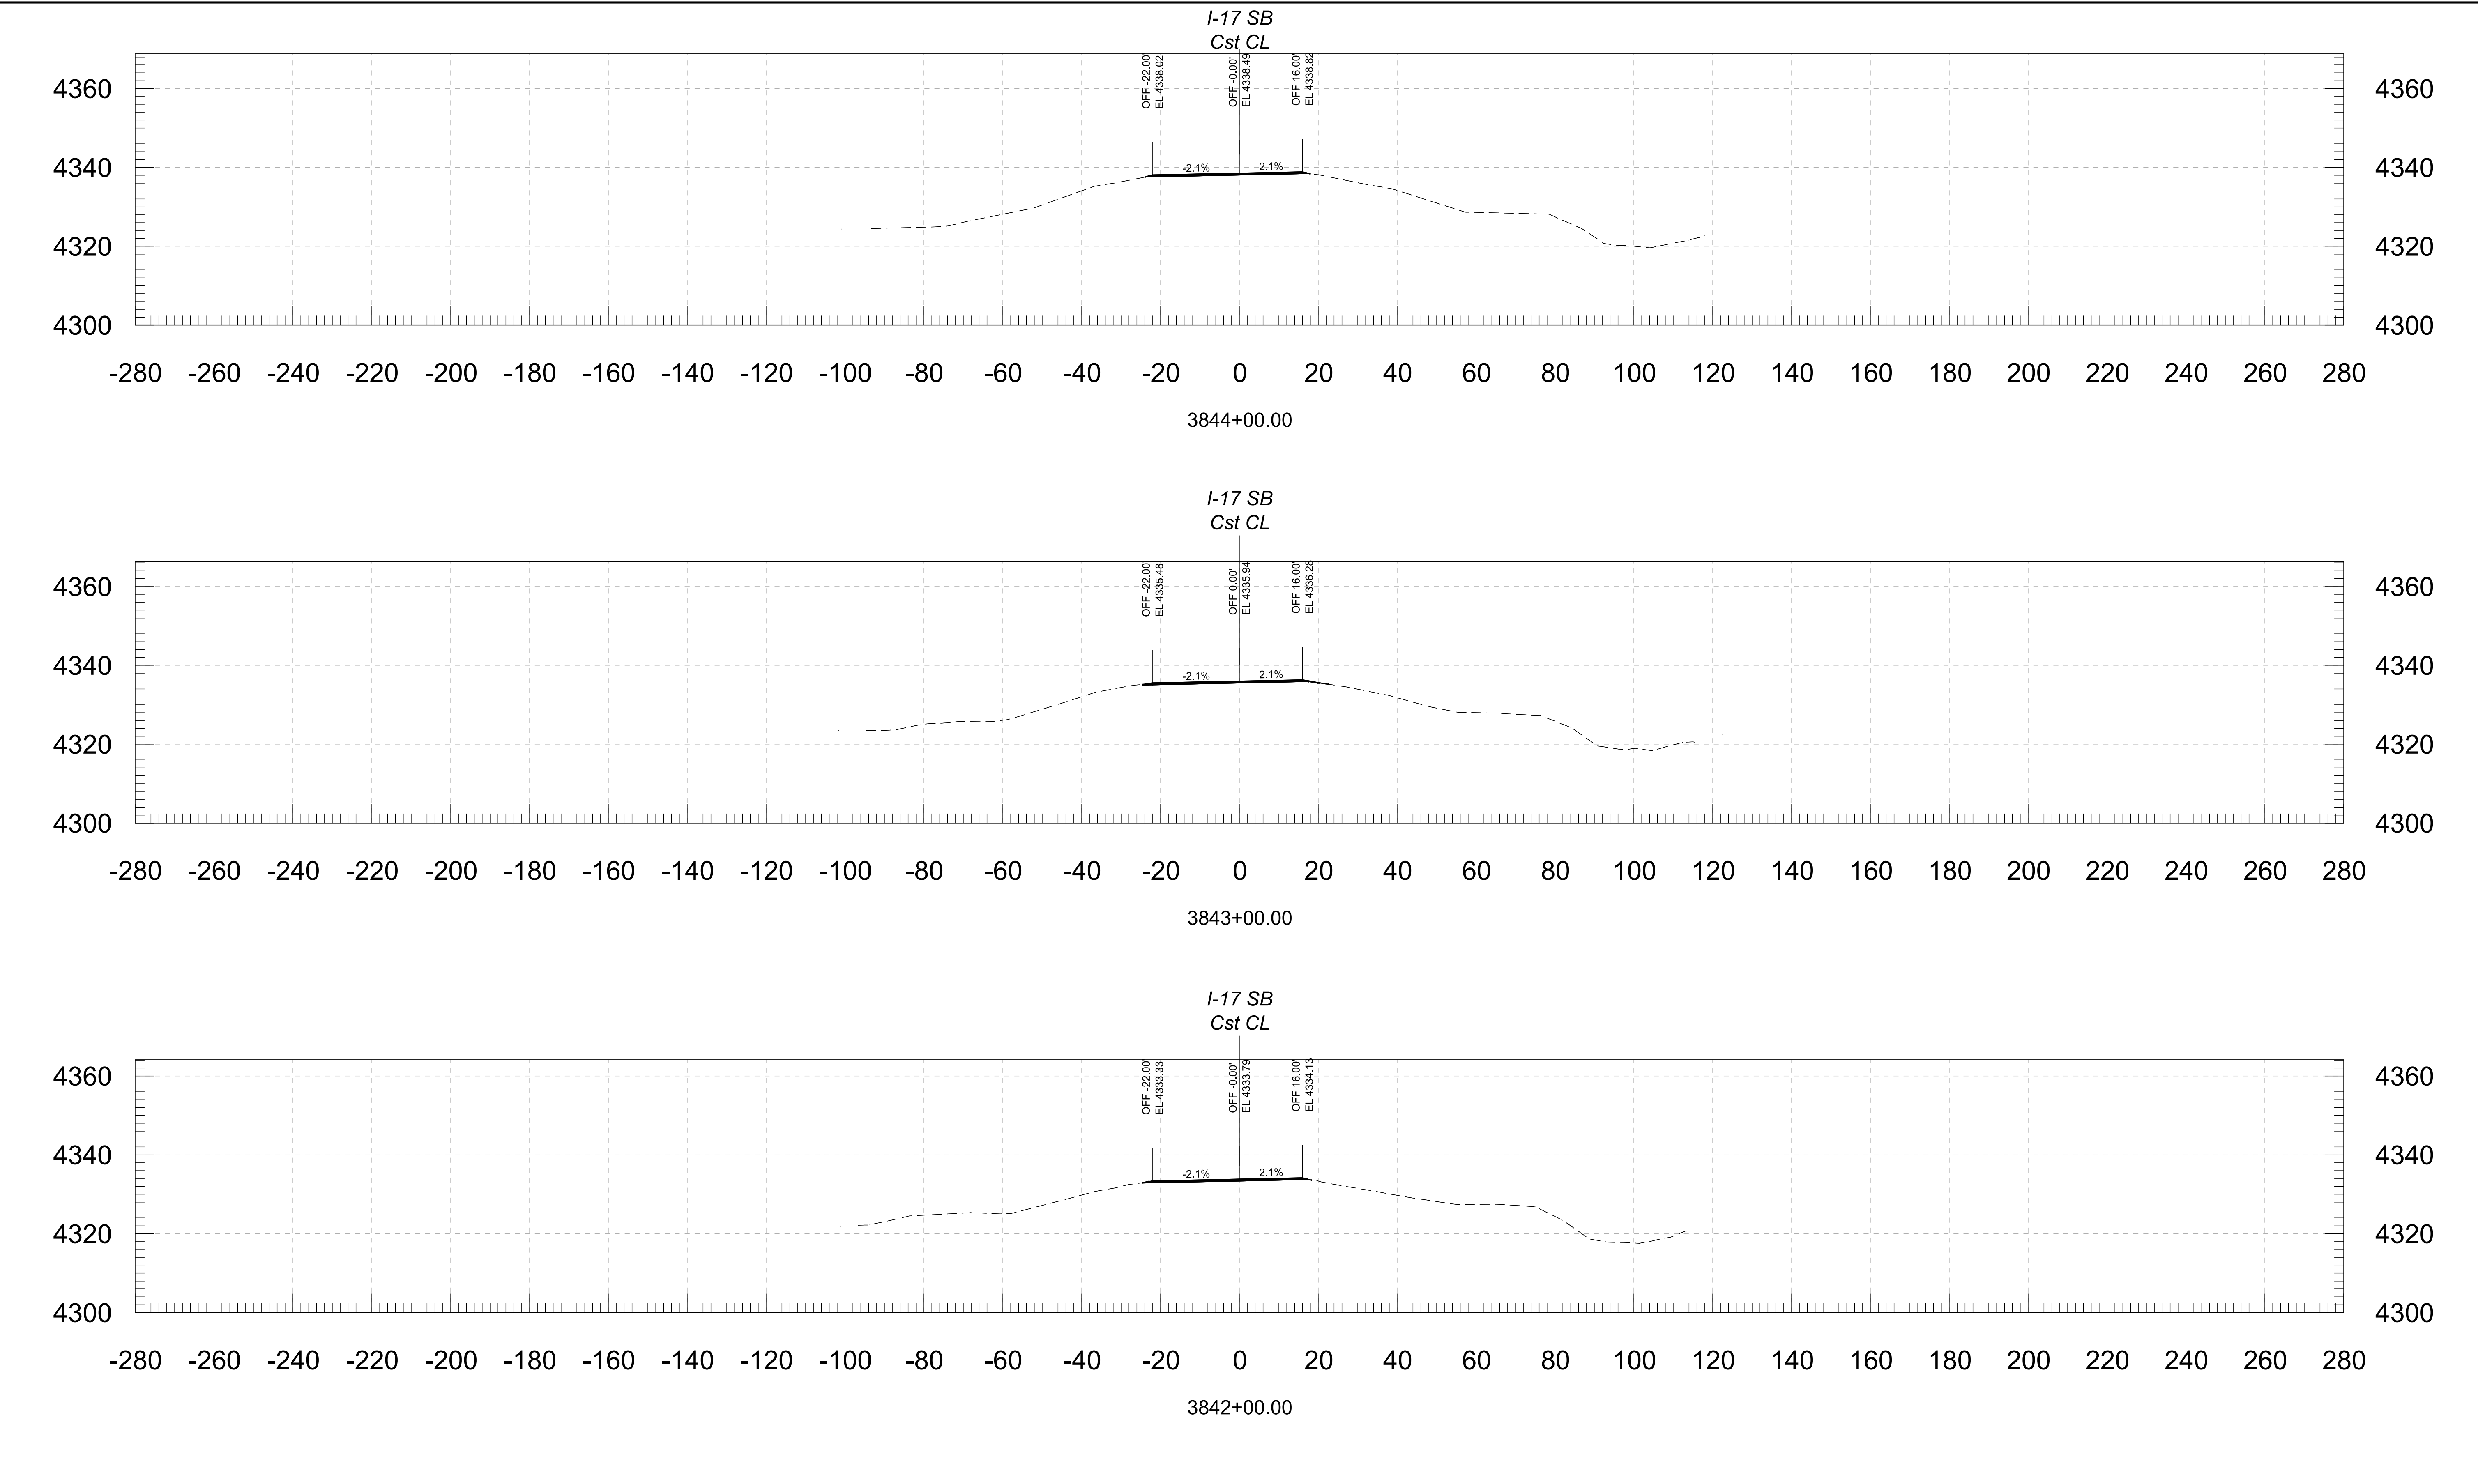




			NAME	DATE	ARIZONA DEPARTMENT OF TRANSPORTATION PROJECT DELIVERY AND OPERATIONS DIVISION ROADWAY DESIGN SERVICES	ROUTE	F.H.W.A. Arizona Division	STATE ARIZ.	PROJECT NO.	FEDERAL ID NO.	SHEET NO.	TOTAL SHEETS	RECORD DRAWING
		DESIGN	BAP	06/26		I-17			017 YV 269	017-B(239)T	107	146	
		DRAWN	RM	06/26			MILEPOST	E DUGAS ROAD - MP 275				DWG NO.	
		CHECKED	KCH	06/26									
		 Stanley Consultants INC.			3133 East Camelback Road, Suite 100 Phoenix, Arizona 85016 Phone: 602.333-2200			CROSS SECTION	TRACS NO. F0616 01C		____ OF ____		

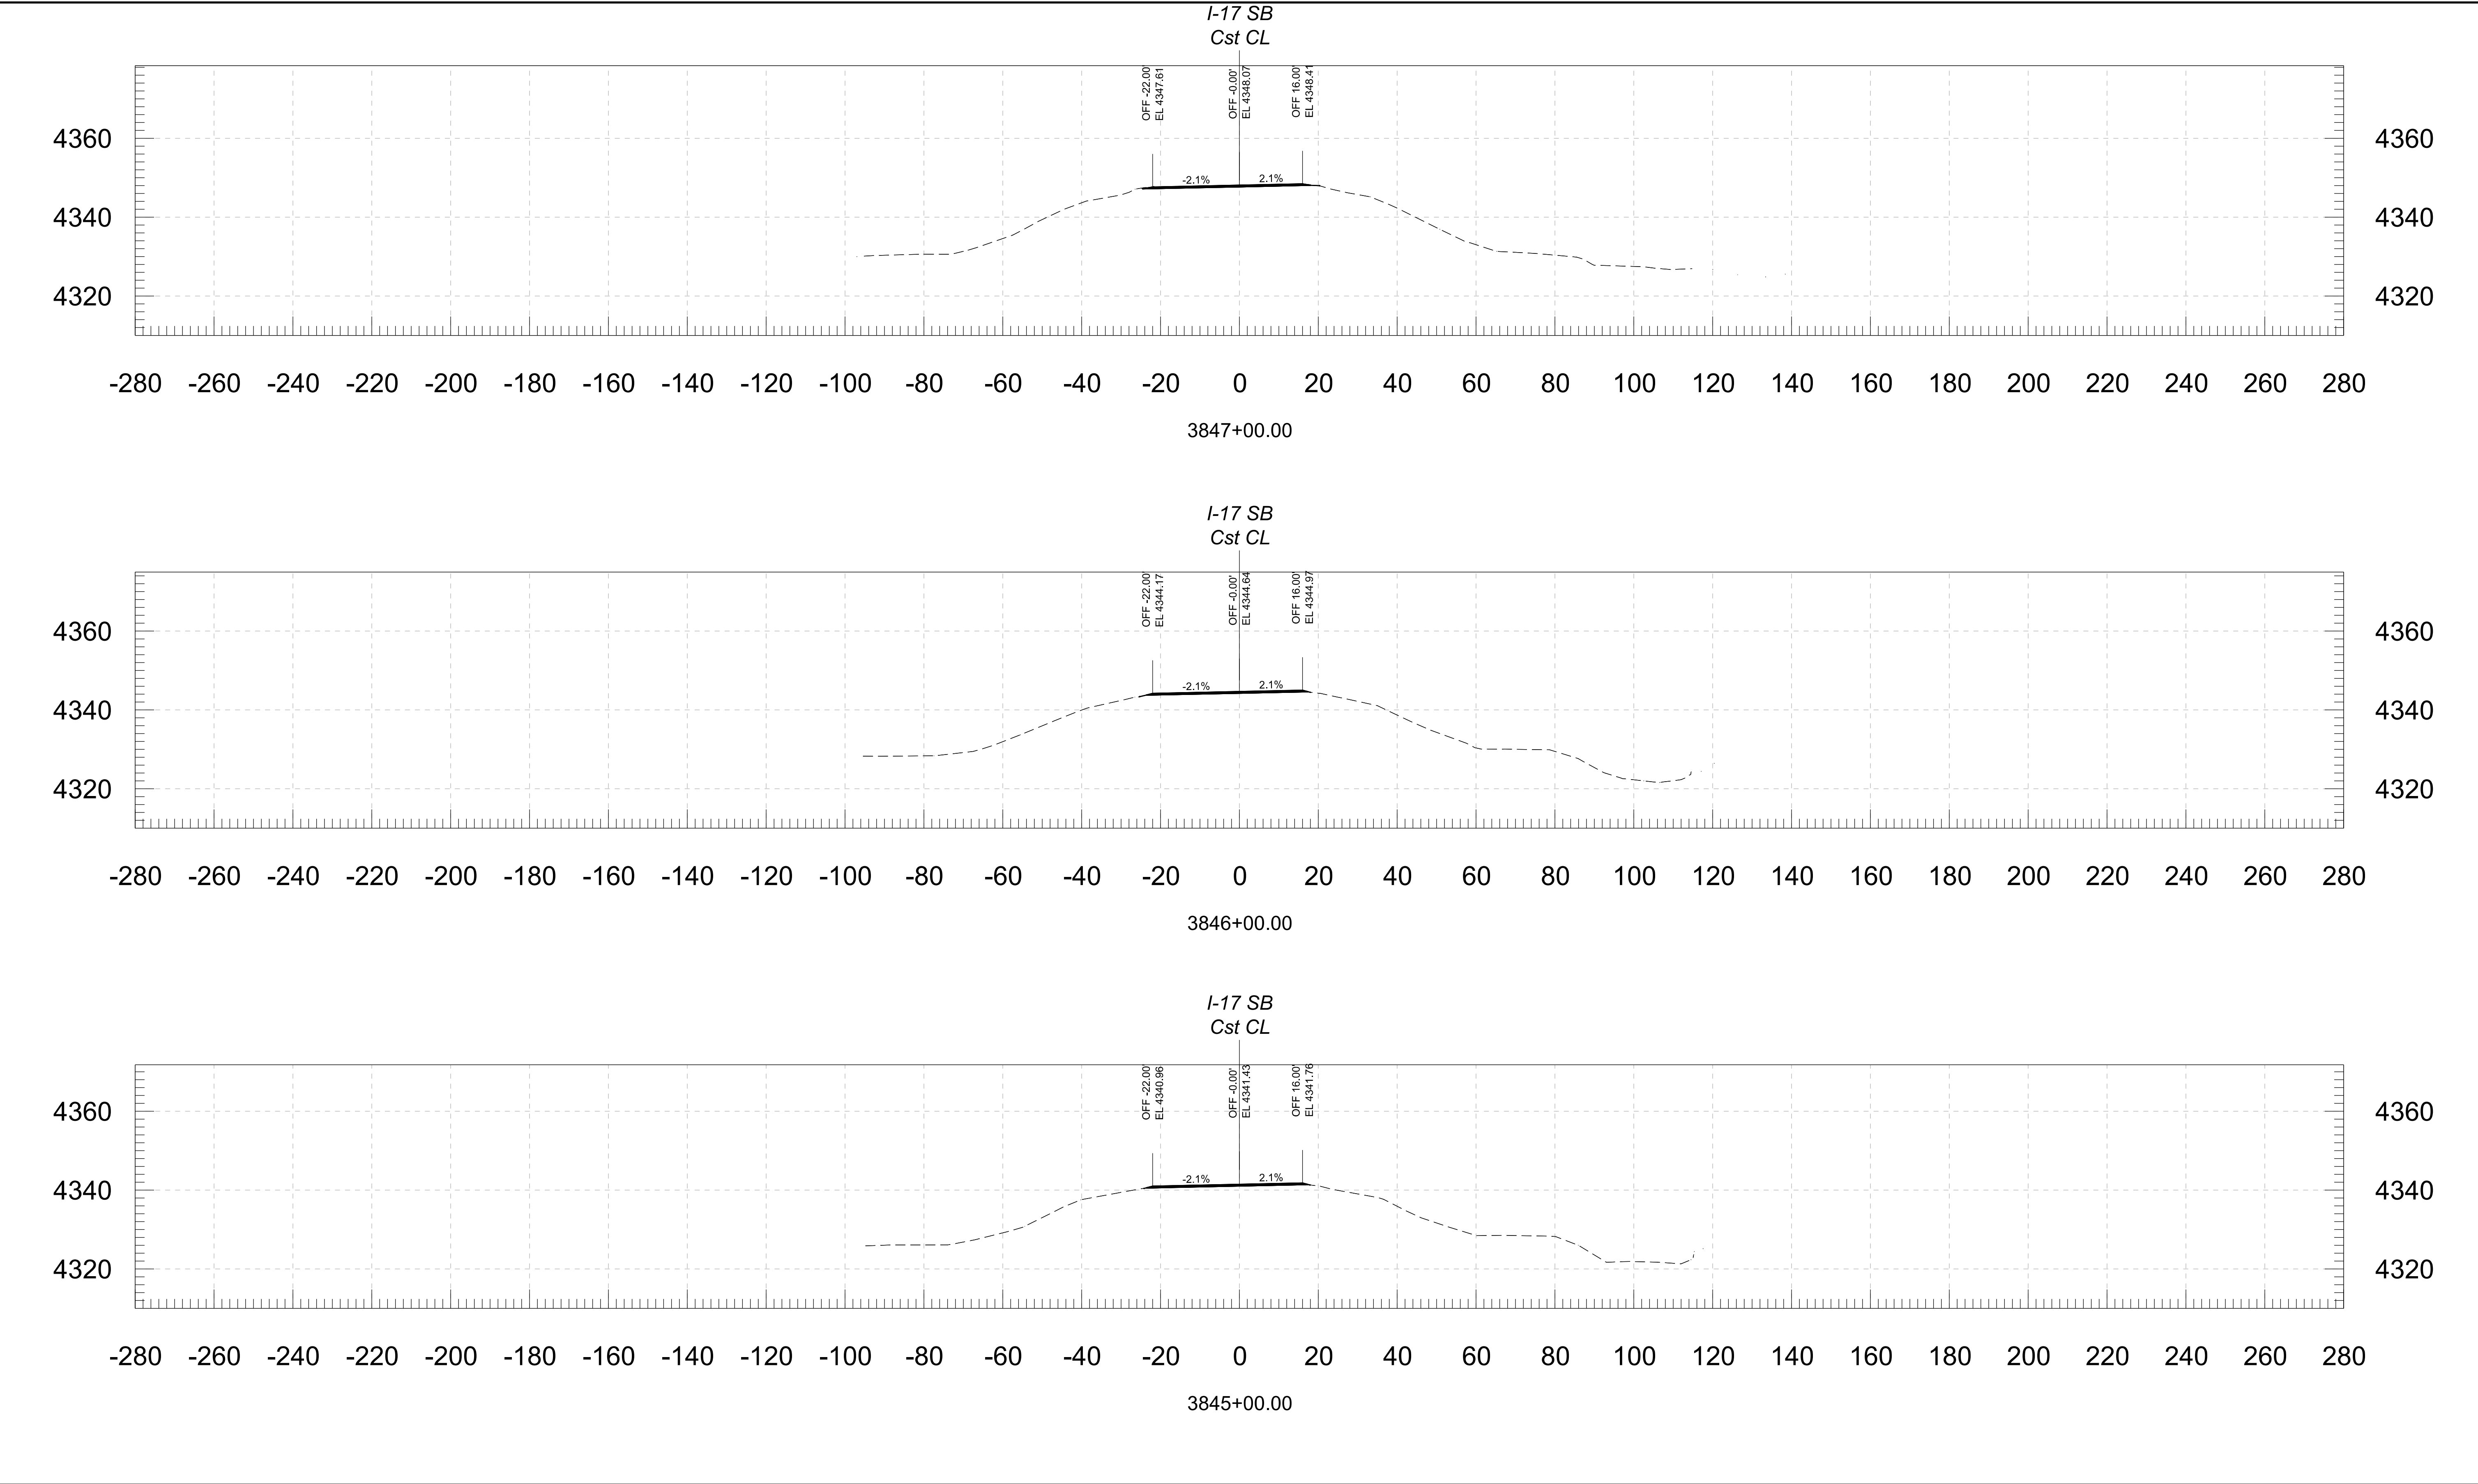 





				NAME	DATE	ARIZONA DEPARTMENT OF TRANSPORTATION PROJECT DELIVERY AND OPERATIONS DIVISION ROADWAY DESIGN SERVICES	ROUTE	F.H.W.A. Arizona Division	STATE ARIZ.	PROJECT NO.	FEDERAL ID NO.	SHEET NO.	TOTAL SHEETS	RECORD DRAWING
			DESIGN	BAP	06/26		I-17			017 YV 269	017-B(239)T	108	146	
			DRAWN	RM	06/26			MILEPOST	E DUGAS ROAD - MP 275				DWG NO.	
			CHECKED	KCH	06/26				STRUCTURE NO.	TRACS NO. F0616 01C				____ OF ____
			 3133 East Camelback Road, Suite 100 Phoenix, Arizona 85016 Phone: (602) 333-2200 Stanley Consultants INC.			CROSS SECTION								

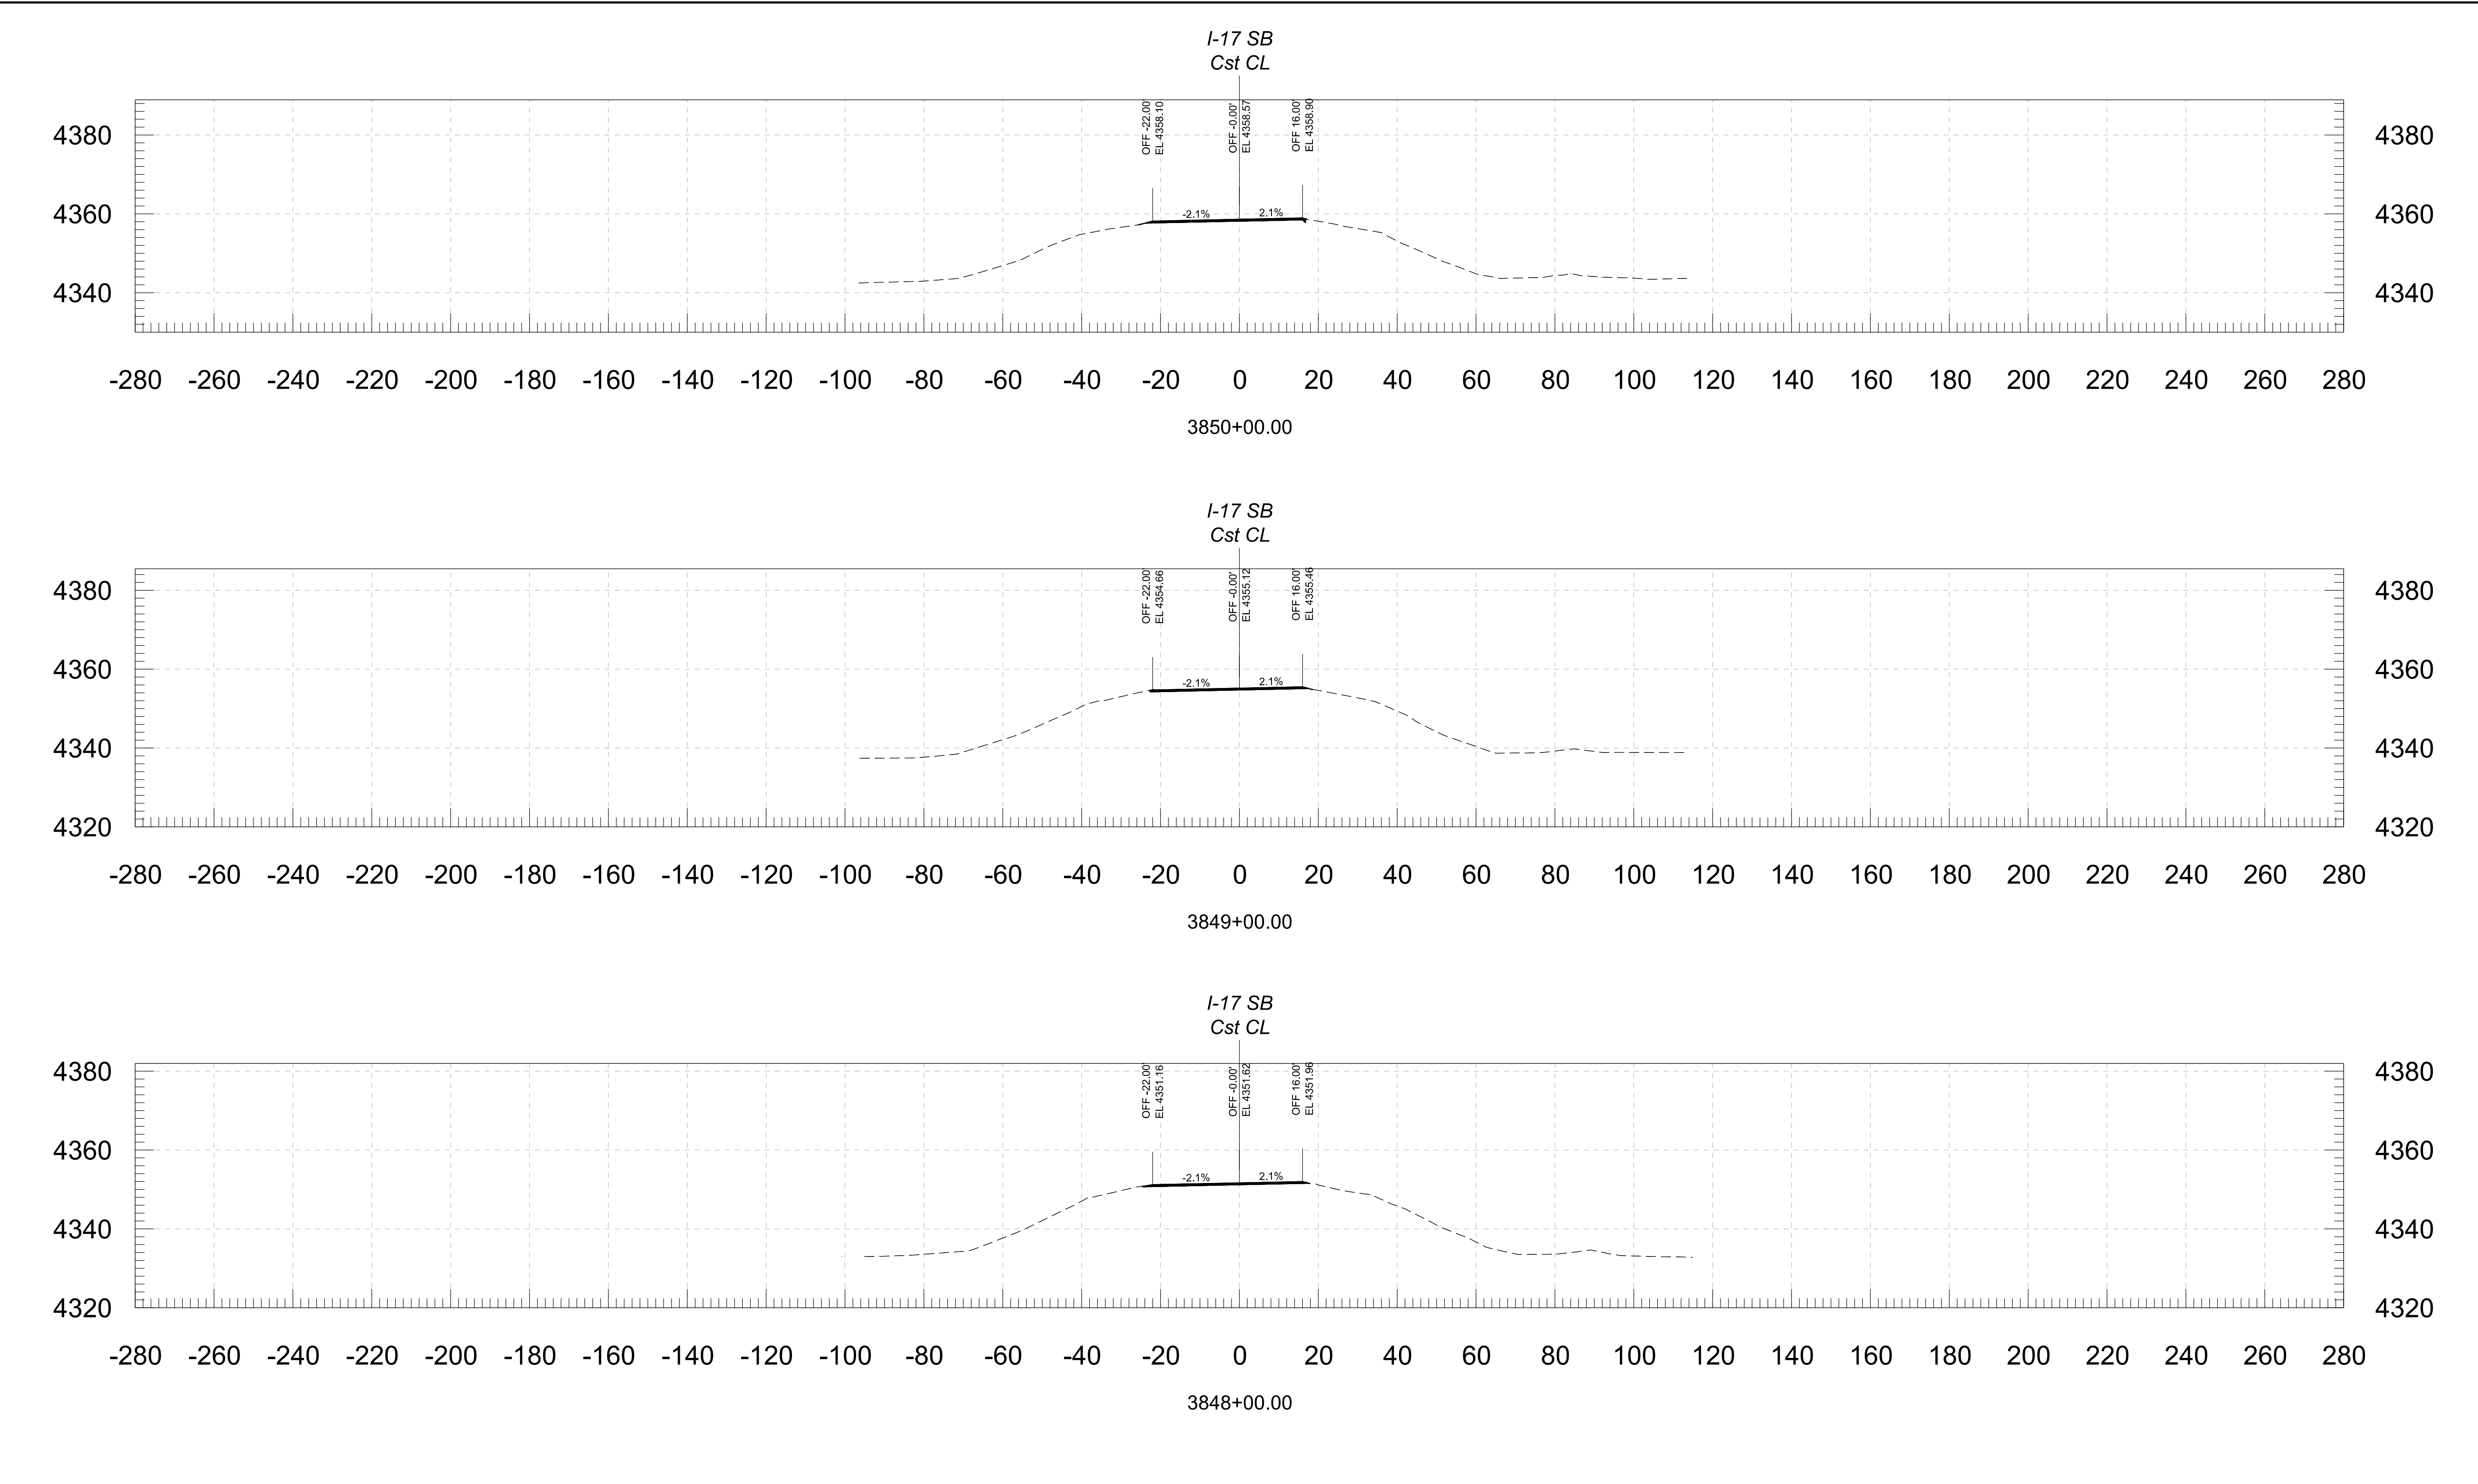



			NAME	DATE	ARIZONA DEPARTMENT OF TRANSPORTATION PROJECT DELIVERY AND OPERATIONS DIVISION ROADWAY DESIGN SERVICES	ROUTE	F.H.W.A. Arizona Division	STATE ARIZ.	PROJECT NO.	FEDERAL ID NO.	SHEET NO.	TOTAL SHEETS	RECORD DRAWING
		DESIGN	BAP	06/26		I-17			017 YV 269	017-B(239)T	109	146	
		DRAWN	RM	06/26			MILEPOST	E DUGAS ROAD - MP 275					DWG NO.
		CHECKED	KCH	06/26				STRUCTURE NO.	TRACS NO. F0616 01C				
		Stanley Consultants INC. 3133 East Camelback Road, Suite 100 Phoenix, Arizona 85016 Phone: 602.333-2200			CROSS SECTION								

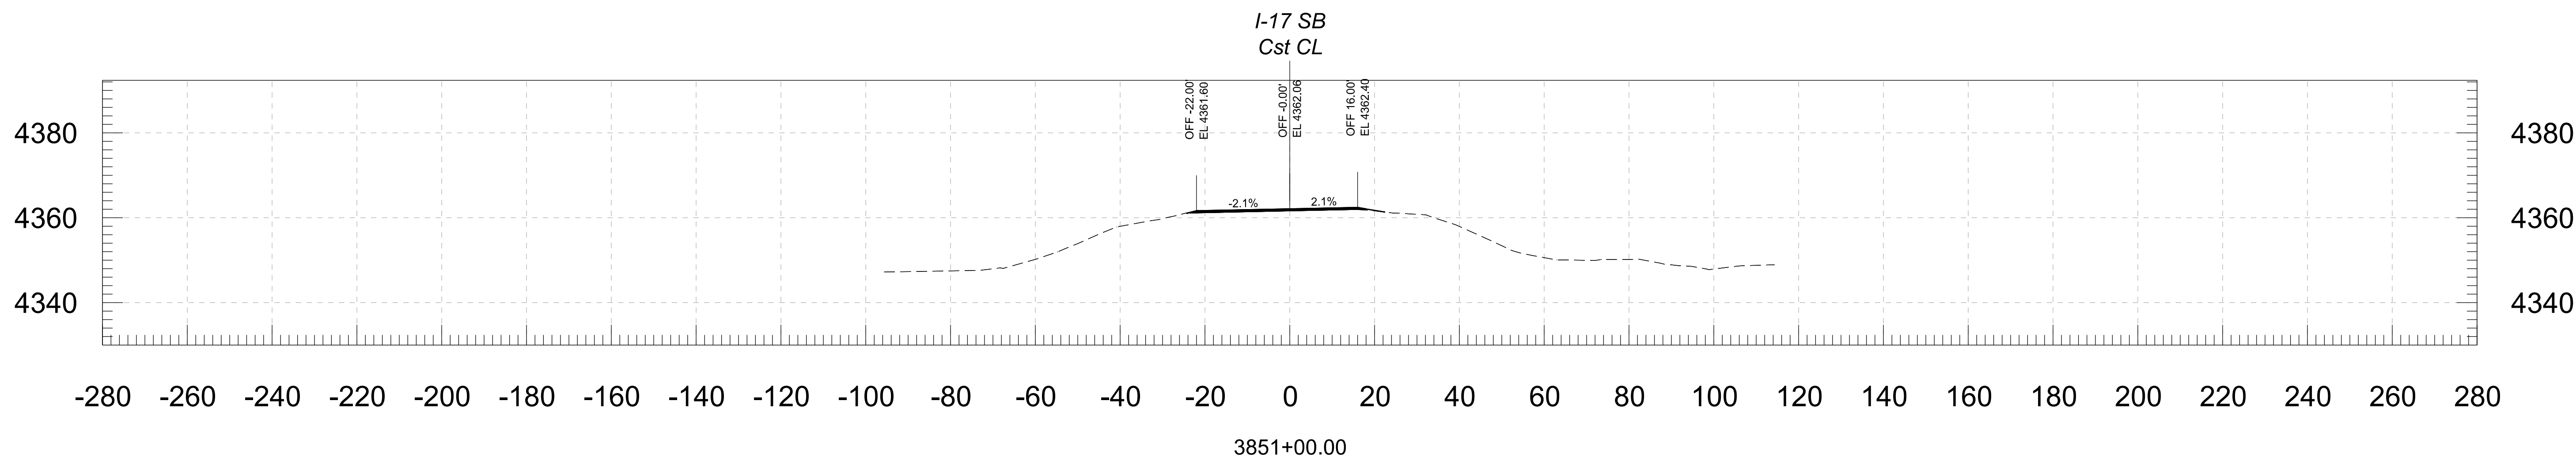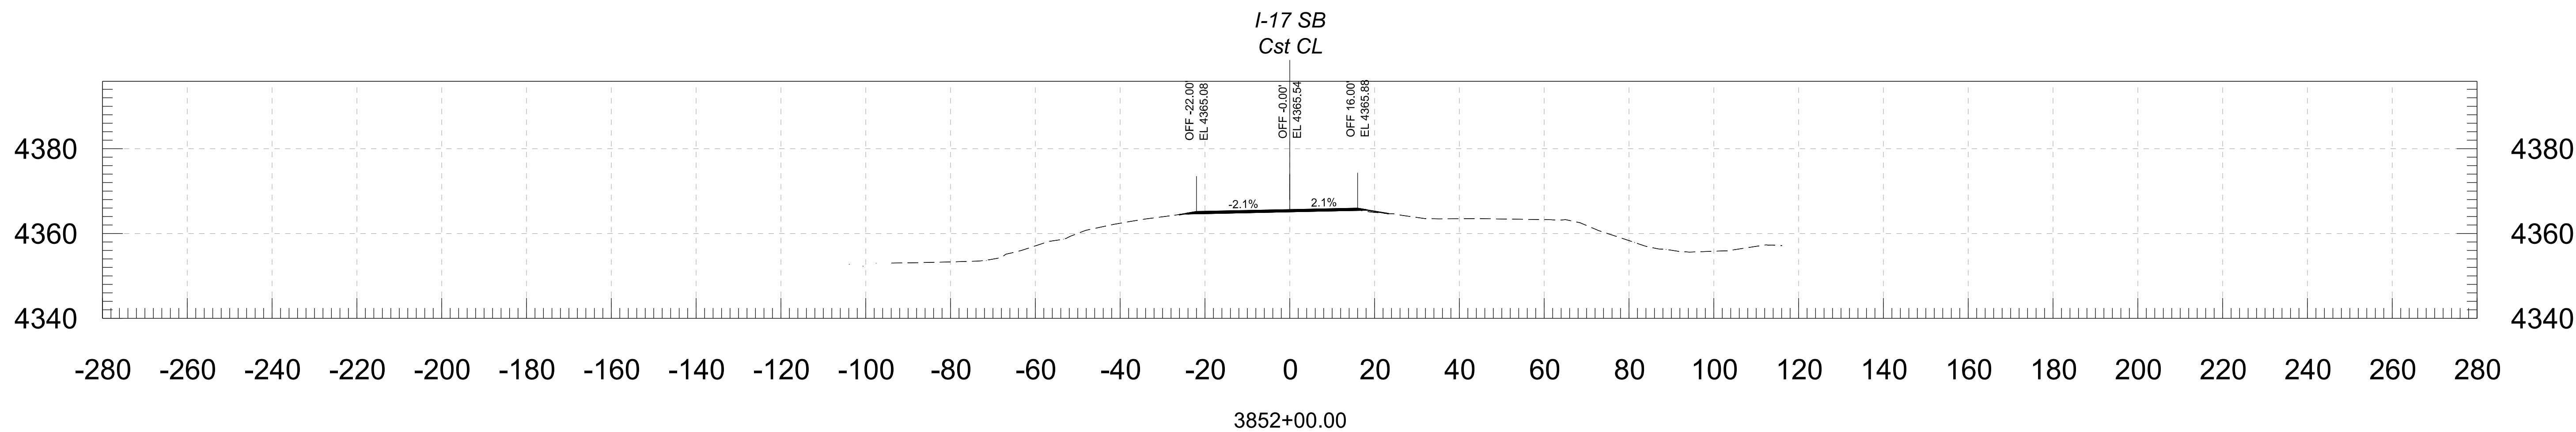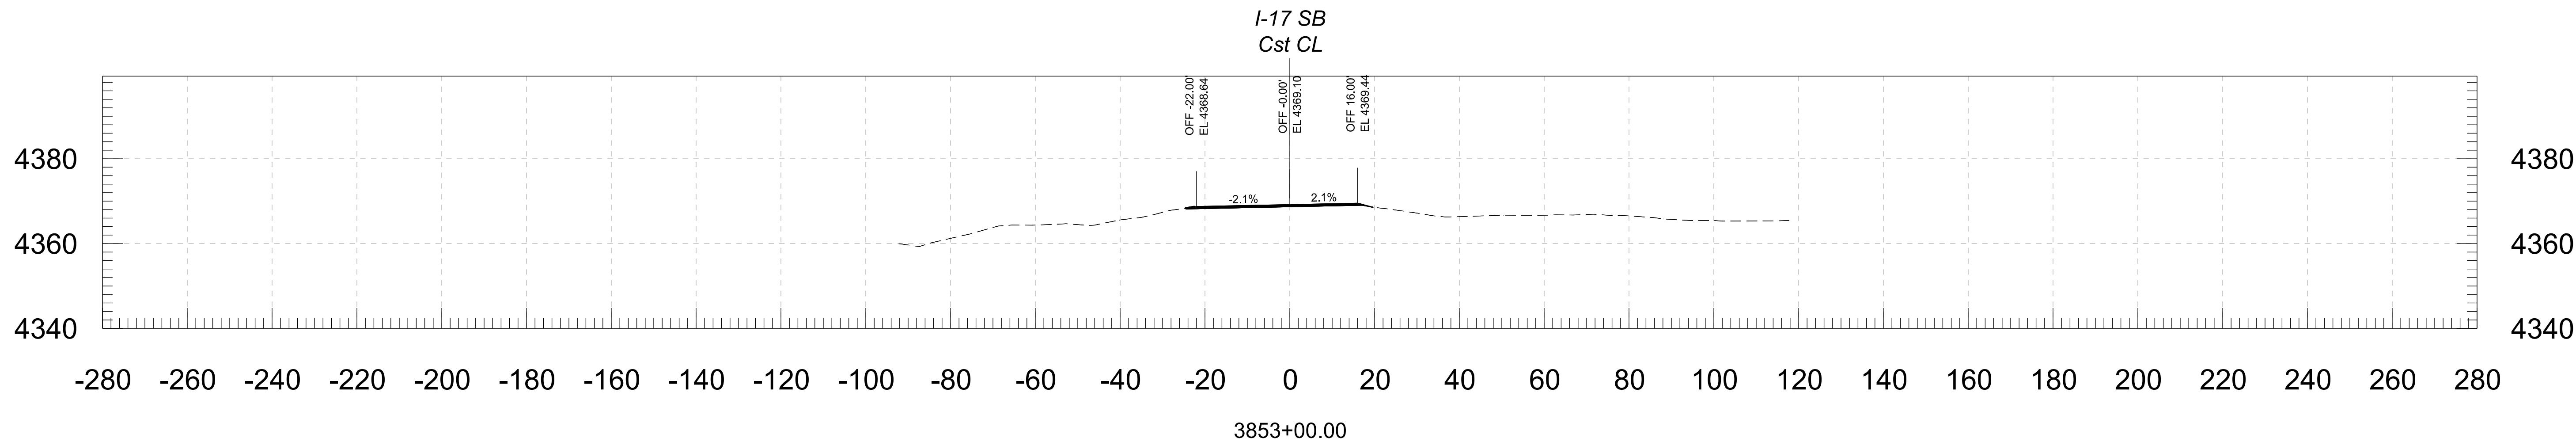

				NAME	DATE	ARIZONA DEPARTMENT OF TRANSPORTATION PROJECT DELIVERY AND OPERATIONS DIVISION ROADWAY DESIGN SERVICES	ROUTE	F.H.W.A. Arizona Division	STATE ARIZ.	PROJECT NO.	FEDERAL ID NO.	SHEET NO.	TOTAL SHEETS	RECORD DRAWING
			DESIGN	BAP	06/26		I-17			017 YV 269	017-B(239)T	110	146	
			DRAWN	RM	06/26									
			CHECKED	KCH	06/26									
			 3133 East Camelback Road, Suite 100 Phoenix, Arizona 85016 Phone: 602.333.2000 Stanley Consultants INC.				CROSS SECTION			MILEPOST	E DUGAS ROAD - MP 275			
						STRUCTURE NO.	TRACS NO. F0616 01C		OF					

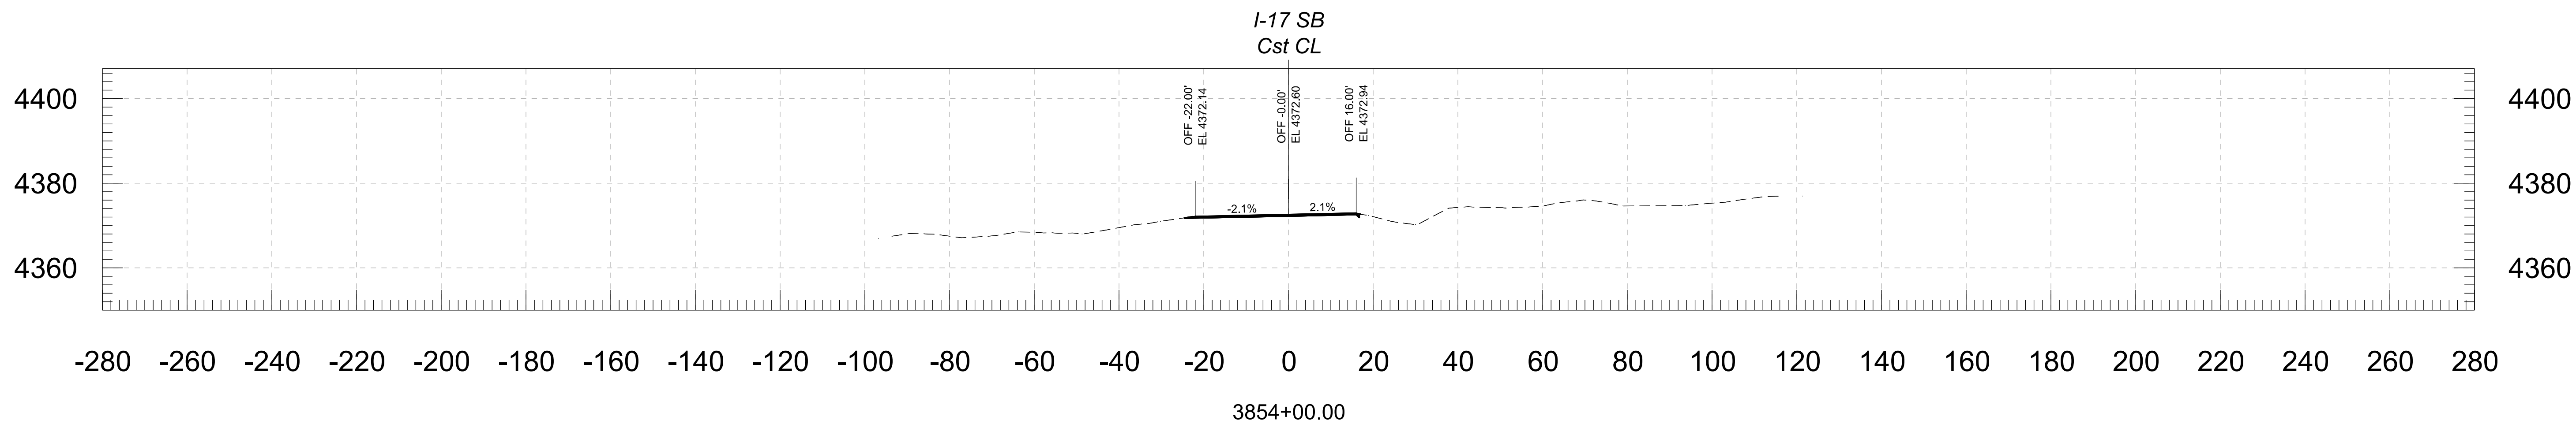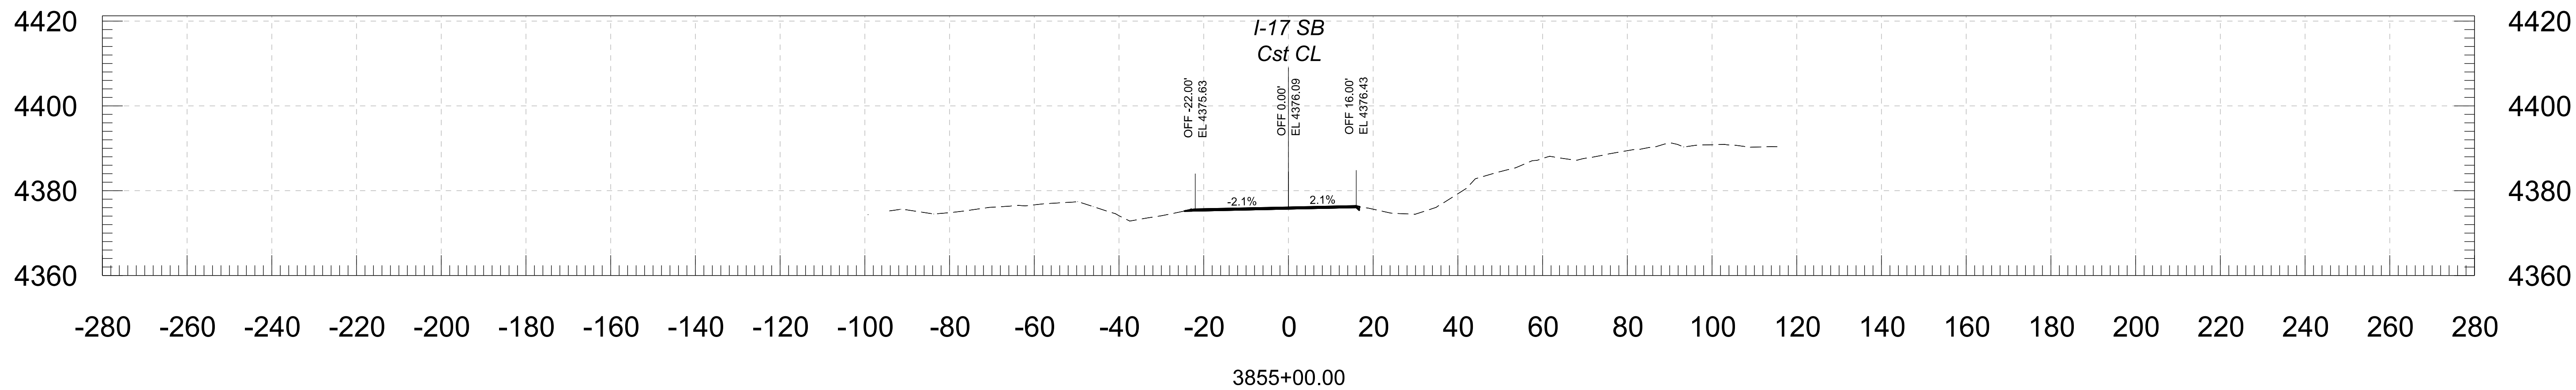
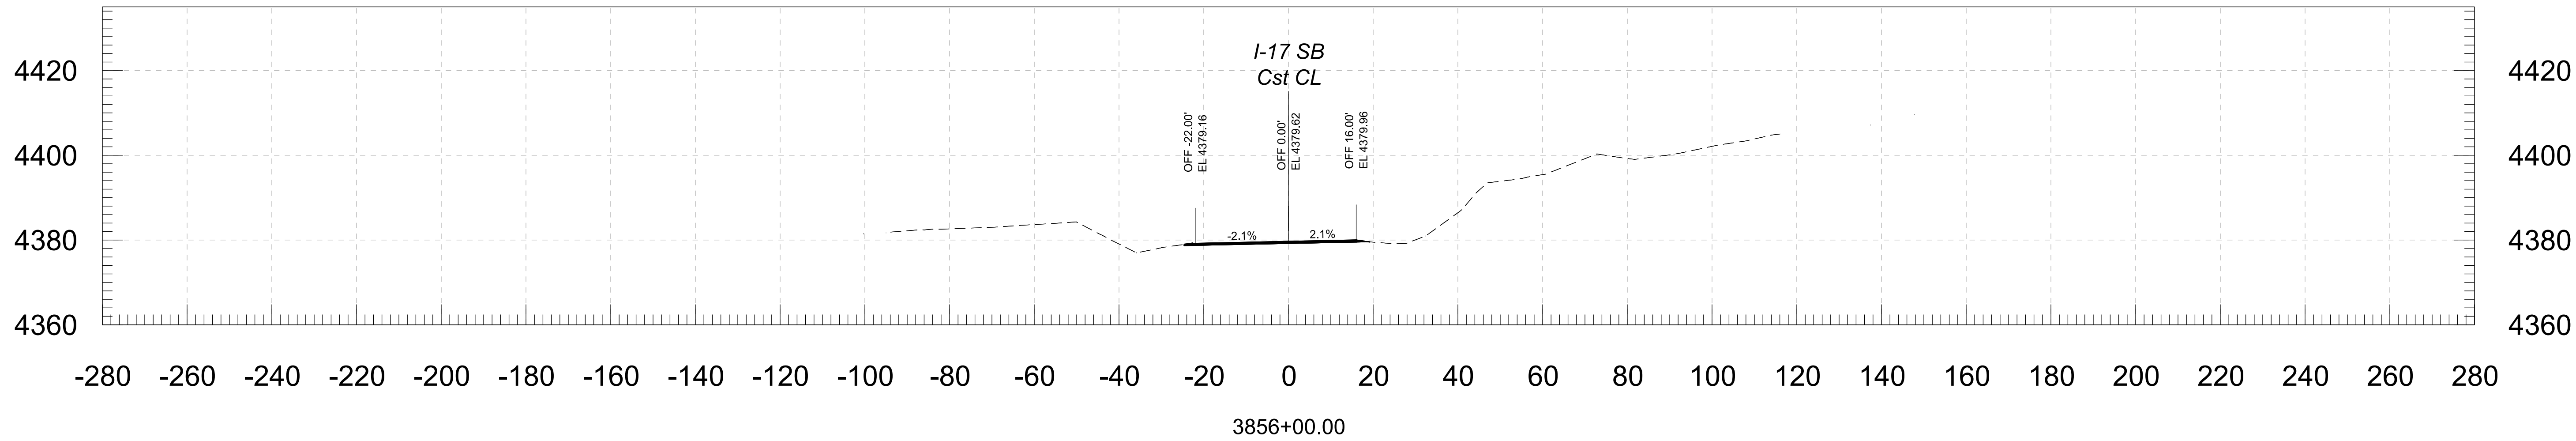


			NAME	DATE	ARIZONA DEPARTMENT OF TRANSPORTATION PROJECT DELIVERY AND OPERATIONS DIVISION ROADWAY DESIGN SERVICES	ROUTE	F.H.W.A. Arizona Division	STATE	PROJECT NO.	FEDERAL ID NO.	SHEET NO.	TOTAL SHEETS	RECORD DRAWING
		DESIGN	BAP	06/26		I-17							
		DRAWN	RM	06/26			MILEPOST	LOCATION	017 YV 269	017-B(239)T	111	146	
		CHECKED	KCH	06/26									STRUCTURE NO.
		 Stanley Consultants INC.	3133 East Camelback Road, Suite 100 Phoenix, Arizona 85016 Phone 602. 333-2200		CROSS SECTION	TRACS NO. F0616 01C	____ OF ____						

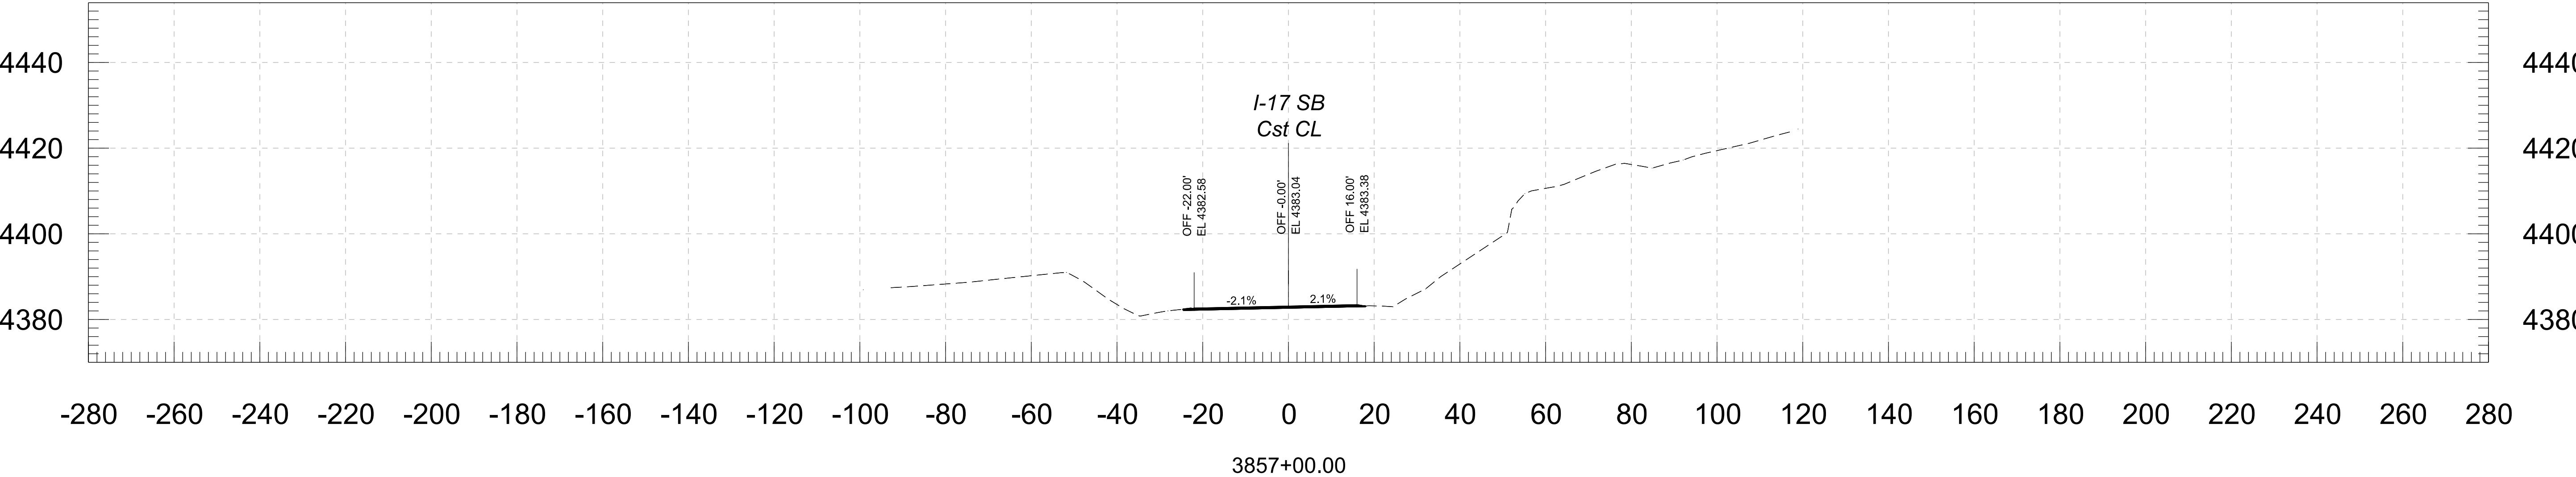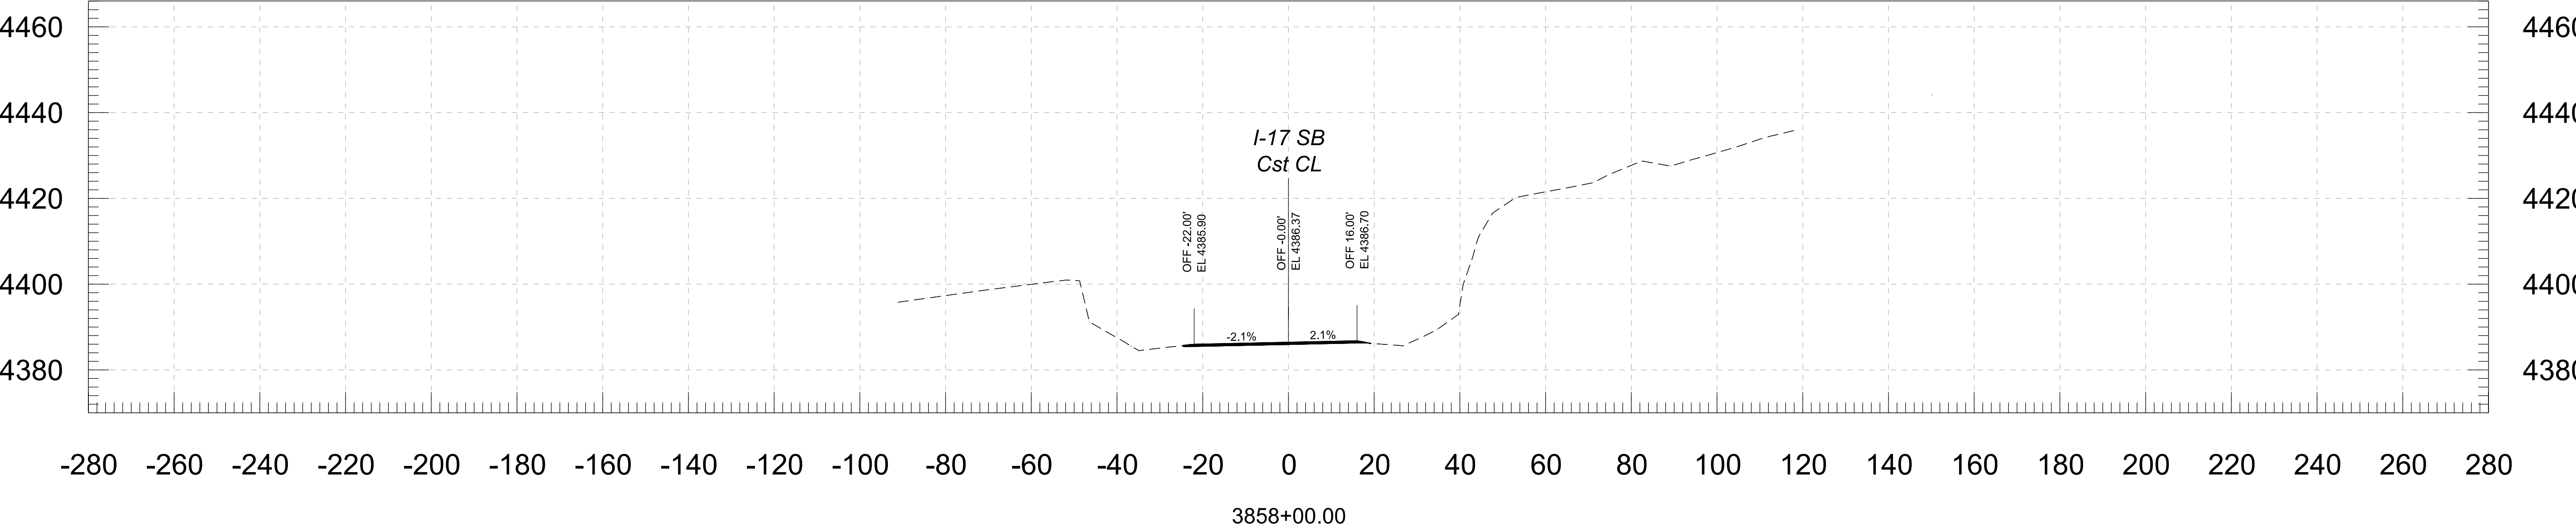


				NAME	DATE	ARIZONA DEPARTMENT OF TRANSPORTATION PROJECT DELIVERY AND OPERATIONS DIVISION ROADWAY DESIGN SERVICES	ROUTE	F.H.W.A. Arizona Division	STATE	PROJECT NO.	FEDERAL ID NO.	SHEET NO.	TOTAL SHEETS	RECORD DRAWING		
			DESIGN	BAP	06/26		I-17			017 YV 269	017-B(239)T	112	146			
			DRAWN	RM	06/26		MILEPOST	LOCATION								DWG NO.
			CHECKED	KCH	06/26			E DUGAS ROAD - MP 275								
			 Stanley Consultants INC.			3133 East Camelback Road, Suite 100 Phoenix, Arizona 85016 Phone: 602. 333-2200			CROSS SECTION	STRUCTURE NO.	TRACS NO. F0616 01C		OF			




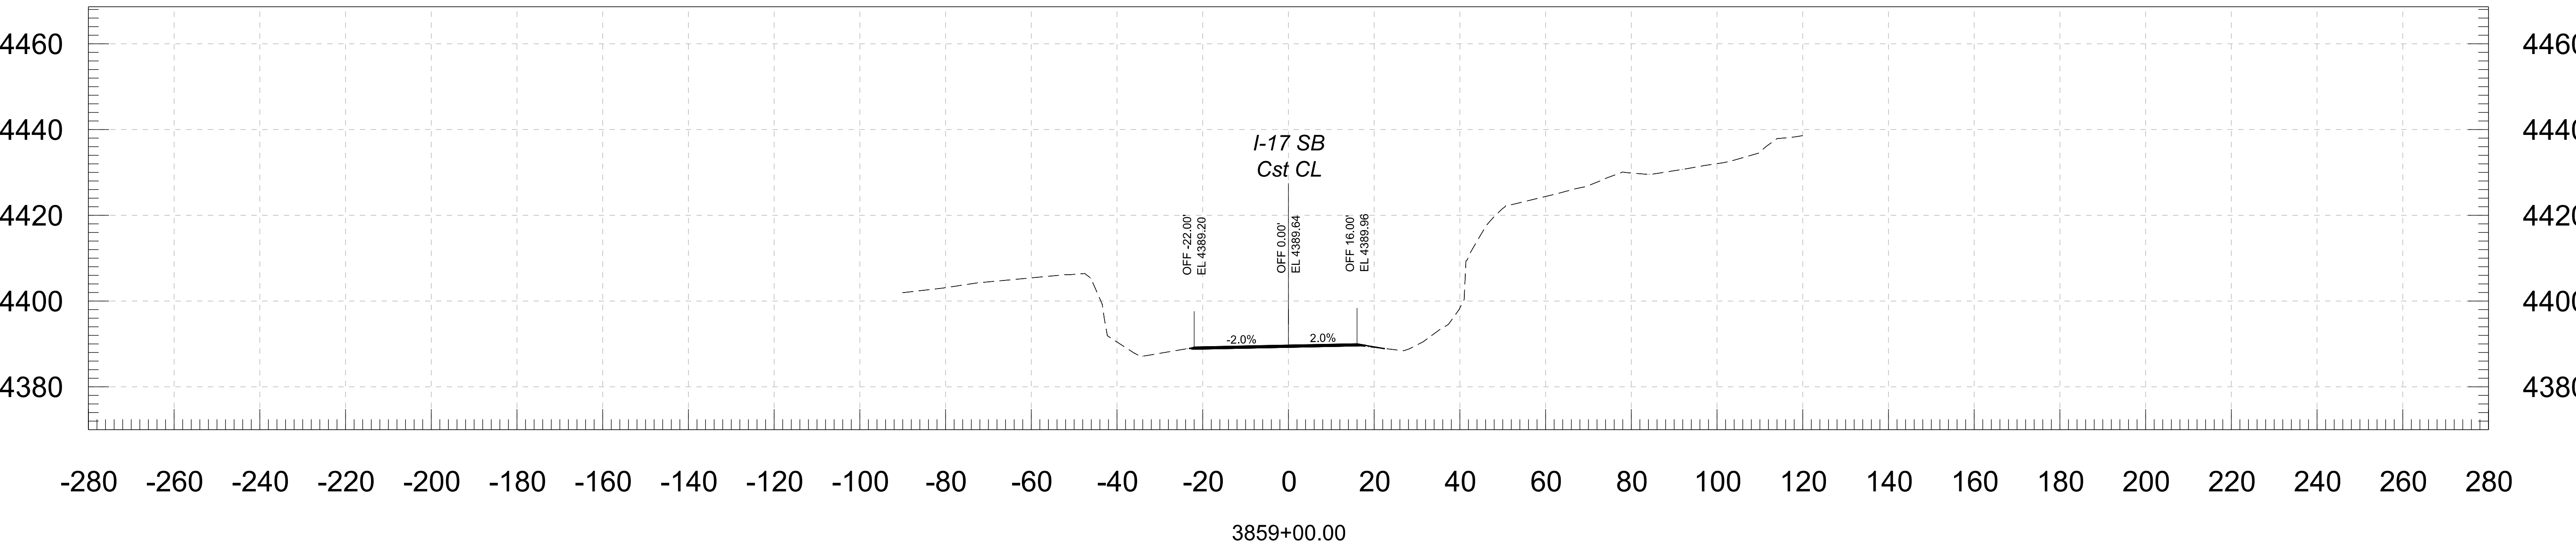
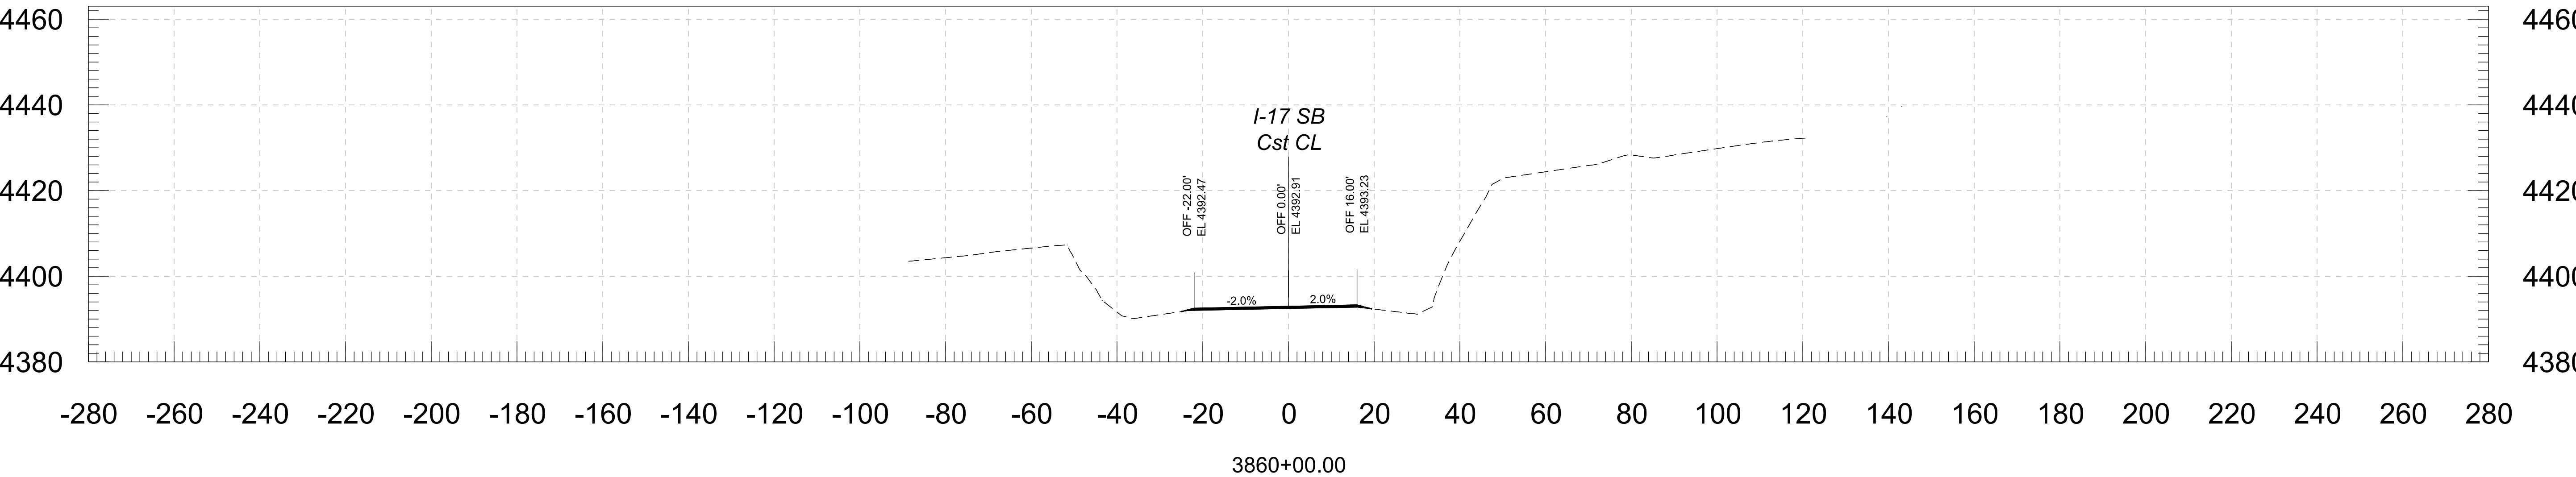


 
				NAME	DATE	ARIZONA DEPARTMENT OF TRANSPORTATION PROJECT DELIVERY AND OPERATIONS DIVISION ROADWAY DESIGN SERVICES	ROUTE	F.H.W.A. Arizona Division	STATE ARIZ.	PROJECT NO.	FEDERAL ID NO.	SHEET NO.	TOTAL SHEETS	RECORD DRAWING
			DESIGN	BAP	06/26		I-17			017 YV 269	017-B(239)T	113	146	
			DRAWN	RM	06/26									
			CHECKED	KCH	06/26									
			 Stanley Consultants INC.			3133 East Camelback Road, Suite 100 Phoenix, Arizona 85016 Phones 602/333-2000	CROSS SECTION	MILEPOST	LOCATION E DUGAS ROAD - MP 275					
					STRUCTURE NO.	TRACS NO. F0616 01C				____ OF ____				


	NAME	DATE
DESIGN	BAP	06/26
DRAWN	RM	06/26
CHECKED	KCH	06/26
 3133 East Camelback Road, Suite 100 Phoenix, Arizona 85016 Phone: 1602 333-2200		

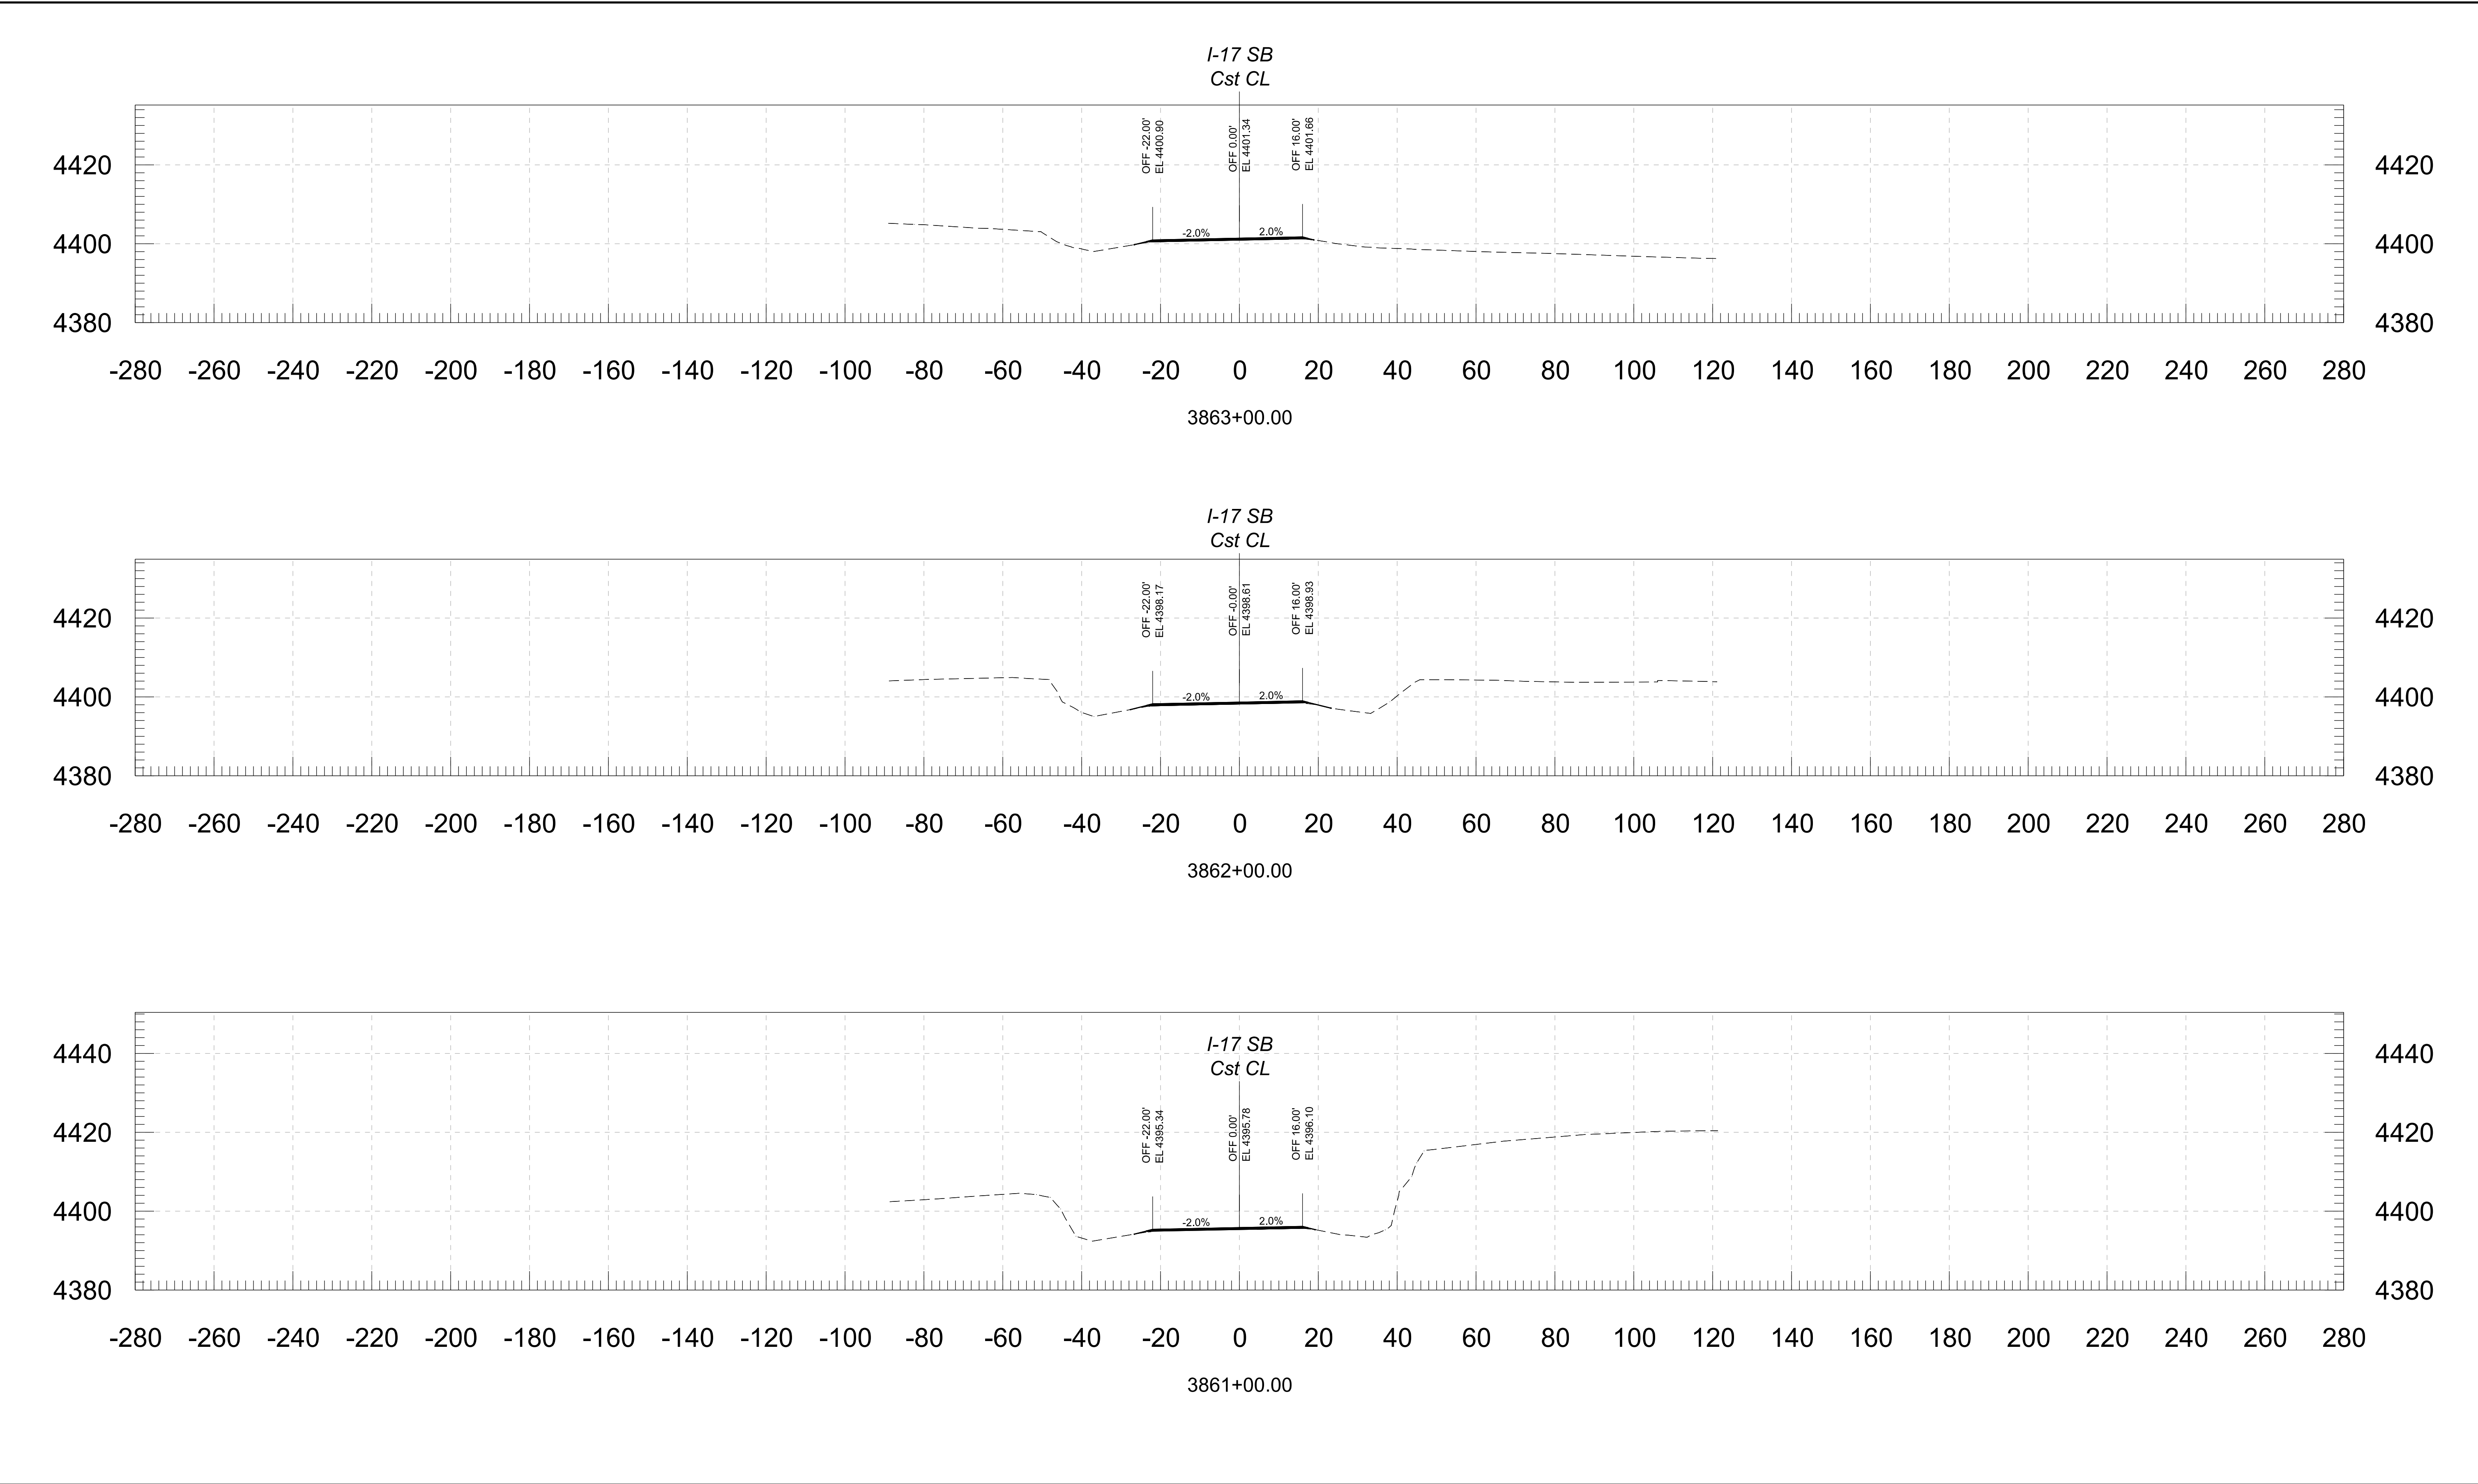




--	--	
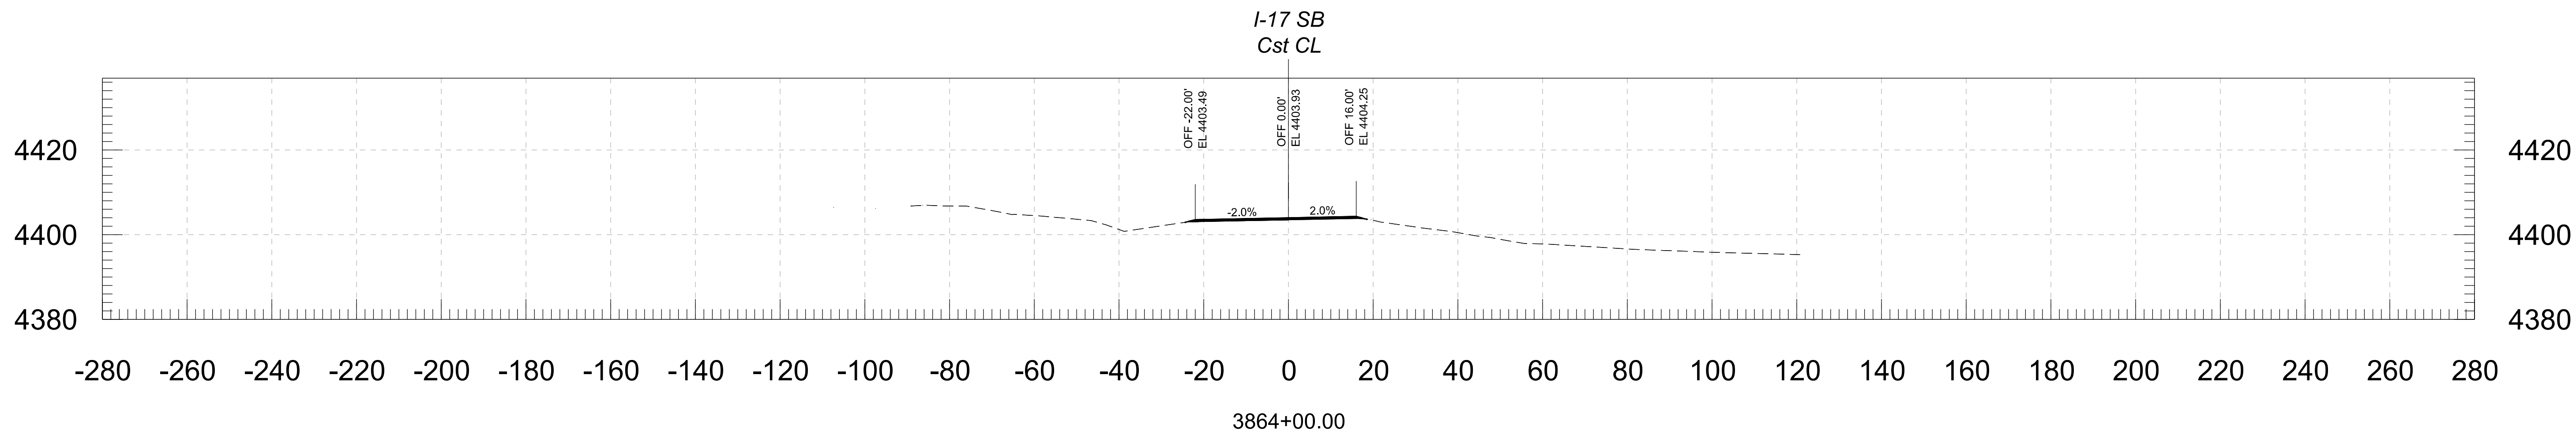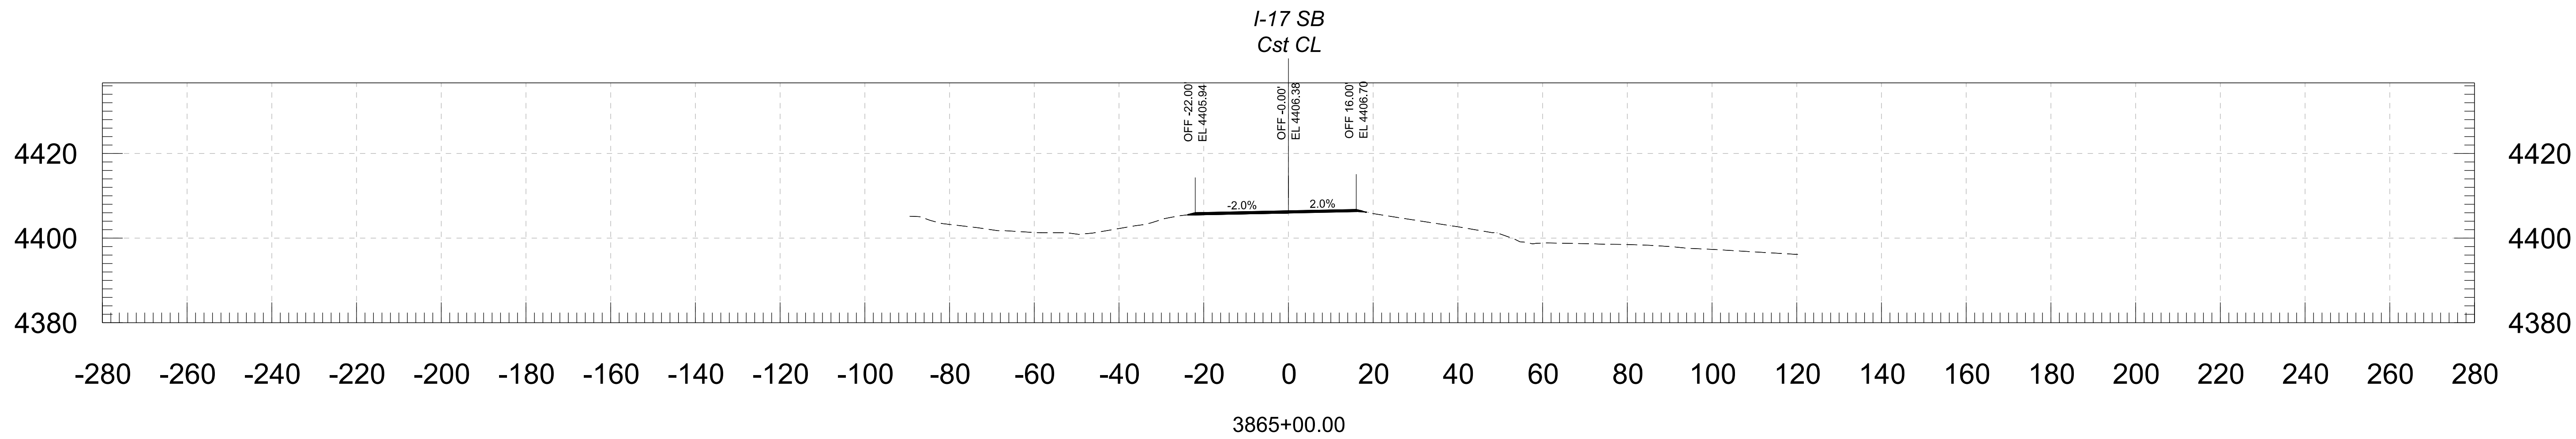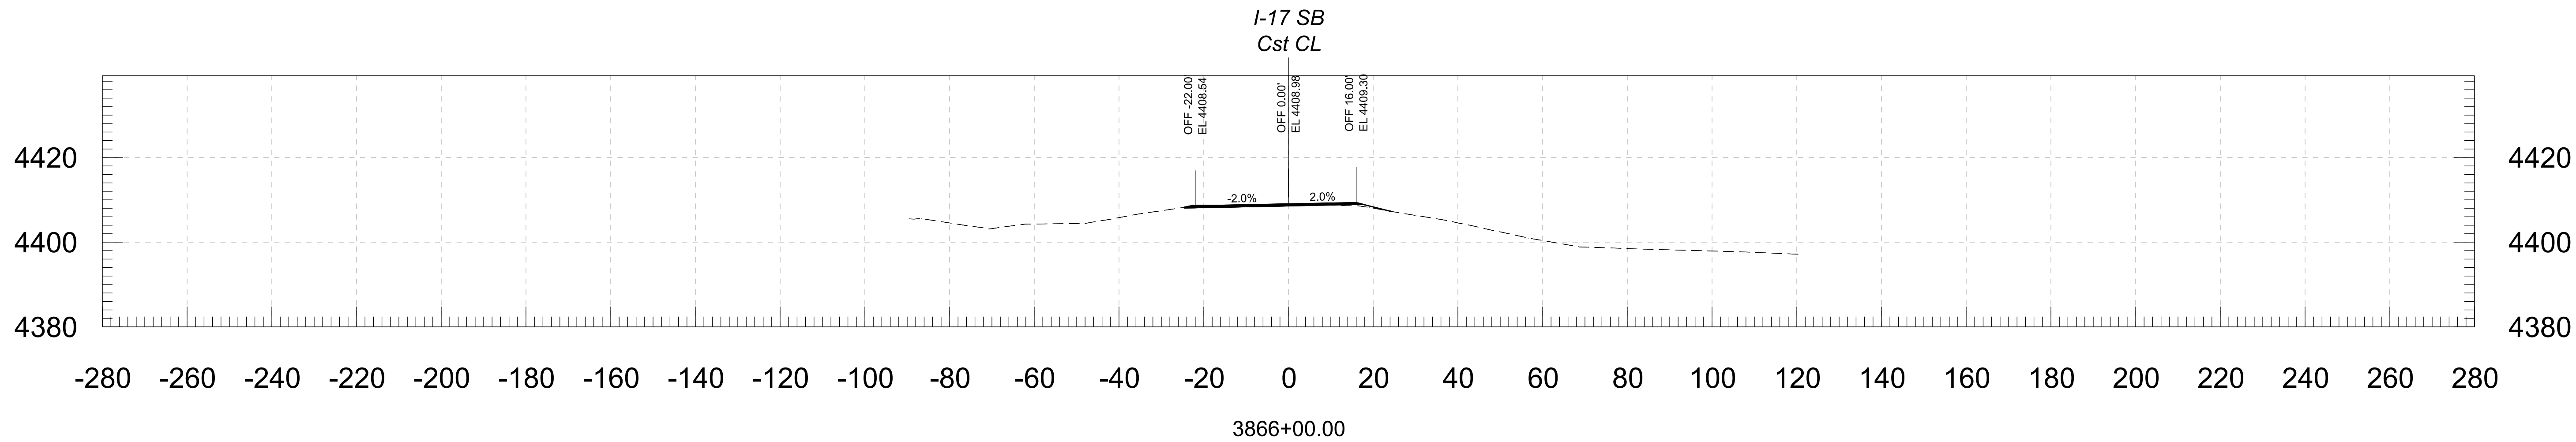




			NAME	DATE	ARIZONA DEPARTMENT OF TRANSPORTATION PROJECT DELIVERY AND OPERATIONS DIVISION ROADWAY DESIGN SERVICES	ROUTE I-17	F.H.W.A. Arizona Division	STATE ARIZ.	PROJECT NO.	FEDERAL ID NO.	SHEET NO.	TOTAL SHEETS	RECORD DRAWING
		DESIGN	BAP	06/26									
		DRAWN	RM	06/26			017 YV 269	017-B(239)T	115	146			
		CHECKED	KCH	06/26									
				 333 East Camelback Road, Suite 100 Phoenix, Arizona 85016 Phone: 602) 333-2200 Stanley Consultants INC.			CROSS SECTION		E DUGAS ROAD - MP 275				DWG NO.
						TRACS NO. F0616 01C	OF						

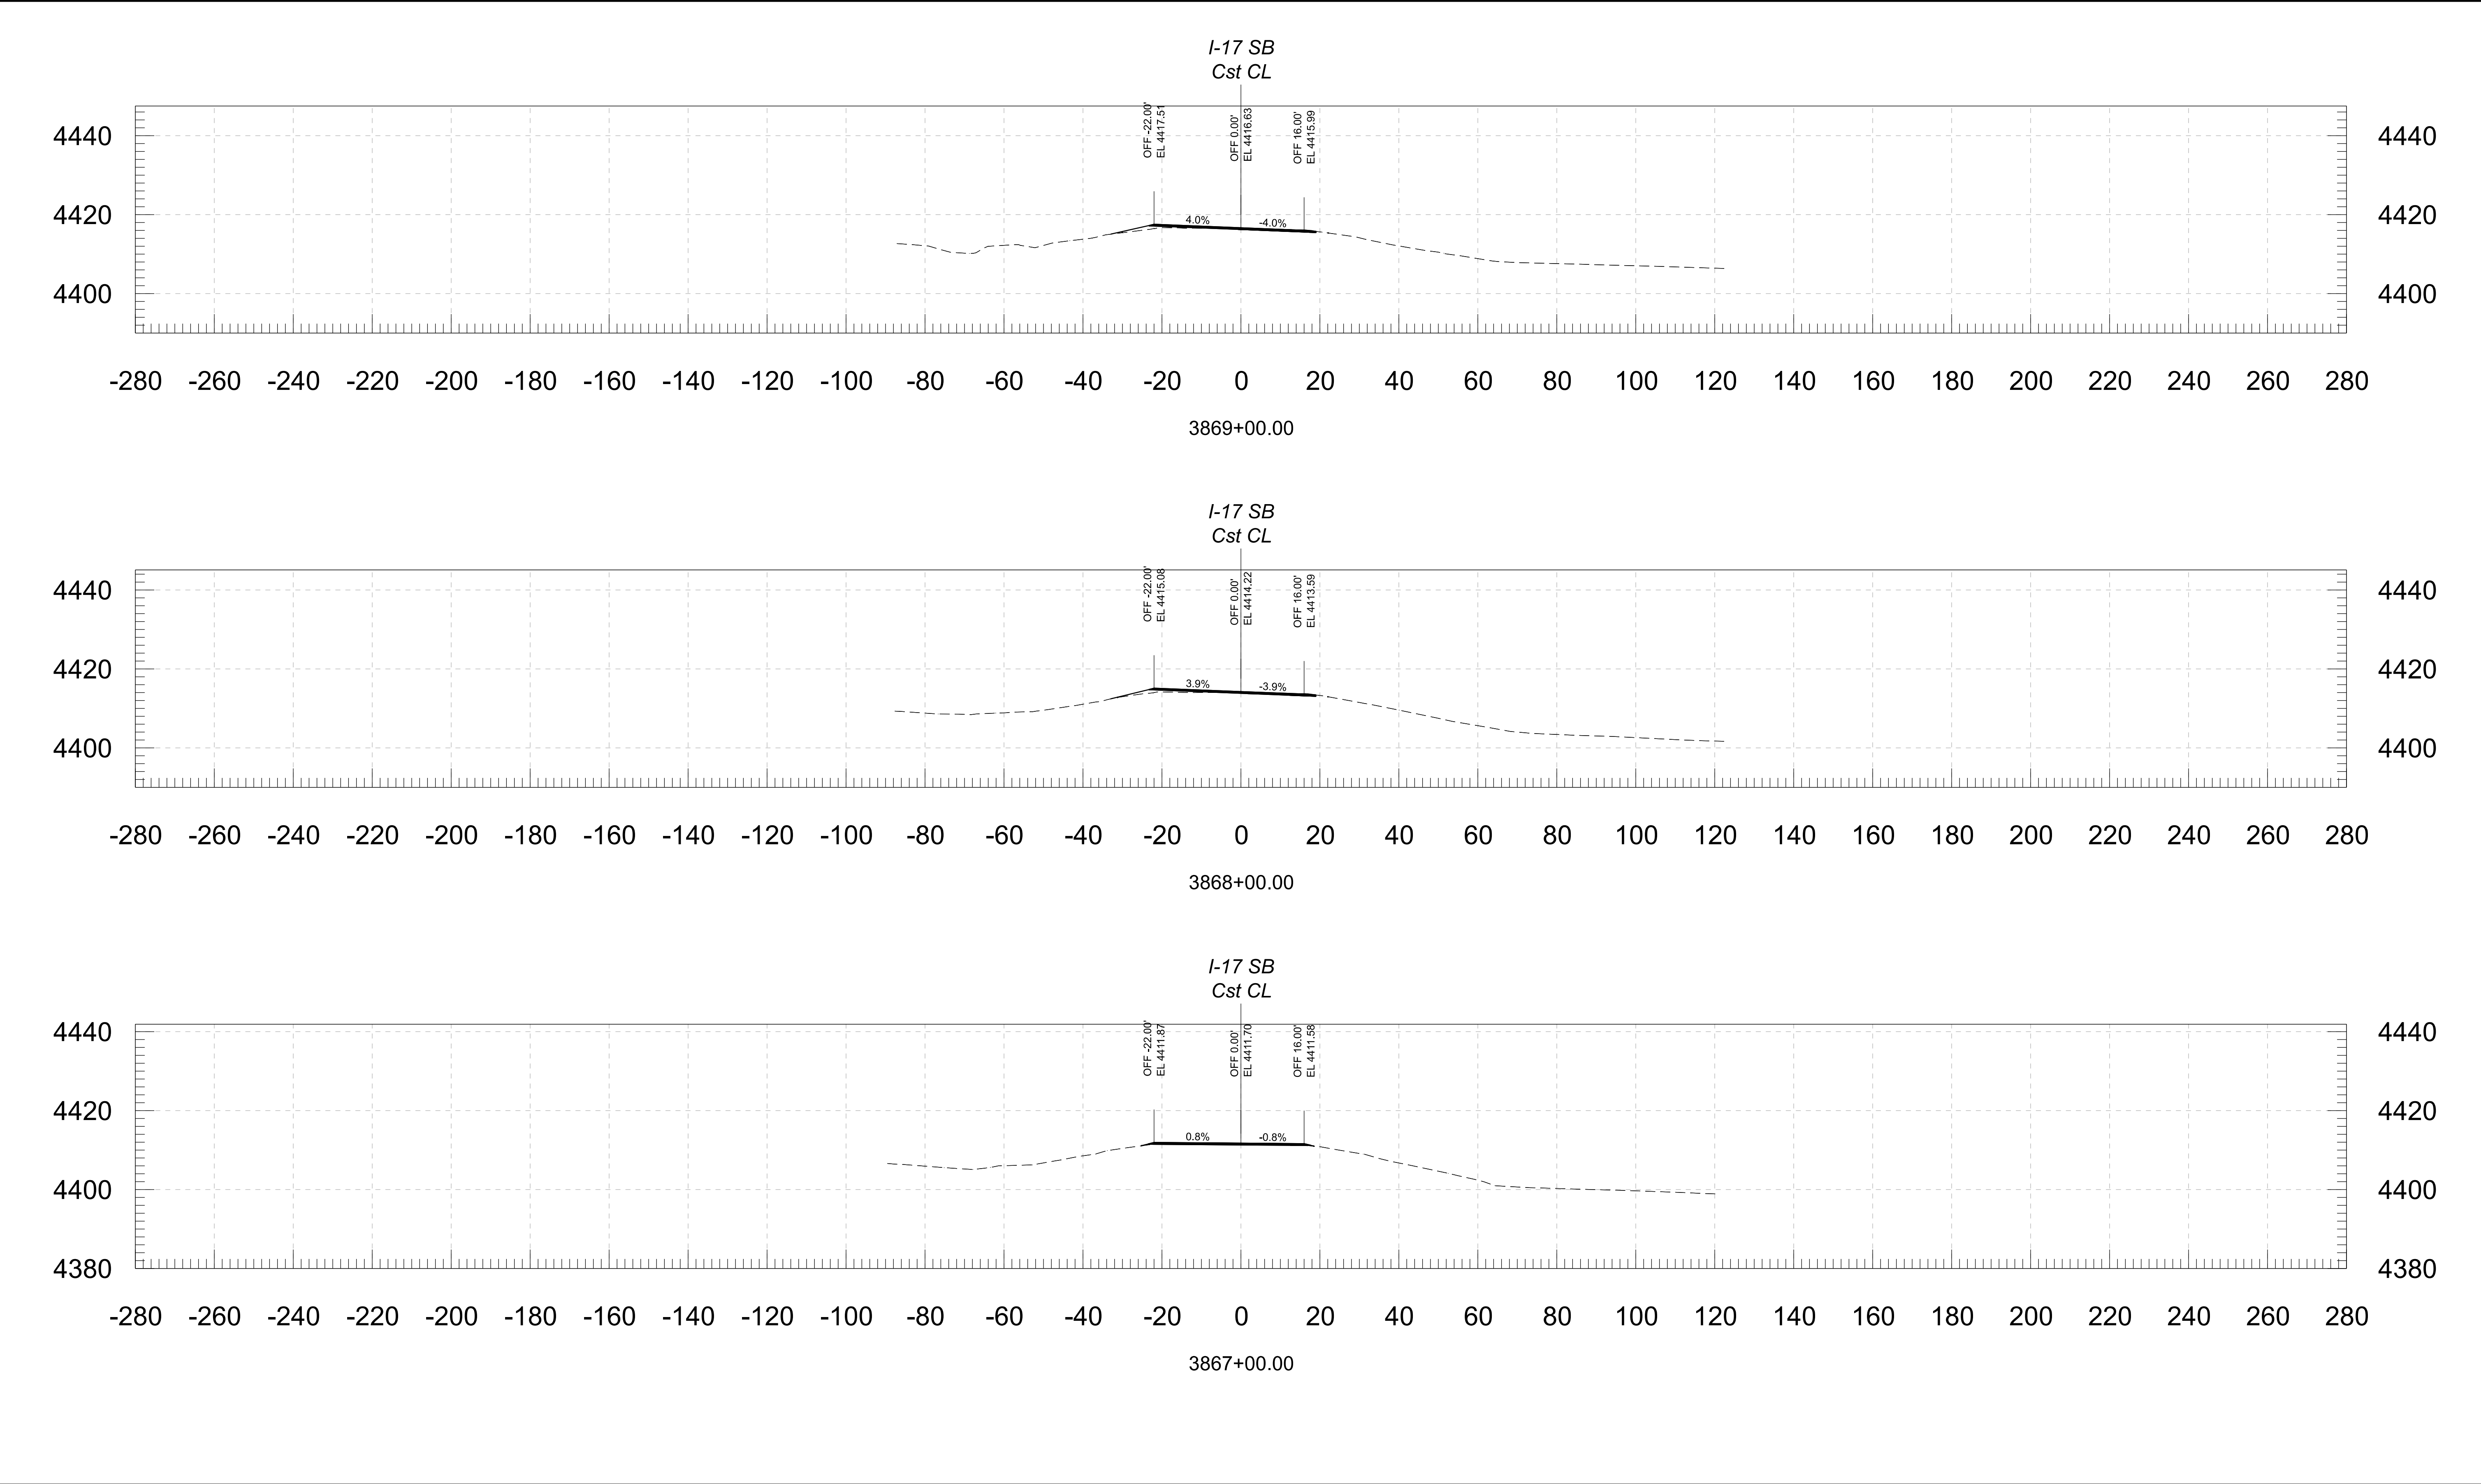 





				NAME	DATE	ARIZONA DEPARTMENT OF TRANSPORTATION PROJECT DELIVERY AND OPERATIONS DIVISION ROADWAY DESIGN SERVICES	ROUTE	F.H.W.A. Arizona Division	STATE ARIZ.	PROJECT NO.	FEDERAL ID NO.	SHEET NO.	TOTAL SHEETS	RECORD DRAWING
			DESIGN	BAP	06/26		I-17			017 YV 269	017-B(239)T	116	146	
			DRAWN	RM	06/26			MILEPOST	E DUGAS ROAD - MP 275				DWG NO.	
			CHECKED	KCH	06/26				STRUCTURE NO.	TRACS NO. F0616 01C				____ OF ____
			 3133 East Camelback Road, Suite 100 Phoenix, Arizona 85016 Phone: (602) 333-2200 Stanley Consultants INC.			CROSS SECTION								

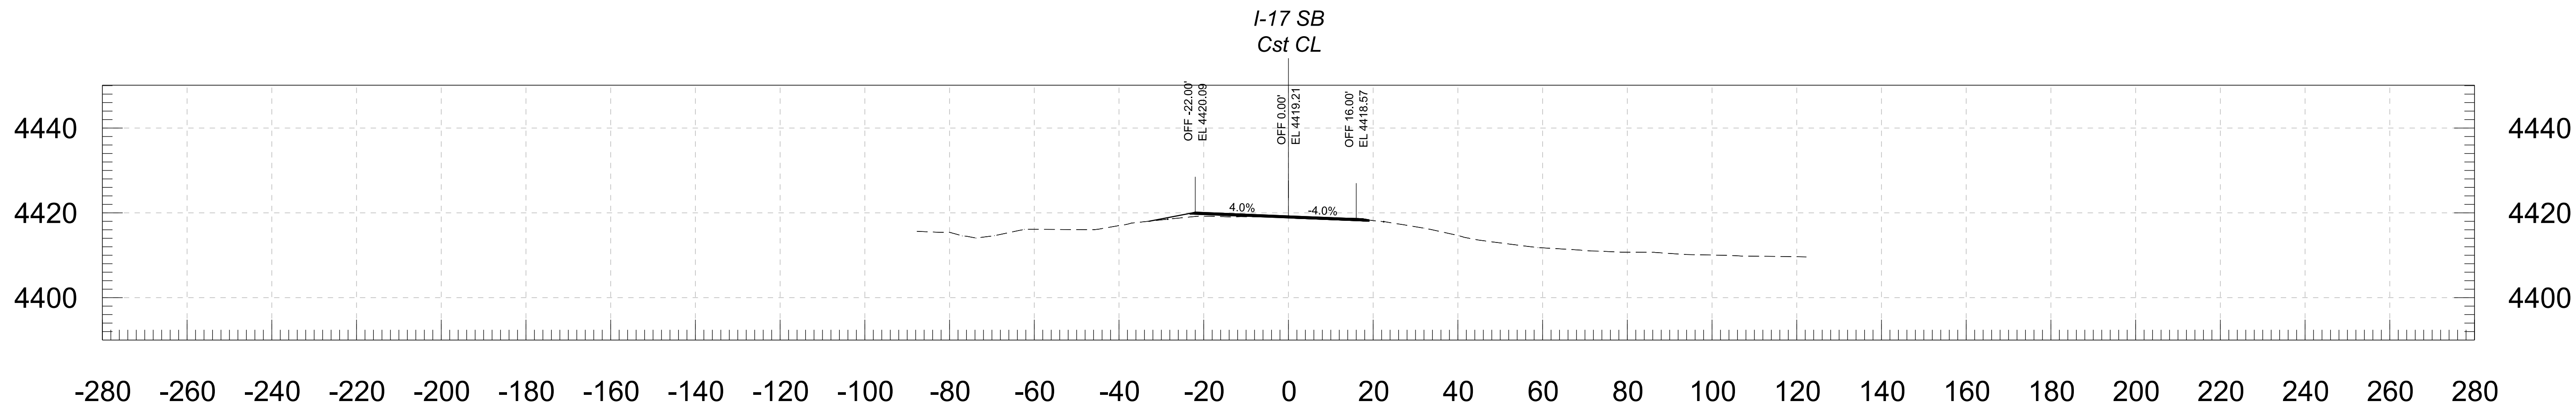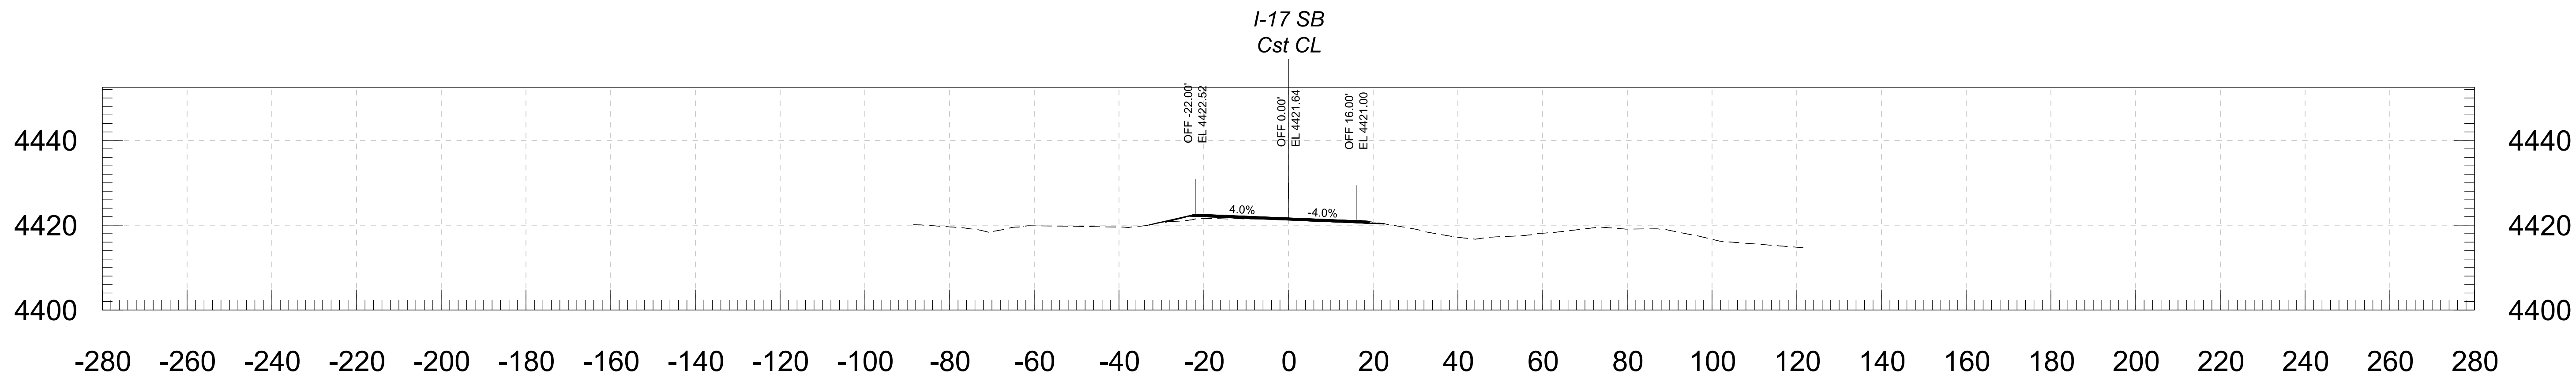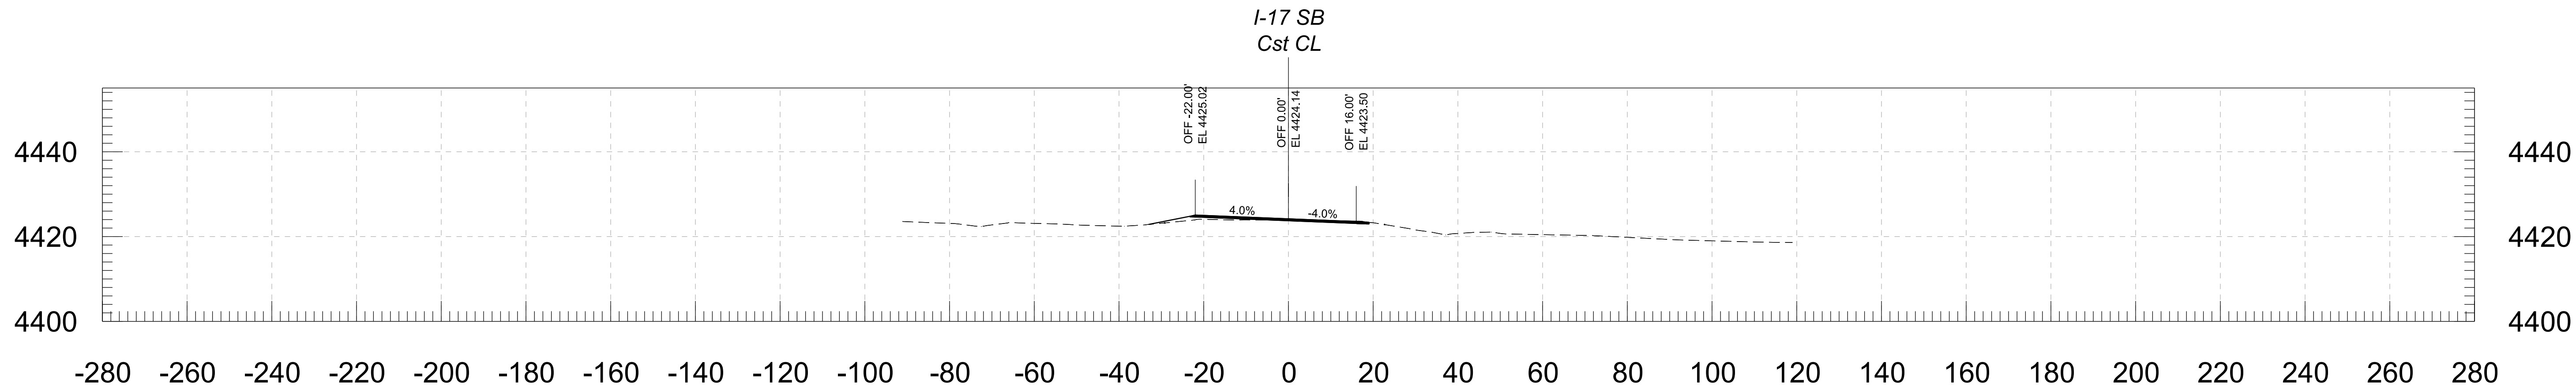 





			NAME	DATE	ARIZONA DEPARTMENT OF TRANSPORTATION PROJECT DELIVERY AND OPERATIONS DIVISION ROADWAY DESIGN SERVICES	ROUTE	F.H.W.A. Arizona Division	STATE	PROJECT NO.	FEDERAL ID NO.	SHEET NO.	TOTAL SHEETS	RECORD DRAWING		
		DESIGN	BAP	06/26		I-17			017 YV 269	017-B(239)T	117	146			
		DRAWN	RM	06/26			MILEPOST	E DUGAS ROAD - MP 275						DWG NO.	
		CHECKED	KCH	06/26											STRUCTURE NO.
 3133 East Camelback Road, Suite 100 Phoenix, Arizona 85016 Phone: 602. 333-2000 Stanley Consultants INC.					CROSS SECTION										

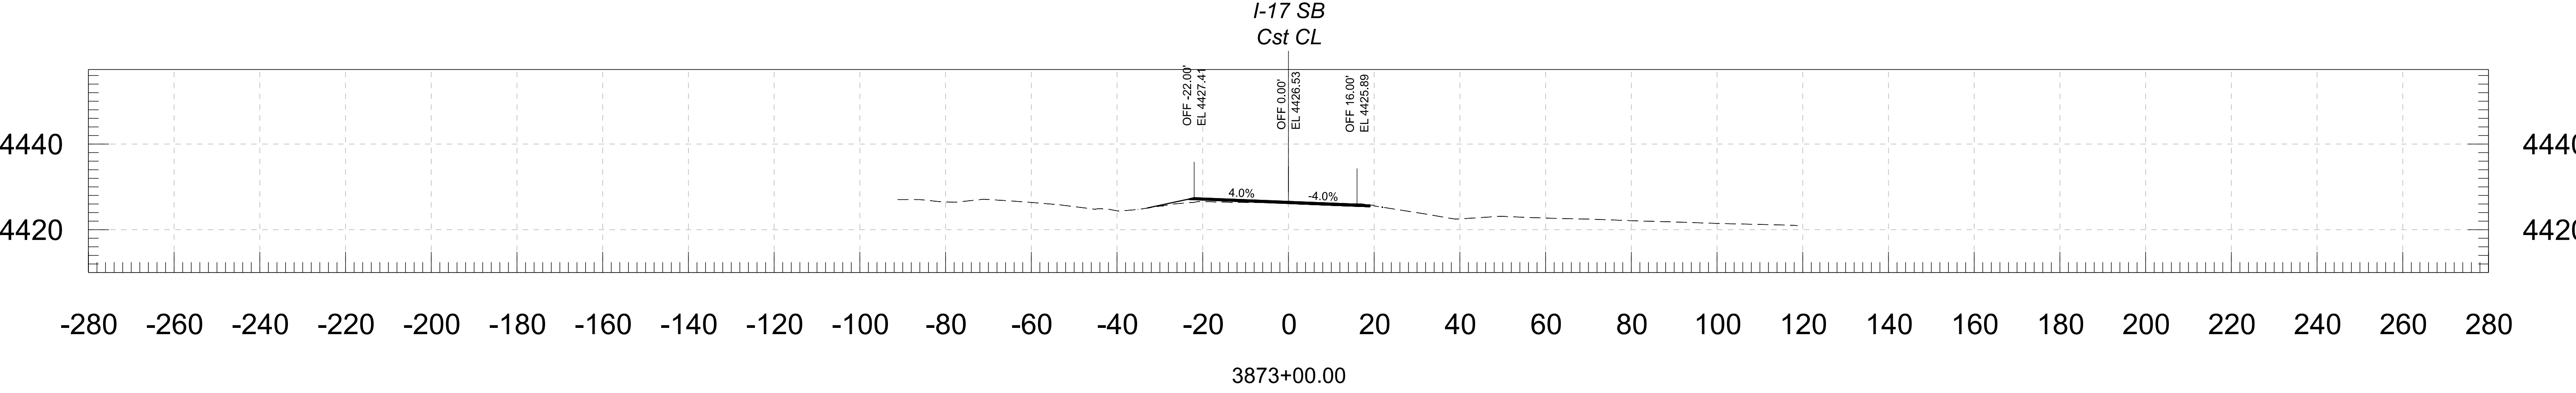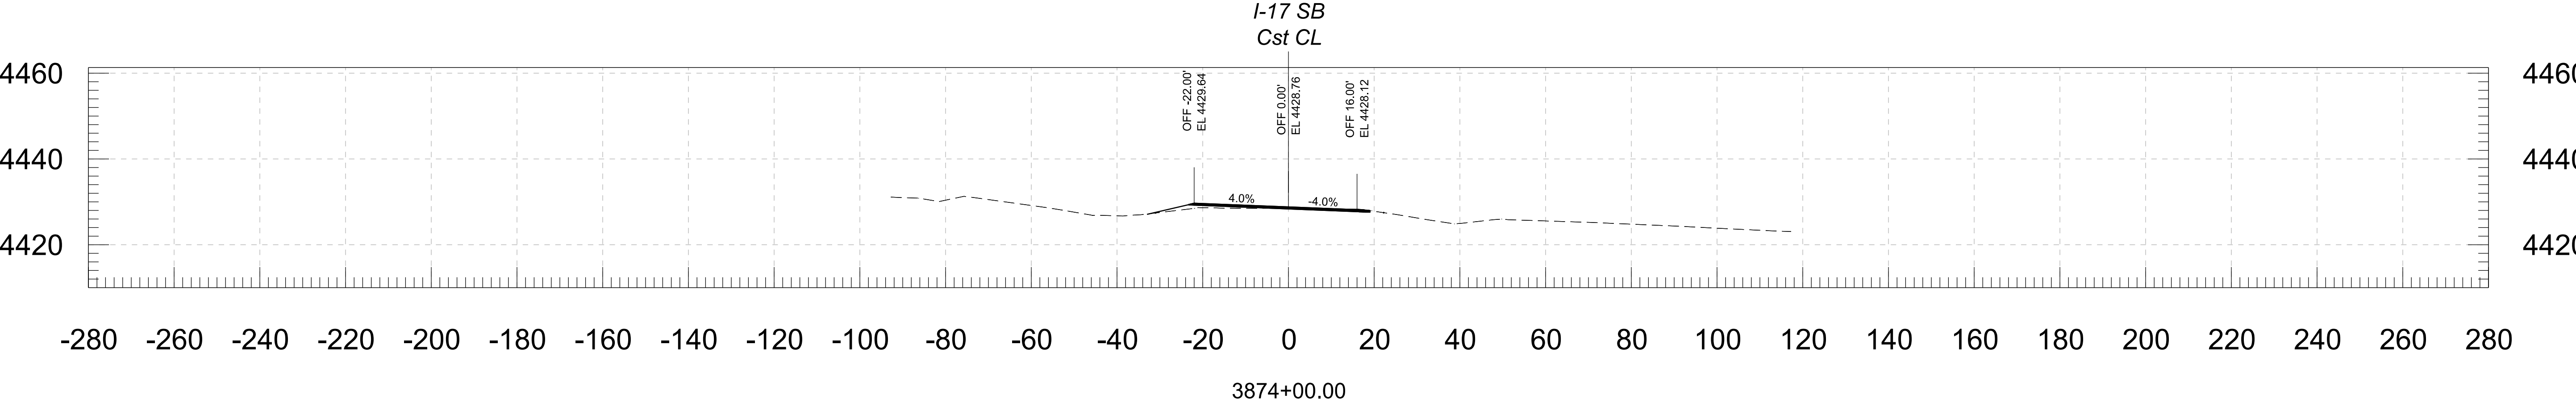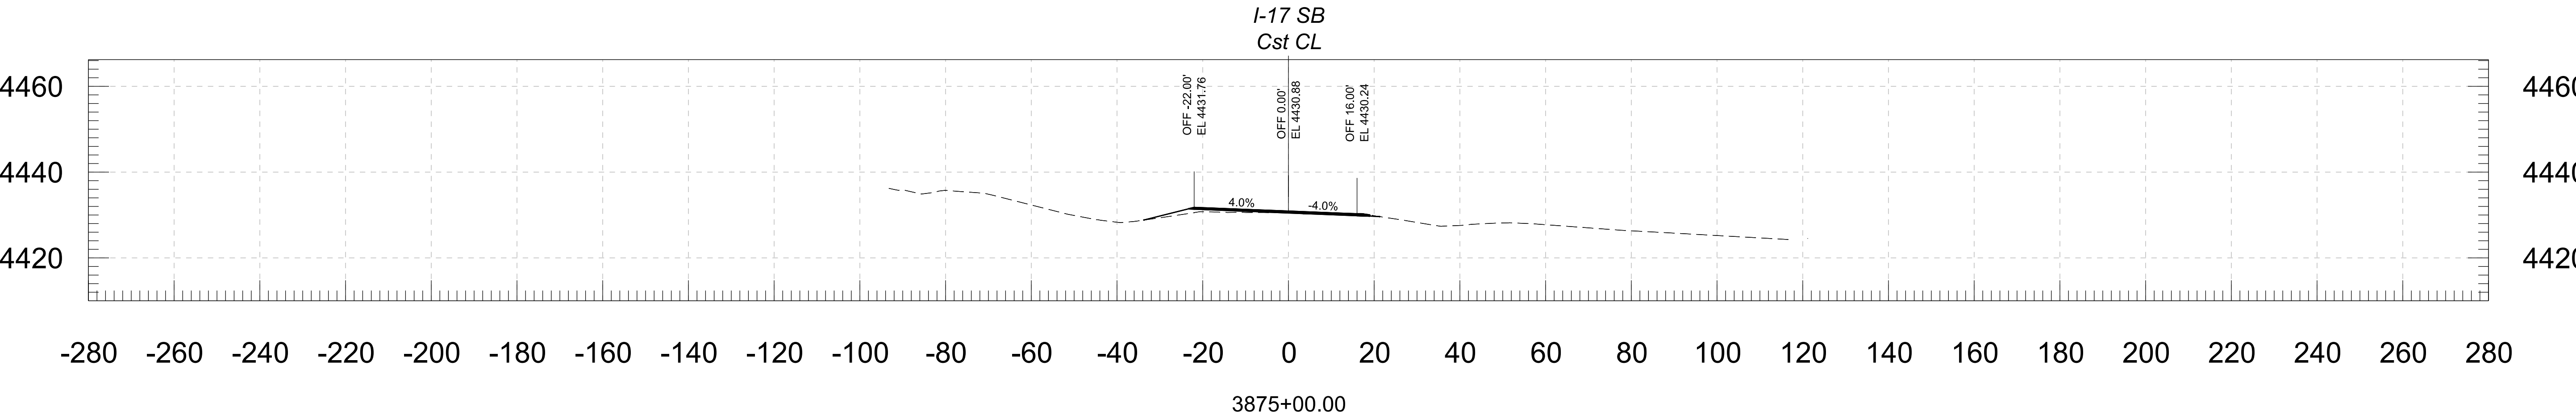




			NAME	DATE	ARIZONA DEPARTMENT OF TRANSPORTATION PROJECT DELIVERY AND OPERATIONS DIVISION ROADWAY DESIGN SERVICES	ROUTE	F.H.W.A. Arizona Division	STATE ARIZ.	PROJECT NO.	FEDERAL ID NO.	SHEET NO.	TOTAL SHEETS	RECORD DRAWING	
		DESIGN	BAP	06/26		I-17			017 YV 269	017-B(239)T	118	146		
		DRAWN	RM	06/26			MILEPOST	LOCATION E DUGAS ROAD - MP 275						DWG NO.
		CHECKED	KCH	06/26				STRUCTURE NO.	TRACS NO. F0616 01C					
		 Stanley Consultants INC.			333 East Camelback Road, Suite 100 Phoenix, Arizona 85016 Phone: 602 333-2200		CROSS SECTION		____ OF ____					

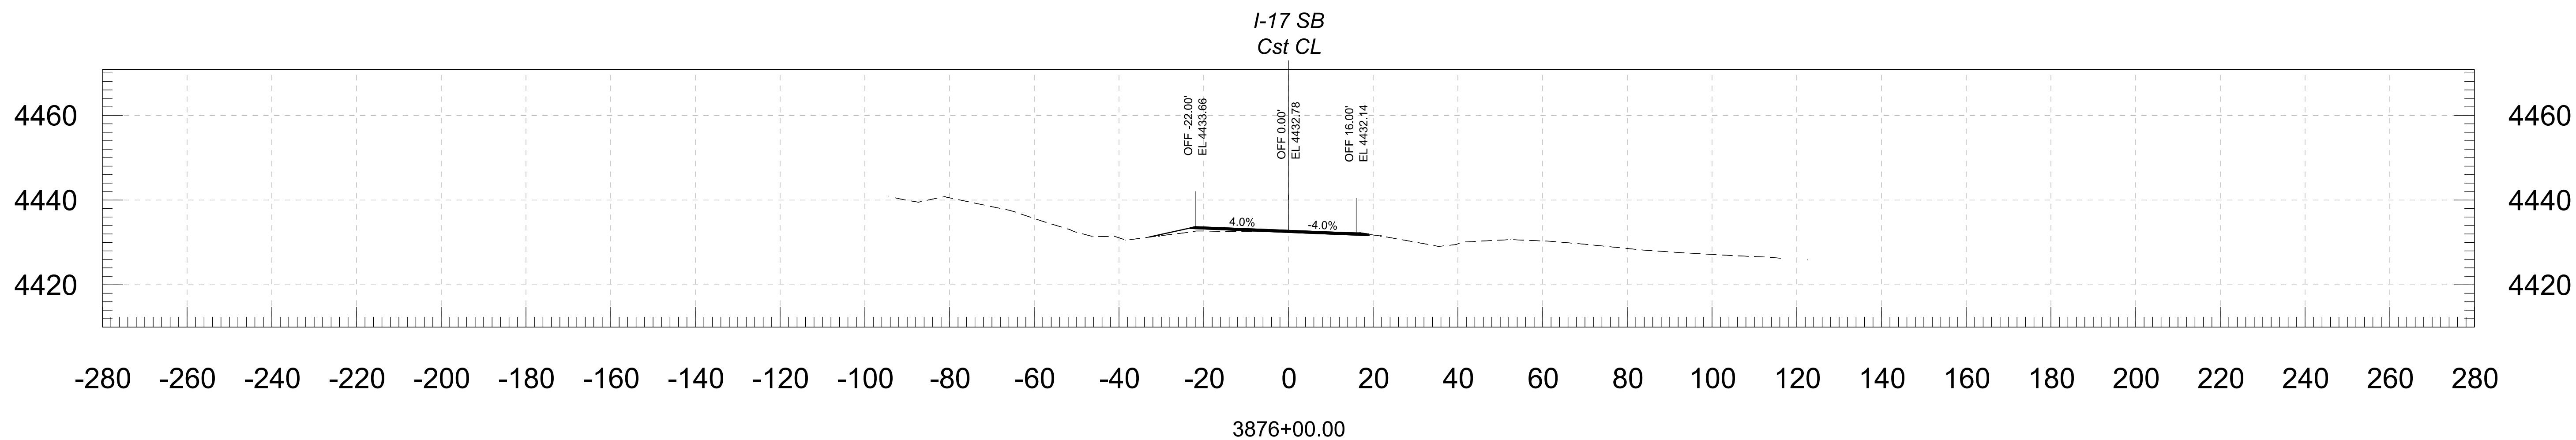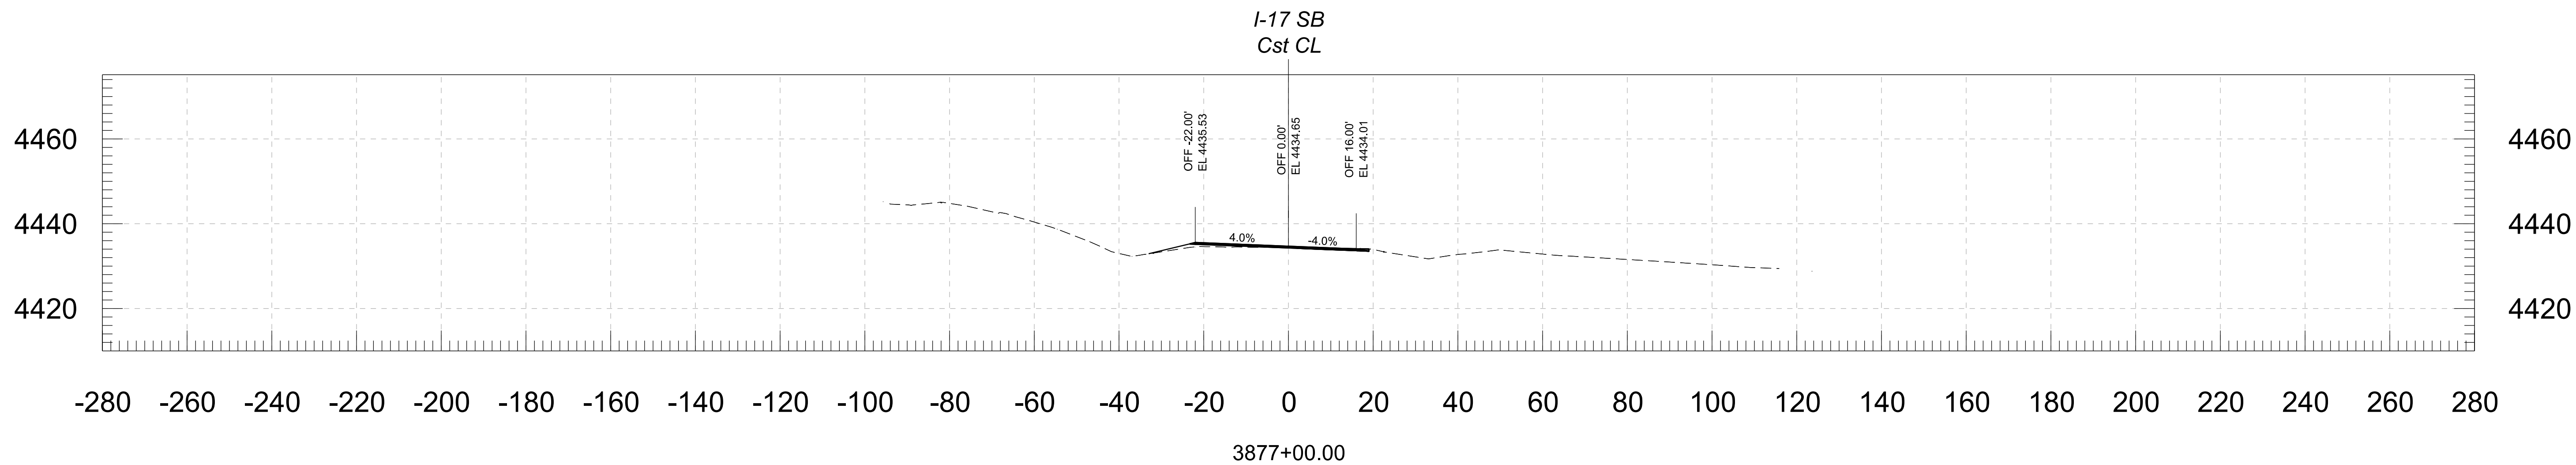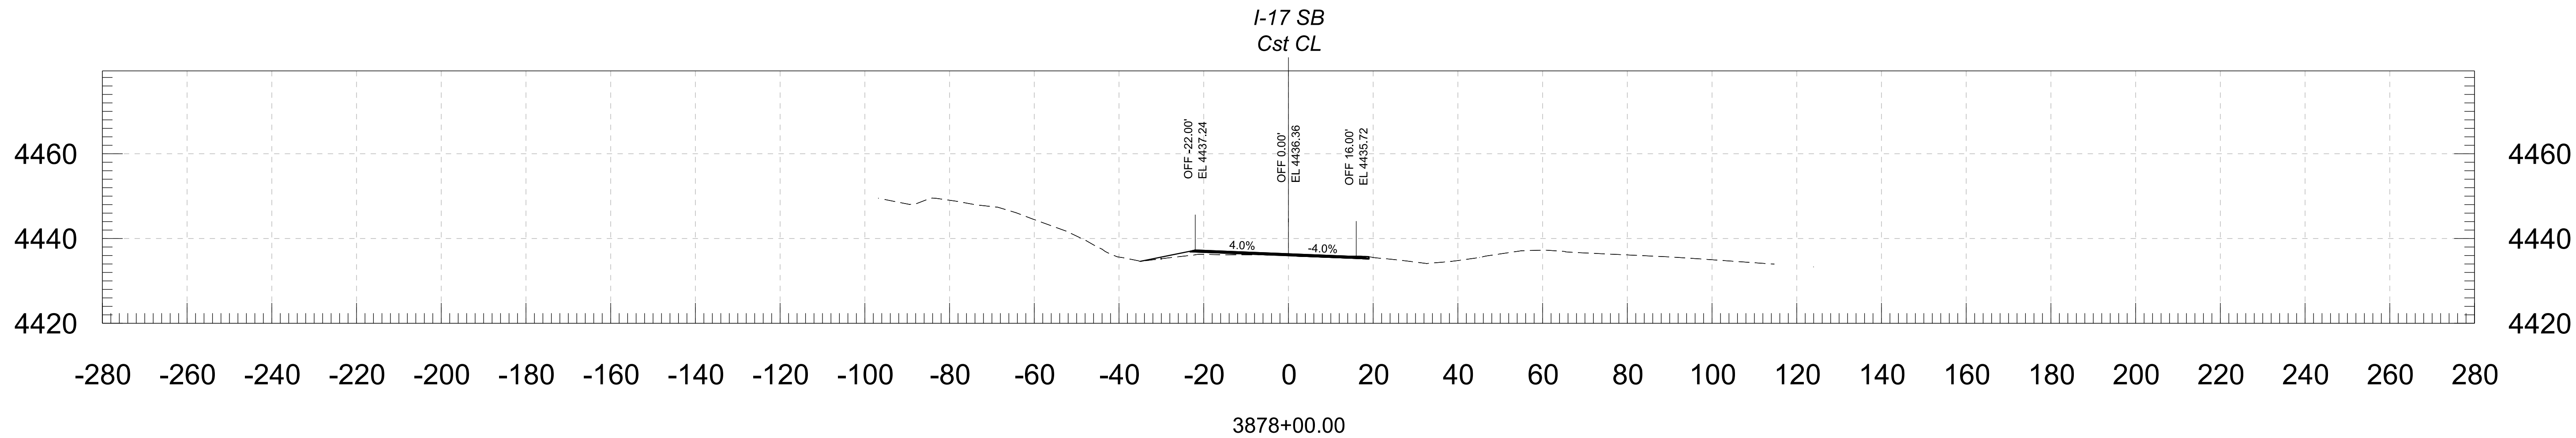


			NAME	DATE	ARIZONA DEPARTMENT OF TRANSPORTATION PROJECT DELIVERY AND OPERATIONS DIVISION ROADWAY DESIGN SERVICES	ROUTE	F.H.W.A. Arizona Division	STATE	PROJECT NO.	FEDERAL ID NO.	SHEET NO.	TOTAL SHEETS	RECORD DRAWING	
		DESIGN	BAP	06/26		I-17			017 YV 269	017-B(239)T	119	146		
		DRAWN	RM	06/26			MILEPOST	LOCATION						DWG NO.
		CHECKED	KCH	06/26				E DUGAS ROAD - MP 275						
		 Stanley Consultants INC.			333 East Camelback Road, Suite 100 Phoenix, Arizona 85016 Phone: 602) 333-2200			CROSS SECTION	TRACS NO. F0616 01C		OF			

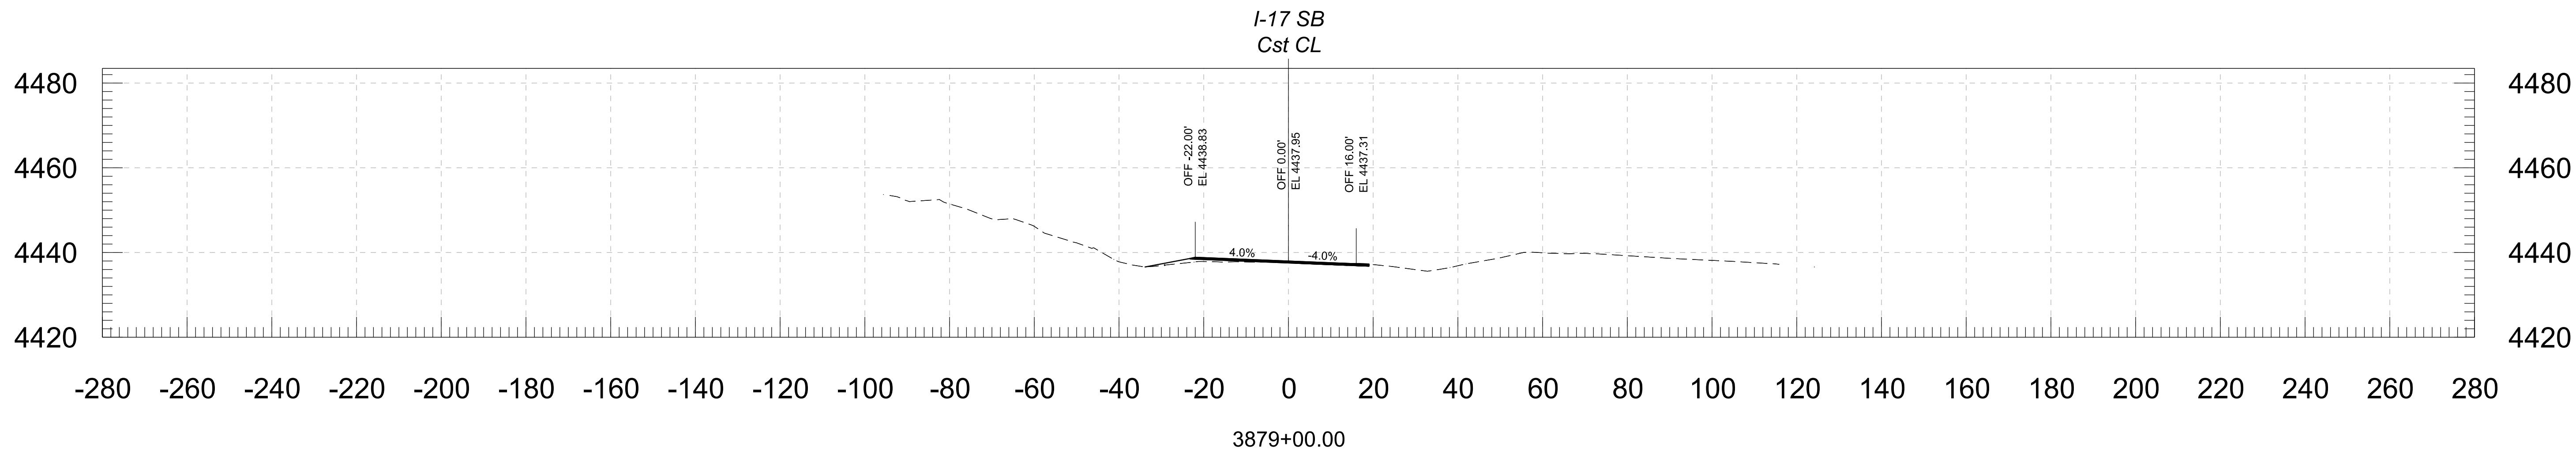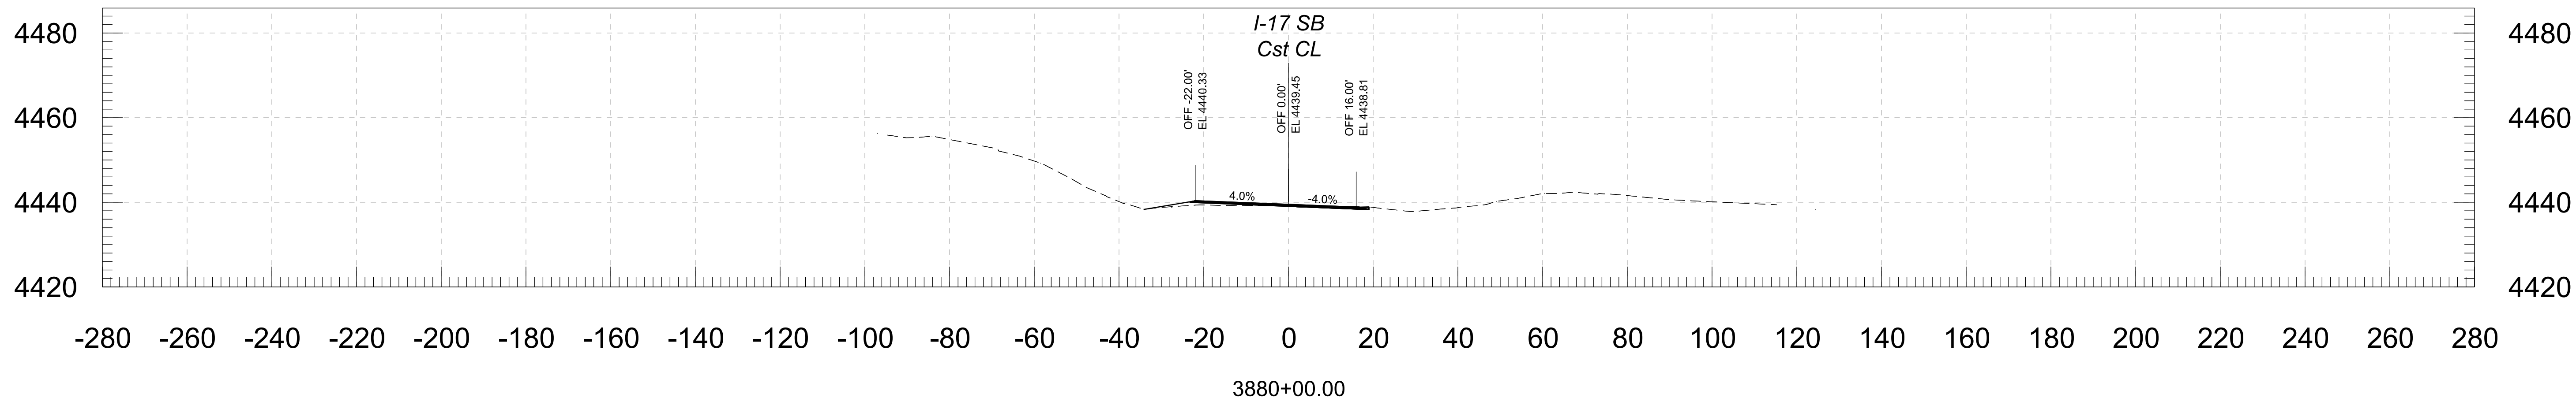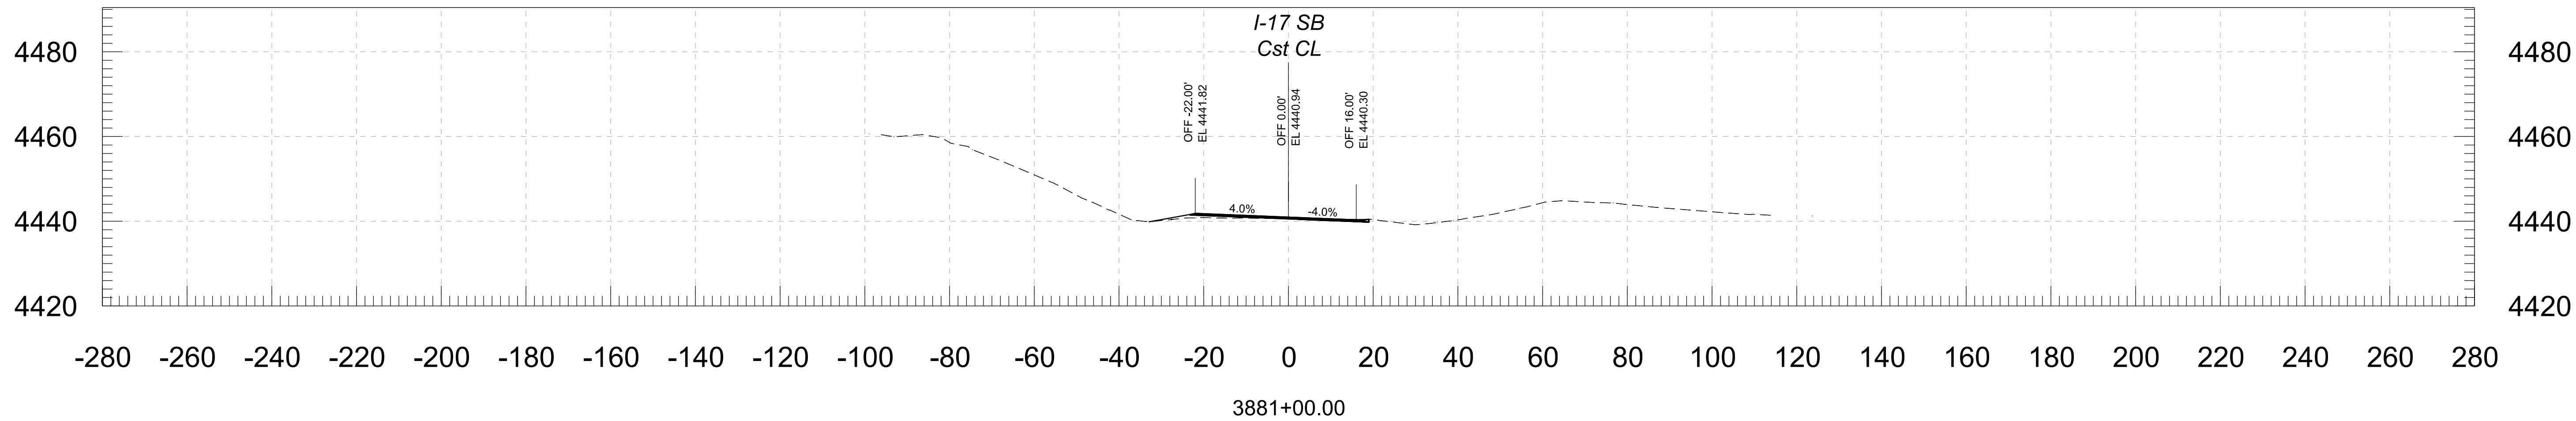


			NAME	DATE	ARIZONA DEPARTMENT OF TRANSPORTATION PROJECT DELIVERY AND OPERATIONS DIVISION ROADWAY DESIGN SERVICES	ROUTE	F.H.W.A. Arizona Division	STATE	PROJECT NO.	FEDERAL ID NO.	SHEET NO.	TOTAL SHEETS	RECORD DRAWING
		DESIGN	BAP	06/26		I-17							
		DRAWN	RM	06/26		MILEPOST	E DUGAS ROAD - MP 275	DWG NO.					
		CHECKED	KCH	06/26									
		 333 East Camelback Road, Suite 100 Phoenix, Arizona 85016 Phone: 602) 333-2200 Stanley Consultants INC.			CROSS SECTION	STRUCTURE NO.			TRACS NO.	F0616 01C	OF		

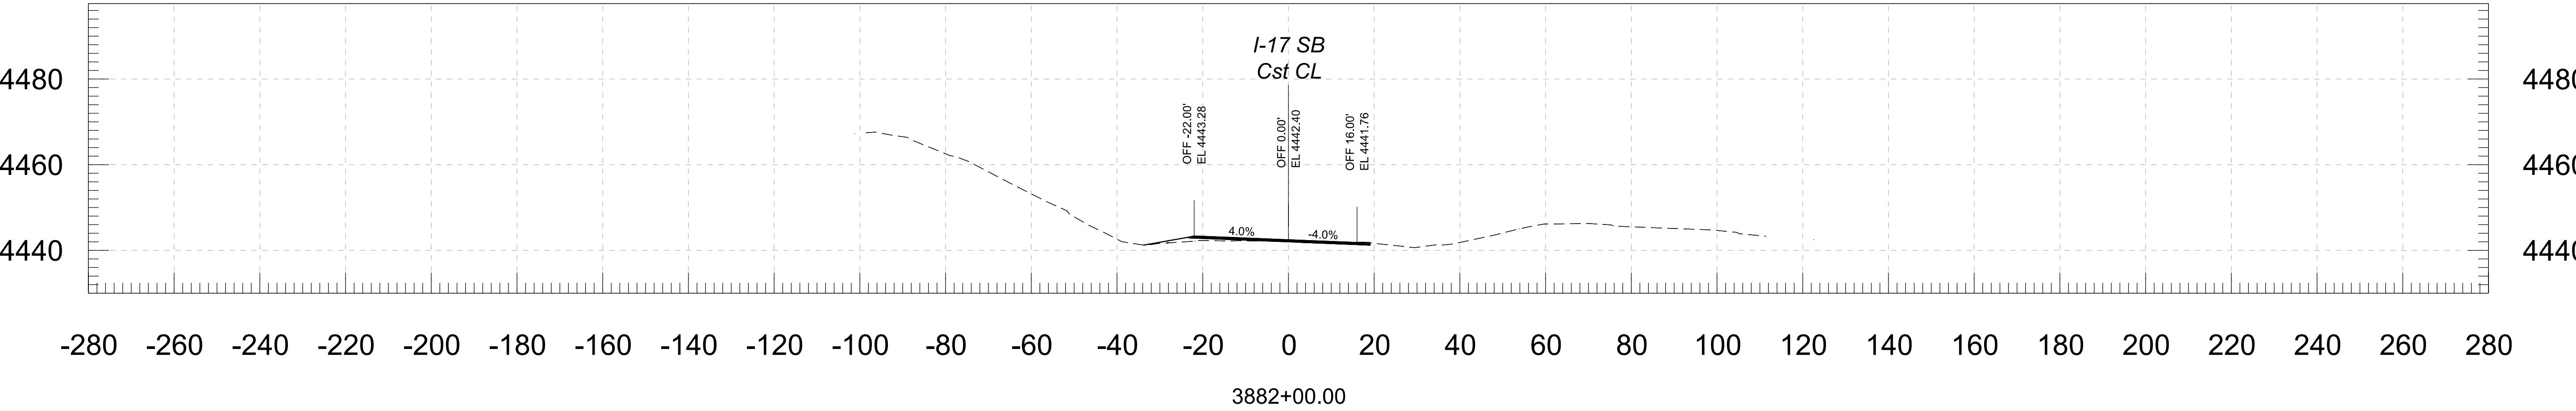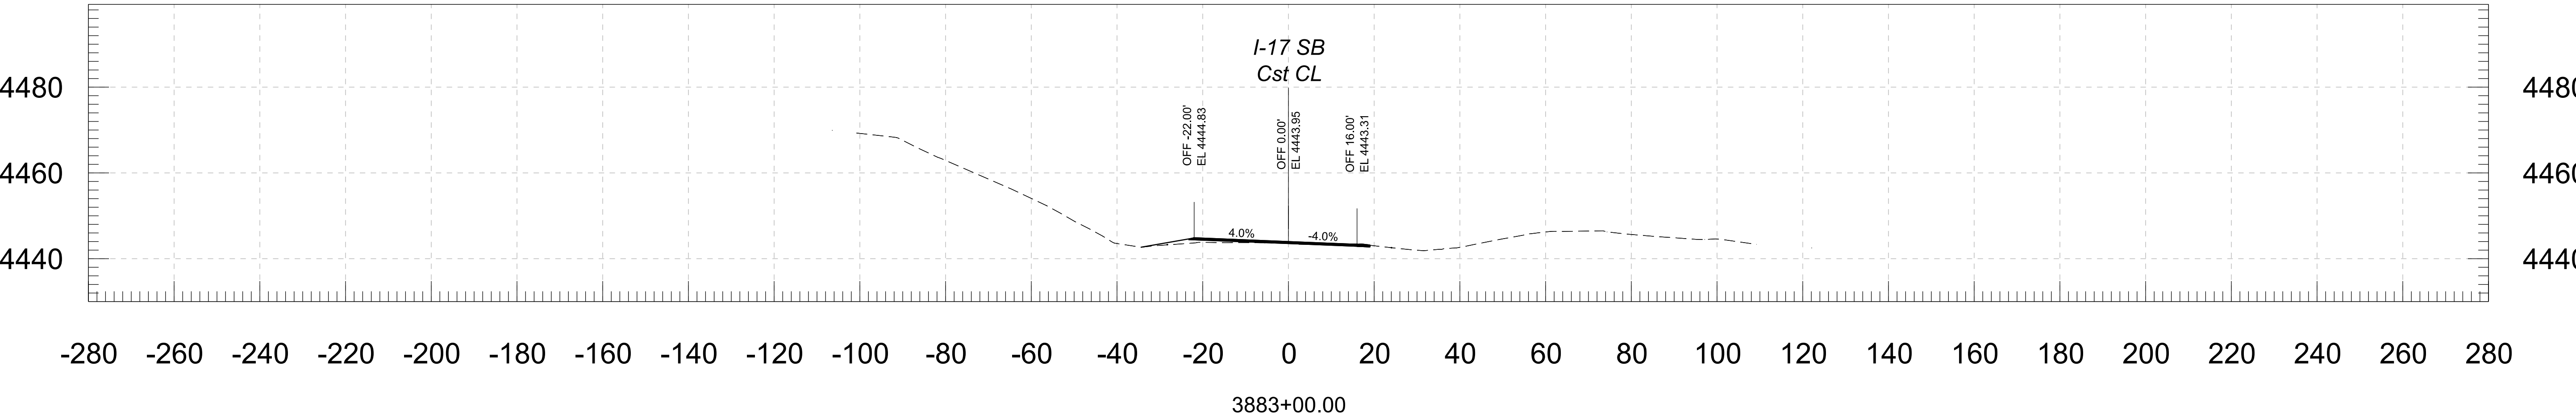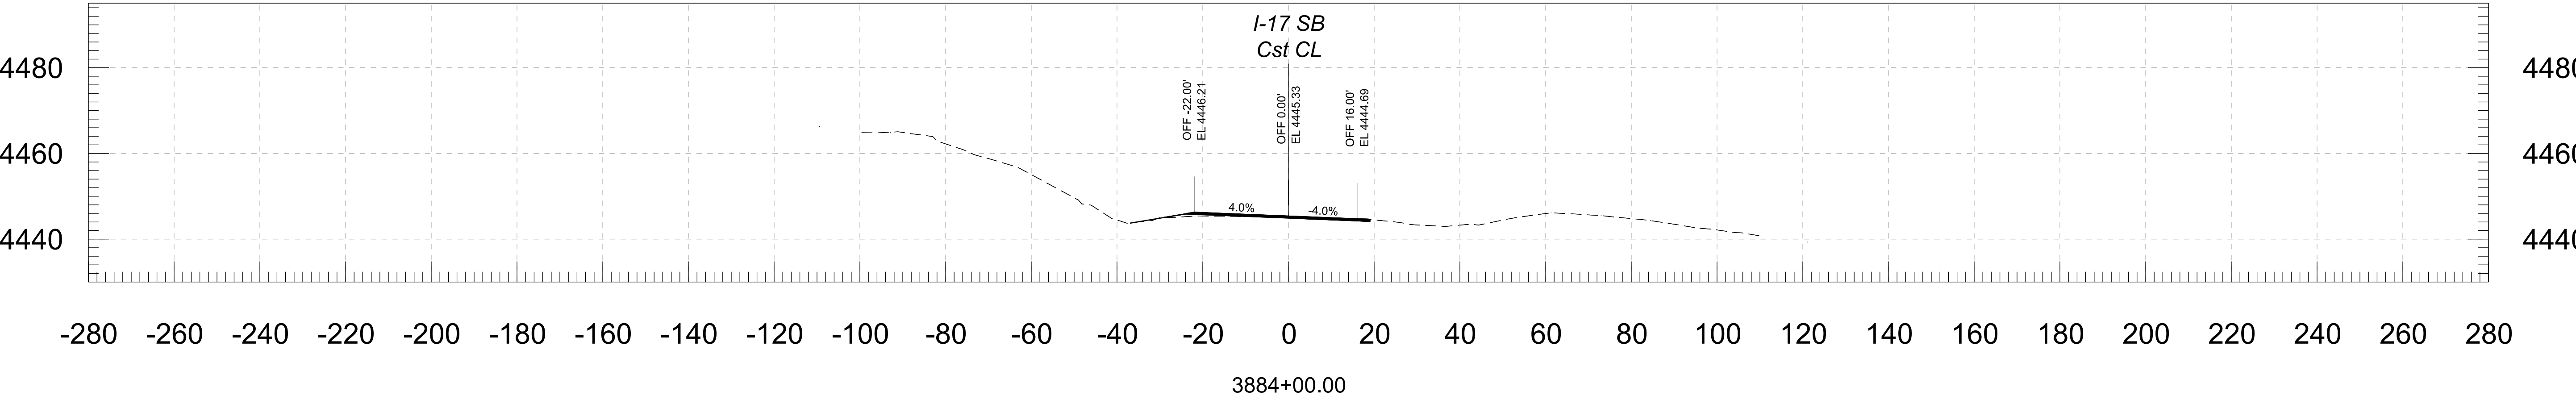


			NAME	DATE	ARIZONA DEPARTMENT OF TRANSPORTATION PROJECT DELIVERY AND OPERATIONS DIVISION ROADWAY DESIGN SERVICES	ROUTE	F.H.W.A. Arizona Division	STATE ARIZ.	PROJECT NO.	FEDERAL ID NO.	SHEET NO.	TOTAL SHEETS	RECORD DRAWING	
		DESIGN	BAP	06/26		I-17			017 YV 269	017-B(239)T	121	146		
		DRAWN	RM	06/26		MILEPOST	LOCATION E DUGAS ROAD - MP 275 DWG NO.							
		CHECKED	KCH	06/26										
		 Stanley Consultants INC.			3133 East Camelback Road, Suite 100 Phoenix, Arizona 85016 Phone: 602. 333-2200			CROSS SECTION			TRACS NO. F0616 01C			____ OF ____

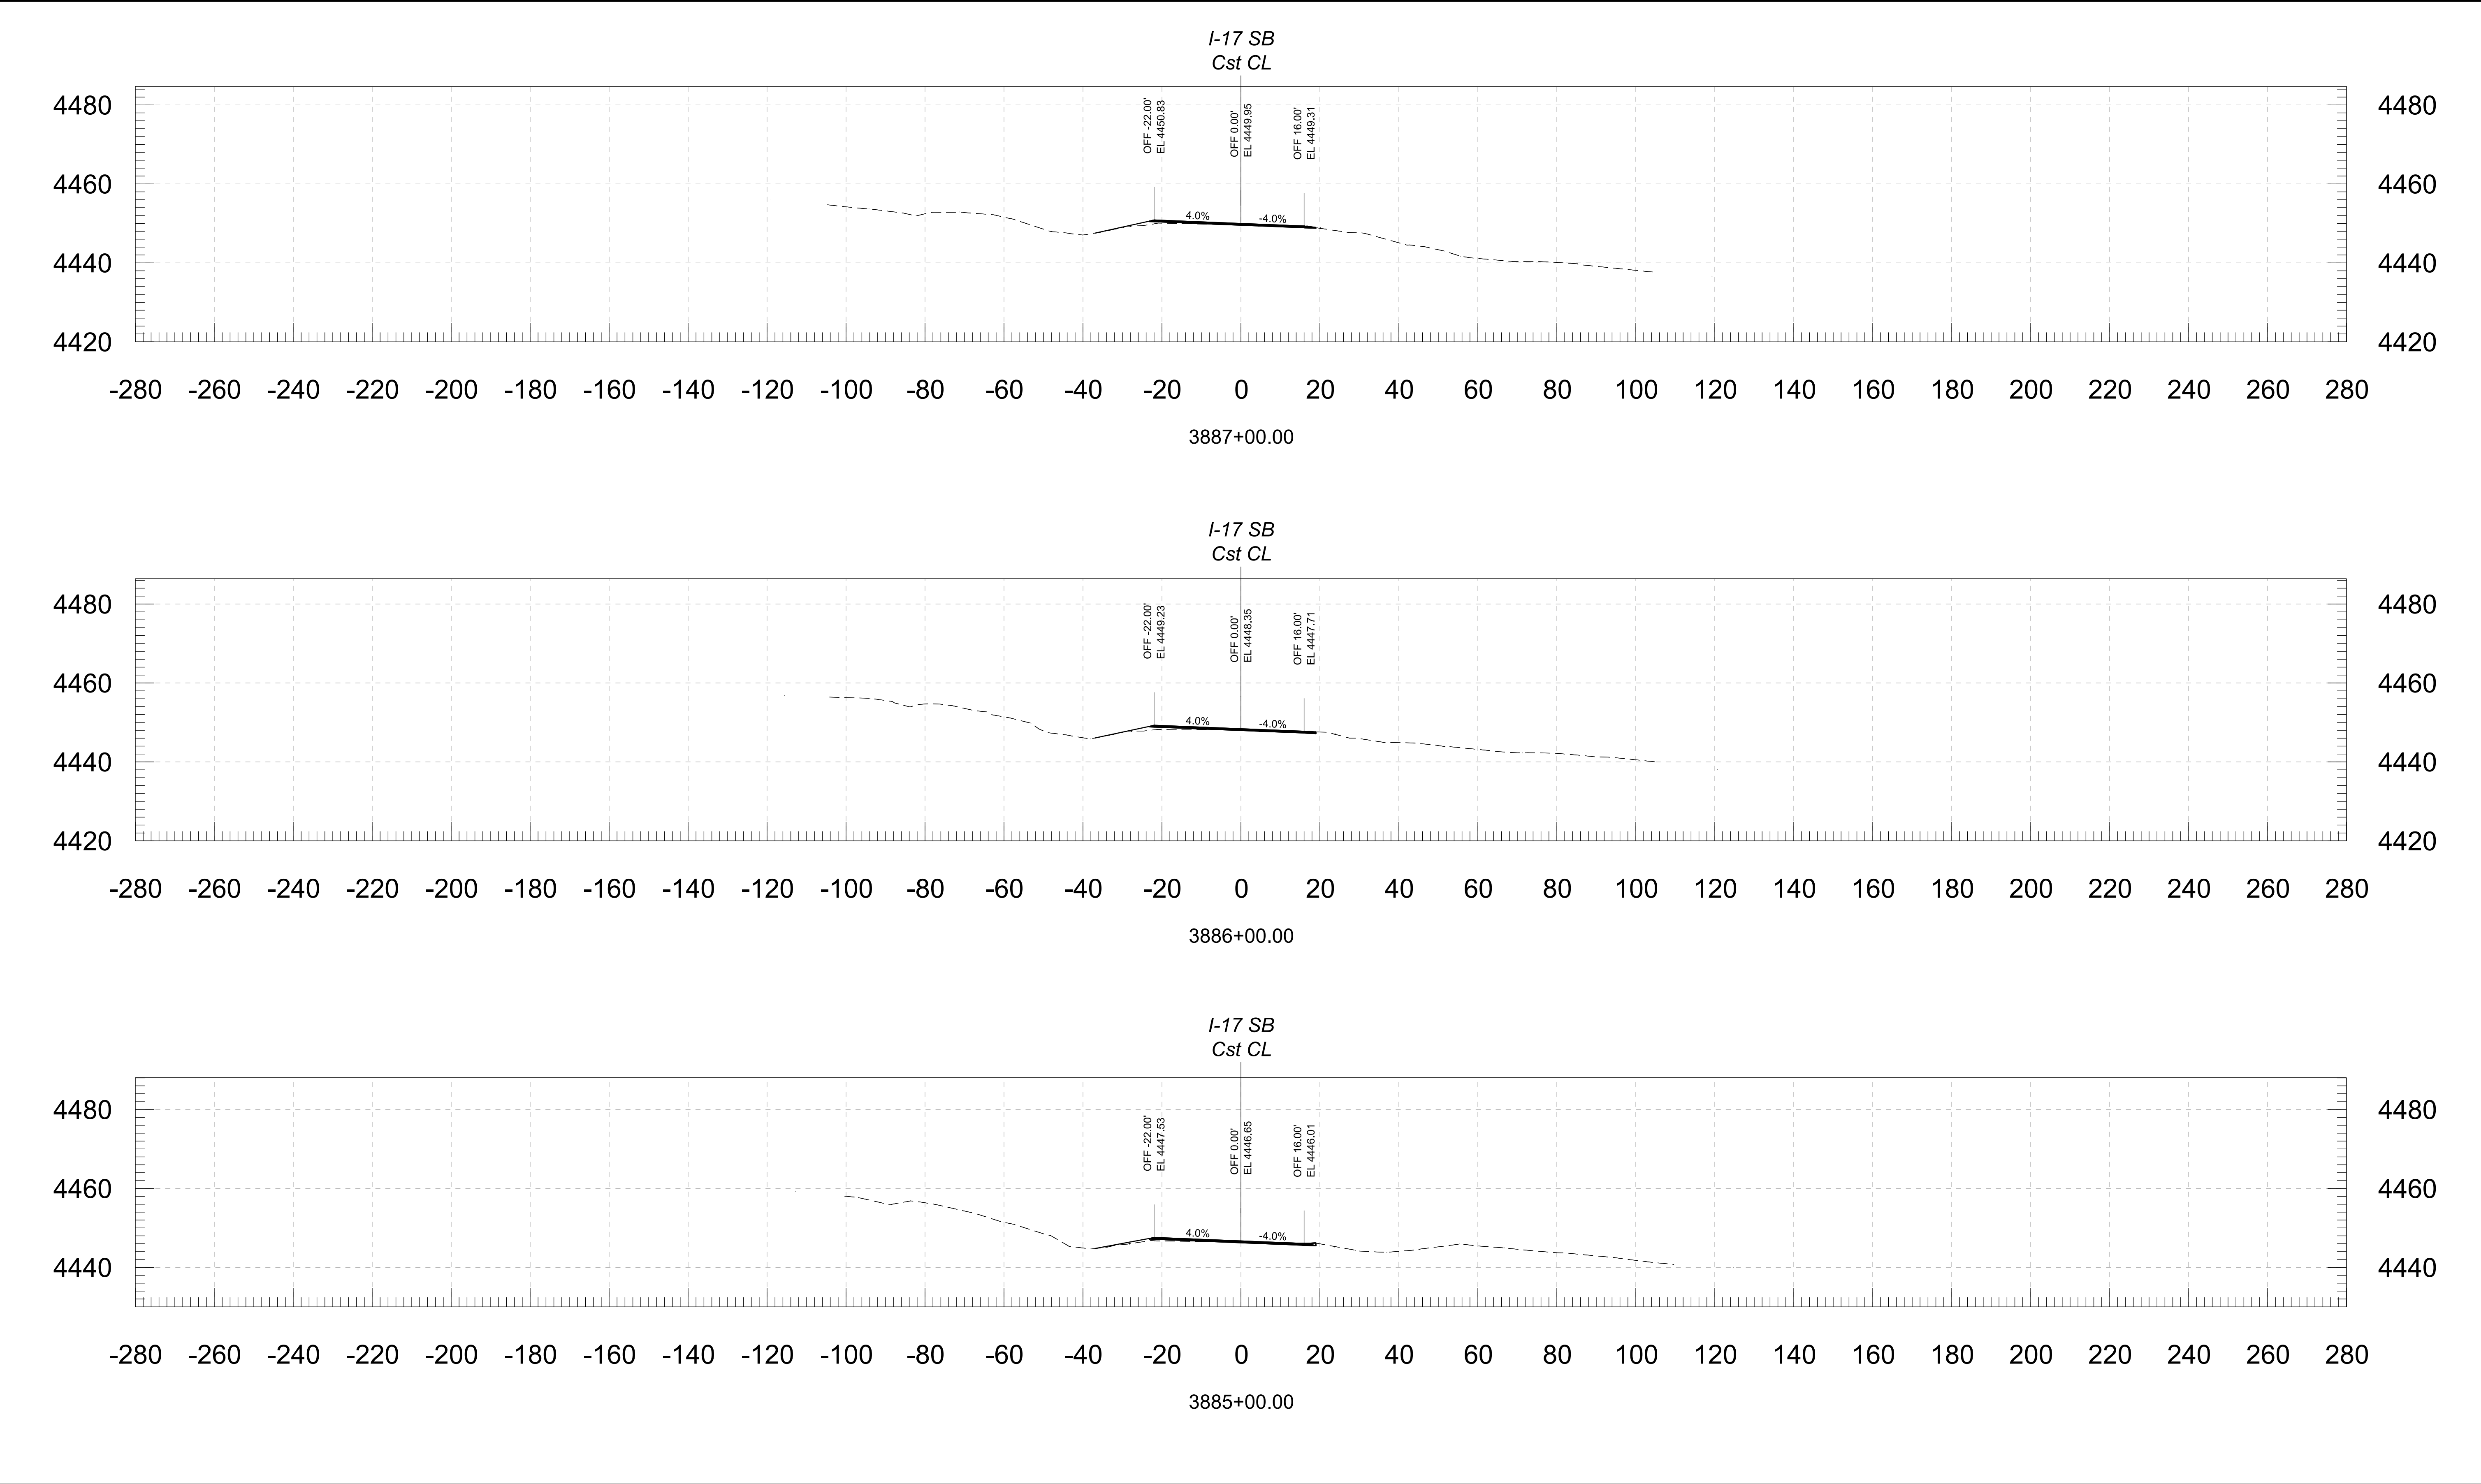


				NAME	DATE	ARIZONA DEPARTMENT OF TRANSPORTATION PROJECT DELIVERY AND OPERATIONS DIVISION ROADWAY DESIGN SERVICES	ROUTE	F.H.W.A. Arizona Division	STATE ARIZ.	PROJECT NO.	FEDERAL ID NO.	SHEET NO.	TOTAL SHEETS	RECORD DRAWING
			DESIGN	BAP	06/26		I-17			122	146			
			DRAWN	RM	06/26									
			CHECKED	KCH	06/26									
			 3133 East Camelback Road, Suite 100 Phoenix, Arizona 85016 Phone: 602.333-2200 Stanley Consultants INC.									CROSS SECTION		
						STRUCTURE NO.	TRACS NO. F0616 01C		____ OF ____					

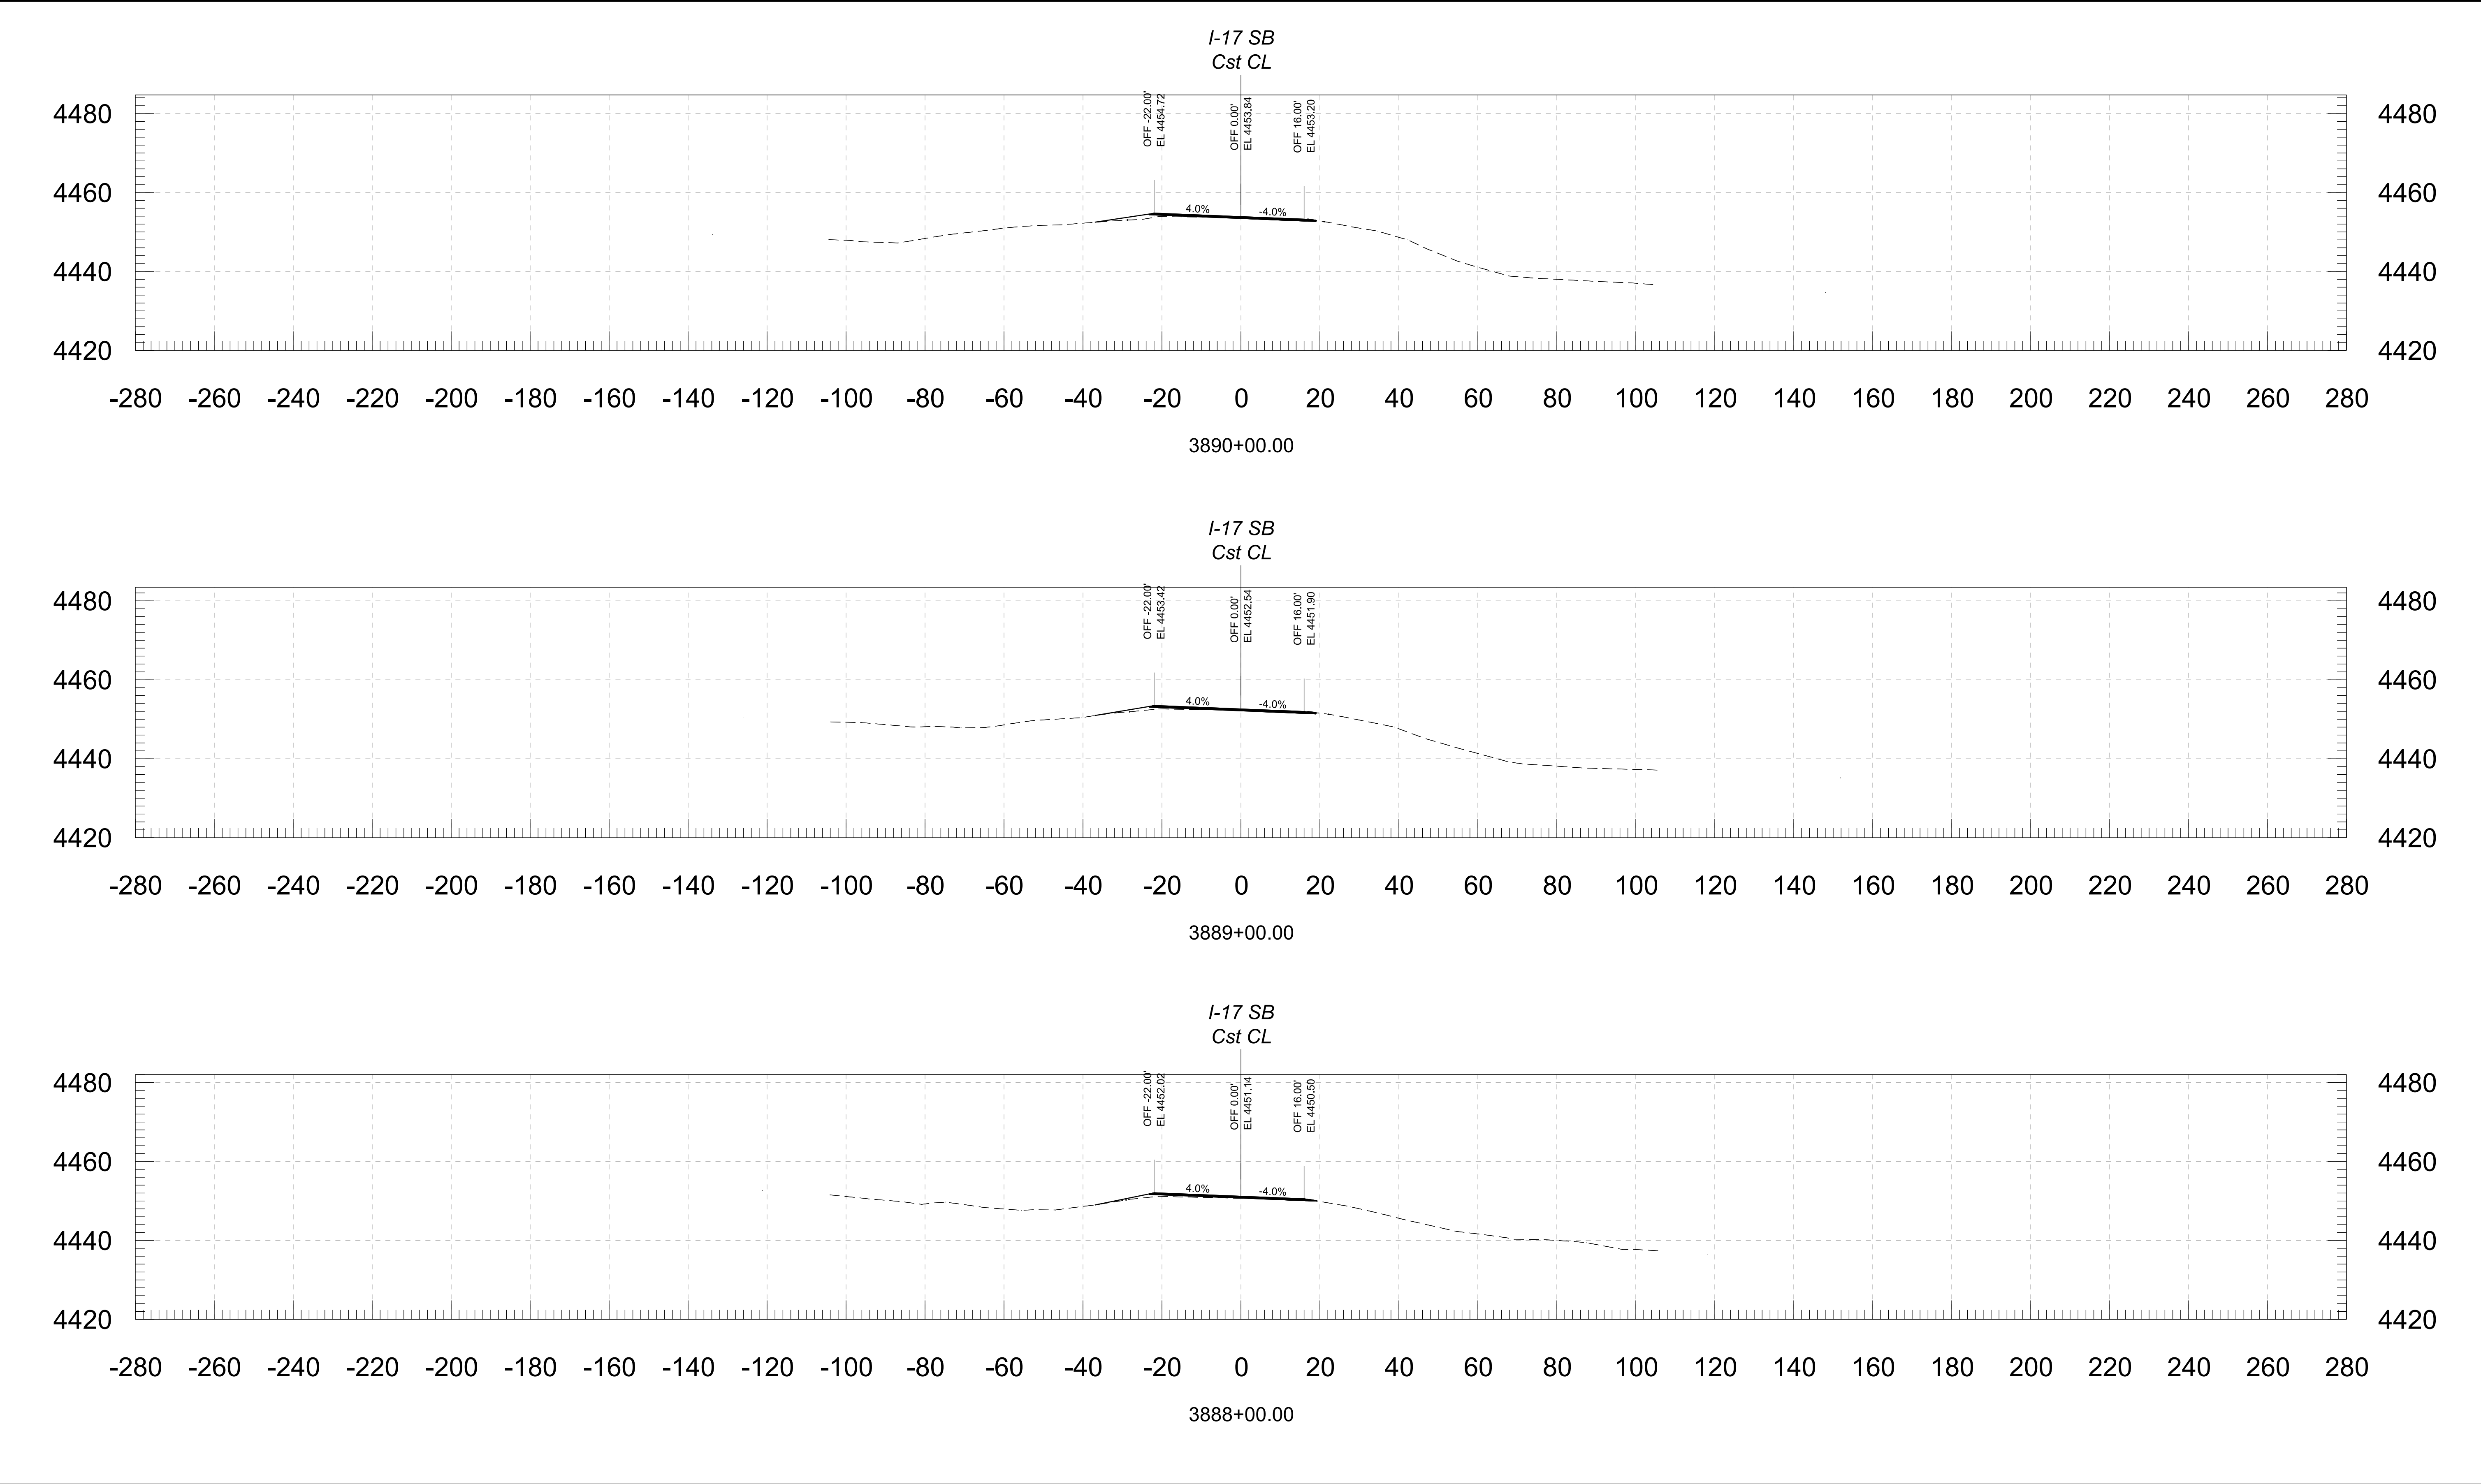 



				NAME	DATE	ARIZONA DEPARTMENT OF TRANSPORTATION PROJECT DELIVERY AND OPERATIONS DIVISION ROADWAY DESIGN SERVICES	ROUTE	F.H.W.A. Arizona Division	STATE ARIZ.	PROJECT NO.	FEDERAL ID NO.	SHEET NO.	TOTAL SHEETS	RECORD DRAWING
			DESIGN	BAP	06/26		I-17			017 YV 269	017-B(239)T	123	146	
			DRAWN	RM	06/26			MILEPOST	LOCATION				E DUGAS ROAD - MP 275	DWG NO.
			CHECKED	KCH	06/26				STRUCTURE NO.	TRACS NO. F0616 01C				
			 3133 East Camelback Road, Suite 100 Phoenix, Arizona 85016 Phone: 602.333-2200 Stanley Consultants INC.				CROSS SECTION							

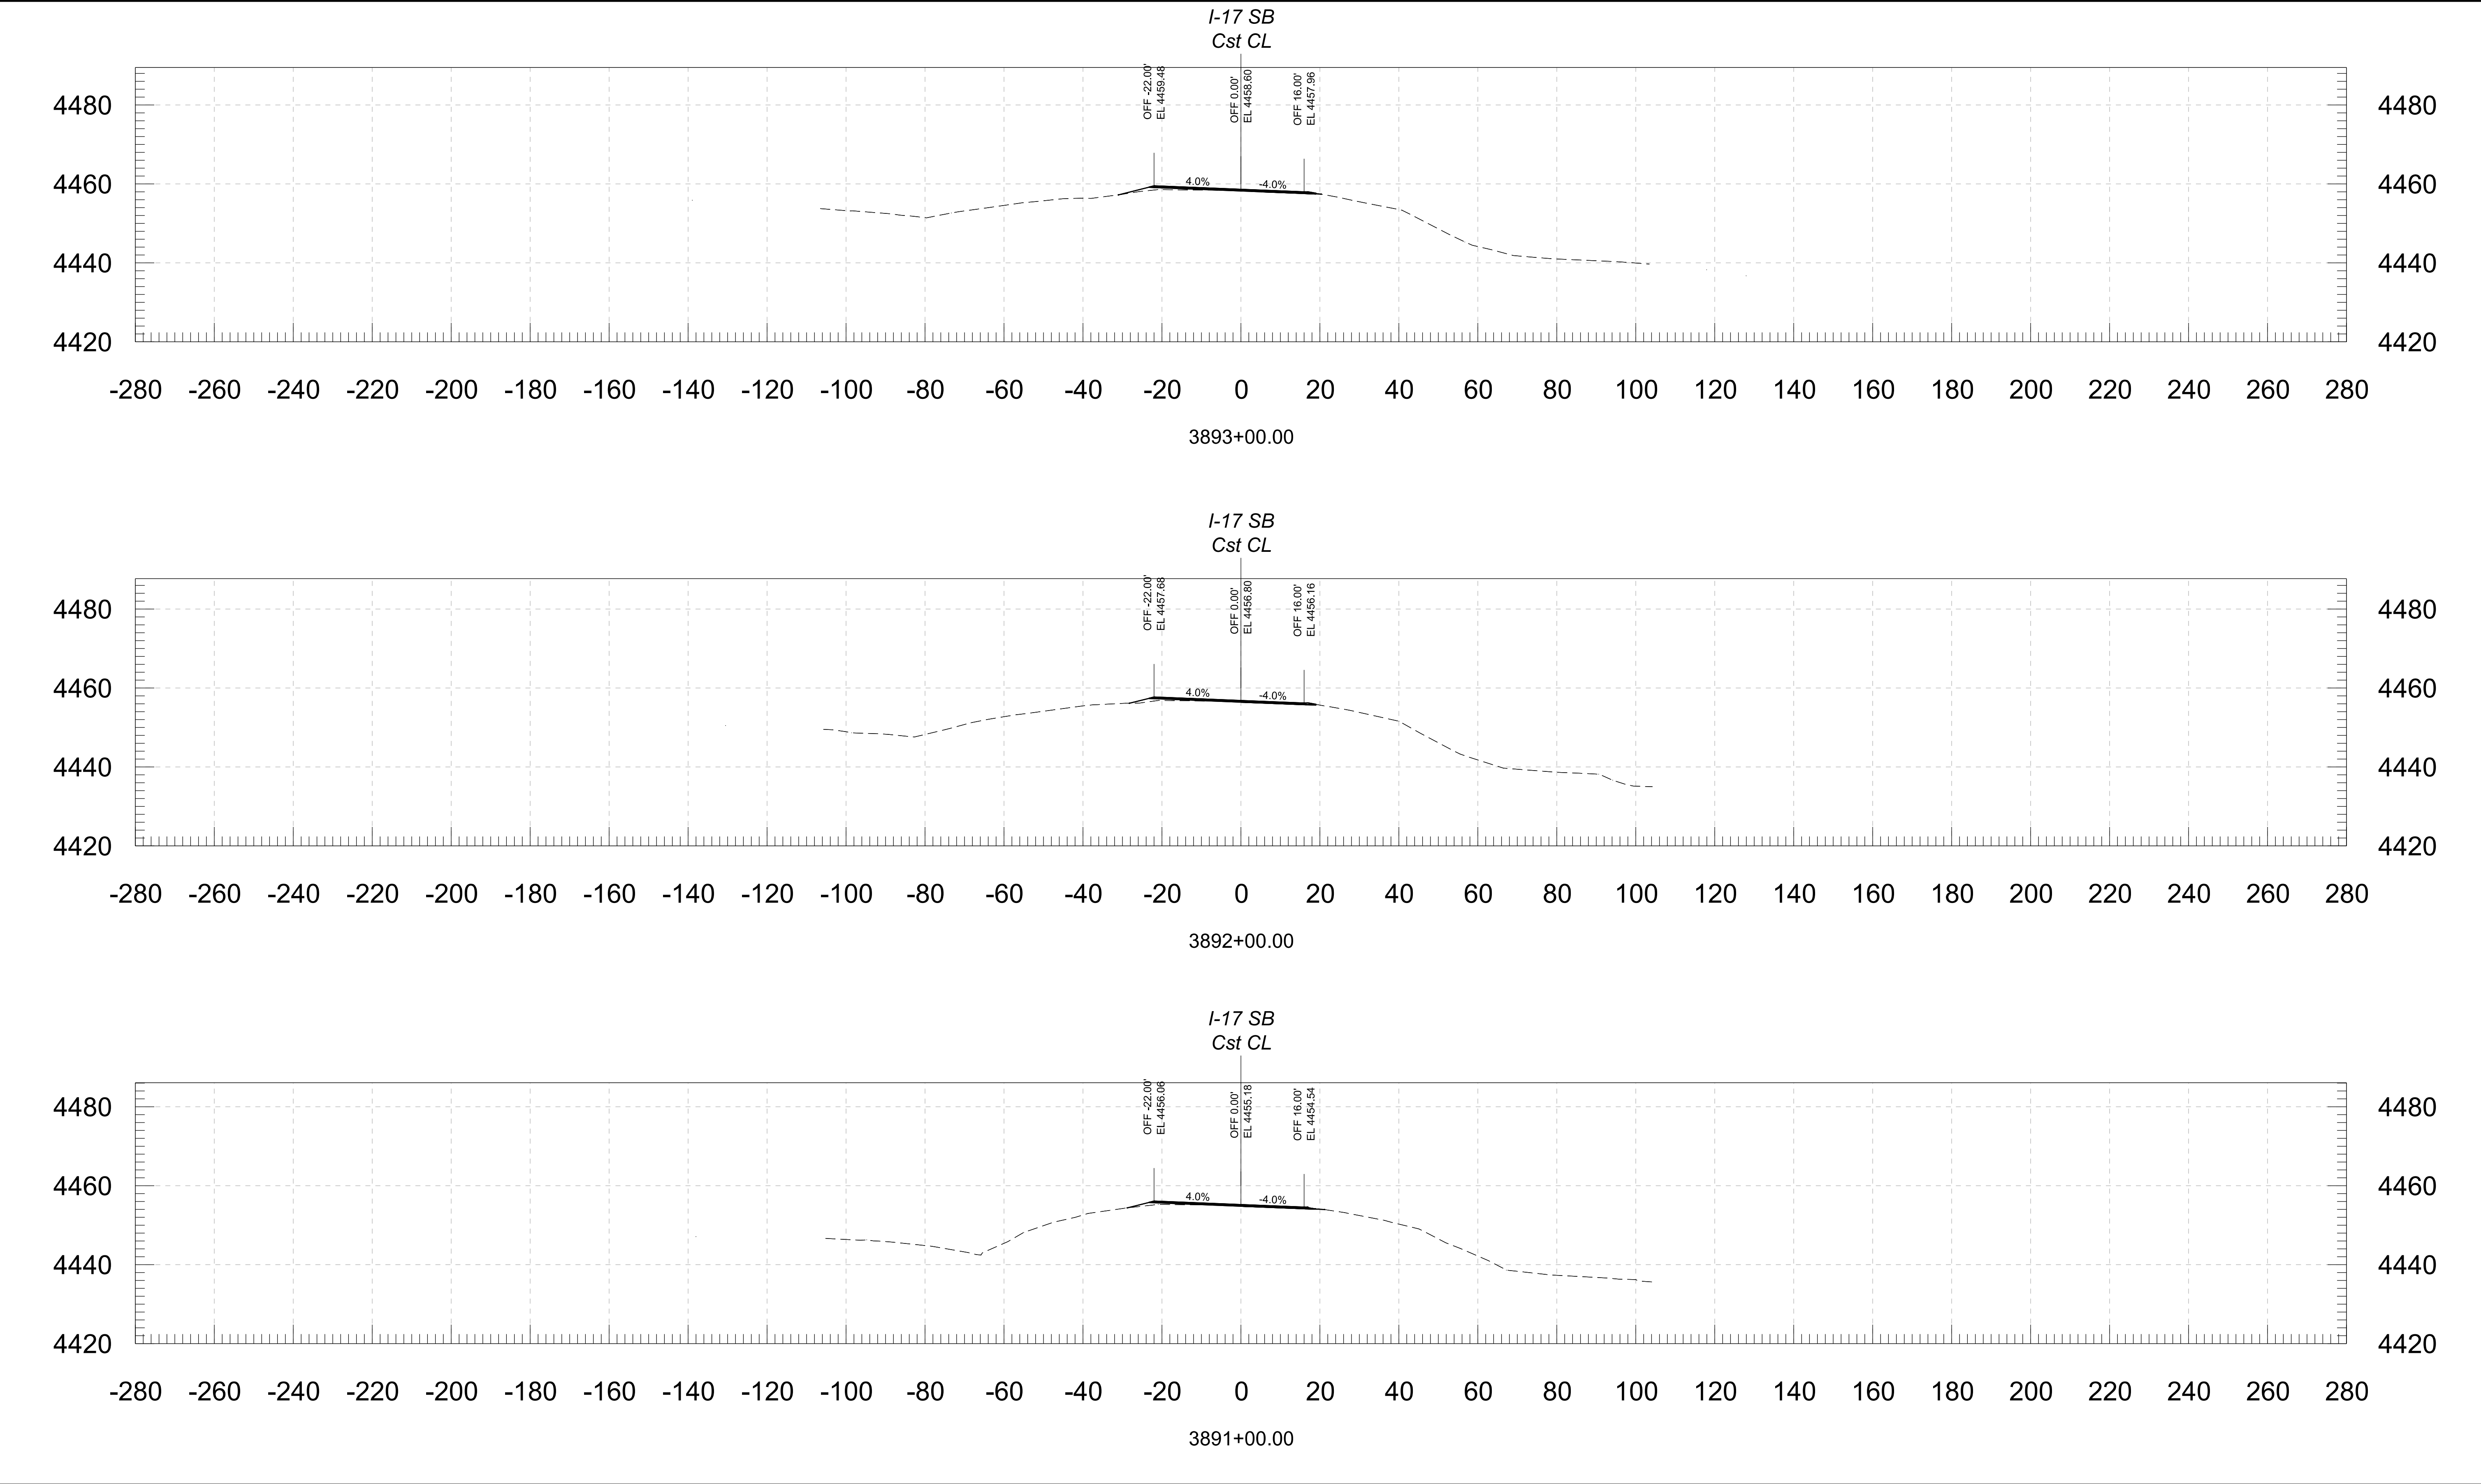


				NAME	DATE	ARIZONA DEPARTMENT OF TRANSPORTATION PROJECT DELIVERY AND OPERATIONS DIVISION ROADWAY DESIGN SERVICES	ROUTE	F.H.W.A. Arizona Division	STATE ARIZ.	PROJECT NO.	FEDERAL ID NO.	SHEET NO.	TOTAL SHEETS	RECORD DRAWING
			DESIGN	BAP	06/26		I-17			017 YV 269	017-B(239)T	124	146	
			DRAWN	RM	06/26									
			CHECKED	KCH	06/26									
			 3135 East Camelback Road, Suite 100 Phoenix, Arizona 85016 Phone: 602.333-2200 Stanley Consultants INC.											
						STRUCTURE NO.	TRACS NO. F0616 01C				____ OF ____			

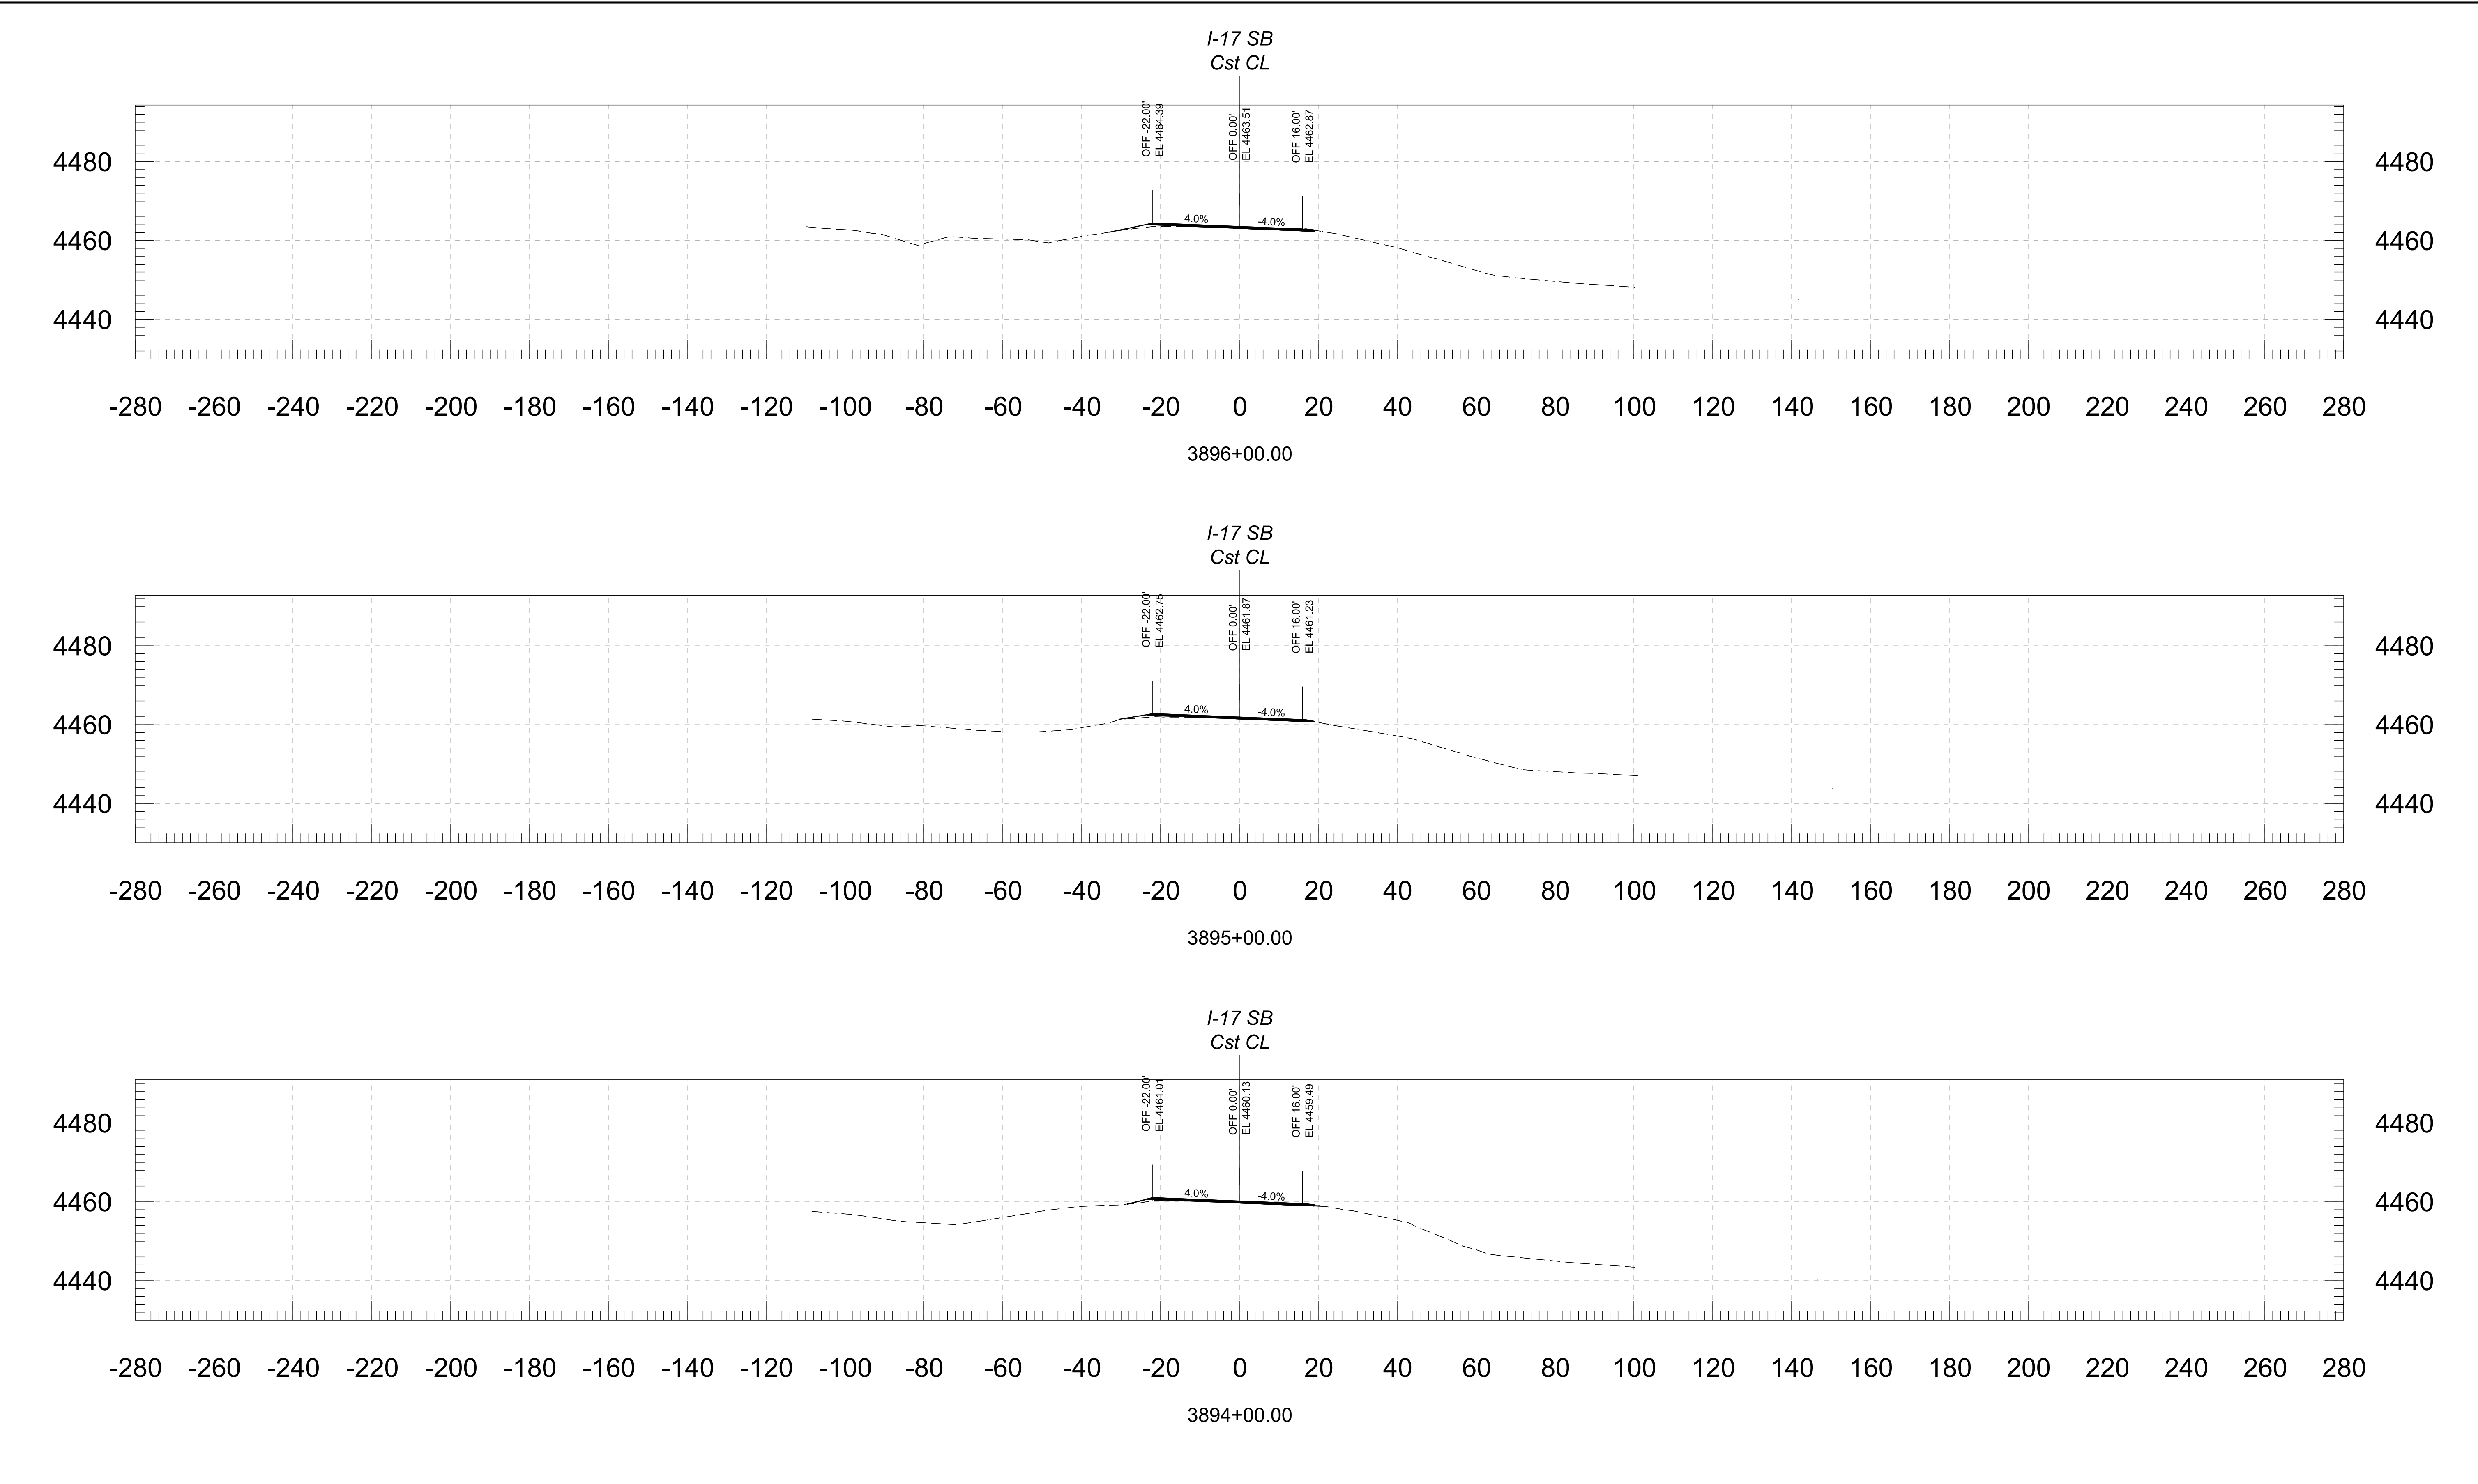


				NAME	DATE	ARIZONA DEPARTMENT OF TRANSPORTATION PROJECT DELIVERY AND OPERATIONS DIVISION ROADWAY DESIGN SERVICES	ROUTE	F.H.W.A. Arizona Division	STATE ARIZ.	PROJECT NO.	FEDERAL ID NO.	SHEET NO.	TOTAL SHEETS	RECORD DRAWING
			DESIGN	BAP	06/26		I-17			125	146			
			DRAWN	RM	06/26									
			CHECKED	KCH	06/26									
			 3133 East Camelback Road, Suite 100 Phoenix, Arizona 85016 Phone: 602.333-2200 Stanley Consultants INC.										CROSS SECTION	
						STRUCTURE NO.	TRACS NO. F0616 01C				____ OF ____			

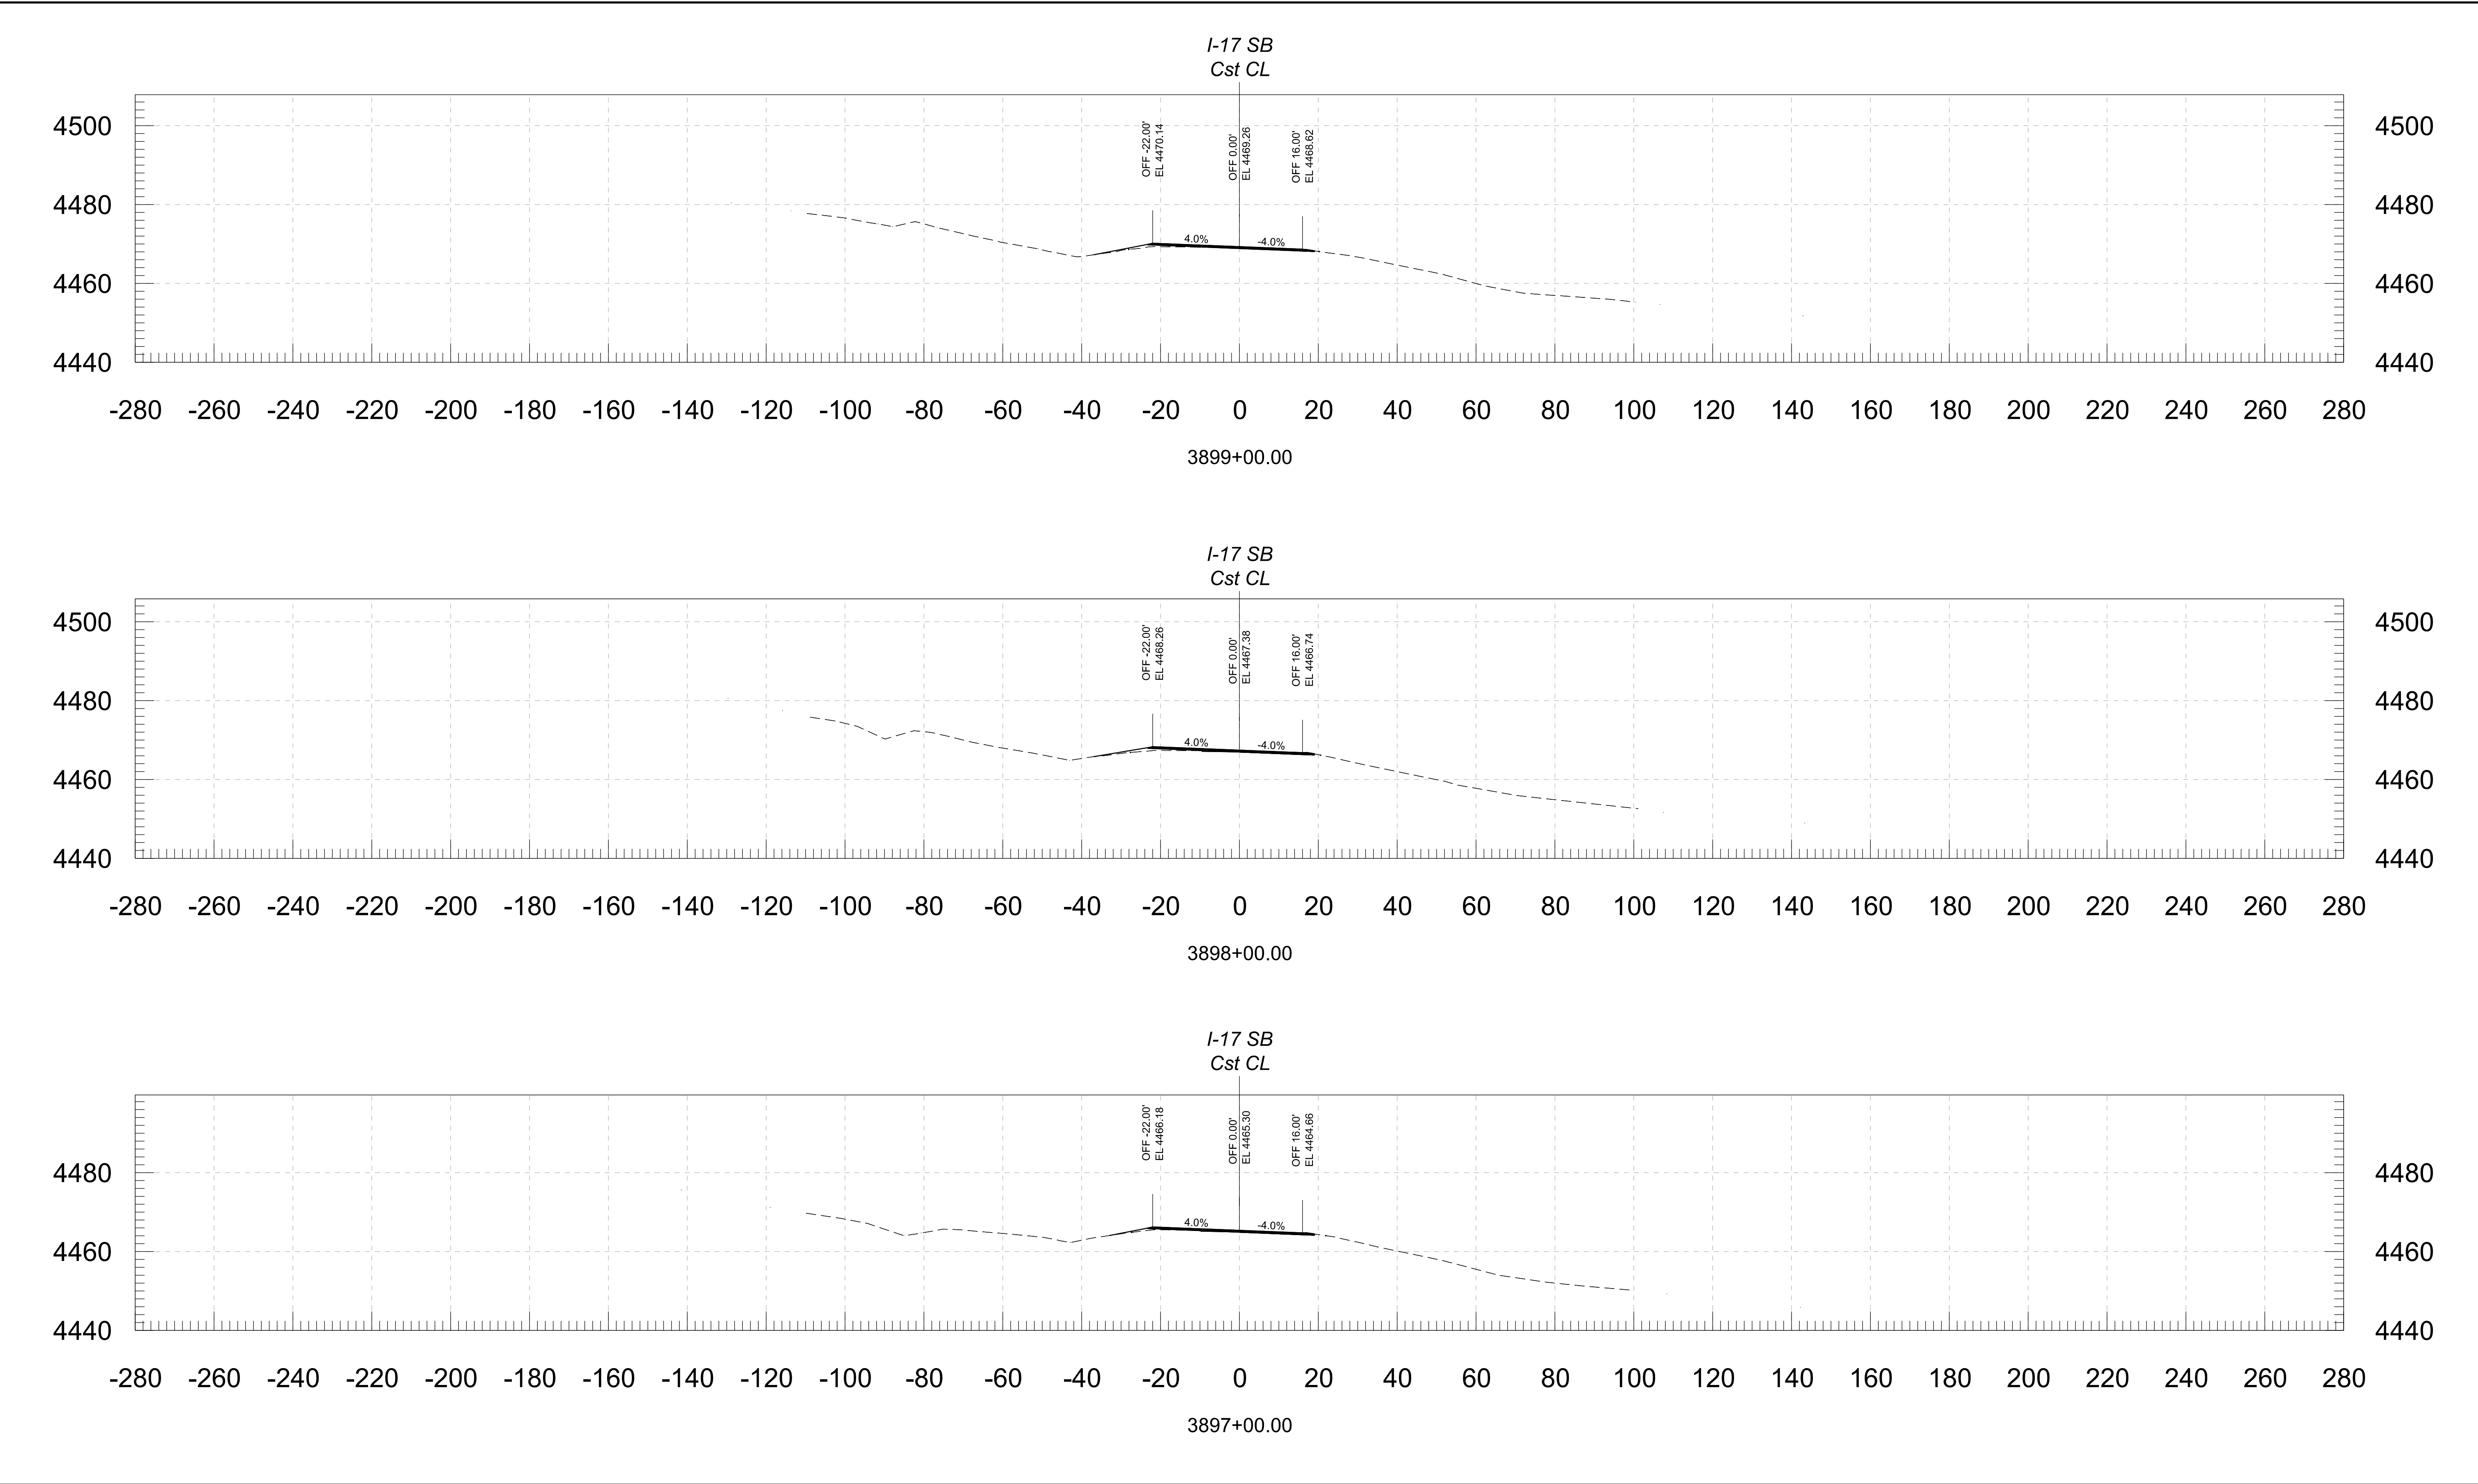 




				NAME	DATE	ARIZONA DEPARTMENT OF TRANSPORTATION PROJECT DELIVERY AND OPERATIONS DIVISION ROADWAY DESIGN SERVICES	ROUTE	F.H.W.A. Arizona Division	STATE ARIZ.	PROJECT NO.	FEDERAL ID NO.	SHEET NO.	TOTAL SHEETS	RECORD DRAWING
			DESIGN	BAP	06/26		I-17			126	146			
			DRAWN	RM	06/26									
			CHECKED	KCH	06/26									
			 3133 East Camelback Road, Suite 100 Phoenix, Arizona 85016 Phone: 602.333-2200 Stanley Consultants INC.									CROSS SECTION		
						STRUCTURE NO.	TRACS NO. F0616 01C				____ OF ____			

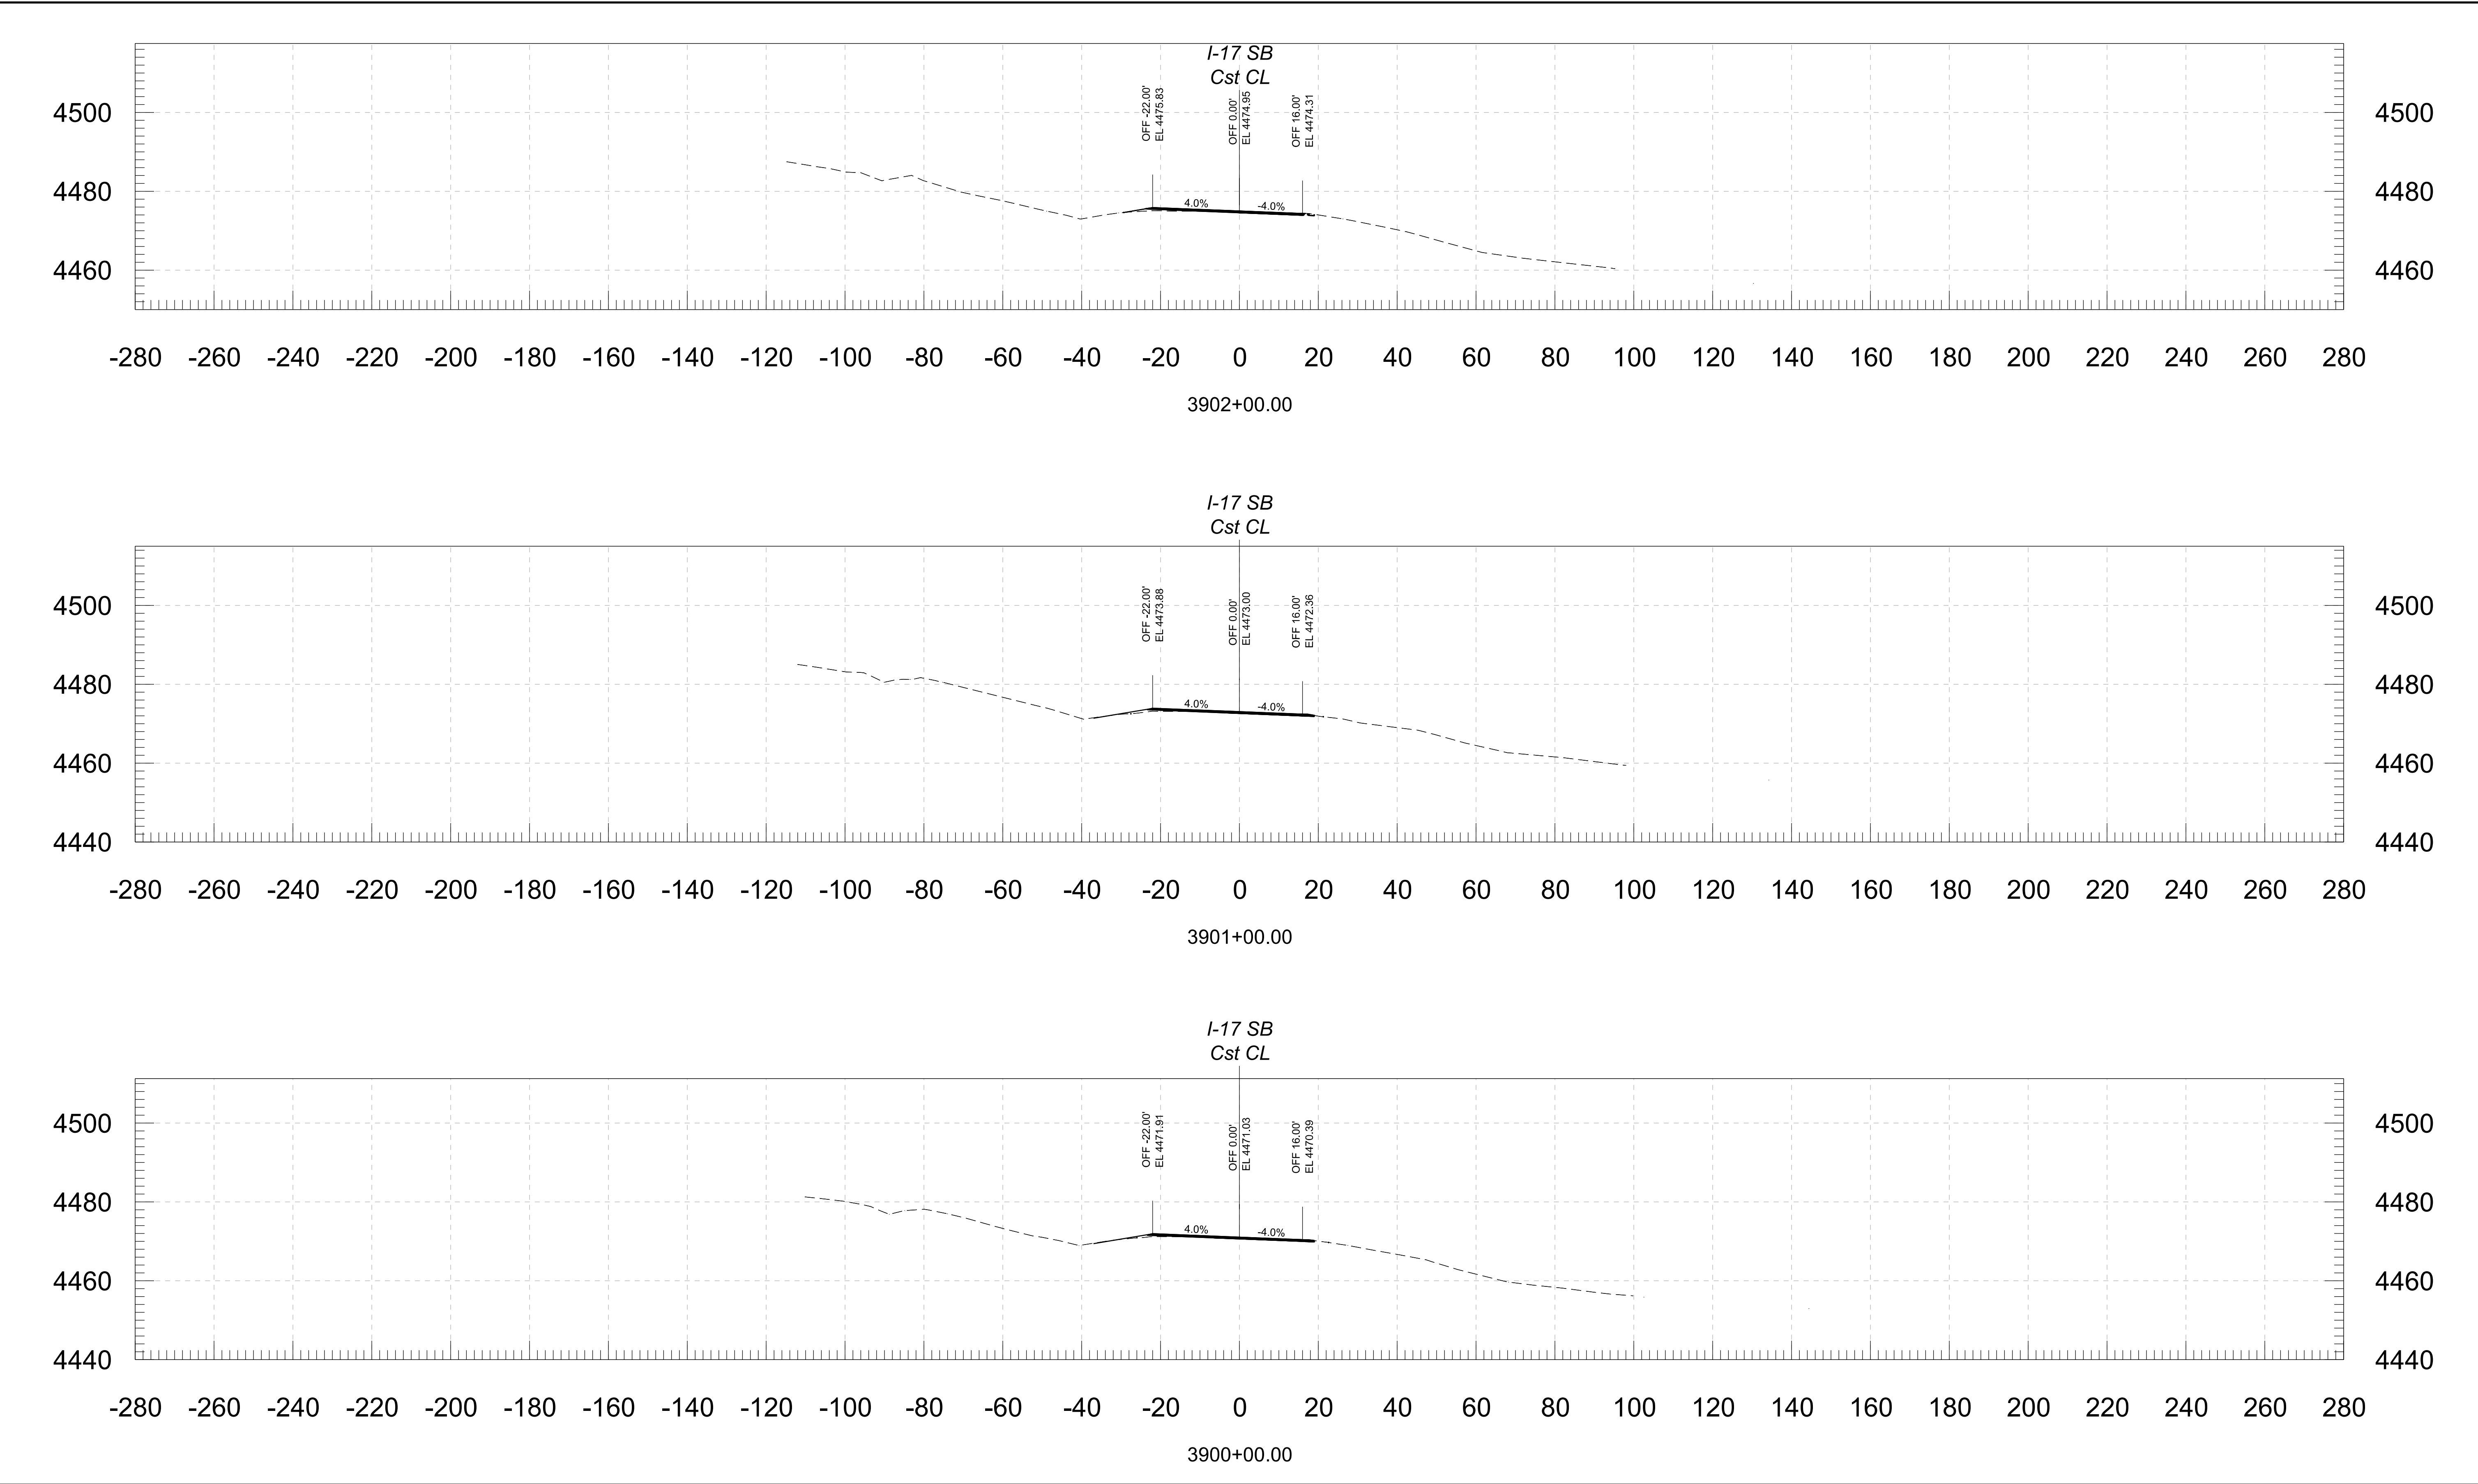



			NAME	DATE	ARIZONA DEPARTMENT OF TRANSPORTATION PROJECT DELIVERY AND OPERATIONS DIVISION ROADWAY DESIGN SERVICES	ROUTE	F.H.W.A. Arizona Division	STATE ARIZ.	PROJECT NO.	FEDERAL ID NO.	SHEET NO.	TOTAL SHEETS	RECORD DRAWING
		DESIGN	BAP	06/26		I-17			017 YV 269	017-B(239)T	127	146	
		DRAWN	RM	06/26			MILEPOST	E DUGAS ROAD - MP 275				DWG NO.	
		CHECKED	KCH	06/26				TRACS NO. F0616 01C					____ OF ____
		 3133 East Camelback Road, Suite 100 Phoenix, Arizona 85016 Phone: (602) 333-2200 Stanley Consultants INC.			CROSS SECTION		STRUCTURE NO.						

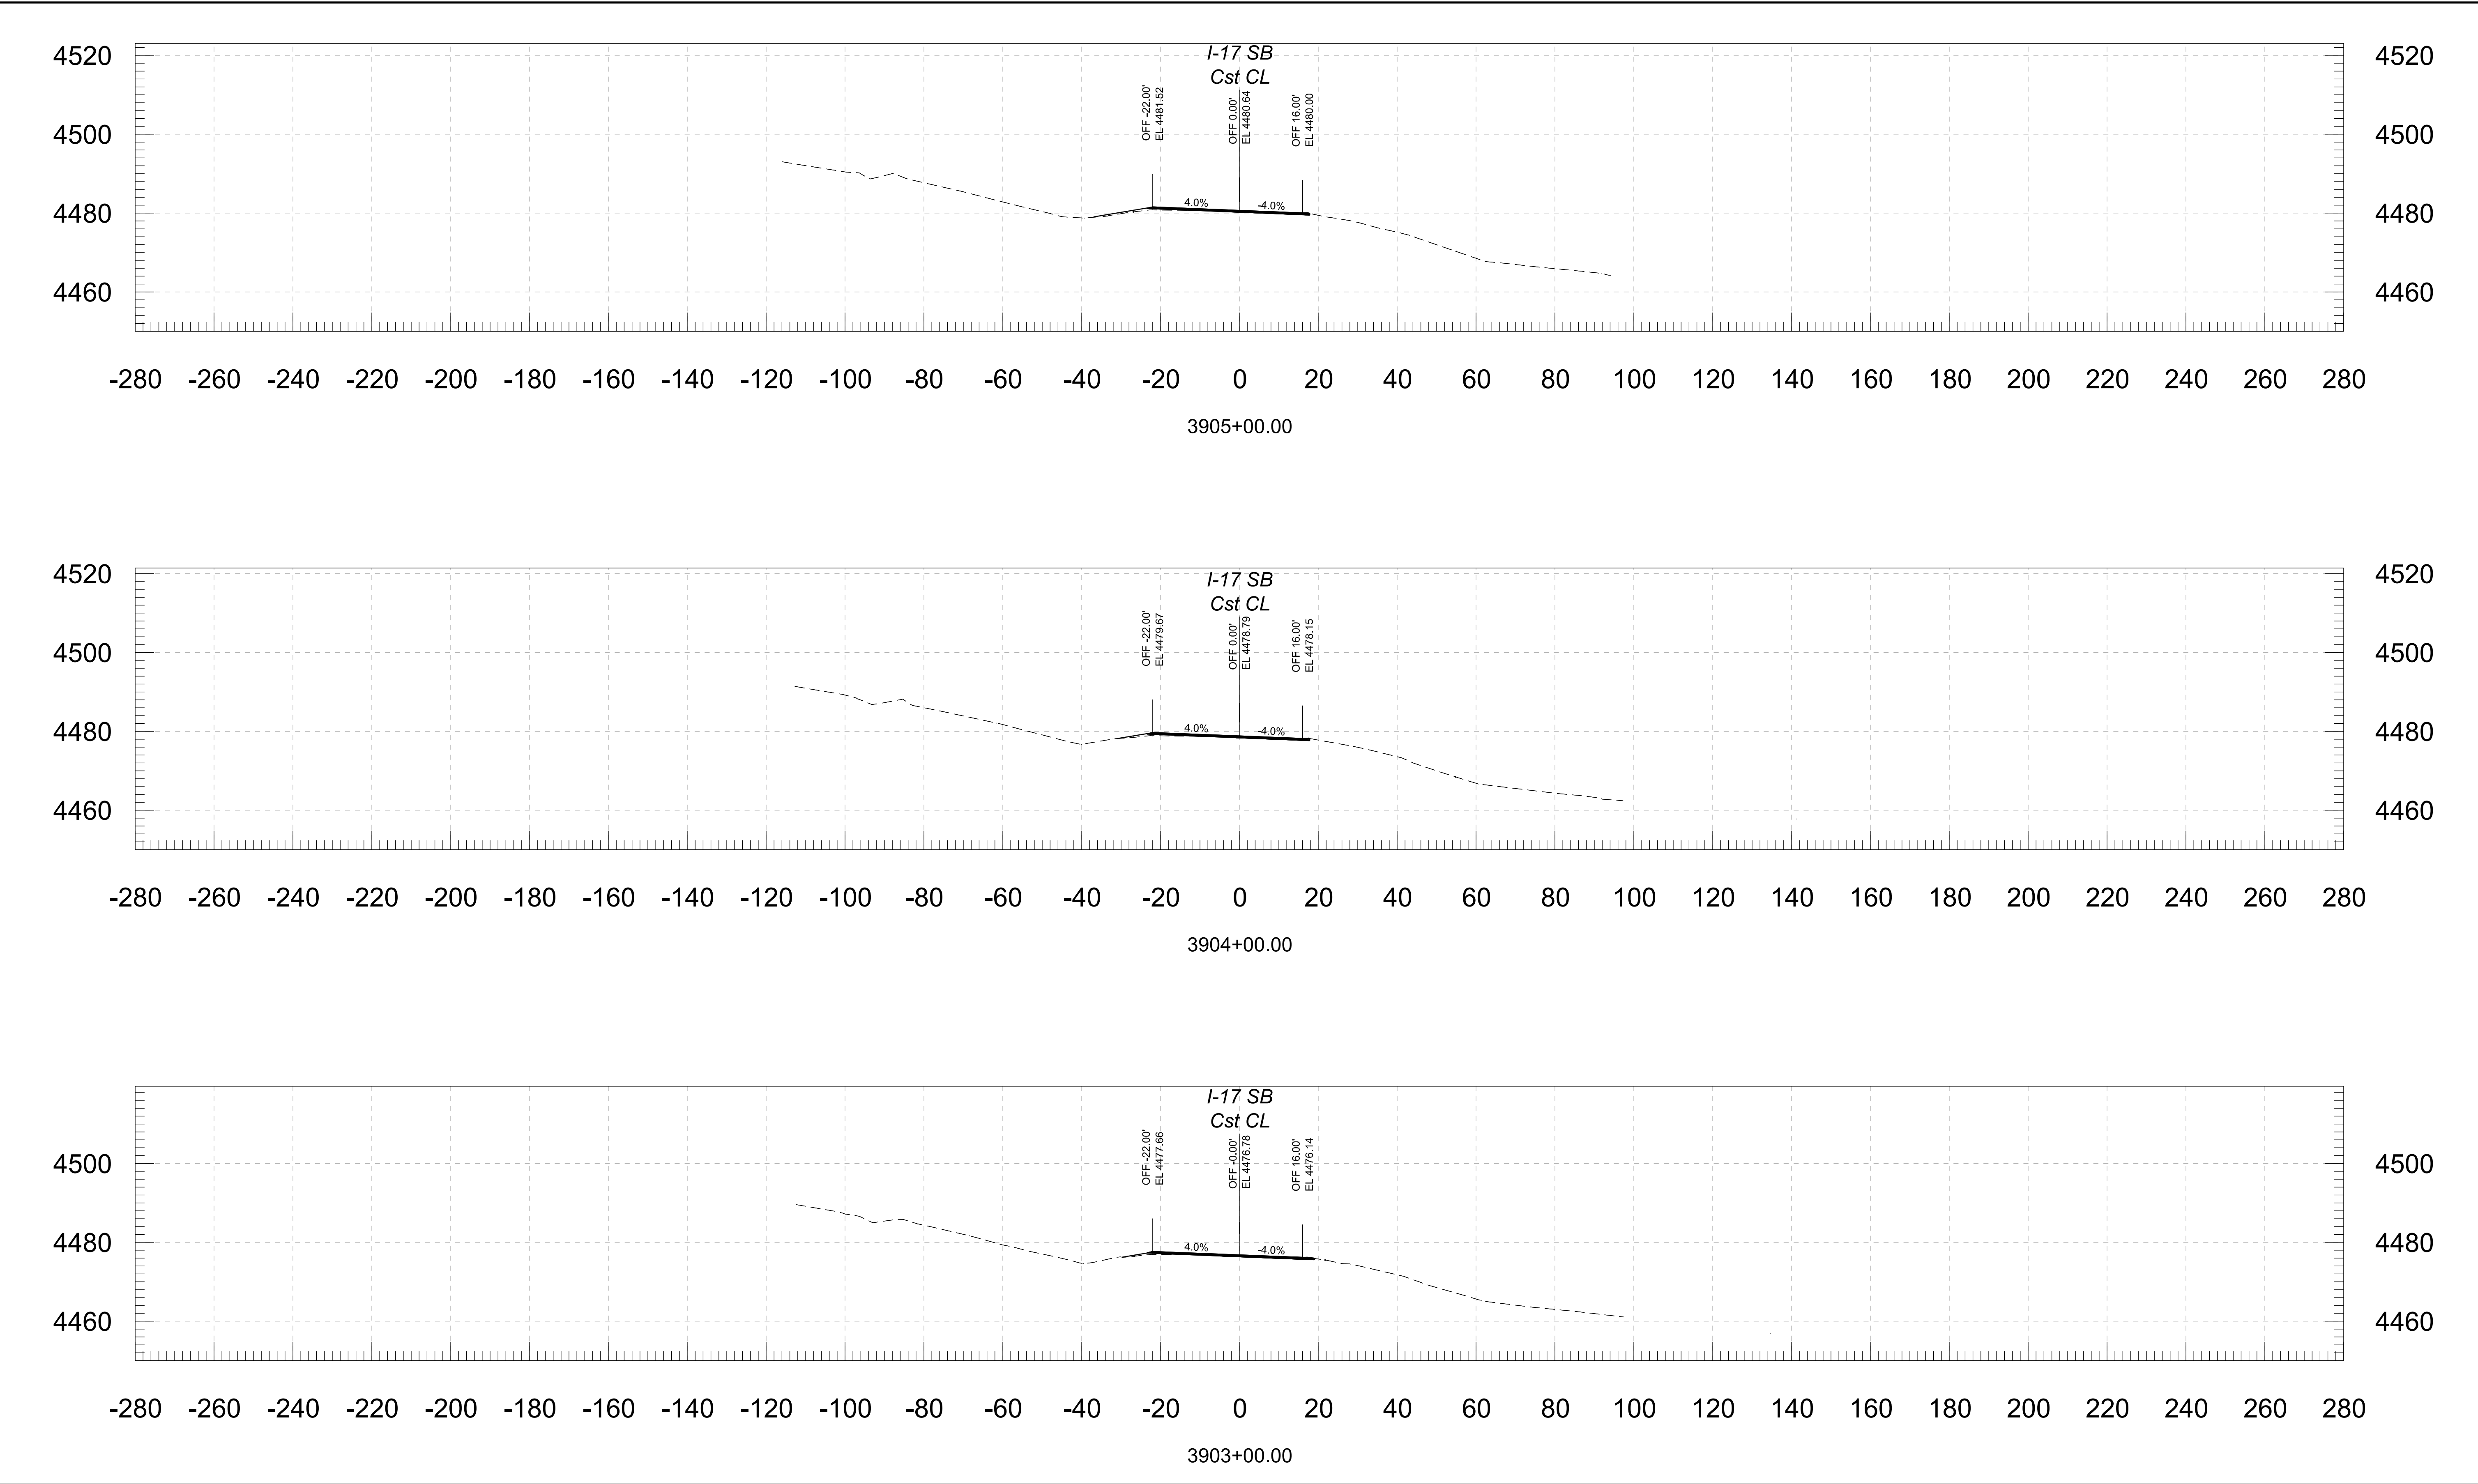



			NAME	DATE	ARIZONA DEPARTMENT OF TRANSPORTATION PROJECT DELIVERY AND OPERATIONS DIVISION ROADWAY DESIGN SERVICES	ROUTE	F.H.W.A. Arizona Division	STATE ARIZ.	PROJECT NO.	FEDERAL ID NO.	SHEET NO.	TOTAL SHEETS	RECORD DRAWING
		DESIGN	BAP	06/26		I-17			017 YV 269	017-B(239)T	128	146	
		DRAWN	RM	06/26									
		CHECKED	KCH	06/26									
		 Stanley Consultants INC.			3133 East Camelback Road, Suite 100 Phoenix, Arizona 85016 Phone: (602) 333-2200		CROSS SECTION	MILEPOST	E DUGAS ROAD - MP 275				
						STRUCTURE NO.	TRACS NO. F0616 01C				____ OF ____		

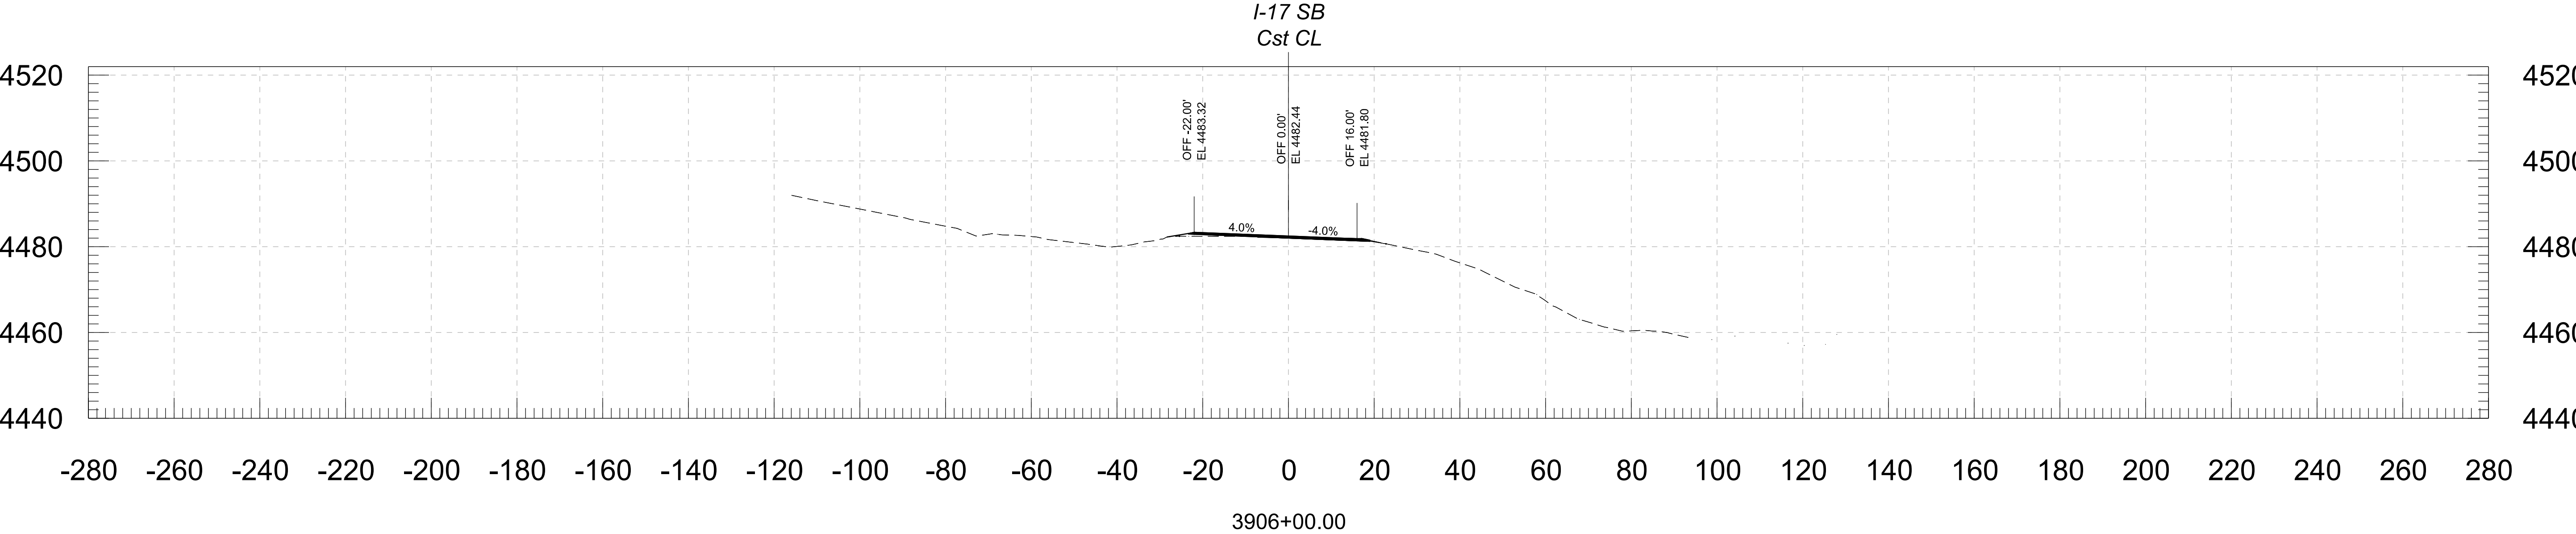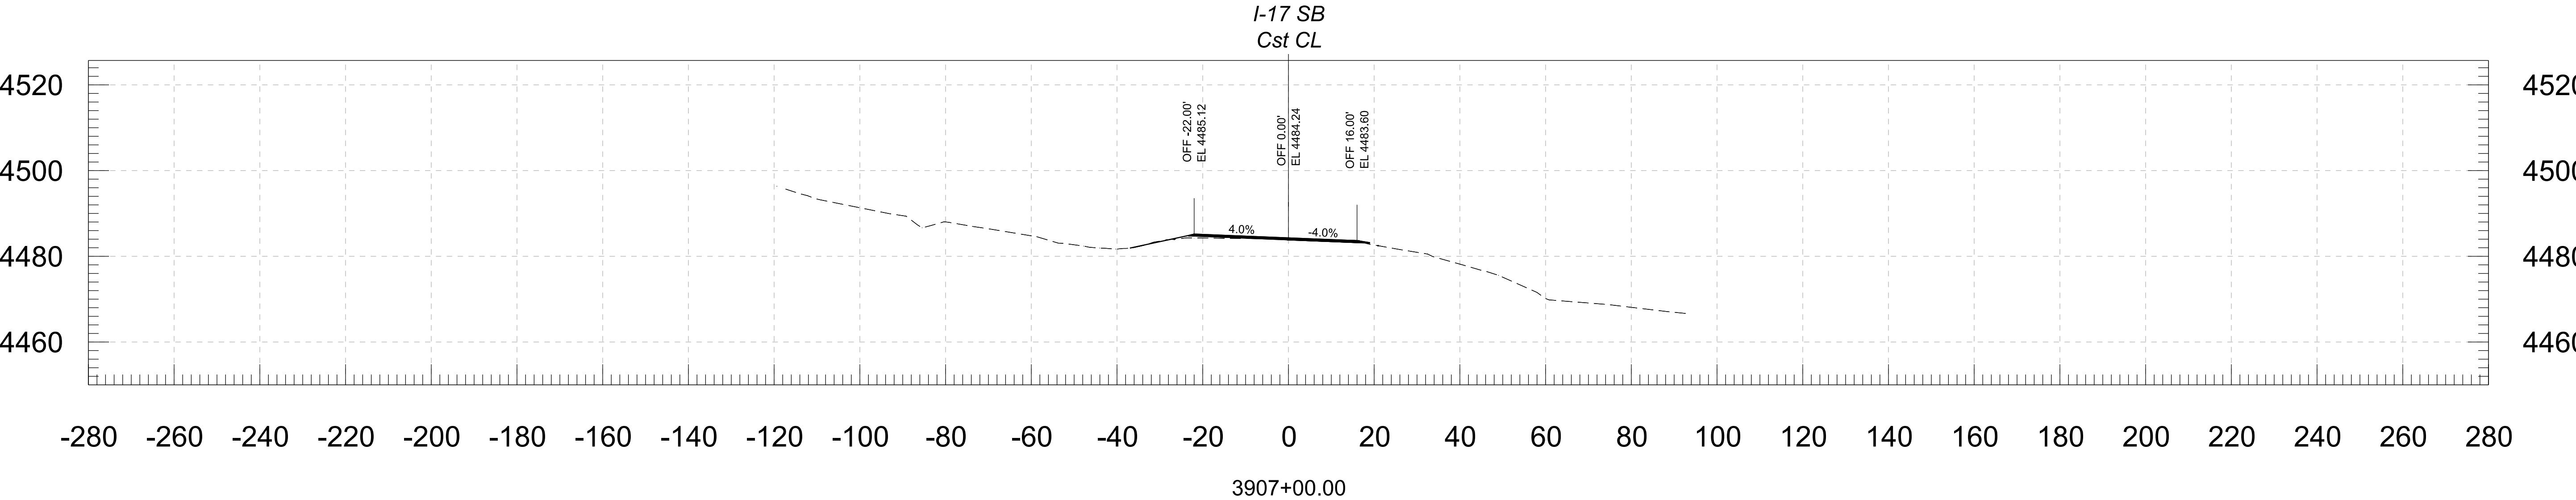



			NAME	DATE	ARIZONA DEPARTMENT OF TRANSPORTATION PROJECT DELIVERY AND OPERATIONS DIVISION ROADWAY DESIGN SERVICES	ROUTE	F.H.W.A. Arizona Division	STATE	PROJECT NO.	FEDERAL ID NO.	SHEET NO.	TOTAL SHEETS	RECORD DRAWING		
		DESIGN	BAP	06/26		I-17			017 YV 269	017-B(239)T	129	146			
		DRAWN	RM	06/26		MILEPOST	LOCATION								DWG NO.
		CHECKED	KCH	06/26			E DUGAS ROAD - MP 275								
		 Stanley Consultants INC.				3133 East Camelback Road, Suite 100 Phoenix, Arizona 85016 Phone: 602. 333-2000		CROSS SECTION	STRUCTURE NO.		TRACS NO. F0616 01C		OF		

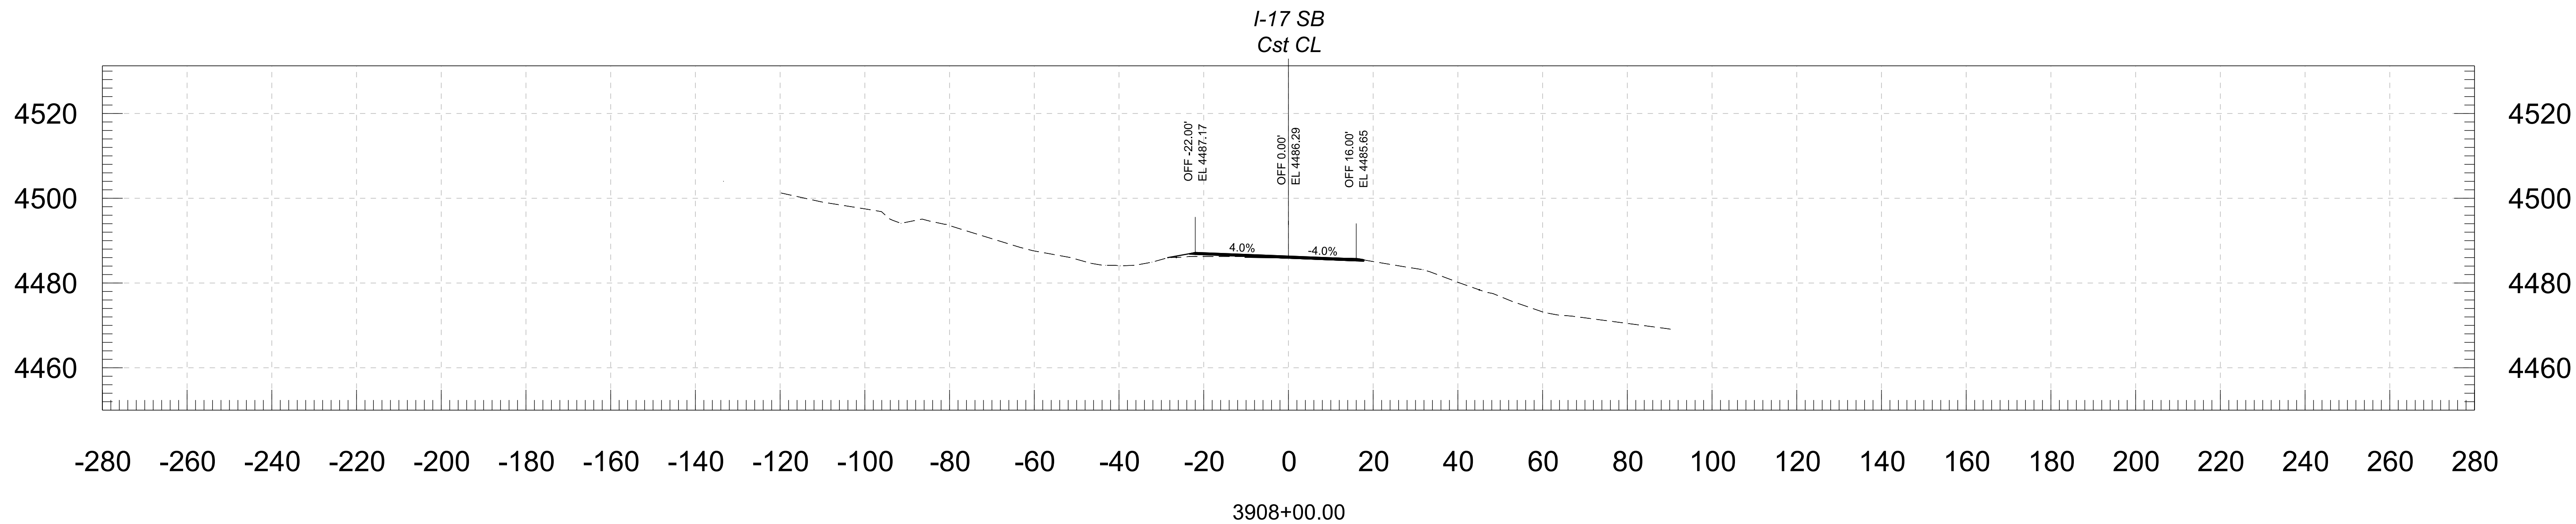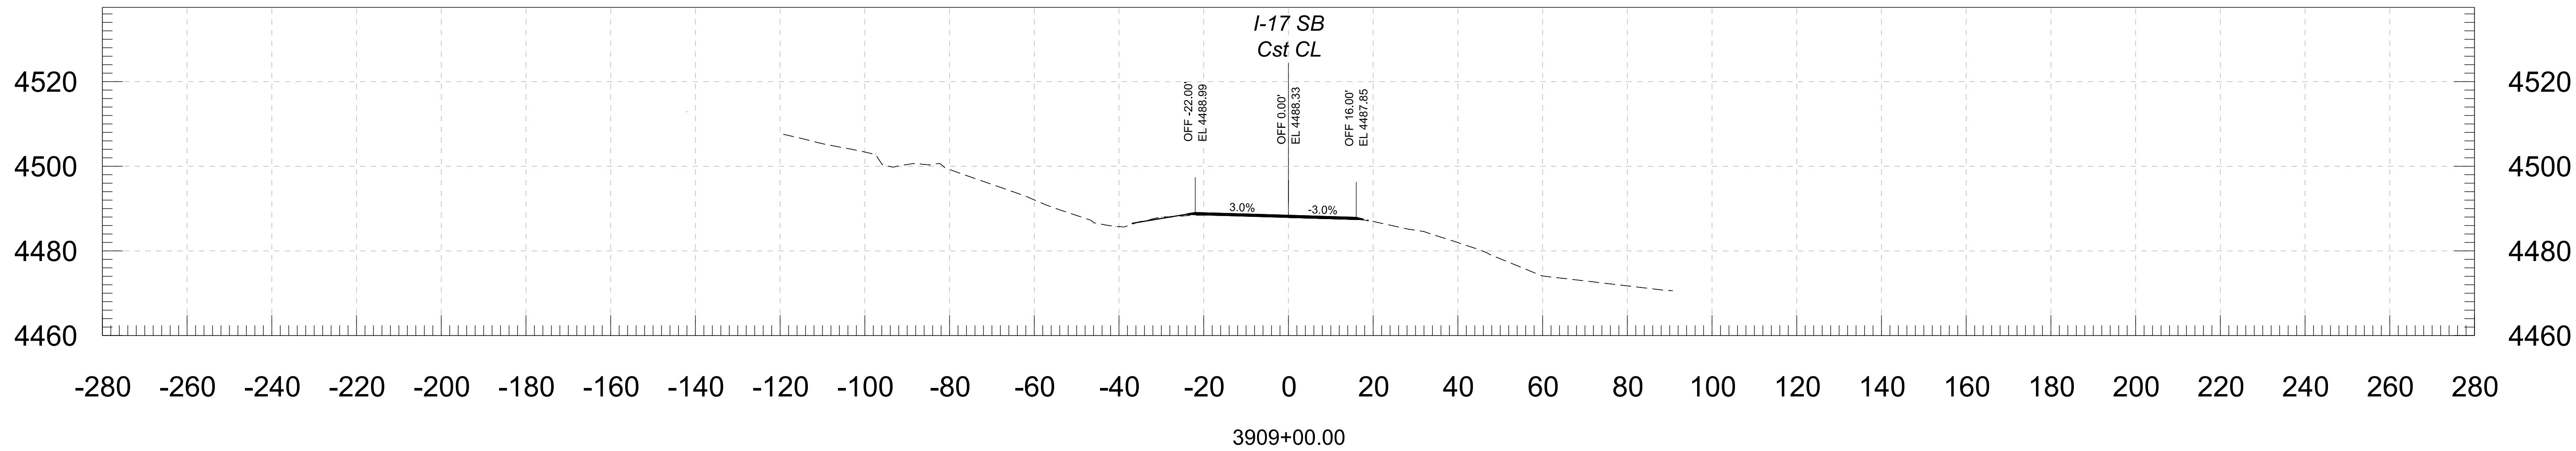



						ARIZONA DEPARTMENT OF TRANSPORTATION PROJECT DELIVERY AND OPERATIONS DIVISION ROADWAY DESIGN SERVICES		ROUTE I-17	F.H.W.A. Arizona Division		STATE ARIZ.	PROJECT NO. 017 YV 269	FEDERAL ID NO. 017-B(239)T	SHEET NO. 130	TOTAL SHEETS 146	RECORD DRAWING
						CROSS SECTION		MILEPOST	E DUGAS ROAD - MP 275						DWG NO.	
								STRUCTURE NO.	TRACS NO. F0616 01C							____ OF ____

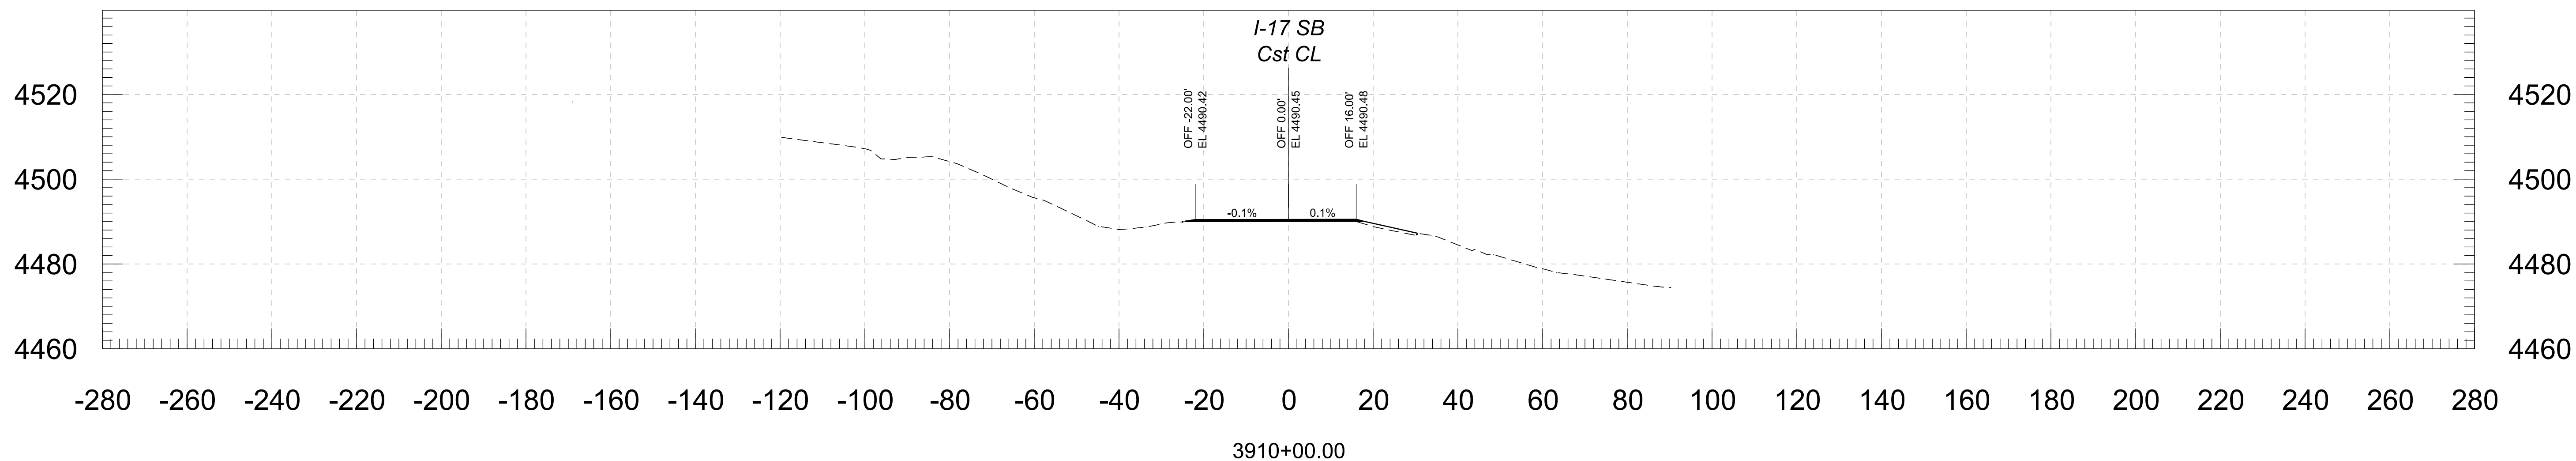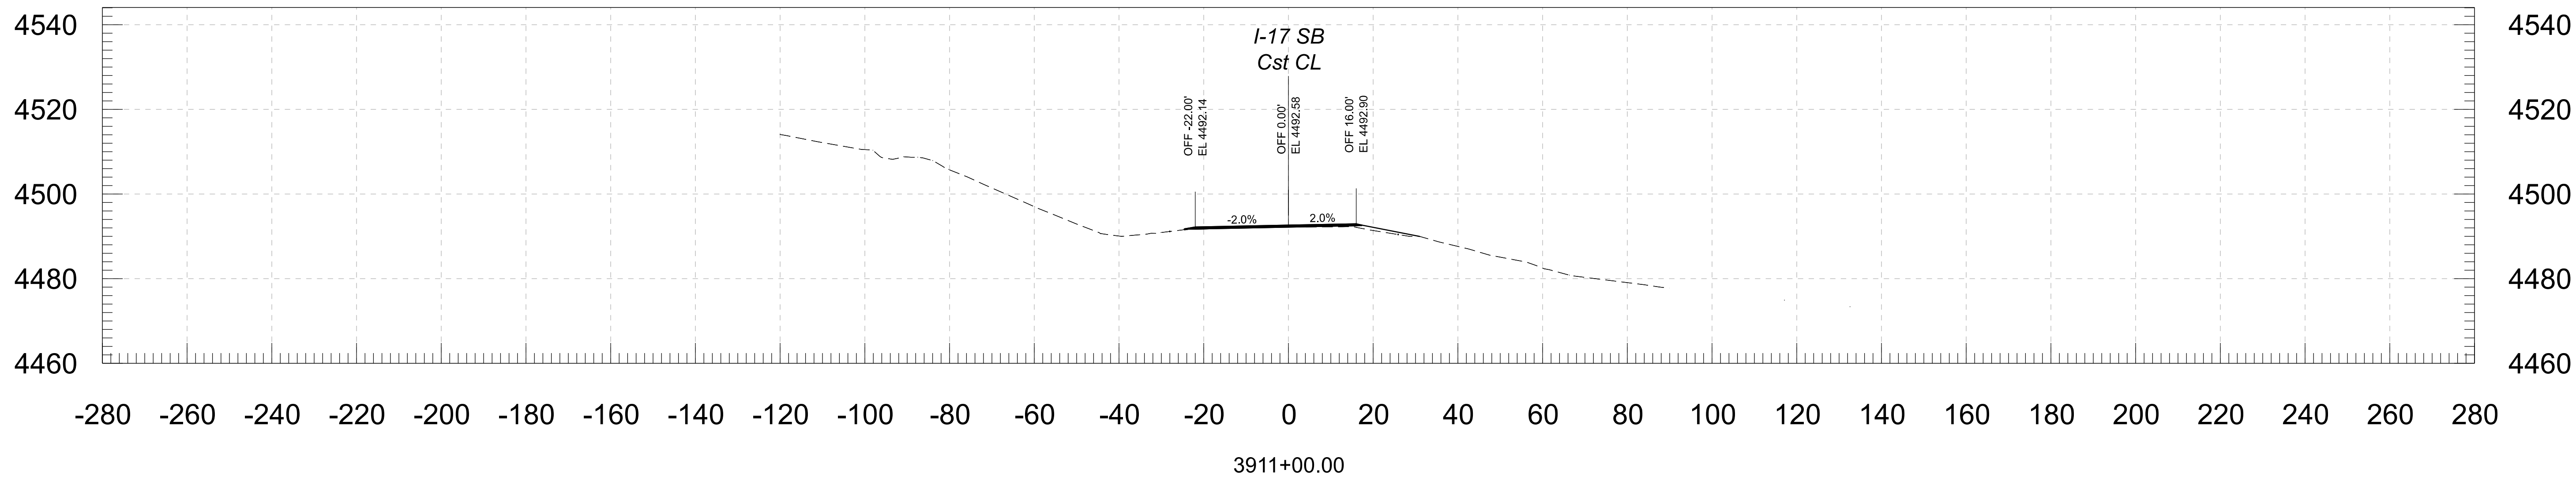


				NAME	DATE	ARIZONA DEPARTMENT OF TRANSPORTATION PROJECT DELIVERY AND OPERATIONS DIVISION ROADWAY DESIGN SERVICES	ROUTE	F.H.W.A. Arizona Division	STATE	PROJECT NO.	FEDERAL ID NO.	SHEET NO.	TOTAL SHEETS	RECORD DRAWING		
			DESIGN	BAP	06/26		I-17			017 YV 269	017-B(239)T	131	146			
			DRAWN	RM	06/26		MILEPOST	E DUGAS ROAD - MP 275								
			CHECKED	KCH	06/26											
			 Stanley Consultants INC.				3133 East Camelback Road, Suite 100 Phoenix, Arizona 85016 Phone: 602.335.2000	CROSS SECTION	STRUCTURE NO.	TRACS NO. F0616 01C				DWG NO.		
				____ OF ____												

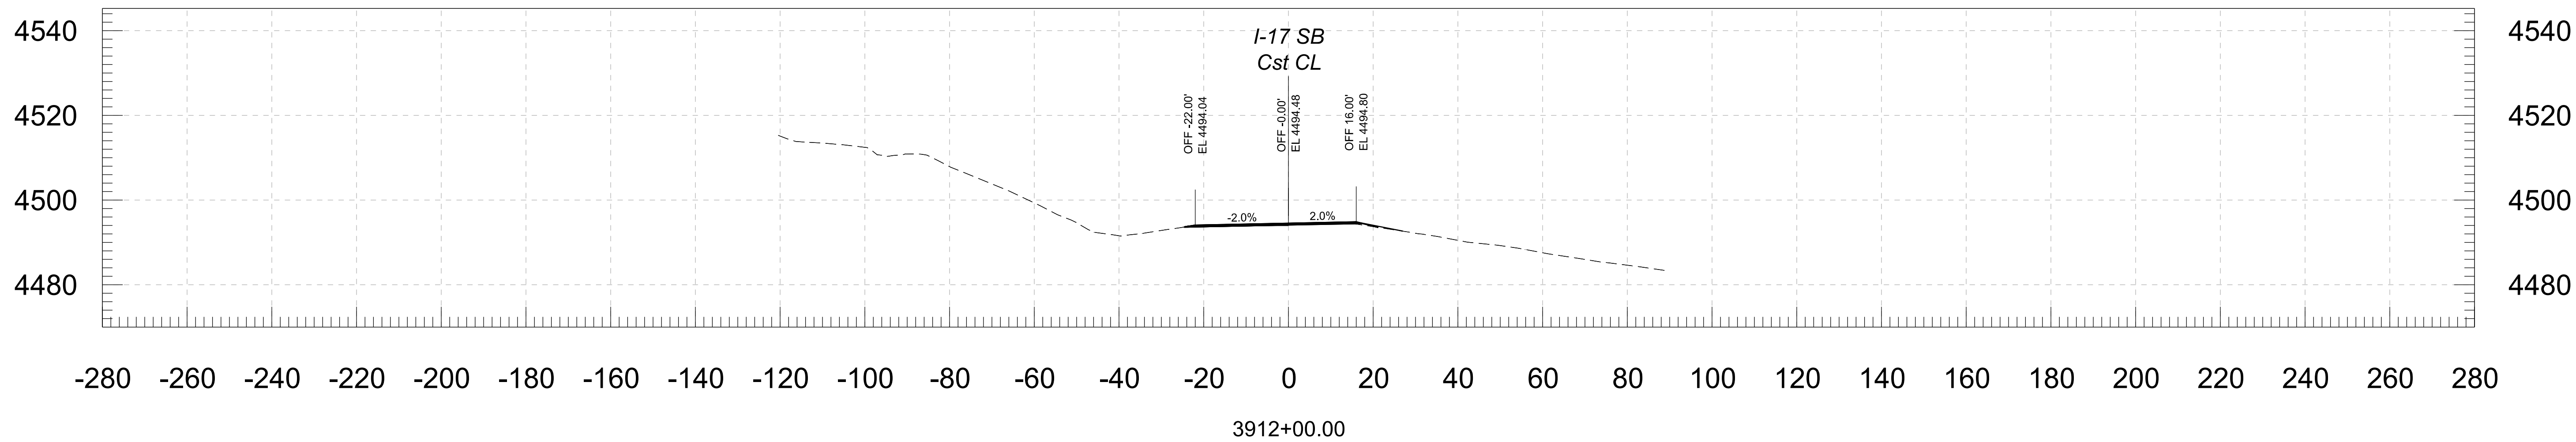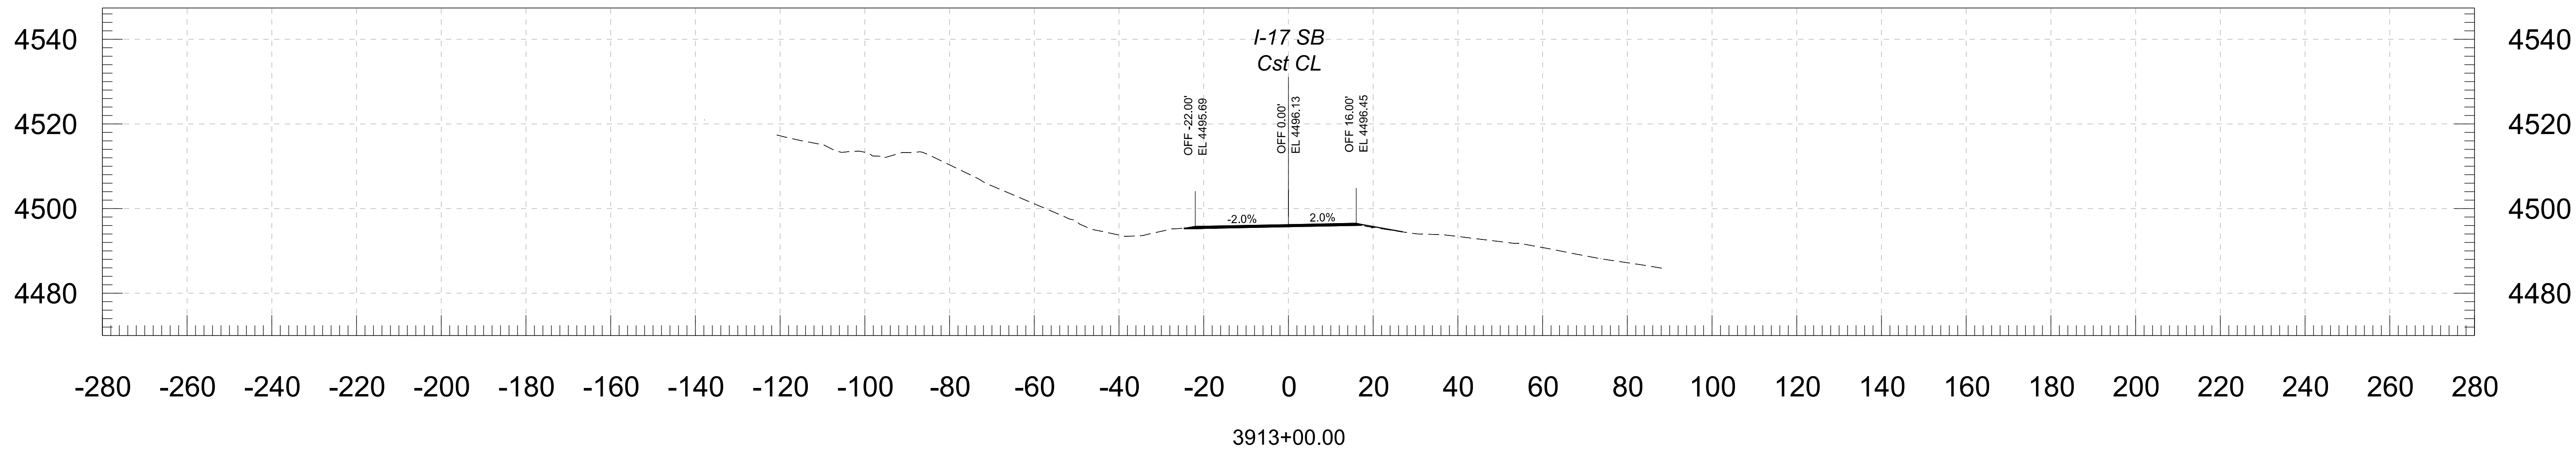 





				NAME	DATE	ARIZONA DEPARTMENT OF TRANSPORTATION PROJECT DELIVERY AND OPERATIONS DIVISION ROADWAY DESIGN SERVICES	ROUTE	F.H.W.A. Arizona Division	STATE	PROJECT NO.	FEDERAL ID NO.	SHEET NO.	TOTAL SHEETS	RECORD DRAWING		
			DESIGN	BAP	06/26		I-17			017 YV 269	017-B(239)T	132	146			
			DRAWN	RM	06/26		MILEPOST	E DUGAS ROAD - MP 275								DWG NO.
			CHECKED	KCH	06/26		STRUCTURE NO.	TRACS NO. F0616 01C		OF						
			 3133 East Camelback Road, Suite 100 Phoenix, Arizona 85016 Phone: 602.333.2000				CROSS SECTION									

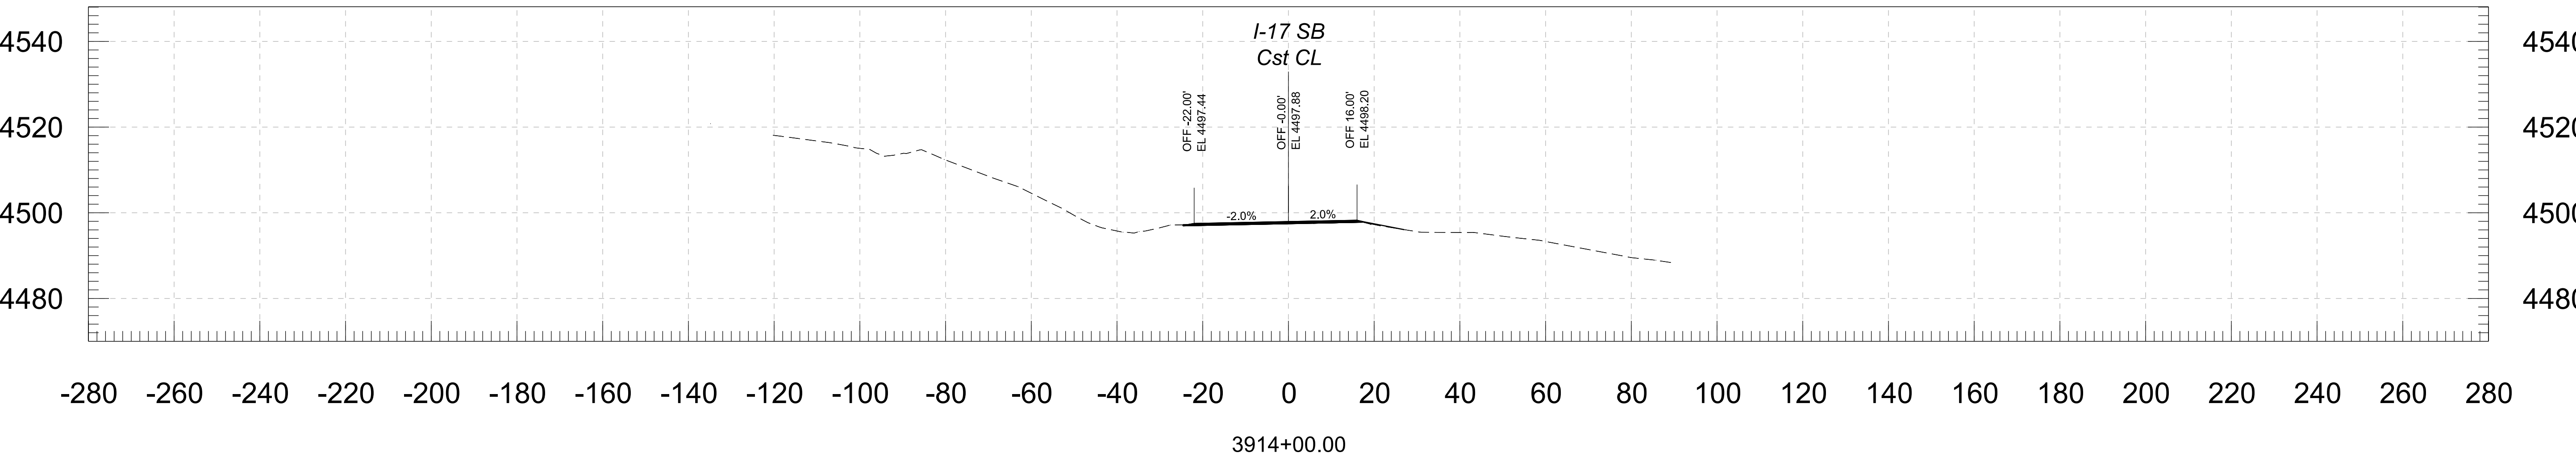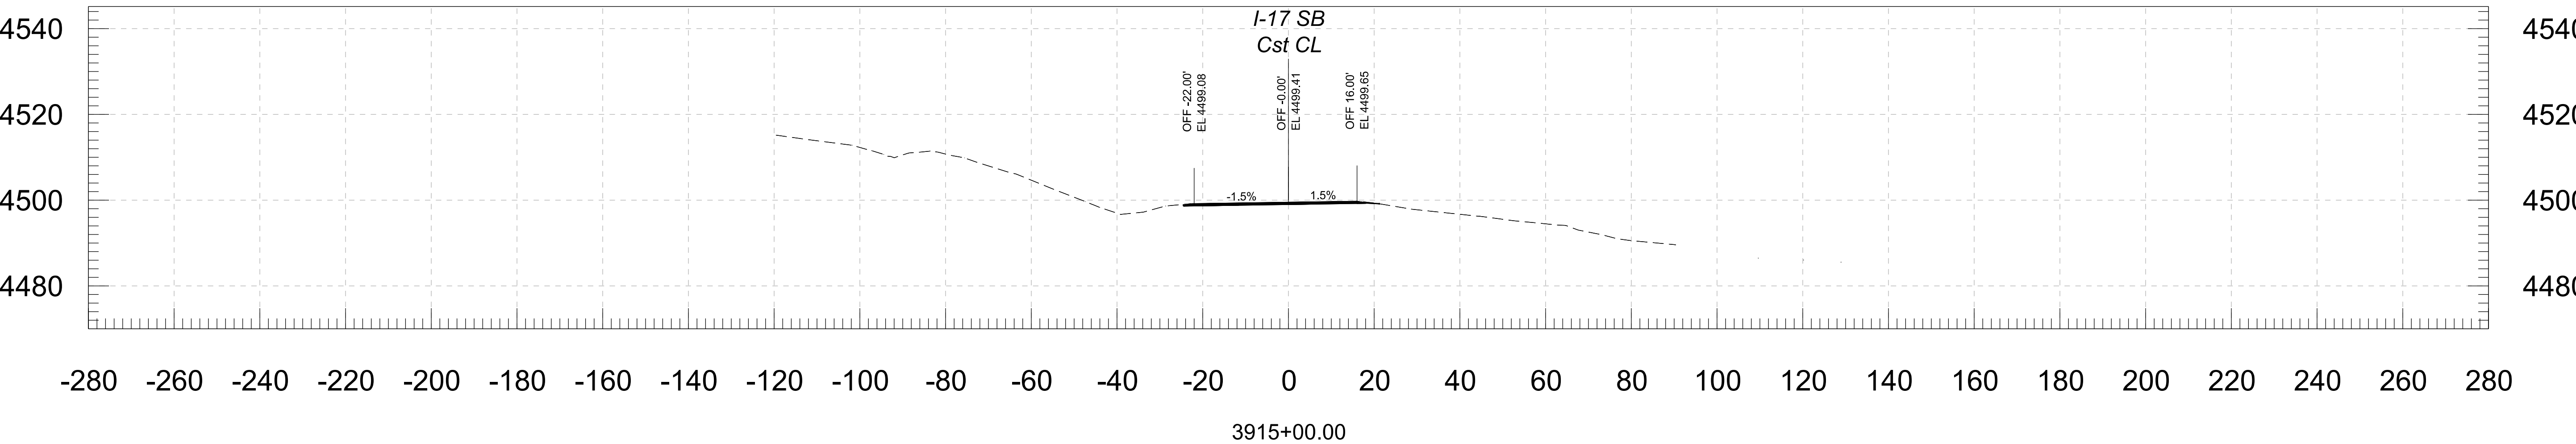




		Stanley Consultants INC.		NAME	DATE	ARIZONA DEPARTMENT OF TRANSPORTATION PROJECT DELIVERY AND OPERATIONS DIVISION ROADWAY DESIGN SERVICES	ROUTE	F.H.W.A. Arizona Division	STATE ARIZ.	PROJECT NO.	FEDERAL ID NO.	SHEET NO.	TOTAL SHEETS	RECORD DRAWING
			DESIGN	BAP	06/26		MILEPOST			LOCATION	E DUGAS ROAD - MP 275	DWG NO.		
			DRAWN	RM	06/26									
			CHECKED	KCH	06/26									
			Stanley Consultants INC.			CROSS SECTION	STRUCTURE NO.	TRACS NO. F0616 01C		OF				

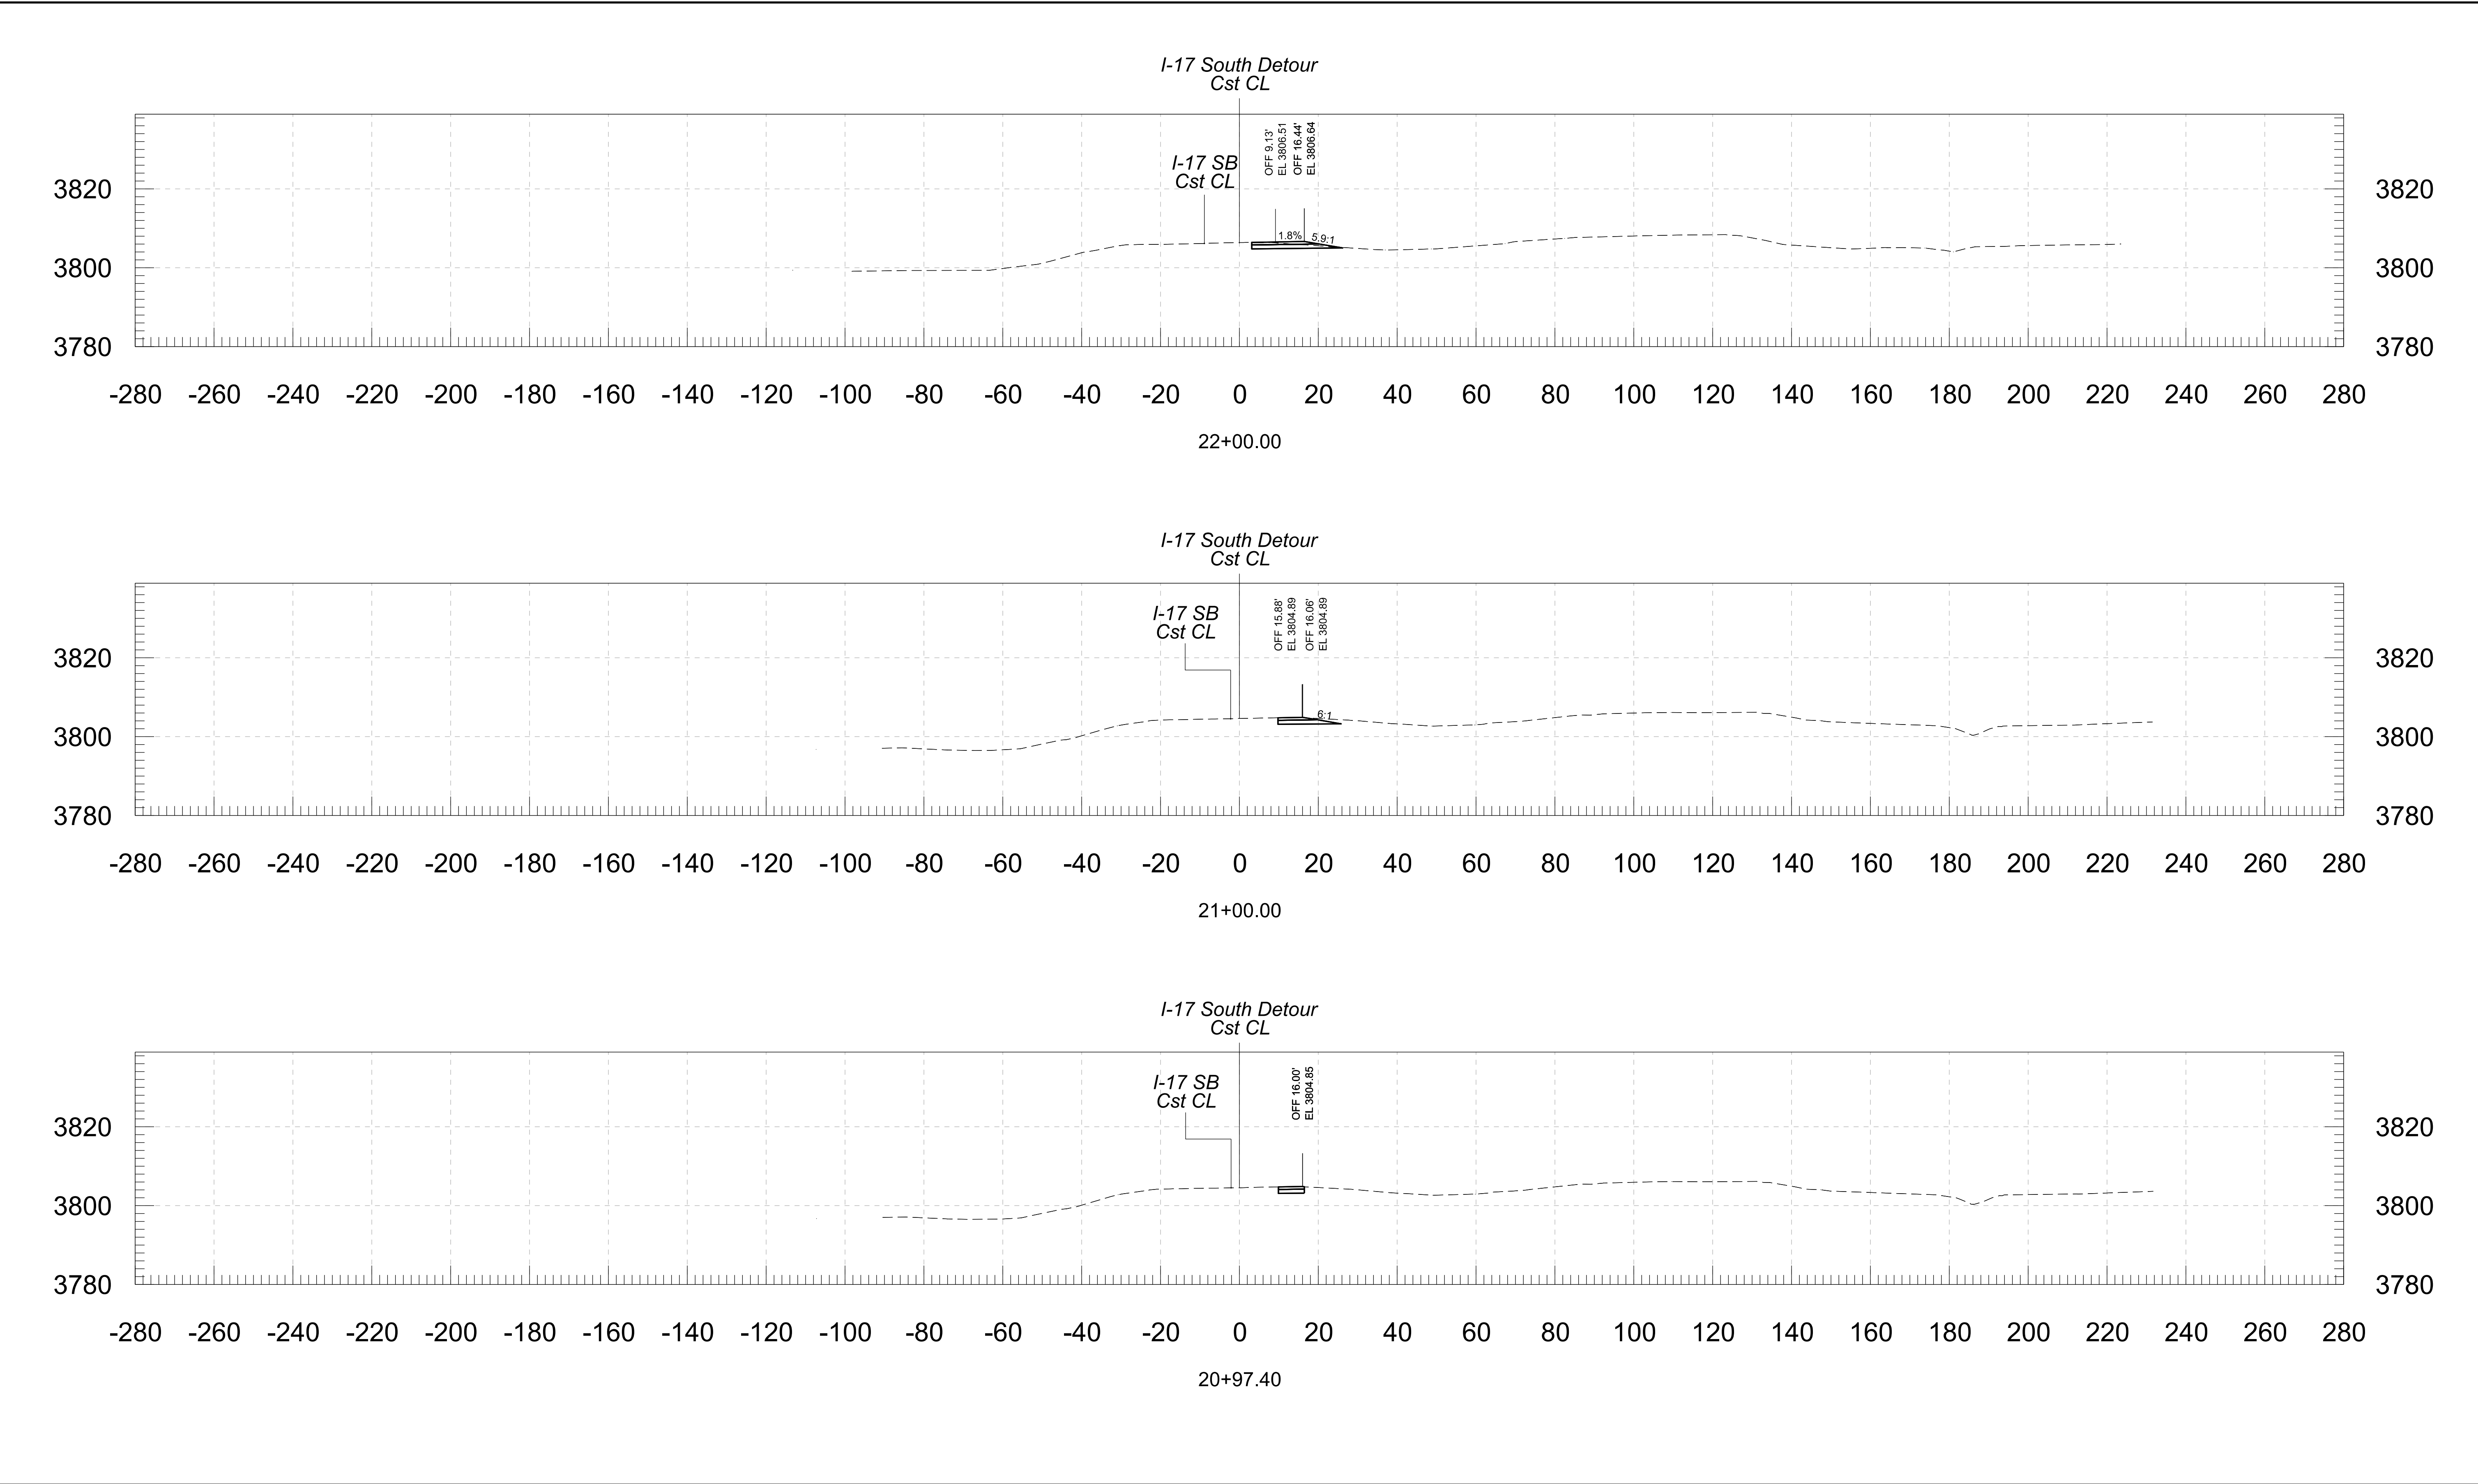


				NAME	DATE	ARIZONA DEPARTMENT OF TRANSPORTATION PROJECT DELIVERY AND OPERATIONS DIVISION ROADWAY DESIGN SERVICES	ROUTE	F.H.W.A. Arizona Division	STATE ARIZ.	PROJECT NO.	FEDERAL ID NO.	SHEET NO.	TOTAL SHEETS	RECORD DRAWING
			DESIGN	BAP	06/26		I-17			017 YV 269	017-B(239)T	134	146	
			DRAWN	RM	06/26									
			CHECKED	KCH	06/26									
			 3133 East Camelback Road, Suite 100 Phoenix, Arizona 85016 Phone: 602.333-2200 Stanley Consultants INC.											
						STRUCTURE NO.	TRACS NO. F0616 01C				____ OF ____			

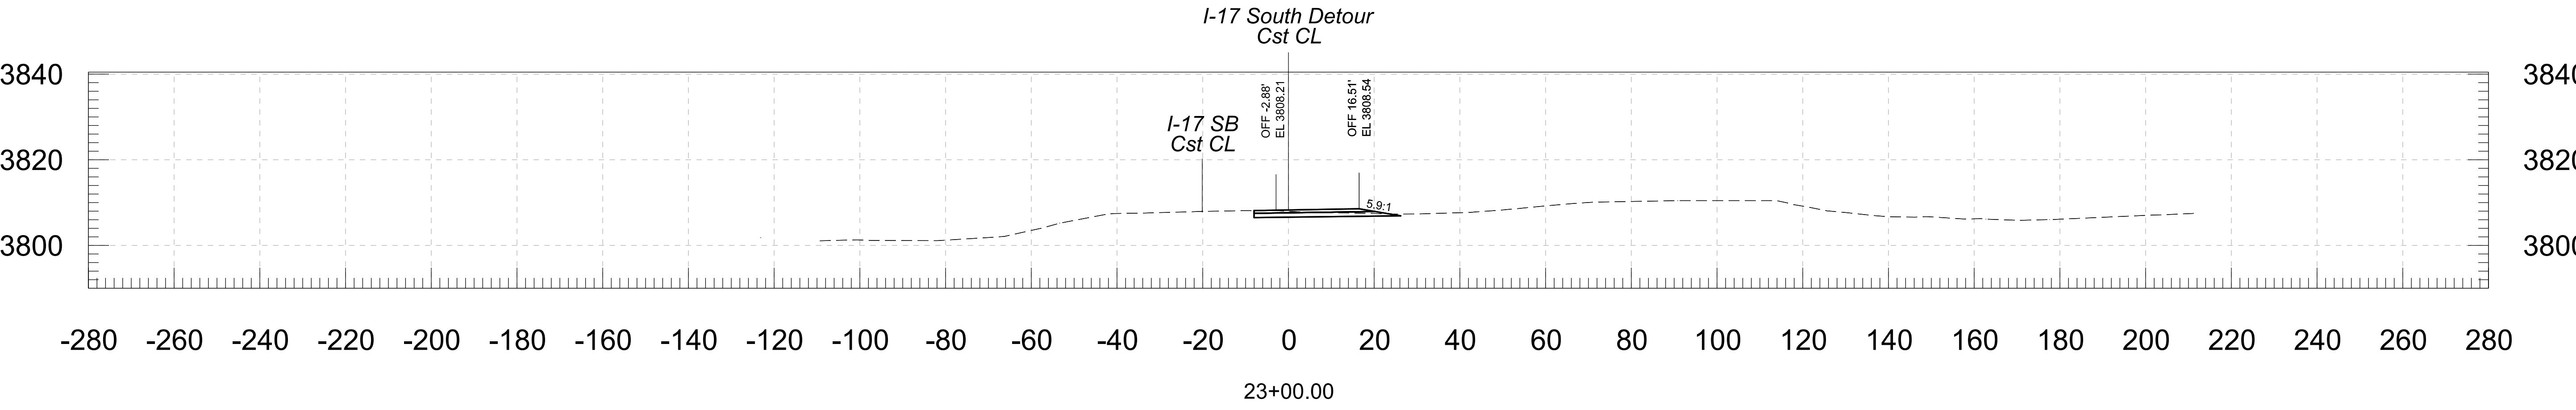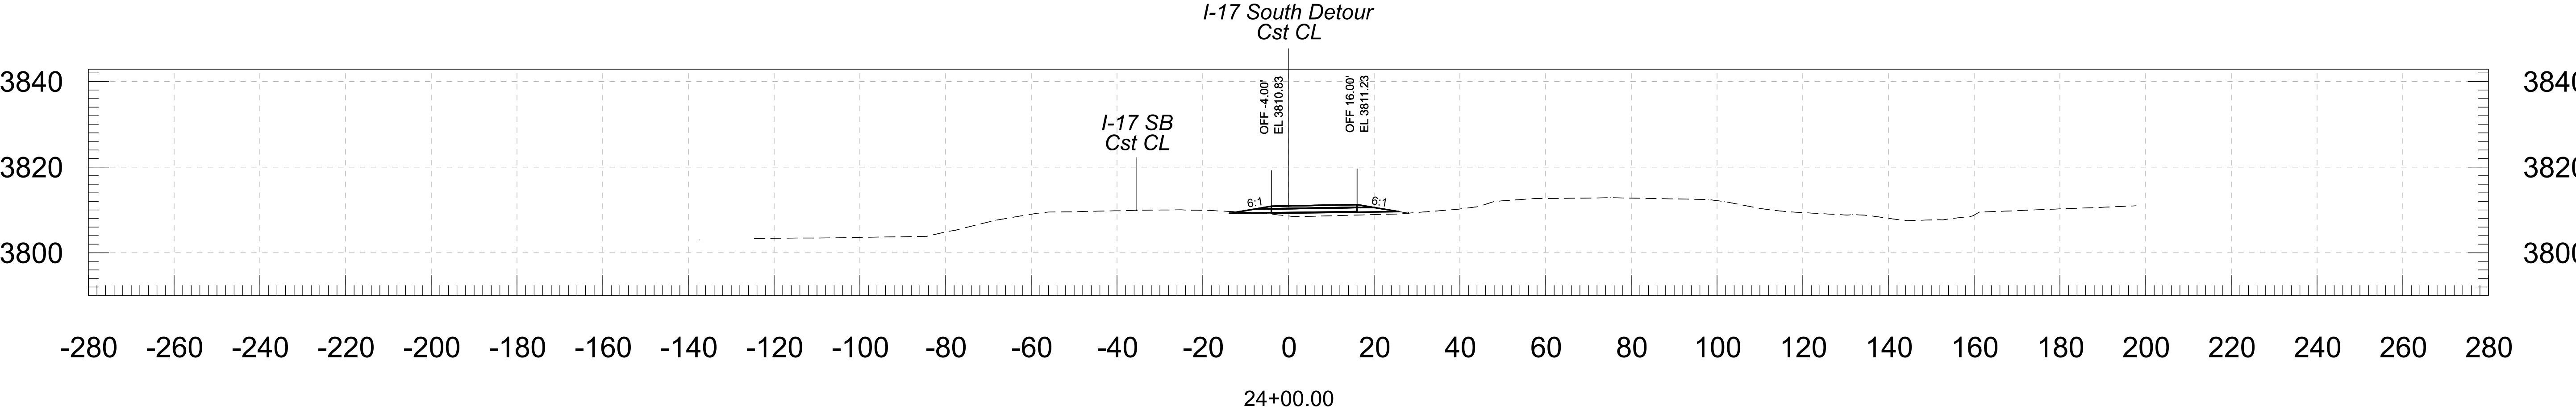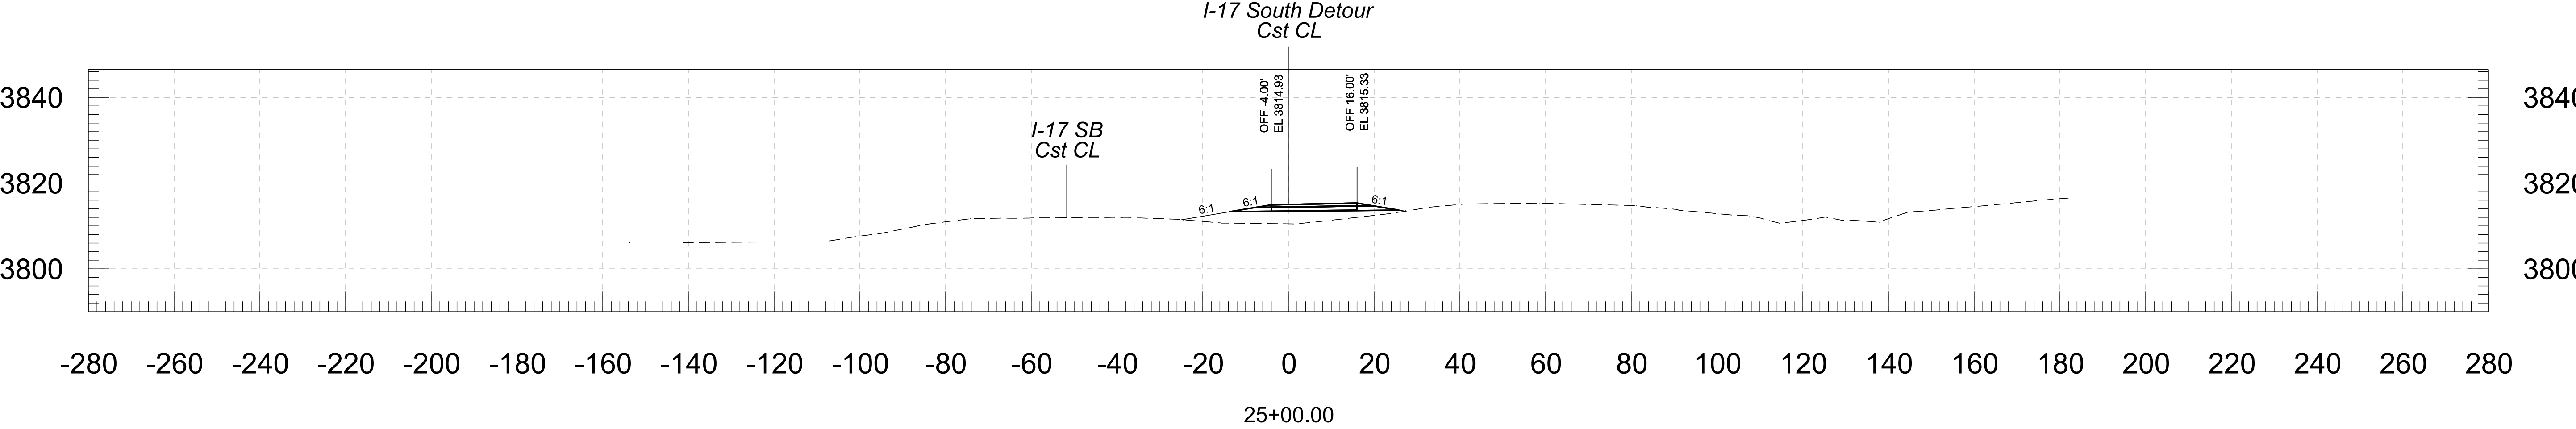

					ARIZONA DEPARTMENT OF TRANSPORTATION PROJECT DELIVERY AND OPERATIONS DIVISION ROADWAY DESIGN SERVICES	ROUTE	F.H.W.A. Arizona Division	STATE	PROJECT NO.	FEDERAL ID NO.	SHEET NO.	TOTAL SHEETS	RECORD DRAWING	
		DESIGN	BAP	06/26		I-17		ARIZ.	017 YV 269	017-B(239)T	135	146		
		DRAWN	RM	06/26		MILEPOST	LOCATION							
		CHECKED	KCH	06/26			E DUGAS ROAD - MP 275							
		 Stanley Consultants INC. 3133 East Camelback Road, Suite 100 Phoenix, Arizona 85016 Phone: 1602 333-2200			CROSS SECTION			STRUCTURE NO.	TRACS NO. F0616 01C				DWG NO.	
										____ OF ____				

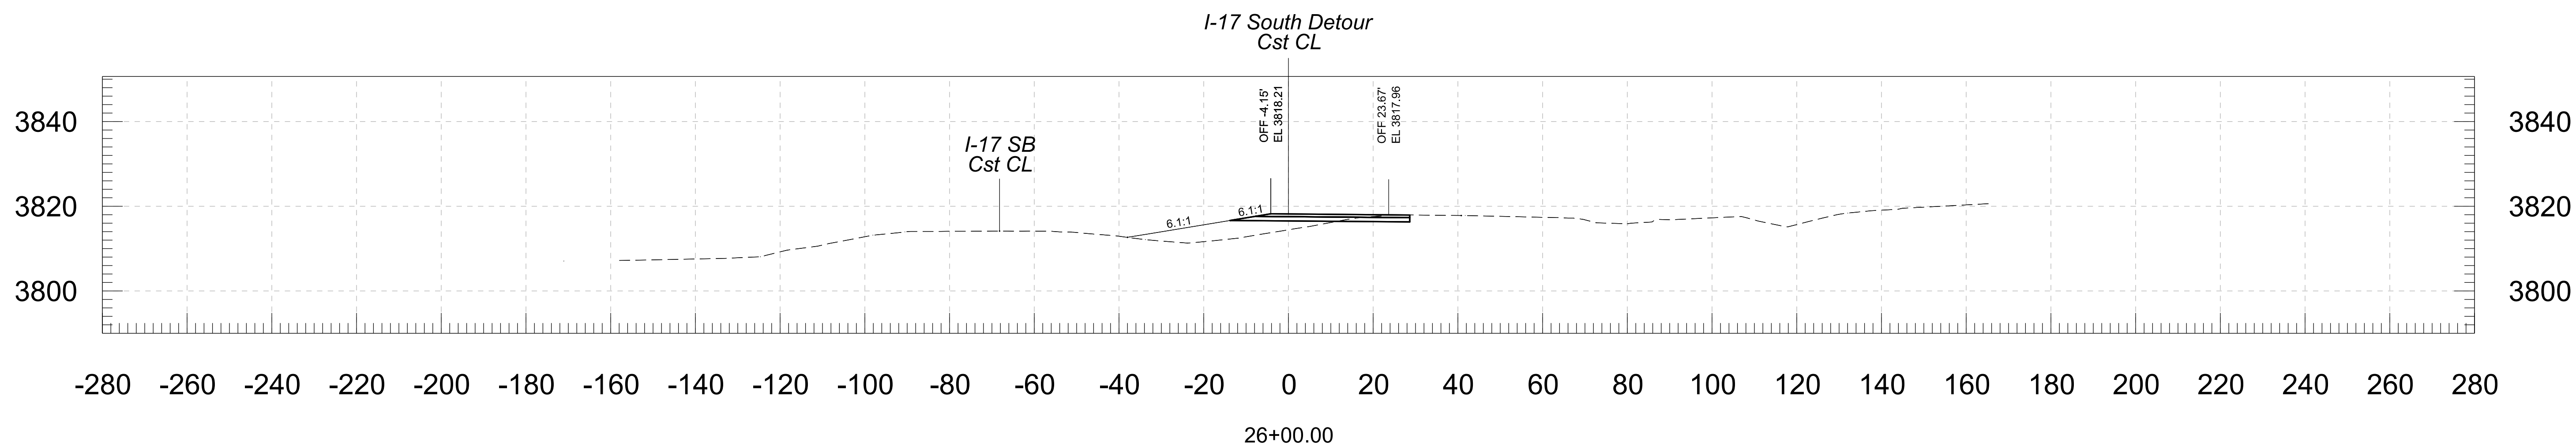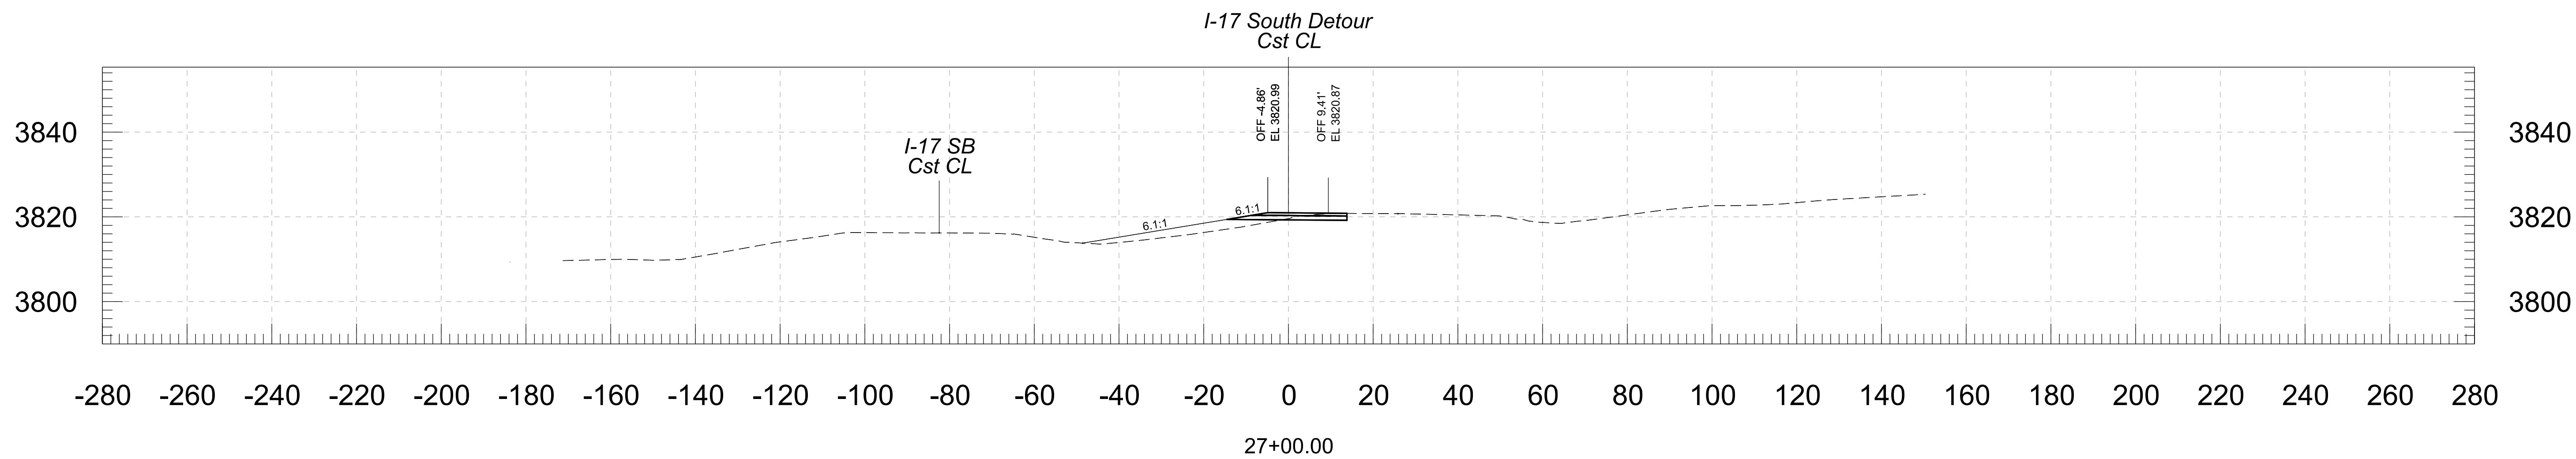
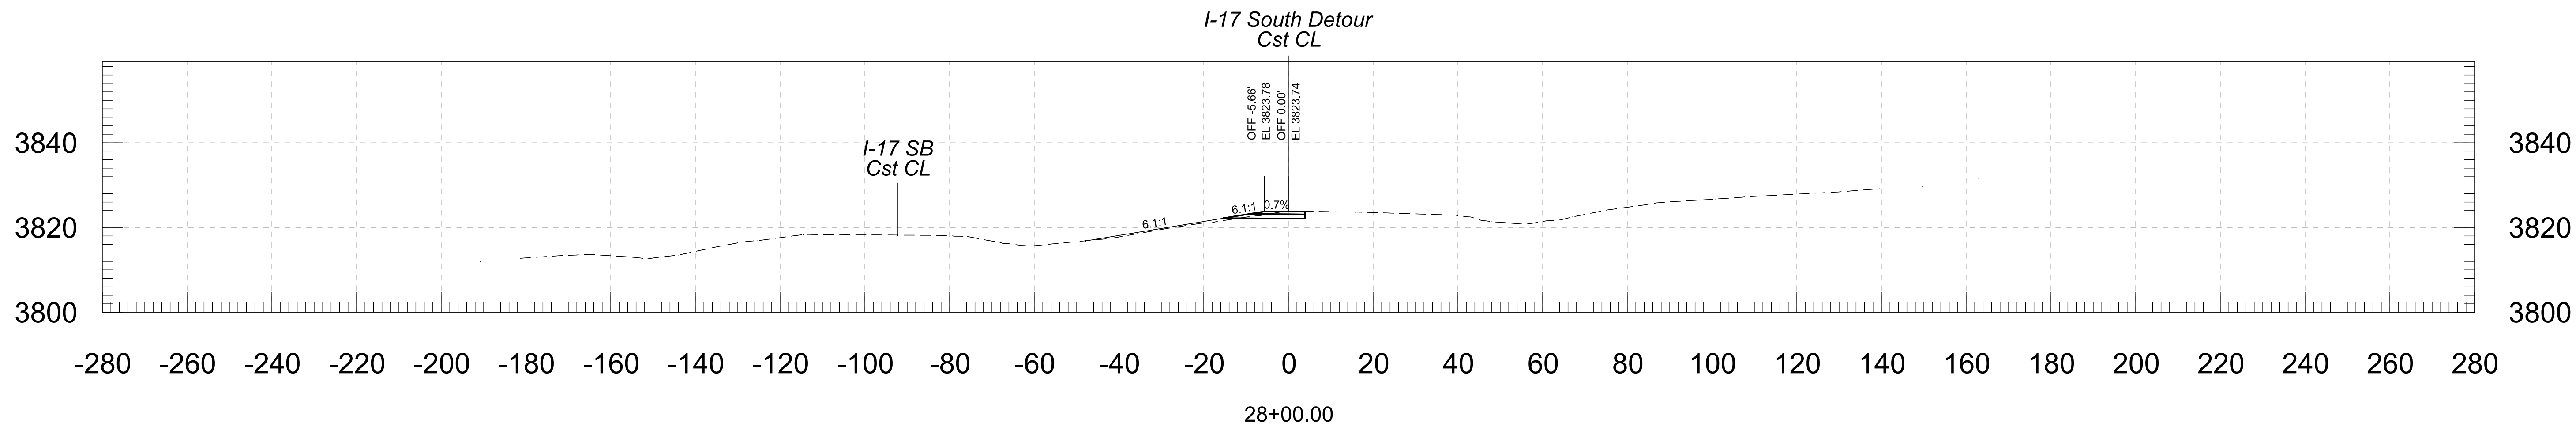


				NAME	DATE	ARIZONA DEPARTMENT OF TRANSPORTATION PROJECT DELIVERY AND OPERATIONS DIVISION ROADWAY DESIGN SERVICES	ROUTE	F.H.W.A. Arizona Division	STATE ARIZ.	PROJECT NO.	FEDERAL ID NO.	SHEET NO.	TOTAL SHEETS	RECORD DRAWING
			DESIGN	BAP	06/26		MILEPOST			LOCATION	E DUGAS ROAD - MP 275	DWG NO.		
			DRAWN	RM	06/26			STRUCTURE NO.	TRACS NO. F0616 01C					OF
			CHECKED	KCH	06/26									
			 3133 East Camelback Road, Suite 100 Phoenix, Arizona 85016 Phonex (602) 335-2200 Stanley Consultants INC.				CROSS SECTION							


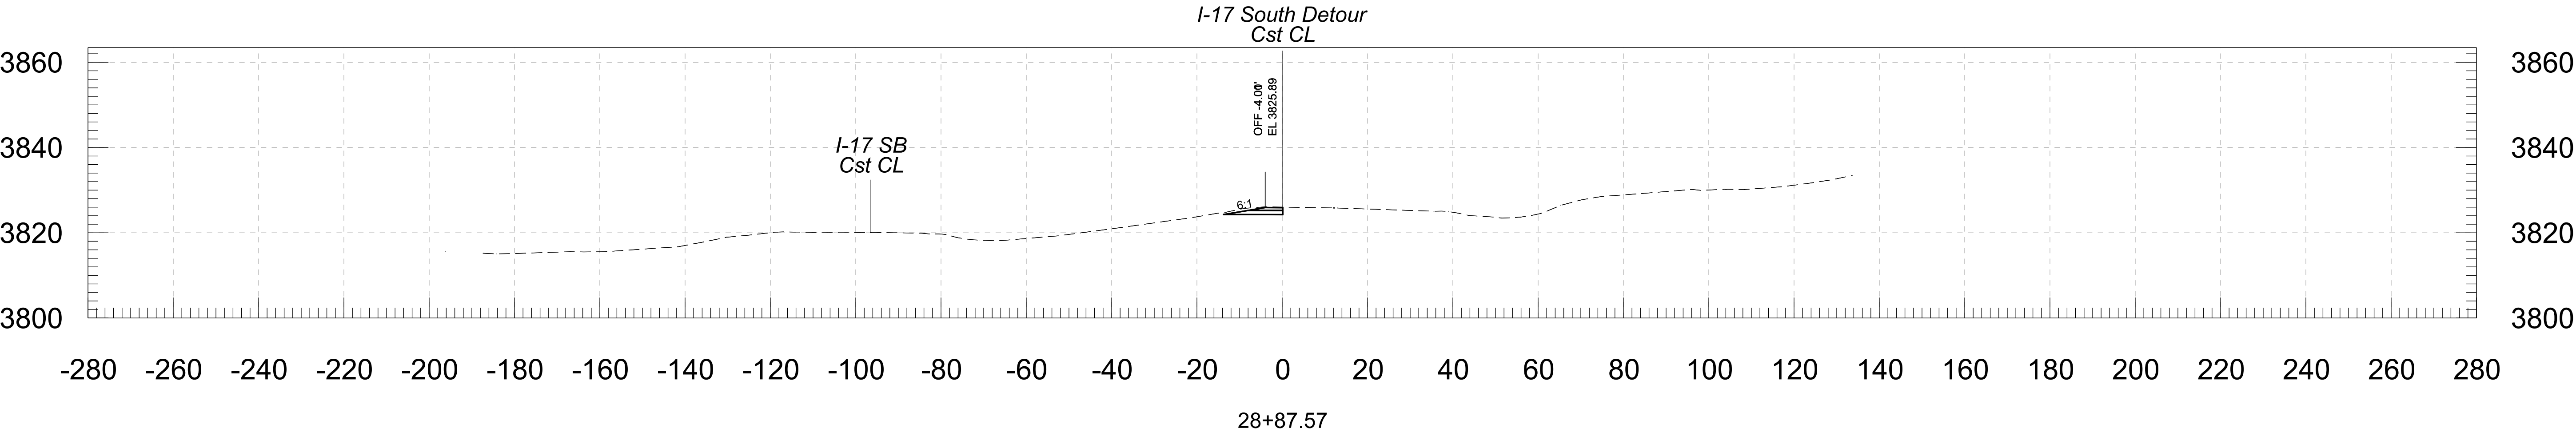


						ARIZONA DEPARTMENT OF TRANSPORTATION PROJECT DELIVERY AND OPERATIONS DIVISION ROADWAY DESIGN SERVICES		ROUTE I-17	F.H.W.A. Arizona Division	STATE ARIZ.	PROJECT NO. 017 YV 269	FEDERAL ID NO. 017-B(239)T	SHEET NO. 137	TOTAL SHEETS 146	RECORD DRAWING
						CROSS SECTION		MILEPOST	E DUGAS ROAD - MP 275					DWG NO.	
								STRUCTURE NO.	TRACS NO. F0616 01C					____ OF ____	



	NAME	DATE
DESIGN	BAP	06/26
DRAWN	RM	06/26
CHECKED	KCH	06/26
 3133 East Camelback Road, Suite 100 Phoenix, Arizona 85016 Phone: 1602) 333-2200		

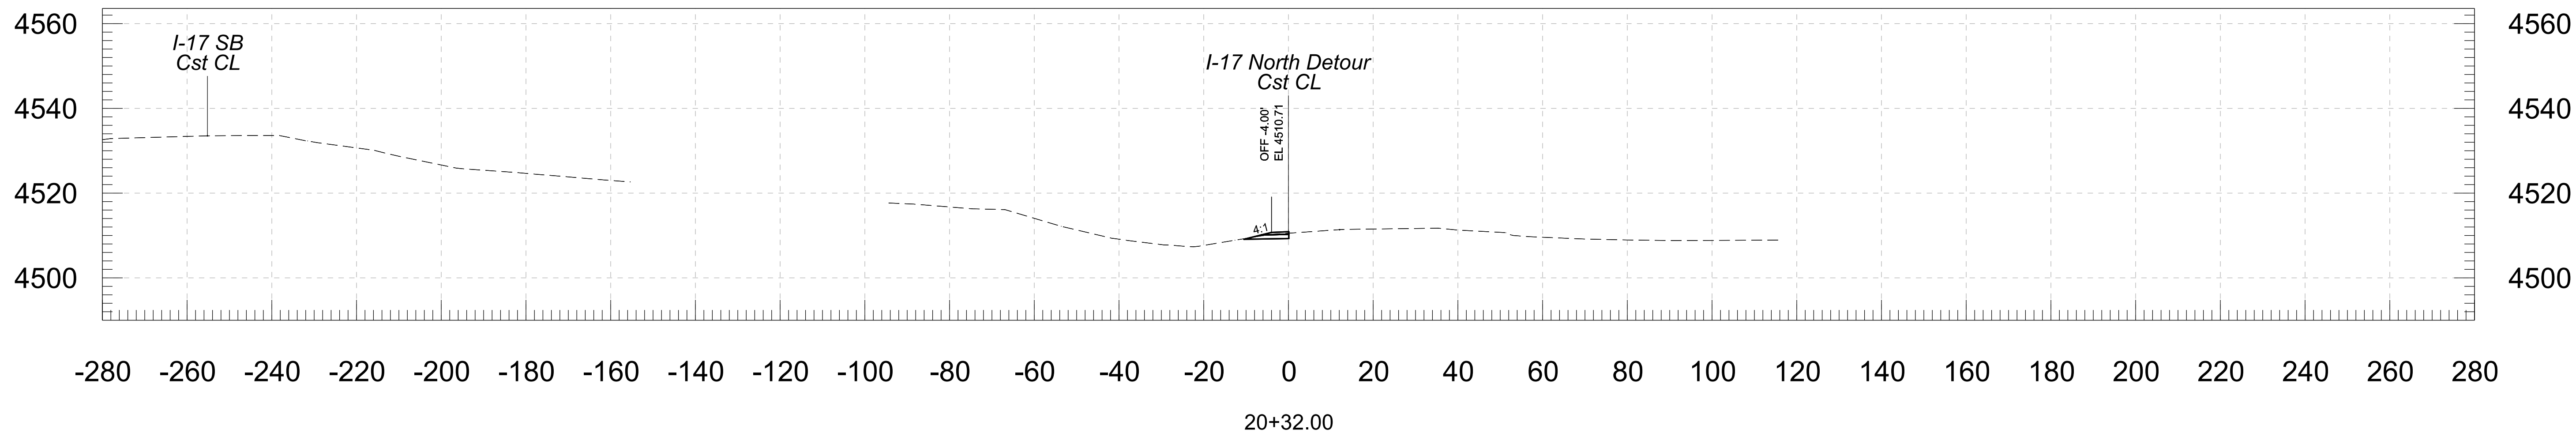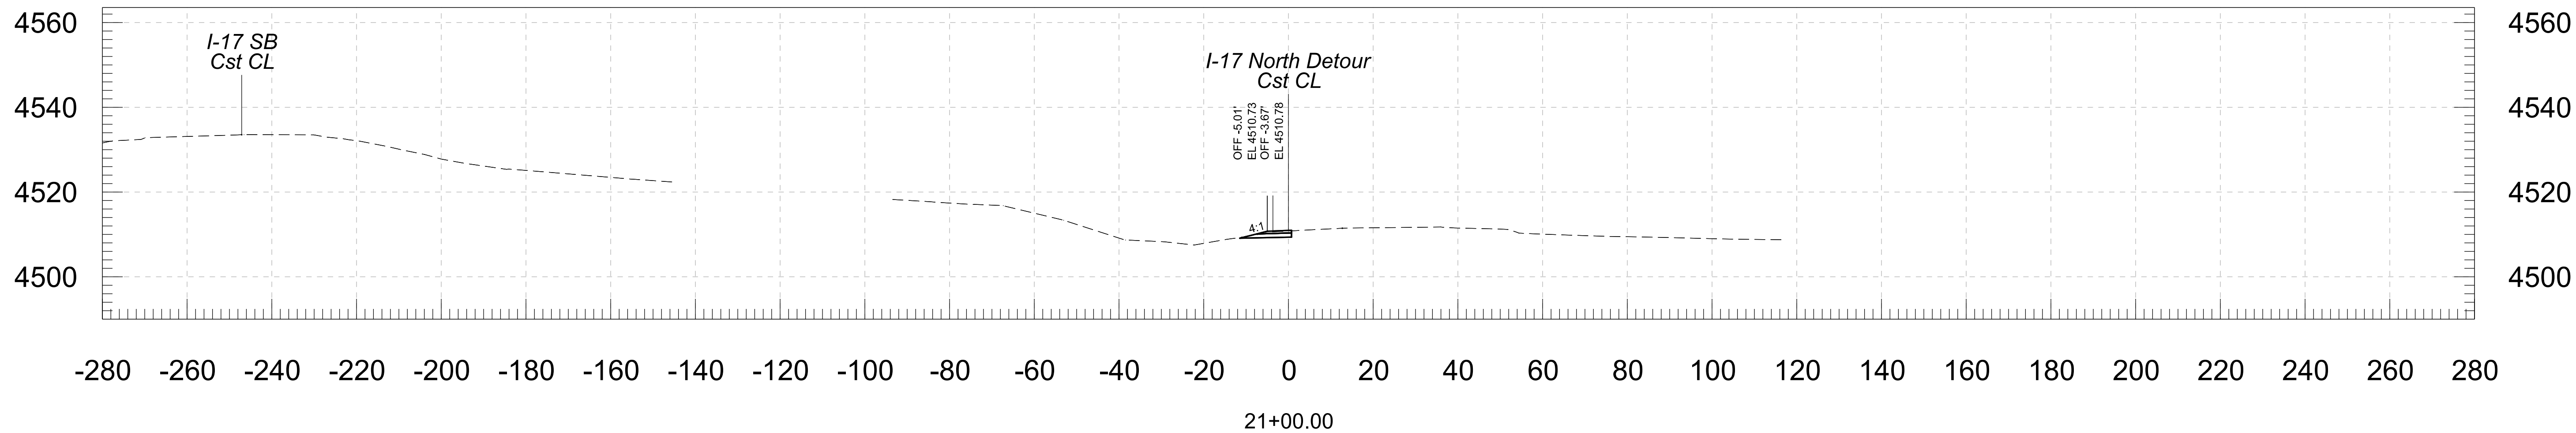



				NAME	DATE	ARIZONA DEPARTMENT OF TRANSPORTATION PROJECT DELIVERY AND OPERATIONS DIVISION ROADWAY DESIGN SERVICES	ROUTE	F.H.W.A. Arizona Division	STATE	PROJECT NO.	FEDERAL ID NO.	SHEET NO.	TOTAL SHEETS	RECORD DRAWING	
			DESIGN	BAP	06/26		I-17			ARIZ.	017 YV 269	017-B(239)T	138		146
			DRAWN	RM	06/26			LOCATION	E DUGAS ROAD - MP 275					DWG NO.	
			CHECKED	KCH	06/26										
 3133 East Camelback Road, Suite 100 Phoenix, Arizona 85016 Phone: 602) 333-2200 Stanley Consultants INC.			CROSS SECTION												

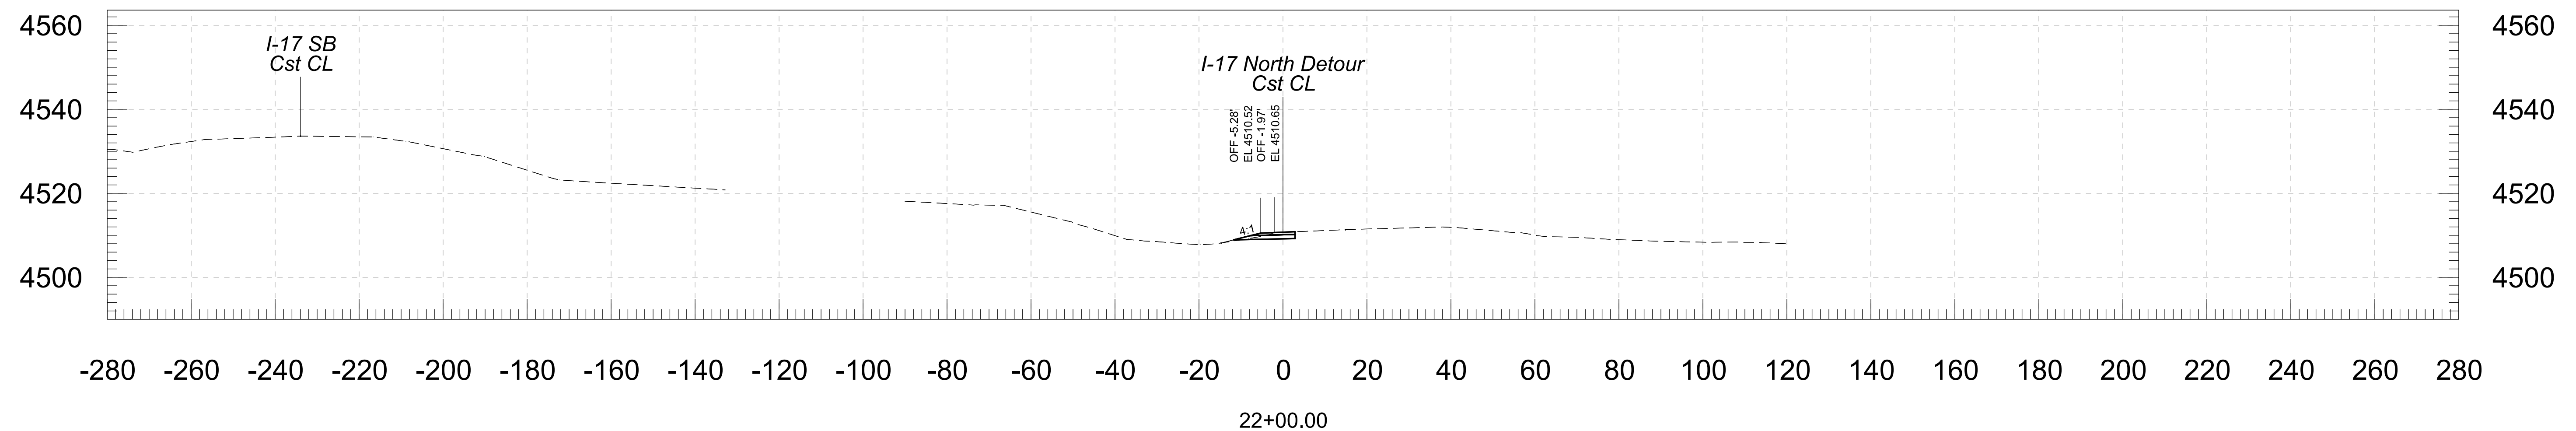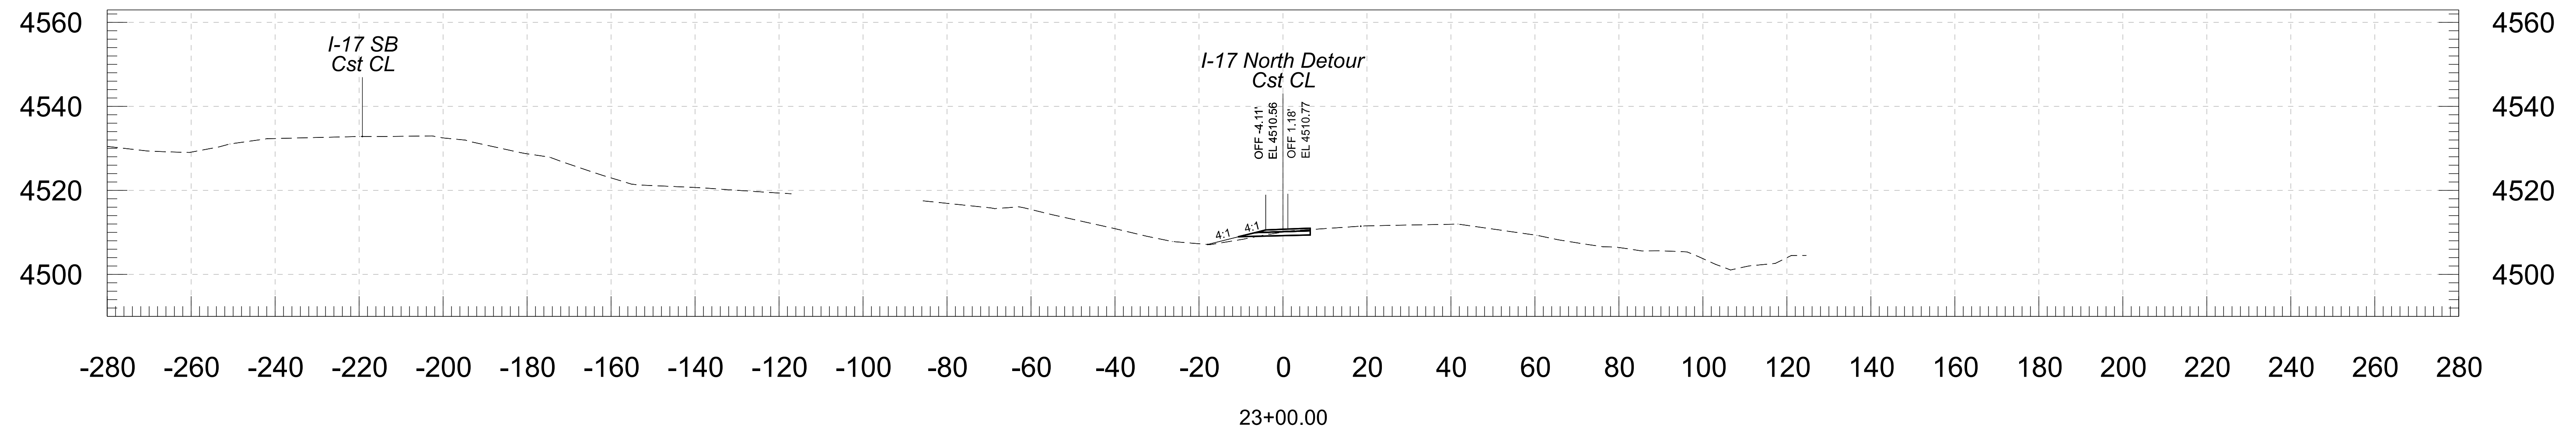



--	--	
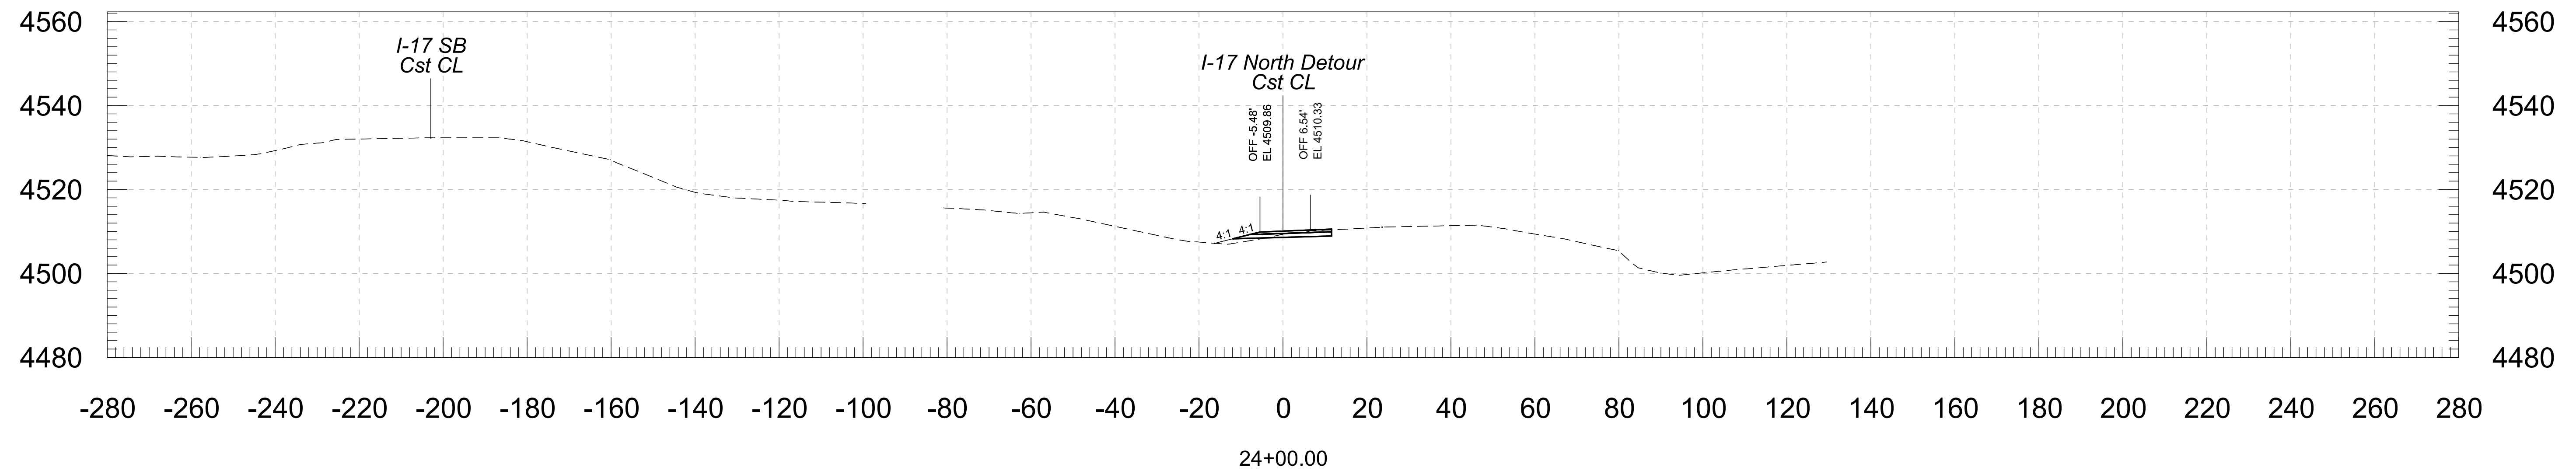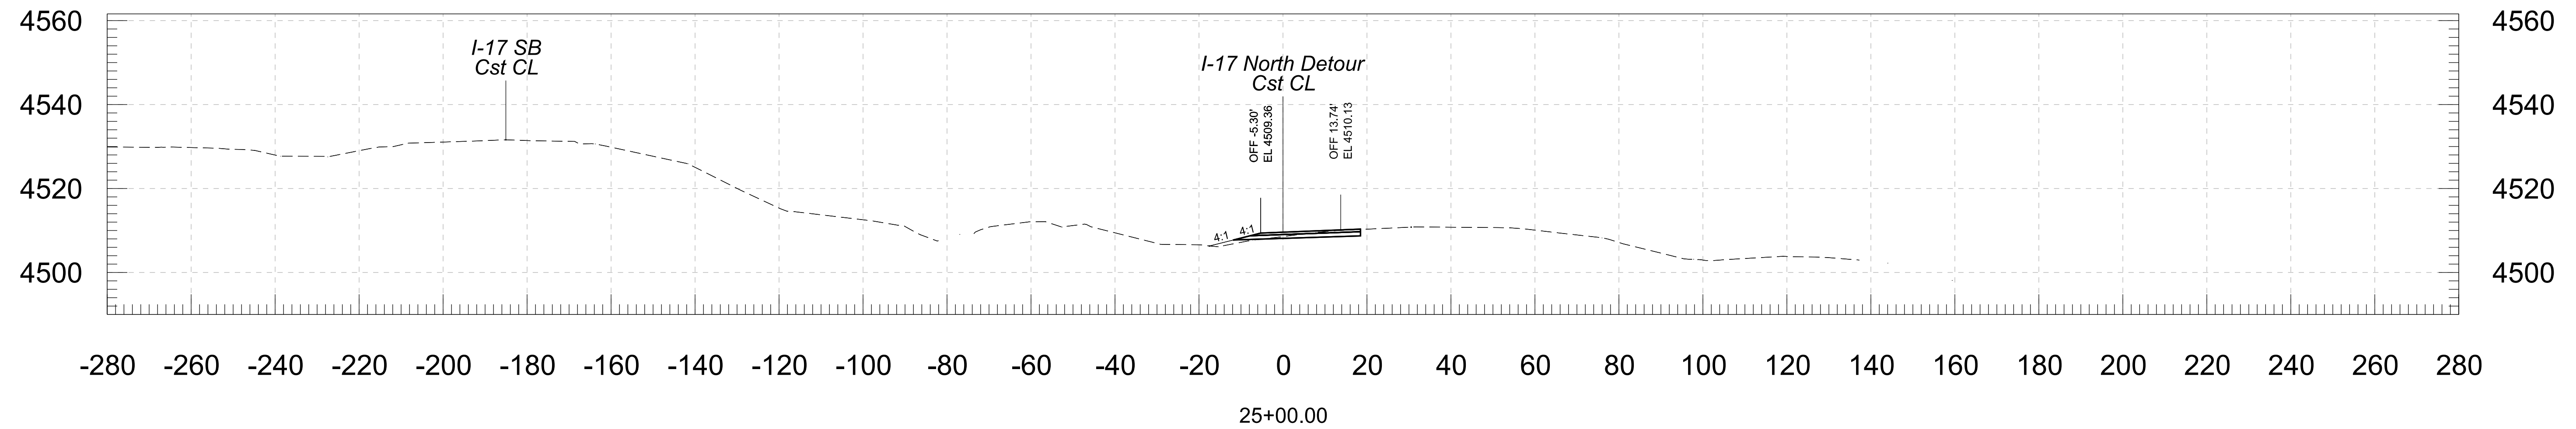

--	--	
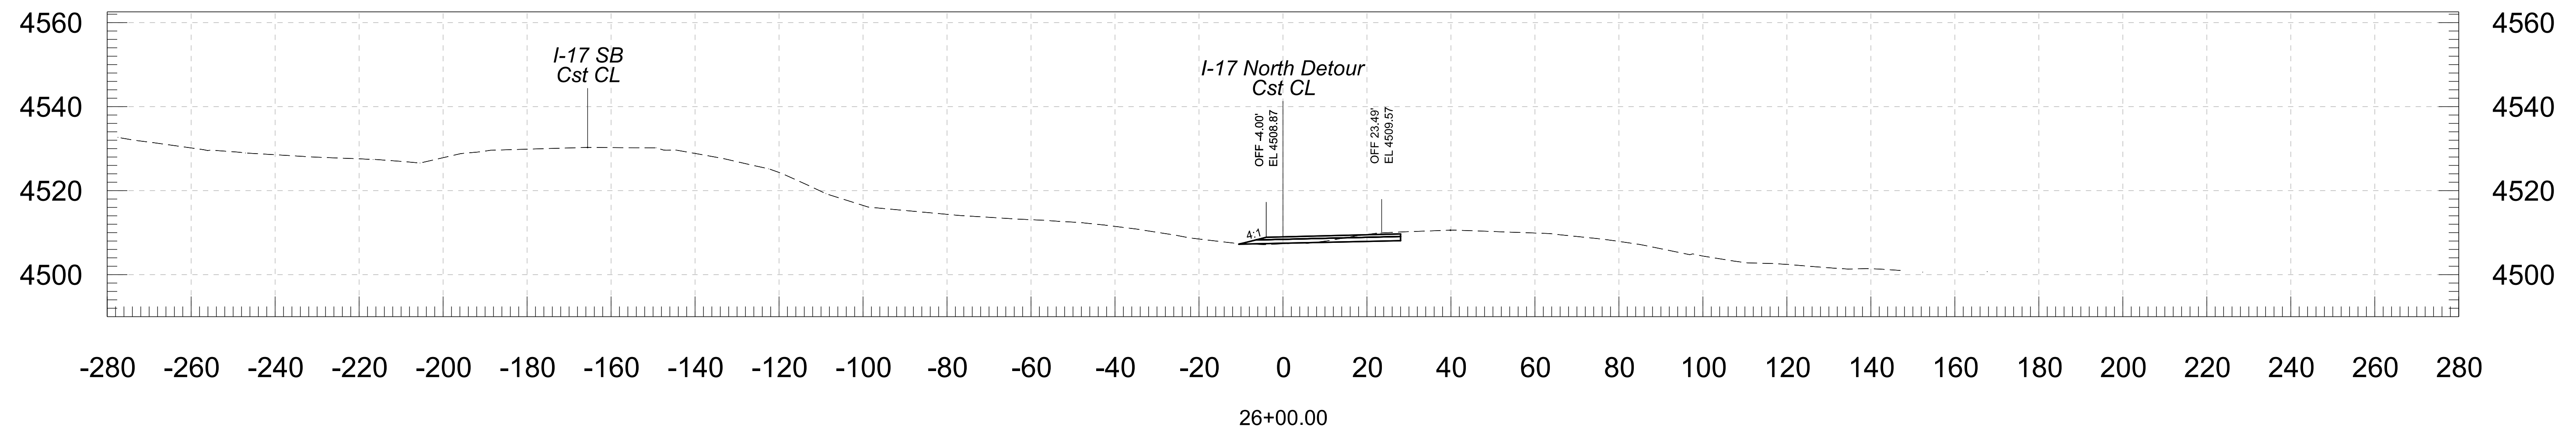
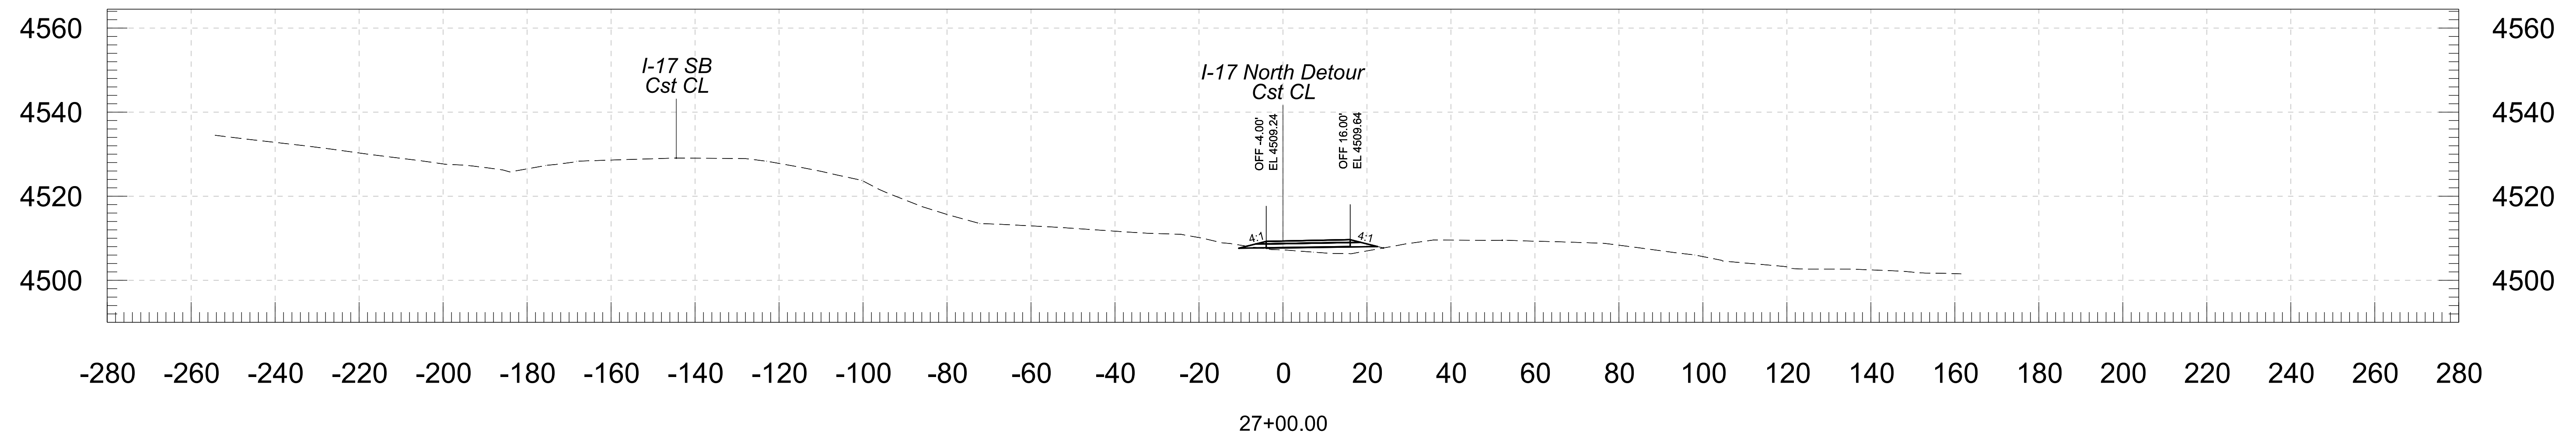


				NAME		DATE	ARIZONA DEPARTMENT OF TRANSPORTATION PROJECT DELIVERY AND OPERATIONS DIVISION ROADWAY DESIGN SERVICES	ROUTE	F.H.W.A. Arizona Division	STATE ARIZ.	PROJECT NO.	FEDERAL ID NO.	SHEET NO.	TOTAL SHEETS	RECORD DRAWING						
				DESIGN	BAP	06/26		I-17			017 YV 269	017-B(239)T	141	146							
				DRAWN	RM	06/26															
				CHECKED	KCH	06/26															
				 3133 East Camelback Road, Suite 100 Phoenix, Arizona 85016 Phone: (602) 333-2200 Stanley Consultants INC.				CROSS SECTION			MILEPOST	LOCATION E DUGAS ROAD - MP 275							DWG NO.		
												STRUCTURE NO.	TRACS NO. F0616 01C				___ OF ___				

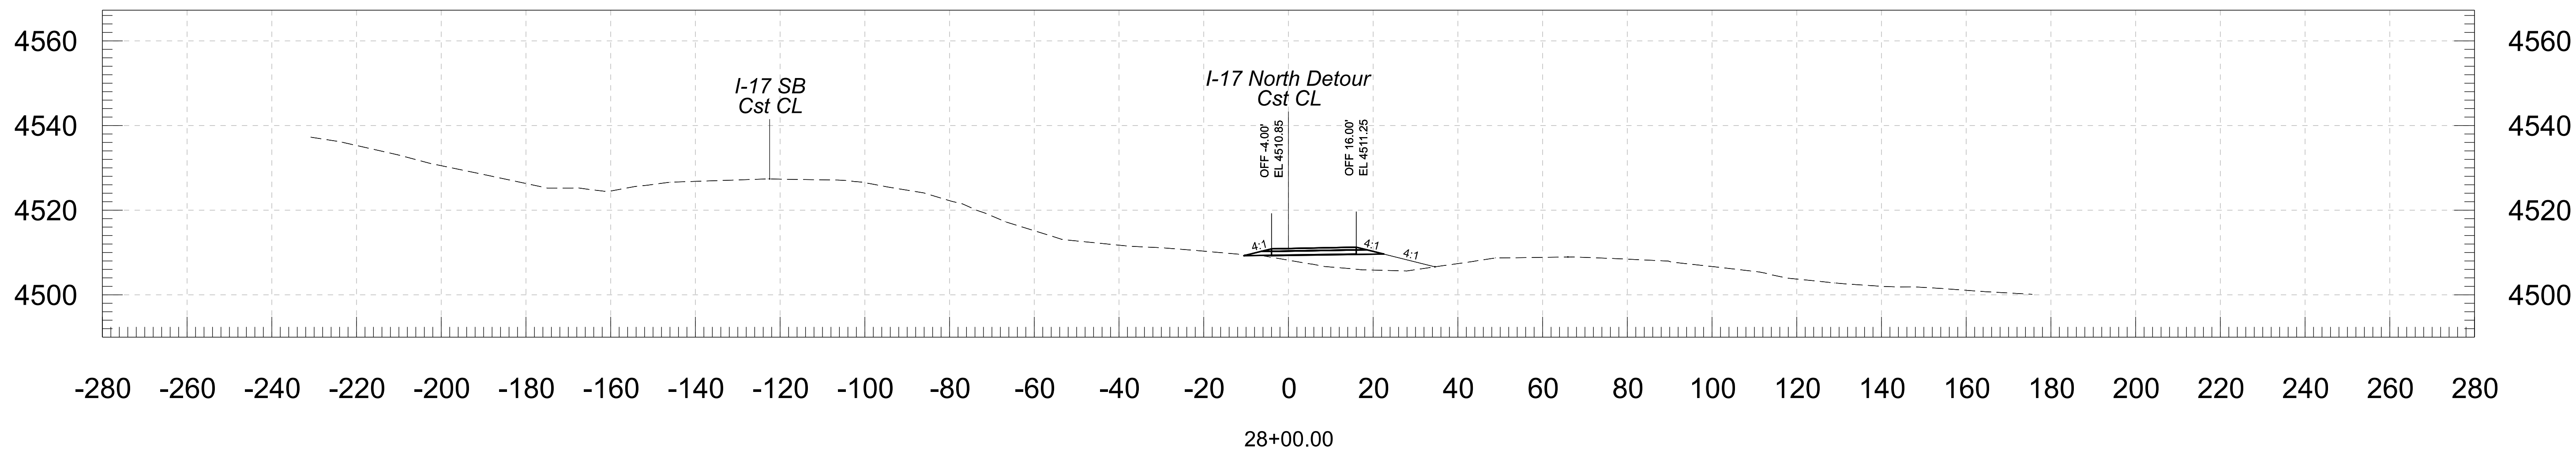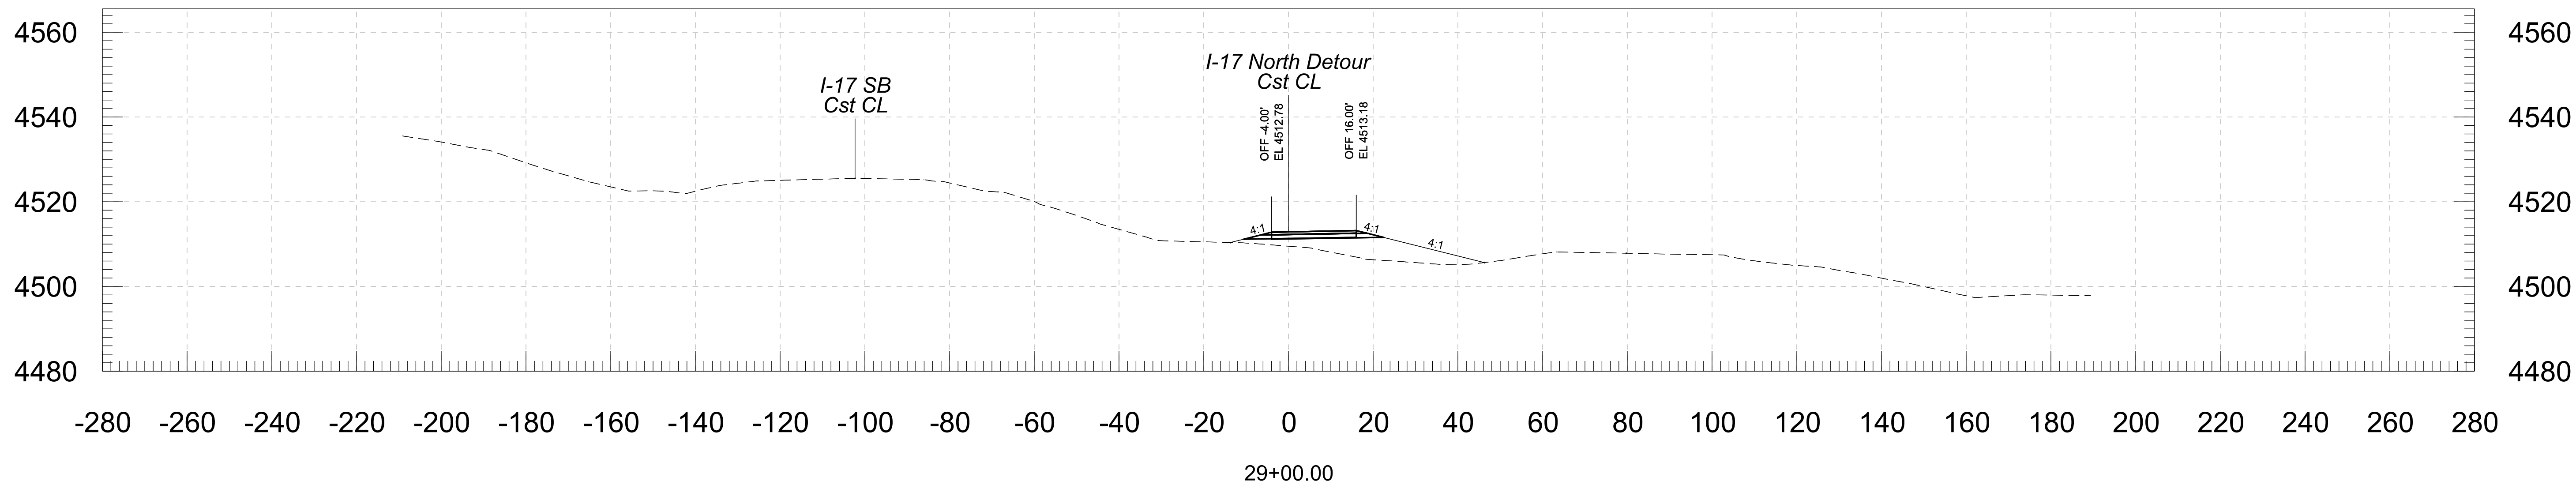


 
				NAME	DATE	ARIZONA DEPARTMENT OF TRANSPORTATION PROJECT DELIVERY AND OPERATIONS DIVISION ROADWAY DESIGN SERVICES	ROUTE	F.H.W.A. Arizona Division	STATE	PROJECT NO.	FEDERAL ID NO.	SHEET NO.	TOTAL SHEETS	RECORD DRAWING
			DESIGN	BAP	06/26		I-17			017 YV 269	017-B(239)T	142	146	
			DRAWN	RM	06/26			MILEPOST	E DUGAS ROAD - MP 275				DWG NO.	
			CHECKED	KCH	06/26			STRUCTURE NO.	TRACS NO. F0616 01C					____ OF ____
			 3133 East Camelback Road, Suite 100 Phoenix, Arizona 85016 Phone: 602.333.2000			CROSS SECTION								


 Stanley Consultants INC.
333 East Camelback Road, Suite 100
Phoenix, Arizona 85016
Phone: 602 333-2200

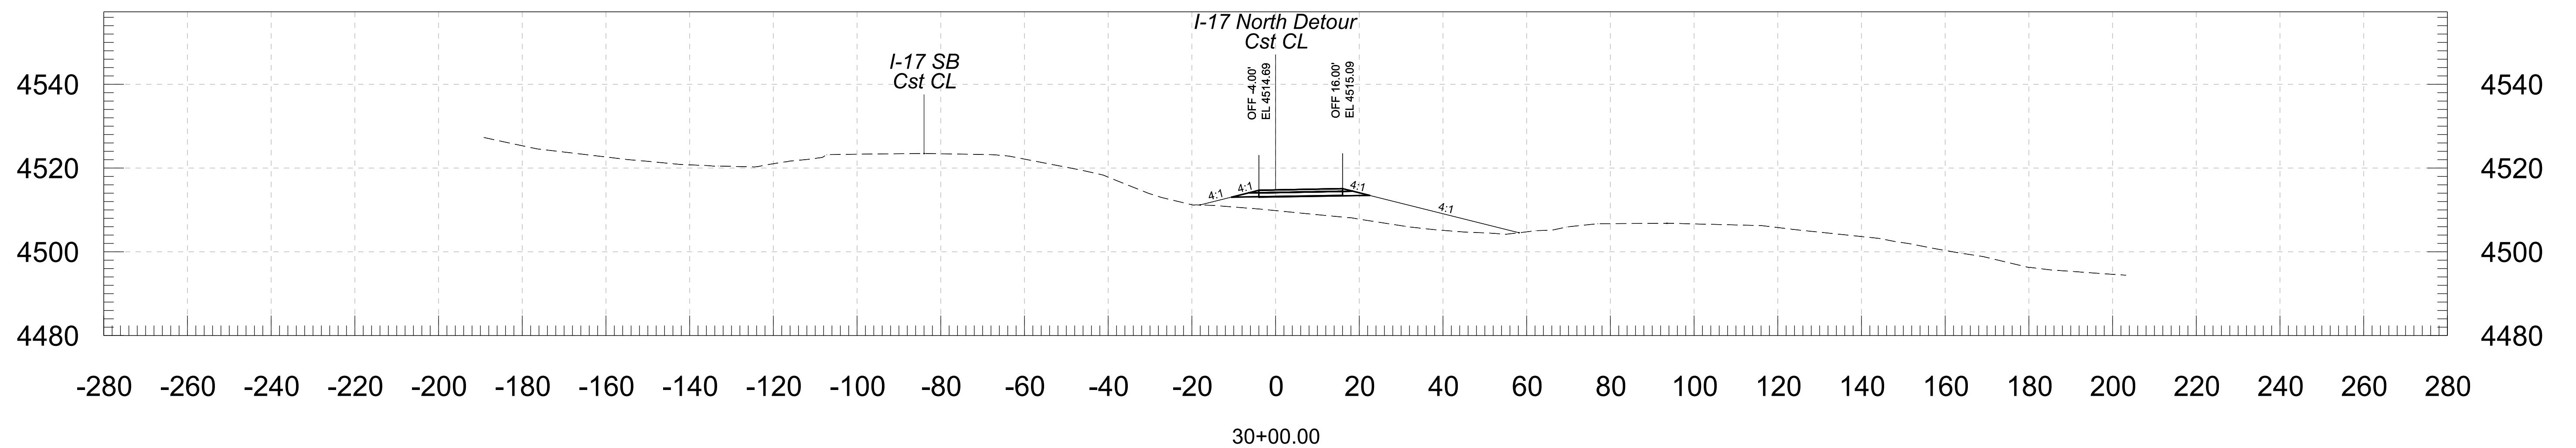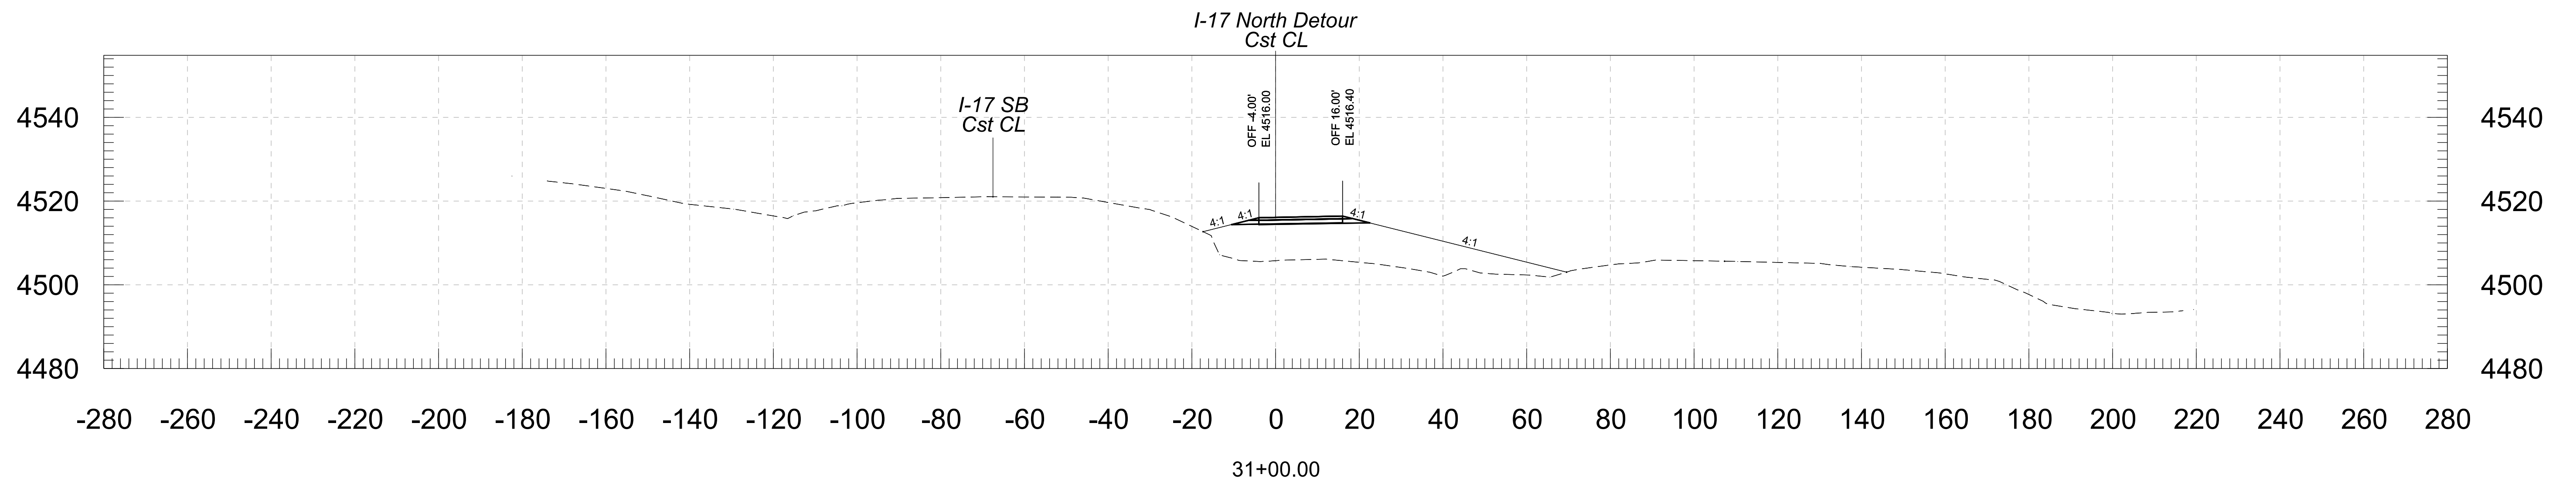


3133 East Camelback Road, Suite 100 Phoenix, Arizona 85016 Phone: (602) 333-2200 Stanley Consultants INC.	<table><tr><th></th><th>NAME</th><th>DATE</th></tr><tr><td>DESIGN</td><td>BAP</td><td>06/26</td></tr><tr><td>DRAWN</td><td>RM</td><td>06/26</td></tr><tr><td>CHECKED</td><td>KCH</td><td>06/26</td></tr></table>		NAME	DATE	DESIGN	BAP	06/26	DRAWN	RM	06/26	CHECKED	KCH	06/26	ARIZONA DEPARTMENT OF TRANSPORTATION PROJECT DELIVERY AND OPERATIONS DIVISION ROADWAY DESIGN SERVICES CROSS SECTION	<table><tr><td>ROUTE</td><td rowspan="2">I-17</td><td rowspan="2">F.H.W.A. Arizona Division</td><td rowspan="2">STATE</td><td>PROJECT NO.</td><td>FEDERAL ID NO.</td><td>SHEET NO.</td><td>TOTAL SHEETS</td><td rowspan="2">RECORD DRAWING</td></tr><tr><td>MILEPOST</td><td>017 YV 269</td><td>017-B(239)T</td><td>143</td><td>146</td></tr><tr><td rowspan="2">STRUCTURE NO.</td><td colspan="7">LOCATION</td><td>DWG NO.</td></tr><tr><td colspan="2">TRACS NO. F0616 01C</td><td colspan="4"></td><td>___ OF ___</td></tr></table>	ROUTE	I-17	F.H.W.A. Arizona Division	STATE	PROJECT NO.	FEDERAL ID NO.	SHEET NO.	TOTAL SHEETS	RECORD DRAWING	MILEPOST	017 YV 269	017-B(239)T	143	146	STRUCTURE NO.	LOCATION							DWG NO.	TRACS NO. F0616 01C						___ OF ___
		NAME	DATE																																										
	DESIGN	BAP	06/26																																										
	DRAWN	RM	06/26																																										
	CHECKED	KCH	06/26																																										
ROUTE	I-17	F.H.W.A. Arizona Division	STATE	PROJECT NO.	FEDERAL ID NO.	SHEET NO.	TOTAL SHEETS	RECORD DRAWING																																					
MILEPOST				017 YV 269	017-B(239)T	143	146																																						
STRUCTURE NO.	LOCATION							DWG NO.																																					
	TRACS NO. F0616 01C						___ OF ___																																						
E DUGAS ROAD - MP 275																																													

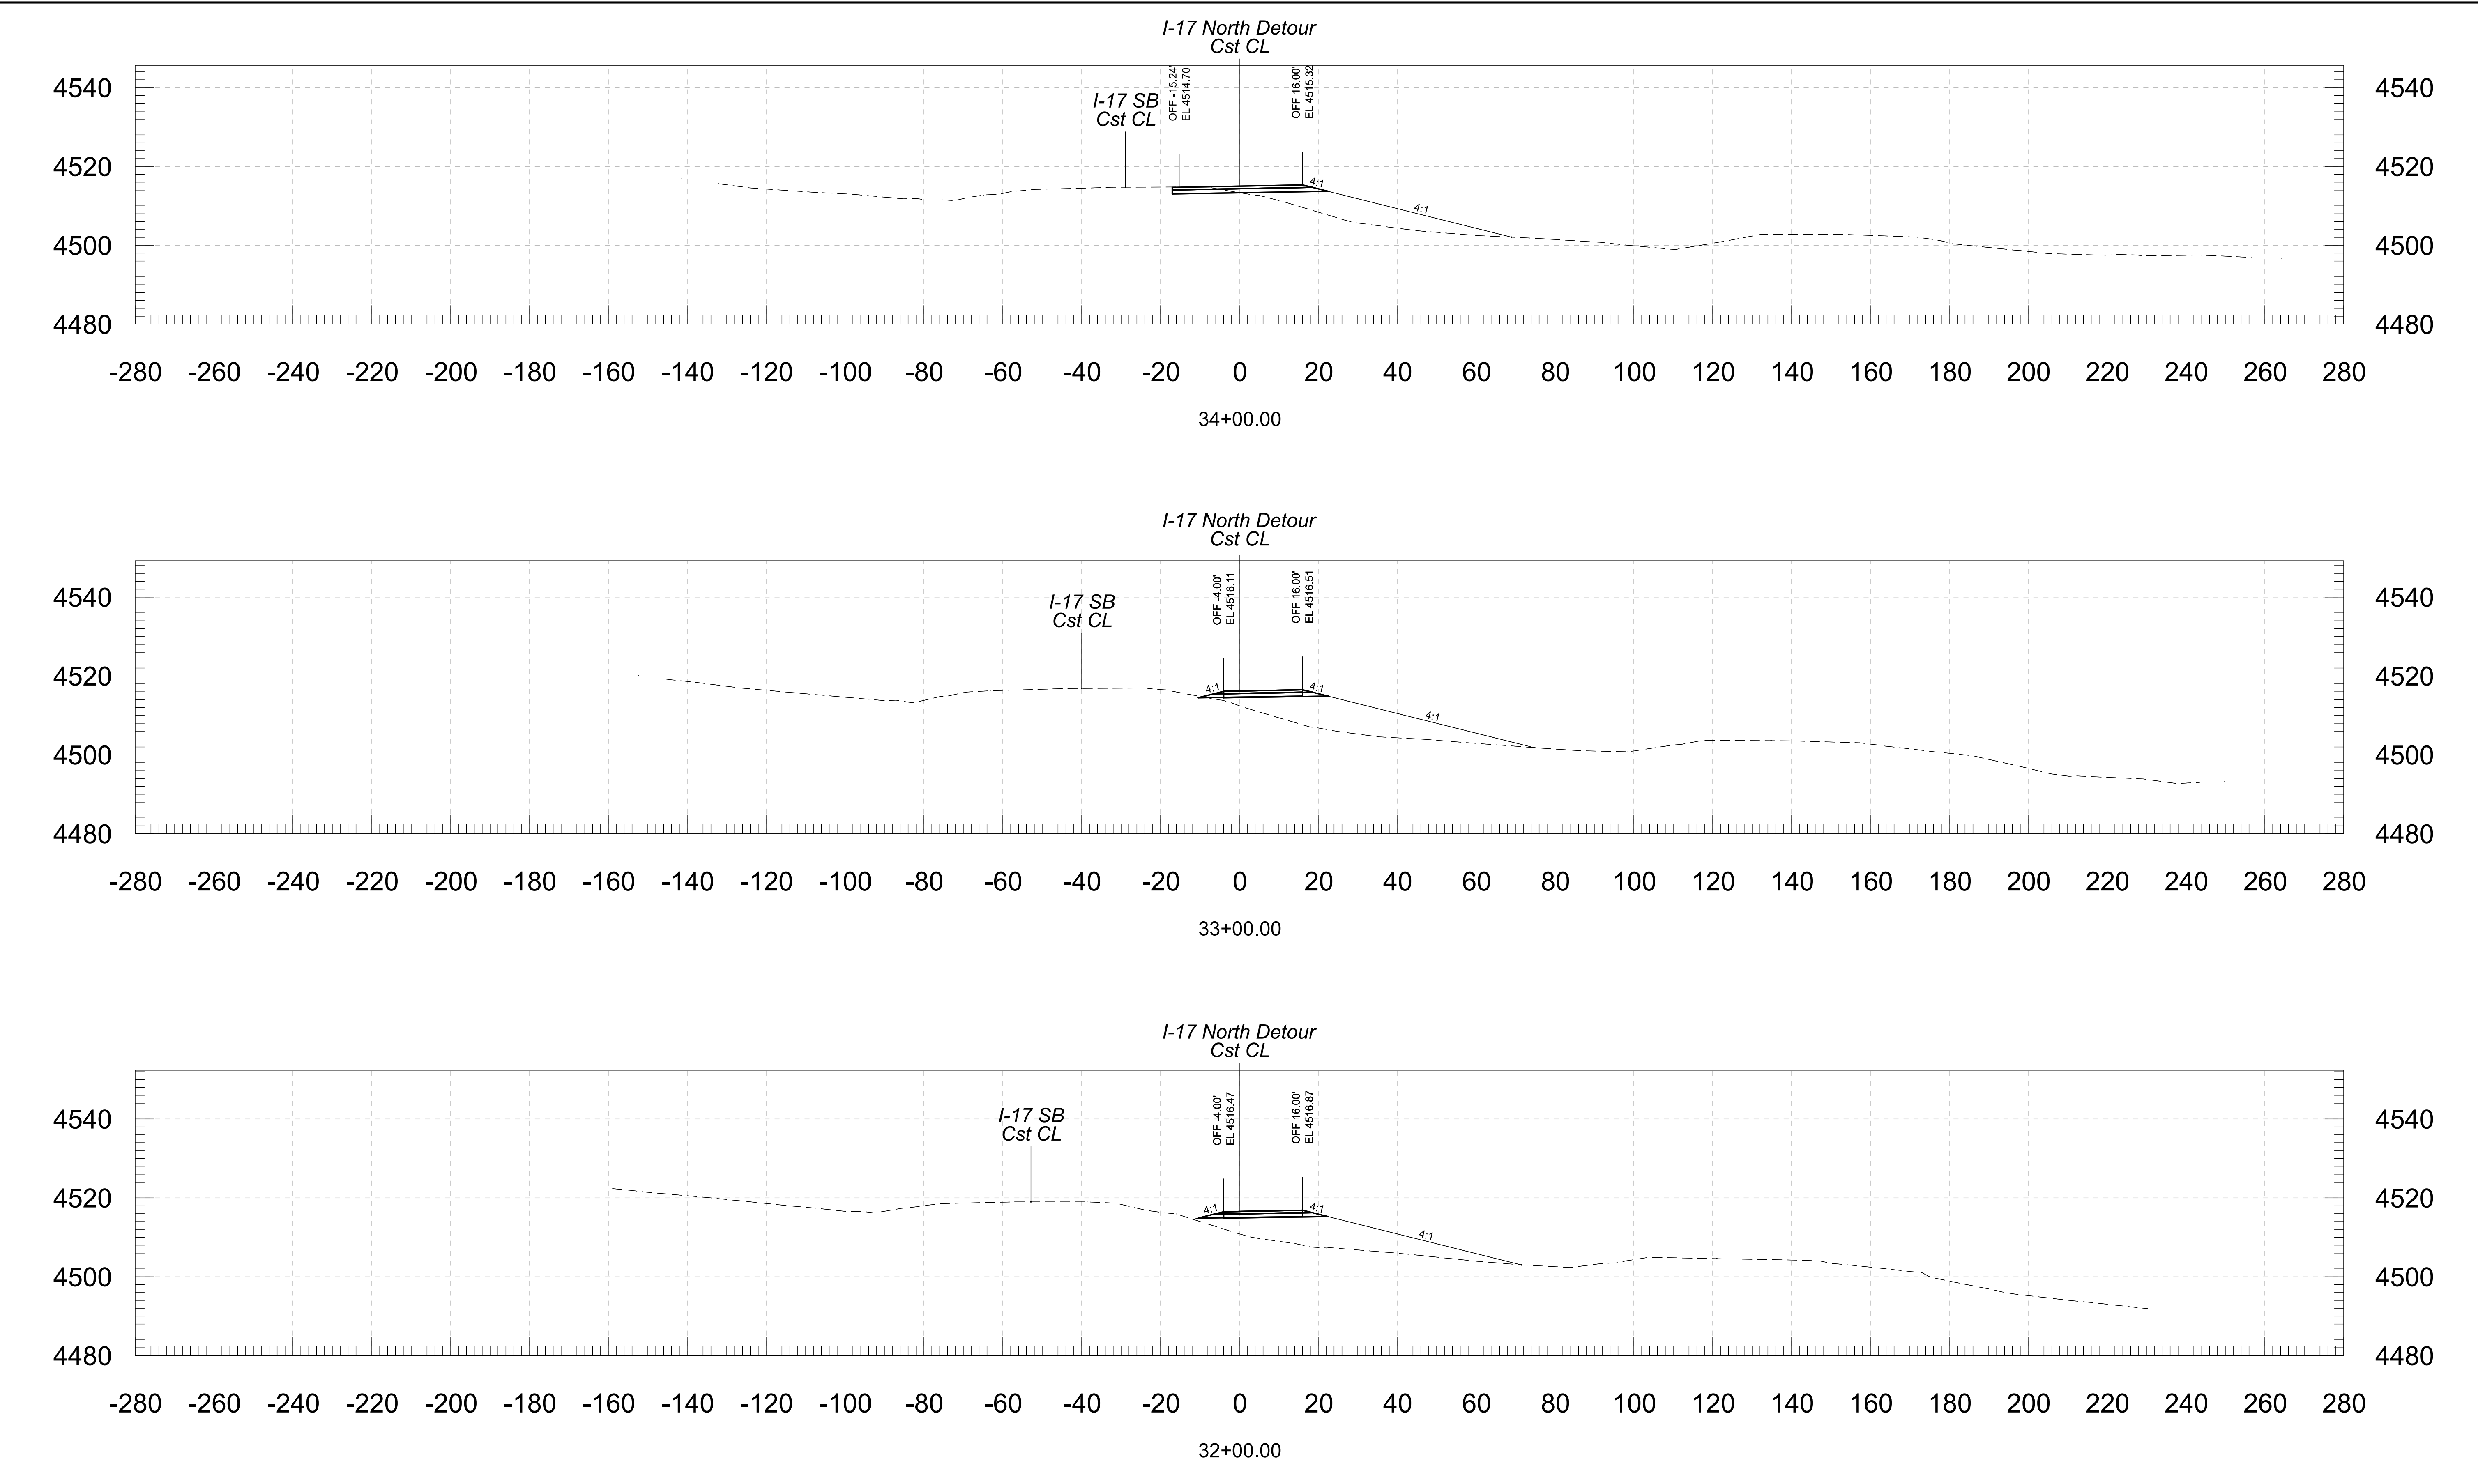 


			NAME	DATE	ARIZONA DEPARTMENT OF TRANSPORTATION PROJECT DELIVERY AND OPERATIONS DIVISION ROADWAY DESIGN SERVICES	ROUTE	F.H.W.A. Arizona Division	STATE ARIZ.	PROJECT NO.	FEDERAL ID NO.	SHEET NO.	TOTAL SHEETS	RECORD DRAWING
		DESIGN	BAP	06/26		I-17			017 YV 269	017-B(239)T	144	146	
		DRAWN	RM	06/26									
		CHECKED	KCH	06/26									
		 Stanley Consultants INC.			3133 East Camelback Road, Suite 100 Phoenix, Arizona 85016 Phone: 602) 333-2200			CROSS SECTION	E DUGAS ROAD - MP 275			DWG NO.	
						STRUCTURE NO.	TRACS NO. F0616 01C			____ OF ____			

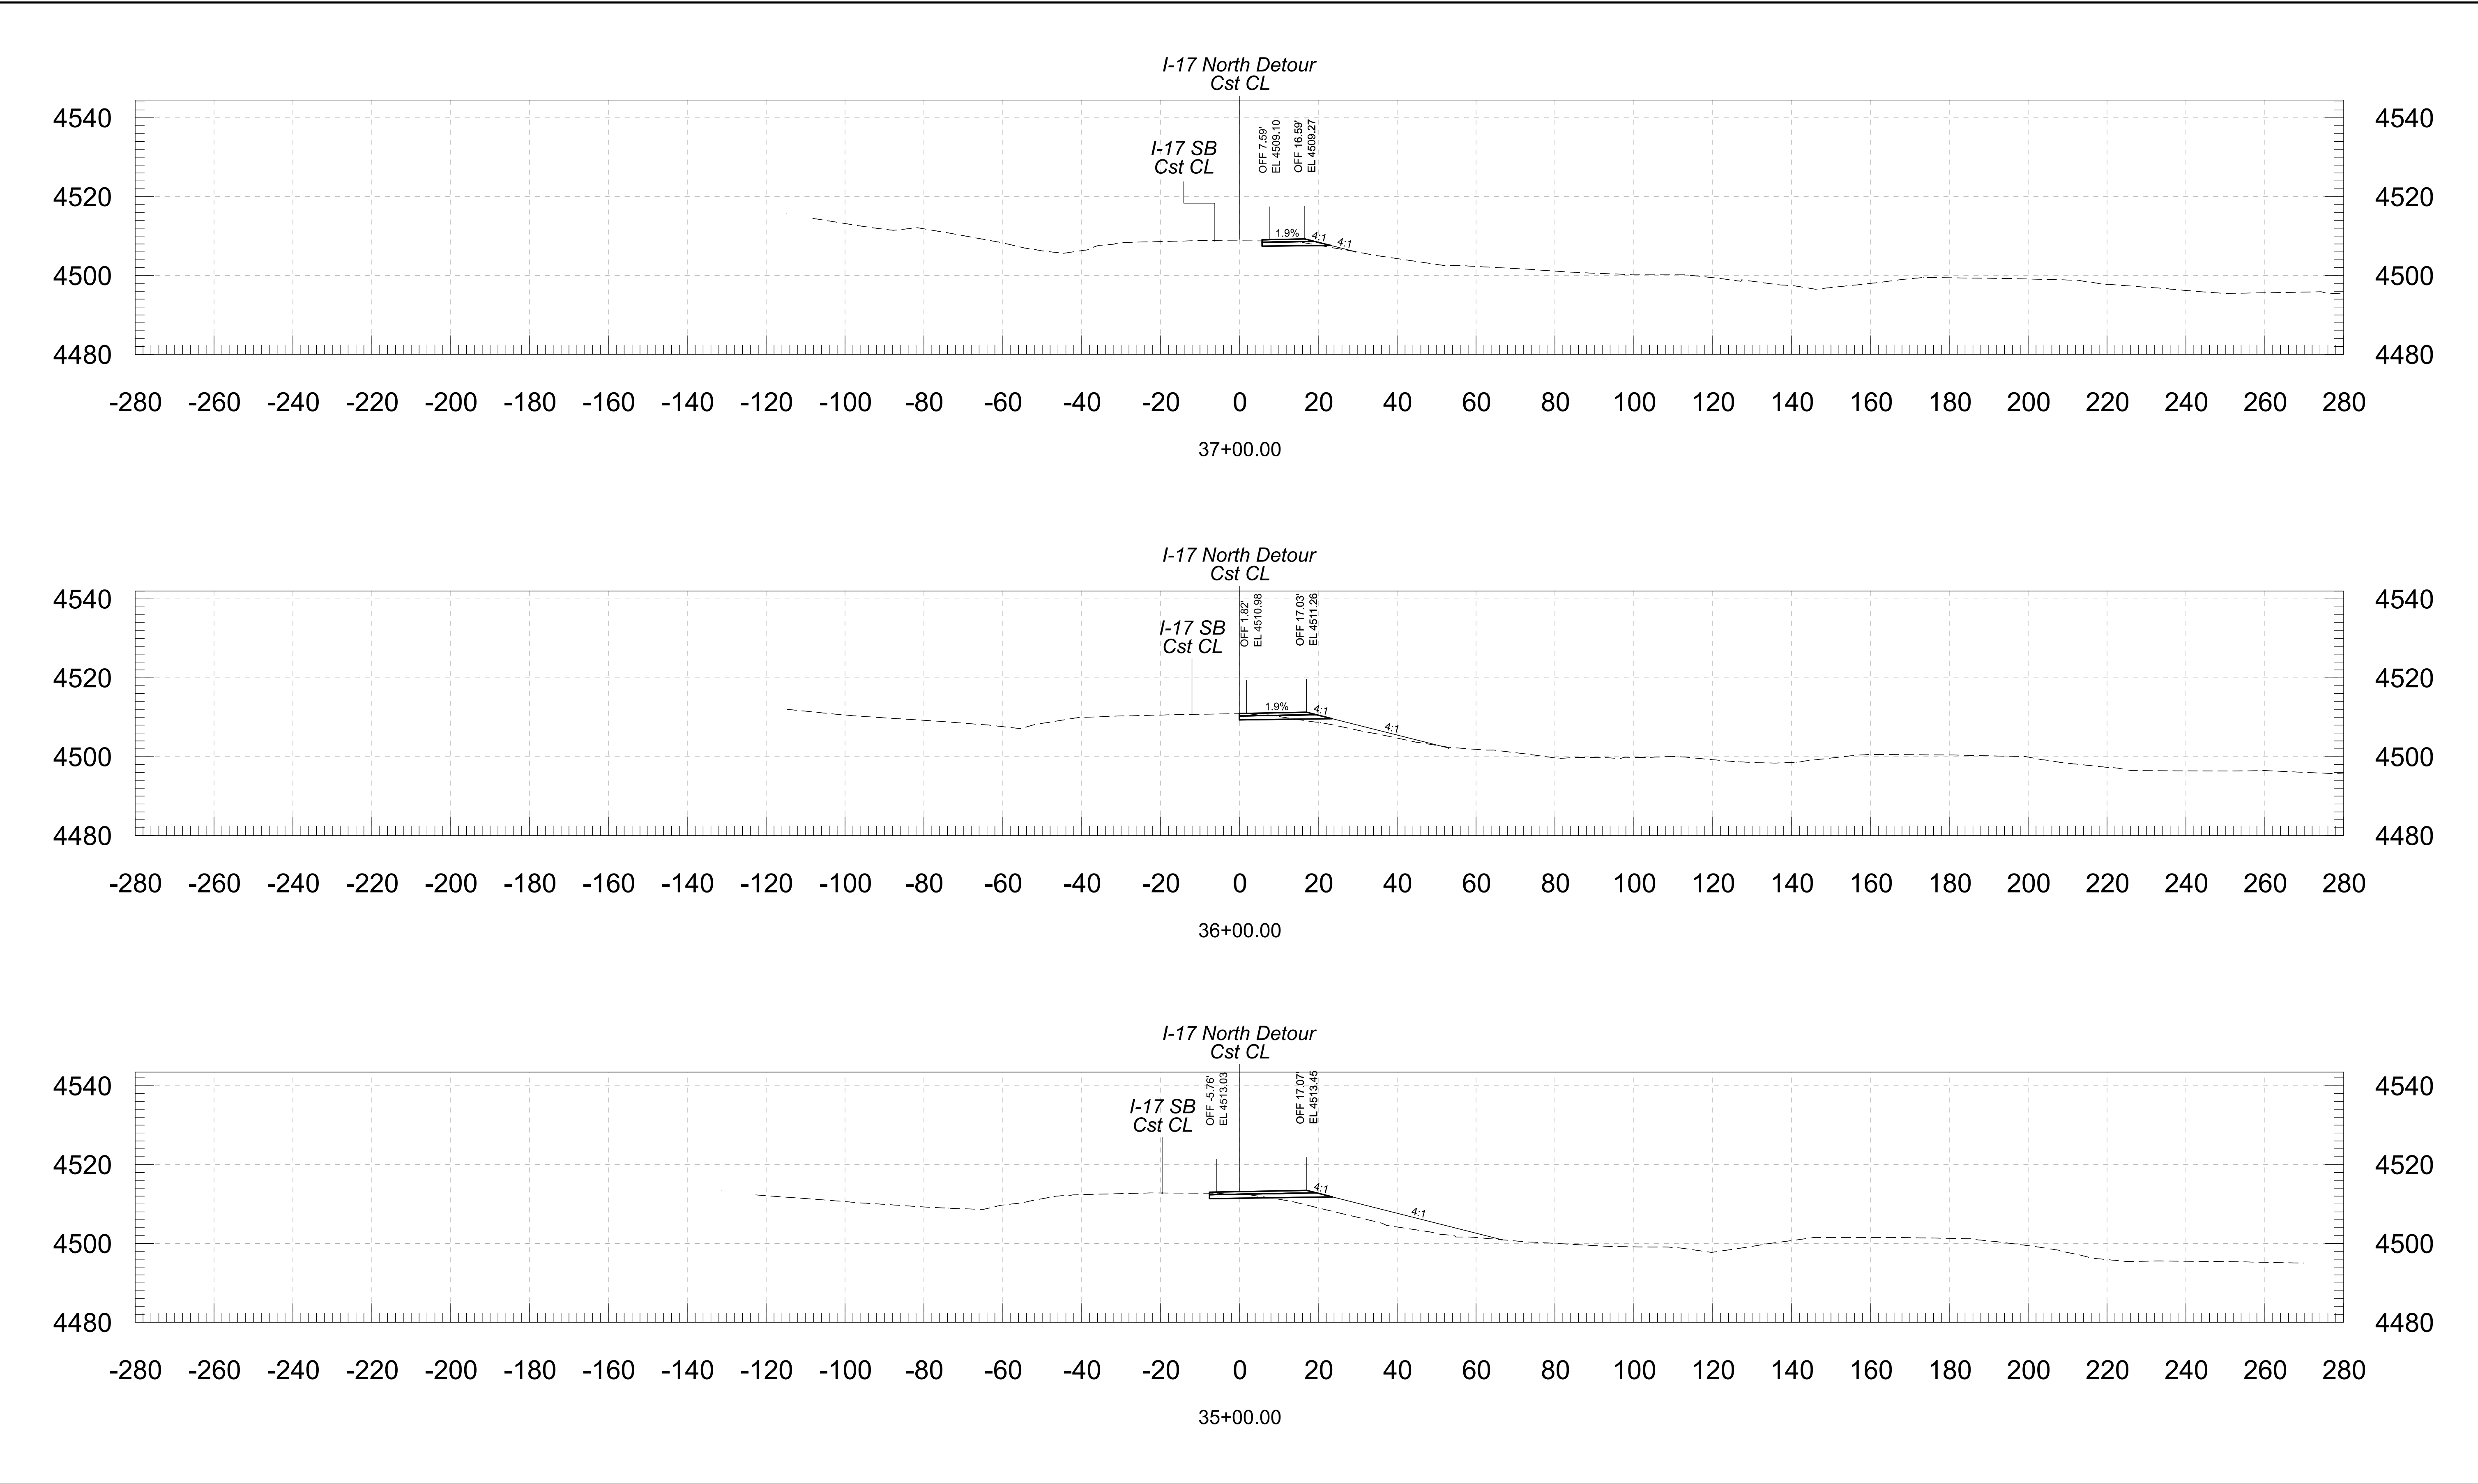

			NAME	DATE	ARIZONA DEPARTMENT OF TRANSPORTATION PROJECT DELIVERY AND OPERATIONS DIVISION ROADWAY DESIGN SERVICES	ROUTE	F.H.W.A. Arizona Division	STATE ARIZ.	PROJECT NO.	FEDERAL ID NO.	SHEET NO.	TOTAL SHEETS	RECORD DRAWING	
		DESIGN	BAP	06/26		I-17			017 YV 269	017-B(239)T	145	146		
		DRAWN	RM	06/26			MILEPOST	LOCATION					E DUGAS ROAD - MP 275	DWG NO.
		CHECKED	KCH	06/26										
		 3133 East Camelback Road, Suite 100 Phoenix, Arizona 85016 Phone: (602) 333-2200 Stanley Consultants INC.			CROSS SECTION									

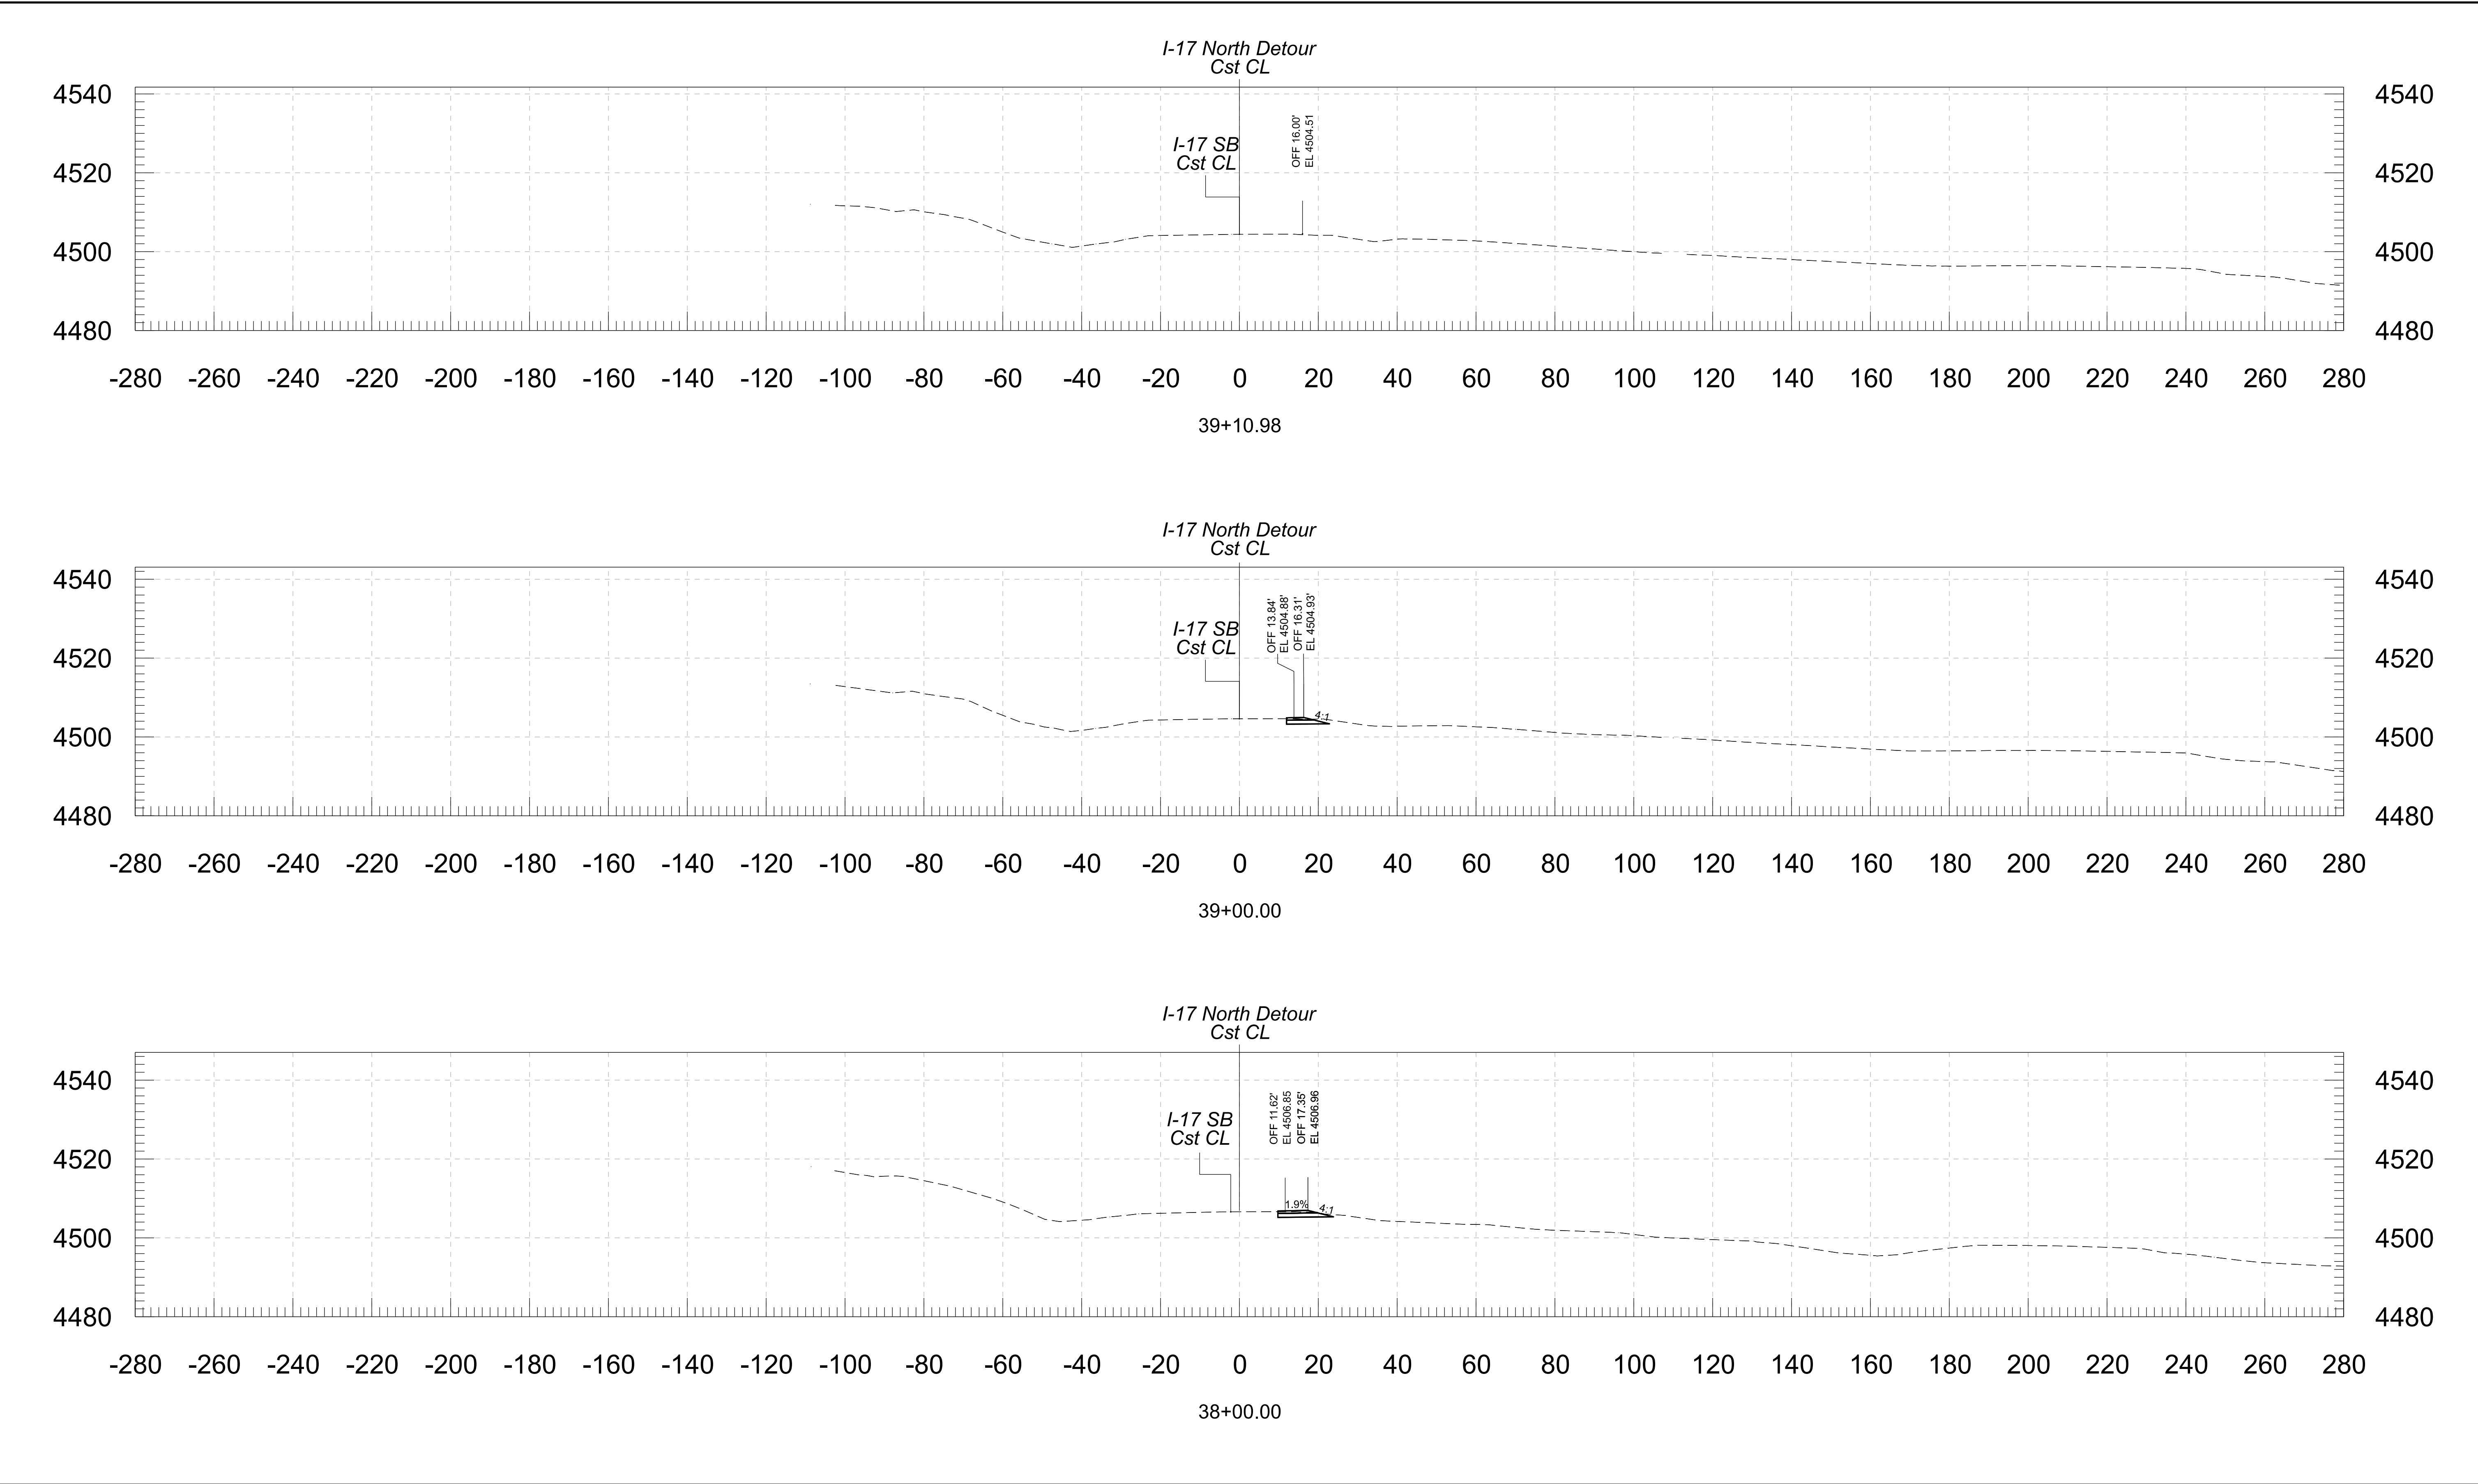

				NAME	DATE	ARIZONA DEPARTMENT OF TRANSPORTATION PROJECT DELIVERY AND OPERATIONS DIVISION ROADWAY DESIGN SERVICES	ROUTE	F.H.W.A. Arizona Division	STATE ARIZ.	PROJECT NO.	FEDERAL ID NO.	SHEET NO.	TOTAL SHEETS	RECORD DRAWING
			DESIGN	BAP	06/26		I-17			017 YV 269	017-B(239)T	146	146	
			DRAWN	RM	06/26									
			CHECKED	KCH	06/26									
			 3135 East Camelback Road, Suite 100 Phoenix, Arizona 85016 Phone: 602.333-2200 Stanley Consultants INC.											
						STRUCTURE NO.	TRACS NO. F0616 01C				____ OF ____			