

NOTE:

- These drawings are to be read in conjunction with the Engineers evaluation, scoping reports and any relevant photos and attachments.
- Contractor to verify extent of repairs, if greater than shown contact the designer (Deborah Wilson Core Civil Solutions Ltd. -03 353 2628).
- Final levelling of floor slopes may vary and should be verified if substantially different from the target levels. Levelling to be carried out by an experienced contractor to ensure the dwelling is relevelled professionally. Contractor needs to ensure that no subsequent damage occurs whilst releveling, notify the design engineer should any damage arise.
- No part of the floor shall have a finished floor level variation greater than 1:200 (0.5%)
- Carpet, vinyl, tile floor coverings to be removed before releveling commences
- Patios/Decks/Palis/Concrete steps/Driveway may need removed to level house, to be reinstated there after. This is to be discussed and confirmed before work commence.

AS BUILT LEVELS:**Site manager**

Name:

Signature:

Project manager

Name:

Signature:

Date of level taken:

1/10/15


**EARTHQUAKE REPAIRS
FOR INTEREX PROJECTS**

 46a Pacific Road, North New
Brighton, Christchurch 8083
CONSULTANTS**ISSUES**
**BUILDING CONSENT
EXEMPTION**
NOTES
 REFER TO ARCHITECTURAL DRAWINGS FOR
DIMENSIONS AND SETTING OUT
CONTRACTOR TO VERIFY ALL DIMENSIONS PRIOR
TO CONSTRUCTION

Revised	Amendment	Reason/Date
01	BUILDING CONSENT EXEMPTION	16 Sep-15

± 1 As Built Levels

**EXISTING FLOOR PLANS
AS BUILT LEVELS**

SCALE: 1:100@ A3

DATE: 16-Sep-15

PROJECT No:

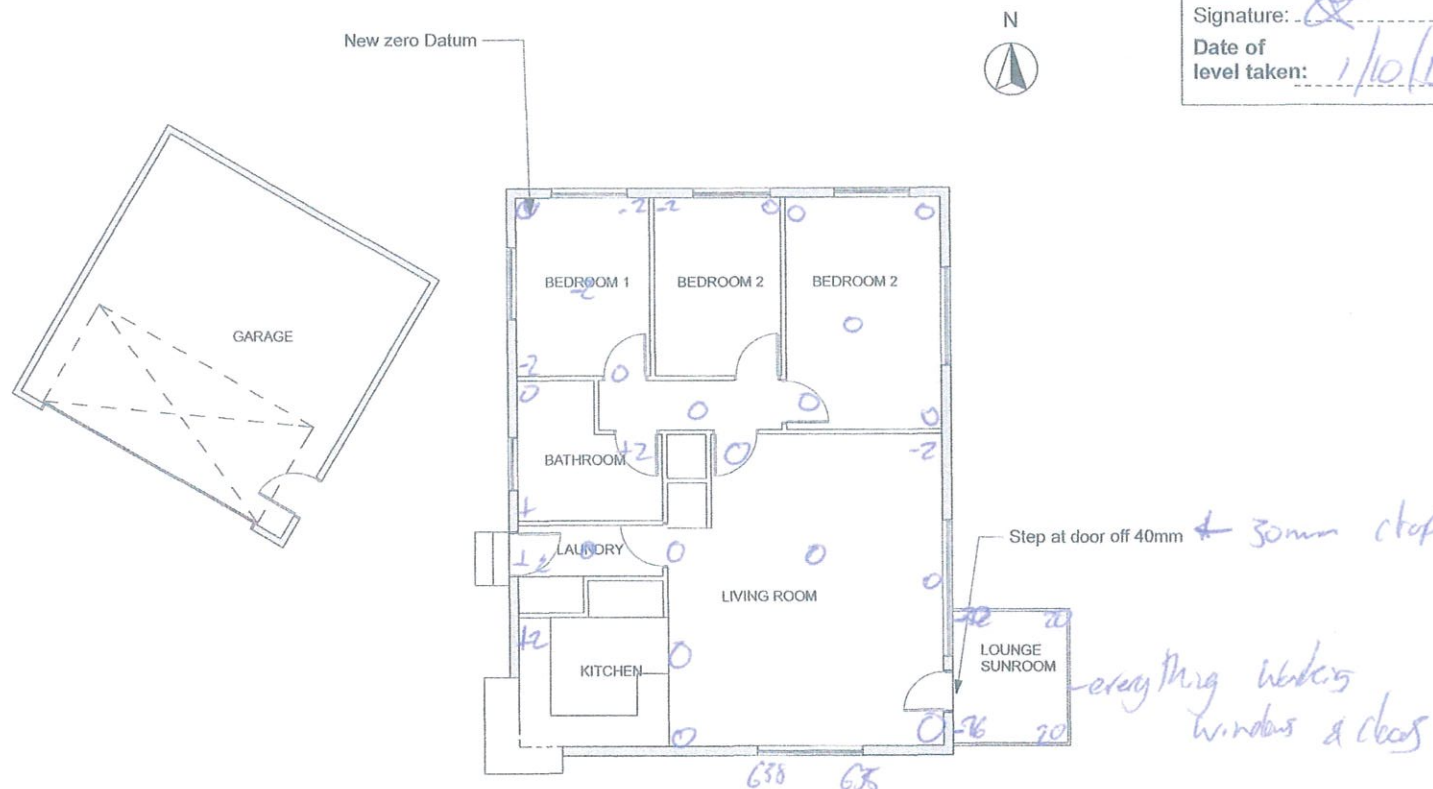
PROJECT STATUS: BUILDING CONSENT

DRAWN: DW CHECKED: RJ

SHEET: 101 REV: R0

 34 Brisbane Street, Sydenham
PO Box 7274, Sydenham 8240
Christchurch, New Zealand
TEL 64 3 365 6135
FAX 64 3 943 9981
WEB www.corecivil.co.nz

 DO NOT SCALE THESE DRAWINGS.
CONTRACTOR TO VERIFY ALL DIMENSIONS PRIOR
TO COMMENCING ANY WORK OR MAKING ANY
SHOP DRAWINGS WHICH MUST BE SUBMITTED
FOR COMMENT PRIOR TO MANUFACTURE.

 COPYRIGHT 2014, Core Civil Solutions Ltd
DESIGN, PLANS, DRAWINGS, IMAGES AND
ELECTRONIC FILES ARE SUBJECT TO COPYRIGHT

EXISTING FLOOR PLANS AS BUILT LEVELS