


Mark Haase 12609
Kyle Marshall 18892

Customer Address: 75 Andover St

Sketch Type (Circle Applicable)
As Built (Damage) / Proposed Repair

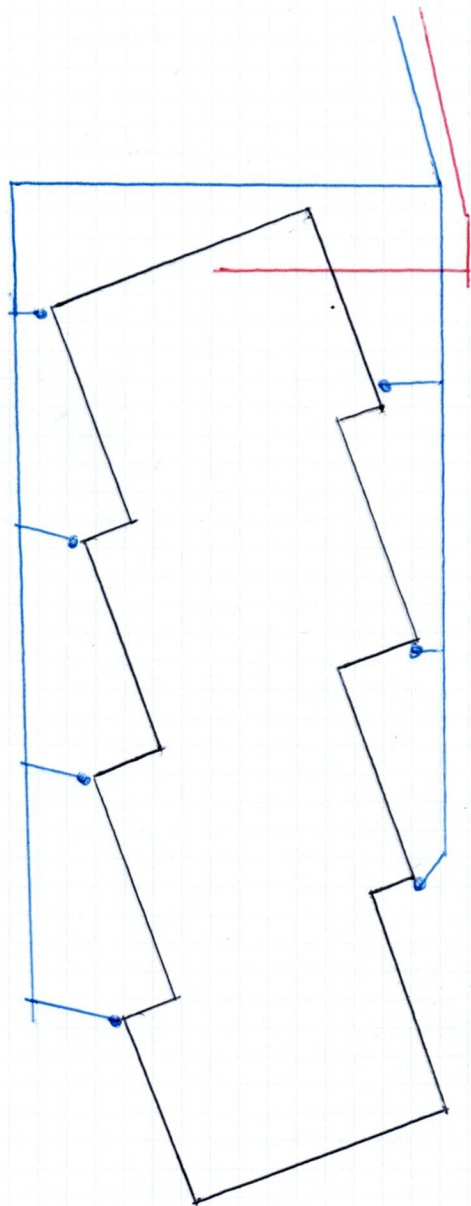

Key

- Existing Sewer Line
Existing Stormwater Line
Pavers / Driveway
Earthquake Damage
Tree
Kerb Outlet
Downpipe / Toilet Vent
SUMP
Non Earthquake Damage

Abbreviations

- Kerb Outlet - KO
SUMP
Down Pipe (S/W) - DP
Boundary Inspection Pipe
Type of Material

- Earthenware - EW
Poly Vinyl Chloride - PVC
C/I - Cast Iron

Bends - show upstream direction

- Left hand bend - LHB
Right Hand Bend - RHB
Inspection Bend - IB

- Left Hand Inspection Bend - LHIB
Right Hand Inspection Bend - RHIB

Junction

- Left Hand Junction - LHJ
Right Hand Junction - RHJ
Inspection Junction - IJ
Inspection Left Junction - ILJ
Inspection Right Junction - IRJ

Fixtures

- Gully Trap - GT
Terminal Vent - TV
Main Vent - MV
Toilet - WC