



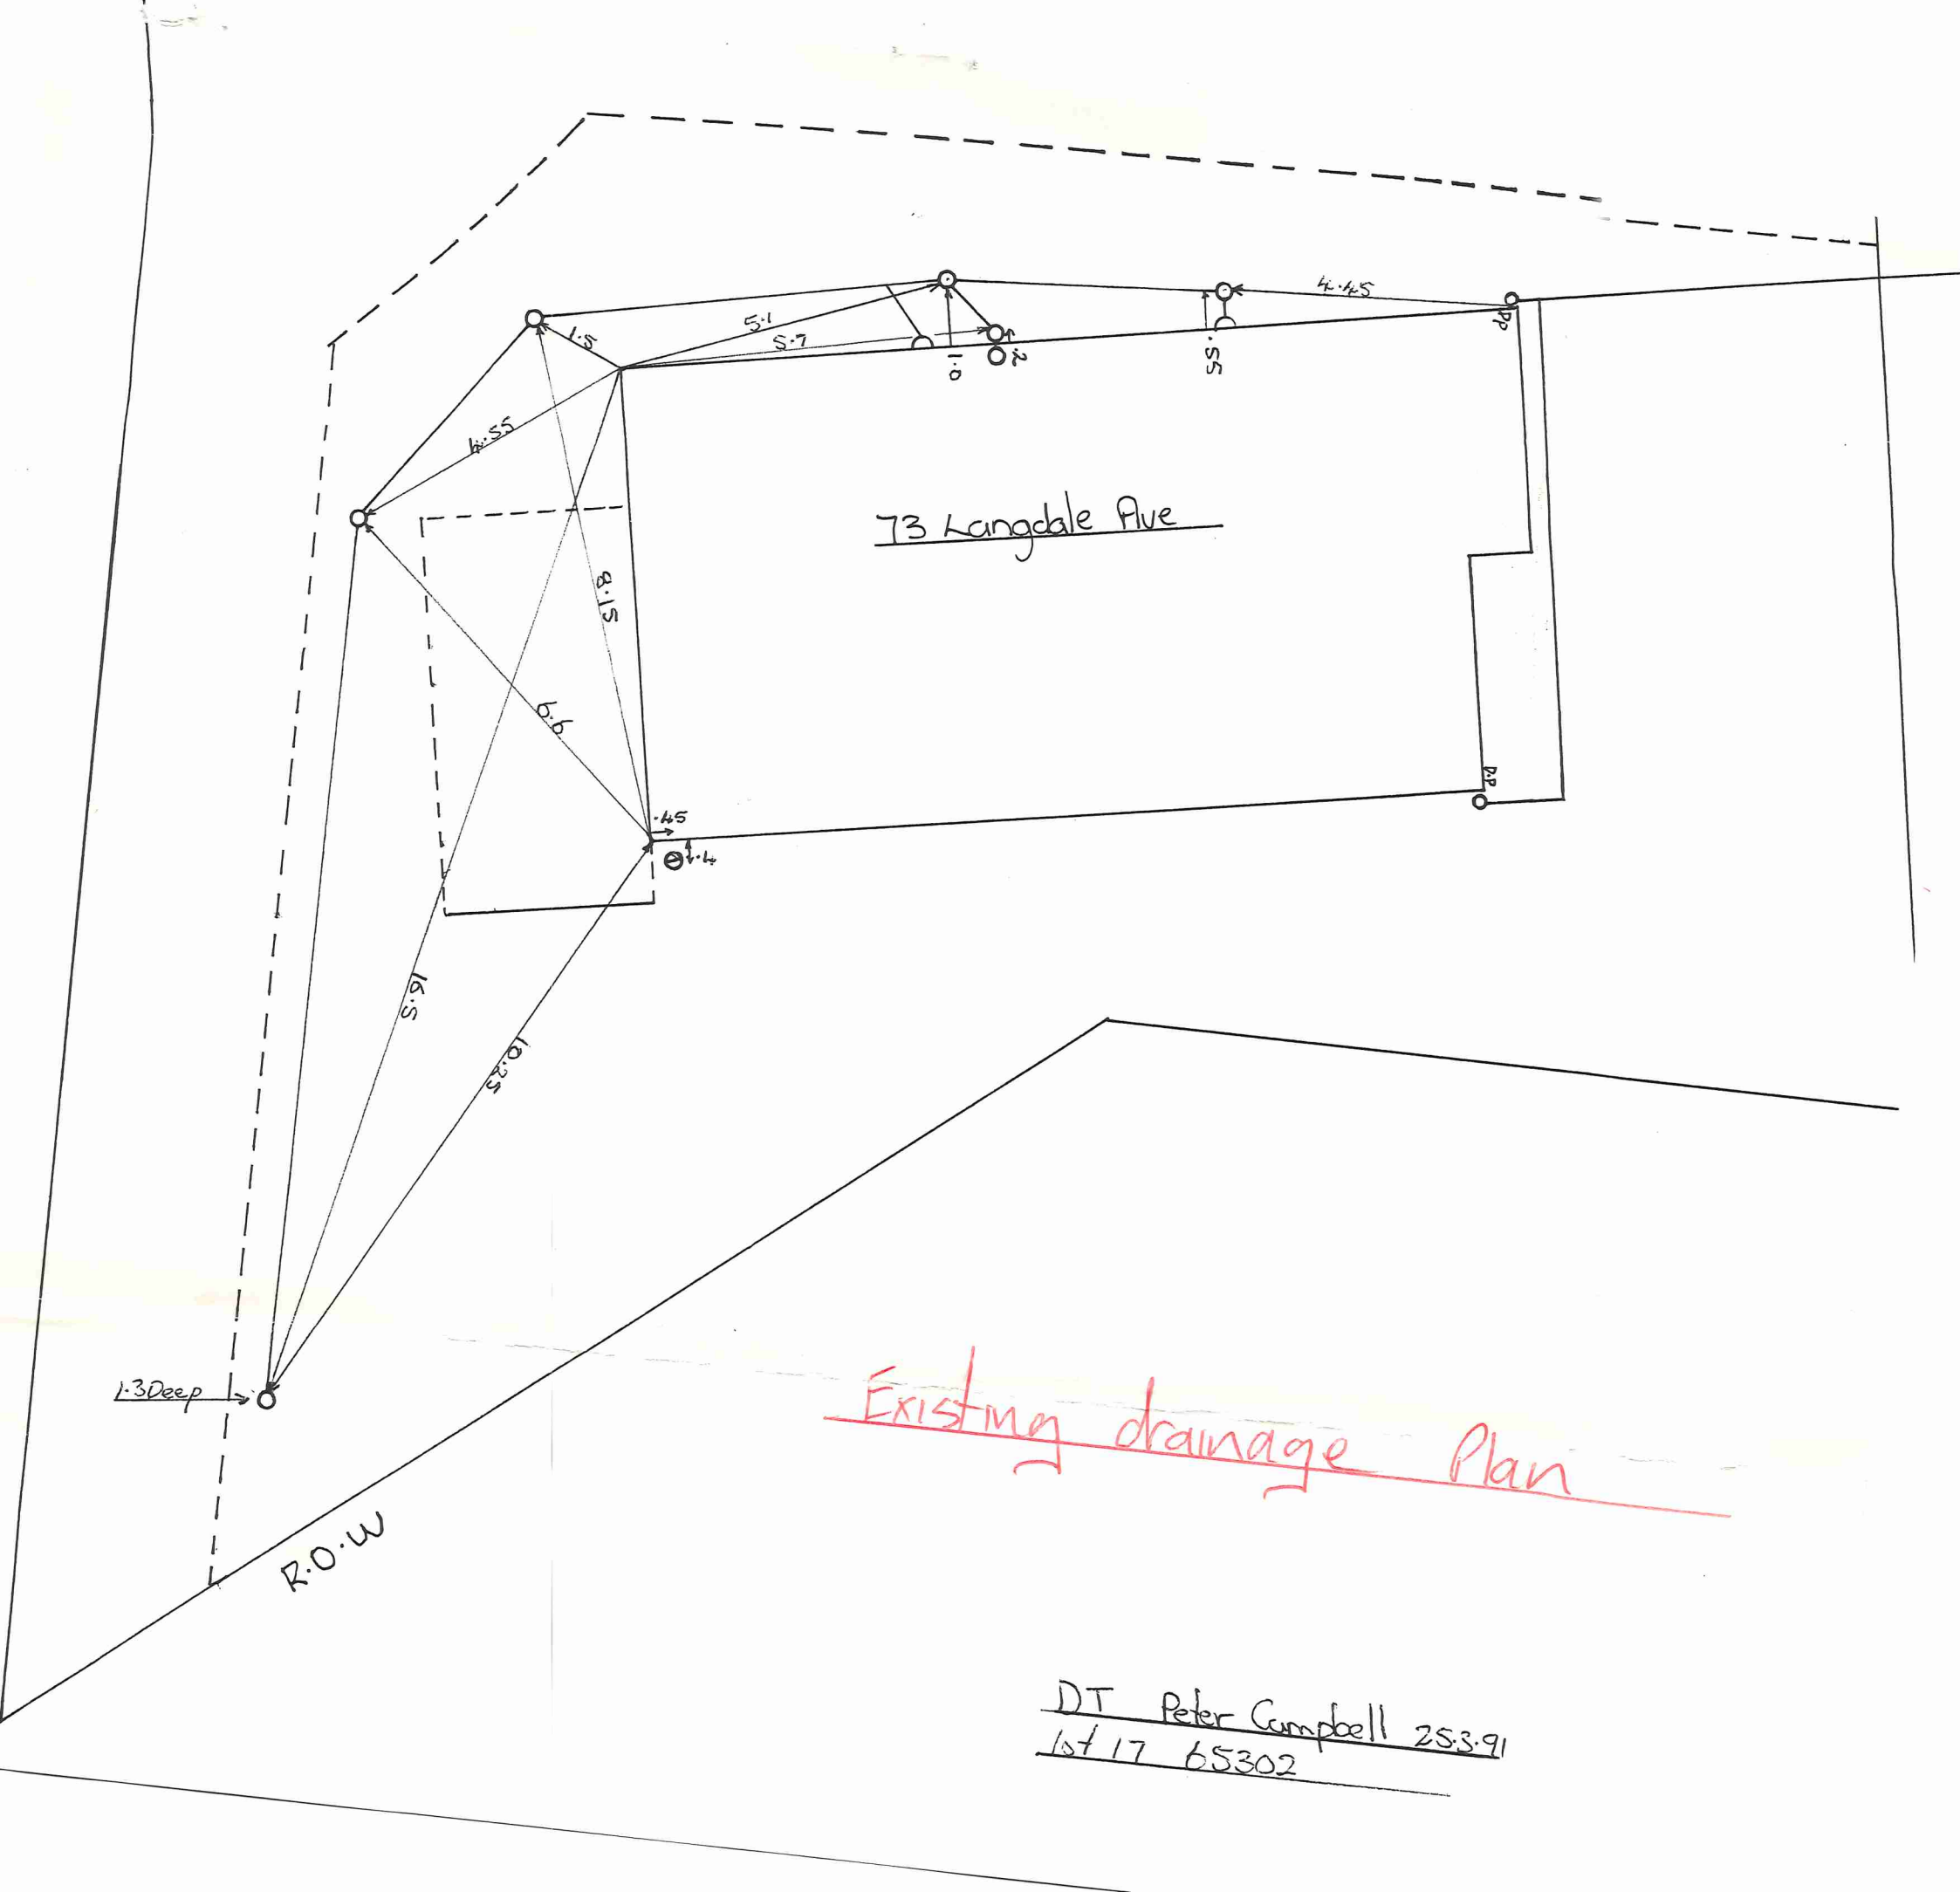

DT Peter Campbell 25.3.91
lot 17 65302

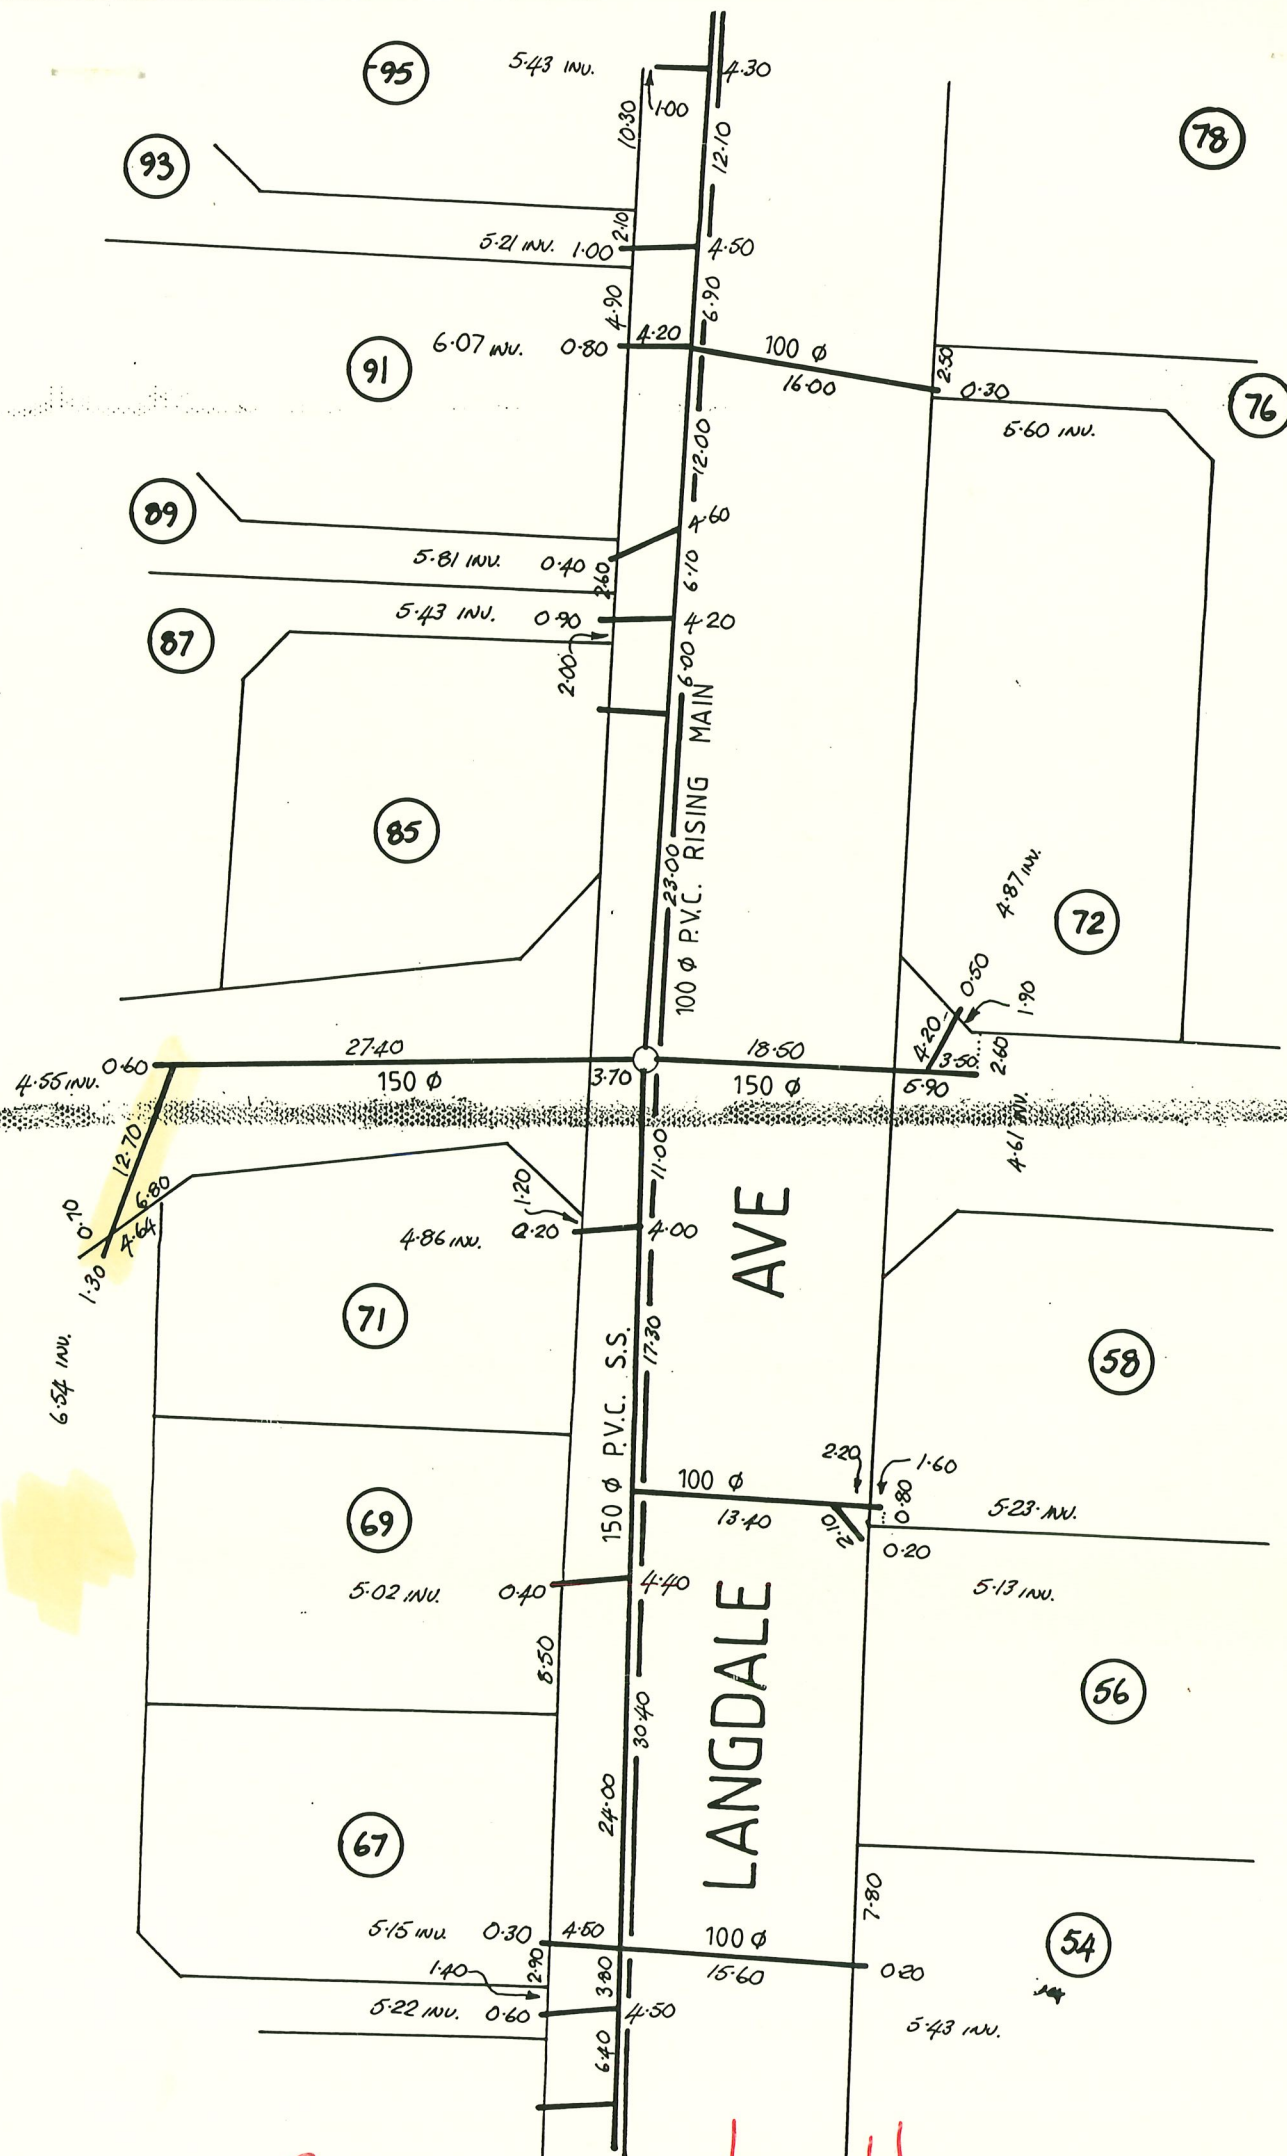

Sewer as built