




NEW PLYMOUTH
DISTRICT COUNCIL
newplymouth.govt.nz

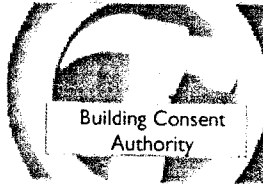


AS-BUILT DRAINAGE PLAN

Building consent BC: 106352

Drainlayer: K. COMPTON 3325

Address: 242 LOWER PITONE RD OKATO

Date: 11/7/07

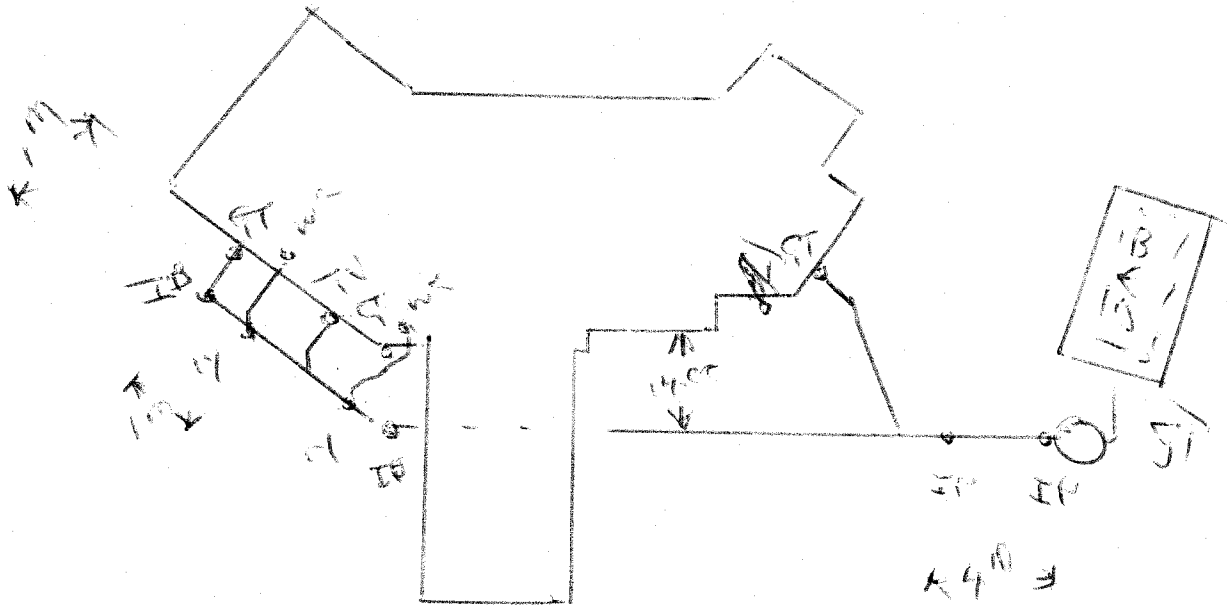

242 Lower Pitone Road
Okato
Building consent: 106352
Property ID: 006135
Lot: 6
DP: 152

Specify system used:

- ☐ AS: G13
- ☐ AS/NZS: 3500

Note: Show terminal vent size, location
and all relevant dimensions to inspection points

Drainage plan may be accepted on another
sheet provided by drainlayer at the discretion of
the inspector.