



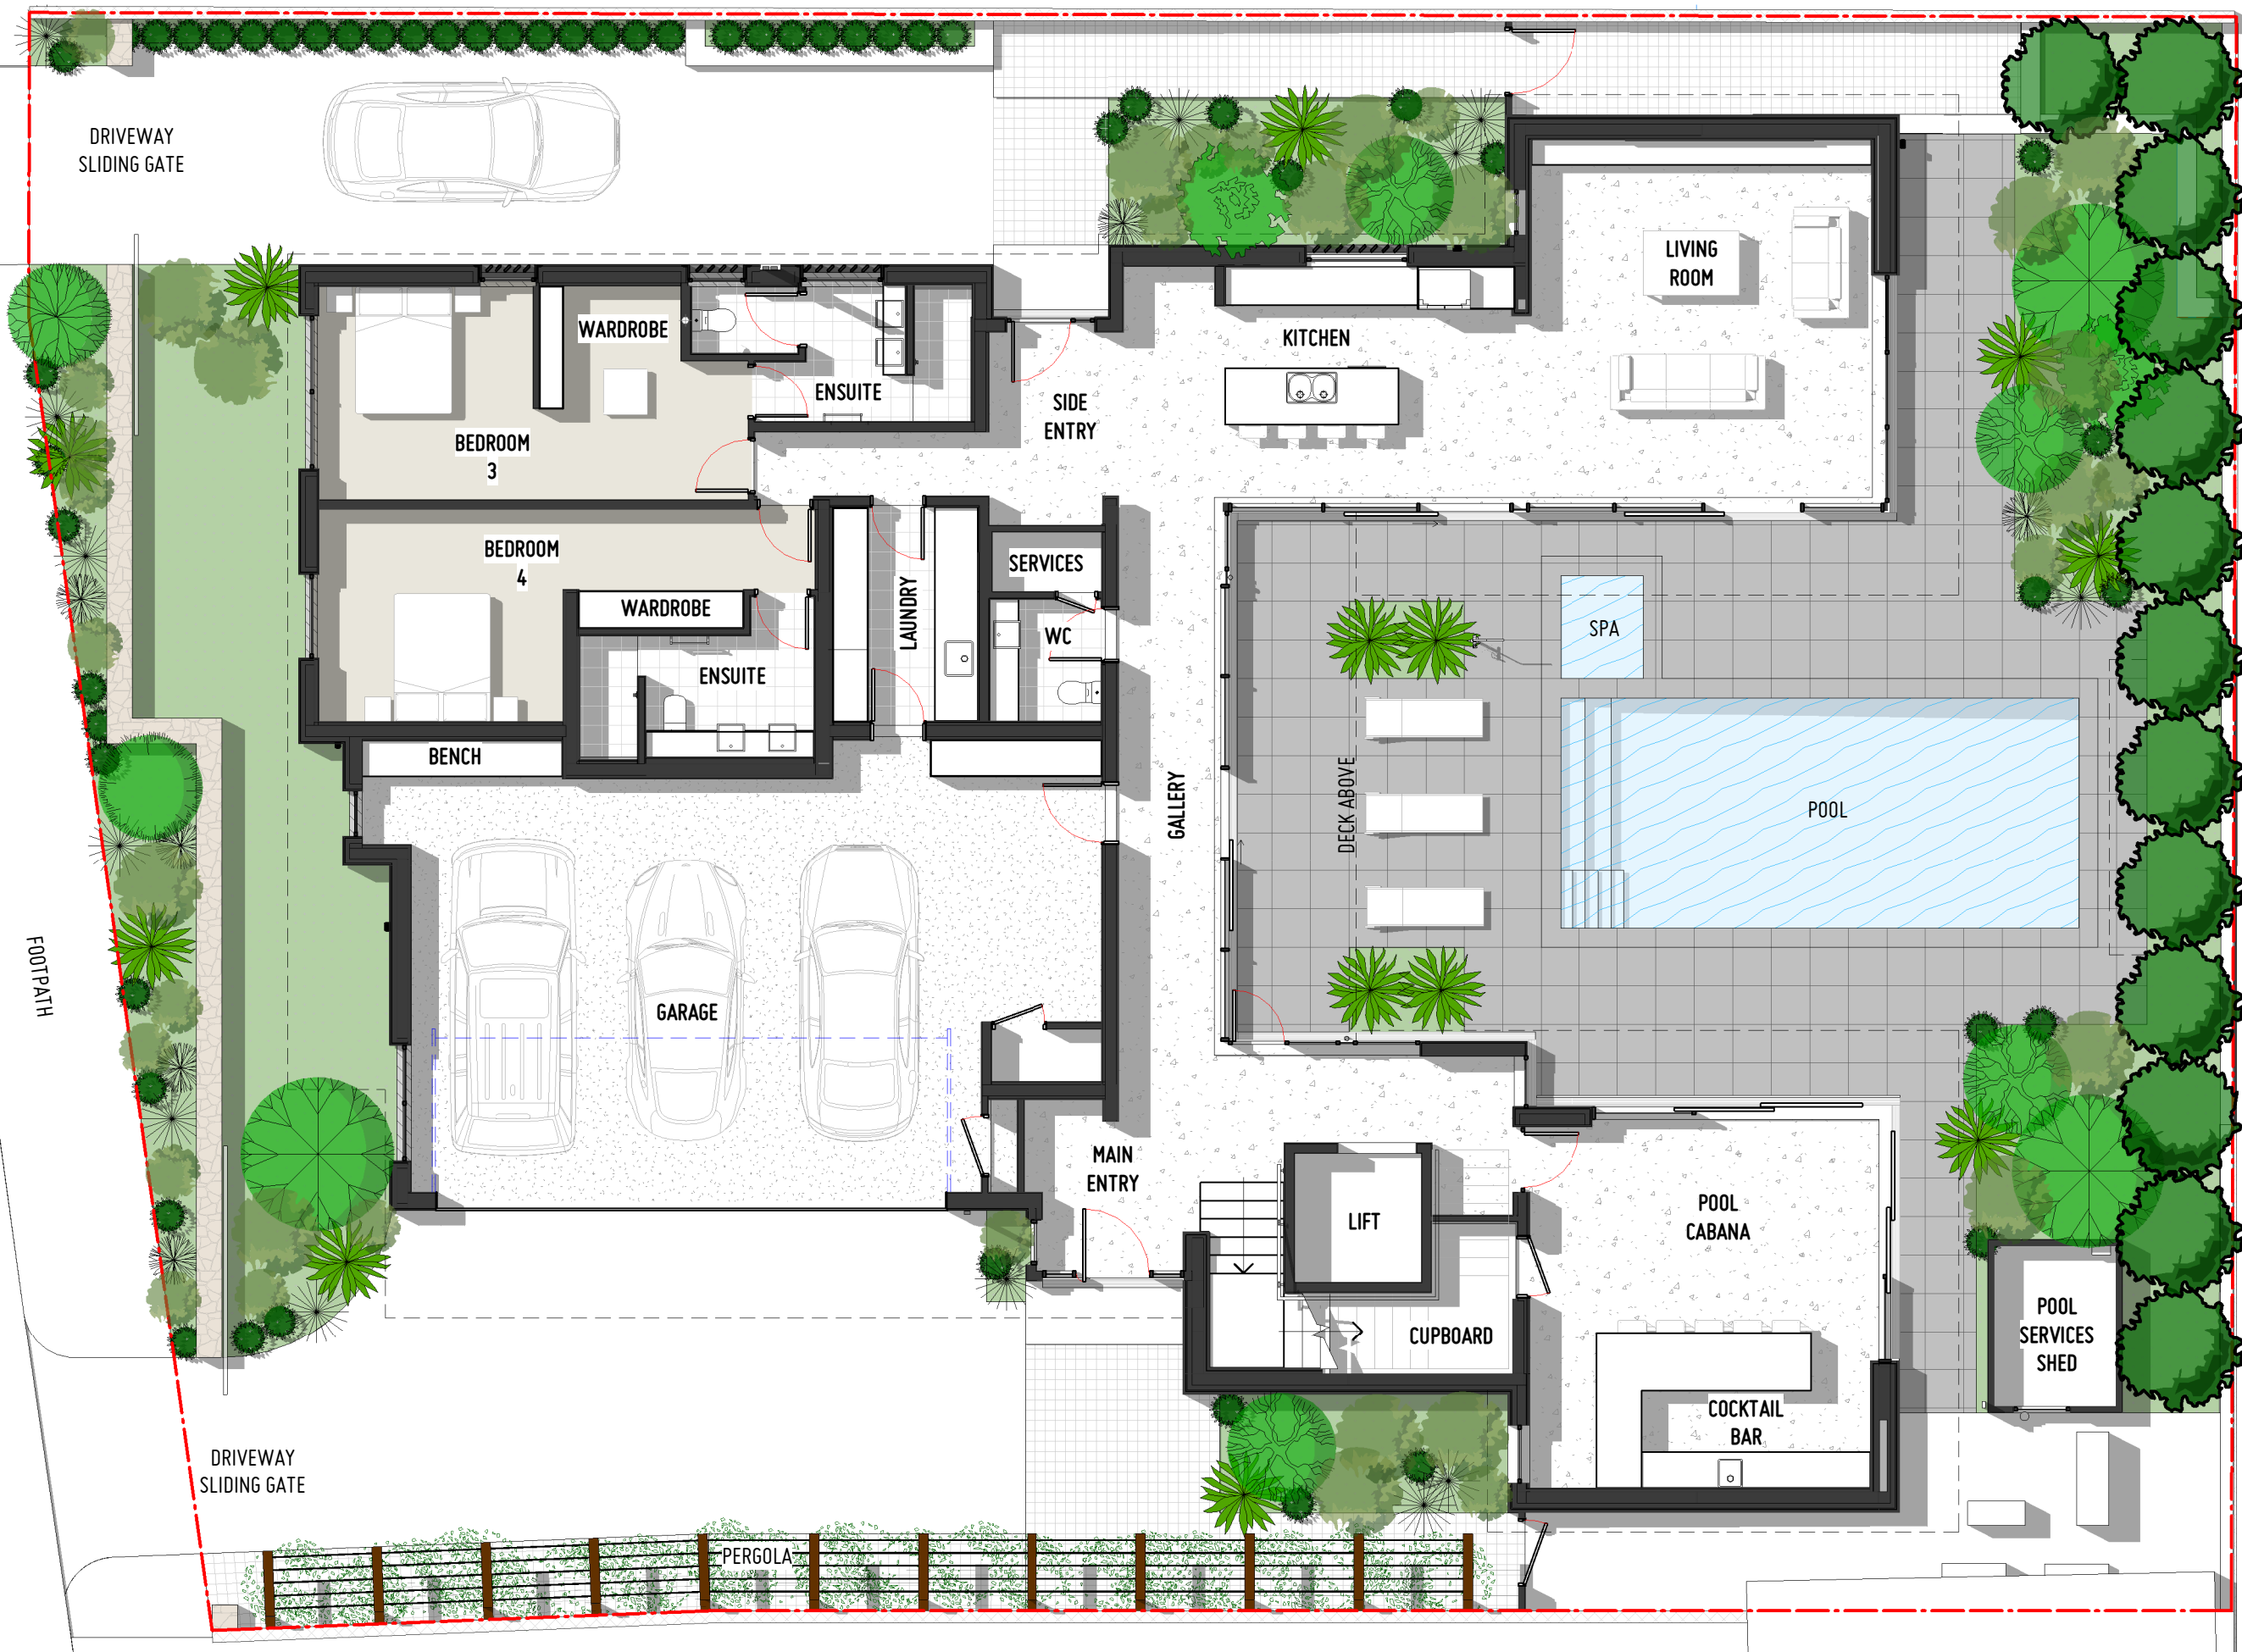

NOTES:

1. Do not scale off this drawing. Use figured dimensions only.
2. Contractor to verify all dimensions and details on site before commencing work.
3. Contractor to report any discrepancy for interpretation prior to affected work proceeding.

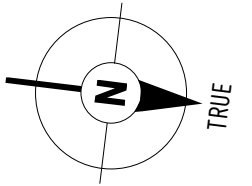

REVISIONS:



DIACK HOUSE

3 Meeanee Quay, Westshore, Napier
for Darren Diack

AS BUILT

GROUND FLOOR PLAN

Scale (A3) 1 : 100

Job No. 21021

Drawing No.

Revision No.

P.01

Plotted : 21/04/2026 10:00:35 am