



HARRISON/BLOY PIPELINES K. Mastell	DRAINAGE PICKUP		CONSENT NUMBER
	Address/Lot #: <u>11 Kainara</u> Owner: <u>Wrightway</u> Date: _____	Drainlayer/Registration #: _____ Inspector: _____ Author of plans: _____	



Relay sewer

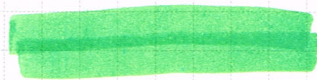

Share line

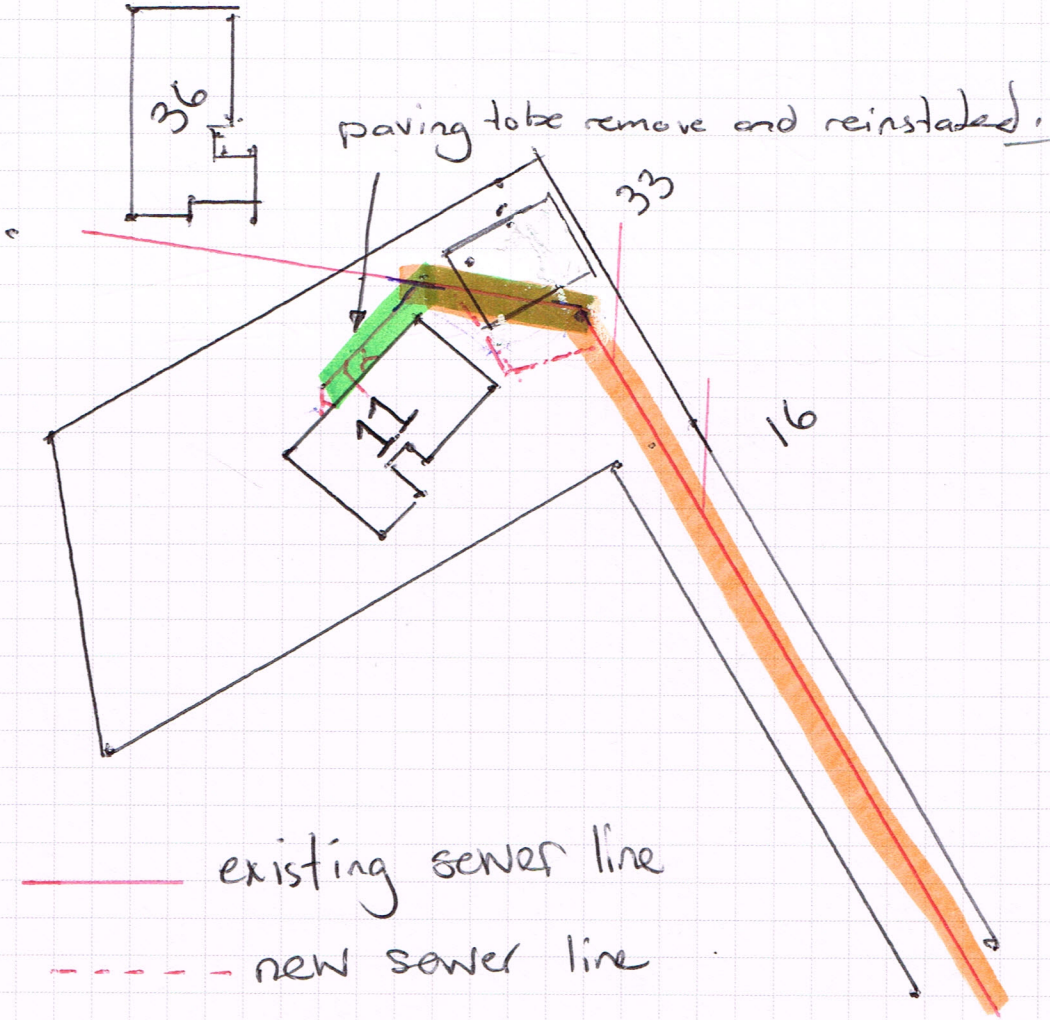

Signature: _____

KEY			
AP	Access points	FAI	Fresh air inlet
RP	Rodding points	TV	Terminal vent
IP	Inspection points	IC	Inspection chamber
YP	Junction pipe	AC	Access chamber
GT	Gully trap	ORG	Overflow relief gully

Consenting & Compliance Group

Producer statement construction (PS3)

All sections of this PS3 must be completed

Tick applicable Contractor for:

- | | | | |
|---|--|---|------------------------------------|
| <input type="checkbox"/> Building | <input type="checkbox"/> Emergency Lighting | <input type="checkbox"/> Cladding | <input type="checkbox"/> Escalator |
| <input type="checkbox"/> Waterproof Membranes | <input checked="" type="checkbox"/> Drainlayer | <input type="checkbox"/> Fire Alarm | <input type="checkbox"/> Lift |
| <input type="checkbox"/> Mechanical (HVAC) | <input type="checkbox"/> Solar Heating | <input type="checkbox"/> Other (specify): _____ | |

Author name:

Kyle Marshall

Author company:

HAASE MARSHALL DRAINAGE

Site address:

11 Kaiwara Street, Hoon Hay, Christchurch

Description of building work:

DRAINAGE

Owners Details:

Scope of work covered by statement:

DRAINAGE

System/Product used (if applicable):

PVC

I (constructor): HAASE MARSHALL DRAINAGE

have been engaged by

Wright Way Construction

(applicant, designer, main contractor etc) part all to construct:

As specified in the attached particulars of Building Consent Number:

and its attached conditions

I am satisfied on reasonable grounds that the building work specified above has been completed to the extent required by that Building Consent and complies with the NZ Building Code.

NZBC clauses:
[select as applicable]

- | | | | | | | | | | | | |
|-----------------------------|-----------------------------|-----------------------------|-----------------------------|-----------------------------|-----------------------------|------------------------------|------------------------------|------------------------------|---|--|------------------------------|
| <input type="checkbox"/> B1 | <input type="checkbox"/> B2 | <input type="checkbox"/> C1 | <input type="checkbox"/> C2 | <input type="checkbox"/> C3 | <input type="checkbox"/> C4 | <input type="checkbox"/> C5 | <input type="checkbox"/> C6 | <input type="checkbox"/> D1 | <input type="checkbox"/> D2 | <input checked="" type="checkbox"/> E1 | <input type="checkbox"/> E2 |
| <input type="checkbox"/> E3 | <input type="checkbox"/> F1 | <input type="checkbox"/> F2 | <input type="checkbox"/> F3 | <input type="checkbox"/> F4 | <input type="checkbox"/> F5 | <input type="checkbox"/> F6 | <input type="checkbox"/> F7 | <input type="checkbox"/> F8 | <input type="checkbox"/> G1 | <input type="checkbox"/> G2 | <input type="checkbox"/> G3 |
| <input type="checkbox"/> G4 | <input type="checkbox"/> G5 | <input type="checkbox"/> G6 | <input type="checkbox"/> G7 | <input type="checkbox"/> G8 | <input type="checkbox"/> G9 | <input type="checkbox"/> G10 | <input type="checkbox"/> G11 | <input type="checkbox"/> G12 | <input checked="" type="checkbox"/> G13 | <input type="checkbox"/> G14 | <input type="checkbox"/> G15 |
| <input type="checkbox"/> H1 | | | | | | | | | | | |

I understand that this Producer Statement, if accepted, may be relied on by the Council for the purpose of establishing compliance with the Building Consent.

Registration No: Or N/A

Qualifications/Experience:

Reg and Certified

Address: Postcode:

Phone: Fax:

Mobile: Email:

Signature: Date: