

5040/120

CITY OF HANUKAU - DRAINAGE PLAN

LOT: 45 DP: 9829 STREET: WALTER STAFORDS WARD: MAURENTH


OWNER: T. G. KILUS

DRAINLAYER: C. M. GALLAGHER

APPROVED

R. A. Maw
INSPECTOR

DATE: 23/1/87.

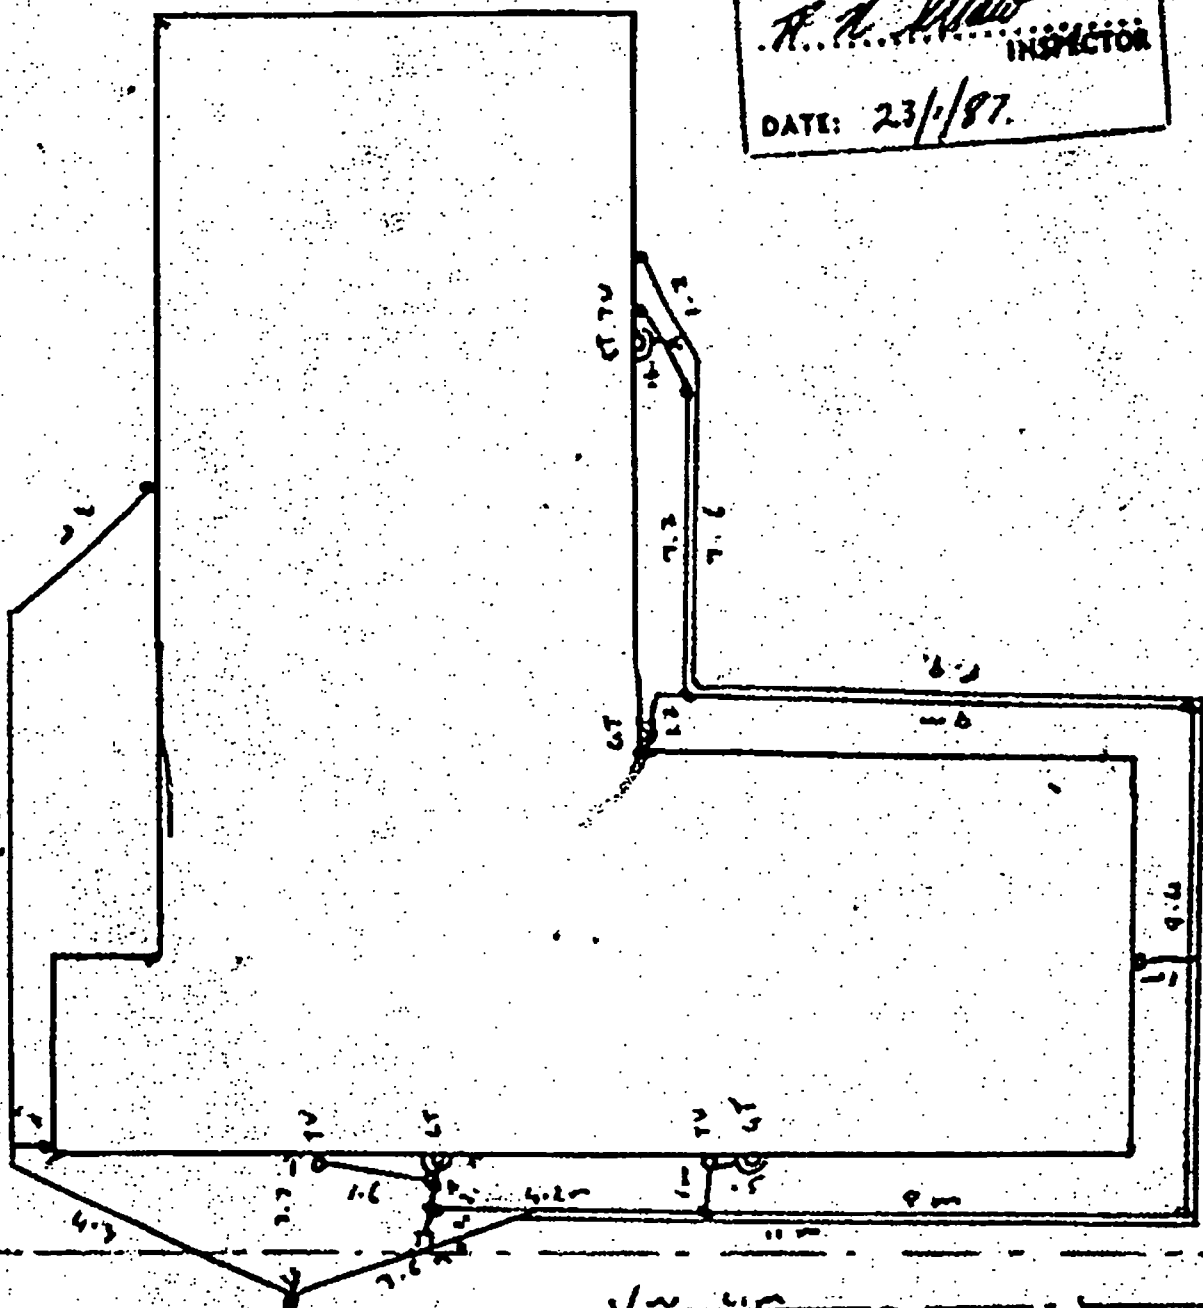

NOTE: PLEASE PROVIDE FIGURED MEASUREMENTS FROM A DEFINED POINT OF REFERENCE.