


Te Kauwhata Road Development As Built Waste Water

Scale 1 : 1000 (A3)
Drawing No. 190918 Hornsby Travers Rd/
190918 As Built Waste Water Rev B
Drawn By: Rodney Pilbrow
Date : 18 October 2019

NOTE:
Coordinates are in terms of:
Geodetic Datum 2000 Mt. Eden Circuit
Elevations are in terms of:
Moturiki Vertical Datum 1953
Origin of Survey IS 501
741221.878N; 433167.079E; 31.938RL

Aerial imagery flown by
Pilbrow Surveying Limited
on 18th September 2019

PSL PILBROW SURVEYING LIMITED
Specialists in Construction Surveying
Pilbrow Surveying Limited
54 Scott Rd, RD2
Te Kauwhata 3782
www.PilbrowSurveying.co.nz
PilbrowSurveying@xtra.co.nz
0800 PSL NOW

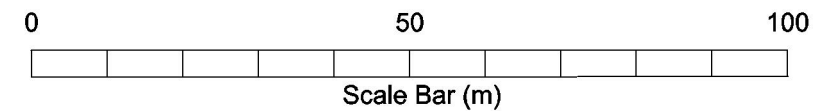

Legend:

- Boundary ——— 60
- Lot No. 60
- WW Manhole ●
- WW Section Connection — X —
- Waste Water Pipe — 150ø uPVC —
- WW Pump Station □
- WW Rising Main 45 Bend X

