


Scale 1 : 1000 (A3)
Drawing No. 190918 Hornsby Travers Rd/
190918 As Built Services Rev. C
Drawn By: Rodney Pilbrow
Date : 2 December 2019

**Aerial imagery flown by
Pilbrow Surveying Limited
on 18th September 2019**



Boundary
Lot No. 60
Street Light 
Power Box 
Chorus Chamber 
Chorus Pit 

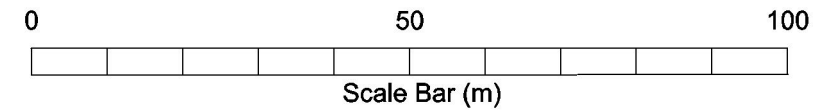