
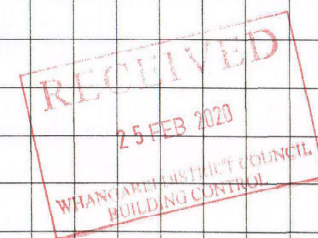


PART C As-built services plan


(to be completed in all cases. If details are already noted on separate drawings then provide copies in duplicate as appropriate and attach to this sheet. Ensure that drawing numbers, etc, is noted below)

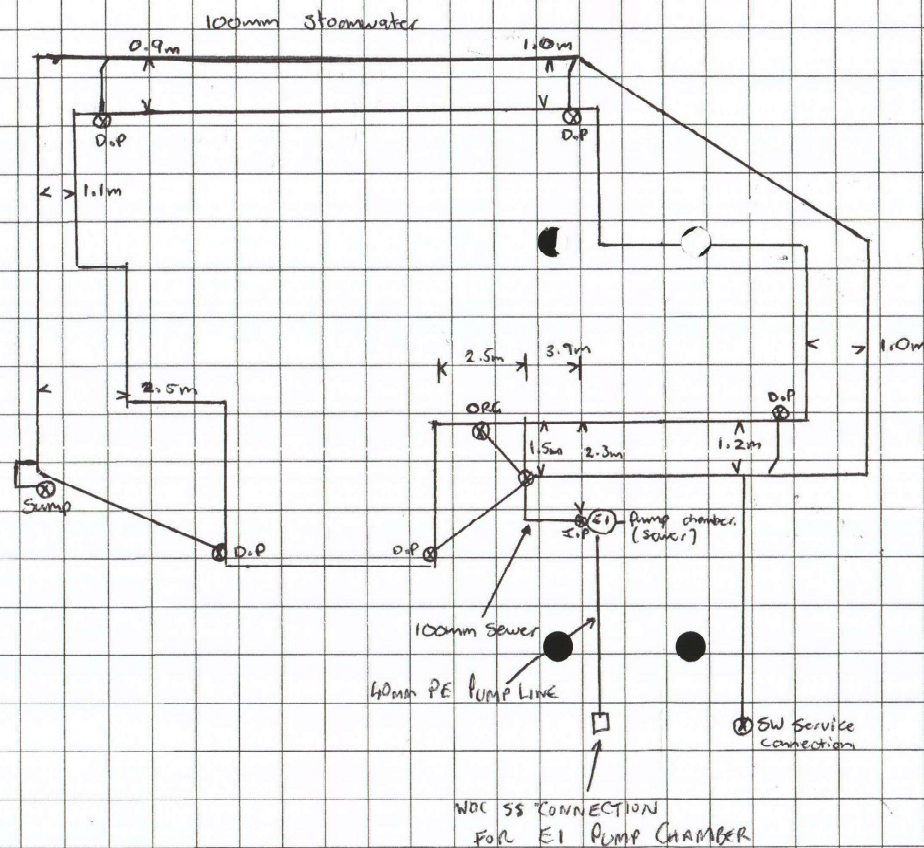

Scale NTS in _____
Site address 2 Suncroft Lane, Whangarei,
0110

PART C *As-built services plan*

(to be completed in all cases. If details are already noted on separate drawings then provide copies in duplicate as appropriate and attach to this sheet. Ensure that drawing numbers, etc, is noted below)

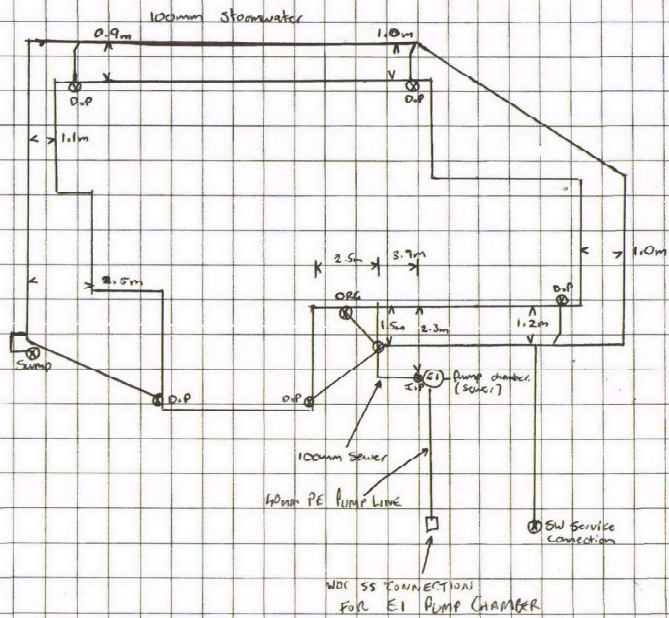

Scale NTS in _____
Site address 2 Syncrest Lane, Whangarei,
0110