

STATEMENT OF PASSING OVER INFORMATION

This information has been supplied by the vendor or the vendor's agents. Accordingly, Ownly (REAA 2008) and Sold On Kapiti Limited is merely passing over the information as supplied to us by the vendor or the vendor's agents.


We cannot guarantee its accuracy and reliability as we have not checked, audited, or reviewed the information and all the intending purchasers are advised to conduct their own due diligence investigation into the same.

To the maximum extent permitted by law Ownly (REAA 2008) and Sold On Kapiti Limited does not accept any responsibility to any person for the accuracy of the information herein.



SOLD ON KĀPITI
REAL ESTATE

As Laid Drainage

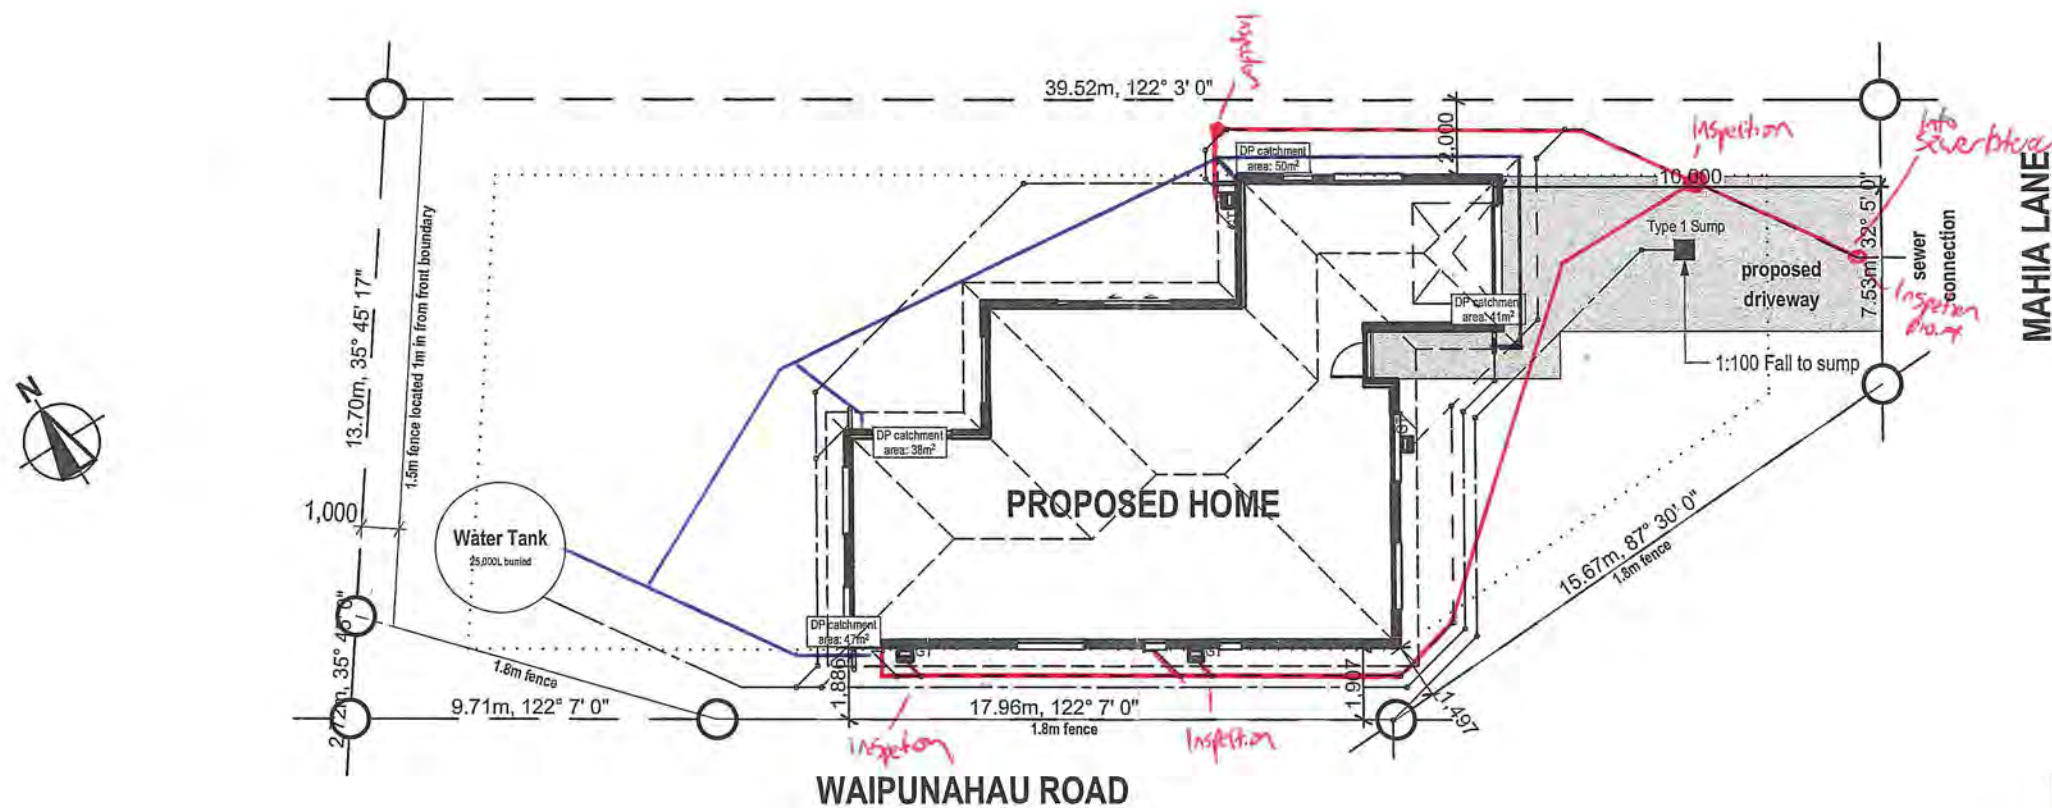

Lot 2 DP 437462

Site area	600m ²
Proposed Building Area	147.72m ²
Proposed Total Site Coverage	24.62%

Figure 8: Type-one Surface Water Sump
Paragraph 3.6.2

