


A



AS-BUILT RECERT.

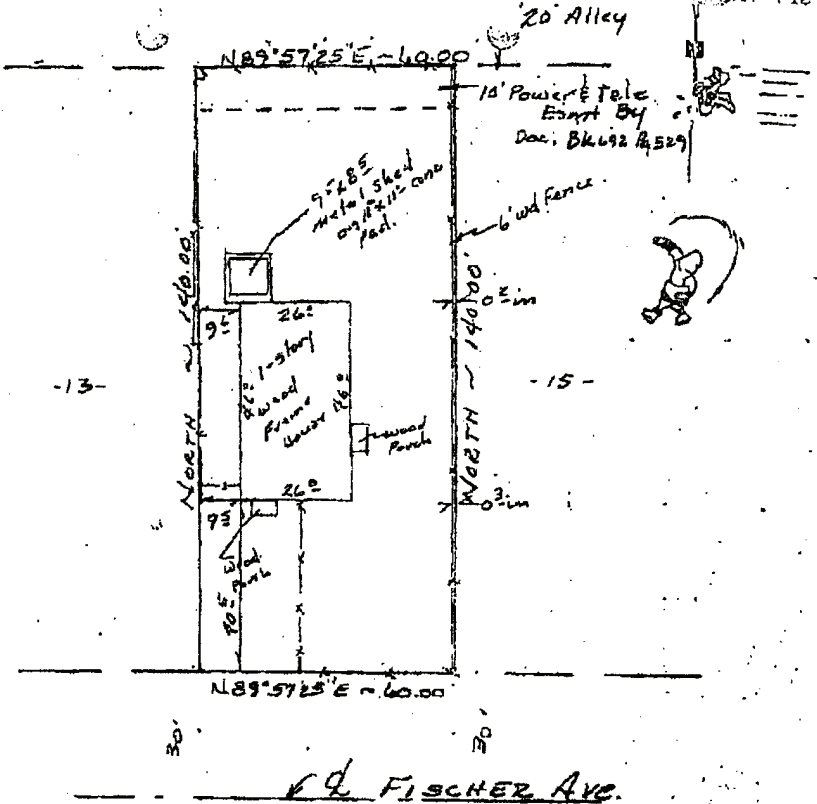

It is the responsibility of the owner to determine the existence of any easements, covenants, or restrictions which do not appear on the recorded subdivision plat. Under no circumstances should any data hereon be used for construction or for establishing boundary or fence lines. The surveyor takes responsibility for the initial transaction only.

NOTE
EASEMENTS OF RECORD, OTHER THAN THOSE SHOWN ON THE RECORDED PLAT, ARE NOT SHOWN HEREON.

LOT 14 BLOCK 4
Aurora Subd. (PLAT NO. _____)
ANCHORAGE RECORDING DISTRICT

- LEGEND**
- ⊙ BRASS CAP MONUMENT
 - IRON PIPE
 - ⊗ REBAR FOUND.
 - NUB & TACK

PREPARED BY: **DOWLING & ASSOCIATES**
804 EAST 15th Ave. Suite 2
ANCHORAGE, ALASKA 99501

DATE	BY	SCALE	WORK ORDER	FIELD BOOK	GRID	DATE
6 Dec. 84	J	1" = 30'	84-301	E1011		2031