
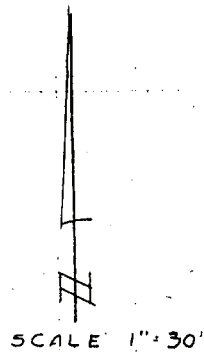


15 75396

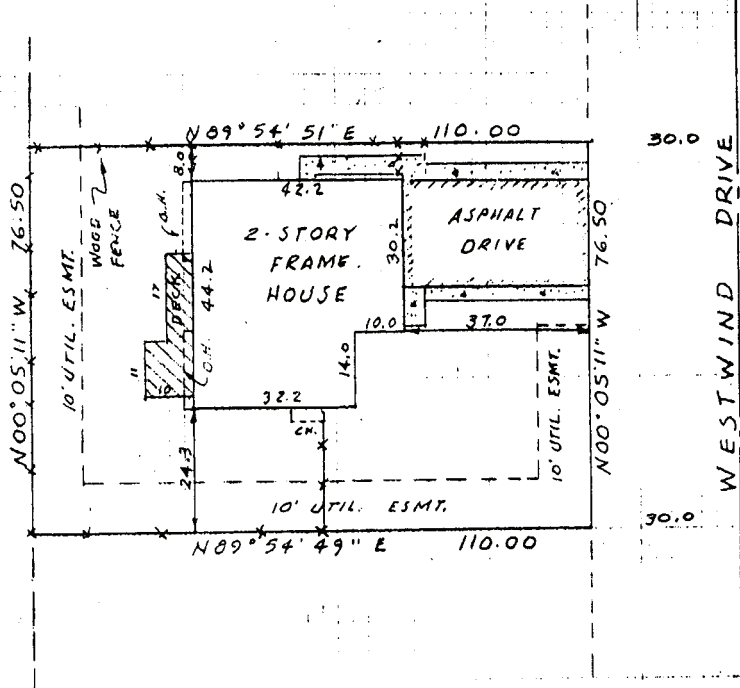

As Built

No Corners Set This Date

Book No.

Page No.

FILE

I hereby certify that I have surveyed the following described property, Lot 18 Block 1
TURNAGAIN VIEW #4 Anchorage recording Precinct, Alaska, and that
the improvements situated thereon are within the property lines and do not overlap or
encroach on the property lying adjacent thereto, that no improvements on property
lying adjacent thereto encroach on the premises in question and that there are no roadways,
transmission lines or other visible easements on said property except as indicated hereon.

Anchorage, Alaska

24 SEPT. 2002

