

Form 2 Seller Disclosure Pack



Realworks

Seller disclosure statement



Queensland
Government

Property Law Act 2023 section 99

Form 2, Version 1 | Effective from: 1 August 2025

WARNING TO BUYER – This statement contains important legal and other information about the property offered for sale. You should read and satisfy yourself of the information in this statement before signing a contract. You are advised to seek legal advice before signing this form. You should not assume you can terminate the contract after signing if you are not satisfied with the information in this statement.

WARNING – You must be given this statement before you sign the contract for the sale of the property.

This statement does not include information about:

- » flooding or other natural hazard history
- » structural soundness of the building or pest infestation
- » current or historical use of the property
- » current or past building or development approvals for the property
- » limits imposed by planning laws on the use of the land
- » services that are or may be connected to the property
- » the presence of asbestos within buildings or improvements on the property.

You are encouraged to make your own inquiries about these matters before signing a contract. You may not be able to terminate the contract if these matters are discovered after you sign.

Part 1 – Seller and property details

Seller **JOHN STANLEY HOGAN, BARBARA ELLEN HOGAN**

Property address
(referred to as the
"property" in this
statement)

1/27 PANGARINDA PL, MOOLOOLABA QLD 4557

Lot on plan description

1/BUP7447

Community titles scheme
or BUGTA scheme:

Is the property part of a community titles scheme or a BUGTA scheme:

☒ **Yes**

☐ **No**

*If Yes, refer to Part 6 of this statement
for additional information*

*If No, please disregard Part 6 of this statement
as it does not need to be completed*

Part 2 – Title details, encumbrances and residential tenancy or rooming accommodation agreement

Title details

The seller gives or has given the buyer the following—

A title search for the property issued under the *Land Title Act 1994* showing interests registered under that Act for the property.

☒ **Yes**

A copy of the plan of survey registered for the property.

☒ **Yes**

Registered encumbrances

Registered encumbrances, if any, are recorded on the title search, and may affect your use of the property. Examples include easements, statutory covenants, leases and mortgages.

You should seek legal advice about your rights and obligations before signing the contract.

Unregistered encumbrances (excluding statutory encumbrances)

There are encumbrances not registered on the title that will continue ☐ **Yes** ☒ **No** to affect the property after **settlement**.

Note—If the property is part of a community titles scheme or a BUGTA scheme it may be subject to and have the benefit of statutory easements that are **NOT** required to be disclosed.

Unregistered lease (if applicable)

If the unregistered encumbrance is an unregistered lease, the details of the agreement are as follows:

» the start and end day of the term of the lease:

» the amount of rent and bond payable:

» whether the lease has an option to renew:

Other unregistered agreement in writing (if applicable)

If the unregistered encumbrance is created by an agreement in writing, and is not an unregistered lease, a copy of the agreement is given, together with relevant plans, if any.

☐ **Yes**

Unregistered oral agreement (if applicable)

If the unregistered encumbrance is created by an oral agreement, and is not an unregistered lease, the details of the agreement are as follows:

Statutory encumbrances

There are statutory encumbrances that affect the property.

☐ **Yes** ☒ **No**

If Yes, the details of any statutory encumbrances are as follows:

Residential tenancy or rooming accommodation agreement

The property has been subject to a residential tenancy agreement or a rooming accommodation agreement under the *Residential Tenancies and Rooming Accommodation Act 2008* during the last 12 months.

☐ **Yes** ☒ **No**

If **Yes**, when was the rent for the premises or each of the residents' rooms last increased? (*Insert date of the most recent rent increase for the premises or rooms*)

Note—Under the *Residential Tenancies and Rooming Accommodation Act 2008* the rent for a residential premises may not be increased earlier than 12 months after the last rent increase for the premises.

As the owner of the property, you may need to provide evidence of the day of the last rent increase. You should ask the seller to provide this evidence to you prior to settlement.

Part 3 – Land use, planning and environment

WARNING TO BUYER – You may not have any rights if the current or proposed use of the property is not lawful under the local planning scheme. You can obtain further information about any planning and development restrictions applicable to the lot, including in relation to short-term letting, from the relevant local government.

Zoning	The zoning of the property is <i>(Insert zoning under the planning scheme, the Economic Development Act 2012; the Integrated Resort Development Act 1987; the Mixed Use Development Act 1993; the State Development and Public Works Organisation Act 1971 or the Sanctuary Cove Resort Act 1985, as applicable)</i>: Medium Density Residential Zone	
Transport proposals and resumptions	The lot is affected by a notice issued by a Commonwealth, State or local government entity and given to the seller about a transport infrastructure proposal* to: locate transport infrastructure on the property; or alter the dimensions of the property. The lot is affected by a notice of intention to resume the property or any part of the property. <i>If Yes, a copy of the notice, order, proposal or correspondence must be given by the seller.</i>	☐ Yes ☒ No ☐ Yes ☒ No
Contamination and environmental protection	The property is recorded on the Environmental Management Register or the Contaminated Land Register under the <i>Environmental Protection Act 1994</i>. The following notices are, or have been, given: A notice under section 408(2) of the <i>Environmental Protection Act 1994</i> (for example, land is contaminated, show cause notice, requirement for site investigation, clean up notice or site management plan). A notice under section 369C(2) of the <i>Environmental Protection Act 1994</i> (the property is a place or business to which an environmental enforcement order applies). A notice under section 347(2) of the <i>Environmental Protection Act 1994</i> (the property is a place or business to which a prescribed transitional environmental program applies).	☐ Yes ☒ No ☐ Yes ☒ No ☐ Yes ☒ No ☐ Yes ☒ No
Trees	There is a tree order or application under the <i>Neighbourhood Disputes (Dividing Fences and Trees) Act 2011</i> affecting the property. <i>If Yes, a copy of the order or application must be given by the seller.</i>	☐ Yes ☒ No
Heritage	The property is affected by the <i>Queensland Heritage Act 1992</i> or is included in the World Heritage List under the <i>Environment Protection and Biodiversity Conservation Act 1999</i> (Cwlth).	☐ Yes ☒ No
Flooding	Information about whether the property is affected by flooding or another natural hazard or within a natural hazard overlay can be obtained from the relevant local government and you should make your own enquires. Flood information for the property may also be available at the FloodCheck Queensland portal or the Australian Flood Risk Information portal.	
Vegetation, habitats and protected plants	Information about vegetation clearing, koala habitats and other restrictions on development of the land that may apply can be obtained from the relevant State government agency.	

Part 4 – Buildings and structures

WARNING TO BUYER – The seller does not warrant the structural soundness of the buildings or improvements on the property, or that the buildings on the property have the required approval, or that there is no pest infestation affecting the property. You should engage a licensed building inspector or an appropriately qualified engineer, builder or pest inspector to inspect the property and provide a report and also undertake searches to determine whether buildings and improvements on the property have the required approvals.

Swimming pool	There is a relevant pool for the property. ☐ Yes ☒ No If a community titles scheme or a BUGTA scheme – a shared pool is located in the scheme. ☐ Yes ☐ No Pool compliance certificate is given. ☐ Yes ☐ No OR Notice of no pool safety certificate is given. ☐ Yes ☐ No
Unlicensed building work under owner builder permit	Building work was carried out on the property under an owner builder permit in the last 6 years. ☐ Yes ☒ No <i>A notice under section 47 of the Queensland Building and Construction Commission Act 1991 must be given by the seller and you may be required to sign the notice and return it to the seller prior to signing the contract.</i>
Notices and orders	There is an unsatisfied show cause notice or enforcement notice under the <i>Building Act 1975</i>, section 246AG, 247 or 248 or under the <i>Planning Act 2016</i>, section 167 or 168. ☐ Yes ☒ No The seller has been given a notice or order, that remains in effect, from a local, State or Commonwealth government, a court or tribunal, or other competent authority, requiring work to be done or money to be spent in relation to the property. ☐ Yes ☒ No <i>If Yes, a copy of the notice or order must be given by the seller.</i>
Building Energy Efficiency Certificate	If the property is a commercial office building of more than 1,000m², a Building Energy Efficiency Certificate is available on the Building Energy Efficiency Register.
Asbestos	The seller does not warrant whether asbestos is present within buildings or improvements on the property. Buildings or improvements built before 1990 may contain asbestos. Asbestos containing materials (ACM) may have been used up until the early 2000s. Asbestos or ACM may become dangerous when damaged, disturbed, or deteriorating. Information about asbestos is available at the Queensland Government Asbestos Website (asbestos.qld.gov.au) including common locations of asbestos and other practical guidance for homeowners.

Part 5 – Rates and services

WARNING TO BUYER – The amount of charges imposed on you may be different to the amount imposed on the seller.

Rates

Whichever of the following applies—

The total amount payable* for all rates and charges (without any discount) for the property as stated in the most recent rate notice is:

Amount: \$1242.41

Date Range: 01/01/2026 - 30/06/2026

OR

The property is currently a rates exempt lot.** ☐

OR

The property is not rates exempt but no separate assessment of rates ☐
is issued by a local government for the property.

*Concessions: A local government may grant a concession for rates. The concession will not pass to you as buyer unless you meet the criteria in section 120 of the *Local Government Regulation 2012* or section 112 of the *City of Brisbane Regulation 2012*.

** An exemption for rates applies to particular entities. The exemption will not pass to you as buyer unless you meet the criteria in section 93 of the *Local Government Act 2009* or section 95 of the *City of Brisbane Act 2010*.

Water

Whichever of the following applies—

The total amount payable as charges for water services for the property as indicated in the most recent water services notice* is:

Amount: \$415.79

Date Range: 11/12/2025 - 12/03/2026

OR

There is no separate water services notice issued for the lot; however, an estimate of the total amount payable for water services is:

Amount:

Date Range:

* A water services notices means a notice of water charges issued by a water service provider under the *Water Supply (Safety and Reliability) Act 2008*.

Part 6 – Community titles schemes and BUGTA schemes


(If the property is part of a community titles scheme or a BUGTA scheme this Part must be completed)

WARNING TO BUYER – If the property is part of a community titles scheme or a BUGTA scheme and you purchase the property, you will become a member of the body corporate for the scheme with the right to participate in significant decisions about the scheme and you will be required to pay contributions towards the body corporate's expenses in managing the scheme. You will also be required to comply with the by-laws. By-laws will regulate your use of common property and the lot.

For more information about living in a body corporate and your rights and obligations, contact the Office of the Commissioner for Body Corporate and Community Management.

Body Corporate and Community Management Act 1997	The property is included in a community titles scheme. (If Yes, complete the information below)	☒ Yes	☐ No
Community Management Statement	A copy of the most recent community management statement for the scheme as recorded under the <i>Land Title Act 1994</i> or another Act is given to the buyer. Note—If the property is part of a community titles scheme, the community management statement for the scheme contains important information about the rights and obligations of owners of lots in the scheme including matters such as lot entitlements, by-laws and exclusive use areas.	☒ Yes	
Body Corporate Certificate	A copy of a body corporate certificate for the lot under the <i>Body Corporate and Community Management Act 1997</i>, section 205(4) is given to the buyer. If No— An explanatory statement is given to the buyer that states: » a copy of a body corporate certificate for the lot is not attached; and » the reasons under section 6 of the <i>Property Law Regulation 2024</i> why the seller has not been able to obtain a copy of the body corporate certificate for the lot.	☒ Yes	☐ No
Statutory Warranties	Statutory Warranties —If you enter into a contract, you will have implied warranties under the <i>Body Corporate and Community Management Act 1997</i> relating to matters such as latent or patent defects in common property or body corporate assets; any actual, expected or contingent financial liabilities that are not part of the normal operating costs; and any circumstances in relation to the affairs of the body corporate that will materially prejudice you as owner of the property. There will be further disclosure about warranties in the contract.		
Building Units and Group Titles Act 1980	The property is included in a BUGTA scheme (If Yes, complete the information below)	☐ Yes	☒ No
Body Corporate Certificate	A copy of a body corporate certificate for the lot under the <i>Building Units and Group Titles Act 1980</i>, section 40AA(1) is given to the buyer. If No— An explanatory statement is given to the buyer that states: » a copy of a body corporate certificate for the lot is not attached; and » the reasons under section 7 of the <i>Property Law Regulation 2024</i> why the seller has not been able to obtain a copy of the body corporate certificate for the lot. Note—If the property is part of a BUGTA scheme, you will be subject to by-laws approved by the body corporate and other by-laws that regulate your use of the property and common property.	☐ Yes	☐ No


Signatures – SELLER

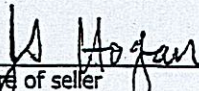


Signature of seller

JOHN STANLEY HOGAN

Name of Seller

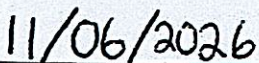


Date

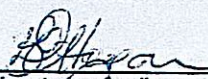

Signature of seller

BARBARA ELLEN HOGAN

Name of Seller

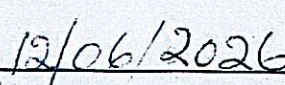

Date

Signatures – BUYER

By signing this disclosure statement the buyer acknowledges receipt of this disclosure statement before entering into a contract with the seller for the sale of the lot.

Signature of buyer

Signature of buyer

Name of buyer

Name of buyer

Date

Date

CURRENT TITLE SEARCH
QUEENSLAND TITLES REGISTRY PTY LTD



Request No: 56444088
Search Date: 09/06/2026 13:32

Title Reference: 16928128
Date Created: 17/07/1986

Previous Title: 15260109

REGISTERED OWNER

Dealing No: 709811972 31/07/2006

JOHN STANLEY HOGAN
BARBARA ELLEN HOGAN JOINT TENANTS

ESTATE AND LAND

Estate in Fee Simple

LOT 1 BUILDING UNIT PLAN 7447
 Local Government: SUNSHINE COAST
 COMMUNITY MANAGEMENT STATEMENT 7801

EASEMENTS, ENCUMBRANCES AND INTERESTS

1. Rights and interests reserved to the Crown by
Deed of Grant No. 14435077 (POR 326)
2. MORTGAGE No 709811978 31/07/2006 at 10:00
WESTPAC BANKING CORPORATION A.B.N. 33 007 457 141

ADMINISTRATIVE ADVICES - NIL
UNREGISTERED DEALINGS - NIL

Caution - Charges do not necessarily appear in order of priority

** End of Current Title Search **

COPYRIGHT QUEENSLAND TITLES REGISTRY PTY LTD [2026]
Requested By: D-ENQ INFOTRACK PTY LIMITED

Noted: R.P. 138549
Charted: MOOLOOLAH 11
Catalogued: 23-7-86

Building Units and Group Titles Act 1980 — 1983
BUILDING UNITS AND GROUP TITLES REGULATIONS 1980
(Form 1)


Regulation 8(1)
Sheet No. 1 of 9 Sheets
signature of sheet 1

NAME OF BUILDING: "GLENVILLA COURT"

Pa. made: 14 AUG 1995

BUILDING UNITS PLAN NO. 7447

SIGNATURE OF REGISTERED PROPRIETOR:

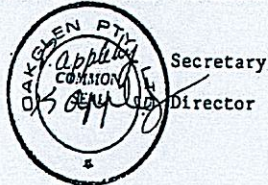

NAME OF REGISTERED PROPRIETOR: OAKGLEN PTY. LTD.

ADDRESS: C/- T.J. Boyce and Co.,
Solicitors,
P.O. Box 9,
MOOLOOLABA, Q. 4557

REFERENCE TO TITLE: VOLUME 5260, FOLIO 109

DESCRIPTION OF PARCEL: Lot 47 on R.P. 138549

COUNTY: Canning

PARISH: Mooloolah

CITY:



BUP7447

CMS7801

NAME OF BODY CORPORATE

The Proprietors -
"Glenvilla Court"
Building Units Plan No.

7447

ADDRESS at which documents
may be served:

T.J. Boyce and Co.,
Solicitors
P.O. Box 9,
MOOLOOLABA, Q. 4557

C/- KING & BURNS PTY LTD.

P.O. Box 467
BUDERIM, QLD
4556

BUILDING UNITS PLAN No.:

7447

REGISTERED 14 JULY 1986

REGISTRAR OF TITLES

Shire Clerk
Town

Surveyor's Reference: 85/562

Local Authority Reference:

COUNCIL OF THE SHIRE OF MAROOCHY

CISP

ANNEXURE 1

TO SHEET NO. 1

OF BUILDING UNITS PLAN NO. 7447 ON

14 AUG 1995

 Landa

REGISTRAR OF TITLES

NO. 7001538777 NOTIFICATION OF CHANGE OF ADDRESS RECORDED

14 AUG 1995


 Landa

Building Units and Group Titles Act 1980 — 1983
BUILDING UNITS AND GROUP TITLES REGULATIONS 1980

Name of Building:

Regulation 8(1)
Sheet No. 2 of 9 Sheets

BUILDING UNITS PLAN NO. 7447

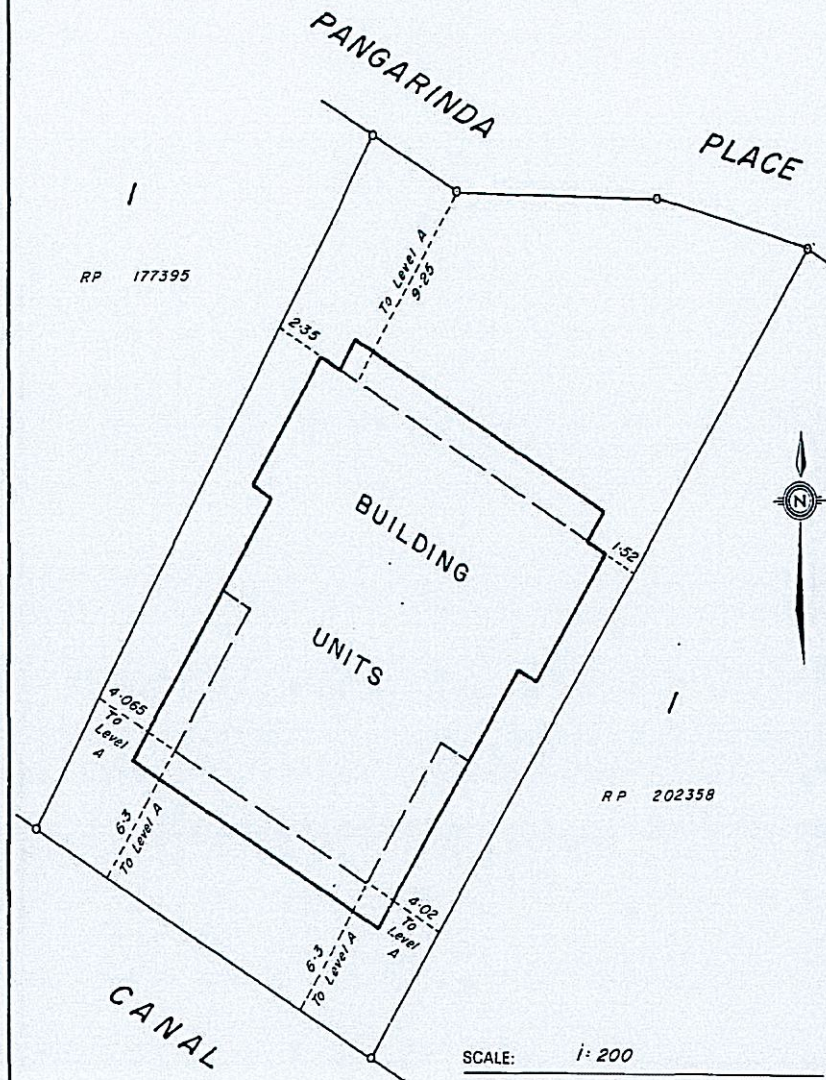

[Signature] Shire Clerk
Town
COUNCIL OF THE SHIRE OF MAROOCHY

Building Units and Group Titles Act 1980 — 1983
BUILDING UNITS AND GROUP TITLES REGULATIONS 1980
(Form 2)

Name of Building:

Regulation 8(1)
Sheet No. 3 of 9 Sheets


BUILDING UNITS PLAN NO. 7447

I. **BRYAN ROBERT McLENNAN** . of **MONTVILLE**

licensed surveyor registered under the Surveyors Act 1977-1983 hereby certify that:—


- (a) The building shown on the "building units plan/~~building units plan of subdivision~~ to which this certificate is annexed is within the external surface boundaries of the parcel the subject of the said plan subject to paragraph (b) of this certificate;
- (b) (i) Where eaves or guttering project beyond such boundaries an appropriate easement has been granted as an appurtenance of the parcel; and
(ii) Where that projection is over a road the local authority has consented thereto pursuant to the ordinances or by-laws as the case may be.

DATED this **SECOND** day of **APRIL** 19 **86**

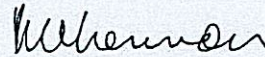

LICENSED SURVEYOR

*Delete whichever is inapplicable

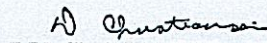 Shire Clerk
Town

COUNCIL OF THE SHIRE OF MAROOCHY

Building Units and Group Titles Act 1980 — 1983
BUILDING UNITS AND GROUP TITLES REGULATIONS 1980
(Form 3)

Name of Building:

Regulation 8(1)
Sheet No. 4 of 9 Sheets

BUILDING UNITS PLAN NO. 7447

CERTIFICATE OF LOCAL AUTHORITY

Council of the Shire of Maroochy hereby certifies that the proposed subdivision of the parcel as illustrated in the abovementioned plan has been approved by the Council of the Shire of Maroochy and that all the requirements of The Local Government Acts; 1936 to 1985 as modified by the Building Units and Group Titles Act 1980-1983 have been complied with in regard to the subdivision.

DATED this SEVENTEENTH day of JUNE, 1986

J. A. Leary

Shire Chairman

A. D. Dintons

Shire Clerk

Council of the Shire of Maroochy

Building Units and Group Titles Act 1980 — 1983
BUILDING UNITS AND GROUP TITLES REGULATIONS 1980
(Form 6)

Name of Building:

Regulation 8(1)
Sheet No. 5 of 9 Sheets

BUILDING UNITS PLAN NO. 7447

I, JAMES ANTHONY DARLEY, of PALMWOODS

~~have been appointed by the Council of the Shire of Maroochy~~

~~to be a building inspector appointed by the Council~~

*a building inspector appointed by the Council of the Shire of Maroochy

hereby certify that the building shown on the *building units plan/~~building units plan~~ to which

to which this certificate is annexed has been substantially completed in accordance with plans

and specifications approved by *the Council of the Shire of Maroochy

~~and designated officer of the Council~~


DATED this

SEVENTEENTH

day of

JUNE

, 1986

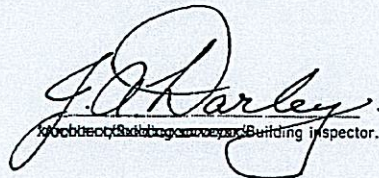
Building Inspector.

* Delete whichever is inapplicable

+ Insert name of local authority


Shire Clerk
Town

COUNCIL OF THE SHIRE OF MAROOCHY

Building Units and Group Titles Act 1980
 BUILDING UNITS AND GROUP TITLES REGULATIONS 1980
 (Form 8)

Regulation 8(1)
 Sheet No. 6 of 9 Sheets

BUILDING UNITS PLAN NO. 7447

SCHEDULE OF LOT ENTITLEMENTS AND REFERENCE TO
 CURRENT CERTIFICATE OF TITLE


Lot No.	Level	Entitlement	Current C's T.		Lot No.	Level	Entitlement	Current C's T.	
			Vol.	Fol.				Vol.	Fol.
1	A	1	6928	128					
2	A & B	1	6928	129					
3	A & B	1	6928	130					
4	A & C	1	6928	131					
5	A & C	1	6928	132					

Name of Building:

Regulation 8(1)
Sheet No 7 of 9 Sheets

BUILDING UNITS PLAN NO. 7447

LEVEL A

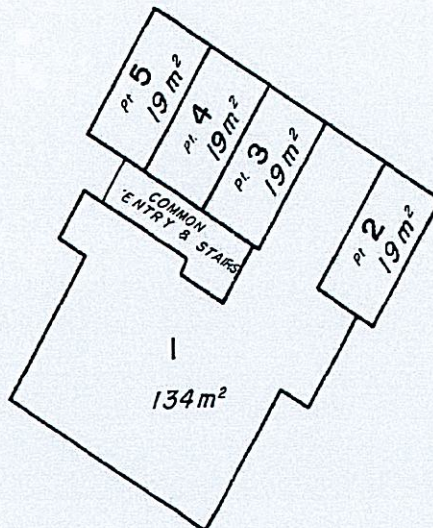

Scale: 1 : 200

Floor areas are approximate only.

SIGNATURE OF REGISTERED PROPRIETOR:

[Signature] Secretary
[Signature] Director

[Signature] Shire Clerk
Town


COUNCIL OF THE SHIRE OF MAROOCHY

Name of Building:

Regulation 8(1)
Sheet No 8 of 9 Sheets

BUILDING UNITS PLAN NO. 7447

LEVEL B

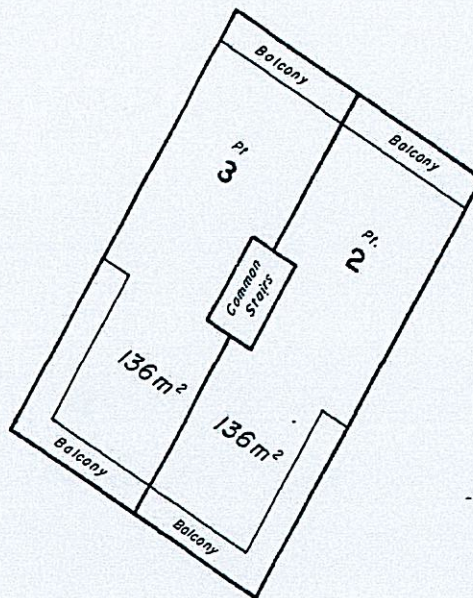

Scale: 1 : 200

Floor areas are approximate only.

SIGNATURE OF REGISTERED PROPRIETOR:

[Signature] Secretary
[Signature] Director

[Signature] Shire Clerk
Town


COUNCIL OF THE SHIRE OF MAROOCHY

Name of Building:

Regulation 8(1)
Sheet No. 9 of 9 Sheets

BUILDING UNITS PLAN NO. 7447

LEVEL C

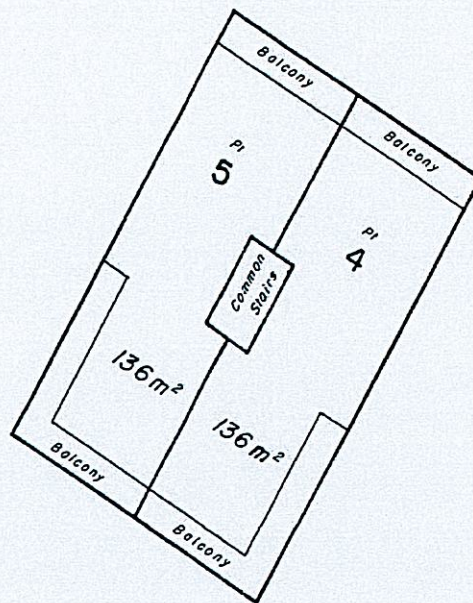

Scale: 1 : 200

Floor areas are approximate only.

SIGNATURE OF REGISTERED PROPRIETOR:

P. [Signature] Secretary
K. [Signature] Director

A. [Signature] Shire Clerk
Town

COUNCIL OF THE SHIRE OF MAROOCHY



Australia and New Zealand Banking Group Limited
66 Currie Street Nambour Qld 4560
PO Box 523 Nambour Qld 4560 Telephone 413 955 (071)

1447

Registrar of Titles,
202 Adelaide Street,
BRISBANE QLD. 4000

Dear Sir,

RE: BUILDING UNITS PLAN "GLENVILLA COURT"
REGISTERED PROPRIETOR OAKGLEN PTY. LTD. X 7447

AUSTRALIA AND NEW ZEALAND BANKING GROUP LIMITED as
Mortgagee under Bill of Mortgage No. H772490 hereby
consents to the above Plan.

Yours faithfully,

AUSTRALIA AND NEW ZEALAND BANKING GROUP LIMITED,
by its Attorney;

OT Shroden
AREA MANAGER.

Witness: *J. J. [Signature]*