RECEIVED: 21 May 2015 SCANNED: 21 May 2015 BOX: 1 BATCH: 130344 DOC: KDCAATIJ

SILVERSTONE CIVIL CONSTRUCTION
Subdivisions, Commercial Drainage, Bulk Excavating

P O Box 7109
Tikipunga
Whangarei
Ph 09 435 7030
Fax 09 435 7031

28/9/9

(11)

MANGAWHAI ECO CARE PROJECT

LIVE HOUSE CONNECTION AS-BUILT RECORD

Date	10-09-09	House No	3 (1)	Street	CNR NORTH & DEY ST
Drainlayer	LANCE		* Also 3 North Ave		


As-built plan (One property per page)

Type of Connection	Unit	Qty
Simple Connection	no.	1
Other Connection	no.	
Labour	hrs	
1x MCN	1	2
Digger	hrs	
110mm PVC	m	.5
Fittings		
GLUE COUAR		2
90° INSPEC		1
22° BEND		1
PLUM QUIK		1

Comments

NO CAP ON END OF DRAIN.

CONNECT SANI PUMP 2 S/LINE

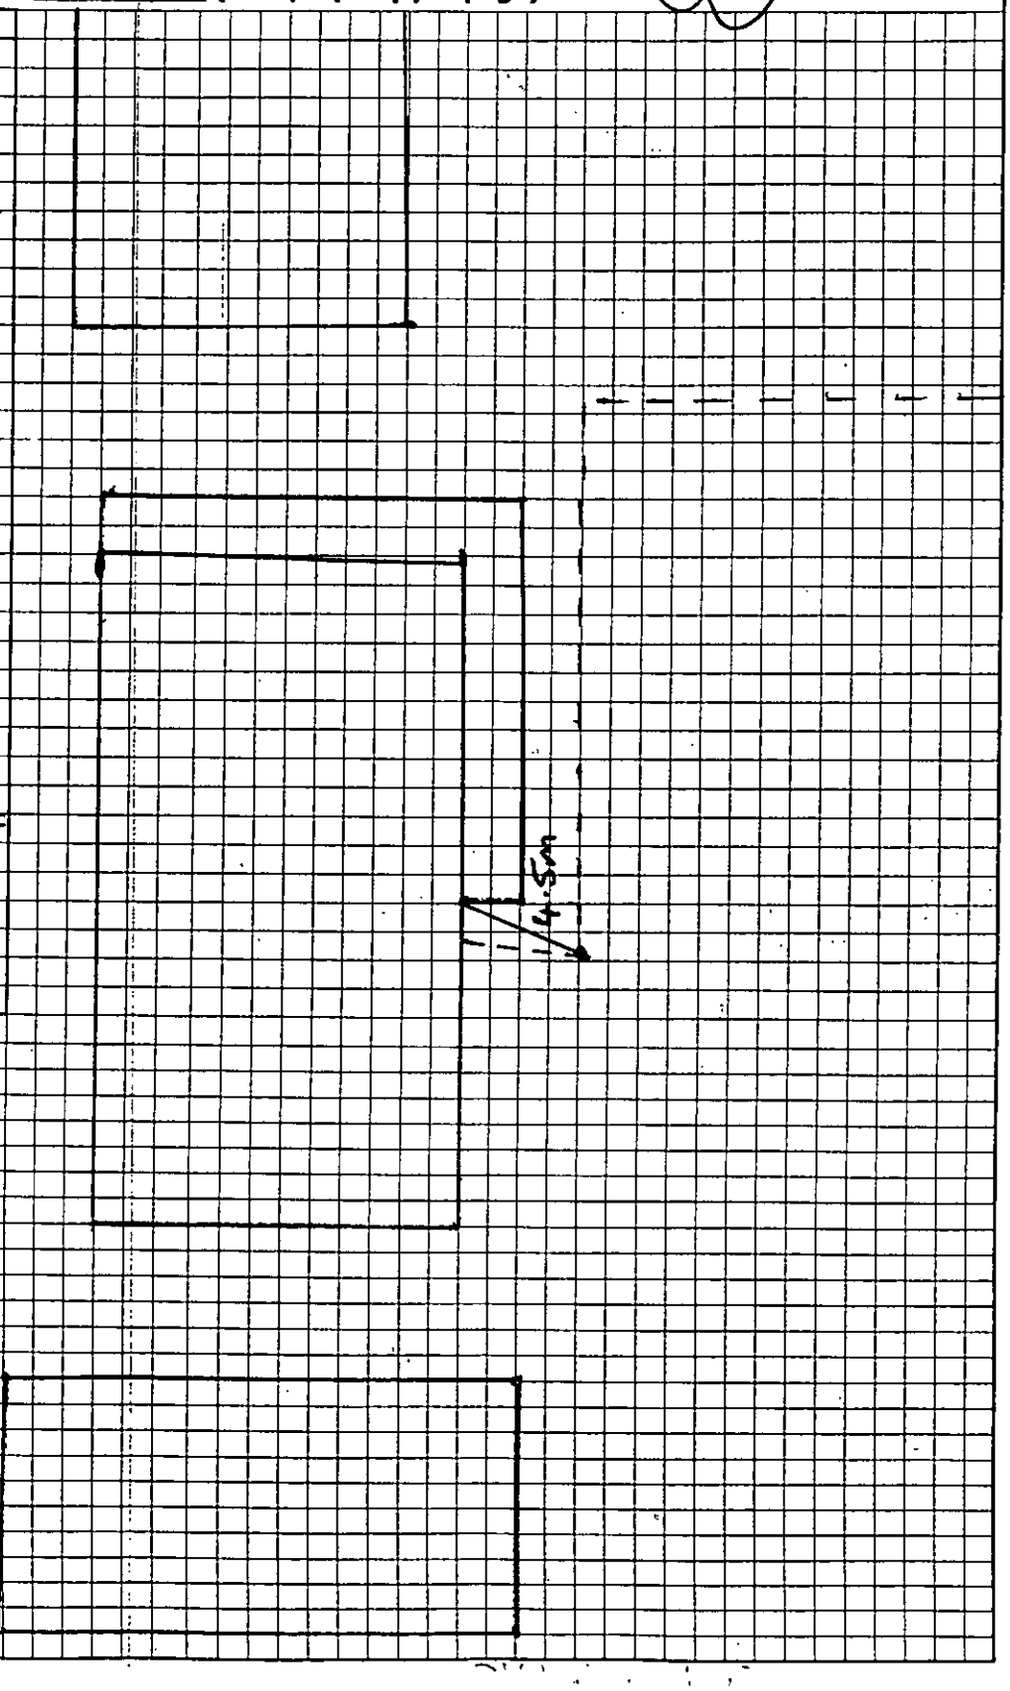

0122132400-D